


CONSTRUCTION PLANS FOR GOLF COURSE POINTE

PUBLIC PAVING, WATER LINE, SANITARY SEWER AND STORM DRAIN IMPROVEMENTS

GOLF COURSE ROAD N.W. ALBUQUERQUE, NEW MEXICO

INDEX

SHEET NUMBER	DESCRIPTION
1	TITLE SHEET, NOTES & VICINITY MAP
2	OVERALL DEMOLITION PLAN
3	OVERALL PAVING, AND STRIPING PLAN
4	GOLF COURSE ROAD, CONTROL, PLAN & PROFILE STA. 11+00 TO 18+00
5	GOLF COURSE ROAD, CONTROL, PLAN & PROFILE STA. 18+00 TO 25+00
6	MARNA LYNN ROAD, CONTROL PLAN & PROFILE (FUTURE, FOR INFORMATION ONLY)
7	OVERALL UTILITY PLAN WATER, SANITARY SEWER AND STORM DRAIN
8	WATERLINE "A" PLAN AND PROFILE
9	WATERLINE "B" "C" "D" PLAN AND PROFILE
10	WATERLINE "E" "F" PLAN AND PROFILE
11	SANITARY SEWER LINE "A" "B" "C" PLAN & PROFILE
12	STORM DRAIN LINE "A" "B" PLAN & PROFILE
13	NOT USED
14	TRAFFIC CONTROL PLAN
15	NOT USED
16-17	FINAL PLAT
18	MASTER DRAINAGE PLAN
19	MASTER GRADING PLAN
20	SIGNING AND CONSTRUCTION TRAFFIC CONTROL STANDARDS
21	TYPICAL TRAFFIC CONTROL & SIGNING EXAMPLES (REF. M.U.T.C.D.)

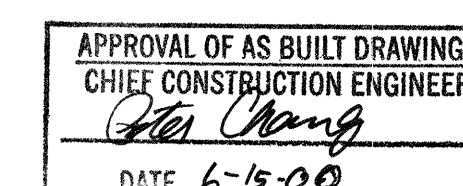

SURVEYOR'S CERTIFICATION


"I, Philip W. Turner, a duly qualified Registered Professional Land Surveyor under the Laws of the State of New Mexico, do hereby certify that the "as-built" information shown on these drawings was obtained from field construction and "as-built" surveys performed by me, or under my supervision, that the "as-built" information shown on these drawings was added by me, or under my supervision and that this "as-built" information is true and correct to the best of my knowledge and belief." Community Sciences Corporation is not responsible for any of the design concepts, calculations, engineering and/or intent of the record drawings.

Philip W. Turner
Philip W. Turner, N.M.P.S. 10204

3-27-00
Date

AS-BUILT

DRB #99-36

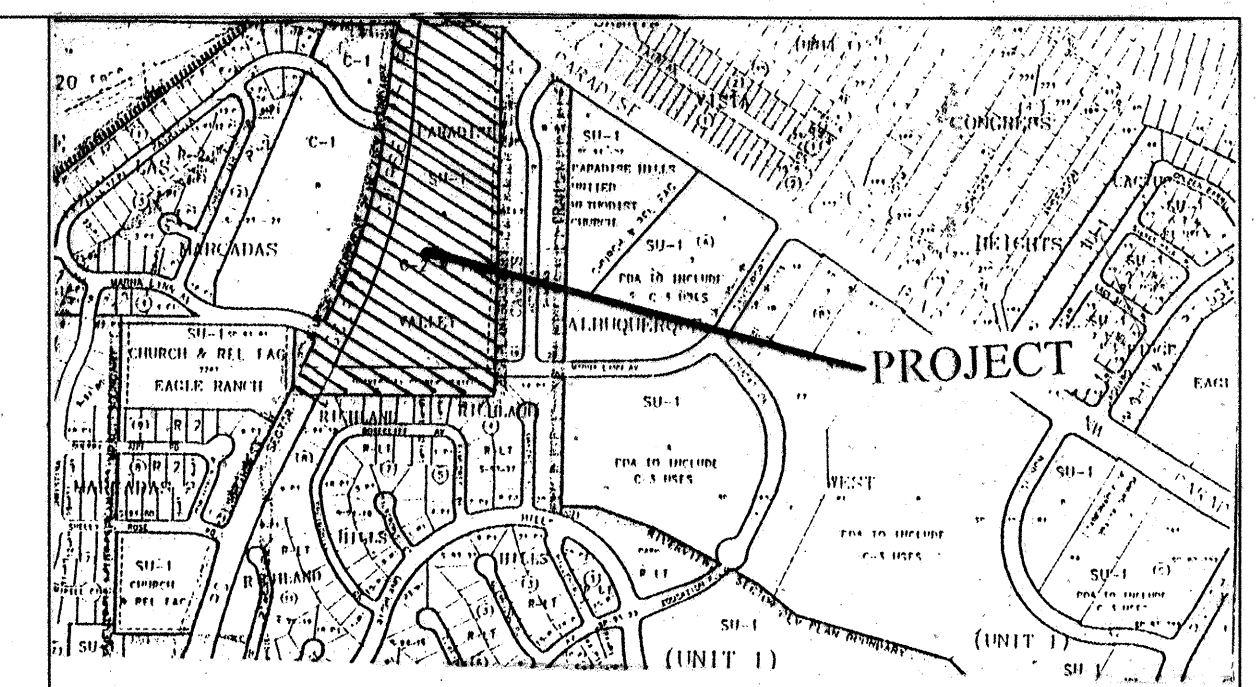

NOT TO SCALE
MAP NO. C-12-Z

NOTICE TO CONTRACTORS

- ALL WORK DETAILED ON THESE PLANS TO BE PERFORMED UNDER CONTRACT SHALL, EXCEPT AS OTHERWISE STATED OR PROVIDED FOR HEREON, BE CONSTRUCTED IN ACCORDANCE WITH THE CITY OF ALBUQUERQUE STANDARD SPECIFICATIONS FOR PUBLIC WORKS CONSTRUCTION, 1986 EDITION, AS AMENDED THROUGH UPDATE #6. ALSO, ALL UTILITIES SHALL BE CONSTRUCTED PER NMUI STD SPECS.
- TWO WORKING DAYS PRIOR TO ANY EXCAVATION, THE CONTRACTOR MUST CONTACT NEW MEXICO ONE CALL SYSTEM (260-1990) FOR LOCATION OF EXISTING UTILITIES.
- PRIOR TO CONSTRUCTION, THE CONTRACTOR SHALL EXCAVATE AND VERIFY THE HORIZONTAL AND VERTICAL LOCATIONS OF ALL OBSTRUCTIONS, SHOULD A CONFLICT EXIST. THE CONTRACTOR SHALL NOTIFY THE ENGINEER OR SURVEYOR IMMEDIATELY SO THAT THE CONFLICT CAN BE RESOLVED WITH A MINIMUM AMOUNT OF DELAY.
- FIVE (5) WORKING DAYS PRIOR TO BEGINNING CONSTRUCTION, THE CONTRACTOR SHALL SUBMIT TO CONSTRUCTION COORDINATION DIVISION A DETAILED CONSTRUCTION SCHEDULE. TWO (2) WORKING DAYS PRIOR TO CONSTRUCTION, THE CONTRACTOR SHALL OBTAIN A BARRICADING PERMIT FROM THE CONST. COORDINATION DIVISION. CONTRACTOR SHALL NOTIFY BARRICADE ENGINEER (768-2551) PRIOR TO OCCUPYING AN INTERSECTION. REFER TO SECTION 19 OF THE GENERAL CONDITIONS OF THE STANDARD SPECIFICATIONS.
- CONTRACTOR SHALL NOTIFY THE ENGINEER NOT LESS THAN SEVEN (7) DAYS PRIOR TO STARTING WORK IN ORDER THAT THE ENGINEER MAY TAKE NECESSARY MEASURES TO INSURE THE PRESERVATION OF SURVEY MONUMENTS. CONTRACTOR SHALL NOT DISTURB PERMANENT SURVEY MONUMENTS WITHOUT THE CONSENT OF THE ENGINEER AND SHALL NOTIFY THE ENGINEER AND BEAR THE EXPENSE OF REPLACING ANY MONUMENT THAT MAY BE DISTURBED WITHOUT PERMISSIBLE REPLACEMENT SHALL BE DONE ONLY BY THE CITY SURVEY SECTION. WHEN A CHANGE IS MADE IN THE FINISHED ELEVATIONS OF THE PAVEMENT OF ANY ROADWAY IN WHICH A PERMANENT SURVEY MONUMENT IS LOCATED, CONTRACTOR SHALL AT HIS OWN EXPENSE, ADJUST THE MONUMENT COVER TO THE NEW GRADE, UNLESS OTHERWISE SPECIFIED. REFER TO SECTION 4.4 OF THE GENERAL CONDITIONS OF THE STANDARD SPECIFICATIONS.
- ANY WORK AFFECTING AN ARTERIAL ROADWAY REQUIRES TWENTY-FOUR (24) HOUR CONSTRUCTION.
- CONTRACTOR SHALL NOTIFY NMUI 3 DAYS PRIOR TO CONSTRUCTION FOR COORDINATION OF WATER SHUTOFF, 898-2661.

THE FOLLOWING NOTES ALSO APPLY WHEN CHECKED

- ☒ ALL UTILITIES AND UTILITY SERVICE LINES SHALL BE INSTALLED PRIOR TO PAVING.
- ☒ BACKFILL COMPACTION SHALL BE ACCORDING TO SPECIFIED STREET USE.
- ☐ TACK COAT REQUIREMENTS SHALL BE DETERMINED BY THE CITY ENGINEER.
- ☒ SIDEWALKS AND WHEELCHAIR RAMPS WITHIN THE CURB RETURNS SHALL BE CONSTRUCTED WHEREVER A NEW CURB RETURN IS CONSTRUCTED.
- ☐ IF CURB IS DEPRESSED FOR A DRIVEPAD, THE DRIVEPAD SHALL BE CONSTRUCTED PRIOR TO ACCEPTANCE OF CURB AND GUTTER.
- ☒ ALL STORM DRAINAGE FACILITIES SHALL BE COMPLETED PRIOR TO FINAL ACCEPTANCE.
- ☒ THE REQUESTER OR DEVELOPER SHALL BE RESPONSIBLE FOR REPAIR OR REPLACEMENT OF ALL CURB AND GUTTER OR SIDEWALK DAMAGED AFTER APPROVAL BY THE CITY ENGINEER OF WORK COMPLETED BY THE CONTRACTOR.

BPLW
Architects & Engineers, Inc.
2460 Louisiana Blvd. NE
AFC #5 Suite 400
Albuquerque, New Mexico 87110
(505) 881-2759
63 East Main Street
Suite 502
Mesa, Arizona 85201
(602) 937-2750
Designing to Shape the Future

REV.	SHEETS	CITY ENGINEER	DATE	USER DEPARTMENT	DATE	USER DEPARTMENT	DATE
ARCHITECTS STAMP & SIGNATURE		APPROVALS		ENGINEER	DATE	*****	
		DRC Chairman	<i>[Signature]</i>		11-23-99	APPROVED FOR CONSTRUCTION	
		Transportation	<i>[Signature]</i>		10-26-99		
		Water/Wastewater	N/A				
		Hydrology	<i>[Signature]</i>		10-18-99		
		Parks					
		Constr. Mngmt.					
		NMUI					
		City Project No.				Sheet	Of
						622981	1 21

PAVEMENT REMOVALS

1. GOLF COURSE RD.
A. SAWCUT, REMOVE & DISPOSE APPROXIMATELY 2,018 S.Y. ASPHALT
2. NORTH DRIVEWAY @ EXISTING GIANT STATION (PRIVATE)
A. SAWCUT, REMOVE & DISPOSE APPROXIMATELY 13 S.Y. ASPHALT

GENERAL NOTES:

1. THE CONTRACTOR SHALL FIELD VERIFY ALL EXISTING UTILITY LOCATIONS & NOTIFY THE ENGINEER IMMEDIATELY OF ANY DISCREPANCIES.
2. TOPOGRAPHICAL & BOUNDARY SURVEY PROVIDED BY HARRIS SURVEYING INC. BPLW IS NOT RESPONSIBLE FOR ANY DISCREPANCIES IN THE SURVEY.
3. CONTRACTOR IS RESPONSIBLE FOR REPAIR AND/OR REPLACEMENT OF ALL DAMAGED UTILITY CONDUITS & EXISTING LINES.
4. ANY ADDITIONAL GRADING REQUIRED TO MATCH PROPOSED STREET GRADES SHALL BE INCIDENTAL TO PAVING ITEMS.
5. CONTRACTOR SHALL PROVIDE INSPECTORS (CITY & PRIVATE) w/ A PROPOSED HYDRO-STATIC TESTING PLAN. THE PLAN MUST BE APPROVED BEFORE TESTING OPERATIONS BEGIN.
6. CONTRACTOR SHALL PARK EQUIPMENT SO AS NOT TO INTERFERE WITH NORMAL ACTIVITIES OF OTHER CONTRACTORS ON SITE.
7. ANY DAMAGE TO THE EXISTING FACILITIES TO REMAIN (CURB & GUTTER, PAVEMENT, CONDUITS, LANDSCAPING, UTILITY LINES, ETC.) DURING CONSTRUCTION SHALL BE REPLACED AT THE CONTRACTORS EXPENSE.
8. REMOVAL OF THE EXISTING CURB & GUTTER OR VALLEY GUTTER SHALL BE AS PER COA STD DWG. 2415 (SAW CUT ONLY).
9. WHEEL CHAIR RAMPS SHALL BE CONSTRUCTED PRIOR TO FINAL ACCEPTANCE OF CURB AND GUTTER.
10. ALL DEMOLITION AND EXCESS SITE MATERIAL SHALL BE REMOVED BY THE CONTRACTOR TO A COA APPROVED DUMP SITE.
11. THE CONTRACTOR SHALL COORDINATE WITH THE BUILDING PERMIT (SITE) CONTRACTOR FOR THE SEQUENCING OF ALL WORK (BOTH PRIVATE & PUBLIC).

AS BUILT INFORMATION		BENCH MARKS		SURVEY INFORMATION		ENGINEER'S SEAL		REVISIONS		DESIGN	
CONTRACTOR	DATE	THE STATION IS A ALUMINUM CAP AND IS STAMPED	DATE	NO.	BY		BY	NO.	DATE	DESIGNED BY: HBM	CHECKED BY: GCJ
WORK ORDER NO.	DATE	DATE	DATE	DATE	DATE						
INSPECTOR'S	DATE	DATE	DATE	DATE	DATE						
ACCEPTANCE BY	DATE	DATE	DATE	DATE	DATE						
DRAWINGS		DRAWINGS		DRAWINGS		DRAWINGS		DRAWINGS		DRAWINGS	
DRAWING NO.		DRAWING NO.		DRAWING NO.		DRAWING NO.		DRAWING NO.		DRAWING NO.	
622981		622981		622981		622981		622981		622981	

LEGEND:

- EXISTING ASPHALT REMOVAL
- ASPHALT SAWCUT
- EXISTING SD INLET
- EXISTING GATE VALVE
- EXISTING FIRE HYDRANT
- EXISTING SAS MANHOLE
- EXISTING SD MANHOLE
- EXISTING WATER MAIN
- EXISTING SANITARY SEWER
- EXISTING UTILITY ESMT

BPLW		CITY OF ALBUQUERQUE PUBLIC WORKS DEPARTMENT ENGINEERING GROUP		BPLW	
TITLE: GOLF COURSE POINT OVERALL DEMOLITION PLAN					
APPROVALS	ENGINEER	DATE	APPROVALS	ENGINEER	DATE
DRC Chairman	Water		Water		
Transportation	Waste Water		Waste Water		
Hydrology					
Parks & Rec.					
DRAWING NO.	622981	MAP NO.	C-12-Z	SHEET	2 OF 21




OVERALL DEMOLITION PLAN
SCALE: 1" = 60'

AS-BUILT

SCANNED BY
MECA DEPO

130RCD02.DWG

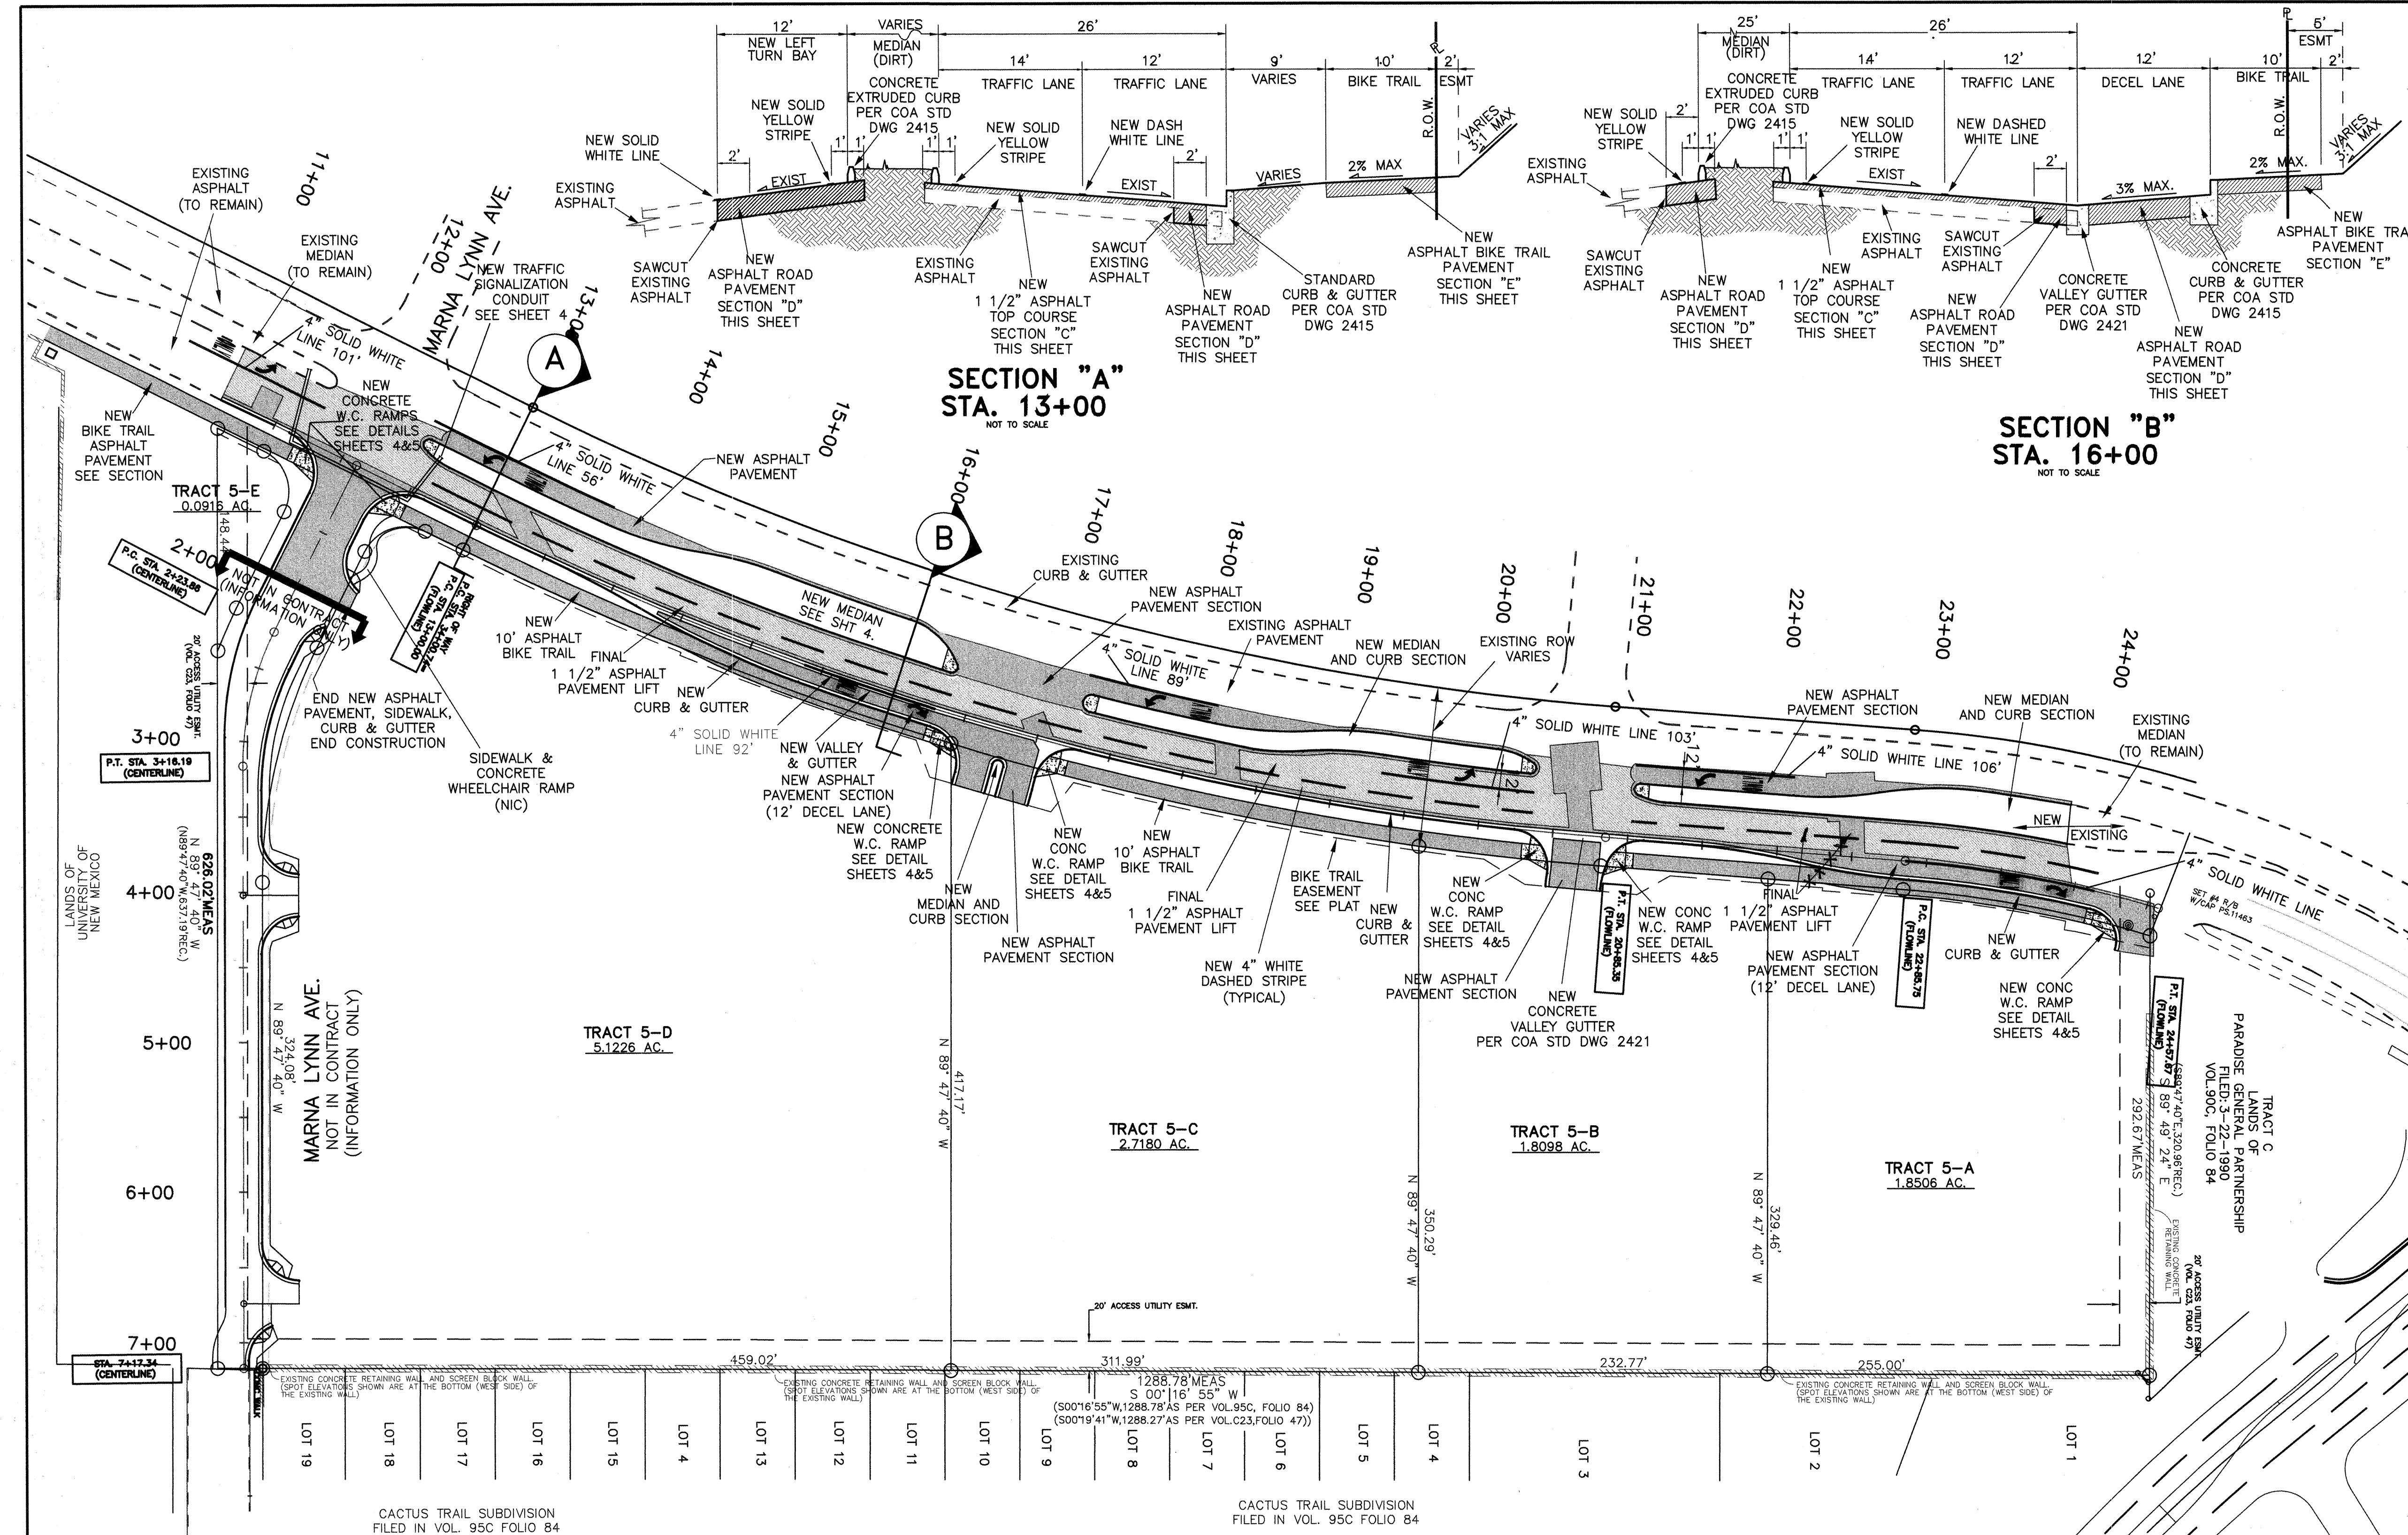


GENERAL NOTES:

- THE CONTRACTOR SHALL FIELD VERIFY ALL EXISTING UTILITY LOCATIONS & NOTIFY THE ENGINEER IMMEDIATELY OF ANY DISCREPANCIES.
- NOT USED
- CONTRACTOR IS RESPONSIBLE FOR REPAIR AND/OR REPLACEMENT OF ALL DAMAGED UTILITY CONDUITS & EXISTING LINES.
- ANY ADDITIONAL GRADING REQUIRED TO MATCH PROPOSED STREET GRADES SHALL BE INCIDENTAL TO PAVING ITEMS.
- CONTRACTOR SHALL PROVIDE INSPECTORS (CITY & PRIVATE) w/ A PROPOSED HYDRO-STATIC TESTING PLAN. THE PLAN MUST BE APPROVED BEFORE TESTING OPERATIONS BEGIN.
- CONTRACTOR SHALL PARK EQUIPMENT SO AS NOT TO INTERFERE WITH NORMAL ACTIVITIES OF OTHER CONTRACTORS ON SITE.
- ANY DAMAGE TO THE EXISTING FACILITIES TO REMAIN (CURB & GUTTER, PAVEMENT, CONDUITS, LANDSCAPING, UTILITY LINES, ETC.) DURING CONSTRUCTION SHALL BE REPLACED AT THE CONTRACTORS EXPENSE.
- REMOVAL OF THE EXISTING CURB & GUTTER OR VALLEY GUTTER SHALL BE AS PER COA STD DWG. 2415 (SAW CUT ONLY).
- WHEEL CHAIR RAMPS SHALL BE CONSTRUCTED PRIOR TO FINAL ACCEPTANCE OF CURB AND GUTTER.
- ALL DEMOLITION AND EXCESS SITE MATERIAL SHALL BE REMOVED BY THE CONTRACTOR TO A COA APPROVED DUMP SITE.
- THE CONTRACTOR SHALL COORDINATE WITH THE BUILDING PERMIT (SITE) CONTRACTOR FOR THE SEQUENCING OF ALL WORK (BOTH PRIVATE & PUBLIC).
- ALL PAVEMENT STRIPING SHALL BE REFLECTIVE PLASTIC TYPE MARKING.

LEGEND:


- NEW CONCRETE PAVEMENT
- NEW 1 1/2" ASPHALT FINAL LIFT
- NEW ASPHALT PAVEMENT
- NEW GATE VALVE
- NEW FIRE HYDRANT
- NEW WATER MAIN CAP
- NEW SD INLET
- NEW SAS MANHOLE
- NEW SD MANHOLE
- NEW WATER MAIN
- NEW SANITARY SEWER
- NEW STORM DRAIN
- NEW UTILITY ESMT
- FUTURE WATER METER
- FUTURE SEWER CLEANOUT
- FUTURE SAS MANHOLE
- EXISTING SD INLET
- EXISTING GATE VALVE
- EXISTING FIRE HYDRANT
- EXISTING SAS MANHOLE
- EXISTING SD MANHOLE
- EXISTING WATER MAIN
- EXISTING SANITARY SEWER
- EXISTING UTILITY ESMT

CITY OF ALBUQUERQUE PUBLIC WORKS DEPARTMENT ENGINEERING GROUP		BPLW	
TITLE: GOLF COURSE POINTE OVERALL PAVING AND STRIPING PLAN			
APPROVALS:	ENGINEER	DATE	APPROVALS:
DRC Chairm	Water	DATE	Water
Transportation	Waste Water	DATE	Waste Water
Hydrology	DESIGN	DATE	DESIGN
Parks & Rec.	REVIEW	DATE	REVIEW
DRAWING NO.	622981	MAP NO.	C-12-Z
SHEET	3	OF	21

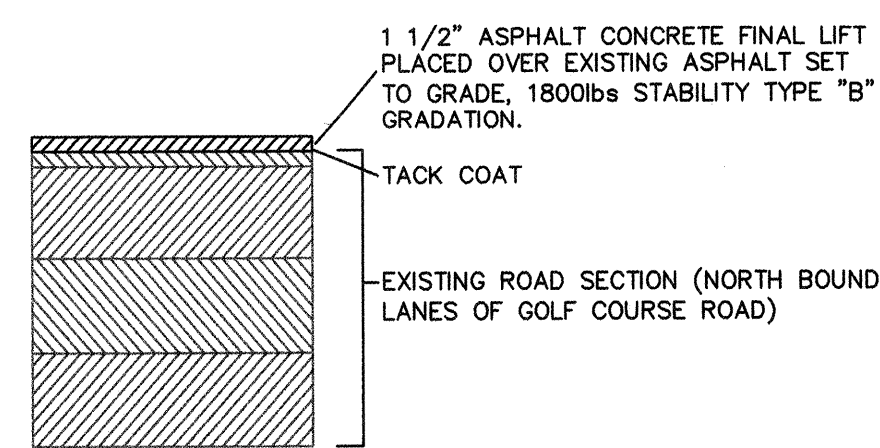


* NOTE: SECTION PER COA PROJECT
#590781 & 590881 BY BHI DEC, 1998

**SECTION "C"
FINAL LIFT
PAVEMENT SECTION**
NOT TO SCALE

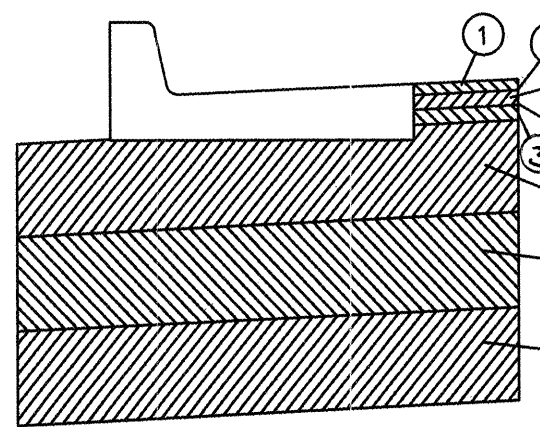

* NOTE: SECTION PER COA PROJECT
#590781 & 590881 BY BHI DEC, 1998

**SECTION "D"
ROAD PAVEMENT SECTION**
NOT TO SCALE


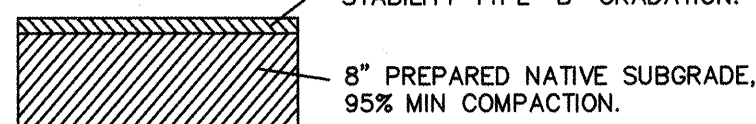


**SECTION "E"
BIKE TRAIL
PAVEMENT SECTION**
NOT TO SCALE




**OVERALL PAVING
AND STRIPING PLAN**
SCALE: 1" = 60'

AS-BUILT

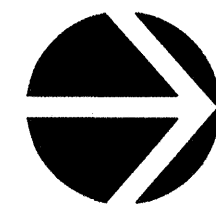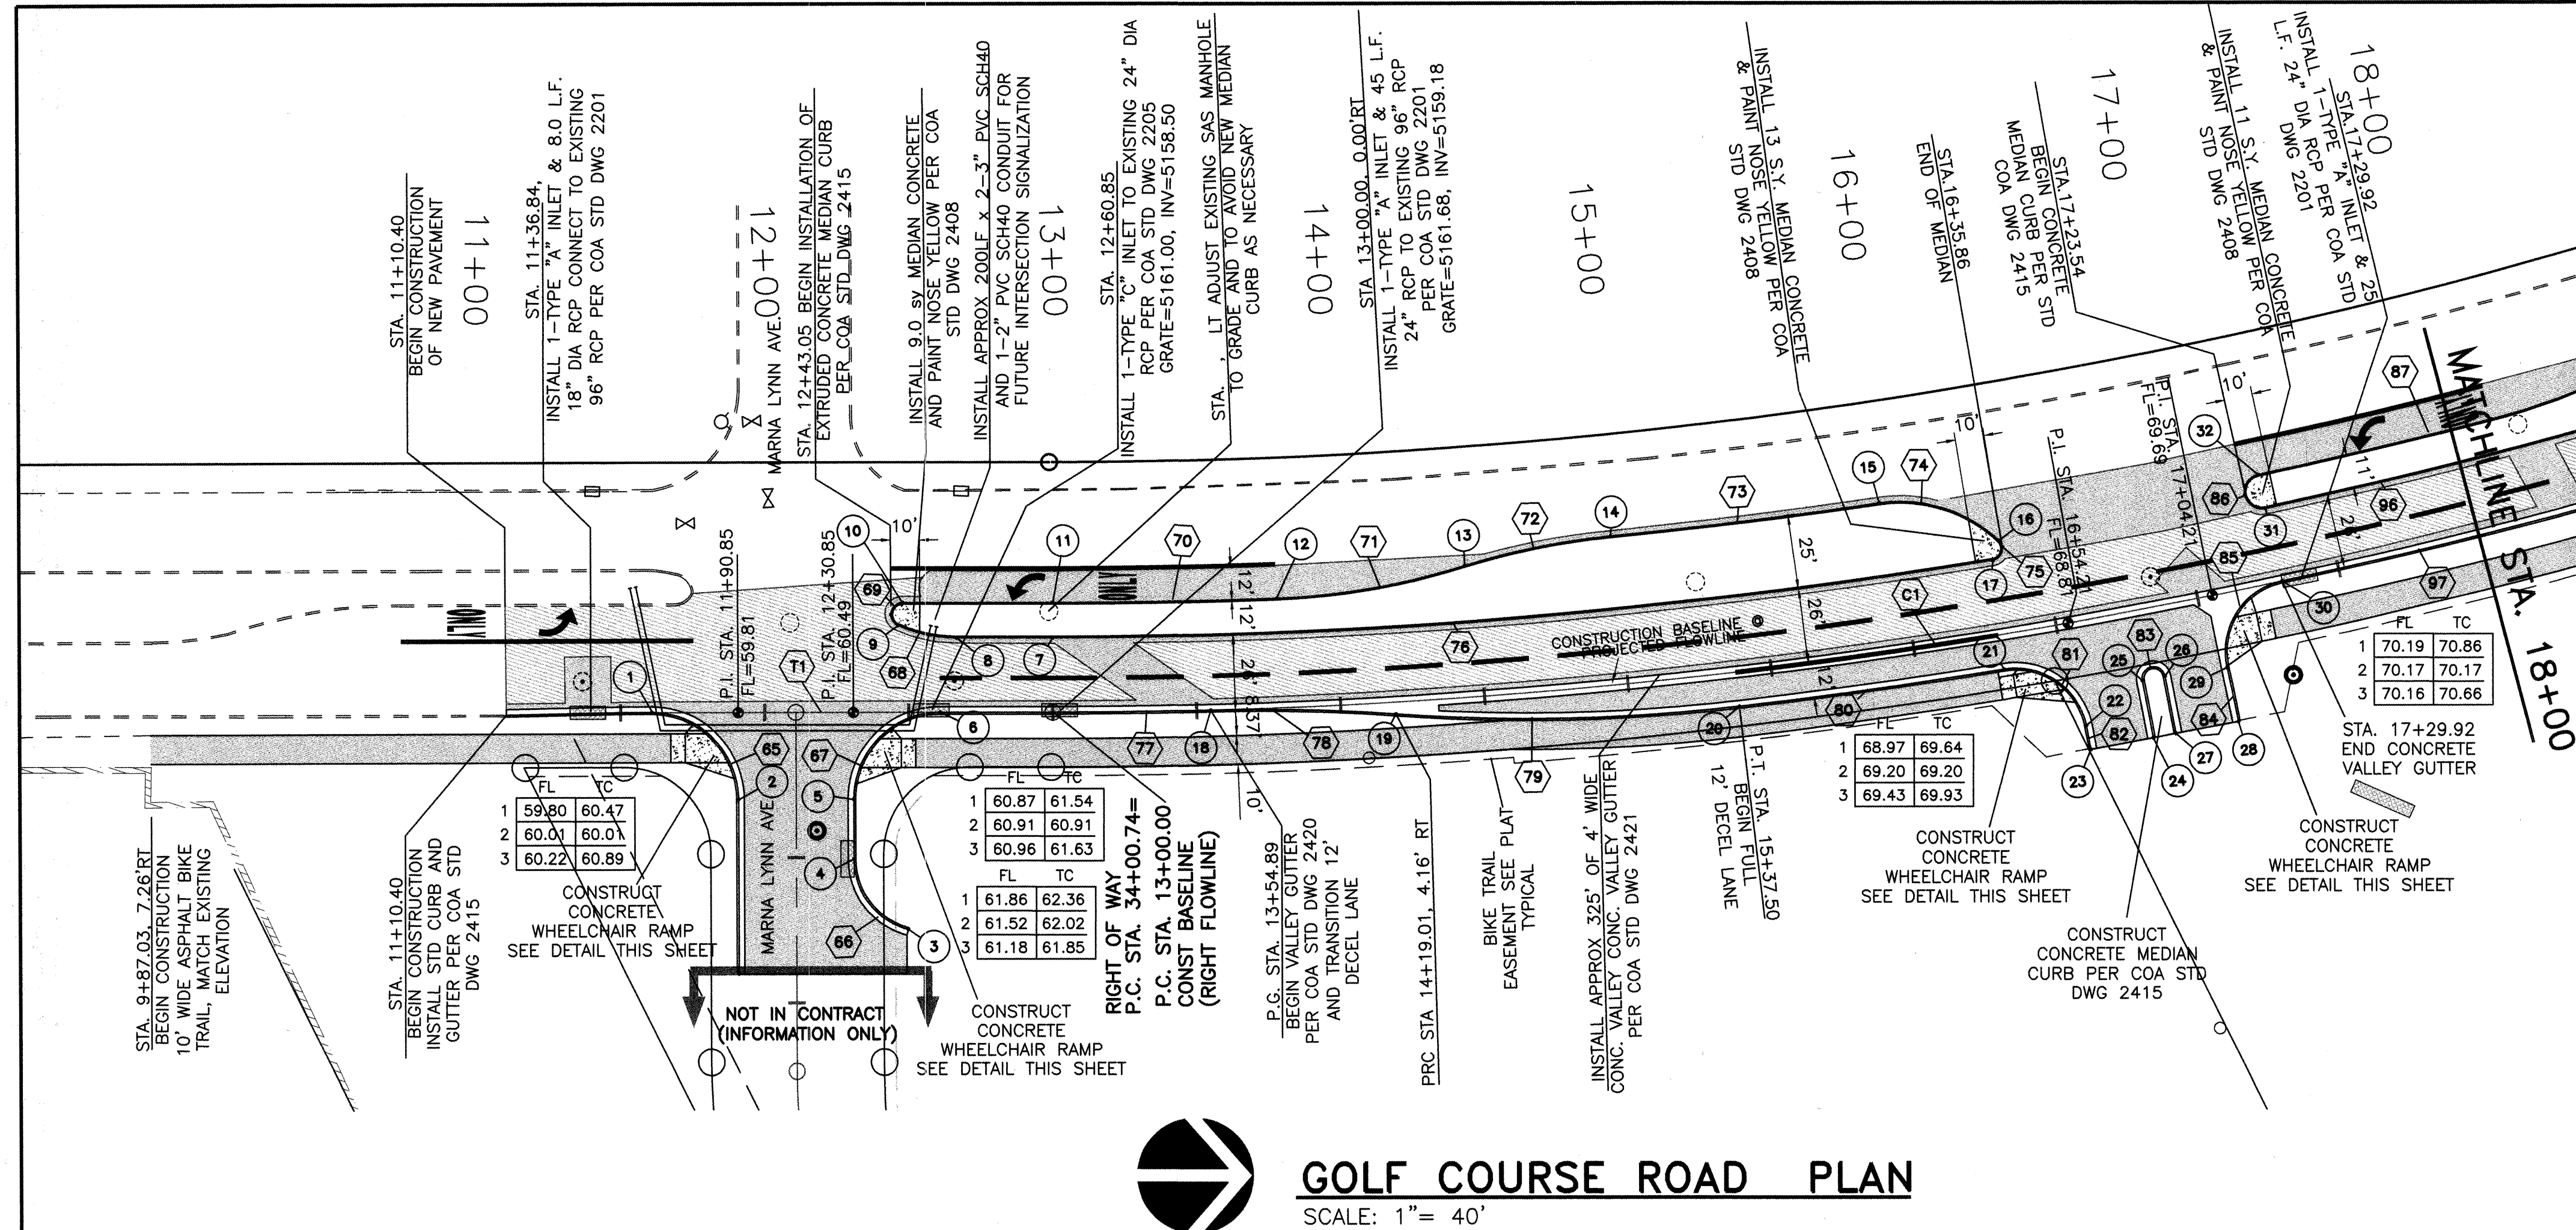

GOLF COURSE ROAD PLAN

SCALE: 1" = 40'

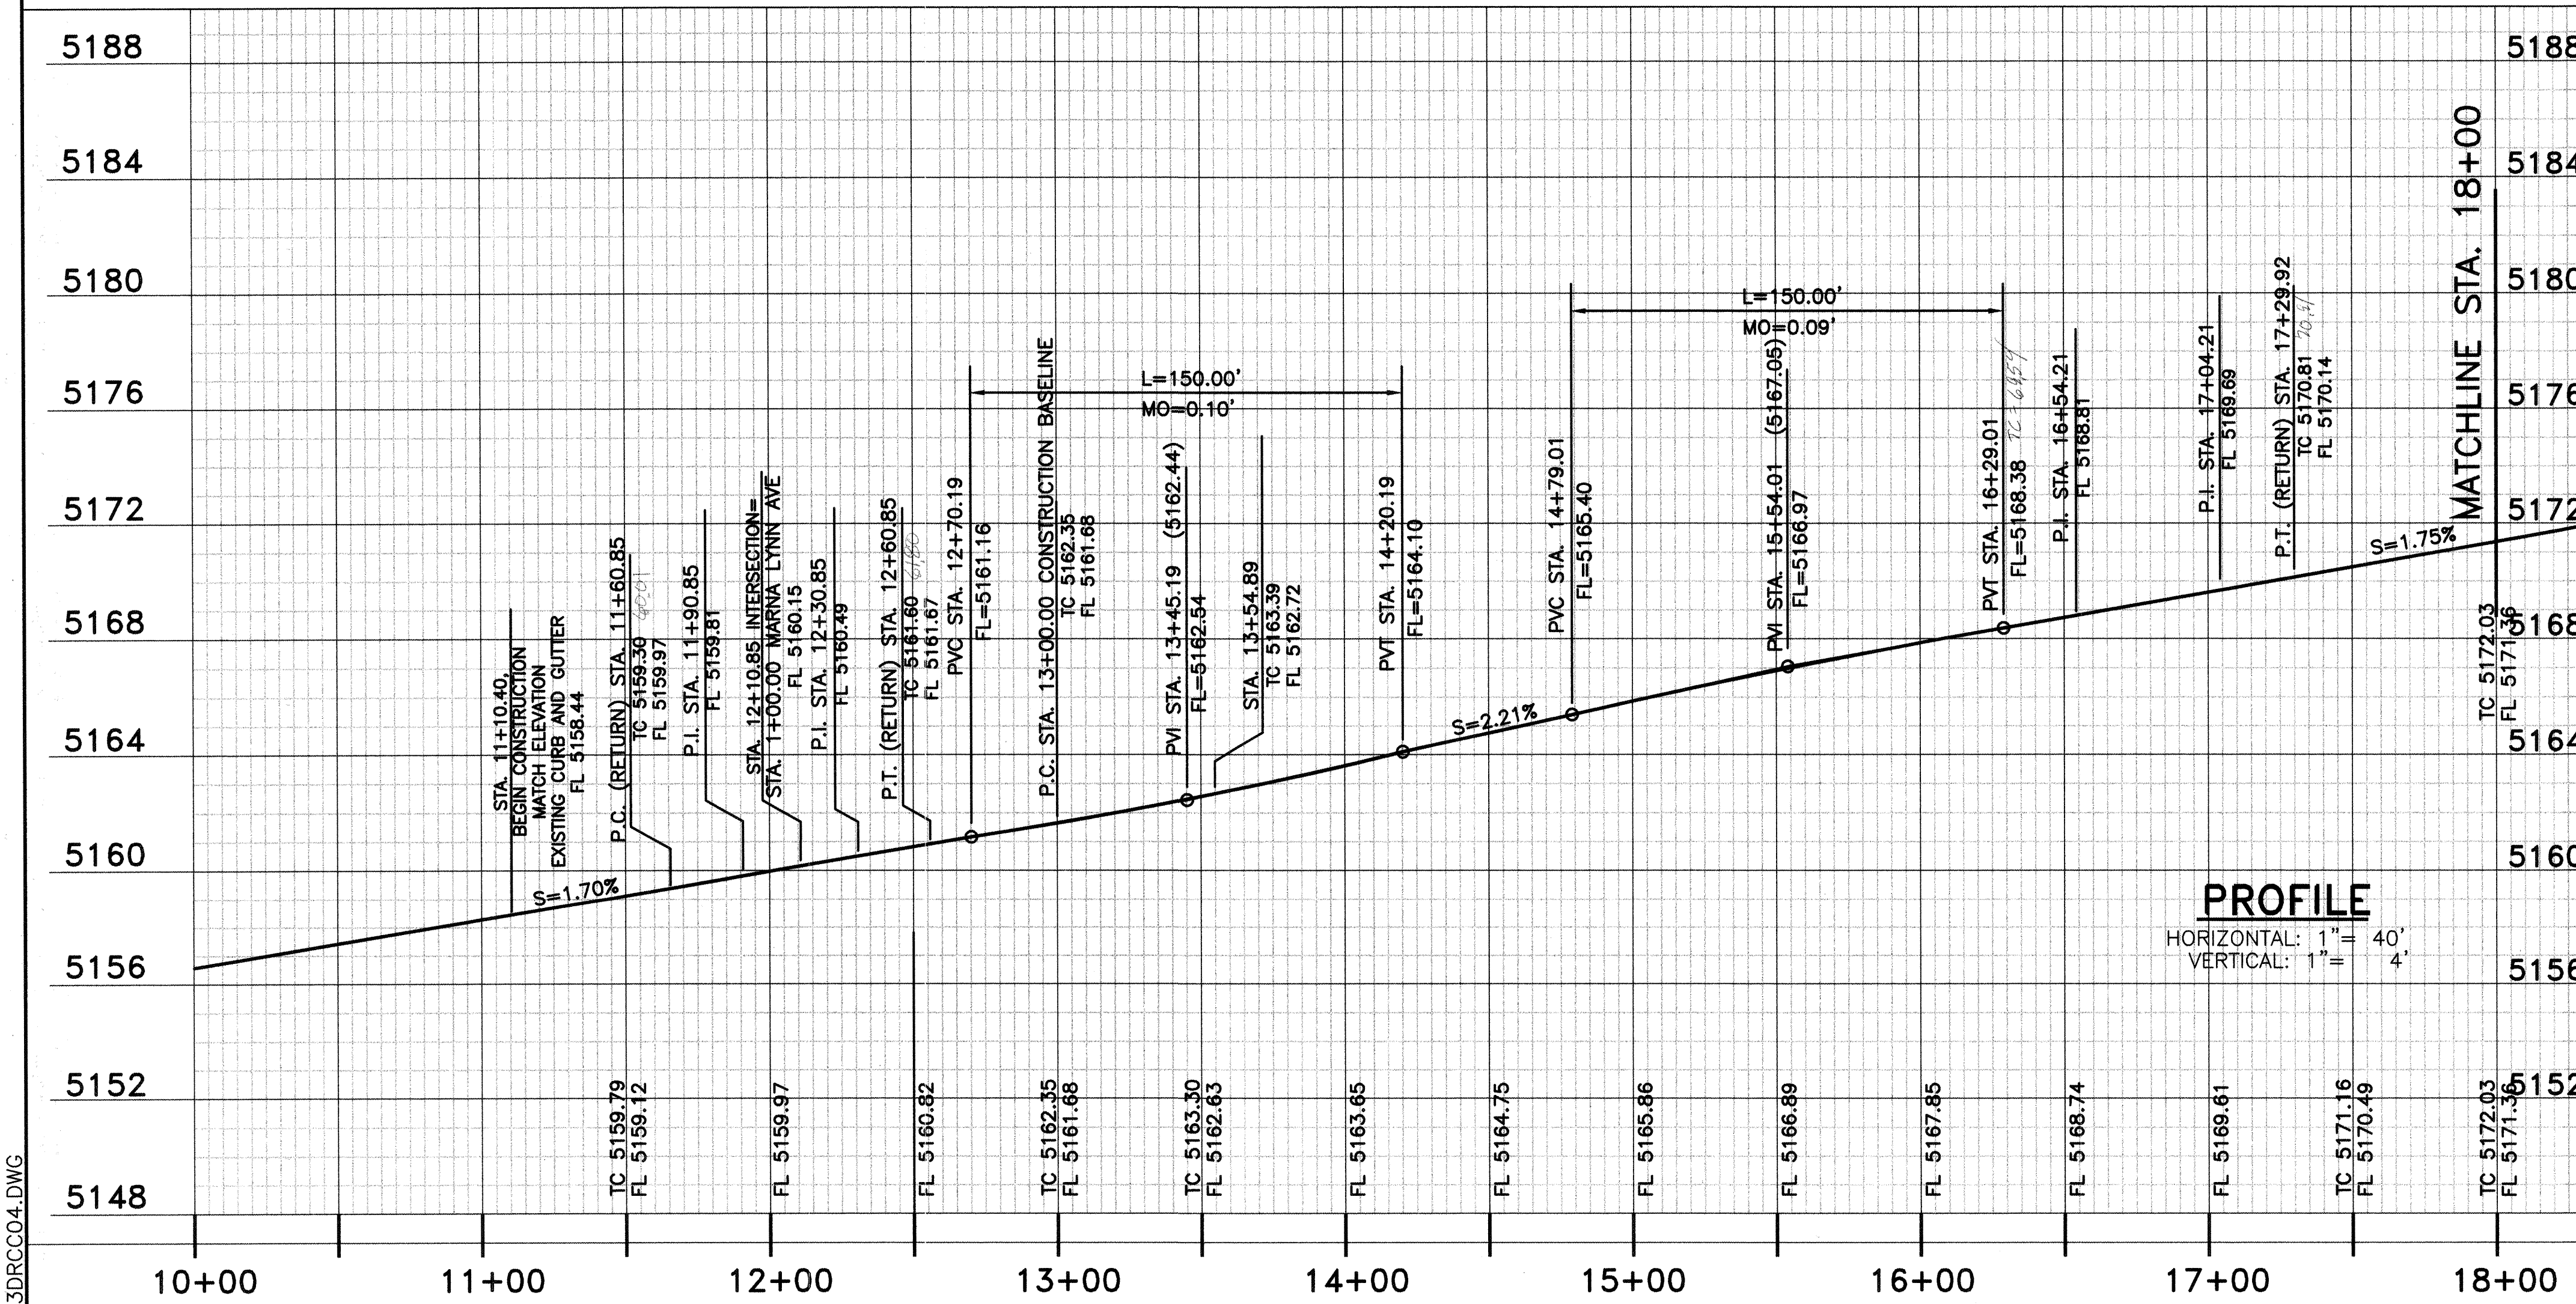

PROFILE

HORIZONTAL: 1" = 40'
VERTICAL: 1" = 4'

CONSTRUCTION BASELINE

① FLOWLINE:

No.	DELTA	AL	T	R
C1	22°07'00"	785.32'	397.61'	2034.00'
C2	12°20'00"	171.92'	86.30'	799.00'

TANGENT SCHEDULE

No.	BEARING	DISTANCE
T1	N 26°35'19" E	200.00'
T2	N 04°29'30" E	200.39'

CURB & GUTTER


POINT SCHEDULE

No.	STATION/OFFSET	ELEVATION
1	P.C. STA. 11+60.85	FLOWLINE TOP CURB
2	P.T. STA. 11+30.05, 20.00' RT	5159.59 5160.28
3	P.C. STA. 11+74.78, 38.83' LT	5160.43 5161.10
4	P.T. STA. 11+50.55, 20.00' LT	5162.20 5162.70
5	P.C. STA. 11+30.05, 20.00' LT	5160.84 5161.51
6	P.T. STA. 12+60.85	5161.00 5161.67
7	P.C. STA. 13+00.00, 26.00' LT	5161.96 5162.46
8	P.T. STA. 12+66.77, 26.00' LT	5161.40 5161.90
9	P.C. STA. 12+46.38, 33.35' LT	5161.09 5161.59
10	P.T. STA. 12+48.01, 38.00' LT	5161.37 5161.87
11	P.T. STA. 13+00.00, 38.00' LT	5162.49 5162.99
12	P.C. STA. 13+79.36, 38.00' LT	5164.11 5164.61
13	P.C. STA. 14+46.57, 45.70' LT	5165.40 5165.90
14	P.C. STA. 14+99.14, 51.70' LT	5166.43 5166.93
15	P.C. STA. 15+95.51, 51.70' LT	5168.28 5168.78
16	P.C. STA. 16+35.29, 32.43' LT	5169.04 5169.54
17	P.C. STA. 16+32.06, 26.00' LT	5168.92 5169.42
18	P.C. STA. 13+54.89	5162.72 5163.39
19	P.C. STA. 14+19.01, 4.16' RT	5164.19 5164.86
20	P.C. STA. 15+37.50, 12.00' RT	5167.00 5167.67
21	P.C. STA. 16+29.70, 12.00' RT	5168.74 5169.41
22	P.T. STA. 16+54.24, 36.18' RT	5169.66 5170.16
23	STA. 16+54.39, 44.50' RT	5169.90 5170.40
24	STA. 16+75.89, 44.41' RT	5170.55 5171.05
25	P.C. STA. 16+75.83, 24.17' RT	5170.04 5170.54
26	P.T. STA. 16+83.74, 24.17' RT	5170.18 5170.68
27	STA. 16+83.72, 44.44' RT	5170.72 5171.22
28	STA. 17+05.28, 44.67' RT	5170.81 5171.31
29	STA. 17+05.23, 25.37' RT	5170.21 5170.71
30	STA. 17+29.92	5170.14 5170.81
31	P.C. STA. 17+29.60, 26.00' LT	5170.50 5171.00
32	P.T. STA. 17+29.60, 38.00' LT	5170.92 5171.42

* MARLA LYNN AVE.

CURVE SCHEDULE

No.	DELTA	AL	T	R
65	90°00'00"	47.12'	30.00'	30.00'
66	75°42'20"	33.03'	19.43'	25.00'
67	90°00'00"	47.12'	30.00'	30.00'
68	24°04'00"	21.01'	10.66'	50.00'
69	155°56'00"	11.28'	18.76'	4.00'
70	02°15'45"	78.82'	39.41'	1996.02'
71	15°14'02"	66.47'	33.43'	250.00'
72	11°51'36"	51.71'	26.97'	250.00'
73	03°28'56"	93.96'	46.99'	1982.30'
74	51°31'09"	44.96'	24.13'	50.00'
75	127°27'04"	8.90'	8.10'	4.00'
76	09°21'08"	327.76'	164.24'	2008.00'
77	01°34'21"	55.82'	27.91'	2034.00'
78	05°51'45"	64.34'	32.20'	628.80'
79	10°52'41"	119.38'	59.87'	628.80'
80	02°35'50"	92.75'	46.38'	2046.00'
81	87°46'33"	38.30'	24.05'	25.00'
82	01°00'19"	8.32'	4.16'	474.00'
83	179°53'17"	12.56'	4095.14'	4.00'
84	02°06'10"	19.30'	9.65'	526.00'
85	90°29'54"	39.49'	25.22'	25.00'
86	180°00'00"	18.85'	-	6.00'
87	02°23'08"	83.11'	41.56'	1996.00'
96	03°11'58"	112.13'	56.08'	2008.00'
97	20°24'07"	724.27'	366.01'	2034.00'

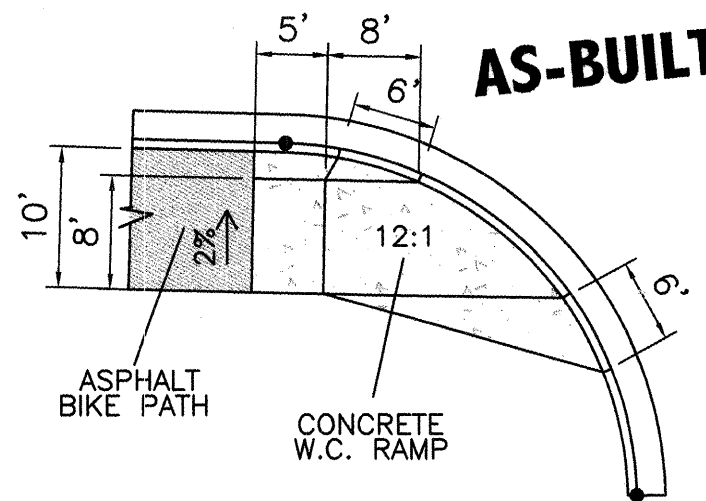

WHEEL CHAIR RAMP
DETAIL
NOT TO SCALE

GENERAL NOTES:



- THE CONTRACTOR SHALL FIELD VERIFY ALL EXISTING UTILITY LOCATIONS & NOTIFY THE ENGINEER IMMEDIATELY OF ANY DISCREPANCIES.
- ALL CURVE DATA & DIMENSIONS REFER TO FACE OF CURB AT FLOWLINE UNLESS OTHERWISE SPECIFIED.
- CONTRACTOR IS RESPONSIBLE FOR ALL REPAIR AND/OR REPLACEMENT OF ALL UTILITY CONDUITS & EXISTING LINES.
- ANY ADDITIONAL GRADING REQUIRED TO MATCH PROPOSED STREET GRADES SHALL BE INCIDENTAL TO PAVING ITEMS.
- CONTRACTOR SHALL PROVIDE INSPECTORS (CITY & PRIVATE) w/ A PROPOSED HYDRO STATIC TESTING PLAN. THE PLAN MUST BE APPROVED BEFORE TESTING OPERATIONS BEGIN.
- CONTRACTOR SHALL PARK EQUIPMENT AND MATERIALS AS NOT TO INTERFERE WITH NORMAL ACTIVITIES OF OTHER CONTRACTORS ON SITE.
- DAMAGE TO THE EXISTING FACILITIES (CURB & GUTTER, PAVEMENT, CONDUITS, DISCHARGES, UTILITY LINES, ETC.) DURING CONSTRUCTION SHALL BE REPLACED AT THE CONTRACTORS EXPENSE.
- REMOVAL OF THE EXISTING CURB & GUTTER OR VALLEY GUTTER SHALL BE AS PER COA STD DWG. 2415 (SAW CUT ONLY).
- WHEEL CHAIR RAMP SHALL BE CONSTRUCTED PRIOR TO ACCEPTANCE OF CURB & GUTTER.

TC 70.45
TC 70.34
TC 70.41
TC 70.10
TC 70.25
TC 70.36
TC 70.95
TC 70.41

LEGEND:

- NEW CONCRETE PAVEMENT
- NEW 1 1/2" ASPHALT FINAL LIFT
- NEW ASPHALT PAVEMENT
- NEW GATE VALVE
- NEW FIRE HYDRANT
- NEW SD INLET
- NEW SAS MANHOLE
- NEW SD MANHOLE
- EXISTING SD INLET
- EXISTING GATE VALVE
- EXISTING FIRE HYDRANT
- EXISTING SAS MANHOLE
- EXISTING SD MANHOLE

CITY OF ALBUQUERQUE PUBLIC WORKS DEPARTMENT ENGINEERING GROUP		BPLW	
TITLE: GOLF COURSE RD. CONTROL P & P STA. 11+00.00 TO STA. 18+00.00			
APPROVALS	ENGINEER	DATE	APPROVALS
DRC Chairman	Water		ENGINEER
Transportation	Waste Water		
Hydrology			
Parks & Rec.			
DRAWING NO.	622981	MAP NO.	C-12-Z
SHEET	4	OF	21

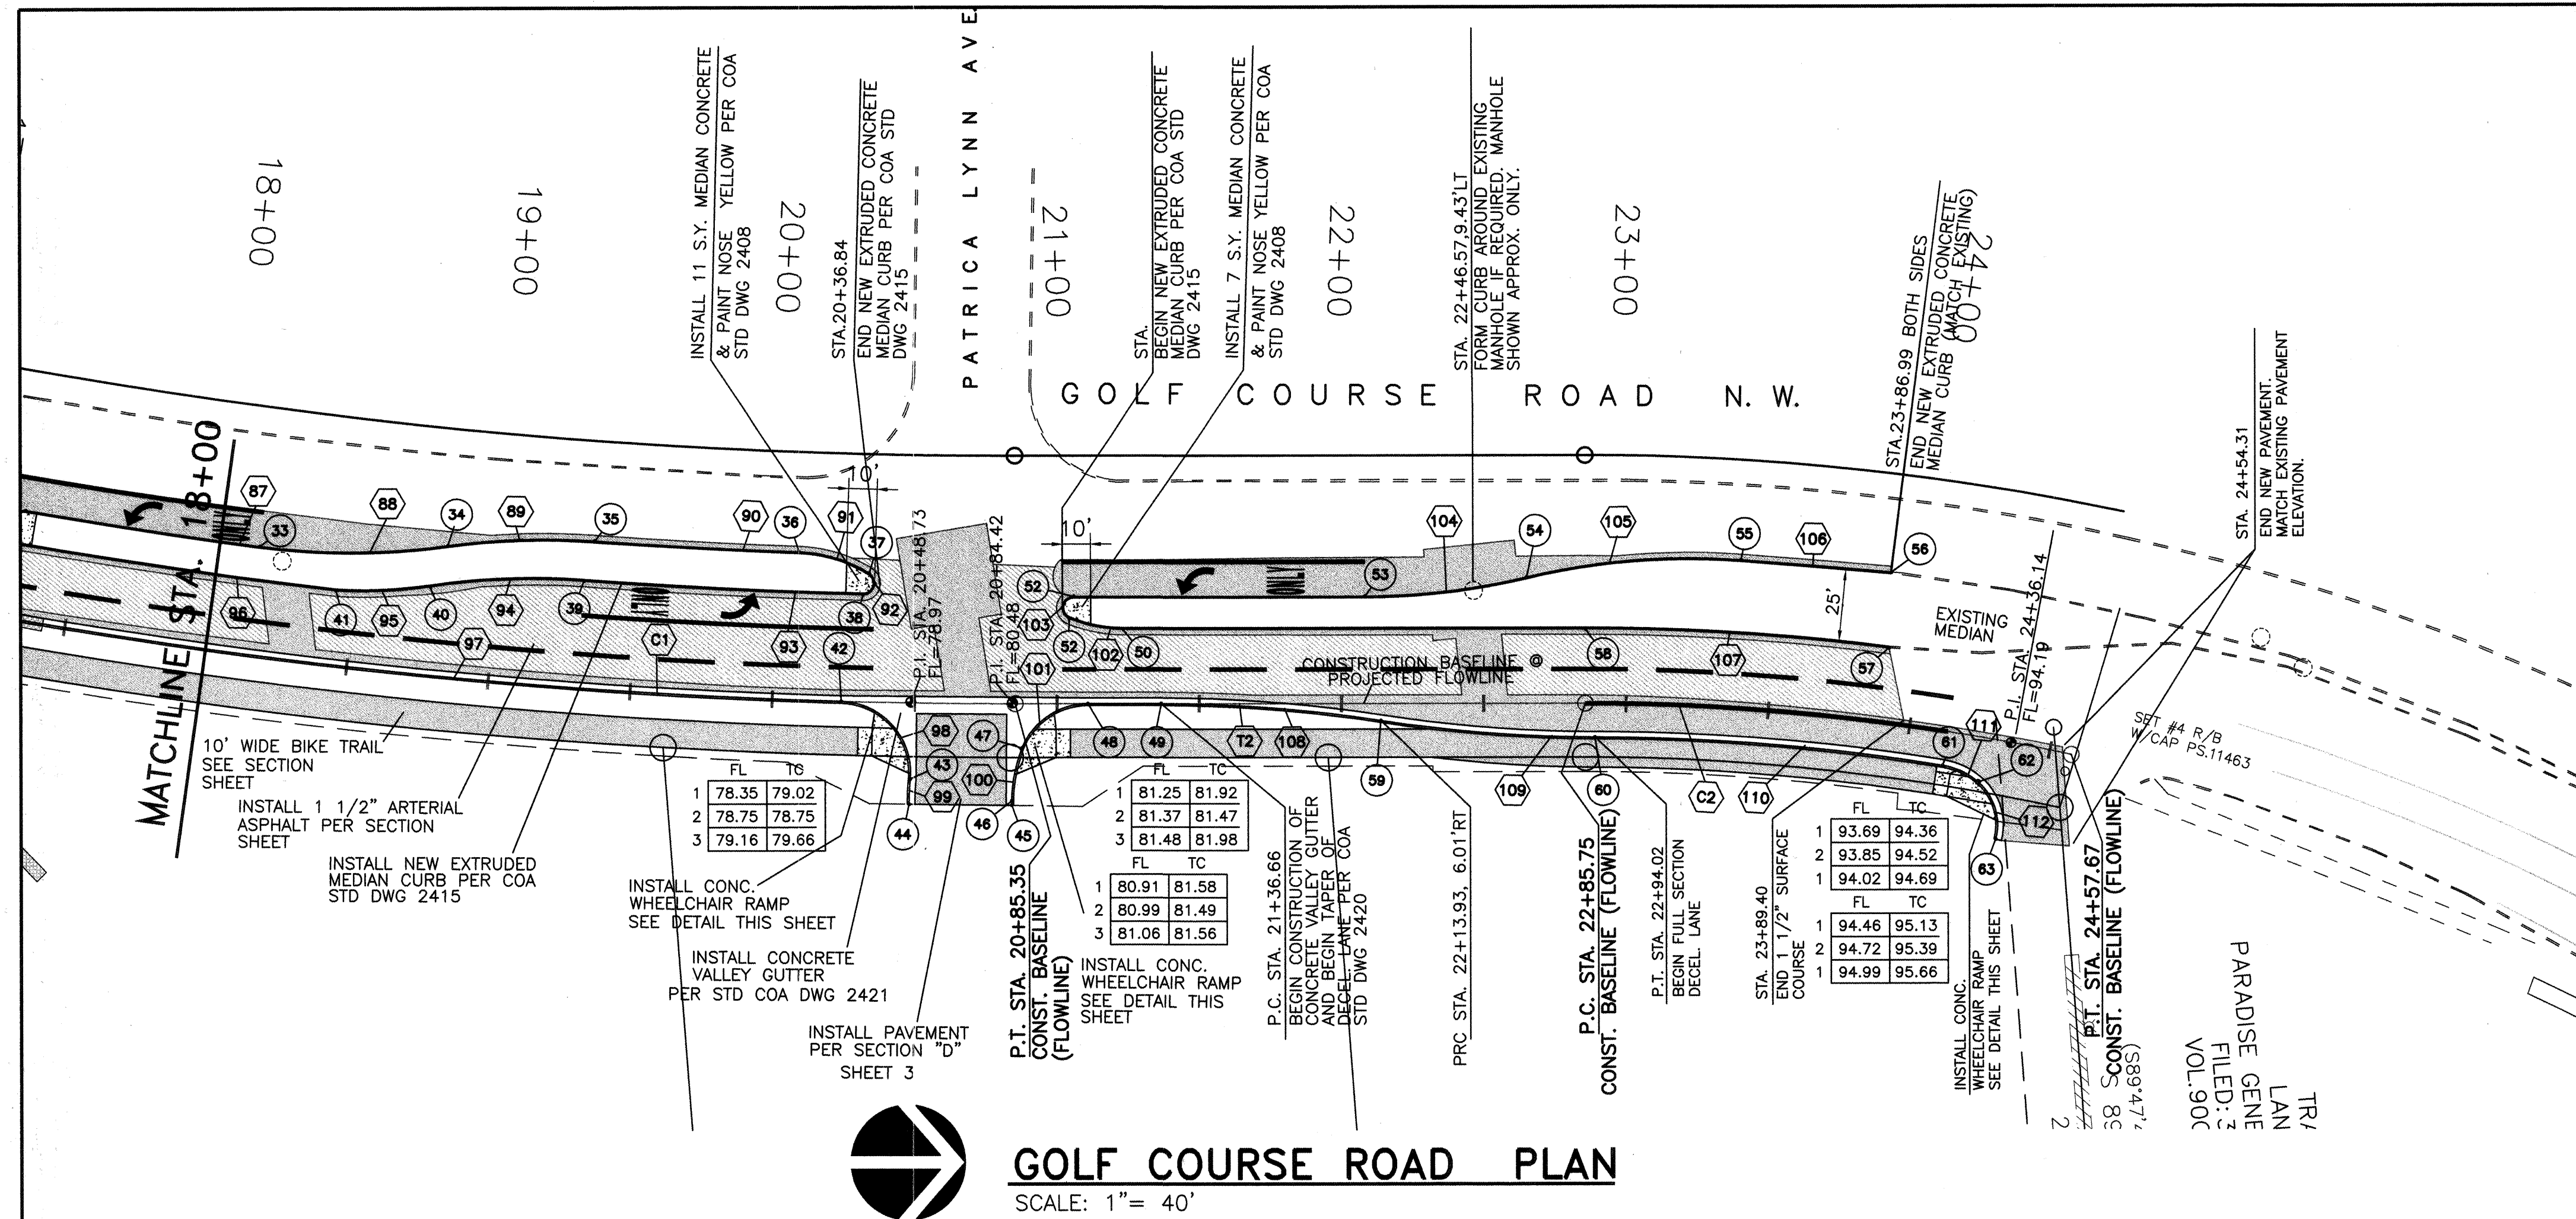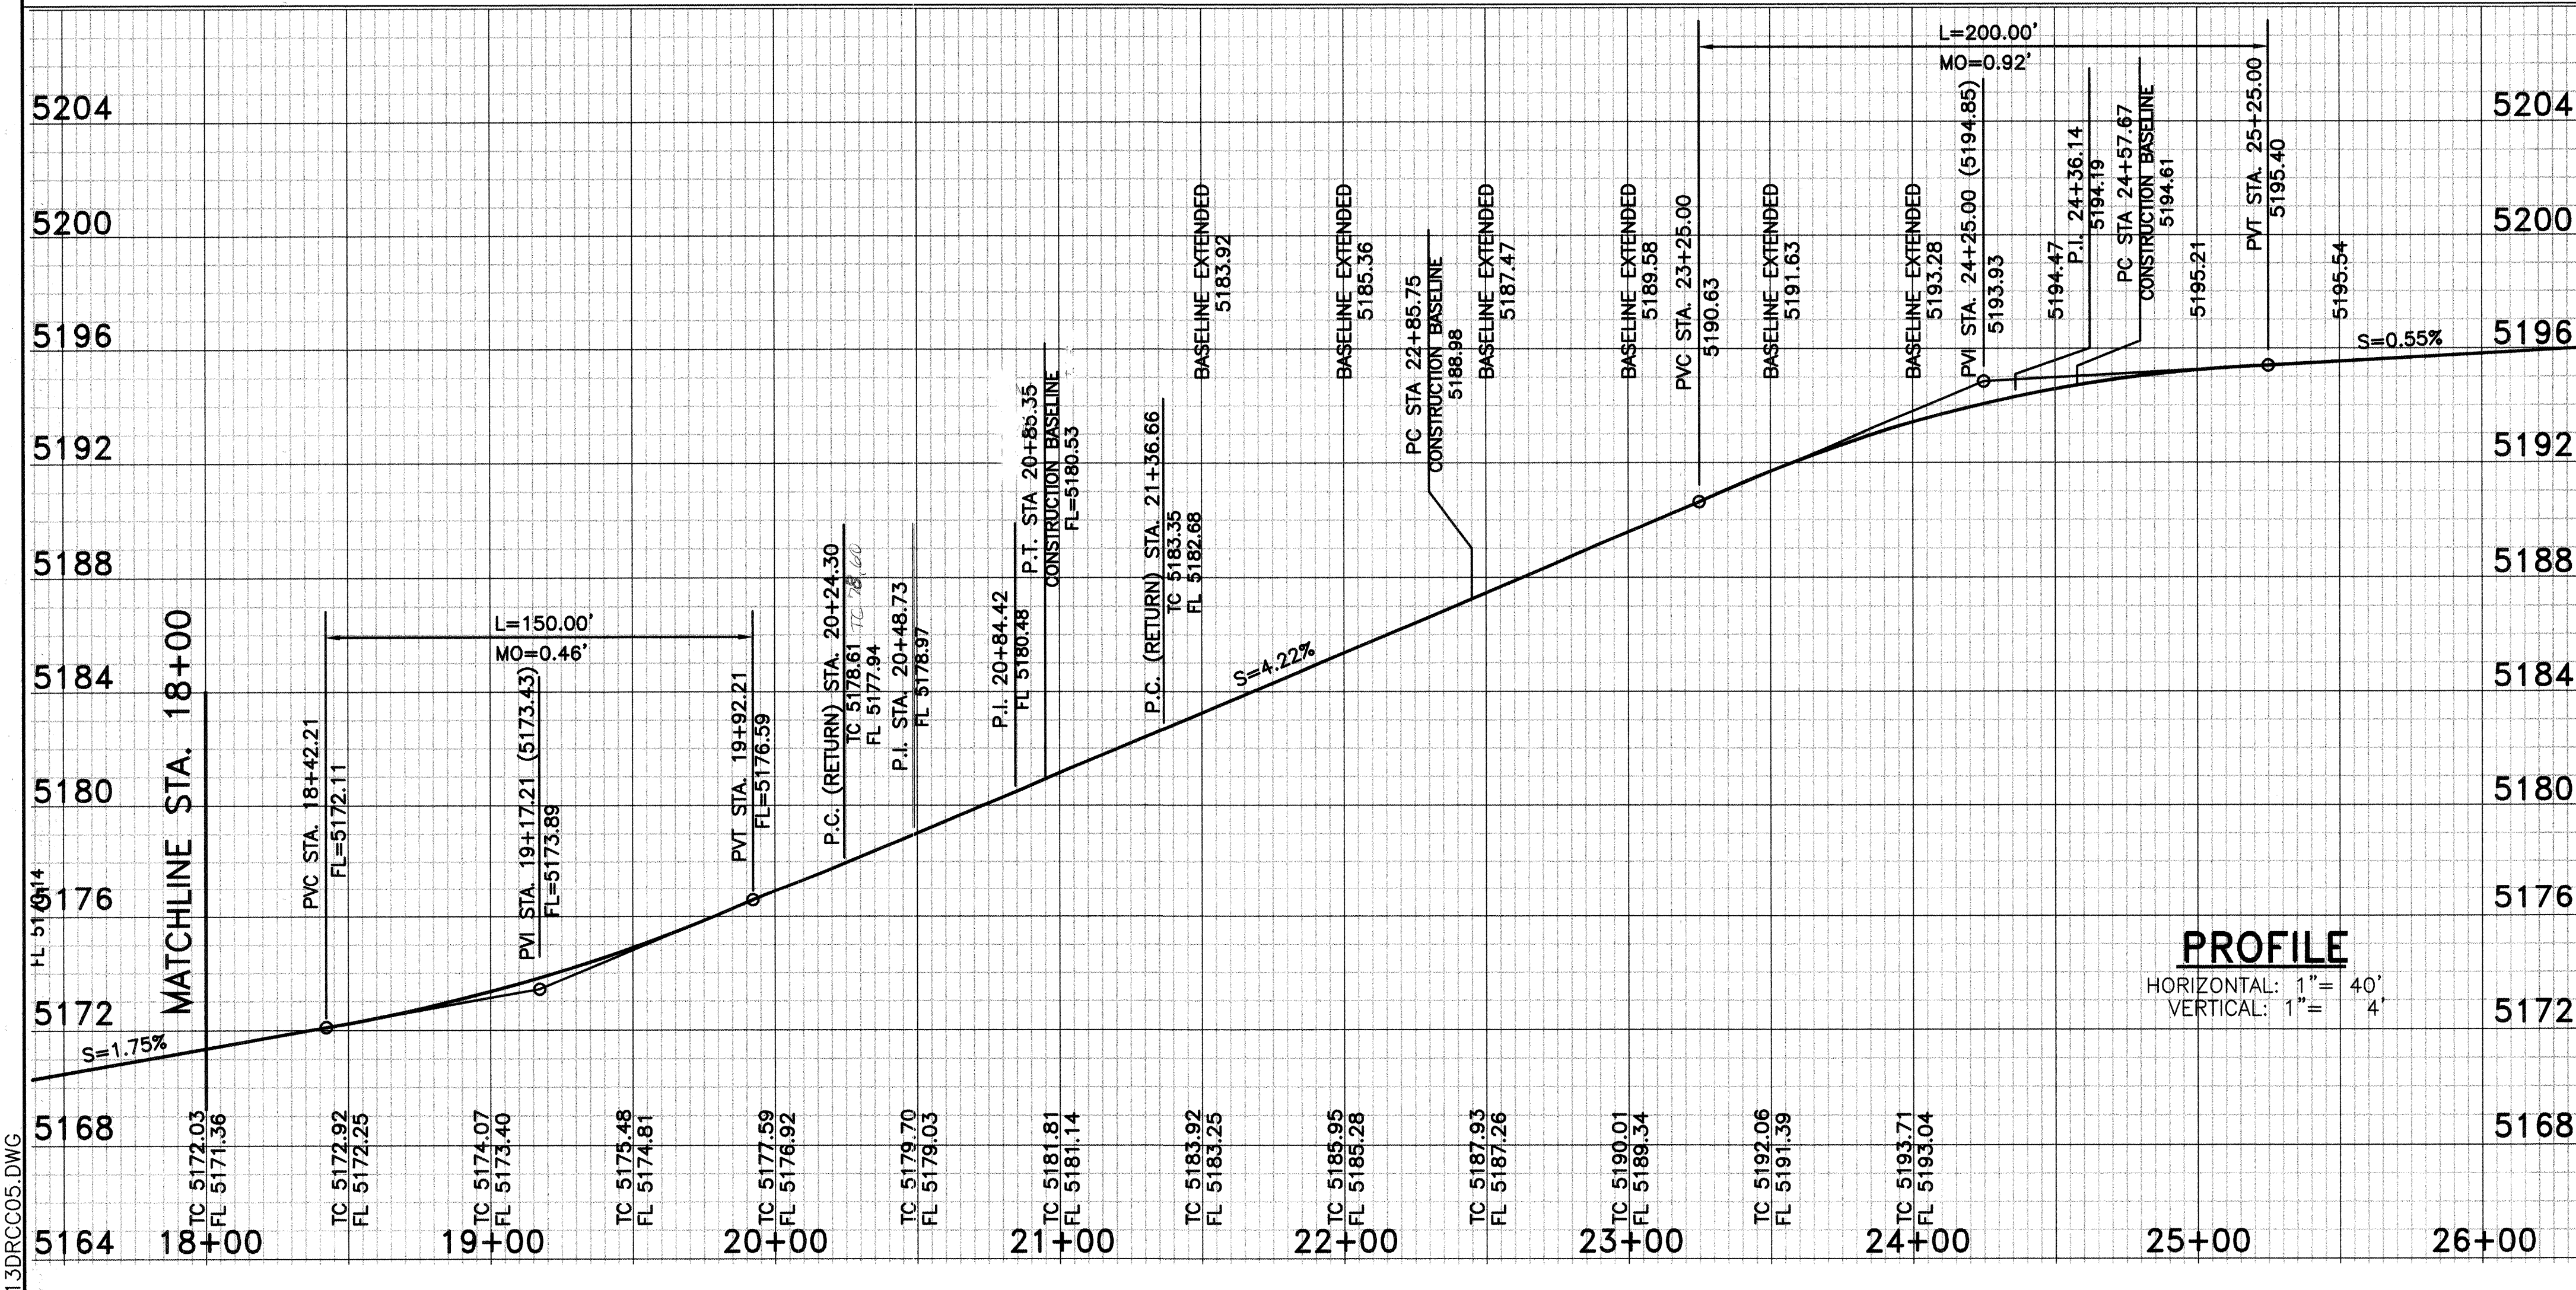

CONSTRUCTION BASELINE CURVE SCHEDULE

No.	DELTA	AL	T	R
C1	22°07'00"	785.32'	397.61'	2034.00'
C2	12°20'00"	171.92'	86.30'	799.00'

TANGENT SCHEDULE

No.	BEARING	DISTANCE
T1	N 26°35'19" E	200.00'
T2	N 04°29'30" E	200.39'

CURB & GUTTER POINT SCHEDULE

No.	STATION/OFFSET	ELEVATION
33	PCC STA. 18+14.32, 38.00' LT	5172.61
34	PRC STA. 18+81.29, 45.70' LT	5173.93
35	PRC STA. 19+33.85, 51.70' LT	5175.29
36	PRC STA. 20+09.88, 51.70' LT	5177.48
37	PCC STA. 20+33.06, 44.95' LT	5178.22
38	PCC STA. 20+30.99, 37.50' LT	5178.35
39	PRC STA. 19+31.05, 37.50' LT	5174.93
40	PRC STA. 18+76.46, 30.93' LT	5173.13
41	PCC STA. 18+43.22, 26.00' LT	5172.62
42	PRC STA. 20+24.30	5177.94
43	P.T. STA. 20+48.92, 26.78' RT	5179.56
44	STA. 20+48.73, 35.66' RT	5179.87
45	STA. 20+84.08, 35.74' RT	5180.85
46	P.C. STA. 20+84.07, 34.21' RT	5180.84
47	PCC STA. 20+87.67, 15.81' RT	5181.13
48	P.T. STA. 21+10.92	5181.60
49	P.C. STA. 21+36.66	5182.68
50	P.C. STA. 21+23.54, 26.00' LT	5182.67
51	P.C. STA. 21+04.41, 29.80' LT	5181.54
52	P.T. STA. 21+05.94, 37.50' LT	5180.75
53	P.C. STA. 22+08.38, 37.50' LT	5184.84
54	PRC STA. 22+65.20, 44.04' LT	5186.62
55	PCC STA. 23+37.36, 51.66' LT	5189.06
56	STA. 26+86.99, 52.42' LT	5191.09
57	STA. 23+89.40, 26.10' LT	5192.88
58	P.C. STA. 22+85.75, 26.00' LT	5189.26
59	PRC STA. 22+13.93, 6.01' RT	5185.89
60	PRC STA. 22+89.13, 12.00' RT	5189.07
61	PCC STA. 24+13.62, 12.00' RT	5193.41
62	PCC STA. 24+34.84, 23.65' RT	5194.19
63	P.T. STA. 24+37.19, 34.39' RT	5195.26

CURVE SCHEDULE

No.	DELTA	AL	T	R
87	02°23'08"	83.11'	41.56'	1996.00'
88	15°10'42"	66.23'	33.31'	250.00'
89	11°51'36"	51.75'	25.97'	250.00'
90	02°04'50"	71.98'	35.99'	1982.30'
91	29°45'57"	25.98'	13.29'	50.00'
92	149°34'39"	10.44'	14.71'	4.00'
93	29°33'37"	98.13'	44.62'	1996.50'
94	12°25'01"	54.18'	27.20'	250.00'
95	11°44'15"	33.20'	16.66'	162.08'
96	03°11'58"	39.27'	56.08'	2008.00'
97	20°24'07"	724.27'	366.01'	2034.00'
98	93°43'55"	40.90'	26.68'	25.00'
99	05°49'21"	8.89'	4.45'	87.47'
100	20°59'00"	18.86'	9.53'	51.49'
101	68°25'15"	29.85'	17.00'	25.00'
102	22°29'42"	19.36'	9.94'	50.00'
103	157°30'18"	11.00'	20.13'	4.00'
104	13°08'07"	57.31'	28.78'	250.00'
105	17°24'44"	75.98'	38.28'	250.00'
106	00°45'09"	52.86'	26.43'	4025.80'
107	07°12'24"	107.02'	53.58'	850.89'
108	08°53'22"	77.57'	38.87'	500.00'
109	08°38'49"	75.46'	37.80'	500.00'
110	08°55'38"	122.62'	61.44'	787.00'
111	31°56'01"	13.93'	7.15'	25.00'
112	63°42'55"	22.24'	12.43'	20.00'

GENERAL NOTES:

- THE CONTRACTOR SHALL FIELD VERIFY ALL EXISTING UTILITY LOCATIONS & NOTIFY THE ENGINEER IMMEDIATELY OF ANY DISCREPANCIES.
- ALL CURVE DATA & DIMENSIONS REFER TO FACE OF CURB AT FLOWLINE UNLESS OTHERWISE SPECIFIED.
- CONTRACTOR IS RESPONSIBLE FOR ALL REPAIR AND/OR REPLACEMENT OF ALL UTILITY CONDUITS & EXISTING LINES.
- ANY ADDITIONAL GRADING REQUIRED TO MATCH PROPOSED STREET GRADES SHALL BE INCIDENTAL TO PAVING ITEMS.
- CONTRACTOR SHALL PROVIDE INSPECTORS (CITY & PRIVATE) w/ A PROPOSED HYDRO STATIC TESTING PLAN. THE PLAN MUST BE APPROVED BEFORE TESTING OPERATIONS BEGIN.
- CONTRACTOR SHALL PARK EQUIPMENT AND VEHICLES AS NOT TO INTERFERE WITH NORMAL ACTIVITIES OF OTHER CONTRACTORS ON SITE.
- ANY DAMAGE TO THE EXISTING FACILITIES (CURB & GUTTER, PAVEMENT, CONDUITS, LANDSCAPING, UTILITY LINES, ETC.) DURING CONSTRUCTION SHALL BE REPLACED AT THE CONTRACTORS EXPENSE.
- REMOVAL OF THE EXISTING CURB & GUTTER OR VALLEY GUTTER SHALL BE AS PER COA STD DWG. 2415 (SAW CUT ONLY).
- WHEEL CHAIR RAMPS SHALL BE CONSTRUCTED PRIOR TO ACCEPTANCE OF CURB & GUTTER.
- TOPOGRAPHICAL & BOUNDARY SURVEY PROVIDED BY HARRIS SURVEYING INC. BPLW IS NOT RESPONSIBLE FOR ANY DISCREPANCIES IN THE SURVEY.

LEGEND:

- NEW CONCRETE PAVEMENT
- NEW 1 1/2" ASPHALT FINAL LIFT
- NEW ASPHALT PAVEMENT
- NEW GATE VALVE
- NEW FIRE HYDRANT
- NEW SD INLET
- NEW SAS MANHOLE
- NEW SD MANHOLE
- EXISTING SD INLET
- EXISTING GATE VALVE
- EXISTING FIRE HYDRANT
- EXISTING SAS MANHOLE
- EXISTING SD MANHOLE

CITY OF ALBUQUERQUE
PUBLIC WORKS DEPARTMENT
ENGINEERING GROUP



BPLW

TITLE: GOLF COURSE RD CONTROL P & P
STA. 18+00.00 TO STA. 25+00.00

APPROVALS: ENGINEER DATE: 9/10/99
DRC Chairman: [Signature]
Transportation: [Signature]
Hydrology: [Signature]
Parks & Rec: [Signature]

DESIGNED BY: HBM
DRAWN BY: HBM
CHECKED BY: GCU

DRAWING NO.: 622981
MAP NO.: C-12-Z
SHEET: 5 OF 21

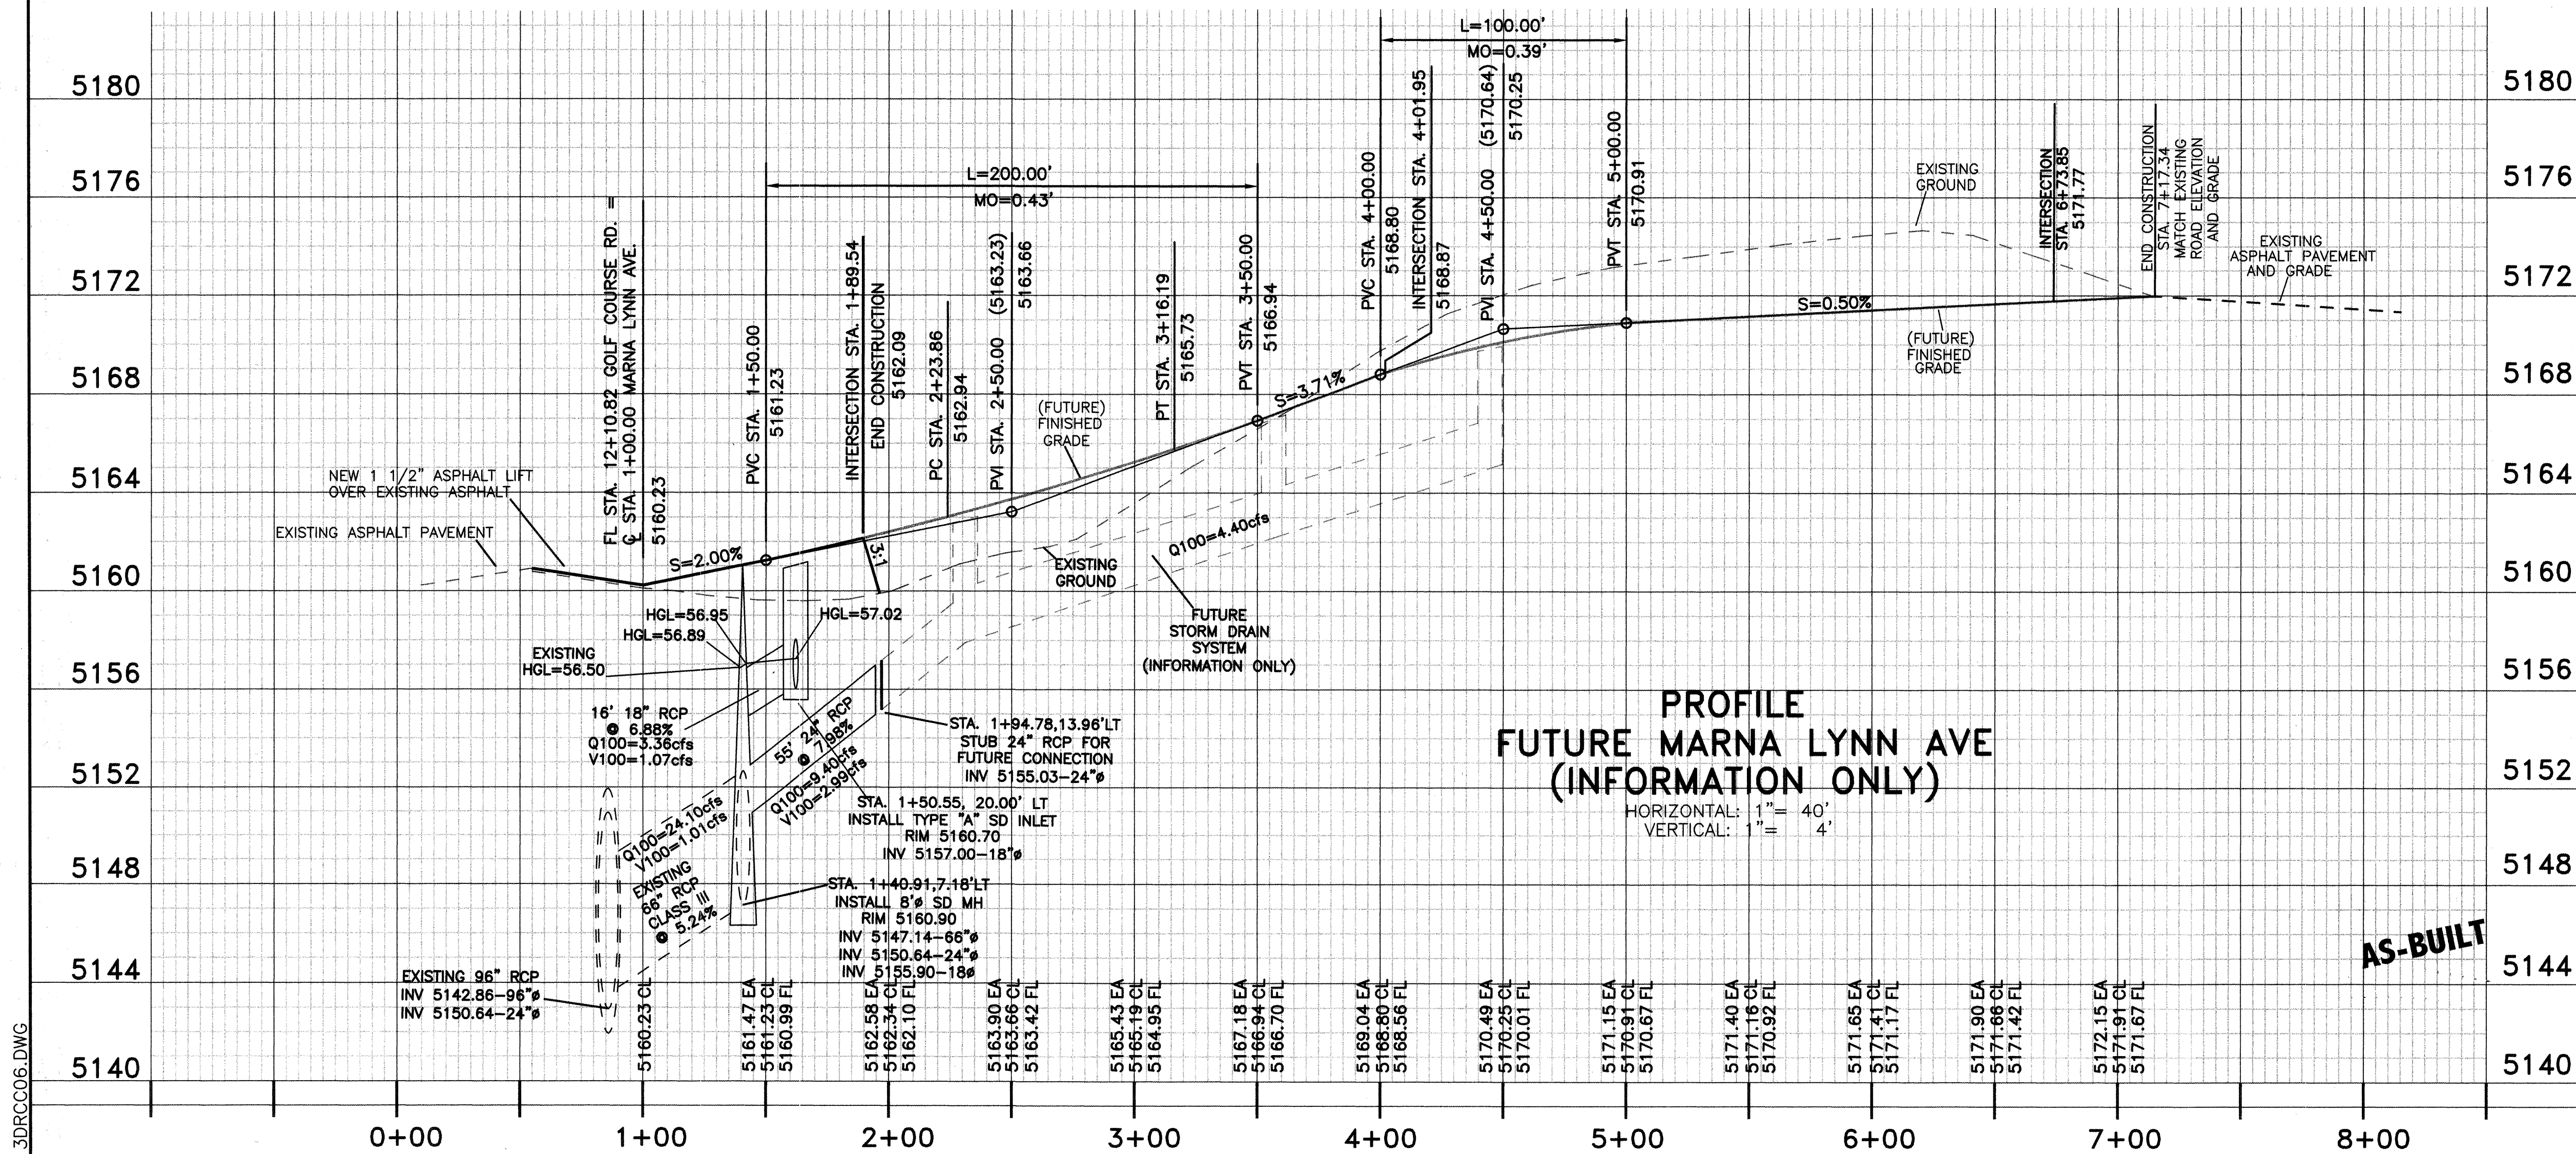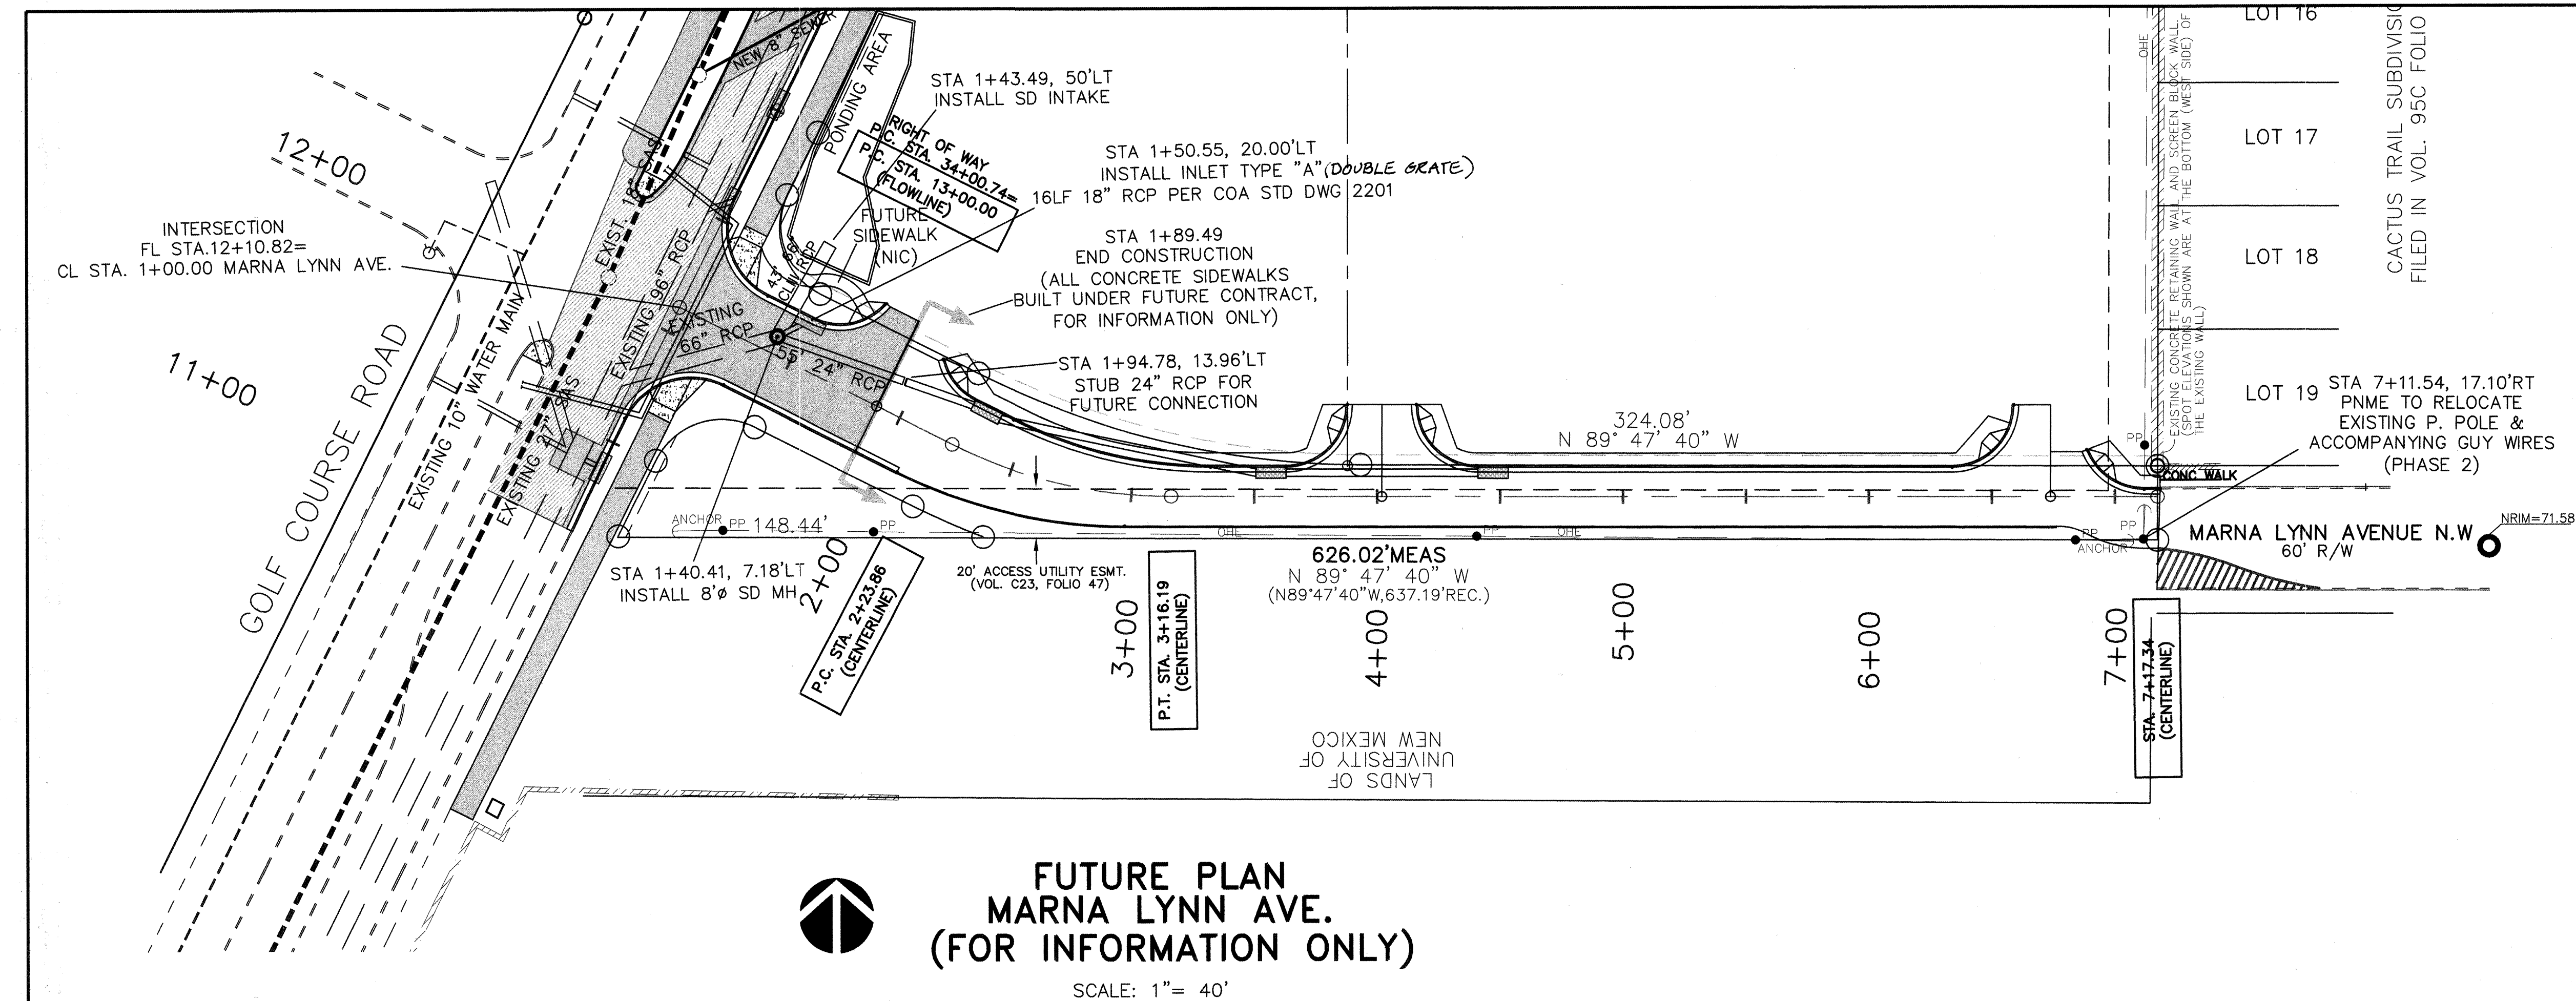


GENERAL NOTES:

- THE CONTRACTOR SHALL FIELD VERIFY ALL EXISTING UTILITY LOCATIONS & NOTIFY THE ENGINEER IMMEDIATELY OF ANY DISCREPANCIES.
- ALL CURVE DATA & DIMENSIONS REFER TO FACE OF CURB AT FLOWLINE UNLESS OTHERWISE SPECIFIED.
- CONTRACTOR IS RESPONSIBLE FOR ALL REPAIR AND/OR REPLACEMENT OF ALL UTILITY CONDUITS & EXISTING LINES.
- ANY ADDITIONAL GRADING REQUIRED TO MATCH PROPOSED STREET GRADES SHALL BE INCIDENTAL TO PAVING ITEMS.
- CONTRACTOR SHALL PROVIDE INSPECTORS (CITY & PRIVATE) w/ A PROPOSED HYDRO STATIC TESTING PLAN. THE PLAN MUST BE APPROVED BEFORE TESTING OPERATIONS BEGIN.
- CONTRACTOR SHALL PARK EQUIPMENT AND VEHICLES AS NOT TO INTERFERE WITH NORMAL ACTIVITIES OF OTHER CONTRACTORS ON SITE.
- ANY DAMAGE TO THE EXISTING FACILITIES (CURB & GUTTER, PAVEMENT, CONDUITS, LANDSCAPING, UTILITY LINES, ETC.) DURING CONSTRUCTION SHALL BE REPLACED AT THE CONTRACTORS EXPENSE.
- REMOVAL OF THE EXISTING CURB & GUTTER OR VALLEY GUTTER SHALL BE AS PER COA STD DWG. 2415 (SAW CUT ONLY).
- WHEEL CHAIR RAMPS SHALL BE CONSTRUCTED PRIOR TO ACCEPTANCE OF CURB & GUTTER.
- TOPOGRAPHICAL & BOUNDARY SURVEY PROVIDED BY HARRIS SURVEYING INC. BPLW IS NOT RESPONSIBLE FOR ANY DISCREPANCIES IN THE SURVEY.

LEGEND:

- NEW CONCRETE PAVEMENT
- NEW 1 1/2" ASPHALT FINAL LIFT
- NEW ASPHALT PAVEMENT
- NEW GATE VALVE
- NEW FIRE HYDRANT
- NEW SD INLET
- NEW SAS MANHOLE
- NEW SD MANHOLE
- EXISTING SD INLET
- EXISTING GATE VALVE
- EXISTING FIRE HYDRANT
- EXISTING SAS MANHOLE
- EXISTING SD MANHOLE

BPLW		CITY OF ALBUQUERQUE PUBLIC WORKS DEPARTMENT ENGINEERING GROUP		BPLW	
TITLE: GOLF COURSE POINTE MARNA LYNN ROAD, CONTROL P & P (FUTURE, FOR INFORMATION ONLY)					
APPROVALS	DATE	APPROVALS	DATE	APPROVALS	DATE
DRC Chairman		Water		Waste Water	
Transportation	NOV 23 1999				
Hydrology					
Parks & Rec.					
DRAWING NO.	622981	MAP NO.	C-12-Z	SHEET	6 OF 21

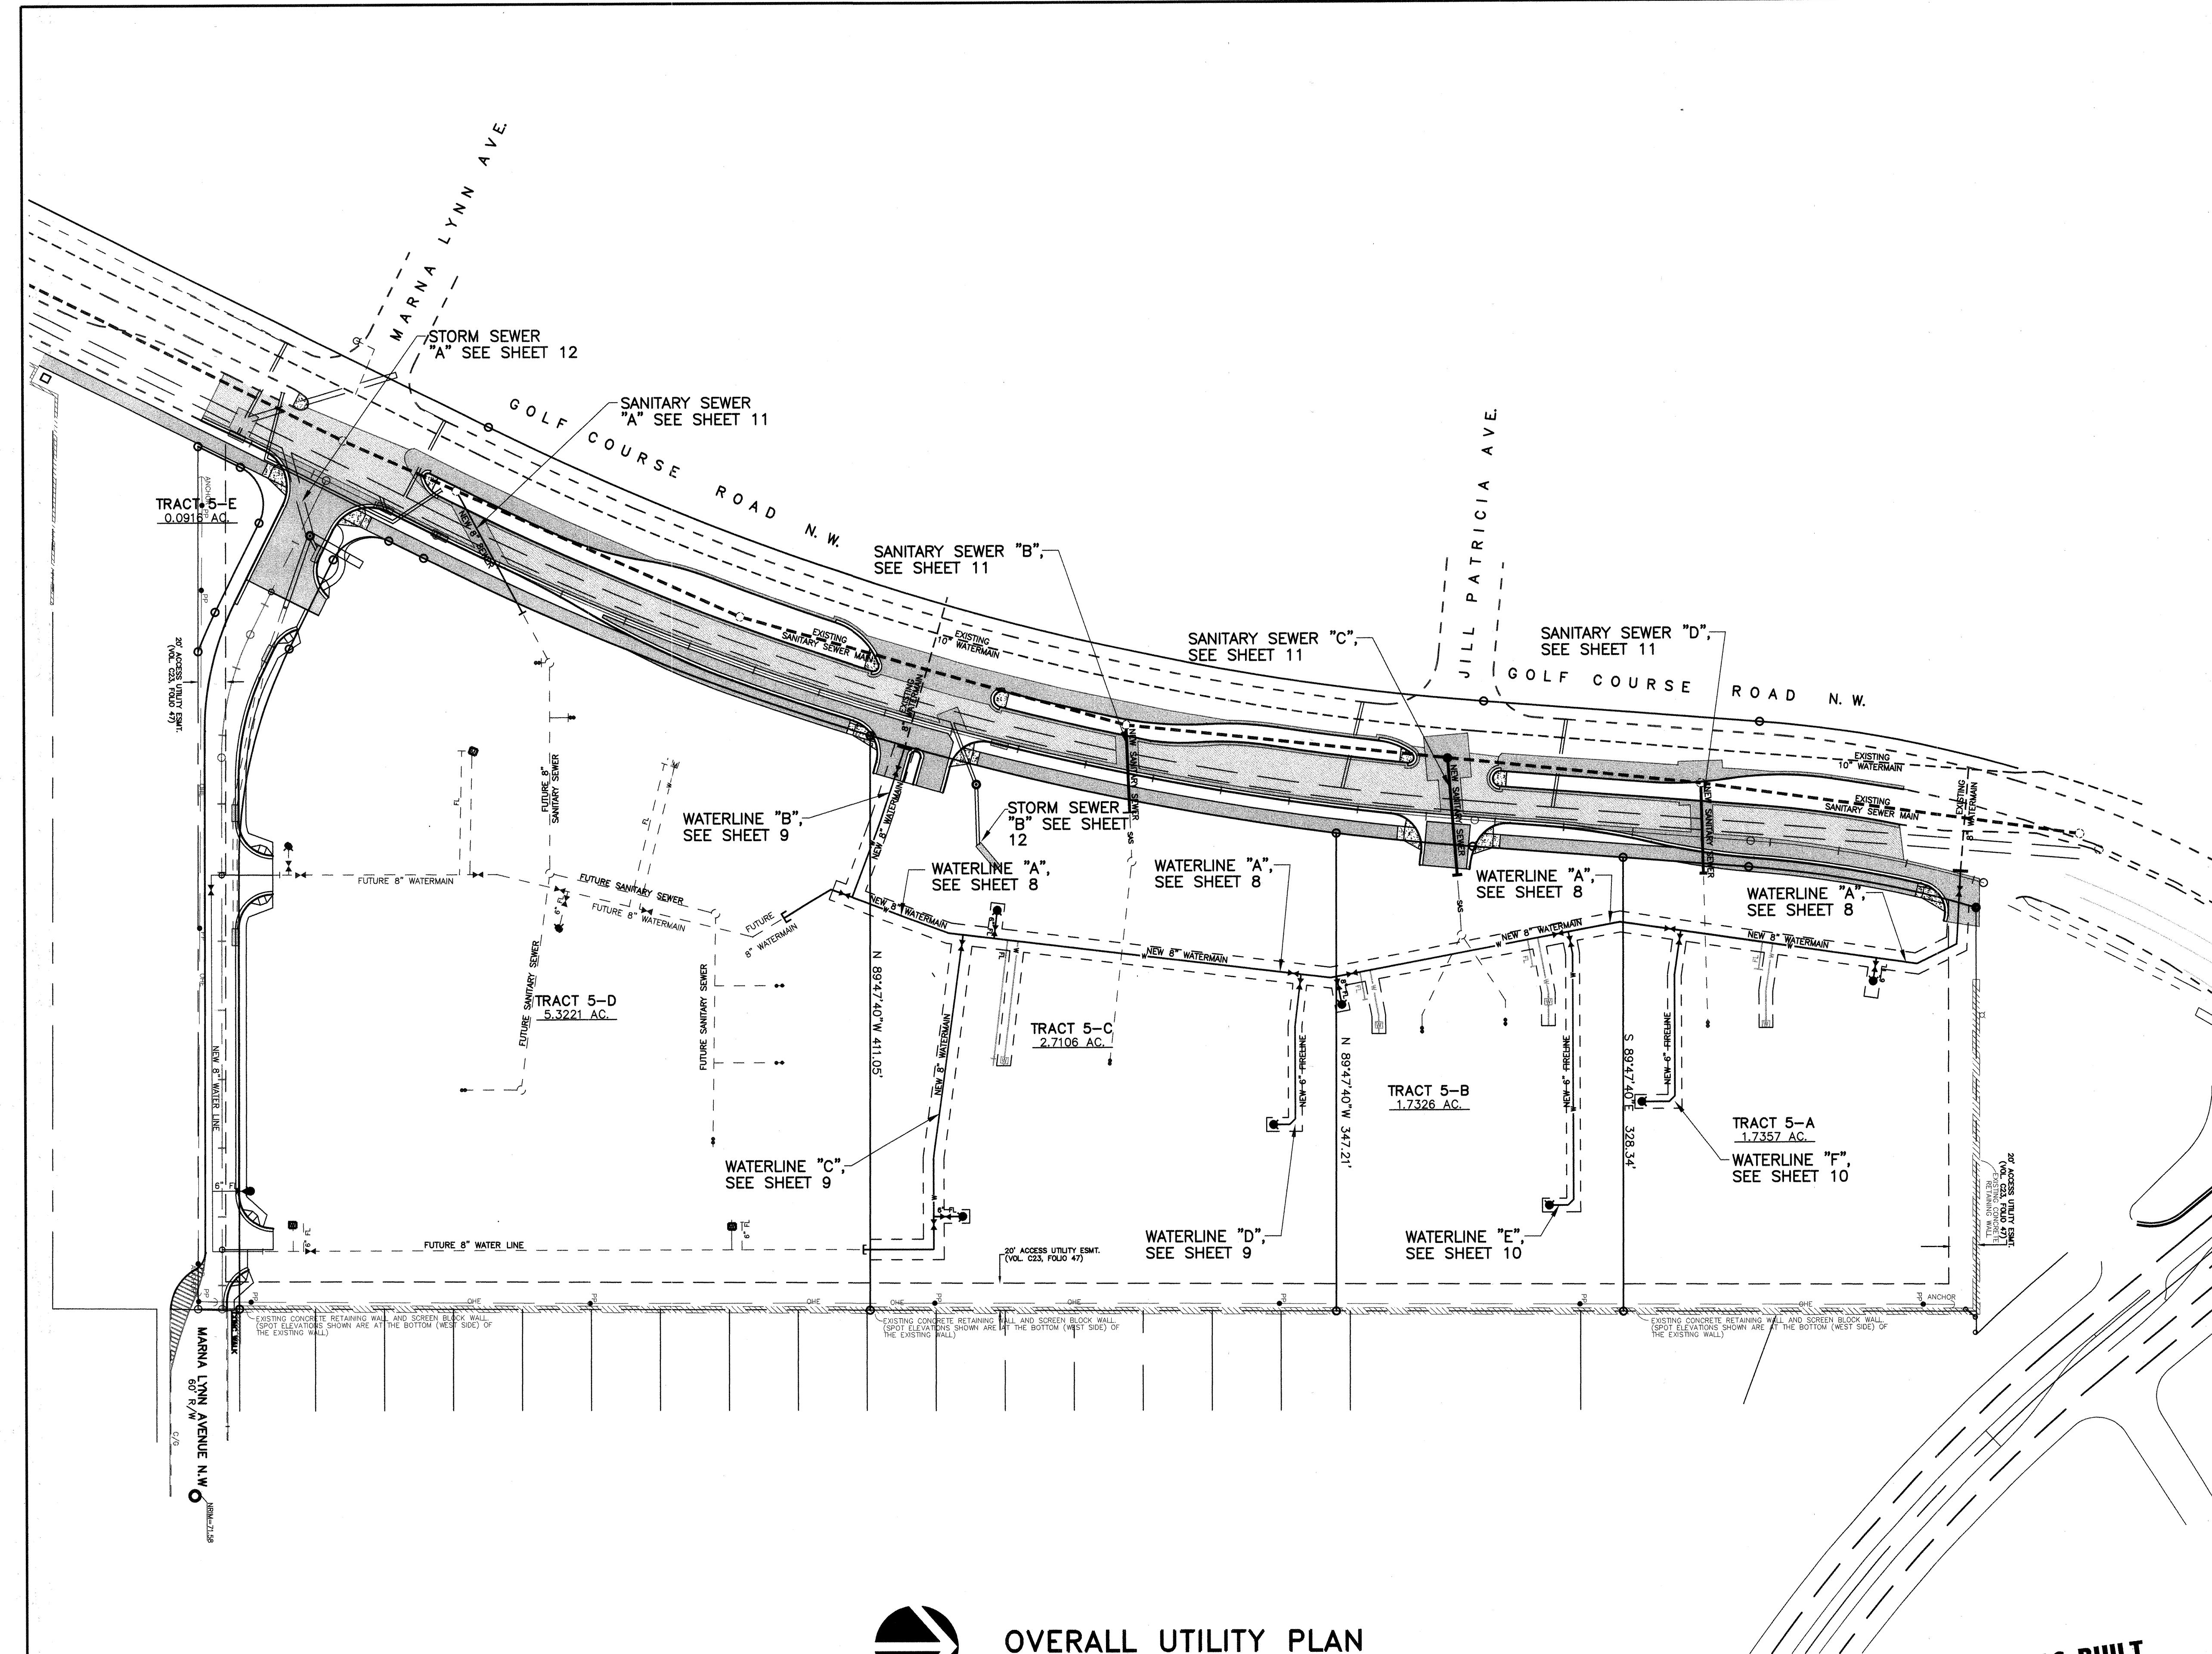

OVERALL UTILITY PLAN

SCALE: 1" = 60'

AS-BUILT


GENERAL NOTES:

- THE CONTRACTOR SHALL FIELD VERIFY ALL EXISTING UTILITY LOCATIONS & NOTIFY THE ENGINEER IMMEDIATELY OF ANY DISCREPANCIES.
- NOT USED
- CONTRACTOR IS RESPONSIBLE FOR REPAIR AND/OR REPLACEMENT OF ALL DAMAGED UTILITY CONDUITS & EXISTING LINES.
- ANY ADDITIONAL GRADING REQUIRED TO MATCH PROPOSED STREET GRADES SHALL BE INCIDENTAL TO PAVING ITEMS.
- CONTRACTOR SHALL PROVIDE INSPECTORS (CITY & PRIVATE) w/ A PROPOSED HYDRO-STATIC TESTING PLAN. THE PLAN MUST BE APPROVED BEFORE TESTING OPERATIONS BEGIN.
- CONTRACTOR SHALL PARK EQUIPMENT SO AS NOT TO INTERFERE WITH NORMAL ACTIVITIES OF OTHER CONTRACTORS ON SITE.
- ANY DAMAGE TO THE EXISTING FACILITIES TO REMAIN (CURB & GUTTER, PAVEMENT, CONDUITS, LANDSCAPING, UTILITY LINES, ETC.) DURING CONSTRUCTION SHALL BE REPLACED AT THE CONTRACTORS EXPENSE.
- REMOVAL OF THE EXISTING CURB & GUTTER OR VALLEY GUTTER SHALL BE AS PER COA STD DWG. 2415 (SAW CUT ONLY).
- WHEEL CHAIR RAMPS SHALL BE CONSTRUCTED PRIOR TO FINAL ACCEPTANCE OF CURB AND GUTTER.
- ALL DEMOLITION AND EXCESS SITE MATERIAL SHALL BE REMOVED BY THE CONTRACTOR TO A COA APPROVED DUMP SITE.
- THE CONTRACTOR SHALL COORDINATE WITH THE BUILDING PERMIT (SITE) CONTRACTOR FOR THE SEQUENCING OF ALL WORK (BOTH PRIVATE & PUBLIC).
- ALL INDIVIDUAL BUILDING FIRELINES, DOMESTIC WATER SERVICE, IRRIGATION & SANITARY SEWER ARE BY SEPARATE BUILDING PERMIT & ARE NOT IN THIS CONTRACT. LOCATION OF BUILDING FIRELINES, DOMESTIC WATER METERS & SANITARY SEWER SERVICES & ON SITE MANHOLES ARE FOR INFORMATION ONLY.



LEGEND:

- NEW CONCRETE PAVEMENT
- NEW 1 1/2" ASPHALT FINAL LIFT
- NEW ASPHALT PAVEMENT
- NEW GATE VALVE
- NEW FIRE HYDRANT
- NEW WATER MAIN CAP
- NEW SD INLET
- NEW SAS MANHOLE
- NEW SD MANHOLE
- NEW WATER MAIN
- NEW SANITARY SEWER
- NEW STORM DRAIN
- NEW UTILITY ESMT
- FUTURE WATER METER
- FUTURE SEWER CLEANOUT
- FUTURE SAS MANHOLE
- EXISTING SD INLET
- EXISTING GATE VALVE
- EXISTING FIRE HYDRANT
- EXISTING SAS MANHOLE
- EXISTING SD MANHOLE
- EXISTING WATER MAIN
- EXISTING SANITARY SEWER
- EXISTING UTILITY ESMT

AS BUILT INFORMATION				BENCH MARKS				SURVEY INFORMATION				ENGINEER'S SEAL			
CONTRACTOR	DATE	WORK	DATE	THE STATION IS A ALUMINUM CAP AND IS STAMPED	DATE	BY	DATE	NO.	DATE	BY	DATE	NO.	DATE	BY	DATE
CONTRACTOR	DATE	WORK	DATE	ACS 6-B11. GEOGRAPHIC POSITION (NAD 1927)	DATE	BY	DATE	NO.	DATE	BY	DATE	NO.	DATE	BY	DATE
CONTRACTOR	DATE	WORK	DATE	N.M. STATE PLANE COORD. (CENTRAL ZONE)	DATE	BY	DATE	NO.	DATE	BY	DATE	NO.	DATE	BY	DATE
CONTRACTOR	DATE	WORK	DATE	X= 365,865.49	DATE	BY	DATE	NO.	DATE	BY	DATE	NO.	DATE	BY	DATE
CONTRACTOR	DATE	WORK	DATE	GROUND TO GRID FACTOR = 0.9996657	DATE	BY	DATE	NO.	DATE	BY	DATE	NO.	DATE	BY	DATE
CONTRACTOR	DATE	WORK	DATE	DELTA ALPHA= -00° 15' 32"	DATE	BY	DATE	NO.	DATE	BY	DATE	NO.	DATE	BY	DATE
CONTRACTOR	DATE	WORK	DATE	ELEVATION =	DATE	BY	DATE	NO.	DATE	BY	DATE	NO.	DATE	BY	DATE

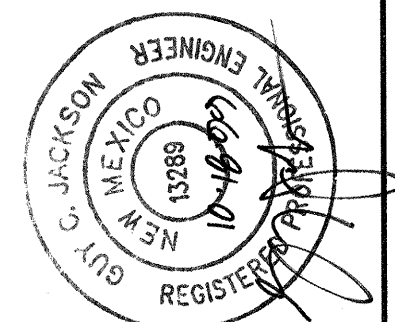

CITY OF ALBUQUERQUE PUBLIC WORKS DEPARTMENT ENGINEERING GROUP				BPLW			
TITLE: GOLF COURSE POINTE OVERALL UTILITY PLAN WATER, SANITARY SEWER & STORM DRAIN				BPLW			
APPROVALS	ENGINEER	DATE	APPROVALS	ENGINEER	DATE	APPROVALS	ENGINEER
DRC Chairman			DRC Chairman			DRC Chairman	
Transportation			Transportation			Transportation	
Hydrology			Hydrology			Hydrology	
Parks & Rec			Parks & Rec			Parks & Rec	
DRAWING NO.	622981	MAP NO.	C-12-Z	SHEET	7	OF	21

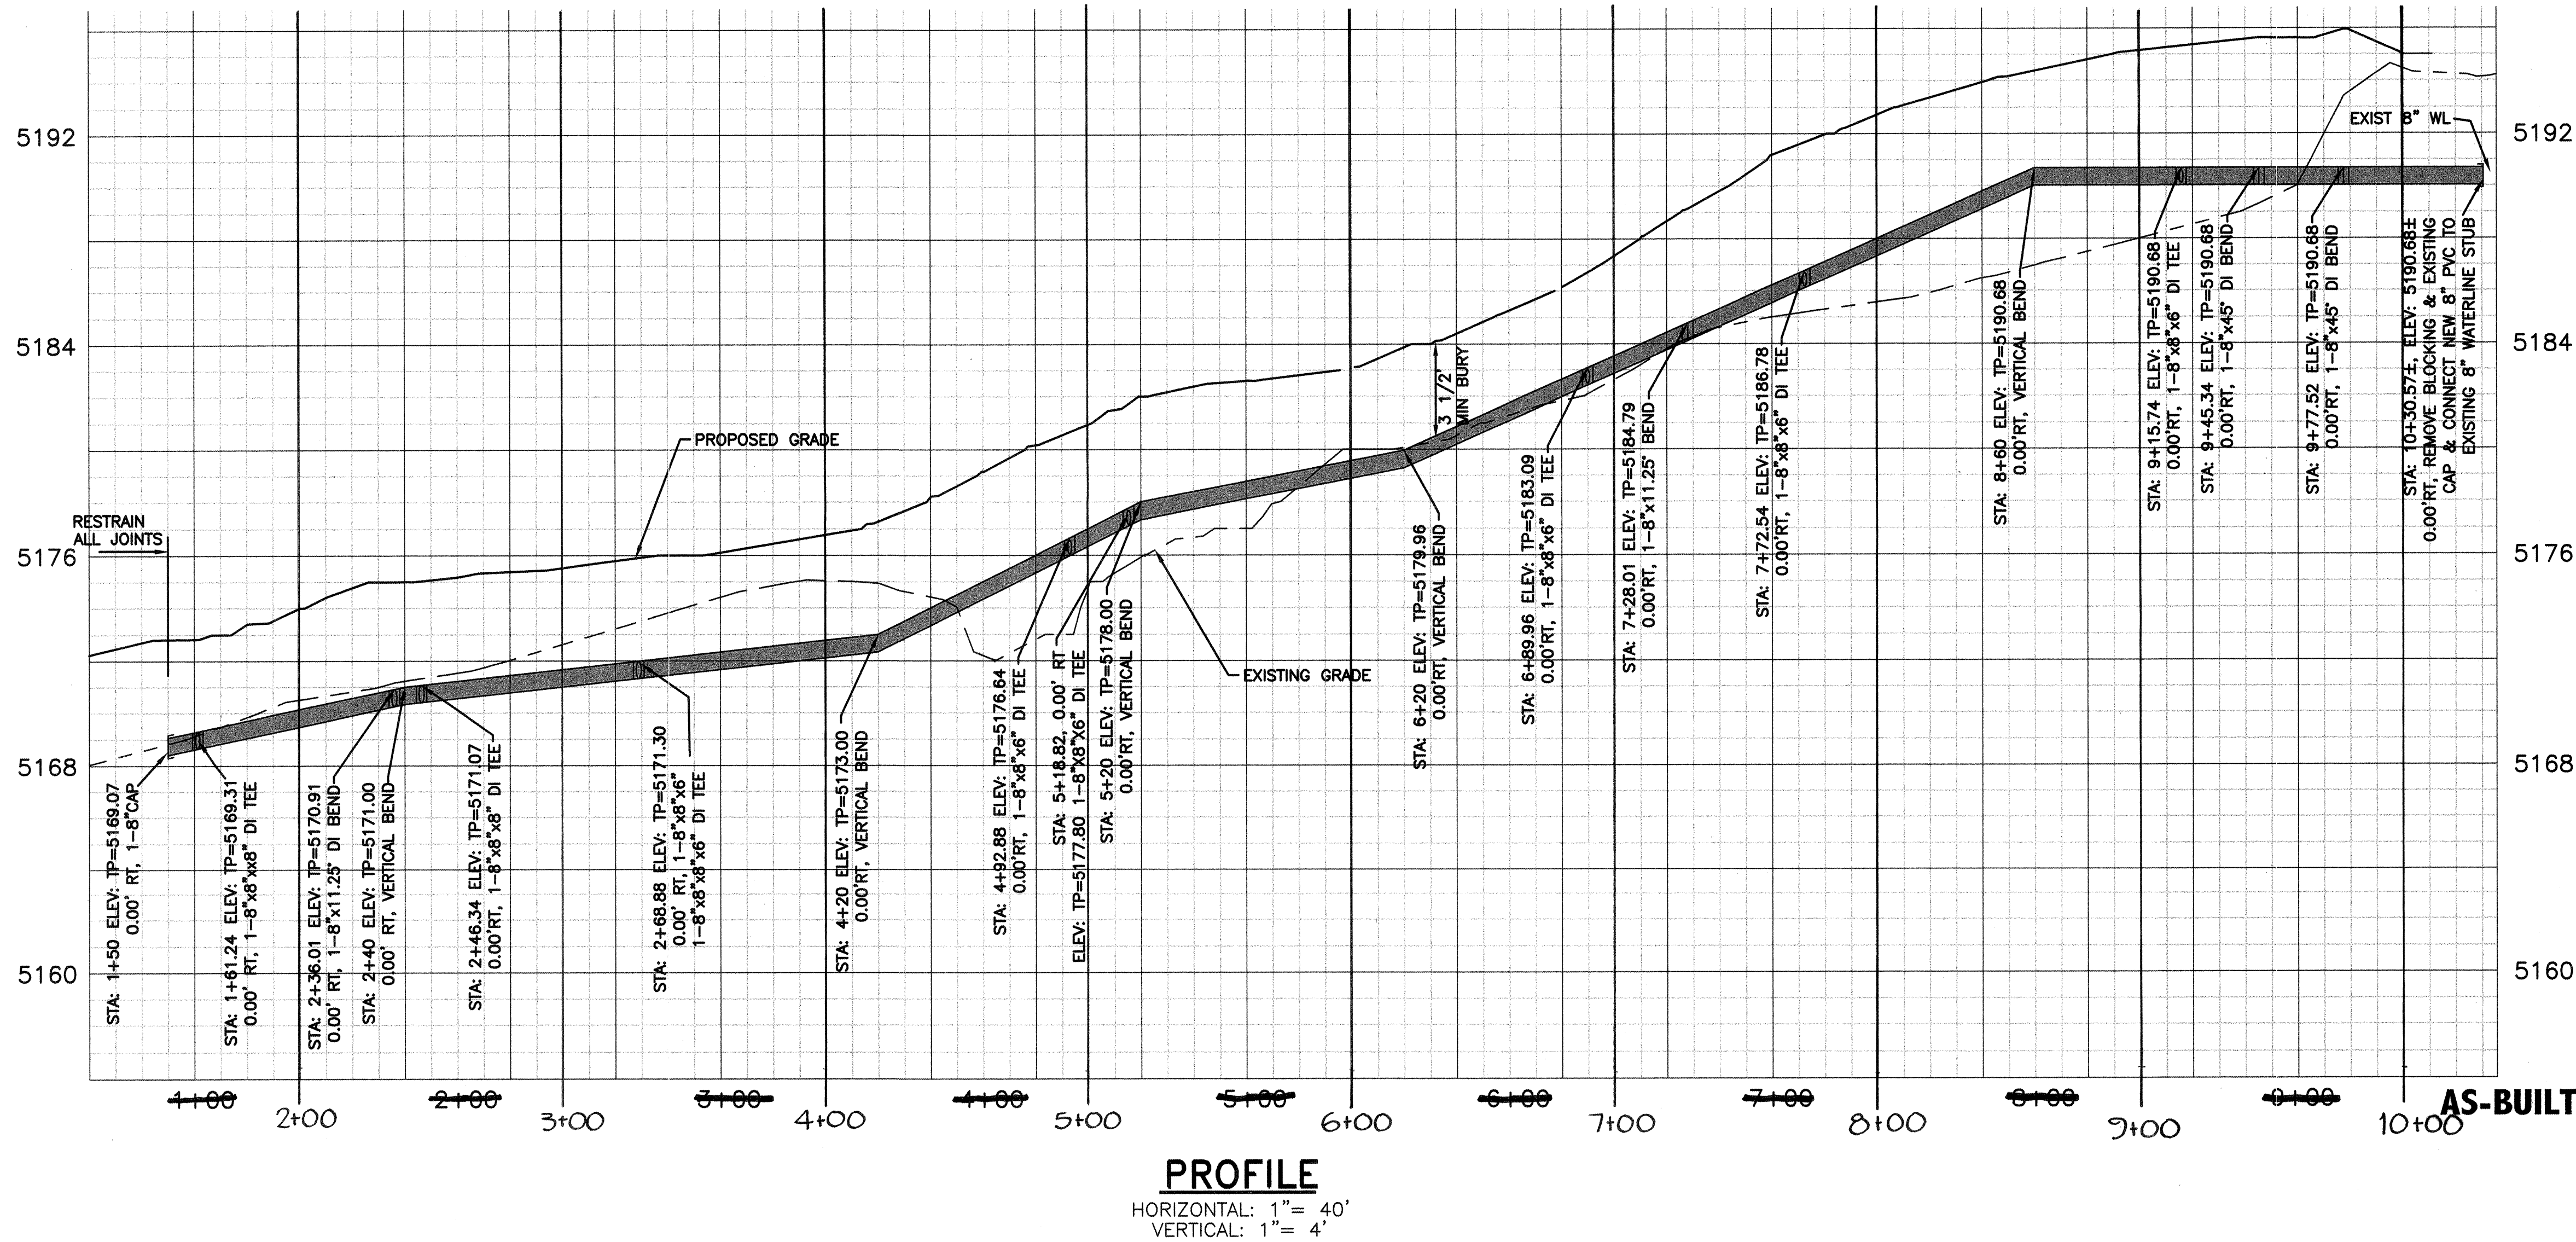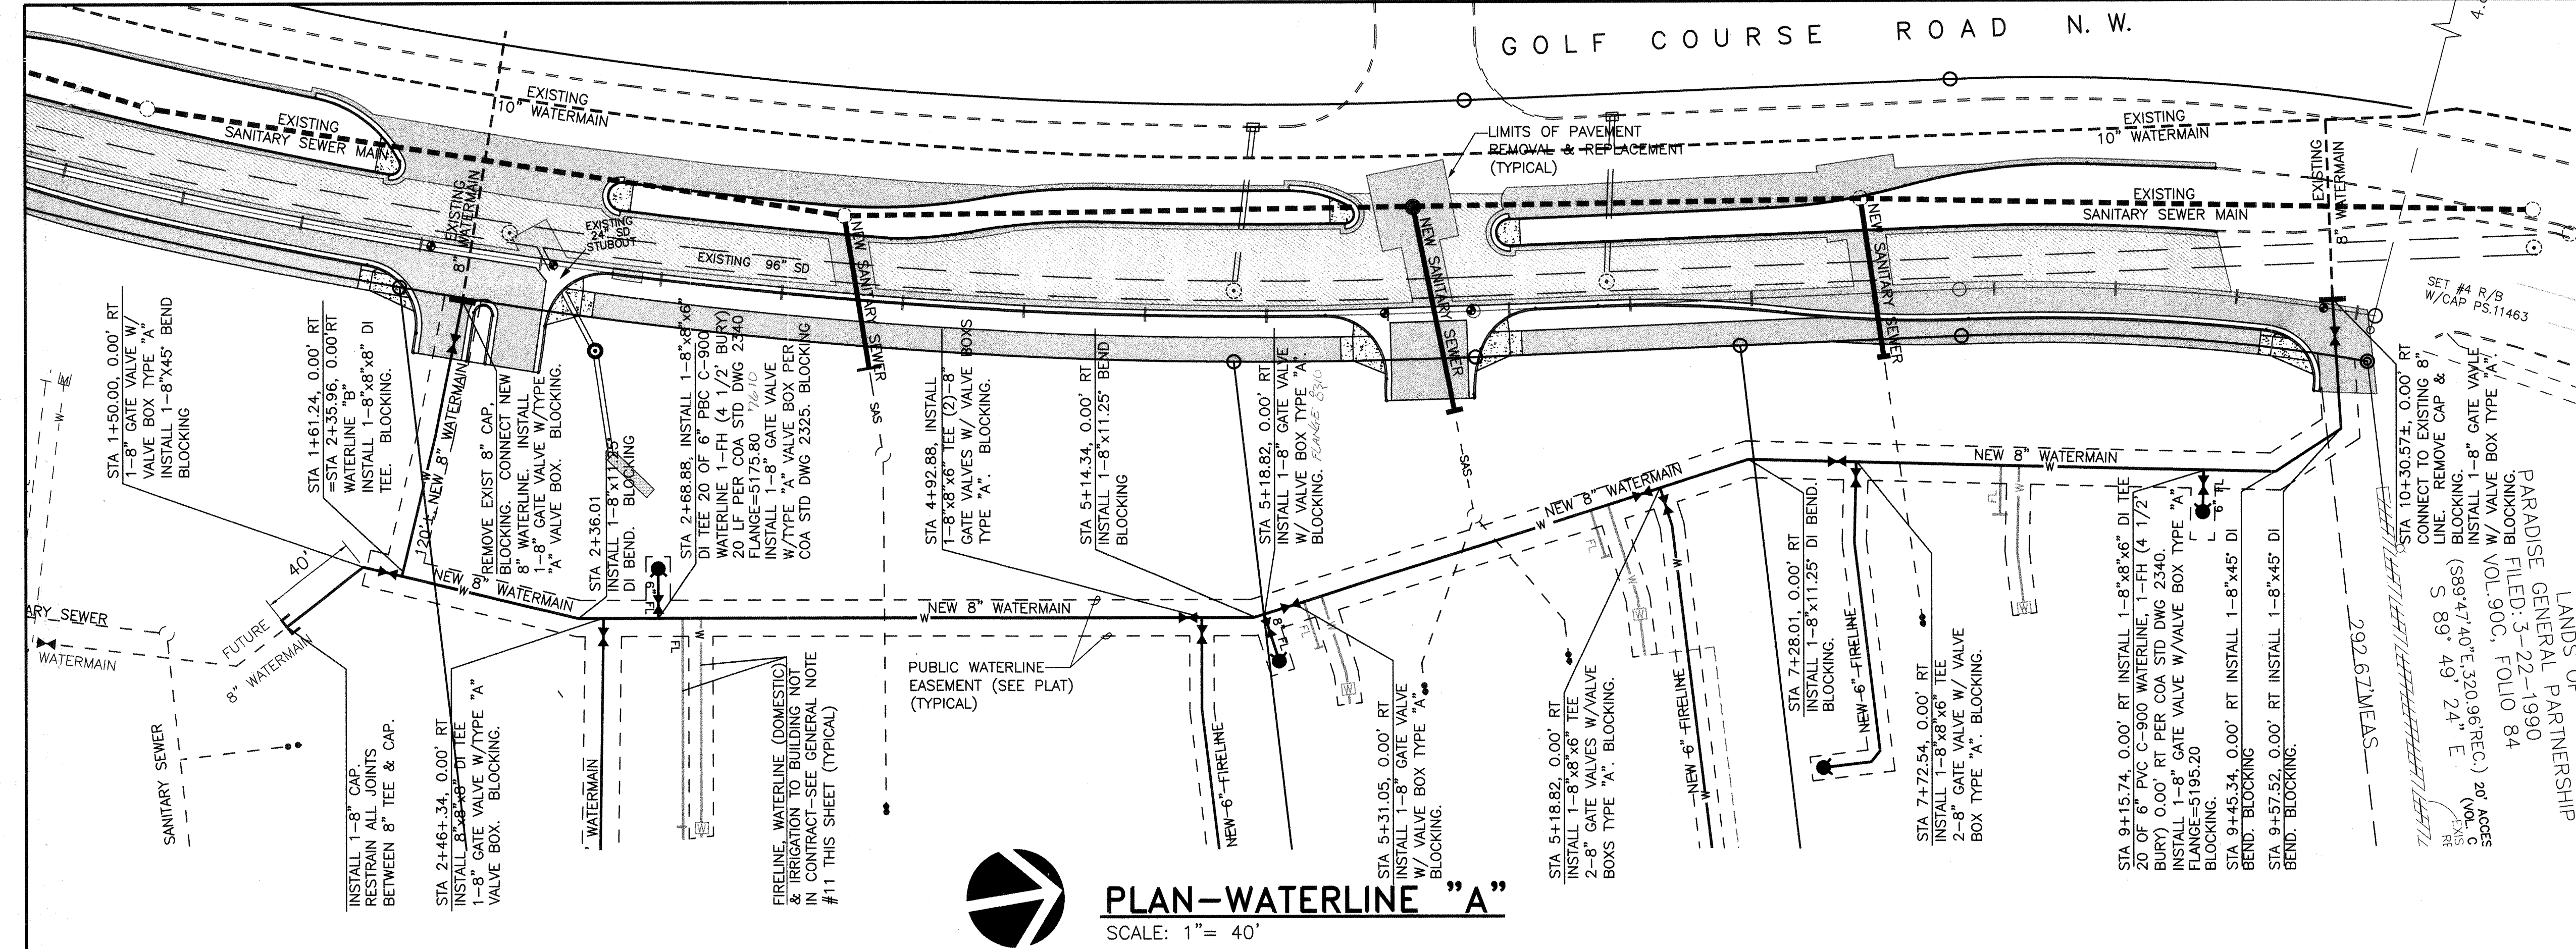


GENERAL NOTES:


- THE CONTRACTOR SHALL FIELD VERIFY ALL EXISTING UTILITY LOCATIONS & NOTIFY THE ENGINEER IMMEDIATELY OF ANY DISCREPANCIES.
- ALL CURVE DATA & DIMENSIONS REFER TO FACE OF CURB AT FLOWLINE UNLESS OTHERWISE SPECIFIED.
- CONTRACTOR IS RESPONSIBLE FOR ALL REPAIR AND/OR REPLACEMENT OF ALL UTILITY CONDUITS & EXISTING LINES.
- ANY ADDITIONAL GRADING REQUIRED TO MATCH PROPOSED STREET GRADES SHALL BE INCIDENTAL TO PAVING ITEMS.
- CONTRACTOR SHALL PROVIDE INSPECTORS (CITY & PRIVATE) w/ A PROPOSED HYDRO STATIC TESTING PLAN. THE PLAN MUST BE APPROVED BEFORE TESTING OPERATIONS BEGIN.
- CONTRACTOR SHALL PARK EQUIPMENT AND VEHICLES AS NOT TO INTERFERE WITH NORMAL ACTIVITIES OF OTHER CONTRACTORS ON SITE.
- ANY DAMAGE TO THE EXISTING FACILITIES (CURB & GUTTER, PAVEMENT, CONDUITS, LANDSCAPING, UTILITY LINES, ETC.) DURING CONSTRUCTION SHALL BE REPLACED AT THE CONTRACTORS EXPENSE.
- REMOVAL OF THE EXISTING CURB & GUTTER OR VALLEY GUTTER SHALL BE AS PER COA STD DWG. 2415 (SAW CUT ONLY).
- WHEEL CHAIR RAMPS SHALL BE CONSTRUCTED PRIOR TO ACCEPTANCE OF CURB & GUTTER.
- TOPOGRAPHICAL & BOUNDARY SURVEY PROVIDED BY HARRIS SURVEYING INC. BPLW IS NOT RESPONSIBLE FOR ANY DISCREPANCIES IN THE SURVEYS.
- ALL INDIVIDUAL BUILDING FIRELINES, DOMESTIC WATER SERVICE, IRRIGATION & SANITARY SEWER ARE BY SEPARATE BUILDING PERMIT & ARE NOT IN THIS CONTRACT. LOCATION OF BUILDING FIRELINES, DOMESTIC WATER METERS & SANITARY SEWER SERVICES & ON SITE MANHOLES ARE FOR INFORMATION ONLY.

LEGEND:

- NEW CONCRETE PAVEMENT
- NEW 1 1/2" ASPHALT FINAL LIFT
- NEW ASPHALT PAVEMENT
- NEW GATE VALVE
- NEW FIRE HYDRANT
- NEW WATER MAIN CAP
- NEW SD INLET
- NEW SAS MANHOLE
- NEW SD MANHOLE
- NEW WATER MAIN
- NEW SANITARY SEWER
- NEW STORM DRAIN
- NEW UTILITY ESMT
- FUTURE WATER METER
- FUTURE SEWER CLEANOUT
- FUTURE SAS MANHOLE
- EXISTING SD INLET
- EXISTING GATE VALVE
- EXISTING FIRE HYDRANT
- EXISTING SAS MANHOLE
- EXISTING SD MANHOLE
- EXISTING WATER MAIN
- EXISTING SANITARY SEWER
- EXISTING UTILITY ESMT


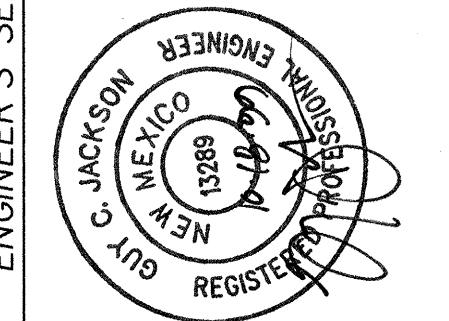


CITY OF ALBUQUERQUE PUBLIC WORKS DEPARTMENT ENGINEERING GROUP		BPLW	
TITLE: GOLF COURSE POINTE WATERLINE "A" PLAN AND PROFILE			
APPROVALS	ENGINEER	DATE	APPROVALS
DRC Chairman	APPROVE	NOV 23 2009	ENGINEER
Transportation			
Hydrology			
Parks & Rec.			
DRAWING NO.	622981	MAP NO.	C-12-Z
		SHEET	8
		OF	21

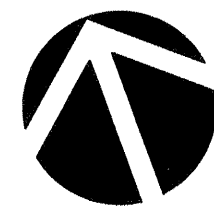



WATERLINE "B" PLAN

SCALE: 1" = 40'

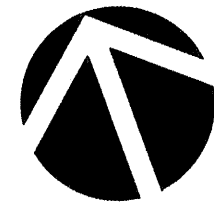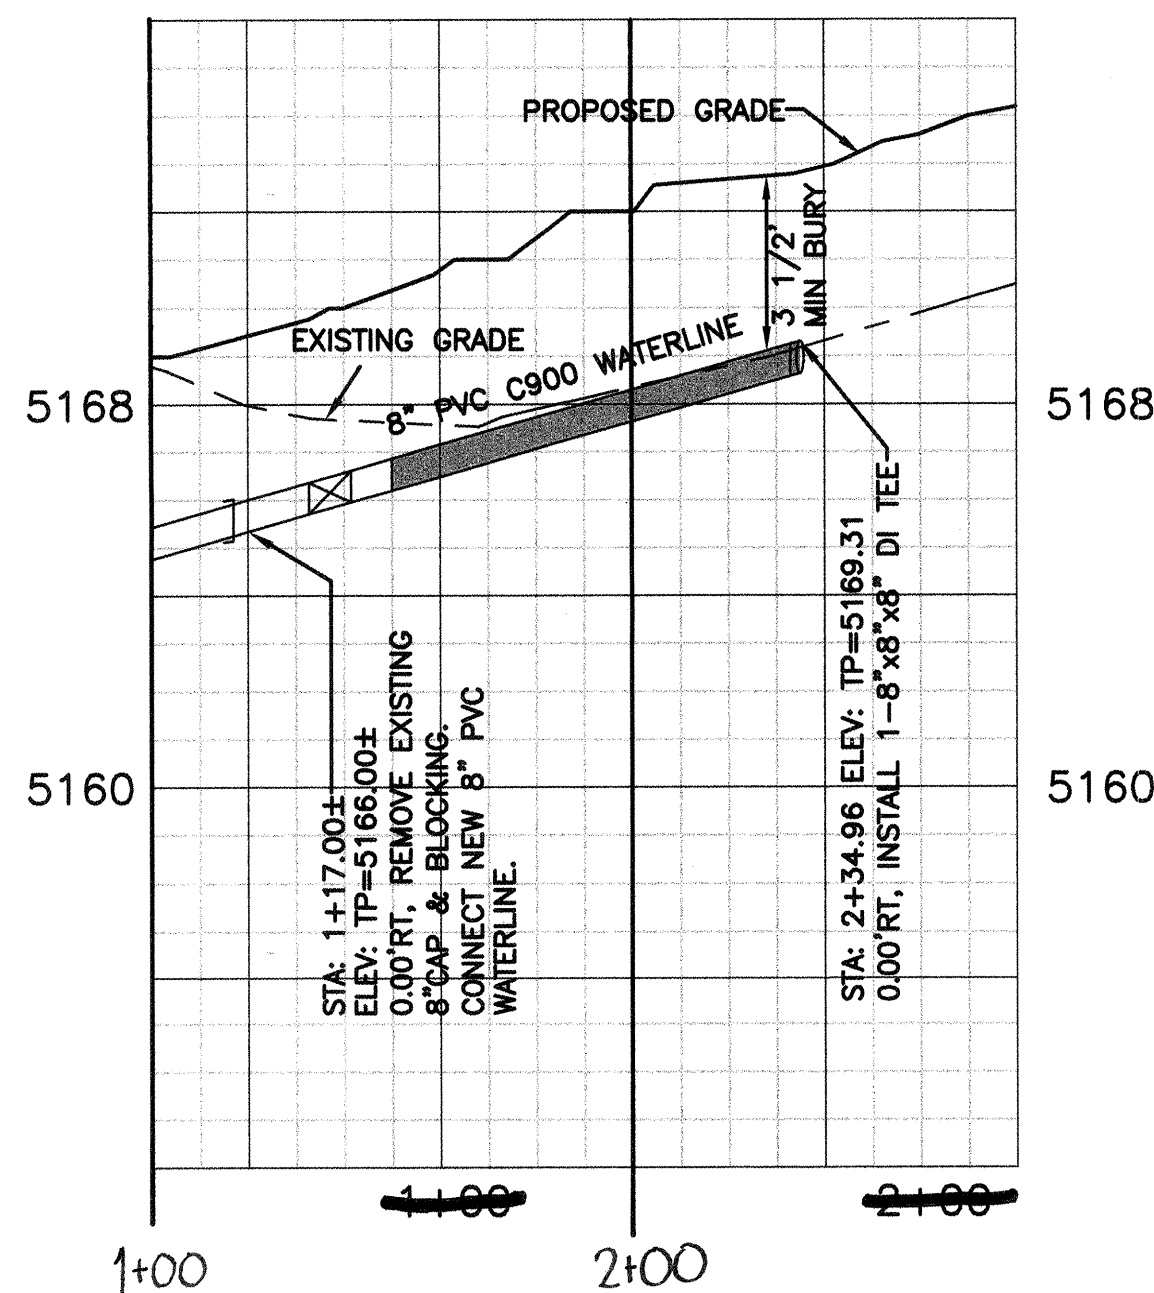


WATERLINE "C" PLAN

SCALE: 1" = 40'

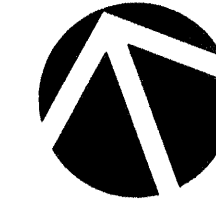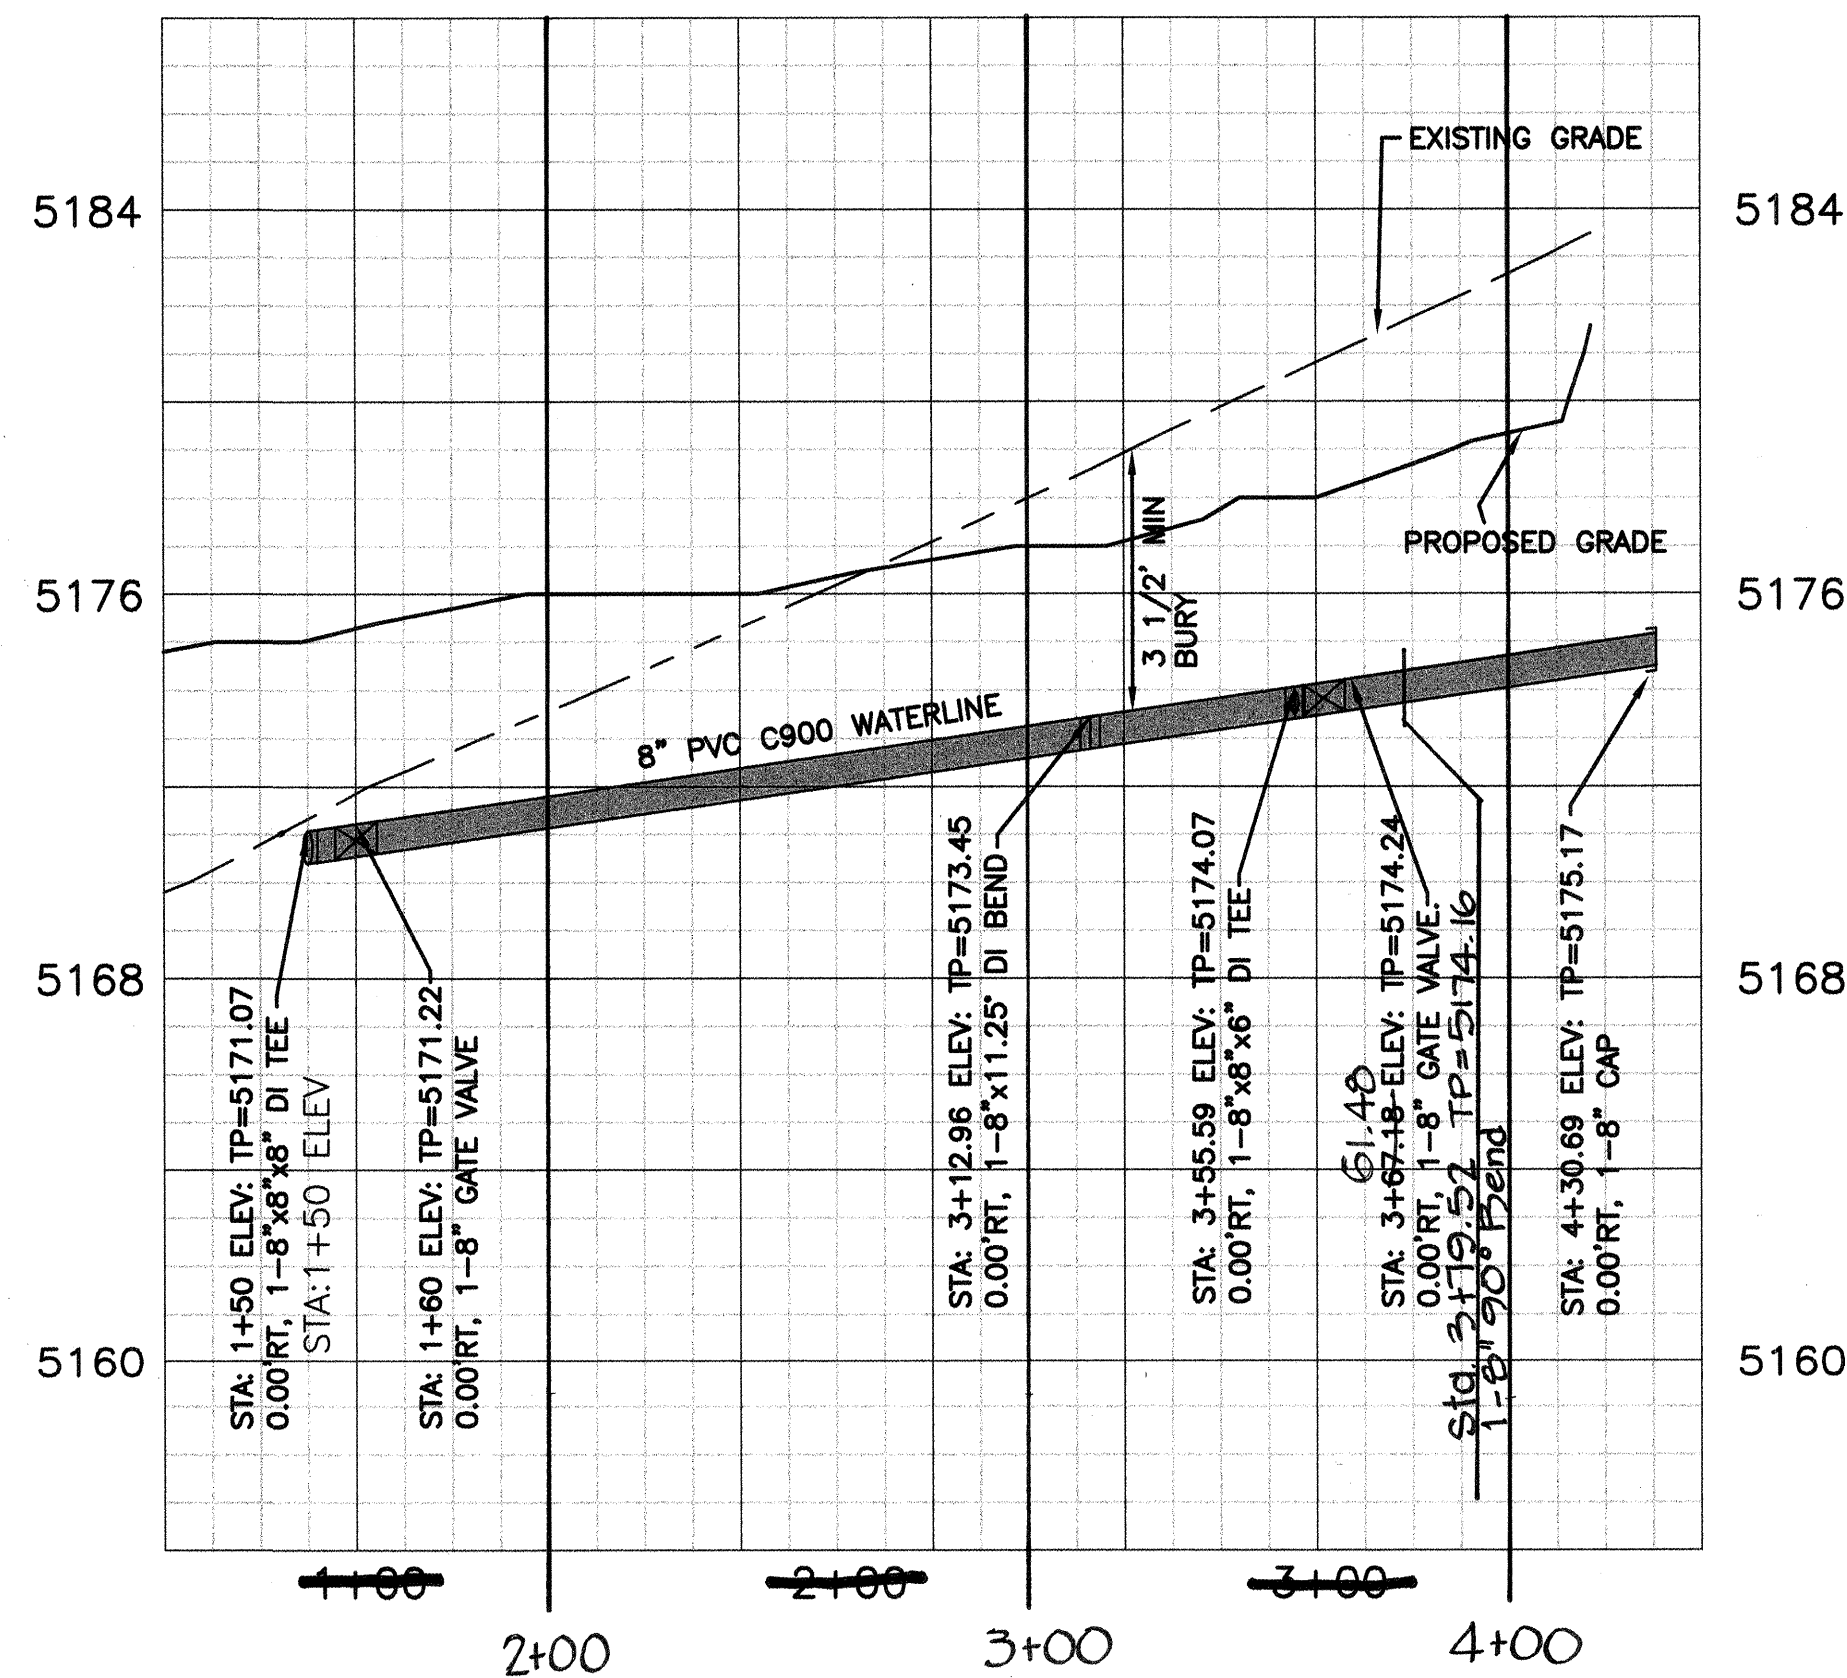

WATERLINE "D" PLAN

SCALE: 1" = 40'

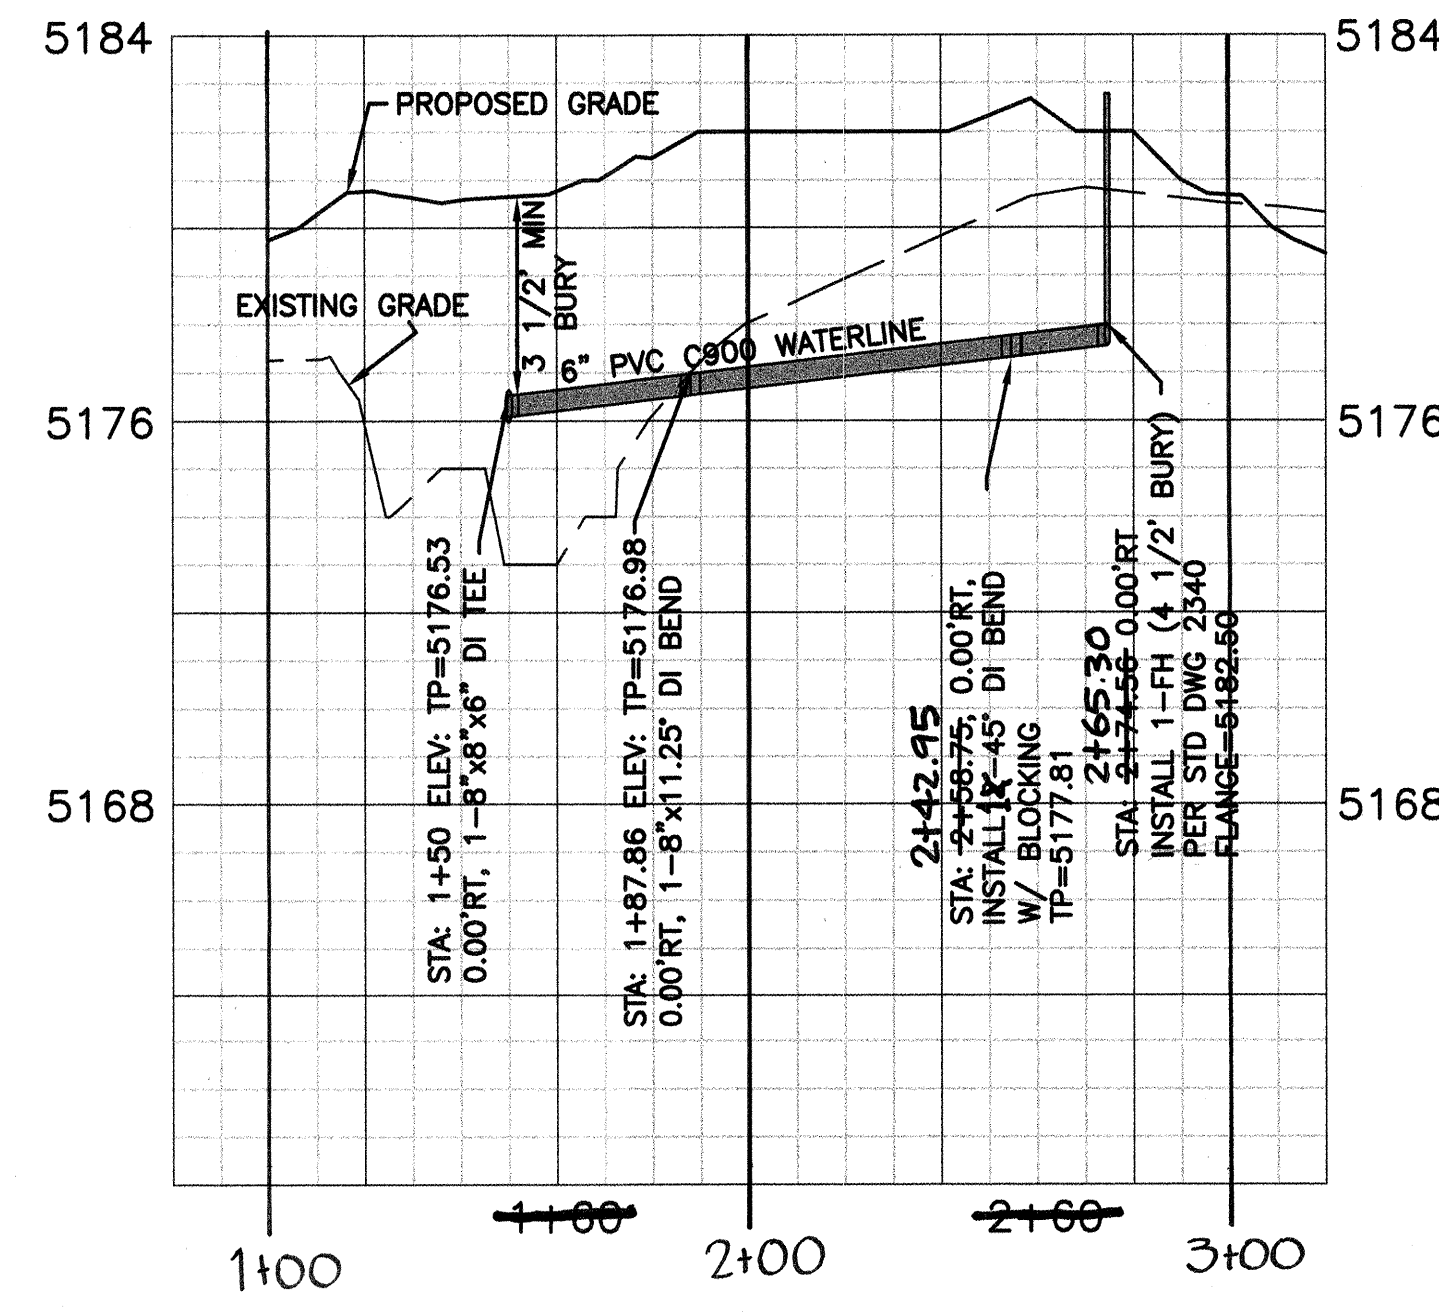

GENERAL NOTES:

- THE CONTRACTOR SHALL FIELD VERIFY ALL EXISTING UTILITY LOCATIONS & NOTIFY THE ENGINEER IMMEDIATELY OF ANY DISCREPANCIES.
- ALL CURVE DATA & DIMENSIONS REFER TO FACE OF CURB AT FLOWLINE UNLESS OTHERWISE SPECIFIED.
- CONTRACTOR IS RESPONSIBLE FOR ALL REPAIR AND/OR REPLACEMENT OF ALL UTILITY CONDUITS & EXISTING LINES.
- ANY ADDITIONAL GRADING REQUIRED TO MATCH PROPOSED STREET GRADES SHALL BE INCIDENTAL TO PAVING ITEMS.
- CONTRACTOR SHALL PROVIDE INSPECTORS (CITY & PRIVATE) W/ A PROPOSED HYDRO STATIC TESTING PLAN. THE PLAN MUST BE APPROVED BEFORE TESTING OPERATIONS BEGIN.
- CONTRACTOR SHALL PARK EQUIPMENT AND VEHICLES AS NOT TO INTERFERE WITH NORMAL ACTIVITIES OF OTHER CONTRACTORS ON SITE.
- ANY DAMAGE TO THE EXISTING FACILITIES (CURB & GUTTER, PAVEMENT, CONDUITS, LANDSCAPING, UTILITY LINES, ETC.) DURING CONSTRUCTION SHALL BE REPLACED AT THE CONTRACTORS EXPENSE.
- REMOVAL OF THE EXISTING CURB & GUTTER OR VALLEY GUTTER SHALL BE AS PER COA STD DWG. 2415 (SAW CUT ONLY).
- WHEEL CHAIR RAMPS SHALL BE CONSTRUCTED PRIOR TO ACCEPTANCE OF CURB & GUTTER.
- TOPOGRAPHICAL & BOUNDARY SURVEY PROVIDED BY HARRIS SURVEYING INC. BPLW IS NOT RESPONSIBLE FOR ANY DISCREPANCIES IN THE SURVEYS.
- ALL INDIVIDUAL BUILDING FIRELINES, DOMESTIC WATER SERVICE, IRRIGATION & SANITARY SEWER ARE BY SEPARATE BUILDING PERMIT & ARE NOT IN THIS CONTRACT. LOCATION OF BUILDING FIRELINES, DOMESTIC WATER METERS & SANITARY SEWER SERVICES & ON SITE MANHOLES ARE FOR INFORMATION ONLY.

LEGEND:


- NEW CONCRETE PAVEMENT
- NEW 1 1/2" ASPHALT FINAL LIFT
- NEW ASPHALT PAVEMENT
- NEW GATE VALVE
- NEW FIRE HYDRANT
- NEW WATER MAIN CAP
- NEW SD INLET
- NEW SAS MANHOLE
- NEW SD MANHOLE
- NEW WATER MAIN
- NEW SANITARY SEWER
- NEW STORM DRAIN
- NEW UTILITY ESMT
- FUTURE WATER METER
- FUTURE SEWER CLEANOUT
- FUTURE SAS MANHOLE
- EXISTING SD INLET
- EXISTING GATE VALVE
- EXISTING FIRE HYDRANT
- EXISTING SAS MANHOLE
- EXISTING SD MANHOLE
- EXISTING WATER MAIN
- EXISTING SANITARY SEWER
- EXISTING UTILITY ESMT

CITY OF ALBUQUERQUE PUBLIC WORKS DEPARTMENT ENGINEERING GROUP		BPLW	
TITLE: GOLF COURSE POINT WATERLINE "B" "C" & "D" PLAN AND PROFILE			
APPROVALS	ENGINEER	DATE	APPROVALS
DRC Chairman	Transportation	Hydrology	Parks & Rec.
NOV 23 1999	NOV 23 1999	NOV 23 1999	NOV 23 1999
DRAWING NO.	622981	MAP NO.	C-12-Z
SHEET	9	OF	21

AS-BUILT



PROFILE

HORIZONTAL: 1" = 40'
VERTICAL: 1" = 4'

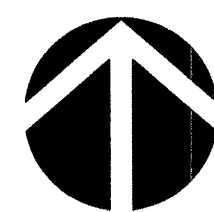

WATERLINE "E" PROFILE

WATERLINE "E" PROFILE

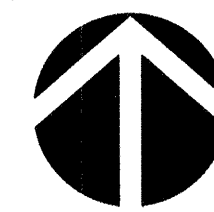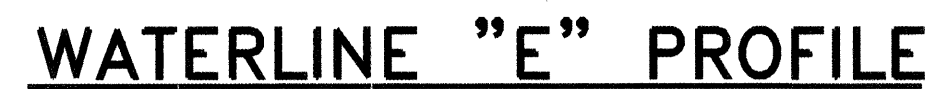

WATERLINE "F" PROFILE


WATERLINE "F" PROFILE




 BPLW		CITY OF ALBUQUERQUE PUBLIC WORKS DEPARTMENT ENGINEERING GROUP		 BPLW	
TITLE:		GOLF COURSE POINTE WATERLINE "A" & "B" "E" & "F" PLAN AND PROFILE			
APPROVALS	ENGINEER	DATE	APPROVALS	ENGINEER	DATE
DRC Chairman		NOV 23 1990	Water		
Transportation			Waste Water		
Hydrology	DESIGN		NMUL		
Parks & Rec.	REVIEW COMMITTEE		CITY ENGINEER		
DRAWING NO.	622981		MAP NO.	SHEET OF	
			C-12-Z	10 21	

ENGINEER'S SEAL										SURVEY INFORMATION										BENCH MARKS										AS BUILT INFORMATION																			
										FIELD NOTES										THE STATION IS A ALUMINUM CAP AND IS STAMPED ACS 6-B11. GEOGRAPHIC POSITION (NAD 1927) X= 365,865.49 Y= 1,526,019.13 GROUND TO GRID FACTOR = 0.9996657 DELTA ALPHA= -00° 15' 32"																													
										NO.					BY																									DATE									
										Harris Surveying Inc.					4/99																																		
NO.					DATE					REMARKS					BY																																		


AS-BUILT

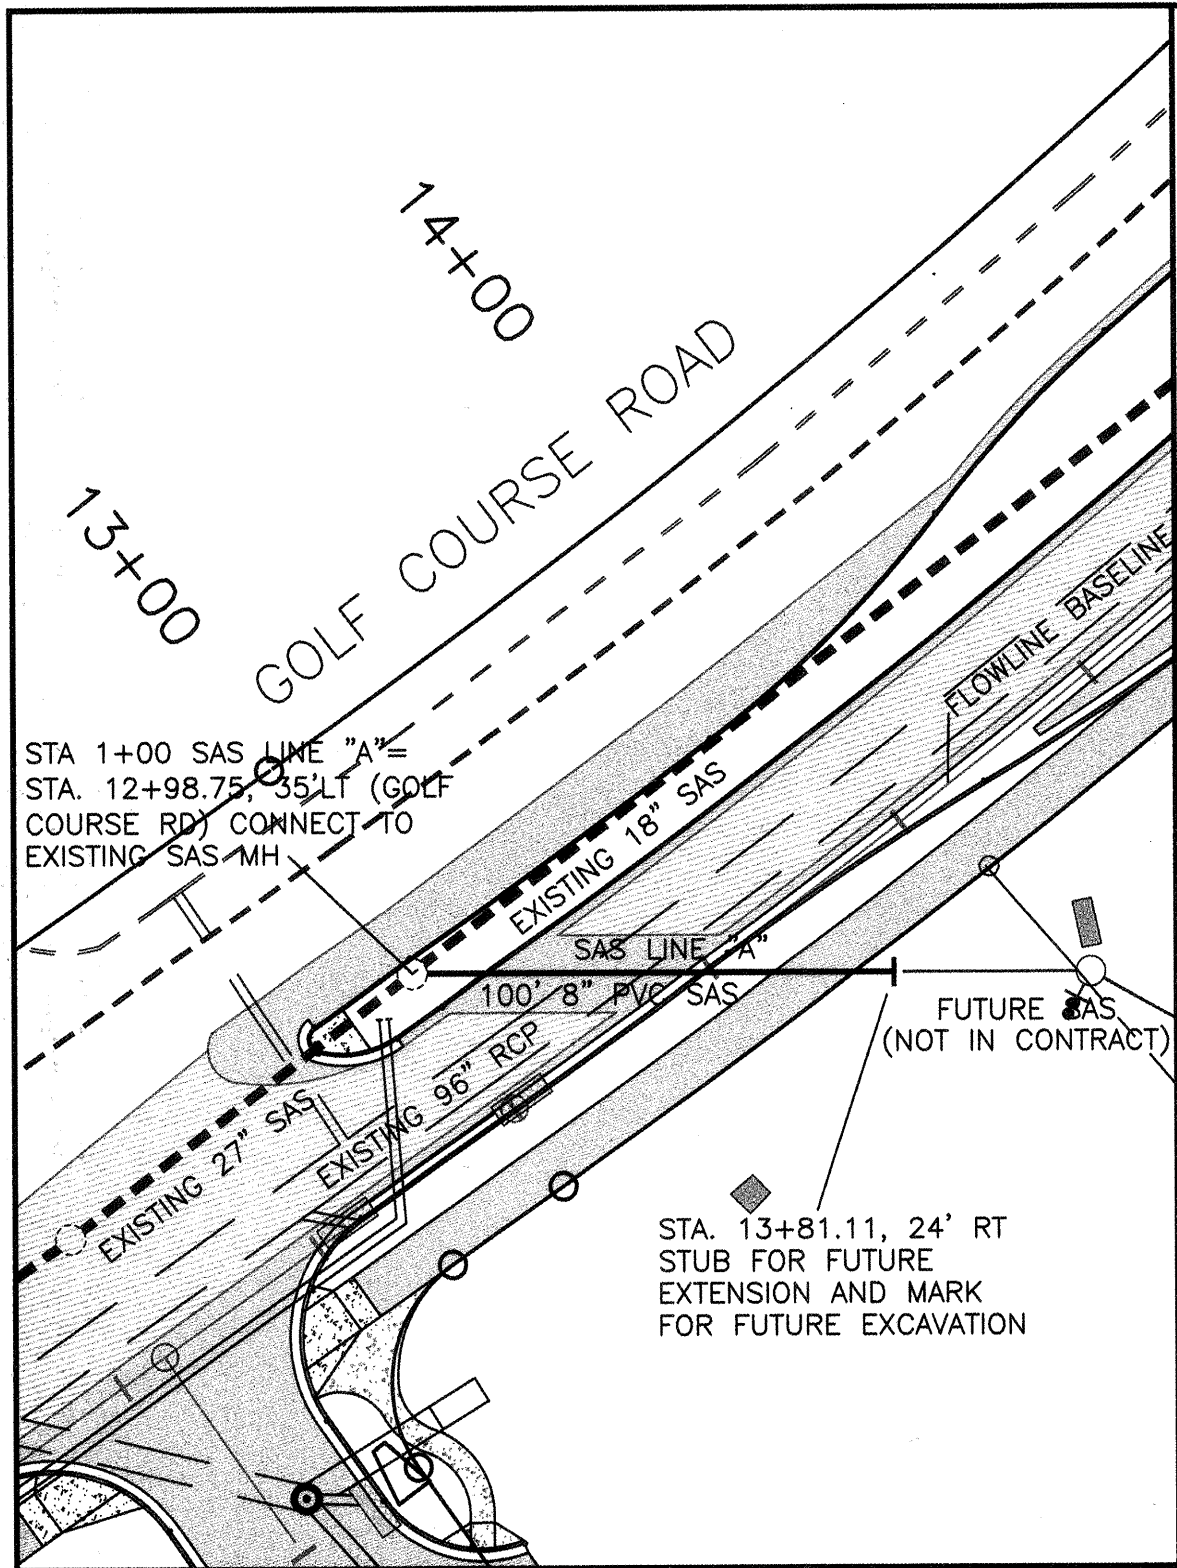


PLAN
SANITARY SEWER LINE "A"
SCALE: 1"= 40'

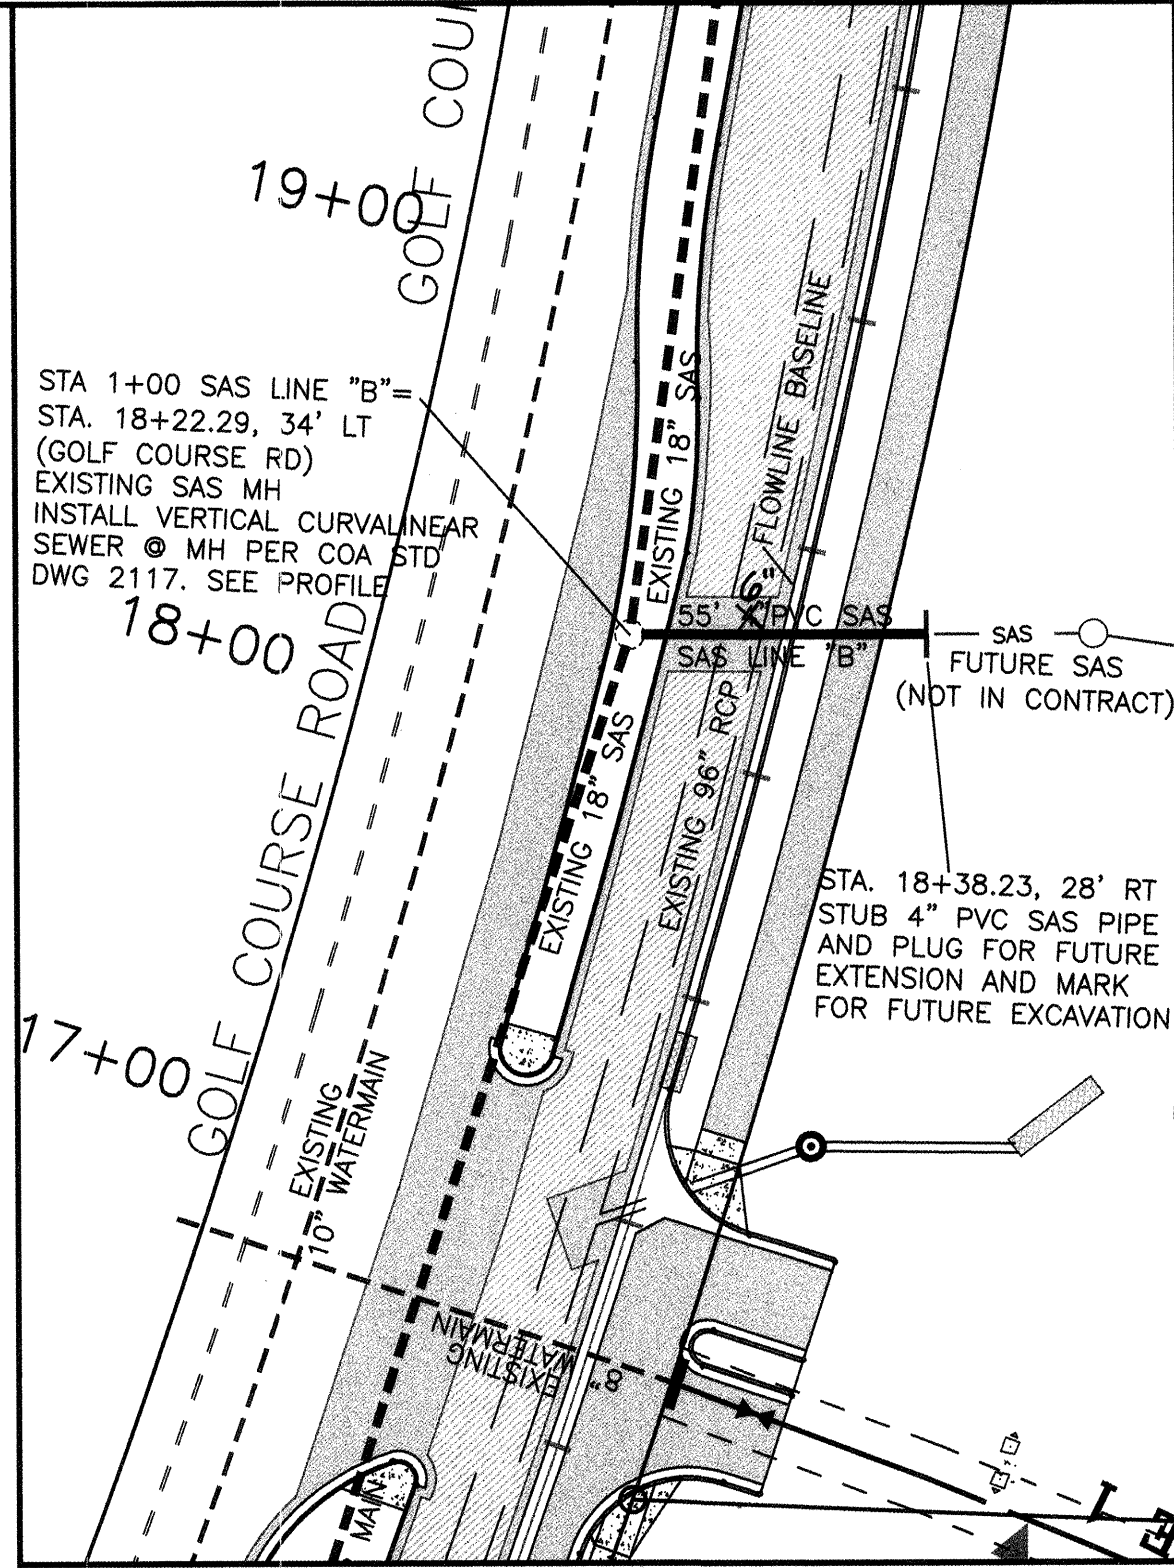

PLAN
SANITARY SEWER LINE "B"
SCALE: 1"= 40'

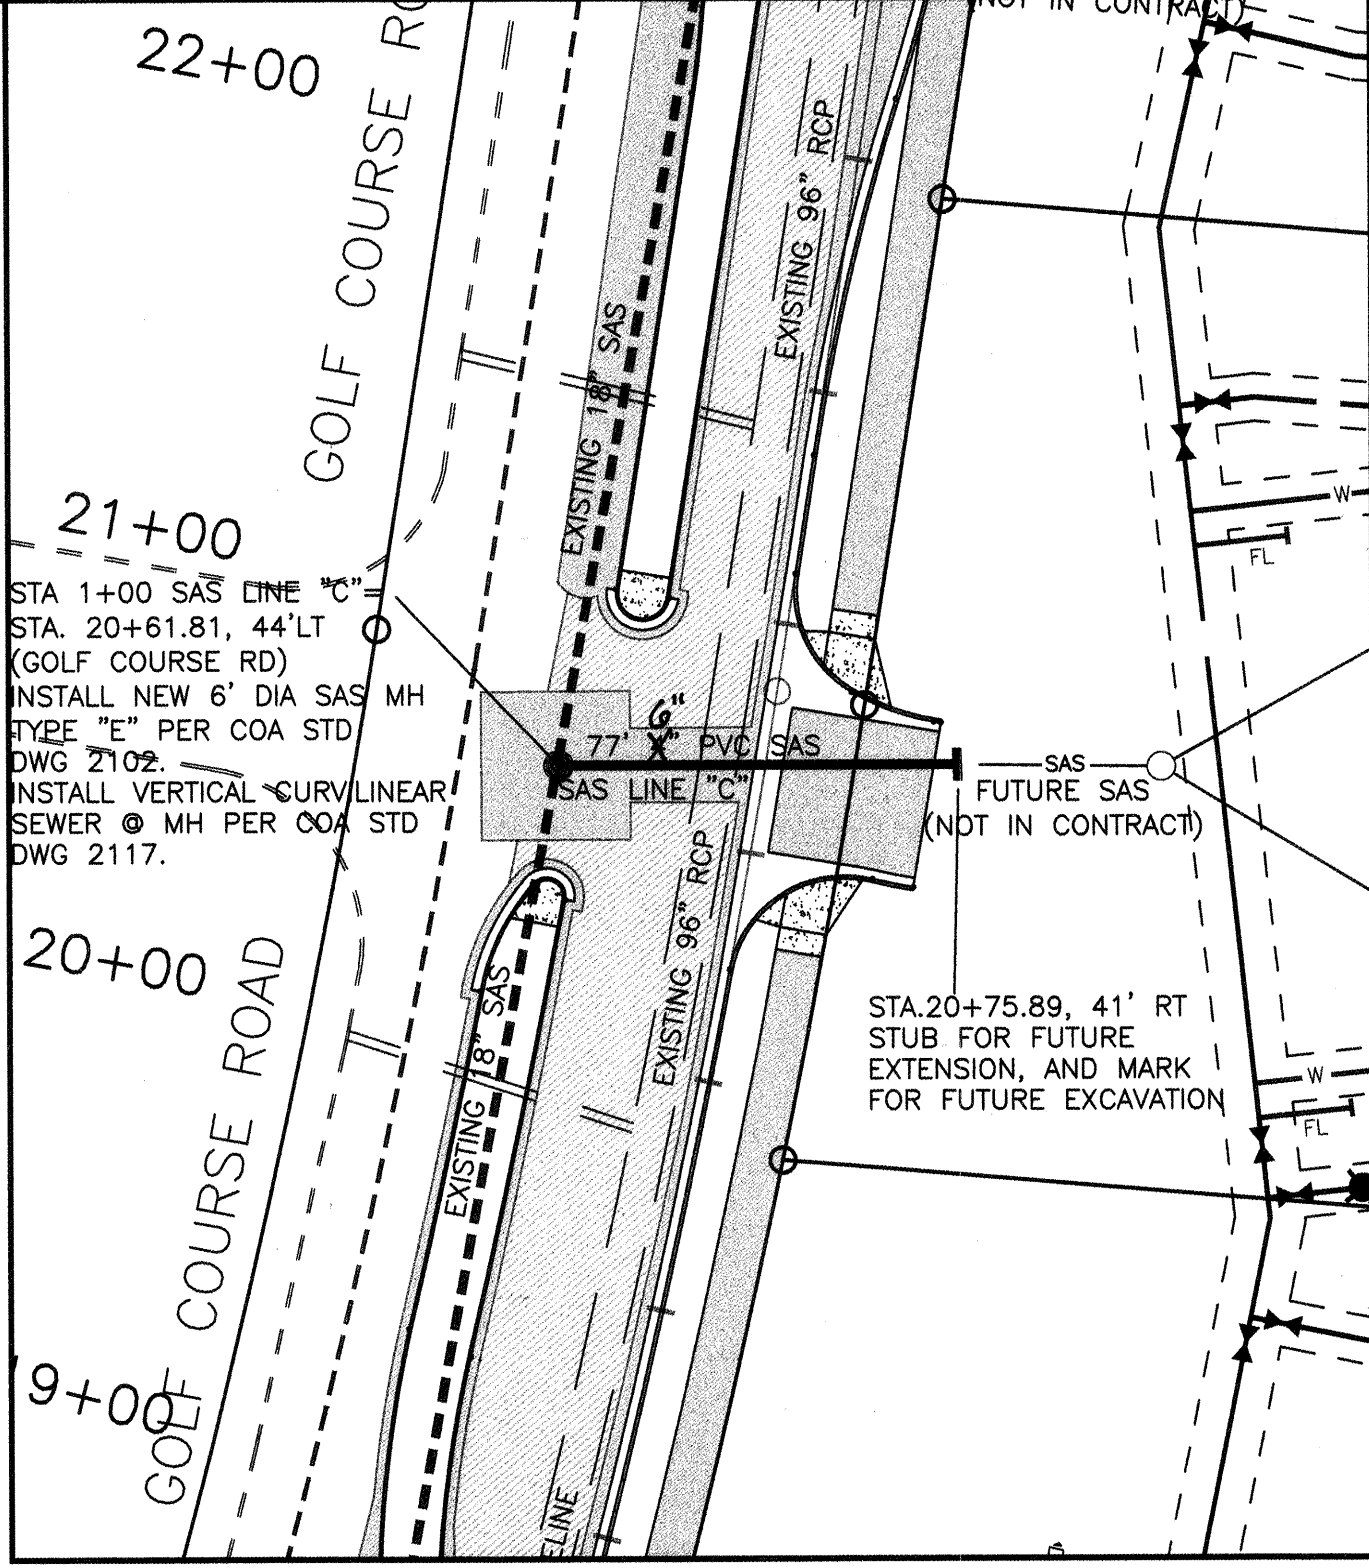

PLAN
SANITARY SEWER LINE "C"
SCALE: 1"= 40'

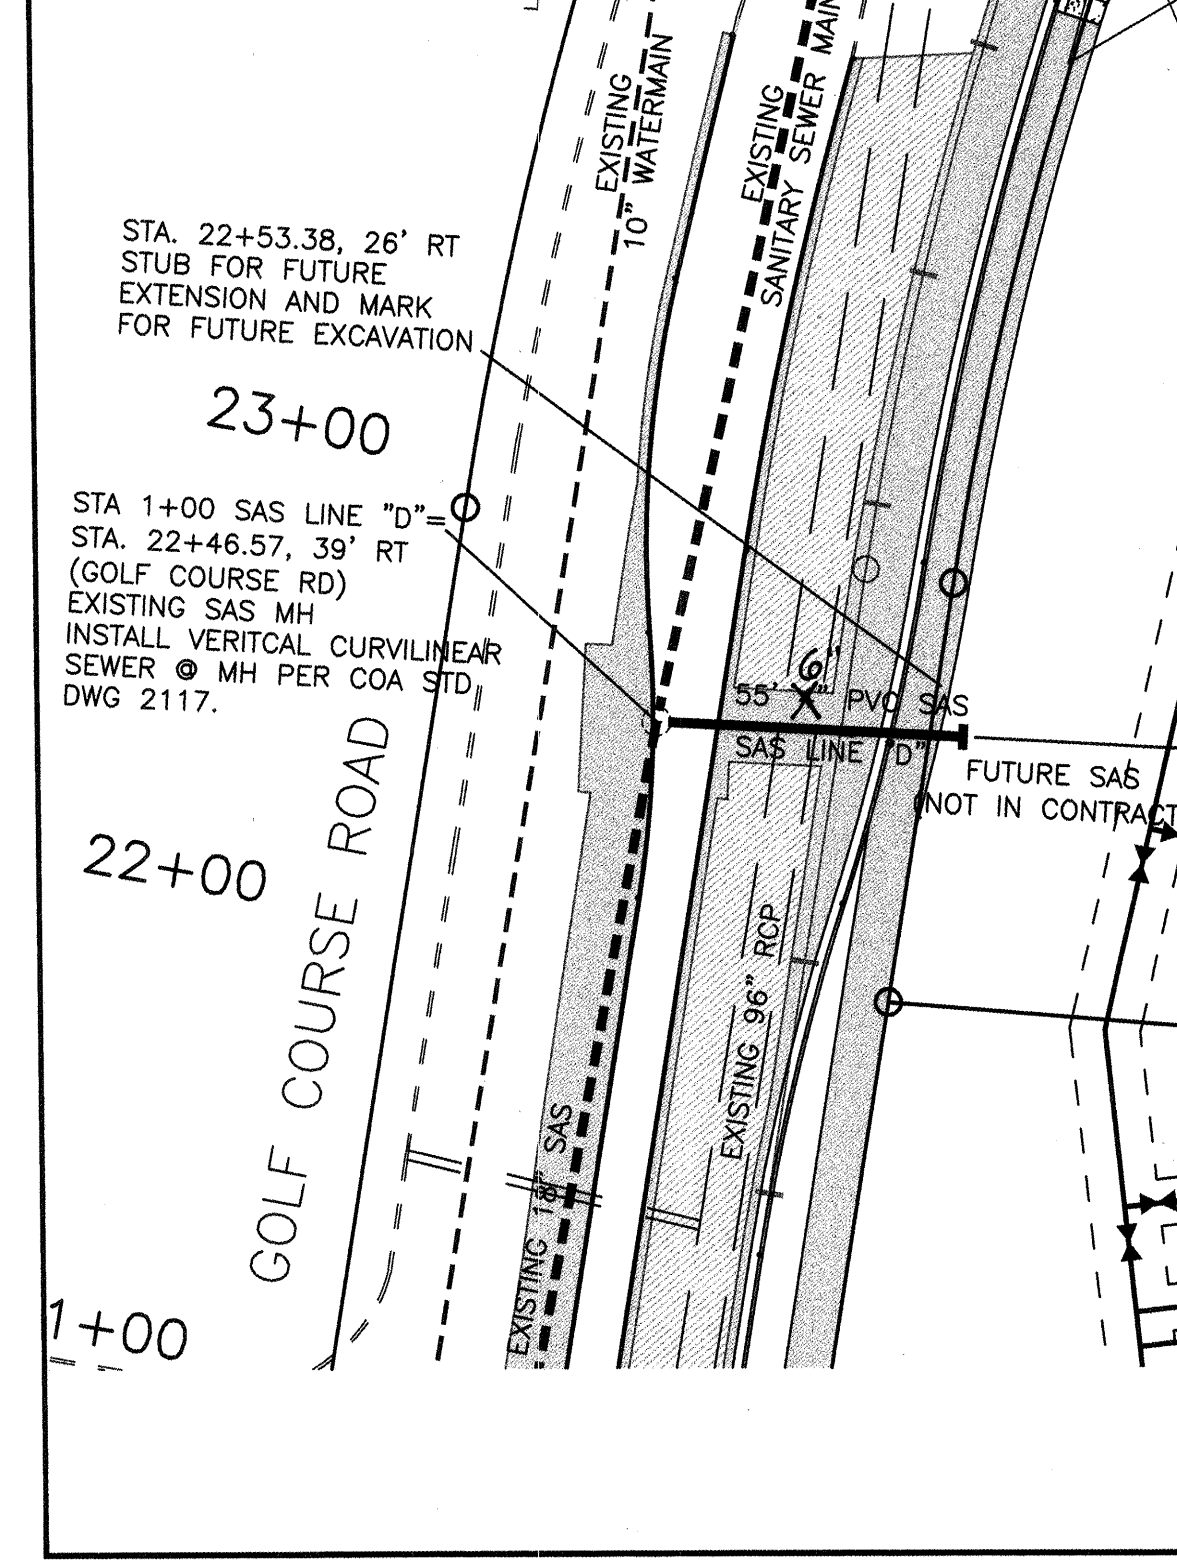


PLAN
SANITARY SEWER LINE "D"
SCALE: 1"= 40'


- GENERAL NOTES:**
- THE CONTRACTOR SHALL FIELD VERIFY ALL EXISTING UTILITY LOCATIONS & NOTIFY THE ENGINEER IMMEDIATELY OF ANY DISCREPANCIES.
 - ALL CURVE DATA & DIMENSIONS REFER TO FACE OF CURB AT FLOWLINE UNLESS OTHERWISE SPECIFIED.
 - CONTRACTOR IS RESPONSIBLE FOR ALL REPAIR AND/OR REPLACEMENT OF ALL UTILITY CONDUITS & EXISTING LINES.
 - ANY ADDITIONAL GRADING REQUIRED TO MATCH PROPOSED STREET GRADES SHALL BE INCIDENTAL TO PAVING ITEMS.
 - CONTRACTOR SHALL PROVIDE INSPECTORS (CITY & PRIVATE) w/ A PROPOSED HYDRO STATIC TESTING PLAN. THE PLAN MUST BE APPROVED BEFORE TESTING OPERATIONS BEGIN.
 - CONTRACTOR SHALL PARK EQUIPMENT AND VEHICLES AS NOT TO INTERFERE WITH NORMAL AREAS OF OTHER CONTRACTORS ON SITE.
 - ANY DAMAGE TO THE EXISTING FACILITIES (CURB & GUTTER, PAVEMENT, CONDUITS, LANDSCAPING, UTILITY LINES, ETC.) DURING CONSTRUCTION SHALL BE REPLACED AT THE CONTRACTORS EXPENSE.
 - REMOVAL OF THE EXISTING CURB & GUTTER OR VALLEY GUTTER SHALL BE AS PER COA STD DWG. 2415 (SAW CUT ONLY).
 - WHEEL CHAIR RAMPS SHALL BE CONSTRUCTED PRIOR TO ACCEPTANCE OF CURB & GUTTER.
 - TOPOGRAPHICAL & BOUNDARY SURVEY PROVIDED BY HARRIS SURVEYING INC. BPLW IS NOT RESPONSIBLE FOR ANY DISCREPANCIES IN THE SURVEYS.
 - ALL INDIVIDUAL BUILDING FIRELINES, DOMESTIC WATER SERVICE, IRRIGATION & SANITARY SEWER ARE BY SEPARATE BUILDING PERMIT & ARE NOT IN THIS CONTRACT. LOCATION OF BUILDING FIRELINES, DOMESTIC WATER METERS & SANITARY SEWER SERVICES & ON SITE MANHOLES ARE FOR INFORMATION ONLY.

LEGEND:


- NEW CONCRETE PAVEMENT
- NEW 1 1/2" ASPHALT FINAL LIFT
- NEW ASPHALT PAVEMENT
- NEW GATE VALVE
- NEW FIRE HYDRANT
- NEW WATER MAIN CAP
- NEW SD INLET
- NEW SAS MANHOLE
- NEW SD MANHOLE
- NEW WATER MAIN
- NEW SANITARY SEWER
- NEW STORM DRAIN
- NEW UTILITY ESMT
- FUTURE WATER METER
- FUTURE SEWER CLEANOUT
- FUTURE SAS MANHOLE
- EXISTING SD INLET
- EXISTING GATE VALVE
- EXISTING FIRE HYDRANT
- EXISTING SAS MANHOLE
- EXISTING SD MANHOLE
- EXISTING WATER MAIN
- EXISTING SANITARY SEWER
- EXISTING UTILITY ESMT

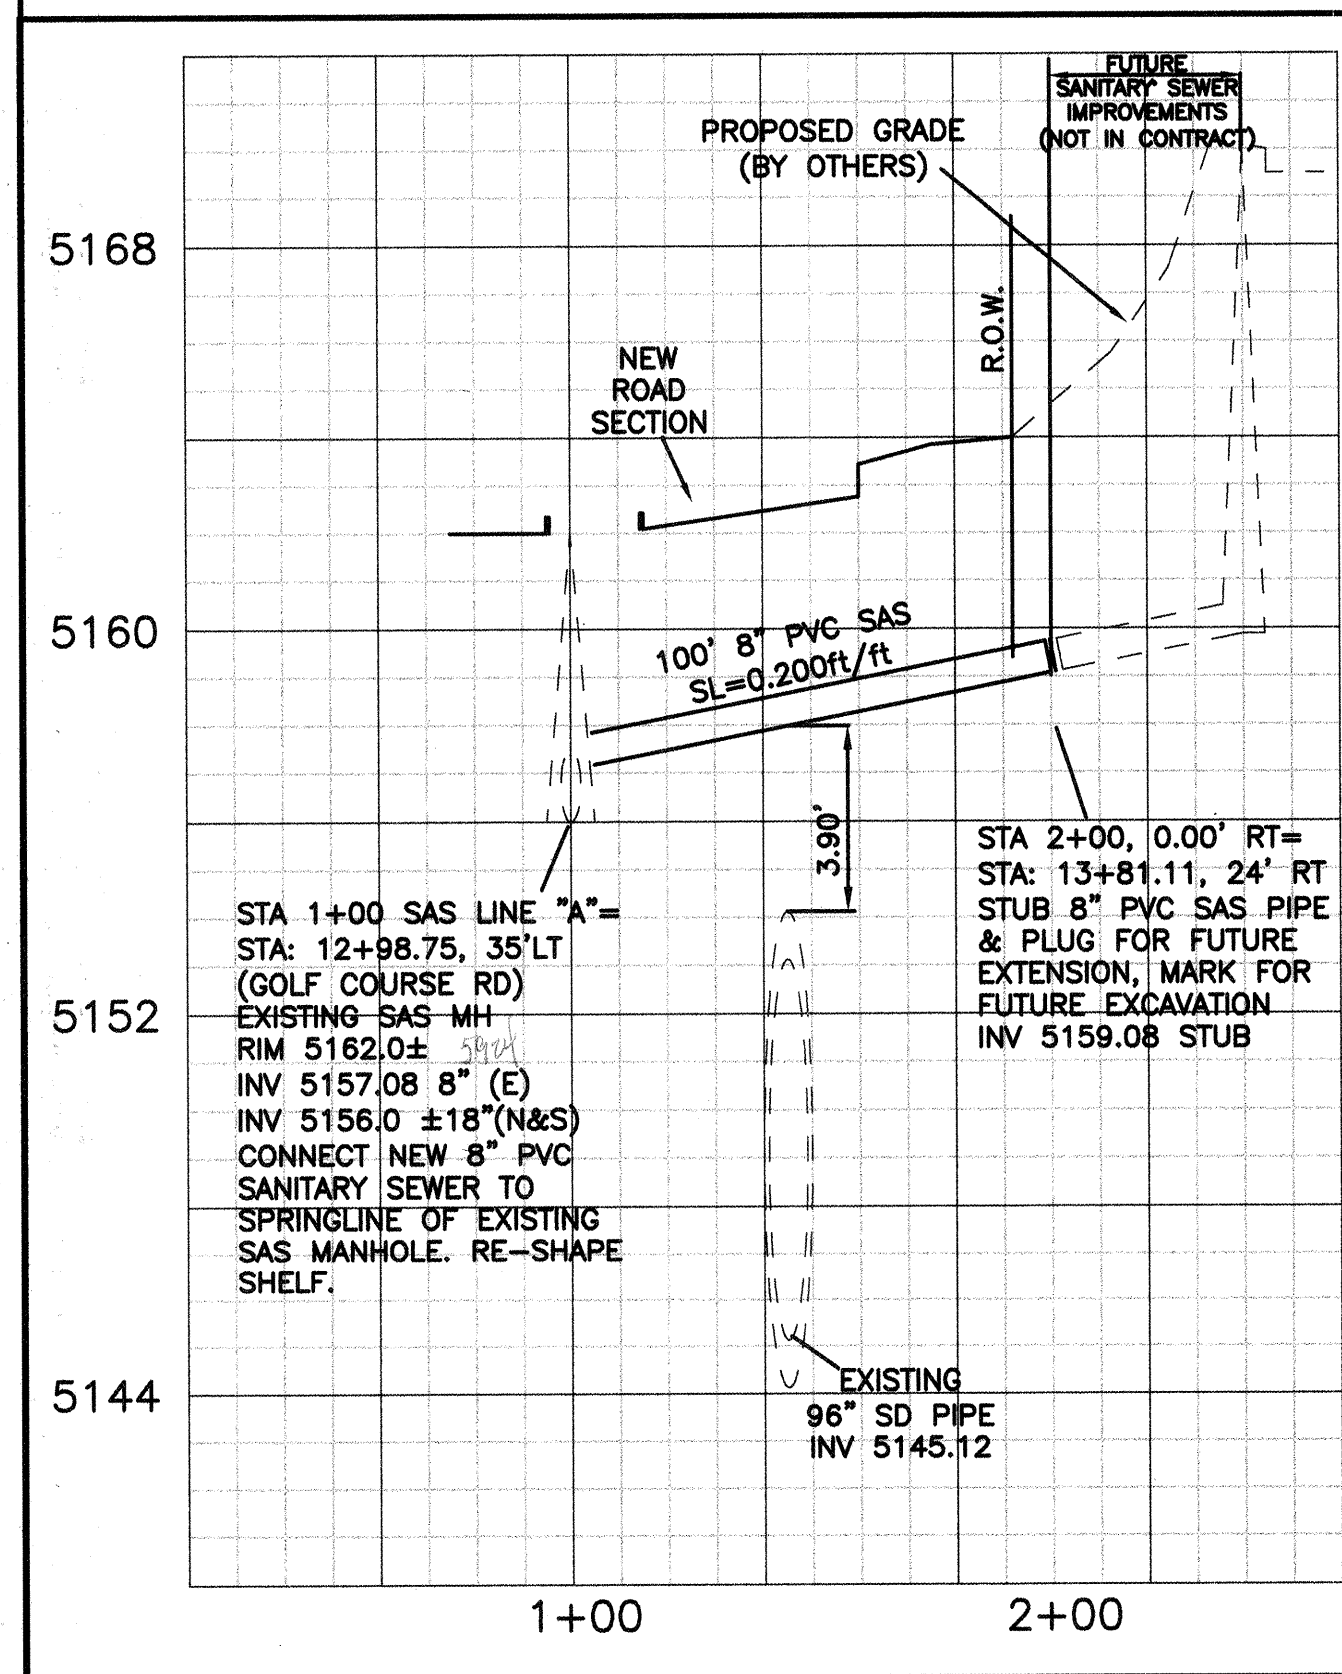


PROFILE
SANITARY SEWER LINE "A"
HORIZONTAL: 1"= 40'
VERTICAL: 1"= 4'

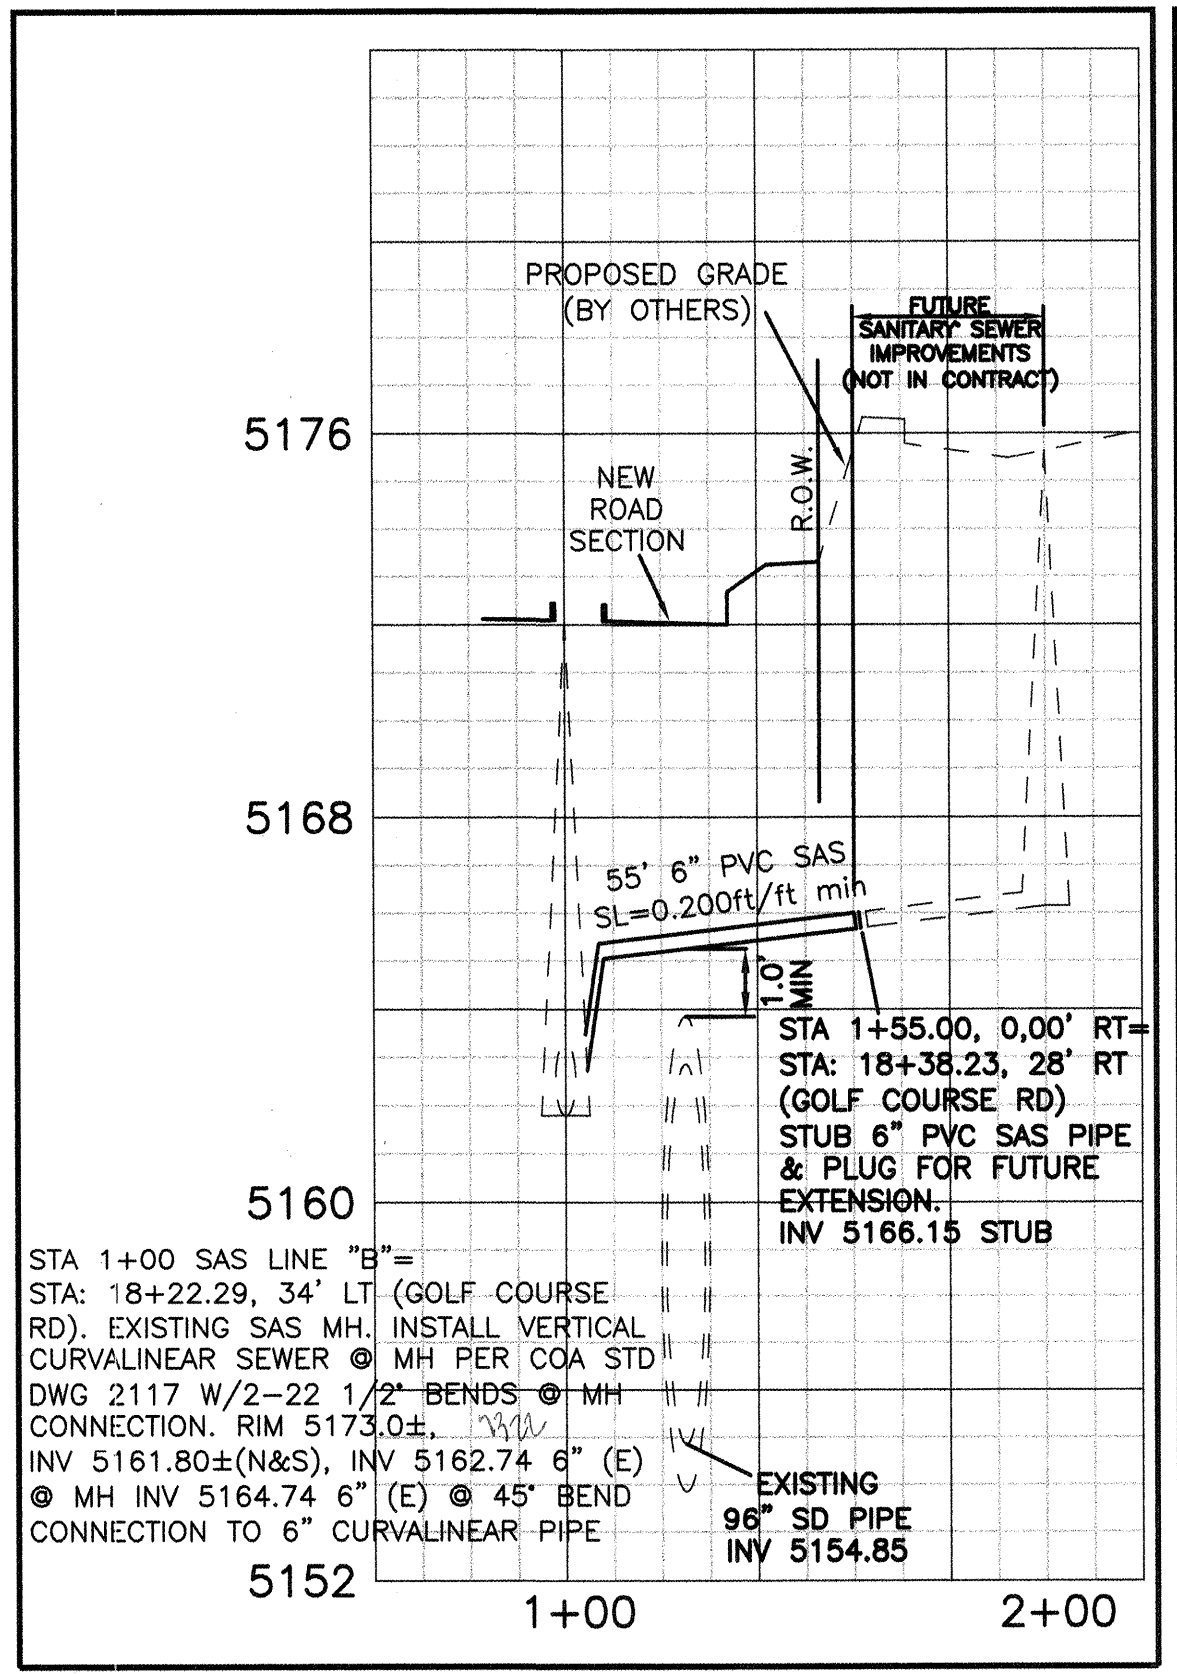

PROFILE
SANITARY SEWER LINE "B"
HORIZONTAL: 1"= 40'
VERTICAL: 1"= 4'

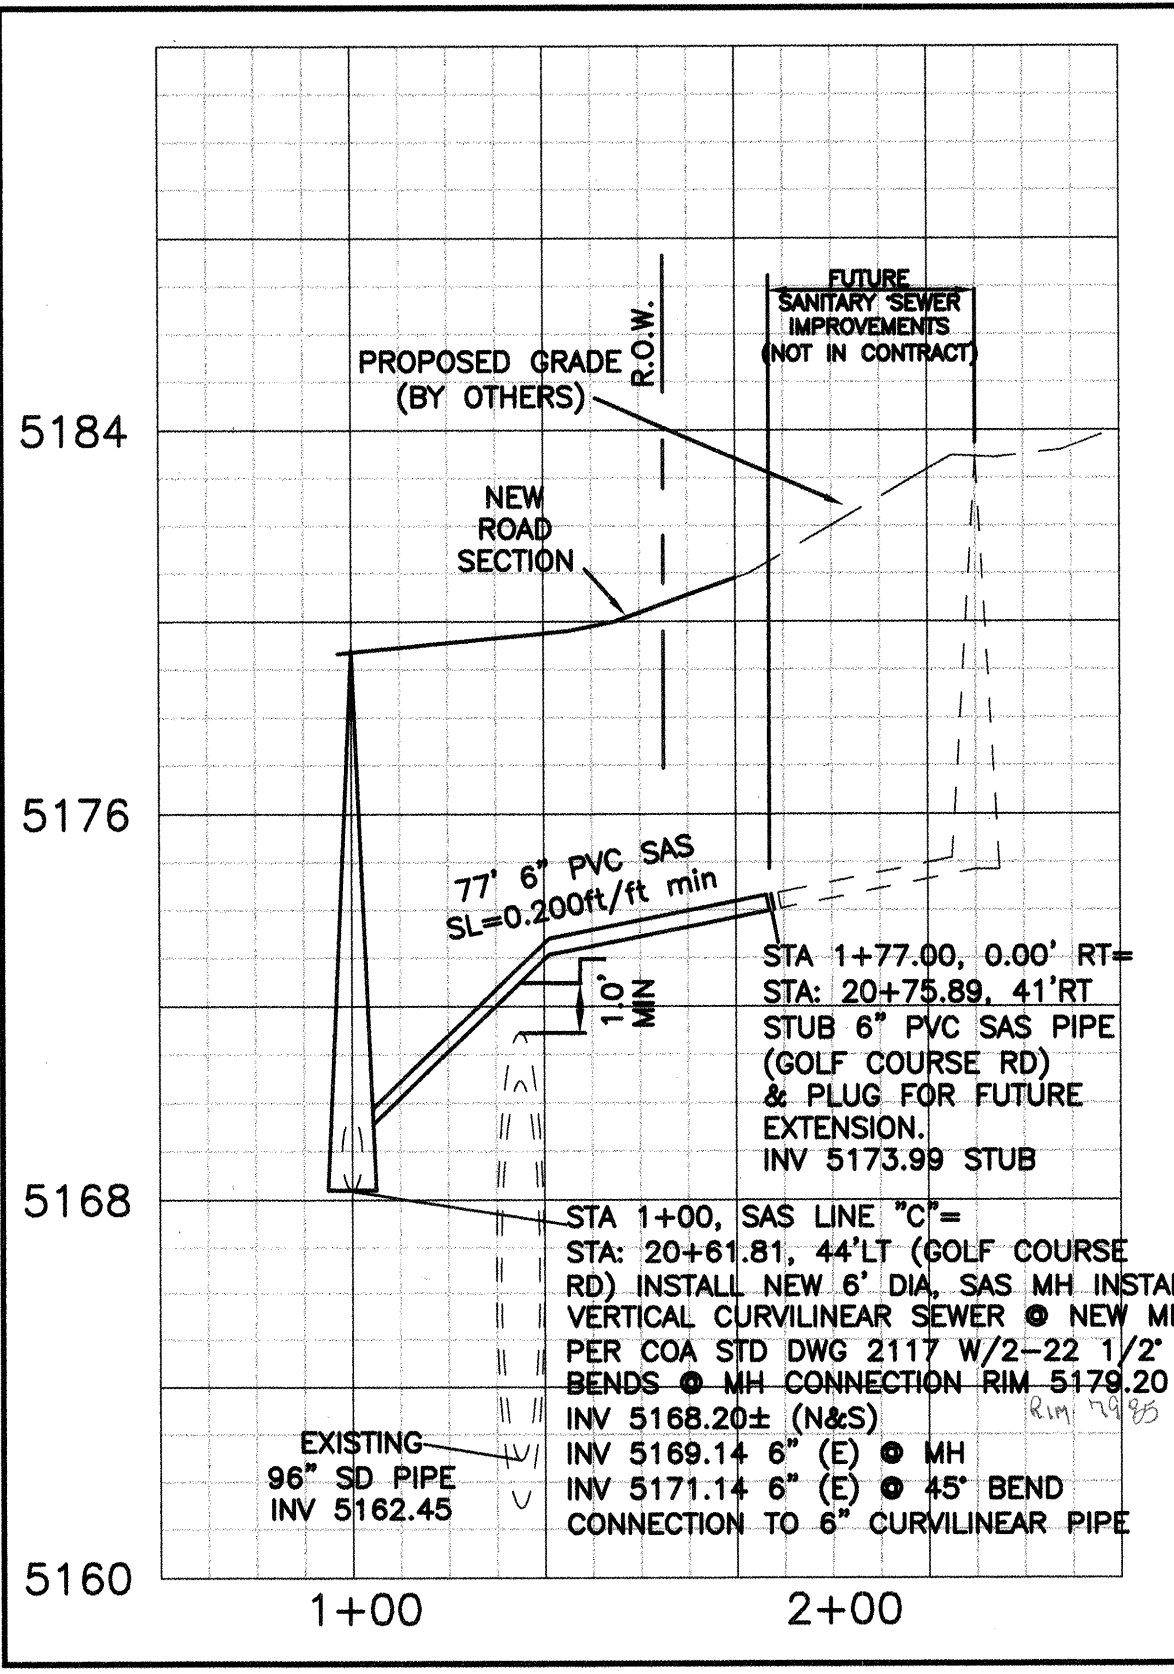

PROFILE
SANITARY SEWER LINE "C"
HORIZONTAL: 1"= 40'
VERTICAL: 1"= 4'

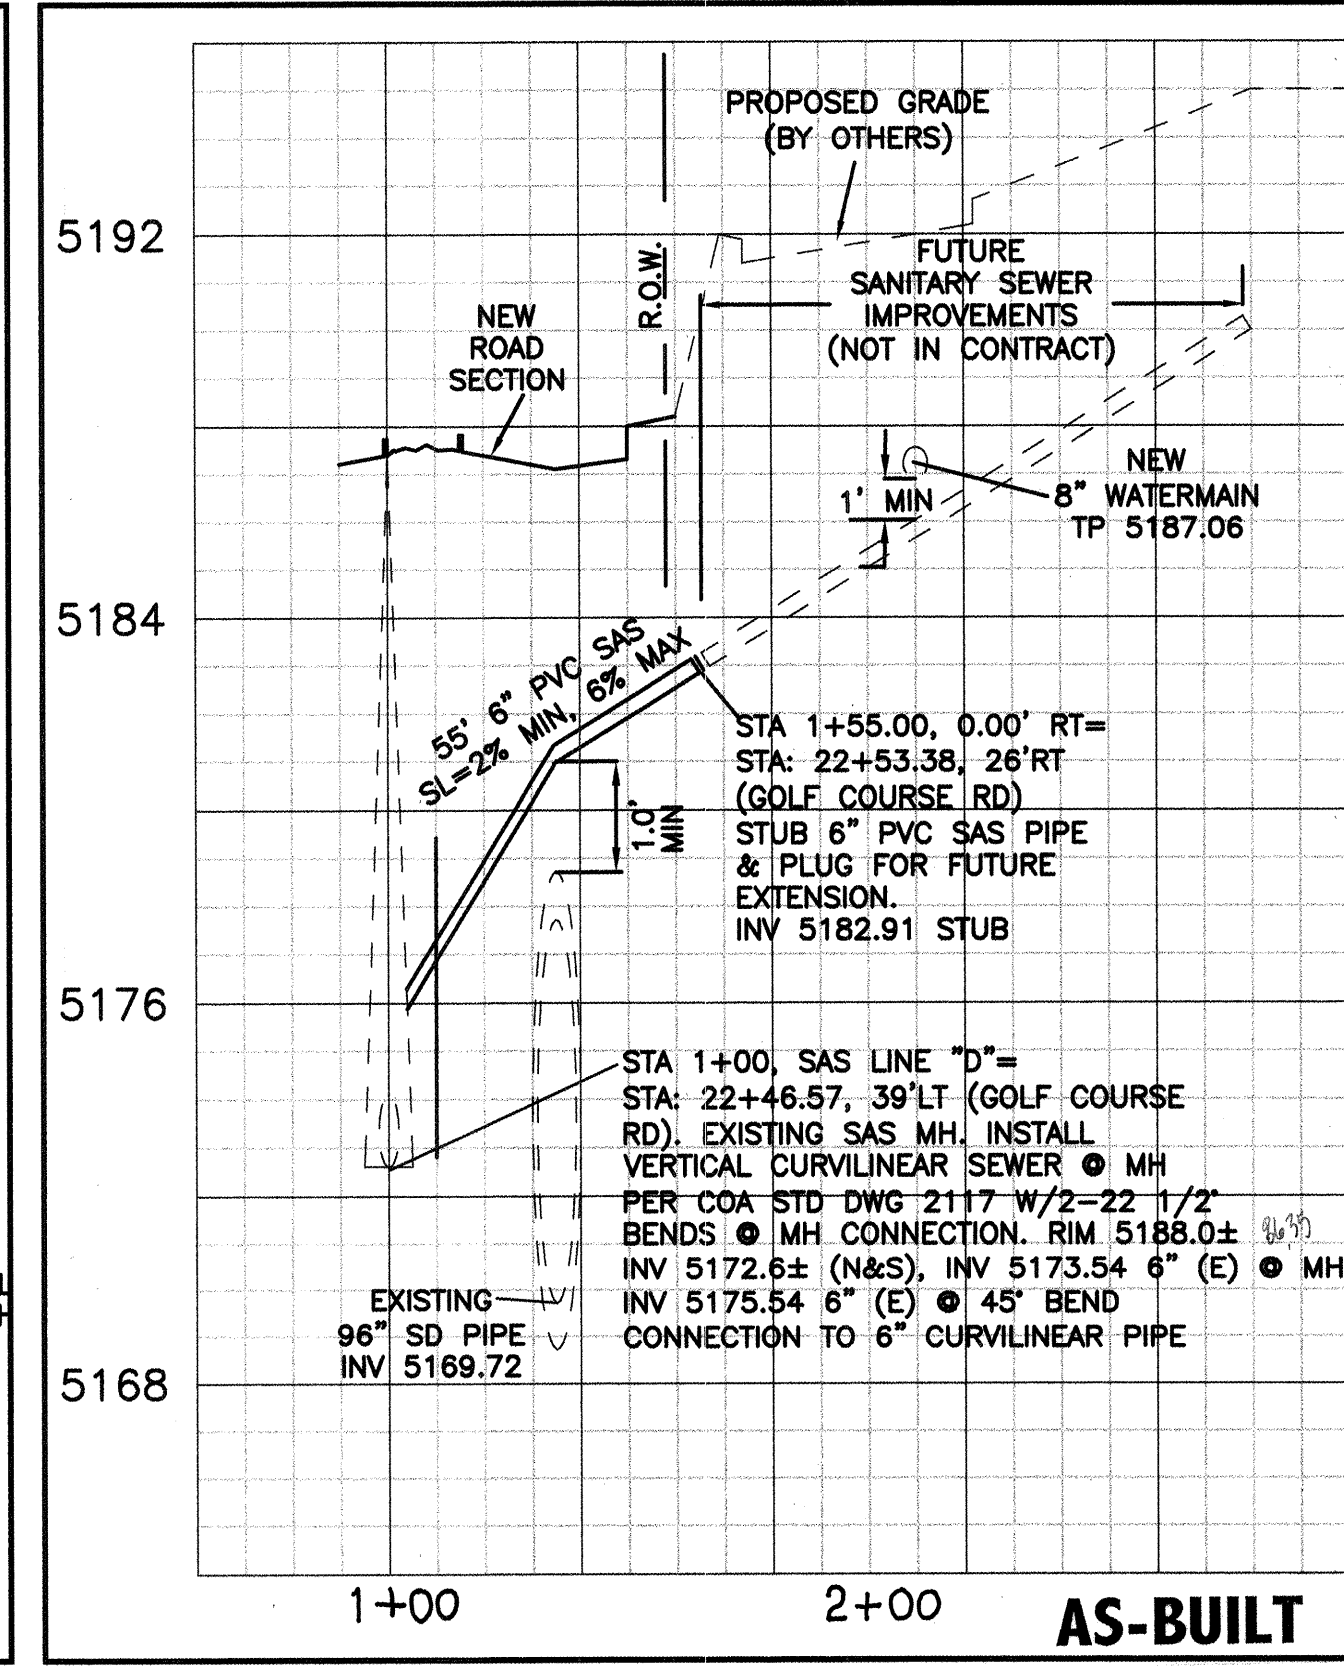

PROFILE
SANITARY SEWER LINE "D"
HORIZONTAL: 1"= 40'
VERTICAL: 1"= 4'

**CITY OF ALBUQUERQUE
PUBLIC WORKS DEPARTMENT
ENGINEERING GROUP**

BPLW

**GOLF COURSE POINTE
SANITARY SEWER LINE "A", "B" & "C"
PLAN AND PROFILE**


APPROVALS

DESIGN	DATE	APPROVALS	ENGINEER	DATE
DESIGN	NOV 23 1999	Water		
REVIEW		Waste Water		
REVIEW		NMUT		


DRAWING NO. 622981

MAP NO. C-12-Z


SHEET 11 OF 21

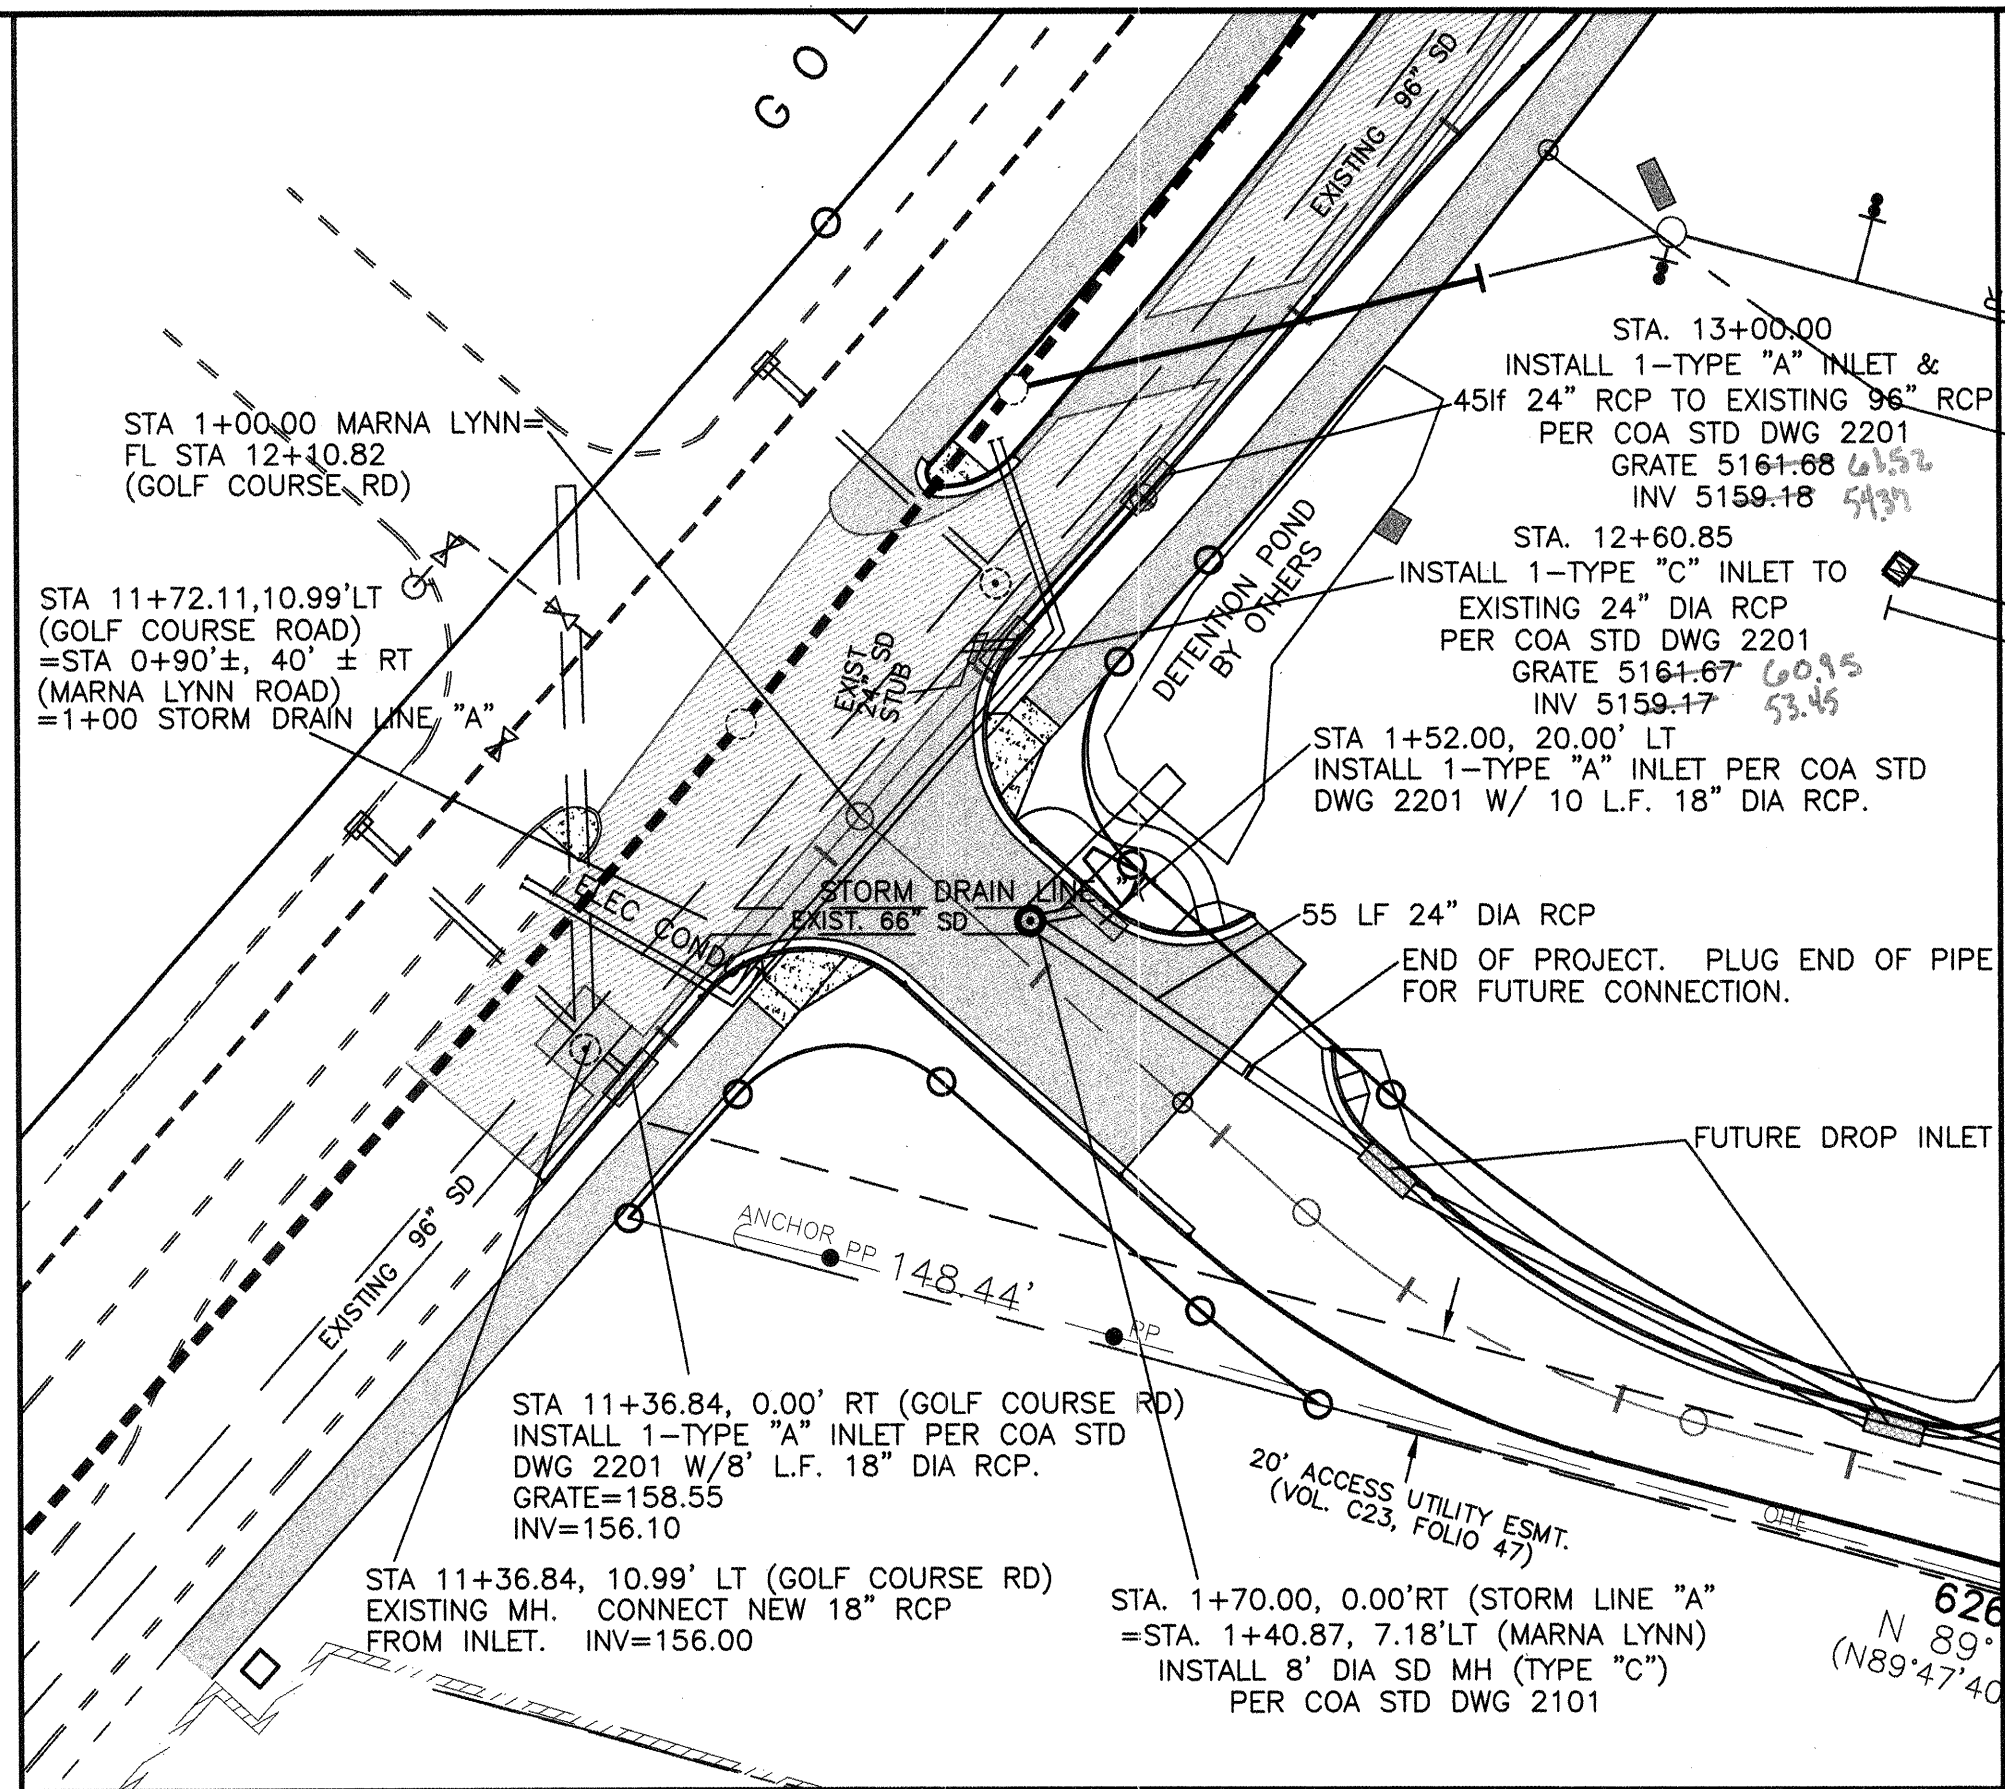


PLAN
STORM DRAIN LINE "A"
SCALE: 1"= 40'

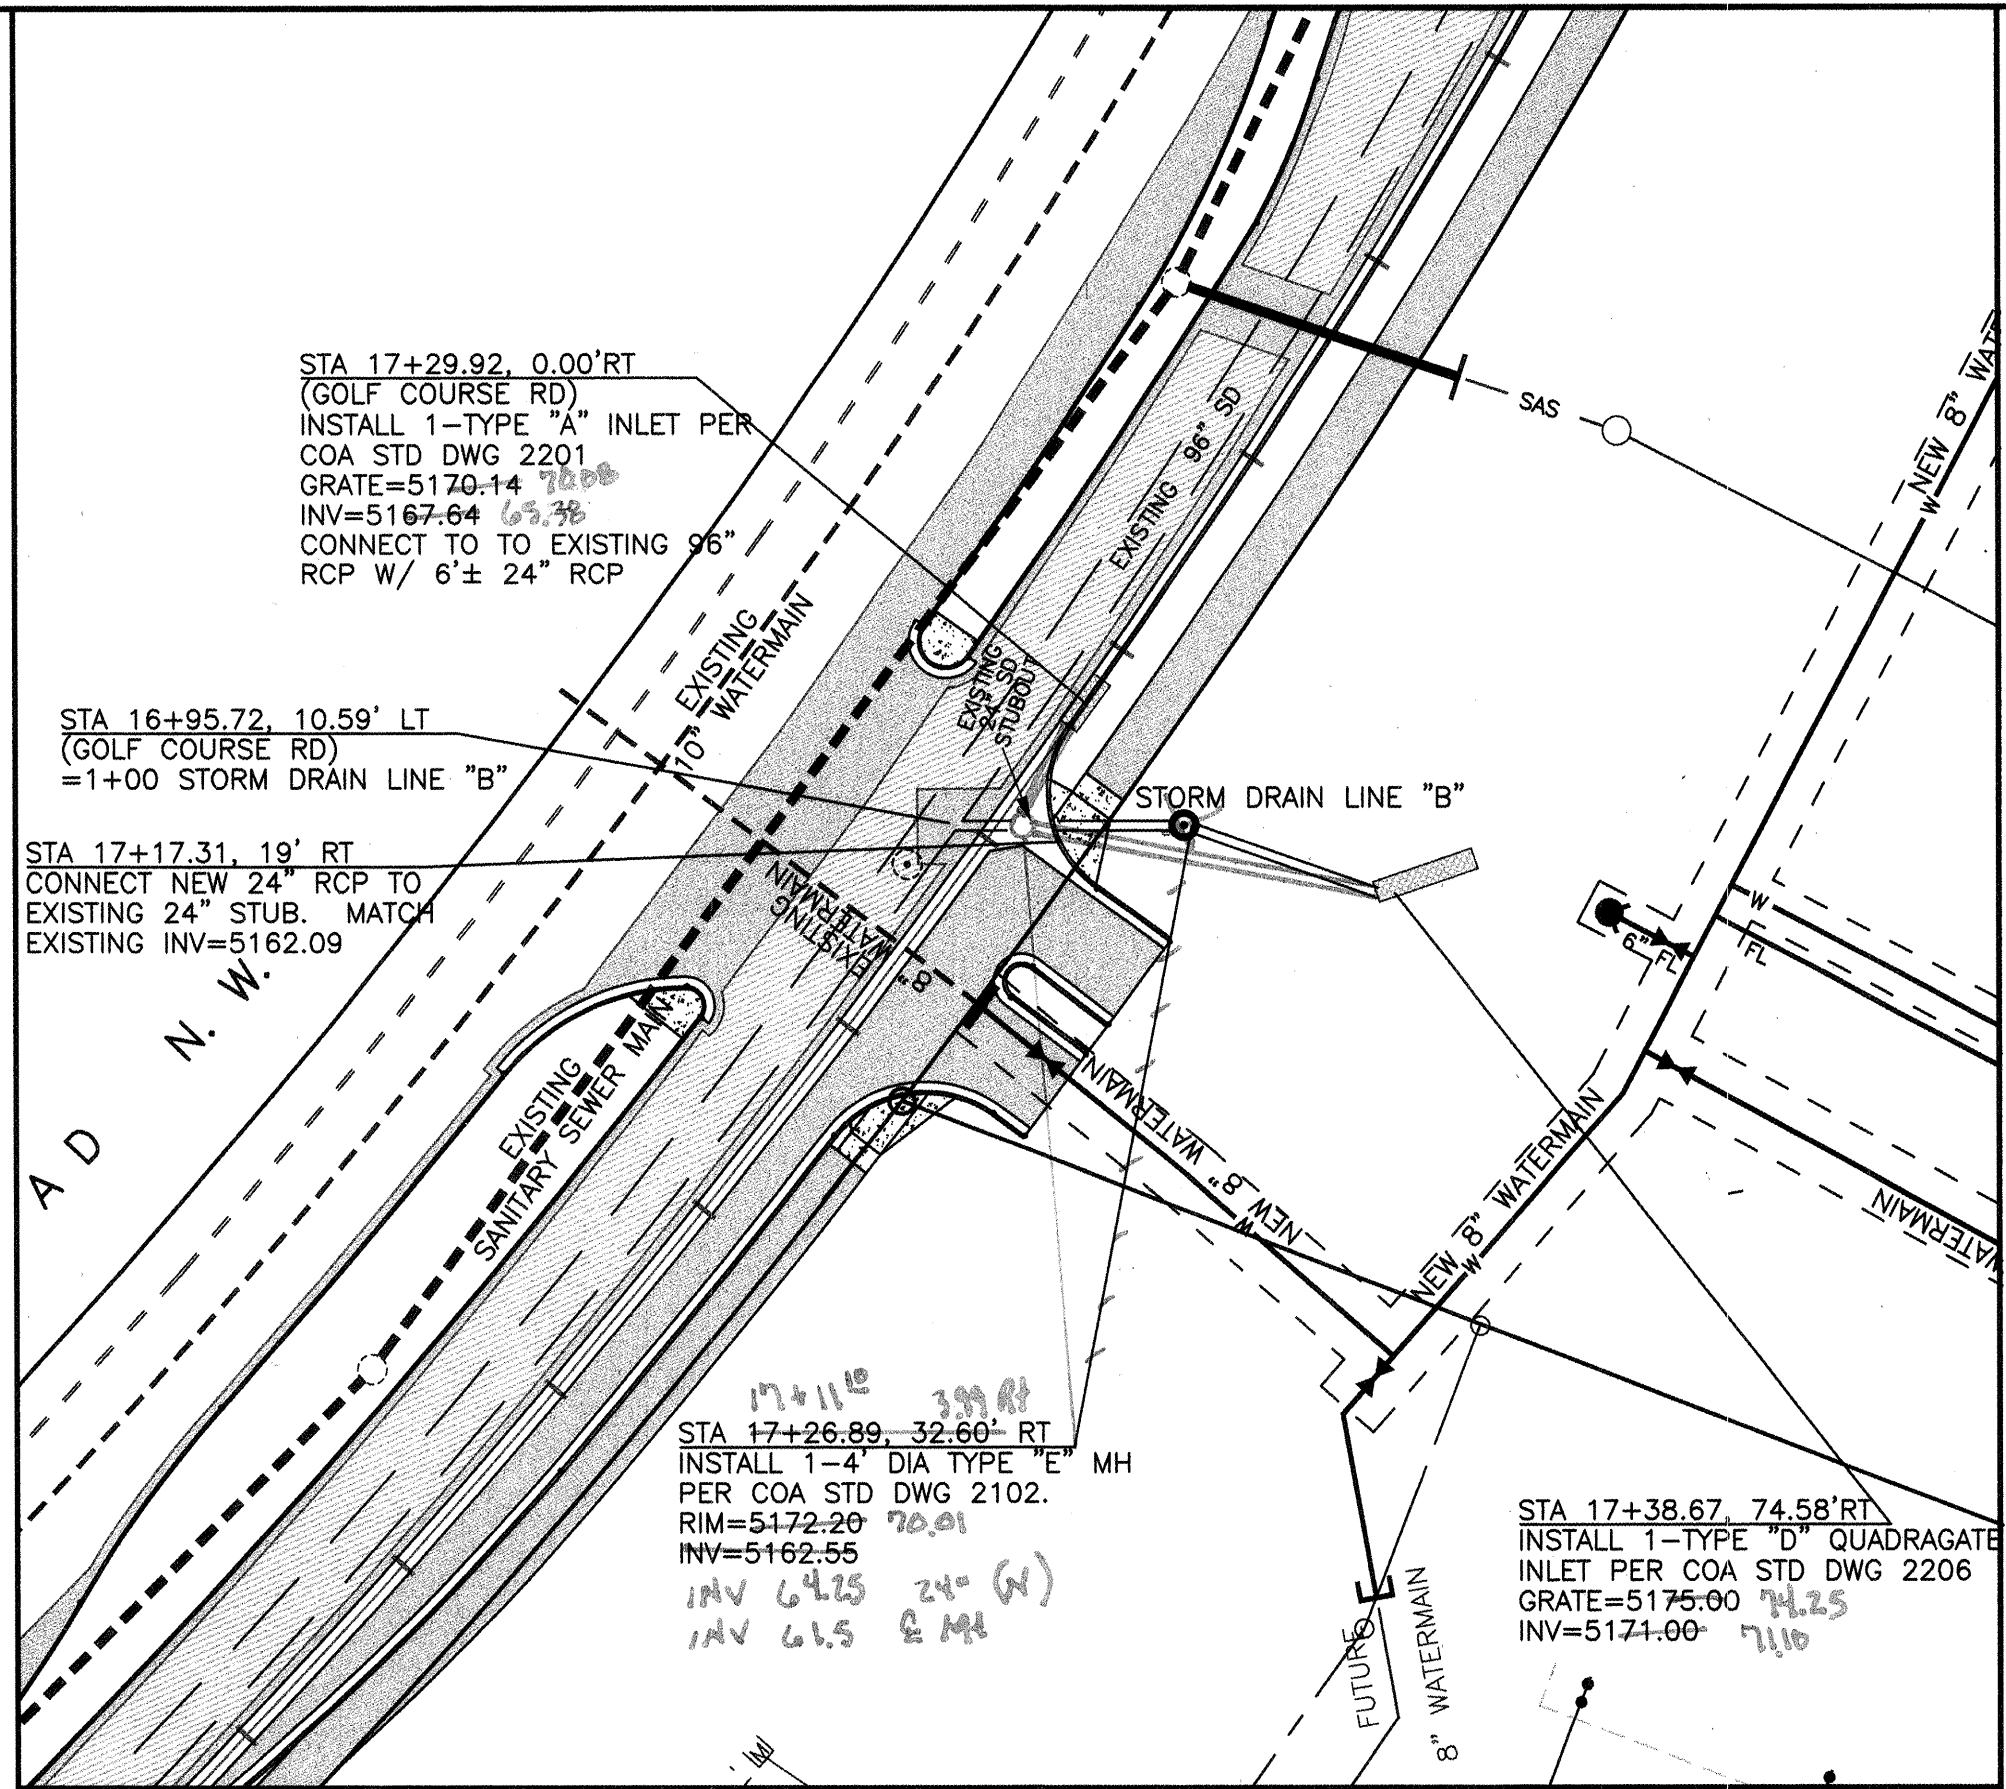

PLAN
STORM DRAIN LINE "B"
SCALE: 1"= 40'

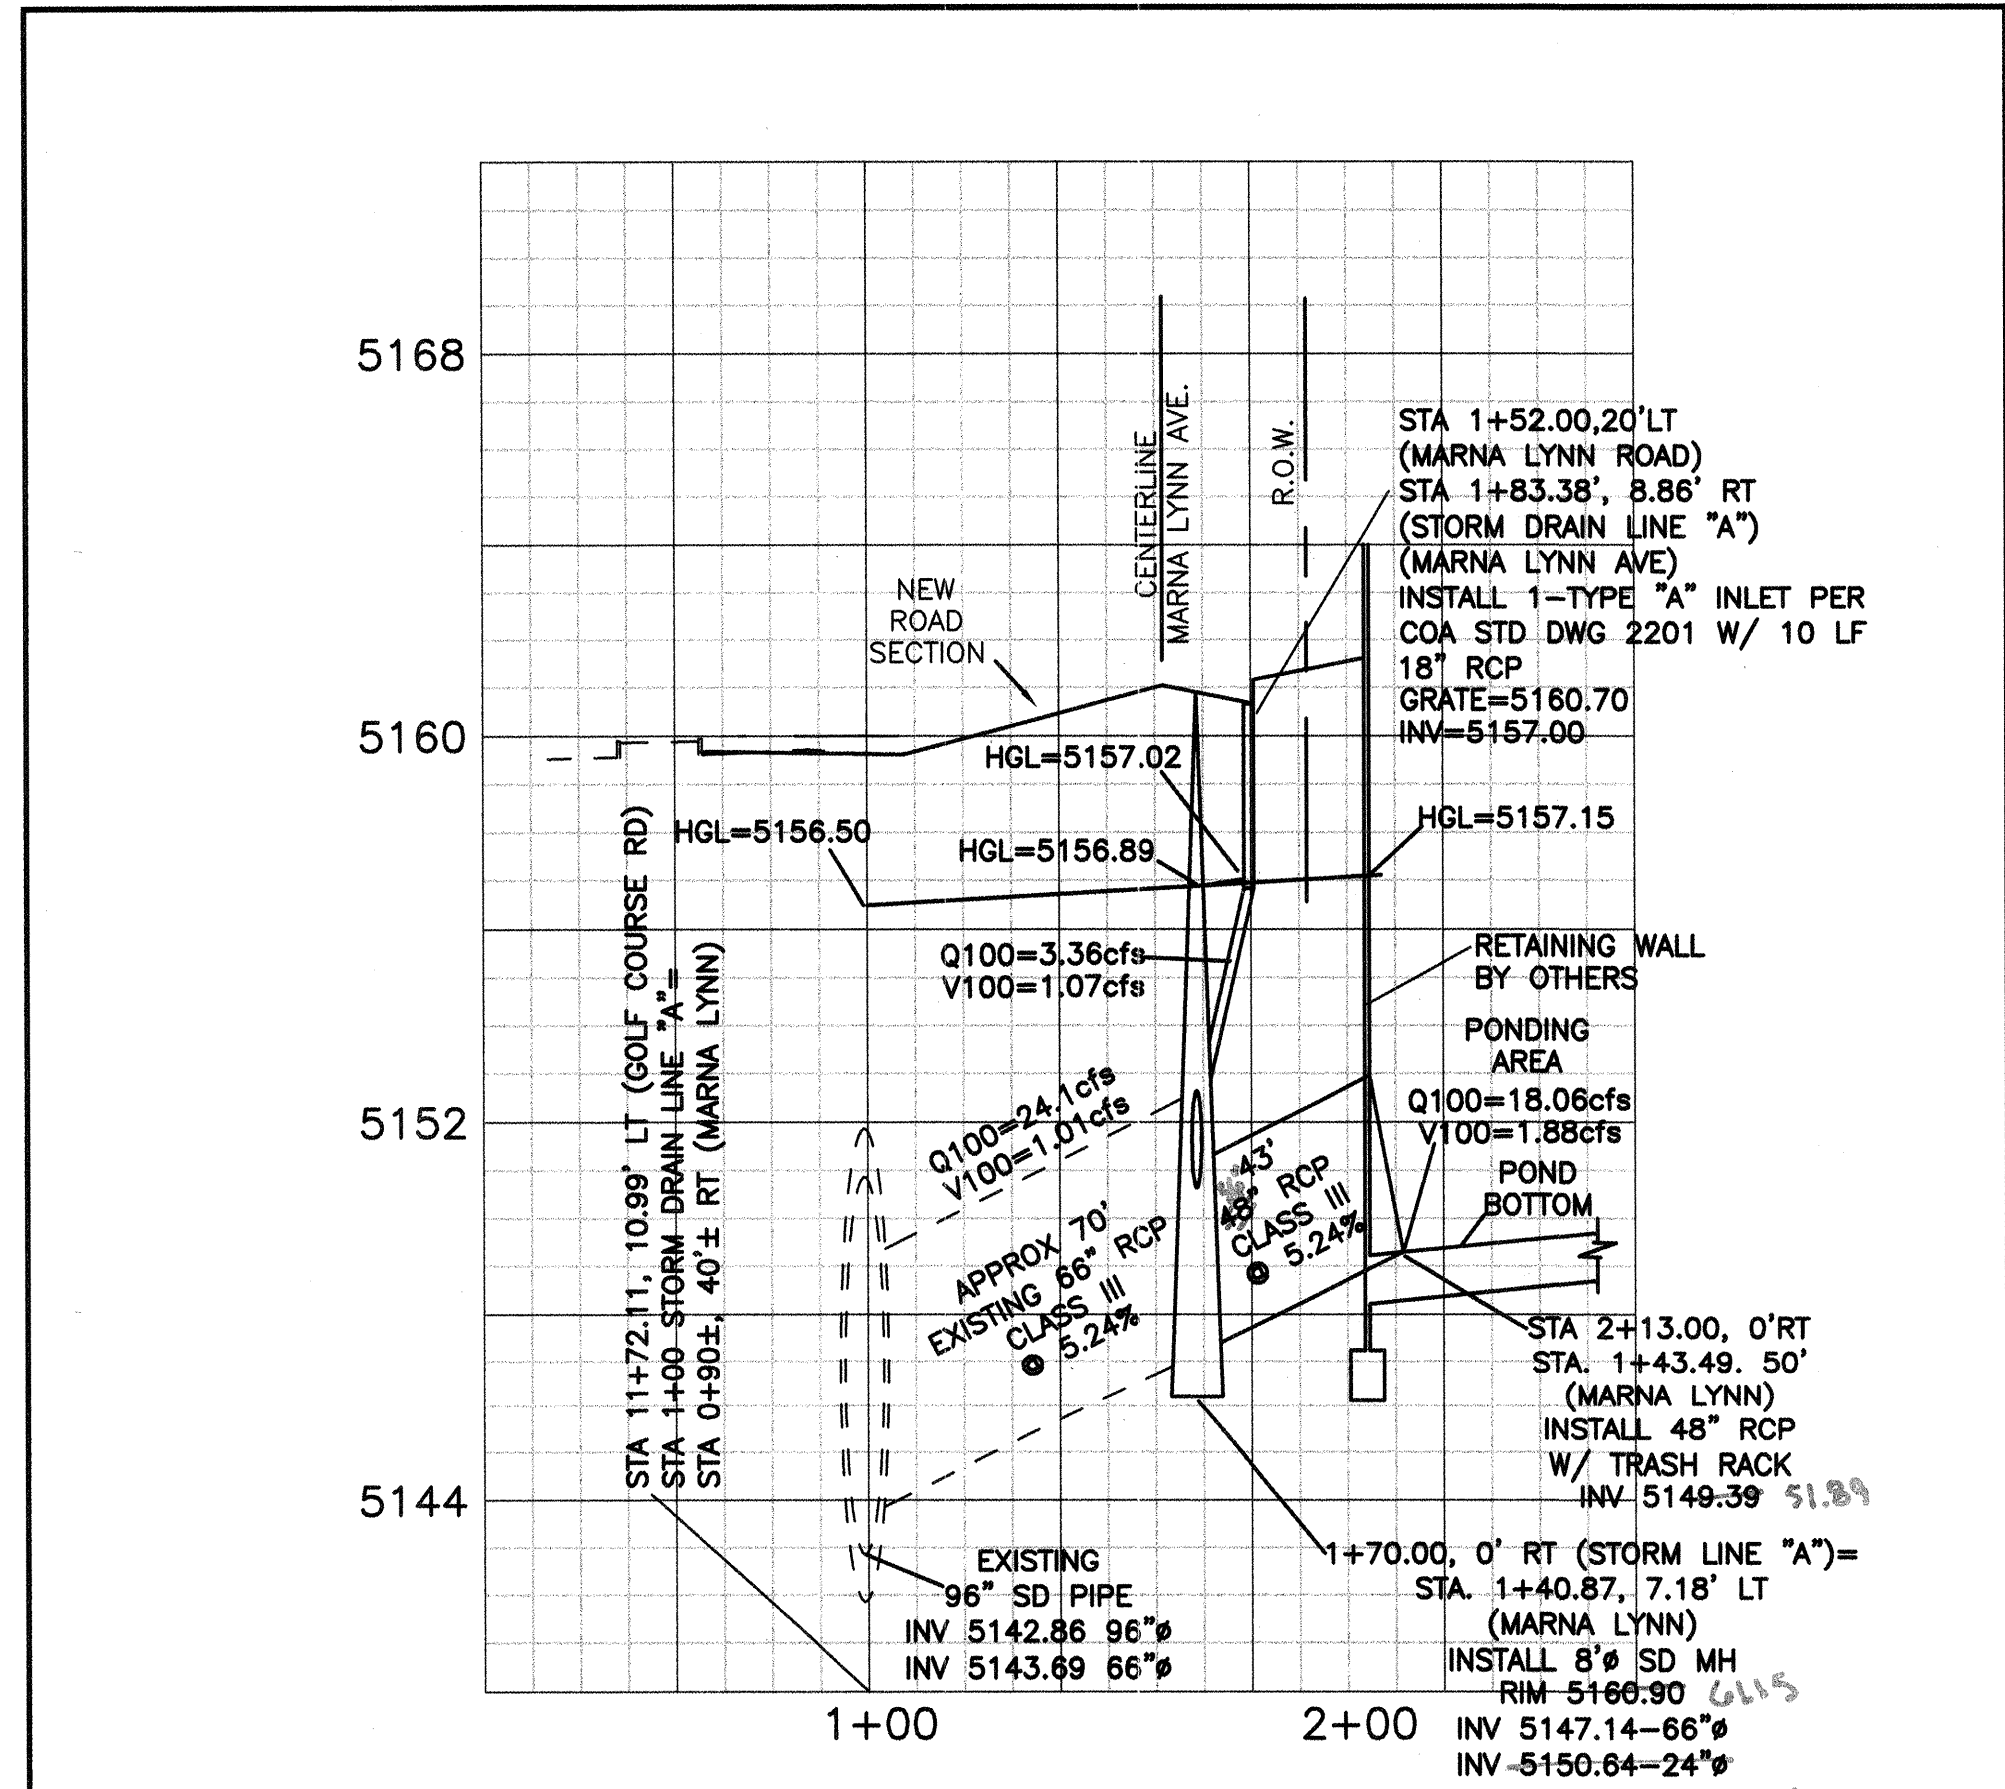

PROFILE
STORM DRAIN LINE "A"
HORIZONTAL: 1"= 40'
VERTICAL: 1"= 4'

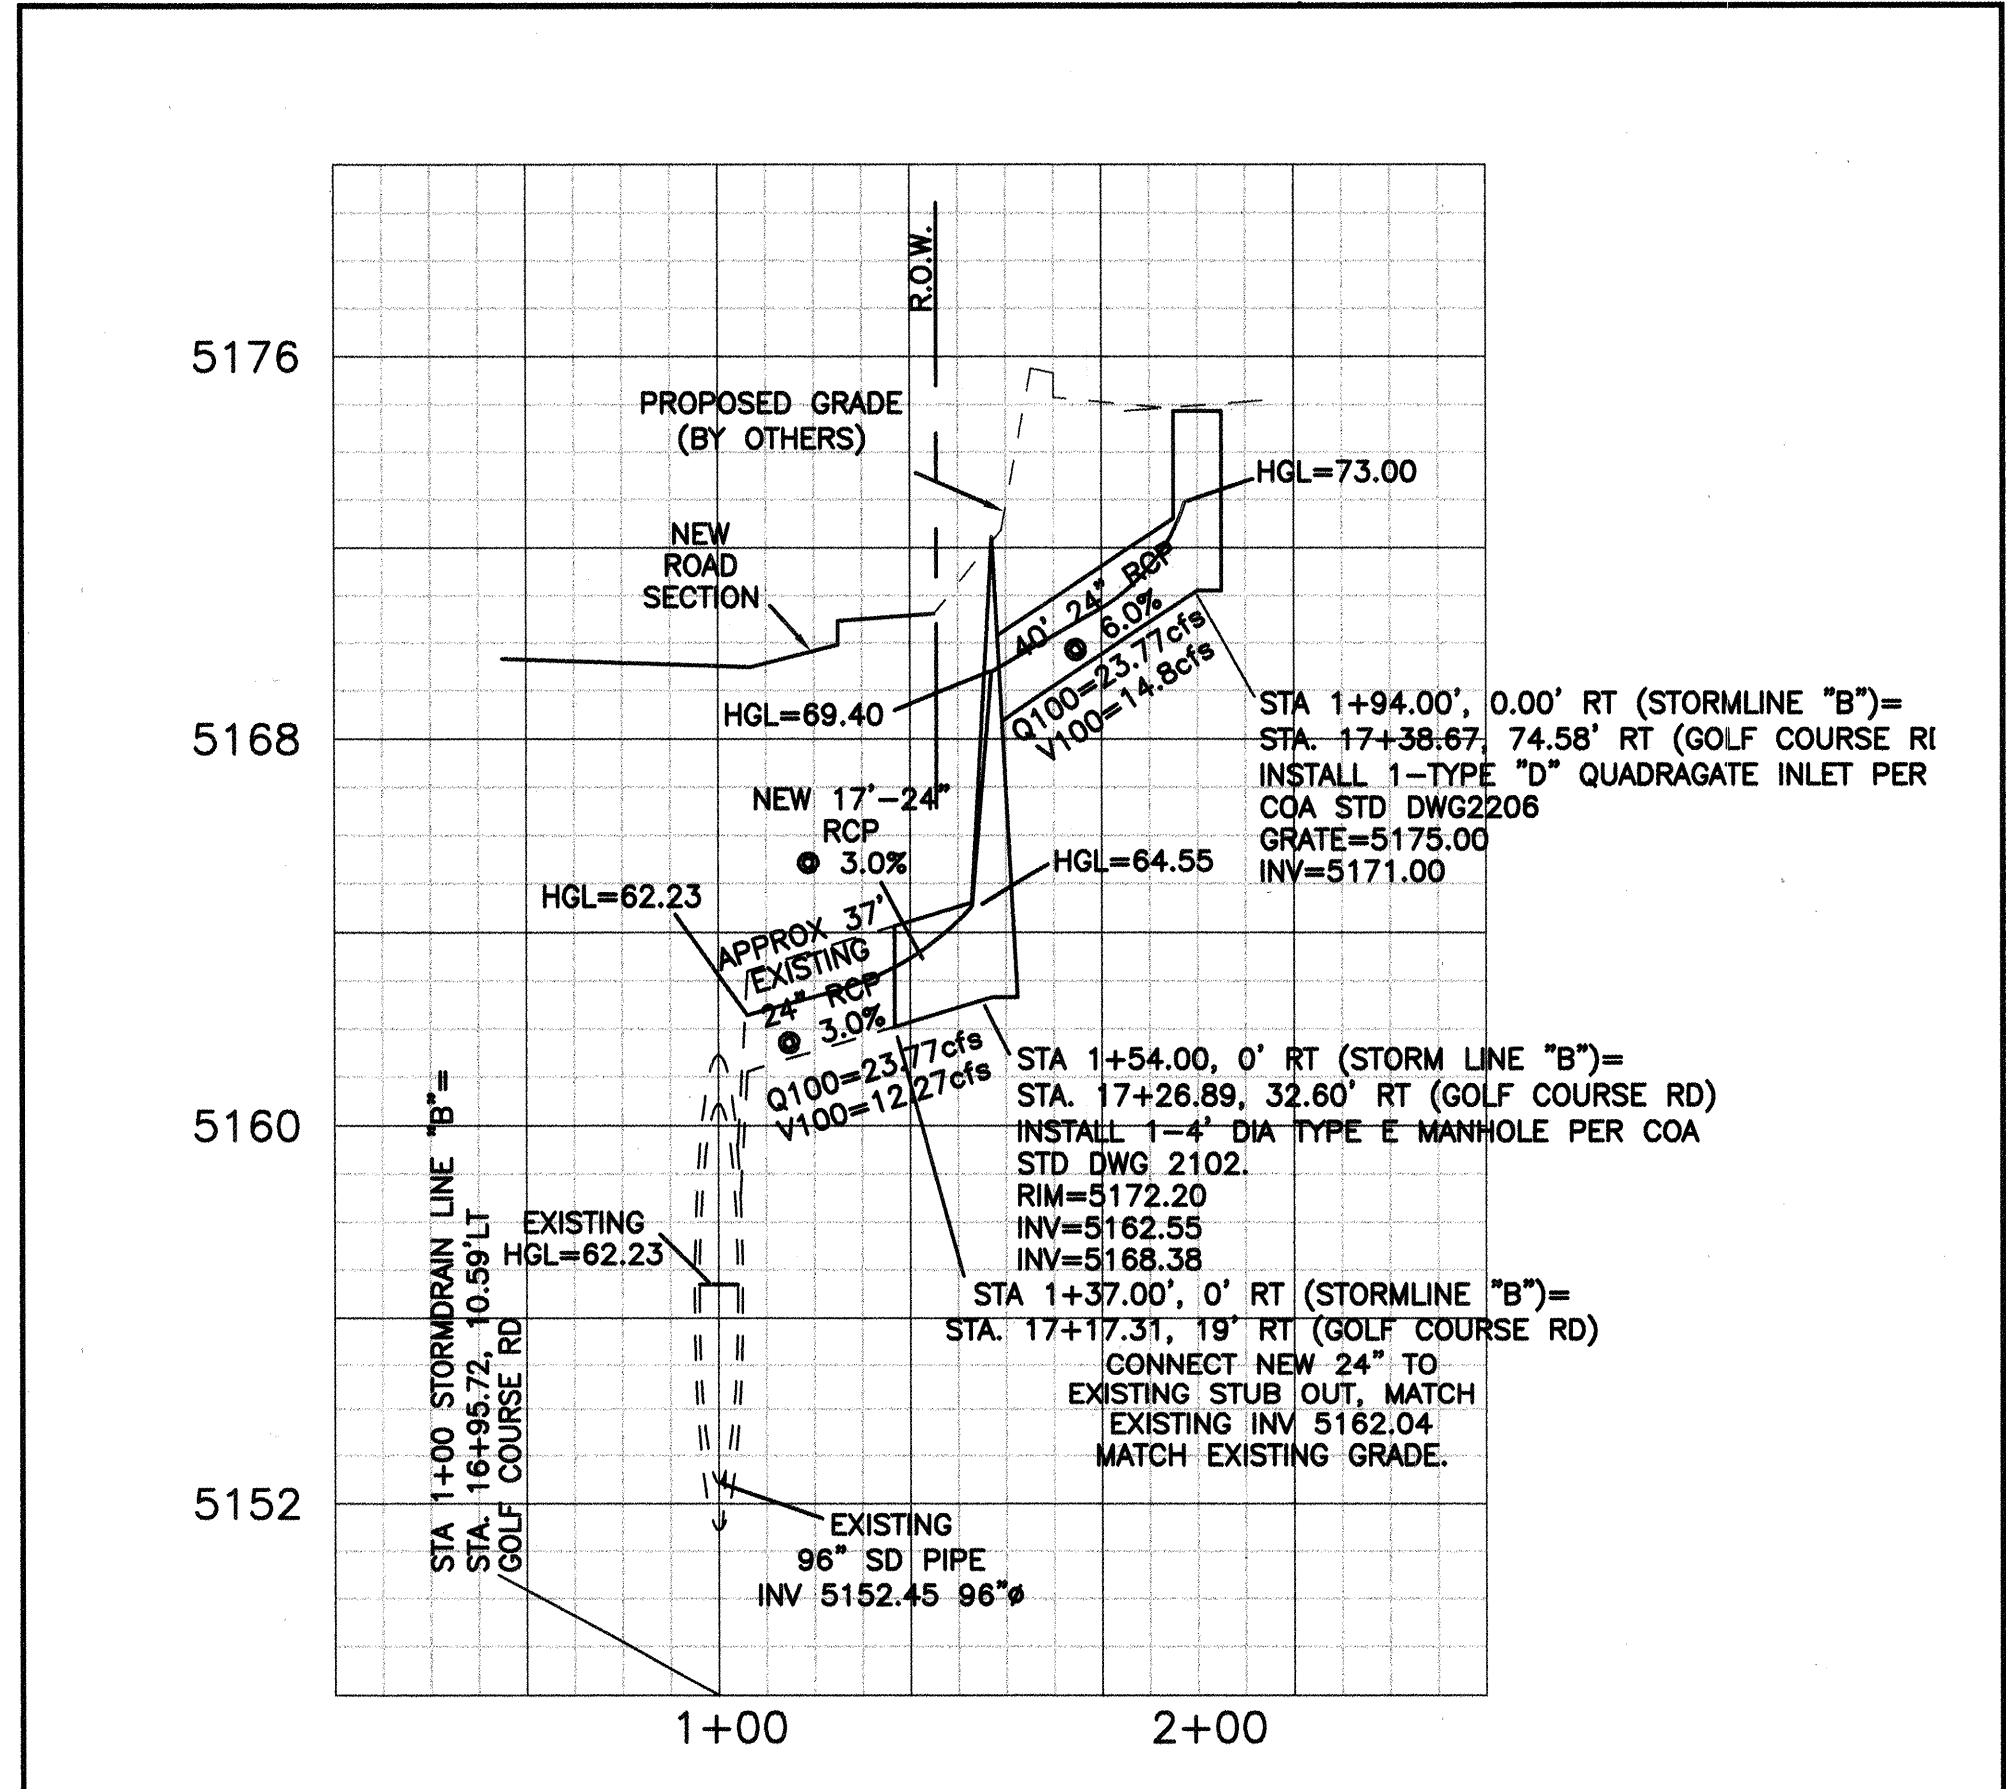

PROFILE
STORM DRAIN LINE "B"
HORIZONTAL: 1"= 40'
VERTICAL: 1"= 4'

GENERAL NOTES:

- THE CONTRACTOR SHALL FIELD VERIFY ALL EXISTING UTILITY LOCATIONS & NOTIFY THE ENGINEER IMMEDIATELY OF ANY DISCREPANCIES.
- ALL CURVE DATA & DIMENSIONS REFER TO FACE OF CURB AT FLOWLINE UNLESS OTHERWISE SPECIFIED.
- CONTRACTOR IS RESPONSIBLE FOR ALL REPAIR AND/OR REPLACEMENT OF ALL UTILITY CONDUITS & EXISTING LINES.
- ANY ADDITIONAL GRADING REQUIRED TO MATCH PROPOSED STREET GRADES SHALL BE INCIDENTAL TO PAVING ITEMS.
- CONTRACTOR SHALL PROVIDE INSPECTORS (CITY & PRIVATE) w/ A PROPOSED HYDRO STATIC TESTING PLAN. THE PLAN MUST BE APPROVED BEFORE TESTING OPERATIONS BEGIN.
- CONTRACTOR SHALL PARK EQUIPMENT AND VEHICLES AS NOT TO INTERFERE WITH NORMAL ACTIVITIES OF OTHER CONTRACTORS ON SITE.
- ANY DAMAGE TO THE EXISTING FACILITIES (CURB & GUTTER, PAVEMENT, CONDUITS, LANDSCAPING, UTILITY LINES, ETC.) DURING CONSTRUCTION SHALL BE REPLACED AT THE CONTRACTORS EXPENSE.
- REMOVAL OF THE EXISTING CURB & GUTTER OR VALLEY GUTTER SHALL BE AS PER COA STD DWG. 2415 (SAW CUT ONLY).
- WHEEL CHAIR RAMPS SHALL BE CONSTRUCTED PRIOR TO ACCEPTANCE OF CURB & GUTTER.
- TOPOGRAPHICAL & BOUNDARY SURVEY PROVIDED BY HARRIS SURVEYING INC. BPLW IS NOT RESPONSIBLE FOR ANY DISCREPANCIES IN THE SURVEYS.
- ALL INDIVIDUAL BUILDING FIRELINES, DOMESTIC WATER SERVICE, IRRIGATION & SANITARY SEWER ARE BY SEPARATE BUILDING PERMIT & ARE NOT IN THIS CONTRACT. LOCATION OF BUILDING FIRELINES, DOMESTIC WATER METERS & SANITARY SEWER SERVICES & ON SITE MANHOLES ARE FOR INFORMATION ONLY.

LEGEND:

- NEW CONCRETE PAVEMENT
- NEW 1 1/2" ASPHALT FINAL LIFT
- NEW ASPHALT PAVEMENT
- NEW GATE VALVE
- NEW FIRE HYDRANT
- NEW WATER MAIN CAP
- NEW SD INLET
- NEW SAS MANHOLE
- NEW SD MANHOLE
- NEW WATER MAIN
- NEW SANITARY SEWER
- NEW STORM DRAIN
- NEW UTILITY ESMT
- FUTURE WATER METER
- FUTURE SEWER CLEANOUT
- FUTURE SAS MANHOLE
- EXISTING SD INLET
- EXISTING GATE VALVE
- EXISTING FIRE HYDRANT
- EXISTING SAS MANHOLE
- EXISTING SD MANHOLE
- EXISTING WATER MAIN
- EXISTING SANITARY SEWER
- EXISTING UTILITY ESMT

CITY OF ALBUQUERQUE PUBLIC WORKS DEPARTMENT ENGINEERING GROUP		CITY ENGINEER	
TITLE: GOLF COURSE POINTE STORM DRAIN LINE "A" & "B" PLAN AND PROFILE			
APPROVALS	ENGINEER	DATE	APPROVALS
DRC Chairman			Water
Transportation			Waste Water
Hydrology			
Parks & Rec.			
DRAWING NO.	622981	MAP NO.	C-12-Z
SHEET 12		OF 21	

AS-BUILT


SCANNED BY
MESA REPRO

13DRC012.DWG

PLAT OF
TRACTS 5-A THRU 5-E
PARADISE VALLEY
CITY OF ALBUQUERQUE, BERNALILLO COUNTY, NEW MEXICO
JUNE, 1999

ACSCALUM CAP="6-B11"
X=1,526,019.13
Y=3,555,865.49
DELTA ALPHA="0015'32"
DELTA ALPHA="0015'32"
CENTRAL ZONE, NAD, 1927

N89°12'40"W (GROUND)
4,827.622 (GROUND)

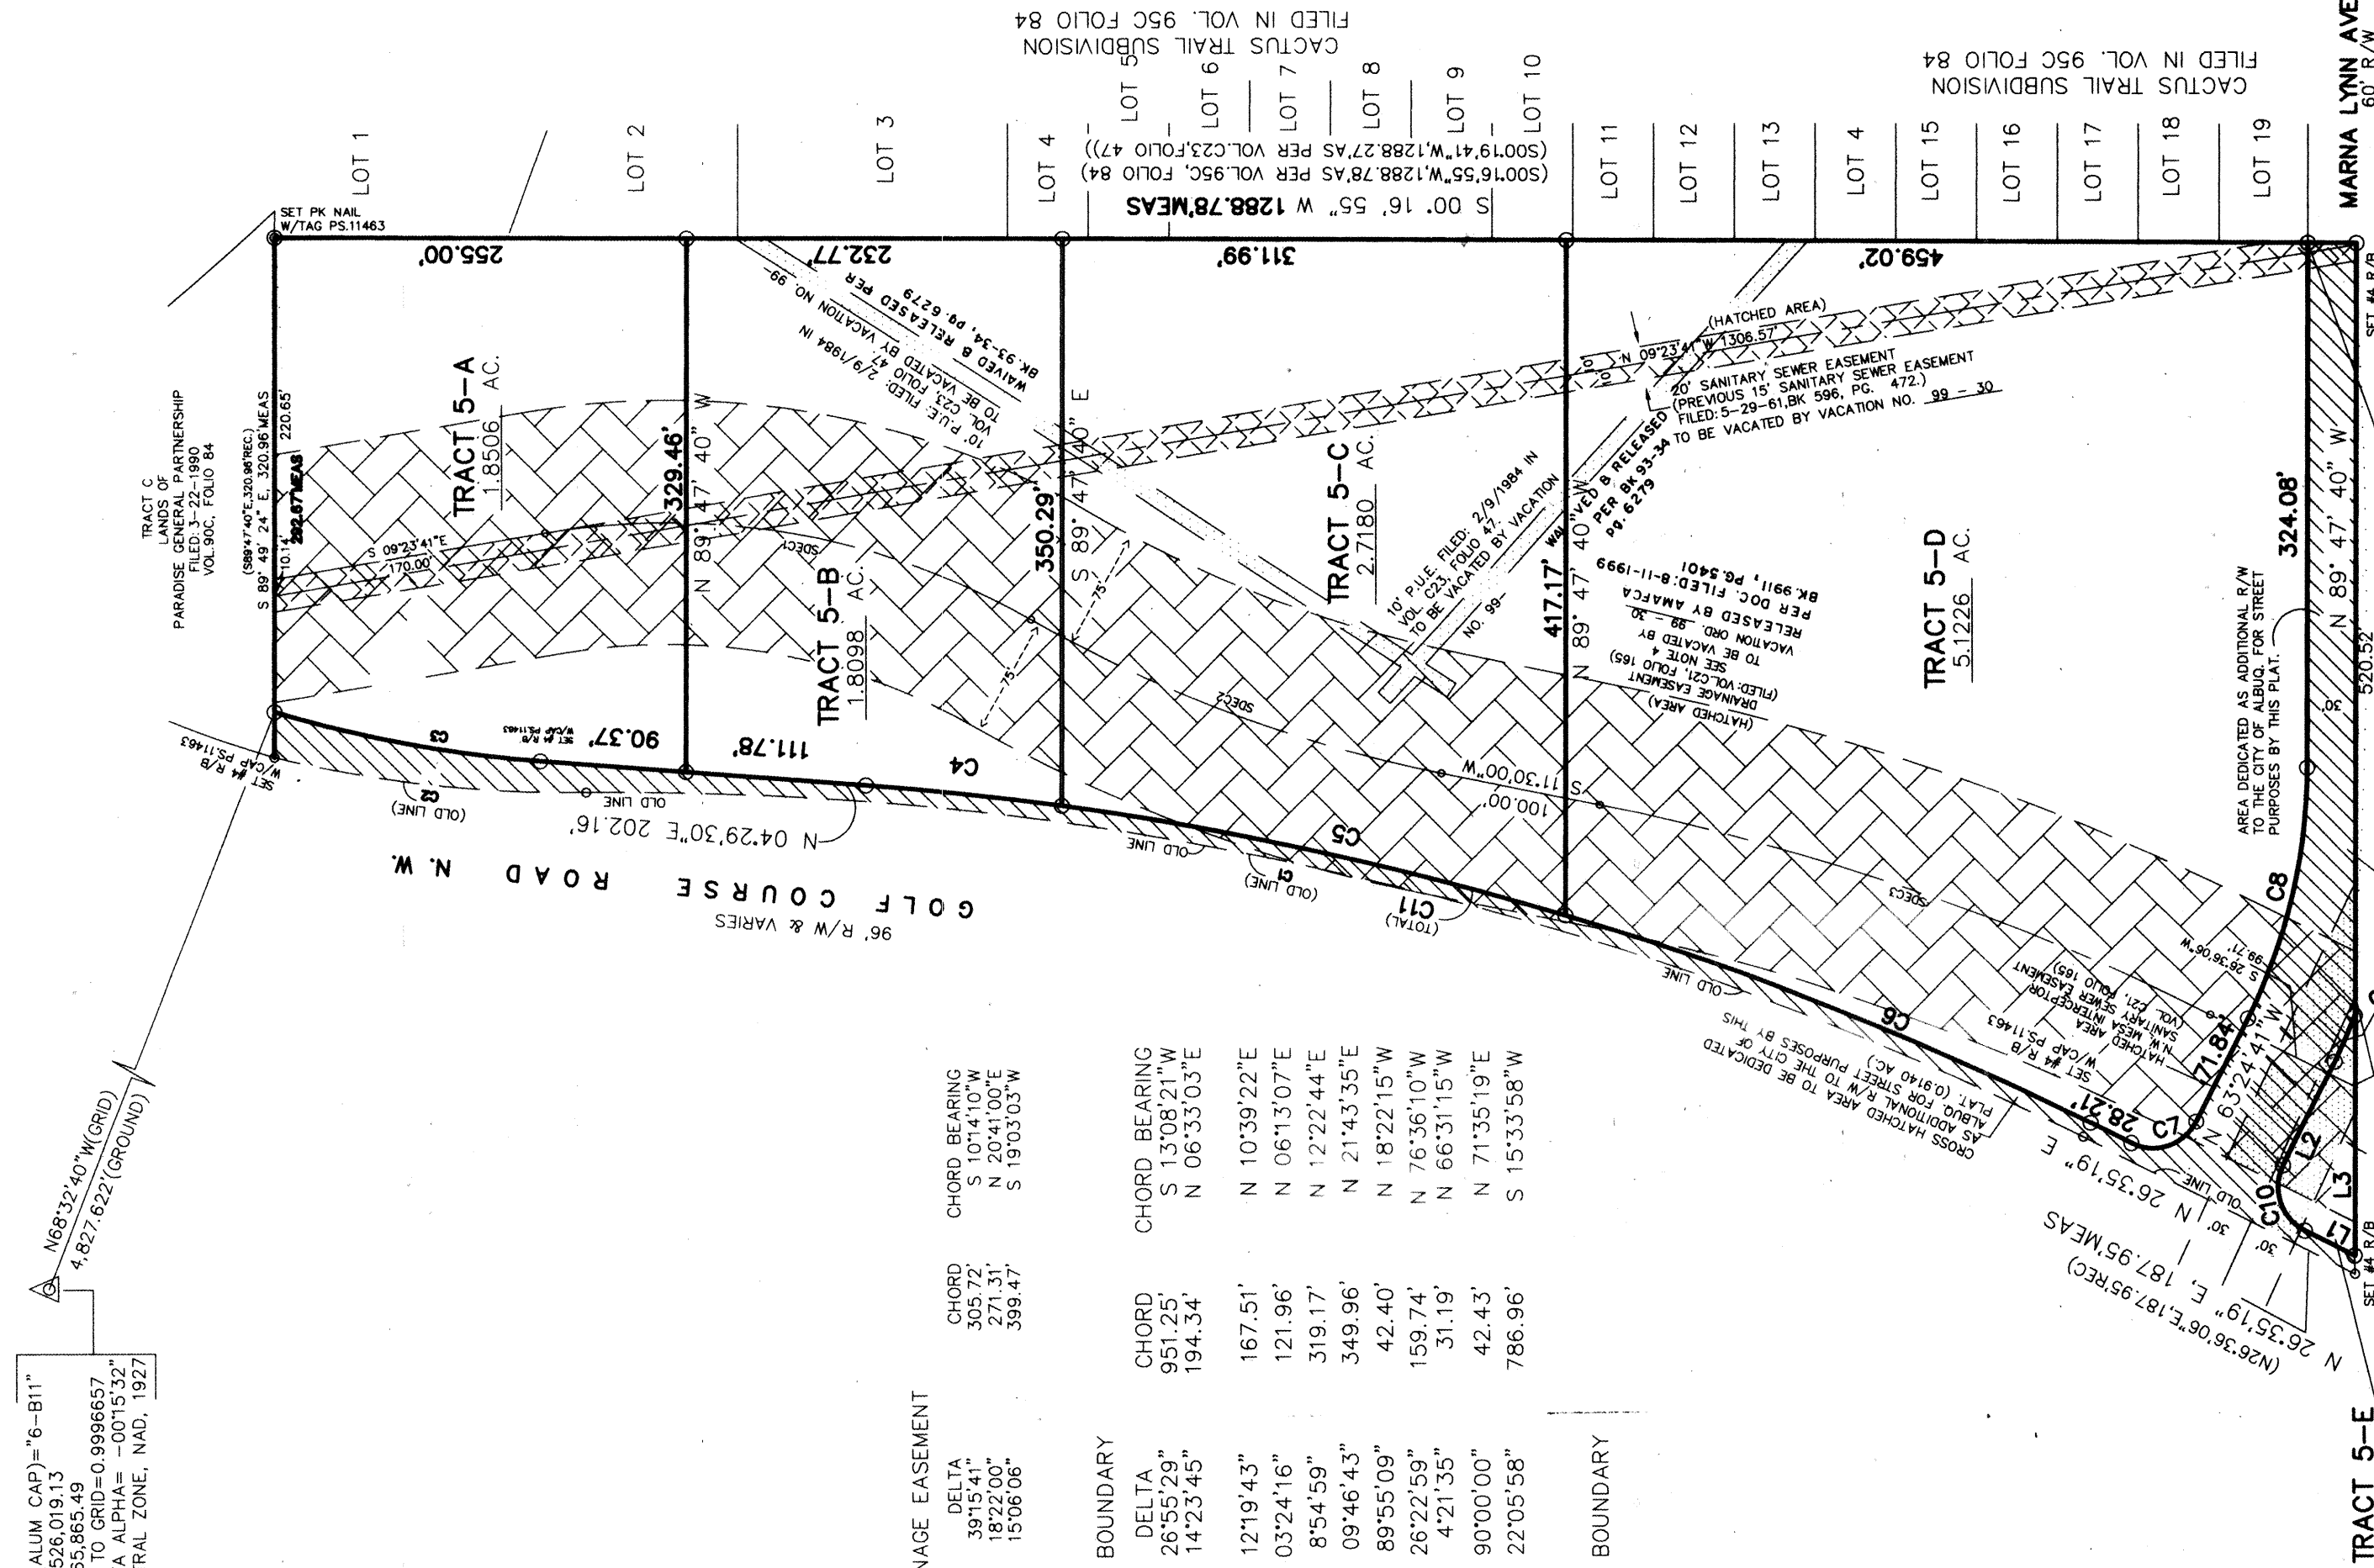

CURVE TABLE FOR DRAINAGE EASEMENT

CURVE TABLE FOR BOUNDARY

LINE TABLE FOR BOUNDARY

AS-BUILT




FOR INFORMATION ONLY

622981

17 of 21

REV: 02-TRACTS 5-A, 5-B, 5-C, 5-D, 5-E (7/99)

ACSCALUM CAP="2-C11"
X=1,526,019.13
Y=3,555,865.49
DELTA ALPHA="0015'32"
DELTA ALPHA="0015'32"
CENTRAL ZONE, NAD, 1927

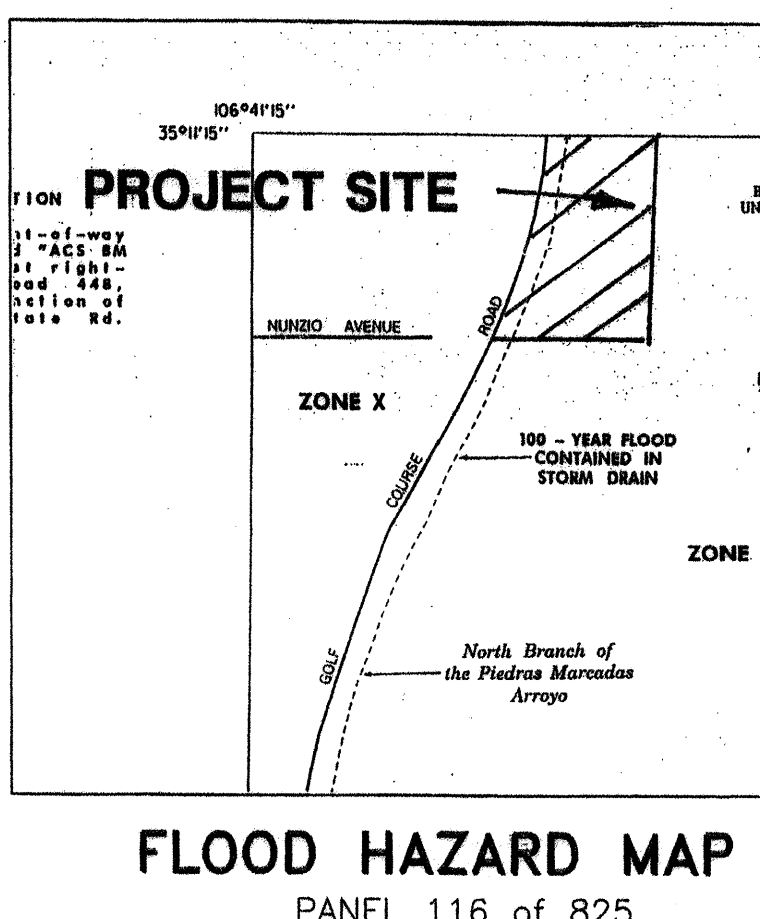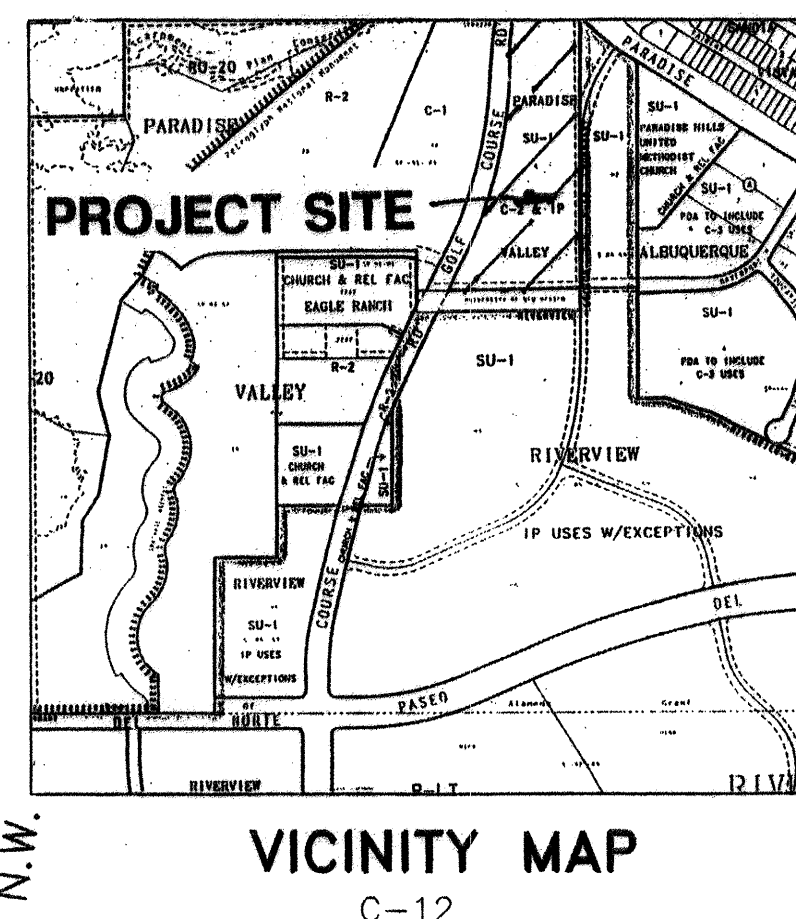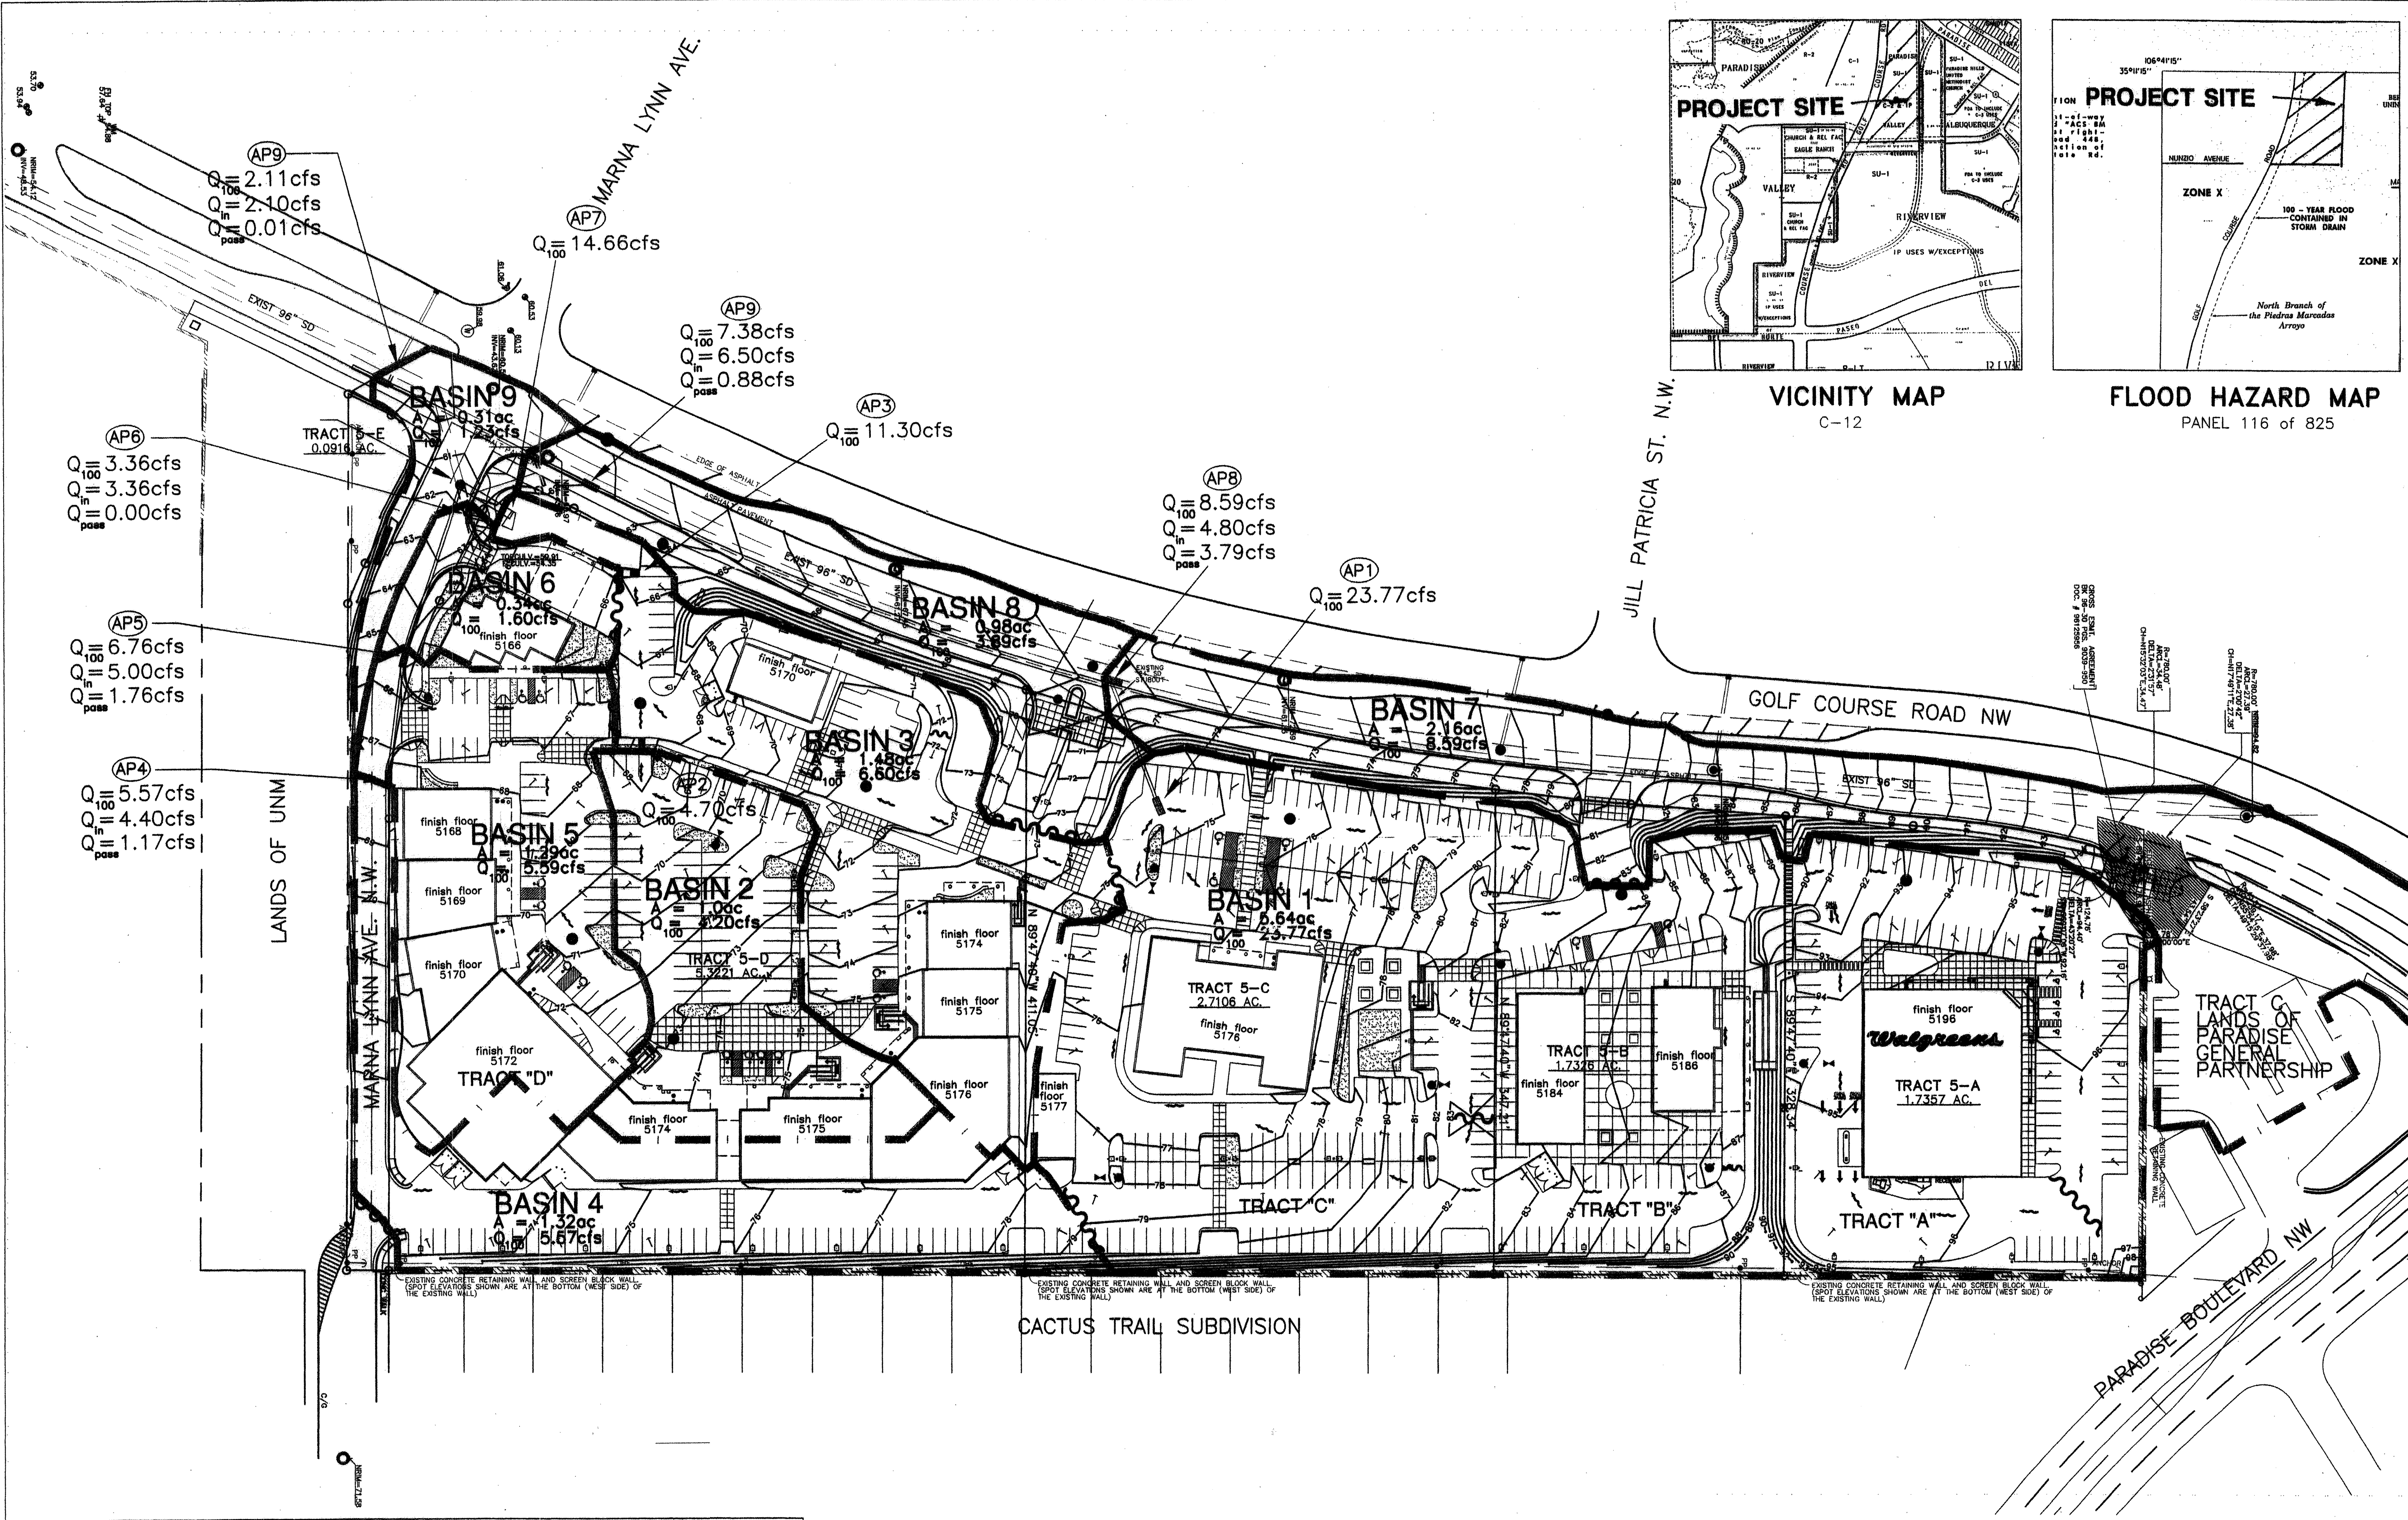


BPLW
Architects & Engineers, Inc.

6200 Uptown Blvd. NE
Suite 400
Albuquerque, New Mexico 87110
(505) 881-2759

49 West First Street
Suite 100
Albuquerque, New Mexico 87102
(505) 827-2759

Designing to Shape the Future

- LEGEND**
- BASIN BOUNDARIES
 - EXISTING INLET
 - PROPOSED INLET
 - EXISTING STORM DRAIN MH
 - PROPOSED STORM DRAIN MH
 - PROPOSED WATER BLOCK
 - PROPOSED DIRECTION OF FLOW

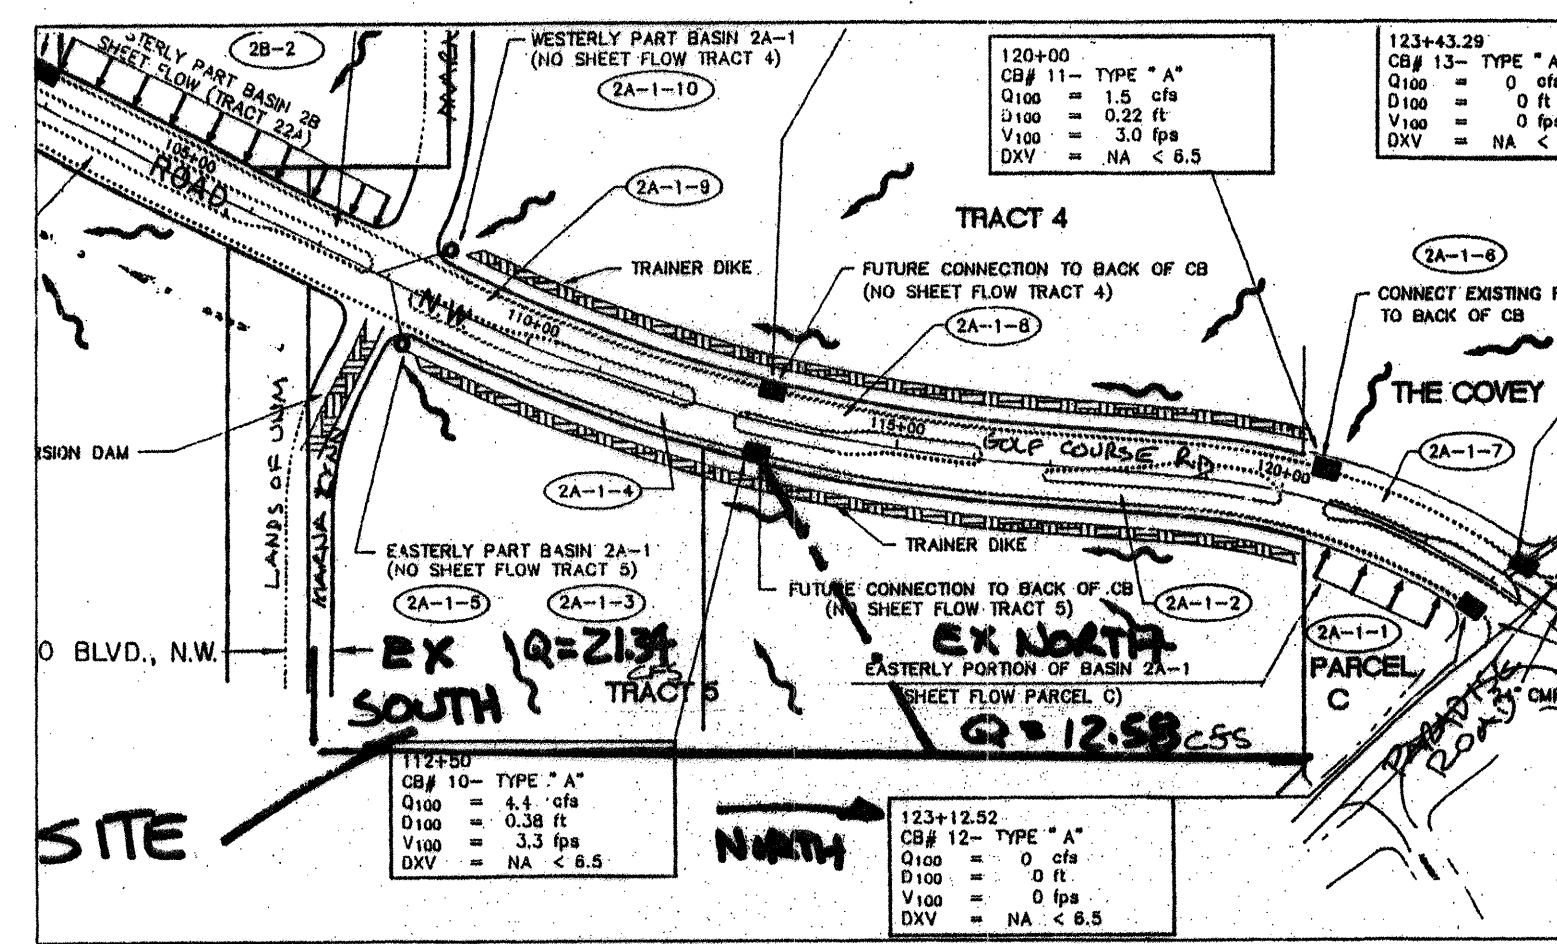

MASTER DRAINAGE PLAN
SCALE: 1"=50'

TRACTS 5-A THRU 5-E

LEGAL DESCRIPTION:
A TRACT OF LAND SITUATE WITHIN THE TOWN OF ALAMEDA GRANT, BERNALILLO COUNTY, NEW MEXICO, BEING TRACT 5 OF THE PLAT OF PARADISE VALLEY, TRACTS 1-A, 2-A, 3-A, 3-B, 4 AND 5 FILED IN THE OFFICE OF THE COUNTY CLERK OF BERNALILLO COUNTY, NEW MEXICO ON FEBRUARY 9, 1984 (VOLUME C23, FOLIO 47) AND BEING MORE PARTICULARLY DESCRIBED AS FOLLOWS: BEGINNING AT THE SOUTHWEST CORNER OF THE TRACT HEREIN DESCRIBED, BEING A POINT ON THE EAST R/W LINE OF GOLF COURSE RD., N.W., FROM WHENCE A U.S.G.L.O. BRASS CAP AT THE CLOSING CORNER OF SECTIONS 13 AND 14 (T 11 N, R 2 E, N.M.P.M.) WITH THE SOUTH BOUNDARY OF THE TOWN OF ALAMEDA GRANT BEARS S. 44° 50' 19" W. 2835.79 FEET; THENCE ALONG SAID R/W LINE N. 26° 36' 06" E. 187.95 FEET; THENCE CONTINUING ALONG A CURVE TO THE LEFT WHOSE RADIUS IS 2043.00 FEET AND WHOSE CHORD BEARS N. 13° 08' 21" E. 951.25 FEET THROUGH A CENTRAL ANGLE OF 26° 55' 29"; THENCE CONTINUING 194.62 FEET ALONG A CURVE TO THE RIGHT WHOSE RADIUS IS 775.51 FEET AND WHOSE CHORD BEARS N. 06° 51' 58" E. 194.11 FEET THROUGH A CENTRAL ANGLE OF 14° 22' 43" TO THE NORTHWEST CORNER; THENCE LEAVING SAID R/W LINE OF GOLF COURSE ROAD, N.W., S. 89° 47' 40" E., 320.96 FEET TO THE NORTHEAST CORNER; THENCE S. 00° 19' 41" W. 1288.27 FEET TO THE SOUTHEAST CORNER; THENCE N. 89° 47' 40" W. 637.19 FEET TO THE SOUTHWEST AND BEGINNING CORNER.

BENCH:
ELEVATIONS ARE BASED ON CITY OF ALBUQUERQUE CONTROL STATION "3-B12", HAVING AN ELEVATION OF 5277.26 FEET ABOVE SEA LEVEL.

AS-BUILT

FOR INFORMATION ONLY

622981

18 of 21

REV.	DESCRIPTION	DATE

GOLF COURSE POINTE

PROJECT NO. 99013 DATE JUNE 14, 1999


MASTER DRAINAGE PLAN

DRAWING NO. **C2.2** SHEET OF

SCANNED BY
MESA REPRO

JULY 1999

REV.	DESCRIPTION	DATE
------	-------------	------

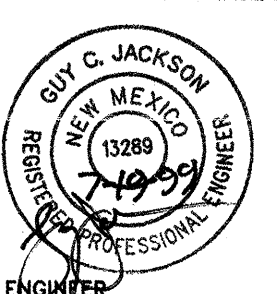

ARCHITECT

**GOLF COURSE
POINTE**

PROJECT NO.
99013

JULY 1999

MASTER GRADING PLAN

DRAWING NO.

C2.1
SHEET OF

AS-BUILT

FOR INFORMATION ONLY

MASTER GRADING PLAN

SCALE: 1"=50'

622981

19 of 21

JUNE 14, 1999

SCANNED BY
MESA REPRO

CONSTRUCTION TRAFFIC CONTROL GENERAL NOTES

1. CONTRACTOR MUST OBTAIN FROM CONSTRUCTION COORDINATION AN EXCAVATION/BARRICADING PERMIT BEFORE ENGAGING IN ANY CONSTRUCTION, MAINTENANCE OR REPAIR WORK IN ANY OF THE CITY OF ALBUQUERQUE'S RIGHTS-OF-WAY. EMERGENCY WORK THAT WOULD PRESERVE LIFE OR PROPERTY IS EXCLUDED WITH THE UNDERSTANDING, THAT A PERMIT SHALL BE OBTAINED WITHIN 24 TO 48 HOURS.

2. CONTRACTOR SHALL AT THE TIME OF PERMIT REQUEST, SUBMIT FOR APPROVAL BY CONSTRUCTION COORDINATION, A TRAFFIC CONTROL PLAN DETAILING ALL EXISTING TOPOGRAPHY SUCH AS LANE WIDTHS, DRIVEWAYS, AND BUSINESS/RESIDENTIAL ACCESSES. THE TRAFFIC CONTROL PLAN SHALL INCLUDE ALL PHASES OF WORK AND SCHEDULES INVOLVED IN THE CONSTRUCTION PROJECT. ANY SEPARATE PHASES OF A CONSTRUCTION PROJECT SHALL BE GIVEN AN INDIVIDUAL PERMIT EACH. BLANKET PERMITS WILL NOT BE ISSUED.

3. THESE TYPICAL TRAFFIC CONTROL PLANS DO NOT REFLECT THE EXISTING TOPOGRAPHY SUCH AS DRIVEWAYS, LANE WIDTHS, AND BUSINESS/RESIDENTIAL ACCESSES. EVERY LOCATION THAT REQUIRES CONSTRUCTION TRAFFIC CONTROL SHALL HAVE A DETAILED TRAFFIC CONTROL PLAN SHOWING ALL EXISTING TOPOGRAPHY.

4. CONSTRUCTION SHALL NOT BEGIN UNLESS A TRAFFIC CONTROL PLAN HAS BEEN APPROVED AND VERIFIED BY CONSTRUCTION COORDINATION.

5. CONSTRUCTION COORDINATION SHALL BE NOTIFIED 48 HOURS PRIOR TO ANY TRAFFIC CONTROL CHANGES NEEDED BY CONTRACTOR, THAT WERE NOT PREVIOUSLY APPROVED. THESE TRAFFIC CONTROL CHANGES SHALL BE REQUESTED IN WRITING ACCOMPANIED WITH A TRAFFIC CONTROL PLAN REFLECTING SUCH CHANGES.

6. ALL CONSTRUCTION TRAFFIC CONTROL DEVICES SHALL COMPLY TO THE MANUAL ON UNIFORM TRAFFIC CONTROL DEVICES (MUTCD), LATEST EDITION. IT IS THE RESPONSIBILITY OF THE CONTRACTOR TO INSTALL, SERVICE AND MAINTAIN ALL TRAFFIC CONTROL DEVICES. TRAFFIC CONTROL DEVICES SHALL NOT BE REMOVED OR ALTERED IN ANY WAY WITHOUT THE APPROVAL OF CONSTRUCTION COORDINATION, PER SECTION 6A-4 OF THE MUTCD, LATEST EDITION.

7. THE CONSTRUCTION TRAFFIC CONTROL INITIAL SET-UP SHALL BE BY AN AMERICAN TRAFFIC SAFETY SERVICES ASSOCIATION (ATSSA) CERTIFIED WORKSITE TRAFFIC SUPERVISOR. THE MAINTENANCE AND SERVICING SHALL ALSO BE DONE BY AN ATSSA CERTIFIED WORKSITE TRAFFIC SUPERVISOR OR EQUIVALENT.

8. CONTRACTOR IS RESPONSIBLE TO MAINTAIN AND SERVICE ALL TRAFFIC CONTROL DEVICES 24 HOURS A DAY, 7 DAYS A WEEK THROUGHOUT LENGTH OF PROJECT. CONTRACTOR IS RESPONSIBLE THAT ALL TRAFFIC CONTROL DEVICES COMPLY WITH THE MUTCD, LATEST EDITION.

9. ALL ADVANCE WARNING SIGNS SHALL BE DOUBLE INDICATED WHENEVER THERE ARE MULTI-LANE TRAFFIC IN ANY ONE GIVEN DIRECTION AND THERE IS SUFFICIENT MEDIAN SPACE.

10. ALL BARRICADES IN ALL TAPERS AND TANGENTS SHALL BE PLACED APART, A DISTANCE MEASURED IN FEET, EQUAL TO THAT OF THE POSTED SPEED LIMIT. NO EXCEPTIONS UNLESS APPROVED BY CONSTRUCTION COORDINATION PER MUTCD SECTION 6A-4.

11. CONTRACTOR SHALL NOT BEGIN WORK BEFORE 7:00 A.M. OR END WORK AFTER 7:00 P.M. WITHOUT THE APPROVAL OF CONSTRUCTION COORDINATION.

12. CONTRACTOR IS RESPONSIBLE TO PROVIDE CONSTRUCTION COORDINATION, A WEEKLY LOG OF DAILY INSPECTIONS OF BARRICADE AND MAINTENANCE SCHEDULES ON PROJECTS THAT ARE OVER ONE WEEK DURATION.

13. EQUIPMENT OR MATERIALS SHALL NOT BE STORED WITHIN 15 FEET OF A TRAVELLED TRAFFIC LANE DURING NON-WORKING HOURS WITHOUT THE APPROVAL OF CONSTRUCTION COORDINATION.

14. CONTRACTOR SHALL PROVIDE AND MAINTAIN A SAFE AND ADEQUATE MEANS OF CHANNELIZING PEDESTRIAN TRAFFIC AROUND AND THROUGH THE CONSTRUCTION AREA.

15. CONTRACTOR IS RESPONSIBLE FOR OBLITERATION OF ANY CONFLICTING STRIPING AND RESPONSIBLE FOR ALL TEMPORARY STRIPING.

16. CONTRACTOR SHALL MAINTAIN ACCESS TO ALL FACILITIES, BUSINESSES AND/OR RESIDENTS AT ALL TIMES.

17. CONTRACTOR SHALL PROVIDE ACCESS SIGNS FOR BUSINESSES LOCATED WITHIN THE CONSTRUCTION AREA UNDER THE SUPERVISION OF CONSTRUCTION COORDINATION. EACH ACCESS SIGN SHALL HAVE 5 INCH, WHITE OPAQUE LETTERING ON BLUE REFLECTORIZED BACKGROUND. ACCESS SIGNS SHALL BE CONSIDERED INCIDENTAL TO THE BID AND NOT PART OF THE CONTRACT UNLESS OTHERWISE STATED. NO MORE THAN 3 BUSINESSES SHALL BE LISTED ON A ACCESS SIGN. SHOPPING CENTERS AND MALLS SHALL BE LISTED AS SUCH.

18. ALL ADVANCE WARNING SIGNS SHALL MEET THE MINIMUM REFLECTIVE INTENSITY REQUIREMENTS SET FORTH BY THE CITY OF ALBUQUERQUE. CONSTRUCTION COORDINATION SHALL DETERMINE ALL REQUIREMENTS AND APPROVE OR DISAPPROVE ANY ADVANCE WARNING SIGN PER SECTION 6A-4 OF THE MUTCD, LATEST EDITION.

19. 24 HOURS PRIOR TO OCCUPANCY OR CLOSING OF A RIGHT-OF-WAY, CONTRACTOR SHALL NOTIFY: POLICE, FIRE DEPARTMENT, SCHOOLS, HOSPITALS, TRANSIT AUTHORITY, BUSINESSES AND/OR RESIDENTS THAT WILL BE AFFECTED BY THE CONSTRUCTION.

20. ANY FIELD ADJUSTMENTS SHALL BE APPROVED BY CONSTRUCTION COORDINATION.

21. EXCAVATIONS SHALL BE PLATED, TEMPORARILY PATCHED OR RESURFACED PRIOR TO OPENING OF TRAFFIC. A MINIMUM OF 11 FEET SHALL BE PROVIDED FOR TRAFFIC IN ANY GIVEN DIRECTION. CONTRACTOR IS RESPONSIBLE FOR ANY WORK INVOLVED IN SATISFYING THESE REQUIREMENTS.


22. CONTRACTOR SHALL AT ALL TIMES COMPLY WITH THE FOLLOWING:
1. STANDARDS AND REQUIREMENTS SET FORTH IN THE MANUAL ON UNIFORM TRAFFIC CONTROL DEVICES, LATEST EDITION.
2. THE CITY OF ALBUQUERQUE TRAFFIC CODE, LATEST EDITION.
3. SECTION 19 OF THE CITY OF ALBUQUERQUE'S STANDARD SPECIFICATIONS FOR PUBLIC WORK CONSTRUCTION, AS WELL AS OTHER SECTIONS.

23. FAILURE TO COMPLY WITH ANY OF THE ABOVE MENTIONED, WILL BE ADEQUATE CAUSE TO CEASE ALL WORK ON ANY CONSTRUCTION PROJECT. WORK WILL NOT RESUME UNTIL ALL REQUIREMENTS ARE ADDRESSED AND APPROVED BY CONSTRUCTION COORDINATION.


24. ALL TRAFFIC CONTROL DEVICES SHALL BE KEPT IN NEW-CLEAN CONDITION. WASHING OF EQUIPMENT IS INCIDENTAL TO ITS PLACEMENT AND MAINTENANCE.

25. TRAFFIC CONTROL STANDARDS APPLY ONLY WHERE THE CONSTRUCTION TRAFFIC CONTROL PLANS ARE NOT SPECIFIC.

26. ADVANCE WARNING SIGNS SHALL BE 36"x36" WITH SUPER ENGINEERING GRADE SHEETING OR BETTER.

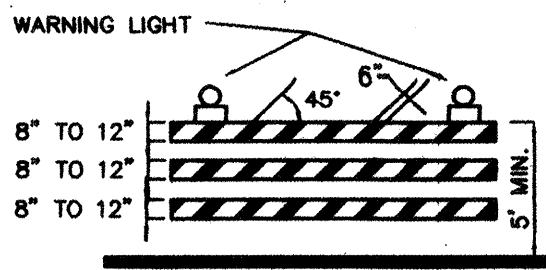


TYPE III BARRICADE

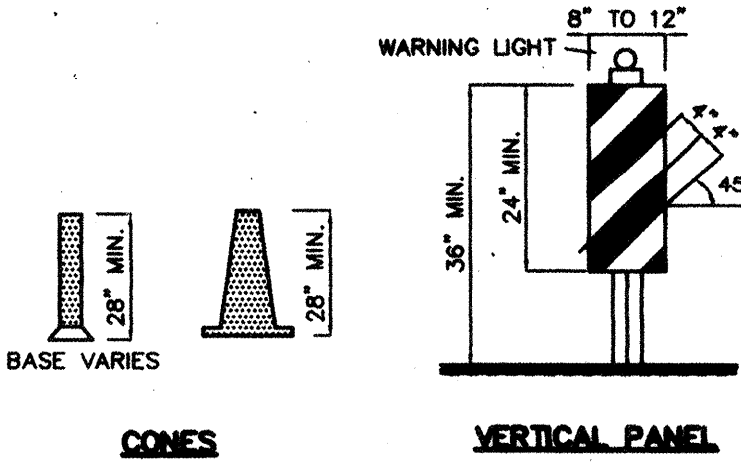


CONES

VERTICAL PANEL


HIGH LEVEL WARNING DEVICE

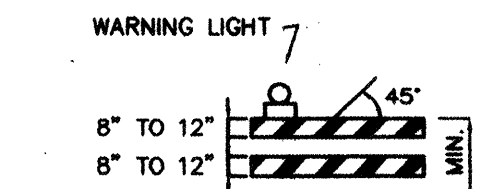


TYPE II BARRICADE COLLAPSIBLE

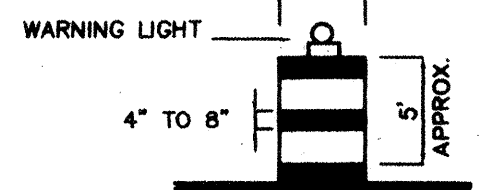

BARREL

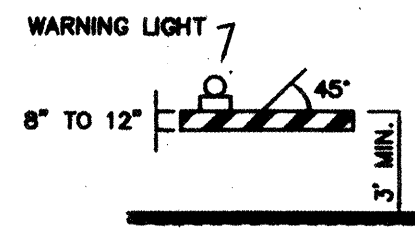

TYPE I BARRICADE COLLAPSIBLE

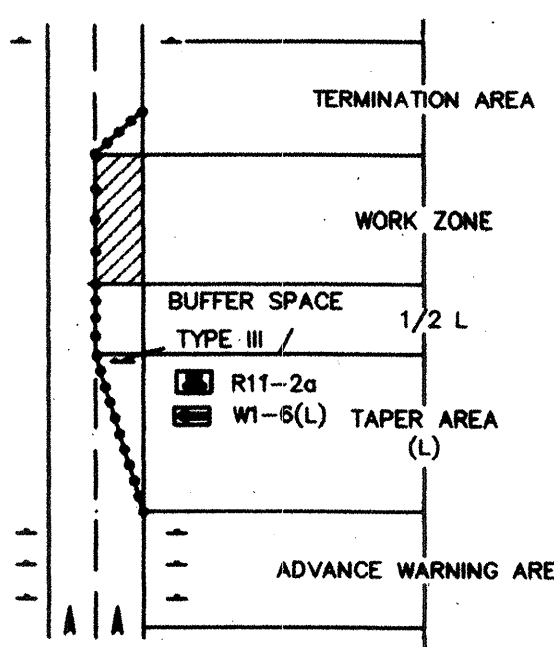

TRAFFIC CONTROL ELEMENTS

LEGEND

WORK AREA

BARRICADE - TYPE I, TYPE II, OR BARREL

BARRICADE - TYPE III

VERTICAL PANEL

WARNING SIGN

DISTANCE BETWEEN SIGNS - A DISTANCE MEASURED IN FEET EQUAL TO A VALUE OF TEN TIMES THE SPEED LIMIT OF THE STREET

FLAGMAN POSITION

SPACING BETWEEN BARRICADES - A DISTANCE MEASURED IN FEET EQUAL TO THE SPEED LIMIT OF THE STREET

TAPER LENGTH - SEE CHART BELOW

THE TANGENT LENGTH IS EQUAL TO THE TAPER LENGTH FOR A GIVEN STREET.

TAPER REQUIREMENTS

SPEED LIMIT (MPH)	TAPER LENGTH (L) (FEET)			MINIMUM NUMBER OF DEVICES FOR TAPER	MAXIMUM DEVICE SPACING IN FEET	
	10' LANE	11' LANE	12' LANE		ALONG TAPER	AFTER TAPER
20	70	75	80	5	20	20
25	105	115	125	6	25	25
30	150	165	180	7	30	30
35	205	225	245	8	35	35
40	270	295	320	9	40	40
45	450	495	540	13	45	45
50	500	550	600	13	50	50
55	550	605	660	13	55	55

RECOMMENDED SIGN SPACING(D) FOR ADVANCE WARNING SIGN SERIES

SPEED LIMIT (MPH)	MINIMUM DISTANCE IN FEET	
	BETWEEN SIGNS	FROM LAST SIGN TO TAPER
0-20	10 X SPEED LIMIT	10 X SPEED LIMIT
25-30	10 X SPEED LIMIT	10 X SPEED LIMIT
30-35	10 X SPEED LIMIT	10 X SPEED LIMIT
40-45	10 X SPEED LIMIT	10 X SPEED LIMIT
50-60	10 X SPEED LIMIT	10 X SPEED LIMIT

TAPER CRITERIA


TYPE OF TAPER	TAPER LENGTH
UPSTREAM TAPER:	
MERGING TAPER	L MINIMUM
SHIFTING TAPER	1/2 L MINIMUM
SHOULDER TAPER	1/2 L MINIMUM
TWO-WAY TRAFFIC TAPER	100 FEET MAXIMUM
DOWNSTREAM TAPERS	100 FEET PER LANE

TAPER LENGTH COMPUTATION

SPEED LIMIT	L = WS ² / 60
40 MPH OR LESS	
45 MPH OR GREATER	L = W x S

L = TAPER LENGTH
W = WIDTH OF OFFSET IN FEET
S = POSTED SPEED OR OFF-PEAK 85-PERCENTILE SPEED IN MPH

SIGN FACE DETAILS

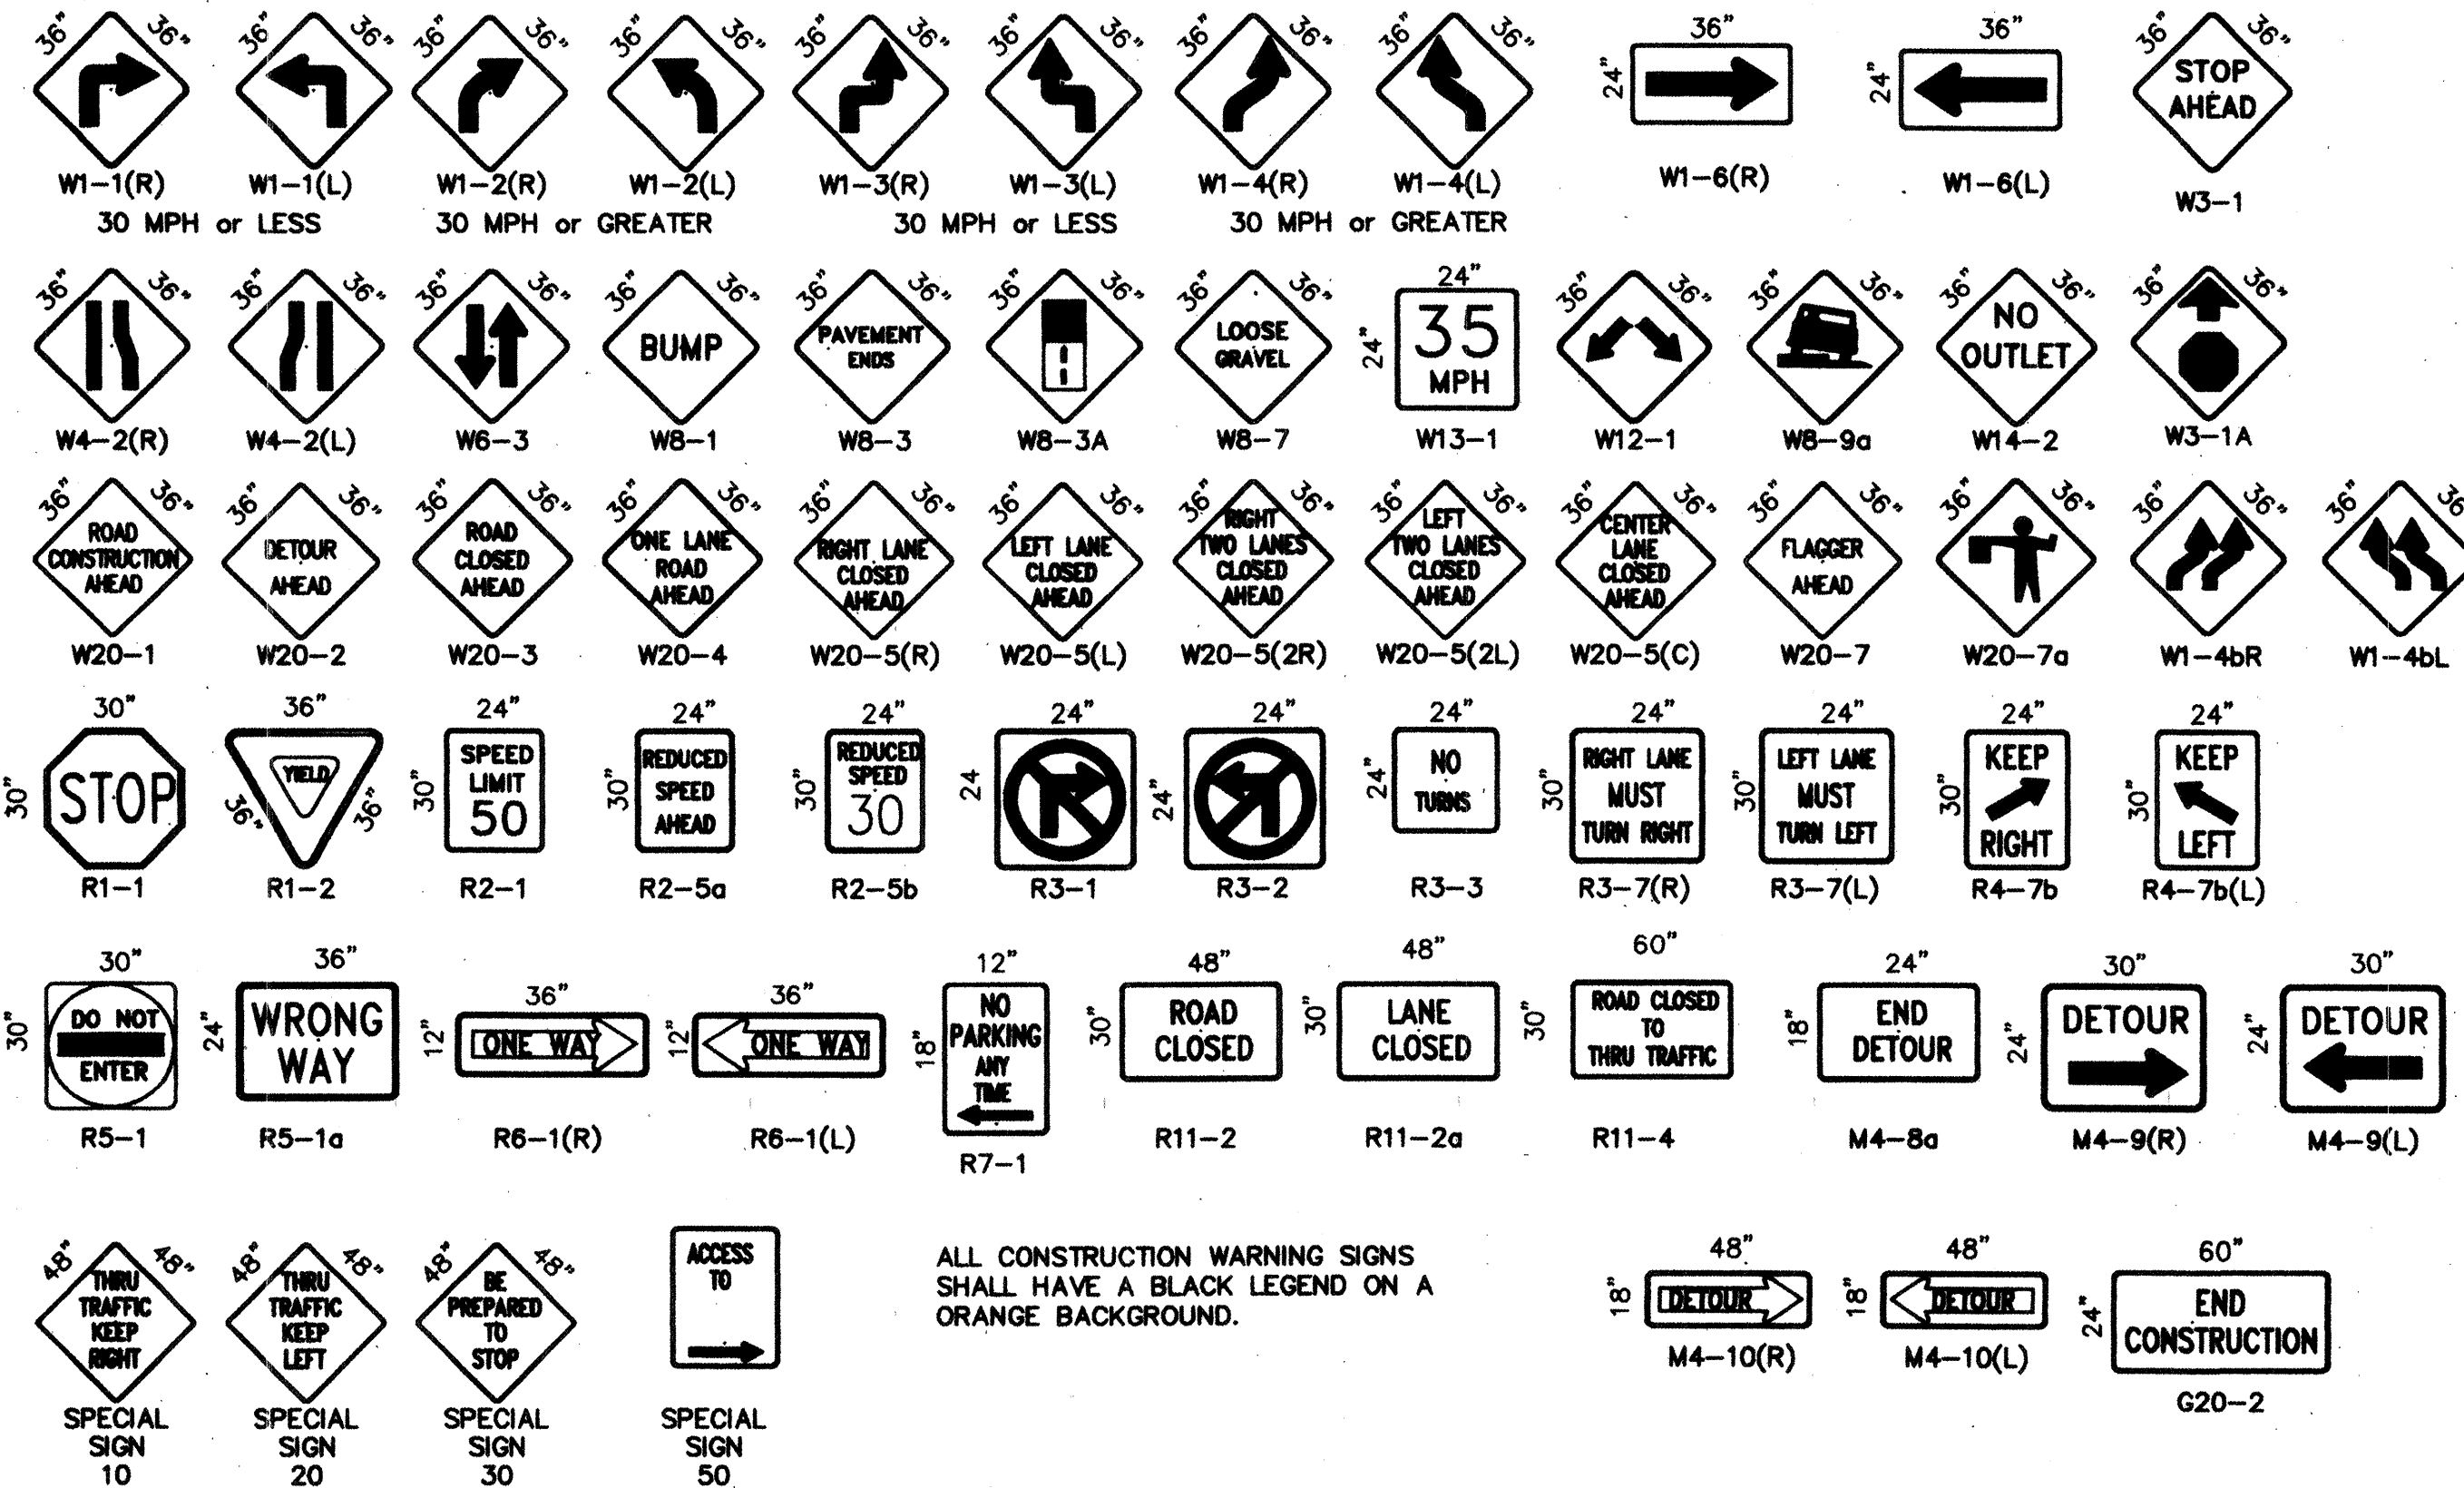

ALL CONSTRUCTION WARNING SIGNS SHALL HAVE A BLACK LEGEND ON A ORANGE BACKGROUND.





AS-BUILT

CITY OF ALBUQUERQUE
PUBLIC WORKS DEPARTMENT
ENGINEERING DEVELOPMENT GROUP

TITLE: **GOLF COURSE POINTE**
SIGNING AND CONSTRUCTION TRAFFIC CONTROL STANDARDS

DESIGN REVIEW COMMITTEE: **COA** CITY ENGINEER APPROVAL: **STP**

PROJECT NO. **622981** MAP NO. **C-12** SHEET **20** OF **21**

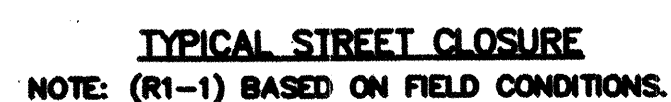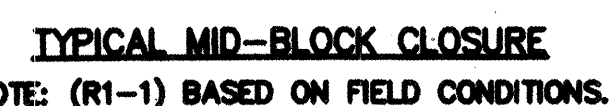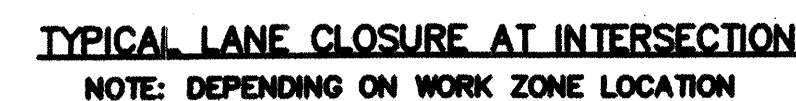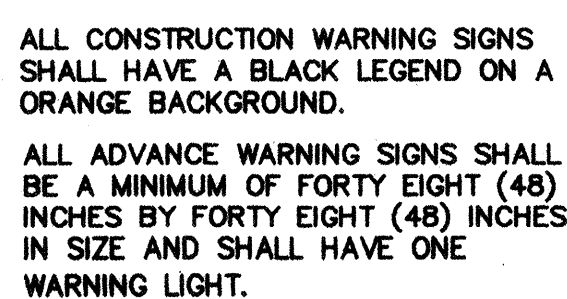

CITY OF ALBUQUERQUE PUBLIC WORKS DEPARTMENT ENGINEERING DEVELOPMENT GROUP			
TITLE: GOLF COURSE POINTE TYPICAL TRAFFIC CONTROL & SIGNING EXAMPLES (REF. M.U.T.C.D.)			
DESIGN REVIEW COMMITTEE	CITY ENGINEER APPROVAL	MO./DAY/YR.	MO./DAY/YR.
		LAST UPDATE	
PROJECT NO.	622981	MAP NO. C-12	SHEET 21 OF 21