


CITY OF ALBUQUERQUE NEW MEXICO




CONSTRUCTION PLANS FOR MIRABELLA UNIT 6

INDEX

- | | |
|--|--|
| 1. TITLE | 13. ELIZABETH STREET UTILITY PLAN AND PROFILE |
| 2. FINAL PLAT SHEET 1 | 14. COLVILLE ROAD UTILITY PLAN AND PROFILE SHEET 1 |
| 3. FINAL PLAT SHEET 2 | 15. COLVILLE ROAD UTILITY PLAN AND PROFILE SHEET 2 |
| 4. GRADING PLAN | 16. KAIBAB ROAD UTILITY PLAN AND PROFILE SHEET 1 |
| 5. OVERALL PAVING PLAN | 17. KAIBAB ROAD UTILITY PLAN AND PROFILE SHEET 2 |
| 6. PAVING DETAILS | 18. OVERALL STORM DRAIN PLAN |
| 7. ELIZABETH STREET PAVING PLAN AND PROFILE | 19. ELIZABETH STREET STORM DRAIN PLAN AND PROFILE |
| 8. COLVILLE ROAD PAVING PLAN AND PROFILE SHEET 1 | 20. GRADING DETAILS |
| 9. COLVILLE ROAD PAVING PLAN AND PROFILE SHEET 2 | 21. TRAFFIC SIGNING |
| 10. KAIBAB ROAD PAVING PLAN AND PROFILE SHEET 1 | 22. TRAFFIC CONTROL |
| 11. KAIBAB ROAD PAVING PLAN AND PROFILE SHEET 2 | |
| 12. OVERALL UTILITY PLAN (AND WATER SHUT-OFF PLAN) | |

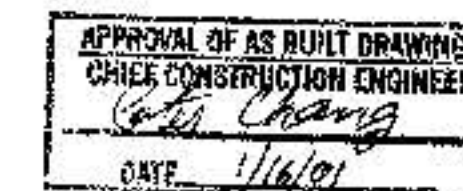

DRB97-209

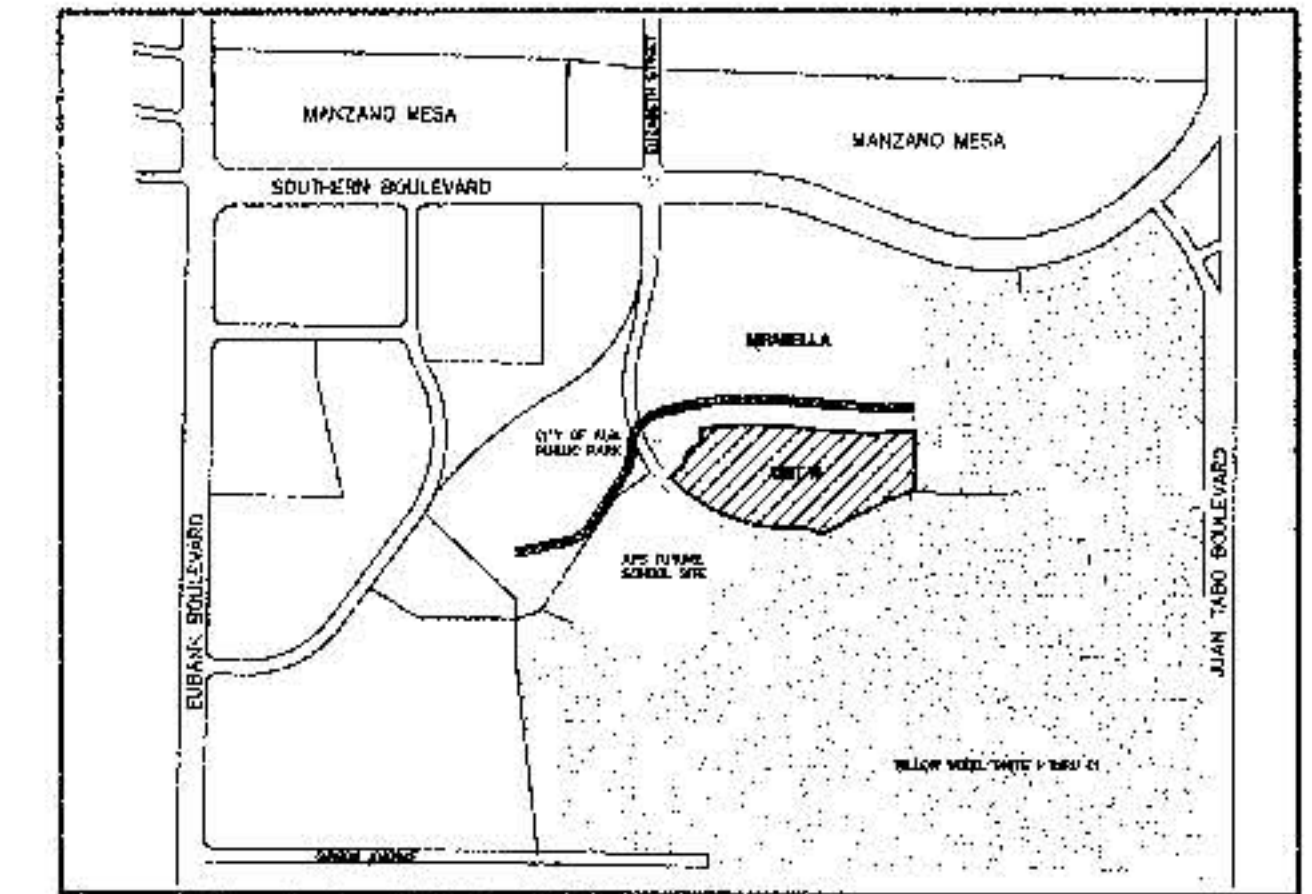

LOCATION MAP
ZONE ATLAS MAP L-21

NTS

GENERAL NOTES

1. ALL WORK DETAILED ON THESE PLANS TO BE PERFORMED UNDER CONTRACT, AND UNLESS STATED OTHERWISE OR PROVIDED FOR HEREON, SHALL BE CONSTRUCTED IN ACCORDANCE WITH THE CITY OF ALBUQUERQUE STANDARD SPECIFICATIONS, PUBLIC WORKS CONSTRUCTION, 1986 EDITION, UPDATE NO. 6.
2. TWO WORKING DAYS PRIOR TO ANY EXCAVATION, THE CONTRACTOR MUST CONTACT NEW MEXICO ONE CALL, 260-1990, FOR LOCATION OF EXISTING UTILITIES.
3. PRIOR TO CONSTRUCTION, THE CONTRACTOR SHALL EXCAVATE AND VERIFY THE HORIZONTAL AND VERTICAL LOCATIONS OF EXISTING UTILITIES BEING CONNECTED TO AND ALL POTENTIAL OBSTRUCTIONS. SHOULD A CONFLICT EXIST, THE CONTRACTOR SHALL NOTIFY THE ENGINEER SO THAT THE CONFLICT CAN BE RESOLVED WITH A MINIMUM AMOUNT OF DELAY.
4. ALL WORK ON THIS PROJECT SHALL BE PERFORMED IN ACCORDANCE WITH APPLICABLE FEDERAL, STATE AND LOCAL LAWS, RULES, AND REGULATIONS CONCERNING SAFETY AND HEALTH.
5. CONTRACTOR SHALL MAINTAIN ACCESS TO ADJACENT PROPERTIES DURING CONSTRUCTION.
6. ALL GAS, ELECTRIC, TELEPHONE LINES, CABLES AND APPURTENANCES ENCOUNTERED DURING CONSTRUCTION THAT REQUIRE RELOCATION SHALL BE DONE BY THE RESPONSIBLE UTILITY. THE CONTRACTOR SHALL BE RESPONSIBLE FOR COORDINATION OF ALL NECESSARY UTILITY ADJUSTMENTS.
7. IT SHALL BE THE CONTRACTOR'S RESPONSIBILITY TO PROTECT AND MAINTAIN IN SERVICE ALL EXISTING UTILITIES.
8. THE CONTRACTOR SHALL BE REQUIRED TO CONFINE HIS WORK WITHIN THE CONSTRUCTION LIMITS AND/OR PUBLIC RIGHT-OF-WAY OR EASEMENTS TO PRESERVE EXISTING VEGETATION AND PRIVATE PROPERTY. OVERNIGHT PARKING OF EQUIPMENT AND/OR STORAGE OF MATERIALS IS NOT ALLOWED EXCEPT BY PERMISSION OF PROPERTY OWNER. RESTORATION OF PRIVATE IMPROVEMENTS WILL BE AT THE CONTRACTOR'S EXPENSE.
9. A DISPOSAL SITE FOR ALL EXCESS EXCAVATION MATERIAL, ASPHALTIC PAVING, CONCRETE CURBS AND SIDEWALKS, ETC. SHALL BE OBTAINED BY THE CONTRACTOR IN COMPLIANCE WITH APPLICABLE ENVIRONMENTAL REGULATIONS AND APPROVED BY THE FIELD ENGINEER. ALL COSTS INCURRED IN OBTAINING A DISPOSAL SITE AND HAUL THERE TO SHALL BE CONSIDERED INCIDENTAL TO THE PROJECT AND NO SEPARATE MEASUREMENT OR PAYMENT SHALL BE MADE.
10. WHEN ABUTTING EXISTING PAVEMENT TO NEW, SAWCUT EXISTING PAVEMENT TO A STRAIGHT EDGE AND AT A RIGHT ANGLE, OR AS APPROVED BY THE PROJECT ENGINEER. REMOVAL OF BROKEN OR CRACKED PAVEMENT WILL ALSO BE REQUIRED.
11. FIVE (5) WORKING DAYS PRIOR TO BEGINNING CONSTRUCTION, THE CONTRACTOR SHALL SUBMIT TO THE CONSTRUCTION COORDINATION DIVISION A DETAILED CONSTRUCTION SCHEDULE. TWO (2) WORKING DAYS PRIOR TO CONSTRUCTION, THE CONTRACTOR SHALL OBTAIN A BARRICADING PERMIT FROM THE CONSTRUCTION COORDINATION DIVISION. CONTRACTOR SHALL NOTIFY BARRICADING ENGINEER (768-2551) PRIOR TO OCCUPYING AN INTERSECTION. SEE SECTION 19 OF THE SPECIFICATIONS.
12. ALL FINAL BACKFILL FOR TRENCHES SHALL BE COMPACTED TO A MINIMUM 90% MAXIMUM DENSITY PER ASTM D-1557 AND AS DIRECTED BY SECTION 701.14.2 AND STANDARD DRAWING NUMBER 2315.
13. CONTRACTOR SHALL SUBMIT A REVEGETATION PLAN TO ENGINEER FOR PRIOR APPROVAL.
14. CONTRACTOR SHALL NOTIFY THE ENGINEER NOT LESS THAN SEVEN (7) DAYS PRIOR TO STARTING WORK IN ORDER THAT THE ENGINEER MAY TAKE NECESSARY MEASURES TO INSURE THE PRESERVATION OF SURVEY MONUMENTS. CONTRACTOR SHALL NOT DISTURB PERMANENT SURVEY MONUMENTS WITHOUT THE CONSENT OF THE ENGINEER AND SHALL NOTIFY THE ENGINEER AND BEAR THE EXPENSE OF REPLACING ANY THAT MAY BE DISTURBED WITHOUT PERMISSION. REPLACEMENT SHALL BE DONE ONLY BY THE CITY SURVEYOR. WHEN A CHANGE IS MADE IN THE FINISHED ELEVATIONS OF PAVEMENT OF ANY ROADWAY IN WHICH A PERMANENT SURVEY MONUMENT IS LOCATED, CONTRACTOR SHALL, AT HIS OWN EXPENSE, ADJUST THE MONUMENT COVER TO THE NEW GRADE UNLESS OTHERWISE SPECIFIED. REFER TO SECTION 4.4 OF GENERAL CONDITIONS OF THE STANDARD SPECIFICATIONS.
15. ANY WORK OCCURRING WITHIN AN ARTERIAL ROADWAY REQUIRES TWENTY-FOUR (24) HOURS CONSTRUCTION.
16. ALL STREET STRIPING ALTERED OR DESTROYED SHALL BE REPLACED WITH PLASTIC REFLECTORIZED PAVEMENT MARKINGS BY CONTRACTOR TO LOCATION AS EXISTING OR AS INDICATED BY THIS PLAN SET.

REV.	SHEETS	CITY ENGINEER	DATE	USER DEPARTMENT	DATE	USER DEPARTMENT	DATE
ENGINEERS STAMP & SIGNATURE		APPROVALS		ENGINEER		DATE	
		DRC Chairman		K. Deane		10-29-99	
		Transportation		K. Deane		10-18-99	
		Water/Wastewater		K. Deane		10-12-99	
		Hydrology		K. Deane		10-12-99	
		Parks		K. Deane		10-12-99	
Constr. Mngmt.		K. Deane		K. Deane		10-12-99	
Constr. Coord.		K. Deane		K. Deane		10-12-99	
City Project No.		6240.81		Sheet		Of	
				1		22	

APPROVED FOR CONSTRUCTION
Date 1/22/01
City Engineer


Bernalillo County
Albuquerque, New Mexico
February 2000

1. Mathematical
 2. Reasoning

PURPOSE AND PLACEMENTS shown on this plot are granted for the location and joint use of:



- [illegible]

1713
 1714
 1715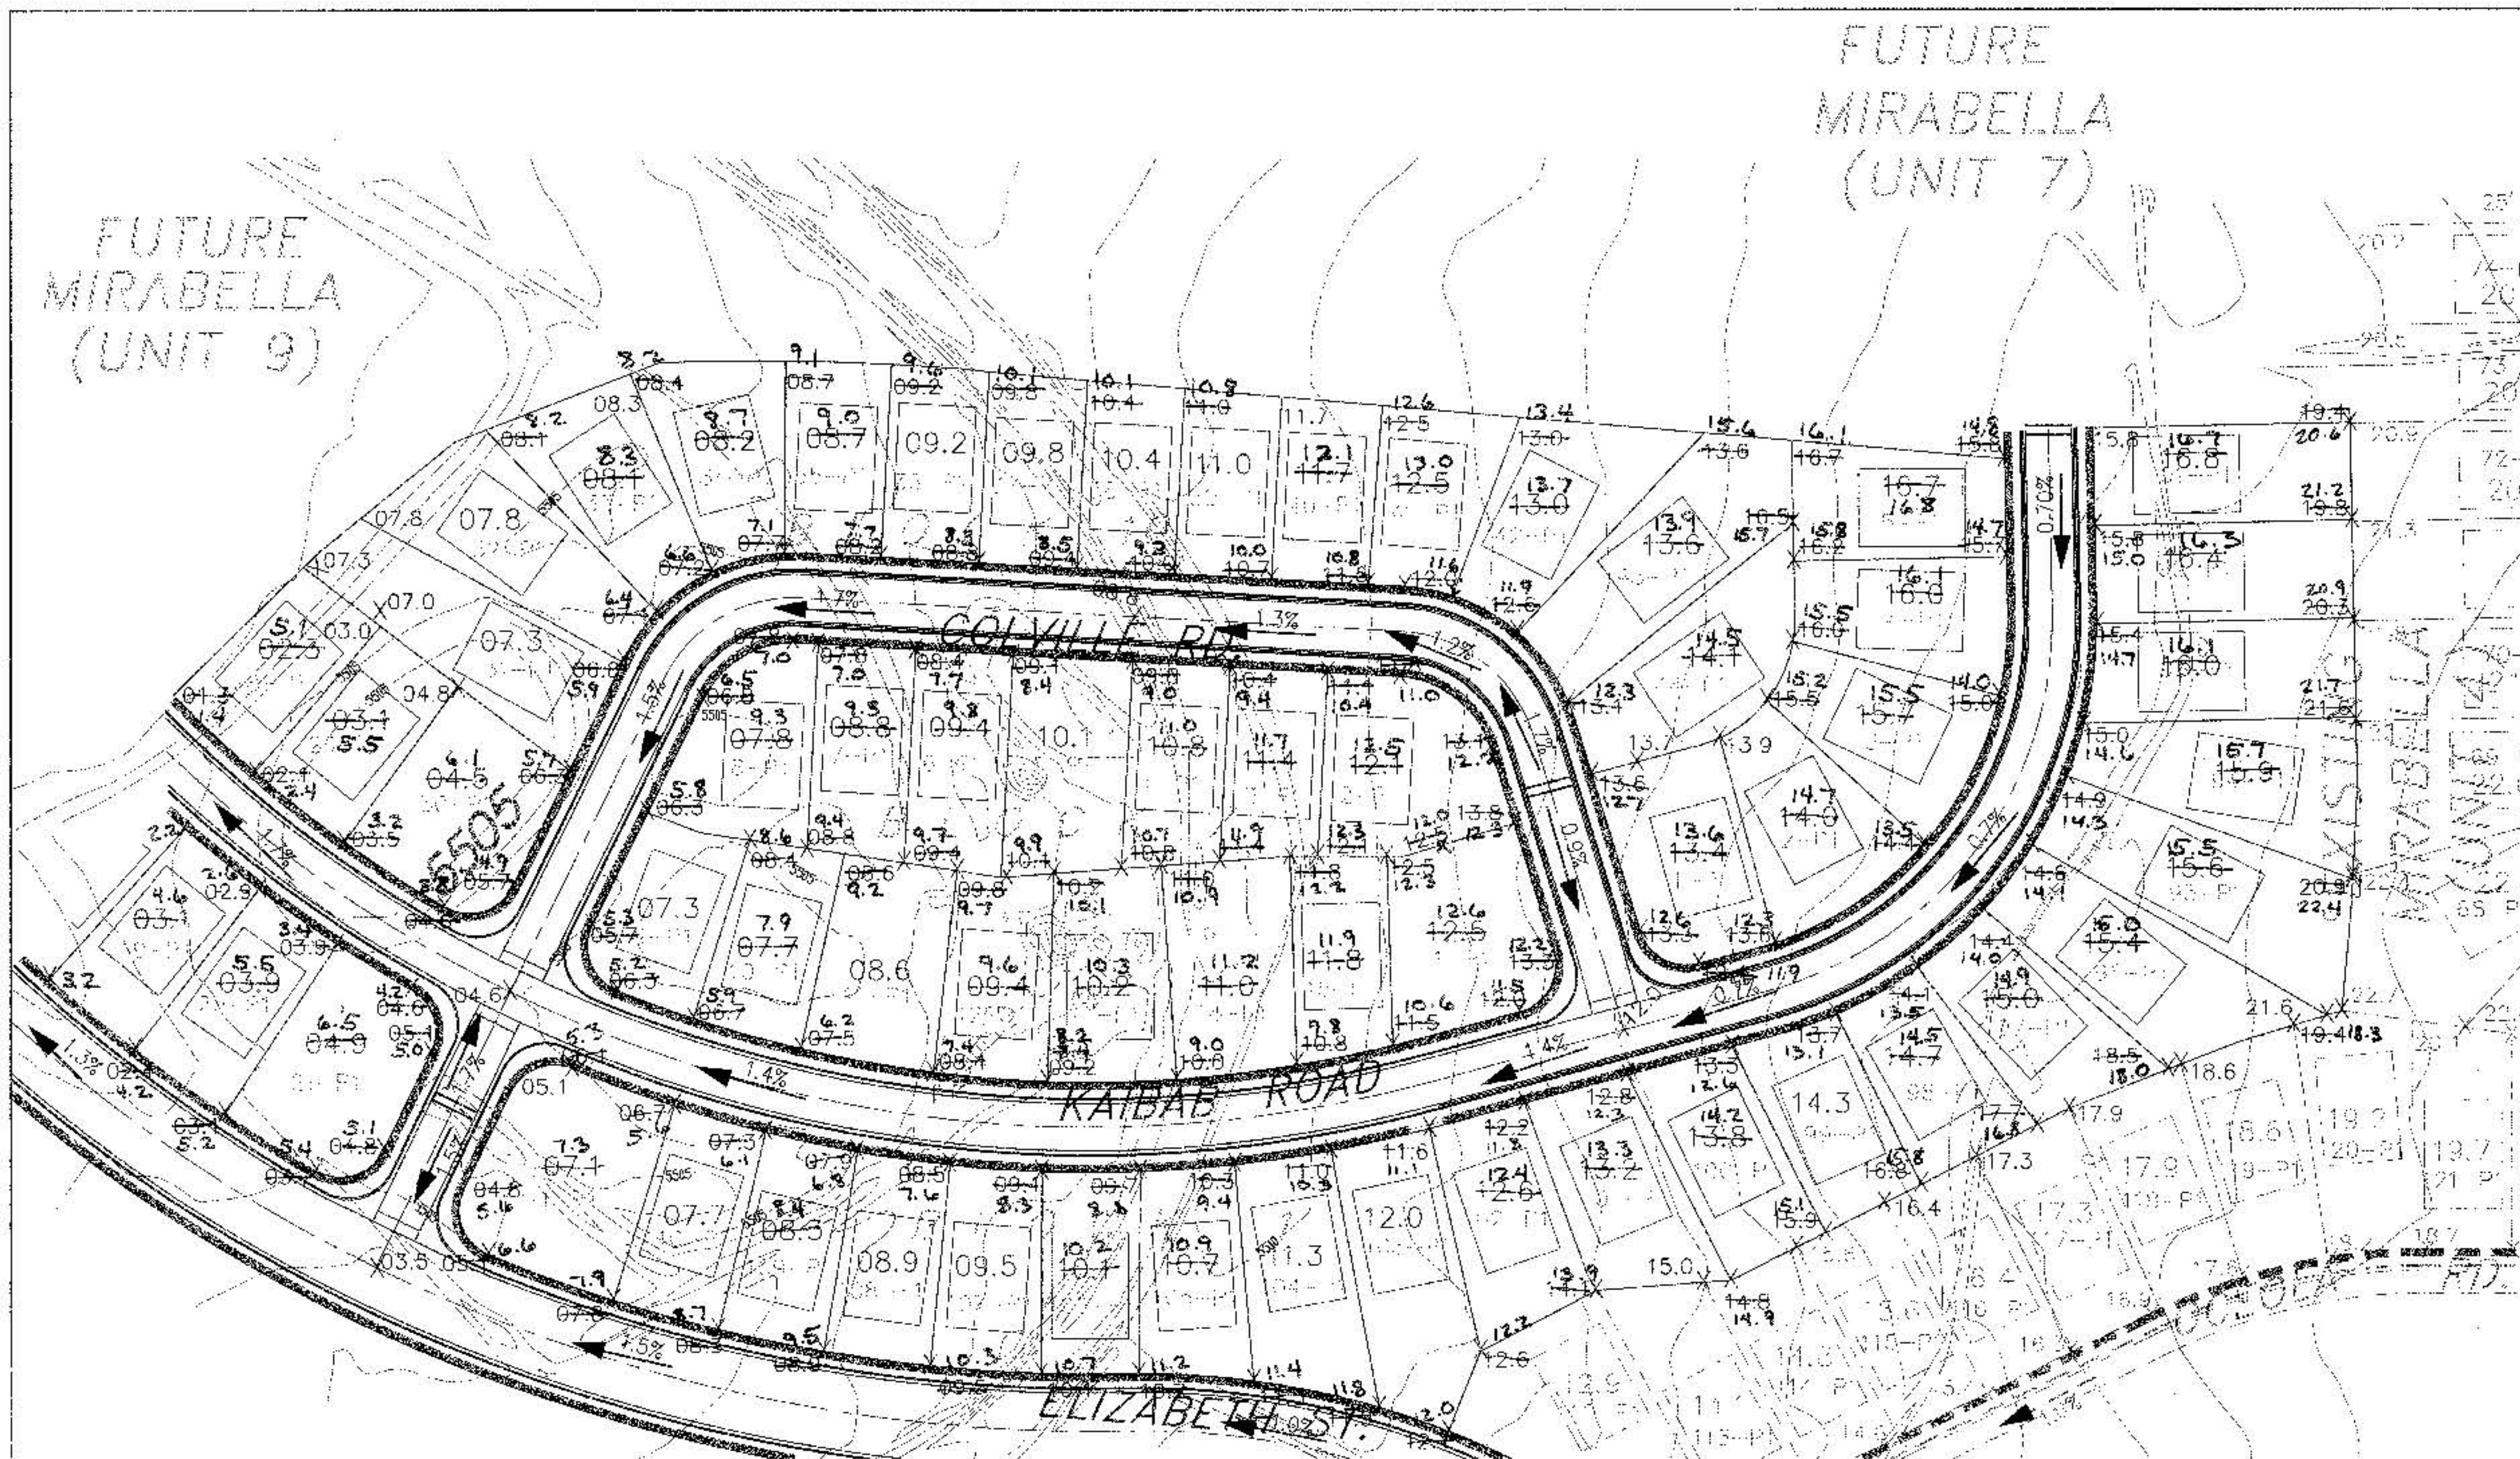
TRACT
D-2-A-1

GRADING & DRAINAGE CERTIFICATION	
I, JAMES V. DOMENICK OF PARSONS BRINCKERHOFF INC., N.M.P.E. #7843 HEREBY CERTIFY THAT THE AS-BUILT DRAINAGE CONDITIONS OF THE SITE ARE IN SUBSTANTIAL COMPLIANCE WITH THE APPROVED GRADING AND DRAINAGE PLAN. TO THE BEST OF MY KNOWLEDGE AND BELIEF AS-BUILT ELEVATIONS, VERIFIED BY ALDRICH LAND SURVEYING, ARE SHOWN ON THIS PLAN. THIS STATEMENT DOES NOT REPRESENT CERTIFICATION OF CONTRACTOR'S METHODS OR MATERIALS.	
NAME <i>James V. Domenick</i>	
DATE 8 FEB 2001	

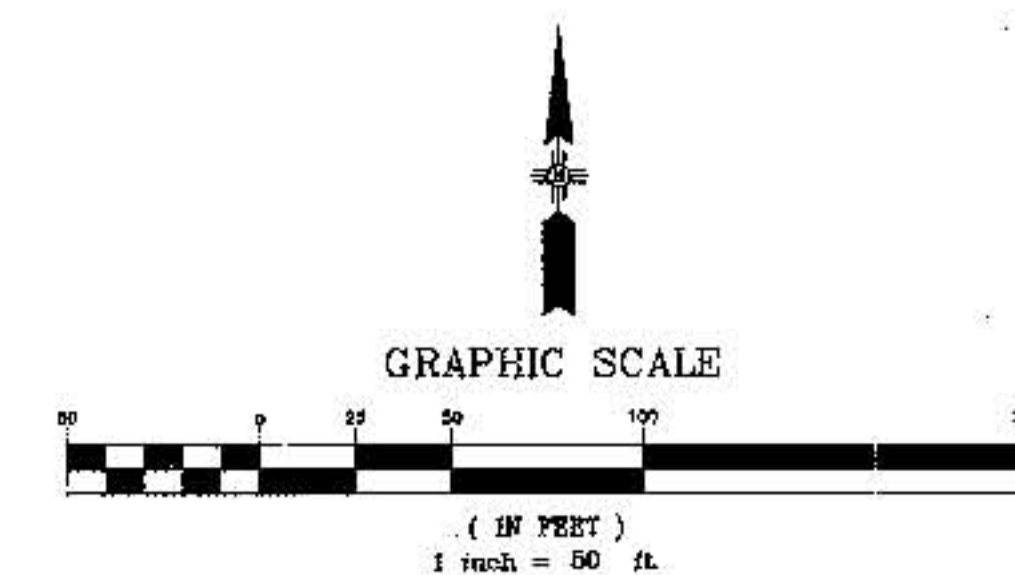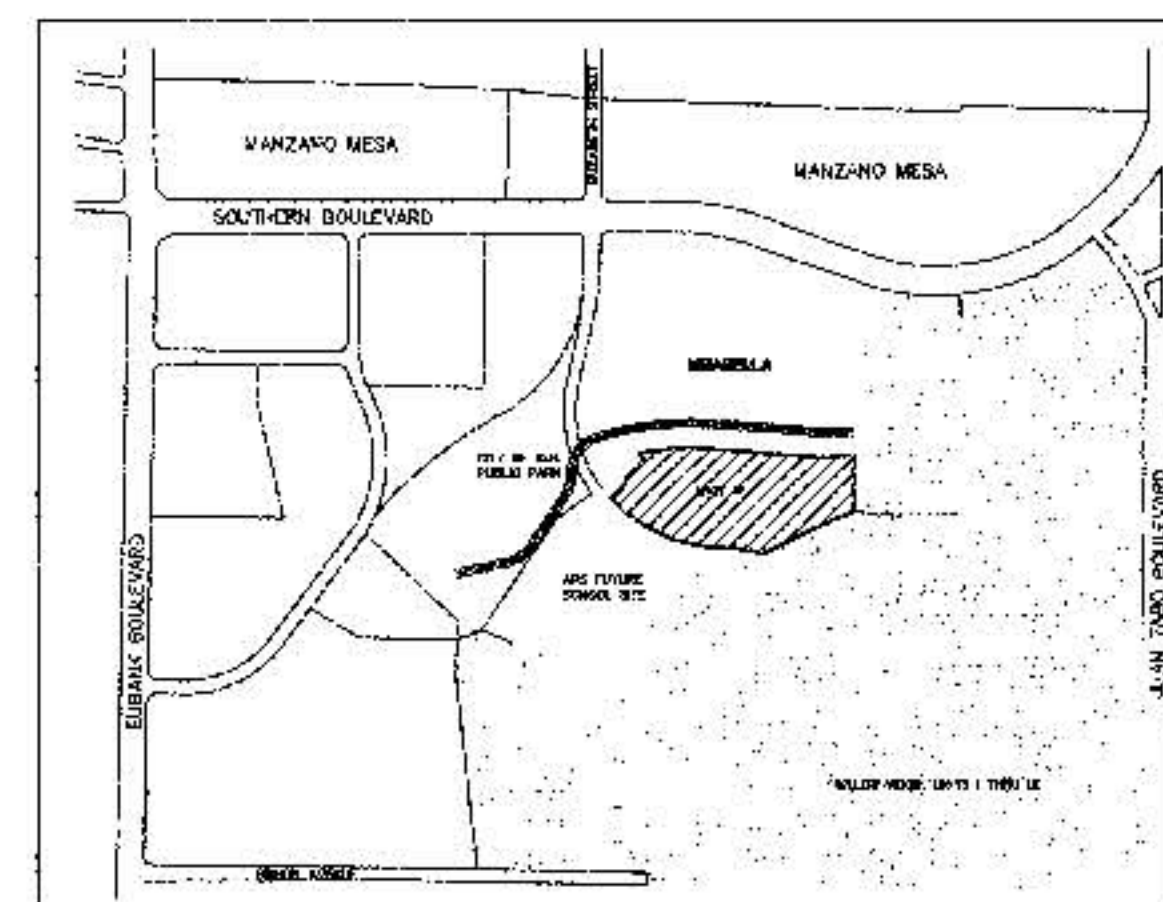

DRB-97-209

LEGEND

- DIRECTION OF SURFACE FLOW
- EXISTING TOPO
- STANDARD C & G
- MOUNTABLE C & G
- EXISTING CURB & GUTTER
- PROPOSED ELEVATION
- EXISTING ELEVATION
- WATER BLOCK
- BACKYARD SLOPE
- PROPOSED MANHOLES
- EXISTING MANHOLES
- PROPOSED BUILDING PAD ELEVATION
- TEMPORARY EROSION CONTROL BERM

NOTES:

- ALL ELEVATIONS SHOWN ARE MEAN SEA LEVEL (MSL)
- TRUNCATED ELEVATIONS: ADD 5500.00 MSL
- ALL BACKYARD SLOPES ARE 4:1 UNLESS OTHERWISE NOTED


AS BUILT INFORMATION		BENCH MARKS		SURVEY INFORMATION		ENGINEER'S SEAL	
NO.	DATE	NO.	DATE	NO.	DATE	NO.	DATE
THE STATION MARK IS A STANDARD ACS BRASS TABLET, STAMPED "1-L21 RESET 1974", LOCATED 7.8 MILES EAST OF DOWNTOWN ALBUQUERQUE, AT THE INTERSECTION OF CENTRAL AVE. AND JUAN TABO BLVD. THE STATION IS ON THE MEDIAN STRIP OF CENTRAL AVE. 91' WEST OF CENTERLINE OF JUAN TABO BLVD. AND FLUSH WITH THE CURB S/D ELEV. 5534.63				REMARKS DESIGN		NO. DATE DESIGNED BY DATE DRAWN BY DATE CHECKED BY DATE	










CITY OF ALBUQUERQUE
PUBLIC WORKS DEPARTMENT
ENGINEERING DEVELOPMENT GROUP
GRADING AND DRAINAGE PLAN
MIRABELLA UNIT 6



DESIGN REVIEW COMMITTEE	CITY ENGINEER APPROVAL	NO. / DAY / YR.	NO. / DAY / YR.

City Project No. 6240.81 Zone Map No. L-21-Z Sheet 4 Of 22

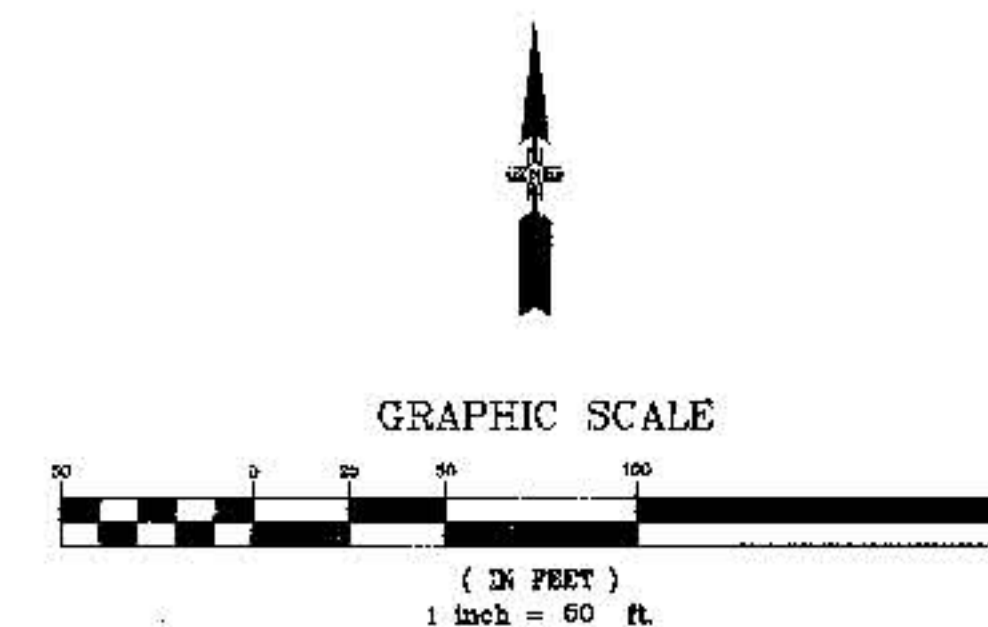


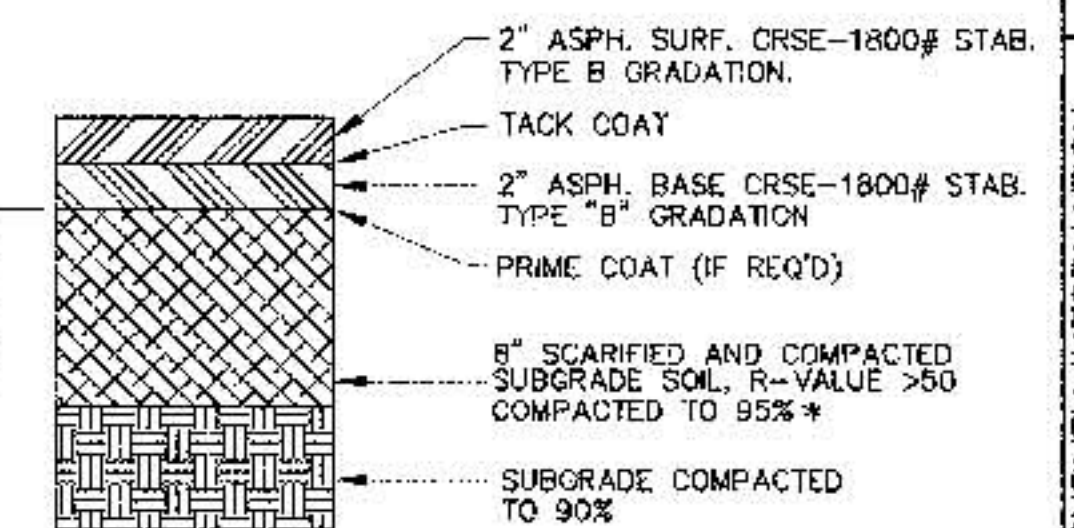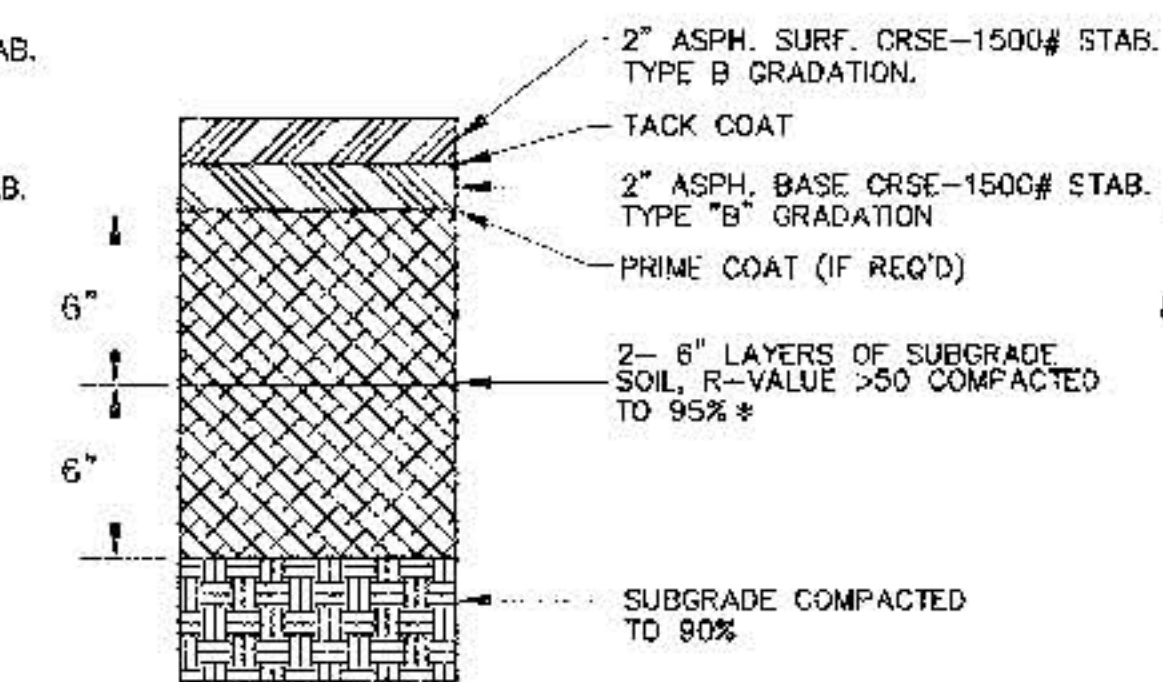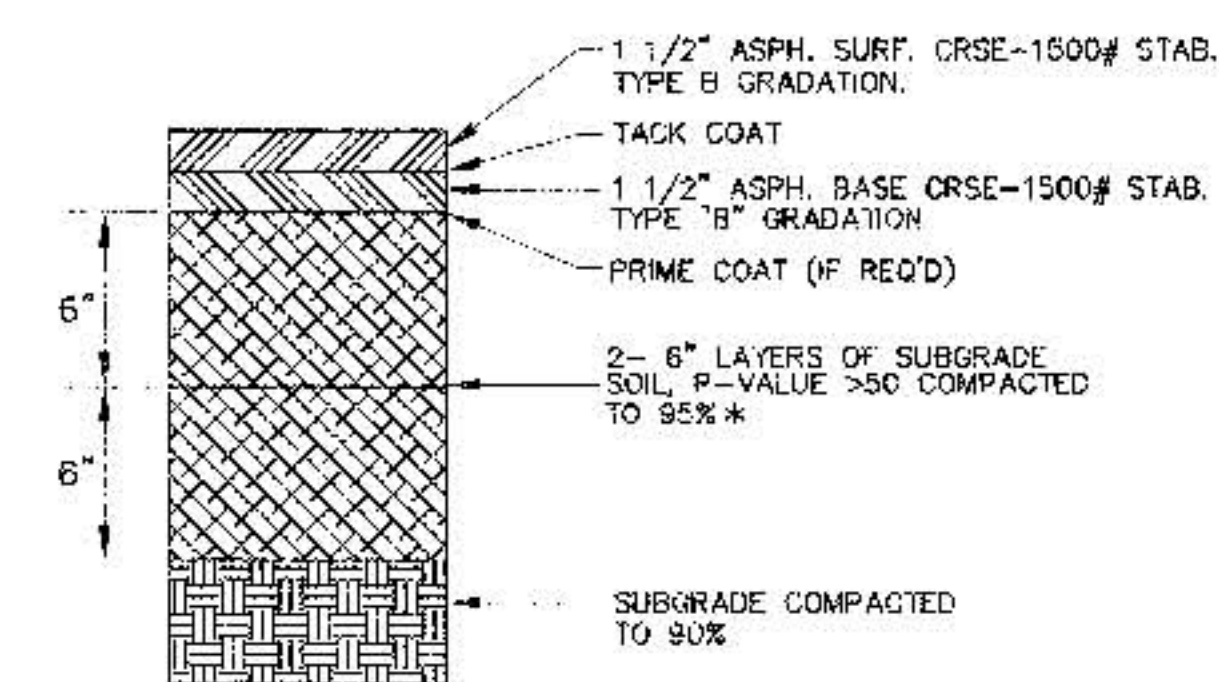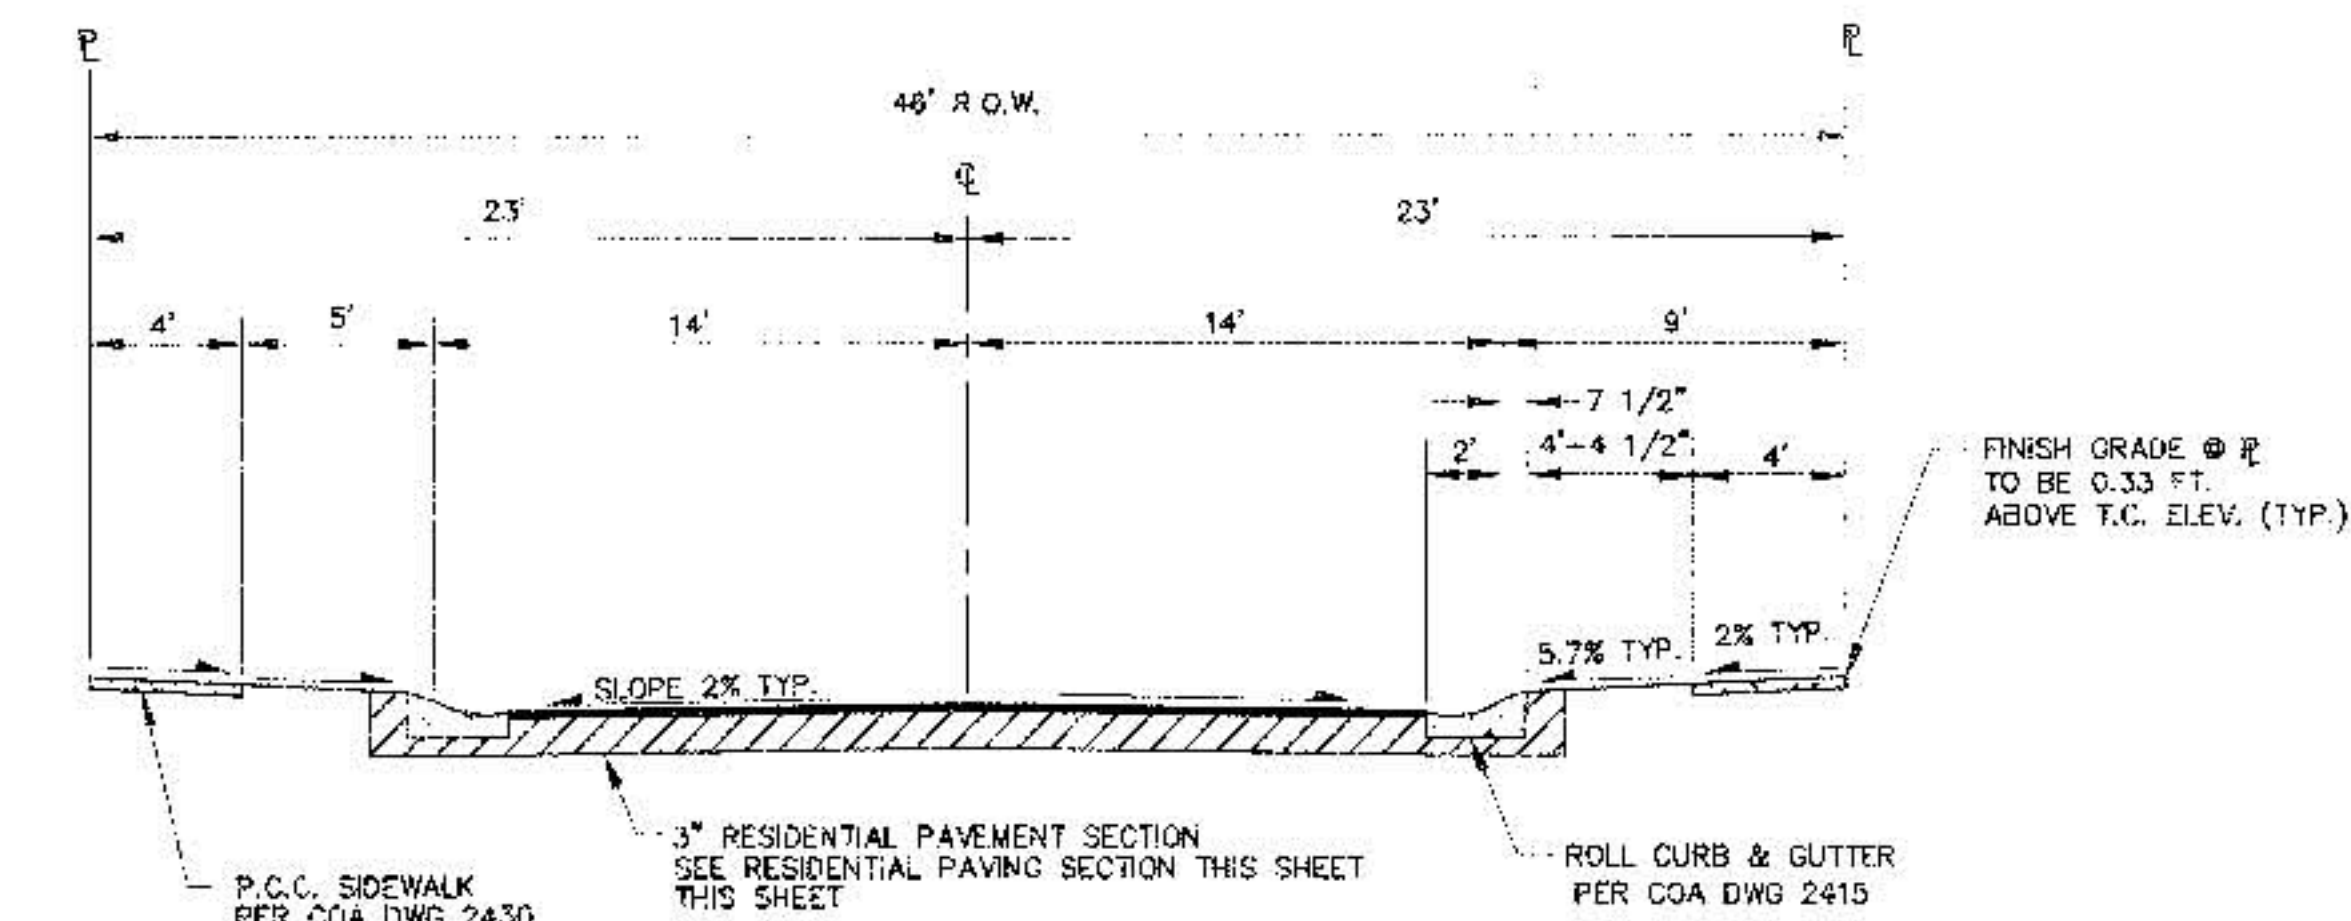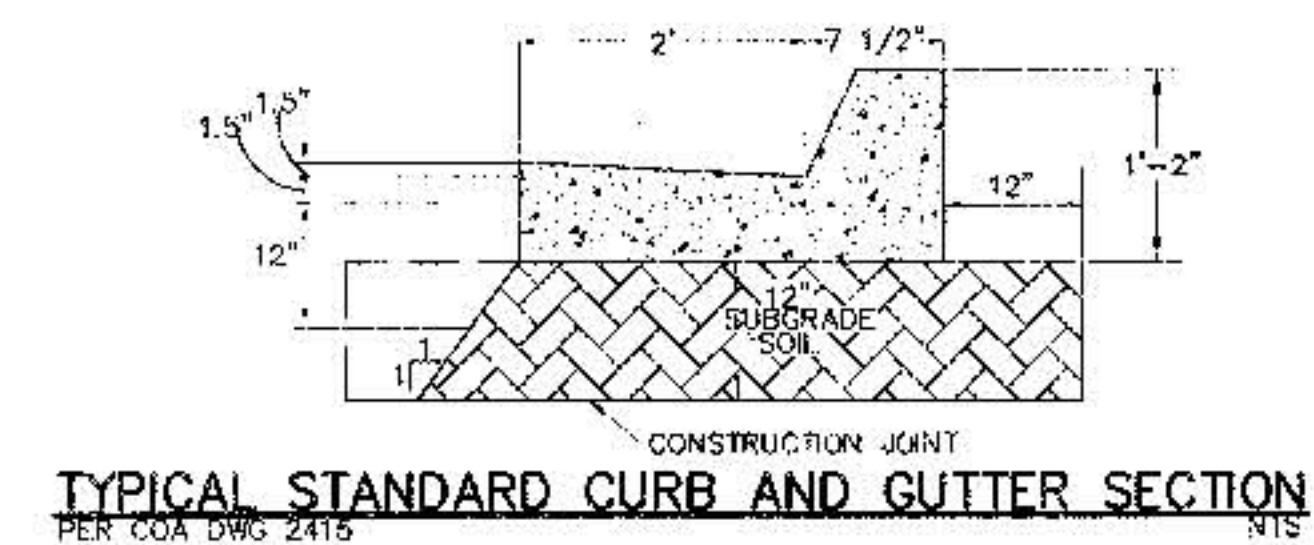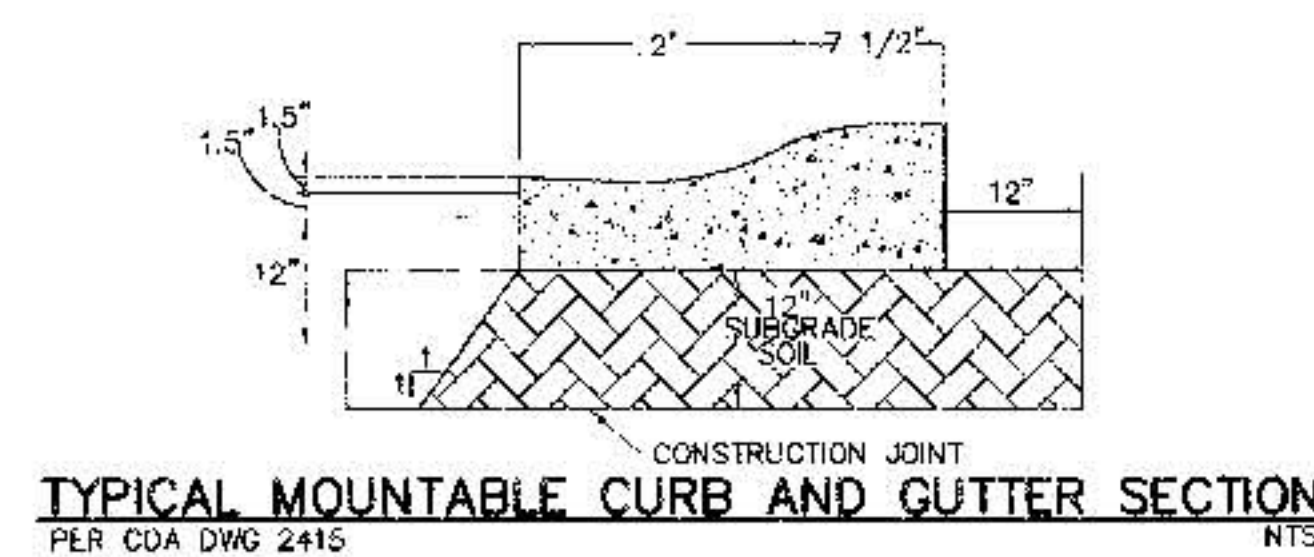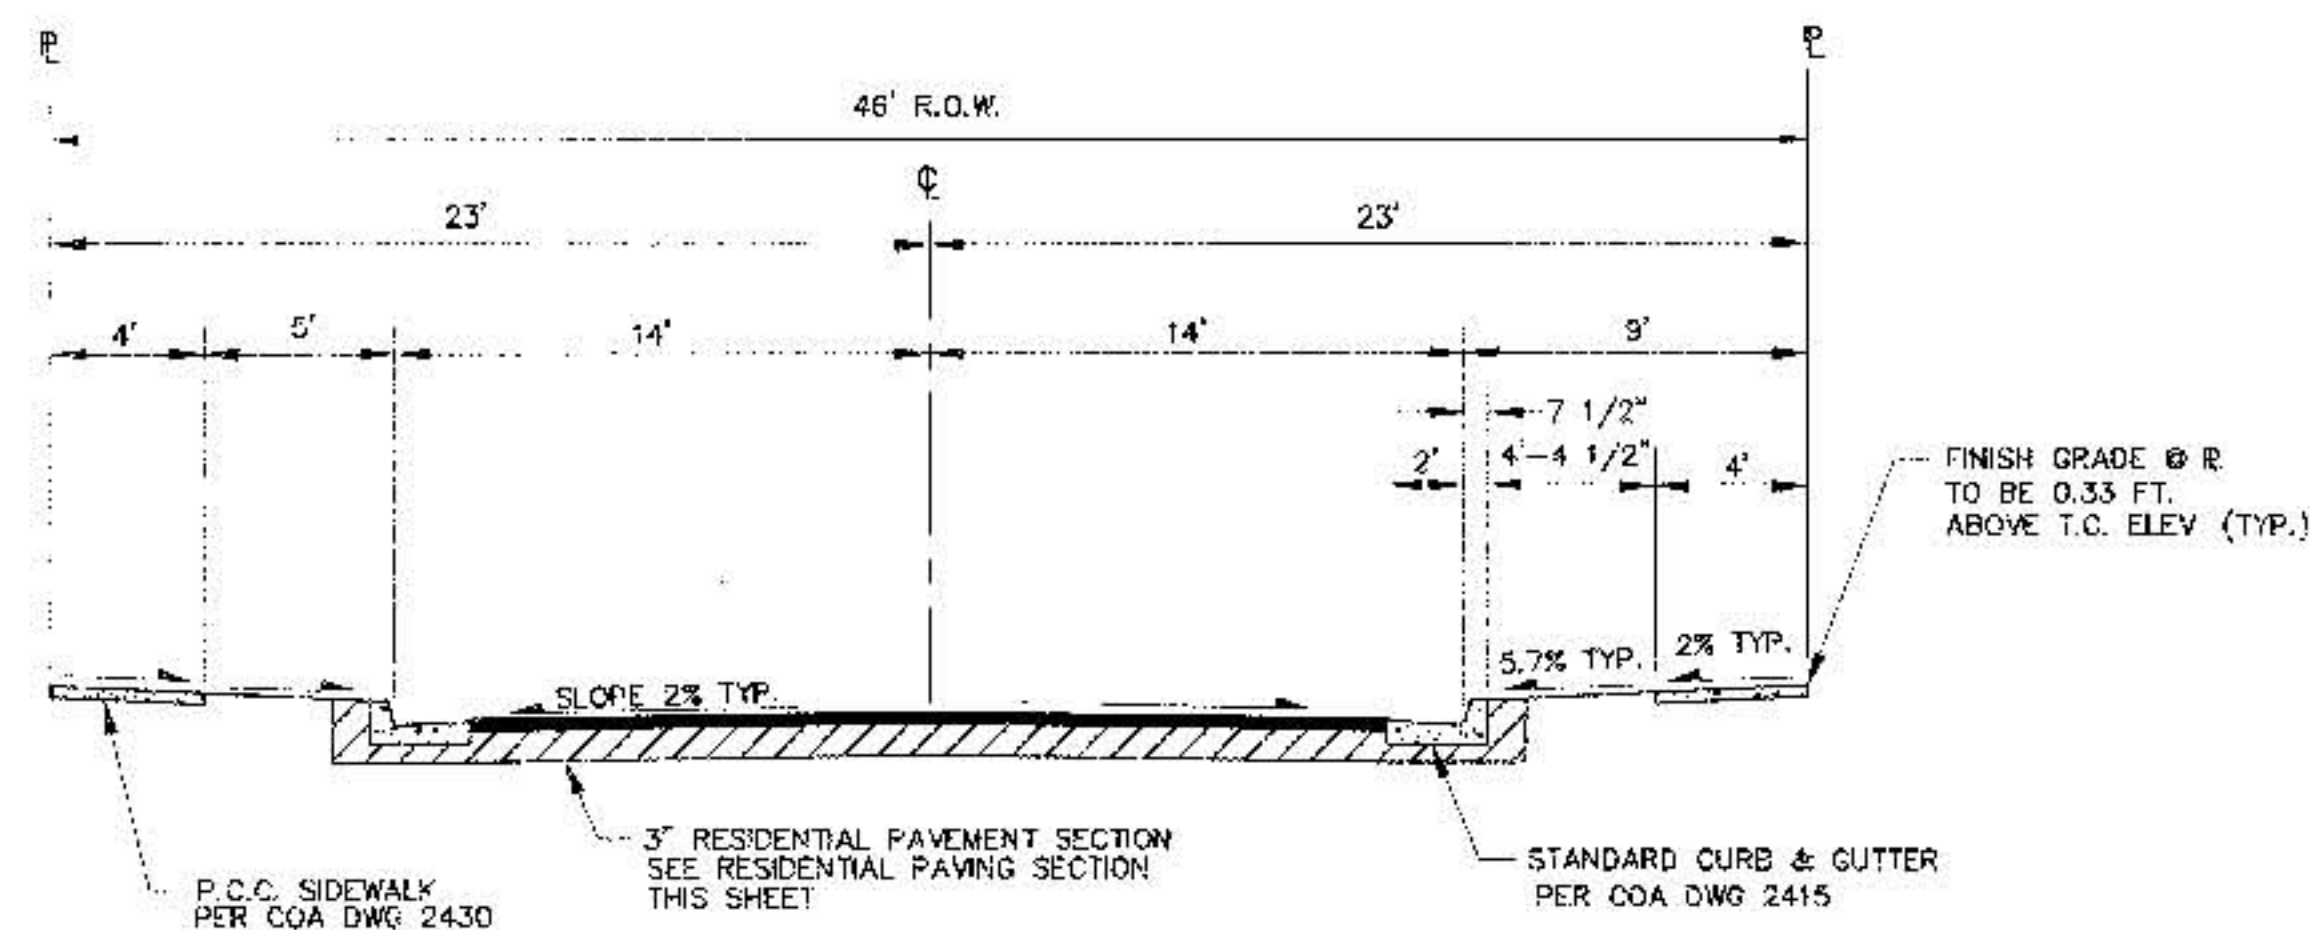

* NOTE: SOIL NOT HAVING THE MINIMUM R-VALUE OF 50, SHALL BE REMOVED TO DEPTH OF 2' AND REPLACED, BY THE CONTRACTOR, WITH SUITABLE MATERIAL OR A PAVEMENT SECTION SHALL BE DESIGNED BY THE CONSULTANT, ACCOMMODATING THE EXISTING R-VALUE PER COA SPECIFICATIONS.

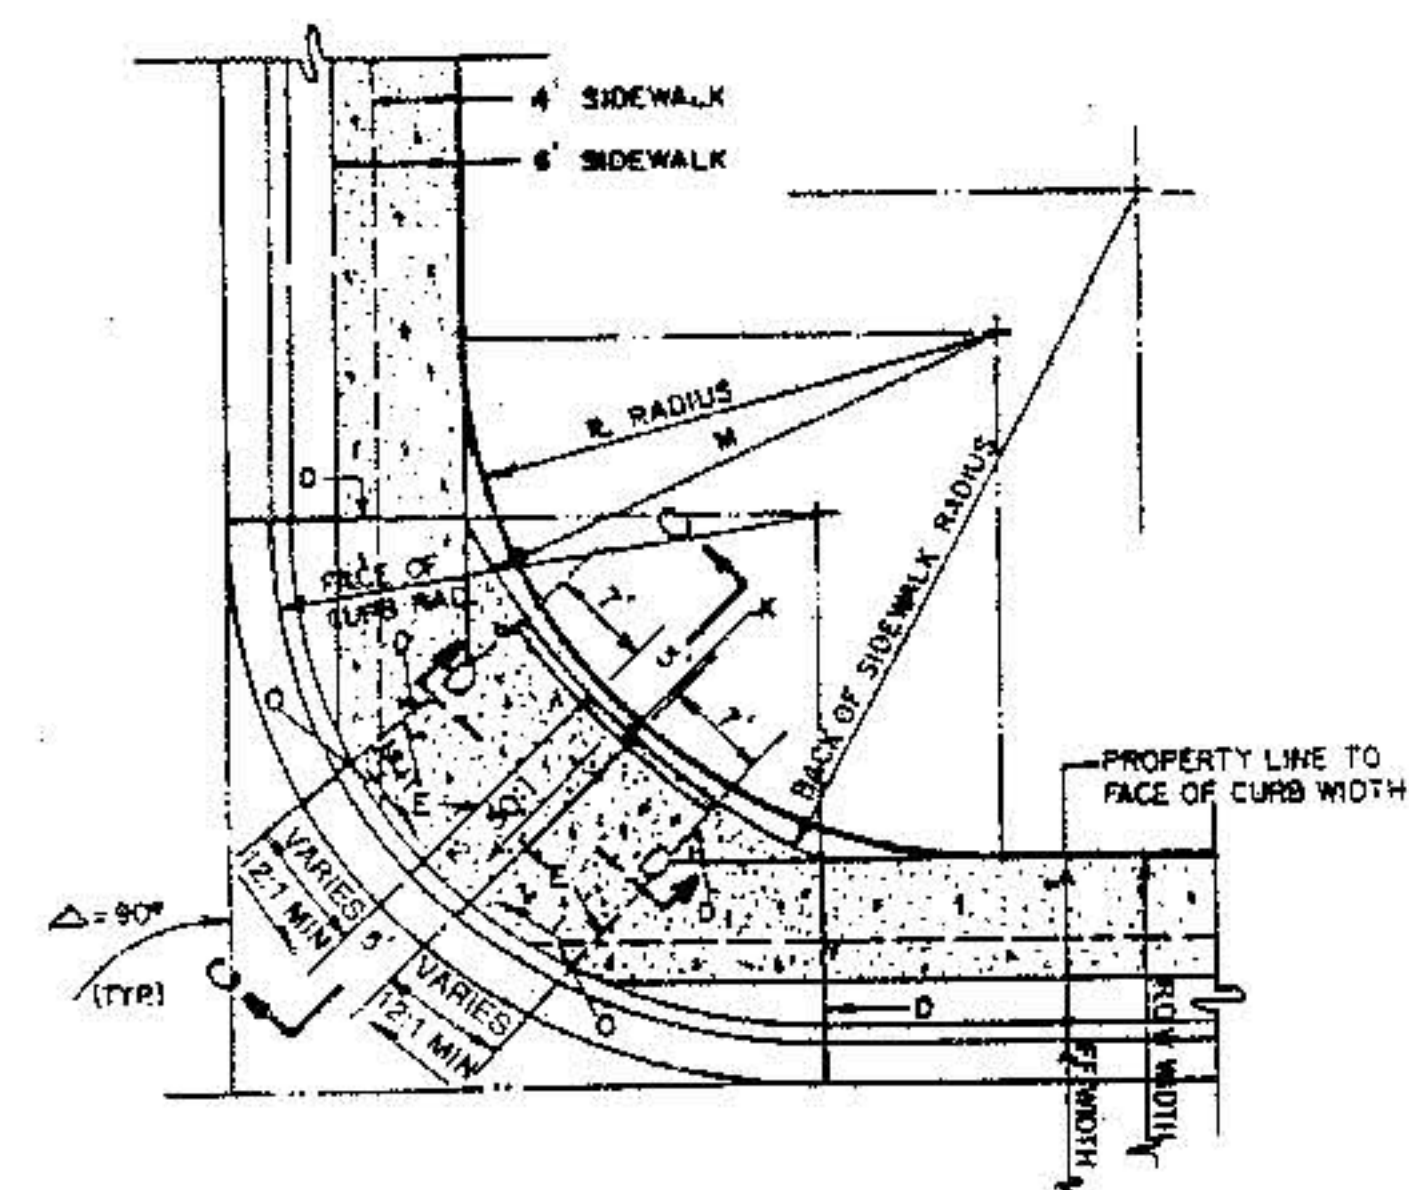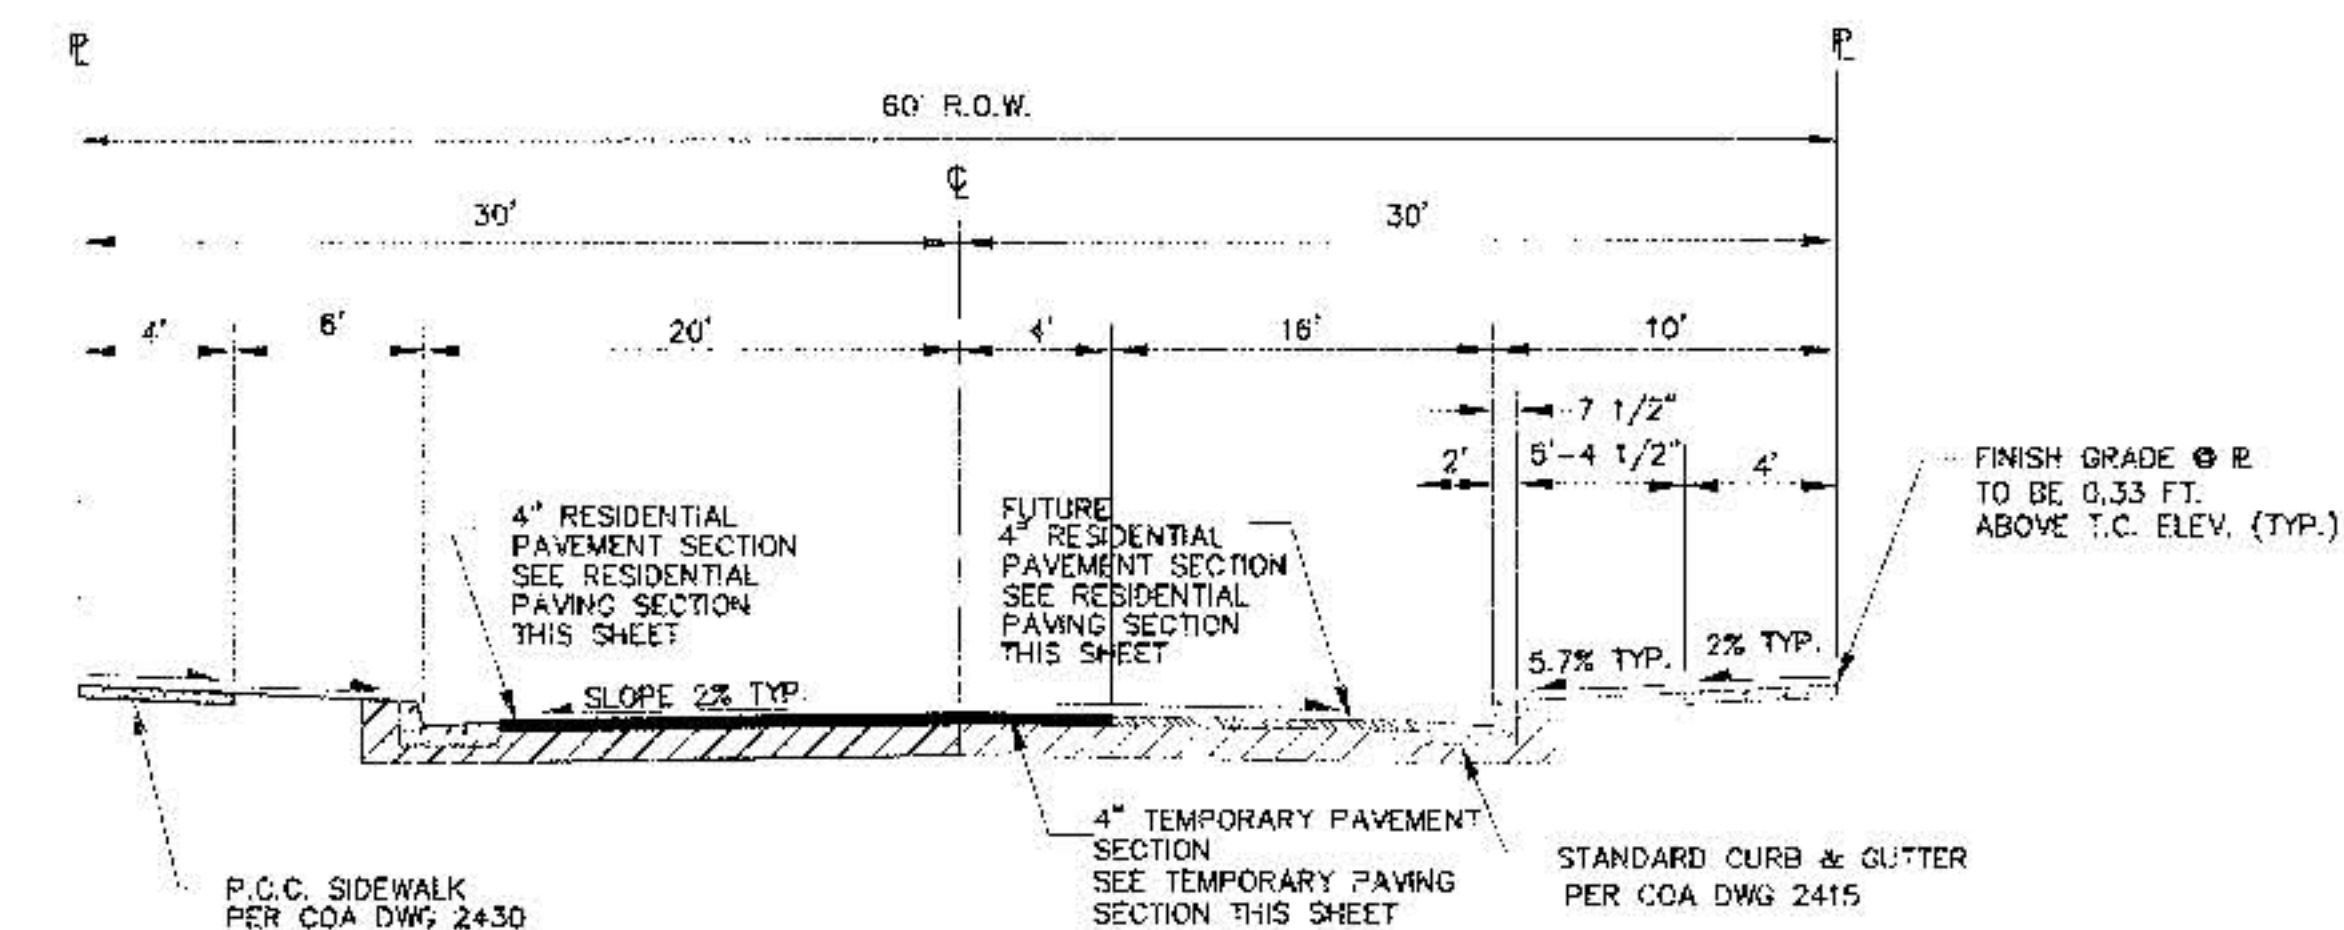


ENGINEER'S SEAL		FIELD NOTES		BENCH MARKS		AS BUILT INFORMATION	
		NO.		DATE		CONTRACTOR	
		BY		DATE		APPROVED BY	
NO. DATE		REMARKS		BY		DATE	
DESIGNED BY		DATE		9/3/99		DRAWN BY	
CHECKED BY		DATE		9/3/99		DATE	
DESIGN		DATE		9/3/99		DATE	
DESIGNED BY		DATE		9/3/99		DATE	
CHECKED BY		DATE		9/3/99		DATE	
DESIGN		DATE		9/3/99		DATE	
DESIGNED BY		DATE		9/3/99		DATE	
CHECKED BY		DATE		9/3/99		DATE	
DESIGN		DATE		9/3/99</			

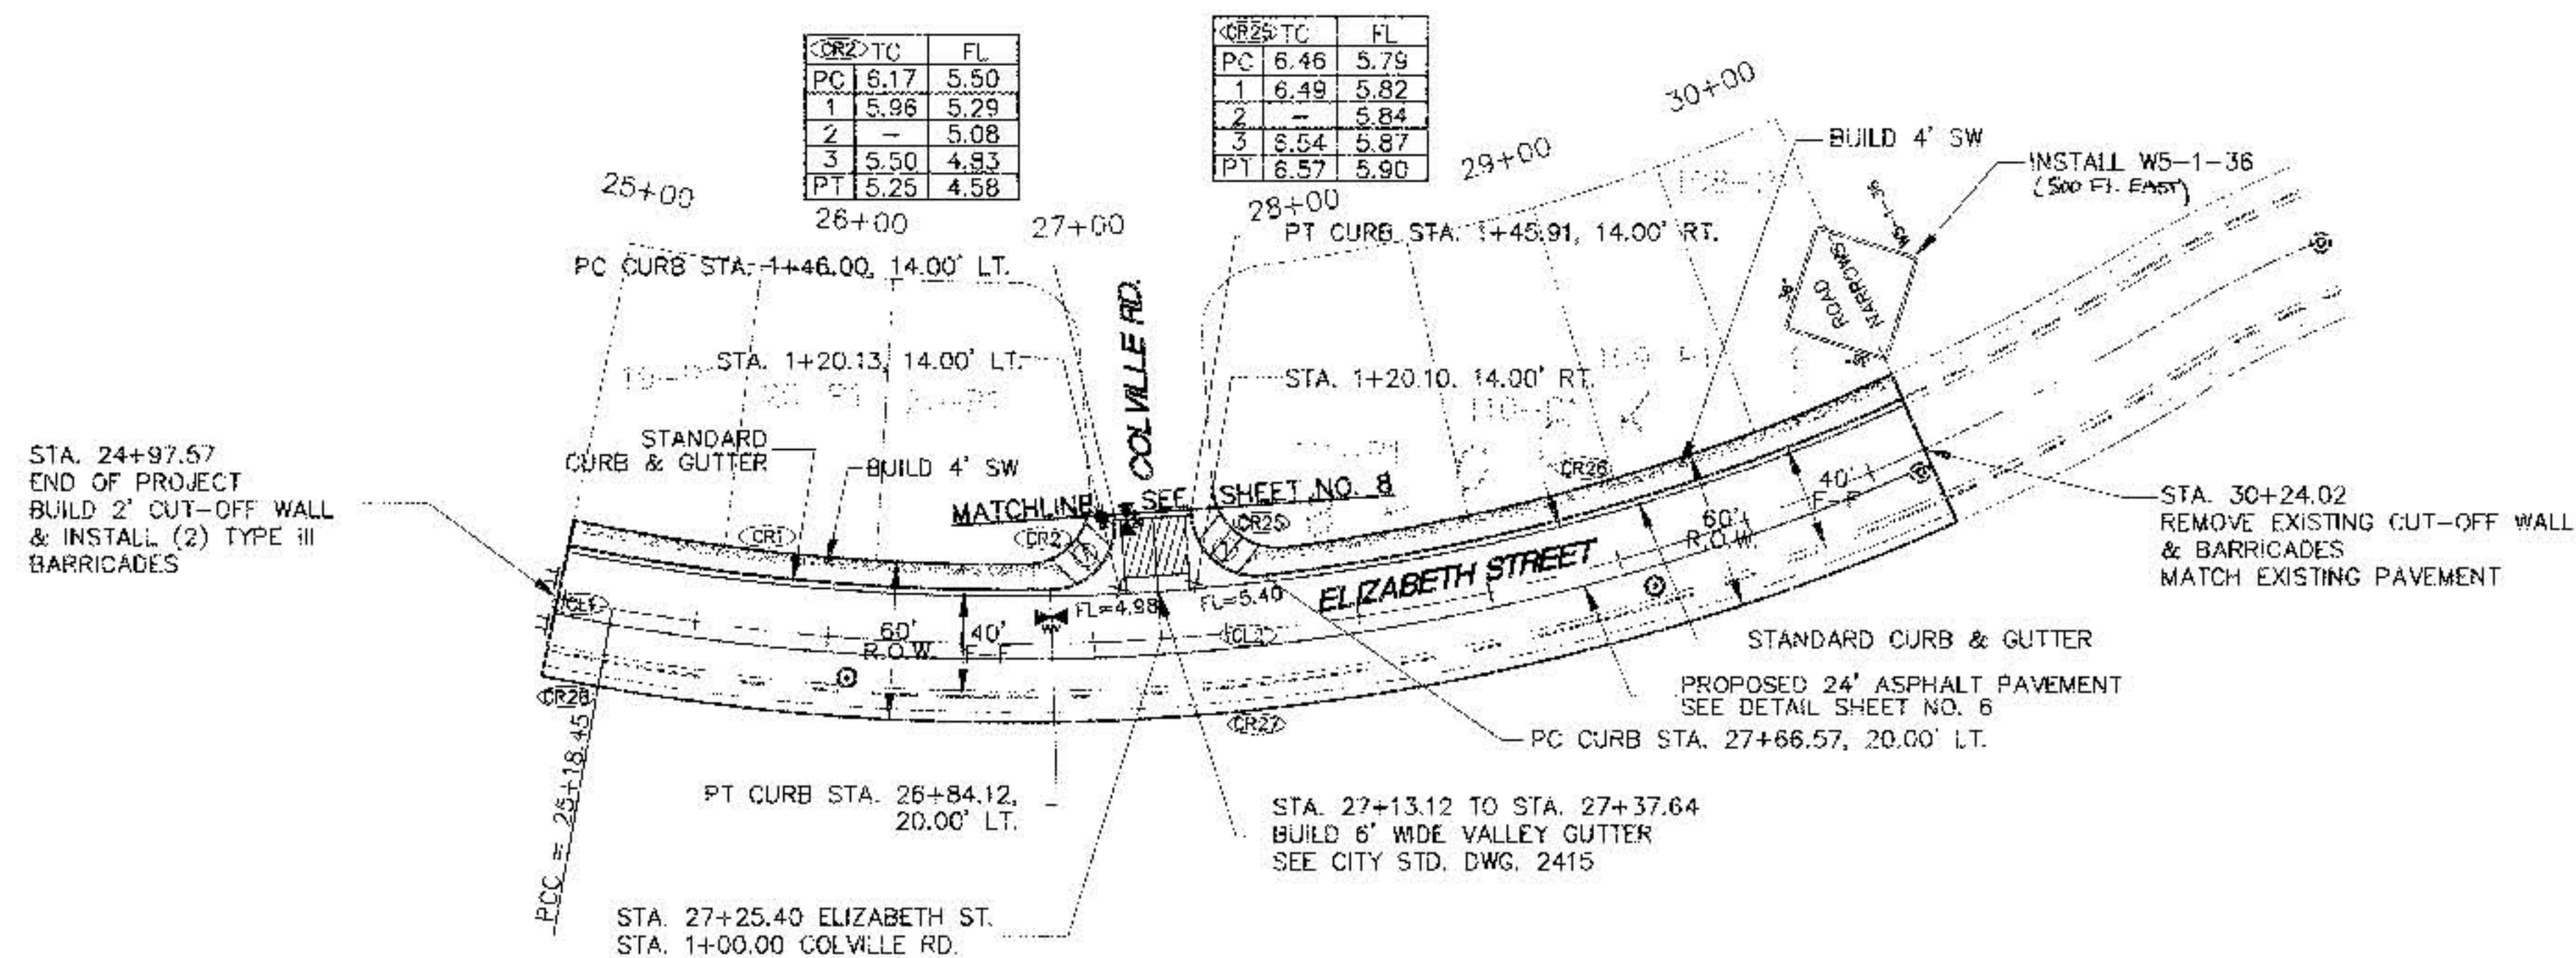

ELIZABETH STREET

SCALE
1" = 50' (HOR)
1" = 5' (VER)

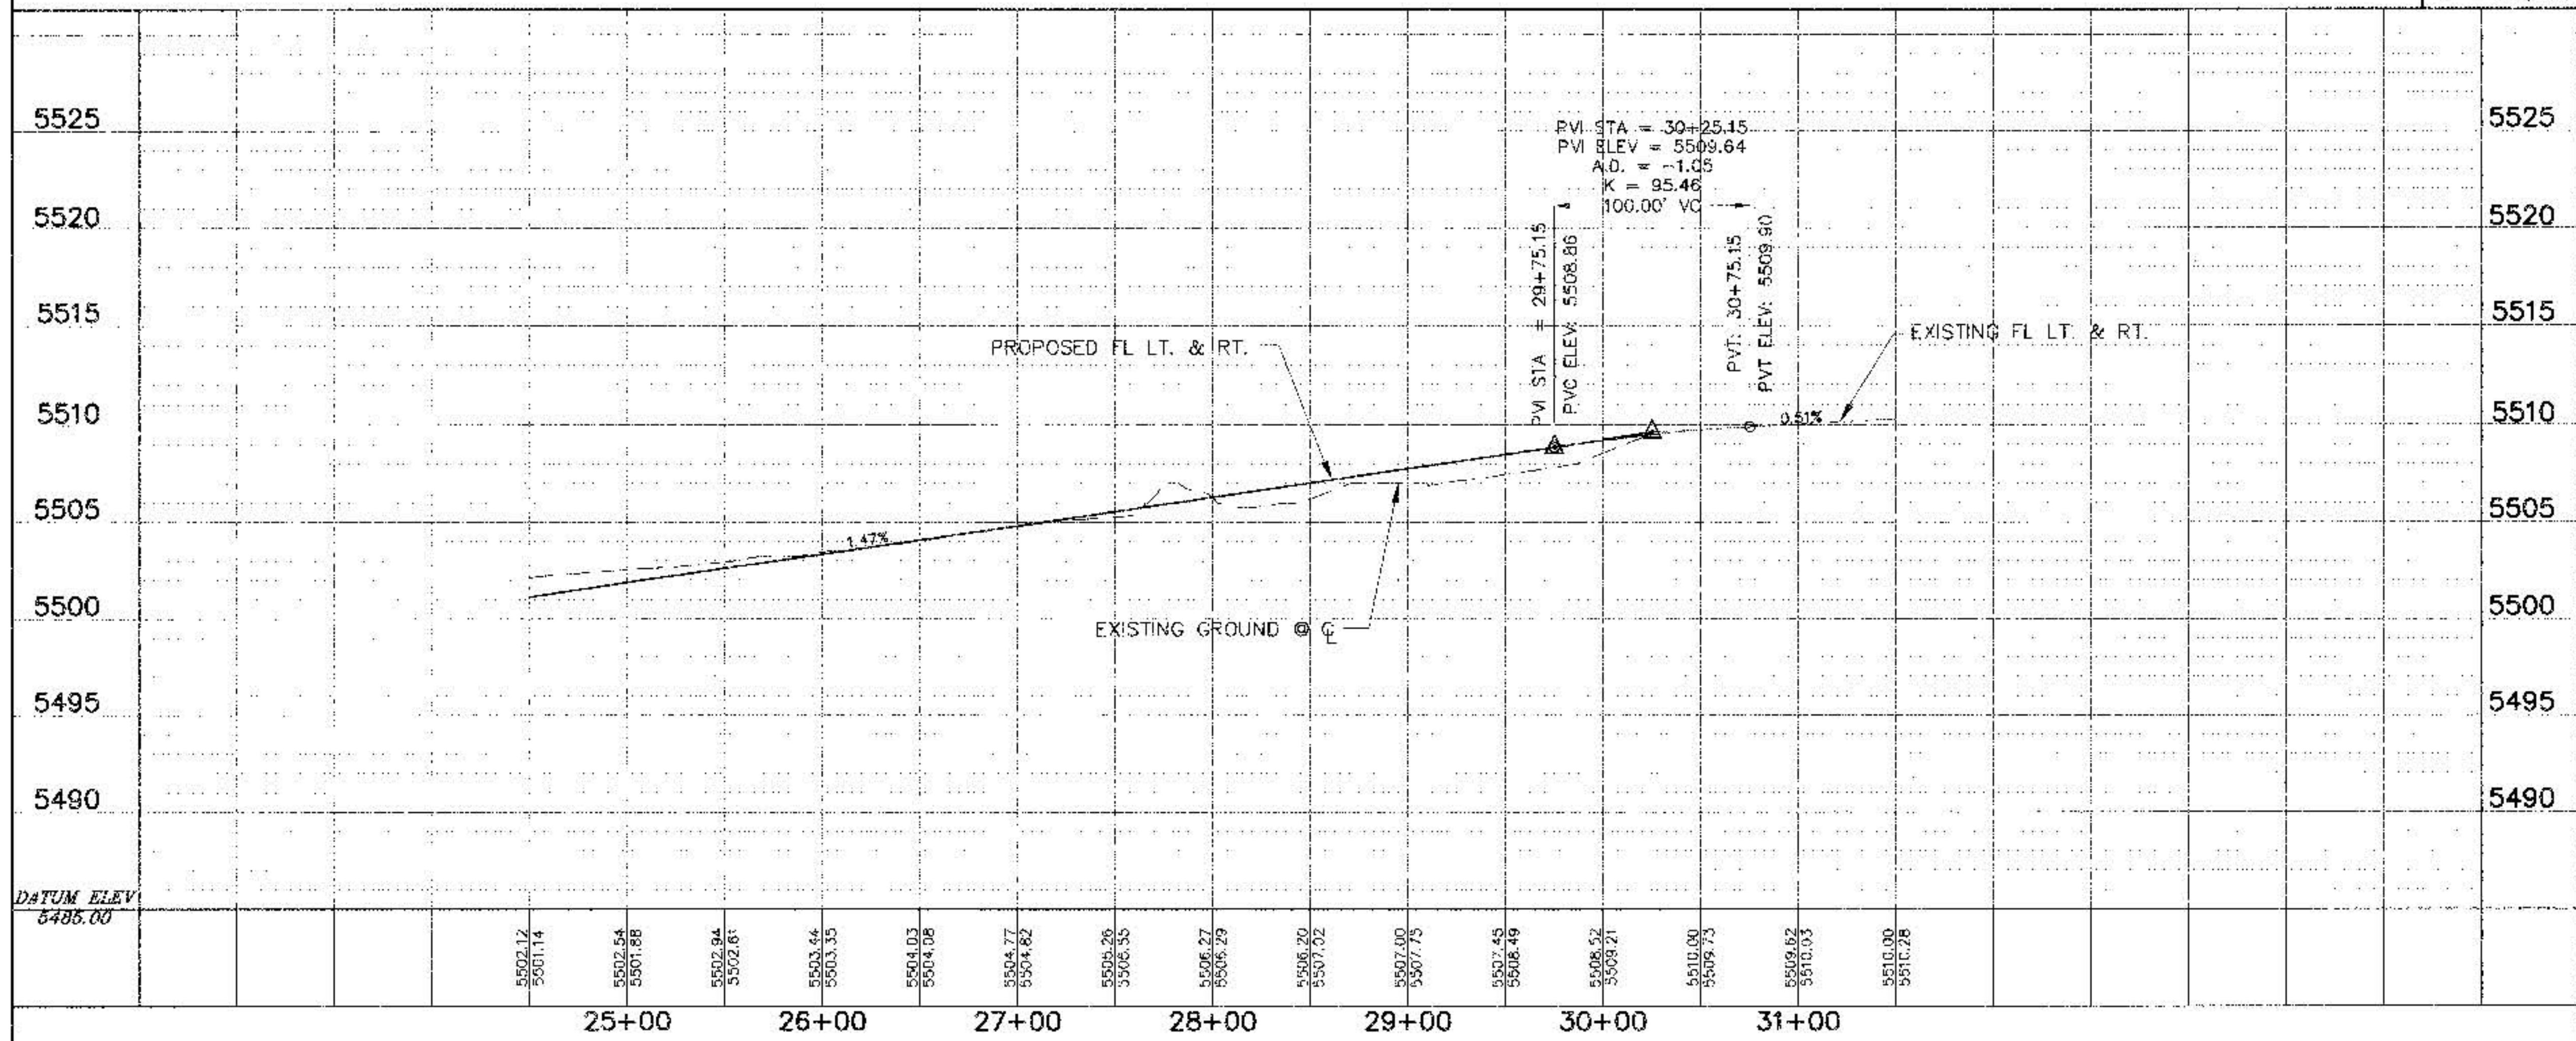

GENERAL NOTES:

1. ALL STATION AND OFFSET DIMENSIONS ARE BASED ON CENTERLINE OF RIGHT-OF-WAY.
2. ALL ELEVATIONS ARE FLOWLINE UNLESS OTHERWISE NOTED.
3. ALL SIDEWALKS TO BE CONSTRUCTED IN THIS PROJECT ARE SHOWN AS SOLID DILUTED LINES.
4. ALL INTERSECTIONS SPOT ELEVATIONS ARE TRUNCATED: ADD 5500 MSL.

KEYED NOTES

1. CONSTRUCT WHEELCHAIR RAMPS PER DETAIL, SHEET NO. 6

ELIZABETH STREET

CURB CURVE DATA

CURVE	DELTA	RADIUS	LENGTH	TANGENT
CR1	12' 43' 38"	819.84	182.11	91.43
CR2	92' 52' 34"	25.00	40.52	26.29
CR3	92' 44' 55"	25.00	40.47	26.23
CR4	17' 25' 38"	819.84	249.36	125.65
CR5	34' 21' 17"	859.84	515.56	265.79
CR6	01' 40' 24"	735.00	21.47	10.73

CENTERLINE CURVE DATA

CURVE	DELTA	RADIUS	LENGTH	TANGENT
CL1	01' 40' 24"	715.00	20.88	10.44
CL2	34' 21' 17"	839.84	503.57	259.61

LEGEND

- CENTERLINE OF STREET
- - - - - EXISTING CURB & GUTTER
- PROPOSED STANDARD CURB & GUTTER
- PROPOSED MOUNTABLE CURB & GUTTER
- PROPOSED WHEELCHAIR RAMP SEE DETAIL, SHEET NO. 6
- PROPOSED CONCRETE VALLEY GUTTER
- TRANSITION SECTION FROM FULL CROWN TO NO CROWN SECTION (MINIMUM 50' TRANSITION) SEE CITY STD. DWG 2401
- PROPOSED MANHOLE
- PROPOSED STORM DRAIN MANHOLE
- * PROPOSED STREET LIGHT LOCATION
- ⊗ PROPOSED WATER VALVE
- ⊕ PROPOSED STORM INLET
- ⊙ PROPOSED FIRE HYDRANT
- ⊗ EXISTING MANHOLE
- ⊙ EXISTING STORM DRAIN MANHOLE
- ⊗ EXISTING WATER VALVES
- ⊕ EXISTING STORM INLET
- DEFERRED SIDEWALK
- PROPOSED SIDEWALK




CITY OF ALBUQUERQUE
PUBLIC WORKS DEPARTMENT
ENGINEERING DEVELOPMENT GROUP

ELIZABETH STREET PAVING PLAN AND PROFILE
MIRABELLA UNIT 6

DESIGN REVIEW COMMITTEE	CITY ENGINEER APPROVAL	MO./DAY/YR.	MO./DAY/YR.
DATE: 9/3/99	DATE: 9/3/99	DATE: 9/3/99	DATE: 9/3/99
DESIGNED BY: MWJ	DRAWN BY: JWD	CHECKED BY: JWD	

City Project No. 6240.81 Zone Map No. L-21-Z Sheet 7 Of 22

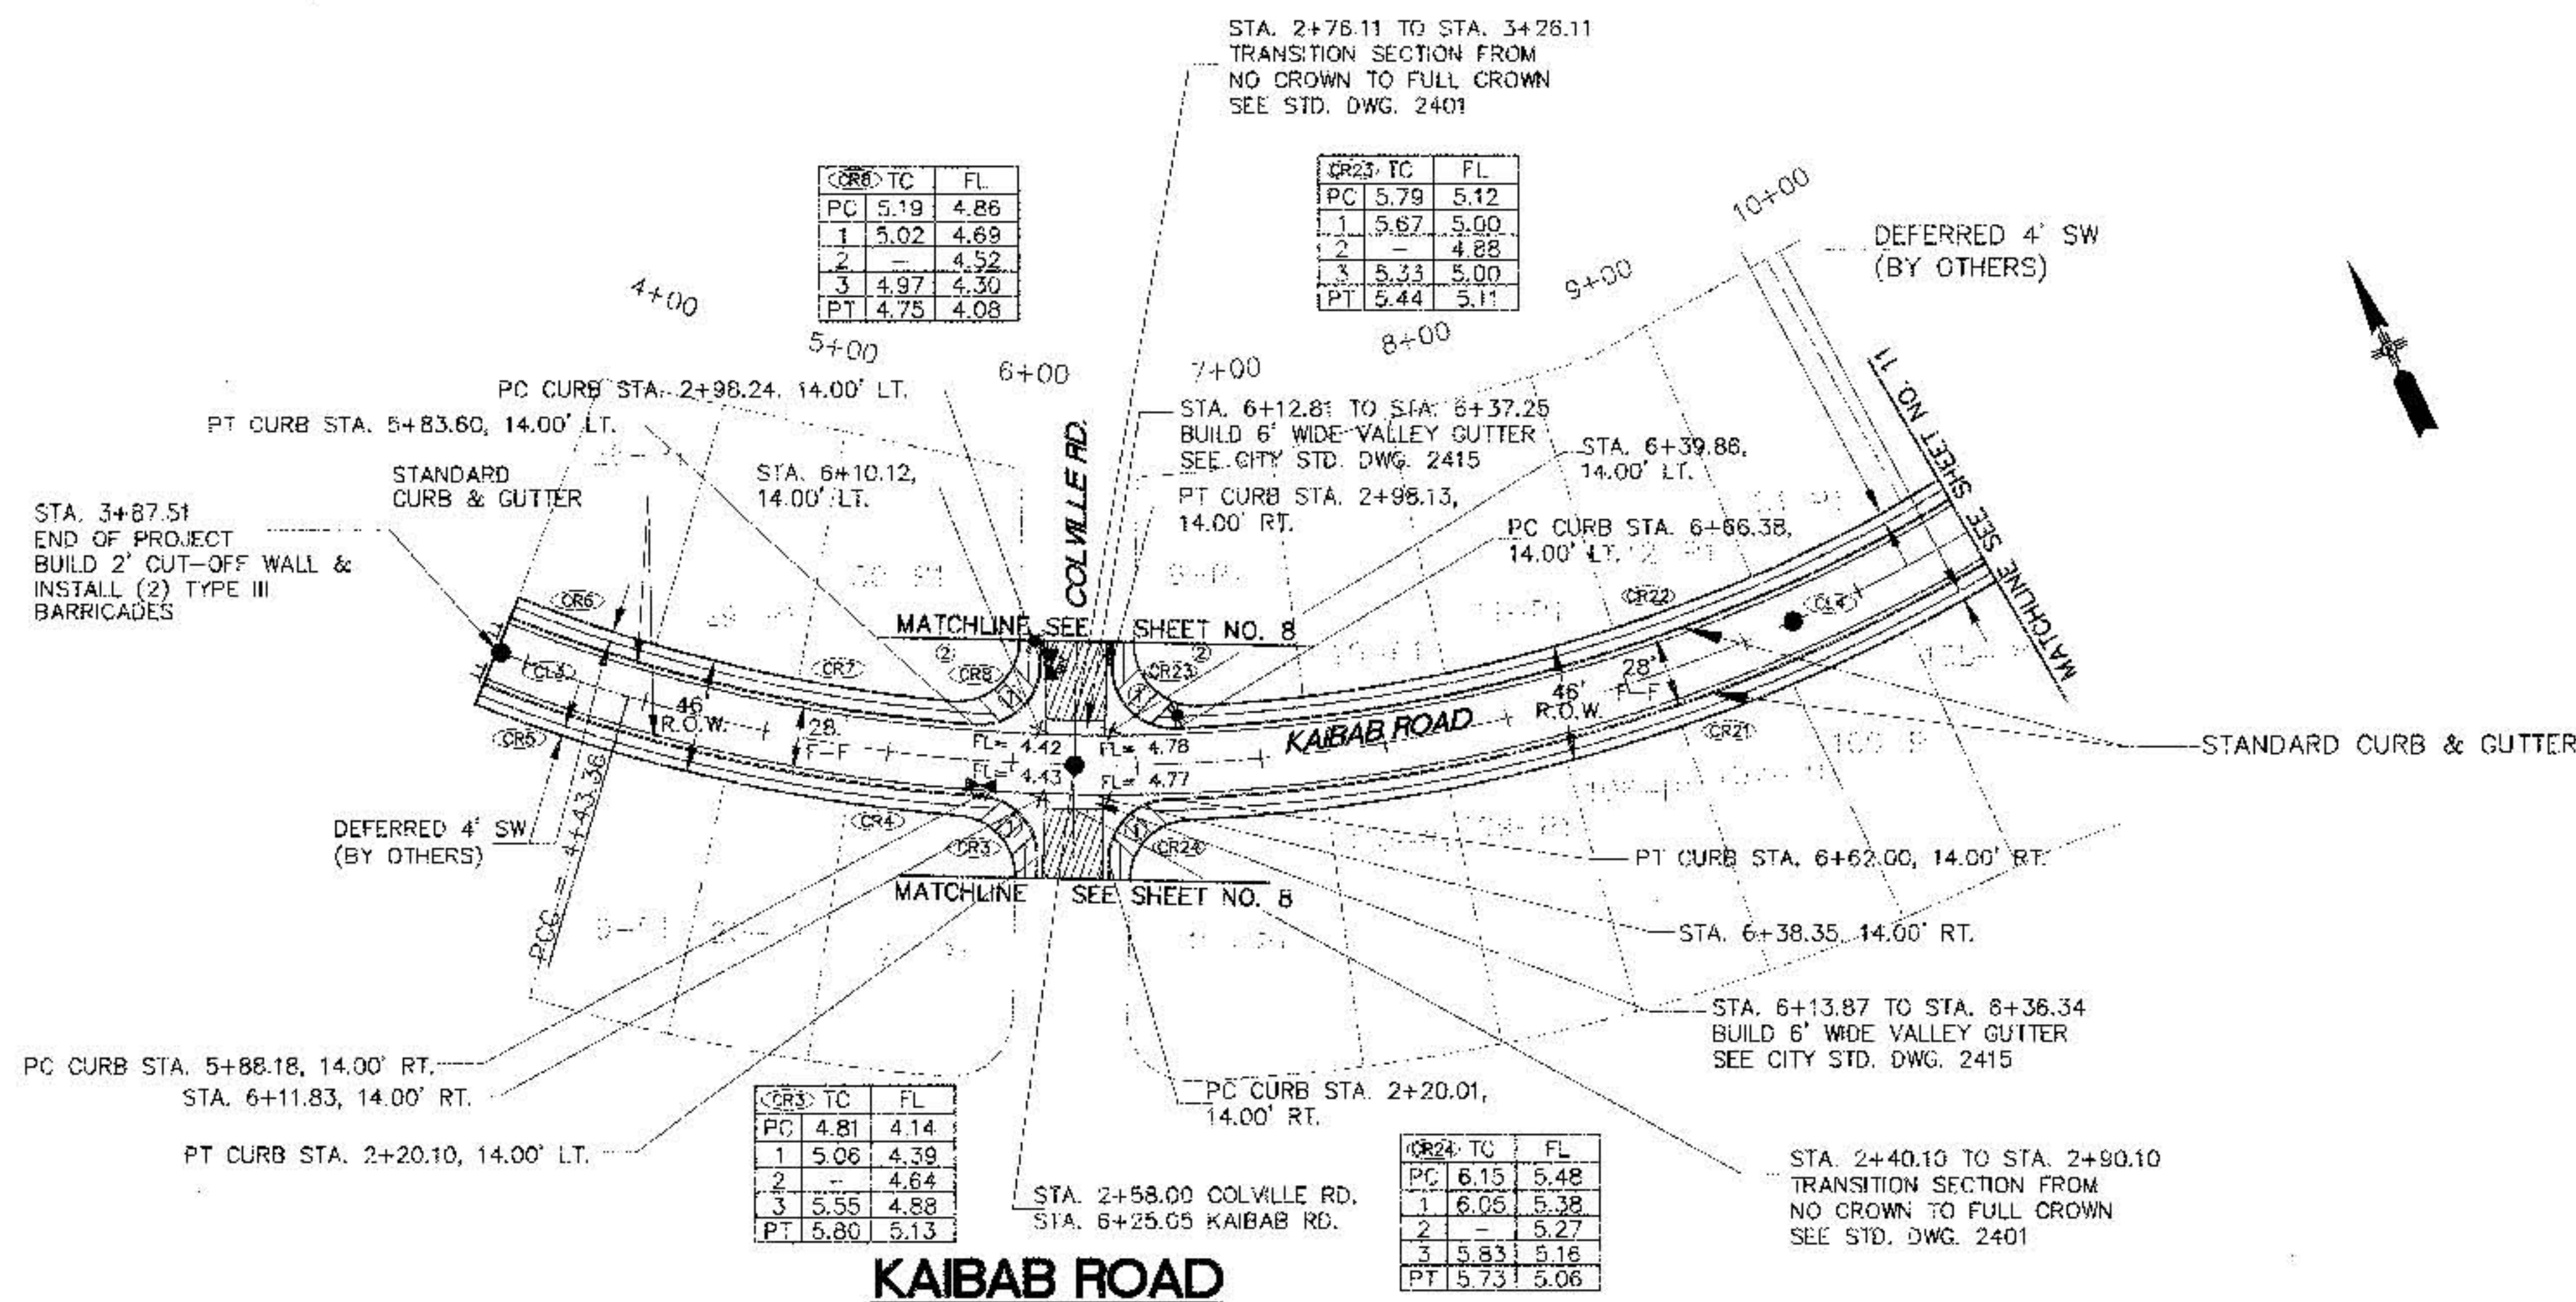

- GENERAL NOTES:**
- ALL STATION AND OFFSET DIMENSIONS ARE BASED ON CENTERLINE OF RIGHT-OF-WAY.
 - ALL ELEVATIONS ARE FLOWLINE UNLESS OTHERWISE NOTED
 - ALL SIDEWALKS TO BE CONSTRUCTED IN THIS PROJECT ARE SHOWN AS SOLID DILUTED LINES.
 - ALL INTERSECTIONS SPOT ELEVATIONS ARE TRUNCATED: ADD 5500 MSL.
- KEYED NOTES**
- CONSTRUCT WHEELCHAIR RAMPS PER DETAIL, SEE SHEET NO. 6
 - TRANSITION FROM STD. CURB & GUTTER TO MOUNTABLE CURB & GUTTER SEE CITY STD. DWG. 2418

KAIBAB ROAD

CURVE DATA

CURVE	DELTA	RADIUS	LENGTH	TANGENT
CR3	86° 49' 42"	25.00	37.89	23.65
CR4	12° 10' 12"	695.84	147.80	74.18
CR5	05° 45' 20"	570.00	57.26	28.65
CR6	05° 45' 20"	542.00	54.45	27.25
CR7	11° 47' 05"	667.84	137.36	68.92
CR8	93° 33' 25"	25.00	40.82	26.60
CR9	38° 02' 49"	695.84	462.07	239.92
CR10	37° 40' 44"	667.84	439.18	227.86
CR11	93° 23' 58"	25.00	40.75	26.53
CR12	88° 58' 08"	25.00	37.95	23.71

CENTERLINE CURVE DATA

CURVE	DELTA	RADIUS	LENGTH	TANGENT
CL3	05° 45' 20"	556.00	55.85	27.95
CL4	56° 25' 12"	681.84	671.41	365.75


LEGEND

- CENTERLINE OF STREET
- EXISTING CURB & GUTTER
- PROPOSED STANDARD CURB & GUTTER
- PROPOSED MOUNTABLE CURB & GUTTER
- PROPOSED WHEELCHAIR RAMP SEE DETAIL, SHEET NO. 6
- PROPOSED CONCRETE VALLEY GUTTER
- TRANSITION SECTION FROM FULL CROWN TO NO CROWN SECTION (MINIMUM 50' TRANSITION) SEE CITY STD. DWG. 2401
- PROPOSED MANHOLE
- PROPOSED STORM DRAIN MANHOLE
- PROPOSED STREET LIGHT LOCATION
- PROPOSED WATER VALVE
- PROPOSED STORM INLET
- PROPOSED FIRE HYDRANT
- EXISTING MANHOLE
- EXISTING STORM DRAIN MANHOLE
- EXISTING WATER VALVES
- EXISTING STORM INLET
- DEFERRED SIDEWALK
- PROPOSED SIDEWALK

SCALE

1" = 50' (HOR)

1" = 5' (VER)

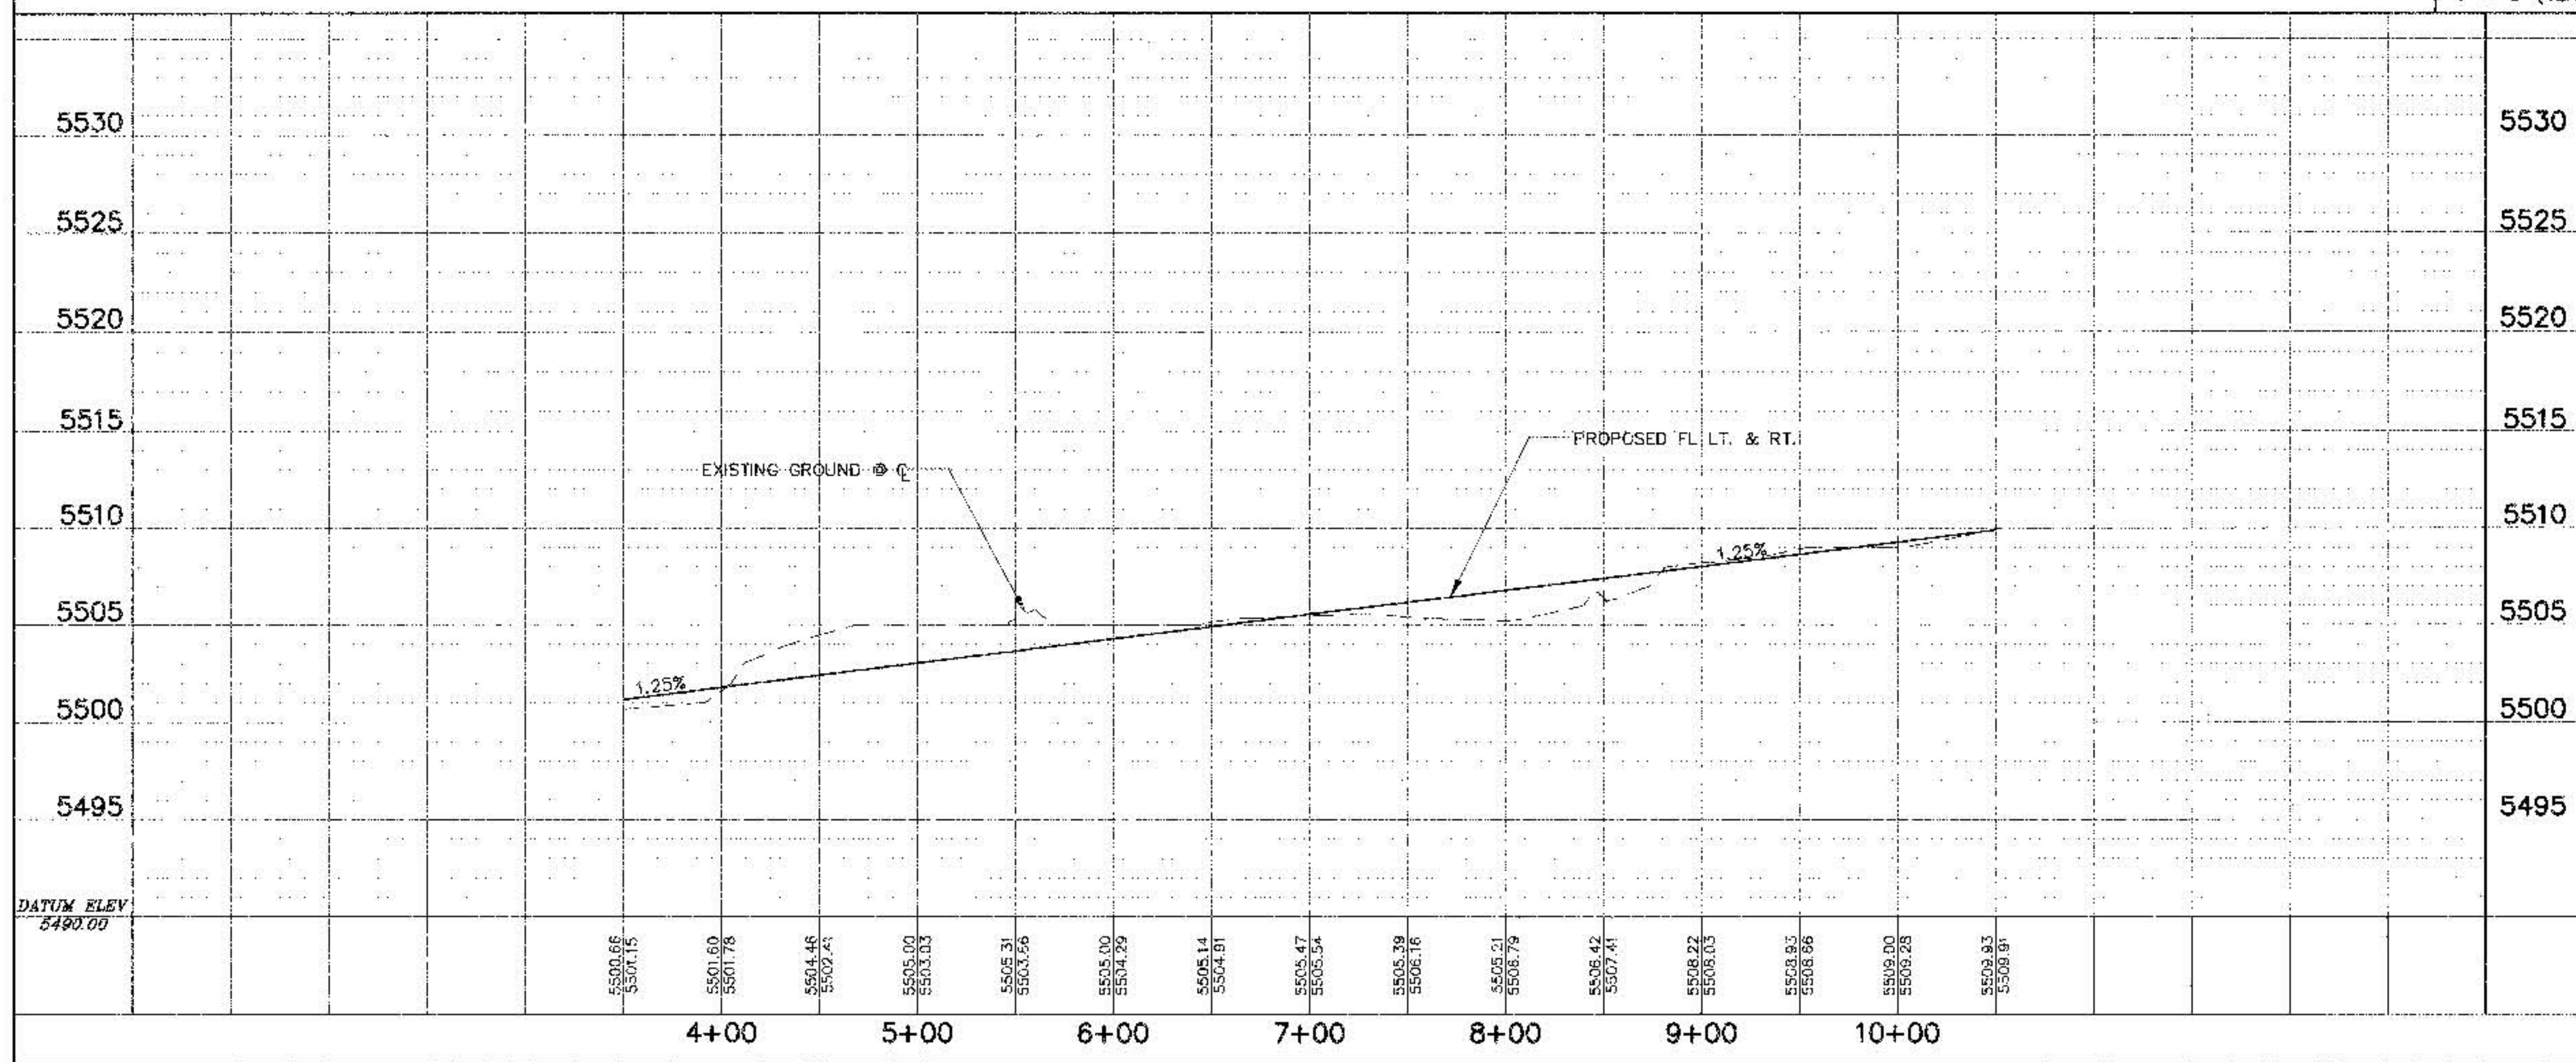

ENGINEER'S SEAL

DESIGNED BY: MVI DATE: 9/3/99

DRAWN BY: JMD DATE: 9/3/99

CHECKED BY: JMD DATE: 9/3/99

PARSONS BRINCKERHOFF

CITY OF ALBUQUERQUE
PUBLIC WORKS DEPARTMENT
ENGINEERING DEVELOPMENT GROUP

KAIBAB ROAD PAVING PLAN AND PROFILE SHEET 1

MIRABELLA UNIT 6


DESIGN REVIEW COMMITTEE

CITY ENGINEER

City Project No. 6240.81

Zone Map No. L-21-Z

Sheet 10 Of 22

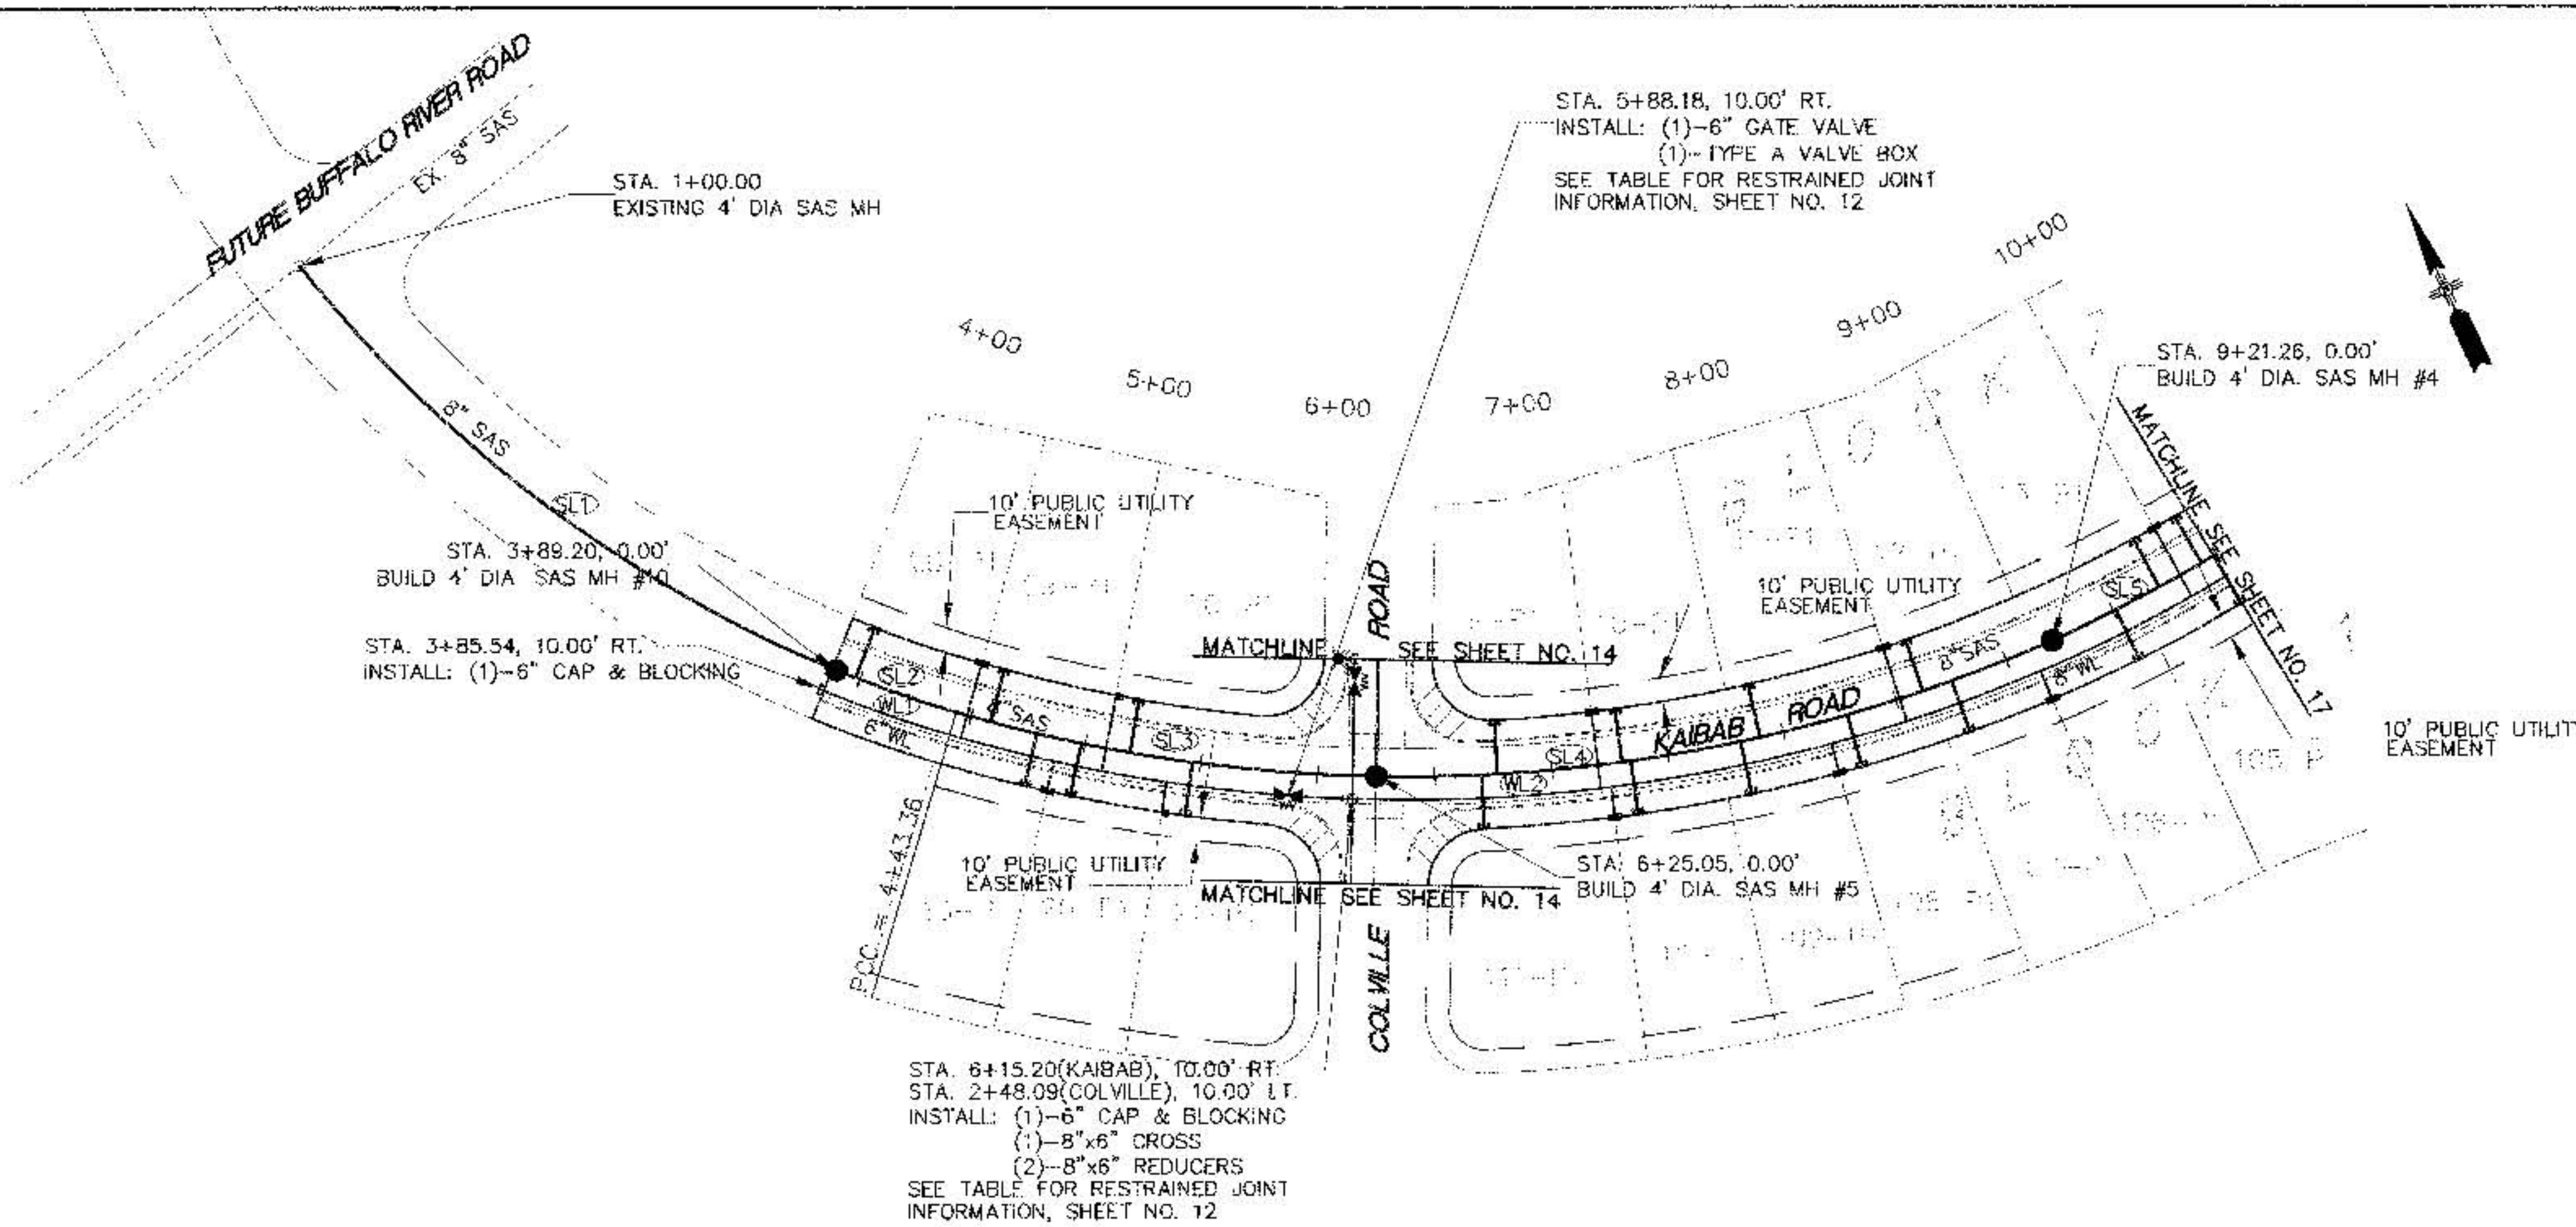

- UTILITY NOTES**
- 1.) STATIONING ALONG C OF STREET UNLESS OTHERWISE NOTED.
 - 2.) SANITARY SEWER LINE LENGTHS COMPUTED FROM MH C TO MH C.
 - 3.) SLOPES ARE COMPUTED INVERT TO INVERT. MH RIM ELEVATIONS GIVEN ARE APPROXIMATE. CONTRACTOR SHALL ADJUST ALL RIMS TO FINAL GRADE.
 - 4.) CONTRACTOR IS RESPONSIBLE FOR COORDINATION WITH UTILITY COMPANIES.
 - 5.) CONTRACTOR SHALL VERIFY ALL EXISTING UTILITIES AND UTILITY CONNECTIONS PRIOR TO BEGINNING CONSTRUCTION. SHOULD A CONFLICT EXIST OR DESIGN REVISIONS BE REQUIRED FOR ANY REASON, THE CONTRACTOR SHALL NOTIFY THE ENGINEER AND ALLOW SUFFICIENT TIME FOR DESIGN REVISIONS SO AS TO NOT DELAY THE CONSTRUCTION SCHEDULE.
 - 6.) REFER TO CITY OF ABQ. STANDARD DRAWINGS FOR WATER & SANITARY SEWER CONSTRUCTION.


CURVILINEAR WATERLINE DATA

CURVE	DELTA	RADIUS	LENGTH	TANGENT
WL1	05°57'29"	566.00'	58.86'	29.46'
WL2	56°25'12"	691.84'	681.26'	371.11'

CURVILINEAR SANITARY SEWER DATA

CURVE	DELTA	RADIUS	LENGTH	TANGENT
SL1	29°48'11"	556.00'	289.21'	147.96'
SL2	05°34'52"	556.00'	54.16'	27.10'
SL3	15°16'03"	681.84'	181.69'	91.38'
SL4	24°53'28"	681.84'	286.21'	150.48'
SL5	16°15'41"	681.84'	193.52'	97.41'

- LEGEND**
- EXISTING WATERLINE
 - EXISTING STORM DRAIN
 - SAS --- EXISTING SANITARY SEWER
 - EXISTING MANHOLE
 - ⊙ EXISTING STORM DRAIN MANHOLE
 - ⊕ EXISTING FIRE HYDRANT
 - ⊕ EXISTING GATE VALVE
 - PROPOSED WATERLINE
 - SAS --- PROPOSED SANITARY SEWER
 - PROPOSED PRIVATE UTILITY EASEMENT
 - PROPOSED MANHOLE
 - ⊙ PROPOSED STORM DRAIN MANHOLE
 - ⊕ PROPOSED FIRE HYDRANT
 - ⊕ PROPOSED WATER VALVE
 - PROPOSED CAP OR PLUG
 - PROPOSED SINGLE METER, WATER SERVICE LINE
 - PROPOSED DOUBLE METER, WATER SERVICE LINE
 - PROPOSED SANITARY SEWER SERVICE LINE
 - + + + PROPOSED CROSS, TEE, OR ELBOW

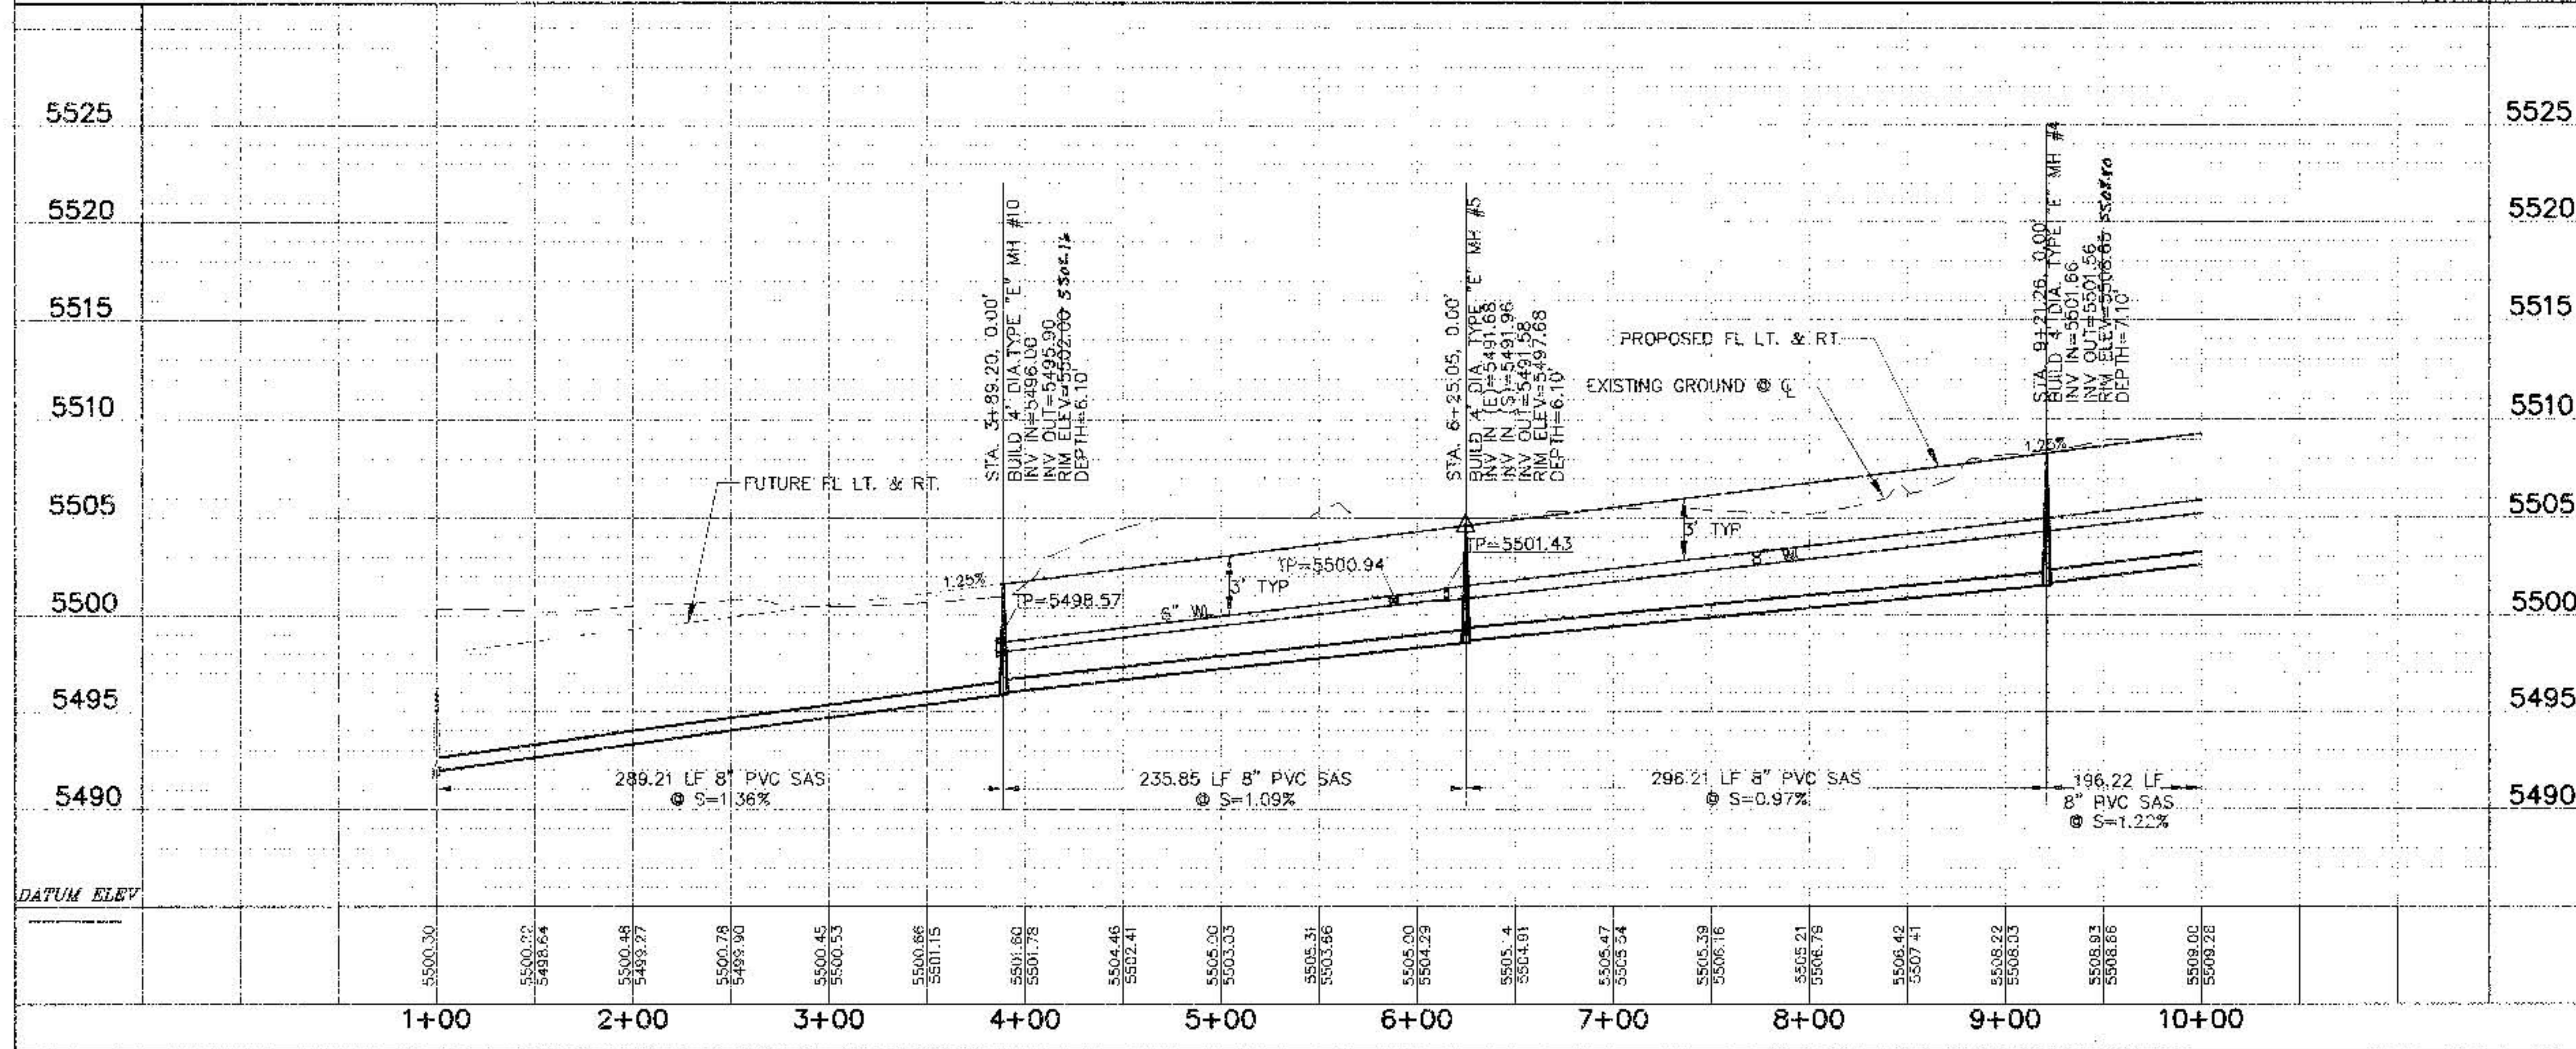


PARSONS BRINCKERHOFF

CITY OF ALBUQUERQUE
PUBLIC WORKS DEPARTMENT
ENGINEERING DEVELOPMENT GROUP

**KAIBAB ROAD UTILITY PLAN AND PROFILE SHEET 1
MIRABELLA UNIT 6**

DESIGN REVIEW COMMITTEE	CITY ENGINEER APPROVAL	MO./DAY/YR.	MO./DAY/YR.

City Project No. 6240.81 Zone Map No. L-21-Z Sheet 16 Of 22

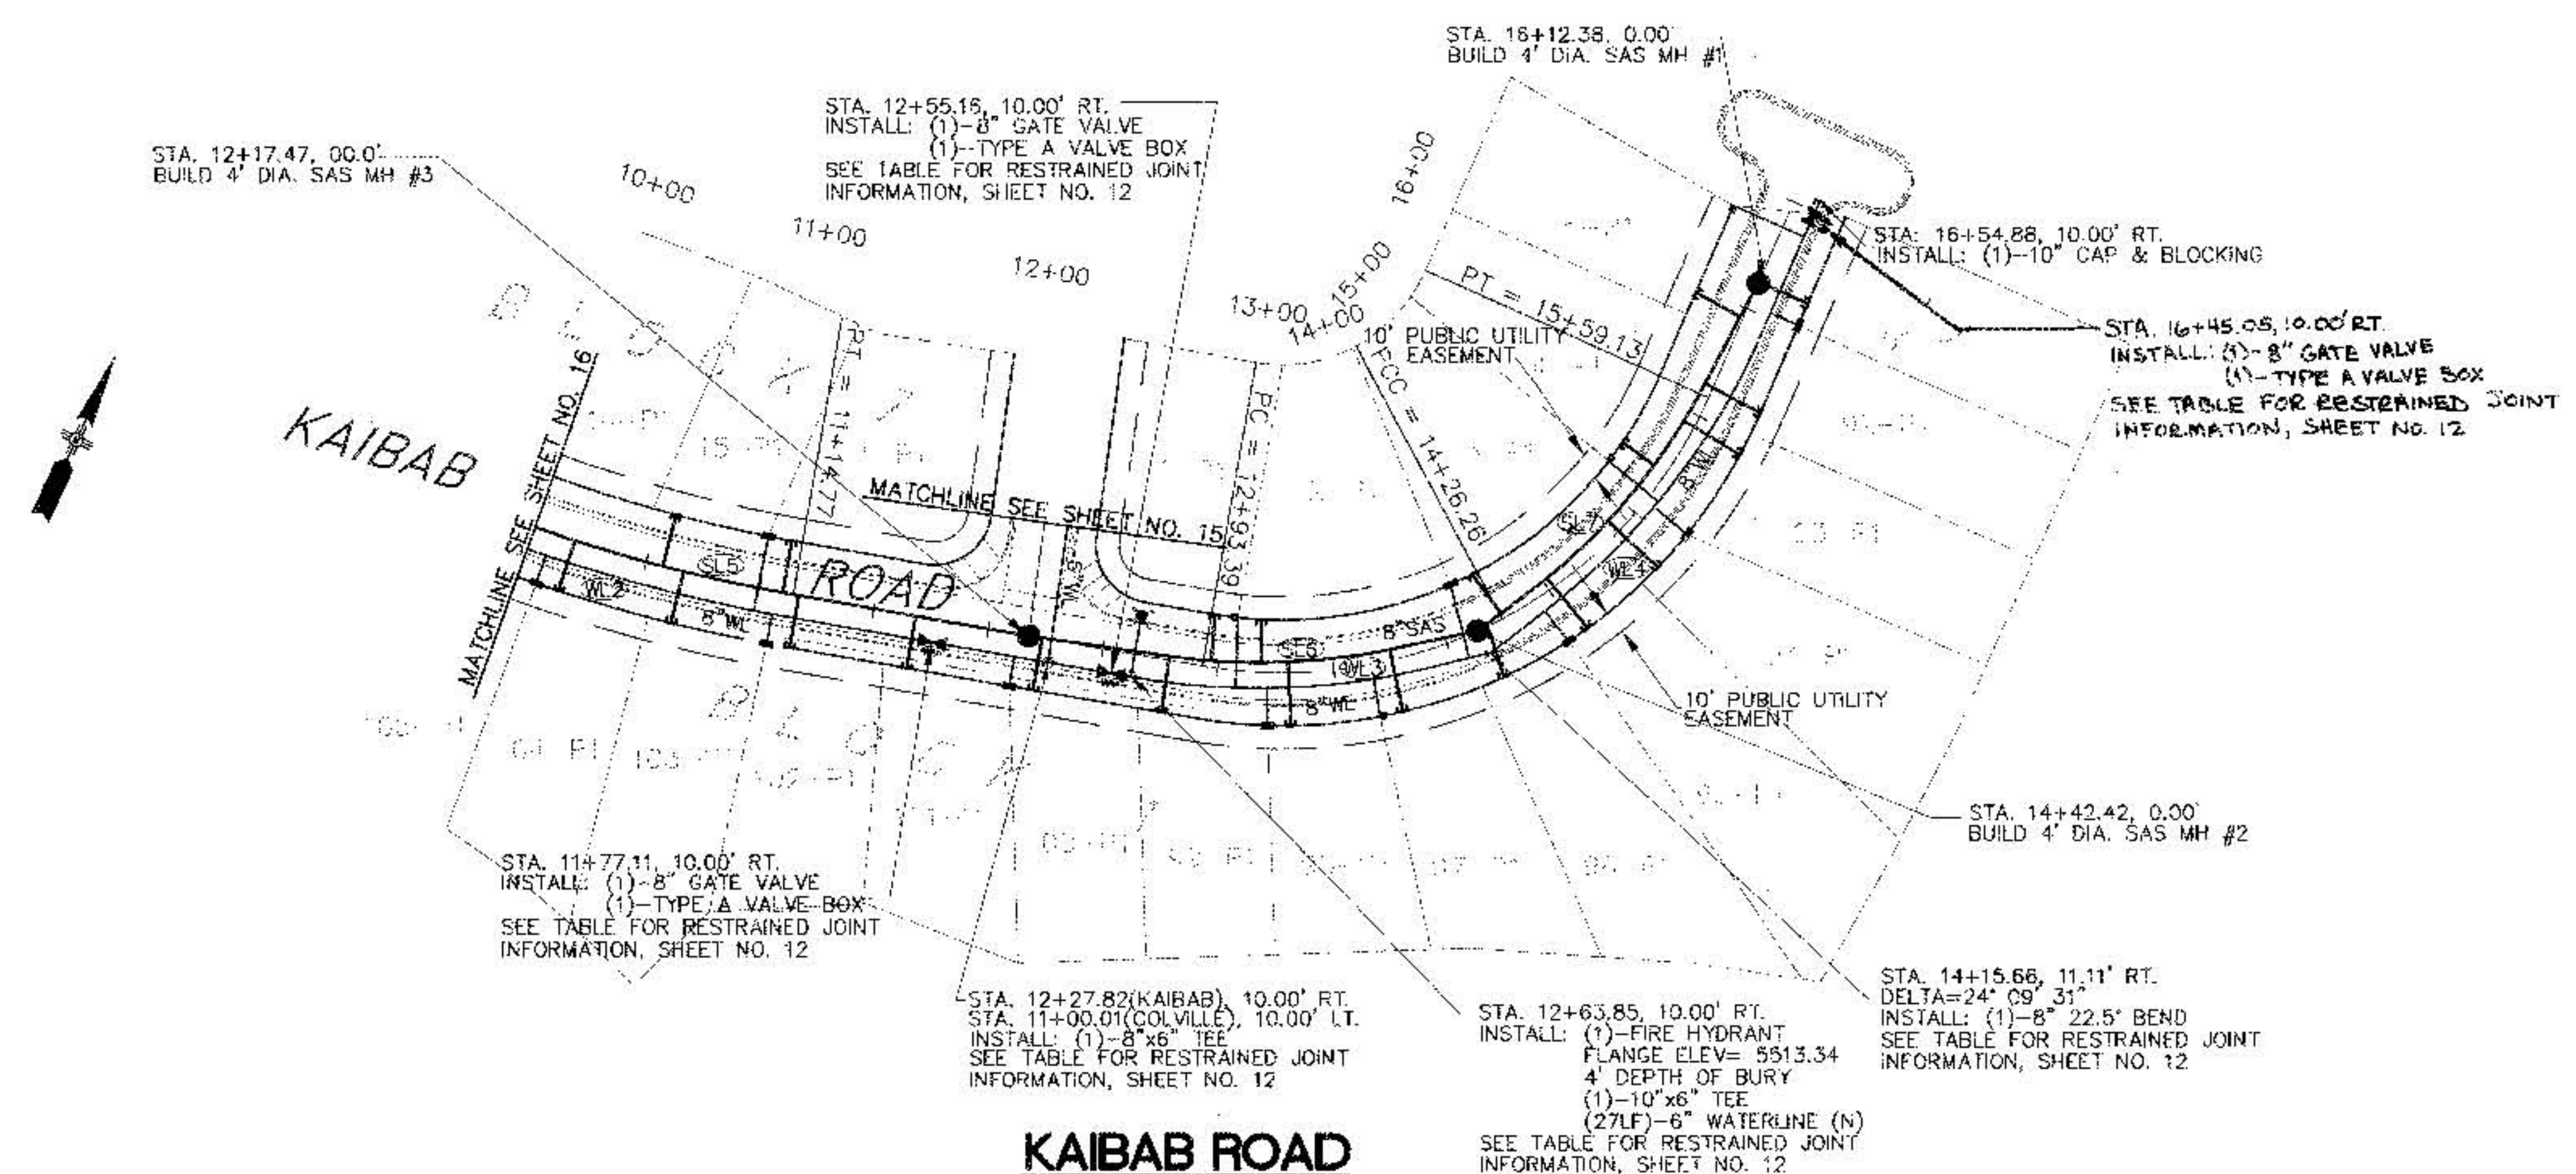

- UTILITY NOTES**
- 1.) STATIONING ALONG C. OF STREET UNLESS OTHERWISE NOTED.
 - 2.) SANITARY SEWER LINE LENGTHS COMPUTED FROM MH C. TO MH C.
 - 3.) SLOPES ARE COMPUTED INVERT TO INVERT. MH RIM ELEVATIONS GIVEN ARE APPROXIMATE. CONTRACTOR SHALL ADJUST ALL RIMS TO FINAL GRADE.
 - 4.) CONTRACTOR IS RESPONSIBLE FOR COORDINATION WITH UTILITY COMPANIES.
 - 5.) CONTRACTOR SHALL VERIFY ALL EXISTING UTILITIES AND UTILITY CONNECTIONS PRIOR TO BEGINNING CONSTRUCTION. SHOULD A CONFLICT EXIST OR DESIGN REVISIONS BE REQUIRED FOR ANY REASON, THE CONTRACTOR SHALL NOTIFY THE ENGINEER AND ALLOW SUFFICIENT TIME FOR DESIGN REVISIONS SO AS TO NOT DELAY THE CONSTRUCTION SCHEDULE.
 - 6.) REFER TO CITY OF ABQ. STANDARD DRAWINGS FOR WATER & SANITARY SEWER CONSTRUCTION.


CURVILINEAR WATERLINE DATA

CURVE	DELTA	RADIUS	LENGTH	TANGENT
WL2	56°25'12"	891.84'	681.26'	371.11
WL3	23°58'36"	310.00'	129.73'	65.83
WL4	27°59'38"	310.00'	151.46'	77.27

CURVILINEAR SANITARY SEWER DATA

CURVE	DELTA	RADIUS	LENGTH	TANGENT
SL5	16°15'41"	881.84'	193.52'	97.41
SL6	20°42'36"	275.00'	99.40'	50.25
SL7	24°46'49"	275.00'	118.94'	60.41

- LEGEND**
- W--- EXISTING WATERLINE
 - S--- EXISTING STORM DRAIN
 - SAS--- EXISTING SANITARY SEWER
 - ⊙ EXISTING MANHOLE
 - ⊗ EXISTING STORM DRAIN MANHOLE
 - ⊕ EXISTING FIRE HYDRANT
 - ⊞ EXISTING GATE VALVE
 - W--- PROPOSED WATERLINE
 - SAS--- PROPOSED SANITARY SEWER
 - EAS--- PROPOSED PRIVATE UTILITY EASEMENT
 - PROPOSED MANHOLE
 - ⊙ PROPOSED STORM DRAIN MANHOLE
 - ⊕ PROPOSED FIRE HYDRANT
 - ⊞ PROPOSED GATE VALVE
 - W--- PROPOSED WATER SERVICE LINE
 - SAS--- PROPOSED SINGLE METER, WATER SERVICE LINE
 - SAS--- PROPOSED DOUBLE METER, WATER SERVICE LINES
 - SAS--- PROPOSED SANITARY SEWER SERVICE LINE
 - SAS--- PROPOSED CROSS, TEE, OR ELBOW

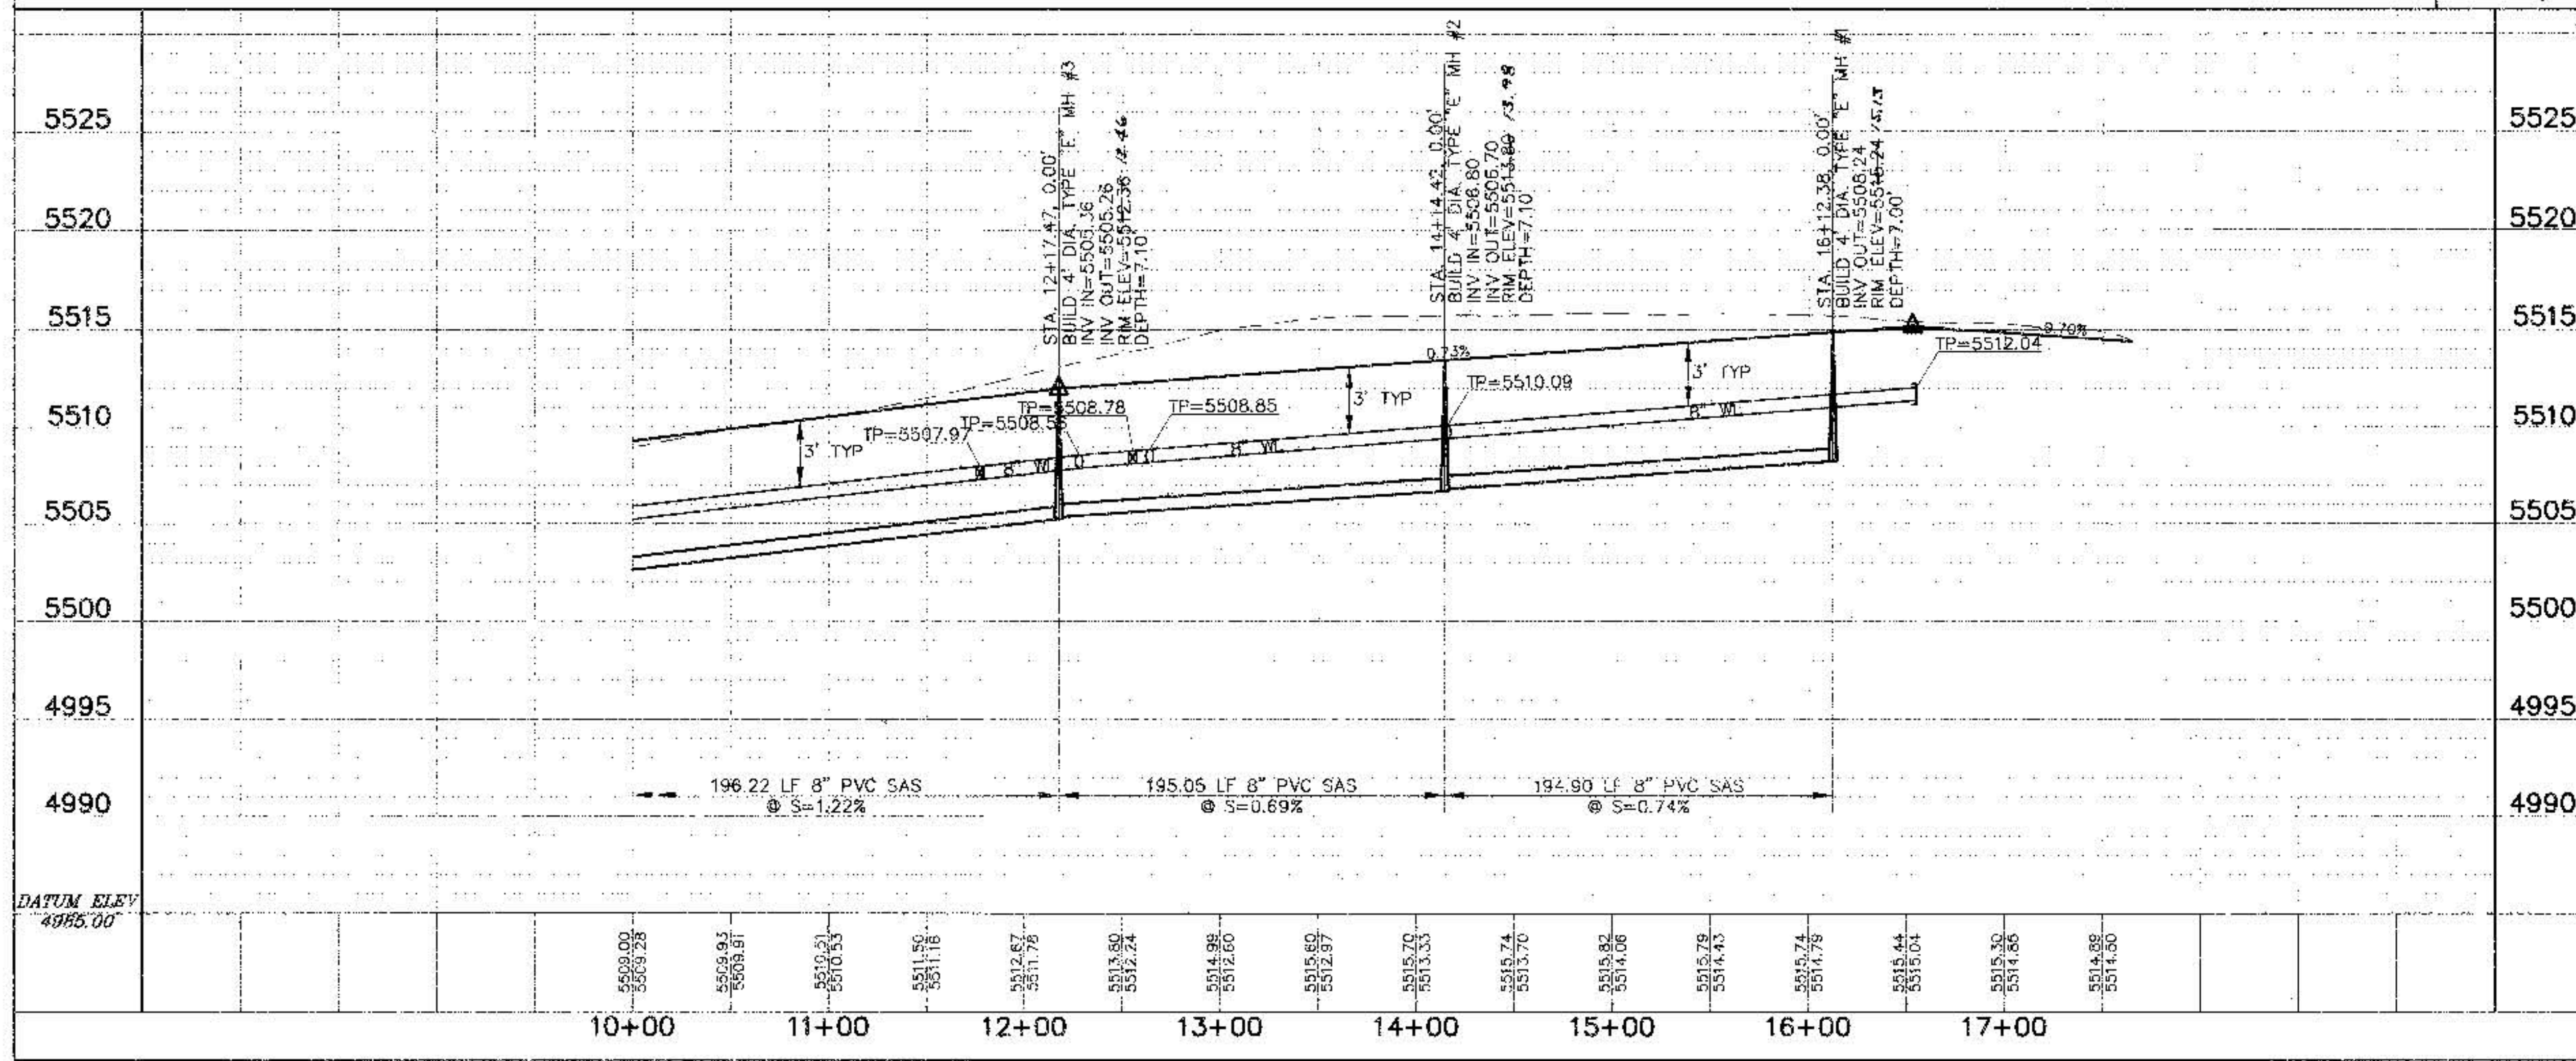



PARSONS BRINCKERHOFF

CITY OF ALBUQUERQUE
PUBLIC WORKS DEPARTMENT
ENGINEERING DEVELOPMENT GROUP

KAIBAB ROAD UTILITY PLAN AND PROFILE SHEET 2
MIRABELLA UNIT 6

DESIGN REVIEW COMMITTEE

City Project No. 6240.81 Zone Map No. L-21-Z Sheet 17 of 22

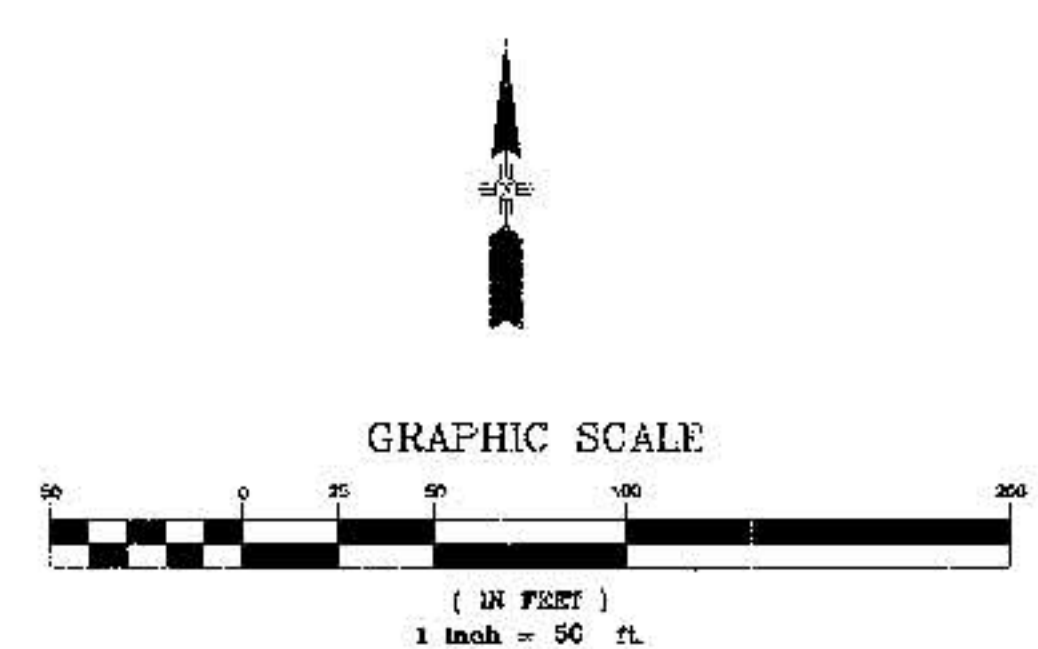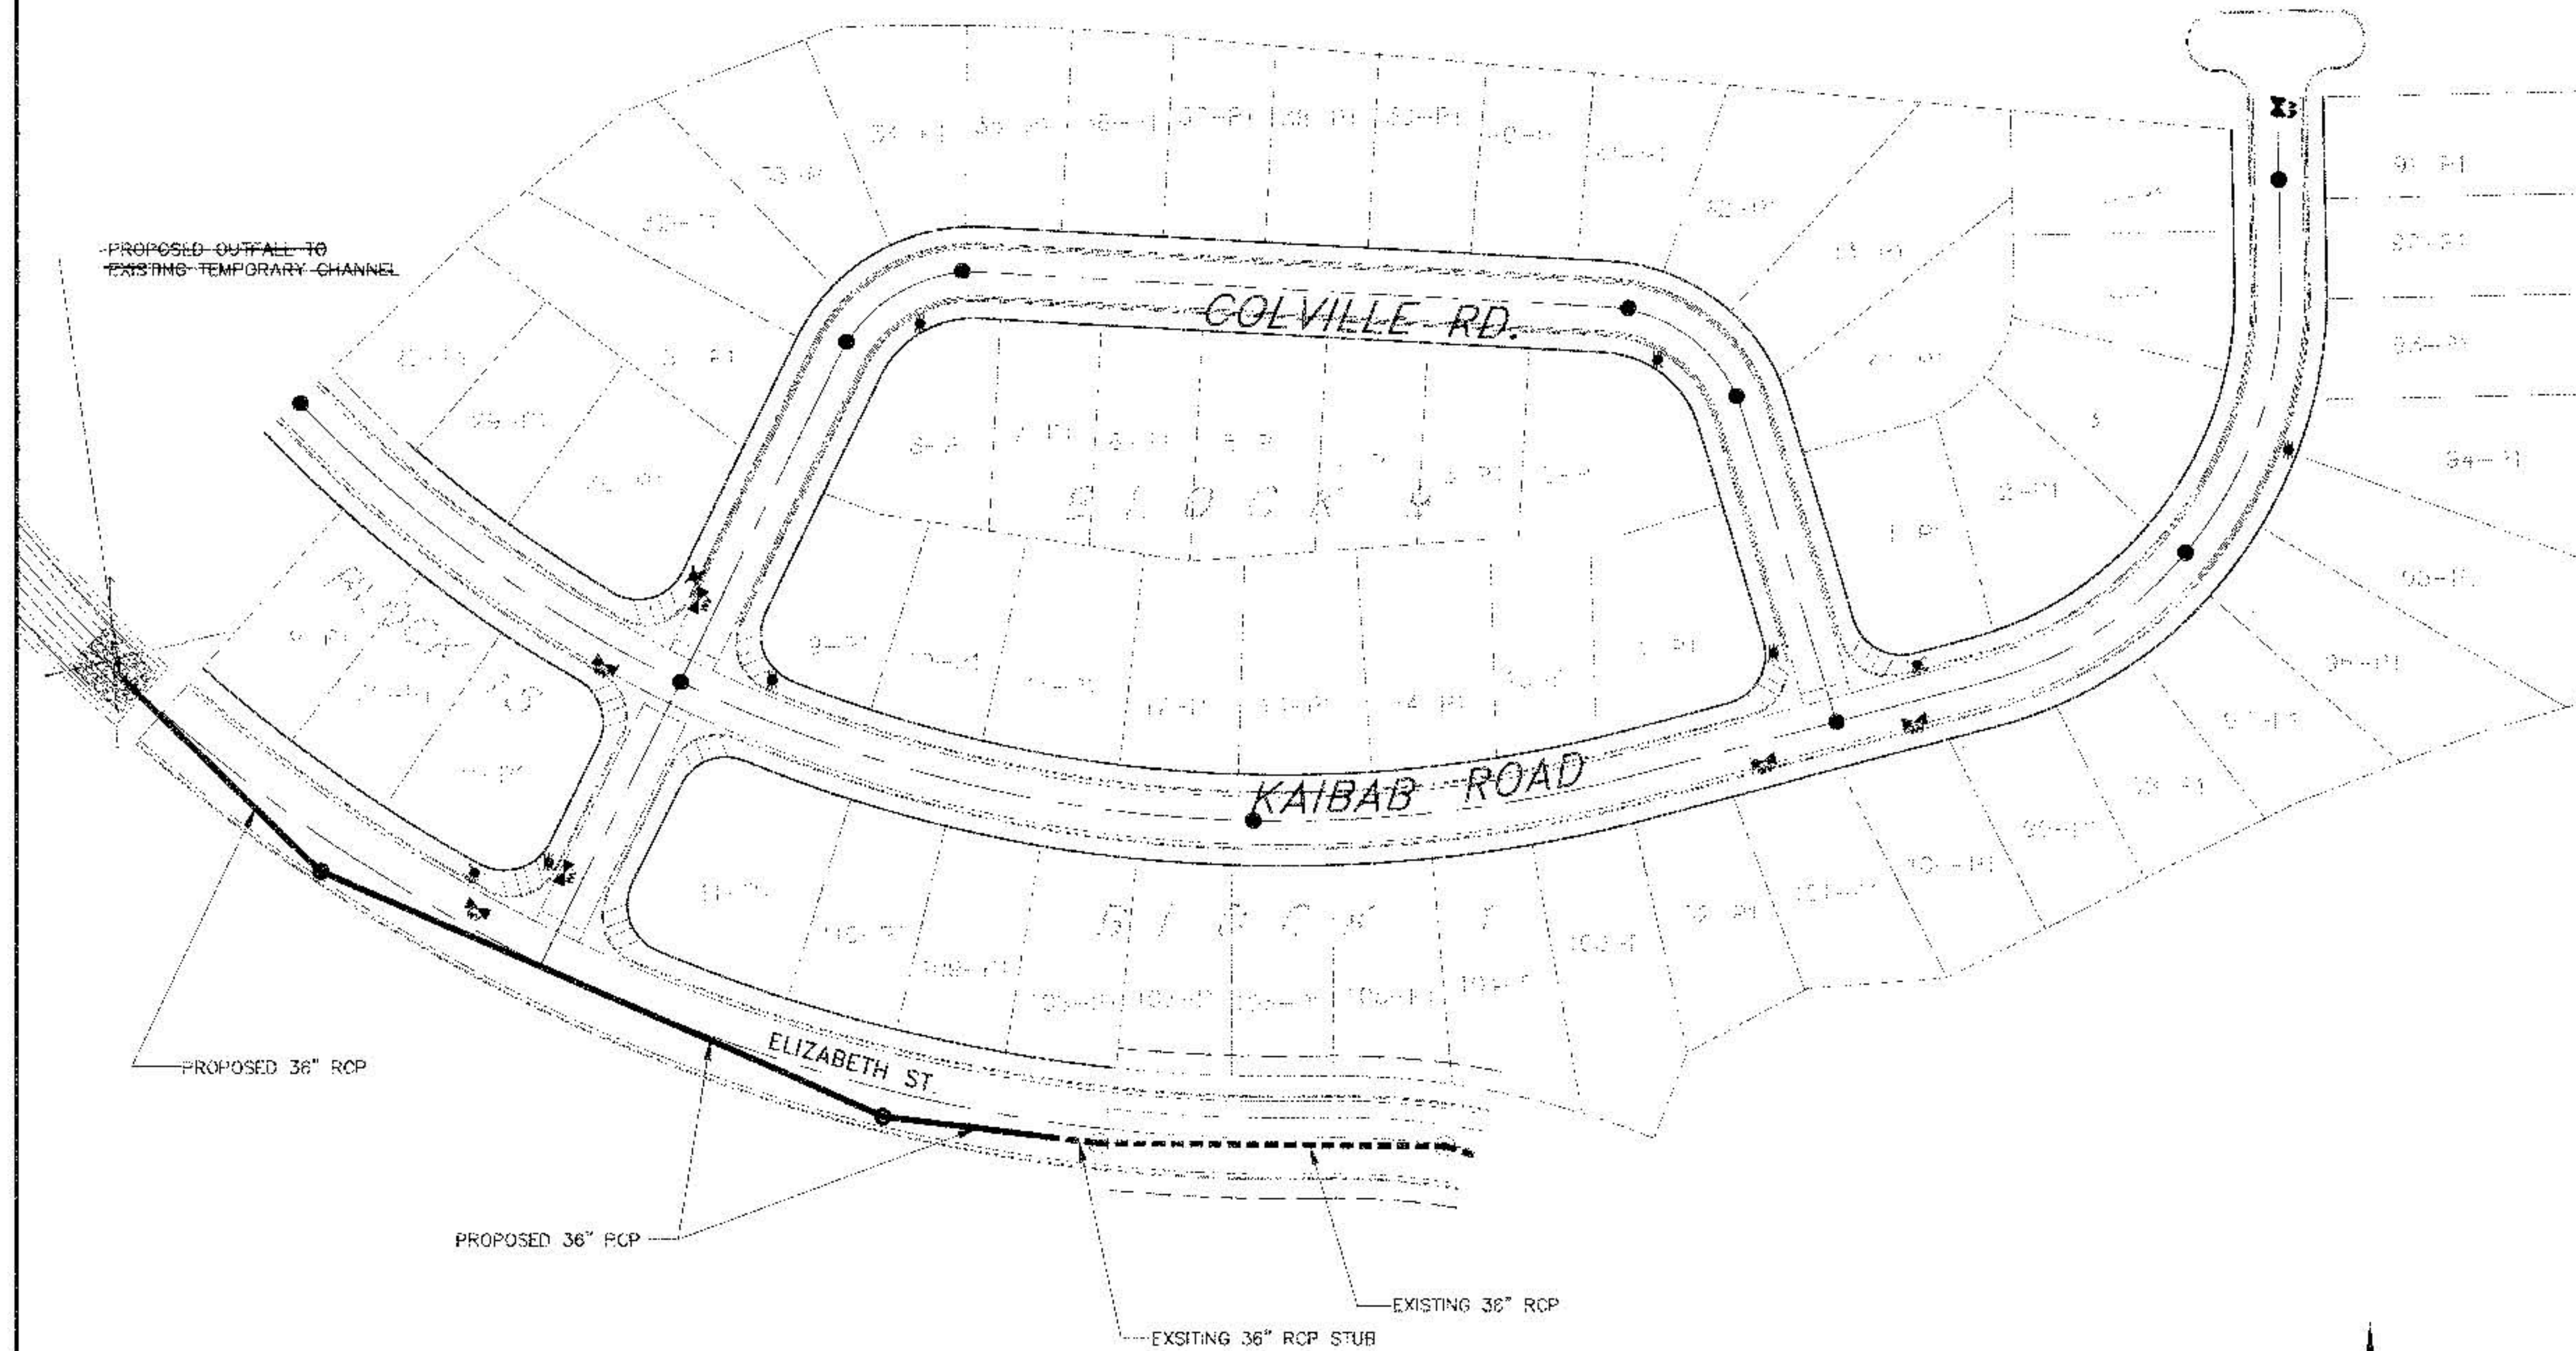

- STORM DRAIN NOTES**
1. STATIONING ALONG C. OF STREET UNLESS OTHERWISE NOTED.
 2. SLOPES ARE COMPUTED INVERT TO INVERT. MIN RIM ELEVATIONS GIVEN ARE APPROXIMATE. CONTRACTOR SHALL ADJUST ALL RIMS TO FINAL GRADE.
 3. DISTANCES ARE FROM CENTER OF MANHOLE TO CENTER OF MANHOLE.
 4. CONTRACTOR IS RESPONSIBLE FOR COORDINATION WITH UTILITY COMPANIES.
 5. CONTRACTOR SHALL VERIFY ALL EXISTING UTILITIES AND UTILITY CONNECTIONS PRIOR TO BEGINNING CONSTRUCTION. SHOULD A CONFLICT EXIST OR DESIGN REVISIONS BE REQUIRED FOR ANY REASON, THE CONTRACTOR SHALL NOTIFY THE ENGINEER AND ALLOW SUFFICIENT TIME FOR DESIGN REVISIONS SO AS TO NOT DELAY THE CONSTRUCTION SCHEDULE.

- LEGEND**
- PROPOSED STORM DRAIN
 - - - - - EXISTING STORM DRAIN
 - - - - - CENTERLINE OF STREET
 - - - - - EXISTING CURB & GUTTER
 - - - - - PROPOSED STANDARD CURB & GUTTER
 - - - - - PROPOSED CONCRETE VALLEY GUTTER
 - PROPOSED MANHOLE
 - ⊙ EXISTING MANHOLE
 - ⊙ PROPOSED STORM DRAIN MANHOLE
 - ⊙ EXISTING STORM DRAIN
 - ⊙ PROPOSED STORM INLET
 - ⊙ PROPOSED FIRE HYDRANT
 - ⊙ EXISTING GATE VALVE
 - ⊙ PROPOSED GATE VALVE
 - ⊙ PROPOSED STREET LIGHT LOCATION




CITY OF ALBUQUERQUE
PUBLIC WORKS DEPARTMENT
ENGINEERING DEVELOPMENT GROUP
OVERALL STORM DRAIN PLAN
MIRABELLA UNIT 6

DESIGN REVIEW COMMITTEE	CITY OF ALBUQUERQUE	NO. / DAY / YR.	NO. / DAY / YR.
DATE: 9/3/99	DATE: 9/3/99	DATE: 9/3/99	DATE: 9/3/99
DESIGNED BY: MUG	DESIGNED BY: MUG	CHECKED BY: MUG	CHECKED BY: MUG
DRAWN BY: MUG	DRAWN BY: MUG	DRAWN BY: MUG	DRAWN BY: MUG
CITY PROJECT NO. 6240.81	ZONE MAP NO. L-21-Z	SHEET 18	OF 22

SURVEY INFORMATION		BENCH MARKS		AS BUILT INFORMATION	
NO.	DATE	NO.	DATE	NO.	DATE
1	9/3/99	1	9/3/99	1	9/3/99
2	9/3/99	2	9/3/99	2	9/3/99
3	9/3/99	3	9/3/99	3	9/3/99
4	9/3/99	4	9/3/99	4	9/3/99
5	9/3/99	5	9/3/99	5	9/3/99
6	9/3/99	6	9/3/99	6	9/3/99
7	9/3/99	7	9/3/99	7	9/3/99
8	9/3/99	8	9/3/99	8	9/3/99
9	9/3/99	9	9/3/99	9	9/3/99
10	9/3/99	10	9/3/99	10	9/3/99


ENGINEER'S SEAL	REMARKS	BY	DATE
1	DESIGN	MUG	9/3/99
2	CHECKED	MUG	9/3/99
3	DRAWN	MUG	9/3/99
4	CHECKED	MUG	9/3/99

RIP-RAP INFORMATION
Rip-Rap: Type L
d50 = 7.56"
Depth of Bury 1.30
Bedding: Type II
Type I Rip-Rap Gradation Requirements
% Smaller Than Given Size By Weight
Interm. Rock Dimension (Inches)
Bedding Type II Gradation Requirements
U.S. Standard Sieve Size
% Passing By Weight

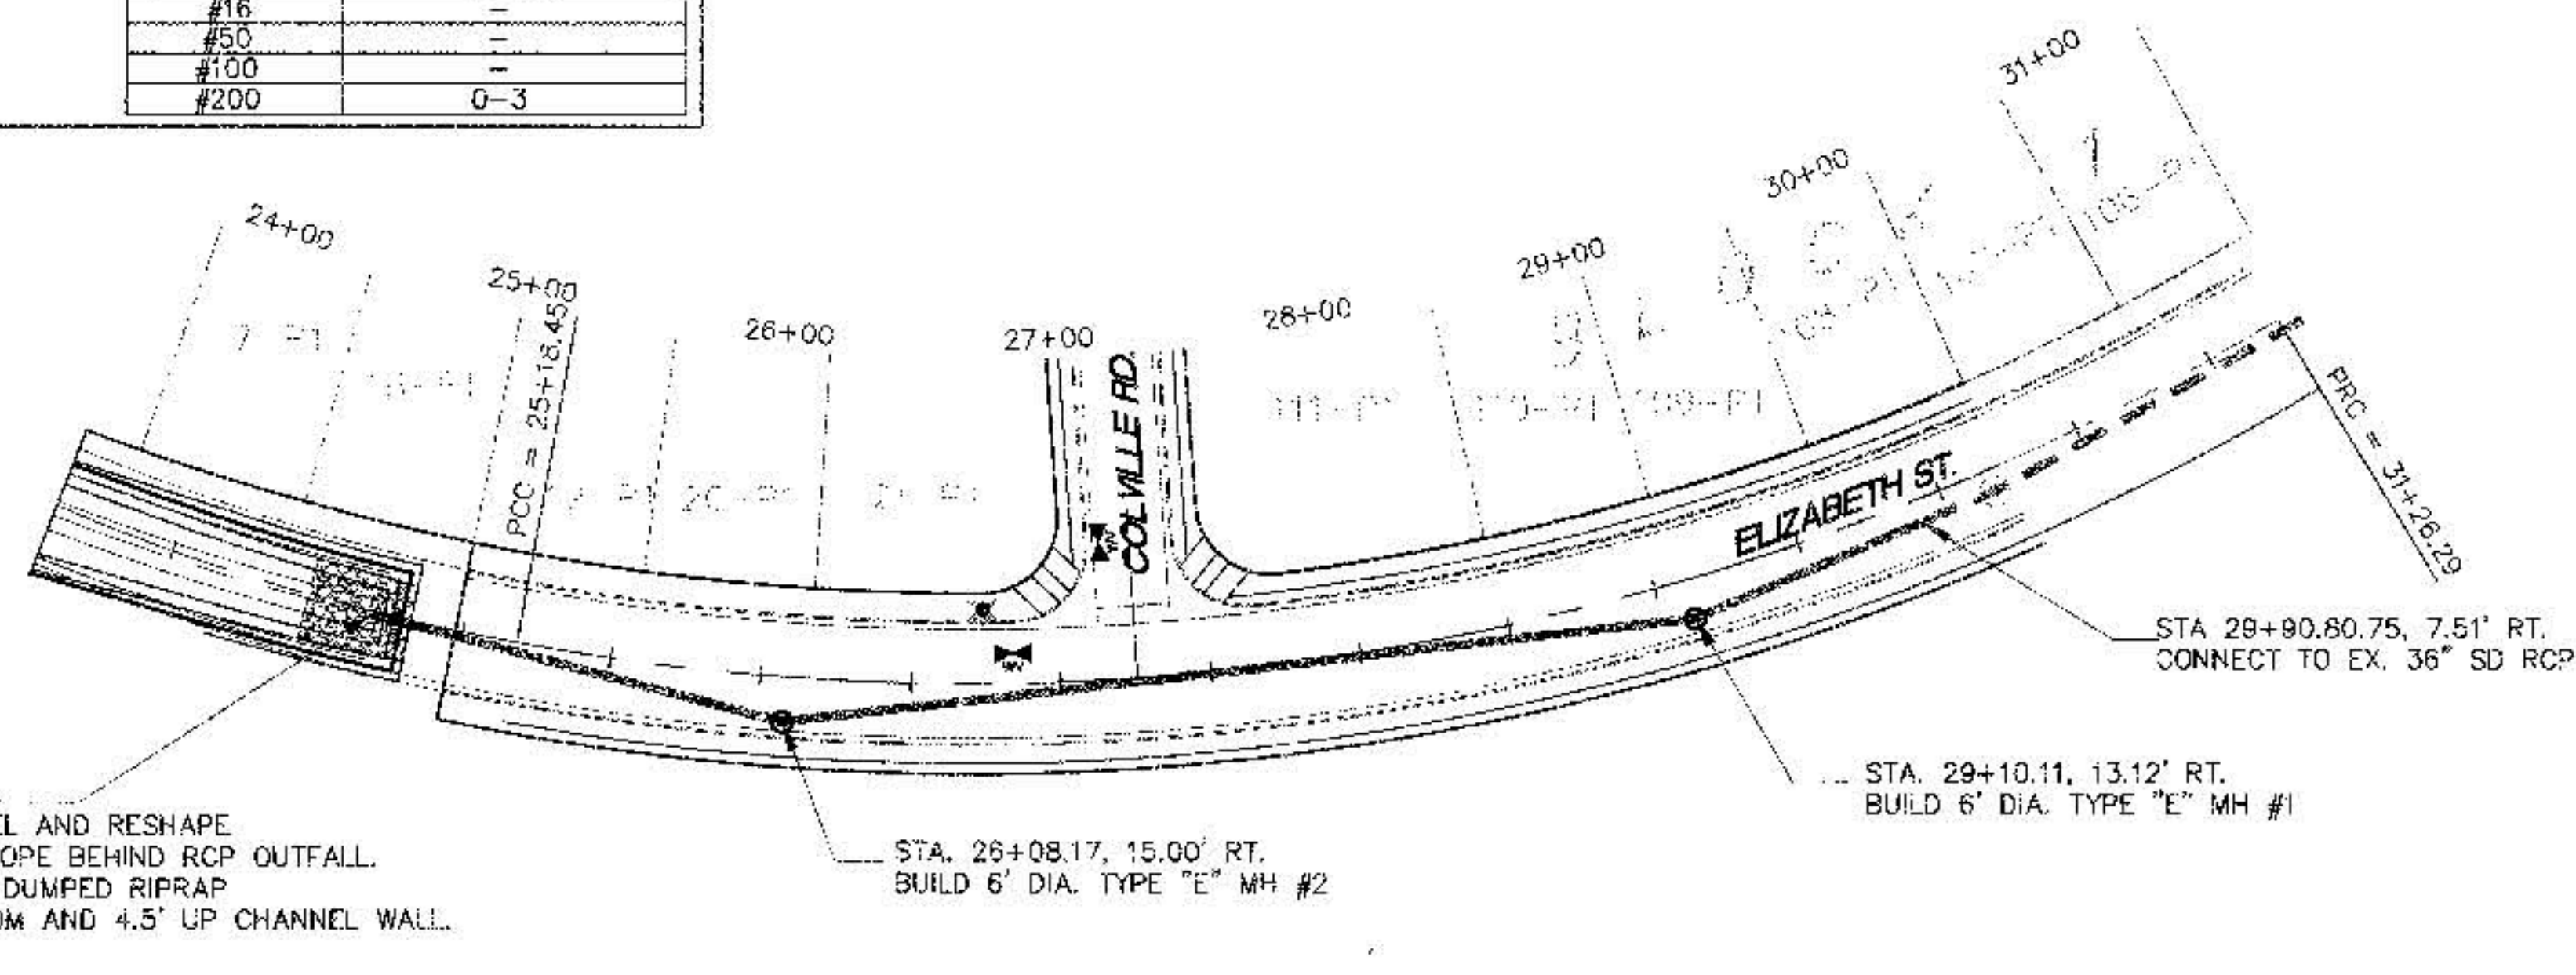

ELIZABETH STREET






SCALE
1" = 50' (HOR)
1" = 5' (VER)

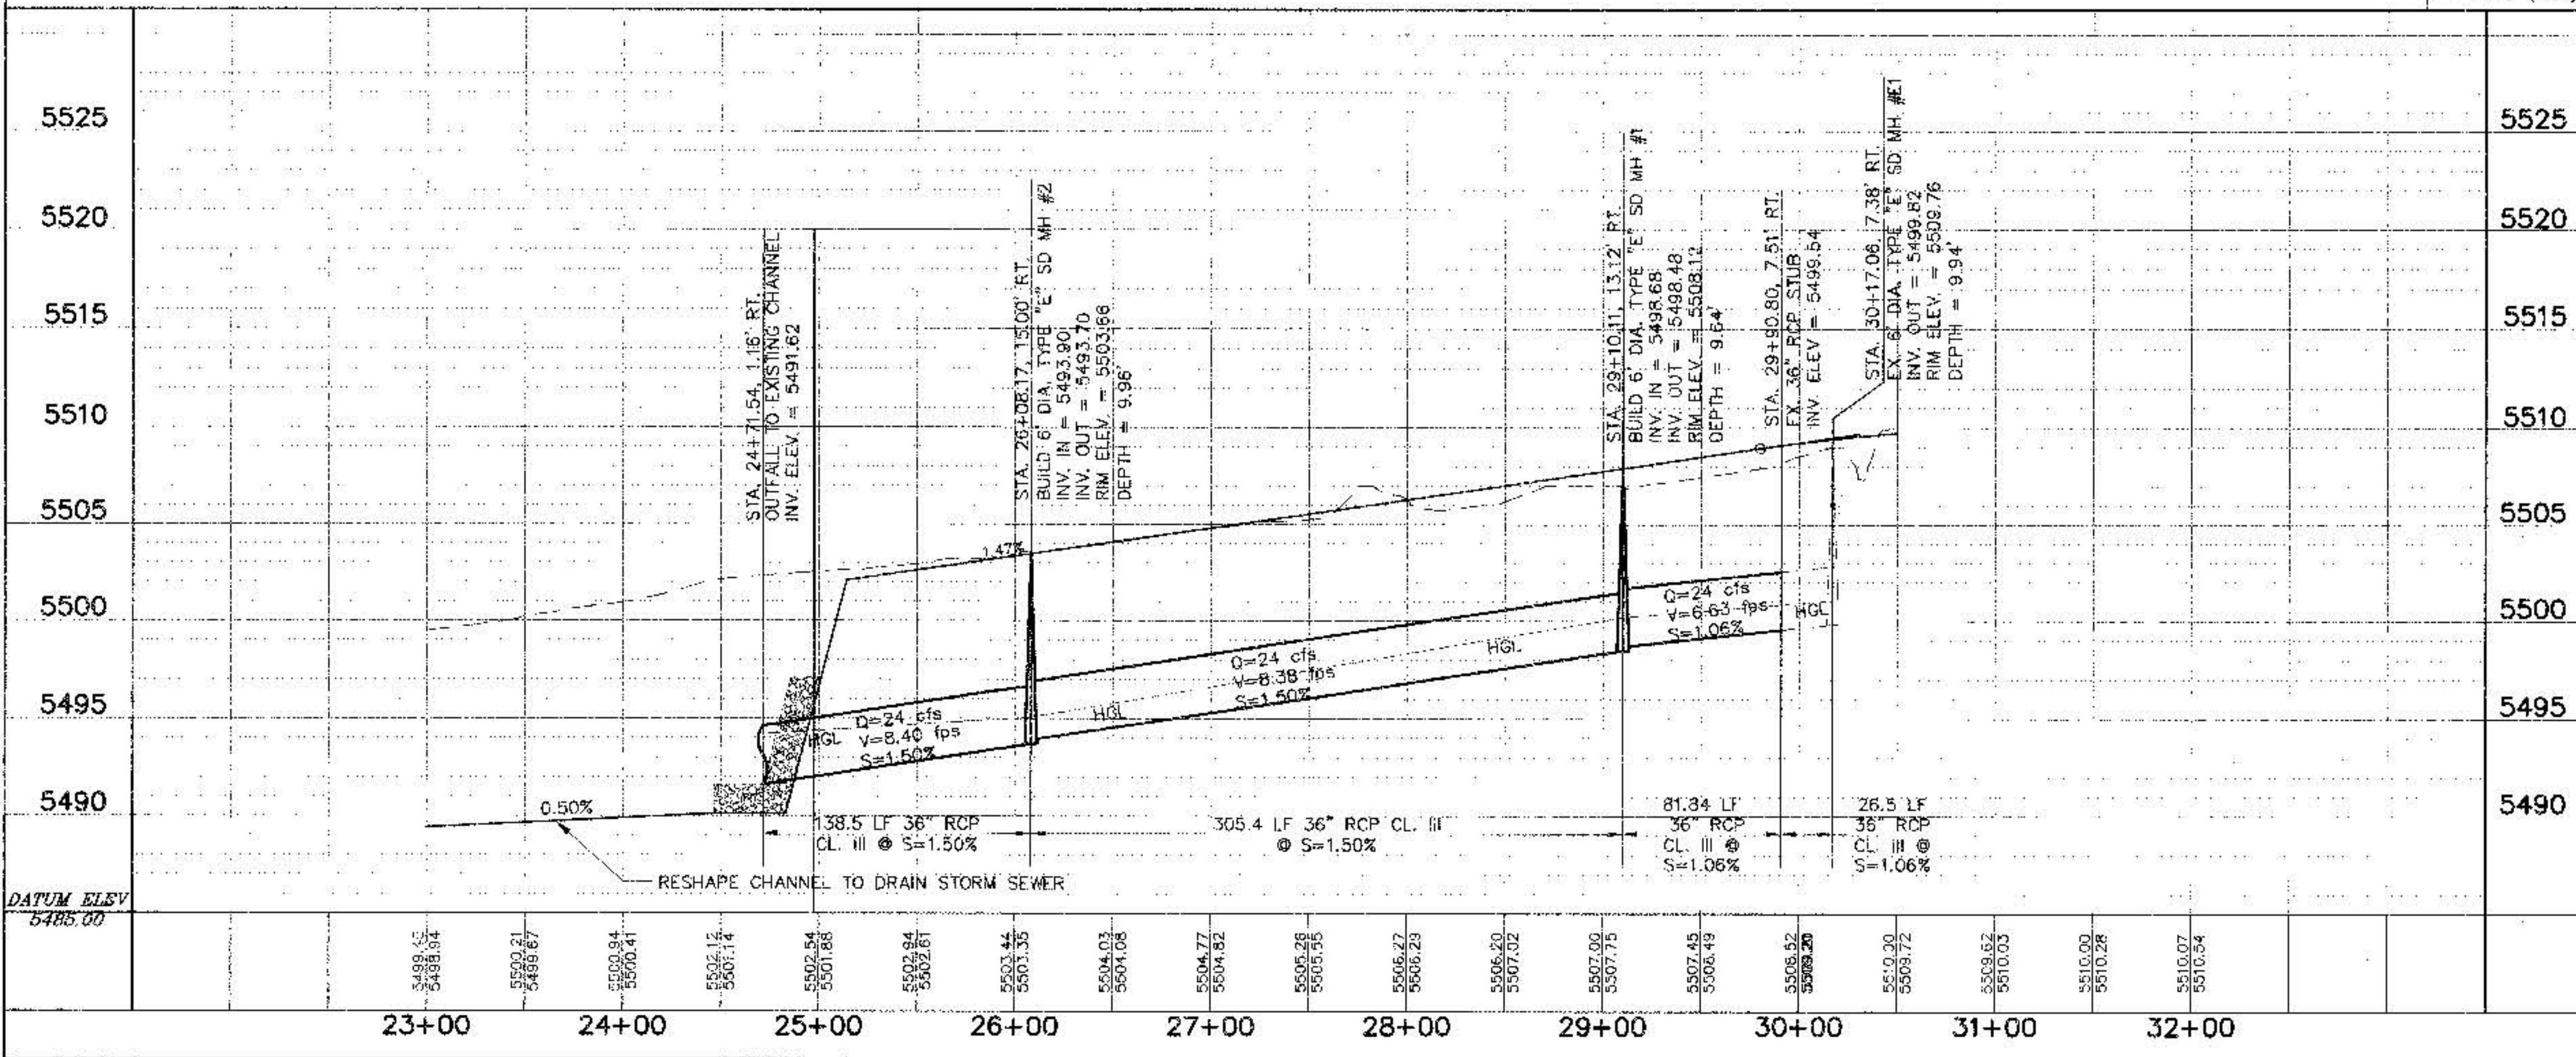

- STORM DRAIN NOTES
1. STATIONING ALONG C. OF STREET UNLESS OTHERWISE NOTED.
 2. SLOPES ARE COMPUTED INVERT TO INVERT. MN RIM ELEVATIONS GIVEN ARE APPROXIMATE. CONTRACTOR SHALL ADJUST ALL RIMS TO FINAL GRADE.
 3. DISTANCES ARE FROM CENTER OF MANHOLE TO CENTER OF MANHOLE.
 4. CONTRACTOR IS RESPONSIBLE FOR COORDINATION WITH UTILITY COMPANIES.
 5. CONTRACTOR SHALL VERIFY ALL EXISTING UTILITIES AND UTILITY CONNECTIONS PRIOR TO BEGINNING CONSTRUCTION. SHOULD A CONFLICT EXIST OR DESIGN REVISIONS BE REQUIRED FOR ANY REASON, THE CONTRACTOR SHALL NOTIFY THE ENGINEER AND ALLOW SUFFICIENT TIME FOR DESIGN REVISIONS SO AS TO NOT DELAY THE CONSTRUCTION SCHEDULE.

- LEGEND
- PROPOSED STORM DRAIN
 - EXISTING STORM DRAIN
 - CENTERLINE OF STREET
 - EXISTING CURB & GUTTER
 - PROPOSED STANDARD CURB & GUTTER
 - PROPOSED CONCRETE VALLEY GUTTER
 - PROPOSED MANHOLE
 - EXISTING MANHOLE
 - PROPOSED STORM DRAIN MANHOLE
 - EXISTING STORM DRAIN
 - PROPOSED STORM INLET
 - PROPOSED FIRE HYDRANT
 - EXISTING GATE VALVE
 - PROPOSED GATE VALVE
 - PROPOSED STREET LIGHT LOCATION

PR Parsons Brinckerhoff
CITY OF ALBUQUERQUE
PUBLIC WORKS DEPARTMENT
ENGINEERING DEVELOPMENT GROUP
ELIZABETH STREET STORM DRAIN PLAN AND PROFILE
MIRABELLA UNIT 6
DESIGN REVIEW COMMITTEE
CITY ENGINEER APPROVAL
City Project No. 6240.81
Zone Map No. L-21-Z
Sheet 19 of 22

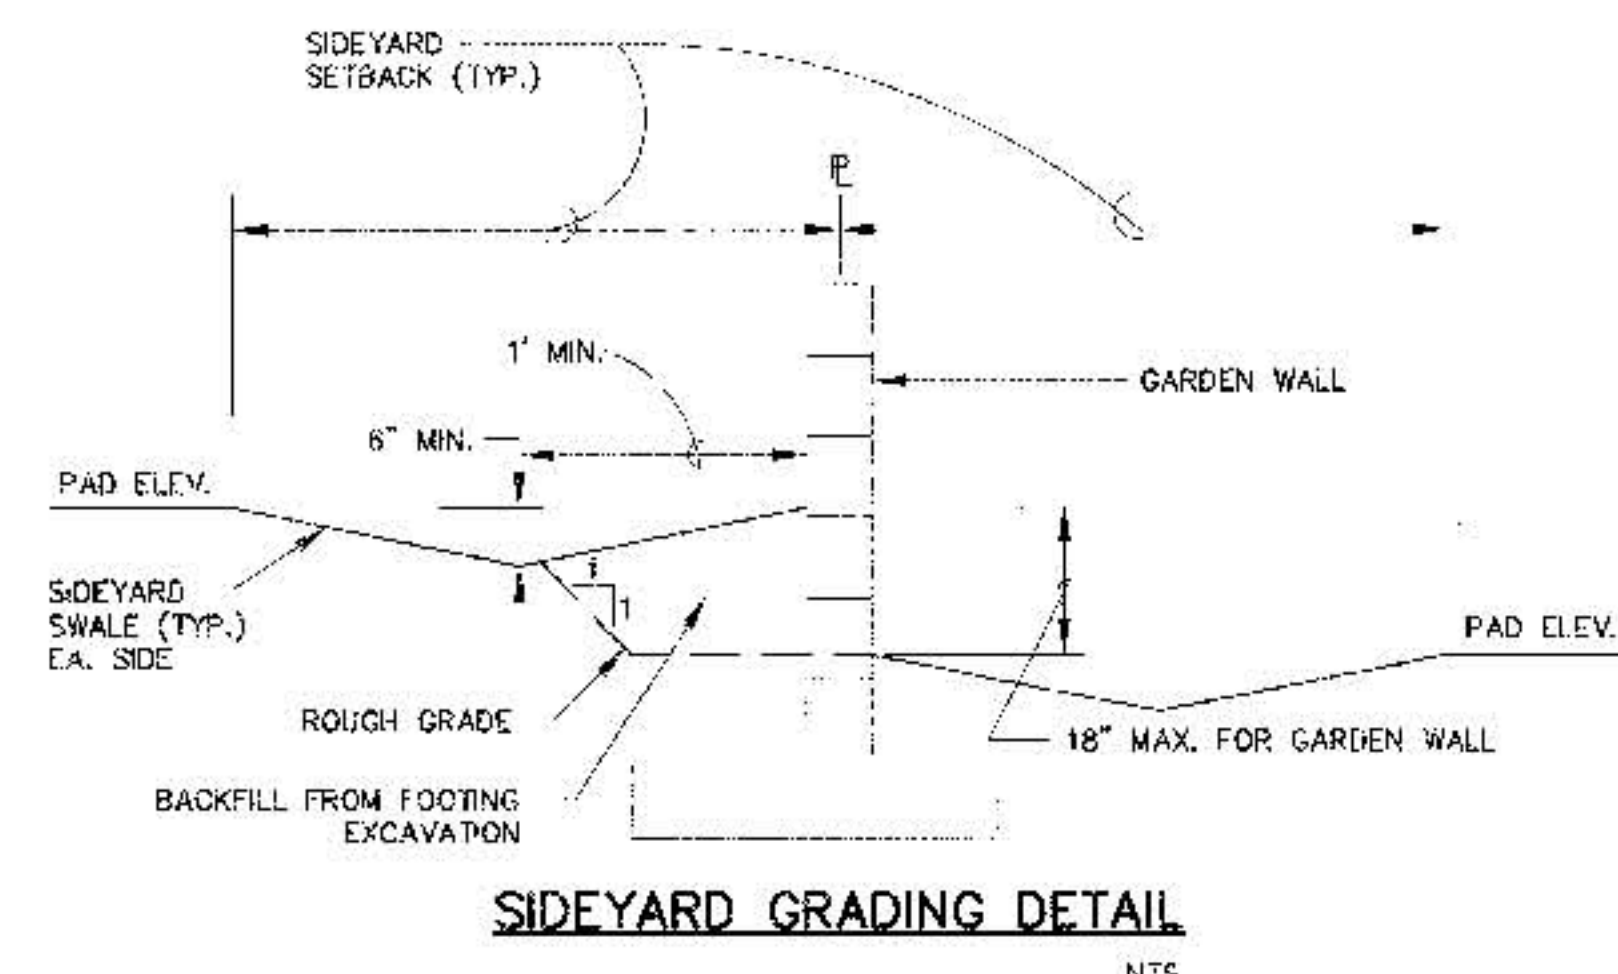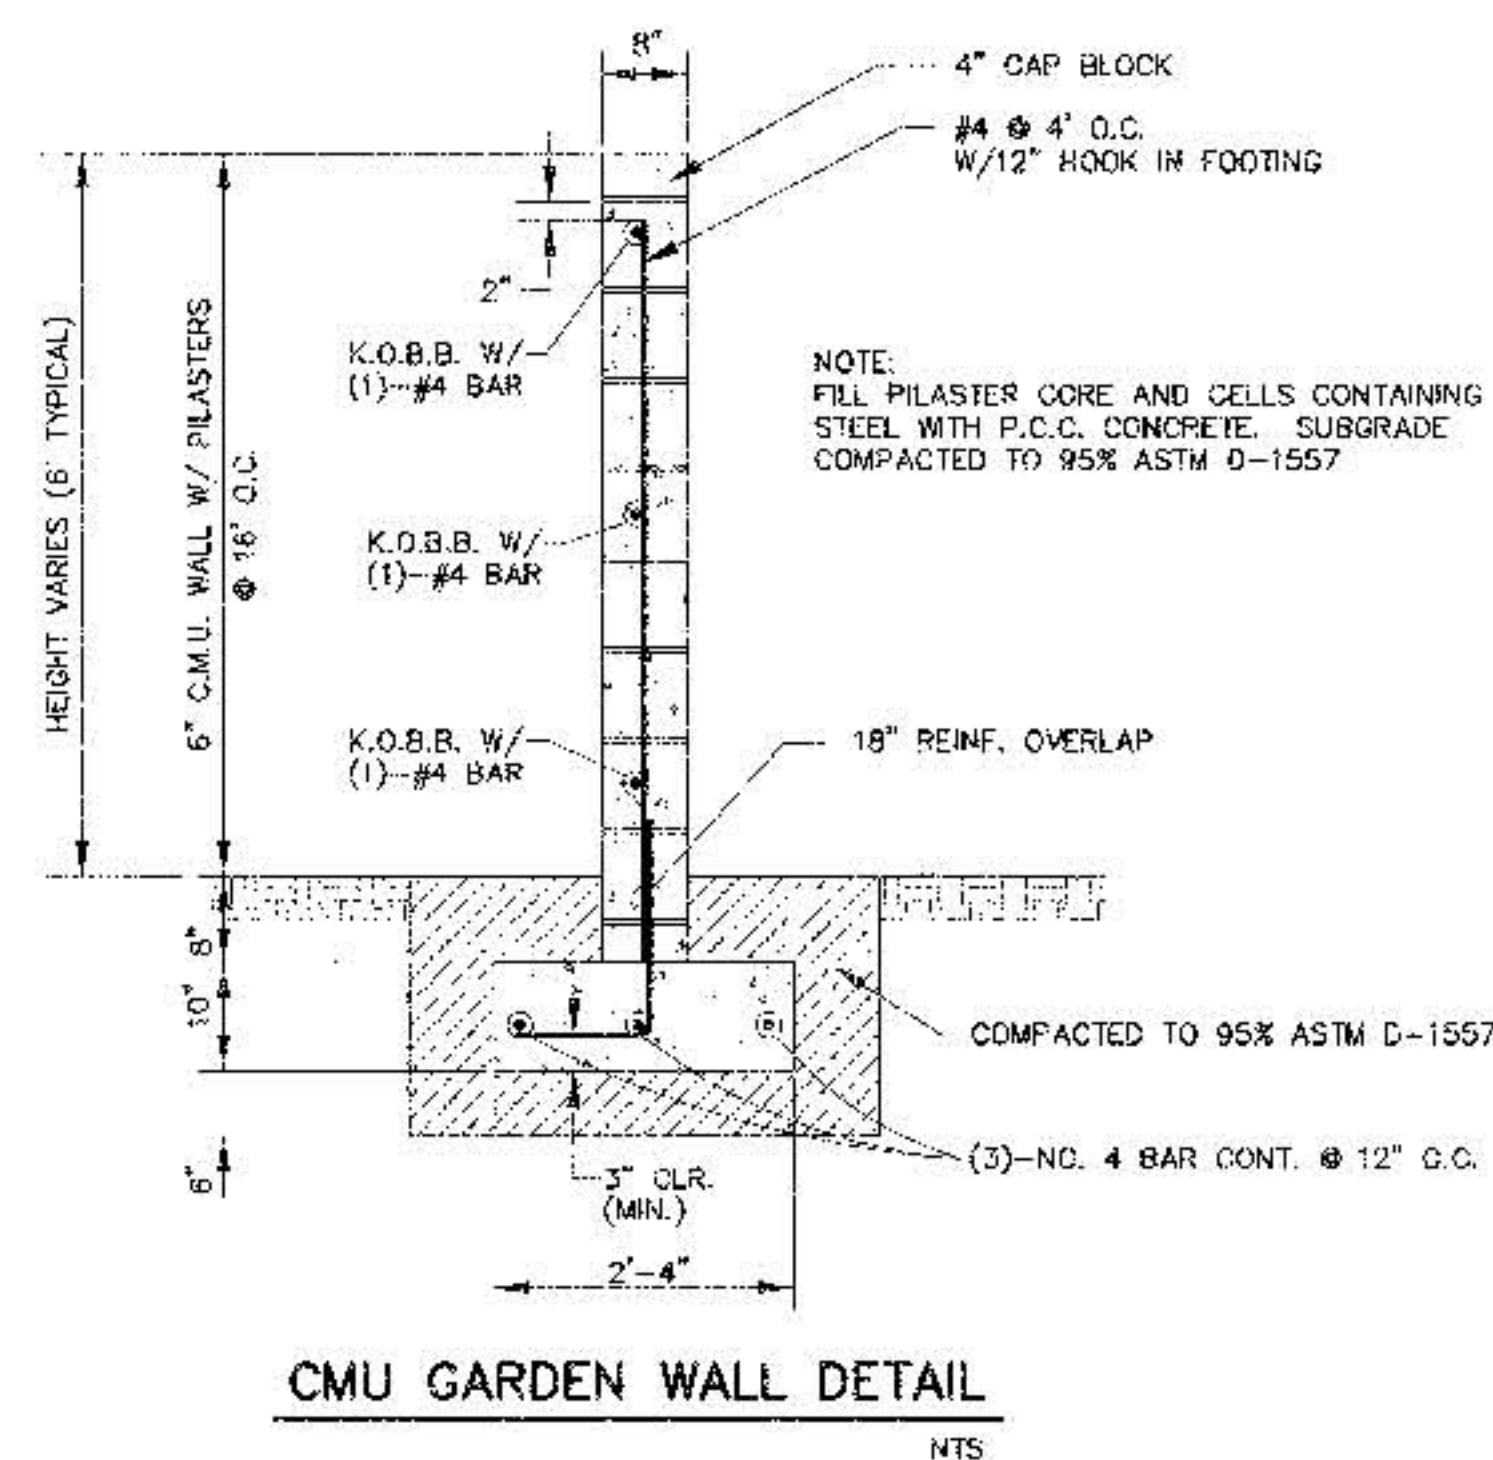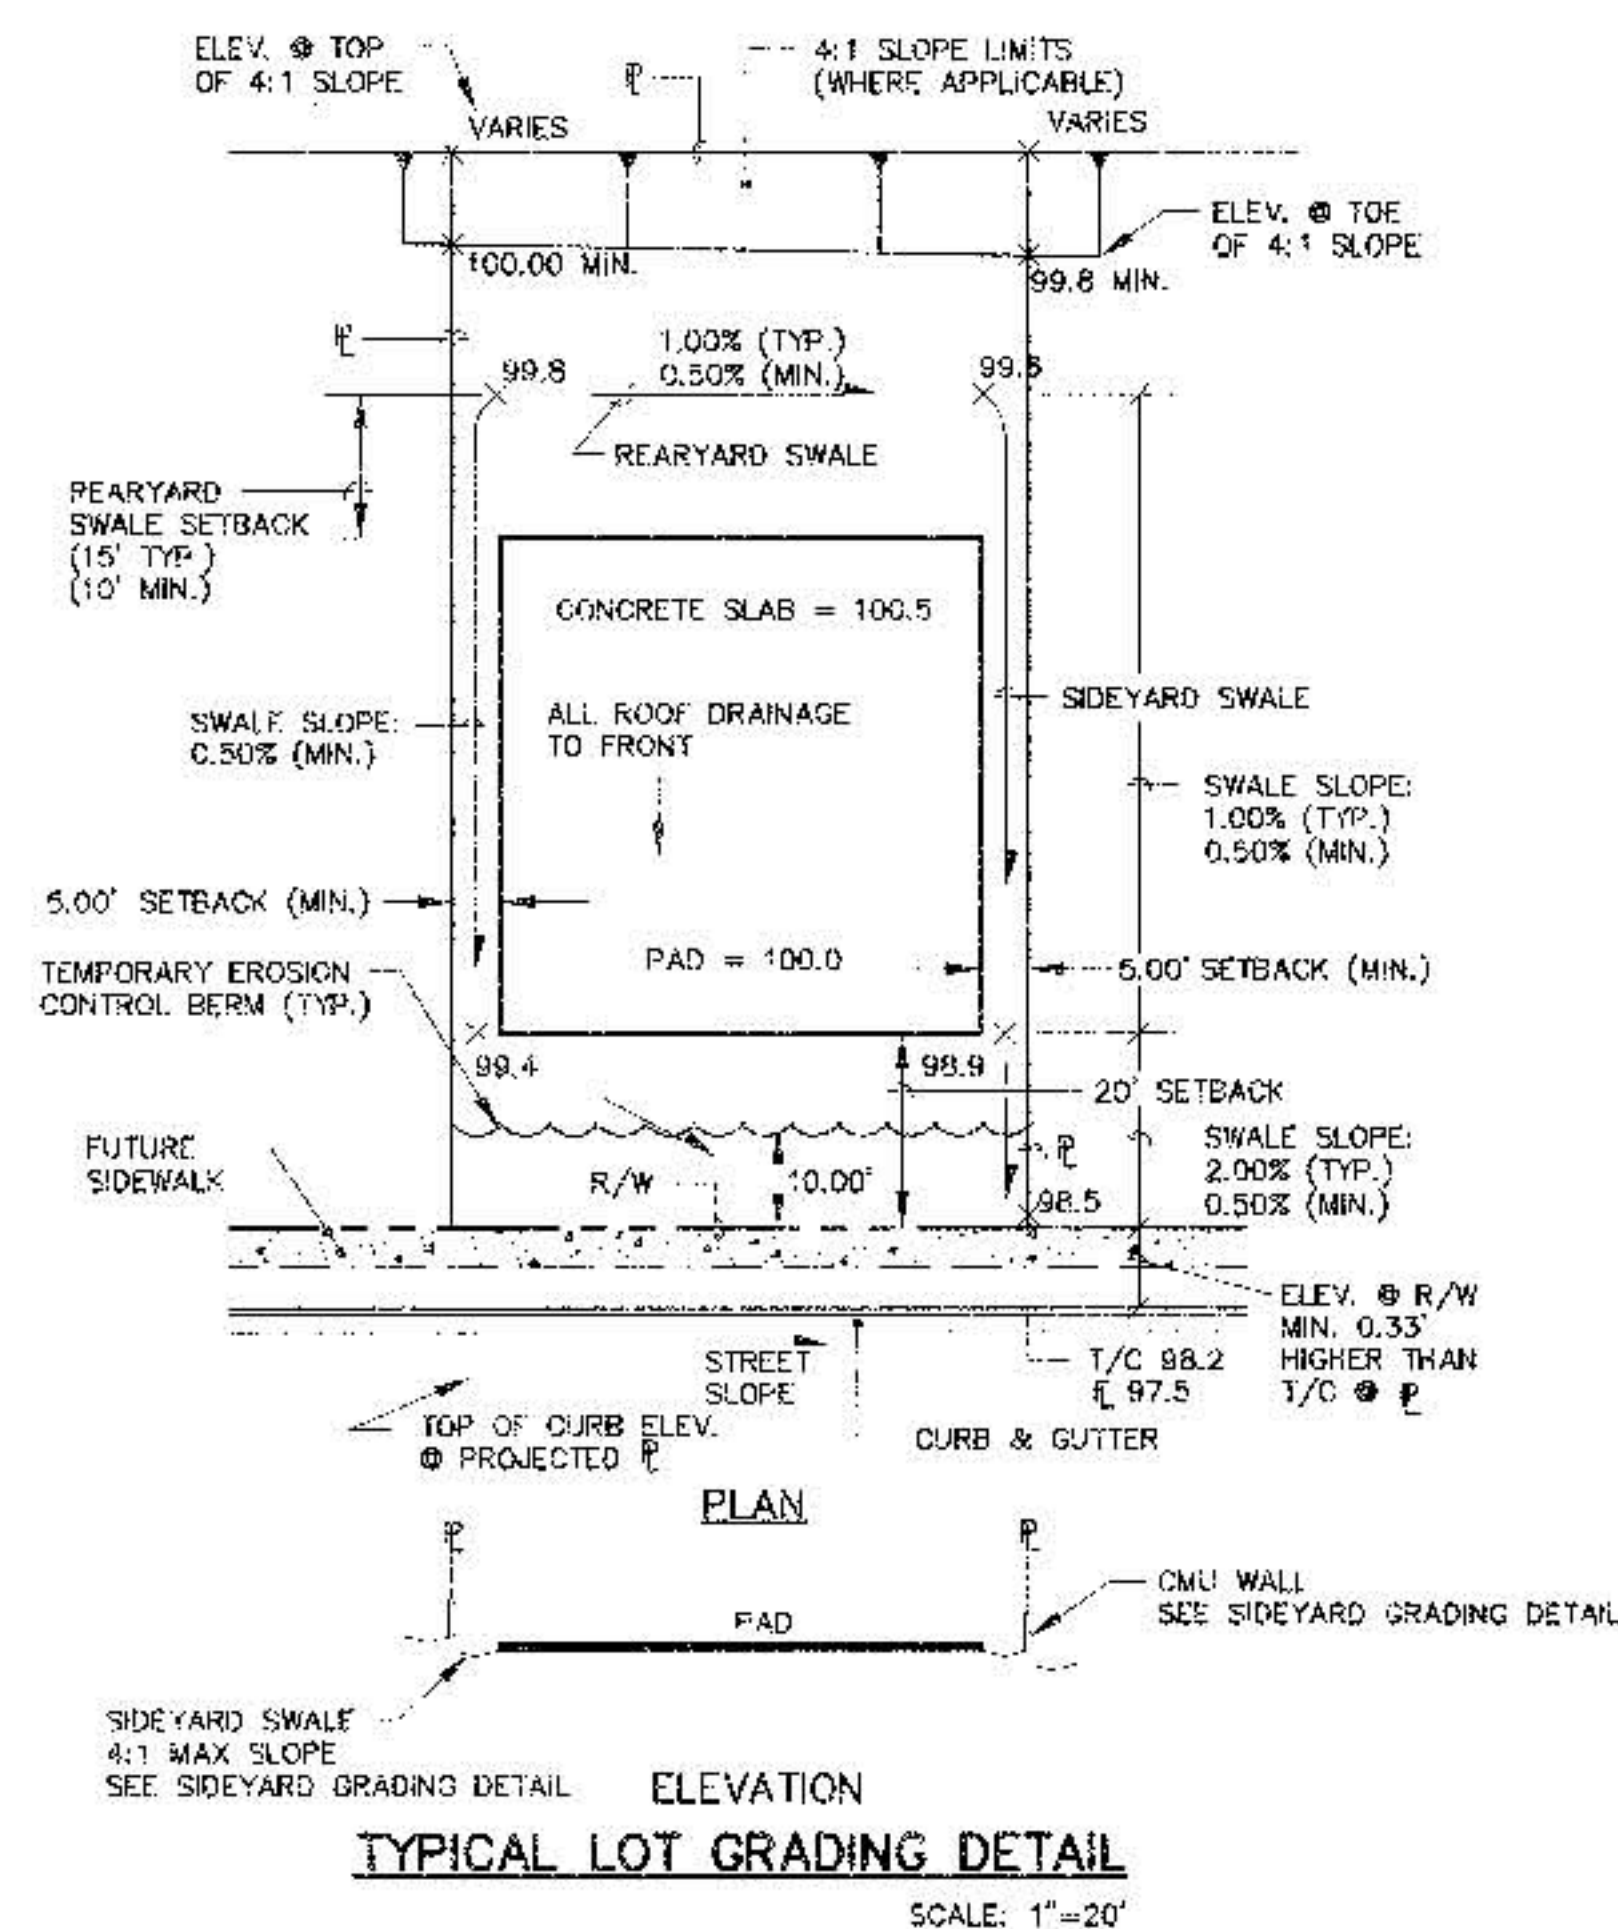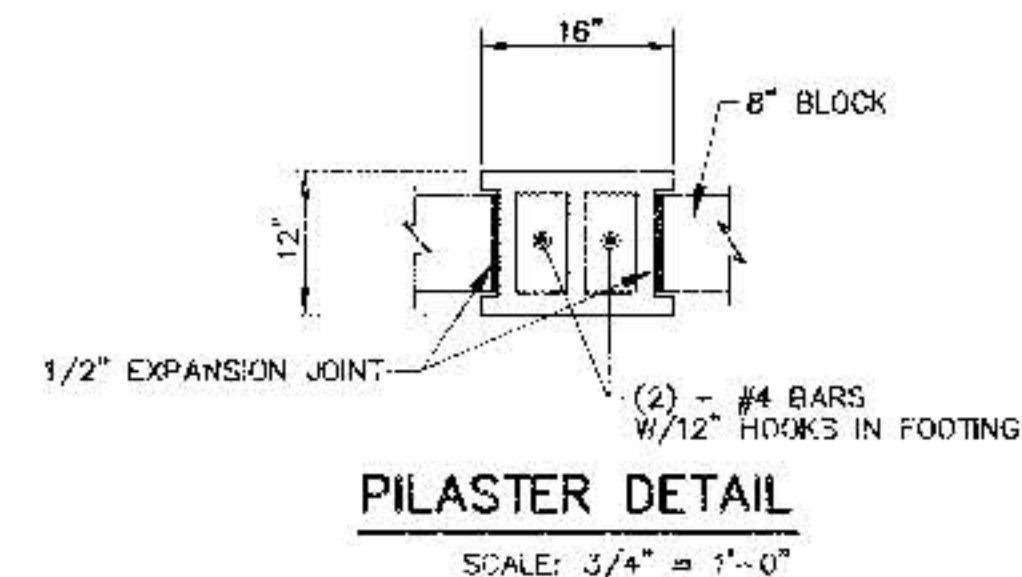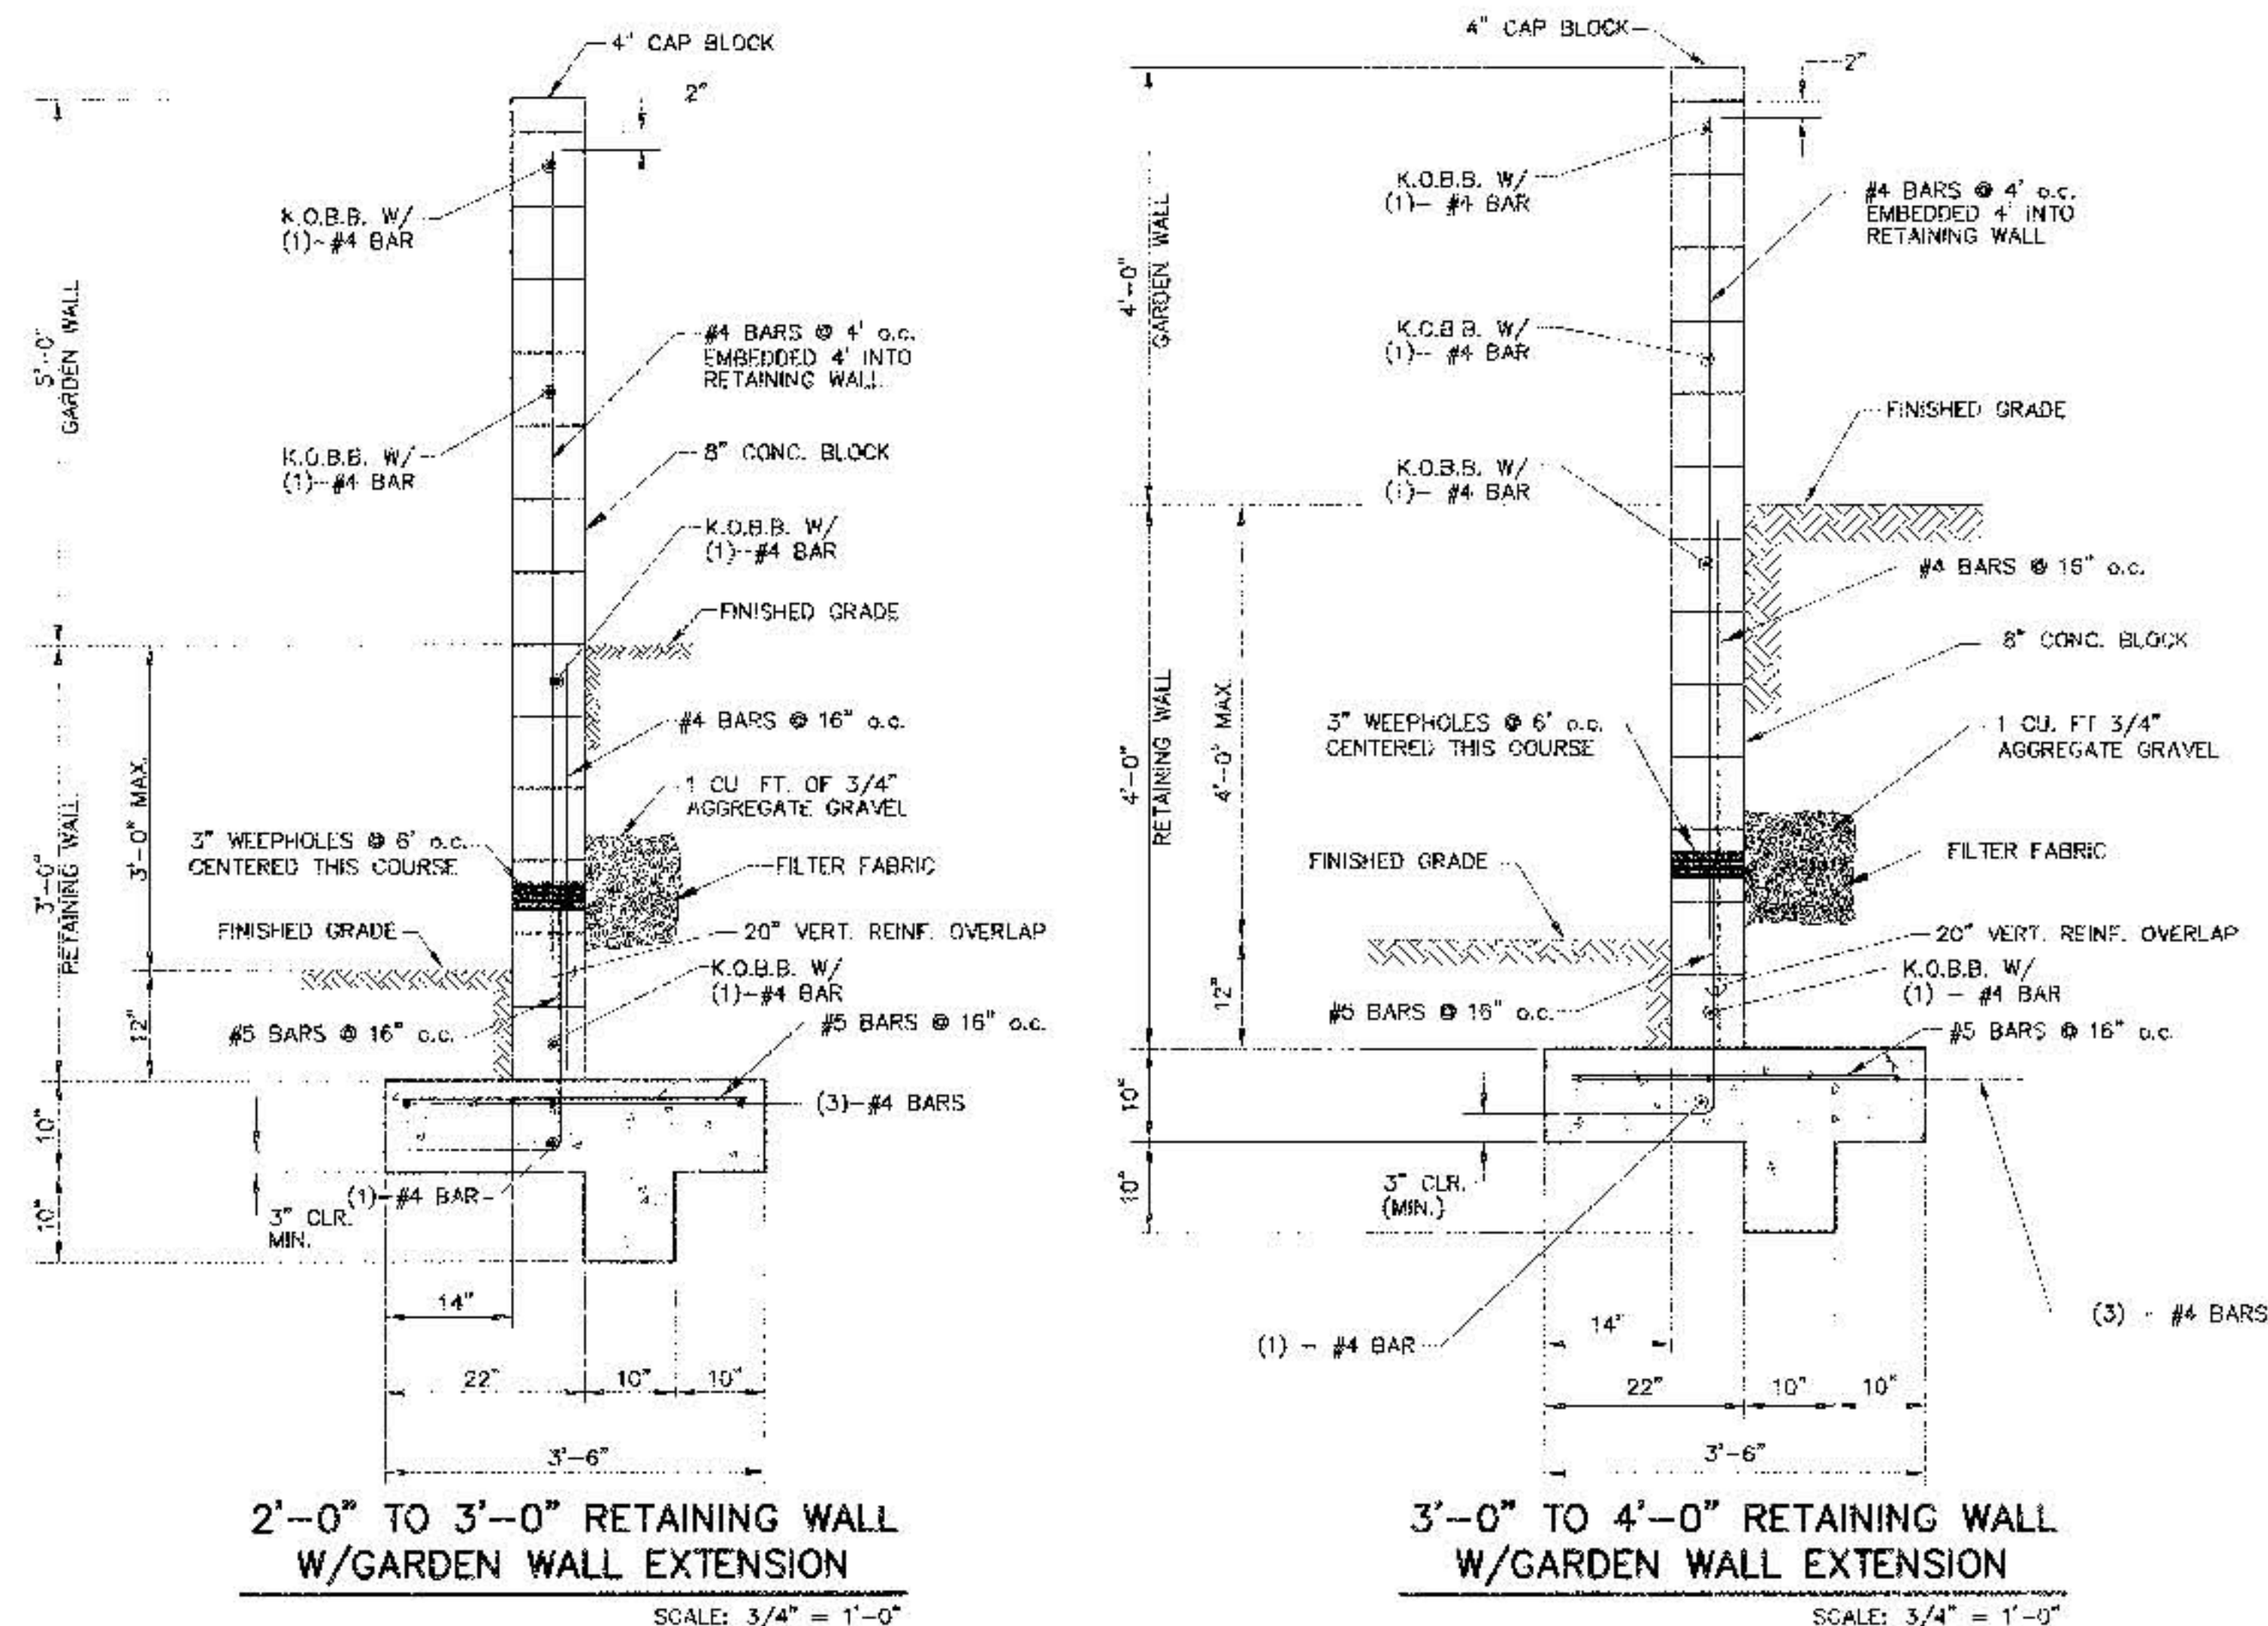


- LOT GRADING GENERAL NOTES:

1. LOT GRADING SHALL MEET THE SITE GRADING AND DRAINAGE CRITERIA FOR PROPOSED CONSTRUCTION AS SET FORTH BY THE DEPARTMENT OF HOUSING AND URBAN DEVELOPMENT - FEDERAL HOUSING ADMINISTRATION IN CIRCULAR LETTER NO. 91-1, OFFICE OF THE MANAGER, ALBUQUERQUE, NEW MEXICO, DATED 1/25/91.
2. ELEVATION OF HIGHTPOINT OF REARYARD SWALE SHALL BE MIN. OF 6" BELOW PAD ELEVATION.
3. FINISHED FLOOR ELEVATIONS (NOT SHOWN) SHALL BE 8" ABOVE PAD ELEVATIONS (SHOWN).
4. FRONT YARD SIDEWALK SLOPE SHALL NOT EXCEED 10%.
5. DRIVEWAY SLOPE SHALL NOT EXCEED 14%. IF DRIVEWAY IS USED AS SIDEWALK, MAX-SLOPE SHALL NOT EXCEED 10%.
6. SLOPES SHALL NOT EXCEED 4:1.
7. THE CONTRACTOR MUST OBTAIN A TOPSOIL DISTURBANCE PERMIT FROM THE ENVIRONMENTAL HEALTH DIVISION PRIOR TO COMMENCING CONSTRUCTION.
8. THE CONTRACTOR IS TO REFER TO EARTHWORK SPECIFICATIONS AS NOTED IN THE SOILS REPORT SUPPLIED BY CURB INC.
9. THE CONTRACTOR SHALL CONFORM TO ALL CITY, COUNTY, STATE AND FEDERAL DUST CONTROL MEASURES AND REQUIREMENTS AND WILL BE RESPONSIBLE FOR PREPARING AND OBTAINING ALL NECESSARY APPLICATIONS AND APPROVALS.
10. THE CONTRACTOR SHALL ENSURE THAT NO SOIL ERODES FROM THE CONSTRUCTION SITE. EROSION CONTROL MEASURES ARE INTENDED TO CONTROL MINOR FLOWS AND PROHIBIT THE RELEASE OF SEDIMENT INTO ADJACENT STREETS AND PROPERTY. EROSION CONTROL AND DIVERSION BERMS SHALL BE CONSTRUCTED IN ACCORDANCE WITH THE DETAIL SHOWN ON THIS SHEET, AT LOCATIONS SHOWN ON THE GRADING PLAN.
11. THE CONTRACTOR IS RESPONSIBLE FOR MAINTAINING TEMPORARY BERMS THROUGHOUT THE CONSTRUCTION PHASE. THE OWNER WILL MAINTAIN BERMS AFTER COMPLETION AND ACCEPTANCE OF CONSTRUCTION.
12. TEMPORARY EROSION CONTROL BERMS LOCATED ON INDIVIDUAL LOTS SHALL REMAIN IN PLACE UNTIL THE CONSTRUCTION OF EACH RESPECTIVE BUILDING IS COMPLETE. ON A LOT BY LOT BASIS.
13. THE TOLERANCES FOR ROUGH GRADING SHALL CONFORM TO THE FOLLOWING:
- PAD SUBGRADE: +/- 0.2'
STREET SUBGRADE: +/- 0.2'
ALL OTHER AREAS: +/- 0.5'
14. BACKYARD DRAINS TO BE PROVIDED AS DESIGNATED.
15. THE CONTRACTOR IS FULLY RESPONSIBLE FOR FIELD VERIFYING ALL EXISTING UTILITIES AND SHALL NOTIFY THE ENGINEER IMMEDIATELY OF ANY DISCREPANCIES. CAUTION SHALL BE EXERCISED WHEN WORKING IN THE VICINITY OF EXISTING UTILITIES. ANY DAMAGE TO EXISTING UTILITIES RESULTING FROM CONSTRUCTION ACTIVITIES WILL BE REPAIRED BY THE CONTRACTOR AT THE CONTRACTOR'S EXPENSE.
16. GRADE ELEVATIONS, WHERE NOTED ARE FOR TOP OF STANDARD CURB UNLESS OTHERWISE SPECIFIED.
17. CONTRACTOR IS RESPONSIBLE FOR REPAIR AND/OR REPLACEMENT OF ALL UTILITY CONDUITS AND EXISTING LINES.
18. ANY DAMAGE TO THE EXISTING FACILITIES (CURB AND GUTTER, PAVEMENT, CONDUITS, LANDSCAPING, UTILITY LINES, ETC.) DURING CONSTRUCTION SHALL BE REPLACED AT THE CONTRACTOR'S EXPENSE.
19. THE CONTRACTOR SHALL REVEGETATE AND RE-ESTABLISH ALL AREAS WHICH ARE DISTURBED BY SITE GRADING AND ARE NOT TO RECEIVE PERMANENT SURFACE TREATMENTS. SPECIFICATIONS FOR SEEDING SHALL BE PER CITY OF ALBUQUERQUE STANDARD SPECIFICATIONS FOR PUBLIC WORKS CONSTRUCTION, LATEST EDITION, SECTION 1011, NATIVE SEEDING CLASS A.
- OPERATION SHALL CONSIST OF PROTECTION OF SITE, PREPARATION OF SEEDBED, MULCHING, FERTILIZATION, AND THE PROVISION OF MATERIALS, LABOR, AND EQUIPMENT NECESSARY TO PERFORM THE OPERATION. THE SEED MIX SHALL BE AS DENOTED IN THE LIST BELOW.
- | <u>SEED TYPE</u> | <u>LB'S. PLS PER ACRE</u> |
|------------------------------|---------------------------|
| <u>GRASSES</u> | |
| INDIAN RICE(10%)
GRASS | 15 LB'S. |
| GALLETA GRASS(30%)
'VIVA' | 3.5 LB'S. |
| SIDE OATS(20%)
GRAMA | 2 LB'S. |
| SAND(10%)
DROPSOED | 1 LB. |
| BLUE GRAMA(30%)
'HACHITA' | 2 LB'S. |
| <u>WILD FLOWERS</u> | |
| TAHOKA
DAISY | 1 LB. |
| YELLOW
CONEFLOWER | 1 LB. |
| GALLARDIA | 1 LB. |

[illegible]

**Parsons
Brinckerhoff**

CITY OF ALBUQUERQUE
PUBLIC WORKS DEPARTMENT
ENGINEERING DEVELOPMENT GROUP
GRADING DETAILS
MIRABELLA UNIT 6

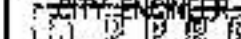CITY ENGINEER'S APPROVAL  CITY ENGINEER		MO./DAY/YR.	MO./DAY/YR.
CITY PROJECT NO. 6240.81		Zone Map No. L-21-Z	Sheet 20
City Project No. 6240.81		Zone Map No. L-21-Z	Of 22

CONSTRUCTION TRAFFIC CONTROL GENERAL NOTES

1. CONTRACTOR MUST OBTAIN FROM CONSTRUCTION COORDINATION AN EXCAVATION/BARRICADING PERMIT BEFORE ENGAGING IN ANY CONSTRUCTION, MAINTENANCE OR REPAIR WORK IN ANY OF THE CITY OF ALBUQUERQUE'S RIGHTS-OF-WAY. EMERGENCY WORK THAT WOULD PRESERVE LIFE OR PROPERTY IS EXCLUDED WITH THE UNDERSTANDING THAT A PERMIT SHALL BE OBTAINED WITHIN 24 TO 48 HOURS.

2. CONTRACTOR SHALL AT THE TIME OF PERMIT REQUEST, SUBMIT FOR APPROVAL BY CONSTRUCTION COORDINATION, A TRAFFIC CONTROL PLAN DETAILING ALL EXISTING TOPOGRAPHY SUCH AS LANE WIDTHS, DRIVEWAYS, AND BUSINESS/RESIDENTIAL ACCESSES. THE TRAFFIC CONTROL PLAN SHALL INCLUDE ALL PHASES OF WORK AND SCHEDULES INVOLVED IN THE CONSTRUCTION PROJECT. ANY SEPARATE PHASES OF A CONSTRUCTION PROJECT SHALL BE GIVEN AN INDIVIDUAL PERMIT EACH. BLANKET PERMITS WILL NOT BE ISSUED.

3. THESE TYPICAL TRAFFIC CONTROL PLANS DO NOT REFLECT THE EXISTING TOPOGRAPHY SUCH AS DRIVEWAYS, LANE WIDTHS, AND BUSINESS/RESIDENTIAL ACCESSES. EVERY LOCATION THAT REQUIRES CONSTRUCTION TRAFFIC CONTROL SHALL HAVE A DETAILED TRAFFIC CONTROL PLAN SHOWING ALL EXISTING TOPOGRAPHY.

4. CONSTRUCTION SHALL NOT BEGIN UNLESS A TRAFFIC CONTROL PLAN HAS BEEN APPROVED AND VERIFIED BY CONSTRUCTION COORDINATION.

5. CONSTRUCTION COORDINATION SHALL BE NOTIFIED 48 HOURS PRIOR TO ANY TRAFFIC CONTROL CHANGES NEEDED BY CONTRACTOR, THAT WERE NOT PREVIOUSLY APPROVED. THESE TRAFFIC CONTROL CHANGES SHALL BE REQUESTED IN WRITING ACCOMPANIED WITH A TRAFFIC CONTROL PLAN REFLECTING SUCH CHANGES.

6. ALL CONSTRUCTION TRAFFIC CONTROL DEVICES SHALL COMPLY TO THE MANUAL ON UNIFORM TRAFFIC CONTROL DEVICES (MUTCD), LATEST EDITION. IT IS THE RESPONSIBILITY OF THE CONTRACTOR TO INSTALL, SERVICE AND MAINTAIN ALL TRAFFIC CONTROL DEVICES. TRAFFIC CONTROL DEVICES SHALL NOT BE REMOVED OR ALTERED IN ANY WAY WITHOUT THE APPROVAL OF CONSTRUCTION COORDINATION, PER SECTION 6A-4 OF THE MUTCD, LATEST EDITION.

7. THE CONSTRUCTION TRAFFIC CONTROL INITIAL SET-UP SHALL BE BY AN AMERICAN TRAFFIC SAFETY SERVICES ASSOCIATION (ATSSA) CERTIFIED WORKSITE TRAFFIC SUPERVISOR. THE MAINTENANCE AND SERVICING SHALL ALSO BE DONE BY AN ATSSA CERTIFIED WORKSITE TRAFFIC SUPERVISOR OR EQUIVALENT.

8. CONTRACTOR IS RESPONSIBLE TO MAINTAIN AND SERVICE ALL TRAFFIC CONTROL DEVICES 24 HOURS A DAY, 7 DAYS A WEEK THROUGHOUT LENGTH OF PROJECT. CONTRACTOR IS RESPONSIBLE THAT ALL TRAFFIC CONTROL DEVICES COMPLY WITH THE MUTCD, LATEST EDITION.

9. ALL ADVANCE WARNING SIGNS SHALL BE DOUBLE INDICATED WHENEVER THERE ARE MULTI-LANE TRAFFIC IN ANY ONE GIVEN DIRECTION AND THERE IS SUFFICIENT MEDIAN SPACE.

10. ALL BARRICADES IN ALL TAPERS AND TANGENTS SHALL BE PLACED APART, A DISTANCE MEASURED IN FEET, EQUAL TO THAT ON THE POSTED SPEED LIMIT. NO EXCEPTIONS UNLESS APPROVED BY CONSTRUCTION COORDINATION PER MUTCD SECTION 6A-4.

11. ALL WORK IN ARTERIAL ROADWAYS SHALL BE ON A CONTINUOUS 24 HOUR PER DAY BASIS UNTIL COMPLETED.

12. CONTRACTOR IS RESPONSIBLE TO PROVIDE CONSTRUCTION COORDINATION, A WEEKLY LOG OF DAILY INSPECTIONS OF BARRICADE AND MAINTENANCE SCHEDULES ON PROJECTS THAT ARE OVER ONE WEEK DURATION.

13. EQUIPMENT OR MATERIALS SHALL NOT BE STORED WITHIN 15 FEET OF A TRAVELLED TRAFFIC LANE DURING NON WORKING HOURS WITHOUT THE APPROVAL OF CONSTRUCTION COORDINATION.

14. CONTRACTOR SHALL PROVIDE AND MAINTAIN A SAFE AND ADEQUATE MEANS OF CHANNELIZING PEDESTRIAN TRAFFIC AROUND AND THROUGH THE CONSTRUCTION AREA.

15. CONTRACTOR IS RESPONSIBLE FOR DEGRADATION OF ANY EXISTING STRIPING AND RESPONSIBLE FOR ALL TEMPORARY STRIPING.

16. CONTRACTOR SHALL MAINTAIN ACCESS TO ALL FACILITIES, BUSINESSES, AND/OR RESIDENTS AT ALL TIMES.

17. CONTRACTOR SHALL PROVIDE ACCESS SIGNS FOR BUSINESSES LOCATED WITHIN THE CONSTRUCTION AREA UNDER THE SUPERVISION OF CONSTRUCTION COORDINATION. EACH ACCESS SIGN SHALL HAVE 5 INCH, WHITE OPAQUE LETTERING ON BLUE REFLECTORIZED BACKGROUND. ACCESS SIGNS SHALL BE CONSIDERED INCIDENTAL TO THE BID AND NOT PART OF THE CONTRACT UNLESS OTHERWISE STATED. NO MORE THAN 3 BUSINESSES SHALL BE LISTED IN A ACCESS SIGN. SHOPPING CENTERS AND MALLS SHALL BE LISTED AS SUCH.

18. ALL ADVANCE WARNING SIGNS SHALL MEET THE MINIMUM REFLECTIVE INTENSITY REQUIREMENTS SET FORTH BY THE CITY OF ALBUQUERQUE. CONSTRUCTION COORDINATION SHALL DETERMINE ALL REQUIREMENTS AND APPROVE OR DISAPPROVE ANY ADVANCE WARNING SIGN PER SECTION 6A-4 OF THE MUTCD, LATEST EDITION.

19. 48 HOURS PRIOR TO OCCUPYING OR CLOSING OF A RIGHT-OF-WAY, CONTRACTOR SHALL NOTIFY POLICE, FIRE DEPARTMENT, SCHOOLS, HOSPITALS, TRANSIT AUTHORITY, BUSINESSES AND/OR RESIDENTS THAT WILL BE AFFECTED BY THE CONSTRUCTION.

20. ANY FIELD ADJUSTMENTS SHALL BE APPROVED BY CONSTRUCTION COORDINATION.

21. EXCAVATIONS SHALL BE PLATED, TEMPORARILY PATCHED OR RESURFACED PRIOR TO OPENING OF TRAFFIC. A MINIMUM OF 11 FEET SHALL BE PROVIDED FOR TRAFFIC IN ANY GIVEN DIRECTION. CONTRACTOR IS RESPONSIBLE FOR ANY WORK INVOLVED IN SATISFYING THESE REQUIREMENTS.

22. CONTRACTOR SHALL AT ALL TIMES COMPLY WITH THE FOLLOWING:
1. STANDARDS AND REQUIREMENTS SET FORTH IN THE MANUAL ON UNIFORM TRAFFIC CONTROL DEVICES, LATEST EDITION.
2. THE CITY OF ALBUQUERQUE TRAFFIC CODE, LATEST EDITION.
3. SECTION 19 OF THE CITY OF ALBUQUERQUE'S STANDARD SPECIFICATIONS FOR PUBLIC WORK CONSTRUCTION, AS WELL AS OTHER SECTIONS.


23. FAILURE TO COMPLY WITH ANY OF THE ABOVE MENTIONED, WILL BE ADEQUATE CAUSE TO CEASE ALL WORK ON ANY CONSTRUCTION PROJECT. WORK WILL NOT RESUME UNTIL ALL REQUIREMENTS ARE ADDRESSED AND APPROVED BY CONSTRUCTION COORDINATION.

24. ALL TRAFFIC CONTROL DEVICES SHALL BE KEPT IN NEW-CLEAN CONDITION. WASHING OF EQUIPMENT IS INCIDENTAL TO ITS PLACEMENT AND MAINTENANCE.


25. TRAFFIC CONTROL STANDARDS APPLY ONLY WHERE THE CONSTRUCTION TRAFFIC CONTROL PLANS ARE NOT SPECIFIC.

26. ADVANCE WARNING SIGNS SHALL BE 36"x36" MIN. WITH SUPER ENGINEERING GRADE SHEETING OR BETTER. MOUNTING HEIGHT AT TOP OF SIGN SHALL BE THE SAME AS FOR A 48" SIGN AS INDICATED IN THE MUTCD.

27. CONTRACTOR SHALL MAINTAIN A GRAFFITI-FREE WORKSITE. ALL GRAFFITI SHALL BE PROMPTLY REMOVED FROM ALL EQUIPMENT, BOTH PERMANENT AND TEMPORARY.

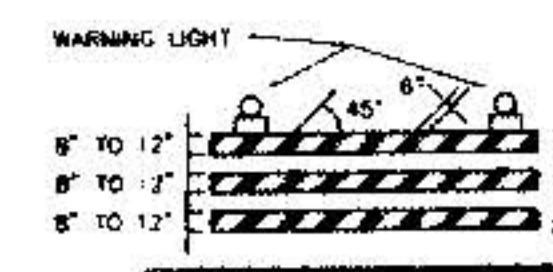


TYPE II BARRICADE

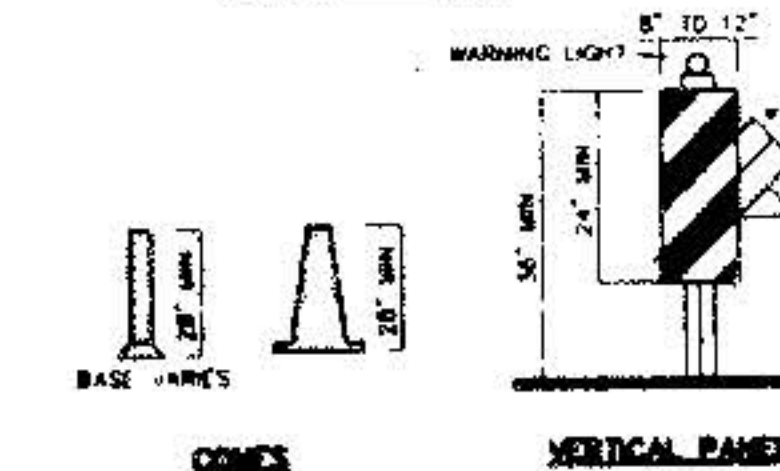


TYPE I BARRICADE



TYPE III BARRICADE

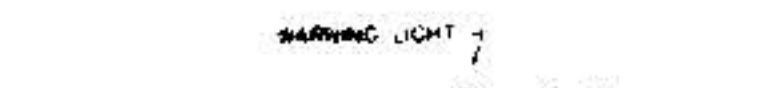


TYPE IV BARRICADE

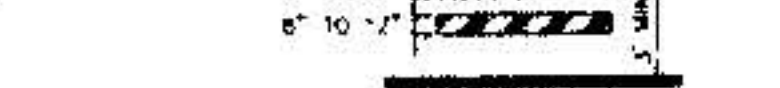

TYPE V BARRICADE




TYPE VI BARRICADE

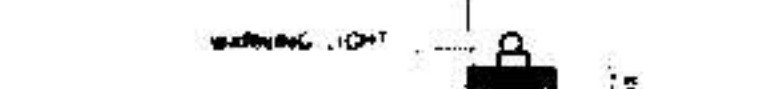

TYPE VII BARRICADE



TYPE VIII BARRICADE

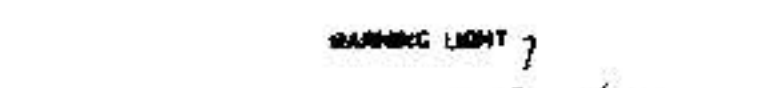

TYPE IX BARRICADE



TYPE X BARRICADE




TYPE XI BARRICADE



TYPE XII BARRICADE



TYPE XIII BARRICADE

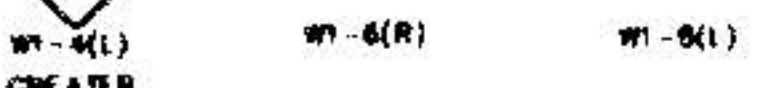

TYPE XIV BARRICADE




TYPE XV BARRICADE



TYPE XVI BARRICADE



TYPE XVII BARRICADE

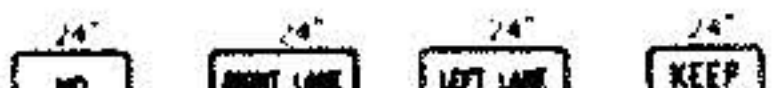

TYPE XVIII BARRICADE




TYPE XIX BARRICADE




TYPE XX BARRICADE



TYPE XXI BARRICADE

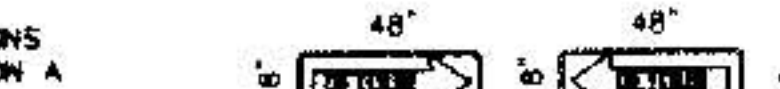

TYPE XXII BARRICADE

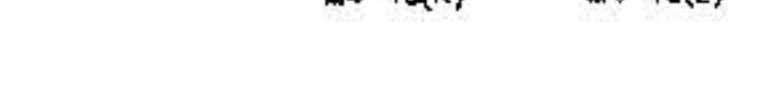

TYPE XXIII BARRICADE



TYPE XXIV BARRICADE



TYPE XXV BARRICADE

LEGEND

- WORK AREA
- BARRICADE - TYPE I, TYPE II, OR BARREL
- BARRICADE - TYPE III
- VERTICAL PANEL
- WARNING SIGN
- DISTANCE BETWEEN SIGNS - A DISTANCE MEASURED IN FEET EQUAL TO A VALUE OF TEN TIMES THE SPEED LIMIT OF THE STREET
- FLAGMAN POSITION
- SPACING BETWEEN BARRICADES - A DISTANCE MEASURED IN FEET EQUAL TO THE SPEED LIMIT OF THE STREET
- TAPER LENGTH - SEE CHART BELOW
- THE TANGENT LENGTH IS EQUAL TO THE TAPER LENGTH FOR A GIVEN STREET

TAPER REQUIREMENTS

SPEED LIMIT (MPH)	TAPER LENGTH (L) (FEET)			MINIMUM NUMBER OF DEVICES FOR TAPER	MAXIMUM DEVICE SPACING IN FEET	
	10' LANE	12' LANE	14' LANE		ALONG TAPER	AFTER TAPER
20	70	75	80	5	20	20
25	105	115	125	6	25	25
30	150	165	180	7	30	30
35	205	225	245	8	35	35
40	270	295	320	9	40	40
45	450	495	540	13	45	45
50	500	550	600	13	50	50
55	550	605	660	13	55	55

RECOMMENDED SIGN SPACING(D) FOR ADVANCE WARNING SIGN SERIES

SPEED LIMIT PER HOUR	MINIMUM DISTANCE IN FEET	
	BETWEEN SIGNS	FROM LAST SIGN TO TAPER
0-20	10 x SPEED LIMIT	10 x SPEED LIMIT
25-40	10 x SPEED LIMIT	10 x SPEED LIMIT
40-55	10 x SPEED LIMIT	10 x SPEED LIMIT
50-60	10 x SPEED LIMIT	10 x SPEED LIMIT


TAPER CRITERIA

TYPE OF TAPER	TAPER LENGTH
DOWNSTREAM TAPER	1 MINIMUM
UPSTREAM TAPER	1/2 MINIMUM
SHOULDER TAPER	1/2 MINIMUM
DOWNSTREAM TAPER	100 FEET MINIMUM
UPSTREAM TAPER	100 FEET MINIMUM

TAPER LENGTH COMPUTATION

SPEED LIMIT	1 - 10
40 MPH OR GREATER	1 - 10
45 MPH OR GREATER	1 - 10
50 MPH OR GREATER	1 - 10
55 MPH OR GREATER	1 - 10
60 MPH OR GREATER	1 - 10

SIGN FACE DETAILS

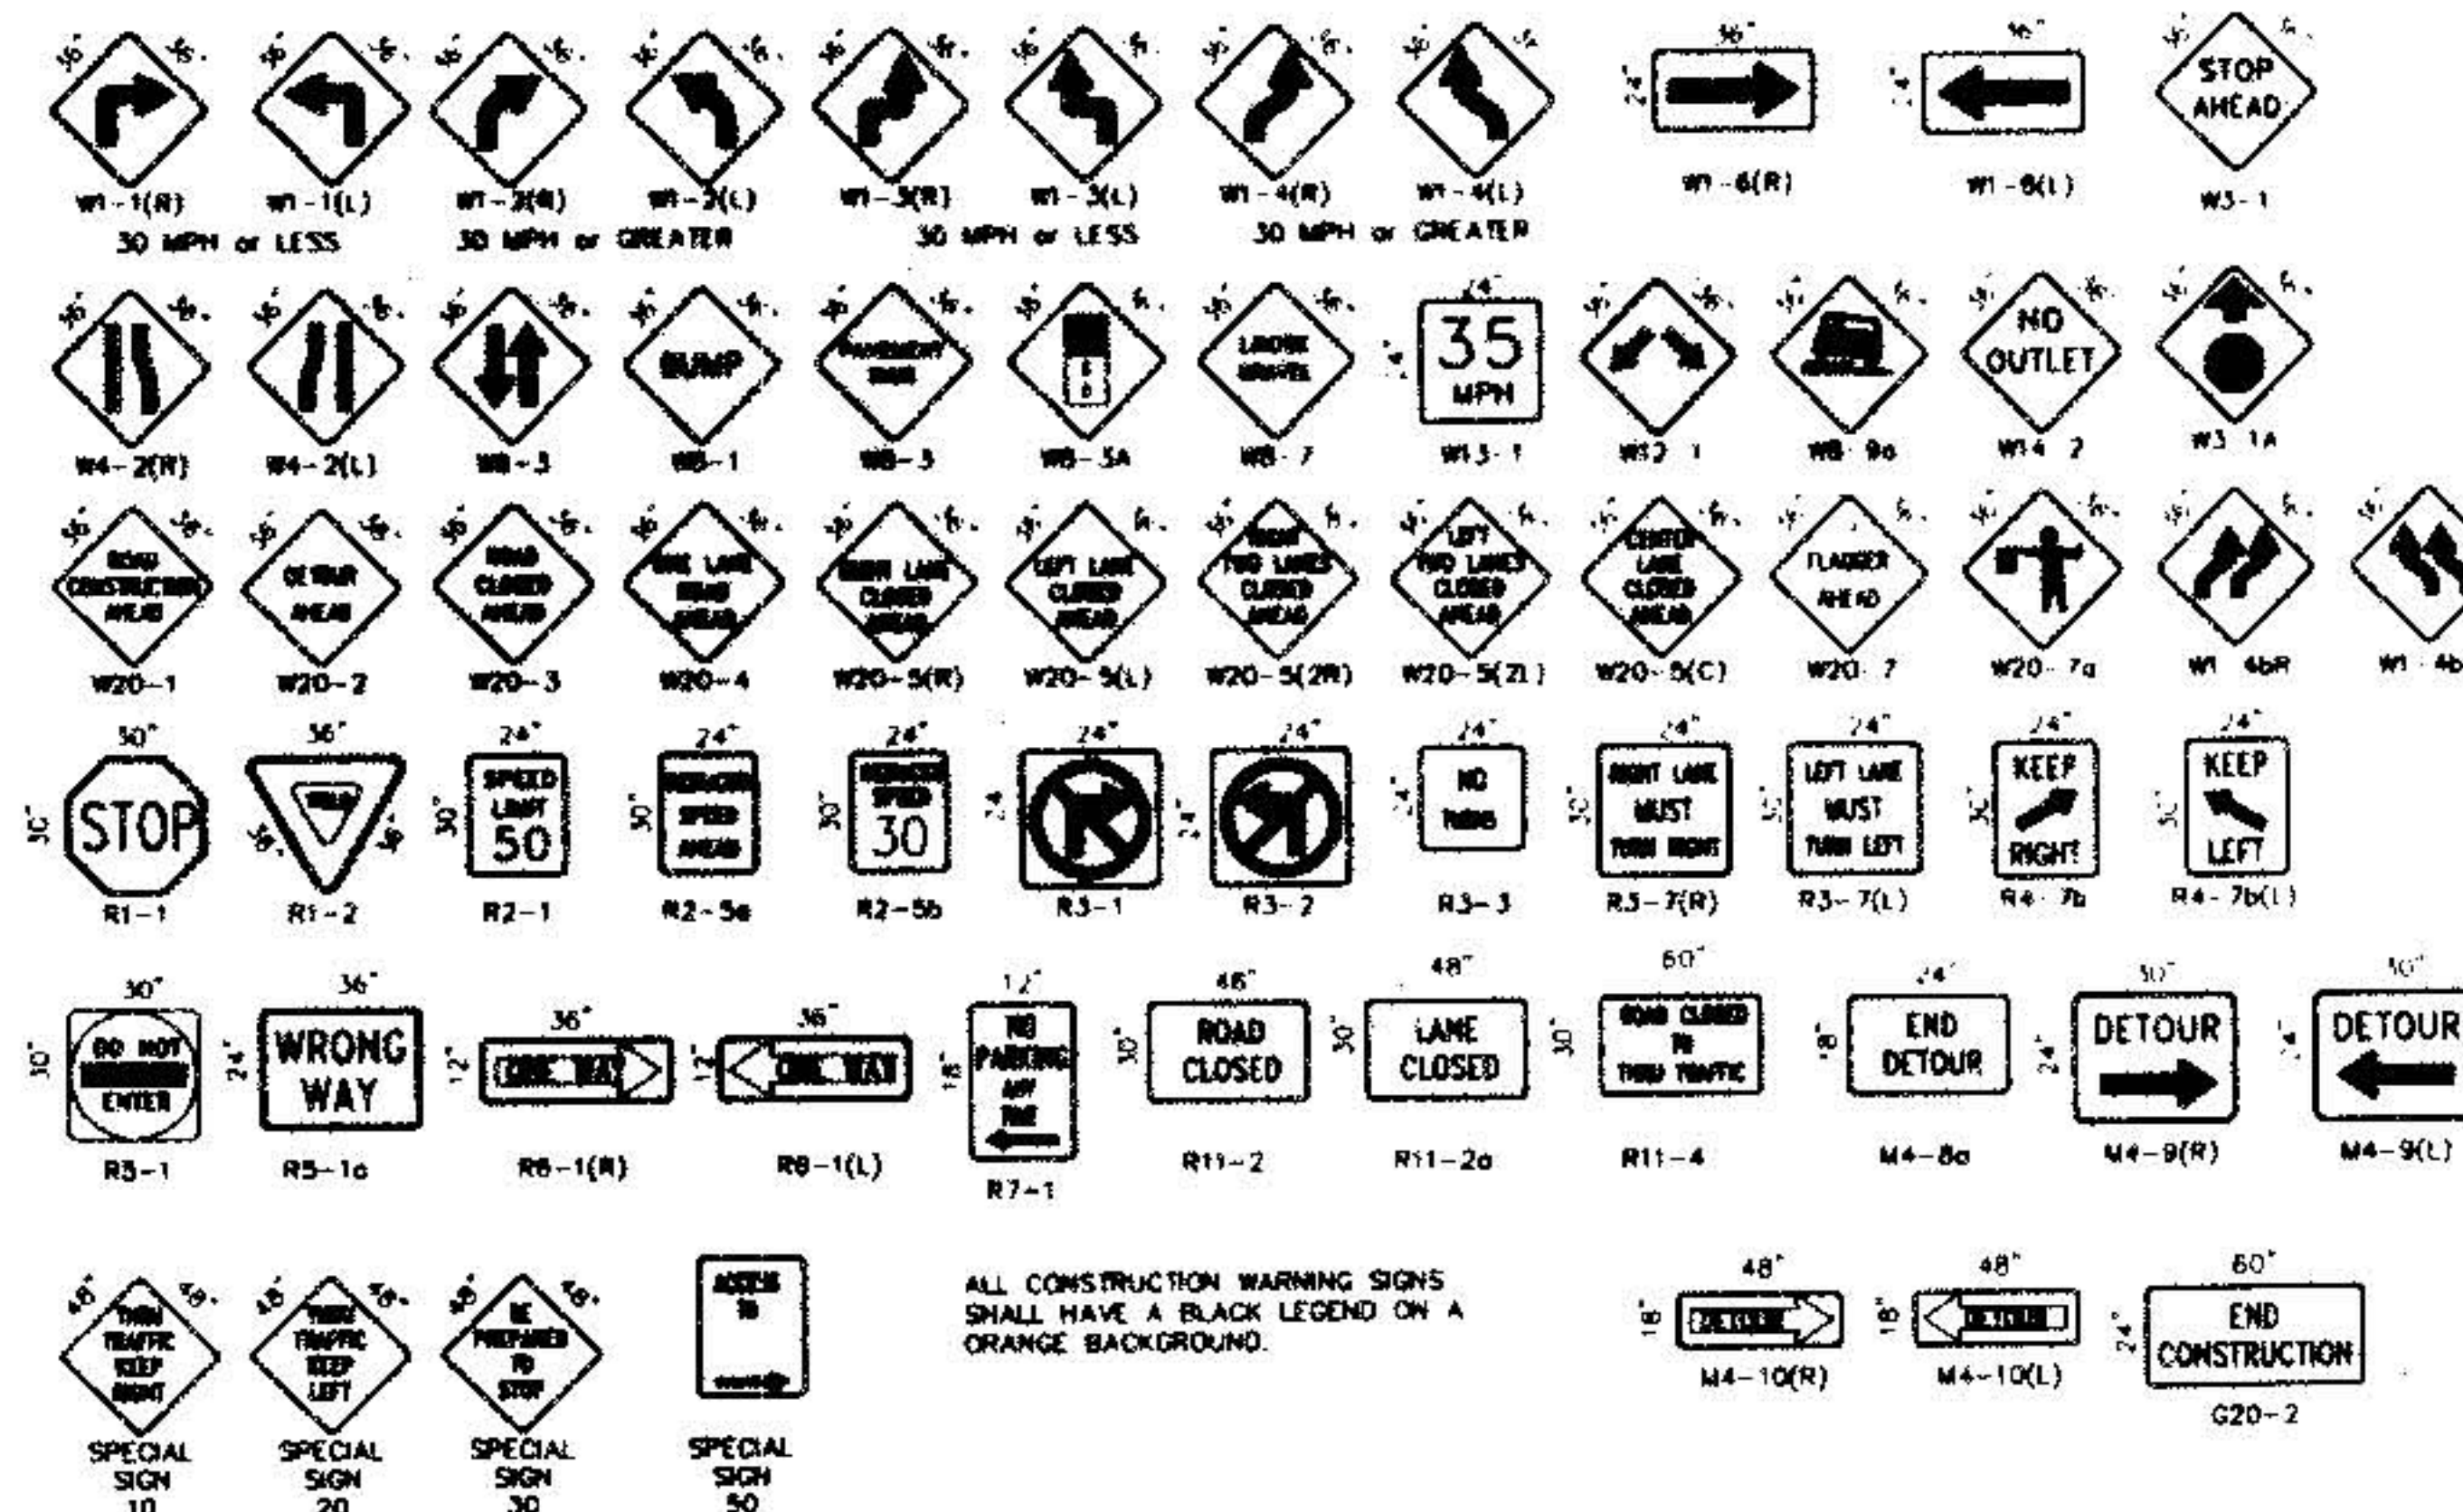

ALL CONSTRUCTION WARNING SIGNS SHALL HAVE A BLACK LEGEND ON A ORANGE BACKGROUND.

CITY OF ALBUQUERQUE
PUBLIC WORKS DEPARTMENT
ENGINEERING DEVELOPMENT GROUP

PROJECT: 6240.81
MAP NO: L-21-Z
SHEET: 21

DESIGN REVIEW COMMITTEE: CITY ENGINEER APPROVAL
DESIGNED BY: COA
DRAWN BY: STD
CHECKED BY: [Signature]

