

FILENET FORM FOR RECORD CENTER

SECURITY	☒ RESTRICTED OR ☐ UNRESTRICTED
PROJECT #	6258.92
PROJECT TITLE	Domingo Becerra Arroyo Phase II North Diversion Channel to Washington St.
ATLAS ZONE	C-17
DATE OF MAP & RECORD STAMP	08/19/05
SERIES	26
NUMBER OF SHEETS	14



CITY OF ALBUQUERQUE PUBLIC WORKS DEPARTMENT PLANS FOR CONSTRUCTION

DOMINGO BACA ARROYO PHASE II


NORTH DIVERSION CHANNEL TO WASHINGTON STREET

INDEX TO DRAWINGS

SHEET NO.	TITLE	SHEET NO.	TITLE
1	TITLE SHEET, VICINITY MAP, SHEET INDEX	13	MISCELLANEOUS DETAILS & SECTIONS #1
2	GENERAL NOTES & LEGEND	14	MISCELLANEOUS DETAILS & SECTIONS #2
3	PROJECT CONTROL INFORMATION		
4	CHANNEL PLAN & PROFILE: STA 12+63.67 TO 14+00		
5	CHANNEL PLAN & PROFILE: STA 14+00 TO 18+50		
6	CHANNEL PLAN & PROFILE: STA 18+50 TO 23+00		
7	CHANNEL PLAN & PROFILE: STA 23+00 TO 27+50		
8	TRANSITION: WEST SIDE OF WASHINGTON ST.		
9	TYPICAL HALF CHANNEL CROSS SECTION		
10	OUTFALL DETAILS AND SECTIONS		
11	STRUCTURAL SHEET #1		
12	STRUCTURAL SHEET #2		

RECORD DRAWINGS

I, Patrick J. Conley of the firm of Smith Engineering Company, A Registered Professional Engineer in the State of New Mexico, do hereby state, to the best of my knowledge and belief, that the infrastructure installed as part of this project has been inspected by a qualified person under my direct supervision and has been constructed in general accordance with the plans and specifications, while someone from Smith Engineering Company was onsite, approved by the City Engineer and that the original design intent of the approved plans has been met, except as noted on the as-built construction drawings. The Certification is based on site inspections by me or personnel under my direction, and as-built survey information provided by BON (Surveyor Name) NMPS

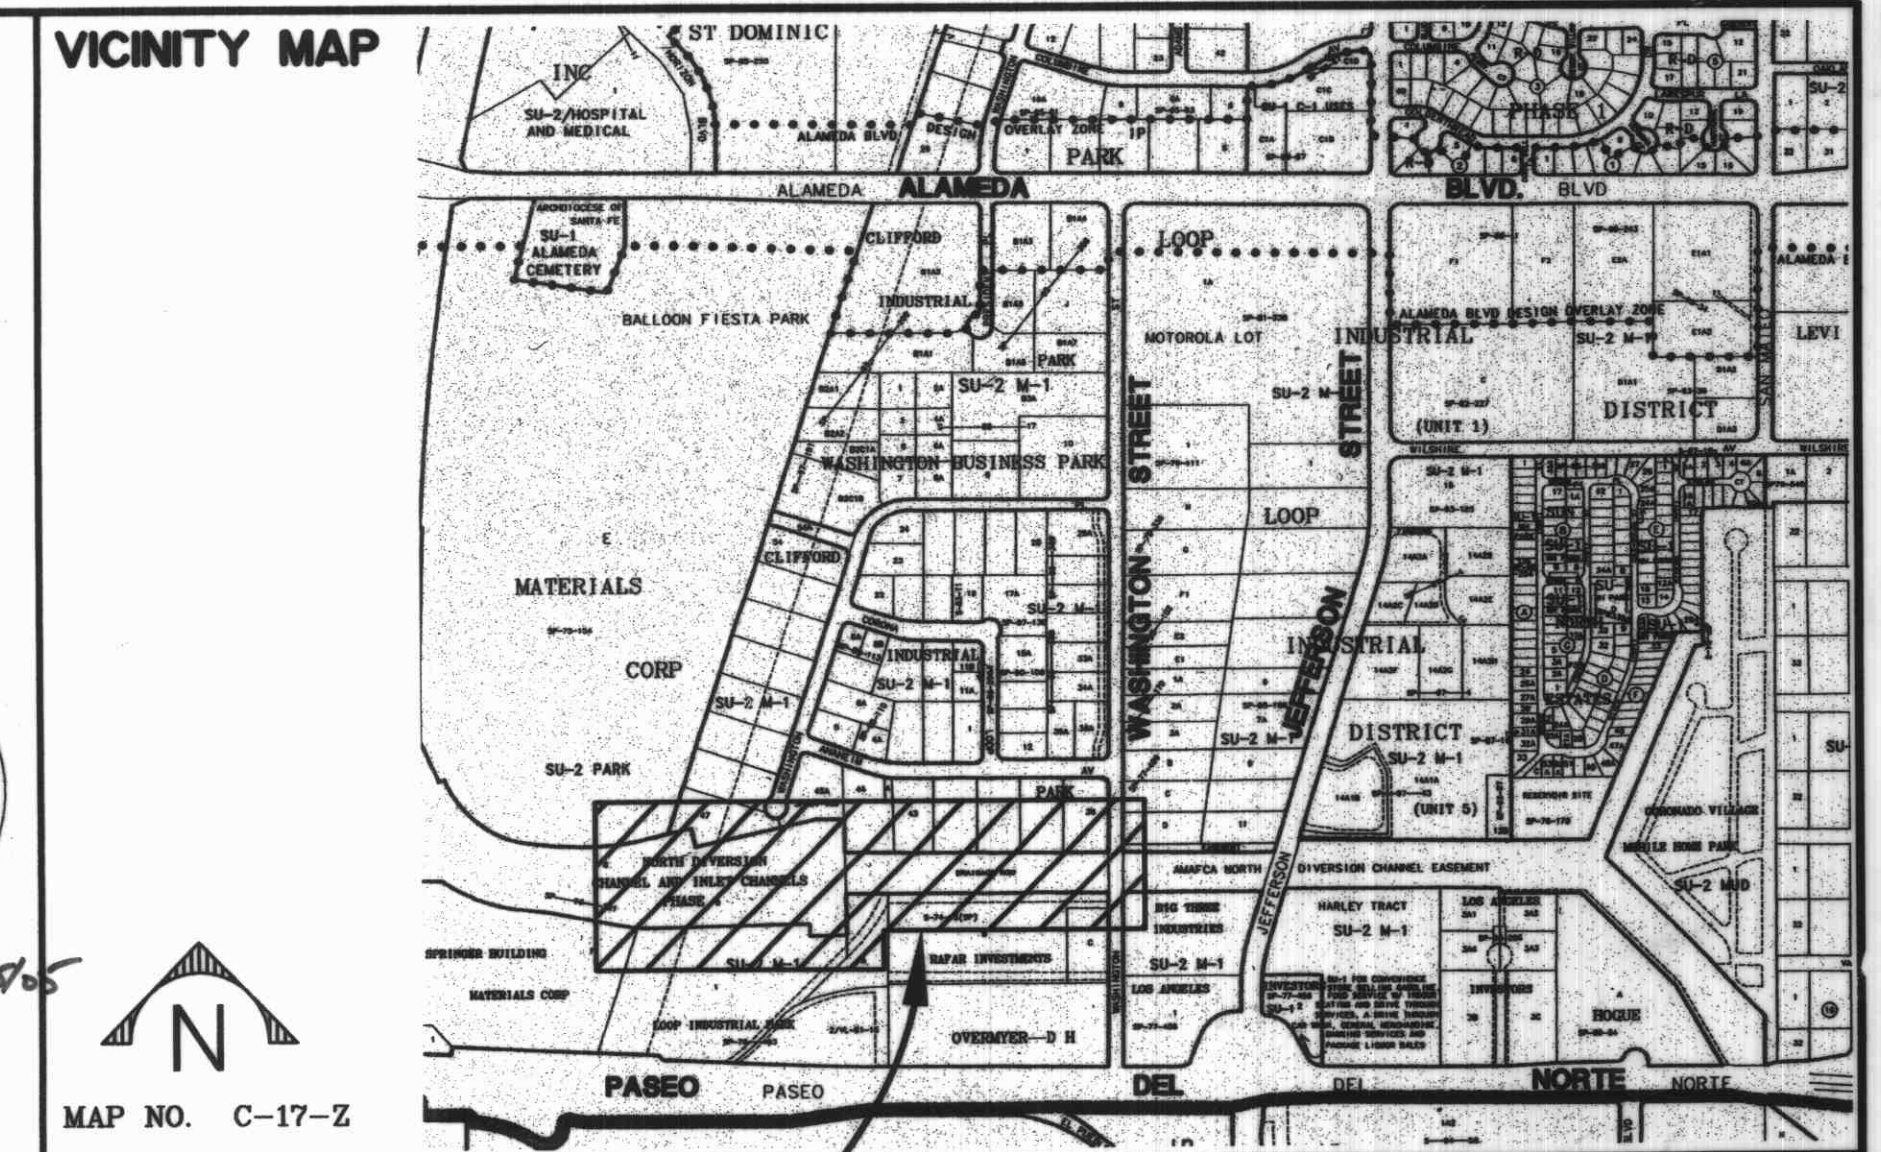

PROJECT LOCATION

UTILITY COMPANY CONTACTS

PNM-ELECTRIC
JAMES VANN Mark Bouchard
Principal Engineer
4201 Edith Blvd., NE
Albuquerque, New Mexico 87107
(505) 241-3496 O.A.

AT&T
DAVID CROWEL
Resource Supervisor
111 Third St., NW
Albuquerque, New Mexico 87103
(505) 842-2911

QWEST/US WEST
DAVID MULLER
Capacity Provisioning Specialist
(505) 245-8706
201 3rd Street NW, Suite 700
Albuquerque, New Mexico 87102

E-SPIRE (ACSI)
JOHN MARES
505 Marquette NE, Suite 1605
Albuquerque, New Mexico 87102
(505) 998-2274

BROOKS/MCI WORLDWIDE
ANDY DARNELL
Operation Manager
3700 Singer Blvd. NE, Suite A
Albuquerque, NM 87109
(505) 346-4476 70

TIME WARNER TELECOM
ROYAL HARRISON
Plant Manager
3830 Singer Blvd. NE, Suite 1000
Albuquerque, NM 87109
(505) 938-7339

PNM-GAS CO.
JEFFERY ROMANOWSKI, PE
Project Leader
4625 Edith Blvd., NE
Albuquerque, New Mexico 87107
(505) 241-7752


COMCAST CABLE
RITA ERICKSON
Planning and Design Supervisor
4611 Montbel Pl., NE
Albuquerque, New Mexico 87107
(505) 761-6235

CITY OF ALBUQUERQUE (WATER & SEWER)
GREG OLSON
PWD/Utility Development
P.O. Box 1293
Albuquerque, New Mexico 87103
(505) 768-2719

McLeodUSA
RICK MUELLER
Supervisor of Outside Techs.
505 Marquette NE, Suite 1600
Albuquerque, New Mexico 87102
(505) 244-3161

PATHNET
LOIS MEEKS
Right-of-Way & Licensing
1661 Gateway Blvd.
Richardson, Texas 75080
(972) 944-7114

GENUITY
DENNIS PAULSON
Manager
OSP Engineering
5221 North O'Connor MC, HQLIA22
Irving, Texas 75039
(972) 791-3277

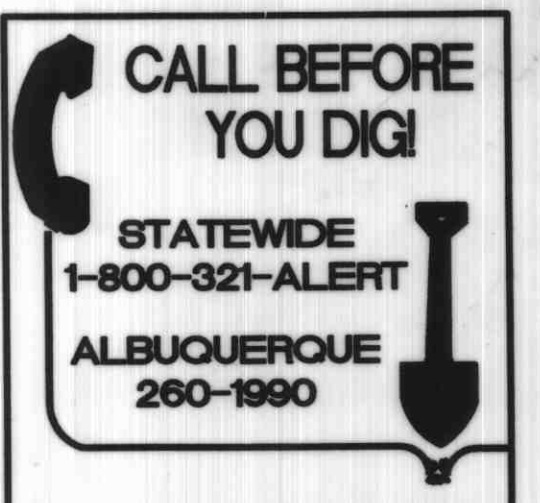

DISCLOSURE STATEMENT:

THE SUBJECT PROPERTY IS LOCATED ON/NEAR A FORMER LANDFILL. DUE TO SUBJECT PROPERTY BEING ON/NEAR A FORMER LANDFILL, CERTAIN PRECAUTIONARY MEASURES MAY NEED TO BE TAKEN TO ENSURE THE HEALTH AND SAFETY OF THE PUBLIC. RECOMMENDATIONS MADE BY A PROFESSIONAL ENGINEER WITH EXPERTISE IN LANDFILLS AND LANDFILL GAS ISSUES (AS REQUIRED BY THE MOST CURRENT VERSION OF THE "INTERIM GUIDELINES FOR DEVELOPMENT WITHIN 1000 FEET OF LANDFILLS") SHALL BE CONSULTED PRIOR TO DEVELOPMENT OF THE SITE.

APPROVED FOR CONSTRUCTION

Marcia Pincus July 7, 2004
MARCIA PINCUS, P.E.
ENVIRONMENTAL HEALTH DEPARTMENT
CITY OF ALBUQUERQUE

APPROVED FOR CONSTRUCTION WITHIN AMAFCA R.O.W.

John P. Kelley 7-7-04
JOHN KELLEY, P.E.
EXECUTIVE ENGINEER
ALBUQUERQUE METROPOLITAN ARROYO FLOOD CONTROL AUTHORITY

REV.	SHEETS	CITY ENGINEER	DATE	USER DEPARTMENT	DATE	USER DEPARTMENT	DATE
ENGINEERS STAMP & SIGNATURE		APPROVED	ENGINEER	DATE			
		DRC Chairman	<u>John P. Kelley</u>	7-8-04			
		Transportation	<u>William Z. Bralich</u>	7-7-04			
		Water/Wastewater	<u>John P. Kelley</u>	7-7-04			
		Hydrology	<u>John P. Kelley</u>	7-7-04			
		Const. Coord.	<u>John P. Kelley</u>	7-8-04			
		Env. Health					
		AMAFCA					
				CITY ENGINEER	DATE		
				PROJECT NUMBER	6258.92	SHEET 1 OF 14	

- 1 THE SPECIFICATIONS USED FOR THIS PROJECT ARE THE CITY OF ALBUQUERQUE STANDARD SPECIFICATIONS FOR PUBLIC WORKS CONSTRUCTION, 1986 EDITION, UPDATE, THROUGH UPDATE NO.7.
- 2 FIVE (5) WORKING DAYS PRIOR TO BEGINNING CONSTRUCTION, THE CONTRACTOR WILL SUBMIT A DETAILED CONSTRUCTION SCHEDULE TO THE CITY CONSTRUCTION COORDINATION DIVISION. TWO (2) DAYS PRIOR TO CONSTRUCTION, THE CONTRACTOR WILL OBTAIN A BARRICADING PERMIT FROM THE CONSTRUCTION COORDINATION DIVISION. CONTRACTOR SHALL NOTIFY BARRICADE ENGINEER (924-3400) PRIOR TO OCCUPYING AN INTERSECTION. REFER TO SECTION 19 OF STANDARD SPECIFICATIONS FOR PUBLIC WORKS.
- 3 THE CONTRACTOR WILL NOTIFY THE FIELD ENGINEER NOT LESS THAN SEVEN (7) DAYS PRIOR TO STARTING WORK, IN ORDER THAT THE CITY SURVEYOR MAY TAKE NECESSARY MEASURES TO INSURE THE PRESERVATION OF SURVEY MONUMENTS. THE CONTRACTOR WILL NOTIFY THE ENGINEER IF A MONUMENT IS DISTURBED. REPLACEMENT WILL BE DONE ONLY BY THE CITY SURVEY SECTION. WHEN A CHANGE IS MADE IN THE FINISHED ELEVATION OF THE PAVEMENT OF ANY ROADWAY IN WHICH A PERMANENT SURVEY MONUMENT IS LOCATED, CONTRACTOR WILL, AT HIS OWN EXPENSE, ADJUST THE MONUMENT COVER TO THE NEW GRADE UNLESS OTHERWISE SPECIFIED. REFER TO SECTION 4 OF STANDARD SPECIFICATIONS FOR PUBLIC WORKS.
- 4 ALL NEW MANHOLES SHALL BE TYPE "E" (COA DWG. 2102) UNLESS OTHERWISE NOTED ON THE PLANS.
- 5 THE CONTRACTOR WILL BE RESPONSIBLE FOR DISPOSING OF ALL DEBRIS, INCLUDING, BUT NOT LIMITED TO HAZARDOUS WASTE AT DISPOSAL SITES APPROVED BY GOVERNMENTAL AGENCIES REGULATING THE DISPOSAL OF SUCH MATERIALS.
- 6 ALL WATER VALVE BOXES AND MANHOLES IN THE STREET CONSTRUCTION ARE TO BE ADJUSTED TO FINISH GRADE AND WILL BE MEASURED AND PAID PER EACH.
- 7 SUBGRADE PREPARATION UNDER SIDEWALKS AND DRIVE PADS, AND SUBGRADE AND SUBBASE PREPARATION UNDER CURB AND GUTTER IS CONSIDERED INCIDENTAL TO THE CONSTRUCTION OF SUCH, AND NO DIRECT PAYMENT SHALL BE MADE FOR THOSE ITEMS OF WORK.
- 8 THE WATER SYSTEMS DIVISION (857-8200) WILL BE NOTIFIED BY THE CONTRACTOR SEVEN (7) WORKING DAYS IN ADVANCE OF ANY WORK WHICH MAY AFFECT THE EXISTING PUBLIC WATER FACILITIES. REFER TO SECTION 18 OF STANDARD SPECIFICATIONS.
- 9 ALL EXCAVATION WILL BE GOVERNED BY FEDERAL, STATE AND LOCAL LAWS, RULES, AND REGULATIONS CONCERNING CONSTRUCTION SAFETY AND HEALTH. ALL EXCAVATING, TRENCHING & SHORING ACTIVITIES MUST BE CARRIED-OUT IN ACCORDANCE WITH OSHA 1926.650 SUBPART P.
- 10 ALL SIGNS AND CODING WILL BE IN ACCORDANCE WITH THE "MANUAL OF UNIFORM TRAFFIC CONTROL DEVICES FOR STREETS AND HIGHWAYS" CURRENT EDITION PUBLISHED BY THE U.S. DEPARTMENT OF TRANSPORTATION.
- 11 THE CONTRACTOR IS TO EXERCISE CARE TO AVOID DISTURBING ANY EXISTING UNDERGROUND UTILITIES. IT WILL BE HIS OF HER RESPONSIBILITY TO COORDINATE WITH THE UTILITY COMPANIES IN ORDER TO PREVENT ANY SERVICE DISRUPTION. SEE SECTION 18 "UTILITIES", CITY OF ALBUQUERQUE, STANDARD SPECIFICATIONS FOR CONTRACTOR REQUIREMENTS.
- 12 WHEN ABUTTING NEW PAVEMENT TO EXISTING INTERSECTING STREETS, SAW CUT EXISTING PAVEMENT TO A STRAIGHT LINE AND AT RIGHT ANGLES AND REMOVE ANY BROKEN OR CRACKED PAVEMENT. NO DIRECT PAYMENT WILL BE MADE FOR SAW CUTTING.
- 13 ALL GAS VALVES, GAS MANHOLES, ELECTRICAL MANHOLES, TELEPHONE MANHOLES, AND UTILITY POLES WILL BE ADJUSTED TO GRADE BY EACH UTILITY COMPANY. CONTRACTOR WILL COORDINATE THROUGH CITY UTILITY COORDINATOR.
- 14 WHEN REMOVAL OF EXISTING CURB AND GUTTER OR SIDEWALK IS REQUIRED, REMOVE BACK TO NEAREST SUITABLE JOINT UNLESS OTHERWISE DIRECTED BY THE CITY FIELD ENGINEER.
- 15 THE CONTRACTOR WILL NOTIFY NEW MEXICO ONE CALL SYSTEM 260-1990 TWO (2) WORKING DAYS PRIOR TO COMMENCING WORK IN NEW AREAS.
- 16 CONTRACTOR WILL MAKE ALL WATER VALVES AND MANHOLES ACCESSIBLE TO THE CITY AT ALL TIMES.
- 17 CONTRACTOR WILL PLACE BITUMINOUS MATERIAL WITH THE USE OF A LAYDOWN MACHINE WHERE PAVEMENT IS 8 FEET IN WIDTH OR WIDER.
- 18 ALL SUBGRADE AND SUBBASE MATERIAL ENCOUNTERED IN PAVEMENT REMOVAL AND REPLACEMENT THAT IS DETERMINED BY THE FIELD ENGINEER TO MEET THE SPECIFICATIONS, CAN BE REUSED. HOWEVER, THE MATERIAL WILL BE PROCESSED AND COMPACTED TO MEET MOISTURE CONTENT AND PERCENT COMPACTION REQUIRED BY THE SPECIFICATIONS.
- 19 CONTRACTOR WILL NOT PAVE OVER ANY SURFACE FEATURE, I.E., GAS VALVE, MANHOLE COVER, ETC. WITHOUT PRIOR APPROVAL FROM THE CITY FIELD ENGINEER.
- 20 CONTRACTOR WILL CONFINE HIS OR HER WORK WITHIN THE CONSTRUCTION EASEMENT LIMITS AND/OR RIGHT-OF-WAY, OR PROVIDE COPIES OF AGREEMENTS WITH ADJACENT LANDOWNERS TO THE CITY OF ALBUQUERQUE.

- 21 ALL WATER VALVES AND FIRE HYDRANTS REMOVED WILL BE SALVAGED AND RETURNED TO THE C.O.A.
- 22 MINIMUM BOTTOM WIDTH OF TRENCHES FOR RIGID PIPE SHALL BE EQUAL TO THE OUTSIDE DIAMETER PLUS 16 INCHES. BEDDING MATERIAL SHALL BE CLASS II, III, OR IV UNLESS OTHERWISE SPECIFICALLY NOTED ON THE PLANS.
- 23 MINIMUM BOTTOM WIDTH OF TRENCHES FOR NON-RIGID PIPE SHALL BE EQUAL TO THE OUTSIDE DIAMETER PLUS 12 INCHES. BEDDING MATERIAL SHALL BE CLASS I, II, OR III.
- 24 THE CONTRACTOR AGREES TO TAKE NECESSARY SAFETY PRECAUTIONS AS REQUIRED BY FEDERAL, STATE AND LOCAL AUTHORITIES TO PROTECT PEDESTRIAN AND VEHICULAR TRAFFIC IN THE CONSTRUCTION AREA, WHICH INCLUDE BUT ARE NOT LIMITED TO: MAINTAINING ADEQUATE WARNING SIGNS, BARRICADES, LIGHTS, GUARD FENCES, WALKS AND BRIDGES.
- 25 ALL STRUCTURAL CONCRETE TO BE 4000 PSI UNLESS OTHERWISE NOTED ON PLANS.
- 26 ALL REINFORCING STEEL TO BE GRADE 60.
- 27 ALL EXPOSED EDGES ON CAST-IN-PLACE CONCRETE STRUCTURES WILL HAVE A 1" CHAMFER UNLESS OTHERWISE NOTED.
- 28 ALL SPLICES IN REINFORCING STEEL WILL BE 2-FOOT 6-INCH MINIMUM UNLESS OTHERWISE NOTED.
- 29 PRIOR TO CONSTRUCTION, THE CONTRACTOR WILL EXCAVATE AND VERIFY THE HORIZONTAL AND VERTICAL LOCATIONS OF ALL POTENTIAL CONFLICTING UTILITIES. SHOULD A CONFLICT EXIST BETWEEN THE FIELD INFORMATION AND THE PLANS, THE CONTRACTOR WILL NOTIFY THE CITY FIELD ENGINEER SO THE CONFLICT CAN BE RESOLVED WITH MINIMUM AMOUNT OF DELAY.
- 30 THE REPLACEMENT OF THE EXISTING UTILITIES AND THE INSTALLATION OF NEW UTILITY LINES WILL BE COMPLETED IN ADVANCE OF STARTING THE PAVEMENT WORK. TEMPORARY PAVEMENT WILL BE PLACED IN ALL TRENCHES REQUIRED FOR THE UTILITY REPLACEMENTS IN THOSE AREAS THAT MUST MAINTAIN TRAFFIC UNTIL THE FINAL PAVEMENT WORK STARTS IN EACH AREA. TEMPORARY STRIPING SHALL BE THE CONTRACTOR'S RESPONSIBILITY. MAINTENANCE OF THE TEMPORARY PAVING AND STRIPING WILL BE AT THE CONTRACTOR'S EXPENSE.
- 31 TACK COAT FOR SURFACE COURSE REQUIREMENTS WILL BE DETERMINED BY THE FIELD ENGINEER.
- 32 THE CONTRACTOR WILL CONTACT THE CITY OF ALBUQUERQUE TRAFFIC DIVISION 764-1599, ONE (1) WEEK IN ADVANCE OF ANY CHANGES REQUIRED IN THE TRAFFIC SIGNALIZATION OF THIS PROJECT. ALL WORK ASSOCIATED WITH NEW TRAFFIC SIGNALIZATION SHALL BE THE RESPONSIBILITY OF THE CONTRACTOR.
- 33 ALL NEW STREET PAVING, DRIVEWAYS, SIDEWALKS, AND CURB AND GUTTERS, ABUTTING EXISTING AREAS SHALL MATCH THE ELEVATION OF THOSE AREAS.
- 34 PERMANENT PAVEMENT STRIPING AND MARKINGS WILL BE PLACED BY THE CONTRACTOR. ROAD SHALL NOT BE OPENED TO TRAFFIC UNTIL IT IS STRIPED. ALL STRIPING, PAVEMENT MARKINGS INCLUDING CROSSWALKS, ARROWS AND LINE MARKINGS ARE TO BE CONSTRUCTED OF HOT PLASTIC OR COLD PLASTIC IN ACCORDANCE WITH THE MANUAL OF UNIFORM TRAFFIC CONTROL DEVICES.
- 35 ALL EXCAVATED MATERIAL THAT IS NOT REQUIRED TO BE REUSED MUST BE REMOVED FROM THE PROJECT AREA WITHIN FOUR DAYS OF EXCAVATION. SPOIL PILES WILL BE ALLOWED ONLY AS DIRECTED BY THE CITY FIELD ENGINEER.
- 36 THE CONTRACTOR WILL COORDINATE THE CONSTRUCTION ACTIVITIES WITH ALL OTHER CONTRACTORS AND UTILITY COMPANIES WORKING IN THE SAME AREA. THE CONTRACTOR MAY BE REQUIRED TO RESCHEDULE THEIR ACTIVITIES TO ALLOW UTILITY CREWS TO PERFORM THEIR REQUIRED WORK. NO ADDITIONAL COMPENSATION WILL BE ALLOWED FOR DELAYS OR INCONVENIENCE CAUSED BY UTILITY COMPANY WORK CREWS. THE CONTRACTOR MAY BE ALLOWED AN EXTENSION OF THE CONTRACT TIME, DUE TO DELAYS, AS DELINEATED IN THE CITY OF ALBUQUERQUE STANDARD SPECIFICATIONS, SECTION 12.
- 37 ALL CONSTRUCTION EASEMENTS ON PRIVATE PROPERTY WILL BE OBTAINED BY THE CONTRACTOR PRIOR TO THE BEGINNING OF CONSTRUCTION.
- 38 EXISTING MEDIAN CURB AND GUTTER AND STANDARD CURB AND GUTTER, NOT DISTURBED BY CONTRACTOR, BUT OUT OF ALIGNMENT, DISPLACED VERTICALLY, BADLY BROKEN AND/OR DETERIORATED, WILL BE REPLACED AS DIRECTED BY THE FIELD ENGINEER AND PAID FOR AT CONTRACT UNIT PRICES.
- 39 ALL TRAFFIC CONTROL DEVICES REQUIRED FOR DRIVEWAY CLOSURES, UTILITY CONSTRUCTION OR FOR OTHER REASONS AND NOT SHOWN ON THE SIGNING PLANS WILL BE FURNISHED BY THE CONTRACTOR AND WILL BE PAID AS SPECIFIED IN THE TECHNICAL SPECIFICATIONS AND BID PROPOSAL. PRIOR TO PLACING THE TRAFFIC CONTROL DEVICES, THE CONTRACTOR WILL NOTIFY THE AFFECTED OWNERS IN ACCORDANCE WITH THE SPECIFICATIONS. CONTRACTOR MUST MAKE PROVISIONS TO PROVIDE ACCESS TO PROPERTIES. REFER TO SECTION 19 OF THE STANDARD SPECIFICATIONS.

- 40 ALL UTILITY LINES WHICH ARE NOT SPECIFICALLY DESIGNATED TO BE REMOVED AND REPLACED ON THE PLANS, WILL BE MAINTAINED IN SERVICE. SHORING, SHEETING AND OTHER MEANS OF SUPPORT SHALL BE EMPLOYED BY THE CONTRACTOR TO PREVENT DAMAGE OR LOSS OF THESE EXISTING UTILITIES. BEAM AND CABLE OR OTHER ADEQUATE SUPPORTS WILL BE USED FOR TEMPORARY SUPPORT OF ALL UTILITY LINES WHICH CROSS THE TRENCH. ANY DAMAGE TO EXISTING UTILITIES WILL PROMPTLY BE REPAIRED AT THE CONTRACTOR'S EXPENSE. THE CONTRACTOR WILL NOTIFY THE ENGINEER IMMEDIATELY OF ANY SIGNIFICANT DEVIATION OF EXPOSED UTILITIES FROM THE LOCATIONS SHOWN ON THE PLANS SO THAT CONFLICTS CAN BE RESOLVED IN A TIMELY MANNER.
- 41 THE CONTRACTOR WILL ASSUME RESPONSIBILITY FOR ANY DAMAGE TO EXISTING COA INFRASTRUCTURE (C & G, PAVING, ETC.) DURING CONSTRUCTION, APART FROM THOSE SECTIONS INDICATED FOR REMOVAL ON THE PLANS, AND WILL REPAIR OR REPLACE SAME AT HIS OR HER OWN EXPENSE. HE/SHE WILL SUITABLY PROTECT THE CURB AND GUTTER FROM INCIDENTAL SPLASHING DURING THE TACK COAT APPLICATION AND WILL BE RESPONSIBLE FOR CLEANING SAME AT HIS OWN COST SHOULD SPLASHING OCCUR.
- 42 ALL INTERFERING PORTIONS OF ABANDONED UTILITY LINES WHICH ARE EXPOSED AS A RESULT OF CONSTRUCTION WILL BE REMOVED AND DISPOSED OF BY THE CONTRACTOR.
- 43 STATIONS OF STORM DRAIN INLETS ARE TO THE CENTER OF GRATE. ALL STORM DRAIN INLETS WILL BE TYPE "A" UNLESS OTHERWISE NOTED ON THE PLANS.
- 44 SHORING COSTS WILL BE CONSIDERED INCIDENTAL TO THE TRENCH AND BACKFILL COSTS.
- 45 THE CONTRACTOR WILL BE RESPONSIBLE FOR SECURING NPDES PERMITS REQUIRED BY APPLICABLE CITY, STATE, AND FEDERAL REGULATIONS.
- 46 ALL STORM DRAIN AND CONNECTOR PIPE WILL BE CLASS IV REINFORCED CONCRETE PIPE UNLESS OTHERWISE NOTED ON THE PLANS.
- 47 THE TERM "REMOVE" USED IN THIS PLAN SET INCLUDES THE DISPOSAL OF SAID MATERIAL IN ACCORDANCE WITH CITY OF ALBUQUERQUE STANDARD SPECIFICATIONS, LATEST EDITION.
- 48 CONTRACTOR WILL SURVEY AND LOG EXISTING ELEVATIONS OF CURB-AND-GUTTER, SIDEWALK, AND PAVEMENT WHICH WILL BE REMOVED FOR CONSTRUCTION OF IMPROVEMENTS. CONTRACTOR WILL REPLACE REMOVED CURB-AND-GUTTER, SIDEWALK, DRIVE PADS, AND PAVEMENT TO ELEVATIONS PRIOR TO REMOVAL UNLESS OTHERWISE INDICATED ON THE PLANS.
- 49 CONTRACTOR WILL CONSTRUCT TEMPORARY ASPHALT PAVEMENT AS DIRECTED BY THE COA ENGINEER TO PROVIDE ACCESS TO LOCAL BUSINESS, ETC. TEMPORARY PAVEMENT SHALL BE REMOVED AND DISPOSED OF PRIOR TO PLACEMENT OF FULL WIDTH PAVEMENT SECTION. TEMPORARY PAVING SHALL BE PER COA STD. DWG. 2415 AND PAID FOR PER COA STD. SPECIFICATIONS.
- 50 ALL EXPOSED CONCRETE SURFACES INCLUDING BUT NOT LIMITED TO RETAINING WALLS, SLOPE PAVING, STRUCTURES, AND CHANNEL LINING SHALL BE TINTED CONCRETE. TINTING SHALL BE SAN DIEGO BUFF AT ONE POUND OF COLOR PER SACK OF CEMENT. THE EXCEPTION IS THE ENTRY FLATWORK ADJACENT TO WASHINGTON.
- 51 PRE-WETTING OF THE EMBANKMENT FOUNDATION AND KEY TRENCH SHALL BE CONSIDERED INCIDENTAL TO THE CONSTRUCTION OF THE EMBANKMENT. NO ADDITIONAL PAYMENT WILL BE MADE FOR THIS WORK.
- 52 ALL ASPHALTIC CONCRETE SHALL BE MINIMUM 1800 LB. STABILITY AND COMPACTED TO 95% MODIFIED MARSHALL DENSITY UNLESS OTHERWISE NOTED ON THE PLANS.
- 53 ALL RIP-RAP MATERIAL USED ON THIS PROJECT SHALL BE A NATURAL ROCK MATERIAL CONFORMING TO THE SIZE AND MATERIAL PROPERTY REQUIREMENTS SET FORTH IN THE COA STANDARD SPECIFICATIONS. NO BROKEN CONCRETE OR RUBBLE WILL BE ACCEPTED.
- 54 CONTRACTOR SHALL MAINTAIN A GRAFFITI-FREE SITE. CONTRACTOR SHALL PROMPTLY REMOVE ANY AND ALL GRAFFITI FROM EQUIPMENT, WHETHER PERMANENT OR TEMPORARY.
- 55 ALL STRIPING ON C.O.A STREETS REMOVED OR DAMAGED MUST BE REPLACED WITH PLASTIC. STRIPING ERADICATION SHALL BE ACCOMPLISHED BY WATER BLASTING OR SURFACE PLANING OF THE ROADWAY TO A MAXIMUM DEPTH OF 0.25 INCHES (MAXIMUM) AND FOR A WIDTH EQUAL TO TWO TIMES THE WIDTH OF THE STRIPE OR MARKING TO BE REMOVED.
- 56 FOR STORM DRAIN CONSTRUCTION, ROP JOINTS SHALL NOT BE GROUTED PRIOR TO FINAL FINAL INSPECTION WILL DETERMINED JOINTS TO BE GROUTED FOR FULL INSPECTION ACCEPTANCE OF THE CONSTRUCTION.
- 57 THE CONTRACTOR SHALL ABIDE BY ALL LOCAL, STATE, AND FEDERAL LAWS, RULES, AND REGULATIONS WHICH APPLY TO THE CONSTRUCTION, INCLUDING WORKER HEALTH AND SAFETY ASPECTS, OF THESE IMPROVEMENTS.
- 58 DISPOSAL SITE FOR ALL EXCESS EXCAVATION MATERIAL AND UNSUITABLE MATERIAL SHALL BE OBTAINED BY THE CONTRACTOR IN COMPLIANCE WITH APPLICABLE ENVIRONMENTAL REGULATIONS. ALL COSTS INCURRED IN OBTAINING A FULLY REGULATED DISPOSAL SITE AND HAUL THERETO SHALL BE CONSIDERED INCIDENTAL TO THE PROJECT AND NO SEPARATE MEASUREMENT OF PAYMENT SHALL BE CONSIDERED.

EXISTING FEATURES LEGEND:

	EXISTING CHAIN-LINK FENCE
	EXISTING GAS LINE W/ VALVE
	EXISTING WATERLINE W/ VALVE
	EXISTING WATERLINE METER
	EXISTING FIRE HYDRANT
	EXISTING SANITARY SEWER LINE W/ MANHOLE
	EXISTING STORM DRAIN
	EXISTING UTILITY POLE
	EXISTING 1' CONTOUR
	EXISTING 5' CONTOUR
	EXISTING CURB & GUTTER
	EXISTING CONCRETE
	EXISTING BUILDING LINE
	EXISTING EASEMENT LINE


NEW FEATURES LEGEND:

	CONSTRUCTION CENTERLINE
	NEW CHAIN-LINK FENCE
	NEW GAS LINE W/ VALVE
	NEW WATERLINE W/ VALVE
	NEW WATERLINE METER
	NEW FIRE HYDRANT
	NEW SANITARY SEWER LINE W/ MANHOLE
	NEW STORM DRAIN
	NEW UTILITY POLE
	NEW 1' CONTOUR
	NEW 5' CONTOUR
	NEW CURB & GUTTER
	NEW CONCRETE
	EAST EASEMENT LINE
	POT HOLE LOCATION W/ NO.
	NEW EDGE OF PAVEMENT

HEALTH AND SAFETY NOTE::

THIS PROJECT IS BEING PERFORMED ON/NEAR A FORMER LANDFILL. THE CONTRACTOR IS RESPONSIBLE FOR THE HEALTH AND SAFETY OF HIS/HER WORKERS. THE WORK DETAILED IN THIS PROJECT MAY REQUIRE THAT A HEALTH AND SAFETY PLAN BE PREPARED ACCORDING TO OSHA 1910.120.

		1001018	
Smith Engineering Company		A Full Service Engineering Company	
4000 University Boulevard, N.E. Suite 2000 Albuquerque, New Mexico 87106			
CITY OF ALBUQUERQUE PUBLIC WORKS DEPARTMENT ENGINEERING DEVELOPMENT GROUP			
TITLE: DOMINGO BACA ARROYO - NORTH DIVERSION CHANNEL TO WASHINGTON ST.			
GENERAL NOTES AND LEGEND			
Design Review Committee	City Engineer Approval	No. / Day / Yr.	No. / Day / Yr.
City Project No.	Zone Map No.	Sheet	Of
6258.92	C-17-Z	2	14

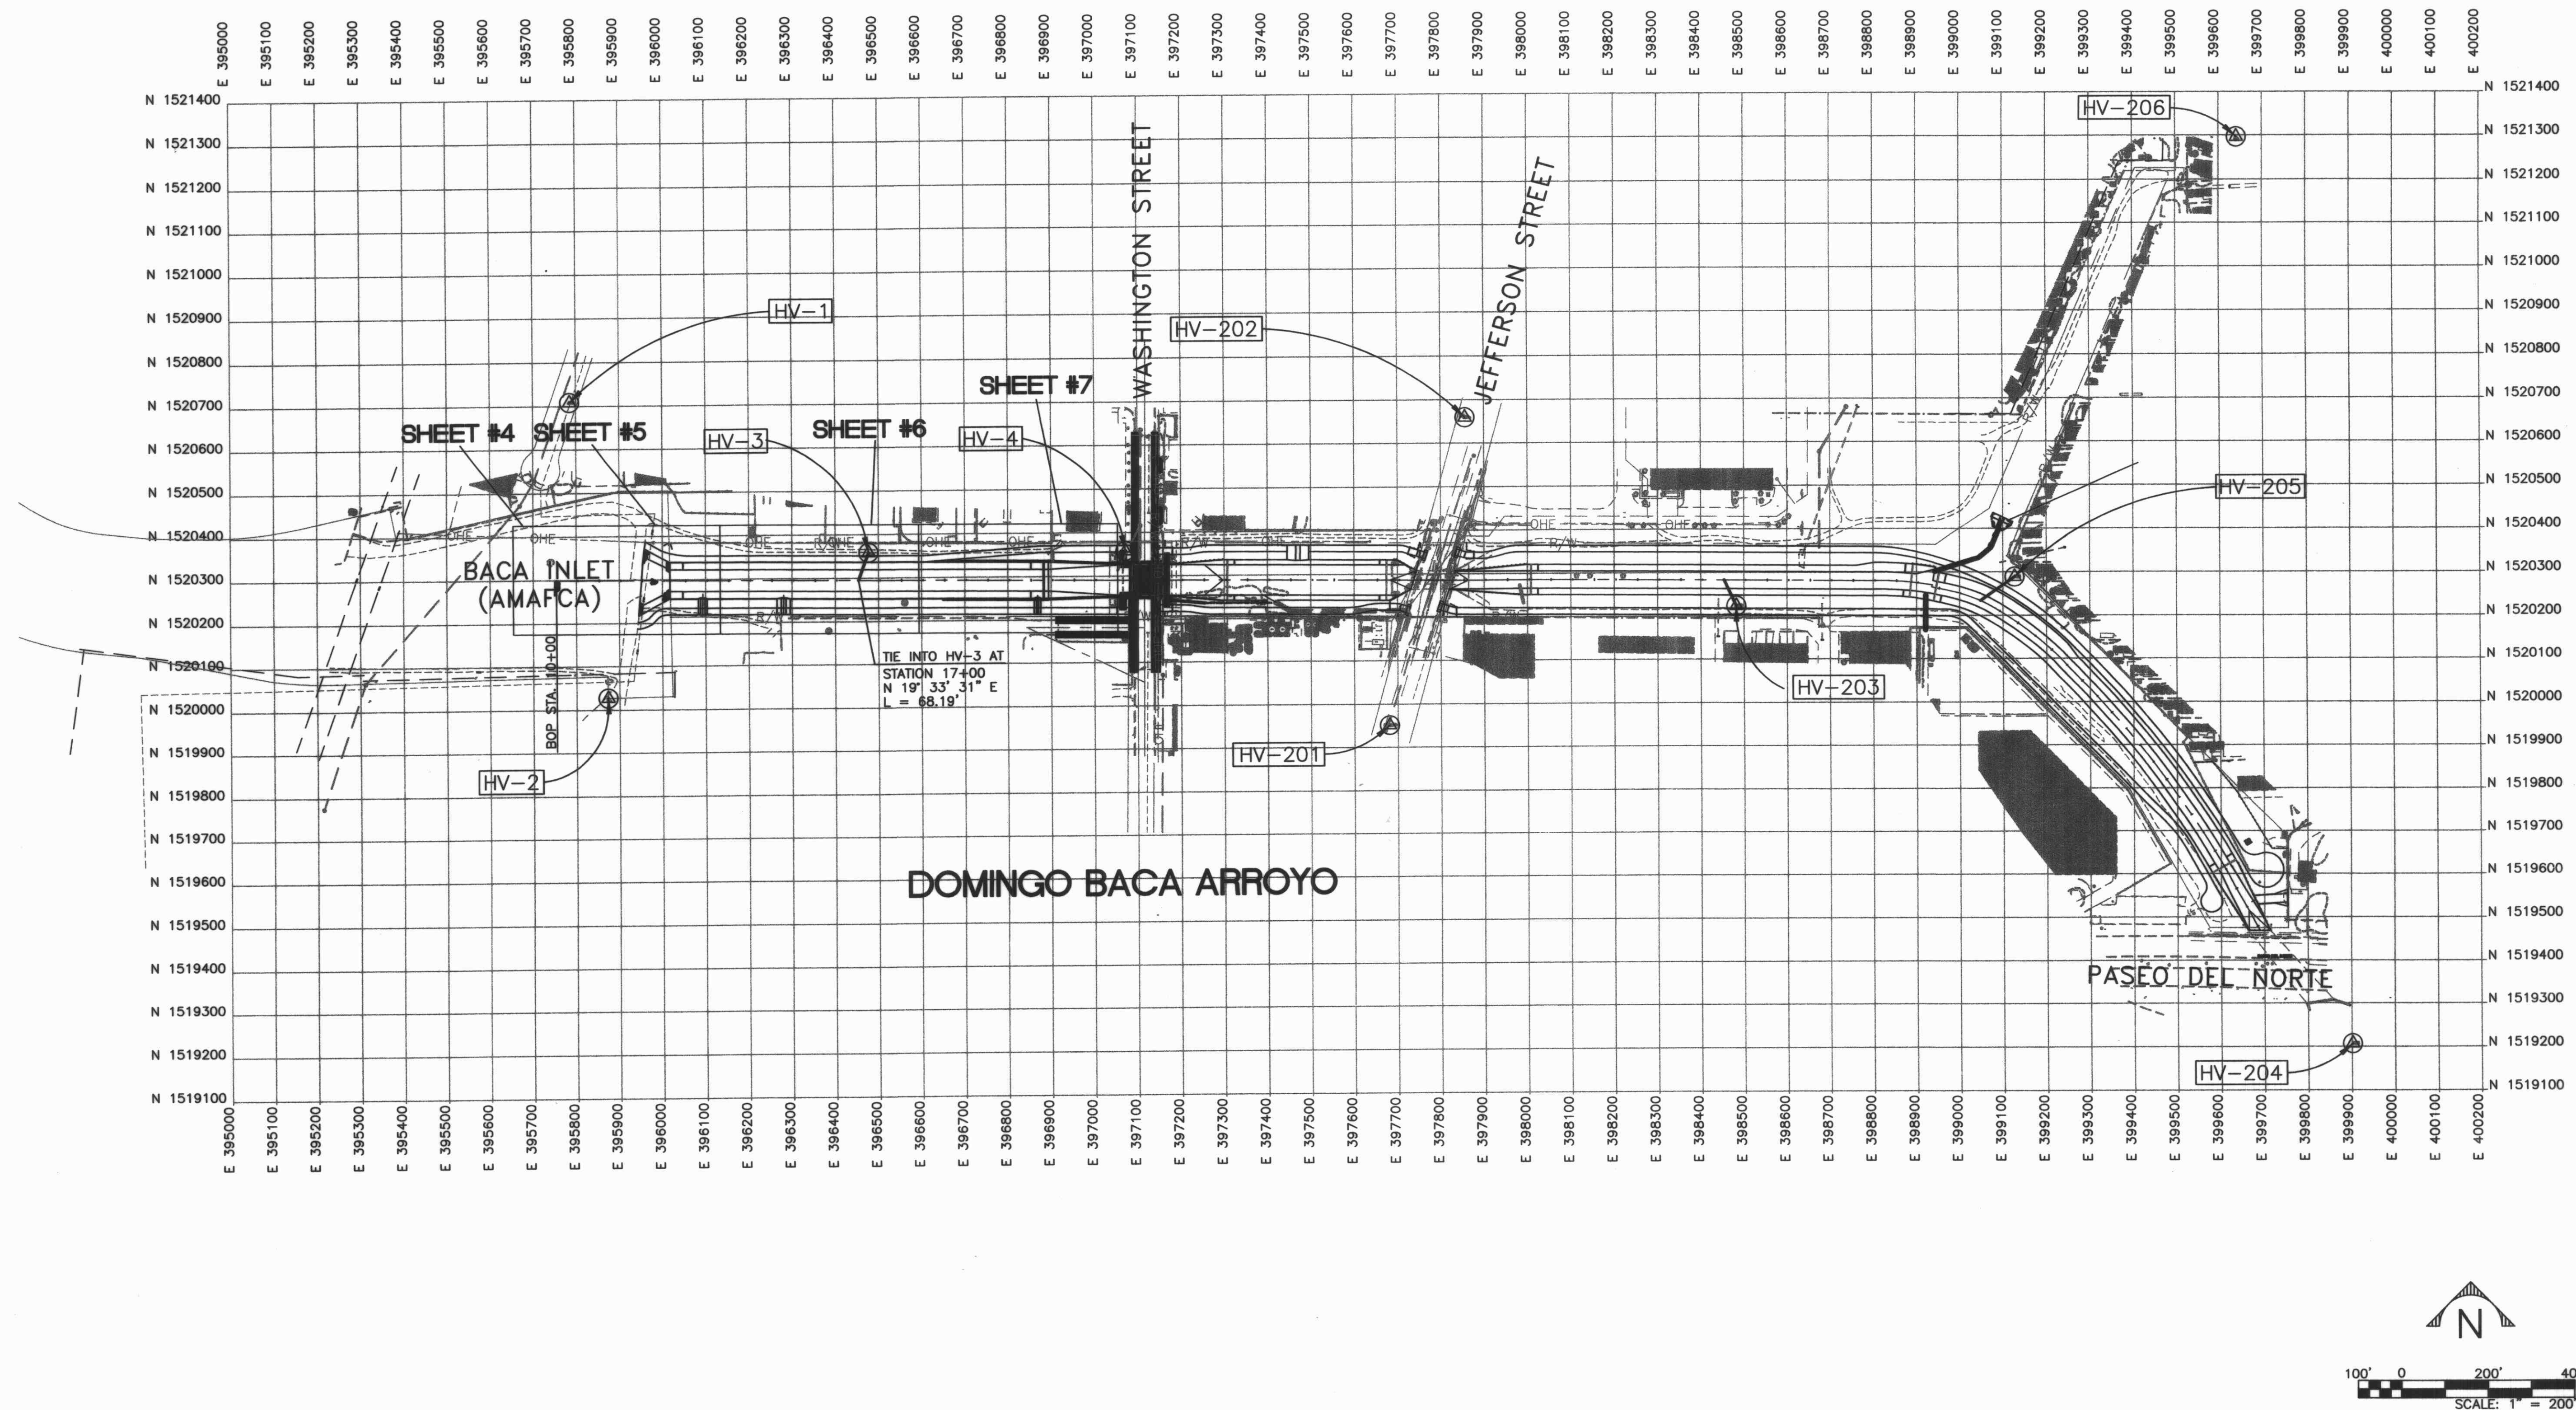

CONTROL INFORMATION

PNT #	DESCRIPTION	NORTHING	EASTING	ELEVATION
HV-1	PK NAIL IN ASPHALT IN CL WASHINGTON PL., 125' +/- SOUTH OF CL INTERSECTION W/ANAHEIM	1520708.66	395784.89	5085.03
HV-2	3" BC IN CM "A.M.A.F.C.A . FLOOD CONTROL R/W N4-19-2 PS 10464"	1520026.97	395873.19	5085.95
HV-3	#5 REBAR WITH PLASTIC CAP WITH ALUMINUM TAG "SCI 97084 1997 PP-3"	1520359.44	396476.61	5097.60
HV-4	#5 REBAR WITH PLASTIC CAP WITH ALUMINUM TAG "SCI 97084 1997 PP-4"	1520358.74	397071.55	5109.40
HV-5/HV-202	#5 RBR WITH PLASTIC CAP WITH TAG "SCI 97084 1997 PP-5"	1520659.78	397855.81	5124.49
HV-201	5/8" REBAR WITH RED SCI CAP, "CONTROL POINT NMPS 11599"	1519951.66	397680.37	5120.70
HV-203	5/8" REBAR WITH RED SCI CAP, "CONTROL POINT NMPS 11599"	1520223.33	398481.93	5134.80
HV-205	5/8" REBAR WITH RED SCI CAP, "CONTROL POINT NMPS 11599"	1520288.80	399126.44	5151.22
HV-206	PK NAIL	1521296.53	399640.99	5165.44
HV-204	5/8" REBAR WITH RED SCI CAP, "CONTROL POINT NMPS 11599"	1519206.75	399901.84	5167.18

○ KEYED NOTES:

100101B



Smith Engineering Company

A Full Service Engineering Company

6400 Uptown Boulevard, N.E. Suite 5000 Albuquerque, New Mexico 87110

CITY OF ALBUQUERQUE
PUBLIC WORKS DEPARTMENT
ENGINEERING DEVELOPMENT GROUP

TITLE: DOMINGO BACA ARROYO - NORTH DIVERSION CHANNEL TO WASHINGTON ST.

PROJECT CONTROL INFORMATION


Design Review Committee 	City Engineer Approval 	No. / Day / Yr.	No. / Day / Yr.

A B A B	---	---	---	---	---	---	---	---	---	---	---	---	---	---	---	---	---	---	---	---	---	---	---	---	---	---	---	---	---	---	---	---

DESIGN REVIEW/COMMENTS	CITY ENGINEER	Last Update		
---------------------------	---------------	----------------	--	--

City Project No. 6258.92	Zone Map No. C-17-Z	Sheet 3	Of 14
------------------------------------	-------------------------------	-------------------	-----------------

[illegible]

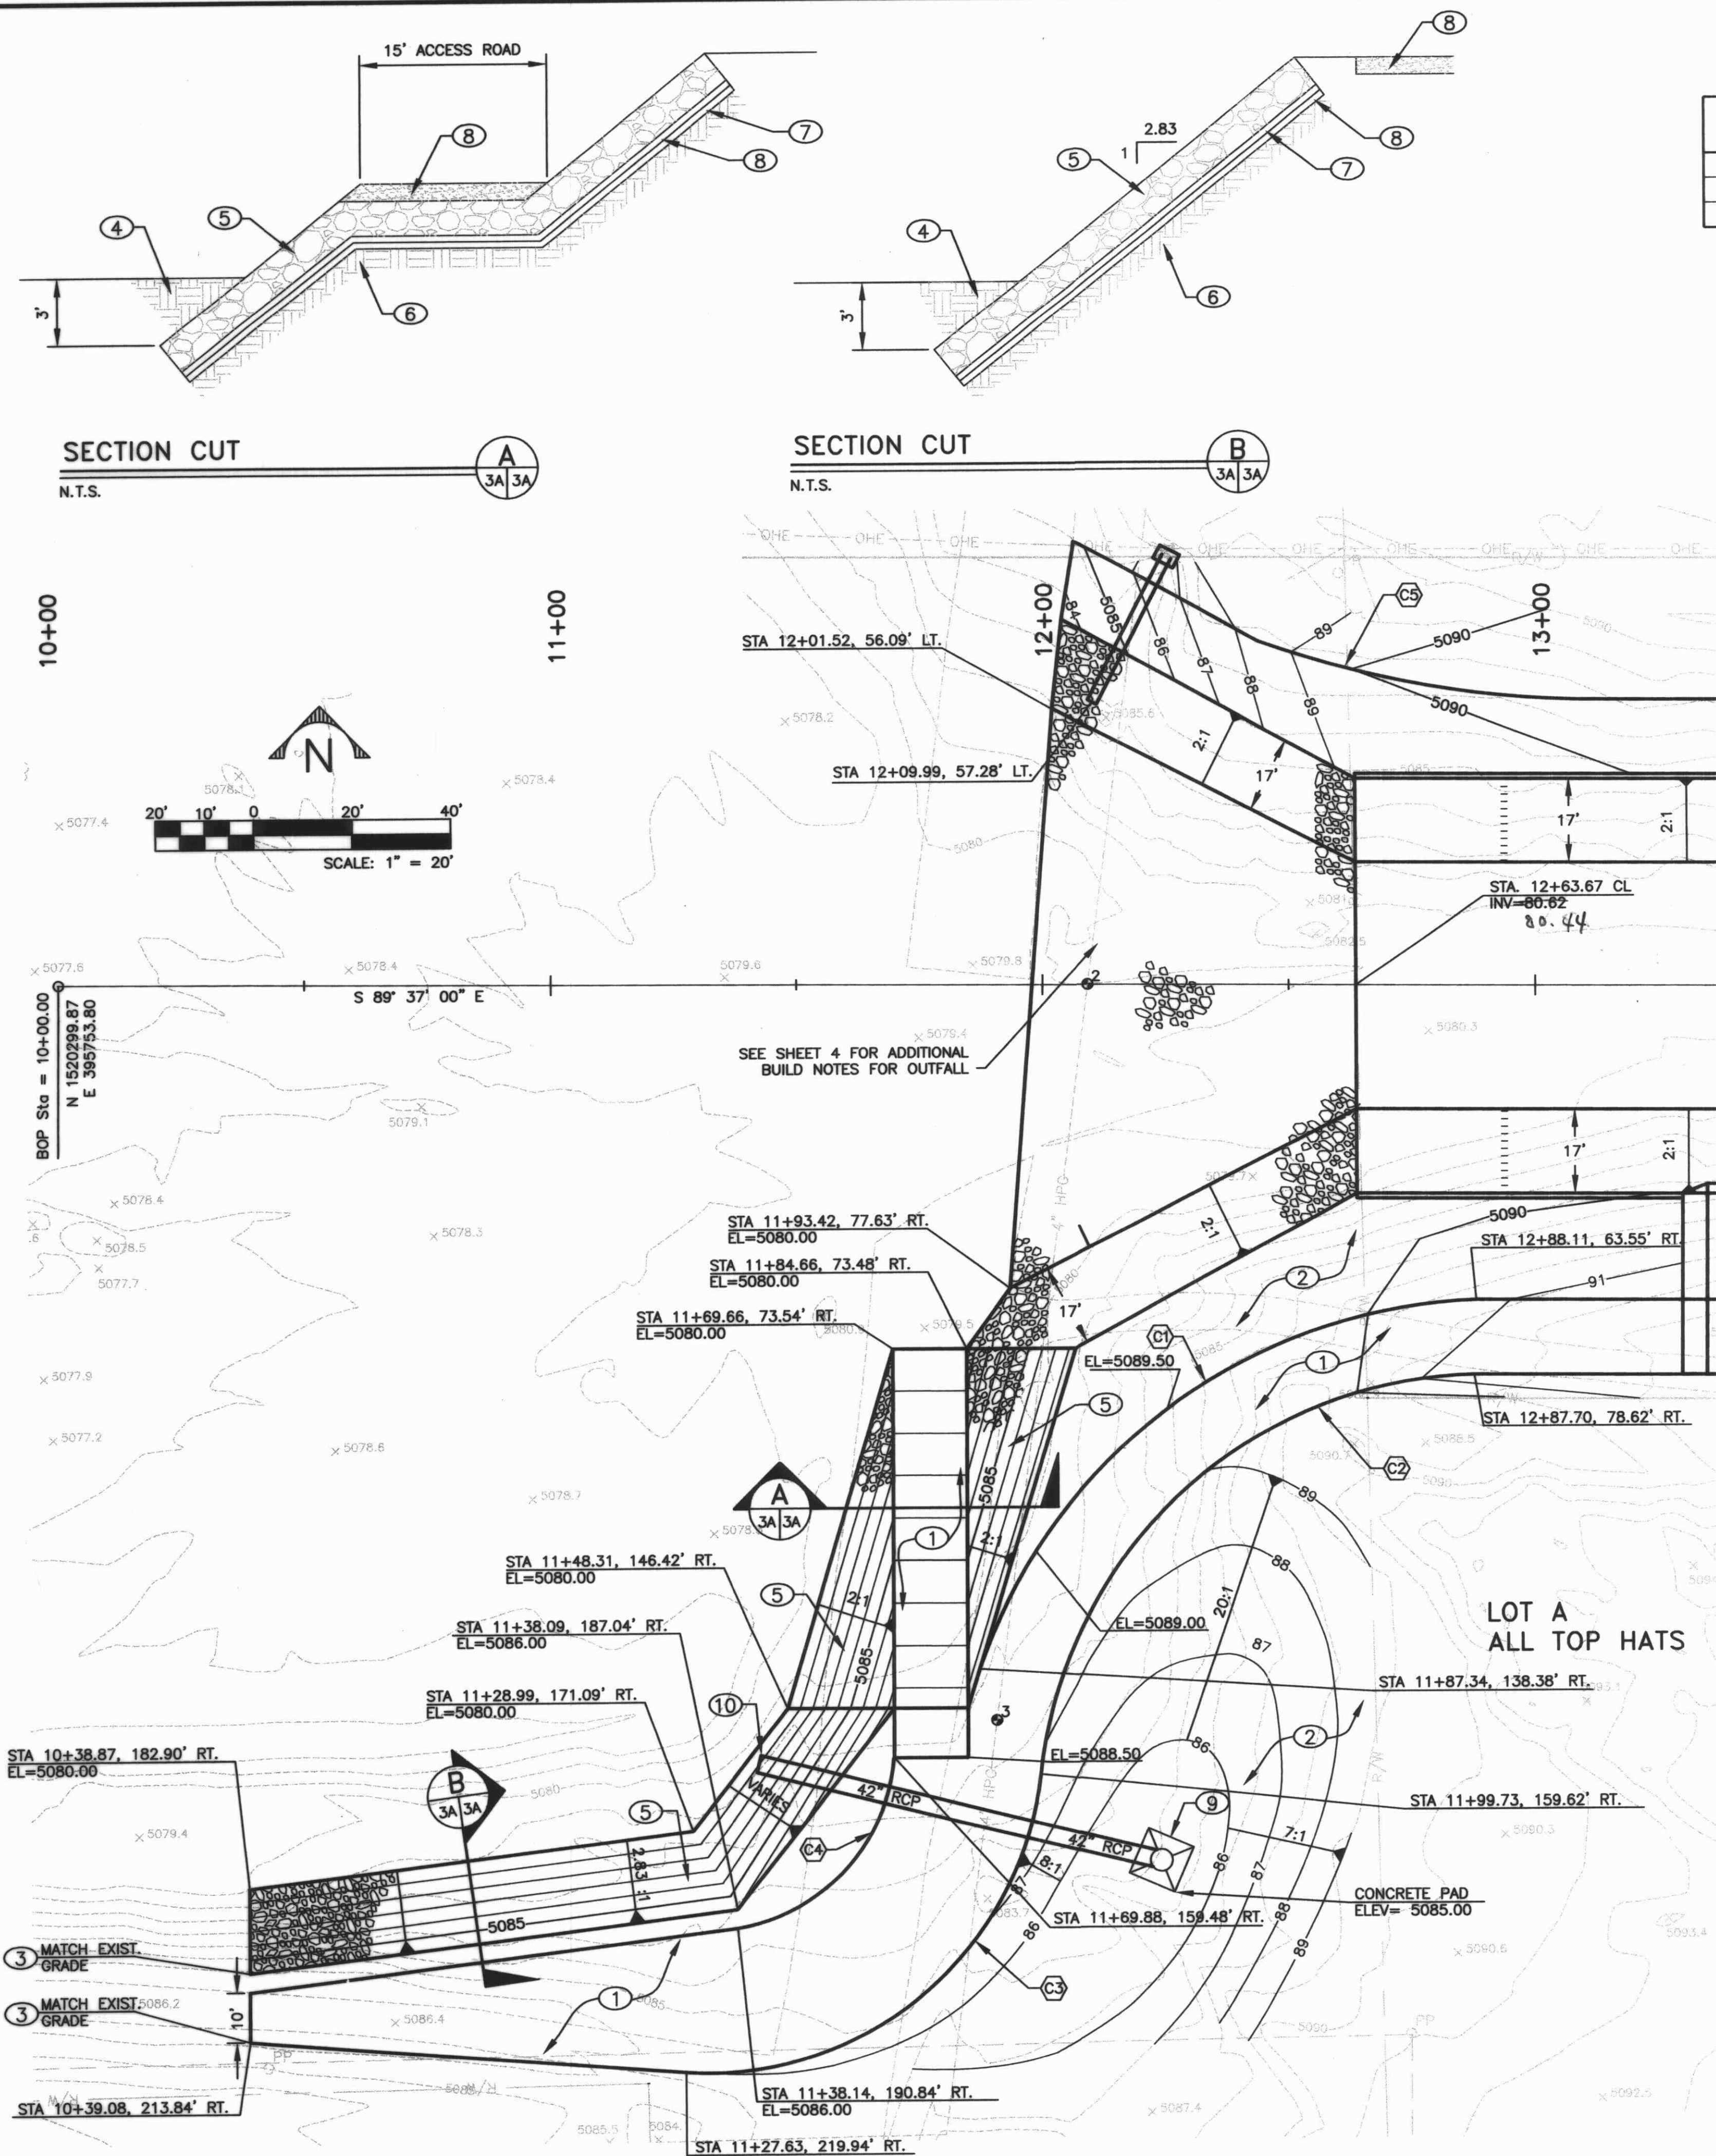

SECTION CUT

N.T.S.



SECTION CUT


N.T.S.



POT HOLING INFORMATION

NO.	BURY TO TOP OF PIPE	ELEV. TO TOP OF PIPE	DESCRIPTION		
			UTILITY	MATERIAL	DIAMETER
1	3'-3"	5084.8	GAS	PVC	4"
2	NOT LOCATED	N/A	N/A	N/A	N/A
3	2'-8"	5078.4	GAS	PVC	4"

NOTE: CONTRACTOR SHALL POT HOLE GAS LINE TO VERIFY ELEVATIONS PRIOR TO CONSTRUCTION.

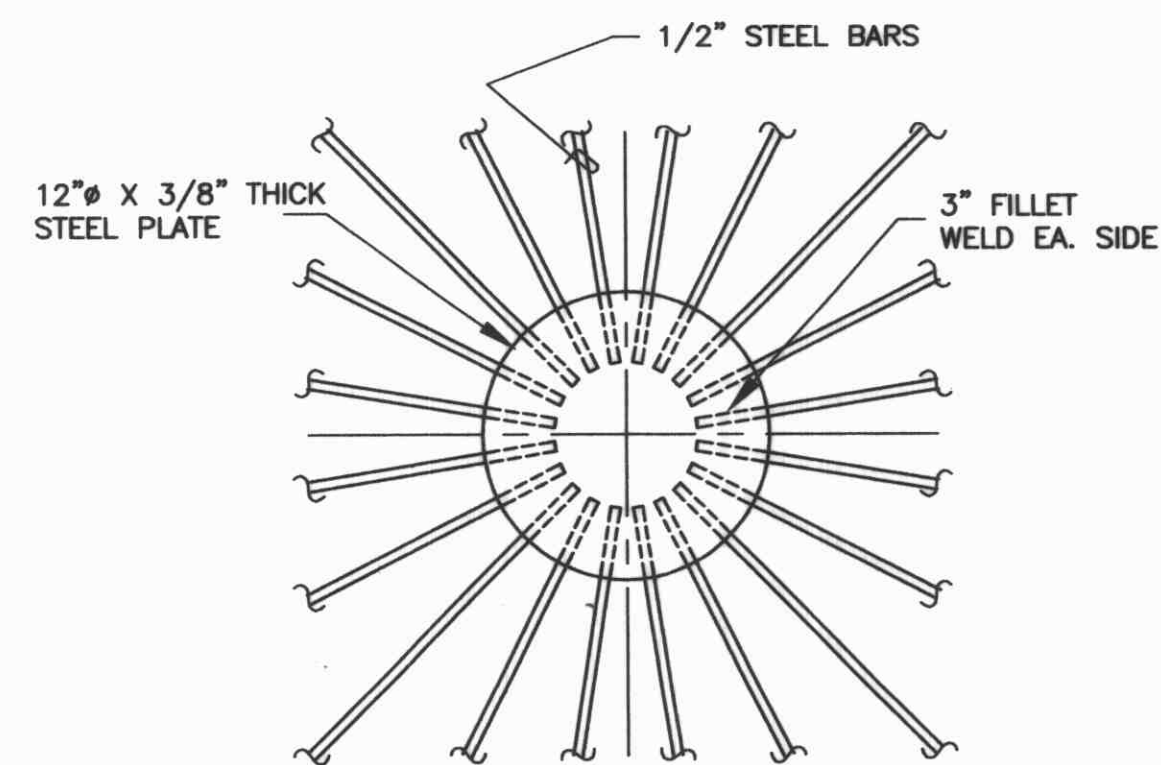

NOTE: PAINT GRATE SAME AS REQUIRED FOR CATCH BASIN GRATES PER COA STD DWG 2220.

STEEL PLATE DETAIL


1 1/2" = 1'-0"

KEYED NOTES:

- CONSTRUCT ACCESS ROAD. SEE DETAIL SHEET 14.
- RESEED DISTURBED AREAS
- CONNECT ACCESS ROAD TO EXISTING ROAD.
- BACKFILL OVER TOE OF STAKED RIP-RAP.
- 1'-6" STAKED RIP-RAP PER COA STD. DWG. 2270.
- 12" SUBGRADE COMPACTED TO 90% ASTM D-1557.
- 6" TYPE II BEDDING MATERIAL COMPACTED TO 90% ASTM D-1557.
- 6" TYPE I BEDDING MATERIAL COMPACTED TO 90% ASTM D-1557.
- STA 12+24.25, 177.11' RT. CONSTRUCT 4" BEEHIVE INLET. SEE DETAILS THIS SHEET. 42" INV= 5083.00
- STA 11+42.48, 157.60' RT. INSTALL 84 LF 42" RCP CLASS IV @ S= 0.025 FT/FT. INV= 5081.00


CURVE DATA

NO.	DELTA	RADIUS	LEN.	TAN.
C1	73°28'14"	110.52	141.71	82.48
C2	82°16'12"	90.89	130.51	79.39
C3	87°42'28"	67.84	103.85	65.18
C4	76°12'56"	37.90	50.42	29.73
C5	20°01'02"	203.71	71.17	35.95

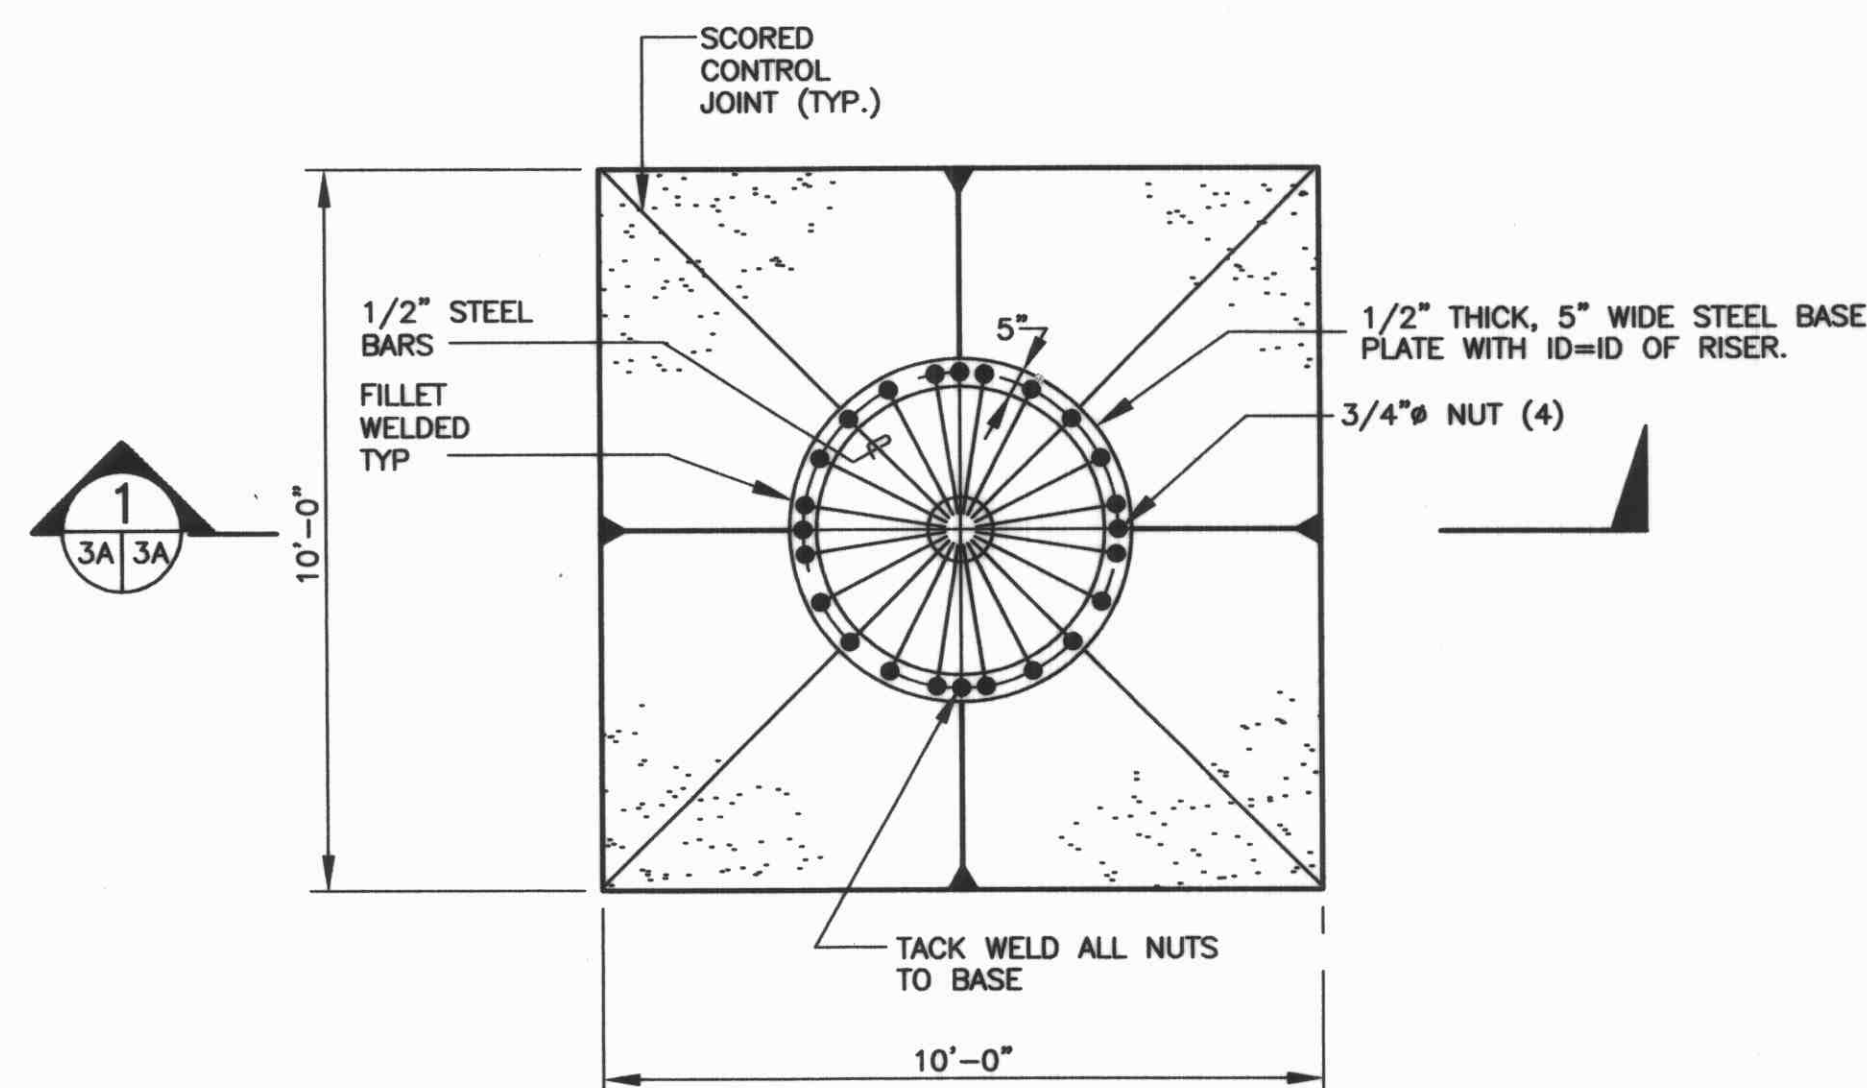

BEEHIVE INLET PLAN VIEW

3/8" = 1'-0"



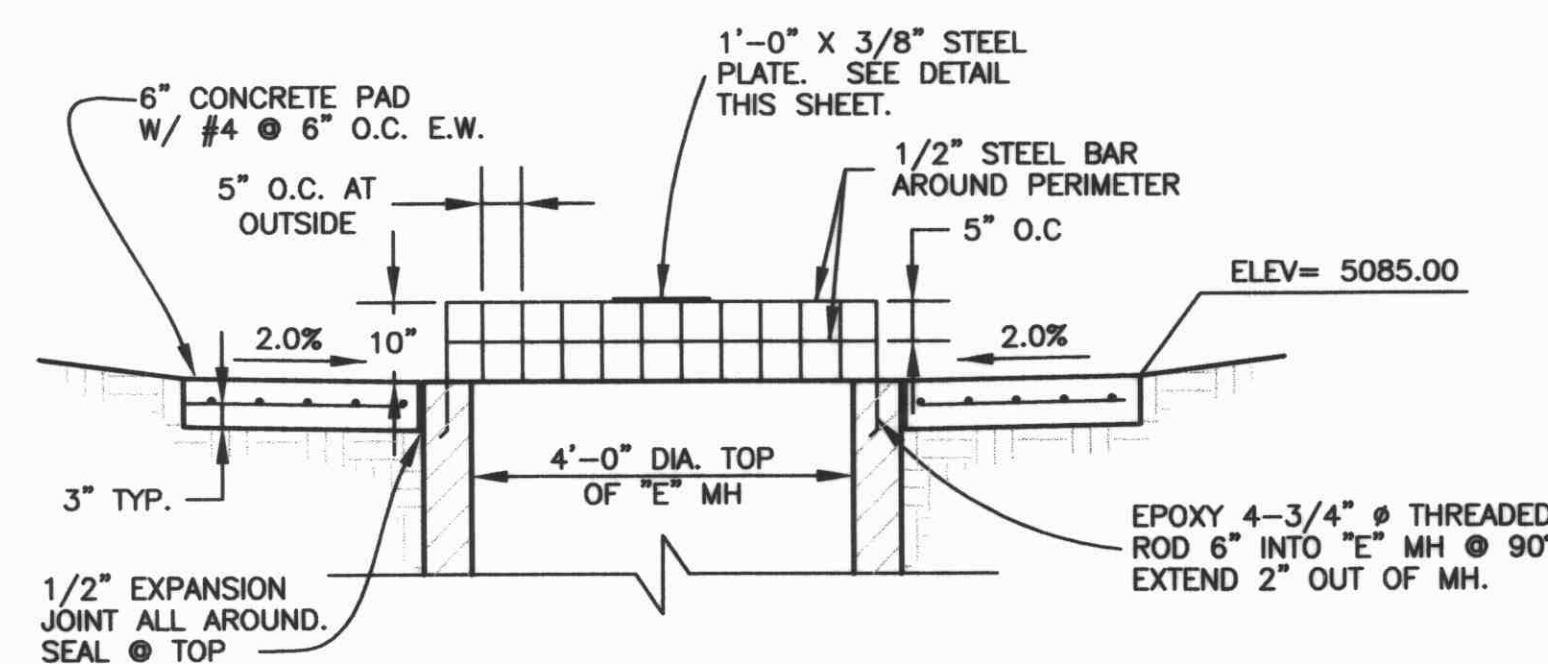



SECTION: BEEHIVE INLET

1 1/2" = 1'-0"




AS BUILT INFORMATION		CONTRACTOR A.S. HONORABLE	
DATE 1/15/04	DATE 1/15/04	DATE 1/15/04	DATE 1/15/04
BENCH MARKS		C.O.A. BENCHMARK "C-24" A.M.A.F.C.A. RIGHT OF WAY	
MARKER STAMPED "NAA-9" LOCATED IN THE SOUTHEAST QUADRANT OF THE INTERSECTION OF PASEO DEL NORTE AND THE NORTH DIVERSION CHANNEL. ELEV. = 5089.27 ft		GROUND COORDINATES: NORTHING = 1,519,215.25 EASTING = 394,264.97	
SURVEY INFORMATION		FIELD NOTES	
NO. 11599	DATE 05/00	BY STEPHEN J. TOLER	FROM SURVEYING CONTROL, INC.
ENGINEER'S SEAL		REMARKS	
DESIGN		REVISIONS	
NO. DATE	BY	DATE	DATE
DESIGNED BY PJC	DATE 06/04	CHECKED BY PJC	DATE 06/04
DRAWN BY CAD	DATE 06/04		
CITY OF ALBUQUERQUE		PUBLIC WORKS DEPARTMENT	
ENGINEERING DEVELOPMENT GROUP		TITLE: DOMINGO BACA ARROYO - NORTH DIVERSION CHANNEL TO WASHINGTON ST.	
CHANNEL OUTFALL PLAN		Design Review Committee	
City Engineer Approval		City Engineer Approval	
Last Design Update		Last Design Update	
City Project No. 6258.92		Zone Map No. C-17-Z	
Sheet 3A		Of 14	

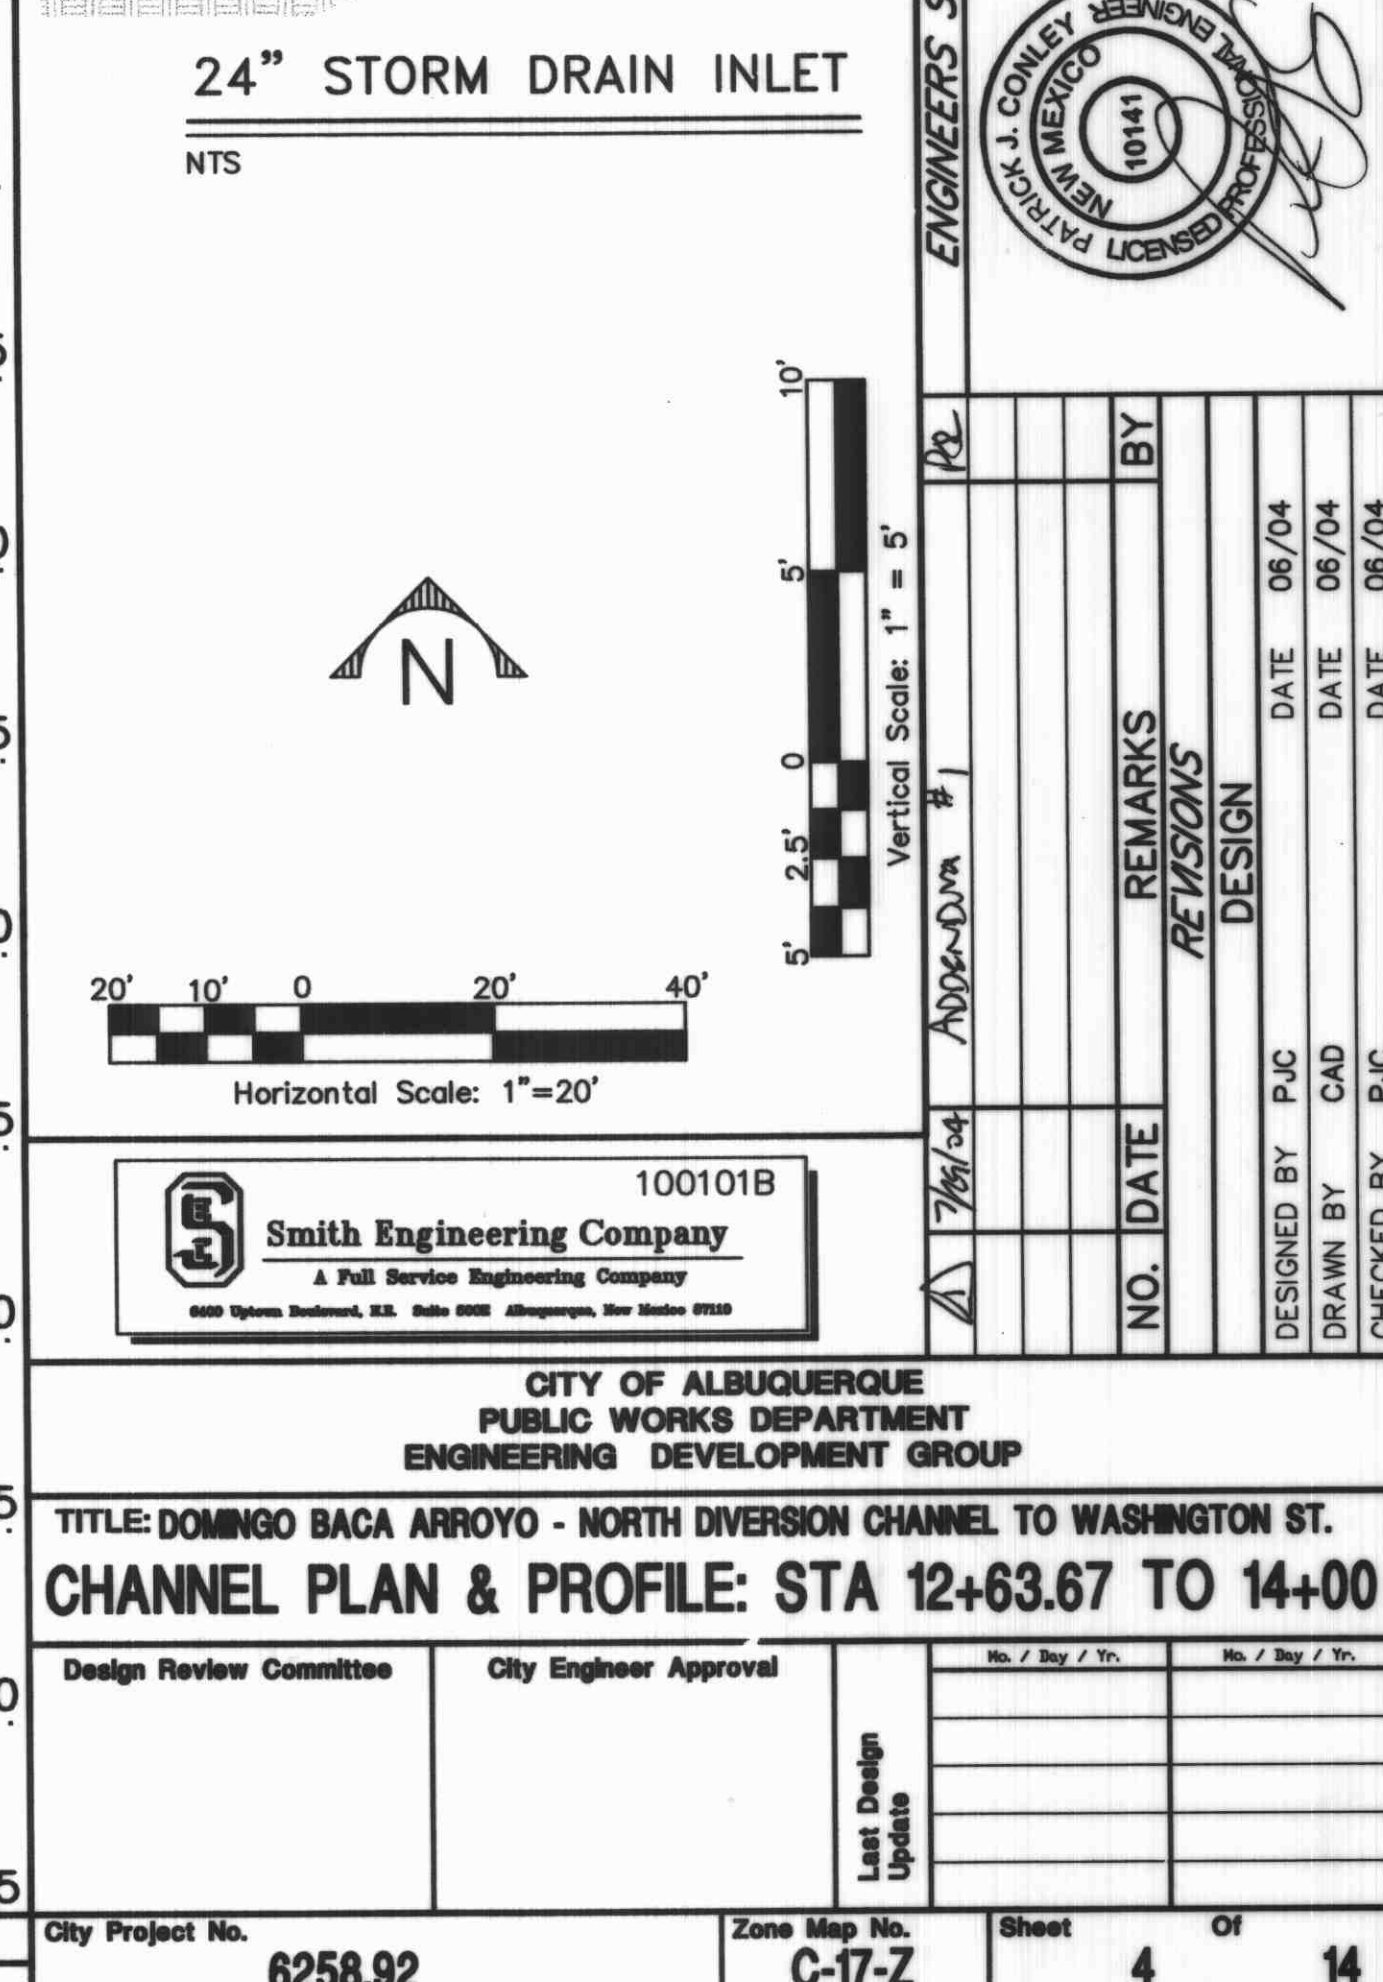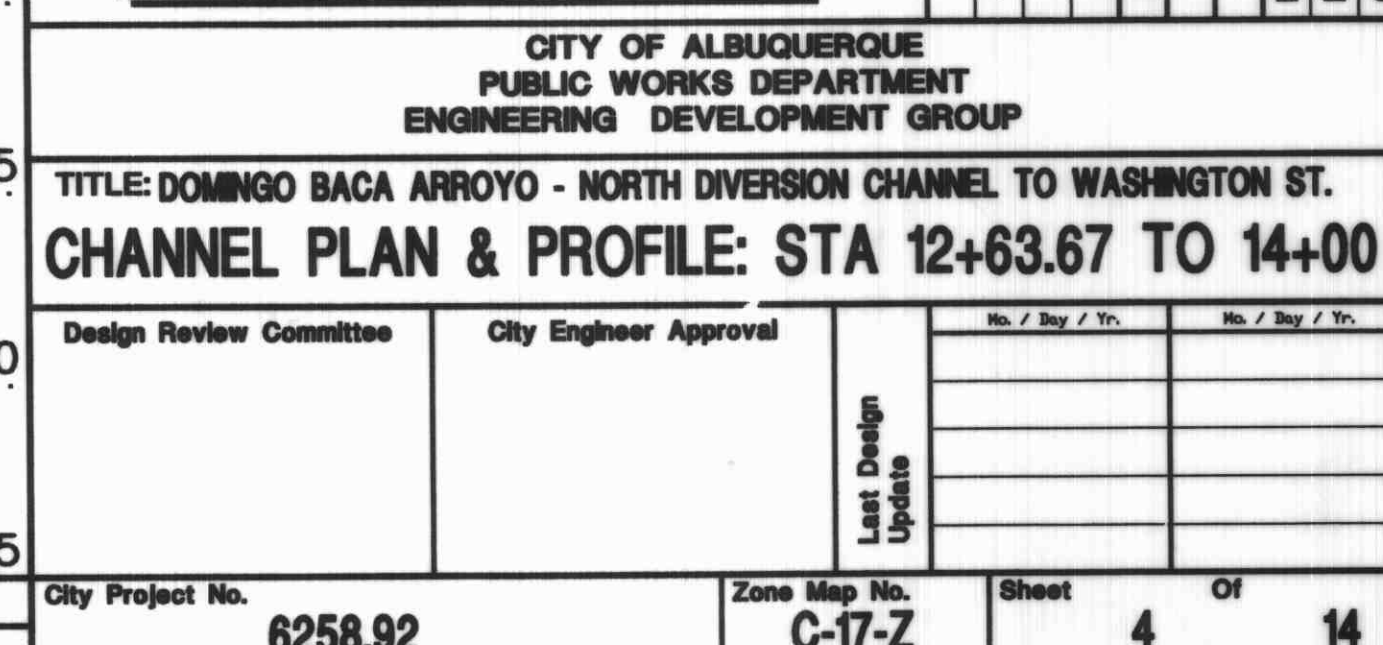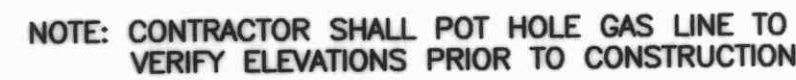

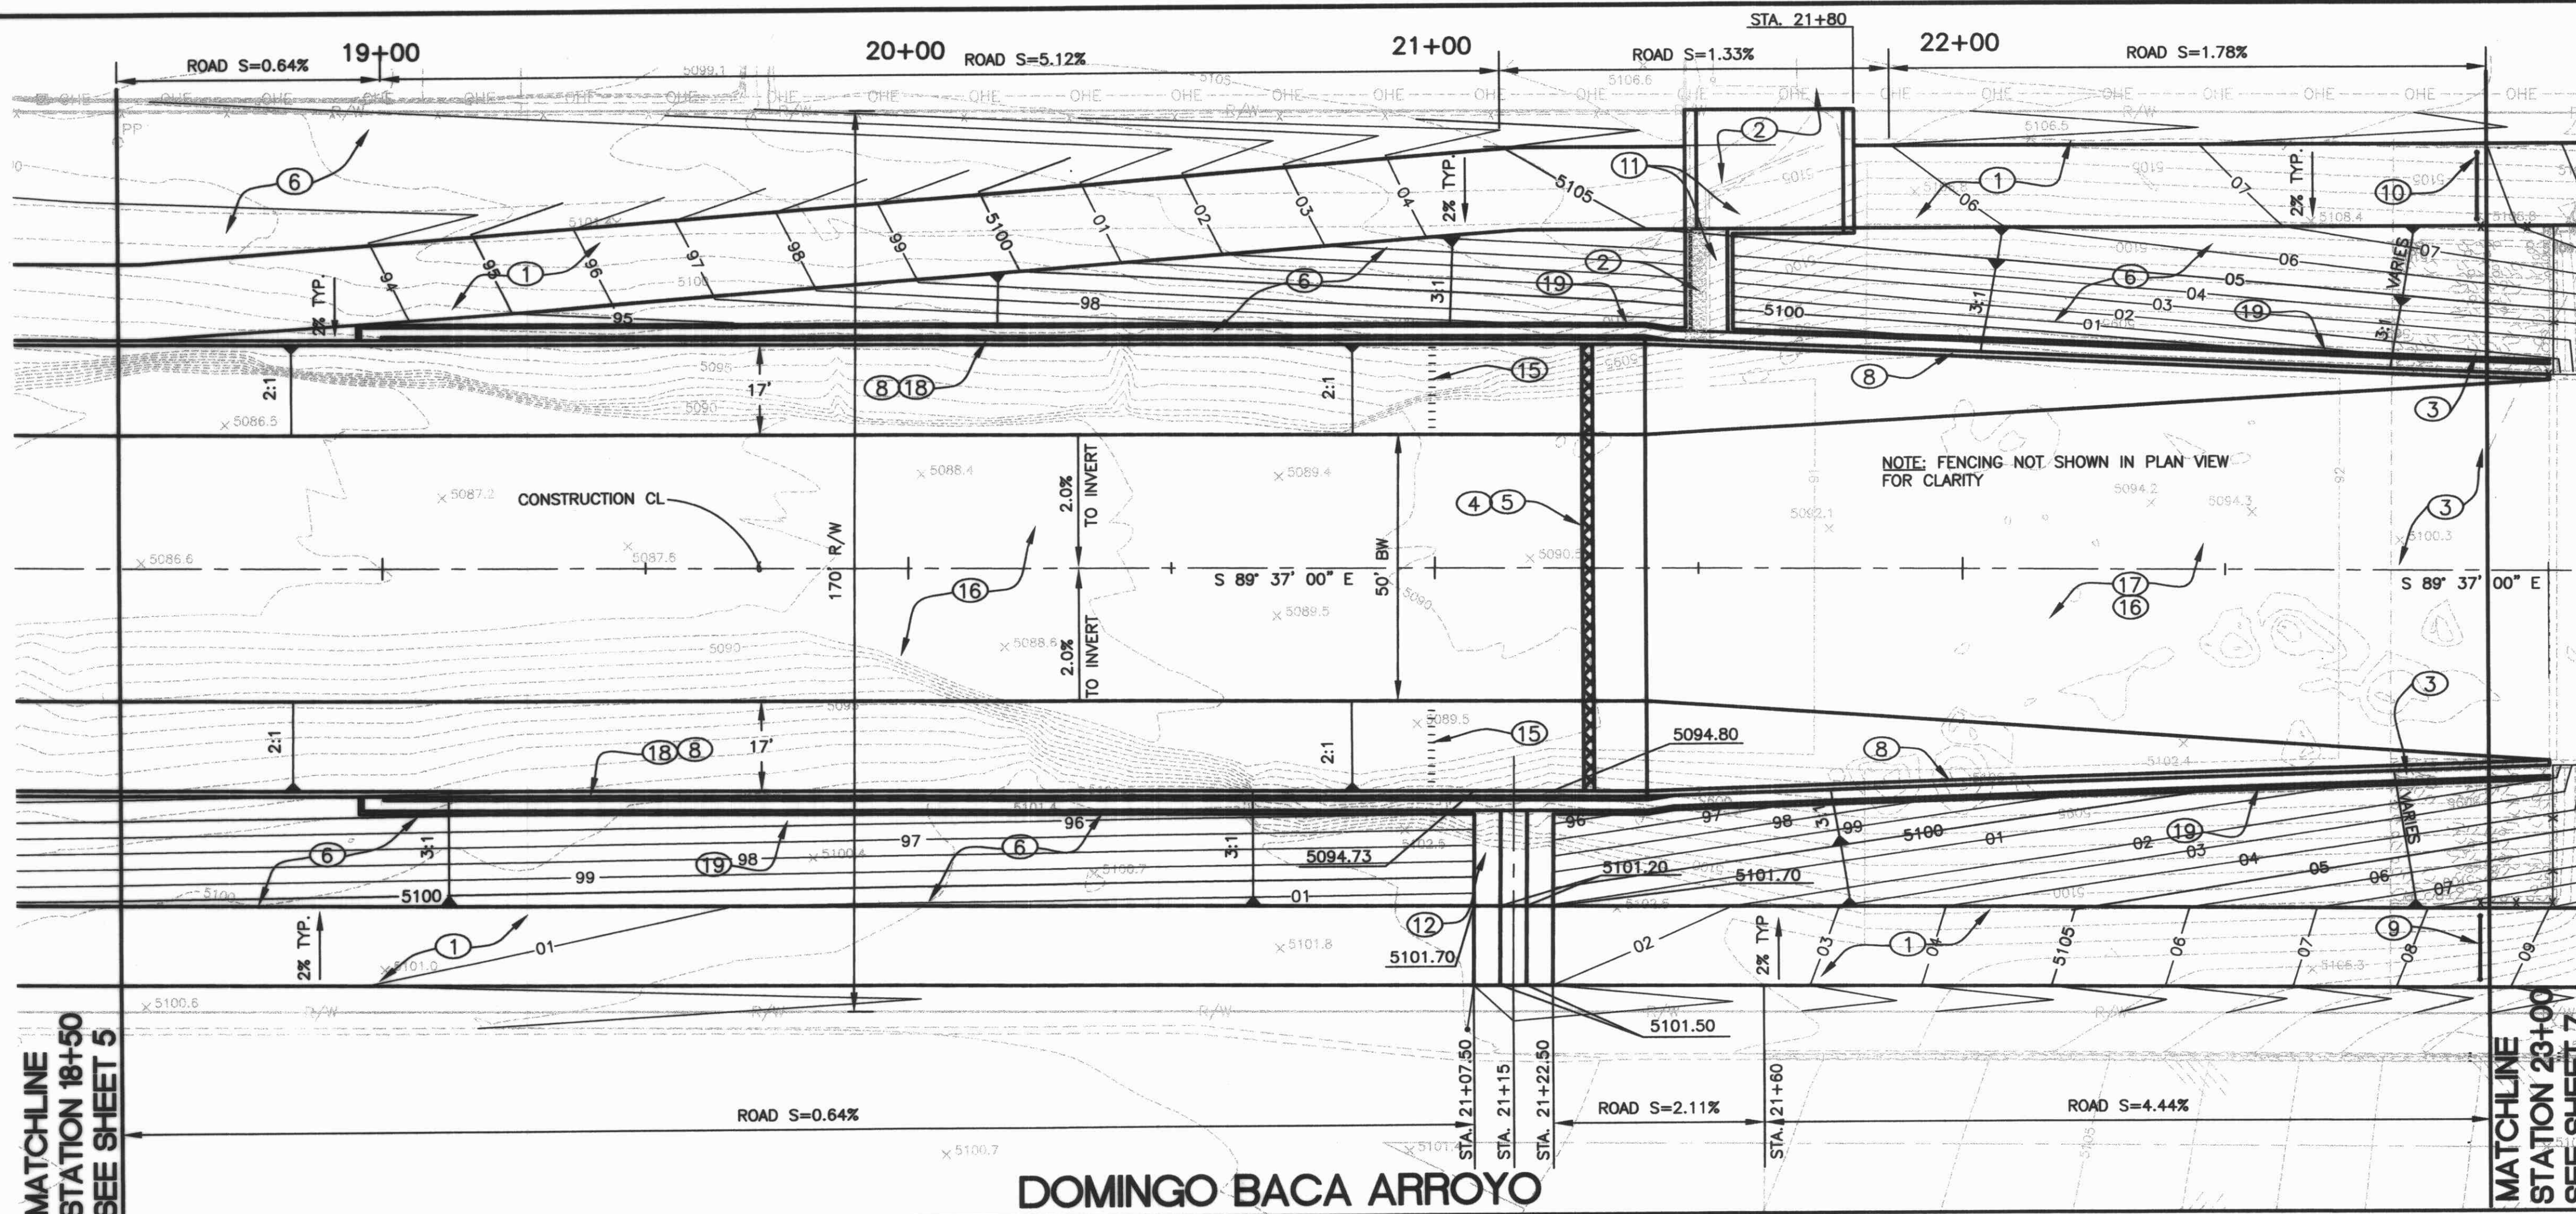

KEYED NOTES:

- CONSTRUCT 15' ACCESS ROAD. SEE SHEET 13.
- REMOVE AND DISPOSE OF EXISTING RPCC RUNDOWN AND RIP-RAP.
- REMOVE AND DISPOSE OF EXISTING RIP-RAP.
- CONSTRUCT CHANNEL EXPANSION JOINT WITH SLEEPER PER C.O.A. STD. DWG. 2265.
- INSTALL STEP JOINT PROTECTION PLATE PER C.O.A. STD. DWG. 2268.
- RESEED DISTURBED AREA PER SPEC 101A.
- VERTICAL WALL OF TRANSITION.
- INSTALL 4' CHAIN LINK FENCE ON VERTICAL WALLS BOTH SIDES. SEE MOUNTING DETAIL SHEET 14.
- CONSTRUCT 12' WIDE PIPE GATE PER COA STD DWG 2251. SET HINGE ON SOUTH AND SWING TO THE WEST.
- CONSTRUCT 12' WIDE PIPE GATE PER COA STD DWG 2251. SET HINGE ON NORTH AND SWING TO THE WEST.
- CONSTRUCT NEW RPCC RUNDOWN. CONNECT TO 2' WIDE CONC. SWALE. SEE DETAILS SHEET 13.
- CONSTRUCT NEW RPCC RUNDOWN. CONNECT TO 2' WIDE CONC. SWALE.
- NOT USED
- NOT USED
- INSTALL ACCESS STEPS PER C.O.A. STD. DWG. 2261.
- CONSTRUCT NEW PCC CHANNEL PER COA STD. DWG. 2261 AND DETAILS SHEET 9.
- CONSTRUCT TRANSITION SEE SHEET 8/16.
- CONSTRUCT 4' WALL AT SHOULDER OF CHANNEL. SEE DETAIL B/11.
- CONSTRUCT 2' WIDE RPCC SWALE. SEE DETAIL SHEET 11.

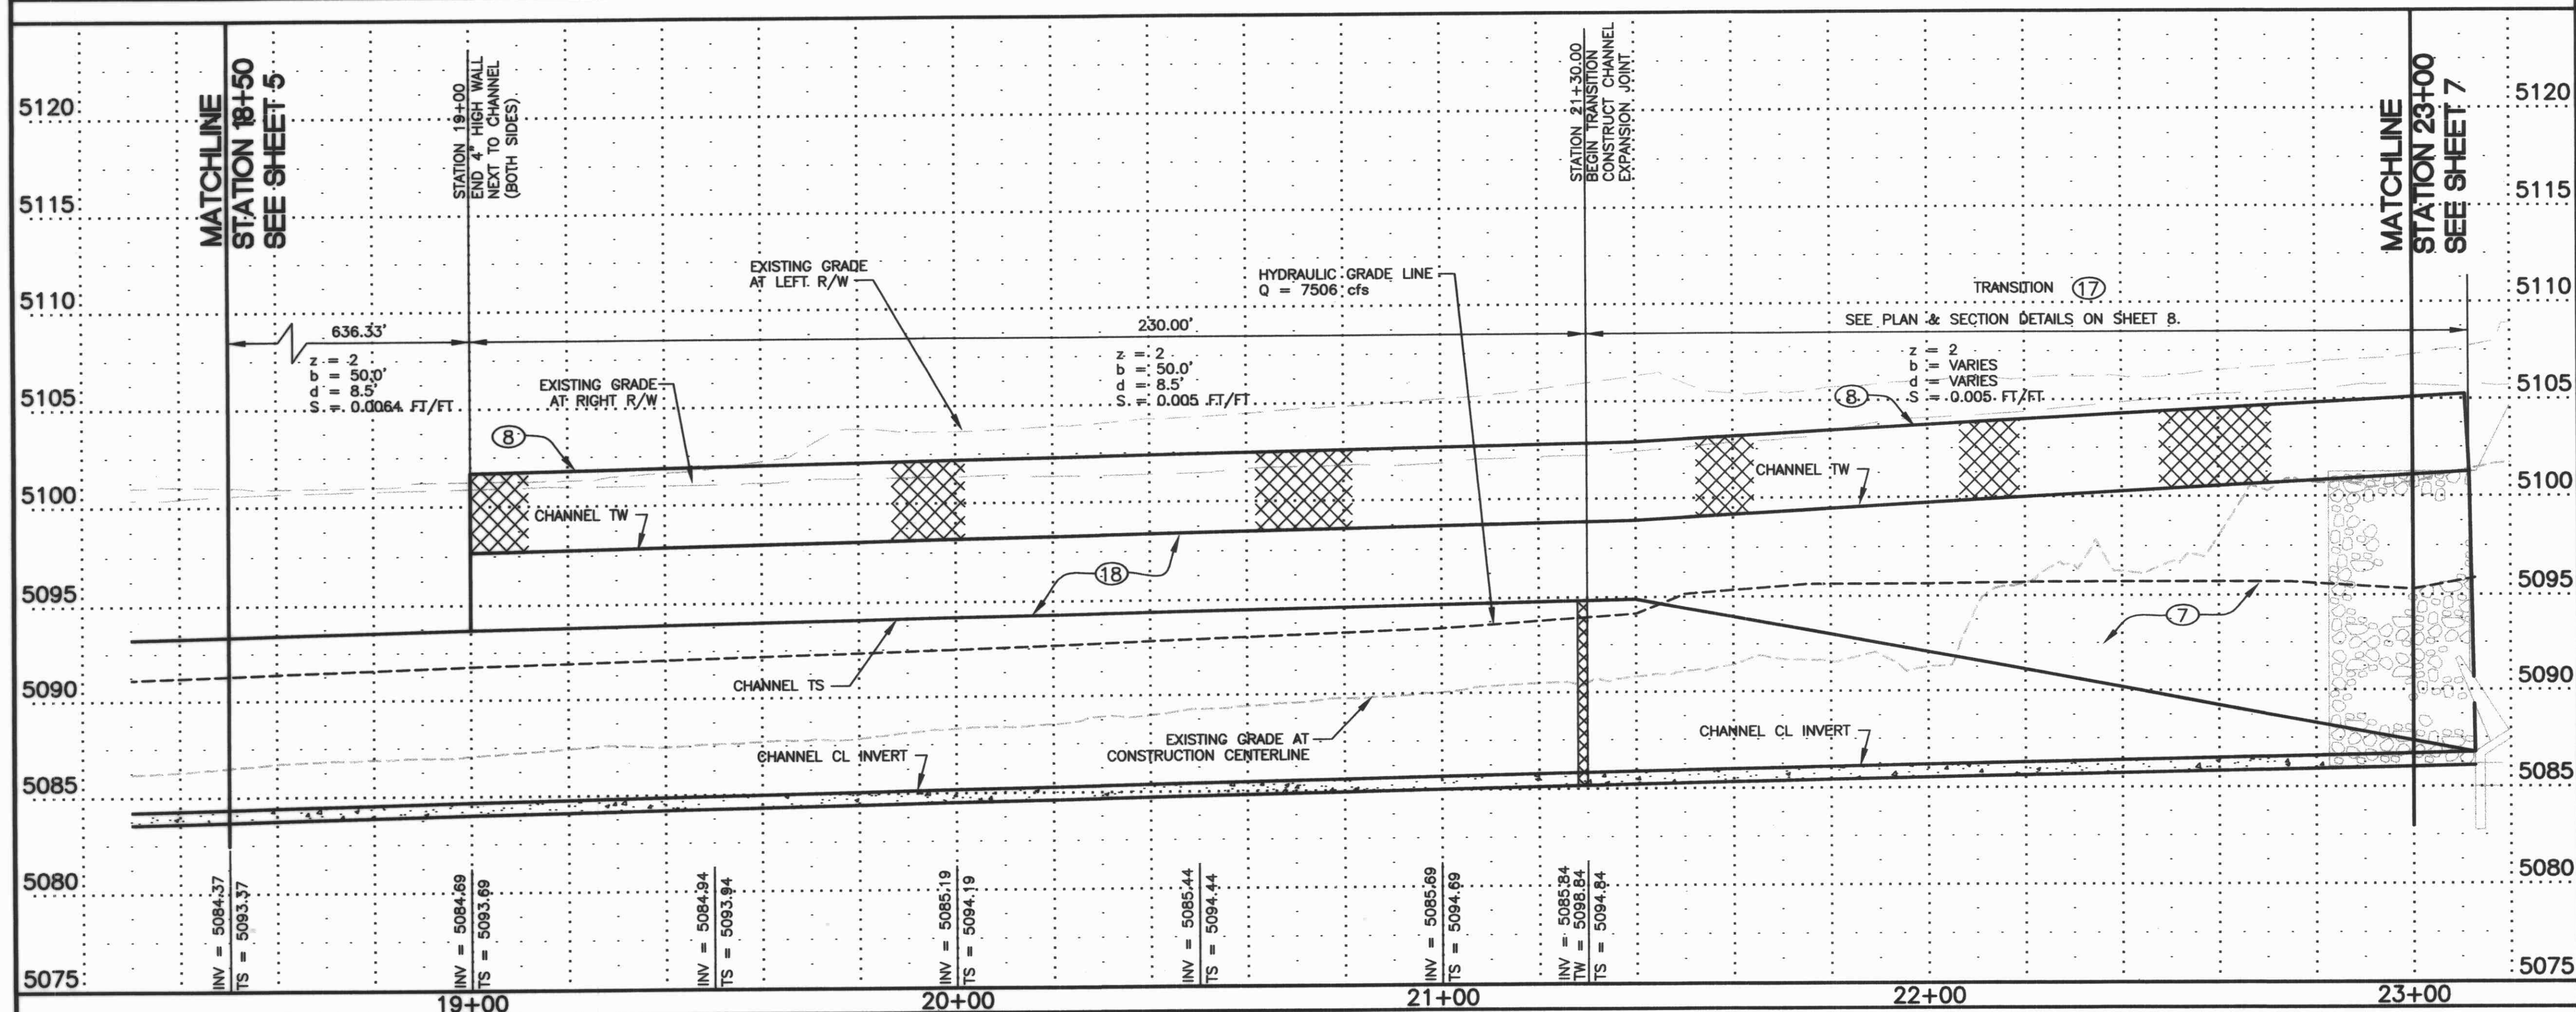

ENGINEERS SEAL

PAUL J. CONLEY
Professional Engineer
No. 10141
State of New Mexico

REVISIONS

NO.	DATE	REVISIONS
1	06/04	DESIGN

DESIGNED BY PJC
DRAWN BY CAD
CHECKED BY PJC

DATE 06/04
DATE 06/04
DATE 06/04

CITY OF ALBUQUERQUE
PUBLIC WORKS DEPARTMENT
ENGINEERING DEVELOPMENT GROUP

TITLE: DOMINGO BACA ARROYO - NORTH DIVERSION CHANNEL TO WASHINGTON ST.
CHANNEL PLAN & PROFILE: STA 18+50 TO 23+00

Design Review Committee

City Engineer Approval

City Engineer

City Engineer



City Project No. 6258.92

Zone Map No. C-17-Z

Sheet 6 **Of** 14

City Project No. 6258.92

Zone Map No. C-17-Z

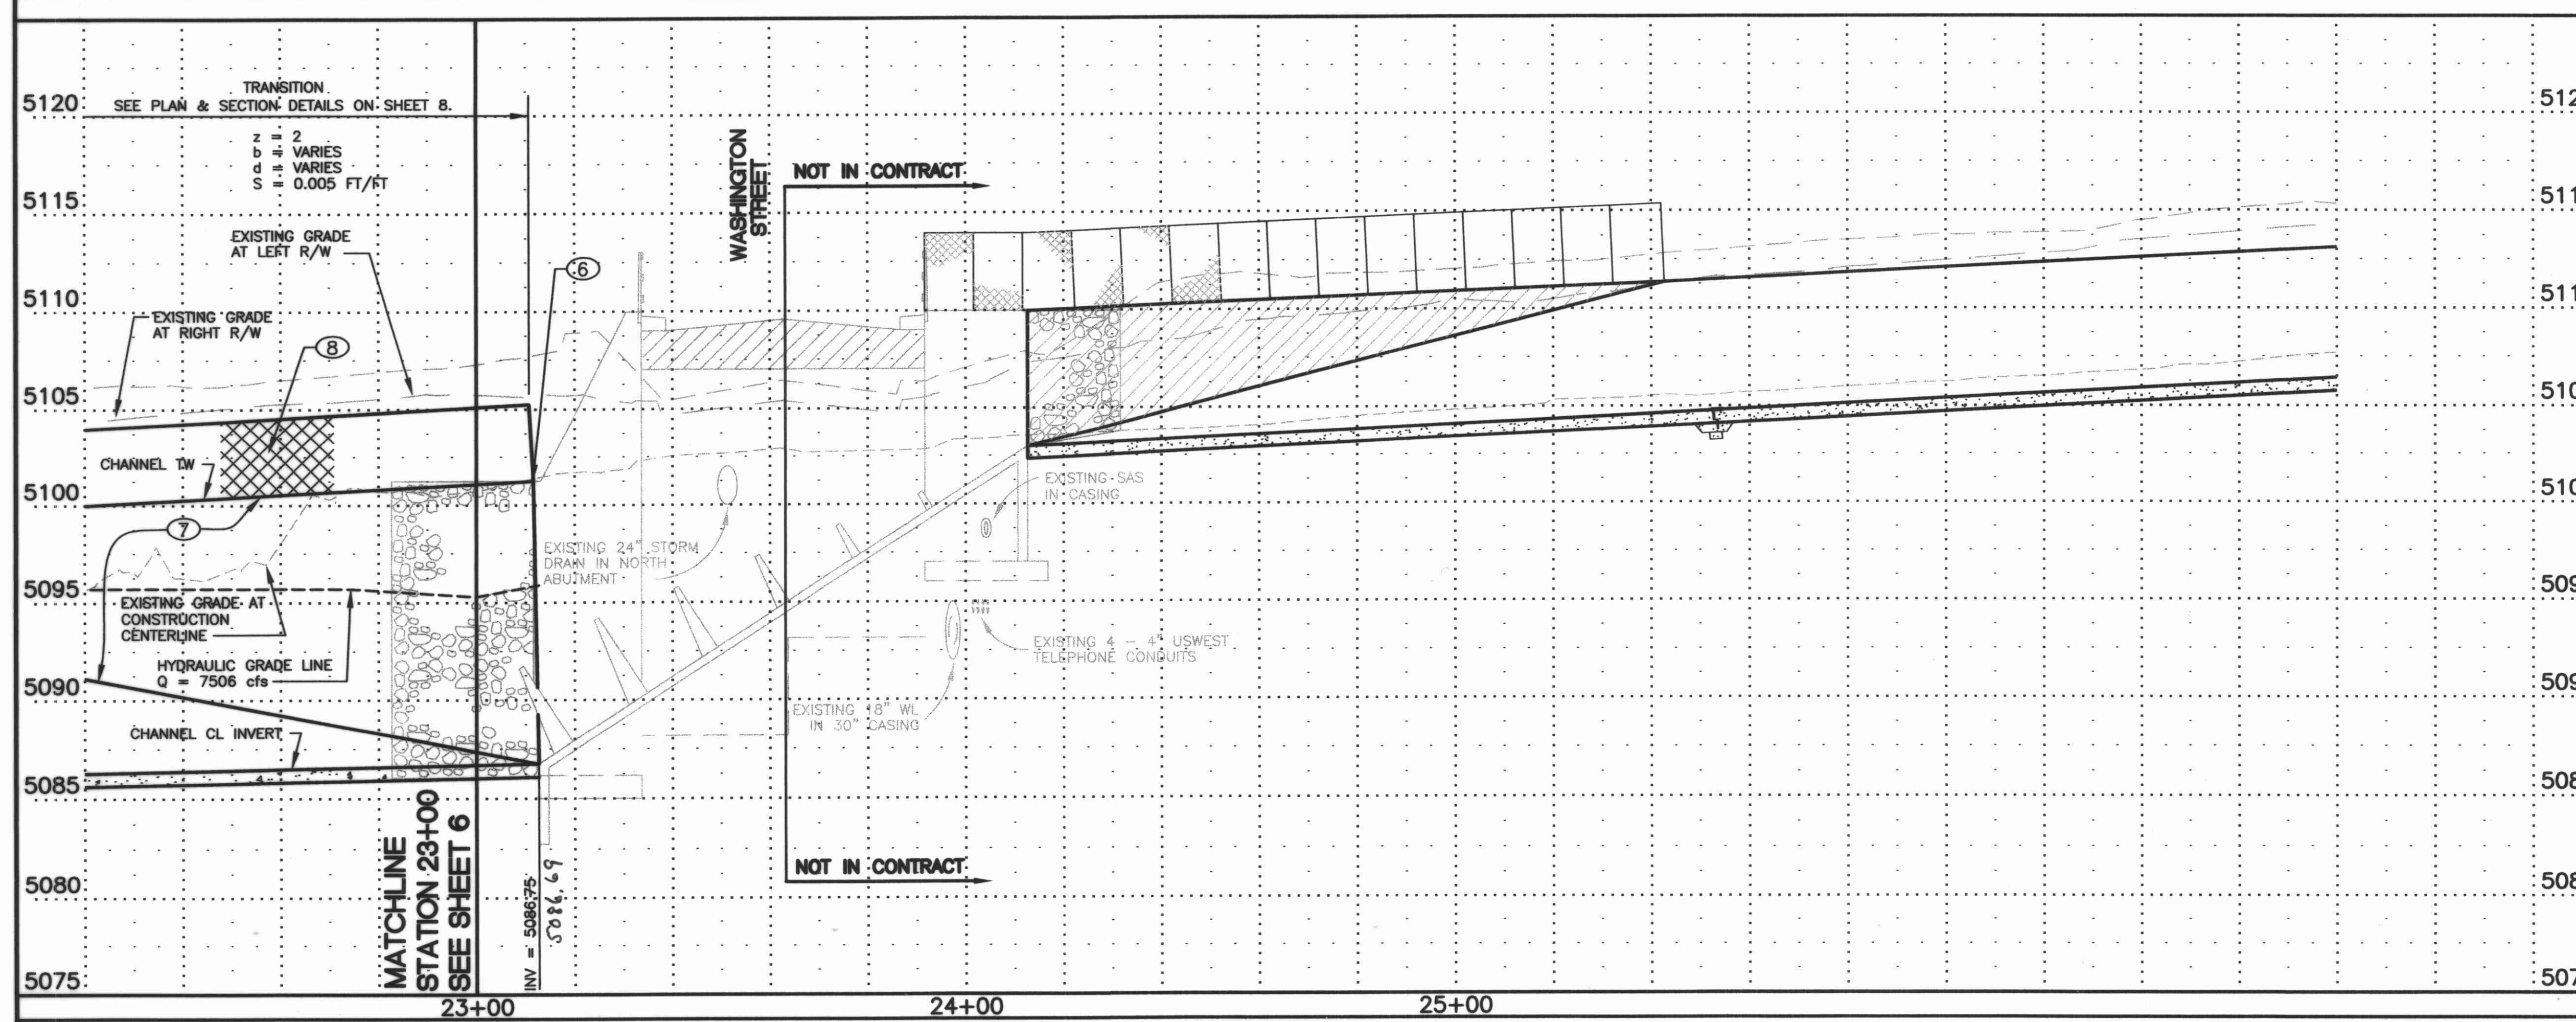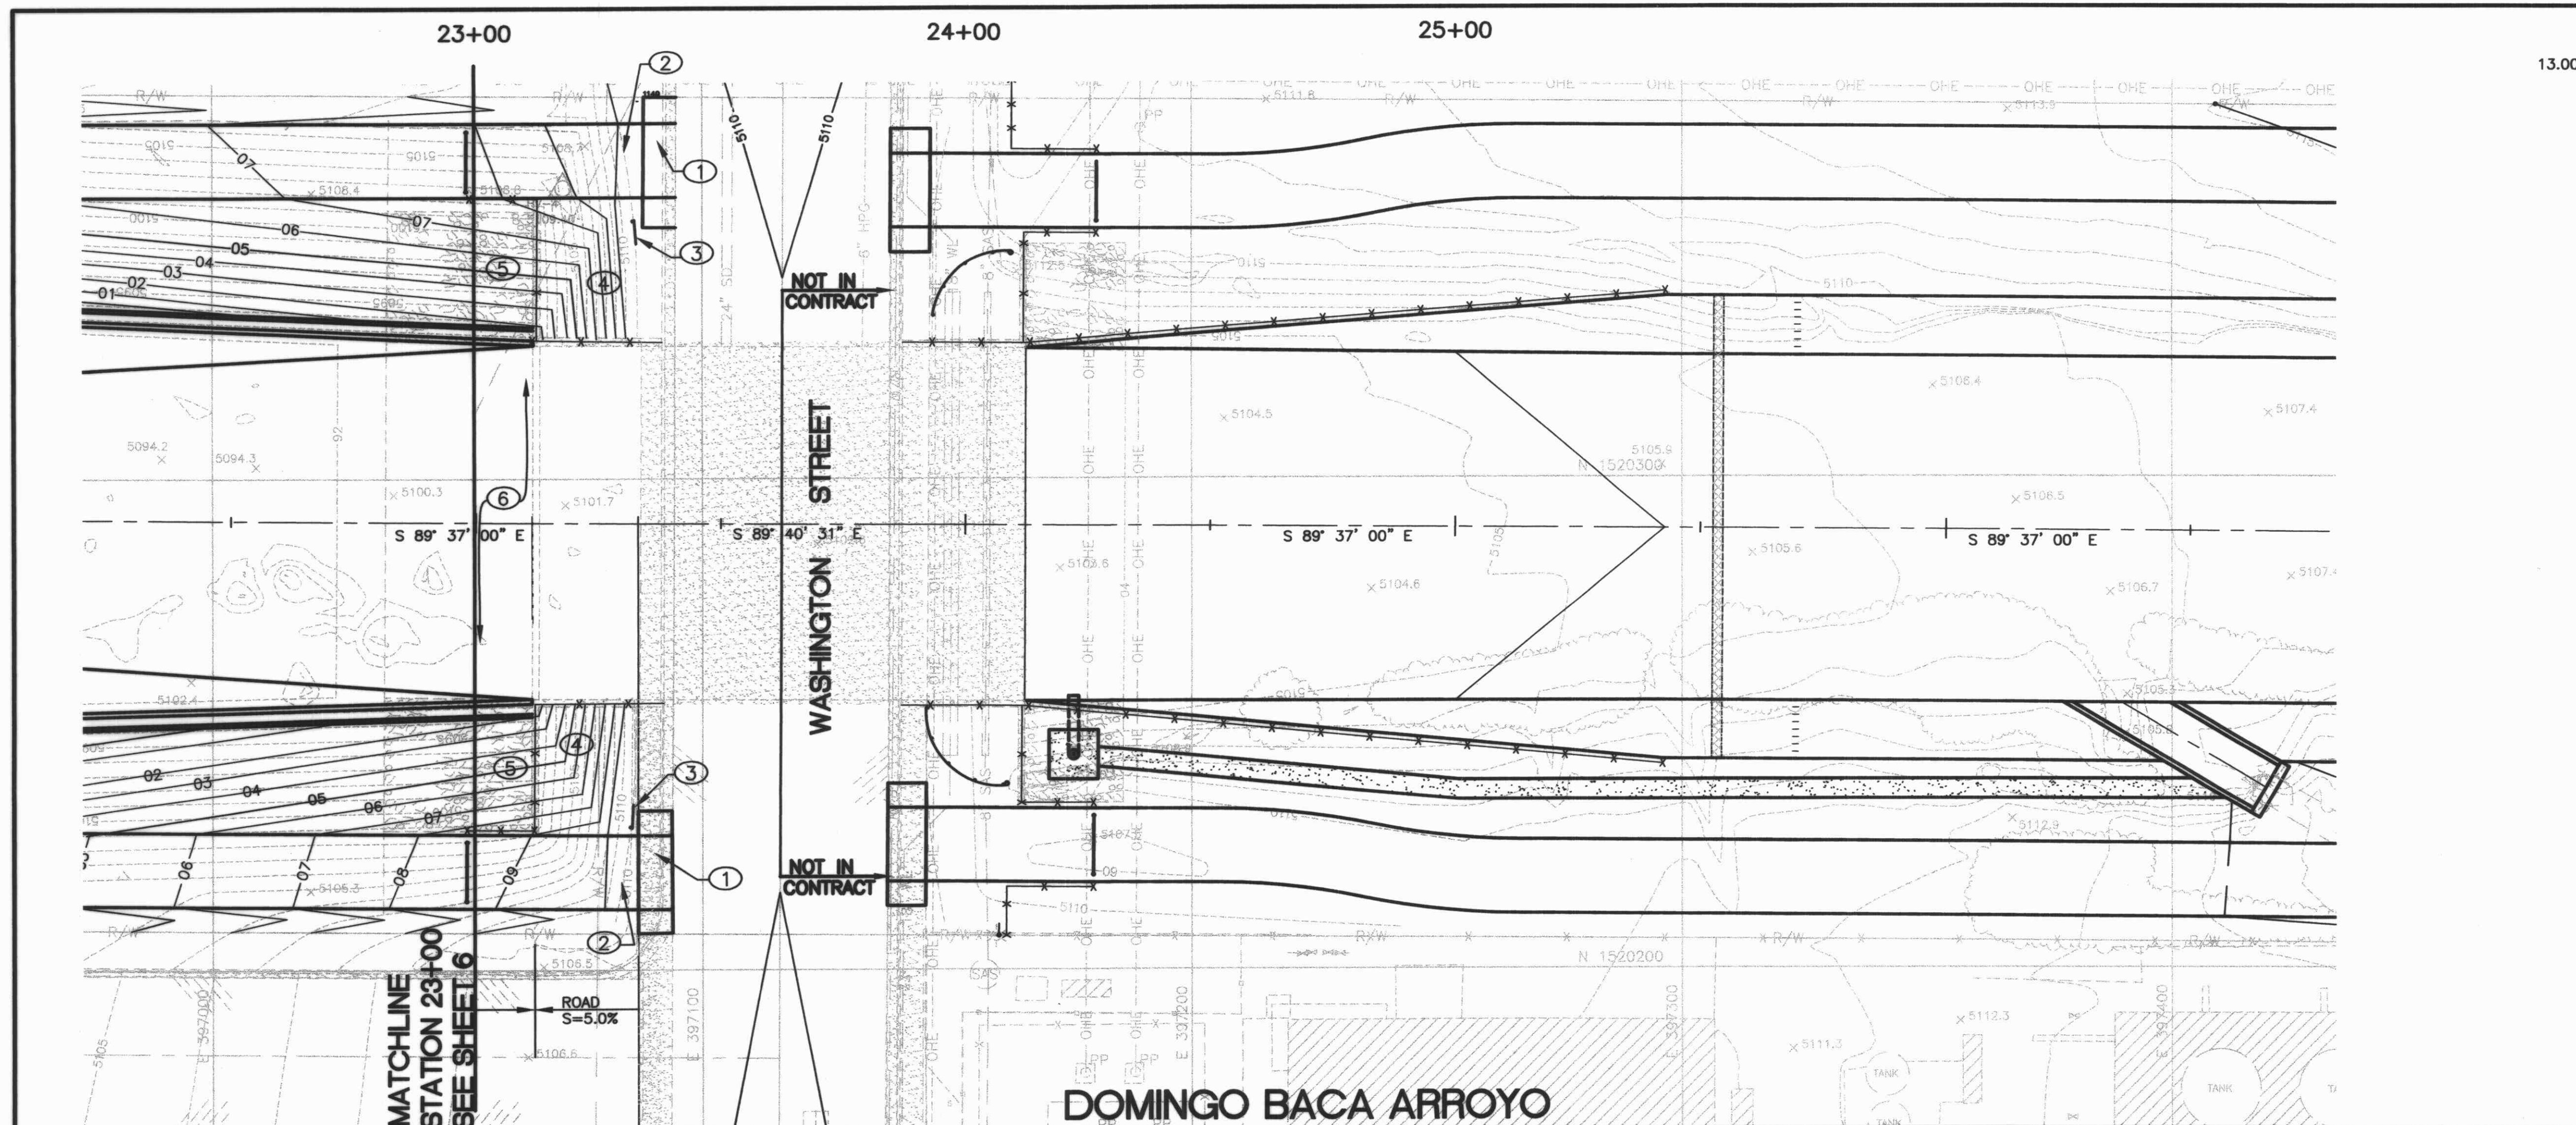


13.00

KEYED NOTES:

1. CONSTRUCT ACCESS ROAD CURB CUTS PER DETAILS SHEET 13.
2. REMOVE AND DISPOSE OF APPROXIMATELY 22 LF OF GUARD RAIL.
3. INSTALL NEW END SECTION ON EXISTING GUARD RAIL PER COA. STD. DWG. 2636.
4. PLACE 2" GRAVEL MULCH AND RESEED AREAS WITH SLOPE >3:1.
5. RESEED AREAS WITH SLOPE = 3:1.
6. SEE SHEET 8 FOR TRANSITION AND CONNECTION DETAILS.
7. VERTICAL WALLS OF TRANSITION.
8. INSTALL 4' CHAIN LINK FENCE ON VERTICAL WALLS BOTH SIDES. SEE MOUNTING DETAIL SHEET 14.


ENGINEER'S SEAL		SURVEY INFORMATION		BENCH MARKS		AS BUILT INFORMATION	
		FIELD NOTES		C.O.A. BENCHMARK "C-244" A.M.A.F.C.A. RIGHT OF WAY MARKER STAMPED "NAA-9" LOCATED IN THE SOUTHEAST QUADRANT OF THE INTERSECTION OF PASEO DEL NORTE AND THE NORTH DIVERSION CHANNEL. ELEV. = 5089.27 ft		CONTRACTOR A.S. 1002 WE	
		DATE 05/00		DATE 11/03		DATE 11/03	
NO. 11599		BY STEPHEN J. TOLER FROM SURVEYING CONTROL, INC.		DATE 05/00		DATE 11/03	
REMARKS		REVISIONS		DATE 06/04		DATE 06/04	
NO. DATE		BY		DATE 06/04		DATE 06/04	
DESIGNED BY PJC		DRAWN BY CAD		CHECKED BY PJC		DATE 06/04	
CITY OF ALBUQUERQUE PUBLIC WORKS DEPARTMENT ENGINEERING DEVELOPMENT GROUP		TITLE: DOMINGO BACA ARROYO - NORTH DIVERSION CHANNEL TO WASHINGTON ST. CHANNEL PLAN & PROFILE: STA 23+00 TO 27+50		Design Review Committee		City Engineer Approval	
City Project No. 6258.92		Zone Map No. C-17-Z		Sheet 7		Of 14	

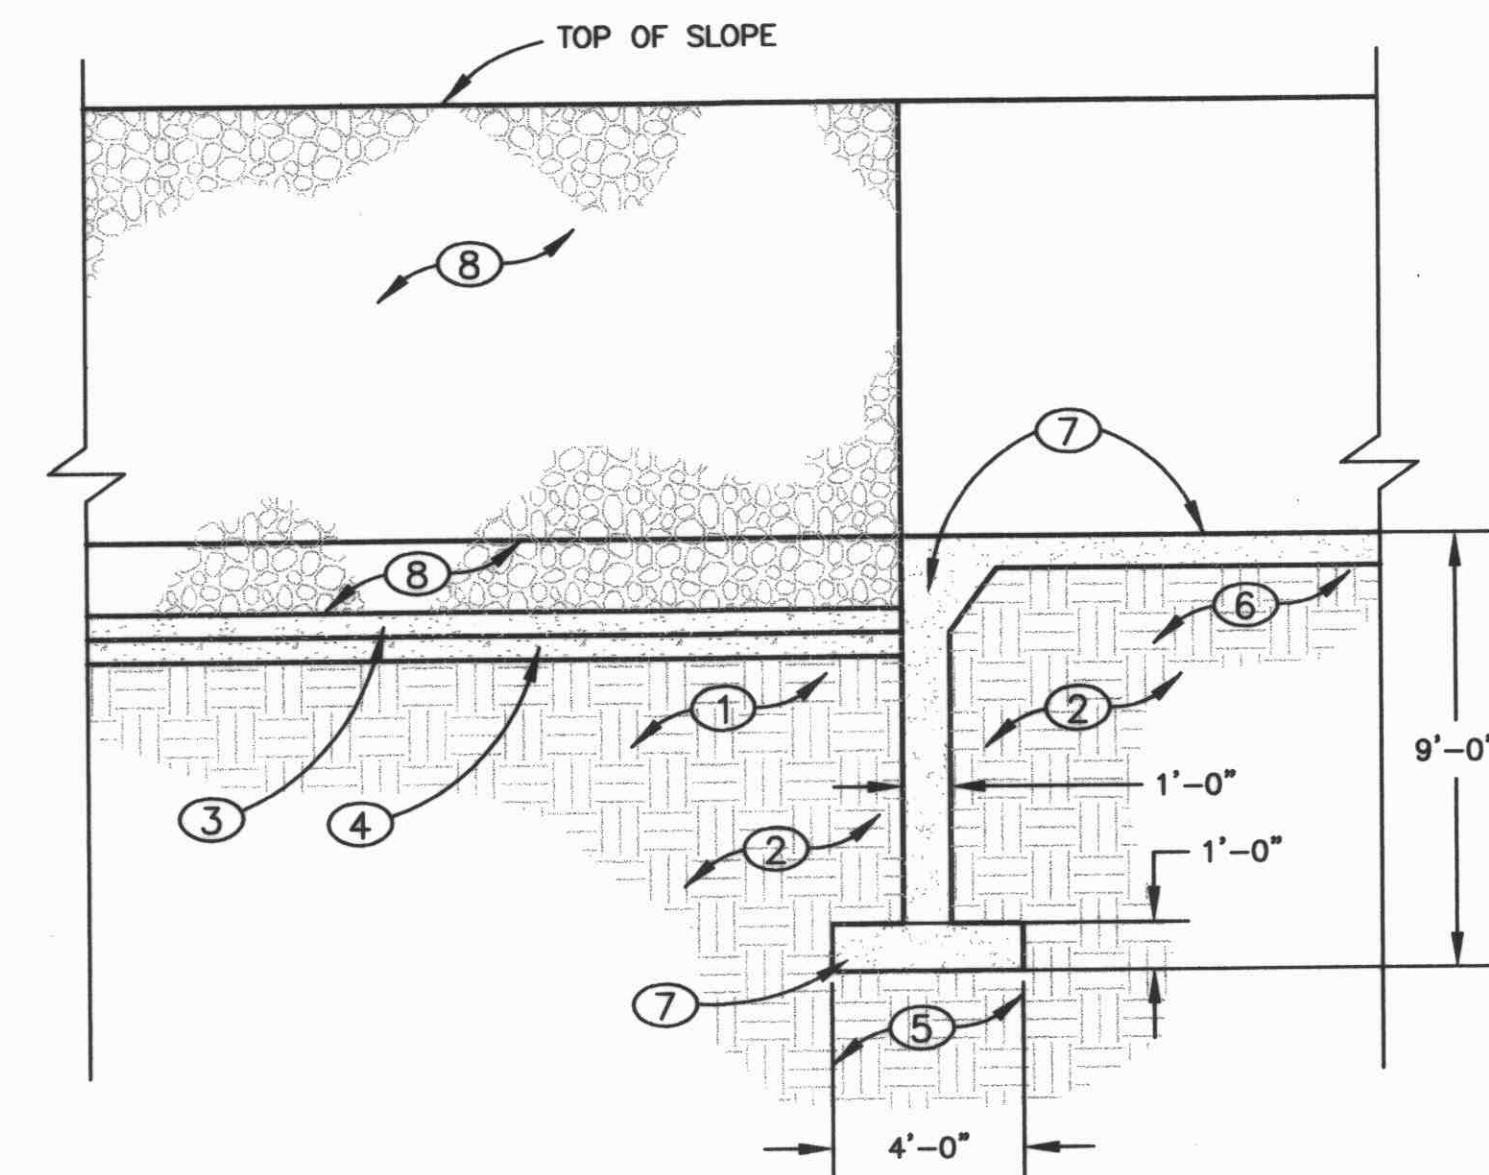

SECTION: CUT-OFF WALL AT END OF CHANNEL

1/4" = 1'-0"

1
4 10

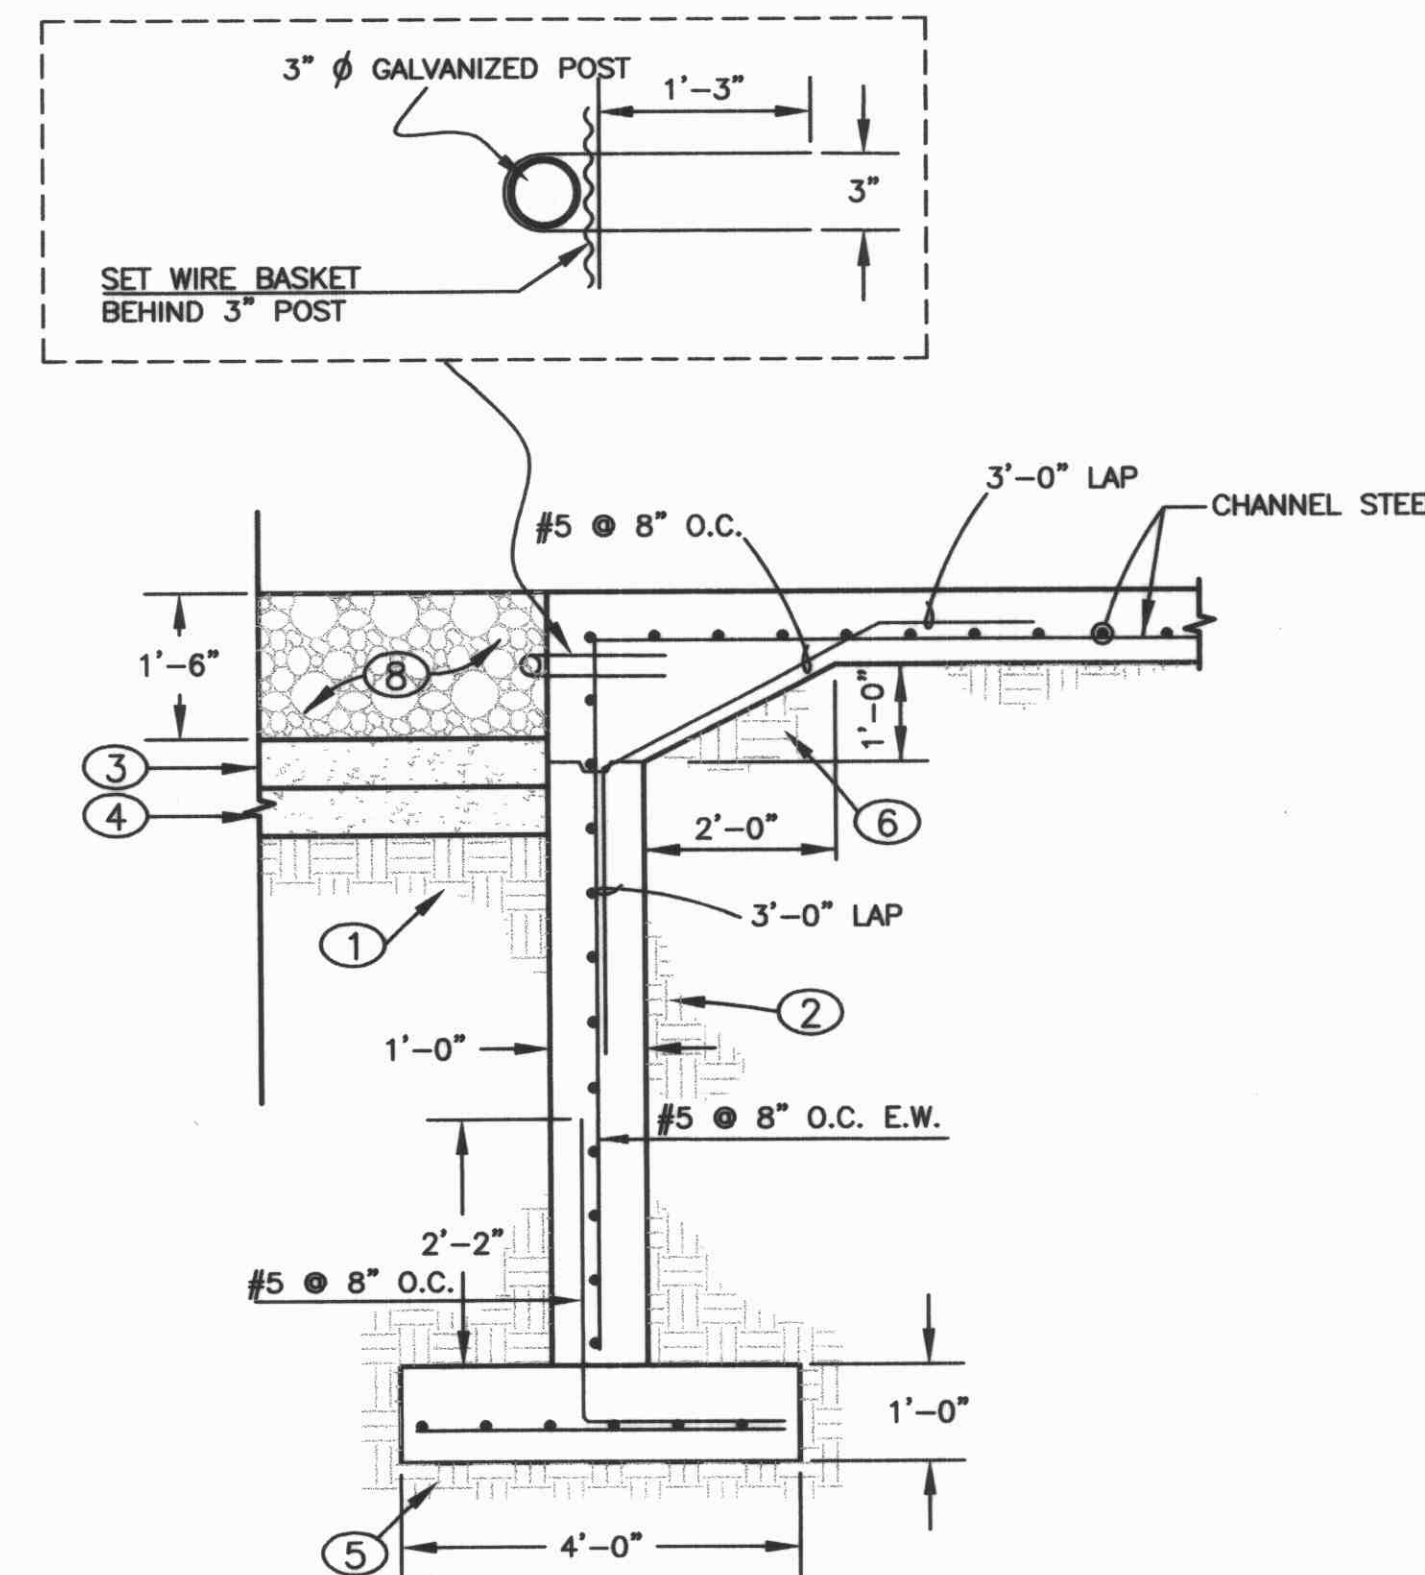


DETAIL: CUT-OFF WALL FOR OUTFALL

N.T.S.

A
10 10

KEYED NOTES:

- 12" SUBGRADE COMPACTED TO 90% ASTM D-1557.
- BACKFILL COMPACTED TO 90% ASTM D-1557.
- 6" TYPE II BEDDING MATERIAL COMPACTED TO 95% ASTM D-1557.
- 6" TYPE I BEDDING MATERIAL COMPACTED TO 95% ASTM D-1557.
- 24" STRUCTURAL FILL COMPACTED TO 95% ASTM D-1557 UNDER FOOTING.
- SUBGRADE PREPARATION PER C.O.A. STD. SPECIFICATIONS FOR RPCC CHANNEL.
- SEE DETAIL A/10 FOR REINFORCING IN CUT-OFF WALL.
- 1'-6" STAKED RIP-RAP PER COA STD. DWG. 2270.

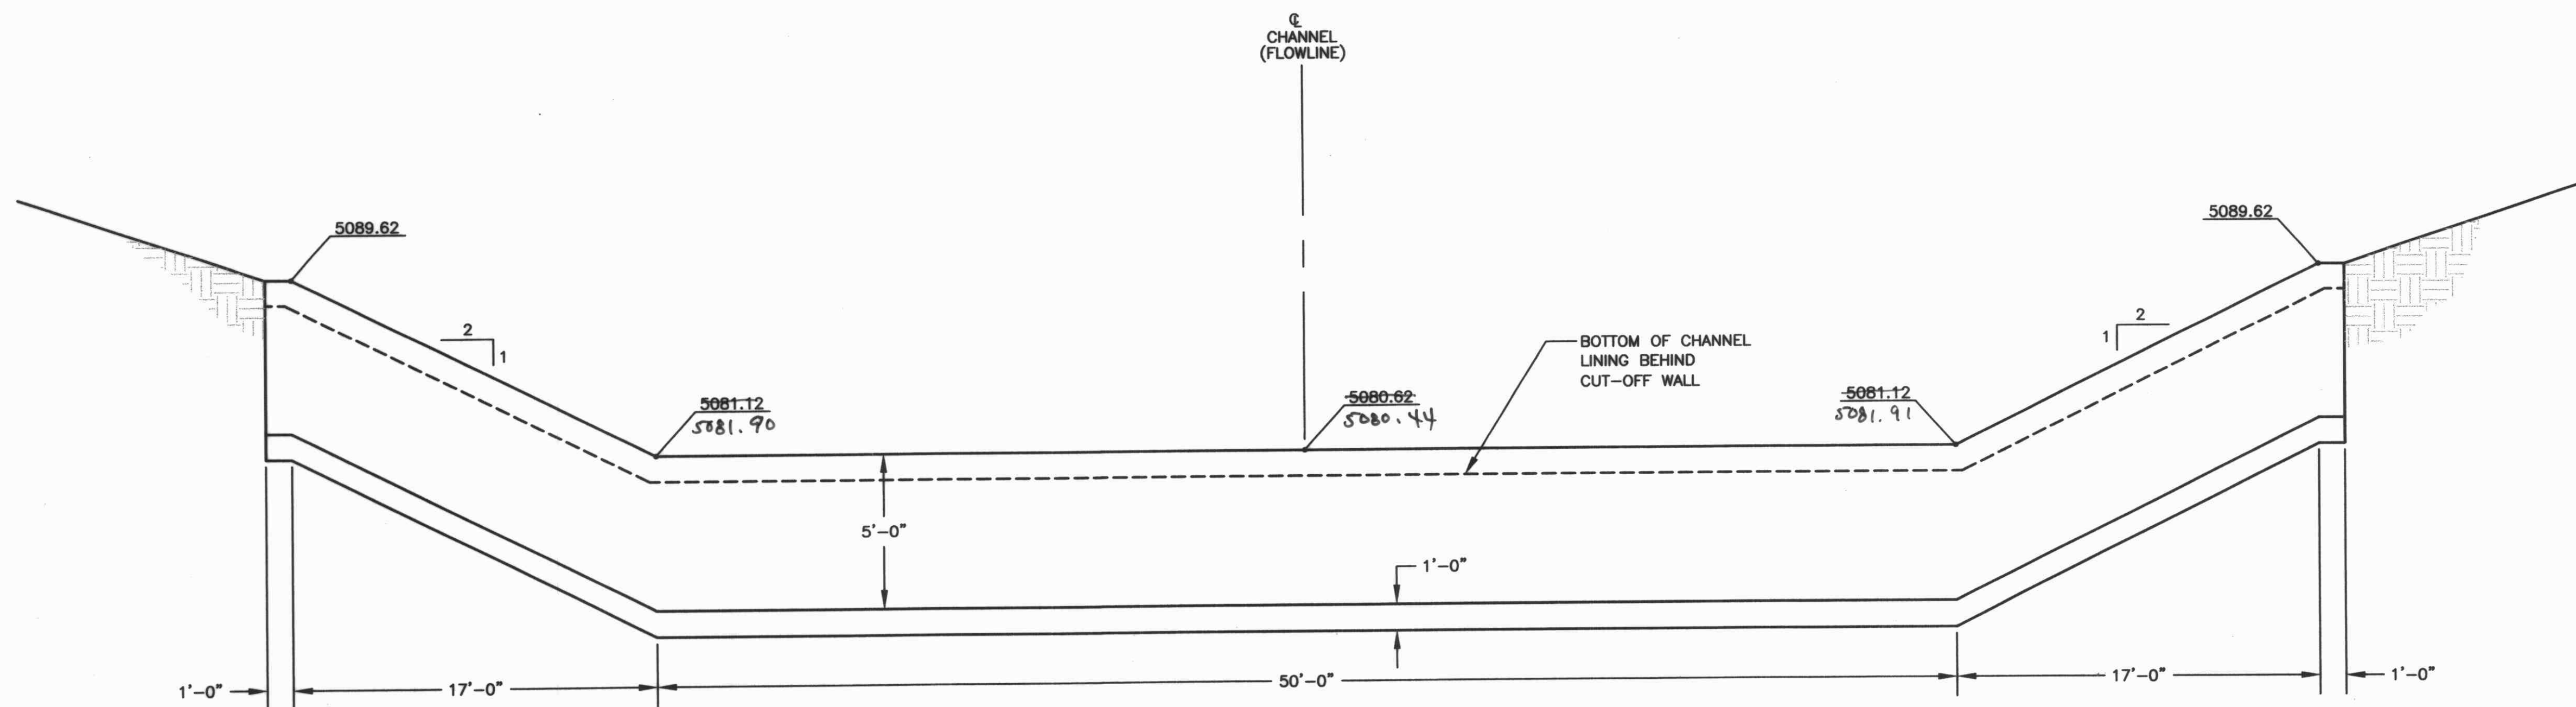

ELEVATION OF CUT-OFF WALL AT END OF CHANNEL

1/4" = 1'-0"




CITY OF ALBUQUERQUE
PUBLIC WORKS DEPARTMENT
ENGINEERING DEVELOPMENT GROUP

TITLE: DOMINGO BACA ARROYO - NORTH DIVERSION CHANNEL TO WASHINGTON ST.
OUTFALL DETAILS & SECTIONS


Design Review Committee	City Engineer Approval	No. / Day / Yr.	No. / Day / Yr.
APPROVED JUL-8-04 DESIGN REVIEW COMMITTEE	APPROVED JUL-8-04 CITY ENGINEER		
City Project No. 6258.92	Zone Map No. C-17-Z	Sheet 10	Of 14

SURVEY INFORMATION				AS BUILT INFORMATION			
NO.	BY	DATE	FIELD NOTES	CONTRACTOR	MARKER	DATE	NO.
11599	STEPHEN J. TOLER	05/00	FROM SURVEYING CONTROL, INC.	C.O.A. BENCHMARK "C-244" A.M.A.F.C.A. RIGHT OF WAY	MARKER STAMPED "NAA-9" LOCATED IN THE SOUTHEAST QUADRANT OF THE INTERSECTION OF PASEO DEL NORTE AND THE NORTH DIVERSION CHANNEL. ELEV. = 5069.27 ft	DATE 10/05	NO. 105
					GROUND COORDINATES: NORTHING = 1,519,215.25 EASTING = 394,264.97	DATE 10/05	NO. 105
						DATE 10/05	NO. 105
						DATE 10/05	NO. 105
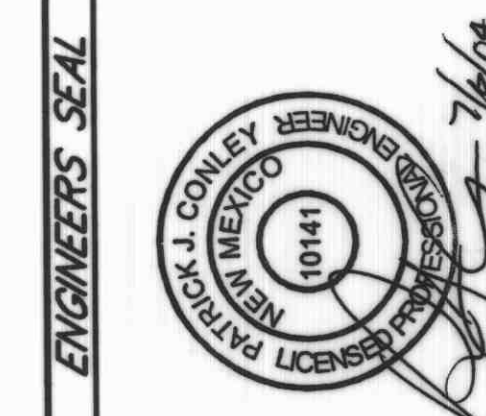

NO.	DATE	REVISIONS	BY

DESIGNED BY	DRAWN BY	CHECKED BY	DATE
PJC	CAD	PJC	06/04
			06/04
			06/04

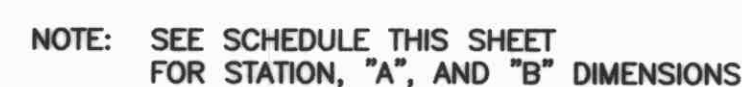

NTS



SCALE: $1/2'' = 1'-0''$

TYPE	"L" BARS	"S" BARS	"W" BARS
"A"	#8@12" O.C.	#7@12" O.C.	#7@12" O.C.
"B"	#7@16" O.C.	#5@16" O.C.	#5@16" O.C.
"C"	#4@16" O.C.	#6@16" O.C.	#4@16" O.C.

$$1/2'' = 1'-0''$$

NTS

$$\underline{\underline{1'' = 1' - 0''}}$$
$$\overline{1/2''} = 1'-0''$$



SCALE: N.T.S.

NTS



$$1/2'' = 1'-0''$$


1. 3/4" EXPANSION JOINT PER DETAIL A/11.
2. BACKFILL COMPACTED TO 90% ASTM D-1557.
3. SUBGRADE FOR CHANNEL PER SHEET 9/14.
4. 36" STRUCTURAL FILL COMPACTED TO 95% ASTM D-1557 OVER 12" SUBGRADE COMPACTED TO 90% ASTM D-1557.
5. 3/4" CHAMFER, TYPICAL.
6. 1/2" EXPANSION JOINT PER DETAIL G, COA STD. DWG. 2426.
7. 12" SUBGRADE COMPACTED TO 95% ASTM D-1557.
8. 8"x1'-6" STANDING CURB WITH REINFORCING AS SHOWN. 3/4" CHAMFER OR 1/2" RADIUS ALONG TOP EDGE.
9. 1/2" SEALANT AT CONSTRUCTION JOINT.
10. 2' WIDE SWALE OUTSIDE EDGE THICKNESS=6" INVERT THICKNESS=6". SEE PLANS FOR FLOWLINE DATA.
11. BACKFILL COMPACTED TO 90% ASTM D-1557.
12. SAWCUT TO EXPOSE REBAR; APPLY EPOXY BINDER TO EXPOSED CONCRETE PER 602.5.6 OF C.O.A. STD. SPECS PRIOR TO POUR.
13. NOT USED.
14. 3/4" POLYETHYLENE FOAM FILLER "PLASTAZONE" OR APPROVED EQUIVALENT.
15. 1" TWO COMPONENT URETHANE SEALANT WITH PRIMER.
16. CONTRACTOR SHALL FILL VERTICAL SCORES IN EXISTING WALL WITH 5000 PSI GROUT PRIOR TO PLACEMENT OF EXPANSION JOINT MATERIAL.

[illegible]

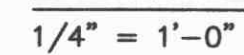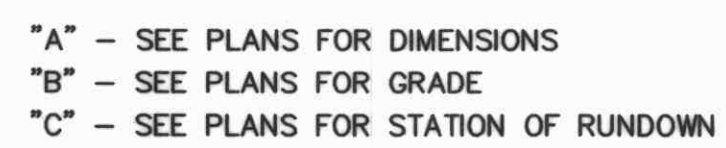


1. BACKFILL COMPACTED TO 90% ASTM D-1557.
2. 12" SUBGRADE COMPACTED TO 95% ASTM D-1557.
3. 3/4" CHAMFER OR 1/2" TOOLED EDGE TYPICAL AT ALL EXPOSED EDGES.

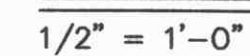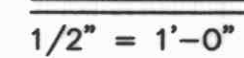


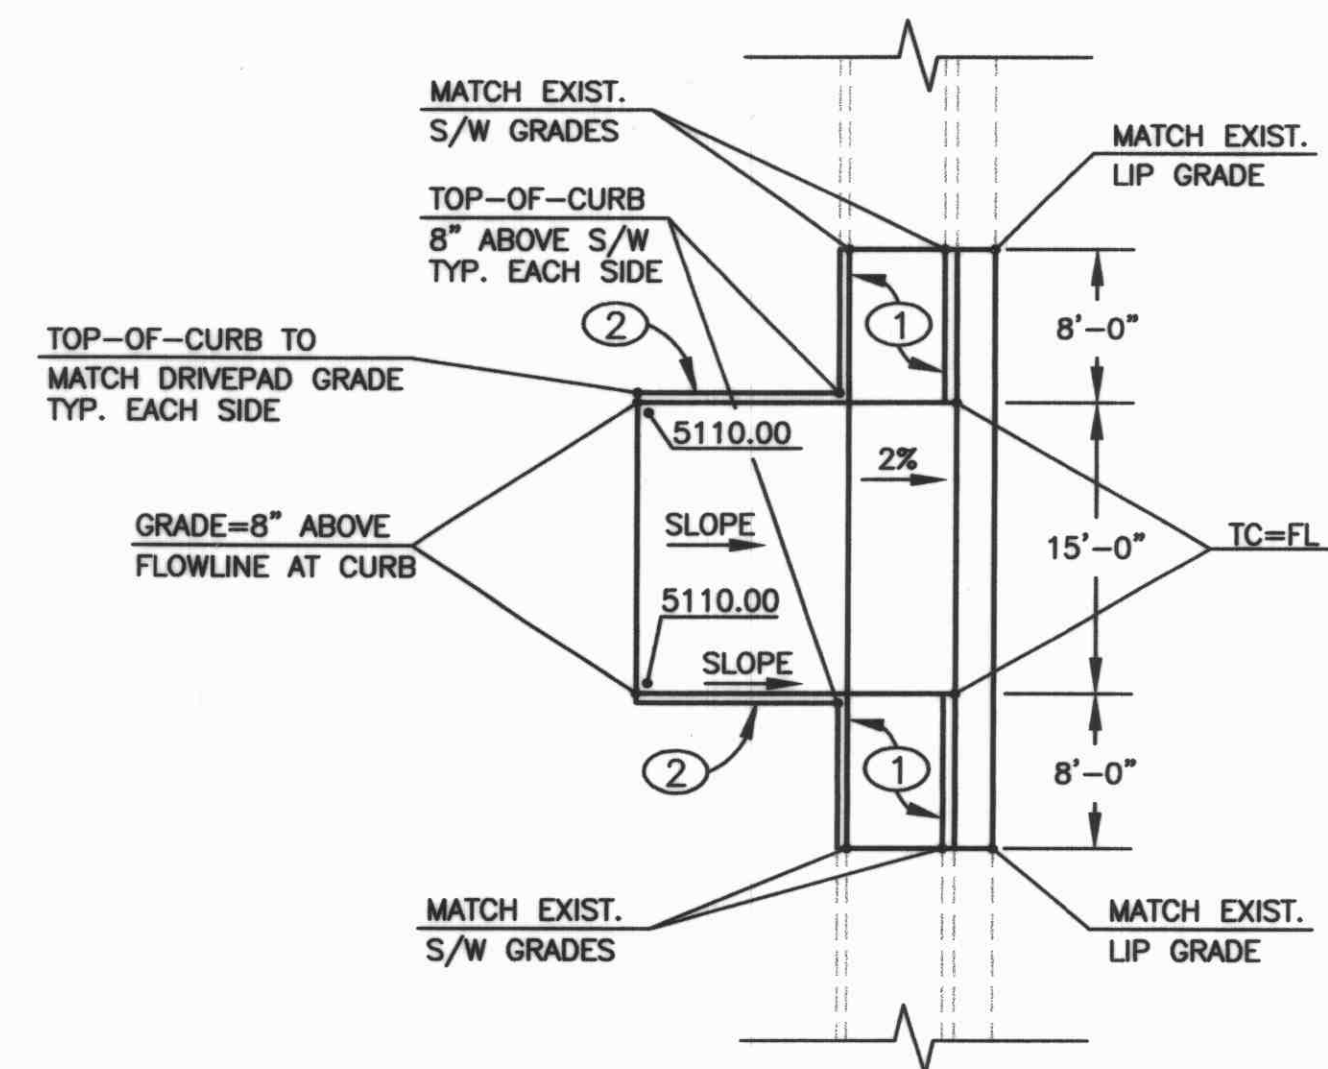


TYPICAL DRIVEPAD DETAIL
1" = 10'

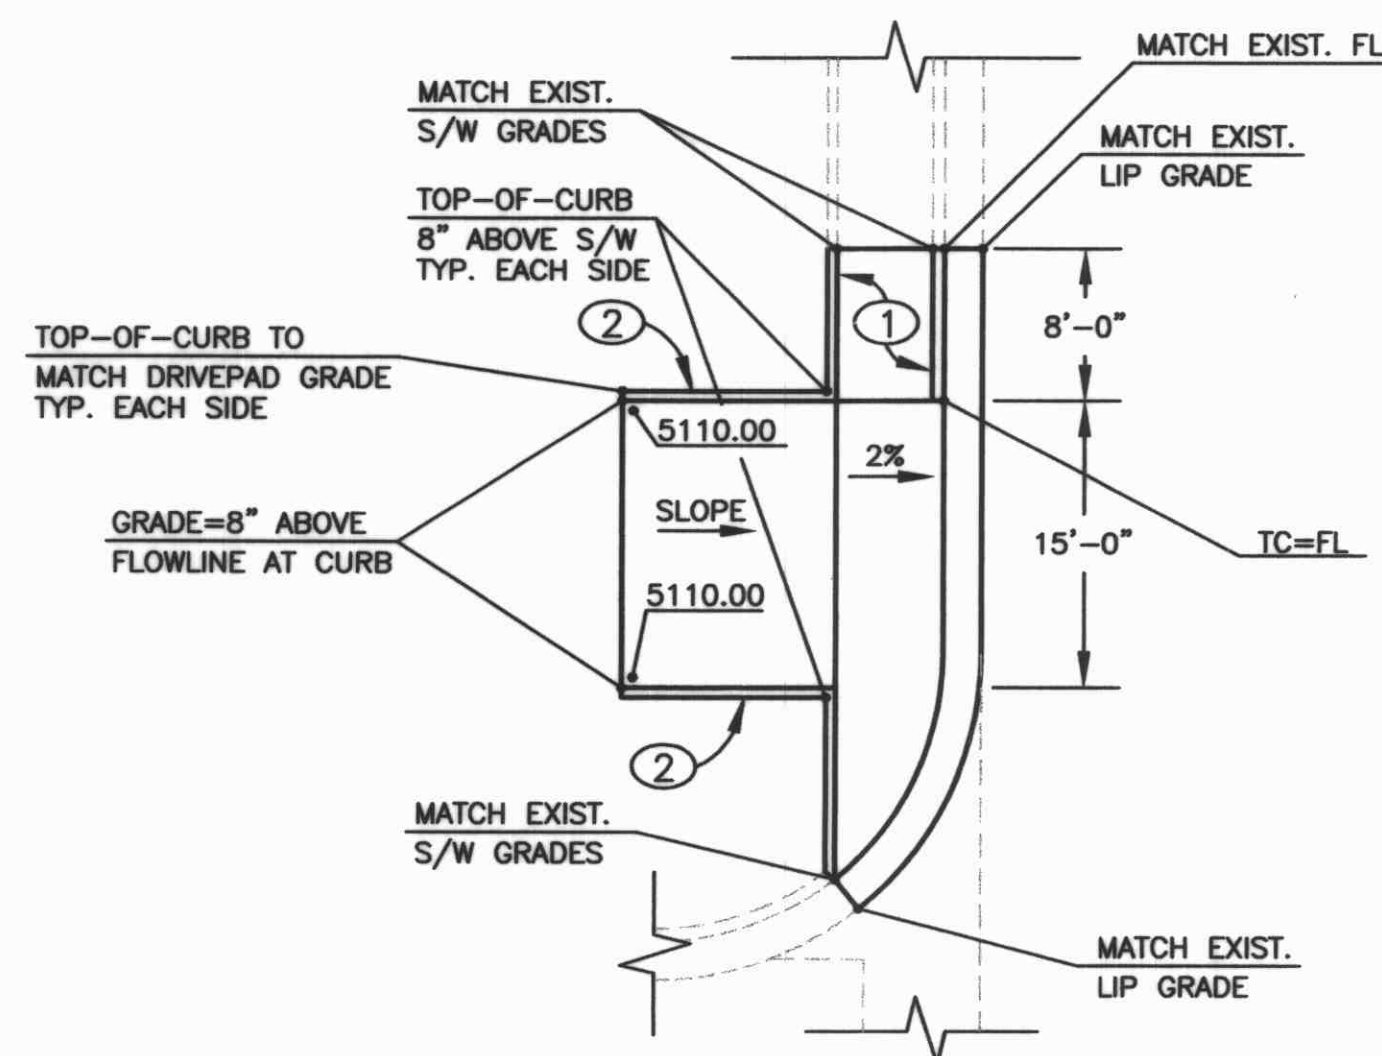

DRIVEPAD DETAIL: SW QUAD OF WASHINGTON ST.
1" = 10'

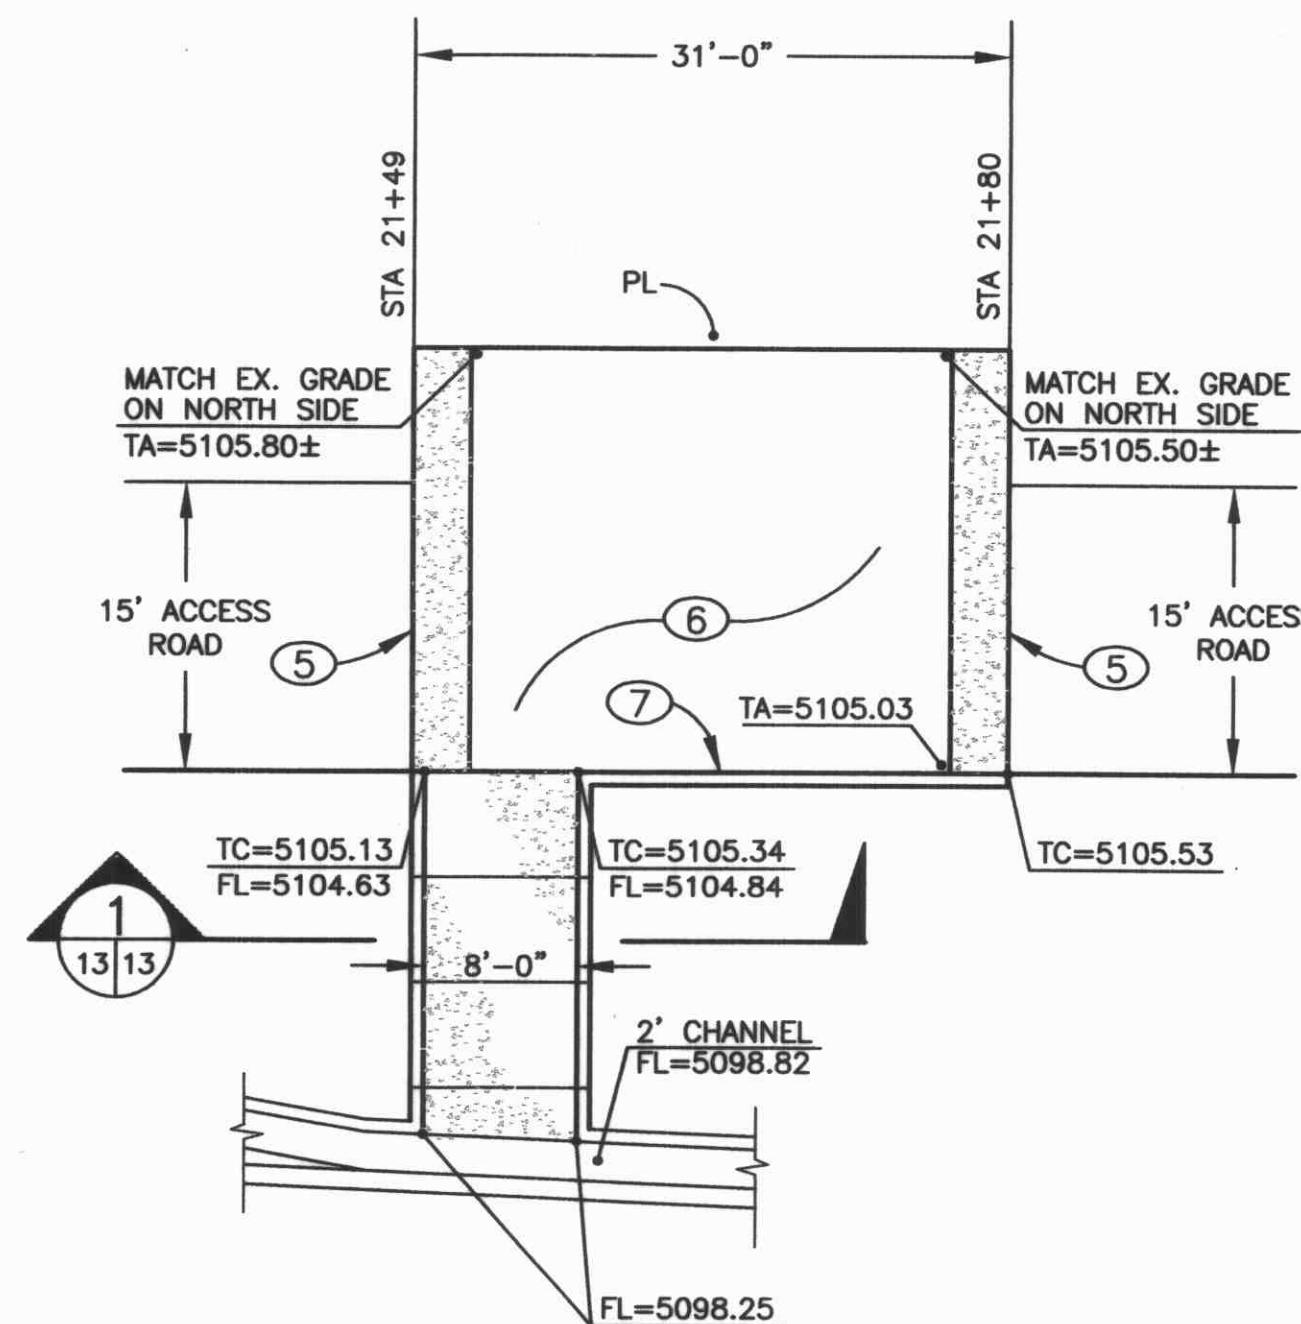

RUNDOWN DETAIL: STA 21+80
1" = 10'

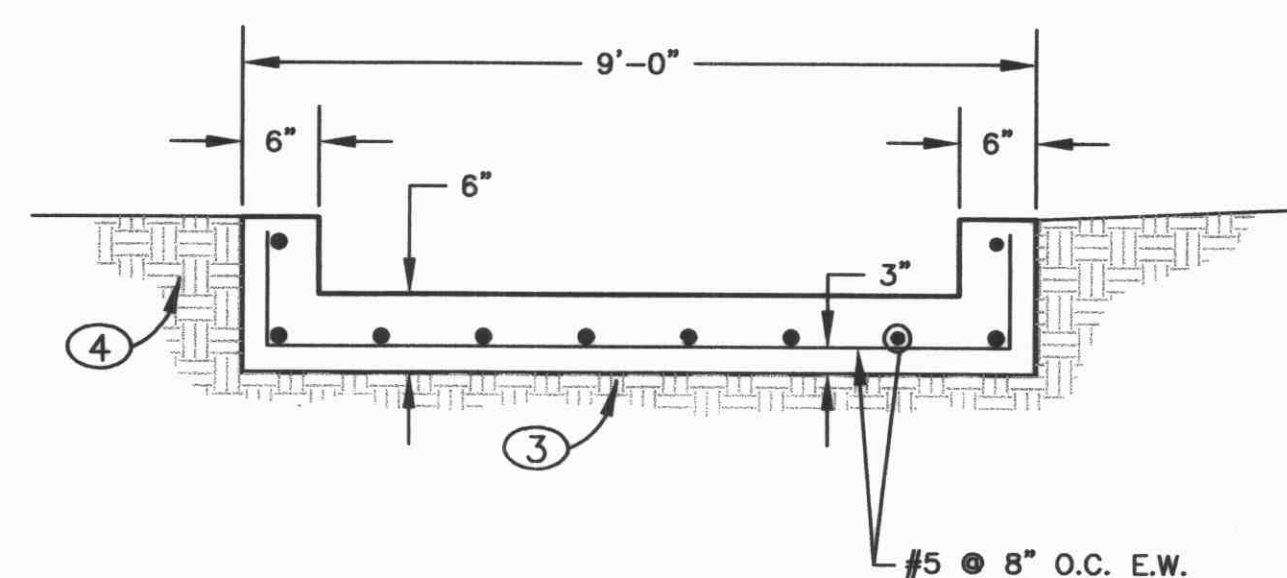

SECTION
N.T.S.

KEYED NOTES:

- 2% CROSS SLOPE TOWARDS STREET. LONGITUDINAL SLOPE NO STEEPER THAN 1:12 (V:H). MAXIMUM WIDTH VARIES DEPENDING ON LOCATION. PLACE 5' WIDTH AT LOCATIONS WHERE NO SIDEWALK EXISTS.
- 6" WIDE HEADER CURB. PLACE 1/2" EXPANSION JOINT BETWEEN HEADER CURB AND DRIVEPAD.
- 12" SUBGRADE AT 95% ASTM D-1557.
- BACKFILL PER COA SPECIFICATIONS.
- CONSTRUCT MOUNTABLE CURB PER COA STD DWG 2415A.
- ASPHALT/PAVING 3" TYPE 1 ARTERIAL OVER 12" SUBGRADE AT 95% ASTM D-1557.
- CONSTRUCT MEDIAN W/ 2% SLOPE IN PAN TOWARDS FACE.
- 8" REINFORCED CONCRETE


																																																																																																																																																																																																																																																																																																																																																																																																																																																																																																																																																																																																																																																																																																																																																																																																																																																																																																																																																																																																																																																																																																																																																																																																																																																																																																																																																																																																																																				</
--	--	----



CITY OF ALBUQUERQUE
PUBLIC WORKS DEPARTMENT
ENGINEERING DEVELOPMENT GROUP

TITLE: DOMINGO BACA ARROYO - NORTH DIVERSION CHANNEL TO WASHINGTON ST.
MISCELLANEOUS DETAILS & SECTIONS #1

Design Review Committee	City Engineer Approval	No. / Day / Yr.	No. / Day / Yr.
DESIGN REVIEW COMMITTEE	CITY ENGINEER		
City Project No.	Zone Map No.	Sheet	Of
6258.92	C-17-Z	13	14

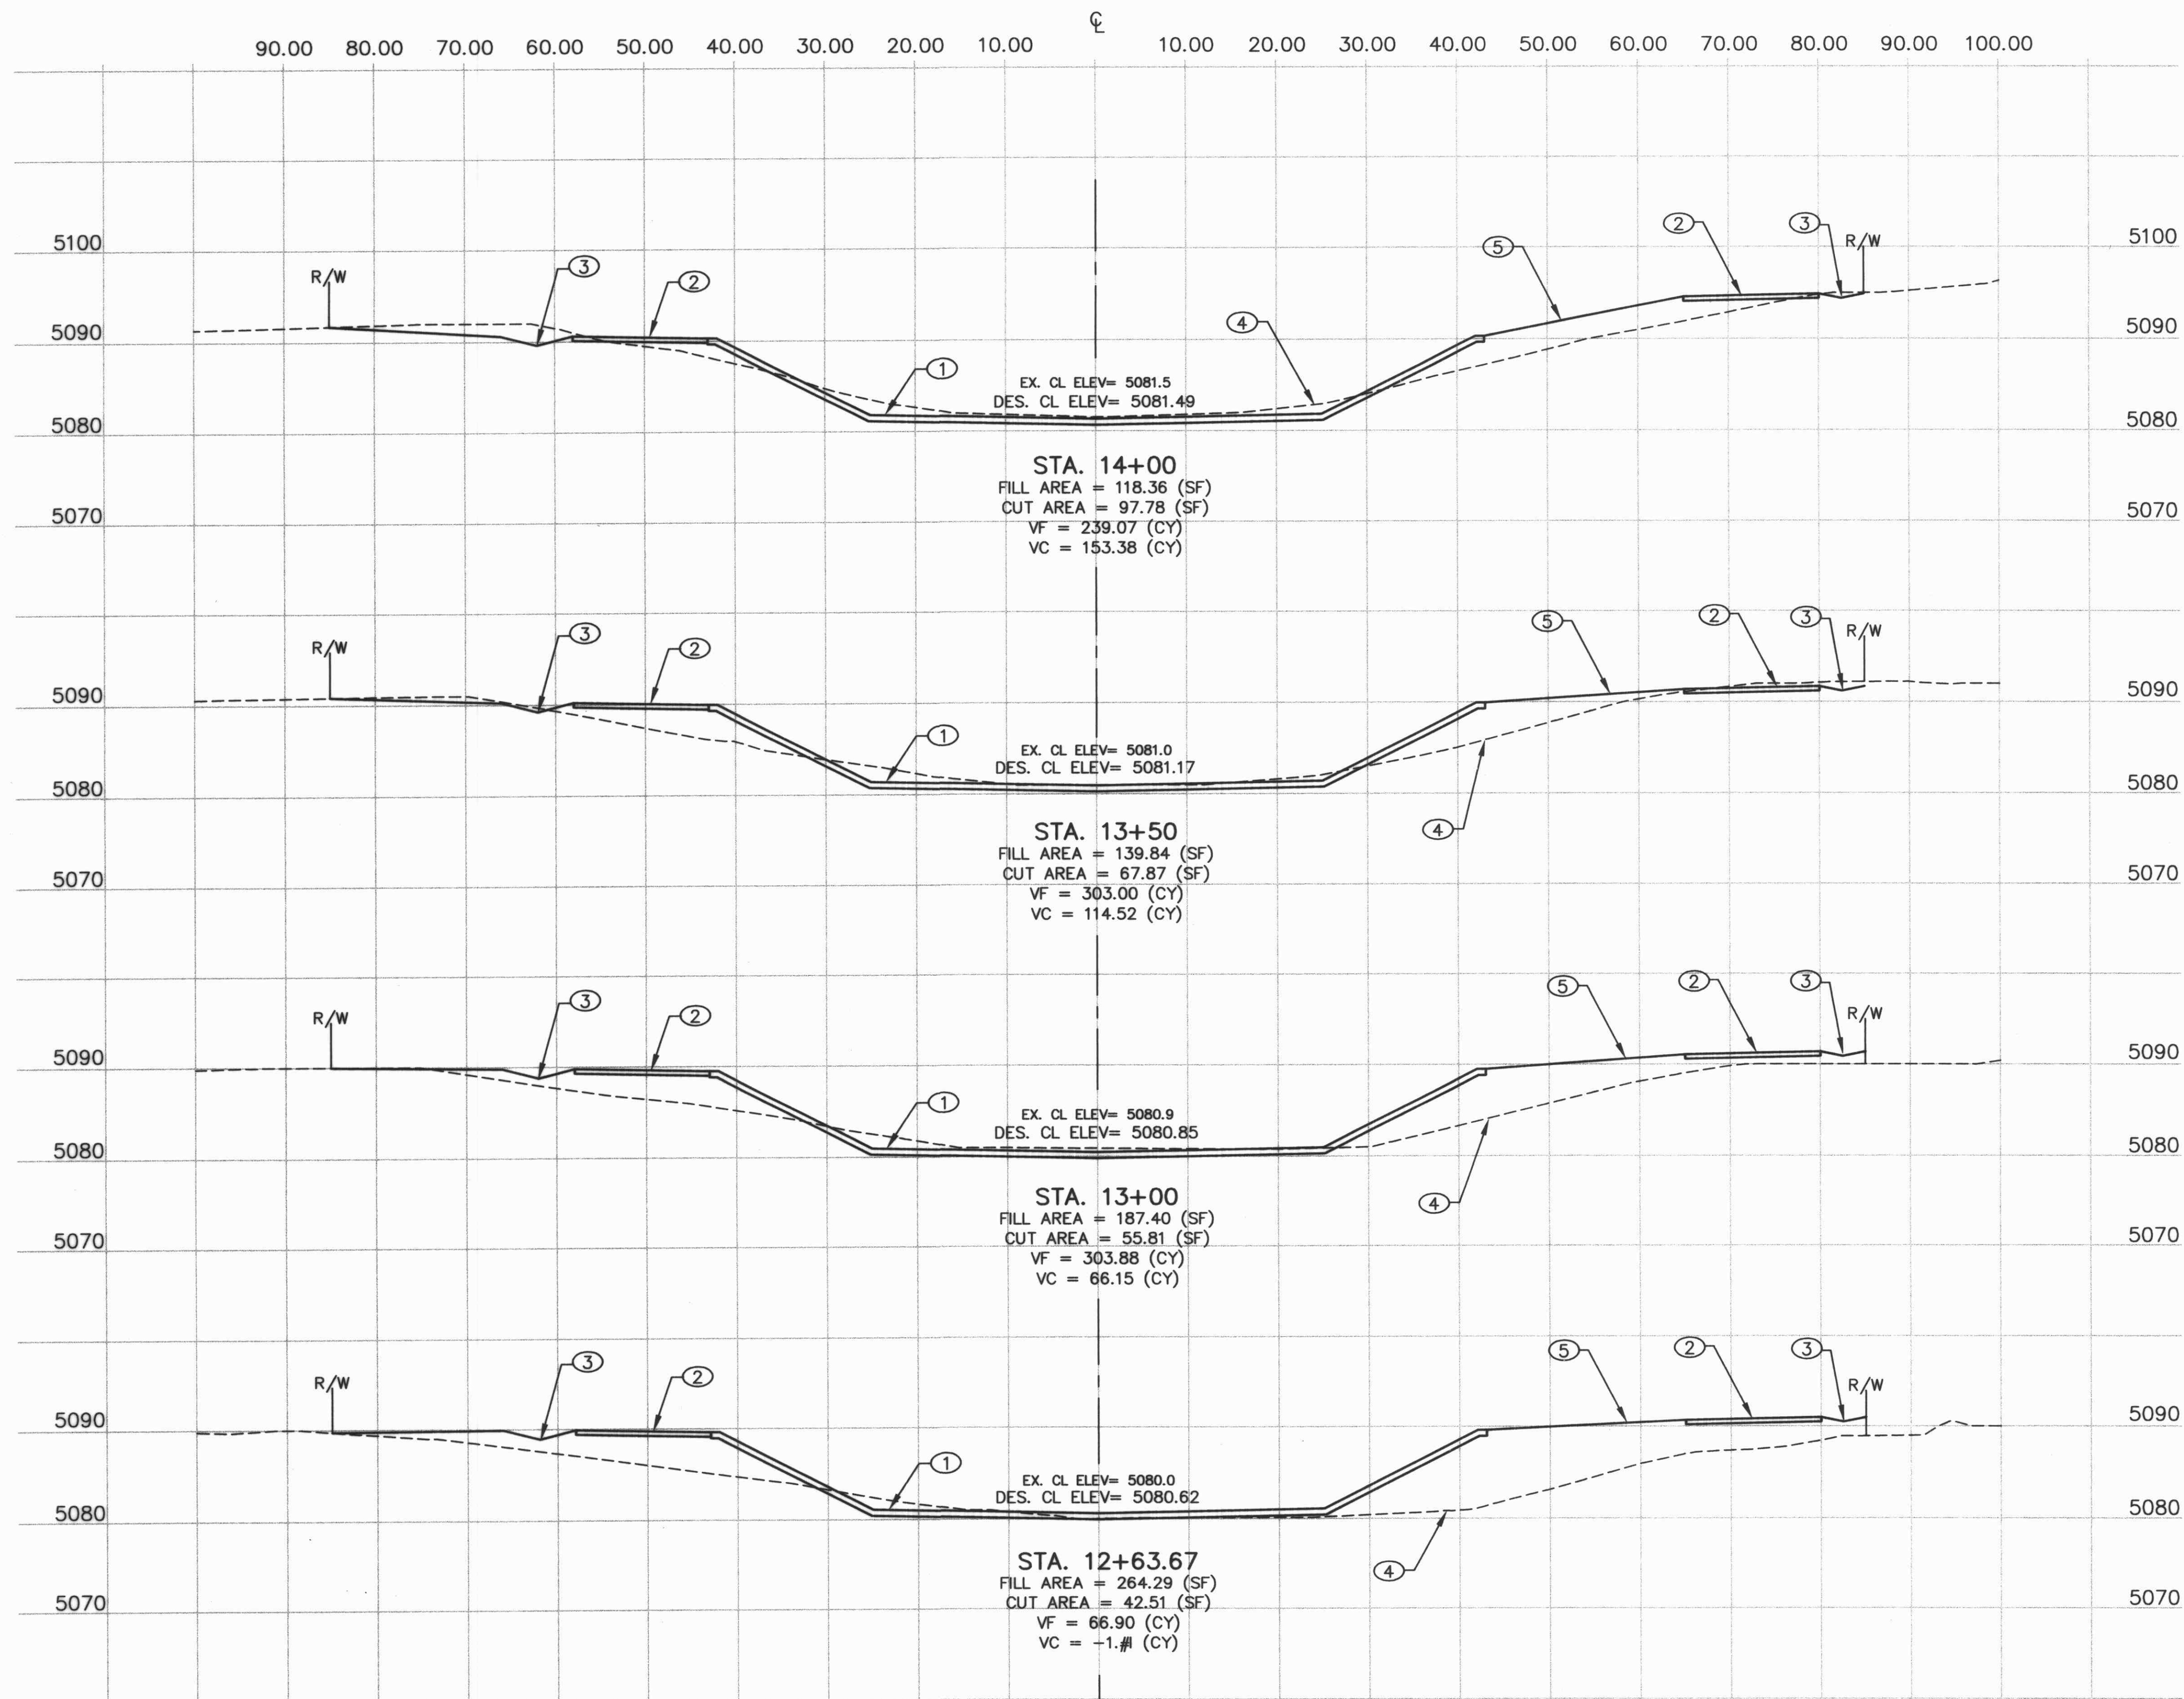

○ KEYED NOTES:


1. NEW RPCC CHANNEL
2. ACCESS ROAD
3. LOW FLOW SWALE
4. EXISTING GROUND
5. PROPOSED GRADE

CROSS SECTION SHOW APPROXIMATE CUT/FILL FOR PROPOSED IMPROVEMENTS. CONTRACTOR SHALL USE PLAN AND PROFILE AND APPROPRIATE DETAIL SHEETS TO CONSTRUCT CHANNEL.

 Smith Engineering Company A Full Service Engineering Company 6010 Uptown Boulevard, N.E. Suite 6000 Albuquerque, New Mexico 87110		100101B					DATE		DESIGNED BY	DRAWN BY	CHECKED BY
CITY OF ALBUQUERQUE PUBLIC WORKS DEPARTMENT ENGINEERING DEVELOPMENT GROUP											
TITLE: DOMINGO BACA ARROYO - NORTH DIVERSION CHANNEL TO WASHINGTON ST.											
CHANNEL CROSS-SECTIONS: STA. 12+63.67 TO 14+00											
Design Review Committee			City Engineer Approval			Last Design Update	No. / Day / Yr.		No. / Day / Yr.		
City Project No.			Zone Map No.			Sheet		Of			
6258.92			C-17-Z			14A				14	

ADDENDUM #1 7/29/69 PAGE 6


[illegible]

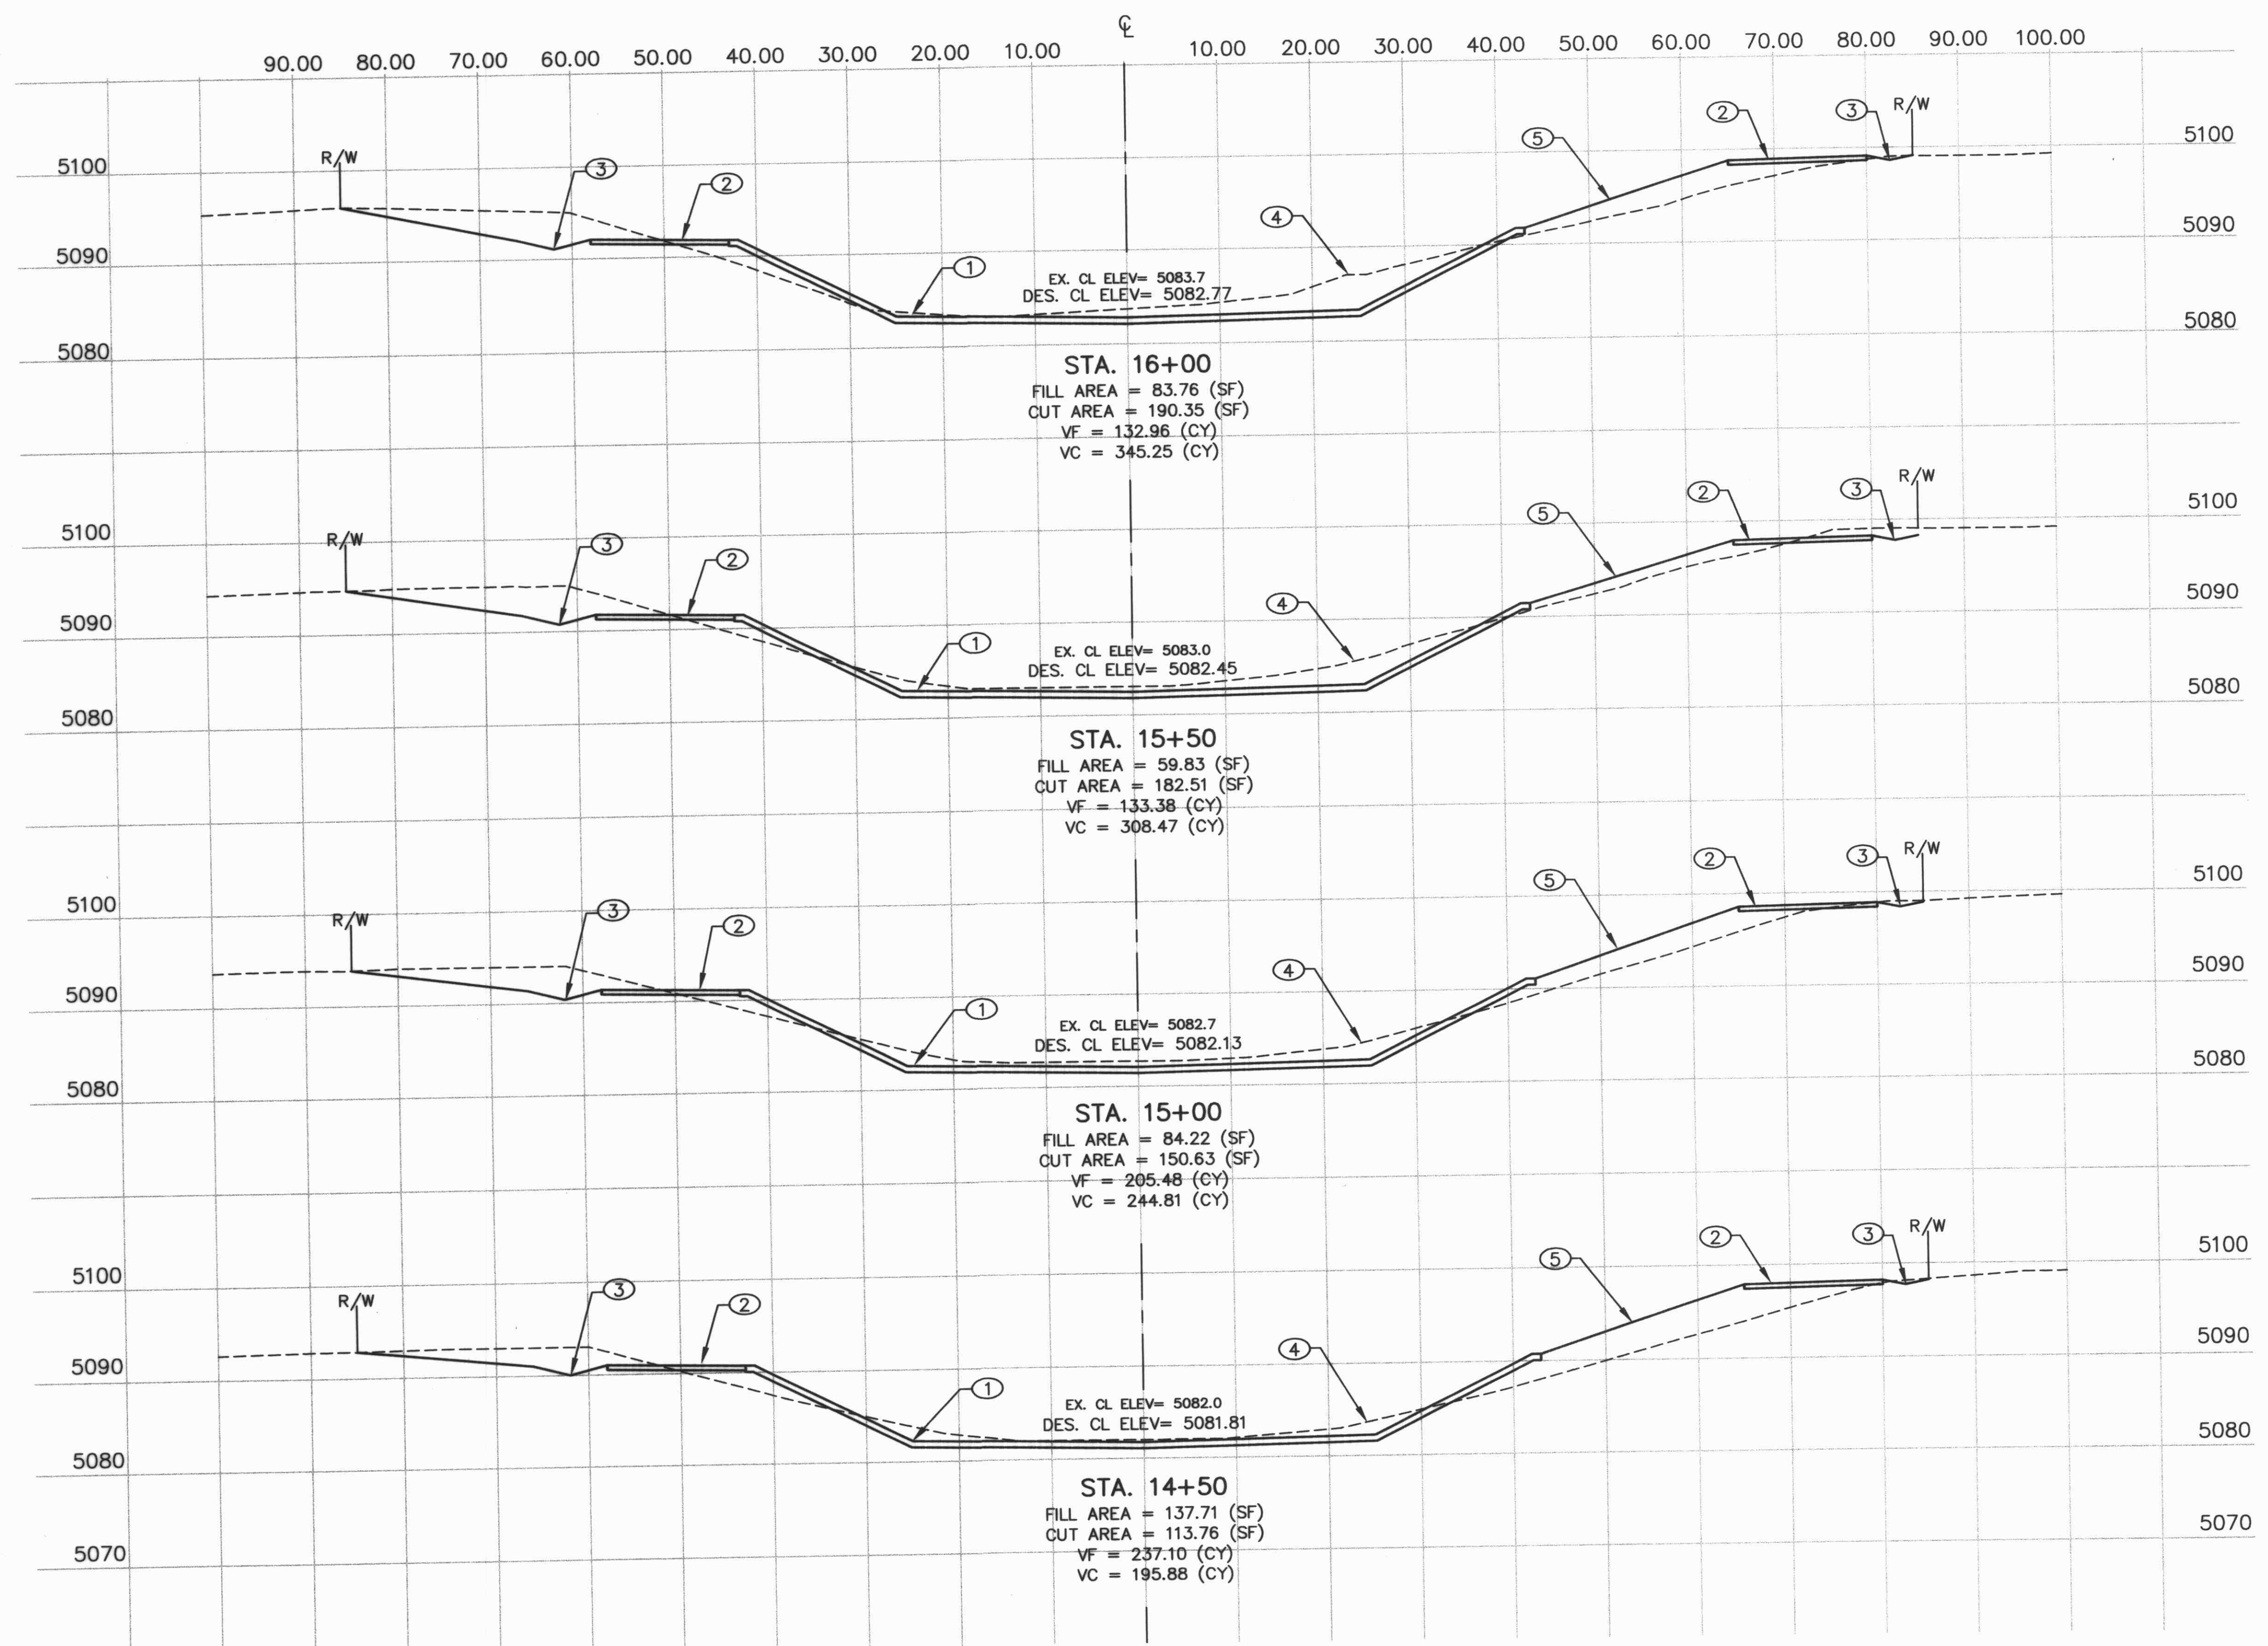

KEYED NOTES:


- NEW RPCC CHANNEL
- ACCESS ROAD
- LOW FLOW SWALE
- EXISTING GROUND
- PROPOSED GRADE

CROSS SECTION SHOW APPROXIMATE CUT/FILL FOR PROPOSED IMPROVEMENTS. CONTRACTOR SHALL USE PLAN AND PROFILE AND APPROPRIATE DETAIL SHEETS TO CONSTRUCT CHANNEL.

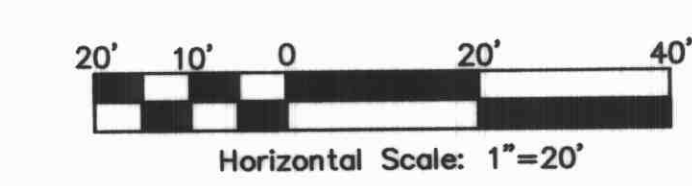

CITY OF ALBUQUERQUE PUBLIC WORKS DEPARTMENT ENGINEERING DEVELOPMENT GROUP			
TITLE: DOMINGO BACA ARROYO - NORTH DIVERSION CHANNEL TO WASHINGTON ST. CHANNEL CROSS-SECTIONS: STA. 14+50 TO 16+00			
Design Review Committee	City Engineer Approval	No. / Day / Yr.	No. / Day / Yr.
City Project No.	Zone Map No.	Sheet	Of
6258.92	C-17-Z	14B	14



AS BUILT INFORMATION		BENCH MARKS		SURVEY INFORMATION		ENGINEER'S SEAL	
CONTRACTOR	DATE	C.O.A. BENCHMARK	DATE	NO.	DATE		
INSPECTOR	DATE	MARKER STAMPED	DATE	BY	DATE		
VERIFICATION BY	DATE	QUADRANT OF THE INTERSECTION	DATE	FROM SURVEYING	DATE		
VERIFICATION BY	DATE	AND THE NORTH DIVERSION CHANNEL	DATE	CONTROL, INC.	DATE		
MICRO-FILM INFORMATION		GROUND COORDINATES		REMARKS		DESIGN	
RECORDED BY	DATE	NORTHING	EASTING	NO. DATE		DESIGNED BY	
NO.		1,519,215.25	394,264.97	REVISIONS		DRAWN BY	
				DATE		CHECKED BY	
				DATE		DATE	

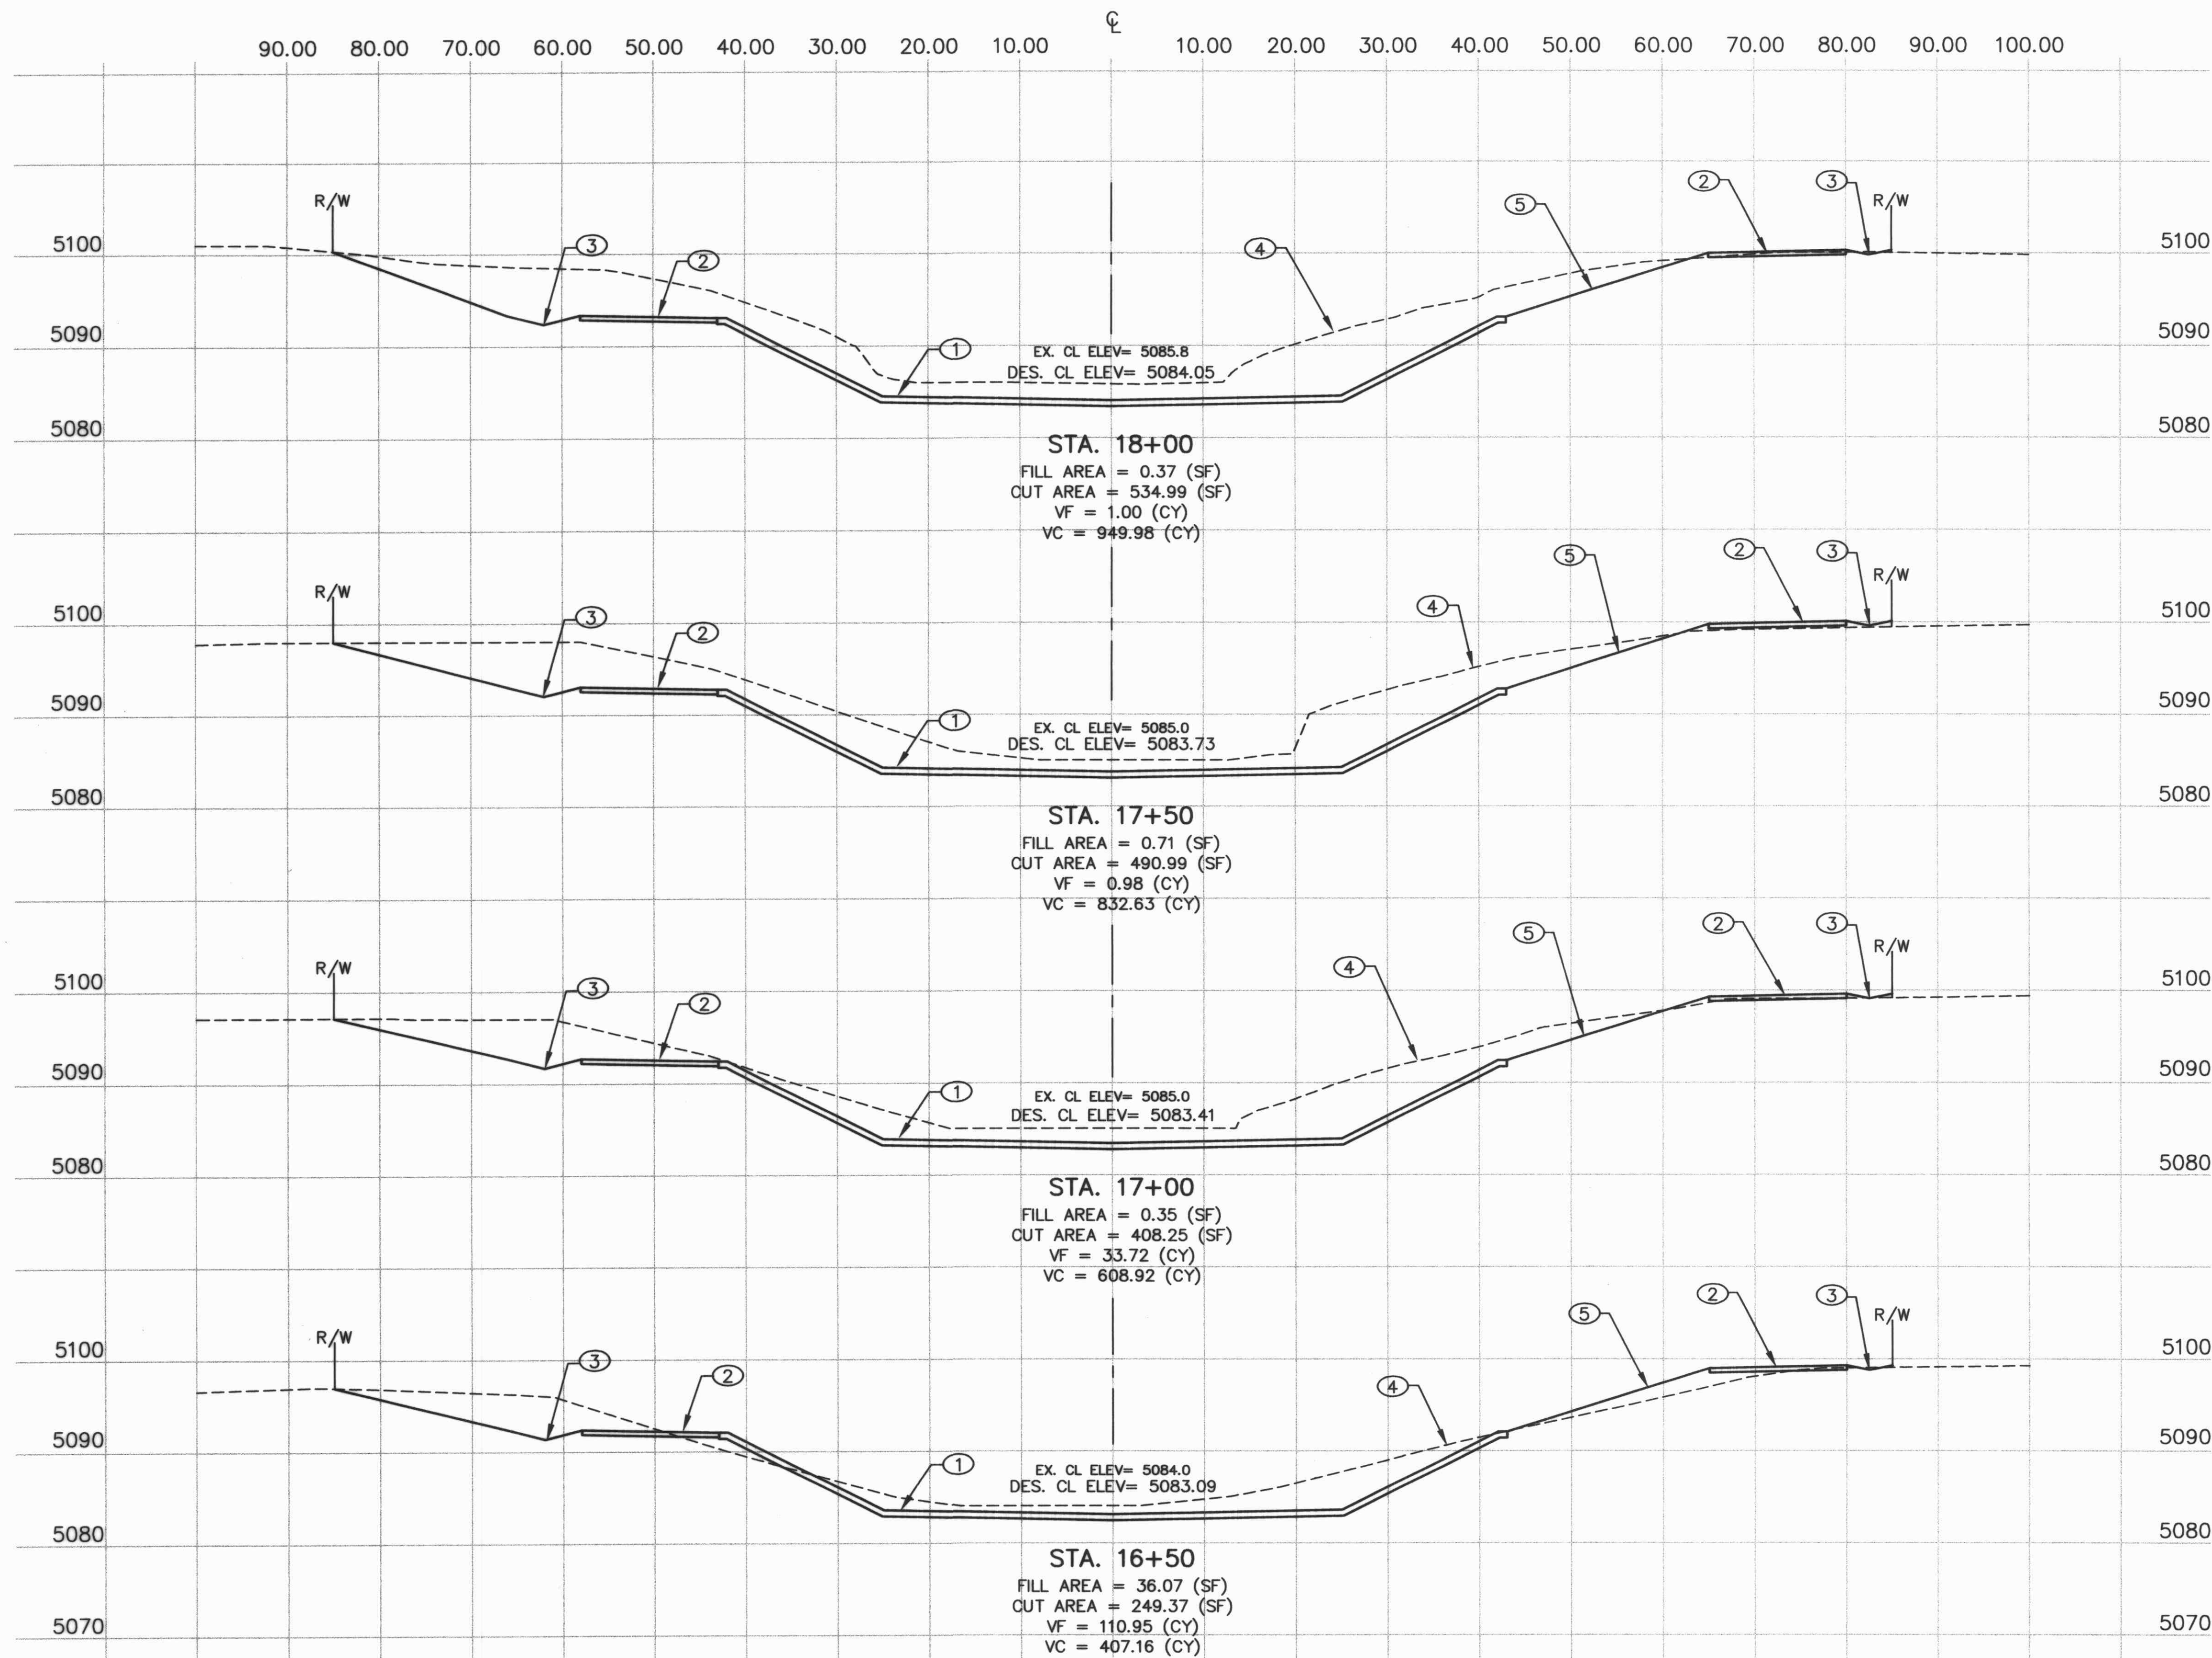


KEYED NOTES:

1. NEW RPCC CHANNEL
2. ACCESS ROAD
3. LOW FLOW SWALE
4. EXISTING GROUND
5. PROPOSED GRADE


CROSS SECTION SHOW APPROXIMATE CUT/FILL FOR PROPOSED IMPROVEMENTS. CONTRACTOR SHALL USE PLAN AND PROFILE AND APPROPRIATE DETAIL SHEETS TO CONSTRUCT CHANNEL.

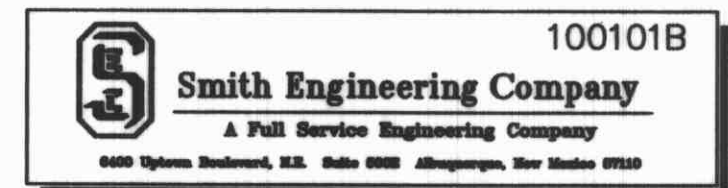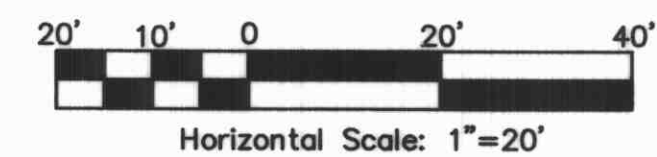

CITY OF ALBUQUERQUE PUBLIC WORKS DEPARTMENT ENGINEERING DEVELOPMENT GROUP			
TITLE: DOMINGO BACA ARROYO - NORTH DIVERSION CHANNEL TO WASHINGTON ST.			
CHANNEL CROSS-SECTIONS: STA. 16+50 TO 18+00			
Design Review Committee	City Engineer Approval	No. / Day / Yr.	No. / Day / Yr.
City Project No.	Zone Map No.	Sheet	Of
6258.92	C-17-Z	14C	14

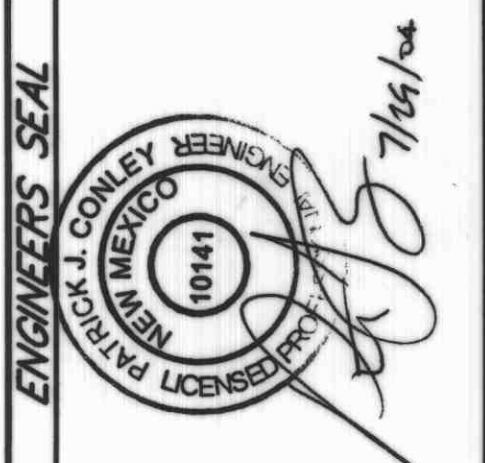



NO.	DATE	REMARKS	BY
11589	05/00	FROM SURVEYING	STEPHEN J. TOLER
		CONTROL, INC.	
		DESIGN	
		DRAWN BY	
		CHECKED BY	
		DATE	
		DATE	
		DATE	

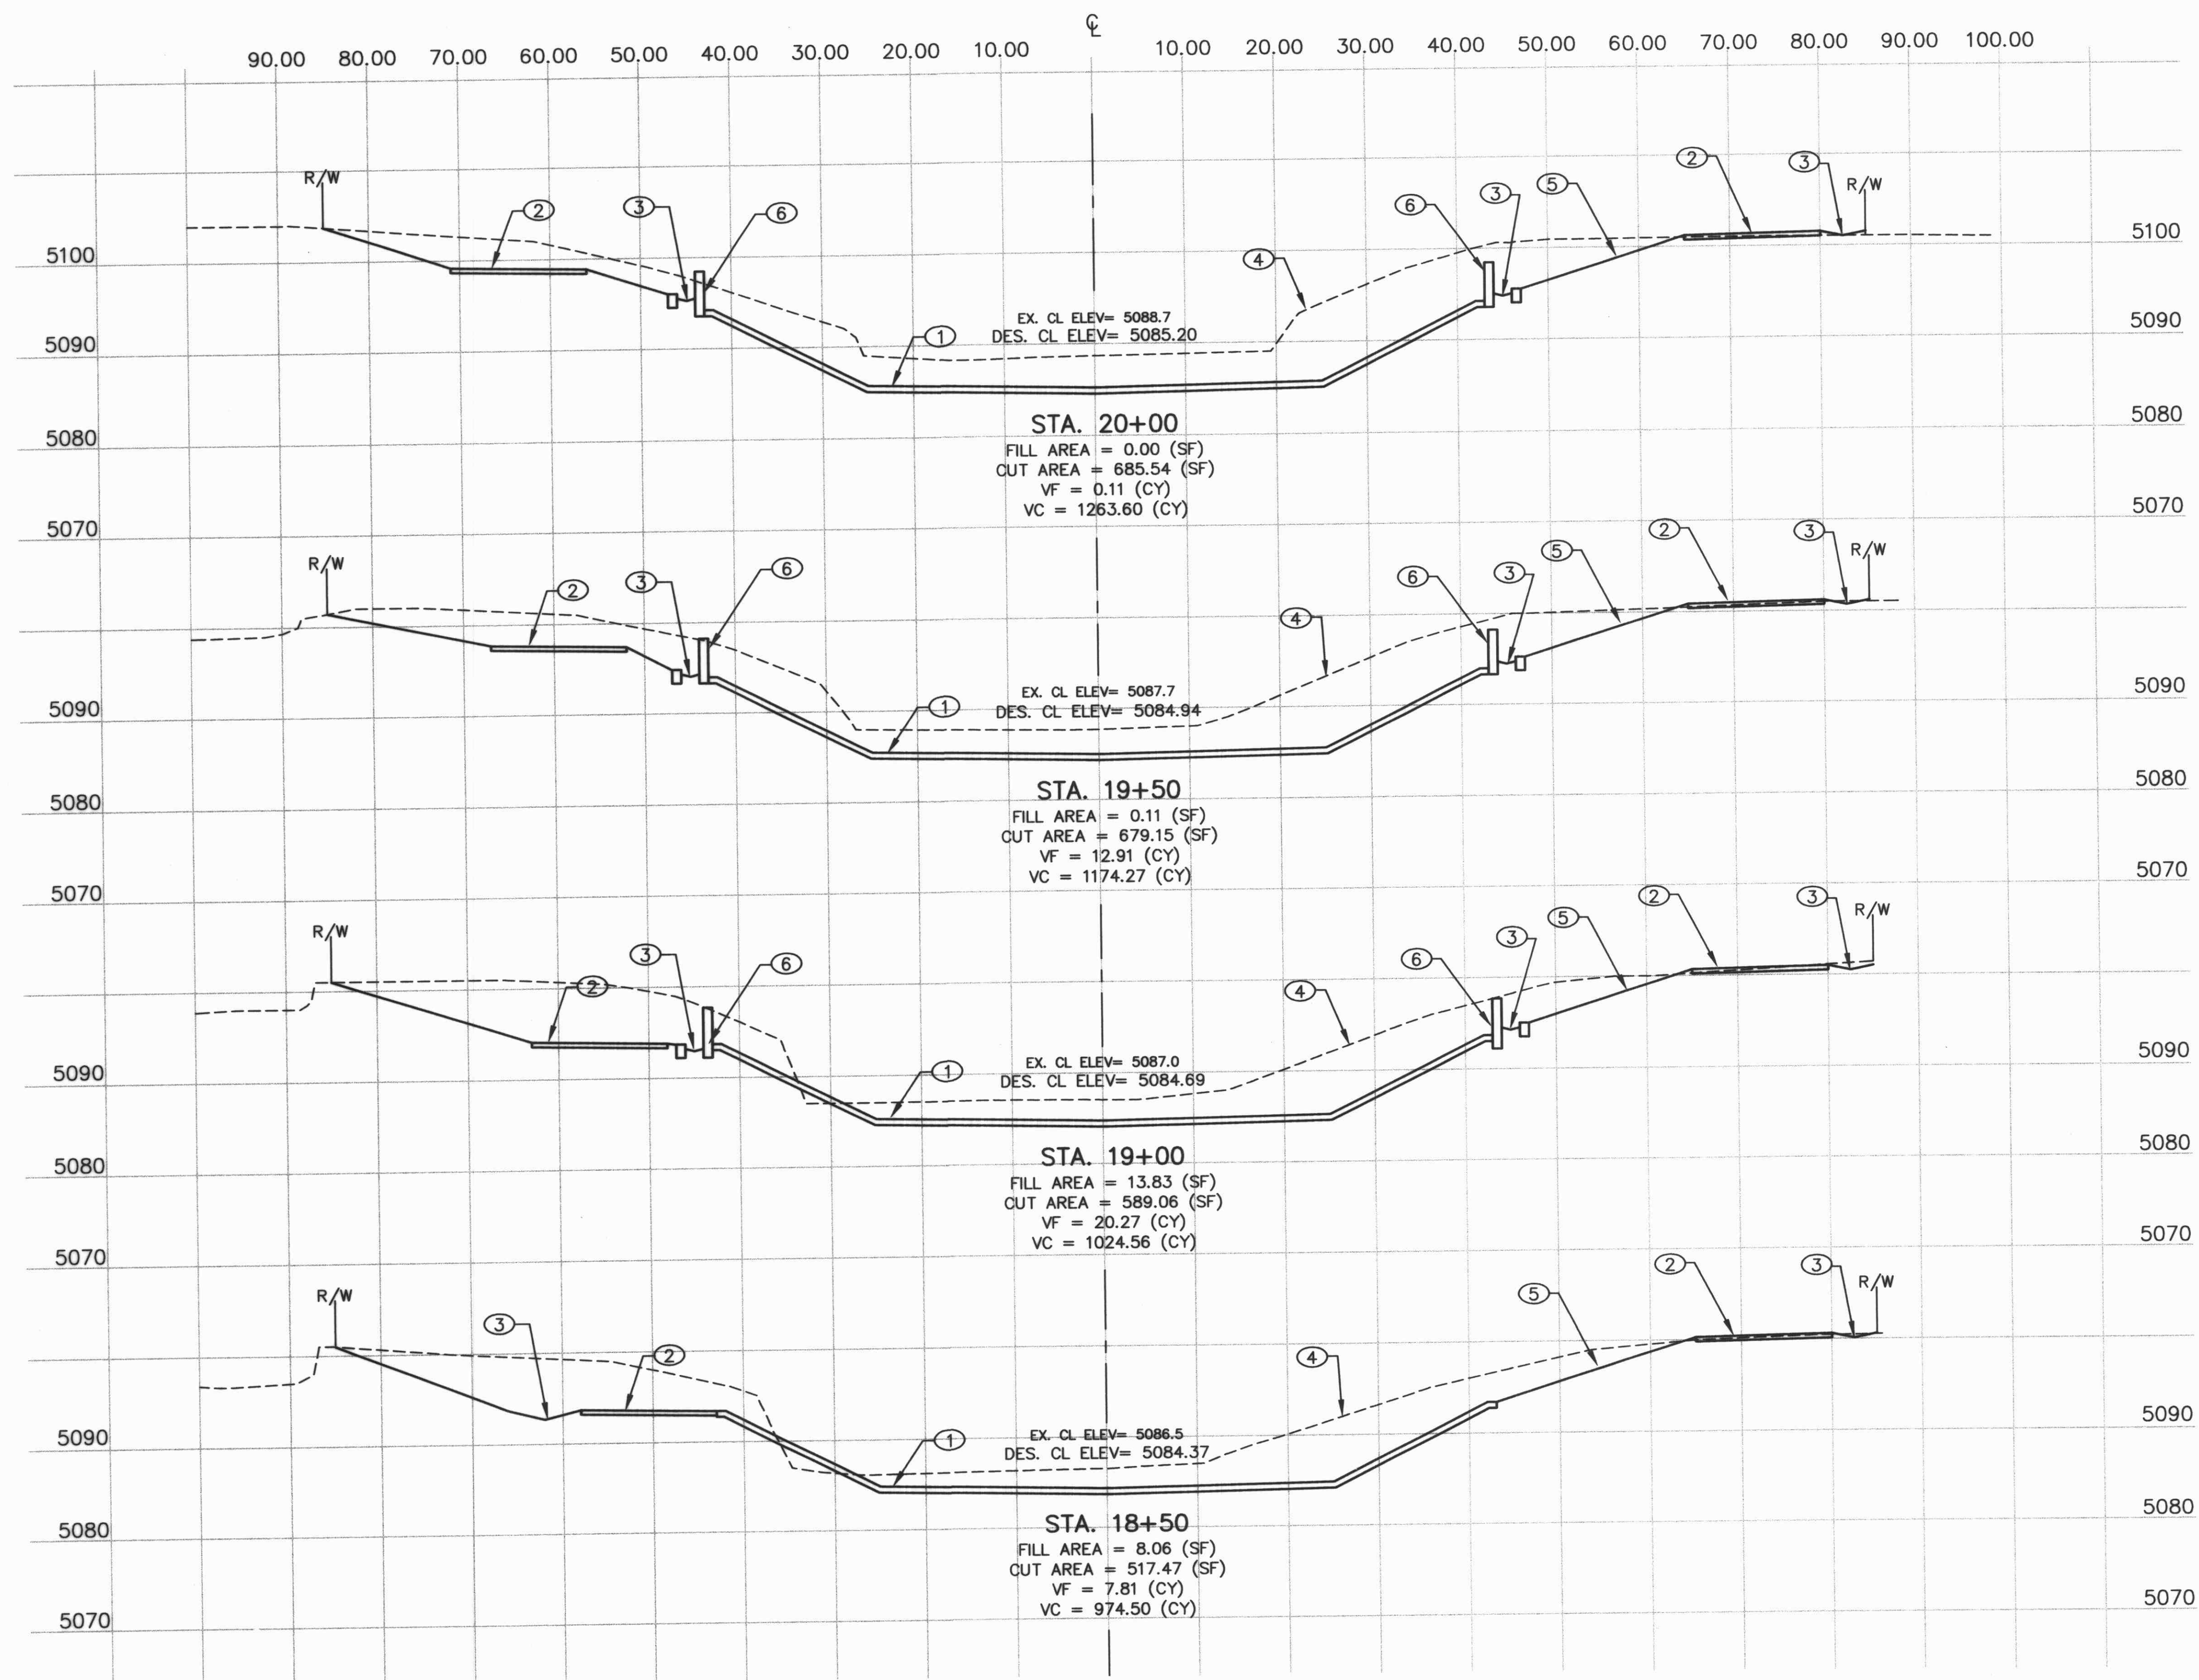

○ KEYED NOTES:

1. NEW RPCC CHANNEL
2. ACCESS ROAD
3. LOW FLOW SWALE
4. EXISTING GROUND
5. PROPOSED GRADE
6. PROPOSED RETAINING WALL. FOOTINGS NOT SHOWN FOR CLARITY.


CROSS SECTION SHOW APPROXIMATE CUT/FILL FOR PROPOSED IMPROVEMENTS. CONTRACTOR SHALL USE PLAN AND PROFILE AND APPROPRIATE DETAIL SHEETS TO CONSTRUCT CHANNEL.

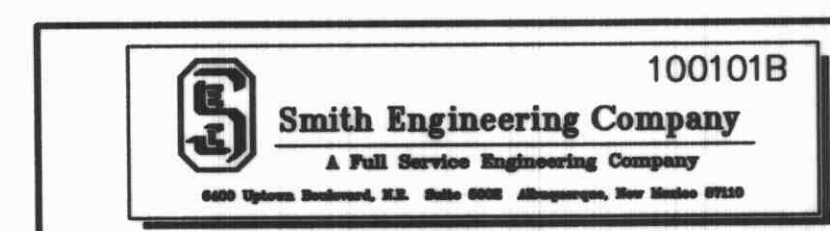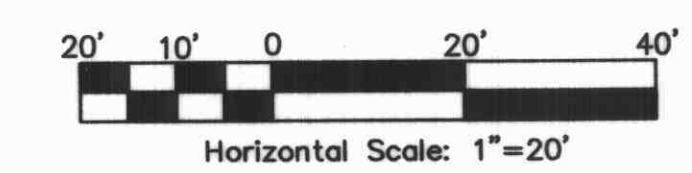

CITY OF ALBUQUERQUE PUBLIC WORKS DEPARTMENT ENGINEERING DEVELOPMENT GROUP			
TITLE: DOMINGO BACA ARROYO - NORTH DIVERSION CHANNEL TO WASHINGTON ST. CHANNEL CROSS-SECTIONS: STA. 18+50 TO 20+00			
Design Review Committee	City Engineer Approval	No. / Day / Yr.	No. / Day / Yr.
City Project No.	Zone Map No.	Sheet	Of
6258.92	C-17-Z	14D	14

AS BUILT INFORMATION		BENCH MARKS		SURVEY INFORMATION		ENGINEER'S SEAL	
CONTRACTOR	DATE	C.O.A. BENCHMARK	DATE	NO.	BY	REMARKS	BY
AS BUILT	DATE 1/03	"C-24" A.M.A.F.C.A. RIGHT OF WAY	05/00	11589	STEPHEN J. TOLER	DESIGN	
WORK STARTED BY	DATE 3/03	MARKER STAMPED "NAA-9" LOCATED IN THE SOUTHEAST QUADRANT OF THE INTERSECTION OF PASEO DEL NORTE AND THE NORTH DIVERSION CHANNEL. ELEV. = 5069.27 ft.	DATE 3/03		FROM SURVEYING		
FIELD ACCEPTANCE BY	DATE 3/03	GROUND COORDINATES: NORTHING = 1,519,215.25 EASTING = 394,264.97	DATE 3/03		CONTROL, INC.		
DRAWINGS	DATE 3/03						
CORRECTED BY	DATE 3/03						
RECORDED BY	DATE						


ADDENDUM #1 7/29/04 PAGE 9

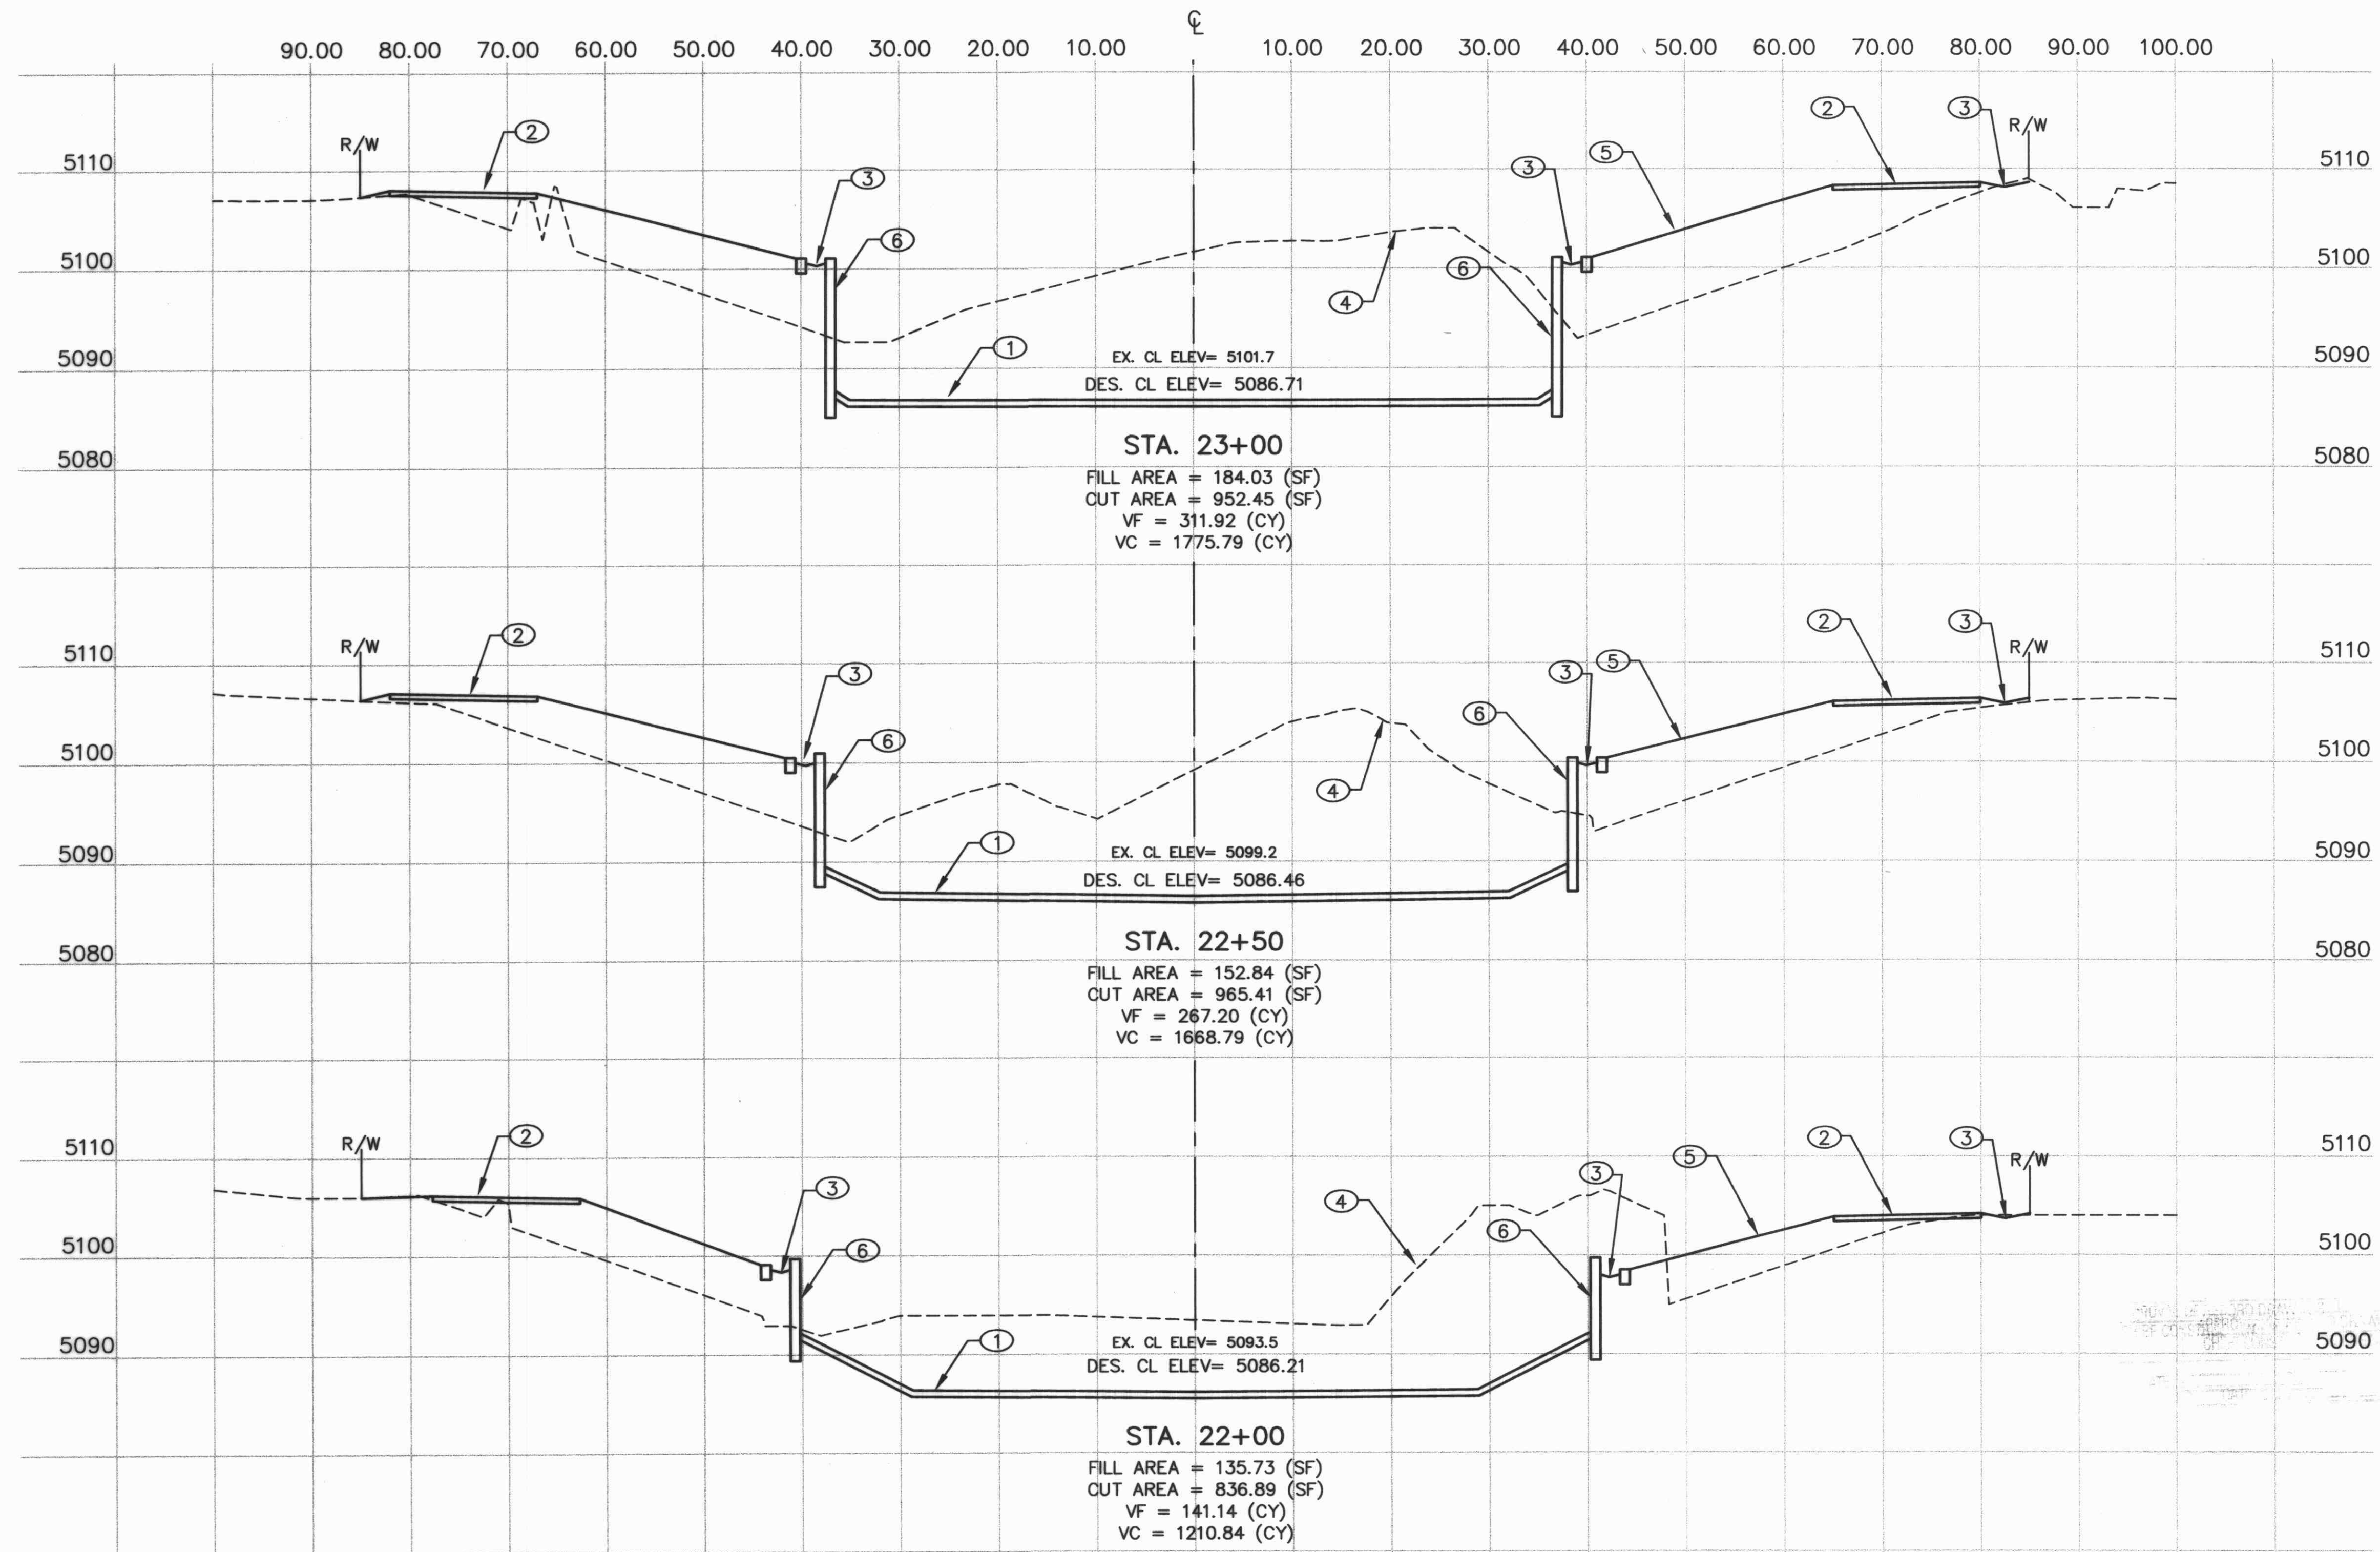

KEYED NOTES:

- NEW RPCC CHANNEL
- ACCESS ROAD
- LOW FLOW SWALE
- EXISTING GROUND
- PROPOSED GRADE
- PROPOSED RETAINING WALL. FOOTINGS NOT SHOWN FOR CLARITY.

CROSS SECTION SHOW APPROXIMATE CUT/FILL FOR PROPOSED IMPROVEMENTS. CONTRACTOR SHALL USE PLAN AND PROFILE AND APPROPRIATE DETAIL SHEETS TO CONSTRUCT CHANNEL.

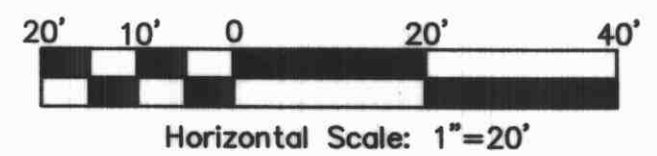

CITY OF ALBUQUERQUE PUBLIC WORKS DEPARTMENT ENGINEERING DEVELOPMENT GROUP	
TITLE: DOMINGO BACA ARROYO - NORTH DIVERSION CHANNEL TO WASHINGTON ST. CHANNEL CROSS-SECTIONS: STA. 22+00 TO 23+00	
Design Review Committee	City Engineer Approval
City Project No. 6258.92	Zone Map No. C-17-Z
Sheet 14F	Of 14



NO.	DATE	REMARKS	BY
11599	05/00	STEPHEN J. TOLER FROM SURVEYING CONTROL, INC.	
	06/04	DESIGN	
	06/04		
	06/04		

SURVEY INFORMATION		FIELD NOTES	
NO.	DATE	BY	DATE
11599	05/00	STEPHEN J. TOLER	05/00
		FROM SURVEYING	
		CONTROL, INC.	
C.O.A. BENCHMARK "C-244" A.M.A.F.C.A. RIGHT OF WAY		CONTRACTOR A.S. HUBBARD	
MARKER STAMPED "NAA-9" LOCATED IN THE SOUTHEAST QUADRANT OF THE INTERSECTION OF PASEO DEL NORTE AND THE NORTH DIVERSION CHANNEL. ELEV. = 5089.27 ft		WORK BY S.D.V. DATE 1/03	
GROUND COORDINATES: NORTHING = 1,519,215.25 EASTING = 394,264.97		ACCEPTANCE BY SEC. DATE 3/03	
		DRAWINGS BY T.J.T. DATE 3/03	
		MICRO-FILM INFORMATION	
		RECORDED BY DATE	
		NO.	