

SCANNED BY
MESA REPRO

SHEET NO.	SHEET
1	TITLE SHEET
2 - 3	PLAT
4 4A	GRADING AND DRAINAGE PLAN
5	MASTER PAVING PLAN
6 - 10	PAVING IMPROVEMENTS
11	MASTER UTILITY PLAN
12 - 15	UTILITY IMPROVEMENTS
16	STORM DRAIN IMPROVEMENTS
17 - 18	TRAFFIC CONTROL

APPROVAL OF AS BUILT DRAWINGS
CHIEF CONSTRUCTION ENGINEER
Peter Chang
DATE 3/8/01

CAUTION:
NOTE THAT ALL EXISTING UTILITIES MAY NOT BE SHOWN. ALL EXISTING SERVICE CONNECTIONS ARE NOT SHOWN. ANY EXISTING UTILITIES THAT ARE SHOWN ARE APPROXIMATE LOCATION ONLY. IT SHALL BE THE SOLE RESPONSIBILITY OF THE CONTRACTOR TO CONTACT ALL THE UTILITY OWNERS AND TO CONDUCT ALL NECESSARY FIELD INVESTIGATIONS PRIOR TO ANY EXCAVATIONS TO DETERMINE THE ACTUAL LOCATION OF UTILITIES AND OTHER IMPROVEMENTS.

dmg D. MARK GOODWIN & ASSOCIATES, P.A.
CONSULTING ENGINEERS
P. O. BOX 90606
ALBUQUERQUE, NEW MEXICO 87199
(505) 828-2200. FAX (505) 797-9539


"I, Timothy Aldrich, a duly qualified Registered Professional Land Surveyor under the laws of the State of New Mexico, do hereby certify that the 'as-built' information shown on these drawings was obtained from field construction and that the 'as-built' information shown on these drawings was added by me or under my supervision and that this 'as-built' information is true and correct to the best of my knowledge and belief." Aldrich Land Surveying is not responsible for any of the design concepts, calculations, engineering or intent of the record drawings.

Timothy Aldrich, P.S. No. 7719

04-19-00

DRB NO. 99-143

9050SCH\TITLE\11-12-99\MJR

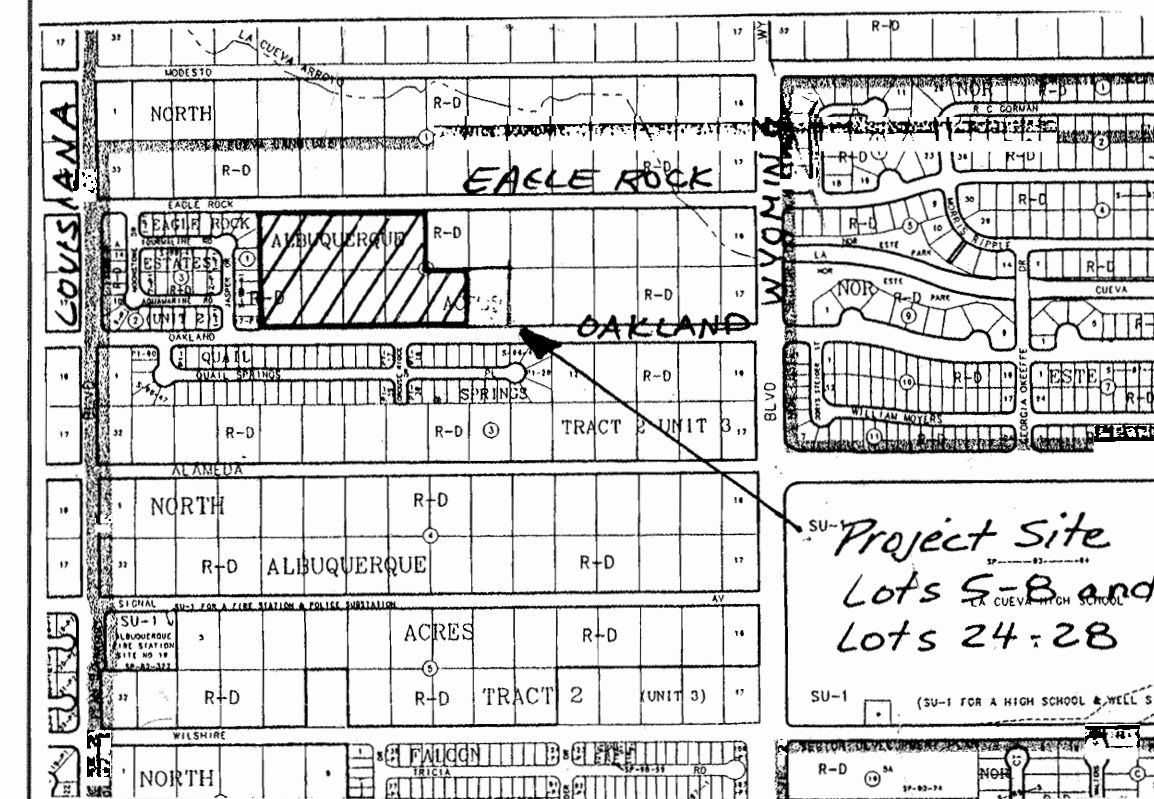VICINITY MAP ZONE ATLAS C-19-Z

GENERAL NOTES


NOTICE TO CONTRACTORS

1. CITY OF ALBUQUERQUE SPECIFICATIONS FOR PUBLIC WORKS CONSTRUCTION, 1986 EDITION AS AMENDED THROUGH UPDATE 6, WILL BE REFERRED TO HEREIN AS THE "STANDARD SPECIFICATIONS".
2. TWO WORKING DAYS PRIOR TO ANY EXCAVATION, CONTRACTOR MUST CONTACT NEW MEXICO ONE CALL SYSTEM (280-1990) AND DETERMINE LOCATION OF EXISTING UTILITIES.
3. PRIOR TO ANY CONSTRUCTION, THE CONTRACTOR SHALL EXCAVATE AND VERIFY THE HORIZONTAL AND VERTICAL LOCATIONS OF ALL OBSTRUCTIONS. SHOULD A CONFLICT EXIST, THE CONTRACTOR SHALL NOTIFY THE ENGINEER OR THE SURVEYOR SO THAT THE CONFLICT CAN BE RESOLVED WITHOUT DELAY.
4. ALL EXISTING SIGNS, MARKERS, DELINEATORS, ETC., WITHIN THE CONSTRUCTION LIMITS SHALL BE REMOVED, STORED AND RE-SET BY THE CONTRACTOR.
5. FIVE (5) WORKING DAYS PRIOR TO BEGINNING CONSTRUCTION THE CONTRACTOR SHALL SUBMIT TO THE CONSTRUCTION COORDINATION DIVISION A DETAILED CONSTRUCTION SCHEDULE. TWO (2) WORKING DAYS PRIOR TO CONSTRUCTION THE CONTRACTOR SHALL OBTAIN A BARRICADING PERMIT FROM THE CONSTRUCTION COORDINATION DIVISION. CONTRACTOR SHALL NOTIFY BARRICADE ENGINEER (788-2551) PRIOR TO OCCUPYING AN INTERSECTION. SEE SECTION 19 OF THE SPECIFICATIONS.
6. ALL STREET STRIPING ALTERED OR DESTROYED SHALL BE REPLACED WITH PLASTIC REFLECTORIZED PAVEMENT MARKINGS BY CONTRACTOR IN EXISTING OR NEW LOCATION AS INDICATED BY THIS SET.
7. THE CONTRACTOR SHALL NOTIFY THE ENGINEER NOT LESS THAN SEVEN (7) DAYS PRIOR TO STARTING WORK IN ORDER THAT THE ENGINEER MAY TAKE NECESSARY MEASURES TO INSURE THE PRESERVATION OF SURVEY MONUMENTS. THE CONTRACTOR SHALL NOT DISTURB PERMANENT SURVEY MONUMENTS WITHOUT THE CONSENT OF THE ENGINEER AND SHALL NOTIFY THE ENGINEER AND BEAR THE EXPENSE OF REPLACING ANY THAT MAY BE DISTURBED WITHOUT PERMISSION. REPLACEMENT SHALL BE DONE ONLY BY THE CITY SURVEYOR. WHEN A CHANGE IS MADE IN THE FINISHED ELEVATIONS OF THE PAVEMENT OF ANY ROADWAY IN WHICH A PERMANENT SURVEY MONUMENT IS LOCATED, THE CONTRACTOR SHALL, AT HIS OWN EXPENSE, ADJUST THE MONUMENT OVER TO THE NEW GRADE UNLESS OTHERWISE SPECIFIED. REFER TO SECTION 4.4 OF THE GENERAL CONDITIONS OF THE STANDARD SPECIFICATIONS.
8. ANY WORK OCCURRING WITHIN AN ARTERIAL ROADWAY REQUIRES 24 HOURS CONSTRUCTION.

THE FOLLOWING NOTES ALSO APPLY WHEN CHECKED

- ☒ ALL UTILITIES ^{AND} UTILITY SERVICE LINES SHALL BE INSTALLED PRIOR TO PAVING.
- ☒ BACKFILL COMPACTION SHALL BE ACCORDING TO SPECIFIED STREET USE.
- ☐ TACK COAT REQUIREMENTS SHALL BE DETERMINED BY THE CITY ENGINEER.
- ☒ SIDEWALK AND WHEELCHAIR RAMPS WITHIN THE CURB RETURNS SHALL BE CONSTRUCTED WHEREVER A NEW CURB RETURN IS CONSTRUCTED.
- ☐ IF CURB IS DEPRESSIONED FOR A DRIVEPAD, THE DRIVEPAD SHALL BE CONSTRUCTED PRIOR TO ACCEPTANCE OF CURB AND GUTTER.
- ☒ ALL STORM DRAINAGE FACILITIES SHALL BE COMPLETED PRIOR TO FINAL ACCEPTANCE.

REV.	SHEETS	CITY ENGINEER	DATE	USER DEPARTMENT	DATE	USER DEPARTMENT	DATE
ENGINEERS STAMP & SIGNATURE			APPROVALS	ENGINEER	DATE	*****	
			DRC CHAIRMAN	<i>[Signature]</i>	<i>11/20/99</i>	APPROVED FOR CONSTRUCTION	
			TRANSPORTATION	<i>[Signature]</i>	<i>11-20-99</i>		
			WATER/WASTEWATER	<i>Bradley J. Bingham</i>	<i>11-30-99</i>		
			HYDROLOGY	<i>Ann Calogre</i>	<i>11-30-99</i>		
			CIP				
			CONSTR. MNGMT.				
			CONSTR. COORD.	<i>[Signature]</i>	<i>11-20-99</i>		
CITY PROJECT NO.			<i>627281</i>			SHEET OF	
						<i>1 18</i>	

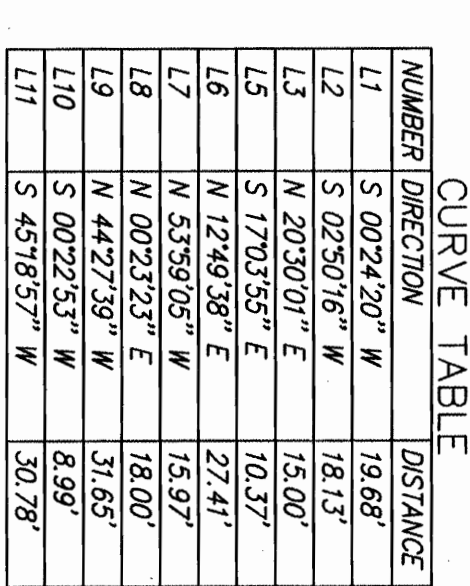


PUBLIC UTILITY EASEMENTS shown on this plat are granted for the common and joint use of :

- Included is the right to build, rebuild, construct, reconstruct, locate, relocate, change, remove, modify, renew, operate and maintain facilities for the purposes described above, together with free access to, from and over said easement, including sufficient working area space for electric transmission lines on the right and privilege to install and use such facilities for the purposes set forth herein. No building, sign, pole, deck, porch, ground or substructure, but tub, concrete or wood pool, diving board, or other structure shall be erected or constructed on said easements, nor shall any well be drilled or operated thereon. Property owners shall be solely responsible for correcting any violations of National Electrical Safety Code caused by construction of poles, decking or any structures adjacent to within or near easements shown on this plat. -
- In approving this plat, the utility companies did not consent, a Title Search of the properties shown herein. Consequently, the utility companies do not waive or release any easement or easement rights which may have been granted by prior plat, record or other document and which are not shown on this plat.


CURVE NUMBER	DELTA	RADIUS	ARC LENGTH	TANGENT LENGTH	CHORD BEARING	CHORD LENGTH
C949	60.49° 41"	75.00	26.53	14.67	S 71°52'07" W	45.35
C950	60.48° 19"	40.00	48.21	27.62	S 76°33'01" W	55.21
C951	73.25° 14"	40.00	34.33	12.01	S 52°43'02" E	36.00
C952	73.25° 45"	40.00	44.99	12.84	S 43°32'00" E	50.26
C953	60.49° 41"	75.00	26.53	14.67	N 17°00'45" W	25.31
C954	60.49° 40"	40.00	1.36	1.63	S 45°05'00" E	3.26
C955	13.10° 02"	97.00	32.29	11.20	S 06°48'55" E	22.24
C956	80.40° 45"	52.00	81.85	59.17	S 44°41'07" E	73.62
C957	89.49° 45"	52.00	81.82	51.84	N 01°10'04" W	18.83
C958	01.03° 17"	1023.00	18.63	23.02	N 02°13'48" W	50.05
C959	02.46° 42"	1023.00	48.52	25.03	N 03°01'08" W	45.31
C960	02.46° 42"	1023.00	48.52	24.76	S 41°59'33" W	45.31
C961	96.47° 42"	25.00	42.23	28.16	S 08°11'44" E	8.00
C962	106.51° 51"	5.00	9.27	6.06	N 40°07'44" E	10.15
C963	11.25° 11"	51.00	10.16	5.00	N 44°03'02" E	27.59
C964	18.22° 45"	14.00	14.56	---	N 49°50'10" E	10.15
C965	11.25° 11"	51.00	10.16	5.00	N 42°50'20" E	8.00
C966	11.06° 51"	5.00	9.27	6.66	N 62°50'50" E	16.71
C967	11.56° 04"	90.00	18.75	9.41	S 44°41'03" E	18.71
C968	11.56° 04"	90.00	11.61	5.63	S 48°01'30" E	11.58
C969	11.52° 31"	34.00	47.15	35.95	S 33°32'41" E	39.92
C970	01.01° 17"	88.00	1.84	0.92	N 24°14'52" E	1.84
C971	25.14° 09"	25.00	11.01	5.60	S 33°33'22" W	10.94
C972	42.27° 22"	25.00	18.53	9.51	N 25°28'31" E	18.10
C973	63.57° 58"	25.00	15.07	7.77	S 27°34'30" E	26.48
C974	33.59° 43"	25.00	14.69	7.56	S 69°49'28" E	14.84
C975	33.59° 43"	25.00	14.69	7.56	N 11°59'15" E	14.86
C976	33.59° 43"	25.00	14.79	7.52	N 08°01'26" E	30.08
C977	03.04° 33"	423.00	10.09	15.05	S 45°32'21" W	27.66
C978	10.51° 56"	5.00	9.26	6.64	S 01°31'05" W	7.29
C979	18.53° 45° 31"	14.00	14.53	---	S 45°32'21" W	27.66
C980	13.02° 36"	5.00	9.26	6.64	S 67°59'43" E	11.59
C981	10.63° 36"	5.00	9.26	6.64	S 47°24'12" E	7.29
C982	11.56° 33"	68.00	18.55	9.31	S 47°38'22" E	18.82
C983	44.94° 53"	75.00	38.78	31.00	S 67°38'22" E	57.29
C984	44.94° 53"	75.00	38.79	31.00	S 22°13'44" E	57.29
C985	00.57° 32"	1000.00	115.74	57.93	N 03°03'52" W	113.67
C986	44.51° 01"	75.00	38.71	30.93	S 67°59'32" W	57.22
C987	44.50° 44"	75.00	38.31	31.31	S 22°52'32" W	61.78
C988	46.29° 59"	74.97	63.46	33.17	N 24°27'40" E	91.58
C989	41.41° 56"	75.01	54.59	28.57	S 62°28'46" E	60.33
C990	12.55° 36"	275.00	60.45	30.35	S 62°28'46" E	60.33
C991	13.72° 43"	437.00	64.37	33.33	S 87°53'19" W	64.33
C992	16.27° 10"	437.00	47.31	32.68	N 87°05'33" E	47.29
C993	45.46° 46"	437.00	44.08	32.06	S 87°05'33" E	44.06
C994	48.41° 20"	75.00	63.78	33.96	S 65°59'32" E	61.87
C995	89.49° 45"	75.00	11.58	74.77	N 44°41'03" W	10.50
C996	00.55° 40"	977.00	10.14	5.07	N 00°07'40" W	10.14

CURVE TABLE


EAGLE ROCK ESTATES UNIT II
BLOCK 1
(06-29-98, 98C-175)

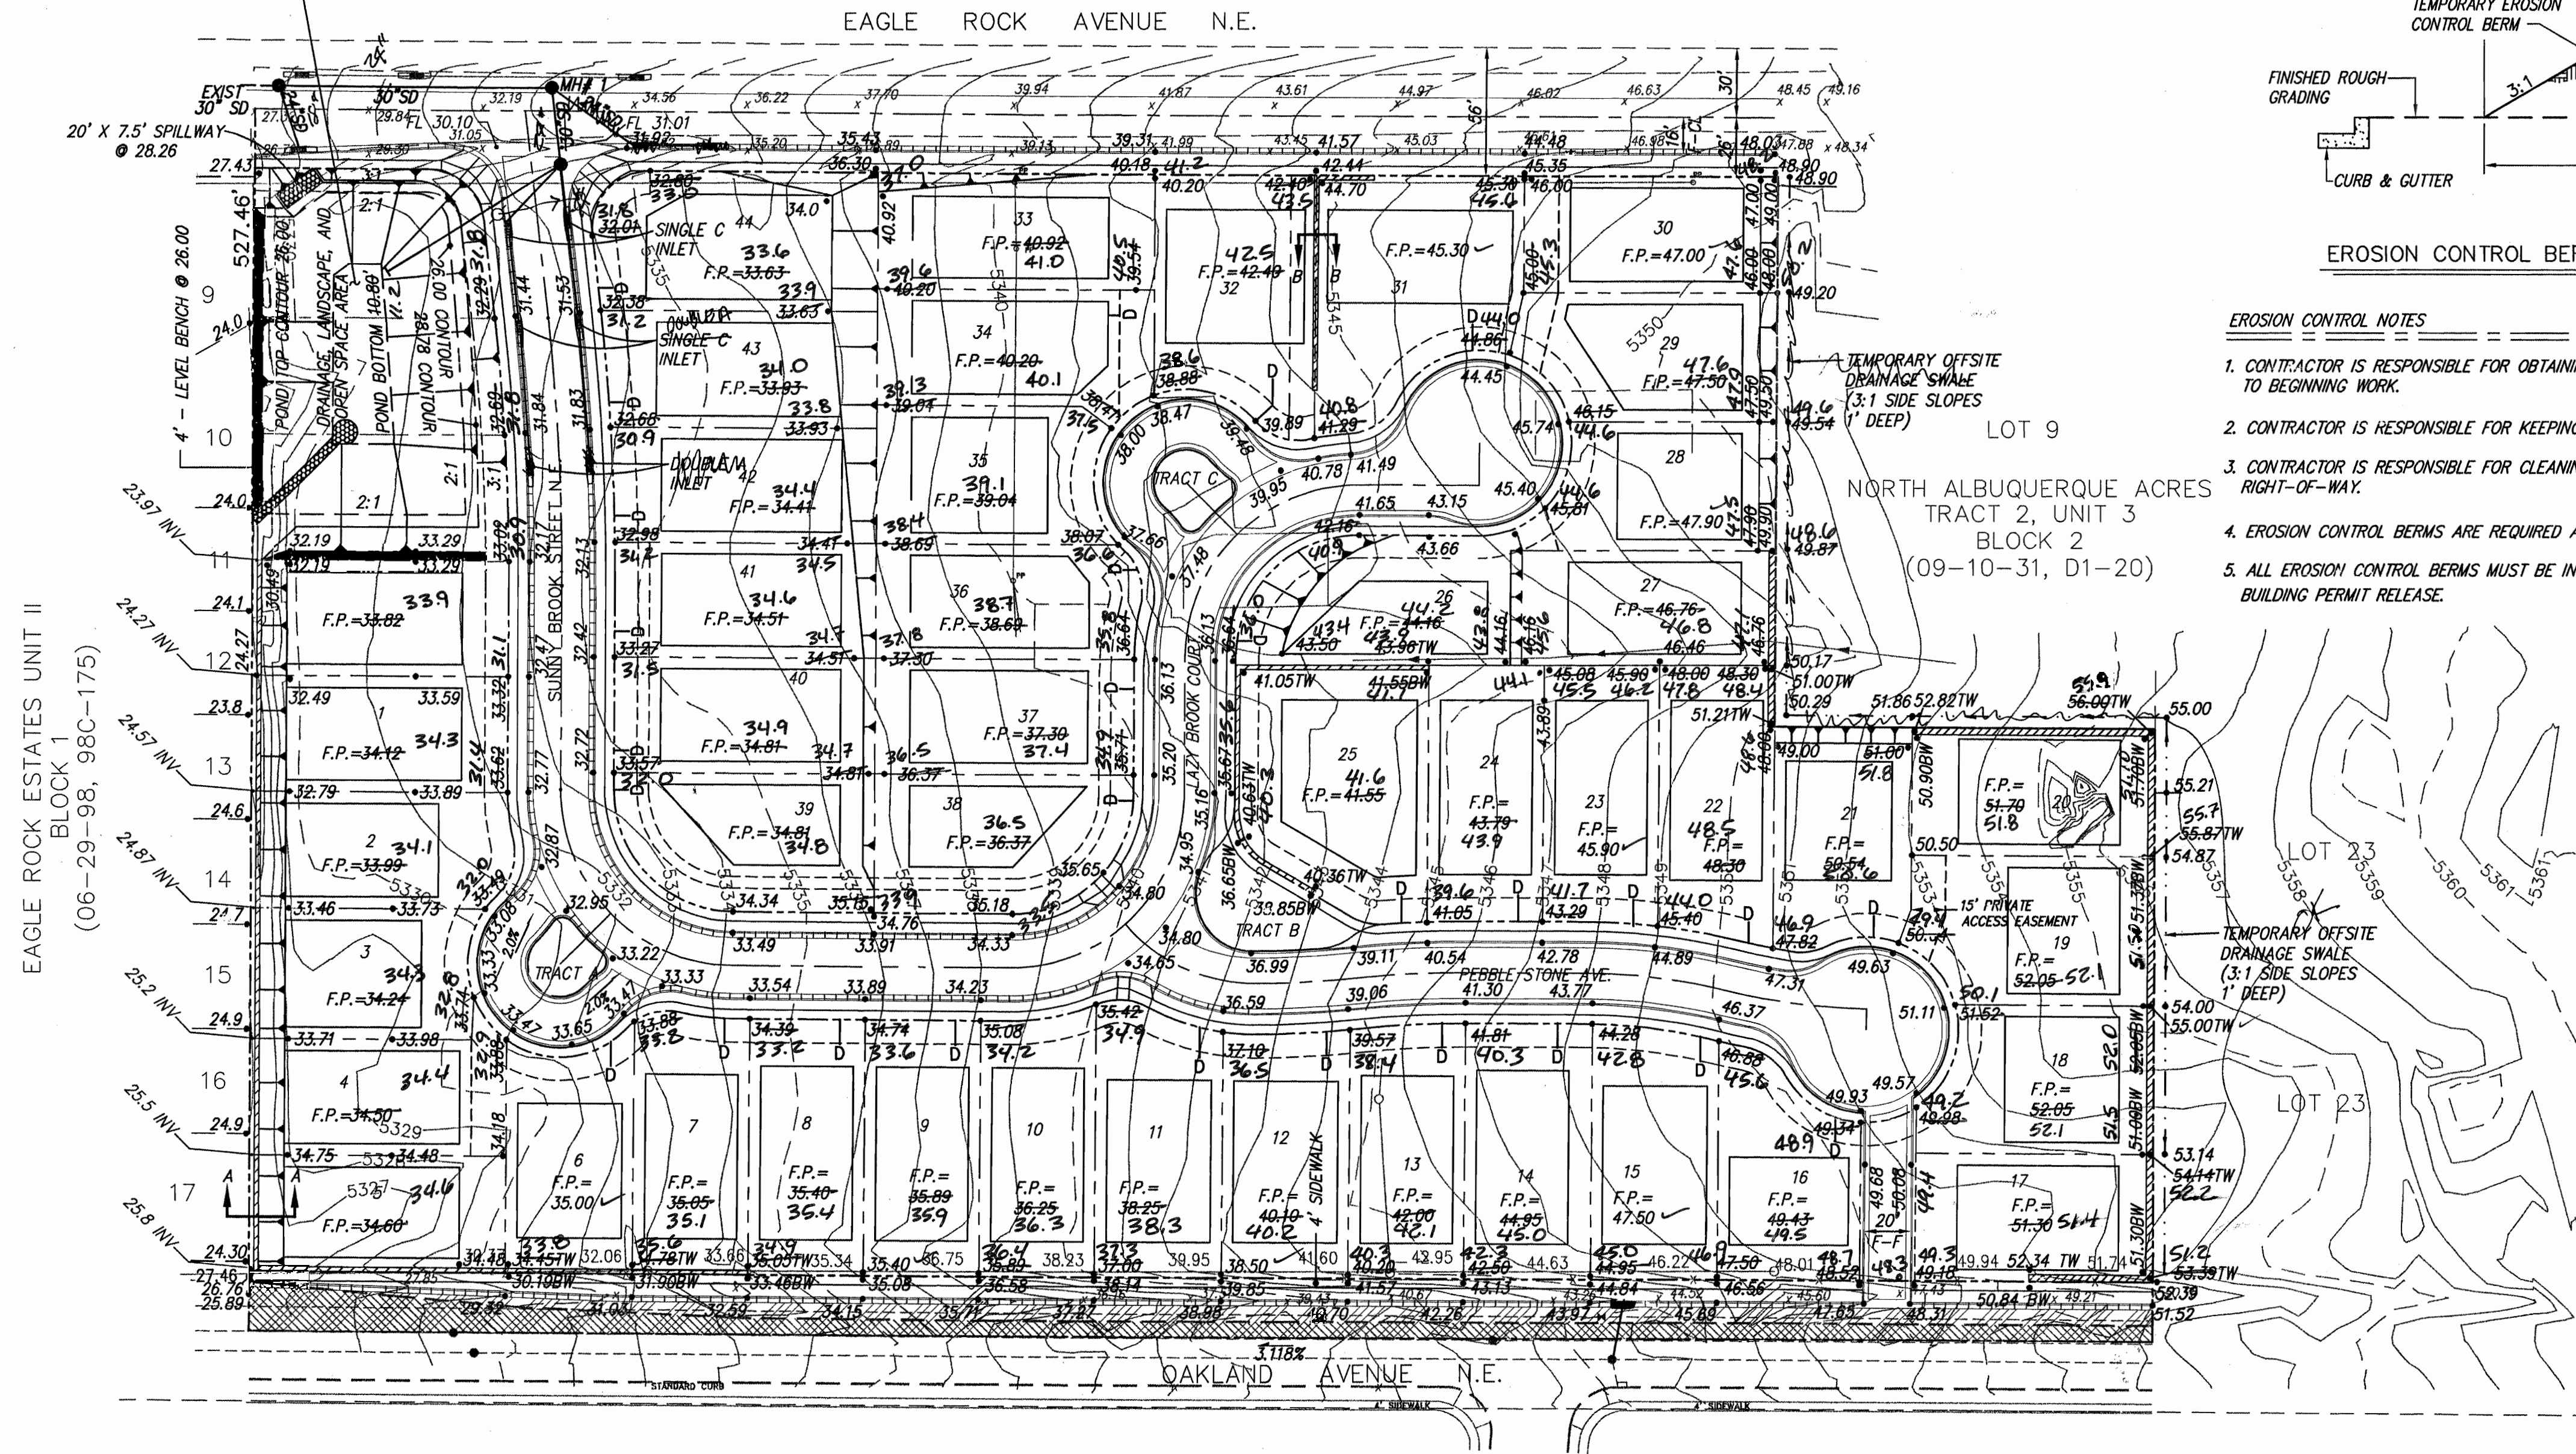


TEMPORARY RETENTION POND
REQ'D VOLUME = 2.31 AC. FT.
DESIGN VOLUME = 2.31 AC. FT.
2:1 MAXIMUM SIDE SLOPES
PROTECTED WITH 2" GRAVEL MULCH
TOP OF POND ELEVATION = 26.00
BOTTOM OF POND ELEVATION = 10.80
DEPTH OF POND = 15.20'

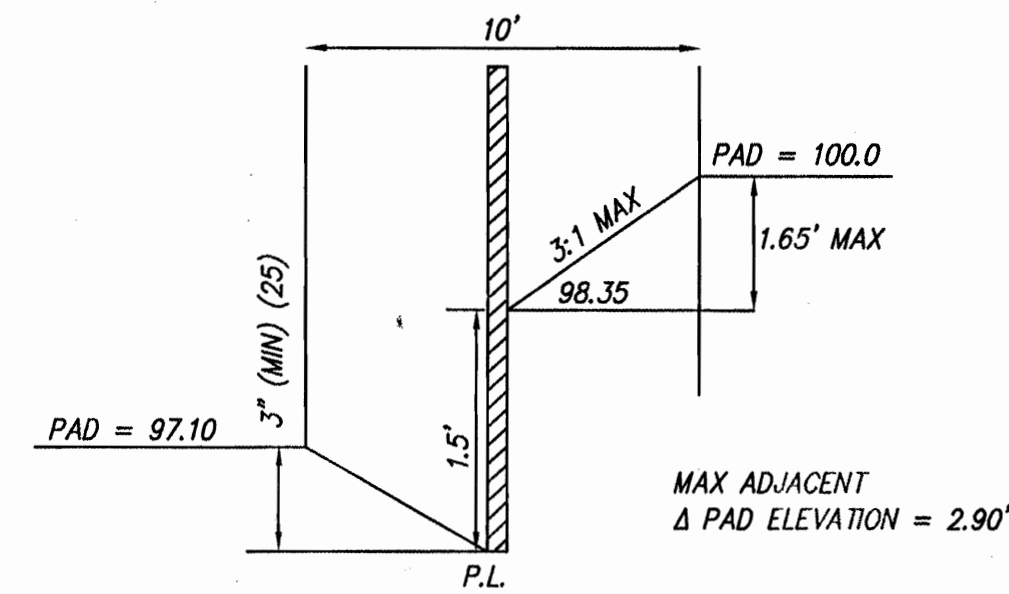


TYPICAL SIDE YARD DRAINAGE DETAIL
DETAIL B - B

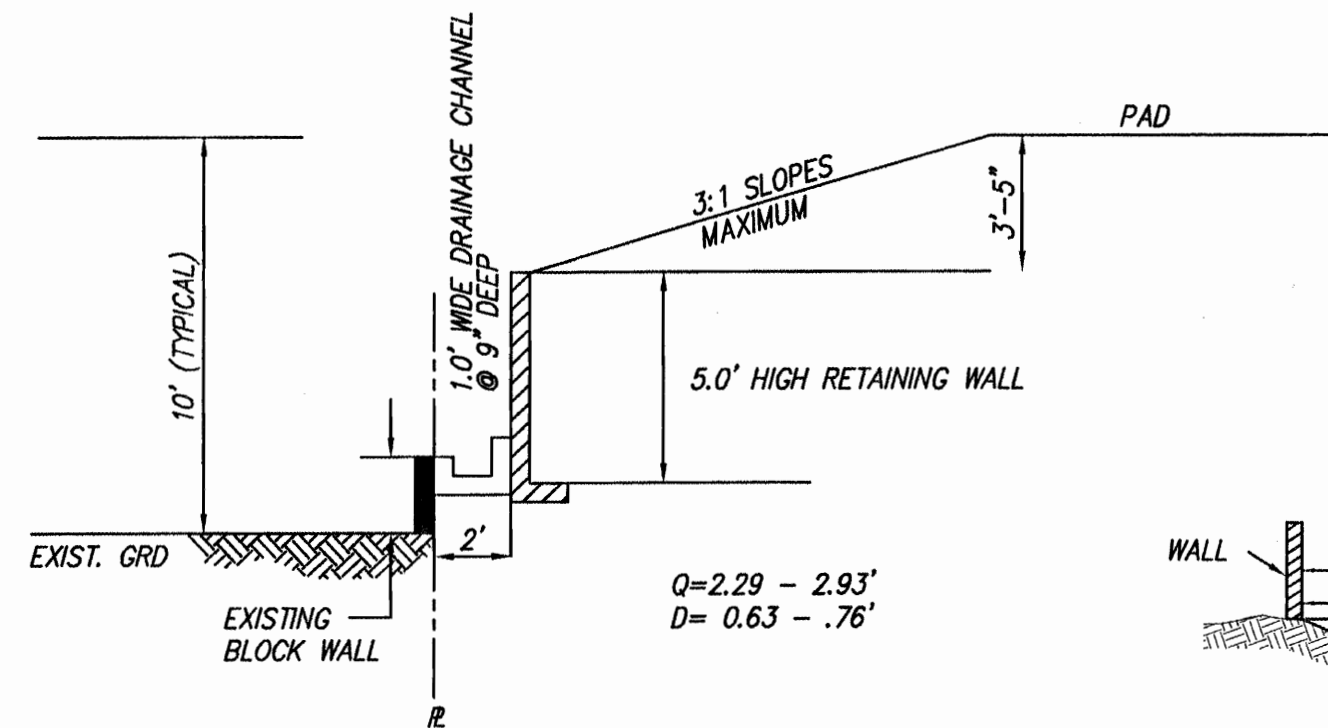

TYPICAL 1.0' WIDE PRIVATE DRAINAGE CHANNEL
DETAIL A - A

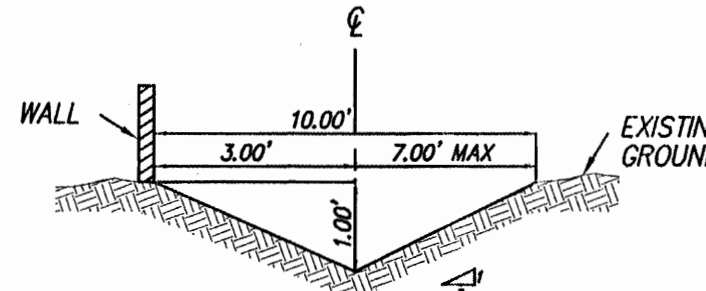

TEMPORARY OFFSITE DRAINAGE SWALE
Q max = 3.43 cfs
DEPTH = 0.57
SLOPE = 1.34%

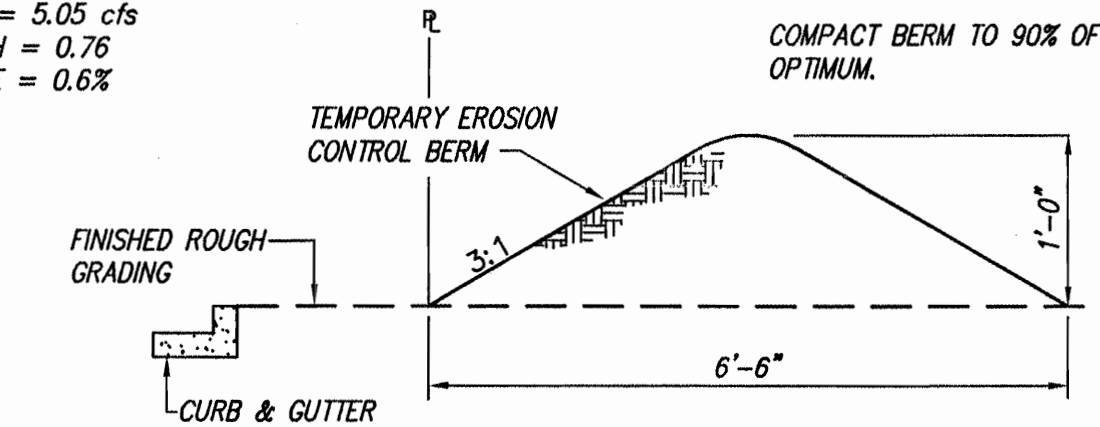


EROSION CONTROL BERM DETAIL
N.T.S.

NOTES

1. OFFSITE FLOWS WILL BE ROUTED ALONG THE RETAINING WALL ON THE PROPERTY LINE TO THE R.O.W. OR ARROYO.
2. CONTRACTOR MUST OBTAIN A TOPSOIL DISTURBANCE PERMIT FROM THE ENVIRONMENTAL HEALTH DIVISION PRIOR TO CONSTRUCTION.
3. CITY OF ALBUQUERQUE STANDARD SPECIFICATIONS FOR PUBLIC WORKS CONSTRUCTION, LATEST EDITIONS SHALL GOVERN ALL WORK.
4. THE CONTRACTOR SHALL CONFORM TO ALL CITY, COUNTY, STATE AND FEDERAL DUST CONTROL MEASURES AND REQUIREMENTS AND WILL BE RESPONSIBLE FOR PREPARING AND OBTAINING ALL NECESSARY APPLICATIONS AND APPROVALS.
5. THE CONTRACTOR SHALL ENSURE THAT NO SOIL ERODES FROM THE LOTS INTO PUBLIC RIGHT-OF-WAY. THIS CAN BE ACHIEVED BY CONSTRUCTING TEMPORARY BERMS AND WETTING THE SOIL TO KEEP IT FROM BLOWING.

EROSION CONTROL NOTES

1. CONTRACTOR IS RESPONSIBLE FOR OBTAINING A TOPSOIL DISTURBANCE PERMIT PRIOR TO BEGINNING WORK.
2. CONTRACTOR IS RESPONSIBLE FOR KEEPING ALL SEDIMENT OUT OF EXISTING RIGHT-OF-WAY.
3. CONTRACTOR IS RESPONSIBLE FOR CLEANING UP ANY SEDIMENT THAT GETS INTO EXISTING RIGHT-OF-WAY.
4. EROSION CONTROL BERMS ARE REQUIRED AROUND THE ENTIRE SITE.
5. ALL EROSION CONTROL BERMS MUST BE IN PLACE AND ENGINEER CERTIFIED PRIOR TO BUILDING PERMIT RELEASE.

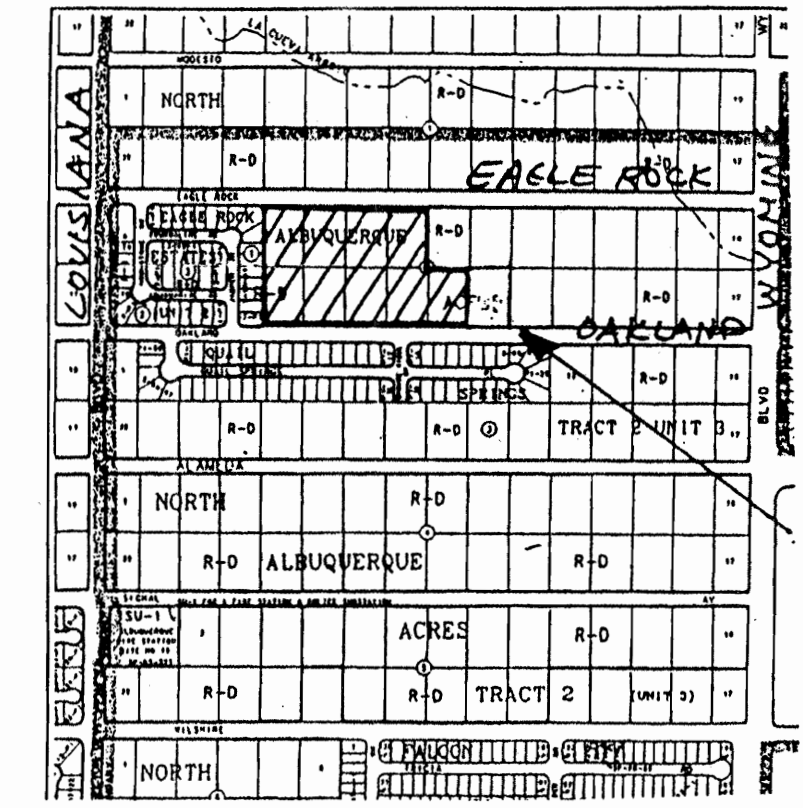

VICINITY MAP

ZONE MAP: C-19-Z

T B M (TEMPORARY BENCHMARK)

LEGAL DESCRIPTION

LOTS 5 - 8, 24 - 28, BLOCK 2, TRACT 2, UNIT 3 N.A.A.

LEGEND

- NEW RETAINING WALL
- 21.01 TW TOP OF WALL
- 18.31 BW BOTTOM OF WALL
- FP=76.98 FINISHED PAD ELEV.
- MOUNTABLE CURB & GUTTER
- STANDARD 8" CURB & GUTTER
- 28.53 PROPOSED SPOT ELEV.
- 3:1 SLOPE
- EXIST. SANITARY SEWER MANHOLE
- EXIST. WATER VALVE
- EXIST. FIRE HYDRANT
- EXIST. STORM SEWER MANHOLE
- EXIST. CONTOUR
- EXIST. CABLE T.V. PEDESTAL
- EXIST. OVERHEAD ELECTRIC LINE
- EXIST. OVERHEAD TELEPHONE LINE
- EXIST. P.P.
- SPOT ELEVATION
- PROPOSED STORM DRAIN LINE
- PROPOSED MANHOLE
- BASIN BOUNDARY
- PROPOSED STORM DRAIN INLET
- EXIST. DROP INLET
- EXIST. TOP OF CURB
- FLOWLINE
- SUGGESTED DRIVEWAY LOCATION

dmg

MARK GOODWIN & ASSOCIATES, P.A.
CONSULTING ENGINEERS
P.O. BOX 90606
ALBUQUERQUE, NEW MEXICO 87199
(505) 828-2200, FAX (505) 797-9539

CITY OF ALBUQUERQUE
PUBLIC WORKS DEPARTMENT
ENGINEERING DEVELOPMENT GROUP

TITLE: **STONEBROOKE ESTATES SUBDIVISION
GRADING AND DRAINAGE PLAN**


DESIGN REVIEW COMMITTEE CITY ENGINEER APPROVAL

APPROVED AS DRB

CITY PROJECT NO. **627281**

ZONE MAP NO. **C-19-Z**


SHEET **4** OF **18**

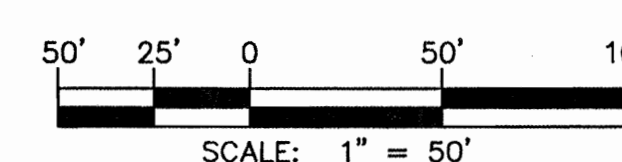

9050SCH/9050GD3.DWG/ 10-15-99 / SPS MJR DLH


SCANNED BY
MESA REPRO

EAGLE ROCK ESTATES UNIT II
BLOCK 1 -
(06-29-98, 98C-175)

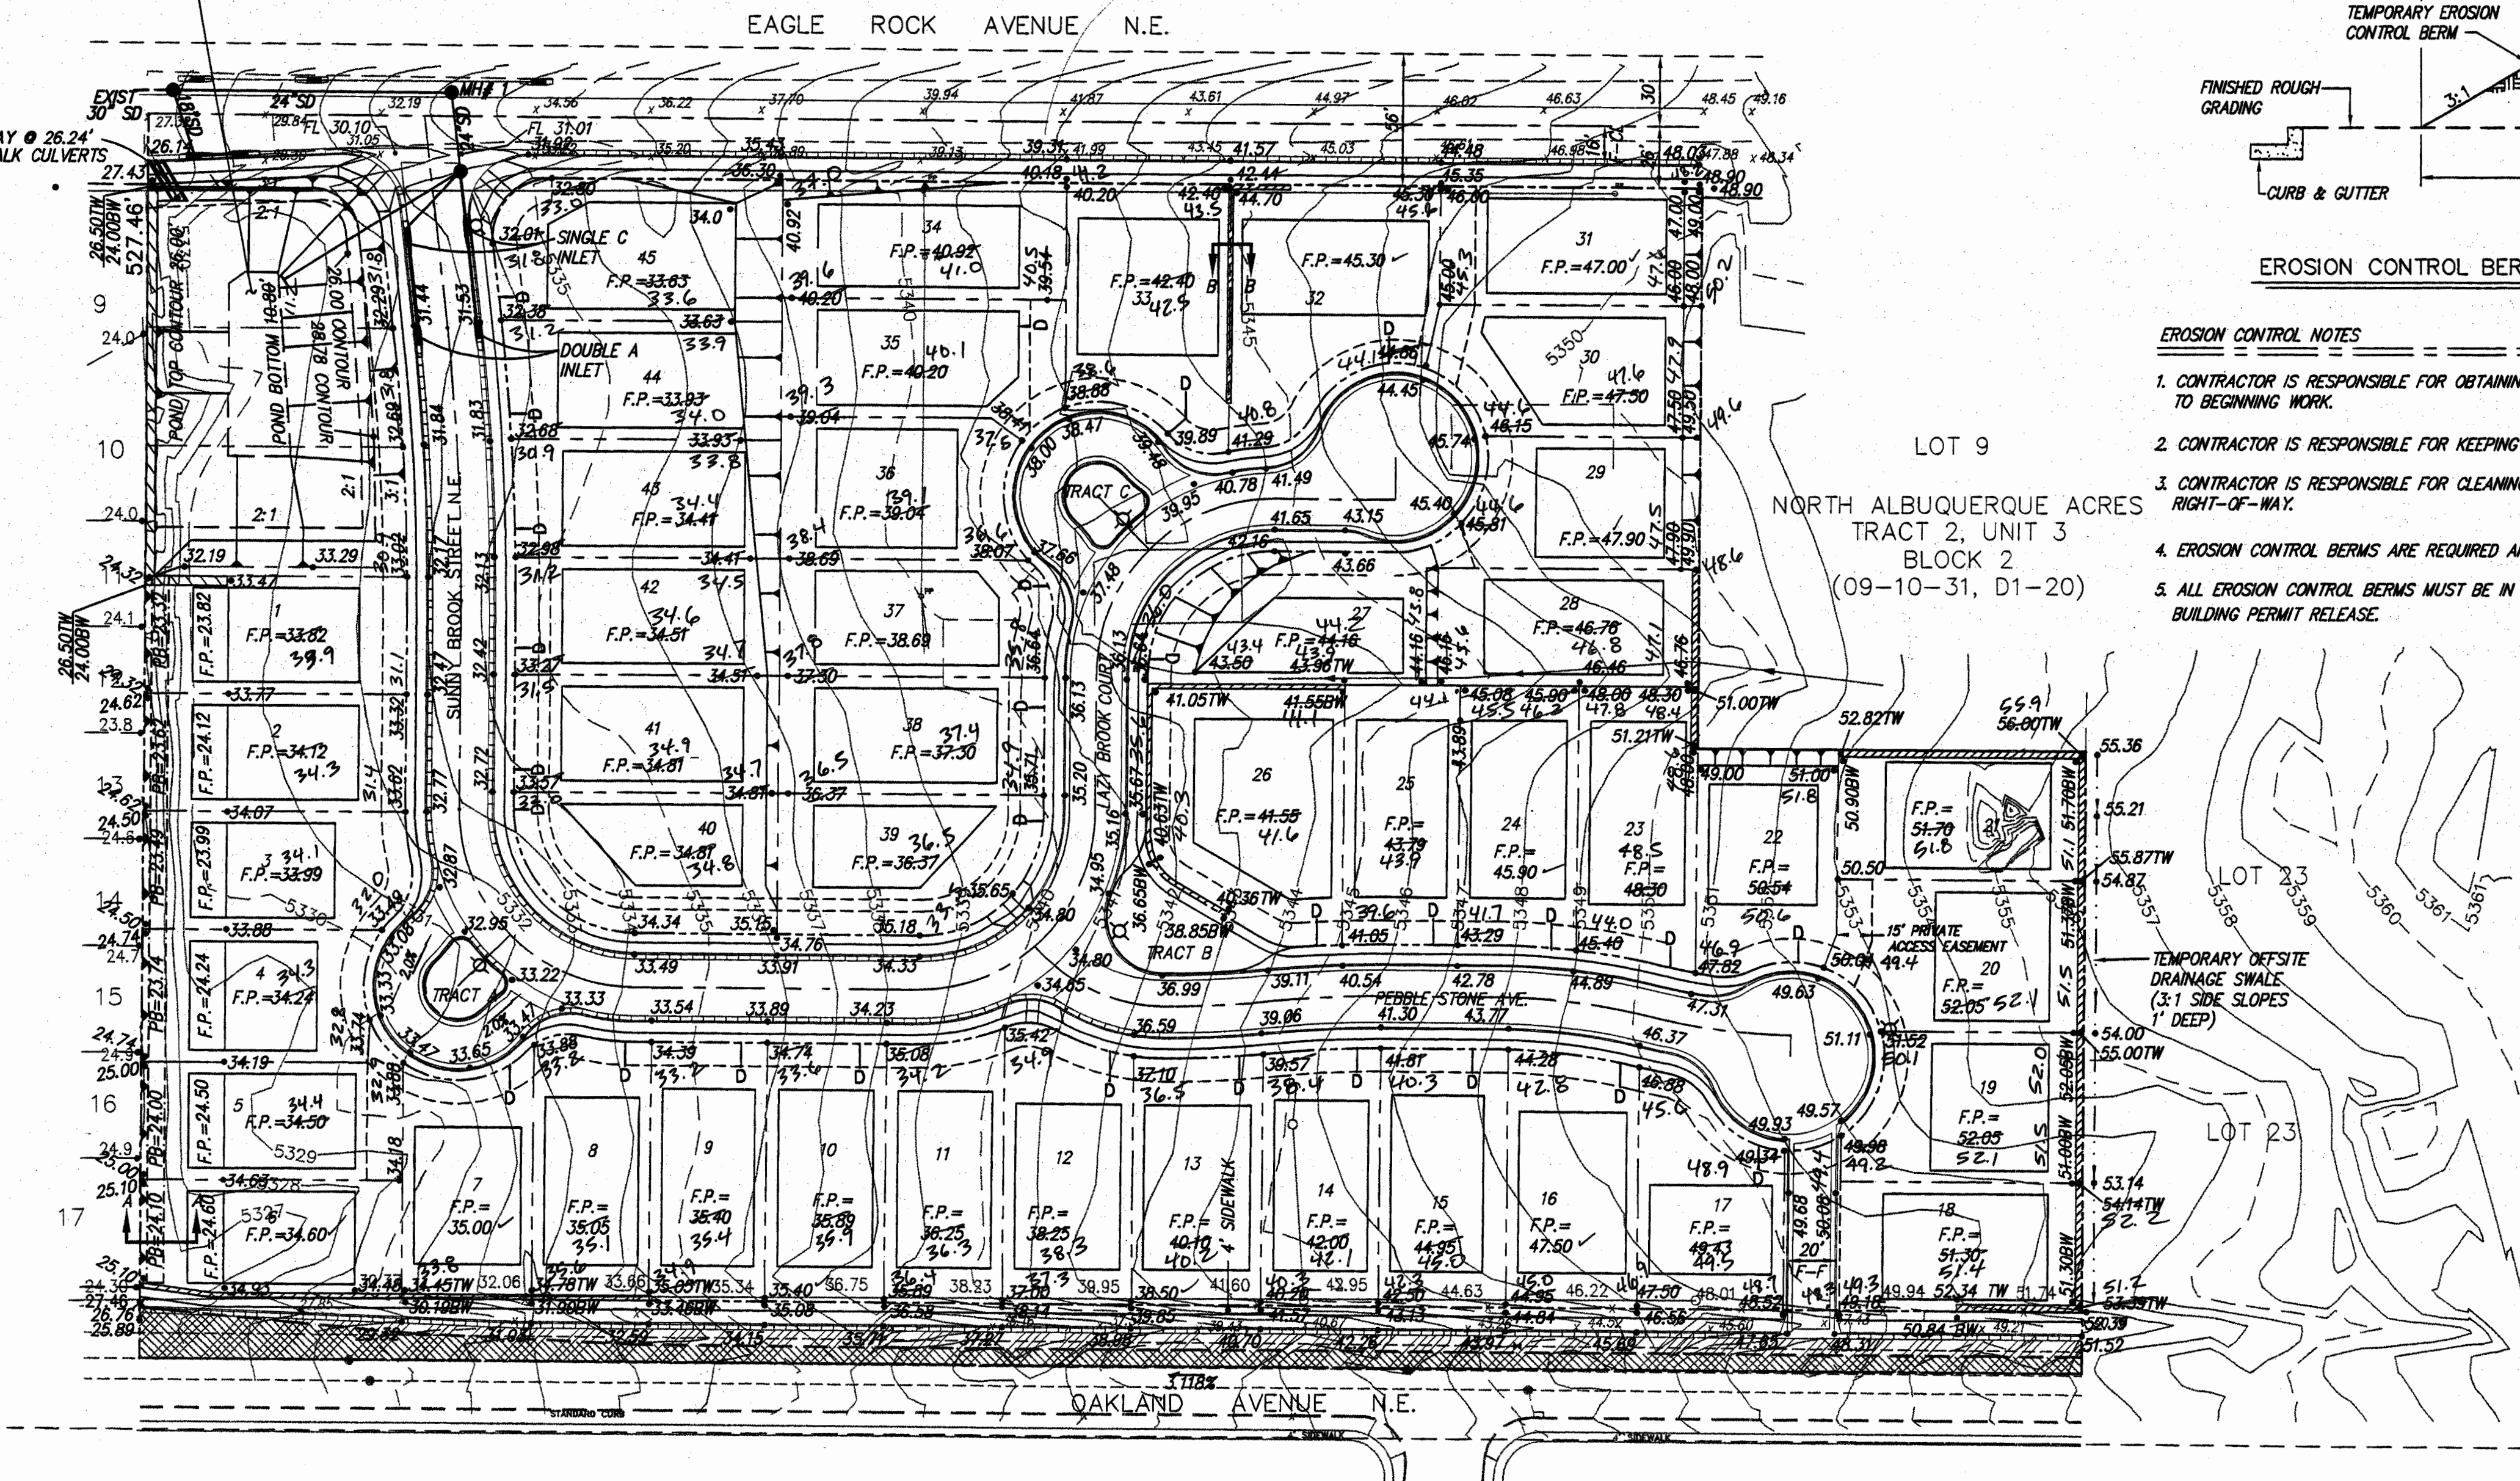

DRAINAGE CRITERIA FOR LOTS 1 THROUGH 6

1. ALL ROOFS SHALL DRAIN TO THE FRONT YARDS.
2. BACK YARD RETENTION POND AREAS ARE FOR RUNOFF FROM BACK YARDS ONLY.
3. BACK YARD PONDS SHALL BE GRADED PER DTL. A-A SHOWN ON THIS SHEET.

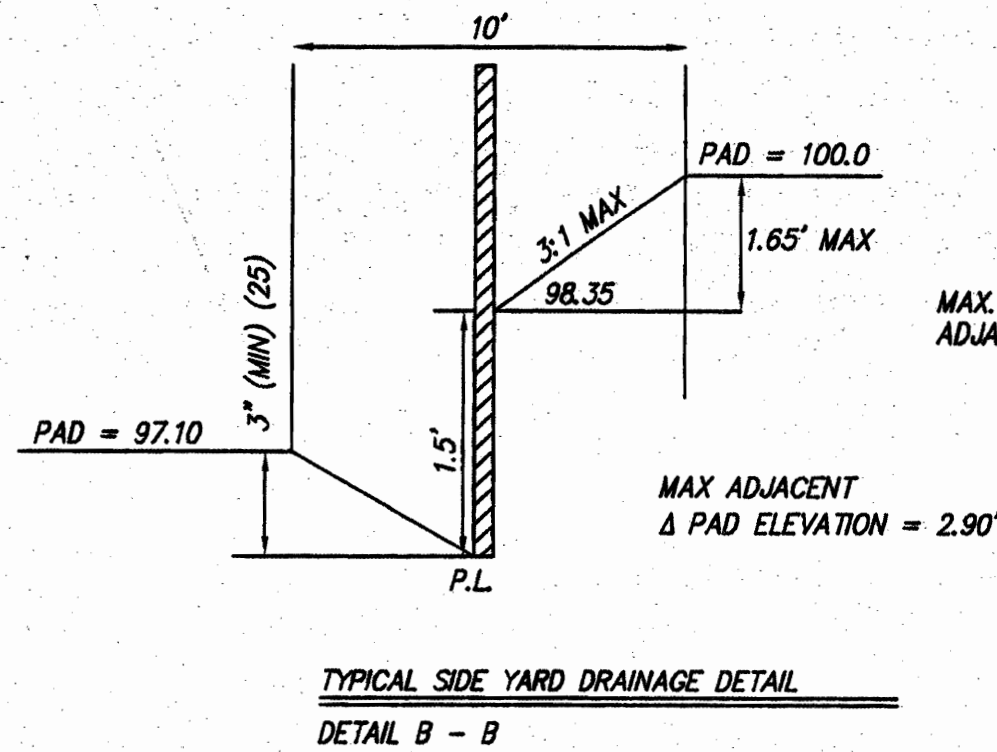

MAX. GRADE DIFFERENCE BETWEEN
ADJACENT PROPERTIES IS 1.0'


POND DESIGN AREA:
7' WIDE x 50' LENGTH x 0.5' DEEP

BACK YARD GRADING DETAIL FOR LOTS 1-6
DETAIL A - A

TEMPORARY OFFSITE DRAINAGE SWALE


Q max = 3.43 cfs
DEPTH = 0.57
SLOPE = 1.34%

Q max = 5.05 cfs
DEPTH = 0.76
SLOPE = 0.6%

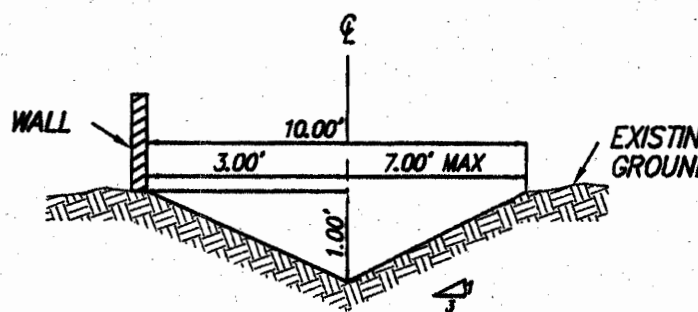

NOTES

1. OFFSITE FLOWS WILL BE ROUTED ALONG THE RETAINING WALL ON THE PROPERTY LINE TO THE R.O.W. OR ARROYO.
2. CONTRACTOR MUST OBTAIN A TOPSOIL DISTURBANCE PERMIT FROM THE ENVIRONMENTAL HEALTH DIVISION PRIOR TO CONSTRUCTION.
3. CITY OF ALBUQUERQUE STANDARD SPECIFICATIONS FOR PUBLIC WORKS CONSTRUCTION, LATEST EDITION SHALL GOVERN ALL WORK.
4. THE CONTRACTOR SHALL CONFORM TO ALL CITY, COUNTY, STATE AND FEDERAL DUST CONTROL MEASURES AND REQUIREMENTS AND WILL BE RESPONSIBLE FOR PREPARING AND OBTAINING ALL NECESSARY APPLICATIONS AND APPROVALS.
5. THE CONTRACTOR SHALL ENSURE THAT NO SOIL ERODES FROM THE LOTS INTO PUBLIC RIGHT-OF-WAY. THIS CAN BE ACHIEVED BY CONSTRUCTING TEMPORARY BERMS AND WETTING THE SOIL TO KEEP IT FROM BLOWING.

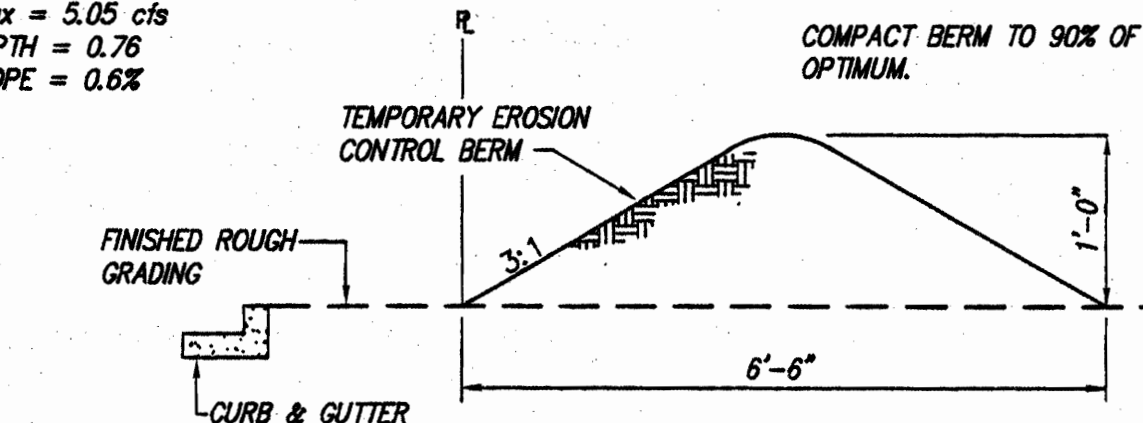

EROSION CONTROL BERM DETAIL

EROSION CONTROL NOTES

1. CONTRACTOR IS RESPONSIBLE FOR OBTAINING A TOPSOIL DISTURBANCE PERMIT PRIOR TO BEGINNING WORK.
2. CONTRACTOR IS RESPONSIBLE FOR KEEPING ALL SEDIMENT OUT OF EXISTING RIGHT-OF-WAY.
3. CONTRACTOR IS RESPONSIBLE FOR CLEANING UP ANY SEDIMENT THAT GETS INTO EXISTING RIGHT-OF-WAY.
4. EROSION CONTROL BERMS ARE REQUIRED AROUND THE ENTIRE SITE.
5. ALL EROSION CONTROL BERMS MUST BE IN PLACE AND ENGINEER CERTIFIED PRIOR TO BUILDING PERMIT RELEASE.

RECORD DRAWING



5-7-01

DATE

DATE


DATE

DATE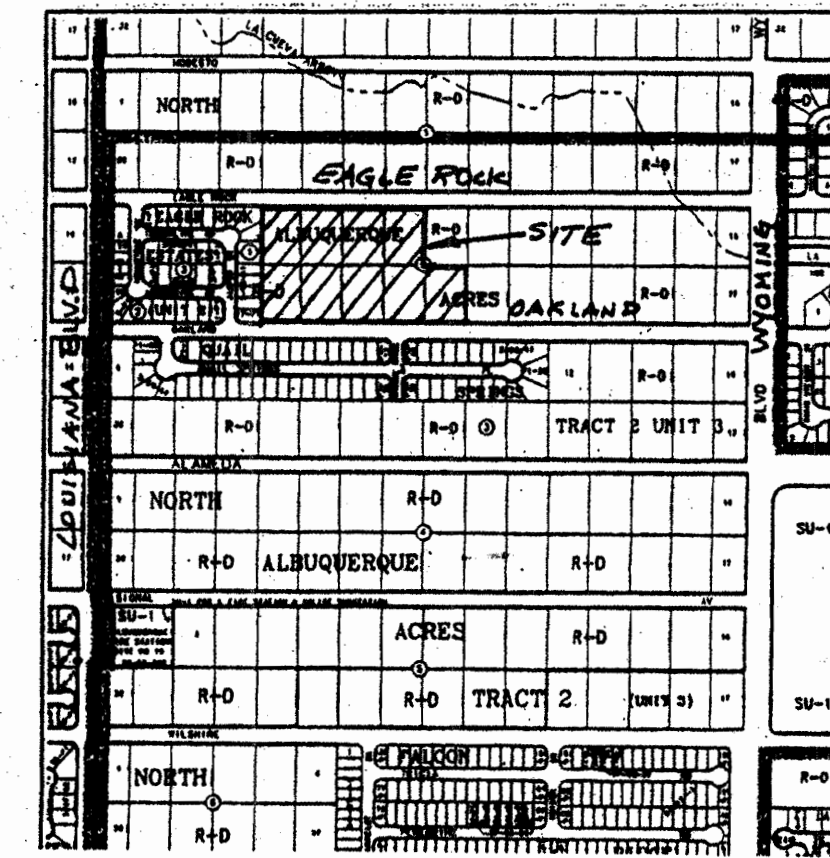

VICINITY MAP

ZONE MAP: C-19-Z

T B M (TEMPORARY BENCHMARK)

LEGAL DESCRIPTION

LOTS 5 - 8, 24 - 28, BLOCK 2, TRACT 2, UNIT 3 N.A.A.

LEGEND

- 24.10 POND BOTTOM ELEVATION
- 21.01 TW NEW RETAINING WALL
- 18.31 BW TOP OF WALL
- FP=76.98 BOTTOM OF WALL
- 28.53 FINISHED PAD ELEV.
- 3:1 SLOPE MOUNTABLE CURB & GUTTER
- 3:1 SLOPE STANDARD 8" CURB & GUTTER
- 3:1 SLOPE PROPOSED SPOT ELEV.
- 3:1 SLOPE EXIST. SANITARY SEWER MANHOLE
- 3:1 SLOPE EXIST. WATER VALVE
- 3:1 SLOPE EXIST. FIRE HYDRANT
- 3:1 SLOPE EXIST. STORM SEWER MANHOLE
- 3:1 SLOPE EXIST. CONTOUR
- 3:1 SLOPE EXIST. CABLE T.V. PEDESTAL
- 3:1 SLOPE EXIST. OVERHEAD ELECTRIC LINE
- 3:1 SLOPE EXIST. OVERHEAD TELEPHONE LINE
- 3:1 SLOPE EXIST. P.P.
- 3:1 SLOPE SPOT ELEVATION
- 3:1 SLOPE PROPOSED STORM DRAIN LINE
- 3:1 SLOPE PROPOSED MANHOLE
- 3:1 SLOPE BASIN BOUNDARY
- 3:1 SLOPE PROPOSED STORM DRAIN INLET
- 3:1 SLOPE EXIST. DROP INLET
- 3:1 SLOPE EXIST. TOP OF CURB
- 3:1 SLOPE EXIST. FLOWLINE
- 3:1 SLOPE SUGGESTED DRIVEWAY LOCATION

MARK GOODWIN & ASSOCIATES, P.A.
CONSULTING ENGINEERS
P.O. BOX 90806
ALBUQUERQUE, NEW MEXICO 87199
(505) 828-2200, FAX (505) 797-9539

**CITY OF ALBUQUERQUE
PUBLIC WORKS DEPARTMENT
ENGINEERING DEVELOPMENT GROUP**

**STONEBROOKE ESTATES SUBDIVISION
GRADING AND DRAINAGE PLAN**

DESIGN REVIEW COMMITTEE CITY ENGINEER APPROVAL

APPROVED
AT DRB

CITY PROJECT NO.

ZONE MAP NO.


SHEET

627281

C-19-Z

4A OF 18

9050SCH/9050GD4R.DWG/ 02-9-00 / SPS MJR DLH WLW

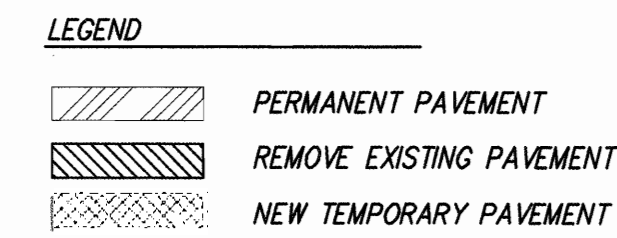

EAGLE ROCK AVENUE N.E.
STA. 8+83.87 TO STA. 15+42.94
SCALE: HORZ. 1" = 50'
VERT. 1" = 10'

Eagle Rock Avenue built as part of Project No. 622581, Vista Del Aguila

NOTES

1. ALL 4' VALLEY GUTTERS PER CITY OF ALBUQUERQUE STANDARD DRAWING 2421 AT KNUCKLES AND 6' VALLEY GUTTERS PER CITY OF ALBUQUERQUE STANDARD DRAWING 2420 AT ALL INTERSECTIONS.
2. ALL 4' INTERIOR SIDEWALKS ARE DEFERRED.
3. ALL HANDICAP RAMPS TO BE CASE II PER CITY OF ALBUQUERQUE STANDARD DRAWING 2441. WHERE GRADES DO NOT PERMIT A MAXIMUM SLOPE OF 12:1 TO BE MAINTAINED WITHIN THE LENGTH AS SPECIFIED. THEN THE "L" LENGTH IS 24' IN DRAWING 2441. THIS WILL BE INCREASED TO MAINTAIN A SLOPE < 12:1.
4. TRANSITION FROM MOUNTABLE CURB TO STANDARD CURB SHALL BE WITHIN 10' SECTION.
5. TRANSITION SECTION FROM FULL CROWN TO NO CROWN TO BE A MINIMUM OF 50', PER CITY OF ALBUQUERQUE STANDARD DRAWING 2401.
6. ALL INTERIOR SUBDIVISION STREETS ARE PRIVATE.

CURVE DATA - DESCRIBES FACE OF CURB

$$\begin{array}{ll} \textcircled{1} \Delta = 83^{\circ}12'19'' & \textcircled{2} \Delta = 96^{\circ}47'41'' \\ R = 25.00' & R = 25.00' \\ L = 36.31' & L = 42.23' \\ T = 22.20' & T = 28.16' \end{array}$$

[illegible]dmc

MARK GOODWIN & ASSOCIATES, P.A.
CONSULTING ENGINEERS
P.O. BOX 90606
ALBUQUERQUE, NEW MEXICO 87199
(505) 828-2200, FAX (505) 797-9539



CITY OF ALBUQUERQUE
PUBLIC WORKS DEPARTMENT
ENGINEERING DEVELOPMENT GROUP
*STONEBROOKE ESTATES
PAYING IMPROVEMENTS
EAGLE ROCK AVENUE*

DESIGN REVIEW COMMITTEE

CITY ENGINEER APPROVAL

JAN - 5 1980

MO./DAY/YR.	MO./DAY/YR.

CITY PROJECT NO.

627281

ZONE MAP NO.
C-19-


SHEET 6 OF 18



9050SCH/9050PP5A/11-09-99/SPS DLH MJR

627281

C-19-

Z	6	18
---	---	----


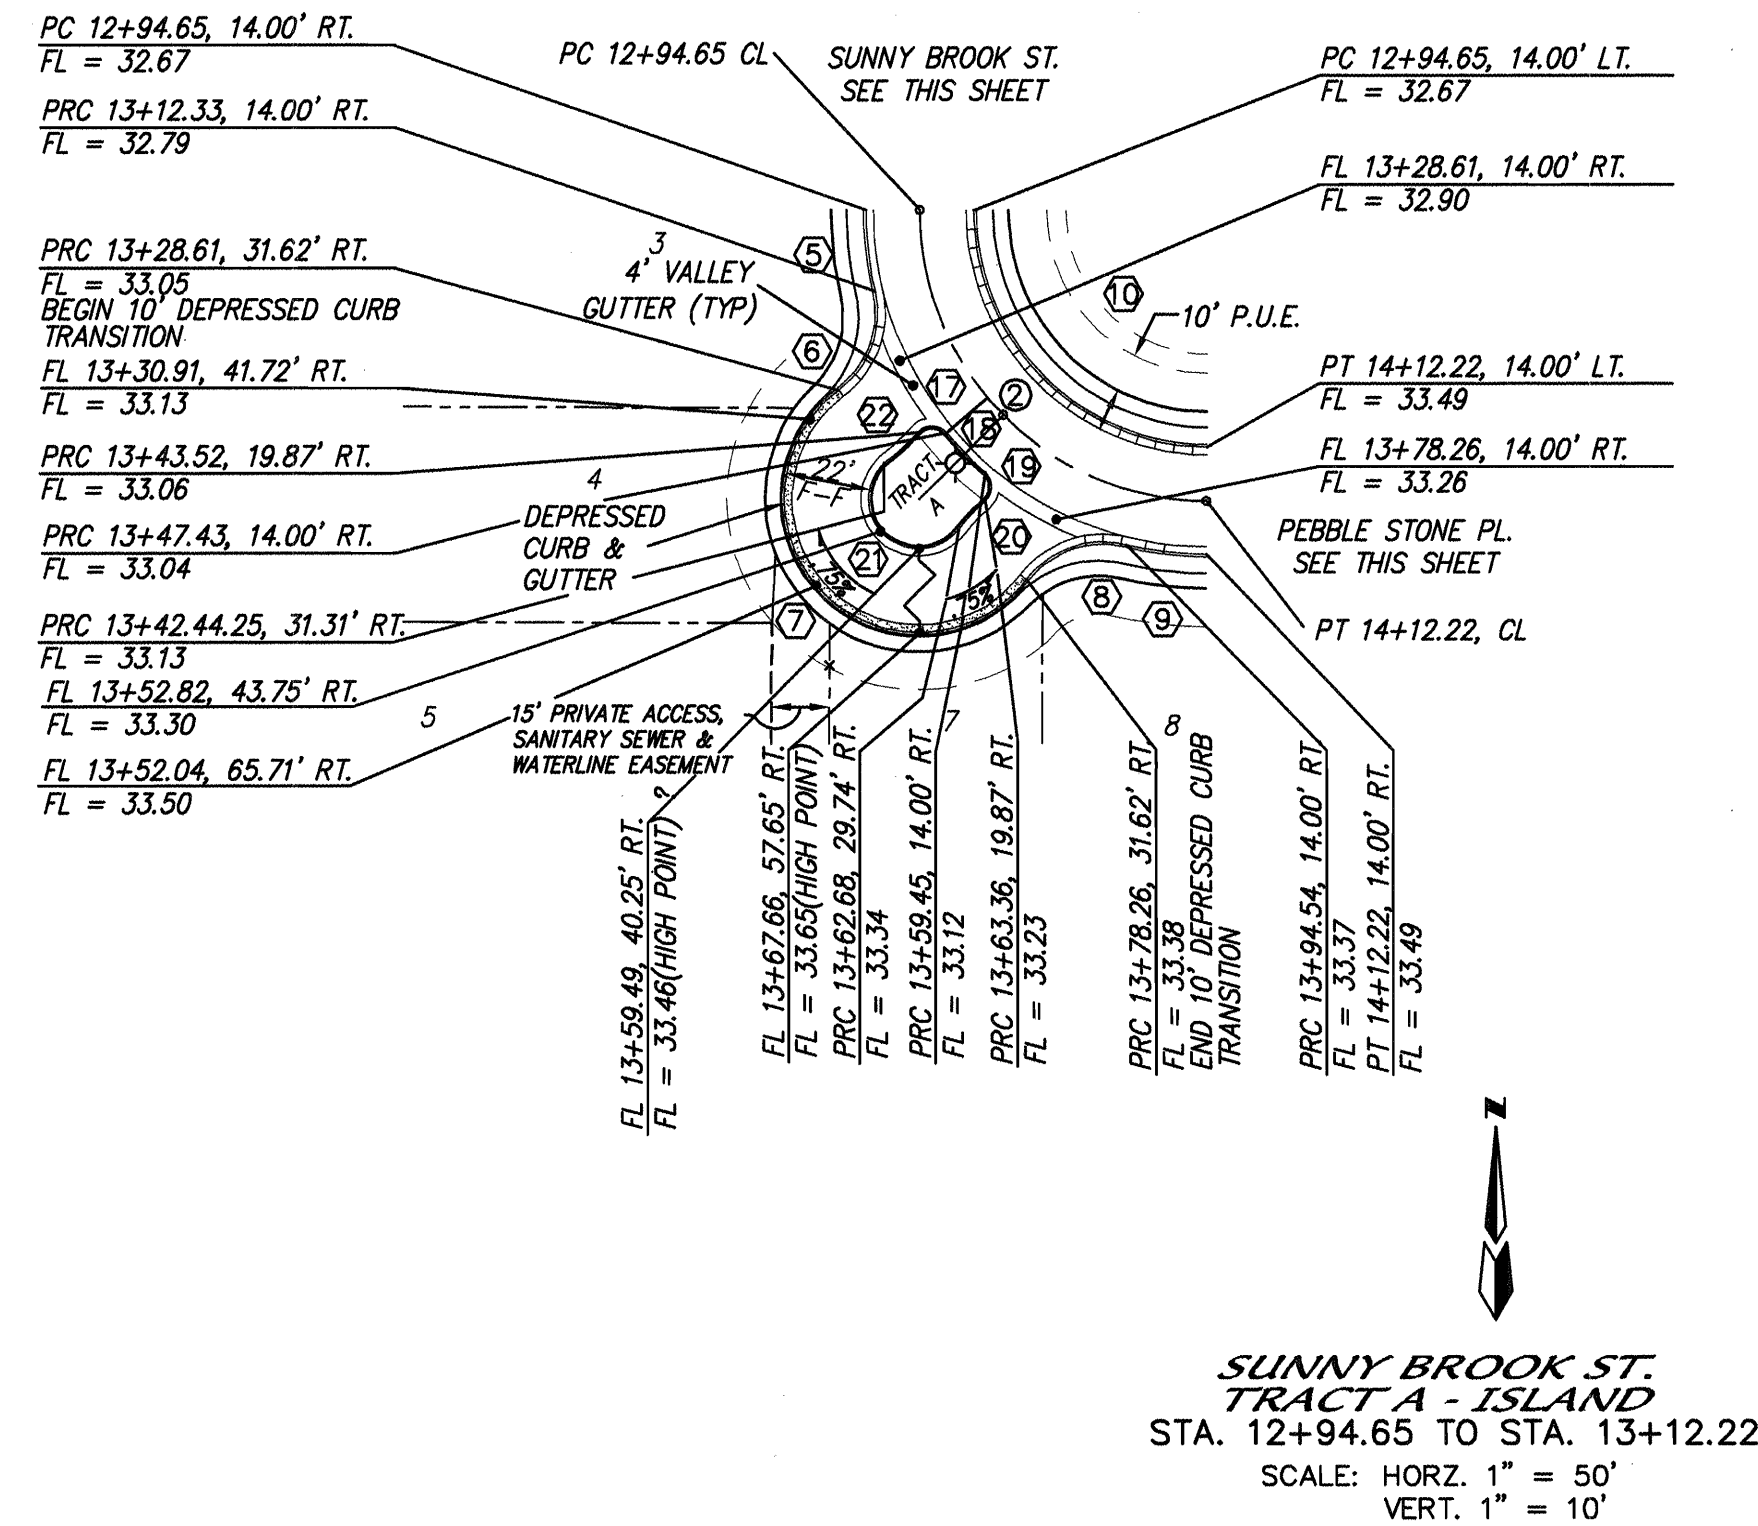
[illegible]

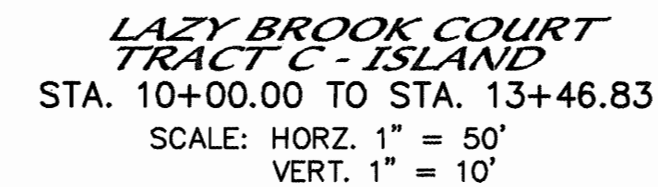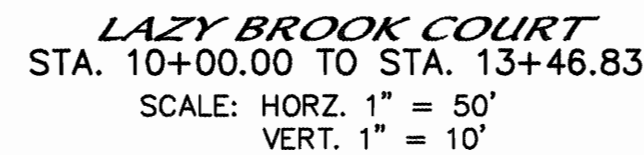

③ $\Delta = 90^{\circ}10'45''$ LT. ④ $\Delta = 90^{\circ}09'48''$ LT.
 $R = 75.00'$ $R = 75.00'$
 $L = 118.04'$ $L = 118.02'$
 $T = 75.24'$ $T = 75.21'$

8 18

SCANNED BY
MESA REPRO

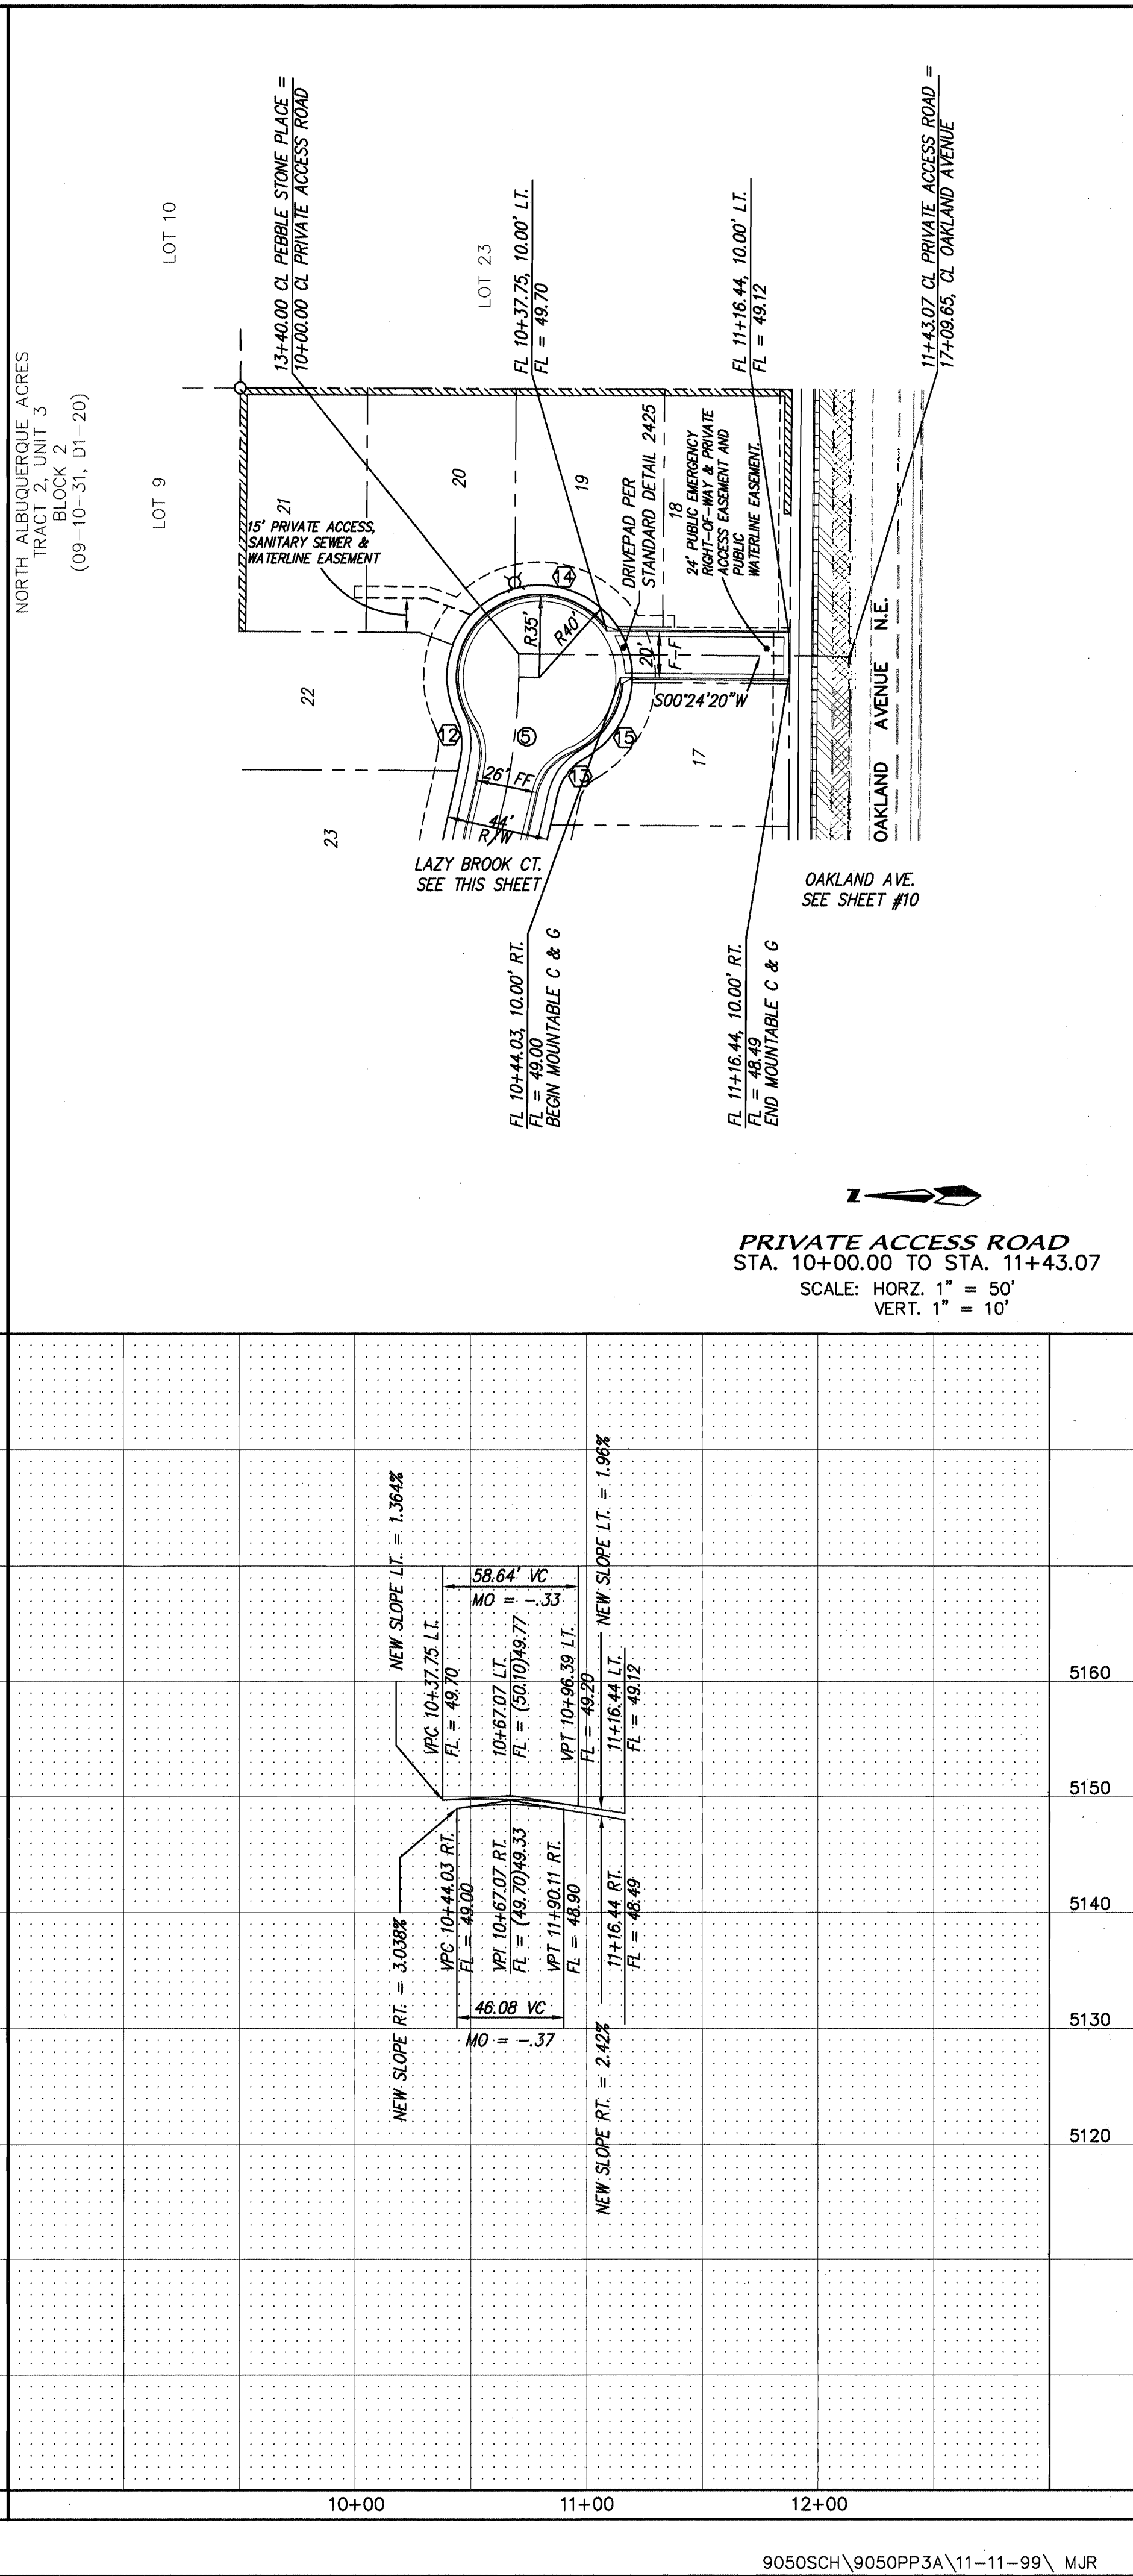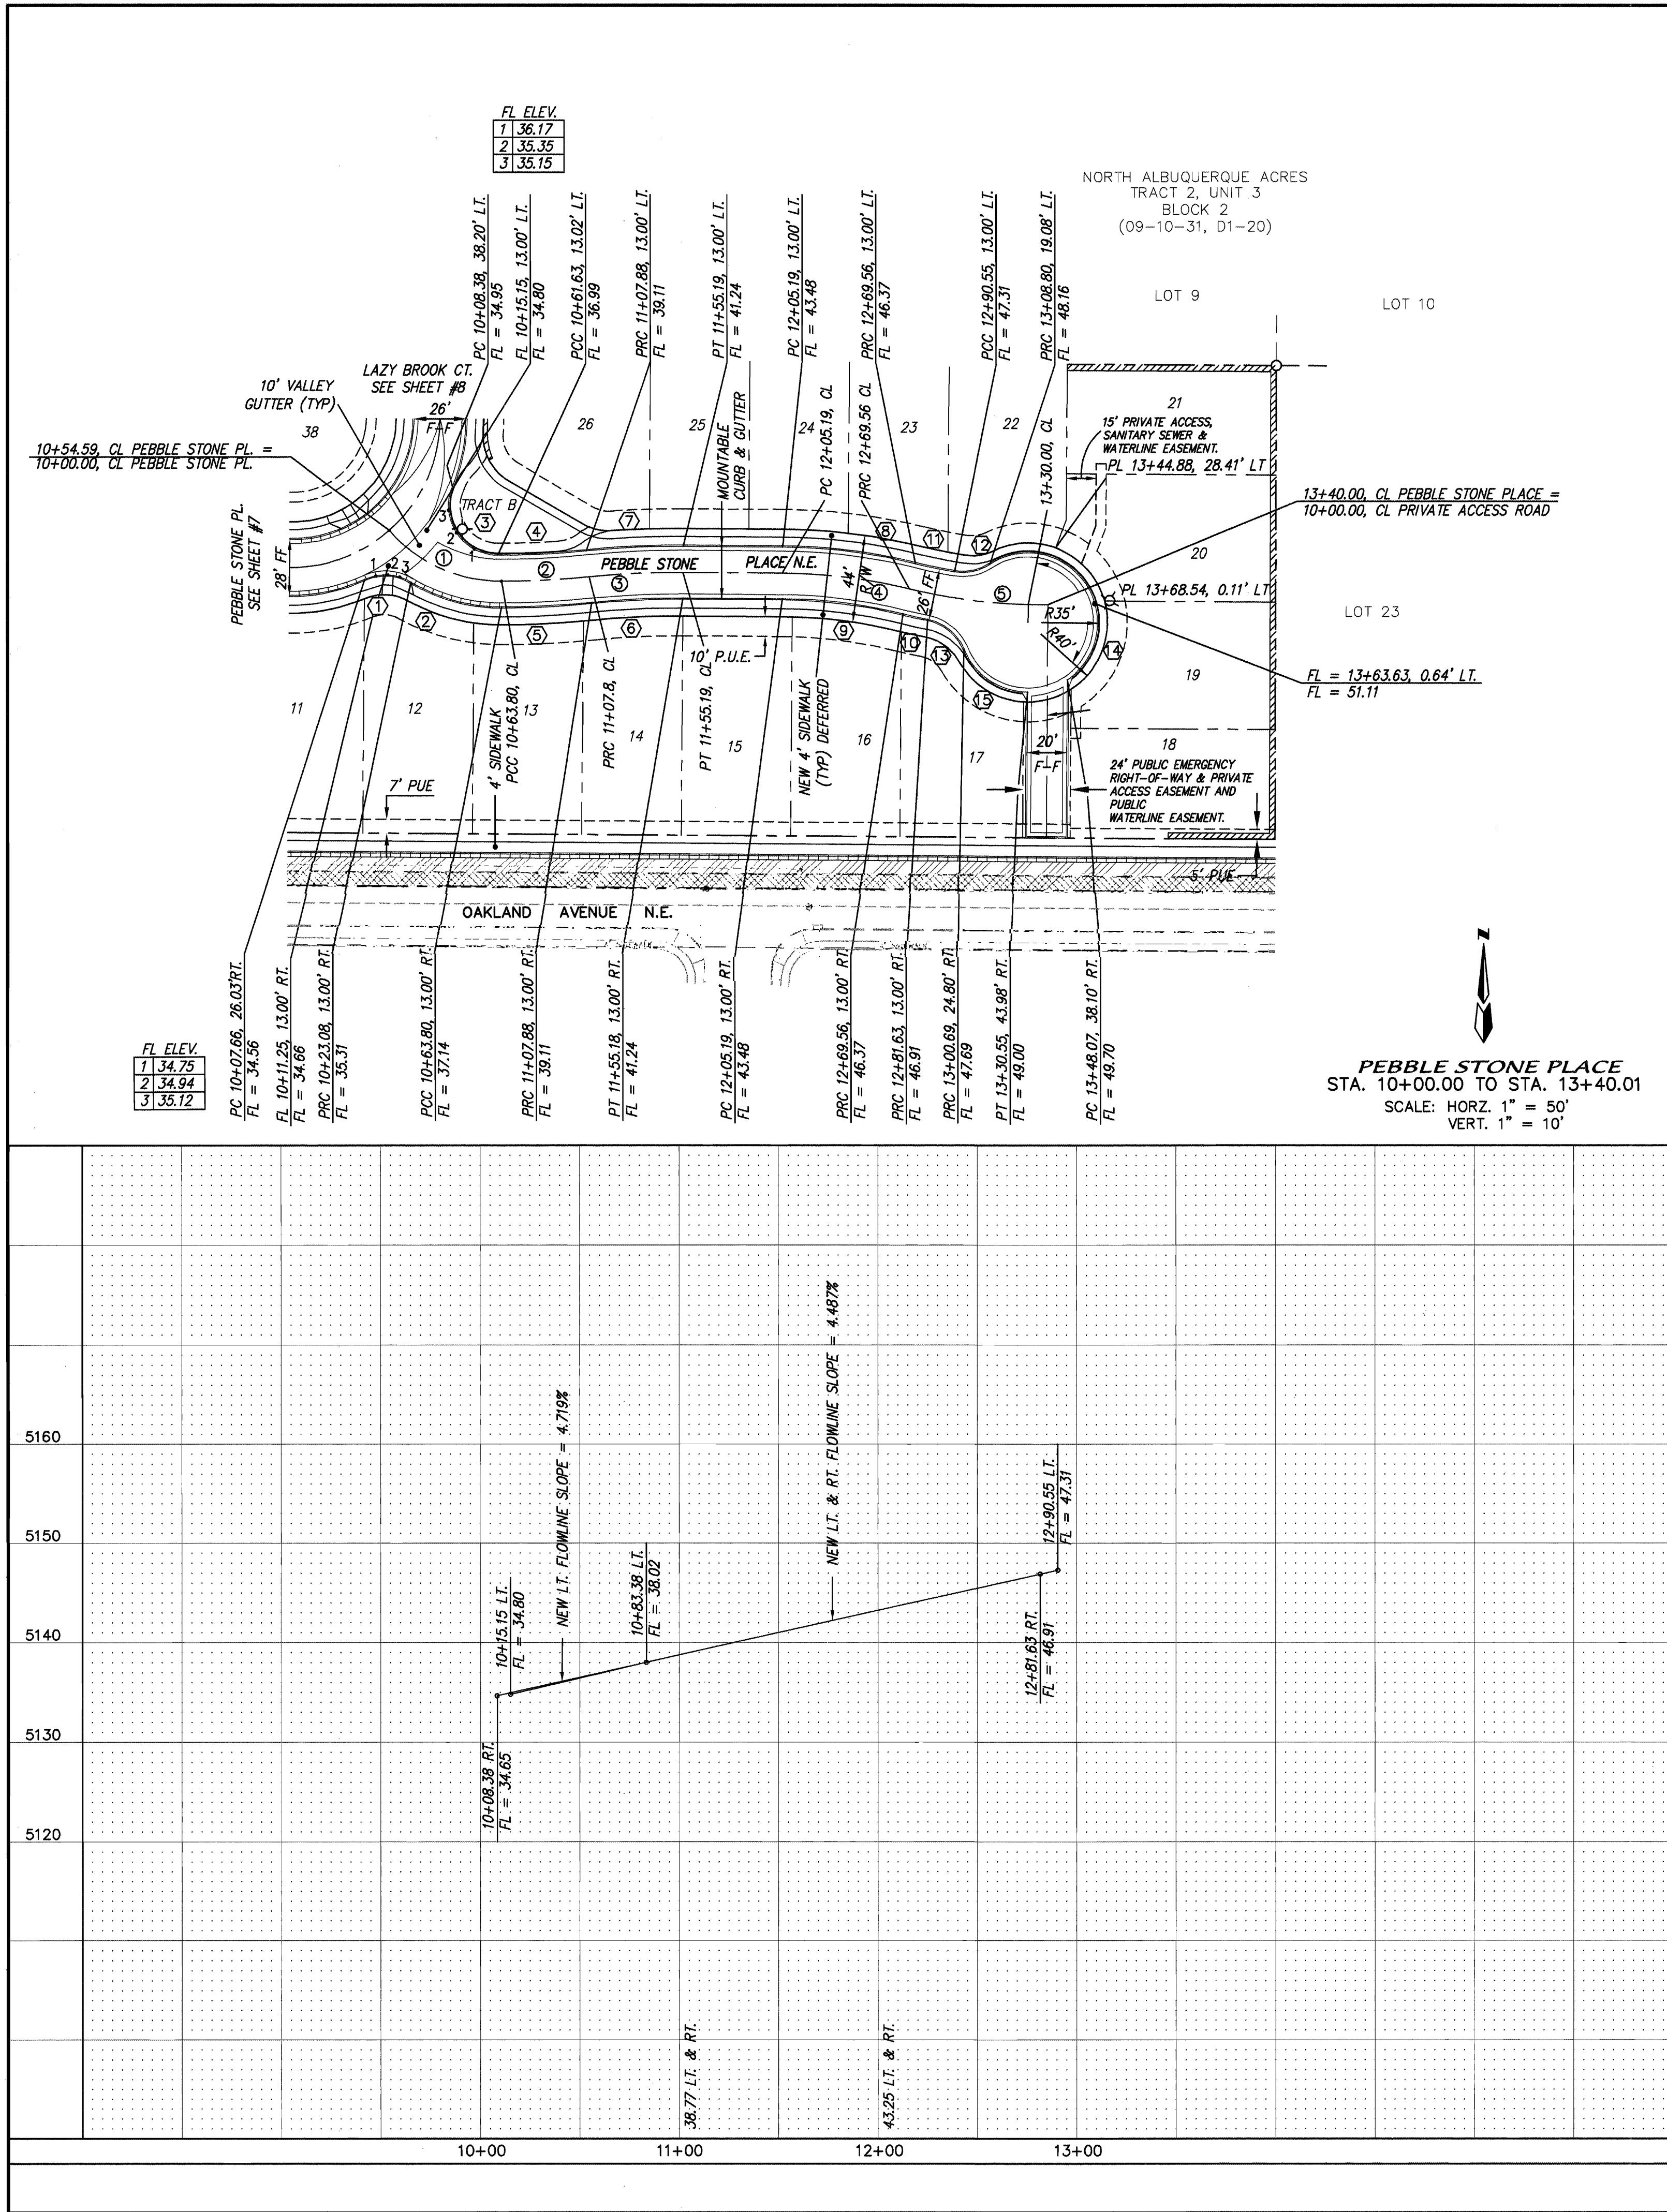

NOTES

CURVE DATA - DESCRIBES FACE OF CURB

1 Δ = 55°42'41"	2 Δ = 31°06'07"
R = 25.00'	R = 88.00'
L = 24.31'	L = 47.77'
T = 13.21'	T = 24.49'
3 Δ = 112°33'11"	4 Δ = 06°01'10"
R = 25.00'	R = 424.43'
L = 49.11'	L = 44.59'
T = 37.45'	T = 22.32'
5 Δ = 05°46'25"	6 Δ = 06°11'31"
R = 450.43'	R = 424.76'
L = 45.39'	L = 45.90'
T = 22.71'	T = 22.97'
7 Δ = 06°11'31"	8 Δ = 13°24'44"
R = 450.76'	R = 288.00'
L = 48.71'	L = 67.42'
T = 24.38'	T = 33.86'
9 Δ = 13°24'44"	10 Δ = 02°30'53"
R = 262.00'	R = 288.00'
L = 61.33'	L = 12.64'
T = 30.81'	T = 6.32'
11 Δ = 14°22'22"	12 Δ = 42°45'54"
R = 262.00'	R = 25.00'
L = 20.00'	L = 18.66'
T = 10.00'	T = 9.79'
13 Δ = 56°09'05"	14 Δ = 178°53'00"
R = 25.00'	R = 35.00'
L = 24.50'	L = 109.27'
T = 13.34'	T = N/A
15 Δ = 67°02'34"	
R = 35.00'	
L = 40.95'	
T = 23.18'	

CURVE DATA - DESCRIBES CENTERLINE

1 Δ = 48°58'32" LT.	2 Δ = 05°46'25" LT.
R = 74.64'	R = 437.43'
L = 63.80'	L = 44.08'
T = 33.99'	T = 22.06'
4 Δ = 06°11'31" RT.	5 Δ = 13°24'44" RT.
R = 437.76'	R = 275.00'
L = 47.31'	L = 64.37'
T = 23.68'	T = 32.33'
7 Δ = 14°39'22" LT.	
R = 275.40'	
L = 70.45'	
T = 35.42'	


dmg

MARK GOODWIN & ASSOCIATES, P.A.
CONSULTING ENGINEERS
P.O. BOX 90606
ALBUQUERQUE, NEW MEXICO 87199
(505) 828-2200, FAX (505) 797-9539



CITY OF ALBUQUERQUE
PUBLIC WORKS DEPARTMENT
ENGINEERING DEVELOPMENT GROUP

TITLE: **STONEBROOKE ESTATES
PAVING IMPROVEMENTS
PEBBLE STONE PLACE & PRIVATE ACCESS ROAD**

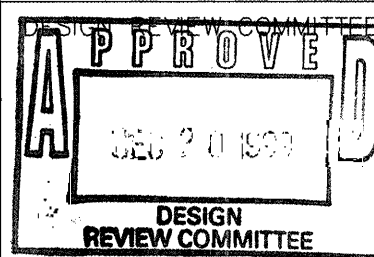

CITY ENGINEER APPROVAL
JAN - 2 1999

LAST DESIGN UPDATE

CITY PROJECT NO.

627281


ZONE MAP NO.

C-19-Z

SHEET OF

9 18

ENGINEER'S SEAL

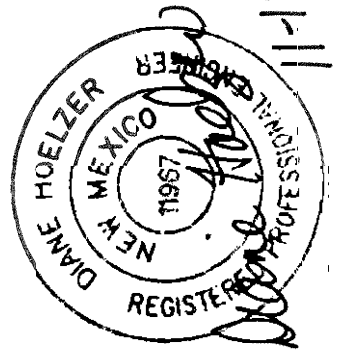

SURVEY INFORMATION


NO.	DATE	BY

BENCH MARKS

AS BUILT INFORMATION


CONTRACTOR	DATE
STAKED BY	DATE
ACCEPTANCE BY	DATE
FIELD OBSERVATION BY	DATE
DESIGNATION BY	DATE
CORRECTED BY	DATE
MICRO-FILM INFORMATION	DATE
RECORDED BY	DATE
NO.	DATE

C:\DWGS\9050SCH\9050util.dwg Thu Dec 02 08:18:08 1999 PLOTTED BY WILLIAM

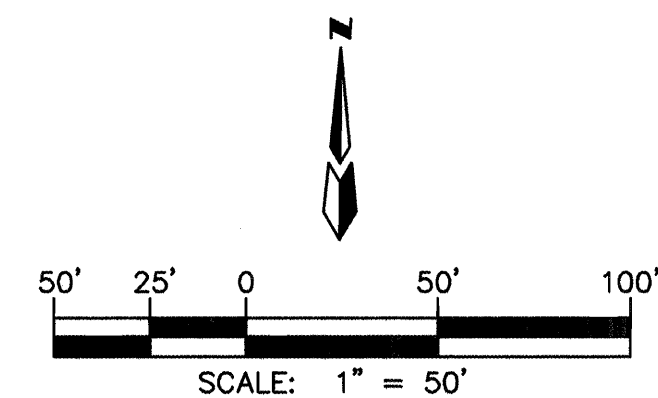


9050SCH\9050UTIL\12-02-99\ SPS MJR DLH WLW

DESIGNED BY		DLH	DATE	8/99
DESIGN				
REVIEWS				
NO.	DATE	REMARKS	BY	

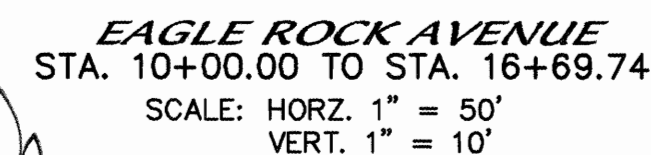


ALL UTILITIES (SAS, WL, SD) IN EAGLE ROCK AVENUE BUILT AS PART OF PROJECT NO. 622581 Vista Del Aguila

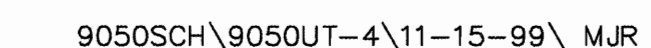

CITY PROJECT NO.	ZONE MAP NO.	SHEET OF
627281	C-19-Z	12 14

CITY PROJECT NO.	ZONE MAP NO.	SHEET OF
627281	C-19-Z	12 14

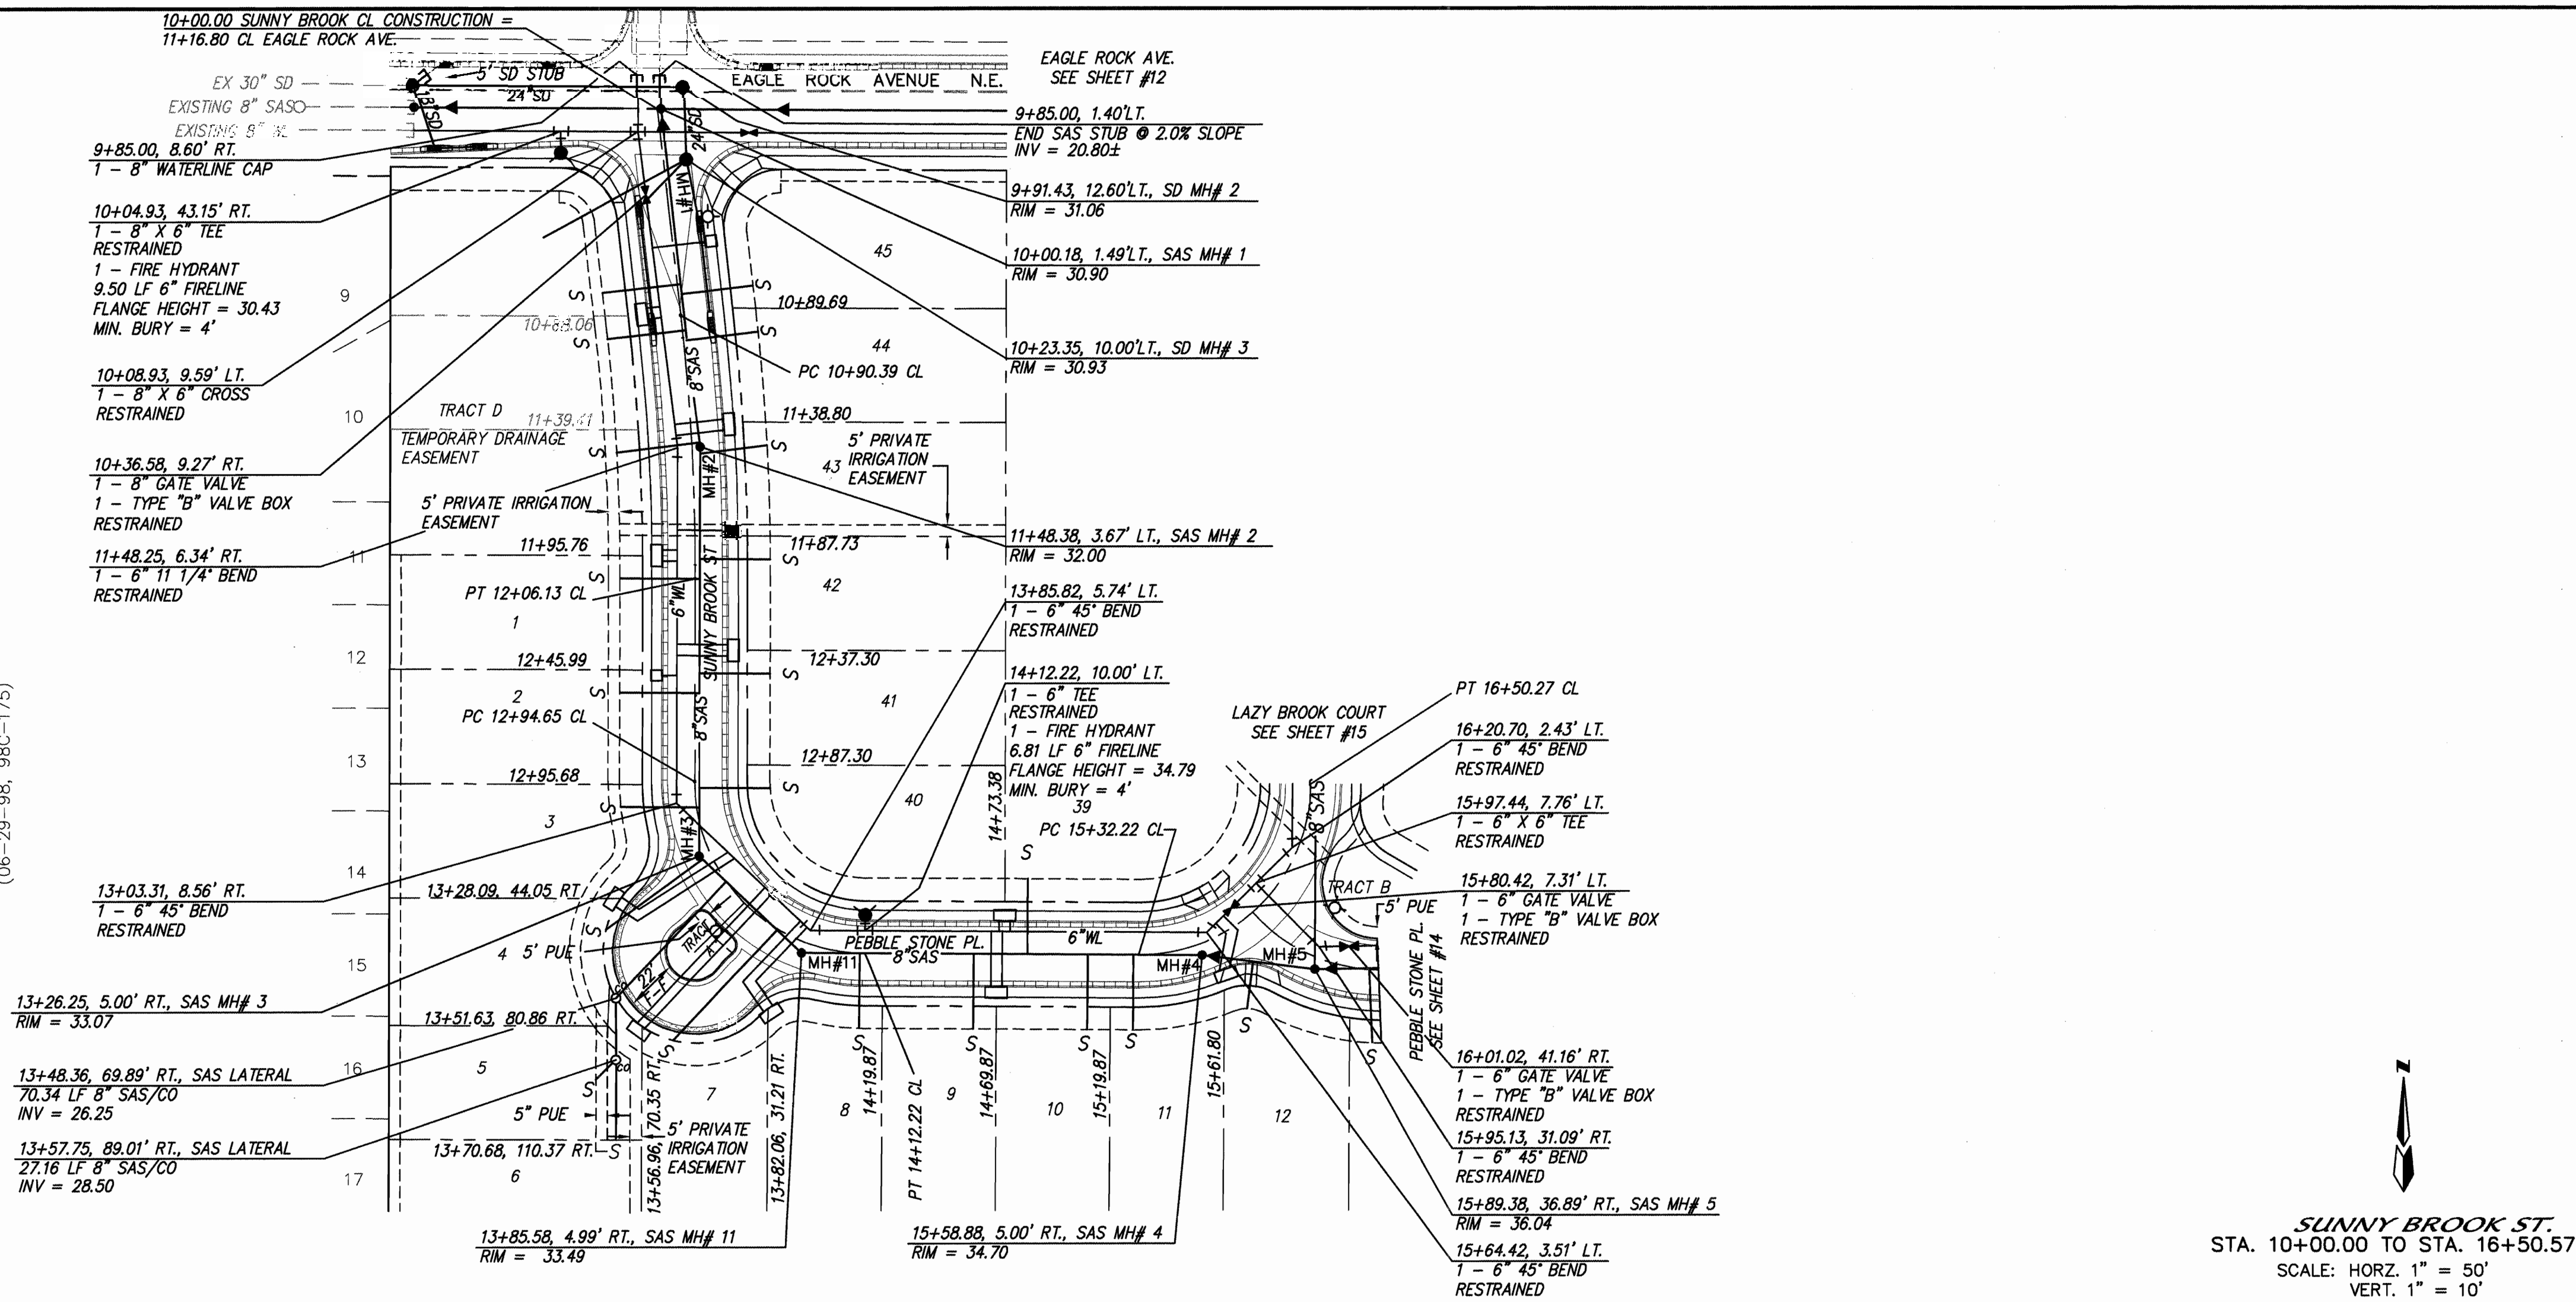

SUNNY BROOK ST.
STA. 10+00.00 TO STA. 16+50.57
SCALE: HORZ. 1" = 50'
VERT. 1" = 10'

	LOT	STATION AT PUE	INV. ELEV. AT PUE	LENGTH AT PUE
		27.81		35.00
1		12+05.76	27.81	35.00
2		12+55.99	28.11	35.00
3		13+02.54	28.40	34.40
4		13+33.57	28.15	52.28
5	13+57.46, 101.57R		29.18	
6	13+66.92, 116.58R		29.18	1
7	13+64.54, 66.45R		28.88	66.70
8	14+10.59		29.15	32.97
9	14+59.87		29.50	33.00
10	15+09.87		29.85	33.00
11	15+29.87		29.99	33.00
39	14+63.35		29.66	33.00
40	12+0.39		28.55	33.00
41	12+47.30		28.06	31.00
42	11+97.58		27.76	30.96
43	11+49.15		27.47	29.57
44	11+00.58		27.17	31.59
45	10+80.79		27.05	31.63
	10+76.83		26.88	34.38
	10+97.19		27.34	35.39
	11+49.08		27.47	35.21

RESTRAINED JOINT LENGTH FOR BENDS, VALVES, DEAD ENDS (FT.)					
PIPE SIZE	90°	45°	22.5°	11.25°	VALVE
6"	17'	7'	3'	2'	46'
8"	22'	9'	4'	2'	60'
LENGTH OF RESTRAINED PIPE ON EACH SIDE OF THE BEND. RESTRAIN BRANCH AT FITTING ONLY MINIMUM ATTACHED PIPE LENGTH, RUN SIDE OF TEE: 10.00 FEET.					

RESTRAINED JOINT LENGTHS FOR REDUCERS (FT.)		
PIPE SIZE	LARGE SIDE	SMALL SIDE
8" X 6"	25'	33'

RESTRAINED JOINT LENGTH FOR TEES (FT.)		
PIPE SIZE	RUN	BRANCH
10"x10"x10"	—	—
8"x8"x6"	7'	5'
6"x6"x6"	10'	2'



dmg MARK GOODWIN & ASSOCIATES, P.A.
CONSULTING ENGINEERS
P.O. BOX 90606
ALBUQUERQUE, NEW MEXICO 87199
(505) 828-2200, FAX (505) 797-9539

	CITY OF ALBUQUERQUE PUBLIC WORKS DEPARTMENT ENGINEERING DEVELOPMENT GROUP
	TITLE: <i>STONEBROOKE ESTATES UTILITY IMPROVEMENTS SUNNY BROOK ST.</i>

DESIGN REVIEW COMMITTEE APPROVAL CITY ENGINEER APPROVAL
JAN 11 1969
DESIGN REVIEW COMMITTEE CITY ENGINEER

CITY PROJECT NO.	ZONE MAP NO.	SHEET	OF
627281	C-19-Z	13	18

DESIGN		REVISIONS		E
DESIGNED BY	DATE	REMARKS	NO.	
DLH <td>9/99 <td></td> <td></td> <td></td> </td>	9/99 <td></td> <td></td> <td></td>			
M/R <td>9/99 <td></td> <td></td> <td></td> </td>	9/99 <td></td> <td></td> <td></td>			
DMC <td>9/99 <td></td> <td></td> <td></td> </td>	9/99 <td></td> <td></td> <td></td>			

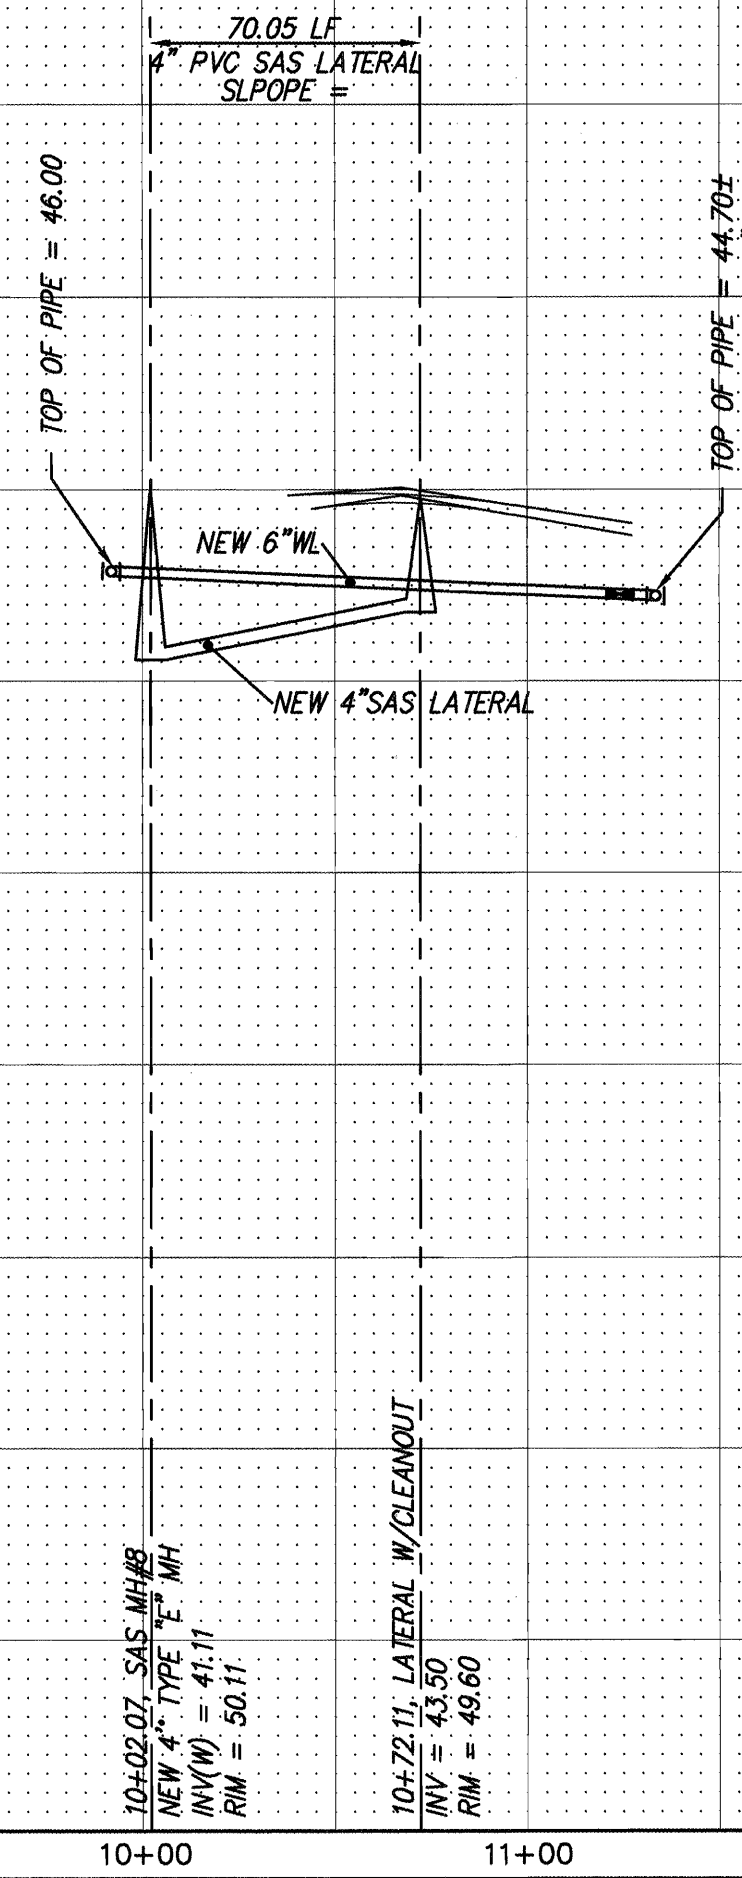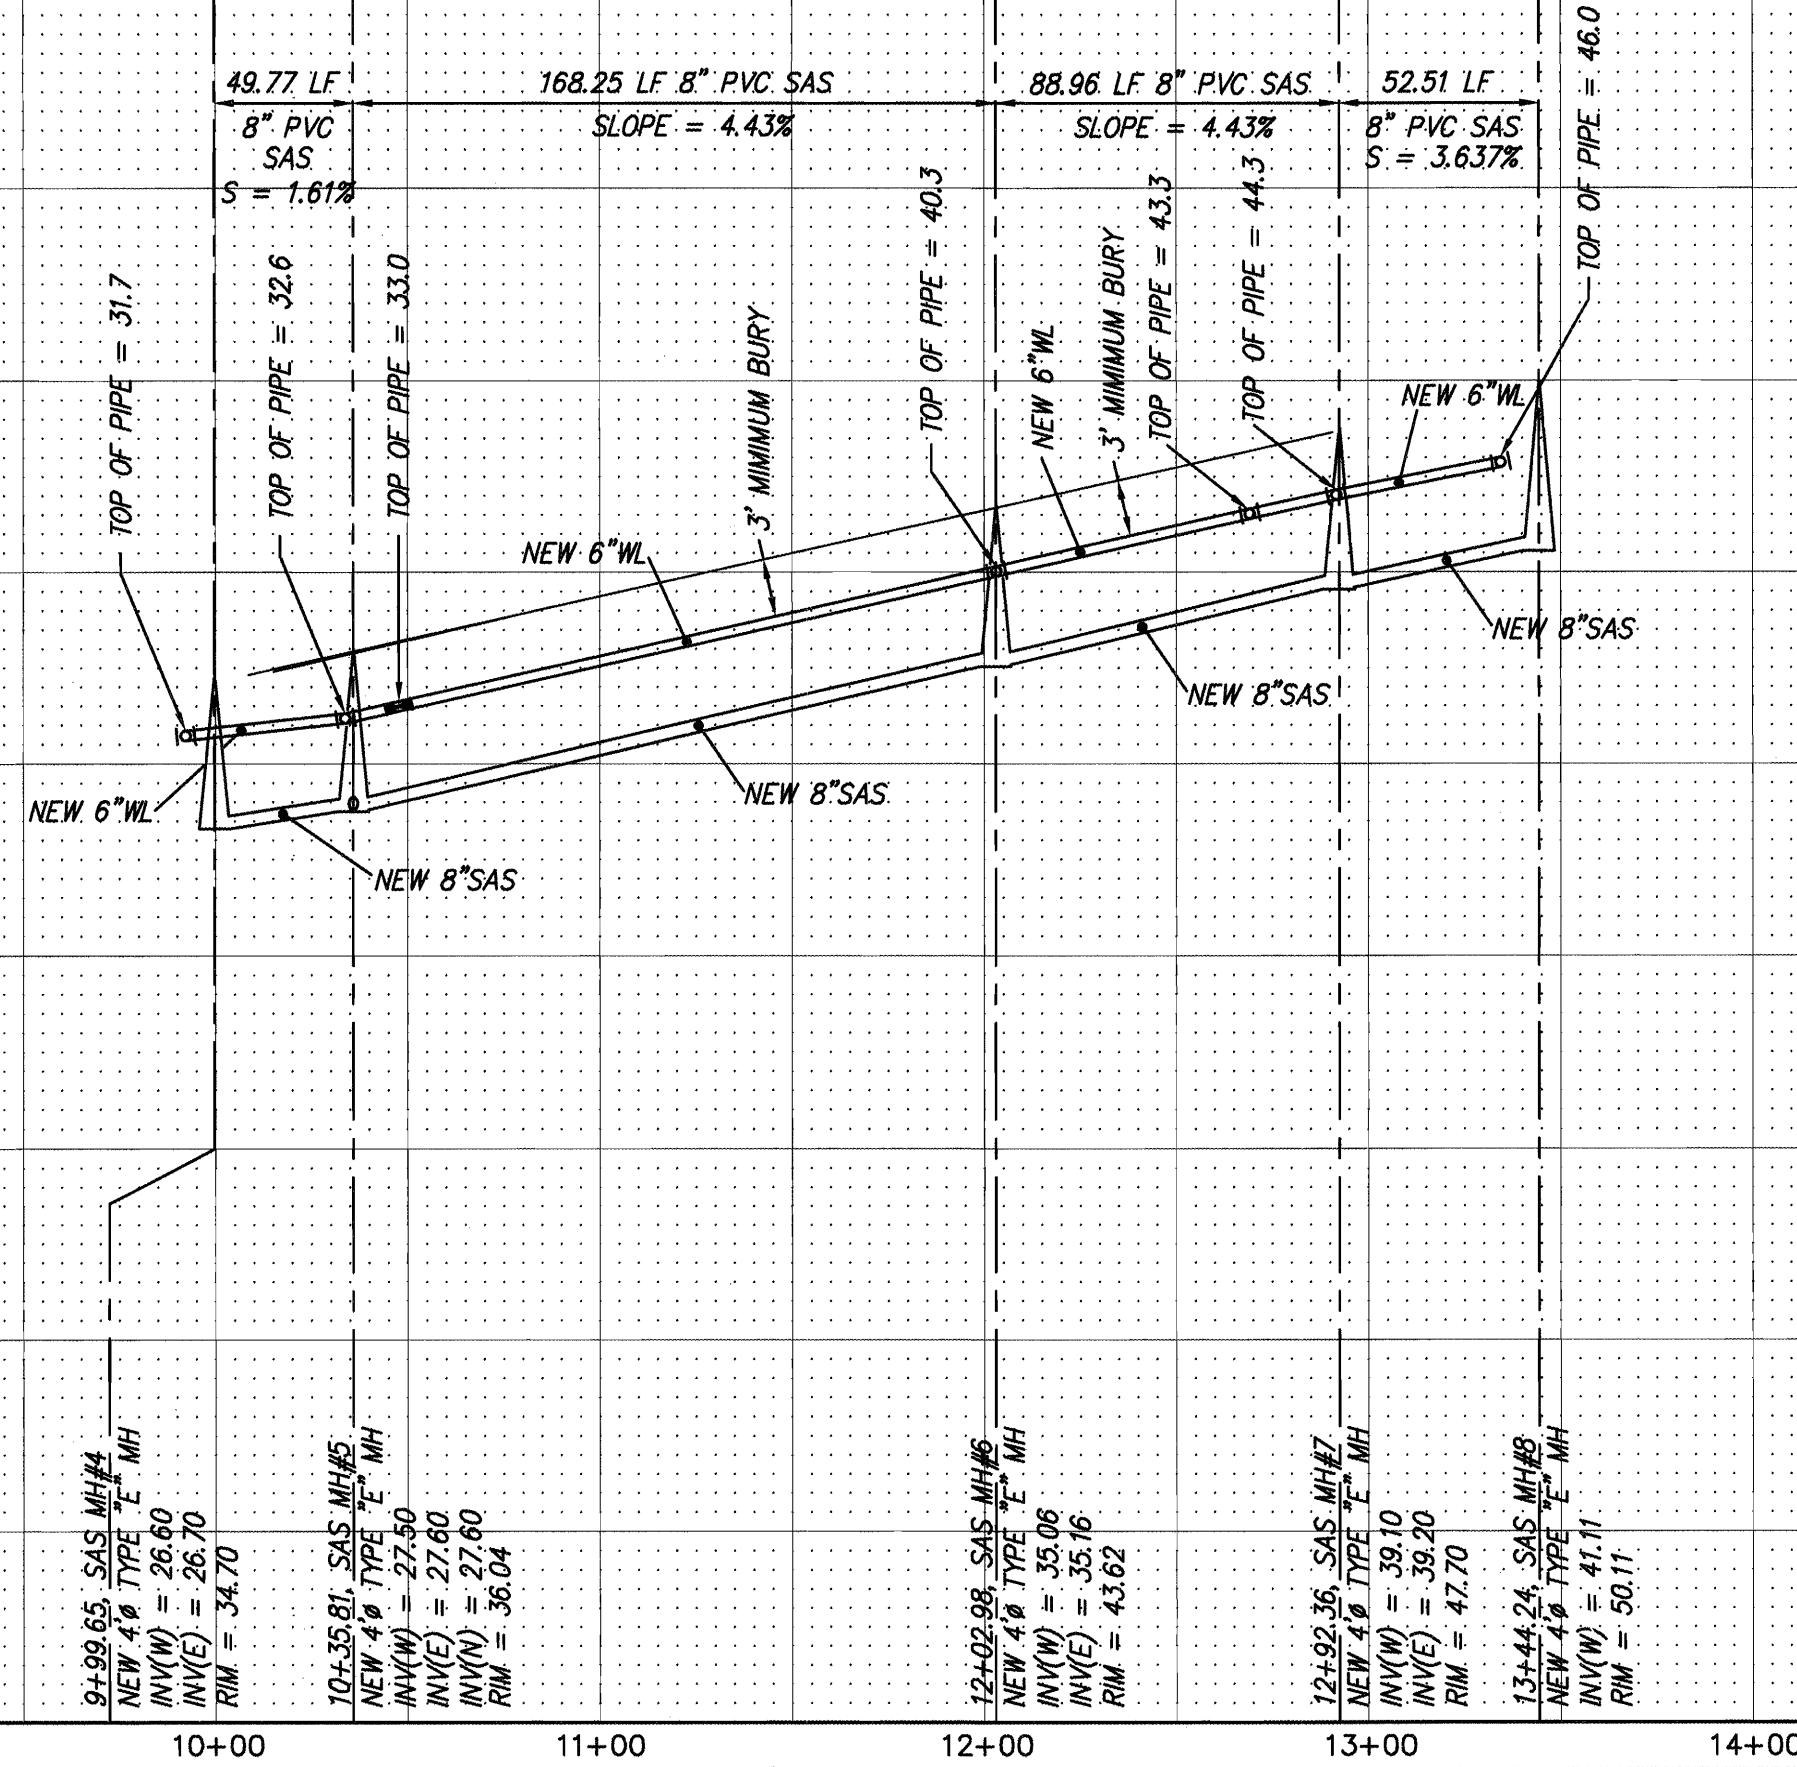

RESTRAINED JOINT LENGTH FOR BENDS, VALVES, DEAD ENDS (FT.)					
PIPE SIZE	90°	45°	22.5°	11.25°	VALVE
6"	17'	7'	3'	2'	46"
8"	22'	9'	4'	2'	60"

LENGTH OF RESTRAINED PIPE ON EACH SIDE OF
THE BEND. RESTRAIN BRANCH AT FITTING ONLY
MINIMUM ATTACHED PIPE LENGTH, RUN SIDE
OF TEE: 10.00 FEET.

RESTRAINED JOINT LENGTHS FOR REDUCERS (FT.)		
PIPE SIZE	LARGE SIDE	SMALL SIDE
8" X 6"	25'	33'


RESTRAINED JOINT LENGTH FOR TEES (FT.)		
PIPE SIZE	RUN	BRANCH
10"x10"x10"	—	—
8"x8"x6"	7'	5'
6"x6"x6"	10'	2'

	CITY OF ALBUQUERQUE PUBLIC WORKS DEPARTMENT ENGINEERING DEVELOPMENT GROUP
	TITLE: <i>STONEBROOKE ESTATES UTILITY IMPROVEMENTS PEBBLE STONE PLACE</i>


CITY ENGINEER APPROVAL

MO./DAY/YR.	MO./DAY/YR.

	SHEET	OF
--	-------	----

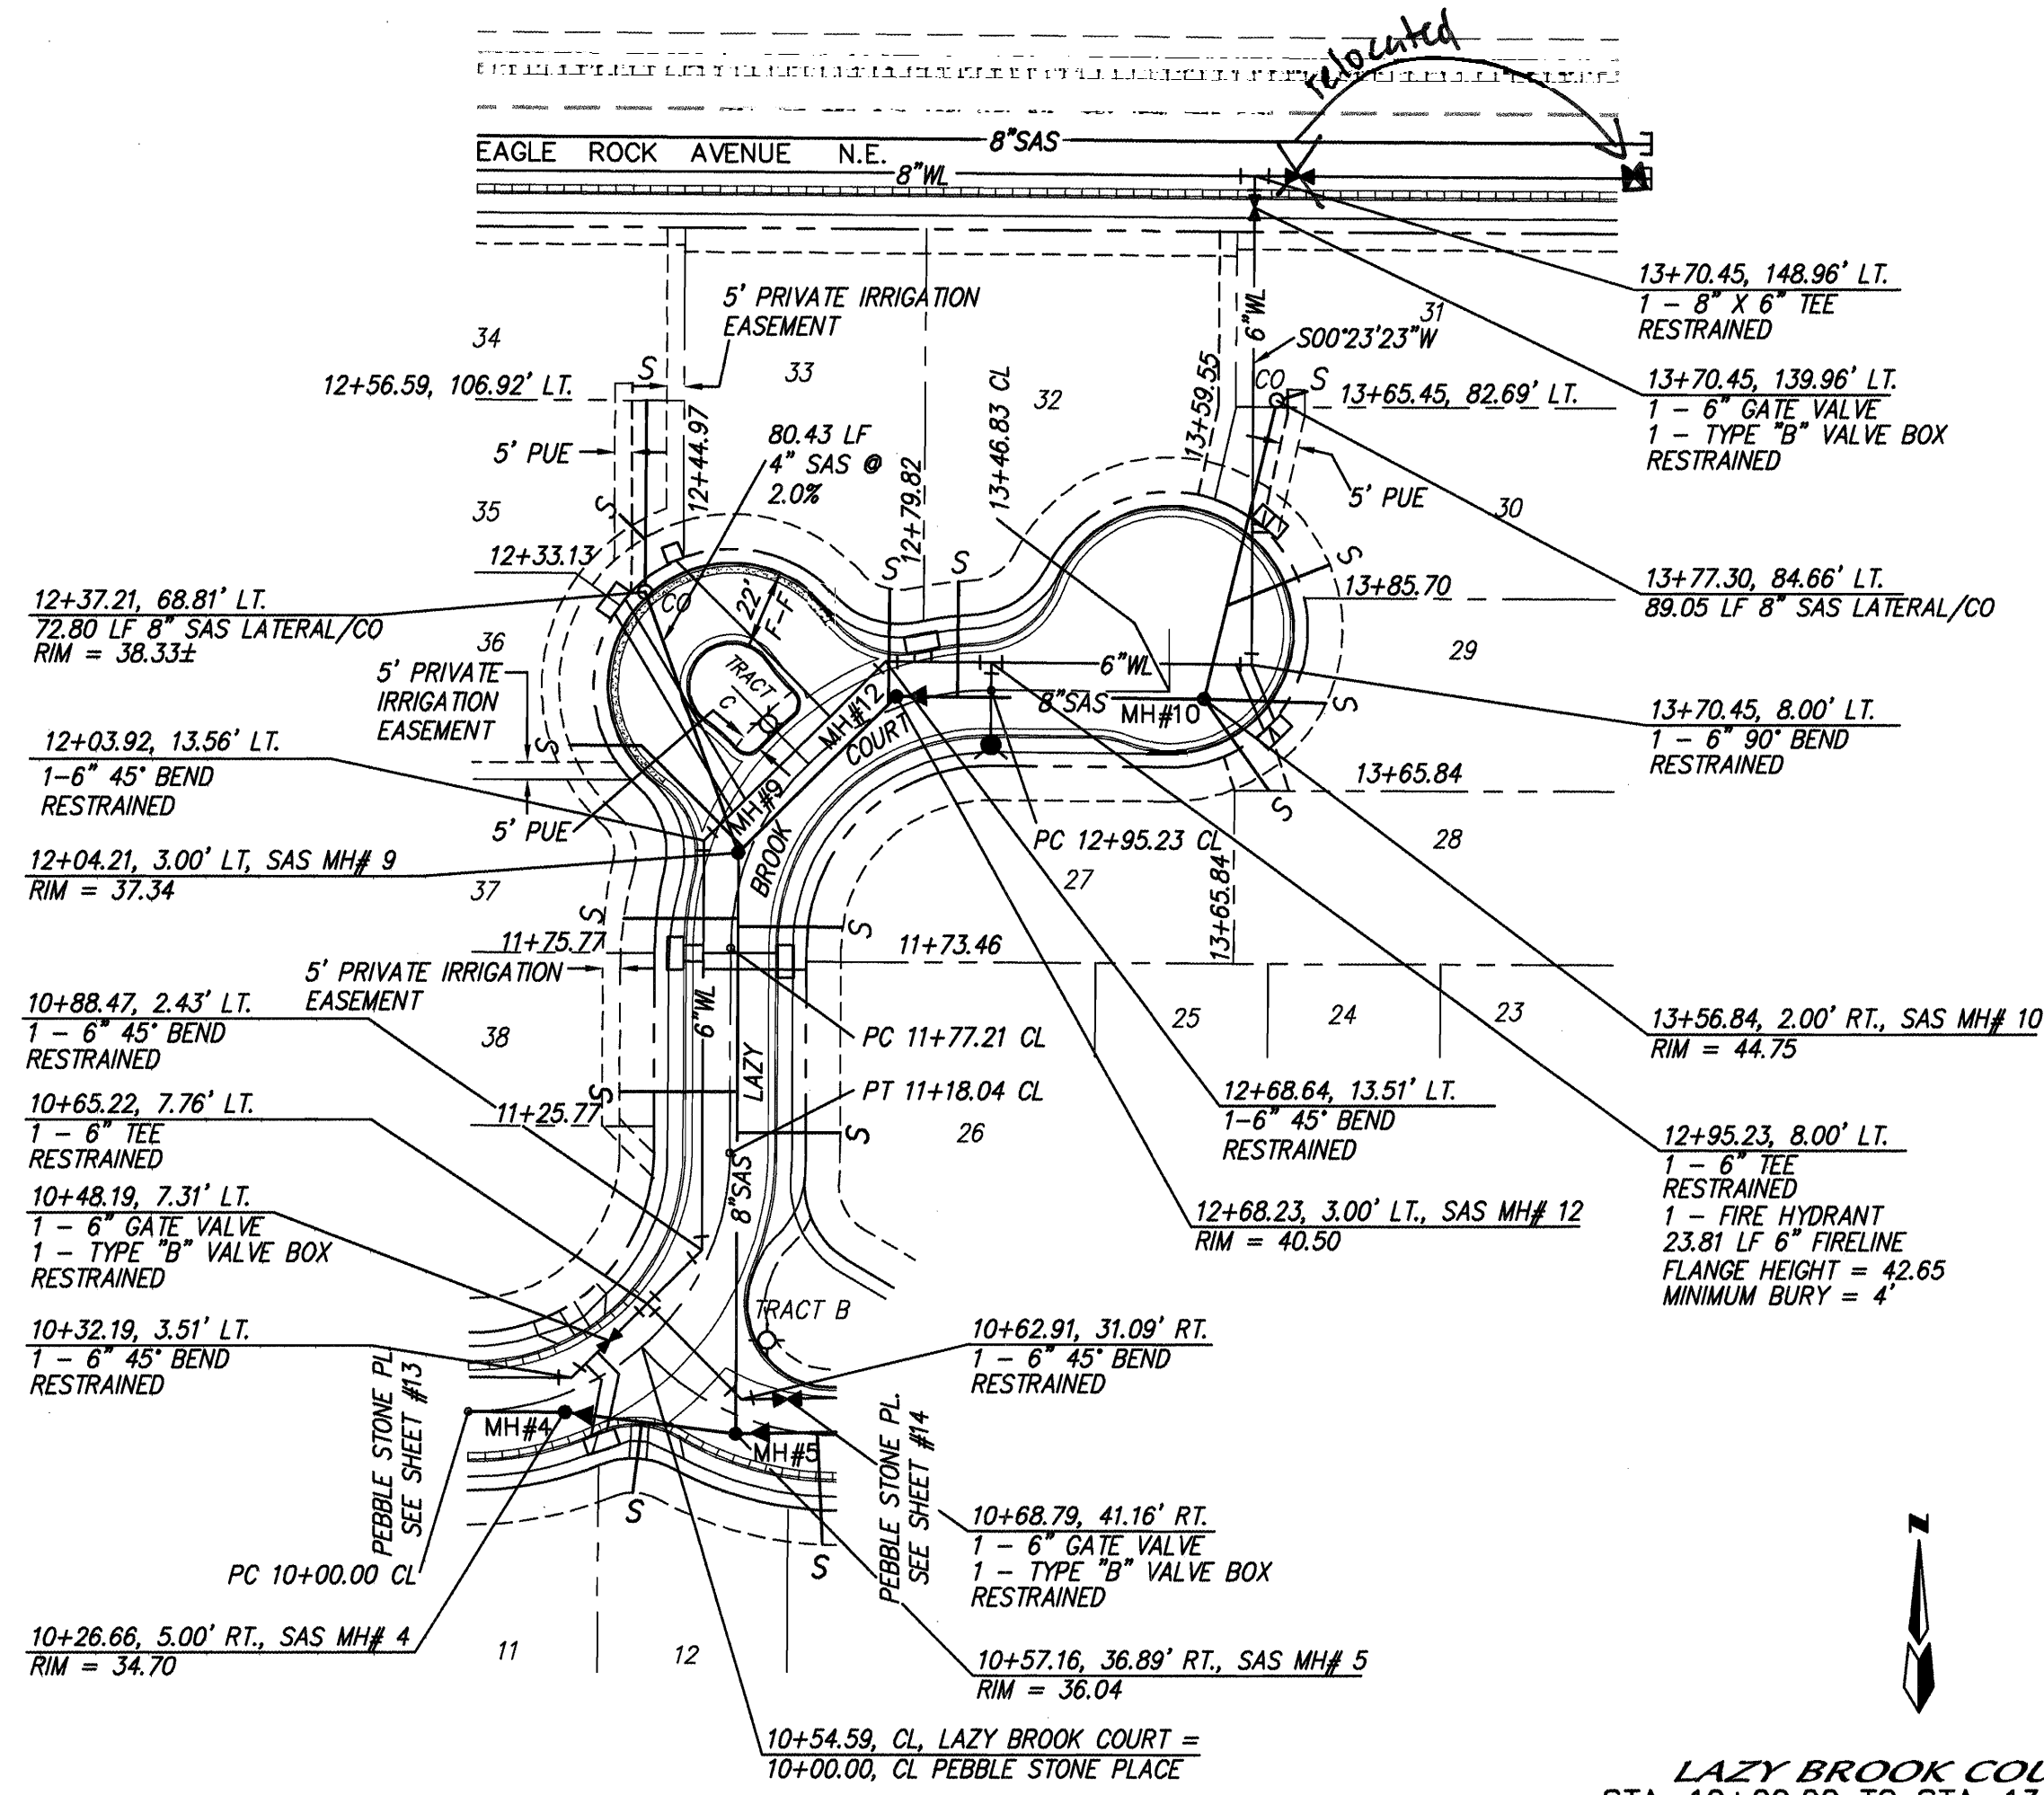

LAZY BROOK COURT
STA. 10+00.00 TO STA. 13+85.70
SCALE: HORIZ. 1" = 50'
VERT. 1" = 10'

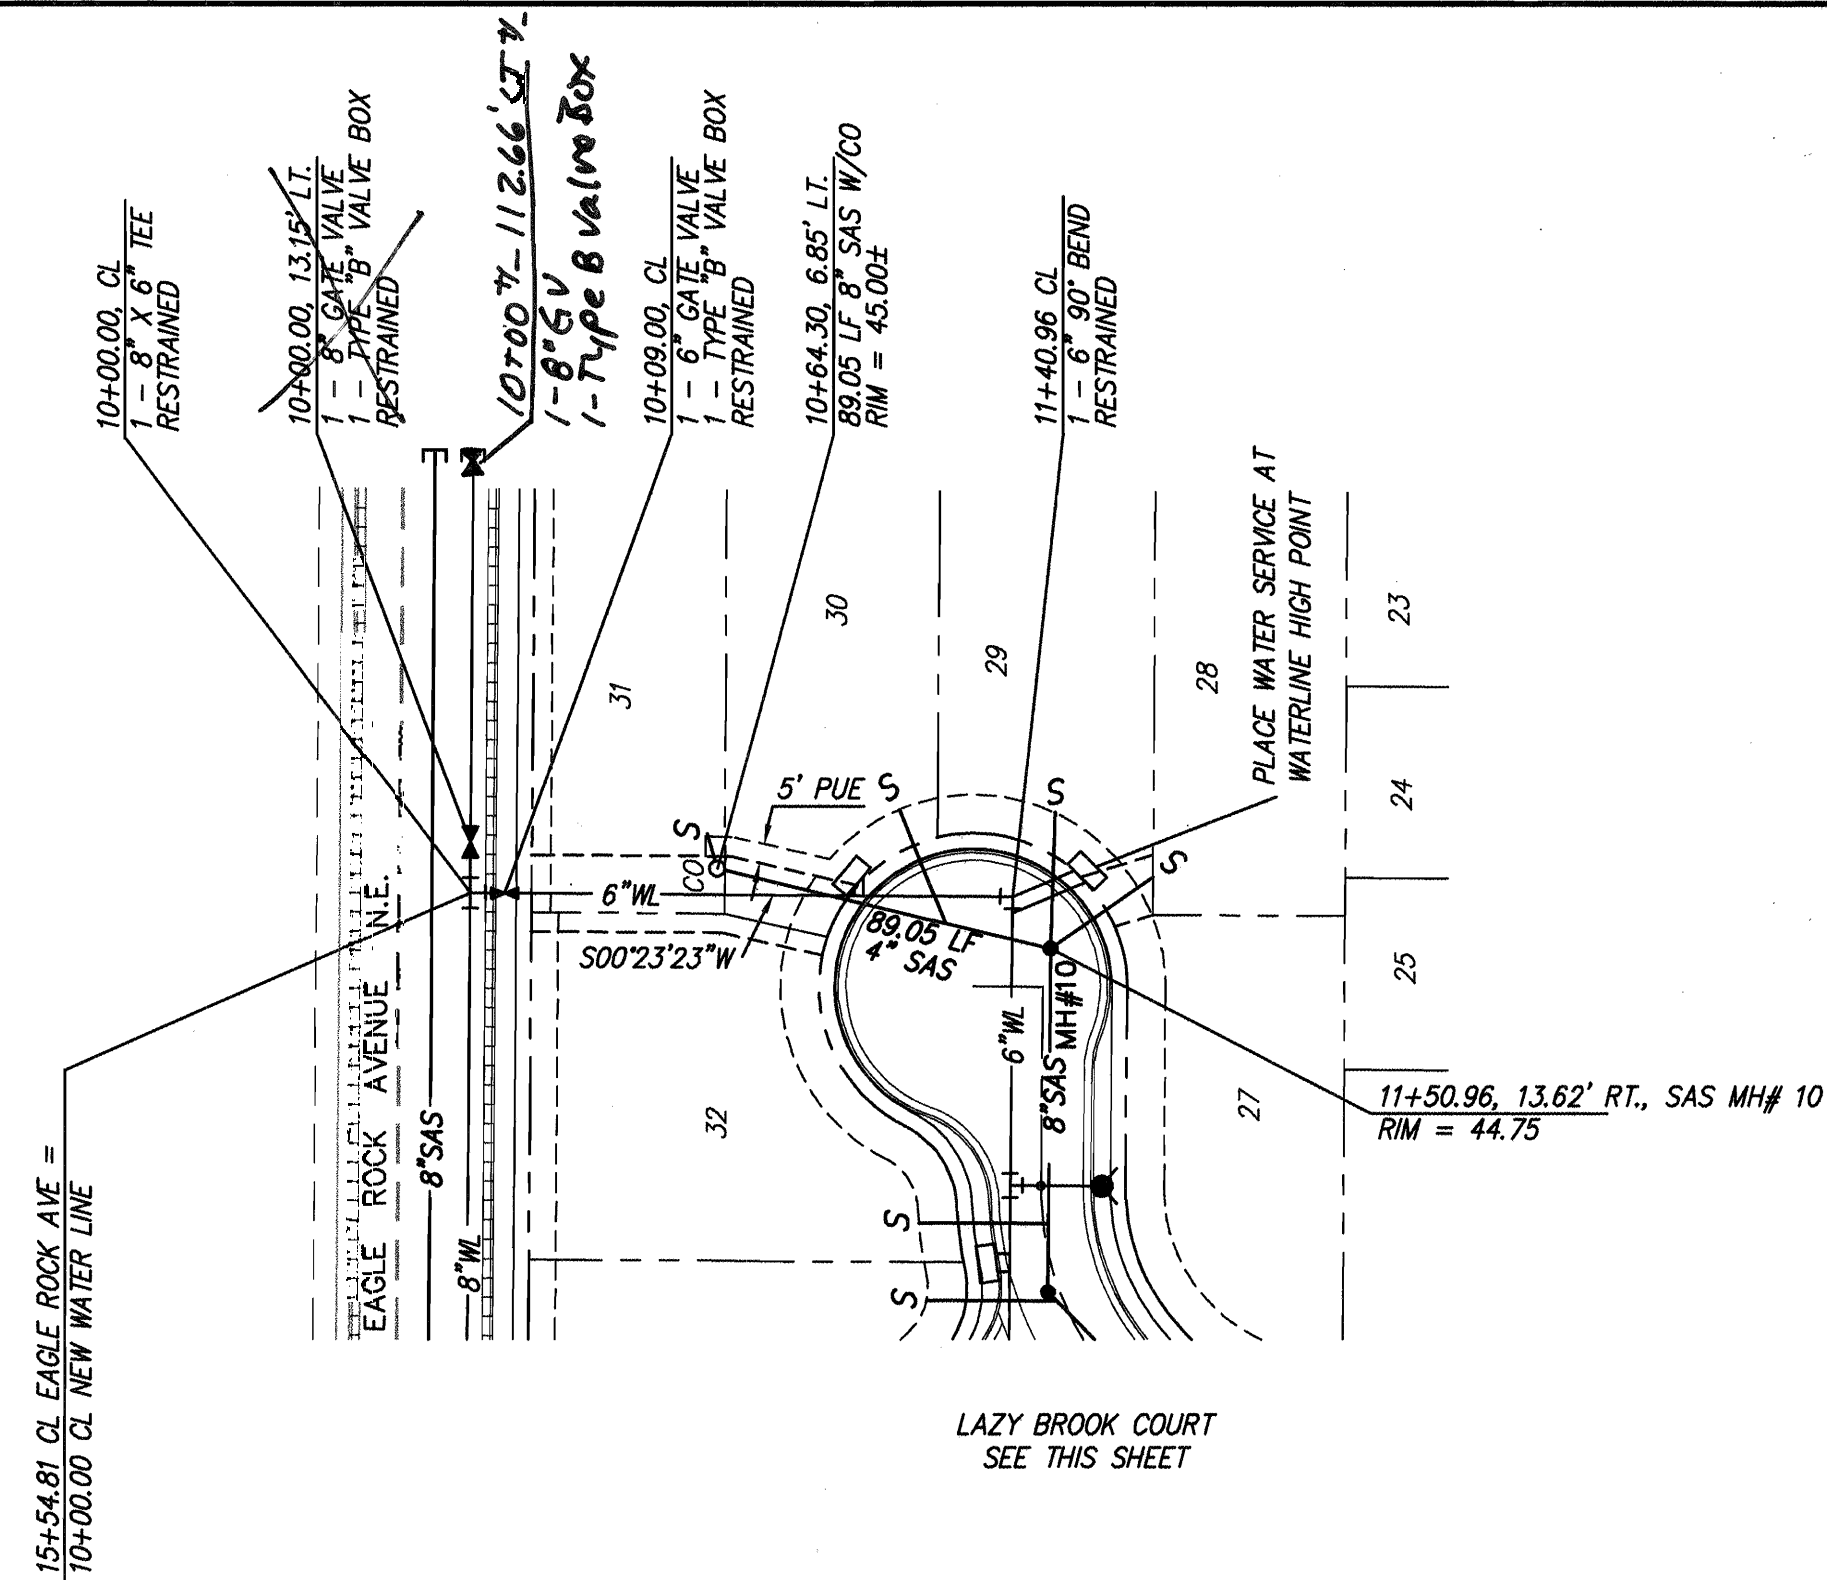



LAZY BROOK COURT
STA. 10+00.00 TO STA. 11+40.96
SCALE: HORIZ. 1" = 50'
VERT. 1" = 10'

49.77 LF 8" PVC SAS
SLOPE = 1.61%

167.83 LF 8" PVC SAS
SLOPE = 0.700%

64.58 LF 8" PVC SAS
SLOPE = 4.093%

89.08 LF 8" PVC SAS
SLOPE = 4.093%

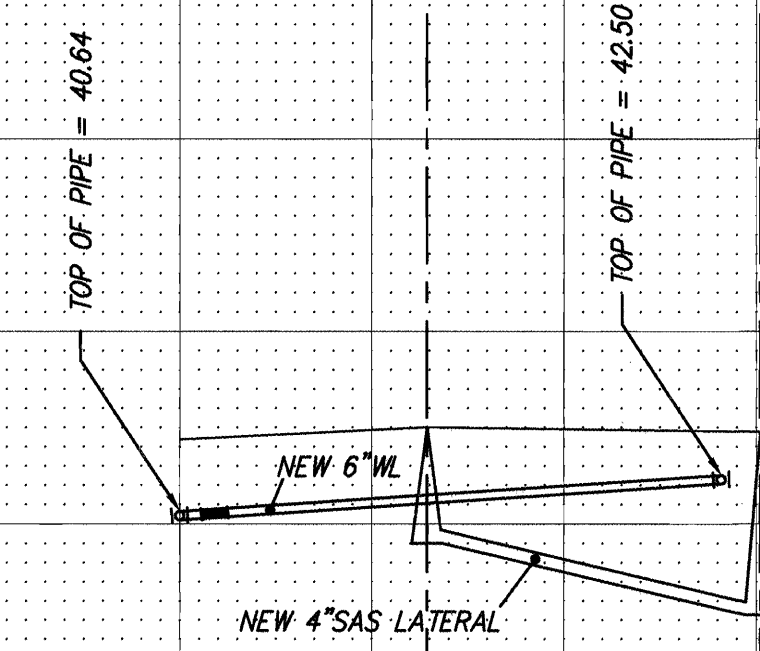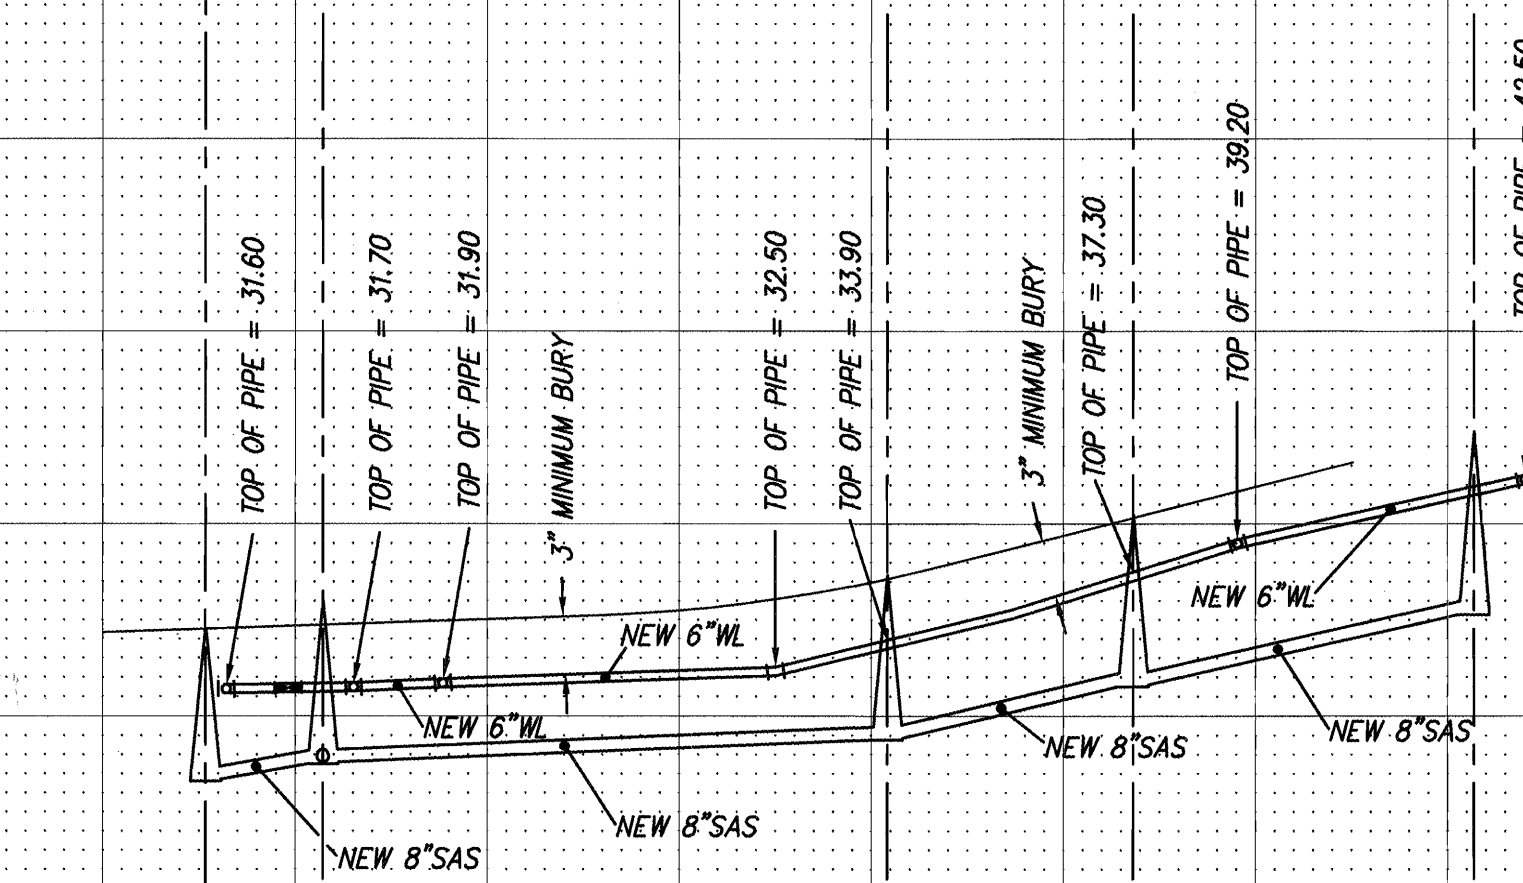

NOTES

1. ALL STATIONING IS CENTERLINE STATIONING.

SANITARY SEWER SERVICES

LOT	STATION AT PUE	INV. ELEV. AT PUE	LENGTH AT PUE
26	11+24.06	30.52	30.00
27	11+88.15	31.93	30.46
28	13+75.84, 28.57R	41.09	32.67
29	13+92.25, 2.91R	40.83	35.43
30	13+92.89, 37.47L	41.07	32.09
31	13+86.19, 87.31L	40.00	7.27
32	12+88.36	36.64	33.55
33	12+74.37	35.81	33.63
34	12+52.75, 112.56L	34.54	55.39
35	12+41.87, 90.40L	34.50	10.54
36	12+10.79	33.00	62.66
37	11+83.25	31.50	33.00
38	11+35.77	30.50	34.00

RESTRAINED JOINT LENGTH FOR BENDS, VALVES, DEAD ENDS (FT.)

PIPE SIZE	90°	45°	22.5°	11.25°	VALVE
6"	17'	7'	3'	2'	46'
8"	22'	9'	4'	2'	60'

LENGTH OF RESTRAINED PIPE ON EACH SIDE OF THE BEND. RESTRAIN BRANCH AT FITTING ONLY MINIMUM ATTACHED PIPE LENGTH, RUN SIDE OF TEE: 10.00 FEET.

RESTRAINED JOINT LENGTHS FOR REDUCERS (FT.)

PIPE SIZE	LARGE SIDE	SMALL SIDE
8" X 6"	25'	33'



RESTRAINED JOINT LENGTH FOR TEES (FT.)

PIPE SIZE	RUN	BRANCH
10"x10"x10"	-	-
8"x8"x6"	7'	5'
6"x6"x6"	10'	2'



MARK GOODWIN & ASSOCIATES, P.A.
CONSULTING ENGINEERS
P.O. BOX 90606
ALBUQUERQUE, NEW MEXICO 87199
(505) 828-2200, FAX (505) 797-9539

CITY OF ALBUQUERQUE
PUBLIC WORKS DEPARTMENT
ENGINEERING DEVELOPMENT GROUP
TITLE: **STONEBROOKE ESTATES
UTILITY IMPROVEMENTS
LAZY BROOK COURT**

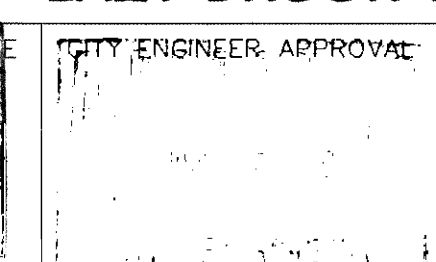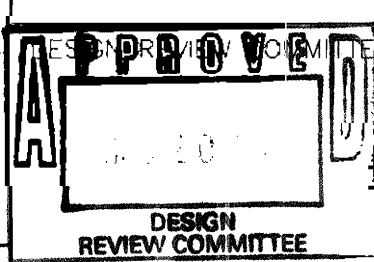

LAST DESIGN UPDATE

CITY PROJECT NO.

627281



ZONE MAP NO.

C-19-Z

SHEET OF

15 18

9050SCH\9050UT-2\12-02-99\MJR WLW

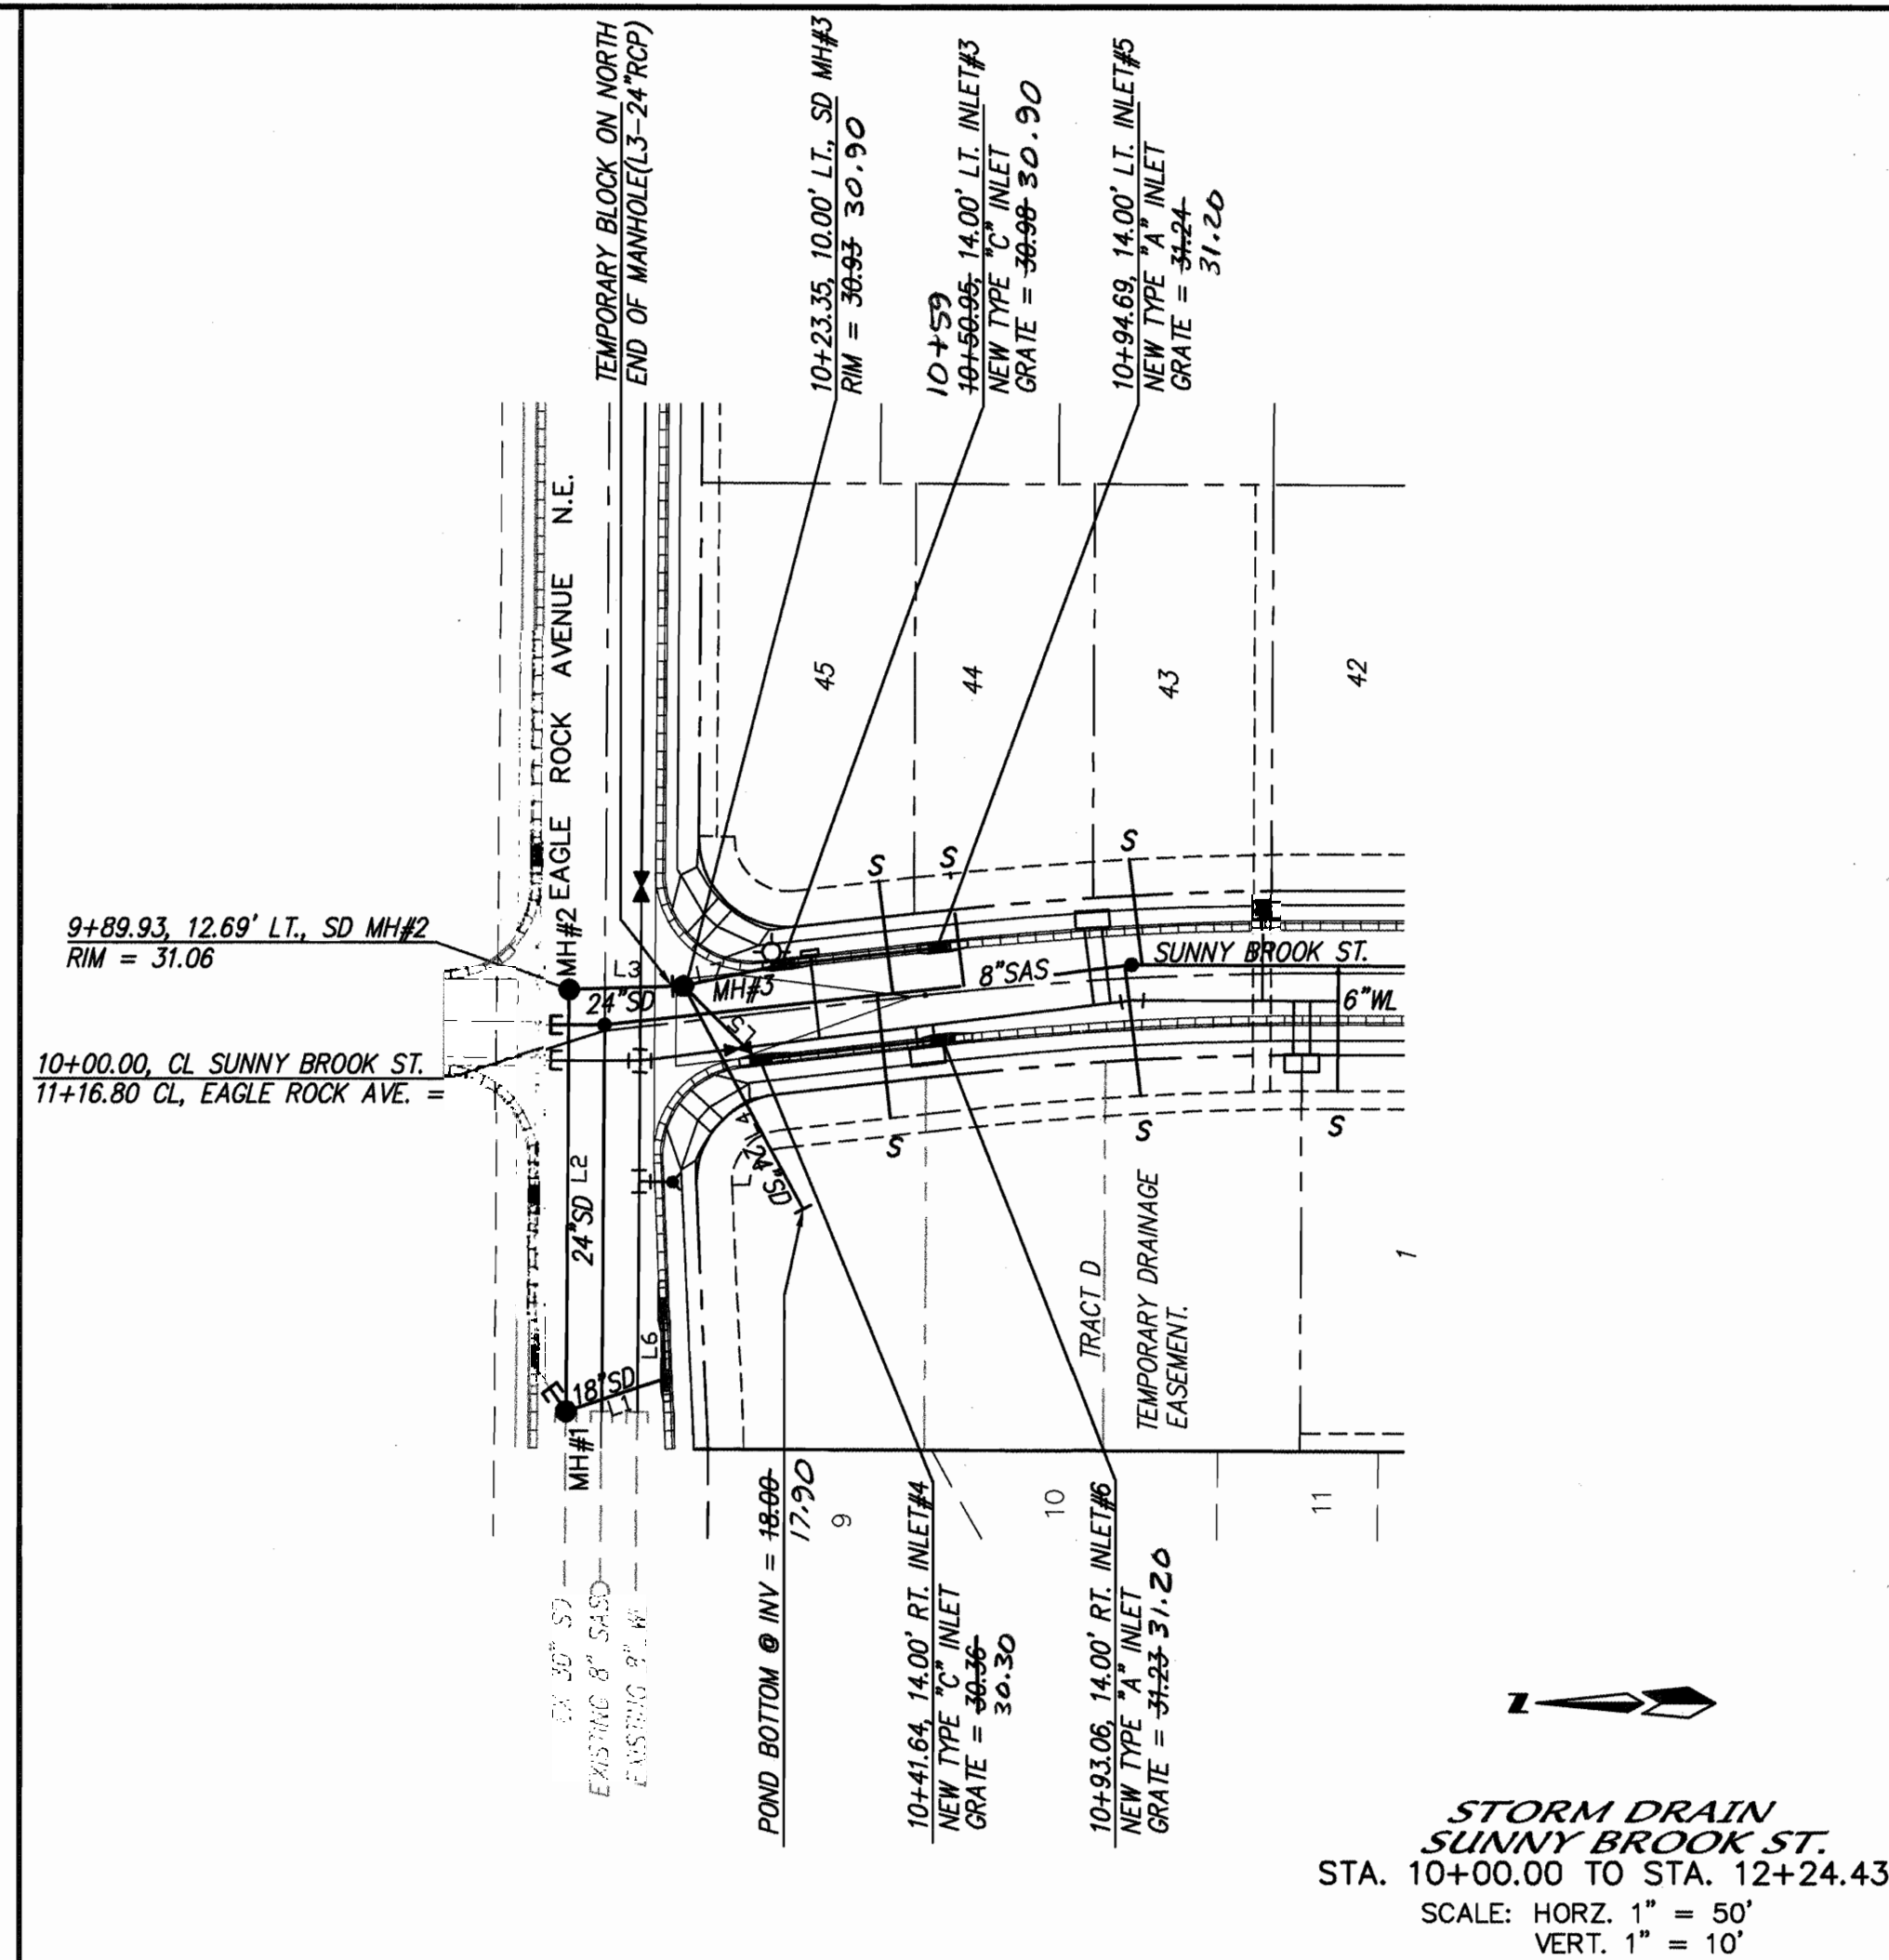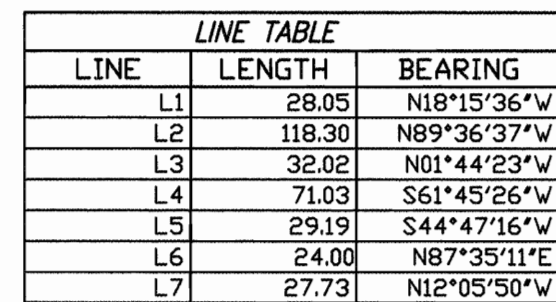

ALL STORM DRAIN IMPROVEMENTS BUILT AS PART OF
PROJECT NO. 622581, VISTA DEL AGUILA



PROJECT NO. 622581, VISTA DEL AGUILA		PROJECT NO. 622581, VISTA DEL AGUILA		PROJECT NO. 622581, VISTA DEL AGUILA	
5350					5350
5340					5340
5330					5330
5320					5320
5310					5310

NOTES

1. ALL STATIONING IS CENTERLINE STATIONING.

ENGINEER'S SEAL		SURVEY INFORMATION		BENCH MARKS		AS BUILT INFORMATION	
		FIELD NOTES					
		NO.	BY	DATE		WORKED BY	DATE
					CITY OF ALBUQUERQUE OF CONTROL MONUMENT "11-C18"	CONTRACTOR	
					A STANDARD ALUMINUM CAP SET IN A 2 1/2" PIPE, LOCATED	INSPECTOR'S	
					APPROXIMATELY 265 FEET NORTH OF THE CENTERLINE OF	ACCEPTANCE BY	
					EAGLE ROCK AVE. AND 32 FEET WEST OF THE CENTER LINE	VERIFICATION BY	
					OF LOUISIANA BLVD	DATE CORRECTED BY	
					ELEVATION 5305.0 FEET	MICRO-FILM INFORMATION	
						RECORDED BY	DATE
						NO.	

DESIGNED BY	DATE
DH	9/99

DRAWN BY	DATE
MJR	9/99

dmg MARK GOODWIN & ASSOCIATES, P.A.
CONSULTING ENGINEERS
P.O. BOX 90606
ALBUQUERQUE, NEW MEXICO 87199
(505) 828-2200, FAX (505) 797-9539

 CITY OF ALBUQUERQUE
PUBLIC WORKS DEPARTMENT
ENGINEERING DEVELOPMENT GROUP

TITLE: ***STONE BROOKE ESTATES
STORM DRAIN IMPROVEMENTS***

APPROVED







DESIGN
REVIEW COMMITTEE

DEC 20 1999

CHY ENGINEER APPROVAL

JAN 5 2000

CITY PROJECT NO.	ZONE MAP NO.	SHEET	OF
627281	C-19-Z	16	18

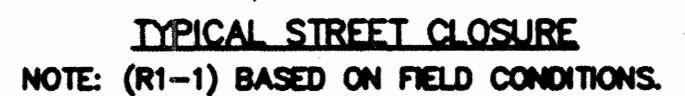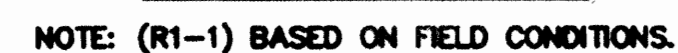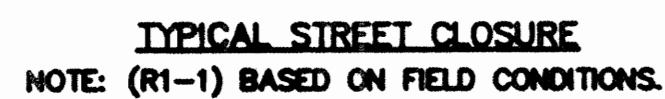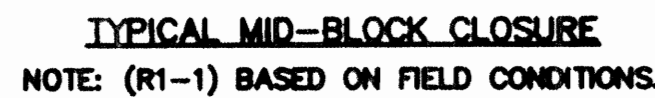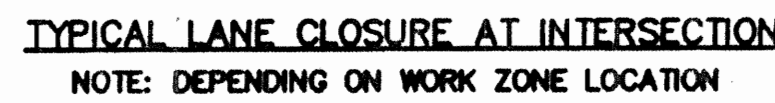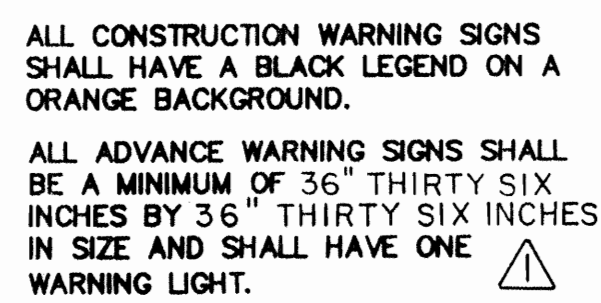

CITY OF ALBUQUERQUE PUBLIC WORKS DEPARTMENT ENGINEERING DEVELOPMENT GROUP				
TITLE: Stonebrooke Estates TYPICAL TRAFFIC CONTROL & SIGNING EXAMPLES (REF. M.U.T.C.D.)				
DESIGN REVIEW COMMITTEE		CITY ENGINEER APPROVAL		MO./DAY/YR.
COA Standard		LAST UPDATE		MO./DAY/YR.
				MO./DAY/YR.
				MO./DAY/YR.
				MO./DAY/YR.
				MO./DAY/YR.
PROJECT NO. 627287		MAP NO. C-19		SHEET 17 OF 18



CONSTRUCTION TRAFFIC CONTROL GENERAL NOTES

- CONTRACTOR MUST OBTAIN FROM CONSTRUCTION COORDINATION AN EXCAVATION/BARRICADING PERMIT BEFORE ENGAGING IN ANY CONSTRUCTION, MAINTENANCE OR REPAIR WORK IN ANY OF THE CITY OF ALBUQUERQUE'S RIGHTS-OF-WAY. EMERGENCY WORK THAT WOULD PRESERVE LIFE OR PROPERTY IS EXCLUDED WITH THE UNDERSTANDING, THAT A PERMIT SHALL BE OBTAINED WITHIN 24 TO 48 HOURS.
- CONTRACTOR SHALL AT THE TIME OF PERMIT REQUEST, SUBMIT FOR APPROVAL BY CONSTRUCTION COORDINATION, A TRAFFIC CONTROL PLAN DETAILING ALL EXISTING TOPOGRAPHY SUCH AS LANE WIDTHS, DRIVEWAYS, AND BUSINESS/RESIDENTIAL ACCESSES. THE TRAFFIC CONTROL PLAN SHALL INCLUDE ALL PHASES OF WORK AND SCHEDULES INVOLVED IN THE CONSTRUCTION PROJECT. ANY SEPARATE PHASES OF A CONSTRUCTION PROJECT SHALL BE GIVEN AN INDIVIDUAL PERMIT EACH. BLANKET PERMITS WILL NOT BE ISSUED.
- THESE TYPICAL TRAFFIC CONTROL PLANS DO NOT REFLECT THE EXISTING TOPOGRAPHY SUCH AS DRIVEWAYS, LANE WIDTHS, AND BUSINESS/RESIDENTIAL ACCESSES. EVERY LOCATION THAT REQUIRES CONSTRUCTION TRAFFIC CONTROL SHALL HAVE A DETAILED TRAFFIC CONTROL PLAN SHOWING ALL EXISTING TOPOGRAPHY.
- CONSTRUCTION SHALL NOT BEGIN UNLESS A TRAFFIC CONTROL PLAN HAS BEEN APPROVED AND VERIFIED BY CONSTRUCTION COORDINATION.
- CONSTRUCTION COORDINATION SHALL BE NOTIFIED 48 HOURS PRIOR TO ANY TRAFFIC CONTROL CHANGES NEEDED BY CONTRACTOR, THAT WERE NOT PREVIOUSLY APPROVED. THESE TRAFFIC CONTROL CHANGES SHALL BE REQUESTED IN WRITING ACCOMPANIED WITH A TRAFFIC CONTROL PLAN REFLECTING SUCH CHANGES.
- ALL CONSTRUCTION TRAFFIC CONTROL DEVICES SHALL COMPLY TO THE MANUAL ON UNIFORM TRAFFIC CONTROL DEVICES (MUTCD), LATEST EDITION. IT IS THE RESPONSIBILITY OF THE CONTRACTOR TO INSTALL, SERVICE AND MAINTAIN ALL TRAFFIC CONTROL DEVICES. TRAFFIC CONTROL DEVICES SHALL NOT BE REMOVED OR ALTERED IN ANY WAY WITHOUT THE APPROVAL OF CONSTRUCTION COORDINATION, PER SECTION 6A-4 OF THE MUTCD, LATEST EDITION.
- THE CONSTRUCTION TRAFFIC CONTROL INITIAL SET-UP SHALL BE BY AN AMERICAN TRAFFIC SAFETY SERVICES ASSOCIATION (ATSSA) CERTIFIED WORKSITE TRAFFIC SUPERVISOR. THE MAINTENANCE AND SERVICING SHALL ALSO BE DONE BY AN ATSSA CERTIFIED WORKSITE TRAFFIC SUPERVISOR OR EQUIVALENT.
- CONTRACTOR IS RESPONSIBLE TO MAINTAIN AND SERVICE ALL TRAFFIC CONTROL DEVICES 24 HOURS A DAY, 7 DAYS A WEEK THROUGHOUT LENGTH OF PROJECT. CONTRACTOR IS RESPONSIBLE THAT ALL TRAFFIC CONTROL DEVICES COMPLY WITH THE MUTCD, LATEST EDITION.
- ALL ADVANCE WARNING SIGNS SHALL BE DOUBLE INDICATED WHENEVER THERE ARE MULTI-LANE TRAFFIC IN ANY ONE GIVEN DIRECTION AND THERE IS SUFFICIENT MEDIAN SPACE.
- ALL BARRICADES IN ALL TAPERS AND TANGENTS SHALL BE PLACED APART, A DISTANCE MEASURED IN FEET, EQUAL TO THAT OF THE POSTED SPEED LIMIT. NO EXCEPTIONS UNLESS APPROVED BY CONSTRUCTION COORDINATION PER MUTCD SECTION 6A-4.
- ALL WORK IN ARTERIAL ROADWAYS SHALL BE ON A CONTINUOUS 24-HOUR PER DAY BASIS UNTIL COMPLETED.
- CONTRACTOR IS RESPONSIBLE TO PROVIDE CONSTRUCTION COORDINATION, A WEEKLY LOG OF DAILY INSPECTIONS OF BARRICADE AND MAINTENANCE SCHEDULES ON PROJECTS THAT ARE OVER ONE WEEK DURATION.
- EQUIPMENT OR MATERIALS SHALL NOT BE STORED WITHIN 15 FEET OF A TRAVELLED TRAFFIC LANE DURING NON-WORKING HOURS WITHOUT THE APPROVAL OF CONSTRUCTION COORDINATION.
- CONTRACTOR SHALL PROVIDE AND MAINTAIN A SAFE AND ADEQUATE MEANS OF CHANNELIZING PEDESTRIAN TRAFFIC AROUND AND THROUGH THE CONSTRUCTION AREA.
- CONTRACTOR IS RESPONSIBLE FOR OBLITERATION OF ANY CONFLICTING STRIPING AND RESPONSIBLE FOR ALL TEMPORARY STRIPING.
- CONTRACTOR SHALL MAINTAIN ACCESS TO ALL FACILITIES, BUSINESSES AND/OR RESIDENTS AT ALL TIMES.
- CONTRACTOR SHALL PROVIDE ACCESS SIGNS FOR BUSINESSES LOCATED WITHIN THE CONSTRUCTION AREA UNDER THE SUPERVISION OF CONSTRUCTION COORDINATION. EACH ACCESS SIGN SHALL HAVE 5 INCH, WHITE OPAQUE LETTERING ON BLUE REFLECTORIZED BACKGROUND. ACCESS SIGNS SHALL BE CONSIDERED INCIDENTAL TO THE BID AND NOT PART OF THE CONTRACT UNLESS OTHERWISE STATED. NO MORE THAN 3 BUSINESSES SHALL BE LISTED ON A ACCESS SIGN. SHOPPING CENTERS AND MALLS SHALL BE LISTED AS SUCH.
- ALL ADVANCE WARNING SIGNS SHALL MEET THE MINIMUM REFLECTIVE INTENSITY REQUIREMENTS SET FORTH BY THE CITY OF ALBUQUERQUE. CONSTRUCTION COORDINATION SHALL DETERMINE ALL REQUIREMENTS AND APPROVE OR DISAPPROVE ANY ADVANCE WARNING SIGN PER SECTION 6A-4 OF THE MUTCD, LATEST EDITION.
- 48 HOURS PRIOR TO OCCUPYING OR CLOSING OF A RIGHT-OF-WAY, CONTRACTOR SHALL NOTIFY: POLICE, FIRE DEPARTMENT, SCHOOLS, HOSPITALS, TRANSIT AUTHORITY, BUSINESSES AND/OR RESIDENTS THAT WILL BE AFFECTED BY THE CONSTRUCTION.
- ANY FIELD ADJUSTMENTS SHALL BE APPROVED BY CONSTRUCTION COORDINATION.

- EXCAVATIONS SHALL BE PLATED, TEMPORARILY PATCHED OR RESURFACED PRIOR TO OPENING OF TRAFFIC. A MINIMUM OF 11 FEET SHALL BE PROVIDED FOR TRAFFIC IN ANY GIVEN DIRECTION. CONTRACTOR IS RESPONSIBLE FOR ANY WORK INVOLVED IN SATISFYING THESE REQUIREMENTS.
- CONTRACTOR SHALL AT ALL TIMES COMPLY WITH THE FOLLOWING:
 - STANDARDS AND REQUIREMENTS SET FORTH IN THE MANUAL ON UNIFORM TRAFFIC CONTROL DEVICES, LATEST EDITION.
 - THE CITY OF ALBUQUERQUE TRAFFIC CODE, LATEST EDITION.
 - SECTION 19 OF THE CITY OF ALBUQUERQUE'S STANDARD SPECIFICATIONS FOR PUBLIC WORK CONSTRUCTION, AS WELL AS OTHER SECTIONS.
- FAILURE TO COMPLY WITH ANY OF THE ABOVE MENTIONED, WILL BE ADEQUATE CAUSE TO CEASE ALL WORK ON ANY CONSTRUCTION PROJECT. WORK WILL NOT RESUME UNTIL ALL REQUIREMENTS ARE ADDRESSED AND APPROVED BY CONSTRUCTION COORDINATION.
- ALL TRAFFIC CONTROL DEVICES SHALL BE KEPT IN NEW-CLEAN CONDITION. WASHING OF EQUIPMENT IS INCIDENTAL TO ITS PLACEMENT AND MAINTENANCE.
- TRAFFIC CONTROL STANDARDS APPLY ONLY WHERE THE CONSTRUCTION TRAFFIC CONTROL PLANS ARE NOT SPECIFIC.

- ADVANCE WARNING SIGNS SHALL BE 36"x36" MIN. WITH SUPER ENGINEERING GRADE SHEETING OR BETTER. MOUNTING HEIGHT AT TOP OF SIGN SHALL BE THE SAME AS FOR A 48" SIGN AS INDICATED IN THE M.U.T.C.D.
- CONTRACTOR SHALL MAINTAIN A GRAFFITI-FREE WORKSITE. ALL GRAFFITI SHALL BE PROMPTLY REMOVED FROM ALL EQUIPMENT, BOTH PERMANENT AND TEMPORARY.

SIGN FACE DETAILS

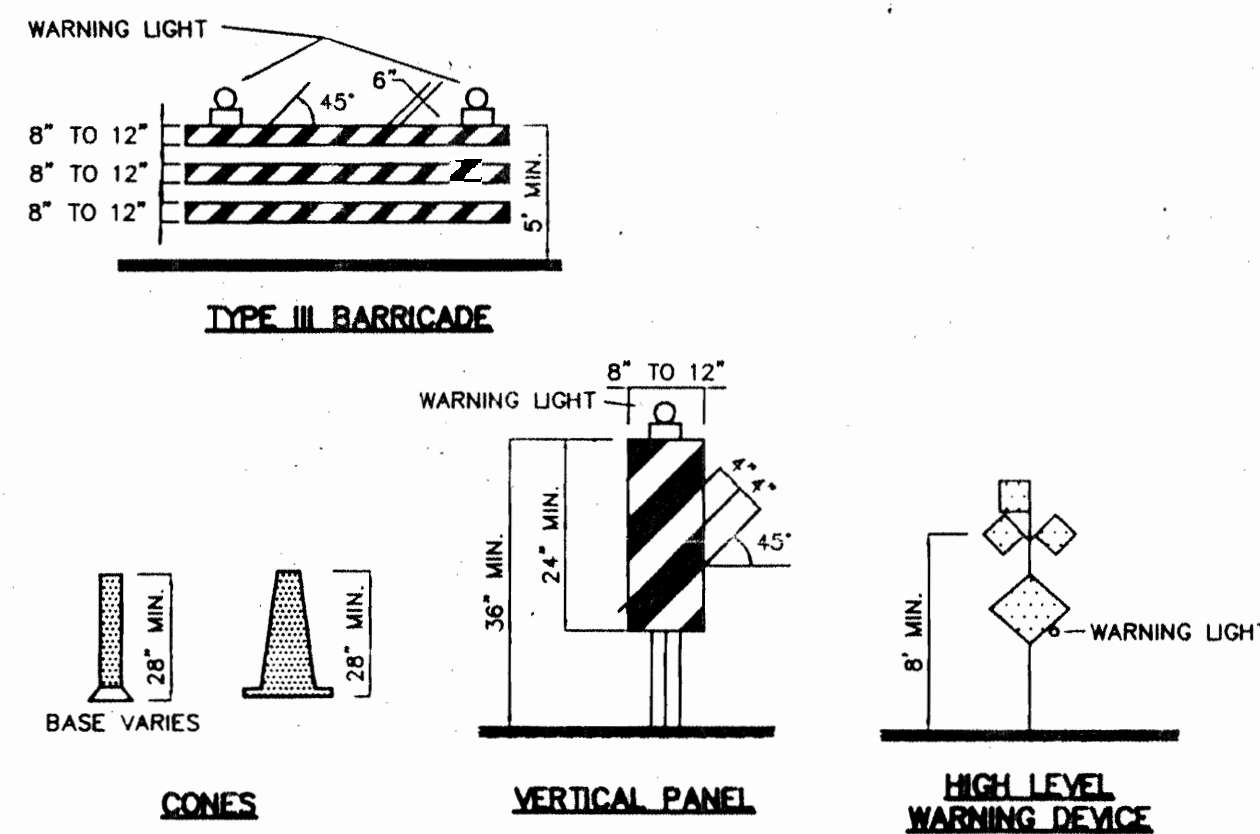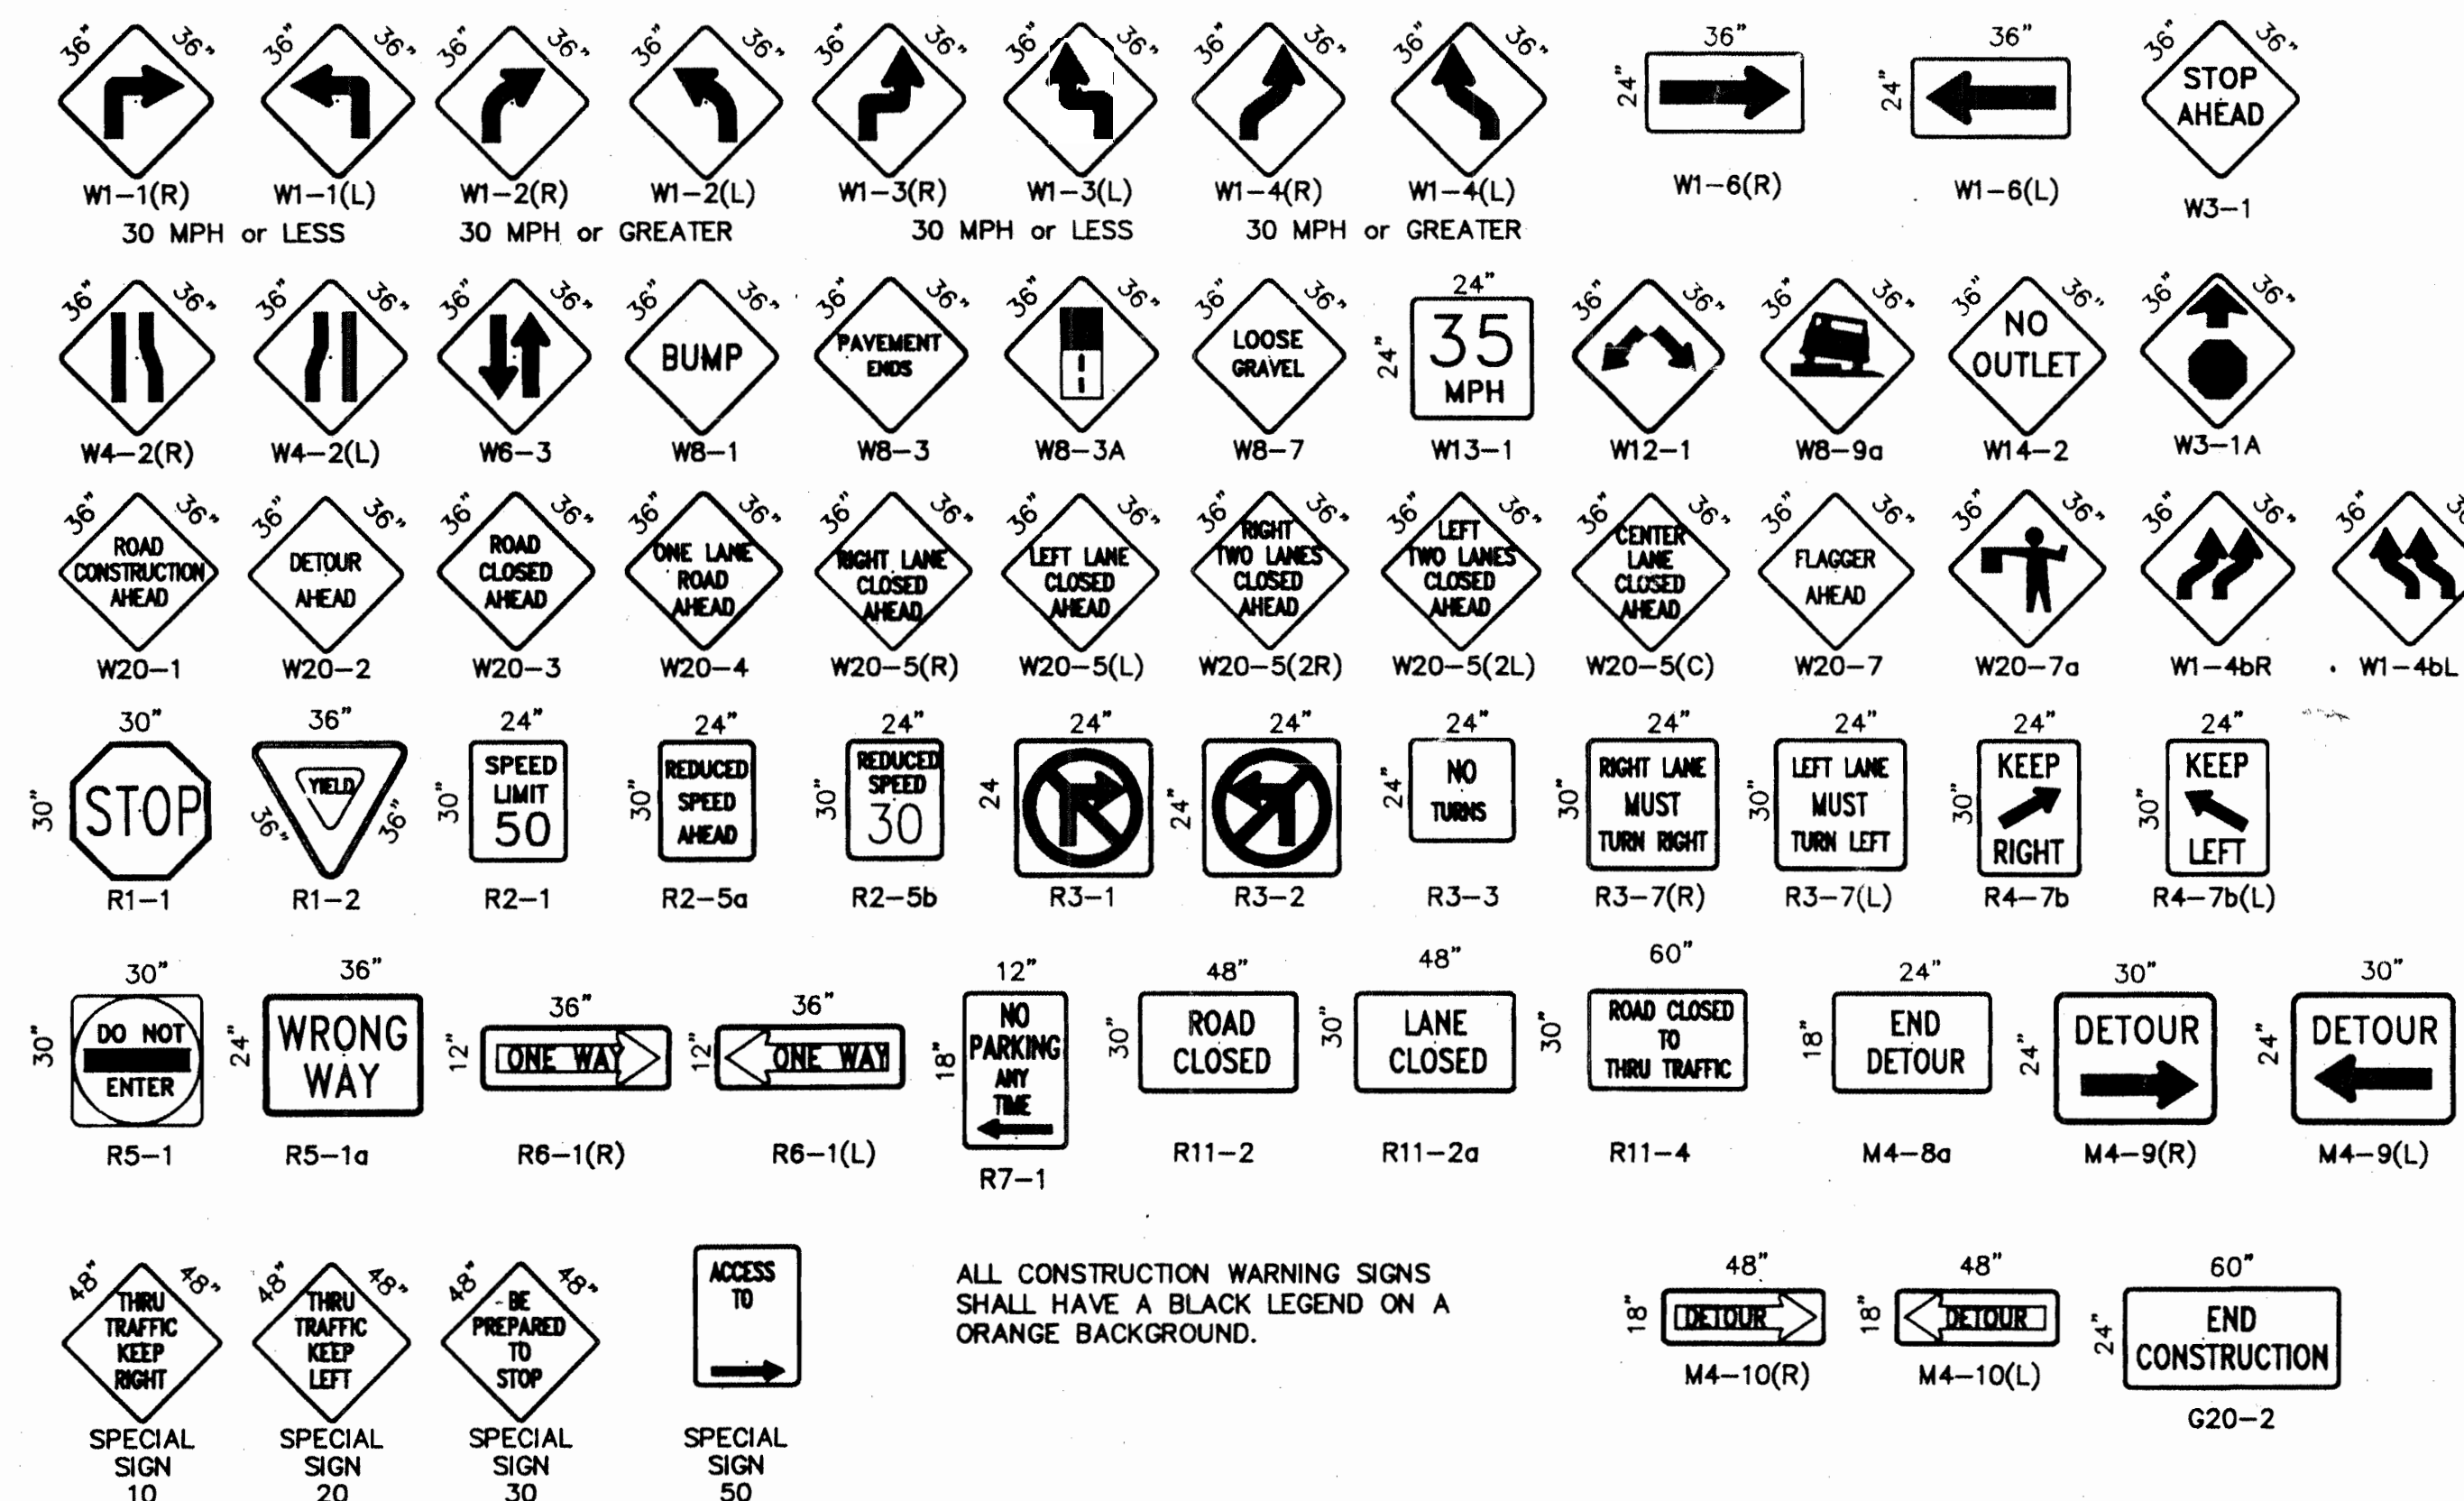

- LEGEND**
- WORK AREA
 - BARRICADE - TYPE I, TYPE II, OR BARREL
 - BARRICADE - TYPE III
 - VERTICAL PANEL
 - WARNING SIGN
 - DISTANCE BETWEEN SIGNS - A DISTANCE MEASURED IN FEET EQUAL TO A VALUE OF TEN TIMES THE SPEED LIMIT OF THE STREET
 - FLAGMAN POSITION
 - SPACING BETWEEN BARRICADES- A DISTANCE MEASURED IN FEET EQUAL TO THE SPEED LIMIT OF THE STREET
 - TAPER LENGTH - SEE CHART BELOW
- THE TANGENT LENGTH IS EQUAL TO THE TAPER LENGTH FOR A GIVEN STREET.

TAPER REQUIREMENTS

SPEED LIMIT (MPH)	TAPER LENGTH (L) (FEET)				MINIMUM NUMBER OF DEVICES FOR TAPER	MAXIMUM DEVICE SPACING IN FEET	
	10' LANE	11' LANE	12' LANE	12' LANE		ALONG TAPER	AFTER TAPER
20	70	75	80	80	5	20	20
25	105	115	125	125	6	25	25
30	150	165	180	180	7	30	30
35	205	225	245	245	8	35	35
40	270	295	320	320	9	40	40
45	450	495	540	540	13	45	45
50	500	550	600	600	13	50	50
55	550	605	660	660	13	55	55

RECOMMENDED SIGN SPACING(D) FOR ADVANCE WARNING SIGN SERIES

SPEED LIMIT (MPH)	MINIMUM DISTANCE IN FEET BETWEEN SIGNS	MINIMUM DISTANCE IN FEET FROM LAST SIGN TO TAPER
0-20	10 X SPEED LIMIT	10 X SPEED LIMIT
25-30	10 X SPEED LIMIT	10 X SPEED LIMIT
30-35	10 X SPEED LIMIT	10 X SPEED LIMIT
40-45	10 X SPEED LIMIT	10 X SPEED LIMIT
50-60	10 X SPEED LIMIT	10 X SPEED LIMIT

TAPER CRITERIA

TYPE OF TAPER	TAPER LENGTH
UPSTREAM TAPER:	
MERGING TAPER	L MINIMUM
SHIFTER TAPER	1/2 L MINIMUM
SHOULDER TAPER	1/2 L MINIMUM
TWO-WAY TRAFFIC TAPER	100 FEET MAXIMUM
DOWNSTREAM TAPERS	100 FEET PER LANE

TAPER LENGTH COMPUTATION

SPEED LIMIT	L = WS ² / 60
40 MPH OR LESS	L = WS ² / 60
45 MPH OR GREATER	L = W x S

L = TAPER LENGTH
W = WIDTH OF OFFSET IN FEET
S = POSTED SPEED OR OFF-PEAK 85-PERCENTILE SPEED IN MPH

CITY OF ALBUQUERQUE
PUBLIC WORKS DEPARTMENT
ENGINEERING DEVELOPMENT GROUP

TITLE: **Stonebrooke Estates**
SIGNING AND CONSTRUCTION TRAFFIC CONTROL STANDARDS

DESIGN REVIEW COMMITTEE: **C O A**
CITY ENGINEER APPROVAL: **Standard**

PROJECT NO. **627281** MAP NO. **C-19** SHEET **18** OF **18**