


Albuquerque Bernalillo County
Water Utility Authority

CONSTRUCTION PLANS
FOR

SMALL DIAMETER WATER AND SEWER REHABILITATION FY11

PROJECT NO. 6312.92

INDEX OF DRAWINGS			
Sheet Number	Sheet Title	Zone Map	Description
1	COVER		
2	GENERAL NOTES & LEGEND		
3	LOCATION MAP		
(1) 4	ALLEY BTWN SAN MATEO PL. & MADEIRA DR. STA. 10+00 TO STA. 16+75	H-18	WATERLINE REPLACEMENT
(1) 5	ALLEY BTWN MADEIRA DR. & LA VETA DR. STA. 10+00 TO STA. 18+80	H-18	WATERLINE REPLACEMENT
(1) 6	ALLEY BTWN MADEIRA DR. & LA VETA DR. STA. 18+80 TO STA. 21+13	H-18	WATERLINE REPLACEMENT
(1) 7	ALLEY BTWN LA VETA DR. & PALOMAS DR. STA. 10+00 TO STA. 18+80	H-18	WATERLINE/SEWER LINE REPLACEMENT
(1) 8	ALLEY BTWN LA VETA DR. & PALOMAS DR. STA. 18+80 TO STA. 21+14	H-18	WATERLINE/SEWER LINE REPLACEMENT
(1) 9	ALLEY BTWN PALOMAS DR. & ALVARADO DR. STA. 10+00 TO STA. 18+80	H-18	WATERLINE REPLACEMENT
(1) 10	ALLEY BTWN PALOMAS DR. & ALVARADO DR. STA. 18+80 TO STA. 21+17	H-18	WATERLINE REPLACEMENT
(1) 11	ALLEY BTWN ALVARADO DR. & VALENCIA DR. STA. 10+00 TO STA. 18+80	H-18	WATERLINE REPLACEMENT
(1) 12	ALLEY BTWN ALVARADO DR. & VALENCIA DR. STA. 18+80 TO STA. 21+15	H-18	WATERLINE REPLACEMENT
(1) 13	ALLEY BTWN CARDENAS DR. & CAGUA DR. STA. 10+00 TO STA. 18+80	H-18	WATERLINE/SEWER LINE REPLACEMENT
(1) 14	ALLEY BTWN CARDENAS DR. & CAGUA DR. STA. 18+80 TO STA. 21+17	H-18	WATERLINE REPLACEMENT
(2) 15	CAROL STREET STA. 10+00 TO STA. 18+80	H-21	SEWER PIPE BURSTING
(2) 16	CAROL STREET STA. 18+80 TO STA. 25+69	H-21	SEWER PIPE BURSTING
(2) 17	MARBLE STREET STA. 10+00 TO STA. 18+80	J-14	SEWER LINE REHAB PIPE BURSTING
(2) 18	FRANCISCAN STREET-MARBLE AVE. STA. 18+80 TO STA. 23+25	J-14	SEWER LINE REHAB PIPE BURSTING
(2) 19	LOBO PLACE STA. 10+00 TO STA. 18+80	J-16	WATERLINE REPLACEMENT/SEWER LINE REHAB
(2) 20	LOBO PLACE STA. 18+80 TO STA. 23+45	J-16	WATERLINE REPLACEMENT/SEWER LINE REHAB
(2) 21	DARTMOUTH DRIVE STA. 10+00 TO STA. 18+80	J-16	WATERLINE REPLACEMENT
(2) 22	DARTMOUTH DRIVE STA. 18+80 TO STA. 21+50	J-16	WATERLINE REPLACEMENT
(2) 23	WILSON PLACE STA. 10+00 TO STA. 17+65	J-16	WATERLINE REPLACEMENT/SEWER LINE REHAB
(2) 24	DARTMOUTH DRIVE STA. 30+00 TO STA. 38+80	K-16	WATERLINE REPLACEMENT
(2) 25	DARTMOUTH DRIVE STA. 38+80 TO STA. 42+30	K-16	WATERLINE REPLACEMENT
(2) 26	GIRARD BOULEVARD STA. 10+00 TO STA. 18+80	K-16	WATERLINE REPLACEMENT
(2) 27	GIRARD BOULEVARD STA. 18+80 TO STA. 28+00	J-16	WATERLINE REPLACEMENT
(2) 28	GIRARD BOULEVARD STA. 28+00 TO STA. 34+00	J-16	WATERLINE REPLACEMENT
(2) 29	VALENCIA DRIVE STA. 10+00 TO STA. 17+10	J-18	WATERLINE REPLACEMENT
(2) 30	CARDENAS DRIVE STA. 10+00 TO STA. 18+80	J-18	WATERLINE REPLACEMENT
(2) 31	CARDENAS DRIVE STA. 18+80 TO STA. 28+00	J-18	WATERLINE REPLACEMENT
(2) 32	CARDENAS DRIVE STA. 28+00 TO STA. 29+76	J-18	WATERLINE REPLACEMENT
(2) 33	CAGUA DRIVE STA. 10+00 TO STA. 18+80	J-18	WATERLINE REPLACEMENT
(2) 34	CAGUA DRIVE STA. 18+80 TO STA. 23+40	J-18	WATERLINE REPLACEMENT
(2) 35	HAINES AVE STA. 10+00 TO STA. 18+40	J-21	SEWER LINE REHAB
(2) 36	HAINES AVENUE STA. 18+40 TO STA. 21+55	J-21	SEWER LINE REHAB
(2) 37	SILVER & ALLEYS BTWN RICH & BRYN MAWR AND WELLESLEY & TULANE	K-16	RECONSTRUCT SEWER MANHOLE
(2) 38	ALLEY AMHERST DR. & CARLISLE BLVD. STA. 10+00 TO STA. 16+75	K/L-16	SEWER LINE REHAB
(2) 39	BARELAS STREET STA. 10+00 TO STA. 14+75	L-14	NEW SEWER LINE/MANHOLE
(2) 40	SUNSHINE TERRACE AVENUE STA. 10+00 TO STA. 18+00	L-15	SEWER LINE REHAB
(2) 41	SUNSHINE TERRACE AVENUE STA. 18+00 TO STA. 27+20	L-15	SEWER LINE REHAB
(2) 42	SUNSHINE TERRACE AVENUE STA. 27+20 TO STA. 30+00	L-15	SEWER LINE REHAB
43	WATER VALVE SHUT- OFF PLAN		
44	RESTRAINED JOINT DETAILS & WATER METER LOCATION		
45	SUPPLEMENTAL STANDARD DETAILS 1	SD 2101, 2109, MH DETAILS	
46	SUPPLEMENTAL STANDARD DETAILS 2	SD 2310, 2326, 2328	
47	SUPPLEMENTAL STANDARD DETAILS 3	SD 2109, 2340, 2370	
48	SUPPLEMENTAL STANDARD DETAILS 4	SD 2460, 2461, TRAP MANHOLE	

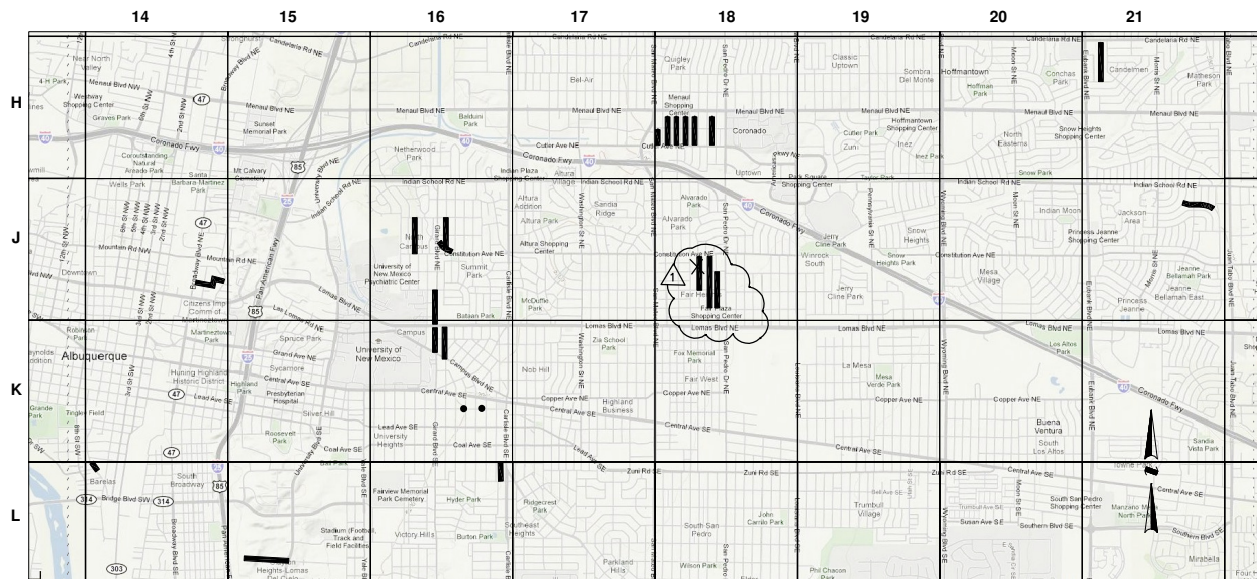

PROJECT LOCATION MAP
ZONE ATLAS
H-18, H-21, J-14, J-16, J-18, J-21, K-14, K-16, L-14, L-15
SEE SHEET 3 FOR DETAILED LOCATIONS

UTILITY CONTACTS

Mr. Andy Darnell MCI Worldcom (505) 346-4470	Ms. Natalia Antonio Qwest (505) 245-5934
Mr. Mike Mortus Comcast (505) 761-6200	Mr. Royal Harrison Time Warner Telecom (505) 938-7339
Mr. Mark Edwards AT&T (505) 227-1151	Mr. Larry Kelly Qwest Long Distance (505) 246-0501
Mr. John Brown BCG Assets (505) 314-0890	Red Flex (Cameras) 23751 N 23rd Ave. Phoenix, Arizona 85085
Mr. Rick Mueller McLeod USA (505) 217-0038	Mr. Anthony Kozlowski PNM Electric Co. (505) 241-3389
Mr. Joe Dunlop New Mexico Gas Co. (505) 241-7771	

SEC JOB # 109126
Smith Engineering Company
A Full Service Engineering Company
600 Ave. Pedro, S.E. Stop #4, Suite 200 Albuquerque, New Mexico 87102

SEE ABOVE	8/13/10					
REV.	SHEETS	CITY ENGINEER	DATE	USER DEPARTMENT	DATE	
ENGINEERS STAMP & SIGNATURE		APPROVED	ENGINEER	DATE		
		DRC Chairman			APPROVED FOR CONSTRUCTION	
		ABCWUA				
		Transportation				
		Hydrology				
		C I P				
		Const. Coord.			CITY ENGINEER	DATE
		CITY OF ALBUQUERQUE				
		PROJECT NUMBER			6312.92	
		SHEET			1 OF 48	

(1) PHASE 1 - SEE SUPPLEMENTAL SPECIAL PROVISIONS SECTION SSP-2
(2) PHASE 2 - SEE SUPPLEMENTAL SPECIAL PROVISIONS SECTION SSP-2

GENERAL NOTES

GENERAL NOTES

1. TWO WORKING DAYS PRIOR TO ANY EXCAVATION, CONTRACTOR MUST CONTACT NEW MEXICO ONE CALL, INC., 811, FOR LOCATION OF EXISTING UTILITIES. CONTRACTOR SHALL ALSO CALL CITY OF ALBUQUERQUE (COA) TRAFFIC ENGINEERING (857-8000) FOR LOCATIONS OF TRAFFIC INTERCONNECT WIRING AND OTHER TRAFFIC SIGNAL EQUIPMENT.
2. ALL WORK DETAILED ON THESE PLANS TO BE PERFORMED UNDER CONTRACT SHALL, EXCEPT AS OTHERWISE STATED OR PROVIDED FOR, BE CONSTRUCTED IN ACCORDANCE WITH COA STANDARD SPECIFICATIONS FOR PUBLIC WORKS CONSTRUCTION (CURRENT EDITION) – REFERENCED TO HEREIN AS “STANDARD SPECIFICATIONS”.
3. QUANTITIES SHOWN FOR UNIT PRICE BID ITEMS ARE FOR BID COMPARISON ONLY. ALBUQUERQUE BERNALILLO COUNTY WATER UTILITY AUTHORITY (ABCWUA) SHALL BASE PAYMENTS TO CONTRACTOR FOR ALL UNIT PRICE BID ITEMS ON ACTUAL QUANTITIES, DETERMINED AS PROVIDED IN CONTRACT DOCUMENTS.
4. DURING PROGRESS OF WORK, CONTRACTOR SHALL KEEP CONSTRUCTION SITE AND OTHER AREAS FREE FROM ACCUMULATIONS OF WASTE MATERIALS, RUBBISH, AND OTHER DEBRIS. REMOVAL AND DISPOSAL OF SUCH WASTE MATERIALS, RUBBISH, AND OTHER DEBRIS SHALL CONFORM TO APPLICABLE LAWS AND REGULATIONS – INCIDENTAL TO CONTRACT.
5. CONTRACTOR SHALL NOT STORE OR PARK EQUIPMENT IN FRONT OF PRIVATE RESIDENCES OVERNIGHT.
6. CONTRACTOR SHALL MAINTAIN A GRAFFITI-FREE WORK SITE. CONTRACTOR SHALL PROMPTLY REMOVE ALL GRAFFITI FROM EQUIPMENT (PERMANENT AND TEMPORARY).
7. CONTRACTOR IS SOLELY RESPONSIBLE FOR JOBSITE SAFETY, AND FOR KNOWLEDGE AND COMPLIANCE WITH APPLICABLE OSHA STANDARDS – INCIDENTAL TO CONTRACT.
8. CONTRACTOR SHALL MAINTAIN ALL TRENCHES IN SAFE CONDITION PROTECTING WORKERS AND PUBLIC. TRENCH PROTECTION SHALL BE IN ACCORDANCE WITH OSHA 29 CFR 1926.650 SUBPART P. CONTRACTOR SHALL SLOPE, BRACE, OR SHORE EXCAVATIONS AS REQUIRED BY OSHA REGULATIONS.
9. CONTRACTOR SHALL BACKFILL OR PROPERLY FENCE ALL OPEN EXCAVATIONS AT END OF EACH WORKDAY. CONTRACTOR SHALL BACKFILL ALL OPEN EXCAVATIONS WHEN CONTRACTOR WILL NOT BE WORKING AT ON-SITE THE FOLLOWING DAY.
10. CONTRACTOR SHALL PROVIDE AND MAINTAIN CONSTRUCTION SIGNING UNTIL ABCWUA AND COA HAVE ACCEPTED THE PROJECT.
11. NINE (9) WORKING DAYS PRIOR TO BEGINNING CONSTRUCTION, CONTRACTOR SHALL SUBMIT TO COA CONSTRUCTION COORDINATION DIVISION A DETAILED CONSTRUCTION SCHEDULE. TWO (2) WORKING DAYS PRIOR TO CONSTRUCTION, CONTRACTOR SHALL OBTAIN A BARRICADING PERMIT FROM COA CONSTRUCTION COORDINATION DIVISION. CONTRACTOR SHALL NOTIFY COA CONSTRUCTION SERVICES (924-3400) PRIOR TO OCCUPYING AN INTERSECTION.
12. COA NOISE CONTROL ORDINANCE FORBIDS LOUD CONSTRUCTION NOISE BETWEEN THE HOURS OF 10:00 PM AND 7:00 AM.
13. CONTRACTOR SHALL NOT LOCATE PUMPS OR COMPRESSORS REQUIRED TO RUN FOR THE DURATION OF THE WORK ADJACENT TO RESIDENTIAL PROPERTY; IF UNAVOIDABLE, CONTRACTOR SHALL EMPLOY NOISE ABATEMENT SOLUTIONS.
14. CONTRACTOR SHALL NOTIFY COA GEODETIC SURVEY (768-3609) NOT LESS THAN THREE (3) WORKING DAYS PRIOR TO STARTING WORK THAT WILL AFFECT ANY EXISTING GEODETIC SURVEY MONUMENT. COA GEODETIC SURVEY SHALL REPLACE, AT CONTRACTOR'S EXPENSE, ANY ACS MONUMENT DAMAGED OR DESTROYED DUE TO FAILURE OF CONTRACTOR TO NOTIFY AS STATED ABOVE.
15. CONTRACTOR SHALL NOTIFY ENGINEER NO LESS THAN SEVEN (7) CALENDAR DAYS PRIOR TO STARTING WORK IN ORDER THAT THE COA GEODETIC SURVEY MAY TAKE NECESSARY MEASURES TO ENSURE PRESERVATION OF ALL OTHER PERMANENT SURVEY MONUMENTS (NON-ACS). CONTRACTOR SHALL NOT DISTURB PERMANENT SURVEY MONUMENTS WITHOUT CONSENT OF THE ENGINEER. CONTRACTOR SHALL BEAR EXPENSE OF REPLACING ANY THAT MAY BE DISTURBED WITHOUT PERMISSION. ONLY THE COA GEODETIC SURVEY SHALL DO REPLACEMENT. WHEN A CHANGE IS MADE IN FINISHED ELEVATION OF PAVEMENT OF ANY ROADWAY IN WHICH A PERMANENT SURVEY MONUMENT IS LOCATED, CONTRACTOR SHALL, AT CONTRACTOR EXPENSE, ADJUST MONUMENT COVER TO NEW GRADE UNLESS OTHERWISE SPECIFIED.
16. LOCATION OF EXISTING UNDERGROUND UTILITIES HAS BEEN DETERMINED BY INFORMATION PROVIDED BY OTHERS, AND SHALL BE CONSIDERED APPROXIMATE ONLY. CONTRACTOR SHALL DETERMINE EXACT LOCATION AND SIZE OF ALL EXISTING UTILITY LINES PRIOR TO CONSTRUCTION AND SHALL BE RESPONSIBLE FOR ALL DAMAGES RESULTING FROM FAILURE TO LOCATE UTILITIES.
17. CONTRACTOR SHALL SUPPORT AND MAINTAIN OPERATIONAL ALL UTILITIES EXPOSED DURING TRENCHING AND OTHER CONSTRUCTION OPERATIONS. ALL CONSTRUCTION ACTIVITIES INVOLVING GAS, POWER, WATER, FIBER OPTIC, TRAFFIC SIGNAL EQUIPMENT, OR OTHER UTILITY LINES SHALL BE COORDINATED WITH UTILITY OWNER PRIOR TO ANY DISTURBANCE. CONTRACTOR SHALL NOTIFYING ALL AFFECTED PARTIES 48 HOURS IN ADVANCE OF CONSTRUCTION ACTIVITY DISRUPTING ANY UTILITY SERVICE.
18. PLANS SHOW APPROXIMATE LOCATIONS OF PIPES AND OTHER UTILITIES. CONTRACTOR SHALL ADJUST ELEVATION OF NEW WATERLINE DURING CONSTRUCTION TO AVOID UTILITIES. CONTRACTOR SHALL MARK EXACT LOCATION OF ENCOUNTERED UTILITIES AND NEW WATERLINE ON AS-BUILT DRAWINGS.

WATER

19. CONTRACTOR SHALL BE RESPONSIBLE FOR TIMING AND COORDINATION OF WATER VALVE SHUTOFFS. AT LEAST SEVEN (7) WORKING DAYS PRIOR TO CONSTRUCTION, CONTRACTOR SHALL CONTACT ABCWUA FIELD OPERATIONS WATER DIVISION (857-8200) TO INITIATE IMPLEMENTATION OF NON-PRESSURIZED CONNECTION PLAN.
20. CONTRACTOR SHALL NOTIFY ABCWUA FIELD OPERATIONS WATER DIVISION (857-8200) AND COA FIRE DEPARTMENT (764-6300) AT LEAST SEVEN (7) WORKING DAYS IN ADVANCE OF ANY FIRE HYDRANT TAKEN OUT OF AND RETURNED TO SERVICE – REFER TO STANDARD SPECIFICATION SECTION.
21. CONTRACTOR SHALL FIELD VERIFY ALL WATERLINE CONNECTIONS TO EXISTING FACILITIES SUFFICIENTLY IN ADVANCE OF CONSTRUCTION TO ALLOW OBTAINING CORRECT ADAPTERS AND OTHER FITTINGS.
22. CONTRACTOR SHALL SALVAGE MATERIAL IN ACCORDANCE WITH STANDARD SPECIFICATION SECTION 801.15 (CONTACT MARK ARCHIBEQUE AT 857-8289).
23. CONTRACTOR SHALL INSTALL NEW WATERLINES WITH A MINIMUM OF THREE (3) FEET OF COVER OVER WATER LINE REGARDLESS OF ALIGNMENT IN STREET.
24. CONTRACTOR SHALL PLACE ELECTRONIC MARKER DEVICES (EMD) ACCORDING TO STANDARD SPECIFICATION SECTION 170 – INCIDENTAL TO CONTRACT.
25. CONTRACTOR SHALL PROVIDE TEMPORARY WATER SERVICE FOR ANY RESIDENCE, SCHOOL, OR BUSINESS THAT WILL BE OUT OF SERVICE MORE THAN FOUR (4) HOURS. SHOEFLY WATERLINE BYPASS IS AN OPTION FOR TEMPORARY SERVICE – INCIDENTAL TO CONSTRUCTION.
26. CONTRACTOR SHALL CONSTRUCT ALL NON-PRESSURIZED WATERLINE CONNECTIONS PER STANDARD DRAWING 2301.
27. CONTRACTOR SHALL FURNISH AND INSTALL MECHANICAL RESTRAINING DEVICES ON NEW WATERLINE FITTINGS, VALVES, AND PIPE JOINTS PER RESTRAINED JOINT DETAIL SHEET.

WATER SERVICE

28. CONTRACTOR SHALL REPLACE ALL WATER SERVICE LINES FROM NEW WATERLINE MAIN TO METER WITH NEW SERVICE LINES (SAME SIZE AS EXISTING METER).
29. CONTRACTOR SHALL INSTALL SERVICE LINES USING TRENCHLESS TECHNOLOGY SUCH AS GRICE SYSTEM, HOLE-HOG SYSTEM, OR EQUIVALENT.

SEWER

30. UNDER NO CIRCUMSTANCE SHALL SEWAGE OR SOLIDS REMOVED FROM MANHOLES BE DISCHARGED ONTO STREETS OR INTO DITCHES, CATCH BASINS, STORM DRAINS, OR SANITARY SEWER MANHOLES, CLEANOUTS, OR DUMPS.
31. IF SEWAGE SPILLS ONTO PUBLIC OR PRIVATE PROPERTY, THE CONTRACTOR SHALL WASH DOWN, CLEAN UP, AND DISINFECT THE SPILLAGE AT ITS OWN EXPENSE TO THE SATISFACTION OF THE PROPERTY OWNER. WITHIN 12 HOURS OF THE INCIDENT, THE CONTRACTOR SHALL REPORT THE INCIDENT TO THE COLLECTION SECTION MANAGER (873-7013). CLEANUP OF SEWAGE SPILLS AND NOTIFICATION SHALL BE INCIDENTAL TO THE INSPECTION ITEM.

PAVEMENT/DRAINAGE/CITY

32. CONTRACTOR SHALL ASSUME RESPONSIBILITY FOR ANY DAMAGE TO EXISTING VALVE BOXES, MANHOLES, SEWER SERVICES, PAVEMENTS, PAVEMENT MARKINGS, CURB AND GUTTER, DRIVE PADS, WHEEL CHAIR RAMPS, AND SIDEWALKS DURING CONSTRUCTION, APART FROM SECTIONS INDICATED ON PLANS AND SHALL REPAIR OR REPLACE PER COA AND ABCWUA STANDARDS AT CONTRACTOR'S EXPENSE.
33. CONTRACTOR SHALL REMOVE AND REPLACE 8-FOOT WIDTH OF PAVEMENT IN STREETS WITH WATERLINE REPLACEMENT. ABCWUA WILL NOT PAY FOR MORE THAN 8-FOOT WIDTH, UNLESS PLANS NOTE OTHERWISE.
34. ANY PAVEMENT, OR CURB AND GUTTER REMOVAL AND REPLACEMENT ASSOCIATED WITH REPLACEMENT OF WATER SERVICE LINES IS INCIDENTAL TO THE SERVICE LINE REPLACEMENT.
35. CONTRACTOR SHALL ADJUST ALL WATER VALVE BOXES AND SEWER MANHOLES WITHIN NEW PAVEMENT TO FINISH GRADE PER COA AND ABCWUA STANDARDS.
36. CONTRACTOR SHALL RESTORE STREET CENTERLINE GRADES TO EXISTING CENTERLINE GRADES UNLESS OTHERWISE DIRECTED BY ENGINEER. CONTRACTOR SHALL MAKE SMOOTH TRANSITIONS BETWEEN EXISTING PAVEMENT REMAINING IN PLACE AND NEW PAVEMENT.
37. CONTRACTOR SHALL REPLACE ALL STREET STRIPING AND MARKINGS ALTERED OR DESTROYED WITH RETRO-REFLECTIVE PREFORMED THERMOPLASTIC PAVEMENT MARKINGS BY CONTRACTOR TO SAME LOCATION AS EXISTING OR AS INDICATED ON PLANS.
38. CONTRACTOR SHALL REPLACE ASPHALT PAVEMENT IN ACCORDANCE WITH COA STANDARD SPECIFICATIONS AND STANDARD DRAWING 2465 BASED ON THE FOLLOWING STREET DESIGNATIONS. ALLEYS WITHIN PROJECT AREA (PAVED OR UNPAVED) ARE DESIGNATED RESIDENTIAL ALLEYS. QUANTITIES SHOWN ON PLANS ARE APPROXIMATE BASED ON PAVEMENT THICKNESS ASSUMPTIONS.
RESIDENTIAL: ALVARADO DR NE, ASPEN AV NE, BARELAS RD SW, BELLAMAH AV NE, BURTON AV NE, CAGUA DR NE, CAMPUS BLVD NE, CARDENAS DR NE, CAROL ST NE, CEDAR ST NE, CLAREMONT AV NE, CUTLER AV NE, DARTMOUTH DR NE, EDITH BLVD NE, FRANCISCAN ST NE, FRONTIER AV NE, GARFIELD AV NE, HAINES AV NE, HANNETT AV NE, KIMO DR NE, LEWIS AV SW, LOBO PL NE, MARBLE AV NE, MARTHA ST NE, MAXINE ST NE, MOUNTAIN RD NE, MURIEL ST NE, OAK ST NE, PRINCESS JEANNE AV NE, PROSPECT AV NE, REVERE PL NE, RICHMOND PL NE, ROMA AV NE, SHIRLEY ST NE, SILVER AV NE, SUMMER AV NE, SUNSHINE TERRACE AV NE, TOMASITA ST NE, VALENCIA DR NE, WILSON PL NE

MAJOR LOCAL: NONE

ARTERIAL: BROADWAY BLVD NE, CANDELARIA RD NE, CONSTITUTION AV NE, GIRARD BLVD NE, LOMAS BLVD NE, SAN PEDRO DR NE, UNIVERSITY BLVD NE

39. CONTRACTOR SHALL CONSTRUCT ALL CURB AND GUTTER IN ACCORDANCE WITH COA STANDARD DRAWINGS 2415A AND 2415B. ALL CURB AND GUTTER ON THESE PLANS ARE STANDARD TYPE UNLESS OTHERWISE NOTED.
40. CONTRACTOR SHALL CONSTRUCT ALL SIDEWALKS IN ACCORDANCE WITH COA STANDARD DRAWINGS 2430, 2431, AND 2432.
41. CONTRACTOR SHALL CONSTRUCT ALL WHEELCHAIR RAMPS SHALL IN ACCORDANCE WITH COA STANDARD DRAWINGS 2440 AND 2441.
42. CONTRACTOR SHALL CONSTRUCT ALL CONCRETE VALLEY GUTTERS IN ACCORDANCE WITH COA STANDARD DRAWING 2420.
43. CONTRACTOR SHALL CONSTRUCT ALL DRIVE PADS IN ACCORDANCE WITH COA STANDARD DRAWING 2425.
44. IF CONTRACTOR CREATES A PAVEMENT DROP-OFF DURING CONSTRUCTION, CONTRACTOR SHALL MODIFY PAVEMENT TO PREVENT ABRUPT PAVEMENT CHANGES – INCIDENTAL TO CONSTRUCTION.
45. CONTRACTOR MUST MAINTAIN EXISTING STORM DRAINAGE SYSTEMS FOR DURATION OF PROJECT. CONTRACTOR SHALL ENSURE STORM WATER DURING CONSTRUCTION DOES NOT AFFECT PRIVATE PROPERTY AND THAT STORM WATER IS NOT DIRECTED ONTO PRIVATE PROPERTY.
46. IF DURING CONTRACTION, CONTRACTOR UNCOVERS DEBILITATED STORM DRAIN COMPONENTS THAT REQUIRE REPLACEMENT OR RELOCATION, CONTRACTOR SHALL COORDINATE REPAIR WORK WITH COA DEPARTMENT OF MUNICIPAL DEVELOPMENT (ROLAND PENTTILA AT 768-2778).

ABBREVIATIONS

CCYL	CONCRETE CYLINDER
CI	CAST IRON
CP	CONCRETE PIPE
FG	FIBER GLASS
LWS	LINER WRAPPED STEEL
PVC	POLYVINYL CHLORIDE
RCP	REINFORCED CONCRETE PIPE
STL	STEEL
VCP	VITRIFIED CLAY PIPE
#5PCAP	NO. 5 REBAR WITH PLASTIC CAP

LEGEND

PROPOSED	EXISTING	DESCRIPTION
NA	— — —	CONSTRUCTION CENTERLINE
NA	— —4945— —	EXISTING CONTOUR
NA	≡ ≡ ≡ ≡	CURB & GUTTER
⋯⋯⋯⋯⋯⋯	⋯⋯⋯⋯⋯⋯	CONCRETE
NA	— — — —	BUILDING LINE
NA	— — — —	EASEMENT LINE
— — — —	— — — —	CHAIN-LINK FENCE
NA	— —UGC— —	CABLE TV
NA	— —UGP— —	TELEPHONE
NA	— —UGFO— —	FIBER OPTIC
NA	— —UGE— —	ELECTRIC
NA	—G—  —G—	GAS LINE W/ VALVE
NA	— —SD — —	STORM DRAIN
=====	— —SAS — —	SANITARY SEWER LINE
—  —	—W—  —W—	WATERLINE W/ VALVE
NA		STORM DRAIN MANHOLE
		SEWER MANHOLE
		WATERLINE METER
		FIRE HYDRANT
NA		UTILITY POLE
	NA	POT HOLE LOCATION W/ NO.
NA		BENCH MARK
	NA	CONTROL POINT
		BEND
		TEE
		CROSS
	NA	CAP OR PLUG
	NA	REDUCER
		CONCRETE DRIVE


AS-BUILT INFORMATION		BENCH MARKS		SURVEY INFORMATION		ENGINEERS SEAL	
CONTRACTOR				FIELD NOTES			
WORK STAKED BY	DATE			BY	DATE		
ACCEPTANCE BY	DATE			NO.			
FIELD VERIFICATION BY	DATE						
DRAWINGS CORRECTED BY	DATE						
MICRO-FILM INFORMATION							
RECORDED BY	DATE						
NO.							

ALBUQUERQUE BERNALILLO COUNTY WATER UTILITY AUTHORITY SMALL DIAMETER WATER & SEWER REHABILITATION FY11			
TITLE: GENERAL NOTES & LEGEND			
Design Review Committee	City Engineer Approval	Last Design Update	No. / Day / Yr.
City Project No.	6312.92	Zone Map No.	Sheet 2 Of 48





 SCALE HORZ: 1" = 40'
SCALE VERT: 1" = 4'




 109126
Smith Engineering Company
A Full Service Engineering Company
2201 San Pedro Boulevard, N.E., Bldg. #4, Suite 200 Albuquerque, New Mexico 87110

***PHASE 1**

City Project No.	Zone Map No.	Sheet	Of
6312.92	H-18	4	48

Q:\SEC-PROJECTS\2009 PROJECTS\109126 ABOVUA - SMALL DIAMETER DRAWINGS\1\AUTOCAD\PLAN\VALLEY BTWN MADEIRA DR. & LA VETA DR. STA. 10+00 TO STA. 18+00.DWG 7/27/10 1:48:28 PM

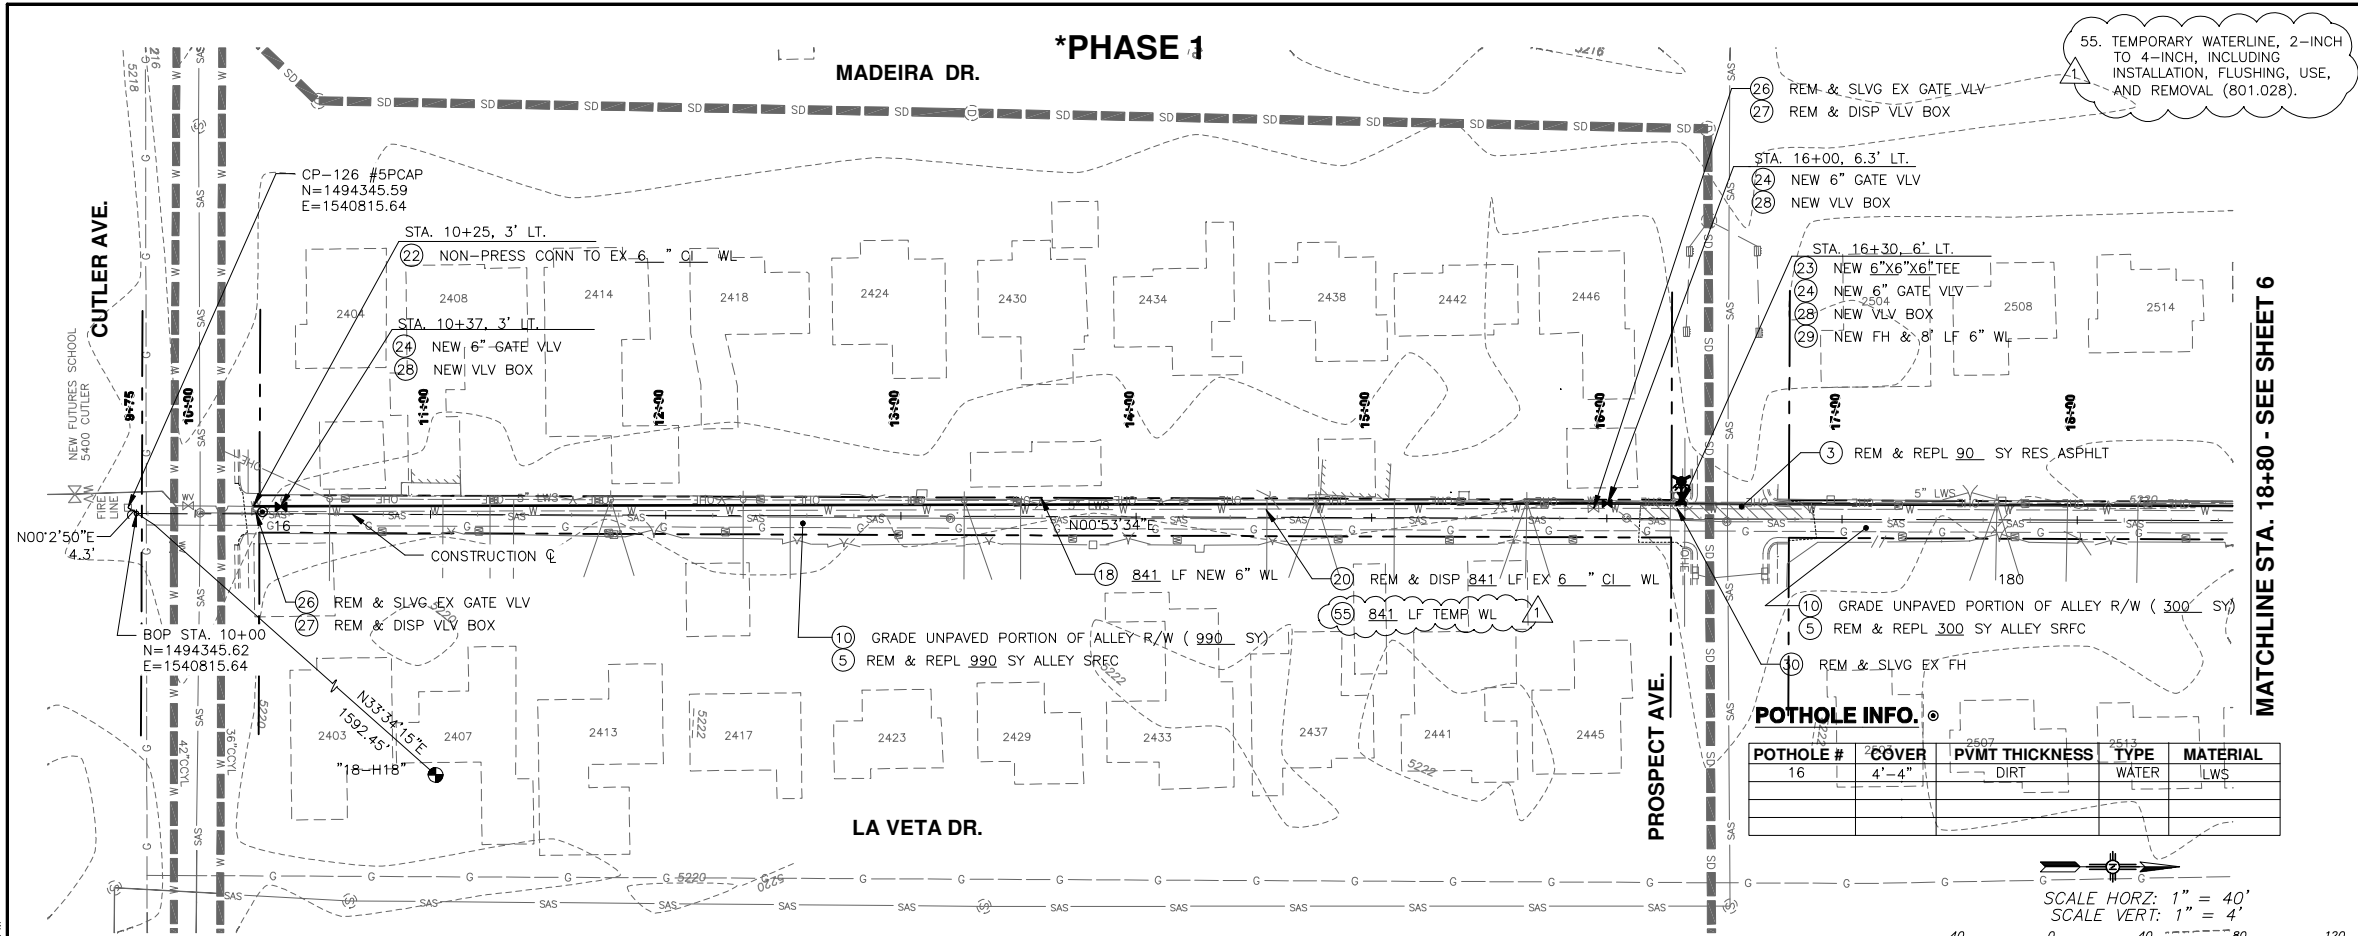

BUILD NOTES:

- REMOVE & REPLACE RESIDENTIAL ASPHALT CONCRETE MATERIAL PER STANDARD DRAWING 2465.
- REMOVE & REPLACE ALLEY SURFACE WITH 6-INCH BASE COURSE MATERIAL PER STANDARD DRAWING 2465.
- GRADE AREA, WITH LESS THAN 2-FOOT EXCAVATION PER DETAIL THIS SHEET AND STANDARD SPECIFICATION SECTION 301.
- FURNISH & INSTALL 6-INCH WATERLINE PIPE INCLUDING TRENCH & COMPACTED BACKFILL (801.002).
- REMOVE & DISPOSE EXISTING WATERLINE WITH FITTINGS (801.055).
- NON-PRESSURIZED CONNECTION TO EXISTING WATERLINE (801.059). PROPOSED CONNECTION CONFIGURATION IS FOR ESTIMATING PURPOSES ONLY. CONTRACTOR SHALL FIELD VERIFY EXISTING PIPE CONFIGURATION, SIZE, TYPE, AND OTHER FIELD CONDITIONS IN ADVANCE OF CONSTRUCTION TO ESTABLISH CORRECT ADAPTERS AND FITTINGS. CONTRACTOR SHALL SHOW FINAL CONNECTION CONFIGURATION ON THE AS-BUILT DRAWINGS.
- FURNISH & INSTALL DUCTILE IRON MECHANICAL JOINT FITTINGS, CLASS 250 (801.002).
- FURNISH & INSTALL 6-INCH GATE VALVE PER STANDARD DRAWING 2326 (801.081).
- REMOVE & SALVAGE EXISTING GATE VALVE (801.102).
- REMOVE & DISPOSE VALVE BOX (801.104).
- FURNISH & INSTALL VALVE BOX PER STANDARD DRAWING 2326 (801.105).
- FURNISH & INSTALL FIRE HYDRANT PER STANDARD DRAWING 2340 (801.113).
- REMOVE & SALVAGE EXISTING FIRE HYDRANT (801.119).

WATER SERVICE LINE SCHEDULE

- REPLACE AND TRANSFER ALL WATER SERVICE LINE(S) PER STANDARD DRAWING 2362.
- RELOCATE EXISTING WATER METER(S) PER SCHEDULE BELOW AND PER STANDARD DRAWING 2362. (EX. BOXES BEHIND WALL SHOULD BE RELOCATED TO ALLEY R/W)
- REHABILITATE WATER METER BOX(ES) PER SCHEDULE BELOW.
- ADJUST ALL METER BOXES TO NEW GRADE (INCIDENTAL TO METER RELOCATE AND REPLACEMENT).

ADDRESS	LOCATION	SERVICE SIZE	REHAB	RELOCATE
5400 CUTLER AVE NE	F6	3"		
5400 CUTLER AVE NE	FIRE LINE	3"		
2403 LA VETA DR NE	B3	3/4"	X	
2404 MADEIRA DR NE	B5	1"	X	X
2407 LA VETA DR NE	B5	3/4"	X	X
2408 MADEIRA DR NE	B5	3/4"	X	X
2413 LA VETA DR NE	B5	3/4"	X	X
2414 MADEIRA DR NE	B3	3/4"	X	X
2417 LA VETA DR NE	B5	3/4"	X	X
2418 MADEIRA DR NE	B5	3/4"	X	
2423 LA VETA DR NE	B5	3/4"	X	
2424 MADEIRA DR NE	B5	3/4"	X	
2429 LA VETA DR NE	B4	3/4"	X	
2430 MADEIRA DR NE	B4	3/4"	X	X
2433 LA VETA DR NE	B5	3/4"	X	
2434 MADEIRA DR NE	B4	3/4"	X	
2437 LA VETA DR NE	B4	3/4"	X	
2438 MADEIRA DR NE	B4	3/4"	X	X
2442 MADEIRA DR NE	B5	3/4"	X	X
2445 LA VETA DR NE	B5	3/4"	X	
2446 MADEIRA DR NE	B4	3/4"	X	X
2503 LA VETA DR NE	B4	3/4"	X	X
2504 MADEIRA DR NE	B6	3/4"	X	X
2507 LA VETA DR NE	B5	3/4"	X	X
2508 MADEIRA DR NE	B6	3/4"	X	
2513 LA VETA DR NE	B3	3/4"	X	
2514 MADEIRA DR NE	B5	3/4"	X	

GRADING DETAIL

SLOPE 1% TO C

SLOPE 1% TO C

REMOVE AND REPLACE ALLEY SURFACE (6" BASE COURSE)

±15'

ALLEY RE-GRADE

***PHASE 1**

ALBUQUERQUE BERNALILLO COUNTY WATER UTILITY AUTHORITY

SMALL DIAMETER WATER & SEWER REHABILITATION FY11

TITLE: ALLEY BTWN MADEIRA DR. & LA VETA DR. STA. 10+00 TO STA. 18+00 FROM CUTLER TO ALLEY SOUTH OF MENAUL

Design Review Committee	City Engineer Approval	No. / Day / Yr.	No. / Day / Yr.

City Project No. 6312.92

Zone Map No. H-18

Sheet 5 of 48

REVISIONS

NO.	DATE	REMARKS

DESIGN

DESIGNED BY RCF DATE Jul 2010

DRAWN BY MAC/VLH DATE Jul 2010

CHECKED BY FAC DATE Jun 2010

ENGINEERS SEAL

REBECCA C. FINK
NEW MEXICO
14232
REGISTERED PROFESSIONAL ENGINEER

AS-BUILT INFORMATION

CONTRACTOR	DATE

BENCH MARKS

CONTRACTOR	DATE

SURVEY INFORMATION

FIELD NOTES	DATE

NO. BY

NO.	BY

COA CONTROL MONUMENT "18-H18"

N=1495167.854
E=1541177.063
ELEV=5232.741 NAVD 1988
NAD 1983 NEW MEXICO
STATE PLANE COORDINATES GROUND TO GRID
FACTOR= 0.99864864

SMITH ENGINEERING COMPANY


109126

A Full Service Engineering Company

2201 San Pedro Southwest, N.E. Bldg. #4, Suite 200 Albuquerque, New Mexico 87110

Q:\SEC-PROJECTS\2009 PROJECTS\109126 ABQ\UA - SMALL DIAMETER DRAWINGS\1\AUTOCAD\PLAN SET\ALLEY BTWN LA VETA DR. & PALOMAS DR. STA. 18+80 TO STA. 21+14.DWG 8/2/10 3:23:12 PM

*PHASE 1

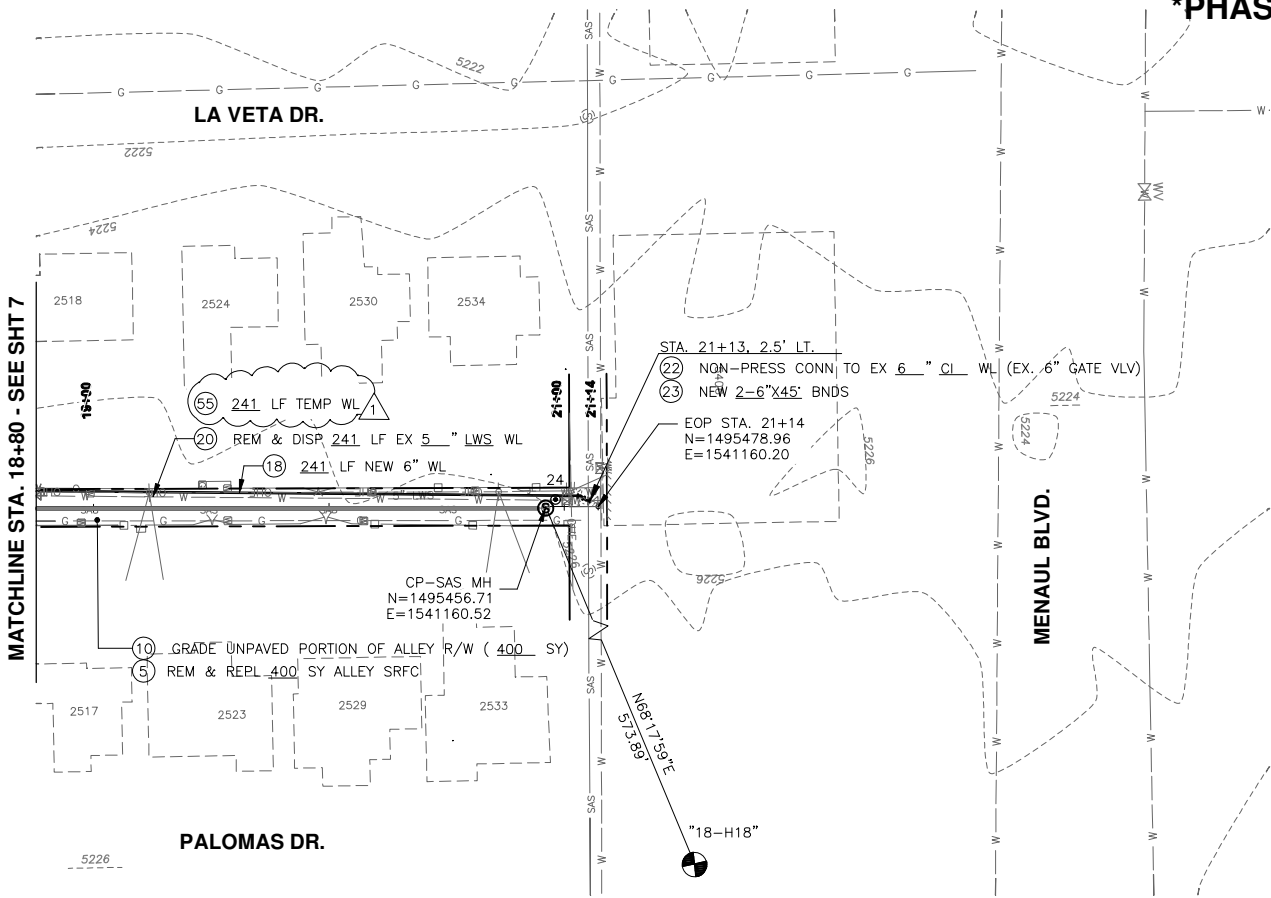

ALLEY BTWN LA VETA DR. & PALOMAS DR. STA. 18+80 TO STA. 21+14

POTHOLE INFO. ☉

POTHOLE #	COVER	PVMT THICKNESS	TYPE	MATERIAL
24	3'-6"	DIRT	WATER	LWS




⊗ BUILD NOTES:

5. REMOVE & REPLACE ALLEY SURFACE WITH 6-INCH BASE COURSE MATERIAL PER STANDARD DRAWING 2465.
10. GRADE AREA, WITH LESS THAN 2-FEET EXCAVATION PER DETAIL THIS SHEET AND STANDARD SPECIFICATION SECTION 301.
18. FURNISH & INSTALL 6-INCH WATERLINE PIPE INCLUDING TRENCH & COMPACTED BACKFILL (801.002).
20. REMOVE & DISPOSE EXISTING WATERLINE WITH FITTINGS (801.055).
22. NON-PRESSURIZED CONNECTION TO EXISTING WATERLINE (801.059). PROPOSED CONNECTION CONFIGURATION IS FOR ESTIMATING PURPOSES ONLY. CONTRACTOR SHALL FIELD VERIFY EXISTING PIPE CONFIGURATION, SIZE, TYPE, AND OTHER FIELD CONDITIONS IN ADVANCE OF CONSTRUCTION TO ESTABLISH CORRECT ADAPTERS AND FITTINGS. CONTRACTOR SHALL SHOW FINAL CONNECTION CONFIGURATION ON THE AS-BUILT DRAWINGS.
23. FURNISH & INSTALL DUCTILE IRON MECHANICAL JOINT FITTINGS, CLASS 250 (801.002).
37. TRENCH, BACKFILL, AND COMPACT 4-INCH TO 15-INCH SEWER PIPE, OVER 16-FEET IN DEPTH (701.040).
38. FURNISH & PLACE 8-INCH SEWER PIPE IN OPEN TRENCH (901.030).
40. REMOVE & DISPOSE SEWER LINE PER STANDARD DRAWING 2125 (901.710).
41. REINSTALL EXISTING 4-INCH SEWER SERVICE LINE TO REPLACEMENT MAIN, INCLUDING FIRST 5-FEET OF NEW SERVICE LINE, PER STANDARD DRAWING 2134 (905.200).
55. TEMPORARY WATERLINE, 2-INCH TO 4-INCH, INCLUDING INSTALLATION, FLUSHING, USE, AND REMOVAL (801.028).

WATER SERVICE LINE SCHEDULE

1. REPLACE AND TRANSFER ALL WATER SERVICE LINE(S) PER STANDARD DRAWING 2362.
2. RELOCATE EXISTING WATER METER(S) PER SCHEDULE BELOW AND PER STANDARD DRAWING 2362. (EX. BOXES BEHIND WALL SHOULD BE RELOCATED TO ALLEY R/W)
3. REHABILITATE WATER METER BOX(ES) PER SCHEDULE BELOW.
4. ADJUST ALL METER BOXES TO NEW GRADE (INCIDENTAL TO METER RELOCATE AND REPLACEMENT).

ADDRESS	LOCATION	SERVICE SIZE	REHAB	RELOCATE
2517 PALOMAS DR NE	B5	3/4"	X	X
2518 LA VETA DR NE	B5	3/4"	X	X
2523 PALOMAS DR NE	B5	3/4"	X	
2524 LA VETA DR NE	B5	3/4"	X	
2529 PALOMAS DR NE	B5	3/4"	X	
2530 LA VETA DR NE	B5	3/4"	X	
2533 PALOMAS DR NE	B5	3/4"	X	X
2534 LA VETA DR NE	B5	3/4"	X	X

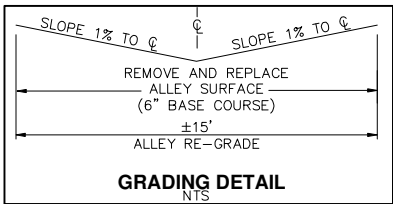


*PHASE 1

ALBUQUERQUE BERNALILLO COUNTY WATER UTILITY AUTHORITY
SMALL DIAMETER WATER & SEWER
REHABILITATION FY11

TITLE: ALLEY BTWN LA VETA DR. & PALOMAS DR.
STA. 18+80 TO STA. 21+14
FROM CUTLER TO ALLEY SOUTH OF MENAUL

Design Review Committee	City Engineer Approval	Mo. / Day / Yr.	Mo. / Day / Yr.

City Project No.	Zone Map No.	Sheet	Of
6312.92	H-18	8	48

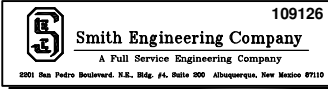

AS-BUILT INFORMATION			
CONTRACTOR	COA CONTROL MONUMENT "18-H18"	DATE	DATE
WORK STAKED BY	N=1495167.854	DATE	DATE
FIELD ACCEPTANCE BY	E=1541177.063	DATE	DATE
FIELD VERIFICATION BY	ELEV=5232.741 NAVD 1988	DATE	DATE
DRAWING CORRECTED BY	NAD 1983 NEW MEXICO	DATE	DATE
MICRO-FILM INFORMATION			
STATE PLANE COORDINATES GROUND TO GRID	FACTOR= 0.99864864	DATE	DATE
RECORDED BY	NO.	DATE	DATE


BENCH MARKS			
NO.	BY	DATE	DATE


SURVEY INFORMATION			
FIELD NOTES	NO.	BY	DATE

ENGINEERS SEAL			
RCF	BY	DATE	DATE


REVISIONS			
NO.	DATE	REMARKS	BY

DESIGNED BY	RCF	DATE	Jul 2010
DRAWN BY	MAC/VLH	DATE	Jul 2010
CHECKED BY	FAC	DATE	Jun 2010

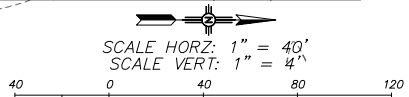

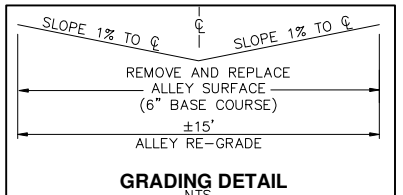BUILD NOTES:				AS-BUILT INFORMATION			
3.	REMOVE & REPLACE RESIDENTIAL ASPHALT CONCRETE MATERIAL PER STANDARD DRAWING 2465.	DATE		CONTRACTOR			
5.	REMOVE & REPLACE ALLEY SURFACE WITH 6-INCH BASE COURSE MATERIAL PER STANDARD DRAWING 2465.	DATE		WORK ORDER BY			
10.	GRADE AREA, WITH LESS THAN 2- FEET EXCAVATION PER DETAIL THIS SHEET AND STANDARD SPECIFICATION SECTION 301.	DATE		INSPECTOR'S ACCEPTANCE BY			
18.	FURNISH & INSTALL 6-INCH WATERLINE PIPE INCLUDING TRENCH & COMPACTED BACKFILL (801.002).	DATE		FIELD VERIFICATION BY			
20.	REMOVE & DISPOSE EXISTING WATERLINE WITH FITTINGS (801.055).	DATE		DRAWINGS CORRECTED BY			
22.	NON-PRESSURIZED CONNECTION TO EXISTING WATERLINE (801.059). <i>PROPOSED CONNECTION CONFIGURATION IS FOR ESTIMATING PURPOSES ONLY. CONTRACTOR SHALL FIELD VERIFY EXISTING PIPE CONFIGURATION, SIZE, TYPE, AND OTHER FIELD CONDITIONS IN ADVANCE OF CONSTRUCTION TO ESTABLISH CORRECT ADAPTERS AND FITTINGS. CONTRACTOR SHALL SHOW FINAL CONNECTION CONFIGURATION ON THE AS-BUILT DRAWINGS.</i>	DATE		MICRO-FILM INFORMATION			
23.	FURNISH & INSTALL DUCTILE IRON MECHANICAL JOINT FITTINGS, CLASS 250 (801.002).	DATE		RECORDED BY			
24.	FURNISH & INSTALL 6-INCH GATE VALVE PER STANDARD DRAWING 2326 (801.081).	DATE		NO.			
26.	REMOVE & SALVAGE EXISTING GATE VALVE (801.102).	DATE					
27.	REMOVE & DISPOSE VALVE BOX (801.104).	DATE					
28.	FURNISH & INSTALL VALVE BOX PER STANDARD DRAWING 2326 (801.105).	DATE					
29.	FURNISH & INSTALL FIRE HYDRANT PER STANDARD DRAWING 2340 (801.113).	DATE					
30.	REMOVE & SALVAGE EXISTING FIRE HYDRANT (801.119).	DATE					
46.	ADJUST EXISTING MANHOLE FRAME & COVER TO GRADE WITH METAL RINGS, 2-INCH OR LESS, PER STANDARD DRAWING 2111 (920.400).	DATE					
WATER SERVICE LINE SCHEDULE				BENCH MARKS			
1.	REPLACE AND TRANSFER ALL WATER SERVICE LINE(S) PER STANDARD DRAWING 2362.	DATE		COA CONTROL MONUMENT "18-H18"			
2.	RELOCATE EXISTING WATER METER(S) PER SCHEDULE BELOW AND PER STANDARD DRAWING 2362. (EX. BOXES BEHIND WALL SHOULD BE RELOCATED TO ALLEY R/W)	DATE		N=1495167.654			
3.	REHABILITATE WATER METER BOX(ES) PER SCHEDULE BELOW.	DATE		E=1541177.063			
4.	ADJUST ALL METER BOXES TO NEW GRADE (INCIDENTAL TO METER RELOCATE AND REPLACEMENT).	DATE		ELEV=5232.741 NAVD 1988			
ENGINEERS SEAL				REVISIONS			
				DESIGN			
GRADING DETAIL				REVISIONS			
				REVISIONS			
*PHASE 1				DESIGN			
ALBUQUERQUE BERNALILLO COUNTY WATER UTILITY AUTHORITY				DESIGNED BY RCF			
SMALL DIAMETER WATER & SEWER				DRAWN BY MAC/VLH			
REHABILITATION FY11				CHECKED BY FAC			
TITLE: ALLEY BTWN PALOMAS DR. & ALVARADO DR.				DATE Jul 2010			
STA. 10+00 TO STA. 18+80				DATE Jul 2010			
FROM CUTLER TO ALLEY SOUTH OF MENAUL				DATE Jun 2010			
Design Review Committee				City Engineer Approval			
City Project No.				Zone Map No.			
26312.92				H-18			
Sheet				Of			
9				48			

*PHASE 1

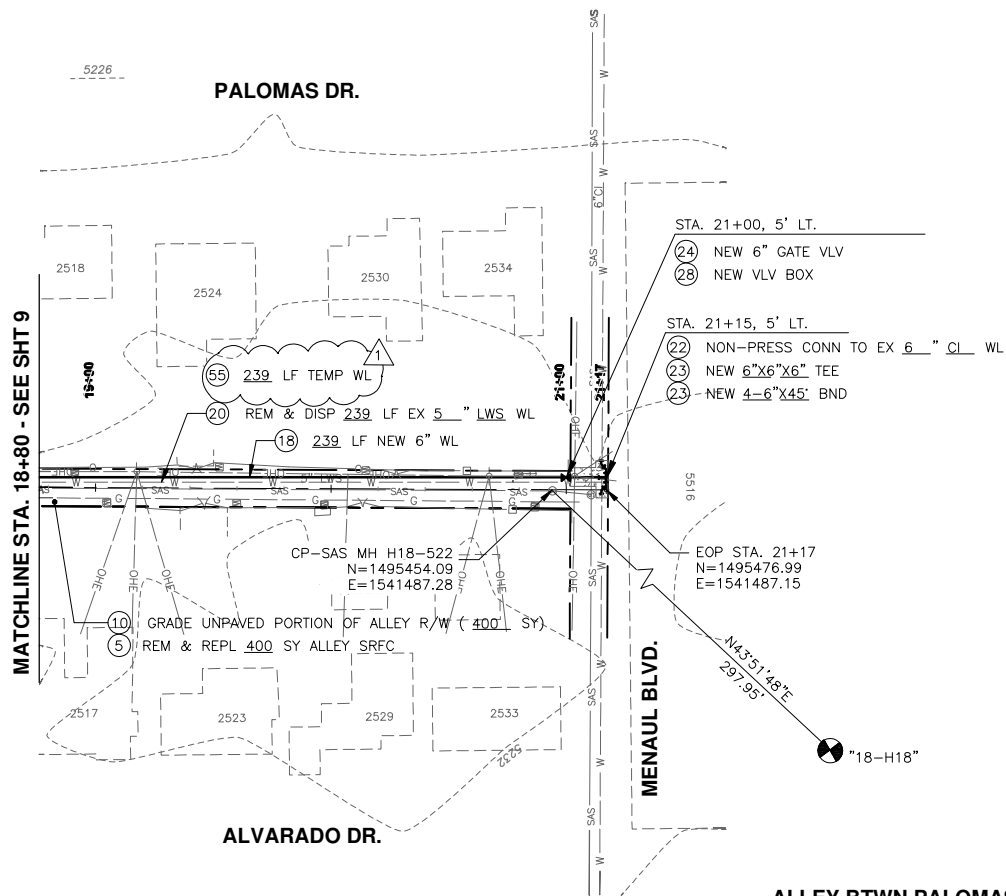

ALLEY BTWN PALOMAS DR. & ALVARADO DR. STA. 18+80 TO STA. 21+17

[illegible]

20+00

(X) BUILD NOTES:


5. REMOVE & REPLACE ALLEY SURFACE WITH 6-INCH BASE COURSE MATERIAL PER STANDARD DRAWING 2465.
10. GRADE AREA, WITH LESS THAN 2-FEET EXCAVATION PER DETAIL THIS SHEET AND STANDARD SPECIFICATION SECTION 301.
18. FURNISH & INSTALL 6-INCH WATERLINE PIPE INCLUDING TRENCH & COMPACTED BACKFILL (801.002).
20. REMOVE & DISPOSE EXISTING WATERLINE WITH FITTINGS (801.055).
22. NON-PRESSURIZED CONNECTION TO EXISTING WATERLINE (801.059). PROPOSED CONNECTION CONFIGURATION IS FOR ESTIMATING PURPOSES ONLY. CONTRACTOR SHALL FIELD VERIFY EXISTING PIPE CONFIGURATION, SIZE, TYPE, AND OTHER FIELD CONDITIONS IN ADVANCE OF CONSTRUCTION TO ESTABLISH CORRECT ADAPTERS AND FITTINGS. CONTRACTOR SHALL SHOW FINAL CONNECTION CONFIGURATION ON THE AS-BUILT DRAWINGS.
23. FURNISH & INSTALL DUCTILE IRON MECHANICAL JOINT FITTINGS. CLASS 250 (801.002).
24. FURNISH & INSTALL 6-INCH GATE VALVE PER STANDARD DRAWING 2326 (801.081).
28. FURNISH & INSTALL VALVE BOX PER STANDARD DRAWING 2326 (801.105).

55. TEMPORARY WATERLINE, 2-INCH TO 4-INCH, INCLUDING INSTALLATION, FLUSHING, USE, AND REMOVAL (801.028).

WATER SERVICE LINE SCHEDULE

1. REPLACE AND TRANSFER ALL WATER SERVICE LINE(S) PER STANDARD DRAWING 2362.
2. RELOCATE EXISTING WATER METER(S) PER SCHEDULE BELOW AND PER STANDARD DRAWING 2362. (EX. BOXES BEHIND WALL SHOULD BE RELOCATED TO ALLEY R/W)
3. REHABILITATE WATER METER BOX(ES) PER SCHEDULE BELOW.
4. ADJUST ALL METER BOXES TO NEW GRADE (INCIDENTAL TO METER RELOCATE AND REPLACEMENT).

ADDRESS	LOCATION	SERVICE SIZE	REHAB	RELOCATE
2517 ALVARADO DR NE	B5	3/4"	X	X
2518 PALOMAS DR NE	B5	3/4"	X	
2523 ALVARADO DR NE	B5	3/4"	X	
2524 PALOMAS DR NE	B5	3/4"	X	
2529 ALVARADO DR NE	B8	3/4"	X	
2530 PALOMAS DR NE	B6	3/4"	X	X
2533 ALVARADO DR NE	B3	3/4"	X	
2534 PALOMAS DR NE	B5	3/4"	X	

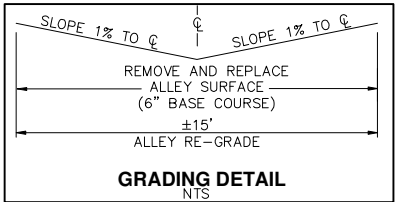

***PHASE 1**


ALBUQUERQUE BERNALILLO COUNTY WATER UTILITY AUTHORITY
SMALL DIAMETER WATER & SEWER
REHABILITATION FY11

TITLE:	ALLEY BTWN PALOMAS DR. & ALVARADO DR. STA. 18+80 TO STA. 21+17 FROM CUTLER TO ALLEY SOUTH OF MENAUL
--------	---

Design Review Committee	City Engineer Approval	Last Design Update	Mo. / Day / Yr.	Mo. / Day / Yr.

City Project No.	Zone Map No.	Sheet	Of
6312.92	H-18	10	48


[illegible]

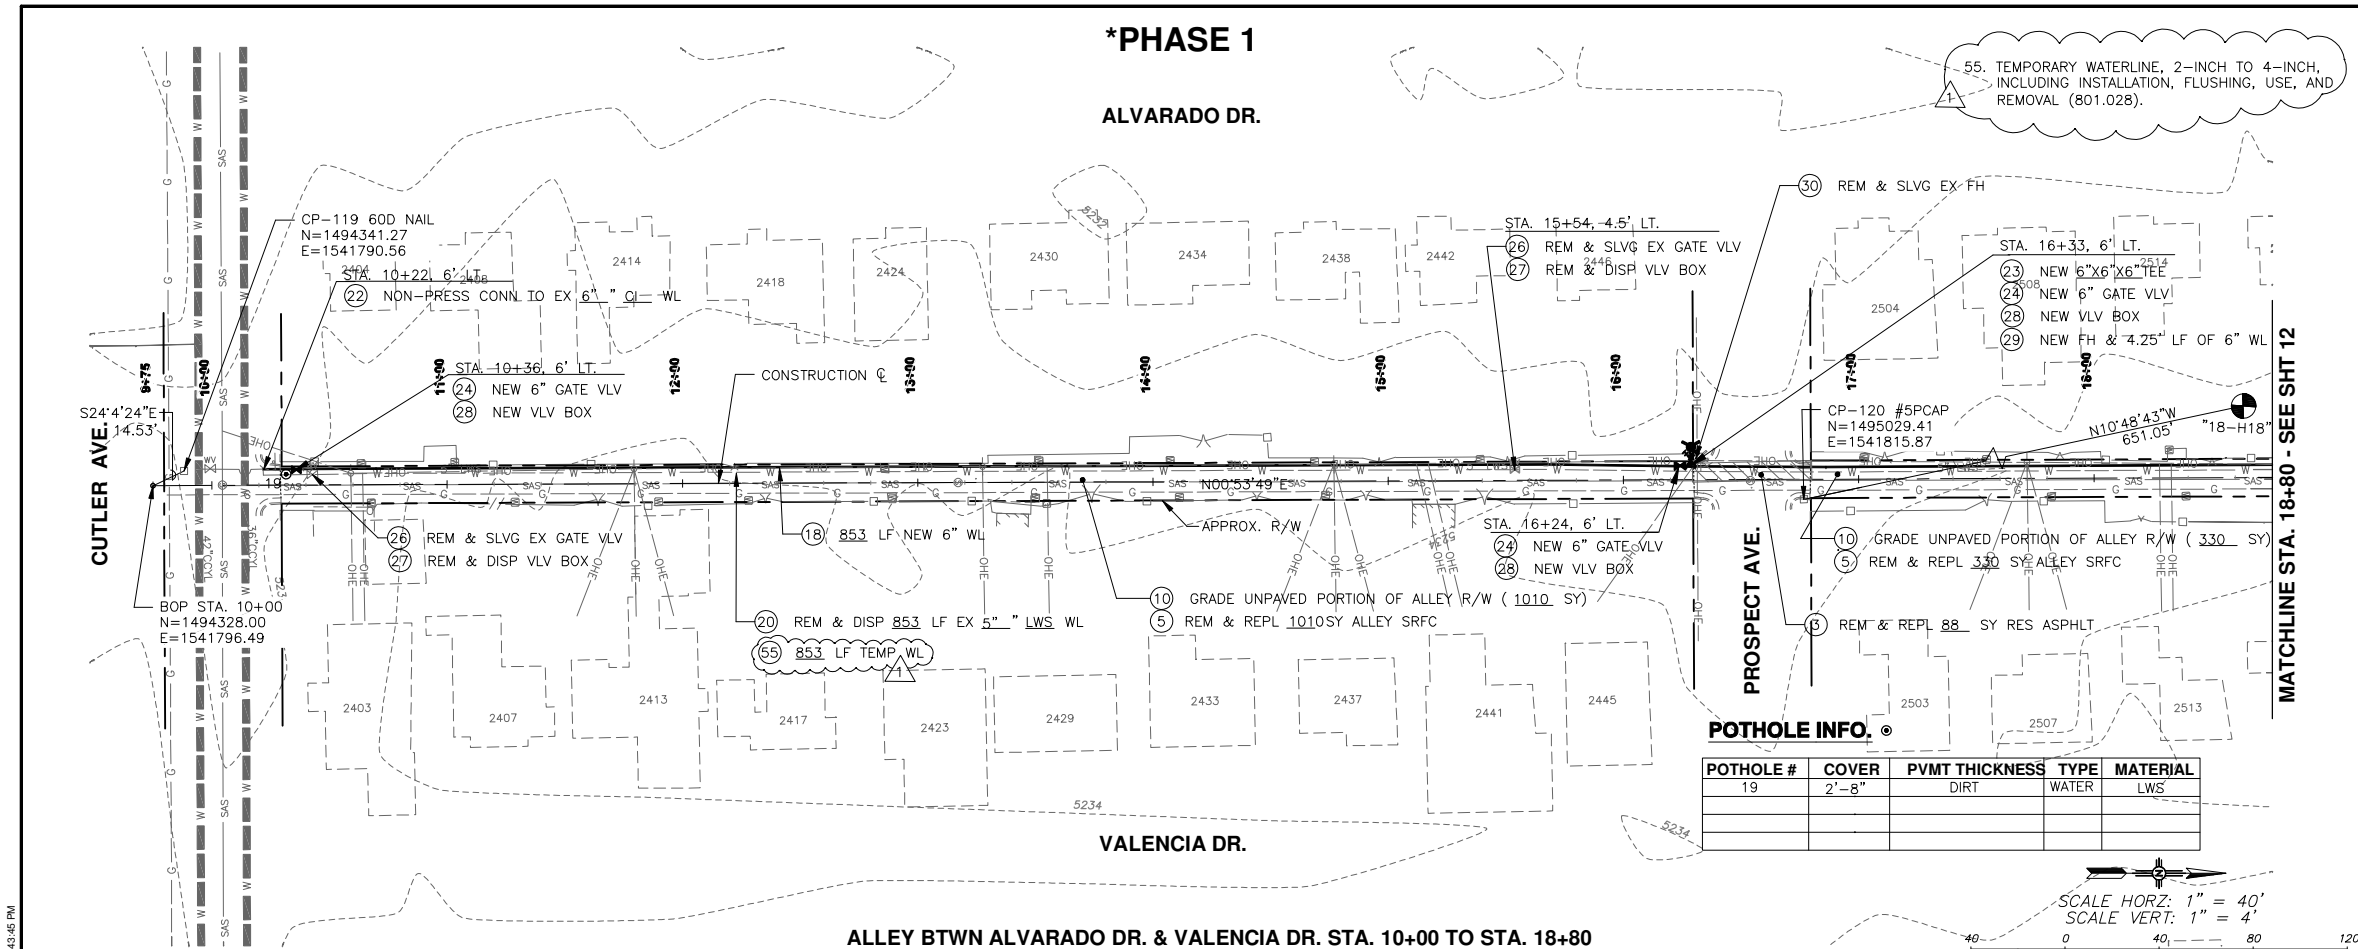

POTHOLE #	COVER	PVMT THICKNESS	TYPE	MATERIAL
19	2'-8"	DIRT	WATER	LWS



ADRE SS	LOCATION	SERVICE SIZE	RE HAB	RELOCATE
2403 VALENCIA DR NE		3/4"	X	X
2404 ALVARADO DR NE	B5	3/4"	X	X
2407 VALENCIA DR NE	B4	3/4"	X	X
2408 ALVARADO DR NE	B3	3/4"	X	X
2413 VALENCIA DR NE	B4	3/4"	X	
2414 ALVARADO DR NE	B5	3/4"	X	
2417 VALENCIA DR NE	B6	3/4"		X
2418 ALVARADO DR NE	B4	3/4"	X	
2423 VALENCIA DR NE	B6	3/4"	X	
2424 ALVARADO DR NE	B4	3/4"	X	
2429 VALENCIA DR NE	B6	3/4"	X	
2430 ALVARADO DR NE	B4	3/4"	X	
2433 VALENCIA DR NE	B5	3/4"	X	X
2434 ALVARADO DR NE	B5	3/4"	X	X
2437 VALENCIA DR NE	B5	3/4"	X	
2438 ALVARADO DR NE	B4	3/4"	X	
2441 VALENCIA DR NE	B5	3/4"	X	
2442 ALVARADO DR NE	B5	3/4"	X	
2445 VALENCIA DR NE	B5	3/4"	X	
2446 ALVARADO DR NE	B5	3/4"	X	
2503 VALENCIA DR NE	B3	3/4"	X	
2504 ALVARADO DR NE	B4	3/4"	X	
2507 VALENCIA DR NE	B5	3/4"	X	
2508 ALVARADO DR NE	B2	3/4"	X	

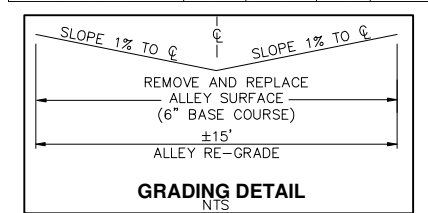[illegible]

(X) BUILD NOTES:


3. REMOVE & REPLACE RESIDENTIAL ASPHALT CONCRETE MATERIAL PER STANDARD DRAWING 2465.
5. REMOVE & REPLACE ALLEY SURFACE WITH 6-INCH BASE COURSE MATERIAL PER STANDARD DRAWING 2465.
10. GRADE AREA, WITH LESS THAN 2- FEET EXCAVATION PER DETAIL THIS SHEET AND STANDARD SPECIFICATION SECTION 301.
18. FURNISH & INSTALL 6-INCH WATERLINE PIPE INCLUDING TRENCH & COMPACTED BACKFILL (801.002).
20. REMOVE & DISPOSE EXISTING WATERLINE WITH FITTINGS (801.055).
22. NON-PRESSURIZED CONNECTION TO EXISTING WATERLINE (801.059). *PROPOSED CONNECTION CONFIGURATION IS FOR ESTIMATING PURPOSES ONLY. CONTRACTOR SHALL FIELD VERIFY EXISTING PIPE CONFIGURATION, SIZE, TYPE, AND OTHER FIELD CONDITIONS IN ADVANCE OF CONSTRUCTION TO ESTABLISH CORRECT ADAPTERS AND FITTINGS. CONTRACTOR SHALL SHOW FINAL CONNECTION CONFIGURATION ON THE AS-BUILT DRAWINGS.*
23. FURNISH & INSTALL DUCTILE IRON MECHANICAL JOINT FITTINGS, CLASS 250 (801.002).
24. FURNISH & INSTALL 6-INCH GATE VALVE PER STANDARD DRAWING 2326 (801.081).
26. REMOVE & SALVAGE EXISTING GATE VALVE (801.102).
27. REMOVE & DISPOSE VALVE BOX (801.104).
28. FURNISH & INSTALL VALVE BOX PER STANDARD DRAWING 2326 (801.105).
29. FURNISH & INSTALL FIRE HYDRANT PER STANDARD DRAWING 2340 (801.113).
30. REMOVE & SALVAGE EXISTING FIRE HYDRANT (801.119).

WATER SERVICE LINE SCHEDULE


1. REPLACE AND TRANSFER ALL WATER SERVICE LINE(S) PER STANDARD DRAWING 2362.
2. RELOCATE EXISTING WATER METER(S) PER SCHEDULE BELOW AND PER STANDARD DRAWING 2362. (EX. BOXES BEHIND WALL SHOULD BE RELOCATED TO ALLEY R/W)
3. REHABILITATE WATER METER BOX(ES) PER SCHEDULE BELOW.
4. ADJUST ALL METER BOXES TO NEW GRADE (INCIDENTAL TO METER RELOCATE AND REPLACEMENT).

[illegible]

*PHASE 1

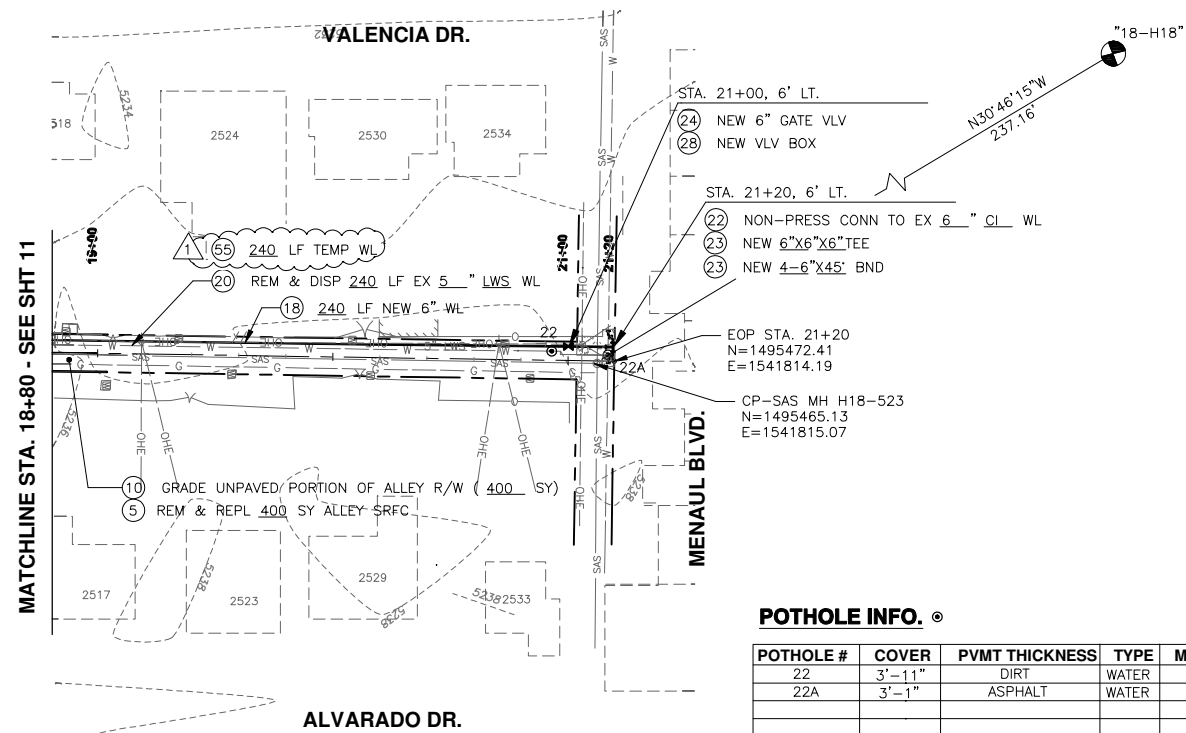

POTHOLE INFO. ©				
POTHOLE #	COVER	PVMT THICKNESS	TYPE	MATERIAL
22	3'-11"	DIRT	WATER	CI
22A	3'-1"	ASPHALT	WATER	LWS

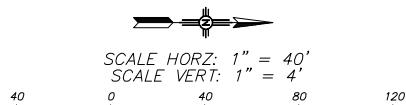ALLEY BTWN ALVARADO DR. & VALENCIA DR. STA. 18+80 TO STA. 21+15[illegible]

20+00


(X) BUILD NOTES:

5. REMOVE & REPLACE ALLEY SURFACE WITH 6-INCH BASE COURSE MATERIAL PER STANDARD DRAWING 2465.
10. GRADE AREA, WITH LESS THAN 2-FOOT EXCAVATION PER DETAIL THIS SHEET AND STANDARD SPECIFICATION SECTION 301.
18. FURNISH & INSTALL 6-INCH WATERLINE PIPE INCLUDING TRENCH & COMPACTED BACKFILL (801.002).
20. REMOVE & DISPOSE EXISTING WATERLINE WITH FITTINGS (801.055).
22. NON-PRESSURIZED CONNECTION TO EXISTING WATERLINE (801.059). *PROPOSED CONNECTION CONFIGURATION IS FOR ESTIMATING PURPOSES ONLY. CONTRACTOR SHALL FIELD VERIFY EXISTING PIPE CONFIGURATION, SIZE, TYPE, AND OTHER FIELD CONDITIONS IN ADVANCE OF CONSTRUCTION TO ESTABLISH CORRECT ADAPTERS AND FITTINGS. CONTRACTOR SHALL SHOW FINAL CONNECTION CONFIGURATION ON THE AS-BUILT DRAWINGS.*
23. FURNISH & INSTALL DUCTILE IRON MECHANICAL JOINT FITTINGS. CLASS 250 (801.002).
24. FURNISH & INSTALL 6-INCH GATE VALVE PER STANDARD DRAWING 2326 (801.081).
28. FURNISH & INSTALL VALVE BOX PER STANDARD DRAWING 2326 (801.105).
55. TEMPORARY WATERLINE, 2-INCH TO 4-INCH, INCLUDING INSTALLATION, FLUSHING, USE, AND REMOVAL (801.028).

WATER SERVICE LINE SCHEDULE

1. REPLACE AND TRANSFER ALL WATER SERVICE LINE(S) PER STANDARD DRAWING 2362.
2. RELOCATE EXISTING WATER METER(S) PER SCHEDULE BELOW AND PER STANDARD DRAWING 2362. (EX. BOXES BEHIND WALL SHOULD BE RELOCATED TO ALLEY R/W)
3. REHABILITATE WATER METER BOX(ES) PER SCHEDULE BELOW.
4. ADJUST ALL METER BOXES TO NEW GRADE (INCIDENTAL TO METER RELOCATE AND REPLACEMENT).

ADDRESS	LOCATION	SE RVCE SIZE	REHAB	RELOCATE
2513 VALE NCIA DR NE	B5	3/4"	X	
2514 ALVARADO DR NE	B5	3/4"	X	X
2517 VALE NCIA DR NE	B5	3/4"	X	X
2518 ALVARADO DR NE	B5	3/4"	X	X
2523 VALE NCIA DR NE	B5	3/4"	X	
2524 ALVARADO DR NE		3/4"	X	
2529 VALE NCIA DR NE	B5	3/4"	X	X
2530 ALVARADO DR NE	B5	3/4"	X	X
2533 VALE NCIA DR NE	B5	3/4"	X	
2534 ALVARADO DR NE	B5	3/4"	X	

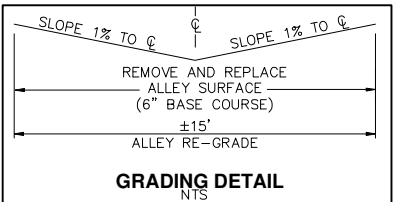

***PHASE 1**

ALBUQUERQUE BERNALILLO COUNTY WATER UTILITY AUTHORITY
SMALL DIAMETER WATER & SEWER
REHABILITATION FY11

TITLE:	ALLEY BTWN ALVARADO DR. & VALENCIA DR. STA. 18+80 TO STA. 21+15 FROM CUTLER TO ALLEY SOUTH OF MENAUL
--------	--


Design Review Committee	City Engineer Approval	Last Design Update	Mo. / Day / Yr.	Mo. / Day / Yr.

City Project No.	Zone Map No.	Sheet	Of
6312.92	H-18	12	48

[illegible]

D:\SEC---PROJECTS\2009 PROJECTS\109126 ABCWUA - SMALL DIAMETER\DRAWINGS\1\AUTOCAD\PLANSET\ALVARADO DR. STA. 18+80 TO STA. 21+15.DWG 7/27/10 3:51:52 PM

CARDENAS DR.

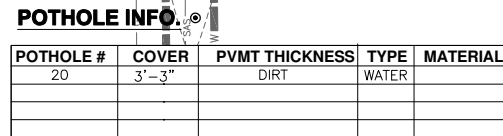**ALLEY BTWN CARDENAS DR. & CAGUA DR. STA. 10+00 TO STA. 18+80**

 109126
Smith Engineering Company
A Full Service Engineering Company
2201 San Pedro Boulevard, N.E., Bldg. #4, Suite 200 Albuquerque, New Mexico 87110

3. REMOVE & REPLACE RESIDENTIAL ASPHALT CONCRETE MATERIAL PER STANDARD DRAWING 2465.
5. REMOVE & REPLACE ALLEY SURFACE WITH 6-INCH BASE COURSE MATERIAL PER STANDARD DRAWING 2465.
10. GRADE AREA, WITH LESS THAN 2-FOOT EXCAVATION PER DETAIL THIS SHEET AND STANDARD SPECIFICATION SECTION 301.
18. FURNISH & INSTALL 6-INCH WATERLINE PIPE INCLUDING TRENCH & COMPACTED BACKFILL (801.002).
20. REMOVE & DISPOSE EXISTING WATERLINE WITH FITTINGS (801.055).
22. NON-PRESSURIZED CONNECTION TO EXISTING WATERLINE (801.059). *PROPOSED CONNECTION CONFIGURATION IS FOR ESTIMATING PURPOSES ONLY. CONTRACTOR SHALL FIELD VERIFY EXISTING PIPE CONFIGURATION, SIZE, TYPE, AND OTHER FIELD CONDITIONS IN ADVANCE OF CONSTRUCTION TO ESTABLISH CORRECT ADAPTERS AND FITTINGS. CONTRACTOR SHALL SHOW FINAL CONNECTION CONFIGURATION ON THE AS-BUILT DRAWING.*
23. FURNISH & INSTALL DUCTILE IRON MECHANICAL JOINT FITTINGS, CLASS 250 (801.002).
24. FURNISH & INSTALL 6-INCH GATE VALVE PER STANDARD DRAWING 2326 (801.081).
26. REMOVE & SALVAGE EXISTING GATE VALVE (801.102).
27. REMOVE & DISPOSE VALVE BOX (801.104).
28. FURNISH & INSTALL VALVE BOX PER STANDARD DRAWING 2326 (801.105).
29. FURNISH & INSTALL FIRE HYDRANT PER STANDARD DRAWING 2340 (801.113).
30. REMOVE & SALVAGE EXISTING FIRE HYDRANT (801.119).
37. TRENCH, BACKFILL, AND COMPACT 4-INCH TO 15-INCH SEWER PIPE, OVER 16-FEET IN DEPTH (701.040).
38. FURNISH & PLACE 8-INCH SEWER PIPE IN OPEN TRENCH (901.030).
40. REMOVE & DISPOSE SEWER LINE PER STANDARD DRAWING 2125 (901.710).
41. REINSTALL EXISTING 4-INCH SEWER SERVICE LINE TO REPLACEMENT MAN, INCLUDING FIRST 5-FEET OF EXISTING LINE, PER STANDARD DRAWING 2134 (905.200).
46. ADJUST EXISTING MANHOLE FRAME & COVER TO GRADE WITH METAL RINGS, 2-INCH OR LESS, PER STANDARD DRAWING 2125 (901.710).

1. REPLACE AND TRANSFER ALL WATER SERVICE LINE(S) PER STANDARD DRAWING 2362.
2. RELOCATE EXISTING WATER METER(S) PER SCHEDULE BELOW AND PER STANDARD DRAWING 2362. (EX. BOXES BEHIND WALL SHOULD BE RELOCATED TO ALLEY R/W)
3. REHABILITATE WATER METER BOX(ES) PER SCHEDULE BELOW.
4. ADJUST ALL METER BOXES TO NEW GRADE (INCIDENTAL TO METER RELOCATE AND REPLACEMENT).

10+00 TO STA. 18+80


		Mo. / Day / Yr.	Mo. / Day / Yr.

Last Design Update		

Map No.	Sheet	Of
H-18	13	48

Q:\SEC-PROJECTS\2009 PROJECTS\109126 ABQ\UA - SMALL DIAMETER DRAWINGS\1\AUTOCAD\PLAN\BTWN CARDENAS DR. & CAGUA DR. STA. 18+80 TO STA. 21+17.DWG 7/28/10 7:28:01 AM

*PHASE 1

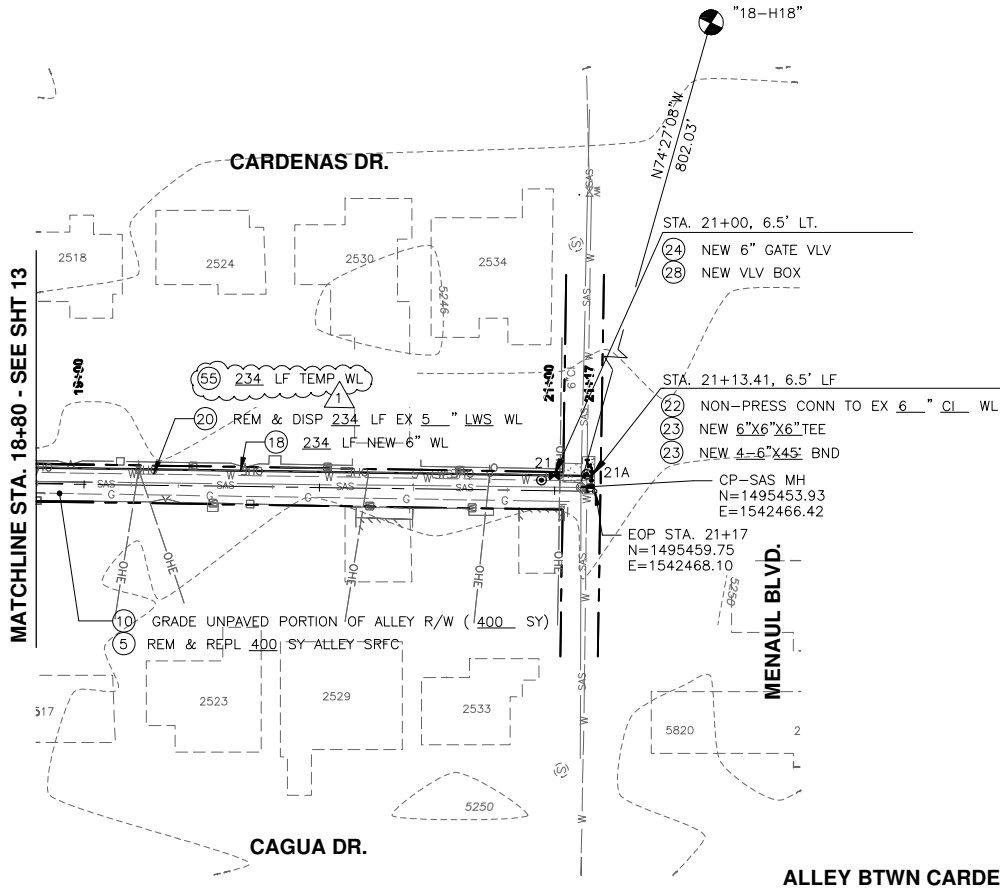

POTHOLE INFO. ☉

POTHOLE #	COVER	PVMT THICKNESS	TYPE	MATERIAL
21	3'-11"	DIRT	WATER	LWS
21A	3'-8"	9"	WATER	LWS




⊗ BUILD NOTES:

5. REMOVE & REPLACE ALLEY SURFACE WITH 6-INCH BASE COURSE MATERIAL PER STANDARD DRAWING 2465.
10. GRADE AREA, WITH LESS THAN 2-FOOT EXCAVATION PER DETAIL THIS SHEET AND STANDARD SPECIFICATION SECTION 301.
18. FURNISH & INSTALL 6-INCH WATERLINE PIPE INCLUDING TRENCH & COMPACTED BACKFILL (801.002).
20. REMOVE & DISPOSE EXISTING WATERLINE WITH FITTINGS (801.055).
22. NON-PRESSURIZED CONNECTION TO EXISTING WATERLINE (801.059). PROPOSED CONNECTION CONFIGURATION IS FOR ESTIMATING PURPOSES ONLY. CONTRACTOR SHALL FIELD VERIFY EXISTING PIPE CONFIGURATION, SIZE, TYPE, AND OTHER FIELD CONDITIONS IN ADVANCE OF CONSTRUCTION TO ESTABLISH CORRECT ADAPTERS AND FITTINGS. CONTRACTOR SHALL SHOW FINAL CONNECTION CONFIGURATION ON THE AS-BUILT DRAWINGS.
23. FURNISH & INSTALL DUCTILE IRON MECHANICAL JOINT FITTINGS, CLASS 250 (801.002).
24. FURNISH & INSTALL 6-INCH GATE VALVE PER STANDARD DRAWING 2326 (801.081).
28. FURNISH & INSTALL VALVE BOX PER STANDARD DRAWING 2326 (801.105).
55. TEMPORARY WATERLINE, 2-INCH TO 4-INCH, INCLUDING INSTALLATION, FLUSHING, USE, AND REMOVAL (801.028).

WATER SERVICE LINE SCHEDULE

1. REPLACE AND TRANSFER ALL WATER SERVICE LINE(S) PER STANDARD DRAWING 2362.
2. RELOCATE EXISTING WATER METER(S) PER SCHEDULE BELOW AND PER STANDARD DRAWING 2362. (EX. BOXES BEHIND WALL SHOULD BE RELOCATED TO ALLEY R/W)
3. REHABILITATE WATER METER BOX(ES) PER SCHEDULE BELOW.
4. ADJUST ALL METER BOXES TO NEW GRADE (INCIDENTAL TO METER RELOCATE AND REPLACEMENT).

ADDRESS	LOCATION	SERVICE SIZE	REHAB	RELOCATE
2517 CAGUA DR NE	B5	3/4"	X	
2518 CARDENAS DR NE	B4	3/4"	X	
2523 CAGUA DR NE	B8	3/4"	X	
2524 CARDENAS DR NE	B5	3/4"	X	
2529 CAGUA DR NE	B5	3/4"	X	
2530 CARDENAS DR NE	B5	3/4"	X	
2533 CAGUA DR NE	B5	3/4"	X	
2534 CARDENAS DR NE	B5	3/4"	X	

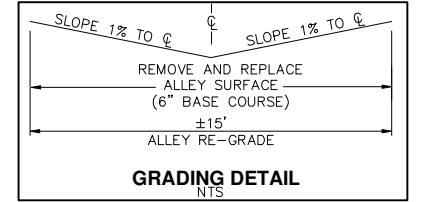

*PHASE 1

ALBUQUERQUE BERNALILLO COUNTY WATER UTILITY AUTHORITY
SMALL DIAMETER WATER & SEWER
REHABILITATION FY11

TITLE: ALLEY BTWN CARDENAS DR. & CAGUA DR.
STA. 18+80 TO STA. 21+17
FROM CUTLER TO ALLEY SOUTH OF MENAUL

Design Review Committee	City Engineer Approval	No. / Day / Yr.	No. / Day / Yr.

City Project No.	Zone Map No.	Sheet	Of
6312.92	H-18	14	48



REVISIONS	DATE	BY

DESIGNED BY RCF DATE Jul 2010
DRAWN BY MAC/VLH DATE Jul 2010
CHECKED BY FAC DATE Jun 2010