


Roger & Luan 9/25/00
CONSTRUCTION ACCEPTANCE

LINE	DIRECTION	DISTANCE
L1	S 83°17'45" E	593.96'
L2	S 00°29'28" W	337.46'
L3	N 89°36'19" W	610.01'
L4	N 00°25'30" E	402.74'
L5	S 89°35'45" E	20.00'
L6	S 89°33'07" E	20.31'
L7	S 15°41'48" E	104.11'
L8	S 03°04'49" E	400.84'
L9	N 89°43'36" W	74.30'
L10	N 00°29'28" E	500.31'

THIS IS NOT A BOUNDARY SURVEY. APPARENT PROPERTY CORNERS ARE SHOWN FOR INFORMATION ONLY. BOUNDARY AND TOPOGRAPHIC DATA SHOWN IS BASED UPON THE PRELIMINARY BOUNDARY AND PARTIAL TOPOGRAPHIC SURVEY PERFORMED BY JMA IN OCTOBER, 1999.

I, CHARLES G. CALA, JR., REGISTERED PROFESSIONAL SURVEYOR IN THE STATE OF NEW MEXICO, DO HEREBY CERTIFY THAT THIS "AS-BUILT" INFORMATION WAS OBTAINED BY ME OR UNDER MY SUPERVISION AND REPRESENTS THE "AS-BUILT" CONDITIONS OF THIS PROJECT, AND IS TRUE AND CORRECT TO THE BEST OF MY KNOWLEDGE AND BELIEF. ALL VERTICAL AND HORIZONTAL DIMENSIONS SHOULD BE FIELD VERIFIED PRIOR TO USE ON FUTURE PROJECTS.

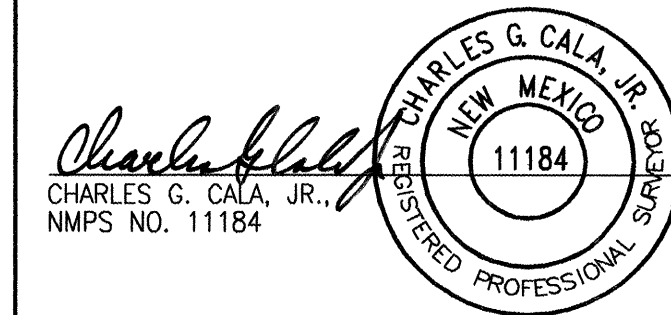

JEFF MORTENSEN & ASSOCIATES, INC.
☐ 6010-B MIDWAY PARK BLVD. N.E.
☐ ALBUQUERQUE ☐ NEW MEXICO 87109
☐ ENGINEERS ☐ SURVEYORS (505) 345-4250

Design Review Committee	City Engineer Approval	Last Design Update	Mo./Day/Yr.	Mo./Day/Yr.

Sheet 1 Of 1