




CITY OF ALBUQUERQUE PUBLIC WORKS DEPARTMENT PLANS FOR CONSTRUCTION

HILTON GARDENS WATERLINE RELOCATION YALE BOULEVARD AND RAILROAD SPUR ROW

INDEX TO DRAWINGS

SHEET NO.	TITLE
1	TITLE SHEET, VICINITY MAP, SHEET INDEX
2	GENERAL NOTES & LEGEND
3	SITE PLAN & WATER FACILITY MAP
4	12" WATERLINE PLAN AND PROFILE STATION 10+00 TO STATION 12+64
5	24" WATERLINE PLAN AND PROFILE STATION 10+00 TO STATION 12+36

APPROVAL OF RECORD DRAWINGS
CHIEF CONSTRUCTION ENGINEER
[Signature]
DATE 6/7/02

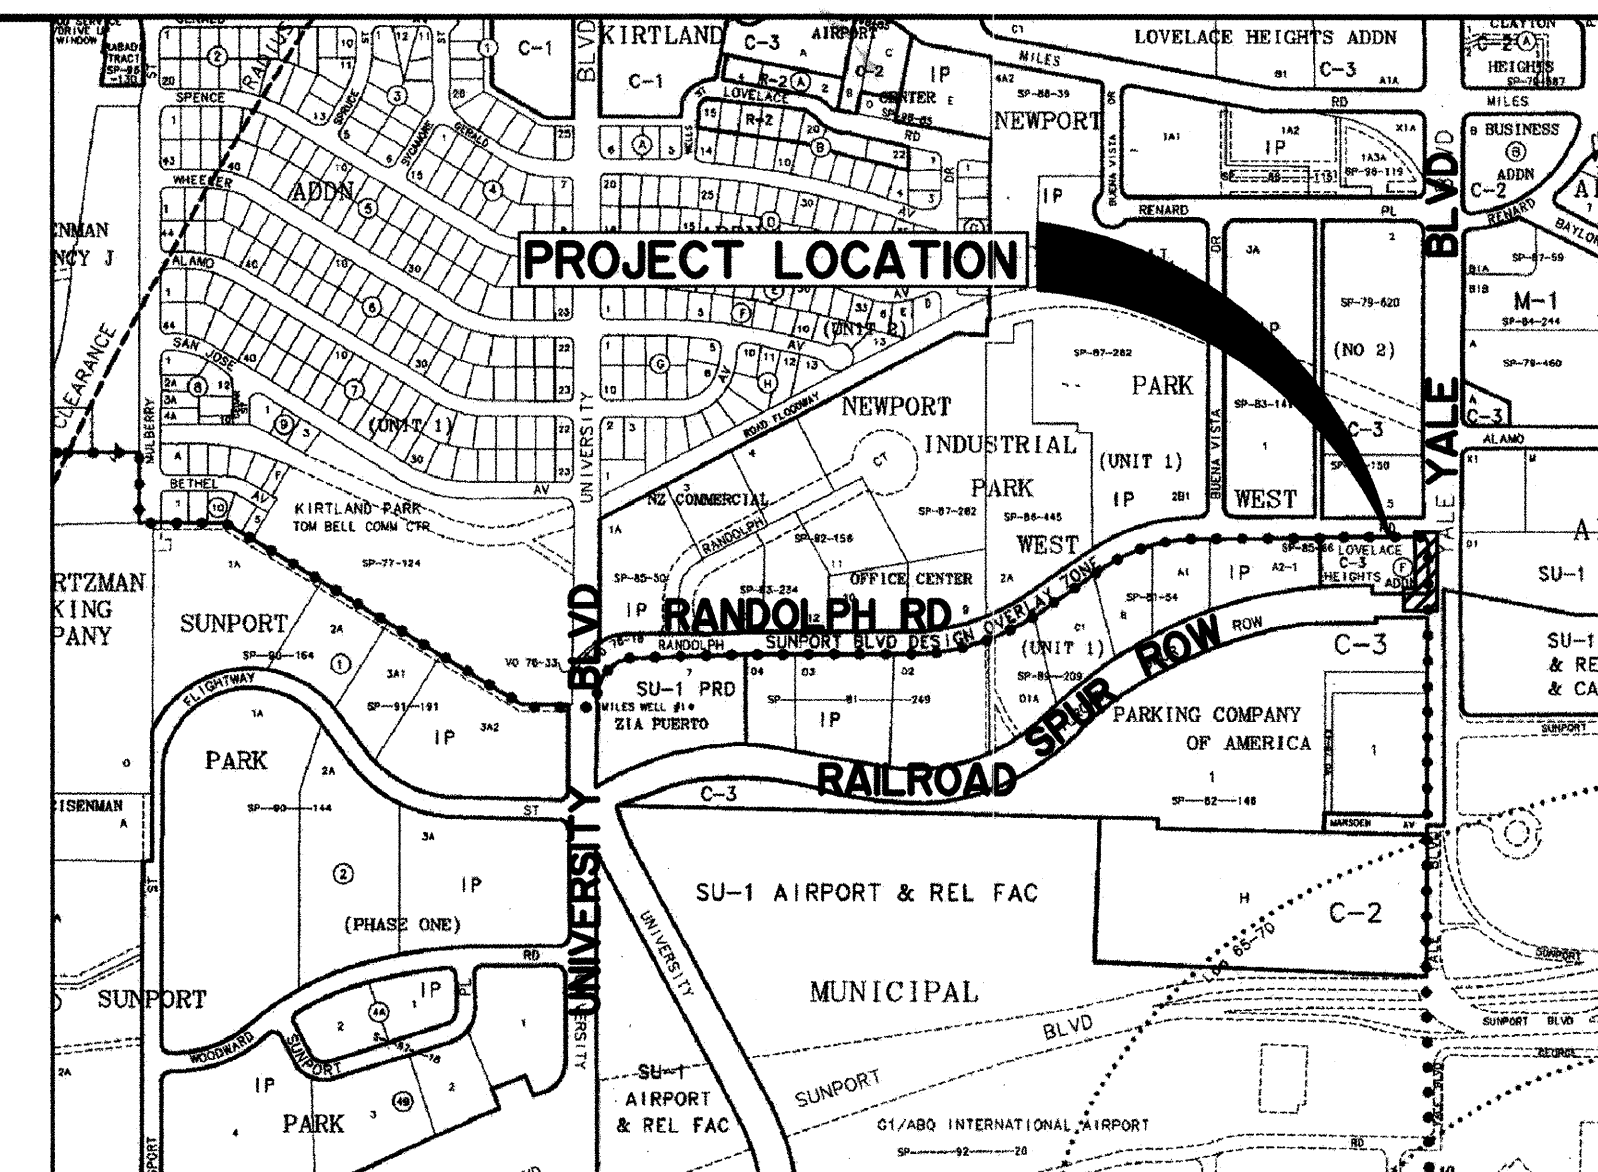

VICINITY MAP



MAP NO. M-15-Z

UTILITY COMPANY CONTACTS

PNM-ELECTRIC
WARREN ARTHUR
Engineering Representative III
4201 Edith Blvd., NE
Albuquerque, New Mexico 87107
(505) 241-3490

AT&T
DAVID CROWL
Resource Supervisor
III Third ST., NW
Albuquerque, New Mexico 87103
(505) 842-2911

QWEST/US WEST
DAVID MULLER
Capacity Provisioning Specialist
(505) 245-8706
201 3rd Street NW, Suite 700
Albuquerque, New Mexico 87102

E-SPIRE (ACSI)
JOHN MARES
505 Marquette NE, Suite 1605
Albuquerque, New Mexico 87102
(505) 998-2274

BROOKS/MCI WORLDCOM
ANDY DARNELL
Operation Manager
3700 Singer Blvd. NE, Suite A
Albuquerque, NM 87109
(505) 346-4476

TIME WARNER TELECOM
ROYAL HARRISON
Plant Manager
3830 Singer Blvd. NE, Suite 1000
Albuquerque, NM 87109
(505) 938-7339

NEW MEXICO UTILITIES
BOB GAY
Operation Supervisor
4700 Irving Blvd. NE, Suite 1000
Albuquerque, NM 87109
(505) 989-2661

PNM-GAS CO.
KELLY BOUSKA
Design Engineer
4625 Edith Blvd., NE
Albuquerque, New Mexico 87107
(505) 241-7752


COMCAST CABLE
RITA ERICKSON
Planning and Design Supervisor
4611 Montbel Pl., NE
Albuquerque, New Mexico 87107
(505) 761-6235

**CITY OF ALBUQUERQUE
(WATER & SEWER)**
GREG OLSON
PWD/Utility Development
P.O. Box 1293
Albuquerque, New Mexico 87103
(505) 768-2719

McLeodUSA
RICK MUELLER
Supervisor of Outside Techs.
505 Marquette NE, Suite 1600
Albuquerque, New Mexico 87102
(505) 244-3161

PATHNET
LOIS MEEKS
Right-of-Way & Licensing
1661 Gateway Blvd.
Richardson, Texas 75080
(972) 944-7114

GENUITY
DENNIS PAULSON
Manager
OSP Engineering
5221 North O'Connor MC, HQL1A22
Irving, Texas 75039
(972) 791-3277

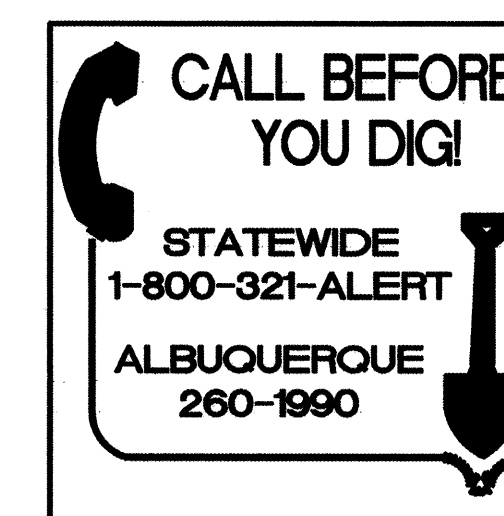

SEC JOB # 101102D
Smith Engineering Company
A Full Service Engineering Company
8000 Uptown Industrial, S.E. Suite 2000 Albuquerque, New Mexico 87123

REV.	SHEETS	CITY ENGINEER	DATE	USER DEPARTMENT	DATE	USER DEPARTMENT	DATE
ENGINEERS STAMP & SIGNATURE		APPROVED		ENGINEER		DATE	
<i>[Signature]</i>		DRC Chairman					
		Transportation					
		Water/Wastewater		<i>[Signature]</i>		6/7/02	
		Hydrology					
		C I P					
Const. Coord.							
Parks							
PROJECT NUMBER				640234		SHEET 1 OF 5	


101102D



Smith Engineering Company
A Full Service Engineering Company

6400 Uptown Boulevard, N.E. Suite 6008 Albuquerque, New Mexico 87110


CITY OF ALBUQUERQUE				
PUBLIC WORKS DEPARTMENT				
ENGINEERING DEVELOPMENT GROUP				
TITLE: HILTON GARDENS WATERLINE RELOCATION				
GENERAL NOTES				
Design Review Committee	City Engineer Approval	Last Design Update	Mo. / Day / Yr.	Mo. / Day / Yr.
City Project No.		Zone Map No.	Sheet	Of
640234		M-15-Z	2	5

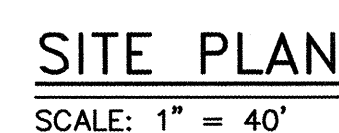

1. ALL WORK DETAILED ON THESE PLANS TO BE PERFORMED, EXCEPT AS OTHERWISE STATED OR PROVIDED FOR HEREON, IN ACCORDANCE WITH THE CITY OF ALBUQUERQUE SPECIFICATIONS FOR PUBLIC WORKS CONSTRUCTION— 1986 EDITION (REFERRED TO HEREIN AS THE STANDARD SPECIFICATIONS) AND THE SUPPLEMENTAL SPECIFICATIONS PROVIDED IN THE CONTRACT DOCUMENTS.
2. DRAFTED BY SMITH ENGINEERING — COORDINATE WITH BILL Y. GOOLSBY, C.O.A. PUBLIC WORKS DEPARTMENT, UTILITY DESIGN DIVISION, 768-2713. NO ENGINEERING WAS PERFORMED OR IMPLIED.

1. 24" LINE SHUT DOWN - OPERATE VALVES 542 AND 292.
2. 12" LINE SHUT DOWN - OPERATE VALVES 391, 392, 393, AND 492.
3. 6" LINE SHUT DOWN - OPERATE VALVES 153 AND 541.

	Smith Engineering Company A Full Service Engineering Company 6400 Uptown Boulevard, N.E. Suite 5008 Albuquerque, New Mexico 87110	1011022D		NO. DATE	DESIGNED BY DRAWN BY
CITY OF ALBUQUERQUE PUBLIC WORKS DEPARTMENT ENGINEERING DEVELOPMENT GROUP					
TITLE: HILTON GARDENS WATERLINE RELOCATION SITE PLAN AND WATER FACILITY MAP					
Design Review Committee	City Engineer Approval	Last Design Update	No. / Day / Yr.		No. / Day / Yr.
City Project No. 640234		Zone Map No. M-15-Z	Sheet 3	Of 5	

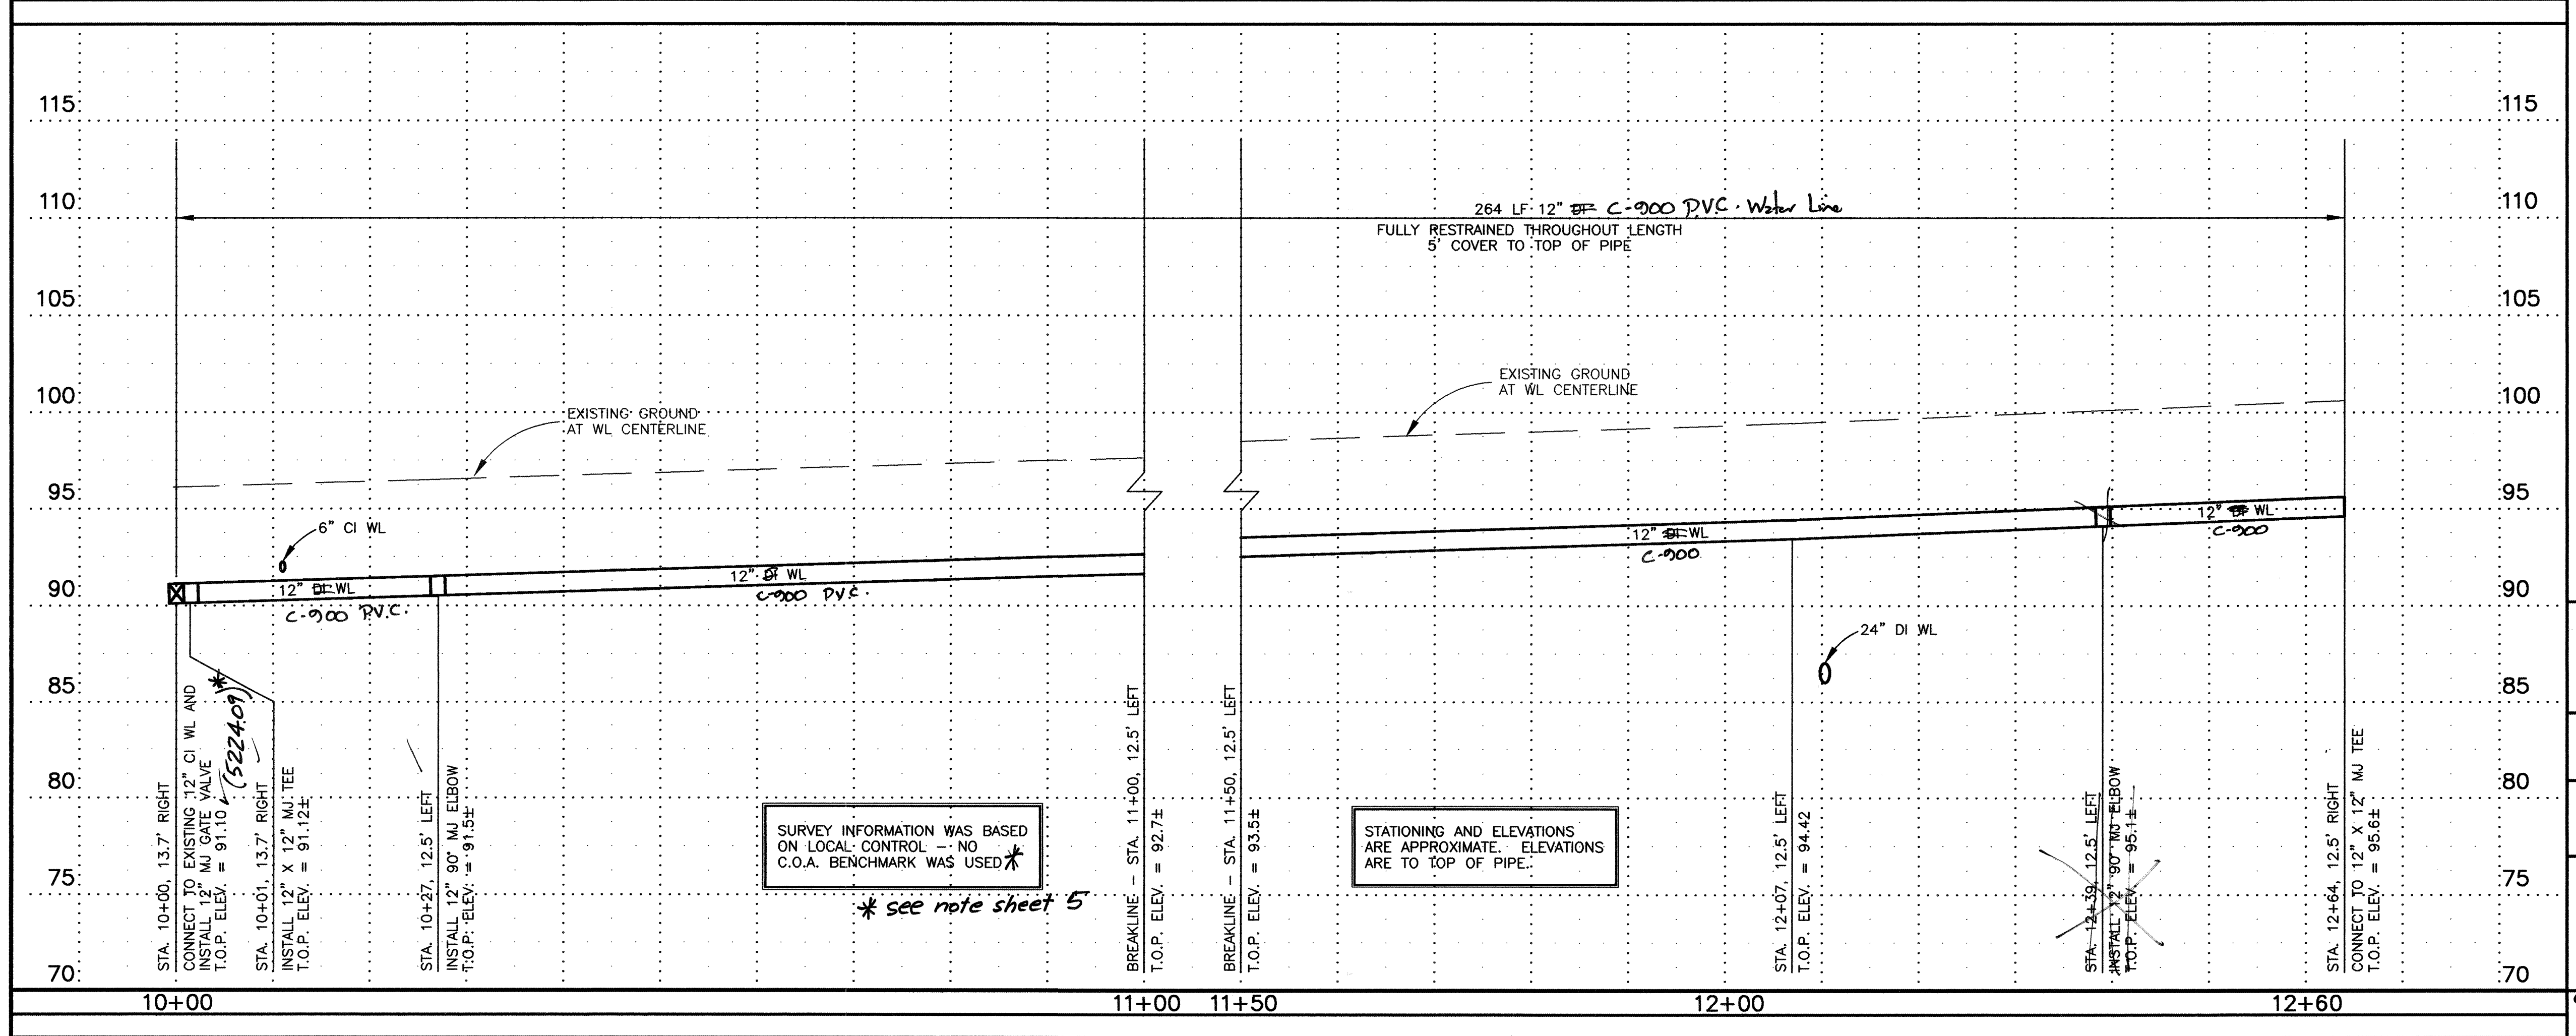

Design Review Committee	City Engineer Approval	Last Design Update	No. / Day / Yr.	No. / Day / Yr.
Project No. 640234		Zone Map No. M-15-Z	Sheet 4	Of 5

[illegible]

