




INDEX OF SHEETS


- 13-1(61A) TITLE SHEET (NMSHTD COVER SHEET) AND
13-2 BROWNING STREET / PASEO DEL NORTE WATERLINES
13-3 BROWNING STREET / PASEO EL NORTE WATERLINE PROFILES
13-4 LOWELL STREET / PASEO DEL NORTE WATERLINES
13-5 LOWELL STREET / PASEO DEL NORTE WATERLINE PROFILES

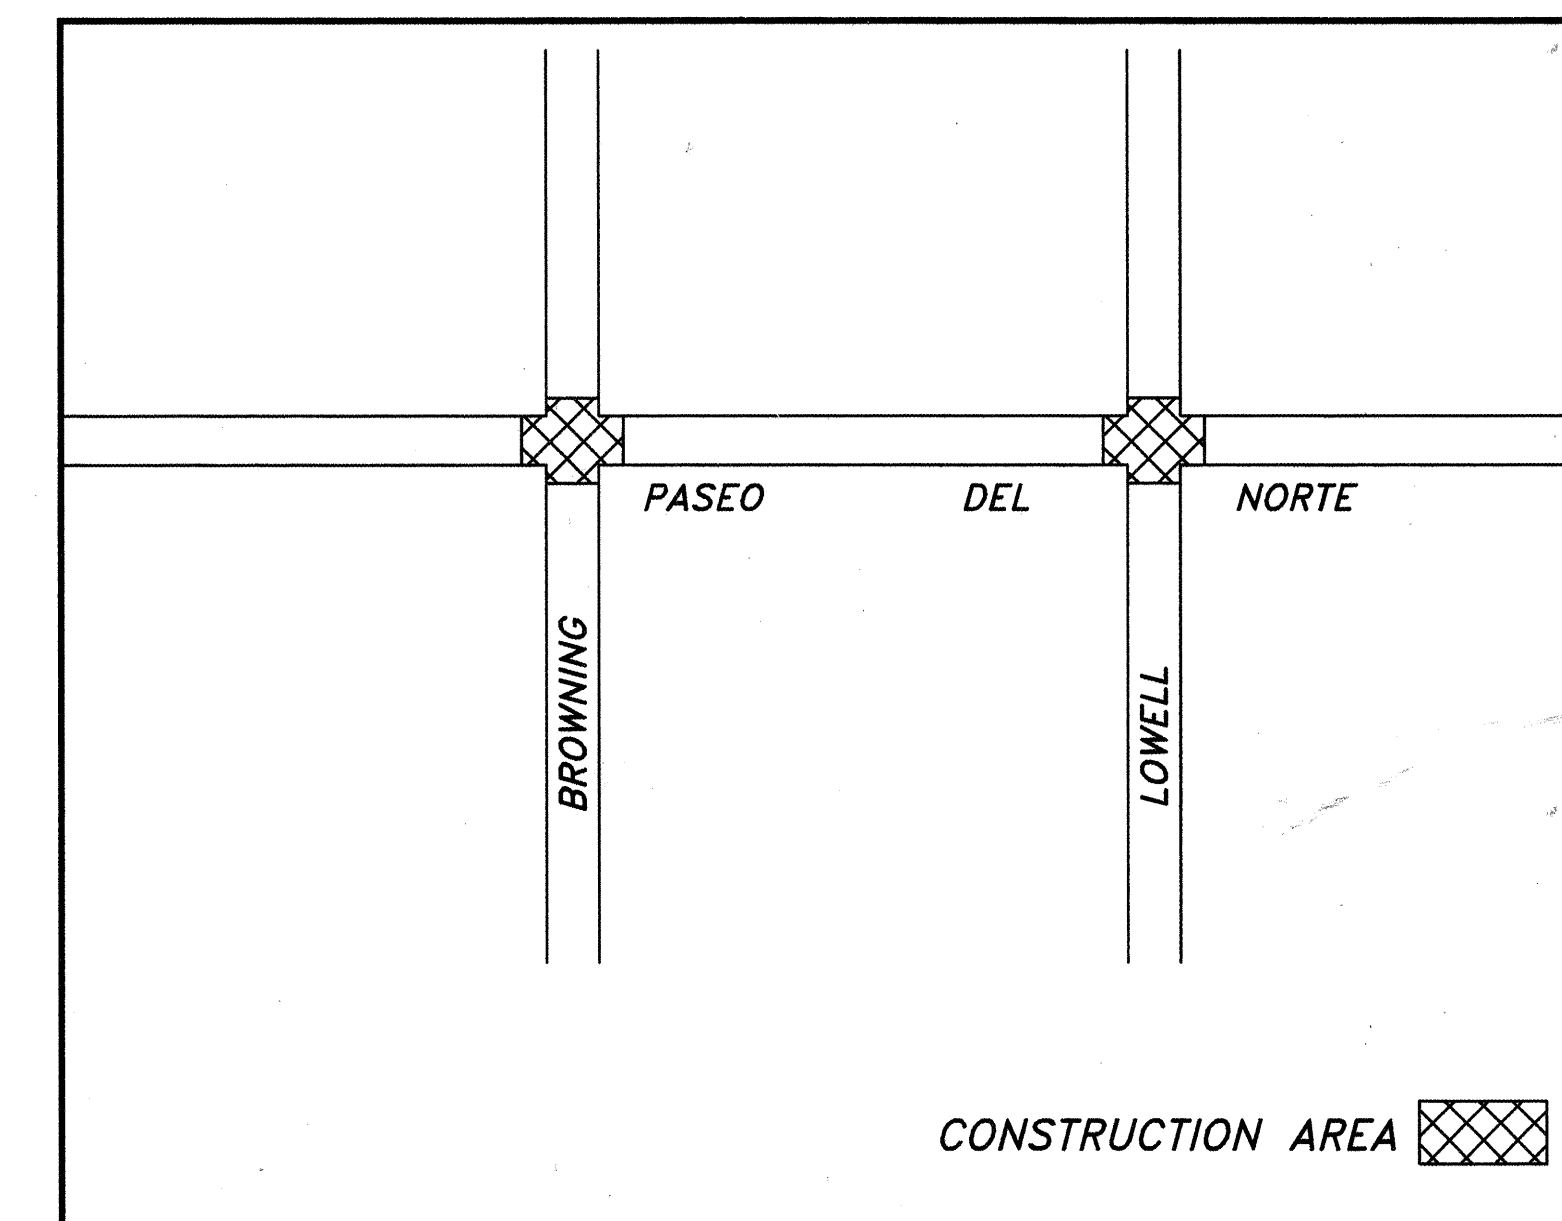


LOCATION MAP
ZONE ATLAS MAP C-22

GENERAL NOTES

1. ALL WORK DETAILED ON THESE PLANS, UNLESS STATED OTHERWISE OR PROVIDED FOR HEREON, SHALL BE PERFORMED IN ACCORDANCE WITH CITY OF ALBUQUERQUE STANDARD SPECIFICATIONS FOR PUBLIC WORKS CONSTRUCTION - THROUGH UPDATE NO. 6.
2. PRIOR TO CONSTRUCTION, THE CONTRACTOR SHALL EXCAVATE AND VERIFY THE HORIZONTAL AND VERTICAL ALIGNMENTS OF ALL POTENTIAL OBSTRUCTIONS. SHOULD A CONFLICT EXIST, THE CONTRACTOR SHALL NOTIFY THE OWNER SO THAT THE CONFLICT CAN BE RESOLVED WITH A MINIMUM OF DELAY.
3. IT WILL BE THE CONTRACTOR'S RESPONSIBILITY TO PROTECT AND MAINTAIN IN SERVICE ALL EXISTING UTILITIES.
4. ALL EXCAVATION, TRENCHING AND SHORING ACTIVITIES MUST BE CARRIED-OUT IN ACCORDANCE WITH OSHA 29 CFR 1926.650 SUBPART P.

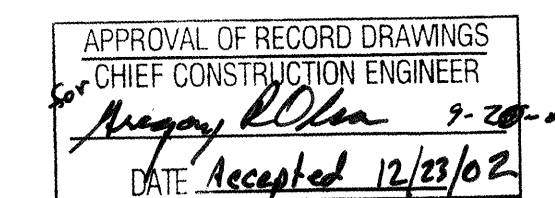

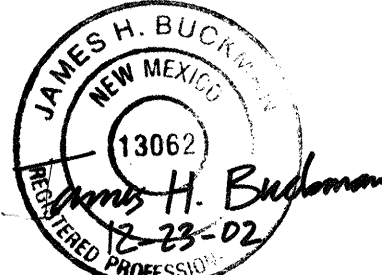REV.	SHEETS	CITY ENGINEER	DATE	USER DEPARTMENT	DATE	USER DEPARTMENT	DATE		
ENGINEERS STAMP & SIGNATURE		APPROVALS		ENGINEER		DATE		*****	
		DRC Chairman						APPROVED FOR CONSTRUCTION	
		Transportation							
		Water/Wastewater							
		Hydrology							
		Parks							
		Constr. Mngmt.							
County								City Engineer Date	
City Project No.								Sheet Of	
				6440.91				13-1 5	

NEW MEXICO STATE HIGHWAY AND TRANSPORTATION DEPARTMENT CONSTRUCTION PLANS

IB-TPU-HPP-4054(2)07 PHASE II PASEO DEL NORTE BERNALILLO COUNTY


CONTROL NO. 2662



SCANNED BY
MESA REPRO

APPROVED FOR CONSTRUCTION
WITHIN AMAFCA RIGHT-OF-WAY

Don't ship for John Kelly 5/1/00
DATE

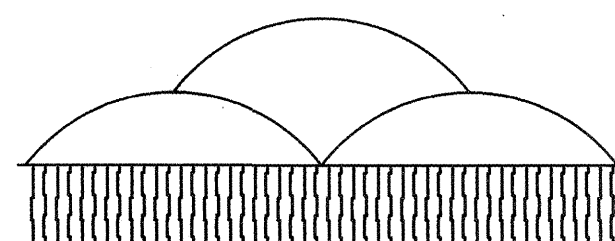


Albuquerque
Metropolitan
Arroyo
Flood
Control
Authority

IB-TPU-HPP-4054(2)07

PASEO DEL NORTE PHASE II
EUBANK BLVD. TO TENNYSON ST.
COUNTY OF BERNALILLO

[Signature]
PUBLIC WORKS
BERNALILLO COUNTY




5/24/00
DATE

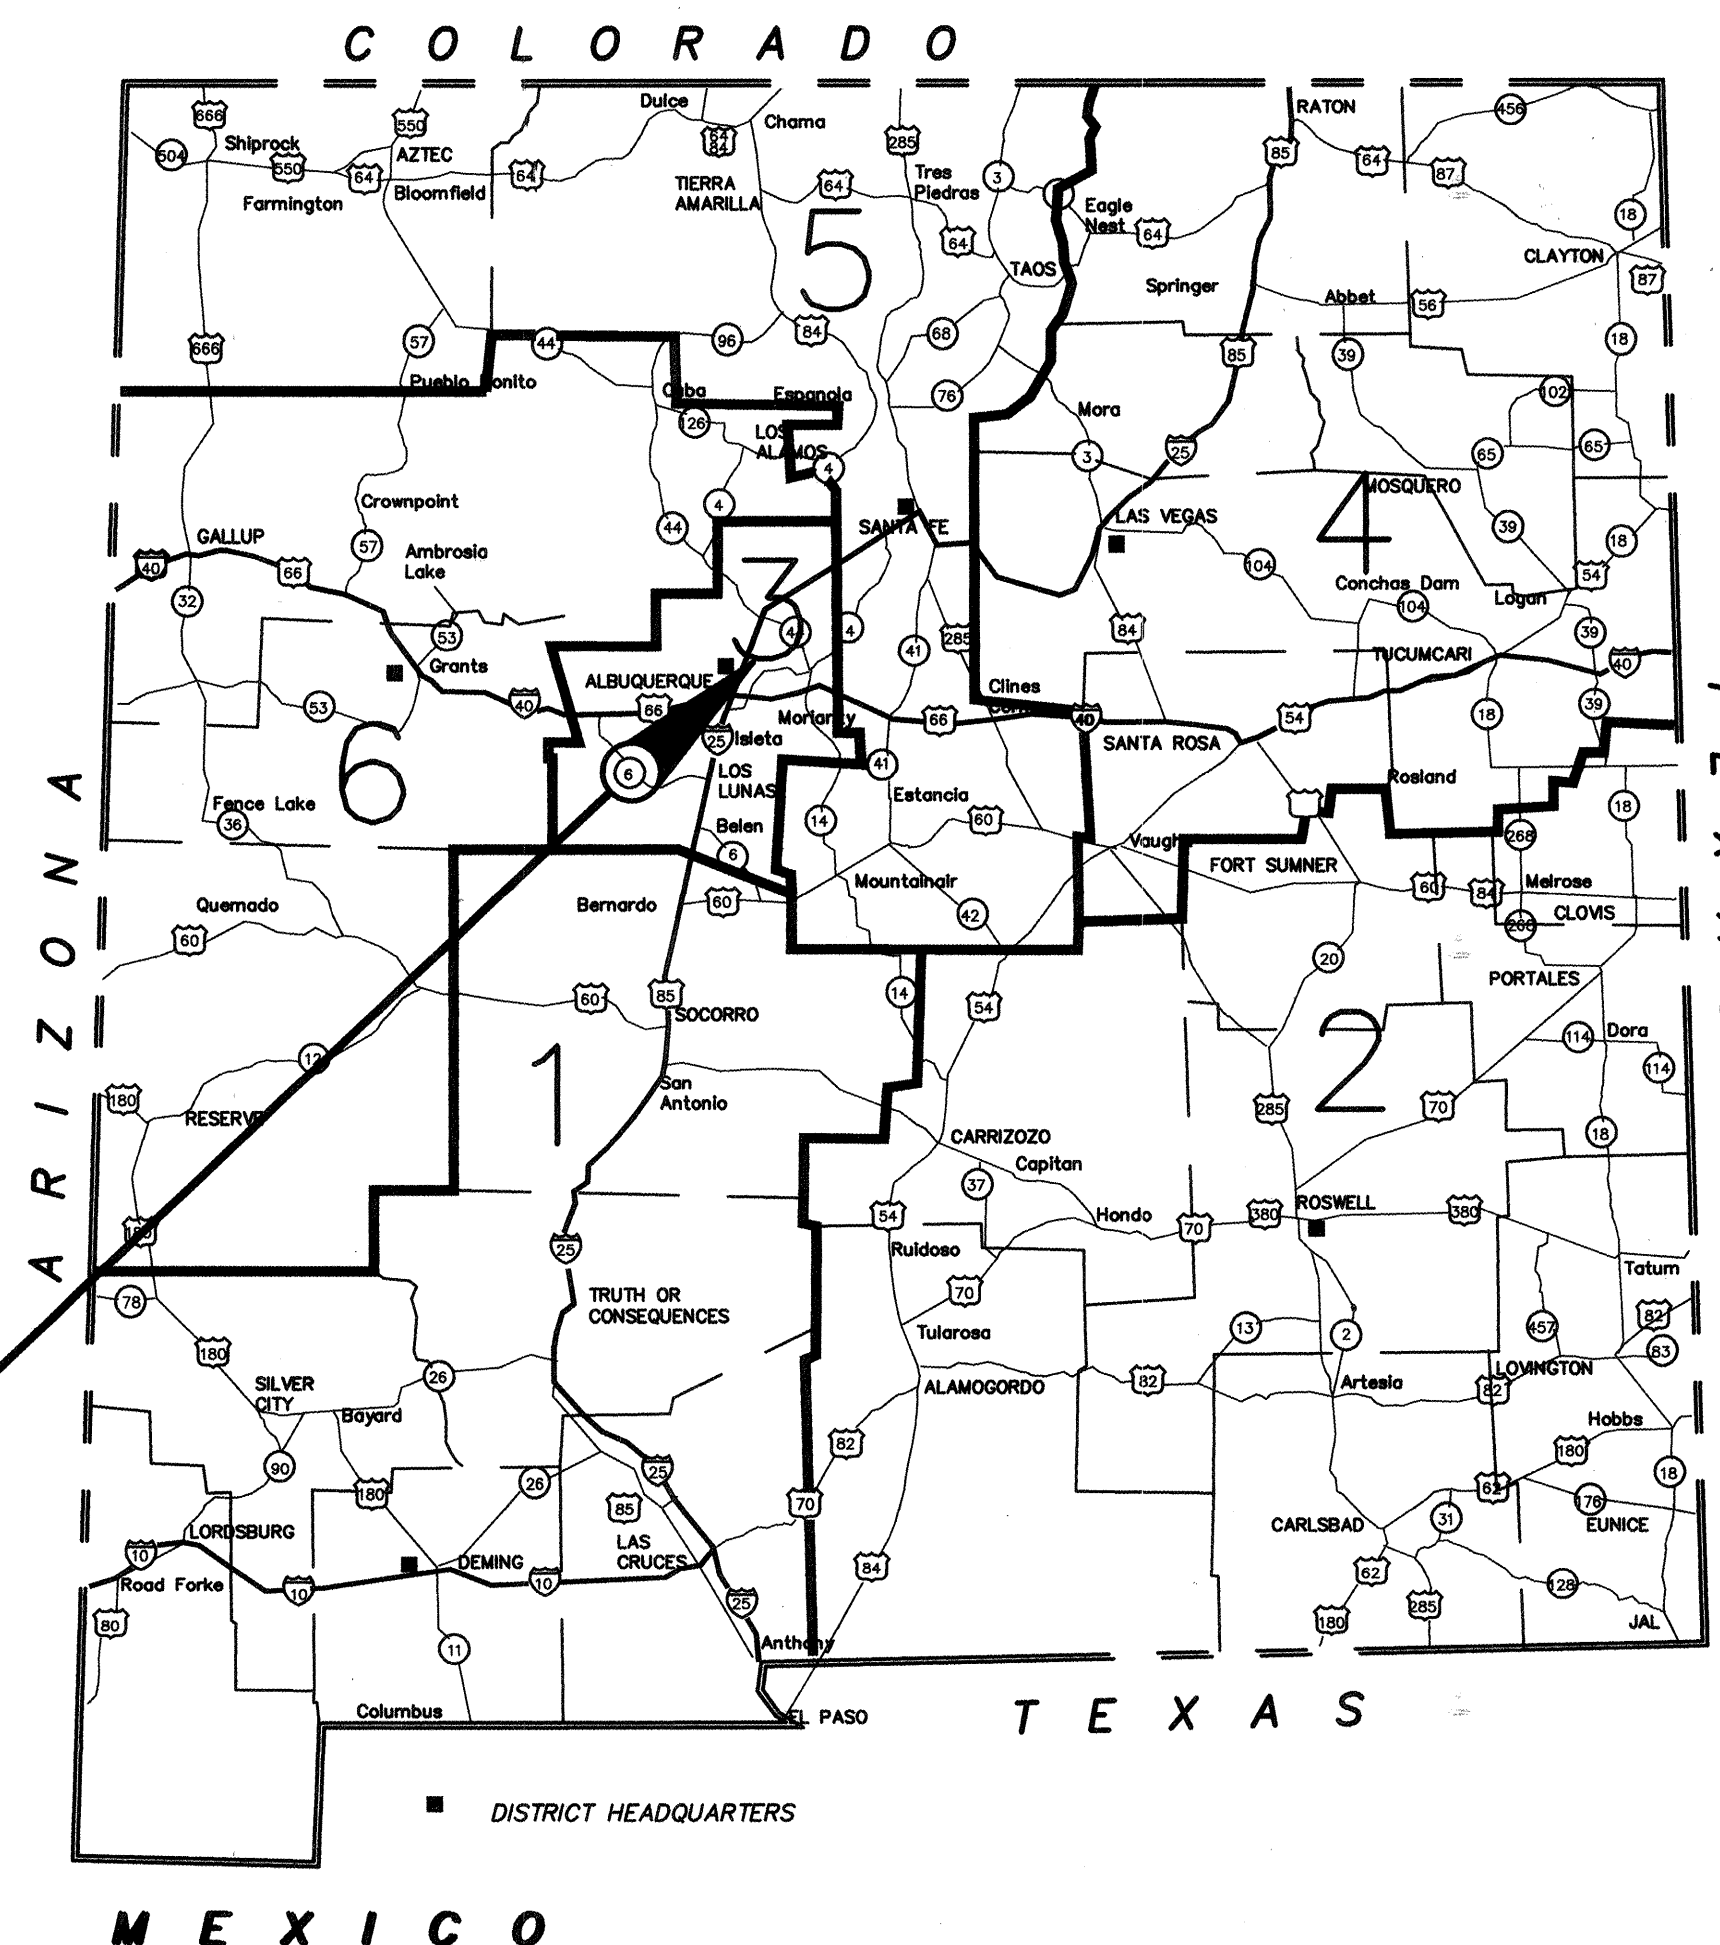

"As-Built" Add

I HEREBY CERTIFY THAT THIS PROJECT WAS CONSTRUCTED IN GENERAL
CONFORMANCE WITH THE PLANS AND SPECIFICATIONS SHOWN HEREON AND
THAT THESE DRAWINGS HAVE BEEN REVISED IN ACCORDANCE WITH
INFORMATION PROVIDED BY THE CONTRACTOR.

James H. Buckman 12-23-02
JAMES H. BUCKMAN, P.E. NO. 13062

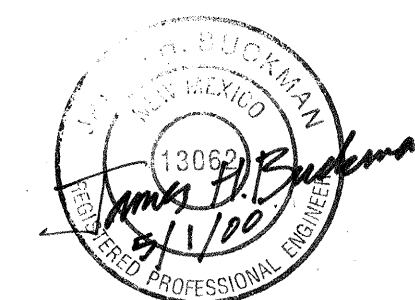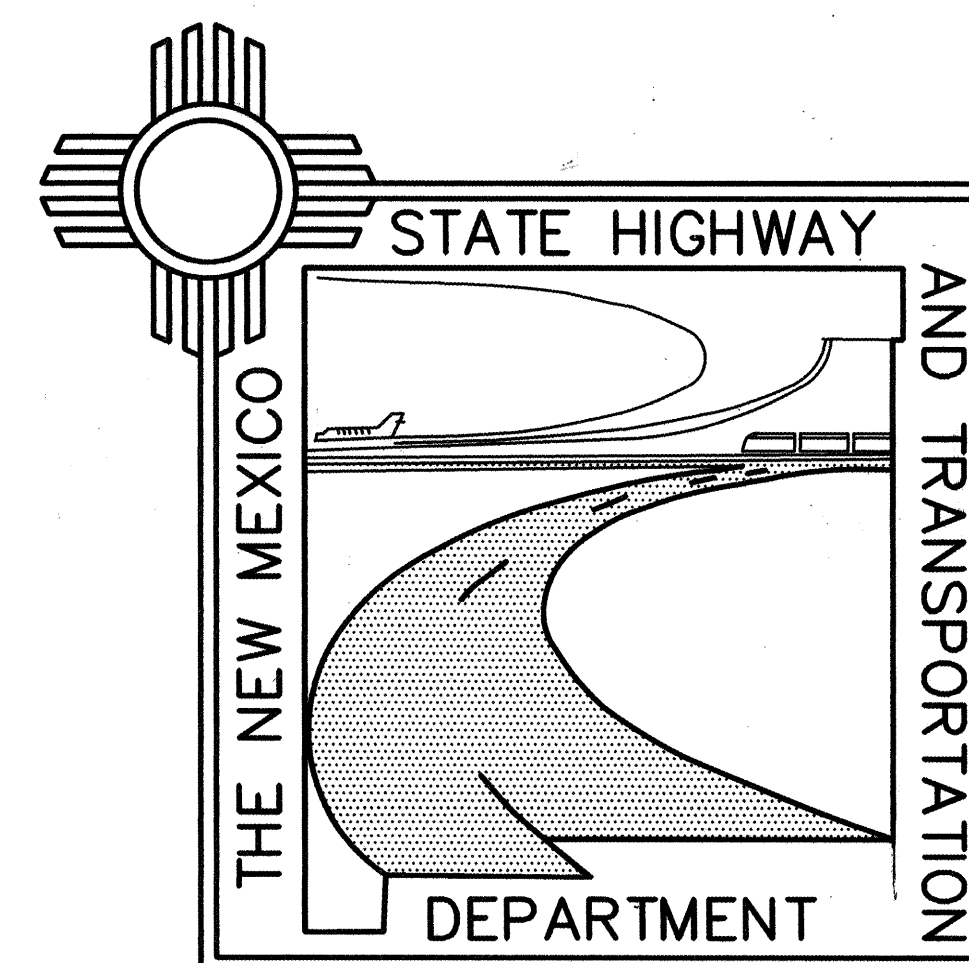
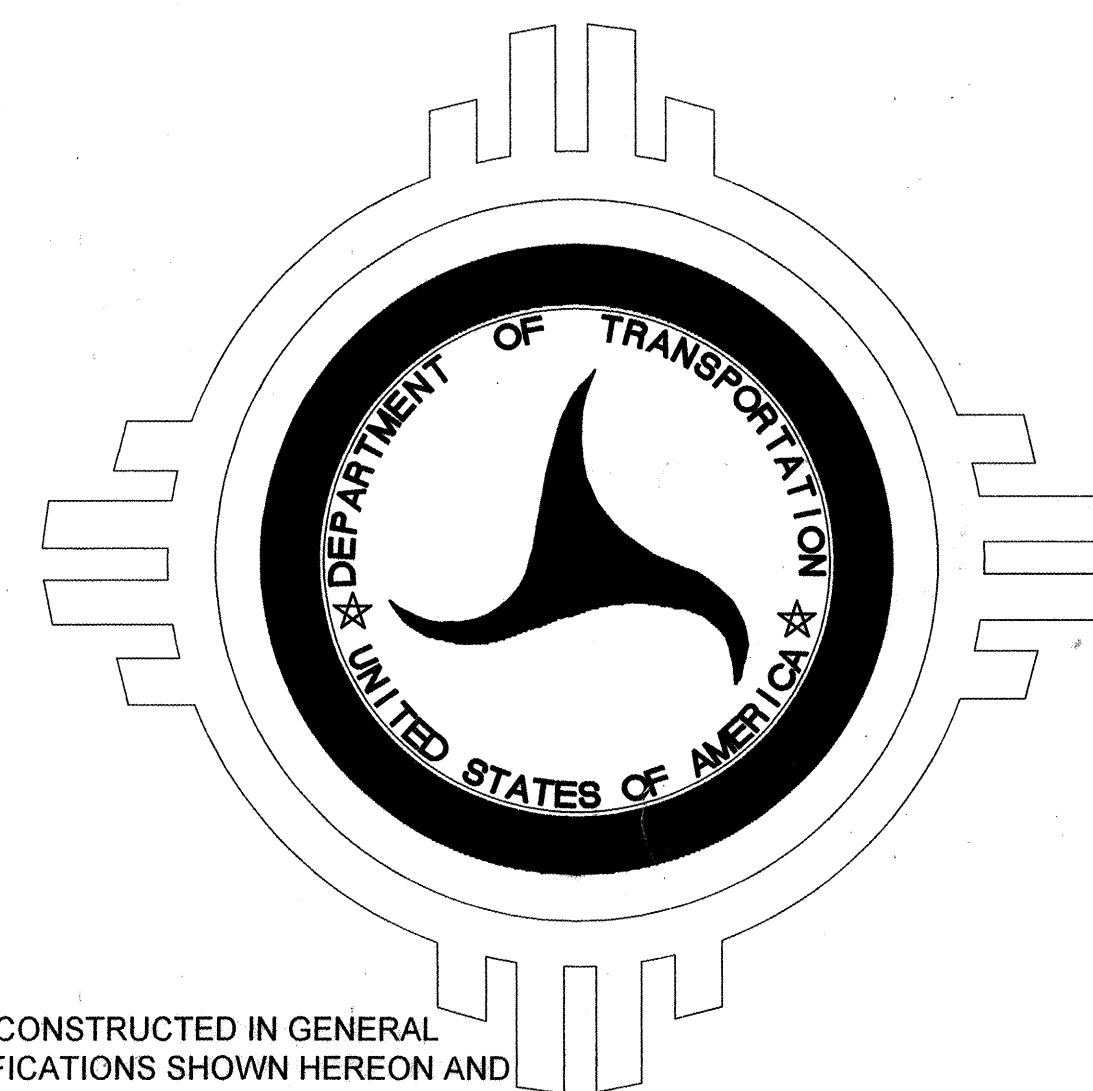


Parsons
Brinckerhoff
5801 Osuna Rd. NE - Suite 200
Albuquerque, NM 87109 - (505) 881-5357

City Project No. 6440.91

DESIGNED BY
CHECKED BY
DRAWN BY


SCANNED BY
MESA REPRO

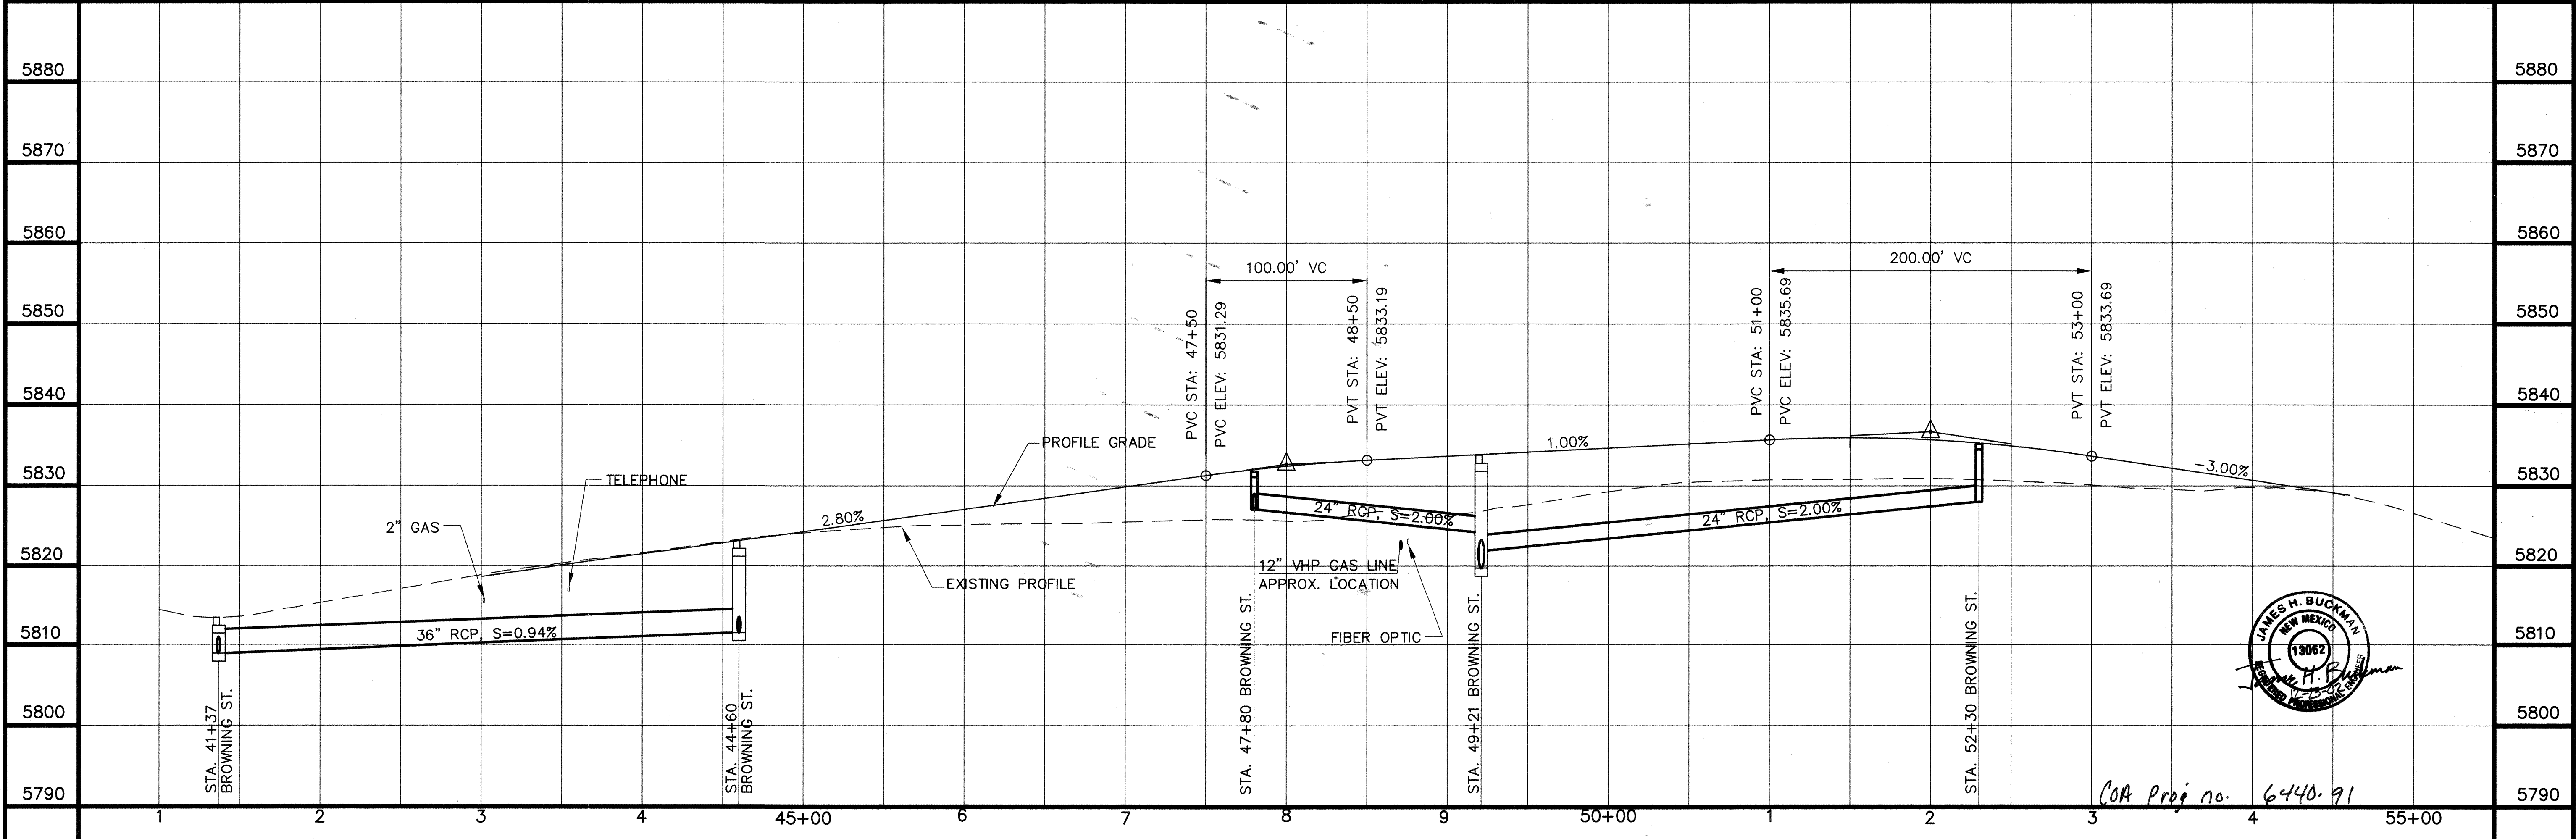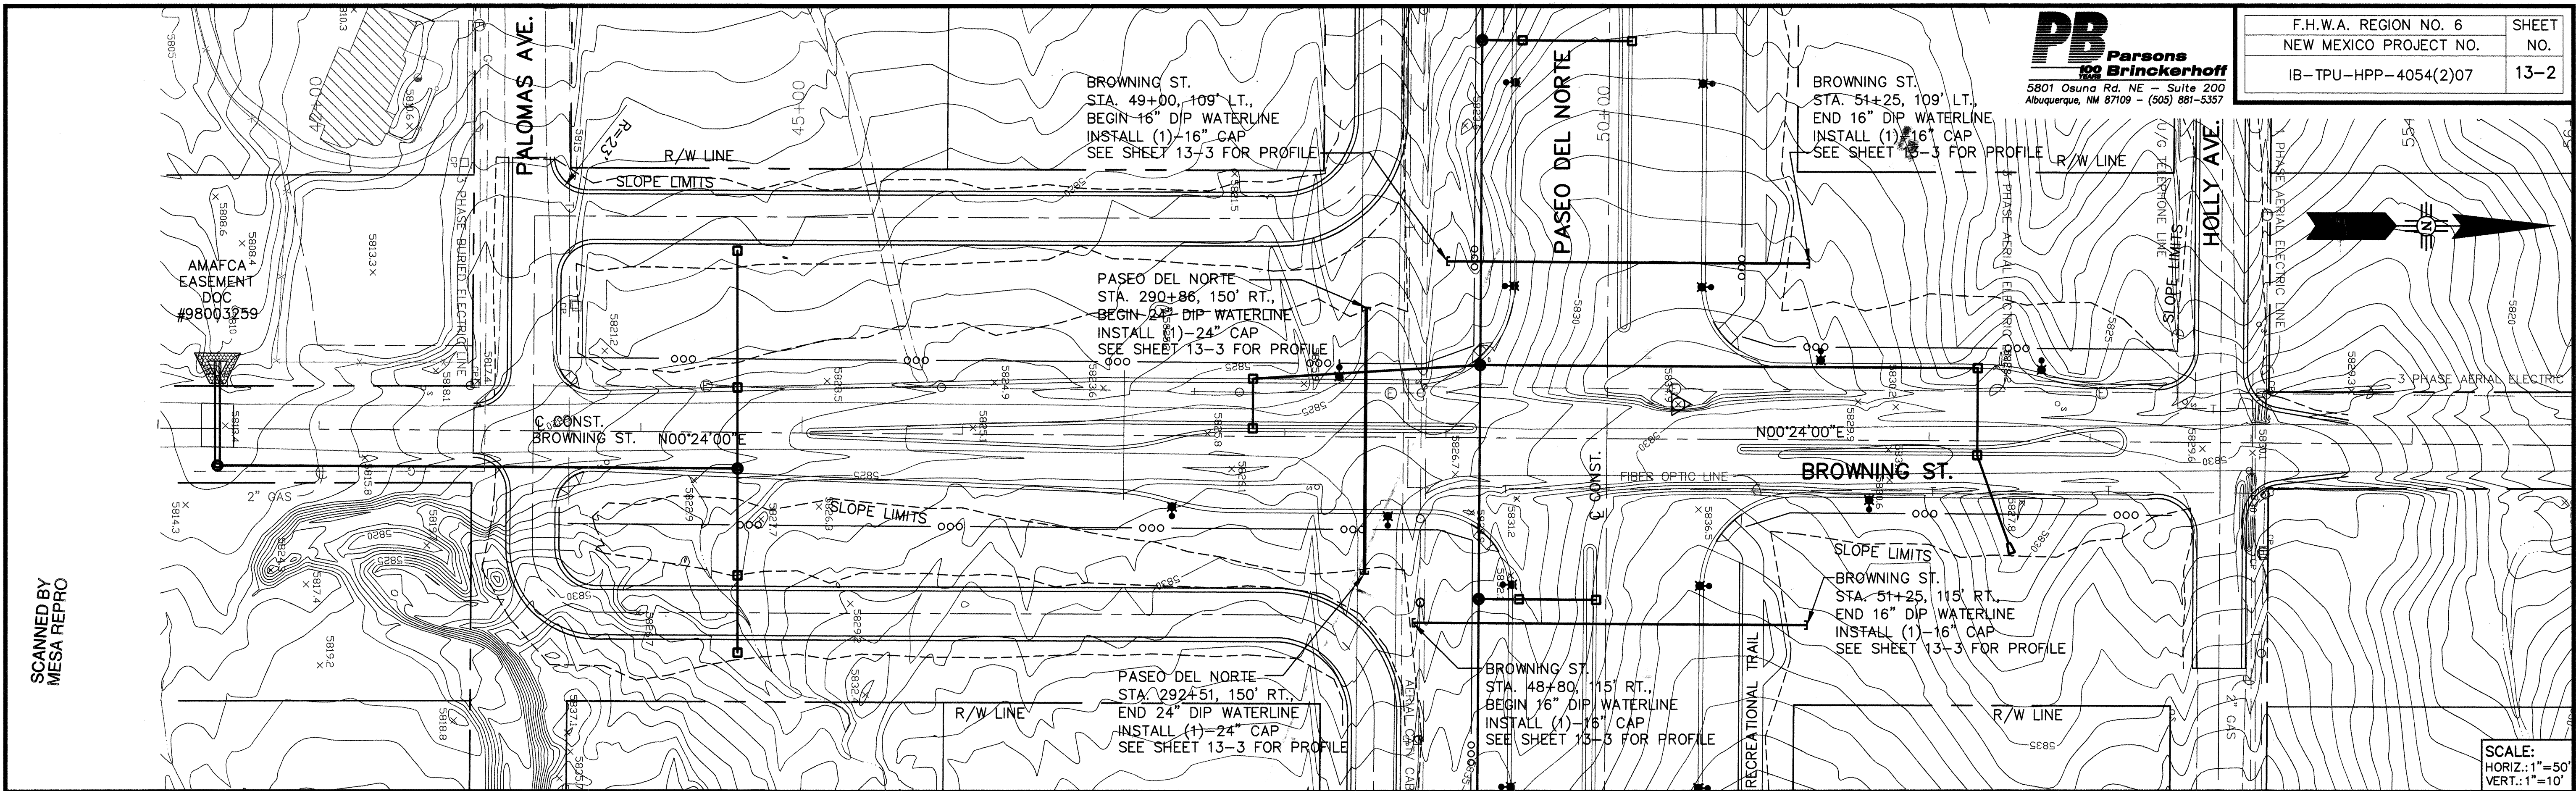

G:\PASE02\DRAWINGS\FINAL\SECTION 13\BROWNING_WL.DWG 6-8-00 1:42:34 pm EST

PB Parsons
Brinkerhoff
5801 Osuna Rd. NE - Suite 200
Albuquerque, NM 87109 - (505) 881-5357

F.H.W.A. REGION NO. 6	SHEET NO.
NEW MEXICO PROJECT NO.	NO.
IB-TPU-HPP-4054(2)07	13-2

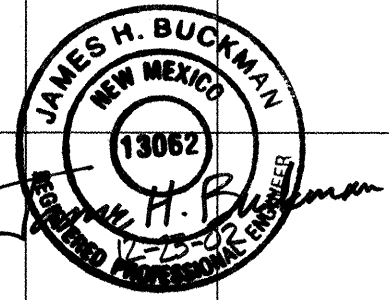


COA Proj no. 6440.91


Contractor: AJI
Staked by:
Inspector's Acceptance by: (COA) G. Olson 9/04
Field Verification by: (COA) G. Olson 9/04
Corrections by: Parsons Brinkerhoff

DESIGNED BY
DRAWN BY
CHECKED BY


SCANNED BY
MESA REPRO

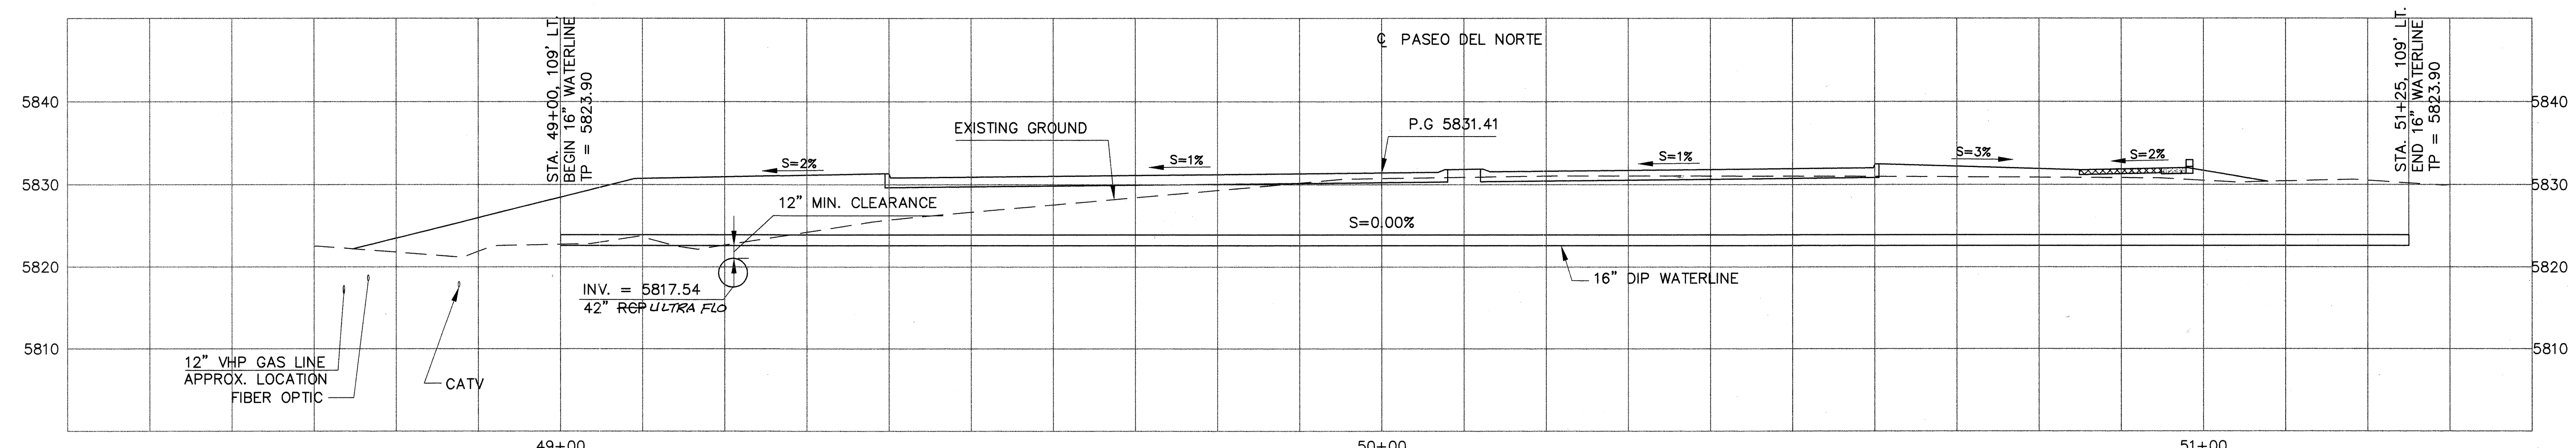


BROWNING ST. & PASEO DEL NORTE WEST 16" WATERLINE

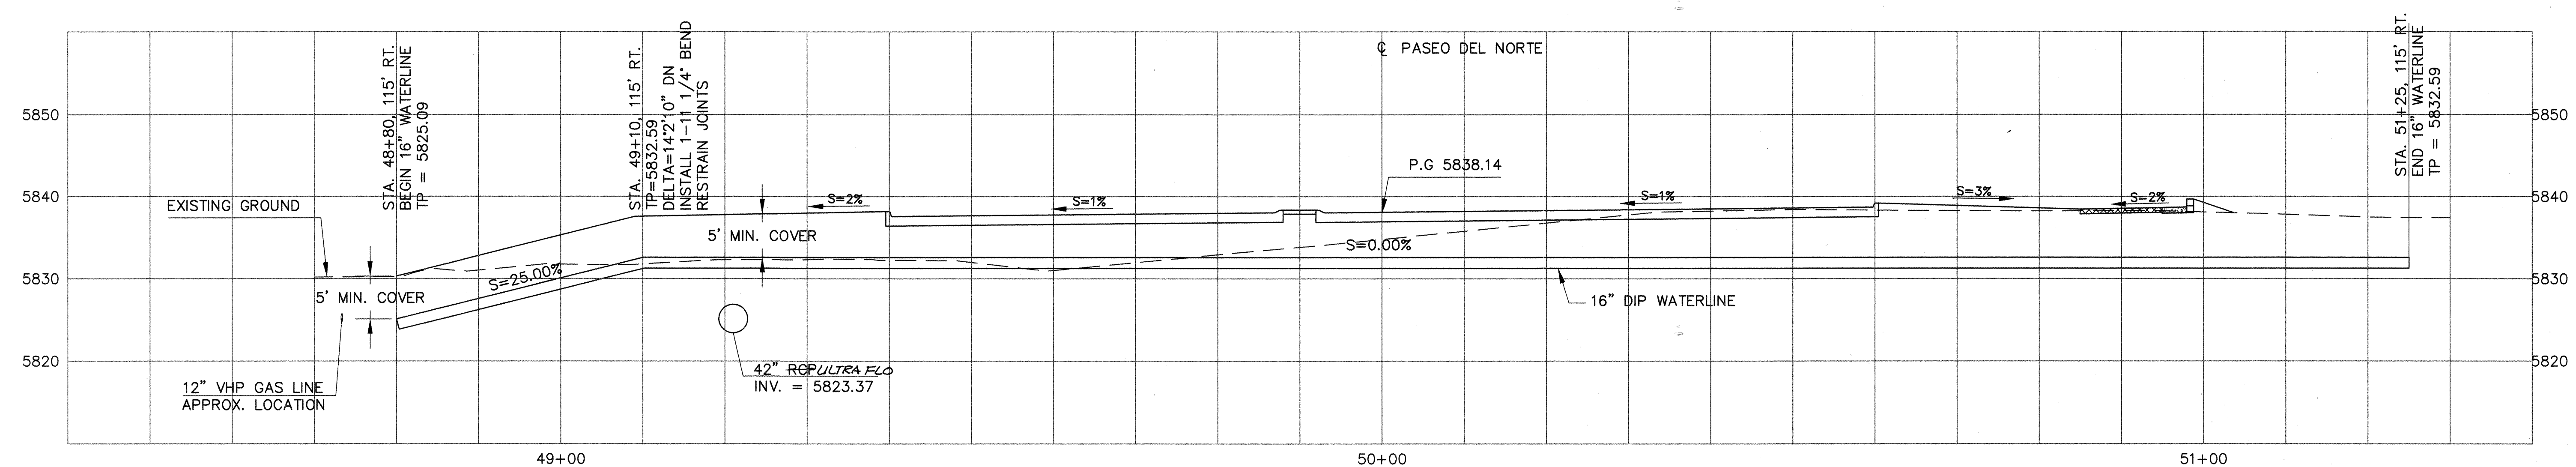

BROWNING ST. & PASEO DEL NORTE EAST 16" WATERLINE

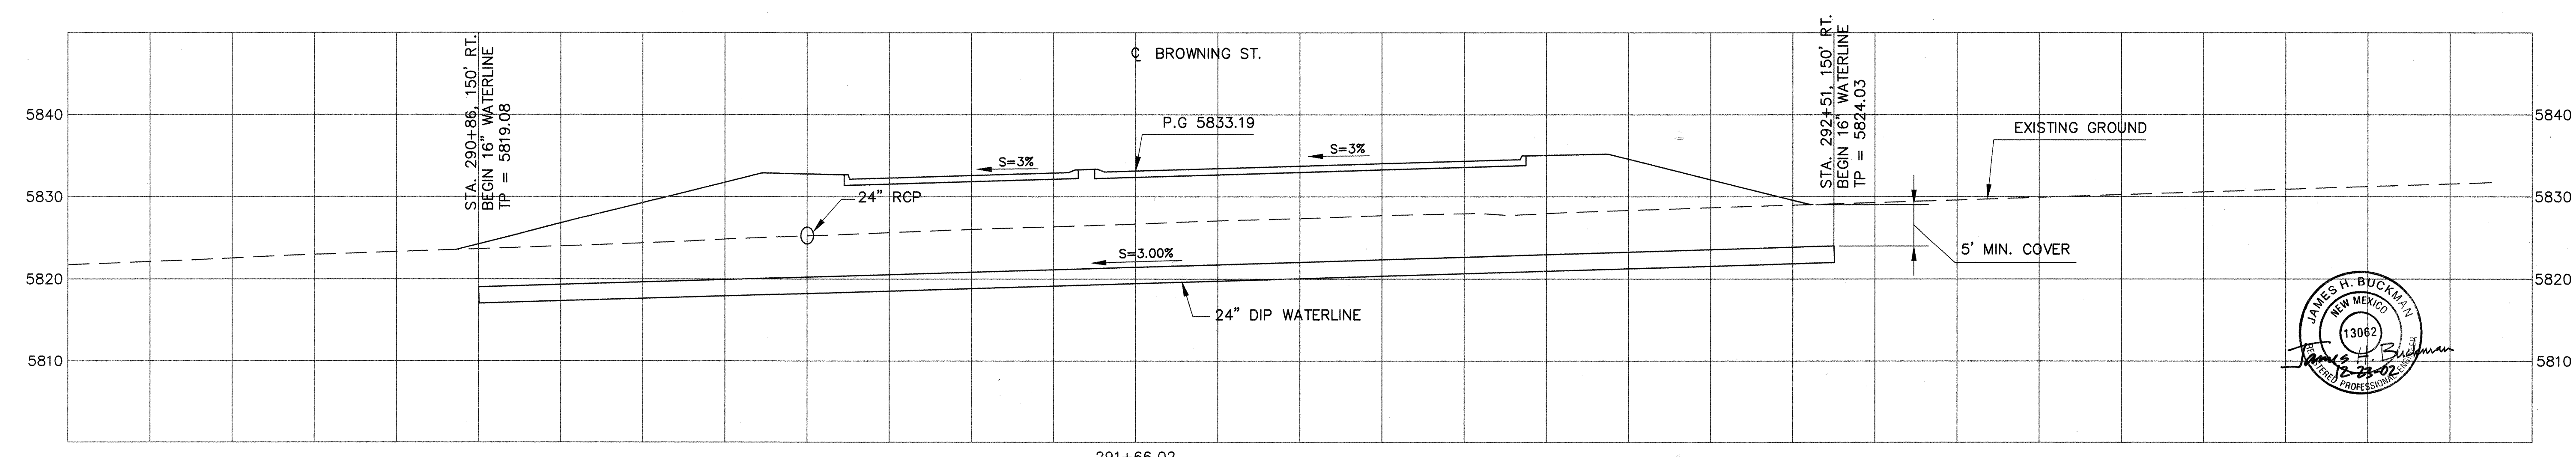


BROWNING ST. & PASEO DEL NORTE SOUTH 24" WATERLINE

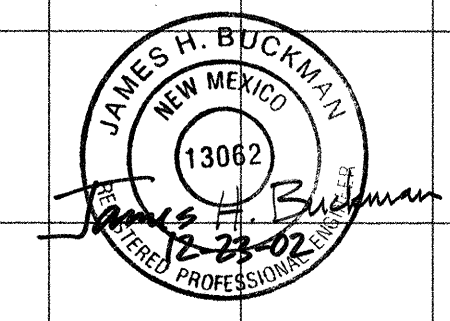


SCALE:
HORIZ. 1" = 10'
VERT. 1" = 10'


PASEO DEL NORTE / BROWNING INTERSECTION
WATERLINE PROFILES
CoA Proj. No. 6440.91

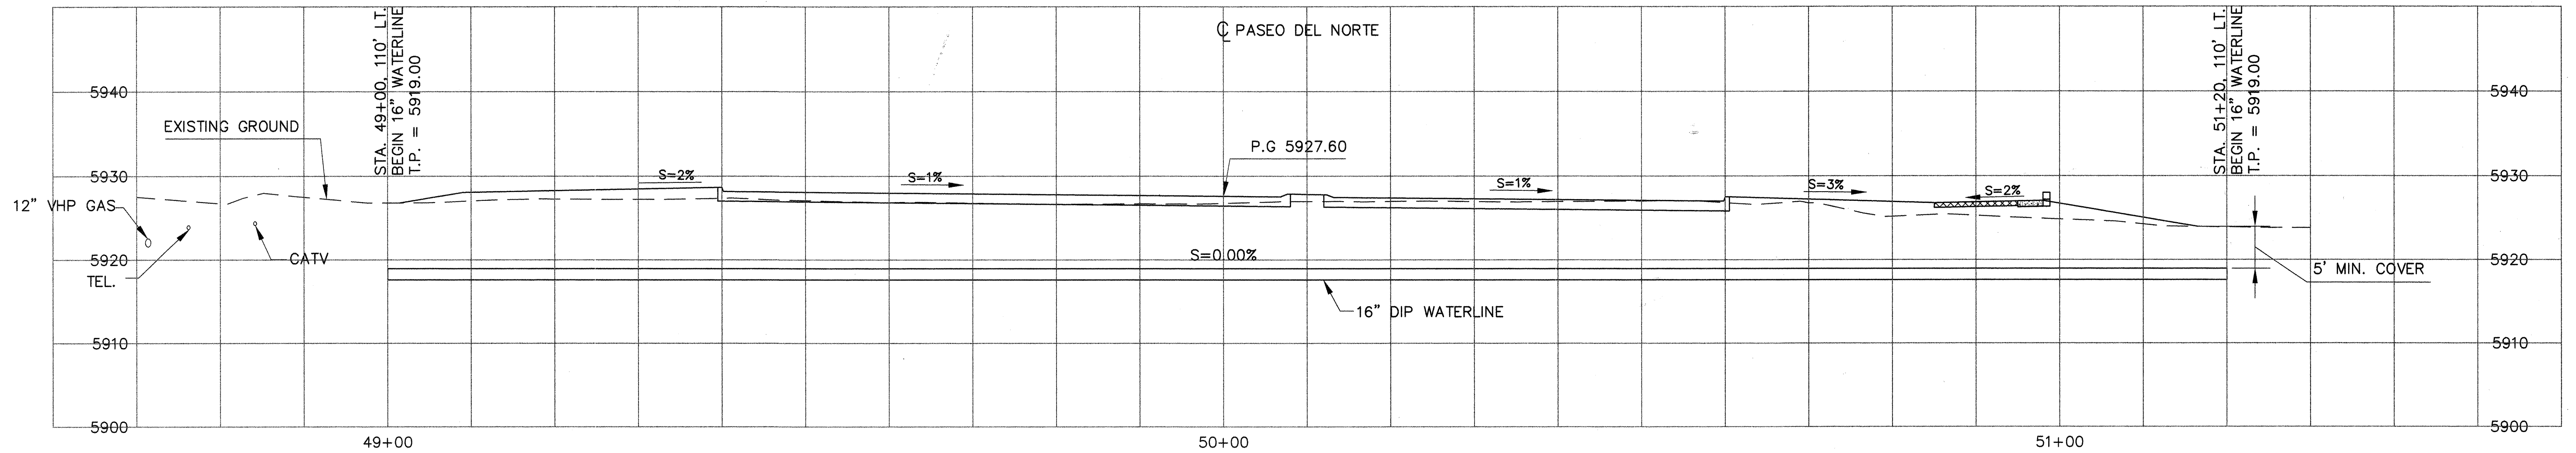

LOWELL ST. & PASEO DEL NORTE WEST 16" WATERLINE

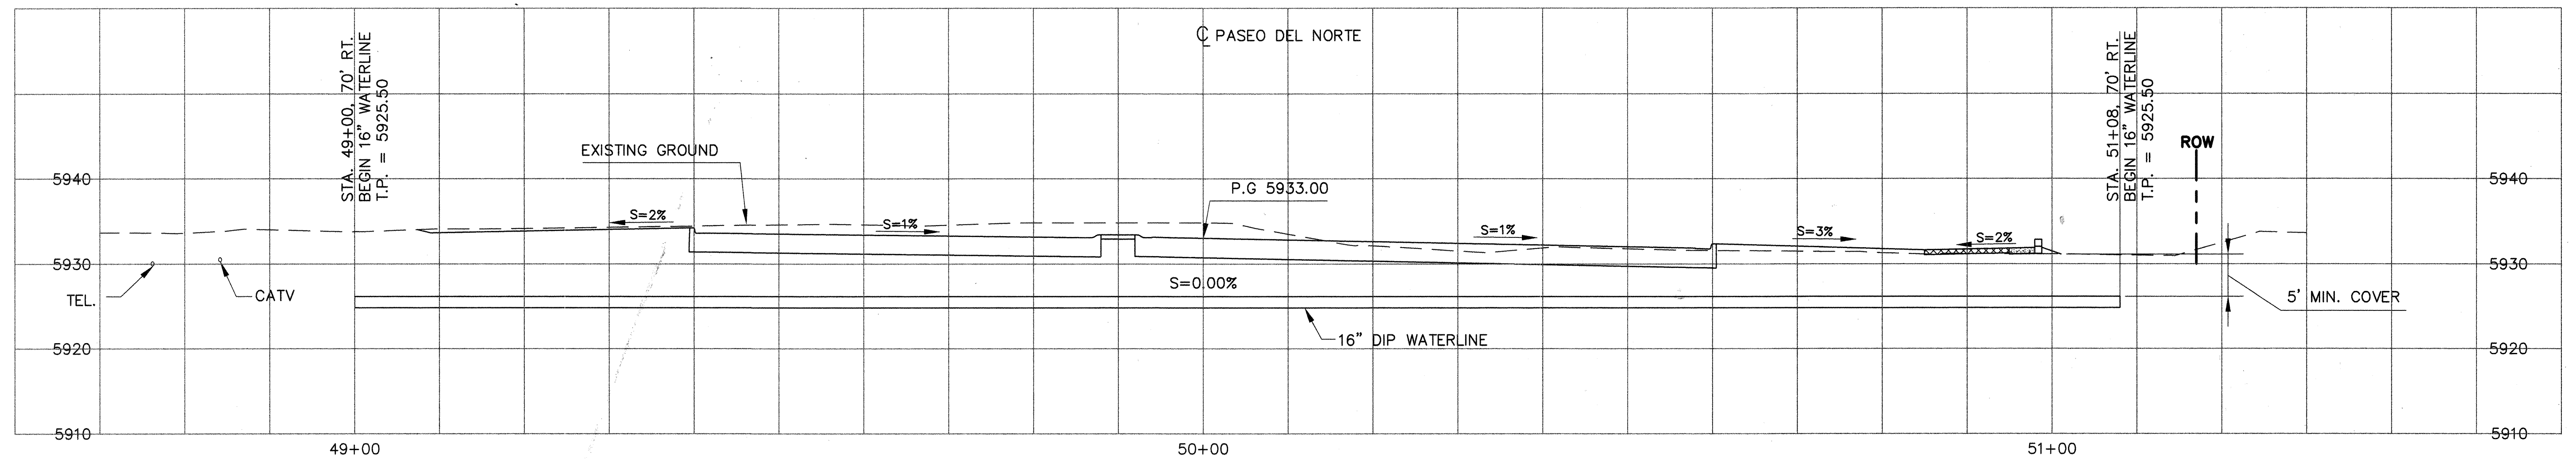

LOWELL ST. & PASEO DEL NORTE EAST 16" WATERLINE

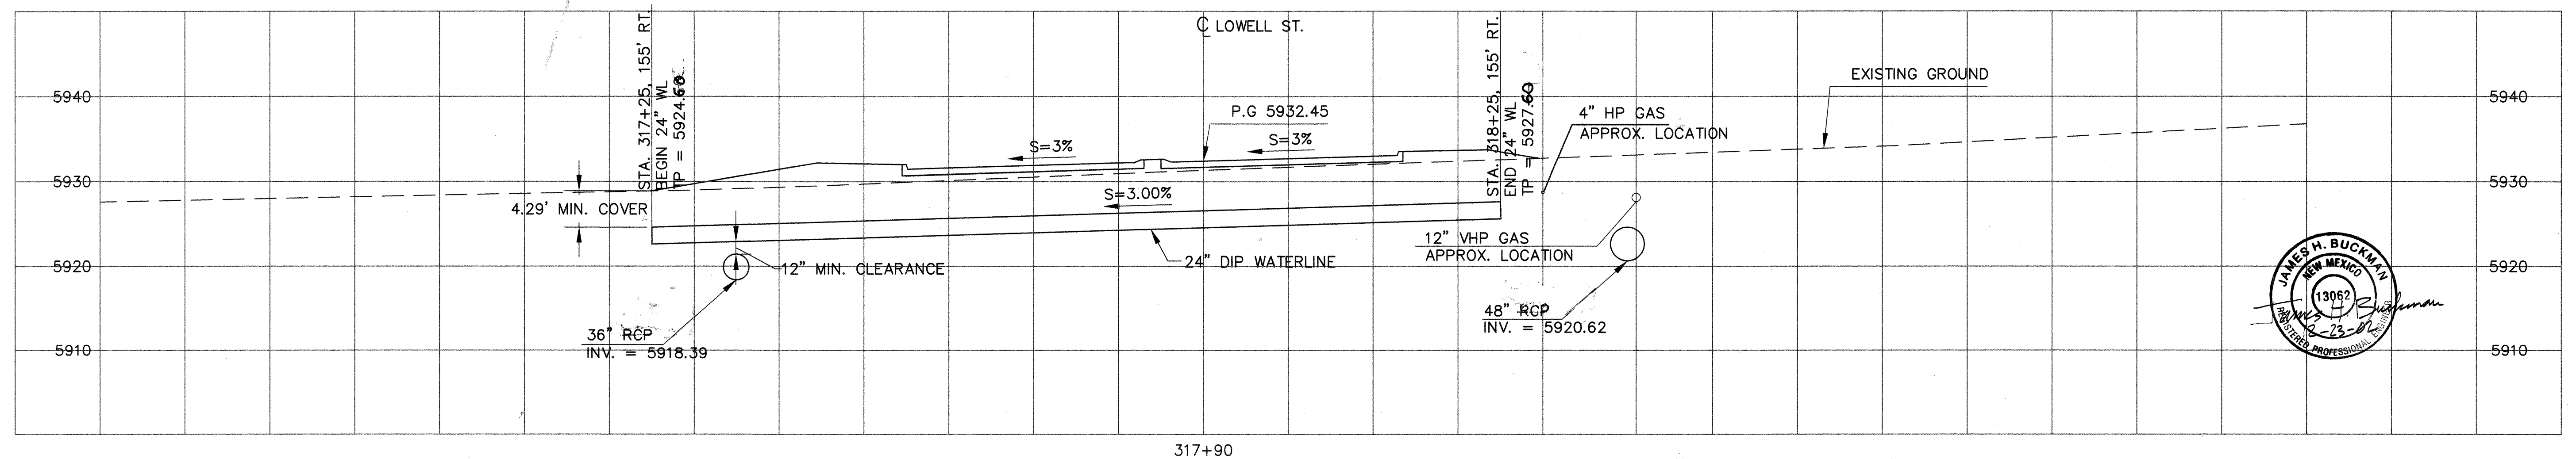

LOWELL ST. & PASEO DEL NORTE SOUTH 24" WATERLINE

SCALE:
HORIZ. 1" = 10'
VERT. 1" = 10'

PASEO DEL NORTE / LOWELL INTERSECTION
WATERLINE PROFILES


CoA Proj No 6440.91

N.M. PROJECT NO. IB-TPU-HPP-4054(2)07 SHEET 13-5


6 of 11

DESIGNED BY
CHECKED BY

SCANNED BY
MESA REPRO

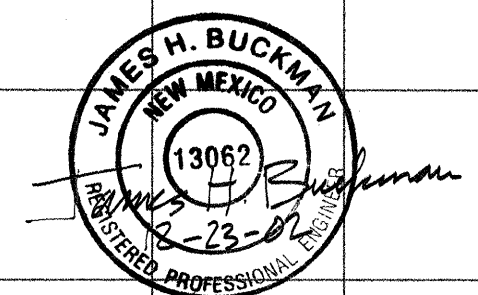


CITY OF ALBUQUERQUE
PUBLIC WORKS DEPARTMENT

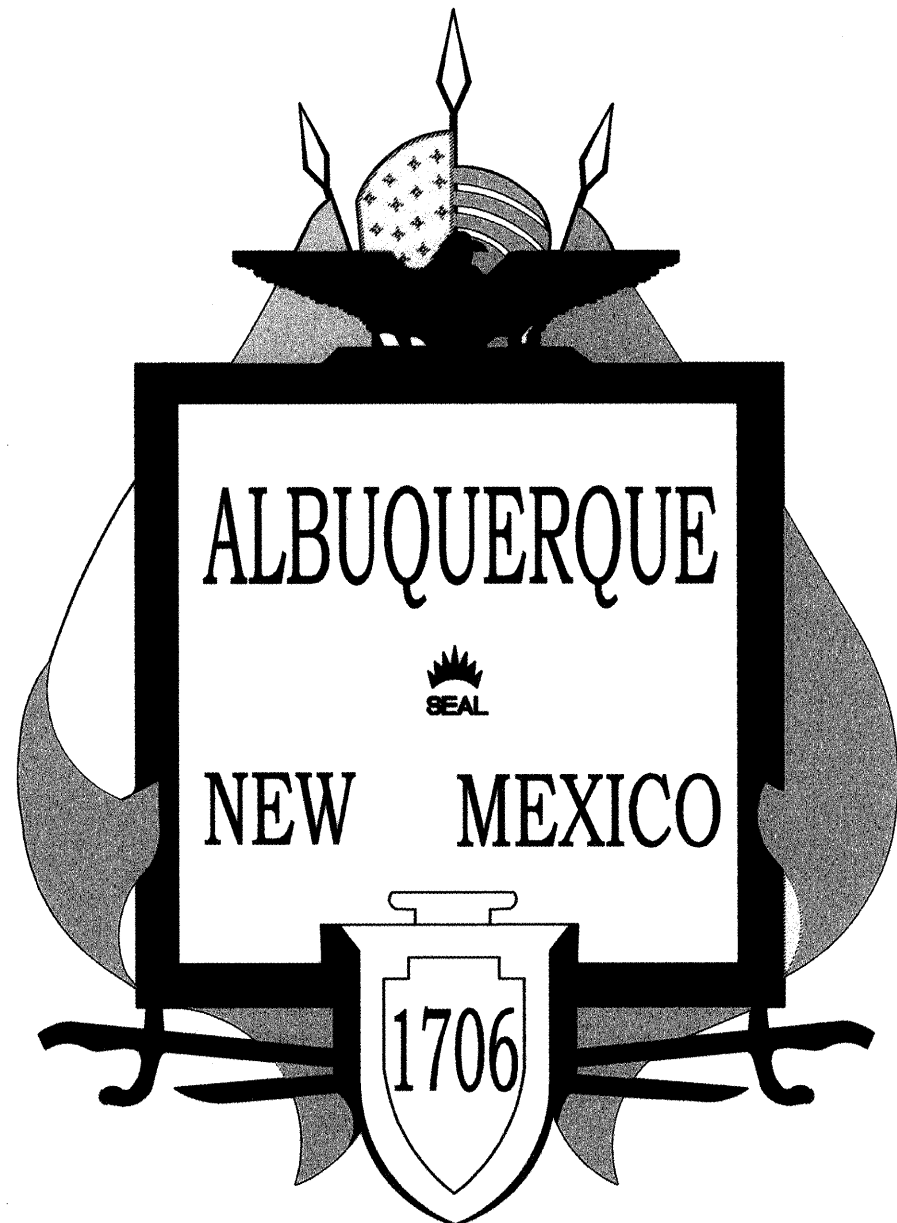

CONSTRUCTION PLANS
PASEO DEL NORTE
WATER LINES - COUNTY, PHASE II
PROJECT NO. 6440.91

INDEX OF SHEETS

13-1	TITLE SHEET
13-2	BROWNING STREET / PASEO DEL NORTE WATERLINES
13-3	BROWNING STREET / PASEO EL NORTE WATERLINE PROFILES
13-4	LOWELL STREET / PASEO DEL NORTE WATERLINES
13-5	LOWELL STREET / PASEO DEL NORTE WATERLINE PROFILES

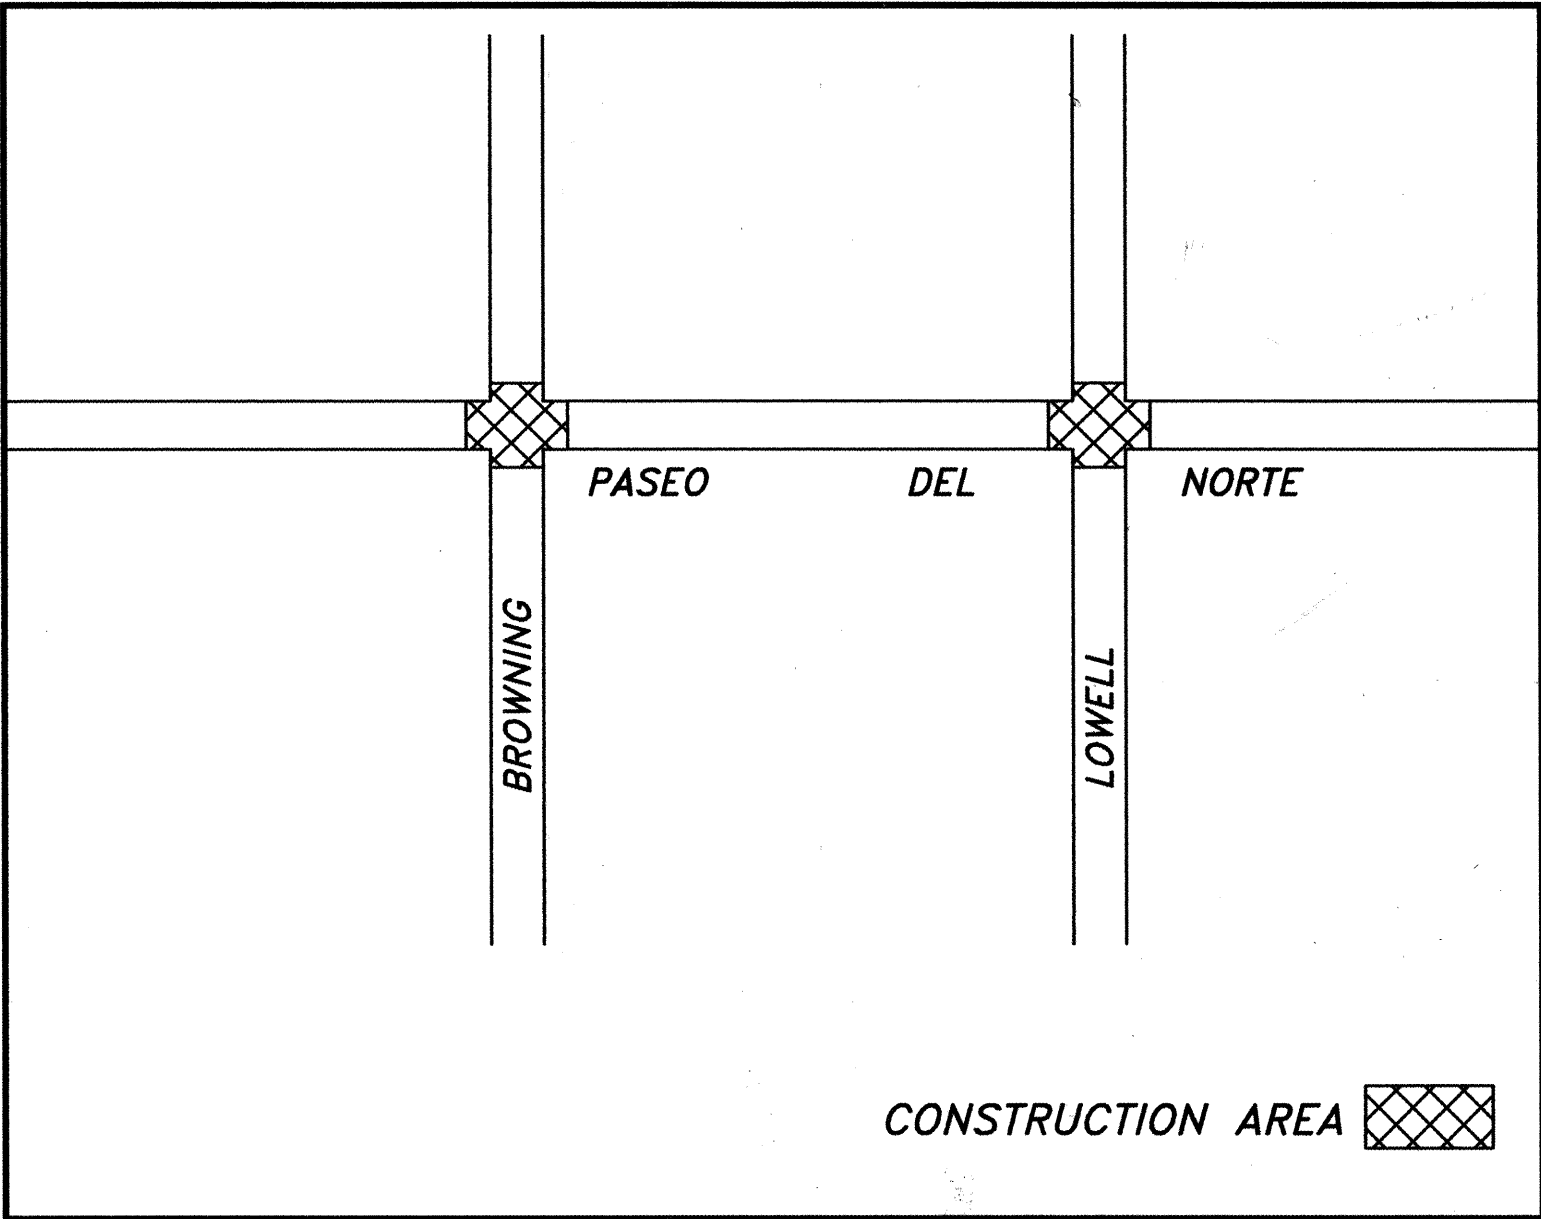

LOCATION MAP
ZONE ATLAS MAP C-22

GENERAL NOTES


- ALL WORK DETAILED ON THESE PLANS, UNLESS STATED OTHERWISE OR PROVIDED FOR HEREON, SHALL BE PERFORMED IN ACCORDANCE WITH CITY OF ALBUQUERQUE STANDARD SPECIFICATIONS FOR PUBLIC WORKS CONSTRUCTION - THROUGH UPDATE NO. 6.
- PRIOR TO CONSTRUCTION, THE CONTRACTOR SHALL EXCAVATE AND VERIFY THE HORIZONTAL AND VERTICAL LOCATIONS OF ALL POTENTIAL OBSTRUCTIONS. SHOULD A CONFLICT EXIST, THE CONTRACTOR SHALL NOTIFY THE OWNER SO THAT THE CONFLICT CAN BE RESOLVED WITH A MINIMUM OF DELAY.
- IT WILL BE THE CONTRACTOR'S RESPONSIBILITY TO PROTECT AND MAINTAIN IN SERVICE ALL EXISTING UTILITIES.
- ALL EXCAVATION, TRENCHING AND SHORING ACTIVITIES MUST BE CARRIED-OUT IN ACCORDANCE WITH OSHA 29 CFR 1926.650 SUBPART P.

Superseded
RDO/tn

REV.	SHEETS	CITY ENGINEER	DATE	USER DEPARTMENT	DATE	USER DEPARTMENT	DATE
ENGINEERS STAMP & SIGNATURE		APPROVALS		ENGINEER	DATE	*****	
		DRC Chairman		<i>[Signature]</i>	8-24-00	APPROVED FOR CONSTRUCTION <i>[Signature]</i> 8/24/00 City Engineer Date	
		Transportation		<i>[Signature]</i>	8-24-00		
		Water/Wastewater		<i>[Signature]</i>	8-24-00		
		Hydrology		<i>[Signature]</i>	8-24-00		
		Parks		<i>[Signature]</i>	8-24-00		
Constr. Mngmt.		<i>[Signature]</i>	8-24-00				
County		<i>[Signature]</i>	8/29/00				
City Project No.		6440.91		Sheet		Of	
				13-1		5	

SCANNED BY
MESA REPRO

DESIGNED BY
CHECKED BY
DRAWN BY
SCANNED BY
MESA REPRO

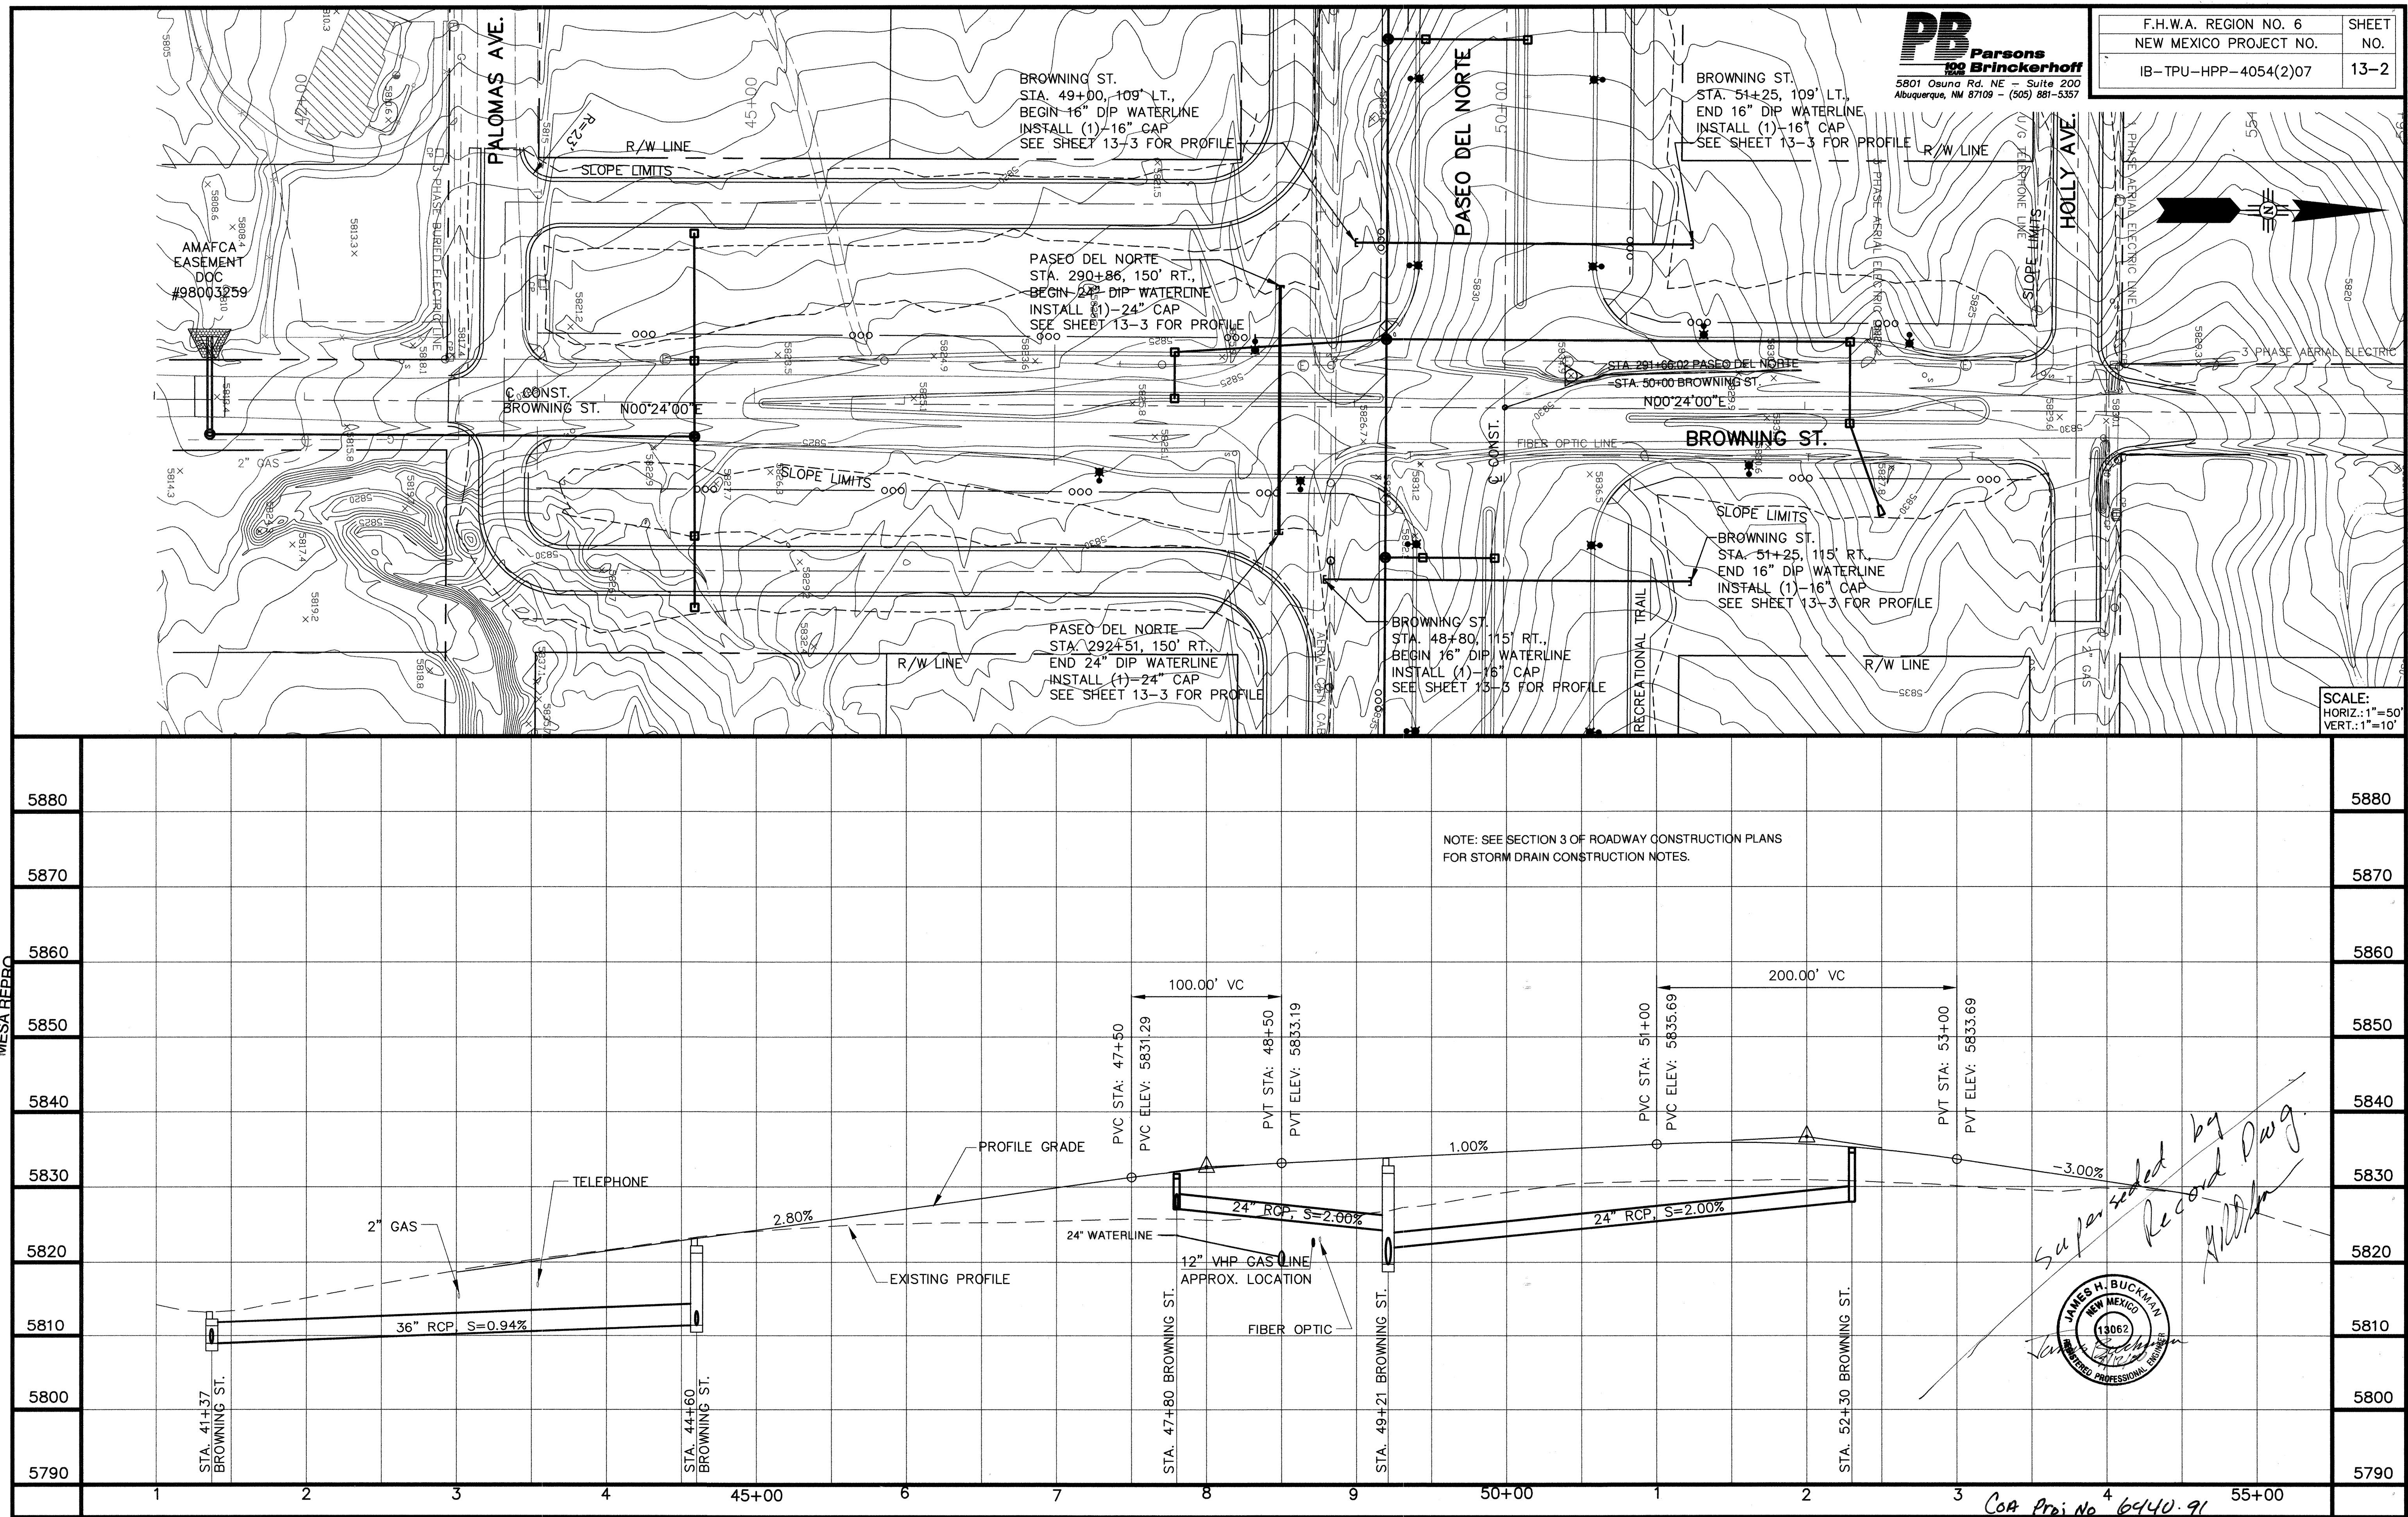

G:\PASEO2\DRAWINGS\FINAL\SECTION 13\BROWNING_WL.DWG 6-8-00 1:42:34 pm EST

BROWNING ST. - WATERLINES

NM PROJECT NO. IB-TPU-HPP-4054(2)07 SHEET NO. 13-2


CN 2662

AUG 24 2000


APPROVE
AUG 24 2000
CITY ENGINEER

DESIGNED BY
CHECKED BY
DRAWN BY

SCANNED BY
MESA REPRO

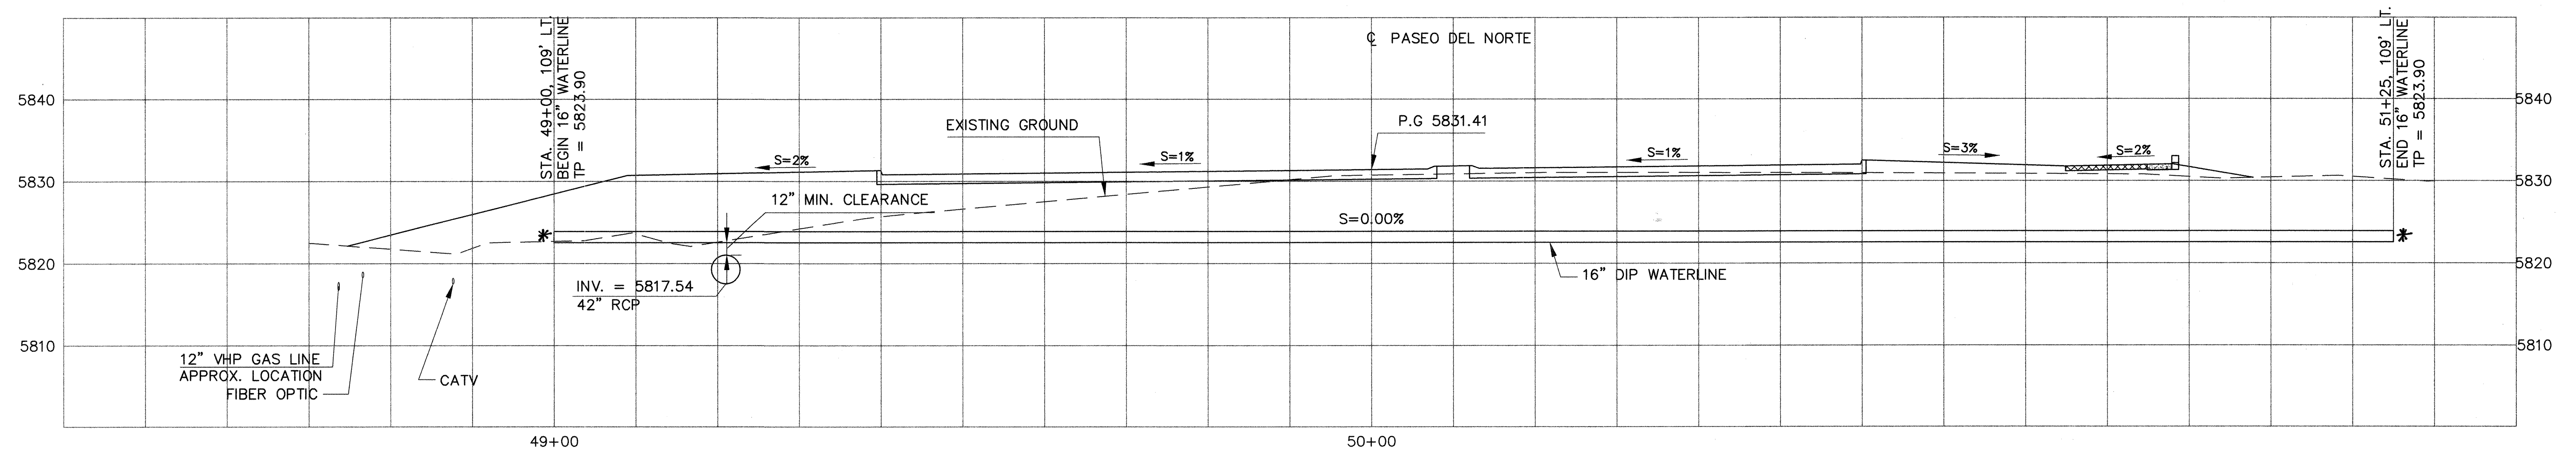


BROWNING ST. & PASEO DEL NORTE WEST 16" WATERLINE

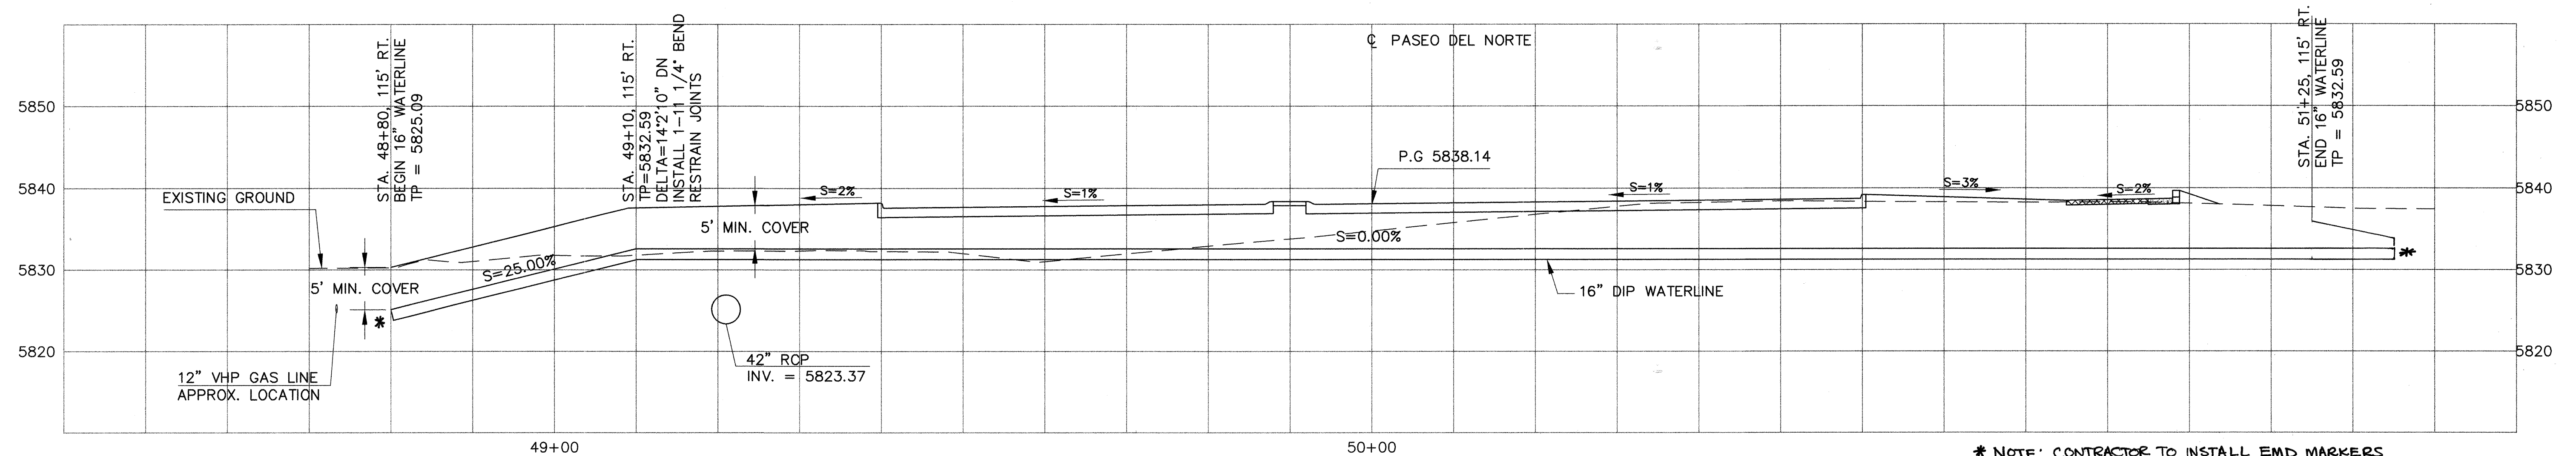

BROWNING ST. & PASEO DEL NORTE EAST 16" WATERLINE

* NOTE: CONTRACTOR TO INSTALL END MARKERS
AT EACH END OF PIPES

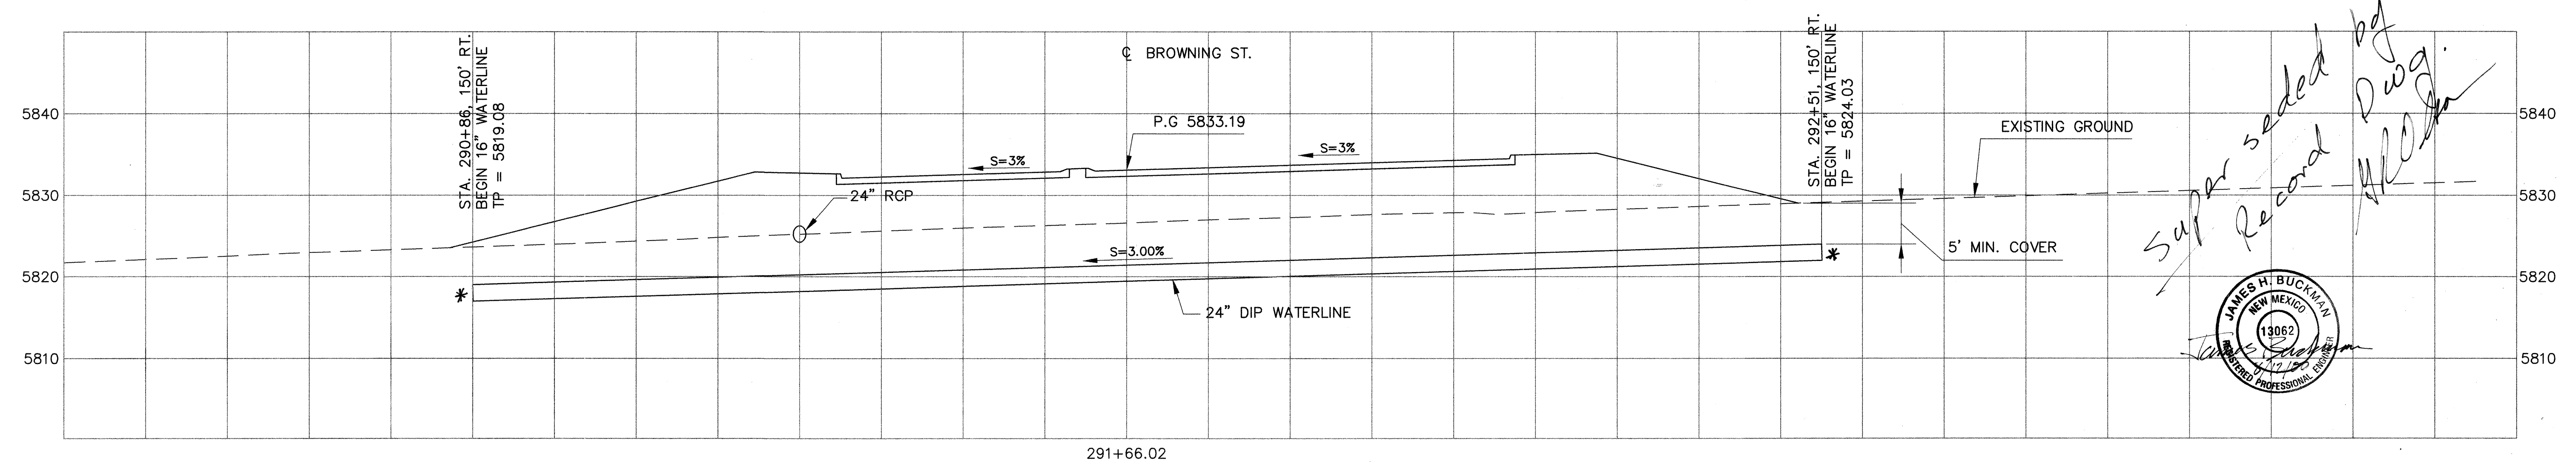


BROWNING ST. & PASEO DEL NORTE SOUTH 24" WATERLINE


SCALE:
HORIZ. 1" = 10'
VERT. 1" = 10'

PASEO DEL NORTE / BROWNING INTERSECTION
WATERLINE PROFILES


COA Proj. No. 6440.91

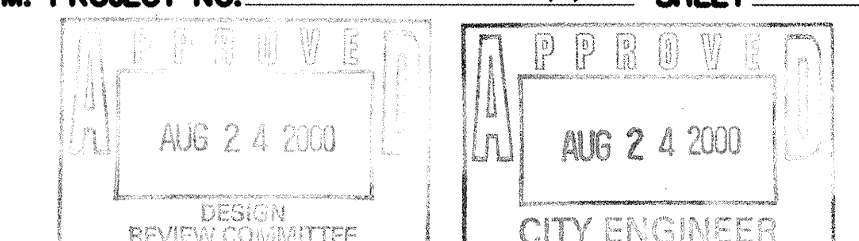

DESIGNED BY
CHECKED BY
DRAWN BY
SCANNED BY
MESA REPRO

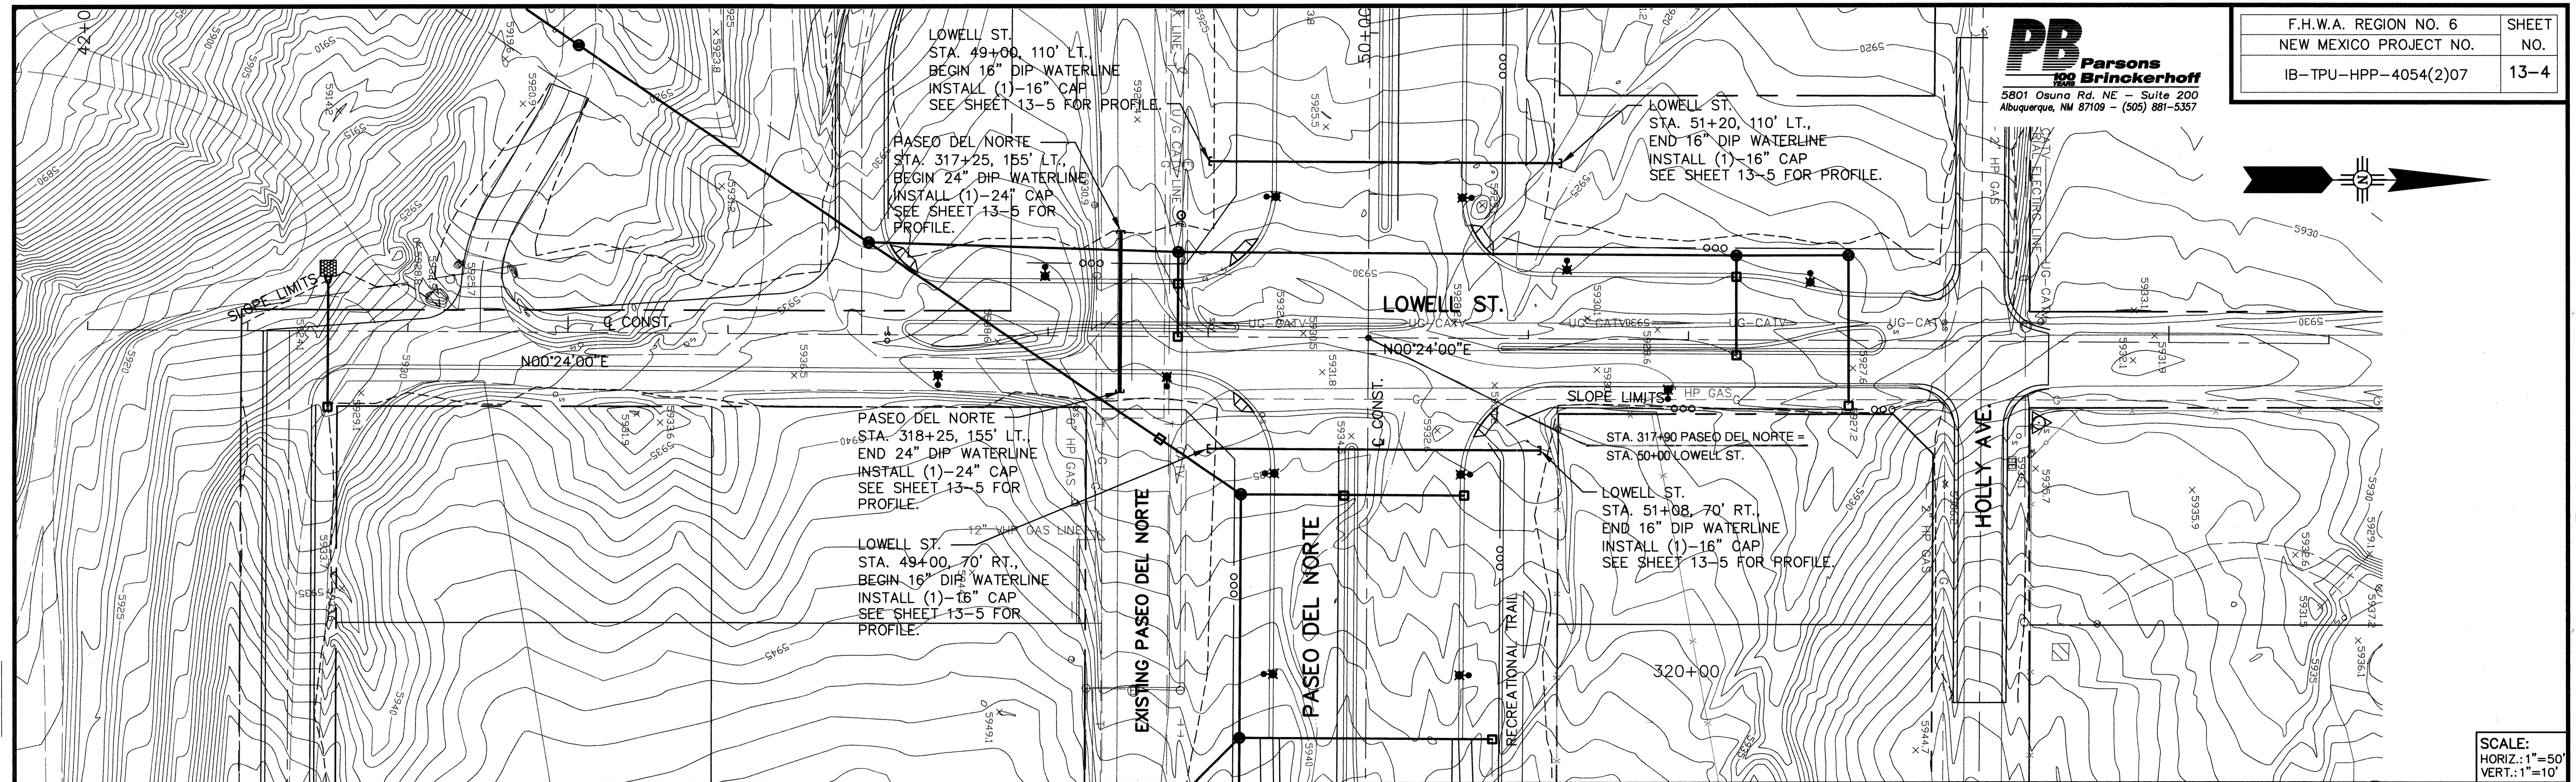

SCALE:
HORIZ.: 1"=50'
VERT.: 1"=10'

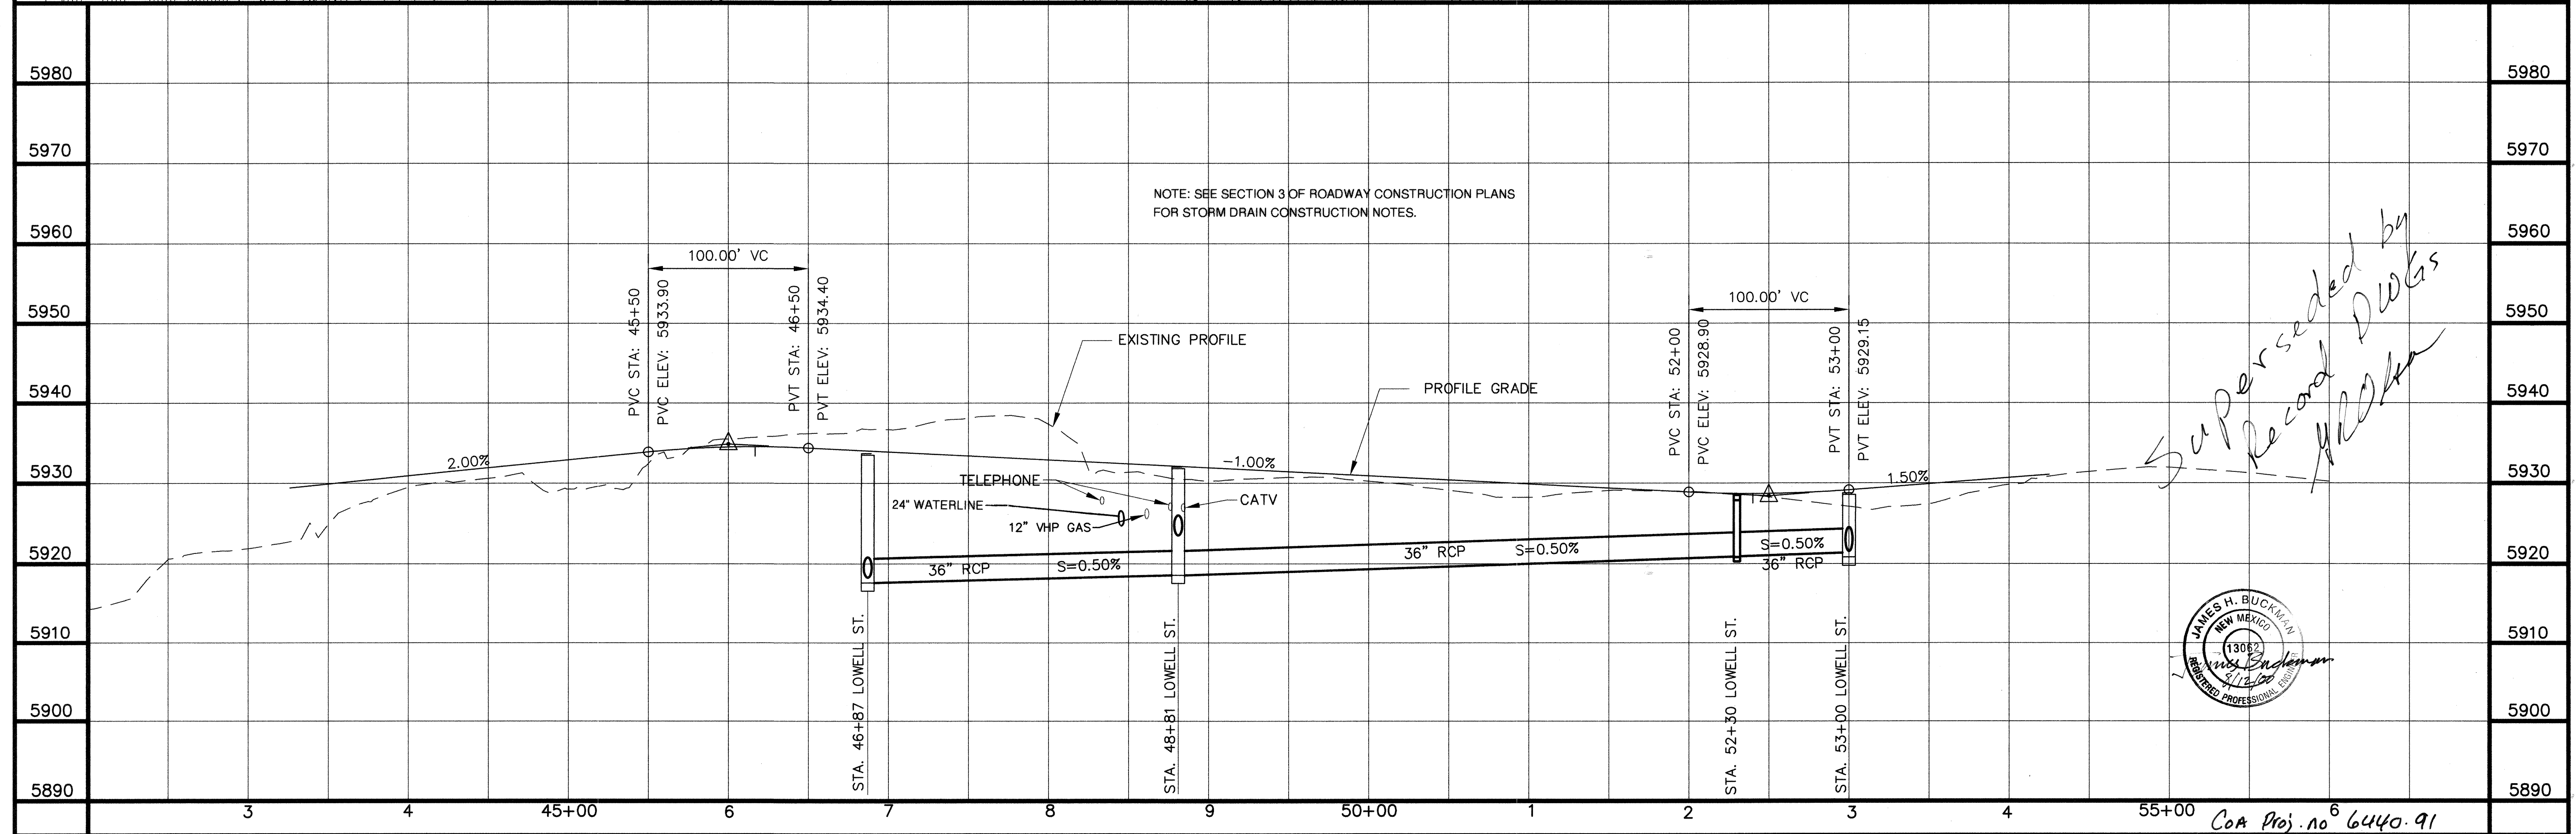

*Superseded by
Record DWGs
HLO*





G:\PASEO2\DRAWINGS\FINAL\SECTION 13\LOWELL_WL.DWG 6-8-00 2:26:40 pm EST

LOWELL ST. - WATERLINES

NM PROJECT NO. IB-TPU-HPP-4054(2)07 SHEET NO. 13-4


CoA Proj. no 6440-91

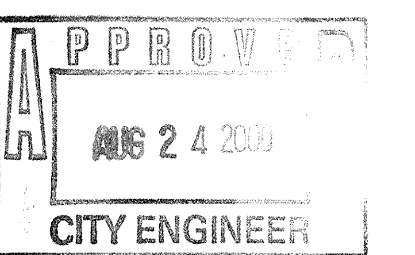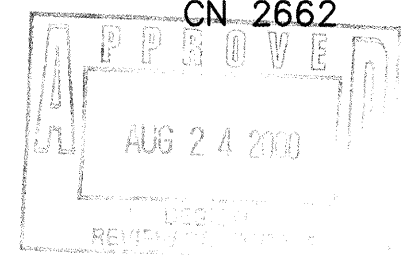


10 of 11

SCANNED BY
MESA REPRO

DESIGNED BY
CHECKED BY
DRAWN BY

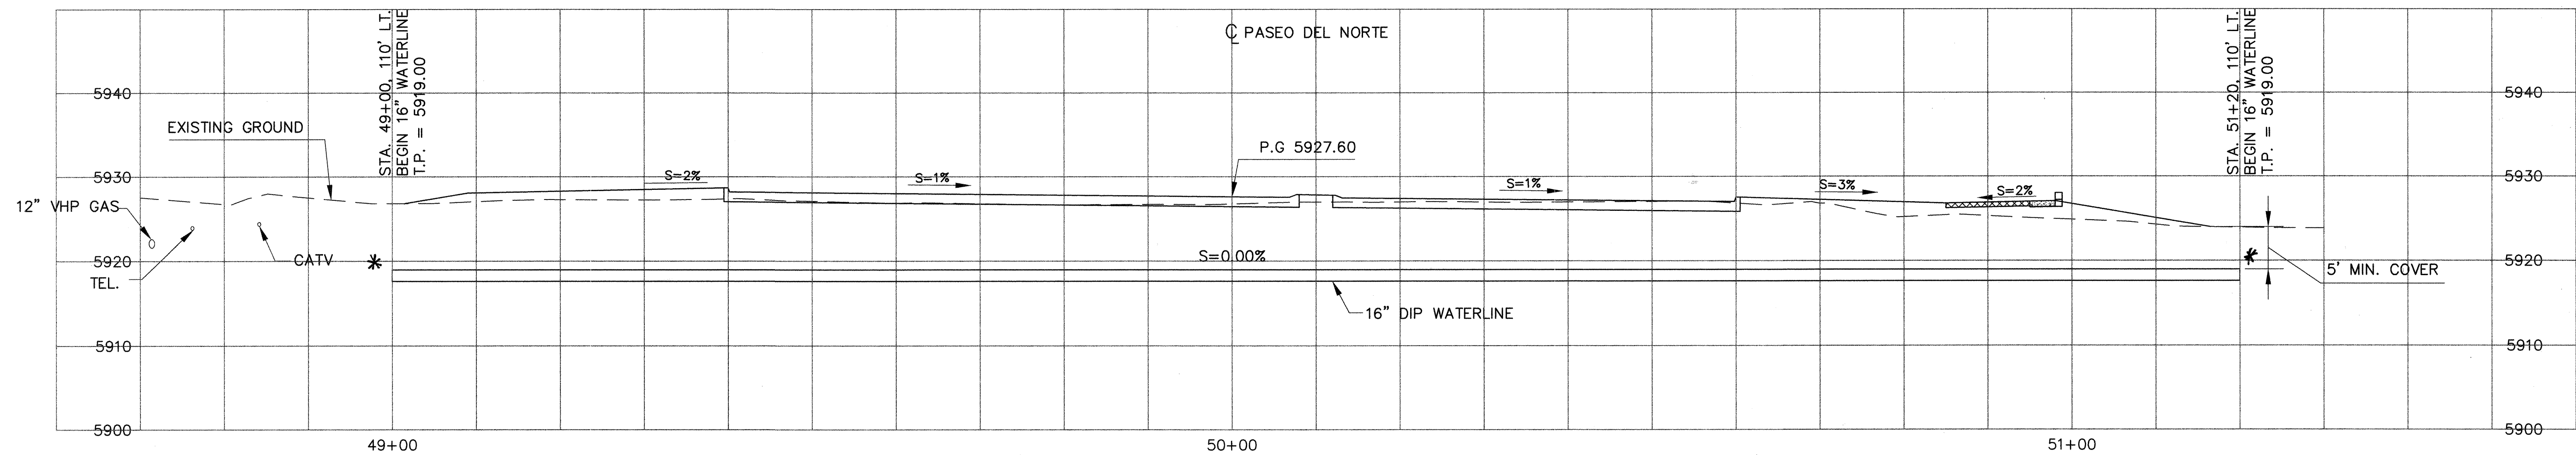


LOWELL ST. & PASEO DEL NORTE WEST 16" WATERLINE

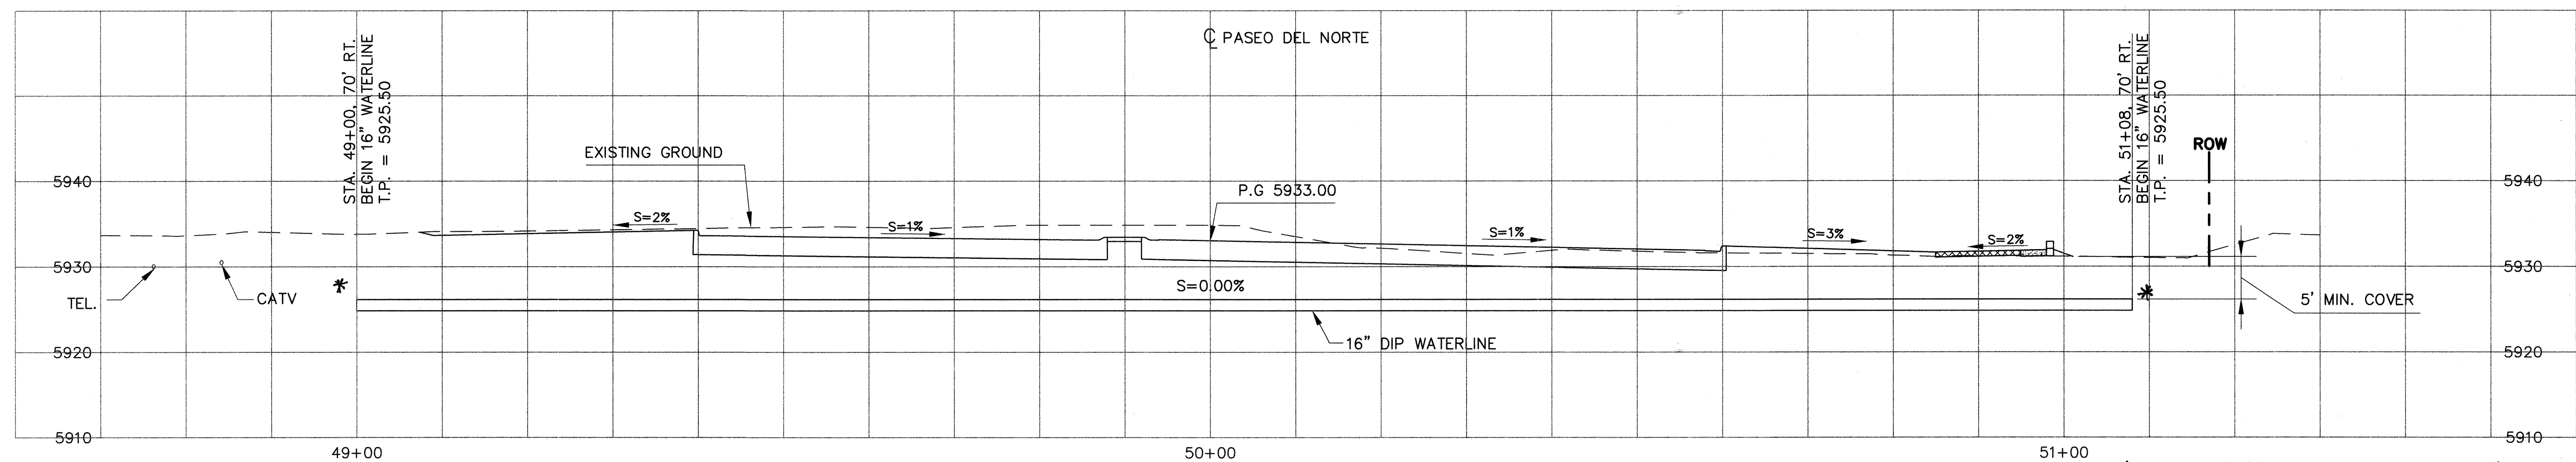

LOWELL ST. & PASEO DEL NORTE EAST 16" WATERLINE

* NOTE: CONTRACTOR TO INSTALL EMD MARKERS
AT EACH END OF PIPES

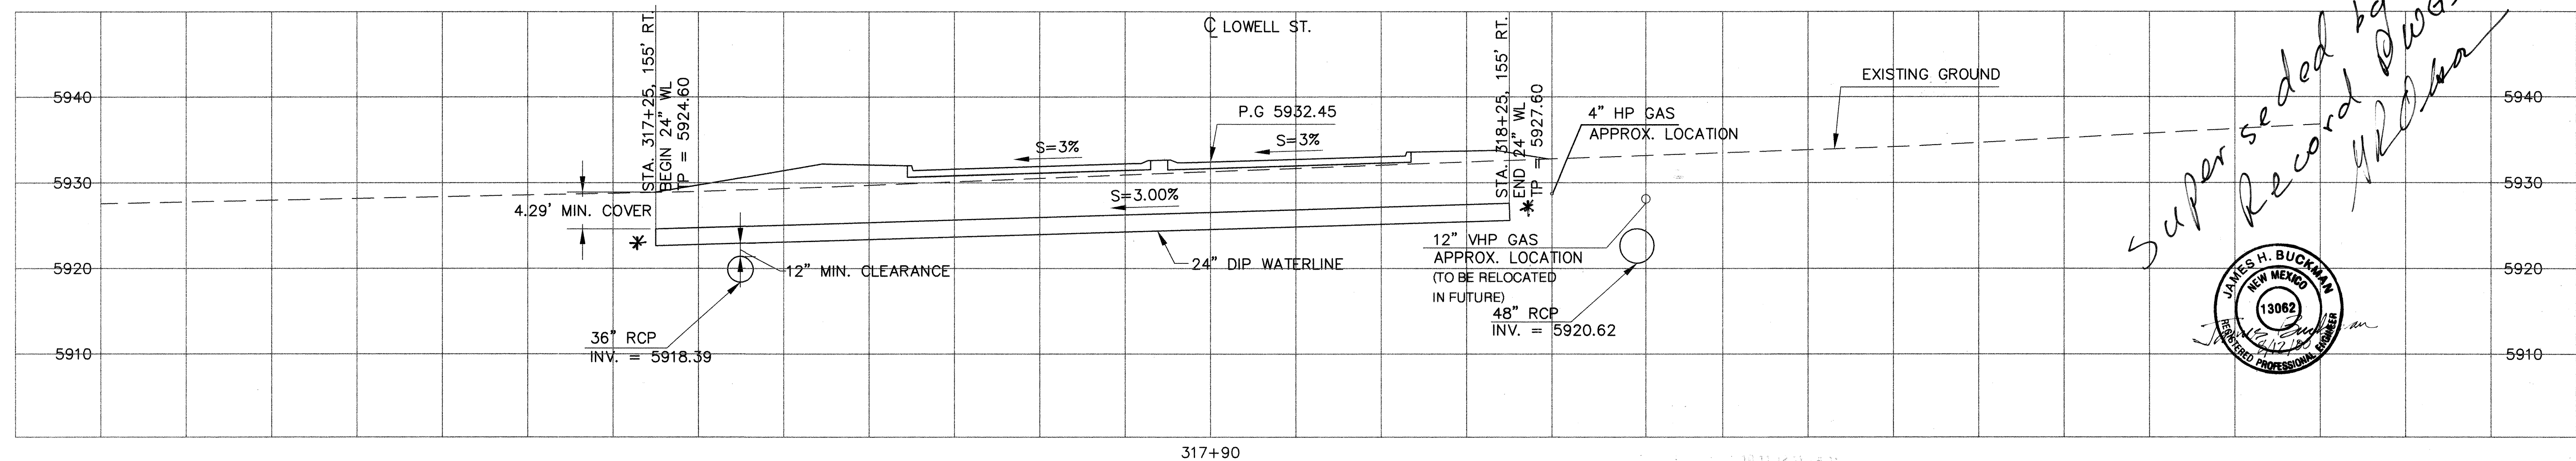

LOWELL ST. & PASEO DEL NORTE SOUTH 24" WATERLINE

SCALE:
HORIZ. 1" = 10'
VERT. 1" = 10'

PASEO DEL NORTE / LOWELL INTERSECTION
WATERLINE PROFILES

CoA Proj. no. 6440-91