


SCANNED BY
MESA REPRO

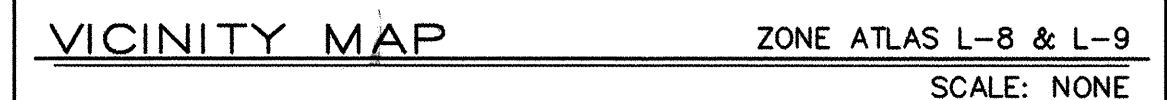

NOTICE TO CONTRACTORS

NOTICE TO CONTRACTORS

- THE FOLLOWING NOTES ALSO APPLY WHEN CHECKED

- ## INDEX TO DRAWINGS

SURVEYOR'S CERTIFICATION

Best of my
responsible
engineering
77MothyAld


7740 John Aldrich, P.S. No. 7719

10-16-01

222

RECORD DRAWING

Mark Goodwin 3/17/01
Mark Goodwin NMPE 8948

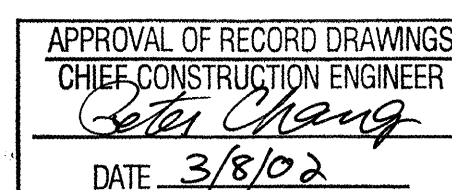


DRB #1000301

CAUTION:

NOTE THAT ALL EXISTING UTILITIES MAY NOT BE SHOWN. ALL EXISTING SERVICE CONNECTIONS ARE NOT SHOWN. ANY EXISTING UTILITIES THAT ARE SHOWN ARE APPROXIMATE LOCATION ONLY. IT SHALL BE THE SOLE RESPONSIBILITY OF THE CONTRACTOR TO CONTACT ALL THE UTILITY OWNERS AND TO CONDUCT ALL NECESSARY FIELD INVESTIGATIONS PRIOR TO ANY EXCAVATIONS TO DETERMINE THE ACTUAL LOCATION OF UTILITIES AND OTHER IMPROVEMENTS.

dmg D. MARK GOODWIN & ASSOCIATES, P.A.
CONSULTING ENGINEERS
P. O. BOX 90606
ALBUQUERQUE, NEW MEXICO 87199
(505) 828-2200, FAX (505) 797-9539

0022\UNIT2\U2-TITLE\10-13-00\ MJR

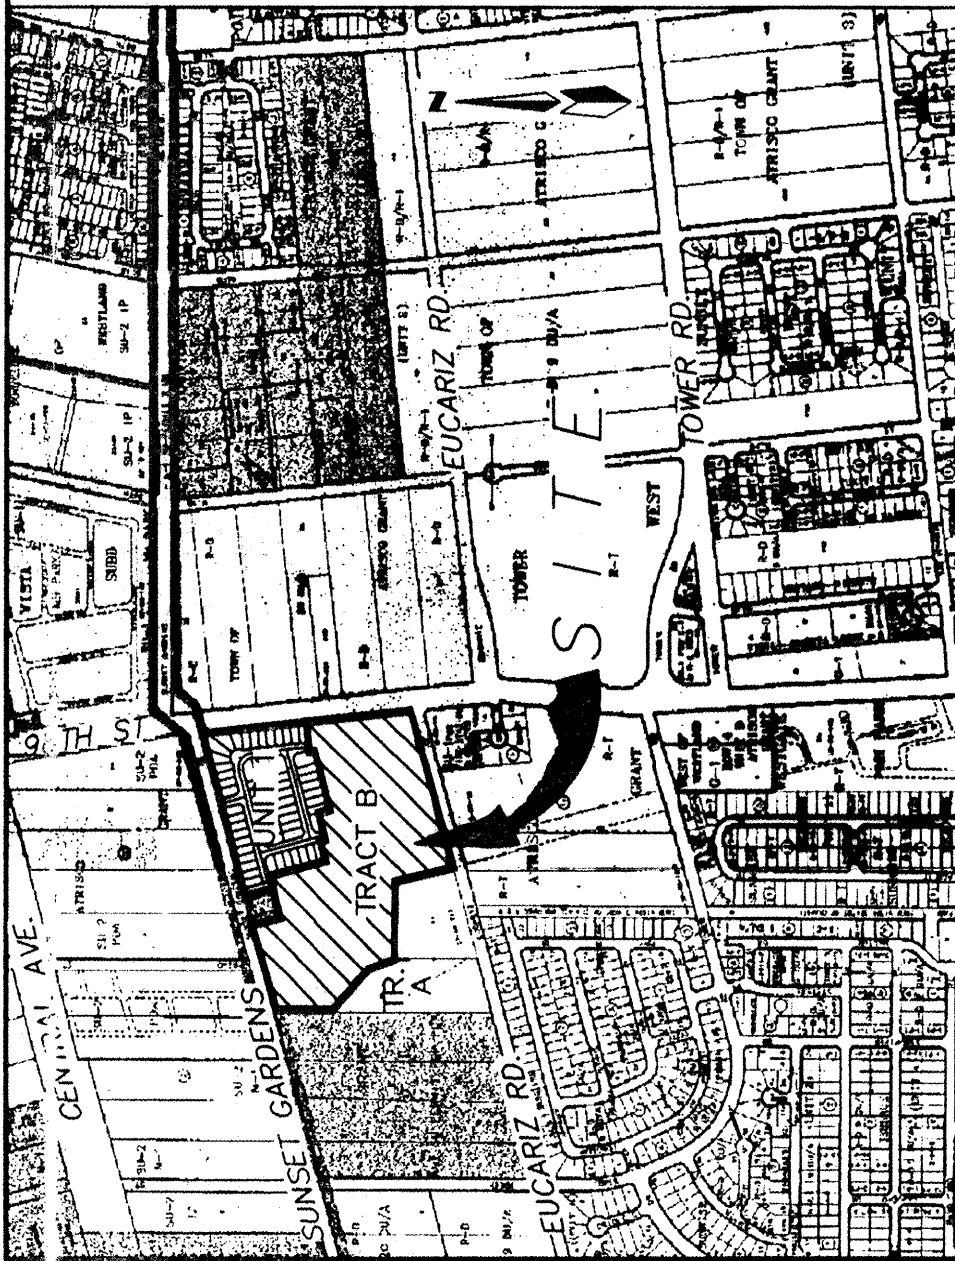

LOCATION MAP
ZONE ATLAS L-8-Z, L-9-Z
SCALE: NONE

SUBDIVISION DATA

PROJECT 1000301
APPLICATION 00440-00000 - 01393
GROSS ACREAGE 18.4112
ZONE ATLAS NO. L-8-Z, L-9-Z
NO. OF EXISTING TRACTS/LOTS 1 TRACT
NO. OF TRACTS/LOTS CREATED 60 LOTS & 1 TRACT
NO. OF TRACTS/LOTS ELIMINATED 1 TRACT
MILES OF FULL WIDTH STREETS CREATED 0.30
AREA DEDICATED TO CITY OF ALBUQUERQUE 1.9616 AC FOR R/W
DATE OF SURVEY JANUARY 1997
UTILITY CONTROL LOCATION SYSTEM LOG NUMBER: 97012613220341

FREE CONSENT AND DEDICATION

The subdivision hereon described is with the free consent and in accordance with the desires of the undersigned owner(s) and/or proprietor(s) thereof and said owner(s) and/or proprietor(s) do hereby dedicate all streets and public utility easements shown hereon including the right to construct, operate, inspect, and maintain facilities therein; and all public utility easements shown hereon for the common and joint use of gas, electrical power and communication services for buried distribution lines, conduits, and pipes for underground utilities where shown or indicated, and including the right of ingress and egress for construction and maintenance, and the right to trim interfering trees and shrubs. Said owner(s) and/or proprietor(s) do hereby consent to all easements hereon and do hereby certify that this subdivision is their free act and deed.

Paul White, Jr.
Paul White, Jr.
Vice President, 98th Street Ltd. Co.
8-1-00
DATE

OWNER'S ACKNOWLEDGMENT

STATE OF NEW MEXICO } ss
COUNTY OF BERNALILLO }
This instrument was acknowledged before me on August 1, 2000
by Paul White, Jr. Vice President, 98th Street Ltd. Co.
a New Mexico Corporation on behalf of said Corporation.

David L. Jones
NOTARY PUBLIC
12-04-03
MY COMMISSION EXPIRES

LEGAL DESCRIPTION

(SEE SHEET 2)

(SEE SHEET 2)

PURPOSE OF PLAT

SUBDIVIDE EXISTING TRACT B, SUNRISE RANCH, UNIT 1,
INTO 60 RESIDENTIAL LOTS AND TRACT B-1.
GRANT NEW EASEMENTS AS SHOWN
DEDICATE NEW RIGHT-OF-WAY AS SHOWN

SCANNED BY
MESA REPRO

PLAT FOR SUNRISE RANCH UNIT 2

TOWN OF ATRISCO GRANT
PROJECTED SECTION 28 & 29
TOWNSHIP 10 NORTH, RANGE 2 EAST, NMPM
CITY OF ALBUQUERQUE
BERNALILLO COUNTY, NEW MEXICO
JULY 2000

APPROVED AND ACCEPTED BY:

APPROVAL AND CONDITIONAL ACCEPTANCE as specified by the Albuquerque Subdivision Ordinance, Article XI of Chapter 7 of the Revised Ordinances of Albuquerque.

Subdivision Case No. _____

Planning Director, City of Albuquerque, N.M.

Date

City Engineer, City of Albuquerque, N.M.

Date

Albuquerque Metropolitan Arroyo Flood Control Authority

Date

Transportation Development City of Albuquerque, N.M.

Date

Utility Development Division, City of Albuquerque, N.M.

Date

Parks and Recreation, City of Albuquerque, N.M.

Date

Date

City Surveyor, City of Albuquerque, N.M.

Date

Property Management, City of Albuquerque, N.M.

Date

PNM GAS

Date

Comcast Cable

Date

Quest Telecommunications

Date

PNM ELECTRIC

Date

Date

SURVEYOR'S CERTIFICATION

"I, Timothy Aldrich, a duly qualified Registered Professional Land Surveyor under the laws of the State of New Mexico, do hereby certify that this plat and description were prepared by me or under my supervision, shows all easements as shown on the plat of record or made known to me by the owners and/or proprietors of the subdivision shown hereon, utility companies and other parties expressing an interest and meets the minimum requirements for monumentation and surveys of the Albuquerque Subdivision Ordinance, and I have met the Minimum Standards for Surveying in the State of New Mexico, and is true and correct to the best of my knowledge and belief."

Timothy Aldrich
TIMOTHY ALDRICH, P.S. No. 7719
DATE 08-14-00

dwg: unit2sheet2 Drawn: SPS Checked: ALS Sheet 1 of 5
Scale: 1"=50' Date: 7-28-00 Job: A00022

LEGAL DESCRIPTION

A tract of land situate within Sections 28 and 29, Township 10 North, Range 2 East, New Mexico Principal Meridian, Bernalillo County, New Mexico, being all of TRACT B, SUNRISE RANCH, UNIT 1 as the same is shown, and designated on said plat filed for record in the office of the County Clerk of Bernalillo County, New Mexico on September 9, 2000 in Volume 2000C, Folio 228 and containing 18.4112 acres more or less.

NOTES

1. Bearings are New Mexico State Plane Grid Bearings (Central Zone).
2. Distances are ground distances.
3. Bearings and distances in parenthesis are record.
4. Basis of boundary are the following plats of record entitled:
SUNRISE RANCH, UNIT 1 (09-06-00, 2000C-228)
LANDS OF THE ATRISCO GRANT (03-26-62, 03-26)
LANDS OF CAPITAL INVESTORS (01-07-88, C35-117)
all being records of Bernalillo County, New Mexico.
5. Field Survey performed January, 1997.
6. Utility Council Location System Log No. 97012613220341
7. Title Report: None provided
8. All property corners are set 5/8" rebar with cap "ALS LS 7719", unless otherwise noted.
9. City of Albuquerque Zoning: R-D, 20 DU/A.
10. Flood Zone Designation: ZONE C (areas of minimal flooding), and ZONE AO (areas of moderate flooding).
11. Flood Hazard Insurance Policy No. 100
(1) and (3) feet as shown on Panel 32 of 50, FLOOD INSURANCE RATE MAP, City of Albuquerque, Bernalillo County, New Mexico dated October 14, 1983.
11. Sunset Gardens Road is a Private Road and is apparently owned by WESTLAND DEVELOPMENT COMPANY.
12. CITY OF ALBUQUERQUE WATER AND SANITARY SEWER SERVICE TO: SUNRISE RANCH UNITS 1-4
MUST BE VERIFIED AND COORDINATED WITH THE PUBLIC WORKS DEPARTMENT, CITY OF ALBUQUERQUE

PUBLIC UTILITY EASEMENTS

PUBLIC UTILITY EASEMENTS shown on this plat are granted for the common and joint use of:

1. The PNM Electric Services Division for the installation, maintenance, and service of overhead and underground electrical lines, transformers, poles and any other equipment, fixtures, structures and related facilities reasonably necessary to provide electrical services.
2. The PNM Gas Services Division for installation, maintenance, and service of natural gas lines, valves and other equipment and facilities reasonably necessary to provide natural gas services.
3. Quest for installation, maintenance and service of all buried and aerial communication lines and other related equipment and facilities reasonably necessary to provide communication services, including but not limited to above ground pedestals and enclosures.
4. Jones Intercable for the installation, maintenance, and service of such lines, cable, and other related equipment and facilities reasonably necessary to provide Cable TV services.

Included, is the right to build, rebuild, construct, reconstruct, locate, relocate, change, remove, modify, renew, operate, and maintain facilities for the purposes described above, together with free access to, from, and over said easements, including sufficient working area space for electric transformers, with the right and privilege to trim and remove trees, shrubs or bushes which interfere with the purposes set forth herein. No building, sign, pool (aboveground or subsurface), hot tub, concrete or wood on said easements, nor shall any well be drilled or constructed thereon. Property owners shall be solely responsible for correcting any violations of the National Electrical Safety Code caused by construction of pools, decking, or any structures adjacent to within or near easements shown on this plat.

In approving this plat, the utility companies did not conduct a title search of the properties shown hereon. Consequently, the utility companies do not waive or release any easement or easement rights which may have been granted by prior plat, replat or other document and which are not shown on this plat.



dwg: unit2sheet2 Drawn: SPS Checked: ALS Sheet 2 of 5
Scale: 1"=200' Date: 07-18-00 Job: A00022

SCANNED BY
MESA REPRO

PLAT FOR
SUNRISE RANCH
UNIT 2

TOWN OF ATRISCO GRANT
PROJECTED SECTION 29
TOWNSHIP 10 NORTH, RANGE 2 EAST, NMPM
CITY OF ALBUQUERQUE
BERNALILLO COUNTY, NEW MEXICO
JULY 2000

NUMBER	R	L	D	T	CH	BEARIN	CHORD LE
C1	25.00	35.33	80°57'41"	21.34	N	34°30'58"	32.46
C2	25.00	4.46	101°37'26"	2.24	N	00°51'08"	4.46
C3	25.00	70.75	54°03'09"	36.26	N	21°03'42"	68.16
C4	75.00	58.03	44°19'56"	30.56	N	16°12'05"	56.59
C5	75.00	58.03	44°19'56"	30.56	N	16°12'05"	56.59
C6	75.00	12.72	09°43'13"	6.38	S	43°13'40"	12.71
C7	323.00	11.61	02°03'37"	29.32	N	25°07'06"	38.05
C8	323.00	60.01	10°38'44"	30.09	S	20°49'52"	59.93
C9	277.00	35.23	07°17'16"	17.64	S	19°14'10"	35.21

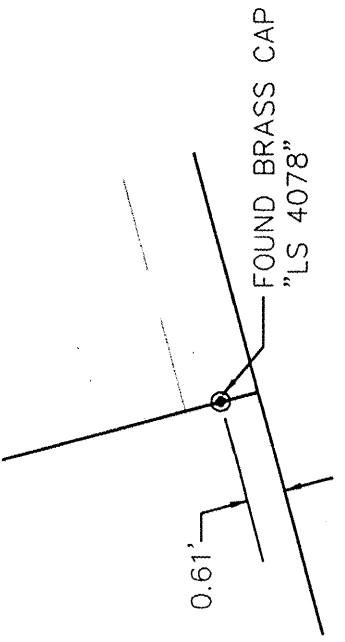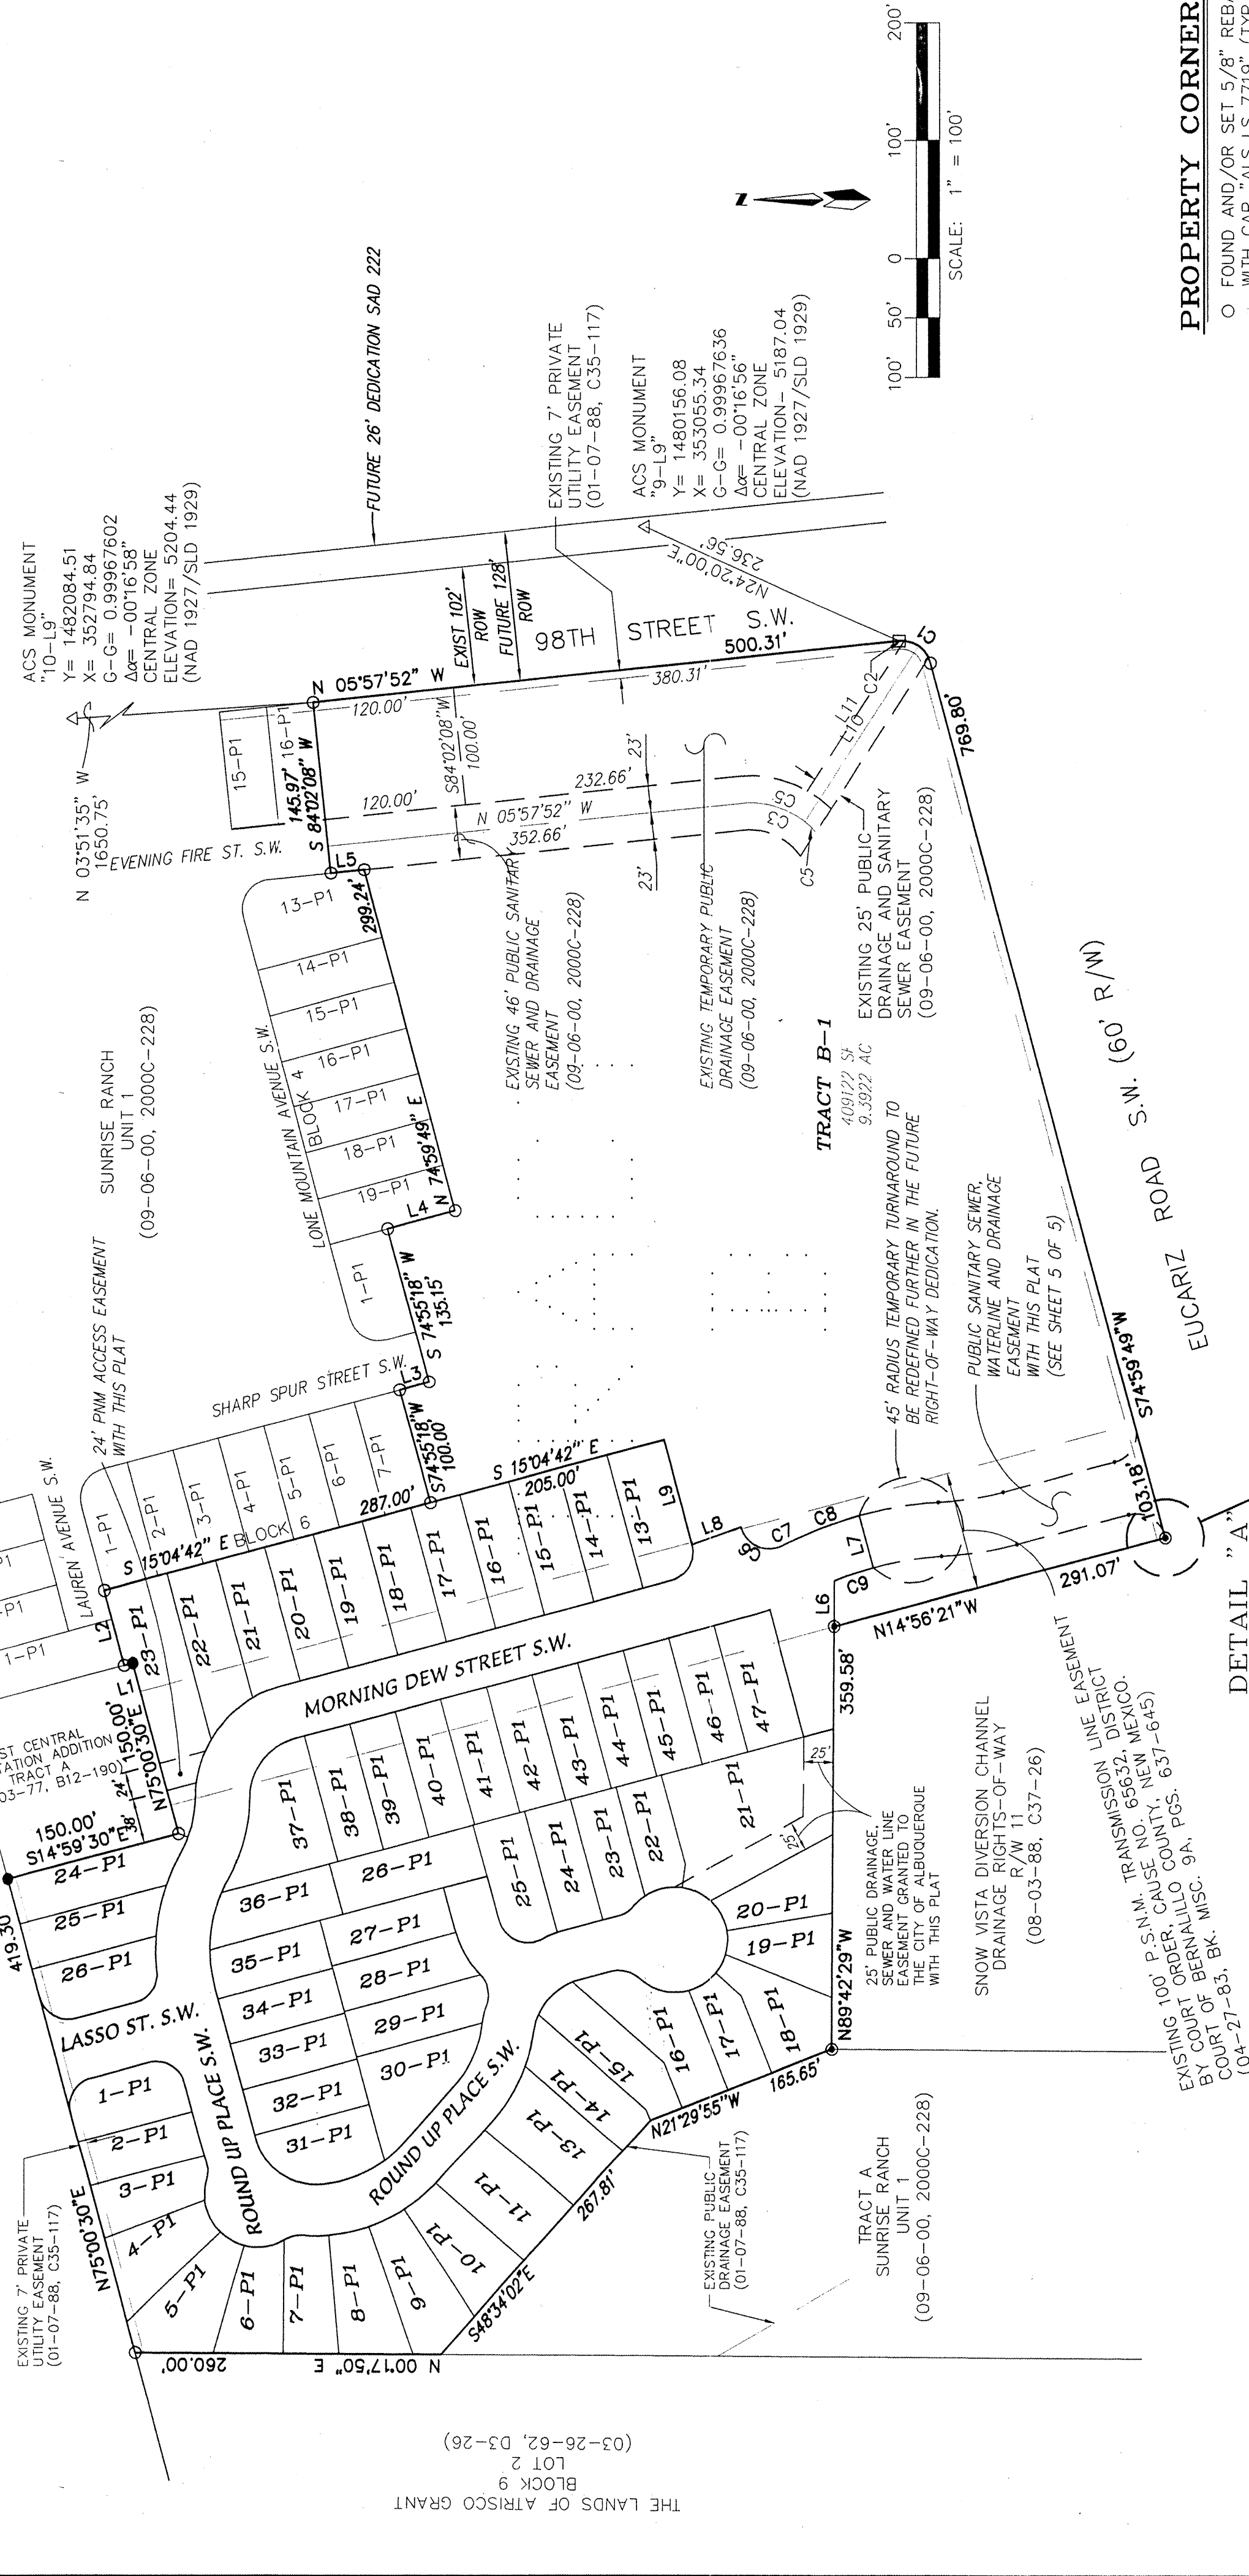

- PROPERTY CORNERS**
- FOUND AND/OR SET 5/8" REBAR WITH CAP "ALS LS 7719" (TYP.)
 - FOUND BRASS CAP (01-07-88, C35-117)
 - FOUND 5/8" REBAR (TYP.)
 - FOUND 5/8" REBAR WITH CAP "LS 3241" (TYP.)

dwg:	unit2sheet3	Drawn:	SFS	Date:	07-28-00	Job:	40022
Scale:	1"=100'						

NOT TO SCALE
DETAIL "A"

dwg:	unit2sheet4	Drawn:	SFS	Date:	07-28-00	Job:	40022
Scale:	1"=50'						

NOT TO SCALE
DETAIL "A"

NOTE: THERE IS A 10' PRIVATE DRAINAGE EASEMENT CENTERED ON ALL INTERIOR SIDE LOT LINES. (SEE TYPICAL LOT DETAIL SHEET 5)

LINE TABLE (THIS SHEET ONLY)

LINE	DIRECTION	DISTANCE
L1	N20°37'18"E	8.73
L2	N51°42'32"W	3.64
L3	N75°51'18"E	10.00
L4	N42°17'17"E	29.53
L5	N82°05'50"W	20.00
L6	N82°05'50"W	20.00


CURVE TABLE (THIS SHEET ONLY)

NUMBER	RADIUS	DELTA	LENGTH	TAN	BEARING	DISTANCE
C8	52.00	74°50'48"	67.93	39.79	N62°26'24"W	63.20
C9	143.00	28°42'23"	17.65	36.59	N75°30'37"W	70.90
C10	127.00	43°50'04"	97.16	51.10	N63°04'28"W	94.81
C11	75.00	74°50'48"	97.16	51.10	N62°26'24"W	91.16
C12	120.00	28°42'23"	10.12	30.71	N63°04'28"W	59.50
C13	150.00	43°50'04"	114.76	60.35	N63°04'28"W	111.98
C14	98.00	74°50'48"	128.02	74.99	N62°26'24"W	119.11
C15	97.00	28°42'23"	48.60	24.82	N75°30'37"W	48.09
C16	73.00	34°56'45"	105.32	54.46	N78°30'37"W	103.89
C17	25.00	81°06'41"	35.39	21.39	N65°32'50"W	32.51
C18	25.00	90°00'00"	39.27	25.00	N60°00'00"W	35.36
C19	25.00	90°00'00"	39.27	25.00	N60°00'00"W	35.36
C20	25.00	90°00'00"	39.27	25.00	N60°00'00"W	35.36
C21	127.00	43°50'04"	10.12	30.71	N63°04'28"W	59.50
C22	127.00	43°50'04"	10.12	30.71	N63°04'28"W	59.50
△ CENTERLINE MONUMENTATION
Centerline (in lieu of R/W monumentation) to be installed at all centerline points, angle points, and street intersections as shown hereon, and will consist of a four inch (4") aluminum alloy cap stamped: CITY OF ALBUQUERQUE
CENTERLINE MONUMENT
DO NOT DISTURB
PLS #7719

PLAT FOR
SUNRISE RANCH
UNIT 2
TOWN OF ATRISCO GRANT
PROJECTED SECTION 29
TOWNSHIP 10 NORTH, RANGE 2 EAST, NMPM
CITY OF ALBUQUERQUE
BERNALILLO COUNTY, NEW MEXICO
JULY 2000

NOTE: THERE IS A 10' PRIVATE
DRAINAGE EASEMENT CENTERED ON
ALL INTERIOR SIDE LOT LINES.
(SEE TYPICAL LOT DETAIL)

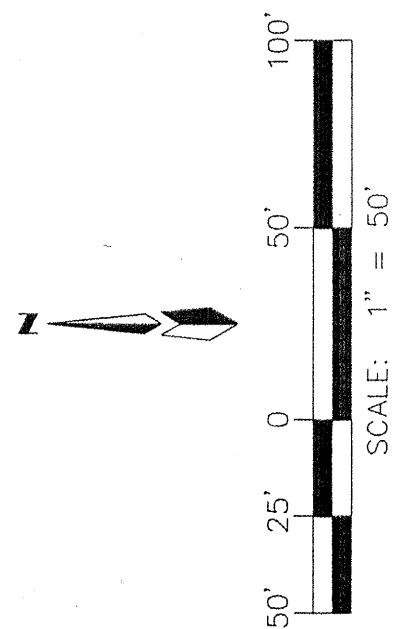

NUMBER	R =	L =	D =	T =	CH BEARIN=	CHORD LE=
C1	25.00	39.26	18°59'12"	24.99	S 60°00'36" E	35.35
C2	25.00	43.24	99°02'25"	29.32	N 25°27'06" E	38.05
C3	346.00	67.26	11°08'14"	33.73	N 20°31'02" W	67.15
C4	300.00	55.53	10°36'22"	27.85	N 20°31'02" W	55.45
C5	300.00	63.30	12°05'22"	31.77	N 09°30'10" W	63.18
C6	300.00	60.52	11°33'30"	30.36	S 09°14'15" E	60.42
C7	323.00	11.61	10°03'37"	5.81	S 25°07'25" E	11.61
C8	323.00	60.00	10°38'38"	30.09	N 20°49'54" W	59.92
C9	369.00	28.12	04°21'59"	14.07	S 17°11'59" E	28.11
C12	277.00	35.23	07°17'16"	17.64	S 19°14'10" E	35.21
C13	277.00	58.66	12°08'02"	29.44	N09°31'31" W	58.55
C14	323.00	62.93	12°03'00"	34.09	N09°29'00" W	62.81
C15	277.00	55.88	11°33'30"	28.04	N09°14'15" W	55.79
C16	323.00	63.16	11°33'30"	32.69	N09°14'15" W	63.09
C19	25.00	39.26	18°59'12"	24.99	N25°27'06" E	35.35
C20	25.00	43.24	99°02'25"	29.32	N 20°31'02" W	67.15

TRACT B-1

409121 SF
9.3921 AC

45' RADIUS TEMPORARY
TURNAROUND TO BE REDEFINED
FURTHER IN FUTURE
RIGHT-OF-WAY DEDICATION
WITH THIS PLAT

EXISTING 100' P.S.N.M. TRANSMISSION LINE EASEMENT
BY COURT ORDER, CAUSE NO. 65632, DISTRICT
COURT OF BERNALILLO COUNTY, NEW MEXICO.
(04-27-83, BK. MISC. 9A, PGS. 637-645)

46' PUBLIC SANITARY
SEWER, WATERLINE AND
DRAINAGE EASEMENT WITH
THIS PLAT


SEE SHEET 3

SNOW VISTA DIVERSION CHANNEL
DRAINAGE RIGHT-OF-WAY
R/W 11
(08-03-88, C37-26)

FUTURE RIGHT-OF-WAY
(20594 SF)
(0.4728 AC)

TYPICAL LOT DETAIL

N.T.S.

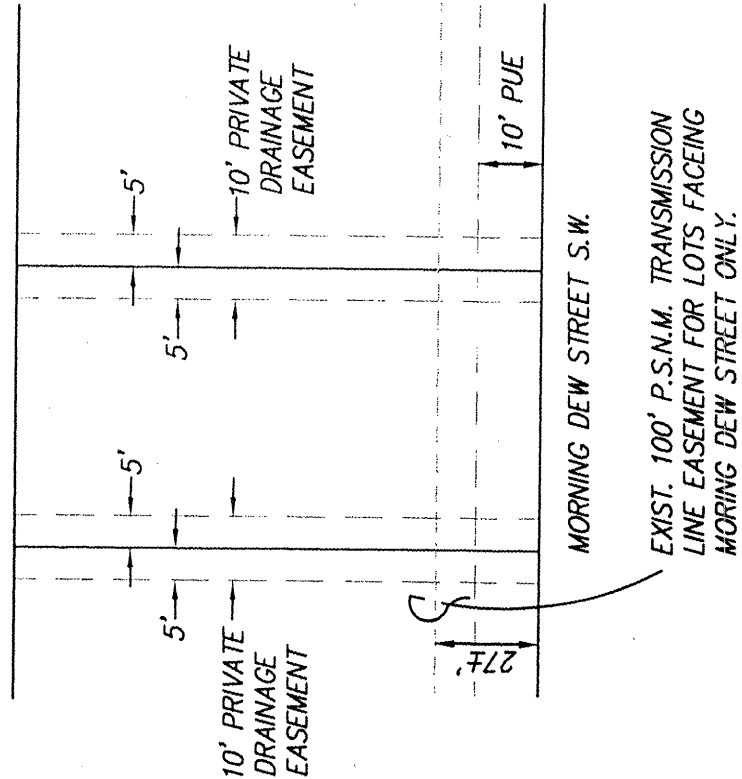

NOTE: THERE IS A 10' PRIVATE
DRAINAGE EASEMENT CENTERED ON
ALL INTERIOR SIDE LOT LINES.
(SEE TYPICAL LOT DETAIL)

△ CENTERLINE MONUMENTATION
Centerline (in lieu of R/W monumentation)
to be installed at all centerline PC's, PT's,
angle points, and street intersections
as shown hereon, and will consist of a
four inch (4") aluminum rod deep stamped:
CITY OF ALBUQUERQUE
CENTERLINE MONUMENT
DO NOT DISTURB
PLS #7719

NOTES

1. OFFSITE FLOWS WILL BE ROUTED ALONG THE RETAINING WALL ON THE PROPERTY LINE TO THE R.O.W. OR ARROYO.
2. CONTRACTOR MUST OBTAIN A TOPSOIL DISTURBANCE PERMIT FROM THE ENVIRONMENTAL HEALTH DIVISION PRIOR TO CONSTRUCTION.
3. CITY OF ALBUQUERQUE STANDARD SPECIFICATIONS FOR PUBLIC WORKS CONSTRUCTION, LATEST EDITION SHALL GOVERN ALL WORK.
4. THE CONTRACTOR SHALL CONFORM TO ALL CITY, COUNTY, STATE AND FEDERAL DUST CONTROL MEASURES AND REQUIREMENTS AND WILL BE RESPONSIBLE FOR PREPARING AND OBTAINING ALL NECESSARY APPLICATIONS AND APPROVALS.

5. THE CONTRACTOR SHALL ENSURE THAT NO SOIL ERODES FROM THE LOTS INTO PUBLIC RIGHT-OF-WAY. THIS CAN BE ACHIEVED BY CONSTRUCTING TEMPORARY BERMS AND MATTING THE SOIL TO KEEP IT FROM BLOWING.

6. SIDE YARD RETAINING WALLS MAY BE REQUIRED WHEN ADJACENT CHANGE IN LOT PADS IS GREATER THAN 14 INCHES.

Diagram illustrating the Erosion Control Swale Detail. The swale has a width of 20'. The elevations are marked as follows: ELEV. 98.85 at the top left, ELEV. 100.35 at the top right, and ELEV. 99.50 at the bottom right. The slope is indicated as 4%.

EROSION CONTROL SWALE DETAIL

EROSION CONTROL NOTES


N.T.S.

EROSION CONTROL NOTES

N.T.S.

EROSION CONTROL NOTES


1. CONTRACTOR IS RESPONSIBLE FOR OBTAINING A TOPSOIL DISTURBANCE PERMIT PRIOR TO BEGINNING WORK.
2. CONTRACTOR IS RESPONSIBLE FOR KEEPING ALL SEDIMENT OUT OF EXISTING RIGHT-OF-WAY.
3. CONTRACTOR IS RESPONSIBLE FOR CLEANING UP ANY SEDIMENT THAT GETS INTO EXISTING RIGHT-OF-WAY.
4. EROSION CONTROL BERMS ARE REQUIRED AROUND THE ENTIRE SITE.
5. ALL EROSION CONTROL BERMS MUST BE IN PLACE AND ENGINEER CERTIFIED PRIOR TO BUILDING PERMIT RELEASE.

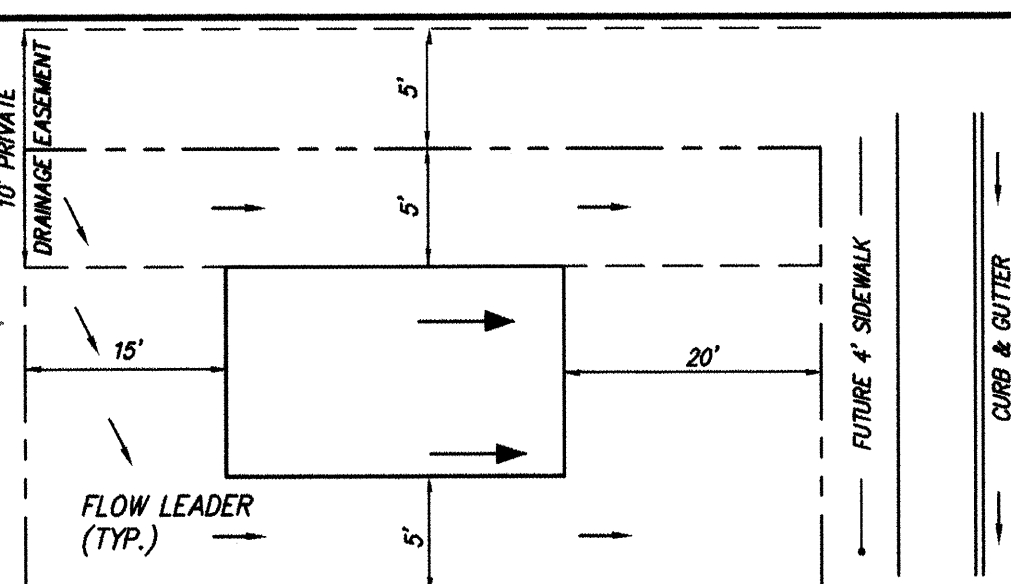


TYPICAL LOT LAYOUT PLAN
N.T.S.

NOTES

1. ADD 5100' TO ALL SPOT ELEVATIONS.
2. MASONRY BLOCK WALLS (CMU) WILL BE CONSTRUCTED ON THE PROPERTY PERIMETER. FENCES WILL BE USED ON ALL INTERNAL PROPERTY LINES UNLESS MASONRY WALLS ARE INDICATED.

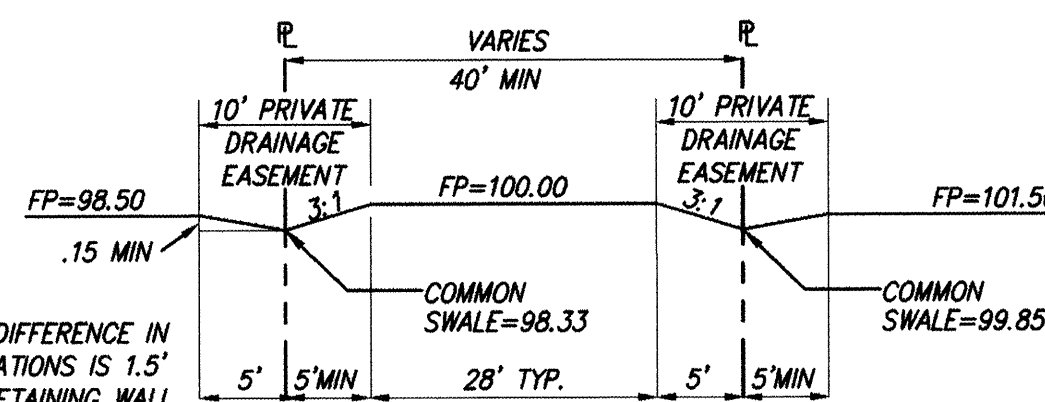


SECTION F-F
NTS

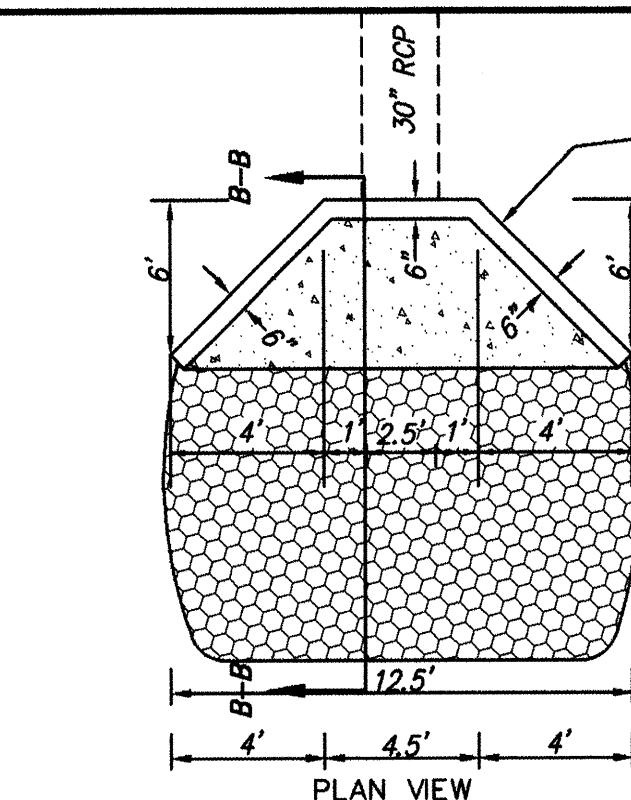

POND HEADWALL DETAIL A


REINFORCING TO BE #4 REBAR @ 12"
EACH WAY GRADE 60 STEEL
4000 PSI CONCRETE


% SMALLER THAN GIVEN SIZE BY WEIGHT	INTERMEDIATE ROCK DIMENSION (INCHES)	MEAN D_{50} (INCHES)
70-100	15	9
50-70	12	
35-50	9	
2-10	3	

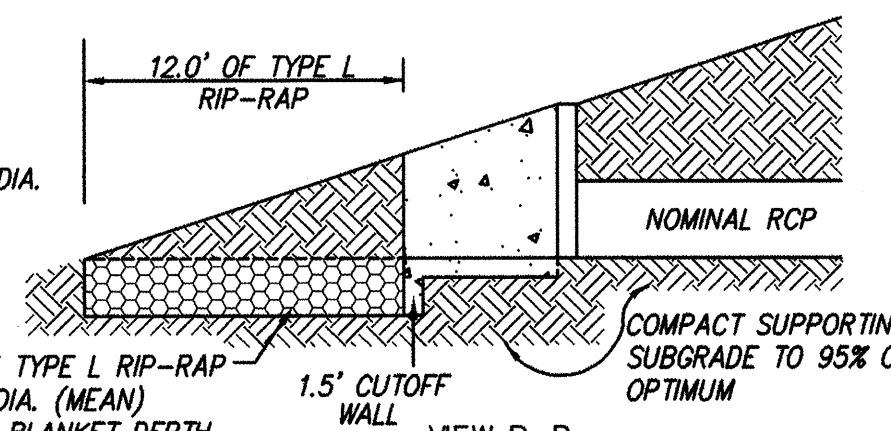

TEMPORARY SWALE DETAIL A-A

 
LEGEND

	FINISHED PAD ELEVATION		EXISTING OVERHEAD ELECTRIC LINE
	MOUNTABLE CURB & GUTTER		TRACT/LOT BOUNDARY
	STANDARD 8" CURB & GUTTER		RIGHT OF WAY
	PROPOSED SPOT ELEVATION		EASEMENTS
	3:1 SLOPE		CENTERLINE OF ROAD
	PROPOSED DRAINAGE BASIN		NEW RETAINING WALL
	WATER BLOCK		NEW GARDEN WALL
	EXISTING WATER VALVE		FLOW DIRECTION
	EXISTING SANITARY SEWER MANHOLE		SWALE
	EXISTING CONTOUR		NEW 4' SIDEWALK
	EXISTING SPOT ELEVATION		

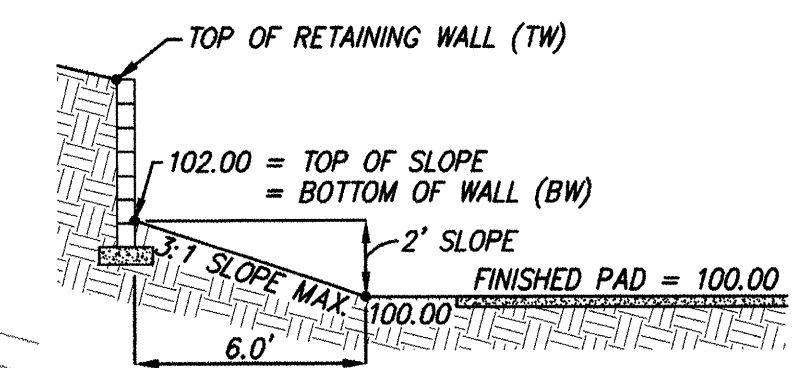


TYPICAL BACKYARD RETAINING WALL/ SLOPE DETAIL B-B

LOCATION	SCOUR WALL ELEVATION	
	TOP	BOTTOM
XS 1030	123.5	113.90
XS 1046	123.5	114.27
XS 1076	123.5	114.67
XS 1102	123.5	115.17
XS 1130	123.5	115.52

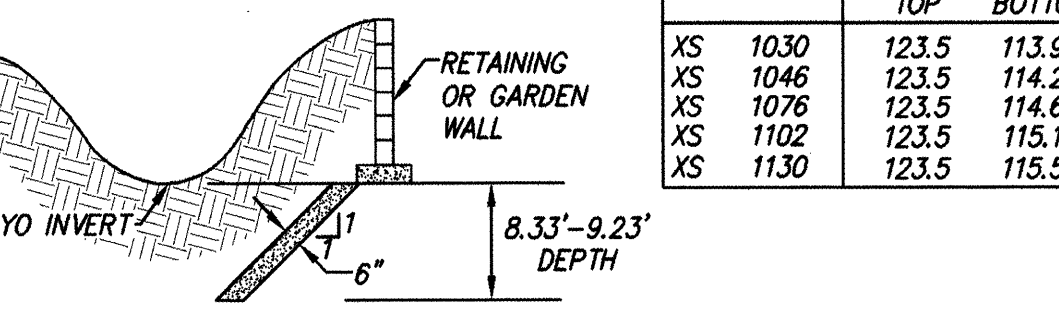

CONCRETE SCOUR WALL DETAIL C-C

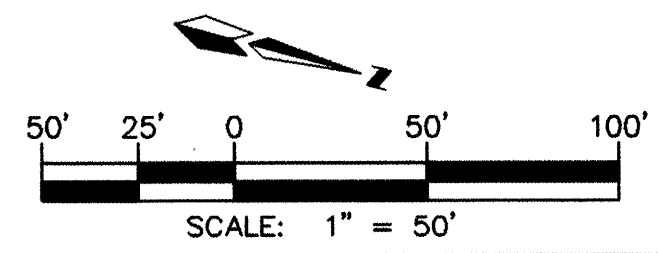

dmg MARK GOODWIN & ASSOCIATES, P.A.
CONSULTING ENGINEERS
P.O. BOX 90606
ALBUQUERQUE, NEW MEXICO 87199
(505) 828-2200, FAX (505) 797-9539

 CITY OF ALBUQUERQUE
PUBLIC WORKS DEPARTMENT
ENGINEERING DEVELOPMENT GROUP

TITLE: ***SUNRISE RANCH - UNIT 2
GRADING AND DRAINAGE PLAN***

DESIGN REVIEW COMMITTEE	CITY ENGINEER APPROVAL	DATE	MO./DAY/YR.	MO./DAY/YR.

Approved DRD	LAST DESIGN U
----------------------------	----------------------

CITY PROJECT NO.	645281	ZONE MAP NO.	L-8 & 9	SHEET	5	OF	20
------------------	--------	--------------	---------	-------	---	----	----



AS BUILT INFORMATION			
CONTRACTOR <i>Franklin's</i>		DATE <i>11/1/01</i>	
WORK STARTED BY	<i>ACS</i>	DATE <i>1/1/02</i>	
ACCEPTANCE BY	<i>MB</i>	DATE <i>3/1/02</i>	
FIELD VERIFICATION BY	<i>ACS</i>	DATE <i>3/1/02</i>	
CHECKED BY	<i>MB</i>	DATE <i>3/1/02</i>	
MICRO-FILM INFORMATION			
RECORDED BY		DATE	
NO.			
C/F Inspector: <i>S. Moya</i>			

6 F	BENCH MARKS
	ACS MONUMENT "9-13"
	Y = 1480156.08
	X = 353065.34
	G-G = 0.99997636
	DELTA ALPHA = $-0016^{\circ}56'$
	CENTRAL ZONE (MAD 1927/SLD 1929)
	ELEVATION = 5187.04

[illegible][illegible]

STUDENT GROUP	
UNIT 2 PAGE PLAN	
MO./DAY/YR.	MO./DAY/YR.
	NO. SHEET OF 8 & 9 5 20

- EROSION CONTROL NOTES
1. CONTRACTOR IS RESPONSIBLE FOR OBTAINING A TOPSOIL DISTURBANCE PERMIT PRIOR TO BEGINNING WORK.
 2. CONTRACTOR IS RESPONSIBLE FOR KEEPING ALL SEDIMENT OUT OF EXISTING RIGHT-OF-WAY.
 3. CONTRACTOR IS RESPONSIBLE FOR CLEANING UP ANY SEDIMENT THAT GETS INTO EXISTING RIGHT-OF-WAY.
 4. EROSION CONTROL SWALES ARE REQUIRED AROUND THE ENTIRE SITE.
 5. ALL EROSION CONTROL SWALES MUST BE IN PLACE AND ENGINEER CERTIFIED PRIOR TO BUILDING PERMIT RELEASE.
 6. SWALES TO BE BLOCKED AT EACH PROPERTY LINE.

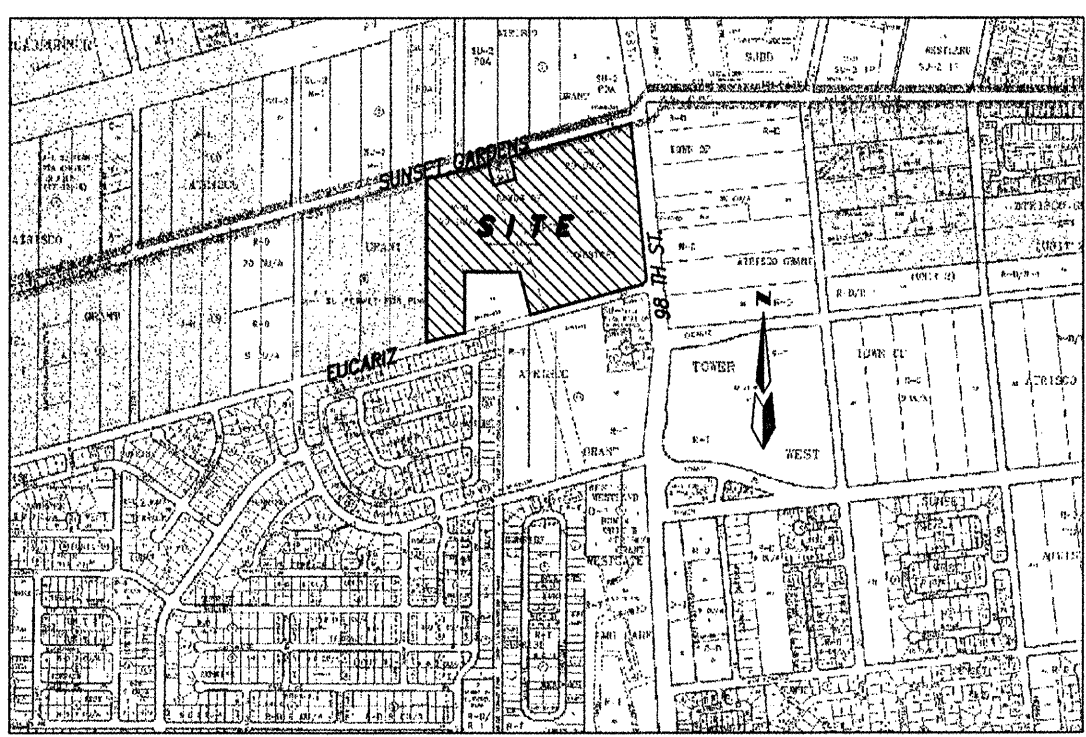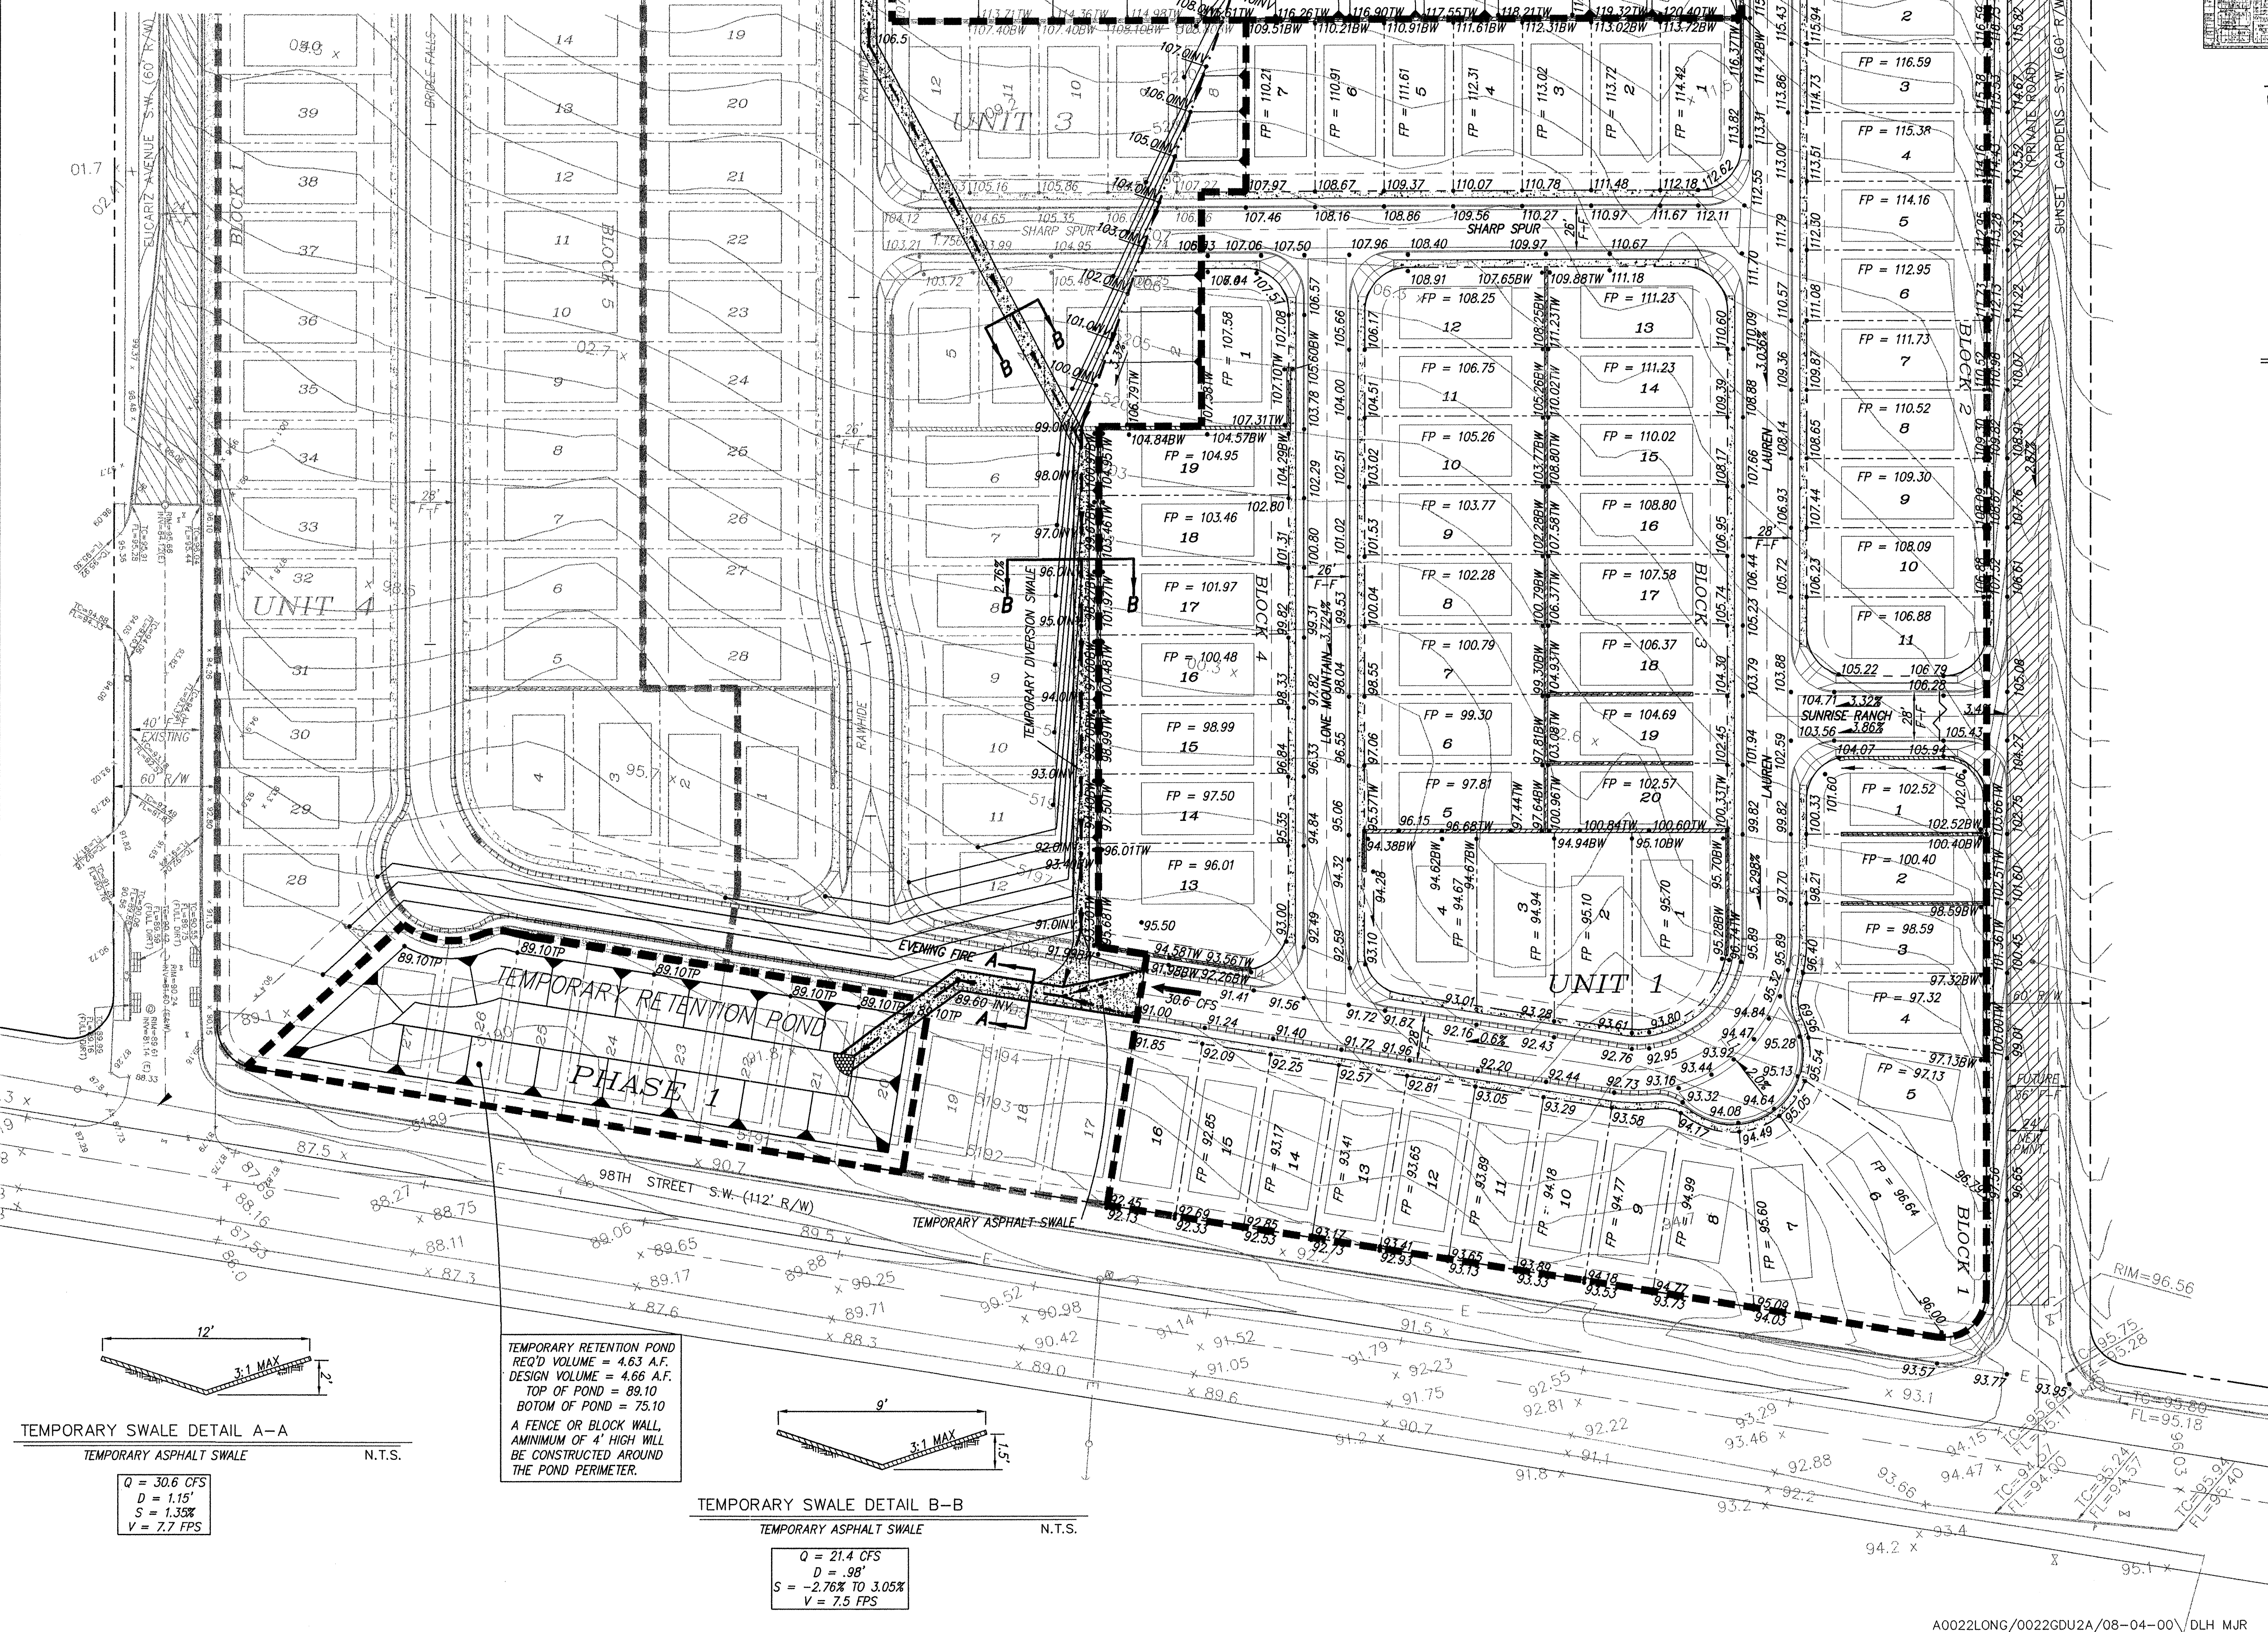


VICINITY MAP

NOTES

1. ADD 5100' TO ALL SPOT ELEVATION.
2. MASONRY BLOCK WALLS(CMU) WILL BE CONSTRUCTED ON THE PROPERTY PERIMETER. FENCES WILL BE USED ON ALL INTERNAL PROPERTY LINES UNLESS MASONRY WALLS ARE INDICATED.

LEGEND


- FP= 30.38 FINISHED PAD ELEVATION
- MOUNTABLE CURB & GUTTER
- STANDARD 8" CURB & GUTTER
- 28.53* PROPOSED SPOT ELEVATION
- 3:1 SLOPE
- 20 LOT 20
- PROPOSED DRAINAGE BASIN
- WATER BLOCK
- EXISTING WATER VALVE
- EXISTING SANITARY SEWER MANHOLE
- EXISTING CONTOUR
- EXISTING SPOT ELEVATION
- EXISTING OVERHEAD ELECTRIC LINE
- EXISTING POWER POLE
- TRACT/LOT BOUNDARY
- RIGHT OF WAY
- EASEMENTS
- CENTERLINE OF ROAD
- NEW RETAINING WALL
- 50' PAVEMENT TRANSITION
- FLOW DIRECTION
- SWALE
- NEW OFFSITE PAVEMENT
- NEW SIDEWALK

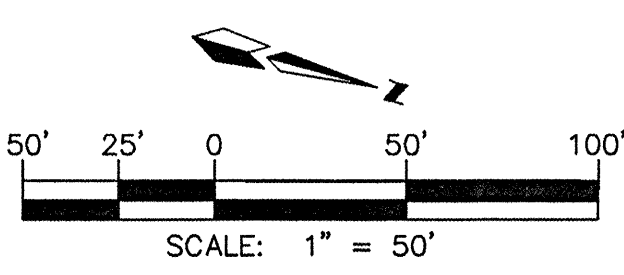


MARK GOODWIN & ASSOCIATES, P.A. CONSULTING ENGINEERS P.O. BOX 90606 ALBUQUERQUE, NEW MEXICO 87199 (505) 828-2200, FAX (505) 797-9539	
CITY OF ALBUQUERQUE PUBLIC WORKS DEPARTMENT ENGINEERING DEVELOPMENT GROUP	
TITLE: SUNRISE RANCH - UNIT 2 GRADING AND DRAINAGE PLAN	
DESIGN REVIEW COMMITTEE	CITY ENGINEER APPROVAL
DESIGNED BY DLH	DATE 3/00
DRAWN BY KIS MJR	DATE 3/00
CHECKED BY DMG	DATE 3/00
CITY PROJECT NO. 645281	ZONE MAP NO. L-8, L-9
SHEET 6	OF 20

SCANNED BY
MESA REPRO

A0022LONG/0022GDU2A/08-04-00\DLH MJR

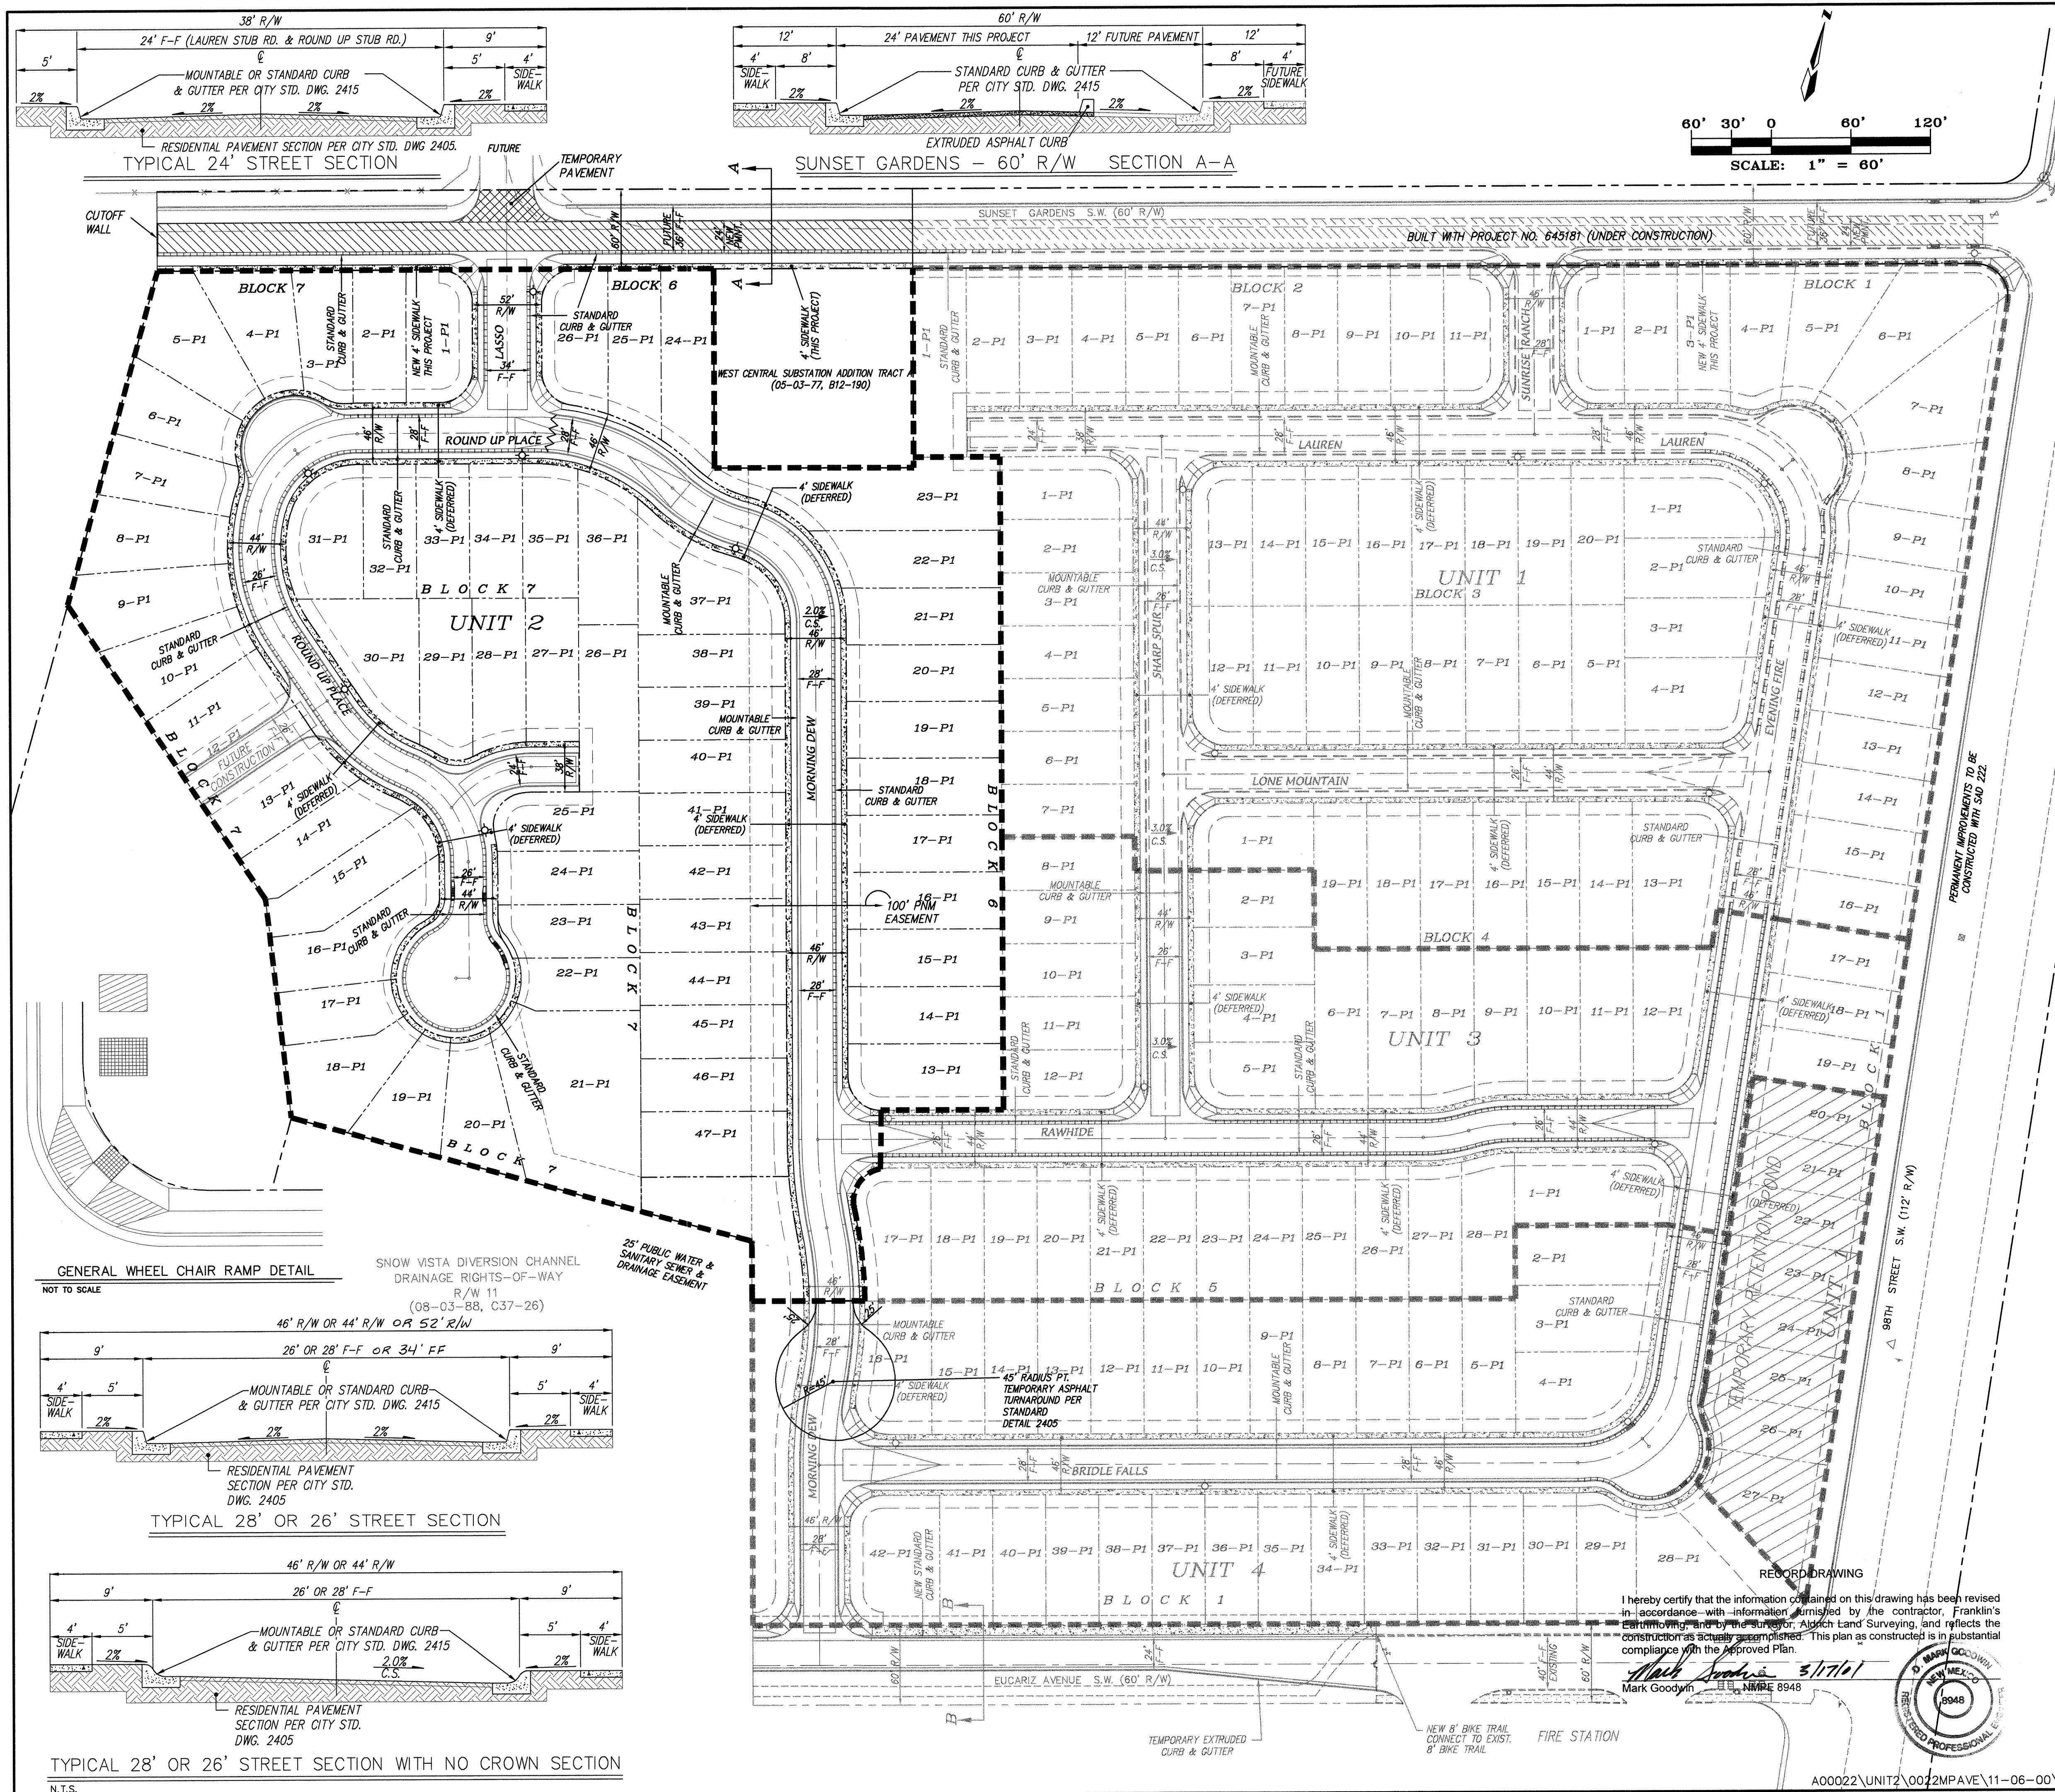


NOTES		AS BUILT INFORMATION				MICRO-FILM INFORMATION			
NO.	DESCRIPTION	CONTRACTOR	WORK INSTALLED BY	DATE	DATE	FIELD INSTRUMENTED BY	DATE	DATE	NO.
1.	ALL 4' VALLEY GUTTERS PER CITY OF ALBUQUERQUE STANDARD DRAWING 2421, AT KNUCKLES AND 6' VALLEY GUTTERS PER CITY OF ALBUQUERQUE STANDARD DRAWING 2420 AT ALL INTERSECTIONS.	Franklin's	AS	1/1/11	1/1/11	AS	1/1/11	1/1/11	
2.	ALL 4' INTERIOR SIDEWALKS ARE DEFERRED.								
3.	ALL HANDICAP RAMPS TO BE CASE II PER CITY OF ALBUQUERQUE STANDARD DRAWING 2441, WHERE GRADES DO NOT PERMIT A MAXIMUM SLOPE OF 12:1 TO BE MAINTAINED WITHIN THE 7' LENGTH AS SPECIFIED. THEN THE 7" LENGTH AS SHOWN IN DRAWING 2441 MUST BE INCREASED TO MAINTAIN A SLOPE < 12:1.								
4.	TRANSITION FROM MOUNTABLE CURB TO STANDARD CURB SHALL BE WITHIN 10' SECTION.								
5.	TRANSITION SECTION FROM FULL CROWN TO NO CROWN TO BE A MINIMUM OF 50', PER CITY OF ALBUQUERQUE STANDARD DRAWING 2401.								

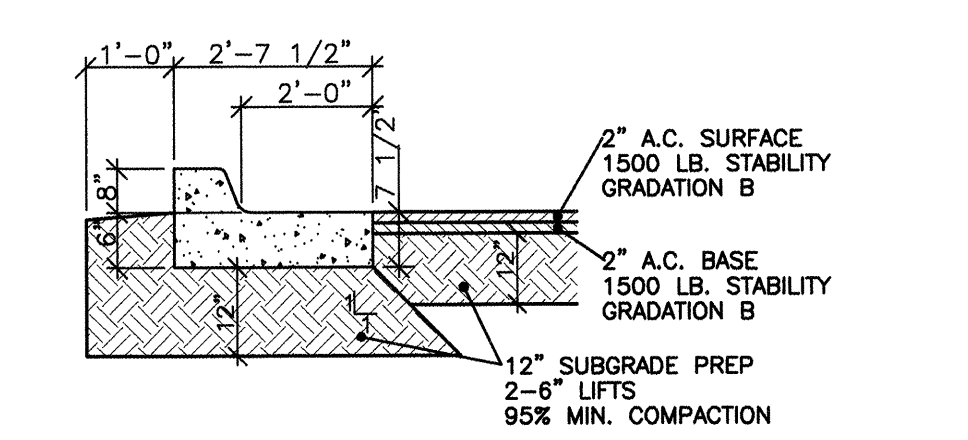

SUNSET GARDENS PAVEMENT SECTION DETAIL

NOT TO SCALE

PAVEMENT SECTION PER COA STD. DWG. 2405

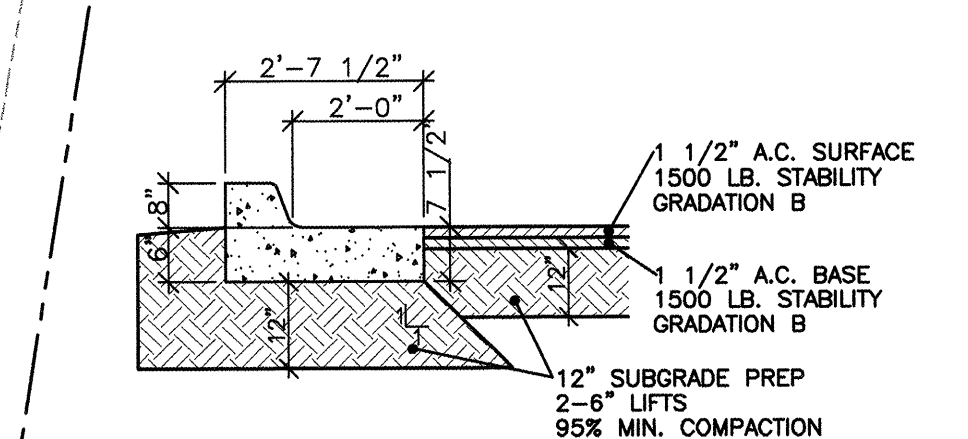


RESIDENTIAL\TEMPORARY PAVEMENT SECTION DETAIL





NOT TO SCALE

PAVEMENT SECTION PER COA STD. DWG. 2405

			ENGINEER'S SEAL		
	FUTURE SANITARY SEWER MANHOLE				
	FUTURE STORM SEWER MANHOLE				
	EXISTING 8" SANITARY SEWER				
	EXISTING STORM DRAIN				
	STANDARD 8" CURB & GUTTER				
	MOUNTABLE CURB & GUTTER				
	RETAINING WALL				
	CENTERLINE				
	TRACT/LOT BOUNDARY				
	SETBACK				
	PROPERTY				
	PUE				
	EASING EASEMENT				
	-5026 EXISTING CONTOUR				
	EXISTING LOTS				
	HANDICAP RAMPS				
	STREET LIGHT				
	SIDEWALK				
	50' CROWN TRANSITION				
	STORM DRAIN INLET				
	CROSS SLOPE, NO CROSS SECTION				
	STREET LIGHT				
MARK GOODWIN & ASSOCIATES, P.A. CONSULTING ENGINEERS P.O. BOX 90606 ALBUQUERQUE, NEW MEXICO 87199 (505) 828-2200, FAX (505) 797-9539		DESIGNED BY DLH DATE 05/00			
		DRAWN BY NJR DATE 05/00			
		CHECKED BY _____ DATE _____			
		REVISIONS			
		NO.			
		DATE			
		REMARKS			
		BY			

00-511

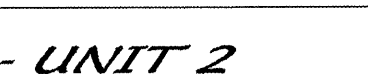	CITY OF ALBUQUERQUE PUBLIC WORKS DEPARTMENT ENGINEERING DEVELOPMENT GROUP												
TITLE:	<i>SUNRISE RANCH - UNIT 2</i> <i>MASTER PAVING PLAN</i>												
DESIGN REVIEW COMMITTEE  NOV 29 2000 DESIGN REVIEW COMMITTEE	CITY ENGINEER APPROVAL  DEC 15 2000 CITY ENGINEER												
LAST DESIGN UPDATE 	<table border="1" style="width: 100%; border-collapse: collapse;"> <thead> <tr> <th style="width: 50%;">MO./DAY/YR.</th> <th style="width: 50%;">MO./DAY/YR.</th> </tr> </thead> <tbody> <tr><td> </td><td> </td></tr> <tr><td> </td><td> </td></tr> <tr><td> </td><td> </td></tr> <tr><td> </td><td> </td></tr> <tr><td> </td><td> </td></tr> </tbody> </table>	MO./DAY/YR.	MO./DAY/YR.										
MO./DAY/YR.	MO./DAY/YR.												
CITY PROJECT NO.  645281	<table border="1" style="width: 100%; border-collapse: collapse;"> <tr> <td style="width: 50%;"> ZONE MAP NO.  L-8, L-9 </td> <td style="width: 50%;"> SHEET OF  7 20 </td> </tr> </table>	ZONE MAP NO.  L-8, L-9	SHEET OF  7 20										
ZONE MAP NO.  L-8, L-9	SHEET OF  7 20												

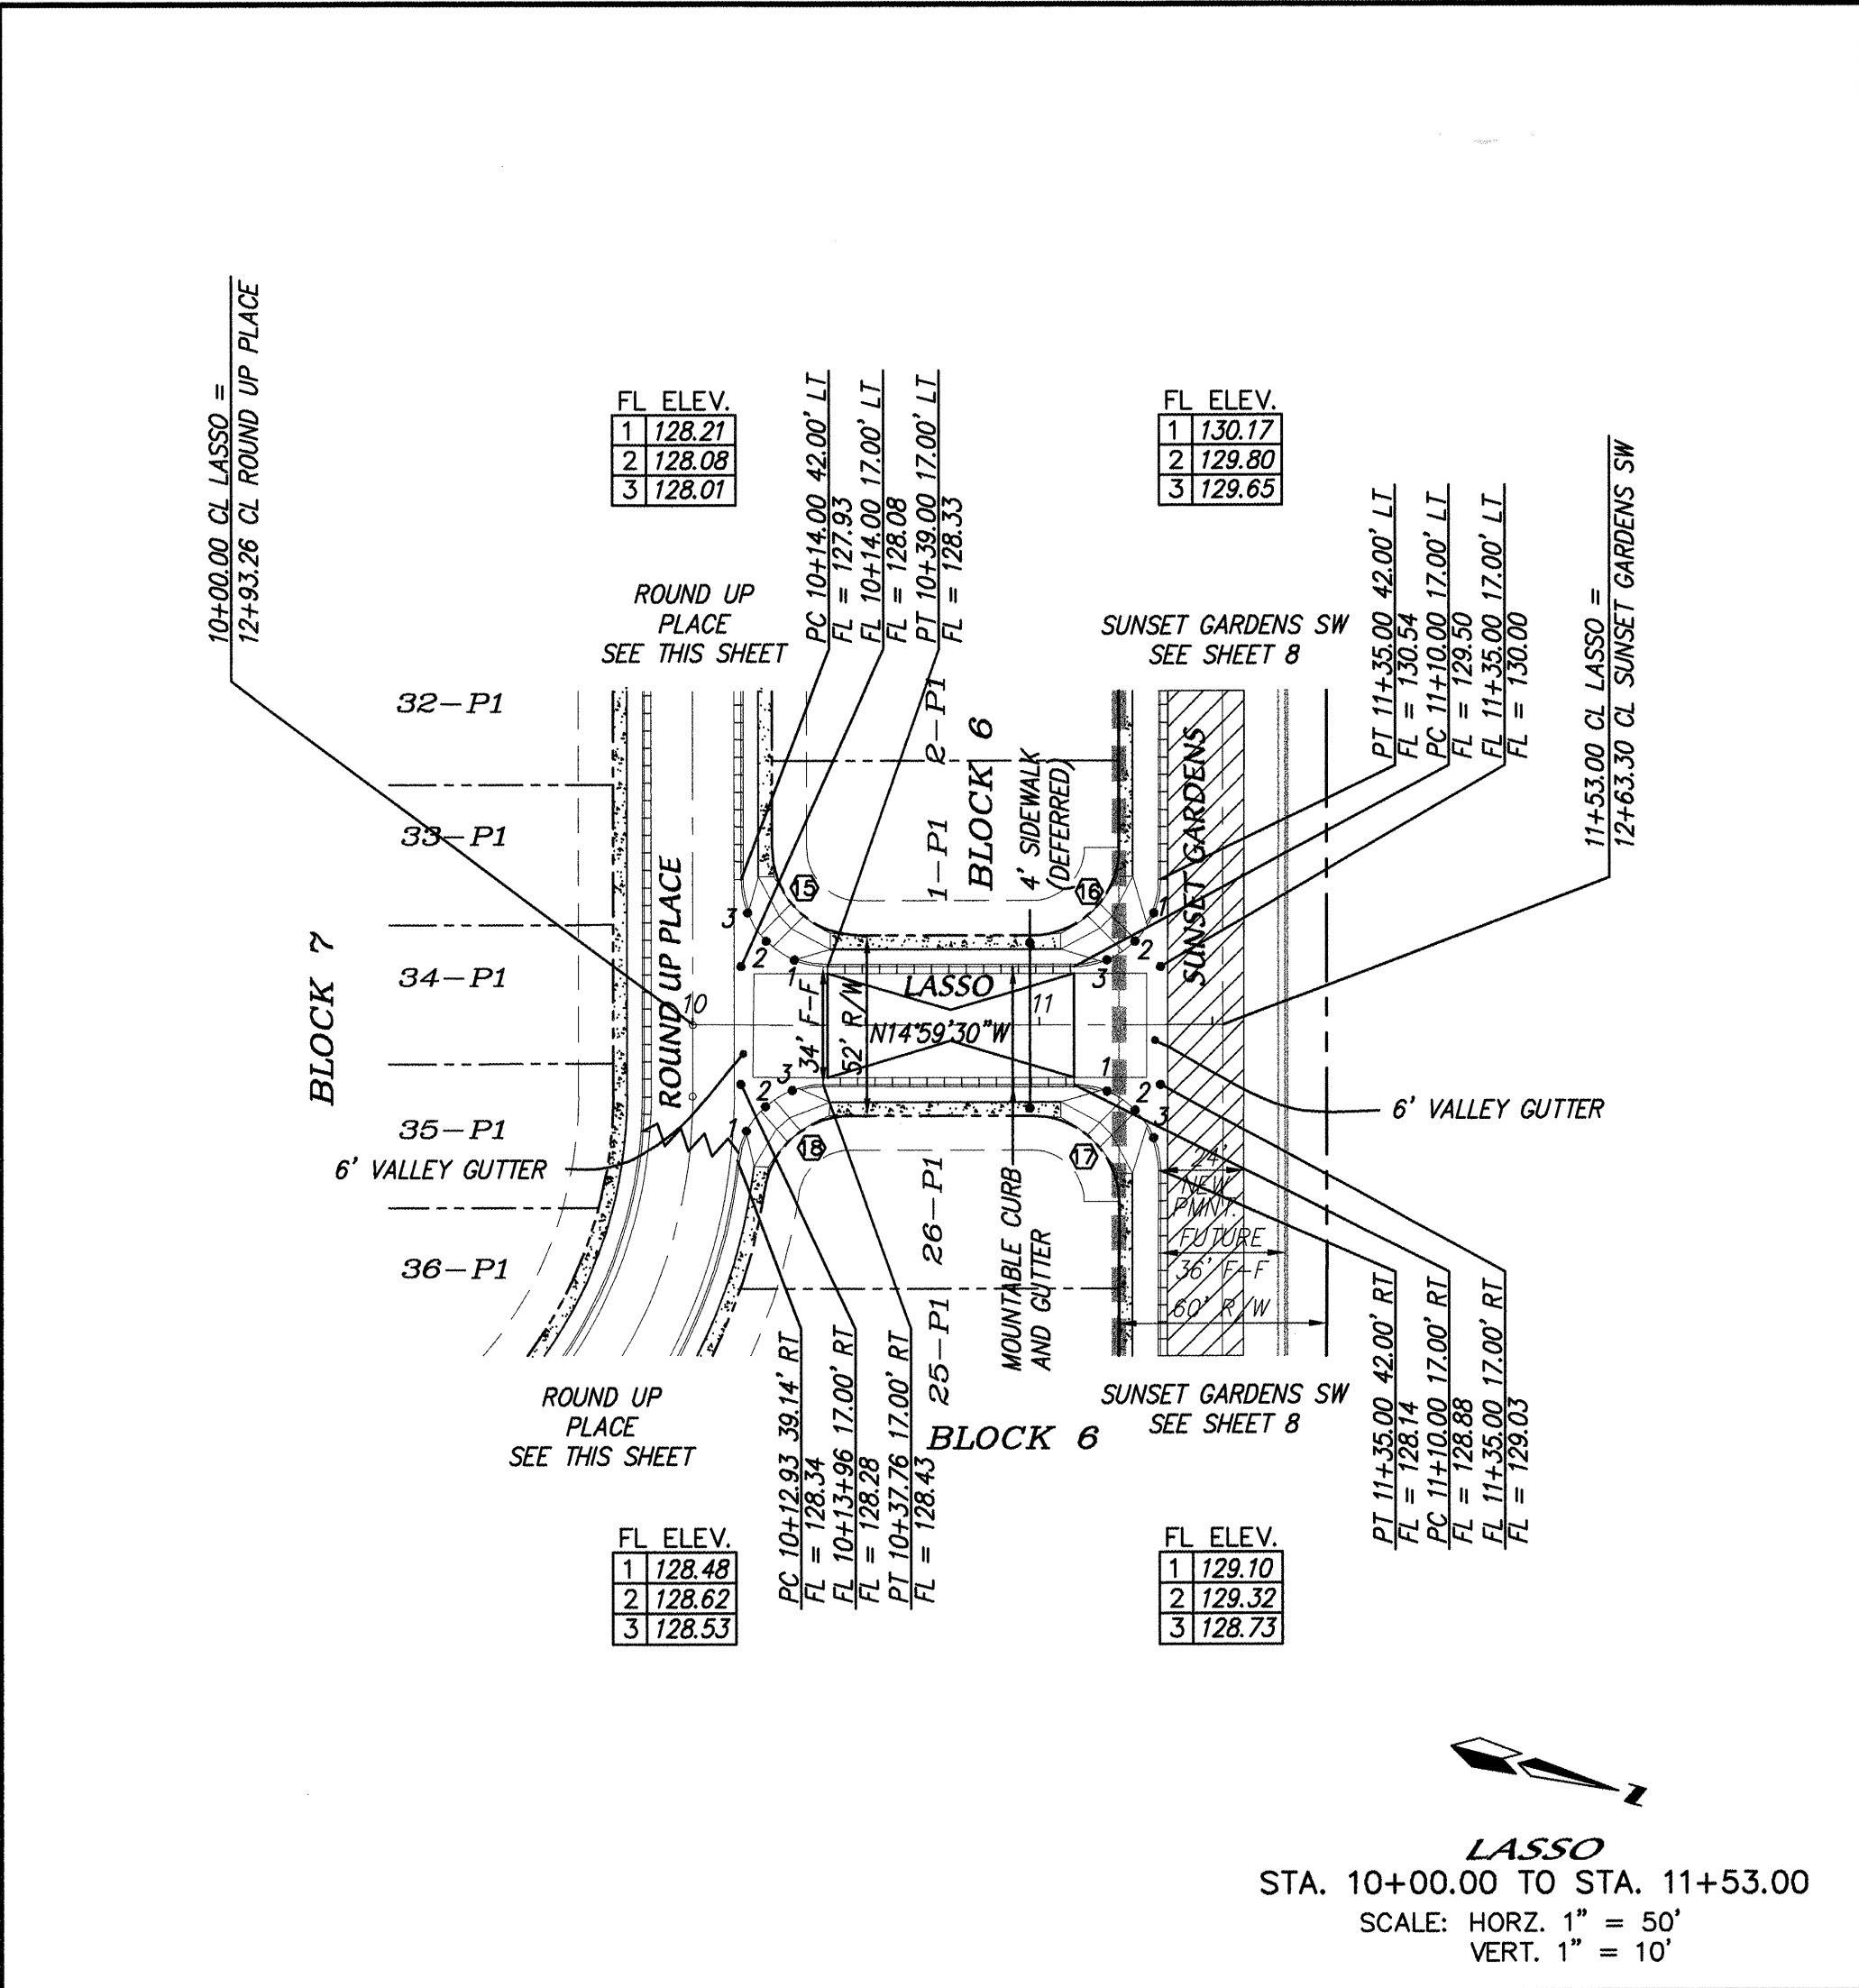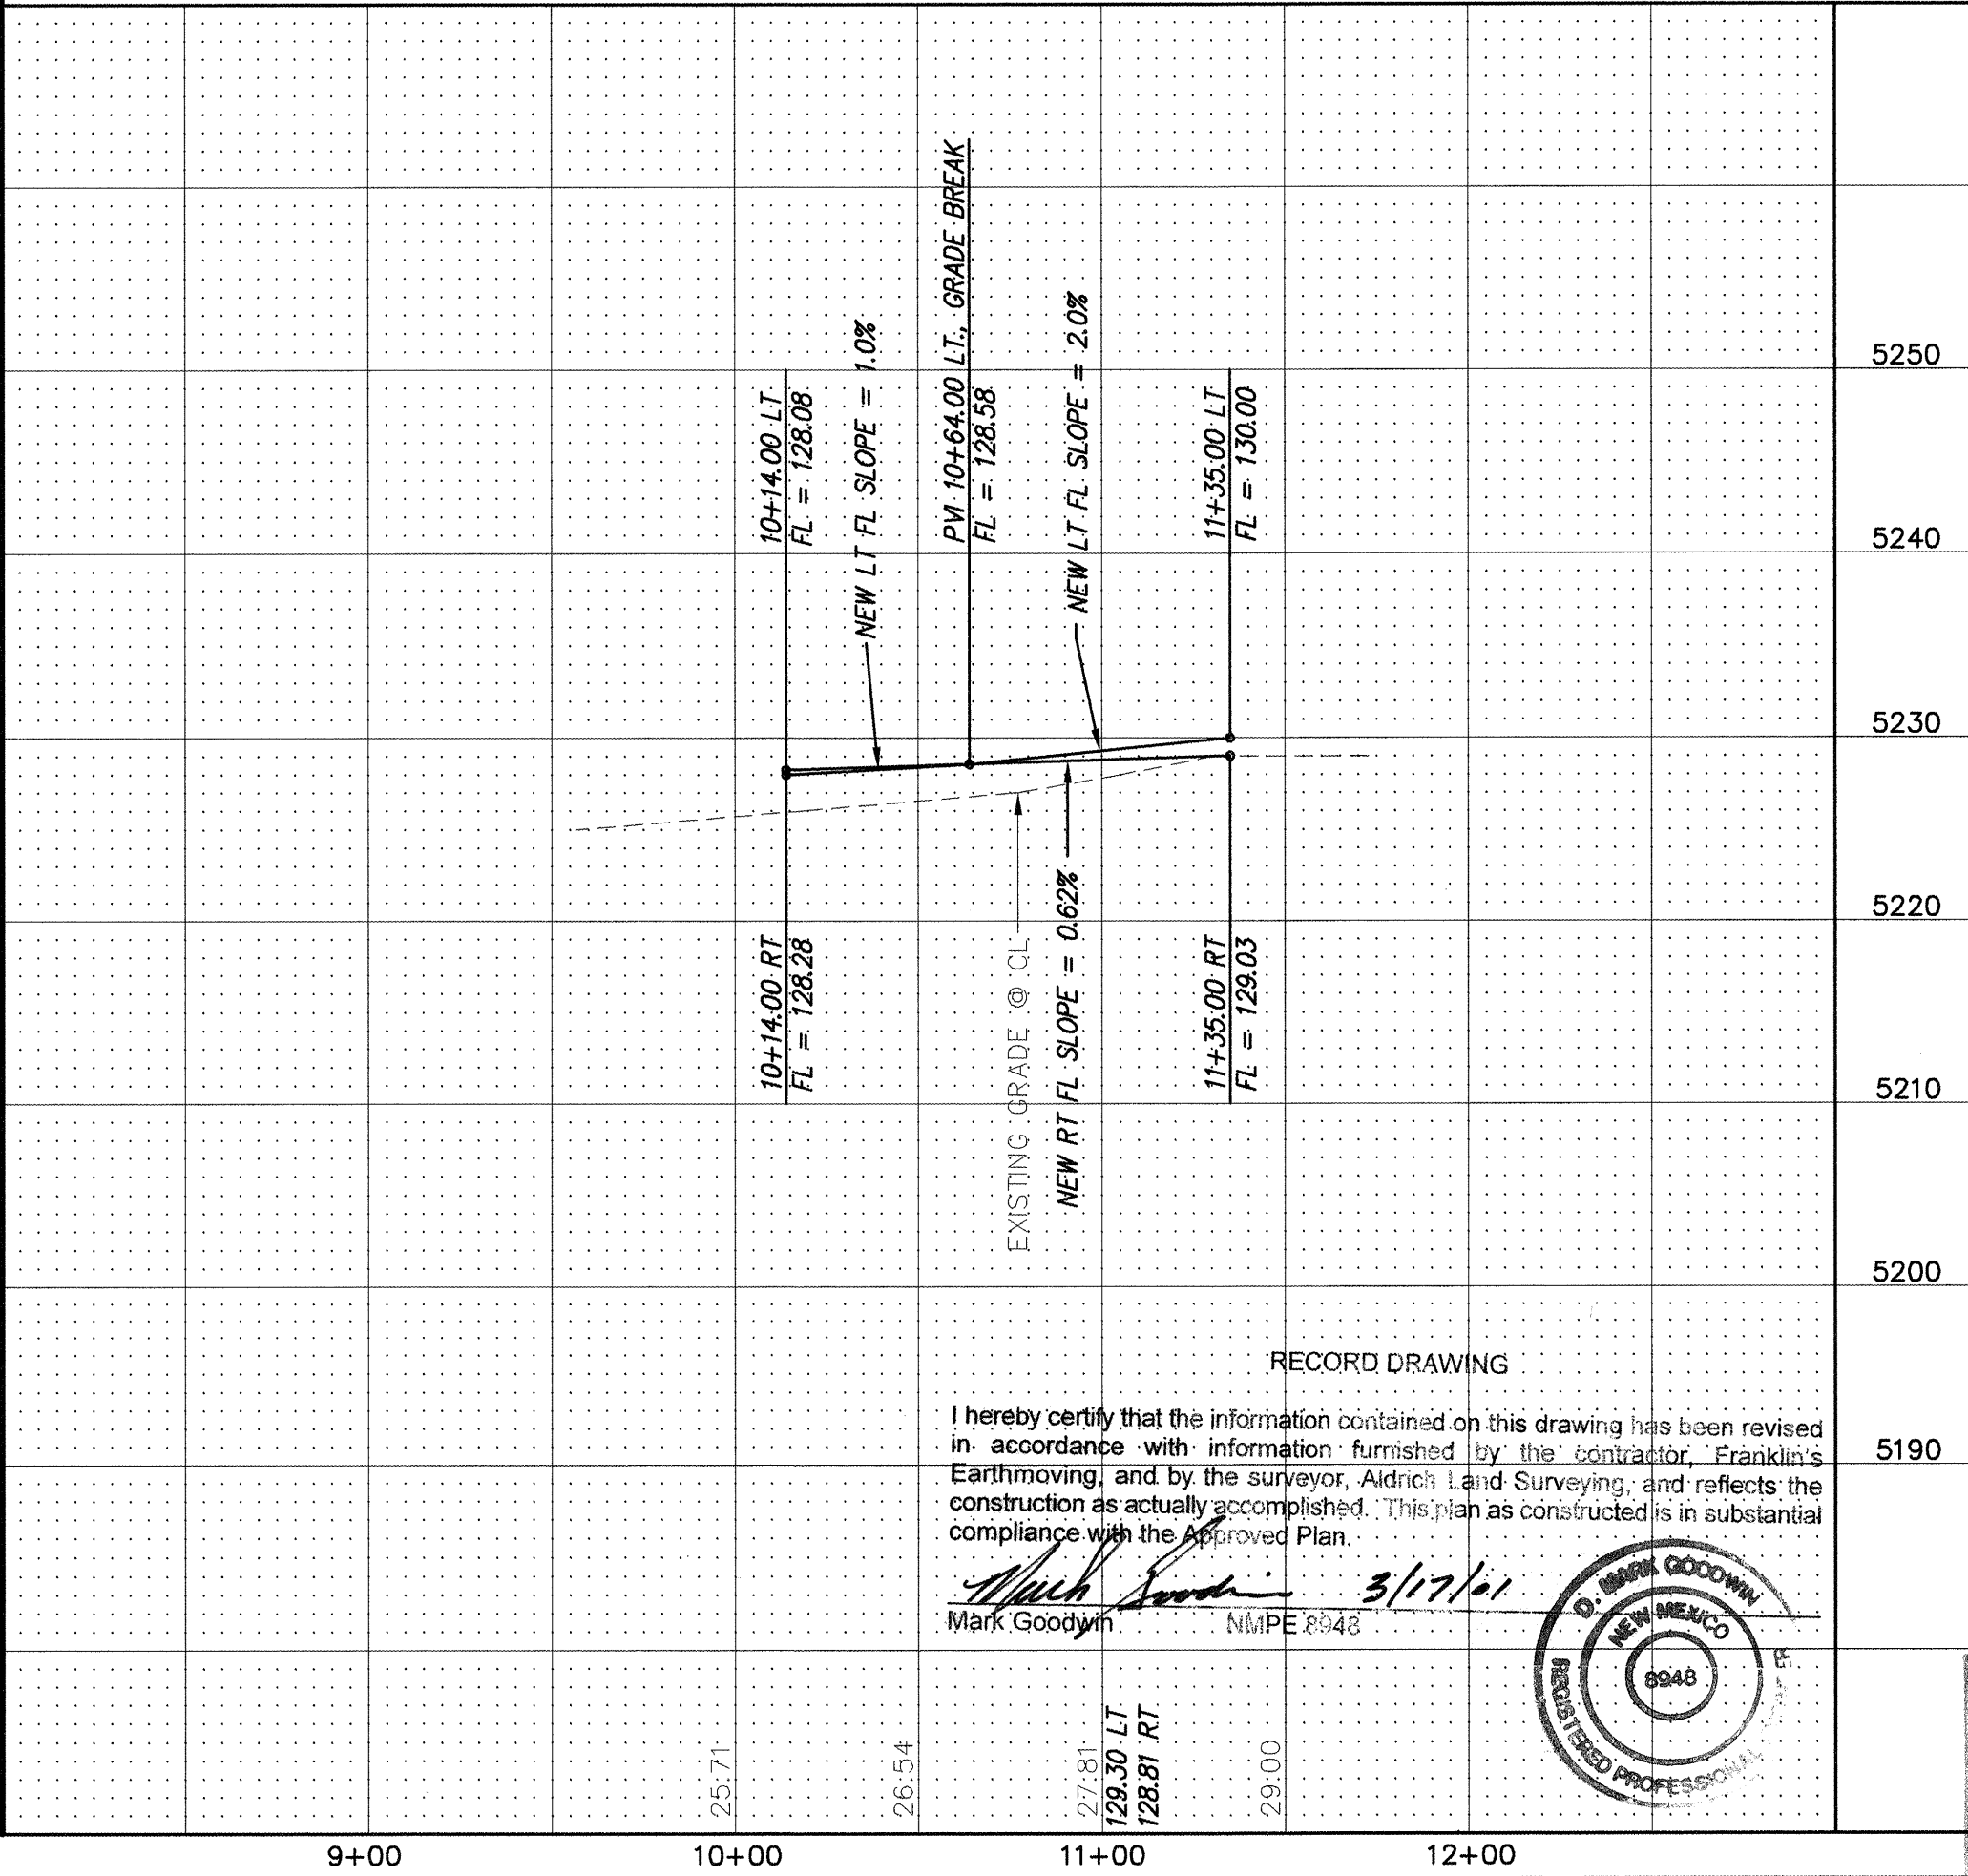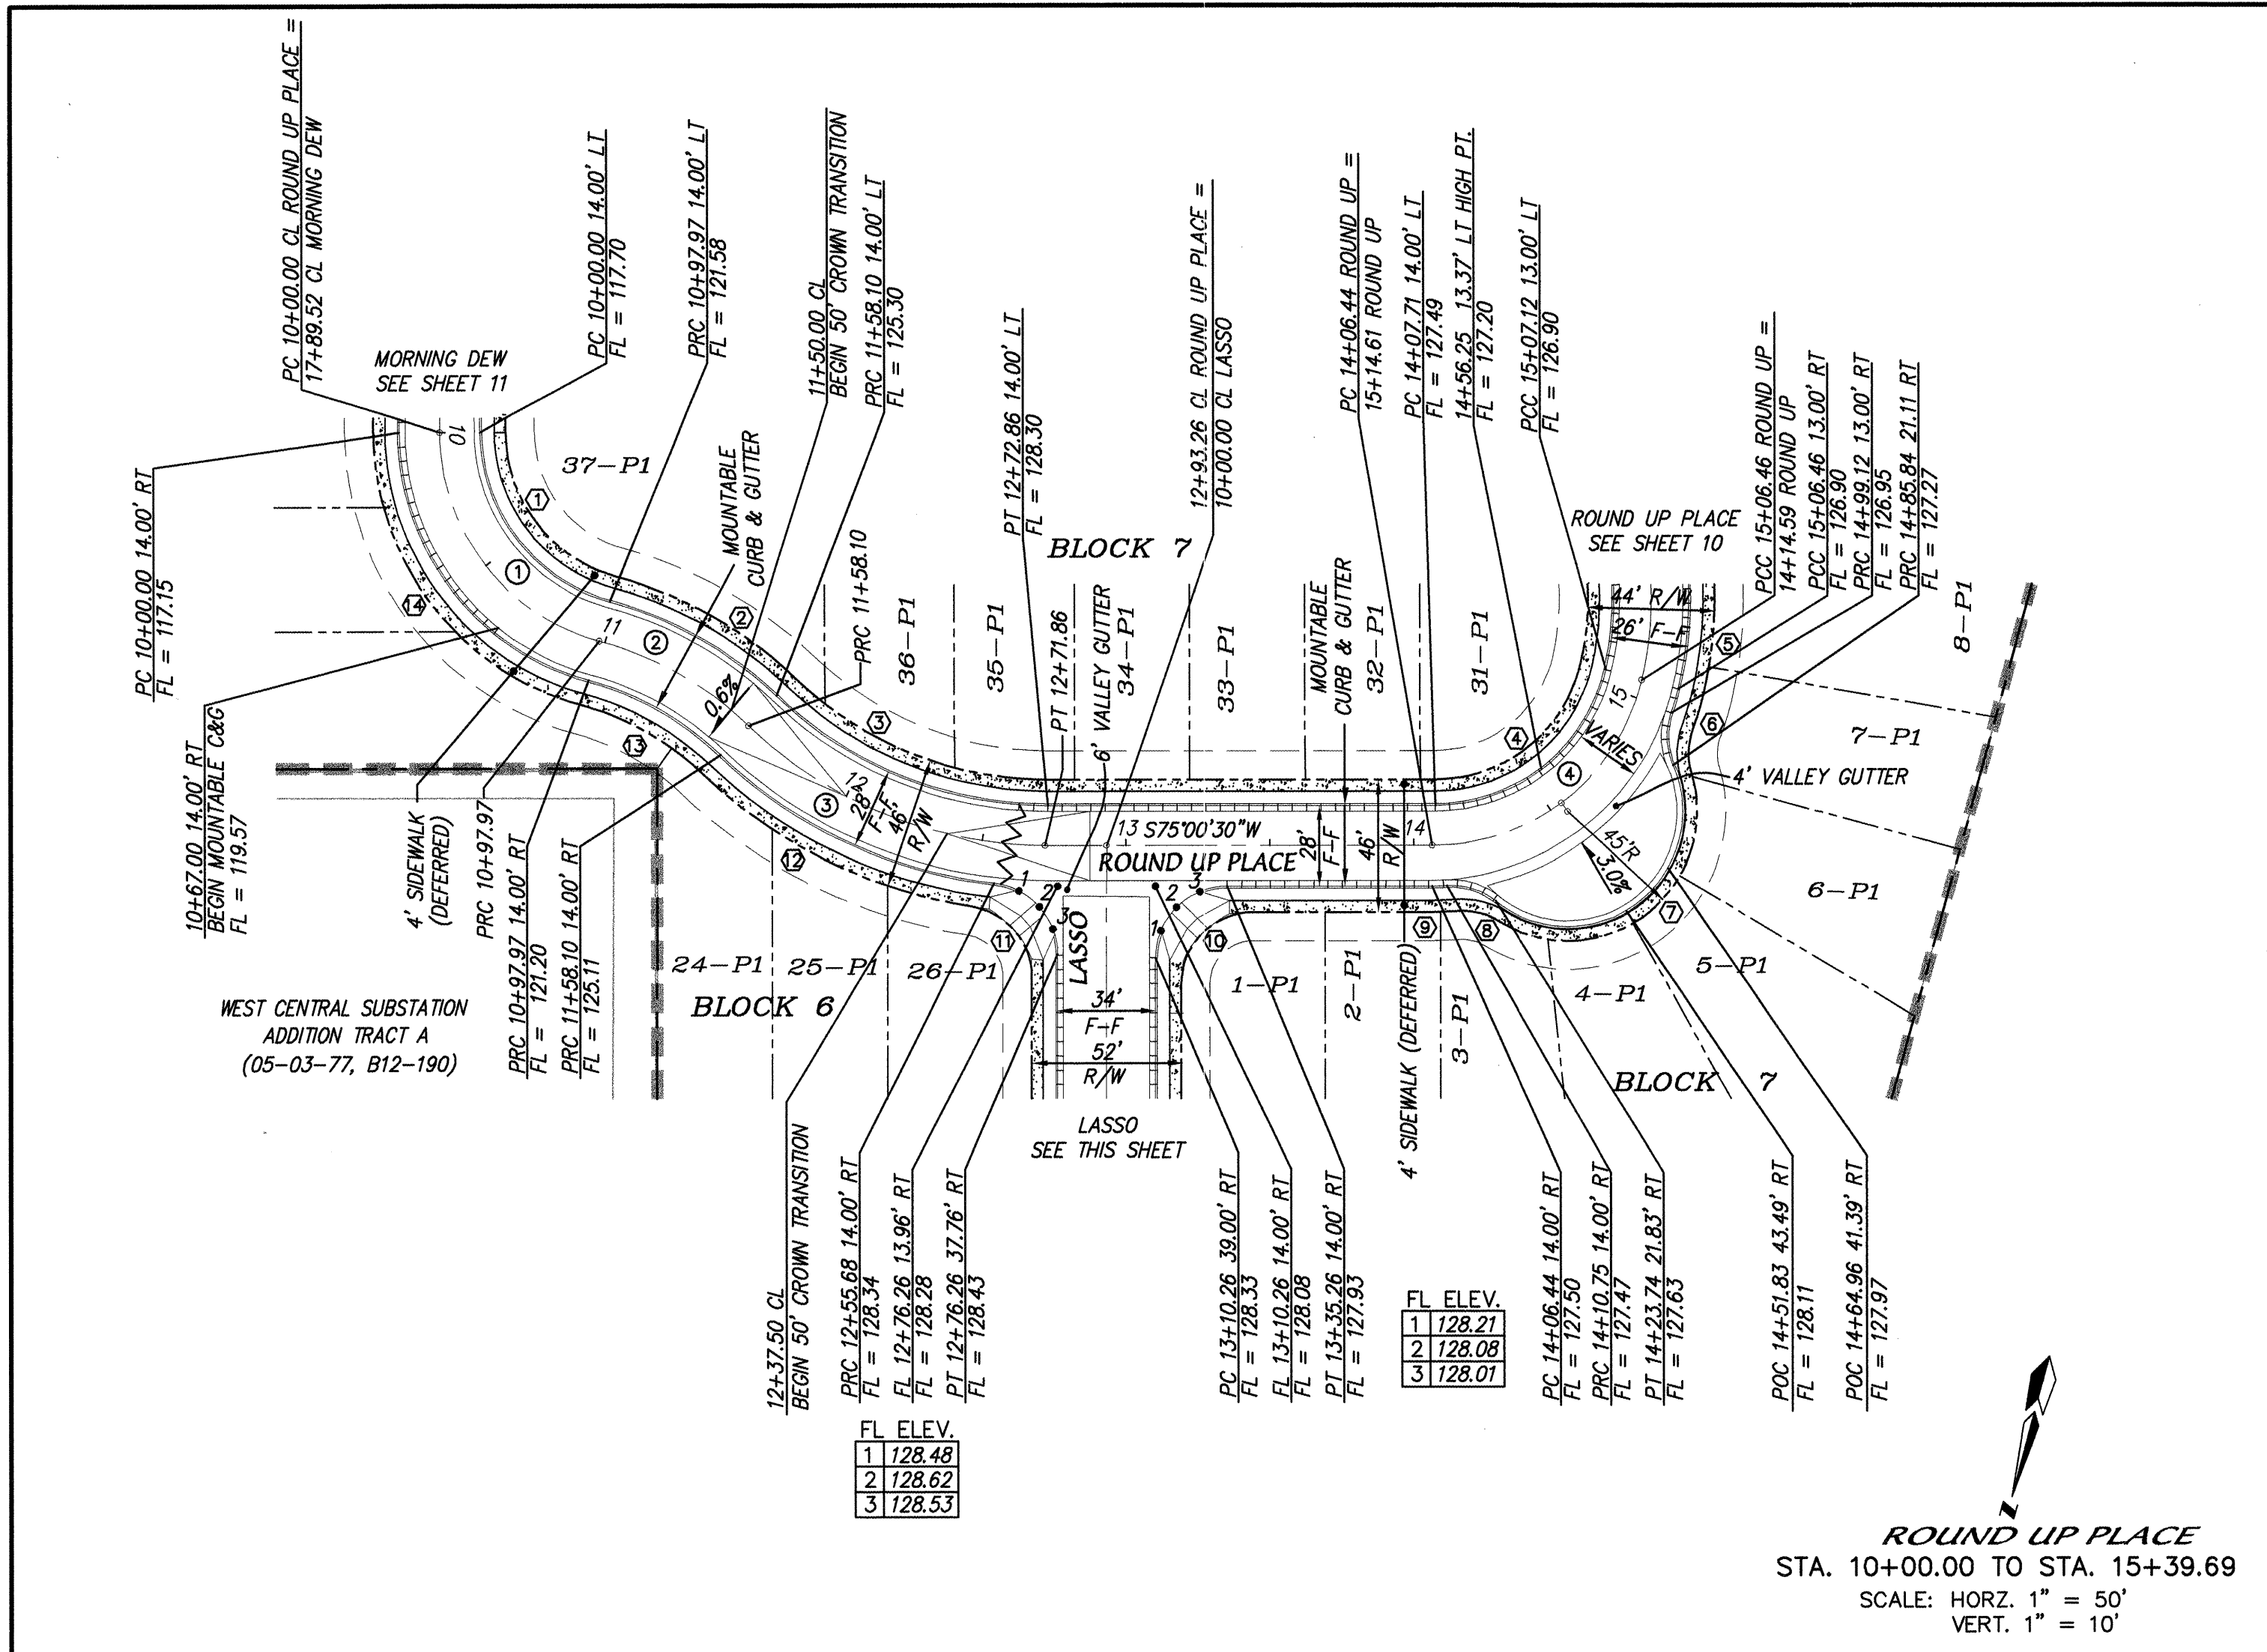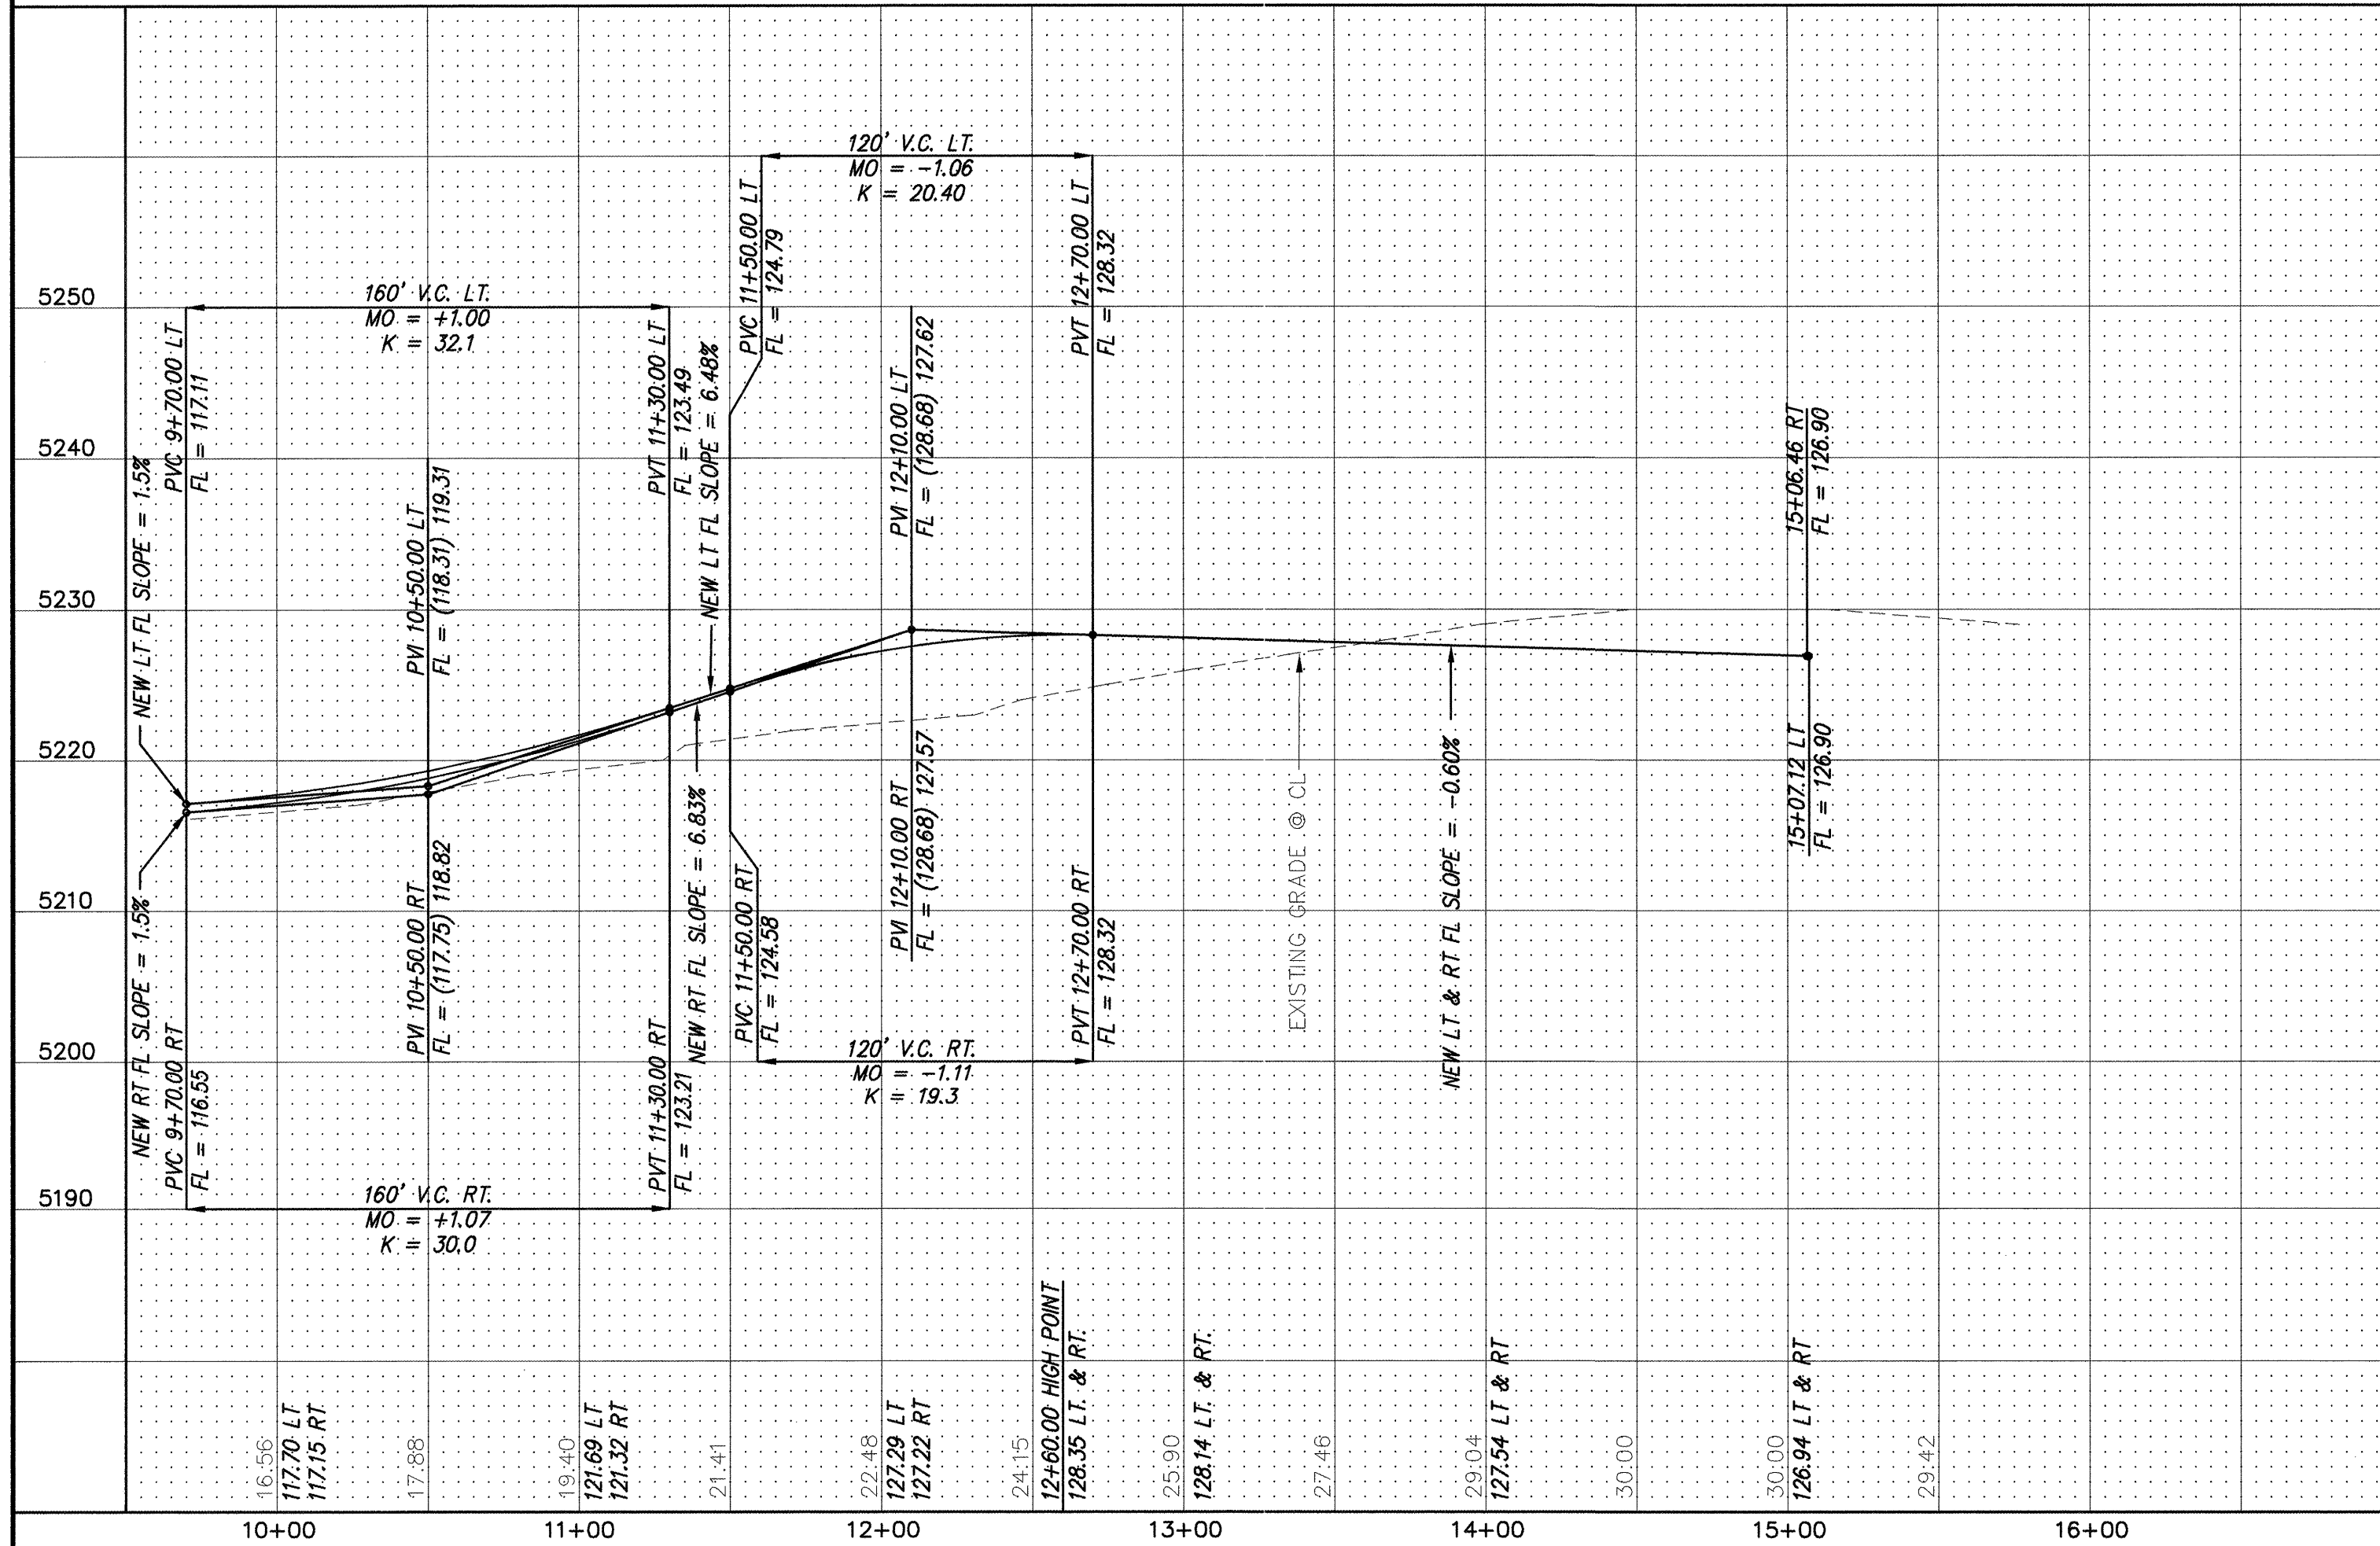

NOTES			
1. ALL STATIONING IS CENTERLINE STATIONING.			
CURVE DATA - DESCRIBES FACE OF CURB			
① Δ = 74°50'48" RT. R = 75.00' L = 92.97' T = 57.39'	② Δ = 28°42'23" RT. R = 120.00' L = 82.12' T = 30.71	③ Δ = 43°26'45" RT. R = 150.00' L = 113.78' T = 59.77'	④ Δ = 76°24'31" RT. R = 75.00' L = 100.02' T = 59.03'

CURVE DATA - DESCRIBES FACE OF CURB			
① Δ = 74°50'48" RT. R = 61.00' L = 78.69' T = 46.68'	② Δ = 28°42'23" RT. R = 134.00' L = 67.14' T = 34.29'	③ Δ = 43°26'45" RT. R = 138.00' L = 104.05' T = 54.72'	④ Δ = 76°24'31" RT. R = 61.00' L = 81.35' T = 48.01'
⑤ Δ = 15°37'38" RT. R = 134.00' L = 36.55' T = 18.39'	⑥ Δ = 41°52'09" RT. R = 25.00' L = 18.27' T = 9.56'	⑦ Δ = 150°41'48" RT. R = 40.00' L = 105.21' T = 153.00'	⑧ Δ = 41°52'09" RT. R = 25.00' L = 18.27' T = 9.56'
⑨ Δ = 37°17'17" RT. R = 89.00' L = 51.17' T = 25.00'	⑩ Δ = 37°17'17" RT. R = 89.00' L = 51.17' T = 25.00'	⑪ Δ = 37°17'17" RT. R = 89.00' L = 51.17' T = 25.00'	⑫ Δ = 37°17'17" RT. R = 89.00' L = 51.17' T = 25.00'
⑬ Δ = 28°42'23" RT. R = 106.00' L = 53.11' T = 27.12'	⑭ Δ = 74°50'48" RT. R = 89.00' L = 116.26' T = 68.10'	⑮ Δ = 90°00'00" RT. R = 25.00' L = 39.27' T = 25.00'	⑯ Δ = 90°00'00" RT. R = 25.00' L = 39.27' T = 25.00'
⑰ Δ = 28°42'23" RT. R = 106.00' L = 53.11' T = 27.12'	⑱ Δ = 74°50'48" RT. R = 89.00' L = 116.26' T = 68.10'	⑲ Δ = 90°00'00" RT. R = 25.00' L = 39.27' T = 25.00'	⑳ Δ = 90°00'00" RT. R = 25.00' L = 39.27' T = 25.00'

CURVE DATA - DESCRIBES FACE OF CURB			
① Δ = 74°50'48" RT. R = 61.00' L = 78.69' T = 46.68'	② Δ = 28°42'23" RT. R = 134.00' L = 67.14' T = 34.29'	③ Δ = 43°26'45" RT. R = 138.00' L = 104.05' T = 54.72'	④ Δ = 76°24'31" RT. R = 61.00' L = 81.35' T = 48.01'
⑤ Δ = 15°37'38" RT. R = 134.00' L = 36.55' T = 18.39'	⑥ Δ = 41°52'09" RT. R = 25.00' L = 18.27' T = 9.56'	⑦ Δ = 150°41'48" RT. R = 40.00' L = 105.21' T = 153.00'	⑧ Δ = 41°52'09" RT. R = 25.00' L = 18.27' T = 9.56'
⑨ Δ = 37°17'17" RT. R = 89.00' L = 51.17' T = 25.00'	⑩ Δ = 37°17'17" RT. R = 89.00' L = 51.17' T = 25.00'	⑪ Δ = 37°17'17" RT. R = 89.00' L = 51.17' T = 25.00'	⑫ Δ = 37°17'17" RT. R = 89.00' L = 51.17' T = 25.00'
⑬ Δ = 28°42'23" RT. R = 106.00' L = 53.11' T = 27.12'	⑭ Δ = 74°50'48" RT. R = 89.00' L = 116.26' T = 68.10'	⑮ Δ = 90°00'00" RT. R = 25.00' L = 39.27' T = 25.00'	⑯ Δ = 90°00'00" RT. R = 25.00' L = 39.27' T = 25.00'
⑰ Δ = 28°42'23" RT. R = 106.00' L = 53.11' T = 27.12'	⑱ Δ = 74°50'48" RT. R = 89.00' L = 116.26' T = 68.10'	⑲ Δ = 90°00'00" RT. R = 25.00' L = 39.27' T = 25.00'	⑳ Δ = 90°00'00" RT. R = 25.00' L = 39.27' T = 25.00'

RECORD DRAWING

I hereby certify that the information contained on this drawing has been revised in accordance with information furnished by the contractor, Franklin's Earthmoving, and by the surveyor, Aldrich Land Surveying, and reflects the construction as actually accomplished. This plan as constructed is in substantial compliance with the approved plan.

Mark Goodwin
NMP# 8148

3/17/01

REGISTERED PROFESSIONAL

CITY OF ALBUQUERQUE
PUBLIC WORKS DEPARTMENT
ENGINEERING DEVELOPMENT GROUP

TITLE:
**SUNRISE RANCH - UNIT 2
ROUND UP PLACE & LASSO
PAVING IMPROVEMENTS**

DESIGN REVIEW COMMITTEE
APPROVED
NOV 29 2000

CITY ENGINEER APPROVAL
DEC 15 2000

LAST DESIGN UPDATE



MO./DAY/YR. MO./DAY/YR.

CITY PROJECT NO. **645281**

ZONE MAP NO. **L-8, L-9**

SHEET **9** OF **20**

ENGINEER'S SEAL			
SURVEY INFORMATION			
FIELD NOTES		BENCH MARKS	
NO.	BY	DATE	AS MONUMENT "30-10" THE STATION IN LOCATED 5.3 MILES
			SOUTHWEST OF DOWNTOWN ALBUQUERQUE, TO REACH THE STATION
			FROM THE INTERSECTION OF I-40 AND 98TH ST., TRAVEL SOUTH ON
			98TH ST. 1.3 MILES TO THE STATION ON THE LEFT. THE STATION IS
			48.2 EAST OF THE CENTERLINE OF 98TH ST., AND IS 0.13 MILES
			NORTH OF RIND CT., S.W.
			THE STATION IS AN ACS 3 1/4" ALUM. CAP INVITED TO A PIPE
			0.25' ABOVE GROUND AND IS STAMPED "9-19, 1089"
			X = 353,055.34 Y = 1,480,156.08 ELEV. = 5187.036
AS BUILT INFORMATION			
CONTRACTOR	FRANKLIN'S	DATE	11/15/00
STAKED BY	ALMA	DATE	11/15/00
FIELD NO.	ALMA	DATE	11/15/00
APPROVED BY	ALMA	DATE	11/15/00
CHECKED BY	ALMA	DATE	11/15/00
RECORDED BY	ALMA	DATE	11/15/00
NO.		DATE	

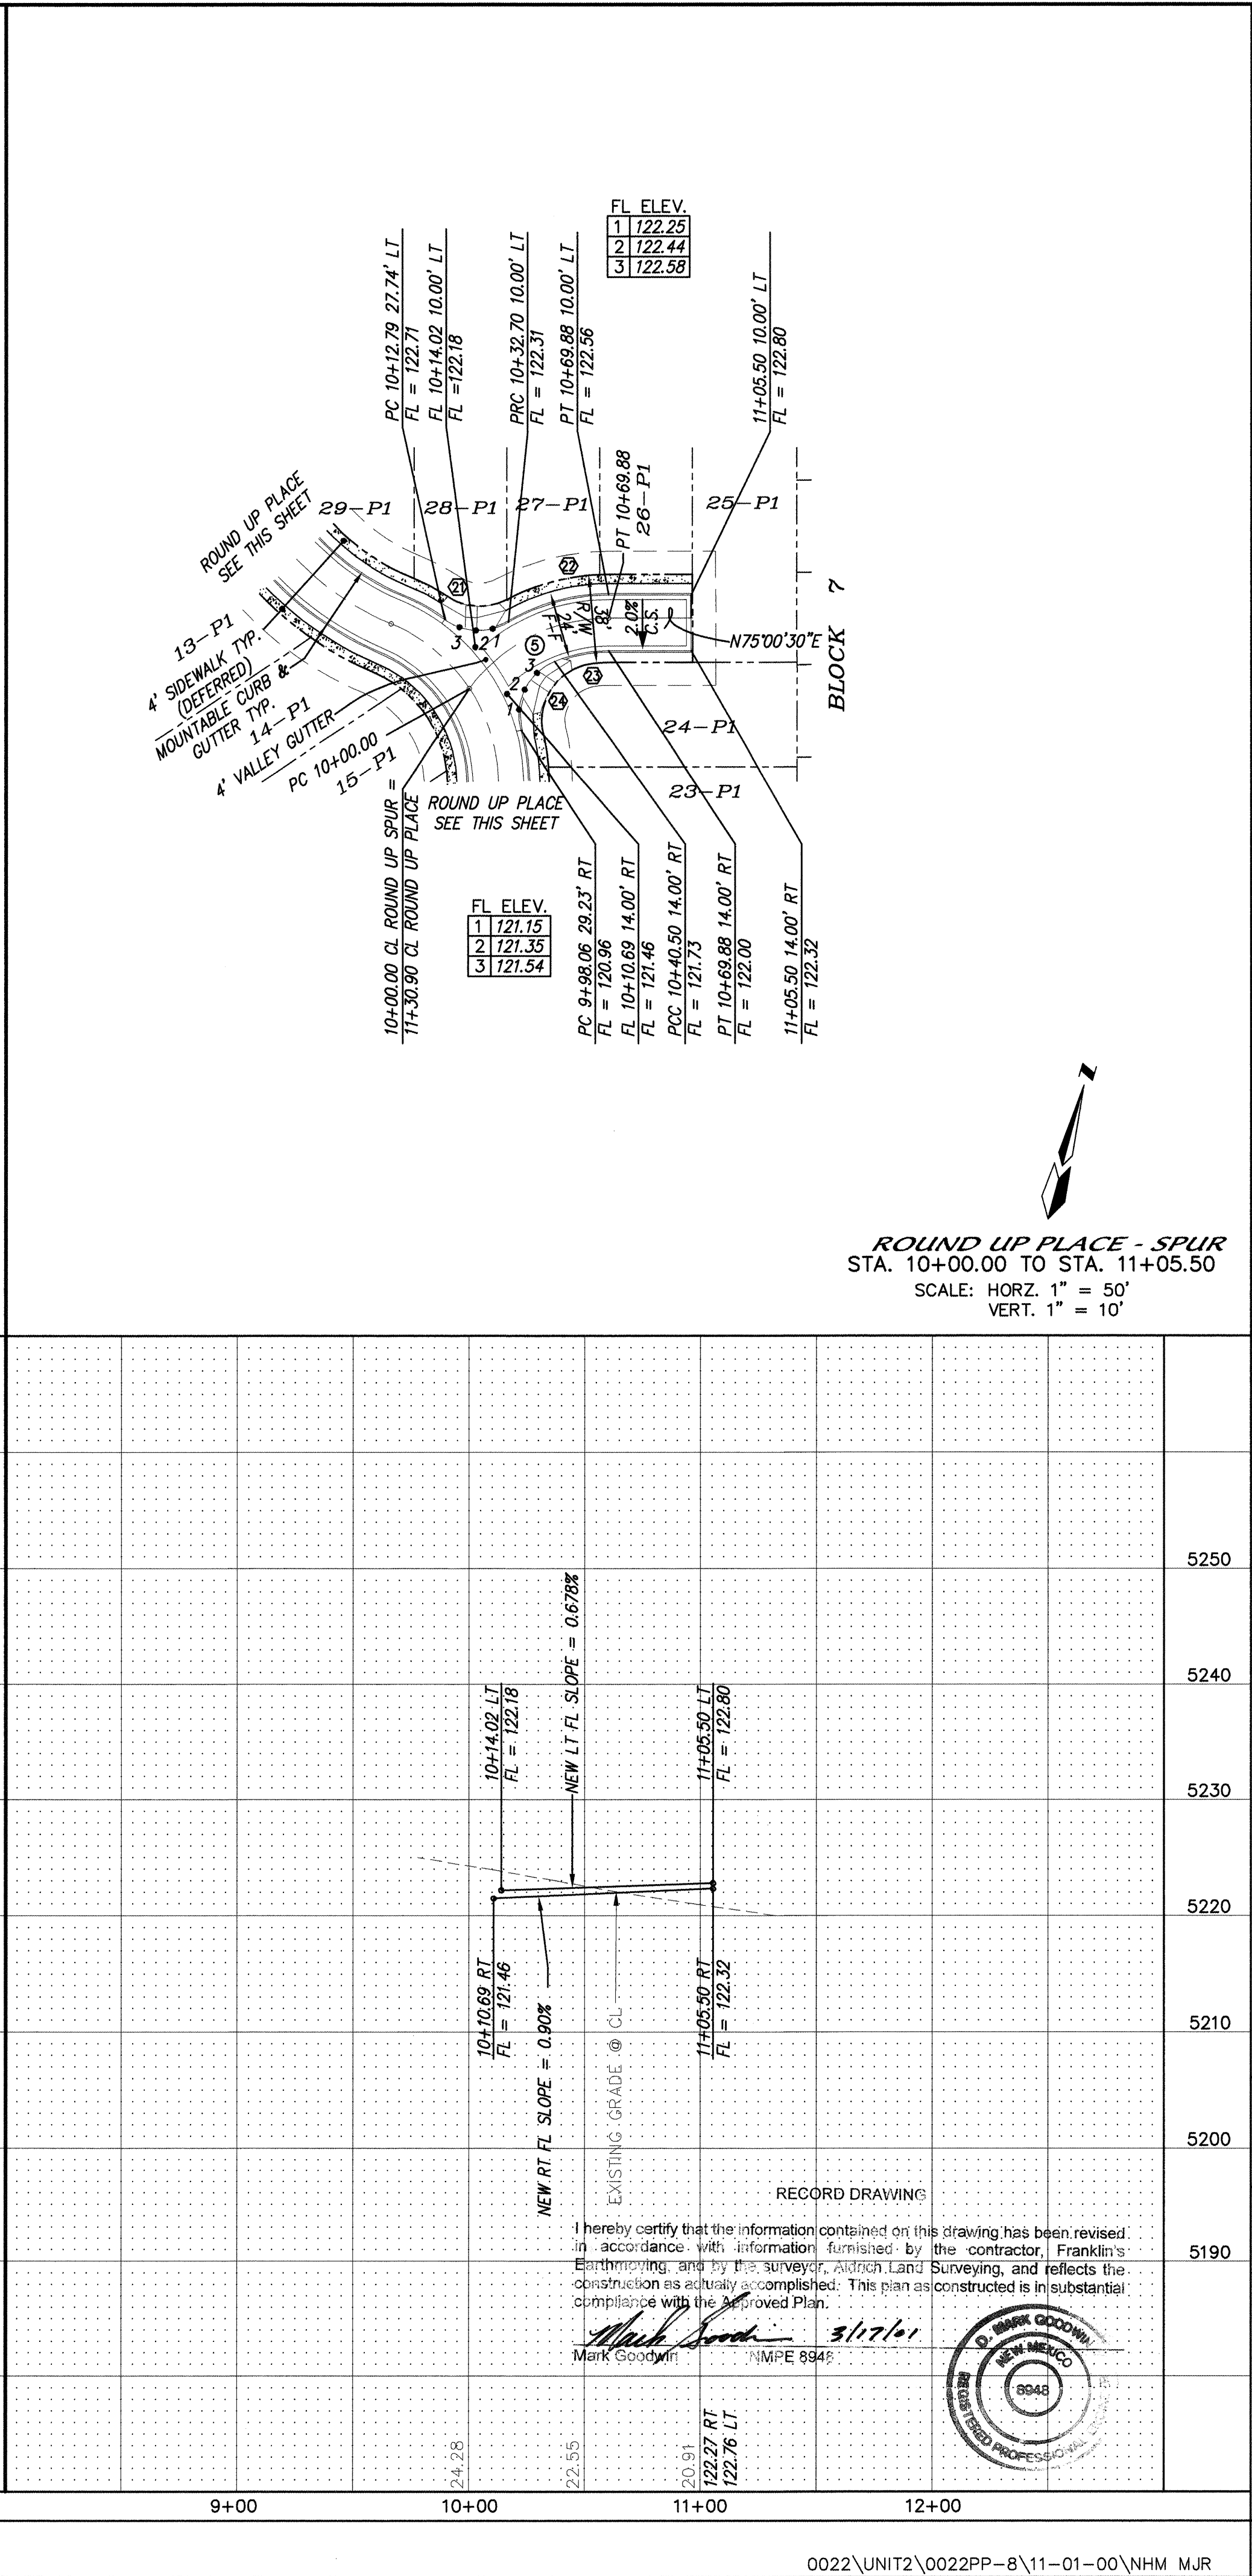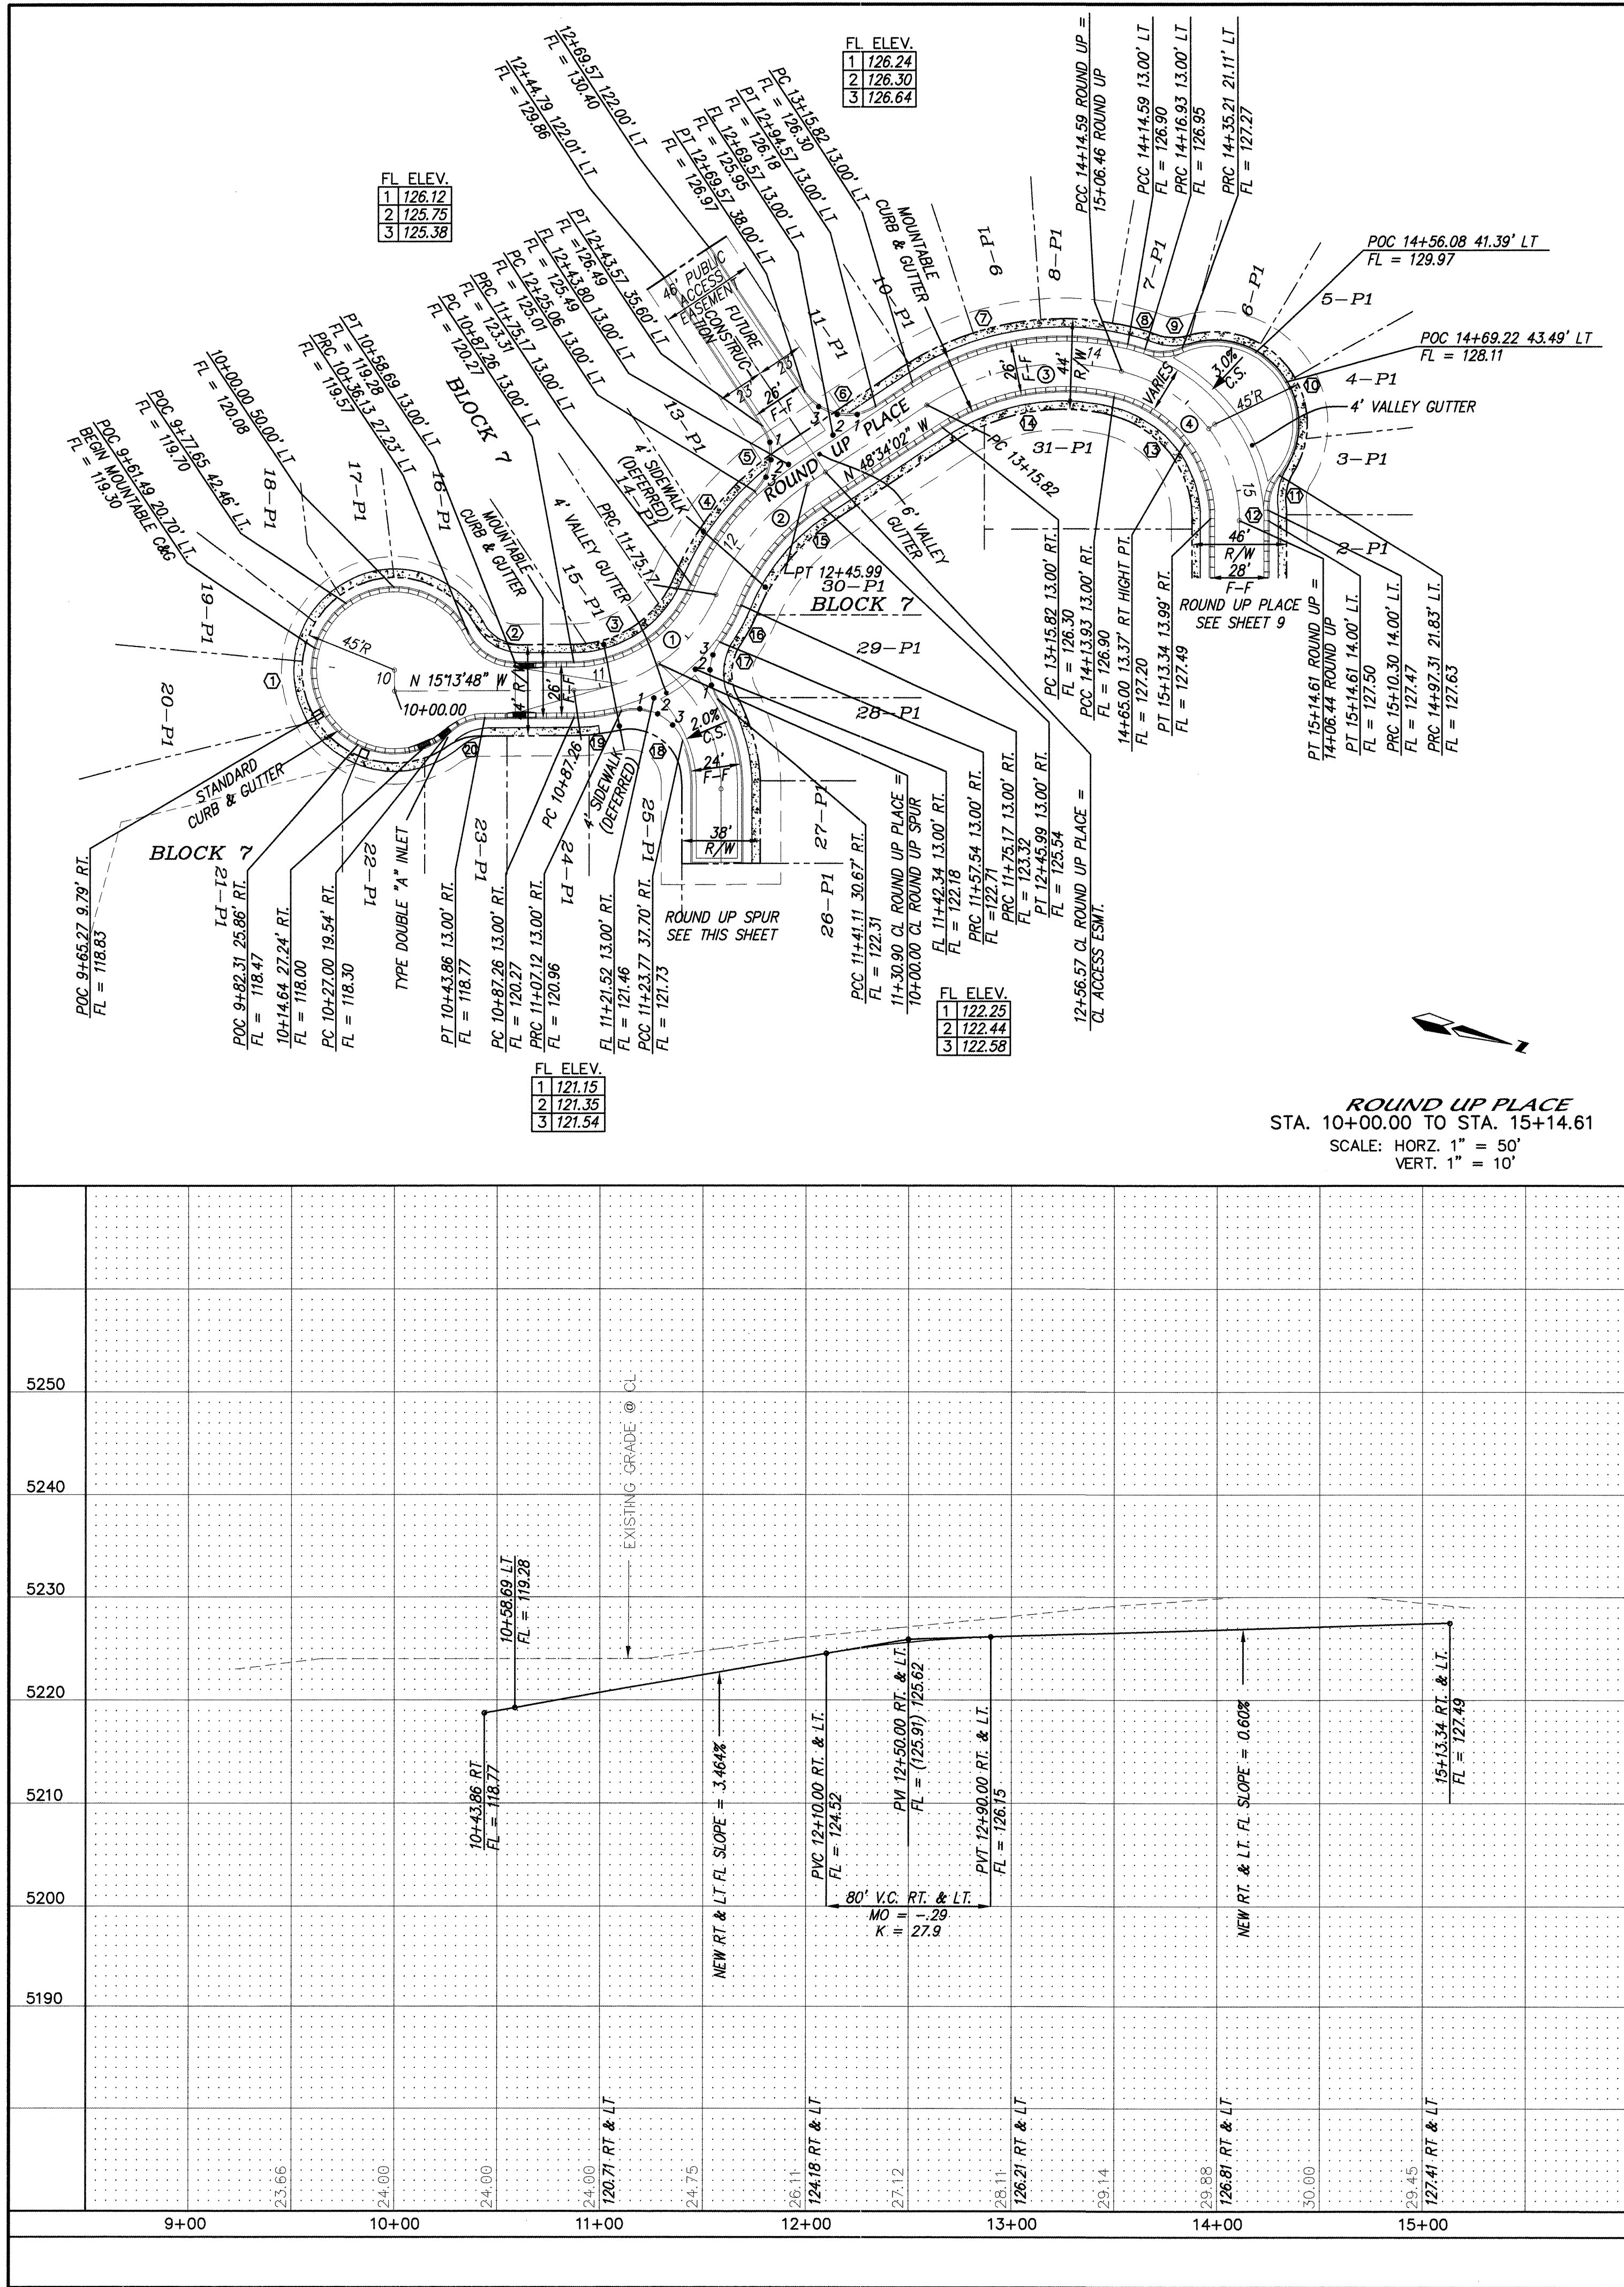

NOTES

1. ALL STATIONING IS CENTERLINE STATIONING.

CURVE DATA - DESCRIBES CENTERLINE

① $\Delta = 67^{\circ}08'18"$ RT. $R = 75.00'$ $L = 87.91'$ $T = 49.79'$	② $\Delta = 33^{\circ}49'04"$ RT. $R = 120.00'$ $L = 70.83'$ $T = 36.48'$	③ $\Delta = 47^{\circ}09'36"$ RT. $R = 120.00'$ $L = 98.77'$ $T = 52.38'$
④ $\Delta = 76^{\circ}24'31"$ RT. $R = 75.00'$ $L = 100.02'$ $T = 59.03'$	⑤ $\Delta = 53^{\circ}23'09"$ RT. $R = 75.00'$ $L = 69.88'$ $T = 37.71'$	

CURVE DATA - DESCRIBES FACE OF CURB

① $\Delta = 286^{\circ}52'59"$ RT. $R = 40.00'$ $L = 200.28'$ $T = -29.68'$	② $\Delta = 64^{\circ}29'01"$ RT. $R = 25.00'$ $L = 28.14'$ $T = 15.77'$	③ $\Delta = 67^{\circ}08'18"$ RT. $R = 75.00'$ $L = 87.91'$ $T = 49.79'$
④ $\Delta = 23^{\circ}49'17"$ RT. $R = 133.00'$ $L = 55.30'$ $T = 28.05'$	⑤ $\Delta = 80^{\circ}00'13"$ RT. $R = 25.00'$ $L = 34.91'$ $T = 20.98'$	⑥ $\Delta = 90^{\circ}00'00"$ RT. $R = 25.00'$ $L = 39.27'$ $T = 25.00'$
⑦ $\Delta = 47^{\circ}09'38"$ RT. $R = 133.00'$ $L = 109.47'$ $T = 58.05'$	⑧ $\Delta = 03^{\circ}36'24"$ RT. $R = 88.00'$ $L = 6.61'$ $T = 4.31'$	⑨ $\Delta = 42^{\circ}37'28"$ RT. $R = 25.00'$ $L = 18.60'$ $T = 9.75'$
⑩ $\Delta = 152^{\circ}00'28"$ RT. $R = 40.00'$ $L = 106.12'$ $T = 160.48'$	⑪ $\Delta = 41^{\circ}52'09"$ RT. $R = 25.00'$ $L = 18.27'$ $T = 9.56'$	⑫ $\Delta = 03^{\circ}17'17"$ RT. $R = 88.00'$ $L = 5.11'$ $T = 2.55'$
⑬ $\Delta = 76^{\circ}43'40"$ RT. $R = 61.00'$ $L = 81.69'$ $T = 48.29'$	⑭ $\Delta = 46^{\circ}50'53"$ RT. $R = 107.00'$ $L = 87.49'$ $T = 46.36'$	⑮ $\Delta = 33^{\circ}49'04"$ RT. $R = 107.00'$ $L = 63.15'$ $T = 32.53'$
⑯ $\Delta = 132^{\circ}27'46"$ RT. $R = 89.00'$ $L = 17.83'$ $T = 8.94'$	⑰ $\Delta = 66^{\circ}45'36"$ RT. $R = 25.00'$ $L = 29.13'$ $T = 16.47'$	⑱ $\Delta = 82^{\circ}57'44"$ RT. $R = 25.00'$ $L = 36.20'$ $T = 22.10'$
⑲ $\Delta = 151^{\circ}01'11"$ RT. $R = 88.00'$ $L = 23.30'$ $T = 11.72'$	⑳ $\Delta = 65^{\circ}07'57"$ RT. $R = 25.00'$ $L = 28.42'$ $T = 15.97'$	㉑ $\Delta = 42^{\circ}23'58"$ RT. $R = 25.00'$ $L = 18.50'$ $T = 9.70'$
㉒ $\Delta = 66^{\circ}45'56"$ RT. $R = 25.00'$ $L = 28.13'$ $T = 16.47'$	㉓ $\Delta = 30^{\circ}41'46"$ RT. $R = 85.00'$ $L = 45.54'$ $T = 23.33'$	㉔ $\Delta = 22^{\circ}26'46"$ RT. $R = 61.00'$ $L = 23.90'$ $T = 12.10'$
㉕ $\Delta = 82^{\circ}57'44"$ RT. $R = 25.00'$ $L = 36.20'$ $T = 22.10'$		

2.0%
C.S. = CROSS SLOPE,
NO CROWN SECTION

dmg MARK GOODWIN & ASSOCIATES, P.A.
CONSULTING ENGINEERS
P.O. BOX 90606
ALBUQUERQUE, NEW MEXICO 87199
(505) 828-2200, FAX (505) 797-9539


CITY OF ALBUQUERQUE
PUBLIC WORKS DEPARTMENT
ENGINEERING DEVELOPMENT GROUP

TITLE: **SUNRISE RANCH - UNIT 2
ROUND UP PLACE & SPUR
PAVING IMPROVEMENTS**

DESIGN REVIEW COMMITTEE APPROVE NOV 29 2000	CITY ENGINEER APPROVAL DEC 15 2000	NO./DAY/YR. MO./DAY/YR.
DESIGN REVIEW COMMITTEE	CITY ENGINEER	

CITY PROJECT NO. **645281** ZONE MAP NO. **L-8, L-9** SHEET **10** OF **20**

AS BUILT INFORMATION		BENCH MARKS		SURVEY INFORMATION		ENGINEER'S SEAL	
CONTRACTOR Franklin's	WORK AS	DATE 11/11/00	STATION 10+00	NO.	BY	REMARKS	BY
STATIONED BY AS	DATE 11/11/00	FIELD AS	DATE 11/11/00	NO.	BY	REMARKS	BY
CHECKED BY AS	DATE 11/11/00	CORRECTED BY AS	DATE 11/11/00	NO.	BY	REMARKS	BY
RECORDED BY AS	DATE 11/11/00	NO.		NO.	BY	REMARKS	BY
THE STATION IS SOUTHWEST OF DOWNTOWN ALBUQUERQUE. TO REACH THE STATION FROM THE INTERSECTION OF I-40 AND 98TH ST., TRAVEL SOUTH ON 98TH ST. 1.3 MILES TO THE STATION ON THE LEFT. THE STATION IS 49.2' EAST OF THE CENTERLINE OF 98TH ST., AND IS 0.13 MILES NORTH OF RYNO CT. S.W.				THE STATION IS AN AC'S 3 1/4" ALUM. CAP RIVETED TO A PIPE 0.25' ABOVE GROUND AND IS STAMPED "9-19-1089". X = 353,055.34 Y = 1,480,156.08 ELEV. = 5187.036			

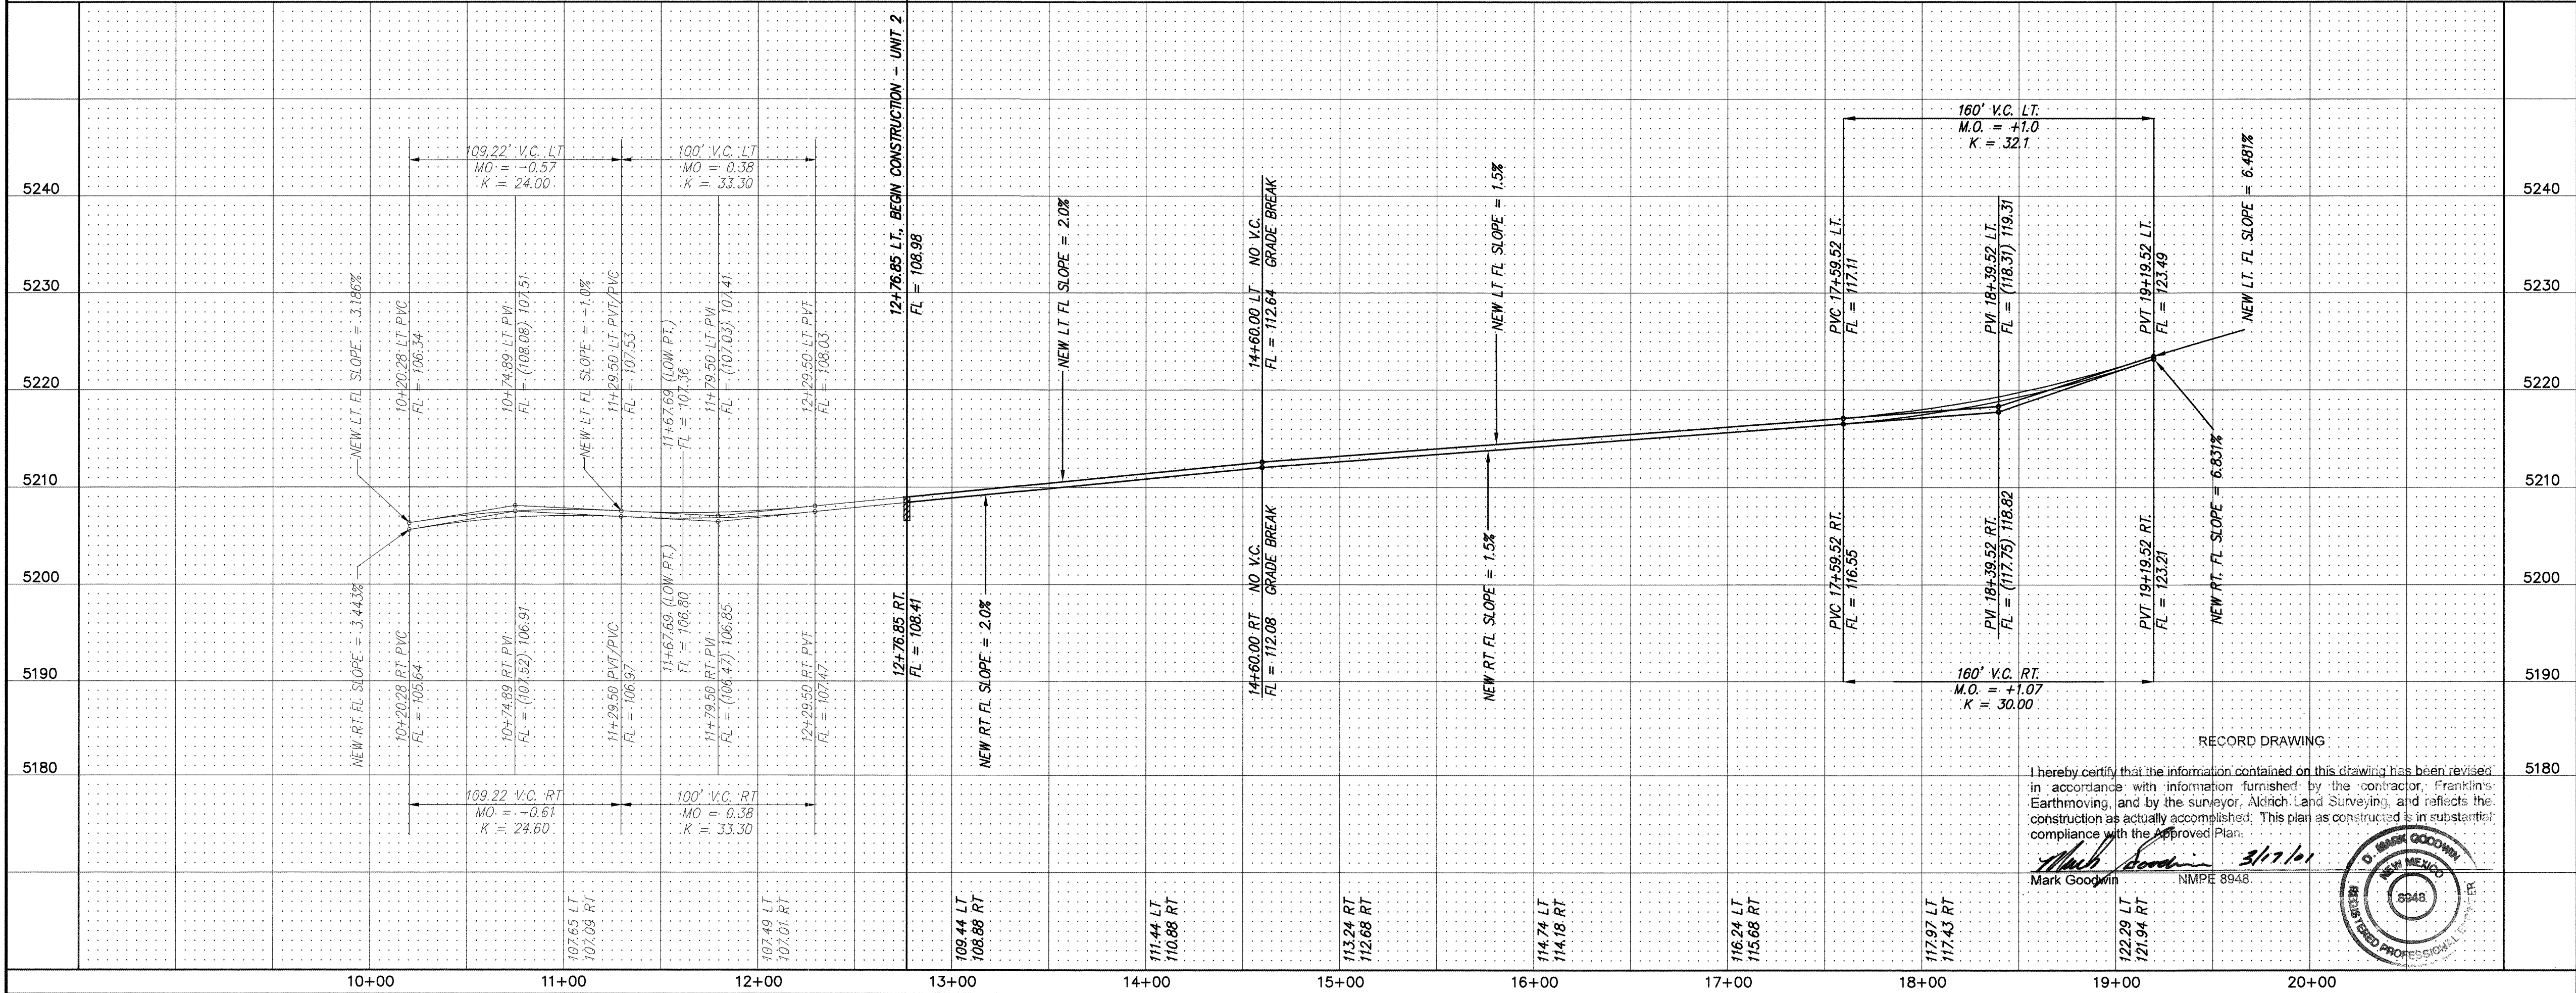

NOTES		
1. ALL STATIONING IS CENTERLINE STATIONING.		
CURVE DATA - DESCRIBES CENTERLINE		
① Δ = 74°50'48" R = 75.00' L = 85.93' T = 57.36'	② Δ = 28°42'23" R = 25.00' L = 60.12' T = 30.71'	③ Δ = 11°33'30" R = 300.00' L = 60.52' T = 30.36'
④ Δ = 12°05'44" R = 300.00' L = 63.33' T = 31.78'	⑤ Δ = 10°36'00" R = 300.00' L = 55.50' T = 27.83'	⑥ Δ = 11°08'14" R = 346.00' L = 67.26' T = 33.73'
CURVE DATA - DESCRIBES FACE OF CURB		
① Δ = 90°00'48" R = 25.00' L = 39.28' T = 25.01'	② Δ = 74°50'48" R = 61.00' L = 79.69' T = 46.68'	③ Δ = 28°42'23" R = 134.00' L = 67.14' T = 34.29'
④ Δ = 28°42'23" R = 106.00' L = 53.11' T = 27.12'	⑤ Δ = 74°50'48" R = 89.00' L = 118.26' T = 68.10'	⑥ Δ = 89°59'12" RT. R = 25.00' L = 39.28' T = 25.01'
⑦ Δ = 97°07'32" R = 106.00' L = 52.91' T = 24.99'	⑧ Δ = 98°34'41" R = 43.01' L = 43.01' T = 28.05'	⑨ Δ = 90°00'48" R = 25.00' L = 39.28' T = 25.01'
⑩ Δ = 89°59'12" R = 25.00' L = 39.28' T = 24.99'	⑪ Δ = 11°33'30" R = 314.00' L = 63.34' T = 31.78'	⑫ Δ = 12°05'44" R = 286.00' L = 58.09' T = 30.30'
⑬ Δ = 10°36'00" R = 286.00' L = 52.91' T = 26.53'	⑭ Δ = 11°08'14" R = 360.00' L = 63.34' T = 31.78'	⑮ Δ = 10°36'00" R = 314.00' L = 58.09' T = 28.13'
⑯ Δ = 12°05'44" R = 314.00' L = 66.29' T = 33.27'	⑰ Δ = 02°58'01" R = 286.00' L = 14.81' T = 7.41'	⑱ Δ = 04°01'30" R = 332.00' L = 23.32' T = 11.67'

2.0%
C.S. = CROSS SLOPE,
NO CROWN SECTION

MORNING DEW
STA. 10+00.00 TO STA. 19+15.94
SCALE: HORIZ. 1" = 50'
VERT. 1" = 10'

dmg MARK GOODWIN & ASSOCIATES, P.A.
CONSULTING ENGINEERS
P.O. BOX 80606
ALBUQUERQUE, NEW MEXICO 87199
(505) 828-2200, FAX (505) 797-9539

CITY OF ALBUQUERQUE
PUBLIC WORKS DEPARTMENT
ENGINEERING DEVELOPMENT GROUP
TITLE: **SUNRISE RANCH - UNIT 2
MORNING DEW
PAVING IMPROVEMENTS**

DESIGN REVIEW COMMITTEE CITY ENGINEER APPROVAL
NOV 29 2000 DEC 15 2000
LAST DESIGN UPDATE
CITY ENGINEER

CITY PROJECT NO. **645281** ZONE MAP NO. **L-8, L-9** SHEET **11** OF **20**



AS BUILT INFORMATION		
CONTRACTOR	DATE	BY
FRANKLIN'S	11/04/00	AKS
WORK STATIONED BY	DATE	BY
AKS	11/04/00	AKS
FIELD ACTION BY	DATE	BY
AKS	11/04/00	AKS
REVISIONS	DATE	BY
NO.	DATE	BY
1	07/00	DLH
2	07/00	MJR
3	07/00	DMG
BENCH MARKS		
ACS MONUMENT "9-19". THE STATION IS LOCATED 5.3 MILES	DATE	BY
SOUTHWEST OF DOWNTOWN ALBUQUERQUE. TO REACH THE STATION	DATE	BY
FROM THE INTERSECTION OF I-40 AND 98TH ST. TRAVEL SOUTH ON	DATE	BY
98TH ST. 1.3 MILES TO THE STATION ON THE LEFT. THE STATION IS	DATE	BY
48.2' EAST OF THE CENTERLINE OF 98TH ST. AND IS 0.13 MILES	DATE	BY
NORTH OF RYO CT. S.W.	DATE	BY
THE STATION IS AN ACS 3 1/4" ALUM. CAP RIVETED TO A PIPE	DATE	BY
0.25' ABOVE GROUND AND IS STAMPED "9-19, 1089".	DATE	BY
X = 353,055.34 Y = 1,480,156.08 ELEV. = 5187.036	DATE	BY
SURVEY INFORMATION		
FIELD NOTES	DATE	BY
NO.	DATE	BY
1	DATE	BY
2	DATE	BY
3	DATE	BY
ENGINEER'S SEAL		
NO.	DATE	BY
1	DATE	BY
2	DATE	BY
3	DATE	BY
NOTE: ALL STATIONING IS
STREET STATIONING




MAP NO.
L-8, L-9

OF
12 20

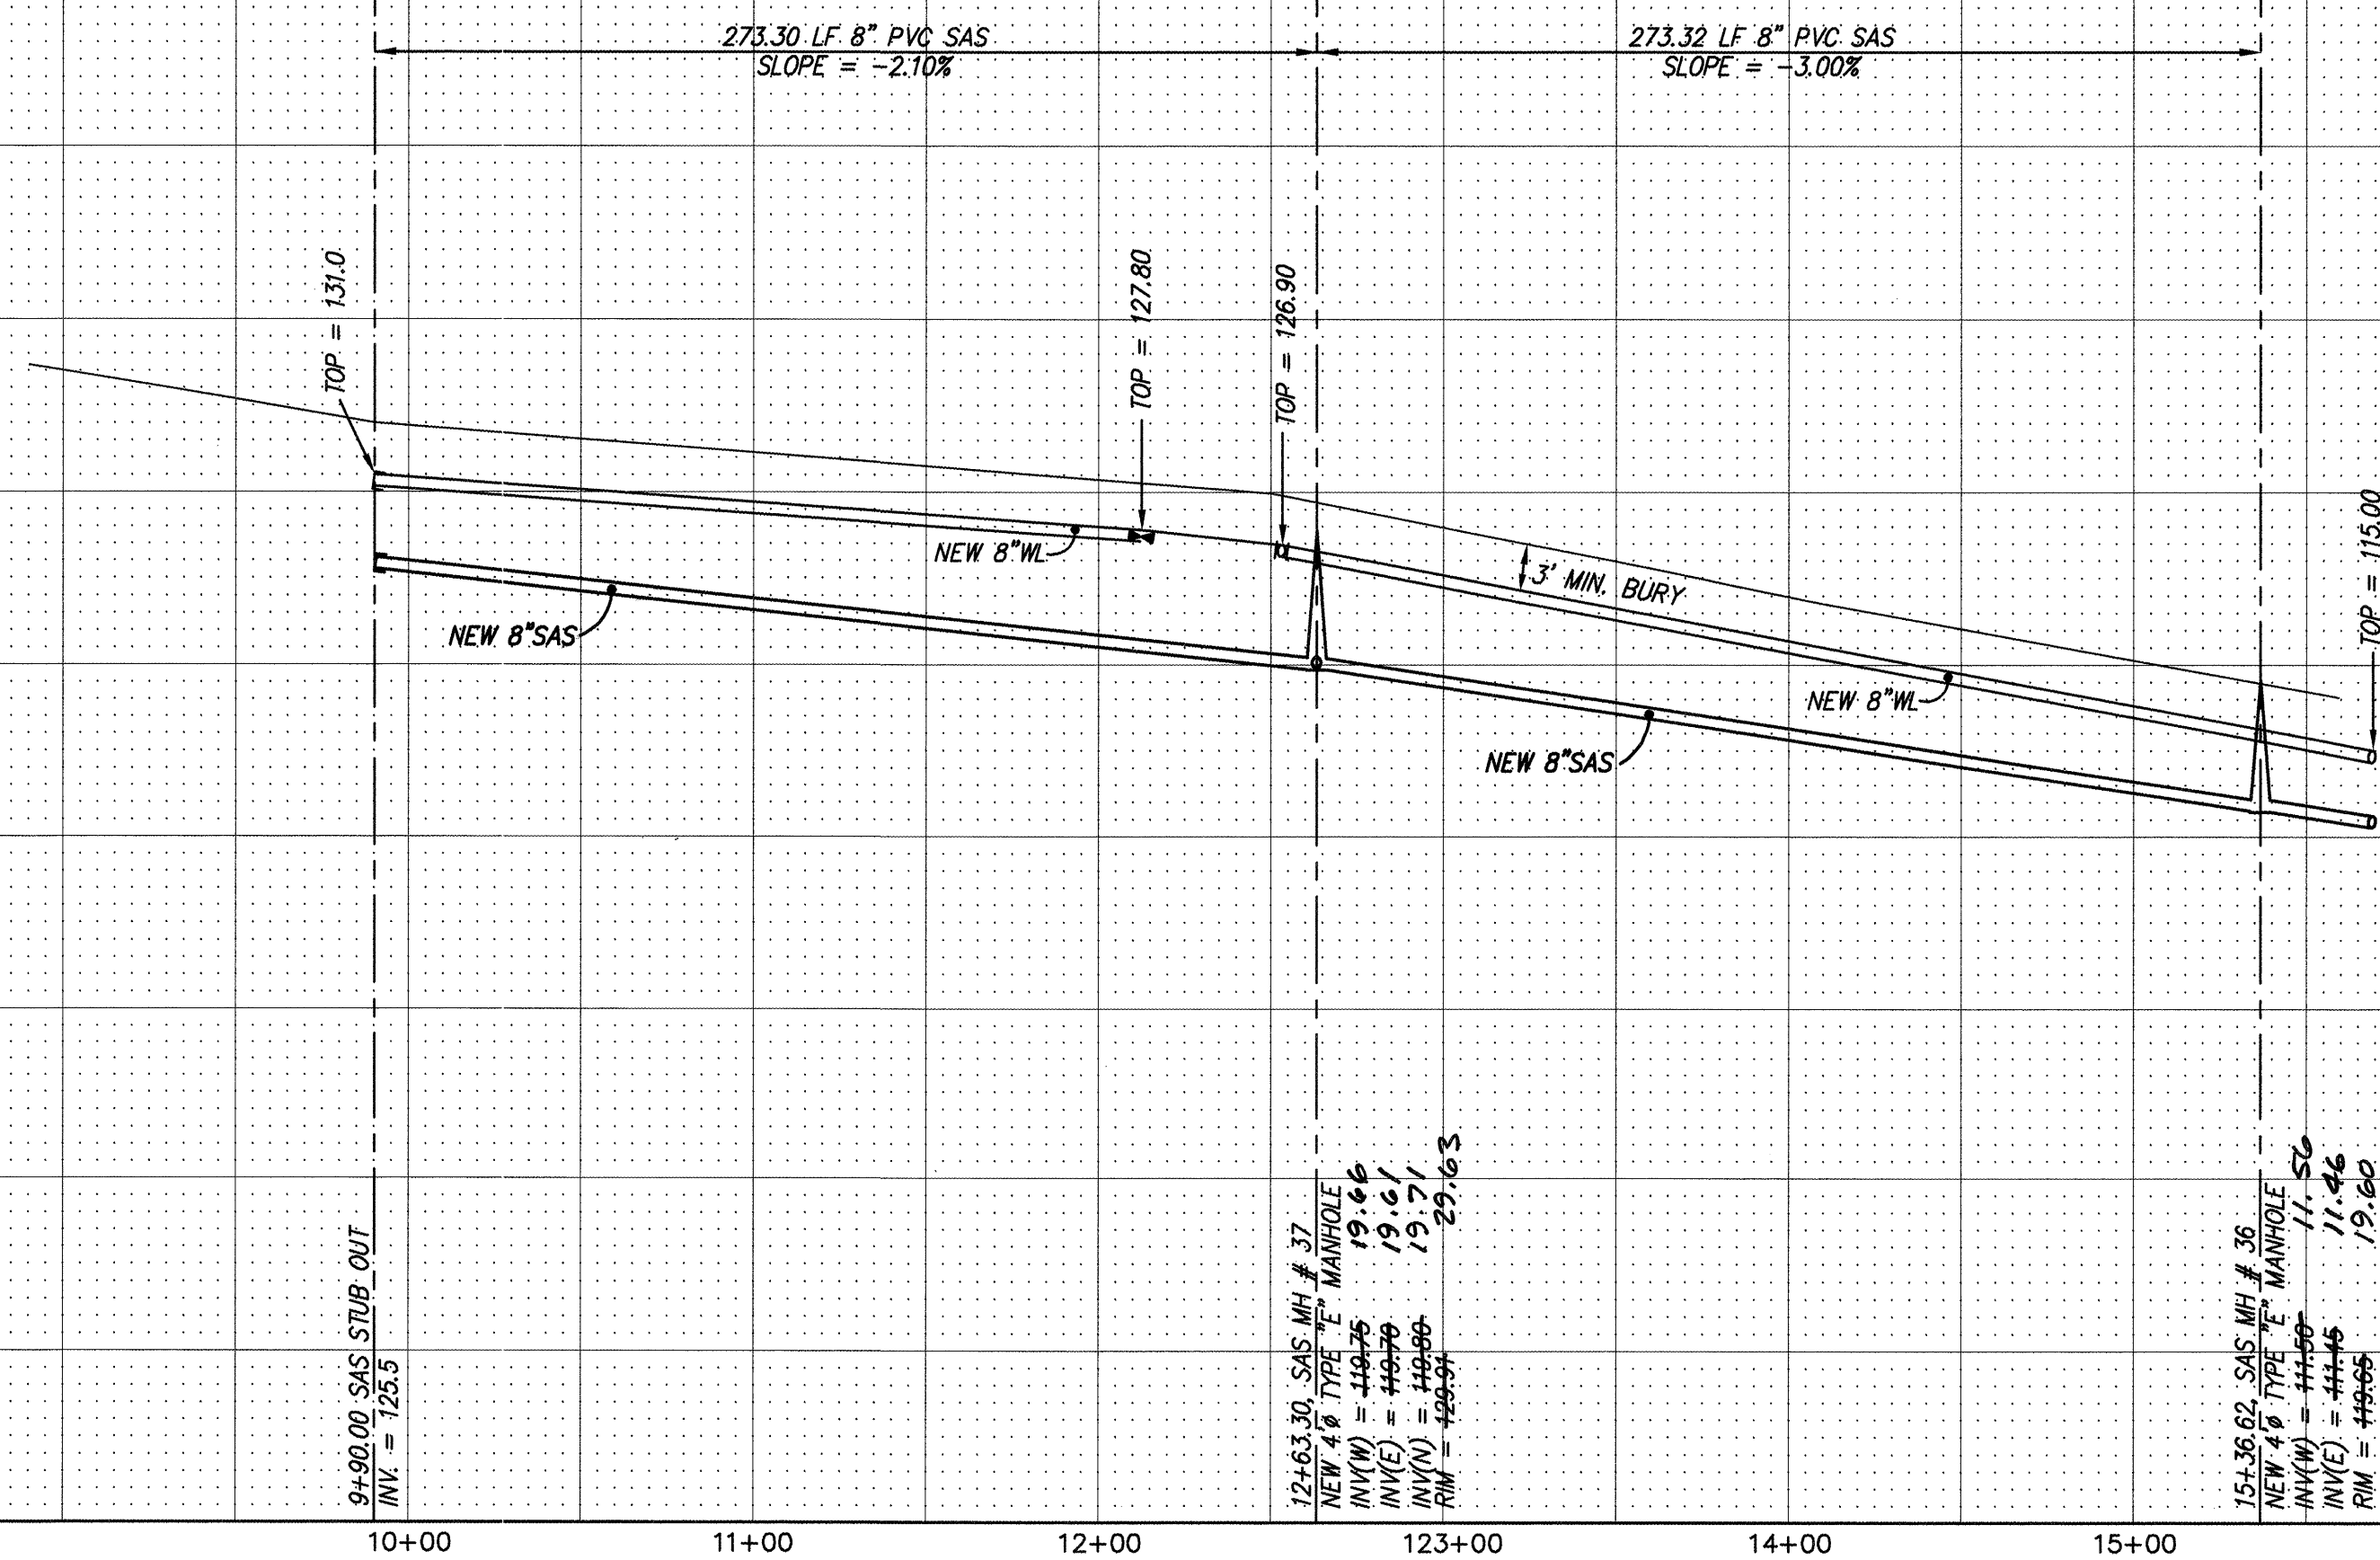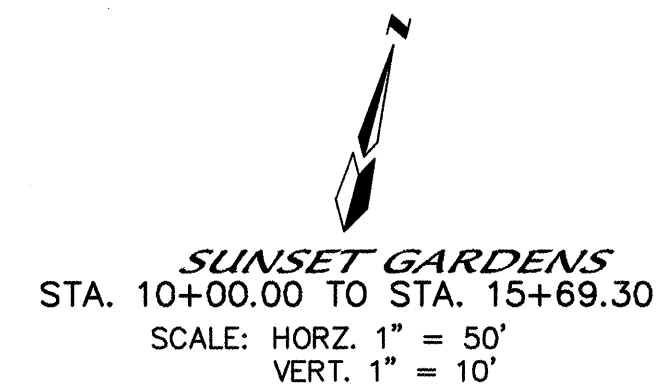

Mark Goodwin NMPE 894

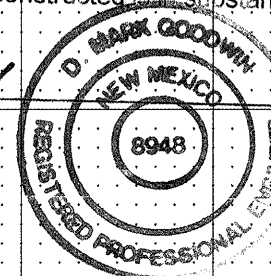

1. ALL STATIONING IS CENTERLINE STATIONING.

SURVEY INFORMATION		BENCH MARKS		AS BUILT INFORMATION	
NO.	BY	DATE	FIELD NOTES	CONTRACTOR	WORK
			ACS MONUMENT "9-19". THE STATION IS LOCATED 5.3 MILES SOUTHWEST OF DOWNTOWN ALBUQUERQUE. TO REACH THE STATION FROM THE INTERSECTION OF I-40 AND 98TH ST., TRAVEL SOUTH ON 98TH ST. 1.3 MILES TO THE STATION ON THE LEFT. THE STATION IS 49.2' EAST OF THE CENTERLINE OF 98TH ST., AND IS 0.13 MILES NORTH OF RINO CT., S.W.	Franklin's	DATE 1/1/
			THE STATION IS AN ACS 3 1/4" ALUM. CAP RIVETED TO A PIPE 0.25' ABOVE GROUND AND IS STAMPED "9-L9, 1089".	AS	DATE 9/1/
			X = 353,055.34 Y = 1,480,156.08 ELEV. = 5187.036	AS	DATE 3/1/
				AS	DATE 7/1/
				MICRO-FILM INFORMATION	DATE
				RECORDED BY	NO.

[illegible]

RESTRAINED JOINT LENGTH FOR BENDS, VALVES, DEAD ENDS (FT.)					
PIPE SIZE	90°	45°	22.5°	11.25°	VALVE
6"	17'	7'	3'	2'	46"
8"	22'	9'	4'	2'	72"
10"	26'	11'	5'	3'	72"

LENGTH OF RESTRAINED PIPE ON EACH SIDE OF THE BEND. RESTRAIN BRANCH AT FITTING ONLY MINIMUM ATTACHED PIPE LENGTH, RUN SIDE OF TEE: 10.00 FEET.

RESTRAINED JOINT LENGTH FOR TEES (FT.)		
PIPE SIZE	RUN	BRANCH
10"x10"x6"	6'	1'
8"x8"x6"	7'	2'
6"x6"x6"	10'	2'


 MARK GOODWIN & ASSOCIATES, P.A.
CONSULTING ENGINEERS
P.O. BOX 90606
ALBUQUERQUE, NEW MEXICO 87199
(505) 828-2200, FAX (505) 797-9539

**CITY OF ALBUQUERQUE
PUBLIC WORKS DEPARTMENT
ENGINEERING DEVELOPMENT GROUP**

**TITLE: *SUNRISE RANCH - UNIT 2
SUNSET GARDENS
UTILITY IMPROVEMENTS***

DESIGN REVIEW COMMITTEE	CITY ENGINEER APPROVAL	LAST DESIGN UPDATE	MO./DAY/YR.	MO./DAY/YR.
NOV 29 2000	DEC 15 2000			

CITY PROJECT NO.	ZONE MAP NO.	SHEET OF
645281	L-8, L-9	13 20

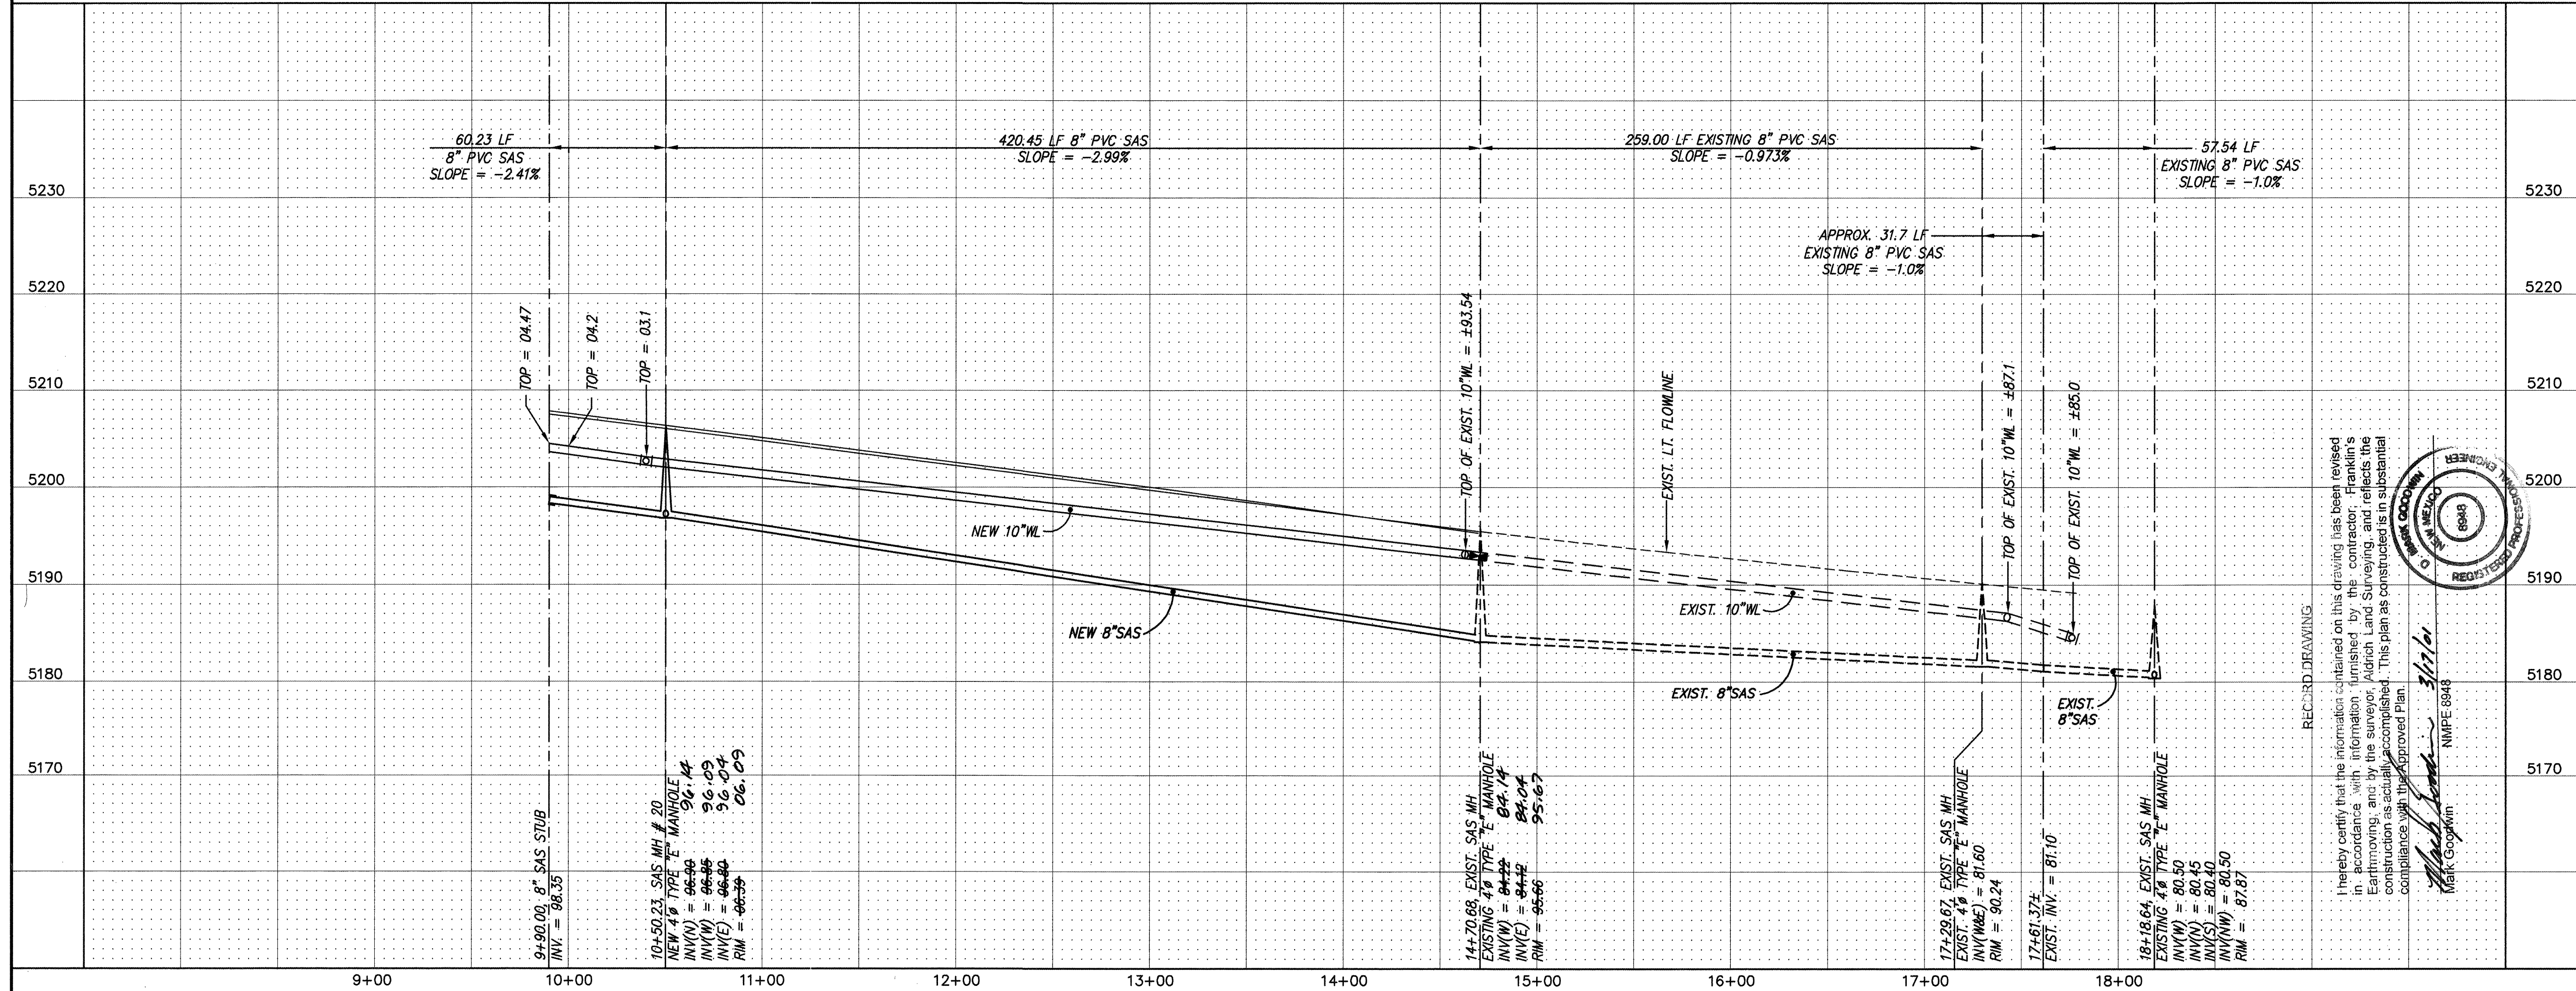

EUCARIZ ROAD
STA. 10+00.00 TO STA. 14+70.68
SCALE: HORIZ. 1" = 50'
VERT. 1" = 10'

NOTES

1. ALL STATIONING IS CENTERLINE STATIONING.

RESTRAINED JOINT LENGTH FOR BENDS, VALVES, DEAD ENDS (FT.)					
PIPE SIZE	90°	45°	22.5°	11.25°	VALVE
6"	17'	7'	3'	2'	46'
8"	22'	9'	4'	2'	72'
10"	26'	11'	5'	3'	72'

LENGTH OF RESTRAINED PIPE ON EACH SIDE OF THE BEND. RESTRAIN BRANCH AT FITTING ONLY MINIMUM ATTACHED PIPE LENGTH, RUN SIDE OF TEE: 10.00 FEET.

RESTRAINED JOINT LENGTH FOR TEES (FT.)		
PIPE SIZE	RUN	BRANCH
10"x10"x6"	6'	1'
8"x8"x6"	7'	2'
6"x6"x6"	10'	2'

dmg MARK GOODWIN & ASSOCIATES, P.A.
CONSULTING ENGINEERS
P.O. BOX 90606
ALBUQUERQUE, NEW MEXICO 87199
(505) 828-2200, FAX (505) 797-9539

CITY OF ALBUQUERQUE
PUBLIC WORKS DEPARTMENT
ENGINEERING DEVELOPMENT GROUP
TITLE: **SUNRISE RANCH - UNIT 2
EUCARIZ ROAD
UTILITY IMPROVEMENTS**


DESIGN REVIEW COMMITTEE	CITY ENGINEER APPROVAL	MO./DAY/YR.	MO./DAY/YR.
NOV 29 2000	DEC 15 2000		
DESIGN REVIEW COMMITTEE	CITY ENGINEER		

CITY PROJECT NO. **645281** ZONE MAP NO. **L-8, L-9** SHEET **14** OF **20**

SURVEY INFORMATION			BENCH MARKS			AS BUILT INFORMATION		
NO.	BY	DATE	ACS MONUMENT "9-19"	THE STATION IS LOCATED 5.3 MILES	CONTRACTOR	NO.	BY	DATE
			SOUTHWEST OF DOWNTOWN ALBUQUERQUE. TO REACH THE STATION	FROM THE INTERSECTION OF I-40 AND 98TH ST. TRAVEL SOUTH ON	FRANKLIN'S			
			98TH ST. 1.3 MILES TO THE STATION ON THE LEFT. THE STATION IS	49.2' EAST OF THE CENTERLINE OF 98TH ST. AND IS 0.13 MILES	INSPECTOR'S			
			NORTH OF RYNO CT. S.W.	THE STATION IS AN ACS 3 1/4" ALUM. CAP RIVETED TO A PIPE	STAKED BY			
			0.25' ABOVE GROUND AND IS STAMPED "9-19, 1089"	X = 353,055.34 Y = 5187,036	FIELD			
					VERIFICATION BY			
					CORRECTED BY			
					RECORDED BY			
					NO.			
					DATE			


ENGINEER'S SEAL
MARK GOODWIN
REGISTERED PROFESSIONAL ENGINEER
NO. 8843
STATE OF NEW MEXICO
1987

REVISIONS
NO. DATE REMARKS BY
DESIGN
DATE 07/00
DATE 07/00
DATE 07/00

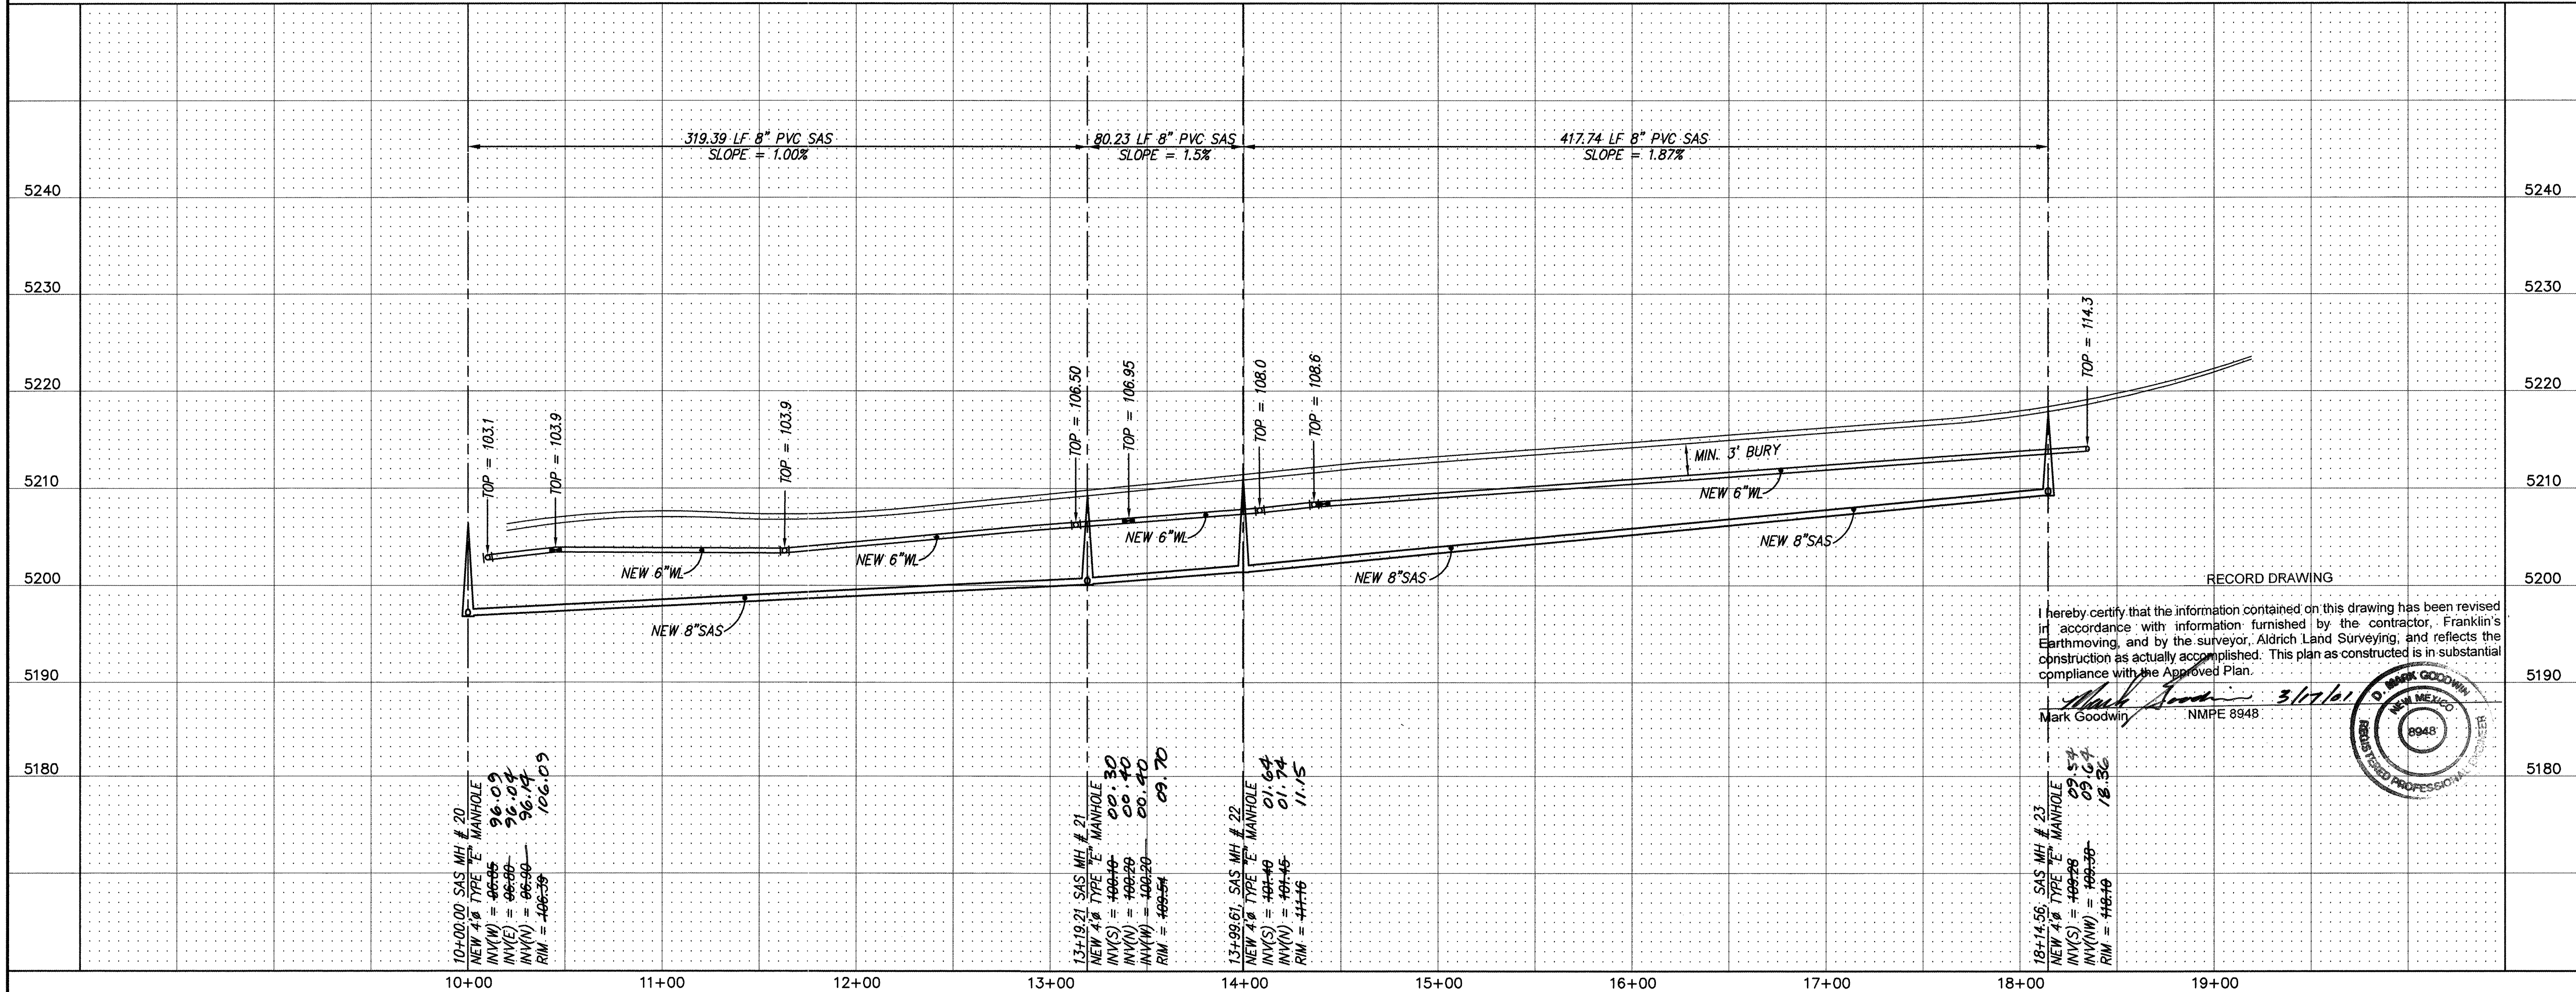

I hereby certify that the information contained on this drawing has been reviewed in accordance with information furnished by the contractor, Franklin's Earthmoving, and by the surveyor, Aldrich Land Surveying, and reflects the construction as actually accomplished. This plan as constructed is in substantial compliance with the Approved Plan.

Mark Goodwin
NMPE 8948

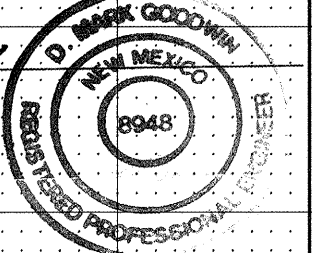

RESTRAINED JOINT LENGTH FOR BENDS, VALVES, DEAD ENDS (FT.)				
PIPE SIZE	90°	45°	22.5°	VALVE
6"	17'	7'	3'	2'
8"	22'	9'	4'	2'
5200	26'	11'	5'	3'

LENGTH OF RESTRAINED PIPE ON EACH SIDE OF THE BEND. RESTRAIN BRANCH AT FITTING ONLY MINIMUM ATTACHED PIPE LENGTH, RUN SIDE OF TEE: 10.00 FEET.

RESTRAINED JOINT LENGTH FOR TEES (FT.)		
PIPE SIZE	RUN	BRANCH
10"x10"x6"	6'	1'
8"x8"x6"	7'	2'
6"x6"x6"	10'	2'
6"x6"x6"	10'	2'

dmg MARK GOODWIN & ASSOCIATES, P.A.
CONSULTING ENGINEERS
P.O. BOX 90606
ALBUQUERQUE, NEW MEXICO 87199
(505) 828-2200, FAX (505) 797-9539

**CITY OF ALBUQUERQUE
PUBLIC WORKS DEPARTMENT
ENGINEERING DEVELOPMENT GROUP**

TITLE: **SUNRISE RANCH - UNIT 2
MORNING DEW
UTILITY IMPROVEMENTS**

DESIGN REVIEW COMMITTEE	CITY ENGINEER APPROVAL	MO./DAY/YR.	MO./DAY/YR.
NOV 29 2000	DEC 15 2000		

CITY PROJECT NO. **645281** ZONE MAP NO. **L-8, L-9** SHEET **15** OF **20**

NOTES

1. ALL STATIONING IS CENTERLINE STATIONING.



SANITARY SEWER SERVICES				
BLOCK	LOT	STATION AT PUE	INV. ELEV. AT PUE	LENGTH AT PUE
6	13-P1	14+61.57	06.66	33.00'
6	14-P1	14+81.57	06.96	33.00'
6	15-P1	15+24.57	07.61	33.00'
6	16-P1	15+67.57	08.25	33.57'
6	17-P1	16+10.57	08.90	37.62'
6	18-P1	16+53.57	09.55	33.00'
6	19-P1	16+96.57	10.19	33.00'
6	20-P1	17+39.57	10.84	33.00'
6	21-P1	17+82.57	11.54	33.00'
6	22-P1	18+14.44	12.34	30.60'
6	23-P1	18+51.08	13.61	41.36'
7	37-P1	17+92.26	11.65	33.00'
7	38-P1	17+51.06	11.01	33.00'
7	39-P1	17+11.06	10.41	33.00'
7	40-P1	16+71.06	09.81	33.00'
7	41-P1	16+31.06	09.21	33.76'
7	42-P1	15+91.06	08.61	37.77'
7	43-P1	15+51.06	08.01	33.00'
7	44-P1	15+11.06	07.41	33.00'
7	45-P1	14+71.06	06.81	33.00'
7	46-P1	14+31.06	06.50	33.00'
7	47-P1	13+83.08	05.54	35.28'



REVISIONS		DATE	DATE
NO.	DATE	REMARKS	BY
1	07/00	DESIGN	DLH
2	07/00	DATE	MJR
3	07/00	DATE	DMG

AS BUILT INFORMATION		DATE	DATE
CONTRACTOR	FRANKLIN'S	DATE	DATE
WORK STARTED BY	ALS	DATE	DATE
INSPECTOR	MGA	DATE	DATE
FIELD ENGINEER	ALS	DATE	DATE
CORRECTION BY	MGA	DATE	DATE
RECORDED BY	NO	DATE	DATE
NO.	NO	DATE	DATE

BENCH MARKS		DATE	DATE
ACS MONUMENT "9-19"	THE STATION IS LOCATED 5.3 MILES SOUTHWEST OF DOWNTOWN ALBUQUERQUE. TO REACH THE STATION FROM THE INTERSECTION OF I-40 AND 98TH ST. TRAVEL SOUTH ON 98TH ST. 1.3 MILES TO THE STATION ON THE LEFT. THE STATION IS 49.2' EAST OF THE CENTERLINE OF 98TH ST. AND IS 0.13 MILES NORTH OF RYMO CT. S.W.	DATE	DATE
THE STATION IS AN ACS 3 1/4" ALUM. CAP RIVETED TO A PIPE 0.25' ABOVE GROUND AND IS STAMPED "9-19, 1089"		DATE	DATE
X = 353,055.34	Y = 1,480,156.08	DATE	DATE
ELEV. = 5187.036		DATE	DATE

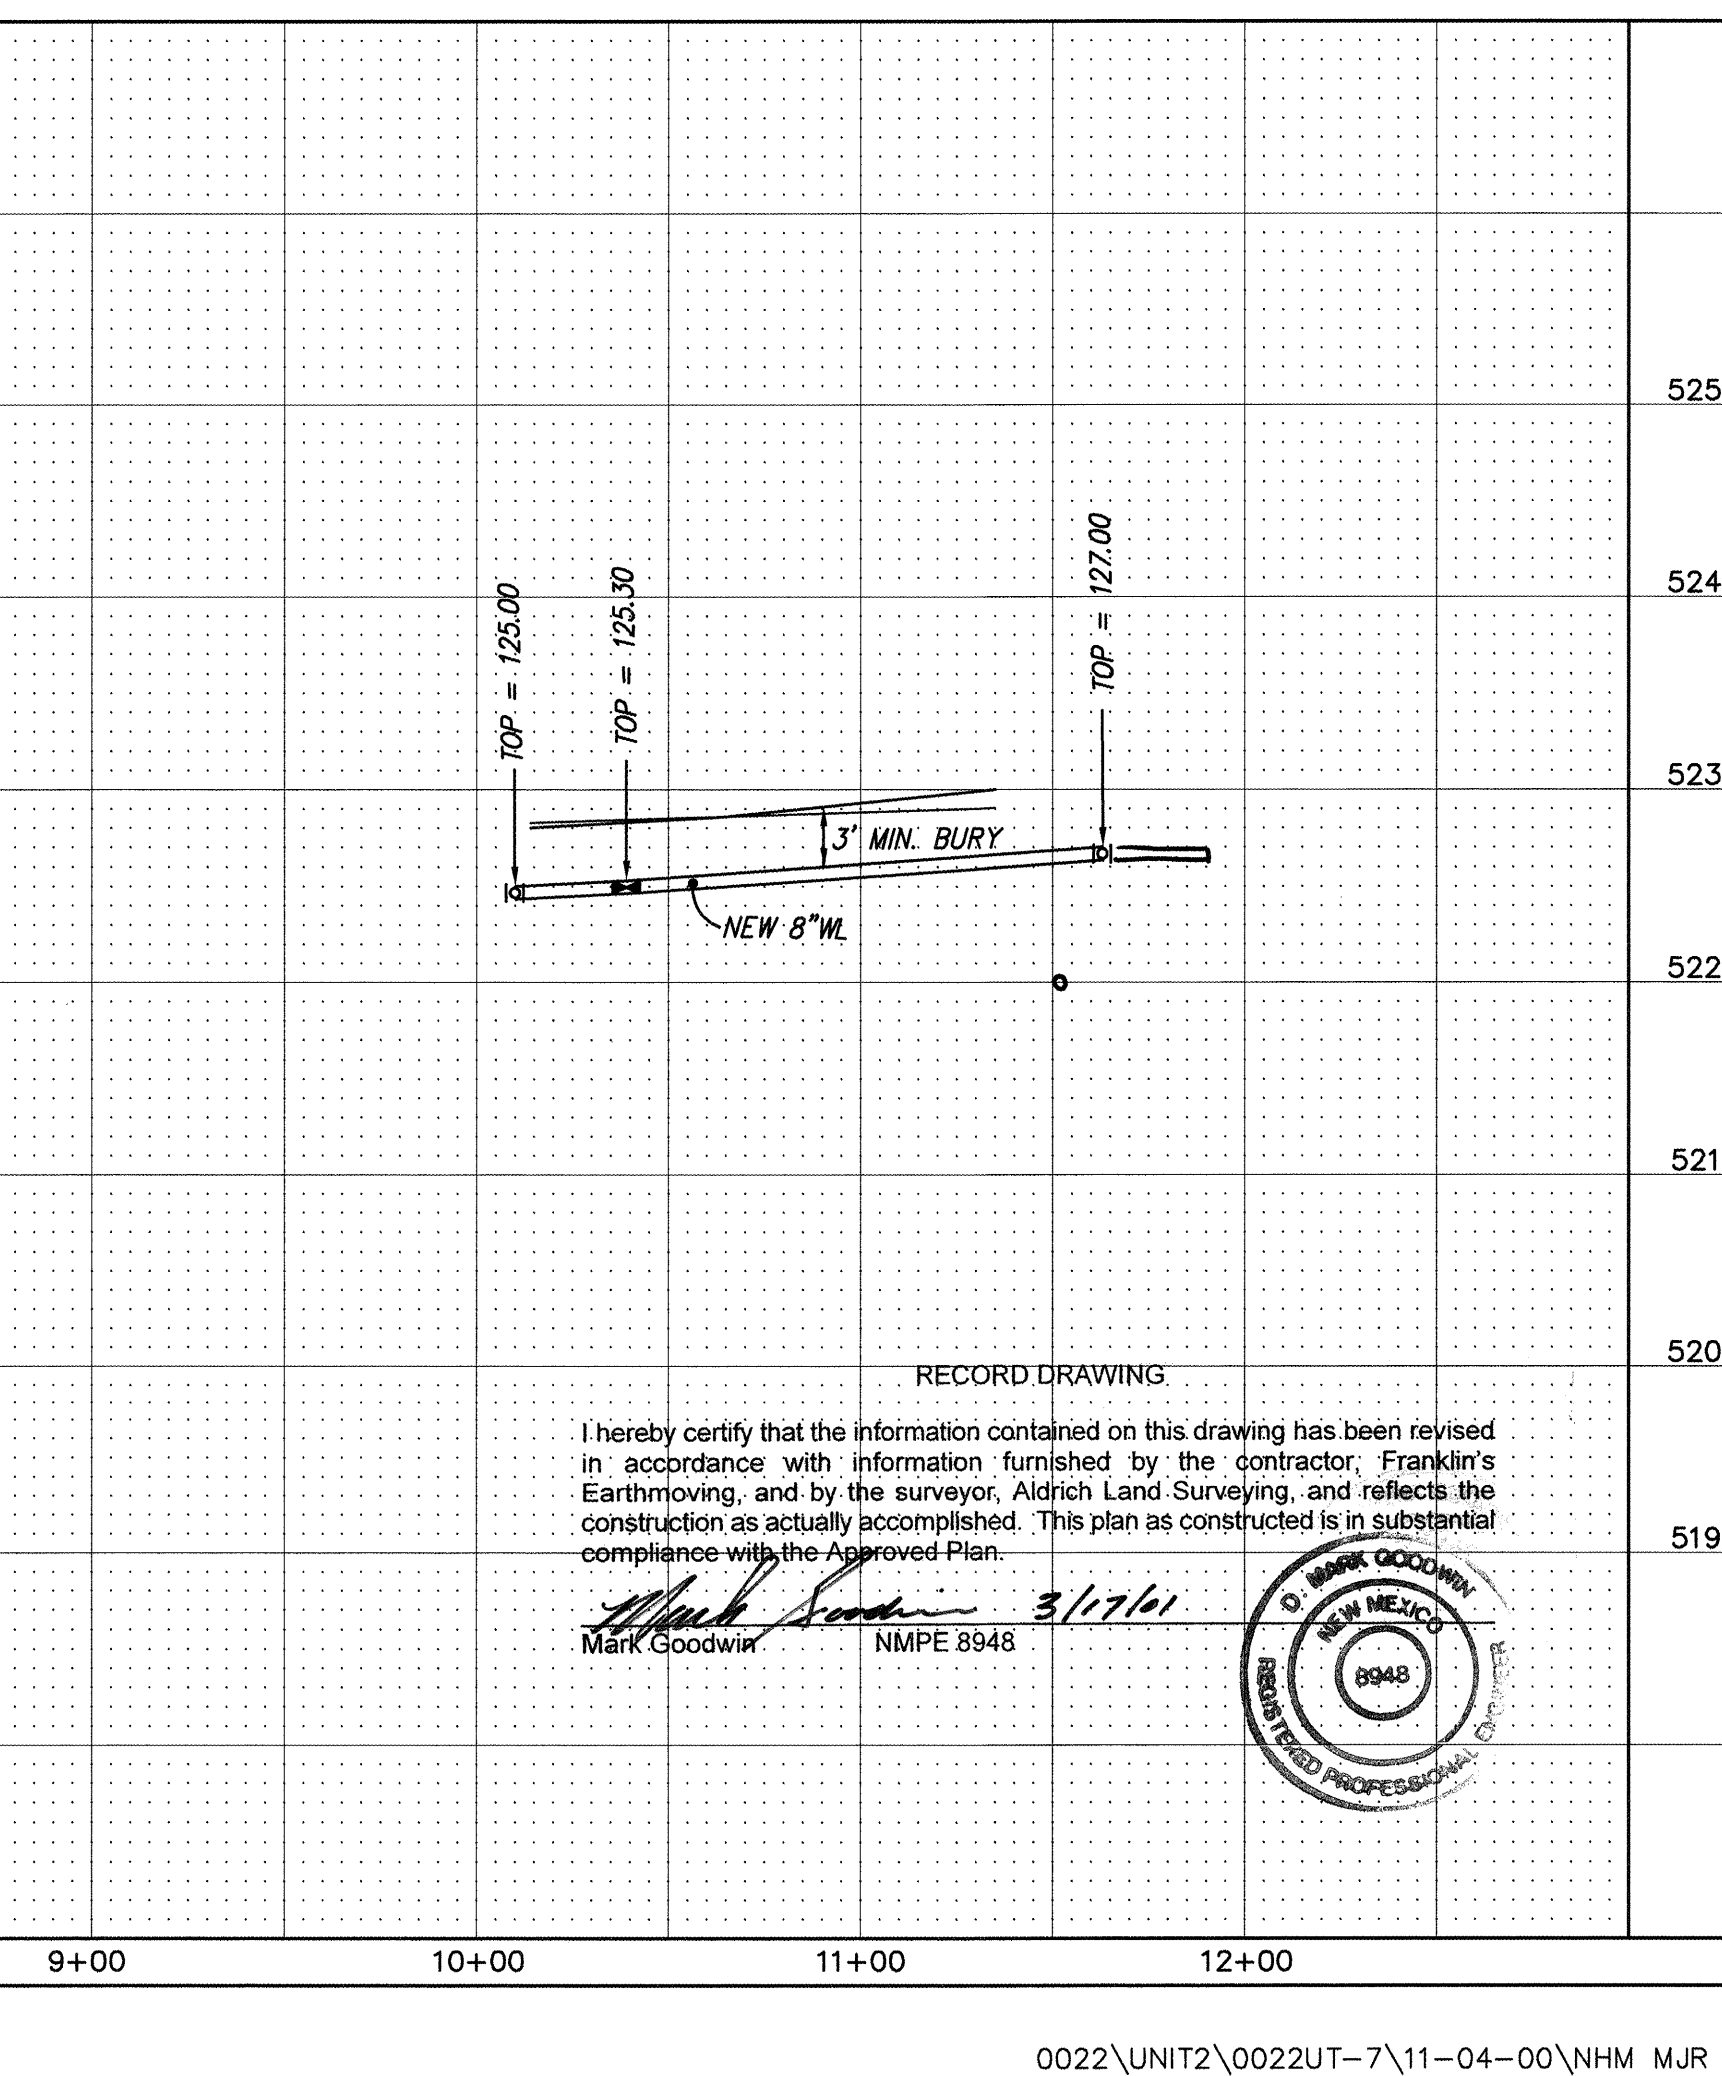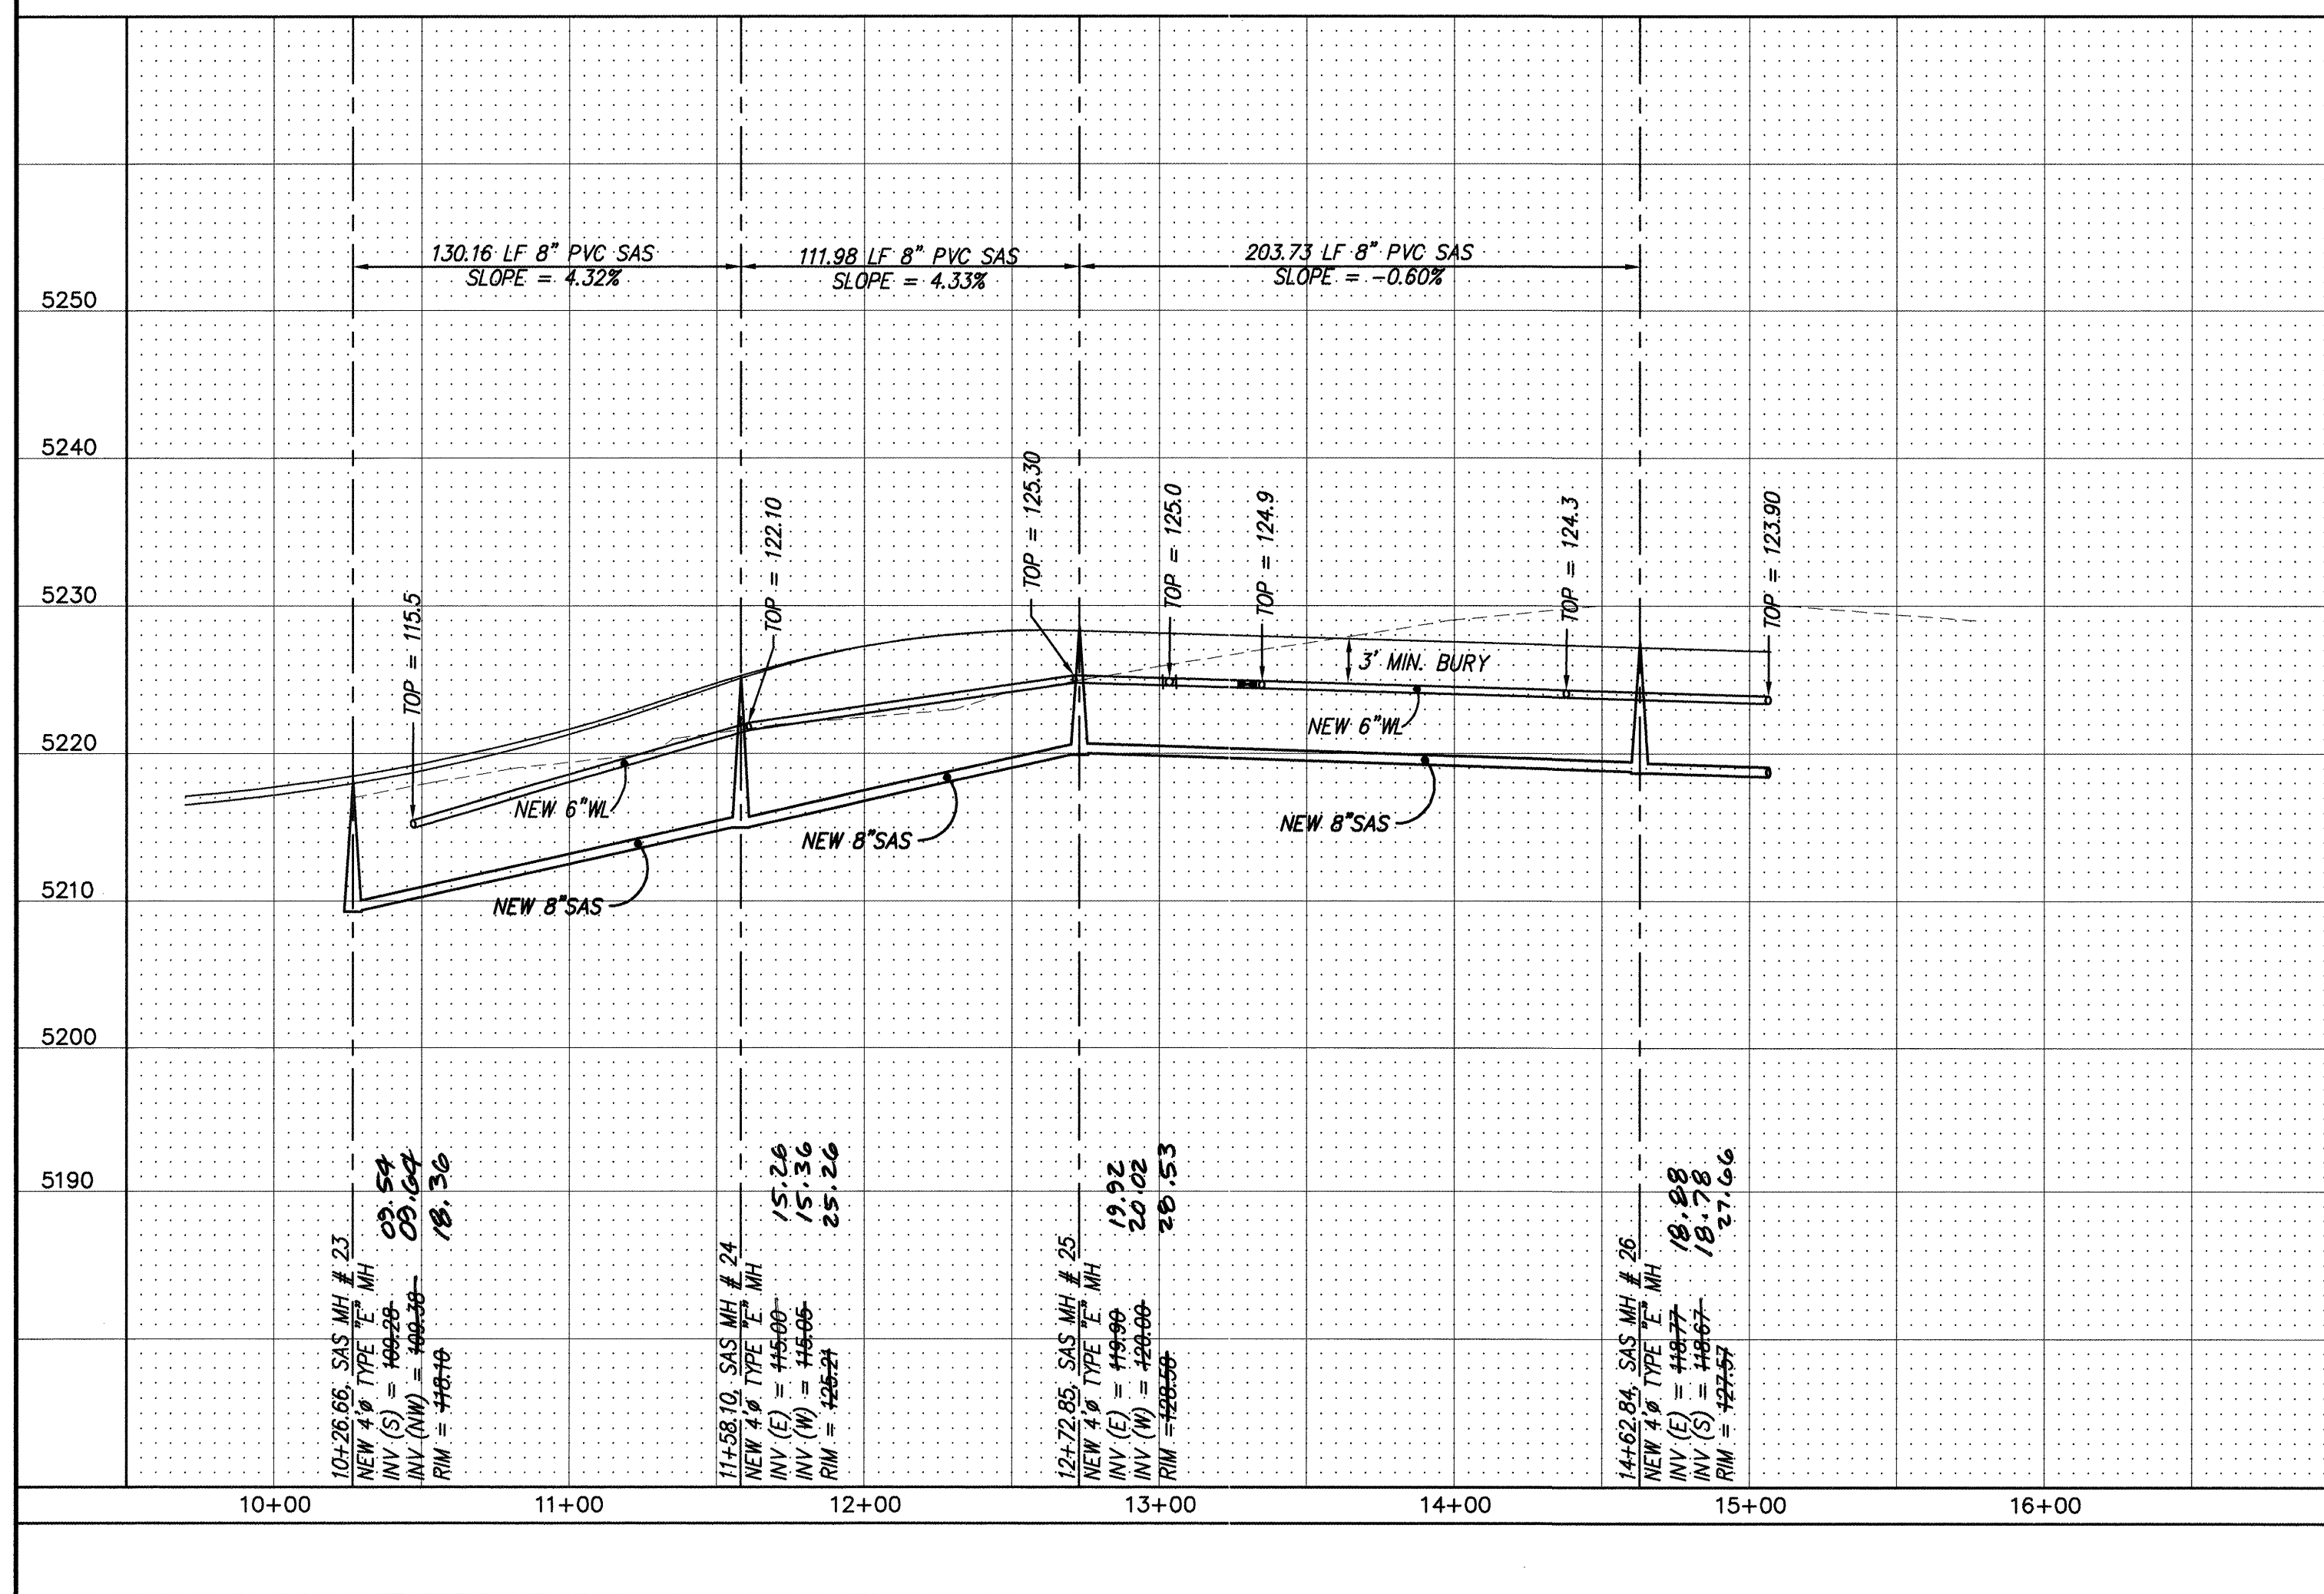

NOTES

1. ALL STATIONING IS CENTERLINE STATIONING.

CONTRACTOR

Franklin's

WORK STARTED BY

AL-S

INSPECTOR'S FIELD VERIFICATION BY

AL-S

DATE

10/1

DATE

10/24

DATE

10/24

DATE

10/24

RECORDED BY

AL-S

NO.

AS BUILT INFORMATION

MICRO-FILM INFORMATION

BLOCK

LOT

STATION AT PUE

INV. ELEV. AT PUE

LENGTH AT PUE

6

22-P1

10+25.03

12.30

28.07'

6

23-P1

10+61.57

13.44

41.36'

6

24-P1

11+54.70

16.03

32.20'

6

25-P1

11+99.85

17.66

42.85'

6

28-P1

12+35.09

19.01

42.28'

7

1-P1

13+59.28

23.47

33.00'

7

2-P1

13+99.28

25.30

33.00'

7

3-P1

14+26.01 (44.60' RT)

25.91

40.55'

7

4-P1

14+45.61 (57.21' RT)

26.13

39.78'

7

5-P1

14+61.49 (57.83' RT)

26.17

30.22'

7

6-P1

14+81.92 (57.83' RT)

26.03

33.56'

7

3-P1

14+16.82 (32.87' LT)

25.74

33.27'

7

31-P1

13+92.25

24.88

33.00'

7

32-P1

13+52.25

23.56

33.00'

7

33-P1

13+12.25

22.01

33.00'

7

34-P1

12+43.95

19.55

24.26'

7

35-P1

11+80.71

16.98

25.29'

7

36-P1

10+01.34

14.68/15.48

33.00'

FIELD NOTES

NO.

BY

DATE

ACCS MONUMENT "9-19". THE STATION IN LOCATED 5.3 MILES SOUTHWEST OF DOWNTOWN ALBUQUERQUE. TO REACH THE STATION FROM THE INTERSECTION OF I-40 AND 98TH ST., TRAVEL SOUTH ON 98TH ST. 1.3 MILES TO THE STATION ON THE LEFT. THE STATION IS 49.2' EAST OF THE CENTERLINE OF 98TH ST. AND IS 0.13 MILES NORTH OF RYMO CT. S.W.

THE STATION IS AN ACS 3 1/4" ALUM. CAP RIVETED TO A PIPE 0.25' ABOVE GROUND AND IS STAMPED "9-19, 1089".

ELEV. = 5187.036

X = 353,055.34

Y = 1,490,156.08

ENGINEER'S SEAL

00-5-11

NEW MEXICO

10867

REGISTERED PROFESSIONAL ENGINEER

DAME E. MOELTER

RESTRAINED JOINT LENGTH FOR BENDS, VALVES, DEAD ENDS (FT.)

PIPE SIZE

90°

45°

22.5°

11.25°

VALVE

6"

17'

7'

-

-

46'

8"

22'

9'

4'

2'

60'

LENGTH OF RESTRAINED PIPE ON EACH SIDE OF THE BEND. RESTRAIN BRANCH AT FITTING ONLY MINIMUM ATTACHED PIPE LENGTH, RUN SIDE OF TEE: 10.00 FEET.

RESTRAINED JOINT LENGTH FOR TEES (FT.)

PIPE SIZE

RUN

BRANCH

8"x8"x6"

7'

5'

6"x6"x6"

10'

2'

MARK GOODWIN & ASSOCIATES, P.A.
CONSULTING ENGINEERS
P.O. BOX 90606
ALBUQUERQUE, NEW MEXICO 87199
(505) 828-2200, FAX (505) 797-9539

CITY OF ALBUQUERQUE
PUBLIC WORKS DEPARTMENT
ENGINEERING DEVELOPMENT GROUP

TITLE:

SUNRISE RANCH - UNIT 2
ROUND UP PLACE & LASSO
UTILITY IMPROVEMENTS

DESIGN REVIEW COMMITTEE

CITY ENGINEER APPROVAL

DATE

APPROVE

NOV 29 2000

DEC 15 2000

CITY ENGINEER

LAST DESIGN UPDATE

MO./DAY/YR.

MO./DAY/YR.

DESIGNED BY

DLH

DATE

07/00

DRAWN BY

NJR

DATE

07/00

CHECKED BY

DMG

DATE

07/00

CITY PROJECT NO.

645281

ZONE MAP NO.



L-8,L-9

SHEET

16

OF

20

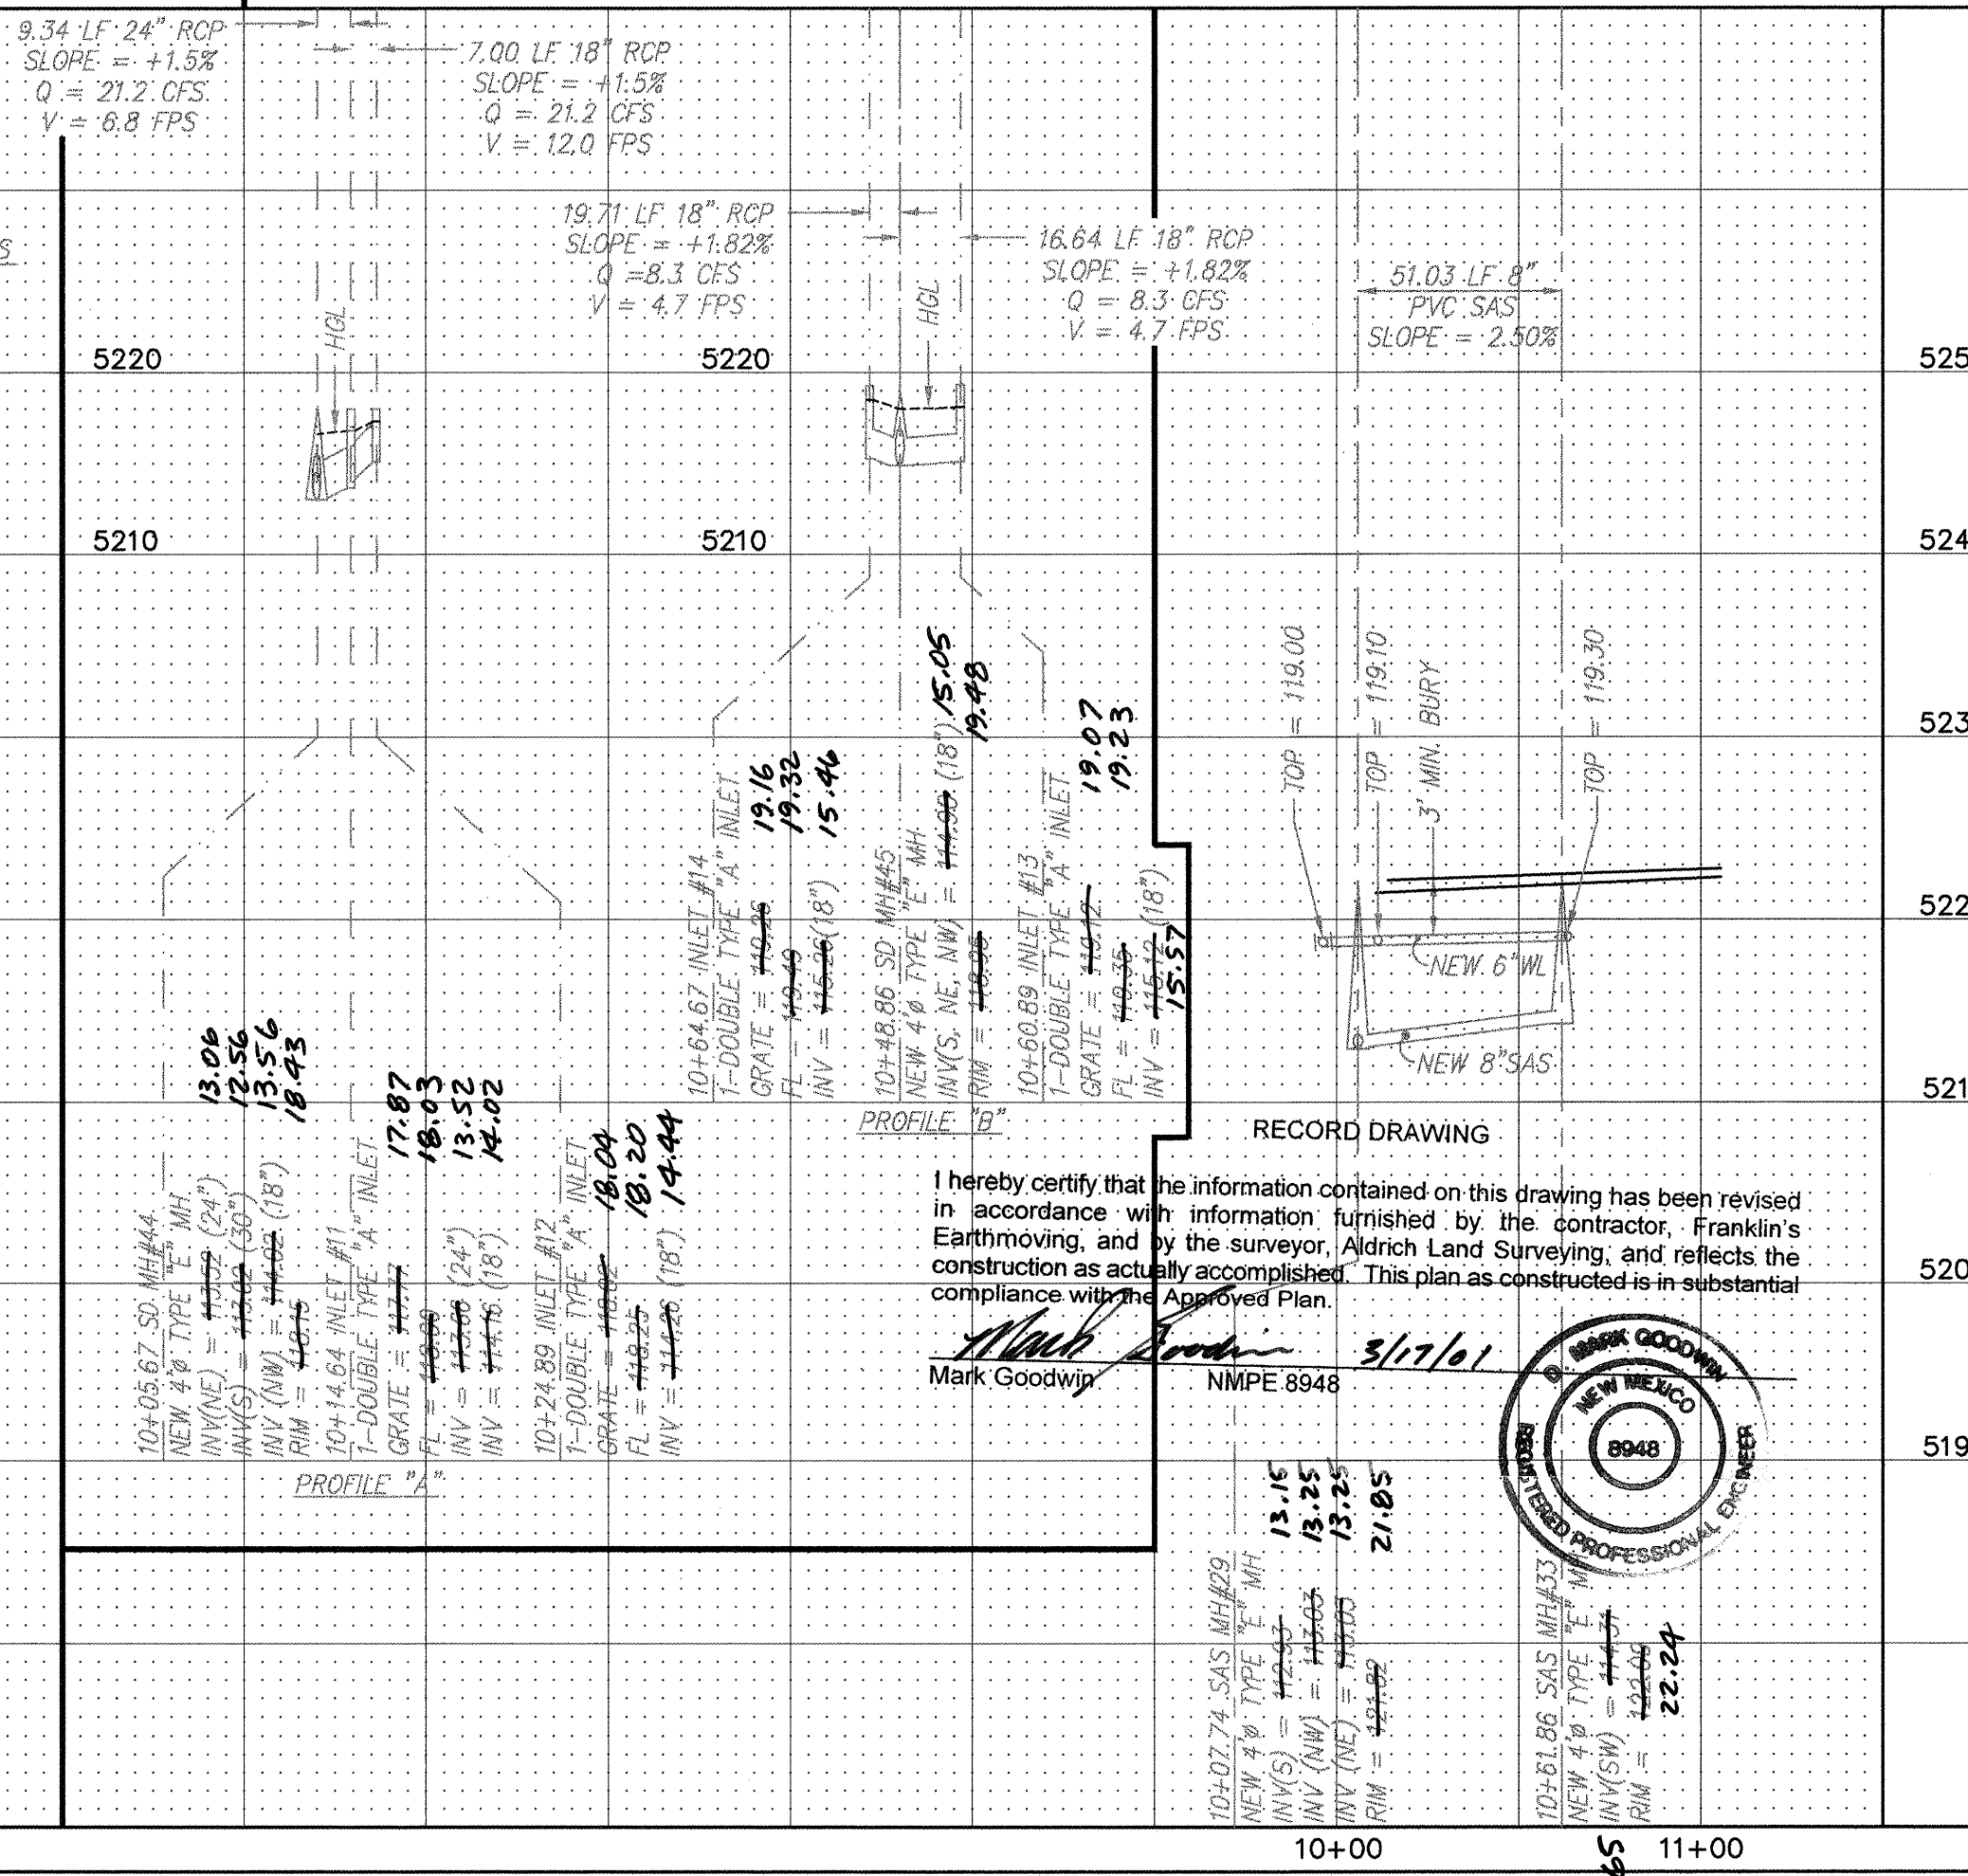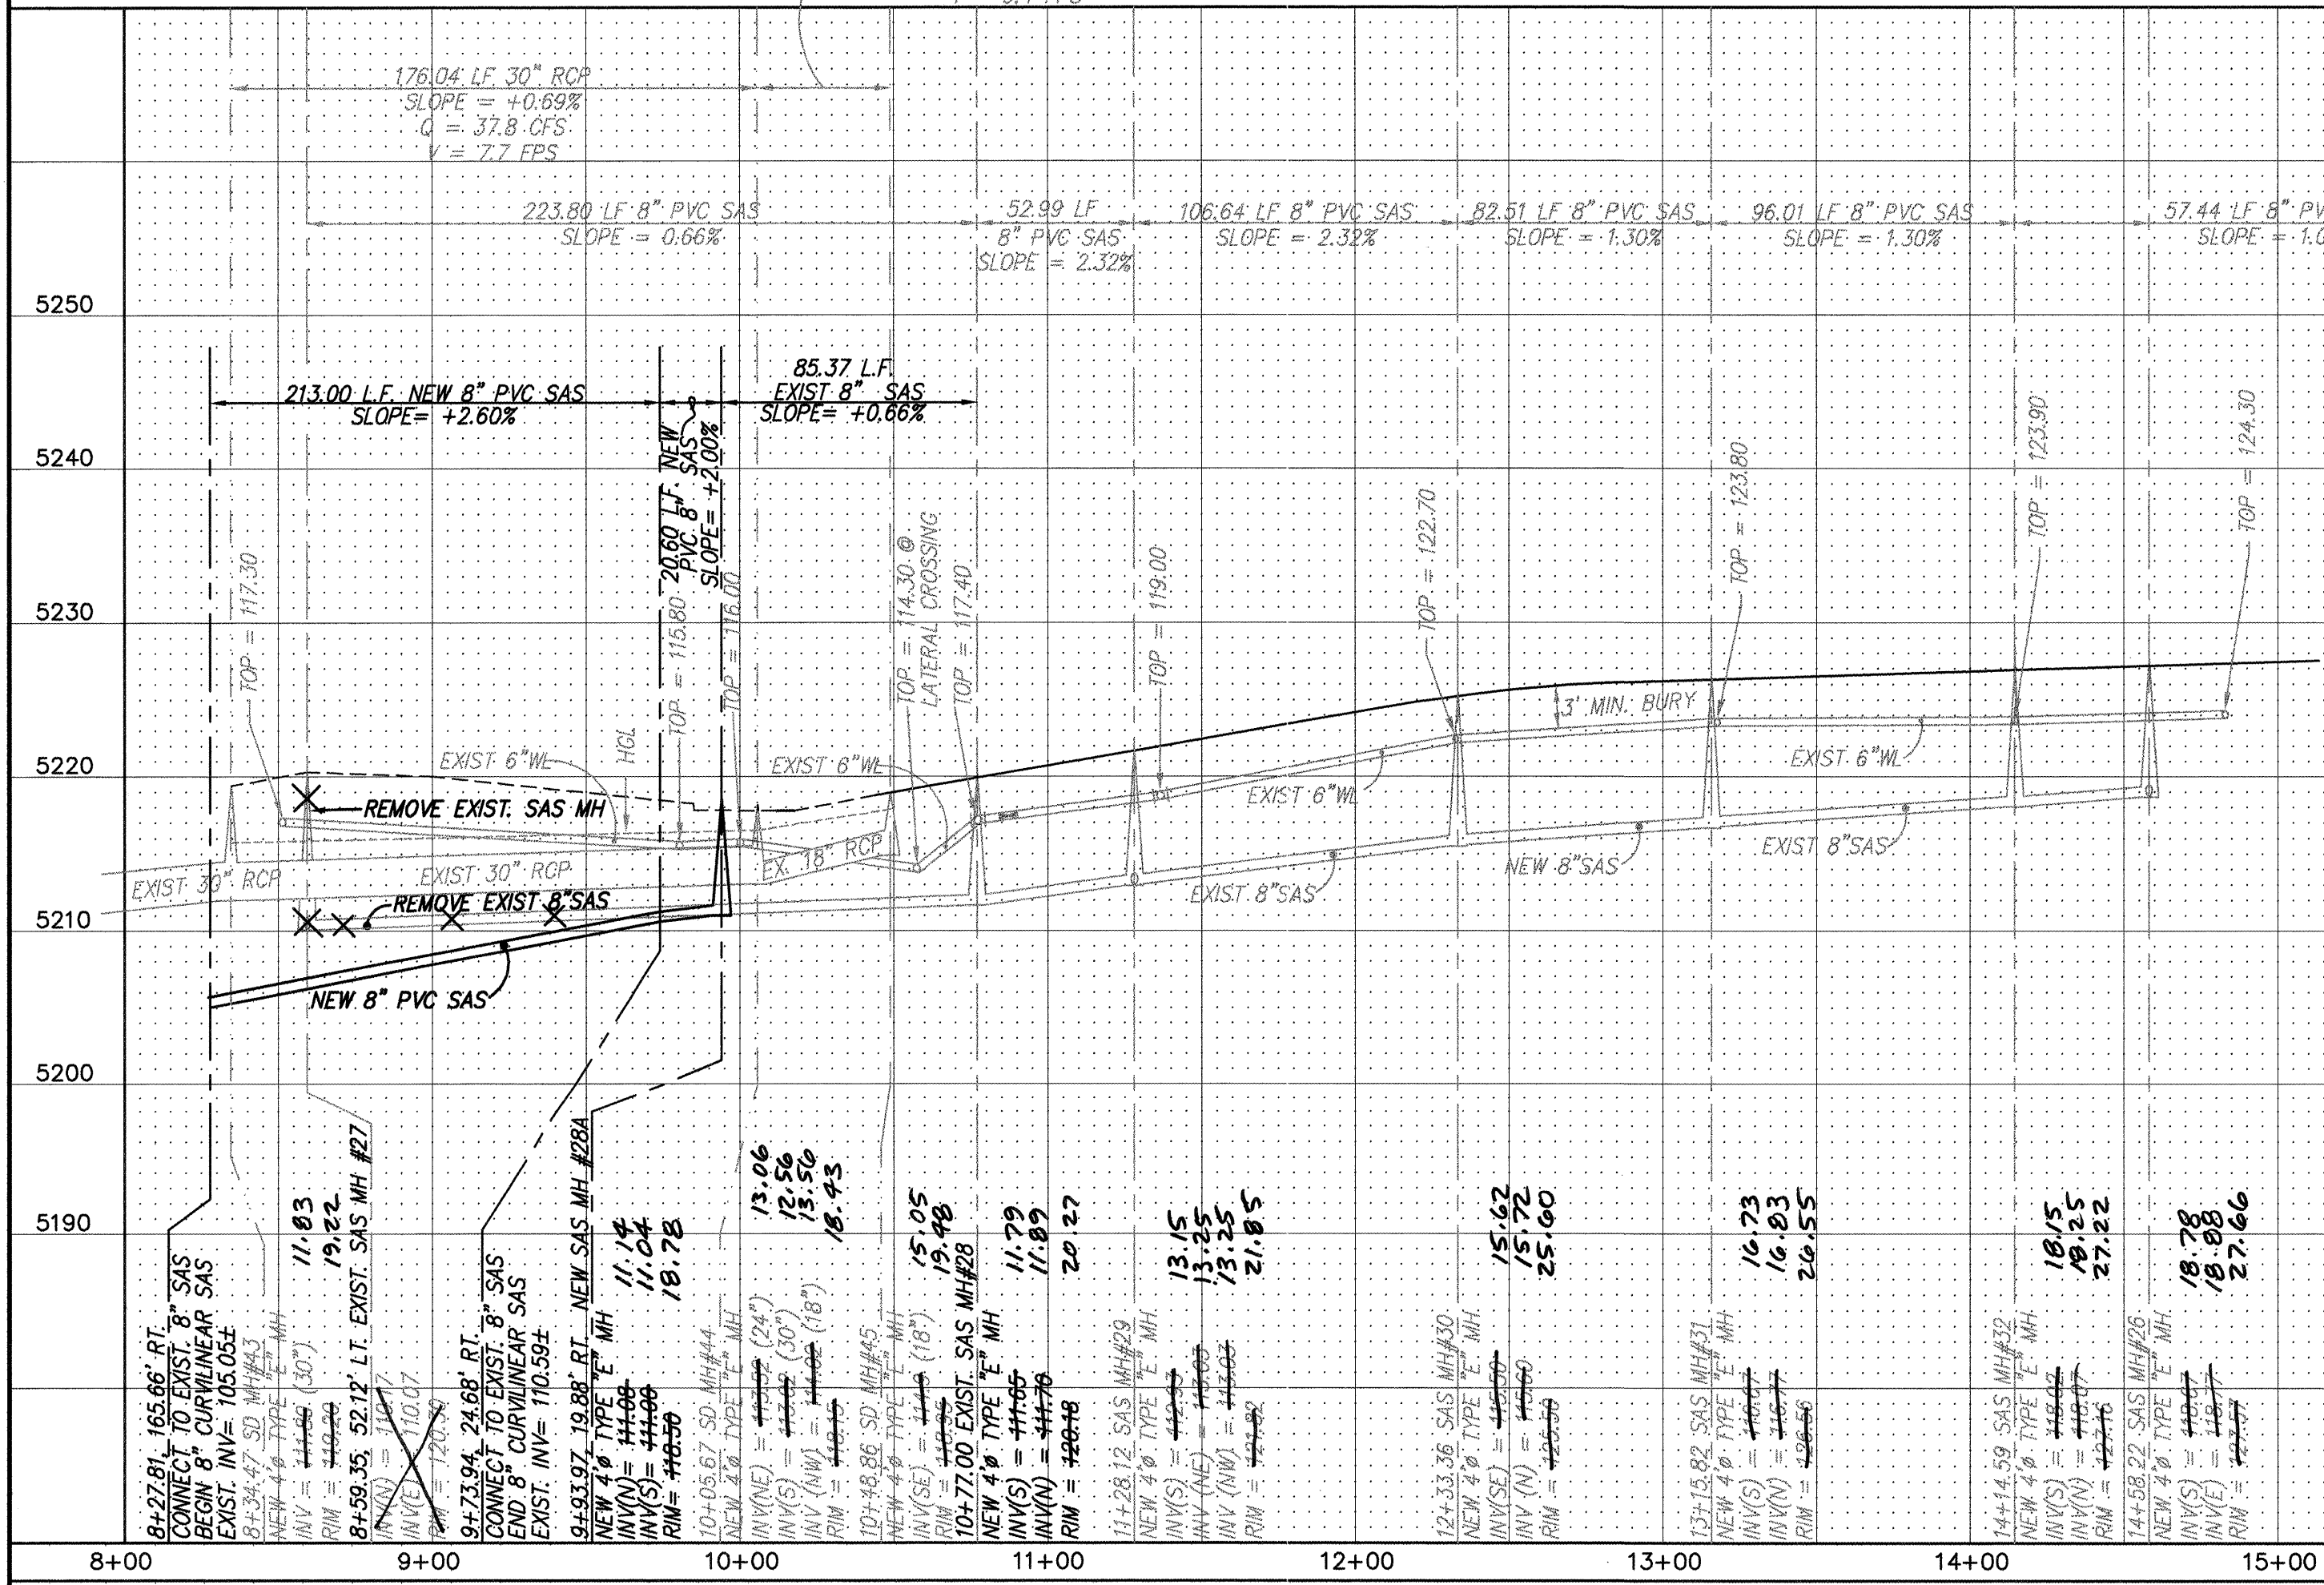

NOTES

1. ALL STATIONING IS CENTERLINE STATIONING.

AS BUILT INFORMATION

CONTRACTOR *Finelines*

WORK STARTED BY *ALC*

DATE *9/10*

INVESTIGATED BY *ALC*

DATE *9/10*

FIELD STATIONING BY *ALC*

DATE *9/10*

DRAWINGS CORRECTED BY *ALC*

DATE *9/10*

MICRO-FILM INFORMATION

RECORDED BY

DATE

NO.

SANITARY SEWER SERVICES - ROUND UP PLACE

BLOCK	LOT	STATION AT PUE	INV. ELEV. AT PUE	LENGTH AT PUE
7	7-P1	144+14.59	25.60	31.52'
7	8-P1	13+84.68	24.73	40.02'
7	9-P1	13+56.26	23.86	41.60'
7	10-P1	13+26.69	22.96	35.28'
7	11-P1	12+89.57	22.00	32.00'
7	13-P1	12+12.05	19.47	35.21'
7	14-P1	11+77.22	18.40	33.27'
7	15-P1	11+16.84	16.58	32.69'
7	16-P1	10+08.92 (64.28' LT)	14.75	78.38'
7	17-P1	9+76.53 (59.73' LT)	14.91	82.31'
7	18-P1	9+59.70 (47.39' LT)	14.58	79.03'
7	19-P1	9+48.96 (30.43' LT)	13.70	68.13'
7	20-P1	9+47.82 (7.29' RT)	13.94	23.00'
7	21-P1	9+69.59 (35.81' RT)	14.38	9.81'
7	22-P1	9+87.98 (43.66' RT)	14.61	16.84'
7	23-P1	10+32.55	13.24	24.68' 35'
7	24-P1	10+65.73	15.97	24.74' 32'
7	25-P1	10+99.45	16.04	33.00'
7	26-P1	11+69.32	18.16	32.00'
7	27-P1	11+94.26	18.92	28.12'

SANITARY SEWER SERVICES - SPUR

BLOCK	LOT	STATION AT PUE	INV. ELEV. AT PUE	LENGTH AT PUE
7	26-P1	11+16.12 (5.40' RT)	17.86	53.72'
7	27-P1	10+76.08 (29.00' LT)	17.44	37.01'
7	28-P1	10+44.92 (29.00' LT)	17.11	37.69'

ENGINEER'S SEAL

ENGINEER'S SEAL

NO. DATE

REMARKS

DESIGN

DRAWN BY

CHECKED BY

DATE

DATE

DATE

1



2/20/01

replace sheet 17 says only



DLH

BY

</

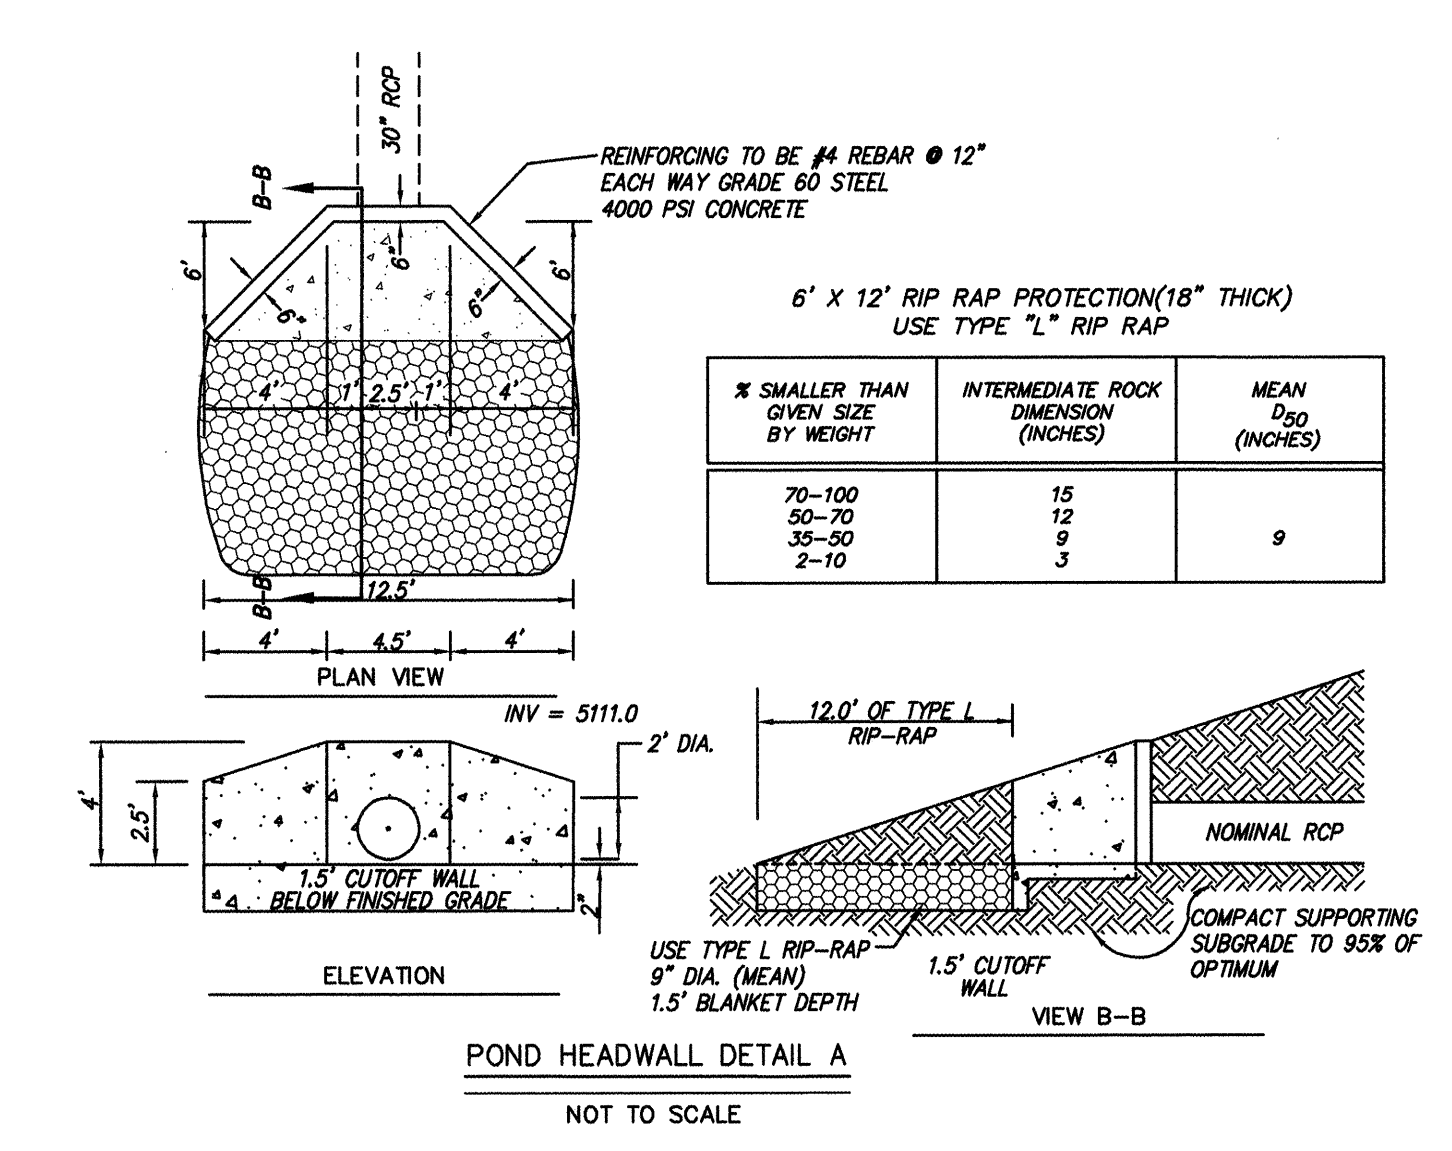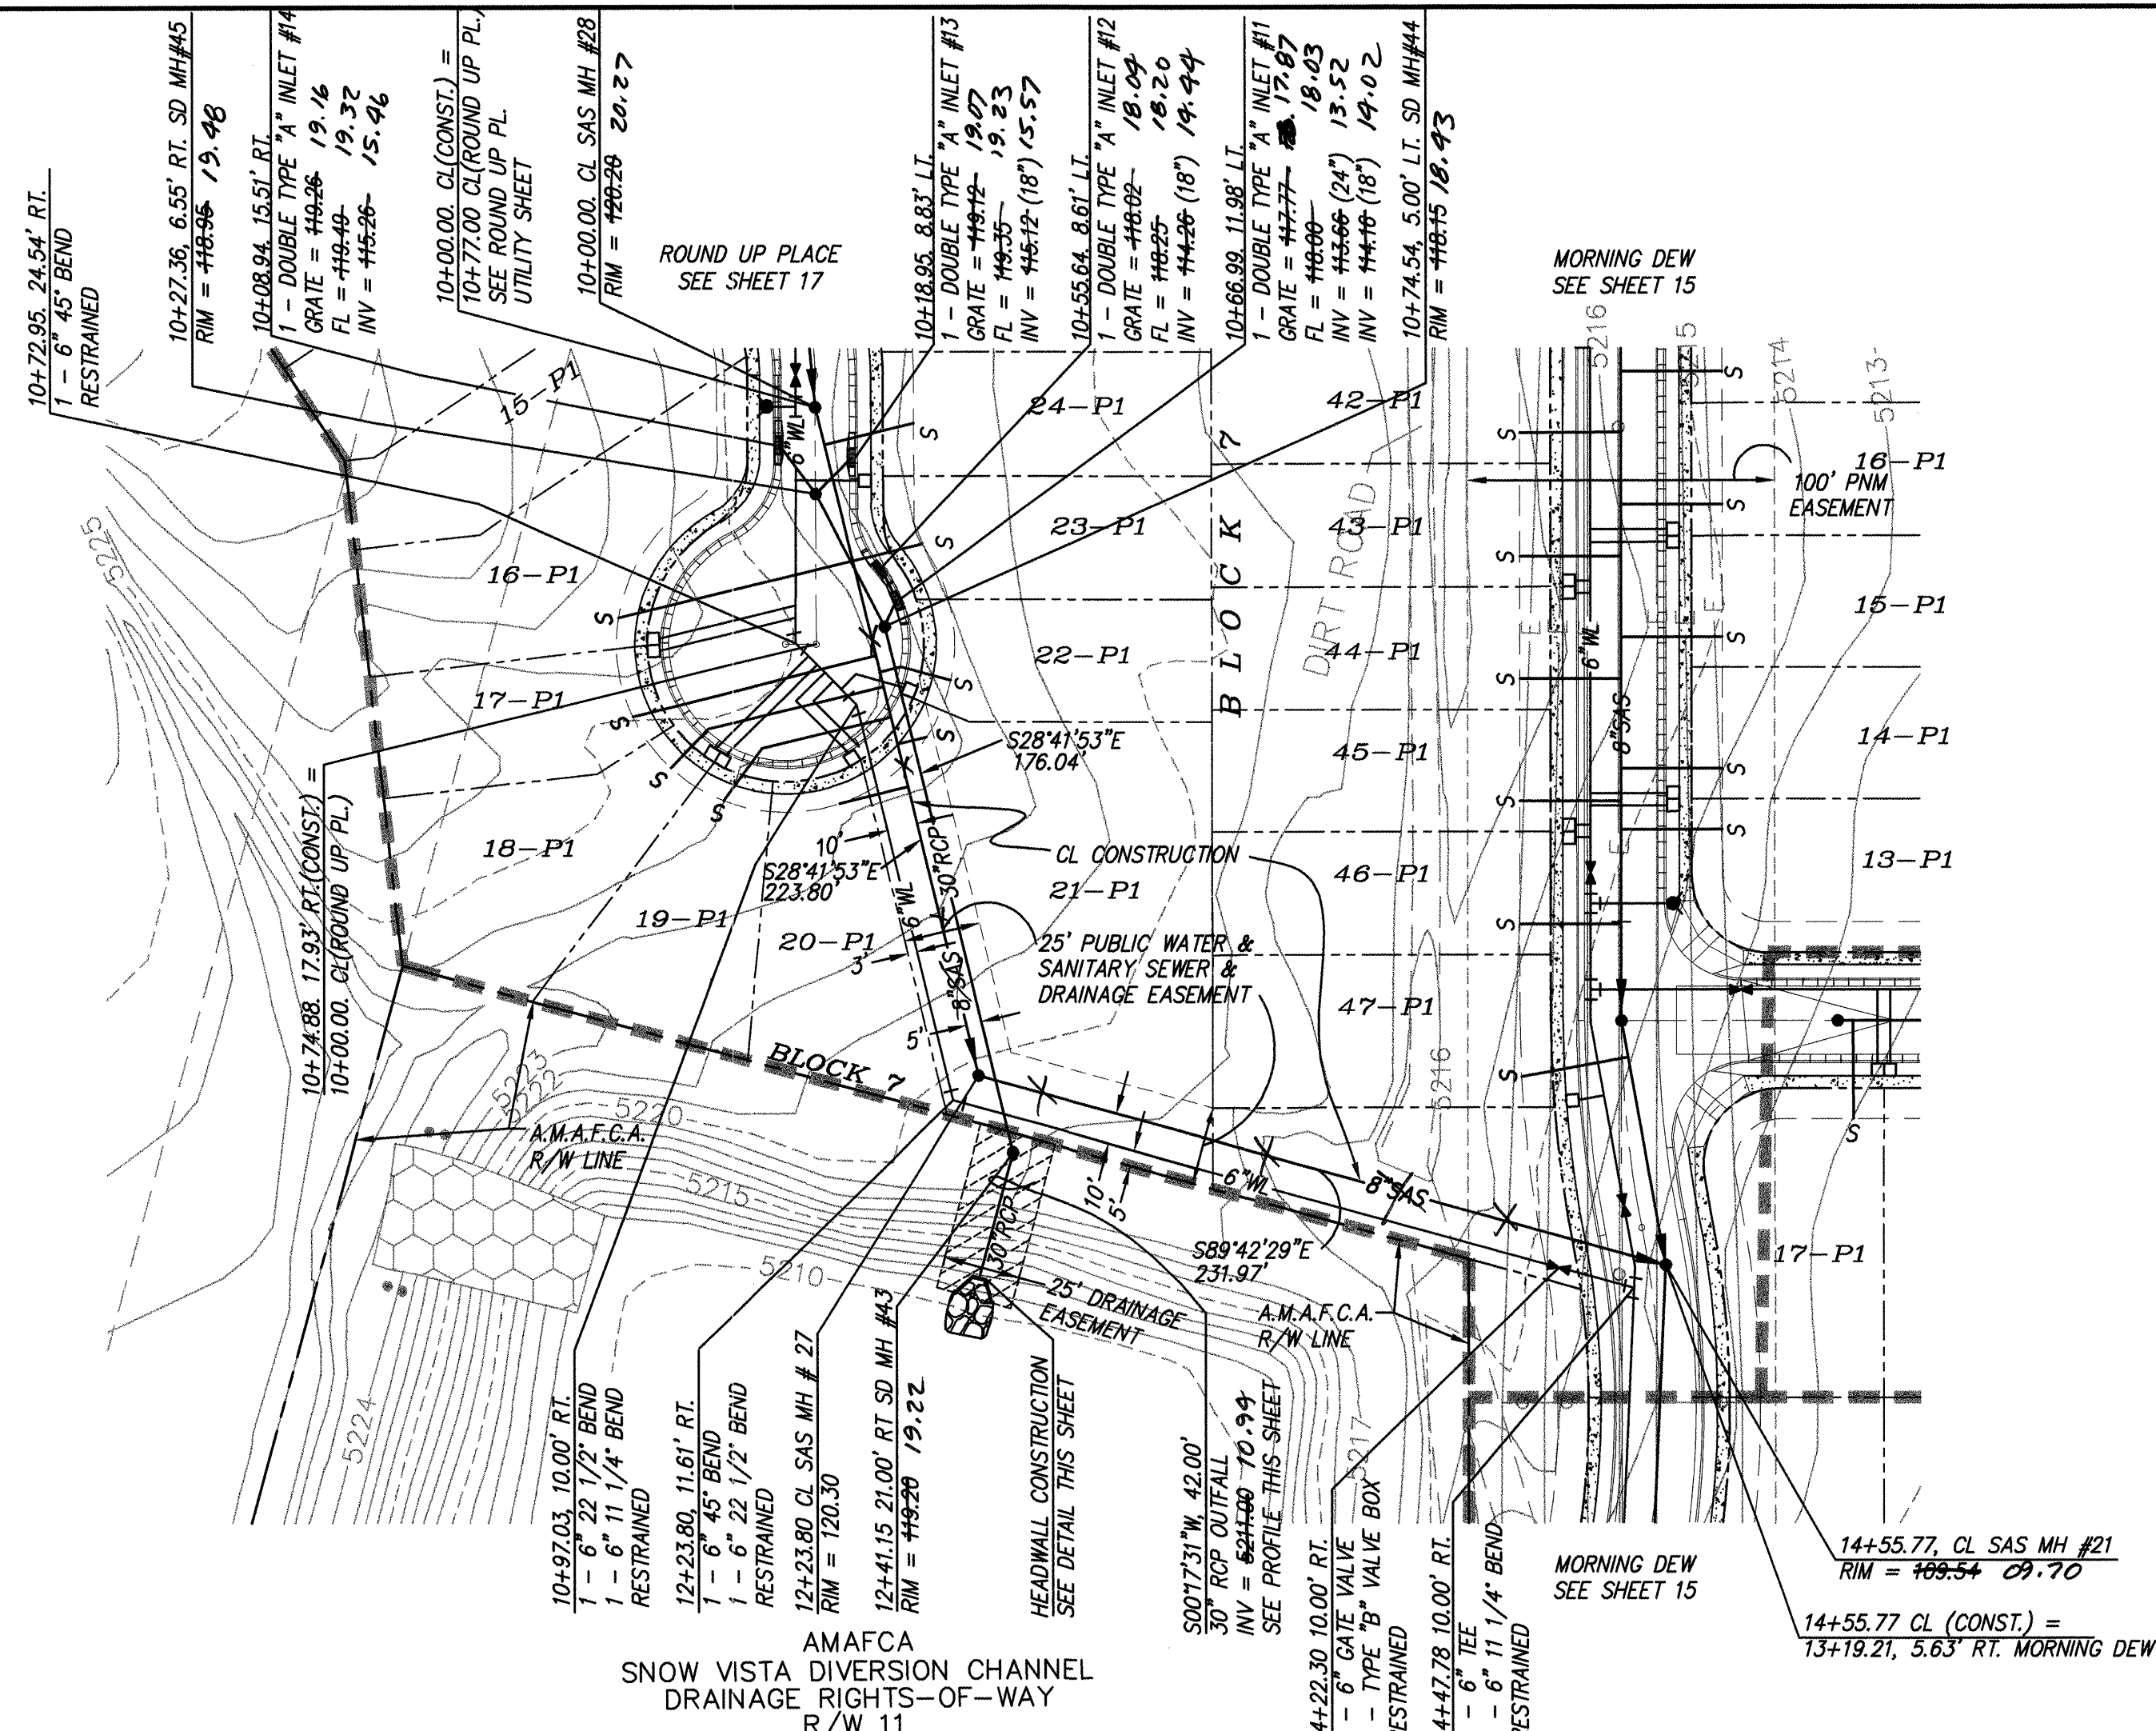

OFFSITE UTILITIES & STORM DRAIN
STA. 9+93.37 TO STA. 14+78.85
SCALE: HORIZ. 1" = 50'
VERT. 1" = 10'

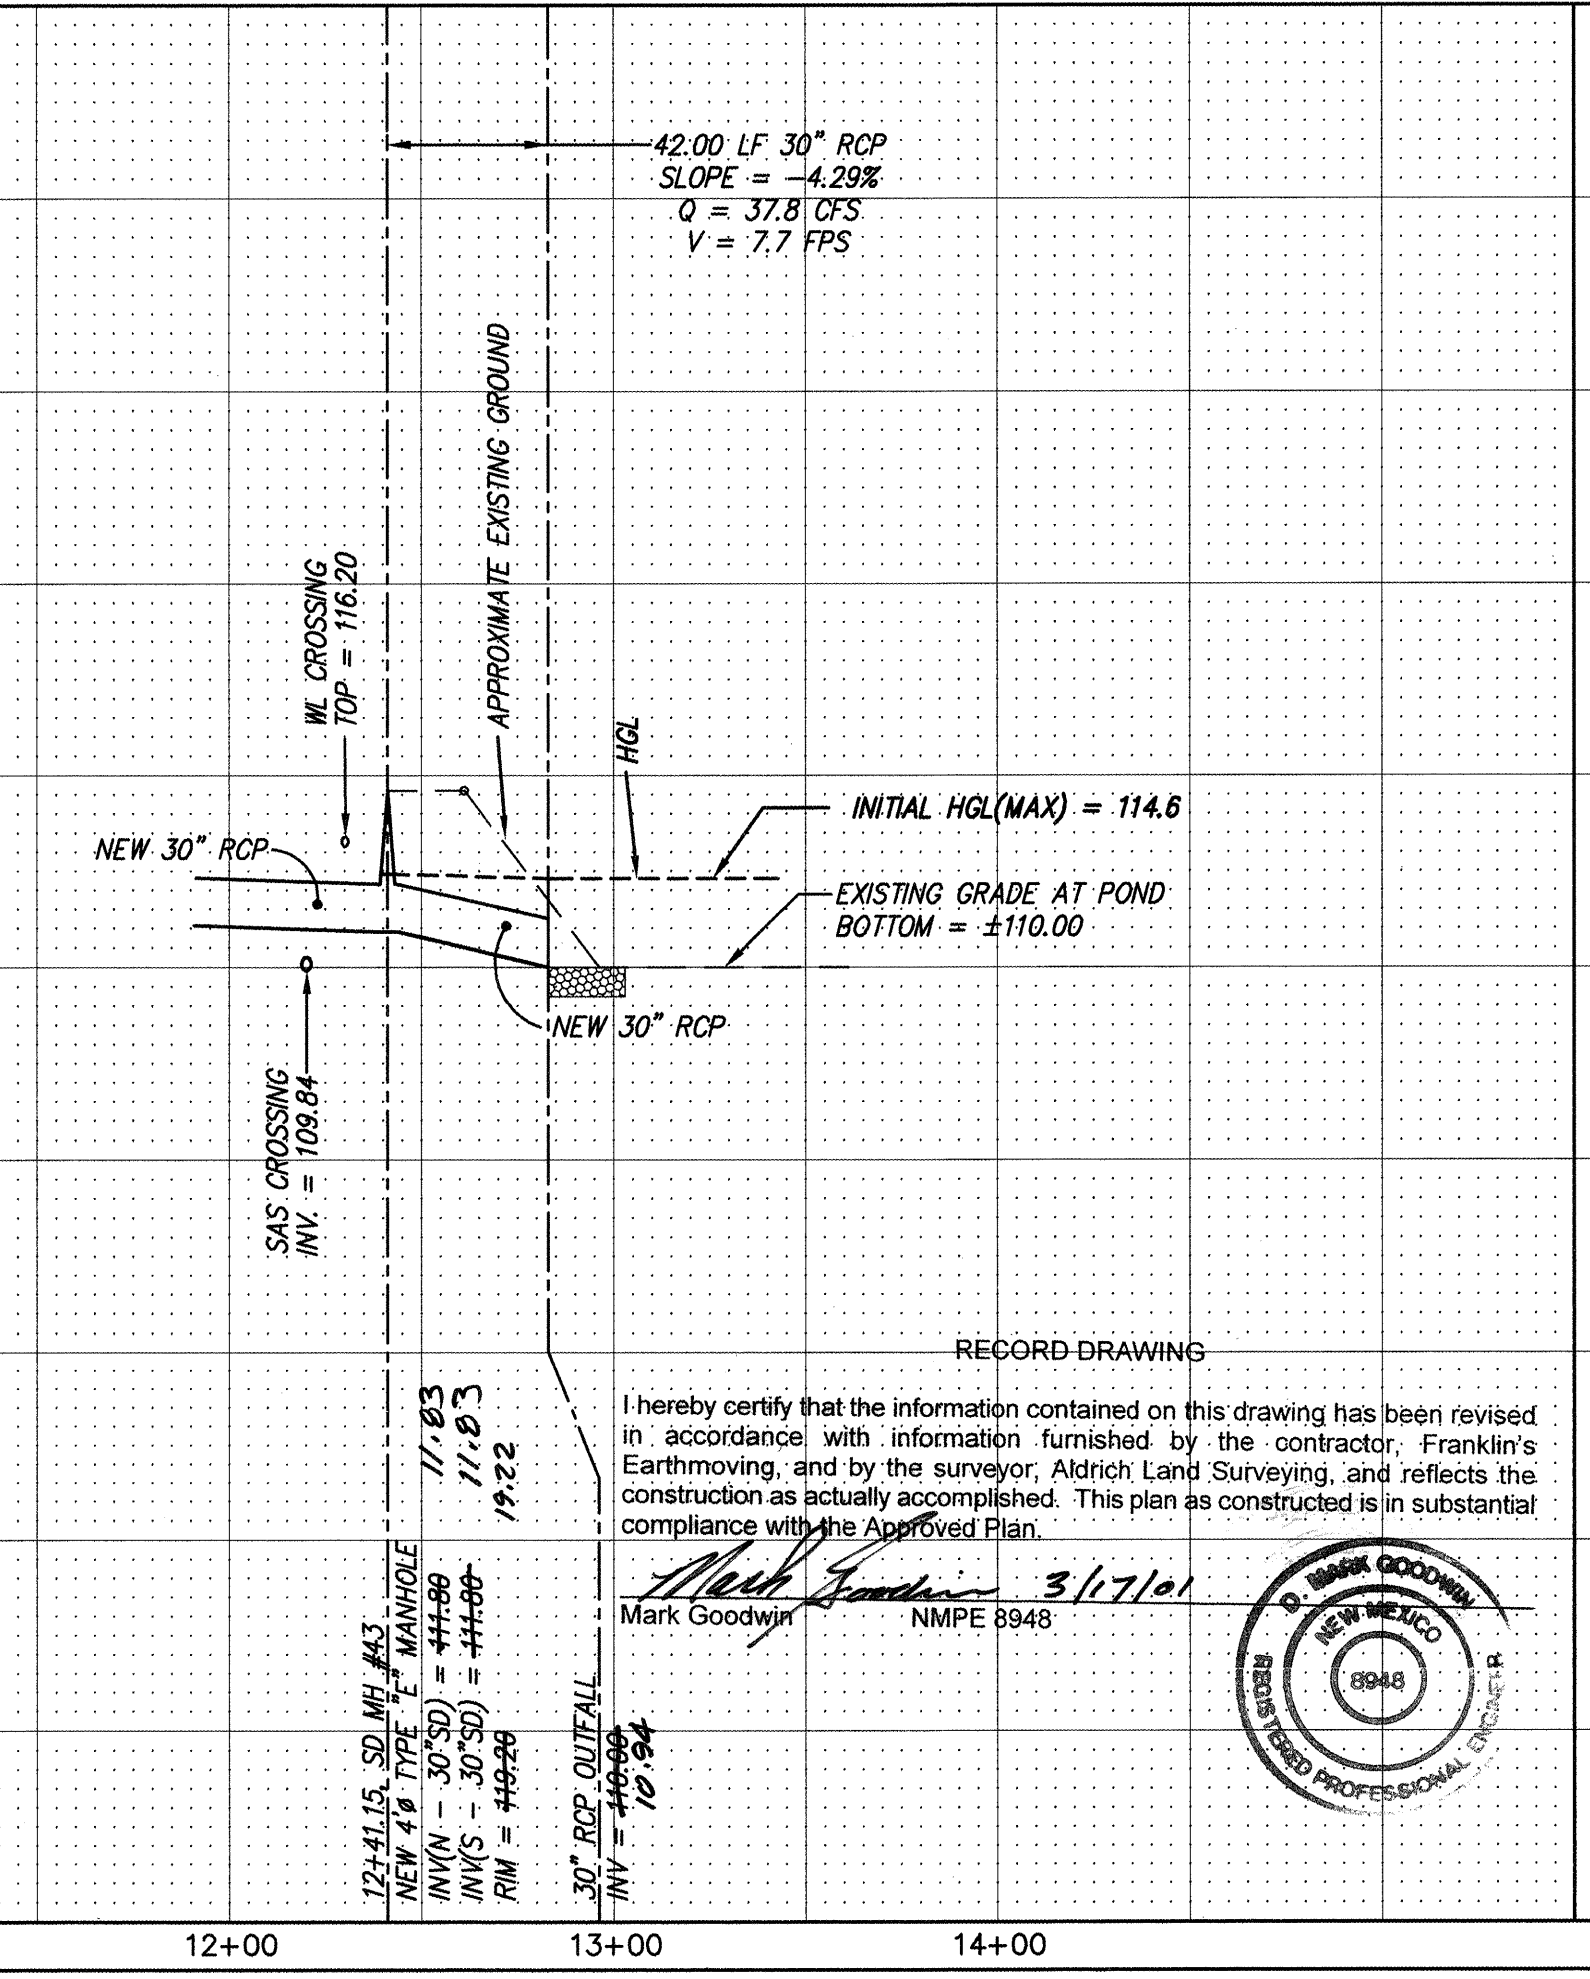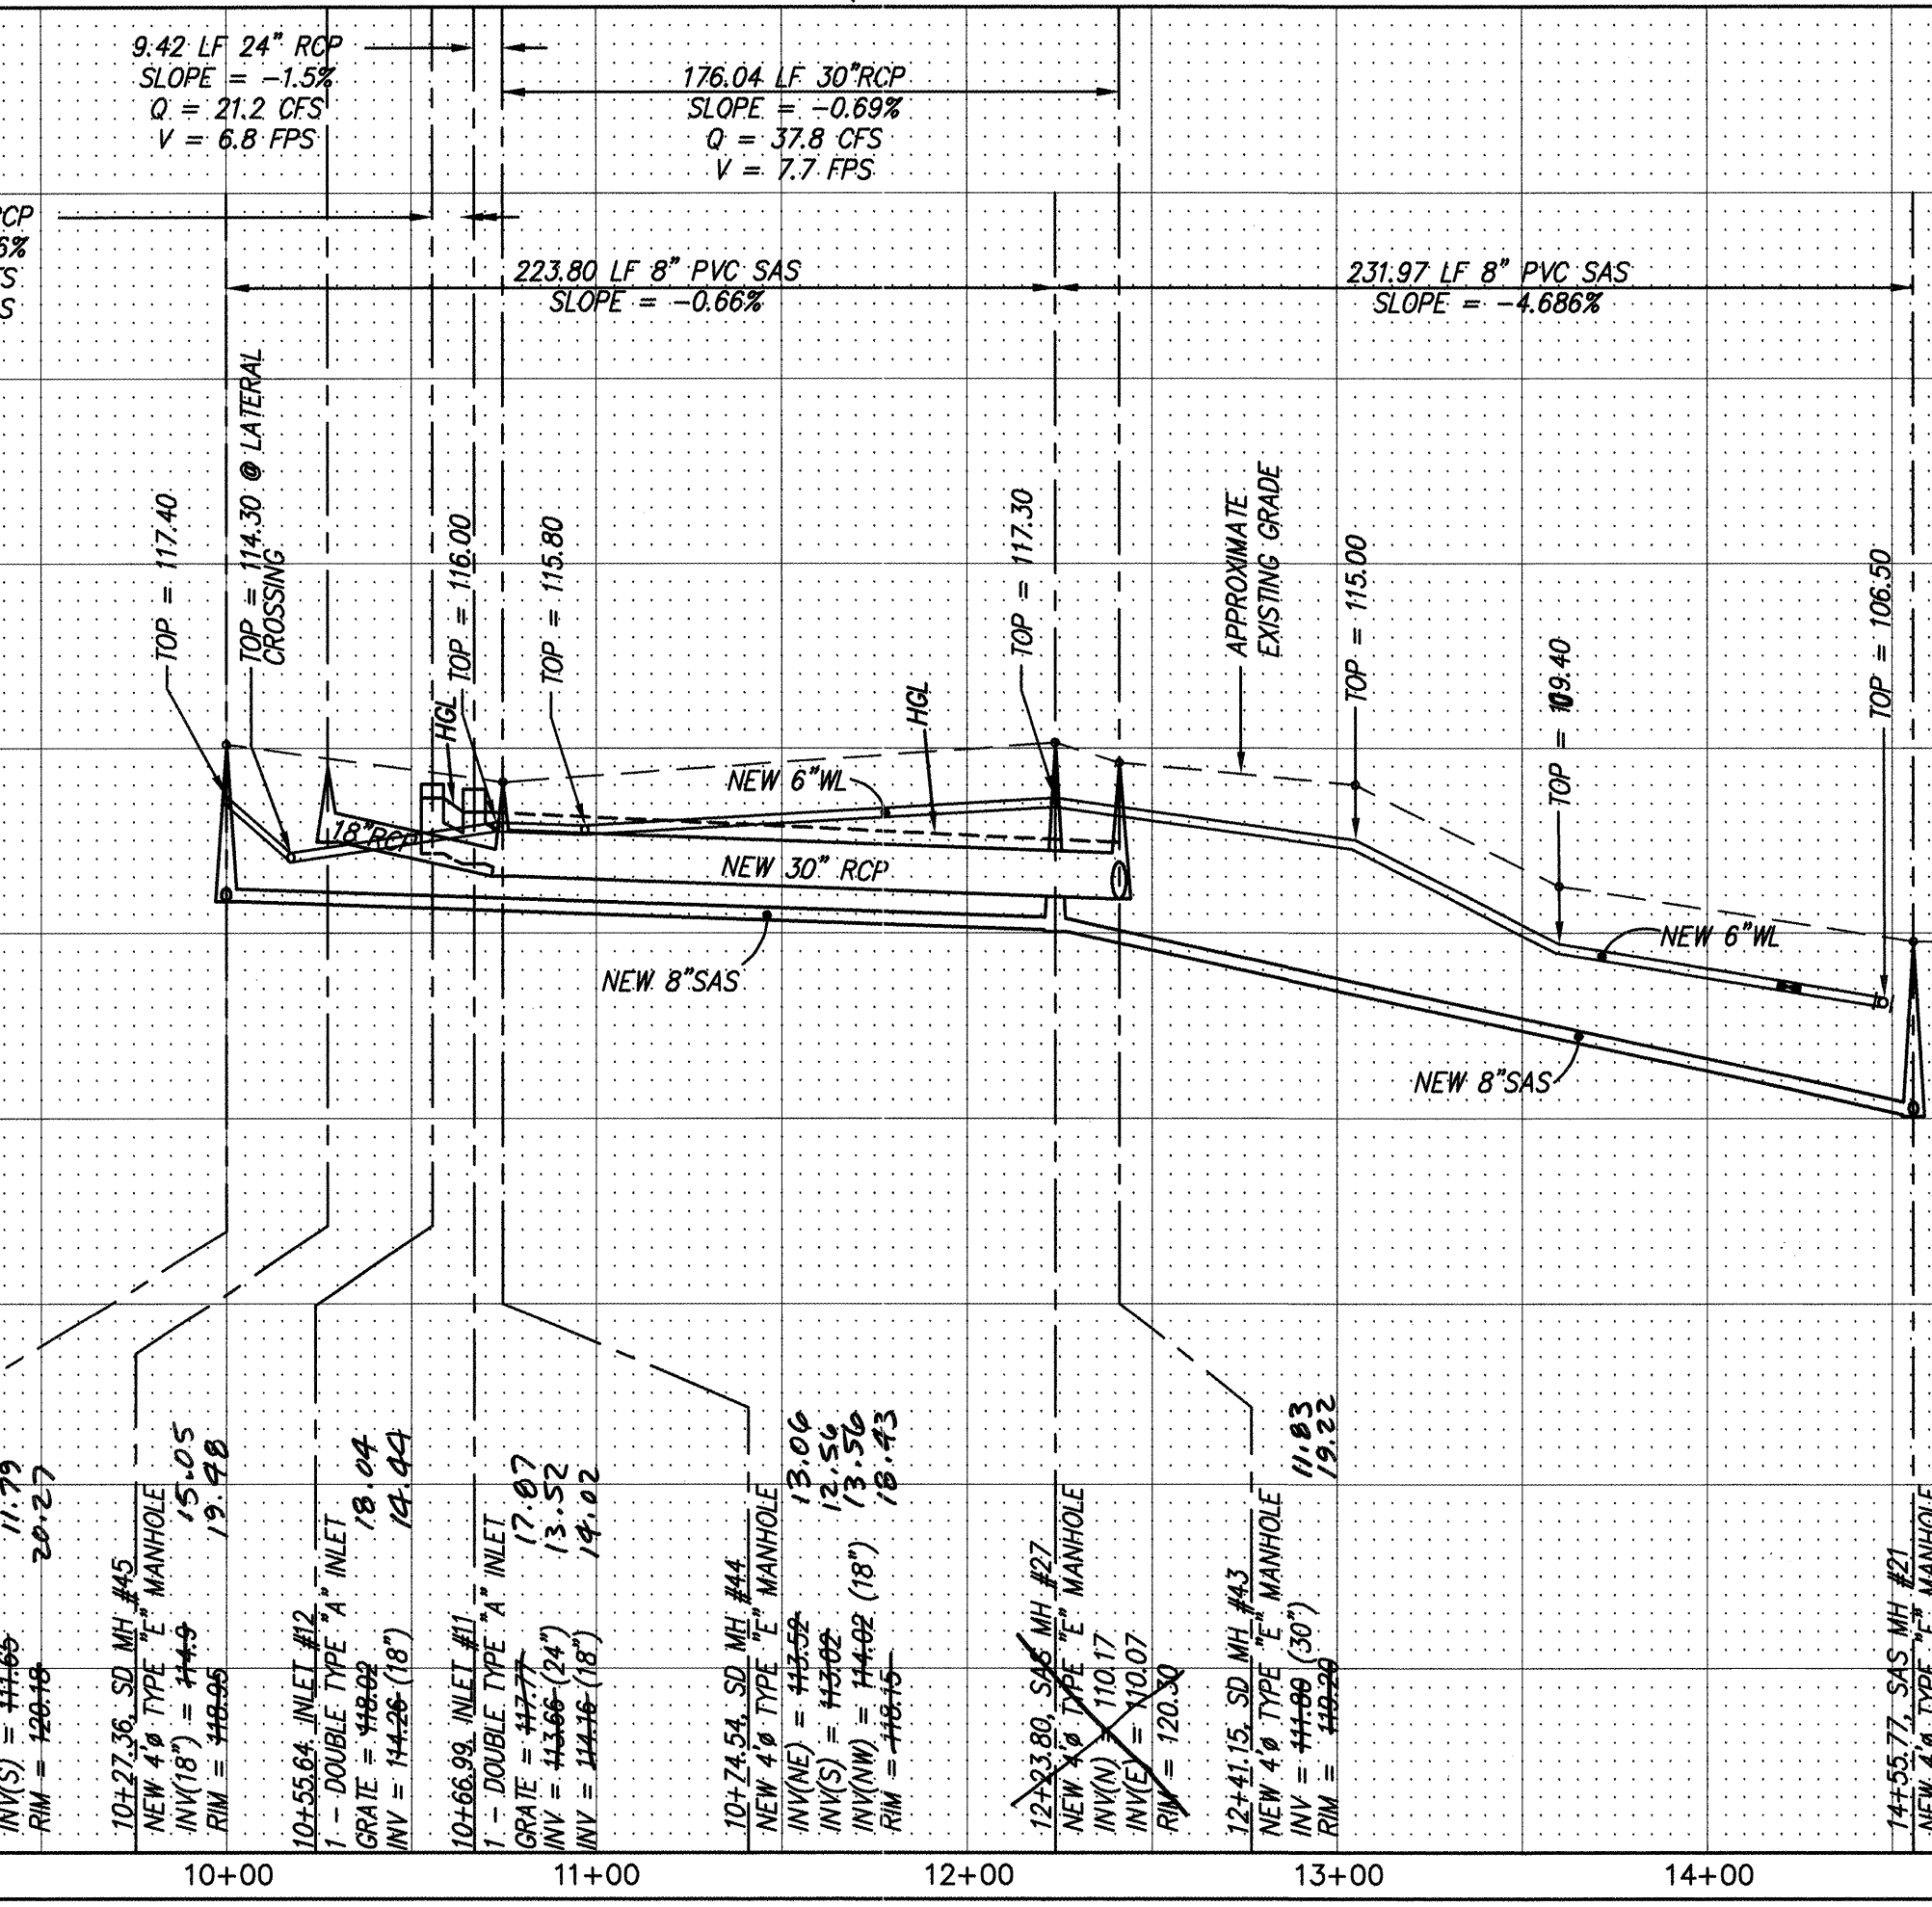

NOTES

- ALL STATIONING IS CENTERLINE STATIONING.

NOTES

- AMAFCA FIELD ENGINEER SHALL BE NOTIFIED 48-HOURS PRIOR TO ANY WORK WITHIN THE AMAFCA R/W. TEL 884-2215 JERRY LOVATO.
- NO WORK WILL BE PERFORMED IN THE AMAFCA R/W BETWEEN APRIL 15 AND OCTOBER 15 WITHOUT WRITTEN PERMISSION FROM AMAFCA.
- ALL SUBGRADE, BACKFILL AND EMBANKMENT SHALL BE COMPACTED TO 95% (MODIFIED PROCTOR) WITHIN AMAFCA R/W. TESTING REPORTS SHALL BE PROVIDED TO AMAFCA FIELD ENGINEER.
- AMAFCA FIELD ENGINEER WILL BE NOTIFIED 48-HOURS PRIOR TO FINAL INSPECTION OF ANY FACILITIES WITHIN THE AMAFCA R/W.

APPROVED FOR CONSTRUCTION

Donald Skiff 11/18/00
FOR AMAFCA DATE

RESTRAINED JOINT LENGTH FOR BENDS, VALVES, DEAD ENDS (FT.)

PIPE SIZE	90°	45°	22.5°	11.25°	VALVE
6"	17'	7'	3'	2'	46'
8"	22'	9'	4'	2'	72'
10"	26'	11'	5'	3'	72'

LENGTH OF RESTRAINED PIPE ON EACH SIDE OF THE BEND. RESTRAIN BRANCH AT FITTING ONLY MINIMUM ATTACHED PIPE LENGTH, RUN SIDE OF TEE: 10.00 FEET.

RESTRAINED JOINT LENGTH FOR TEES (FT.)

PIPE SIZE	RUN	BRANCH
10"x10"x6"	6'	1'
8"x8"x6"	7'	2'
6"x6"x6"	10'	2'

MARK GOODWIN & ASSOCIATES, P.A.
CONSULTING ENGINEERS
P.O. BOX 90606
ALBUQUERQUE, NEW MEXICO 87199
(505) 828-2200, FAX (505) 797-9539

**CITY OF ALBUQUERQUE
PUBLIC WORKS DEPARTMENT
ENGINEERING DEVELOPMENT GROUP**

TITLE: **SUNRISE RANCH - UNIT 2
OFFSITE UTILITY & STORM DRAIN
UTILITY & STORM DRAIN IMPROVEMENTS**

DESIGN REVIEW COMMITTEE CITY ENGINEER APPROVAL

NOV 29 2000 DEC 15 2000

CITY PROJECT NO. **645281** ZONE MAP NO. **L-8, L-9** SHEET **18** OF **20**

CURVE DATA - DESCRIBES CURVILINEAR 8" SAS

CONSTRUCTION NOTES FOR CURVILINEAR PVC PIPE INSTALLATION:

TOTAL CURVILINEAR LENGTH=213 FEET.
USE (10)-20' JOINT LENGTHS AT A DEFLECTION OF 5 DEG. 43 MINS. 43 SECS.
(1)-13' JOINT LENGTH OF DEFLECTION OF 3 DEG. 43 MINS. 23 SECS.
MECHANICAL MEANS SHOULD NOT BE USED TO ACCOMPLISH THE RADII.
IT IS THE INTENT THIS SHOULD BE ACCOMPLISHED MANUALLY IN THE TRENCH
BY THE WORKERS. THE CURVE SHOULD BE ACCOMPLISHED BY BENDING THE PIPE
RATHER THAN DEFLECTING THE JOINTS. OVERBELLING OF THE JOINTS SHOULD
BE AVOIDED.

AMAFCA
SNOW VISTA DIVERSION CH.
DRAINAGE RIGHTS-OF-W
R/W 11
(08-03-88, C37-26)

OFFSITE UTILITIES & STORM DRAIN
STA. 9+93.37 TO STA. 14+78.85
SCALE: HORZ. 1" = 50'
VERT. 1" = 10'

NOTES

1. ALL STATIONING IS CENTERLINE STATIONING.

NOTES

1. AMAFCA FIELD ENGINEER SHALL BE NOTIFIED 48-HOURS PRIOR TO ANY WORK WITHIN THE AMAFCA R/W. TEL 884-2215 JERRY LOVATO.
2. NO WORK WILL BE PERFORMED IN THE AMAFCA R/W BETWEEN APRIL 15 AND OCTOBER 15 WITHOUT WRITTEN PERMISSION FROM AMAFCA.
3. ALL SUBGRADE, BACKFILL AND EMBANKMENT SHALL BE COMPACTED TO 95% (MODIFIED PROCTOR) WITHIN AMAFCA FIELD ENGINEER'S SHALL BE PROVIDED TO AMAFCA FIELD ENGINEER.
4. AMAFCA FIELD ENGINEER WILL BE NOTIFIED 48-HOURS PRIOR TO FINAL INSPECTION OF ANY FACILITIES WITHIN THE AMAFCA R/W.

APPROVED FOR CONSTRUCTION

FOR AMAFCA

DATE _____

SURVEY INFORMATION			BENCH MARKS	AS BUILT INFORMATION		
NO.	FIELD NOTES			CONTRACTOR	WORK STARTED BY	DATE
			ACS MONUMENT "9-19". THE STATION IS LOCATED 5.3 MILES SOUTHWEST OF DOWNTOWN ALBUQUERQUE. TO REACH THE STATION FROM THE INTERSECTION OF I-40 AND 98TH ST., TRAVEL SOUTH ON 98TH ST. 1.3 MILES TO THE STATION ON THE LEFT. THE STATION IS 49.2' EAST OF THE CENTERLINE OF 98TH ST., AND IS 0.13 MILES NORTH OF RIND CT., S.W.	<i>F-Tank Inc's</i>	<i>ALCS</i>	<i>10/1</i>
			THE STATION IS AN ACS 3 1/4" ALUM. CAP RIWETTED TO A PIPE 0.25" ABOVE GROUND AND IS STAMPED "9-19, 1089".		<i>ALCS</i>	<i>9/10</i>
			X = 353,055.34 Y = 1,460,156.08 ELEV. = 5187.036		<i>ALCS</i>	<i>9/10</i>
					<i>MGBH</i>	<i>8/10</i>
				<i>MICRO-FILM INFORMATION</i>		
				RECORDED BY		DATE
				NO.		

[illegible]

PIPE SIZE	90°	45°	22.5°	11.25°	VALVE
6"	17'	7'	3'	2'	46'
8"	22'	9'	4'	2'	72'
10"	26'	11'	5'	3'	72'

LENGTH OF RESTRAINED PIPE ON EACH SIDE OF THE BEND. RESTRAIN BRANCH AT FITTING ONLY MINIMUM ATTACHED PIPE LENGTH, RUN SIDE OF TEE: 10.00 FEET.

RESTRAINED JOINT LENGTH FOR TEES (FT.)		
PIPE SIZE	RUN	BRANCH
10"x10"x6"	6'	1'
8"x8"x6"	7'	2'
6"x6"x6"	10'	2'




dmg MARK GOODWIN & ASSOCIATES, P.A.
CONSULTING ENGINEERS
P.O. BOX 90606
ALBUQUERQUE, NEW MEXICO 87199
(505) 828-2200, FAX (505) 797-9539

	CITY OF ALBUQUERQUE PUBLIC WORKS DEPARTMENT ENGINEERING DEVELOPMENT GROUP
	TITLE: <i>SUNRISE RANCH - UNIT 2 OFFSITE UTILITY & STORM DRAIN UTILITY & STORM DRAIN IMPROVEMENTS</i>

DESIGN REVIEW COMMITTEE	CITY ENGINEER APPROVAL	LAST DESIGN UPDATE	MO./DAY/YR.	MO./DAY/YR.

0022\UNIT2\0022ut13A\02-14-00\MJR NHM KJS

CITY PROJECT NO. 645281	ZONE MAP NO. L-8, L-9	SHEET OF 18A 20
-----------------------------------	---------------------------------	---------------------------

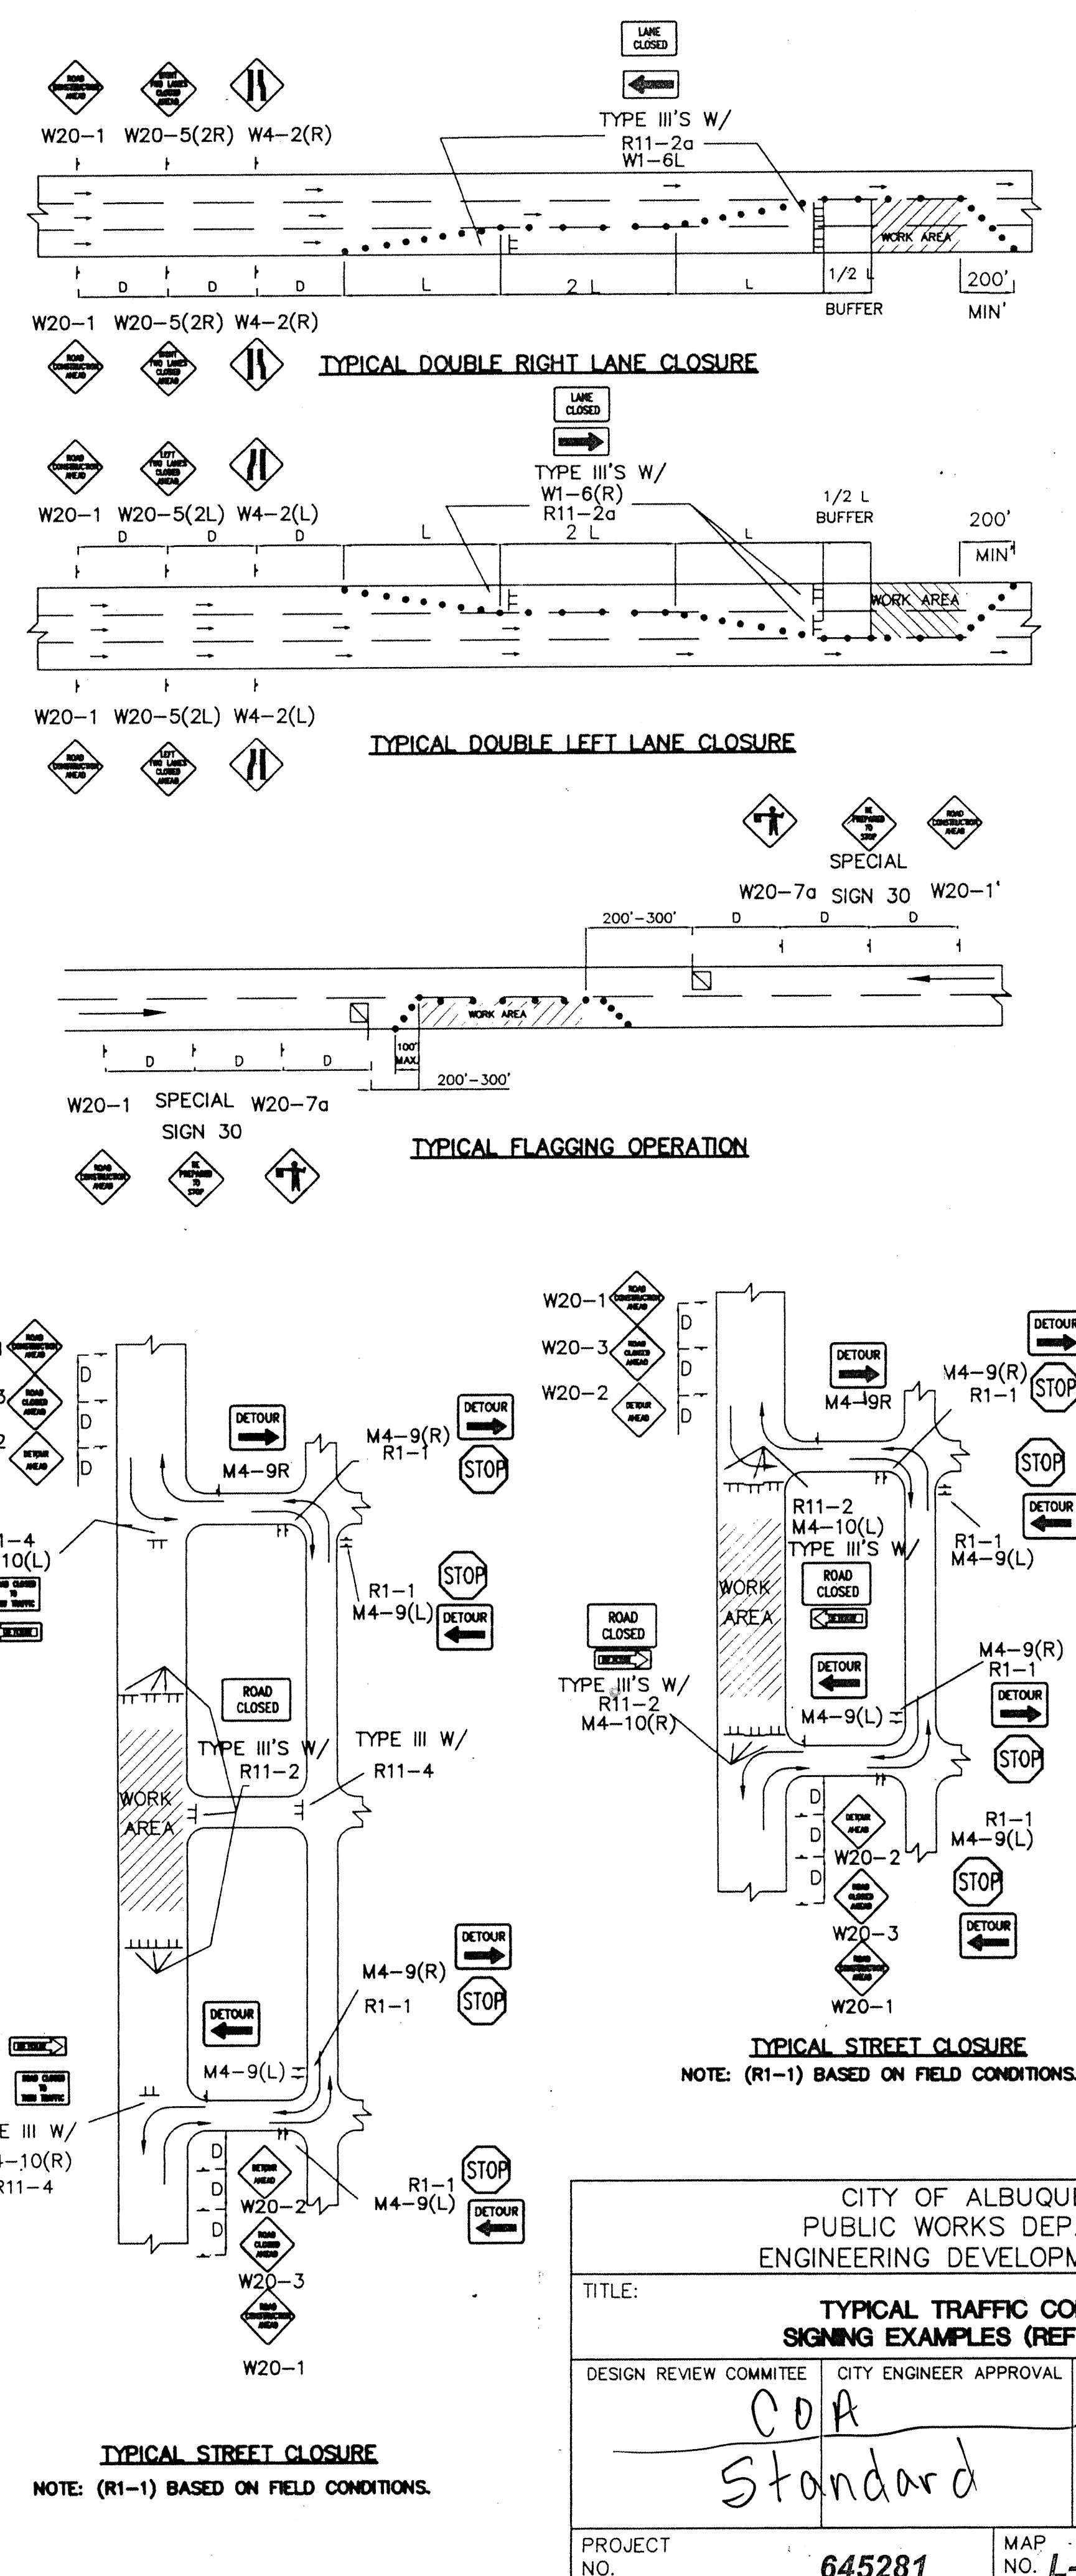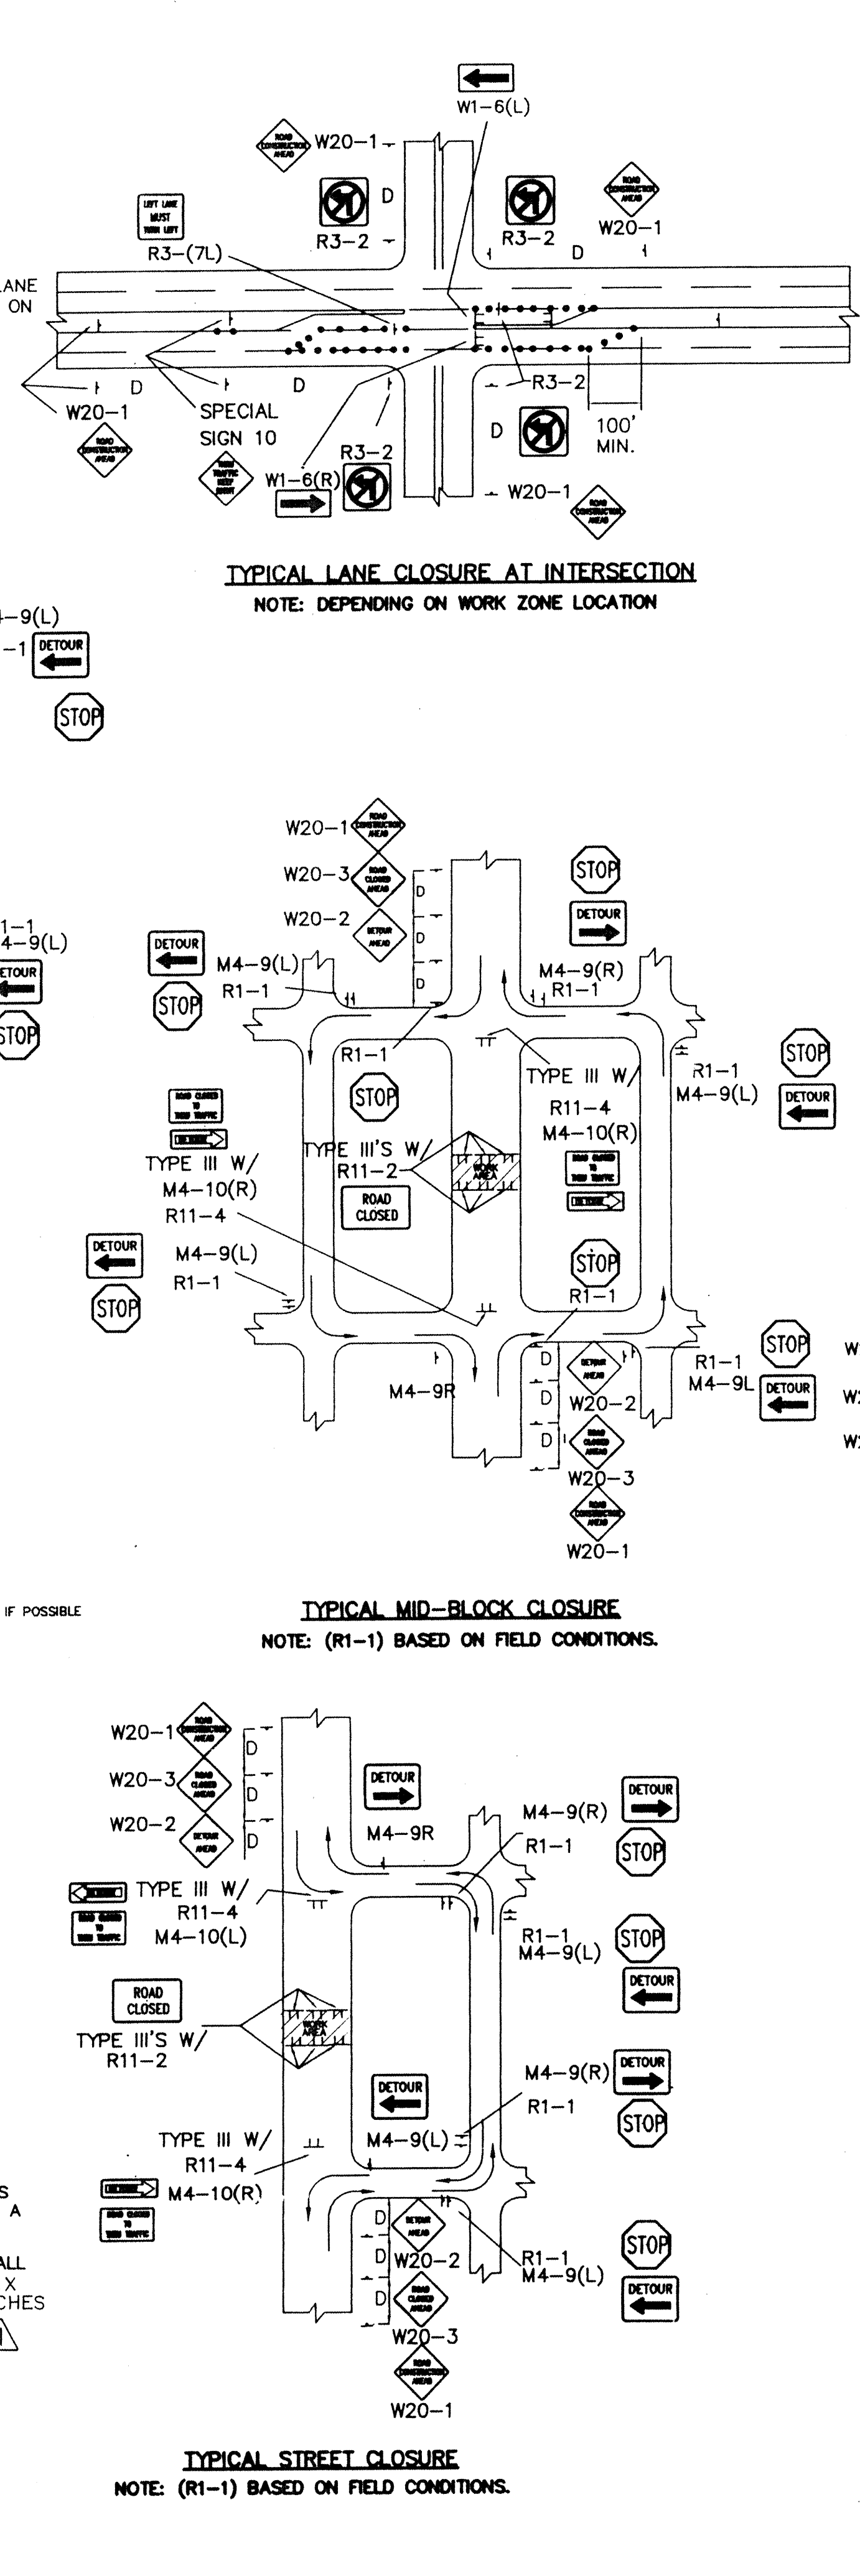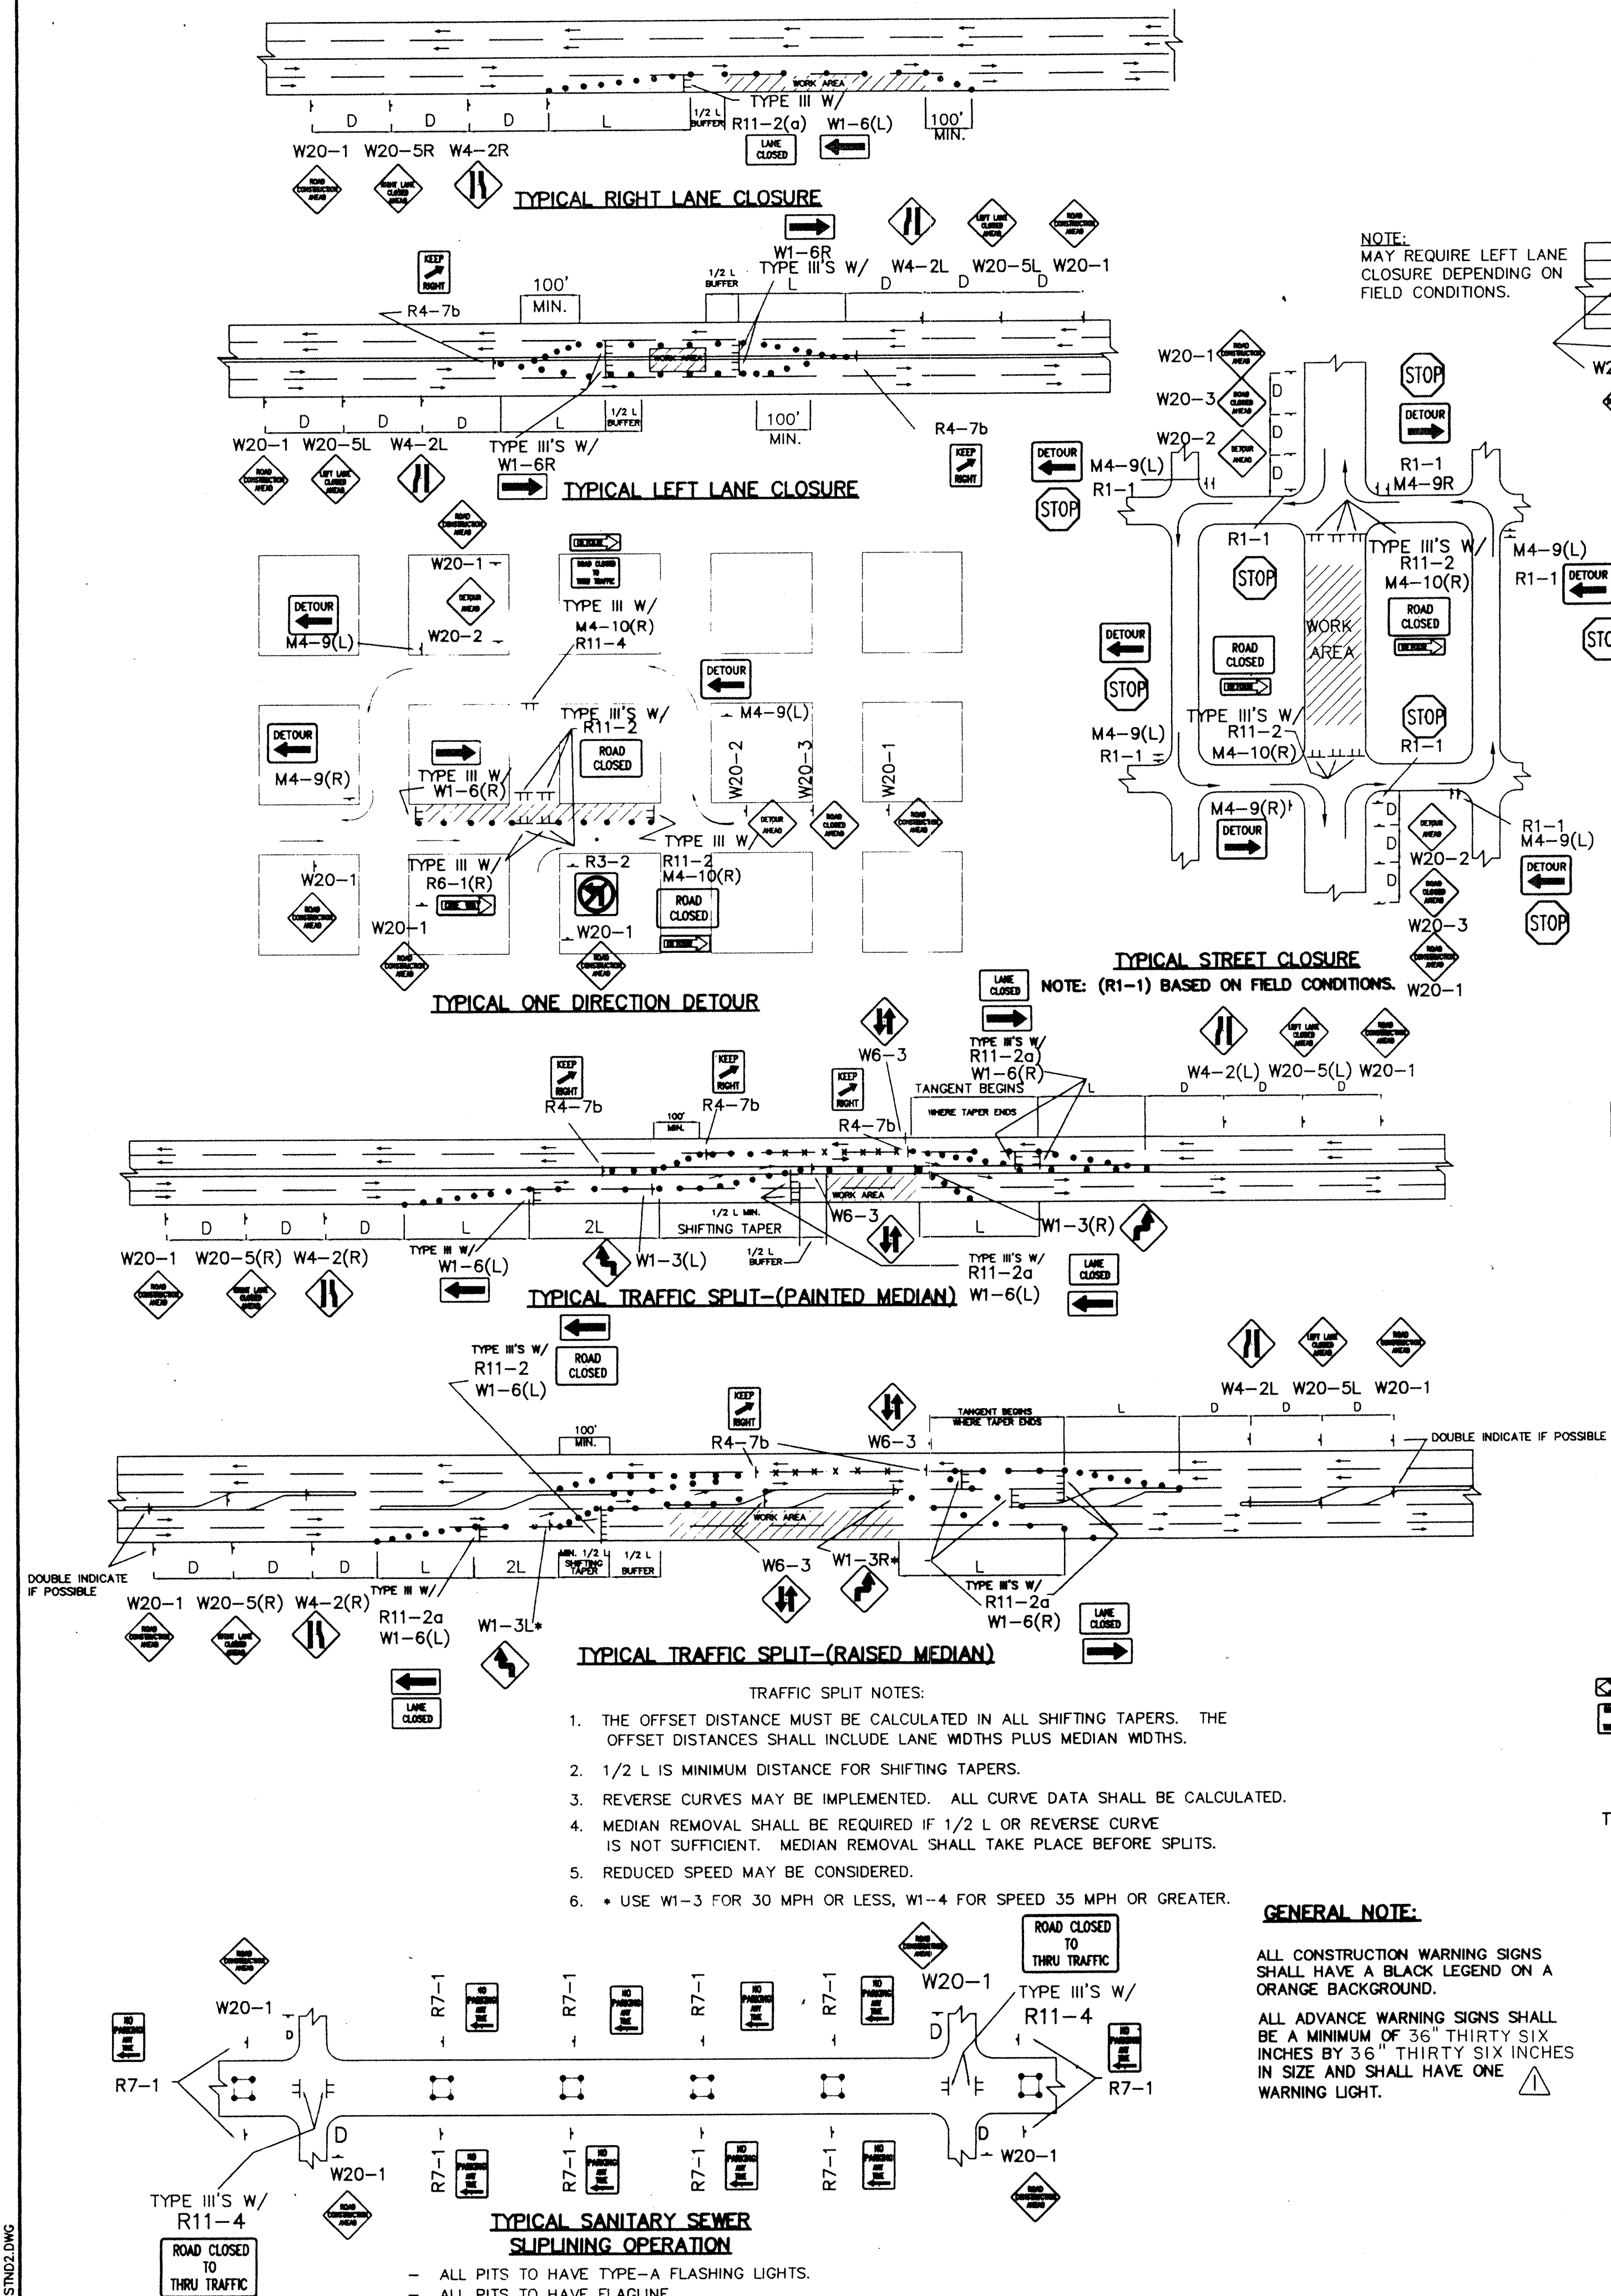

CITY OF ALBUQUERQUE
PUBLIC WORKS DEPARTMENT
ENGINEERING DEVELOPMENT GROUP

TITLE: **TYPICAL TRAFFIC CONTROL & SIGNING EXAMPLES (REF. M.U.T.C.D.)**

DESIGN REVIEW COMMITTEE: **COA**
CITY ENGINEER APPROVAL: **Standard**

PROJECT NO. **645281** MAP NO. **L-8/9** SHEET **20** OF **20**

AS BUILT INFORMATION		BENCH MARKS		SURVEY INFORMATION		ENGINEER'S SEAL	
CONTRACTOR	DATE	NO.	DATE	FIELD NOTES	NO.	DATE	DATE
WORK	DATE	NO.	DATE	NO.	DATE	DATE	DATE
SUBMITTALS	DATE	NO.	DATE	NO.	DATE	DATE	DATE
ACCEPTANCE BY	DATE	NO.	DATE	NO.	DATE	DATE	DATE
VERIFICATION BY	DATE	NO.	DATE	NO.	DATE	DATE	DATE
DRAWINGS	DATE	NO.	DATE	NO.	DATE	DATE	DATE
CORRECTED BY	DATE	NO.	DATE	NO.	DATE	DATE	DATE
MICRO-FILM INFORMATION	DATE	NO.	DATE	NO.	DATE	DATE	DATE
RECORDED BY	DATE	NO.	DATE	NO.	DATE	DATE	DATE