

SCANNED BY
MESA REPRO

APPROVAL OF RECORD DRAWINGS
CHIEF CONSTRUCTION ENGINEER
Peter Chang
DATE 5/29/02



This is a detailed plat map of a portion of the City of Miami, showing various land parcels, streets, and zoning designations. The map includes labels for 'INDUSTRIAL', 'SINGLE-FAMILY RESIDENTIAL', 'COMMERCIAL', and 'PARK'. It also shows 'MIAMI ROAD', 'JUNIPER ROAD', and 'SOUTH AVENUE'. A specific area is highlighted with a hatched pattern and labeled 'SITE'. The map is titled 'PLAT MAP' and includes a scale bar and north arrow.

GENERAL NOTES

1. CITY OF ALBUQUERQUE SPECIFICATIONS FOR PUBLIC WORKS CONSTRUCTION, 1986 EDITION AS AMENDED THROUGH UPDATE 6, WILL BE REFERRED TO HEREIN AS THE "STANDARD SPECIFICATIONS".
2. TWO WORKING DAYS PRIOR TO ANY EXCAVATION, CONTRACTOR MUST CONTACT NEW MEXICO ONE CALL SYSTEM, (260-1990) AND DETERMINE LOCATION OF EXISTING UTILITIES.
3. PRIOR TO ANY CONSTRUCTION, THE CONTRACTOR SHALL EXCAVATE AND VERIFY THE HORIZONTAL AND VERTICAL LOCATIONS OF ALL OBSTRUCTIONS. SHOULD A CONFLICT EXIST, THE CONTRACTOR SHALL NOTIFY THE ENGINEER OR THE SURVEYOR SO THAT THE CONFLICT CAN BE RESOLVED WITHOUT DELAY.
4. ALL EXISTING SIGNS, MARKERS, DELINEATORS, ETC., WITHIN THE CONSTRUCTION LIMITS SHALL BE REMOVED, STORED AND RE-SET BY THE CONTRACTOR.
5. FIVE (5) WORKING DAYS PRIOR TO BEGINNING CONSTRUCTION THE CONTRACTOR SHALL SUBMIT TO THE CONSTRUCTION COORDINATION DIVISION A DETAILED CONSTRUCTION SCHEDULE. TWO (2) WORKING DAYS PRIOR TO CONSTRUCTION THE CONTRACTOR SHALL OBTAIN A BARRICADING PERMIT FROM THE CONSTRUCTION COORDINATION DIVISION. CONTRACTOR SHALL NOTIFY BARRICADE ENGINEER (788-2551) PRIOR TO OCCUPYING AN INTERSECTION. SEE SECTION 19 OF THE SPECIFICATIONS.
6. ALL STREET STRIPING ALTERED OR DESTROYED SHALL BE REPLACED WITH PLASTIC REFLECTORIZED PAVEMENT MARKINGS BY CONTRACTOR IN EXISTING OR NEW LOCATION AS INDICATED BY THIS SET.
7. THE CONTRACTOR SHALL NOTIFY THE ENGINEER NOT LESS THAN SEVEN (7) DAYS PRIOR TO STARTING WORK IN ORDER THAT THE ENGINEER MAKE NECESSARY MEASURES TO INSURE THE PRESERVATION OF SURVEY MONUMENTS. CONTRACTOR SHALL NOT DISTURB PERMANENT SURVEY MONUMENTS WITHOUT THE CONSENT OF THE ENGINEER AND SHALL NOTIFY THE ENGINEER AND BEAR THE EXPENSE OF REPLACING ANY THAT MAY BE DISTURBED WITHOUT PERMISSION. REPLACEMENT SHALL BE DONE ONLY BY THE CITY SURVEYOR. WHEN A CHANGE IS MADE IN THE FINISHED ELEVATIONS OF THE PAVEMENT OF ANY ROADWAY IN WHICH A PERMANENT SURVEY MONUMENT IS LOCATED, CONTRACTOR SHALL, AT HIS OWN EXPENSE, ADJUST THE MONUMENT COVER TO THE NEW GRADE UNLESS OTHERWISE SPECIFIED. REFER TO SECTION 4.4 OF THE GENERAL CONDITIONS OF THE STANDARD SPECIFICATIONS.
8. ANY WORK OCCURRING WITHIN AN ARTERIAL ROADWAY REQUIRES 24 HOURS CONSTRUCTION.

☒ ALL UTILITIES AND UTILITY SERVICE LINES SHALL BE INSTALLED PRIOR TO PAVING.

☒ BACKFILL COMPACTION SHALL BE ACCORDING TO SPECIFIED STREET USE.

☐ TACK COAT REQUIREMENTS SHALL BE DETERMINED BY THE CITY ENGINEER.

☒ SIDEWALK AND WHEELCHAIR RAMPS WITHIN THE CURB RETURNS SHALL BE CONSTRUCTED WHEREVER A NEW CURB RETURN IS CONSTRUCTED.

☐ IF CURB IS DERESSED FOR A DRIVEPAD, THE DRIVEPAD SHALL BE CONSTRUCTED PRIOR TO ACCEPTANCE OF CURB AND GUTTER.

☐ ALL STORM DRAINAGE FACILITIES SHALL BE COMPLETED PRIOR TO FINAL ACCEPTANCE.

dmg D. MARK GOODWIN & ASSOCIATES, P.A.
CONSULTING ENGINEERS
P. O. BOX 90606
ALBUQUERQUE, NEW MEXICO 87199
(505) 828-2200, FAX (505) 797-9539


REV.	SHEETS	CITY ENGINEER	DATE	USER DEPARTMENT	DATE	USER DEPARTMENT	DATE
ENGINEERS STAMP & SIGNATURE		APPROVALS	ENGINEER	DATE	*****		
		DRC CHAIRMAN		-20-01	APPROVED FOR CONSTRUCTION.		
		TRANSPORTATION		12-14-00			
		WATER/WASTEWATER		12-14-00			
		HYDROLOGY	Bradley L. Bingham	12-14-00			
		CIP					
		CONSTR. MNGMT.					
		CONSTR. COORD.		12-14-00	CITY ENGINEER	DATE	
CITY PROJECT NO.		6455.81			SHEET OF		
					1 9		

PLAT FOR
**LADERA BREEZE
EAST**

WITHIN THE
TOWN OF ATRISCO GRANT
PROJECTED SECTION 10
TOWNSHIP 10, NORTH, RANGE 2 EAST, N.M.P.M.
CITY OF ALBUQUERQUE
BERNALILLO COUNTY, NEW MEXICO
MARCH, 2000

TYPICAL LOT DETAIL

N.T.S.

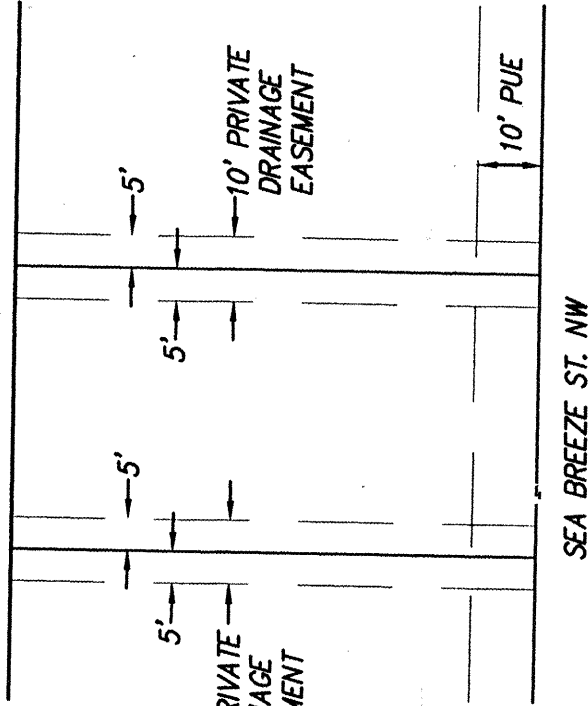


NOTE: THERE IS A 10' PRIVATE
DRAINAGE EASEMENT CENTERED ON
ALL INTERIOR SIDE LOT LINES.
(SEE TYPICAL LOT DETAIL)

KIMBAR SUBDIVISION
UNIT ONE
(05-09-97, 97C-143)

NUMBER	R	L	D	T	CH BEARIN	CHORD LE
C1	25.00	39.27	89°59'43"	25.00	N 44°22'07" W	35.35
C2	25.00	39.27	90°00'17"	25.00	R 45°37'53" E	35.35
C3	25.00	39.27	90°00'00"	25.00	N 44°22'16" W	35.35
C4	25.00	39.27	90°00'00"	25.00	N 45°37'44" E	35.35
C5	25.00	39.27	90°00'20"	25.00	N 44°22'16" W	35.35
C6	25.00	39.27	89°59'41"	25.00	N 45°37'35" E	35.35


ACS MONUMENT
"6-H10"
Y=149217.53
X=360389.13
G-C=0.99987760
ΔA=-00°16'06"
CENTRAL ZONE
(NAU 1-27/SLD 1929)
ELEVATION=5117.13

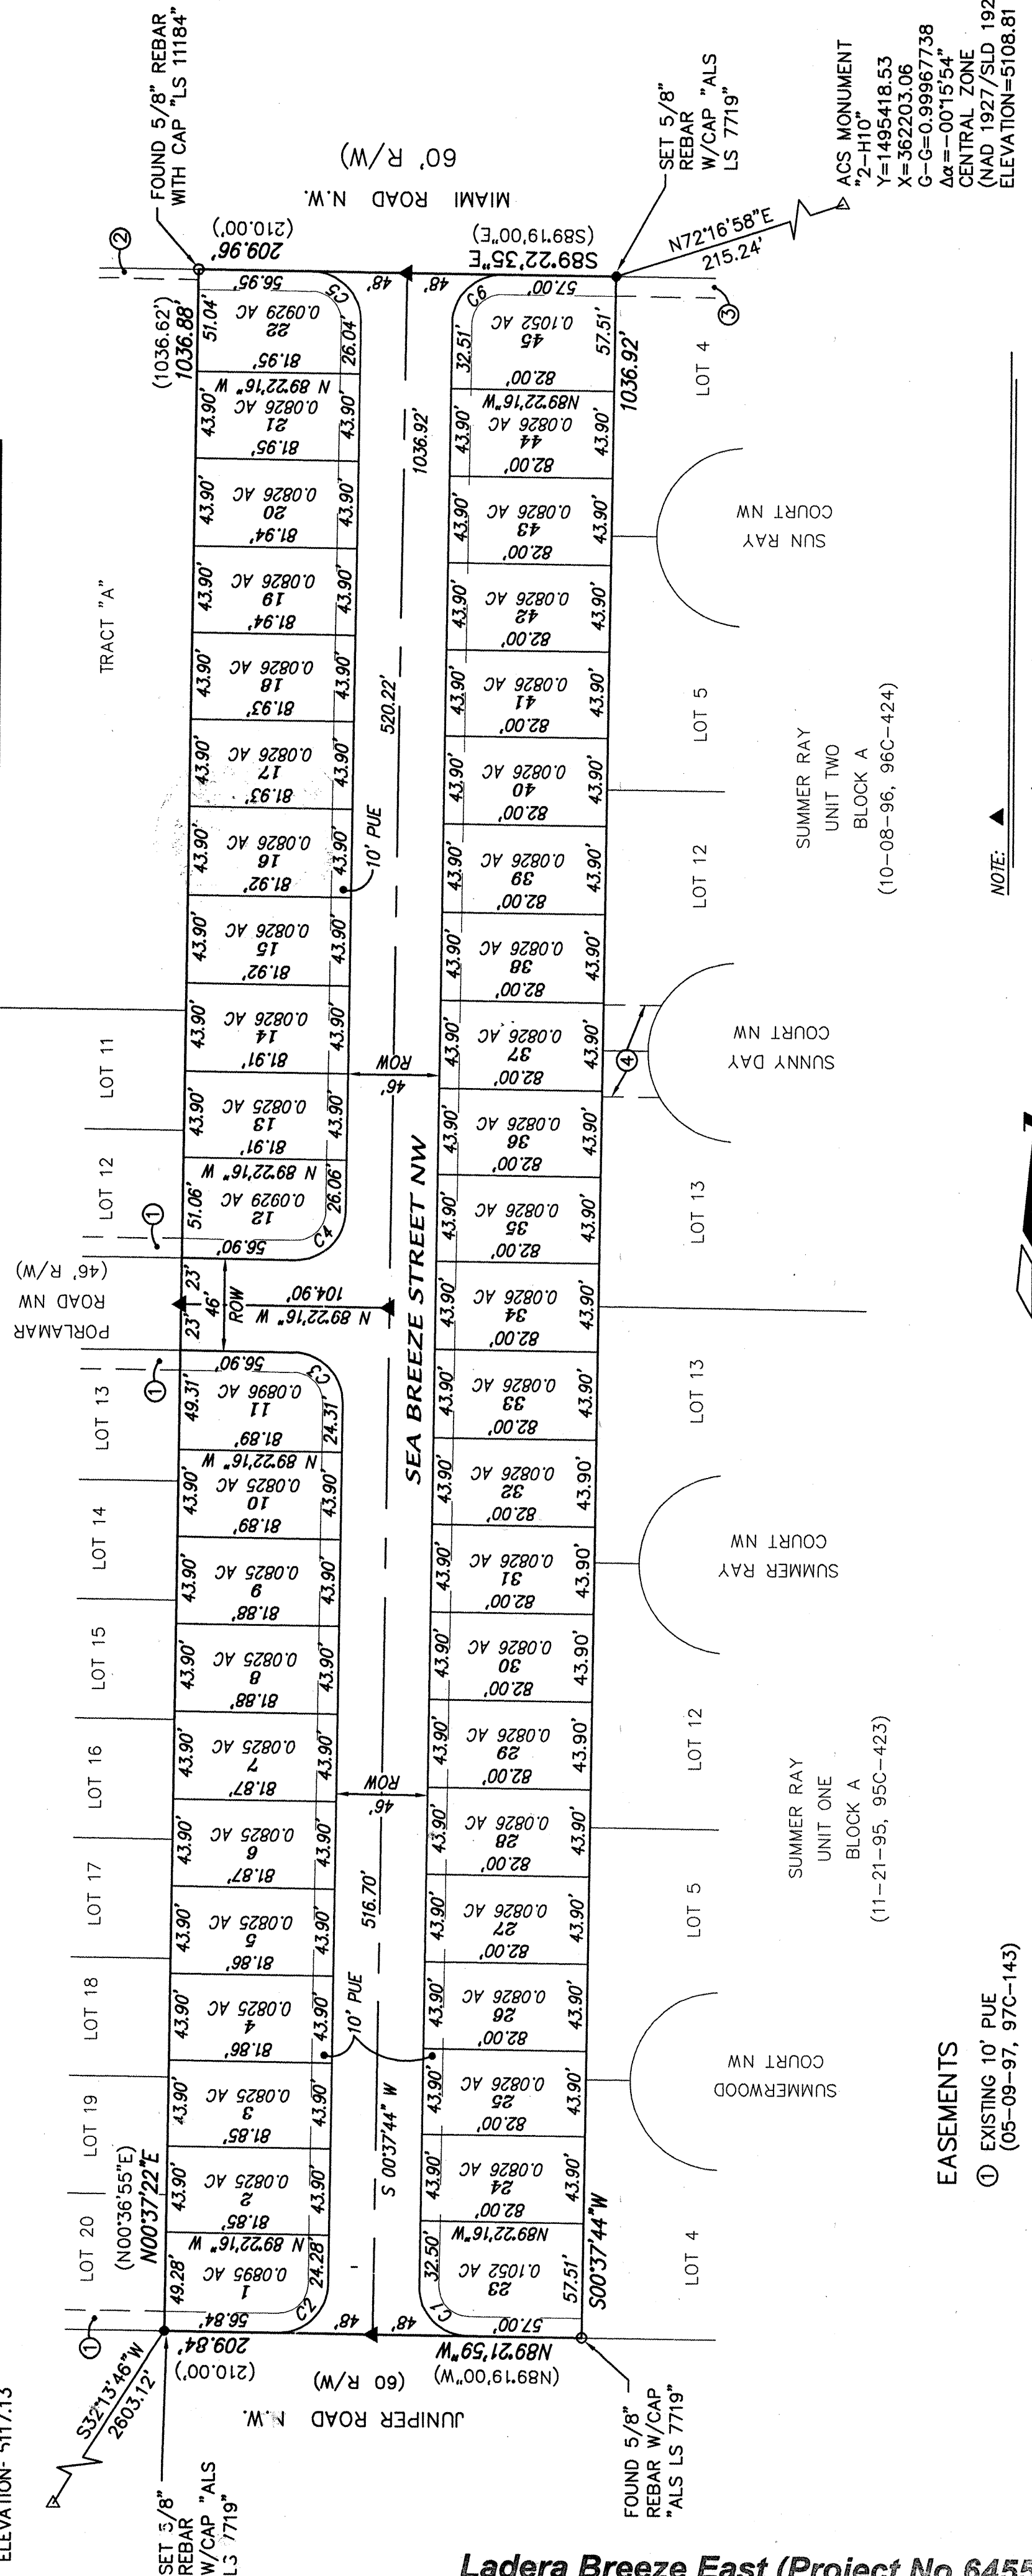


EASEMENTS

- EXISTING 10' PUE
(05-09-97, 97C-143)
- EXISTING 5' PNM ELECTRICAL
SERVICES EASEMENT
(05-09-97, 97C-143)
- EXISTING 10' PUE
(11-21-95, 95C-423)
- EXISTING 46' ROADWAY EASEMENT
(10-08-96, 96C-424)

NOTE: CENTERLINE (IN LIEU OF P/M) MONUMENTATION IS TO BE INSTALLED
AT ALL CORNERS, PLS. ANGLE POINTS AND STREET
INTERSECTIONS. MONUMENTS SHALL BE FOUR
INCH (4") ALUMINUM ALLOY CAP STAMPED "CITY OF ALBUQUERQUE",
"CENTERLINE MONUMENT", "DO NOT DISTURB", PLS # 7719.

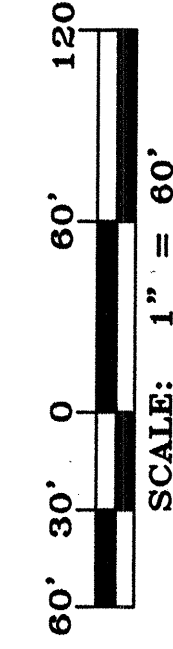

06-01-00
T.M. [Signature]
1111

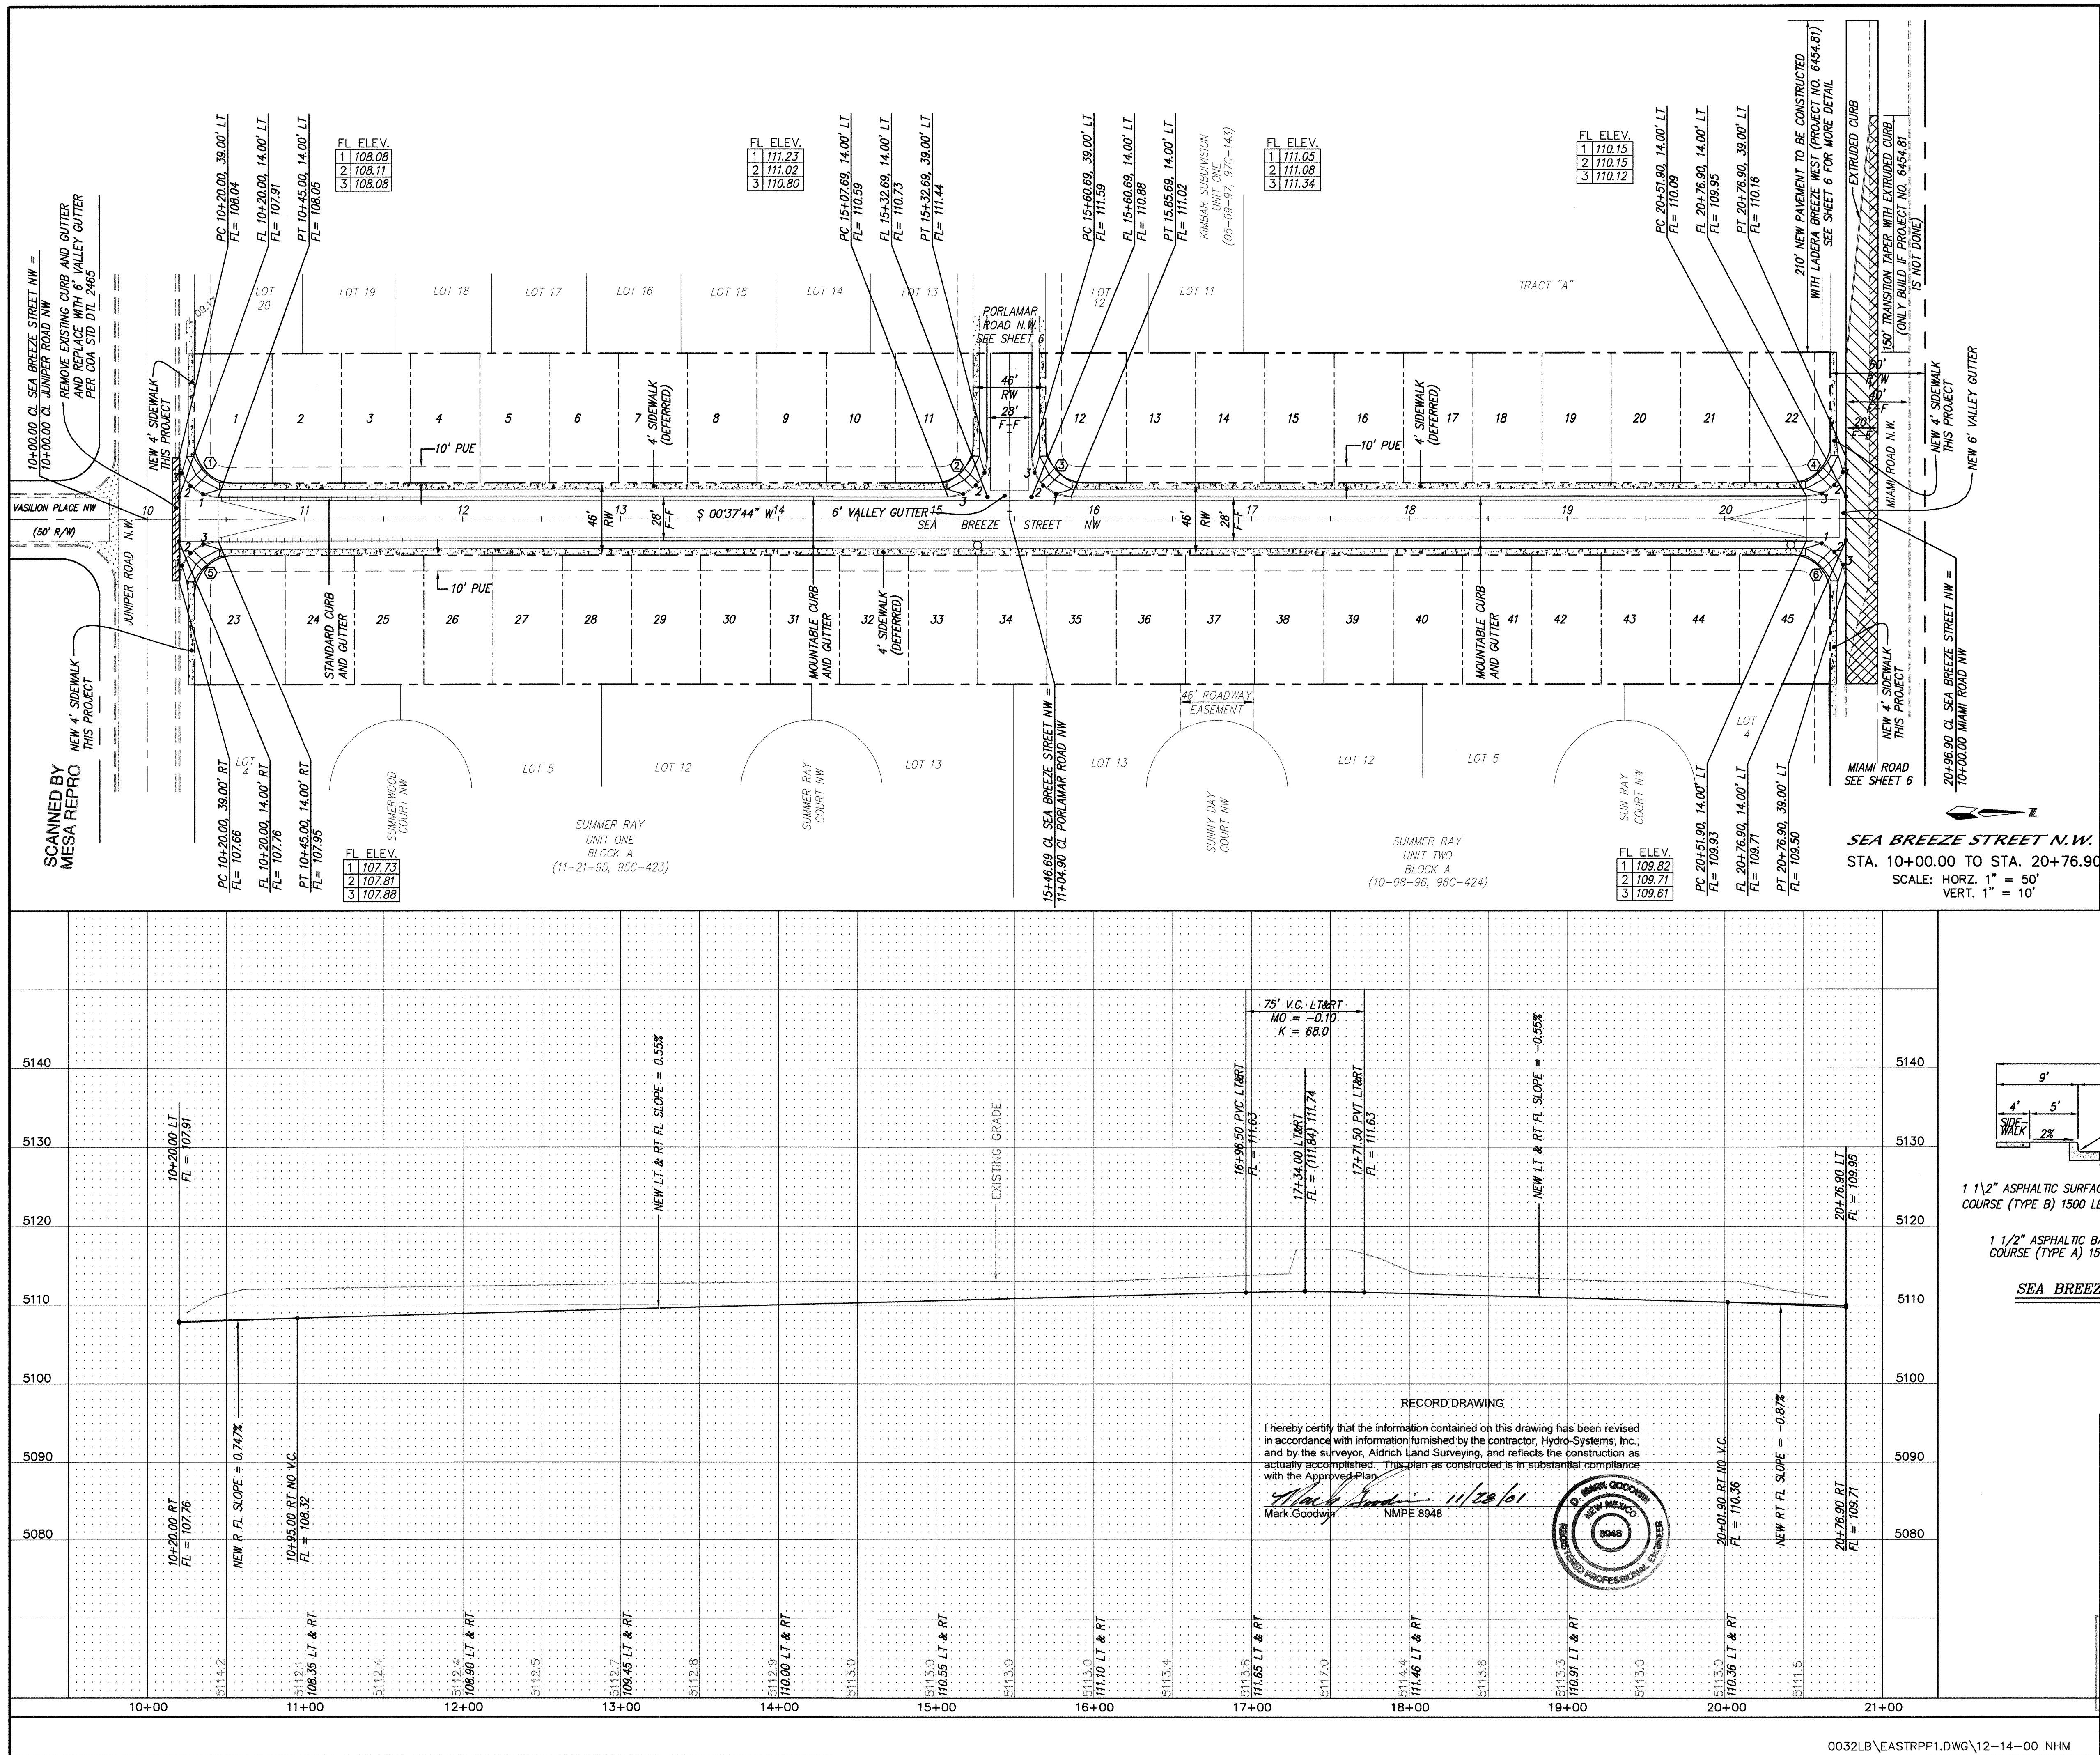

NOTES

- ALL STATIONING IS CENTERLINE STATIONING
- ALL SIDEWALKS PER CITY OF ALBUQUERQUE STANDARD DRAWING 2430.
- ALL 6" VALLEY GUTTERS PER CITY OF ALBUQUERQUE STANDARD DRAWING 2420.
- ALL 4" INTERIOR SIDEWALKS ARE DEFERRED.
- ALL HANDICAP RAMPS ARE PER DETAIL ON SHEET 6.
- TRANSITION SECTION FROM FULL CROWN TO NO CROWN TO BE A MINIMUM OF 50 FEET.

CURVE DATA - DESCRIBES FACE OF CURB

① $\Delta = 90^{\circ}00'17''$ RT. R = 25.00' L = 39.27' T = 25.00'	② $\Delta = 90^{\circ}00'00''$ RT. R = 25.00' L = 39.27' T = 25.00'	③ $\Delta = 90^{\circ}00'00''$ RT. R = 25.00' L = 39.27' T = 25.00'	④ $\Delta = 90^{\circ}00'19''$ RT. R = 25.00' L = 39.27' T = 25.00'	⑤ $\Delta = 89^{\circ}59'43''$ RT. R = 25.00' L = 39.27' T = 25.00'	⑥ $\Delta = 89^{\circ}59'41''$ RT. R = 25.00' L = 39.27' T = 25.00'
--	--	--	--	--	--

LEGEND

- NEW SIDEWALK
- 50' CROWN TRANSITION
- STANDARD CURB & GUTTER
- MOUNTABLE CURB & GUTTER
- RETAINING WALL
- STREET LIGHT
- TRACT/LOT BOUNDARY
- RIGHT OF WAY
- PROPERTY LINE
- HANDICAP RAMPS PER DETAIL SHEET 6
- NEW OFFSITE PAVEMENT PER MIAMI ROAD PAVEMENT SECTION
- REMOVE IF TEMPORARY PAVEMENT SECTION. REPLACE WITH MIAMI PAVEMENT SECTION PER DETAIL SHEET 6.

SEA BREEZE STREET N.W.

STA. 10+00.00 TO STA. 20+76.90
SCALE: HORIZ. 1" = 50'
VERT. 1" = 10'

SEA BREEZE & PORLAMAR ROAD PAVEMENT SECTION

RECORD DRAWING

I hereby certify that the information contained on this drawing has been revised in accordance with information furnished by the contractor, Hydro-Systems, Inc., and by the surveyor, Aldrich Land Surveying, and reflects the construction as actually accomplished. This plan as constructed is in substantial compliance with the Approved Plan.

Mark Goodwin 11/22/01
Mark Goodwin NMPE 8948

CITY OF ALBUQUERQUE
PUBLIC WORKS DEPARTMENT
ENGINEERING DEVELOPMENT GROUP

TITLE:
LADERA BREEZE EAST SUBDIVISION
PAVING IMPROVEMENTS

DESIGN REVIEW COMMITTEE
APPROVED
JAN 2 0 2001
DESIGN REVIEW COMMITTEE

CITY ENGINEER APPROVAL
APPROVED
SEP 14 2001
CITY ENGINEER

LAST DESIGN UPDATE

CITY PROJECT NO.
6455.81

ZONE MAP NO.
H-10

SHEET
5 OF
9

AS BUILT INFORMATION



CONTRACTOR	ALPS - SYSTEMS
WORK STARTED BY	ALPS
DATE	DATE 11/21/01
INSPECTOR'S NAME	ALPS
FIELD VERIFICATION BY	ALPS
DATE	DATE 11/21/01
CORRECTED BY	ALPS
DATE	DATE 11/21/01
MICRO-FILM INFORMATION	
RECORDED BY	
NO.	
DATE	

City Engineer R. Baca

SURVEY INFORMATION


FIELD NOTES	DATE
NO.	BY
1	ALPS
2	ALPS
3	ALPS
ENGINEER'S SEAL

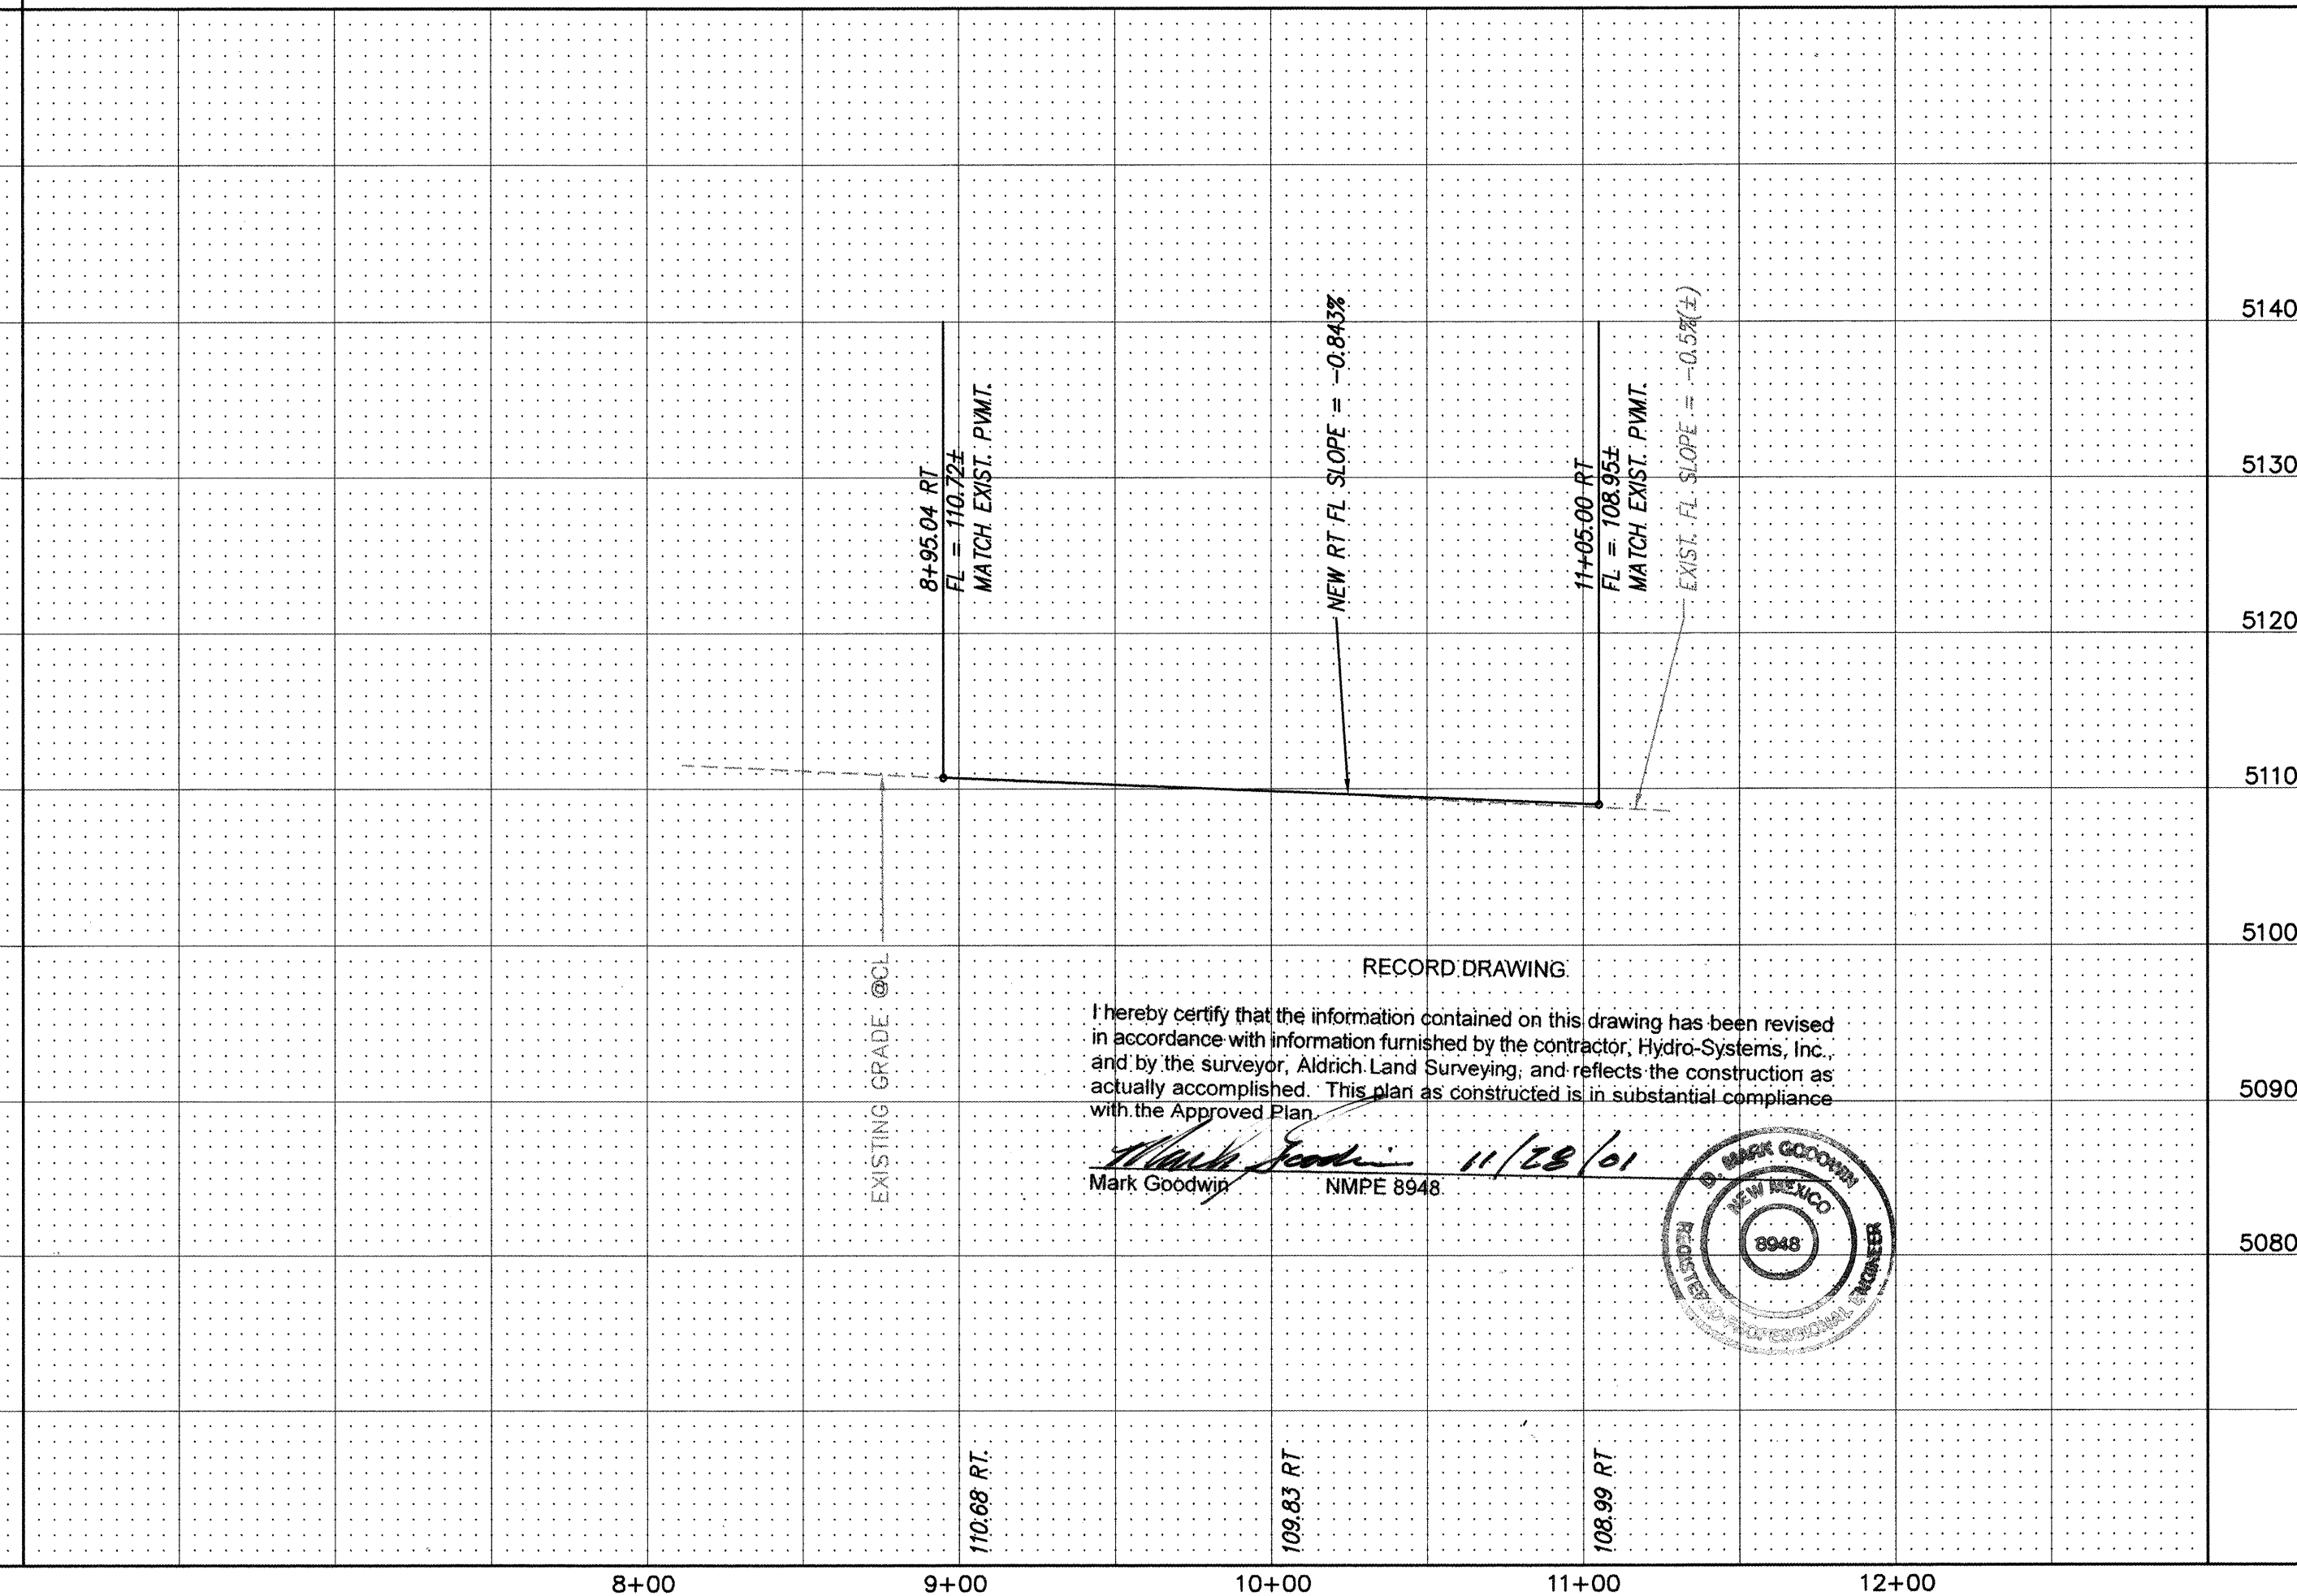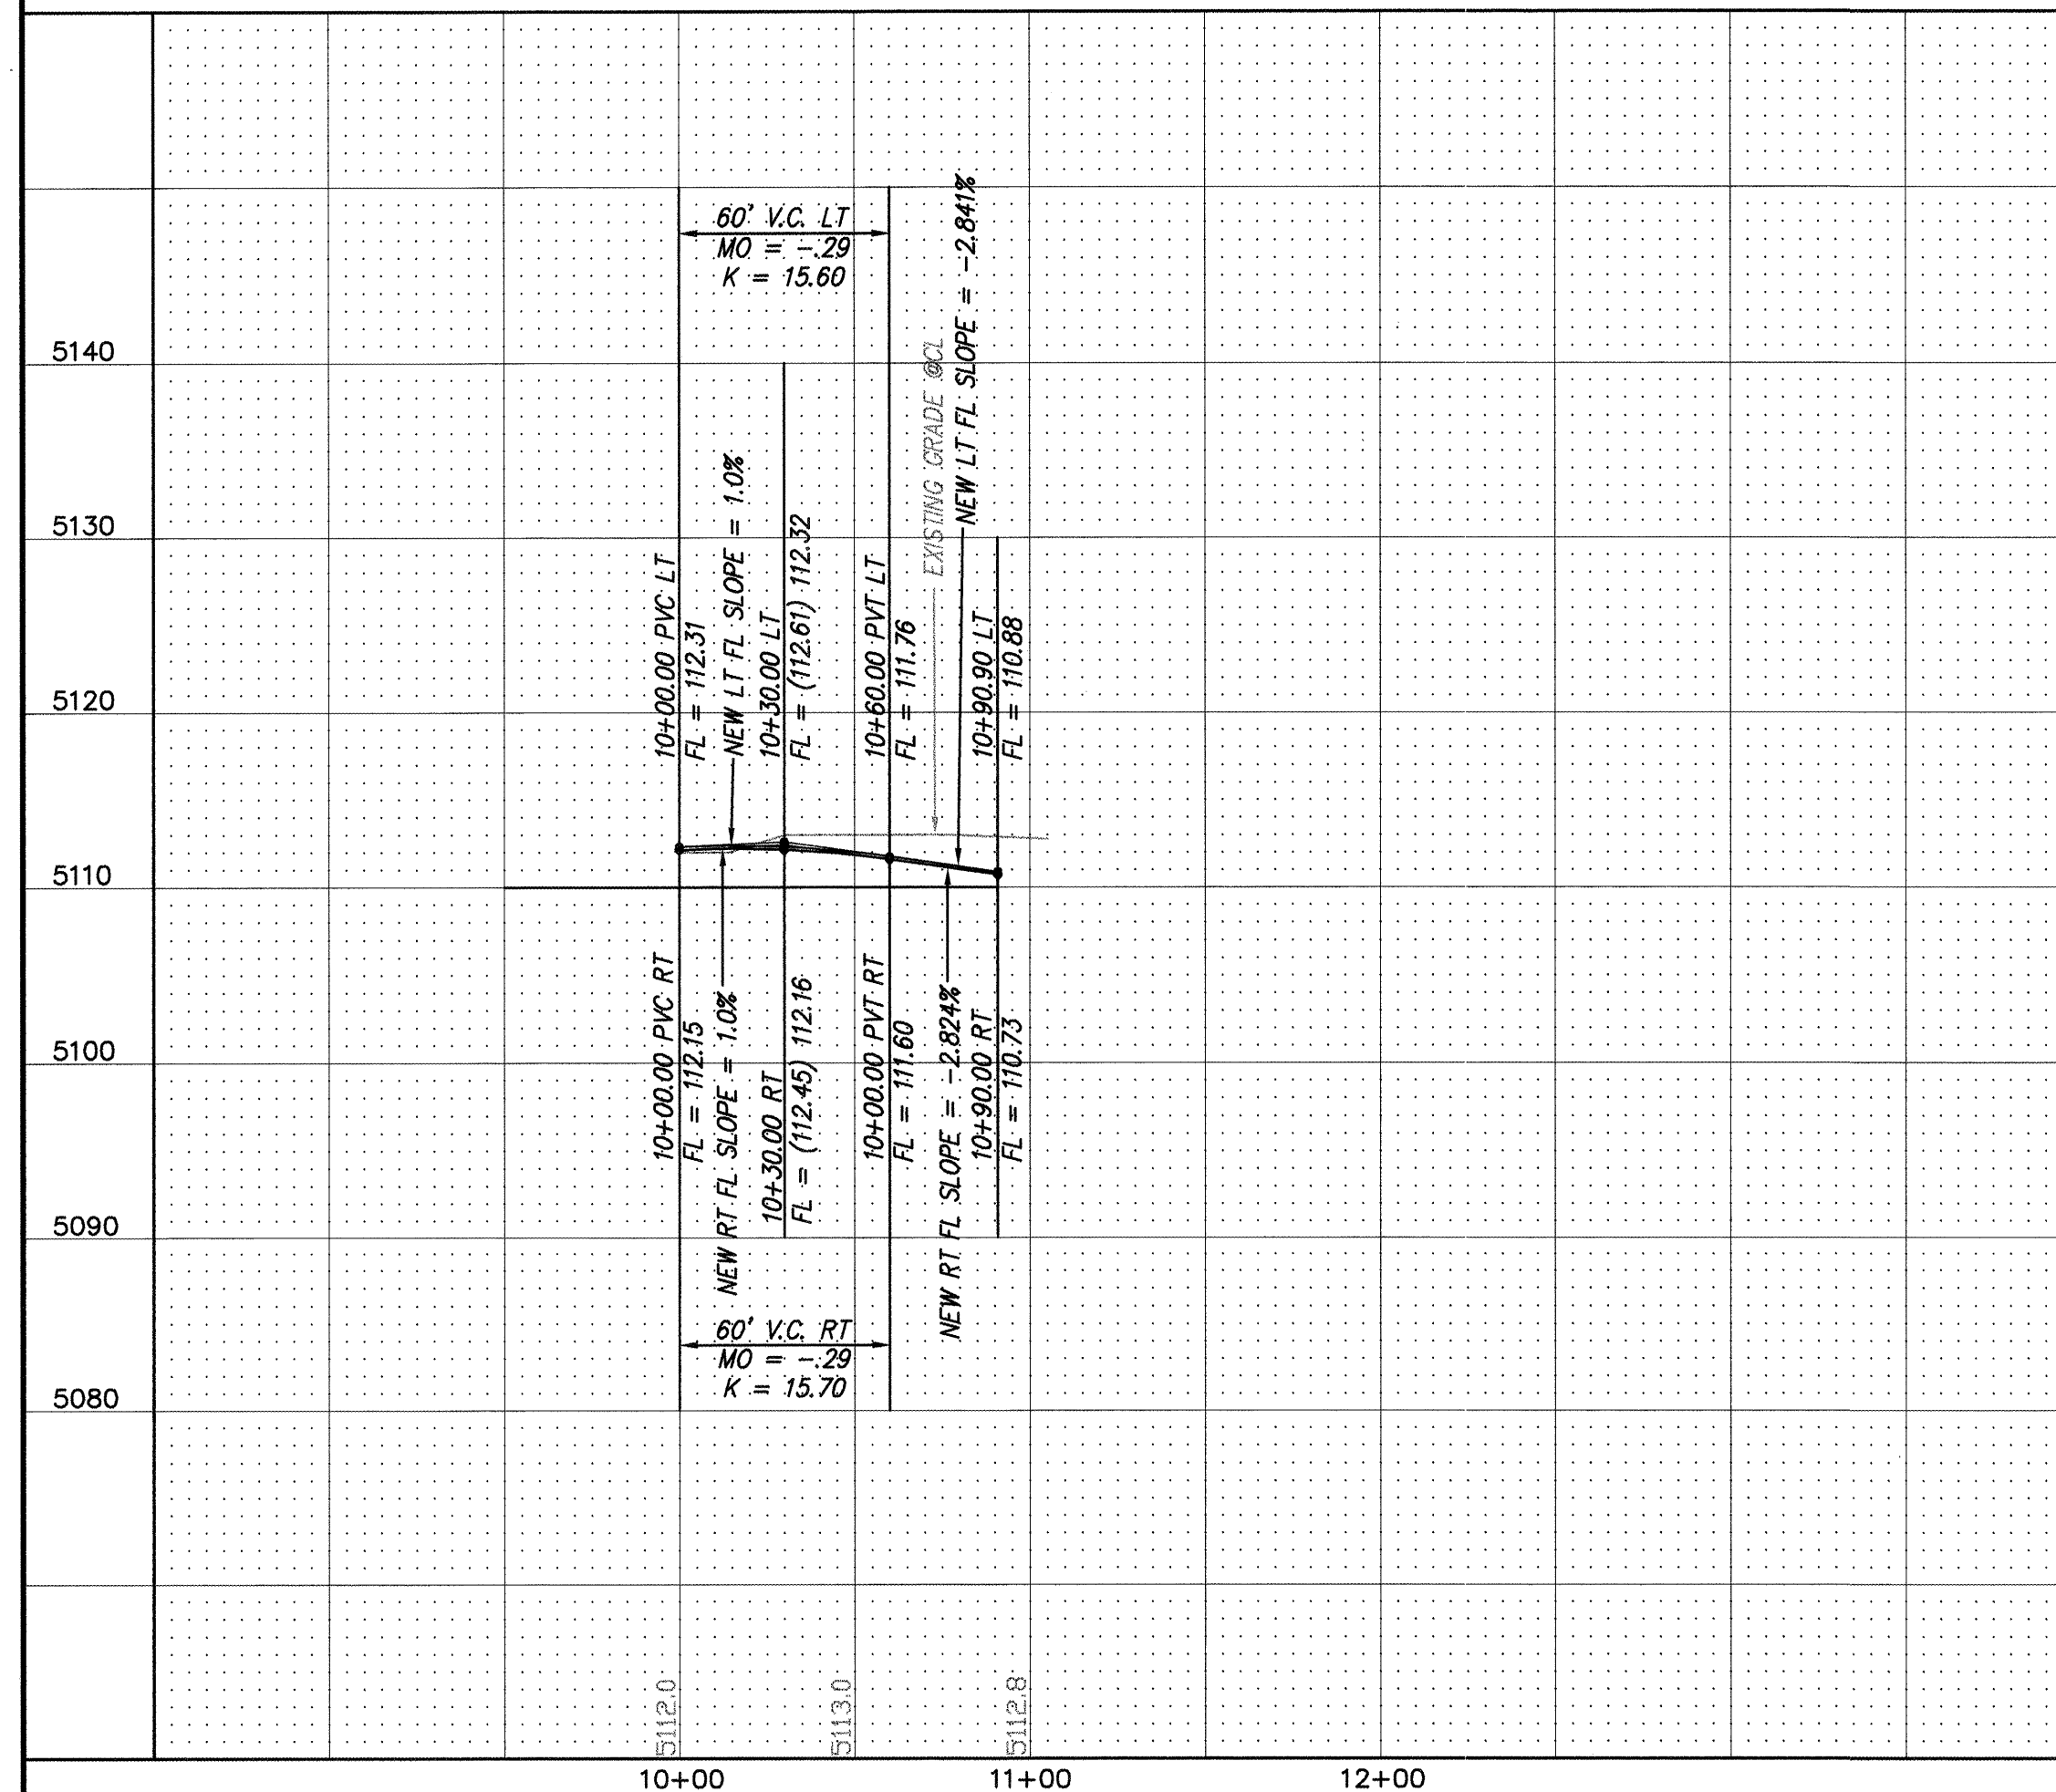

- [illegible]

 CITY OF ALBUQUERQUE PUBLIC WORKS DEPARTMENT ENGINEERING DEVELOPMENT	
TITLE: <i>LADERA BREEZE EAST SIDE PAVING IMPROVEMENT</i>	
DESIGN REVIEW COMMITTEE 	CITY ENGINEER APPROVAL 
LAST DESIGN UPDATE	

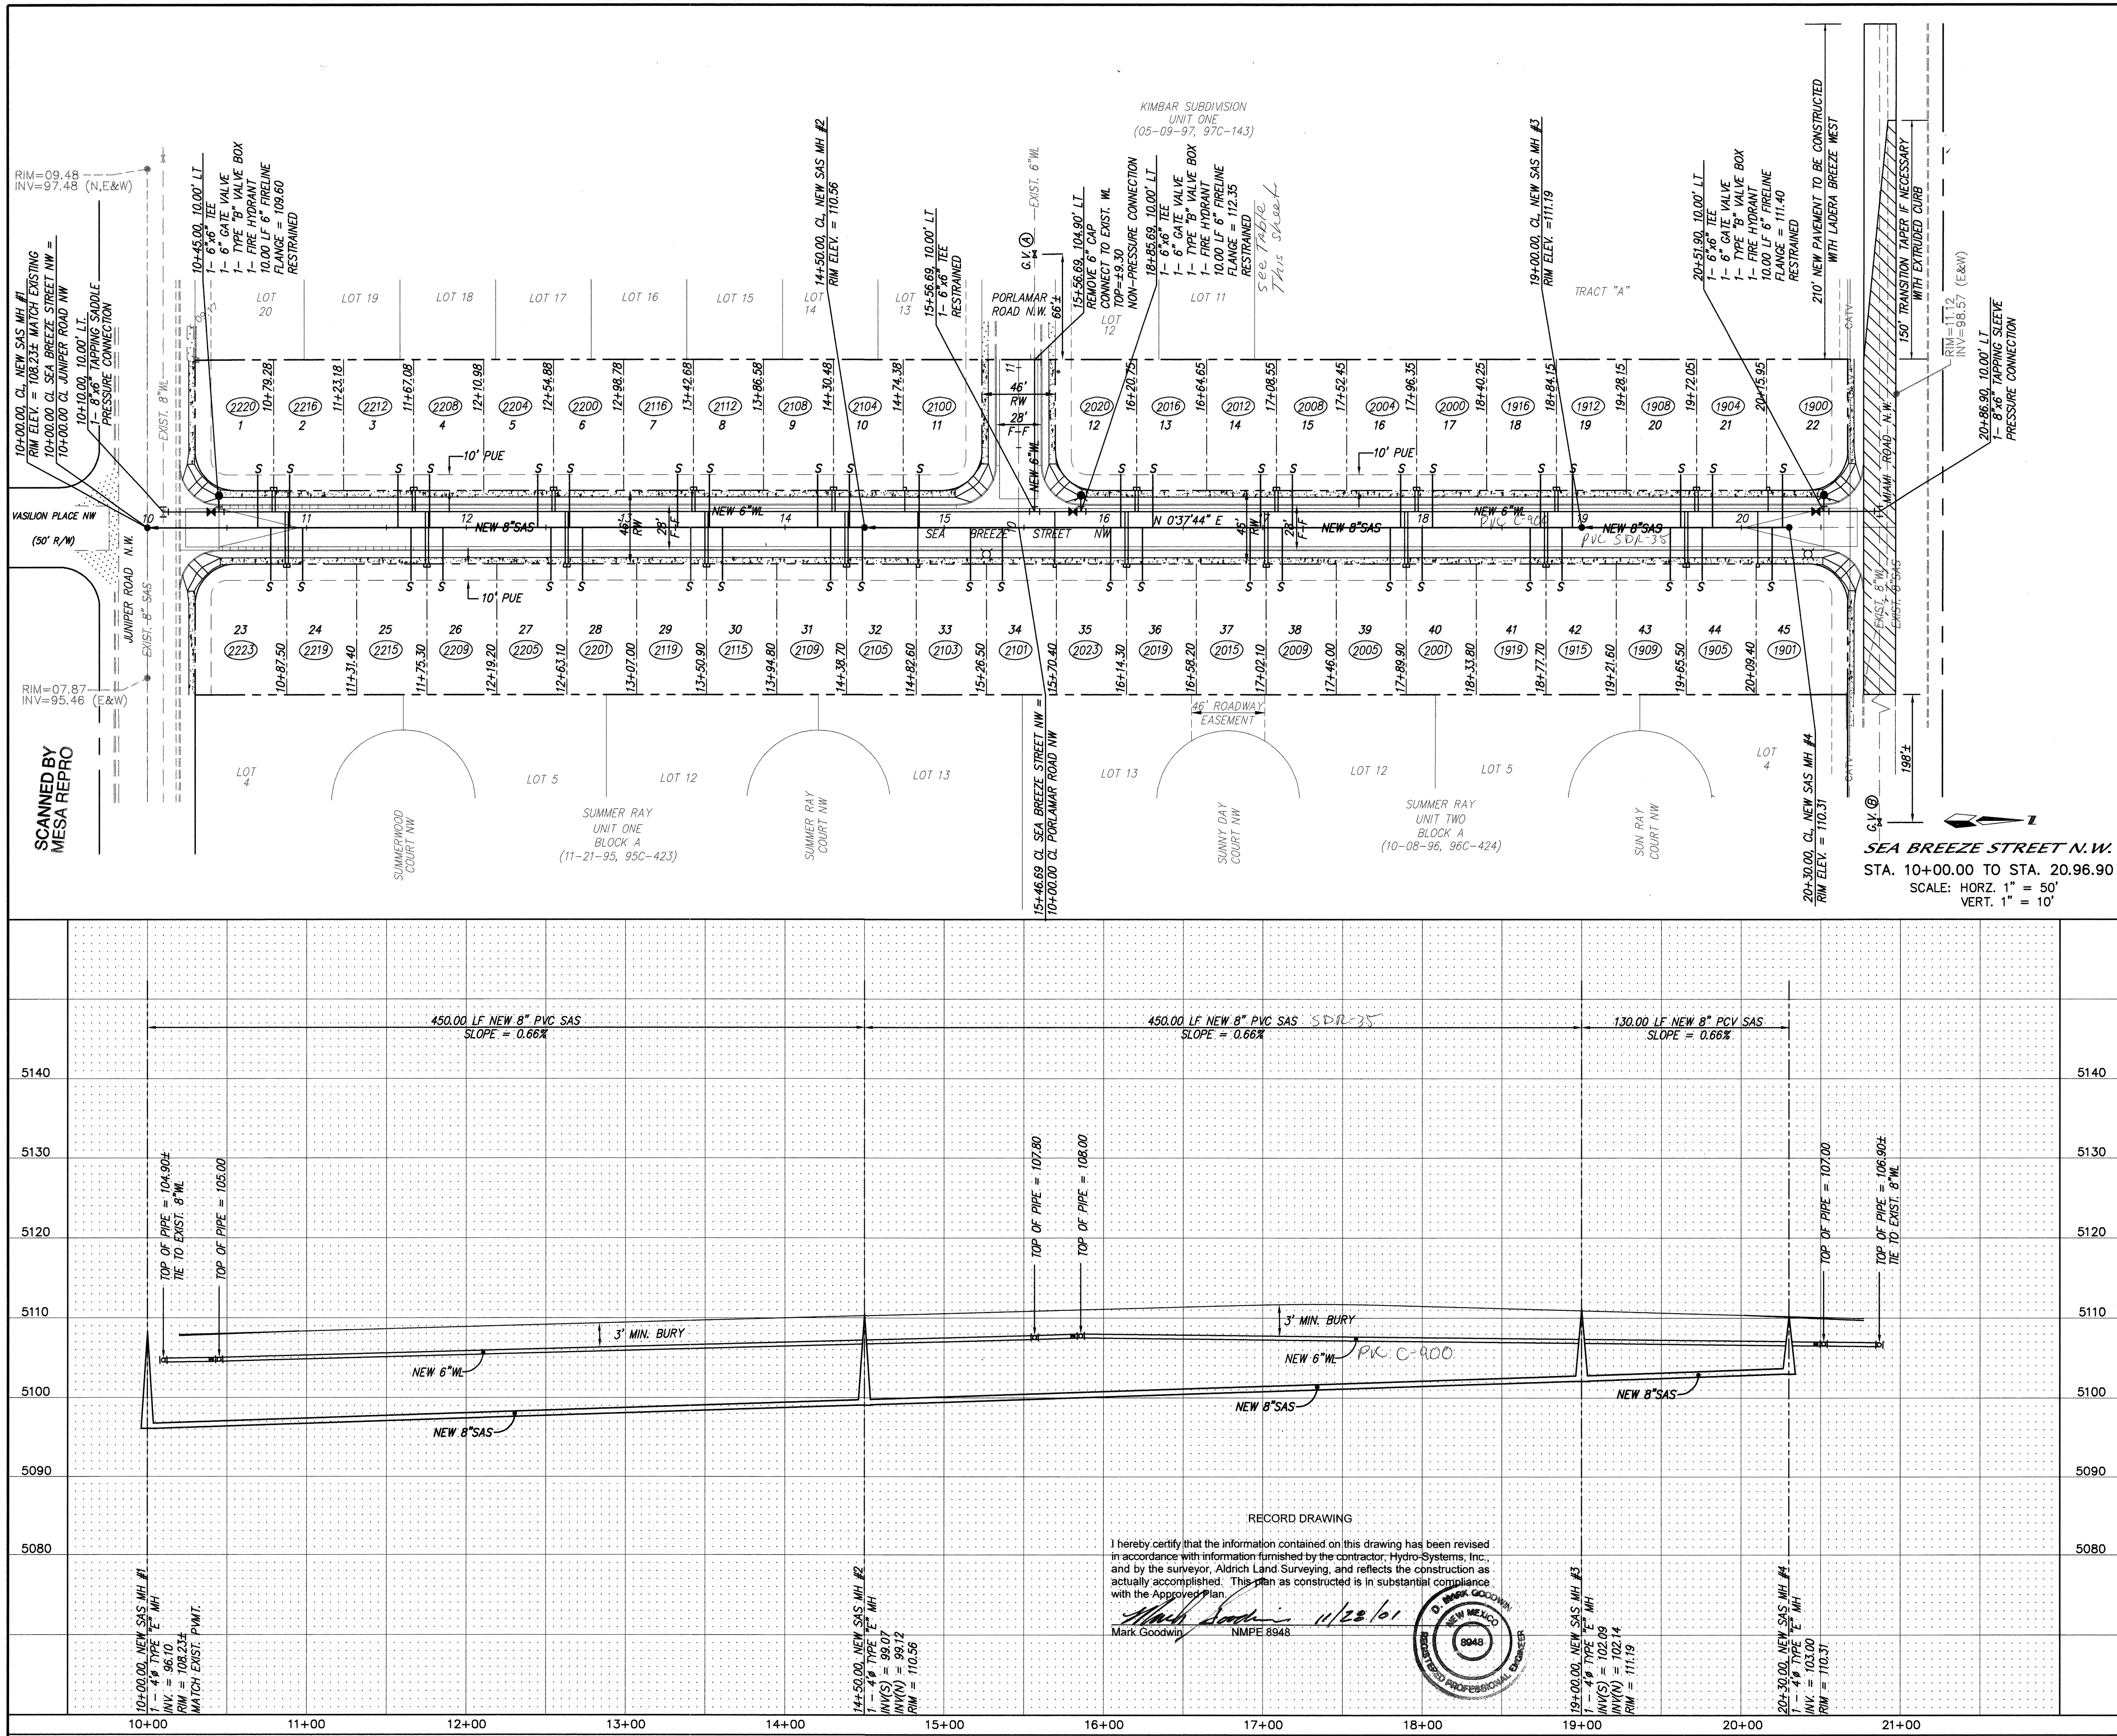

NOTES

1. ALL STATIONING IS CENTERLINE STATIONING

LEGEND

CENTERLINE OF ROAD

EXISTING CURB AND GUTTER

NEW RETAINING WALL

MOUNTABLE CURB & GUTTER

STANDARD 8" CURB & GUTTER

TRACT/LOT BOUNDARY

RIGHT OF WAY

SIDEWALK

PROPERTY LINE

WATERLINE

SAS LINE

SAS MANHOLE

FLOW LINE

WATER VALVE

WATER METER

FIRE HYDRANT

ADDRESSING

SANITARY SEWER SERVICES

LOT	STATION AT PUE	INV. ELEV. AT PUE	LENGTH AT PUE
1	10+69.28	5102.18	33.00'
2	10+89.28	5102.29	33.00'
3	11+57.08	5102.66	33.00'
4	11+77.08	5102.77	33.00'
5	12+44.88	5103.15	33.00'
6	12+64.88	5103.26	33.00'
7	13+32.68	5103.63	33.00'
8	13+52.68	5103.74	33.00'
9	14+20.48	5104.11	33.00'
10	14+40.48	5104.22	33.00'
11	14+84.38	5104.46	33.00'
12	16+10.75	5105.16	33.00'
13	16+30.75	5105.27	33.00'
14	16+98.55	5105.64	33.00'
15	17+18.55	5105.75	33.00'
16	17+86.35	5105.55	33.00'
17	18+06.35	5105.44	33.00'
18	18+74.15	5105.07	33.00'
19	18+94.15	5104.96	33.00'
20	19+61.95	5104.58	33.00'
21	19+81.95	5104.47	33.00'
22	20+25.85	5104.21	33.00'
23	10+77.50	5102.19	33.00'
24	10+97.50	5102.34	33.00'
25	11+65.30	5102.71	33.00'
26	11+85.30	5102.82	33.00'
27	12+53.10	5103.19	33.00'
28	12+73.10	5103.30	33.00'
29	13+40.90	5103.67	33.00'
30	13+60.90	5103.79	33.00'
31	14+28.70	5104.16	33.00'
32	14+48.70	5104.27	33.00'
33	15+16.50	5106.64	33.00'
34	15+36.50	5104.75	33.00'
35	16+04.30	5105.12	33.00'
36	16+24.30	5105.23	33.00'
37	16+92.10	5105.61	33.00'
38	17+12.10	5105.70	33.00'
39	17+79.90	5105.58	33.00'
40	17+99.90	5105.47	33.00'
41	18+67.70	5105.10	33.00'
42	18+87.70	5104.99	33.00'
43	19+55.50	5104.62	33.00'
44	19+75.50	5104.51	33.00'
45	20+19.50	5104.21	33.00'

RESTRAINED JOINT LENGTH FOR BENDS, VALVES, DEAD ENDS (FT.)

PIPE SIZE	90°	45°	22.5°	11.25°	VALVE
8"	22'	9'	4'	2'	60'
10"	-	11'	5'	3'	72'

LENGTH OF RESTRAINED PIPE ON EACH SIDE OF THE BEND. RESTRAIN BRANCH AT FITTING ONLY MINIMUM ATTACHED PIPE LENGTH, RUN SIDE OF TEE: 10.00 FEET.

RESTRAINED JOINT LENGTH FOR TEES (FT.)

PIPE SIZE	RUN	BRANCH
8"x8"x6"	7'	5'
8"x8"x8"	13'	3'

MARK GOODWIN & ASSOCIATES, P.A.
CONSULTING ENGINEERS
P.O. BOX 90606
ALBUQUERQUE, NEW MEXICO 87199
(505) 828-2200, FAX (505) 797-9539

CITY OF ALBUQUERQUE
PUBLIC WORKS DEPARTMENT
ENGINEERING DEVELOPMENT GROUP

TITLE: **LADERA BREEZE EAST SUBDIVISION
UTILITY IMPROVEMENTS**

DESIGN REVIEW COMMITTEE
JAN 20 2001

CITY ENGINEER APPROVAL
SEP 14 2001

DESIGNED BY
DLH

DRAWN BY
NHM

CHECKED BY
DMG

REVISIONS
DATE
DATE
DATE

CONTRACTOR: **HYDRO-SYSTEMS**

WORK ORDER: **ALS**

INSPECTOR'S ACCEPTANCE: **ALS**

VERIFICATION BY: **ALS**

DRAWINGS BY: **ALS**

CORRECTIONS BY: **ALS**

MICRO-FILM INFORMATION: **ALS**

RECORDED BY: **ALS**

NO. **ALS**


CITY PROJECT NO. **6455.81**

ZONE MAP NO. **H-10**

SHEET **7** OF **9**

A0032LB\EAST-UT1.DWG\12-14-00 NHM

SCANNED BY
MESA REPRO



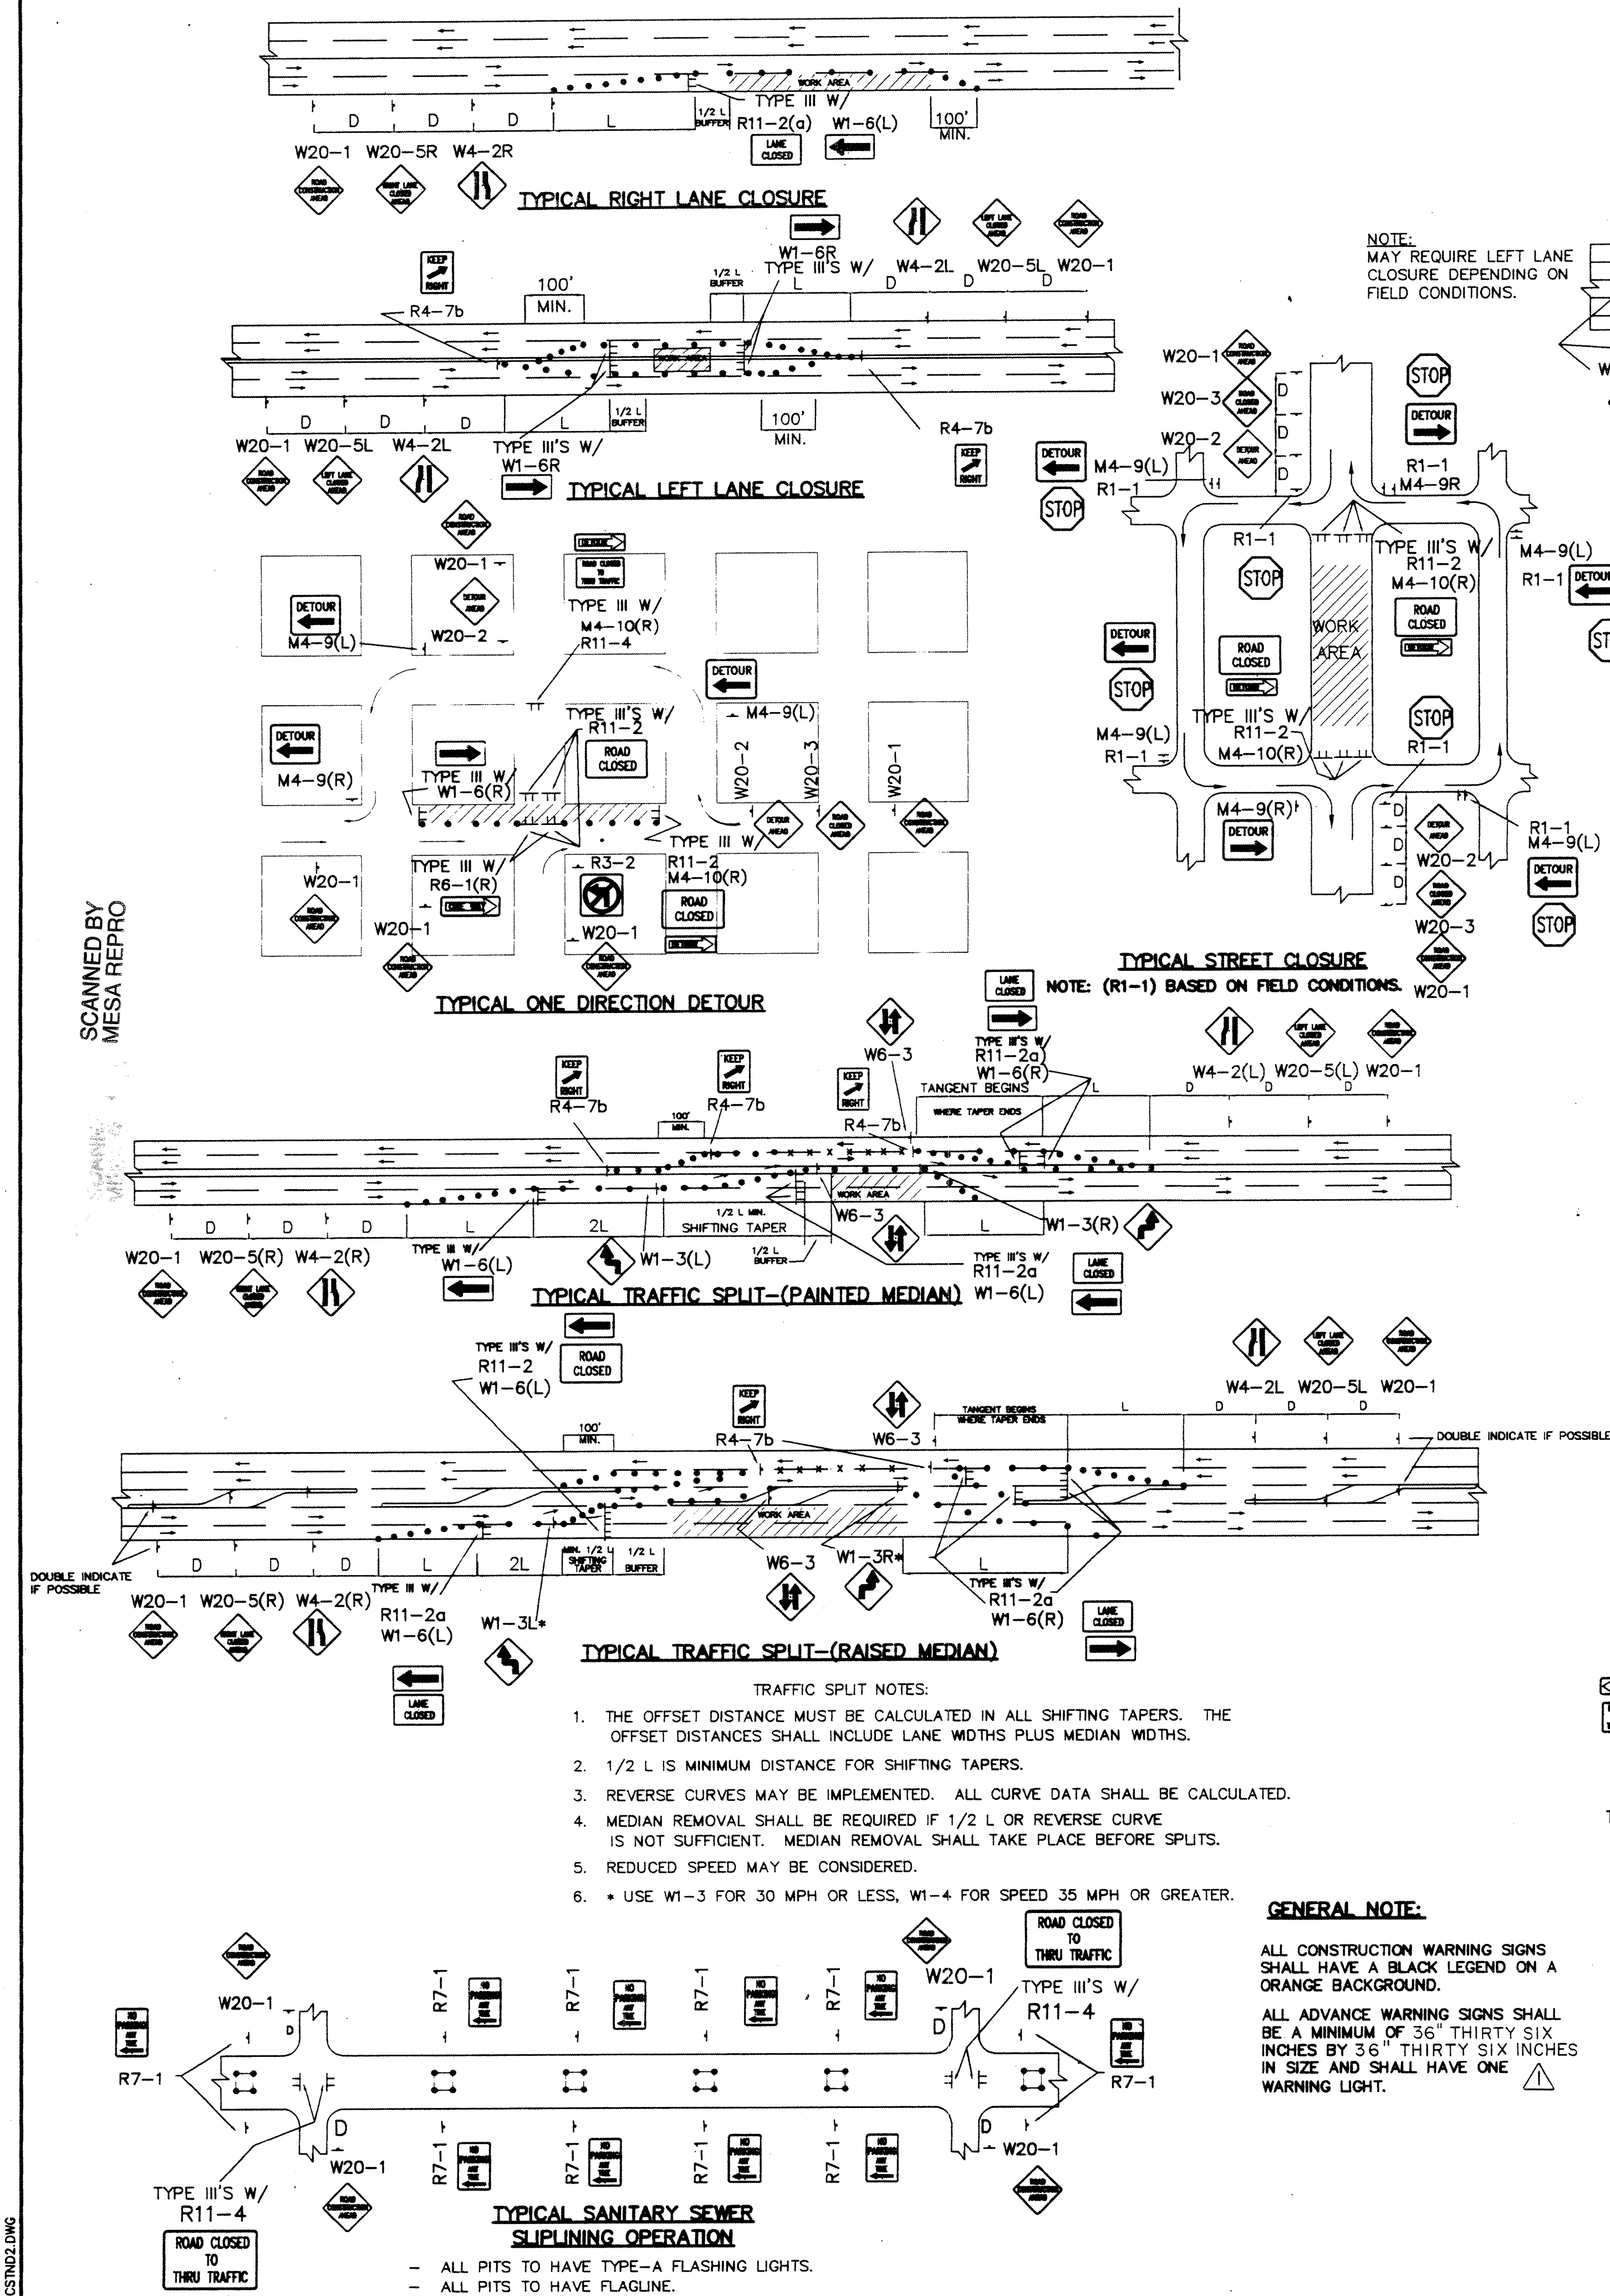


NOTE:
MAY REQUIRE LEFT LANE
CLOSURE DEPENDING ON
FIELD CONDITIONS.

TYPICAL LANE CLOSURE AT INTERSECTION
NOTE: DEPENDING ON WORK ZONE LOCATION

TYPICAL MID-BLOCK CLOSURE
NOTE: (R1-1) BASED ON FIELD CONDITIONS.

TYPICAL STREET CLOSURE
NOTE: (R1-1) BASED ON FIELD CONDITIONS.

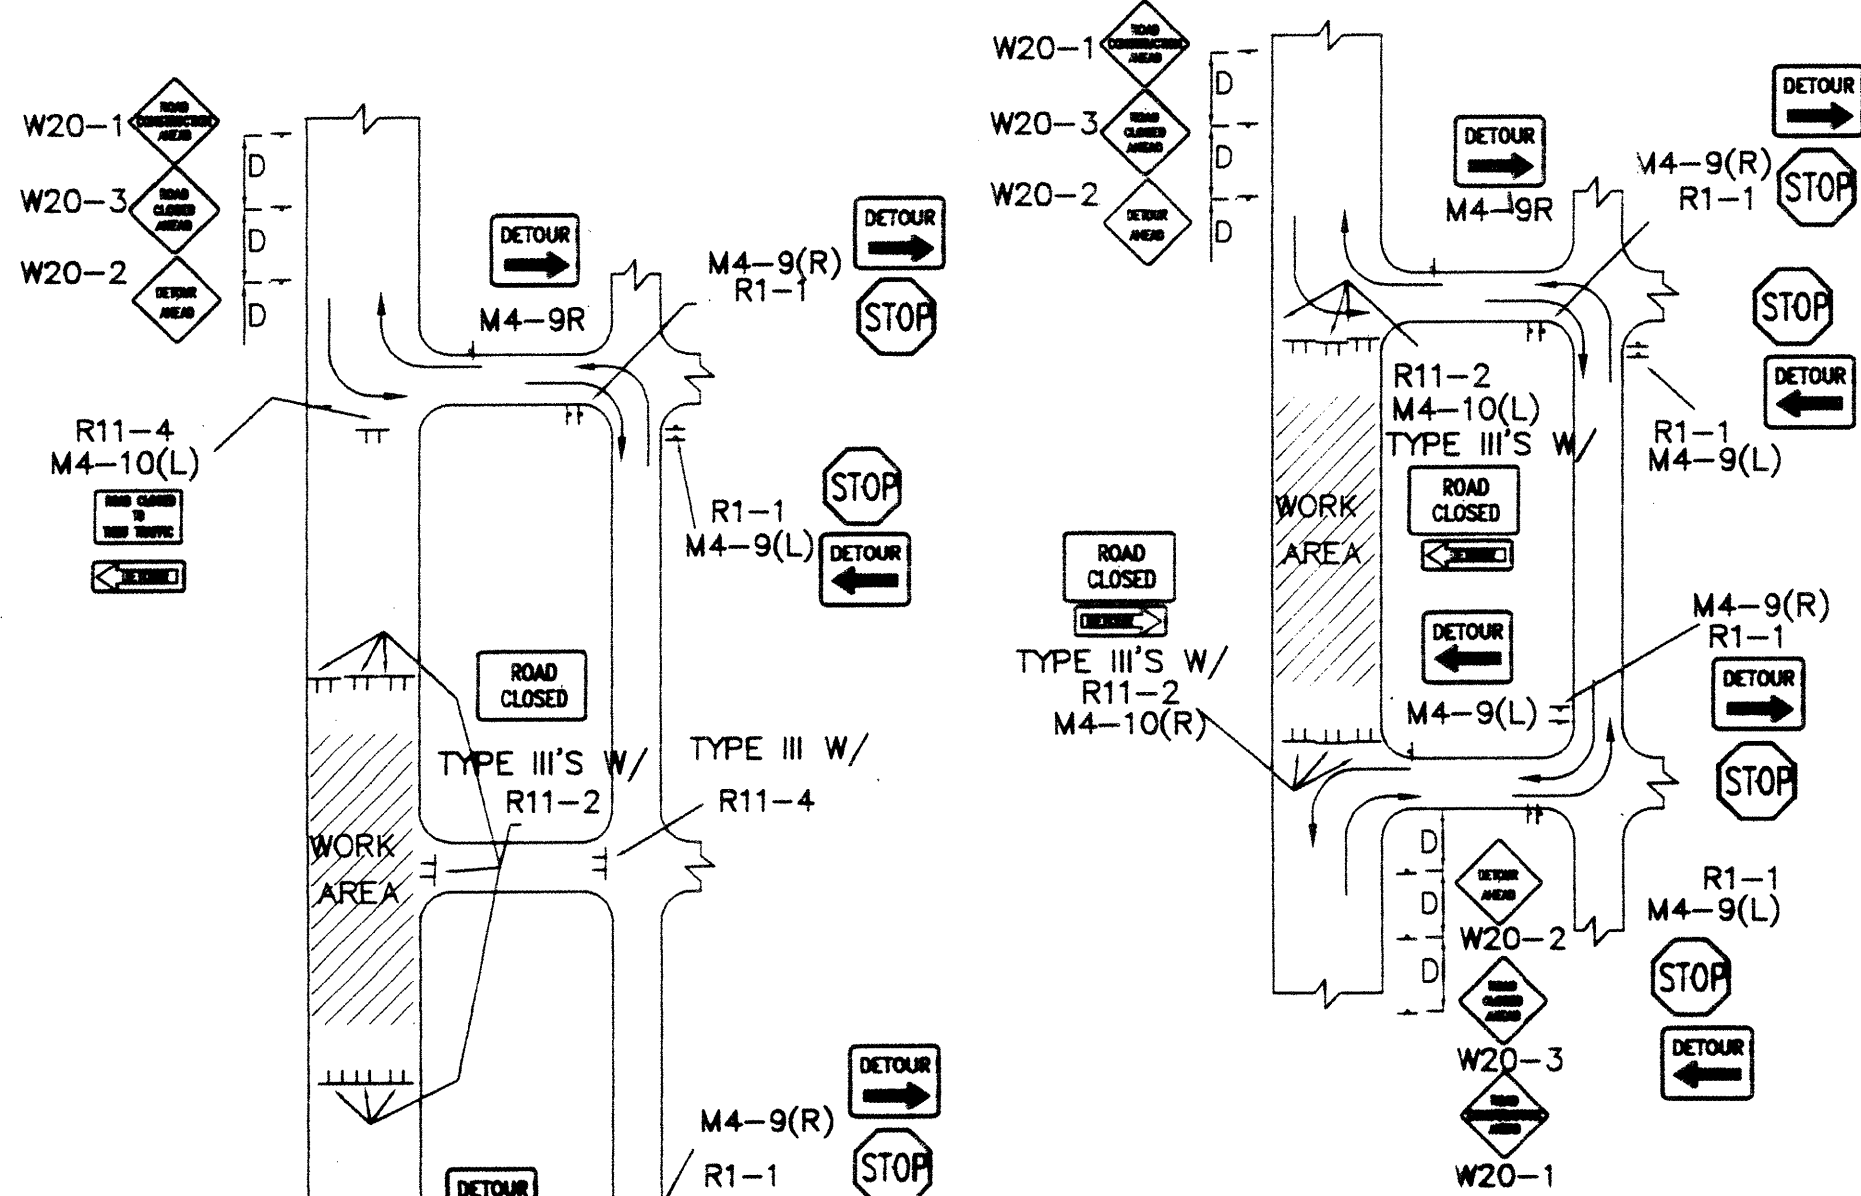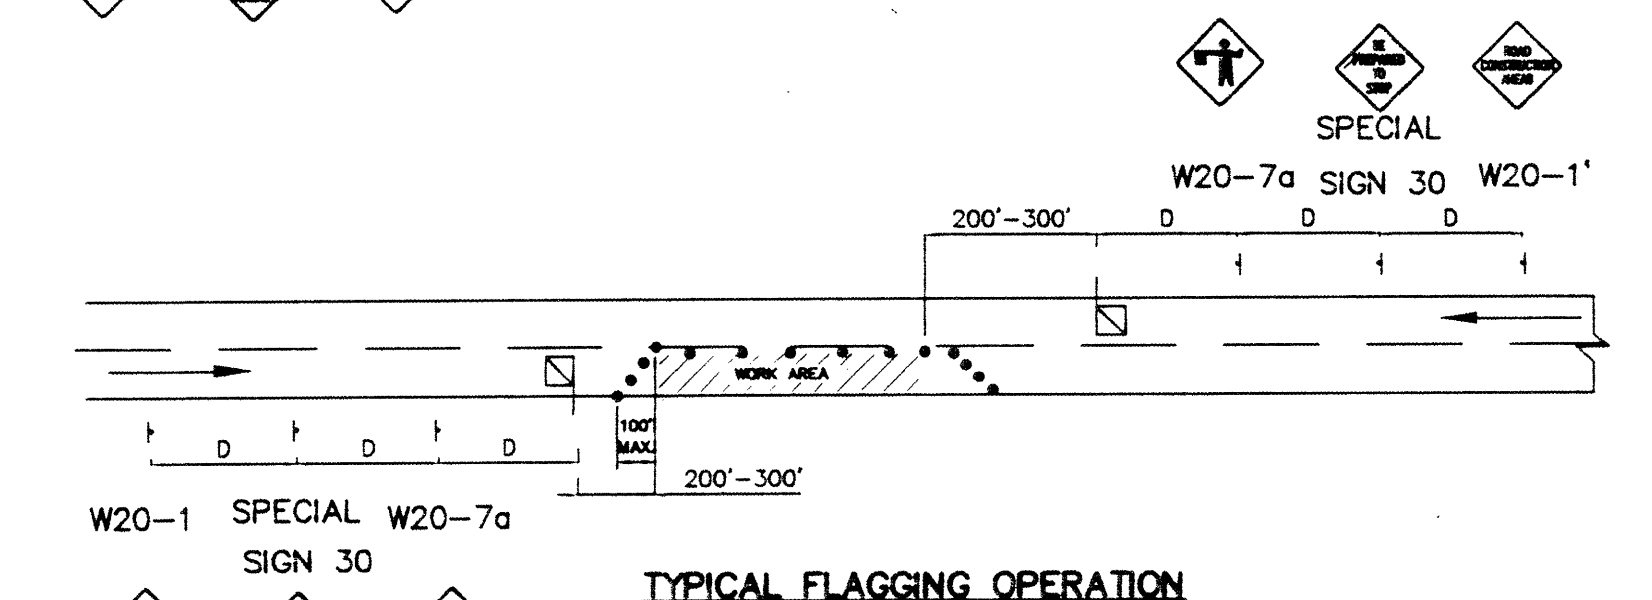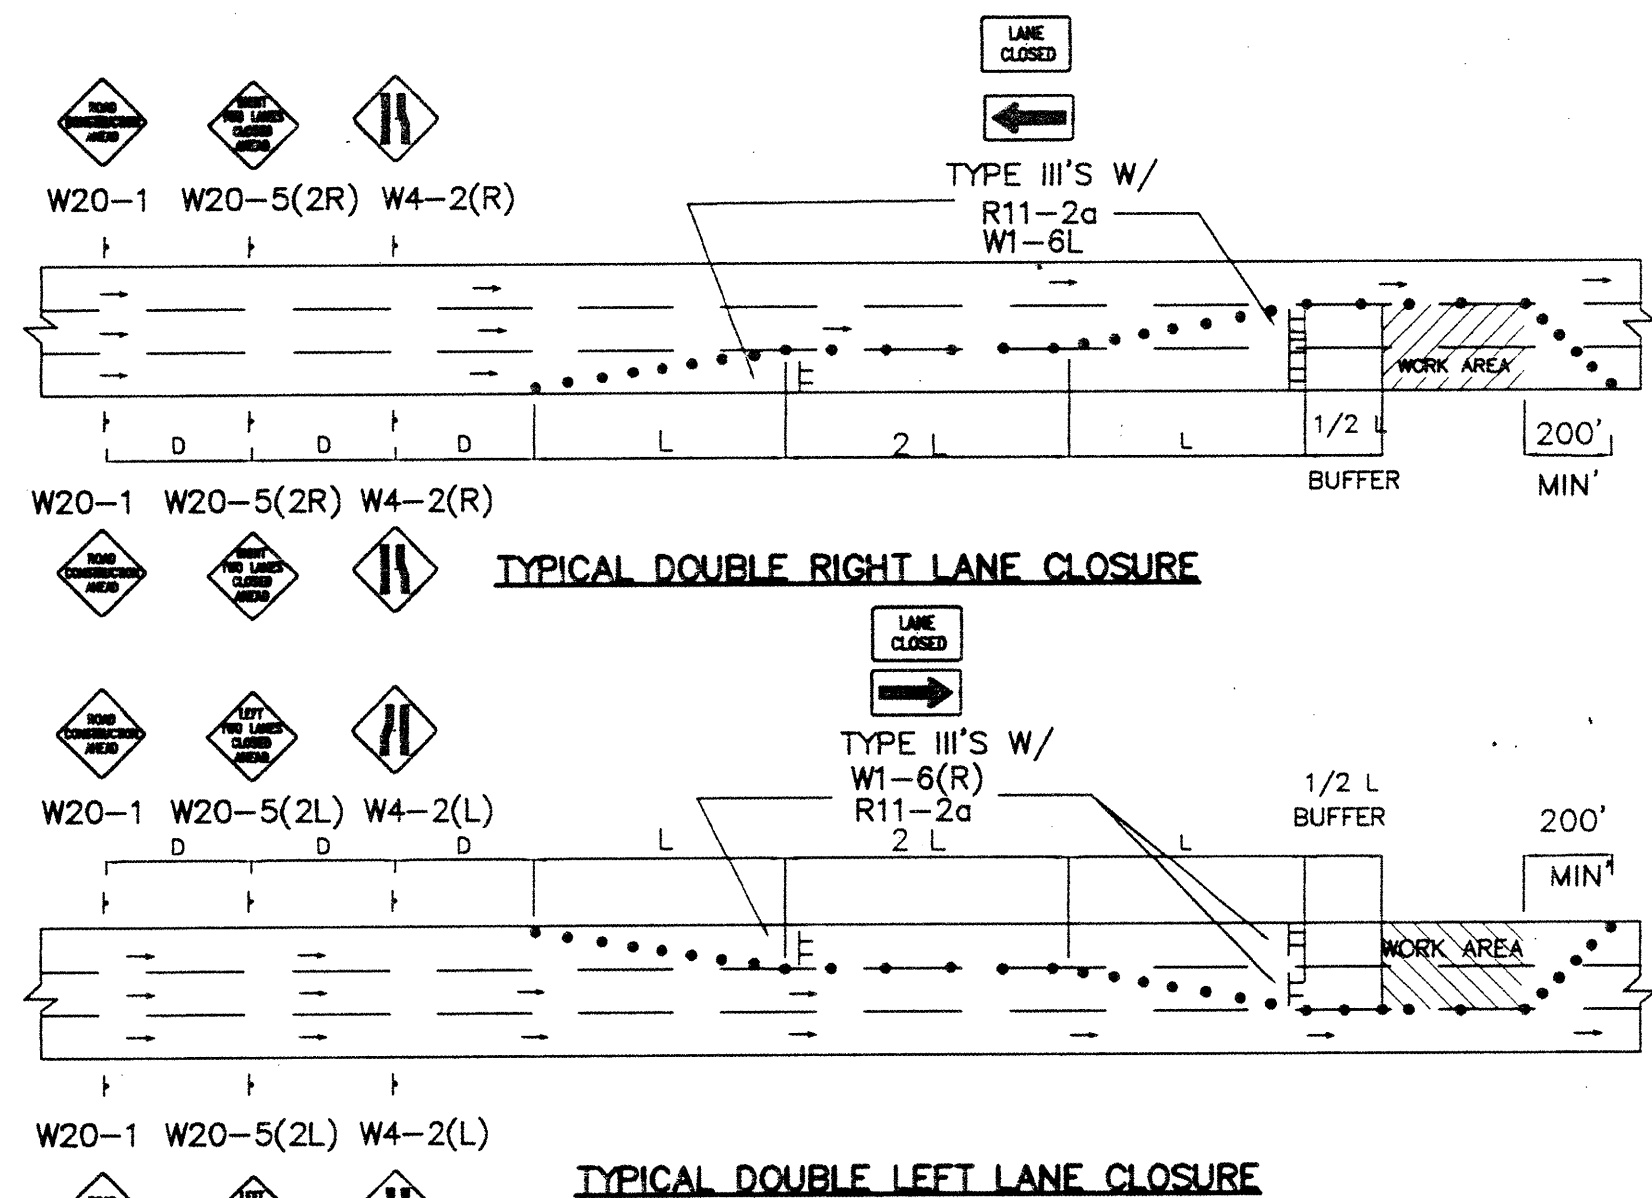

TYPICAL STREET CLOSURE
NOTE: (R1-1) BASED ON FIELD CONDITIONS.

CITY OF ALBUQUERQUE
PUBLIC WORKS DEPARTMENT
ENGINEERING DEVELOPMENT GROUP

TITLE: **Ladera Breeze East**
TYPICAL TRAFFIC CONTROL & SIGNING EXAMPLES (REF. M.U.T.C.D.)

DESIGN REVIEW COMMITTEE: **COP**
CITY ENGINEER APPROVAL: **Standard**

PROJECT NO. **645581** MAP NO. **H-10** SHEET **8** OF **9**

AS BUILT INFORMATION

CONTRACTOR: **N/A** DATE: **N/A**

INSPECTOR'S NAME: **N/A** DATE: **N/A**

APPROVED BY: **N/A** DATE: **N/A**

CORRECTED BY: **N/A** DATE: **N/A**

RECORDED BY: **N/A** DATE: **N/A**

BENCH MARKS

SURVEY INFORMATION

FIELD NOTES

NO. **1** BY **DATE**

ENGINEER'S SEAL

REVISIONS

NO. DATE

REMARKS

DESIGNED BY: **C.O.A. STANDARDS** DATE: **DATE**

DRAWN BY: **DATE**

CHECKED BY: **DATE**

