


ELDORADO PARK SUBDIVISION/TOWER WEST SUBDIVISION
UNIT 2
Albuquerque, New Mexico



GENERAL NOTES


1. ALL WORK DETAILED ON THESE PLANS TO BE PERFORMED UNDER CONTRACT SHALL, EXCEPT AS OTHERWISE STATED OR PROVIDED FOR HEREON, BE IN ACCORDANCE WITH THE CITY OF ALBUQUERQUE STANDARD SPECIFICATIONS FOR PUBLIC WORKS CONSTRUCTION, 1986 EDITION AND SHALL INCLUDE UPDATE NO. 6.
2. PRIOR TO CONSTRUCTION, THE CONTRACTOR SHALL EXCAVATE & VERIFY THE HORIZONTAL AND VERTICAL LOCATIONS OF ALL OBSTRUCTIONS. SHOULD A CONFLICT EXIST, THE CONTRACTOR SHALL NOTIFY THE ENGINEER SO THAT THE CONFLICT CAN BE RESOLVED WITH MINIMUM DELAY.
3. TWO WORKING DAYS PRIOR TO ANY EXCAVATION, THE CONTRACTOR MUST CONTACT NEW MEXICO ONE CALL SYSTEM @ (260-1990) FOR LOCATION OF EXISTING UTILITIES.
4. CONTRACTOR SHALL SUPPORT ALL EXISTING UNDERGROUND UTILITY LINES WHICH BECOME EXPOSED DURING CONSTRUCTION. PAYMENT FOR ALL SUPPORTING WORK SHALL BE INCIDENTAL TO WATERLINE AND/OR SEWERLINE COSTS.
5. ALL STATIONING REFERS TO STREET CENTERLINE STATIONING; OR TO CENTERLINE OF UTILITY IF NOT IN A STREET LOCATION.
6. CONTRACTOR SHALL NOTIFY THE ENGINEER NOT LESS THAN SEVEN (7) DAYS PRIOR TO STARTING WORK IN ORDER THAT THE CITY SURVEYOR MAY TAKE NECESSARY MEASURES TO INSURE THE PRESERVATION OF SURVEY MONUMENTS. CONTRACTOR SHALL NOT DISTURB PERMANENT SURVEY MONUMENTS WITHOUT THE CONSENT OF THE CITY SURVEYOR AND SHALL NOTIFY THE CITY SURVEYOR AND BEAR THE EXPENSE OF REPLACING ANY THAT MAY BE DISTURBED WITHOUT PERMISSION. REPLACEMENT SHALL BE DONE ONLY BY THE CITY SURVEYOR. WHEN A CHANGE IS MADE IN THE FINISHED ELEVATIONS OF THE PAVEMENT OF ANY ROADWAY IN WHICH A PERMANENT SURVEY MONUMENT IS LOCATED, CONTRACTOR SHALL, AT HIS OWN EXPENSE, ADJUST THE MONUMENT COVER TO THE NEW GRADE UNLESS OTHERWISE SPECIFIED. REFER TO SECTION 4.4 OF THE GENERAL CONDITIONS OF THE STANDARD SPECIFICATIONS.
7. AN EXCAVATION/CONSTRUCTION PERMIT WILL BE REQUIRED BEFORE BEGINNING ANY WORK WITHIN THE CITY RIGHT-OF-WAY.
8. CONTRACTOR SHALL MAINTAIN A GRAFFITI-FREE WORK SITE. CONTRACTOR SHALL PROMPTLY REMOVE ANY GRAFFITI FROM ALL EQUIPMENT, WHETHER PERMANENT OR TEMPORARY.
9. ALL STREET STRIPING ALTERED OR DESTROYED SHALL BE REPLACED W/PLASTIC REFLECTORIZED PAVEMENT MARKING BY CONTRACTOR TO LOCATION AS EXISTING OR AS INDICATED BY THIS PLAN SET.
10. CONTRACTOR SHALL CONDUCT OPERATIONS IN A MANNER WHICH WILL MINIMIZE INTERFERENCE WITH LOCAL TRAFFIC. CONTRACTOR SHALL COMPLY WITH ALL APPLICABLE LAWS, ORDINANCES, RULES, REGULATIONS, AND ORDERS OF ANY PUBLIC BODY HAVING JURISDICTION FOR THE SAFETY OF PERSONS OR PROPERTY, AND TO PROTECT THEM FROM DAMAGE, INJURY, OR LOSS. CONTRACTOR SHALL ERECT AND MAINTAIN, AS REQUIRED BY THE CONDITIONS AND PROGRESS OF THE WORK, ALL NECESSARY SAFEGUARDS FOR SAFETY CONTINUOUSLY AND NOT LIMITED TO NORMAL WORKING HOURS, THROUGHOUT THE DURATION OF THE PROJECT. CONTRACTOR SHALL ADHERE TO SECTION 19 (CONSTRUCTION TRAFFIC CONTROL) OF THE GENERAL CONDITIONS OF THE CITY OF ALBUQUERQUE STANDARD SPECIFICATIONS FOR PUBLIC WORKS CONSTRUCTION, 1986 EDITION W/UPDATE #6.
11. PROPOSED WATERLINE MATERIALS SHALL BE EITHER P.V.C. PIPE MEETING AWWA C900 REQUIREMENTS (6" - 12" DIAM.) OR DUCTILE IRON PIPE, THICKNESS CLASS 50 (6" - 16" DIAM.).
12. THE CONTRACTOR AGREES TO ASSUME THE SOLE AND COMPLETE RESPONSIBILITY FOR THE JOB SITE CONDITIONS DURING THE COURSE OF CONSTRUCTION OF THIS PROJECT, INCLUDING SAFETY OF ALL PERSONS AND PROPERTY; THAT THIS REQUIREMENT SHALL APPLY CONTINUOUSLY AND NOT BE LIMITED TO NORMAL WORKING HOURS; AND THAT THE CONTRACTOR SHALL DEFEND, INDEMNIFY, AND HOLD HARMLESS THE OWNER & ENGINEER FROM ANY AND ALL LIABILITY REAL OR ALLEGED, IN CONNECTION WITH THE PERFORMANCE OF WORK ON THIS PROJECT, EXCEPTING LIABILITY ARISING FROM THE SOLE NEGLIGENCE OF THE OWNER OR ENGINEER.

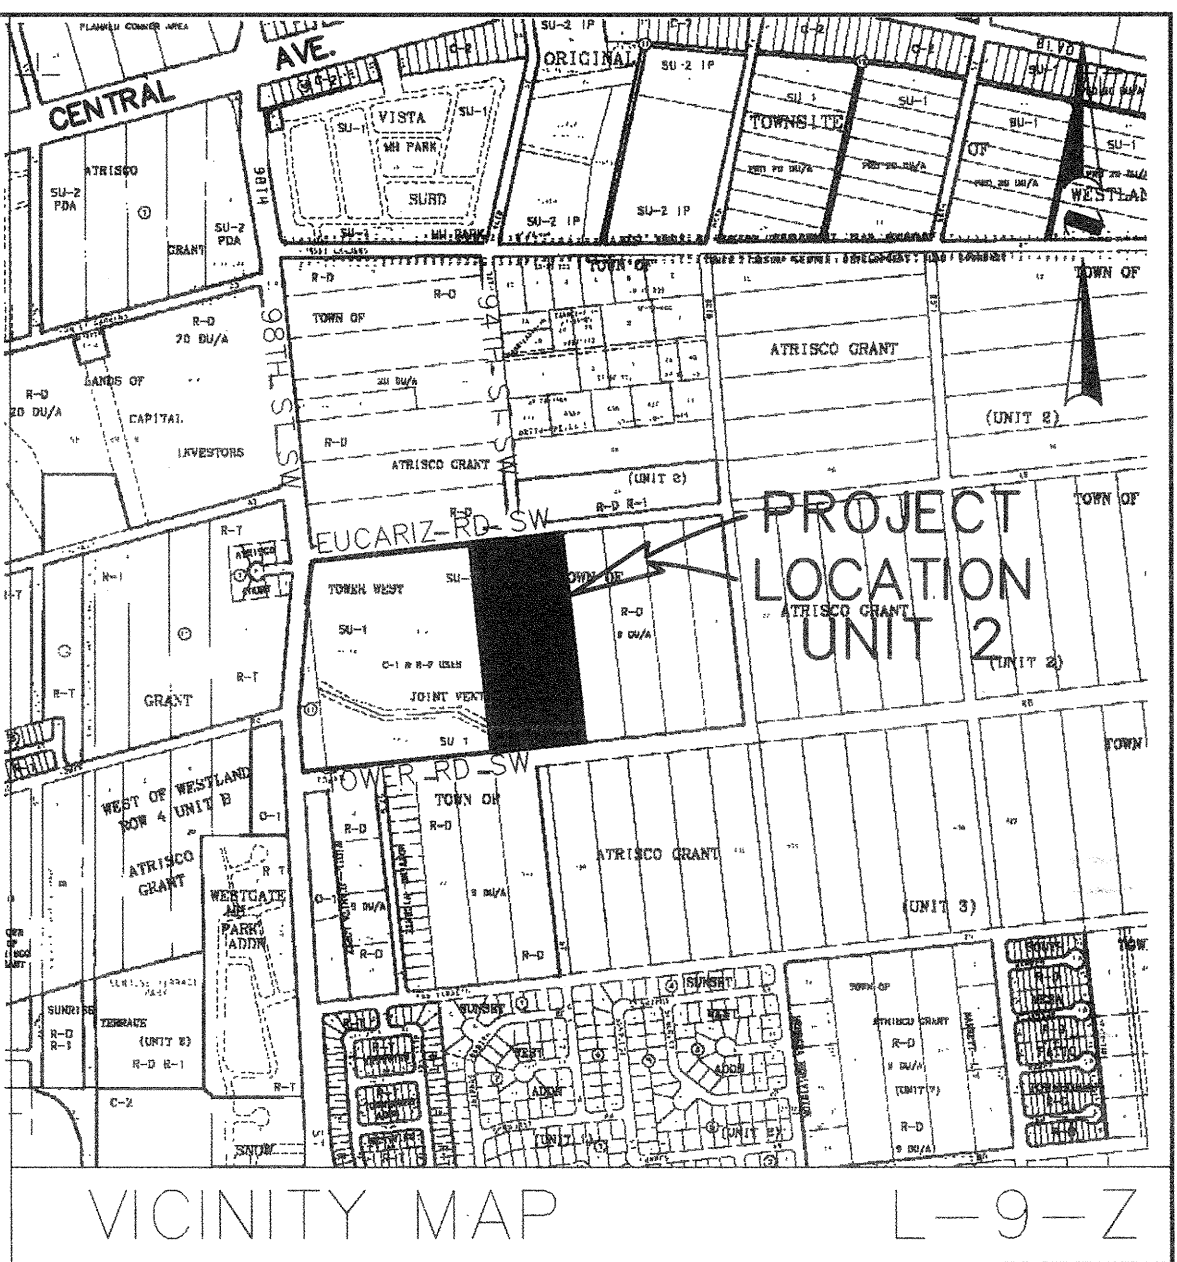

13. FIVE (5) WORKING DAYS PRIOR TO BEGINNING CONSTRUCTION THE CONTRACTOR SHALL SUBMIT TO THE CONSTRUCTION COORDINATION DIVISION A DETAILED CONSTRUCTION SCHEDULE. TWO (2) WORKING DAYS PRIOR TO CONSTRUCTION, THE CONTRACTOR SHALL OBTAIN A BARRICADING PERMIT FROM THE CONSTRUCTION COORDINATION DIVISION. CONTRACTOR SHALL NOTIFY BARRICADE ENGINEER (768-2551) PRIOR TO OCCUPYING AN INTERSECTION. REFER TO SECTION 19 OF THE GENERAL CONDITIONS OF THE STANDARD SPECIFICATIONS.
14. CONTRACTOR SHALL PROMPTLY CLEAN UP ANY MATERIAL EXCAVATED WITHIN THE PUBLIC RIGHT-OF-WAY SO THAT THE EXCAVATED MATERIAL IS NOT SUSCEPTIBLE TO BEING WASHED DOWN THE STREET.
15. CONTRACTOR SHALL ASSIST THE ENGINEER/INSPECTOR IN THE RECORDING OF DATA ON ALL UTILITY LINES AND ACCESSORIES AS REQUIRED BY THE CITY OF ALBUQUERQUE FOR THE PREPARATION OF RECORD DRAWINGS. CONTRACTOR SHALL NOT COVER UTILITY LINES AND ACCESSORIES UNTIL ALL DATA HAS BEEN OBTAINED AND RECORDED.
16. EXISTING CURB AND GUTTER NOT CALLED OUT TO BE REMOVED UNDER THE CONTRACT WHICH IS DAMAGED OR DISPLACED BY THE CONTRACTOR SHALL BE REMOVED AND REPLACED BY THE CONTRACTOR AT THE CONTRACTOR'S OWN EXPENSE.
17. ALL WORK ON THIS PROJECT SHALL BE PERFORMED IN ACCORDANCE WITH APPLICABLE FEDERAL, STATE, AND LOCAL LAWS, RULES, AND REGULATIONS CONCERNING CONSTRUCTION SAFETY AND HEALTH.
18. ALL FITTINGS ON WATERLINES SHALL HAVE JOINT RESTRAINTS IN ACCORDANCE WITH THE JOINT RESTRAINT LENGTHS SHOWN ON UTILITY PLAN AND PROFILE DRAWINGS AND ARE TO HAVE LOCKED MECHANICAL JOINTS.
19. THE CONTRACTOR IS RESPONSIBLE FOR PROTECTING AND MAINTAINING ALL EXISTING MONUMENTATION CONTROLS. IN THE EVENT OF INADVERTENT DESTRUCTION OR ALTERATION, THE CONTRACTOR MUST IMMEDIATELY NOTIFY THE CITY CHIEF SURVEYOR, ALSO SEE NOTE NO. 6.
20. PNM (PUBLIC SERVICE CO. OF NEW MEXICO) WILL PROVIDE AT NO COST TO THE CITY OR TO THE CONTRACTOR THE REQUIRED PERSONNEL FOR INSPECTION OR OBSERVATION DEEMED NECESSARY BY PNM WHILE THE CONTRACTOR IS EXPOSING PNM'S CABLES. HOWEVER, THE CONTRACTOR SHALL BE CHARGED THE TOTAL COST ASSOCIATED WITH REPAIRS TO ANY DAMAGED CABLES OR FOR ANY COST ASSOCIATED WITH SUPPORTING OR RELOCATING THE POLES AND CABLES DURING CONSTRUCTION.
21. ** WARNING ** - EXISTING UTILITY LINE LOCATIONS ARE SHOWN IN APPROXIMATE MANNER ONLY, AND SUCH LINES MAY EXIST WHERE NONE ARE SHOWN. THE LOCATION OF ANY SUCH EXISTING LINES IS BASED UPON INFORMATION PROVIDED BY THE UTILITY COMPANY, THE OWNER, OR BY OTHERS, AND THE INFORMATION MAY BE INCOMPLETE OR MAY BE OBSOLETE BY THE TIME CONSTRUCTION COMMENCES.
- THE ENGINEER HAS UNDERTAKEN NO FIELD VERIFICATION OF THE LOCATION, DEPTH, SIZE, OR TYPE OF EXISTING UNDERGROUND UTILITY LINES. MAKES NO REPRESENTATION PERTAINING THERETO, AND ASSUMES NO RESPONSIBILITY OR LIABILITY THEREFOR. THE CONTRACTOR SHALL INFORM ITSELF OF THE LOCATION OF ANY UTILITY LINE IN OR NEAR THE AREA OF THE WORK IN ADVANCE OF AND DURING EXCAVATION WORK. THE CONTRACTOR IS FULLY RESPONSIBLE FOR ANY AND ALL DAMAGE CAUSED BY ITS FAILURE TO LOCATE, IDENTIFY, AND PRESERVE ANY AND ALL EXISTING UTILITIES. THE CONTRACTOR SHALL COMPLY WITH STATE STATUTES, MUNICIPAL AND LOCAL ORDINANCES, RULES AND REGULATIONS PERTAINING TO THE LOCATION OF THESE LINES AND FACILITIES, IN PLANNING AND CONDUCTING EXCAVATION, WHETHER BY CALLING OR NOTIFYING THE UTILITIES, COMPLYING WITH "BLUE STAKES" PROCEDURES, OR OTHERWISE.
22. ANY CONSTRUCTION OCCURRING WITHIN AN ARTERIAL ROADWAY REQUIRES TWENTY-FOUR HOUR CONSTRUCTION.
23. SIDEWALKS SHALL BE BUILT IN CONJUNCTION WITH HOUSE CONSTRUCTION ON EACH LOT.

INDEX OF SHEETS

SHEET	TITLE
1	COVER SHEET
2	ELDORADO PARK UNIT 2 PLAT (Sheets 1of4 and 2of4).
3	ELDORADO PARK UNIT 2 PLAT (Sheets 3of4 and 4of4).
4	ELDORADO PARK SUBDIVISION UNIT 2 GRADING & DRAINAGE PLAN
5	ELDORADO PARK SUBDIVISION UNIT 2 OFFSITE DRAINAGE PLAN
6	ELDORADO PARK SUBDIVISION PAVING MASTER PLAN
7	ELDORADO PARK SUBDIVISION UNIT 2 94th STREET PAVING PLAN & PROFILE
8	ELDORADO PARK SUBDIVISION UNIT 2 ROWEN ROAD PAVING PLAN & PROFILE
9	ELDORADO PARK SUBDIVISION MASTER UTILITY PLAN
10	ELDORADO PARK SUBDIVISION UNIT 2 94th STREET UTILITY PLAN & PROFILE
11	ELDORADO PARK SUBDIVISION UNIT 2 ROWEN ROAD UTILITY PLAN & PROFILE
12	ELDORADO PARK SUBDIVISION UNIT 1 TEMPORARY STORM DRAIN & POND
13	ELDORADO PARK SUBDIVISION UNIT 1 PAVING DETAILS & TYPICAL ROAD SECTIONS
14	ELDORADO PARK SUBDIVISION UNIT 1 TRAFFIC CONTROL SIGNING
15	ELDORADO PARK SUBDIVISION UNIT 1 TRAFFIC CONTROL STANDARDS

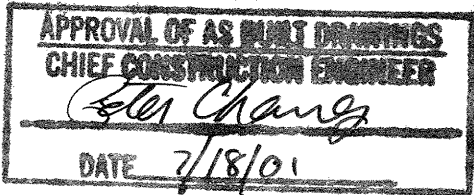

I, ELVADIO V. DINIZ CERTIFY THAT THE DRAWING OF THE PROJECT SUBMITTED HEREON WAS PREPARED UNDER MY SUPERVISION. *EDV*

Resource Technology, Inc.
ENGINEERS AND ENVIRONMENTAL SCIENTISTS
1720-B Randolph Rd. SE • Albuquerque, New Mexico 87106
Telephone: (505) 243-7300 • Fax: (505) 243-7400 • E-mail: rti@rti.com
Civil • Environmental • Water Resources • Recreation • Planning

REV.	SHEET	CITY ENGINEER	DATE	USER DEPARTMENT	DATE	USER DEPARTMENT	DATE
ENGINEERS STAMP & SIGNATURE		APPROVALS	ENGINEER	DATE	*****		
		DRC Chairman	<i>[Signature]</i>	<i>10-12-00</i>	APPROVED FOR CONSTRUCTION <i>[Signature]</i> 10/25/00 City Engineer Date		
		Transportation	<i>[Signature]</i>	<i>10-12-00</i>			
		Water/Wastewater	<i>[Signature]</i>	<i>10-12-00</i>			
		Hydrology	<i>[Signature]</i>	<i>10-12-00</i>			
		Parks	<i>[Signature]</i>	<i>10-12-00</i>			
AMAFCA		Const.	<i>[Signature]</i>	<i>10-12-00</i>			
City Project No.		648281				Sheet	Of
						1	15

DRB CASE NO. 97-13

As built data added 2/26/01

PLAT OF
ELDORADO PARK, UNIT 2
SITUATE WITHIN PROJECTED SECTION 28
T. 10 N., R. 3 E., N.M.P.M.
CITY OF ALBUQUERQUE
BERNALILLO COUNTY, NEW MEXICO
JULY 2000
SHEET 3 OF 3

SCALE: 1" = 60'
PROJECT NO. 0004P903
PLOT BY PGB
ZONE ATLAS: L-9-Z





MONUMENT LEGEND

- = FOUND MONUMENT AS NOTED
- = FOUND #4 REBAR W/CAP PS12651
- = CALCULATED CORNER
- ⊙ = SET #4 REBAR W/CAP PS12651
- △ = CENTERLINE MONUMENT-SEE NOTE #6

EASEMENT LEGEND

- (A) = 10' PUBLIC UTILITY ESMT. PER PLAT OF TOWER WEST FILED 5-27-1999 IN BK. 99C, PG. 125
- (B) = 8' PUBLIC UTILITY ESMT. PER PLAT OF TOWER WEST FILED 5-27-1999 IN BK. 99C, PG. 125
- (C) = 40' PUBLIC WATER & SANITARY SEWER ESMT. PER PLAT OF TOWER WEST FILED 5-27-1999 IN BK. 99C, PG. 125
- (D) = 10' PUBLIC UTILITY ESMT. (GRANTED BY THIS PLAT)
- (E) = 20' PUBLIC BICYCLE ESMT. PER PLAT OF TOWER WEST FILED 5-27-1999 IN BK. 99C, PG. 125 (VACATED BY THIS PLAT)
- (F) = 10' PUBLIC UTILITY ESMT. PER PLAT OF ELDORADO PARK FILED 2-25-2000 IN BK. 2000C, PG. 60
- (G) = PUBLIC WATER, SEWER & DRAINAGE ESMT. AND PUBLIC ROADWAY ESMT. (TO BE DEDICATED AS ADDITIONAL PUBLIC RIGHT-OF-WAY WHEN REQUESTED BY THE GOVERNMENTAL AGENCY HAVING JURISDICTION OVER MONICATT DRIVE S.W. AND POLAN ROAD S.W.) PER PLAT OF ELDORADO PARK FILED 2-25-2000 IN BK. 2000C, PG. 60
- (H) = 7' P.U.E. (GRANTED BY THIS PLAT)
- (I) = 25' PUBLIC PEDESTRIAN ESMT. & PUBLIC WATER LINE ESMT. (GRANTED BY THIS PLAT)
- (J) = 20' PUBLIC BICYCLE ESMT. (GRANTED BY THIS PLAT)
- (K) = 20' TEMPORARY DRAINAGE ESMT. FILED 10-7-1999 IN BK. 9913, PG. 8303
- (M) = TEMPORARY F.E.M.A. FLOODPLAIN ESMT. (GRANTED BY THIS PLAT)

CURVE	RADIUS	LENGTH	CHORD	BEARING	DELTA
C14	30.00'	47.09'	42.40'	N 50°57'34" W	88°56'00"
C15	25.00'	20.38'	16.82'	N 17°21'41" E	46°42'28"
C17	25.00'	20.38'	16.82'	S 28°20'48" E	46°42'28"
C18	30.00'	48.48'	44.05'	S 41°42'26" W	94°28'00"
C19	110.00'	85.20'	85.18'	N 89°18'26" W	04°26'16"
C27	45.00'	17.14'	17.04'	N 30°10'58" E	21°49'46"
C28	45.00'	30.59'	30.00'	N 00°12'12" W	38°56'33"
C29	45.00'	29.72'	29.18'	N 38°35'36" W	37°50'16"
C30	45.00'	30.22'	29.66'	N 76°45'09" W	38°28'50"
C31	45.00'	26.04'	27.55'	S 66°09'12" W	35°42'28"
C32	45.00'	26.46'	28.93'	S 29°32'48" W	37°30'21"
C33	45.00'	27.63'	27.20'	S 06°47'56" E	35°11'06"
C34	45.00'	22.20'	22.01'	S 38°32'46" E	28°18'34"
C35	28.00'	43.98'	38.60'	S 39°00'26" W	90°00'00"
C36	28.00'	43.98'	38.60'	S 50°59'34" E	90°00'00"

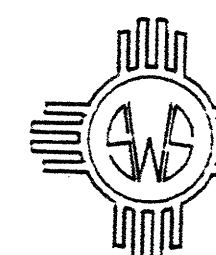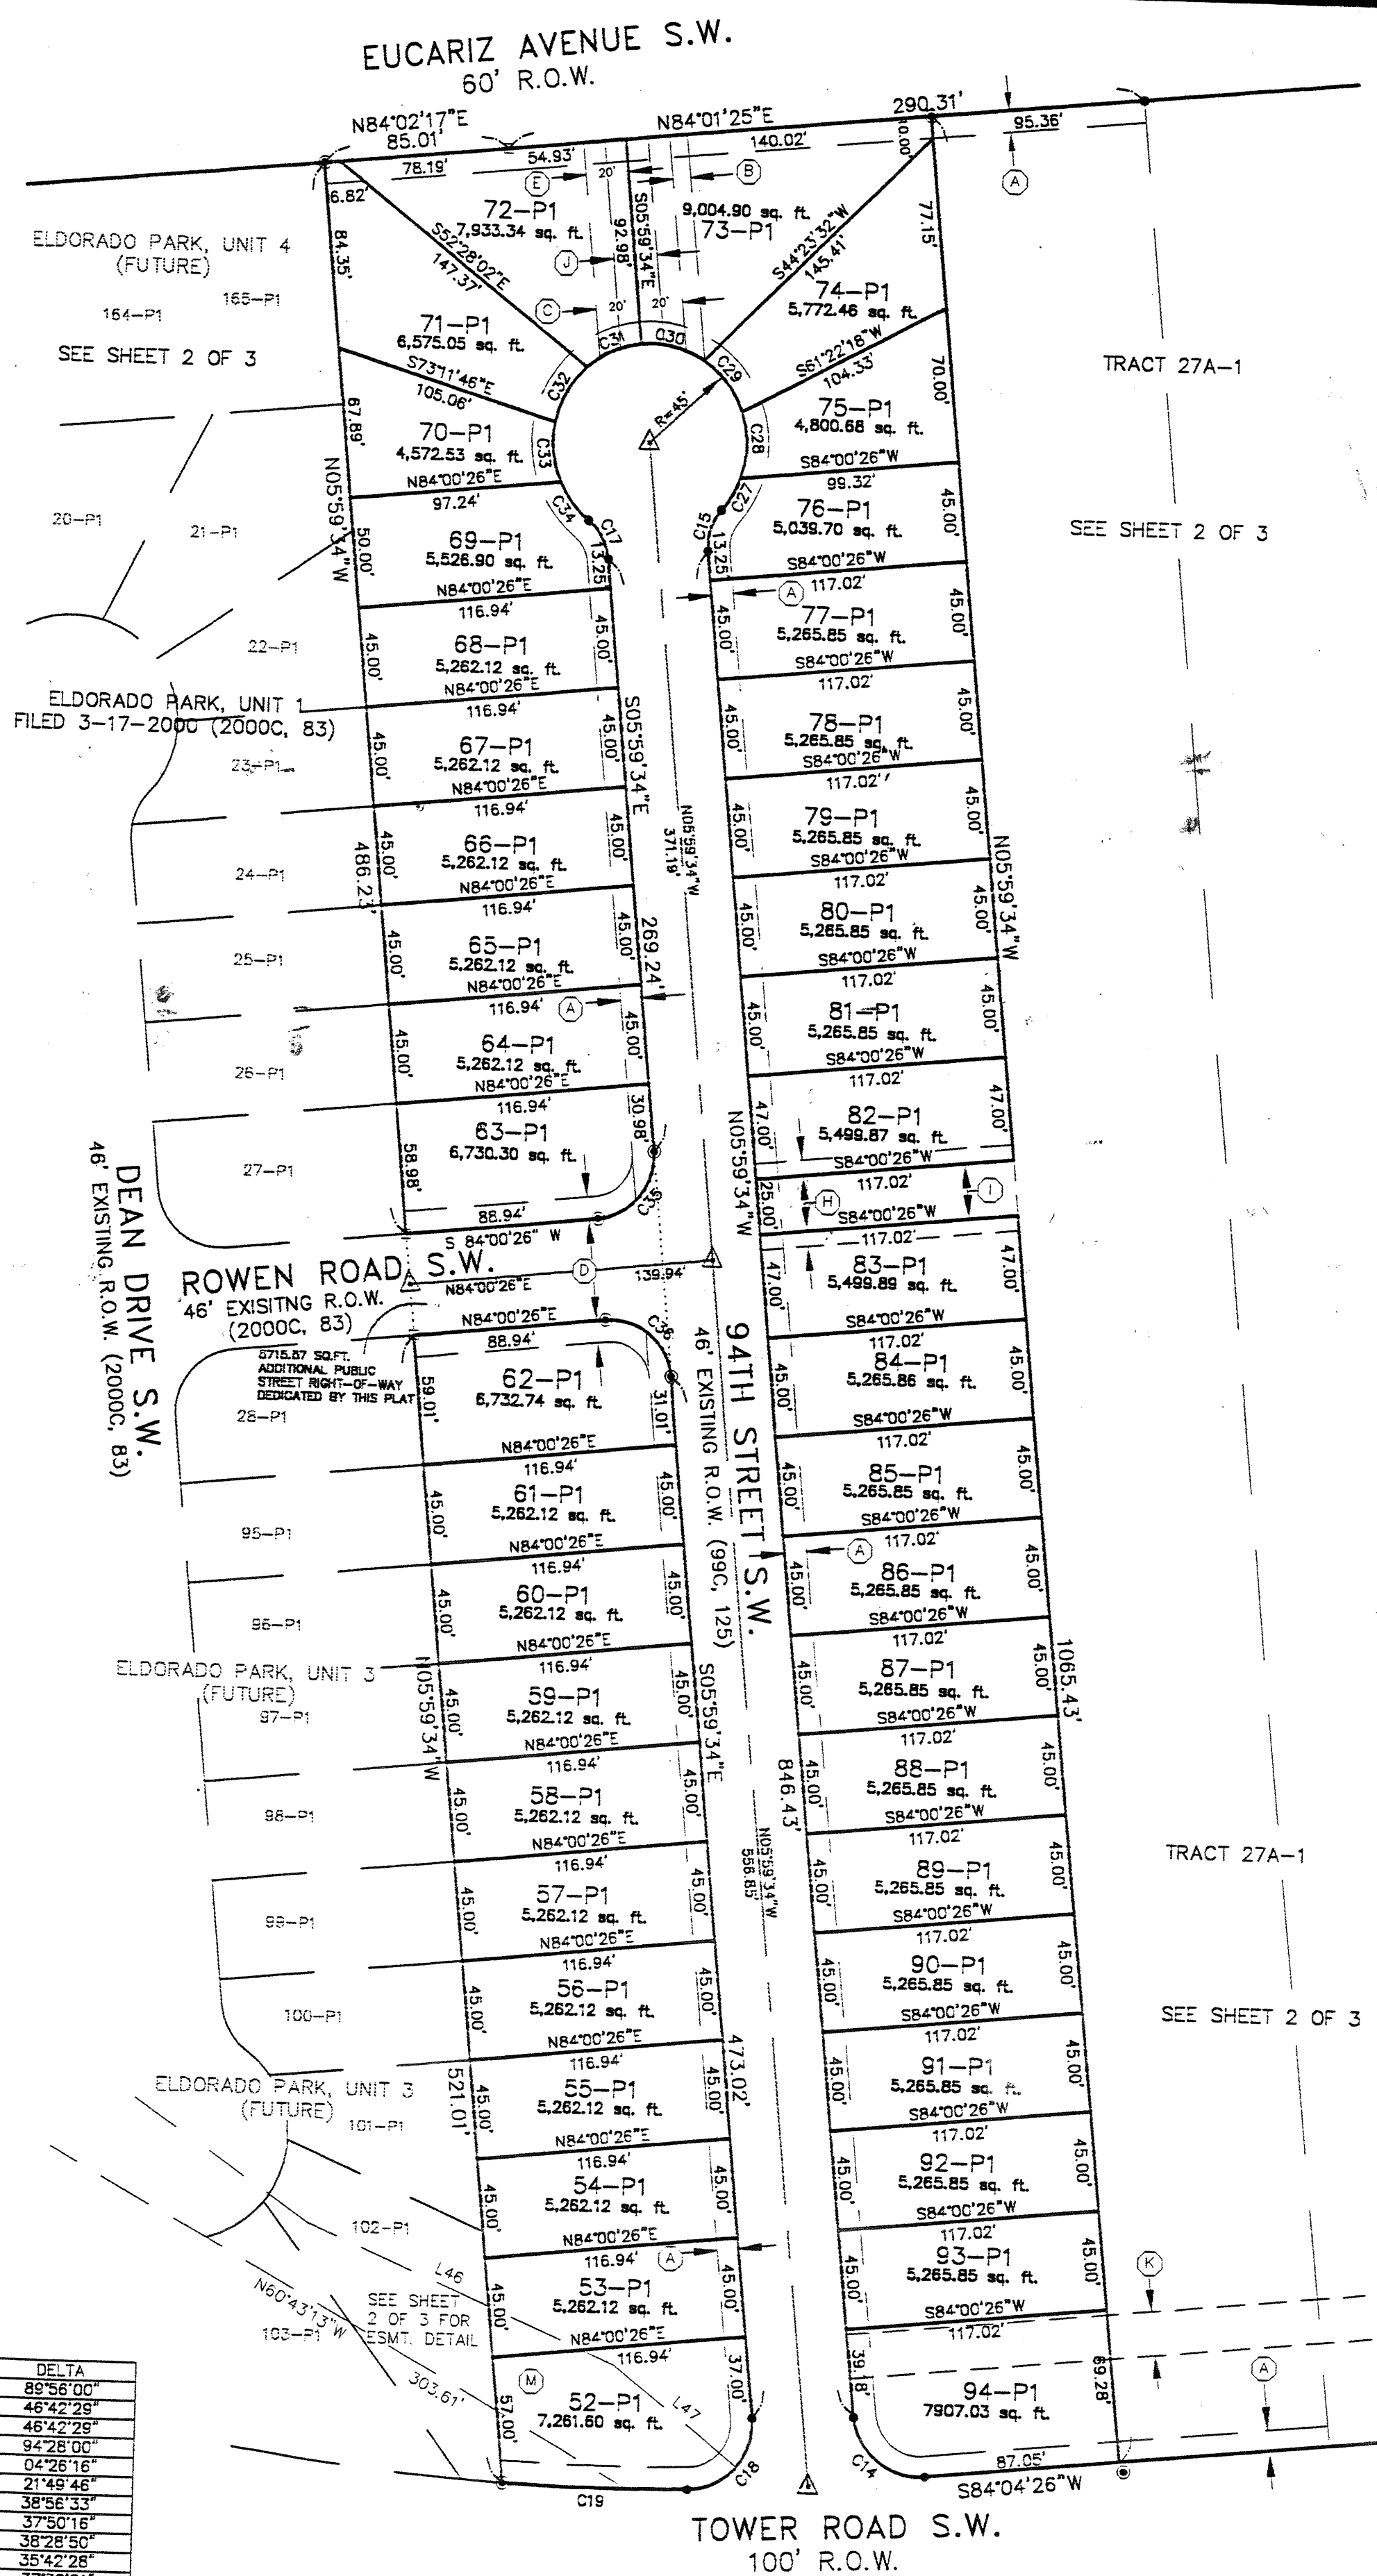


SOUTHWEST SURVEYING CO., INC.

333 LOMAS BLVD., N.E.
ALBUQUERQUE, NEW MEXICO 87102
PHONE: (505) 998-0303
FAX: (505) 998-0306

T10N R2E SEC. 28

3 of 15

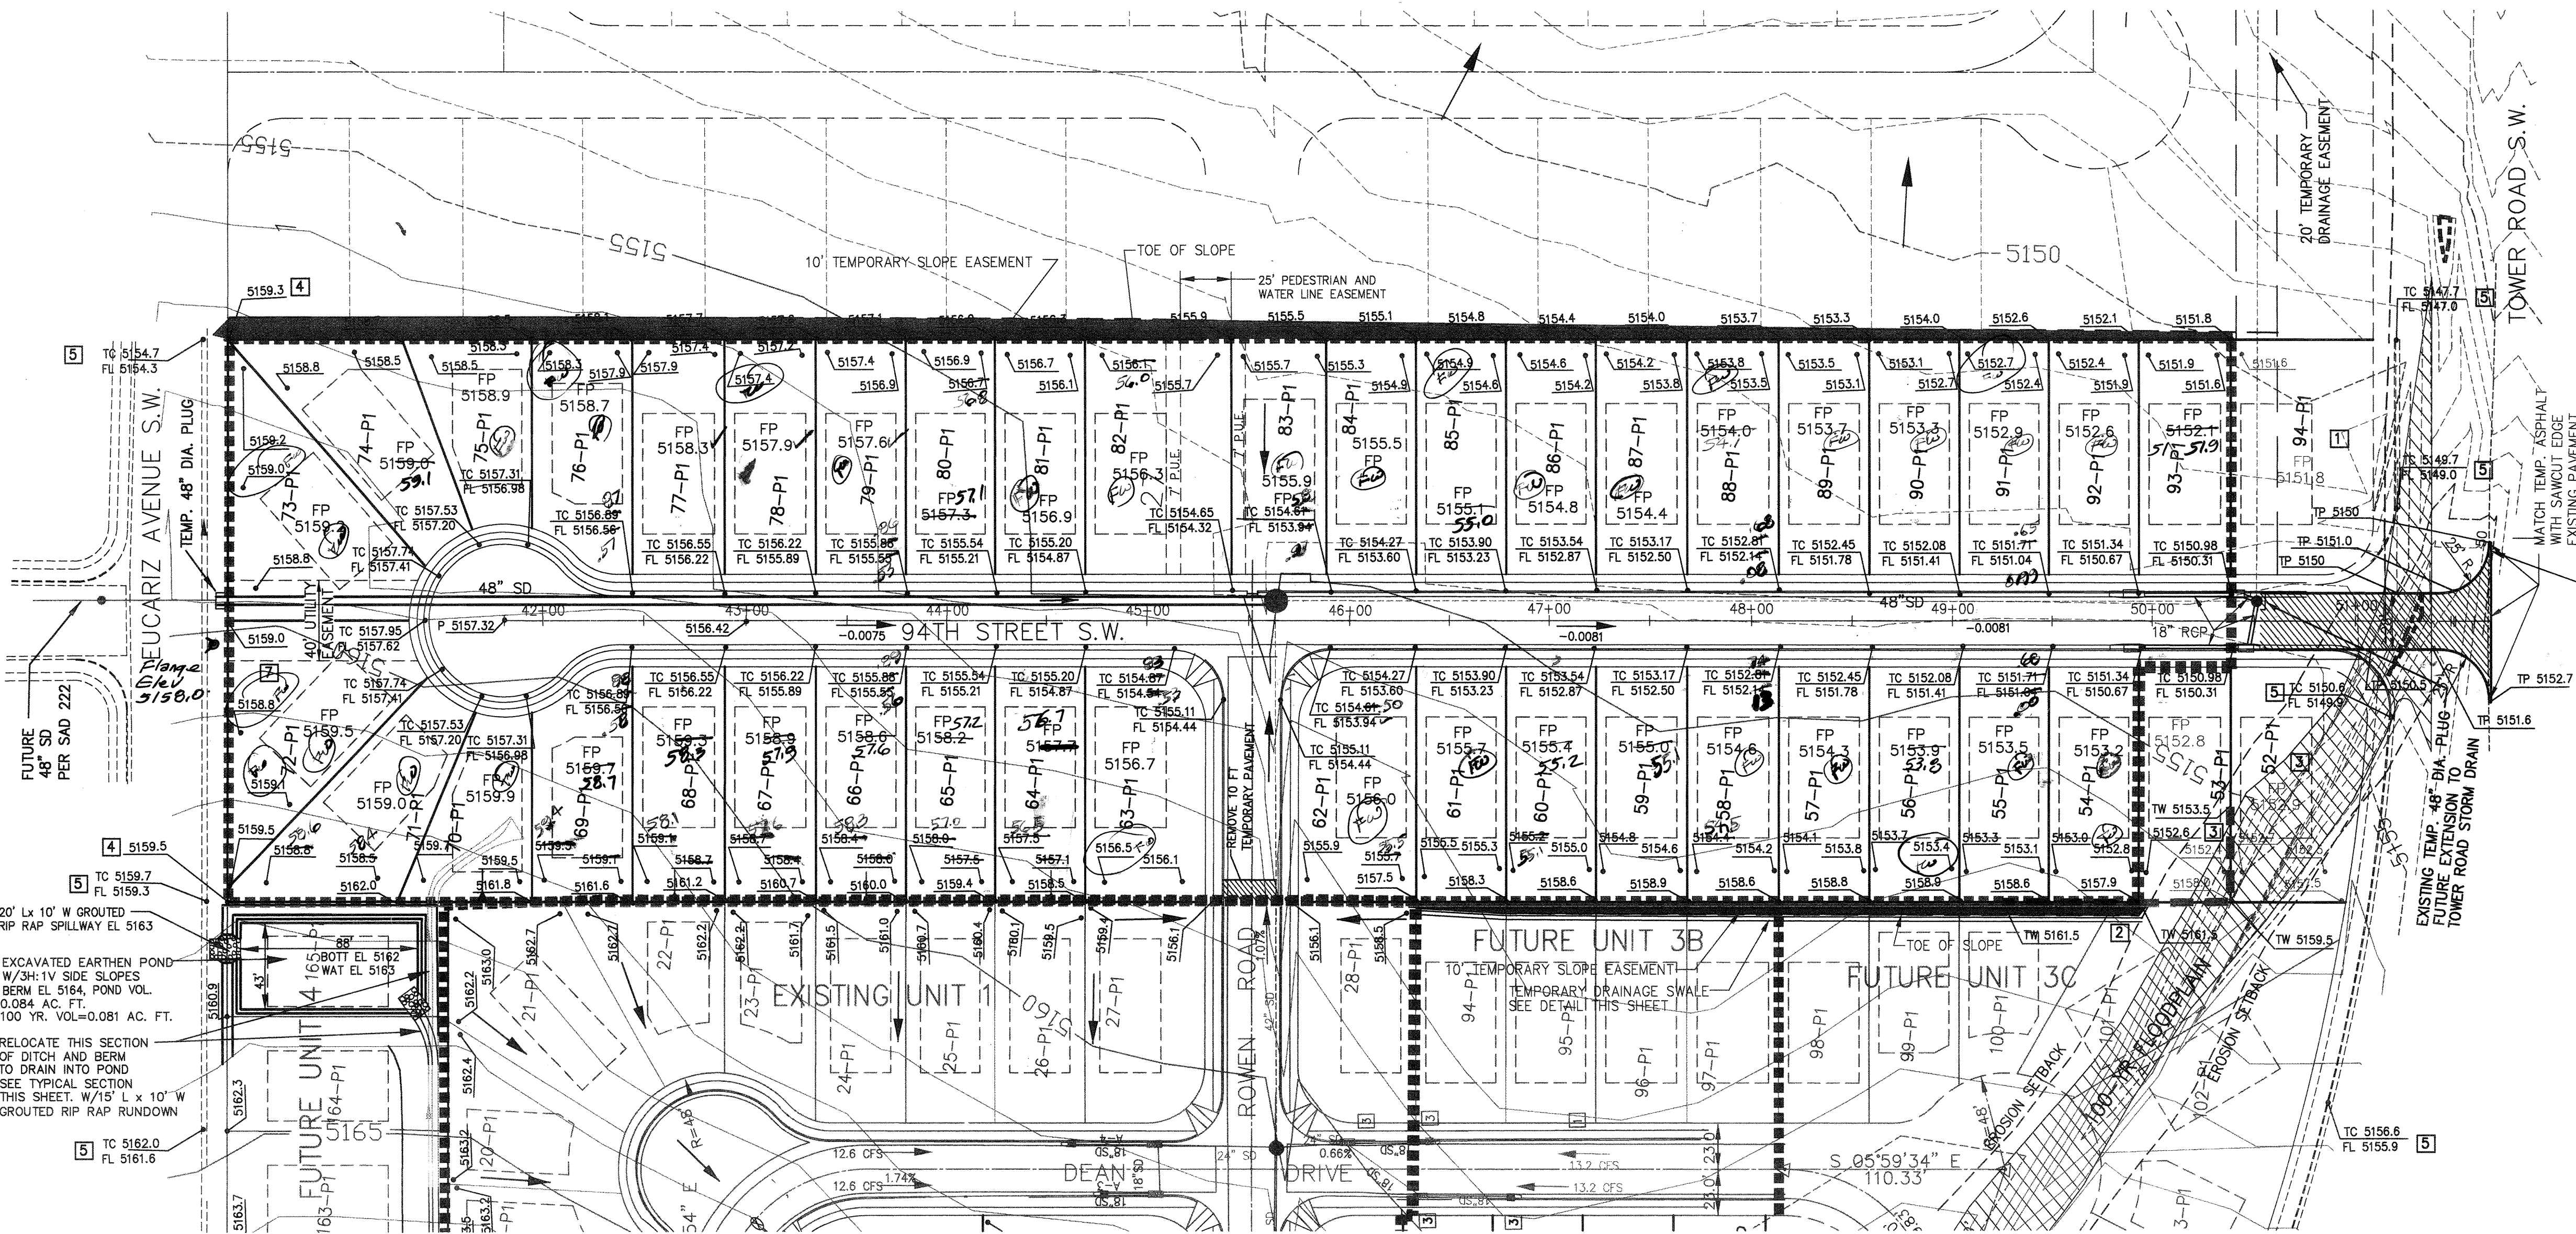

I, ELVIDIO V. DINIZ, REGISTERED PROFESSIONAL ENGINEER NO. 7111 DO HEREBY CERTIFY THAT THE AS-BUILT ELEVATIONS FOR UNIT 2 HAVE BEEN UNDER MY DIRECTION AND THIS DRAINAGE PLAN IS IN SUBSTANTIAL COMPLIANCE WITH THE APPROVED DRAINAGE PLAN.

KEYED NOTES

- LOT 94-P1 TO BE DEVELOPED AFTER SAD 222 IS BUILT
- INTERIM ONLY-END OF RETAINING WALL SW CORNER OF LOT 54-P1
- LOTS 52-P1 AND 53-P1 AND RETAINING WALL, TO REMAIN IN TEMPORARY EASEMENT UNTIL, UNIT 3C IS DEVELOPED AND FLOOD PLAIN IS REMOVED OR AFTER SAD 222 IS BUILT
- PROPOSED CONSTRUCTION WILL REQUIRE A TEMPORARY SLOPE EASEMENT TO MATCH EXISTING GRADES. FINAL GRADE ON EUCLARZ AVE. WILL HAVE TO ACCOMMODATE PLAN ELEVATIONS.
- FROM "SAD 222 DRAINAGE ANALYSIS", ANDREWS, ASBURY & ROBERT, APRIL 1995

FOR TEMPORARY PAVEMENT CENTERLINE PROFILE SEE PROFILE DETAIL BELOW

LEGEND

- EXIST. CONTOUR LINE
- TEMPORARY PAVEMENT
- CONSTRUCTION EASEMENT/TRANSITION SLOPES
- FLOW DIRECTION
- BUILDING PAD
- FINISHED PAD ELEVATION
- FINISHED GRADE SPOT ELEVATION
- STANDARD CURB & GUTTER COA STAND. DWG 2415
- ROLL TYPE CURB & GUTTER COA STAND. DWG 2415
- WHEELCHAIR RAMP COA STAND. DWG 2418
- RETAINING WALL

TW = TOP OF WALL ELEVATION (MIN.)
FG(F) = FINISHED GRADE ELEVATION (FUTURE UNIT)
FL = FLOW LINE ELEVATION
TC = TOP OF CURB ELEVATION

ROLL TYPE CURB CAPACITY	
LONGITUDINAL SLOPE %	1/2 STREET CAPACITY (CFS)
0.5	2.3
1.0	3.3
1.5	4.0
2.0	4.6
2.5	5.1

STANDARD CURB CAPACITY	
LONGITUDINAL SLOPE %	STREET CAPACITY (CFS)
0.5	57.7
1.0	81.6
1.5	99.9
2.0	115.4
2.5	129.0


* FLOW DEPTH AT TOP OF CURB

I, ELVIDIO V. DINIZ CERTIFY THAT THE DRAWING OF THE "AS BUILT" DIMENSIONS WAS DONE UNDER MY SUPERVISION.

TYPICAL SWALE SECTION
NOT TO SCALE

TYPICAL HALF SECTION
PROPOSED STREET WITH ROLL TYPE CURB
NOT TO SCALE

TYPICAL HALF SECTION
PROPOSED STREET WITH STANDARD CURB
NOT TO SCALE

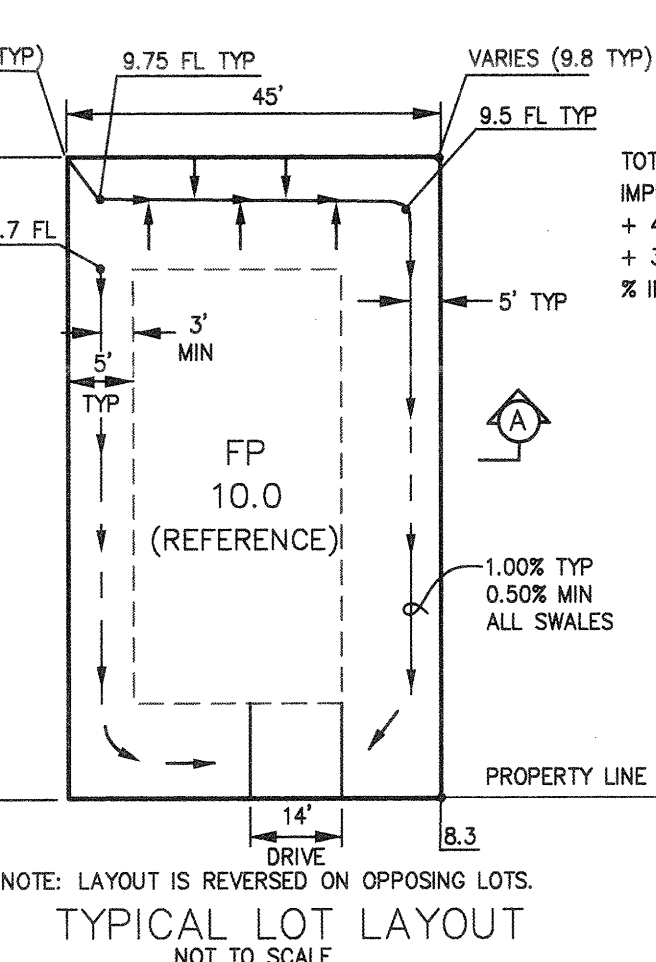

SECTION A-A
TYPICAL LOT SECTION
NOT TO SCALE

TYPICAL RETAINING WALL
NOT TO SCALE

Q PROFILE
TEMPORARY PAVEMENT
N.T.S.


DITCH (DETAIL)

Resource Technology, Inc.
ENGINEERS AND ENVIRONMENTAL SCIENTISTS
1720-B Randolph Rd. SE • Albuquerque, New Mexico • 87106
Telephone: (505) 243-7300 • Fax: (505) 243-7400 • E-mail: rti@rrmc.com
CIVIL • ENVIRONMENTAL • WATER RESOURCES • RECREATION • PLANNING


CITY OF ALBUQUERQUE
PUBLIC WORKS DEPARTMENT
ENGINEERING DEVELOPMENT GROUP

TITLE:
ELDORADO PARK SUBDIVISION UNIT 2
GRADING & DRAINAGE PLAN



Design Review Committee	City Engineer Approval	Mo./Day/Yr.	Mo./Day/Yr.
Approved @ [Signature]	[Signature]		
City Project No. 648281	Zone Map No. L-9-Z	Sheet 4	Of 15

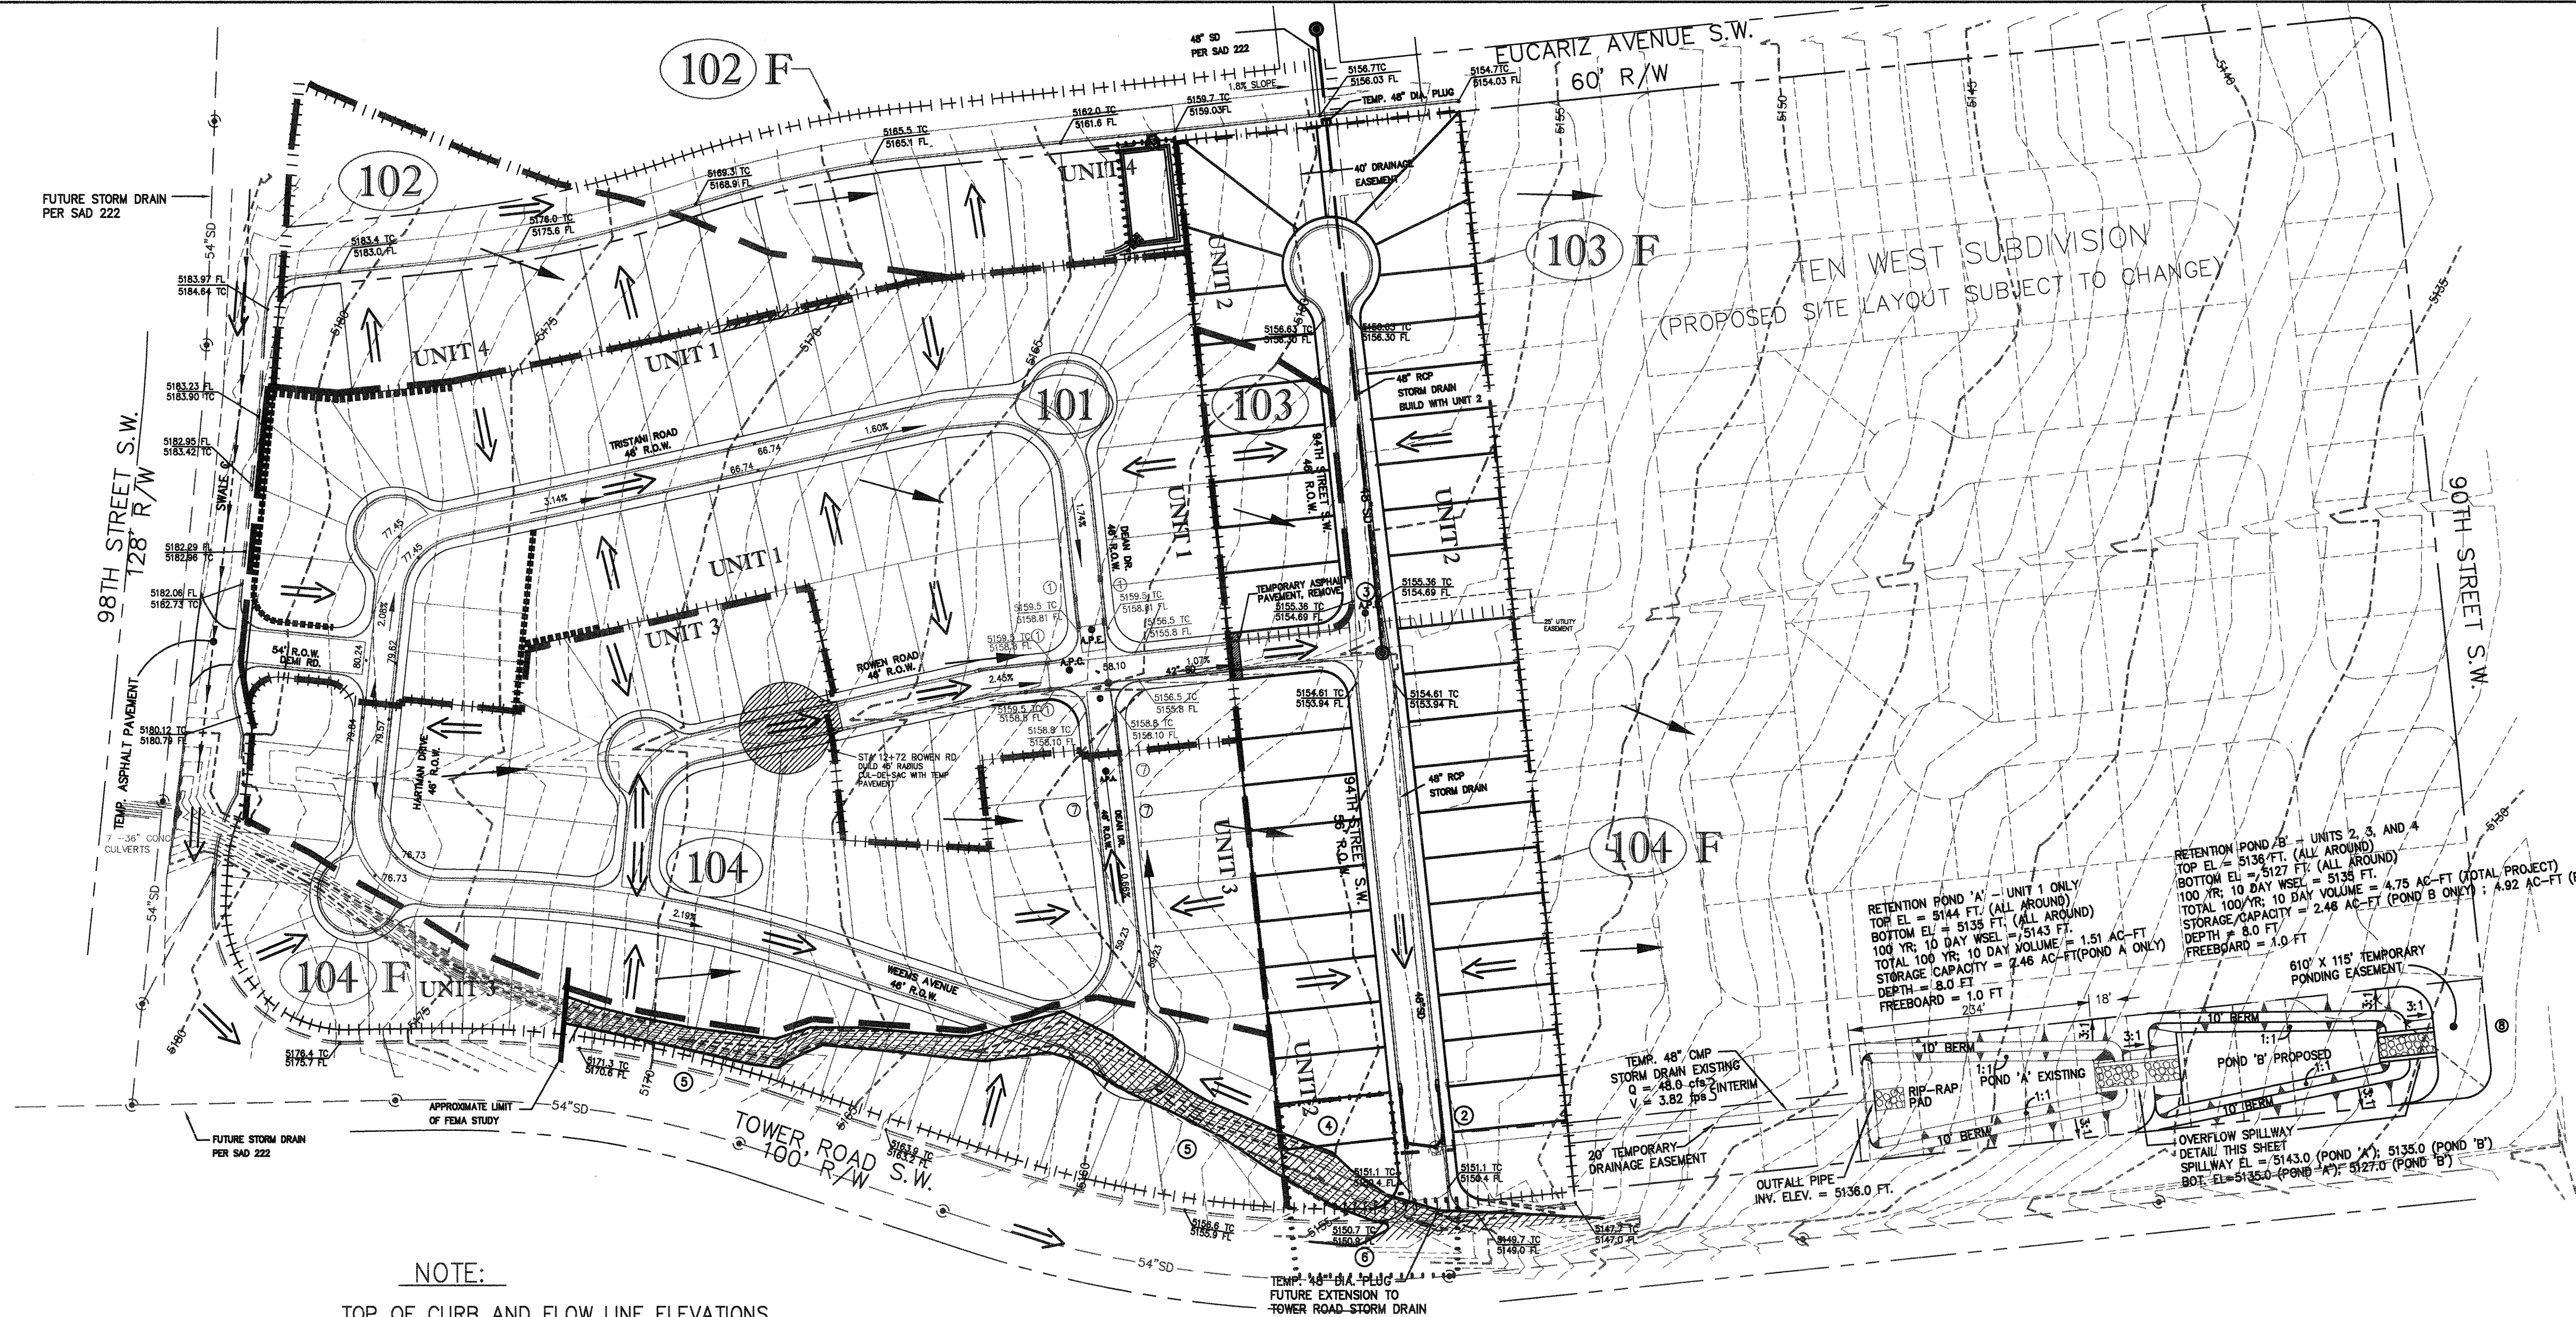

NOTE:
TOP OF CURB AND FLOW LINE ELEVATIONS
FOR TOWER ROAD AND 94th. ST. AND 98th. ST.
FROM SAD 222 PLAN.

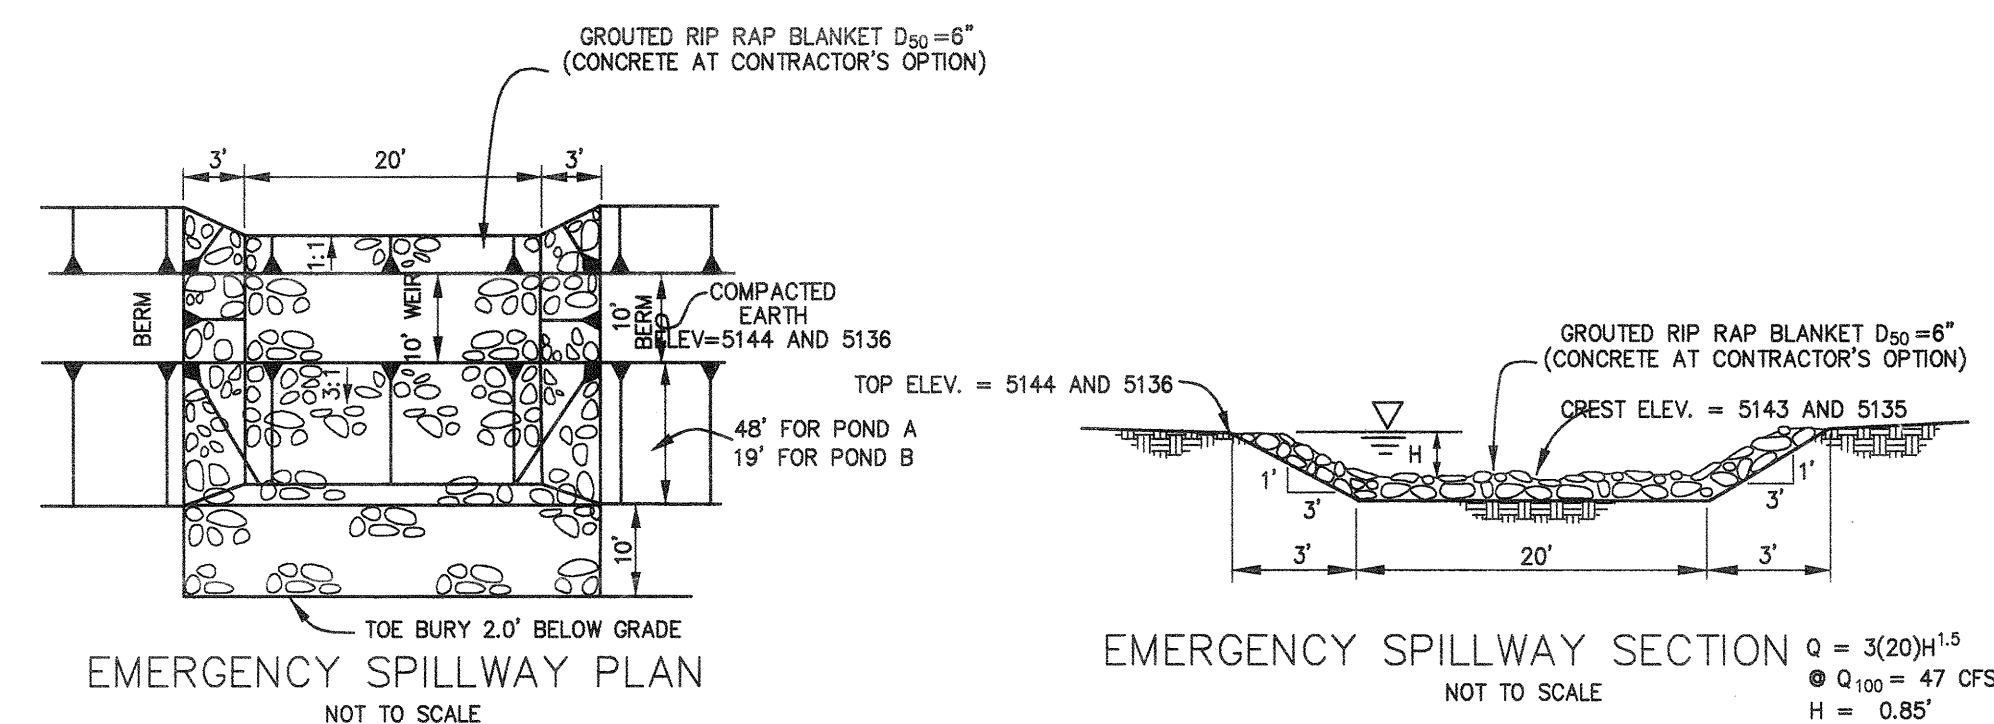


NOTE:
ONE SECTION OF RCP TO BE PLUGGED
WHEN FUTURE STORM DRAIN IS BUILT.

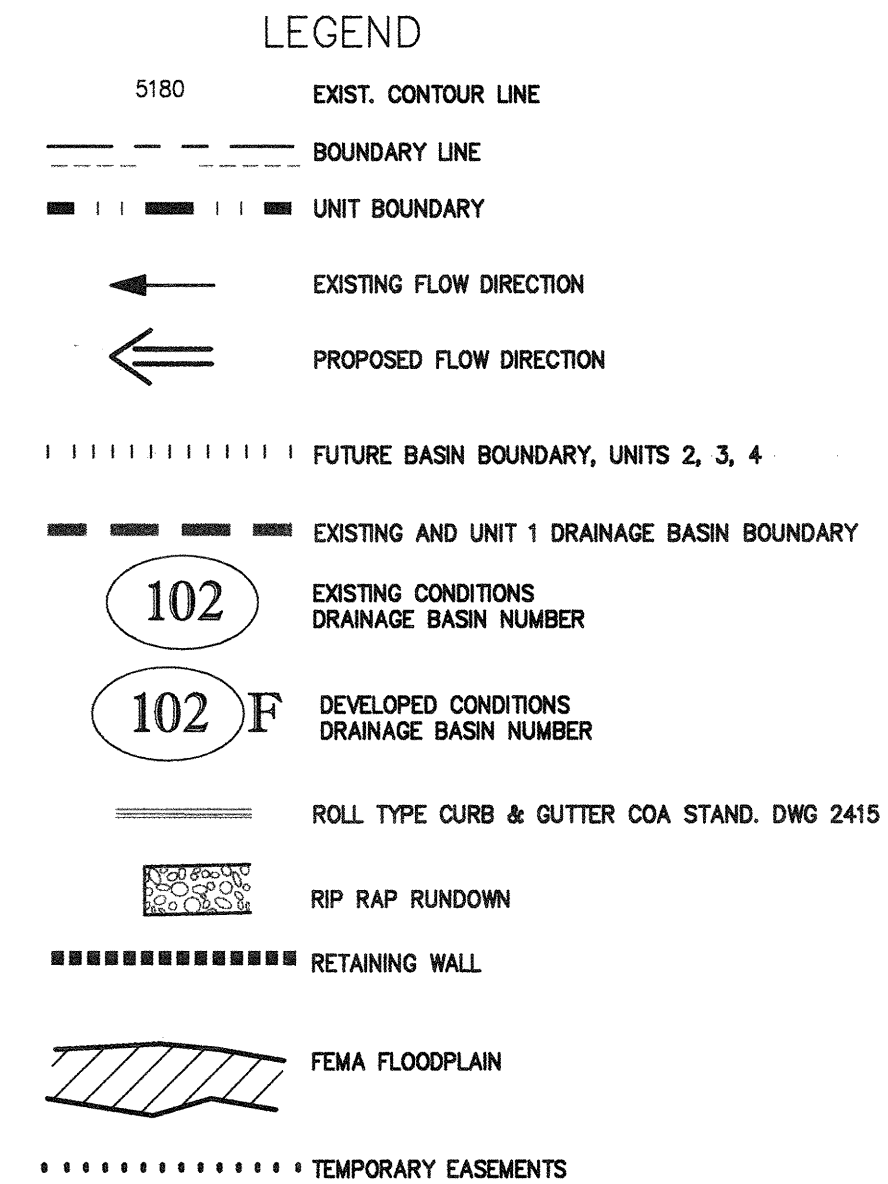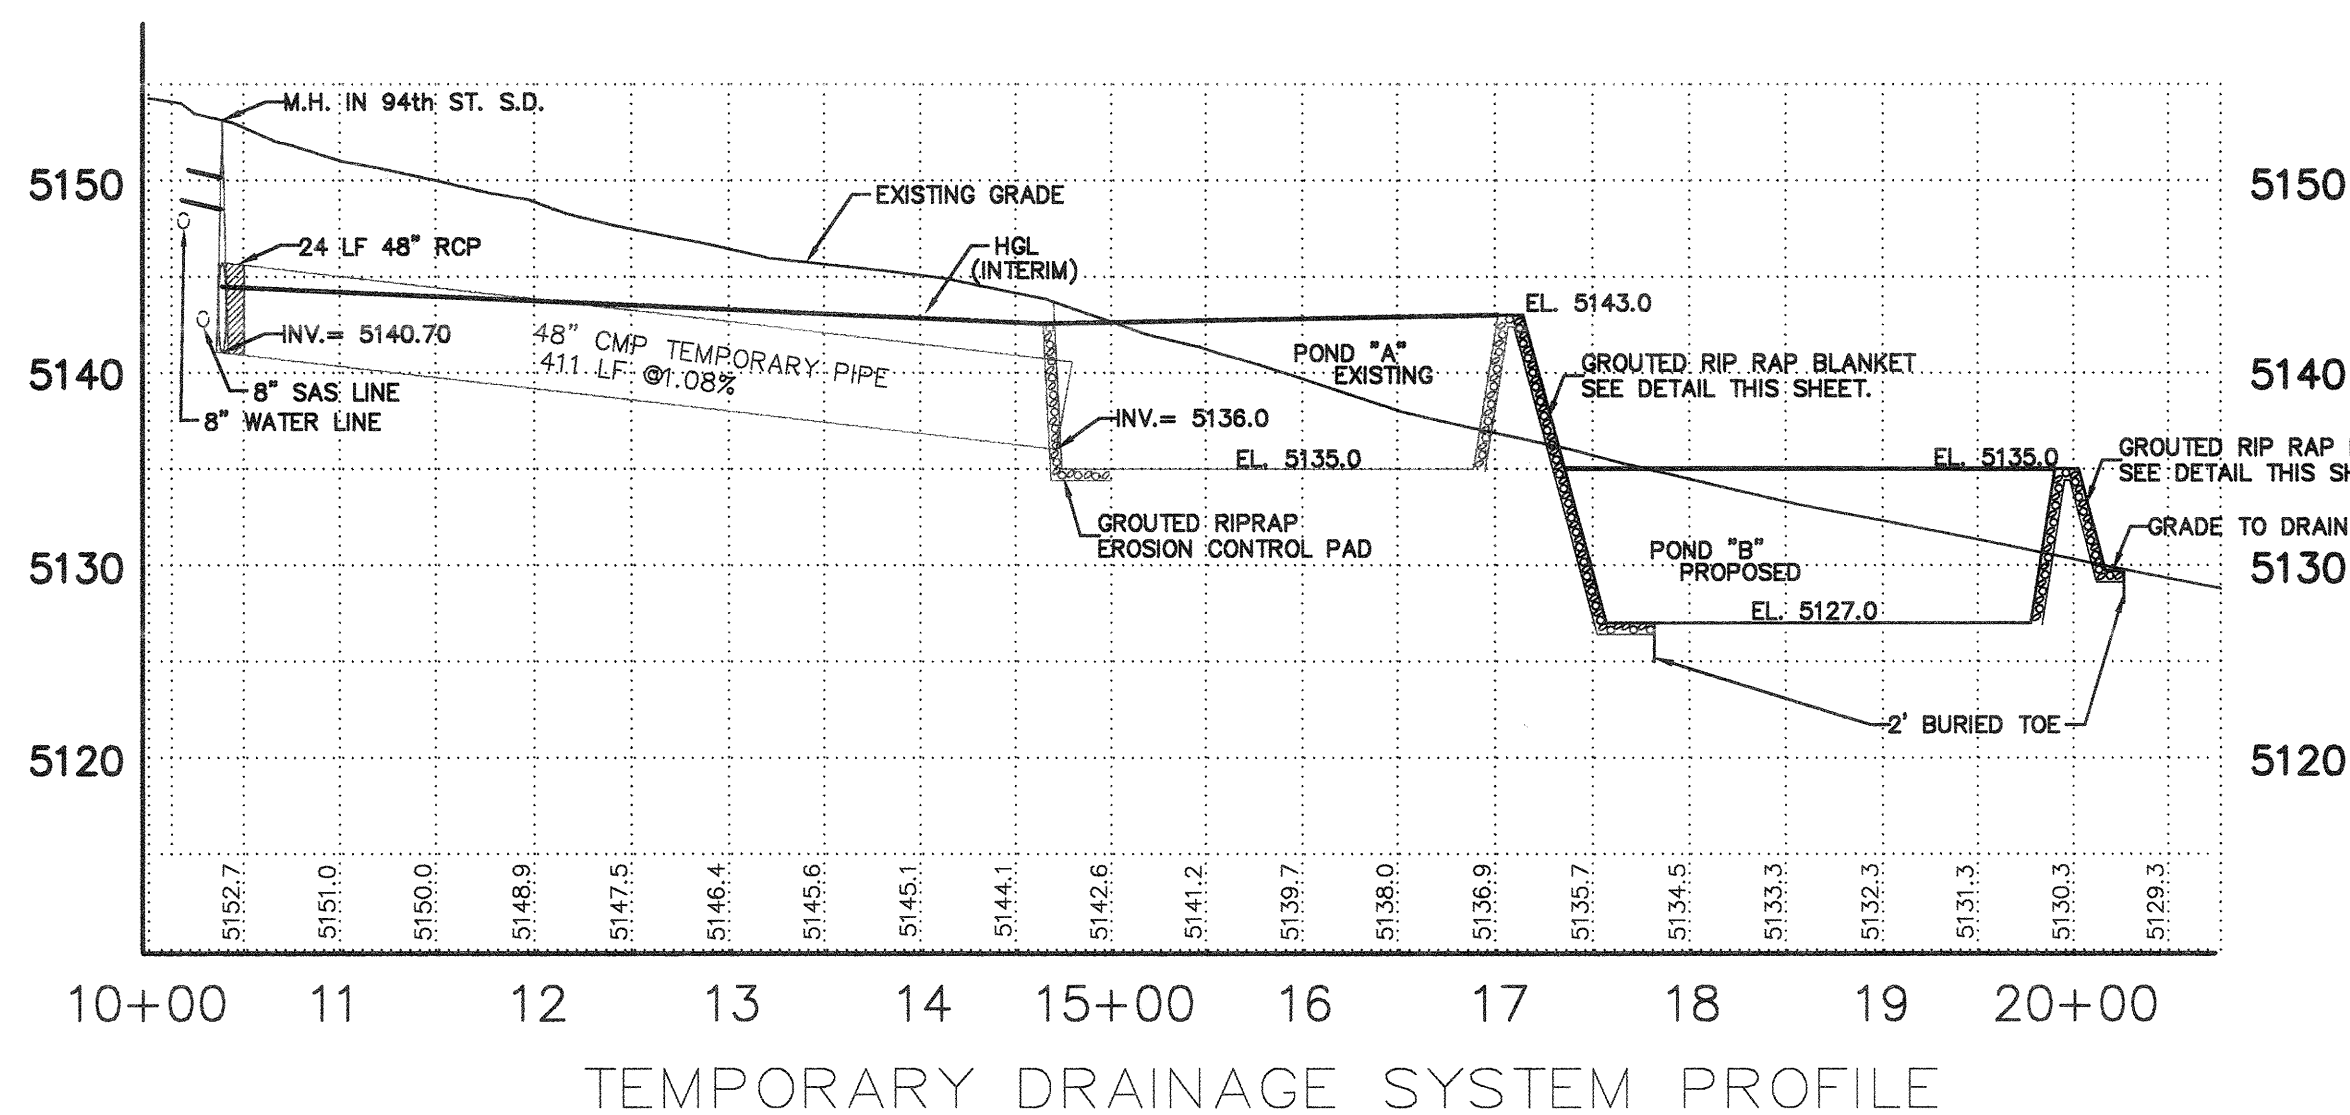



I, ELVIDIO V. DINIZ, REGISTERED PROFESSIONAL
ENGINEER NO. 7111 DO HEREBY CERTIFY THAT
THE AS-BUILT ELEVATIONS FOR UNIT 2 HAVE
BEEN UNDER MY DIRECTION AND THIS DRAINAGE
PLAN IS IN SUBSTANTIAL COMPLIANCE WITH
THE APPROVED DRAINAGE PLAN.

I, ELVIDIO V. DINIZ CERTIFY THAT
THE DRAINAGE OF THE "AS BUILT"
DRAINAGE WAS DONE UNDER
MY SUPERVISION.

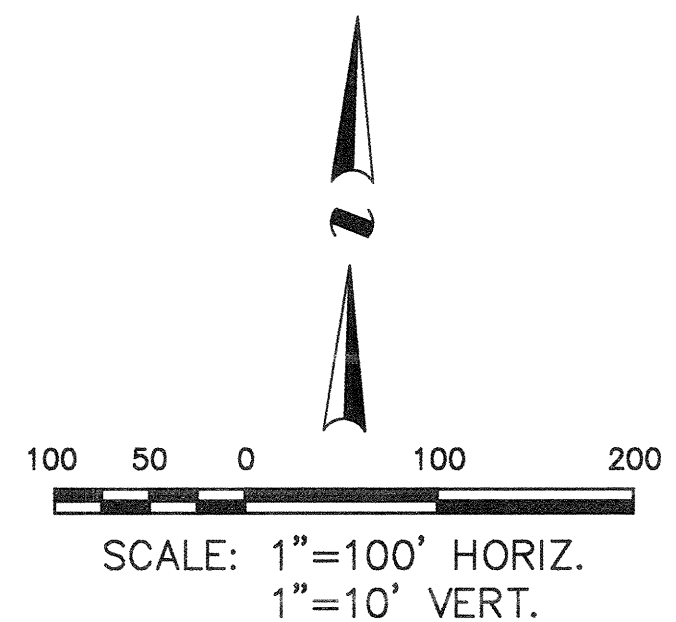

Resource Technology, Inc.
Civil Engineering 1720 - B Randolph Road SE
Environmental Sciences Albuquerque, New Mexico 87108
Water Resources E-mail: rtd@rtd.com
Landscape Architecture Telephone: (505) 243-7200
Planning Facsimile: (505) 243-7400

CITY OF ALBUQUERQUE PUBLIC WORKS DEPARTMENT ENGINEERING GROUP				
TITLE: ELDORADO PARK SUBDIVISION UNIT 2 OFFSITE DRAINAGE PLAN				
APPROVALS	ENGINEER	DATE	APPROVALS	ENGINEER
D.R.C. Chair			WATER	
TRANS. DEV.			WASTE WATER	
HYDROLOGY			TRAF. OPER.	
OTHER			CITY ENGINEER	
PROJECT NO.	648281	MAP NO.	L-9-Z	SHEET 5 OF 15

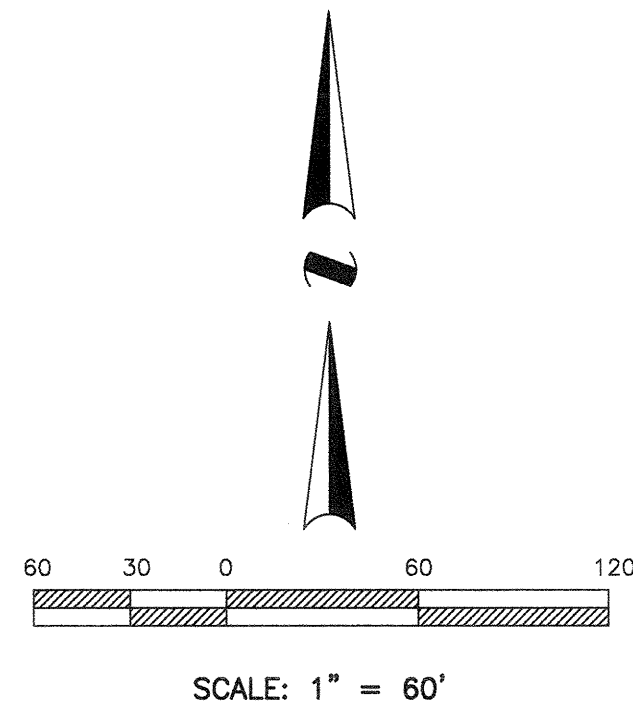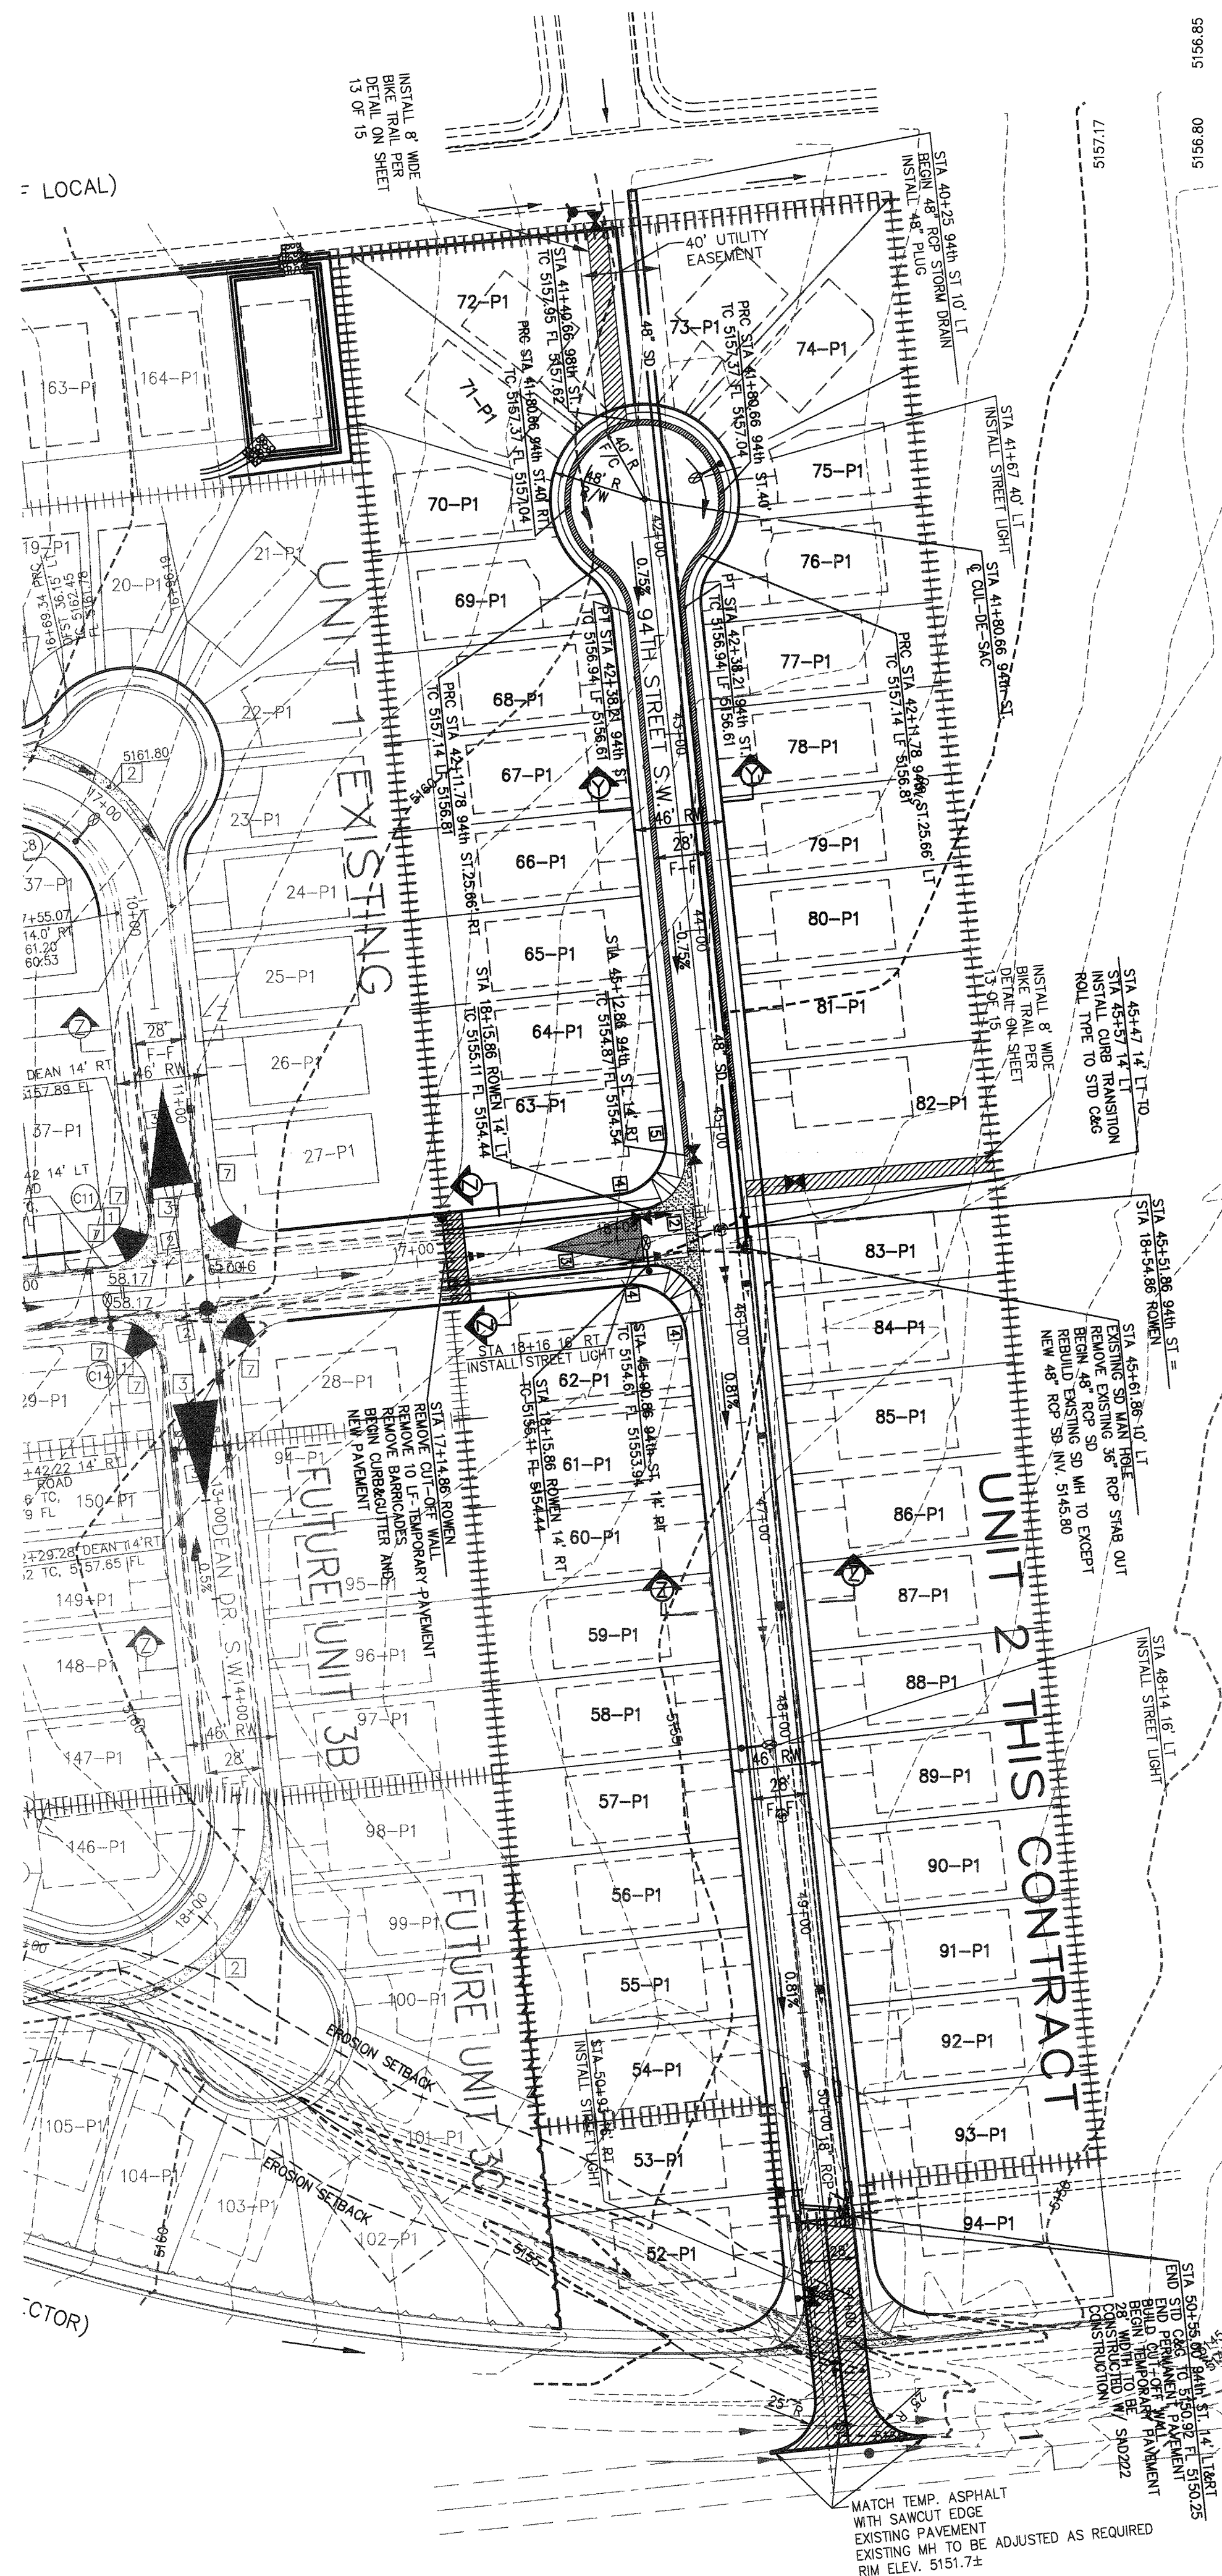

1. SEE PLAT, SHEETS 2 & 3 OF 19 FOR R.O.W. WIDTHS, STREET CENTERLINE BEARINGS & DISTANCES, AND EASEMENT INFORMATION.
2. SEE SHEET 13 OF 16 FOR TYPICAL ROADWAY SECTIONS.
3. DRIVEPAD LOCATIONS ARE APPROXIMATE. SEPARATE APPROVAL MUST BE OBTAINED WITH BUILDING PERMIT FOR EACH LOT.

1. CONSTRUCT P.C.C. SIDEWALK, 4" THICK, & TRANSITIONS TO WHEELCHAIR RAMPS PER C.O.A. STD DWG 2418.
2. CONSTRUCT 6' WIDE P.C.C. VALLEY GUTTER AND CURB & GUTTER PER C.O.A. STD. DWG 2421.
3. FULL CROWN TO NO CROWN TRANSITION (50' LENGTH) PER C.O.A. STD. DWG. 2401
4. NOT USED
5. BUILD 10 L.F. TRANSITION BETWEEN STD CURB & GUTTER AND ROLL CURB & GUTTER.
6. HALF CROWN TO NO CROWN TRANSITION (25' LENGTH) PER C.O.A. STD. DWG. 2401
7. CONSTRUCT STD C&G THIS SIDE OF WHEELCHAIR RAMP OR TRANSITION PER C.O.A. STD. DWG. 2418.
8. CONSTRUCT ROLL C&G THIS SIDE OF WHEELCHAIR RAMP OR TRANSITION PER C.O.A. STD. DWG. 2418.

	6' WIDE CONC. VALLEY GUTTER
	STANDARD CURB & GUTTER
	ROLL CURB & GUTTER
	WHEELCHAIR RAMP
	CROWN TRANSITION
	UNIT BOUNDARY
	FLOW DIRECTION
	GRADE BREAK
	STREET LIGHTING

I, ELVIDIO V. DINIZ CERTIFY THAT
THE DRAWING OF THE "AS-BUILT"
DIMENSIONS WAS DONE UNDER
MY SUPERVISION. *EVV*

Resource Technology, Inc.
ENGINEERS AND ENVIRONMENTAL SCIENTISTS
1720-B Randolph Rd. SE • Albuquerque, New Mexico • 87106
Telephone: (505) 243-7300 • Fax (505) 243-7400 • E-mail rti@rti.com
CIVIL • ENVIRONMENTAL • WATER RESOURCES • RECREATION • PLANNING

CITY OF ALBUQUERQUE
PUBLIC WORKS DEPARTMENT
ENGINEERING DEVELOPMENT GROUP

TITLE: ELDORADO PARK SUBDIVISION
PAVING MASTER PLAN

Design Review Committee	City Engineer Approval
-------------------------	------------------------

City Project No.

564281

Zone Map No. 1-9-7

Sheet 6 Of 15

AS BUILT INFORMATION	CONTRACTOR	WORK	INSPECTOR'S	DATE
		STARTED BY	ACCEPTANCE BY	
		VERIFICATION BY	VERIFICATION BY	
		DRAWINGS	CORRECTED BY	
		MICRO-FILM INFORMATION		
		RECORDED BY	DATE	
		NO.		
		U. Franco		


<i>BENCH MARKS</i>	
ACS STA 7 - I9	
GROUND TO GRID = 0.99467727	
NM STATE PLANE COORDINATE SYSTEM CENTRAL ZONE	
NAD 1927	
NORTHING: 1478346.71	
EASTING: 3529781.4	
ELEVATION: 5175.735	

[illegible]

Professional Engineer Seal for the State of Illinois, No. 1461, signed by David A. Hines.

NO.		DATE	REMARKS	BY
<i>REVISIONS</i>				
DESIGN				
DESIGNED BY		ED	DATE	4/2000
DRAWN BY		RJH	DATE	4/2000
CHECKED BY		RJH	DATE	4/2000

Mo./Day/Yr.	Mo./Day/Yr.

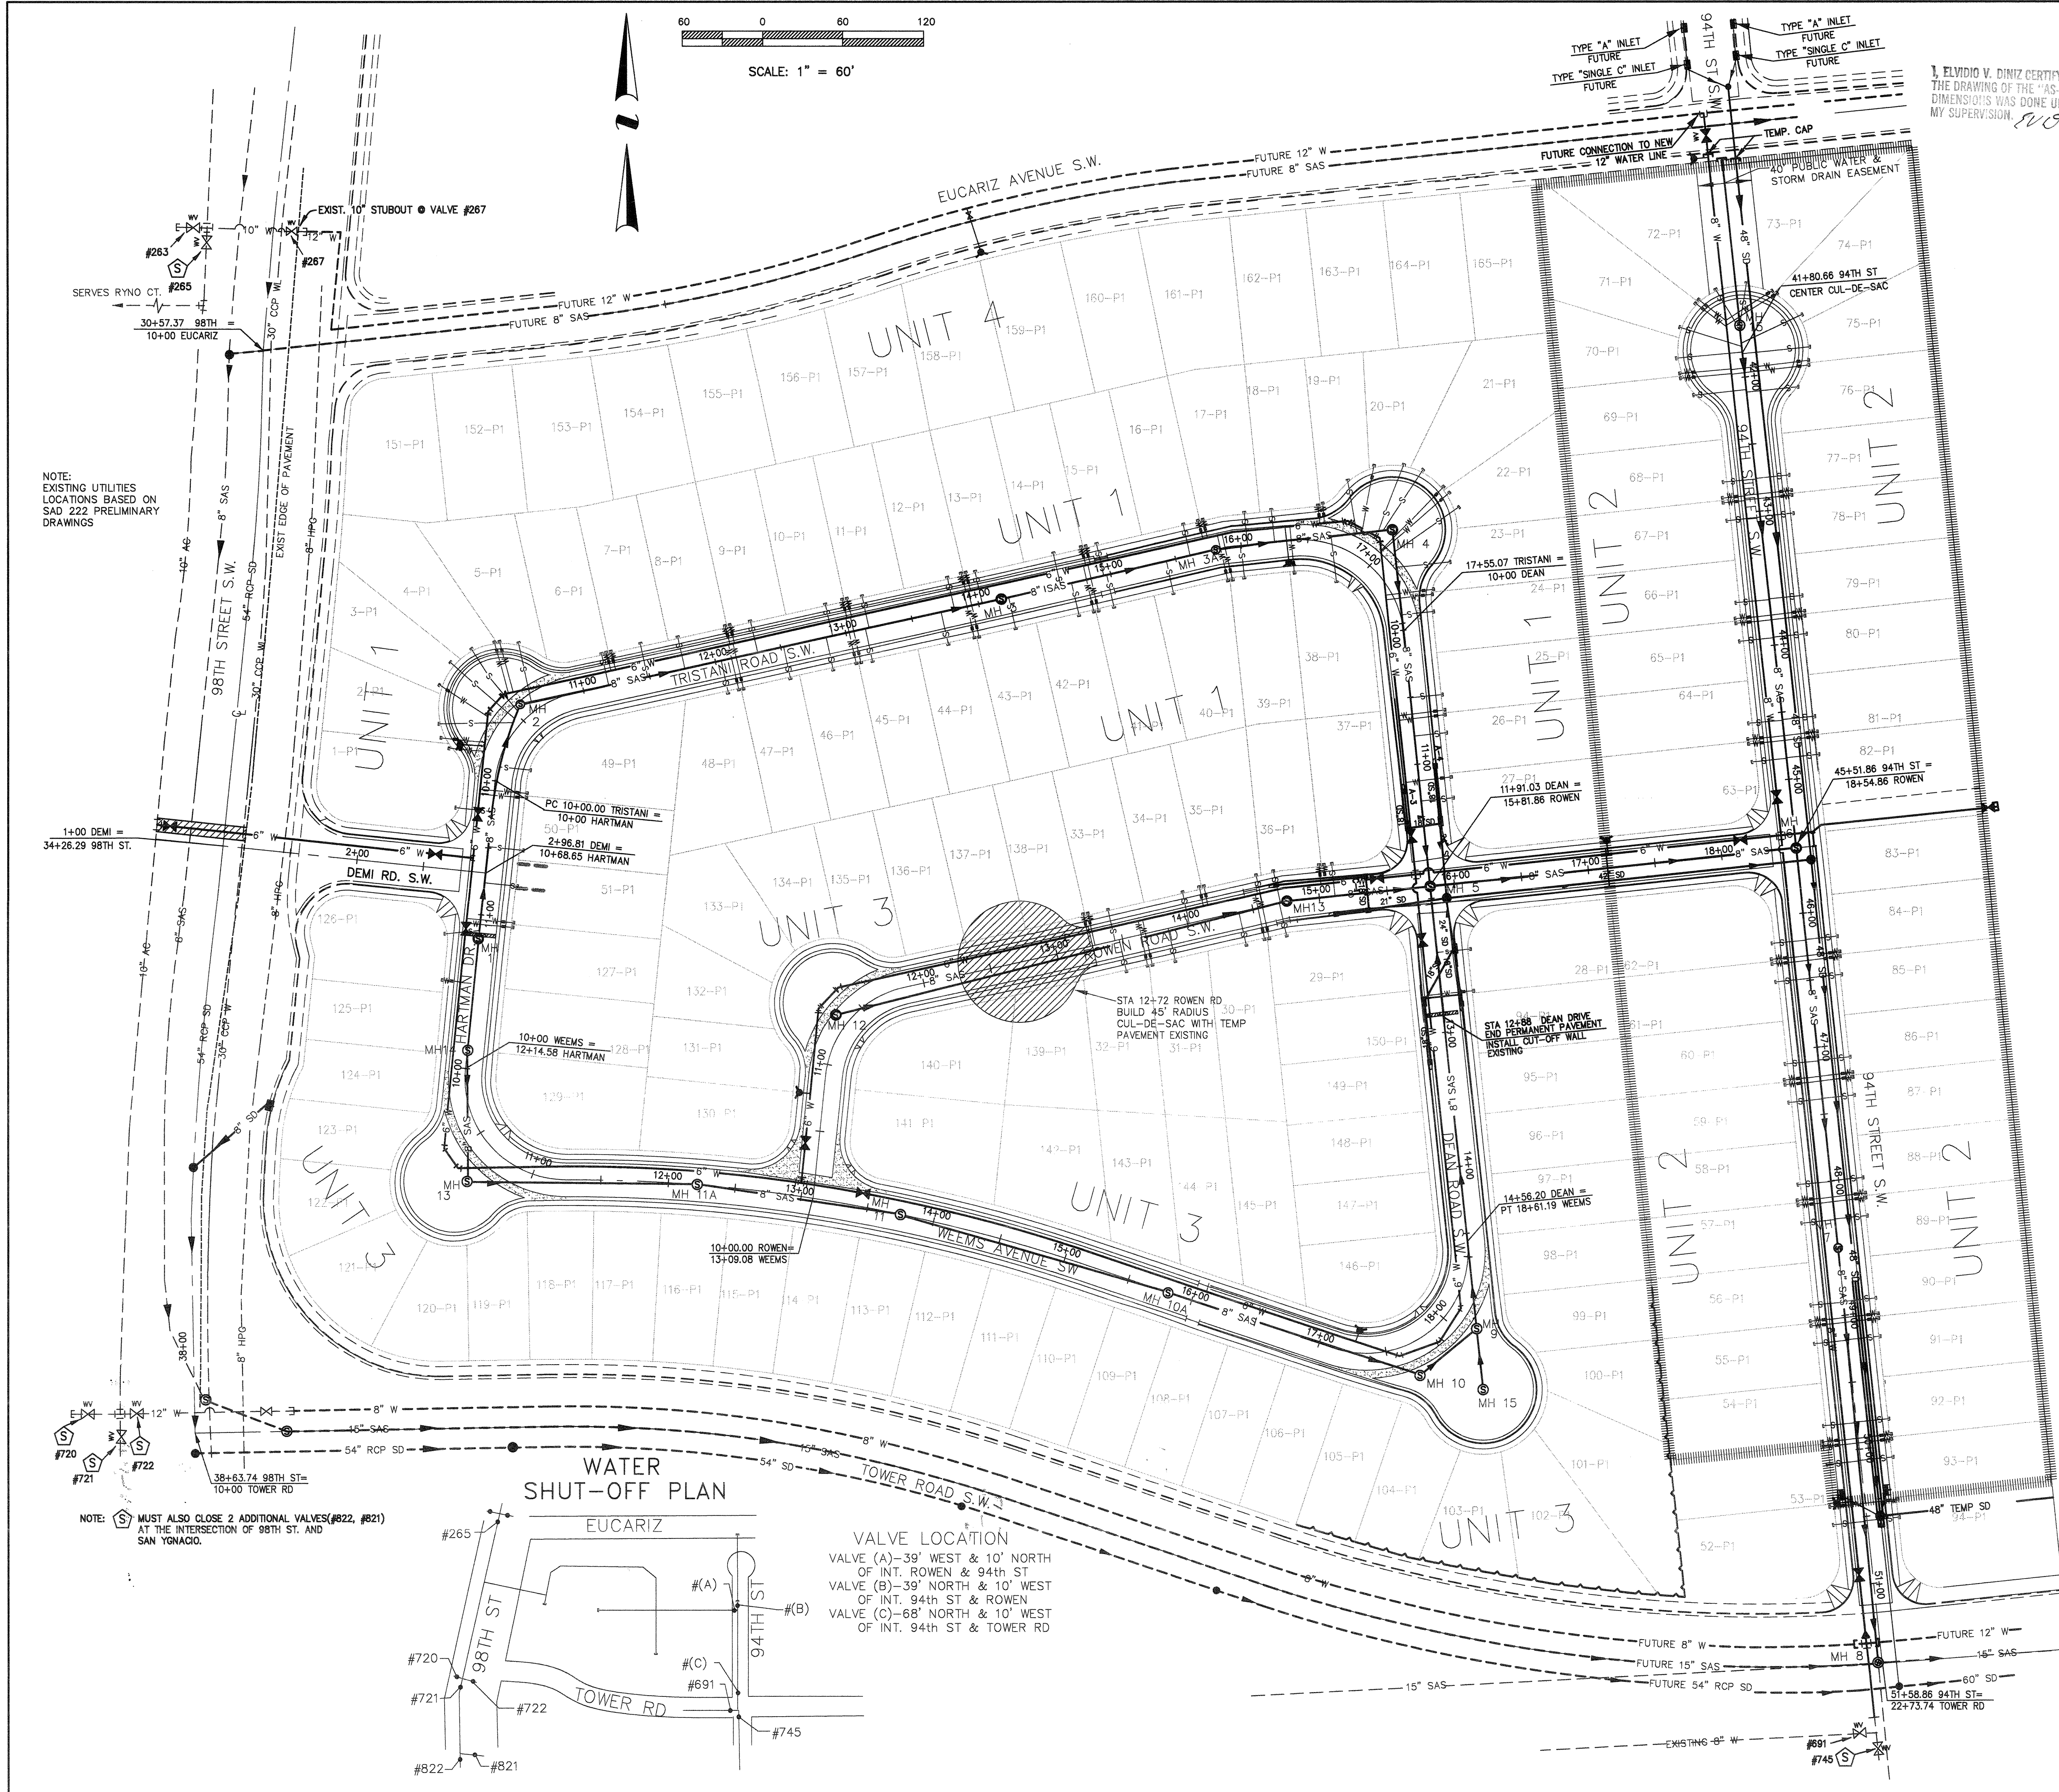

GENERAL UTILITY NOTES

- THE FOLLOWING CITY OF ALBUQUERQUE STANDARD DRAWINGS APPLY TO THIS SHEET:
DWG. 2401-TYP. RES. ST. INTERS.
DWG. 2415-CURB & GUTTER
DWG. 2418-ROLL CURB TO STD. CURB TRANSITION
DWG. 2420-CONC. VALLEY GUTTER
DWG. 2425-DRIVEPADS
DWG. 2430-SIDEWALK DETAILS
*DWG. 2440-WHEELCHAIR RAMP
*DWG. 2441-WHEELCHAIR RAMP
- SEE PLAT, SHEETS 2 & 3 OF 15 FOR R.O.W. WIDTHS, STREET CENTERLINE BEARINGS & DISTANCES, AND EASEMENT INFORMATION.
- SEE SHEET 13 OF 15 FOR TYPICAL ROADWAY SECTIONS.
- DRIVEPAD LOCATIONS ARE NOT APPROVED WITH THIS PLAN SET. SEPARATE APPROVAL MUST BE OBTAINED WITH BUILDING PERMIT FOR EACH LOT.
- RESTRAIN ALL JOINTS BETWEEN SERVICE TEE AND FIRE HYDRANT.
- USE FULL SECTION OF PIPE (20') WHERE POSSIBLE OR PRACTICAL, ADJACENT TO ALL FITTINGS (I.E. VALVES, TEES, ELBOWS) TO MINIMIZE NEED FOR SUPPLEMENTAL JOINT RESTRAINT.
- JOINT RESTRAINT TO CONSIST OF EBAA IRON, INC. "MEGALUG" AND SERIES 1500/6500 RETAINERS, OR APPROVED EQUIVALENT.
- SEWERLINES TO BE BUILT AT STREET CL.
WATERLINES TO BE BUILT 10' WEST OF CL. 10' NORTH OF PL
STORM DRAINS TO BE BUILT 10' EAST OF CL.

WATER SHUT-OFF

- CONTRACTOR SHALL BE RESPONSIBLE FOR TIMING AND COORDINATION OF THE WATER SHUT-OFF REQUIRED FOR THE NON-PRESSURIZED CONNECTION OF THE PROJECT TO THE EXISTING WATERLINES, AS SHOWN.
- AT LEAST FIVE WORKING DAYS PRIOR TO THE CONNECTION, THE CONTRACTOR SHALL CONTACT PWD/WATER SYSTEMS DIVISION (857-8200) TO ARRANGE FOR THE SHUT-OFF.
- EXISTING WATER VALVES TO BE CLOSED BY THE PWD WATER SYSTEM PERSONNEL FOR CONNECTION OF UNIT 2 OF THIS PROJECT ARE INDICATED WITH THE SYMBOL (A) ON THIS DRAWING. TO COMPLETE NON-PRESSURE CONNECTIONS, THE EXISTING VALVES LISTED BELOW AND SHOWN ON MAP MUST BE CLOSED

MAP NO.	VALVE	LOCATION
L-9	(A)	ROWEN & 94th ST
L-9	(B)	94th ST & ROWEN
L-9	(C)	94th ST & TOWER RD

LEGEND

EXIST	PROPOSED	
— 8" SAS —	— 8" SAS —	10' CURB TRANSITION
— 6" W —	— 6" W —	SANITARY SEWER LINE W/PIPE SIZE
— 6" W —	— 6" W —	SANITARY SEWER MANHOLE
— 6" W —	— 6" W —	WATER LINE W/PIPE SIZE
— 6" W —	— 6" W —	WATER VALVE
— 6" W —	— 6" W —	FIRE HYDRANT
— 6" W —	— 6" W —	TEE
— 6" W —	— 6" W —	CROSS
— 6" W —	— 6" W —	BEND
— 6" W —	— 6" W —	CAP & PLUG
— 6" W —	— 6" W —	SAS SERVICE CONNECTION
— 6" W —	— 6" W —	WATER SERVICE CONNECTION
— SD —	— SD —	STORM SEWER, CURB INLET & MANHOLE
— HPD —	— HPD —	HIGH PRESSURE GAS LINE
— HPD —	— HPD —	STANDARD CURB & GUTTER
— HPD —	— HPD —	ROLL CURB & GUTTER
— HPD —	— HPD —	4' SIDEWALK
— HPD —	— HPD —	WHEELCHAIR RAMP
— HPD —	— HPD —	UNIT BOUNDARY

WATER SHUT-OFF PLAN

NOTE: MUST ALSO CLOSE 2 ADDITIONAL VALVES (#822, #821) AT THE INTERSECTION OF 98TH ST. AND SAN YGNACIO.

VALVE LOCATION

VALVE (A)—39' WEST & 10' NORTH OF INT. ROWEN & 94th ST
VALVE (B)—39' NORTH & 10' WEST OF INT. 94th ST & ROWEN
VALVE (C)—68' NORTH & 10' WEST OF INT. 94th ST & TOWER RD

Resource Technology, Inc.

ENGINEERS AND ENVIRONMENTAL SCIENTISTS
1720-B Randolph Rd. SE • Albuquerque, New Mexico • 87106
Telephone: (505) 243-7300 • Fax: (505) 243-7400 • E-mail: rt@mia.com
CIVIL • ENVIRONMENTAL • WATER RESOURCES • RECREATION • PLANNING

CITY OF ALBUQUERQUE

PUBLIC WORKS DEPARTMENT
ENGINEERING DEVELOPMENT GROUP


TITLE: ELDORADO PARK SUBDIVISION
MASTER UTILITY PLAN

Design Review Committee	City Engineer Approval	City Engineer

City Project No. 648281 Zone Map No. L-9-z Sheet 9 of 15

AS BUILT INFORMATION		BENCH MARKS		SURVEY INFORMATION		ENGINEERS SEAL	
CONTRACTOR	DATE	ACCS STA 7 - L9	DATE	NO.	BY	NO.	BY
CONTRACTOR	DATE	ACCS STA 7 - L9	DATE	NO.	BY	NO.	BY
INSPECTOR	DATE	GROUND TO GRID = 0.9996727	DATE	NO.	BY	NO.	BY
ACCEPTANCE BY	DATE	NM STATE PLANE COORDINATE SYSTEM CENTRAL ZONE	DATE	NO.	BY	NO.	BY
VERIFICATION BY	DATE	NAD 1927	DATE	NO.	BY	NO.	BY
DRAWN BY	DATE	NORTHING: 1478346.71	DATE	NO.	BY	NO.	BY
CHECKED BY	DATE	EASTING: 352978.14	DATE	NO.	BY	NO.	BY
RECORDED BY	DATE	ELEVATION: 5175.735	DATE	NO.	BY	NO.	BY
NO.	DATE		DATE	NO.	BY	NO.	BY

TOD-UNIT2.dwg 8-14-00 9:13:45 am EST
WCR PFI

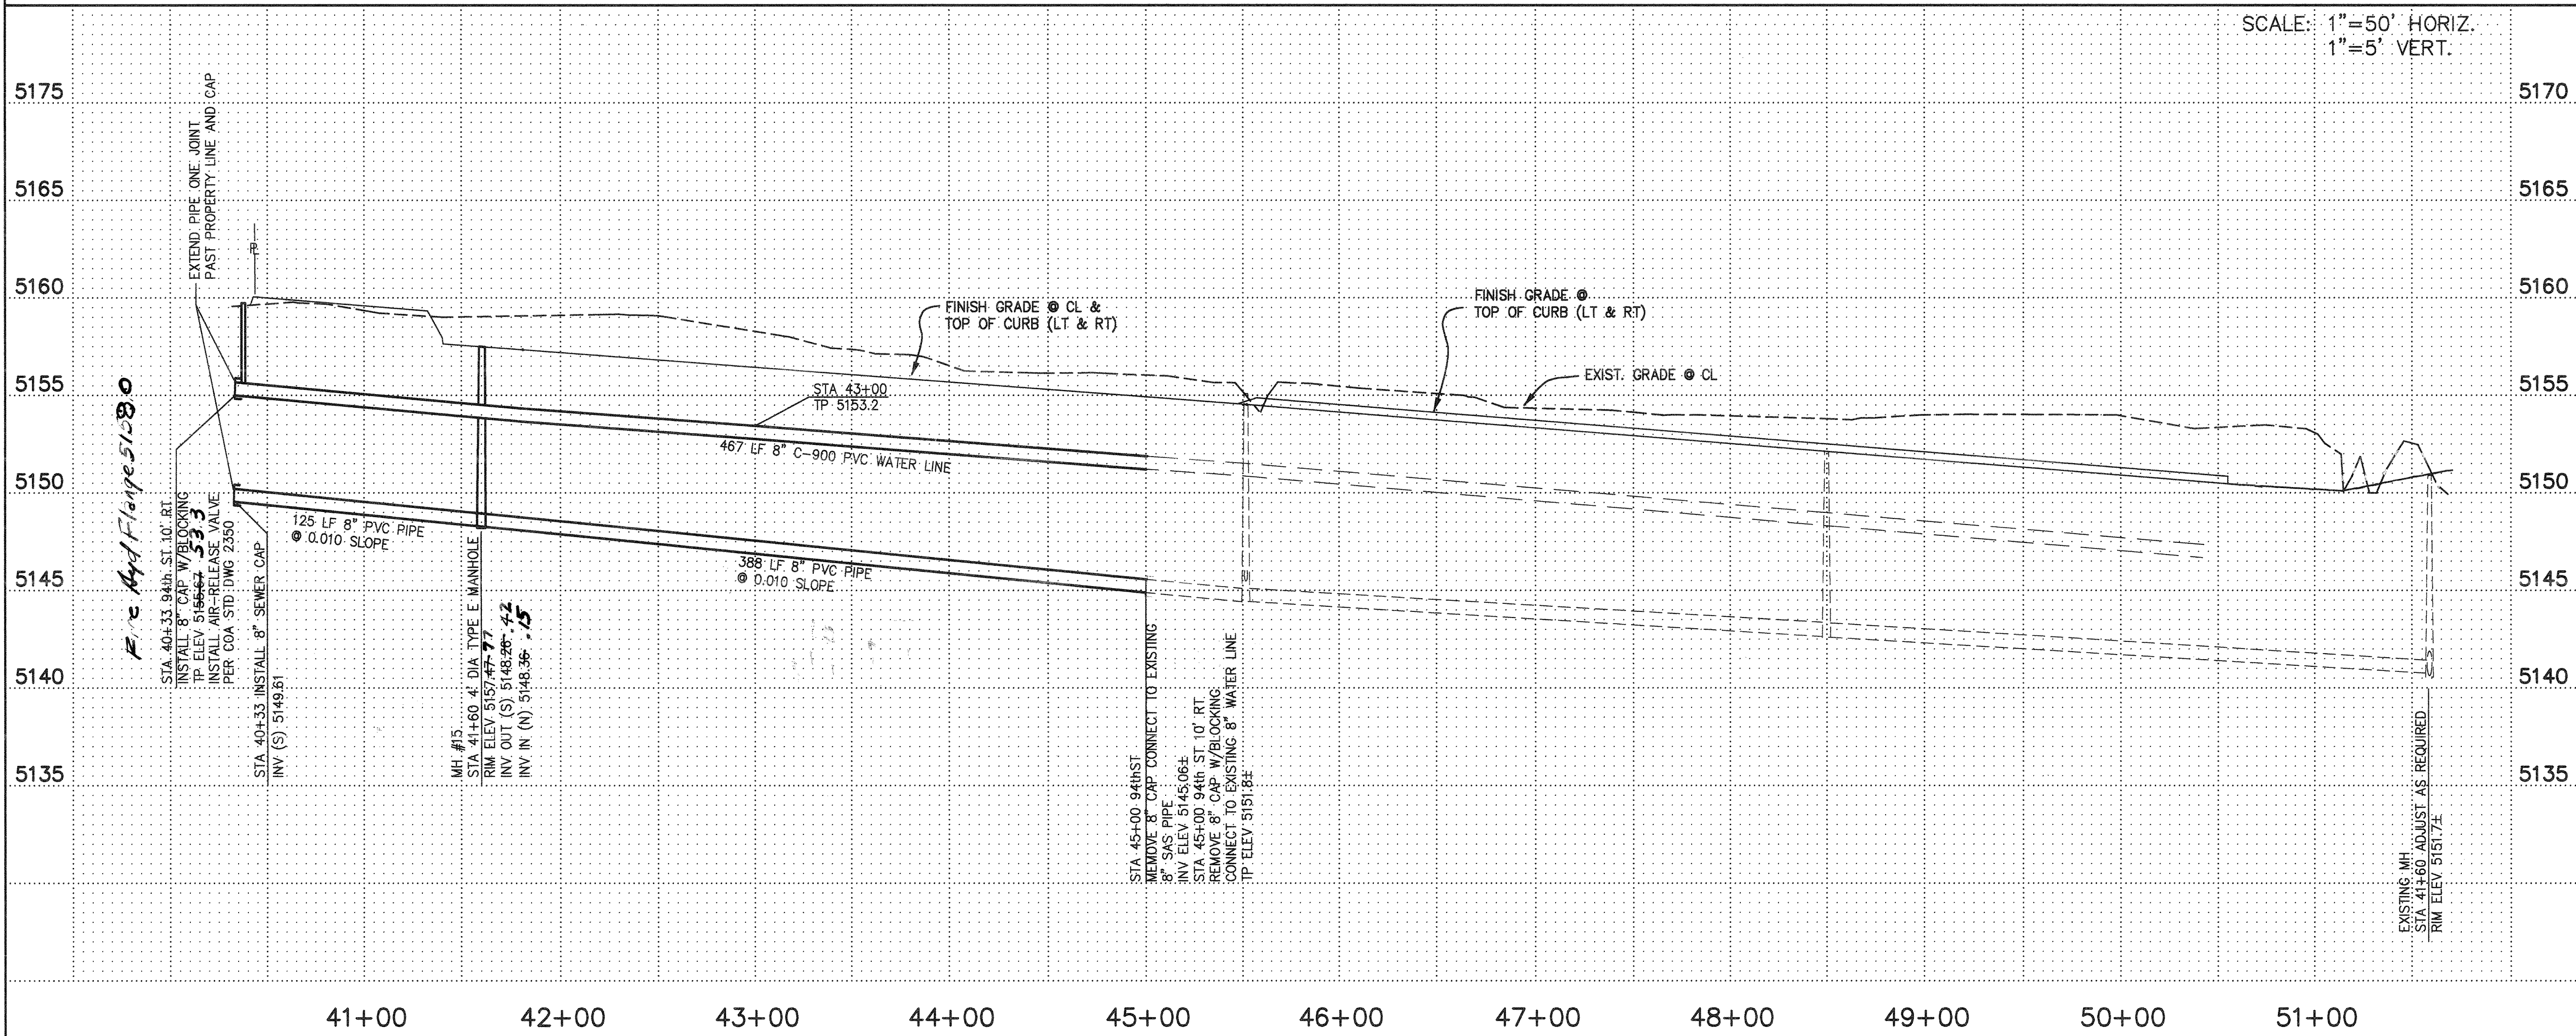

LEGEND

EXIST	PROPOSED	DESCRIPTION
—	—	TOP OF PIPE ELEVATION
—	—	10' CURB TRANSITION
—	—	SANITARY SEWER LINE W/PIPE SIZE
—	—	SANITARY SEWER MANHOLE
—	—	WATER LINE W/PIPE SIZE
—	—	WATER VALVE
—	—	FIRE HYDRANT
—	—	TEE
—	—	CROSS
—	—	BEND
—	—	CAP & PLUG
—	—	SAS SERVICE CONNECTION
—	—	WATER SERVICE CONNECTION
—	—	STORM SEWER
—	—	HIGH PRESSURE GAS LINE
—	—	STANDARD CURB & GUTTER
—	—	ROLL CURB & GUTTER
—	—	4' SIDEWALK
—	—	WHEELCHAIR RAMP
—	—	UNIT BOUNDARY


Resource Technology, Inc.
ENGINEERS AND ENVIRONMENTAL SCIENTISTS
1720-B Randolph Rd. SE • Albuquerque, New Mexico • 87106
Telephone: (505) 243-7300 • Fax: (505) 243-7400 • E-mail: rti@mta.com
CIVIL • ENVIRONMENTAL • WATER RESOURCES • RECREATION • PLANNING

CITY OF ALBUQUERQUE
PUBLIC WORKS DEPARTMENT
ENGINEERING DEVELOPMENT GROUP

TITLE: ELDORADO PARK SUBDIVISION UNIT 2
94TH ST UTILITY PLAN & PROFILE


Design Review Committee	City Engineer Approval	Mo./Day/Yr.	Mo./Day/Yr.
REVIEW COMMITTEE	CITY ENGINEER		

City Project No. 648281 Zone Map No. L-9-Z Sheet 10 of 15

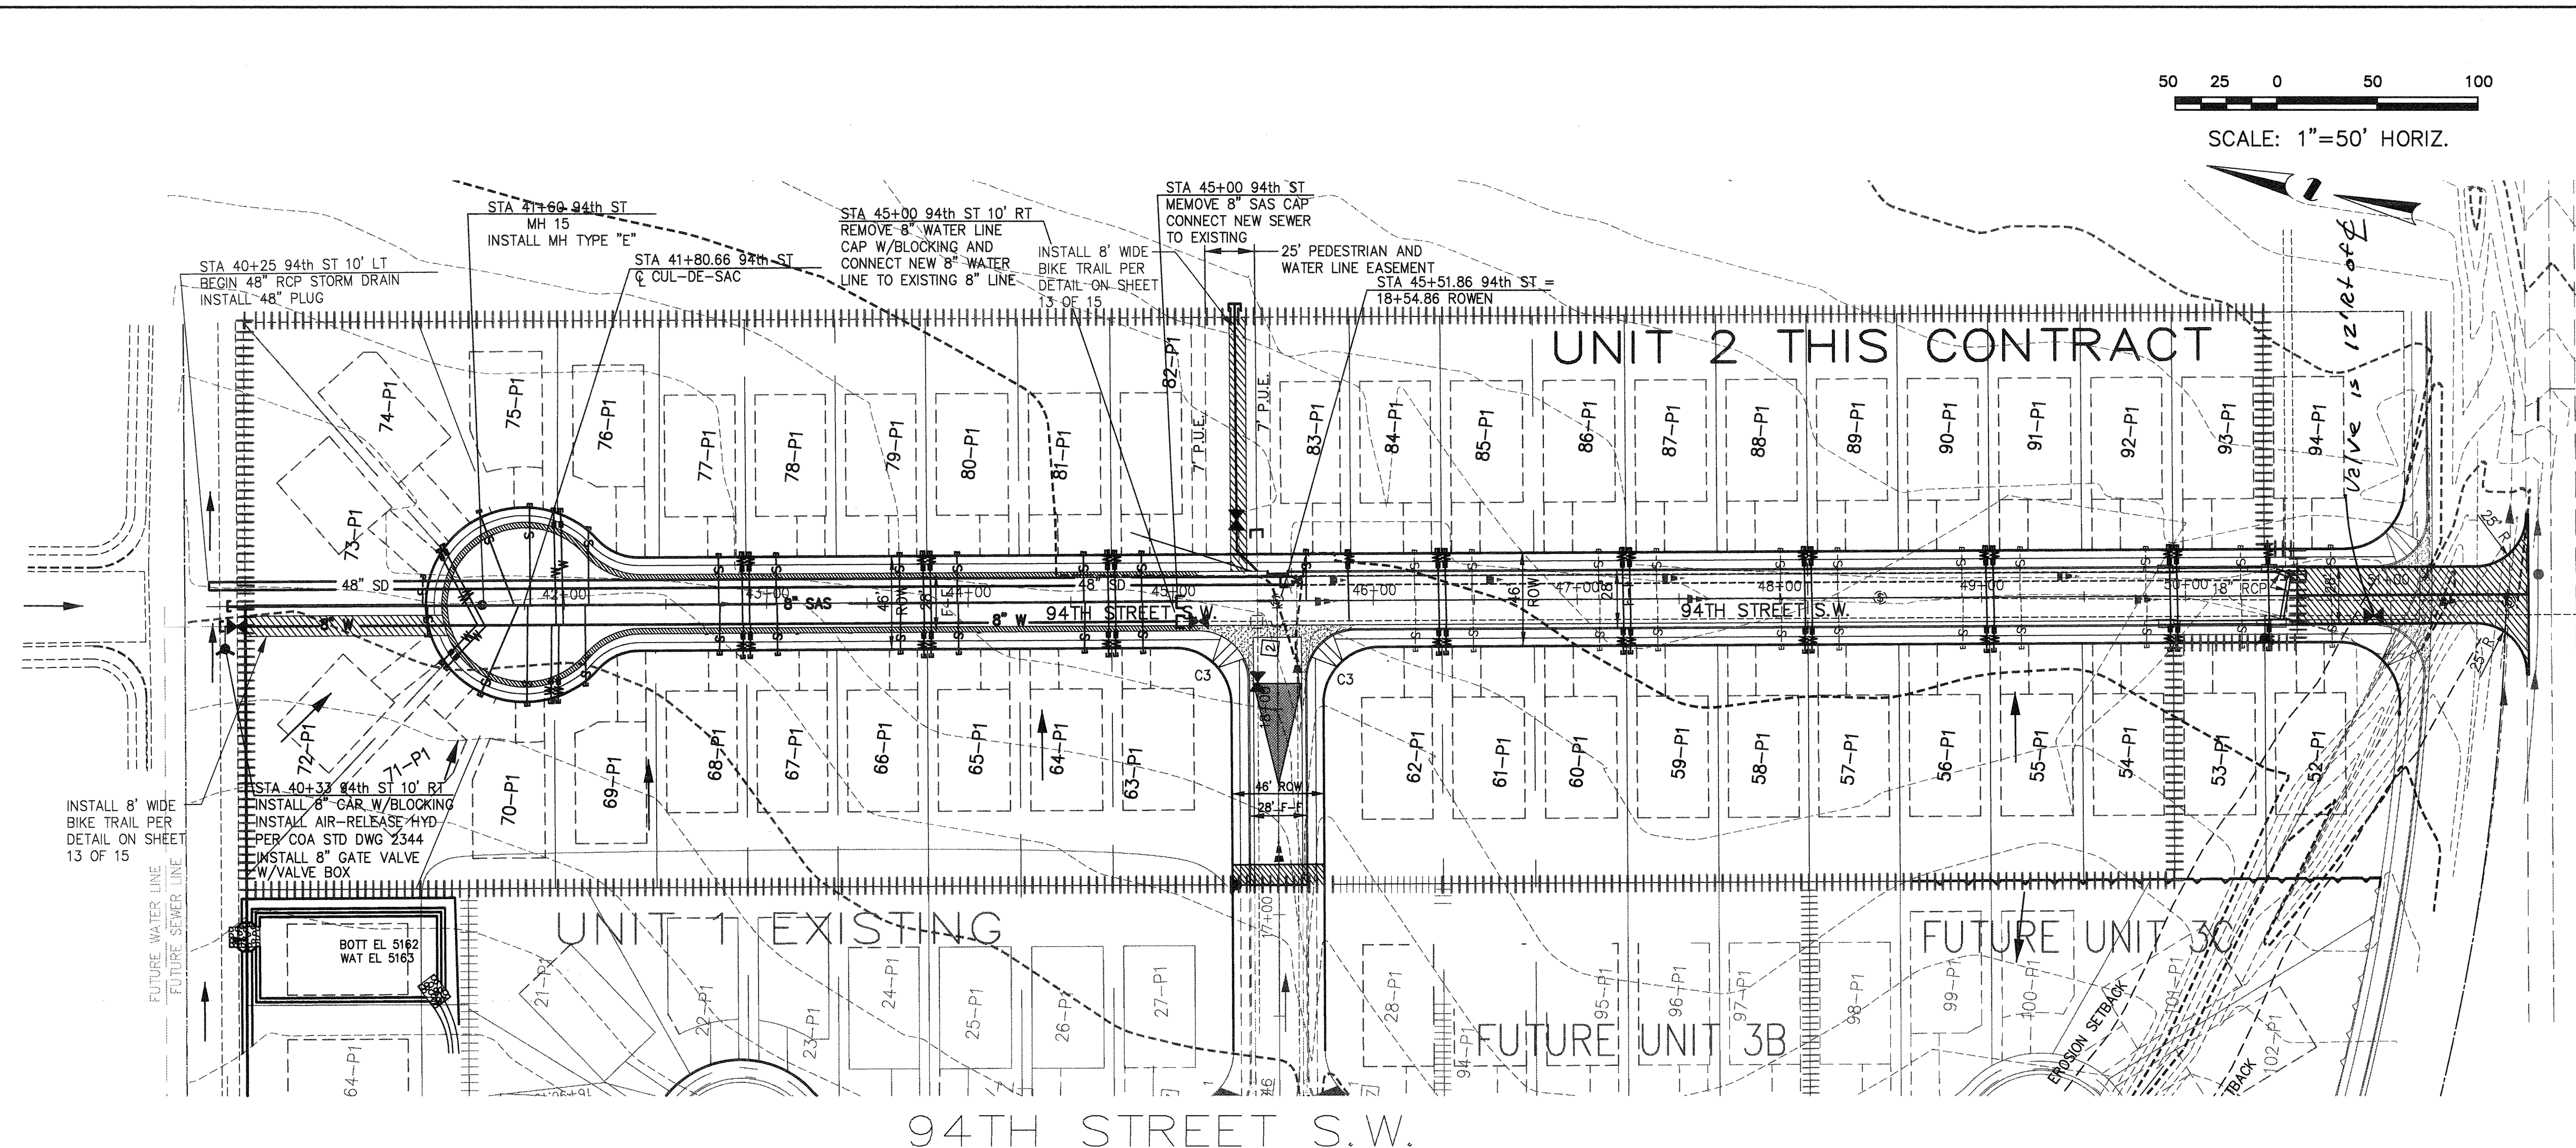




I, ELVIDIO V. DINIZ CERTIFY THAT
THE DRAWING OF THE "AS-BUILT"
DIMENSIONS WAS DONE UNDER
MY SUPERVISION.

SURVEY INFORMATION		BENCH MARKS		AS-BUILT INFORMATION	
NO.	FIELD NOTES	DATE	BY	CONTRACTOR	DATE
	NO.				
	ACS STA 7 - L9			DATE	DATE
	GROUND TO GRID = 0.99967727			INSPECTED BY	DATE
	NM STATE PLANE COORDINATE SYSTEM CENTRAL ZONE			VERIFIED BY	DATE
	NAD 1927			CORRECTED BY	DATE
	NORTHING: 1478346.71			MICRO-FILM INFORMATION	
	EASTING: 352978.14			RECORDED BY	DATE
	ELEVATION: 5175.735			NO.	

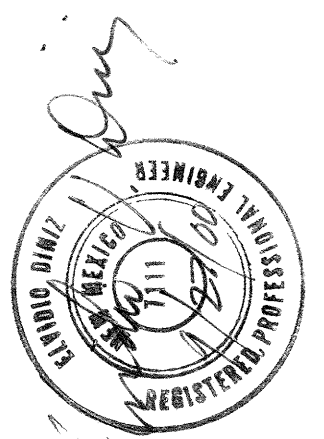

2/26/01


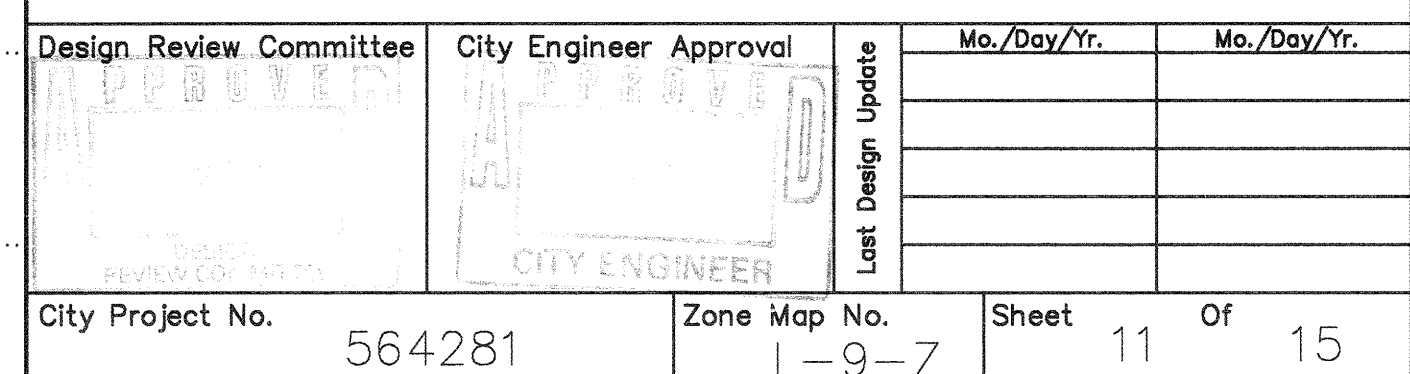


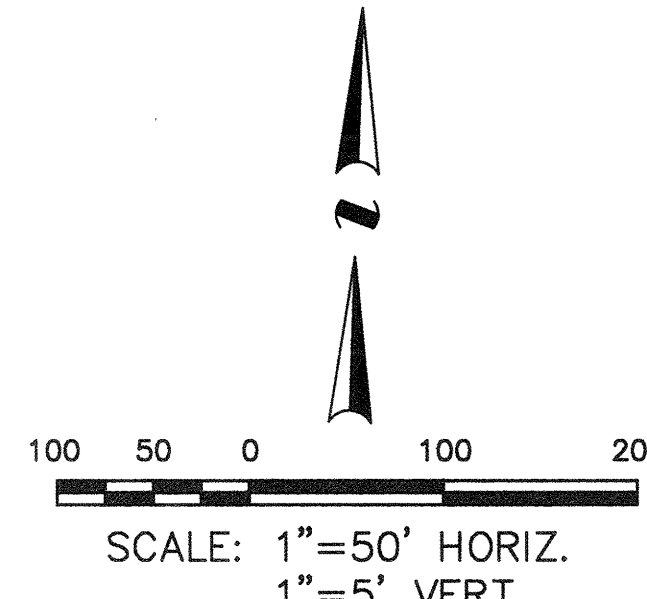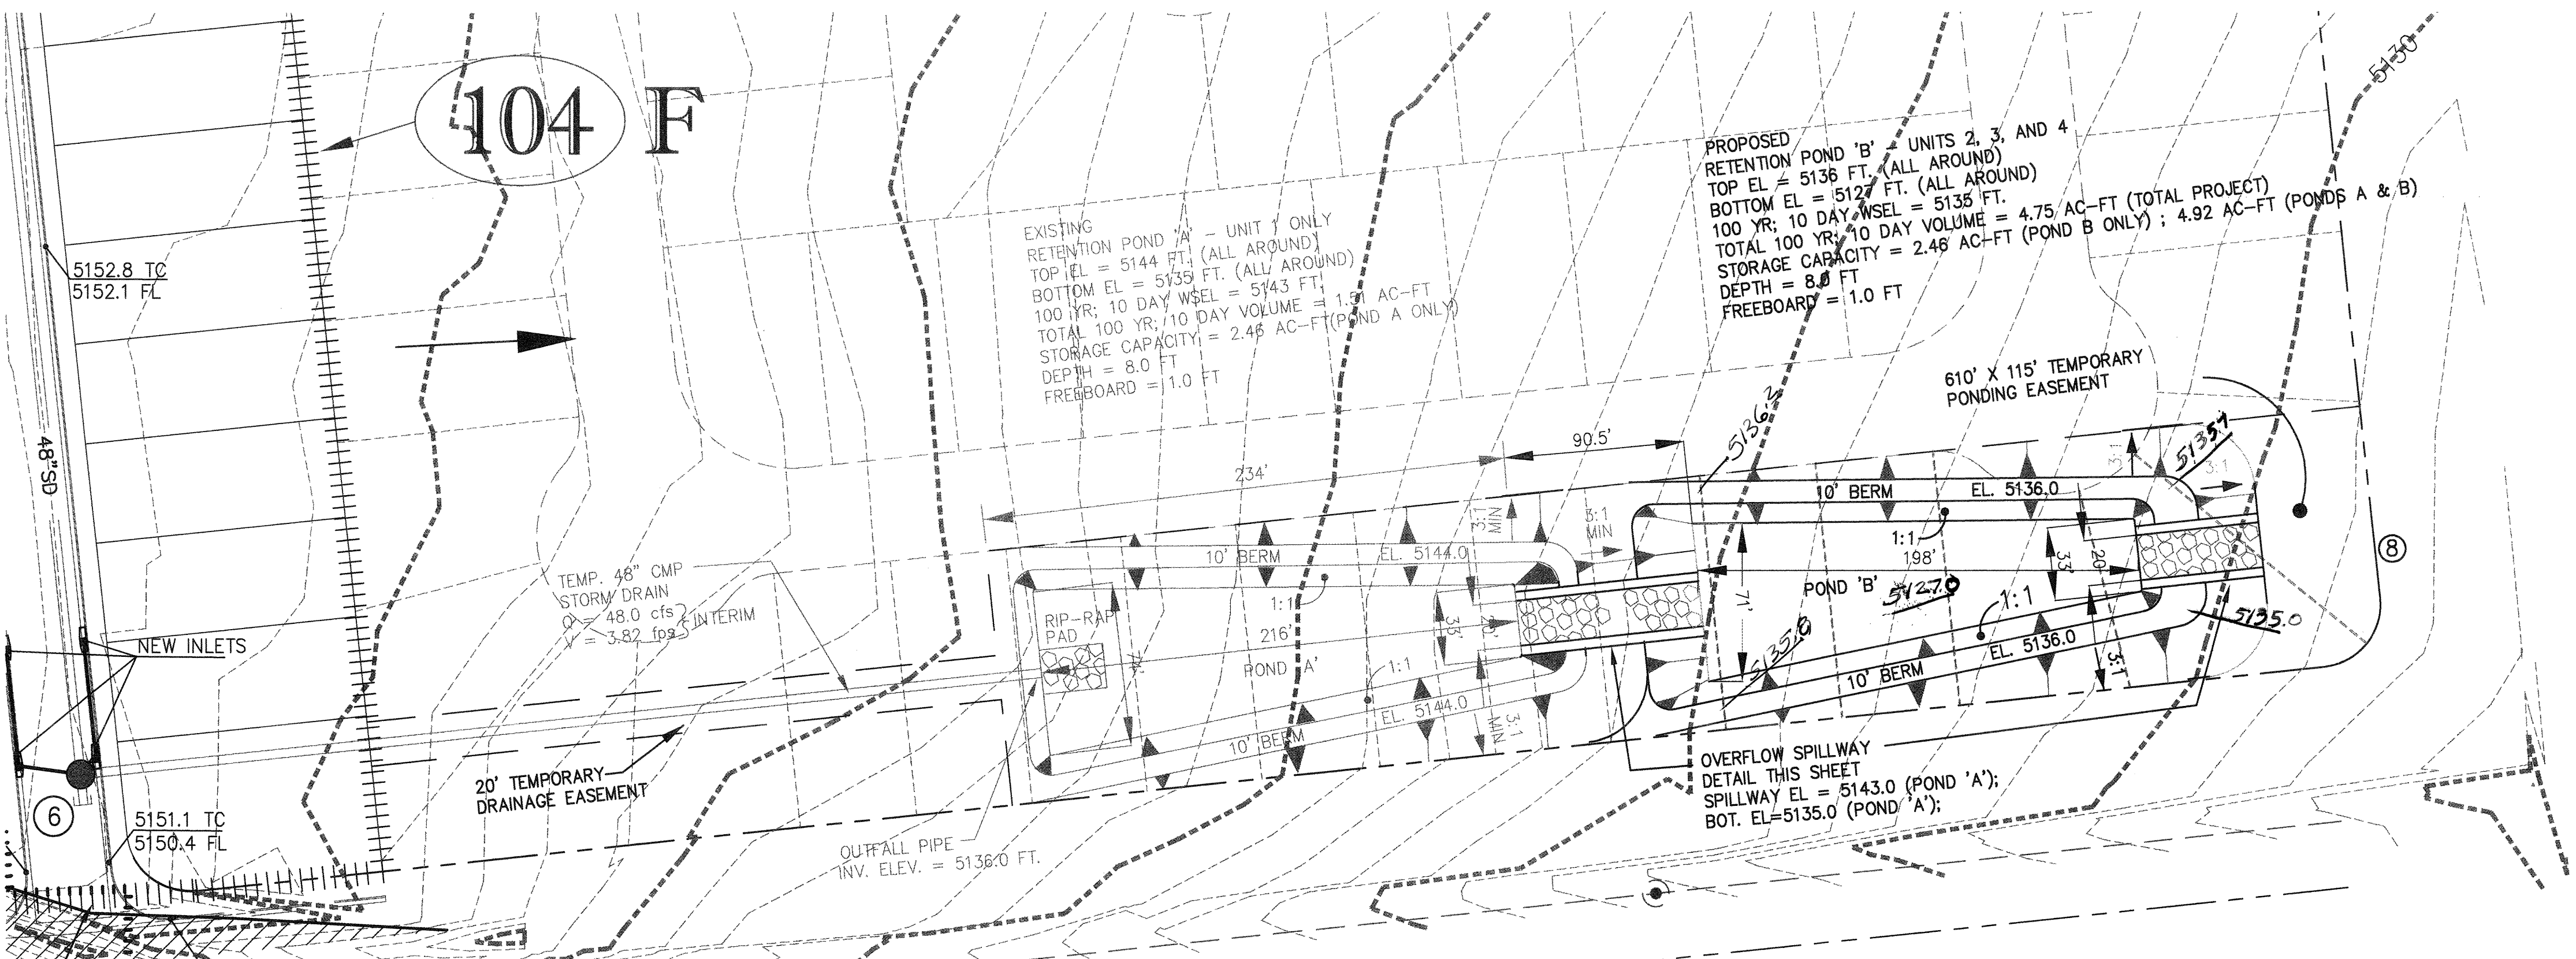

- LEGEND**
- 5180 EXIST. CONTOUR LINE
 - BOUNDARY LINE
 - UNIT BOUNDARY
 - EXISTING FLOW DIRECTION
 - PROPOSED FLOW DIRECTION
 - FUTURE BASIN BOUNDARY, UNITS 2, 3, 4
 - EXISTING AND UNIT 1 DRAINAGE BASIN BOUNDARY
 - 102 EXISTING CONDITIONS DRAINAGE BASIN NUMBER
 - 102 F DEVELOPED CONDITIONS DRAINAGE BASIN NUMBER
 - ROLL TYPE CURB & GUTTER COA STAND. DWG 2415
 - RIP RAP RUNDOWN
 - RETAINING WALL
 - FEMA FLOODPLAIN
 - TEMPORARY EASEMENTS


- NOTES:**
- HAND PLACED 3" WIDE (2.5" EACH SIDE) CONCRETE COLLAR 6-IN. THICK W/6# WIRE MESH REINFORCEMENT AROUND ROP AND CMP JUNCTION.
 - NOT USED
 - 94TH STREET STORM DRAIN WILL BE EXTENDED NORTH OF ROWEN ROAD WITH UNIT 2 DEVELOPMENT.
 - NOT USED
 - NOT USED
 - STREET INTERSECTION WILL BE TEMPORARY PAVED UNTIL TOWER ROAD IS CONSTRUCTED UNDER SAD 222.
 - NOT USED
 - BUILD 6' CHAIN LINK FENCE ON PERIMETER OF POND EASEMENT LINE (1450 LF.)

I, ELVIDIO V. DINIZ, REGISTERED PROFESSIONAL ENGINEER NO. 7111 DO HEREBY CERTIFY THAT THE AS-BUILT ELEVATIONS FOR UNIT 2 HAVE BEEN UNDER MY DIRECTION AND THIS DRAINAGE PLAN IS IN SUBSTANTIAL COMPLIANCE WITH THE APPROVED DRAINAGE PLAN. *ELV*

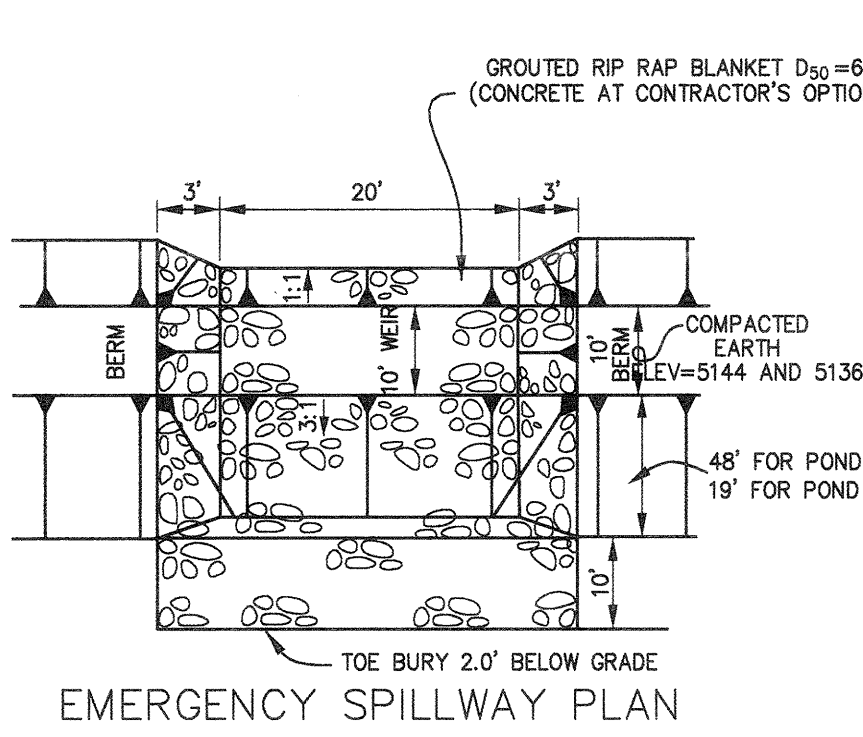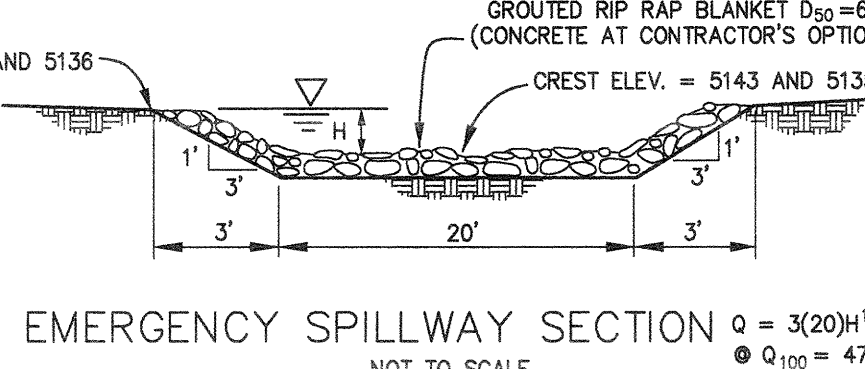


Resource Technology, Inc.
Civil Engineering 1720 - B Randolph Road SE
Environmental Sciences Albuquerque, New Mexico 87106
Water Resources Email: rti@rti.com Phone: (505) 243-7300
Landscape Architecture Planning Fax: (505) 243-7400


CITY OF ALBUQUERQUE PUBLIC WORKS DEPARTMENT ENGINEERING GROUP					
TITLE: ELDORADO PARK SUBDIVISION UNIT 2 TEMPORARY STORM DRAINAGE AND POND					
APPROVALS	ENGINEER	DATE	APPROVALS	ENGINEER	DATE
D.R.C. Chair			WATER		
TRANS. DEV.			WASTE WATER		
HYDROLOGY			TRAF. OPER.		
OTHER			OTHER		
PROJECT NO.	648281		MAP NO.	L-9-Z	SHEET 12 OF 15

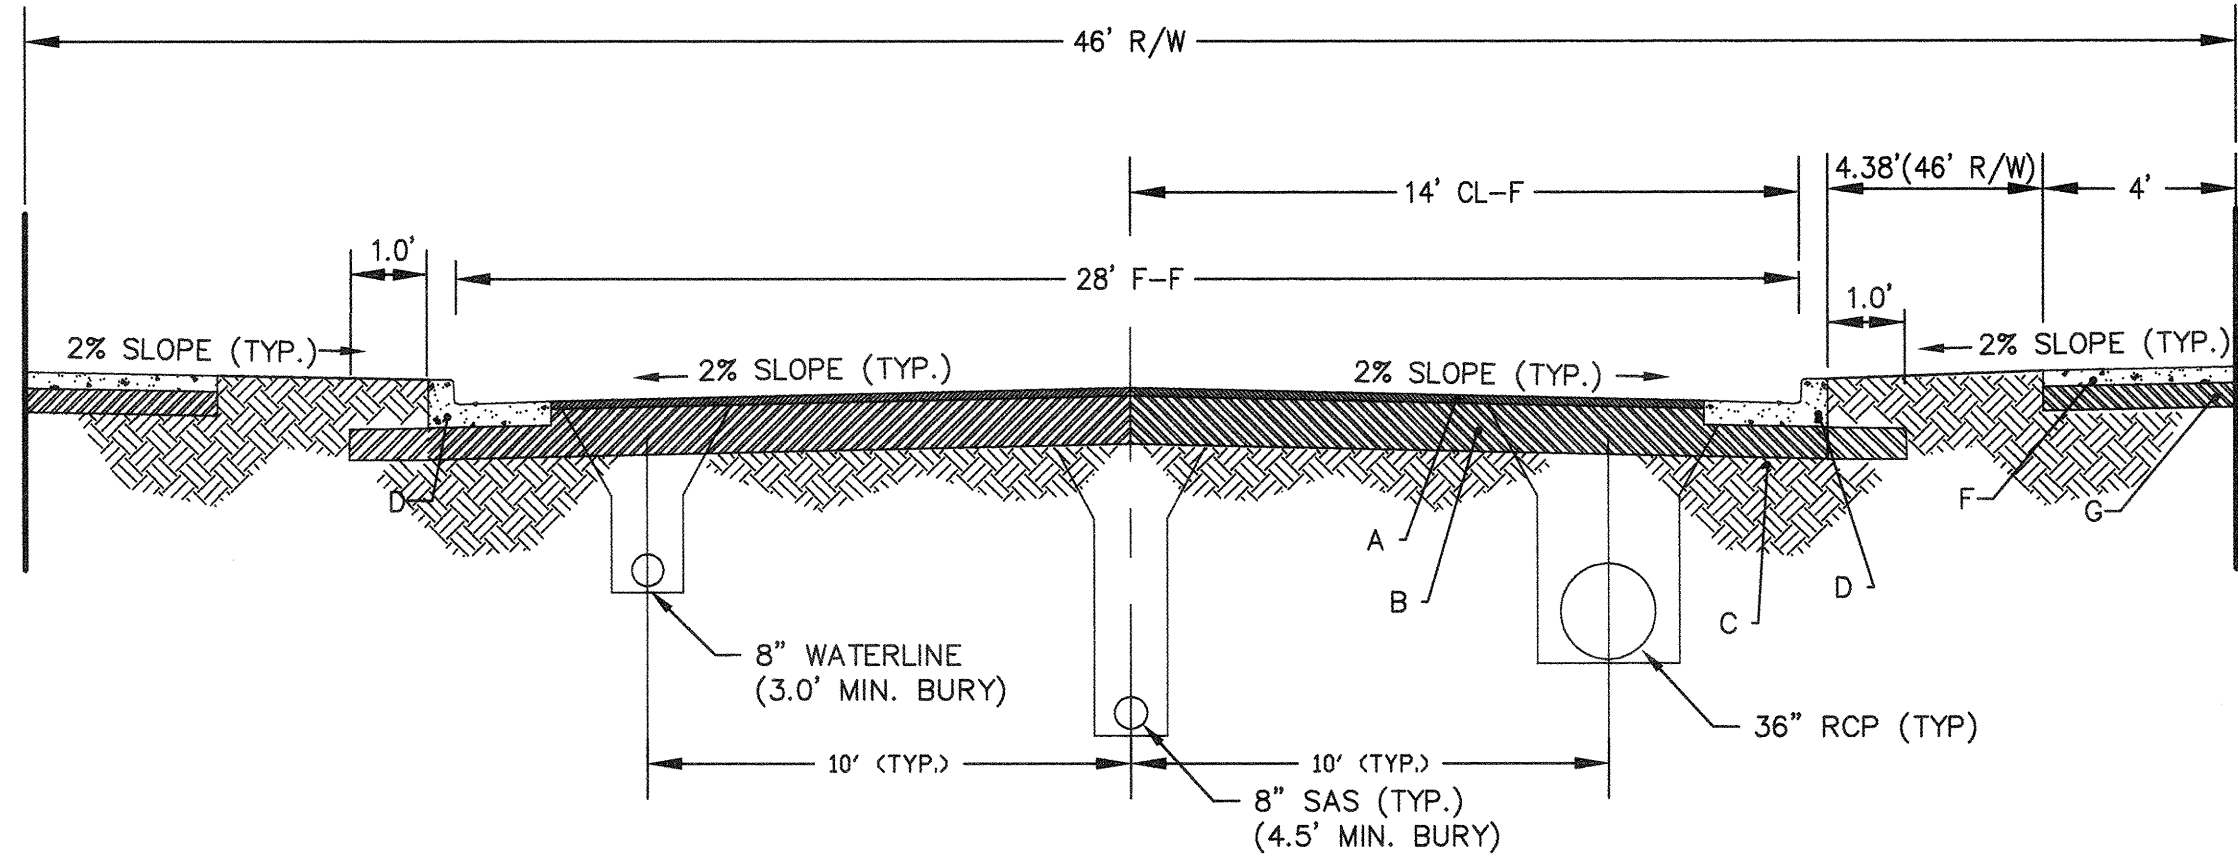

STREET SECTION Z-Z (28' F-F STREET WIDTH)
W/ STANDARD C & G BOTH SIDES
NOT TO SCALE

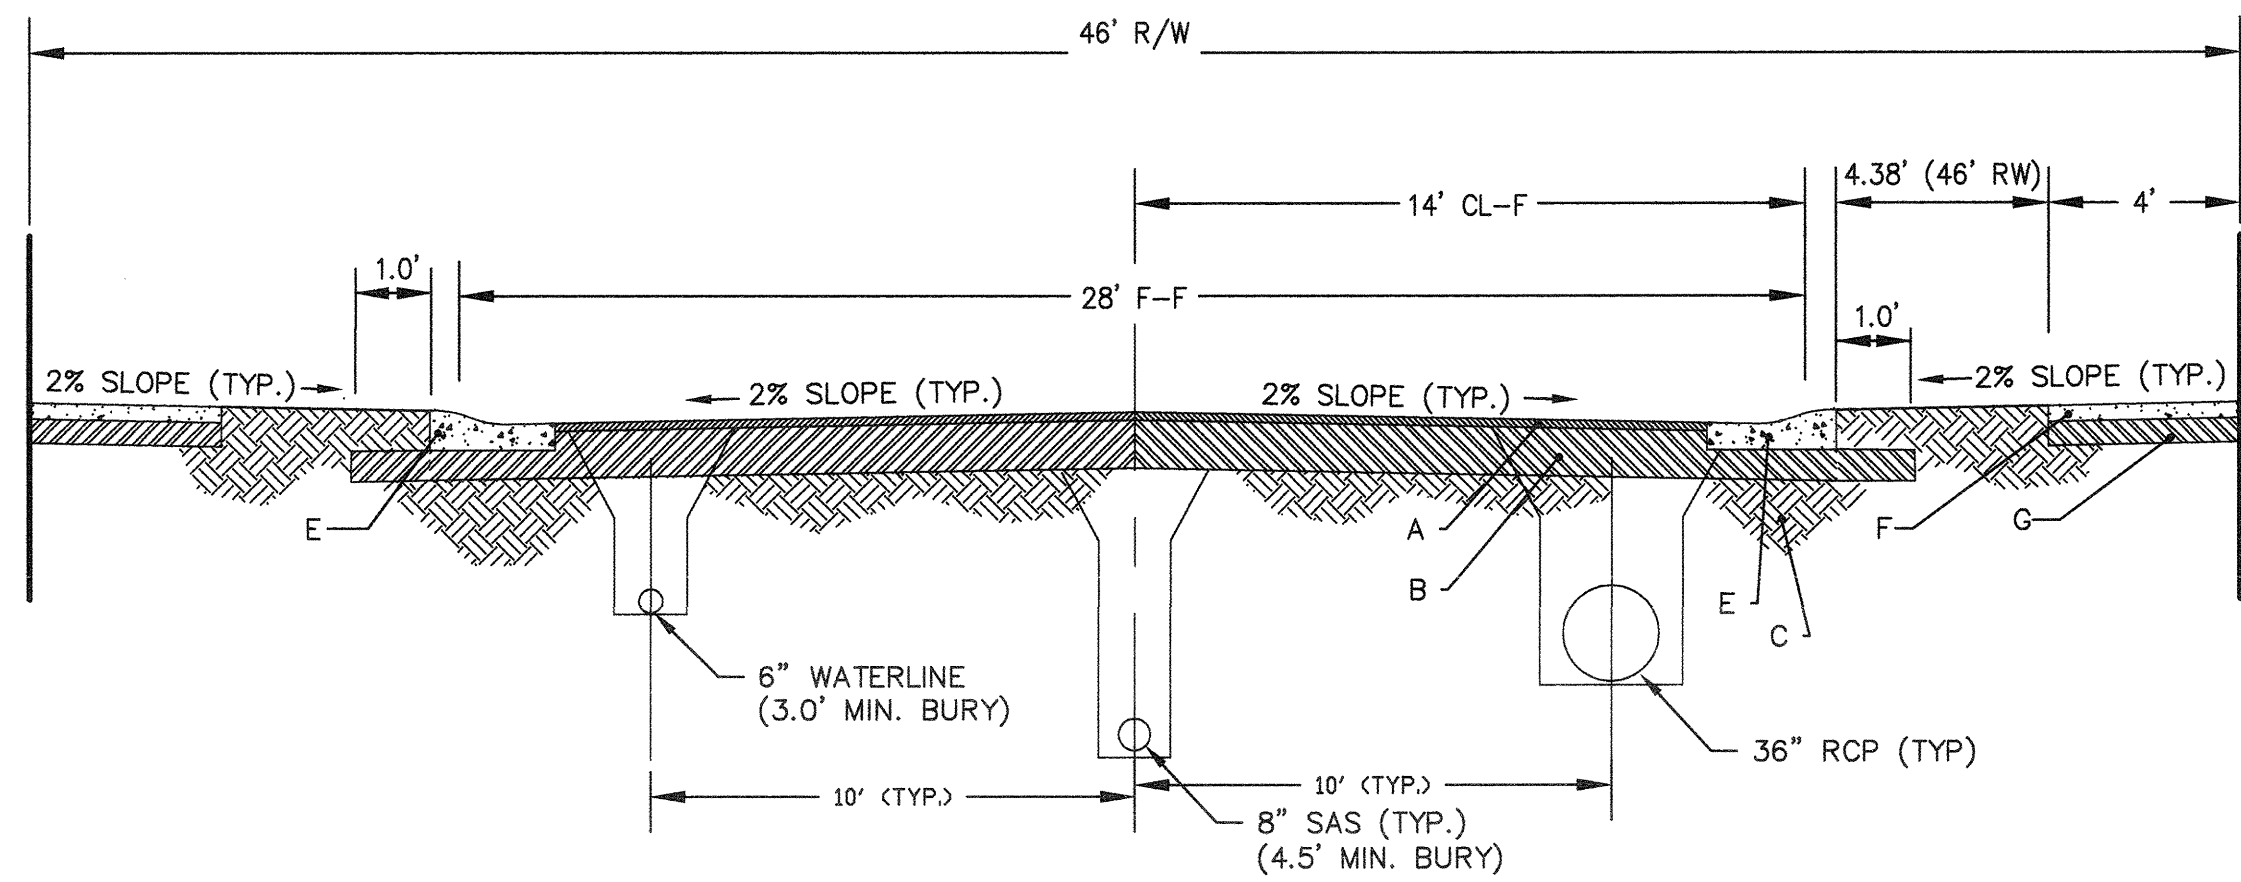


STREET SECTION Y-Y (28' F-F STREET WIDTH)
W/ MOUNTABLE CURB, BOTH SIDES
NOT TO SCALE



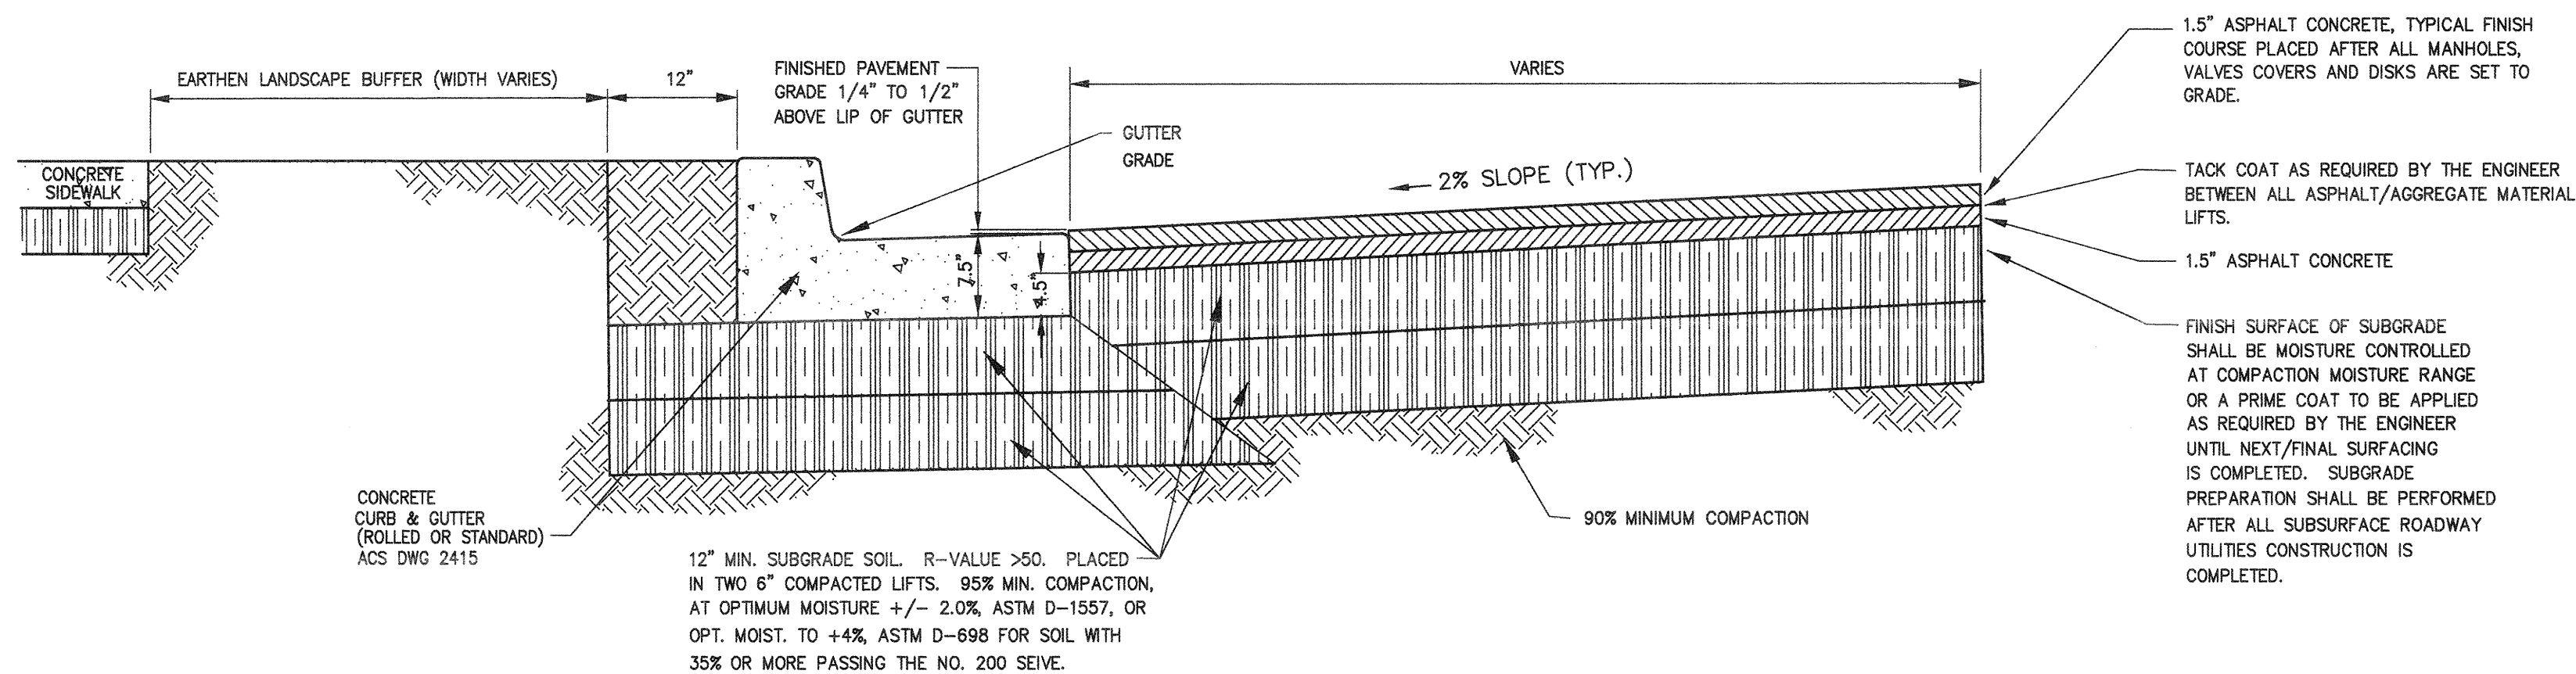


TYPICAL RESIDENTIAL STREET PAVEMENT DETAIL
(SECTIONS Y-Y AND Z-Z)
(ASPHALTIC CONCRETE PAVEMENT)
REFERENCE COA STANDARD DWG. 2405 - RESIDENTIAL STREET SECTION
NOT TO SCALE

- DETAIL NOTES FOR TYPICAL STREET SECTIONS
(COA STD DWG 2405 AND 2407)
- A 3" A.C. PAVEMENT
 - B 12" COMPACTED SUBGRADE MATERIAL (95% COMPACTION)
 - C COMPACTED SUBGRADE (90% COMPACTION)
 - D P.C.C. STANDARD CURB & GUTTER (SEE DETAIL BELOW)
 - E P.C.C. MOUNTABLE CURB, ROLL TYPE (SEE DETAIL BELOW)
 - F 4' P.C.C. SIDEWALK
 - G 6" COMPACTED SUBGRADE MATERIAL (95% COMPACTION)
 - H 6" AGGREGATE BASE COURSE PAVEMENT (SECTION X-X ONLY)

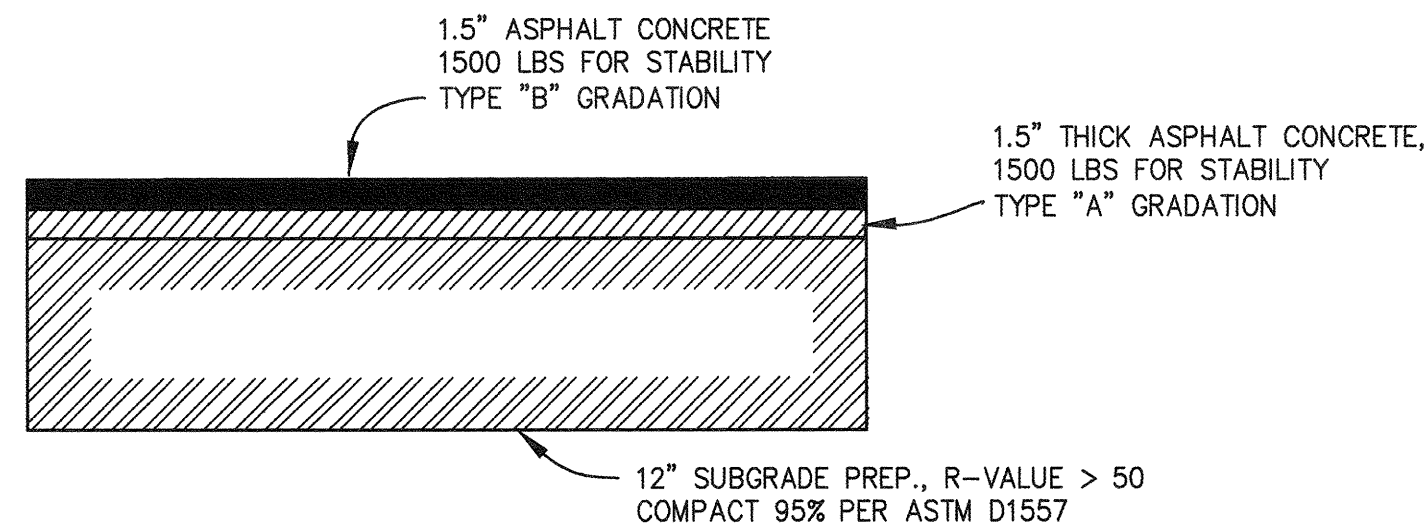

TYPICAL PAVEMENT SECTION
SECTIONS Y-Y AND Z-Z
NOT TO SCALE

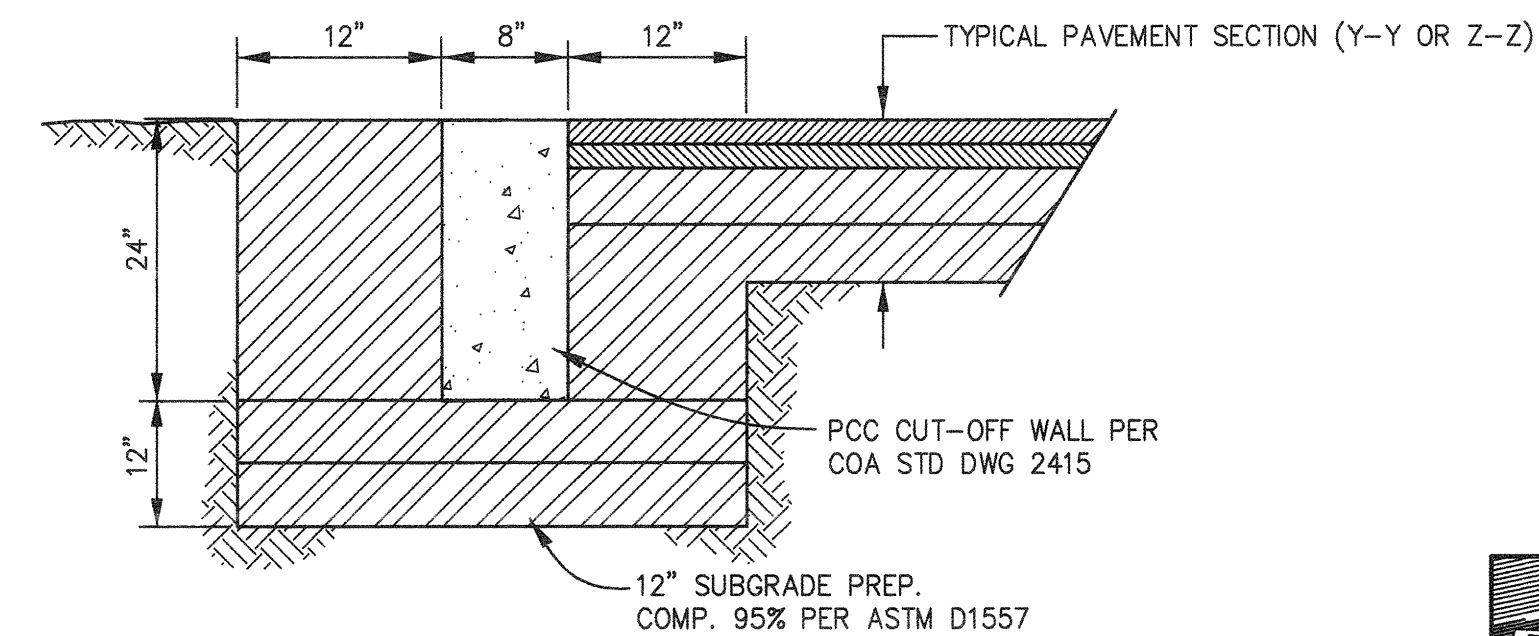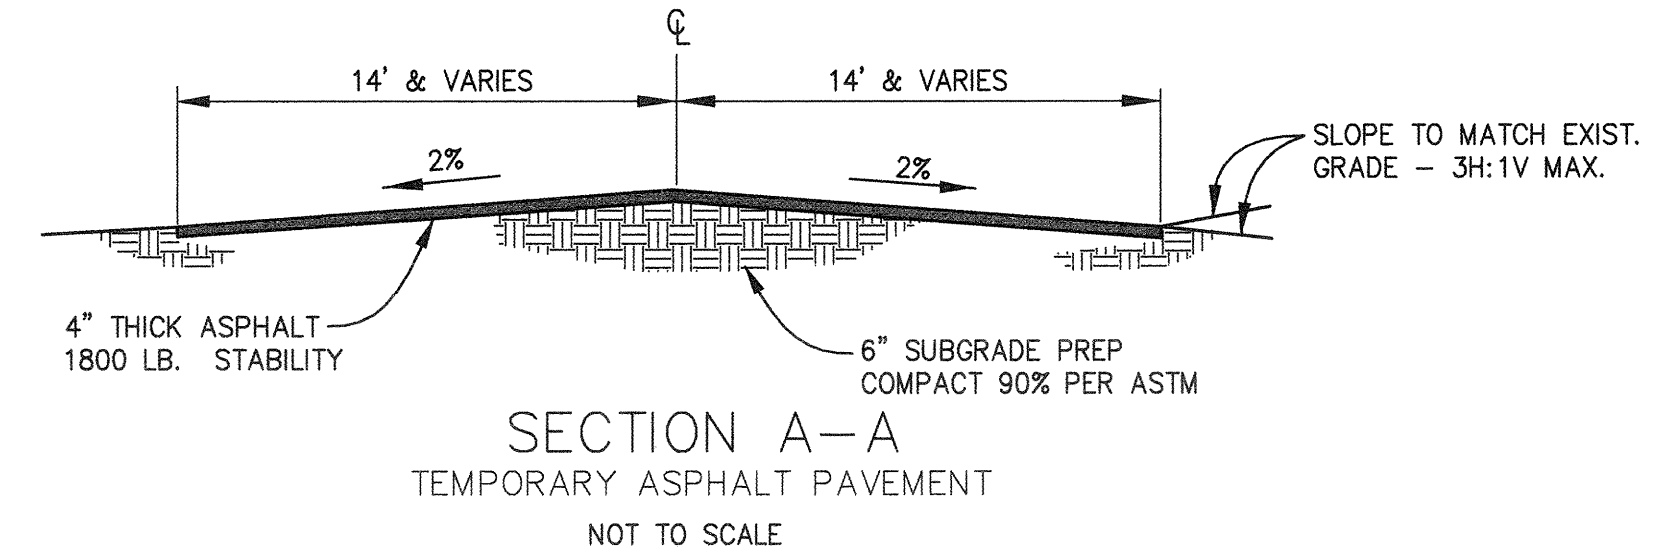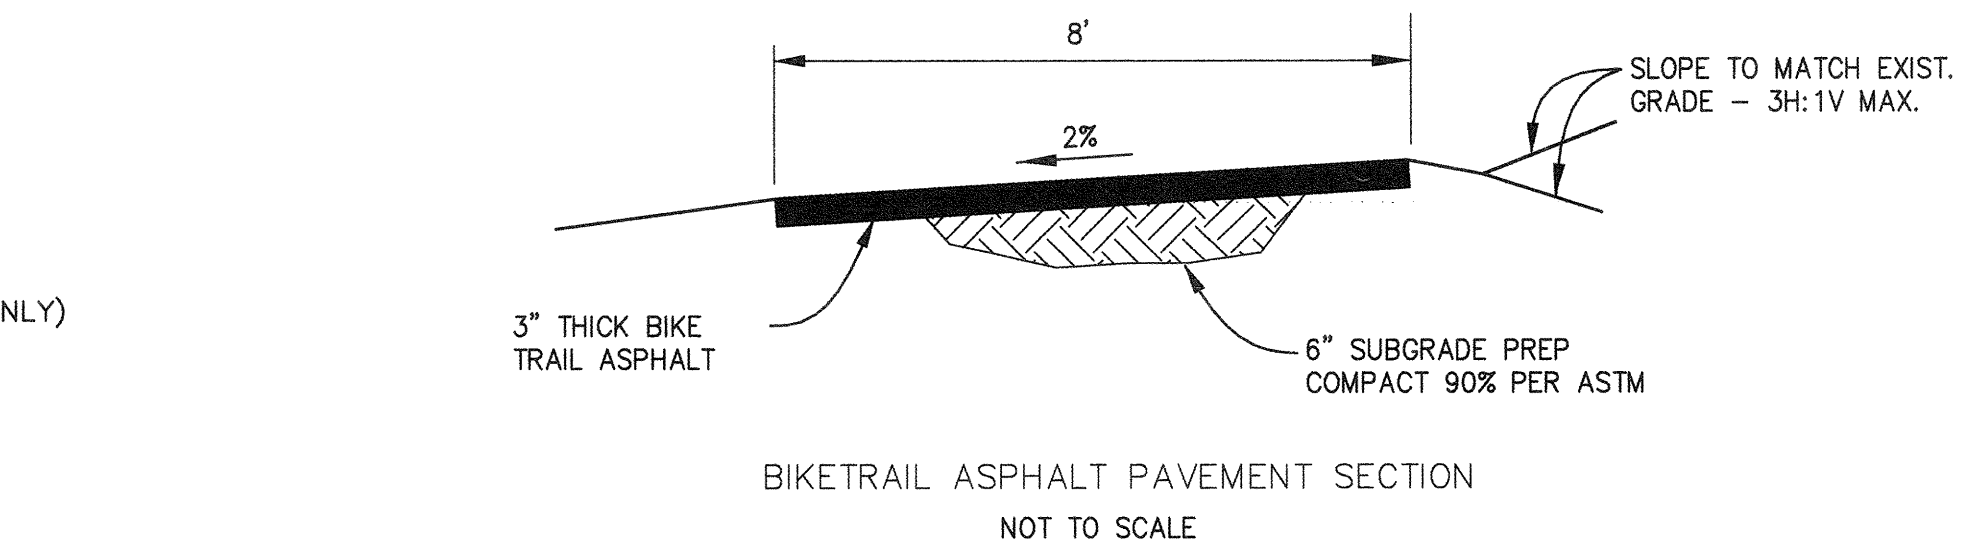

TYPICAL CUT-OFF WALL DETAIL
NOT TO SCALE


I, ELWIDIO V. DINIZ CERTIFY THAT
THE DRAWING OF THE "AS BUILT"
DIMENSIONS WAS DONE UNDER
MY SUPERVISION. *[Signature]*

Resource Technology, Inc.
ENGINEERS AND ENVIRONMENTAL SCIENTISTS
1720-B Randolph Rd. SE • Albuquerque, New Mexico • 87106
Telephone: (505) 243-7300 • Fax: (505) 243-7400 • E-mail: rti@earthlink.net
CIVIL • ENVIRONMENTAL • WATER RESOURCES • RECREATION • PLANNING

CITY OF ALBUQUERQUE PUBLIC WORKS DEPARTMENT ENGINEERING DEVELOPMENT GROUP	
TITLE: ELDORADO PARK SUBDIVISION PAVING DETAILS & TYPICAL ROADWAY SECTIONS	
Design Review Committee	City Engineer Approval
Mo./Day/Yr.	Mo./Day/Yr.
City Project No. 648281	Zone Map No. L-9-Z
Sheet 13	Of 15

AS BUILT INFORMATION	
NO changes to typical sections Side Street plan & profile	
BENCH MARKS	
ACS STA 7 - L 9	
GROUND TO GRID = 0.99867727	
NM STATE PLANE COORDINATE SYSTEM CENTRAL ZONE	
NAD 1927	
NORTHING: 1478346.71	
EASTING: 352978.14	
ELEVATION: 5175.735	
MICRO-FILM INFORMATION	

SURVEY INFORMATION	
FIELD NOTES	DATE
BY	
NO.	

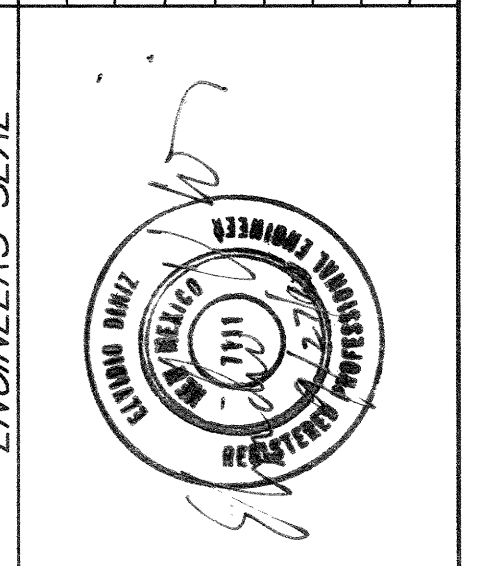


ENGINEERS SEAL	
REMARKS	BY
DESIGN	8/2000
ED	8/2000
RJH	8/2000
ED	8/2000

CONSTRUCTION TRAFFIC CONTROL GENERAL NOTES

1. CONTRACTOR MUST OBTAIN FROM CONSTRUCTION COORDINATION AN EXCAVATION/BARRICADING PERMIT BEFORE ENGAGING IN ANY CONSTRUCTION, MAINTENANCE OR REPAIR WORK IN ANY OF THE CITY OF ALBUQUERQUE'S RIGHTS-OF-WAY. EMERGENCY WORK THAT WOULD PRESERVE LIFE OR PROPERTY IS EXCLUDED WITH THE UNDERSTANDING, THAT A PERMIT SHALL BE OBTAINED WITHIN 24 TO 48 HOURS.
2. CONTRACTOR SHALL AT THE TIME OF PERMIT REQUEST, SUBMIT FOR APPROVAL BY CONSTRUCTION COORDINATION, A TRAFFIC CONTROL PLAN DETAILING ALL EXISTING TOPOGRAPHY SUCH AS LANE WIDTHS, DRIVEWAYS, AND BUSINESS/RESIDENTIAL ACCESSES. THE TRAFFIC CONTROL PLAN SHALL INCLUDE ALL PHASES OF WORK AND SCHEDULES INVOLVED IN THE CONSTRUCTION PROJECT. ANY SEPARATE PHASES OF A CONSTRUCTION PROJECT SHALL BE GIVEN AN INDIVIDUAL PERMIT EACH. BLANKET PERMITS WILL NOT BE ISSUED.
3. THESE TYPICAL TRAFFIC CONTROL PLANS DO NOT REFLECT THE EXISTING TOPOGRAPHY SUCH AS DRIVEWAYS, LANE WIDTHS, AND BUSINESS/RESIDENTIAL ACCESSES. EVERY LOCATION THAT REQUIRES CONSTRUCTION TRAFFIC CONTROL SHALL HAVE A DETAILED TRAFFIC CONTROL PLAN SHOWING ALL EXISTING TOPOGRAPHY.
4. CONSTRUCTION SHALL NOT BEGIN UNLESS A TRAFFIC CONTROL PLAN HAS BEEN APPROVED AND VERIFIED BY CONSTRUCTION COORDINATION.
5. CONSTRUCTION COORDINATION SHALL BE NOTIFIED 48 HOURS PRIOR TO ANY TRAFFIC CONTROL CHANGES NEEDED BY CONTRACTOR, THAT WERE NOT PREVIOUSLY APPROVED. THESE TRAFFIC CONTROL CHANGES SHALL BE REQUESTED IN WRITING ACCOMPANIED WITH A TRAFFIC CONTROL PLAN REFLECTING SUCH CHANGES.
6. ALL CONSTRUCTION TRAFFIC CONTROL DEVICES SHALL COMPLY TO THE MANUAL ON UNIFORM TRAFFIC CONTROL DEVICES (MUTCD), LATEST EDITION. IT IS THE RESPONSIBILITY OF THE CONTRACTOR TO INSTALL, SERVICE AND MAINTAIN ALL TRAFFIC CONTROL DEVICES. TRAFFIC CONTROL DEVICES SHALL NOT BE REMOVED OR ALTERED IN ANY WAY WITHOUT THE APPROVAL OF CONSTRUCTION COORDINATION, PER SECTION 6A-4 OF THE MUTCD, LATEST EDITION.
7. THE CONSTRUCTION TRAFFIC CONTROL INITIAL SET-UP SHALL BE BY AN AMERICAN TRAFFIC SAFETY SERVICES ASSOCIATION (ATSSA) CERTIFIED WORKSITE TRAFFIC SUPERVISOR. THE MAINTENANCE AND SERVICING SHALL ALSO BE DONE BY AN ATSSA CERTIFIED WORKSITE TRAFFIC SUPERVISOR OR EQUIVALENT.
8. CONTRACTOR IS RESPONSIBLE TO MAINTAIN AND SERVICE ALL TRAFFIC CONTROL DEVICES 24 HOURS A DAY, 7 DAYS A WEEK THROUGHOUT LENGTH OF PROJECT. CONTRACTOR IS RESPONSIBLE THAT ALL TRAFFIC CONTROL DEVICES COMPLY WITH THE MUTCD, LATEST EDITION.
9. ALL ADVANCE WARNING SIGNS SHALL BE DOUBLE INDICATED WHENEVER THERE ARE MULTI-LANE TRAFFIC IN ANY ONE GIVEN DIRECTION AND THERE IS SUFFICIENT MEDIAN SPACE.
10. ALL BARRICADES IN ALL TAPERS AND TANGENTS SHALL BE PLACED APART, A DISTANCE MEASURED IN FEET, EQUAL TO THAT OF THE POSTED SPEED LIMIT. NO EXCEPTIONS UNLESS APPROVED BY CONSTRUCTION COORDINATION PER MUTCD SECTION 6A-4.
11. ALL WORK IN ARTERIAL ROADWAYS SHALL BE ON A CONTINUOUS 24 HOUR PER DAY BASIS UNTIL COMPLETED.
12. CONTRACTOR IS RESPONSIBLE TO PROVIDE CONSTRUCTION COORDINATION, A WEEKLY LOG OF DAILY INSPECTIONS OF BARRICADE AND MAINTENANCE SCHEDULES ON PROJECTS THAT ARE OVER ONE WEEK DURATION.
13. EQUIPMENT OR MATERIALS SHALL NOT BE STORED WITHIN 15 FEET OF A TRAVELED TRAFFIC LANE DURING NON-WORKING HOURS WITHOUT THE APPROVAL OF CONSTRUCTION COORDINATION.
14. CONTRACTOR SHALL PROVIDE AND MAINTAIN A SAFE AND ADEQUATE MEANS OF CHANNELIZING PEDESTRIAN TRAFFIC AROUND AND THROUGH THE CONSTRUCTION AREA.
15. CONTRACTOR IS RESPONSIBLE FOR OBLITERATION OF ANY CONFLICTING STRIPING AND RESPONSIBLE FOR ALL TEMPORARY STRIPING.
16. CONTRACTOR SHALL MAINTAIN ACCESS TO ALL FACILITIES, BUSINESSES AND/OR RESIDENTS AT ALL TIMES.
17. CONTRACTOR SHALL PROVIDE ACCESS SIGNS FOR BUSINESSES LOCATED WITHIN THE CONSTRUCTION AREA UNDER THE SUPERVISION OF CONSTRUCTION COORDINATION. EACH ACCESS SIGN SHALL HAVE 5 INCH, WHITE OPAQUE LETTERING ON BLUE REFLECTORIZED BACKGROUND. ACCESS SIGNS SHALL BE CONSIDERED INCIDENTAL TO THE BID AND NOT PART OF THE CONTRACT UNLESS OTHERWISE STATED. NO MORE THAN 3 BUSINESSES SHALL BE LISTED ON A ACCESS SIGN. SHOPPING CENTERS AND MALLS SHALL BE LISTED AS SUCH.
18. ALL ADVANCE WARNING SIGNS SHALL MEET THE MINIMUM REFLECTIVE INTENSITY REQUIREMENTS SET FORTH BY THE CITY OF ALBUQUERQUE. CONSTRUCTION COORDINATION SHALL DETERMINE ALL REQUIREMENTS AND APPROVE OR DISAPPROVE ANY ADVANCE WARNING SIGN PER SECTION 6A-4 OF THE MUTCD, LATEST EDITION.
19. 48 HOURS PRIOR TO OCCUPYING OR CLOSING OF A RIGHT-OF-WAY, CONTRACTOR SHALL NOTIFY: POLICE, FIRE DEPARTMENT, SCHOOLS, HOSPITALS, TRANSIT AUTHORITY, BUSINESSES AND/OR RESIDENTS THAT WILL BE AFFECTED BY THE CONSTRUCTION.
20. ANY FIELD ADJUSTMENTS SHALL BE APPROVED BY CONSTRUCTION COORDINATION.

21. EXCAVATIONS SHALL BE PLATED, TEMPORARILY PATCHED OR RESURFACED PRIOR TO OPENING OF TRAFFIC. A MINIMUM OF 11 FEET SHALL BE PROVIDED FOR TRAFFIC IN ANY GIVEN DIRECTION. CONTRACTOR IS RESPONSIBLE FOR ANY WORK INVOLVED IN SATISFYING THESE REQUIREMENTS.
22. CONTRACTOR SHALL AT ALL TIMES COMPLY WITH THE FOLLOWING:
1. STANDARDS AND REQUIREMENTS SET FORTH IN THE MANUAL ON UNIFORM TRAFFIC CONTROL DEVICES, LATEST EDITION.
 2. THE CITY OF ALBUQUERQUE TRAFFIC CODE, LATEST EDITION.
 3. SECTION 19 OF THE CITY OF ALBUQUERQUE'S STANDARD SPECIFICATIONS FOR PUBLIC WORK CONSTRUCTION, AS WELL AS OTHER SECTIONS.
23. FAILURE TO COMPLY WITH ANY OF THE ABOVE MENTIONED, WILL BE ADEQUATE CAUSE TO CEASE ALL WORK ON ANY CONSTRUCTION PROJECT. WORK WILL NOT RESUME UNTIL ALL REQUIREMENTS ARE ADDRESSED AND APPROVED BY CONSTRUCTION COORDINATION.
24. ALL TRAFFIC CONTROL DEVICES SHALL BE KEPT IN NEW-CLEAN CONDITION, WASHING OF EQUIPMENT IS INCIDENTAL TO IT'S PLACEMENT AND MAINTENANCE.
25. TRAFFIC CONTROL STANDARDS APPLY ONLY WHERE THE CONSTRUCTION TRAFFIC CONTROL PLANS ARE NOT SPECIFIC.

26. ADVANCE WARNING SIGNS SHALL BE 36"x36" MIN. WITH SUPER ENGINEERING GRADE SHEETING OR BETTER. MOUNTING HEIGHT AT TOP OF SIGN SHALL BE THE SAME AS FOR A 48" SIGN AS INDICATED IN THE M.U.T.C.D.
27. CONTRACTOR SHALL MAINTAIN A GRAFFITI-FREE WORKSITE. ALL GRAFFITI SHALL BE PROMPTLY REMOVED FROM ALL EQUIPMENT, BOTH PERMANENT AND TEMPORARY.

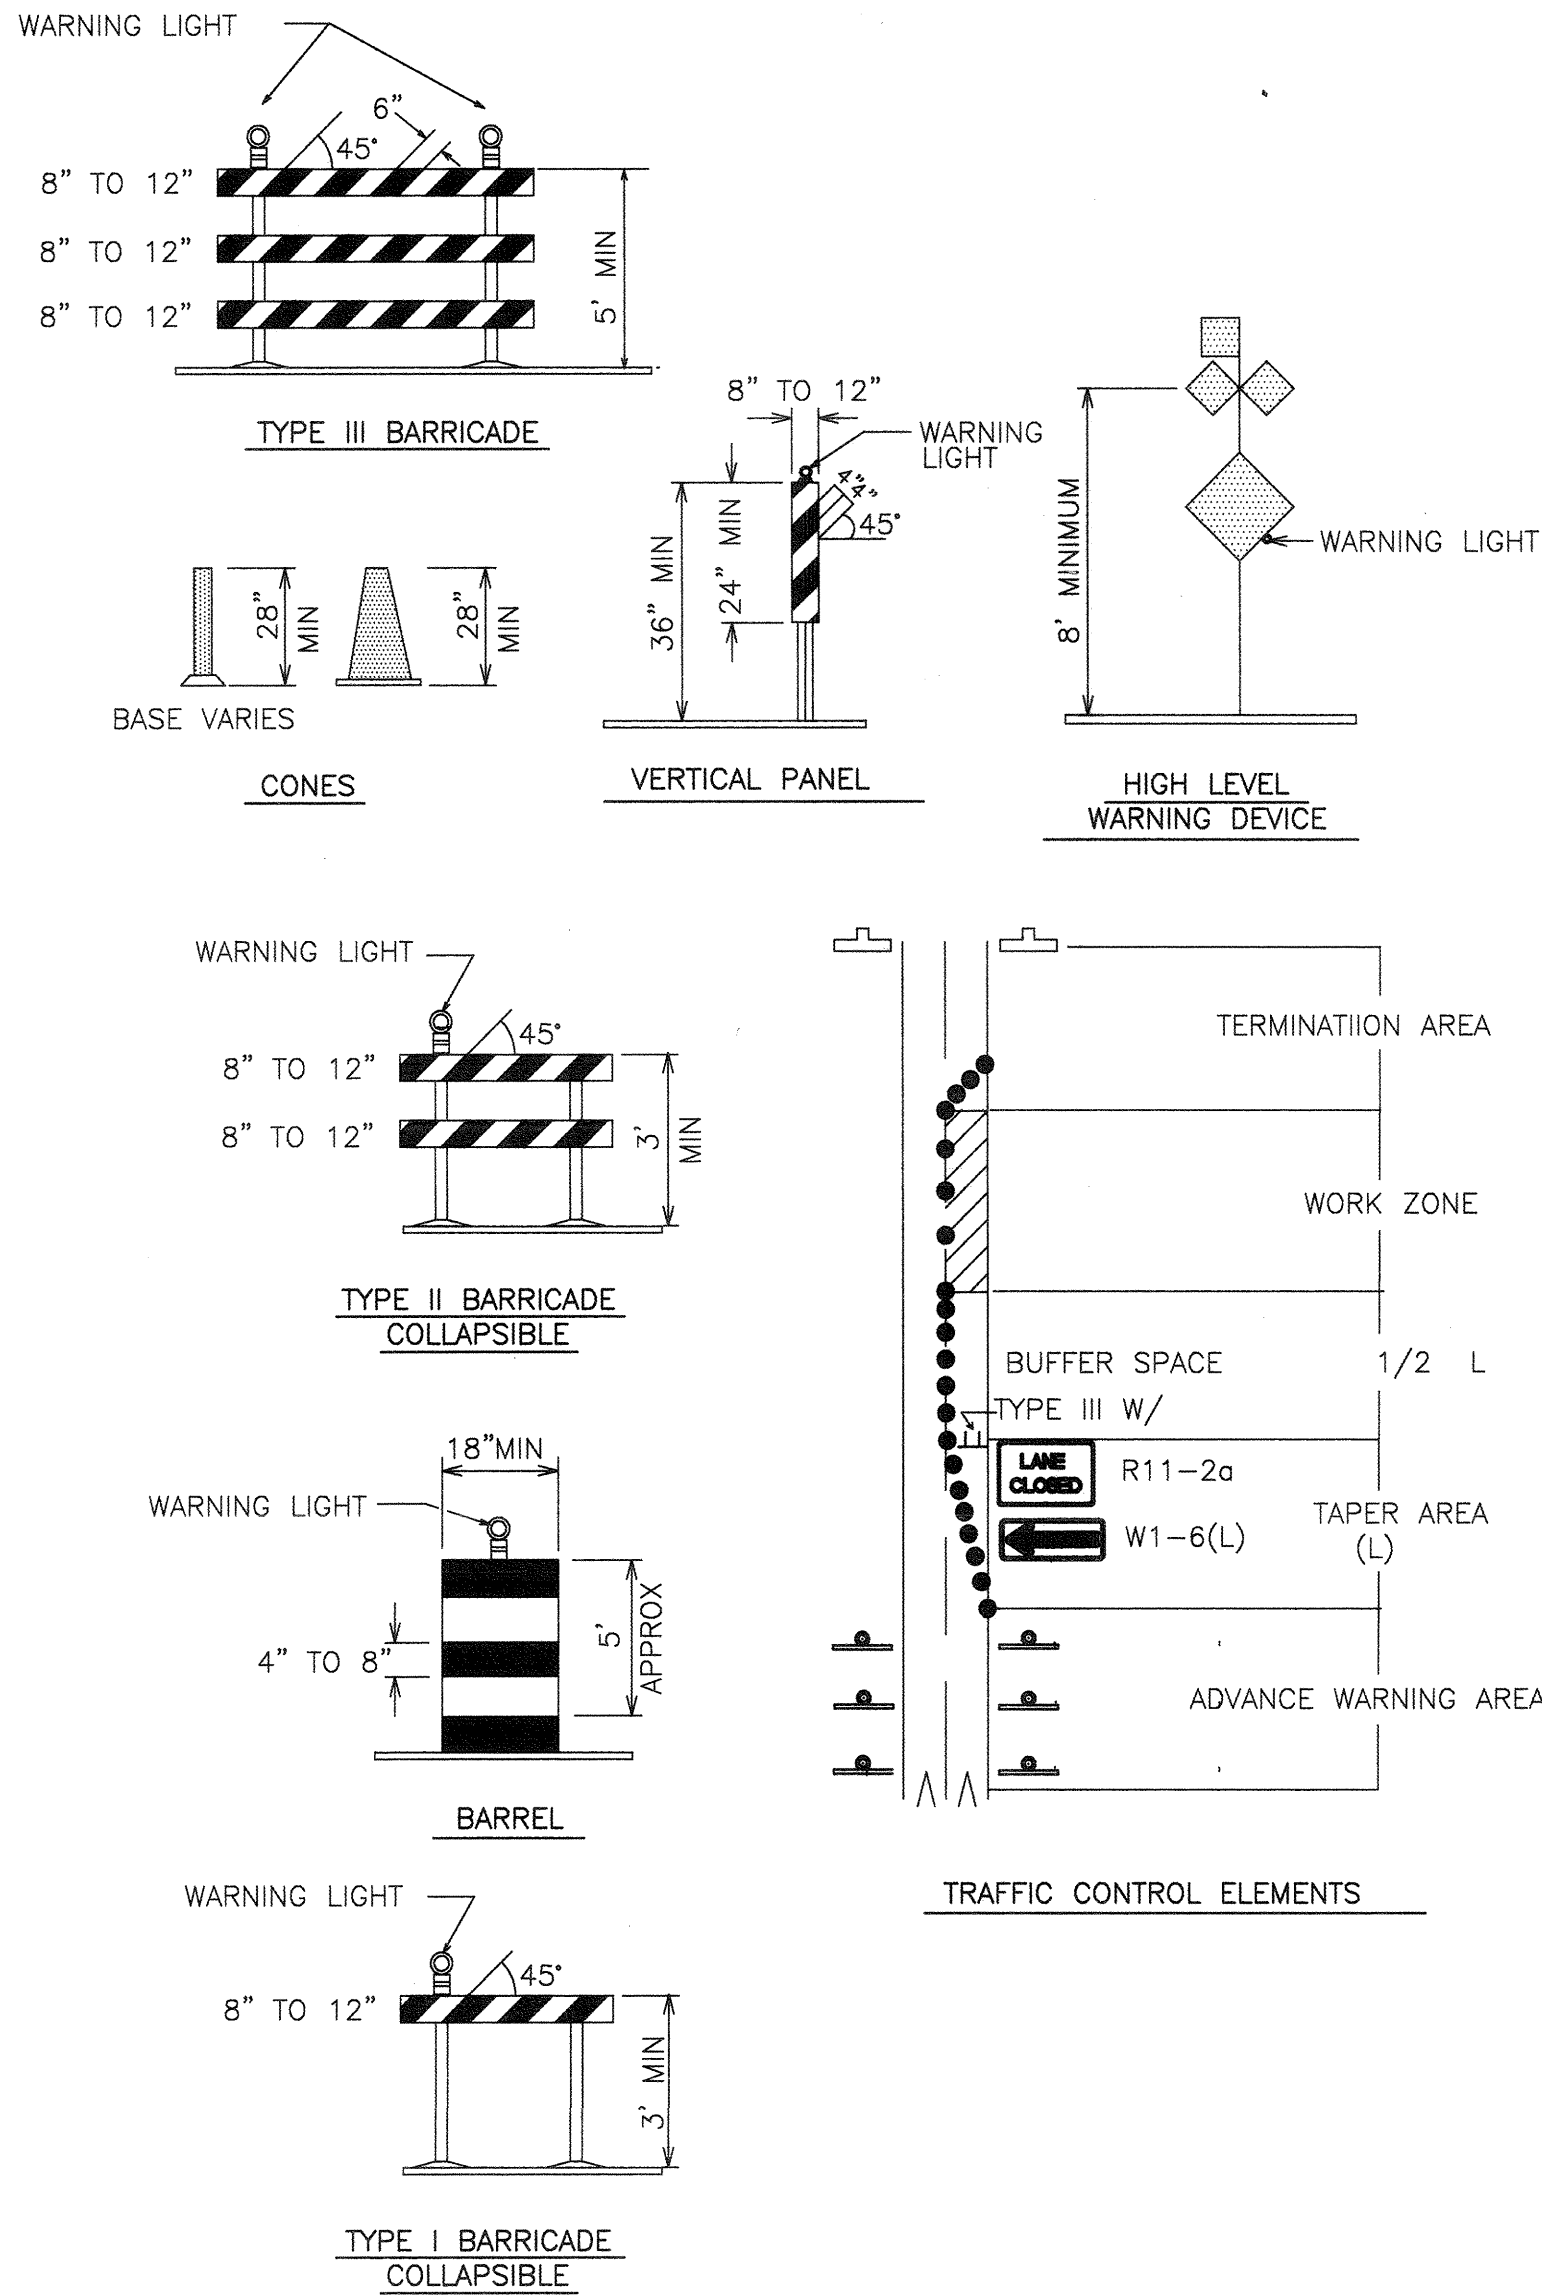

LEGEND

- WORK AREA
- BARRICADE - TYPE I, TYPE II, OR BARREL
- BARRICADE - TYPE III
- VERTICAL PANEL
- WARNING SIGN
- DISTANCE BETWEEN SIGNS - A DISTANCE MEASURED IN FEET EQUAL TO A VALUE OF TEN TIMES THE SPEED LIMIT OF THE STREET
- FLAGMAN POSITION
- SPACING BETWEEN BARRICADES - A DISTANCE MEASURED IN FEET EQUAL TO THE STREET LIMIT OF THE STREET
- TAPER LENGTH - SEE CHART BELOW

THE TANGENT LENGTH IS EQUAL TO THE TAPER LENGTH FOR A GIVEN STREET.

TAPER REQUIREMENT

SPEED LIMIT (MPH)	TAPER LENGTH(L) (FEET)			MINIMUM NUMBER OF DEVICES FOR TAPER	MAXIMUM DEVICE SPACING IN FEET	
	10' LANE	11' LANE	12' LANE		ALONG TAPER	AFTER TAPER
20	70	75	80	5	20	20
25	105	115	125	6	25	25
30	150	165	180	7	30	30
35	205	225	245	8	35	35
40	270	295	320	9	40	40
45	450	495	540	13	45	45
50	500	550	600	13	50	50
55	550	605	660	13	55	55

RECOMMENDED SIGN SPACING(D) FOR ADVANCE WARNING SIGN SERIES

SPEED MILES PER HOUR	MINIMUM DISTANCE IN FEET BETWEEN SIGNS	FROM LAST SIGN TO TAPER
0-20	10 X SPEED LIMIT	10 X SPEED LIMIT
25-30	10 X SPEED LIMIT	10 X SPEED LIMIT
30-35	10 X SPEED LIMIT	10 X SPEED LIMIT
40-45	10 X SPEED LIMIT	10 X SPEED LIMIT
50-60	10 X SPEED LIMIT	10 X SPEED LIMIT

TAPER CRITERIA

TYPE OF TAPER	TAPER LENGTH
---------------	--------------


UPSTREAM TAPER:
MERGING TAPER 1/2 L MINIMUM
SHIFTING TAPER 1/2 L MINIMUM
SHOULDER TAPER 1/2 L MINIMUM
TWO-WAY TRAFFIC TAPER 100 FEET MAXIMUM
DOWNSTREAM TAPERS 100 FEET PER LANE

TAPER LENGTH COMPUTATION

SPEED LIMIT	
40 MPH OR LESS	$L = \frac{WS^2}{60}$
40 MPH OR GREATER	$L = W \times S$

L = TAPER LENGTH
W = WIDTH OF OFFSET IN FEET
S = POSTED SPEED OR OFF-PEAK 85-PERCENTILE SPEED IN MPH

SIGN FACE DETAILS

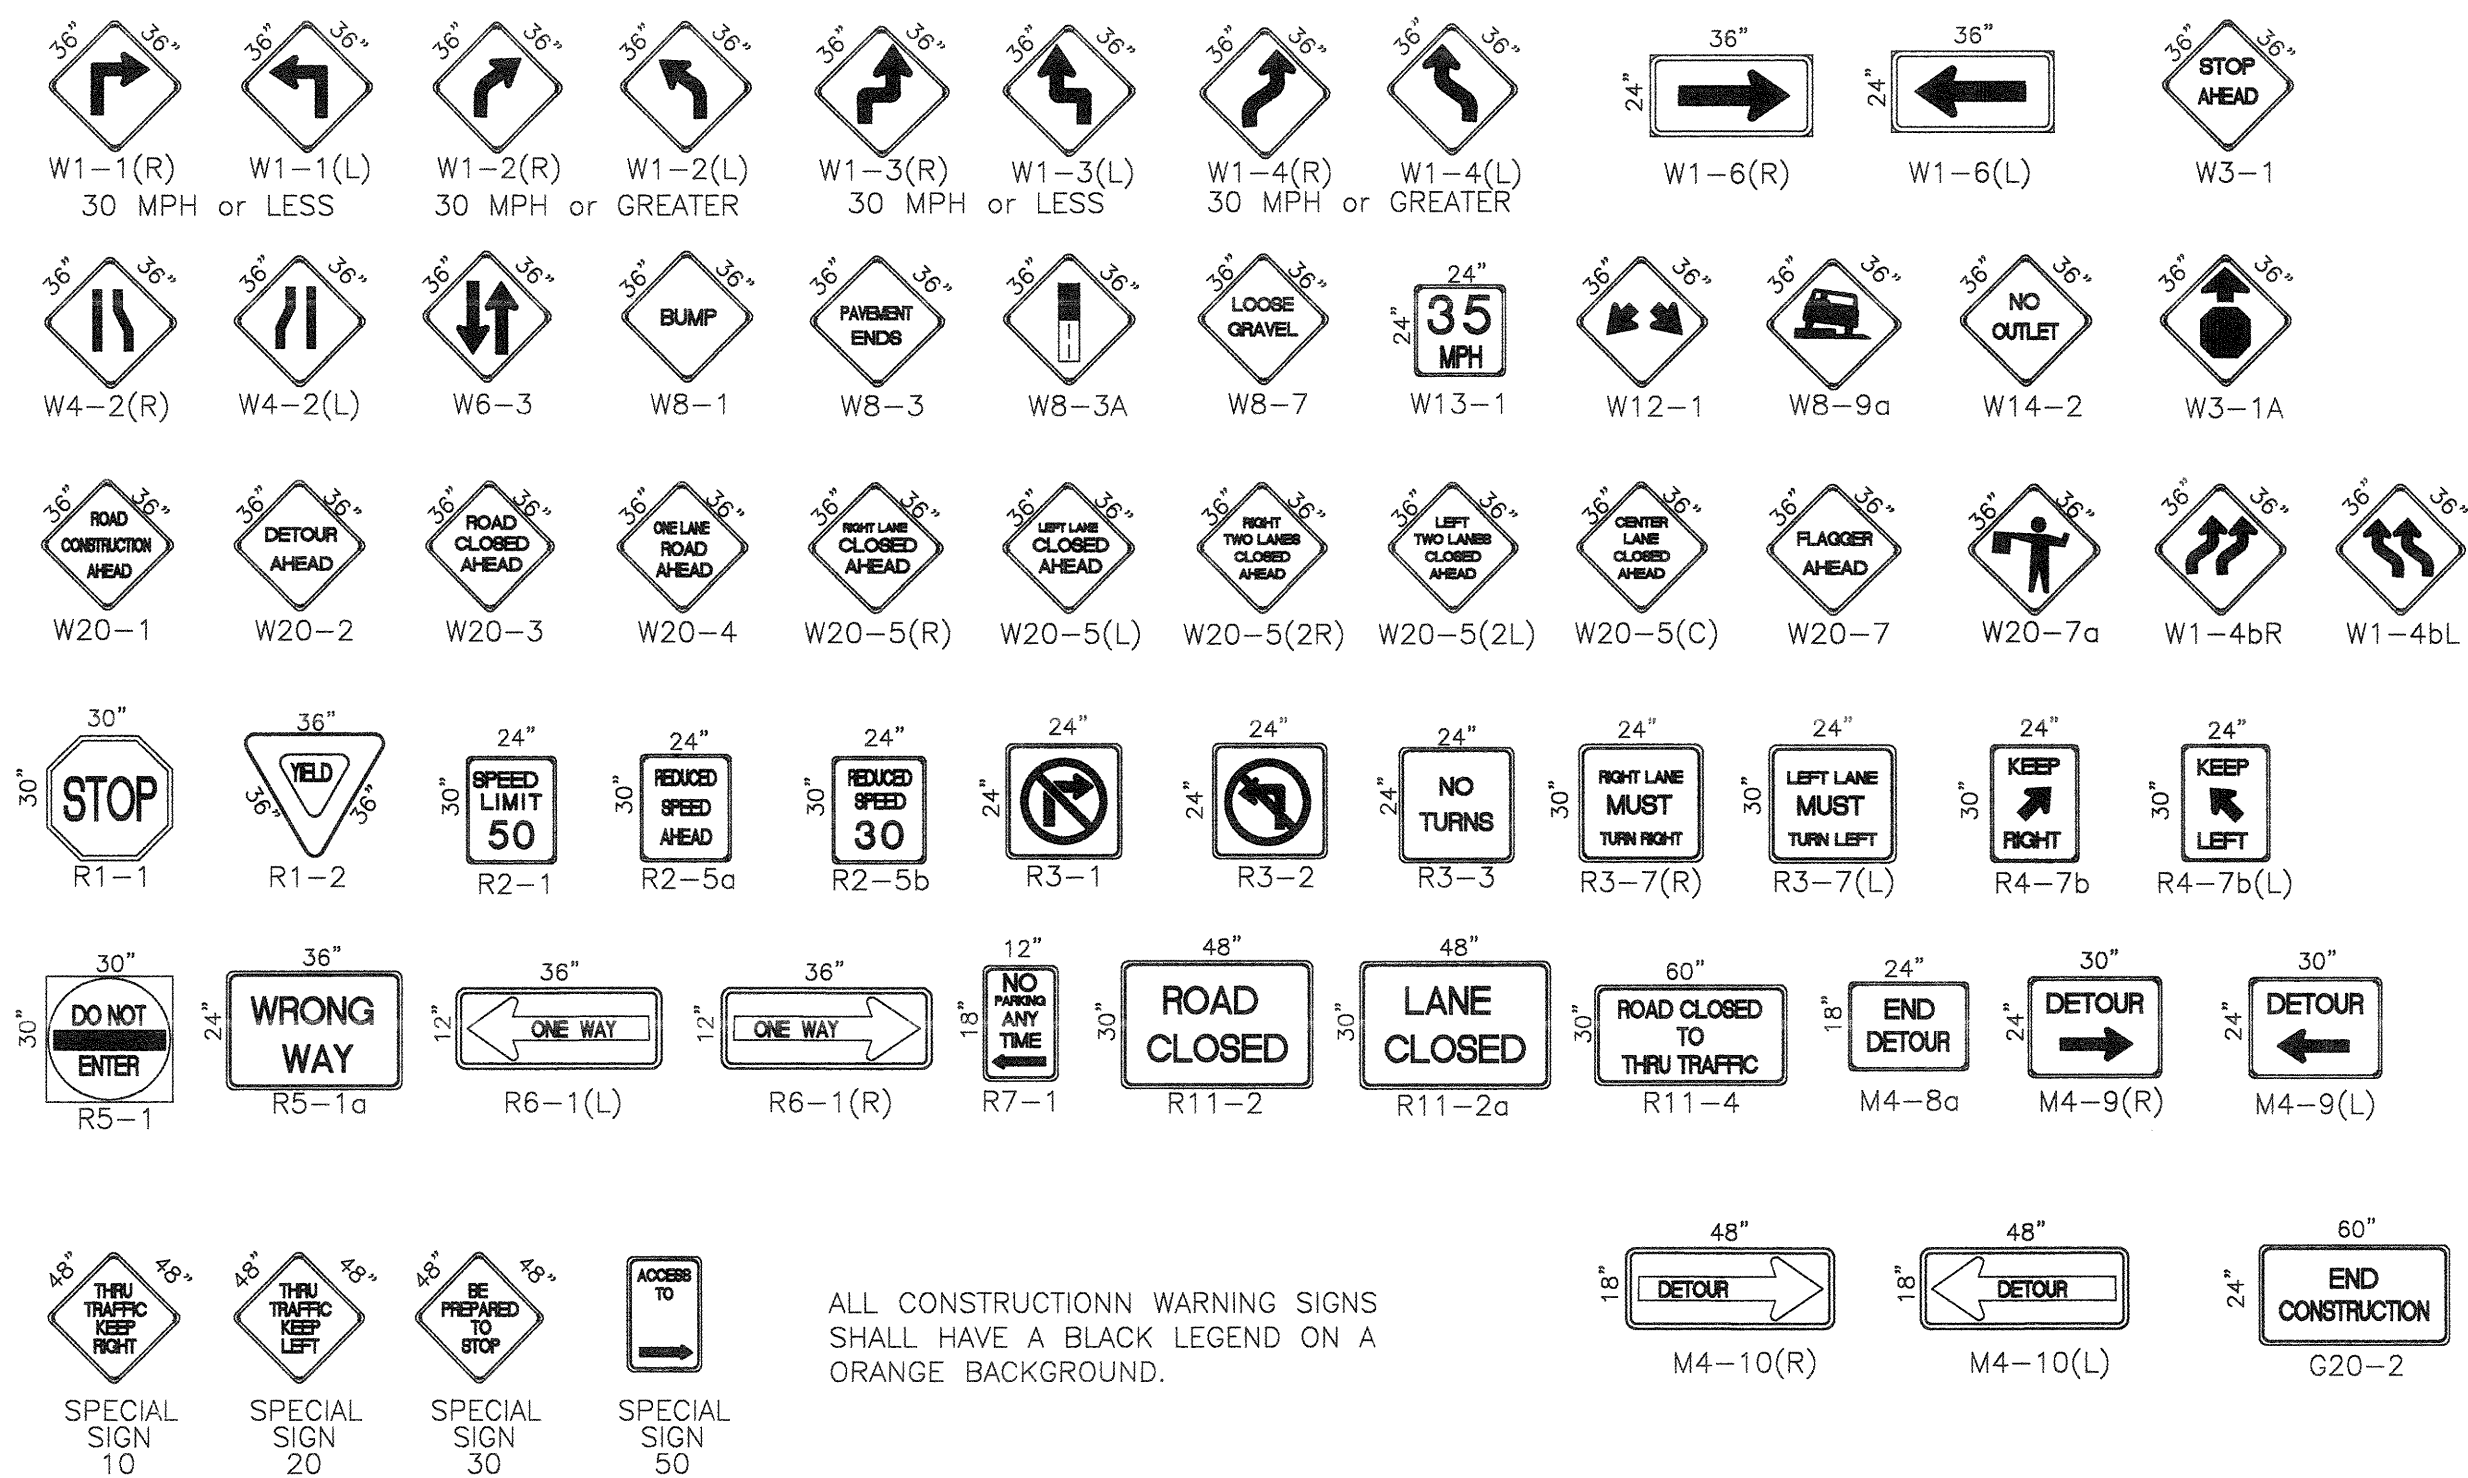

ALL CONSTRUCTION WARNING SIGNS SHALL HAVE A BLACK LEGEND ON A ORANGE BACKGROUND.









CITY OF ALBUQUERQUE
PUBLIC WORKS DEPARTMENT
ENGINEERING DEVELOPMENT GROUP


TITLE: TRAFFIC CONTROL
SIGNING AND CONSTRUCTION TRAFFIC CONTROL STANDARDS

DESIGN REVIEW COMMITTEE	CITY ENGINEER APPROVAL	MO./DAY/YR.	MO./DAY/YR.
CA	STP		

CITY PROJECT NO. 648281
ZONE MAP NO. L-9-Z
SHEET 14 OF 15

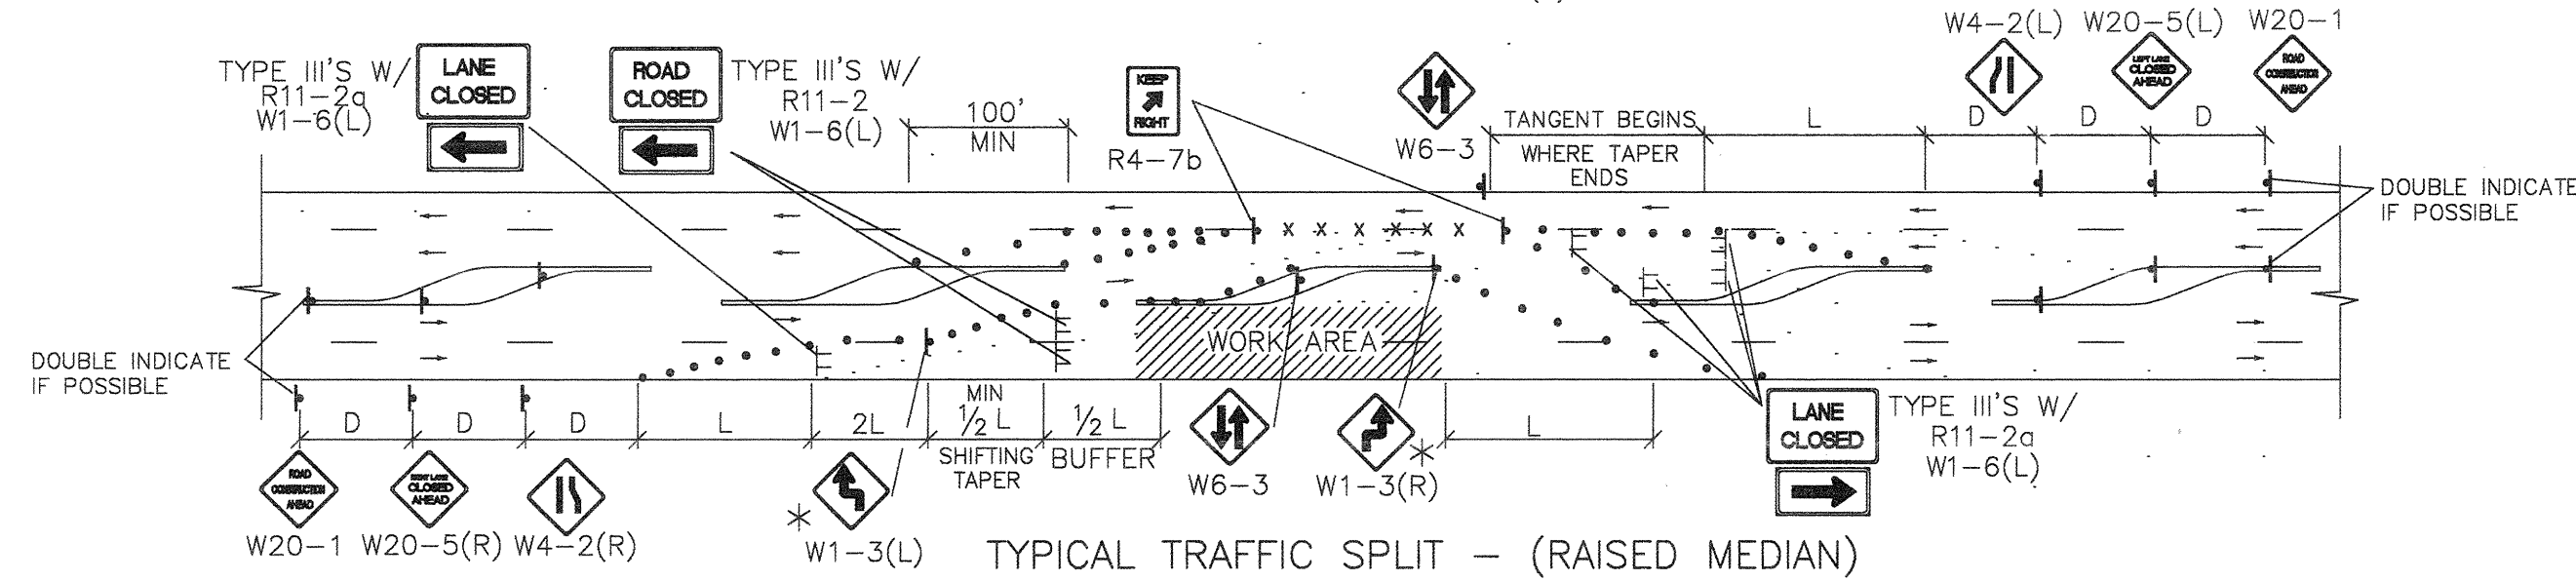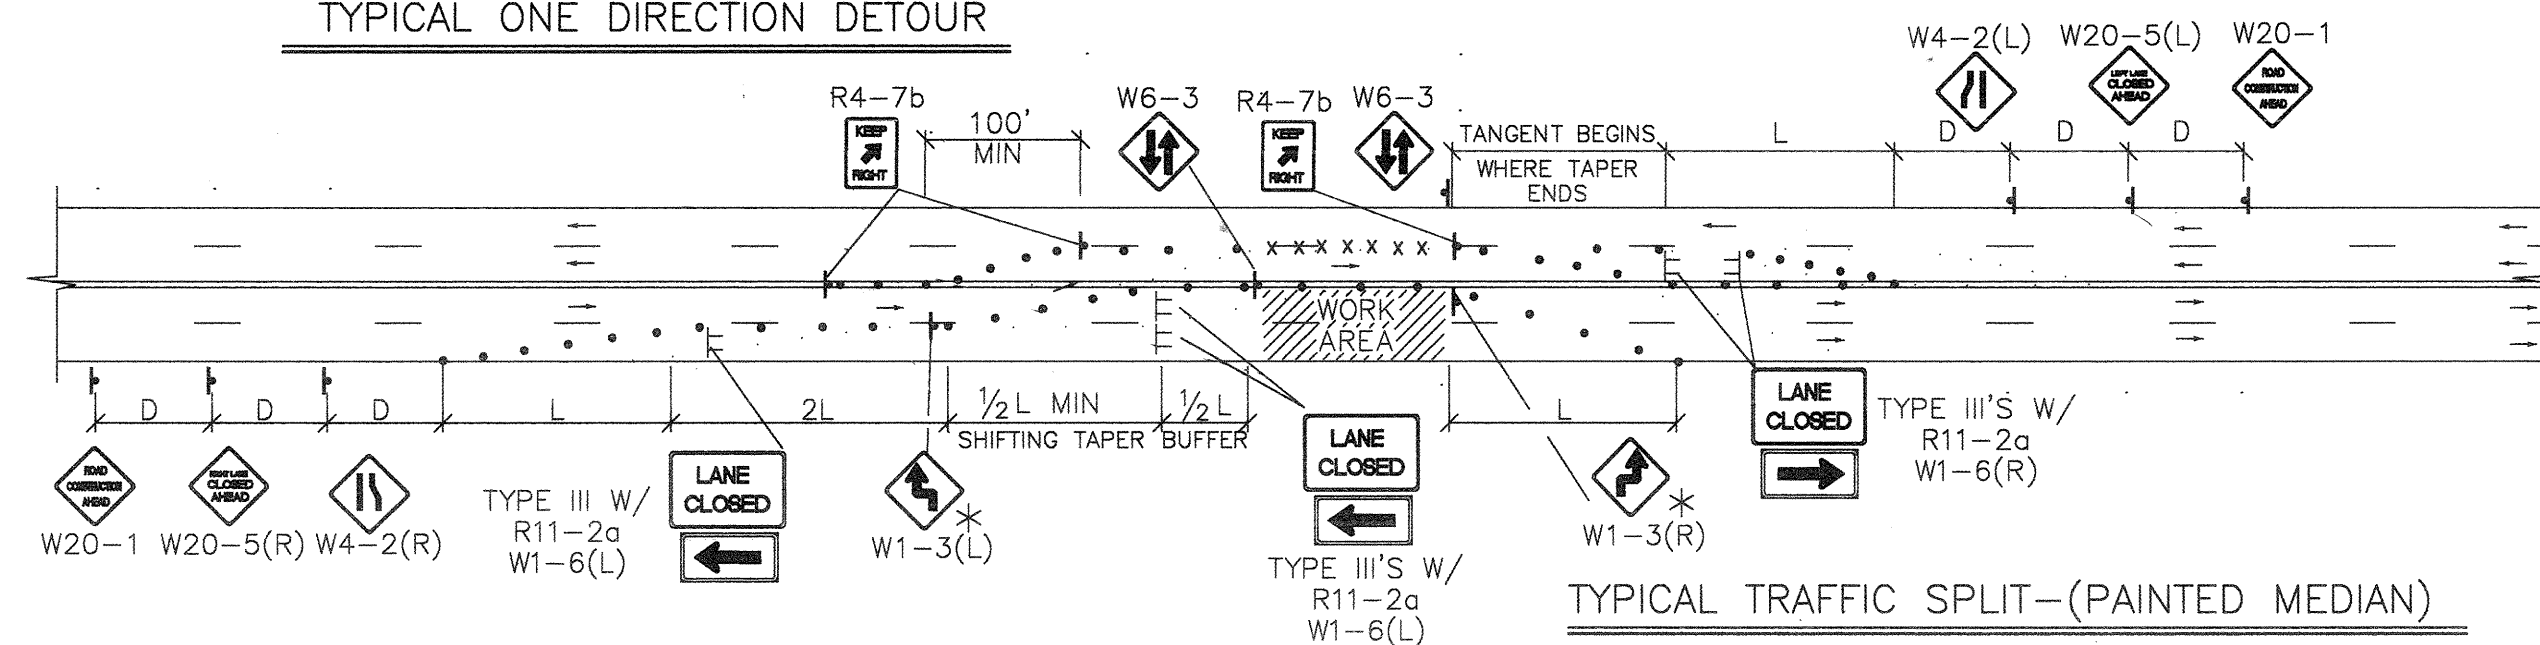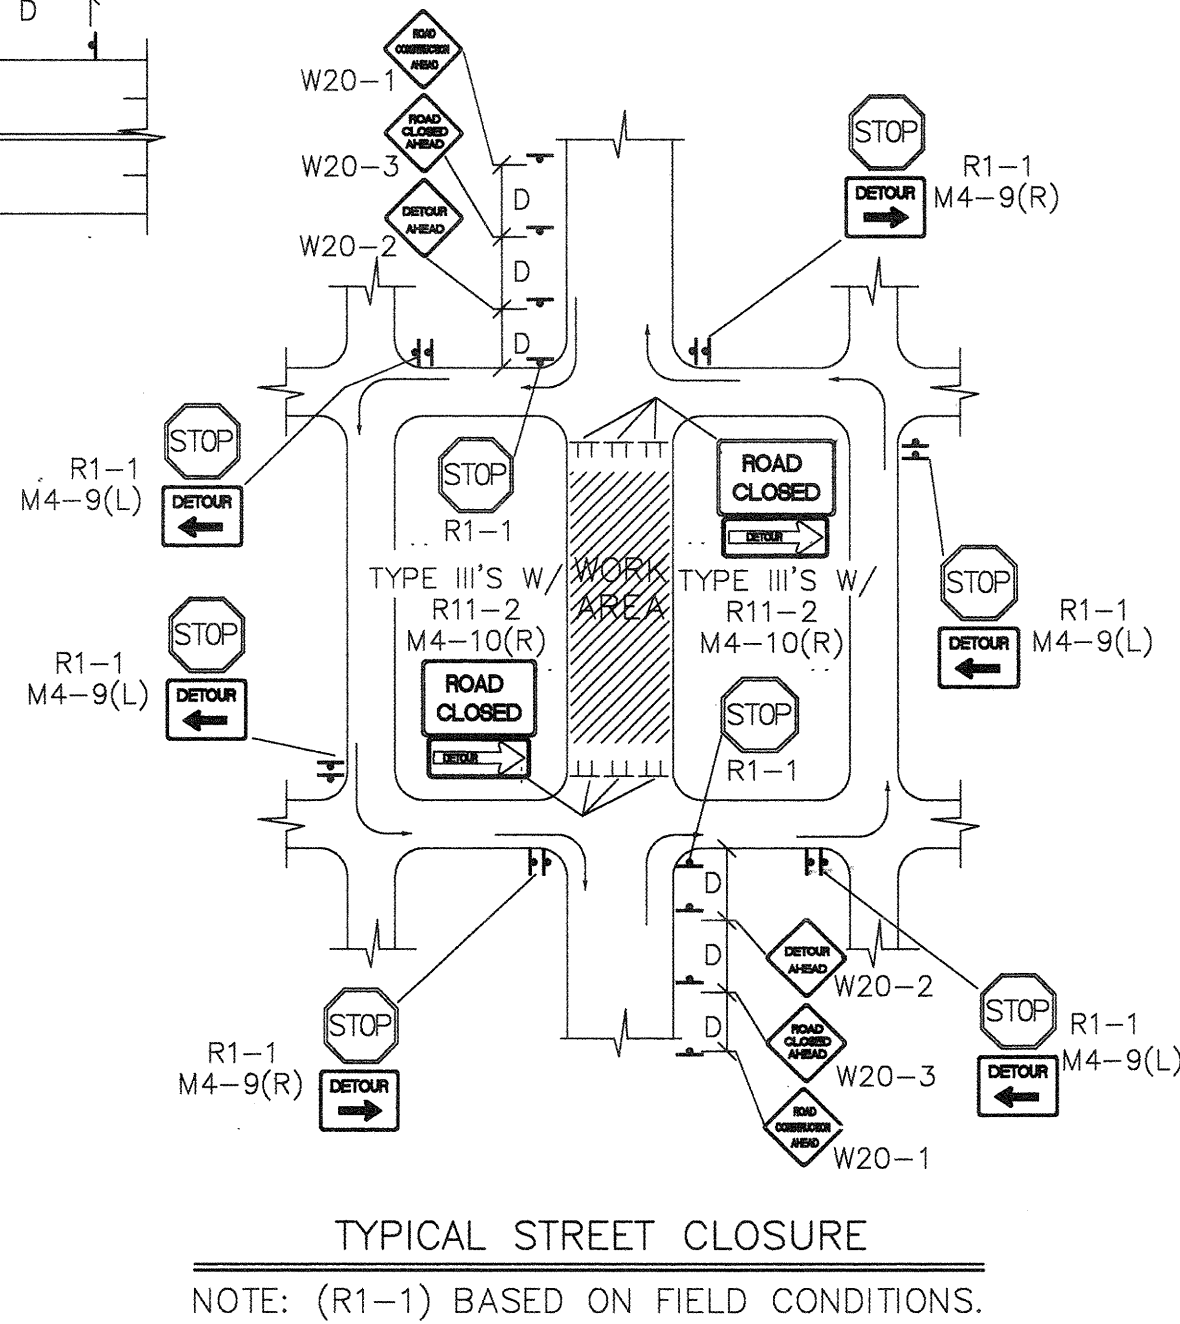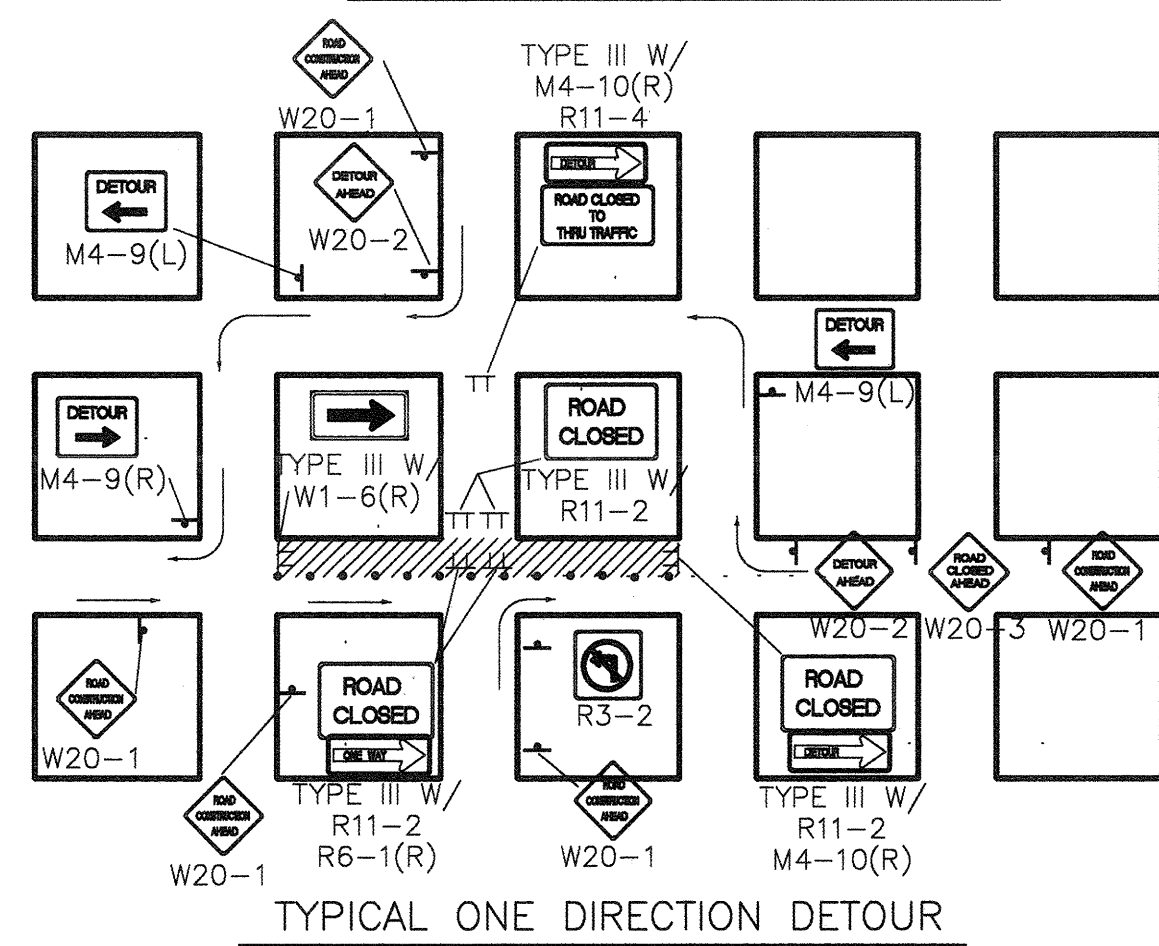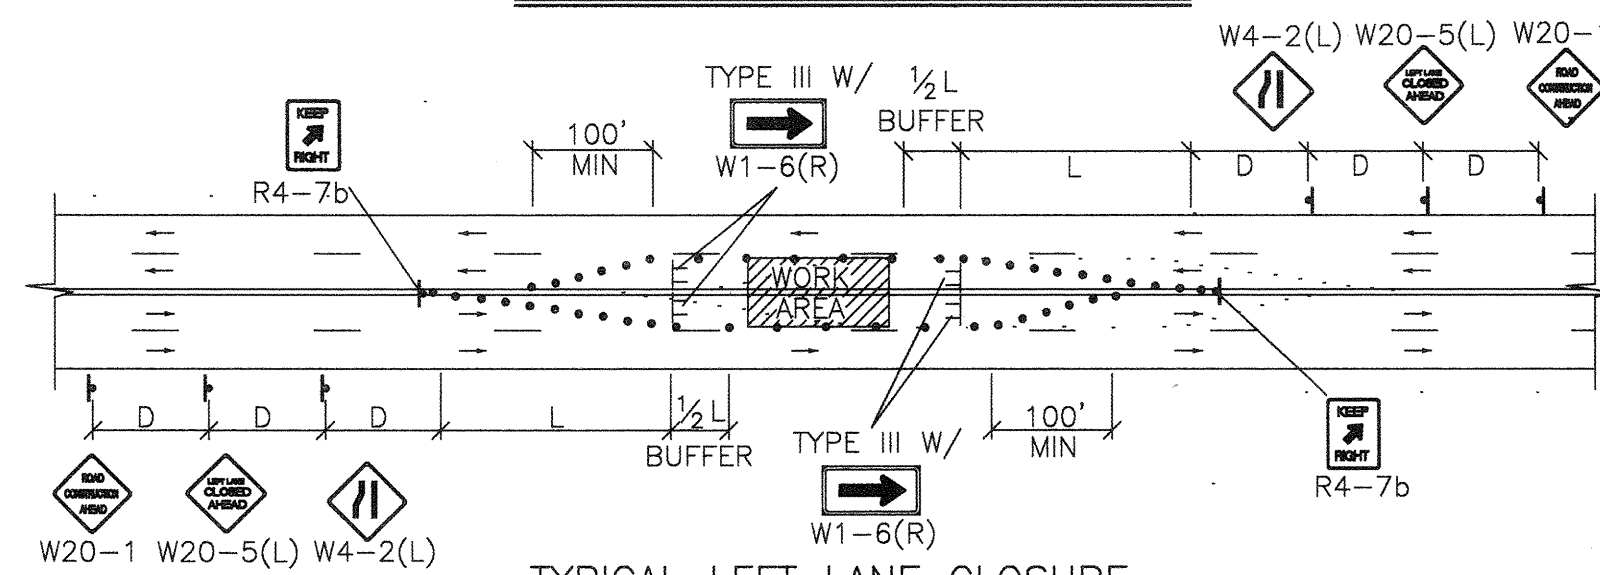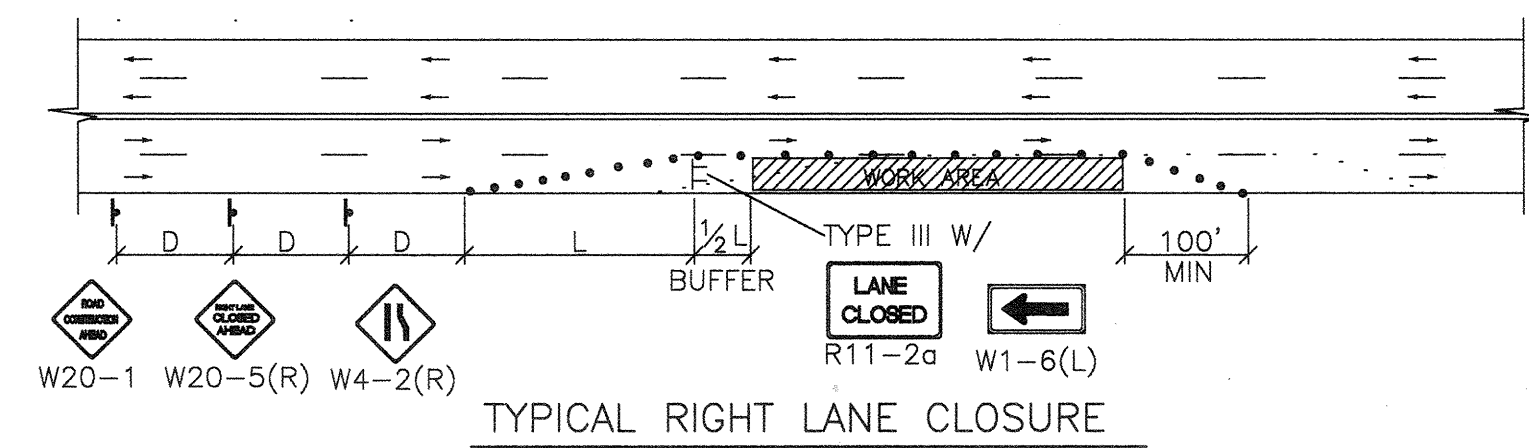

- TRAFFIC SPLIT NOTES:**
1. THE OFFSET DISTANCE MUST BE CALCULATED IN ALL SHIFTING TAPERS. THE OFFSET DISTANCES SHALL INCLUDE LANE WIDTHS PLUS MEDIAN WIDTHS.
 2. 1/2 L IS THE MINIMUM DISTANCE FOR SHIFTING TAPERS.
 3. REVERSE CURVES MAY BE IMPLEMENTED. ALL CURVE DATA SHALL BE CALCULATED.
 4. MEDIAN REMOVAL SHALL BE REQUIRED IF 1/2 L OR REVERSE CURVE IS NOT SUFFICIENT FOR MEDIAN REMOVAL. SHALL TAKE PLACE BEFORE SPLITS.
 5. REDUCED SPEED MAY BE CONSIDERED.
 6. * USE W1-3 FOR 30 MPH OR LESS, W1-4 FOR SPEED 35 MPH OR GREATER.

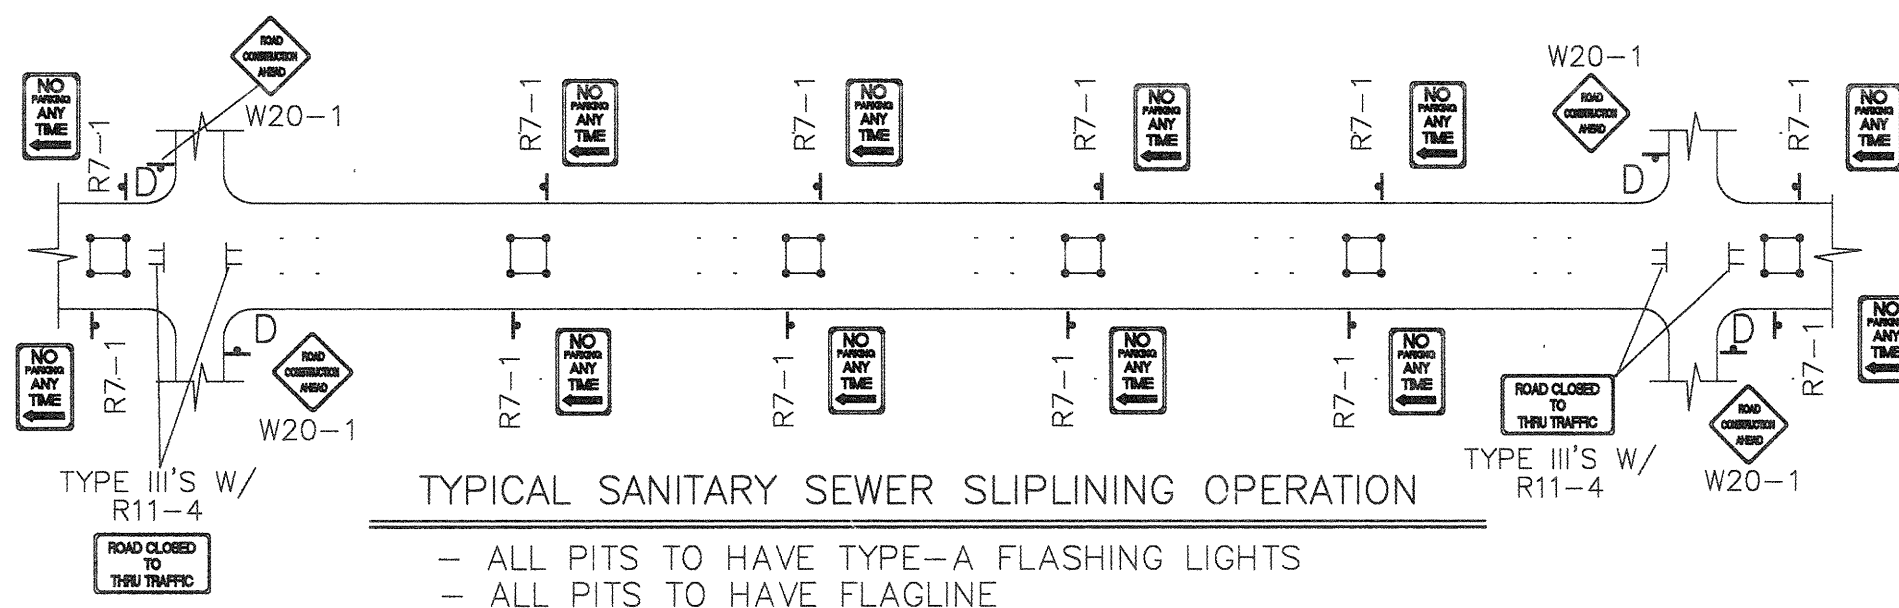


GENERAL NOTE:

ALL CONSTRUCTION WARNING
SIGNS SHALL HAVE A BLACK
LEGEND ON A ORANGE
BACKGROUND.


△ ALL ADVANCE WARNING SIGNS SHALL BE A MINIMUM OF 36" THIRTY SIX INCHES BY 36" THIRTY SIX INCHES IN SIZE AND SHALL HAVE ONE WARNING LIGHT.

NOTE:
MAY REQUIRE LEFT LANE
CLOSURE DEPENDING ON
FIELD CONDITIONS.

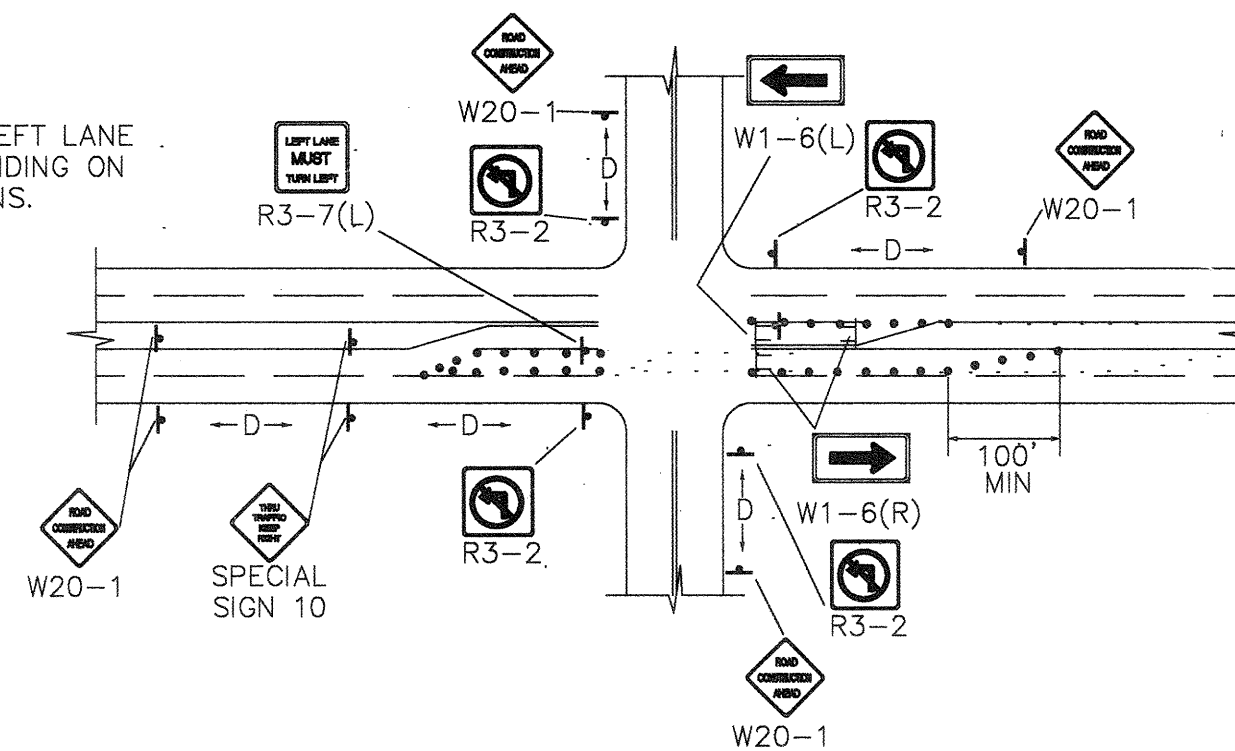


TYPICAL LANE CLOSURE AT INTERSECTION

NOTE: DEPENDING ON WORK ZONE LOCATION.

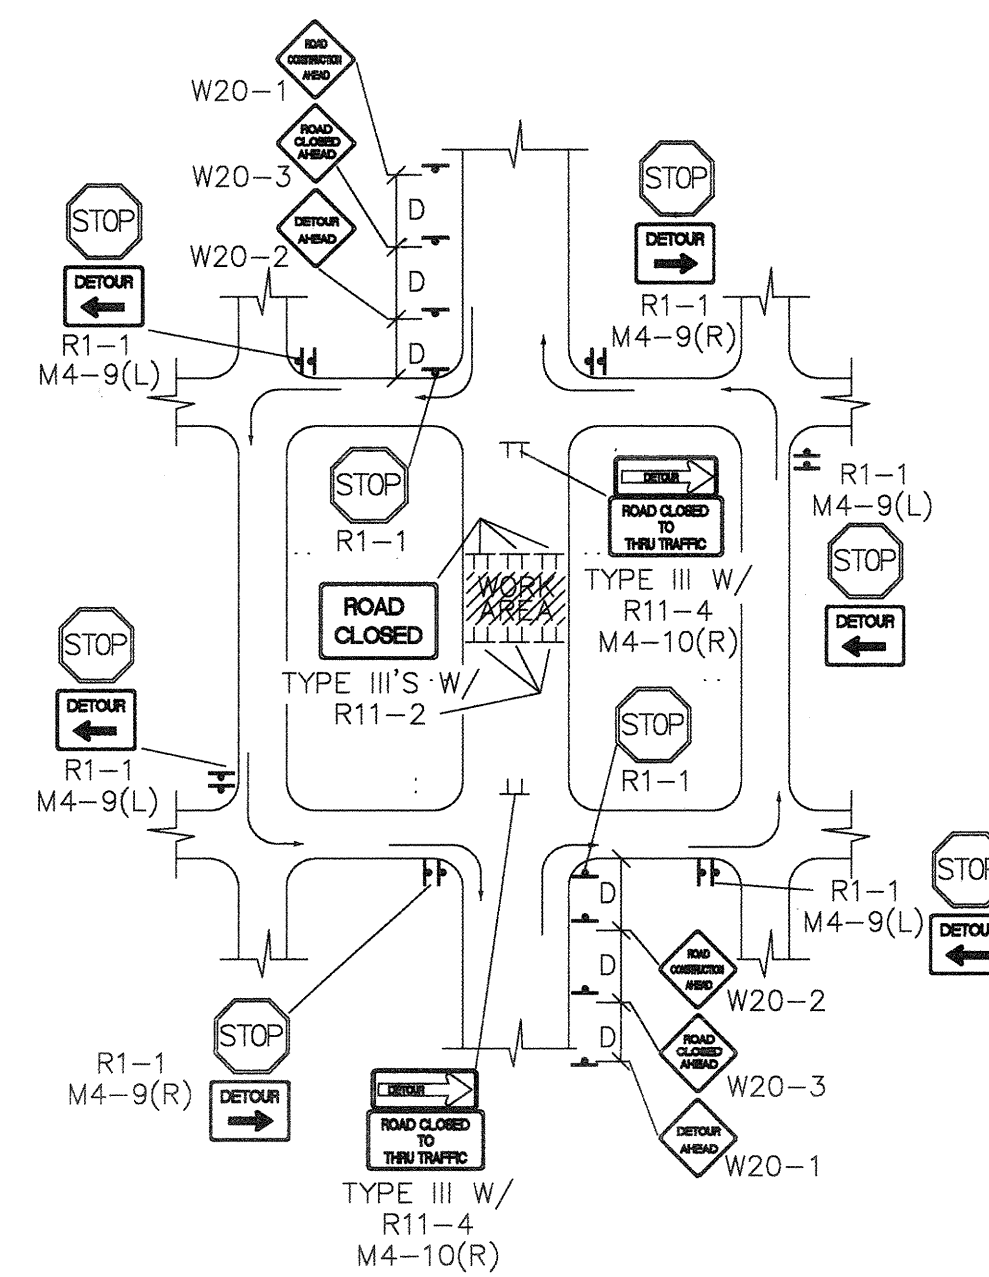





TYPICAL MID-BLOCK CLOSURE

NOTE: (R1-1) BASED ON FIELD CONDITIONS.

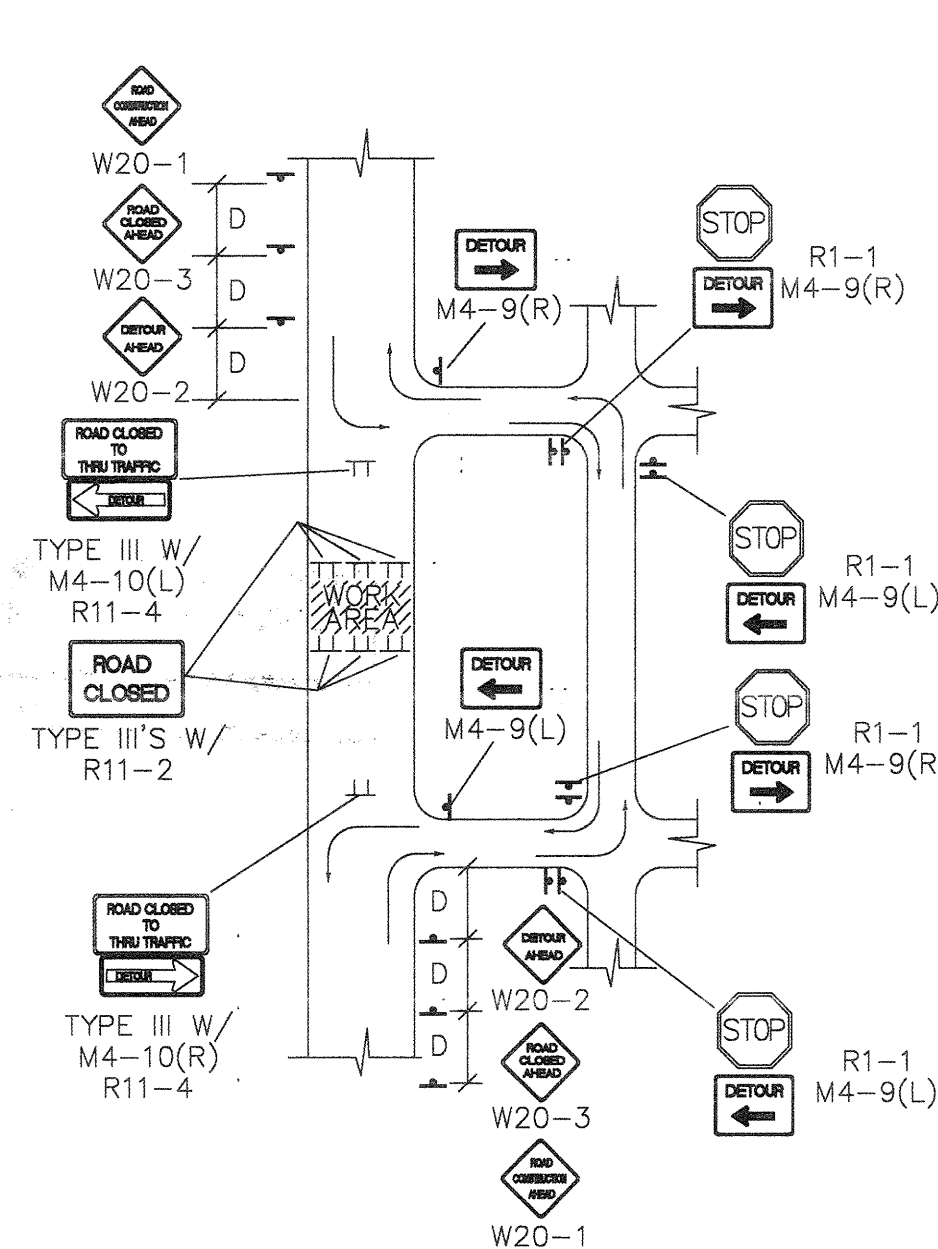

TYPICAL STREET CLOSURE

NOTE: (R1-1) BASED ON FIELD CONDITIONS.

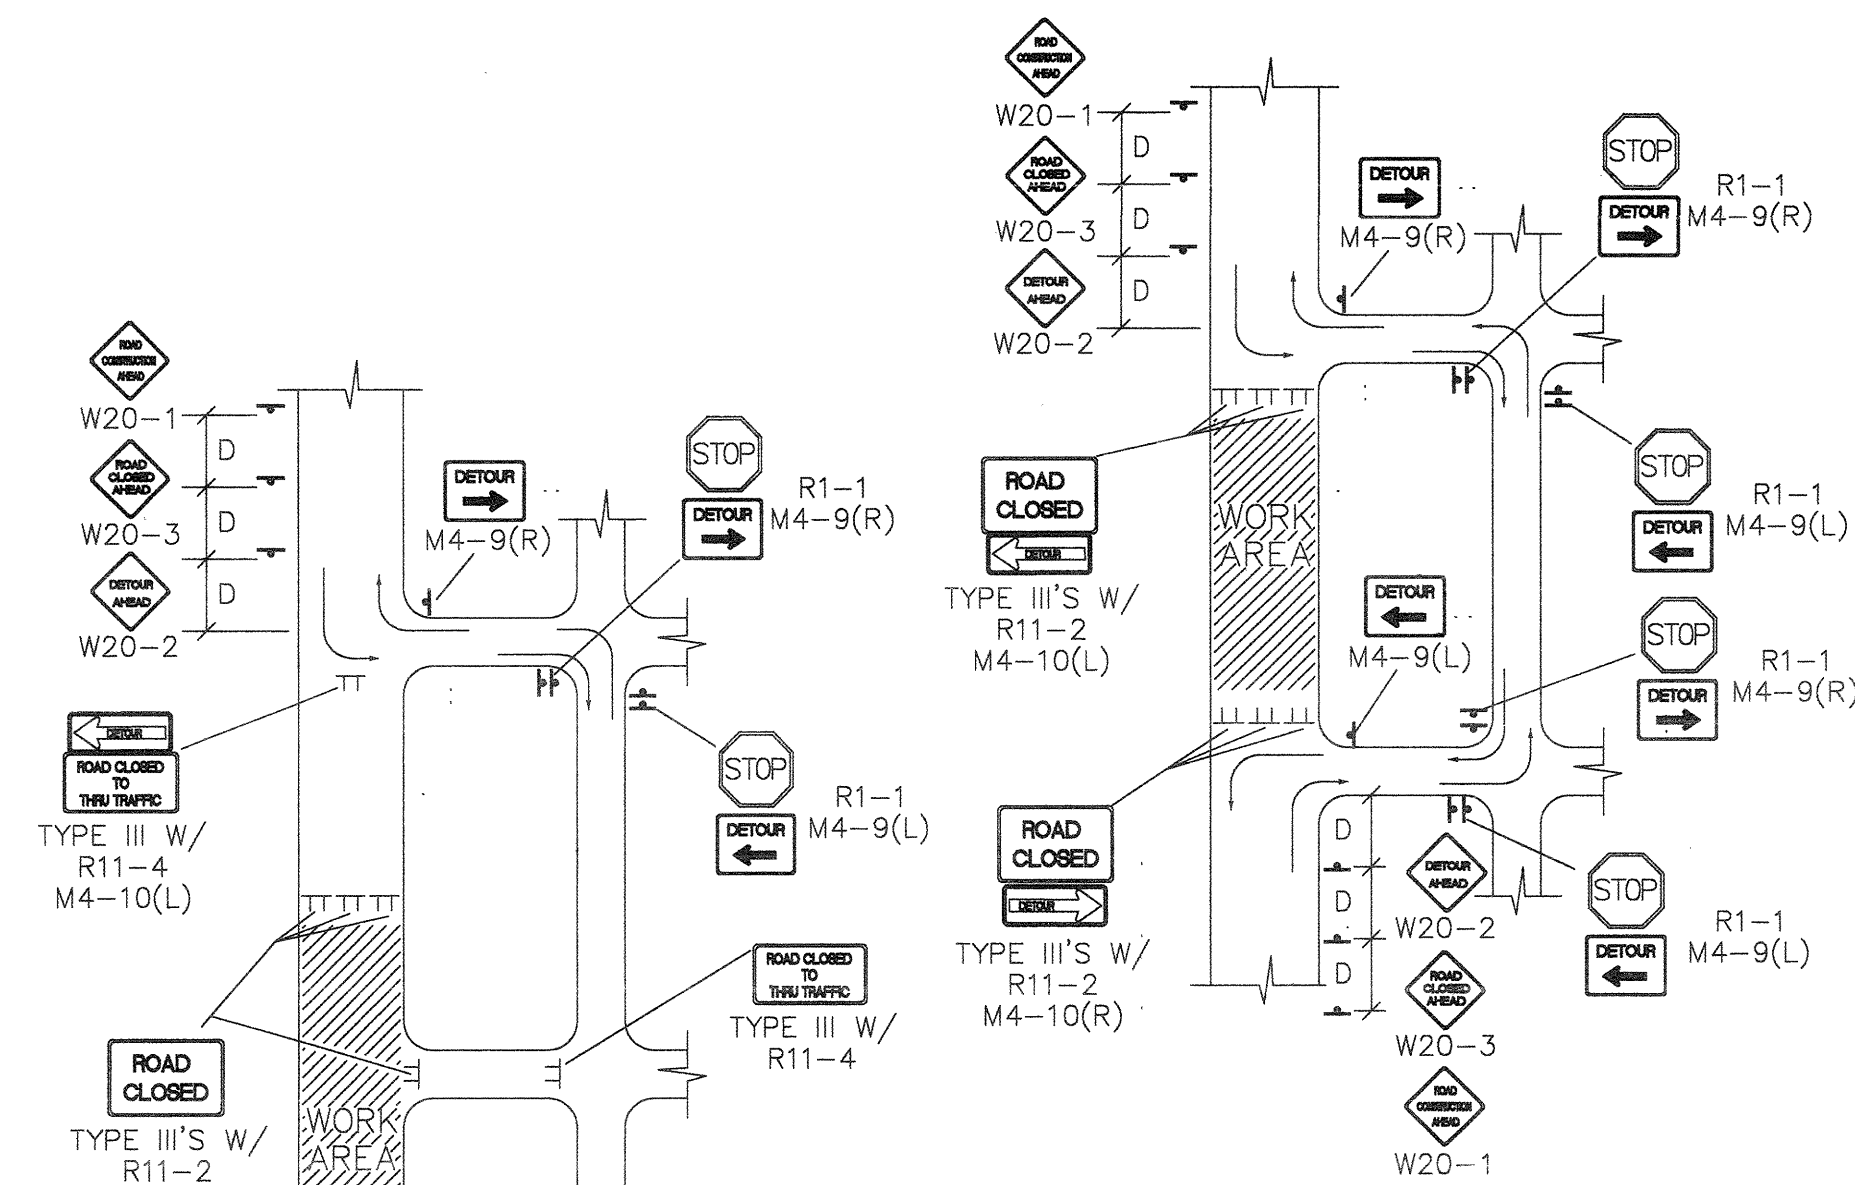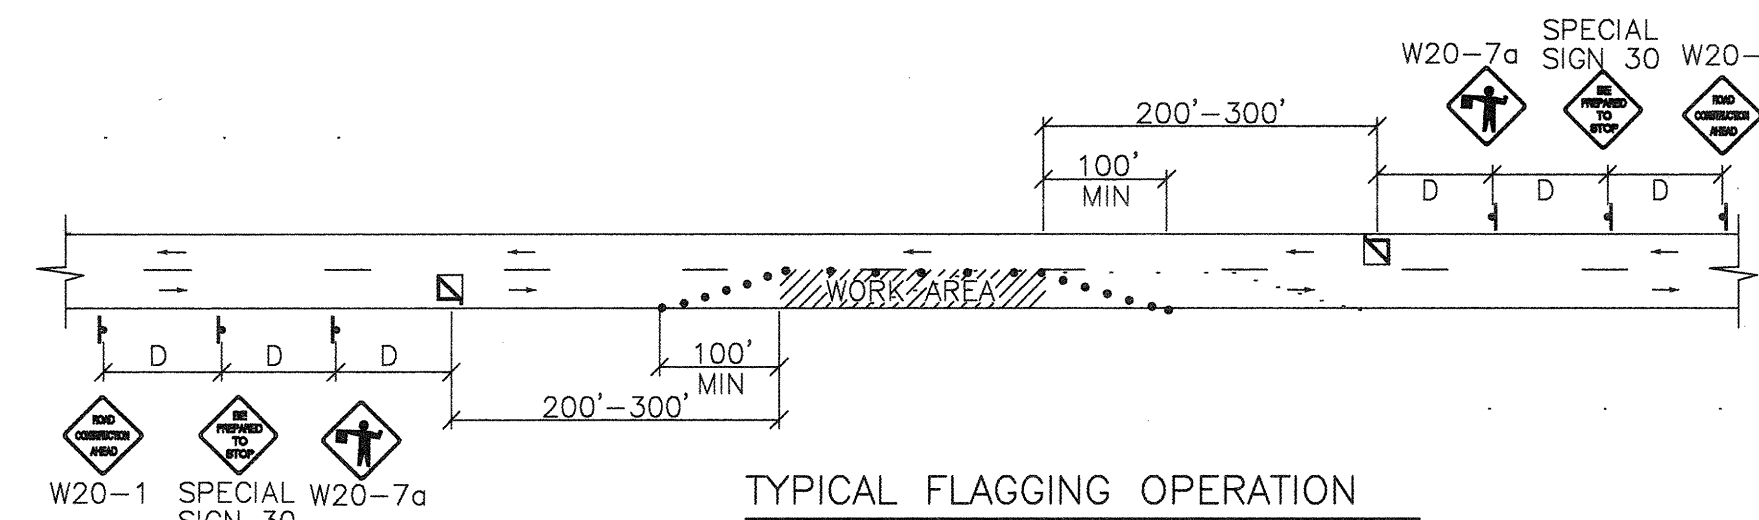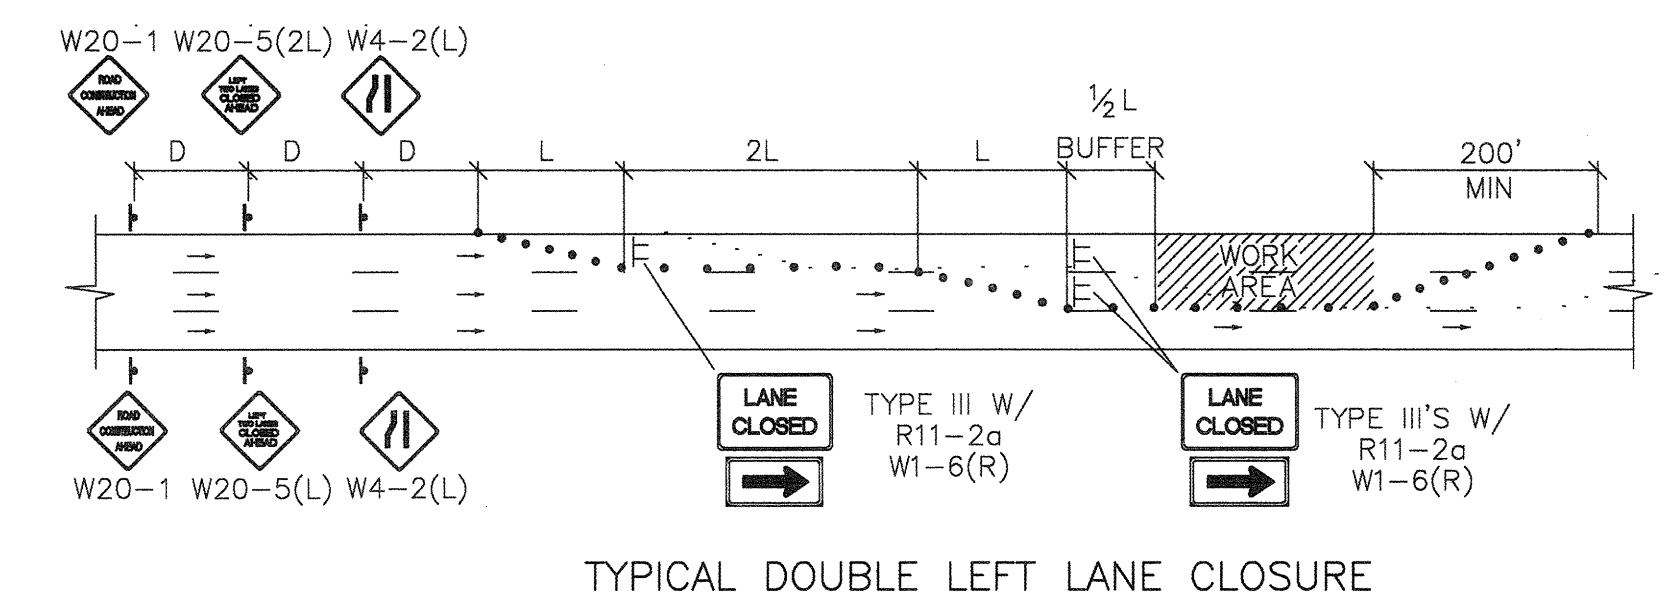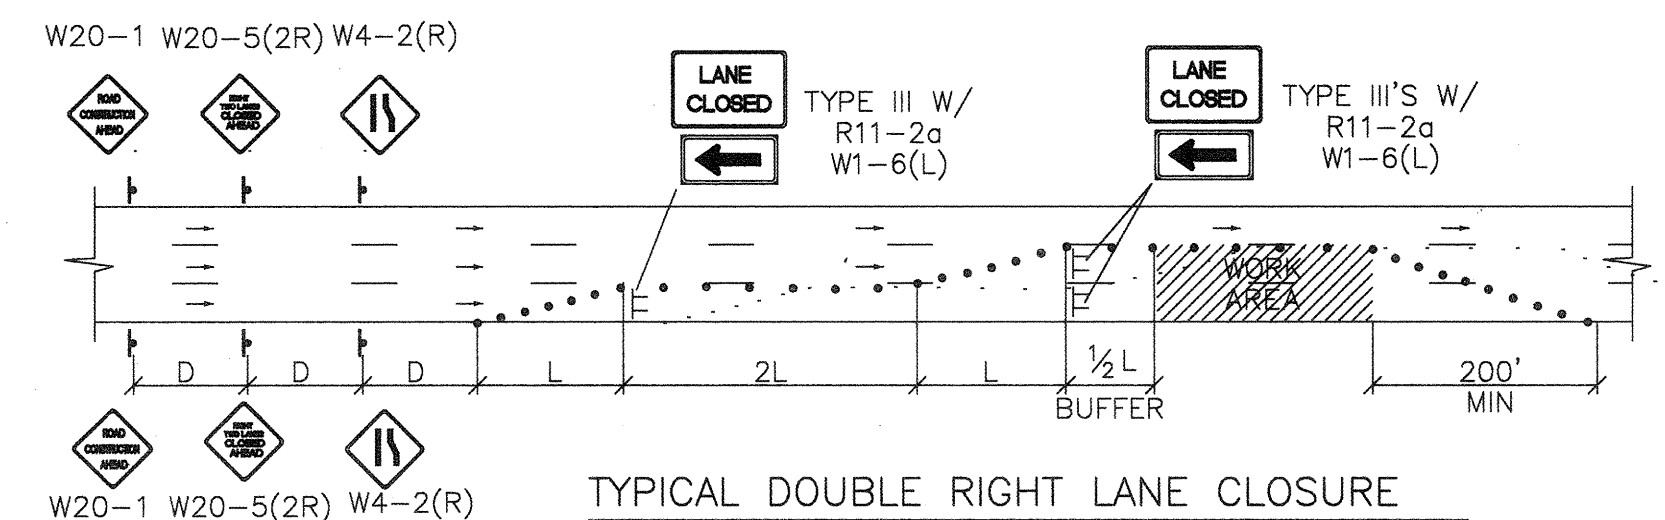

TYPICAL STREET CLOSURE

NOTE: (R1-1) BASED ON FIELD CONDITIONS.

 CITY OF ALBUQUERQUE PUBLIC WORKS DEPARTMENT ENGINEERING DEVELOPMENT GROUP			
TITLE: TYPICAL TRAFFIC CONTROL & SIGNING EXAMPLES (REF MUTCD)			
DESIGN REVIEW COMMITTEE 	CITY ENGINEER APPROVAL 	LAST DESIGN UPDATE	MO./DAY/YR.
			MO./DAY/YR.
			MO./DAY/YR.
			MO./DAY/YR.
			MO./DAY/YR.
CITY PROJECT NO. 648281	ZONE MAP NO. L-9-Z	SHEET 15	OF 15