


CONSTRUCTION PLANS
FOR
SUNDORO SUBDIVISION
UNIT 2
(PROPERTY OF WESTLAND NORTH)
ALBUQUERQUE, NEW MEXICO

INDEX

SHEET NUMBER	DESCRIPTION
	TITLE SHEET
2A-2B	PLAT
3A-3F	FINAL GRADING PLAN
4	OVERALL PAVING PLAN
	PAVING AND STORM DRAIN PLAN & PROFILE SHEETS
5	SUNDORO PLACE STA. 9+50.00 TO STA. 20+29.95
6	SUNDORO PLACE STA. 20+29.95 TO STA. 30+00.00
7	KANAGA DRIVE AND SUNDORO STREET
8	TALANG STREET
9	OVERALL UTILITY PLAN
	UTILITY PLAN AND PROFILE SHEETS
10	SUNDORO PLACE STA. 9+50.00 TO STA. 20+29.95
11	SUNDORO PLACE STA. 20+29.95 TO STA. 30+00.00
12	KANAGA DRIVE AND TRACT E EASEMENT
13	TALANG STREET

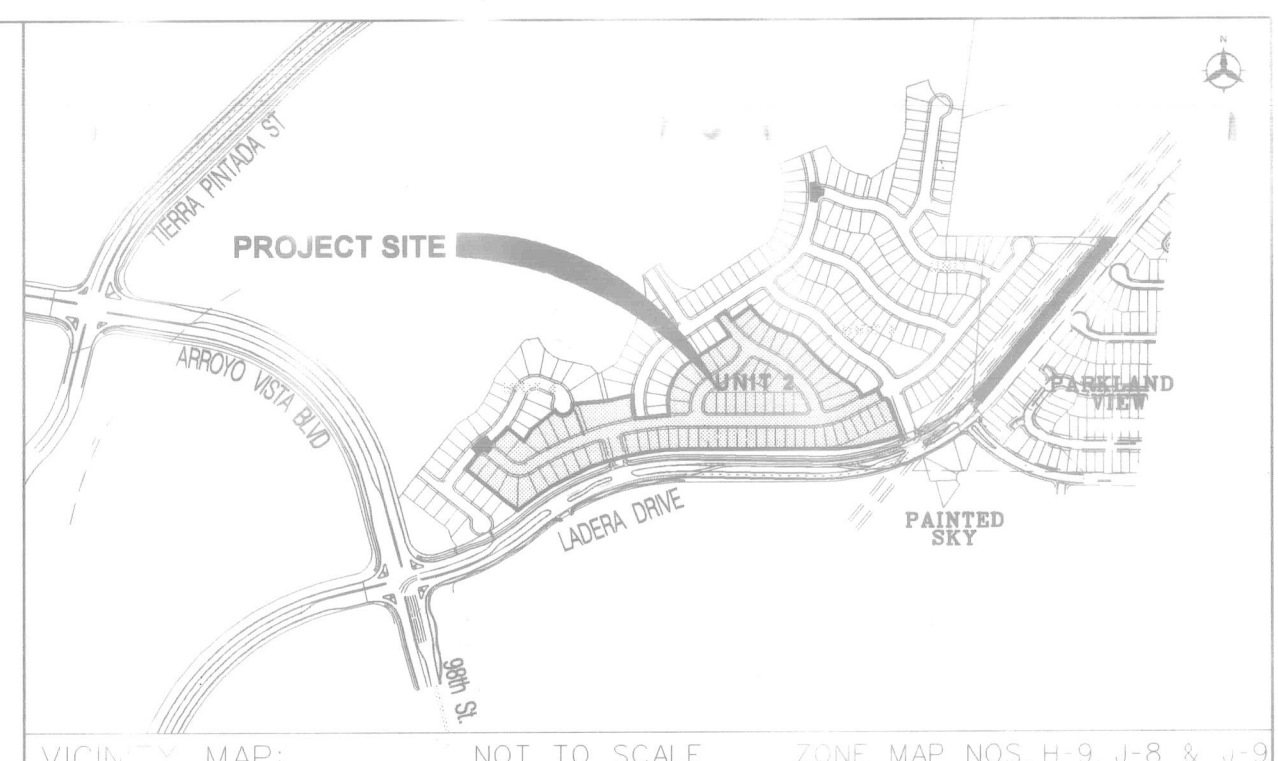

- NOTICE TO CONTRACTORS**
- AN EXCAVATION/CONSTRUCTION PERMIT WILL BE REQUIRED BEFORE BEGINNING ANY WORK WITHIN THE CITY RIGHT-OF-WAY.
 - ALL WORK DETAILED ON THESE PLANS TO BE PERFORMED UNDER CONTRACT SHALL EXCEPT AS OTHERWISE STATED OR PROVIDED HEREON, BE CONSTRUCTED IN ACCORDANCE WITH THE CITY OF ALBUQUERQUE STANDARD SPECIFICATIONS FOR PUBLIC WORKS CONSTRUCTION, 1986 EDITION AS REVISED THROUGH UPDATE No. 7.
 - TWO WORKING DAYS PRIOR TO ANY EXCAVATION, THE CONTRACTOR MUST CONTACT NEW MEXICO ONE CALL SYSTEM (260-1990) FOR LOCATION OF EXISTING UTILITIES.
 - PRIOR TO CONSTRUCTION, THE CONTRACTOR SHALL EXCAVATE AND VERIFY THE HORIZONTAL AND VERTICAL LOCATIONS OF ALL OBSTRUCTIONS. SHOULD A CONFLICT EXIST, THE CONTRACTOR SHALL NOTIFY THE ENGINEER OR SURVEYOR IMMEDIATELY SO THAT THE CONFLICT CAN BE RESOLVED WITH A MINIMUM AMOUNT OF DELAY.
 - FIVE (5) WORKING DAYS PRIOR TO BEGINNING CONSTRUCTION, THE CONTRACTOR SHALL SUBMIT TO CONSTRUCTION COORDINATION DIVISION A DETAILED CONSTRUCTION SCHEDULE TWO (2) WORKING DAYS PRIOR TO CONSTRUCTION. THE CONTRACTOR SHALL OBTAIN A BARRICADING PERMIT FROM THE CONST. COORDINATION DIVISION. CONTRACTOR SHALL NOTIFY CONSTRUCTION COORDINATION ENGINEER (924-3400) PRIOR TO OCCUPYING AN INTERSECTION. REFER TO SECTION 9 OF THE GENERAL CONDITIONS OF THE STANDARD SPECIFICATIONS.
 - ALL WORK EFFECTING ARTERIAL ROADWAYS REQUIRES TWENTY-FOUR HOUR CONSTRUCTION.
 - ALL STREET STRIPING ALTERED OR DESTROYED SHALL BE REPLACED W/ PLASTIC REFLECTORIZED PAVEMENT MARKING BY CONTRACTOR TO THE SAME LOCATION AS EXISTING OR AS INDICATED BY THIS PLAN SET.
 - CONTRACTOR SHALL NOTIFY THE ENGINEER NOT LESS THAN SEVEN (7) DAYS PRIOR TO STARTING WORK IN ORDER THAT THE CITY SURVEYOR MAY TAKE NECESSARY MEASURES TO INSURE THE PRESERVATION OF SURVEY MONUMENTS. CONTRACTOR SHALL NOT DISTURB PERMANENT SURVEY MONUMENTS WITHOUT THE CONSENT OF THE CITY SURVEYOR AND SHALL NOTIFY THE CITY SURVEYOR AND BEAR THE EXPENSE OF REPLACING ANY THAT MAY BE DISTURBED WITHOUT PERMISSION. REPLACEMENT SHALL BE DONE ONLY BY THE CITY SURVEYOR. WHEN A CHANGE IS MADE IN THE FINISHED ELEVATIONS OF THE PAVEMENT OF ANY ROADWAY IN WHICH A PERMANENT SURVEY MONUMENT IS LOCATED, CONTRACTOR SHALL, AT HIS OWN EXPENSE, ADJUST THE MONUMENT COVER TO THE NEW GRADE UNLESS OTHERWISE SPECIFIED. REFER TO SECTION 4.4 OF THE GENERAL CONDITIONS OF THE STANDARD SPECIFICATIONS.
 - CONTRACTOR SHALL RECORD DATA ON ALL UTILITY LINES AND ACCESSORIES AS REQUIRED BY THE CITY OF ALBUQUERQUE FOR THE PREPARATION OF "AS CONSTRUCTED" DRAWING. CONTRACTOR SHALL NOT COVER UTILITY LINES AND ACCESSORIES UNTIL ALL DATA HAS BEEN RECORDED.
 - CONTRACTOR SHALL MAINTAIN A GRAFFITI-FREE WORK SITE. CONTRACTOR SHALL PROMPTLY REMOVE ANY GRAFFITI FROM ALL EQUIPMENT, WHETHER PERMANENT OR TEMPORARY.
 - CONTRACTOR SHALL COORDINATE WITH THE CITY OF ALBUQUERQUE WATER SYSTEMS DIVISION (857-8200) SEVEN WORKING DAYS IN ADVANCE OF ANY WORK THAT MAY AFFECT EXISTING PUBLIC WATER OR SEWER UTILITIES. EXISTING VALVES TO BE OPERATED BY CITY PERSONNEL ONLY. CONTRACTOR SHALL NOTIFY THE WATER SYSTEMS DIVISION SEVEN (7) DAYS PRIOR TO NEEDING VALVES TURNED ON OR OFF.
- THE FOLLOWING NOTES ALSO APPLY WHEN CHECKED**
- ☒ ALL UTILITIES AND UTILITY SERVICE LINES SHALL BE INSTALLED PRIOR TO PAVING.
 - ☒ BACKFILL COMPACTION SHALL BE ACCORDING TO SPECIFIED STREET USE.
 - ☐ TACK COAT REQUIREMENTS SHALL BE DETERMINED BY THE ENGINEER.
 - ☒ SIDEWALKS AND WHEELCHAIR RAMPS WITHIN THE CURB RETURNS SHALL BE CONSTRUCTED WHEREVER A NEW CURB RETURN IS CONSTRUCTED.
 - ☐ IF CURB IS DEPRESSED FOR A DRIVEPAD, THE DRIVEPAD SHALL BE CONSTRUCTED PRIOR TO ACCEPTANCE OF CURB AND GUTTER.
 - ☒ ALL STORM DRAINAGE FACILITIES SHALL BE COMPLETED PRIOR TO FINAL ACCEPTANCE.
 - ☒ THE REQUESTOR OR DEVELOPER SHALL BE RESPONSIBLE FOR REPAIR OR REPLACEMENT OF ALL CURB AND GUTTER OR SIDEWALK DAMAGED AFTER APPROVAL BY THE CITY ENGINEER OF WORK COMPLETED BY THE CONTRACTOR.

RECORD DRAWINGS

I, PATRICK J. CONLEY of the firm of SMITH ENGINEERING CO.
A Registered Professional Engineer in the State of New Mexico, do hereby certify, to the best of my knowledge and belief, that the infrastructure installed as part of this project has been inspected by me or by a qualified person under my direct supervision and has been constructed in accordance with the plans and specifications, while someone from Smith Engineering Company was onsite, approved by the City Engineer and that the original design intent of the approved plans has been met, except as noted by me on the as-built construction drawings. This Certification is based on site inspections by me or personnel under my direction and survey information provided by LARRY W. MEDRANO (Surveyor Name) NMPS number 11993 (PS #).

Engineers Seal & Signature

1 2 3 4 5 6 7 8 9 10 11 12 13 14 15
26 6502.84 05

AS BUILT CERTIFICATION

I, LARRY W. MEDRANO, DO HEREBY ATTEST TO THE FACT THAT THE AS-BUILT INFORMATION SHOWN HEREON IS THE RESULT OF A FIELD SURVEY PERFORMED BY ME OR UNDER MY DIRECT SUPERVISION, AND THAT THE SAME ARE TRUE AND CORRECT TO THE BEST OF MY KNOWLEDGE AND BELIEF.

LARRY W. MEDRANO
NEW MEXICO PROFESSIONAL
LAND SURVEYOR NO. 11993
DATE: 12/3/04

PRECISION SURVEYS, INC.
8414-D JEFFERSON STREET, N.E.
ALBUQUERQUE, NM 87113
(505)856-5700

Bohannon & Huston
Courtyard I 7500 Jefferson St. NE Albuquerque, NM 87109-4335
ENGINEERING • SPATIAL DATA • ADVANCED TECHNOLOGIES

APPROVED AS RECORD DRAWINGS
DESIGN REVIEW SECTION
CITY ENGINEER
DATE: 10/18/04

REV.	SHEETS	CITY ENGINEER	DATE	USER DEPARTMENT	DATE	USER DEPARTMENT	DATE
ENGINEERS STAMP & SIGNATURE	APPROVALS	ENGINEER	DATE	*****			
	DRC Chairman Transportation Water/Wastewater Hydrology CIP Const. Mngmt. Const. Coord. AMAFCA	 	3-11-04 1/12/04 1/14/04 1/12/04 3-11-04	APPROVED FOR CONSTRUCTION		4-26-04	Date
DRB Case Number 1002935	City Project No. 650284	Sheet 1	Of 13				

GENERAL NOTES

- EXISTING ZONING FOR: SU-2/R-LT
EXISTING ZONING FOR: R-D
PROPOSED ZONING: R-D W/USES PERMISSIVE IN R-T
PROPOSED RESIDENTIAL DEVELOPMENT:
SINGLE FAMILY DETACHED RESIDENTIAL
- TOTAL ACREAGE:
EXISTING PARCEL I = 218.85 ACRES
EXISTING TRACT A
PARKWAY SUBDIVISION = 5.79 ACRES
TOTAL AREA = 224.60 ACRES
TRACT I-1
SUNDORO SUBDIVISION = 164.60 ACRES
PUBLIC R-O-W LADERA DR. = 1.04 ACRES
TOTAL AREA = 224.60 ACRES

GROSS ACREAGE:
UNIT 1 = 16.9346 ACRES
UNIT 2 = 15.7857 ACRES
UNIT 3 = 12.2247 ACRES
UNIT 4 = 14.0550 ACRES
TOTAL GROSS ACREAGE 59.0000 ACRES

NET ACREAGE:
UNIT 1 = 11.2176 ACRES
UNIT 2 = 10.5816 ACRES
UNIT 3 = 9.6380 ACRES
UNIT 4 = 9.2947 ACRES
TOTAL NET ACREAGE 40.7319 ACRES

NUMBER OF LOTS:
UNIT 1 = 73 LOTS
UNIT 2 = 80 LOTS
UNIT 3 = 70 LOTS
UNIT 4 = 60 LOTS
TOTAL NUMBER OF LOTS: 283

PROPOSED DENSITY: 4.79 D.U./ACRE

- MINIMUM DETACHED LOT DIMENSIONS 40' x 100.00'
MINIMUM DETACHED LOT AREA 4000 S.F.

- ALL STREETS, UTILITIES AND DRAINAGE IMPROVEMENTS ARE TO BE PUBLIC, TO BE DEDICATED FOR MAINTENANCE TO THE CITY OF ALBUQUERQUE.

- ALL LOTS SHOWN WITH "P1" DESIGNATION ON THIS PLAT SHALL CONFORM TO INTERMITTENT PARKING DESIGN CRITERIA, ITEM #1 ON TABLE 23.2.1.C OF THE DPM VOLUME 11.

- LOT SETBACKS SHALL CONFORM TO R-T ZONE REGULATIONS. REQUIRES SETBACKS SHALL INCLUDE:
FRONT YARD: 20' TYP. (15' W/20' TO GARAGE MIN.)
SIDE YARD: 5' MIN.
BACK YARD: 15' MIN.

- TRACTS A, B, C, D, E, F, G, AND H SHALL BE PRIVATELY OWNED AND MAINTAINED BY THE HOMEOWNER'S ASSOCIATION.

OWNER

LEROY CHAVEZ, VICE PRESIDENT OF DEVELOPMENT
WESTLAND DEVELOPMENT COMPANY INC.


SURVEY NOTES:

- UNLESS OTHERWISE NOTED, ALL BOUNDARY CORNERS SHOWN THUS (●) SHALL BE MARKED BY A #5 REBAR STAMPED "WEAVER LS 6544".
- ALL STREET CENTERLINE MONUMENTATION SHALL BE INSTALLED AT DESIGNATED CENTERLINE PC'S, PT'S, ANGLE POINTS AND STREET INTERSECTIONS AND SHOWN THUS (Δ) WILL BE MARKED BY A FOUR (4") ALUMINUM CAP STAMPED "CITY OF ALBUQUERQUE, CENTERLINE MONUMENTATION, DO NOT DISTURB, P.L.S. 6544".
- THE SUBDIVISION BOUNDARY WILL BE TIED TO THE NEW MEXICO STATE PLANE COORDINATE SYSTEM AS SHOWN.
- BASIS OF BEARINGS WILL BE NEW MEXICO STATE PLANE GRID BEARINGS.
- DISTANCES SHALL BE GROUND DISTANCES.
- MANHOLES WILL BE OFFSET AT ALL POINTS OF CURVATURE, POINTS OF TANGENCY, STREET INTERSECTIONS AND ALL OTHER ANGLE POINTS TO ALLOW THE USE OF CENTERLINE MONUMENTATION.

APPROVED

CITY SURVEYOR DATE 8-29-03



BOHANNAN HUSTON BRASS CAP STAMPED "BH-41"
GEOGRAPHIC POSITION (NAD 1927)
N.M. STATE PLANE COORDINATES (CENTRAL ZONE)
X=351,455.56 Y=1,496,546.13
GROUND TO GRID FACTOR = 0.99966704
DELTA ALPHA = -00°17'08"
NGVD 1929 ELEVATION = 5398.63

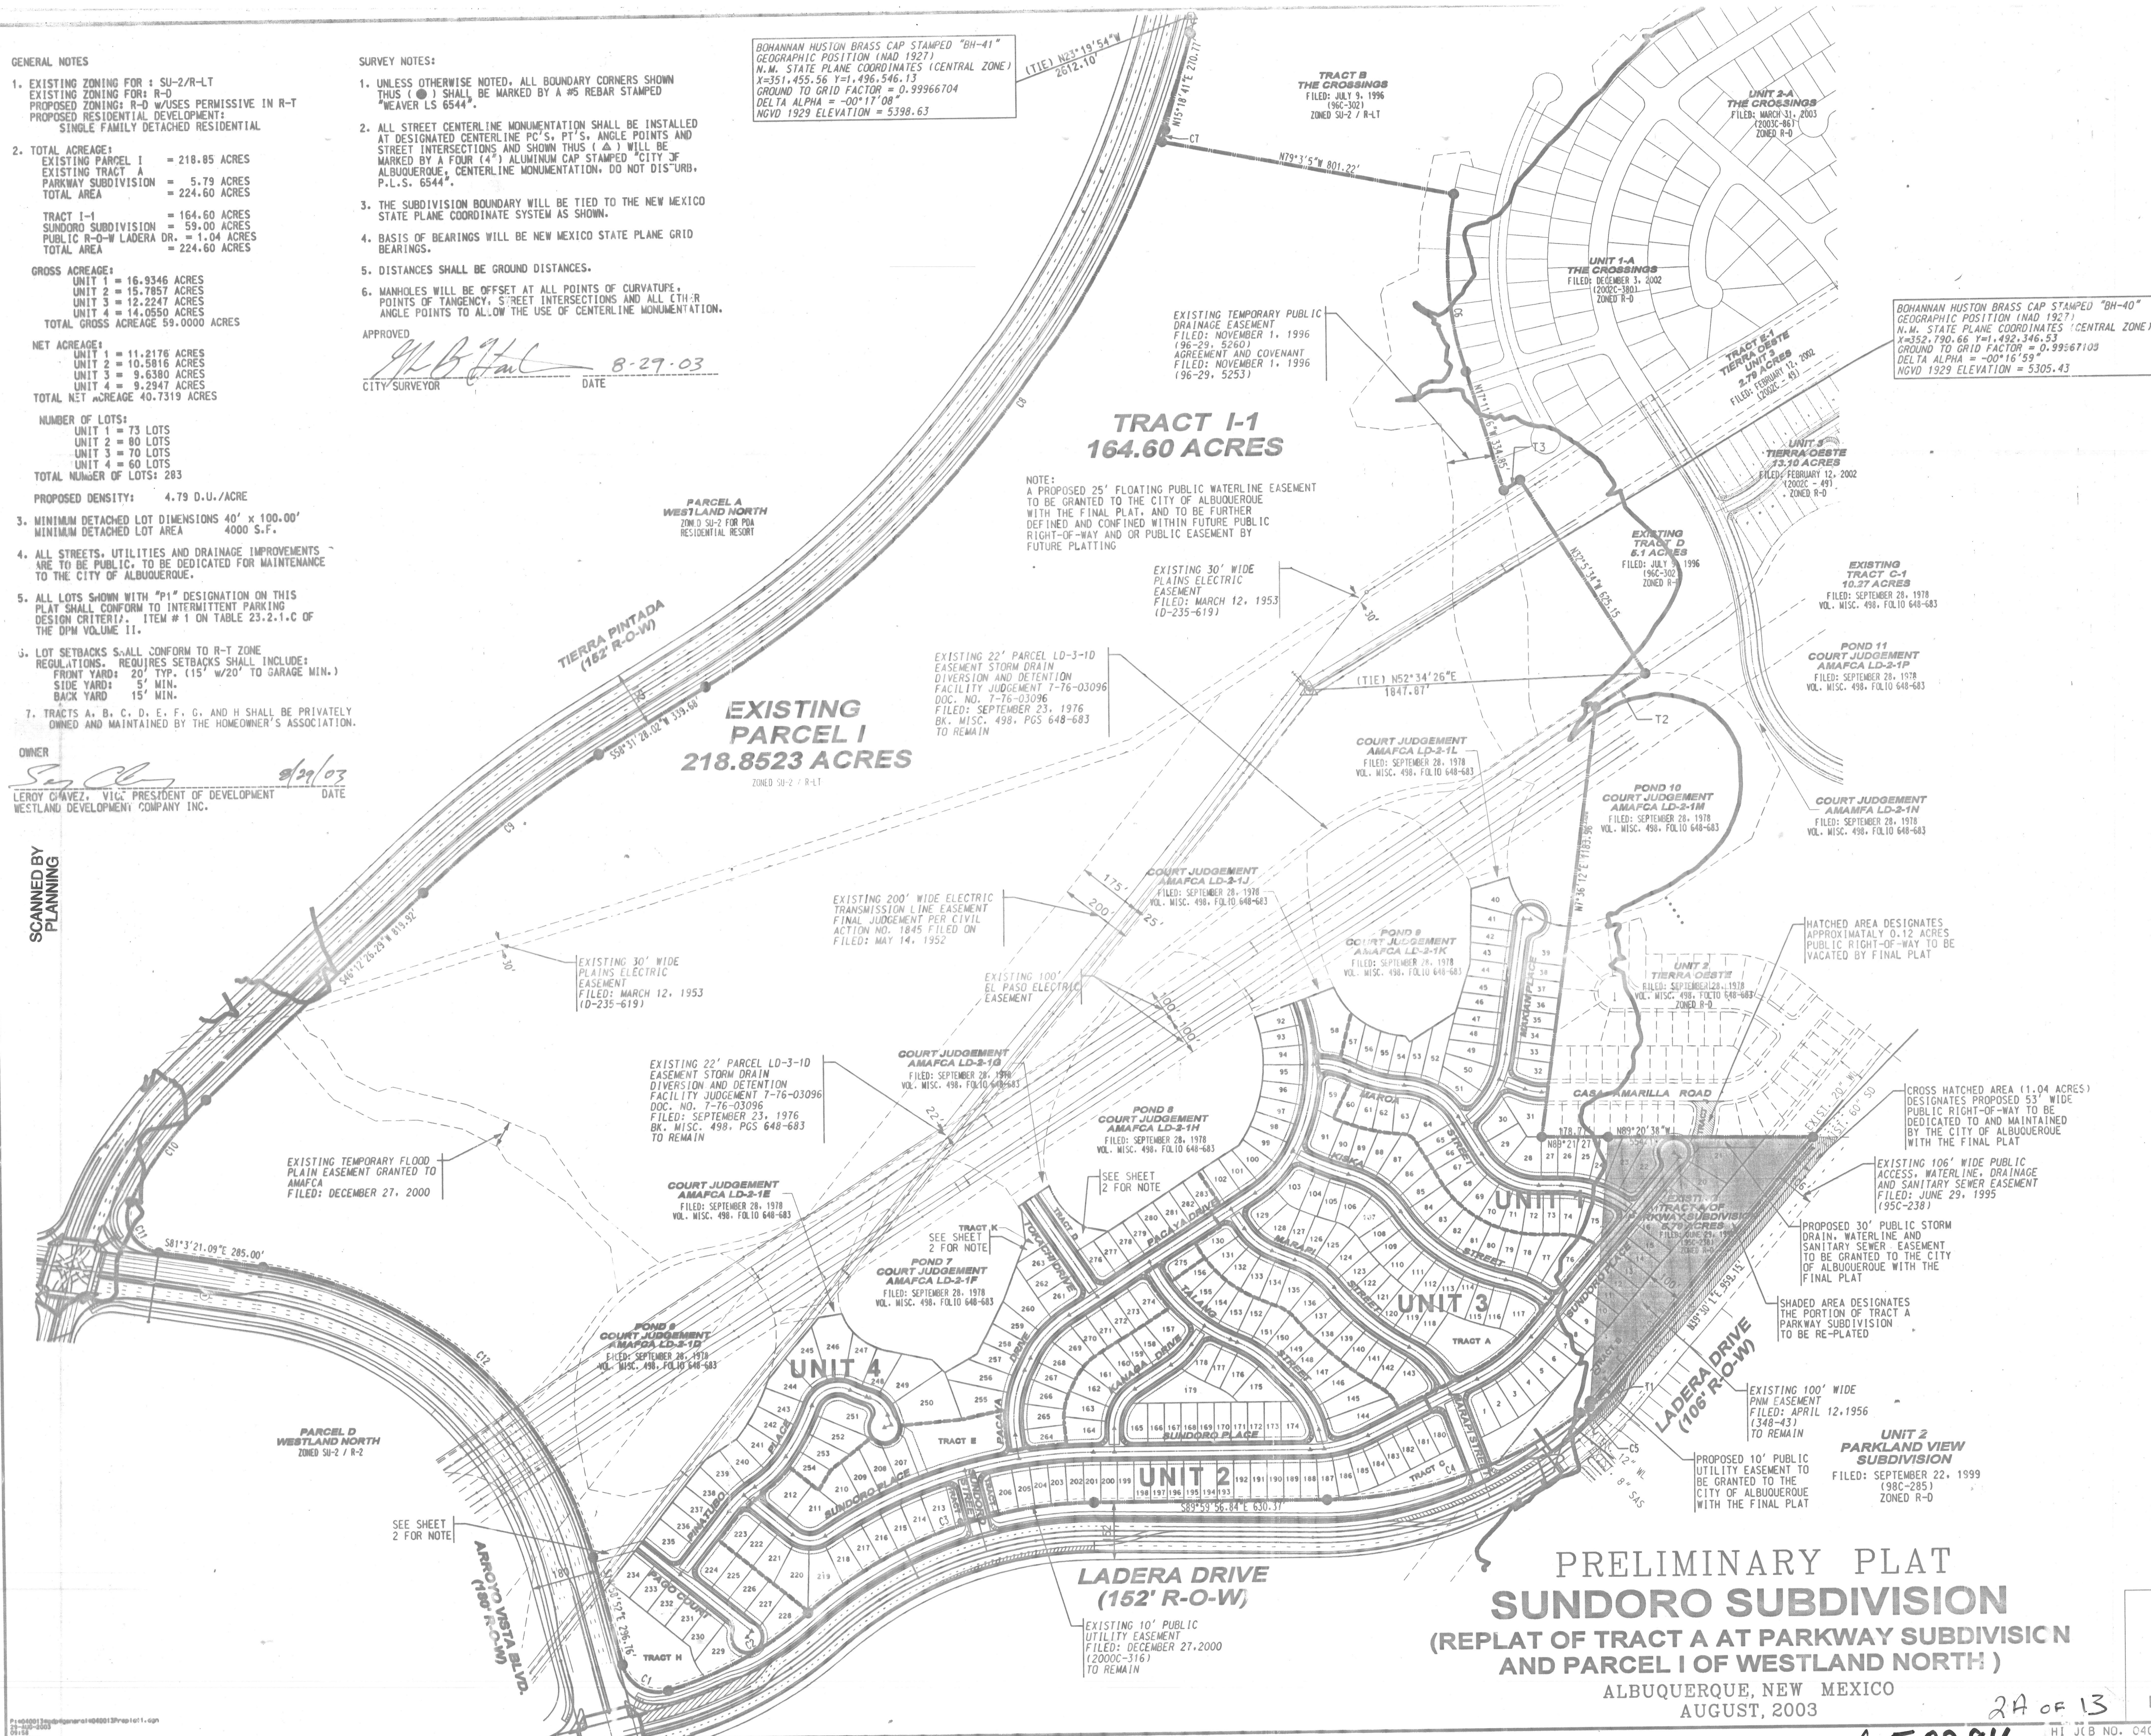

CURVE DATA				
No.	DELTA	TANGENT	ARC	RADIUS
C1	91°06'25"	101.96	159.01	100.00
C2	24°10'11"	219.24	431.97	1024.00
C3	40°16'30"	439.66	842.81	1200.00
C4	36°24'53"	379.70	733.98	1154.39
C5	23°55'02"	21.18	41.74	100.00
C6	28°08'06"	258.60	506.76	1032.00
C7	01°11'52"	16.80	33.61	1608.00
C8	43°20'43"	1192.19	2269.57	3000.00
C9	12°19'01"	303.42	604.50	2812.00
C10	19°47'16"	176.51	349.50	1012.00
C11	107°28'32"	136.32	187.58	100.00
C12	66°04'29"	708.87	1257.01	1090.00

TANGENT DATA		
No.	BEARING	DISTANCE
T1	S 04°17'13" W	15.06
T2	N 56°43'01" E	160.20
T3	S 57°54'25" W	52.40

LEGEND	
SUBDIVISION BOUNDARY LINE	---
PHASE BOUNDARY LINE	---
PROPOSED CURB AND GUTTER	---
EXISTING CURB AND GUTTER	---
PROPOSED STORM DRAIN MANHOLE	○
EXISTING STORM DRAIN MANHOLE	○
PROPOSED SANITARY SEWER MANHOLE	○
EXISTING SANITARY SEWER MANHOLE	○
EXISTING FIRE HYDRANT	○
EXISTING GATE VALVE	○
GUY WIRE	---
EXISTING ELECTRIC LINE	---
POWER POLE	○

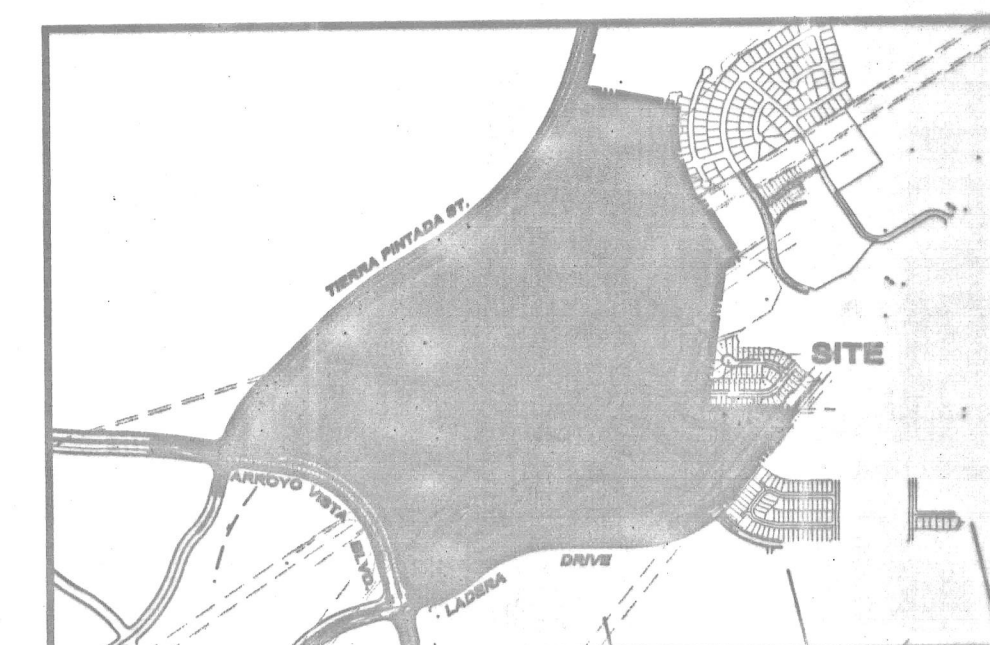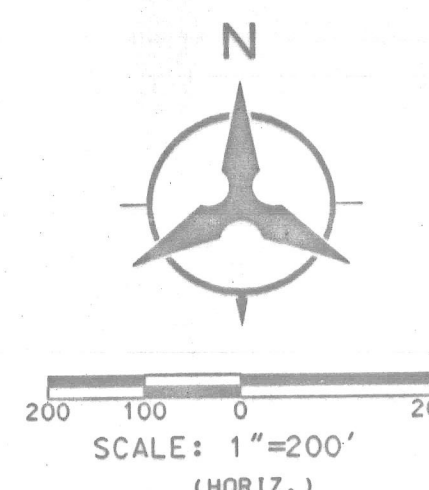

PRELIMINARY PLAT
SUNDORO SUBDIVISION
(REPLAT OF TRACT A AT PARKWAY SUBDIVISION
AND PARCEL I OF WESTLAND NORTH)
ALBUQUERQUE, NEW MEXICO
AUGUST, 2003

Bohannon & Huston
Court yard I 7500 Jefferson St. NE Albuquerque, NM 87109-4338
ENGINEERING & SPATIAL DATA & ADVANCED TECHNOLOGIES

2A OF 13

650284

HI JCB NO. 040013 003

COPYRIGHT BOHANNAN HUSTON, INC. 2003

LEGEND

- SUBDIVISION BOUNDARY LINE
- PHASE BOUNDARY LINE
- PROPOSED CURB AND GUTTER
- EXISTING CURB AND GUTTER
- PROPOSED STORM DRAIN MANHOLE
- EXISTING STORM DRAIN MANHOLE
- PROPOSED SANITARY SEWER MANHOLE
- EXISTING SANITARY SEWER MANHOLE
- EXISTING FIRE HYDRANT
- EXISTING GATE VALVE
- GUY WIRE
- EXISTING ELECTRIC LINE
- POWER POLE

TRACT I-1
164.60 ACRES

NOTE:
A PROPOSED 25' FLOATING PUBLIC WATERLINE EASEMENT
TO BE GRANTED TO THE CITY OF ALBUQUERQUE
WITH THE FINAL PLAT, AND TO BE FURTHER
DEFINED AND CONFINED WITHIN FUTURE PUBLIC
RIGHT-OF-WAY AND OR PUBLIC EASEMENT BY
FUTURE PLATTING

EXISTING
TRACT LD-2-1G
FILED: SEPTEMBER 28, 1978
VOL. MISC. 498, FOLIO 648-683

EXISTING 22' PARCEL LD-3-1D
EASEMENT STORM DRAIN
DIVERSION AND DETENTION
FACILITY JUDGEMENT 7-76-03096
DOC. NO. 7-76-03096
FILED: SEPTEMBER 23, 1976
BK. MISC. 498, PGS 648-683
TO REMAIN

EXISTING
TRACT LD-2-1E
FILED: SEPTEMBER 28, 1978
VOL. MISC. 498, FOLIO 648-683

EXISTING POND
TRACT LD-2-1F
FILED: SEPTEMBER 28, 1978
VOL. MISC. 498, FOLIO 648-683

PROPOSED 25' PUBLIC STORM
DRAIN AND WATERLINE EASEMENT
TO BE GRANTED TO THE CITY
OF ALBUQUERQUE WITH THE
FINAL PLAT

A PROPOSED PUBLIC
BLANKET DRAINAGE
EASEMENT TO BE
GRANTED TO AMFCA
WITH THE FINAL PLAT
OVER TRACT D

EXISTING POND
TRACT LD-2-1H
FILED: SEPTEMBER 28, 1978
VOL. MISC. 498, FOLIO 648-683

EXISTING
TRACT LD-2-1J
FILED: SEPTEMBER 28, 1978
VOL. MISC. 498, FOLIO 648-683

EXISTING POND
TRACT LD-2-1K
FILED: SEPTEMBER 28, 1978
VOL. MISC. 498, FOLIO 648-683

UNIT 2
TIERRA OESTE
FILED: SEPTEMBER 28, 1978
VOL. MISC. 498, FOLIO 648-683
ZONED R-D

HATCHED AREA DESIGNATES
APPROXIMATELY 0.12 ACRES
PUBLIC RIGHT-OF-WAY TO BE
VACATED BY FINAL PLAT

PROPOSED 30' PUE-IC STORM
DRAIN, WATERLINE AND
SANITARY SEWER EASEMENT
TO BE GRANTED TO THE CITY
OF ALBUQUERQUE WITH THE
FINAL PLAT

CROSS HATCHED AREA DESIGNATES
PROPOSED 53' WIDE PUBLIC
RIGHT-OF-WAY TO BE DEDICATED
TO AND MAINTAINED BY THE
CITY OF ALBUQUERQUE WITH
THE FINAL PLAT


SHADED AREA DESIGNATES
THE PORTION OF TRACT #
PARKWAY SUBDIVISION
TO BE RE-PLATTED

EXISTING 106' WIDE PUBLIC
ACCESS, WATERLINE, DRAINAGE
AND SANITARY SEWER EASEMENT
FILED: JUNE 29, 1995
(95C-238)

EXISTING 100' WIDE
PNM EASEMENT
FILED: APRIL 12, 1956
(348-43)
TO REMAIN

PROPOSED 10' PUBLIC
UTILITY EASEMENT TO
BE GRANTED TO THE
CITY OF ALBUQUERQUE
WITH THE FINAL PLAT

UNIT 2
PARKLAND VIEW
SUBDIVISION
FILED: SEPTEMBER 22, 1999
(99C-285)
ZONED R-D

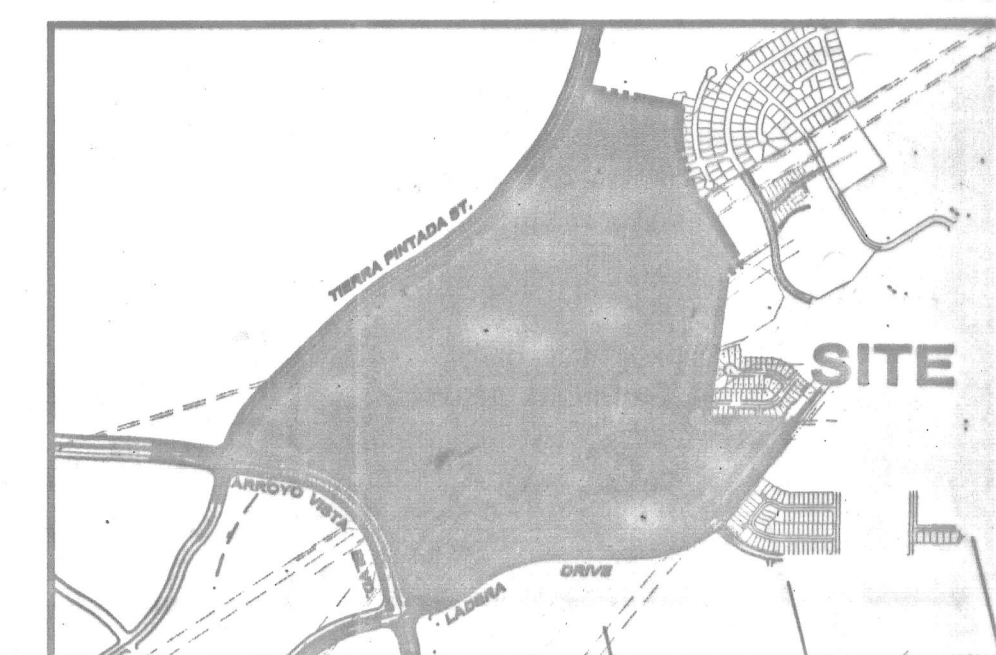

LOCATION MAP
ZONE ATLAS MAP NO. H-9, J-8, J-9
NOT TO SCALE

Bohannon & Huston


Courtyard | 7500 Jefferson St. NE Albuquerque, NM 87109-4336

ENGINEERING & SPATIAL DATA & ADVANCED TECHNOLOGIES

2B of 13

650284

PRELIMINARY PLAT SUNDORO SUBDIVISION (REPLAT OF TRACT A AT PARKWAY SUBDIVISION AND PARCEL I OF WESTLAND NORTH) ALBUQUERQUE, NEW MEXICO AUGUST, 2003

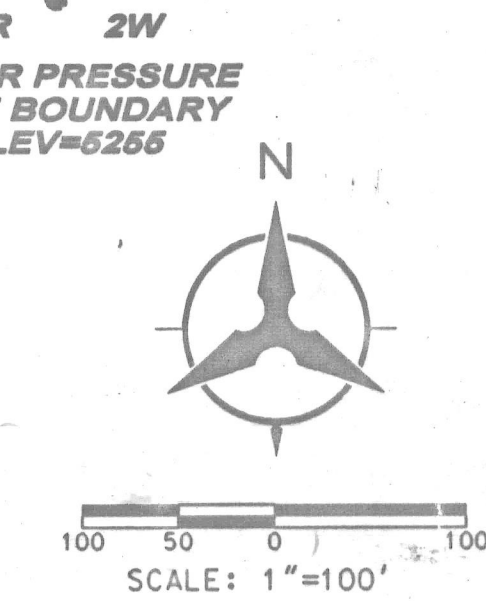


3WR 2W
WATER PRESSURE
ZONE BOUNDARY
ELEV=6265

EXISTING 10' PUBLIC
UTILITY EASEMENT
FILED: DECEMBER 27, 2000
(2000C-316)
TO REMAIN

LADERA DRIVE
(152' R-O-W)

SCANNED BY
PLANNING

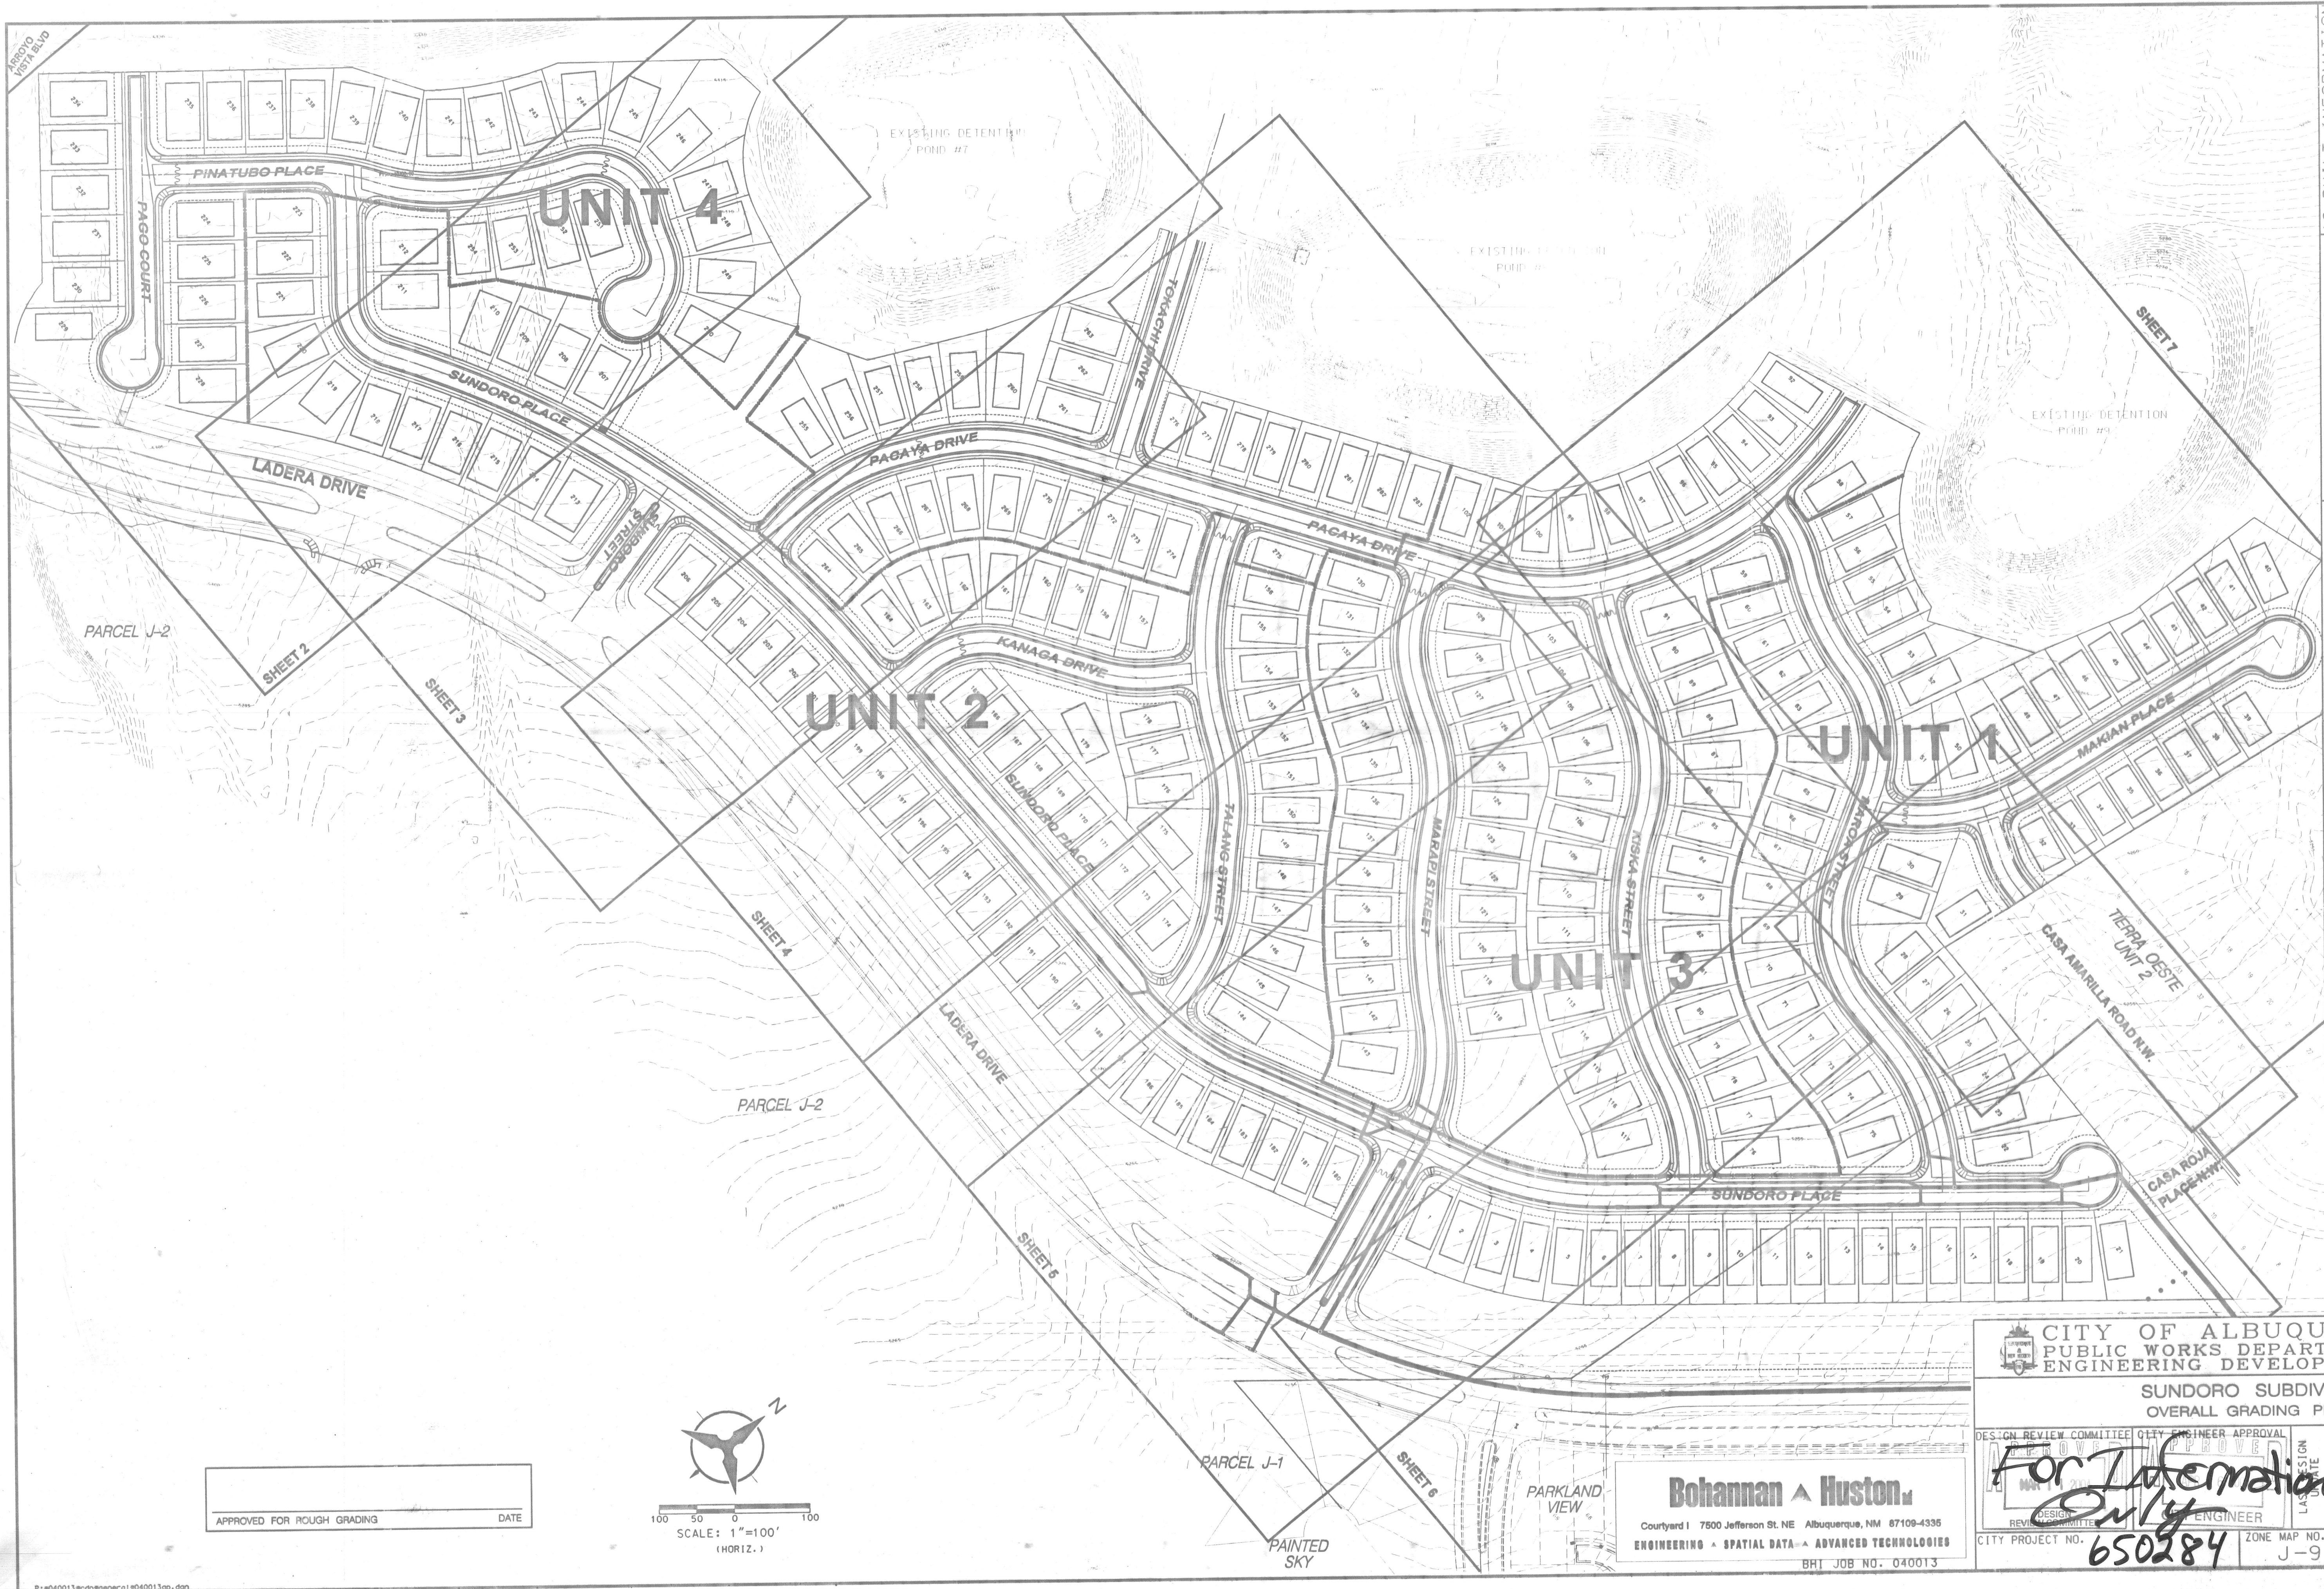

--	--	

CITY OF ALBUQUERQUE
PUBLIC WORKS DEPARTMENT
ENGINEERING DEVELOPMENT GROUP
SUNDORO SUBDIVISION
OVERALL GRADING PLAN

Bohannon & Huston
Courtland | 7500 Jefferson St. NE | Albuquerque, NM 87109-4335
ENGINEERING & SPATIAL DATA & ADVANCED TECHNOLOGIES
BHT JOB NO. 040013

For Information Only
CITY PROJECT NO. **650284**
ZONE MAP NO. **J-9**
SHEET **3A** OF **13**

DESIGN REVIEW COMMITTEE CITY ENGINEER APPROVAL
MO. / DAY / YR.
MO. / DAY / YR.

SCANNED BY
PLANNING

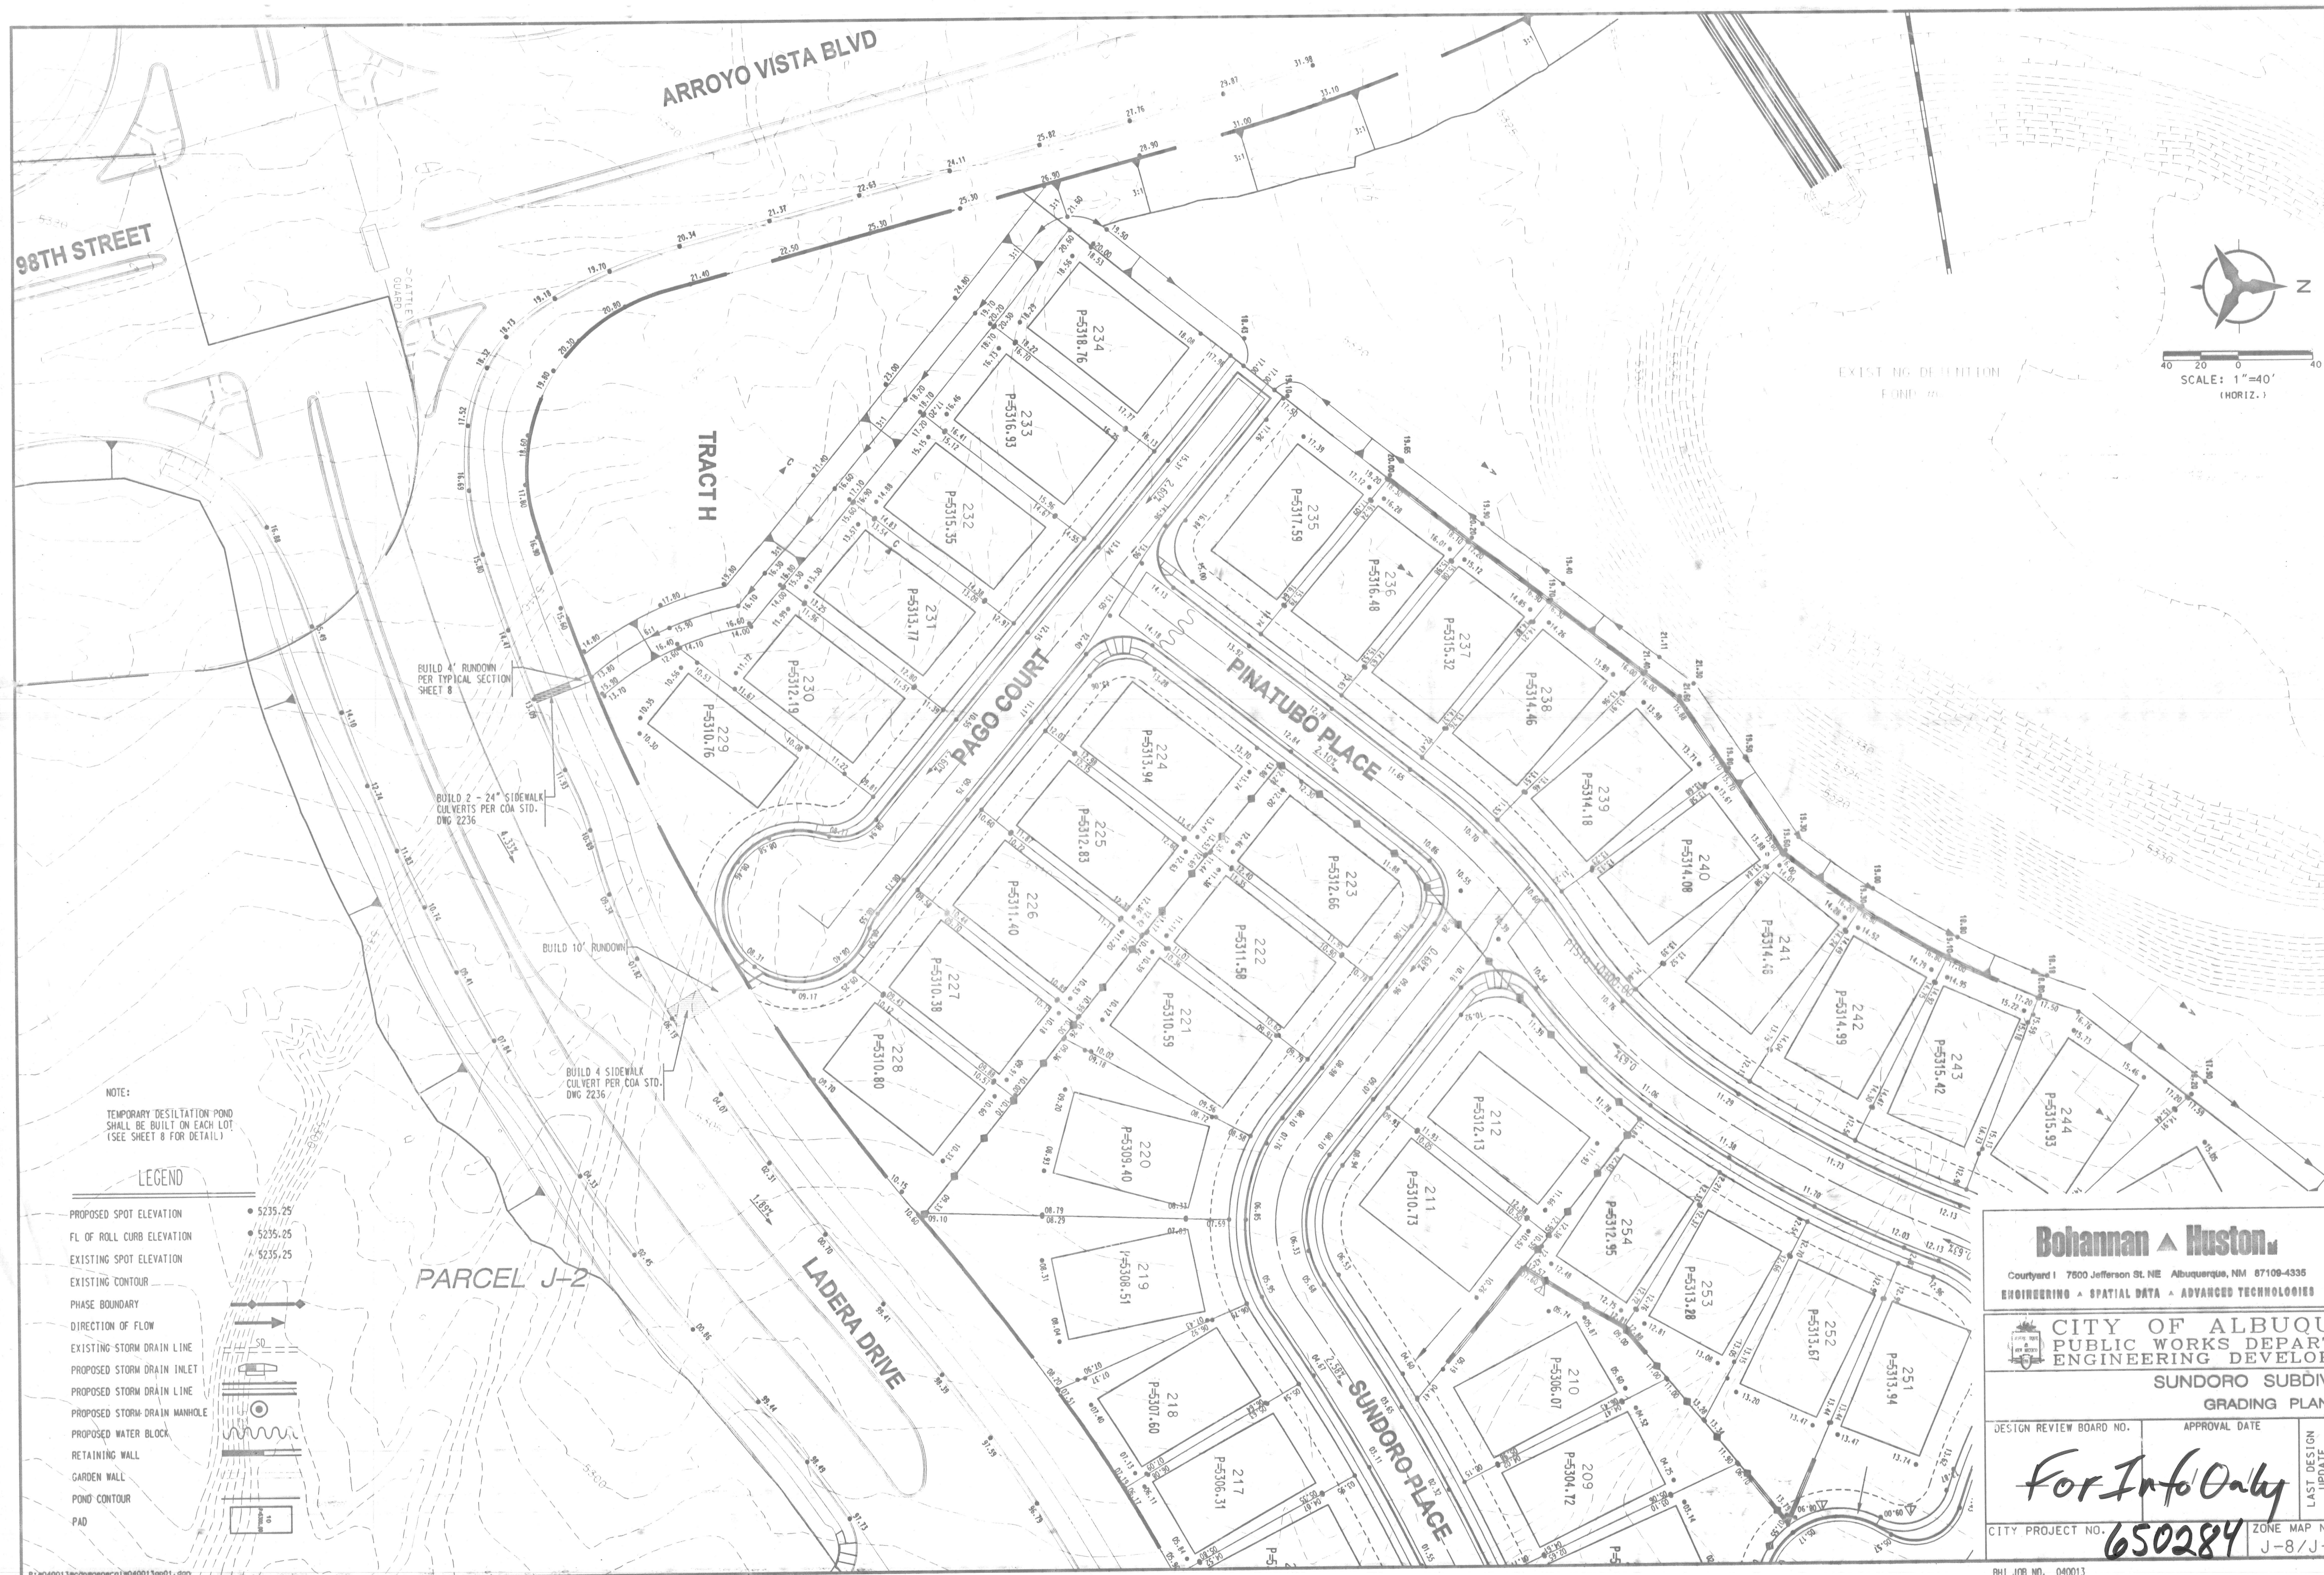[illegible]

SCANNED BY
PLANNING



P: #040013#cdp#general#040013gp02.dgn
19-DEC-2003
09:16
caholitts

[illegible]

PARCEL 7-2

LADERA DRIVE

SUNDORO PLACE

KANAGA DRIVE

TALANG STREET

PACAYA DRIVE


TOKACHI DRIVE

MARAPI STREET

NOTE:
TEMPORARY DESILTATION POND
SHALL BE BUILT ON EACH LOT
(SEE SHEET 8 FOR DETAIL)

LEGEND

- PROPOSED SPOT ELEVATION
- FL. OF ROLL CURB ELEVATION
- EXISTING SPOT ELEVATION
- EXISTING CONTOUR
- PHASE BOUNDARY
- DIRECTION OF FLOW
- EXISTING STORM DRAIN LINE
- PROPOSED STORM DRAIN INLET
- PROPOSED STORM DRAIN LINE
- PROPOSED STORM DRAIN MANHOLE
- PROPOSED WATER BLOCK
- RETAINING WALL
- GARDEN WALL
- POND CONTOUR
- PAO

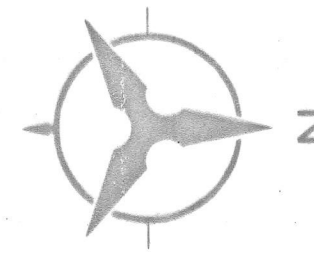

Bohannon & Huston
 Courtyard 1 7500 Jefferson St. NE Albuquerque, NM 87109-4335
 ENGINEERING • SPATIAL DATA • ADVANCED TECHNOLOGIES

CITY OF ALBUQUERQUE
 PUBLIC WORKS DEPARTMENT
 ENGINEERING DEVELOPMENT GROUP

SUNDORO SUBDIVISION
GRADING PLAN


DESIGN REVIEW BOARD NO.	APPROVAL DATE	MO./DAY/YR.	MO./DAY/YR.
<i>For Info only</i>		LAST DESIGN UPDATE	
CITY PROJECT NO. 650284	ZONE MAP NO. J-8/J-9	SHEET 3D	OF 13

AS-BUILT INFORMATION		BENCH MARKS		SURVEY INFORMATION		FIELD NOTES	
CONTRACTOR	DATE	ACCS STATION NAMED	DATE	NO.	BY	NO.	BY
INSPECTOR'S	DATE	3-1/4" ALUM. CAP	DATE				
ACCEPTANCE BY	DATE	HY18 = 4 - K6	DATE				
VERIFICATION BY	DATE	X=1.477, 665.89, Y=1.484, 081.55	DATE				
DRAWN BY	DATE	ELEV=5733.00	DATE				
CHECKED BY	DATE	ON PASSED DEL VULCAN. 0.91 MI NORTH	DATE				
RECORDED BY	DATE	OF 1 - 40. 0.74 MI SOUTH OF	DATE				
NO.		POWER LINES. 39.6' NM OF CENTERLINE	DATE				
		OF PASSED DEL VULCAN	DATE				



CHANGES PER AMFCA, SHEETS 3 AND 4	CJS	DATE 08/08/2003	CJS
ADD 160 LF OF RETAINING WALL ON SHTS 2, 4	CJS	DATE 08/08/2003	CJS
REVISIONS		DATE 08/08/2003	CJS
DESIGN		DATE 08/08/2003	CJS
DRAWN BY	CJS	DATE 08/08/2003	CJS
CHECKED BY	CJS	DATE 08/08/2003	CJS

PARCEL J-2

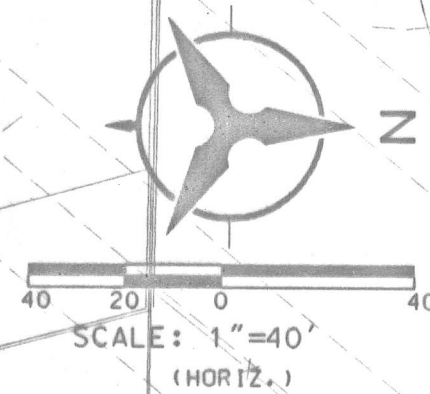

LEGEND

- PROPOSED SPOT ELEVATION
- FL OF ROLL CURB ELEVATION
- EXISTING SPOT ELEVATION
- EXISTING CONTOUR
- DIRECTION OF FLOW
- EXISTING STORM DRAIN LINE
- PROPOSED STORM DRAIN INLET
- PROPOSED STORM DRAIN LINE
- PROPOSED STORM DRAIN MANHOLE
- PROPOSED WATER BLOCK
- RETAINING WALL
- GARDEN WALL
- POND CONTOUR
- TEMP. DESILTATION BASIN
(SEE SHEET 8 FOR DETAIL)
- PAD

PARCEL I-1

LADERA DRIVE

MARAPI STREET

SUNDORO PLACE

TALANG STREET

MARAPI STREET

STREET

KISKI

PACAYA DRIVE

TRACT A

TRACT B

Bohannon & Huston
 Courtyard 1 7600 Jefferson St. NE Albuquerque, NM 87109-4335
 ENGINEERING • SPATIAL DATA • ADVANCED TECHNOLOGIES




CITY OF ALBUQUERQUE
 PUBLIC WORKS DEPARTMENT
 ENGINEERING DEVELOPMENT GROUP
SUNDORO SUBDIVISION
GRADING PLAN

DESIGN REVIEW BOARD NO. _____ APPROVAL DATE _____ MO./DAY/YR. / MO./DAY/YR.


For Info only

CITY PROJECT NO. **650284** ZONE MAP NO. J-8/J-9 SHEET **3F** OF **13**

NOTIFICATION INFORMATION		BENCH MARK		FIELD INFORMATION		SEALS	
CONTRACTOR	INSPECTOR'S NAME	DATE	NO.	DATE	NO.	DATE	NO.
DATE	DATE	DATE	DATE	DATE	DATE	DATE	DATE
MICRO-FILM INFORMATION				MICRO-FILM INFORMATION			
ON PASO DEL VULCAN, 0.9 MI NORTH OF 40° 0.74 MI SOUTH OF POWERLINES, 39.6' NW OF CENTERLINE OF PASO DEL VULCAN				ON PASO DEL VULCAN, 0.9 MI NORTH OF 40° 0.74 MI SOUTH OF POWERLINES, 39.6' NW OF CENTERLINE OF PASO DEL VULCAN			
ENGINEER S. J. S.				ENGINEER S. J. S.			
CHANGES PER AMFCA, SHEETS 3 AND 4				CHANGES PER AMFCA, SHEETS 3 AND 4			
ADD 160 LF OF RETAINING WALL ON SHTS 2, 4, CJS				ADD 160 LF OF RETAINING WALL ON SHTS 2, 4, CJS			
REVISIONS				REVISIONS			
DESIGN				DESIGN			
DATE 08/20/03				DATE 08/20/03			
DRAWN BY CJS				DRAWN BY CJS			
CHECKED BY CJS				CHECKED BY CJS			

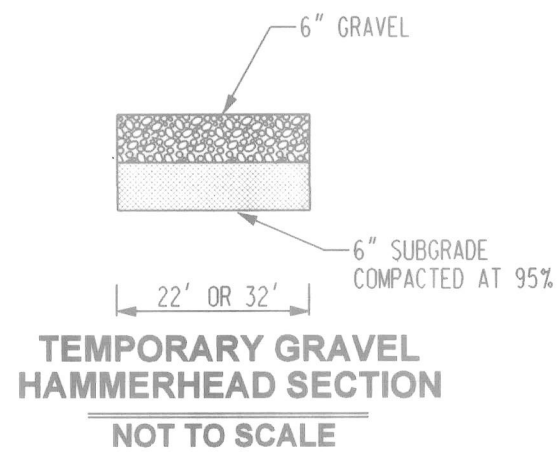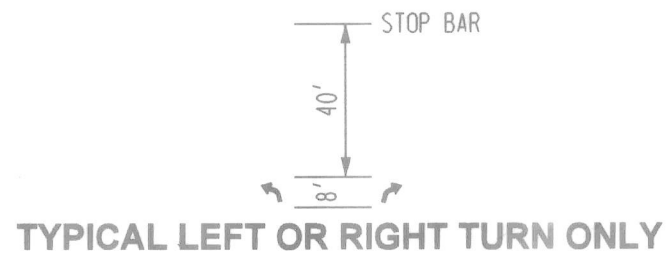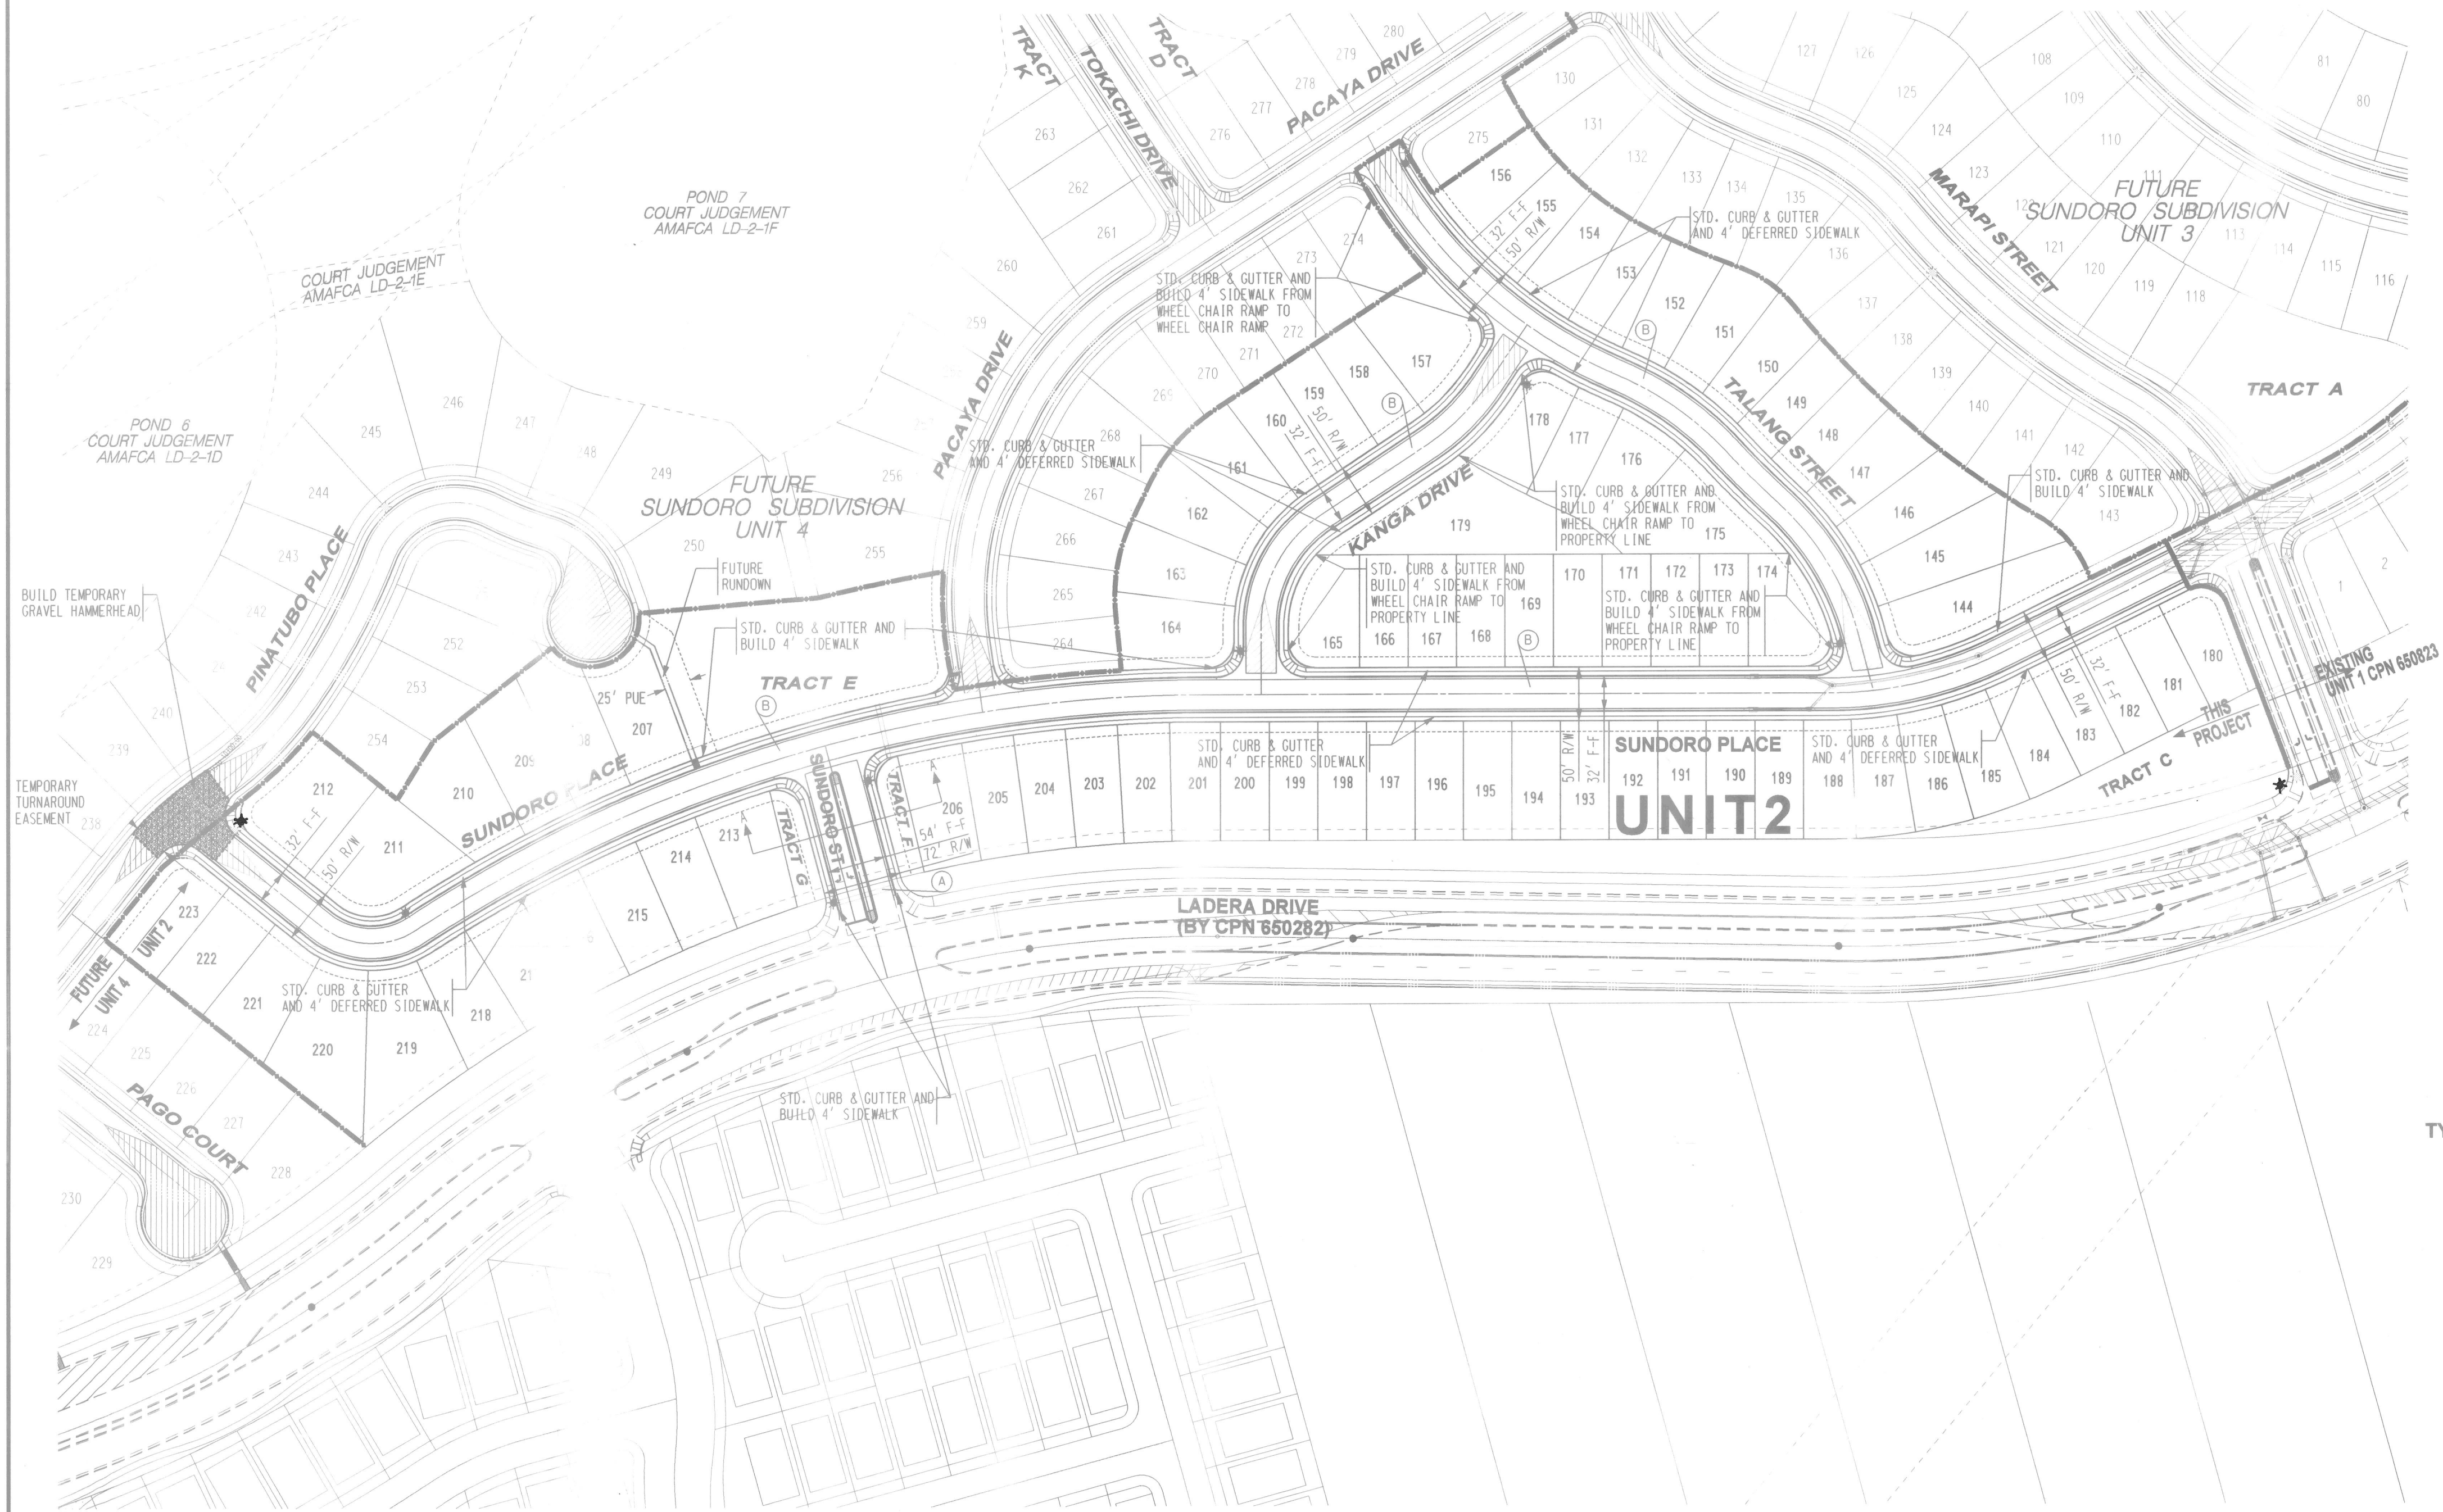


WHEEL CHAIR RAMP DETAIL A
SEE MODIFIED STD. DWG. 2441 CASE II
NOT TO SCALE

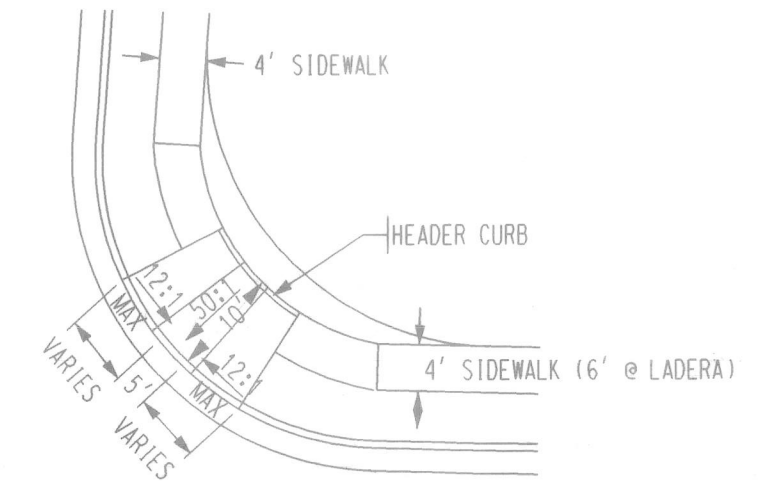


LEGEND

- PROPOSED PHASE BOUNDARY
- PROPOSED CURB AND GUTTER
- EXISTING CURB AND GUTTER
- PROPOSED STORM DRAIN INLET
- PROPOSED STORM MANHOLE
- EXISTING STORM DRAIN MANHOLE
- PROPOSED SANITARY SEWER MANHOLE
- EXISTING SANITARY SEWER MANHOLE
- PROPOSED FIRE HYDRANT
- PROPOSED GATE VALVE
- EXISTING FIRE HYDRANT
- PROPOSED STREET LIGHT
- SIDEWALK
- CROWN FLATTENING
- PROPOSED WATER METER

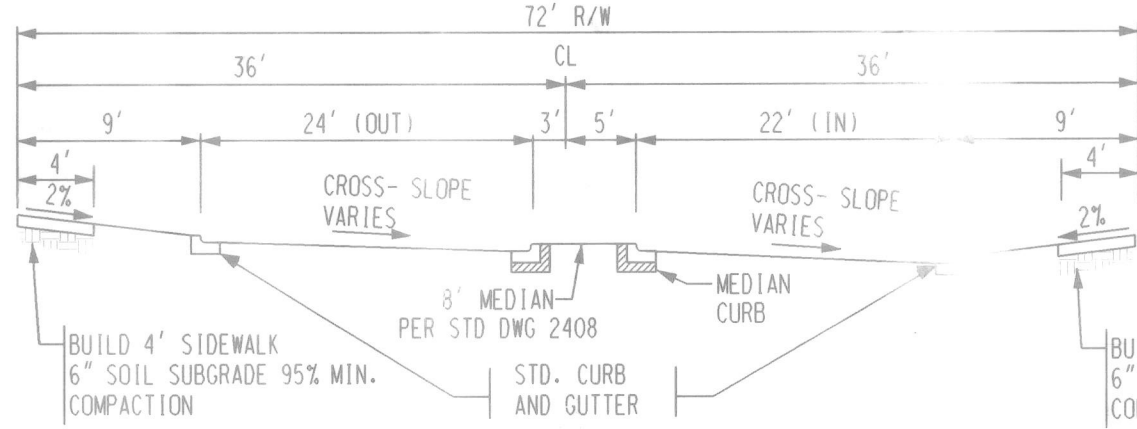


ENTRANCE TO SUBDIVISION STREET SECTION A-A
NOT TO SCALE

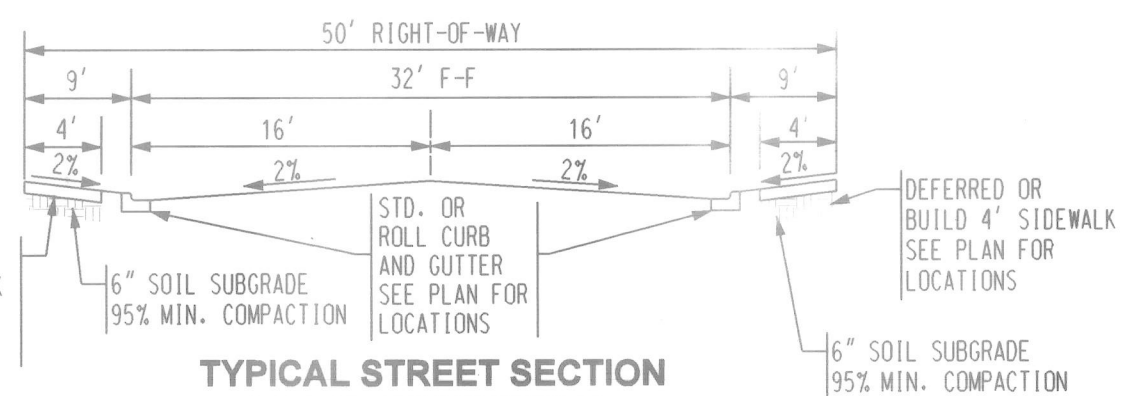


TYPICAL STREET SECTION
LOCAL RESIDENTIAL
NOT TO SCALE

NOTE:
"SOIL NOT HAVING THE MINIMUM R-VALUE OF 50, SHALL BE REMOVED TO A DEPTH OF 2 FEET AND REPLACED, BY THE CONTRACTOR, WITH SUITABLE MATERIAL OR PAVEMENT SECTION SHALL BE DESIGNED, BY THE CONSULTANT ACCOMMODATING THE EXISTING R-VALUE PER COA STANDARD SPECIFICATIONS."

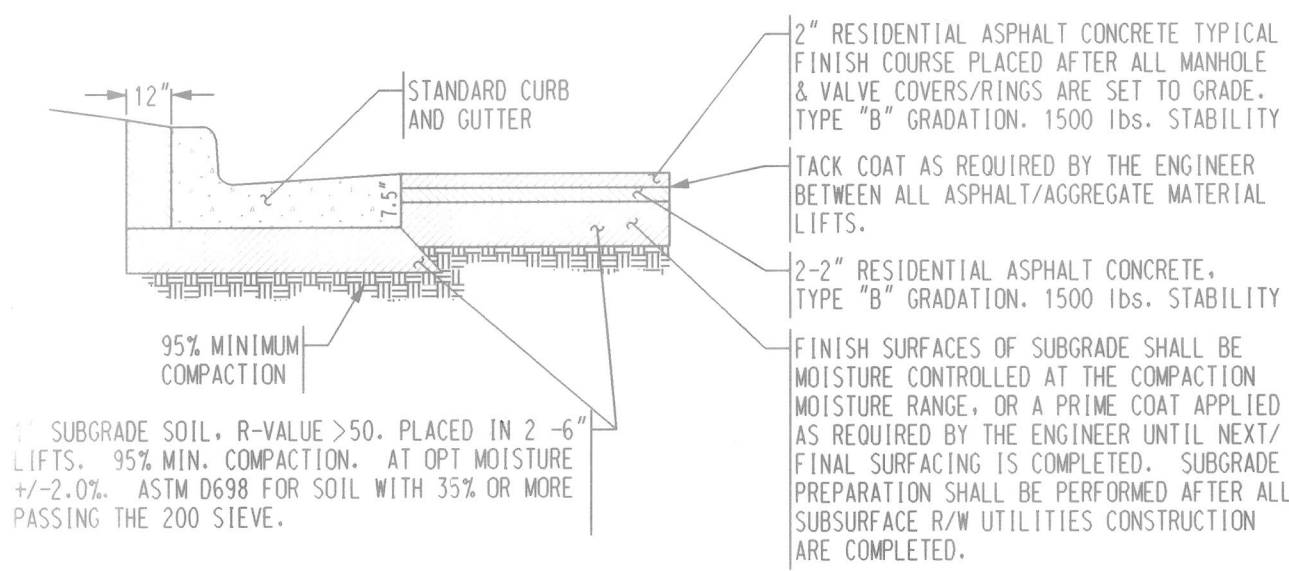

ENTRANCE TO SUBDIVISION
PAVEMENT SECTION
NOT TO SCALE

NOTE:
"SOIL NOT HAVING THE MINIMUM R-VALUE OF 50, SHALL BE REMOVED TO A DEPTH OF 2 FEET AND REPLACED, BY THE CONTRACTOR, WITH SUITABLE MATERIAL OR PAVEMENT SECTION SHALL BE DESIGNED, BY THE CONSULTANT ACCOMMODATING THE EXISTING R-VALUE PER COA STANDARD SPECIFICATIONS."

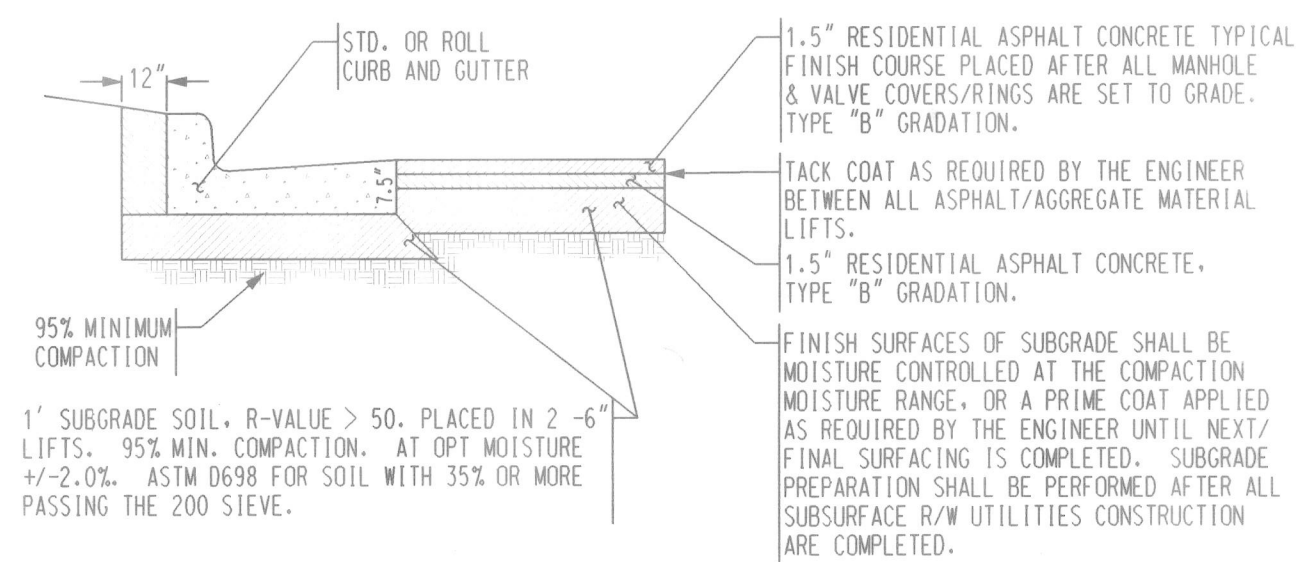

TYPICAL SUBDIVISION PAVEMENT SECTION
(REFER TO COA STD. DWG. 2405A)
(EXCEPT TYPE "B" GRADATION SHALL BE USED)
(AS ACCEPTED ON COA PROJECT #628881)
NOT TO SCALE

CONTRACTOR SHALL COORDINATE WITH ALL WET AND DRY UTILITY COMPANIES FOR EXACT LOCATIONS OF UTILITIES PRIOR TO ANY WORK WITHIN LADERA DRIVE. CONTRACTOR SHALL CONTACT ENGINEER IMMEDIATELY UPON THE DISCOVERY OF ANY DISCREPANCIES.



ENGINEER'S SEAL		SURVEY INFORMATION		BENCH MARKS		AS-BUILT INFORMATION	
DATE		DATE		DATE		DATE	
BY		BY		BY		BY	
NO.		NO.		NO.		NO.	
REMARKS		REMARKS		REMARKS		REMARKS	
DESIGN		DESIGN		DESIGN		DESIGN	
DATE 09/2003		DATE 09/2003		DATE 09/2003		DATE 09/2003	
DESIGNED BY		DESIGNED BY		DESIGNED BY		DESIGNED BY	
DRAWN BY		DRAWN BY		DRAWN BY		DRAWN BY	
CHECKED BY		CHECKED BY		CHECKED BY		CHECKED BY	
CITY PROJECT NO.		CITY PROJECT NO.		CITY PROJECT NO.		CITY PROJECT NO.	
650284		650284		650284		650284	
ZONE MAP NO.		ZONE MAP NO.		ZONE MAP NO.		ZONE MAP NO.	
J-8, J-9		J-8, J-9		J-8, J-9		J-8, J-9	
SHEET		SHEET		SHEET		SHEET	
4		4		4		4	
OF		OF		OF		OF	
13		13		13		13	

Bohannon & Huston
Courtyard 1 7500 Jefferson St. NE Albuquerque, NM 87109-4335
ENGINEERING • SPATIAL DATA • ADVANCED TECHNOLOGIES

CITY OF ALBUQUERQUE
PUBLIC WORKS DEPARTMENT
ENGINEERING DEVELOPMENT GROUP

SUNDORO SUBDIVISION UNIT 2
OVERALL PAVING PLAN

DESIGN REVIEW COMMITTEE		CITY ENGINEER APPROVAL		MO./DAY/YR.	
APPROVED		APPROVED			
MAR 11 2004		APR 26 2004			
DESIGN REVIEW COMMITTEE		CITY ENGINEER		LAST DESIGN UPDATE	

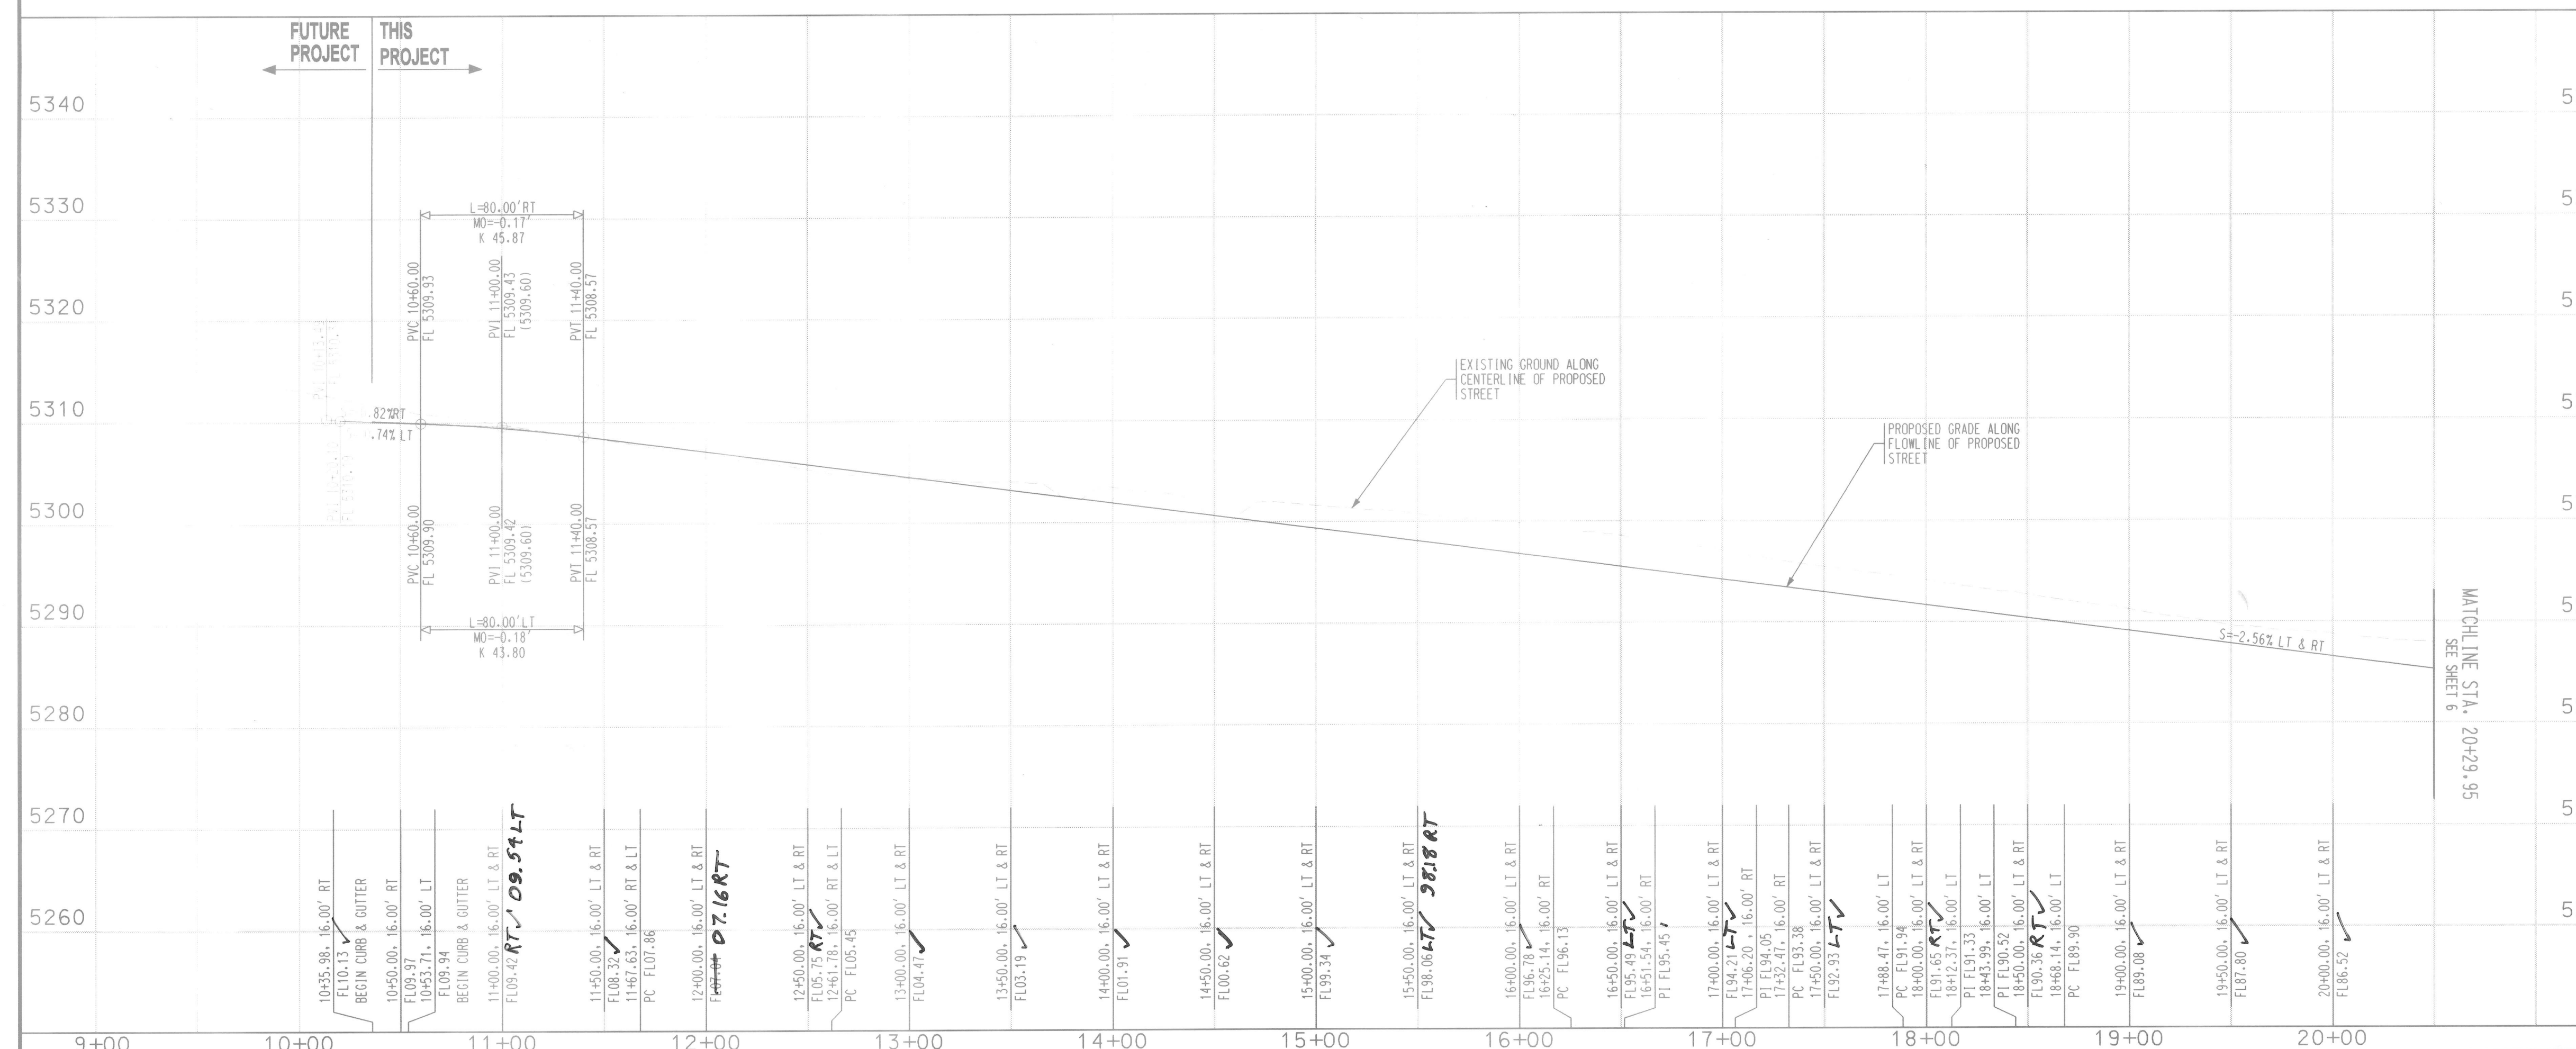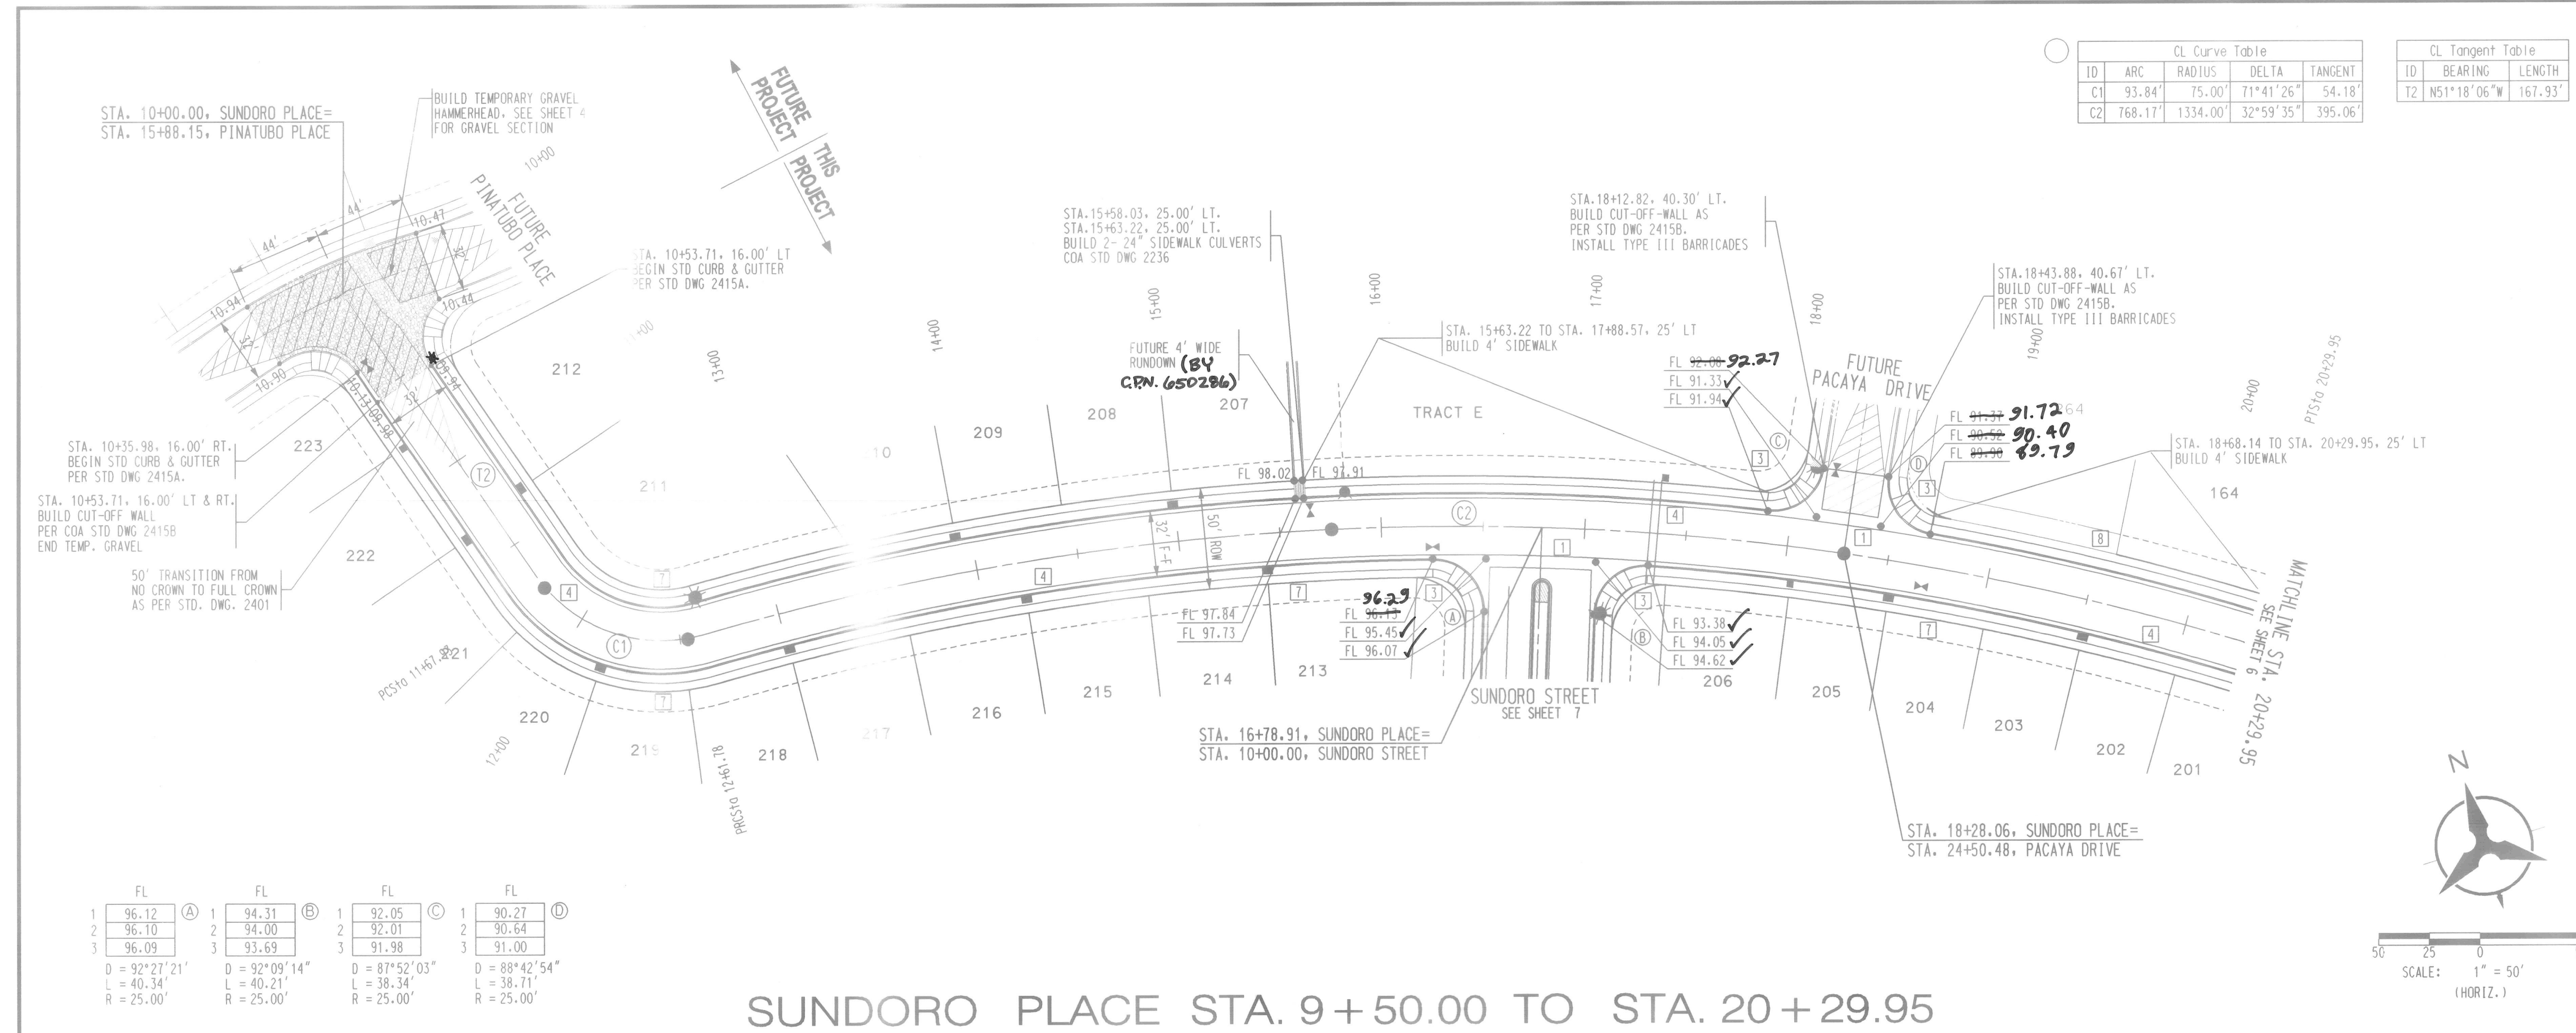

NOTES

- THE CONTRACTOR SHALL FIELD VERIFY ALL EXISTING UTILITY LOCATIONS AND NOTIFY THE ENGINEER IMMEDIATELY OF ANY DISCREPANCIES.
- ALL CURB RETURN RADII SHALL BE 25' UNLESS OTHERWISE SPECIFIED.
- ALL CURVE DATA AND DIMENSIONS REFER TO FACE OF CURB UNLESS OTHERWISE SPECIFIED.
- GRADE ELEVATIONS, WHERE NOTED, ARE ALONG FLOWLINE OF STANDARD CURB UNLESS OTHERWISE SPECIFIED.
- CONTRACTOR IS TO INSTALL A 4" X 4" X 5' POST AND END AT THE END OF EACH SANITARY SEWER SERVICE.
- CONTRACTOR IS RESPONSIBLE FOR REPAIR AND/OR REPLACEMENT OF ALL UTILITY CONDUITS AND EXISTING LINES.
- ANY ADDITIONAL GRADING REQUIRED TO MATCH PROPOSED STREET GRADES SHALL BE INCIDENTAL TO PAVING ITEMS.
- CONTRACTOR SHALL PROVIDE THE INSPECTORS, (CITY AND PRIVATE) WITH THE PROPOSED HYDROSTATIC TESTING PLAN. THE PLAN MUST BE APPROVED BEFORE TESTING OPERATIONS BEGIN.
- CONTRACTOR SHALL PARK EQUIPMENT AND VEHICLES AS NOT TO INTERFERE WITH NORMAL ACTIVITIES OF RESIDENTS OR OTHER CONTRACTORS ON SITE.
- ANY DAMAGE TO THE EXISTING FACILITIES (CURB & GUTTER), PAVEMENT, CONDUITS, LANDSCAPING, UTILITY LINES, ETC.) DURING CONSTRUCTION SHALL BE REPLACED AT THE CONTRACTORS' EXPENSE.
- REMOVAL OF THE EXISTING CURB AND GUTTER SHALL BE AS PER COA STD. DWG. 2415 (SAWCUT ONLY).
- WHEELCHAIR RAMPS SHALL BE CONSTRUCTED PRIOR TO ACCEPTANCE OF CURB & GUTTER.
- ALL EXCAVATION, TRENCHING AND SHORING ACTIVITIES MUST BE CARRIED-OUT IN ACCORDANCE WITH OSHA 29 CFR 1926.650 SUBPART P.

KEYED GENERAL NOTES

- INSTALL 6' CONCRETE VALLEY GUTTER AS PER STD. DWG. 2420
- INSTALL 12' CONCRETE VALLEY GUTTER AS PER STD. DWG. 2422
- INSTALL WHEELCHAIR RAMP AS PER MODIFIED STD. DWG. 2441, CASE II WITH ALTERNATE SECTION AA AND AS PER DETAIL SHEET 4
- STD. CURB & GUTTER AS PER STD. DWG. 2415A
- MEDIAN CURB & GUTTER AS PER STD. DWG. 2415B
- ROLL CURB & GUTTER AS PER STD. DWG. 2415A
- DEFERRED 4' SIDEWALK
- BUILD 4' SIDEWALK N PER COA STD DWG 2430
- BUILD 10' ASPHALT TRAIL UNLESS OTHERWISE NOTED
- BUILD 4" TEXTURED MEDIAN PAVEMENT FROM MEDIAN NOSE TO 10' FROM NOSE (BAJA RED) PER STD DWG 2408. MEDIAN NOSES SHALL BE PAINTED YELLOW TO APPROX. 6' BEHIND PC/PT.

Bohannon Huston
 Courtyard I 7500 Jefferson St. NE Albuquerque, NM 87109-4335
 ENGINEERING • SPATIAL DATA • ADVANCED TECHNOLOGIES

CITY OF ALBUQUERQUE
 PUBLIC WORKS DEPARTMENT
 ENGINEERING DEVELOPMENT GROUP

SUNDORO SUBDIVISION - UNIT 2
 PAVING PLAN & PROFILE
 SUNDORO PLACE STA. 9+50.00 - 20+29.95

APPROVED: MAR 11 2004
 DESIGN REVIEW COMMITTEE

APPROVED: APR 26 2004
 CITY ENGINEER

MO. / DAY / YR. SHEET 5 OF 13

ENGINEER'S SEAL INFORMATION

NO. DATE BY REMARKS REVISIONS DESIGN


DESIGNED BY CJS DATE 10/2003
 DRAWN BY BS DATE 10/2003
 CHECKED BY CJS DATE 10/2003

ID	BEARING	LENGTH
T1	N89°38'11"W	58.44
T2	N66°35'22"W	21.29
T3	S43°37'21"W	31.09
T4	S89°37'46"W	50.35
T5	S63°33'23"W	231.50


SD Curve Table				
ID	ARC	RADIUS	DELTA	TANGENT
C1	138.63'	500.00'	5°25'37"	67.72

CL Curve Table				
ID	ARC	RADIUS	DELTA	TANGENT
C4	161.54'	350.00'	26°26'40"	82.24

ID	BEARING	LENGTH
T4	N89°59'57"W	585.89
T5	S63°33'23"W	331.24

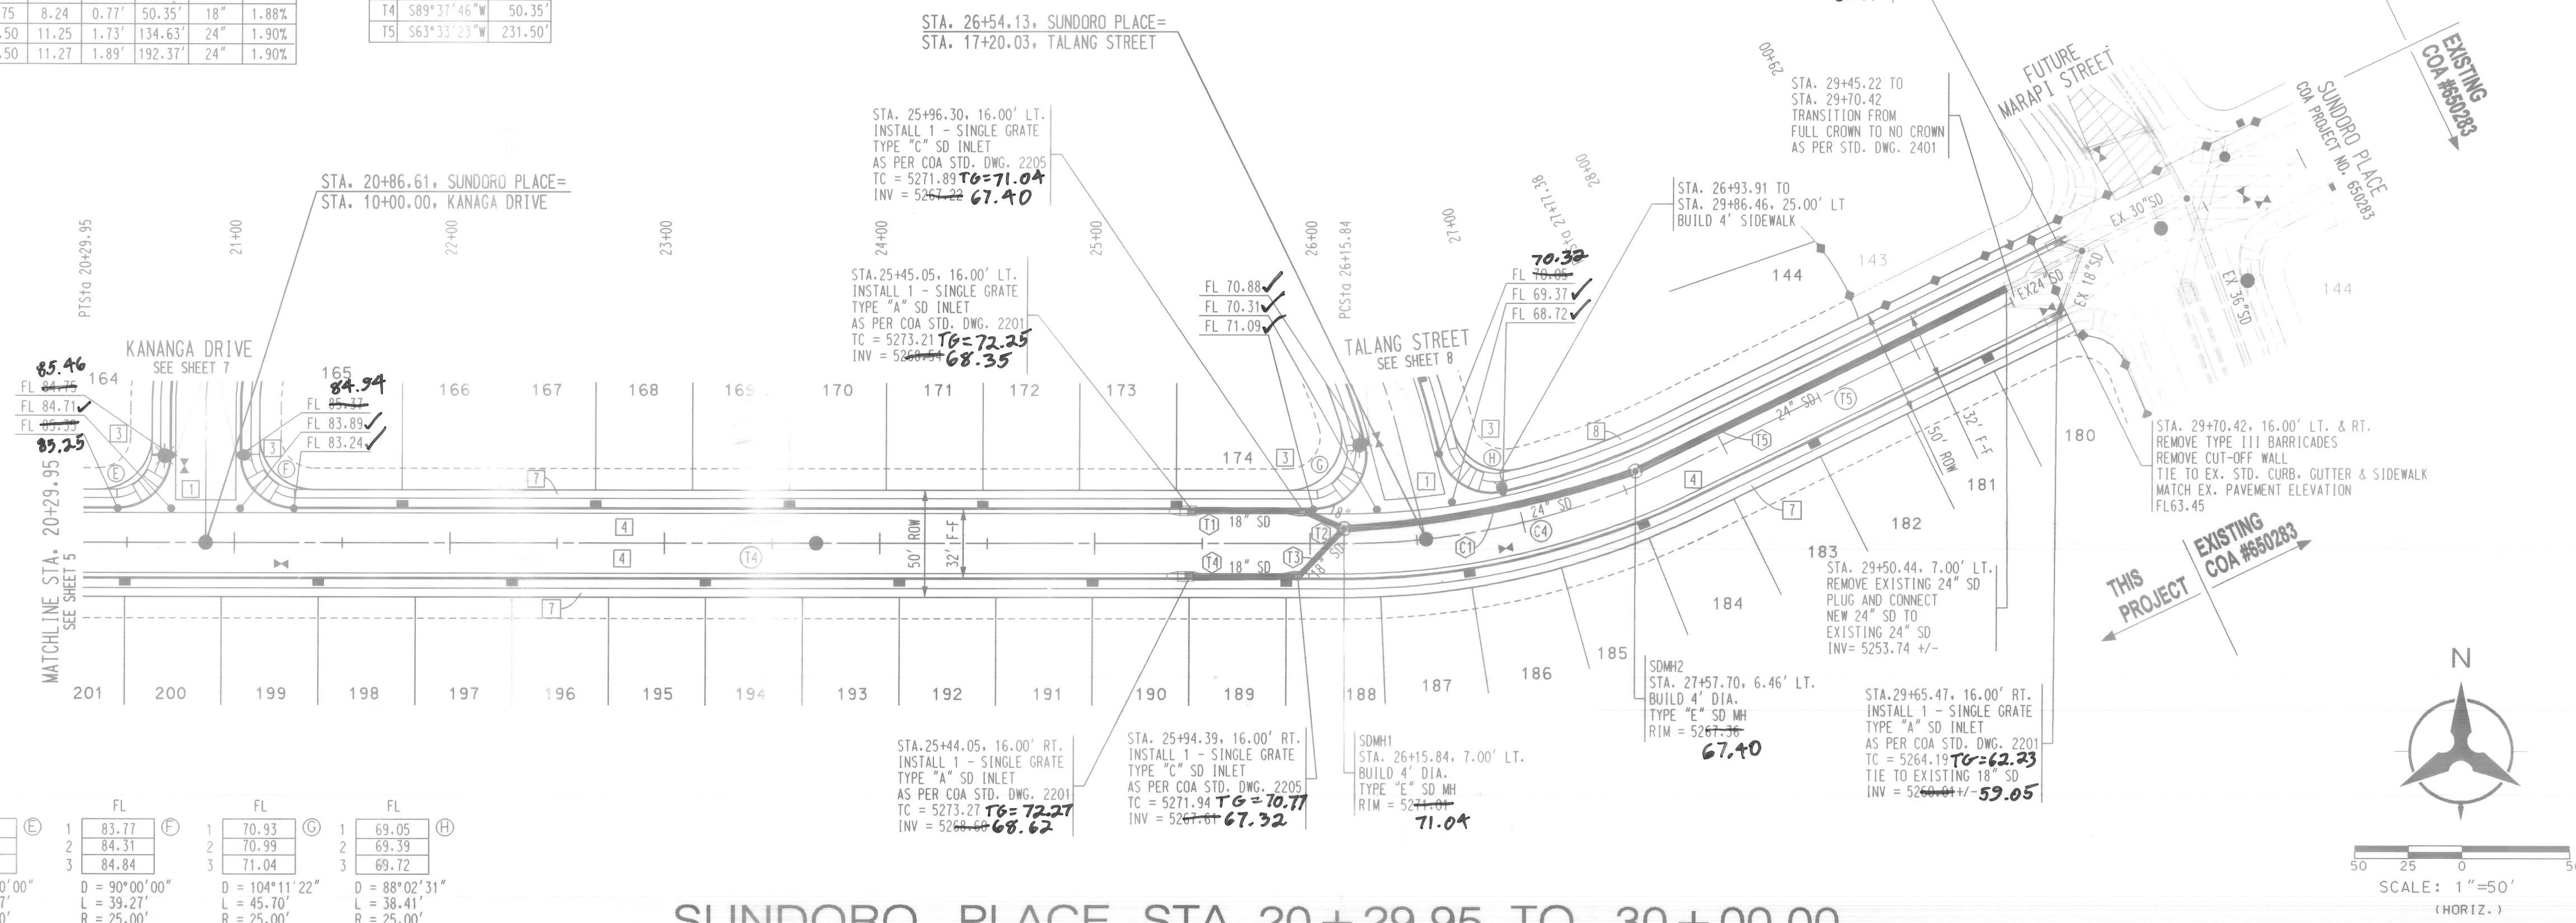

SUNDORO PLACE STA. 20+29.95 TO 30+00.00

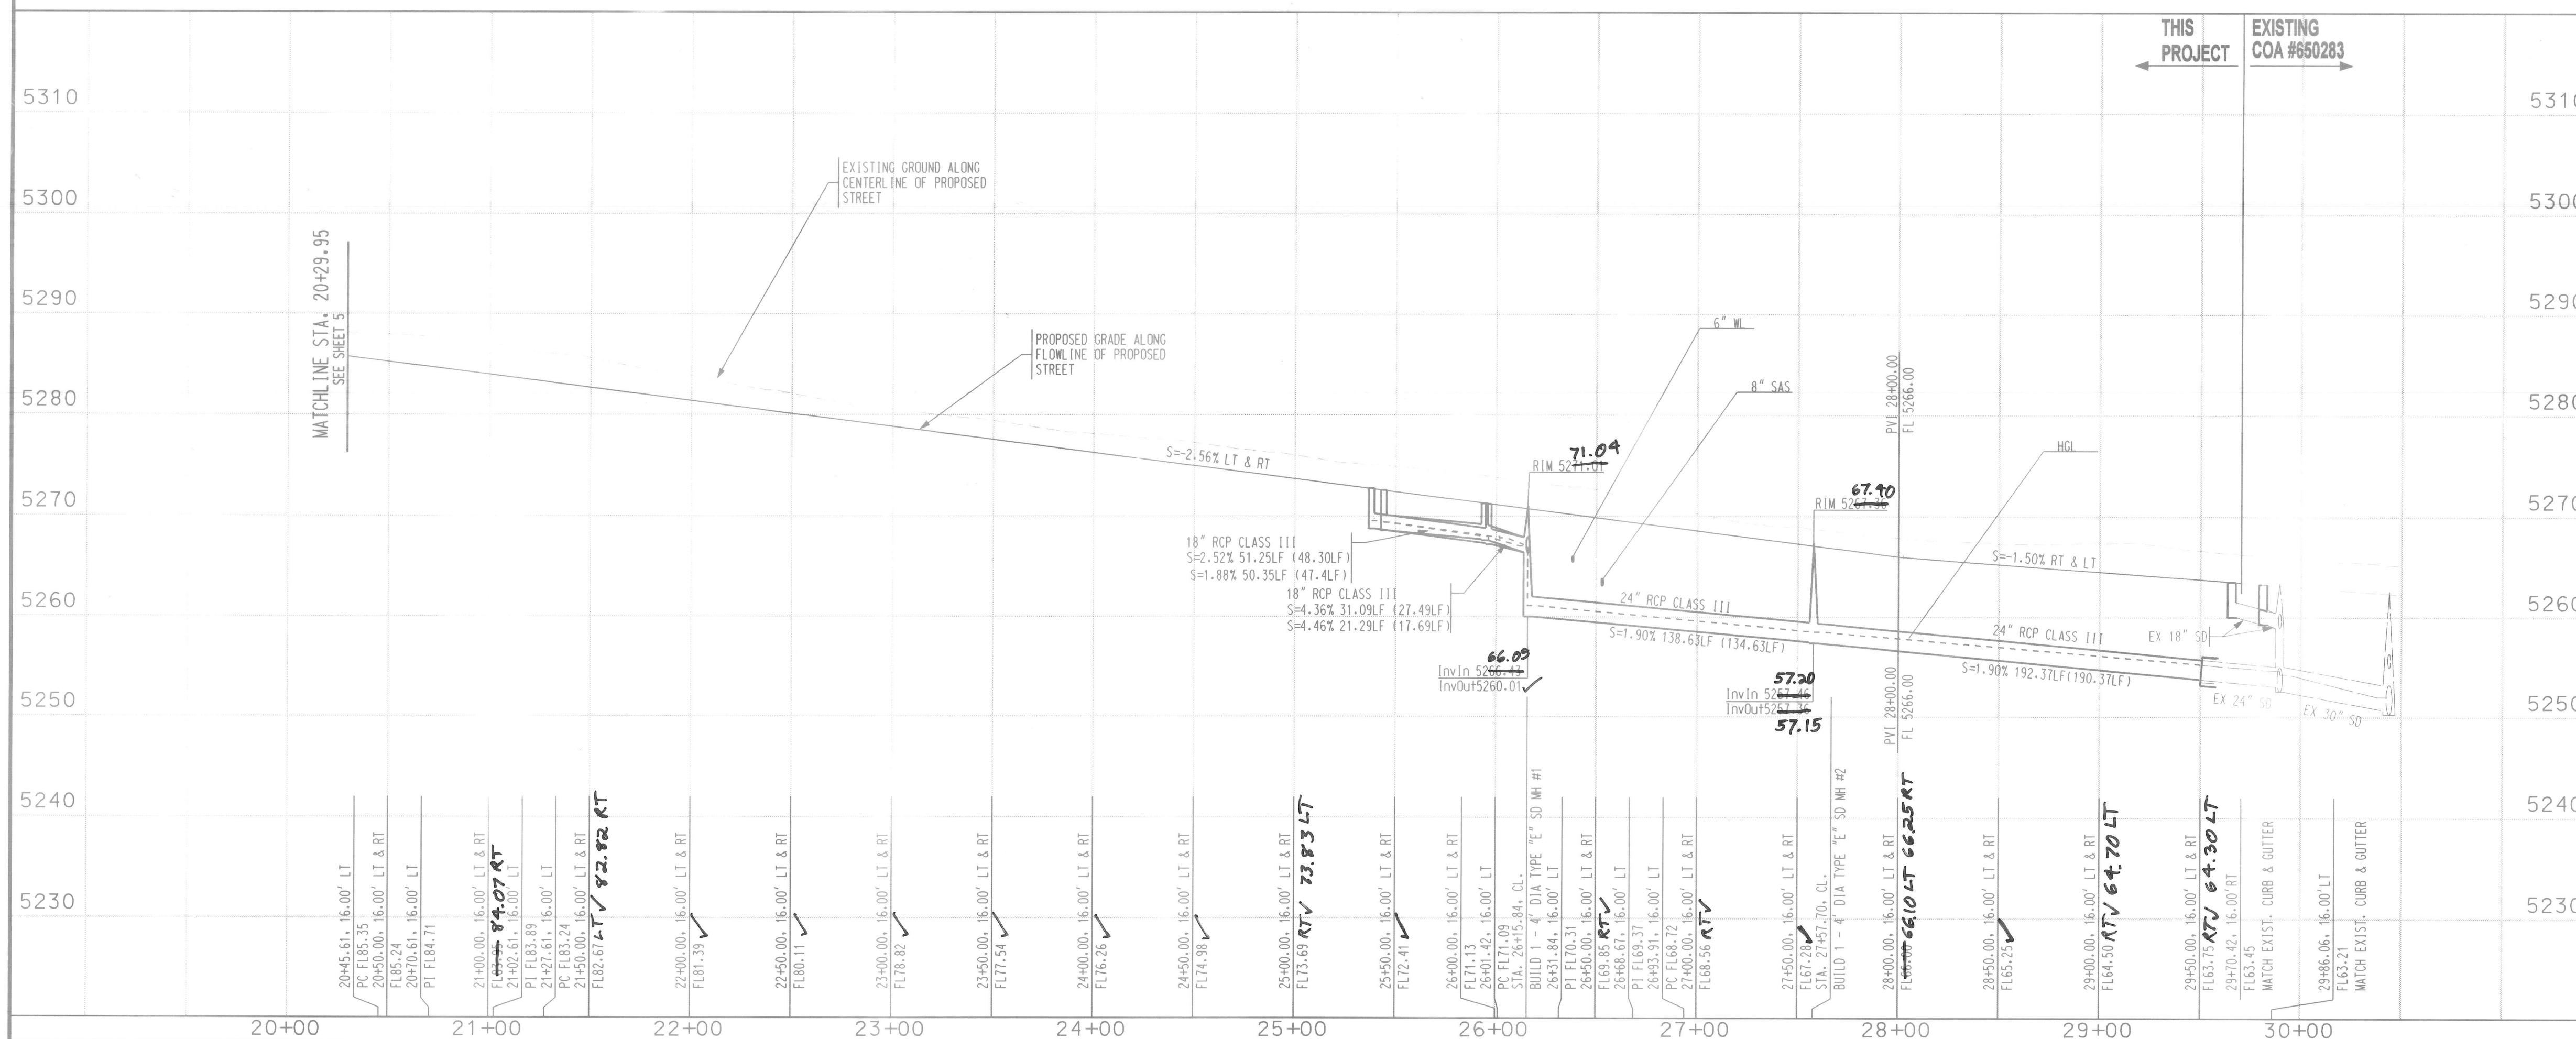

BHI JOB NO. 04 0013

SCALE: 1" = 50' (HORIZ.)
1" = 10' (VERT.)

NOTES

1. THE CONTRACTOR SHALL FIELD VERIFY ALL EXISTING UTILITY LOCATIONS AND NOTIFY THE ENGINEER IMMEDIATELY OF ANY DISCREPANCIES.
2. ALL CURB RETURN RADII SHALL BE 25' UNLESS OTHERWISE SPECIFIED.
3. ALL CURVE DATA AND DIMENSIONS REFER TO FACE OF CURB UNLESS OTHERWISE SPECIFIED.
4. GRADE ELEVATIONS, WHERE NOTED, ARE ALONG FLOWLINE OF STANDARD CURB UNLESS OTHERWISE SPECIFIED.
5. CONTRACTOR IS TO INSTALL A 4" X 4" X 5' POST AND END AT THE END OF EACH SANITARY SEWER SERVICE.
6. CONTRACTOR IS RESPONSIBLE FOR REPAIR AND/OR REPLACEMENT OF ALL UTILITY CONDUITS AND EXISTING LINES.
7. ANY ADDITIONAL GRADING REQUIRED TO MATCH PROPOSED STREET GRADES SHALL BE INCIDENTAL TO PAVING ITEMS.
8. CONTRACTOR SHALL PROVIDE THE INSPECTOR, (CITY AND PRIVATE) WITH THE PROPOSED CRYOSTATIC TESTING PLAN. THE PLAN MUST BE APPROVED BEFORE TESTING OPERATIONS BEGIN.
9. CONTRACTOR SHALL PARK EQUIPMENT AND VEHICLES AS NOT TO INTERFERE WITH NORMAL ACTIVITIES OF RESIDENTS OR OTHER CONTRACTORS ON SITE.
10. ANY DAMAGE TO THE EXISTING FACILITIES (CURB & GUTTER), PAVEMENT, CONDUITS, LANDSCAPING, UTILITY LINES, ETC.) DURING CONSTRUCTION SHALL BE REPLACED AT THE CONTRACTORS' EXPENSE.
11. REMOVAL OF THE EXISTING CURB AND GUTTER SHALL BE AS PER COA STD. DWG. 2415 (SAWCUT ONLY).
12. WHEELCHAIR RAMPS SHALL BE CONSTRUCTED PRIOR TO ACCEPTANCE OF CURB & GUTTER.
13. ALL EXCAVATION, TRENCHING AND SHORING ACTIVITIES MUST BE CARRIED OUT IN ACCORDANCE WITH OSHA 29 CFR 1926.650 SUBPART P.

KEYED GENERAL NOTES

- 1 INSTALL 6' CONCRETE VALLEY GUTTER
AS PER STD. DWG. 2420
- 2 INSTALL 12' CONCRETE VALLEY GUTTER
AS PER STD. DWG. 2422
- 3 INSTALL WHEELCHAIR RAMP AS
PER MODIFIED STD. DWG. 2441,
CASE 11 WITH ALTERNATE SECTION
AA AND AS PER DETAIL SHEET 4
- 4 CURB & GUTTER
AS PER STD. DWG. 2415A
- 5 MEDIAN CURB & GUTTER
AS PER STD. DWG. 2415B
- 6 ROLL CURB & GUTTER
AS PER STD. DWG. 2415A
- 7 DEFERRED 4' SIDEWALK
- 8 BUILD 4' SIDEWALK
N PER COA STD DWG 2430
- 9 BUILD 10' ASPHALT TRAIL
UNLESS OTHERWISE NOTED
- 10 BUILD 4" TEXTURED MEDIAN PAVEMENT
FROM MEDIAN NOSE TO 10' FROM NOSE
(A RED) MEDIAN NOSE SHALL BE PAINTED YELLOW
TO APPROX. 6" BEHIND CP/PT.

Bohannon  **Huston**^{INC.}

Courtyard I 7500 Jefferson St. NE Albuquerque, NM 87109-4335
ENGINEERING & SPATIAL DATA & ADVANCED TECHNOLOGIES







CITY OF ALBUQUERQUE
PUBLIC WORKS DEPARTMENT
ENGINEERING DEVELOPMENT GROUP

SUNDORO SUBDIVISION – UNIT 2

SONDORO SUBDIVISION - UNIT 2
PAVING PLAN & PROFILE

SUNDORO PLACE STA. 20+29.95 - 30+00.00			
APPROVE 	APPROVE 	MO./DAY/YR.	MO./DAY/YR.
		LAST DESIGN UPDATE	

CITY PROJECT NO.	650284	ZONE MAP NO.	J-8, J-9	SHEET	6	OF	13
------------------	--------	--------------	----------	-------	---	----	----

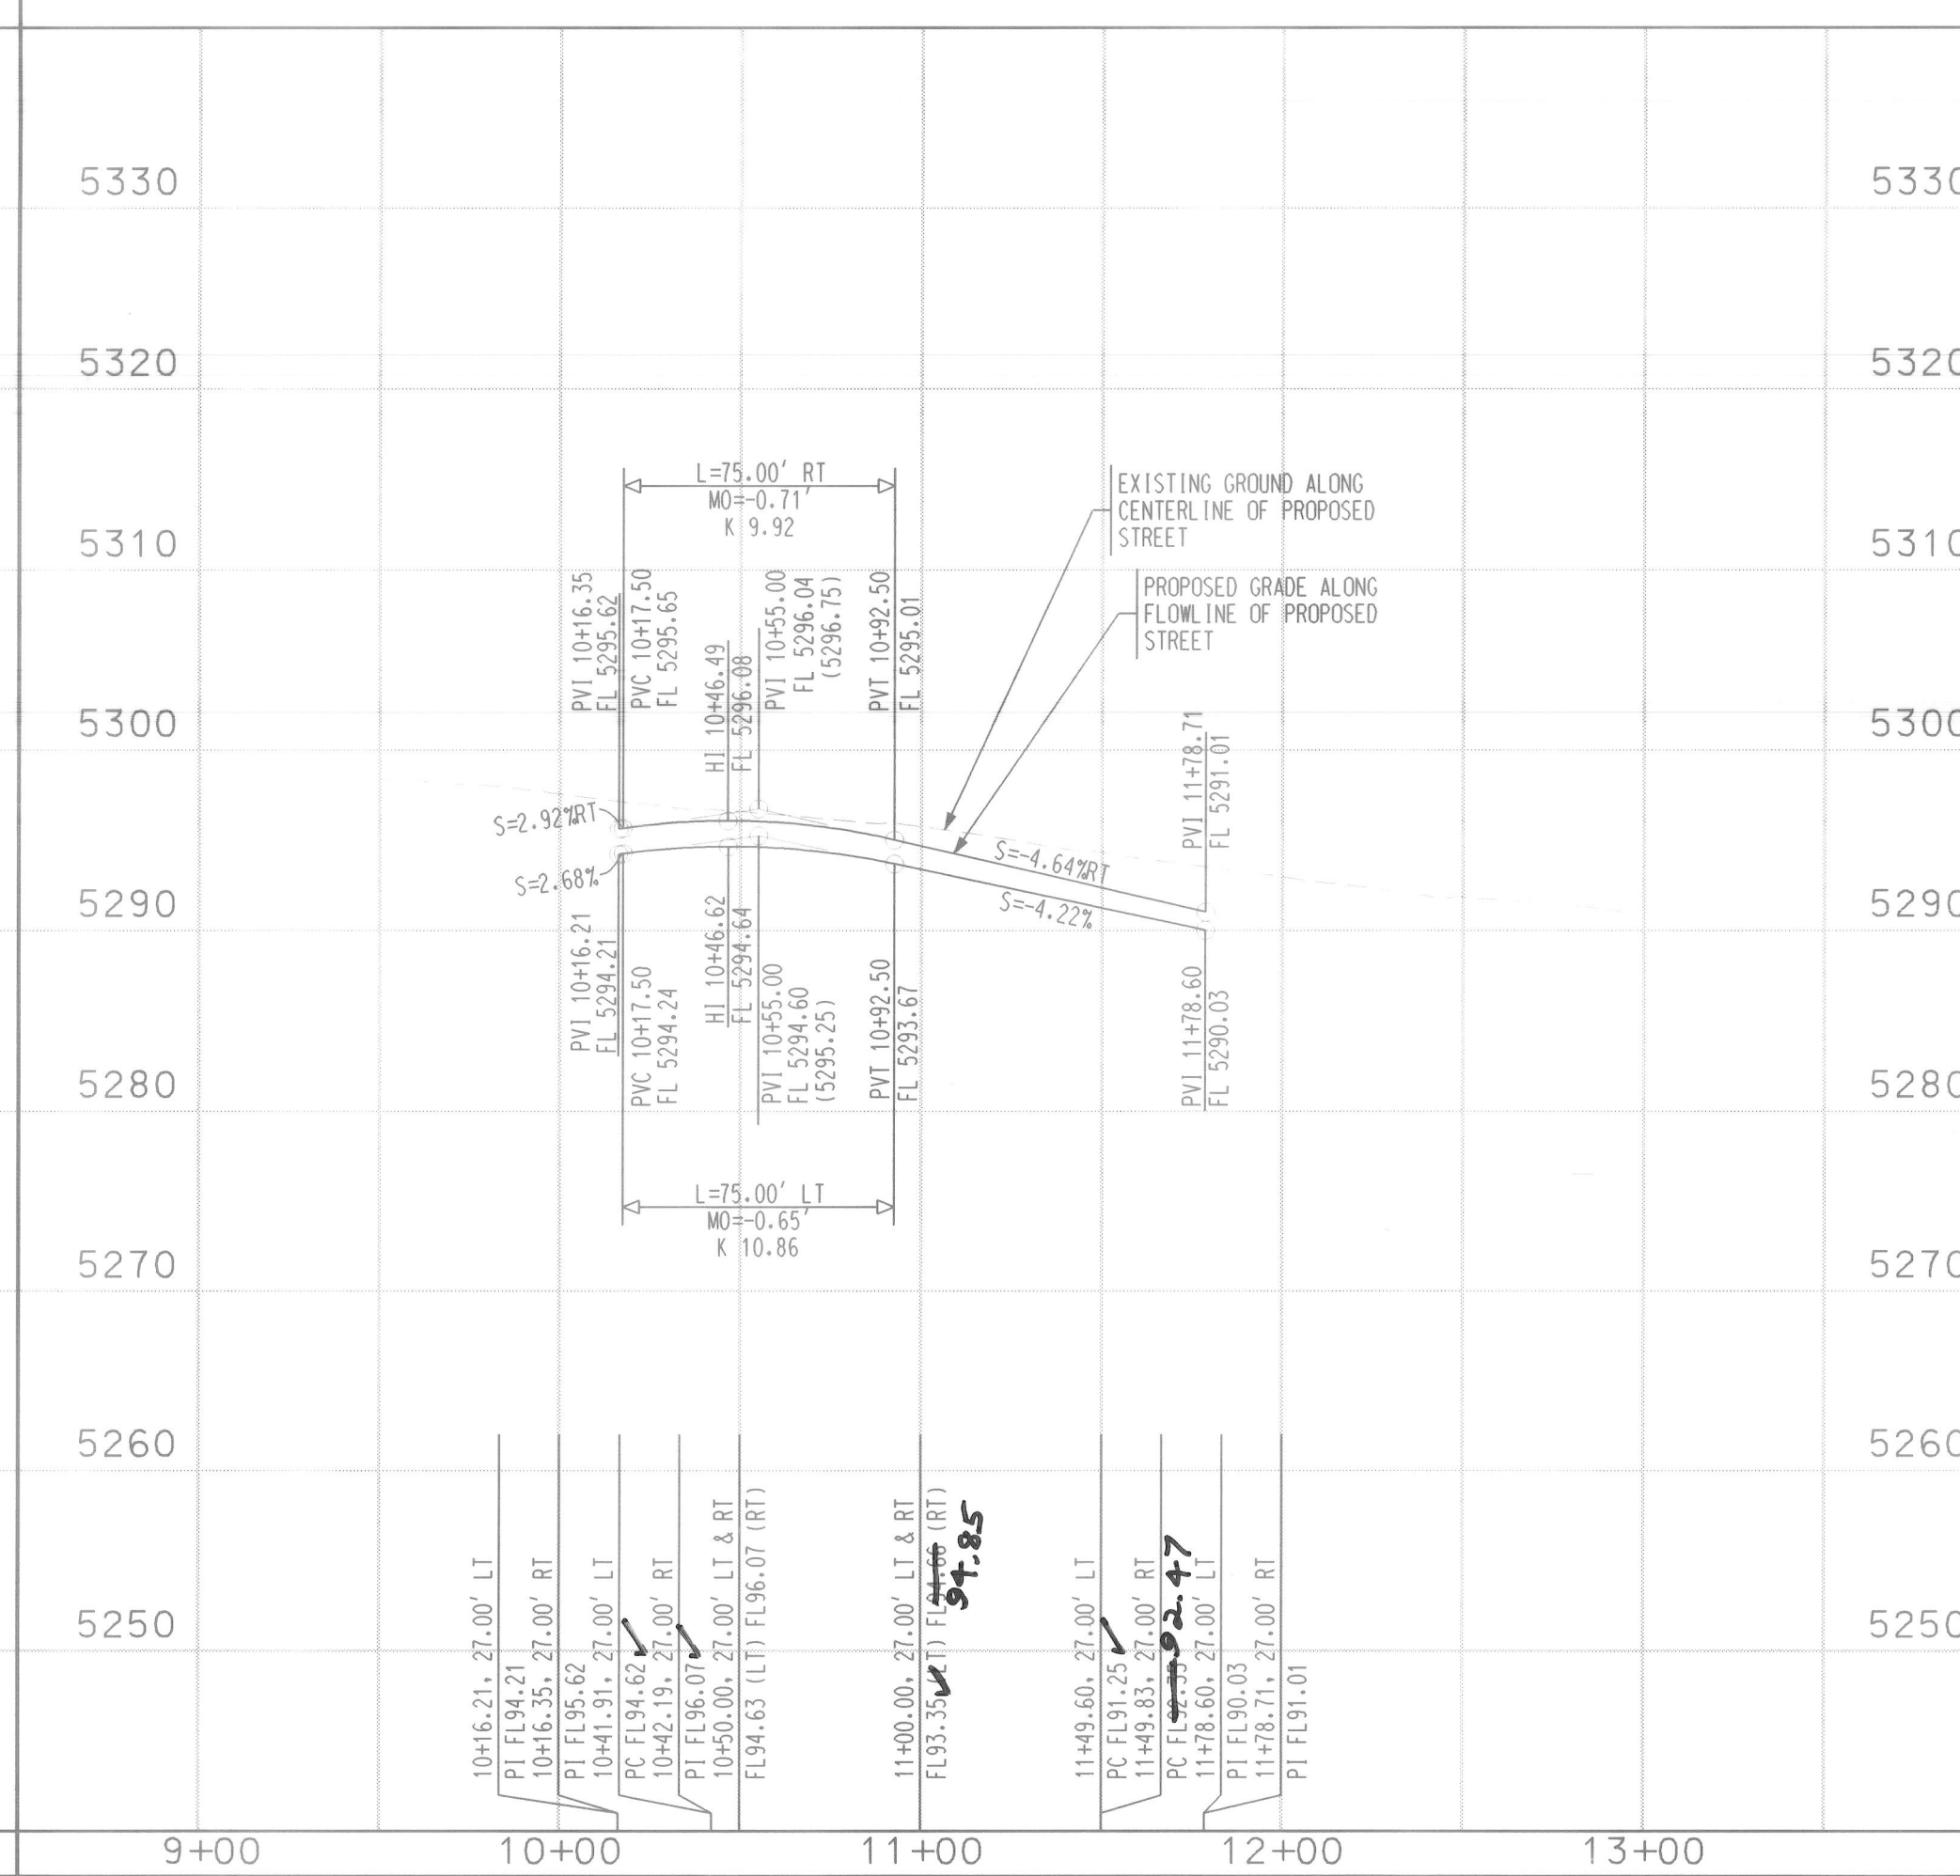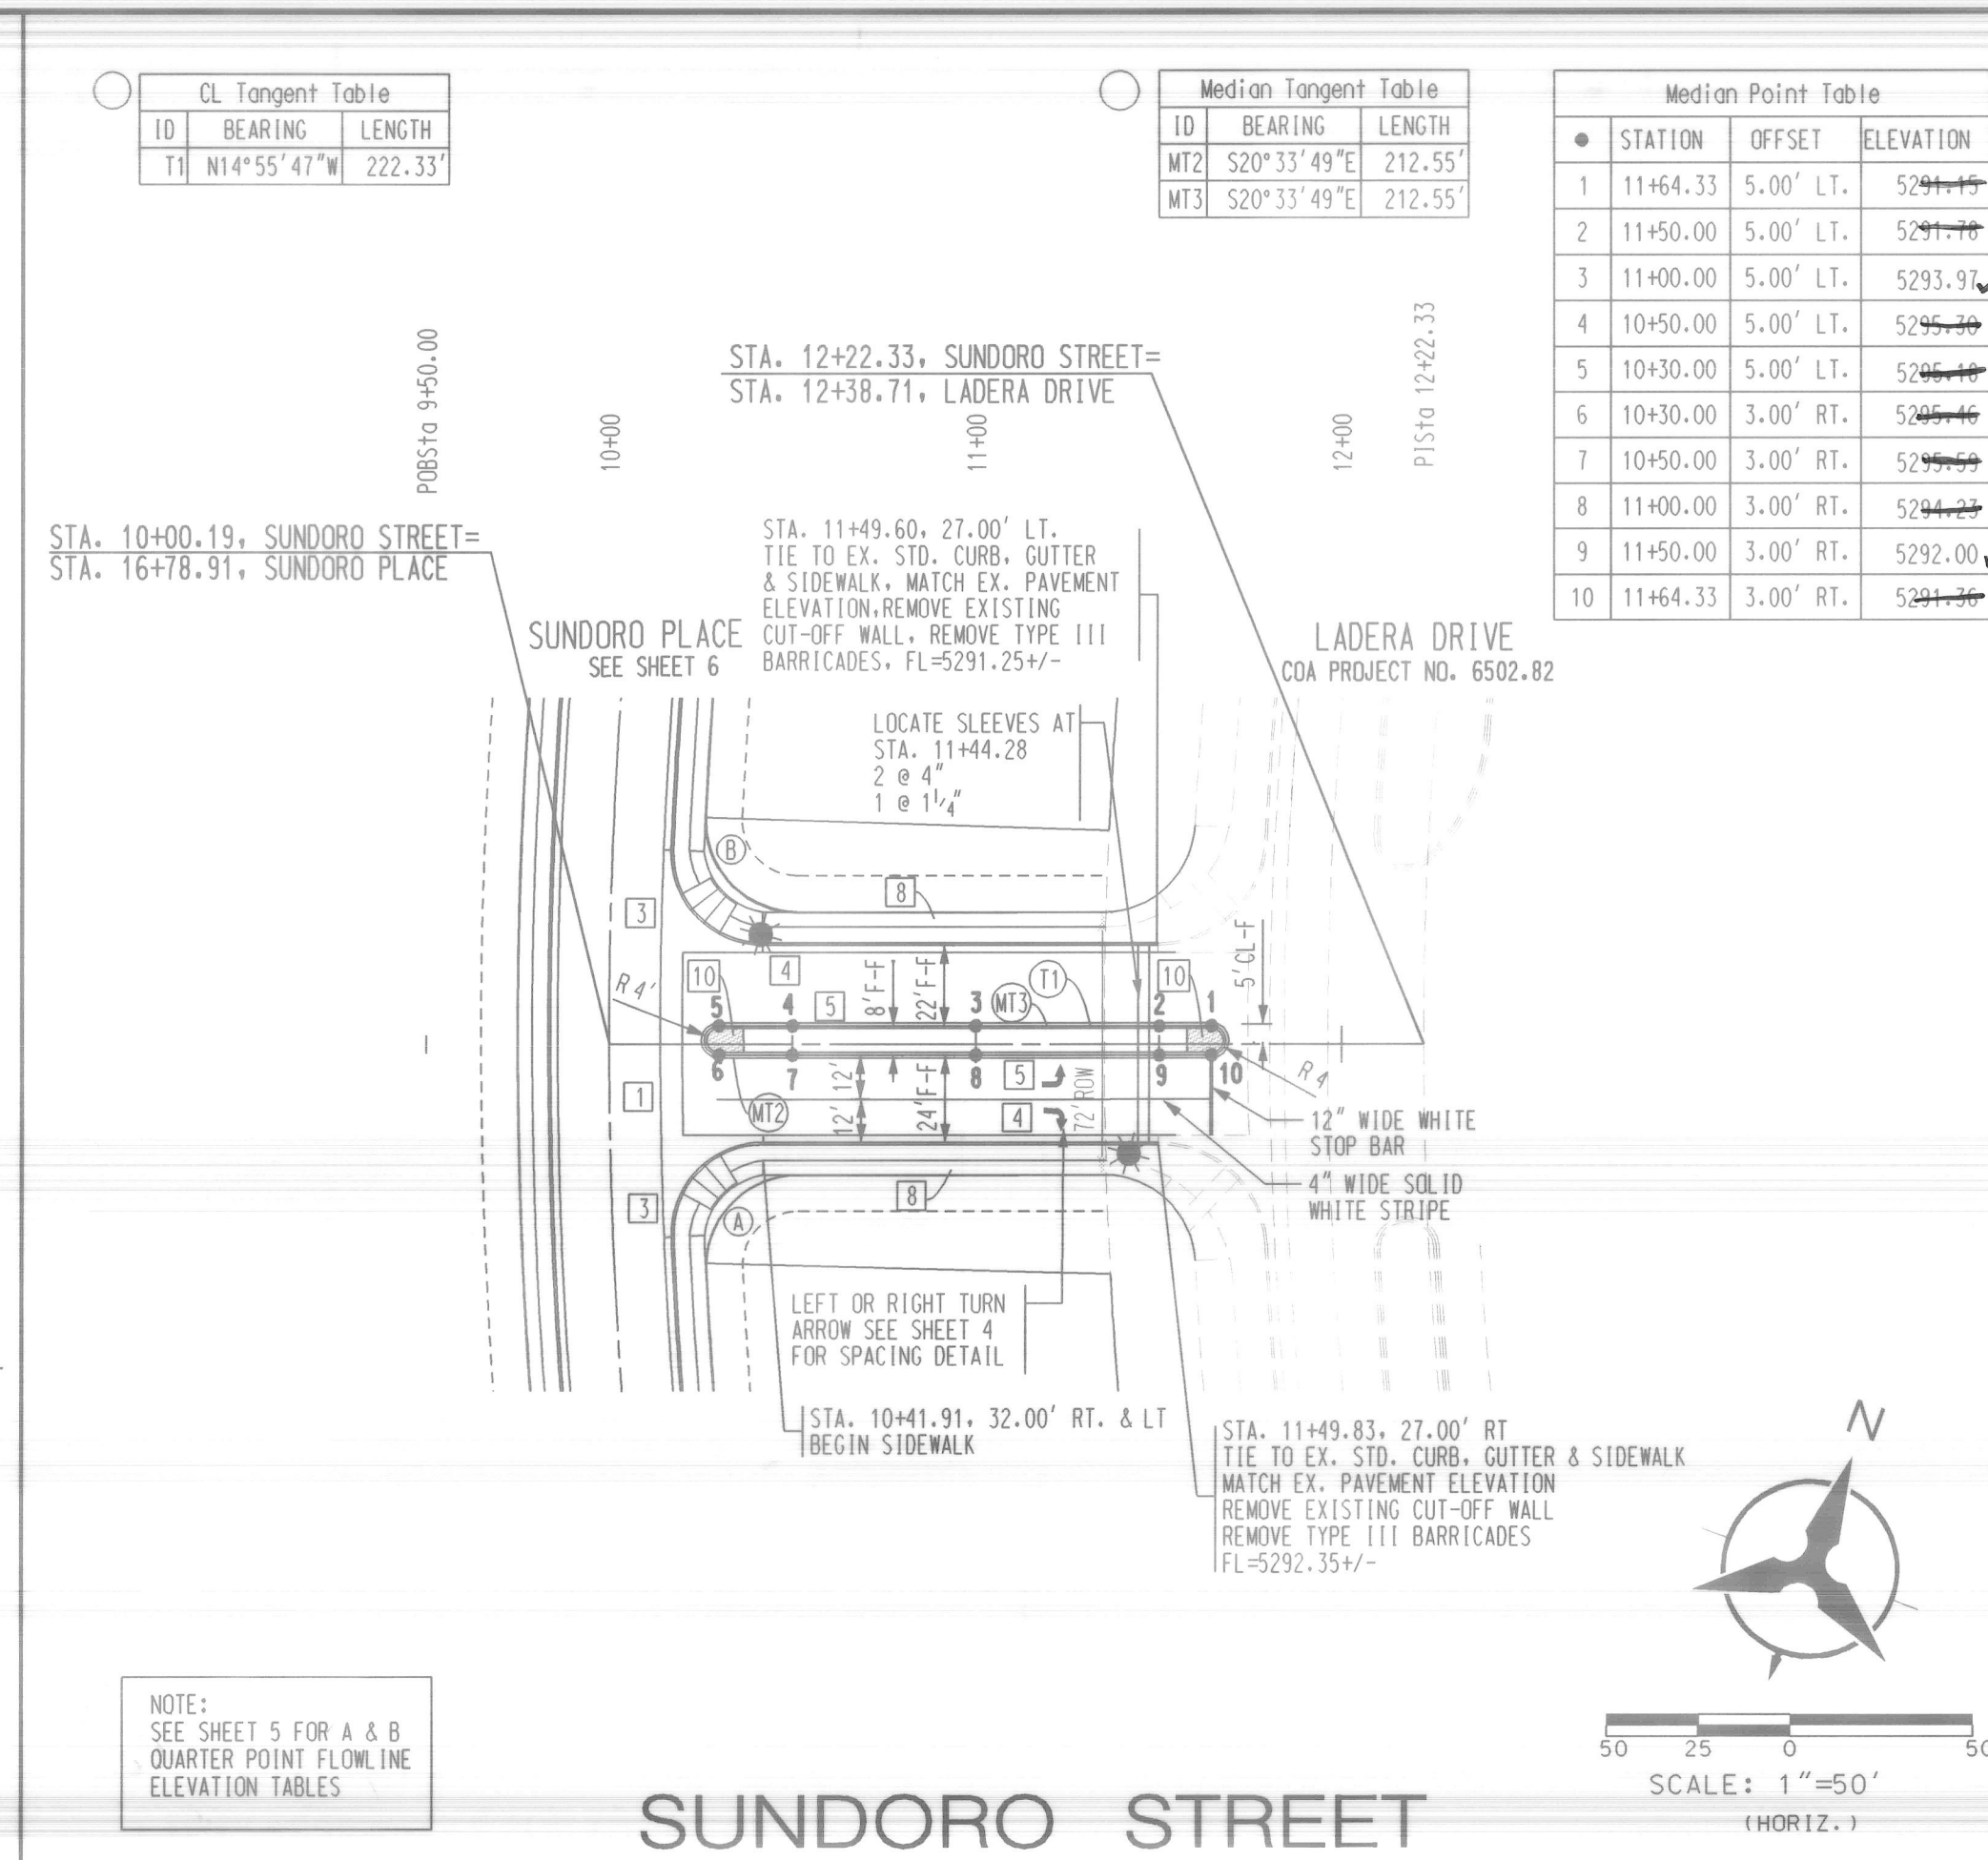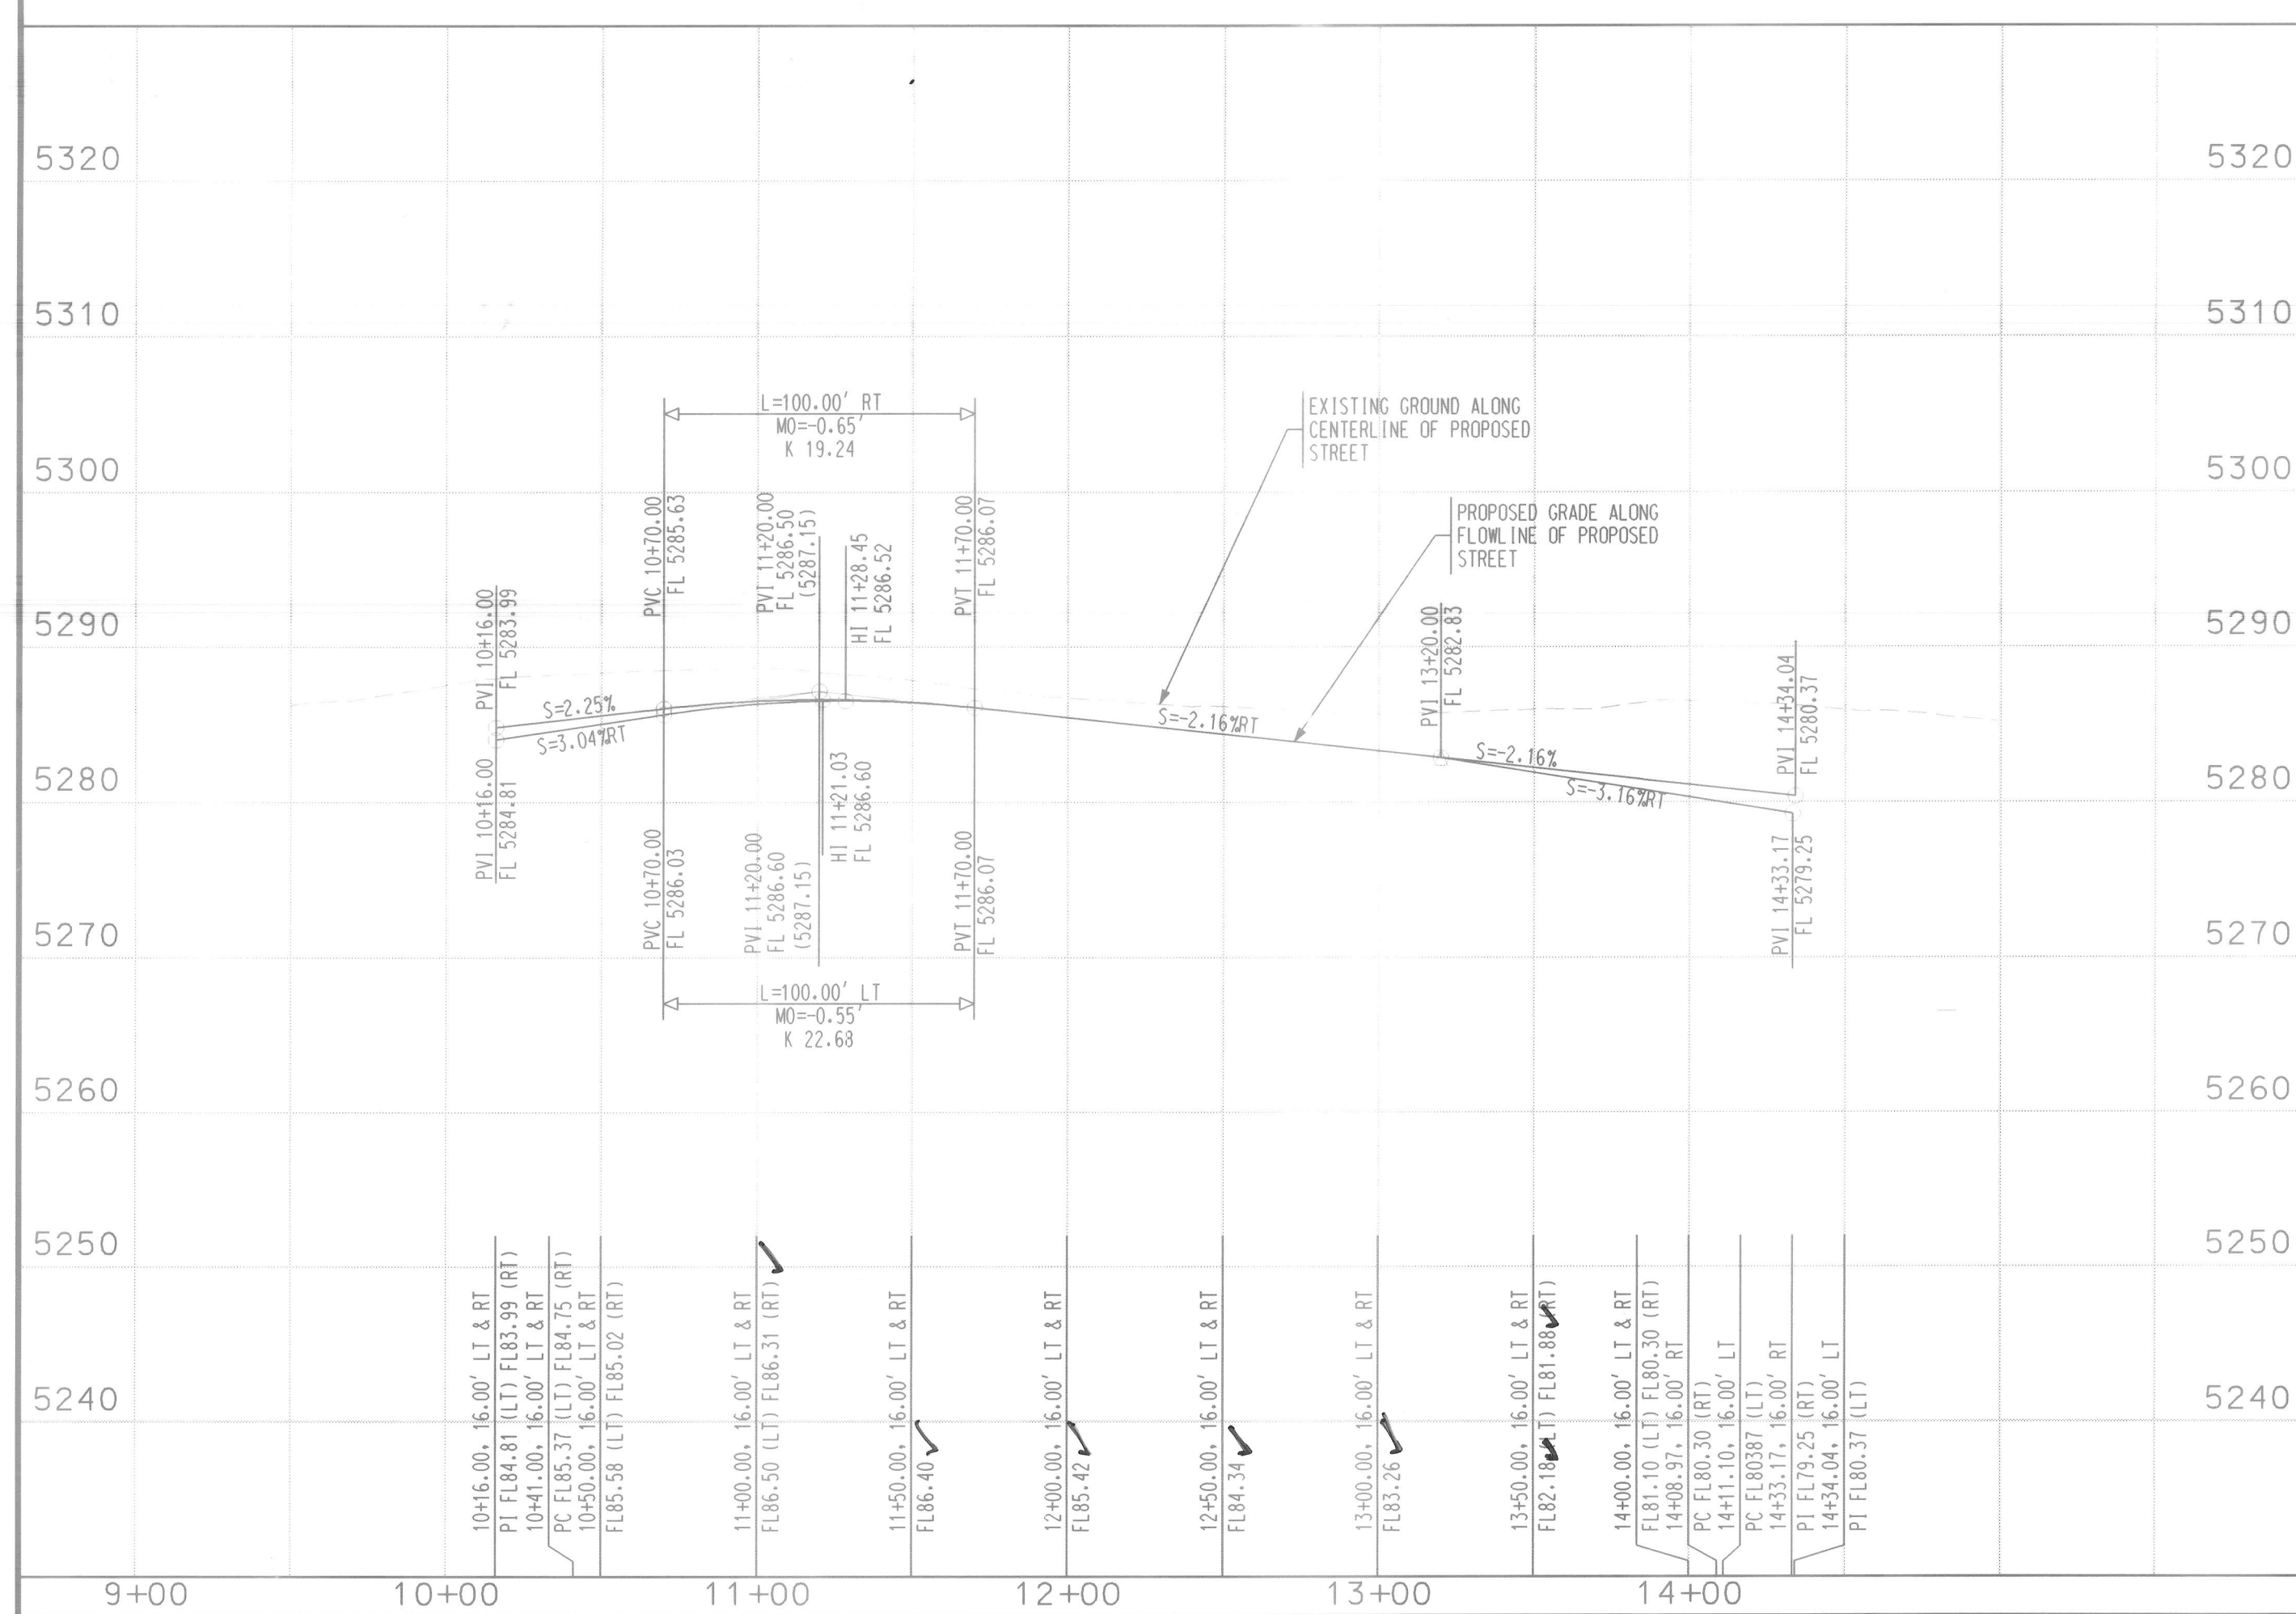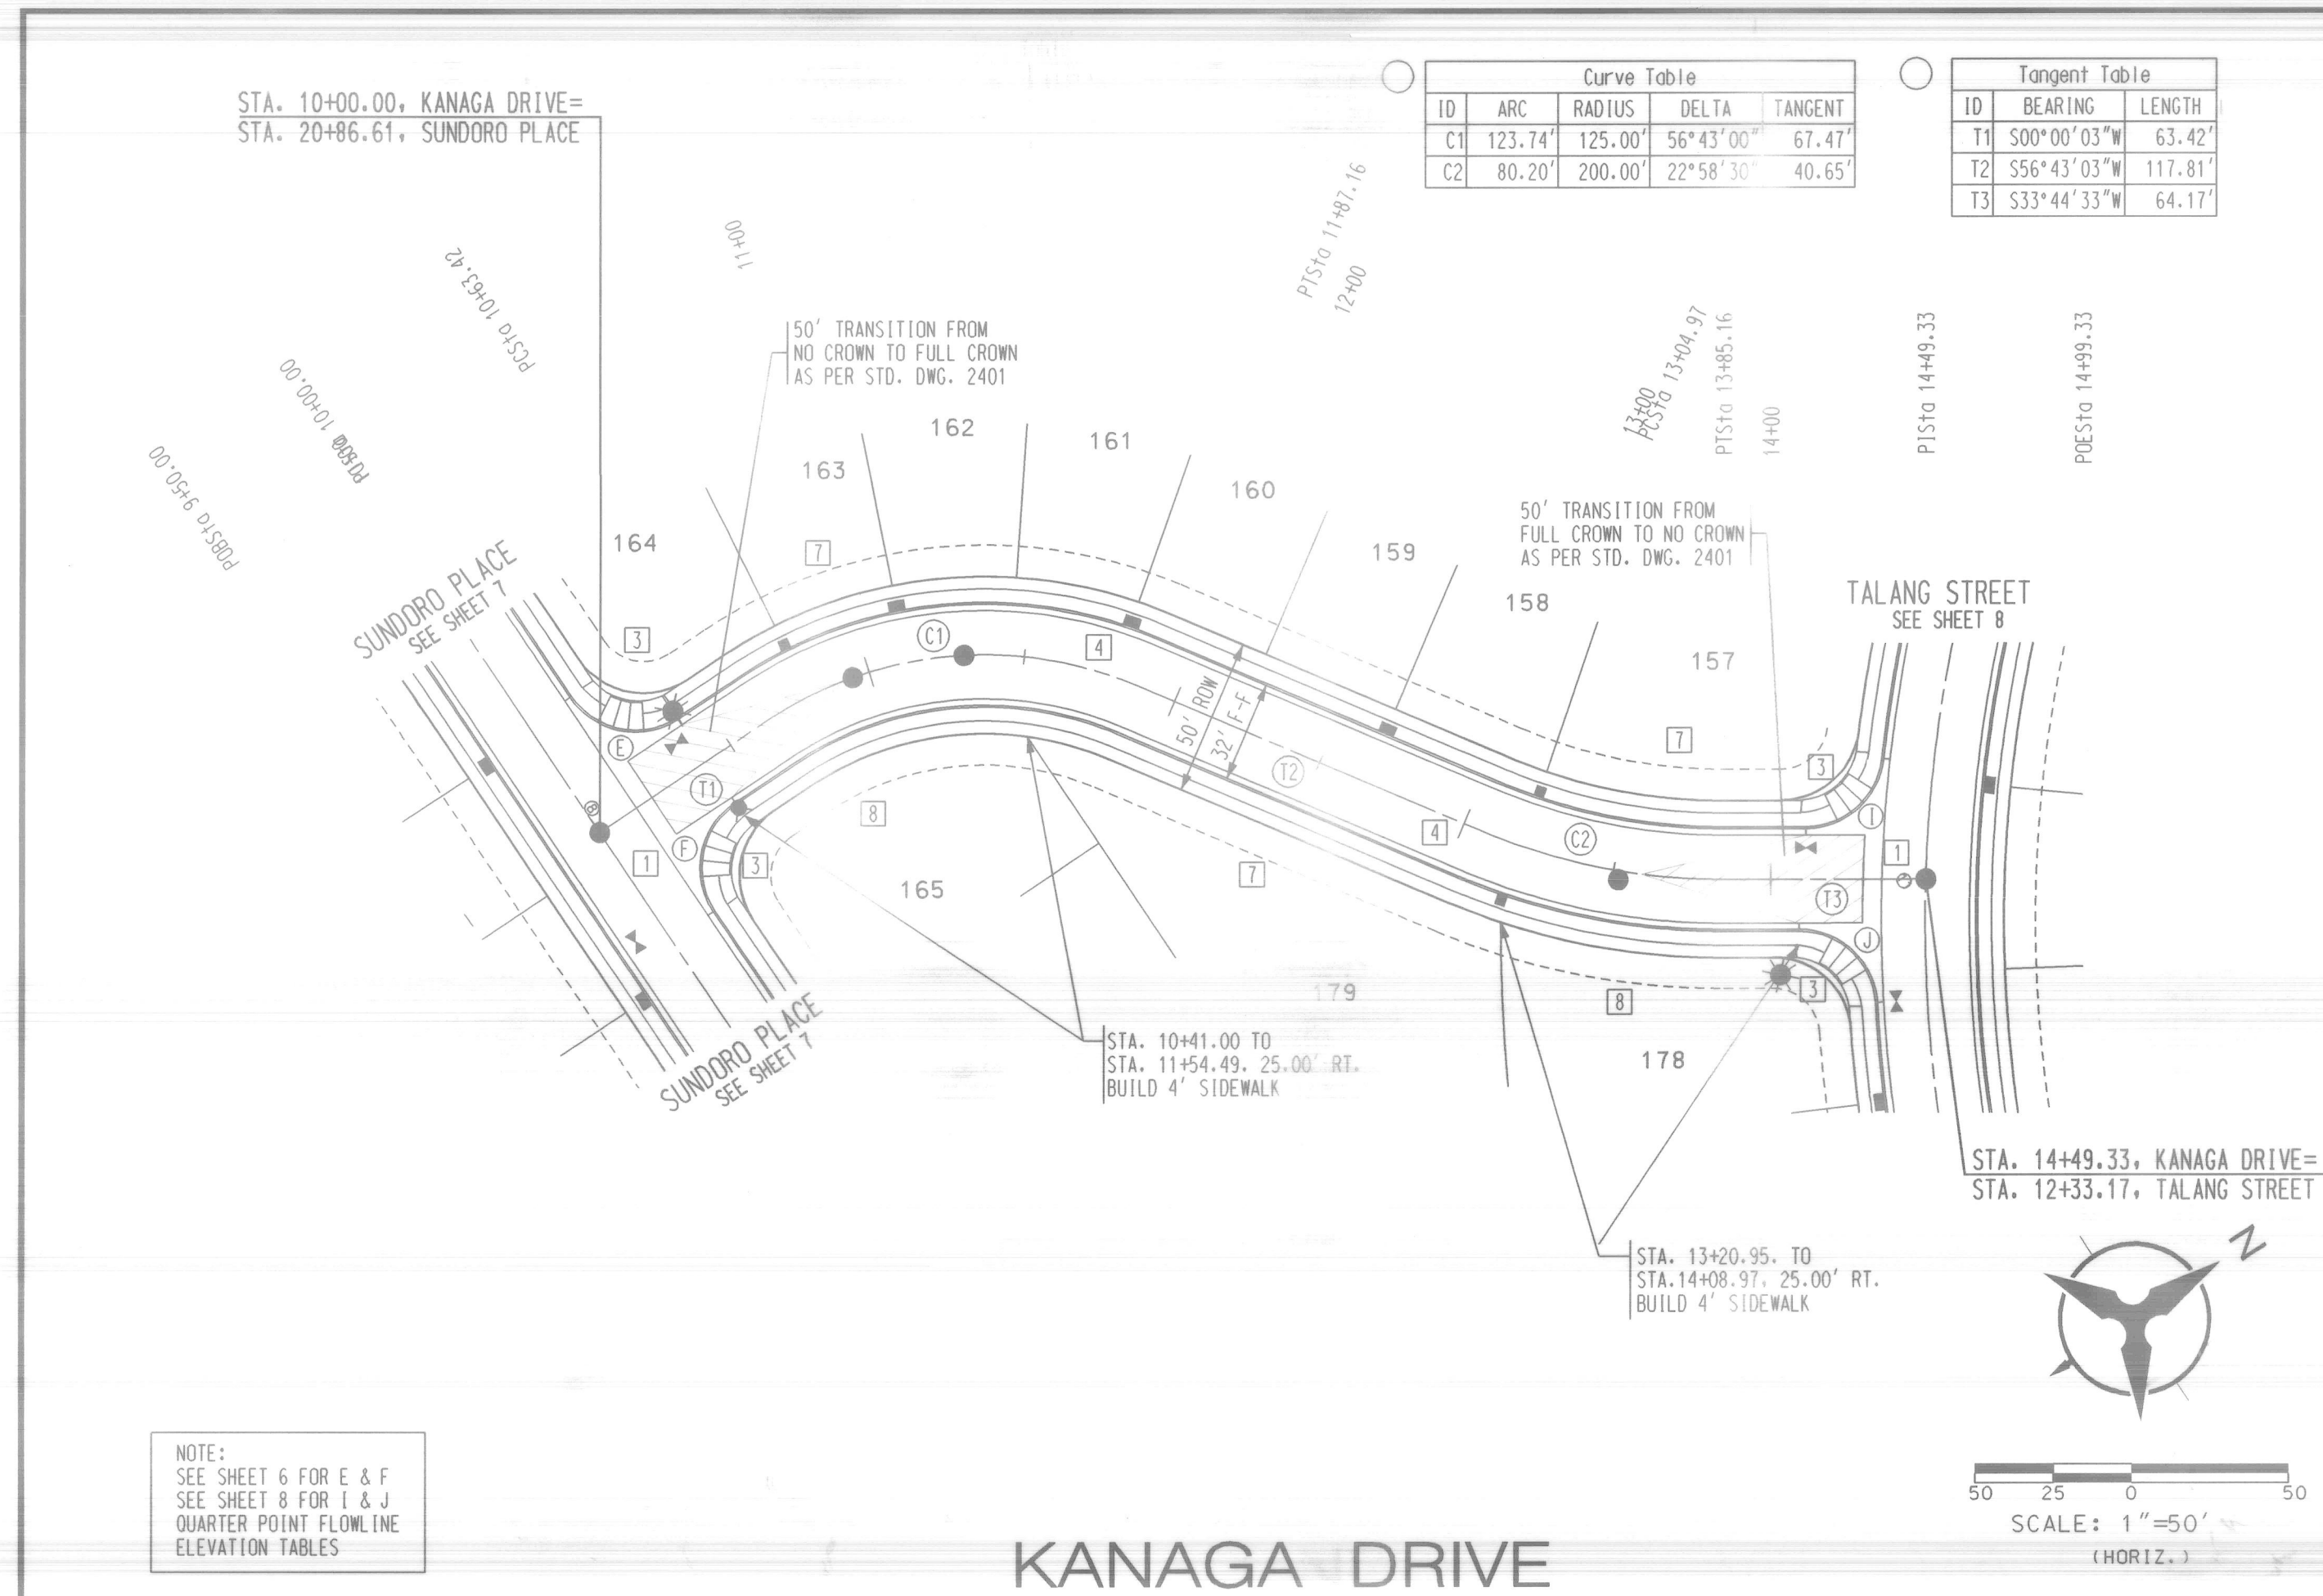

NOTES

1. THE CONTRACTOR SHALL FIELD VERIFY ALL EXISTING UTILITY LOCATIONS AND NOTIFY THE ENGINEER IMMEDIATELY OF ANY DISCREPANCIES.
2. ALL CURB RETURN RADII SHALL BE 25' UNLESS OTHERWISE SPECIFIED.
3. ALL CURVE DATA AND DIMENSIONS REFER TO FACE OF CURB UNLESS OTHERWISE SPECIFIED.
4. GRADE ELEVATIONS, WHERE NOTED, ARE ALONG FLOWLINE OF STANDARD CURB UNLESS OTHERWISE SPECIFIED.
5. CONTRACTOR IS TO INSTALL A 4" X 4" X 5' POST AND END AT THE END OF EACH SANITARY SEWER SERVICE.
6. CONTRACTOR IS RESPONSIBLE FOR REPAIR AND/OR REPLACEMENT OF ALL UTILITY CONDUITS AND EXISTING LINES.
7. ANY ADDITIONAL GRADING REQUIRED TO MATCH PROPOSED STREET GRADES SHALL BE INCIDENTAL TO PAVING ITEMS.
8. CONTRACTOR SHALL PROVIDE THE INSPECTORS, (CITY AND PRIVATE) WITH THE PROPOSED HYDROSTATIC TESTING PLAN. THE PLAN MUST BE APPROVED BEFORE TESTING OPERATIONS BEGIN.
9. CONTRACTOR SHALL PARK EQUIPMENT AND VEHICLES AS NOT TO INTERFERE WITH NORMAL ACTIVITIES OF RESIDENTS OR OTHER CONTRACTORS ON SITE.
10. ANY DAMAGE TO THE EXISTING FACILITIES (CURB & GUTTER), PAVEMENT, CONDUITS, LANDSCAPING, UTILITY LINES, ETC.) DURING CONSTRUCTION SHALL BE REPLACED AT THE CONTRACTORS' EXPENSE.
11. REMOVAL OF THE EXISTING CURB AND GUTTER SHALL BE AS PER COA STD. DWG. 2415 (SAWCUT ONLY).
12. WHEELCHAIR RAMPS SHALL BE CONSTRUCTED PRIOR TO ACCEPTANCE OF CURB & GUTTER.
13. ALL EXCAVATION, TRENCHING AND SHORING ACTIVITIES MUST BE CARRIED-OUT IN ACCORDANCE WITH OSHA 29 CFR 1926.650 SUBPART P.

KEYED GENERAL NOTES

1. INSTALL 6' CONCRETE VALLEY GUTTER AS PER STD. DWG. 2420
2. INSTALL 12' CONCRETE VALLEY GUTTER AS PER STD. DWG. 2422
3. INSTALL WHEELCHAIR RAMP AS PER MODIFIED STD. DWG. 2441, CASE II WITH ALTERNATE SECTION AA AND AS PER DETAIL SHEET 4
4. STD. CURB & GUTTER AS PER STD. DWG. 2415A
5. MEDIAN CURB & GUTTER AS PER STD. DWG. 2415B
6. ROLL CURB & GUTTER AS PER STD. DWG. 2415A
7. DEFERRED 4' SIDEWALK
8. BUILD 4' SIDEWALK N PER COA STD DWG 2430
9. BUILD 10' ASPHALT TRAIL UNLESS OTHERWISE NOTED
10. BUILD 4" TEXTURED MEDIAN PAVEMENT FROM MEDIAN NOSE TO 10' FROM NOSE (BAJA RED) PER STD DWG 2408. MEDIAN NOSES SHALL BE PAINTED YELLOW TO APPROX. 6' BEHIND PC/PT.

AS-BUILT INFORMATION

CONTRACTOR: **Michael Cortez**
 STAKED BY: **Frederick Surveys**
 DATE: **04-24-2004**
 ACCEPTANCE BY: **SSC**
 DATE: **05-04-2004**
 FIELD LOCATION BY: **Frederick Surveys**
 DATE: **05-04-2004**
 DRAWINGS CORRECTED BY: **SSC**
 DATE: **05-04-2004**

BENCH MARKS

ACS STATION MARKED 4 - 46.3 3 - 1/4" ALUM. CAP

NO. 1 BY DATE

NO. 2 BY DATE

NO. 3 BY DATE

NO. 212 BY DATE


NO. 213 BY DATE

NO. 214 BY DATE

NO. 215 BY DATE

NO. 216 BY DATE


NO

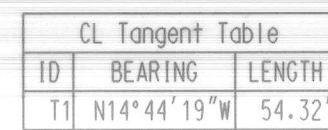

ID	ARC	RADIUS	DELTA	TANGENT
C1	314.34°	450.00'	40°01'24"	163.89'
C2	19.79°	1165.41'	00°58'23"	9.90'
C3	119.84°	300.00'	22°53'14"	60.73'
C4	70.39°	990.00'	04°04'25"	35.74'
C5	141.36°	250.00'	32°23'47"	72.62'

	FL		FL
1	81.15	①	78.94
2	81.06	②	79.30
3	80.96	③	79.66
D = 83°43'19"		D = 86°41'42"	
L = 36.53'		L = 37.83'	
R = 25.00'		R = 25.00'	

NOTE:
SEE SHEET 6 FOR
QUARTER POINT FLOWLINE
ELEVATION TABLES FOR G & H

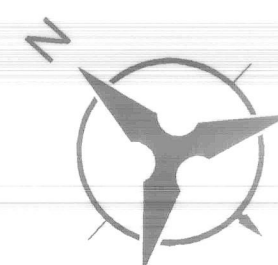

50 25 0 50
SCALE: 1"=50'
(HORIZ.)

5240



NOTES

1. THE CONTRACTOR SHALL FIELD VERIFY ALL EXISTING UTILITY LOCATIONS AND NOTIFY THE ENGINEER IMMEDIATELY OF ANY DISCREPANCIES.
2. ALL CURB RETURN RADI SHALL BE 25' UNLESS OTHERWISE SPECIFIED.

ALL CURVE DATA AND DIMENSIONS REFER TO FACE OF CURB UNLESS OTHERWISE SPECIFIED.
4. GRADE ELEVATIONS, WHERE NOTED, ARE ALONG FLOWLINE OF STANDARD CURB UNLESS OTHERWISE SPECIFIED.
5. CONTRACTOR IS TO INSTALL A 4" x 4" x 5' POST AND END AT THE END OF EACH SANITARY SEWER SERVICE.
6. CONTRACTOR IS RESPONSIBLE FOR REPAIR AND/OR REPLACEMENT OF ALL UTILITY CONDUITS AND EXISTING LINES.
7. ANY ADDITIONAL GRADING REQUIRED TO MATCH PROPOSED STREET GRADES SHALL BE INCIDENTAL TO PAVING ITEMS.
8. CONTRACTOR SHALL PROVIDE THE INSPECTORS, (CITY AND PRIVATE) WITH THE PROPOSED HYDROSTATIC TESTING PLAN. THE PLAN MUST BE APPROVED BEFORE TESTING OPERATIONS BEGIN.
9. CONTRACTOR SHALL PARK EQUIPMENT AND VEHICLES AS NOT TO INTERFERE WITH NORMAL ACTIVITIES OF RESIDENTS OR OTHER CONTRACTORS ON SITE.
10. ANY DAMAGE TO THE EXISTING FACILITIES (CURB & GUTTER), PAVEMENT, CONDUITS, LANDSCAPING, UTILITY LINES, ETC.) DURING CONSTRUCTION SHALL BE REPLACED AT THE CONTRACTORS' EXPENSE.
11. REMOVAL OF THE EXISTING CURB AND GUTTER SHALL BE AS PER COA STD. DWG. 2415 (SAWCUT ONLY).
12. WHEELCHAIR RAMPS SHALL BE CONSTRUCTED PRIOR TO ACCEPTANCE OF CURB & GUTTER.
13. ALL EXCAVATION, TRENCHING AND SHORING SHALL BE CARRIED-OUT IN ACCORDANCE WITH OSHA 29 CFR 1926.650 SUBPART P.

KEYED GENERAL NOTES

1. INSTALL 6' CONCRETE VALLEY GUTTER
AS PER STD. DWG. 2420
2. INSTALL 12' CONCRETE VALLEY GUTTER
AS PER STD. DWG. 2422
3. INSTALL WHEELCHAIR RAMP AS
PER MODIFIED STD. DWG. 2441,
CASE 11 WITH ALTERNATE SECTION
AA AND AS PER DETAIL SHEET 4
4. STD. CURB & GUTTER
AS PER STD. DWG. 2415A
5. MEDIAN CURB & GUTTER
AS PER STD. DWG. 2415B
6. ROLL CURB & GUTTER
AS PER STD. DWG. 2415A
7. DEFERRED 4' SIDEWALK
8. BUILD 4' SIDEWALK N
PER COA STD DWG 2430
9. BUILD 10' ASPHALT TRAIL
UNLESS OTHERWISE NOTED
10. BUILD 4" TEXTURED MEDIAN PAVEMENT
FROM MEDIAN NOSE TO 10' FROM NOSE
(BAJA RED) N DWG 2408
MEDIAN NOSES SHALL BE PAINTED YELLOW
TO APPROX. 6' BEHIND CP/PT.



CITY OF ALBUQUERQUE
PUBLIC WORKS DEPARTMENT
ENGINEERING DEVELOPMENT GROUP

SUNDORO SUBDIVISION – UNIT 2
PAVING PLAN & PROFILE
TALANG STREET

DESIGN REVIEW COMMITTEE

APPROVED

MAR 11 2004

DESIGN
REVIEW COMMITTEE

CITY ENGINEER APPROVAL
APPROVED
APR 26 2004
CITY ENGINEER

LAST DESIGN
UPDATE

MO

DAY,

YR.	

MO. /

AY/Y

6	

P:\040013\cdp\pnp\Unit 2\040013pnp09.dgn
P:\040013\cdp\pnp\Unit 2\040013pnp09.dgn
12-JAN-2004
08:07

BHI JOB NO. 04 0013

SCALE: 1" = 50' (HORIZ.)
1" = 10' (VERT.)


CITY PROJECT NO.

ZONE MAP NO

SHEET

OF

SCANNED BY
PLANNING

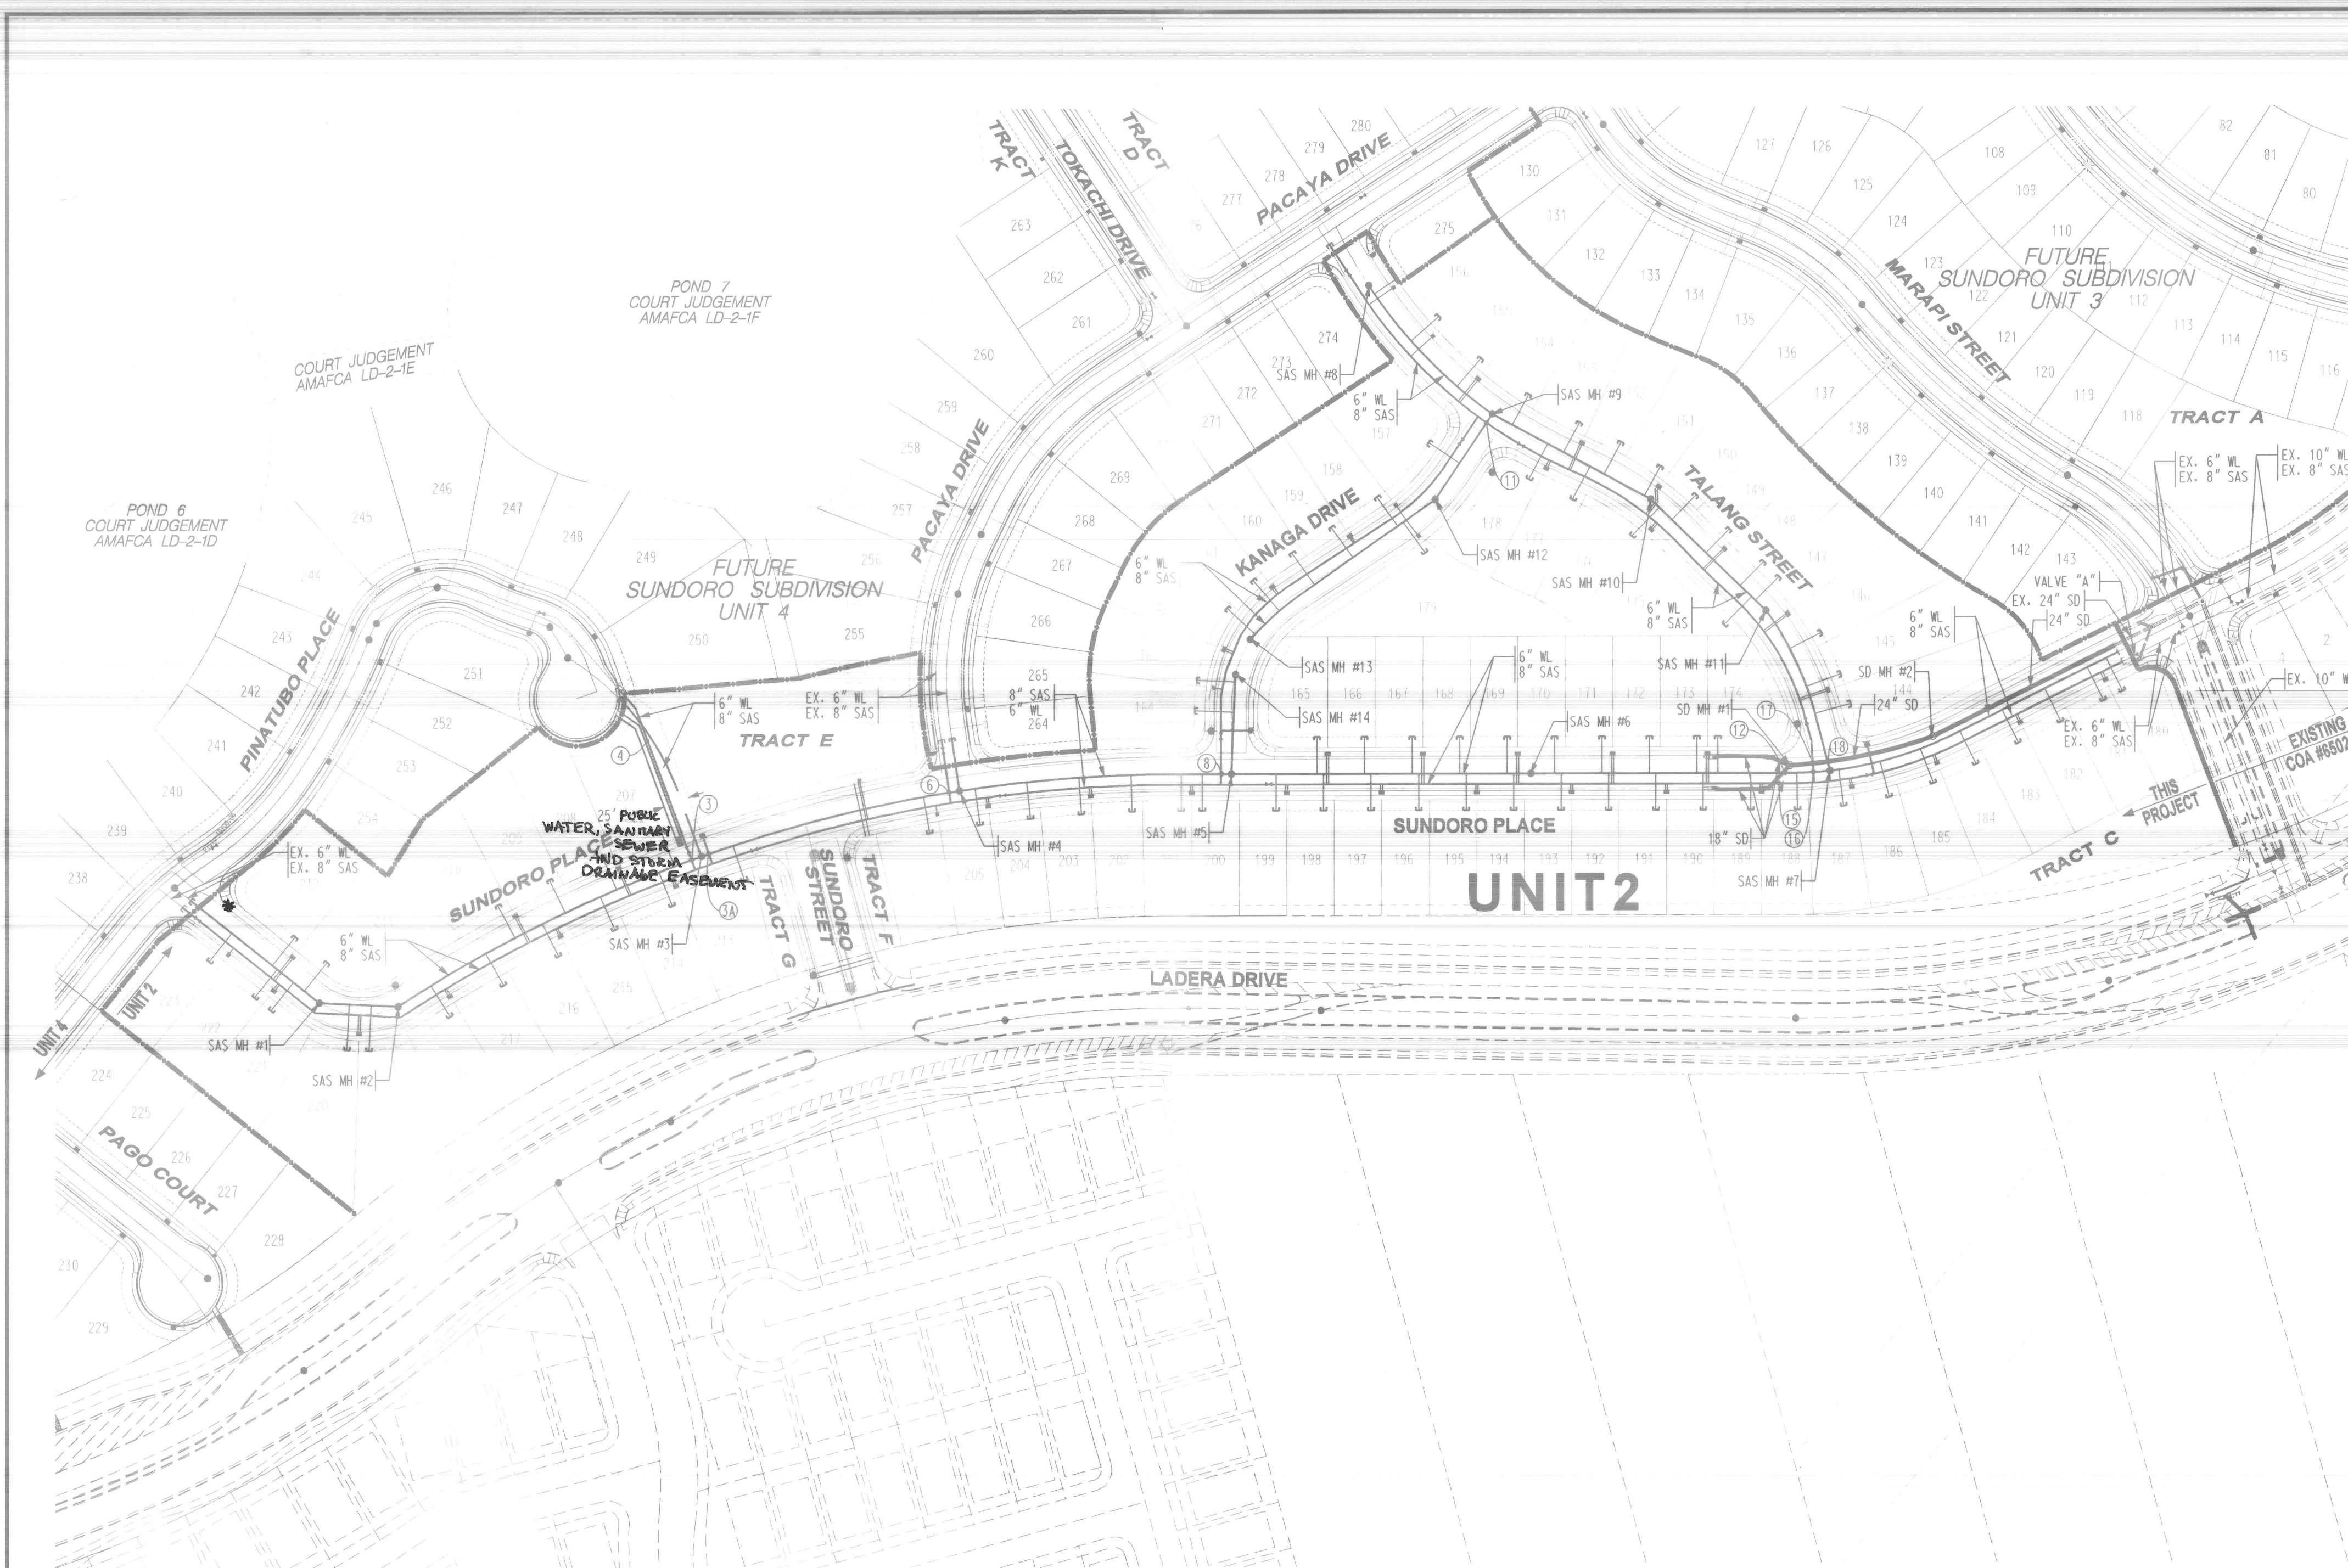

UNIT 2 CROSSINGS				
DES	SAS	SD	WL	Clearance
3	8" TP 90.72 8" INV 90.00	-----	6" TP 95.16 6" INV 94.62	3.89
3A	8" TP 90.29 8" INV 89.57	-----	6" TP 94.38 6" INV 93.84	3.55
4	8" TP 94.96 8" INV 94.24	-----	6" TP 99.23 6" INV 98.69	3.73
6	8" TP 84.33 8" INV 83.61	-----	6" TP 88.46 6" INV 87.92	3.59
8	8" TP 77.70 8" INV 76.98	-----	6" TP 81.89 6" INV 81.34	3.64
11	8" TP 72.95 8" INV 72.23	-----	6" TP 76.98 6" INV 76.44	3.49
12	8" TP 64.61 8" INV 63.89	18" TP 68.47 18" INV 66.55	-----	1.94
15	-----	18" TP 69.08 18" INV 67.16	6" TP 65.61 6" INV 65.07	1.55
16	8" TP 63.96 8" INV 63.24	-----	6" TP 66.21 6" INV 65.67	1.71
17	-----	24" TP 61.89 24" INV 59.39	6" TP 66.33 6" INV 65.79	3.90
18	8" TP 63.81 8" INV 63.09	24" TP 61.61 24" INV 59.11	-----	##1.47

CONTRACTOR SHALL COORDINATE WITH ALL WET AND DRY UTILITY COMPANIES FOR EXACT LOCATIONS OF UTILITIES PRIOR TO ANY WORK WITHIN LADERA DRIVE. CONTRACTOR SHALL CONTACT ENGINEER IMMEDIATELY UPON THE DISCOVERY OF ANY DISCREPANCIES.

- GATE VALVES AND BOXES AS PER COA STD DWGS 2326 & 2328
- WATER METERS AND SERVICES AS PER COA STD DWG 2362
- SANITARY SEWER SERVICES AS PER COA STD DWG 2125
- SEE SPECIFICATIONS FOR WATER & SANITARY SEWER SERVICE INSTALLATION

CONTRACTOR WILL BE RESPONSIBLE FOR THE TIMING AND COORDINATION OF THE WATER SHUT-OFF REQUIREMENTS IN CONJUNCTION WITH THE COMPLETION OF THE PROJECT.

AT LEAST SEVEN (7) WORKING DAYS PRIOR TO CONSTRUCTION, THE CONTRACTOR SHALL CONTACT PW/UTILITY SYSTEM DIV. (1857-8200) TO INITIATE IMPLEMENTATION OF THIS WATER SHUT-OFF PLAN. CONTRACTOR SHALL NOT OPERATE CITY VALVES. WATER SHUT-OFF REQUIREMENTS:

WATER SHUT-OFF PLAN:

1. 8" NON-PRESSURE CONNECTION TO THE EXISTING 8" STUB-OUT IN SUNDORO PLACE @ MARAPI ST. BUILT WITH CPN 650283

NOTE: VALVE "A" IS NOT SHOWN ON THE COA AUTOMATED WATER DISTRIBUTION SYSTEM SECTIONAL MAPS, AND FOR THIS REASON ARE LABELED AS SUCH FOR THIS PLAN ONLY. THE CONTRACTOR SHALL COORDINATE THE SHUT-OFF PLAN WITH THE OWNER.

CLOSE VALVE
VALVE "A"

LEGEND

- PROPOSED PHASE BOUNDARY
- PROPOSED SANITARY SEWER MANHOLE
- EXISTING SANITARY SEWER MANHOLE
- PROPOSED FIRE HYDRANT
- EXISTING FIRE HYDRANT
- PROPOSED GATE VALVE
- EXISTING GATE VALVE
- PROPOSED SANITARY SEWER LINE
- EXISTING SANITARY SEWER LINE
- PROPOSED WATER LINE
- EXISTING WATER LINE
- PROPOSED SANITARY SEWER SERVICE
- PROPOSED WATER METER SERVICE

Bohannon Huston

Courtyard I 7500 Jefferson St. NE Albuquerque, NM 87109-4335
ENGINEERING • SPATIAL DATA • ADVANCED TECHNOLOGIES


CITY OF ALBUQUERQUE
PUBLIC WORKS DEPARTMENT
ENGINEERING DEVELOPMENT GROUP

SUNDORO SUBDIVISION UNIT 2 OVERALL UTILITY PLAN


DESIGN REVIEW COMMITTEE APPROVED MAR 11 2004	CITY ENGINEER APPROVAL APPROVED APR 26 2004	MO./DAY/YR.	MO./DAY/YR.
DESIGN REVIEW COMMITTEE	CITY ENGINEER	LAST DESIGN UPDATE	

CITY PROJECT NO. 650284 ZONE MAP NO. J-8, J-9 SHEET 9 OF 13

SCANNED BY
PLANNING

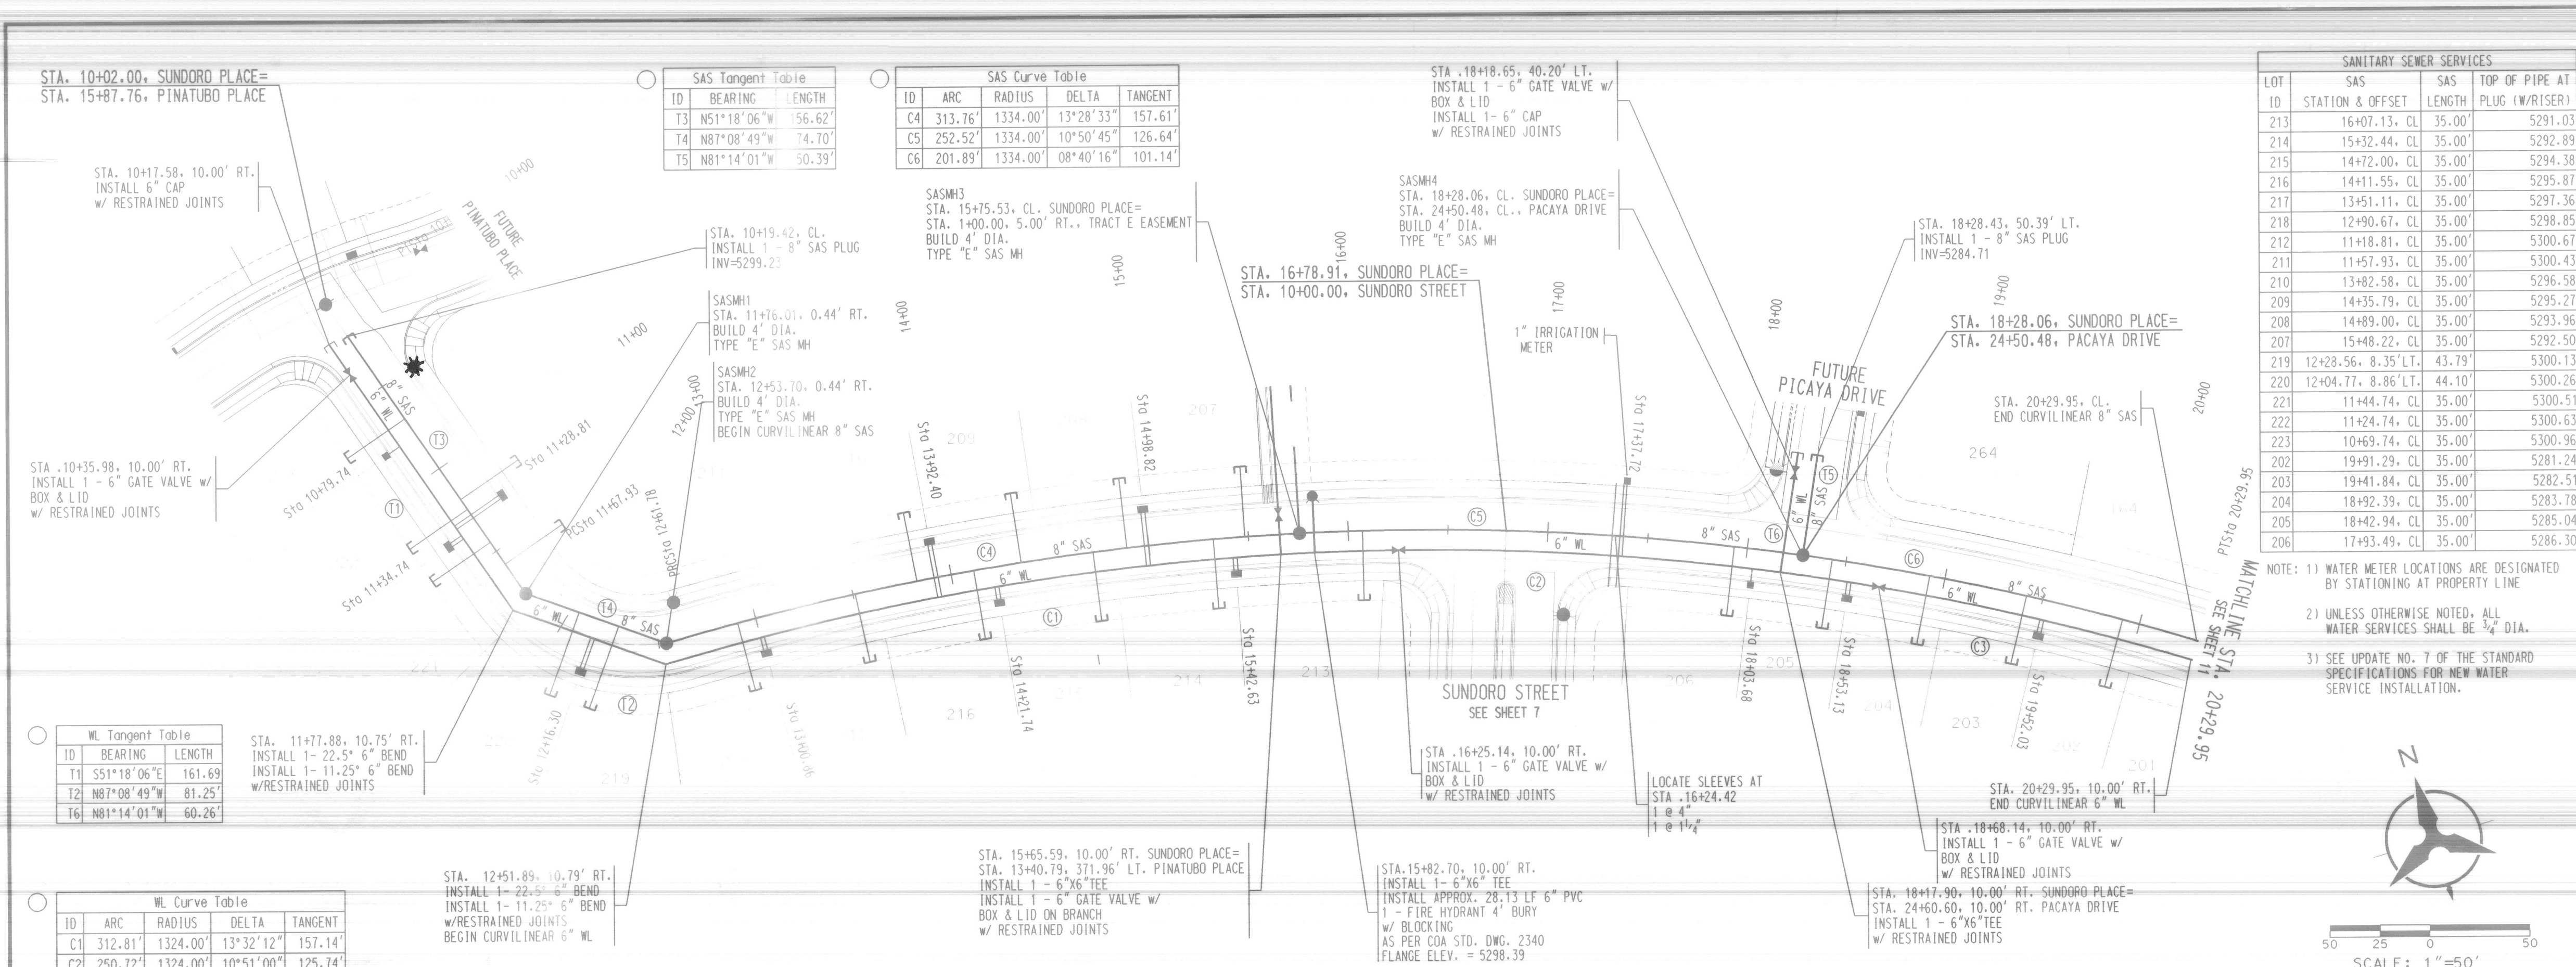

SUNDORO PLACE STA. 9+50.00 TO STA. 20+29.95

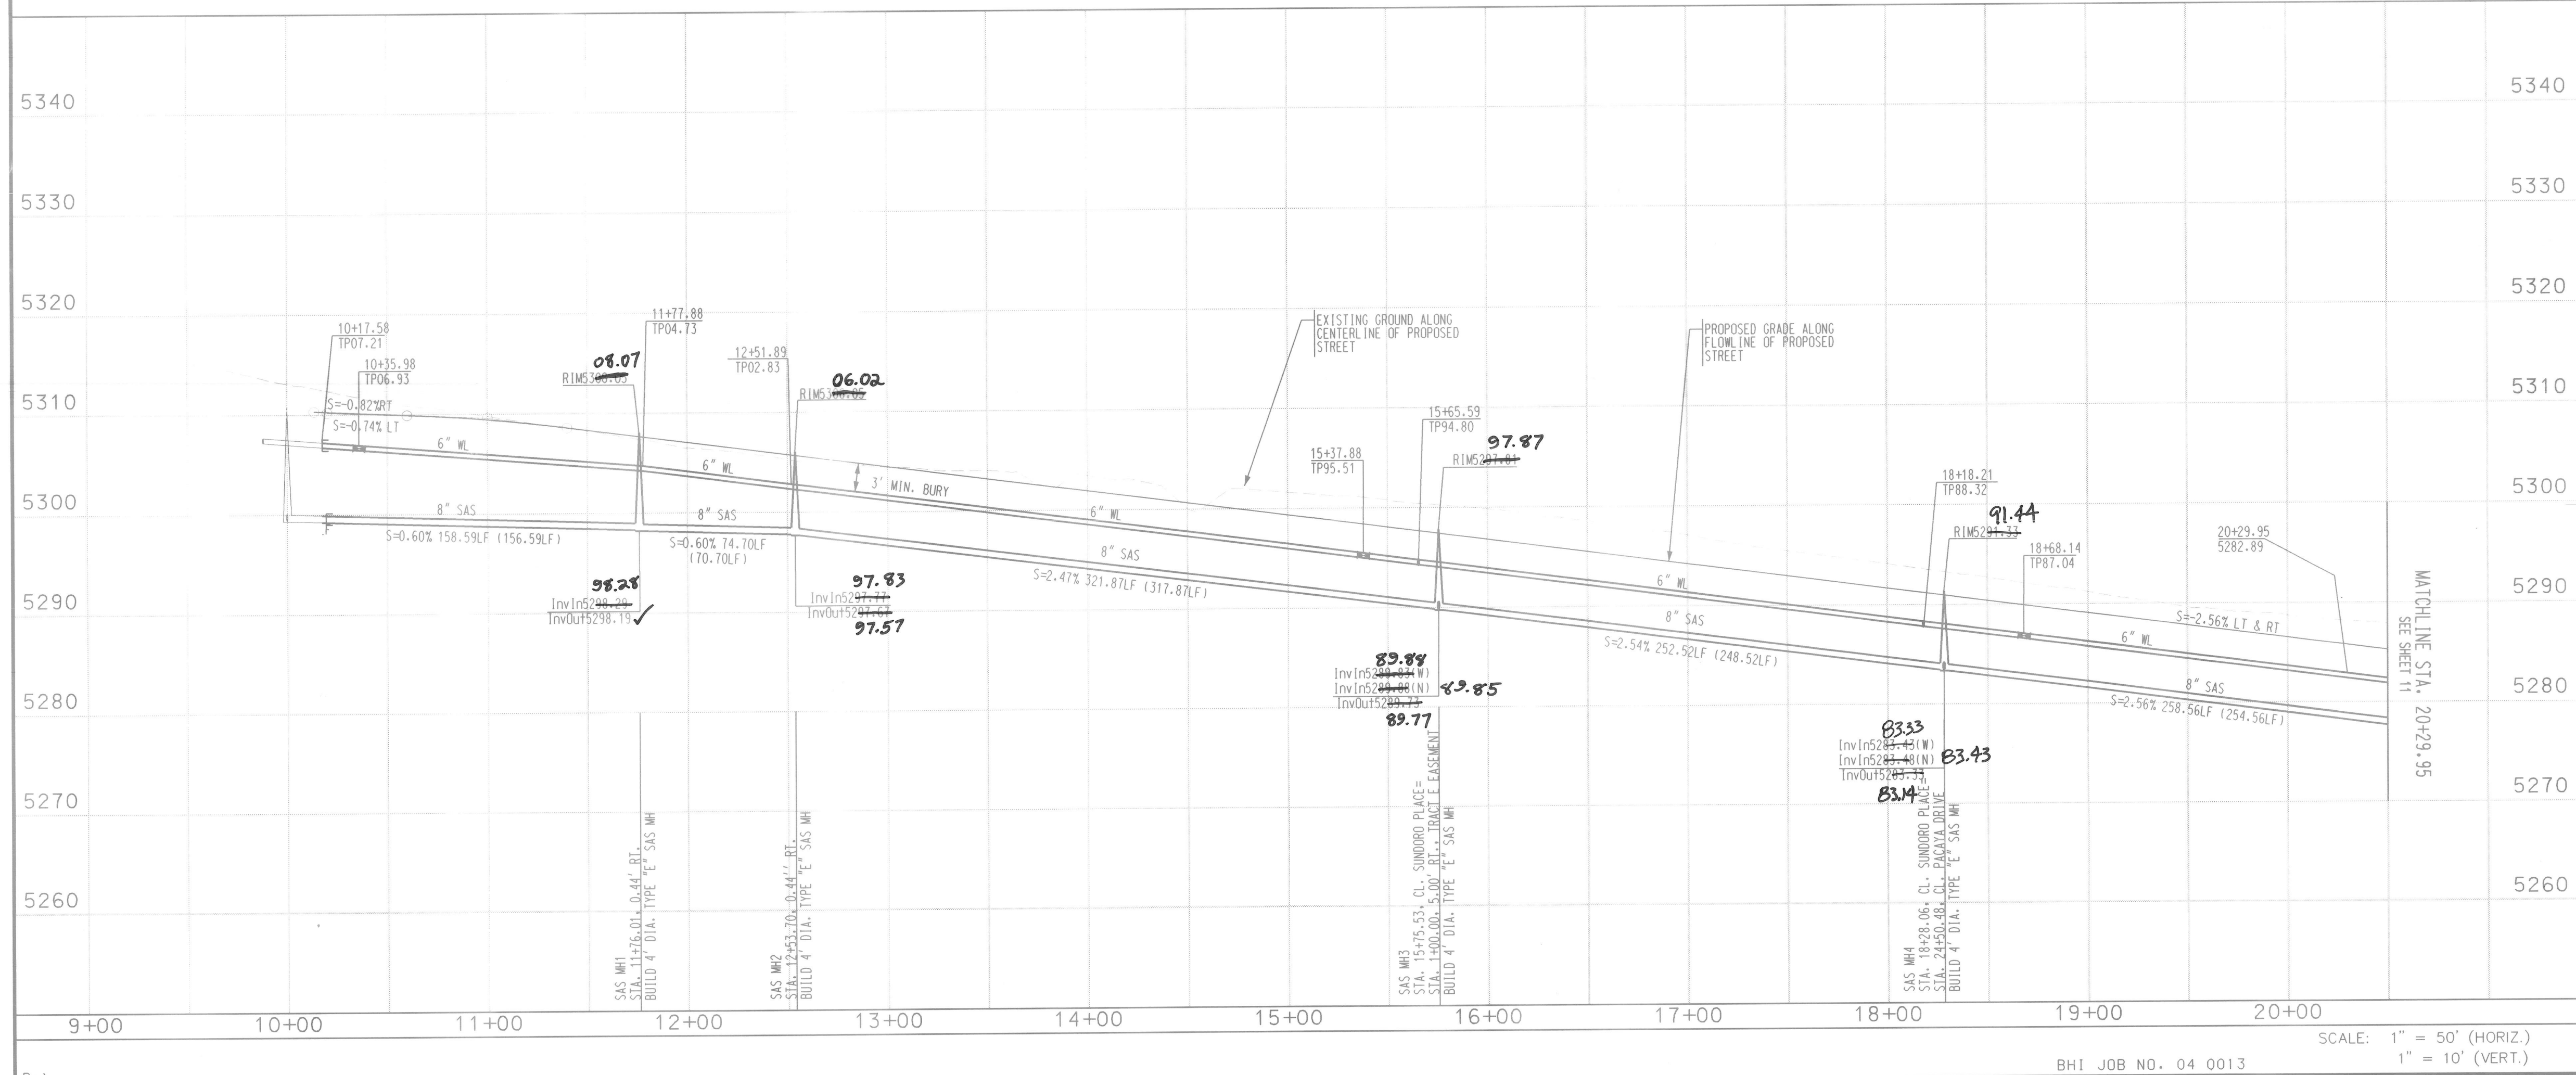

BHI JOB NO. 04 0013

SCALE: 1" = 50' (HORIZ.)
1" = 10' (VERT.)



NOTES		AS-BUILT INFORMATION		BENCH MARKS		SURVEY INFORMATION		ENGINEER'S SEAL		FIELD NOTES		DATE		NO.		BY		REMARKS		DESIGNED BY		DRAWN BY		CHECKED BY		DATE		NO.		BY		REVISIONS		DESIGN		DATE		NO.		BY		REVISIONS		DESIGN		DATE		NO.		BY	
-------	--	-----------------------------	--	--------------------	--	---------------------------	--	------------------------	--	--------------------	--	-------------	--	------------	--	-----------	--	----------------	--	--------------------	--	-----------------	--	-------------------	--	-------------	--	------------	--	-----------	--	------------------	--	---------------	--	-------------	--	------------	--	-----------	--	------------------	--	---------------	--	-------------	--	------------	--	-----------	--

ID	BEARING	LENGTH
T6	S89°59'57"E	46.67'
T7	S89°59'57"E	539.23'
T8	N63°33'23"E	173.07'

ID	ARC	RADIUS	DELTA	TANGENT
C7	23.03°	360.00'	03°39'56"	11.52'
C8	143.12°	360.00'	22°46'44"	72.52'

ID	BEARING	LENGTH
T9	N89°59'57"W	56.67'
T10	N89°59'57"W	283.72'
T11	N89°59'57"W	245.51'
T12	S63°33'23"W	249.52'

ID	ARC	RADIUS	DELTA	TANGENT
C9	38.29°	350.00'	06°16'06"	19.16'
C10	123.25°	350.00'	20°10'34"	62.27'

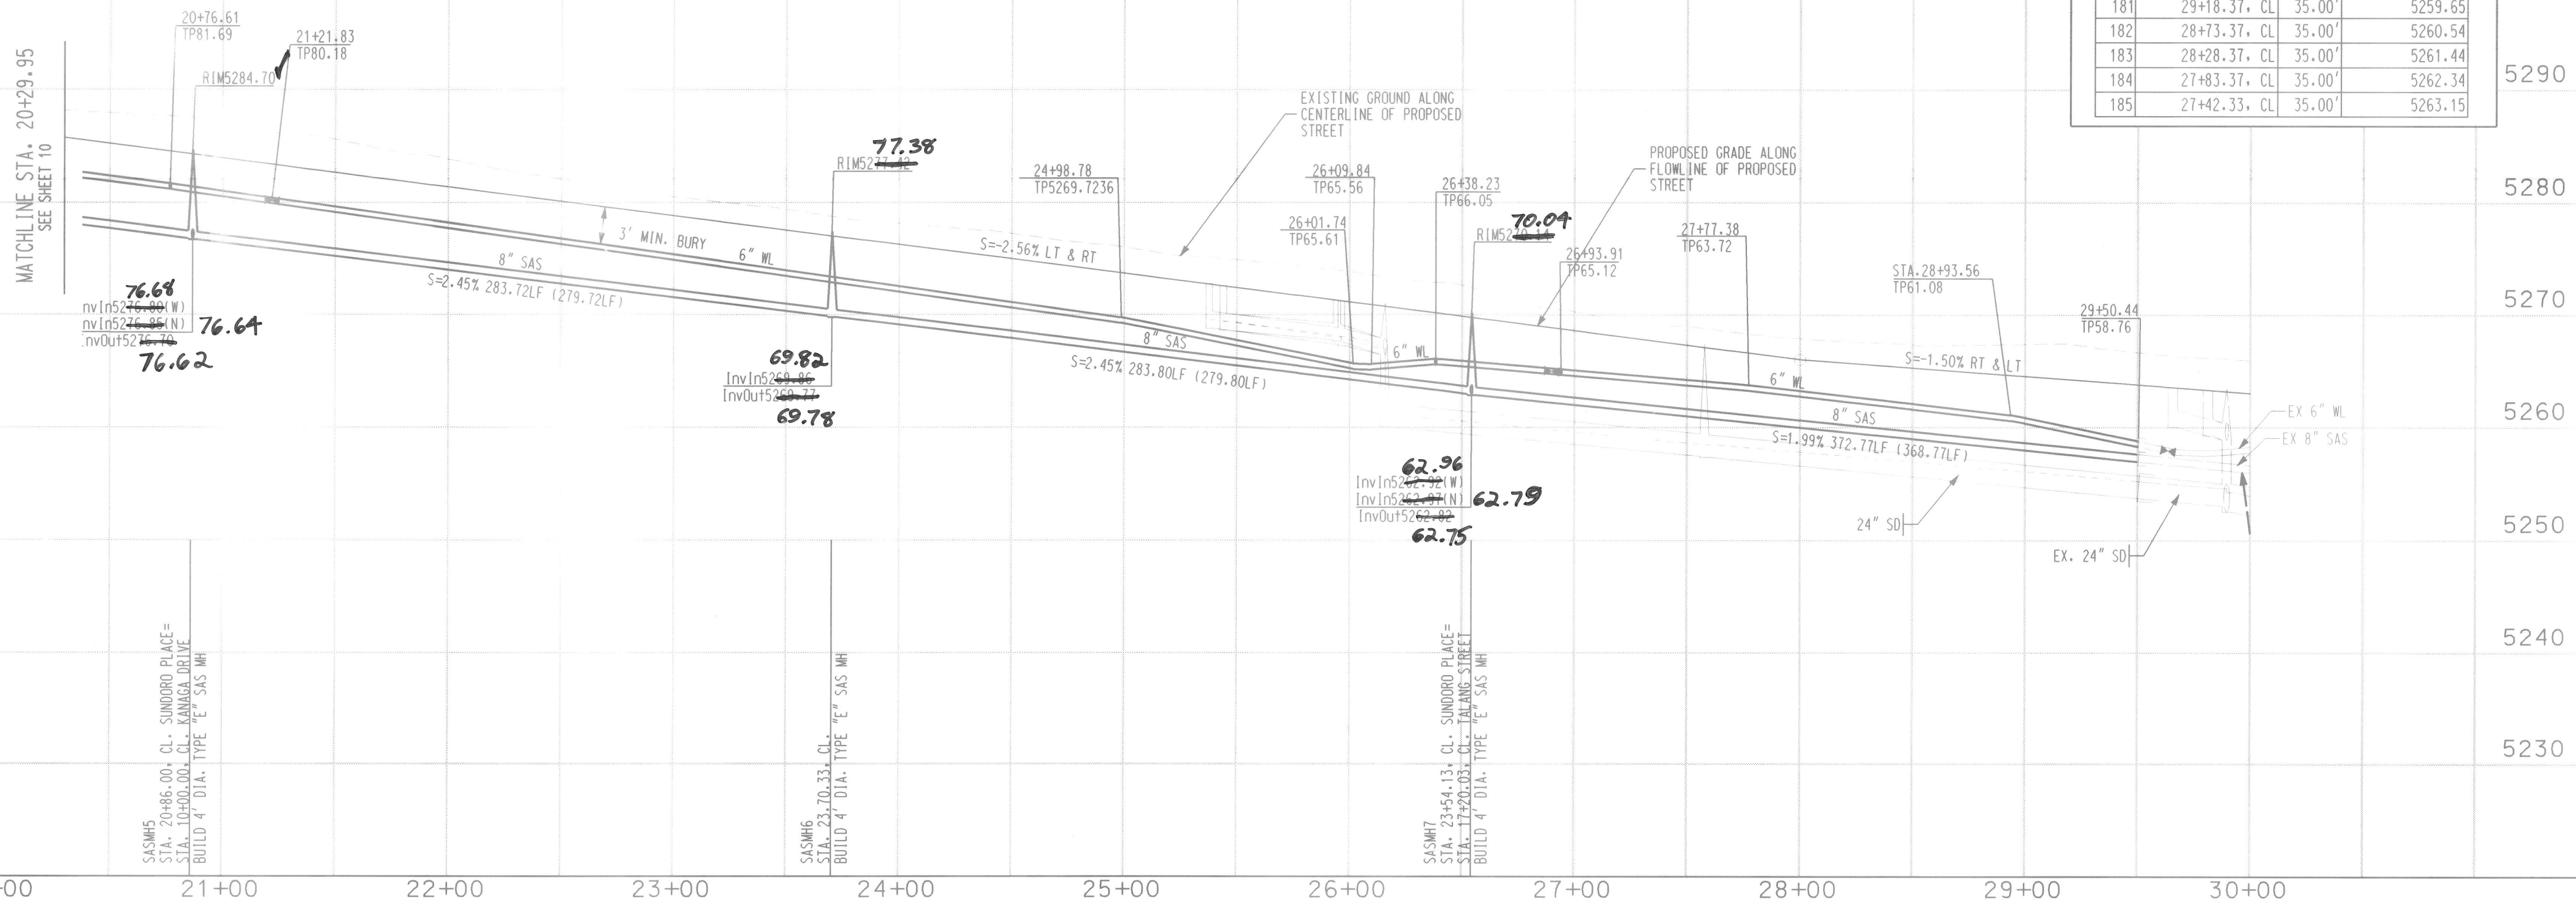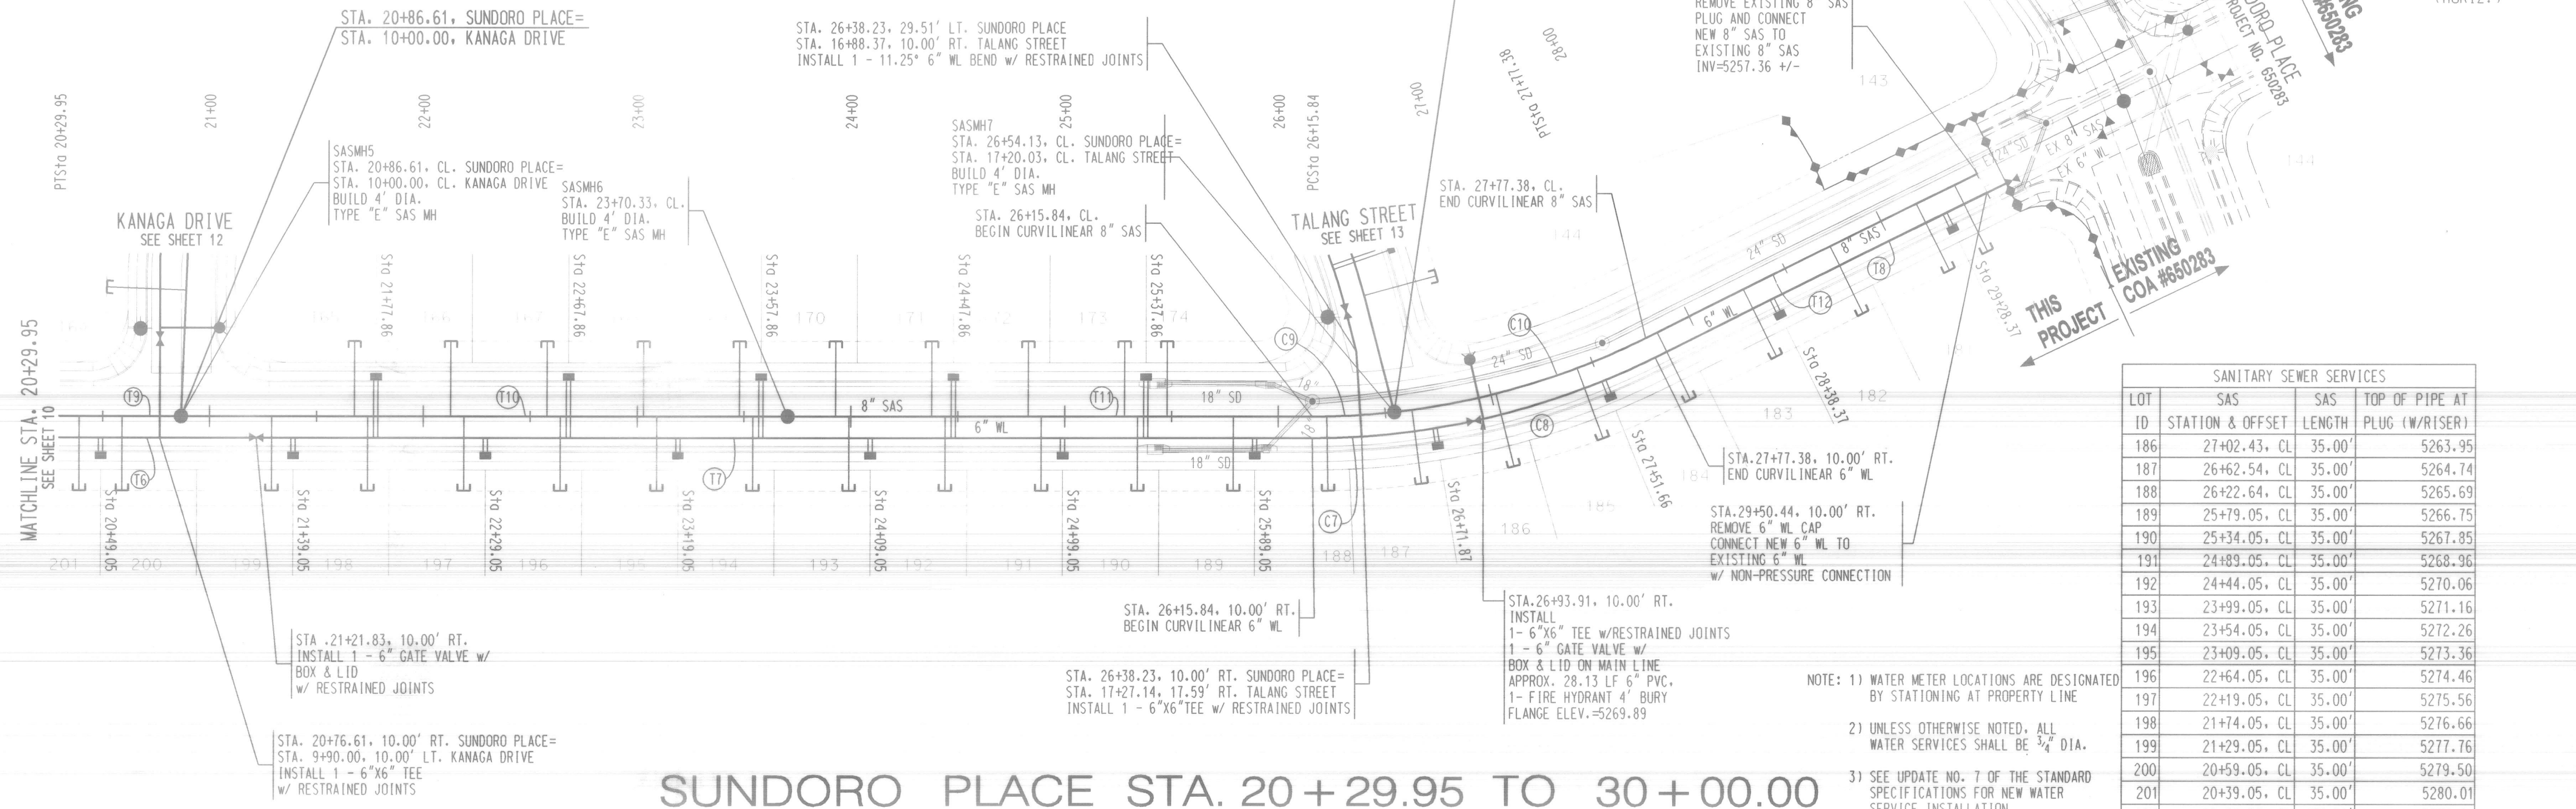


- NOTES**
- THE CONTRACTOR SHALL FIELD VERIFY ALL EXISTING UTILITY LOCATIONS AND NOTIFY THE ENGINEER IMMEDIATELY OF ANY DISCREPANCIES.
 - ALL CURB RETURN RADII SHALL BE 25' UNLESS OTHERWISE SPECIFIED.
 - ALL CURVE DATA AND DIMENSIONS REFER TO FACE OF CURB UNLESS OTHERWISE SPECIFIED.
 - GRADE ELEVATIONS, WHERE NOTED, ARE ALONG FLOWLINE OF STANDARD CURB UNLESS OTHERWISE SPECIFIED.
 - CONTRACTOR IS TO INSTALL A 4" X 4" X 5' POST AND END AT THE END OF EACH SANITARY SEWER SERVICE.
 - CONTRACTOR IS RESPONSIBLE FOR REPAIR AND/OR REPLACEMENT OF ALL UTILITY CONDUITS AND EXISTING LINES.
 - ANY ADDITIONAL GRADING REQUIRED TO MATCH PROPOSED STREET GRADES SHALL BE INCIDENTAL TO PAVING ITEMS.
 - CONTRACTOR SHALL PROVIDE THE INSPECTORS (CITY AND PRIVATE) WITH THE PROPOSED HYDROSTATIC TESTING PLAN. THE PLAN MUST BE APPROVED BEFORE TESTING OPERATIONS BEGIN.
 - CONTRACTOR SHALL PARK EQUIPMENT AND VEHICLES AS NOT TO INTERFERE WITH NORMAL ACTIVITIES OF RESIDENTS OR OTHER CONTRACTORS ON SITE.
 - ANY DAMAGE TO THE EXISTING FACILITIES (CURB & GUTTER, PAVEMENT, CONDUITS, LANDSCAPING, UTILITY LINES, ETC.) DURING CONSTRUCTION SHALL BE REPLACED AT THE CONTRACTORS' EXPENSE.
 - REMOVAL OF THE EXISTING CURB AND GUTTER SHALL BE AS PER COA STD. DWG. 2415 (SAWCUT ONLY).
 - WHEELCHAIR RAMPS SHALL BE CONSTRUCTED PRIOR TO ACCEPTANCE OF CURB & GUTTER.
 - ALL EXCAVATION, TRENCHING AND SHORING ACTIVITIES MUST BE CARRIED-OUT IN ACCORDANCE WITH OSHA 29 CFR 1926.650 SUBPART P.

RESTRAINING JOINT TABLE

MECHANICAL JOINTS	LENGTH OF RESTRAINED JOINTS	
	6"	8"
6" X 6" TEE	1	-
8" X 6" TEE	1	1
8" X 8" CROSS	-	1
8" X 6" REDUCER	-	30
90° HORIZ. BEND	20	26
45° HORIZ. BEND	8	11
22.5° HORIZ. BEND	4	5
11.25° HORIZ. BEND	2	3
GATE VALVE/CAP	55	72
22.5° VERT. BEND	-	14
UPPER	-	14
LOWER	-	2

- NOTE:**
- ALL MECHANICAL JOINTS SHALL BE RESTRAINED AT THE FITTING.
 - THE CONTRACTOR SHALL PROVIDE A MINIMUM PIPE LENGTH OF 20 LF FROM ALL MECHANICAL JOINTS. ALL PIPE JOINTS WITHIN 20 LF OF MJ SHALL BE RESTRAINED AT THE CONTRACTORS EXPENSE.
 - THE CONTRACTOR SHALL RESTRAIN ALL PIPE JOINTS IN THE SPECIFIED DISTANCE LISTED IN THE TABLE ABOVE. (SEE NOTE 2 ABOVE).
 - THE CONTRACTOR SHALL RESTRAIN ALL FIRE HYDRANTS JOINTS FROM THE TEE ON THE MAIN TO THE FIRE HYDRANT FLANGE.
 - ALL CAPS SHALL UTILIZE PCC BLOCKING, UNLESS OTHERWISE NOTED.
 - RESTRAINED LENGTH IN ON LARGE SIDE ON ALL REDUCERS
 - RESTRAIN ALL JOINTS BETWEEN UPPER AND LOWER VERTICAL BENDS.

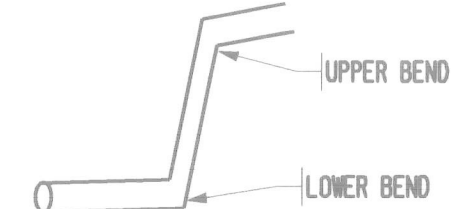

Bohannon & Huston

Courtyard I 7500 Jefferson St. NE Albuquerque, NM 87109-4335

ENGINEERING • SPATIAL DATA • ADVANCED TECHNOLOGIES

CITY OF ALBUQUERQUE

PUBLIC WORKS DEPARTMENT

ENGINEERING DEVELOPMENT GROUP

SUNDORO SUBDIVISION - UNIT 2

UTILITY PLAN & PROFILE

SUNDORO PLACE STA. 9+50.00 - 20+29.95

APPROVED

MAR 11 2004

APPROVED

APR 26 2004

DESIGN REVIEW COMMITTEE

CITY ENGINEER

LAST DESIGN UPDATE

CITY PROJECT NO. 650284

ZONE MAP NO. J-8, J-9

SHEET 11 OF 13

AS-BUILT INFORMATION

CONTRACTOR: *Bohannon & Huston*

STAKED BY: *Bohannon & Huston*

DATE: *04/26/04*

BENCH MARKS

ACS STATION NAMED 4 - K6, 3 - 1/4" ALUM. CAP

HYD # 4 - K6 GEOSPHERIC POSITION (1927)

N.M. STATE PLANE COORDINATES (CENTRAL ZONE)

X=3,369,918.47 Y=1,483,515.05

GROUND-TO-GRID FACTOR = .09965356

NOV 1929 ELEVATION = 5732.892

ON PASEO DEL VULCAN - 0.91 MI NORTH

OF 1-MO. 0.74 MI SOUTH OF POWERLINES, 39.6'

NW OF CENTERLINE OF PASEO DEL VULCAN

FIELD NOTES

NO. BY DATE

ENGINEER'S SEAL

CHRISTIAN J. SHELTON

PROFESSIONAL ENGINEER

01-12-04

REVISIONS

NO. DATE BY

DESIGNED BY CJS


DRAWN BY BS

CHECKED BY CJS


DATE 09/2003

DATE 09/2003

DATE 09/2003

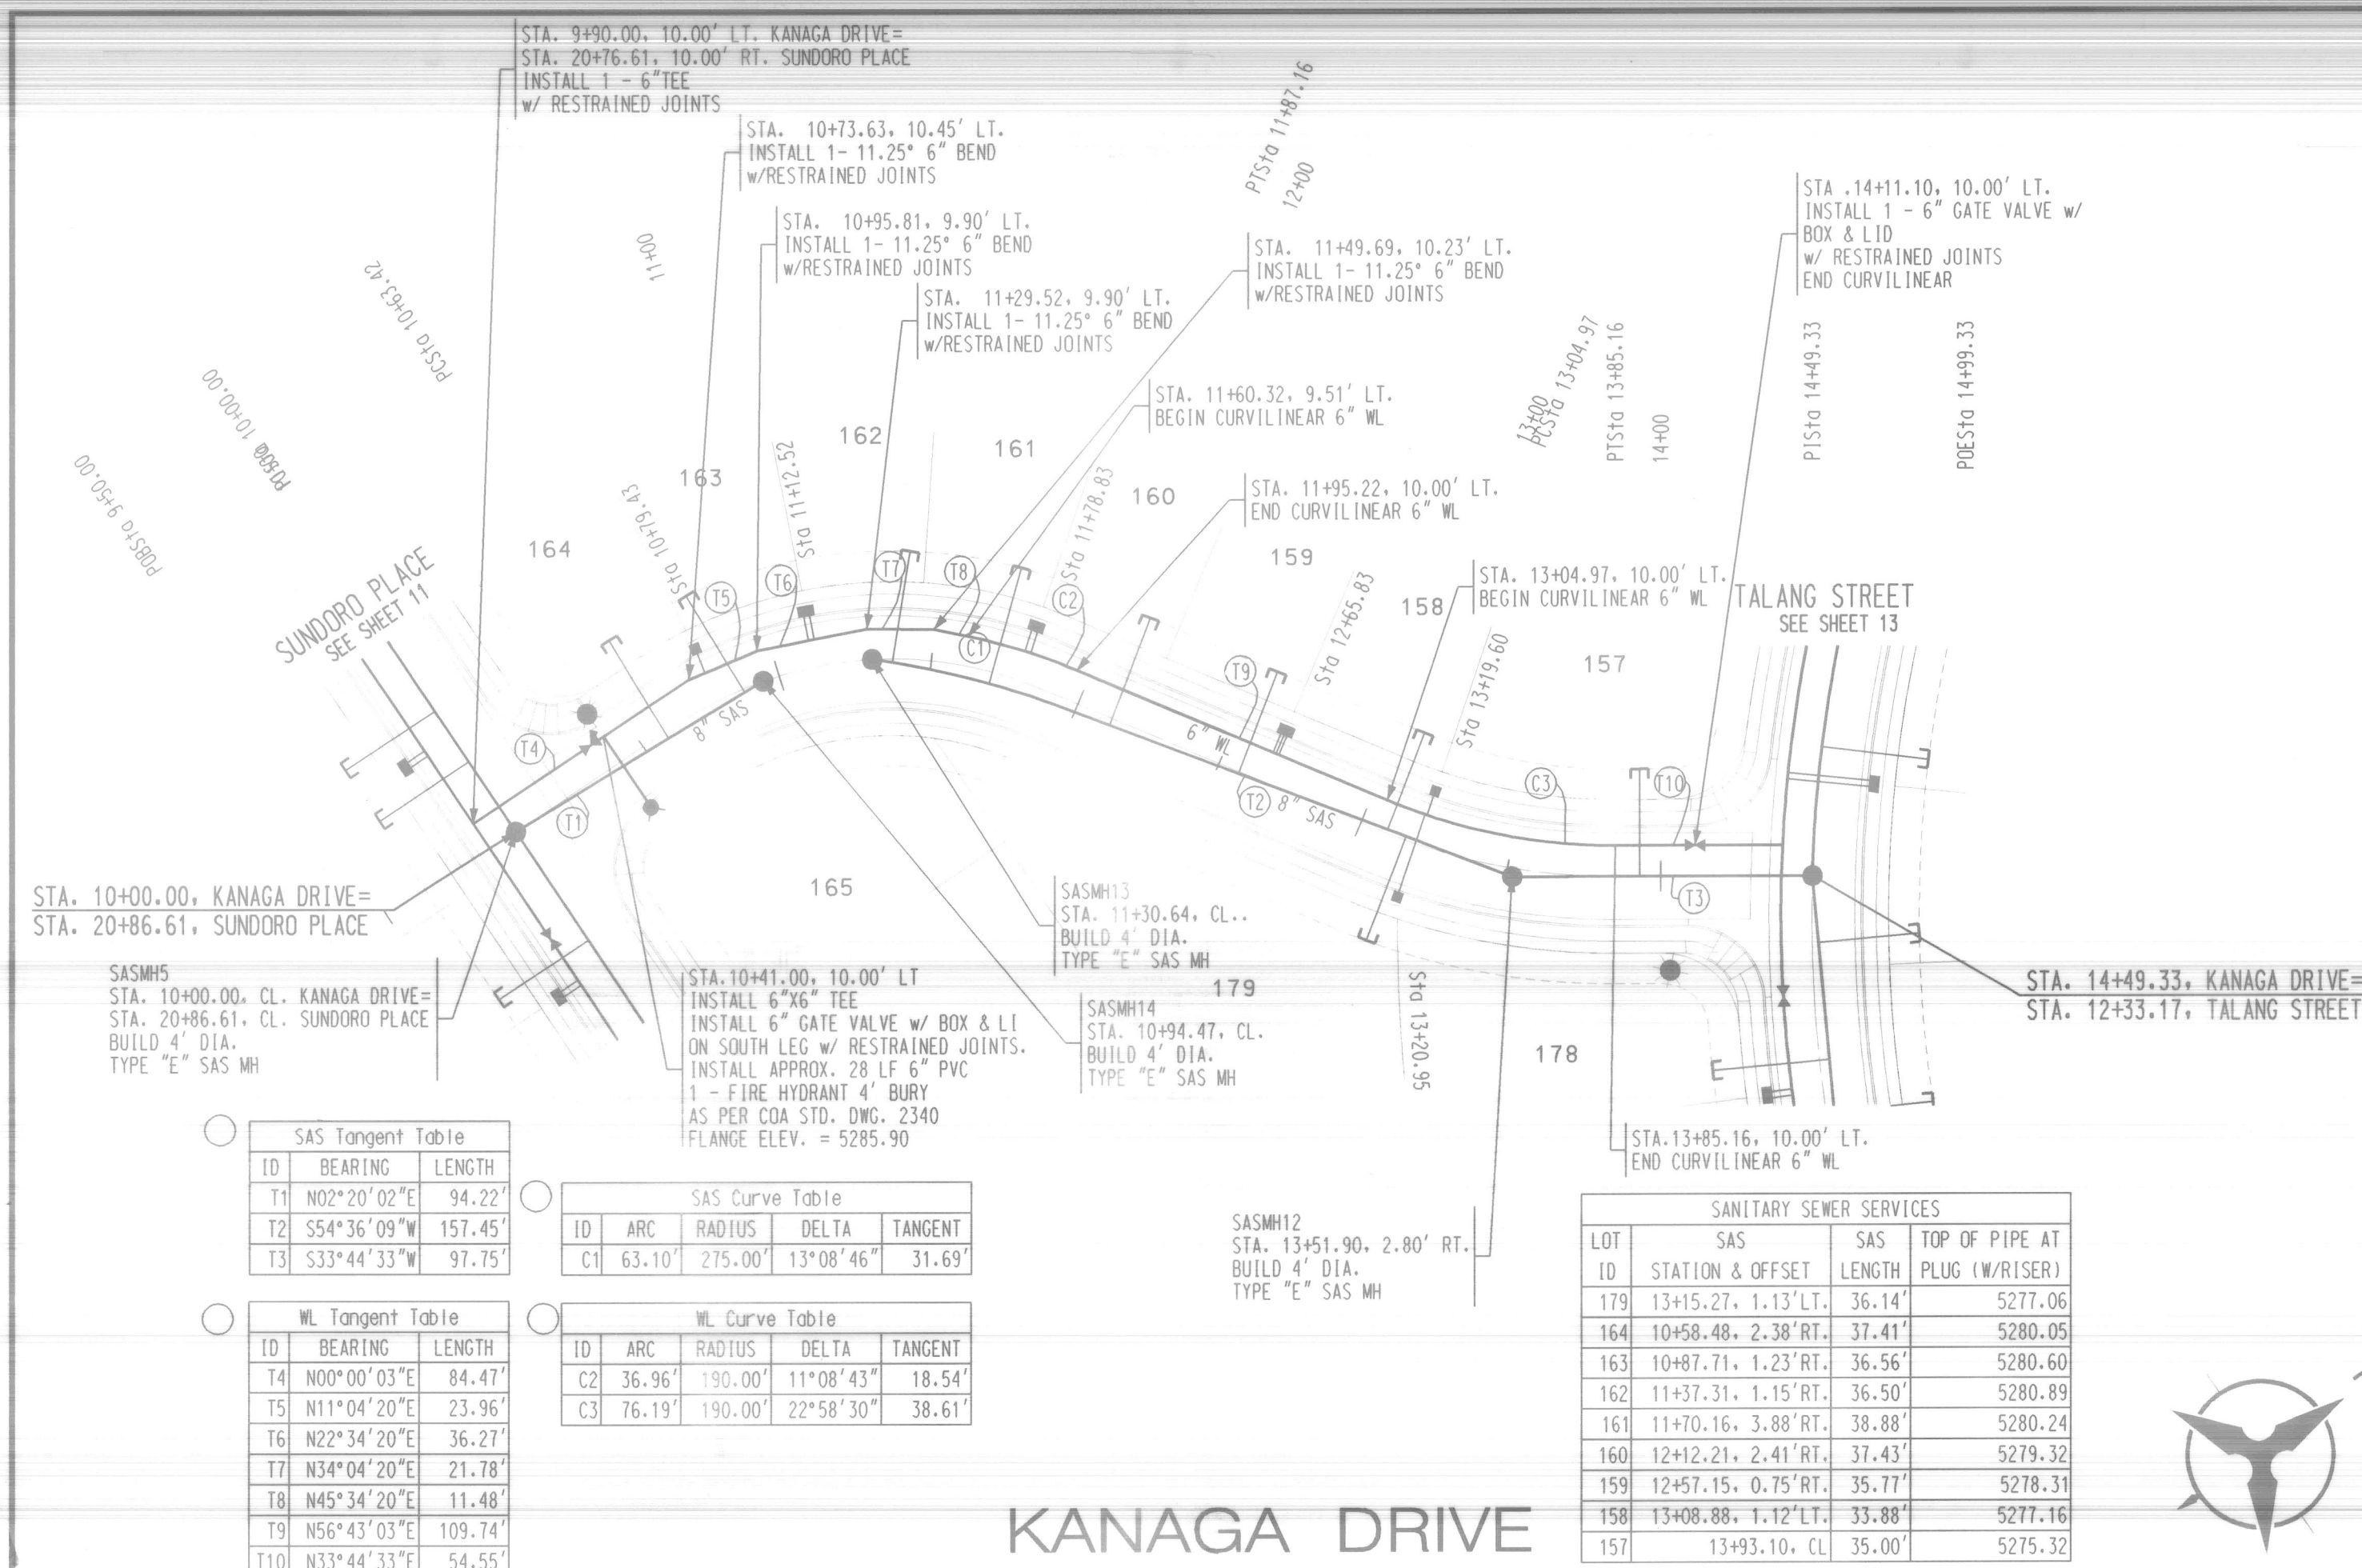

SAS Tangent Table			SAS Curve Table			
ID	BEARING	LENGTH	ID	ARC	RADIUS	DELTA
T11	N20°16'05"W	63.88'	C4	104.80'	250.00'	22°31'82"
						TANGENT
						53.18'

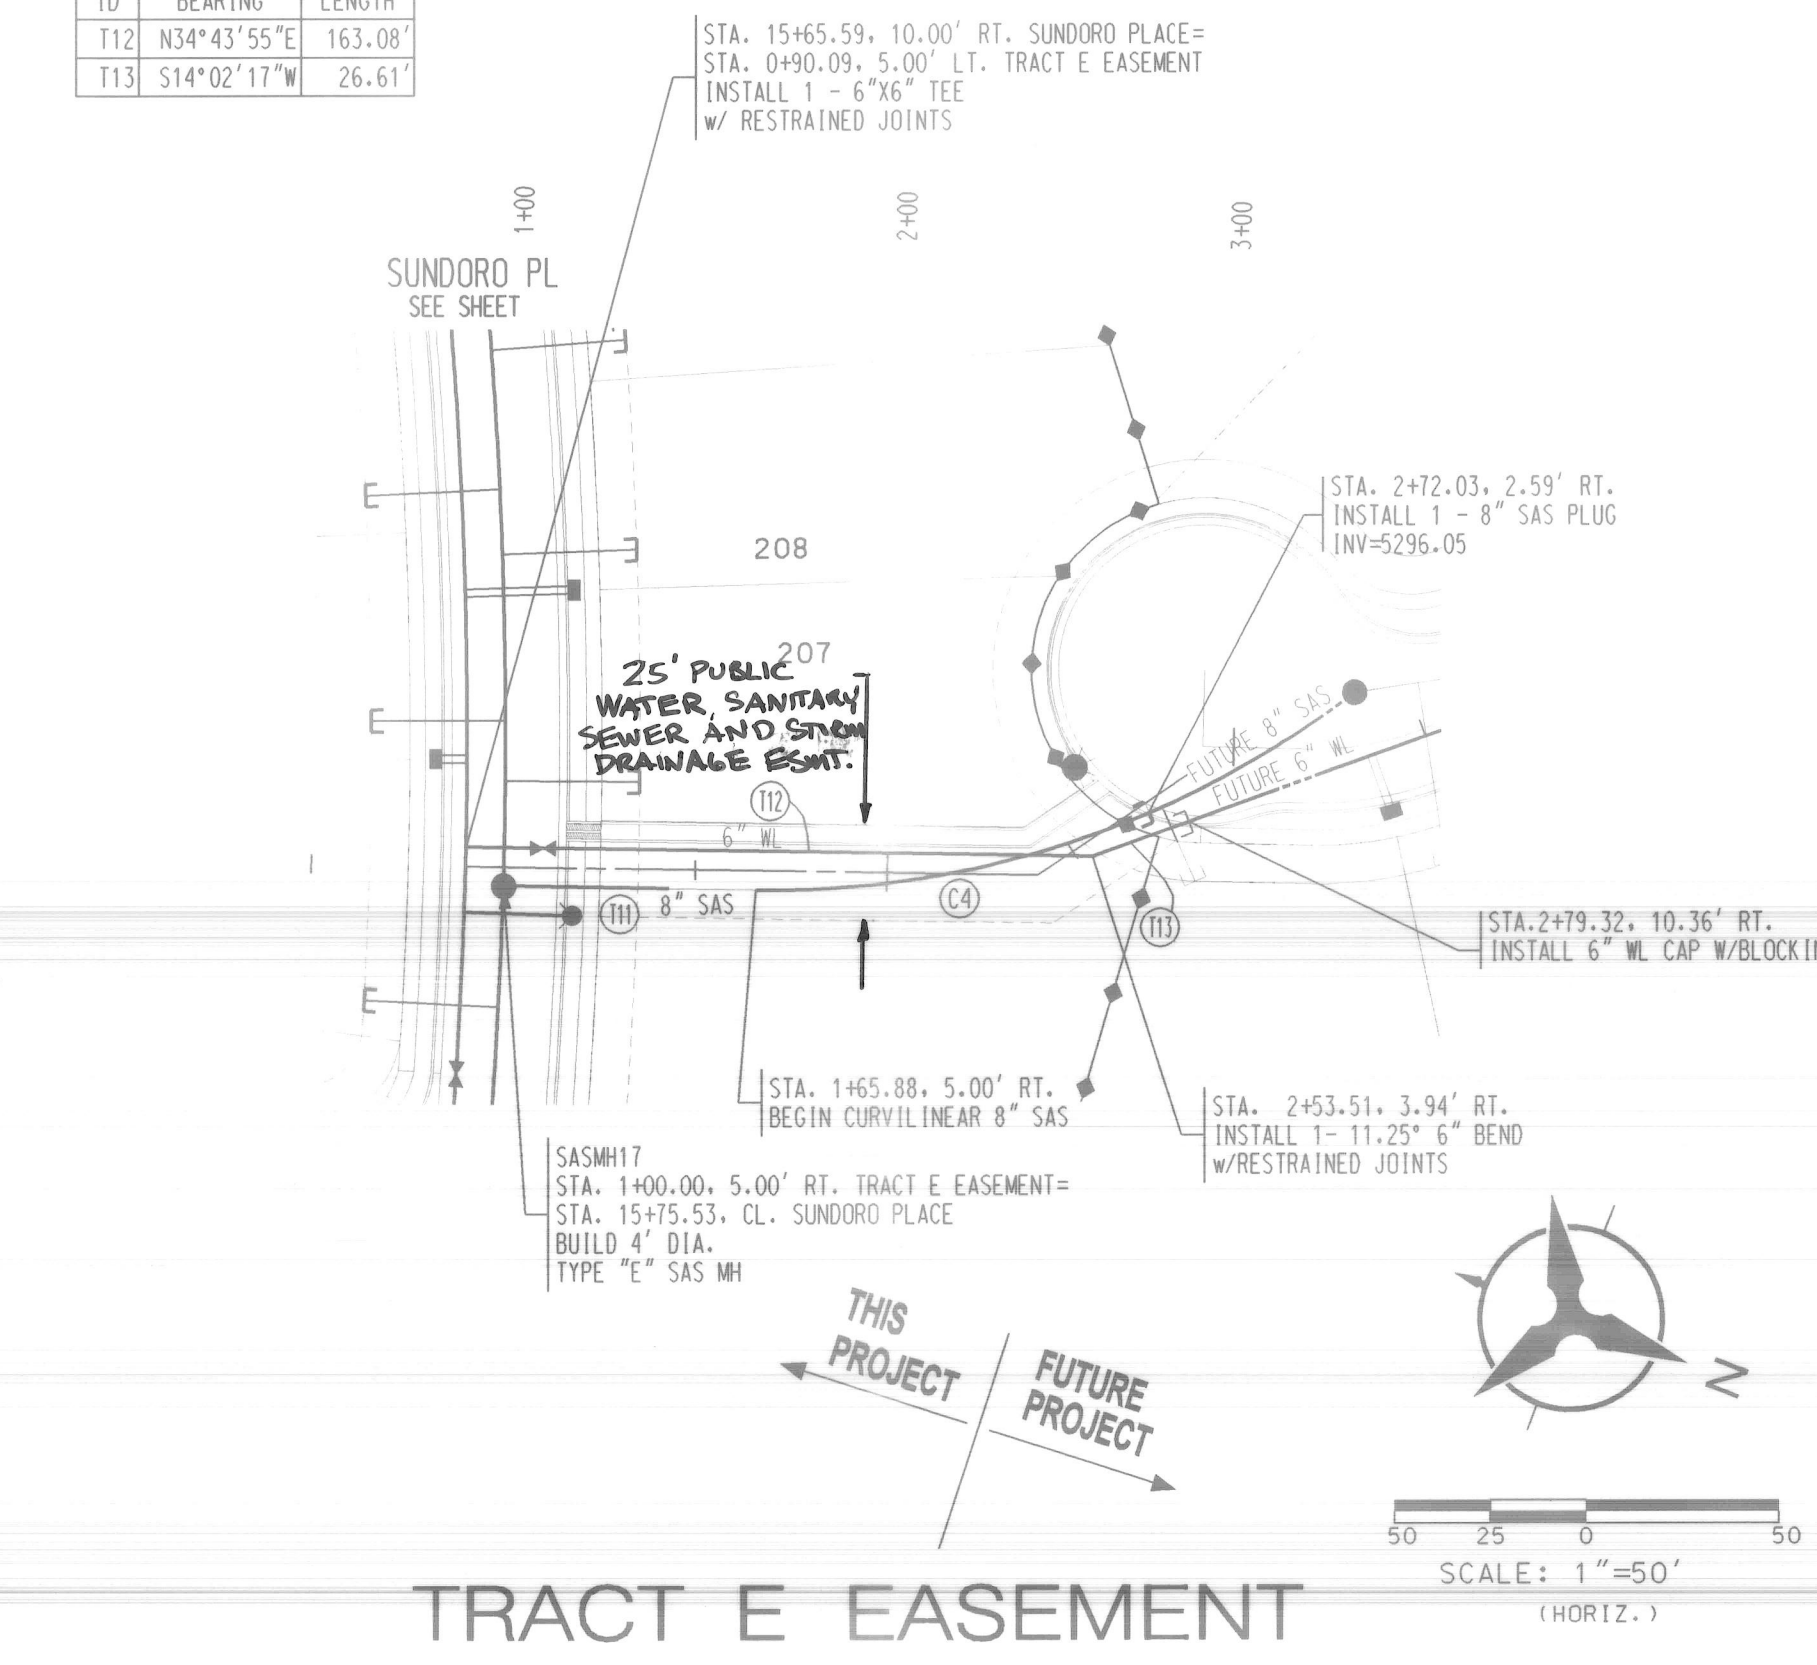


- NOTES**
- THE CONTRACTOR SHALL FIELD VERIFY ALL EXISTING UTILITY LOCATIONS AND NOTIFY THE ENGINEER IMMEDIATELY OF ANY DISCREPANCIES.
 - ALL CURB RETURN RADII SHALL BE 25' UNLESS OTHERWISE SPECIFIED.
 - ALL CURVE DATA AND DIMENSIONS REFER TO FACE OF CURB UNLESS OTHERWISE SPECIFIED.
 - GRADE ELEVATIONS, WHERE NOTED, ARE ALONG FLOWLINE OF STANDARD CURB UNLESS OTHERWISE SPECIFIED.
 - CONTRACTOR IS TO INSTALL A 4" X 4" X 5' POST AND END AT THE END OF EACH SANITARY SEWER SERVICE.
 - CONTRACTOR IS RESPONSIBLE FOR REPAIR AND/OR REPLACEMENT OF ALL UTILITY CONDUITS AND EXISTING LINES.
 - ANY ADDITIONAL GRADING REQUIRED TO MATCH PROPOSED STREET GRADES SHALL BE INCIDENTAL TO PAVING ITEMS.
 - CONTRACTOR SHALL PROVIDE THE INSPECTORS, (CITY AND PRIVATE) WITH THE PROPOSED HYDROSTATIC TESTING PLAN. THE PLAN MUST BE APPROVED BEFORE TESTING OPERATIONS BEGIN.
 - CONTRACTOR SHALL PARK EQUIPMENT AND VEHICLES AS NOT TO INTERFERE WITH NORMAL ACTIVITIES OF RESIDENTS OR OTHER CONTRACTORS ON SITE.
 - ANY DAMAGE TO THE EXISTING FACILITIES (CURB & GUTTER), PAVEMENT, CONDUITS, LANDSCAPING, UTILITY LINES, ETC.) DURING CONSTRUCTION SHALL BE REPLACED AT THE CONTRACTORS' EXPENSE.
 - REMOVAL OF THE EXISTING CURB AND GUTTER SHALL BE AS PER COA STD. DWG. 2415 (SAW CUT ONLY).
 - WHEELCHAIR RAMPS SHALL BE CONSTRUCTED PRIOR TO ACCEPTANCE OF CURB & GUTTER.
 - ALL EXCAVATION, TRENCHING AND SHORING ACTIVITIES MUST BE CARRIED-OUT IN ACCORDANCE WITH OSHA 29 CFR 1926.650 SUBPART P.

RESTRAINING JOINT TABLE

MECHANICAL JOINTS	LENGTH OF RESTRAINED JOINTS	
	6"	8"
6" X 6" TEE	1	-
8" X 6" TEE	1	1
8" X 8" CROSS	-	1
8" X 6" REDUCER	-	30
90° HORIZ. BEND	20	26
45° HORIZ. BEND	8	11
22.5° HORIZ. BEND	4	5
11.25° HORIZ. BEND	2	3
GATE VALVE/CAP	55	72
22.5° VERT. BEND	-	14
UPPER	-	14
LOWER	-	2

- NOTE:**
- ALL MECHANICAL JOINTS SHALL BE RESTRAINED AT THE FITTING.
 - THE CONTRACTOR SHALL PROVIDE A MINIMUM PIPE LENGTH OF 20 LF FROM ALL MECHANICAL JOINTS. ALL PIPE POINTS WITHIN 20 LF OF MJ SHALL BE RESTRAINED AT THE CONTRACTORS EXPENSE.
 - THE CONTRACTOR SHALL RESTRAIN ALL PIPE JOINTS IN THE SPECIFIED DISTANCE LISTED IN THE TABLE ABOVE. (SEE NOTE 2 ABOVE).
 - THE CONTRACTOR SHALL RESTRAIN ALL FIRE HYDRANT JOINTS FROM THE TEE ON THE MAIN TO THE FIRE HYDRANT FLANGE.
 - ALL CAPS SHALL UTILIZE PCC BLOCKING, UNLESS OTHERWISE NOTED.
 - RESTRAINED LENGTH IN ON LARGE SIDE ON ALL REDUCERS
 - RESTRAIN ALL JOINTS BETWEEN UPPER AND LOWER VERTICAL BENDS.

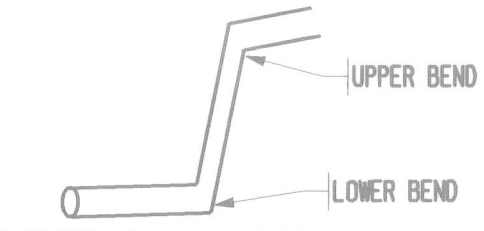

Bohannon & Huston

Courtyard | 7500 Jefferson St. NE Albuquerque, NM 87109-4335

ENGINEERING • SPATIAL DATA • ADVANCED TECHNOLOGIES

CITY OF ALBUQUERQUE

PUBLIC WORKS DEPARTMENT

ENGINEERING DEVELOPMENT GROUP

SUNDORO SUBDIVISION - UNIT 2

UTILITY PLAN & PROFILE

KANAGA DRIVE AND TRACT E EASEMENT

APPROVED

MAR 11 2004

DESIGN REVIEW COMMITTEE

APPROVED

APR 26 2004

CITY ENGINEER

CITY PROJECT NO. **650284**

ZONE MAP NO. **J-8, J-9**

SHEET **12** OF **13**

ENGINEER'S SEAL

AS-BUILT INFORMATION

CONTRACTOR: **Wagner Leander**

WORKED BY: **Priscilla Sandoz**

DATE: **01-12-04**

ENGINEER'S SEAL

DATE: **01-12-04**


REVISIONS

NO.	DATE	REVISIONS
1	03/2003	DESIGN
2	09/2003	DESIGN
3	09/2003	DESIGN

DESIGNED BY CJS

DRAWN BY BS

CHECKED BY CJS

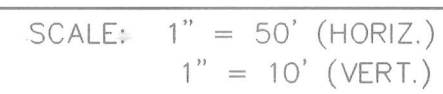

NOTE: 1) WATER METER LOCATIONS ARE DESIGNATED
BY STATIONING AT PROPERTY LINE

2) UNLESS OTHERWISE NOTED, ALL
WATER SERVICES SHALL BE $\frac{3}{4}$ " DIA.

3) SEE UPDATE NO. 7 OF THE STANDARD
SPECIFICATIONS FOR NEW WATER
SERVICE INSTALLATION.

1. THE CONTRACTOR SHALL FIELD VERIFY ALL EXISTING UTILITY LOCATIONS AND NOTIFY THE ENGINEER IMMEDIATELY OF ANY DISCREPANCIES.
2. ALL CURB RETURN RADII SHALL BE 25' UNLESS OTHERWISE SPECIFIED.
3. ALL CURVE DATA AND DIMENSIONS REFER TO FACE OF CURB UNLESS OTHERWISE SPECIFIED.
4. GRADE ELEVATIONS, WHERE NOTED, ARE ALONG FLOWLINE OF STANDARD CURB UNLESS OTHERWISE SPECIFIED.
5. CONTRACTOR IS TO INSTALL A 4" X 4" X 5' POST AND END AT THE END OF EACH SANITARY SEWER SERVICE.
6. CONTRACTOR IS RESPONSIBLE FOR REPAIR AND/OR REPLACEMENT OF ALL UTILITY CONDUITS AND EXISTING LINES.
7. ANY ADDITIONAL GRADING REQUIRED TO MATCH PROPOSED STREET GRADES SHALL BE INCIDENTAL TO PAVING ITEMS.
8. CONTRACTOR SHALL PROVIDE THE TESTS (SPECIFIC AND PRIVATE) WITH THE PROPOSED HYDROSTATIC TESTING PLAN. THE PLAN MUST BE APPROVED BEFORE TESTING OPERATIONS BEGIN.
9. CONTRACTOR SHALL PARK EQUIPMENT AND VEHICLES AS NOT TO INTERFERE WITH NORMAL ACTIVITIES OF RESIDENTS OR OTHER CONTRACTORS ON SITE.
10. ANY DAMAGE TO THE EXISTING FACILITIES (CURB & GUTTER), PAVEMENT, CONDUITS, LANDSCAPING, UTILITY LINES, ETC.) DURING CONSTRUCTION SHALL BE REPLACED AT THE CONTRACTOR'S EXPENSE.
11. REMOVAL OF THE EXISTING CURB AND GUTTER SHALL BE AS PER COA STD. DWG. 2415 (SAWCUT ONLY).
12. WHEELCHAIR RAMPS SHALL BE CONSTRUCTED PRIOR TO ACCEPTANCE OF CURB & GUTTER.
13. ALL EXCAVATION, TRENCHING AND SHORING ACTIVITIES MUST BE CARRIED-OUT IN ACCORDANCE WITH OSHA 29 CFR 1926.650 SUBPART P.

NOTE:	LOWER	-	2	
-------	-------	---	---	--

- ALL MECHANICAL JOINTS SHALL BE RESTRAINED AT THE FITTING.
- THE CONTRACTOR SHALL PROVIDE A MINIMUM PIPE LENGTH OF 20 LF FROM ALL MECHANICAL JOINTS. ALL PIPE PORTS WITHIN 20 LF OF MJ SHALL BE RESTRAINED AT THE CONTRACTORS EXPENSE.
- THE CONTRACTOR SHALL RESTRAIN ALL PIPE JOINTS IN THE SPECIFIED DISTANCE LISTED IN THE TABLE ABOVE. (SEE NOTE 2 ABOVE).
- THE CONTRACTOR SHALL RESTRAIN ALL FIRE HYDRANTS JOINTS FROM THE TEE ON THE MAIN TO THE FIRE HYDRANT FLANGE.
- ALL CAPS SHALL UTILIZE PCC BLOCKING, UNLESS OTHERWISE NOTED.
- RESTRAINED LENGTH IN ON LARGE SIDE ON ALL REDUCERS.
- RESTRAIN ALL JOINTS BETWEEN UPPER AND LOWER VERTICAL BENDS.



DESIGN REVIEW COMMITTEE APPROVED MAR 11 2004 DESIGN REVIEW COMMITTEE	CITY ENGINEER - APPROVAL APPROVED APR 26 2004 CITY ENGINEER
---	--

LAST DESIGN UPDATE

		ENGINEER'S SEAL		SURVEY INFORMATION		BENCH MARKS		AS-BUILT INFORMATION	
		 01-12-24		FIELD NOTES		CONTRACTOR		WORKS BUILT	
				NO.		BY		DATE	
						AGCS STATION		NAME	
						N.M. STATE PLANE COORDINATES (CENTRAL ZONE)		INSPECTED BY	
						X=3,369,918.47, Y=1,483,515.05		ACCEPTANCE BY	
						GROUND-TO-GRID FACTOR = .099856356		FIELD LOCATION	
						NGVD 1929 ELEVATION = 5732.892		DRAWINGS	
						ON PASO DEL VULCAN = 0.91 MI NORTH		CORRECTED BY	
						ON PASO DEL VULCAN, 0.91 MI NORTH		RECORDED BY	
						OF 1-40, 0.74 MI. SOUTH OF POWERLINES, 39'-6"		DATE	
						NW OF CENTERLINE OF PASO DEL VULCAN		NO.	