

The map shows a street grid with Canyon Blvd at the top, followed by Paseo Blvd, Andalusiun Ave, Young St, Park, Vista Diversion Channel, De Vargas Street, Cavetti Street, and Del Maestro Drive. A large, cross-hatched rectangular area is labeled 'SITE' with an arrow pointing to it. To the right of the site is a north arrow pointing upwards, labeled 'N'.

NOTICE TO CONTRACTORS

- THE FOLLOWING NOTES ALSO APPLY WHEN CHECKED

- ☒ ALL UTILITIES AND UTILITY SERVICE LINES SHALL BE INSTALLED PRIOR TO PAYING.
- ☒ BACKFILL COMPACTION SHALL BE ACCORDING TO SPECIFIED STREET USE.
- ☒ TACK COAT REQUIREMENTS SHALL BE DETERMINED BY THE CITY ENGINEER.
- ☒ SIDEWALKS AND WHEELCHAIR RAMPS WITHIN THE CURB RETURNS SHALL BE CONSTRUCTED WHEREVER A NEW CURB RETURN IS CONSTRUCTED.
- ☒ IF CURB IS DEPRESSIONED FOR A DRIVEPAD, THE DRIVEPAD SHALL BE CONSTRUCTED PRIOR TO ACCEPTANCE OF CURB AND GUTTER.
- ☒ ALL STORM DRAINAGE FACILITIES SHALL BE COMPLETED PRIOR TO FINAL ACCEPTANCE.
- ☒ THE REQUESTOR OR DEVELOPER SHALL BE RESPONSIBLE FOR REPAIR OR REPLACEMENT OF ALL CURB AND GUTTER OR SIDEWALK DAMAGED AFTER APPROVAL BY THE CITY ENGINEER OF WORK COMPLETED BY THE CONTRACTOR.

UTILITY PLANS

SHEET NUMBER	DESCRIPTION
17,18	TEAL ROAD
19	TEAL RD, WL ESMT & CERILLOS RD
20,21	RED ROBIN ROAD
22	HAWK DRIVE
23	TANAGER DRIVE
24	COCKATIEL DRIVE
25	OSPREY DRIVE & PARK AREA
26	DE VARGAS ROAD
27	OFF-SITE STORM DRAIN TO UNIT-2

"I, Timothy Aldrich, a duly qualified Registered Professional Land Surveyor under the laws of the State of New Mexico, do hereby certify that the 'as-built' information shown on these drawings was obtained from the original construction and 'as-built' surveys performed by me or under my supervision, and that this 'as-built' information is shown on these drawings was added by me or under my supervision, and that this 'as-built' information is true and correct to the best of my knowledge and belief." Aldrich Land Surveying is not responsible for any error or omissions on these drawings, or for any misreading or intent of the record drawings.

11-12-01

I HEREBY CERTIFY THAT THE INFORMATION CONTAINED ON THESE DRAWINGS HAS BEEN REVISED IN ACCORDANCE WITH THE INFORMATION FURNISHED BY THE CONTRACTOR, FRANKLINS CONSTRUCTION INC. AND ALDRICH LAND SURVEYING CONSTRUCTION STAKING AND REFLECTS THE CONSTRUCTION AS ACTUALLY ACCOMPLISHED WHILE A CONSTRUCTION OBSERVER FROM SMITH ENGINEERING CO. WAS PRESENT. THESE PLAN DRAWINGS AS CONSTRUCTED IS IN SUBSTANTIAL COMPLIANCE WITH THE APPROVED PLAN DRAWINGS.

DATE _____

1	2	3	4	5	6	7	8	9	10	11	12	13	14	15
2	6		6	5	1	6	.	8	1				0	4

Bohannon ▲ Huston

ENGINEERS PLANNERS PHOTOGRAMMETRISTS SURVEYORS SOFTWARE DEVELOPERS

1. THE CONTRACTOR SHALL ABIDE BY ALL LOCAL, STATE, AND FEDERAL LAWS, RULES AND REGULATIONS WHICH APPLY TO THE CONSTRUCTION OF THESE IMPROVEMENTS.
2. PRIOR TO CONSTRUCTION SHALL EXCAVATE AND VERIFY THE HORIZONTAL AND VERTICAL LOCATIONS OF ALL POTENTIAL OBSTRUCTIONS. SHOULD A CONFLICT EXIST, THE CONTRACTOR SHALL NOTIFY THE ENGINEER OR CONSTRUCTION OBSERVER SO THAT THE CONFLICT CAN BE RESOLVED WITH A MINIMUM AMOUNT OF DELAY.
3. ALL ELECTRICAL, TELEPHONE, CABLE TV, GAS AND OTHER UTILITY LINES, CABLES AND APPURTENANCES ENCOUNTERED DURING CONSTRUCTION THAT REQUIRE RELOCATION, SHALL BE COORDINATED WITH THAT UTILITY. THE CONTRACTOR SHALL BE RESPONSIBLE FOR COORDINATION OF ALL NECESSARY UTILITY ADJUSTMENTS. NO ADDITIONAL COMPENSATION WILL BE ALLOWED FOR DELAYS OR INCONVENIENCES CAUSED BY UTILITY COMPANY WORK CREWS. THE CONTRACTOR MAY BE REQUIRED TO RESCHEDULE HIS ACTIVITIES TO ALLOW UTILITY CREWS TO PERFORM THEIR REQUIRED WORK.
4. DISPOSAL SITE FOR ALL EXCESS EXCAVATION MATERIAL, AND UNSUITABLE MATERIAL SHALL BE OBTAINED BY THE CONTRACTOR IN COMPLIANCE WITH APPLICABLE ENVIRONMENTAL REGULATIONS AND APPROVED BY THE CONSTRUCTION OBSERVER. ALL COSTS INCURRED IN OBTAINING A DISPOSAL SITE AND HAUL THERE TO SHALL BE CONSIDERED INCIDENTAL TO THE PROJECT AND NO SEPARATE MEASUREMENT OR PAYMENT SHALL BE MADE.

5. THE CONTRACTOR IS RESPONSIBLE FOR PROTECTING THE EXISTING UTILITY LINES WITHIN THE CONSTRUCTION AREA. ANY DAMAGE TO EXISTING FACILITIES CAUSED BY CONSTRUCTION ACTIVITY SHALL BE REPAIRED OR REPLACED AT THE CONTRACTOR'S EXPENSE AND APPROVED BY THE CONSTRUCTION OBSERVER.
6. CONSTRUCTION ACTIVITY SHALL BE LIMITED TO THE PROPERTY AND/OR PROJECT LIMITS. ANY DAMAGE TO ADJACENT PROPERTIES RESULTING FROM THE CONSTRUCTION PROCESS IS THE RESPONSIBILITY OF THE CONTRACTOR. ANY COSTS INCURRED FOR REPAIRS SHALL BE THE COST OF THE CONTRACTOR.
7. OVERNIGHT PARKING OF CONSTRUCTION EQUIPMENT SHALL NOT OBSTRUCT DRIVEWAYS OR DESIGNATED TRAFFIC LANES. THE CONTRACTOR SHALL NOT STORE ANY EQUIPMENT OR MATERIAL WITHIN THE PUBLIC RIGHT-OF-WAY.
8. THE CONTRACTOR SHALL OBTAIN ALL THE NECESSARY PERMITS FOR THE PROJECT PRIOR TO COMMENCING CONSTRUCTION (I.E. BARRICADING, SURFACE DISTURBANCE)
9. THE CONTRACTOR SHALL BE RESPONSIBLE TO REPLACE AT HIS EXPENSE ANY AND ALL PROPERTY CORNERS DESTROYED DURING CONSTRUCTION. ALL PROPERTY CORNERS MUST BE RESET BY A REGISTERED LAND SURVEYOR.
10. ALL PERMANENT PAVEMENT MARKING AND TRAFFIC SIGNING SHALL BE FURNISHED BY THE CONTRACTOR PER PLAN

11. THE CONTRACTOR SHALL FOLLOW THE CONSTRUCTION TRAFFIC CONTROL AND SIGNING PLAN PROVIDED HEREIN. THE CONTRACTOR SHALL COORDINATE WITH THE CITY OF ALBUQUERQUE, TRAFFIC ENGINEERING DEPARTMENT, PRIOR TO BEGINNING ANY CONSTRUCTION WORK ON ADJACENT TO EXISTING STREETS.
12. ALL BARRICADES AND CONSTRUCTION SIGNING SHALL CONFORM TO APPLICABLE SECTIONS OF THE "MANUAL OF UNIFORM TRAFFIC CONTROL DEVICES" (MUTCD), U.S. DEPARTMENT OF TRANSPORTATION, LATEST EDITION.
13. THE CONTRACTOR SHALL MAINTAIN ALL CONSTRUCTION BARRICADES AND SIGNING AT ALL TIMES. THE CONTRACTOR SHALL VERIFY THE PROPER LOCATION OF ALL BARRICADE AT THE END AND BEGINNING OF EACH DAY.
14. ALL SAWCUT PAVEMENT SHALL HAVE A UNIFORM EDGE AND BE SPRAYED WITH TACK.
15. WHEN ABUTTING NEW CURB AND GUTTER TO EXISTING PAVEMENT, A 1' WIDE SECTION OF EXISTING PAVEMENT ADJACENT TO THE CURB AND GUTTER SHALL BE SAWCUT, REMOVED, AND REPLACED AS PER THE STANDARD SPECIFICATIONS.
16. THE CONTRACTOR SHALL ASSUME RESPONSIBILITY FOR ANY DAMAGE TO EXISTING PAVEMENTS, PAVEMENT MARKINGS, CURB & GUTTER, DRIVE PAVES, WHEEL OAVAR RAMPES, AND SIDEWALK DURING CONSTRUCTION, APART FROM THE LOCATIONS INDICATED FOR REMOVAL ON THE PLANS AND SHALL REPAIR OR REPLACE PER CQA STANDARDS, AT HIS OWN EXPENSE.

SCANNED BY
MESA REPRO

COMPRISED OF
PARCEL 1, TIMARRON WEST UNIT 2
TRACT 2, LANDS OF GREVEY/LIBERMAN
SITUATE WITHIN
THE TOWN OF ATRISCO GRANT
"PROJECTED" SECTION 32, T10N, R2E, N1/4M.1.
BERNALILLO COUNTY, NEW MEXICO
MAY, 1998

A BLANKET PUBLIC DRAINAGE EASEMENT ENCUMBERING
H.O.A. TRACTS P & R GRANTED WITH THIS PLAT.

ZONE: ATLAS NO.	L-8-2/W-8-2
FEMA MAP NO.	33001C0336 0
ZONING	SU-1 PRO 9 DU/AC
MILES OF FULL WIDTH STREETS CREATED	1.8 MILES
NO. OF EXISTING PARCELS	2
NO. OF LOTS CREATED	1 9
NUMBER OF PARCELS CREATED (TRACT 2-A)	
DENSITY	4 TO DU/AC
NO. OF H.O.A. TRACTS CREATED	1
AREA OF UNITS 3 & 4	3.6 ACRES




1. EXISTING ZONING: SU-1 PRD 9 DU/AC
PROPOSED ZONING: NO CHANGE
PROPOSED DEVELOPMENT:
SINGLE FAMILY DETACHED RESIDENTIAL
2. PROPOSED NET ACREAGE 36.6 ACRES (UNITS 3 & 4)
NUMBER OF LOTS 169 D.U.
PROPOSED DENSITY 4.62 DU/ACRE
3. TYPICAL LOT DIMENSIONS: 45'x105'
MIN/MAX LOT DIMENSIONS: 45'x105' MIN., 65'x145' MAX.
SMALLEST MINIMUM LOT AREA: 4725 SQ. FT.
4. ALL STREETS, UTILITIES, AND STORM DRAIN IMPROVEMENTS AREA TO BE PUBLIC, AND TO BE DEDICATED TO THE CITY OF ALBUQUERQUE FOR MAINTENANCE.
5. LOT SETBACKS SHALL CONFORM TO R-1 ZONING REQUIREMENTS
6. NO INDIVIDUAL LOTS SHALL BE ALLOWED DIRECT ACCESS TO WARDAS ROAD OR 114TH STREET

CENTEX HOMES
6710 JEFFERSON NE BUILDING B
ALBUQUERQUE, NEW MEXICO 87109
PH: (505) 761-9600

Tom Hume
CENTEX HOME

 Courtyard One 7500 JEFFERSON NE Albuquerque NEW MEXICO 87109

ENGINEERS PLANNERS PHOTOGRAMMETRISTS SURVEYORS SOI ARE DEVELOPERS

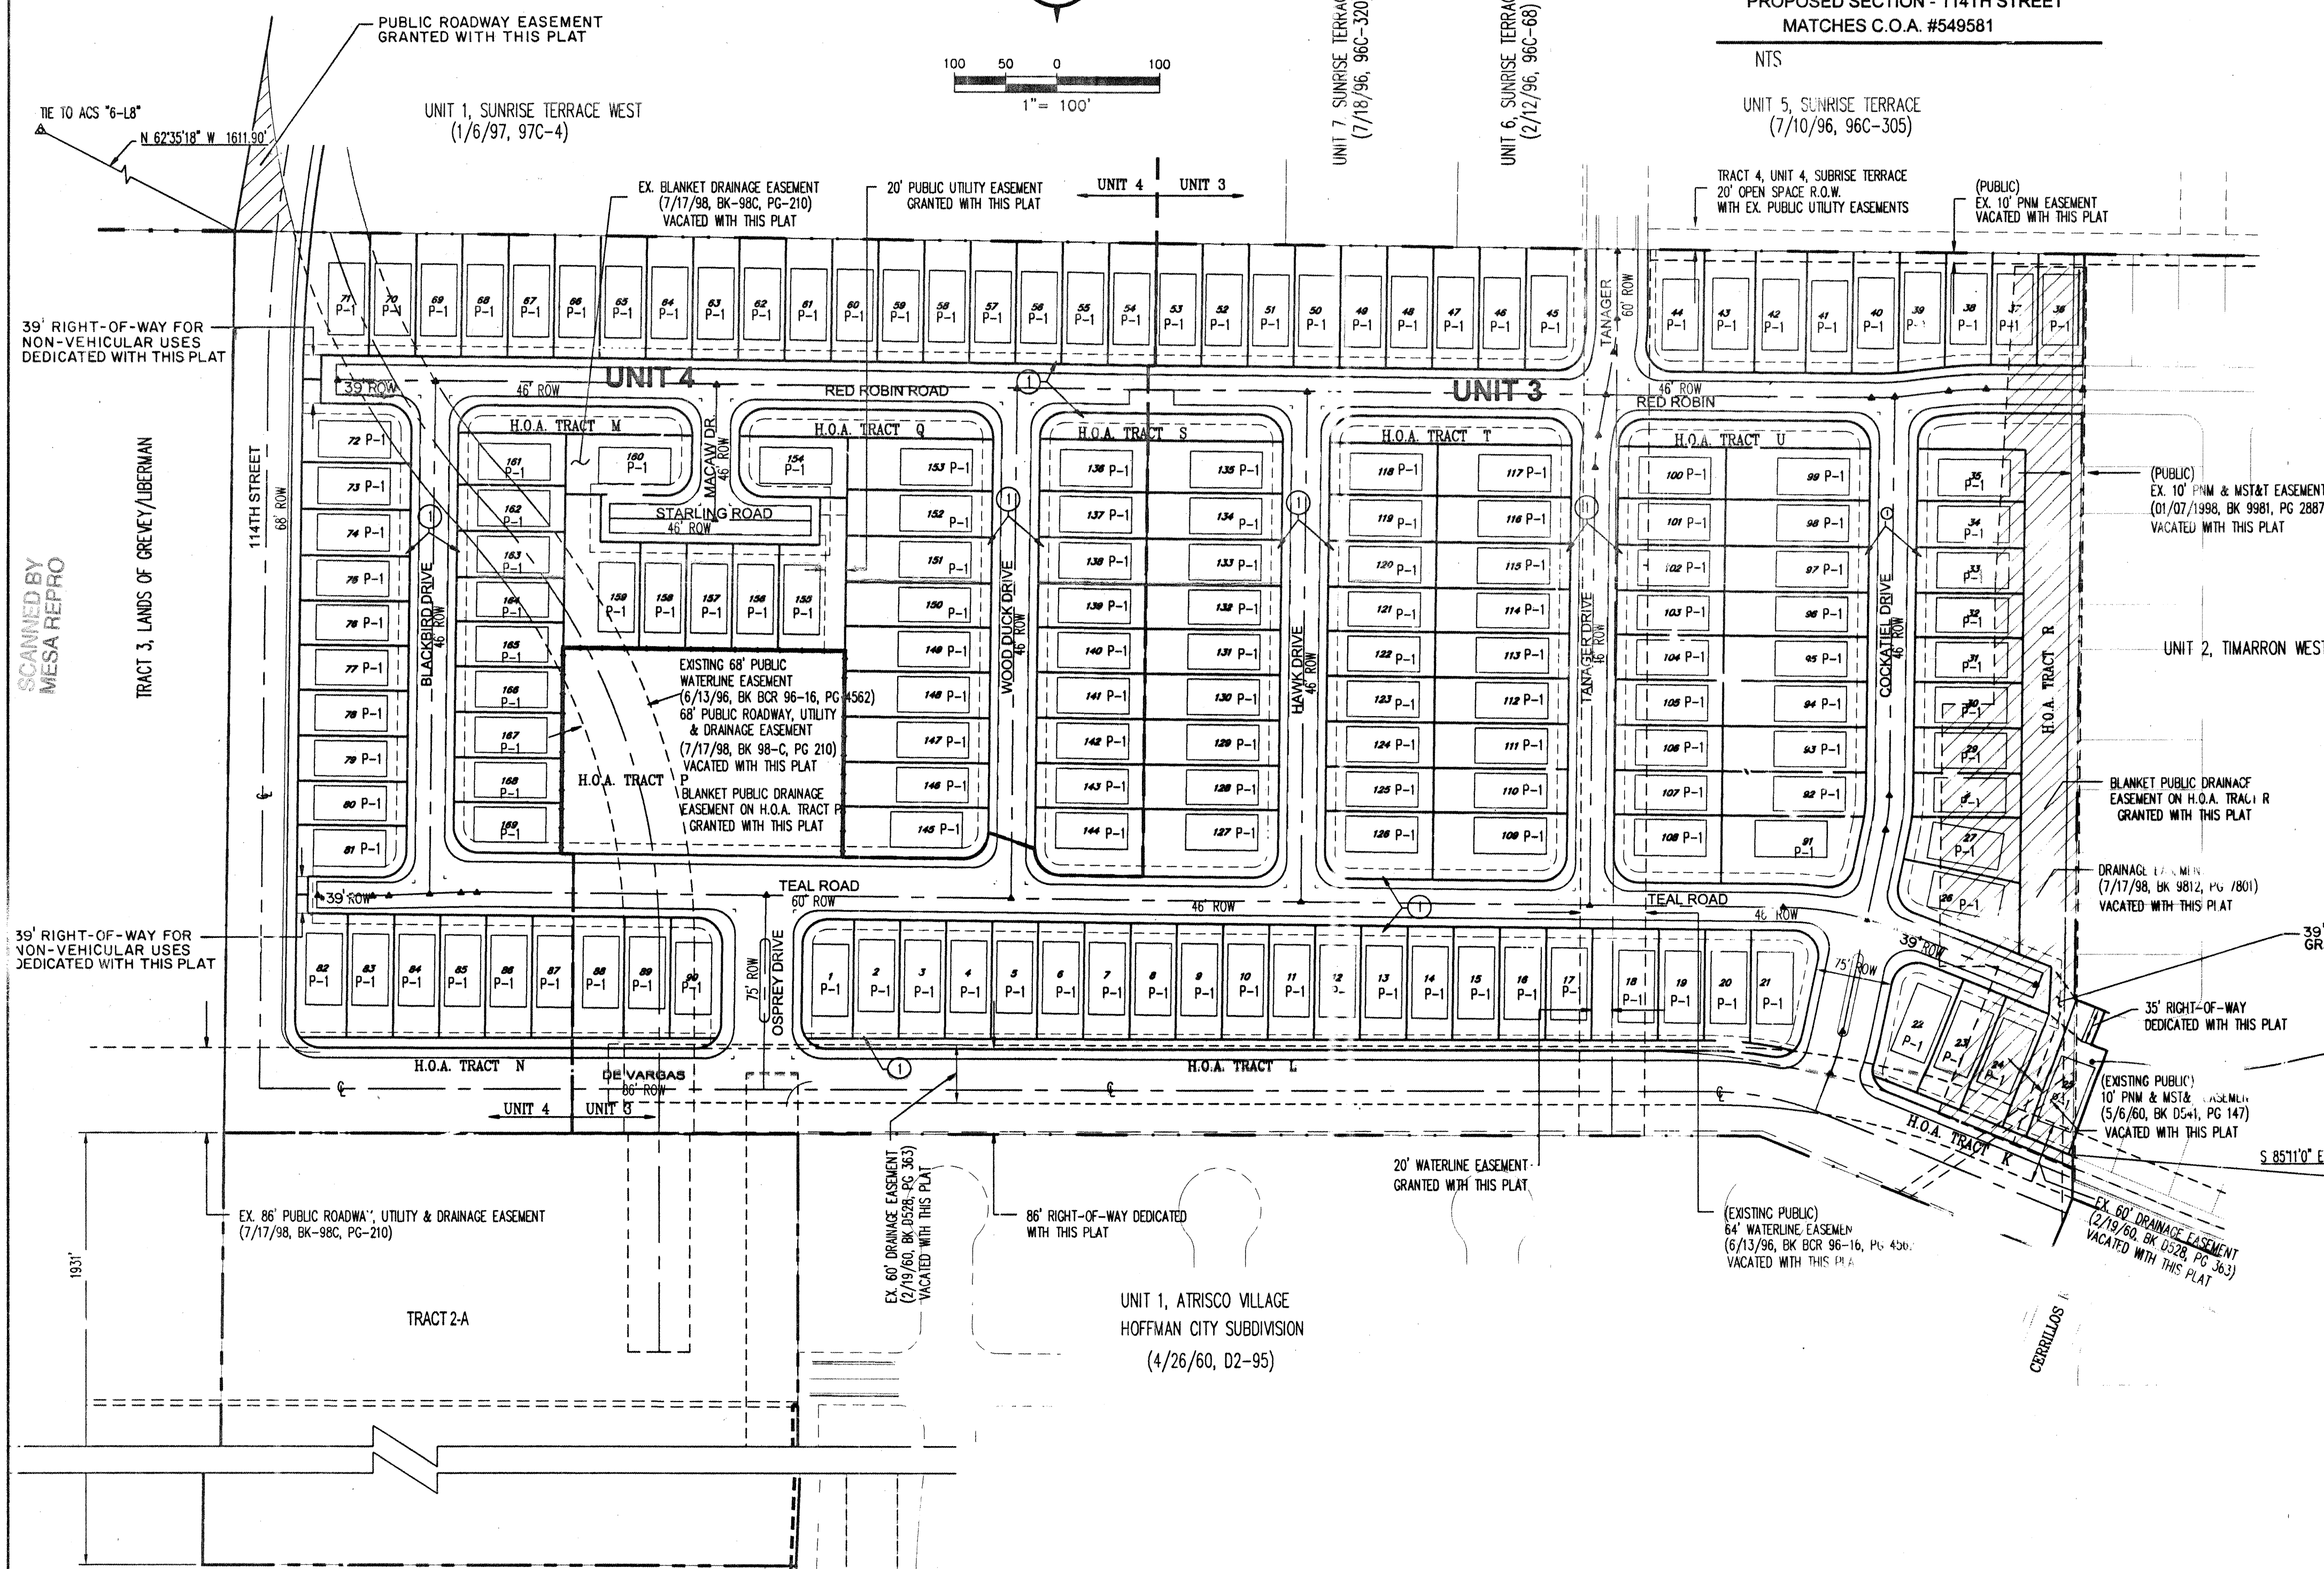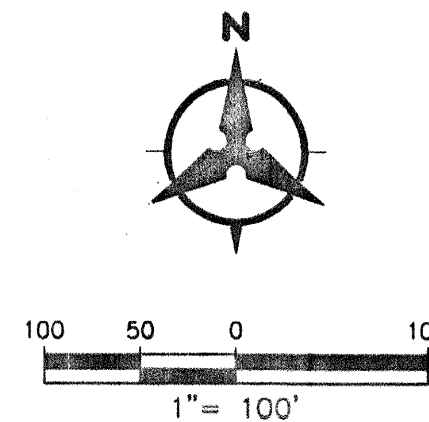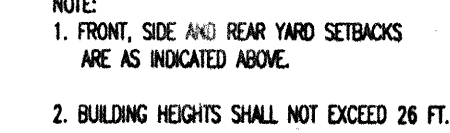

SCANNED BY
MESA REPRO

TRACT 3, LANDS OF GREVEY/LIBERMAN

39' RIGHT-OF-WAY FOR —
NON-VEHICULAR USES
DEDICATED WITH THIS PLAT

931'

TRACT 2-A

UNIT 1, ATRISCO VILLAGE
HOFFMAN CITY SUBDIVISION
(4/26/60, D2-95)

20' WATERLINE EASEMENT
GRANTED WITH THIS PLAT.

(EXISTING PUBLIC)
64' WATERLINE EASEMENT
(6/13/96, BK BCR 96-16, PG. 430)
VACATED WITH THIS PLA

TIMARRON WEST
UNIT 4

PROPOSED SECTION - 114TH STREET
MATCHES C.O.A. #549581

NTS

UNIT 5, SUNRISE TERRACE
(7/10/96, 96C-305)

TRACT 4, UNIT 4, SUBRISE TERRACE
20' OPEN SPACE R.O.W.
WITH EX. PUBLIC UTILITY EASEMENTS

(PUBLIC)
EX. 10' PNM EASEMENT
VACATED WITH THIS PLAT

UNIT 2, TIMARRON WEST

BLANKET PUBLIC DRAINAGE
EASEMENT ON H.O.A. TRACT
GRANTED WITH THIS PLAT



— 39' PUBLIC UTILITY EASEMENT

GRANTED WITH THIS FEAT

PARCEL 1, TIMARRON WEST UNIT 2

55.0.

... ..

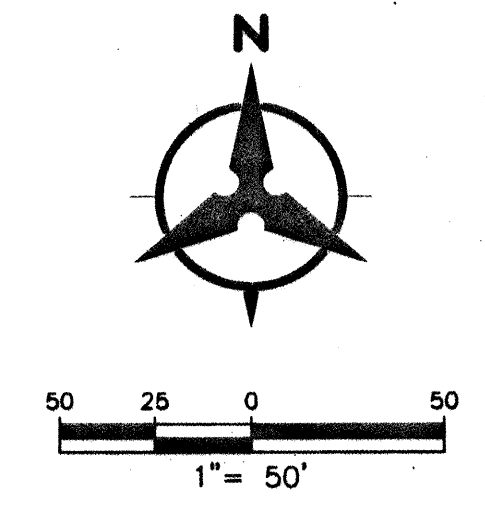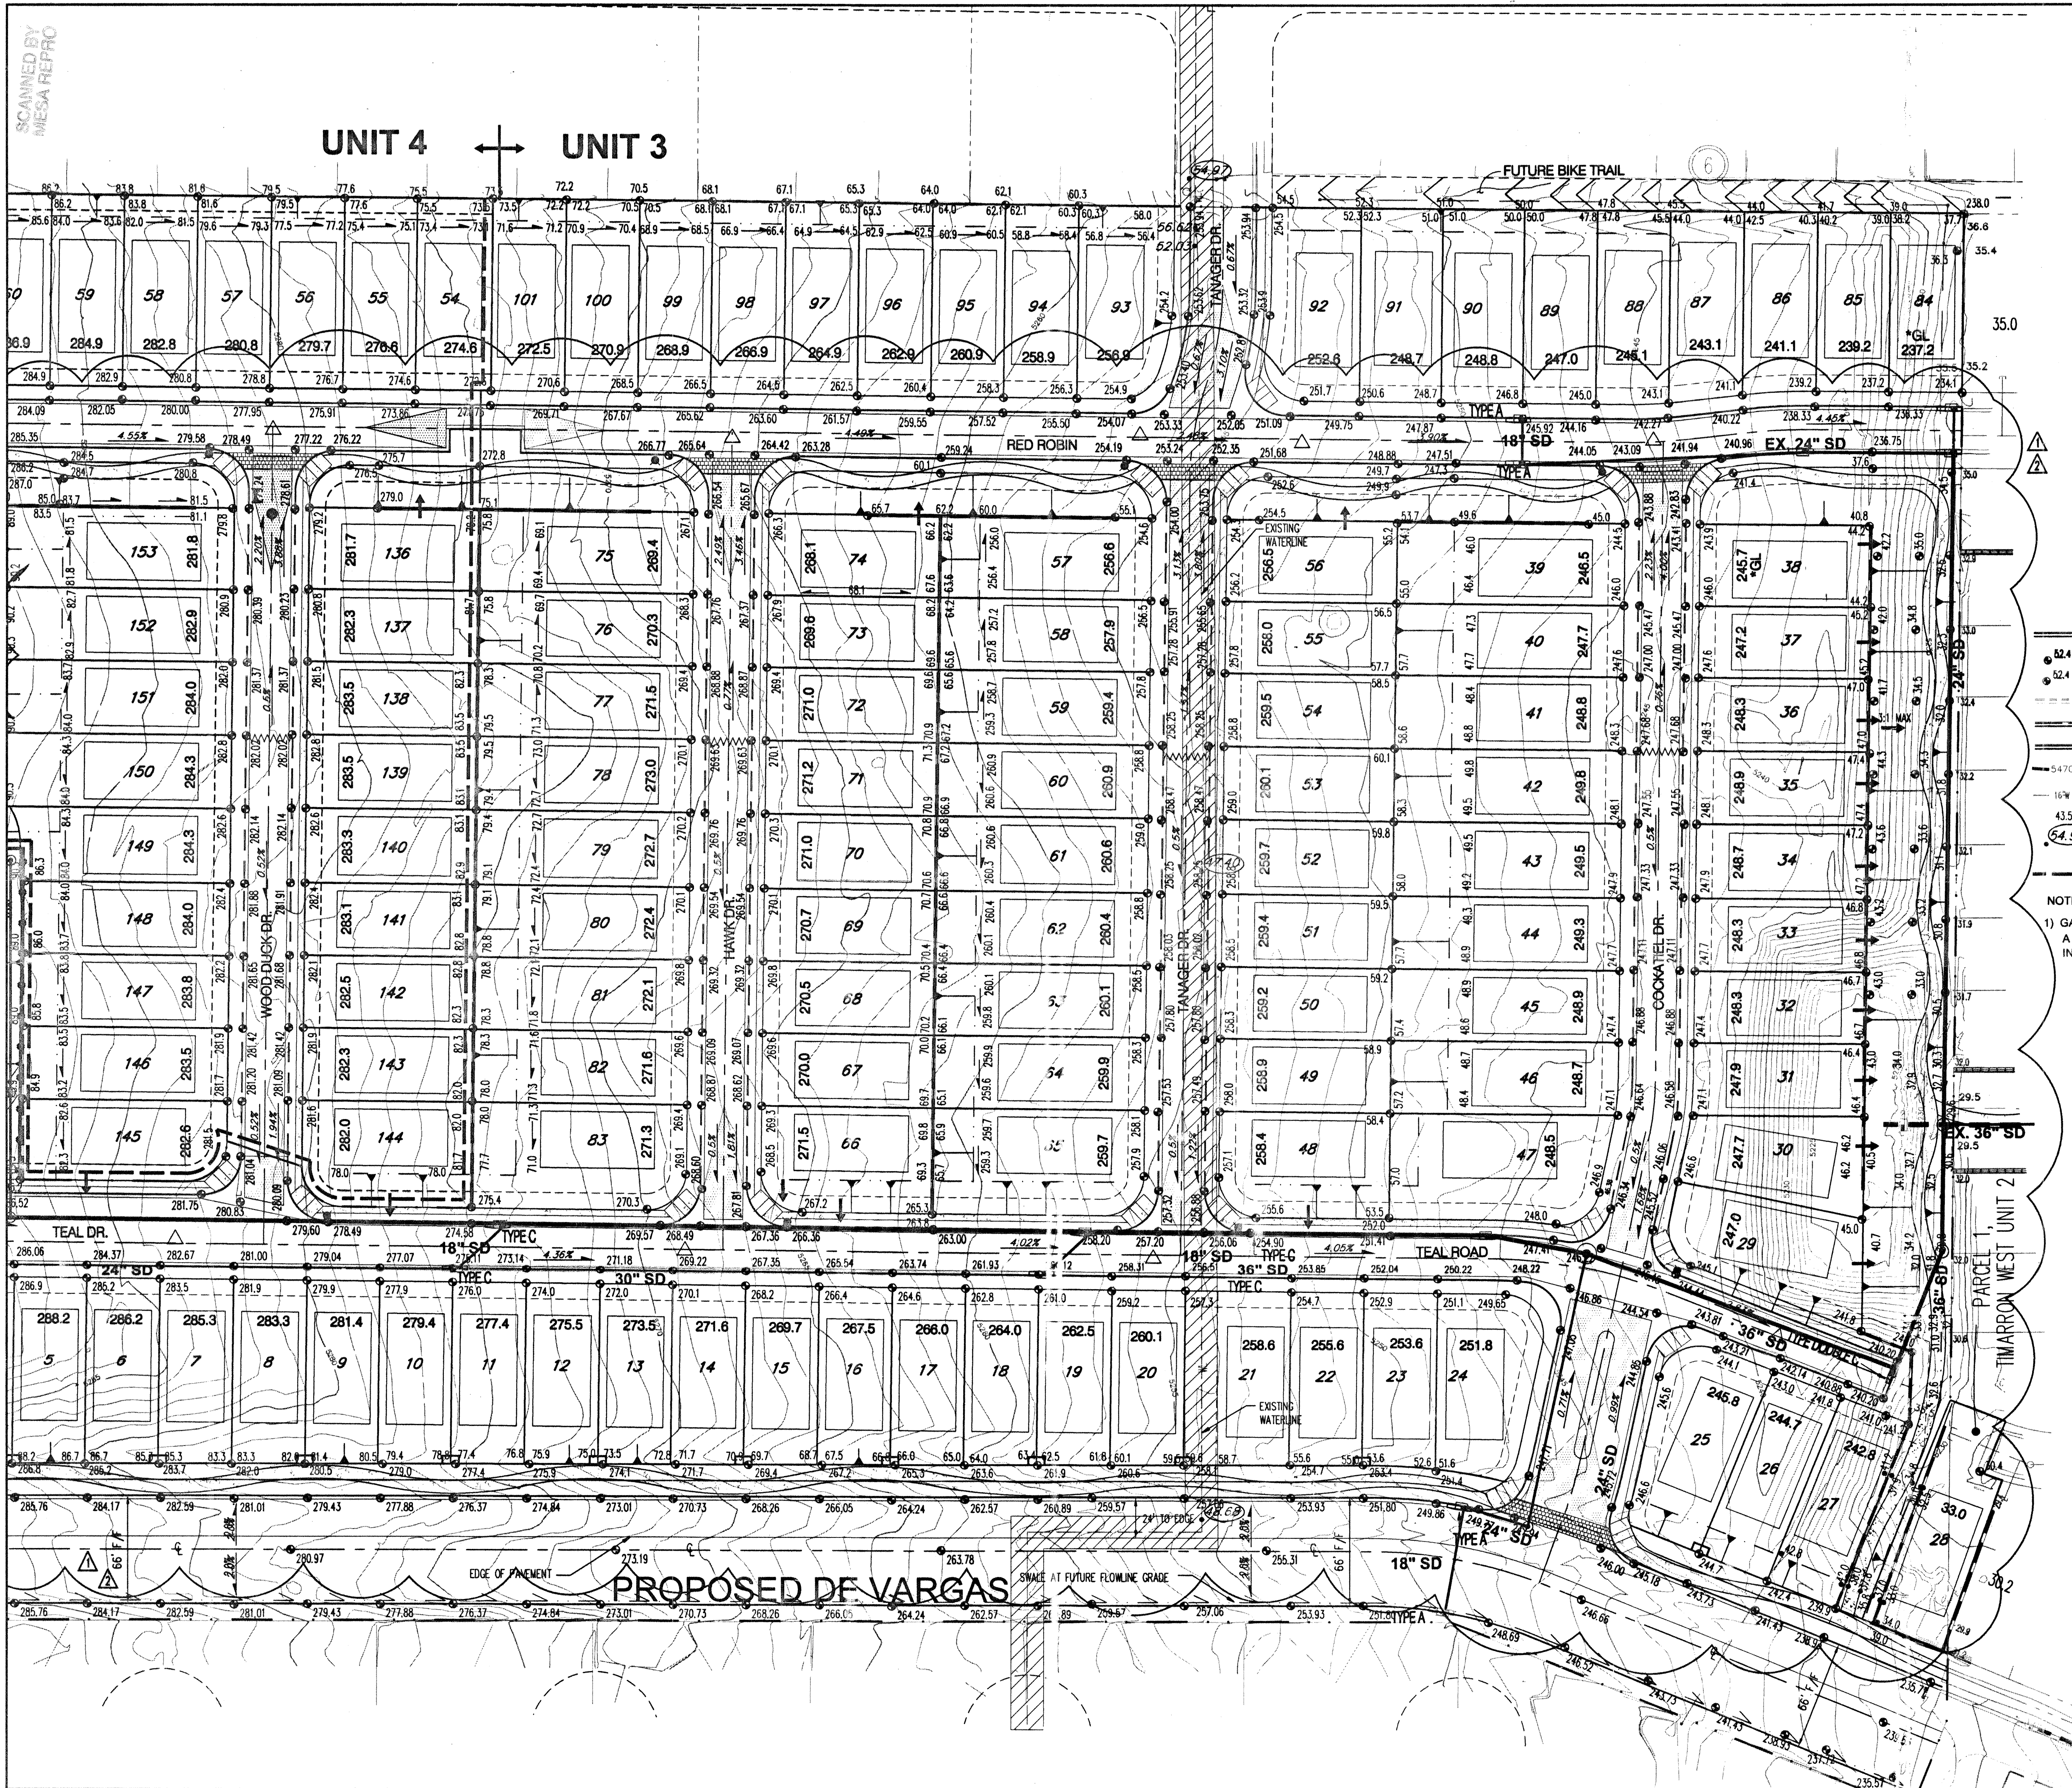

LEGEND

	PROPOSED SPOT ELEVATION		SWALE
	EXISTING SPOT ELEVATION (GROUND & TC)		FLOW ARROW
	EXISTING CURB & GUTTER		PROPOSED RETAINING WALL
	PROPOSED MOUNTABLE CURB & GUTTER		WATER BLOCK
	PROPOSED STANDARD CURB & GUTTER		PROPOSED SLOPE
	EXISTING CONTOUR W/ INDEX ELEVATION		MANDATORY DRIVEWAY LOCATION
	EXISTING WATER MAIN		STORM DRAIN INLET
	BACKYARD SWALE		
	EXISTING TOP OF PIPE WATERLINE ELEVATION		
	PHASE BOUNDARY		

NOTES:

1) GARDEN WALLS ARE NOT DRAWN
A 1.5' MAX GRADE BREAK AT A PROPERTY LINE
INDICATES A GARDEN WALL IS REQUIRED

EX. WATERLINE TO REMAIN
DENOTES EXISTING WATERLINE.
CONTRACTOR WILL USE CAUTION
WHEN WORKING OVER OR CROSSING
EXISTING WATERLINE. DAMAGE
TO WATERLINE DUE TO EARTH WORK
CONSTRUCTION WILL BE REPAIRED
BY THE CONTRACTOR AT
THE CONTRACTOR'S EXPENSE

F RELIMINARY
SUBJECT TO CITY REVIEW
10/16/00



Bohannon & Huston
Courtyard One 7500 JEFFERSON NE ALBUQUERQUE NEW MEXICO 87109
ENGINEERS PLANNERS PHOTOGRAMMETRISTS SURVEYORS SOFTWARE DEVELOPERS

CITY OF ALBUQUERQUE
PUBLIC WORKS DEPARTMENT
ENGINEERING DEVELOPMENT GROUP
TIMARRON WEST UNIT 3
GRADING & EROSION CONTROL PLAN


Design Review Committee	City Engineer Approval	Mo./Day/Yr.	Mo./Day/Yr.
<i>Approved</i>	<i>DB</i>		
Project No.	Zone Map No.	Sheet	Of
	L8/M8	3	32

NOTE:


1. CONTRACTOR IS TO MASS GRADE ROADS TO 2' BEYOND FUTURE CURB. EXCESS FROM DRY UTILITY TRENCH IS TO BE USED TO BACK FILL BEHIND CURB.
2. FRONT YARD ARE TO BE GRADED AS SHOWN ON THIS DETAIL FOR FINAL GRADING AND CERTIFICATION THIS DETAIL TO BE COORDINATED WITH.
3. HOME BUILDER TO BRING FRONT YARD TO ULTIMATE FRONT YARD GRADES AFTER HOME CONSTRUCTION IS COMPLETED. SEE ULTIMATE FRONT YARD GRADING DETAIL ON THIS SHEET.

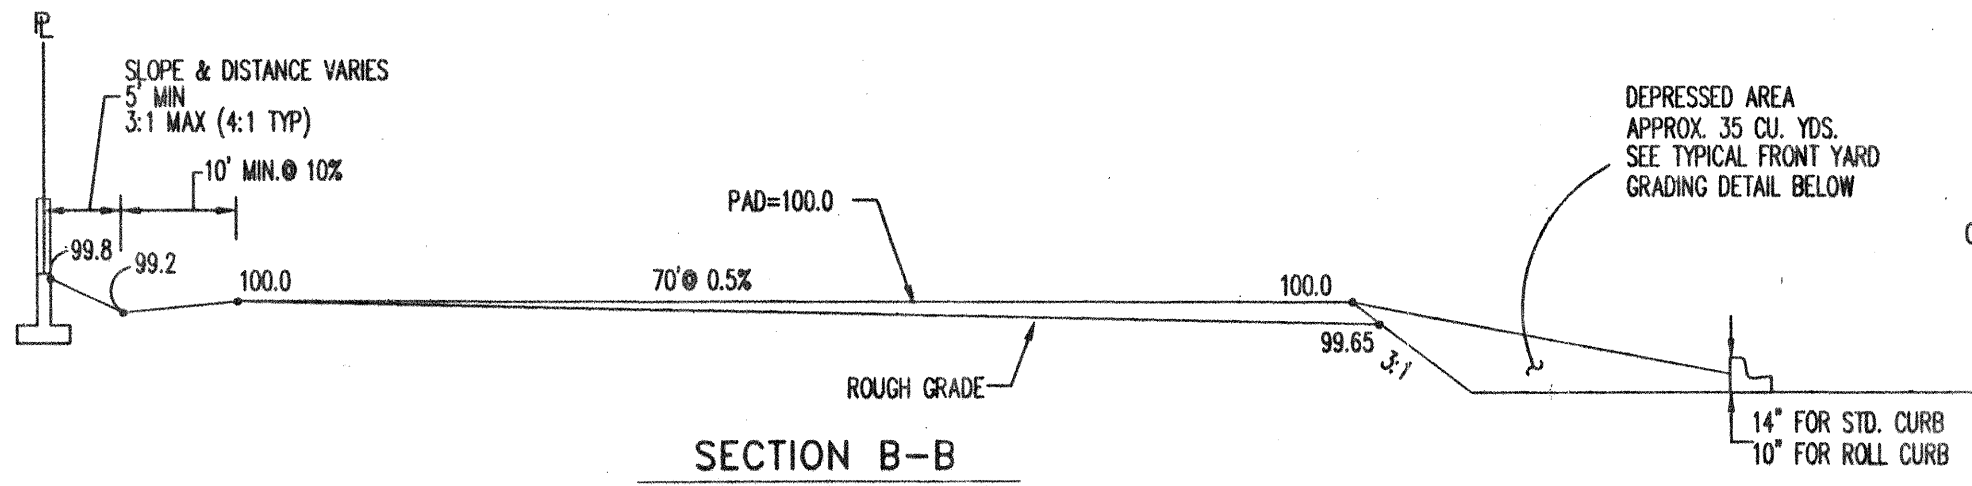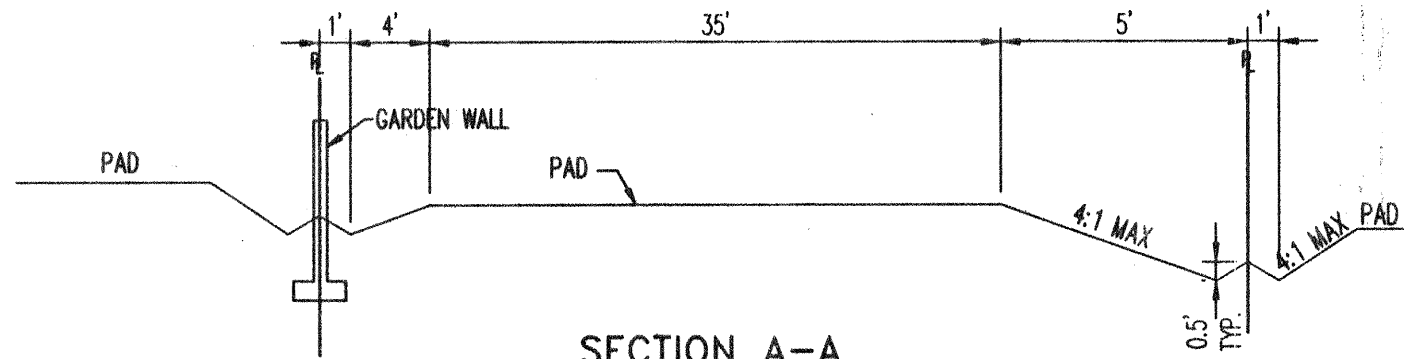


TYPICAL LOT GRADING DETAILS
NO SCALE

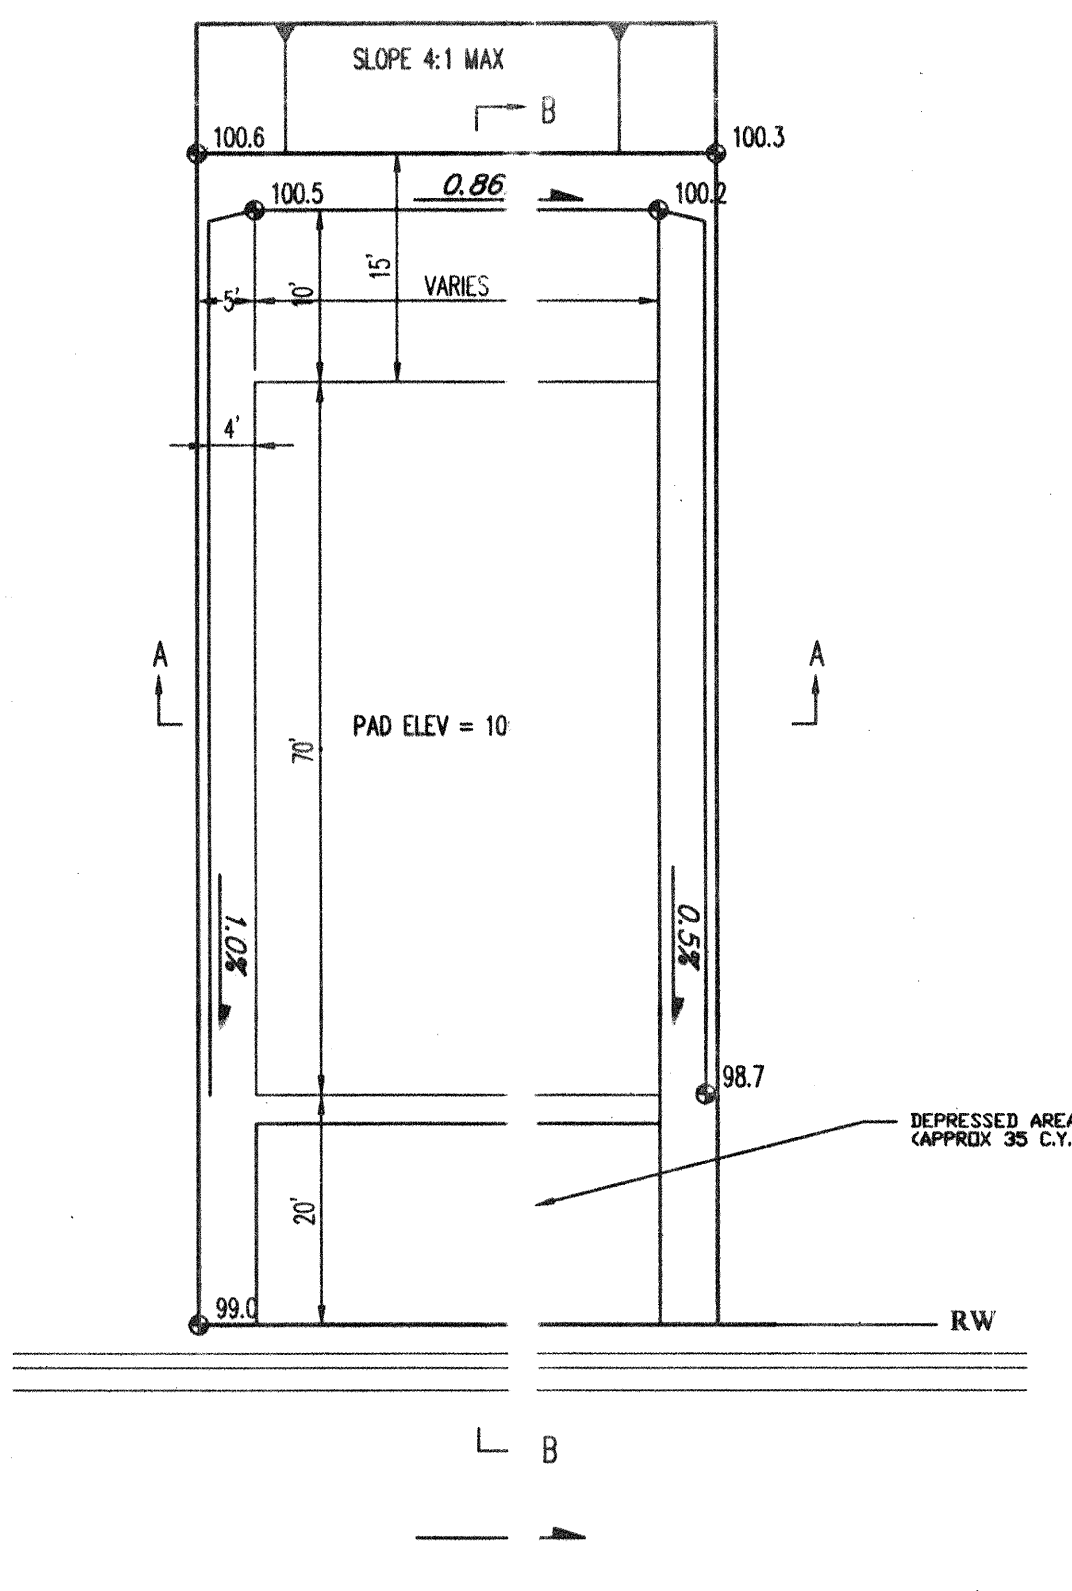

TYPICAL HIGH SIDE LOT GRADE DETAIL

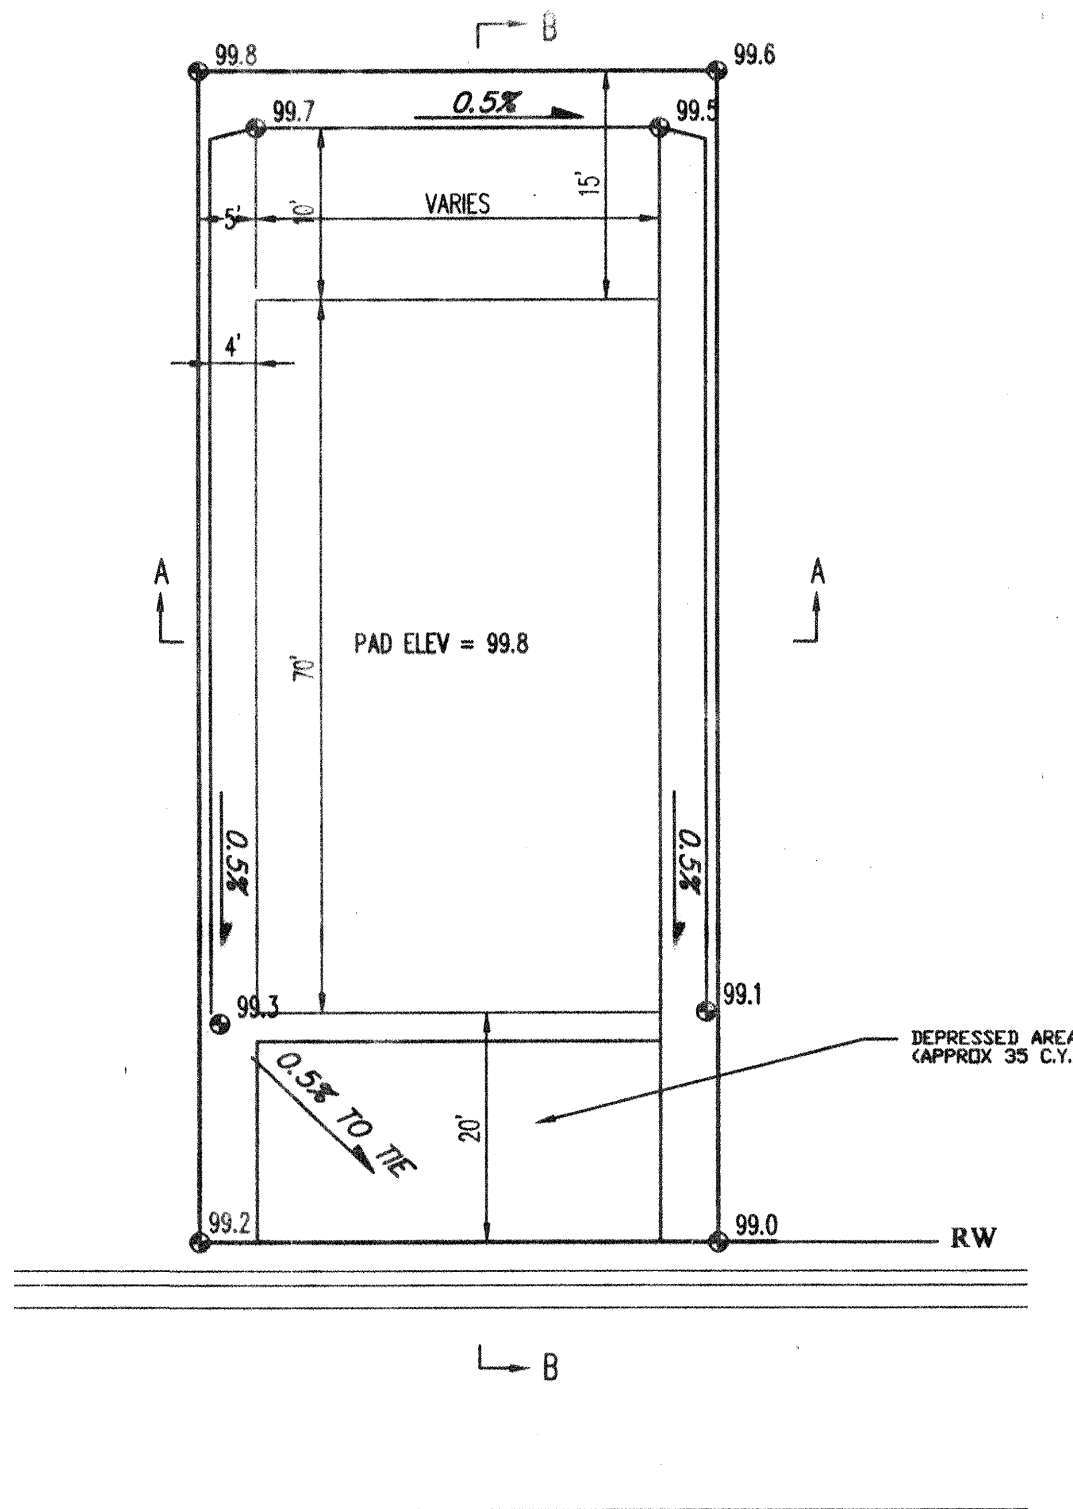

TYPICAL LOW SIDE LOT GRADE DETAIL

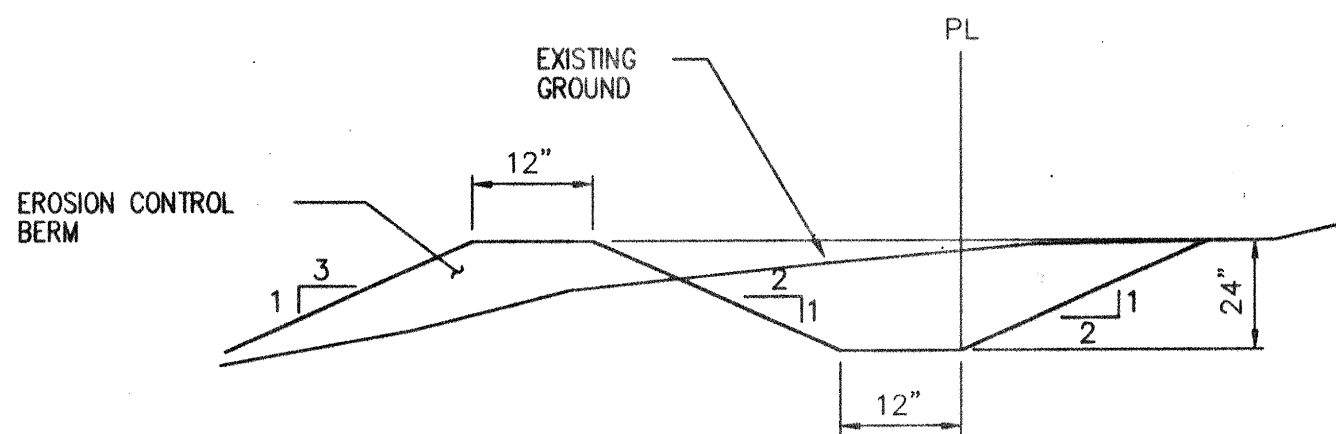


EROSION CONTROL BERM


1. TO PREVENT EROSION FROM THE SITE, DURING GRADING & CONSTRUCTION OPERATIONS, A BERM OF THE ABOVE DIMENSIONS SHALL BE MAINTAINED ON THE WEST WEST BOUNDARY OF THE SITE.
2. WIND EROSION SHALL BE PREVENTED BY MAINTAINING AN ADEQUATELY MOISTENED SITE.
3. AFTER CONSTRUCTION ALL SURFACES WILL BE PAVED OR LANDSCAPED TO PREVENT EROSION.
4. CONTRACTOR MUST OBTAIN A TOP SOIL DISTURBANCE PERMIT FROM ENVIRONMENTAL HEALTH DIVISION PRIOR TO CONSTRUCTION

EROSION CONTROL PLAN


NO SCALE

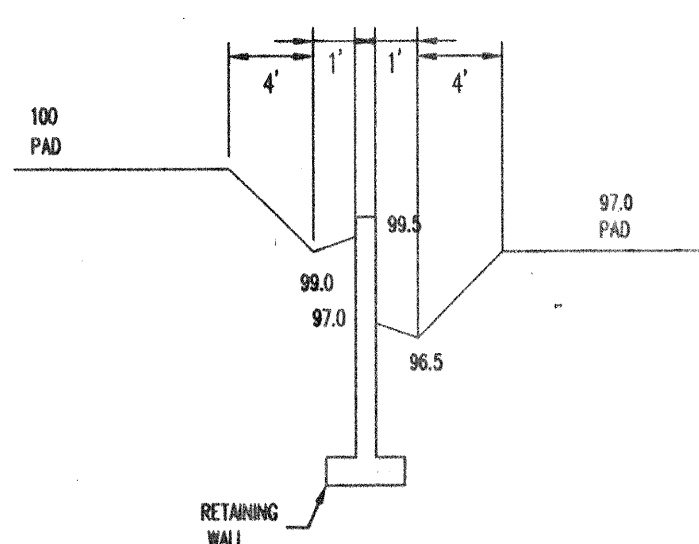


SIDE YARD RETAINING WALL DETAIL
N.T.S.

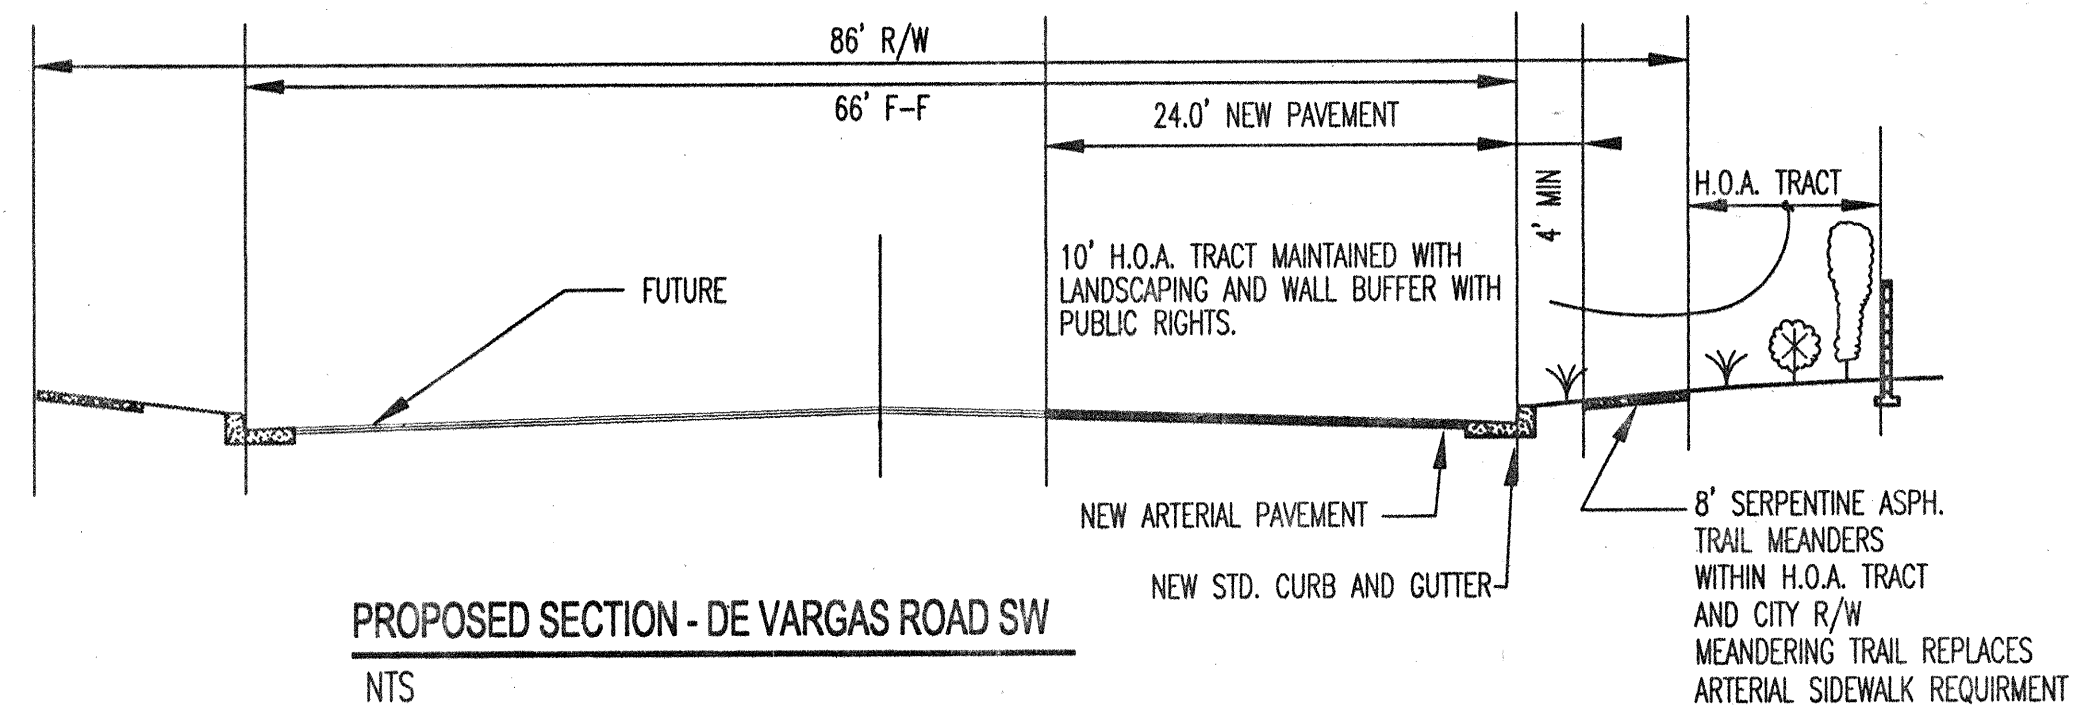

PROPOSED SECTION - DE VARGAS ROAD SW
N.T.S.

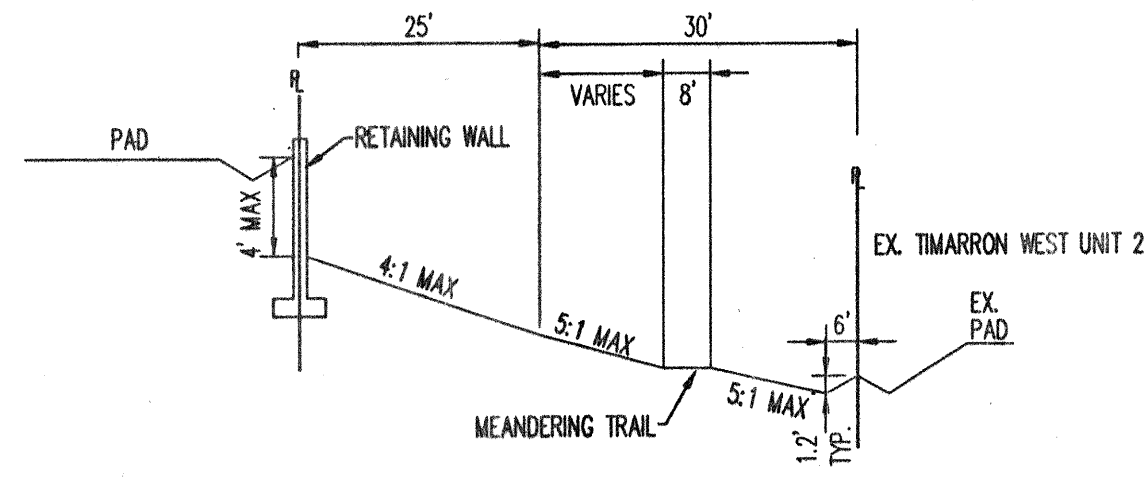

TYPICAL CROSS SECTION
EASTERN BOUNDARY
H.O.A. TRACT 'R'
N.T.S.

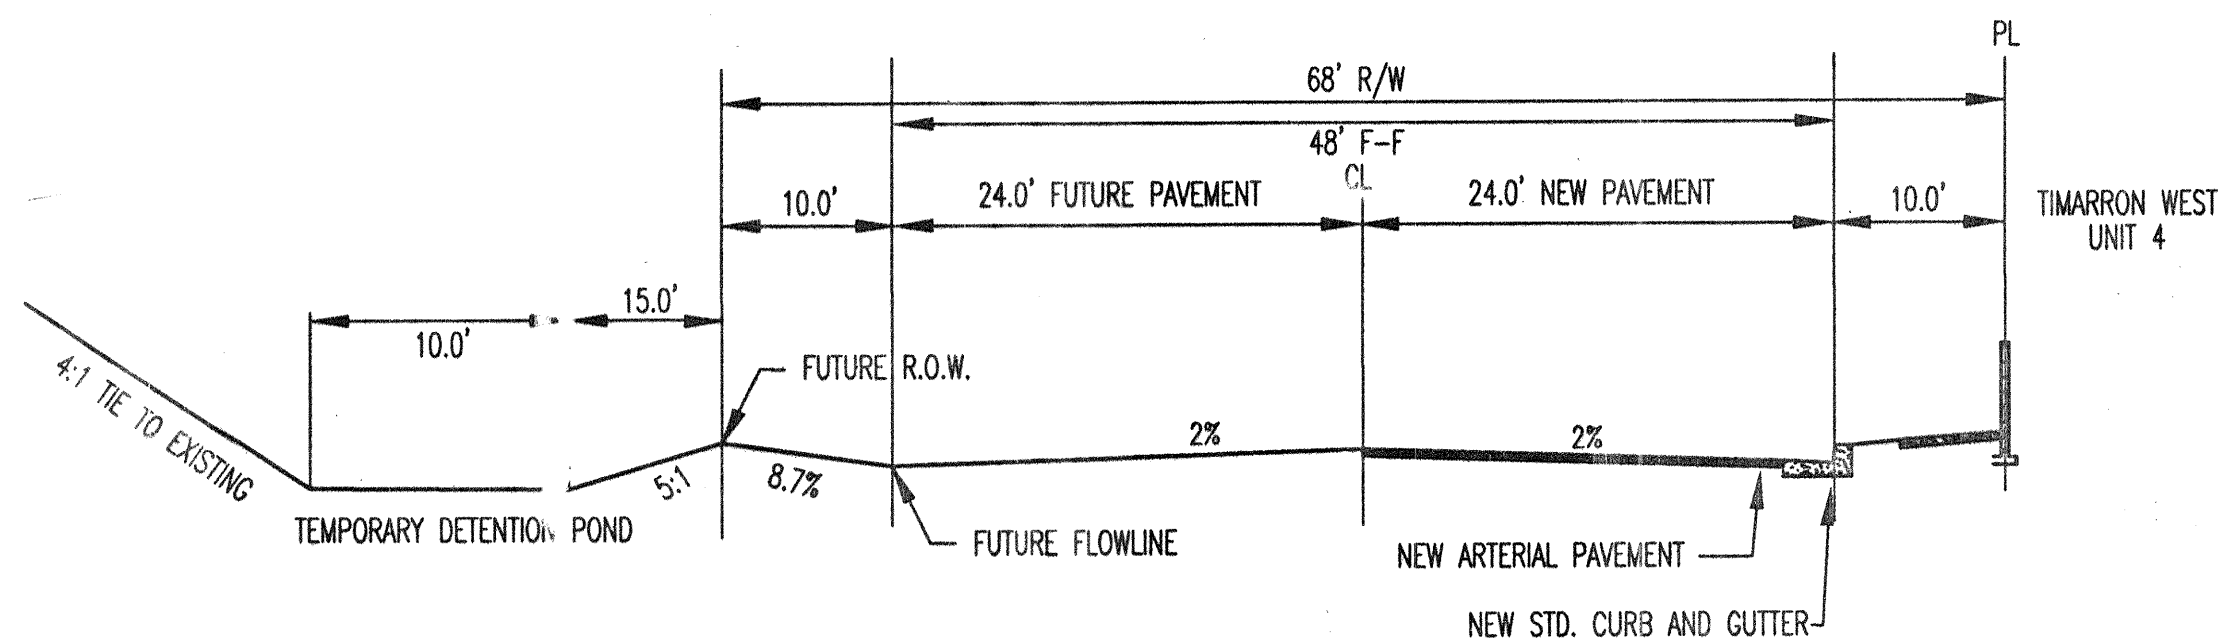

PROPOSED SECTION - 114TH STREET
MATCHES COA #549581
N.T.S.

Bohannon & Huston
Courtney One 7500 JEFFERSON NE Albuquerque NEW MEXICO 87109

ENGINEERS PLANNERS PHOTOGRAMMETRISTS SURVEYORS SOFTWARE DEVELOPERS

CITY OF ALBUQUERQUE
PUBLIC WORKS DEPARTMENT
ENGINEERING DEVELOPMENT GROUP



TIMARRON WEST UNITS 3 & 4
GRADING DETAILS

Design Review Committee City Engineer Approval
City Project No. Zone Map No. L-8/M-8 Sheet 5 Of 32

SURVEY INFORMATION			BENCH MARKS	AS-BUILT INFORMATION	
FIELD NOTES		CONTRACTOR		DATE	
NO.	BY	DATE			
			ACS Brass Tablet stamped "A-11-1980"		
			Geographic Position (NAD 1927)	DATE	
			N.M. State Plane Coordinates (Central Zone)	DATE	
			X= 365,236.60 Y= 1,531,771.91	DATE	
			Ground-to-Grid Factor= 0.9996658	DATE	
			adj= -0075.36"		
				MICRO-FILM INFORMATION	
				RECORDED BY	
				DATE	
				NO.	
			SLD 1929 Elevation= 5331.73		

SCANNED BY
MESA REPRO

TRACT 3
241.4640 ACRES
(EXCLUDING ATRISCO UTILITIES, INC. PROPERTY)
(ALSO EXCLUDING R/W 1, R/W 2, & R/W 3)

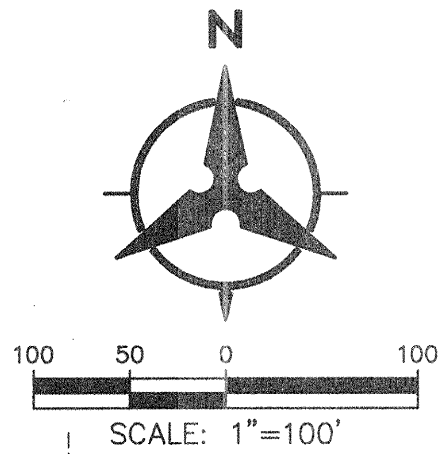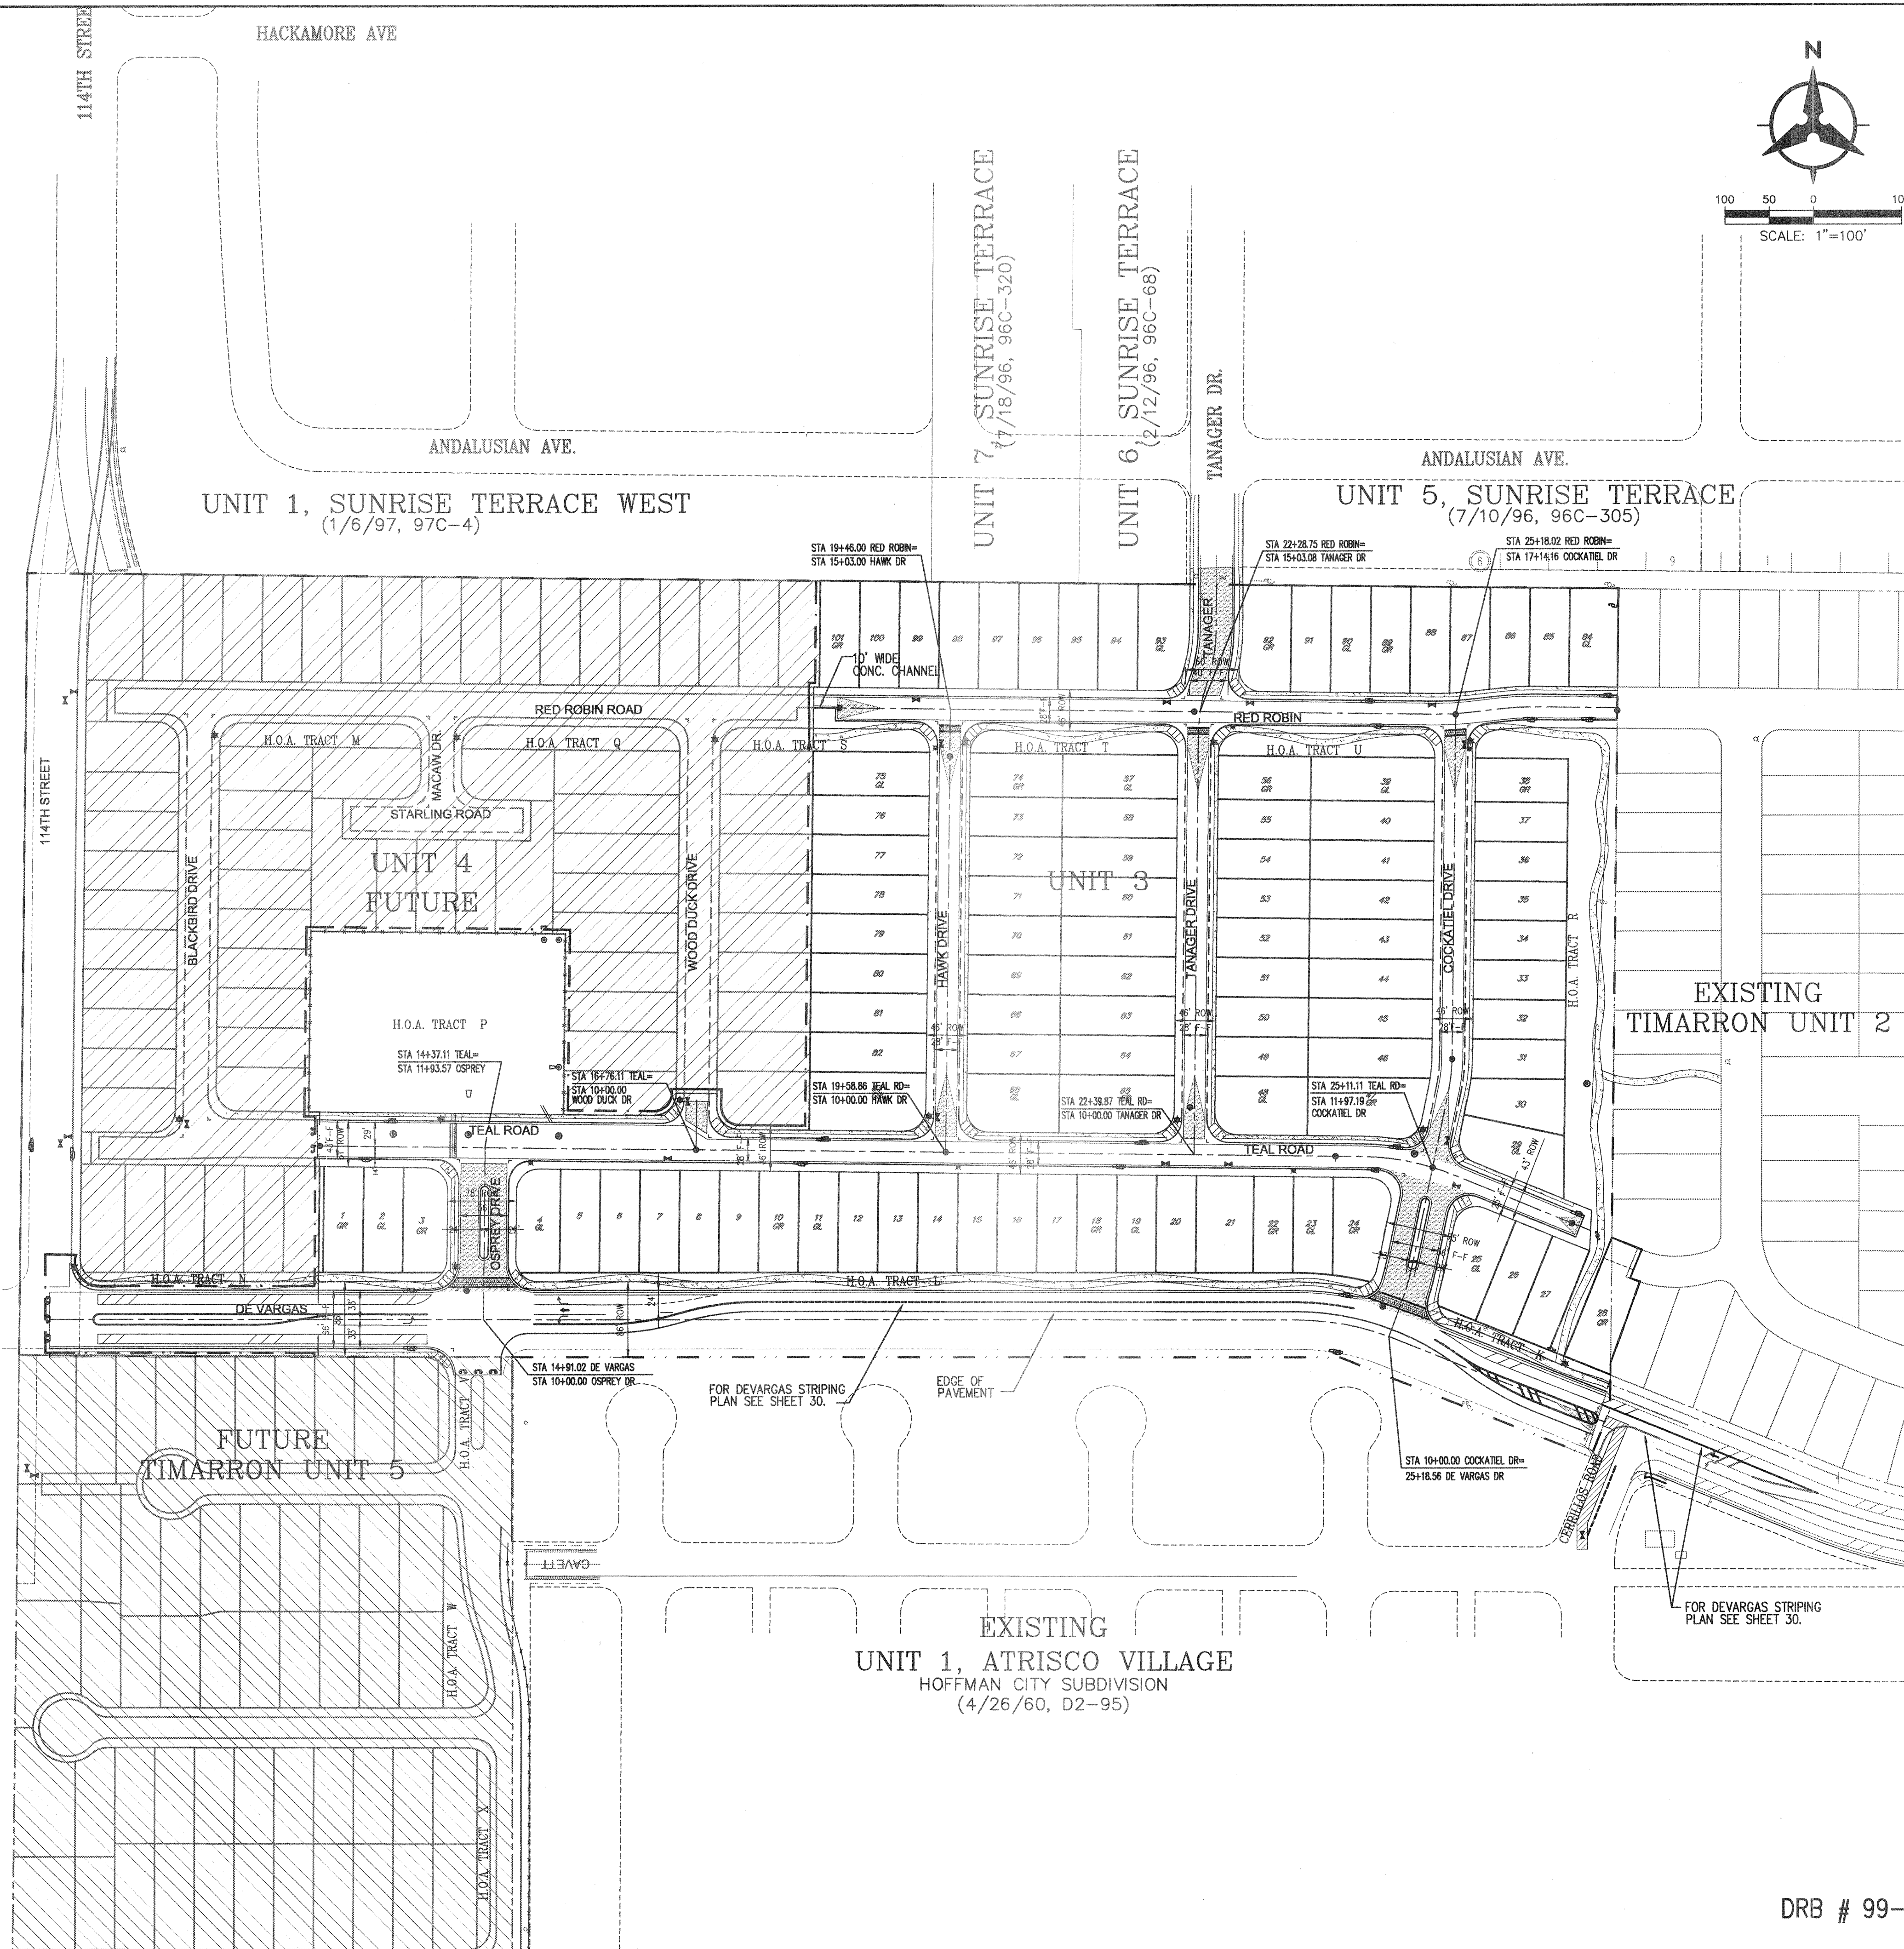

GENERAL NOTES

1. THE CONTRACTOR SHALL FIELD VERIFY ALL EXISTING UTILITY LOCATIONS AND NOTIFY THE ENGINEER IMMEDIATELY OF ANY DISCREPANCIES.
2. ALL CURVE DATA AND DIMENSIONS REFER TO FACE OF CURB UNLESS OTHERWISE SPECIFIED.
3. GRADE ELEVATIONS, WHERE NOTED, ARE FOR FLOWLINE OF STANDARD CURB UNLESS OTHERWISE SPECIFIED.
4. CONTRACTOR IS RESPONSIBLE FOR REPAIR AND/OR REPLACEMENT OF ALL UTILITY CONDUITS AND EXISTING LINES.
5. ANY ADDITIONAL GRADING REQUIRED TO MATCH PROPOSED STREET GRADES SHALL BE INCIDENTAL TO PAVING ITEMS.
6. CONTRACTOR SHALL PARK EQUIPMENT AND VEHICLES AS NOT TO INTERFERE WITH NORMAL ACTIVITIES OF RESIDENTS OR OTHER CONTRACTORS ON SITE.
7. ANY DAMAGE TO THE EXISTING FACILITIES, (C&G), PAVEMENT, CONDUITS, LANDSCAPING, UTILITY LINES, ETC.) DURING CONSTRUCTION SHALL BE REPLACED AT THE CONTRACTORS' EXPENSE.
8. REMOVAL OF THE EXISTING C&G SHALL BE AS PER COA STD. DWG. 2415 (SAWCUT ONLY).
9. WHEELCHAIR RAMPS SHALL BE CONSTRUCTED PRIOR TO ACCEPTANCE OF CURB & GUTTER.
10. DENOTES CROWN TRANSITION PER COA STD DWG. 2401.
11. FOR QUARTER POINT TABLE REFER TO TYPICAL INTERSECTION RETURN DETAIL, SHEET 28.
12. INSTALL COLORED PATTERNED CONCRETE IN MEDIANS.
13. MH RIMS & CATCH BASIN INLET ELEVATIONS ARE APPROXIMATE. CONTRACTOR SHALL FIELD VERIFY AND ADJUST TO FINAL PAVEMENT ELEVATIONS.
14. CONTRACTOR SHALL FIELD VERIFY ALL EXISTING UTILITIES AND TRANSMISSION GAS LINES. CONTRACTOR SHALL COORDINATE RELOCATION OF GAS LINES WITH GAS COMPANY IF REQUIRED.

NOTE:
SEE DETAIL SHEETS 28-30 FOR STREET
CROSS-SECTIONS & PAVEMENT DETAILS

LEGEND

- EXISTING R/W LINE
- EXISTING CURB & GUTTER
- EXISTING FENCE
- PROPOSED R/W LINE
- PROPERTY LINE
- PROPOSED STD CURB & GUTTER
- PROPOSED ROLL TYPE C&G
- PROPOSED PHASE BOUNDARY
- EASEMENT
- PROPOSED STREET LIGHT
- PROPOSED STORM DRAIN MANHOLE
- PROPOSED STORM DRAIN INLET
- PROPOSED FIRE HYDRANT
- PROPOSED MAIN VALVE
- PROPOSED SAS MANHOLE

Bohannon & Huston

Courtyard One 7500 JEFFERSON NE Albuquerque NEW MEXICO 87109

ENGINEERS PLANNERS PHOTOGRAMMETRISTS SURVEYORS SOFTWARE DEVELOPERS


CITY OF ALBUQUERQUE
PUBLIC WORKS DEPARTMENT
ENGINEERING DEVELOPMENT GROUP

TIMARRON WEST UNIT 3
OVERALL PAVING PLAN

Design Review Committee	City Engineer Approval	Mo./Day/Yr.	Mo./Day/Yr.
DESIGN REVIEW COMMITTEE	CITY ENGINEER	Last Design Update	
City Project No.	Zone Map No.	Sheet	Of
651681	L-8,M-8	6	32

DRB # 99-165

16+62.11, 54.00' LT
END CURB RETURN

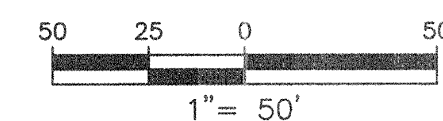

1. THE CONTRACTOR SHALL FIELD VERIFY ALL EXISTING UTILITY LOCATIONS AND NOTIFY THE ENGINEER IMMEDIATELY OF ANY DISCREPANCIES.
2. ALL CURVE DATA AND DIMENSIONS REFER TO FACE OF CURB UNLESS OTHERWISE SPECIFIED.
3. GRADE ELEVATIONS, WHERE NOTED, ARE FOR FLOWLINE OF CURB UNLESS OTHERWISE SPECIFIED.
4. CONTRACTOR IS RESPONSIBLE FOR REPAIR AND/OR REPLACEMENT OF ALL UTILITY CONDUITS AND EXISTING LINES.
5. ANY ADDITIONAL GRADING REQUIRED TO MATCH PROPOSED STREET GRADES SHALL BE INCIDENTAL TO PAVING ITEMS.
6. CONTRACTOR SHALL PARK EQUIPMENT AND VEHICLES AS NOT TO INTERFERE WITH NORMAL ACTIVITIES OF RESIDENTS OR OTHER CONTRACTORS ON SITE.
7. ANY DAMAGE TO THE EXISTING FACILITIES, C&G, PAVEMENT, CONDUITS, LANDSCAPING, EXISTING LINES, ETC.) DURING CONSTRUCTION SHALL BE REPLACED AT THE CONTRACTORS' EXPENSE.
8. REMOVAL OF THE EXISTING CURB & GUTTER SHALL BE AS PER COA STD. DWG. 2415 (SAWCUT ONLY).
9. WHEELCHAIR RAMPS SHALL BE CONSTRUCTED PRIOR TO ACCEPTANCE OF CURB & GUTTER.
10. DENOTES CROWN TRANSITION PER COA STD. DWG. 2401.
11. QUARTER POINT TABLES ARE SPECIFIED ON PAVING SHEETS. FOR ADDITIONAL INFORMATION REFER TO TYPICAL INTERSECTION RETURN DETAIL, SHEET 29.
12. INSTALL COLORED PATTERNED CONCRETE IN ALL MEDIANS.
13. MH RIMS, CATCH BASIN INLET, & FH FLANGE ELEVATIONS ARE APPROXIMATE. CONTRACTOR SHALL FIELD VERIFY AND ADJUST TO FINAL PAVEMENT ELEVATIONS.
14. CONTRACTOR SHALL FIELD VERIFY ALL EXISTING UTILITIES AND TRANSMISSION GAS LINES. CONTRACTOR SHALL COORDINATE RELOCATION OF UTILITY LINES WITH UTILITY COMPANIES AS REQUIRED.

- ① INSTALL CONCRETE VALLEY GUTTER AS PER COA STD. DWG. 2420.
- ② INSTALL SPECIAL HANDICAP RAMP AS PER DETAIL "A", SHEET 29.
- ③ BUILD STD. CURB & GUTTER AS PER COA STD. DWG. 2415.
- ④ BUILD RESIDENTIAL PAVEMENT AS PER RESIDENTIAL SECTION, SHEET 28.
- ⑤ 4' SIDEWALK, DEFERRED.
- * ⑥ BUILD ROLL TYPE CURB & GUTTER AS PER COA STD. DWG. 2415.
- ⑦ NO SIDEWALK ON THIS SIDE, WAIVED.
- ⑧ 6" D X 10" W X 24" L (VARIES) PCC PWT W/WIRE MES RUNNING BOND PATTERN, BAJA RED, PER DETAIL SHEET 28. GROOVES NOT TO EXCEED 1/4" DEPTH-SHAPE, DEPTH, & PATTERN OF CROSSWALK MUST MEET ADA STANDARD. PLACE (2) 12" WIDE WHITE PLASTIC STRIPES ON EACH SIDE OF PATTERNED CROSSWALK.
- ⑨ BUILD PAVEMENT AS PER TEAL RD 43' F-F PAVE SECTION, SHEET 28.
- ⑩ TRANSITION FROM STD C&G TO ROLL TYPE C&G THRU RETURN PER COA STD DWG 2418.
- ⑪ INSTALL SPECIAL HANDICAP RAMP PER DETAIL "B" SHEET 29.
- ⑫ INSTALL (2) TYPE III BARRICADES.

Bohannon ▲ Huston

 Courtyard One 7500 JEFFERSON NE Albuquerque NEW MEXICO 87109

ENGINEERS PLANNERS PHOTOGRAMMETRISTS SURVEYORS SOFTWARE DEVELOPERS

Design Review Committee	City Engineer Approval		Mo./Day/Yr.	Mo./Day/Yr.
APPROVED	APPROVED			
FEB 13 2001	FEB 23 2001			
DESIGN REVIEW COMMITTEE	CITY ENGINEER			

Post Design Update

City Project No.	Zone Map No.	Sheet	Of
651681	L8-M8	7	32

SURVEY INFORMATION			BENCH MARKS	AS-BUILT INFORMATION
FIELD NOTES				
NO.	BY	DATE		
			ACS 1.3/4" Alum. disk stamped "ACS BM 14-W8" LOCATED AT THE ESE QUADRANT OF VARGAS RD. AND CERRILLOS ROAD EXPOSED TO TOP OF CONCRETE CURB Elevation= 5233.928	CONTRACTOR <i>FRANKLIN'S</i> DATE <i>01</i> STAMPED BY <i>ATLS</i> DATE <i>11-01</i> INSPECTOR'S FIELD CHECKED BY <i>ATLS</i> DATE <i>01</i> VERIFICATION BY <i>ATLS</i> DATE <i>11/01</i> MICRO-FILM INFORMATION RECORDED BY DATE NO.
				<i>City Inspector: G. Shand's</i>

Professional Engineer Seal for Richard Lynn Beltram, New Mexico, No. 18596, dated 1/12/01.

	No.	Date	REMARKS	By
DESIGN REVISIONS				
DESIGN				
Designed By: EES				DATE: 11/00
Drawn By: DH/KSH				DATE: 11/00
Checked By: RUB				DATE: 11/00

22+25.87, 39.00' LT
BEGIN CURB RETURN

22+78.87, 14.00' LT
BEGIN CURB RETURN

24+96.02, 38.77' LT
BEGIN CURB RETURN

25+43.79, 12.50' LT
BEGIN CURB RETURN

22+00.87, 14.00' LT
END CURB RETURN

22+53.87, 39.00' LT
END CURB RETURN

24+73.88, 14.00' LT
END CURB RETURN

25+21.37, 33.80' LT
END CURB RETURN

22+25.87, 39.00' LT
BEGIN CURB RETURN

22+78.87, 14.00' LT
BEGIN CURB RETURN

24+96.02, 38.77' LT
BEGIN CURB RETURN


25+43.79, 12.50' LT
BEGIN CURB RETURN

22+00.87, 14.00' LT
END CURB RETURN


22+53.87, 39.00' LT
END CURB RETURN

24+73.88, 14.00' LT
END CURB RETURN

25+21.37, 33.80' LT
END CURB RETURN

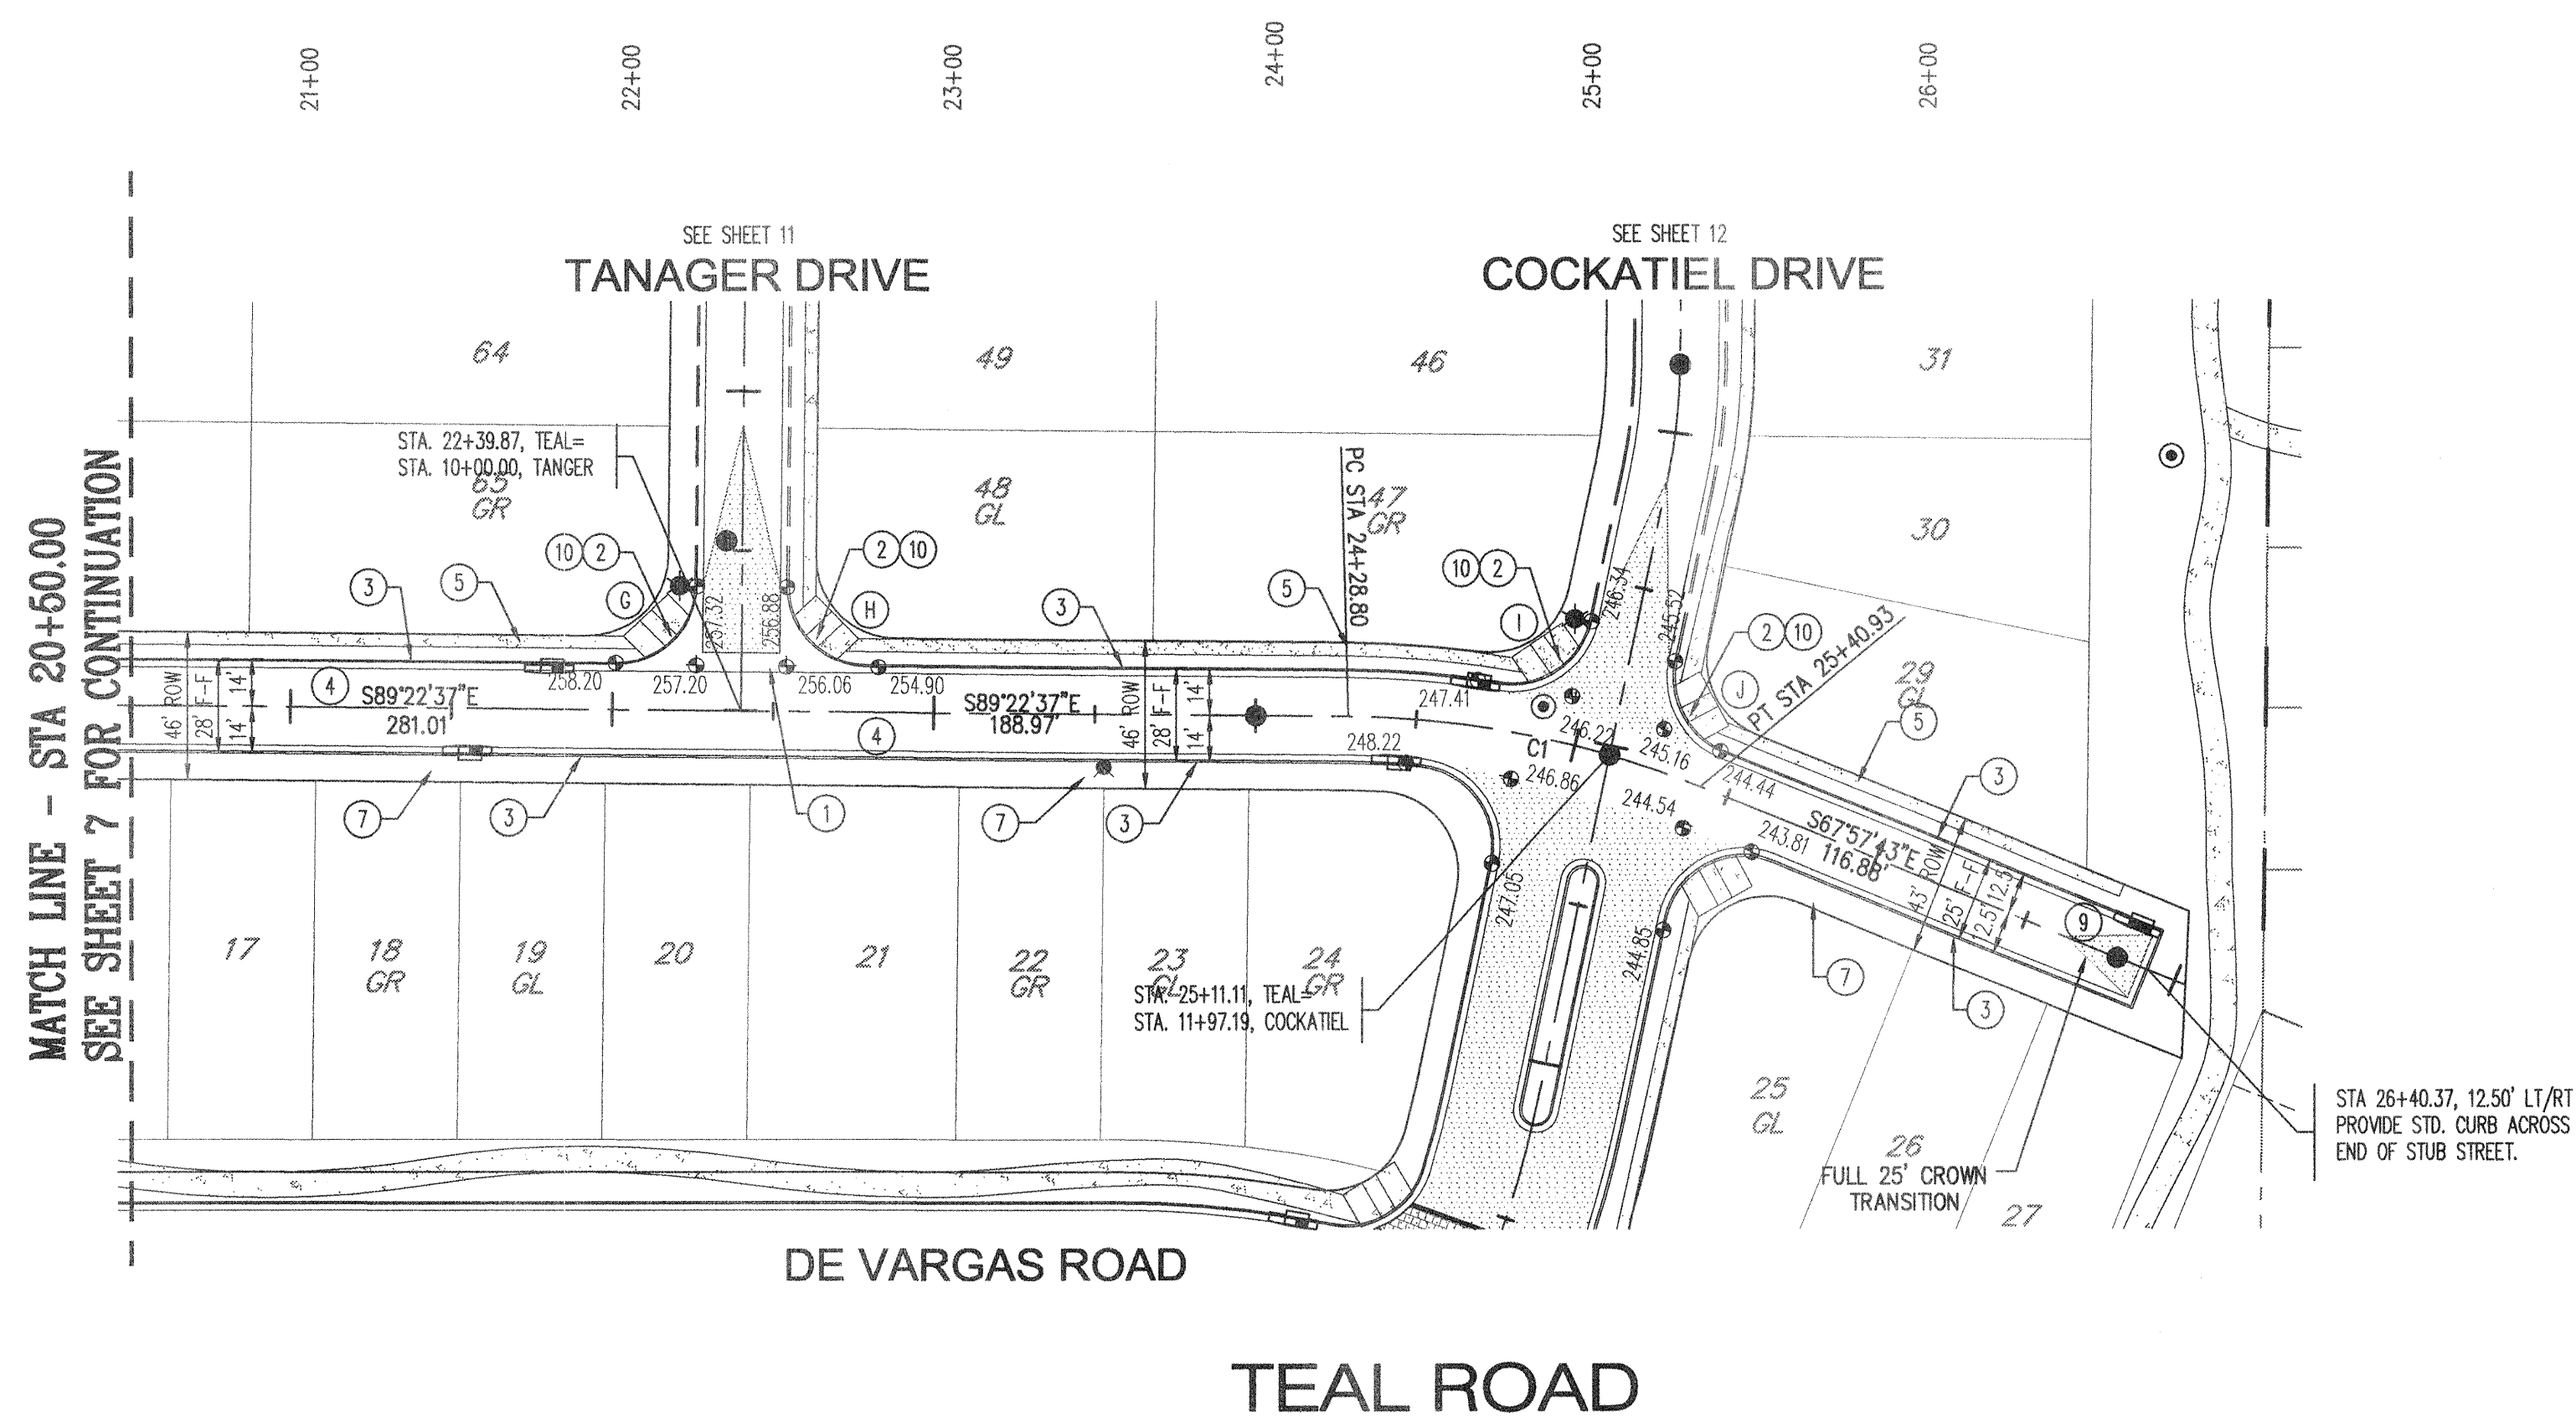

CURVE TABLE				
NUMBER	RADIUS	LENGTH	DELTA	TANGENT
C1	300.00'	112.13'	21°24'32"	56.73'

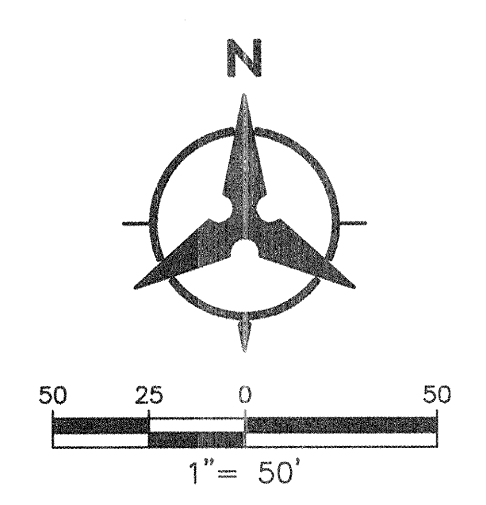

- GENERAL NOTES
1. THE CONTRACTOR SHALL FIELD VERIFY ALL EXISTING UTILITY LOCATIONS AND NOTIFY THE ENGINEER IMMEDIATELY OF ANY DISCREPANCIES.

2. ALL CURVE DATA AND DIMENSIONS REFER TO FACE OF CURB UNLESS OTHERWISE SPECIFIED.

3. GRADE ELEVATIONS, WHERE NOTED, ARE FOR FLOWLINE OF CURB UNLESS OTHERWISE SPECIFIED.

4. CONTRACTOR IS RESPONSIBLE FOR REPAIR AND/OR REPLACEMENT OF ALL UTILITY CONDUITS AND EXISTING LINES.

5. ANY ADDITIONAL GRADING REQUIRED TO MATCH PROPOSED STREET GRADES SHALL BE INCIDENTAL TO PAVING ITEMS.

6. CONTRACTOR SHALL PARK EQUIPMENT AND VEHICLES AS NOT TO INTERFERE WITH NORMAL ACTIVITIES OF RESIDENTS OR OTHER CONTRACTORS ON SITE.

7. ANY DAMAGE TO THE EXISTING FACILITIES, C&G, PAVEMENT, CONDUITS, LANDSCAPING, EXISTING LINES, ETC.) DURING CONSTRUCTION SHALL BE REPLACED AT THE CONTRACTORS' EXPENSE.

8. REMOVAL OF THE EXISTING CURB & GUTTER SHALL BE AS PER COA STD. DWG. 2415 (SAWCUT ONLY).

9. WHEELCHAIR RAMPS SHALL BE CONSTRUCTED PRIOR TO ACCEPTANCE OF CURB & GUTTER.

10. DENOTES CROWN TRANSITION PER COA STD. DWG. 2401.

11. QUARTER POINT TABLES ARE SPECIFIED ON PAVING SHEETS. FOR ADDITIONAL INFORMATION REFER TO TYPICAL INTERSECTION RETURN DETAIL, SHEET 29.

12. INSTALL COLORED PATTERNED CONCRETE IN ALL MEDIANS.

13. MH RIMS, CATCH BASIN INLET, & FH FLANGE ELEVATIONS ARE APPROXIMATE. CONTRACTOR SHALL FIELD VERIFY AND ADJUST TO FINAL PAVEMENT ELEVATIONS.

14. CONTRACTOR SHALL FIELD VERIFY ALL EXISTING UTILITIES AND TRANSMISSION GAS LINES. CONTRACTOR SHALL COORDINATE RELOCATION OF UTILITY LINES WITH UTILITY COMPANIES AS REQUIRED.

- KEYED NOTES
1. INSTALL CONCRETE VALLEY GUTTER AS PER COA STD. DWG. 2420.

2. INSTALL SPECIAL HANDICAP RAMP AS PER DETAIL "A", SHEET 29.

3. BUILD STD. CURB & GUTTER AS PER COA STD. DWG. 2415.

4. BUILD RESIDENTIAL PAVEMENT AS PER RESIDENTIAL SECTION, SHEET 28.

5. 4' SIDEWALK, DEFERRED.


6. BUILD ROLL TYPE CURB & GUTTER AS PER COA STD. DWG. 2415.

7. NO SIDEWALK ON THIS SIDE, WAIVED.

8. 6" X 10" X 24" (VARIES) PCC PWMT w/ WIRE MESH, RUNNING BOND PATTERN, BAJA RED, PER DETAIL SHEET 28. GROOVES NOT TO EXCEED 1/4" DEPTH. SHAPE, DEPTH, & PATTERN OF CROSSWALK MUST MEET ADA STANDARD. PLACE (2) 12" WIDE WHITE PLASTIC STRIPES ON EACH SIDE OF PATTERNED CROSSWALK.

9. BUILD PWMT PER RESIDENTIAL SUB STREET 25' F-F PWMT SECTION, SHT 28.

10. TRANSITION FROM STD C&G TO ROLL TYPE C&G THRU RETURN PER COA STD DWG 2418.
- * NOT USED THIS SHEET

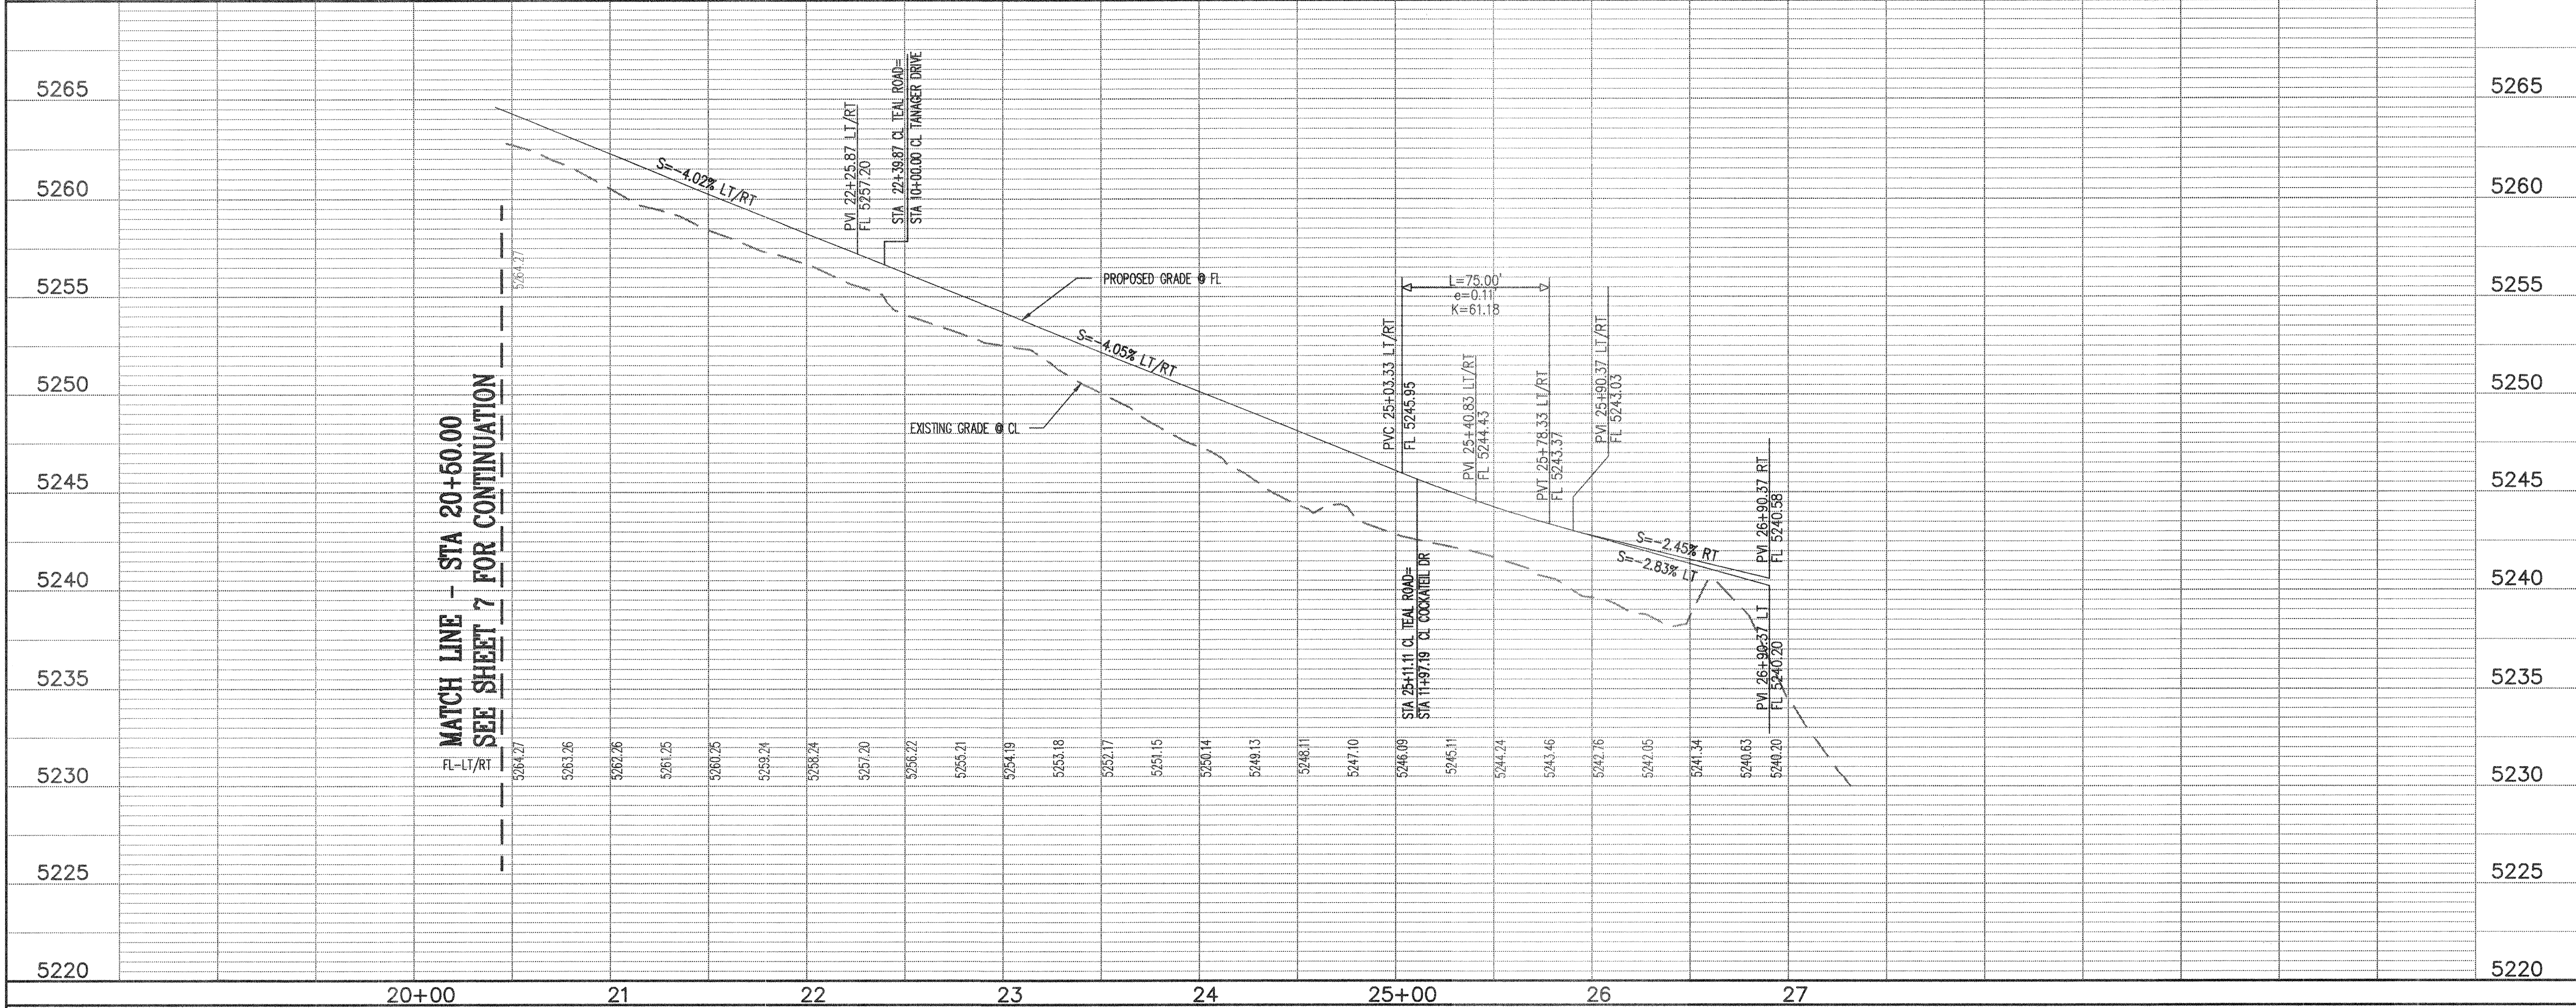

ENGINEER'S SEAL

By: [Signature]
No. [Blank] Date [Blank]
REMARKS
DESIGN
REVISIONS

Bohannon & Huston

Courtyard One 7500 JEFFERSON NE Albuquerque NEW MEXICO 87109

ENGINEERS PLANNERS PHOTOGRAMMETRISTS SURVEYORS SOFTWARE DEVELOPERS

CITY OF ALBUQUERQUE
PUBLIC WORKS DEPARTMENT
ENGINEERING DEVELOPMENT GROUP

TIMARRON WEST UNIT 3 SUBDIVISION
PAVING PLAN & PROFILE
TEAL ROAD STA 20+50.00 - 27+00.00

Design Review Committee

FEB 13 2001

City Engineer Approval

FEB 23 2001

Mo./Day/Yr.
[Blank]

Mo./Day/Yr.
[Blank]

City Project No. 651681 Zone Map No. L8-M8 Sheet 8 Of 32

19+07.00, 14.00' RT BEGIN CURB RETURN			
FLOWLINE DATA			
PC	66.77	A=90°00'00"	
1	66.77	R=25.00'	
2	66.66	L=38.27'	
3	66.60	T=25.00'	
PT	66.54		

14+64.00, 14.00' RT BEGIN CURB RETURN			
FLOWLINE DATA			
PC	65.67	A=90°00'00"	
1	65.07	R=25.00'	
2	64.48	L=38.27'	
3	63.88	T=25.00'	
PT	63.28		

21+88.00, 14.00' RT BEGIN CURB RETURN			
FLOWLINE DATA			
PC	54.19	A=90°00'00"	
1	54.14	R=25.00'	
2	54.10	L=38.27'	
3	54.05	T=25.00'	
PT	54.00		



22+41.00, 39.00' RT BEGIN CURB RETURN			
FLOWLINE DATA			
PC	53.75	A=90°00'00"	
1	53.10	R=25.00'	
2	52.53	L=38.27'	
3	52.06	T=25.00'	
PT	51.68		

22+14.04, 29.60' LT BEGIN CURB RETURN			
FLOWLINE DATA			
PC	53.40	A=67°54'17"	
1	53.57	R=25.00'	
2	53.74	L=38.27'	
3	53.90	T=16.83'	
PT	54.07		

22+84.98, 14.00' LT BEGIN CURB RETURN			
FLOWLINE DATA			
PC	51.09	A=103°02'36"	
1	51.52	R=25.00'	
2	51.95	L=38.27'	
3	52.38	T=31.45'	
PT	52.81		

24+79.00, 14.00' RT BEGIN CURB RETURN			
FLOWLINE DATA			
PC	44.05	A=90°00'00"	
1	44.01	R=25.00'	
2	43.97	L=38.27'	
3	43.92	T=25.00'	
PT	43.88		

25+28.17, 36.02' RT BEGIN CURB RETURN			
FLOWLINE DATA			
PC	42.83	A=83°06'26"	
1	42.36	R=25.00'	
2	42.90	L=38.27'	
3	41.43	T=22.16'	
PT	40.96		

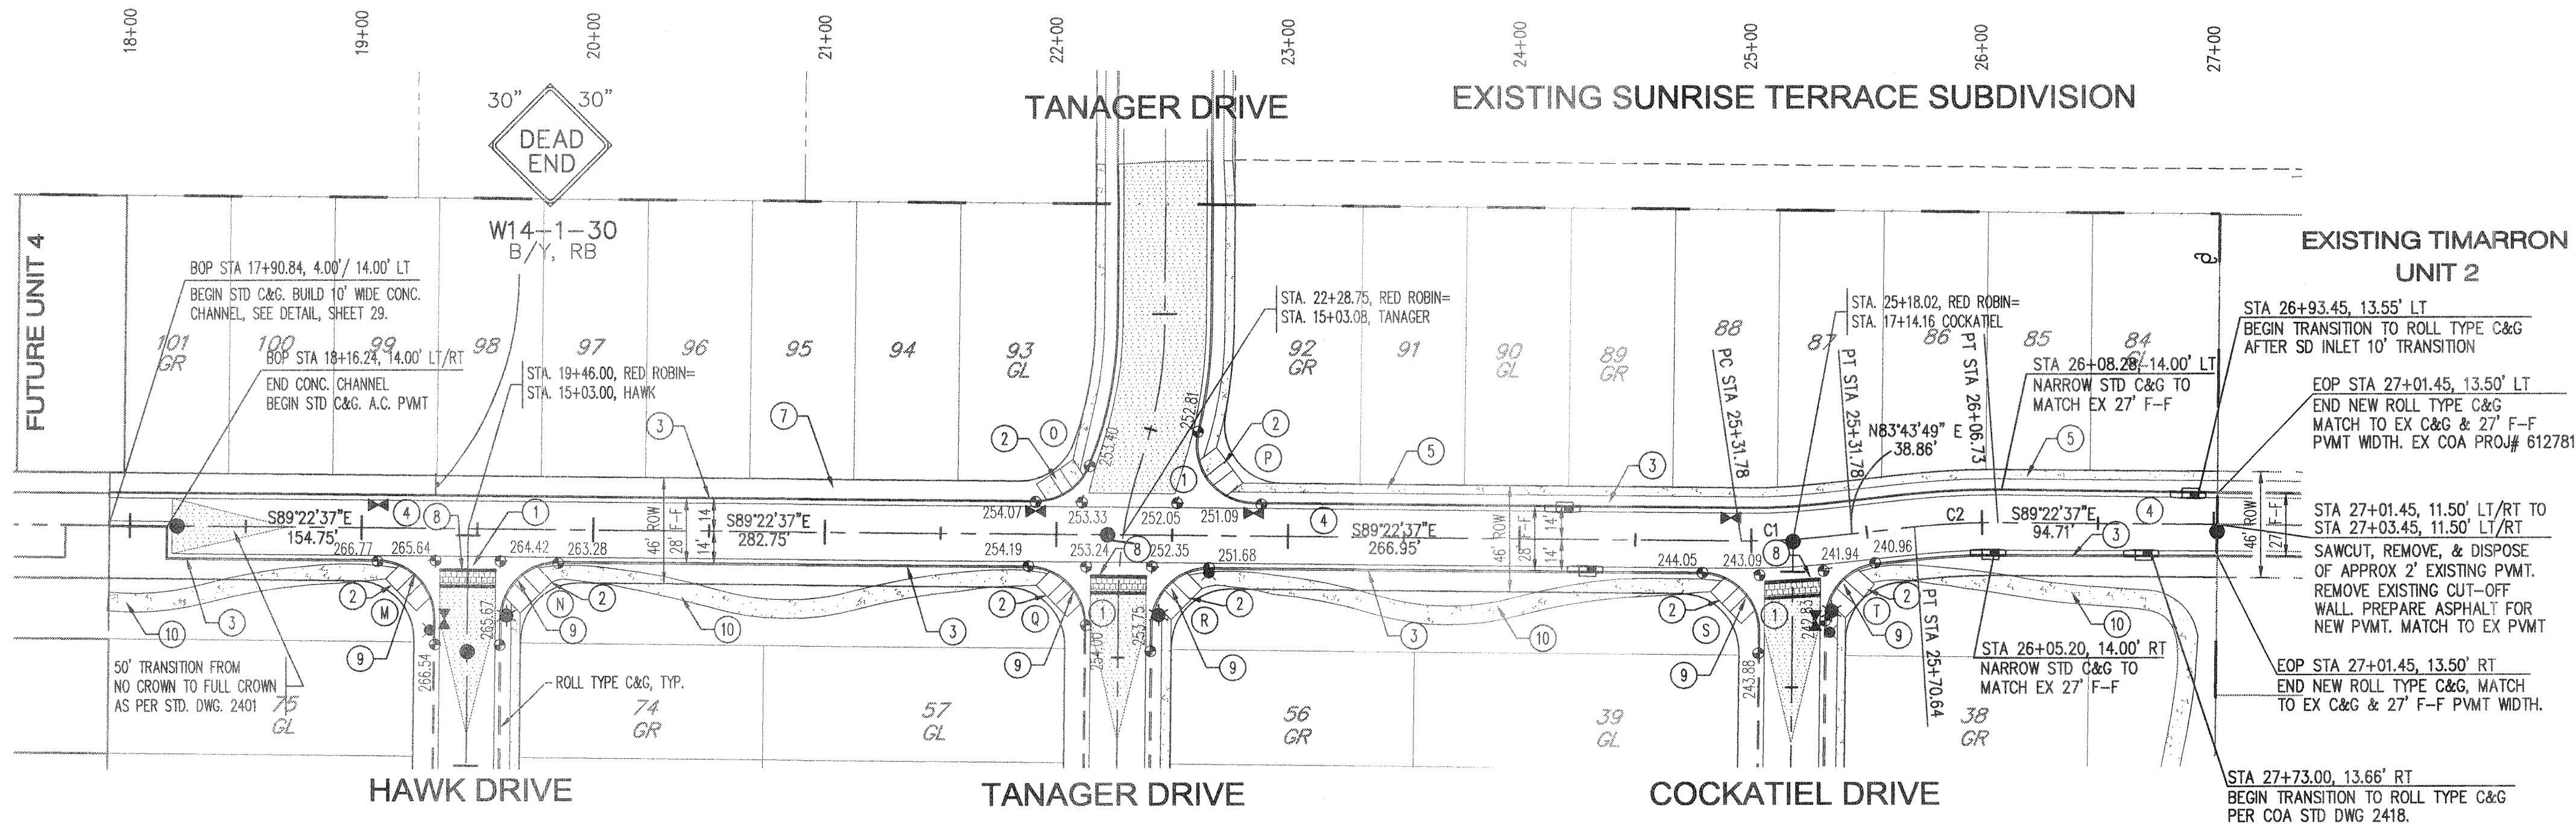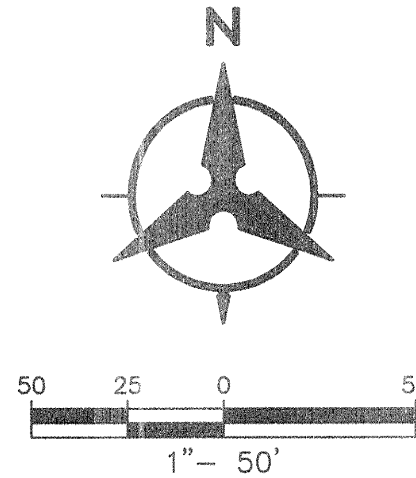

CURVE TABLE				
NUMBER	RADIUS	LENGTH	DELTA	TANGENT
C1	300.00'	36.09'	06°53'34"	18.07'
C2	300.00'	36.09'	06°53'34"	18.07'


- ### GENERAL NOTES
- THE CONTRACTOR SHALL FIELD VERIFY ALL EXISTING UTILITY LOCATIONS AND NOTIFY THE ENGINEER IMMEDIATELY OF ANY DISCREPANCIES.
 - ALL CURVE DATA AND DIMENSIONS REFER TO FACE OF CURB UNLESS OTHERWISE SPECIFIED.
 - GRADE ELEVATIONS, WHERE NOTED, ARE FOR FLOWLINE OF CURB UNLESS OTHERWISE SPECIFIED.
 - CONTRACTOR IS RESPONSIBLE FOR REPAIR AND/OR REPLACEMENT OF ALL UTILITY CONDUITS AND EXISTING LINES.
 - ANY ADDITIONAL GRADING REQUIRED TO MATCH PROPOSED STREET GRADES SHALL BE INCIDENTAL TO PAVING ITEMS.
 - CONTRACTOR SHALL PARK EQUIPMENT AND VEHICLES AS NOT TO INTERFERE WITH NORMAL ACTIVITIES OF RESIDENTS OR OTHER CONTRACTORS ON SITE.
 - ANY DAMAGE TO THE EXISTING FACILITIES, C&G, PAVEMENT, CONDUITS, LANDSCAPING, EXISTING LINES, ETC.) DURING CONSTRUCTION SHALL BE REPLACED AT THE CONTRACTORS' EXPENSE.
 - REMOVAL OF THE EXISTING CURB & GUTTER SHALL BE AS PER COA STD. DWG. 2415 (SAWCUT ONLY).
 - WHEELCHAIR RAMPS SHALL BE CONSTRUCTED PRIOR TO ACCEPTANCE OF CURB & GUTTER.
 - DENOTES CROWN TRANSITION PER COA STD. DWG. 2401.
 - QUARTER POINT TABLES ARE SPECIFIED ON PAVING SHEETS. FOR ADDITIONAL INFORMATION REFER TO TYPICAL INTERSECTION RETURN DETAIL, SHEET 29.
 - INSTALL COLORED PATTERNED CONCRETE IN ALL MEDIANS.
 - MH RIMS, CATCH BASIN INLET, & FH FLANGE ELEVATIONS ARE APPROXIMATE. CONTRACTOR SHALL FIELD VERIFY AND ADJUST TO FINAL PAVEMENT ELEVATIONS.
 - CONTRACTOR SHALL FIELD VERIFY ALL EXISTING UTILITIES AND TRANSMISSION GAS LINES. CONTRACTOR SHALL COORDINATE RELOCATION OF UTILITY LINES WITH UTILITY COMPANIES AS REQUIRED.


- ### KEYED NOTES
- INSTALL CONCRETE VALLEY GUTTER AS PER COA STD. DWG. 2420.
 - INSTALL SPECIAL HANDICAP RAMP AS PER DETAIL "A", SHEET 29.
 - BUILD STD. CURB & GUTTER AS PER COA STD. DWG. 2415.
 - BUILD RESIDENTIAL PAVEMENT AS PER RESIDENTIAL SECTION, SHEET 28.
 - 4' SIDEWALK, DEFERRED.
 - BUILD ROLL TYPE CURB & GUTTER AS PER COA STD. DWG. 2415.
 - NO SIDEWALK ON THIS SIDE, WAIVED.
 - 6"D X 10"W X 24'L (VARIES) PCC PAVT w/WIRE MESH, RUNNING BOND PATTERN, BAJA RED, PER DETAIL SHEET 28. GROOVES NOT TO EXCEED 1/4" DEPTH. SHAPE, DEPTH, & PATTERN OF CROSSWALK MUST MEET ADA STANDARD. PLACE (2) 12" WIDE WHITE PLASTIC STRIPES ON EACH SIDE OF PATTERNED CROSSWALK.
 - TRANSITION FROM STD C&G TO ROLL TYPE C&G THRU RETURN PER COA STD DWG 2418.
 - 8' PEDESTRIAN TRAIL, SEE DETAIL, SHT 29.

Bohannon & Huston
 Countywide One 7500 JEFFERSON NE ALBUQUERQUE NEW MEXICO 87109
 ENGINEERS PLANNERS PHOTOGRAMMETRISTS SURVEYORS SOFTWARE DEVELOPERS

CITY OF ALBUQUERQUE
PUBLIC WORKS DEPARTMENT
ENGINEERING DEVELOPMENT GROUP
TIMARRON WEST UNIT 3 SUBDIVISION
PAVING PLAN & PROFILE
RED ROBIN

Design Review Committee	City Engineer Approval	Mo./Day/Yr.	Mo./Day/Yr.
City Project No. 651681	Zone Map No. L8-M8	Sheet 9	Of 32

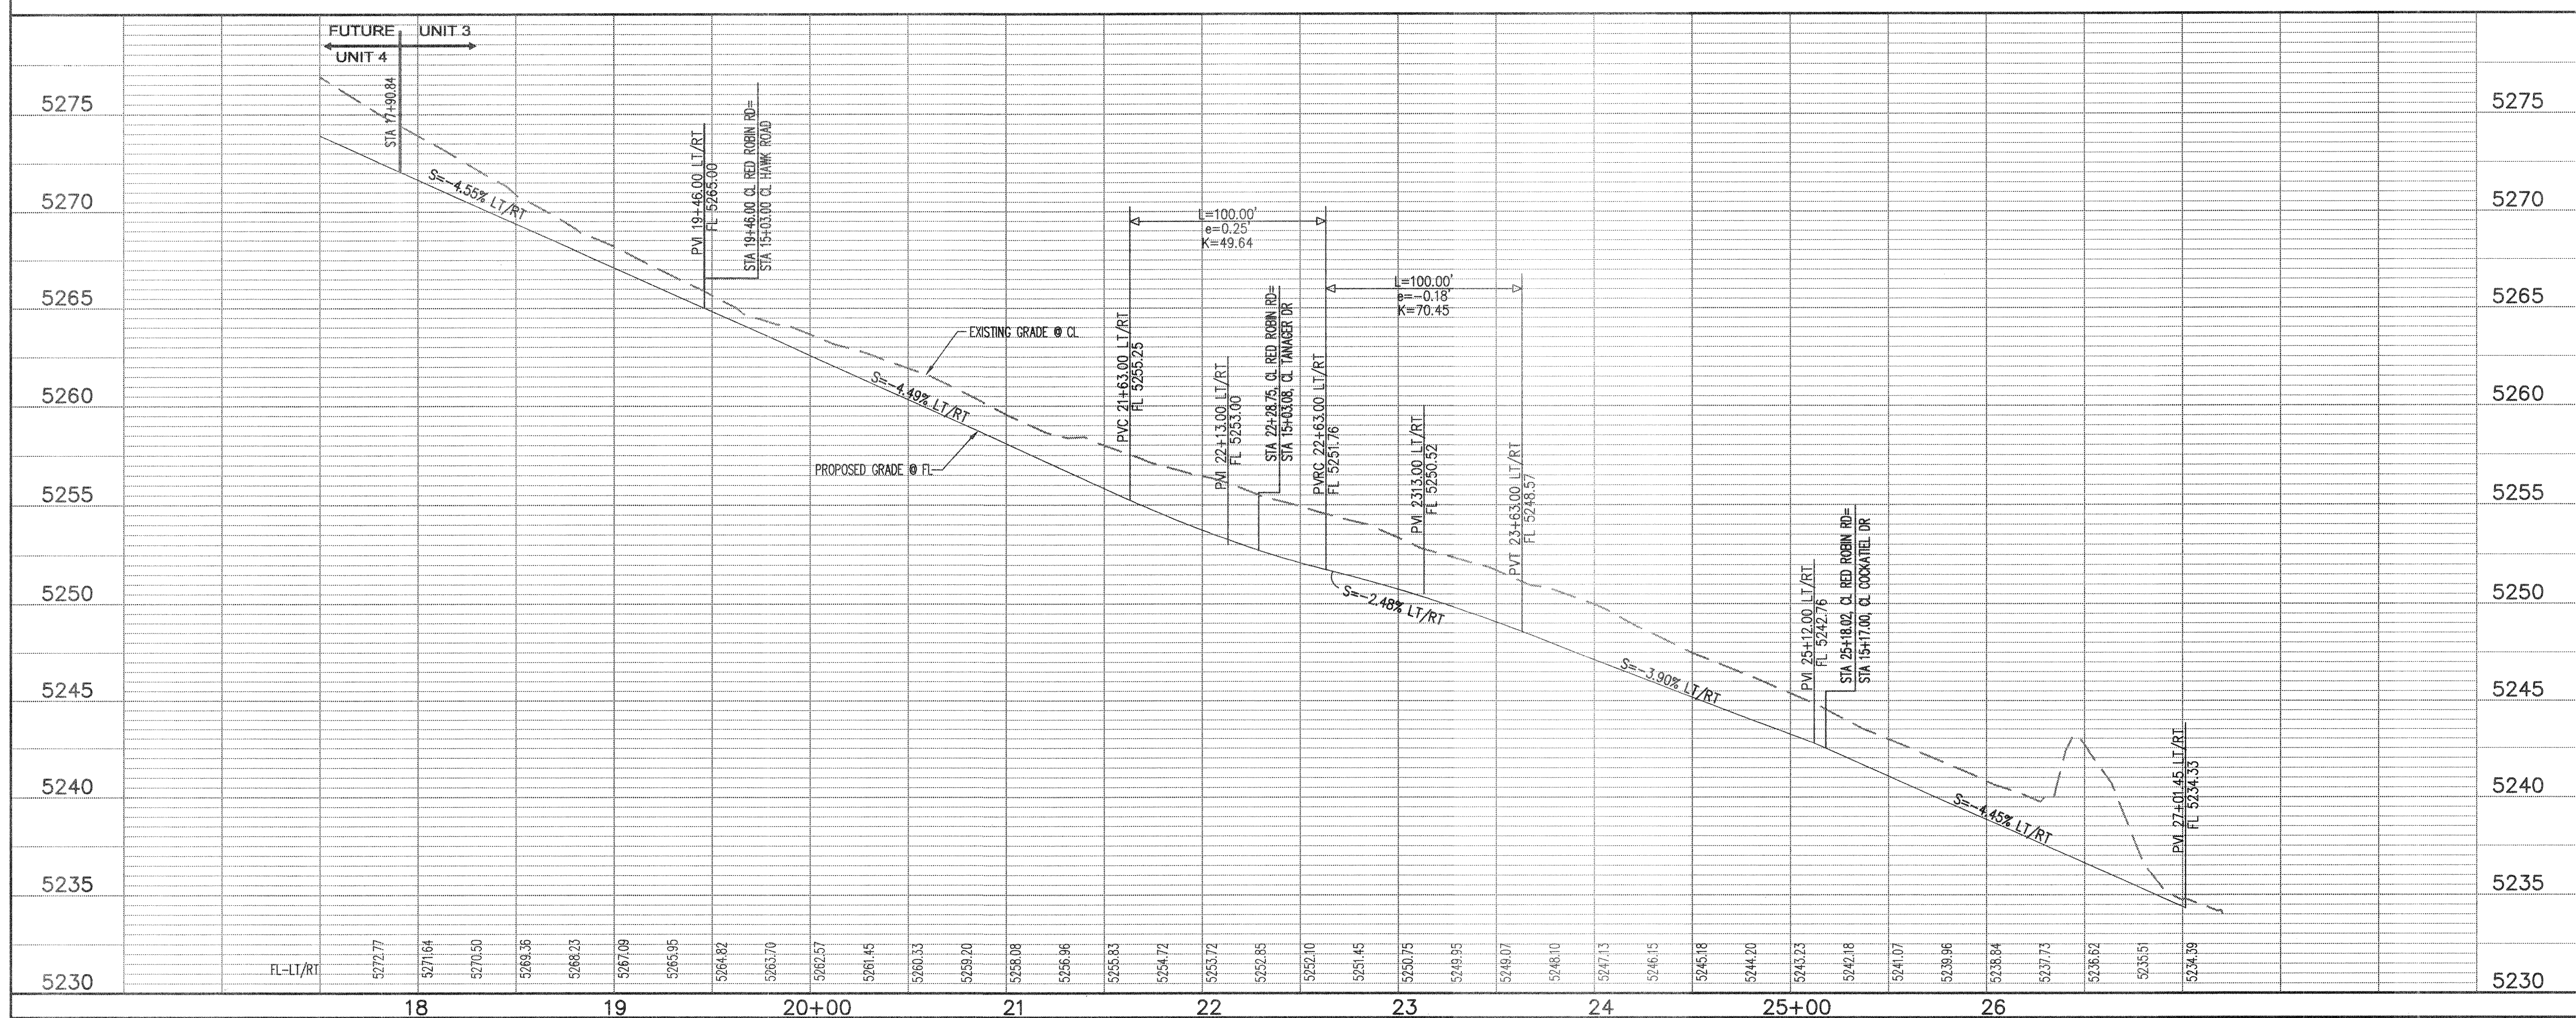

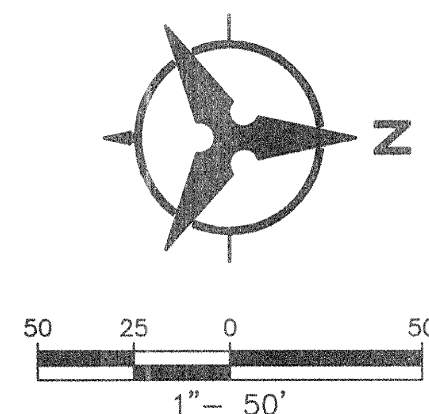[illegible]

1. THE CONTRACTOR SHALL FIELD VERIFY ALL EXISTING UTILITY LOCATIONS AND NOTIFY THE ENGINEER IMMEDIATELY OF ANY DISCREPANCIES.
2. ALL CURVE DATA AND DIMENSIONS REFER TO FACE OF CURB UNLESS OTHERWISE SPECIFIED.
3. GRADE ELEVATIONS, WHERE NOTED, ARE FOR FLOWLINE OF CURB UNLESS OTHERWISE SPECIFIED.
4. CONTRACTOR IS RESPONSIBLE FOR REPAIR AND/OR REPLACEMENT OF ALL UTILITY CONDUITS AND EXISTING LINES.
5. ANY ADDITIONAL GRADING REQUIRED TO MATCH PROPOSED STREET GRADES SHALL BE INCIDENTAL TO PAVING ITEMS.
6. CONTRACTOR SHALL PARK EQUIPMENT AND VEHICLES AS NOT TO INTERFERE WITH NORMAL ACTIVITIES OF RESIDENTS OR OTHER CONTRACTORS ON SITE.
7. ANY DAMAGE TO THE EXISTING FACILITIES, C&G, PAVEMENT, CONDUITS, LANDSCAPING, EXISTING LINES, ETC.) DURING CONSTRUCTION SHALL BE REPLACED AT THE CONTRACTORS' EXPENSE.
8. REMOVAL OF THE EXISTING CURB & GUTTER SHALL BE AS PER COA STD. DWG. 2415 (SAWCUIT ONLY).
9. WHEELCHAIR RAMPS SHALL BE CONSTRUCTED PRIOR TO ACCEPTANCE OF CURB & GUTTER.
10. DENOTES CROWN TRANSITION PER COA STD. DWG. 2401.
11. QUARTER POINT TABLES ARE SPECIFIED ON PAVING SHEETS. FOR ADDITIONAL INFORMATION REFER TO TYPICAL INTERSECTION RETURN DETAIL, SHEET 29.
12. INSTALL COLORED PATTERNED CONCRETE IN ALL MEDIANS.
13. MH RIMS, CATCH BASIN INLET, & FH FLANGE ELEVATIONS ARE APPROXIMATE. CONTRACTOR SHALL FIELD VERIFY AND ADJUST TO FINAL PAVEMENT ELEVATIONS.
14. CONTRACTOR SHALL FIELD VERIFY ALL EXISTING UTILITIES AND TRANSMISSION GAS LINES, CONTRACTOR SHALL COORDINATE RELOCATION OF UTILITY LINES WITH UTILITY COMPANIES AS REQUIRED.

- * ① INSTALL CONCRETE VALLEY GUTTER AS PER COA STD. DWG. 2420.
- * ② INSTALL SPECIAL HANDICAP RAMP AS PER DETAIL "A", SHEET 29.
- * ③ BUILD STD. CURB & GUTTER AS PER COA STD. DWG. 2415.
- ④ BUILD RESIDENTIAL PAVEMENT AS PER RESIDENTIAL SECTION, SHEET 28.
- ⑤ 4' SIDEWALK, DEFERRED.
- ⑥ BUILD ROLL. TYPE CURB & GUTTER AS PER COA STD. DWG. 2415.
- ⑦ NO SIDEWALK ON THIS SIDE, WAIVED.
- * ⑧ 6"D x 10"W x 24'L (VARIES) PCC PVMT w/ WIRE MESH, RUNNING BOND PATTERN, BAJA RED, PER DETAIL SHEET 28. GROOVES NOT TO EXCEED 1/4" DEPTH. SHAPE, DEPTH, & PATTERN OF CROSSWALK MUST MEET ADA STANDARD. PLACE (2) 12" WIDE WHITE PLASTIC STRIPES ON EACH SIDE OF PATTERNED CROSSWALK.

* NOT USED THIS SHEET

* NOT USED THIS SHEET

Bohannon ▲ Huston

 Courtyard One 7500 JEFFERSON NE Albuquerque NEW MEXICO 87109

ENGINEERS PLANNERS PHOTOGRAMMETRISTS SURVEYORS SOFTWARE DEVELOPERS

 **CITY OF ALBUQUERQUE**
PUBLIC WORKS DEPARTMENT
ENGINEERING DEVELOPMENT GROUP

TIMARRON WEST UNIT 3 SUBDIVISION

PAVING PLAN & PROFILE
HAWK DRIVE

Design Review Committee
APPROVED
FEB 13 2001
DESIGN
REVIEW COMMITTEE

City Engineer Approval

A P P R O V E D

FEB 23 2001

CITY ENGINEER



ast Design Update

Mo./Day/Yr.	Mo./Day/Yr.

City Project No.	651681	Zone Map No.	L8-M8	Sheet	10	Of	32
------------------	--------	--------------	-------	-------	----	----	----

P: \99470\CDP\PNP\UNIT_3\PPNP_05.DWG


SCANNED BY
MESA REPRO

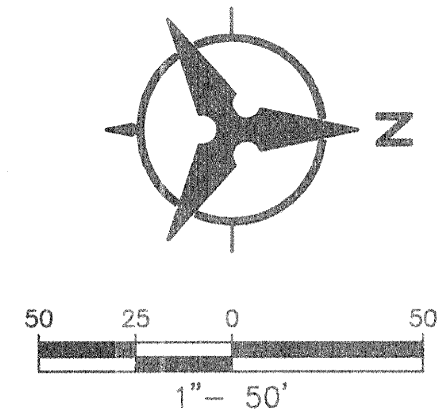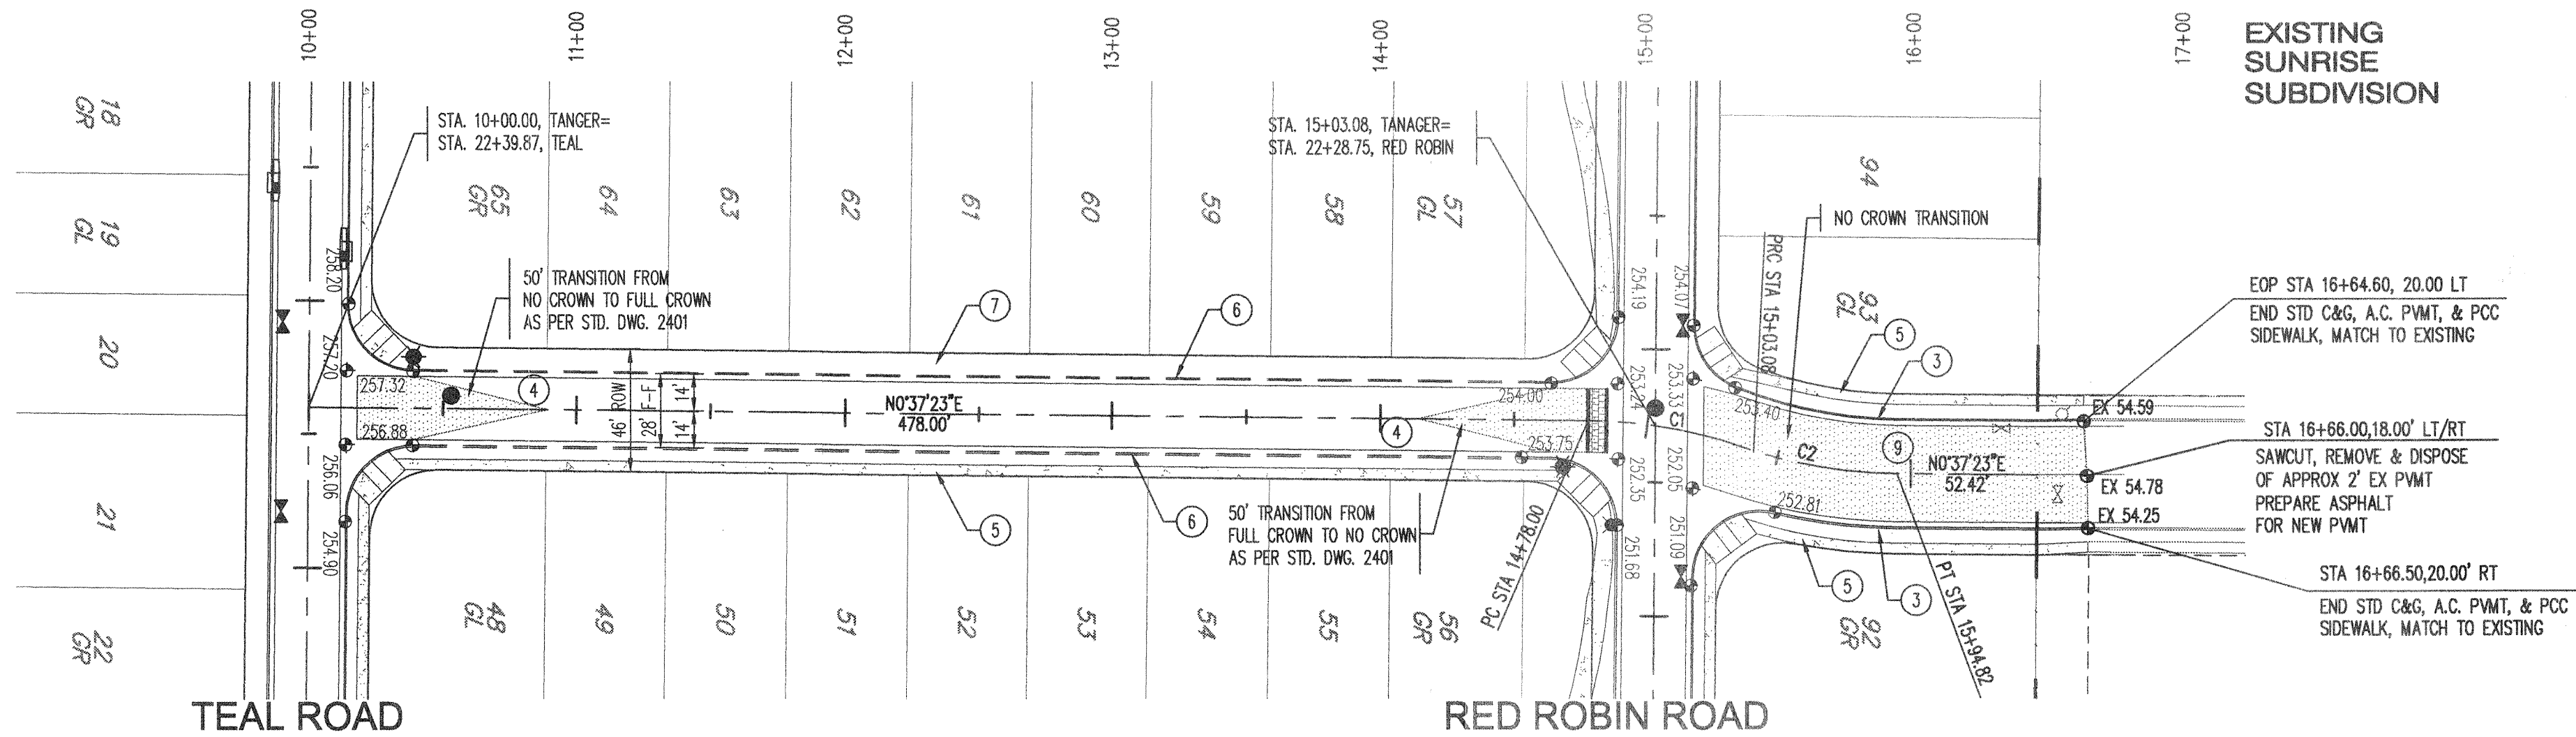

EXISTING
SUNRISE
SUBDIVISION

CURVE TABLE				
NUMBER	RADIUS	LENGTH	DELTA	TANGENT
C1	180.00'	31.42'	10°00'00"	15.75'
C2	180.00'	33.46'	10°39'04"	16.78'

TANAGER DRIVE

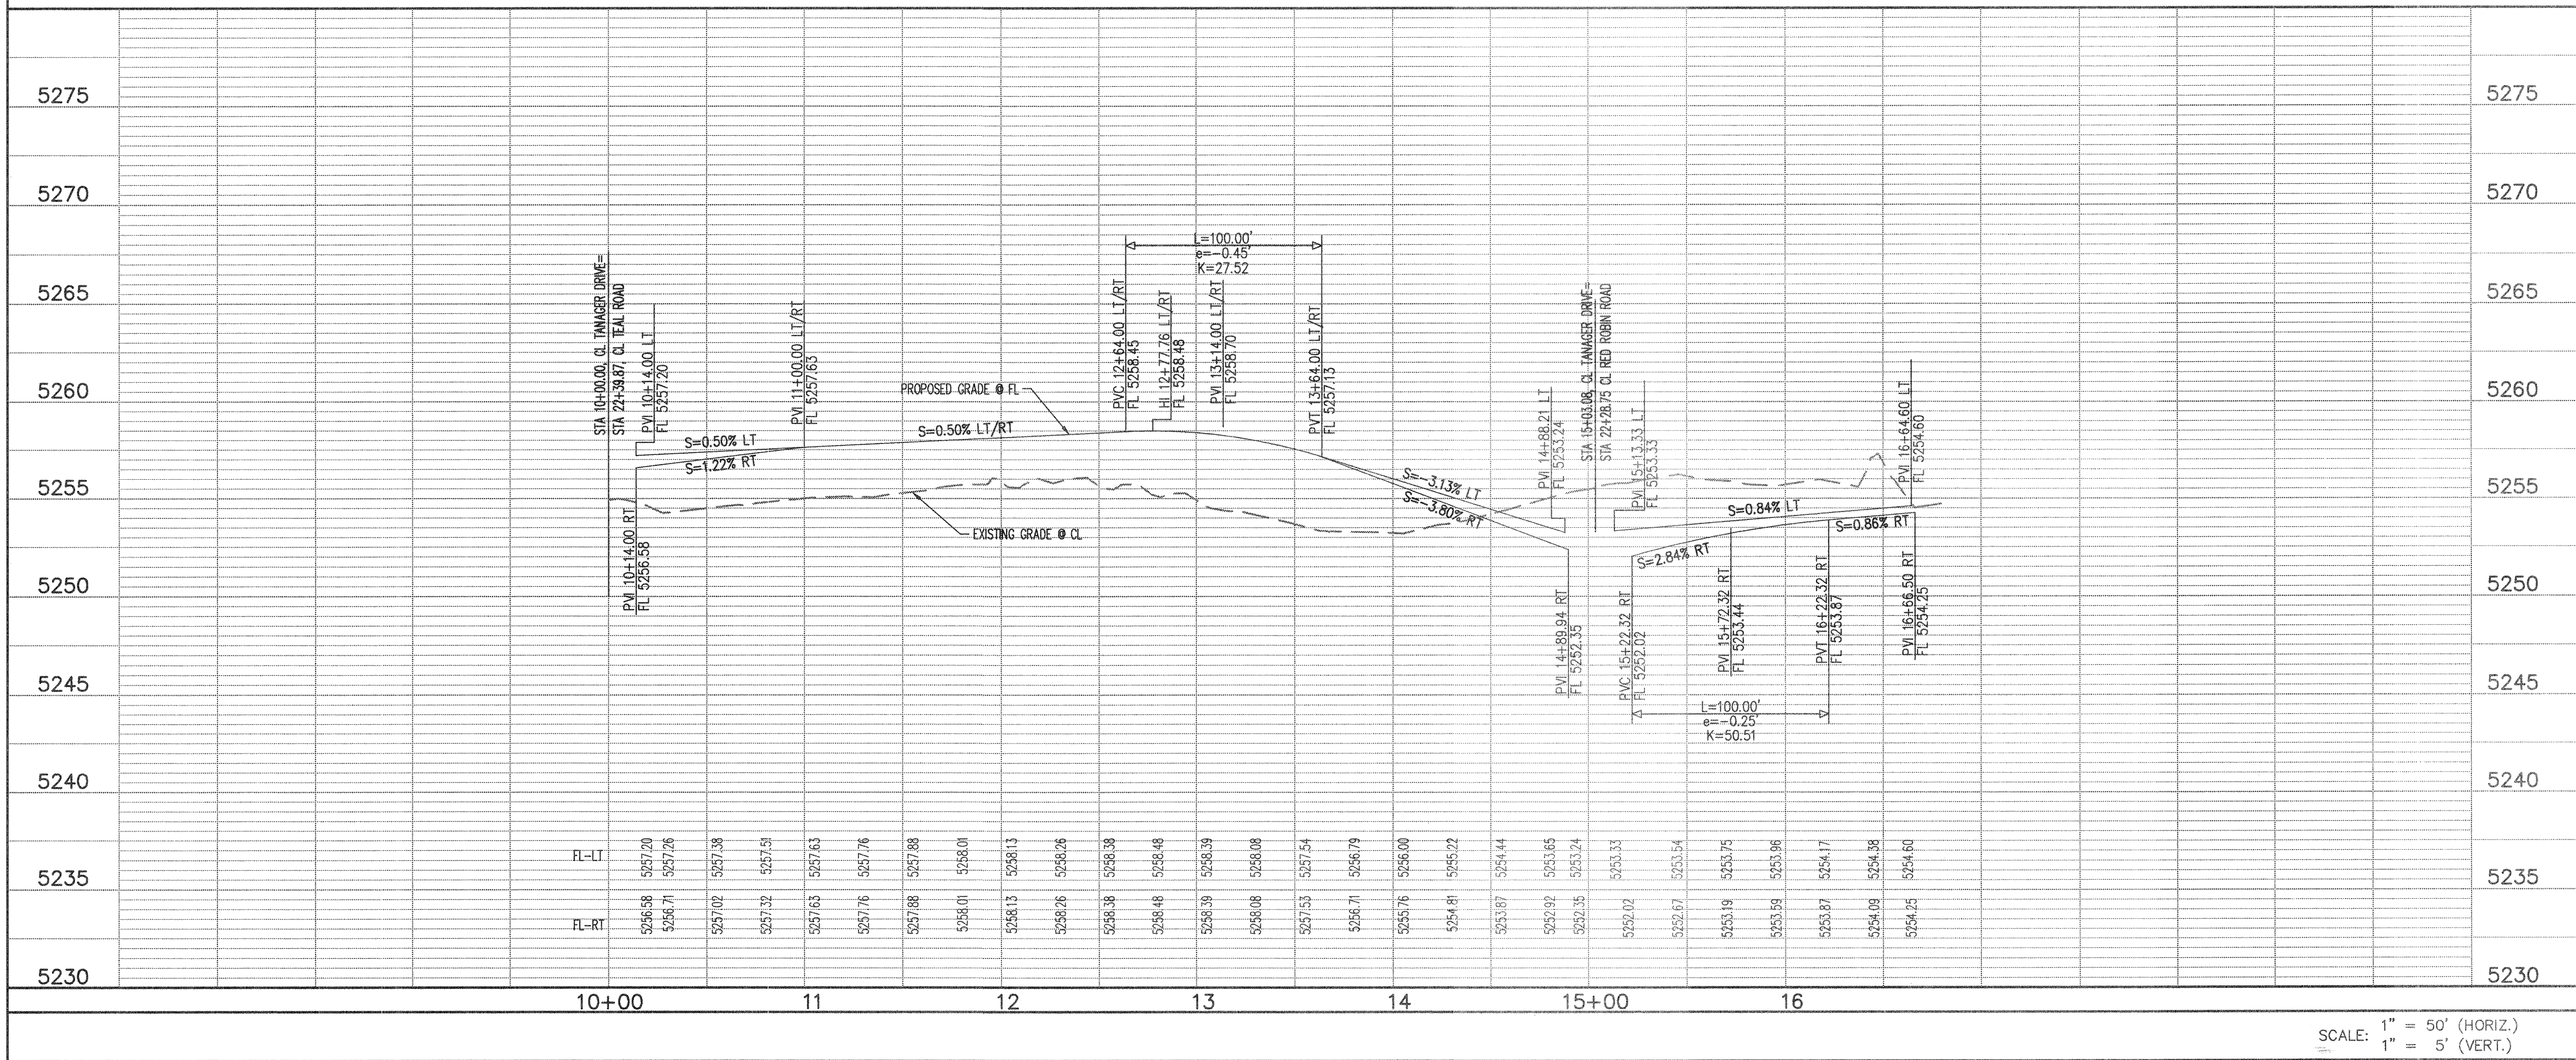

GENERAL NOTES

- THE CONTRACTOR SHALL FIELD VERIFY ALL EXISTING UTILITY LOCATIONS AND NOTIFY THE ENGINEER IMMEDIATELY OF ANY DISCREPANCIES.
- ALL CURVE DATA AND DIMENSIONS REFER TO FACE OF CURB UNLESS OTHERWISE SPECIFIED.
- GRADE ELEVATIONS, WHERE NOTED, ARE FOR FLOWLINE OF CURB UNLESS OTHERWISE SPECIFIED.
- CONTRACTOR IS RESPONSIBLE FOR REPAIR AND/OR REPLACEMENT OF ALL UTILITY CONDUITS AND EXISTING LINES.
- ANY ADDITIONAL GRADING REQUIRED TO MATCH PROPOSED STREET GRADES SHALL BE INCIDENTAL TO PAVING ITEMS.
- CONTRACTOR SHALL PARK EQUIPMENT AND VEHICLES AS NOT TO INTERFERE WITH NORMAL ACTIVITIES OF RESIDENTS OR OTHER CONTRACTORS ON SITE.
- ANY DAMAGE TO THE EXISTING FACILITIES, C&G, PAVEMENT, CONDUITS, LANDSCAPING, EXISTING LINES, ETC.) DURING CONSTRUCTION SHALL BE REPLACED AT THE CONTRACTORS' EXPENSE.
- REMOVAL OF THE EXISTING CURB & GUTTER SHALL BE AS PER COA STD. DWG. 2415 (SAWCUT ONLY).
- WHEELCHAIR RAMPS SHALL BE CONSTRUCTED PRIOR TO ACCEPTANCE OF CURB & GUTTER.
- DENOTES CROWN TRANSITION PER COA STD. DWG. 2401.
- QUARTER POINT TABLES ARE SPECIFIED ON PAVING SHEETS. FOR ADDITIONAL INFORMATION REFER TO TYPICAL INTERSECTION RETURN DETAIL, SHEET 29.
- INSTALL COLORED PATTERNED CONCRETE IN ALL MEDIANS.
- MH RIMS, CATCH BASIN INLET, & FH FLANGE ELEVATIONS ARE APPROXIMATE. CONTRACTOR SHALL FIELD VERIFY AND ADJUST TO FINAL PAVEMENT ELEVATIONS.
- CONTRACTOR SHALL FIELD VERIFY ALL EXISTING UTILITIES AND TRANSMISSION GAS LINES. CONTRACTOR SHALL COORDINATE RELOCATION OF UTILITY LINES WITH UTILITY COMPANIES AS REQUIRED.

KEYED NOTES

- ① INSTALL CONCRETE VALLEY GUTTER AS PER COA STD. DWG. 2420.
- ② INSTALL SPECIAL HANDICAP RAMP AS PER DETAIL "A", SHEET 29.
- ③ BUILD STD. CURB & GUTTER AS PER COA STD. DWG. 2415.
- ④ BUILD RESIDENTIAL PAVEMENT AS PER RESIDENTIAL SECTION, SHEET 28.
- ⑤ 4' SIDEWALK, DEFERRED.
- ⑥ BUILD ROLL TYPE CURB & GUTTER AS PER COA STD. DWG. 2415.
- ⑦ NO SIDEWALK ON THIS SIDE, WAIVED.
- ⑧ 6" D X 10" W X 24" L (VARIES) PCC PMT w/ WIRE MESH, RUNNING BOND PATTERN, BAJA RED, PER DETAIL SHEET 28. GROOVES NOT TO EXCEED 1/4" DEPTH. SHAPE, DEPTH, & PATTERN OF CROSSWALK MUST MEET ADA STANDARD. PLACE (2) 12" WIDE WHITE PLASTIC STRIPES ON EACH SIDE OF PATTERNED CROSSWALK.
- ⑨ BUILD PAVEMENT PER TANAGER 40' F-F PMT SECTION, SHEET 28.

* NOT USED THIS SHEET

Bohannon & Huston

Courtyard One 7500 JEFFERSON NE Albuquerque NEW MEXICO 87109

ENGINEERS PLANNERS PHOTOGRAMMETRISTS SURVEYORS SOFTWARE DEVELOPERS



CITY OF ALBUQUERQUE
PUBLIC WORKS DEPARTMENT
ENGINEERING DEVELOPMENT GROUP

TIMARRON WEST UNIT 3 SUBDIVISION
PAVING PLAN & PROFILE
TANAGER DRIVE

Design Review Committee	City Engineer Approval	Mo./Day/Yr.	Mo./Day/Yr.
APPROVED FEB 13 2001	APPROVED FEB 23 2001		
DESIGN REVIEW COMMITTEE	CITY ENGINEER		


City Project No.	Zone Map No.	Sheet	Of
651681	L8-M8	11	32

SCANNED BY
MESA REPRO

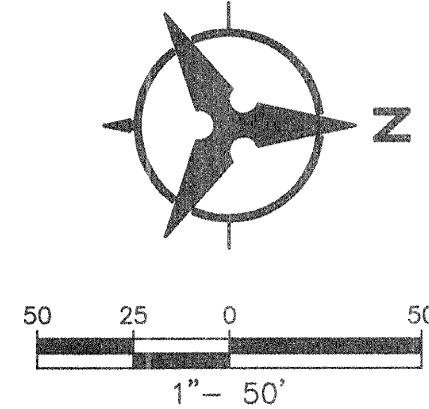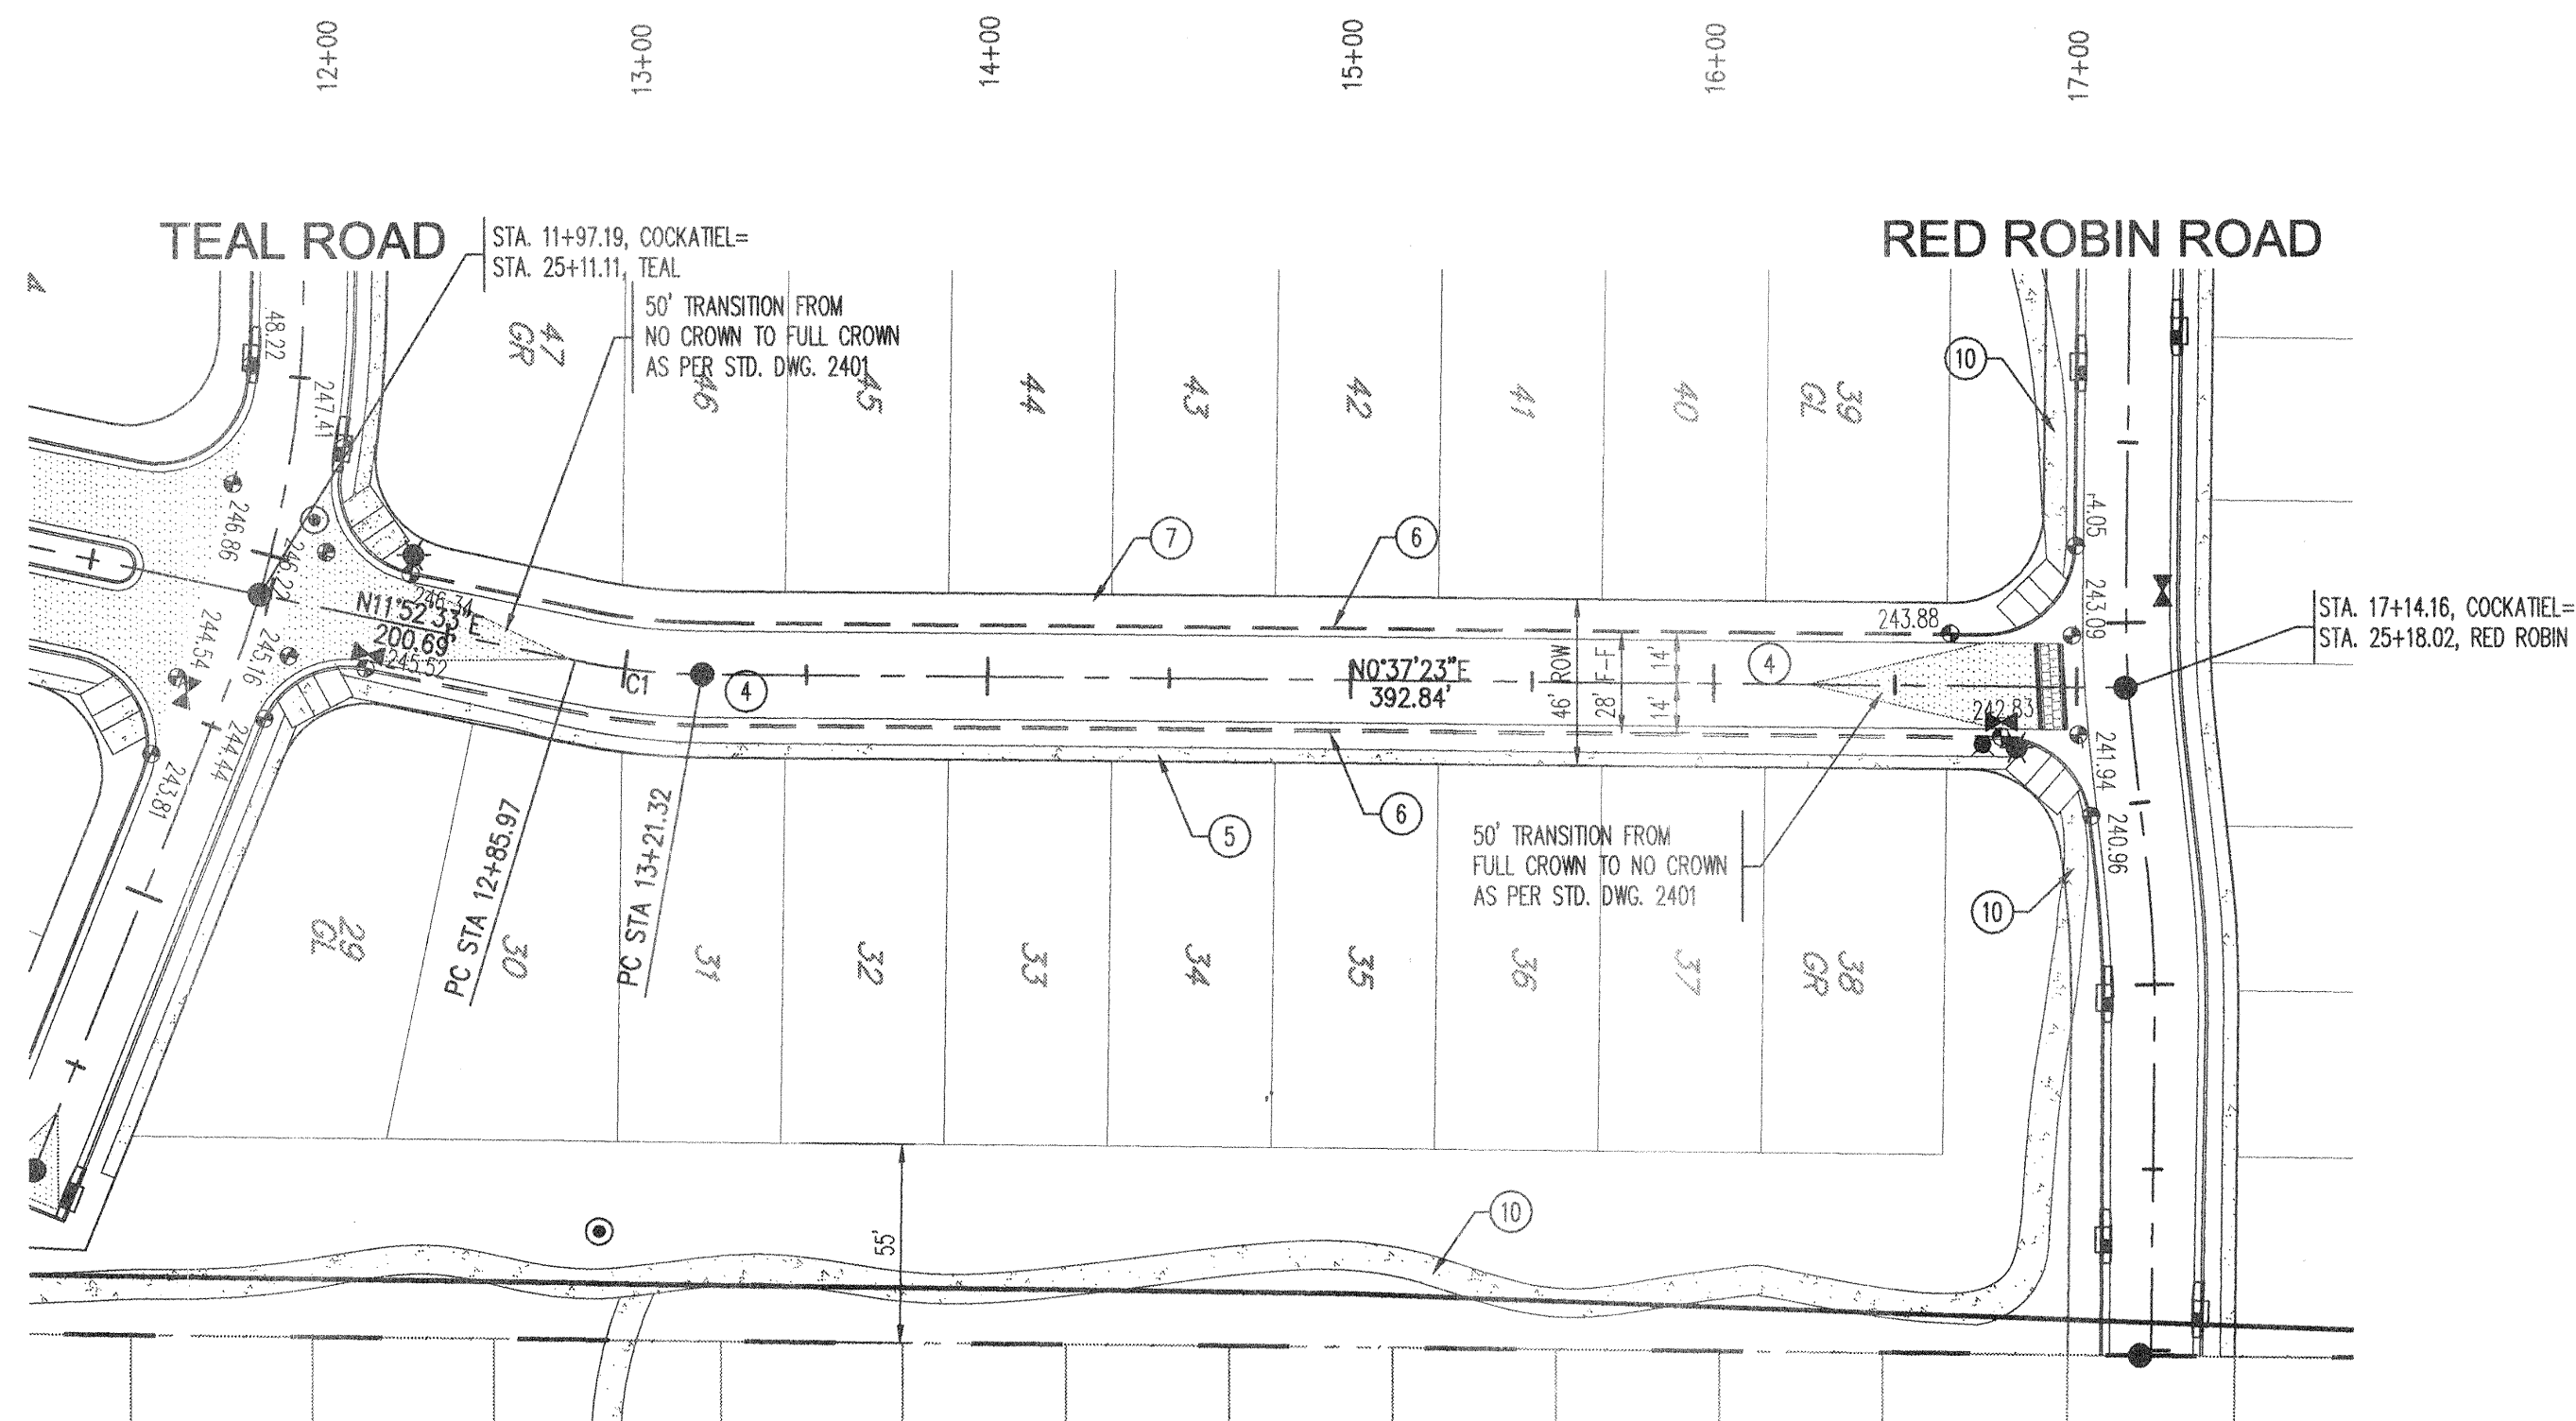

CURVE TABLE				
NUMBER	RADIUS	LENGTH	DELTA	TANGENT
C1	180.00'	33.35'	11°15'01"	17.73'

COCKATIEL DRIVE

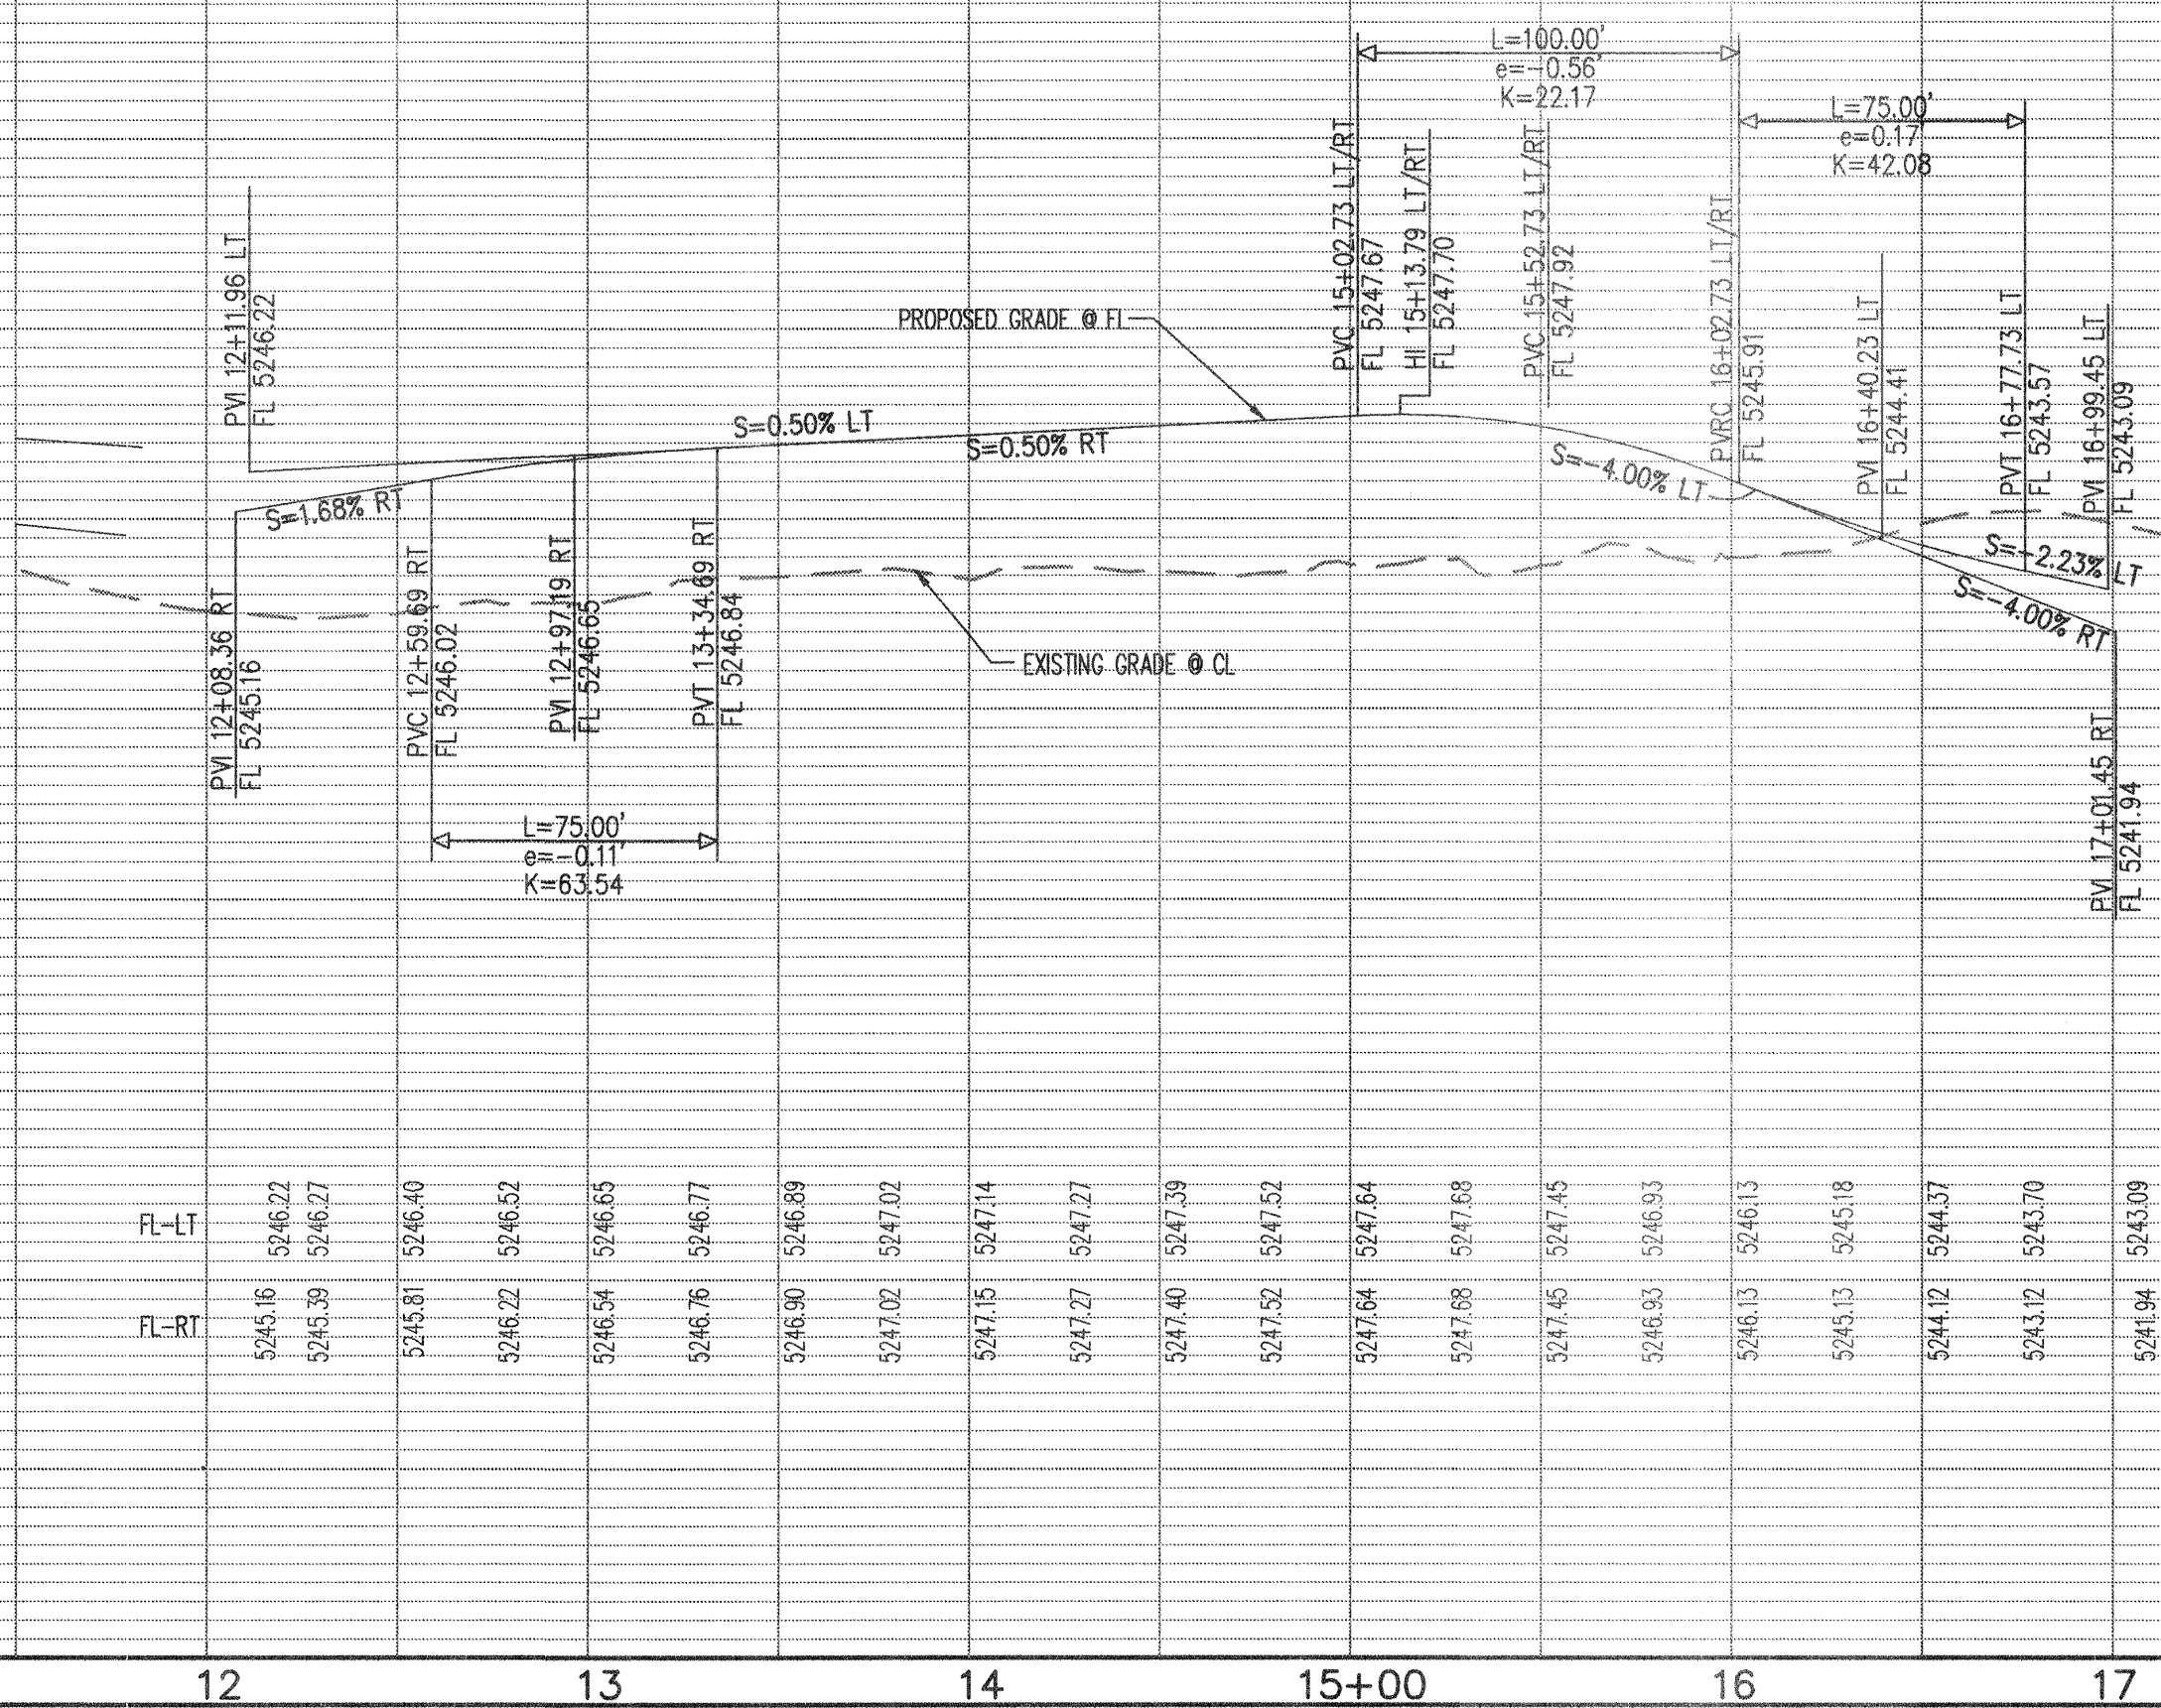

GENERAL NOTES

1. THE CONTRACTOR SHALL FIELD VERIFY ALL EXISTING UTILITY LOCATIONS AND NOTIFY THE ENGINEER IMMEDIATELY OF ANY DISCREPANCIES.
2. ALL CURVE DATA AND DIMENSIONS REFER TO FACE OF CURB UNLESS OTHERWISE SPECIFIED.
3. GRADE ELEVATIONS, WHERE NOTED, ARE FOR FLOWLINE OF CURB UNLESS OTHERWISE SPECIFIED.
4. CONTRACTOR IS RESPONSIBLE FOR REPAIR AND/OR REPLACEMENT OF ALL UTILITY CONDUITS AND EXISTING LINES.
5. ANY ADDITIONAL GRADING REQUIRED TO MATCH PROPOSED STREET GRADES SHALL BE INCIDENTAL TO PAVING ITEMS.
6. CONTRACTOR SHALL PARK EQUIPMENT AND VEHICLES AS NOT TO INTERFERE WITH NORMAL ACTIVITIES OF RESIDENTS OR OTHER CONTRACTORS ON SITE.
7. ANY DAMAGE TO THE EXISTING FACILITIES, C&G, PAVEMENT, CONDUITS, LANDSCAPING, EXISTING LINES, ETC.) DURING CONSTRUCTION SHALL BE REPLACED AT THE CONTRACTORS' EXPENSE.
8. REMOVAL OF THE EXISTING CURB & GUTTER SHALL BE AS PER COA STD. DWG. 2415 (SAWCUT ONLY).
9. WHEELCHAIR RAMPS SHALL BE CONSTRUCTED PRIOR TO ACCEPTANCE OF CURB & GUTTER.
10. DENOTES CROWN TRANSITION PER COA STD. DWG. 2401.
11. QUARTER POINT TABLES ARE SPECIFIED ON PAVING SHEETS. FOR ADDITIONAL INFORMATION REFER TO TYPICAL INTERSECTION RETURN DETAIL, SHEET 29.
12. INSTALL COLORED PATTERNED CONCRETE IN ALL MEDIANS.
13. MH RIMS, CATCH BASIN INLET, & FH FLANGE ELEVATIONS ARE APPROXIMATE. CONTRACTOR SHALL FIELD VERIFY UTILITIES AND TRANSMISSION GAS LINES. CONTRACTOR SHALL COORDINATE RELOCATION OF UTILITY LINES WITH UTILITY COMPANIES AS REQUIRED.
14. CONTRACTOR SHALL FIELD VERIFY ALL EXISTING UTILITIES AND TRANSMISSION GAS LINES. CONTRACTOR SHALL COORDINATE RELOCATION OF UTILITY LINES WITH UTILITY COMPANIES AS REQUIRED.

KEYED NOTES

- * ① INSTALL CONCRETE VALLEY GUTTER AS PER COA STD. DWG. 2420.
- * ② INSTALL SPECIAL HANDICAP RAMP AS PER DETAIL "A", SHEET 29.
- * ③ BUILD STD. CURB & GUTTER AS PER COA STD. DWG. 2415.
- ④ BUILD RESIDENTIAL PAVEMENT AS PER RESIDENTIAL SECTION, SHEET 28.
- ⑤ 4' SIDEWALK, DEFERRED.
- ⑥ BUILD ROLL TYPE CURB & GUTTER AS PER COA STD. DWG. 2415.
- ⑦ NO SIDEWALK ON THIS SIDE, WAIVED.
- * ⑧ 6" D X 10" W X 24" L (VARIES) PCC PWMT w/ WIRE MESH, RUNNING BOND PATTERN, BAJA RED, PER DETAIL SHEET 28. GROOVES NOT TO EXCEED 1/4" DEPTH. SHAPE, DEPTH, & PATTERN OF CROSSWALK MUST MEET ADA STANDARD. PLACE (2) 12" WIDE WHITE PLASTIC STRIPES ON EACH SIDE OF PATTERNED CROSSWALK.
- * ⑨ BUILD HANDICAP RAMP PER DETAIL "B", SHT 29.
- ⑩ 8' PCC PEDESTRIAN TRAIL, SEE DETAIL, SHT 29.
- * NOT USED THIS SHEET


Bohannon & Huston

Courtyard One 7500 JEFFERSON NE Albuquerque NEW MEXICO 87109

ENGINEERS PLANNERS PHOTOGRAMMETRISTS SURVEYORS SOFTWARE DEVELOPERS

CITY OF ALBUQUERQUE
PUBLIC WORKS DEPARTMENT
ENGINEERING DEVELOPMENT GROUP

TIMARRON WEST UNIT 3 SUBDIVISION
PAVING PLAN & PROFILE
COCKATIEL DRIVE

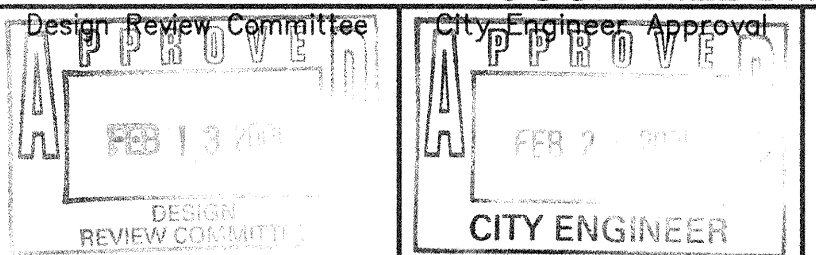

City Project No.

651681

Zone Map No.
L8-M8

Sheet


12 Of 32

10+54.63, 33.00' LT
END CURB RETURN

14+57.44, 63.00' RT
END CURB RETURN

NUMBER	BEARING	DISTANCE
T1	S 00°03'00" W	17.00'
T2	N 89°57'00" W	87.76'
T3	N 89°57'00" W	611.24'


CURVE	RADIUS	LENGTH	TANGENT	DELTA
C1	30.00'	47.12'	30.00'	89°59'49"
C2	300.00'	86.91'	43.76'	16°35'52"
C3	300.00'	86.91'	43.76'	16°35'52"

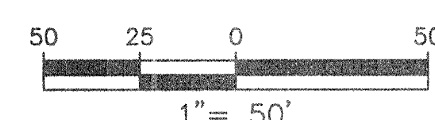

SCANNED BY
MESA REPRO

MATCH LINE - STA 20+00.00
SEE SHEET 16 FOR CONTINUATION

DE VARGAS ROAD

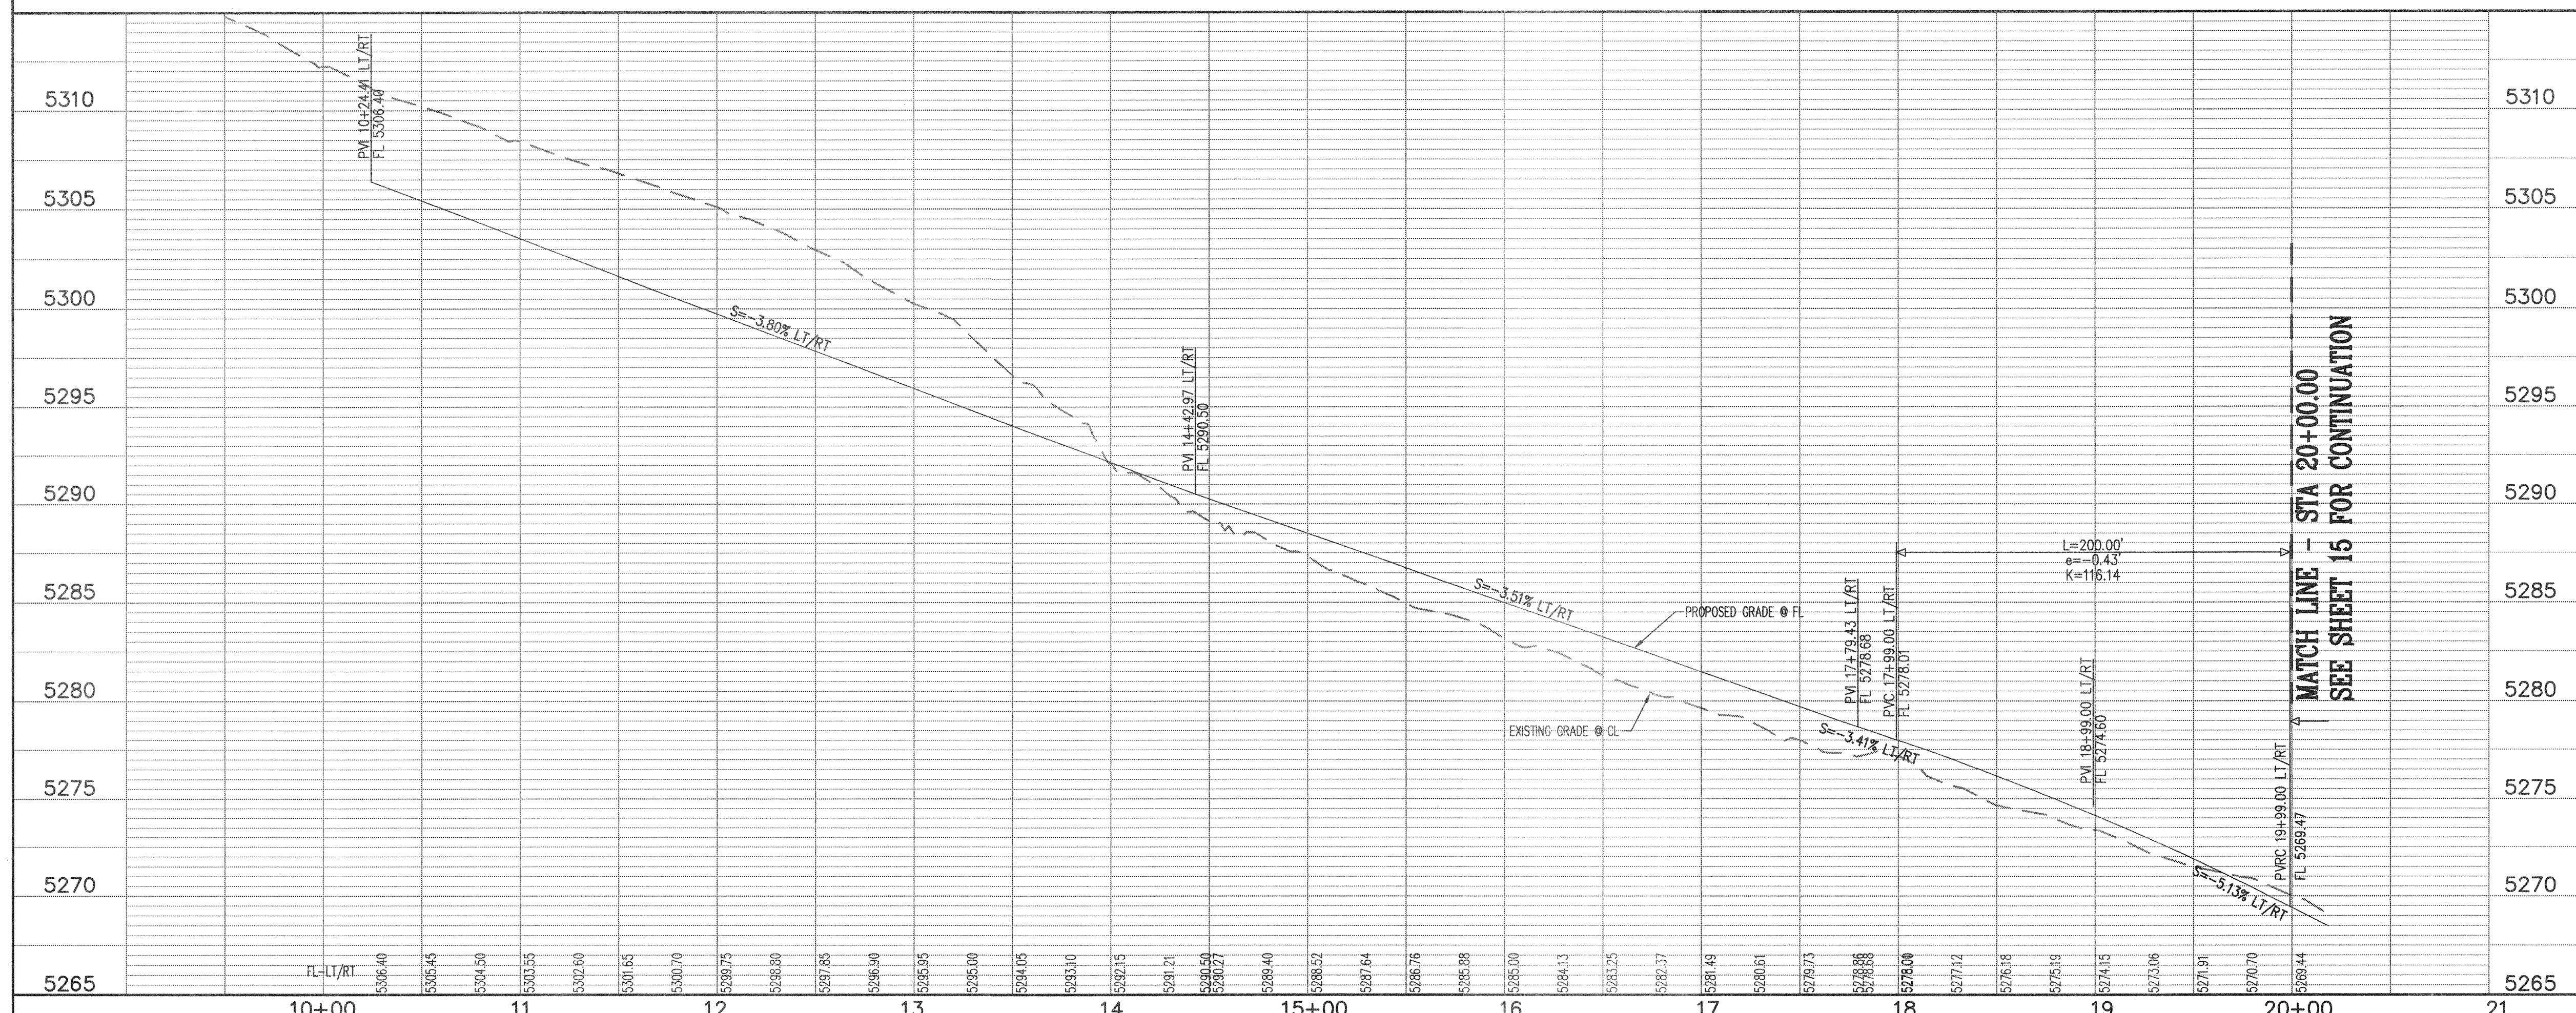

SCALE: 1" = 50' (HORIZ.)
1" = 5' (VERT.)

1. THE CONTRACTOR SHALL FIELD VERIFY ALL EXISTING UTILITY LOCATIONS AND NOTIFY THE ENGINEER IMMEDIATELY OF ANY DISCREPANCIES.
2. ALL CURVE DATA AND DIMENSIONS REFER TO FACE OF CURB UNLESS OTHERWISE SPECIFIED.
3. GRADE ELEVATIONS, WHERE NOTED, ARE FOR FLOWLINE OF CURB UNLESS OTHERWISE SPECIFIED.
4. CONTRACTOR IS RESPONSIBLE FOR REPAIR AND/OR REPLACEMENT OF ALL UTILITY CONDUITS AND EXISTING LINES.
5. ANY ADDITIONAL GRADING REQUIRED TO MATCH PROPOSED STREET GRADES SHALL BE INCIDENTAL TO PAVING ITEMS.
6. CONTRACTOR SHALL PARK EQUIPMENT AND VEHICLES AS NOT TO INTERFERE WITH NORMAL ACTIVITIES OF RESIDENTS OR OTHER CONTRACTORS ON SITE.
7. ANY DAMAGE TO THE EXISTING FACILITIES, C&G, PAVEMENT, CONDUITS, LANDSCAPING, EXISTING LINES, ETC.) DURING CONSTRUCTION SHALL BE REPLACED AT THE CONTRACTORS' EXPENSE.
8. REMOVAL OF THE EXISTING CURB & GUTTER SHALL BE AS PER COA STD. DWG. 2415 (SAWCUT ONLY).
9. WHEELCHAIR RAMPS SHALL BE CONSTRUCTED PRIOR TO ACCEPTANCE OF CURB & GUTTER.
10. DENOTES CROWN TEXTURE PER COA STD. DWG. 2401.
11. QUARTER POINT TABLES ARE SPECIFIED ON PAVING SHEETS. FOR ADDITIONAL INFORMATION REFER TO TYPICAL INTERSECTION RETURN DETAIL, SHEET 29.
12. INSTALL COLORED PATTERNED CONCRETE IN ALL MEDIANS.
13. MH RIMS, CATCH BASIN INLET, & FH FLANGE ELEVATIONS ARE APPROXIMATE. CONTRACTOR SHALL FIELD VERIFY AND ADJUST TO FINAL PAVEMENT ELEVATIONS.
14. CONTRACTOR SHALL FIELD VERIFY ALL EXISTING UTILITIES AND TRANSMISSION GAS LINES. CONTRACTOR SHALL COORDINATE RELOCATION OF UTILITY LINES WITH UTILITY COMPANIES AS REQUIRED.

- ① INSTALL CONCRETE VALLEY GUTTER AS PER COA STD. DWG. 2420.
- ② INSTALL SPECIAL HANDICAP RAMP AS PER DETAIL "A", SHEET 29.
- ③ BUILD STD. CURB & GUTTER AS PER COA STD. DWG. 2415.
- * ④ BUILD RESIDENTIAL PAVEMENT AS PER RESIDENTIAL SECTION, SHEET 28.
- ⑤ 4' SIDEWALK, DEFERRED.
- * ⑥ BUILD ROLL TYPE CURB & GUTTER AS PER COA STD. DWG. 2415.
- * ⑦ NO SIDEWALK ON THIS SIDE, WAIVED.
- * ⑧ 6'D X 10'W X 24'L (VARIES) PCC PVMT W/ MRE MES RUNNING BOND PATTERN, BAJA RED, PER DETAIL SHEET 28. GROOVES NOT TO EXCEED 1/4" DEPTH SHAPE, DEPTH, & PATTERN OF CROSSWALK MUST MEET ADA STANDARD. PLACE (2) 12" WIDE WHITE PLASTIC STRIPES ON EACH SIDE OF PATTERNED CROSSWALK.
- ⑨ BUILD PAVEMENT AS PER DE VARGAS 24' PVI SECTION, SHEET 28. SEE SHEET 30 FOR STR PLAN.
- ⑩ 8' ~~PCC~~^{AC} PEDESTRIAN TRAIL, SEE DETAIL SHT
- ⑪ BUILD PAVEMENT AS PER DE VARGAS 66' PVI SECTION, SHEET 28. REFER TO STRIPPING PLAN SHEET 30.
- ⑫ MERGE RIGHT TYPE III BARRICADE
- ⑬ RELOCATE EXISTING TYPE III BARRICADES SEE SHEET 15.
- * NOT USED THIS SHEET

 Courtyard One 7500 JEFFERSON NE Albuquerque NEW MEXICO 87109

ENGINEERS PLANNERS PHOTOGRAMMETRISTS SURVEYORS SOFTWARE DEVELOPERS



CITY OF ALBUQUERQUE
PUBLIC WORKS DEPARTMENT
ENGINEERING DEVELOPMENT GROUP

TIMARRON WEST UNIT 3 SUBDIVISION

PAVING PLAN & PROFILE

DE VARGAS ROAD STA 10+00.00. - 20+00.00	
Design Review Committee	City Engineer Approval
APPROVED FEB 13 2001 DESIGN REVIEW COMMITTEE	APPROVED FEB 23 2001 CITY ENGINEER
	Last Design Update

City Project No.	Zone Map No.	Sheet	Of
651681	18-M8	14	32

P:\99470\CDP\UNIT 3\PPNP 09.DWG


SCANNED BY
MESA REPRO

CENTERLINE CURVE TABLE				
NUMBER	RADIUS	LENGTH	DELTA	TANGENT
C4	300.00'	115.10'	21°59'00"	58.27'

EDGE OF PAVEMENT TANGENT TABLE		
NUMBER	BEARING	DISTANCE
T3	N89°57'00"W	611.24'
T4	S68°01'00"E	73.03'

EDGE OF PAVEMENT CURVE TABLE				
NUMBER	RADIUS	LENGTH	DELTA	TANGENT
C5	300.00'	205.71'	39°17'14"	107.08'
C6	300.00'	90.46'	17°16'38"	45.58'

MATCH LINE - STA 20+00.00
SEE SHEET 14 FOR CONTINUATION

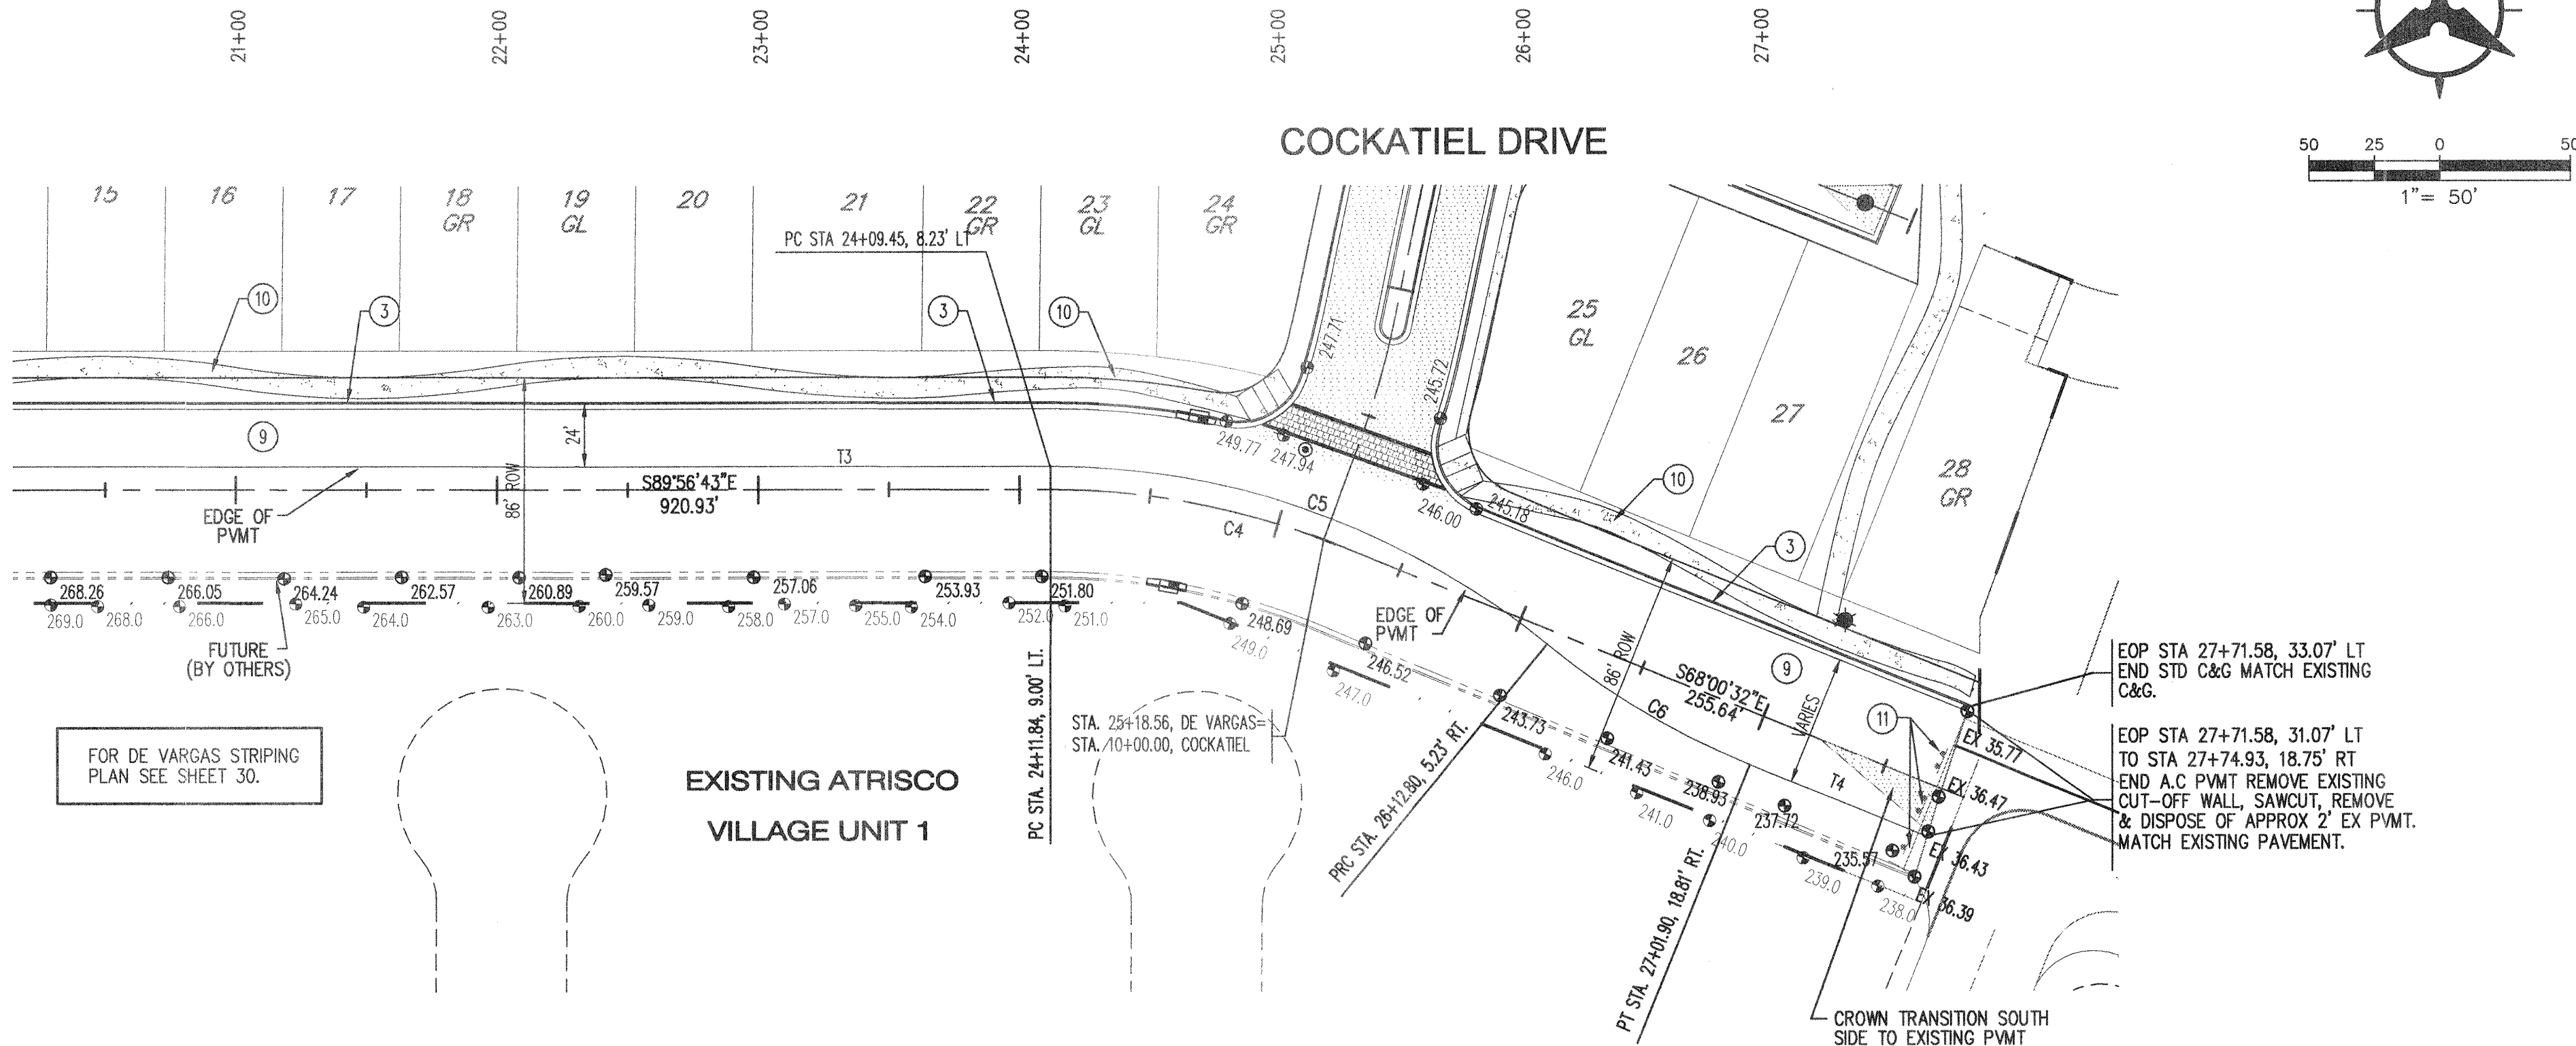


FOR DE VARGAS STRIPING
PLAN SEE SHEET 30.

EXISTING ATRISCO
VILLAGE UNIT 1

DE VARGAS ROAD

MATCH LINE - STA 20+00.00
SEE SHEET 14 FOR CONTINUATION

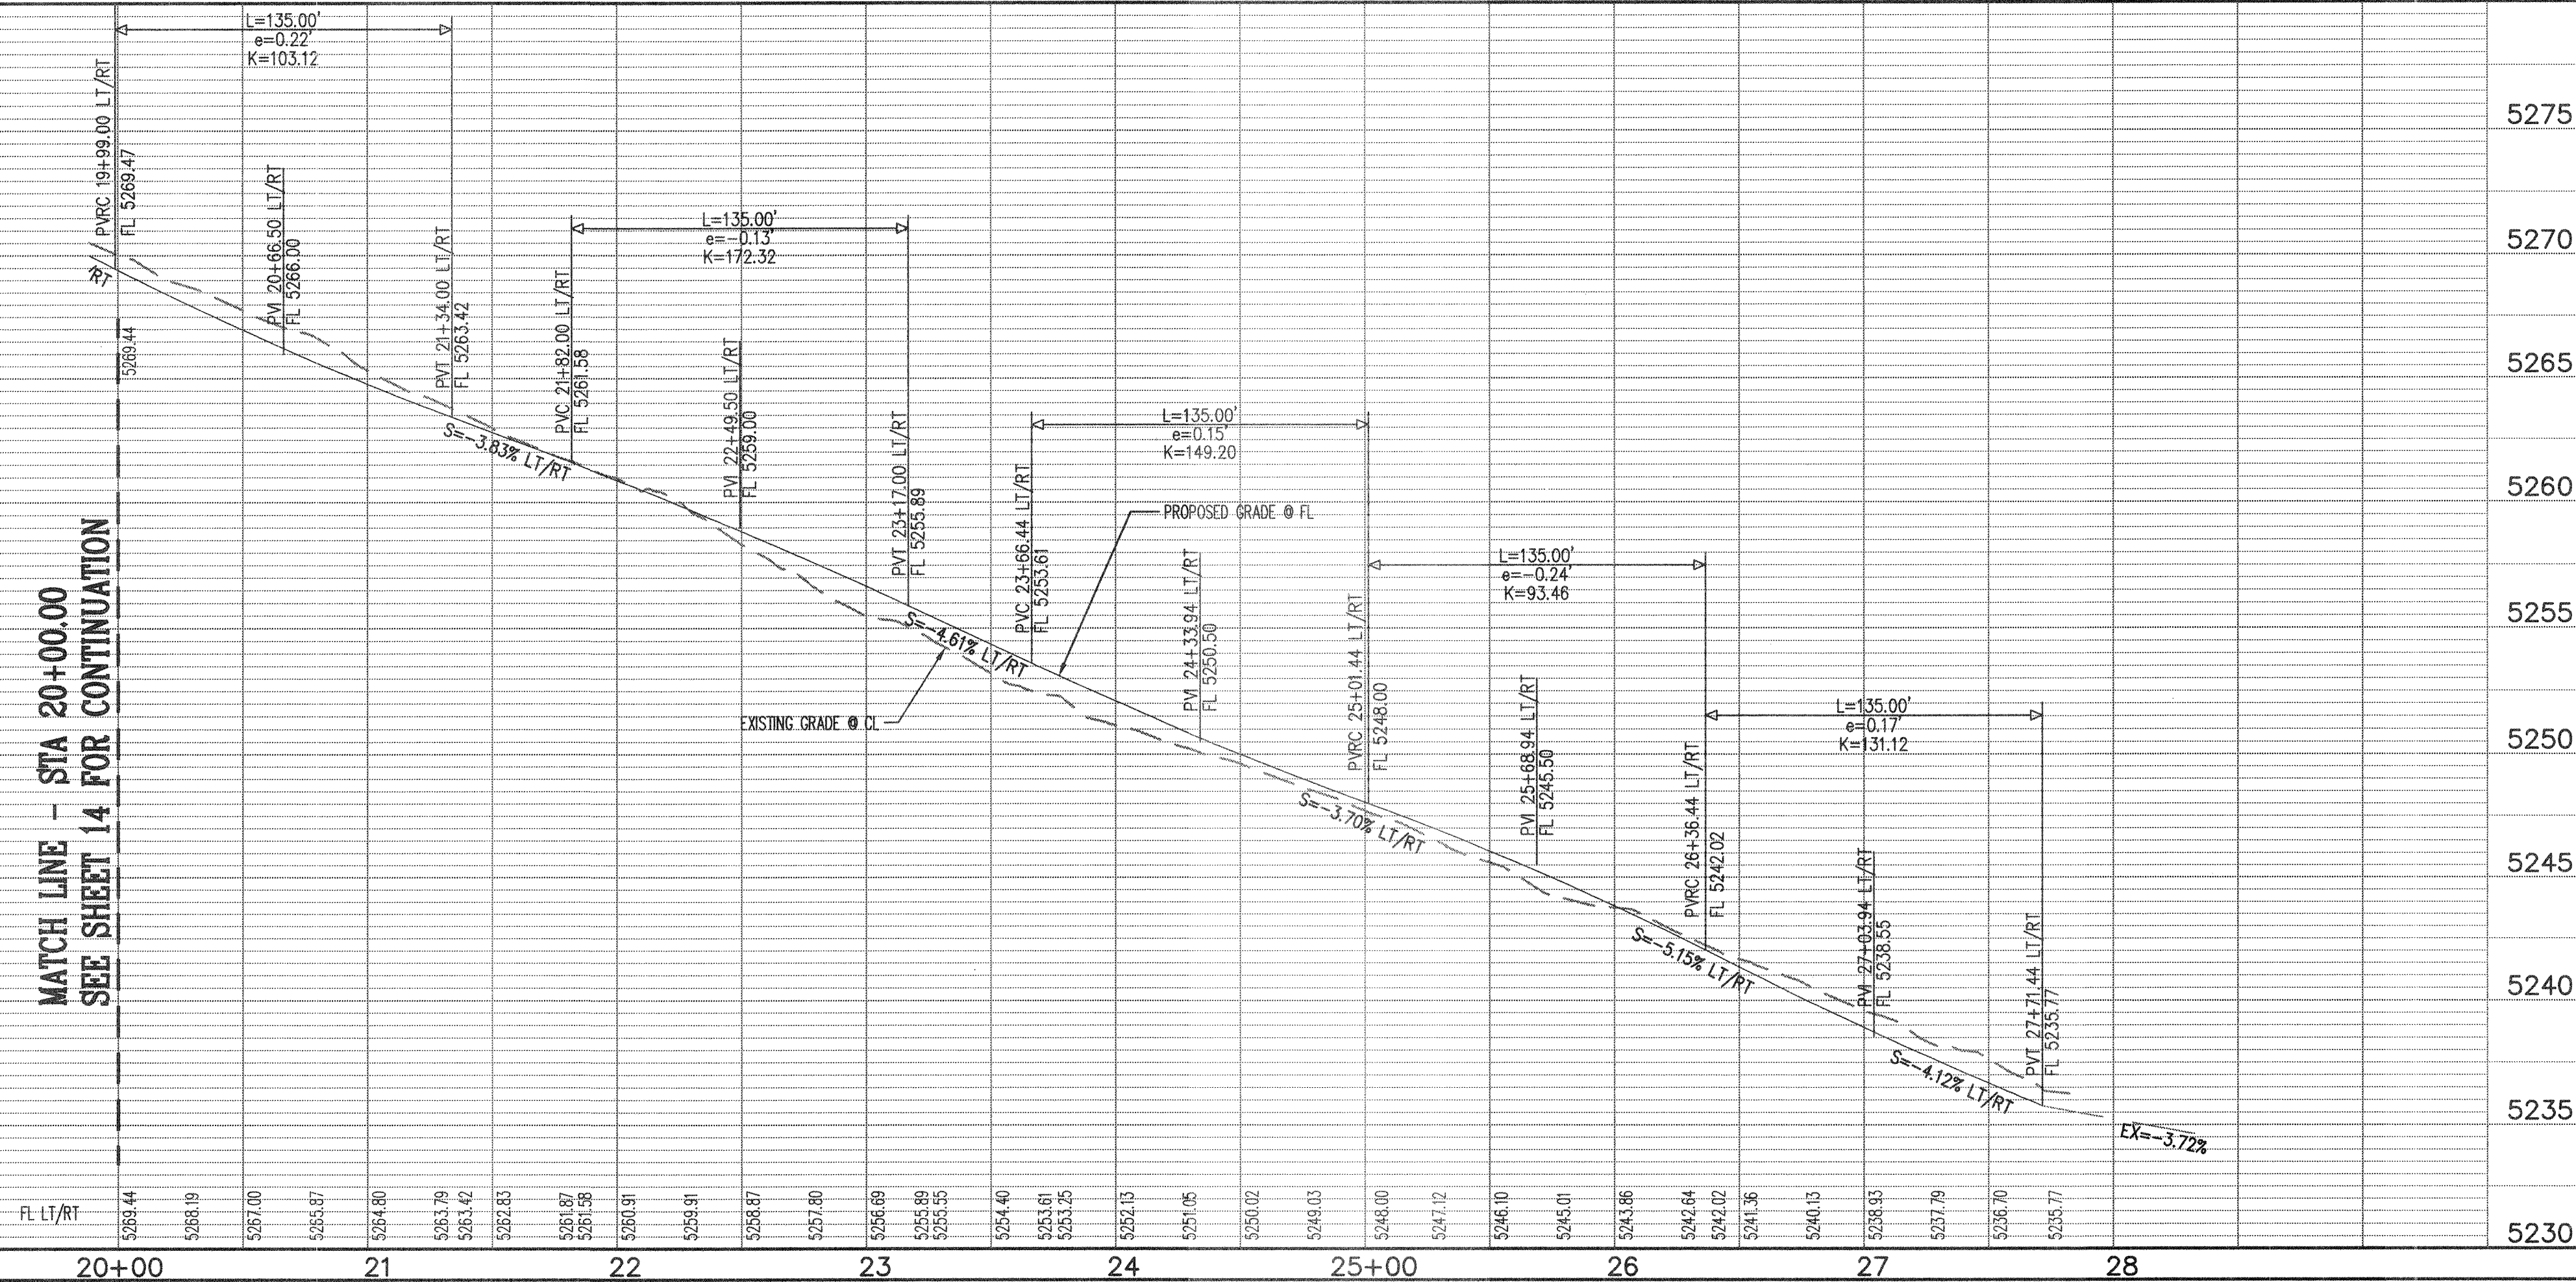

GENERAL NOTES

- THE CONTRACTOR SHALL FIELD VERIFY ALL EXISTING UTILITY LOCATIONS AND NOTIFY THE ENGINEER IMMEDIATELY OF ANY DISCREPANCIES.
- ALL CURVE DATA AND DIMENSIONS REFER TO FACE OF CURB UNLESS OTHERWISE SPECIFIED.
- GRADE ELEVATIONS, WHERE NOTED, ARE FOR FLOWLINE OF CURB UNLESS OTHERWISE SPECIFIED.
- CONTRACTOR IS RESPONSIBLE FOR REPAIR AND/OR REPLACEMENT OF ALL UTILITY CONDUITS AND EXISTING LINES.
- ANY ADDITIONAL GRADING REQUIRED TO MATCH PROPOSED STREET GRADES SHALL BE INCIDENTAL TO PAVING ITEMS.
- CONTRACTOR SHALL PARK EQUIPMENT AND VEHICLES AS NOT TO INTERFERE WITH NORMAL ACTIVITIES OF RESIDENTS OR OTHER CONTRACTORS ON SITE.
- ANY DAMAGE TO THE EXISTING FACILITIES, C&G, PAVEMENT, CONDUITS, LANDSCAPING, EXISTING LINES, ETC.) DURING CONSTRUCTION SHALL BE REPLACED AT THE CONTRACTORS' EXPENSE.
- REMOVAL OF THE EXISTING CURB & GUTTER SHALL BE AS PER COA STD. DWG. 2415 (SAWCUT ONLY).
- WHEELCHAIR RAMP SHALL BE CONSTRUCTED PRIOR TO ACCEPTANCE OF CURB & GUTTER.
- DENOTES CROWN TRANSITION PER COA STD. DWG. 2401.
- QUARTER POINT TABLES ARE SPECIFIED ON PAVING SHEETS. FOR ADDITIONAL INFORMATION REFER TO TYPICAL INTERSECTION RETURN DETAIL, SHEET 29.
- INSTALL COLORED PATTERNED CONCRETE IN ALL MEDIANS.
- MH RIMS, CATCH BASIN INLET, & FH FLANGE ELEVATIONS ARE APPROXIMATE. CONTRACTOR SHALL FIELD VERIFY AND ADJUST TO FINAL PAVEMENT ELEVATIONS.
- CONTRACTOR SHALL FIELD VERIFY ALL EXISTING UTILITIES AND TRANSMISSION GAS LINES. CONTRACTOR SHALL COORDINATE RELOCATION OF UTILITY LINES WITH UTILITY COMPANIES AS REQUIRED.

KEYED NOTES

- ① INSTALL CONCRETE VALLEY GUTTER AS PER COA STD. DWG. 2420.
 - ② INSTALL SPECIAL HANDICAP RAMP AS PER DETAIL "A", SHEET 29.
 - ③ BUILD STD. CURB & GUTTER AS PER COA STD. DWG. 2415.
 - ④ BUILD RESIDENTIAL PAVEMENT AS PER RESIDENTIAL SECTION, SHEET 28.
 - ⑤ 4' SIDEWALK, DEFERRED.
 - ⑥ BUILD ROLL TYPE CURB & GUTTER AS PER COA STD. DWG. 2415.
 - ⑦ NO SIDEWALK ON THIS SIDE, WAIVED.
 - ⑧ 6" D X 10" W X 24" L (VARIES) PCC PMWT w/WIRE MESH, RUNNING BOND PATTERN, BAJA RED, PER DETAIL SHEET 28. GROOVES NOT TO EXCEED 1/4" DEPTH. SHAPE, DEPTH, & PATTERN OF CROSSWALK MUST MEET ADA STANDARD. PLACE (2) 12" WIDE WHITE PLASTIC STRIPES ON EACH SIDE OF PATTERNED CROSSWALK.
 - ⑨ BUILD PAVEMENT AS PER DE VARGAS 24' PMWT SECTION, SHEET 28.
 - ⑩ 8' WIDE PCC PEDESTRIAN TRAIL, SEE SHT 29.
 - ⑪ REMOVE AND RELOCATE EXISTING TYPE III BARRICADES TO DE VARGAS & OSPREY SEE SHEET 14.
- * NOT USED THIS SHEET

Bohannon & Huston

Courtyard One 7500 JEFFERSON NE Albuquerque NEW MEXICO 87109

ENGINEERS PLANNERS PHOTOGRAMMETRISTS SURVEYORS SOFTWARE DEVELOPERS

CITY OF ALBUQUERQUE
PUBLIC WORKS DEPARTMENT
ENGINEERING DEVELOPMENT GROUP


TIMARRON WEST SUBDIVISION

PAVING PLAN & PROFILE

DE VARGAS ROAD STA 20+00.00 - 28+00.00

Design Review Committee	City Engineer Approval	Last Design Update	Mo./Day/Yr.	Mo./Day/Yr.
APPROVED FEB 13 2001	APPROVED FEB 23 2001			
DESIGN REVIEW COMMITTEE	CITY ENGINEER			

City Project No. 651681 Zone Map No. L8-M8 Sheet 15 of 32

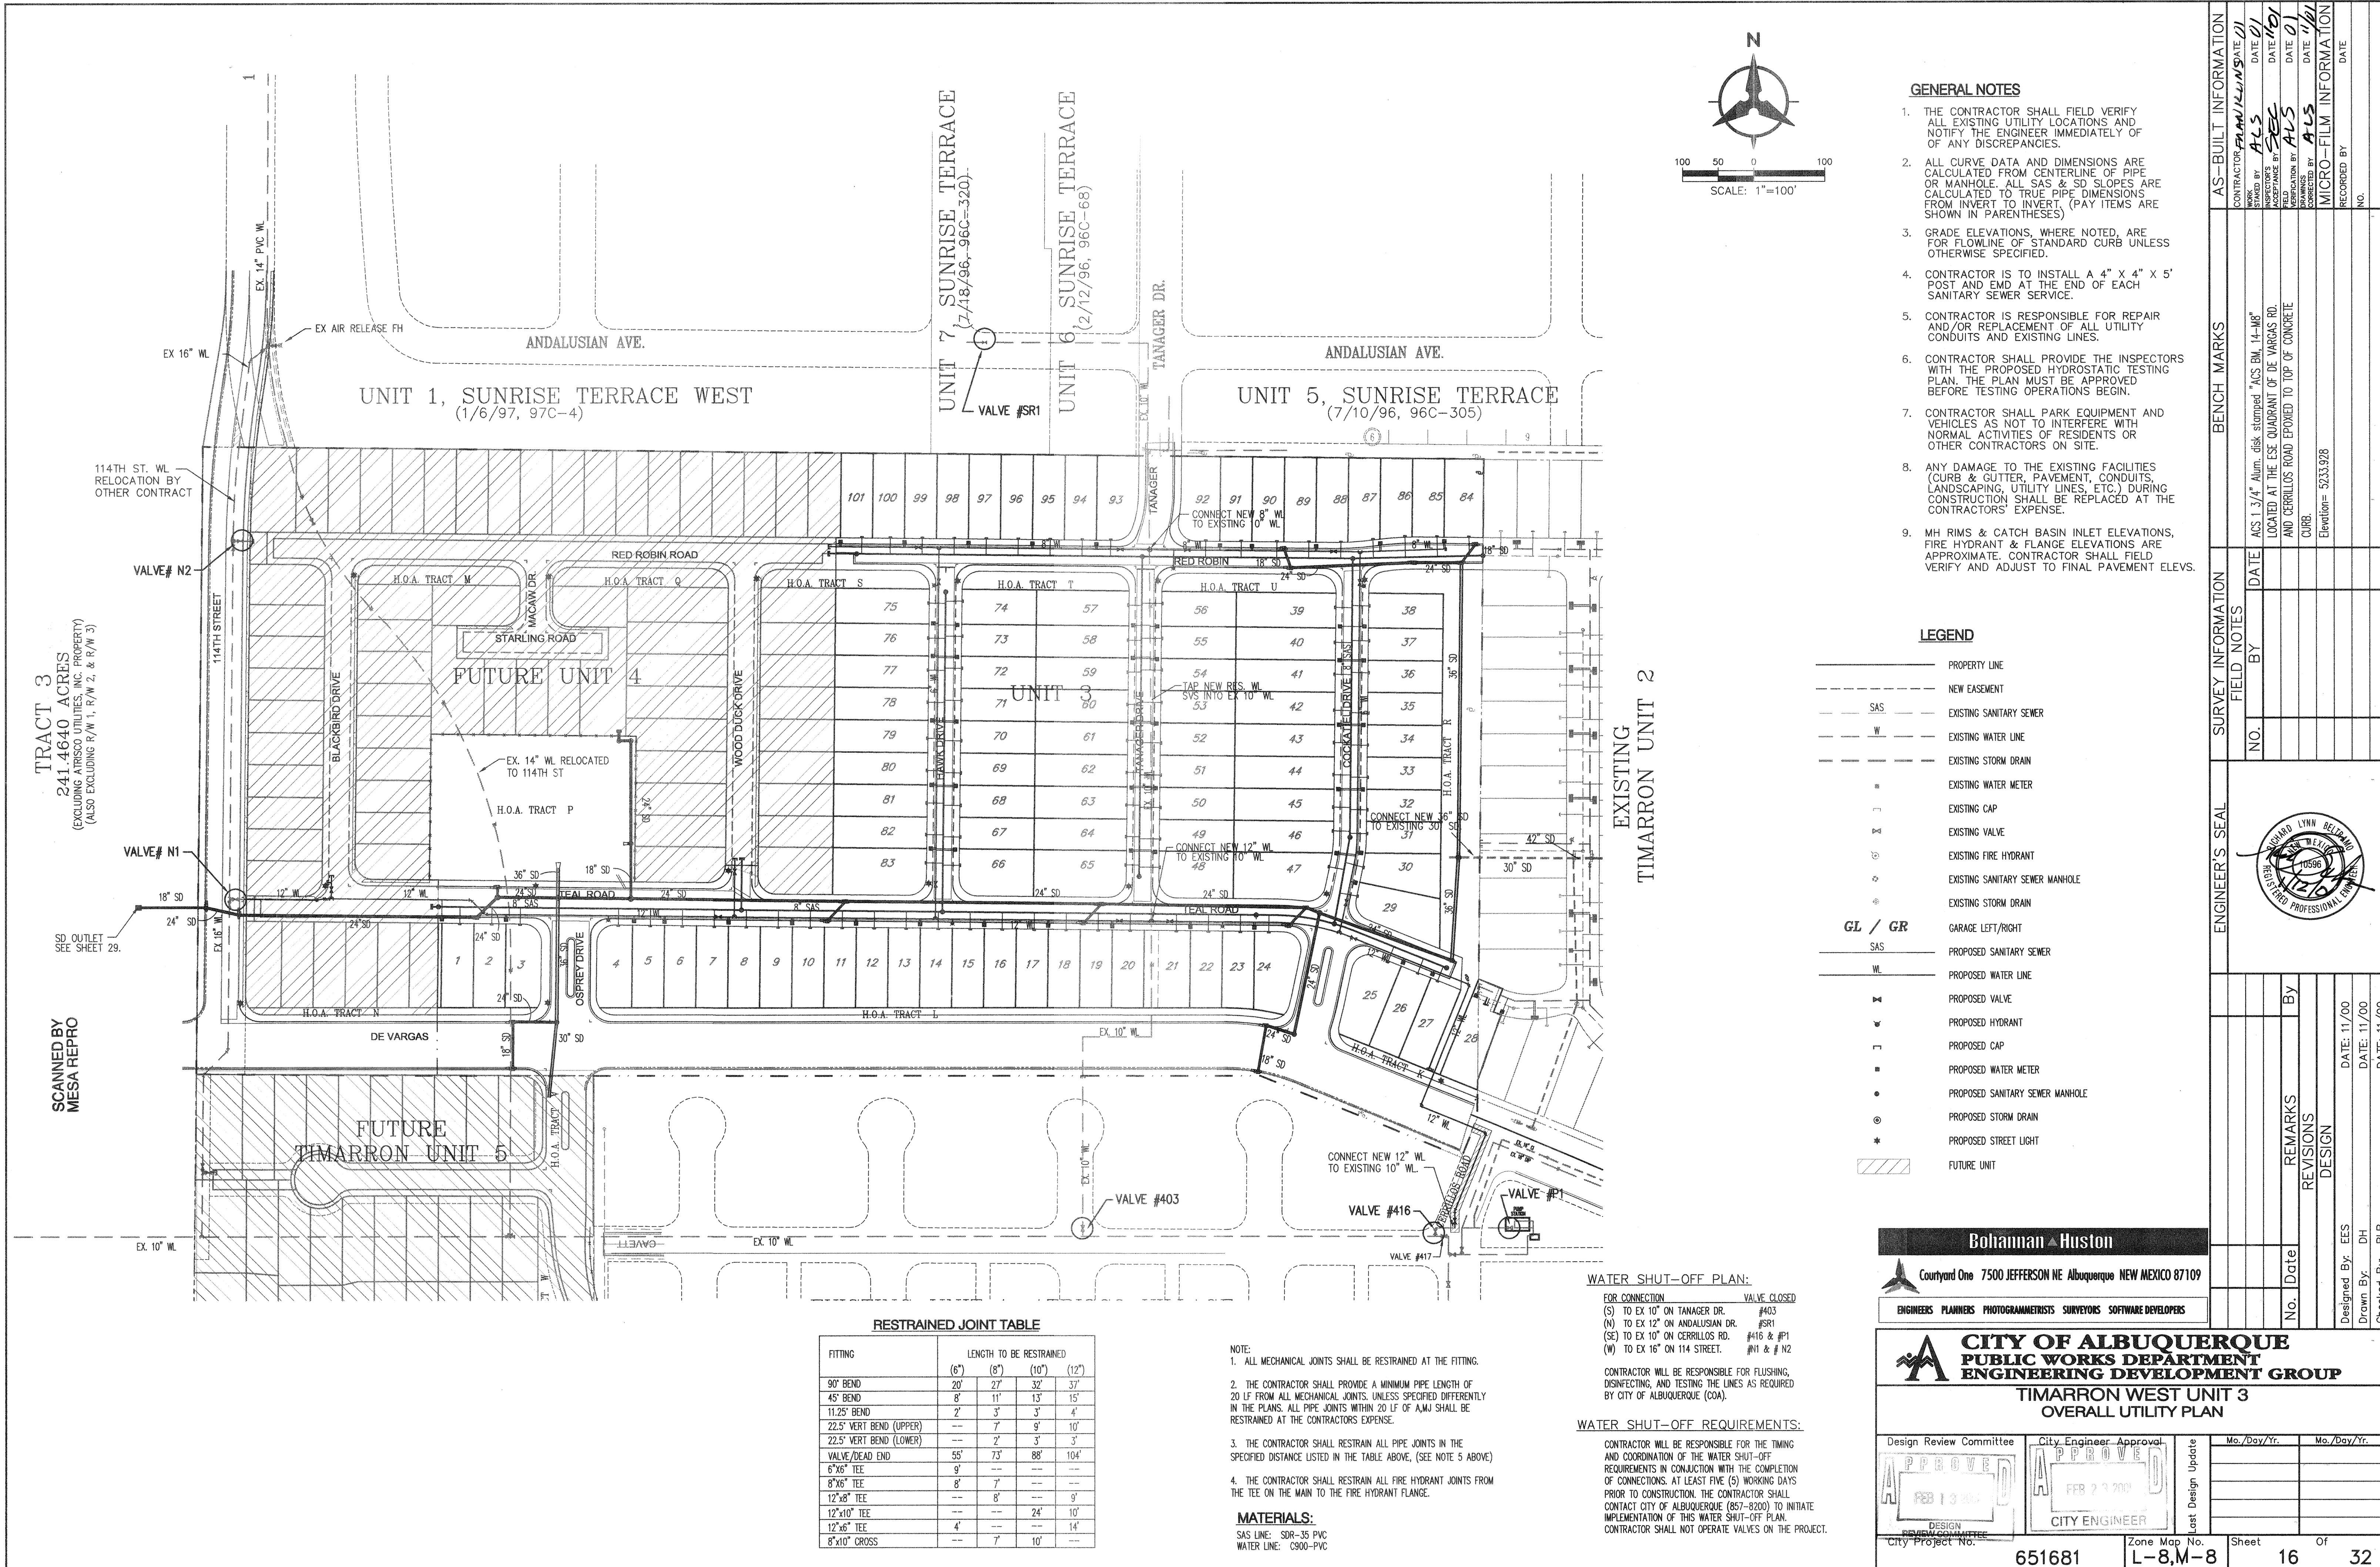

- GENERAL NOTES**
- THE CONTRACTOR SHALL FIELD VERIFY ALL EXISTING UTILITY LOCATIONS AND NOTIFY THE ENGINEER IMMEDIATELY OF ANY DISCREPANCIES.
 - ALL CURVE DATA AND DIMENSIONS ARE CALCULATED FROM CENTERLINE OF PIPE OR MANHOLE. ALL SAS & SD SLOPES ARE CALCULATED TO TRUE PIPE DIMENSIONS FROM INVERT TO INVERT. (PAY ITEMS ARE SHOWN IN PARENTHESES)
 - GRADE ELEVATIONS, WHERE NOTED, ARE FOR FLOWLINE OF STANDARD CURB UNLESS OTHERWISE SPECIFIED.
 - CONTRACTOR IS TO INSTALL A 4" X 4" X 5' POST AND EMD AT THE END OF EACH SANITARY SEWER SERVICE.
 - CONTRACTOR IS RESPONSIBLE FOR REPAIR AND/OR REPLACEMENT OF ALL UTILITY CONDUITS AND EXISTING LINES.
 - CONTRACTOR SHALL PROVIDE THE INSPECTORS WITH THE PROPOSED HYDROSTATIC TESTING PLAN. THE PLAN MUST BE APPROVED BEFORE TESTING OPERATIONS BEGIN.
 - CONTRACTOR SHALL PARK EQUIPMENT AND VEHICLES AS NOT TO INTERFERE WITH NORMAL ACTIVITIES OF RESIDENTS OR OTHER CONTRACTORS ON SITE.
 - ANY DAMAGE TO THE EXISTING FACILITIES (CURB & GUTTER, PAVEMENT, CONDUITS, LANDSCAPING, UTILITY LINES, ETC.) DURING CONSTRUCTION SHALL BE REPLACED AT THE CONTRACTORS' EXPENSE.
 - MH RIMS & CATCH BASIN INLET ELEVATIONS, FIRE HYDRANT & FLANGE ELEVATIONS ARE APPROXIMATE. CONTRACTOR SHALL FIELD VERIFY AND ADJUST TO FINAL PAVEMENT ELEV.

- LEGEND**
- PROPERTY LINE
 - NEW EASEMENT
 - SAS
 - EXISTING SANITARY SEWER
 - EXISTING WATER LINE
 - EXISTING STORM DRAIN
 - EXISTING WATER METER
 - EXISTING CAP
 - EXISTING VALVE
 - EXISTING FIRE HYDRANT
 - EXISTING SANITARY SEWER MANHOLE
 - EXISTING STORM DRAIN
 - GL / GR
 - SAS
 - PROPOSED SANITARY SEWER
 - PROPOSED WATER LINE
 - PROPOSED VALVE
 - PROPOSED HYDRANT
 - PROPOSED CAP
 - PROPOSED WATER METER
 - PROPOSED SANITARY SEWER MANHOLE
 - PROPOSED STORM DRAIN
 - PROPOSED STREET LIGHT
 - FUTURE UNIT

RESTRAINED JOINT TABLE

FITTING	LENGTH TO BE RESTRAINED			
	(6")	(8")	(10")	(12")
90° BEND	20'	27'	32'	37'
45° BEND	8'	11'	13'	15'
11.25° BEND	2'	3'	3'	4'
22.5° VERT BEND (UPPER)	---	7'	9'	10'
22.5° VERT BEND (LOWER)	---	2'	3'	3'
VALVE/DEAD END	55'	73'	88'	104'
6"x6" TEE	9'	---	---	---
8"x6" TEE	8'	7'	---	---
12"x8" TEE	---	8'	---	9'
12"x10" TEE	---	---	24'	10'
12"x6" TEE	4'	---	---	14'
8"x10" CROSS	---	7'	10'	---

- NOTE:**
- ALL MECHANICAL JOINTS SHALL BE RESTRAINED AT THE FITTING.
 - THE CONTRACTOR SHALL PROVIDE A MINIMUM PIPE LENGTH OF 20 LF FROM ALL MECHANICAL JOINTS, UNLESS SPECIFIED DIFFERENTLY IN THE PLANS. ALL PIPE JOINTS WITHIN 20 LF OF A MJ SHALL BE RESTRAINED AT THE CONTRACTORS EXPENSE.
 - THE CONTRACTOR SHALL RESTRAIN ALL PIPE JOINTS IN THE SPECIFIED DISTANCE LISTED IN THE TABLE ABOVE. (SEE NOTE 5 ABOVE)
 - THE CONTRACTOR SHALL RESTRAIN ALL FIRE HYDRANT JOINTS FROM THE TEE ON THE MAIN TO THE FIRE HYDRANT FLANGE.

MATERIALS:
SAS LINE: SDR-35 PVC
WATER LINE: C900-PVC


WATER SHUT-OFF PLAN:
FOR CONNECTION VALVE CLOSED
(S) TO EX 10" ON Tanager Dr. #403
(N) TO EX 12" ON ANDALUSIAN DR. #SR1
(SE) TO EX 10" ON CERRILLOS RD. #416 & #P1
(W) TO EX 16" ON 114 STREET. #11 & # N2

WATER SHUT-OFF REQUIREMENTS:
CONTRACTOR WILL BE RESPONSIBLE FOR THE TIMING AND COORDINATION OF THE WATER SHUT-OFF REQUIREMENTS IN CONJUNCTION WITH THE COMPLETION OF CONNECTIONS. AT LEAST FIVE (5) WORKING DAYS PRIOR TO CONSTRUCTION, THE CONTRACTOR SHALL CONTACT CITY OF ALBUQUERQUE (857-8200) TO INITIATE IMPLEMENTATION OF THIS WATER SHUT-OFF PLAN. CONTRACTOR SHALL NOT OPERATE VALVES ON THE PROJECT.

Bohannon & Huston
Court yard One 7500 JEFFERSON NE Albuquerque NEW MEXICO 87109
ENGINEERS PLANNERS PHOTOGRAMMETRISTS SURVEYORS SOFTWARE DEVELOPERS

CITY OF ALBUQUERQUE
PUBLIC WORKS DEPARTMENT
ENGINEERING DEVELOPMENT GROUP
TIMARRON WEST UNIT 3
OVERALL UTILITY PLAN

Design Review Committee	City Engineer Approval	Mo./Day/Yr.	Mo./Day/Yr.
APPROVED FEB 13 2001	APPROVED FEB 7 2001		
DESIGN REVIEW COMMITTEE	CITY ENGINEER	Last Design Update	
City Project No.	Zone Map No.	Sheet	Of
651681	L-8,M-8	16	32

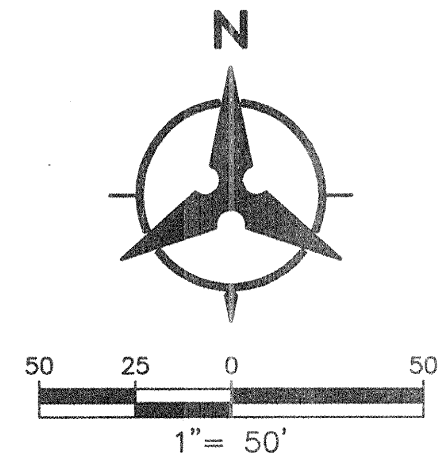

SANITARY SEWER SERVICES			
LOT No.	SAS STATION & OFFSET	SAS LENGTH	INV. @ PLUG (W/RISE)
1	12+80.11, CL	25.00'	5284.94 (-)
2	13+25.10, CL	25.00'	5285.30 (2')
3	13+65.10, CL	25.00'	5283.70 (2')
4	15+03.11, CL	25.00'	5278.88 (3')
5	15+48.12, CL	25.00'	5277.08 (3')
6	15+93.10, CL	25.00'	5275.28 (3')

STORM DRAIN TANGENT TABLE
NUMBER BEARING LENGTH
T20 S89°59'60"E 94.86'
T21 S82°37'1"E 48.14'
T22 S89°22'37"E 333.87'
T23 N45°42'11"E 40.83'
T24 S03°3'23"W 14.73'
T25 S89°22'37"E 85.04'
T26 S89°22'37"E 102.55'
T27 S89°13'47"E 302.40'

WATERLINE TANGENT TABLE		
NUMBER	BEARING	LENGTH
T5J	S89°22'37"E	102.97'
T53A	S79°25'05"E	10.70'
T53B	S89°22'37"E	10.00'
T54	S89°22'37"E	196.54'
T55	S44°22'37"E	28.28'
T56	S89°22'37"E	350.46'

LEGEND

- | | |
|---|-----------------------|
|  | DOUBLE WATER METER |
|  | SINGLE WATER METER |
|  | WL AIR RELEASE VALVE |
|  | WATER LINE GATE VALVE |
|  | WATER LINE CAP |
|  | WATER LINE REDUCER |
|  | EXISTING WATERLINE |
|  | WATER LINE TEE |
|  | SAS LATERAL |
|  | SAS MANHOLE |
|  | STORM DRAIN MANHOLE |
|  | STORM DRAIN INLET |
|  | PROPOSED FIRE HYDRANT |
|  | EXISTING WATER VALVE |
|  | PROPOSED STREET LIGHT |


GENERAL NOTES

1. THE CONTRACTOR SHALL FIELD VERIFY ALL EXISTING UTILITY LOCATIONS AND NOTIFY THE ENGINEER IMMEDIATELY OF ANY DISCREPANCIES.
2. ALL CURVE DATA AND DIMENSIONS ARE CALCULATED FROM CENTERLINE OF PIPE OR MANHOLE. ALL SAS & SD SLOPES ARE CALCULATED TO TRUE PIPE DIMENSIONS FROM INVERT TO INVERT. (PAY ITEMS ARE SHOWN IN PARENTHESES)
3. GRADE ELEVATIONS, WHERE NOTED, ARE FOR FLOWLINE OF STANDARD CURB UNLESS OTHERWISE SPECIFIED.
4. CONTRACTOR IS TO INSTALL A 4" X 4" X 5' POST AND END AT THE END OF EACH SANITARY SEWER SERVICE.
5. CONTRACTOR IS RESPONSIBLE FOR REPAIR AND/OR REPLACEMENT OF ALL UTILITY CONDUITS AND EXISTING LINES.
6. CONTRACTOR SHALL PROVIDE THE INSPECTORS WITH THE PROPOSED TESTING PLAN. THE PLAN MUST BE APPROVED BEFORE TESTING OPERATIONS BEGIN.
7. CONTRACTOR SHALL PARK EQUIPMENT AND VEHICLES AS NOT TO INTERFERE WITH NORMAL ACTIVITIES OF RESIDENTS OR OTHER CONTRACTORS ON SITE.
8. ANY DAMAGE TO THE EXISTING FACILITIES (CURB & GUTTER, PAVEMENT, CONDUITS, LANDSCAPING, UTILITY LINES, ETC.) DURING CONSTRUCTION SHALL BE REPLACED AT THE CONTRACTORS' EXPENSE.
9. MH RIMS & CATCH BASIN INLET ELEVATIONS, FIRE HYDRANT & FLANGE ELEVATIONS ARE APPROXIMATE. CONTRACTOR SHALL FIELD VERIFY AND ADJUST TO FINAL PAVEMENT GRADES.
10. SAS STATIONING FOLLOWS CL OF ROAD UNLESS OTHERWISE NOTED.
11. STATIONING OF DROP INLET IS TO MIDDLE OF DOWN HILL GRATE AT FACE OF CURB.
12. SAS LATERALS ARE 20' INSIDE PL ON DOWNHILL SIDE OF PROPERTY UNLESS OTHERWISE SPECIFIED.
13. ALL WATERLINE APPURTENANCES SHALL USE RESTRAINED JOINTS, REFER TO TABLES LISTED ON OVERALL UTILITY SHEET 16.
14. TYPICAL DEPTH TO WATERLINE IS 4 FEET. MINIMUM IS 3 FEET.

KEYED NOTES:

- ① INSTALL ORIFICE PLATE PER DETAIL, SHEET 29.

SURVEY INFORMATION			BENCH MARKS	AS-BUILT INFORMATION	
NO.	BY	DATE		CONTRACTOR	DATE
			ACS 1 3/4" Alum. disk stamped "ACS BM 14-H6"	FRANKLINS	01
			LOCATED AT THE ESE QUADRANT OF VARGAS RD.	SKINNED BY	01
			AND CERRILLOS ROAD EPOXYED TO TOP OF CONCRETE	INSPECTOR'S	11/01
			CURB.	DATE BY	SEC
			Elevation= 5233.928	INSPECTION BY	01
				CORRECTED BY	11/01
				MICRO-FILM INFORMATION	
				RECORDED BY	DATE
				NO.	

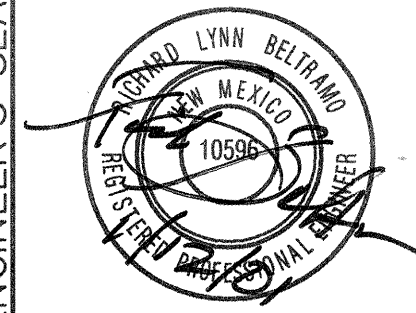[illegible]

Bohannon ▲ Huston

 Courtyard One 7500 JEFFERSON NE Albuquerque NEW MEXICO 87109

ENGINEERS PLANNERS PHOTOGRAMMETRISTS SURVEYORS SOFTWARE DEVELOPERS

**A CITY OF ALBUQUERQUE
PUBLIC WORKS DEPARTMENT
ENGINEERING DEVELOPMENT GROUP**

TIMARRON WEST SUBDIVISION

UTILITY PLAN & PROFILE

[illegible]



City Project No.	Zone Map No.	Sheet	Of
651681	L8-M8	17	32

SCALE: 1" = 50' (HORIZ.)
1" = 5' (VERT.)

651681

one Map No.
L8-M8

Sheet 17 Of 32

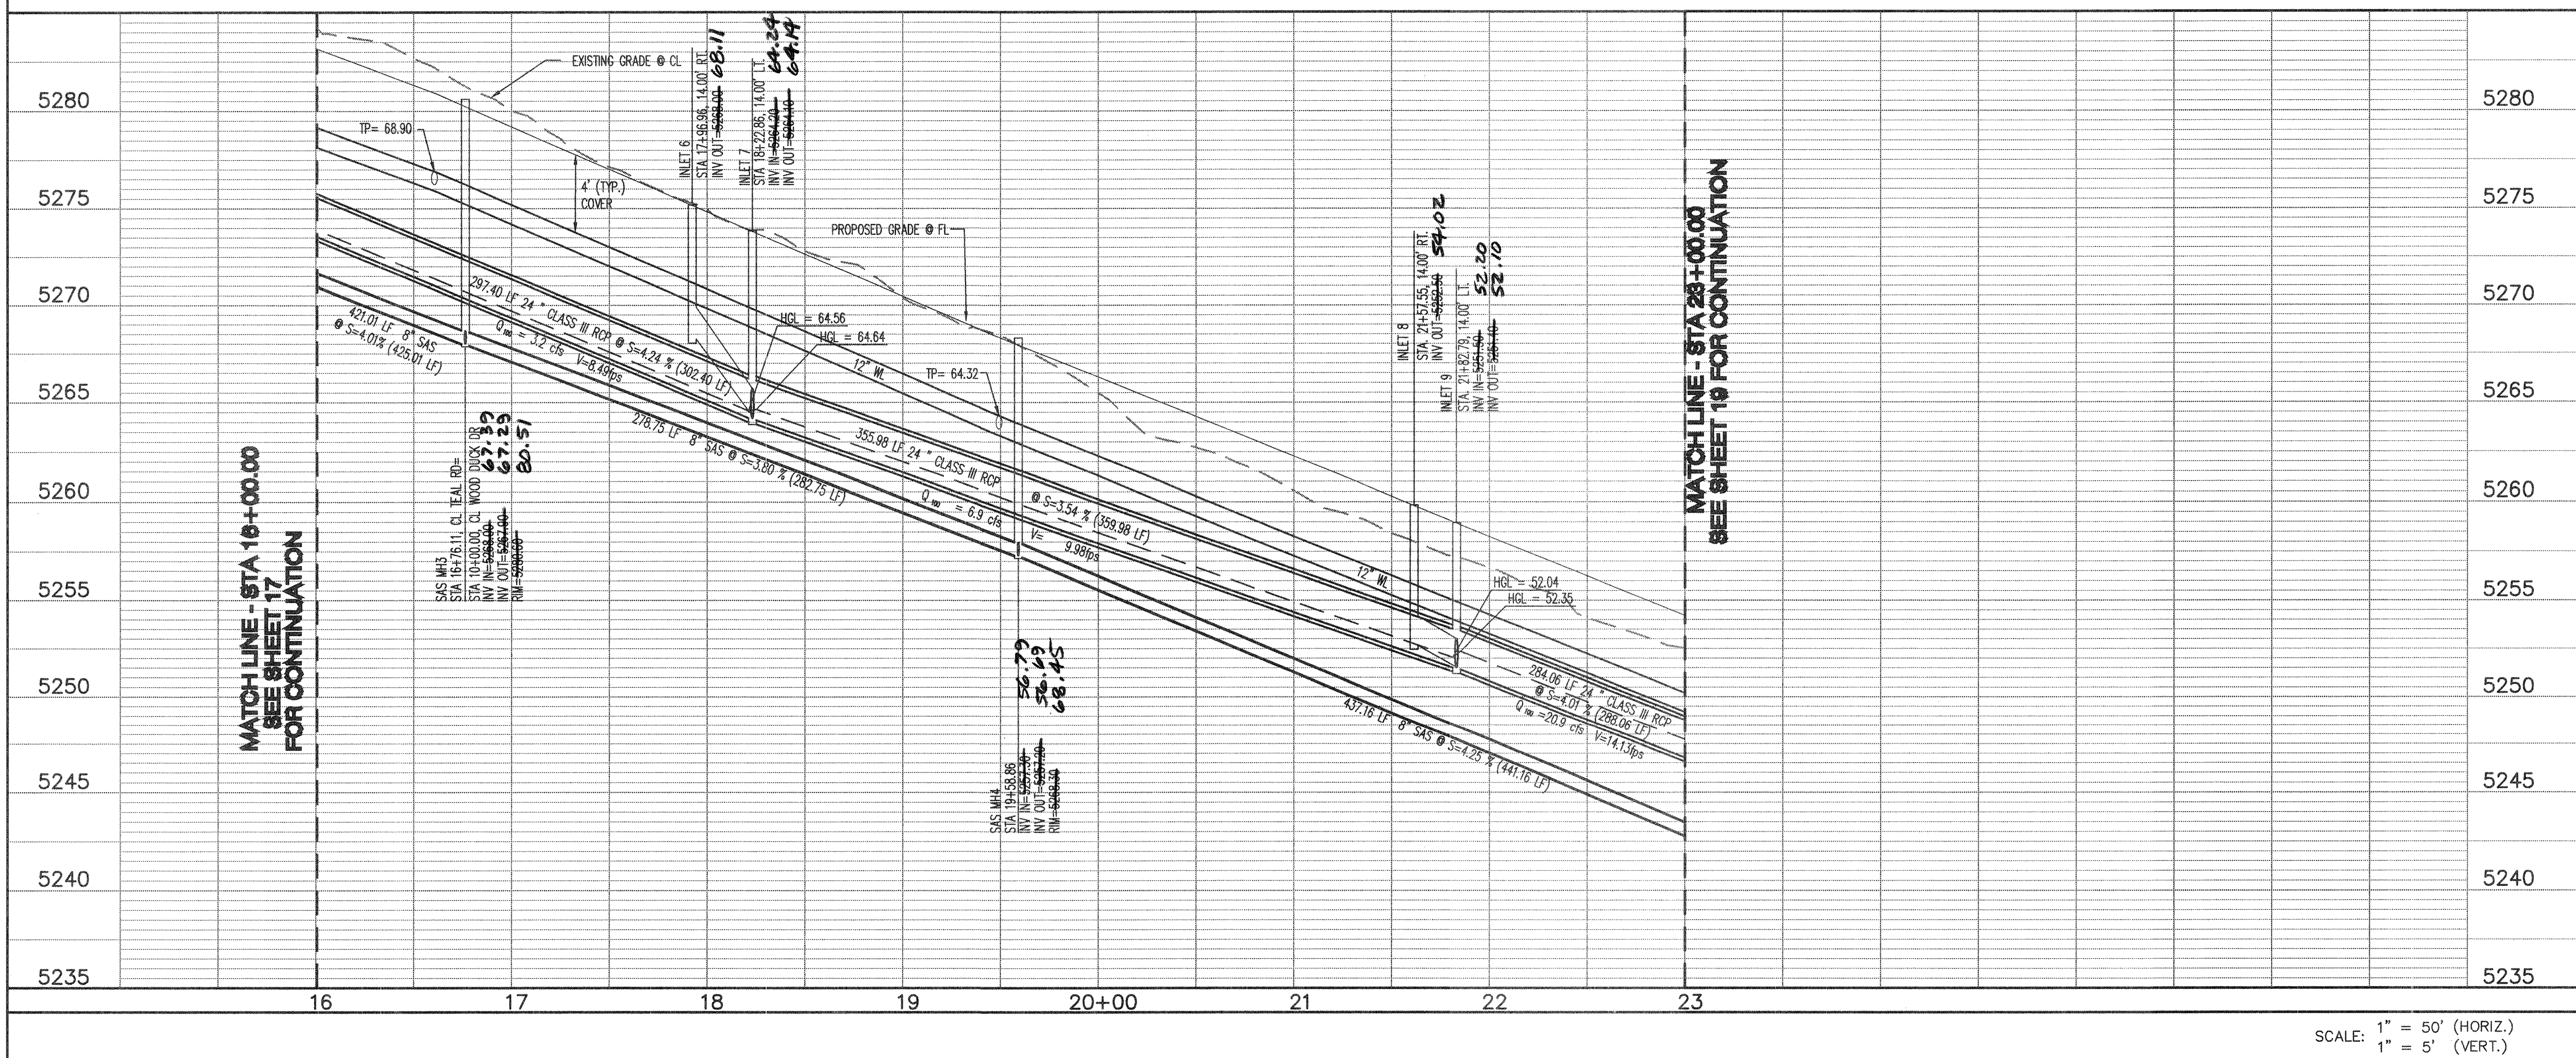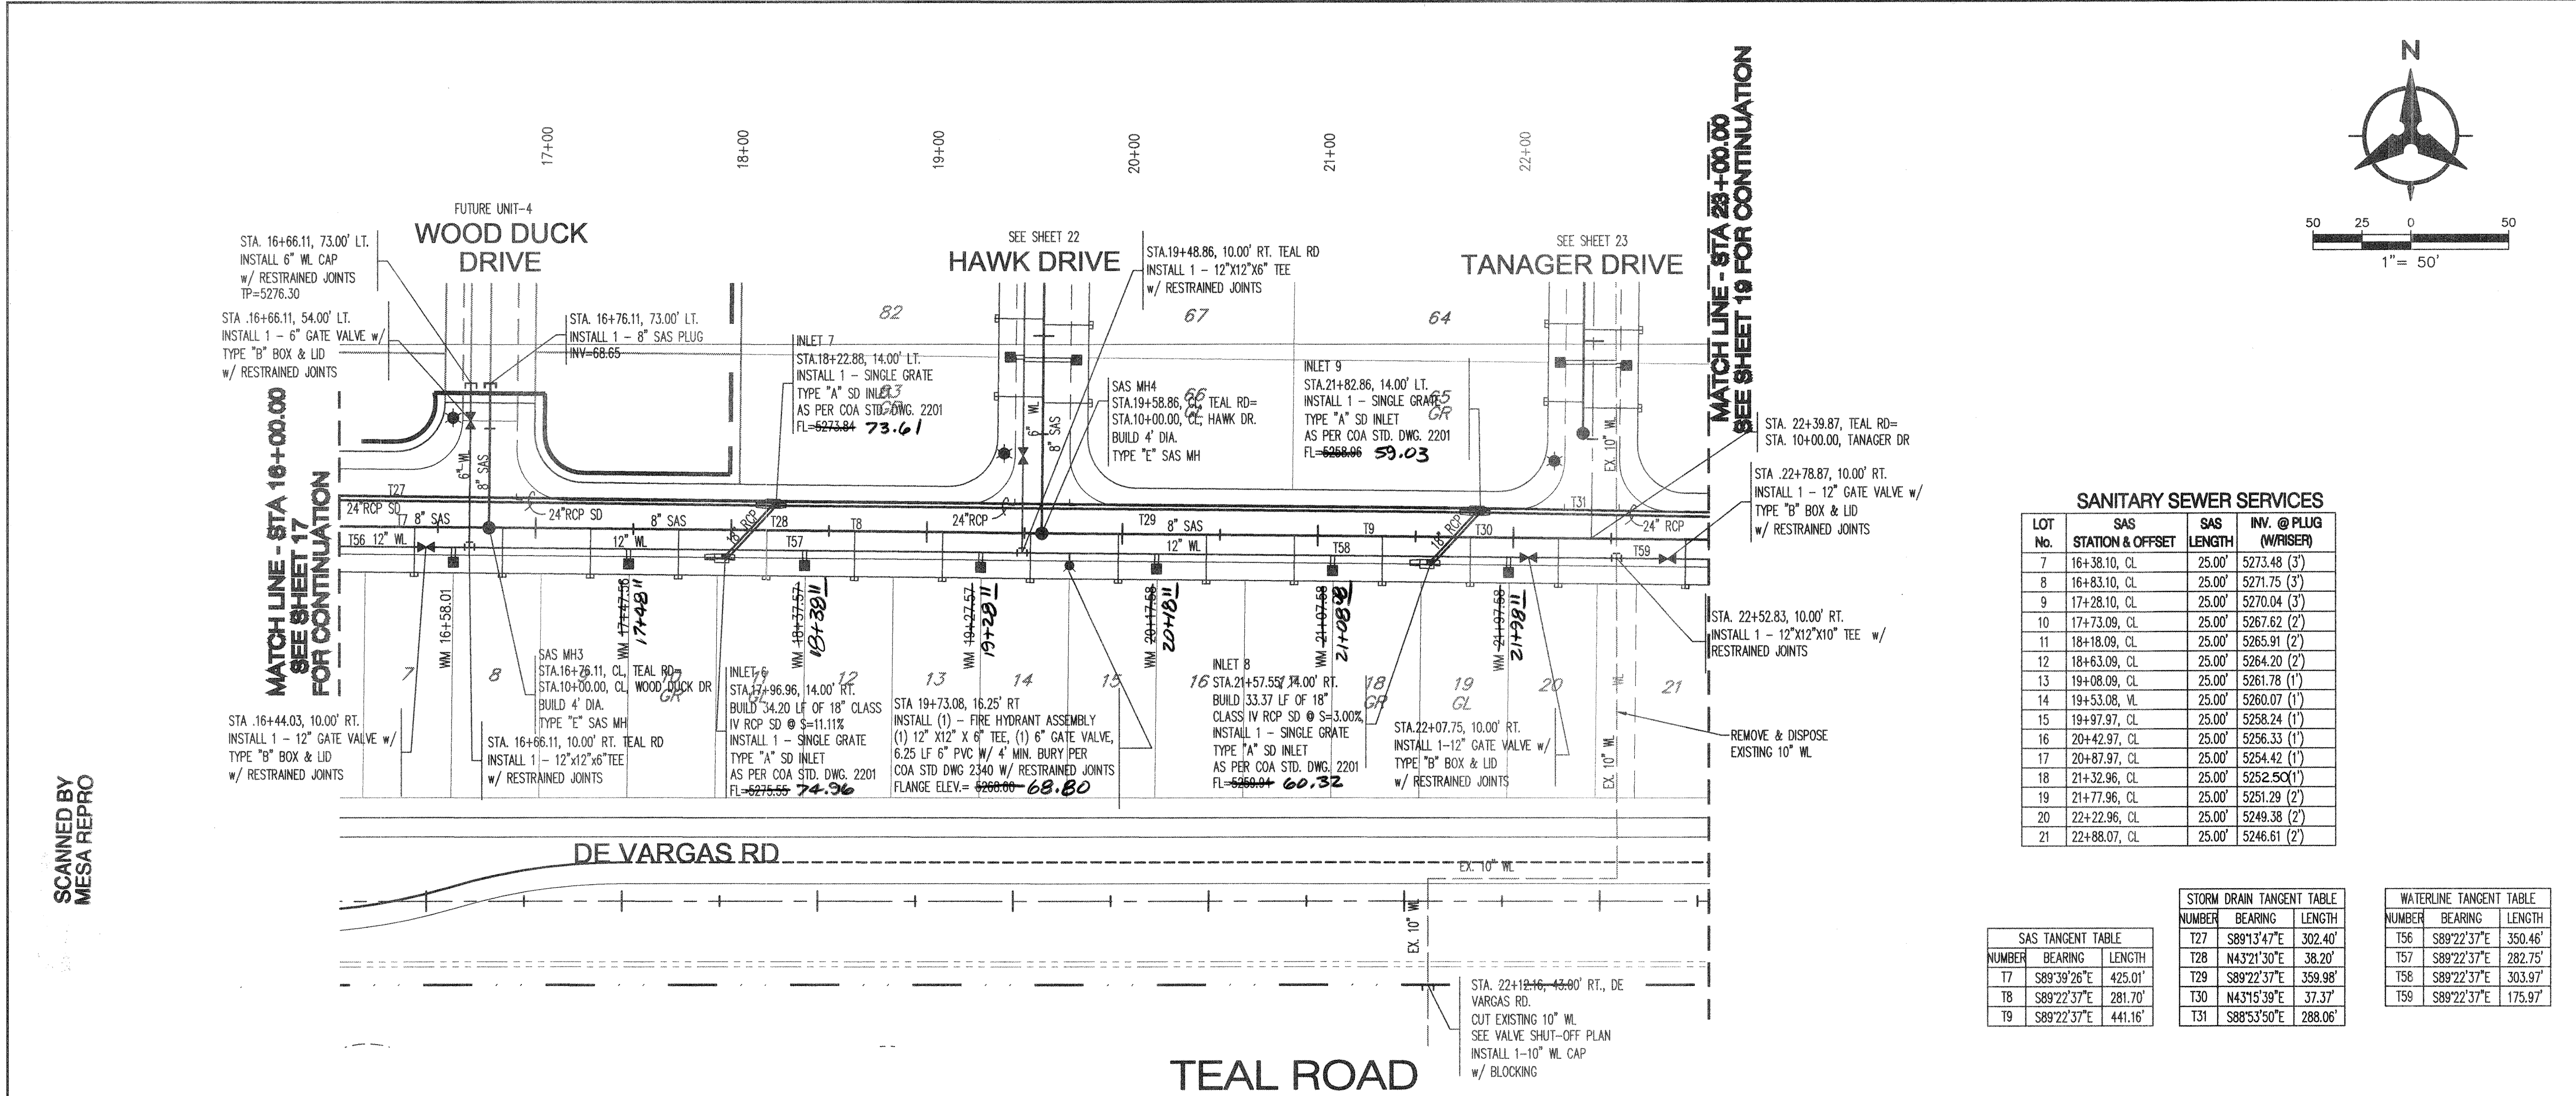

GENERAL NOTES

- THE CONTRACTOR SHALL FIELD VERIFY ALL EXISTING UTILITY LOCATIONS AND NOTIFY THE ENGINEER IMMEDIATELY OF ANY DISCREPANCIES.
- ALL CURVE DATA AND DIMENSIONS ARE CALCULATED FROM CENTERLINE OF PIPE OR MANHOLE. ALL SAS & SD SLOPES ARE CALCULATED TO TRUE PIPE DIMENSIONS FROM INVERT TO INVERT. (PAY ITEMS ARE SHOWN IN PARENTHESES)
- GRADE ELEVATIONS, WHERE NOTED, ARE FOR FLOWLINE OF STANDARD CURB UNLESS OTHERWISE SPECIFIED.
- CONTRACTOR IS TO INSTALL A 4" X 4" X 5' POST AND END AT THE END OF EACH SANITARY SEWER SERVICE.
- CONTRACTOR IS RESPONSIBLE FOR REPAIR AND/OR REPLACEMENT OF ALL UTILITY CONDUITS AND EXISTING LINES.
- CONTRACTOR SHALL PROVIDE THE INSPECTORS WITH THE PROPOSED TESTING PLAN. THE PLAN MUST BE APPROVED BEFORE TESTING OPERATIONS BEGIN.
- CONTRACTOR SHALL PARK EQUIPMENT AND VEHICLES AS NOT TO INTERFERE WITH NORMAL ACTIVITIES OF RESIDENTS OR OTHER CONTRACTORS ON SITE.
- ANY DAMAGE TO THE EXISTING FACILITIES (CURB & GUTTER, PAVEMENT, CONDUITS, LANDSCAPING, UTILITY LINES, ETC.) DURING CONSTRUCTION SHALL BE REPLACED AT THE CONTRACTORS' EXPENSE.
- MH RIMS & CATCH BASIN INLET ELEVATIONS, FIRE HYDRANT & FLANGE ELEVATIONS ARE APPROXIMATE. CONTRACTOR SHALL FIELD VERIFY AND ADJUST TO FINAL PAVEMENT GRADES.
- SAS STATIONING FOLLOWS CL OF ROAD UNLESS OTHERWISE NOTED.
- STATIONING OF DROP INLET IS TO MIDDLE OF DOWN HILL GRATE AT FACE OF CURB.
- SAS LATERALS ARE 20" INSIDE PL ON DOWNHILL SIDE OF PROPERTY UNLESS OTHERWISE SPECIFIED.
- ALL WATERLINE APPURTENANCES SHALL USE RESTRAINED JOINTS, REFER TO TABLES LISTED ON OVERALL UTILITY SHEET 16.
- TYPICAL DEPTH TO WATERLINE IS 4 FEET. MINIMUM IS 3 FEET.

LEGEND

- DOUBLE WATER METER
- SINGLE WATER METER
- WL AIR RELEASE VALVE
- WATER LINE GATE VALVE
- WATER LINE CAP
- WATER LINE REDUCER
- EXISTING WATERLINE
- WATER LINE TEE
- SAS LATERAL
- SAS MANHOLE
- STORM DRAIN MANHOLE
- STORM DRAIN INLET
- PROPOSED FIRE HYDRANT
- EXISTING WATER VALVE
- PROPOSED STREET LIGHT

AS-BUILT INFORMATION

CONTRACTOR	DATE
PLANNING	01

BENCH MARKS

NO.	DATE
ACS 1.3/4" Alum. disk stamped "ACS BM 14-M8"	01

SURVEY INFORMATION

NO.	DATE
ACS 1.3/4" Alum. disk stamped "ACS BM 14-M8"	01

ENGINEER'S SEAL

Bohannon & Huston

Countywide One 7500 JEFFERSON NE ALBUQUERQUE NEW MEXICO 87109

ENGINEERS PLANNERS PHOTOGRAMMETRISTS SURVEYORS SOFTWARE DEVELOPERS

CITY OF ALBUQUERQUE

PUBLIC WORKS DEPARTMENT

ENGINEERING DEVELOPMENT GROUP


TIMARRON WEST UNIT 3 SUBDIVISION



UTILITY PLAN & PROFILE

TEAL ROAD STA 16+00.00 - 23+00.00

Design Review Committee: FEB 13 2001
City Engineer Approval: FEB 23 2001

City Project No. 651681
Zone Map No. L8-M8
Sheet 18 of 32

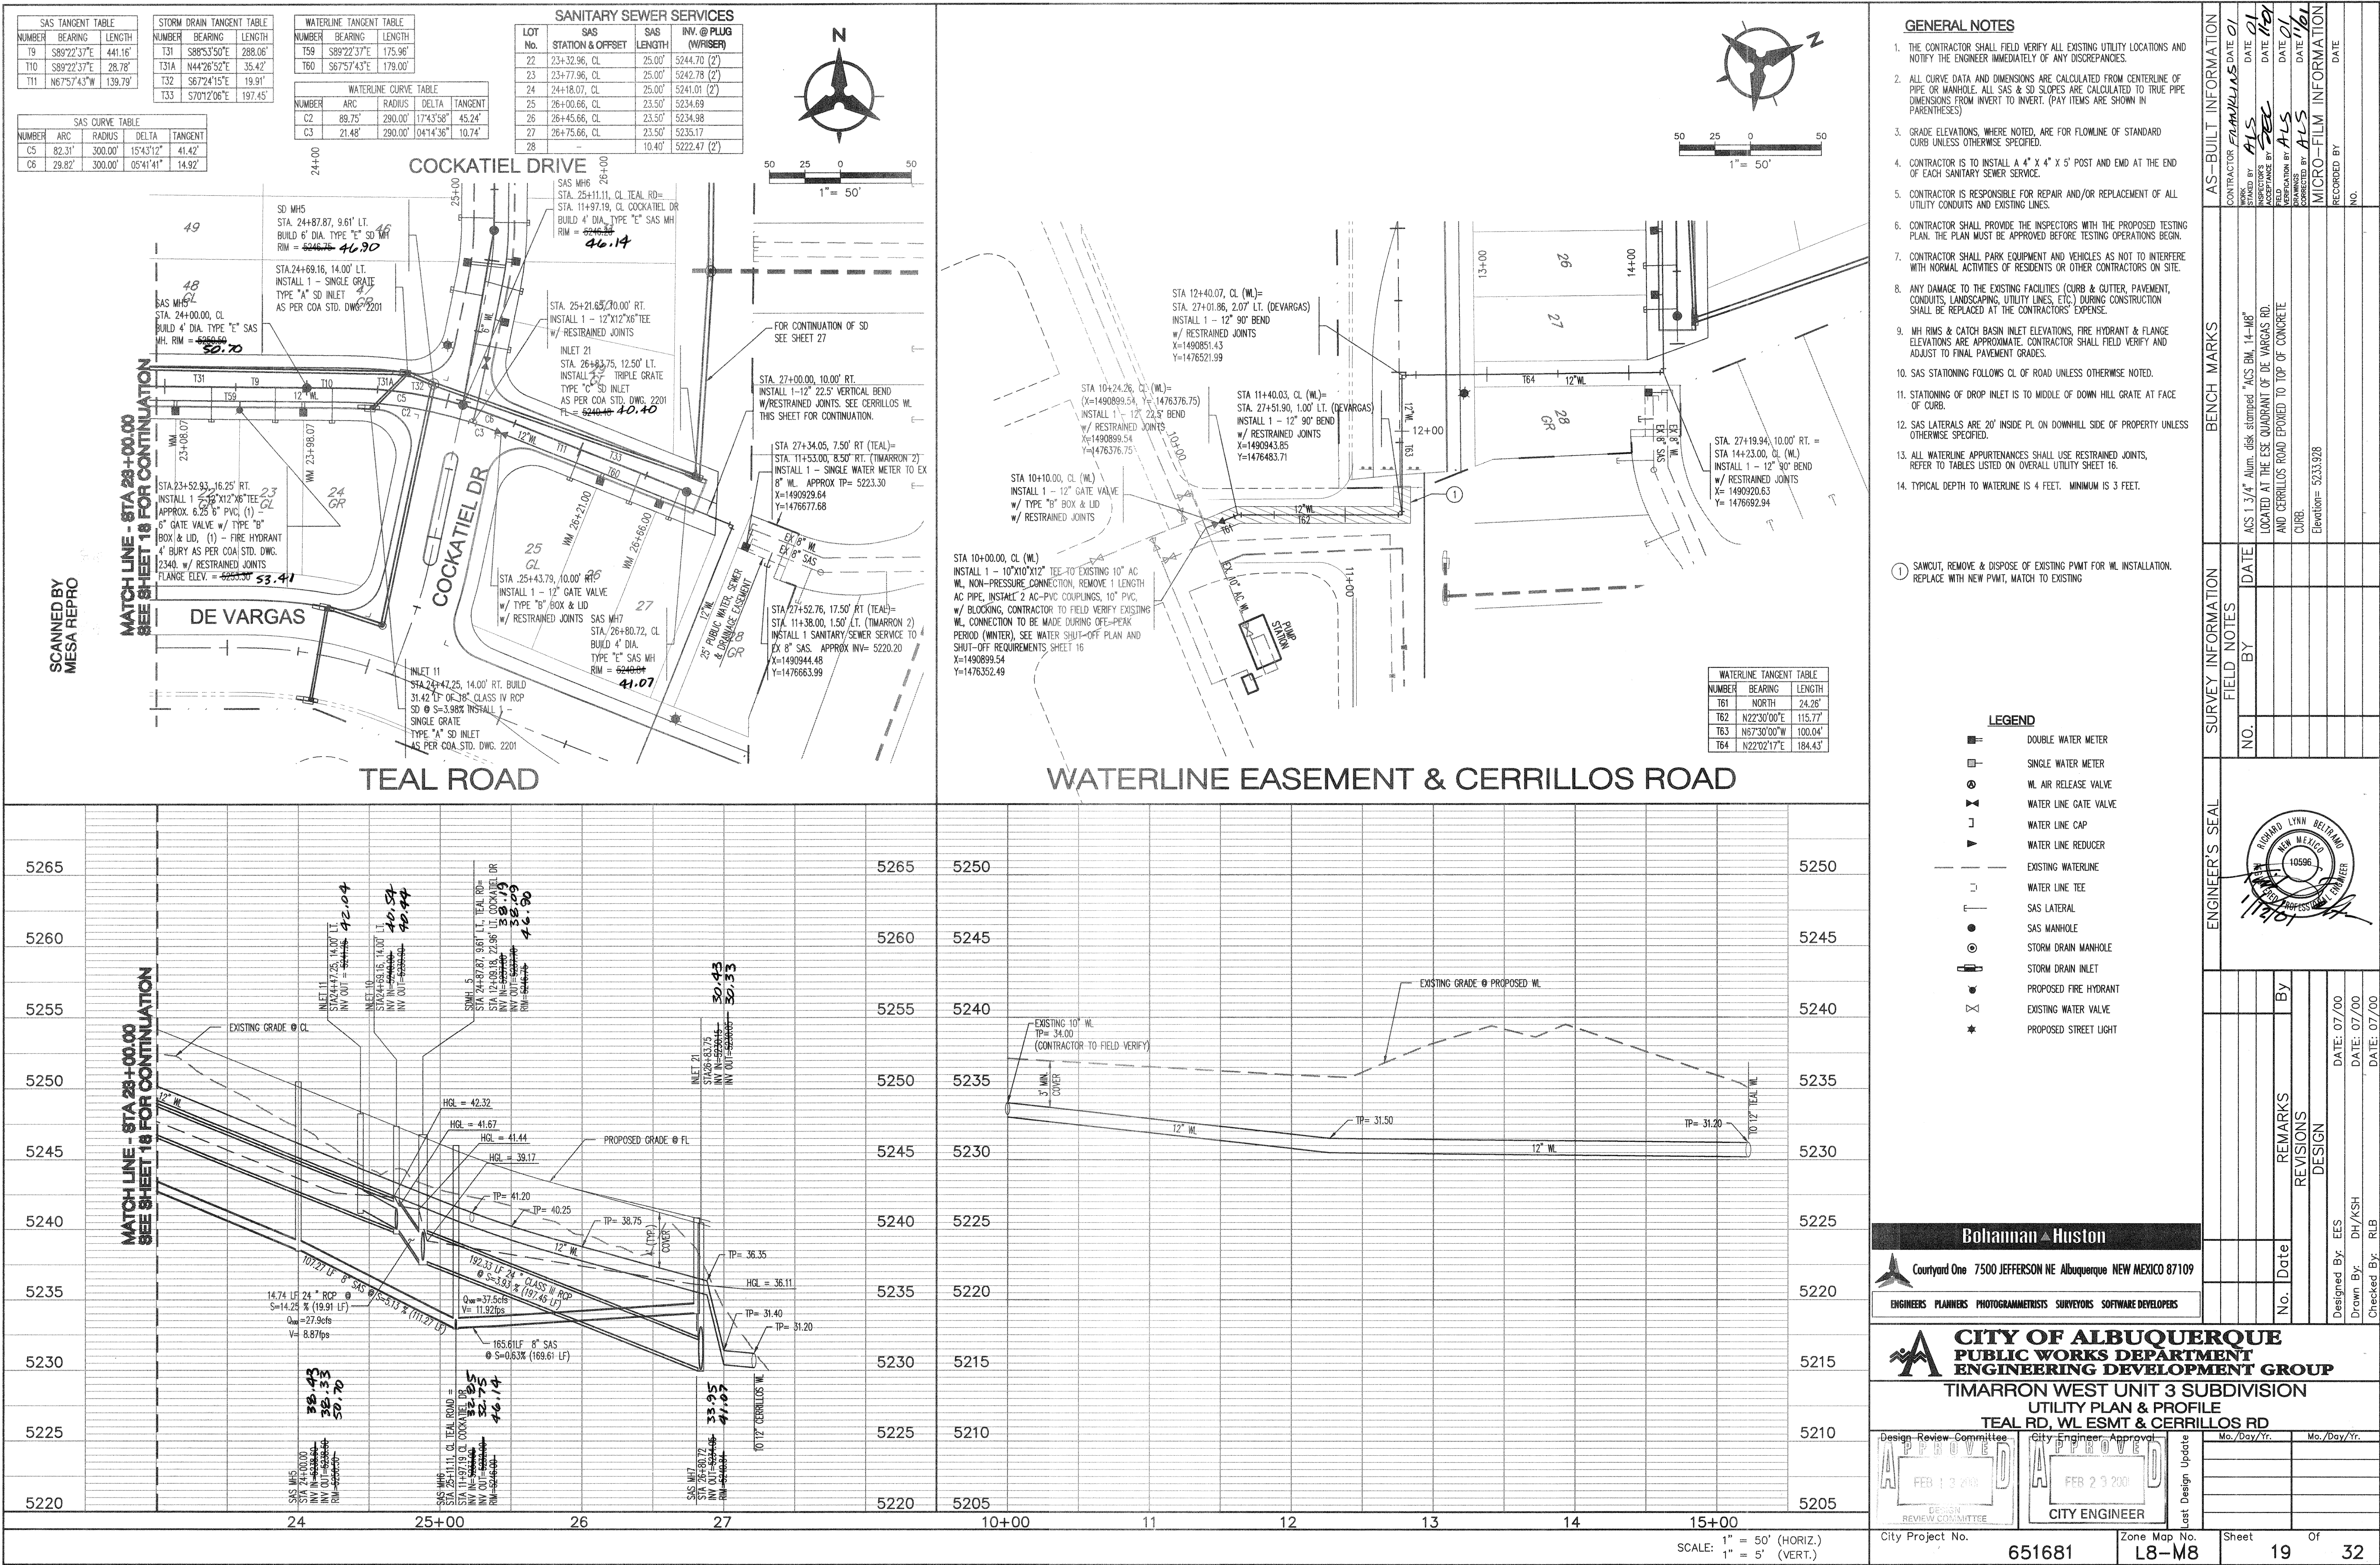

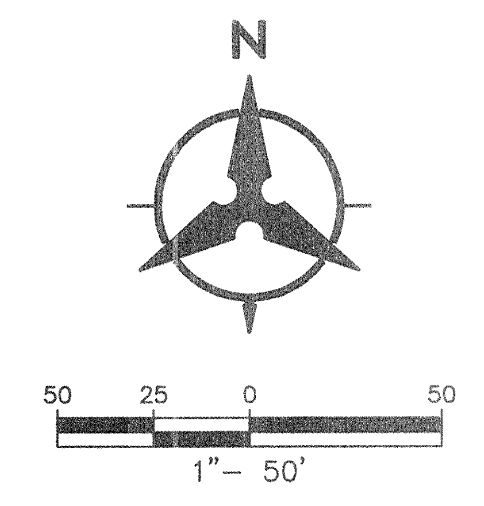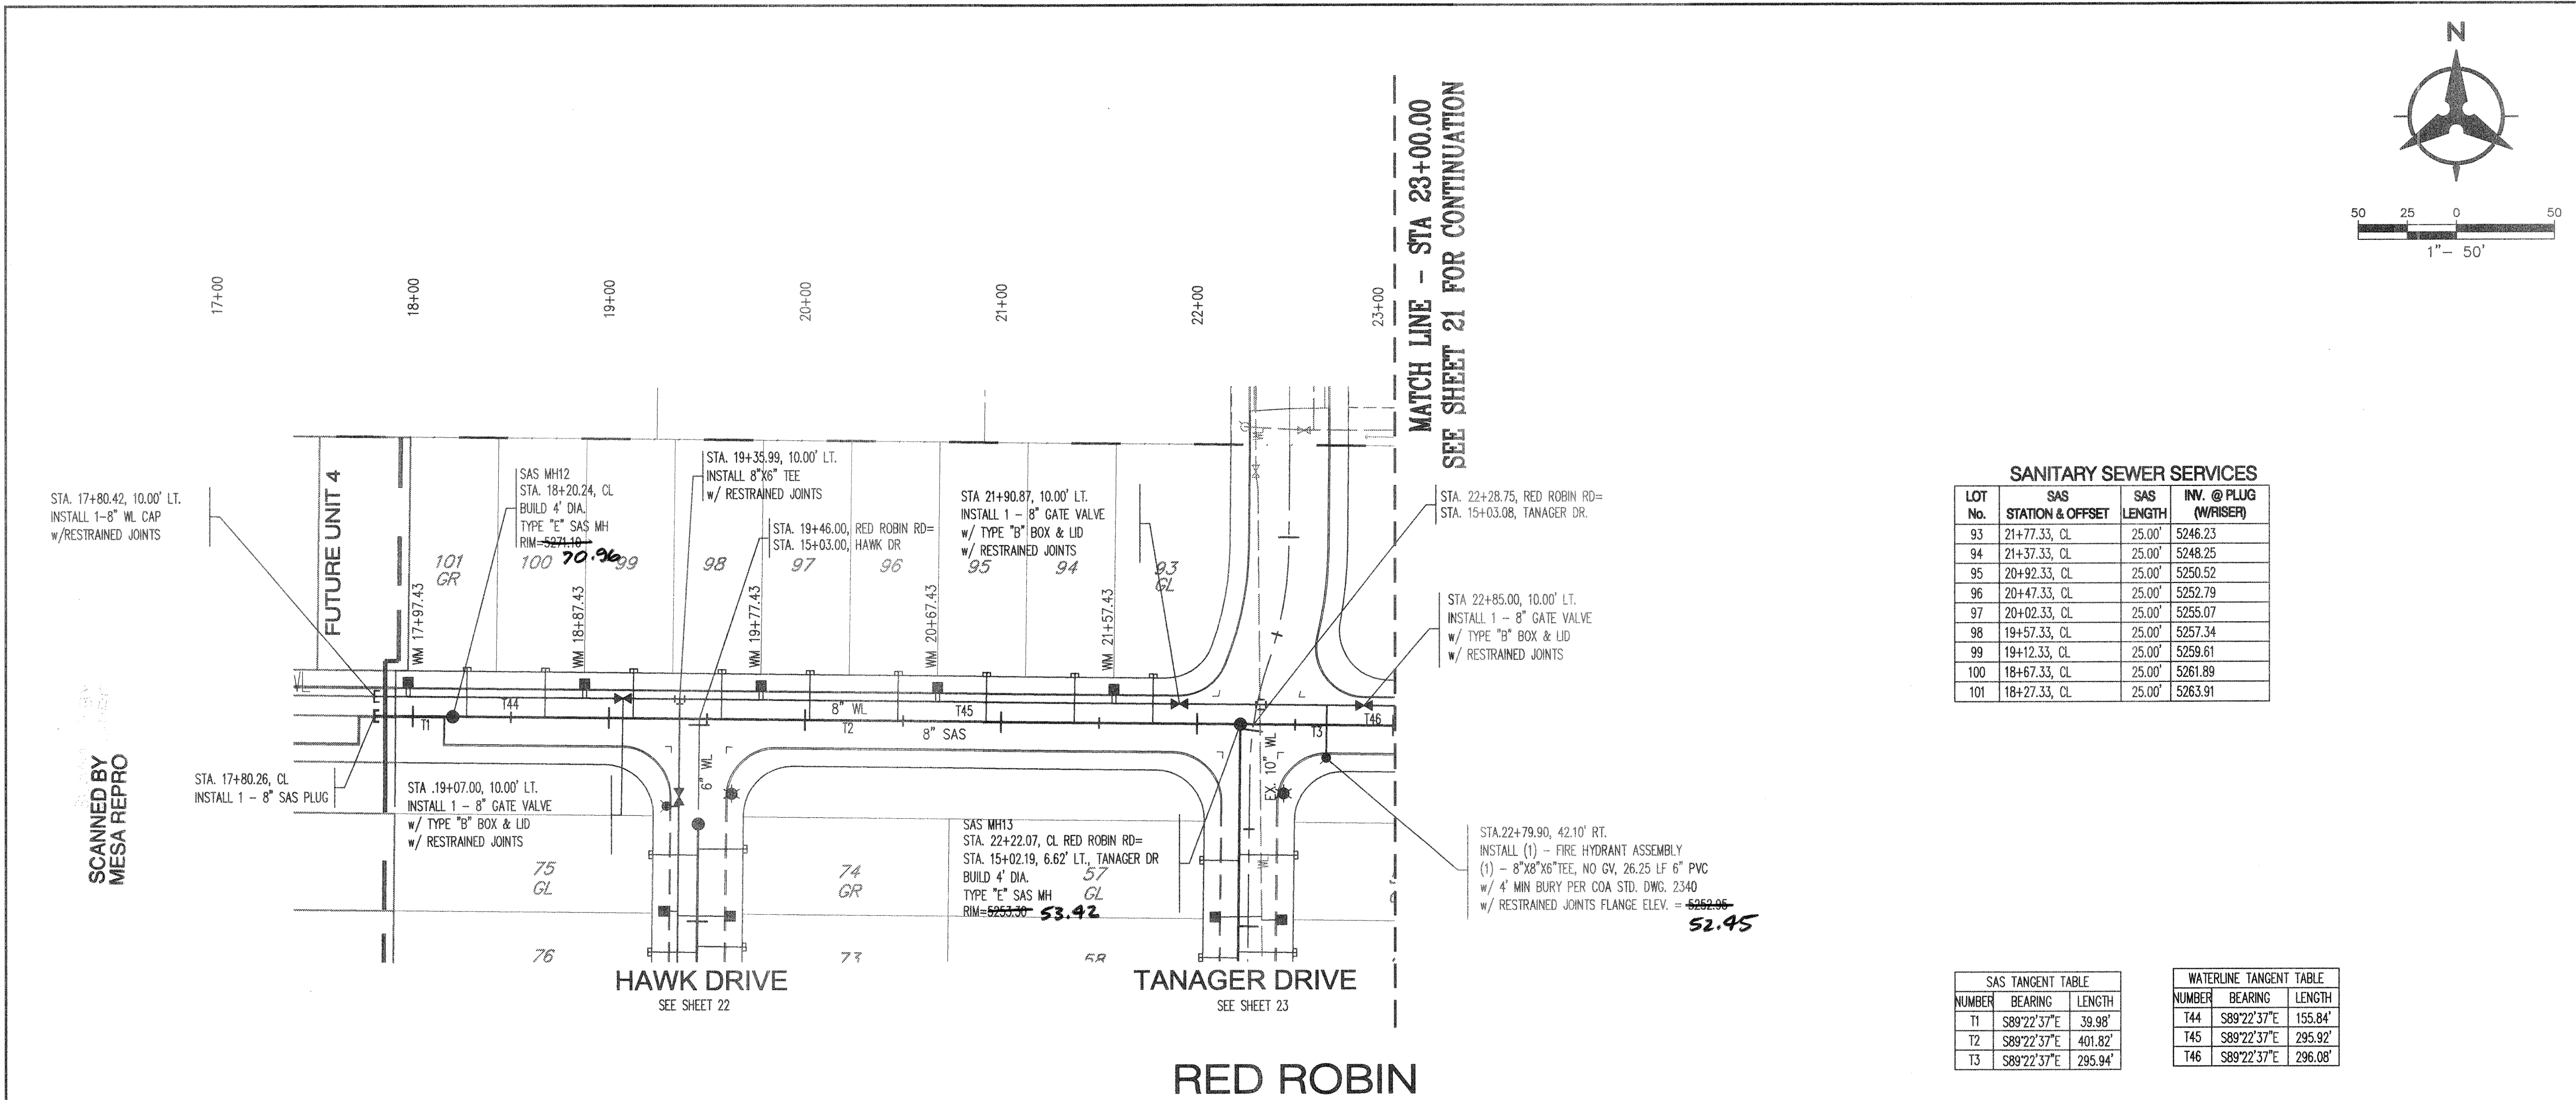


SANITARY SEWER SERVICES			
LOT No.	SAS STATION & OFFSET	SAS LENGTH	INV. @ PLUG (W/RISE)
93	21+77.33, CL	25.00'	5246.23
94	21+37.33, CL	25.00'	5248.25
95	20+92.33, CL	25.00'	5250.52
96	20+47.33, CL	25.00'	5252.79
97	20+02.33, CL	25.00'	5255.07
98	19+57.33, CL	25.00'	5257.34
99	19+12.33, CL	25.00'	5259.61
100	18+67.33, CL	25.00'	5261.89
101	18+27.33, CL	25.00'	5263.91

SAS TANGENT TABLE			WATERLINE TANGENT TABLE		
NUMBER	BEARING	LENGTH	NUMBER	BEARING	LENGTH
T1	S89°22'37"E	39.98'	T44	S89°22'37"E	155.84'
T2	S89°22'37"E	401.82'	T45	S89°22'37"E	295.92'
T3	S89°22'37"E	295.94'	T46	S89°22'37"E	296.08'

- GENERAL NOTES**
- THE CONTRACTOR SHALL FIELD VERIFY ALL EXISTING UTILITY LOCATIONS AND NOTIFY THE ENGINEER IMMEDIATELY OF ANY DISCREPANCIES.
 - ALL CURVE DATA AND DIMENSIONS ARE CALCULATED FROM CENTERLINE OF PIPE OR MANHOLE. ALL SAS & SD SLOPES ARE CALCULATED TO TRUE PIPE DIMENSIONS FROM INVERT TO INVERT. (PAY ITEMS ARE SHOWN IN PARENTHESES)
 - GRADE ELEVATIONS, WHERE NOTED, ARE FOR FLOWLINE OF STANDARD CURB UNLESS OTHERWISE SPECIFIED.
 - CONTRACTOR IS TO INSTALL A 4" X 4" X 5' POST AND END AT THE END OF EACH SANITARY SEWER SERVICE.
 - CONTRACTOR IS RESPONSIBLE FOR REPAIR AND/OR REPLACEMENT OF ALL UTILITY CONDUITS AND EXISTING LINES.
 - CONTRACTOR SHALL PROVIDE THE INSPECTORS WITH THE PROPOSED TESTING PLAN. THE PLAN MUST BE APPROVED BEFORE TESTING OPERATIONS BEGIN.
 - CONTRACTOR SHALL PARK EQUIPMENT AND VEHICLES AS NOT TO INTERFERE WITH NORMAL ACTIVITIES OF RESIDENTS OR OTHER CONTRACTORS ON SITE.
 - ANY DAMAGE TO THE EXISTING FACILITIES (CURB & GUTTER, PAVEMENT, CONDUITS, LANDSCAPING, UTILITY LINES, ETC.) DURING CONSTRUCTION SHALL BE REPLACED AT THE CONTRACTOR'S EXPENSE.
 - MH RIMS & CATCH BASIN INLET ELEVATIONS, FIRE HYDRANT & FLANGE ELEVATIONS ARE APPROXIMATE. CONTRACTOR SHALL FIELD VERIFY AND ADJUST TO FINAL PAVEMENT GRADES.
 - SAS STATIONING FOLLOWS CL OF ROAD UNLESS OTHERWISE NOTED.
 - STATIONING OF DROP INLET IS TO MIDDLE OF DOWN HILL GRATE AT FACE OF CURB.
 - SAS LATERALS ARE 20" INDI PL ON DOWNHILL SIDE OF PROPERTY UNLESS OTHERWISE SPECIFIED.
 - ALL WATERLINE APPURTENANCES SHALL USE RESTRAINED JOINTS, REFER TO TABLES LISTED ON OVERALL UTILITY SHEET 16.
 - TYPICAL DEPTH TO WATERLINE IS 4 FEET. MINIMUM IS 3 FEET.

LEGEND

- DOUBLE WATER METER
- SINGLE WATER METER
- WL AIR RELEASE VALVE
- WATER LINE GATE VALVE
- WATER LINE CAP
- WATER LINE REDUCER
- EXISTING WATERLINE
- WATER LINE TEE
- SAS LATERAL
- SAS MANHOLE
- STORM DRAIN MANHOLE
- STORM DRAIN INLET
- PROPOSED FIRE HYDRANT
- EXISTING WATER VALVE
- PROPOSED STREET LIGHT


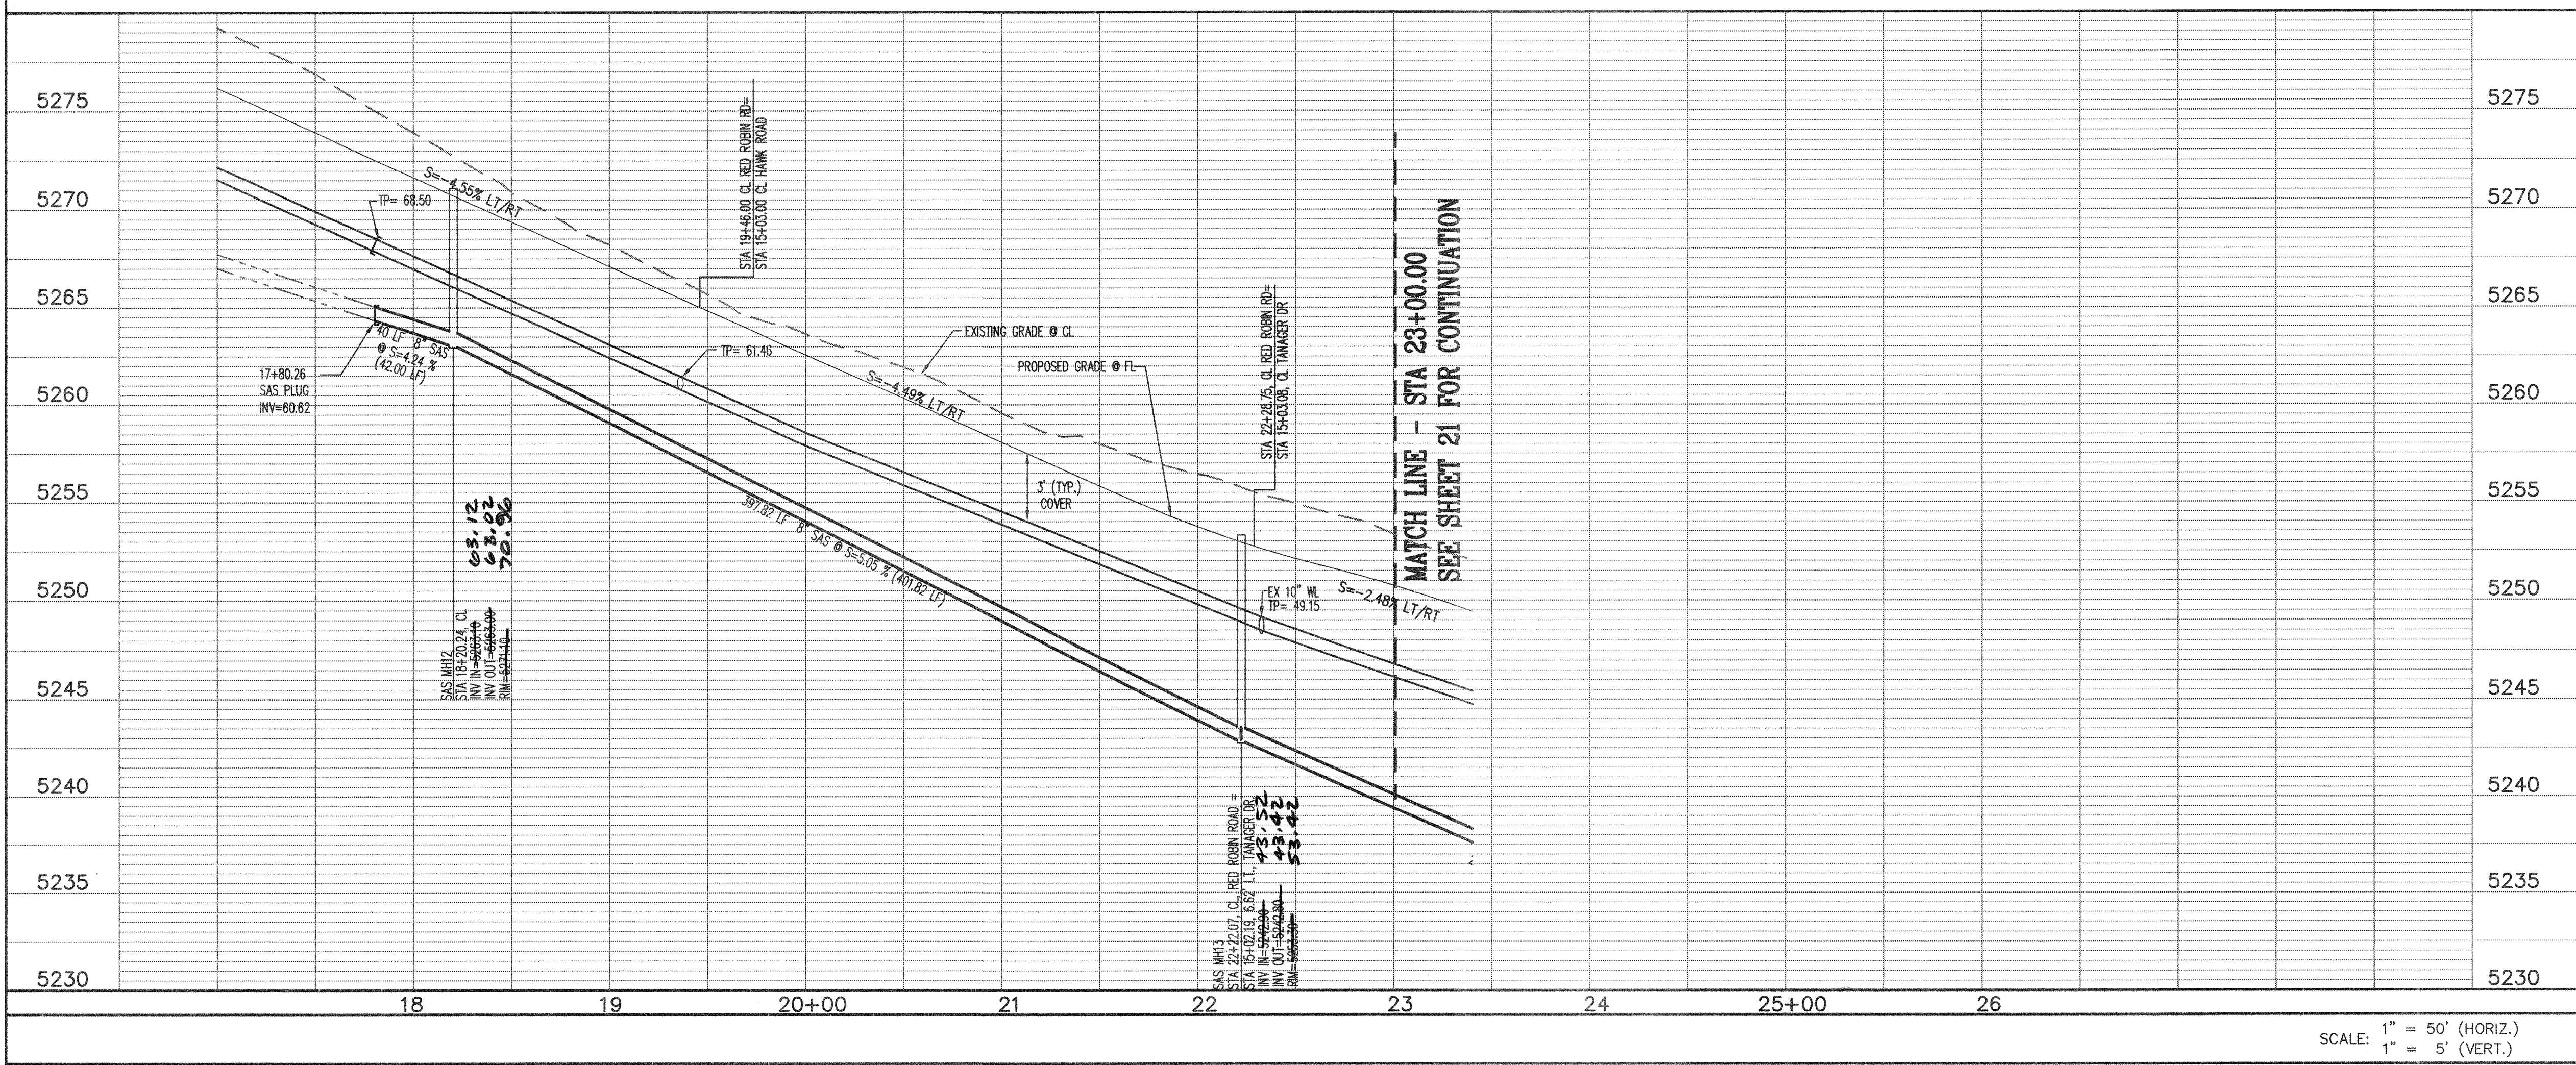


Bohannon & Huston
Court yard One 7500 JEFFERSON NE Albuquerque NEW MEXICO 87109
ENGINEERS PLANNERS PHOTOGRAMMETRISTS SURVEYORS SOFTWARE DEVELOPERS

CITY OF ALBUQUERQUE
PUBLIC WORKS DEPARTMENT
ENGINEERING DEVELOPMENT GROUP
TIMARRON WEST UNIT 3 SUBDIVISION
UTILITY PLAN & PROFILE
RED ROBIN ROAD

Design Review Committee: APPROVED FEB 13 2001
City Engineer Approval: APPROVED FEB 23 2001


City Project No. 651681
Zone Map No. L8-M8
Sheet 20 of 32

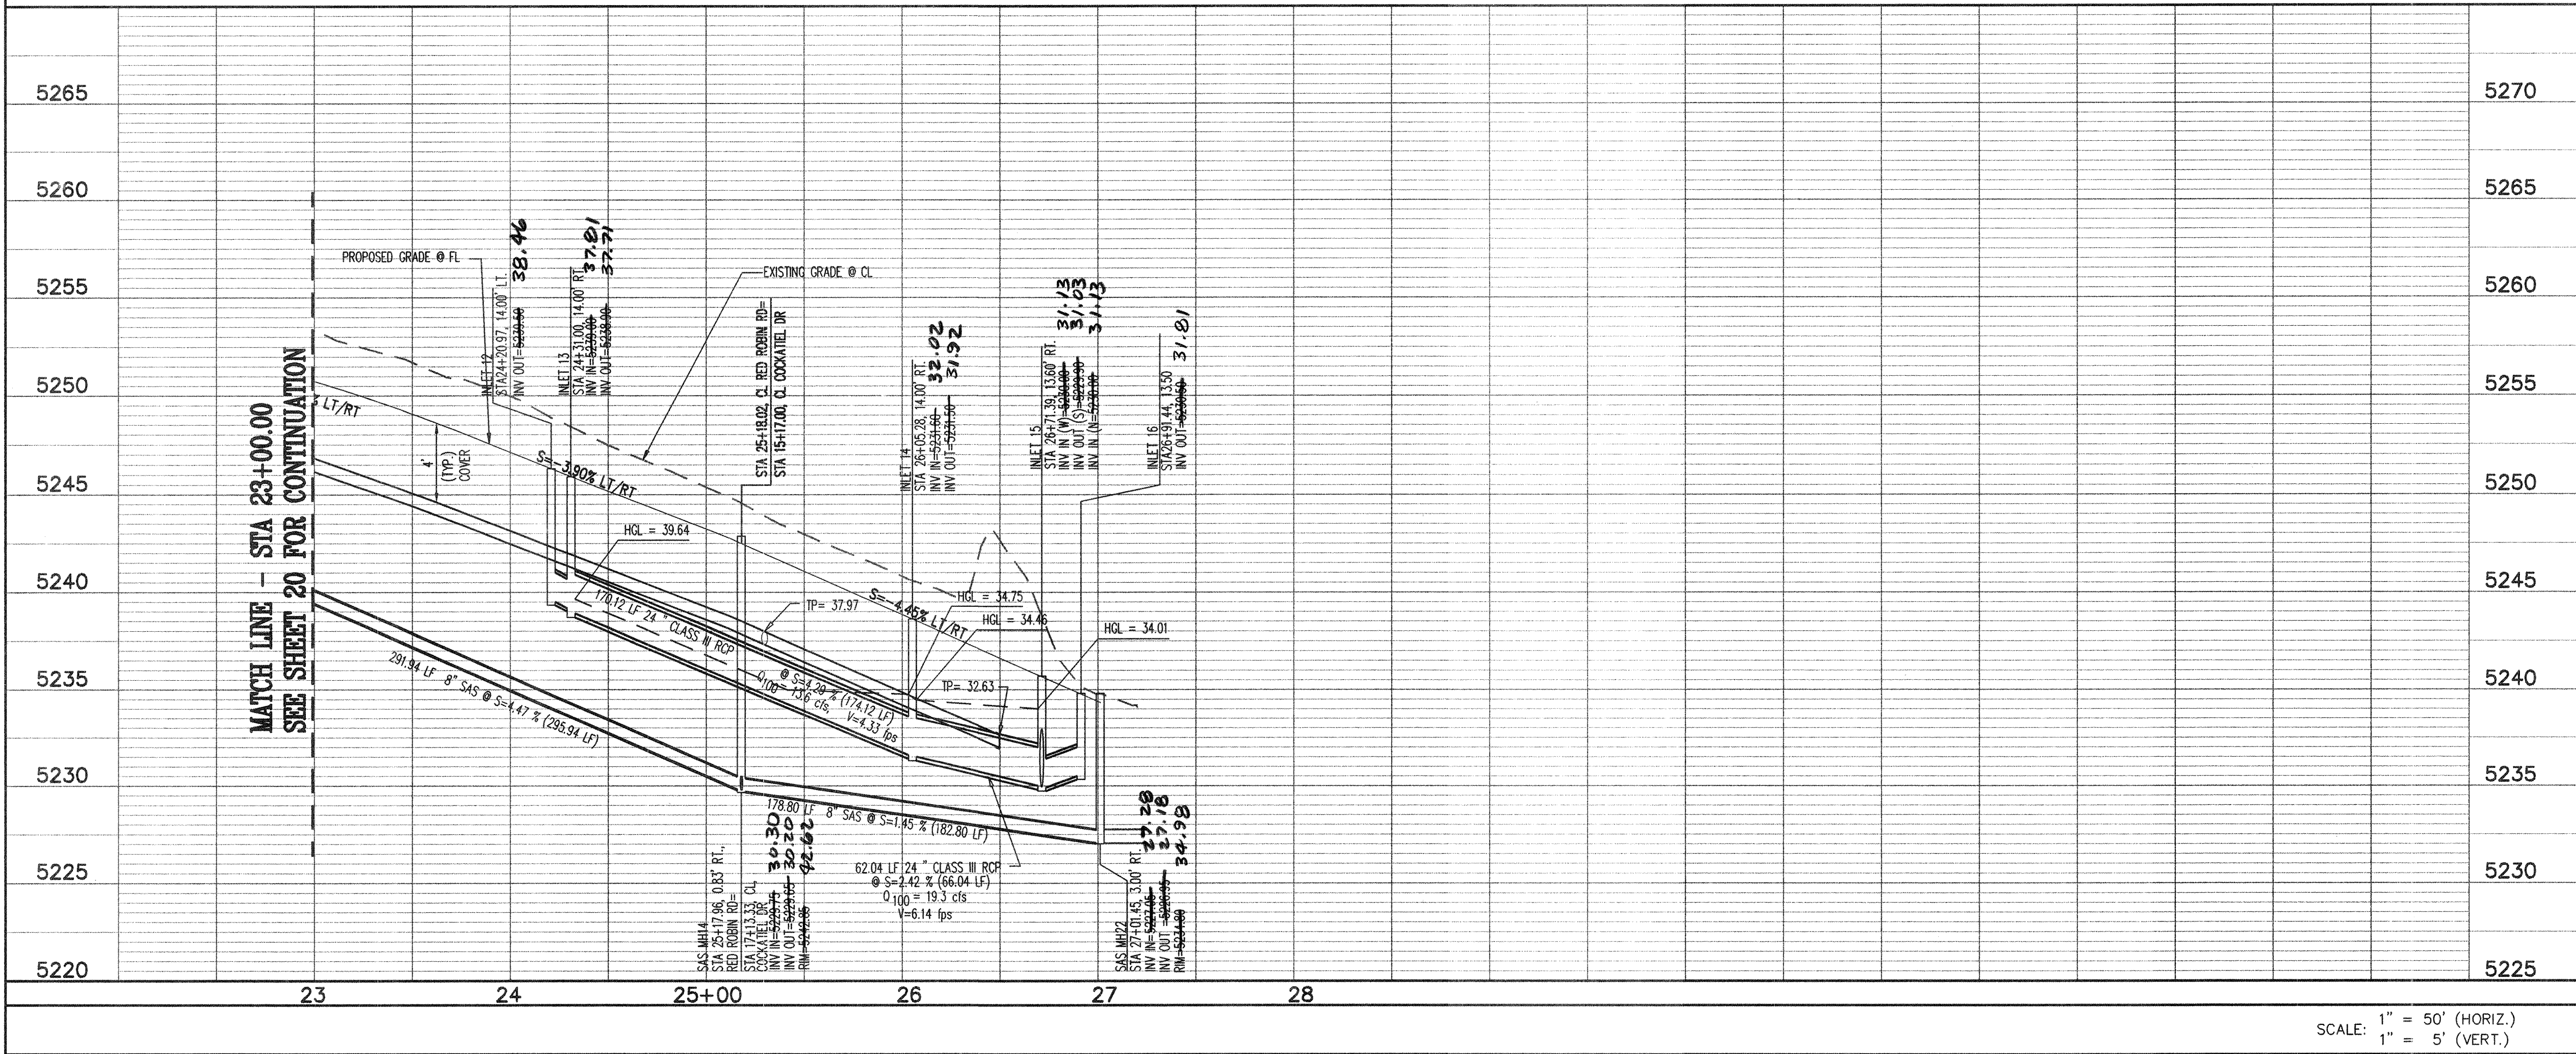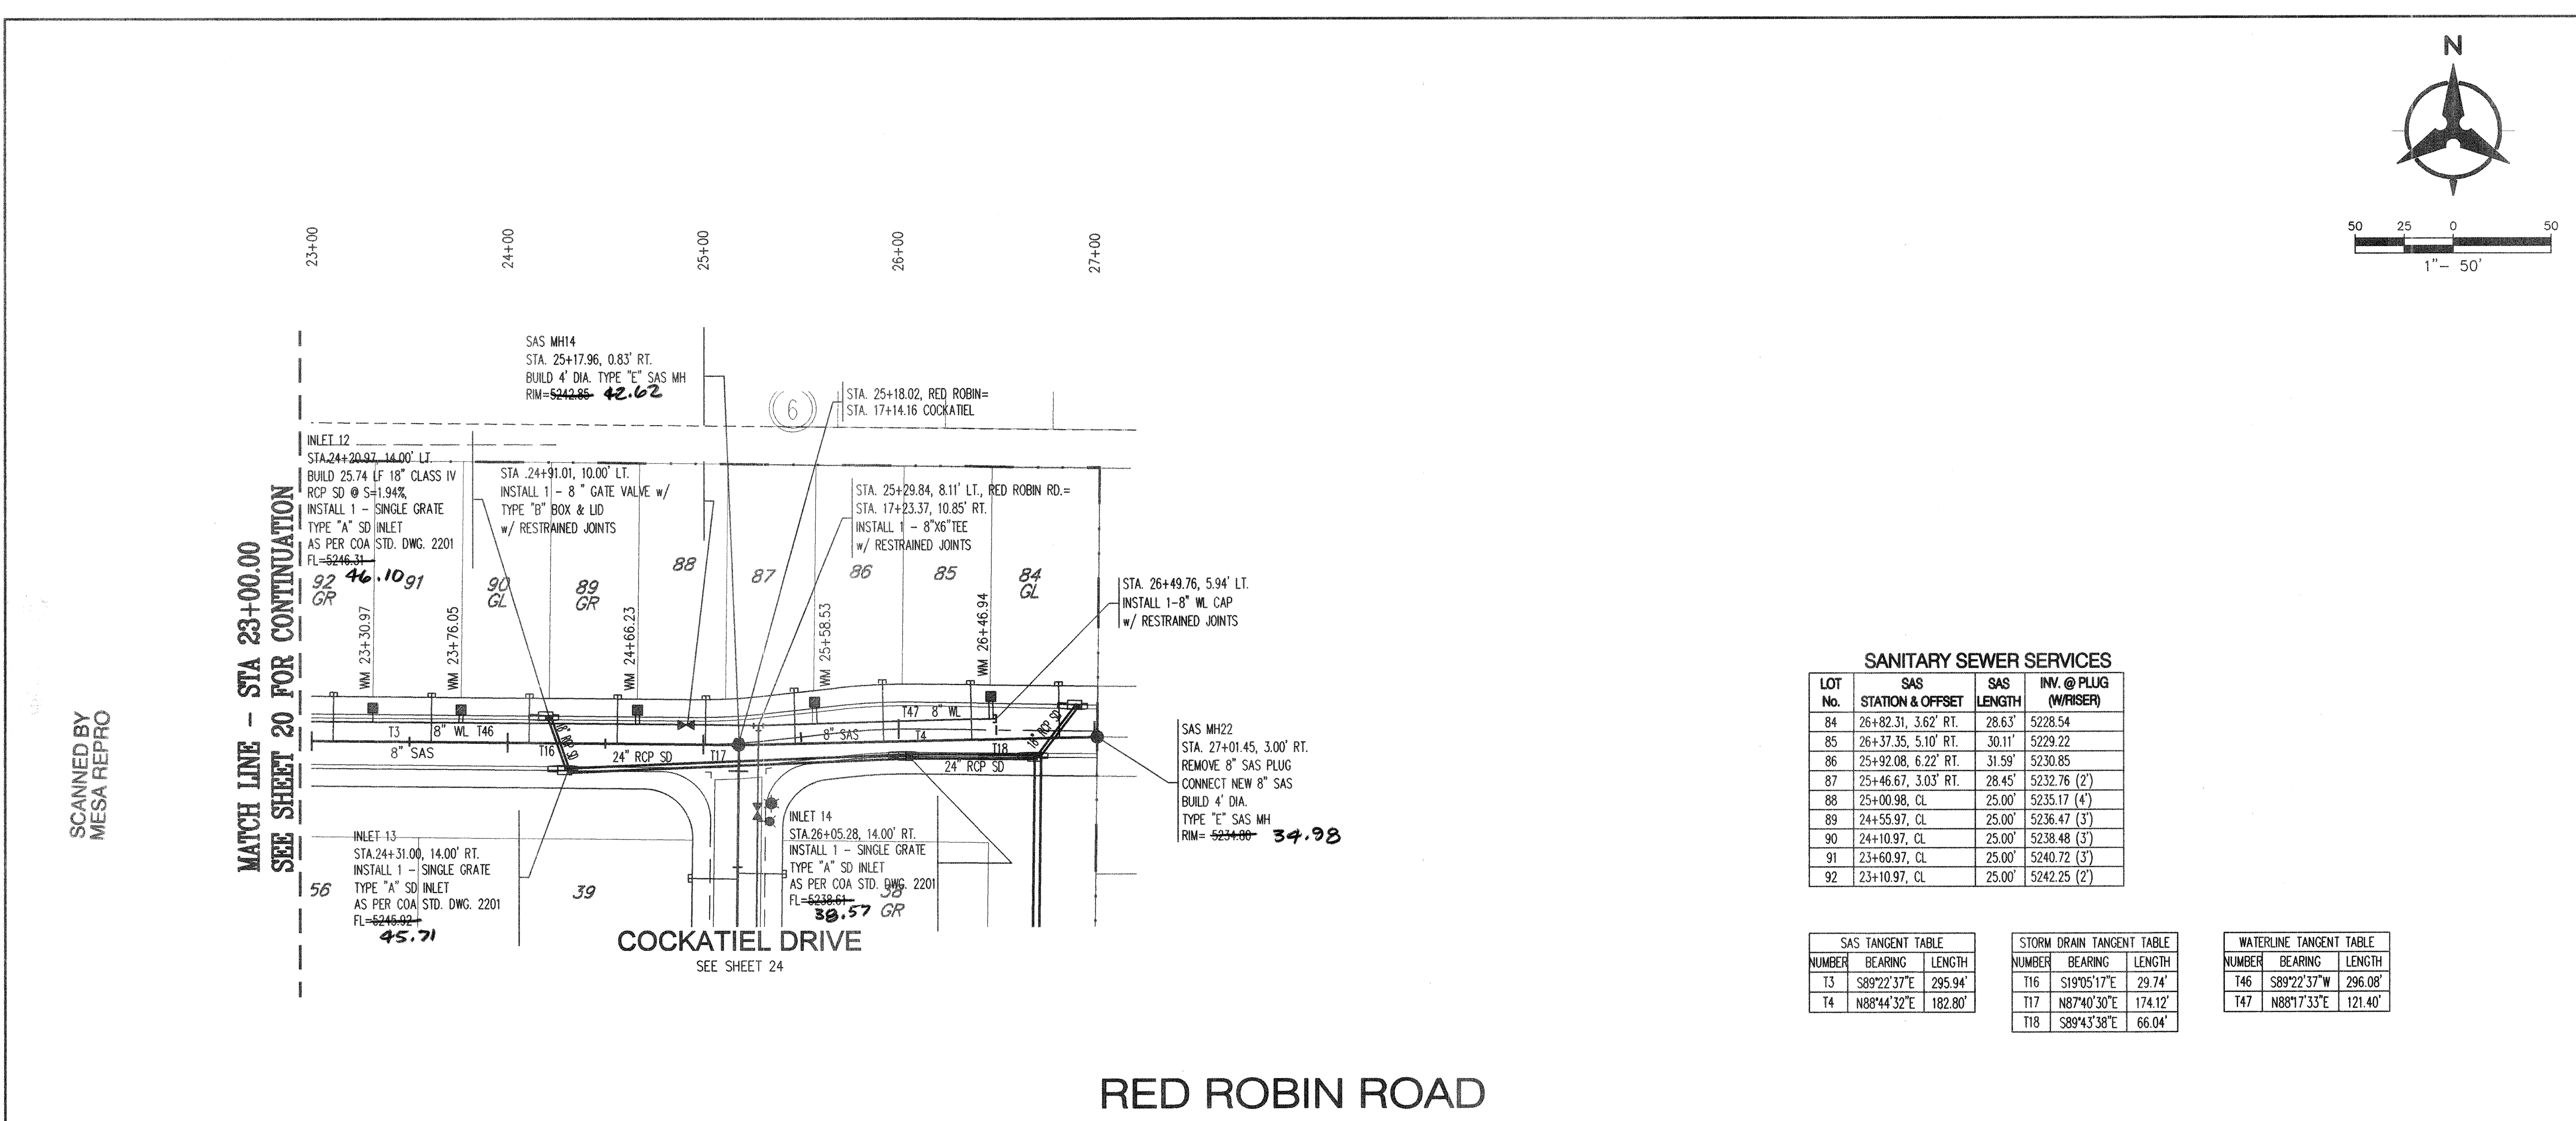

SCANNED BY
MESA REPRO


SANITARY SEWER SERVICES

LOT NO.	SAS STATION & OFFSET	SAS LENGTH	INV. @ PLUG (WHISER)
48	10+66.03, 4.94' LT.	29.94'	5248.40 (1')
49	11+05.91, 4.94' LT.	29.94'	5248.87 (2')
50	11+50.91, 4.94' LT.	29.94'	5249.30 (3')
51	11+95.91, 4.94' LT.	29.94'	5249.74 (4')
52	12+40.91, 4.94' LT.	29.94'	5250.17 (5')
53	12+96.91, 4.94' LT.	29.94'	5249.83 (5')
54	13+42.08, 4.94' LT.	29.94'	5249.56 (5')
55	13+86.91, 4.94' LT.	29.94'	5246.46 (1')
56	14+36.91, 4.94' LT.	29.94'	5246.16 (1')
57	14+33.91, 4.94' LT.	20.07'	5246.39 (2')
58	13+83.91, 4.94' LT.	20.07'	5248.11 (4')
59	13+38.08, 4.94' LT.	20.07'	5249.09 (5')
60	12+93.91, 4.94' LT.	20.07'	5249.36 (5')
61	12+43.91, 4.94' LT.	20.07'	5249.66 (5')
62	11+98.91, 4.94' LT.	20.07'	5249.93 (5')
63	11+53.91, 4.94' LT.	20.07'	5249.50 (4')
64	11+08.91, 4.94' LT.	20.07'	5249.07 (3')
65	10+69.03, 4.94' LT.	20.07'	5249.31 (3')

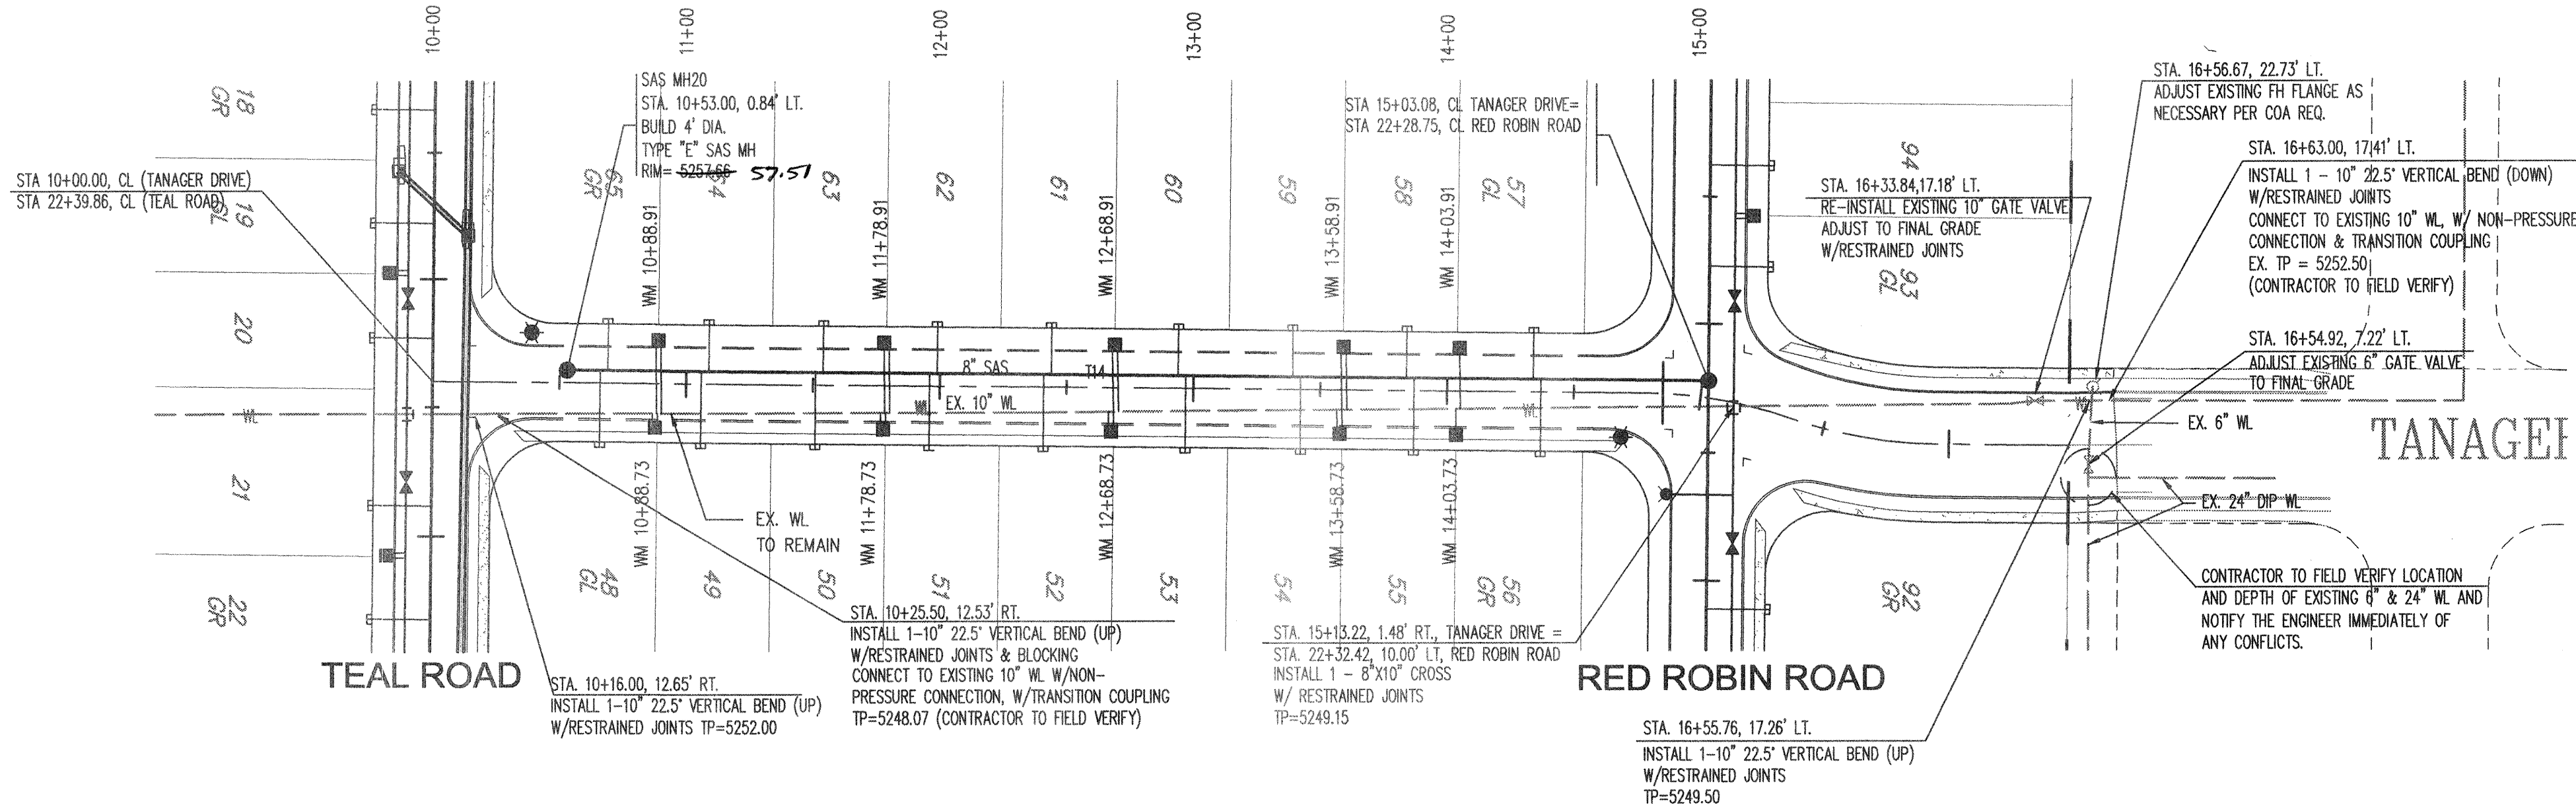

SAS TANGENT TABLE		
NUMBER	BEARING	LENGTH
T14	N 00°37'23" E	450.00'

TANAGER DRIVE

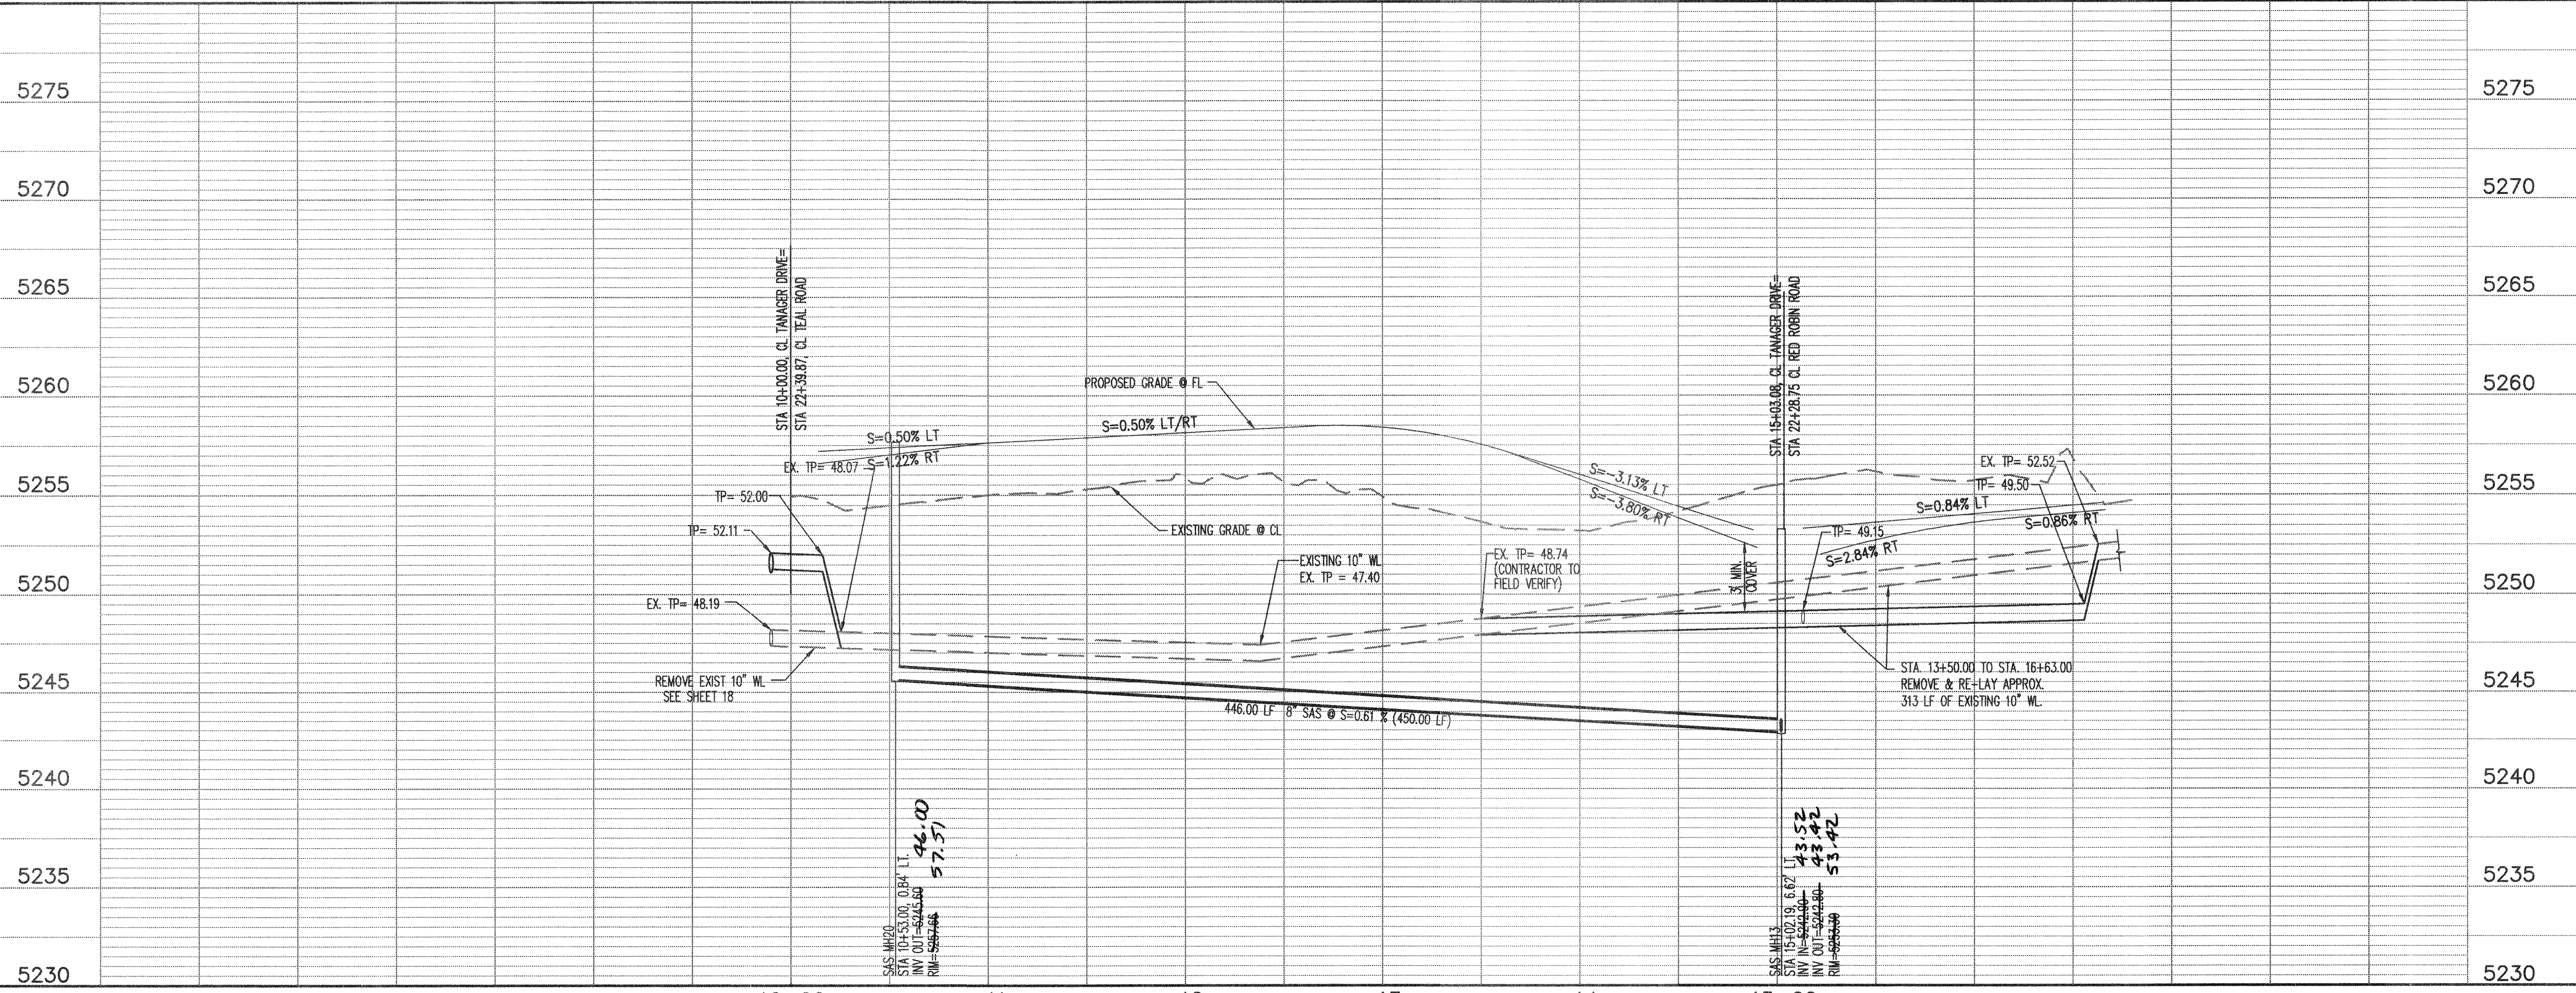

SCALE: 1" = 50' (HORIZ.)
1" = 5' (VERT.)

GENERAL NOTES

- THE CONTRACTOR SHALL FIELD VERIFY ALL EXISTING UTILITY LOCATIONS AND NOTIFY THE ENGINEER IMMEDIATELY OF ANY DISCREPANCIES.
- ALL CURVE DATA AND DIMENSIONS ARE CALCULATED FROM CENTERLINE OF PIPE OR MANHOLE. ALL SAS & SD SLOPES ARE CALCULATED TO TRUE PIPE DIMENSIONS FROM INVERT TO INVERT. (PAY ITEMS ARE SHOWN IN PARENTHESES)
- GRADE ELEVATIONS, WHERE NOTED, ARE FOR FLOWLINE OF STANDARD CURB UNLESS OTHERWISE SPECIFIED.
- CONTRACTOR IS TO INSTALL A 4" X 4" X 5' POST AND EMD AT THE END OF EACH SANITARY SEWER SERVICE.
- CONTRACTOR IS RESPONSIBLE FOR REPAIR AND/OR REPLACEMENT OF ALL UTILITY CONDUITS AND EXISTING LINES.
- CONTRACTOR SHALL PROVIDE THE INSPECTORS WITH THE PROPOSED TESTING PLAN. THE PLAN MUST BE APPROVED BEFORE TESTING OPERATIONS BEGIN.
- CONTRACTOR SHALL PARK EQUIPMENT AND VEHICLES AS NOT TO INTERFERE WITH NORMAL ACTIVITIES OF RESIDENTS OR OTHER CONTRACTORS ON SITE.
- ANY DAMAGE TO THE EXISTING FACILITIES (CURB & GUTTER, PAVEMENT, CONDUITS, LANDSCAPING, UTILITY LINES, ETC.) DURING CONSTRUCTION SHALL BE REPLACED AT THE CONTRACTORS' EXPENSE.
- WH RIMS & CATCH BASIN INLET ELEVATIONS, FIRE HYDRANT & FLANGE ELEVATIONS ARE APPROXIMATE. CONTRACTOR SHALL FIELD VERIFY AND ADJUST TO FINAL PAVEMENT GRADES.
- SAS STATIONING FOLLOWS CL OF ROAD UNLESS OTHERWISE NOTED.
- STATIONING OF DROP INLET IS TO MIDDLE OF DOWN HILL GRATE AT FACE OF CURB.
- SAS LATERALS ARE 20' INSIDE PL ON DOWNHILL SIDE OF PROPERTY UNLESS OTHERWISE SPECIFIED.
- ALL WATERLINE APPURTENANCES SHALL USE RESTRAINED JOINTS, REFER TO TABLES LISTED ON OVERALL UTILITY SHEET 16.
- TYPICAL DEPTH TO WATERLINE IS 4 FEET. MINIMUM IS 3 FEET.

LEGEND

- DOUBLE WATER METER
- SINGLE WATER METER
- WL AIR RELEASE VALVE
- WATER LINE GATE VALVE
- WATER LINE CAP
- WATER LINE REDUCER
- EXISTING WATERLINE
- WATER LINE TEE
- SAS LATERAL
- SAS MANHOLE
- STORM DRAIN MANHOLE
- PROPOSED FIRE HYDRANT
- EXISTING WATER VALVE
- PROPOSED STREET LIGHT

AS-BUILT INFORMATION		BENCH MARKS		SURVEY INFORMATION		ENGINEER'S SEAL	
CONTRACTOR	DATE	NO.	BY	NO.	BY	REMARKS	
FLANKLINS	01					DESIGN	
WORKS BY	DATE					REVISIONS	
INSPECTOR'S	DATE					DESIGN	
APPROVED BY	DATE					DESIGN	
REVISIONS	DATE					DESIGN	
BY	DATE					DESIGN	
RECORDED BY	DATE					DESIGN	
NO.						DESIGN	
MICRO-FILM INFORMATION		ELEVATION		DATE		DATE	
		5233.928					



Bohannon & Huston

Courtyard One 7500 JEFFERSON NE Albuquerque NEW MEXICO 87109


ENGINEERS PLANNERS PHOTOGRAMMETRISTS SURVEYORS SOFTWARE DEVELOPERS

CITY OF ALBUQUERQUE
PUBLIC WORKS DEPARTMENT
ENGINEERING DEVELOPMENT GROUP

TIMARRON WEST UNIT 3 SUBDIVISION
UTILITY PLAN & PROFILE
TANAGER DRIVE

Design Review Committee	City Engineer Approval	Mo./Day/Yr.	Mo./Day/Yr.
APPROVED	APPROVED		
FEB 13 2008	FEB 23 2008		
DESIGN REVIEW COMMITTEE	CITY ENGINEER		
Design Update			


City Project No. 651681 Zone Map No. L8-M8 Sheet 23 Of 32

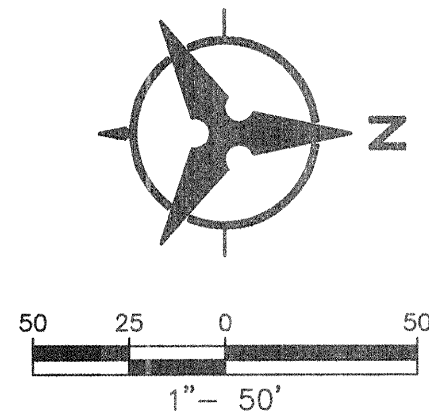

* VERTICAL RISER REQUIRED





WATERLINE CURVE TABLE				
NUMBER	LENGTH	RADIUS	DELTA	TANGENT
C1	19.58'	300.00'	03°44'21"	9.79'
C2	37.32'	190.00'	11°15'10"	18.72'

	DOUBLE WATER METER
	SINGLE WATER METER
	W/L AIR RELEASE VALVE
	WATER LINE GATE VALVE
	WATER LINE CAP
	WATER LINE REDUCER
	EXISTING WATERLINE
	WATER LINE TEE
	SAS LATERAL
	SAS MANHOLE
	STORM DRAIN MANHOLE
	STORM DRAIN INLET
	PROPOSED FIRE HYDRANT
	EXISTING WATER VALVE
	PROPOSED STREET LIGHT

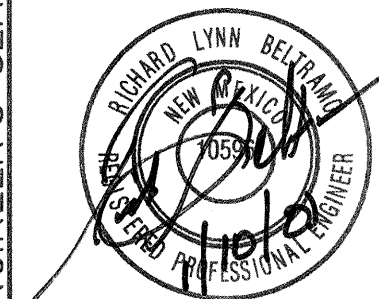

No.	Date	REMARKS	By
REVISIONS			
DESIGN			
Designed By:		DATE:	
Drawn By:		DATE:	
Checked By:		DATE:	

Sheet	Of
-------	----

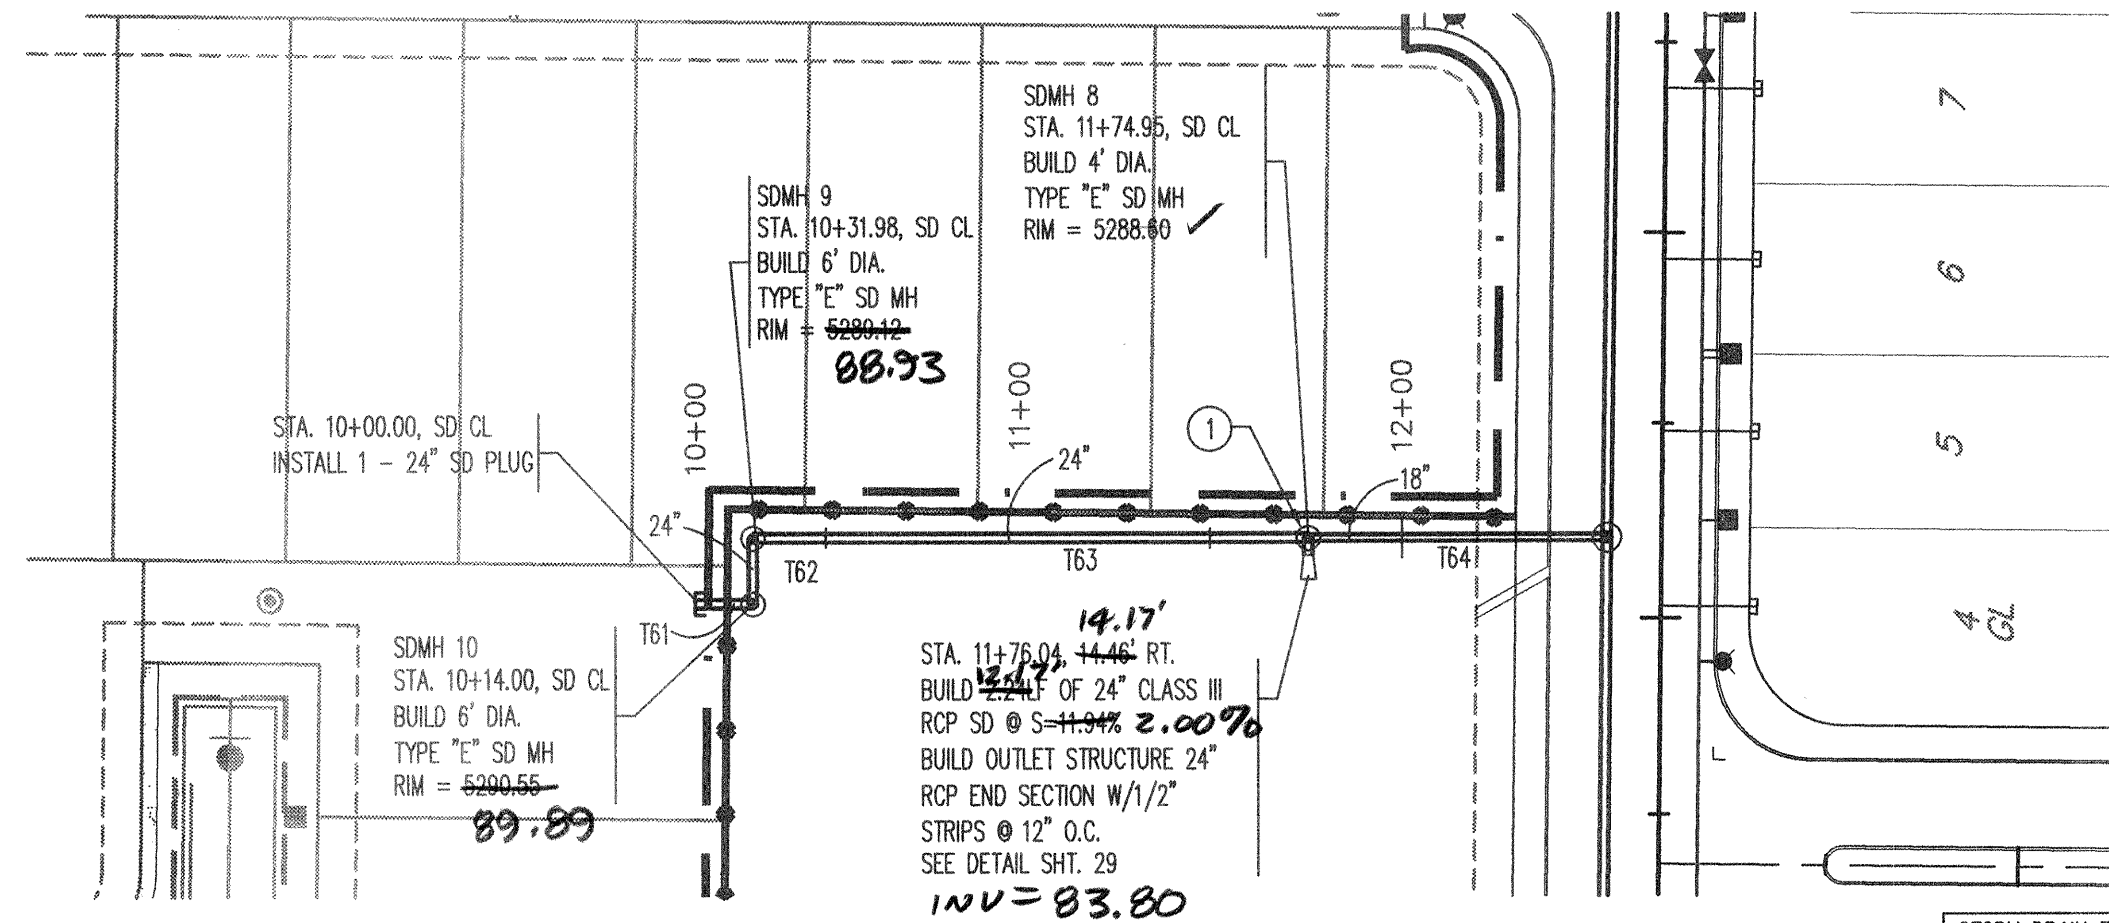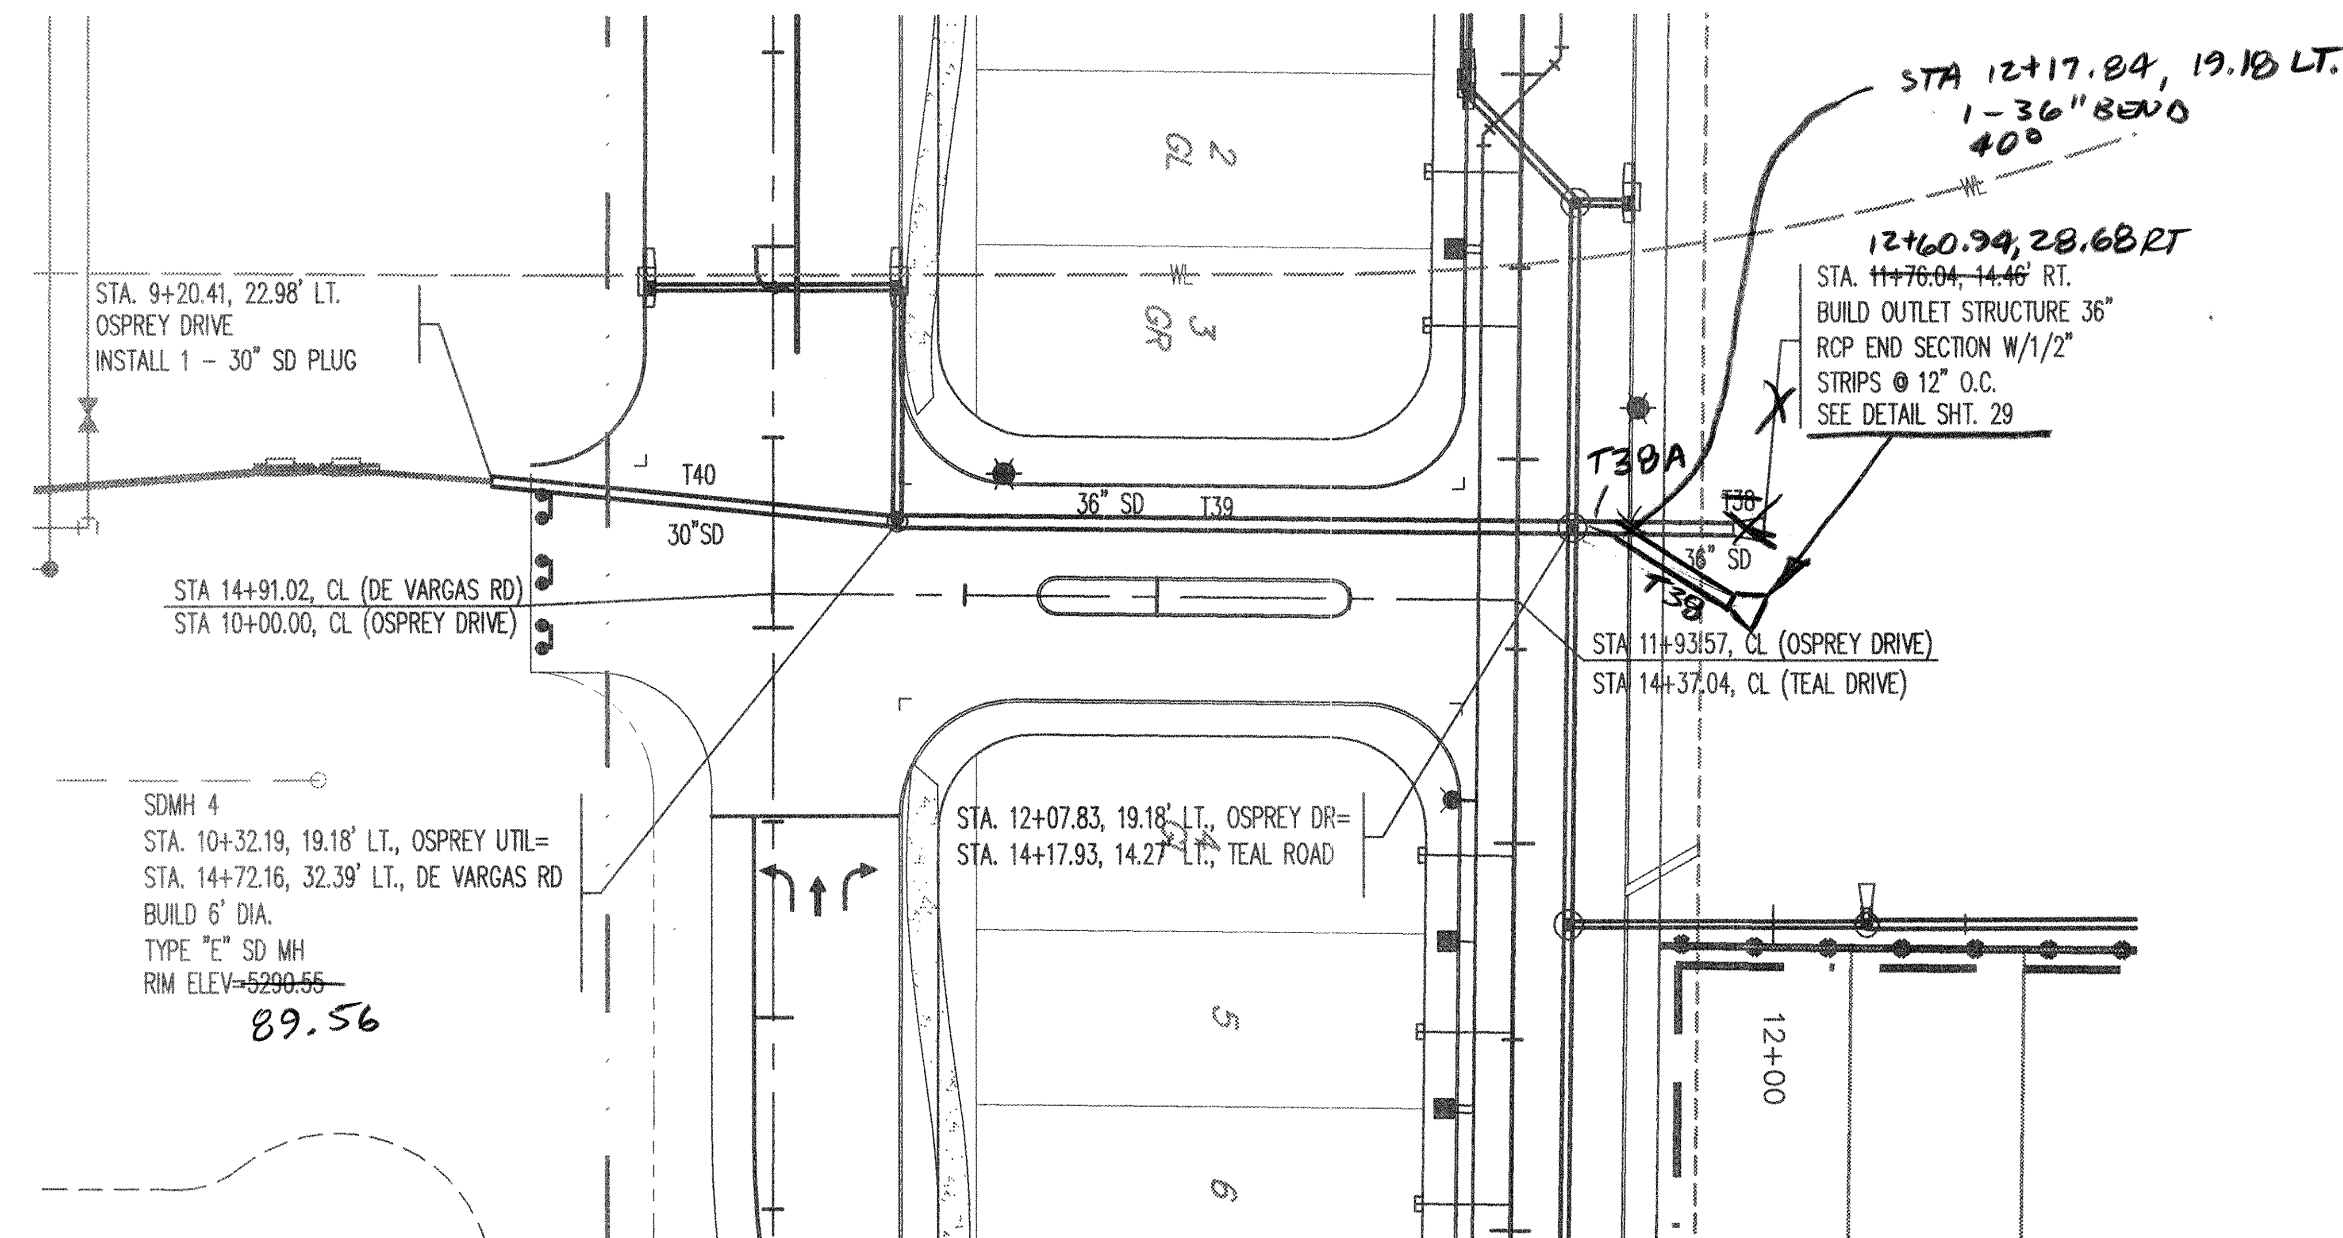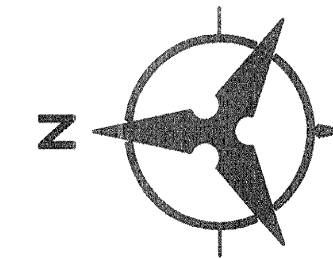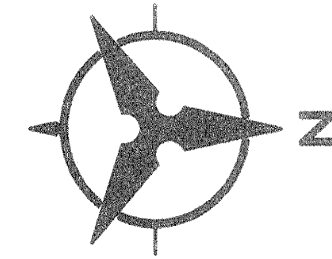


STORM DRAIN TANGENT TABLE		
NUMBER	BEARING	LENGTH
T61	S0°0'0"W	15.00'
T62	N90°0'0"E	16.70'
T63	S0°0'0"E	144.51'
T64	S0°0'0"W	77.73'

STORM DRAIN TANGENT TABLE		
NUMBER	BEARING	LENGTH
T38	N0°37'23"E	41.85'
T39	N0°37'23"E	175.64'
T40	N5°16'E	105.93'

T28 N 40°37'23\"/>


PARK STORM DRAIN

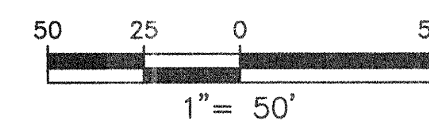

LEGEND

- DOUBLE WATER METER
- SINGLE WATER METER
- WL AIR RELEASE VALVE
- WATER LINE GATE VALVE
- WATER LINE CAP
- WATER LINE REDUCER
- EXISTING WATERLINE
- WATER LINE TEE
- SAS LATERAL
- SAS MANHOLE
- STORM DRAIN MANHOLE
- STORM DRAIN INLET
- PROPOSED FIRE HYDRANT
- EXISTING WATER VALVE
- PROPOSED STREET LIGHT

OSPREY DRIVE

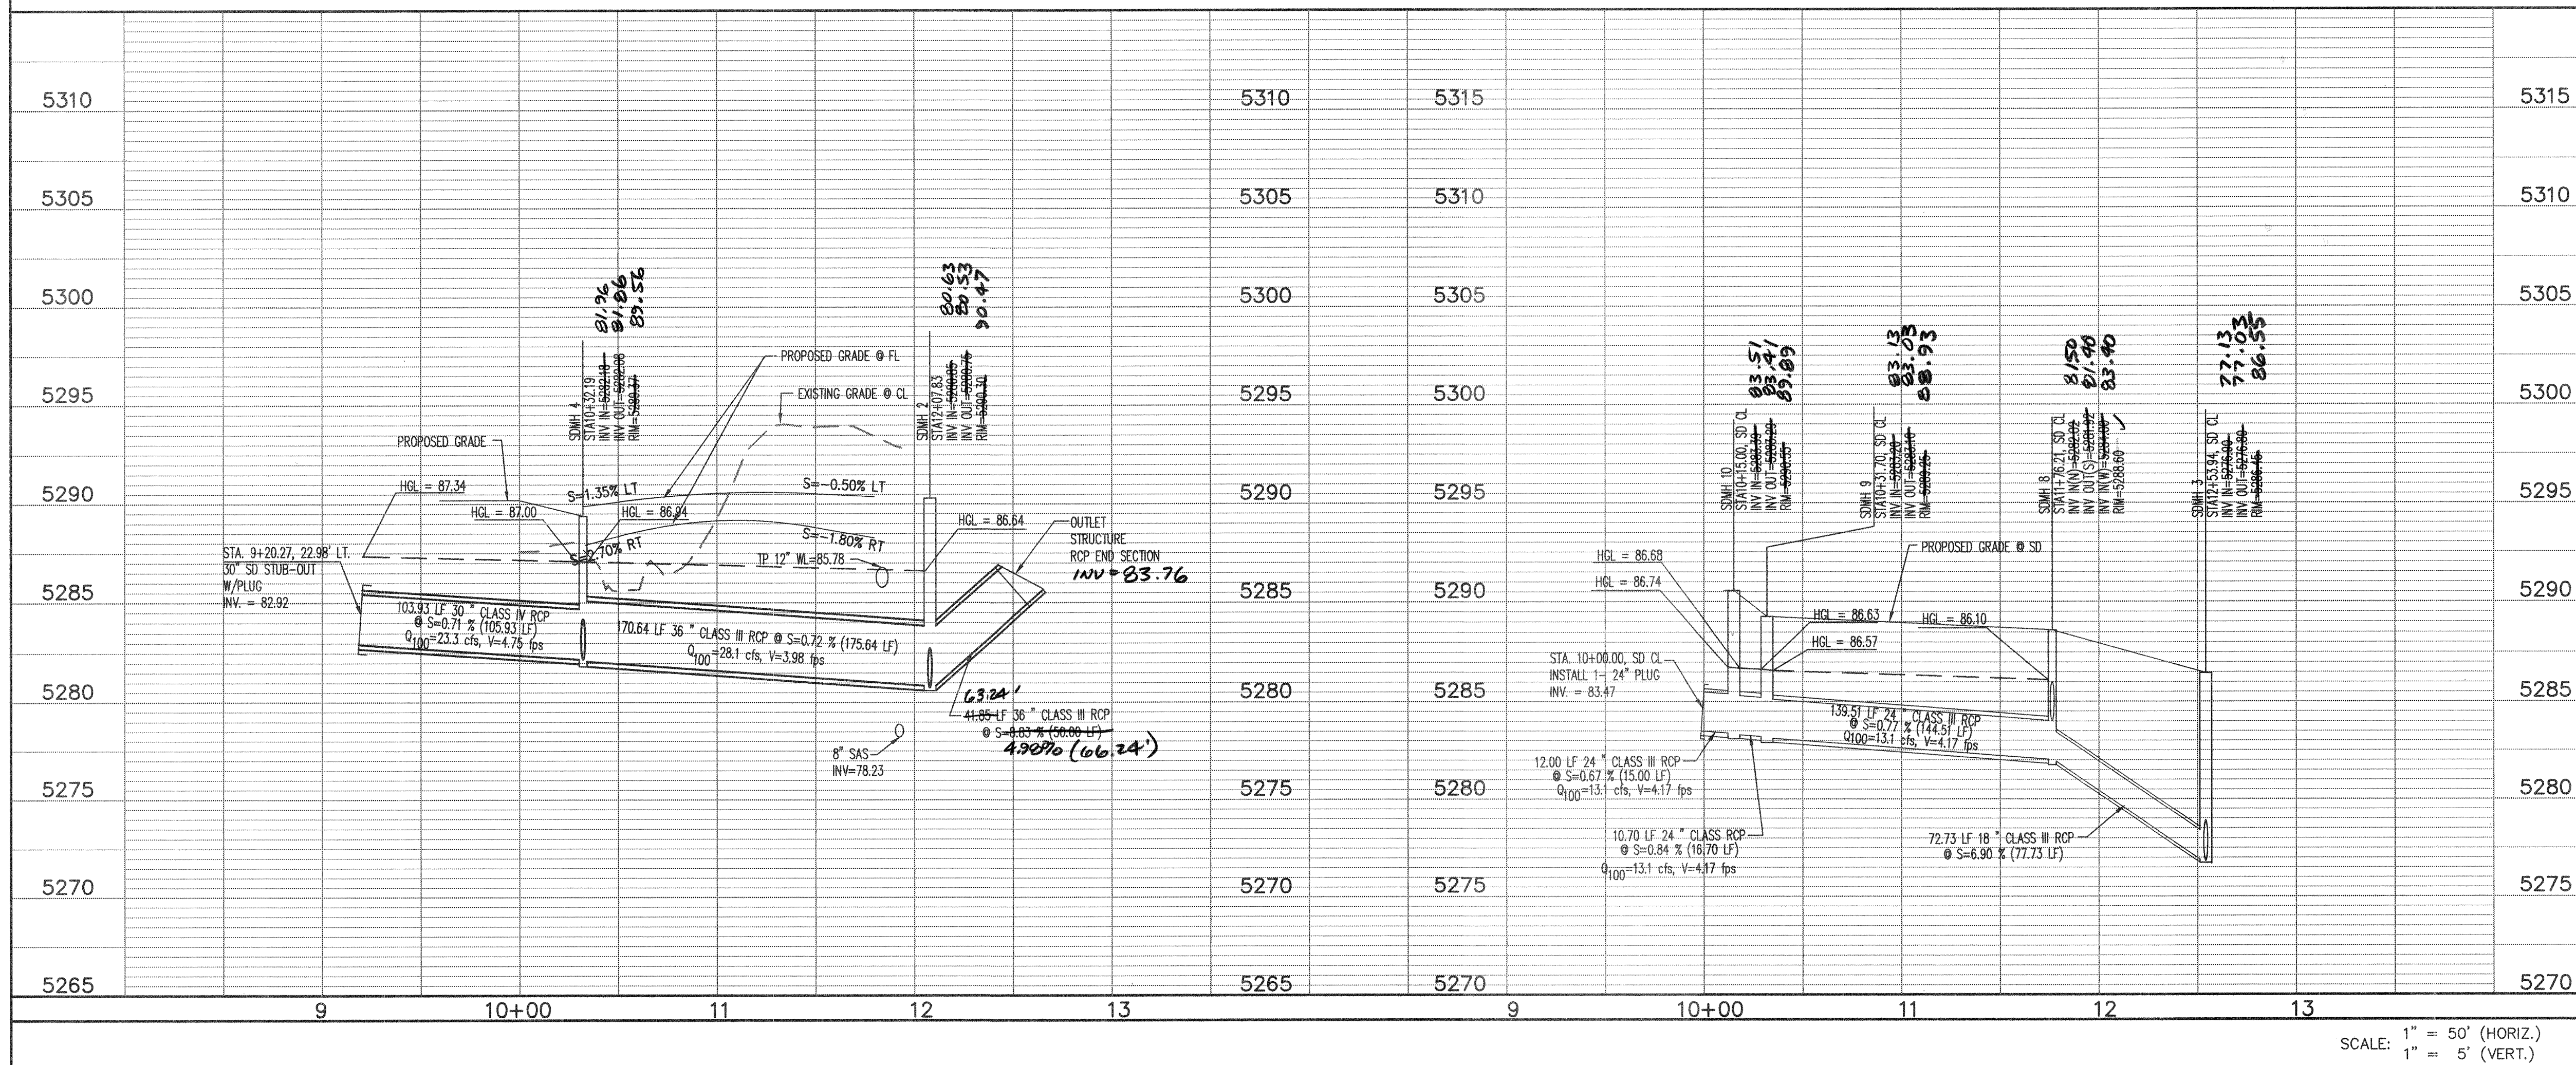

SCALE: 1\"/>

GENERAL NOTES

- THE CONTRACTOR SHALL FIELD VERIFY ALL EXISTING UTILITY LOCATIONS AND NOTIFY THE ENGINEER IMMEDIATELY OF ANY DISCREPANCIES.
- ALL CURVE DATA AND DIMENSIONS ARE CALCULATED FROM CENTERLINE OF PIPE OR MANHOLE. ALL SAS & SD SLOPES ARE CALCULATED TO TRUE PIPE DIMENSIONS FROM INVERT TO INVERT. (PAY ITEMS ARE SHOWN IN PARENTHESES)
- GRADE ELEVATIONS, WHERE NOTED, ARE FOR FLOWLINE OF STANDARD CURB UNLESS OTHERWISE SPECIFIED.
- CONTRACTOR IS TO INSTALL A 4\"/>
- CONTRACTOR IS RESPONSIBLE FOR REPAIR AND/OR REPLACEMENT OF ALL UTILITY CONDUITS AND EXISTING LINES.
- CONTRACTOR SHALL PROVIDE THE INSPECTORS WITH THE PROPOSED TESTING PLAN. THE PLAN MUST BE APPROVED BEFORE TESTING OPERATIONS BEGIN.
- CONTRACTOR SHALL PARK EQUIPMENT AND VEHICLES AS NOT TO INTERFERE WITH NORMAL ACTIVITIES OF RESIDENTS OR OTHER CONTRACTORS ON SITE.
- ANY DAMAGE TO THE EXISTING FACILITIES (CURB & GUTTER, PAVEMENT, CONDUITS, LANDSCAPING, UTILITY LINES, ETC.) DURING CONSTRUCTION SHALL BE REPLACED AT THE CONTRACTORS' EXPENSE.
- MH RIMS & CATCH BASIN INLET ELEVATIONS, FIRE HYDRANT & FLANGE ELEVATIONS ARE APPROXIMATE. CONTRACTOR SHALL FIELD VERIFY AND ADJUST TO FINAL PAVEMENT GRADES.
- SAS STATIONING FOLLOWS CL OF ROAD UNLESS OTHERWISE NOTED.
- STATIONING OF DROP INLET IS TO MIDDLE OF DOWN HILL GRATE AT FACE OF CURB.
- SAS LATERALS ARE 20\"/>
- ALL WATERLINE APPURTENANCES SHALL USE RESTRAINED JOINTS, REFER TO TABLES LISTED ON OVERALL UTILITY SHEET 16.
- TYPICAL DEPTH TO WATERLINE IS 4 FEET. MINIMUM IS 3 FEET.

KEYED NOTES:

- ① INSTALL ORIFICE PLATE PER DETAIL, SHEET 29.

AS-BUILT INFORMATION		BENCH MARKS		SURVEY INFORMATION		ENGINEER'S SEAL	
CONTRACTOR	DATE	NO.	BY	NO.	BY	REMARKS	
PLANNING	01	NO.	BY	NO.	BY	REVISIONS	
WORK BY	DATE	NO.	BY	NO.	BY	DESIGN	
ACCEPTANCE BY	DATE	NO.	BY	NO.	BY	DATE: 11/00	
APPROVED BY	DATE	NO.	BY	NO.	BY	DATE: 11/00	
RECORDED BY	DATE	NO.	BY	NO.	BY	DATE: 11/00	





Richard Lynn
Professional Engineer
License No. 10596
State of New Mexico

City of Albuquerque
Public Works Department
Engineering Development Group
TIMARRON WEST UNIT 3 SUBDIVISION
UTILITY PLAN & PROFILE
OSPREY DRIVE / PARK STORM DRAIN

Design Review Committee
APPROVED
FEB 13 2001
DESIGN REVIEW COMMITTEE

City Engineer Approval
APPROVED
FEB 23 2001
CITY ENGINEER

City Project No. 651681
Zone Map No. L8-M8
Sheet 25 Of 32

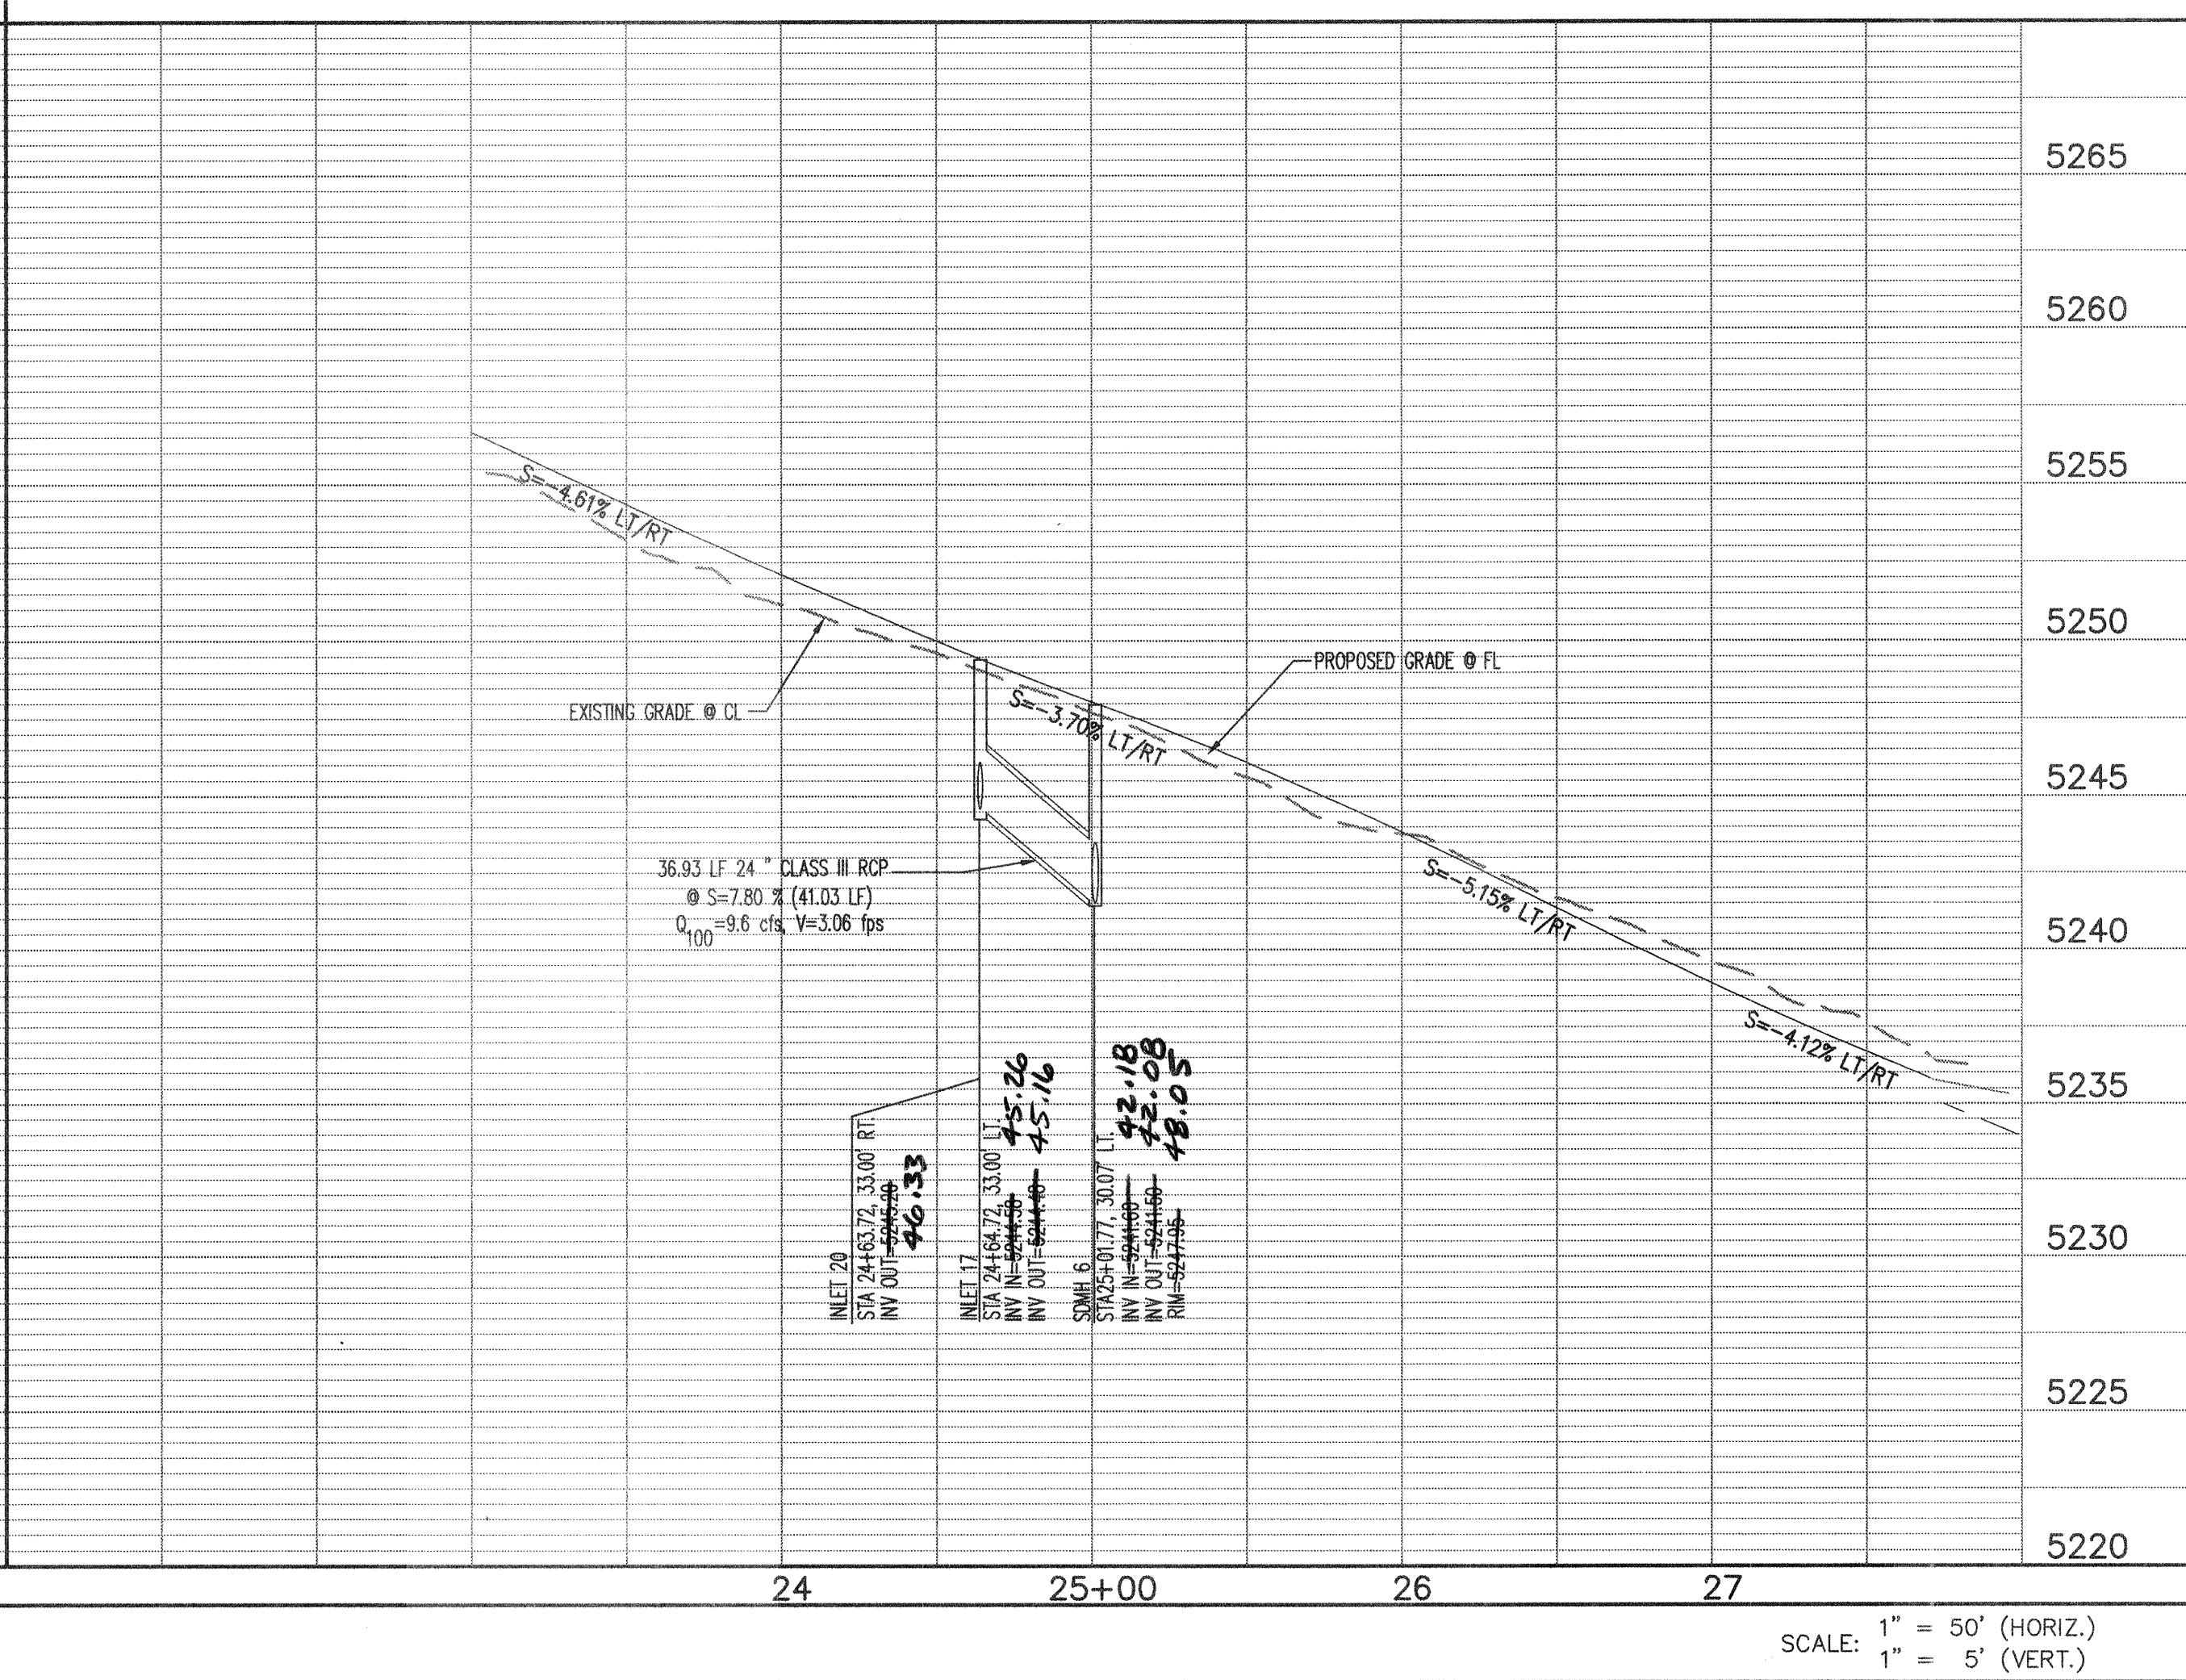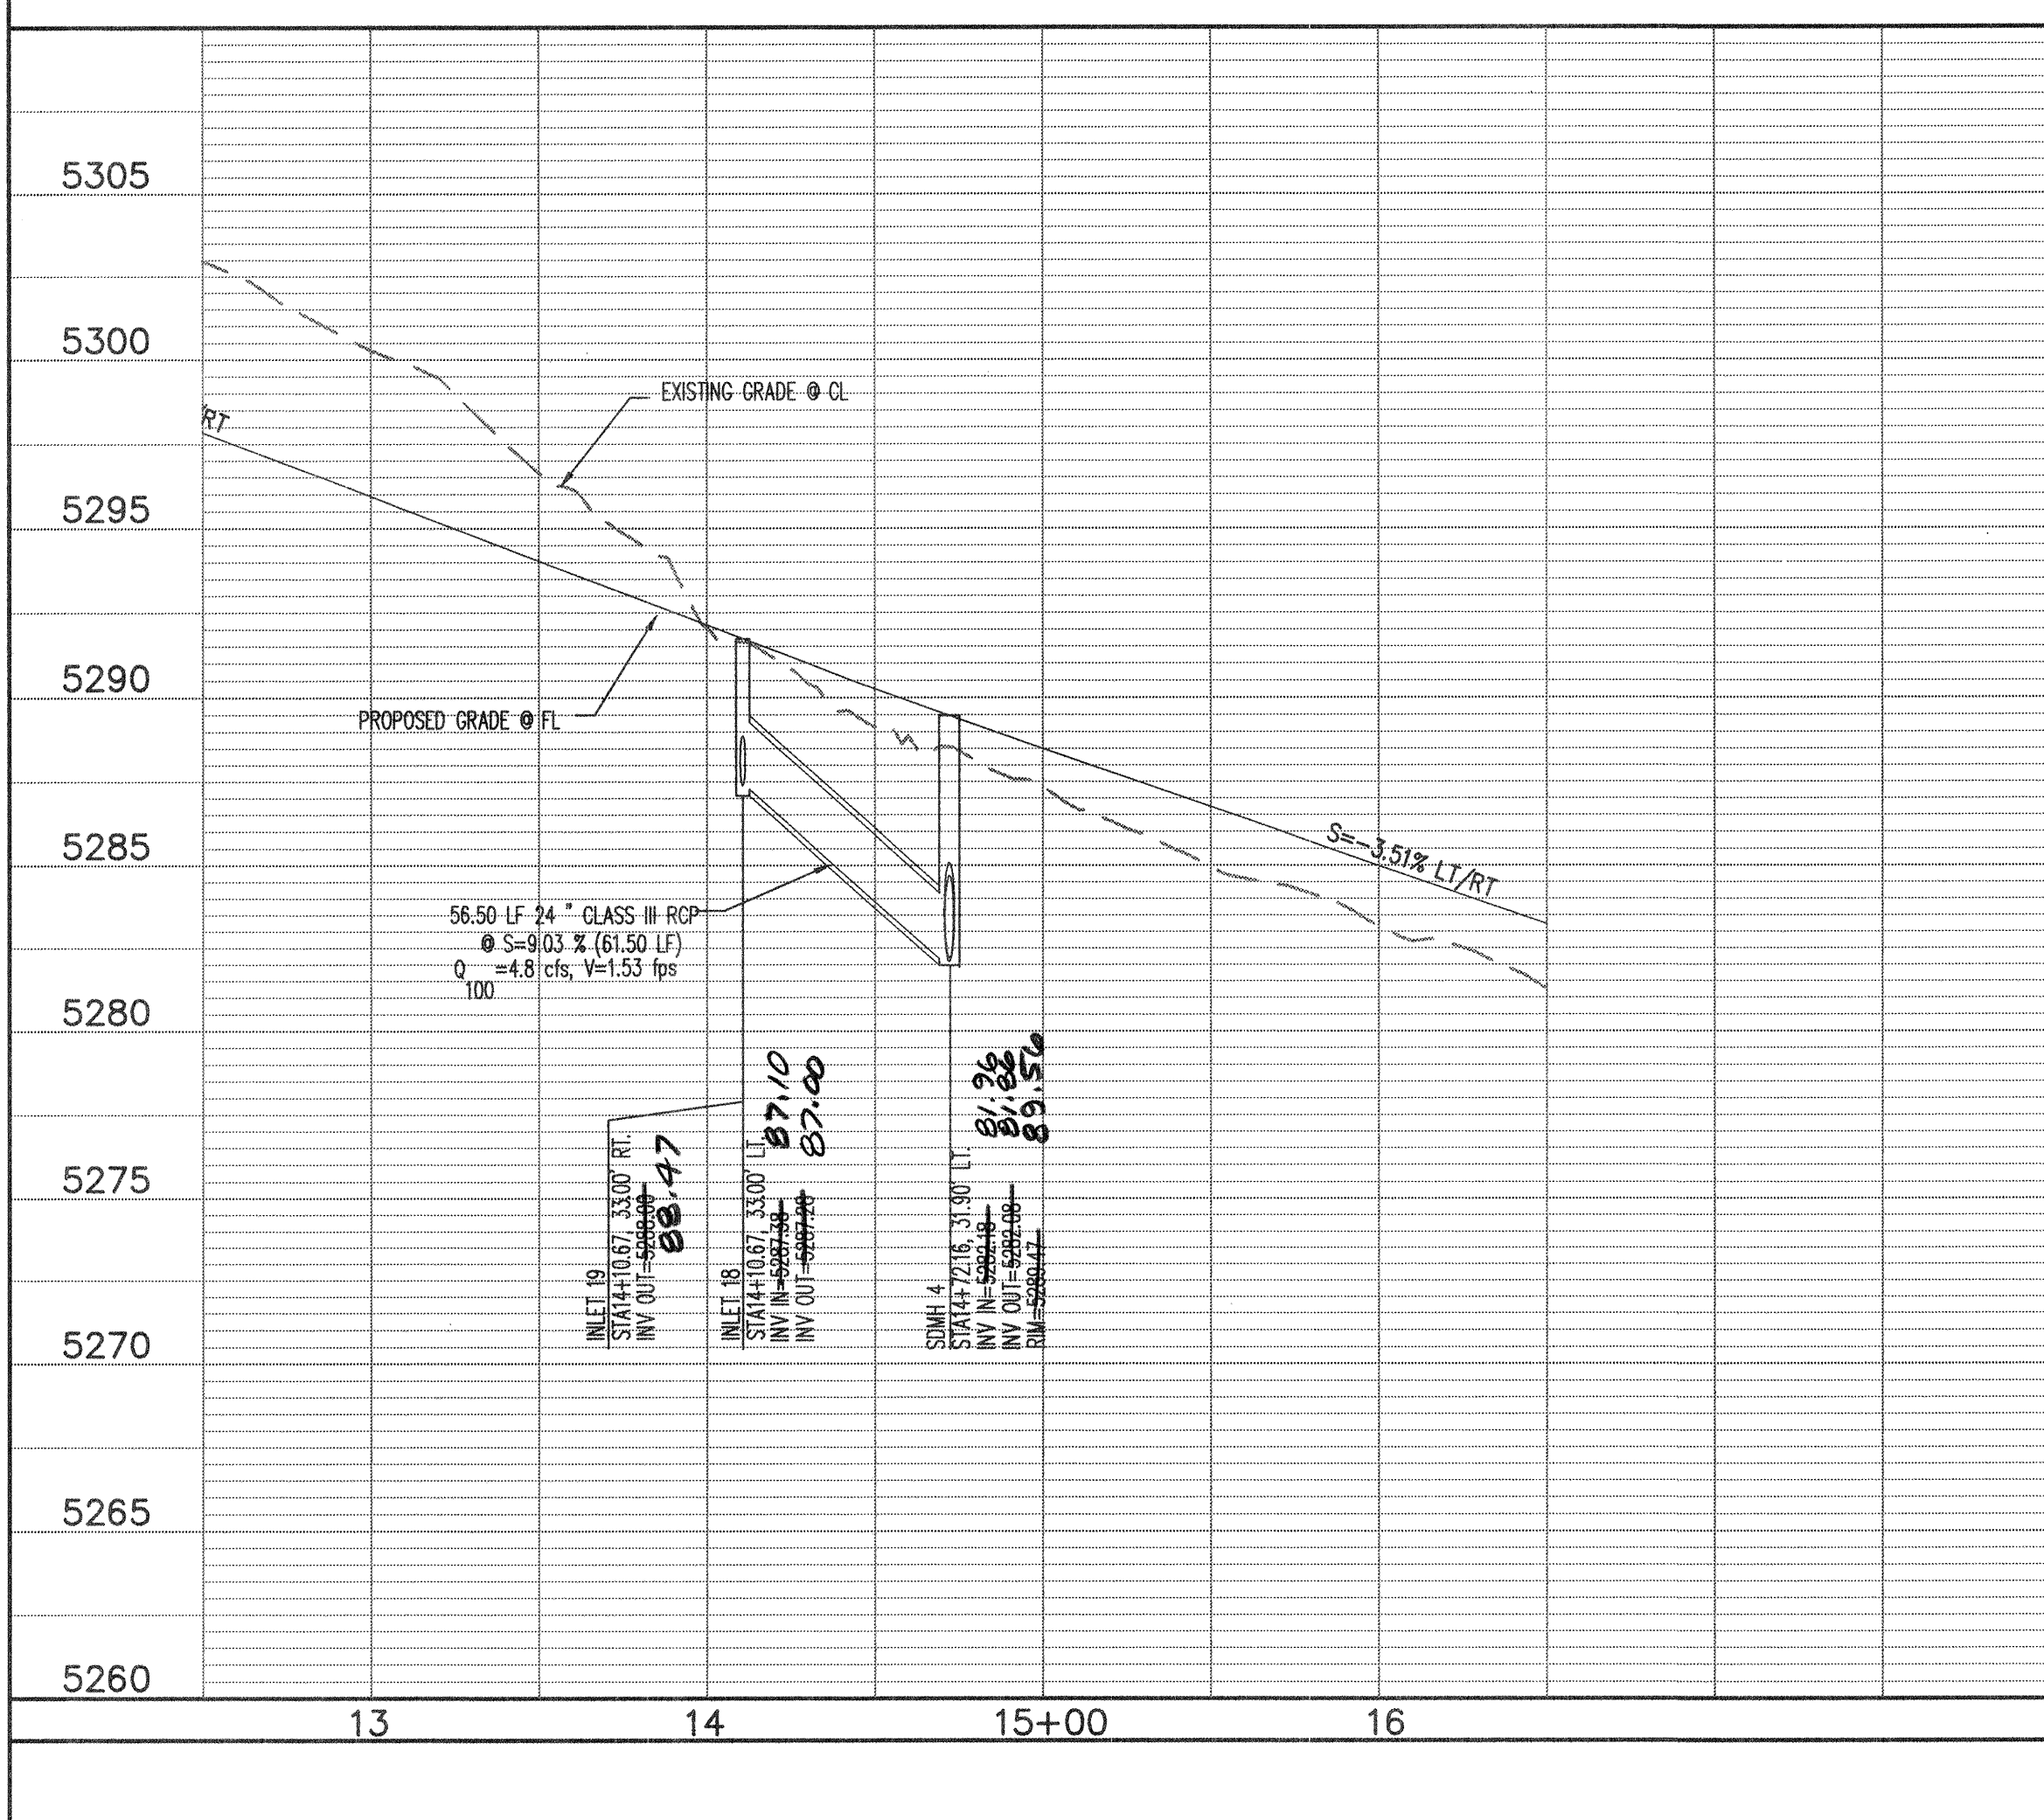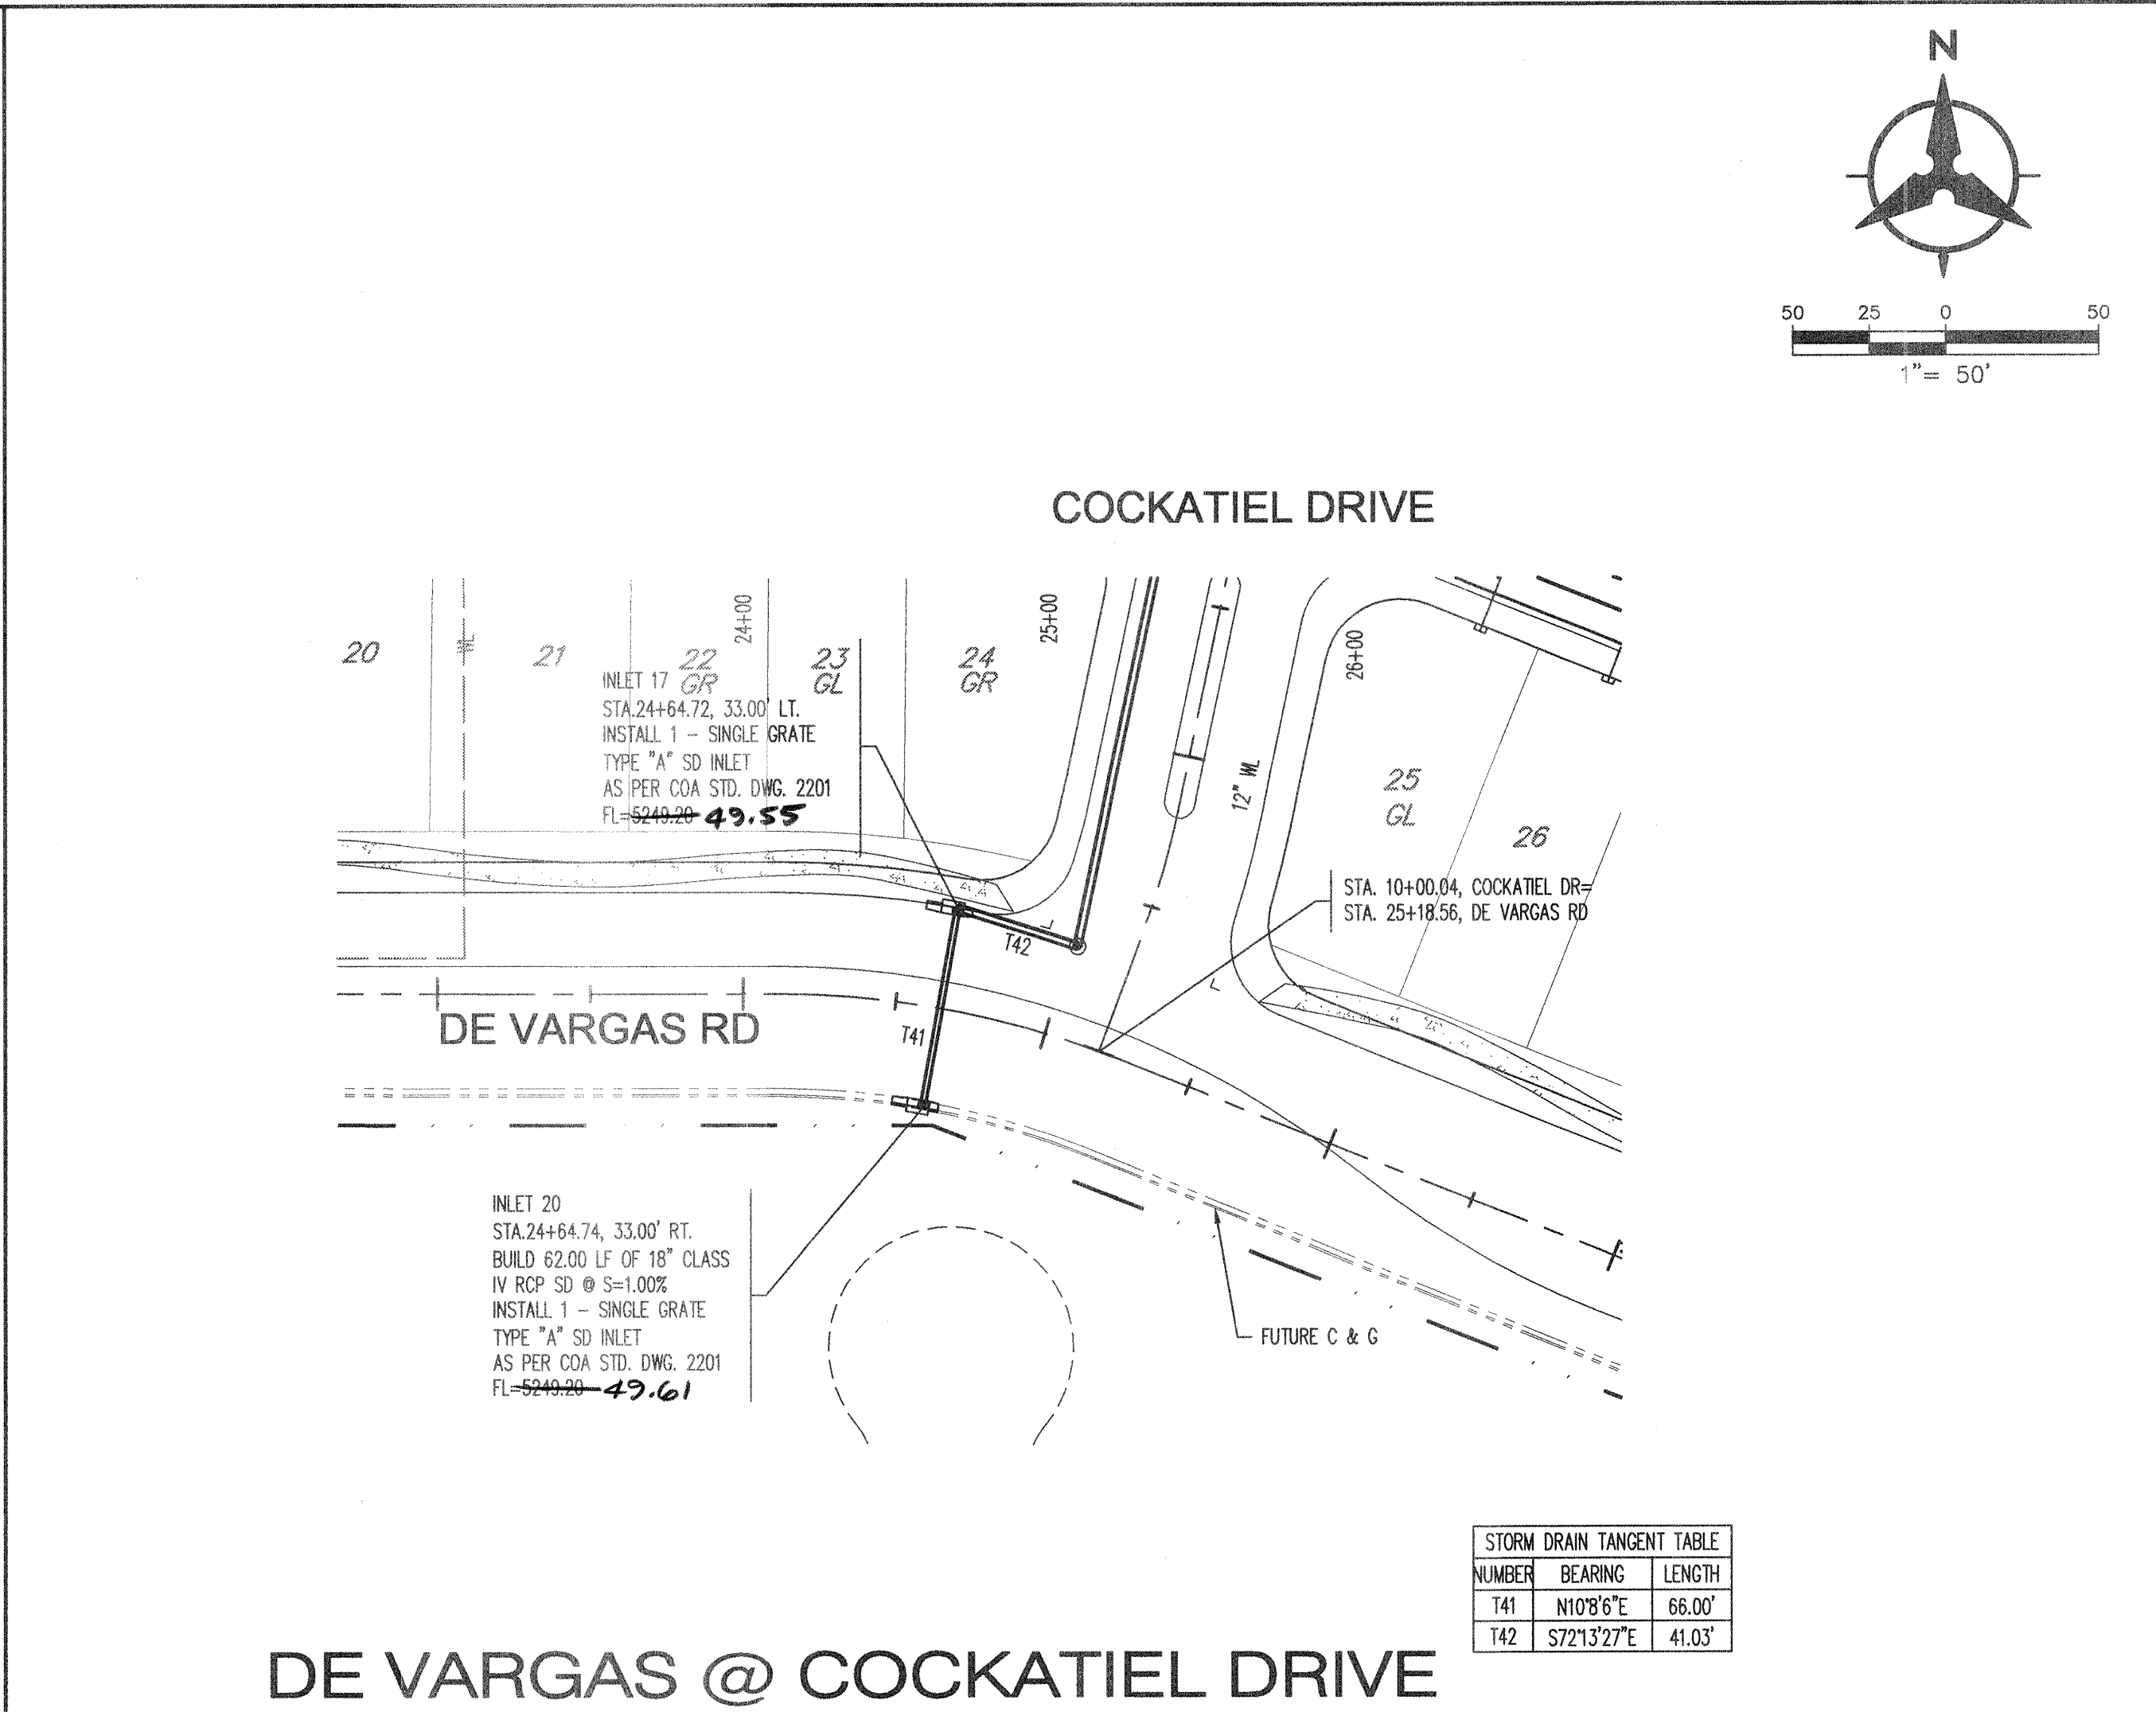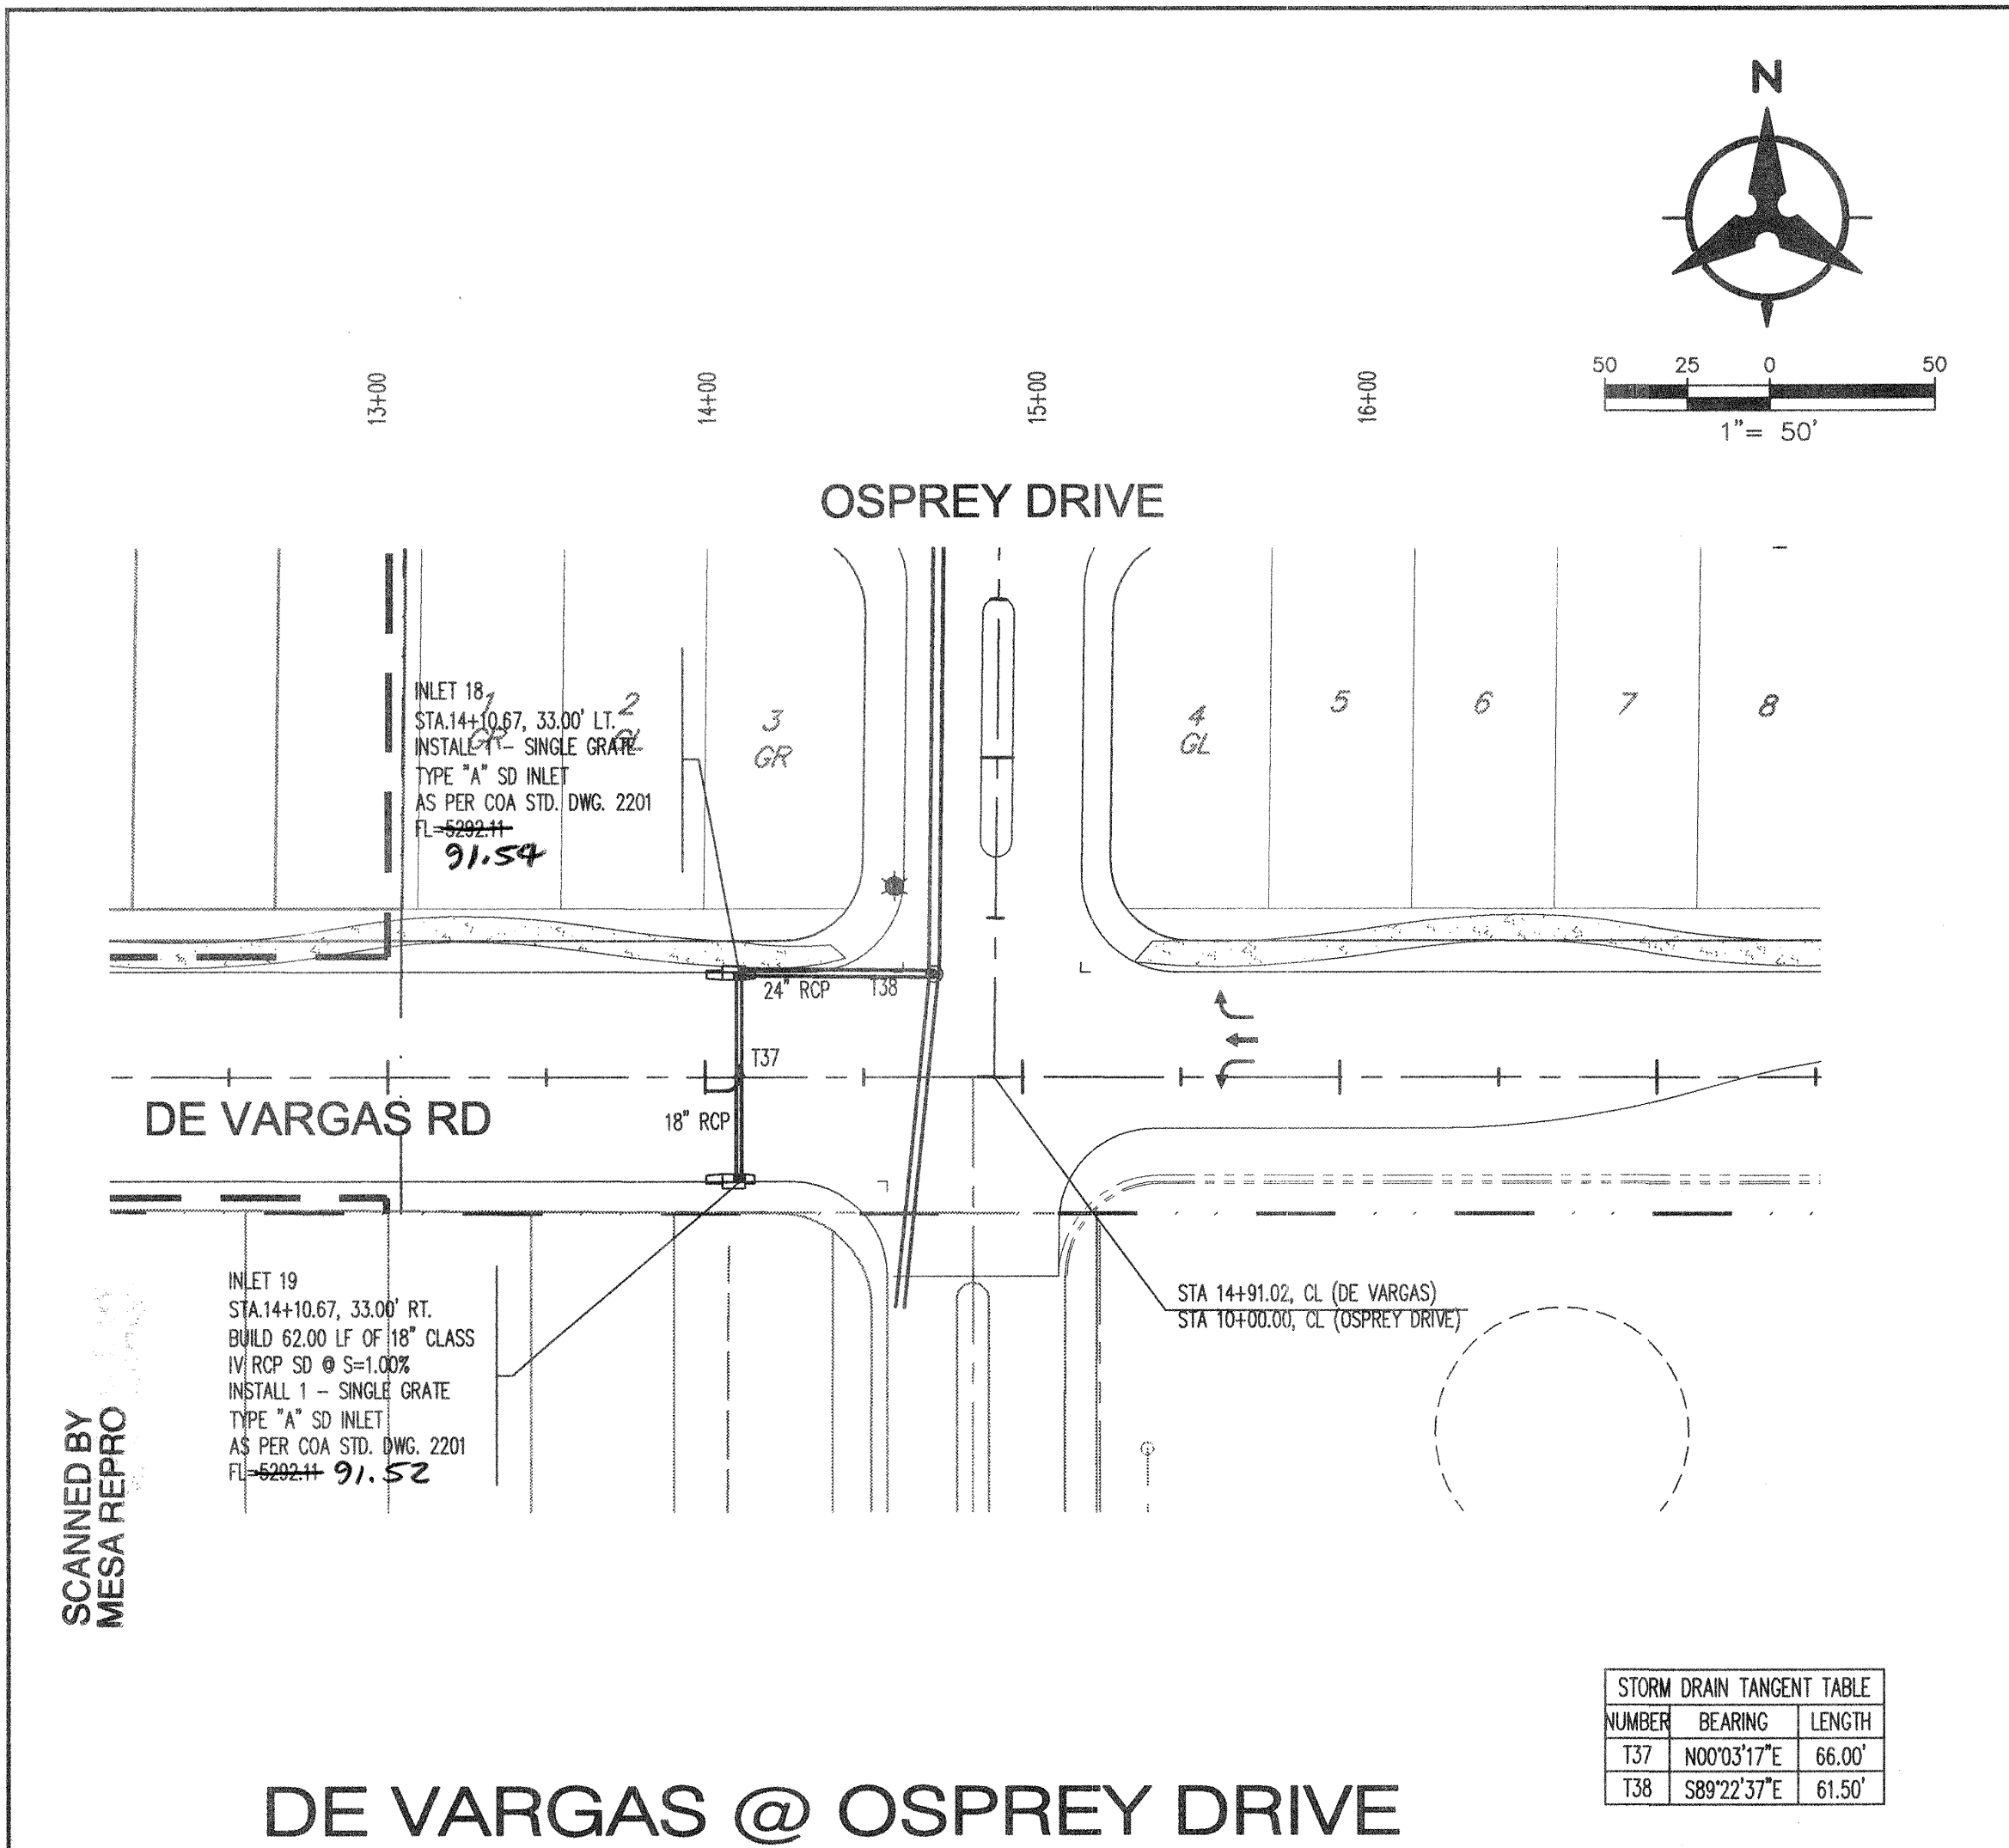

GENERAL NOTES

- THE CONTRACTOR SHALL FIELD VERIFY ALL EXISTING UTILITY LOCATIONS AND NOTIFY THE ENGINEER IMMEDIATELY OF ANY DISCREPANCIES.
- ALL CURVE DATA AND DIMENSIONS ARE CALCULATED FROM CENTERLINE OF PIPE OR MANHOLE. ALL SAS & SD SLOPES ARE CALCULATED TO TRUE PIPE DIMENSIONS FROM INVERT TO INVERT. (PAY ITEMS ARE SHOWN IN PARENTHESES)
- GRADE ELEVATIONS, WHERE NOTED, ARE FOR FLOWLINE OF STANDARD CURB UNLESS OTHERWISE SPECIFIED.
- CONTRACTOR IS TO INSTALL A 4" X 4" X 5' POST AND END AT THE END OF EACH SANITARY SEWER SERVICE.
- CONTRACTOR IS RESPONSIBLE FOR REPAIR AND/OR REPLACEMENT OF ALL UTILITY CONDUITS AND EXISTING LINES.
- CONTRACTOR SHALL PROVIDE THE INSPECTORS WITH THE PROPOSED TESTING PLAN. THE PLAN MUST BE APPROVED BEFORE TESTING OPERATIONS BEGIN.
- CONTRACTOR SHALL PARK EQUIPMENT AND VEHICLES AS NOT TO INTERFERE WITH NORMAL ACTIVITIES OF RESIDENTS OR OTHER CONTRACTORS ON SITE.
- ANY DAMAGE TO THE EXISTING FACILITIES (CURB & GUTTER, PAVEMENT, CONDUITS, LANDSCAPING, UTILITY LINES, ETC.) DURING CONSTRUCTION SHALL BE REPLACED AT THE CONTRACTORS' EXPENSE.
- MH RIMS & CATCH BASIN INLET ELEVATIONS, FIRE HYDRANT & FLANGE ELEVATIONS ARE APPROXIMATE. CONTRACTOR SHALL FIELD VERIFY AND ADJUST TO FINAL PAVEMENT GRADES.
- SAS STATIONING FOLLOWS CL OF ROAD UNLESS OTHERWISE NOTED.
- STATIONING OF DROP INLET IS TO MIDDLE OF DOWN HILL GRATE AT FACE OF CURB.
- SAS LATERALS ARE 20" INSIDE PL ON DOWNHILL SIDE OF PROPERTY UNLESS OTHERWISE SPECIFIED.
- ALL WATERLINE APPURTENANCES SHALL USE RESTRAINED JOINTS, REFER TO TABLES LISTED ON OVERALL UTILITY SHEET 16.
- TYPICAL DEPTH TO WATERLINE IS 4 FEET. MINIMUM IS 3 FEET.

LEGEND

- DOUBLE WATER METER
- SINGLE WATER METER
- WL AIR RELEASE VALVE
- WATER LINE GATE VALVE
- WATER LINE CAP
- WATER LINE REDUCER
- WATER LINE TEE
- EXISTING WATERLINE
- SAS LATERAL
- SAS MANHOLE
- STORM DRAIN MANHOLE
- STORM DRAIN INLET
- PROPOSED FIRE HYDRANT
- EXISTING WATER VALVE
- PROPOSED STREET LIGHT

AS-BUILT INFORMATION

CONTRACTOR	DATE
ANKINS	01

BENCH MARKS

MARK	DATE
ACS 1.3/4" Alum. disk stamped "ACS BM 14-48"	01

SURVEY INFORMATION

NO.	BY	DATE

ENGINEER'S SEAL

REMARKS
DESIGN

By
No. Date

Designed By: EES
Drawn By: KSH
Checked By: RLB

DATE: 11/00
DATE: 11/00
DATE: 11/00

Bohannon & Huston
Courtyard One 7500 JEFFERSON NE Albuquerque NEW MEXICO 87109
ENGINEERS PLANNERS PHOTOGRAMMETRISTS SURVEYORS SOFTWARE DEVELOPERS

**CITY OF ALBUQUERQUE
PUBLIC WORKS DEPARTMENT
ENGINEERING DEVELOPMENT GROUP**


**TIMARRON WEST SUBDIVISION
UTILITY PLAN & PROFILE
DE VARGAS ROAD**

Design Review Committee
APPROVED
FEB 13 2001
REVIEW CITY ENGINEER

City Engineer Approval
APPROVED
FEB 23 2001
CITY ENGINEER

Mo./Day/Yr. Mo./Day/Yr.

City Project No. 651681 Zone Map No. L8-M8 Sheet 26 Of 32

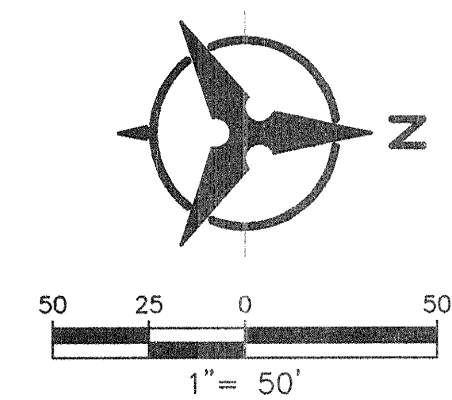

NUMBER	BEARING	LENGTH
T34	N03°44'50"E	145.59'
T35	N00°37'23"E	414.19'
T36	N37°00'42"E	33.80'

LEGEND

- | | |
|---|-----------------------|
|  | DOUBLE WATER METER |
|  | SINGLE WATER METER |
|  | ML AIR RELEASE VALVE |
|  | WATER LINE GATE VALVE |
|  | WATER LINE CAP |
|  | WATER LINE REDUCER |
|  | EXISTING WATERLINE |
|  | WATER LINE TEE |
|  | SAS LATERAL |
|  | SAS MANHOLE |
|  | STORM DRAIN MANHOLE |
|  | STORM DRAIN INLET |
|  | PROPOSED FIRE HYDRANT |
|  | EXISTING WATER VALVE |
|  | PROPOSED STREET LIGHT |

GENERAL NOTES

1. THE CONTRACTOR SHALL FIELD VERIFY ALL EXISTING UTILITY LOCATIONS AND NOTIFY THE ENGINEER IMMEDIATELY OF ANY DISCREPANCIES.
2. ALL CURVE DATA AND DIMENSIONS ARE CALCULATED FROM CENTERLINE OF ROAD OR HWM. ALL S&S & S+D (SPES) ARE CALCULATED TO TRUE PIPE DIMENSIONS FROM INVERT TO INVERT. (PAY ITEMS ARE SHOWN IN PARENTHESES)
3. GRADE ELEVATIONS, WHERE NOTED, ARE FOR FLOWLINE OF STANDARD CURB UNLESS OTHERWISE SPECIFIED.
4. CONTRACTOR IS TO INSTALL A 4" X 4" X 5' POST AND END AT THE END OF EACH SANITARY SEWER SERVICE.
5. CONTRACTOR IS RESPONSIBLE FOR REPAIR AND/OR REPLACEMENT OF ALL UTILITY CONDUITS AND EXISTING LINES.
6. CONTRACTOR SHALL PROVIDE THE INSPECTORS WITH THE PROPOSED TESTING PLAN. THE PLAN MUST BE APPROVED BEFORE TESTING OPERATIONS BEGIN.
7. CONTRACTOR SHALL PARK EQUIPMENT AND VEHICLES AS NOT TO INTERFERE WITH NORMAL ACTIVITIES OF RESIDENTS OR OTHER CONTRACTORS ON SITE.
8. ANY DAMAGE TO THE EXISTING FACILITIES (CURB & GUTTER, PAVEMENT, CONDUITS, LANDSCAPING, UTILITY LINES, ETC.) DURING CONSTRUCTION SHALL BE REPLACED AT THE CONTRACTORS' EXPENSE.
9. MH RIMS & CATCH BASIN INLET ELEVATIONS, FIRE HYDRANT & FLUVE ELEVATIONS ARE APPROPRIATE. CONTRACTOR SHALL FIELD VERIFY AND ADJUST TO FINAL PAVEMENT GRADES.
10. S&S STATIONING FOLLOWS CL OF ROAD UNLESS OTHERWISE NOTED.
11. STATIONING OF DROP INLET IS TO MIDDLE OF DOWN HILL GRATE AT FACE OF CURB.
12. S&S LATERALS ARE 20' INSIDE PL ON DOWNHILL SIDE OF PROPERTY UNLESS OTHERWISE SPECIFIED.
13. ALL WATERLINE APPURTENANCES SHALL USE RESTRAINED JOINTS, REFER TO TABLES LISTED ON OVERALL UTILITY SHEET 16.
14. TYPICAL DEPTH TO WATERLINE IS 4 FEET. MINIMUM IS 3 FEET.

SURVEY INFORMATION		BENCH MARKS	AS-BUILT INFORMATION	
FIELD NOTES			CONTRACTOR	DATE
NO.	DATE BY	ACS 1.3/4" Alum. disk stamped "ACS BM, 14-M8" LOCATED AT THE ESE QUADRANT OF DE VAREAS RD. AND CERRILLOS ROAD EXPOSED TO TOP OF CONCRETE CURB. Elevation= 5233.928	WORKS STAGED BY: ALS ACCEPTANCE BY: ALS FIELD INSPECTION BY: ALS DRAWINGS CORRECTED BY: ALS	DATE 11/01 DATE 01 DATE 01 DATE 11/01
			MICRO-FILM INFORMATION	
			RECORDED BY	DATE
			NO.	

ENGINEER'S SEAL



No.	Date	REMARKS	By
REVISIONS			
DESIGN			
Designed By:			DATE:
Drawn By:			DATE:
Checked By:			DATE:


Bohannon ▲ Huston

 Courtyard One 7500 JEFFERSON NE Albuquerque NEW MEXICO 87109

ENGINEERS PLANNERS PHOTOGRAMMETRISTS SURVEYORS SOFTWARE DEVELOPERS

 **CITY OF ALBUQUERQUE**
PUBLIC WORKS DEPARTMENT
ENGINEERING DEVELOPMENT GROUP

**TIMARRON WEST SUBDIVISION
UTILITY PLAN & PROFILE
OFFSITE SD**

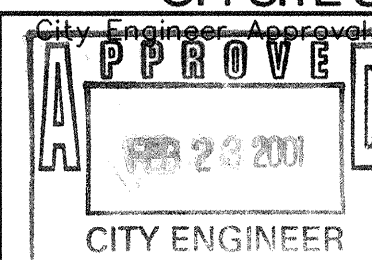


Mo./Day/Yr.	Mo./Day/Yr.


City Project No.	651681	Zone Map No.	L8-M8	Sheet	27	Of	32
------------------	--------	--------------	-------	-------	----	----	----

P: \99470\CDP\PNP\UNIT_3\99470UPNP09.DWG


SCALE: 1" = 50' (HORIZ.)
1" = 5' (VERT.)

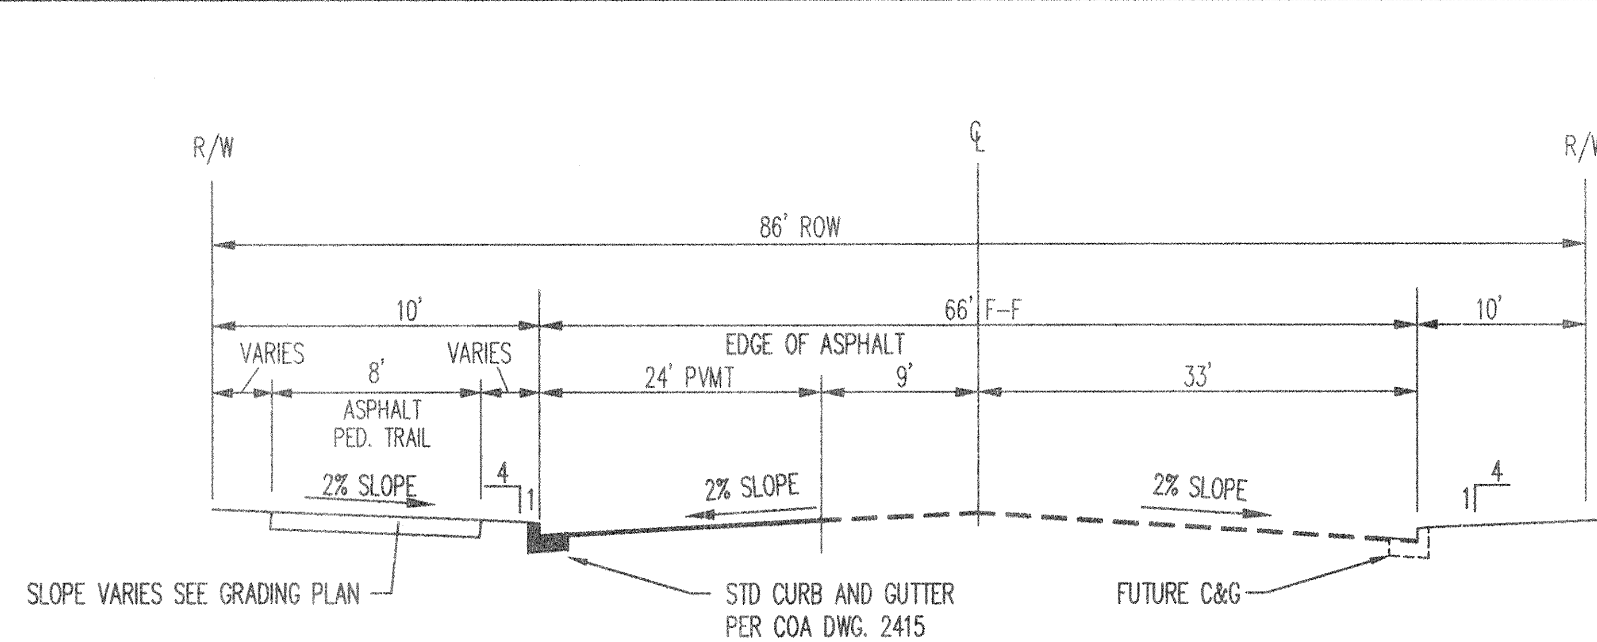


DE VARGAS RD - 24' PVMT
N.T.S.

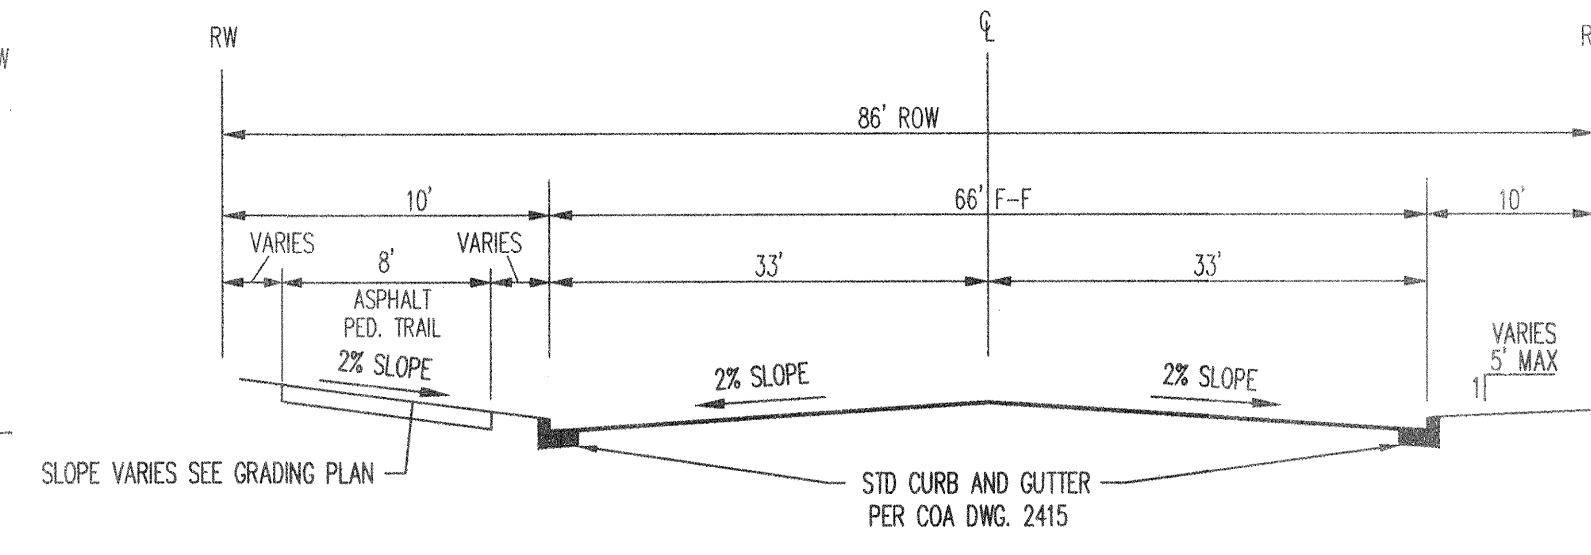


DE VARGAS RD - 66' F-F
NOT TO SCALE

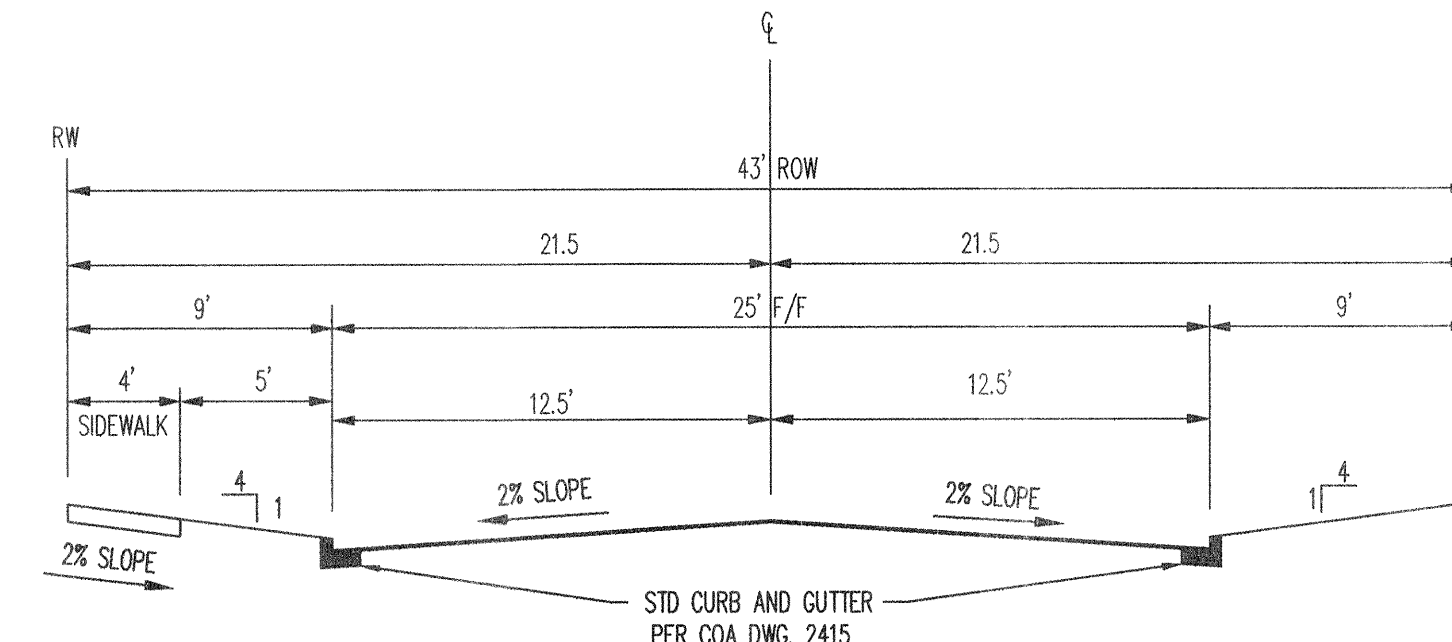


RESIDENTIAL STUB STREET 25' PVMT SECTION
NOT TO SCALE

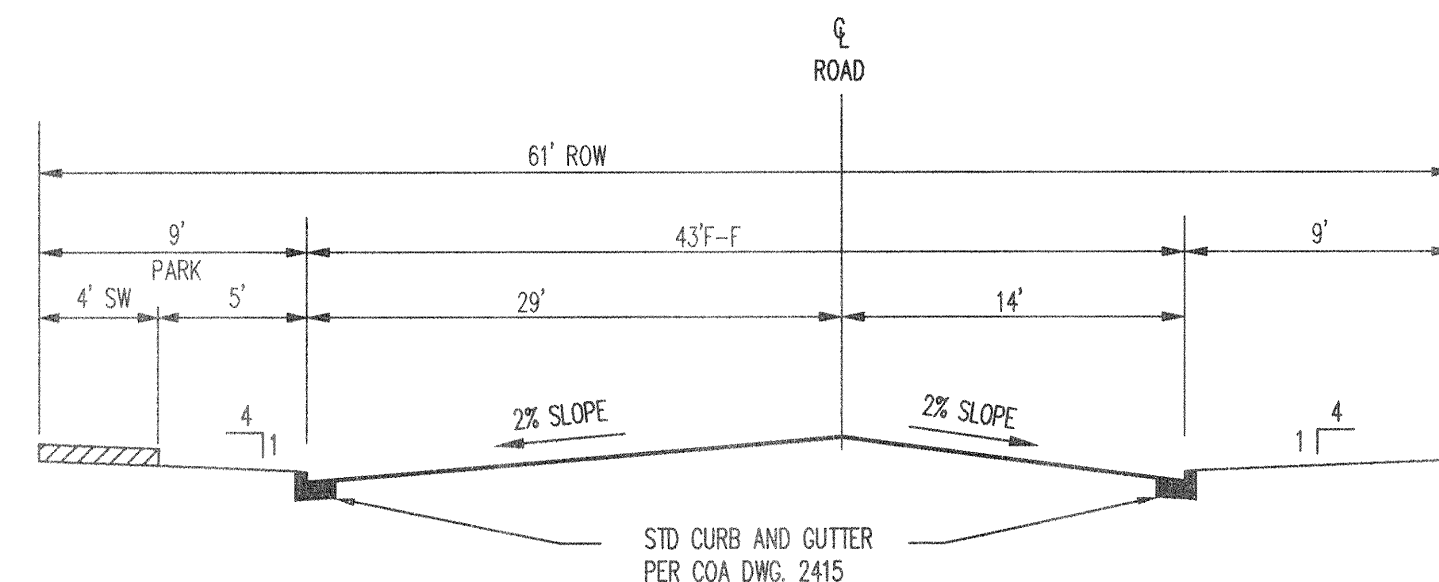


TEAL RD AT PARK - 43' F-F
N.T.S.

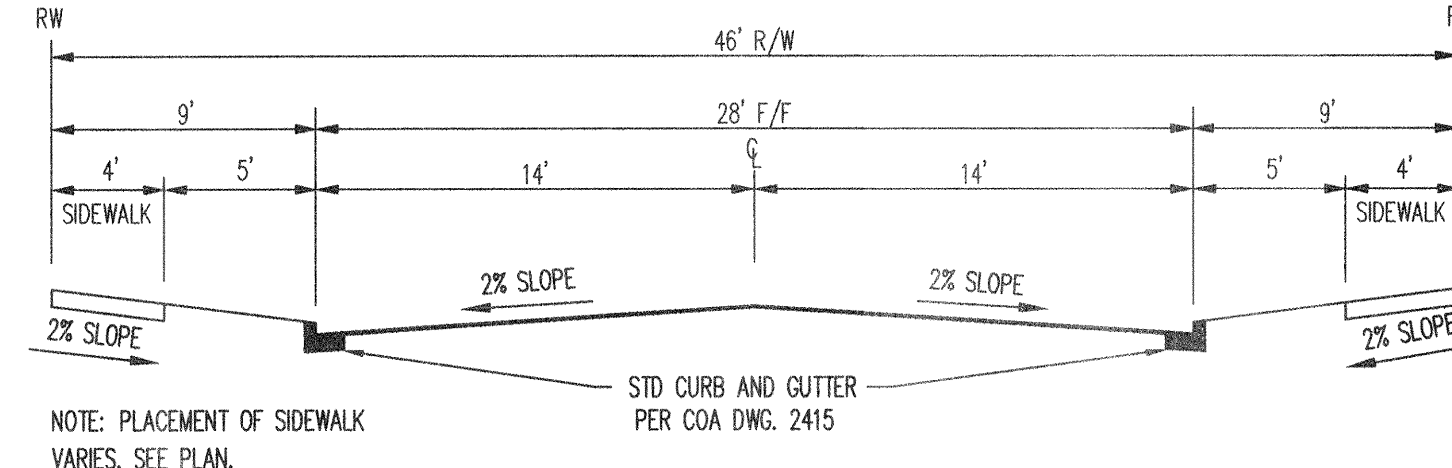


TYPICAL RESIDENTIAL - 28' F-F
NOT TO SCALE

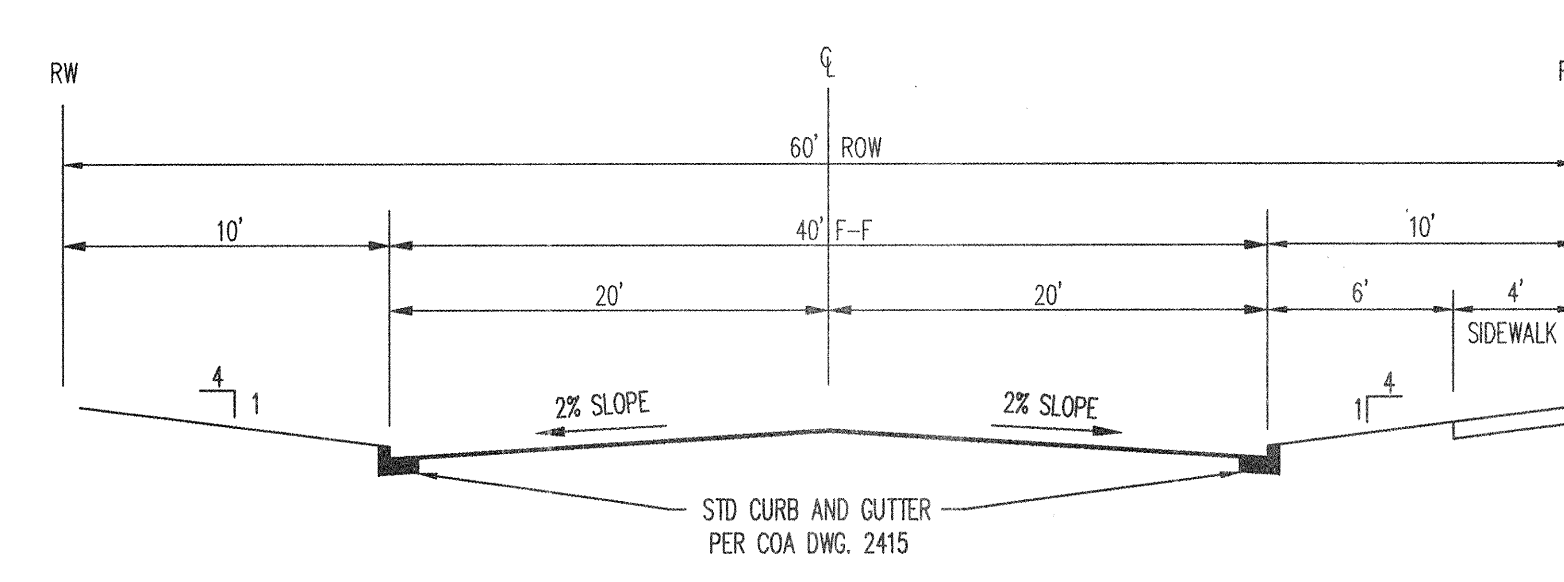


TANAGER DR ENTRANCE - 40' F-F
N.T.S.

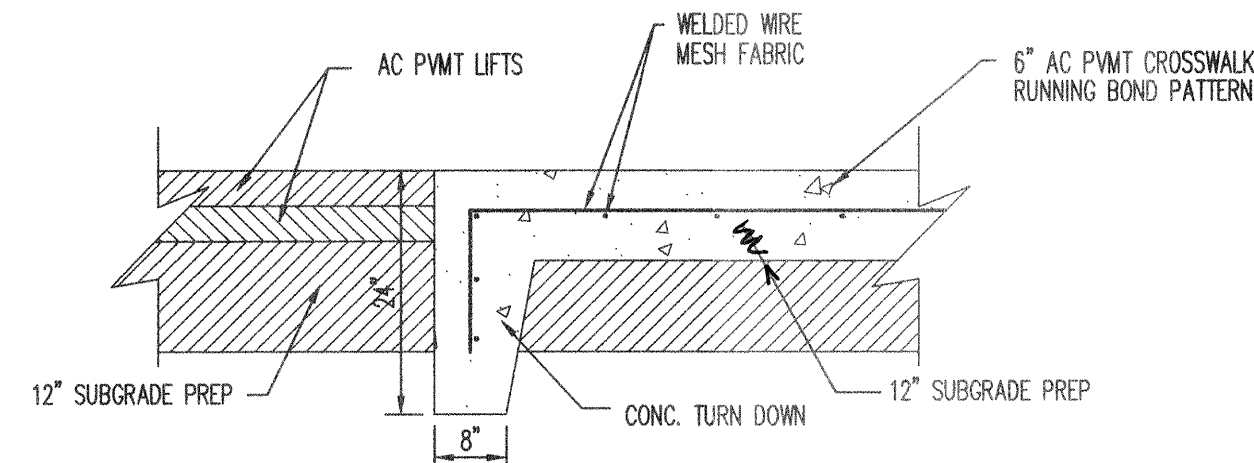


TYPICAL AC/PCC PVMT CROSSWALK JOINT DETAIL

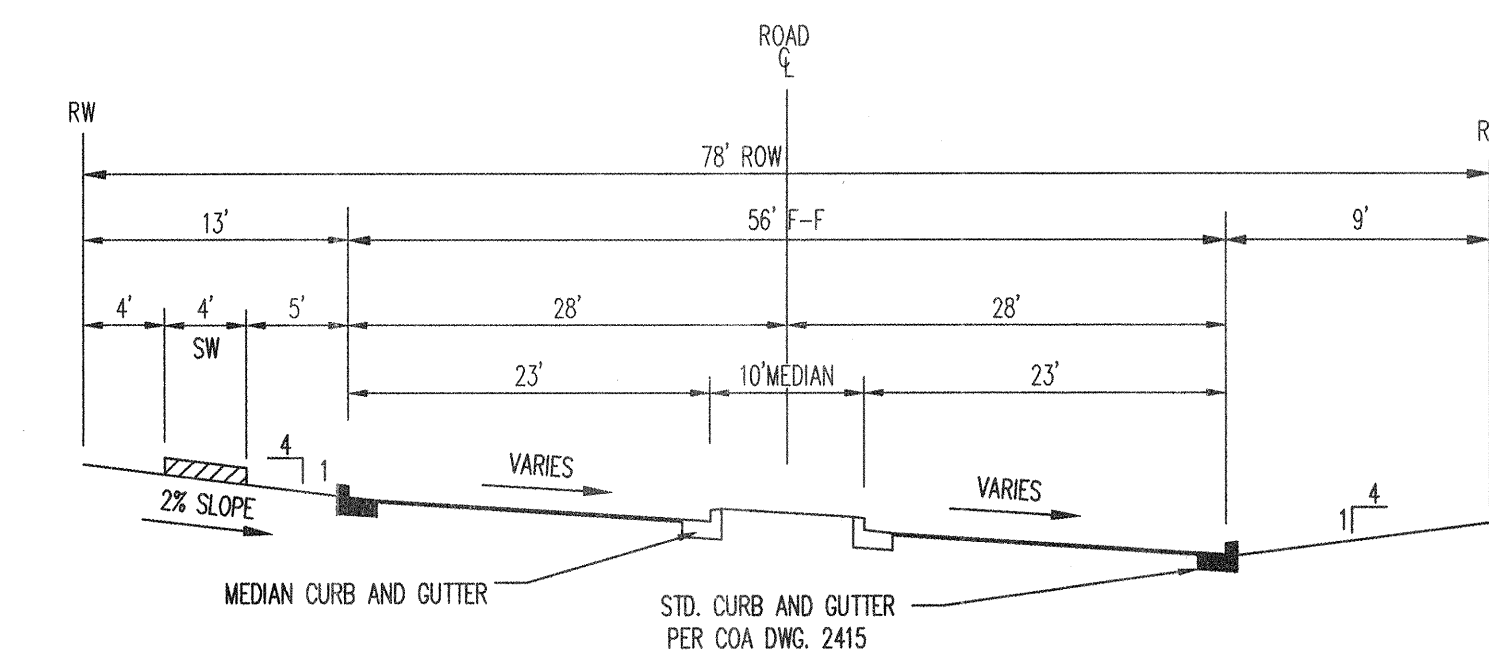


OSPREY DR ENTRANCE - 56' F-F
N.T.S.

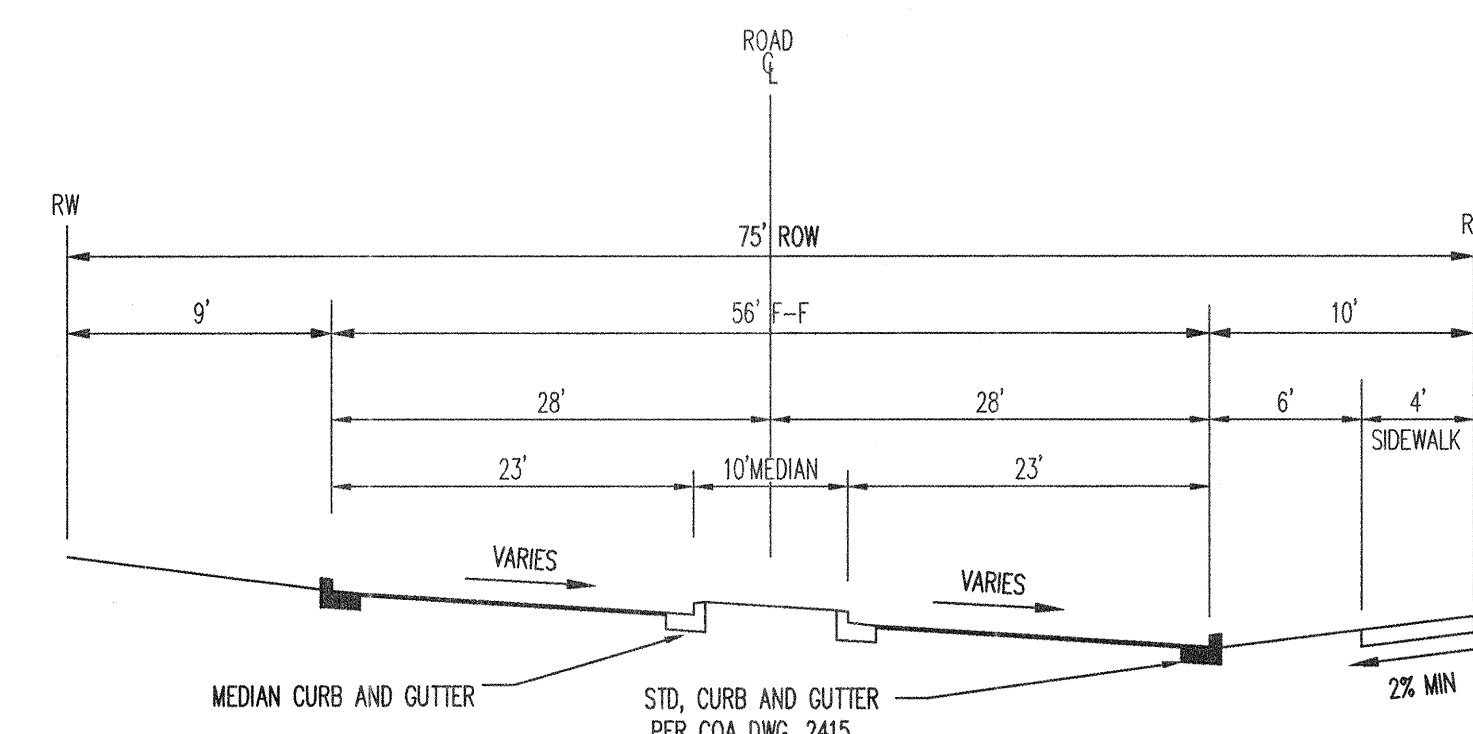


COCKATIEL DR ENTRANCE - 56' F-F
N.T.S.

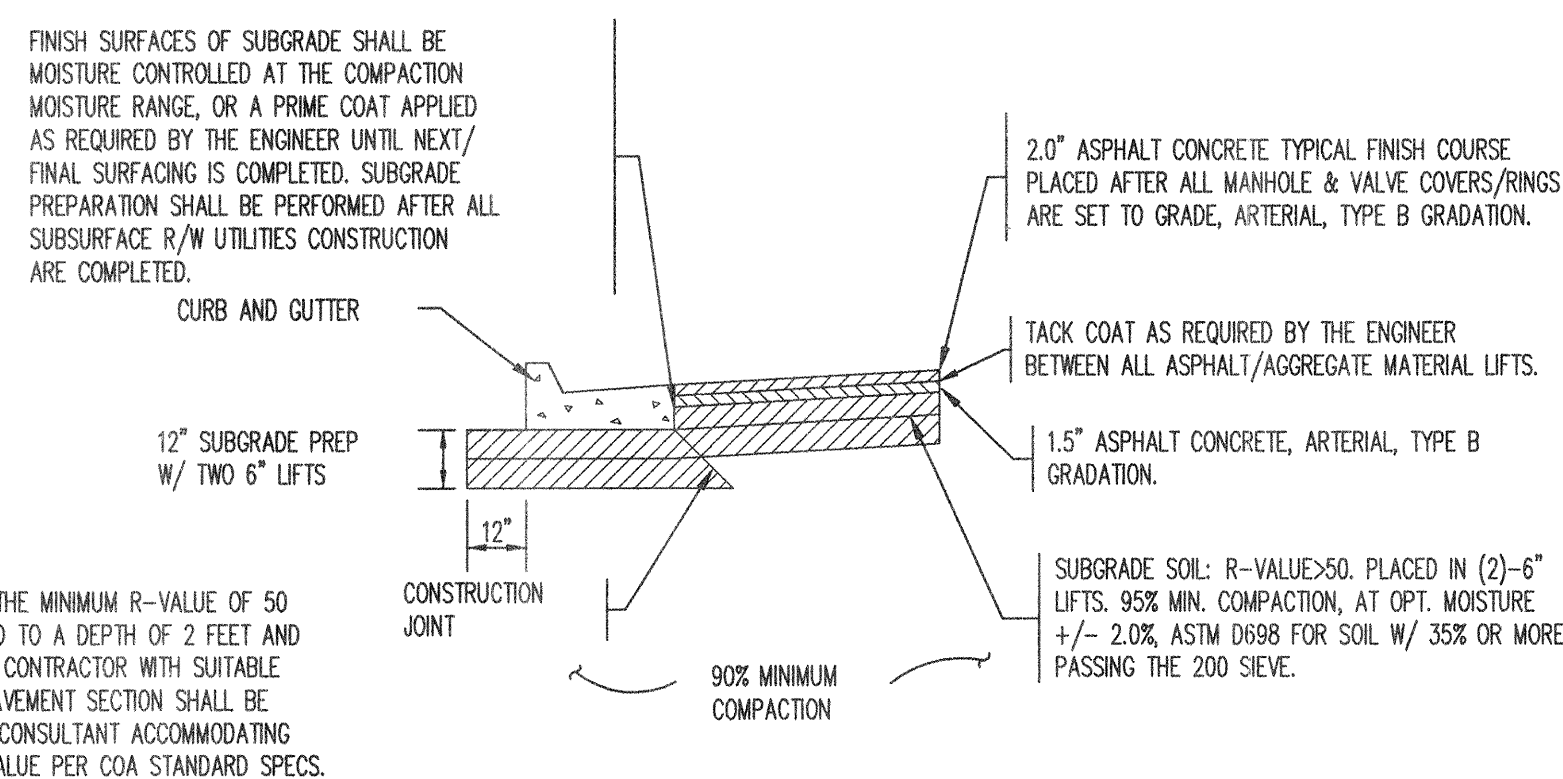


RESIDENTIAL PAVEMENT SECTION - 3.5" ASPHALT
TEAL, WOOD DUCK, & COCKATIEL

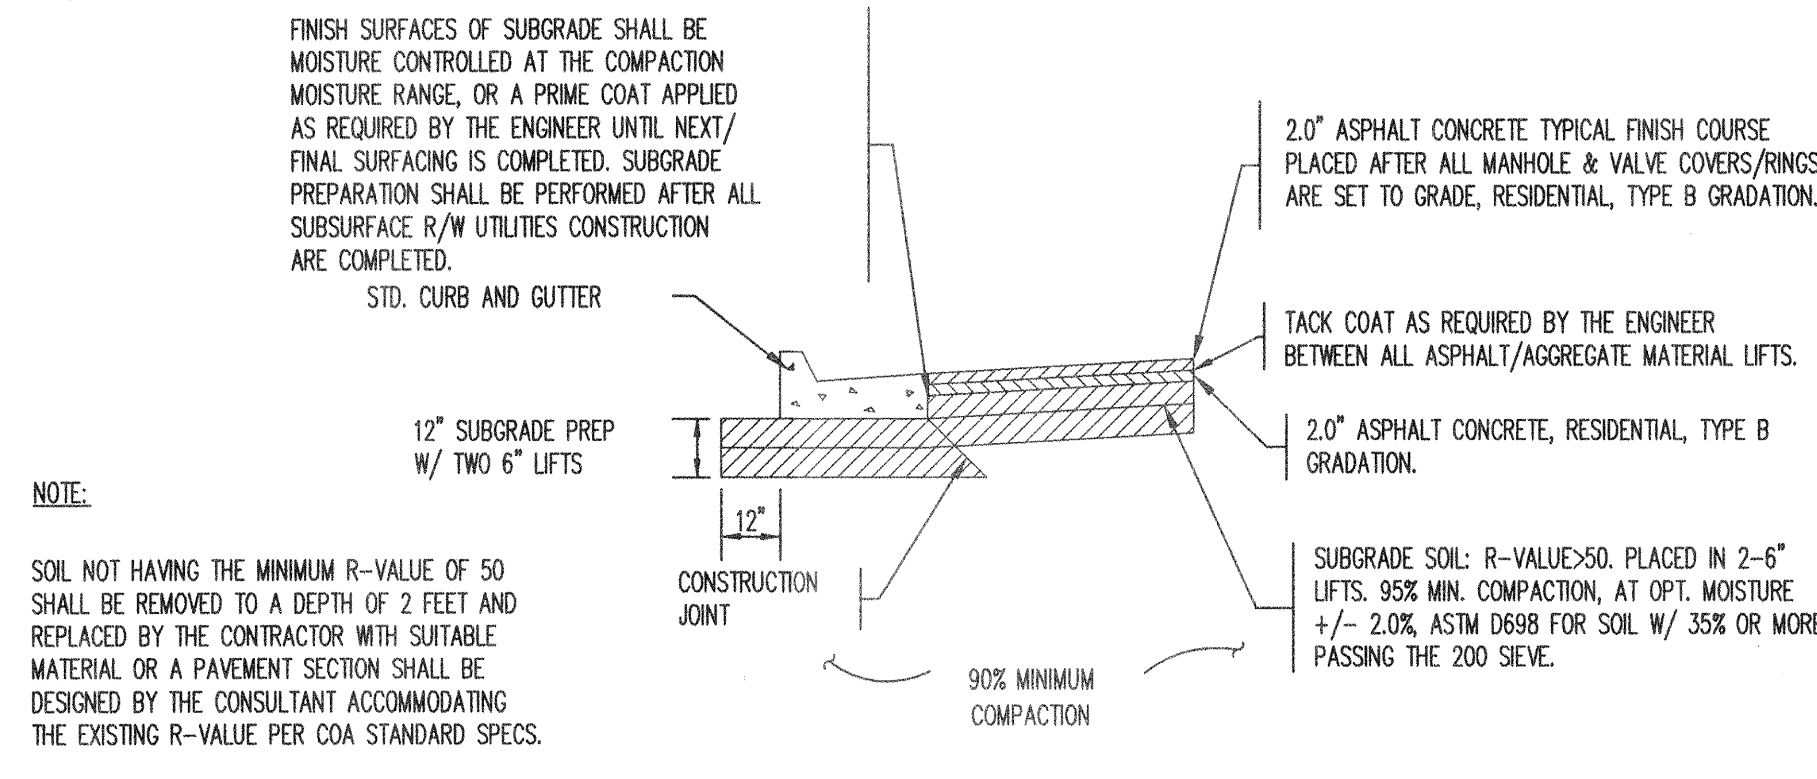


**RESIDENTIAL PAVEMENT SECTION - 4" ASPHALT
(SUBDIVISION ENTRANCES) COCKATIEL & OSPREY**

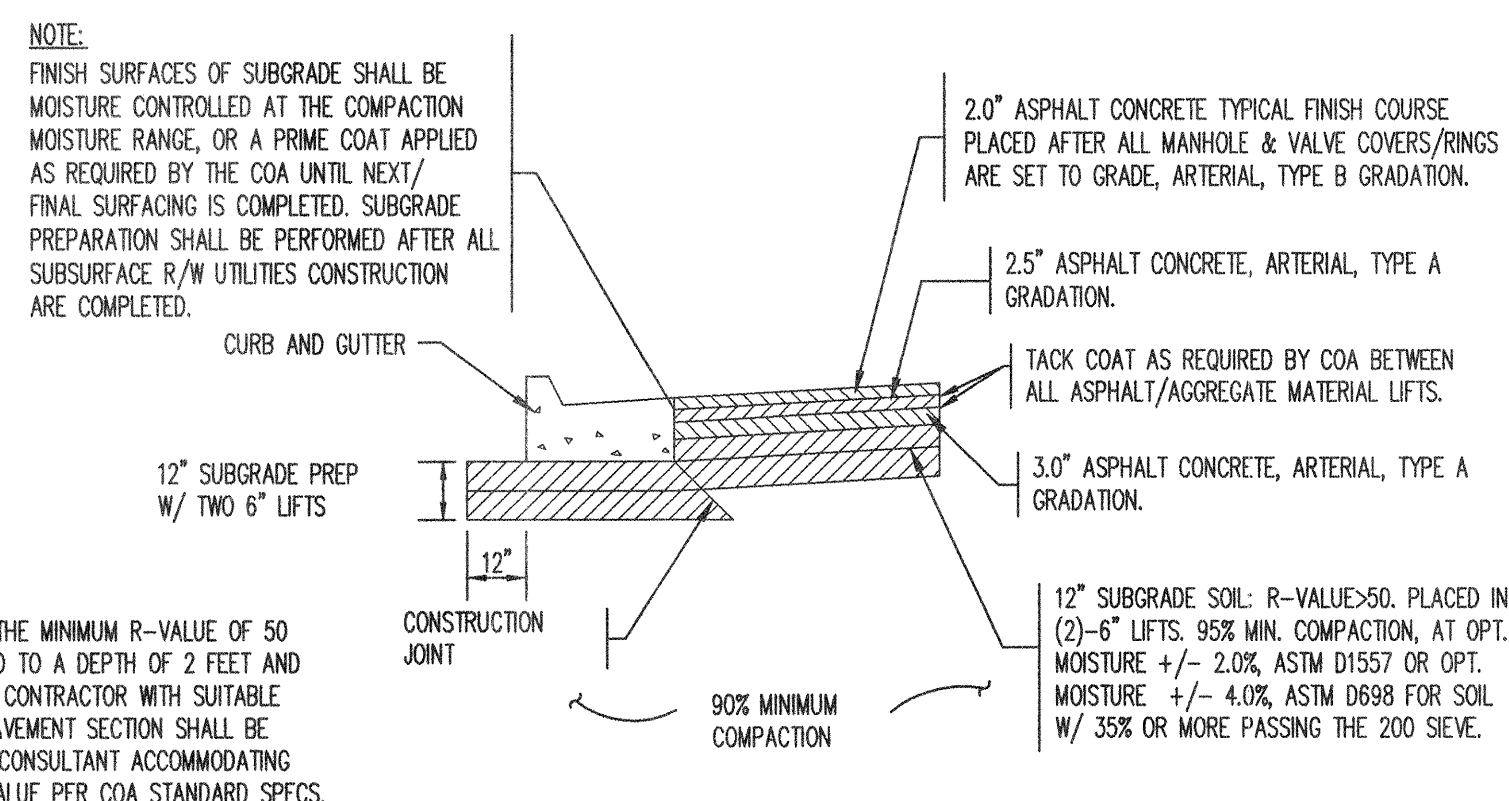

ARTERIAL PAVEMENT SECTION
DE VARGAS ROAD
N.T.S. PER COA PROJECT No. 612781

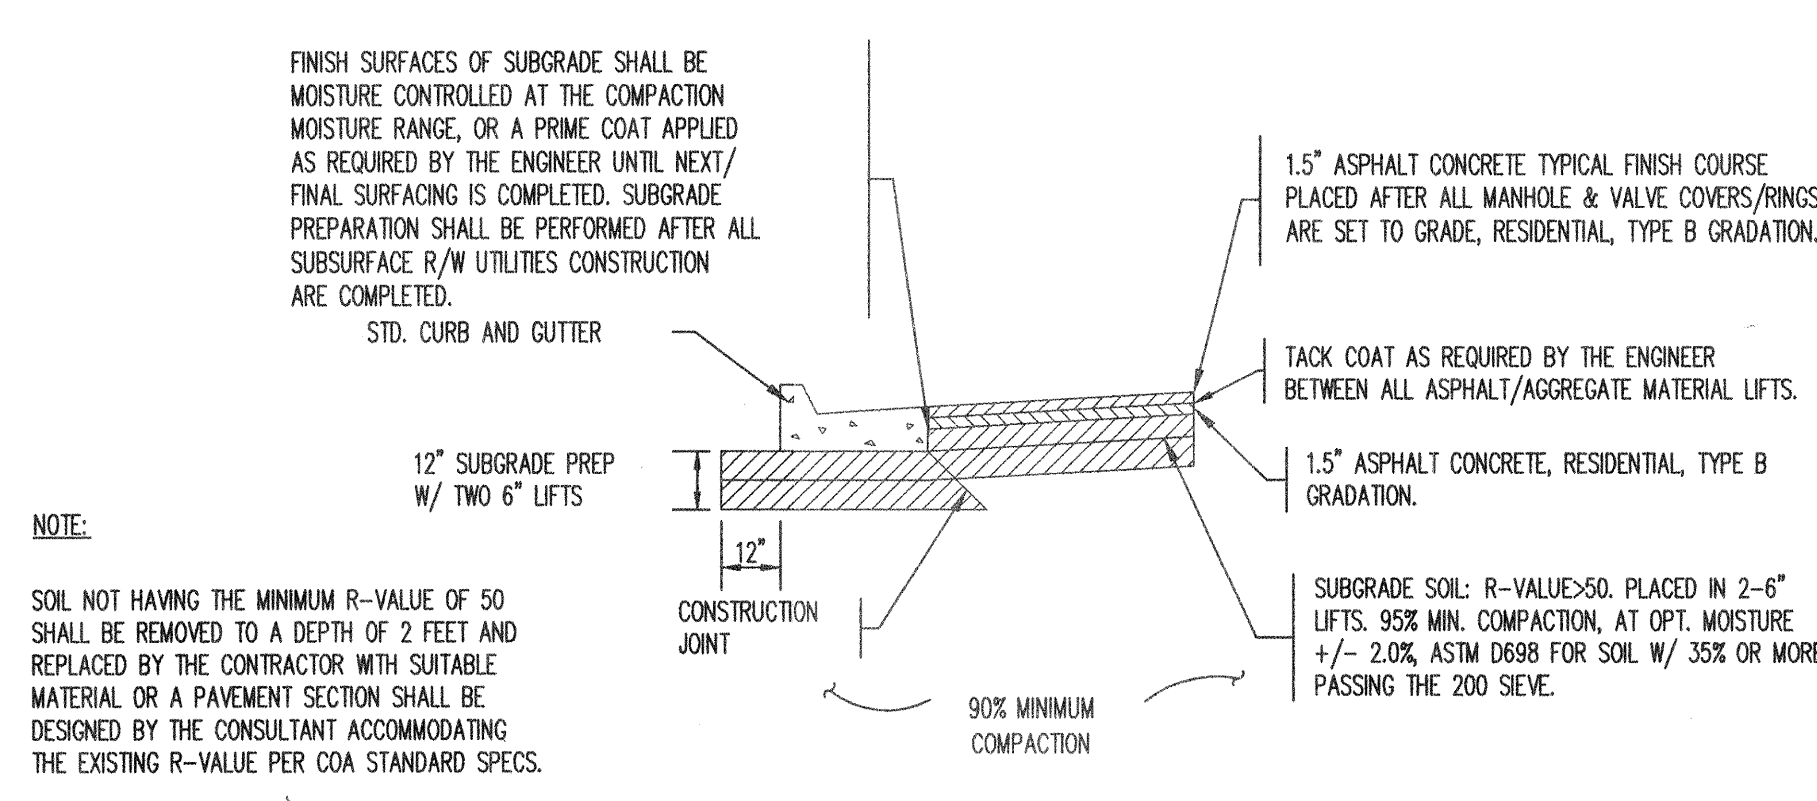

RESIDENTIAL PAVEMENT SECTION - 3" ASPHALT
RED ROBIN, HAWK, Tanager, & 25' TEAL STUB-STREET
N.T.S.

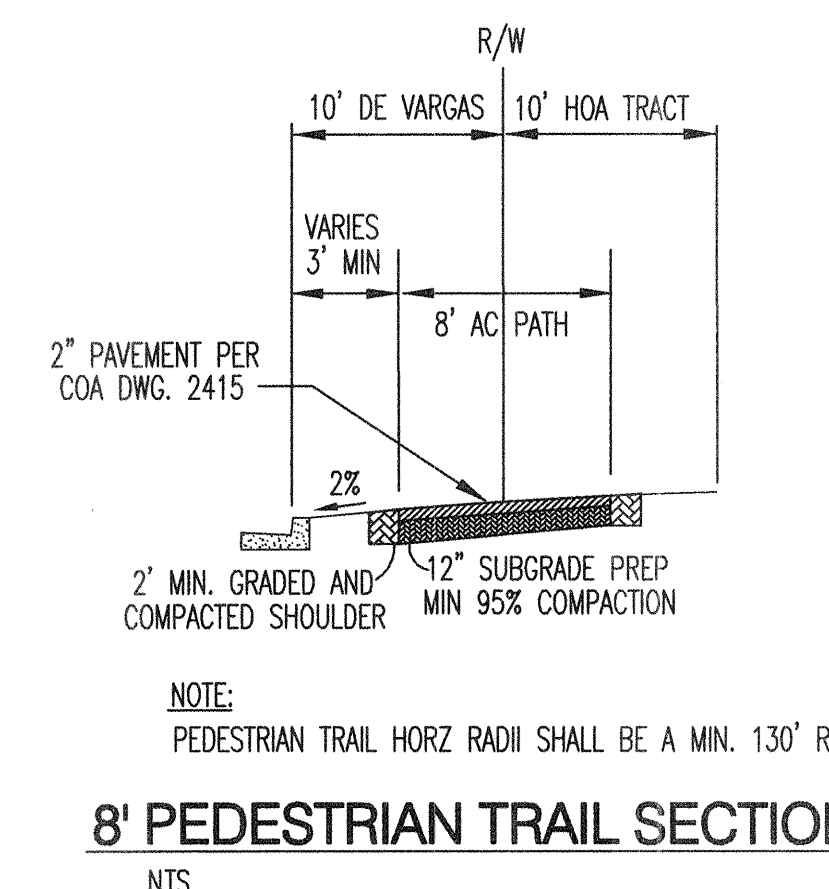

8' PEDESTRIAN TRAIL SECTION
NTS

[illegible]



1. CURB ACCESS RAMPS ARE NORMALLY TO BE LOCATED AT THE CENTER OF THE RETURN OR AS DIRECTED BY THE CITY TRAFFIC ENGINEER.
2. SURFACE TEXTURE OF CURB ASSESS RAMPS SHALL BE OBTAINED BY HEAVY BROOMING. (TEXTURE DEPTH .035"), TRANSVERSE TO THE SLOPE OF THE RAMP.
3. GUTTER FLOW-LINE PROFILE SHALL BE MAINTAINED THROUGH THE AREA OF THE RAMP. DRAINAGE CATCH BASIN STRUCTURES SHALL NOT BE PLACED IN LINE WITH RAMPS.
4. WIDTH OF SIDEWALK AND RAMP MUST BE MAINTAINED AT A MINIMUM OF 5'-0" THROUGH ENTIRE RAMP LENGTH.




- A. SLOPE OF GUTTER DEPENDENT ON REQUIREMENTS FOR VALLEY GUTTER.
- B. 1/4" UP ABOVE FLOW LINE (VERTICAL). SEE STD. DWG 2415
- C. CURB & GUTTER. (SEE STD. DWG 2415 - GUTTER AT THE CURB ACCESS RAMP).
- D. 1/2" EXPANSION JOINT.
- E. PARALLEL LINES - TOP AND BOTTOM OF RAMP.
- F. 12:1 SLOPE AT FACE OF CURB. (SEE STD. DWG 2418)
- G. CONTRACTION (DUMMY) JOINT.
- H. VARIES WITH AVAILABLE R.O.W.
- I. VARIABLE.
- J. HEADER CURB, SEE DWG. 2415.
- L. BACK OF SIDEWALK.
- M. BACK OF SIDEWALK RADIUS TO BE ESTABLISHED SO AS TO MAINTAIN 5'-0" RADIUS WIDTH (MINIMUM) OR MORE THROUGHOUT. SEE STD. DWG 2440 (NOTE 5) IF LESS THAN 5'-0" IS AVAILABLE, DUE TO UNTILTY UNSURVEYABLE CONSTRAINTS.
- N. 4 1/2" MAX.
- P. ANY PESTILE LANDSCAPING AND OR IRRIGATION SHALL BE RESTORED TO ORIGINAL CONDITION. SHOULD ANY RPRATE, IMPROVEMENT NEED TO BE REMOVED, OWNER MUST BE NOTIFIED.
- R. 12:1 SLOPE MAXIMUM ON RAMP.



NOT TO SCALE




NOT TO SCALE

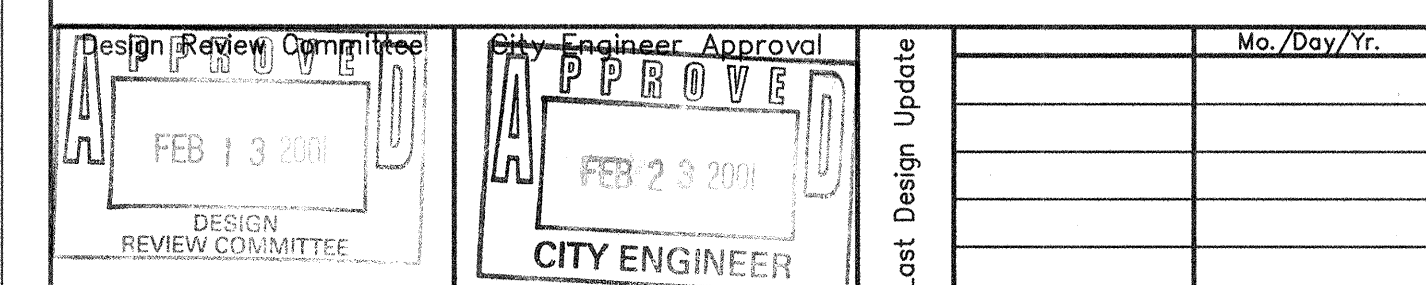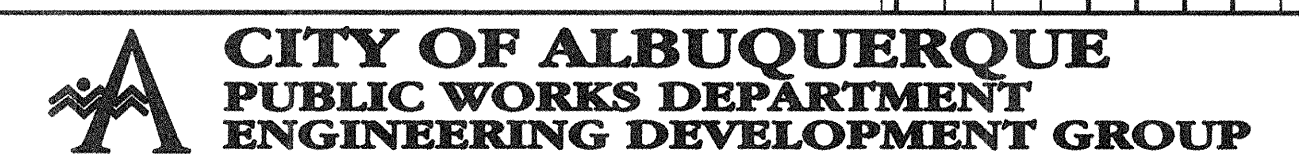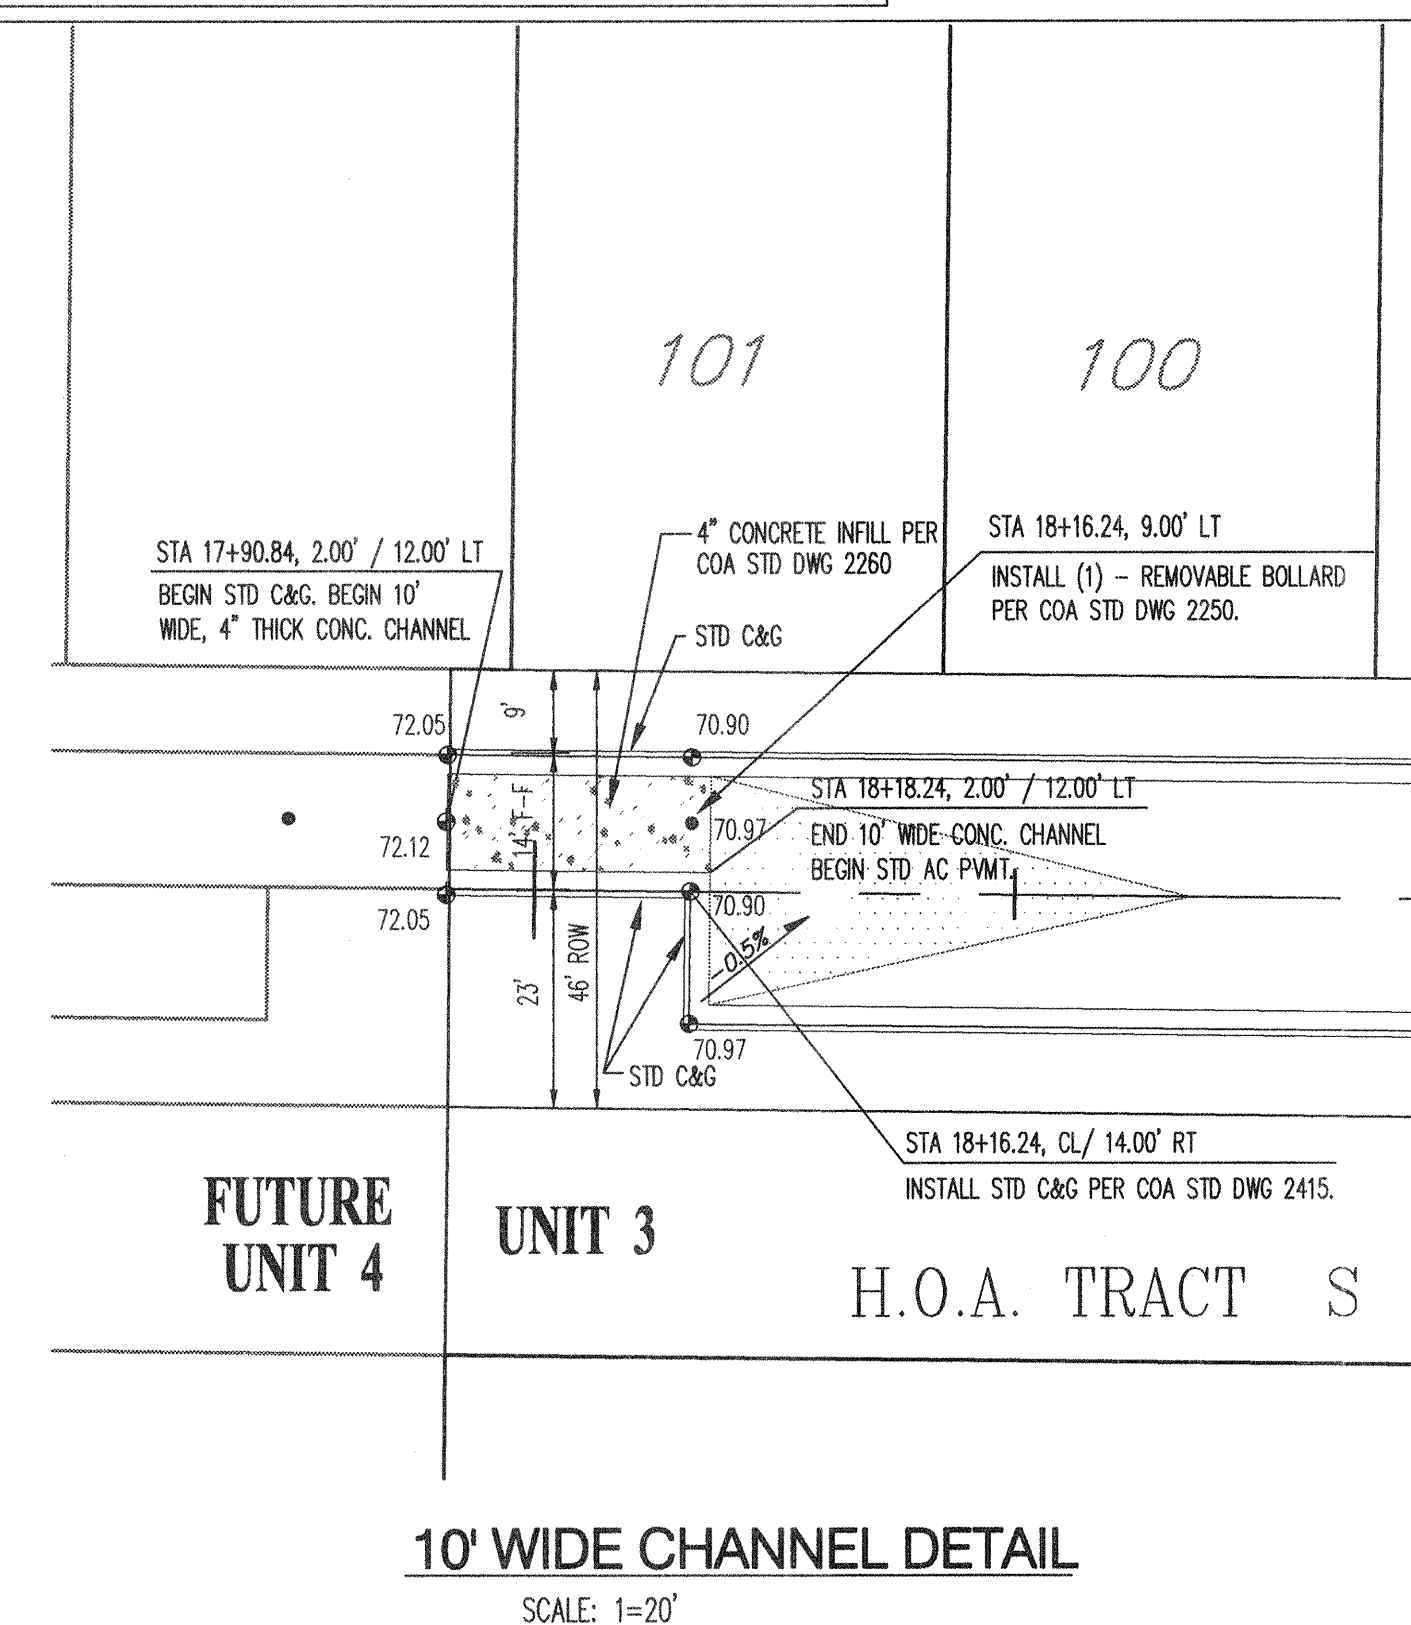

CONSTRUCTION TRAFFIC CONTROL GENERAL NOTES

- CONTRACTOR MUST OBTAIN FROM CONSTRUCTION COORDINATION AN EXCAVATION/BARRICADING PERMIT BEFORE ENGAGING IN ANY CONSTRUCTION, MAINTENANCE OR REPAIR WORK IN ANY OF THE CITY OF ALBUQUERQUE'S RIGHTS-OF-WAY. EMERGENCY WORK THAT WOULD PRESERVE LIFE OR PROPERTY IS EXCLUDED WITH THE UNDERSTANDING, THAT A PERMIT SHALL BE OBTAINED WITHIN 24 TO 48 HOURS.
- CONTRACTOR SHALL AT THE TIME OF PERMIT REQUEST, SUBMIT FOR APPROVAL BY CONSTRUCTION COORDINATION, A TRAFFIC CONTROL PLAN DETAILING ALL EXISTING TOPOGRAPHY SUCH AS LANE WIDTHS, DRIVEWAYS, AND BUSINESS/RESIDENTIAL ACCESSES. THE TRAFFIC CONTROL PLAN SHALL INCLUDE ALL PHASES OF WORK AND SCHEDULES INVOLVED IN THE CONSTRUCTION PROJECT. ANY SEPARATE PHASES OF A CONSTRUCTION PROJECT SHALL BE GIVEN AN INDIVIDUAL PERMIT EACH. BLANKET PERMITS WILL NOT BE ISSUED.
- THESE TYPICAL TRAFFIC CONTROL PLANS DO NOT REFLECT THE EXISTING TOPOGRAPHY SUCH AS DRIVEWAYS, LANE WIDTHS, AND BUSINESS/RESIDENTIAL ACCESSES. EVERY LOCATION THAT REQUIRES CONSTRUCTION TRAFFIC CONTROL SHALL HAVE A DETAILED TRAFFIC CONTROL PLAN SHOWING ALL EXISTING TOPOGRAPHY.
- CONSTRUCTION SHALL NOT BEGIN UNLESS A TRAFFIC CONTROL PLAN HAS BEEN APPROVED AND VERIFIED BY CONSTRUCTION COORDINATION.
- CONSTRUCTION COORDINATION SHALL BE NOTIFIED 48 HOURS PRIOR TO ANY TRAFFIC CONTROL CHANGES NEEDED BY CONTRACTOR, THAT WERE NOT PREVIOUSLY APPROVED. THESE TRAFFIC CONTROL CHANGES SHALL BE REQUESTED IN WRITING ACCOMPANIED WITH A TRAFFIC CONTROL PLAN REFLECTING SUCH CHANGES.
- ALL CONSTRUCTION TRAFFIC CONTROL DEVICES SHALL COMPLY TO THE MANUAL ON UNIFORM TRAFFIC CONTROL DEVICES (MUTCD), LATEST EDITION. IT IS THE RESPONSIBILITY OF THE CONTRACTOR TO INSTALL, SERVICE AND MAINTAIN ALL TRAFFIC CONTROL DEVICES. TRAFFIC CONTROL DEVICES SHALL NOT BE REMOVED OR ALTERED IN ANY WAY WITHOUT THE APPROVAL OF CONSTRUCTION COORDINATION, PER SECTION 6A-4 OF THE MUTCD, LATEST EDITION.
- THE CONSTRUCTION TRAFFIC CONTROL INITIAL SET-UP SHALL BE BY AN AMERICAN TRAFFIC SAFETY SERVICES ASSOCIATION (ATSSA) CERTIFIED WORKSITE TRAFFIC SUPERVISOR. THE MAINTENANCE AND SERVICING SHALL ALSO BE DONE BY AN ATSSA CERTIFIED WORKSITE TRAFFIC SUPERVISOR OR EQUIVALENT.
- CONTRACTOR IS RESPONSIBLE TO MAINTAIN AND SERVICE ALL TRAFFIC CONTROL DEVICES 24 HOURS A DAY, 7 DAYS A WEEK THROUGHOUT LENGTH OF PROJECT. CONTRACTOR IS RESPONSIBLE THAT ALL TRAFFIC CONTROL DEVICES COMPLY WITH THE MUTCD, LATEST EDITION.
- ALL ADVANCE WARNING SIGNS SHALL BE DOUBLE INDICATED WHENEVER THERE ARE MULTI-LANE TRAFFIC IN ANY ONE GIVEN DIRECTION AND THERE IS SUFFICIENT MEDIAN SPACE.
- ALL BARRICADES IN ALL TAPERS AND TANGENTS SHALL BE PLACED APART, A DISTANCE MEASURED IN FEET, EQUAL TO THAT OF THE POSTED SPEED LIMIT. NO EXCEPTIONS UNLESS APPROVED BY CONSTRUCTION COORDINATION PER MUTCD SECTION 6A-4.
- ALL WORK IN ARTERIAL ROADWAYS SHALL BE ON A CONTINUOUS 24 HOUR PER DAY BASIS UNTIL COMPLETED.
- CONTRACTOR IS RESPONSIBLE TO PROVIDE CONSTRUCTION COORDINATION, A WEEKLY LOG OF DAILY INSPECTIONS OF BARRICADE AND MAINTENANCE SCHEDULES ON PROJECTS THAT ARE OVER ONE WEEK DURATION.
- EQUIPMENT OR MATERIALS SHALL NOT BE STORED WITHIN 15 FEET OF A TRAVELED TRAFFIC LANE DURING NON-WORKING HOURS WITHOUT THE APPROVAL OF CONSTRUCTION COORDINATION.
- CONTRACTOR SHALL PROVIDE AND MAINTAIN A SAFE AND ADEQUATE MEANS OF CHANNELIZING PEDESTRIAN TRAFFIC AROUND AND THROUGH THE CONSTRUCTION AREA.
- CONTRACTOR IS RESPONSIBLE FOR OBLITERATION OF ANY CONFLICTING STRIPING AND RESPONSIBLE FOR ALL TEMPORARY STRIPING.
- CONTRACTOR SHALL MAINTAIN ACCESS TO ALL FACILITIES, BUSINESSES AND/OR RESIDENTS AT ALL TIMES.
- CONTRACTOR SHALL PROVIDE ACCESS SIGNS FOR BUSINESSES LOCATED WITHIN THE CONSTRUCTION AREA UNDER THE SUPERVISION OF CONSTRUCTION COORDINATION. EACH ACCESS SIGN SHALL HAVE 5 INCH, WHITE OPAQUE LETTERING ON BLUE REFLECTORIZED BACKGROUND. ACCESS SIGNS SHALL BE CONSIDERED INCIDENTAL TO THE BID AND NOT PART OF THE CONTRACT UNLESS OTHERWISE STATED. NO MORE THAN 3 BUSINESSES SHALL BE LISTED ON AN ACCESS SIGN. SHOPPING CENTERS AND MALLS SHALL BE LISTED AS SUCH.
- ALL ADVANCE WARNING SIGNS SHALL MEET THE MINIMUM REFLECTIVE INTENSITY REQUIREMENTS SET FORTH BY THE CITY OF ALBUQUERQUE. CONSTRUCTION COORDINATION SHALL DETERMINE ALL REQUIREMENTS AND APPROVE OR DISAPPROVE ANY ADVANCE WARNING SIGN PER SECTION 6A-4 OF THE MUTCD, LATEST EDITION.
- 48 HOURS PRIOR TO OCCUPYING OR CLOSING OF A RIGHT-OF-WAY, CONTRACTOR SHALL NOTIFY: POLICE, FIRE DEPARTMENT, SCHOOLS, HOSPITALS, TRANSIT AUTHORITY, BUSINESSES AND/OR RESIDENTS THAT WILL BE AFFECTED BY THE CONSTRUCTION.
- ANY FIELD ADJUSTMENTS SHALL BE APPROVED BY CONSTRUCTION COORDINATION.

- EXCAVATIONS SHALL BE PLATED, TEMPORARILY PATCHED OR RESURFACED PRIOR TO OPENING OF TRAFFIC. A MINIMUM OF 11 FEET SHALL BE PROVIDED FOR TRAFFIC IN ANY GIVEN DIRECTION. CONTRACTOR IS RESPONSIBLE FOR ANY WORK INVOLVED IN SATISFYING THESE REQUIREMENTS.
- CONTRACTOR SHALL AT ALL TIMES COMPLY WITH THE FOLLOWING:
 - STANDARDS AND REQUIREMENTS SET FORTH IN THE MANUAL ON UNIFORM TRAFFIC CONTROL DEVICES, LATEST EDITION.
 - THE CITY OF ALBUQUERQUE TRAFFIC CODE, LATEST EDITION.
 - SECTION 19 OF THE CITY OF ALBUQUERQUE'S STANDARD SPECIFICATIONS FOR PUBLIC WORK CONSTRUCTION, AS WELL AS OTHER SECTIONS.
- FAILURE TO COMPLY WITH ANY OF THE ABOVE MENTIONED, WILL BE ADEQUATE CAUSE TO CEASE ALL WORK ON ANY CONSTRUCTION PROJECT. WORK WILL NOT RESUME UNTIL ALL REQUIREMENTS ARE ADDRESSED AND APPROVED BY CONSTRUCTION COORDINATION.
- ALL TRAFFIC CONTROL DEVICES SHALL BE KEPT IN NEW-CLEAN CONDITION, WASHING OF EQUIPMENT IS INCIDENTAL TO IT'S PLACEMENT AND MAINTENANCE.
- TRAFFIC CONTROL STANDARDS APPLY ONLY WHERE THE CONSTRUCTION TRAFFIC CONTROL PLANS ARE NOT SPECIFIC.
- ADVANCE WARNING SIGNS SHALL BE 36"x36" MIN. WITH SUPER ENGINEERING GRADE SHEETING OR BETTER. MOUNTING HEIGHT AT TOP OF SIGN SHALL BE THE SAME AS FOR A 48" SIGN AS INDICATED IN THE M.U.T.C.D.
- CONTRACTOR SHALL MAINTAIN A GRAFFITI-FREE WORKSITE. ALL GRAFFITI SHALL BE PROMPTLY REMOVED FROM ALL EQUIPMENT, BOTH PERMANENT AND TEMPORARY.

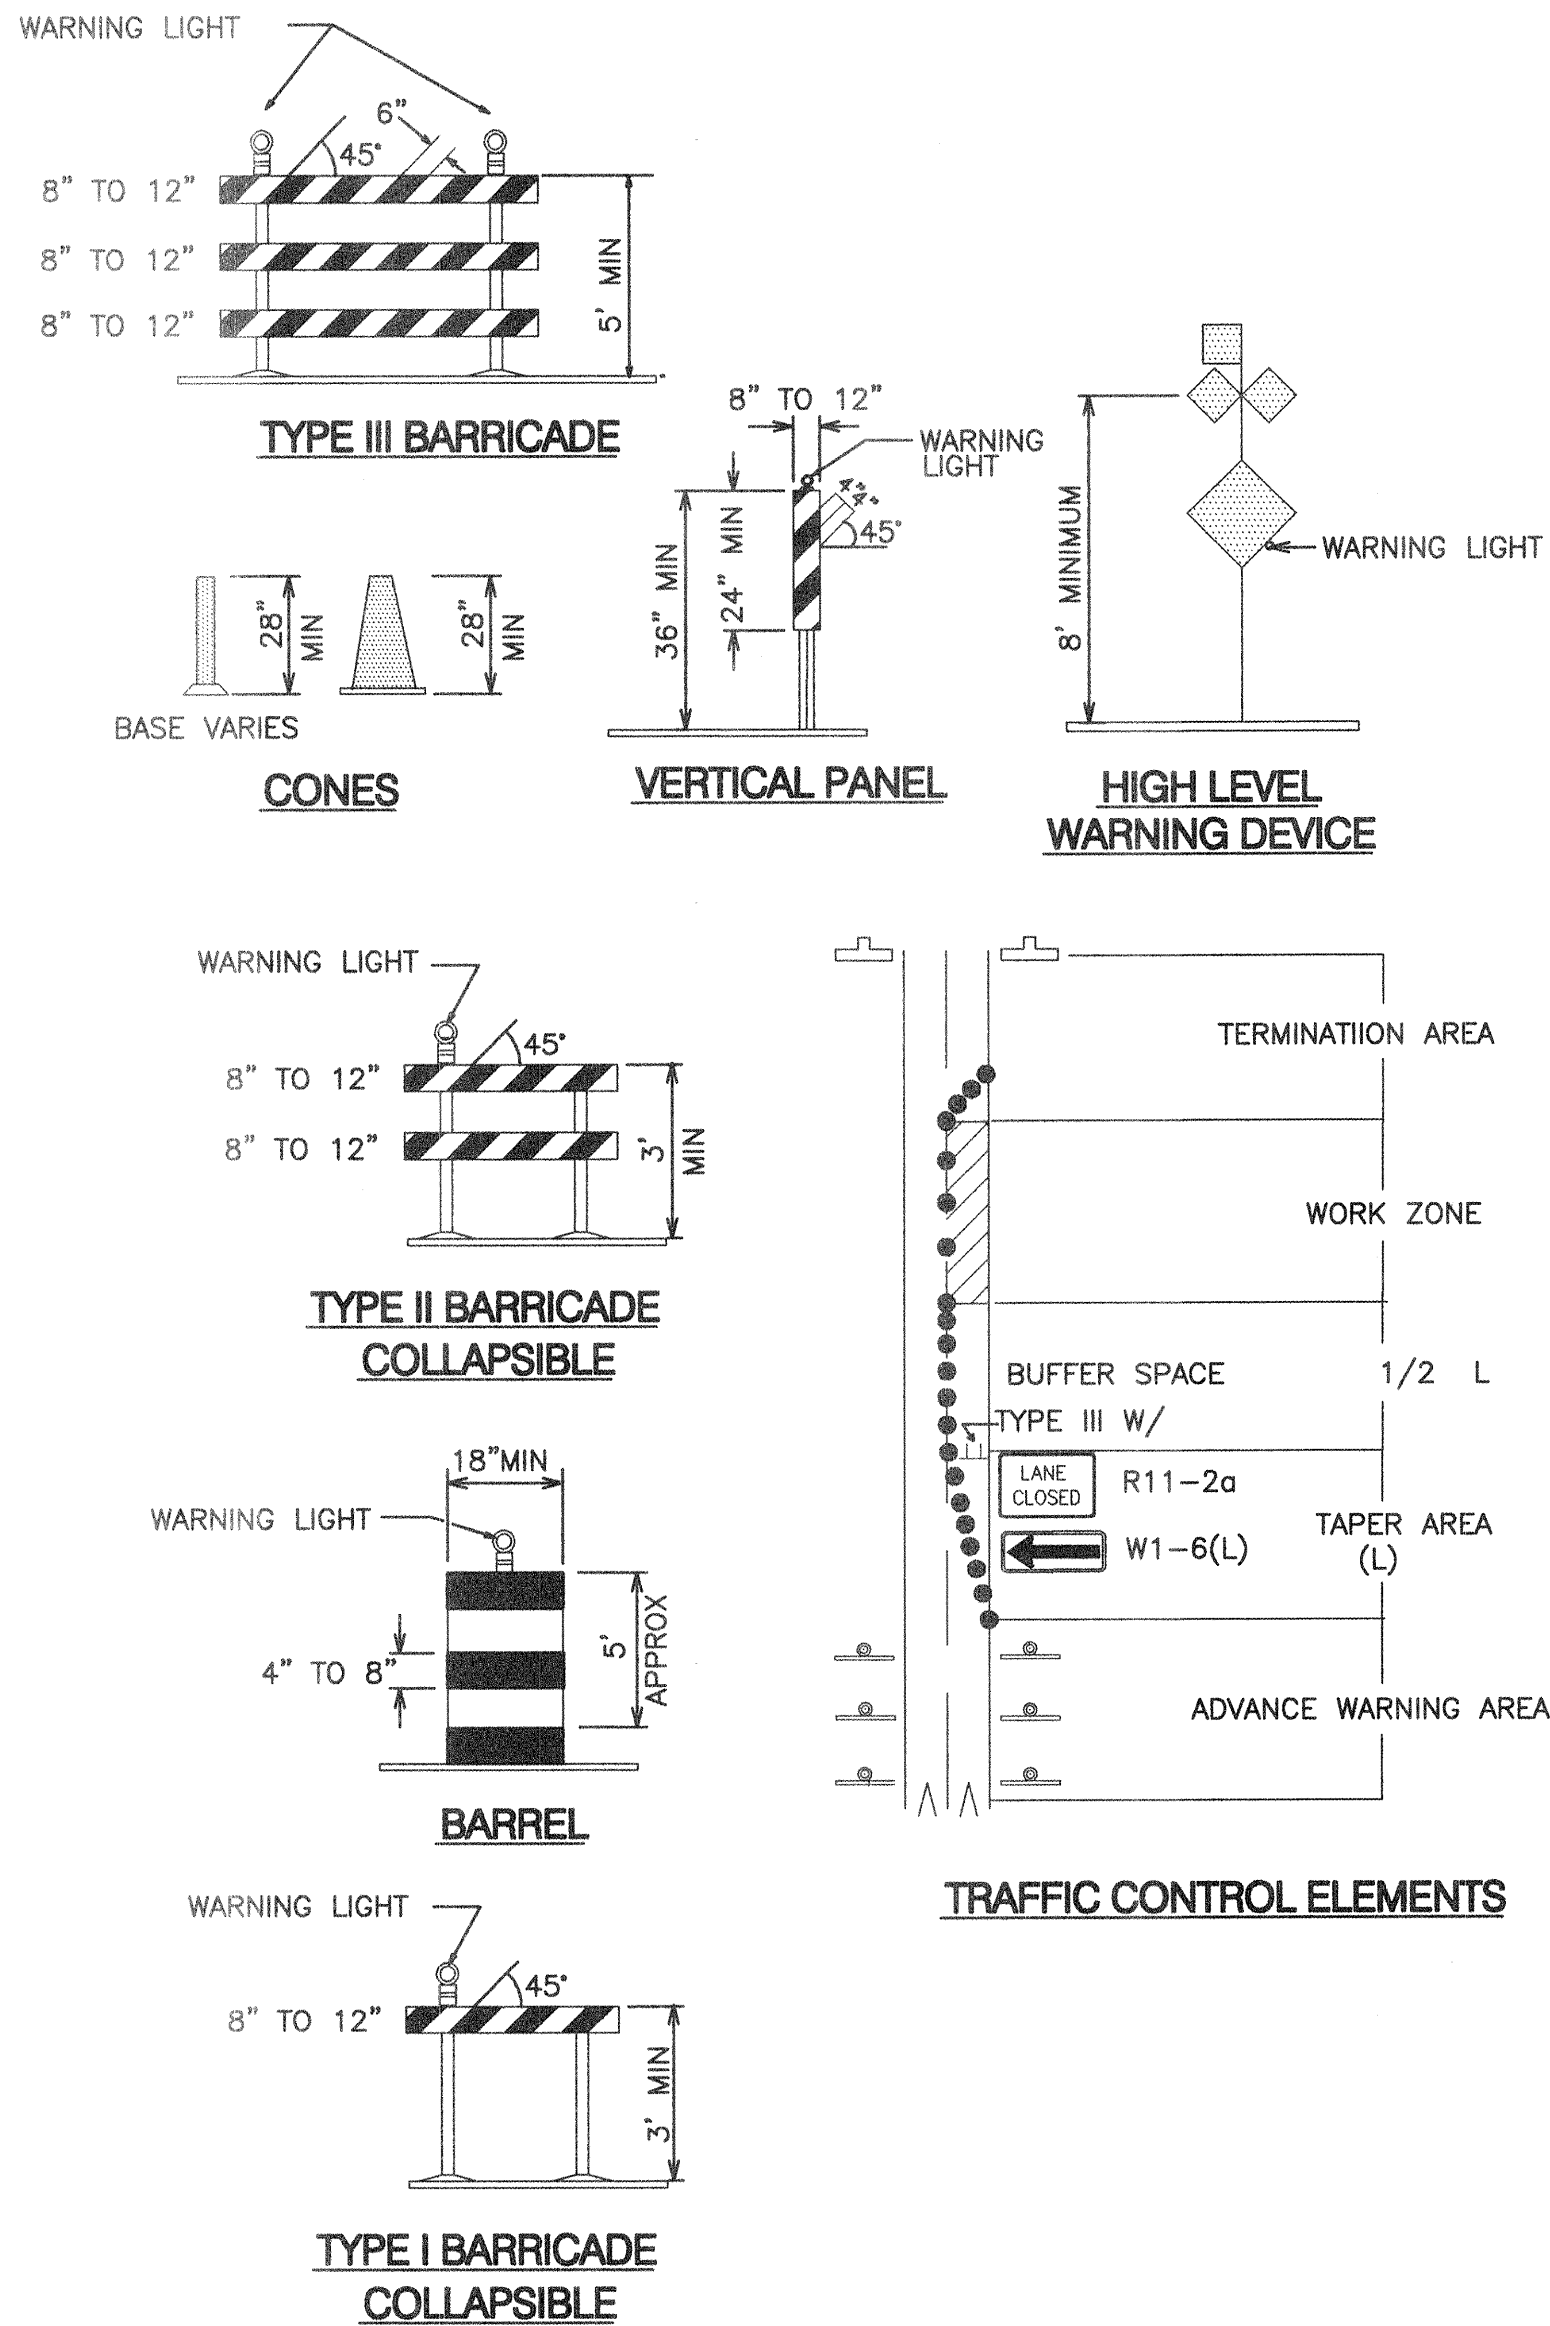

LEGEND

- WORK AREA
- BARRICADE -- TYPE I, TYPE II, OR BARREL
- BARRICADE -- TYPE III
- VERTICAL PANEL
- WARNING SIGN
- DISTANCE BETWEEN SIGNS -- A DISTANCE MEASURED IN FEET EQUAL TO A VALUE OF TEN TIMES THE SPEED LIMIT OF THE STREET
- FLAGMAN POSITION
- SPACING BETWEEN BARRICADES -- A DISTANCE MEASURED IN FEET EQUAL TO THE STREET LIMIT OF THE STREET
- TAPER LENGTH -- SEE CHART BELOW

THE TANGENT LENGTH IS EQUAL TO THE TAPER LENGTH FOR A GIVEN STREET.

TAPER REQUIREMENT

SPEED LIMIT (MPH)	TAPER LENGTH(L) (FEET)			MINIMUM NUMBER OF DEVICES FOR TAPER	MAXIMUM DEVICE SPACING IN FEET	
	10' LANE	11' LANE	12' LANE		ALONG TAPER	AFTER TAPER
20	70	75	80	5	20	20
25	105	115	125	6	25	25
30	150	165	180	7	30	30
35	205	225	245	8	35	35
40	270	295	320	9	40	40
45	450	495	540	13	45	45
50	500	550	600	13	50	50
55	550	605	660	13	55	55

RECOMMENDED SIGN SPACING(D) FOR ADVANCE WARNING SIGN SERIES

SPEED MILES PER HOUR	MINIMUM DISTANCE IN FEET BETWEEN SIGNS	FROM LAST SIGN TO TAPER
0-20	10 X SPEED LIMIT	10 X SPEED LIMIT
25-30	10 X SPEED LIMIT	10 X SPEED LIMIT
30-35	10 X SPEED LIMIT	10 X SPEED LIMIT
40-45	10 X SPEED LIMIT	10 X SPEED LIMIT
50-60	10 X SPEED LIMIT	10 X SPEED LIMIT

TAPER CRITERIA


TYPE OF TAPER	TAPER LENGTH
UPSTREAM TAPER:	
MERGING TAPER	L MINIMUM
SHIFTING TAPER	1/2 L MINIMUM
SHOULDER TAPER	1/2 L MINIMUM
TWO-WAY TRAFFIC TAPER	100 FEET MAXIMUM
DOWNSTREAM TAPERS	100 FEET PER LANE

TAPER LENGTH COMPUTATION

SPEED LIMIT	
40 MPH OR LESS	$L = \frac{WS^2}{60}$
40 MPH OR GREATER	$L = W \times S$

L = TAPER LENGTH
W = WIDTH OF OFFSET IN FEET
S = POSTED SPEED OR OFF-PEAK 85-PERCENTILE SPEED IN MPH

SIGN FACE DETAILS

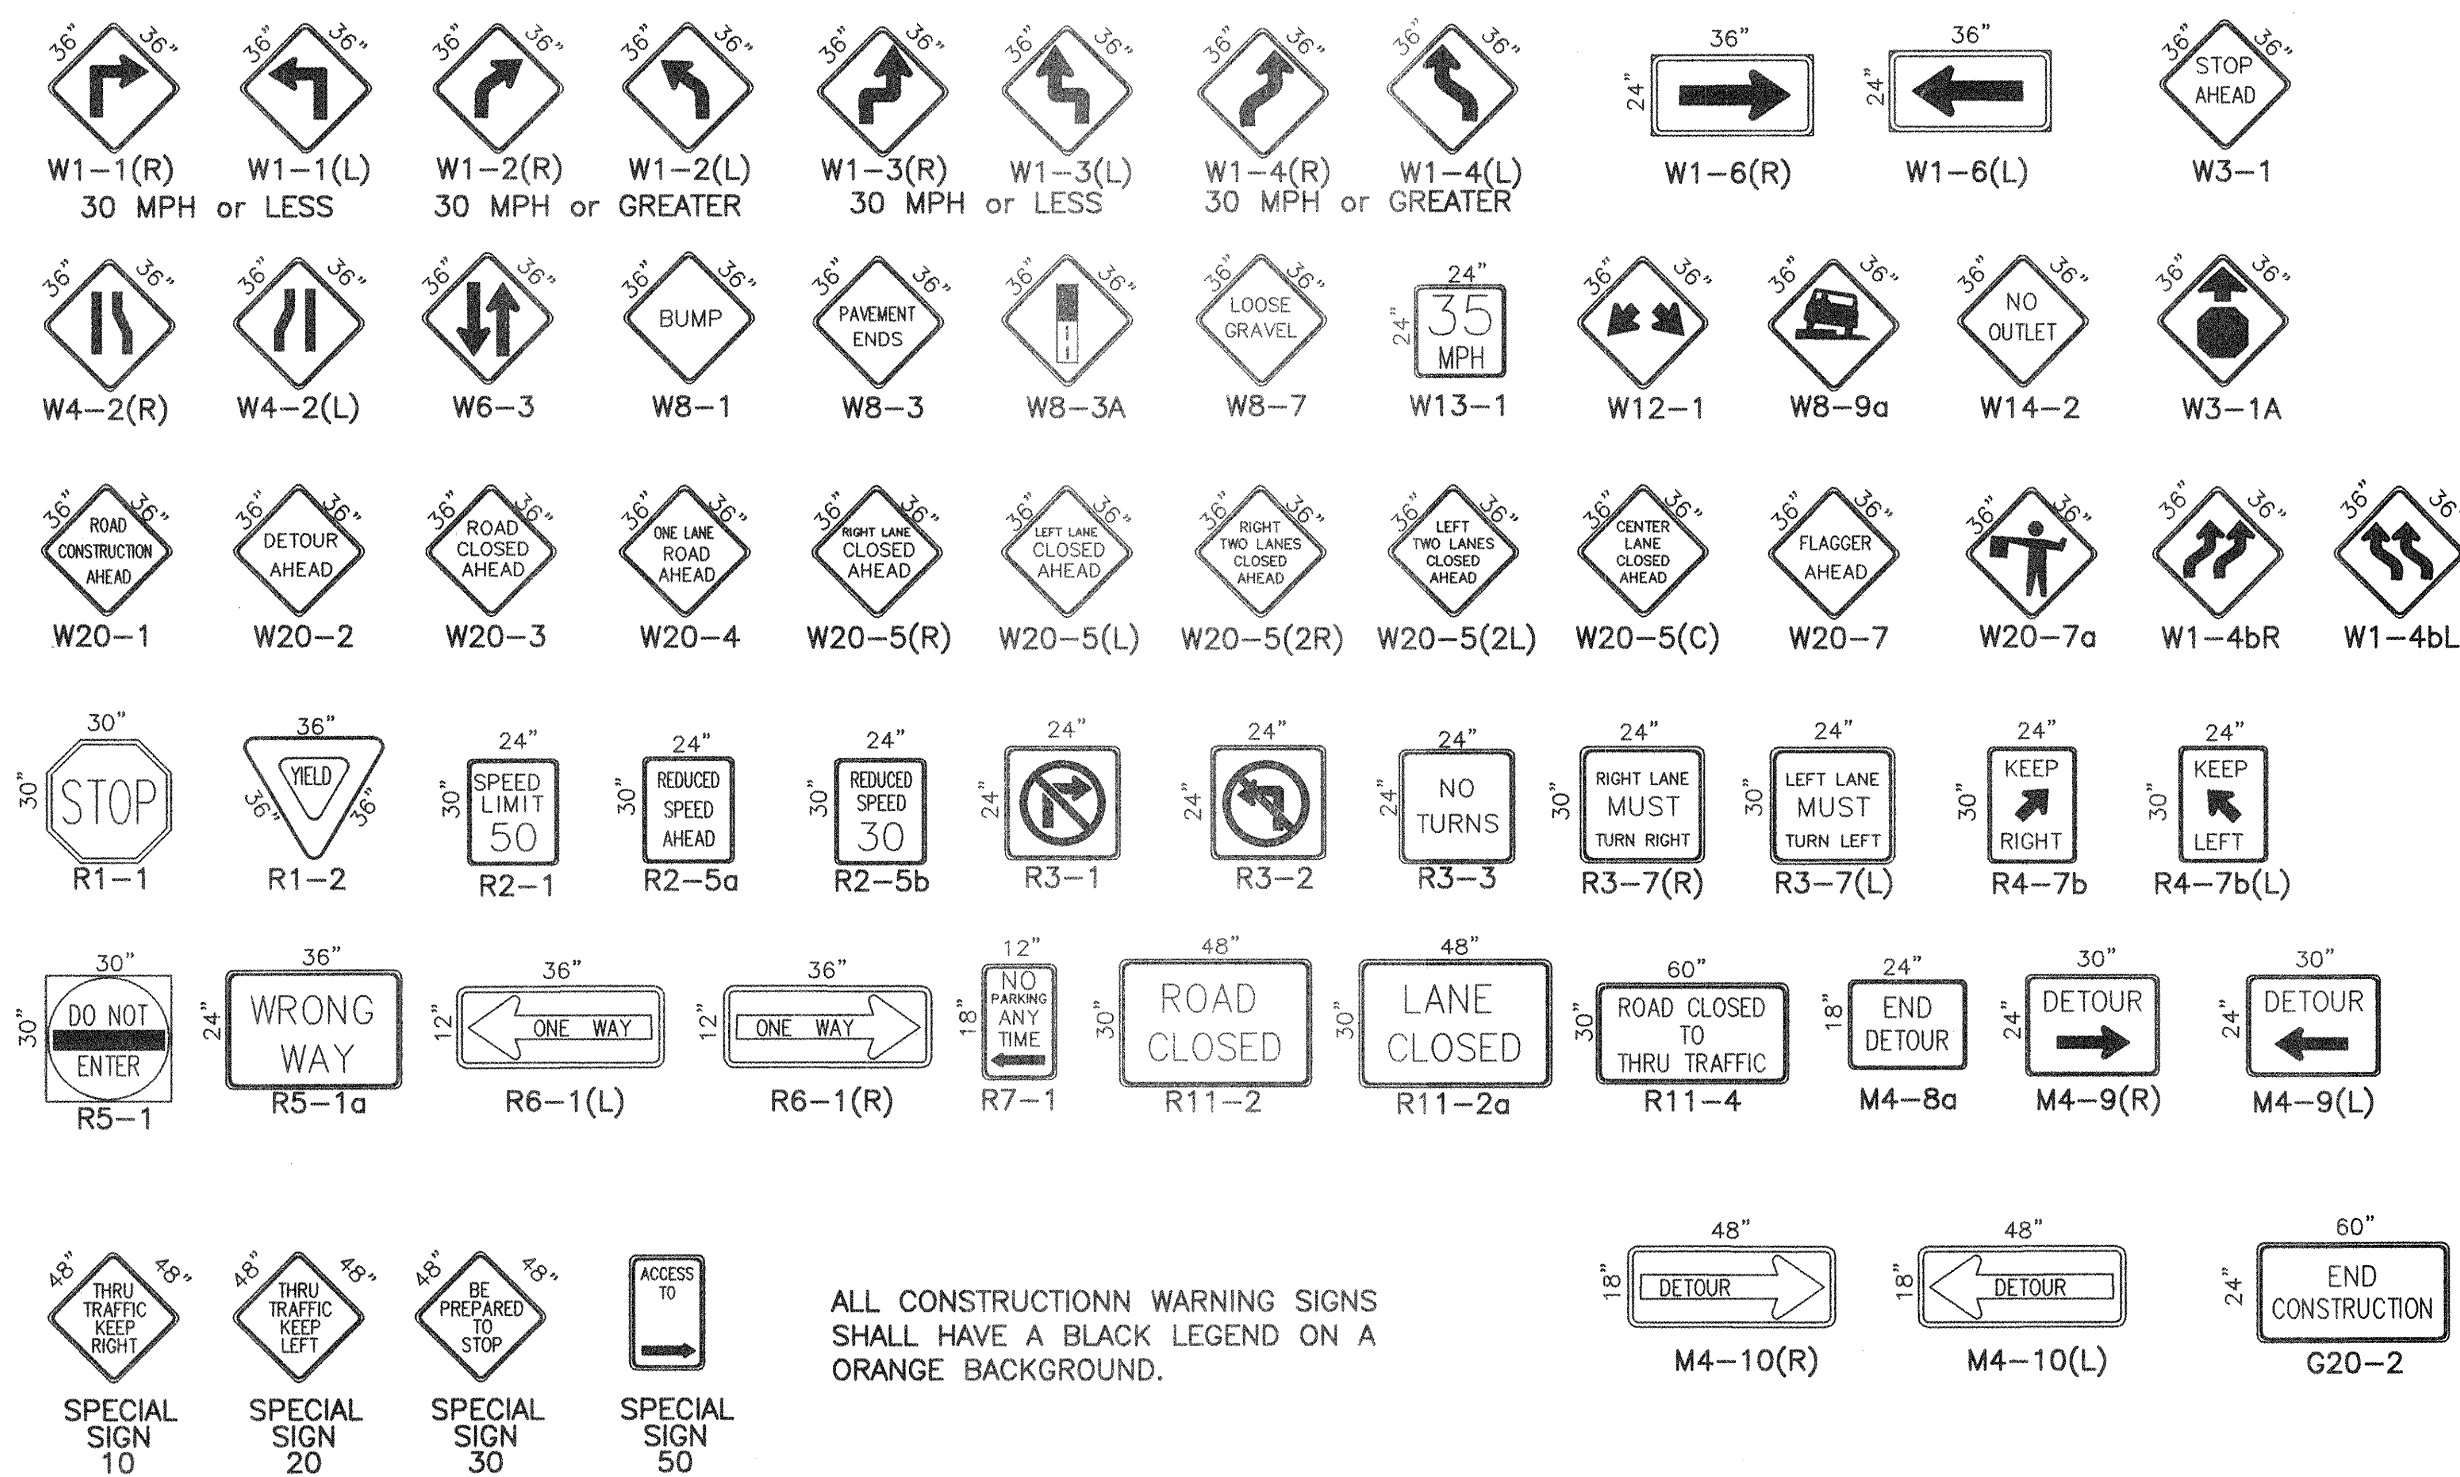


ALL CONSTRUCTION WARNING SIGNS SHALL HAVE A BLACK LEGEND ON A ORANGE BACKGROUND.

SCANNED BY
MESA REPRO


Bohannon & Huston
Court yard One 7500 JEFFERSON NE Albuquerque NEW MEXICO 87109
ENGINEERS PLANNERS PHOTOGRAMMETRISTS SURVEYORS SOFTWARE DEVELOPERS

CITY OF ALBUQUERQUE
PUBLIC WORKS DEPARTMENT
ENGINEERING DEVELOPMENT GROUP
TIMARRON WEST UNIT 3 SUBDIVISION
TRAFFIC CONTROL SIGNING & CONSTRUCTION TRAFFIC CONTROL STANDARDS
Design Review Committee City Engineer Approval
City Project No. 651681 Zone Map No. L8-M8 Sheet 31 Of 32
Last Design Update
Ms./Day/Yr. Ms./Day/Yr.


SCANNED BY
MESA REPRO

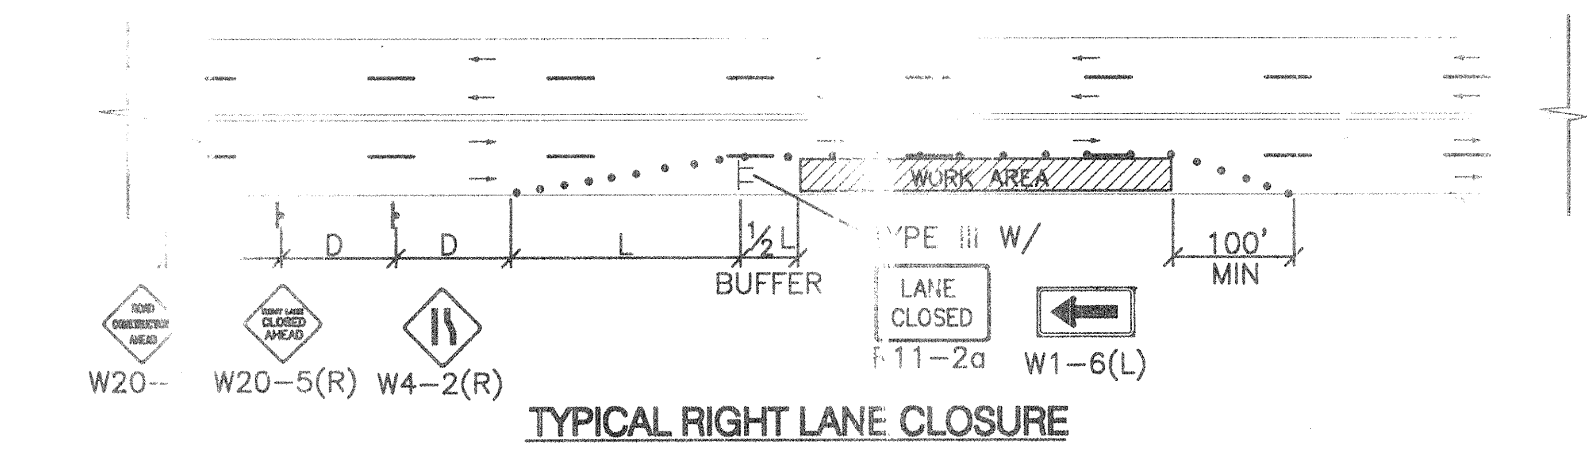


TYPICAL RIGHT LANE CLOSURE

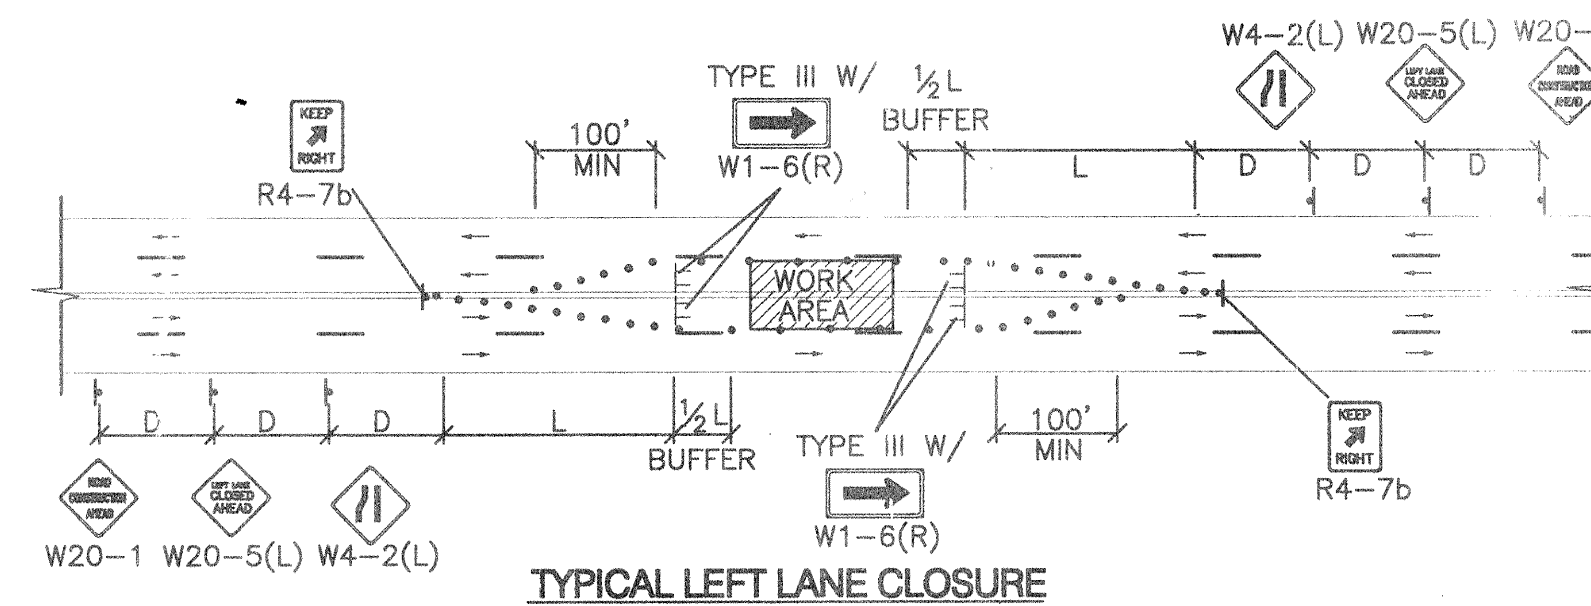


TYPICAL LEFT LANE CLOSURE

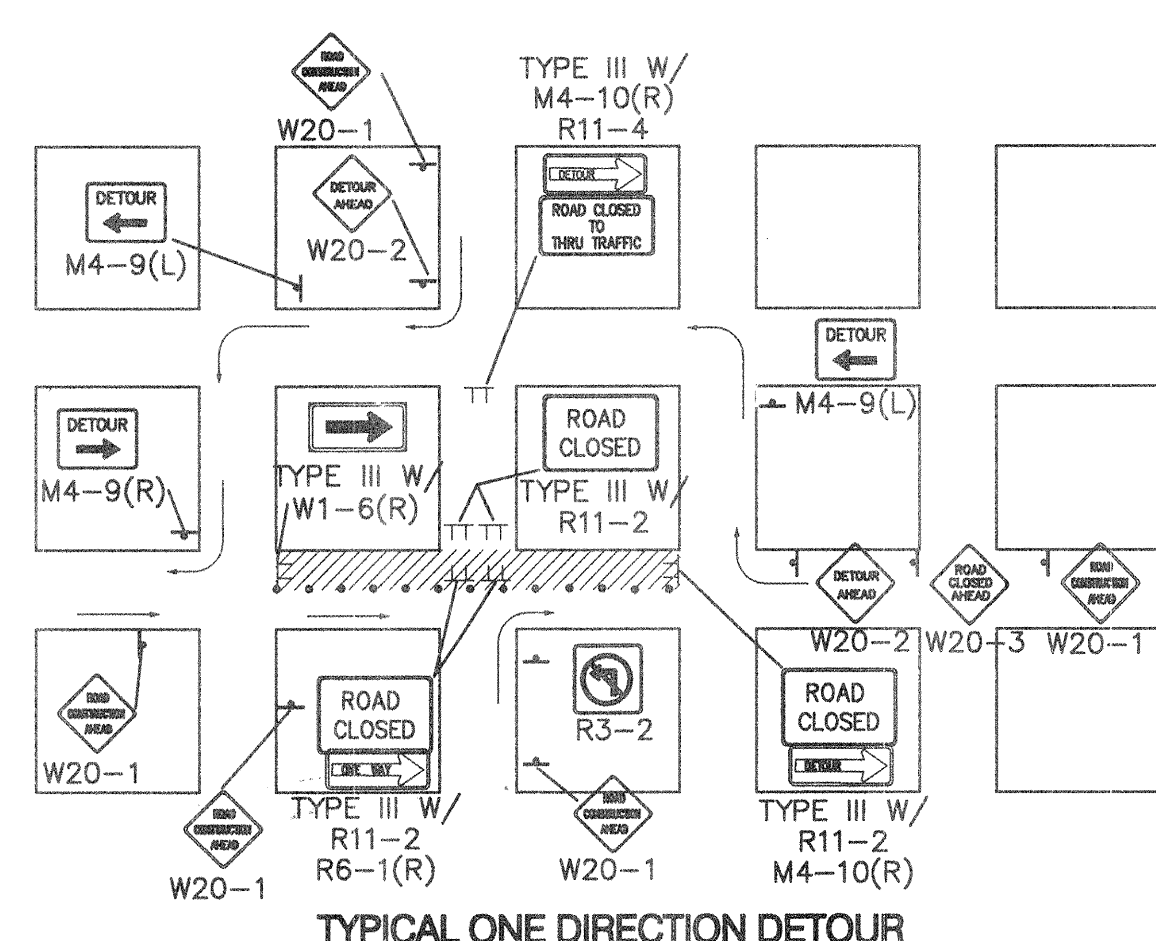

TYPICAL ONE DIRECTION DETOUR

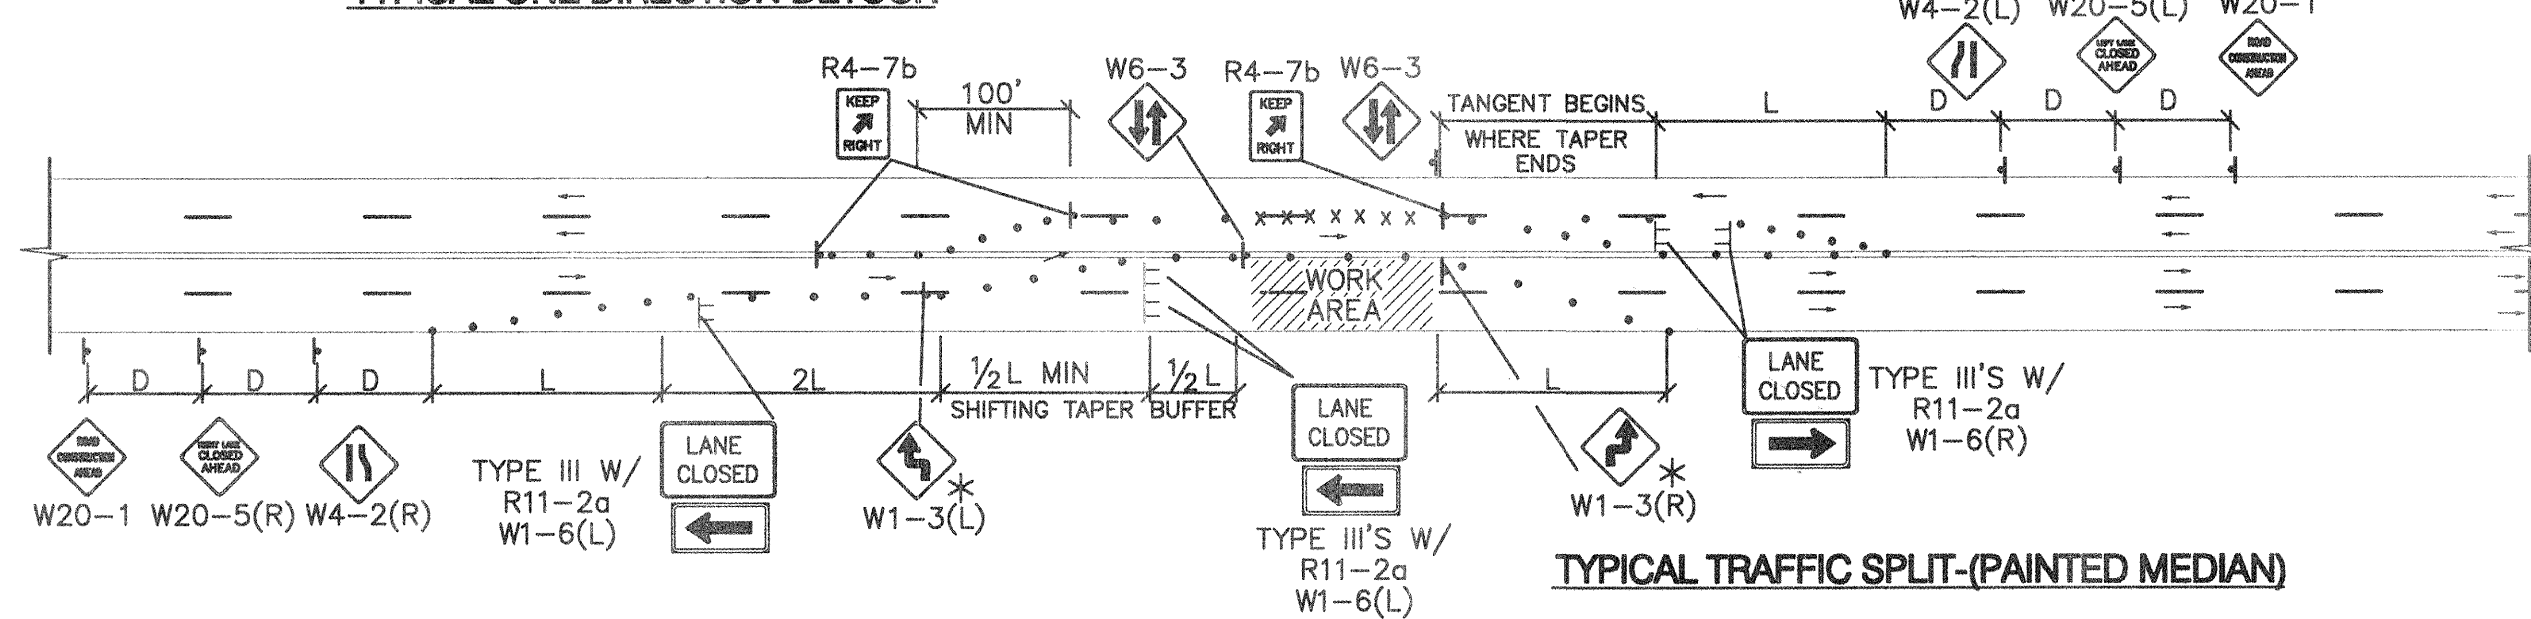


TYPICAL TRAFFIC SPLIT (PAINTED MEDIAN)

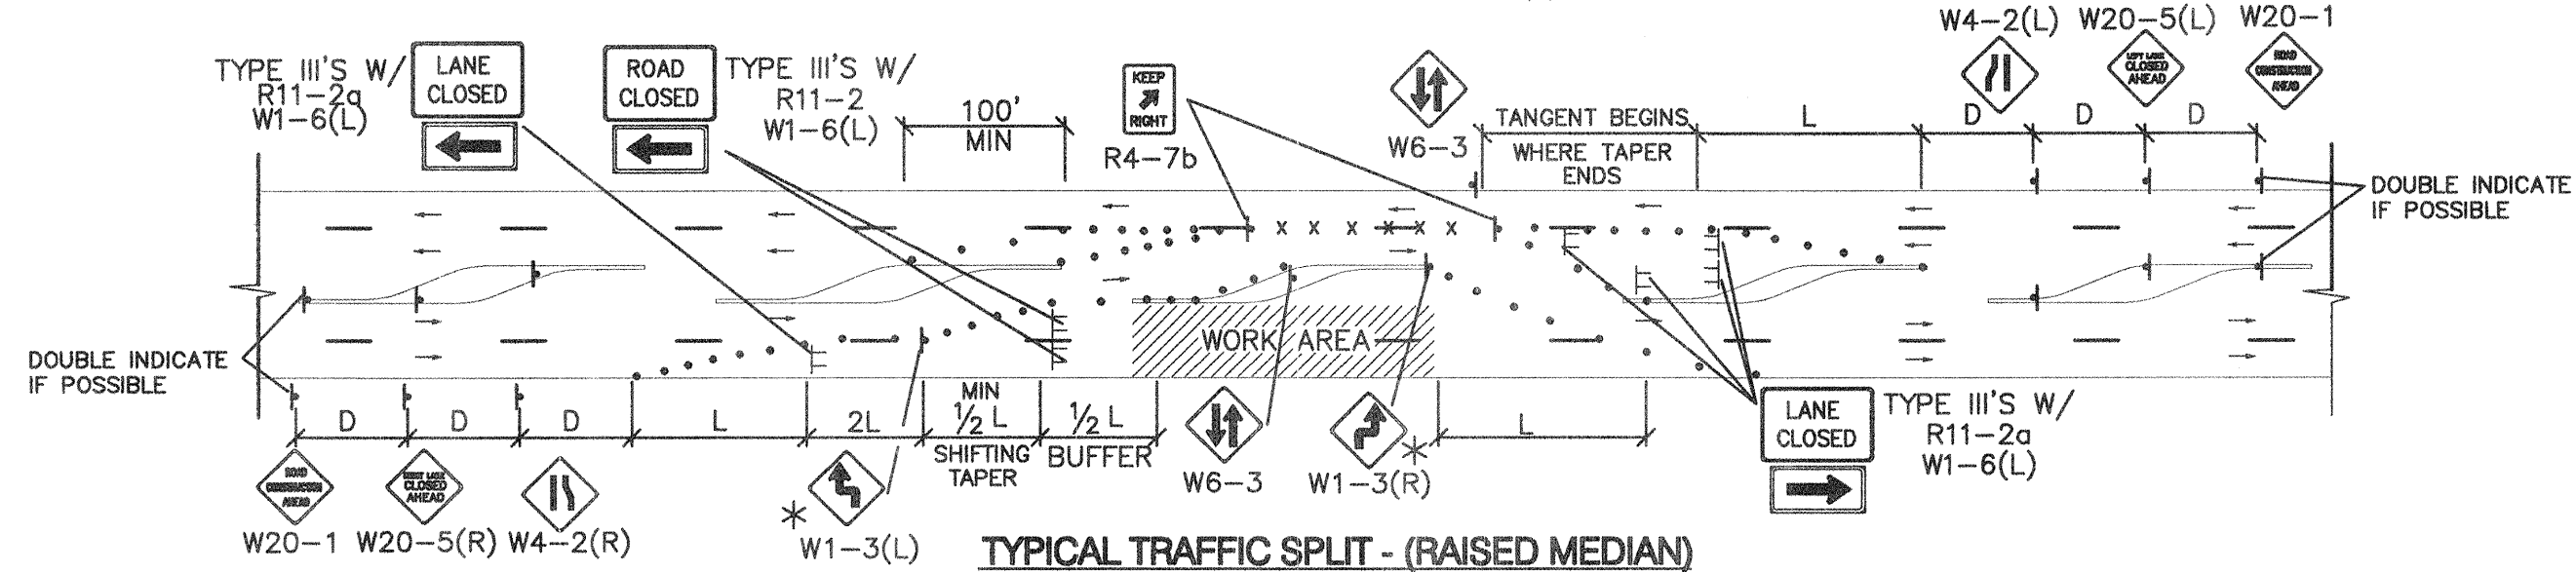

TYPICAL TRAFFIC SPLIT - (RAISED MEDIAN)

TRAFFIC SPLIT NOTES:


1. THE OFFSET DISTANCE MUST BE CALCULATED IN ALL SHIFTING TAPERS. THE OFFSET DISTANCES SHALL INCLUDE LANE WIDTHS PLUS MEDIAN WIDTHS.
2. 1/2 L IS THE MINIMUM DISTANCE FOR SHIFTING TAPERS.
3. REVERSE CURVES MAY BE IMPLEMENTED. ALL CURVE DATA SHALL BE CALCULATED.
4. MEDIAN REMOVAL SHALL BE REQUIRED IF 1/2 L OR REVERSE CURVE IS NOT SUFFICIENT. MEDIAN REMOVAL SHALL TAKE PLACE BEFORE SPLITS.
5. REDUCED SPEED MAY BE CONSIDERED.
6. * USE W1-3 FOR 30 MPH OR LESS, W1-4 FOR SPEED 35 MPH OR GREATER.

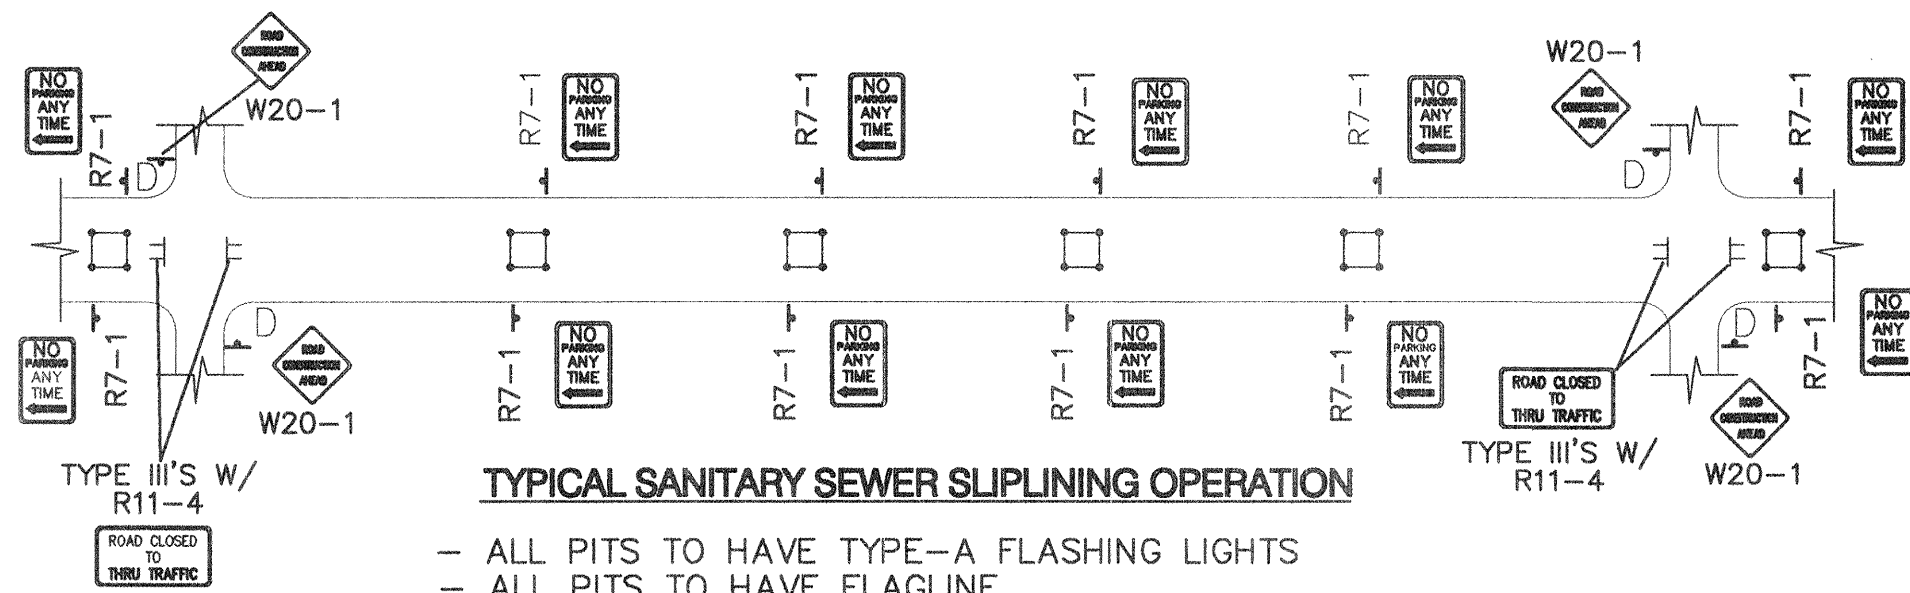

TYPICAL SANITARY SEWER SLIPLINING OPERATION


- ALL PITS TO HAVE TYPE-A FLASHING LIGHTS
- ALL PITS TO HAVE FLAGLINE

NOTE:
MAY REQUIRE LEFT LANE
CLOSURE DEPENDING ON
FIELD CONDITIONS.

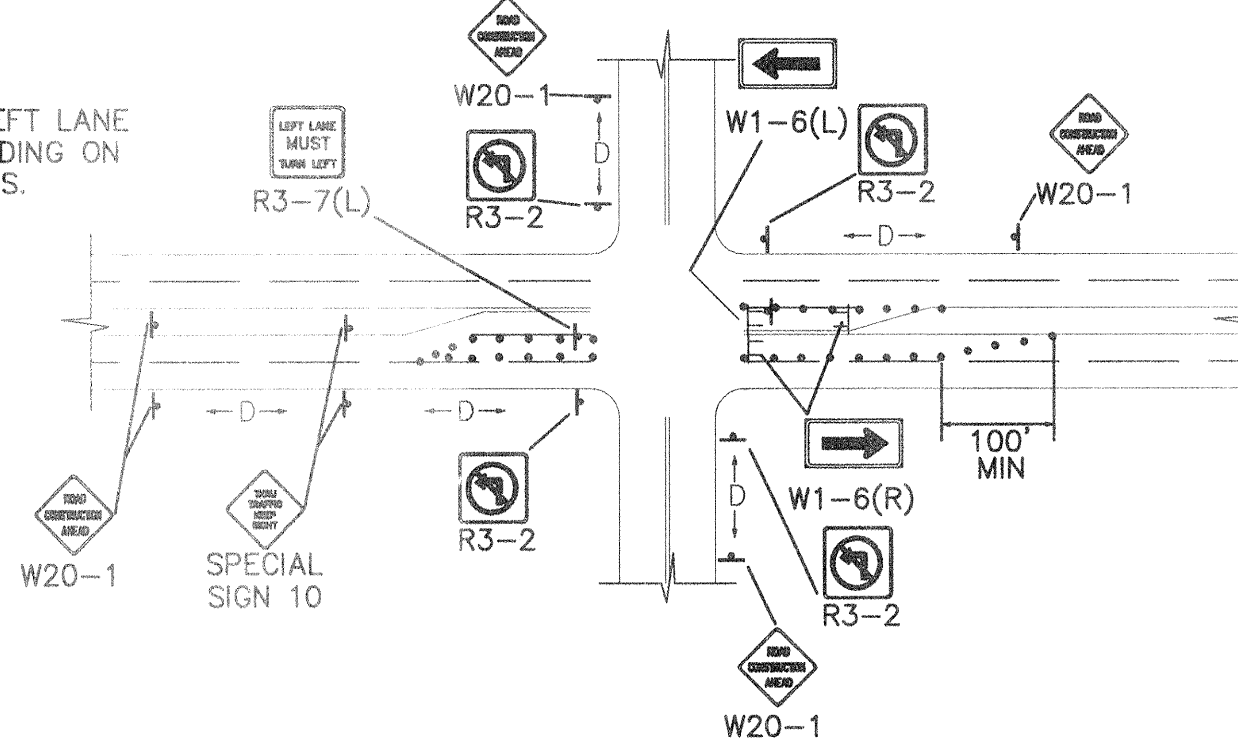


TYPICAL LANE CLOSURE AT INTERSECTION

NOTE: DEPENDING ON WORK ZONE LOCATION.

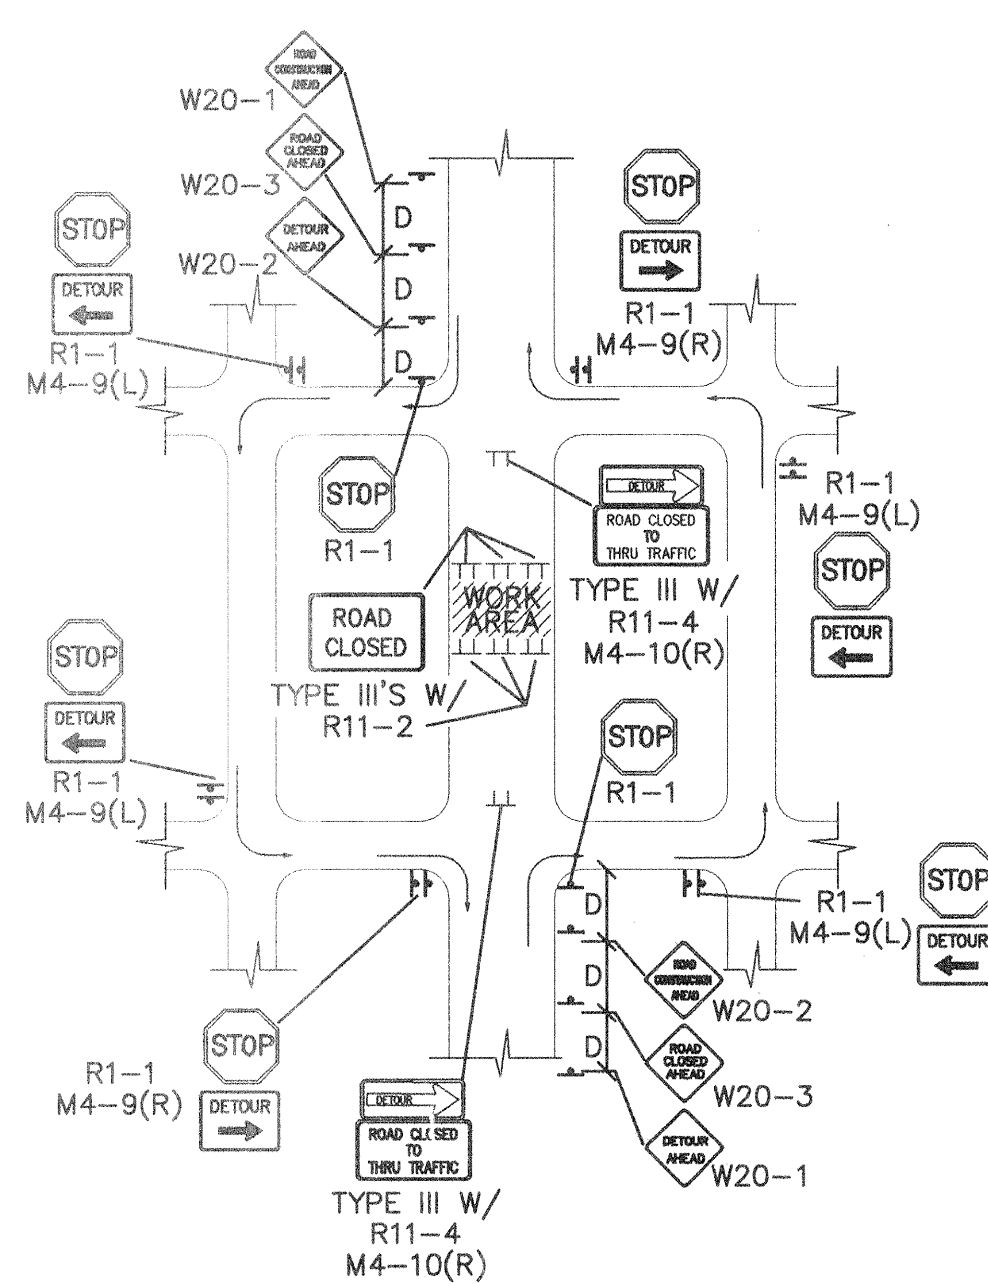


TYPICAL MID-BLOCK CLOSURE

NOTE: (R1-1) BASED ON FIELD CONDITIONS.

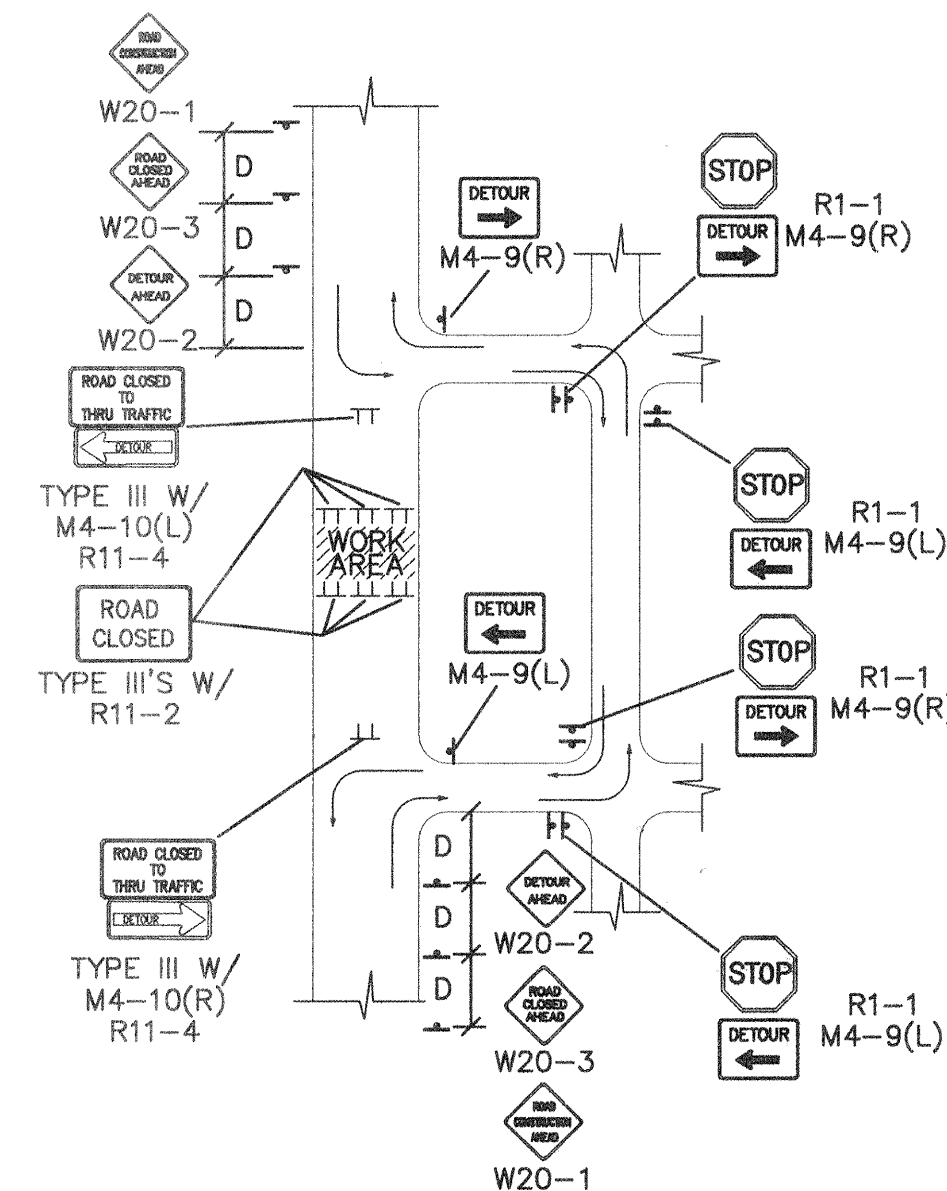


TYPICAL STREET CLOSURE


NOTE: (R1-1) BASED ON FIELD CONDITIONS.

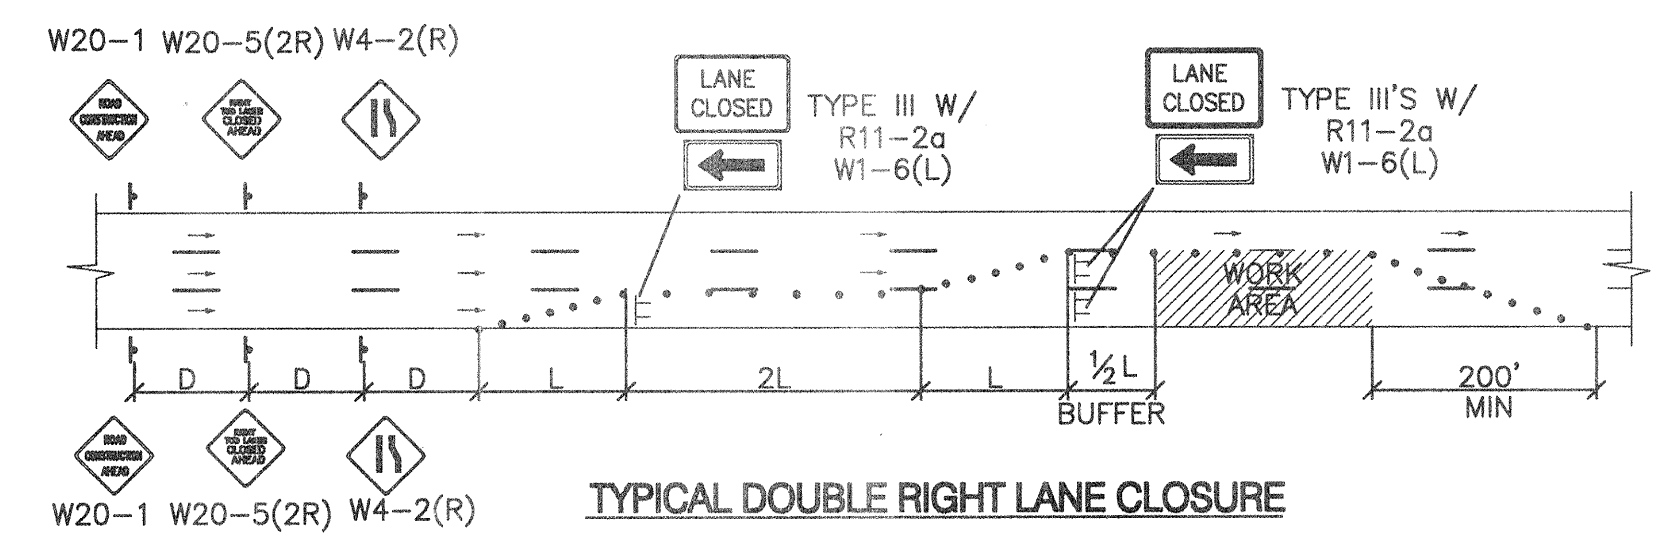


TYPICAL DOUBLE RIGHT LANE CLOSURE

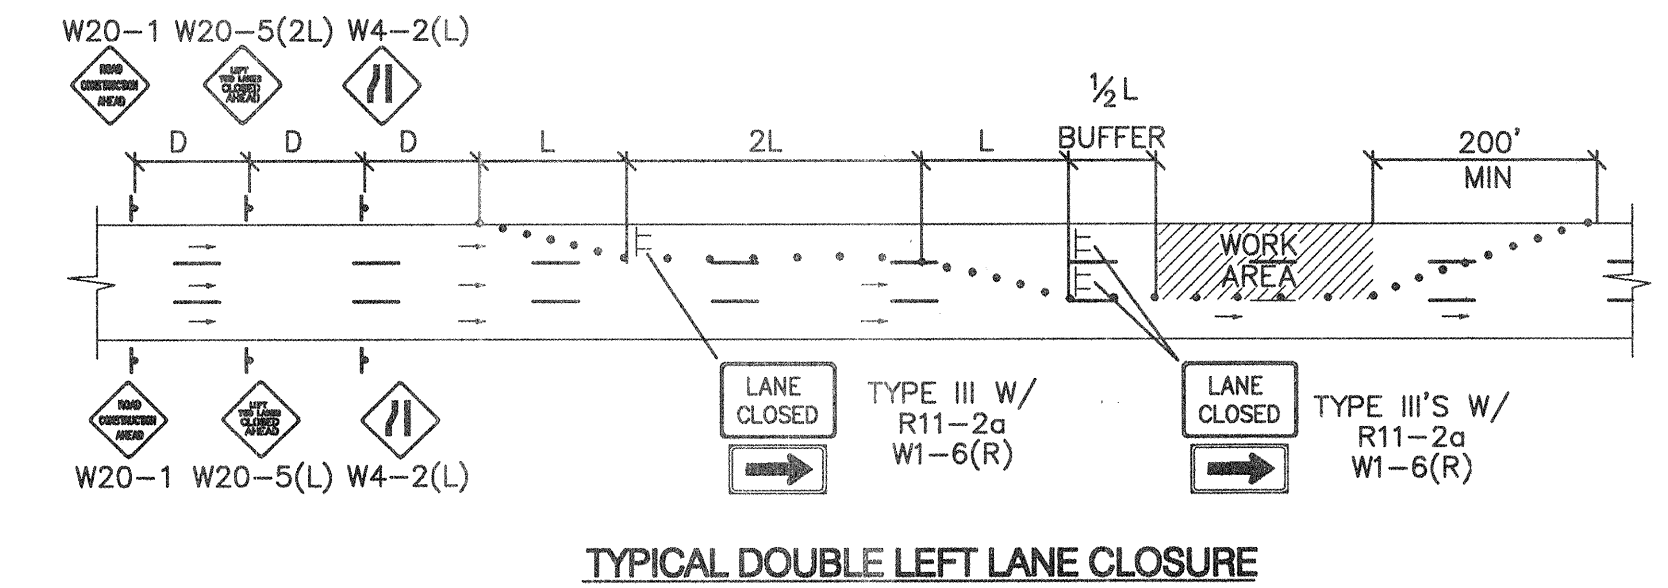

TYPICAL DOUBLE LEFT LANE CLOSURE

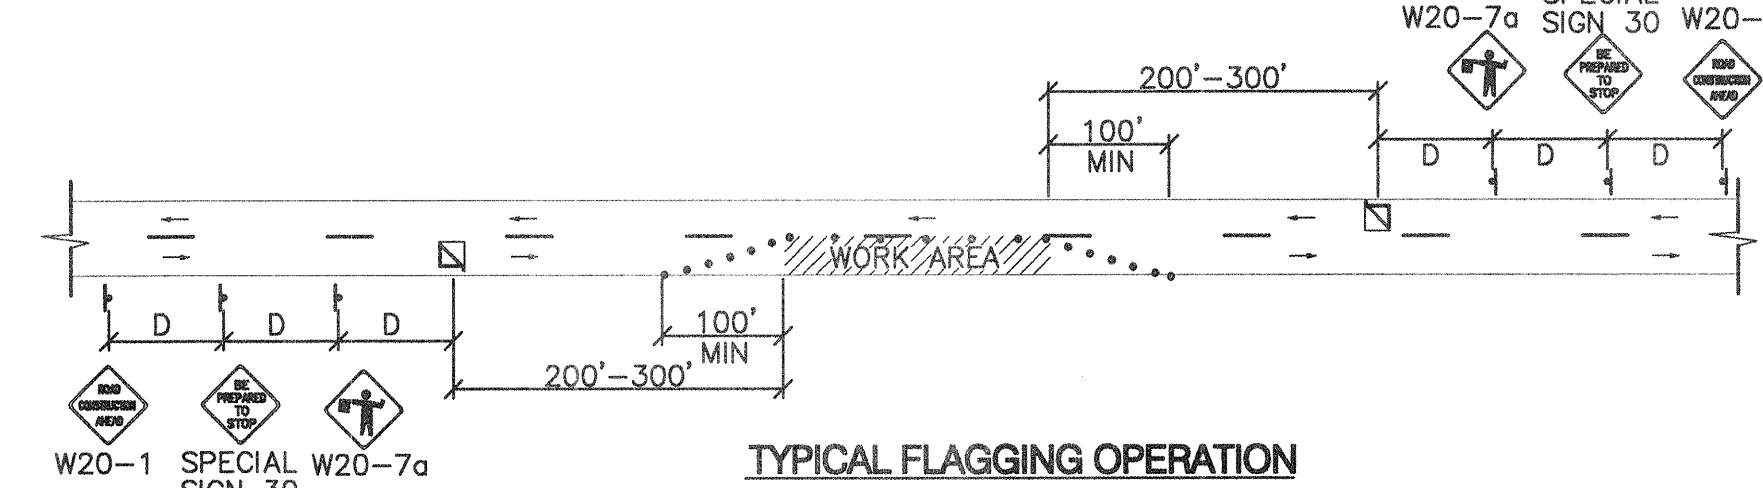

TYPICAL FLAGGING OPERATION

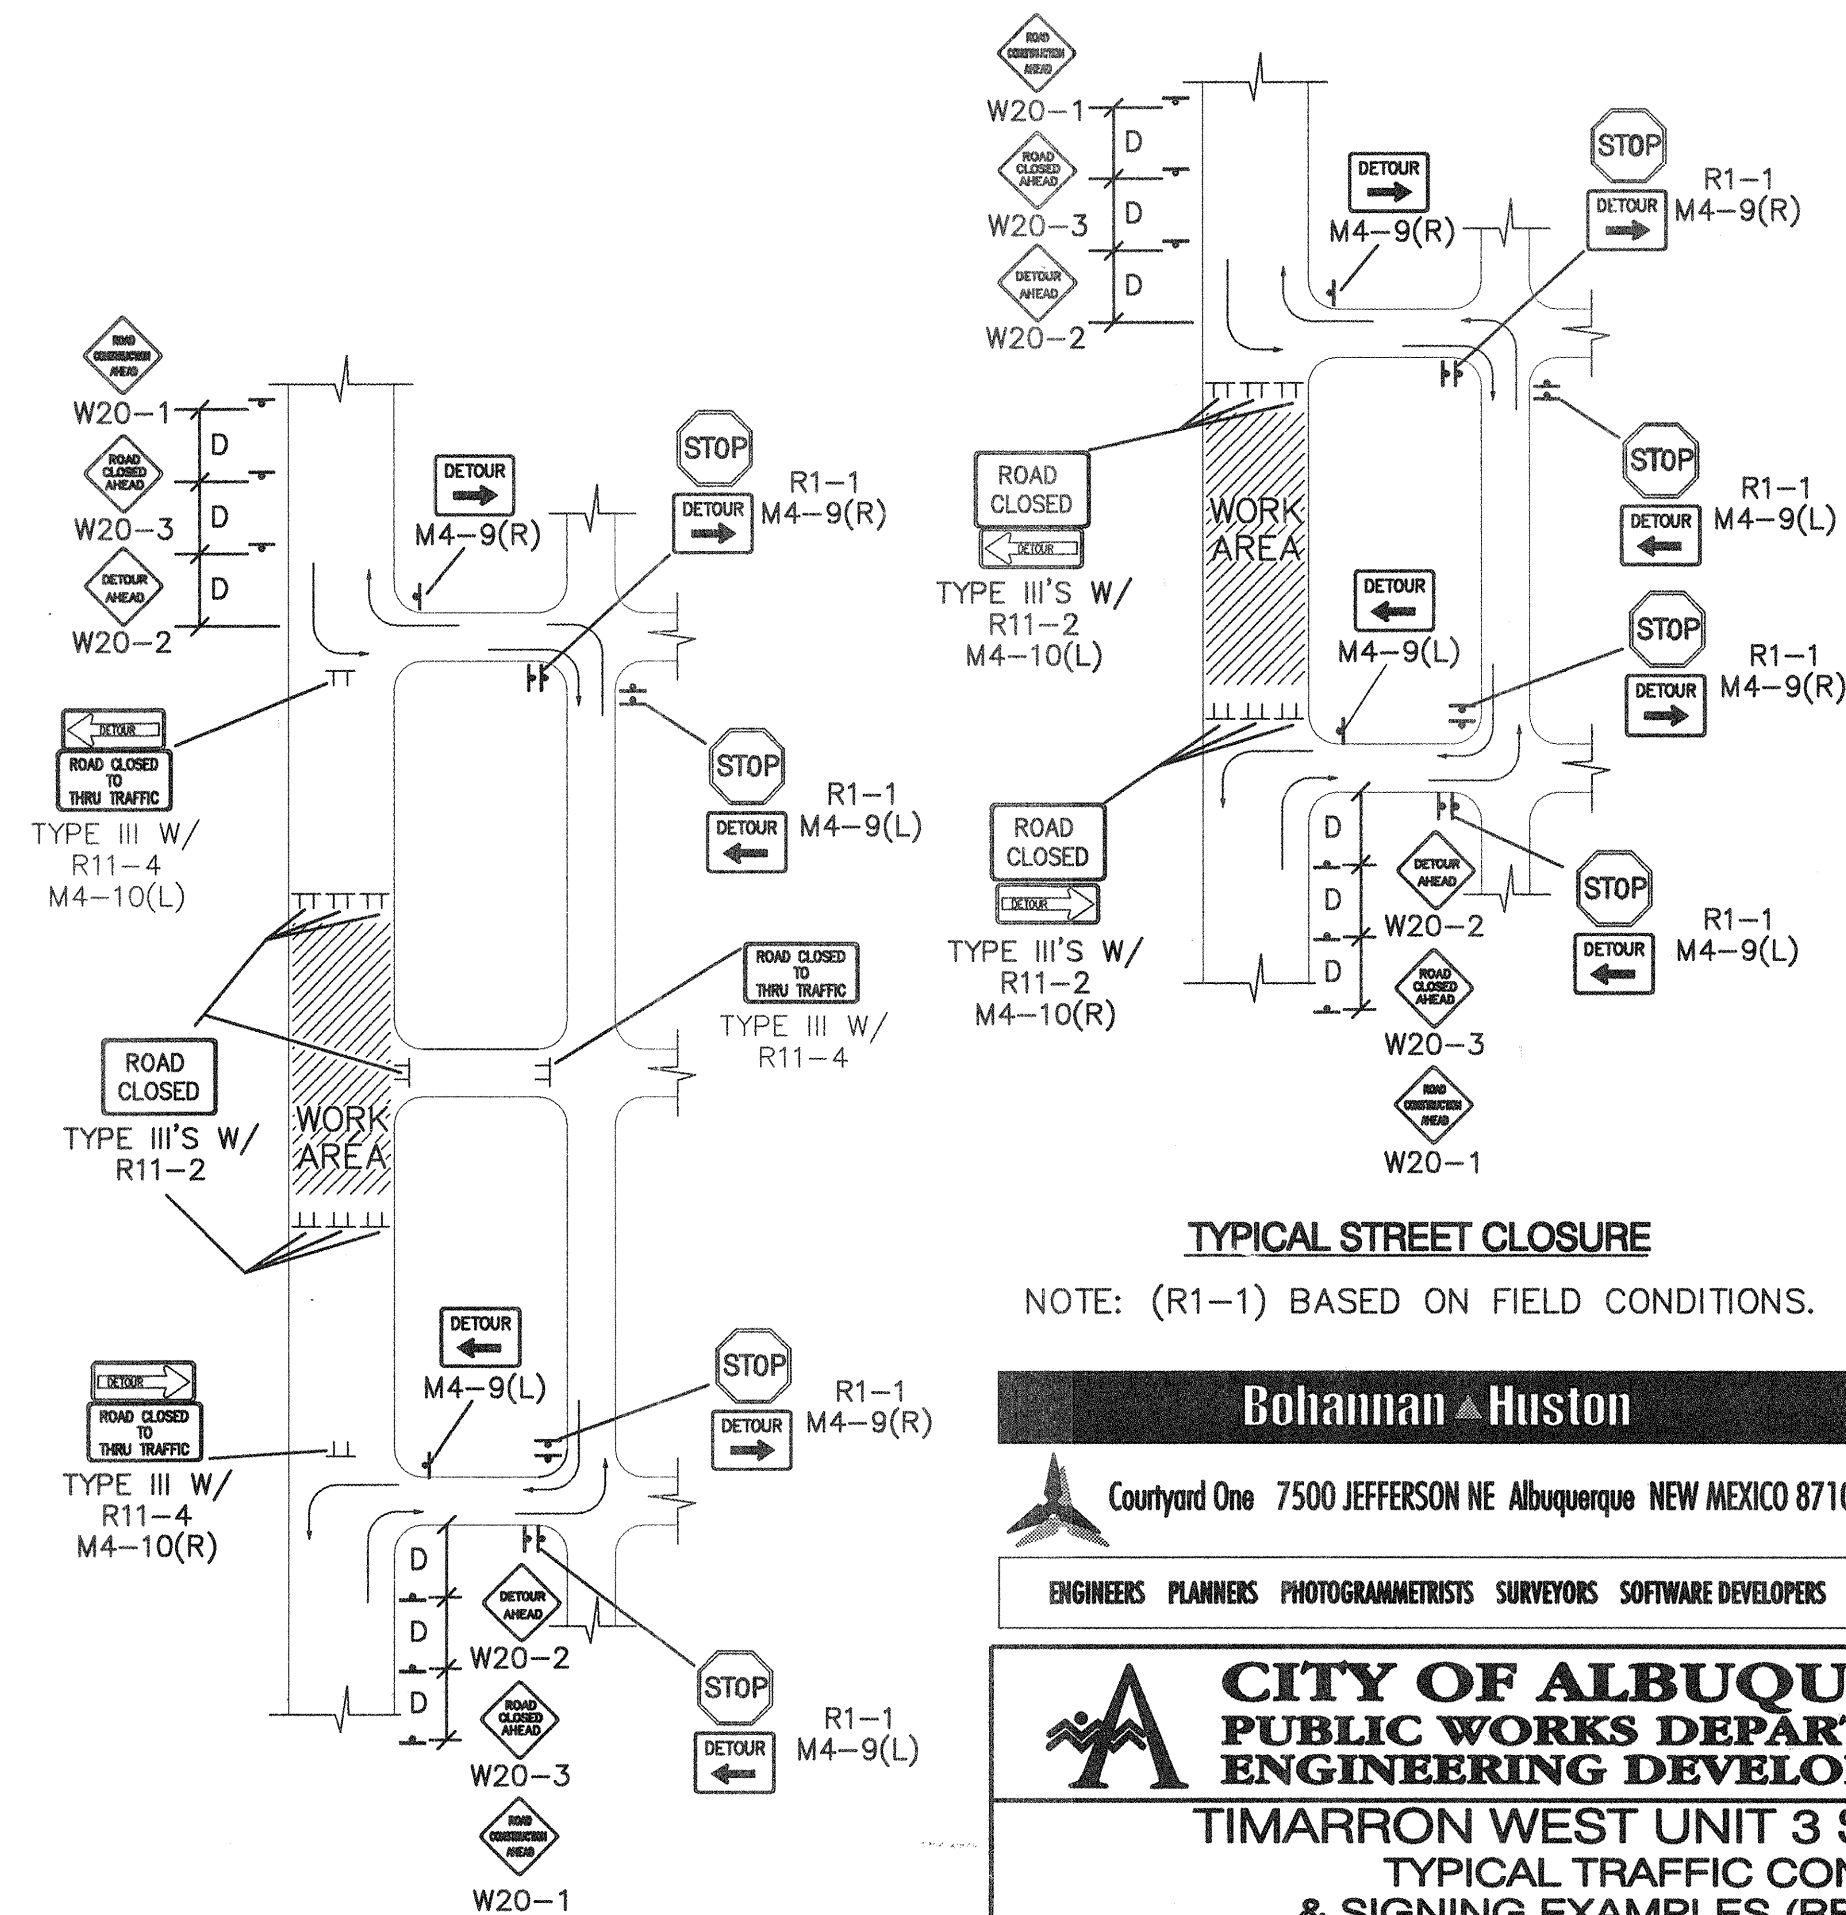

TYPICAL STREET CLOSURE

NOTE: (R1-1) BASED ON FIELD CONDITIONS.

Bohannon & Huston

Courtyard One 7500 JEFFERSON NE ALBUQUERQUE NEW MEXICO 87109

ENGINEERS PLANNERS PHOTOGRAMMETRISTS SURVEYORS SOFTWARE DEVELOPERS

CITY OF ALBUQUERQUE
PUBLIC WORKS DEPARTMENT
ENGINEERING DEVELOPMENT GROUP

TIMARRON WEST UNIT 3 SUBDIVISION

TYPICAL TRAFFIC CONTROL

& SIGNING EXAMPLES (REF MUTCD)

Design Review Committee	City Engineer Approval	Mo./Day/Yr.	Mo./Day/Yr.
COP	STP		
City Project No.	Zone Map No.	Sheet	Of
651681	L8-M8	32	32