


CITY OF ALBUQUERQUE

INDEX

SHEET	DESCRIPTION
1	TITLE SHEET
2–7	CONSTRUCTION PLANS
8–13	PLANTING PLANS
14–19	IRRIGATION PLANS
20	CONSTRUCTION DETAILS
21–22	IRRIGATION DETAILS
23	SIGNING & CONSTRUCTION TRAFFIC CONTROL STANDARDS
24	TYPICAL TRAFFIC CONTROL & SIGNING EXAMPLES (REF MUTCD)

CONSTRUCTION NOTES:

1. WHEN ABUTTING NEW CURB AND GUTTER TO EXISTING PAVEMENT, A 1' WIDE SECTION OF EXISTING PAVEMENT ADJACENT TO THE CURB AND GUTTER SHALL BE SAWCUT, REMOVED, AND REPLACED AS PER THE STANDARD SPECIFICATIONS.
2. THE CONTRACTOR SHALL ABIDE BY ALL LOCAL, STATE, AND FEDERAL LAWS, RULES AND REGULATIONS WHICH APPLY TO THE CONSTRUCTION OF THESE IMPROVEMENTS.
3. ALL ELECTRICAL, TELEPHONE, CABLE TV, GAS AND OTHER UTILITY LINES, CABLES, AND APPURTENANCES ENCOUNTERED DURING CONSTRUCTION THAT REQUIRE RELOCATION, SHALL BE COORDINATED WITH THAT UTILITY. THE CONTRACTOR SHALL BE RESPONSIBLE FOR COORDINATION OF ALL NECESSARY UTILITY ADJUSTMENTS. NO ADDITIONAL COMPENSATION WILL BE ALLOWED FOR DELAYS OR INCONVENIENCES CAUSED BY UTILITY COMPANY WORK CREWS. THE CONTRACTOR MAY BE REQUIRED TO RESCHEDULE HIS ACTIVITIES TO ALLOW UTILITY CREWS TO PERFORM THEIR REQUIRED WORK.
4. A DISPOSAL SITE FOR ALL EXCESS EXCAVATION MATERIAL, AND UNSUITABLE MATERIAL SHALL BE OBTAINED BY THE CONTRACTOR IN COMPLIANCE WITH APPLICABLE ENVIRONMENTAL REGULATIONS AND APPROVED BY THE CONSTRUCTION OBSERVER. ALL COSTS INCURRED IN OBTAINING A DISPOSAL SITE AND HAUL THERETO SHALL BE CONSIDERED INCIDENTAL TO THE PROJECT AND NO SEPARATE MEASUREMENT OR PAYMENT SHALL BE MADE.
5. THE CONTRACTOR IS RESPONSIBLE FOR PROTECTING THE EXISTING UTILITY LINES WITHIN THE CONSTRUCTION AREA. ANY DAMAGE TO EXISTING FACILITIES CAUSED BY CONSTRUCTION ACTIVITY SHALL BE REPAIRED OR REPLACED AT THE CONTRACTOR'S EXPENSE AND APPROVED BY THE CONSTRUCTION OBSERVER.
6. CONSTRUCTION ACTIVITY SHALL BE LIMITED TO THE PROPERTY AND/OR PROJECT LIMITS. ANY DAMAGE TO ADJACENT PROPERTIES RESULTING FROM THE CONSTRUCTION PROCESS IS THE RESPONSIBILITY OF THE CONTRACTOR. ANY COSTS INCURRED FOR REPAIRS SHALL BE THE COST OF THE CONTRACTOR.
7. OVERNIGHT PARKING OF CONSTRUCTION EQUIPMENT SHALL NOT OBSTRUCT DRIVEWAYS OR DESIGNATED TRAFFIC LANES. THE CONTRACTOR SHALL NOT STORE ANY EQUIPMENT OR MATERIAL WITHIN THE PUBLIC RIGHT-OF-WAY.
8. THE CONTRACTOR SHALL OBTAIN ALL THE NECESSARY PERMITS FOR THE PROJECT PRIOR TO COMMENCING CONSTRUCTION (I.E. BARRICADING, TOPSOIL DISTURBANCE AND EXCAVATION PERMITS, ETC.)
9. THE CONTRACTOR SHALL BE RESPONSIBLE TO REPLACE AT HIS EXPENSE ANY AND ALL PROPERTY CORNERS DESTROYED DURING CONSTRUCTION. ALL PROPERTY CORNERS MUST BE RESET BY A REGISTERED LAND SURVEYOR.
10. ALL PERMANENT PAVEMENT MARKING AND TRAFFIC SIGNING SHALL BE FURNISHED AND INSTALLED BY THE CONTRACTOR PER PLAN.
11. THE CONTRACTOR SHALL PREPARE A CONSTRUCTION TRAFFIC CONTROL AND SIGNING PLAN AND OBTAIN APPROVAL OF SUCH PLAN FROM THE CITY OF ALBUQUERQUE, TRAFFIC ENGINEERING DEPARTMENT, PRIOR TO BEGINNING ANY CONSTRUCTION WORK ON OR ADJACENT TO EXISTING STREETS.
12. ALL BARRICADES AND CONSTRUCTION SIGNING SHALL CONFORM TO APPLICABLE SECTIONS OF THE "MANUAL ON UNIFORM TRAFFIC CONTROL DEVICES" (MUTCD), U.S. DEPARTMENT OF TRANSPORTATION, LATEST EDITION.
13. THE CONTRACTOR SHALL MAINTAIN ALL CONSTRUCTION BARRICADES AND SIGNING AT ALL TIMES. THE CONTRACTOR SHALL VERIFY THE PROPER LOCATION OF ALL BARRICADING AT THE END AND BEGINNING OF EACH DAY.
14. ALL SAWCUT PAVEMENT SHALL HAVE A UNIFORM EDGE AND BE SPRAYED WITH TACK.


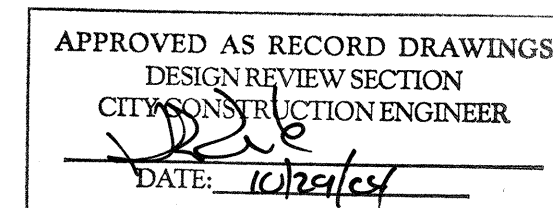


121 TIJERAS NE SUITE 3100
ALBUQUERQUE, NM 87102
PHONE: 505-822-8200
FAX: 505-822-8282
E-MAIL: mail@sites-sw.com
WEB: www.sites-sw.com


PLANNING
LANDSCAPE ARCHITECTURE
MARKET ANALYSIS

CERTIFICATE OF SUBSTANTIAL COMPLIANCE ON PLANS

I, Patrick Gay of the firm of Sites Southwest, a Registered Professional Landscape Architect in the State of New Mexico, do hereby certify to the best of my knowledge and belief that the infrastructure installed as part of this project has been inspected by me or a qualified person under my direct supervision and has been constructed in accordance with the plans and specifications approved by the City Engineer and that the original design intent of the approved plans has been met, except as noted by me on the as-built construction drawings. This Certification is based on site inspections by me or personnel under my direction.

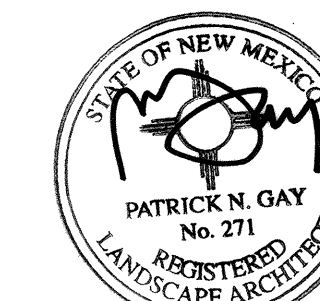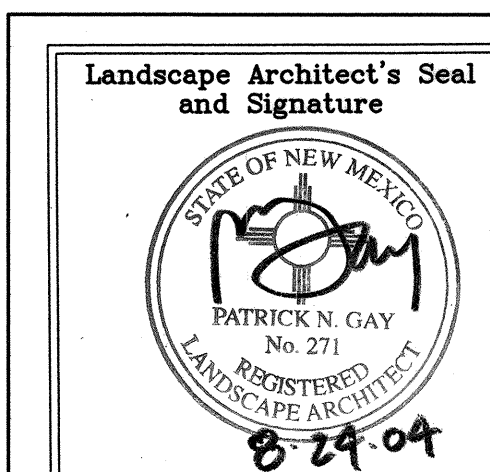[illegible][illegible]

11/04/03

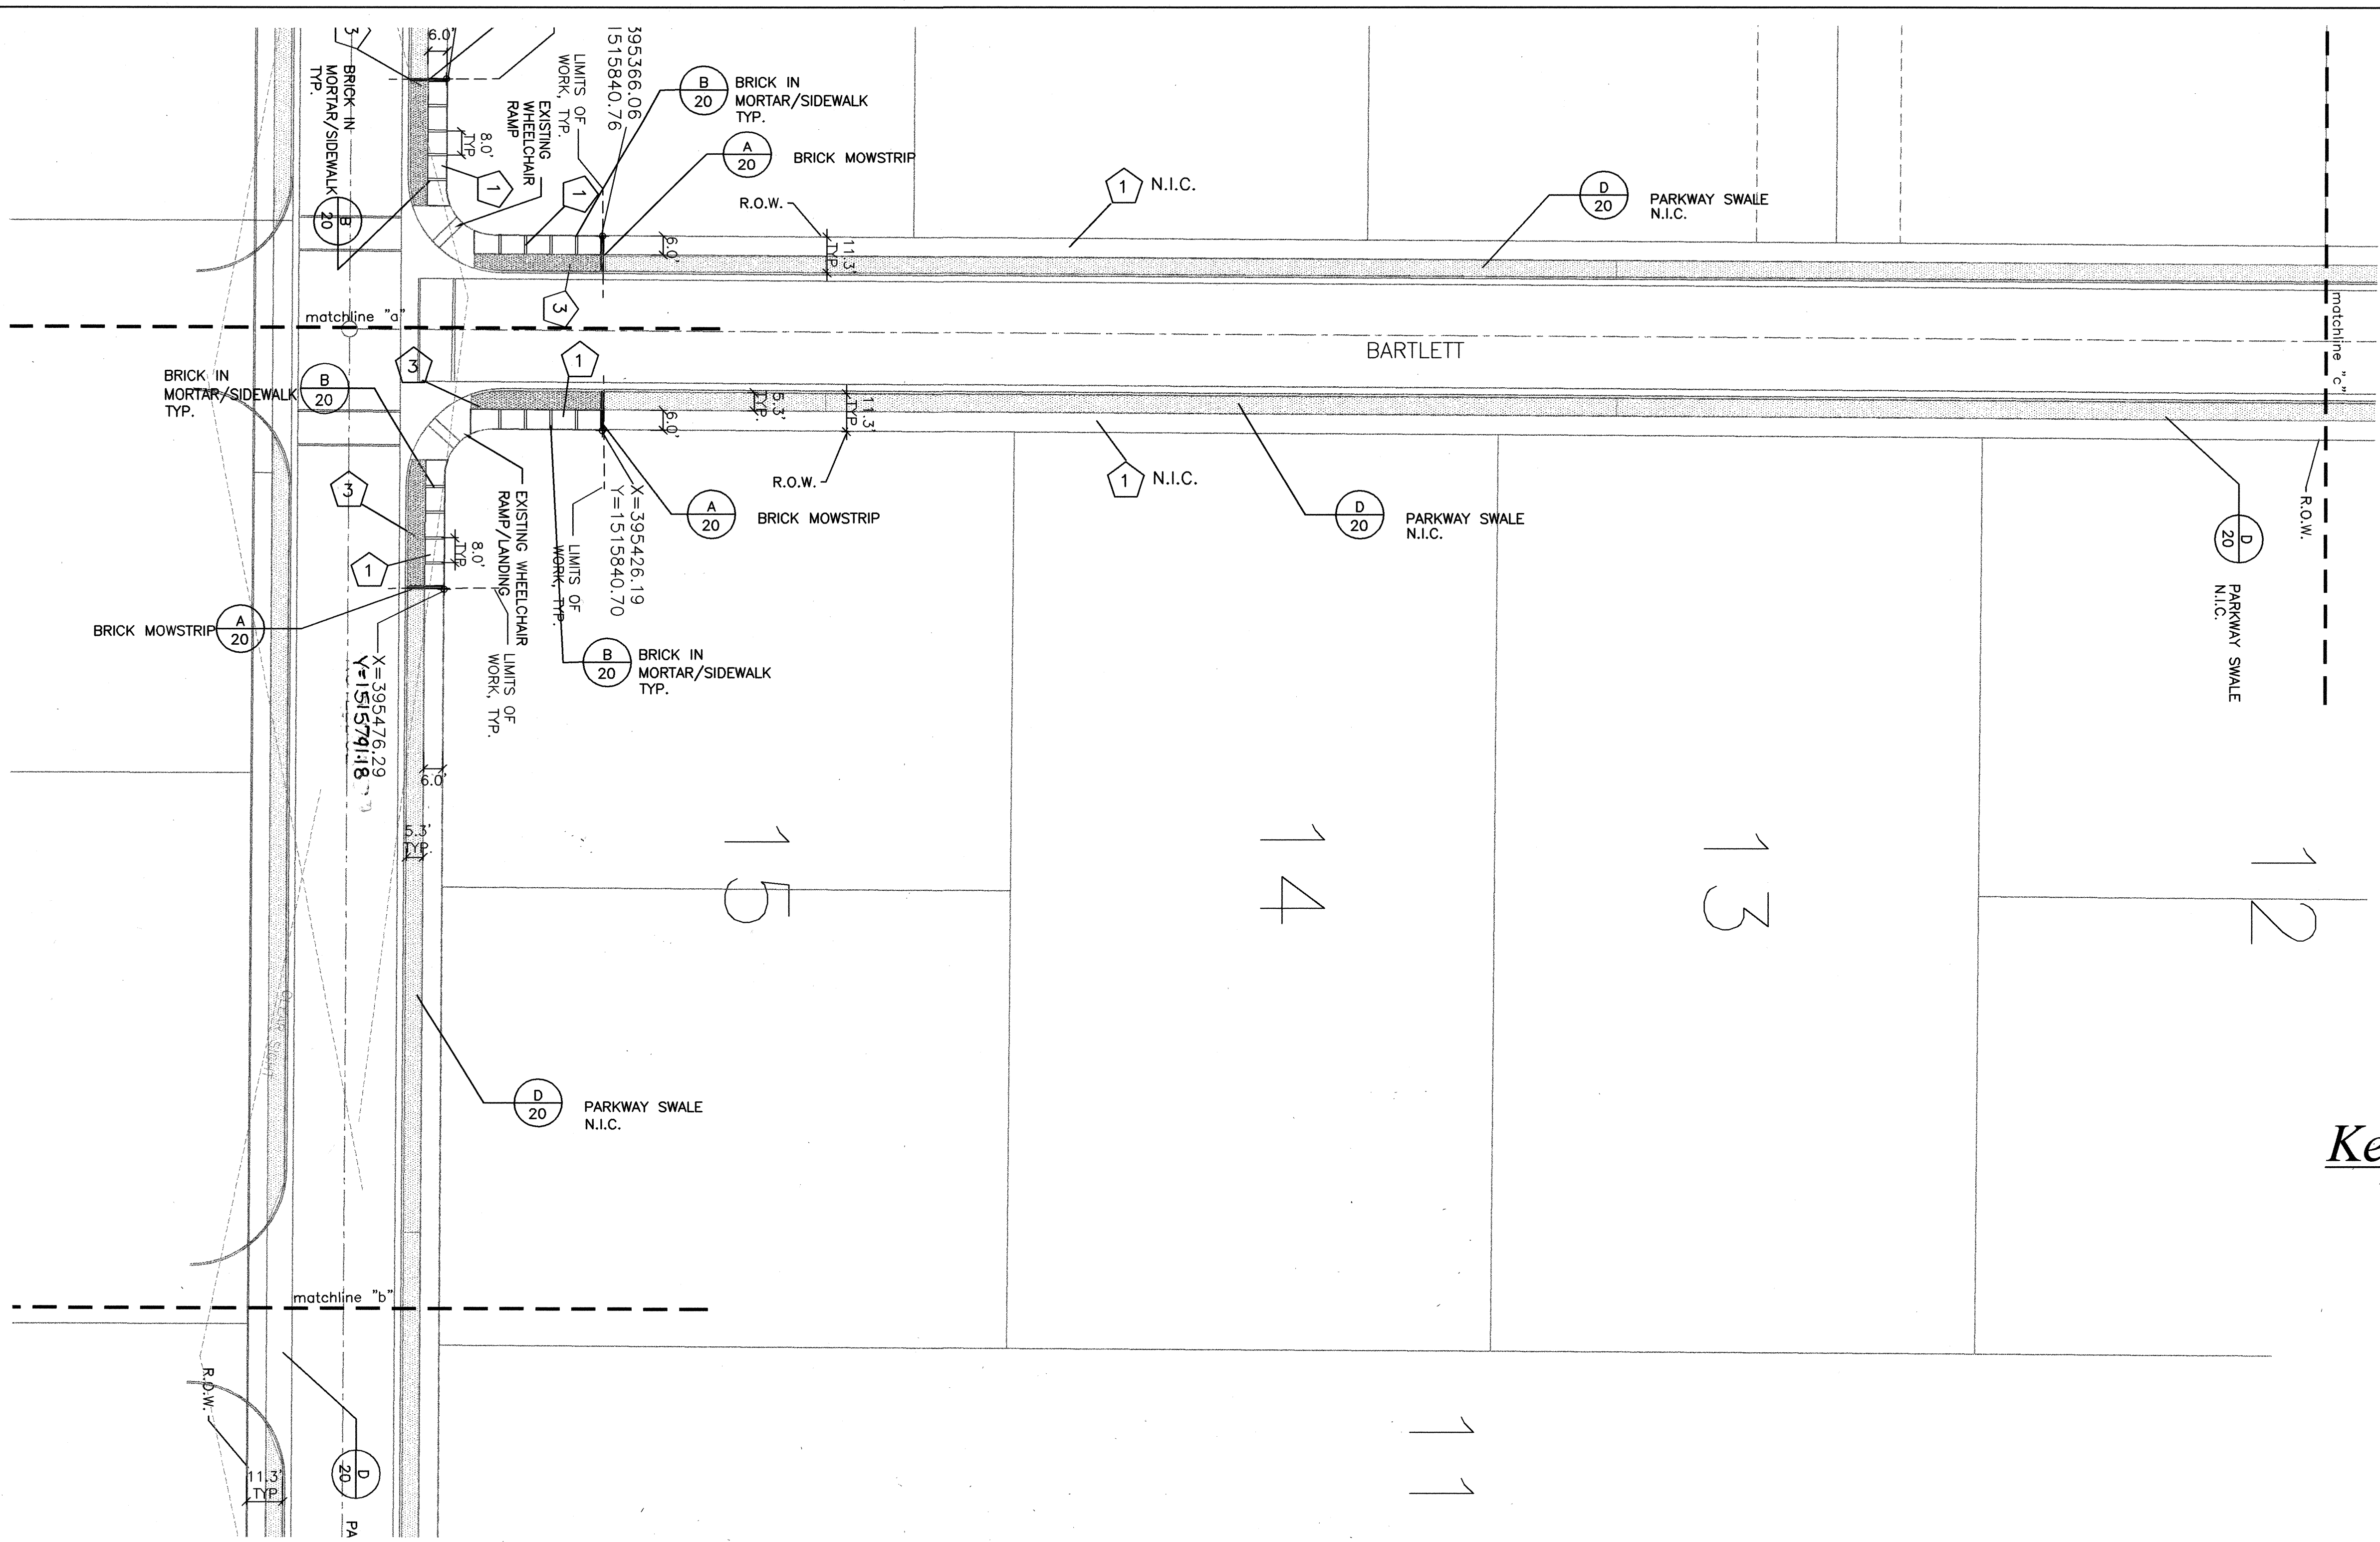


Keyed Construction Notes


1. PROVIDE 4" DEPTH CONCRETE SIDEWALK AS PER C.O.A. STD. DWG #2430. FINISH TO BE BROOM FINISH.
2. PROVIDE BENCH AS PER MANUFACTURER'S RECOMMENDATIONS. SEE SITE FURNISHINGS LEGEND.
3. PROVIDE 3" DEPTH SANTA ANA TAN CRUSHER FINES MULCH.
4. PROVIDE RYERSON STEEL EDGER AT R.O.W. LIMITS AND LIMITS OF WORK.
5. PROVIDE CONCRETE MOWSTRIP AS PER C.O.A. STD DWG #2726.
6. PROVIDE LITTER BIN AS PER MANUFACTURER'S RECOMMENDATIONS. SEE SITE FURNISHINGS LEGEND.
7. PROVIDE BOLLARD AS PER MANUFACTURER'S RECOMMENDATIONS. SEE SITE FURNISHINGS LEGEND.
8. PROVIDE WATERPROOFING ALONG CURB AS PER C.O.A. STD DWG #2930.
9. PROVIDE ENTRY MONUMENT SIGN AS PER DETAIL D/20.
10. INSTALL MOSS ROCK RETAINING WALL AS PER DETAIL ON SHEET.

Materials Legend

- CRUSHER FINES
- COBBLE STONE

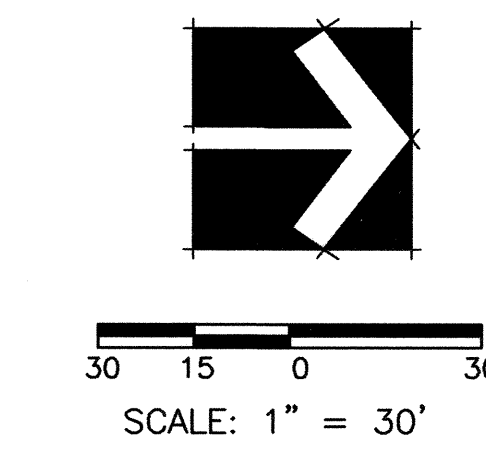


Key Map

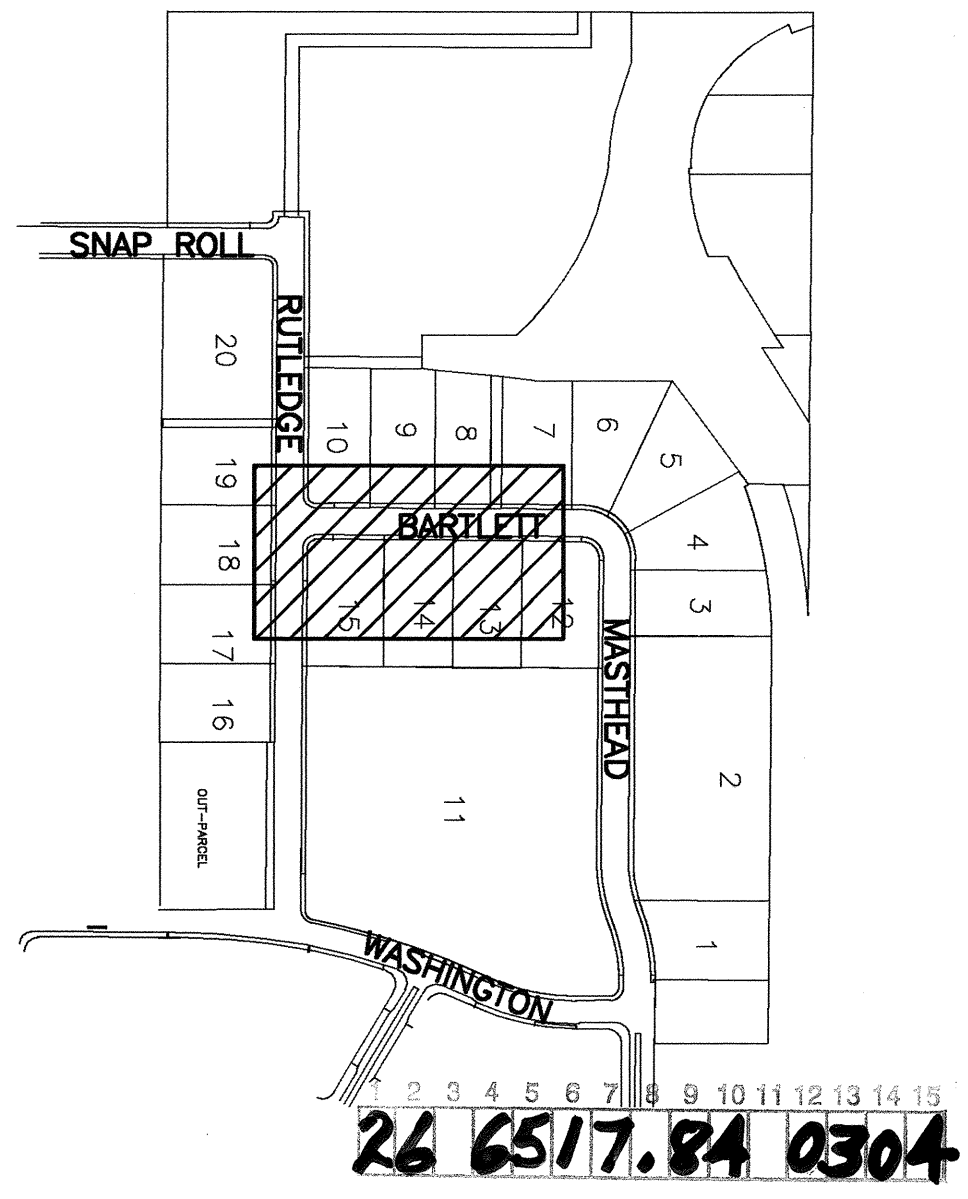


		CITY OF ALBUQUERQUE PUBLIC WORKS DEPARTMENT ENGINEERING DEVELOPMENT GROUP	
CONSTRUCTION PLANS			
Design Review Committee	City Engineer Approval	Mo./Day/Yr.	Mo./Day/Yr.
JAN 19 2004	FEB 2 2004		
City Project No.	Zone Map No.	Sheet	Of
6517.84	D-17	3	24

AS-BUILT INFORMATION		BENCH MARKS		SURVEY INFORMATION		LANDSCAPE ARCHITECT'S SEAL	
CONTRACTOR	DATE	ACS BRASS TABLET	STAMPED	FIELD NOTES	BY	NO.	DATE
Hewes up	9/23/04	"1-A11-1980"					
WORK BY	DATE	GEOGRAPHIC POSITION (NAD 1927)					
REVISIONS	DATE	NM STATE PLANE COORDINATES (CENTRAL ZONE)					
ACCEPTANCE BY	DATE	X= 365,236.60 Y=1,531,711.91					
VERIFICATION BY	DATE	GROUND TO GRID FACTOR= .9996658					
DRAWINGS	DATE	SLD 1929 ELEVATION= 5331.73					
MICRO-FILM INFORMATION	DATE						
RECORDED BY	DATE						
NO.							

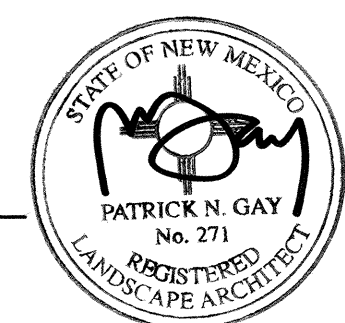

11403

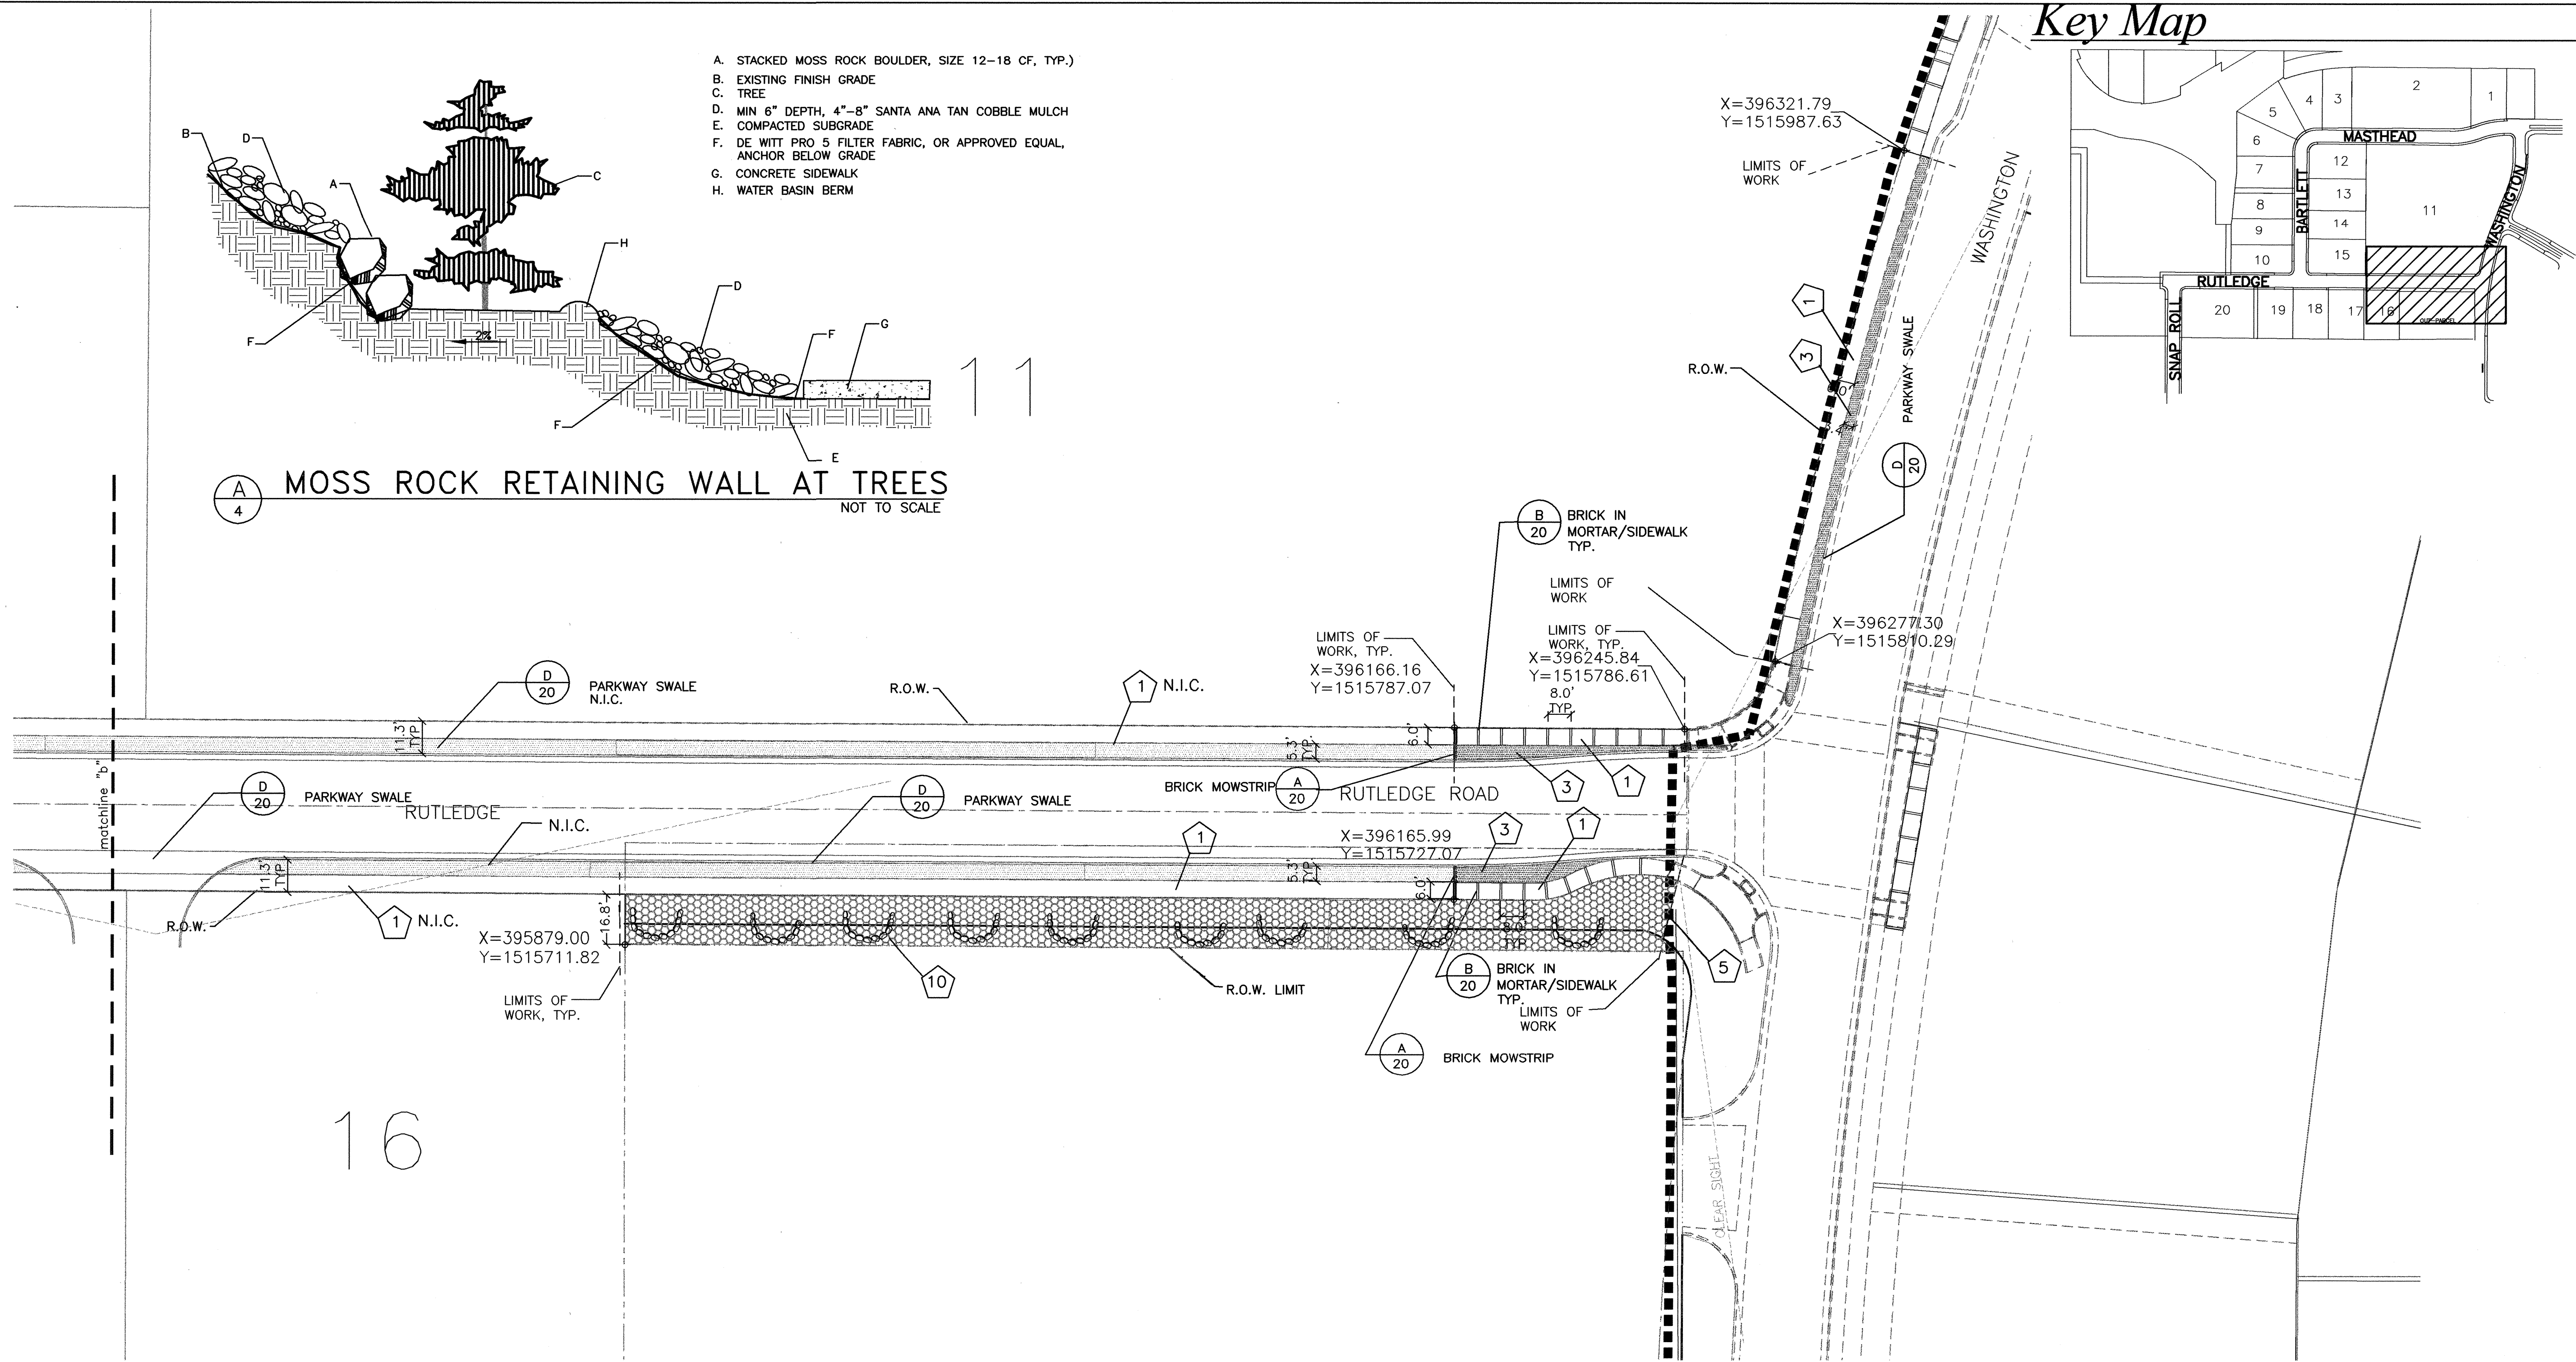


Keyed Construction Notes

- 1. PROVIDE 4" DEPTH CONCRETE SIDEWALK AS PER C.O.A. STD. DWG #2430. FINISH TO BE BROOM FINISH.
- 2. PROVIDE BENCH AS PER MANUFACTURER'S RECOMMENDATIONS. SEE SITE FURNISHINGS LEGEND.
- 3. PROVIDE 3" DEPTH SANTA ANA TAN CRUSHER FINES MULCH.
- 4. PROVIDE RYERSON STEEL EDGER AT R.O.W. LIMITS AND LIMITS OF WORK.
- 5. PROVIDE CONCRETE MOWSTRIP AS PER C.O.A. STD DWG #2726.
- 6. PROVIDE LITTER BIN AS PER MANUFACTURER'S RECOMMENDATIONS. SEE SITE FURNISHINGS LEGEND.
- 7. PROVIDE BOLLARD AS PER MANUFACTURER'S RECOMMENDATIONS. SEE SITE FURNISHINGS LEGEND.
- 8. PROVIDE WATERPROOFING ALONG CURB AS PER C.O.A. STD DWG #2930.
- 9. PROVIDE ENTRY MONUMENT SIGN AS PER DETAIL D/20.
- 10. INSTALL MOSS ROCK RETAINING WALL AS PER DETAIL ON SHEET.


Materials Legend

- CRUSHER FINES
- COBBLE STONE

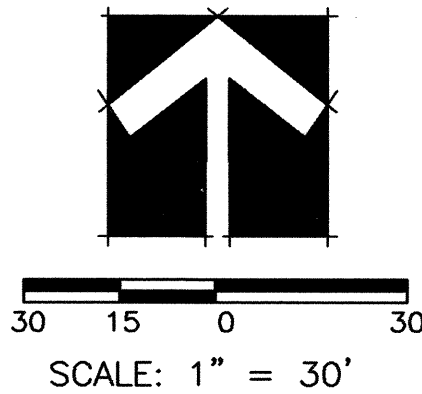


		CITY OF ALBUQUERQUE PUBLIC WORKS DEPARTMENT ENGINEERING DEVELOPMENT GROUP	
JOURNAL CENTER 2-UNIT 2 CONSTRUCTION PLANS			
Design Review Committee	City Engineer Approval	Mo./Day/Yr.	
City Project No. 6517.84		Zone Map No. D-17	Sheet 4 Of 24

LANDSCAPE ARCHITECT'S SEAL		SURVEY INFORMATION		BENCH MARKS		AS-BUILT INFORMATION	
		FIELD NOTES		ACS BRASS TABLET STAMPED		CONTRACTOR	
114-03		BY		"1-A11-1980"		DATE	
		NO.		GEOGRAPHIC POSITION (NAD 1927)		DATE	
				NM STATE PLANE COORDINATES (CENTRAL ZONE)		DATE	
				X= 365,236.60 Y=1,531,711.91		DATE	
				GROUND TO GRID FACTOR= .9996658		DATE	
				SLD 1929 ELEVATION= 5331.73		DATE	

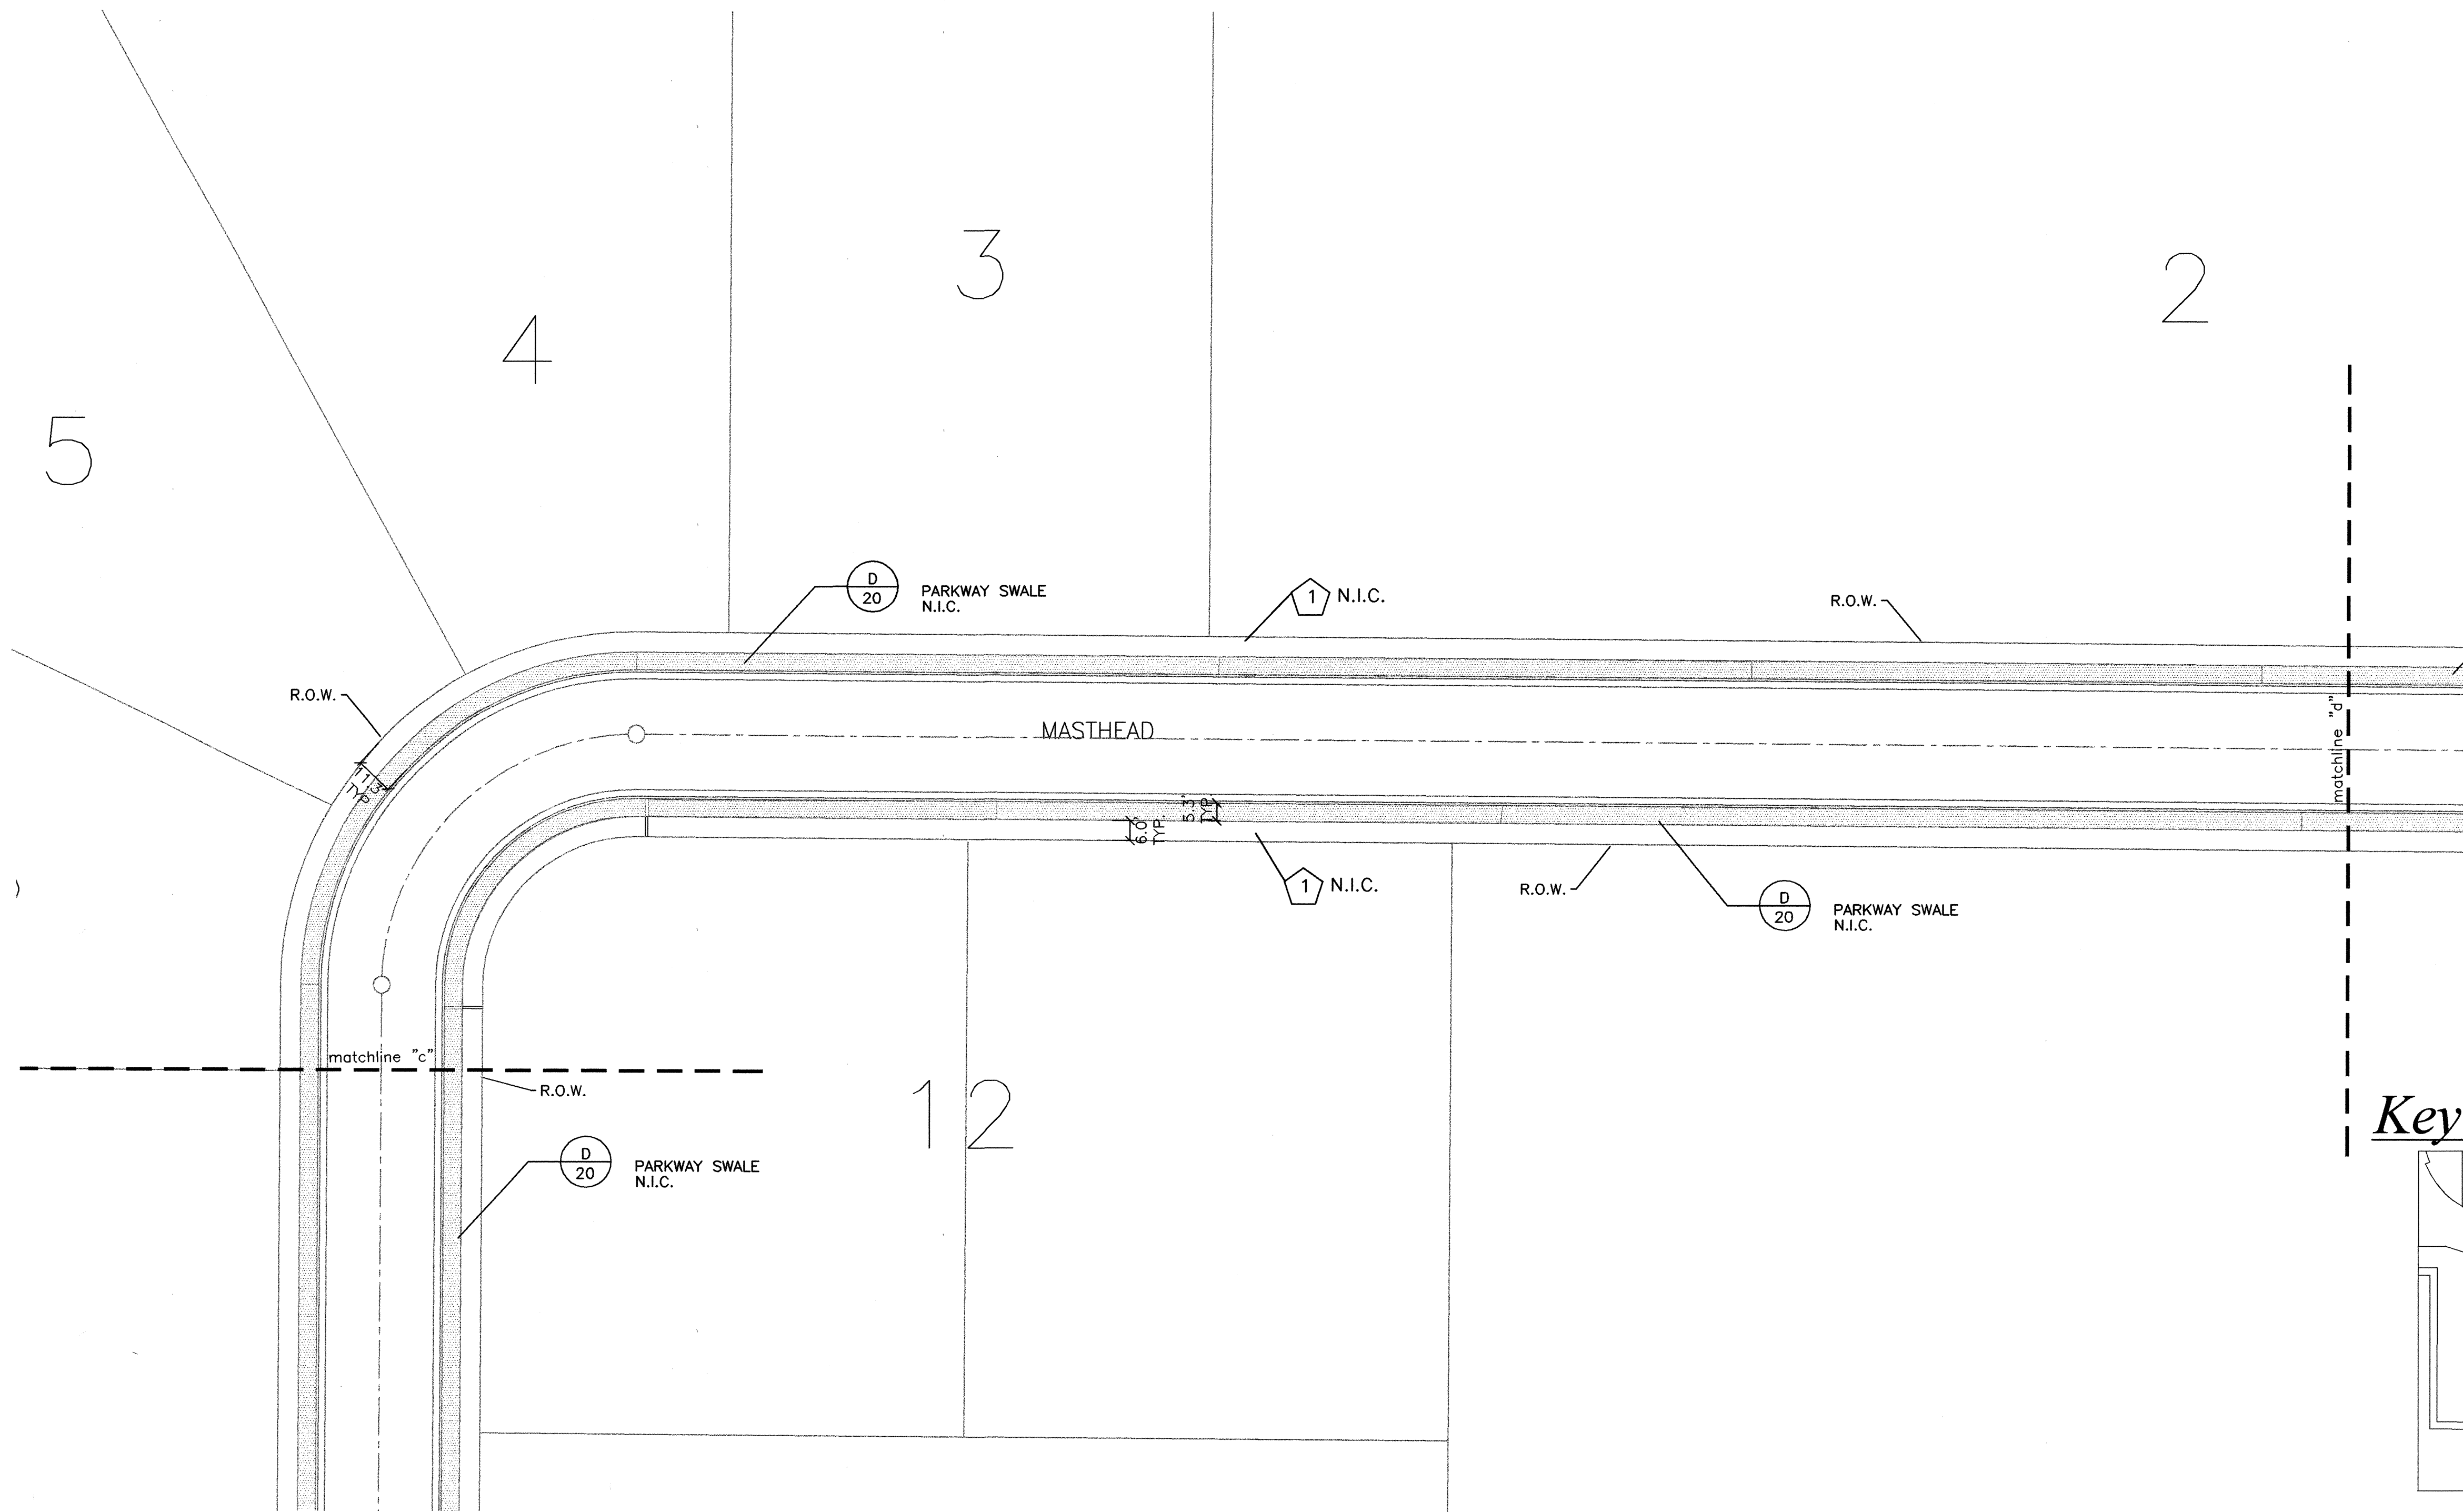

Key Map

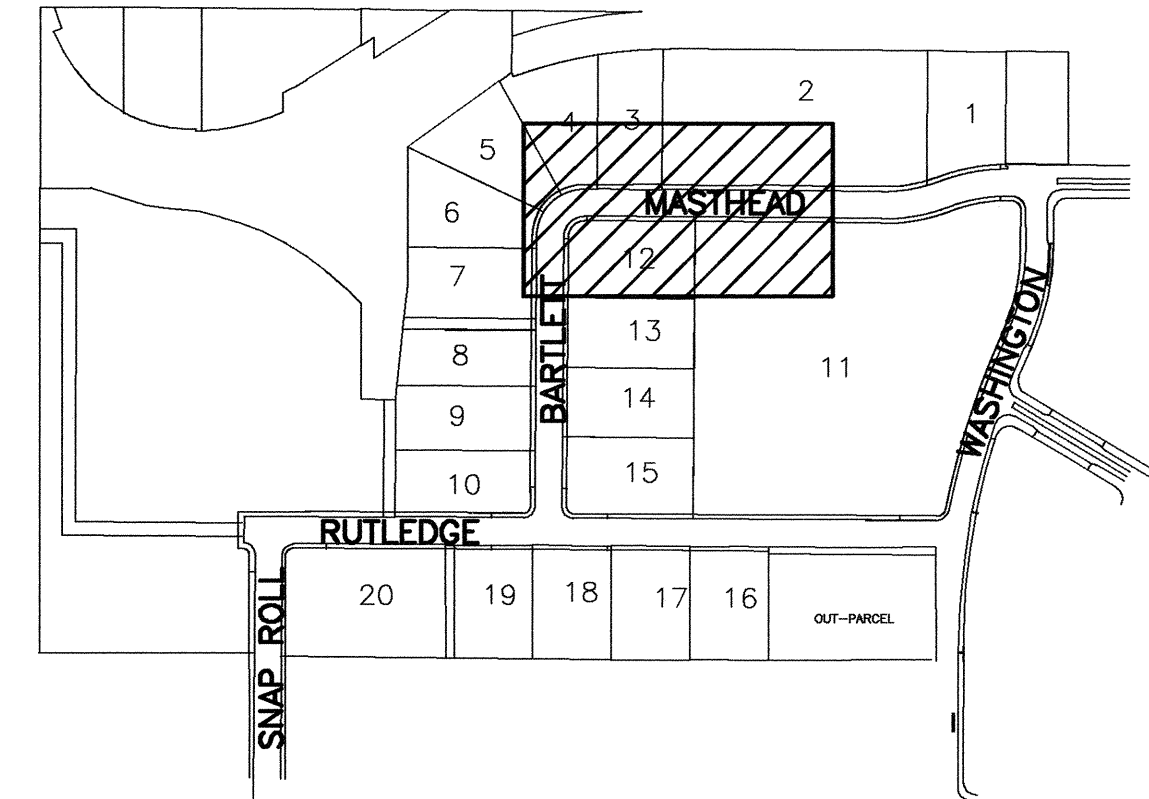


Keyed Construction Notes

1. PROVIDE 4" DEPTH CONCRETE SIDEWALK AS PER C.O.A. STD. DWG #2430. FINISH TO BE BROOM FINISH.
2. PROVIDE BENCH AS PER MANUFACTURER'S RECOMMENDATIONS. SEE SITE FURNISHINGS LEGEND.
3. PROVIDE 3" DEPTH SANTA ANA TAN CRUSHER FINES MULCH.
4. PROVIDE RYERSON STEEL EDGER AT R.O.W. LIMITS AND LIMITS OF WORK.
5. PROVIDE CONCRETE MOWSTRIP AS PER C.O.A. STD DWG #2726.
6. PROVIDE LITTER BIN AS PER MANUFACTURER'S RECOMMENDATIONS. SEE SITE FURNISHINGS LEGEND.
7. PROVIDE BOLLARD AS PER MANUFACTURER'S RECOMMENDATIONS. SEE SITE FURNISHINGS LEGEND.
8. PROVIDE WATERPROOFING ALONG CURB AS PER C.O.A STD DWG #2930.
9. PROVIDE ENTRY MONUMENT SIGN AS PER DETAIL D/20.
10. INSTALL MOSS ROCK RETAINING WALL AS PER DETAIL ON SHEET.

Materials Legend

- CRUSHER FINES
- COBBLE STONE


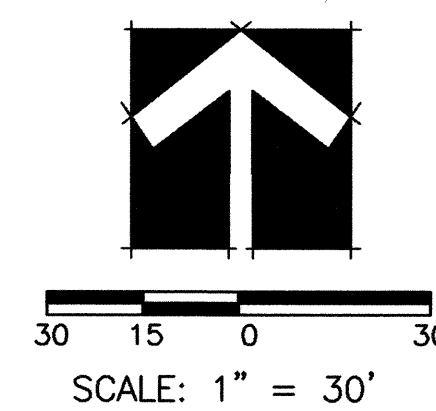


26 6517.84 0504

		CITY OF ALBUQUERQUE PUBLIC WORKS DEPARTMENT ENGINEERING DEVELOPMENT GROUP	
JOURNAL CENTER 2-UNIT 2 CONSTRUCTION PLANS			
Design Review Committee JAN 19 2004 DESIGN REVIEW COMMITTEE	City Engineer Approval FEB - 2 2004	Last Design Update	
City Project No. 6517.84	Zone Map No. D-17	Sheet 5	Of 24

LANDSCAPE ARCHITECT'S SEAL		SURVEY INFORMATION		BENCH MARKS		AS-BUILT INFORMATION	
		FIELD NOTES		ACS BRASS TABLET STAMPED		CONTRACTOR	
		NO.		"1-A11-1980"		WORK BY	
		BY		DATE		INSPECTOR'S	
		DATE		GEOGRAPHIC POSITION (NAD 1927)		ACCEPTANCE BY	
		DATE		NM STATE PLANE COORDINATES (CENTRAL ZONE)		VERIFICATION BY	
DATE		X= 365,236.60 Y=1,531,711.91		DRAWINGS		MICRO-FILM INFORMATION	
DATE		GROUND TO GRID FACTOR= .9996658		NO.		RECORDED BY	
DATE		SLD 1929 ELEVATION= 5331.73		NO.		DATE	

Key Map

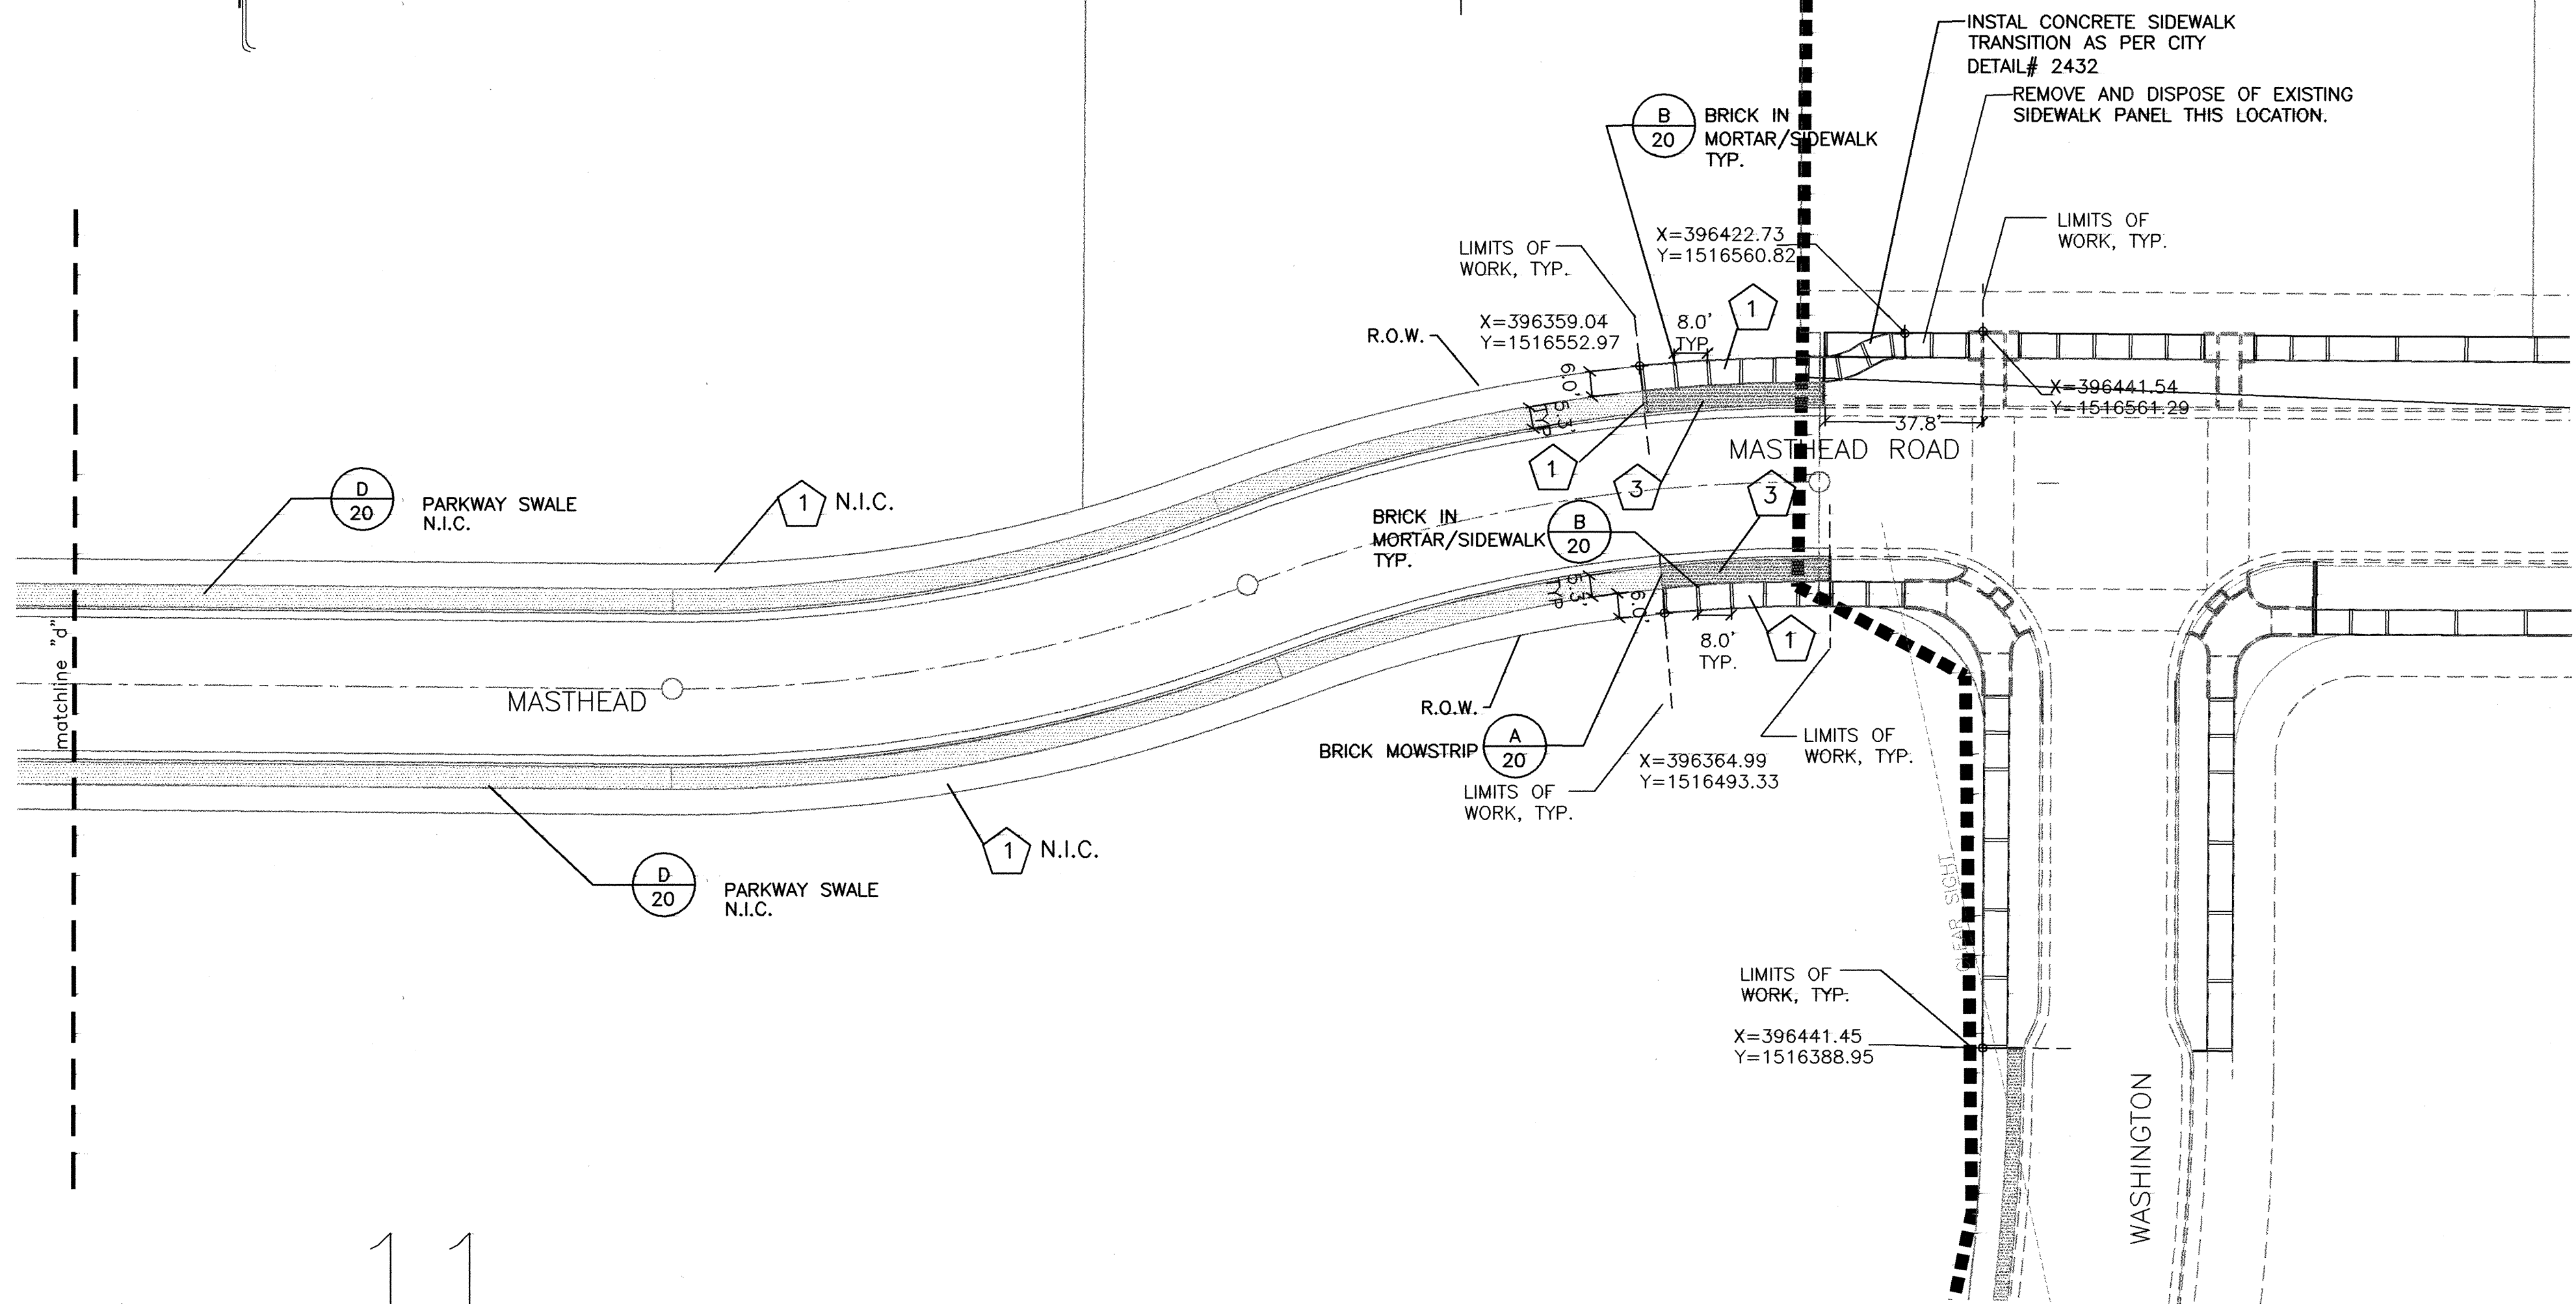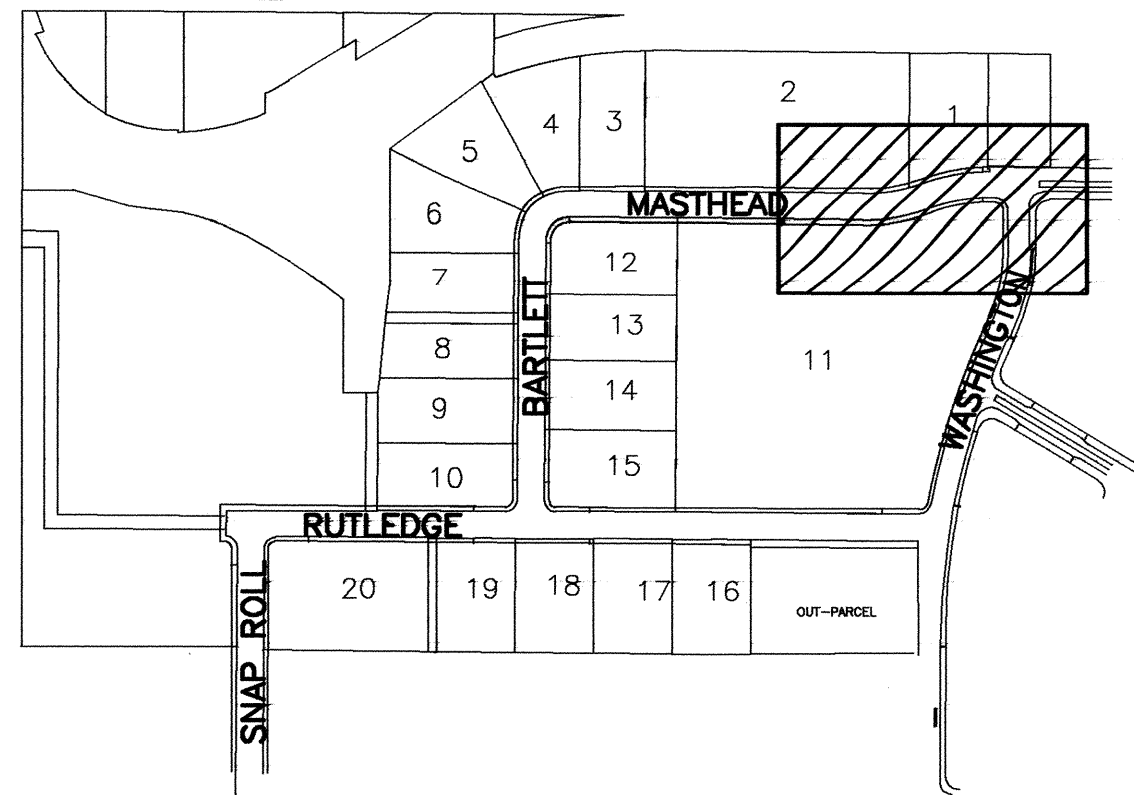


Keyed Construction Notes

1. PROVIDE 4" DEPTH CONCRETE SIDEWALK AS PER C.O.A. STD. DWG #2430. FINISH TO BE BROOM FINISH.
2. PROVIDE BENCH AS PER MANUFACTURER'S RECOMMENDATIONS. SEE SITE FURNISHINGS LEGEND.
3. PROVIDE 3" DEPTH SANTA ANA TAN CRUSHER FINES MULCH.
4. PROVIDE RYERSON STEEL EDGER AT R.O.W. LIMITS AND LIMITS OF WORK.
5. PROVIDE CONCRETE MOWSTRIP AS PER C.O.A. STD DWG #2726.
6. PROVIDE LITTER BIN AS PER MANUFACTURER'S RECOMMENDATIONS. SEE SITE FURNISHINGS LEGEND.
7. PROVIDE BOLLARD AS PER MANUFACTURER'S RECOMMENDATIONS. SEE SITE FURNISHINGS LEGEND.
8. PROVIDE WATERPROOFING ALONG CURB AS PER C.O.A. STD DWG #2930.
9. PROVIDE ENTRY MONUMENT SIGN AS PER DETAIL D/20.
10. INSTALL MOSS ROCK RETAINING WALL AS PER DETAIL ON SHEET.

Materials Legend


- CRUSHER FINES
- COBBLE STONE

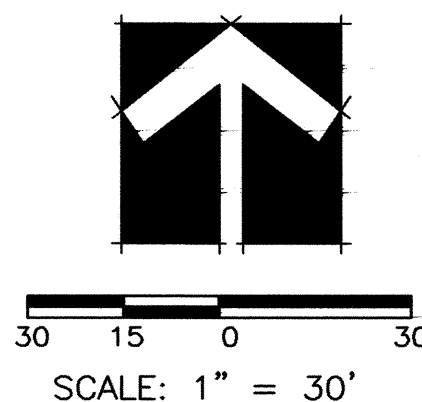

26 6517.84 0604

CITY OF ALBUQUERQUE PUBLIC WORKS DEPARTMENT ENGINEERING DEVELOPMENT GROUP			
JOURNAL CENTER 2-UNIT 2 CONSTRUCTION PLANS			
Design Review Committee	City Engineer Approval	Last Design Update	
JAN 19 2016	FEB 2 2016		
City Project No.	Zone Map No.	Sheet	
6517.84	D-17	6	24

LANDSCAPE ARCHITECT'S SEAL		SURVEY INFORMATION		BENCH MARKS		AS-BUILT INFORMATION	
		FIELD NOTES		ACS BRASS TABLET STAMPED		CONTRACTOR	
		NO.		DATE		NO.	
		BY		DATE		DATE	
		REVISIONS		GEOGRAPHIC POSITION (NAD 1927)		INSPECTOR'S	
		DESIGN		NM STATE PLANE COORDINATES (CENTRAL ZONE)		ACCEPTANCE BY	
Designed By: GRAD		DATE: 11/04/03		DATE		MICRO-FILM INFORMATION	
Drawn By: PACBD		DATE: 11/04/03		DATE		NO.	
Checked By: PGAY		DATE: 11/04/03		DATE		NO.	

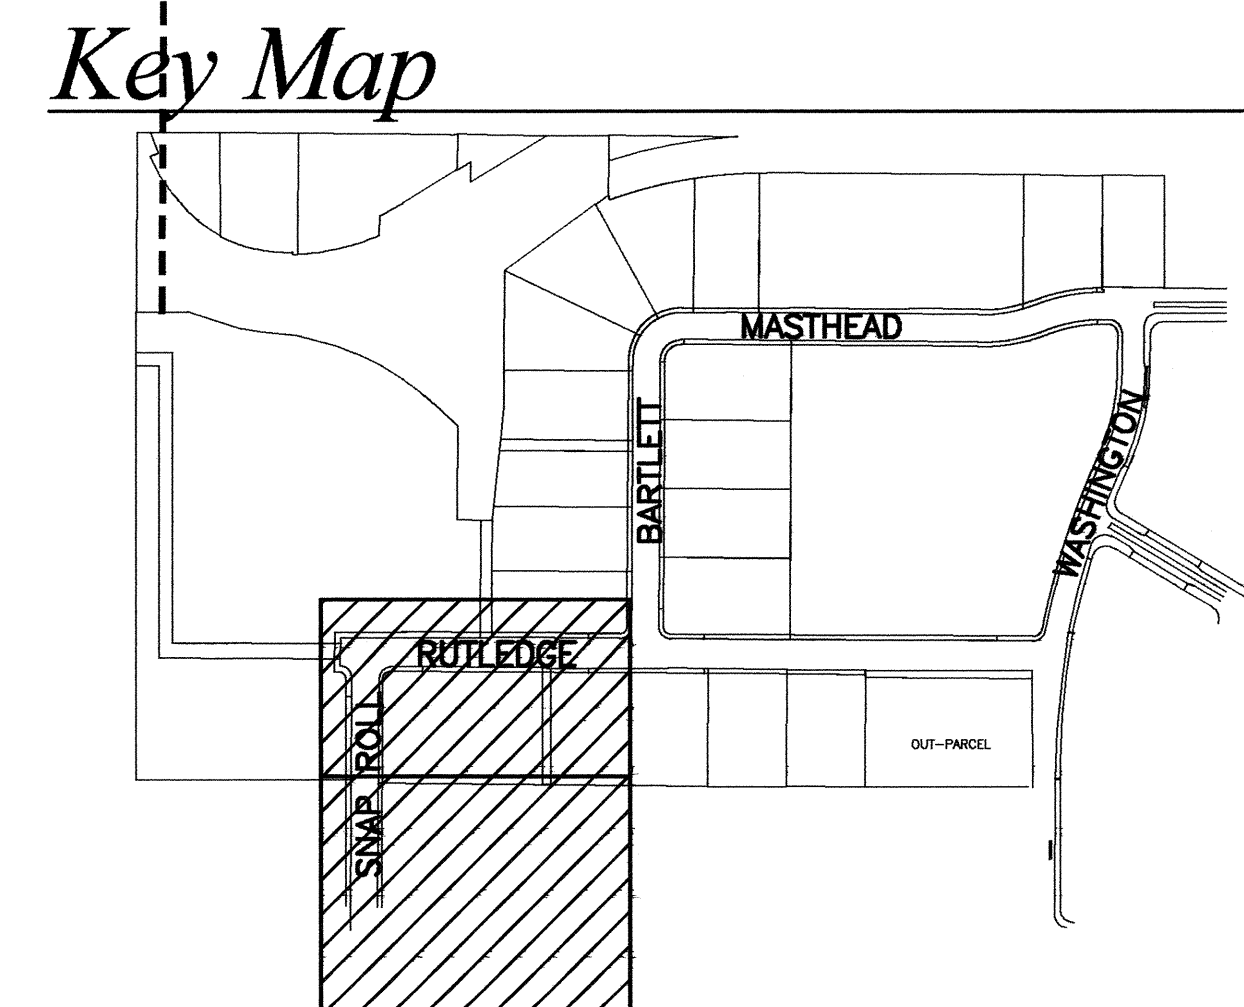


SYMBOL	BOTANICAL NAME	COMMON NAME	QTY	SIZE	NOTES	MATURE SIZE HT x SPD
Trees-- Install as per C.O.A. Std Dwg # 2714 and 2715						
	<i>Pinus strobiformis</i>	SOUTHWEST WHITE PINE	0	8'-10' HT		30' X 20'
	<i>Fraxinus velutina</i> 'Modesto'	MODESTO ASH	N.I.C	2 1/2" CAL.		40' X 40'
	or <i>Fraxinus velutina</i> var. <i>Berinda</i>	BERINDA ASH	N.I.C	2 1/2" CAL.		30' X 30'
	or <i>Crataegus ambigua</i>	RUSSIAN HAWTHORN	0	2 1/2" CAL.		20' X 25'
	<i>Celtis occidentalis</i>	COMMON HACKBERRY	6	2 1/2" CAL.		40' X 40'
	<i>Quercus virginiana</i> "Heritage"	HERITAGE LIVE OAK	21	6'-8' HT.		40' X 30'

SYMBOL	BOTANICAL NAME	COMMON NAME	QTY	SPACING	SIZE	NOTES	MATURE SIZE HT' x SPD
Shrubs-- Install as per C.O.A. Std. Dwg # 2717							
	<i>Cercocarpus ledifolius</i>	CURL-LEAF MOUNTAIN MAHOGANY	108	4.0' O.C.	5 GAL.		4' x 6'
	<i>Fallugia paradoxa</i>	APACHE PLUME	42	5.0' O.C.	5 GAL.		5' x 5'
Ground Covers--Install as per C.O.A. Std. Dwg # 2718							
	<i>Lavendula angustifolia</i>	ENGLISH LAVENDER	99	2.5' O.C.	1 GAL.		36" x 36"
	<i>Pennisetum 'Hameln'</i>	DWARF FOUNTAINGRASS	111	2.0' O.C.	1 GAL.		24" x 24"
	<i>Muhlenbergia capillaris</i> "Regal Mist"	REGAL MIST	77	3.0' O.C.	5 GAL.		36" x 36"


RUSSIAN HAWTHORN SHALL HAVE A MINIMUM CANOPY HEIGHT OF 8 FEET WHEN INSTALLED.

DEVELOPER SHALL PROVIDE MAINTENANCE FOR ALL PLANT MATERIALS AND IRRIGATION WITHIN THE RIGHT-OF-WAY THROUGH A PRIVATE LANDSCAPE MAINTENANCE CONTRACTOR SUBSEQUENT TO INSTALLATION.


ALL WORK TO BE PERFORMED WITHIN THE PUBLIC RIGHT OF WAY

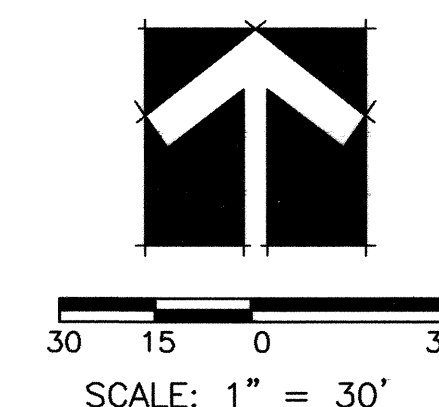


	CITY OF ALBUQUERQUE PUBLIC WORKS DEPARTMENT ENGINEERING DEVELOPMENT GROUP												
	JOURNAL CENTER 2-UNIT 2 PLANTING PLANS												
Design Review Committee A P P R O V E JAN 19 2004 DESIGN REVIEW COMMITTEE	City Engineer Approval A P P R O V E FEB - 2 2004	Last Design Update	<table border="1" style="width: 100%; border-collapse: collapse;"> <thead> <tr> <th style="width: 50%;">Mo./Day/Yr.</th> <th style="width: 50%;">Mo./Day/Yr.</th> </tr> </thead> <tbody> <tr><td> </td><td> </td></tr> <tr><td> </td><td> </td></tr> <tr><td> </td><td> </td></tr> <tr><td> </td><td> </td></tr> </tbody> </table>	Mo./Day/Yr.	Mo./Day/Yr.								
Mo./Day/Yr.	Mo./Day/Yr.												
City Project No.	Zone Map No.	Sheet Of											
6517.84	D-17	8 24											

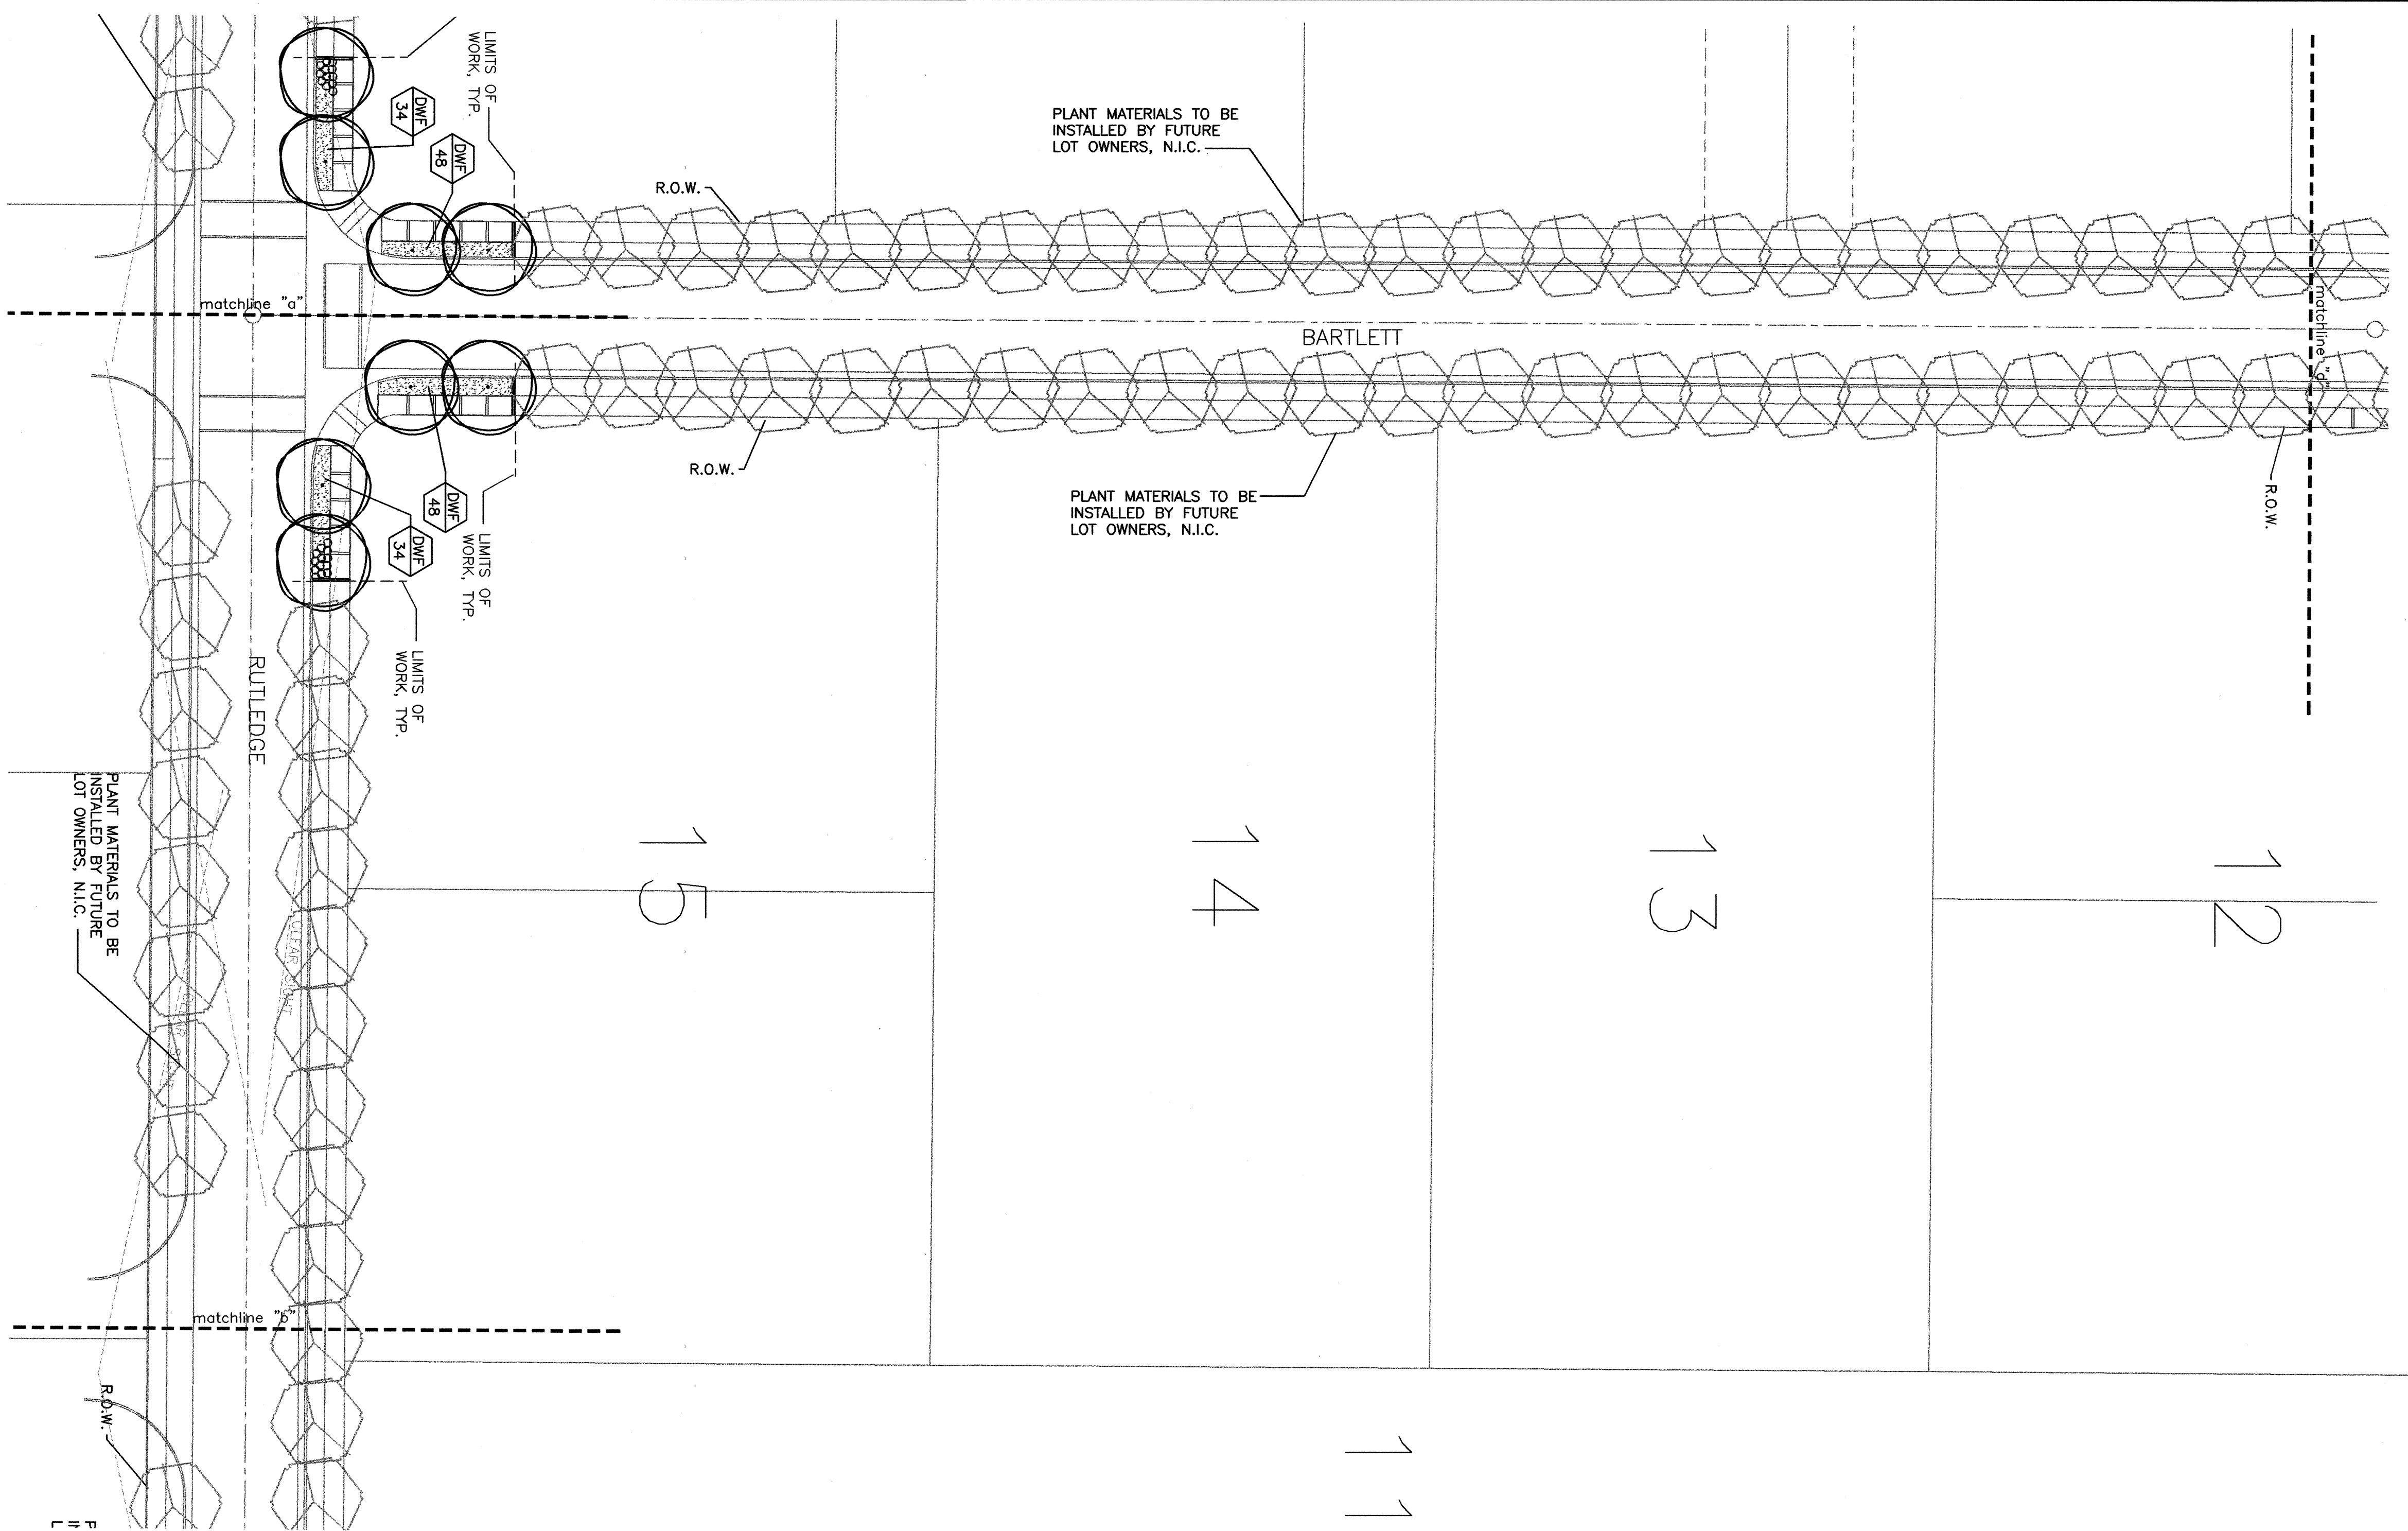

Key Map

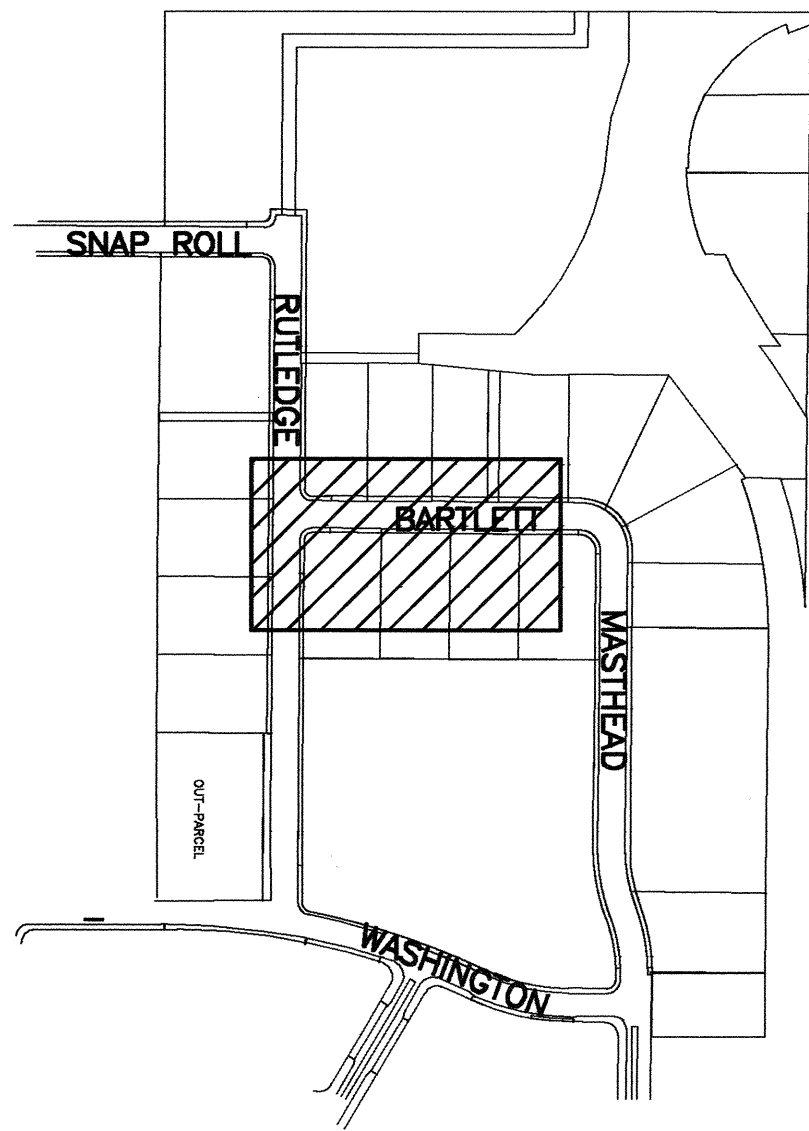


Plant Legend

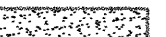SYMBOL	BOTANICAL NAME	COMMON NAME	QTY	SIZE	NOTES	MATURE SIZE HT x SPD	SYMBOL	BOTANICAL NAME	COMMON NAME	QTY	SPACING	SIZE	NOTES	MATURE SIZE HT x SPD
Trees-- Install as per C.O.A. Std Dwg # 2714 and 2715							Shrubs-- Install as per C.O.A. Std. Dwg # 2717							
	Pinus strobiformis	SOUTHWEST WHITE PINE	0	8'-10' HT		30' X 20'		Cercocarpus ledifolius	CURL-LEAF MOUNTAIN MAHOGANY	0	4.0' O.C.	5 GAL.		4' X 6'
	Fraxinus velutina 'Modesto'	MODESTO ASH	N.I.C.	2 1/2" CAL.		40' X 40'		Fallugia paradoxa	APACHE PLUME	0	5.0' O.C.	5 GAL.		5' X 5'
	or Fraxinus velutina var. Berinda	BERINDA ASH	N.I.C.	2 1/2" CAL.		30' X 30'	Ground Covers--Install as per C.O.A. Std. Dwg # 2718							
								Lavendula angustifolia	ENGLISH LAVENDER	24	2.5' O.C.	1 GAL.		36" X 36"
								Pennisetum villosum	DWARF FOUNTAINGRASS	164	2.0' O.C.	1 GAL.		24" X 24"
	Crataegus ambigua	RUSSIAN HAWTHORN	0	2 1/2" CAL.		20' X 25'		Muhlenbergia capillaris "Regal Mist"	REGAL MIST	0	3.0' O.C.	5 GAL.		36" X 36"
	Celtis occidentalis	COMMON HACKBERRY	8	2 1/2" CAL.		40' X 40'								
	Quercus virginiana "Heritage"	HERITAGE LIVE OAK	0	6'-8' HT.		40' X 30'								

Planting Notes

DEVELOPER SHALL PROVIDE MAINTENANCE FOR ALL PLANT MATERIALS AND IRRIGATION WITHIN THE RIGHT-OF-WAY THROUGH A PRIVATE LANDSCAPE MAINTENANCE CONTRACTOR SUBSEQUENT TO INSTALLATION.
ALL WORK TO BE PERFORMED WITHIN THE PUBLIC RIGHT OF WAY

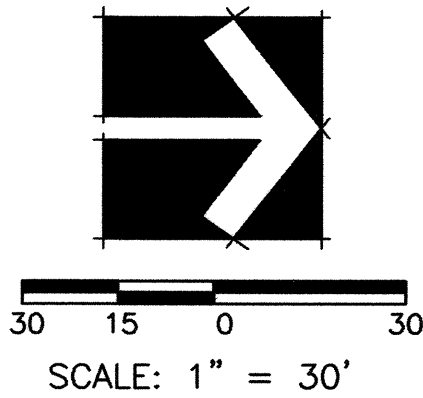


26 6517.84 0904



CITY OF ALBUQUERQUE
PUBLIC WORKS DEPARTMENT
ENGINEERING DEVELOPMENT GROUP

JOURNAL CENTER 2-UNIT 2
PLANTING PLANS

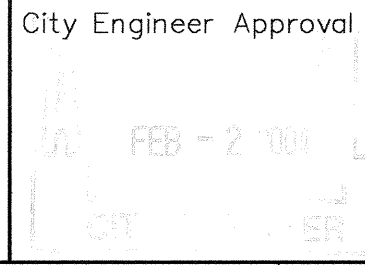


Last Design Update

City Project No. 6517.84


Zone Map No. D-17

Sheet 9 Of 24

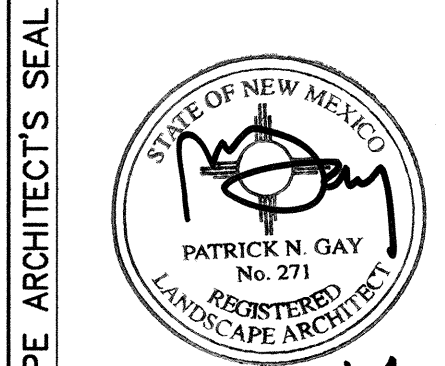


11-4-03




REVISIONS	BY	DATE
DESIGN		
GRAD/P&GAY		DATE: 11/04/03
P&C&B		DATE: 11/04/03
P&GAY		DATE: 11/04/03

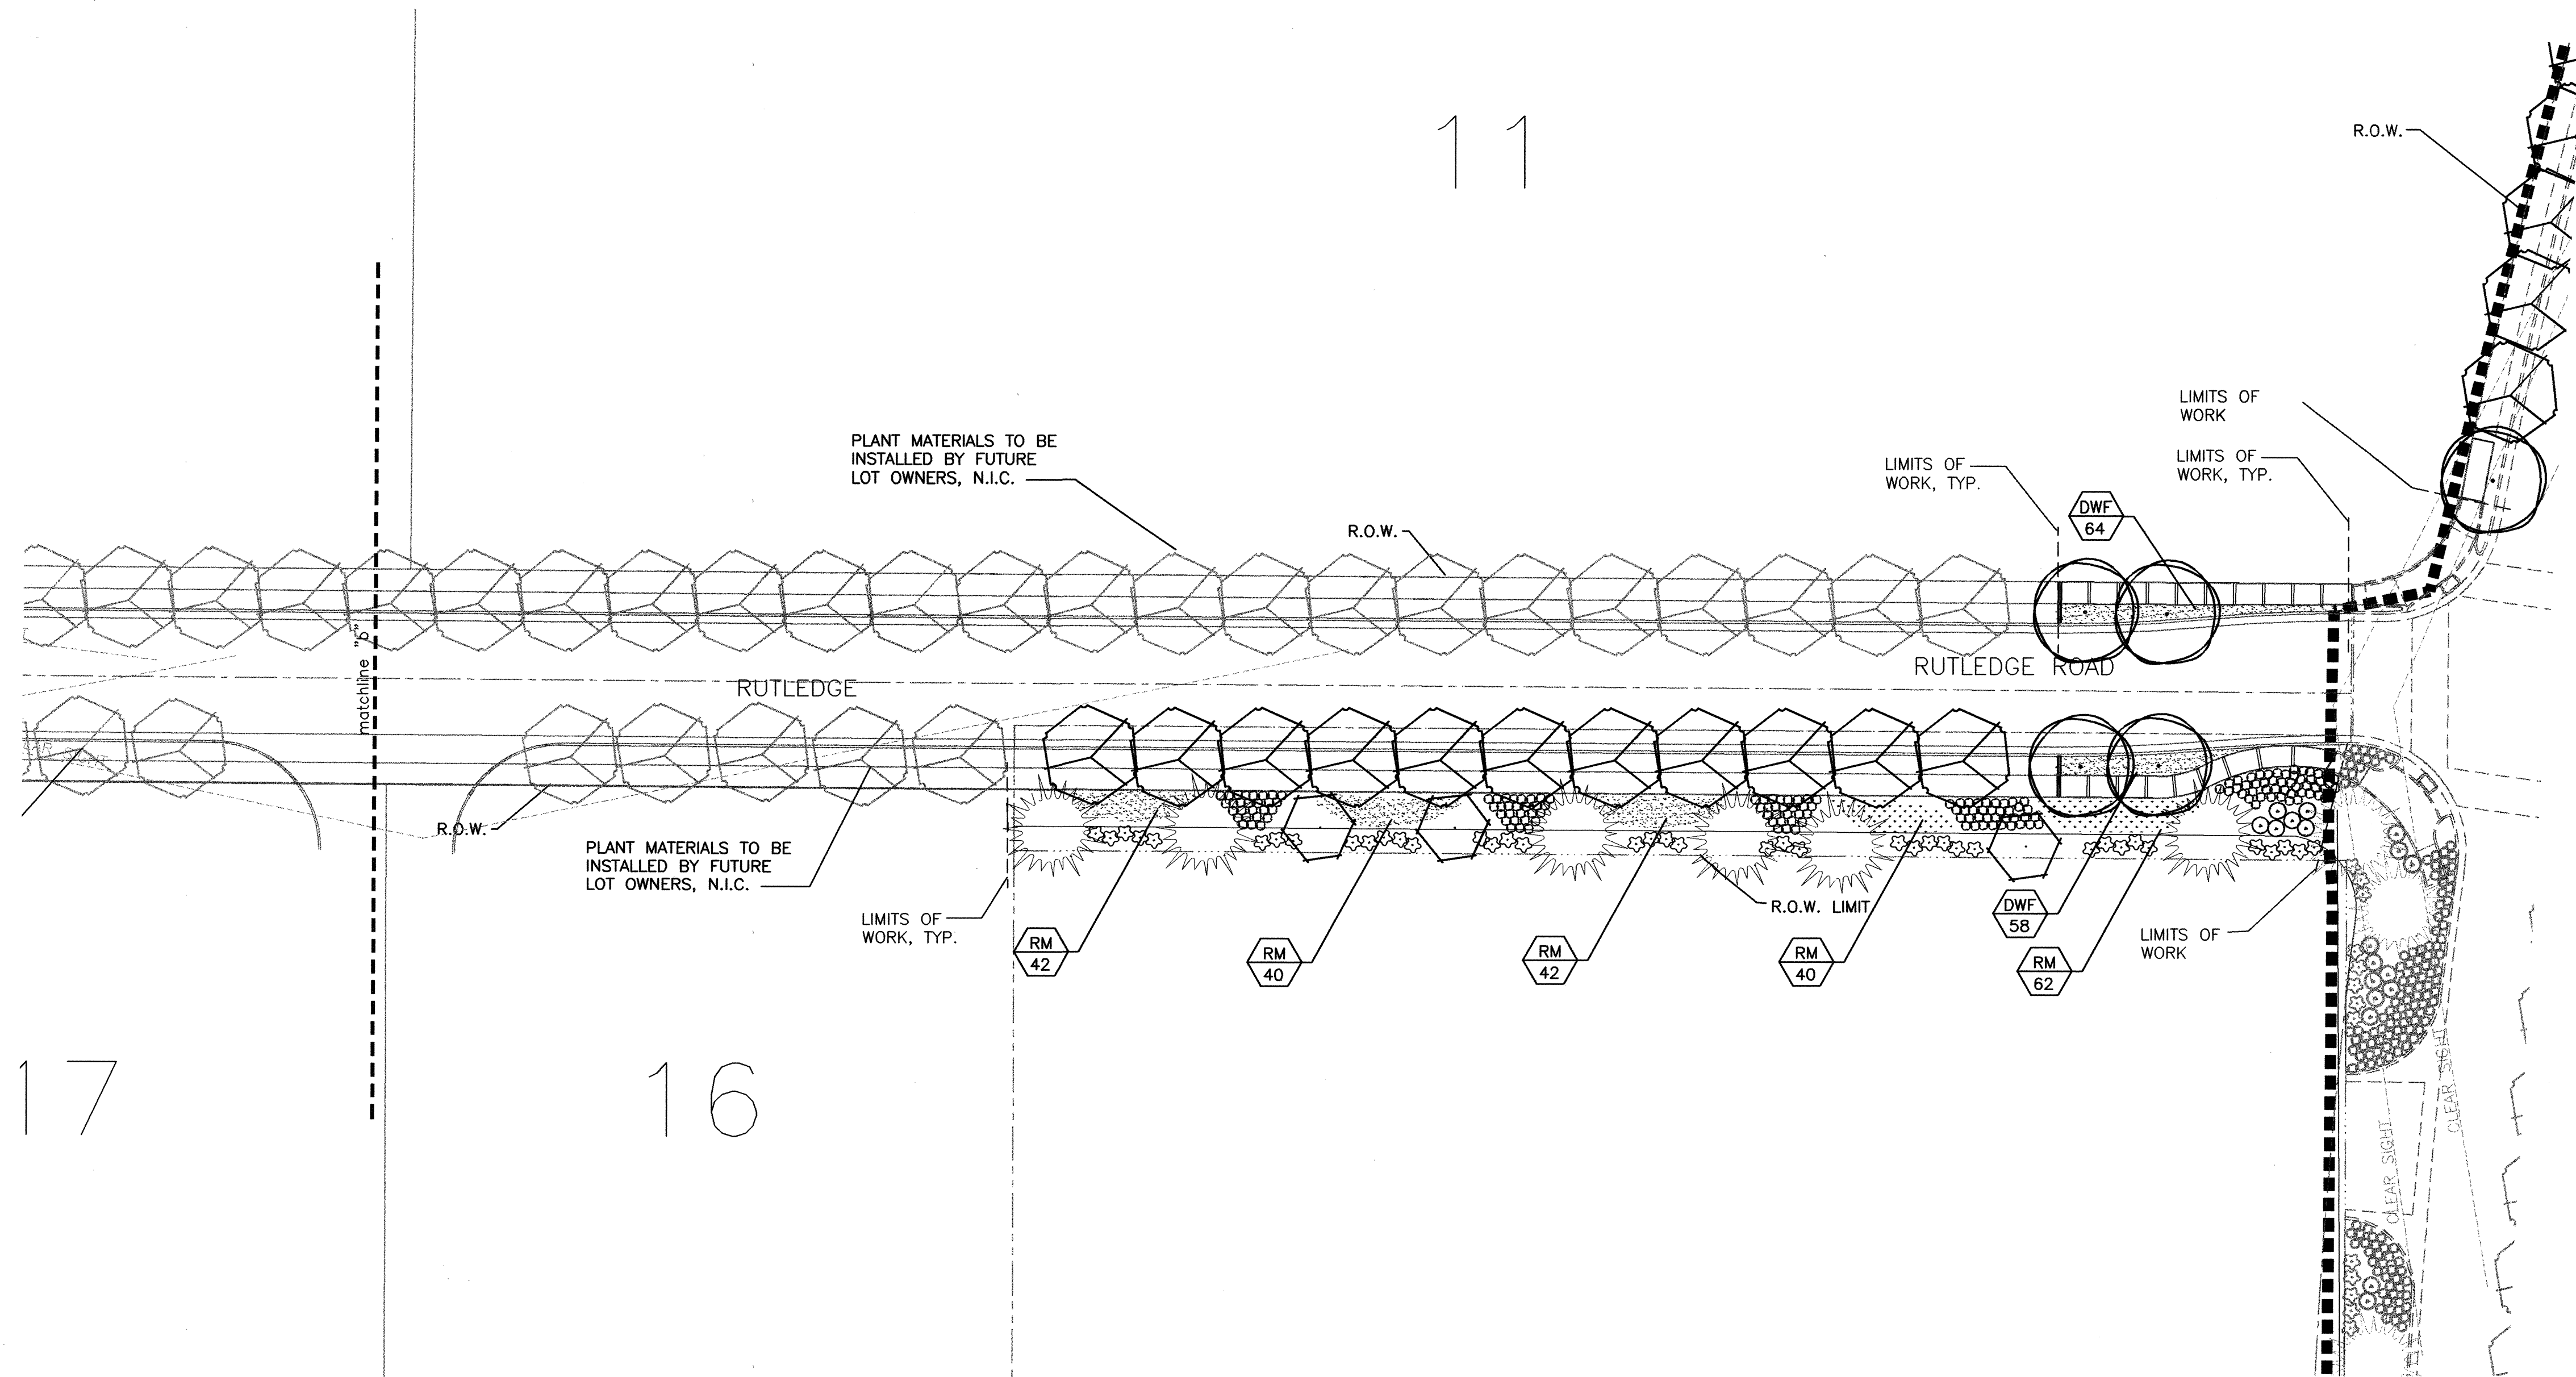

Key Map

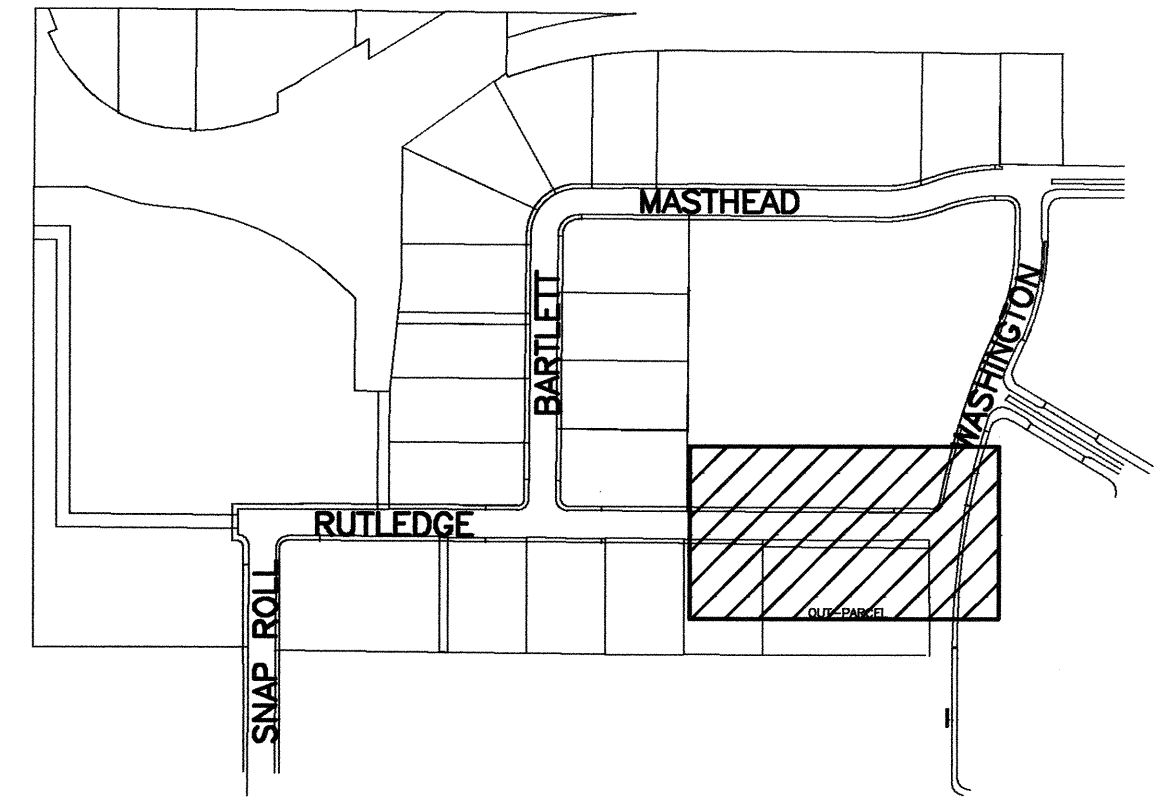


Plant Legend

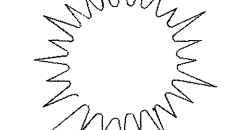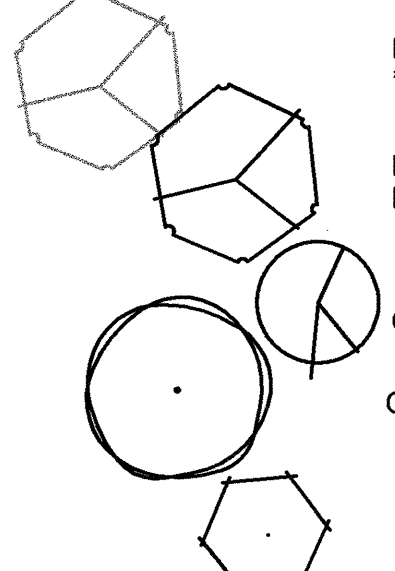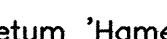SYMBOL	BOTANICAL NAME	COMMON NAME	QTY	SIZE	NOTES	MATURE SIZE HT x SPD	SYMBOL	BOTANICAL NAME	COMMON NAME	QTY	SPACING	SIZE	NOTES	MATURE SIZE HT x SPD
Trees-- Install as per C.O.A. Std Dwg # 2714 and 2715							Shrubs-- Install as per C.O.A. Std. Dwg # 2717							
	Pinus strobiformis	SOUTHWEST WHITE PINE	6	8'-10' HT		30' x 20'		Cercocarpus ledifolius	CURL-LEAF MOUNTAIN MAHOGANY	40	4.0' O.C.	5 GAL.		4' x 6'
								Fallugia paradoxa	APACHE PLUME	6	5.0' O.C.	5 GAL.		5' x 5'
	Fraxinus velutina 'Modesto'	MODESTO ASH	N.I.C.	2 1/2" CAL.		40' x 40'	Ground Covers--Install as per C.O.A. Std. Dwg # 2718							
	Fraxinus velutina var. Berinda	BERINDA ASH	12	2 1/2" CAL.		30' x 30'		Lavendula angustifolia	ENGLISH LAVENDER	185	2.5' O.C.	1 GAL.		36" x 36"
	Crataegus ambigua	RUSSIAN HAWTHORN	0	2 1/2" CAL.		20' x 25'		Pennisetum 'Hameln'	DWARF FOUNTAIN GRASS	122	2.0' O.C.	1 GAL.		24" x 24"
	Celtis occidentalis	COMMON HACKBERRY	5	2 1/2" CAL.		40' x 40'		Muhlenbergia capillaris "Regal Mist"	REGAL MIST	226	3.0' O.C.	5 GAL.		36" x 36"
		HERITAGE LIVE OAK	3	6'-8' HT.		40' x 30'								

Planting Notes


DEVELOPER SHALL PROVIDE MAINTENANCE FOR ALL PLANT MATERIALS AND IRRIGATION WITHIN THE RIGHT-OF-WAY THROUGH A PRIVATE LANDSCAPE MAINTENANCE CONTRACTOR SUBSEQUENT TO INSTALLATION.
ALL WORK TO BE PERFORMED WITHIN THE PUBLIC RIGHT OF WAY

26 6517.84 1004

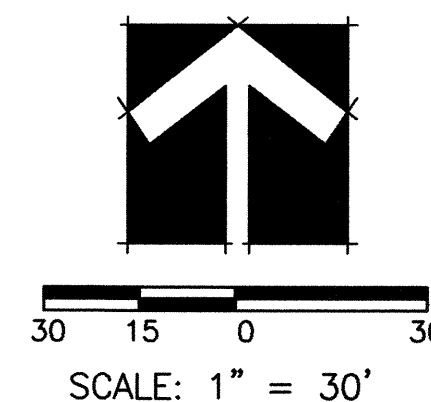


		CITY OF ALBUQUERQUE PUBLIC WORKS DEPARTMENT ENGINEERING DEVELOPMENT GROUP	
JOURNAL CENTER 2-UNIT 2 PLANTING PLANS			
Design Review Committee APPROVED JAN 19 2004	City Engineer Approval APPROVED FEB - 2 2004	Mo./Day/Yr. Mo./Day/Yr.	
City Project No. 6517.84		Zone Map No. D-17	Sheet 10 Of 24

Key Map

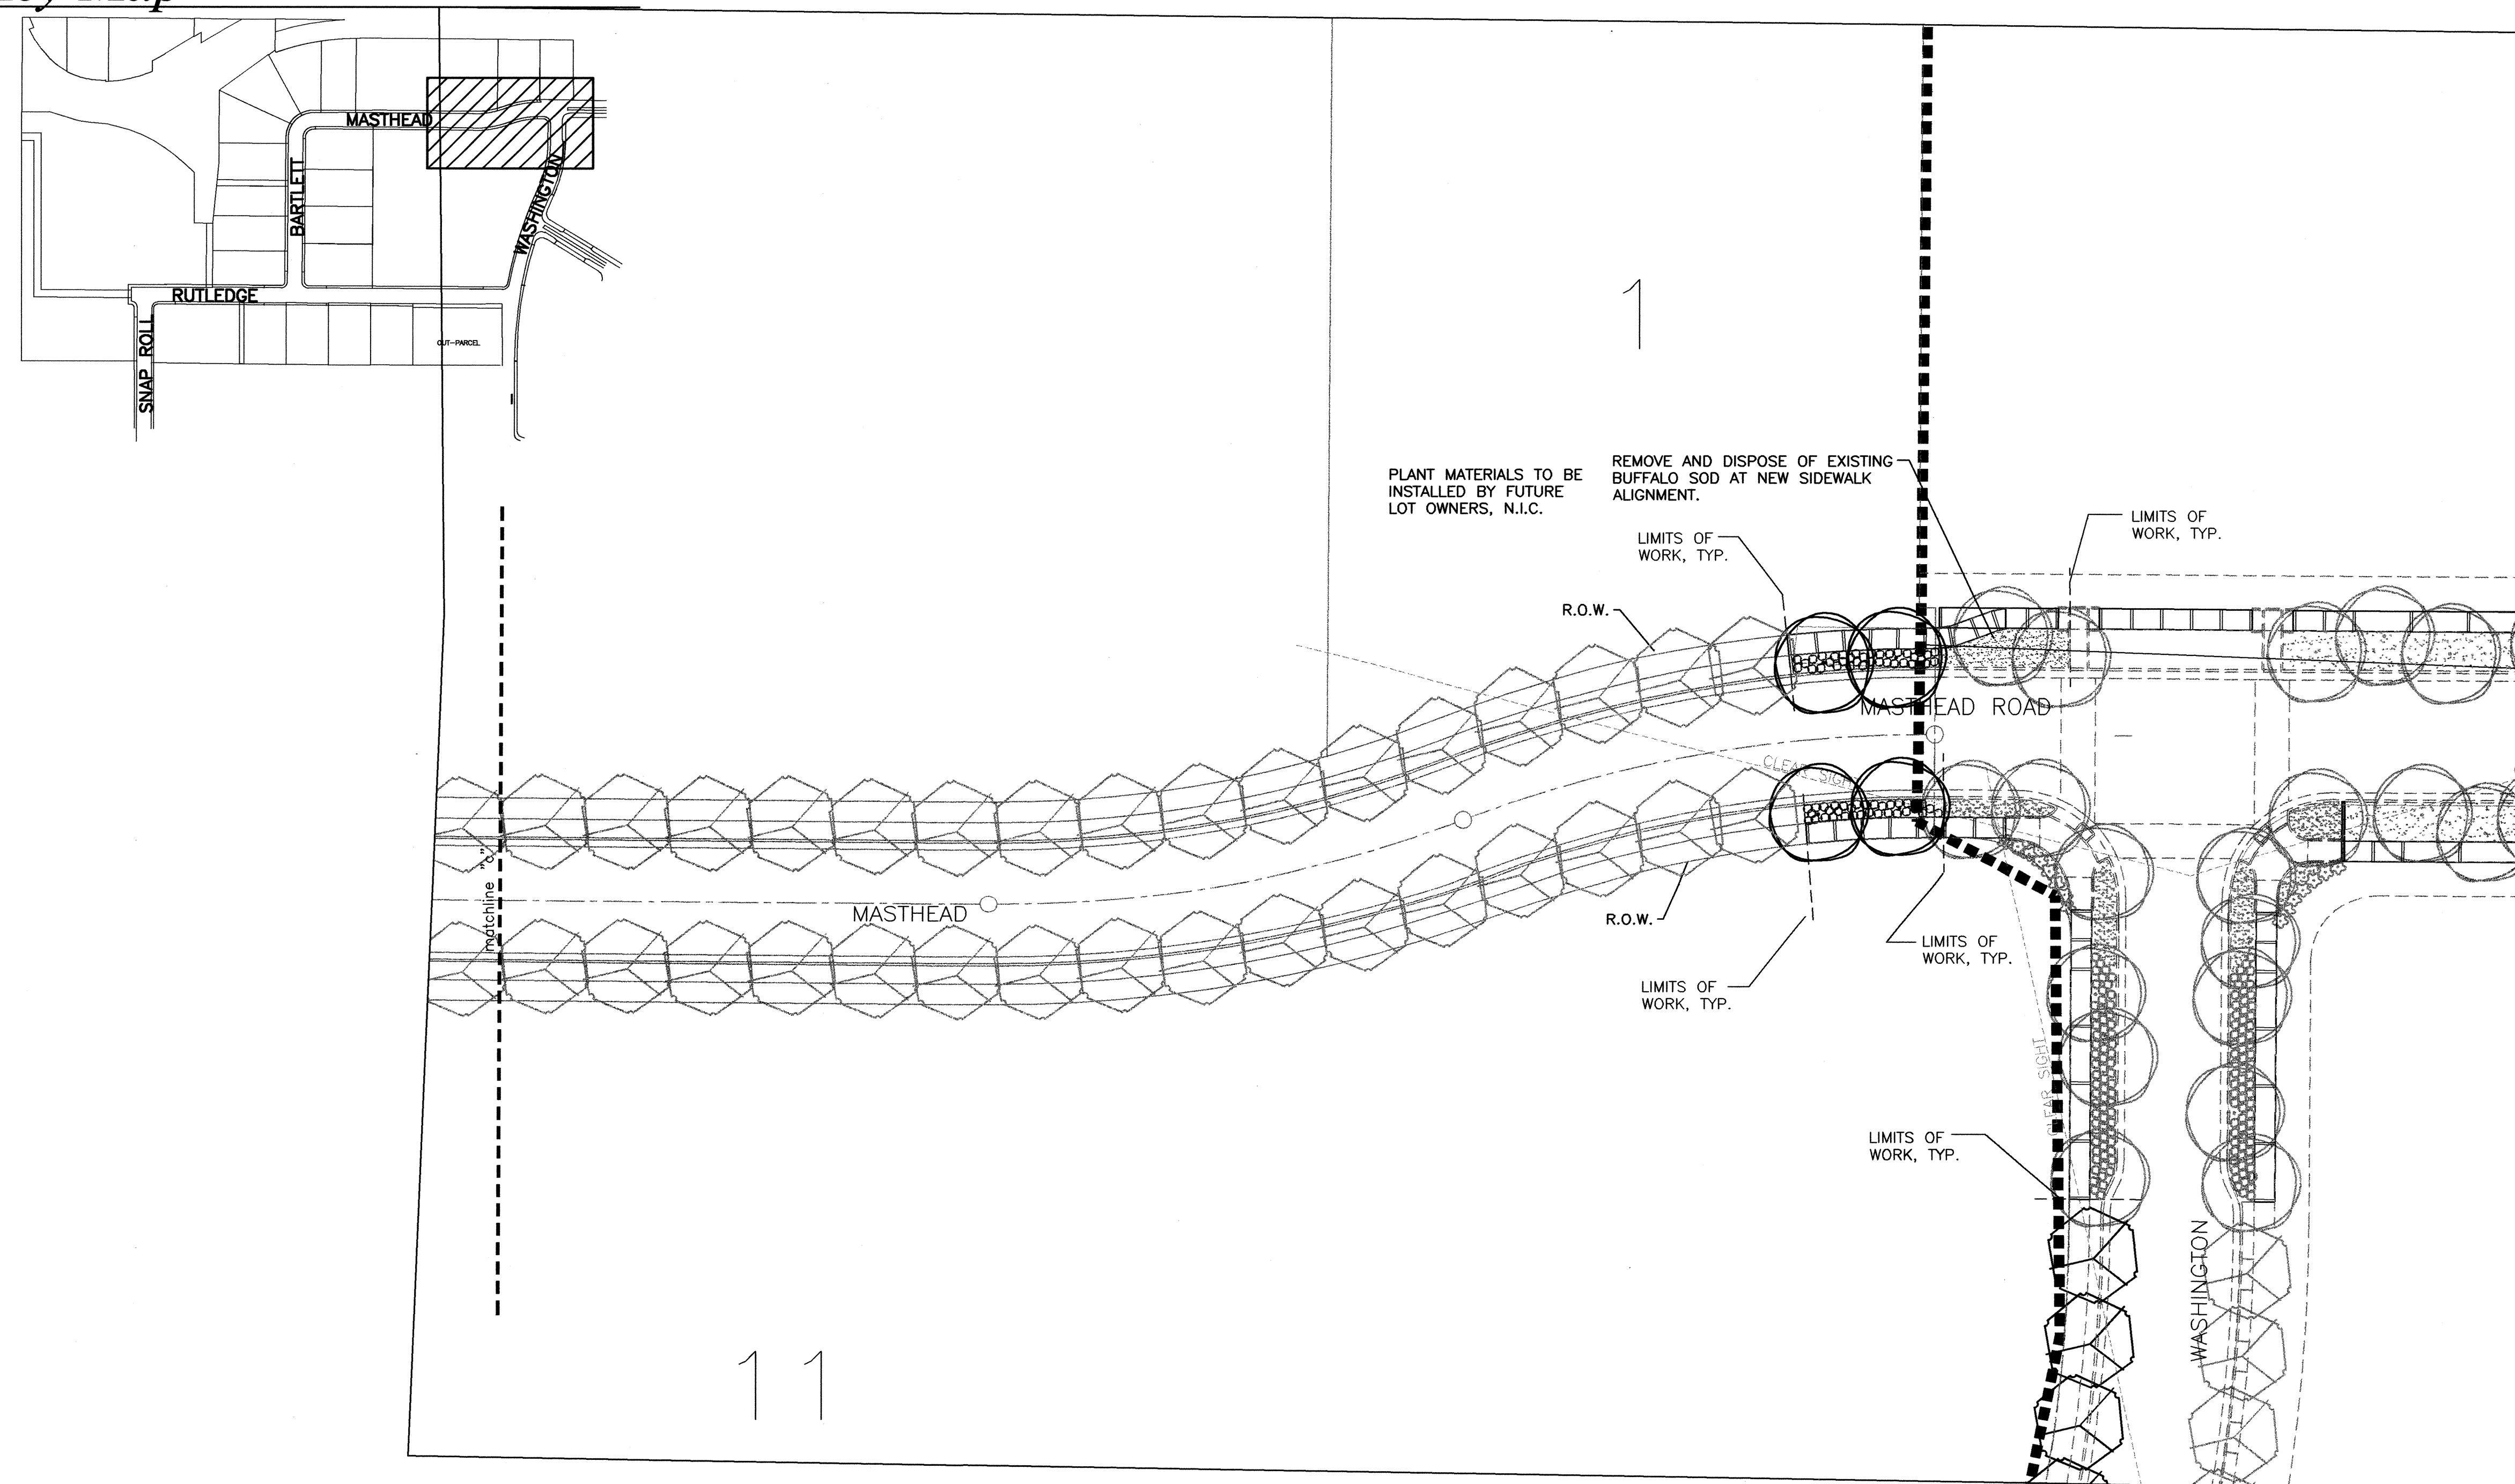

Plant Legend

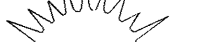
SYMBOL	BOTANICAL NAME	COMMON NAME	QTY	SIZE	NOTES	MATURE SIZE	SYMBOL	BOTANICAL NAME	COMMON NAME	QTY	SPACING	SIZE	NOTES	MATURE SIZE
Trees-- Install as per C.O.A. Std. Dwg # 2714 and 2715							Shrubs-- Install as per C.O.A. Std. Dwg # 2717							
	<i>Pinus strobiformis</i>	SOUTHWEST WHITE PINE	0	8'-10' HT		HT x SPD		<i>Cercocarpus ledifolius</i>	CURL-LEAF MAHOGANY	0	4.0' O.C.	5 GAL.		4' x 6'
								<i>Fallugia paradoxa</i>	APACHE PLUME	0	5.0' O.C.	5 GAL.		5' x 5'
	<i>Fraxinus velutina</i> 'Modesto'	MODESTO ASH	N.I.C	2 1/2" CAL.		40' x 40'	Ground Covers--Install as per C.O.A. Std. Dwg # 2718							
	or <i>Fraxinus velutina</i> var. <i>Berinda</i>	BERINDA ASH	N.I.C	2 1/2" CAL.		30' x 30'		<i>Lavendula angustifolia</i>	ENGLISH LAVENDER	32	2.5' O.C.	1 GAL.		36" x 36"
	<i>Crataegus ambigua</i>	RUSSIAN HAWTHORN	0	2 1/2" CAL.		20' x 25'		<i>Pennisetum 'Harmeln'</i>	DWARF FOUNTAINGRASS	0	2.0' O.C.	1 GAL.		24" x 24"
	<i>Celtis occidentalis</i>	COMMON HACKBERRY	4	2 1/2" CAL.		40' x 40'		<i>Muhlenbergia "Regal Mist"</i> <i>capillaris</i>	REGAL MIST	0	3.0' O.C.	5 GAL.		36" x 36"
	<i>Quercus virginiana</i> "Heritage"	HERITAGE LIVE OAK	0	6'-8' HT.		40' x 30'								

Planting Notes

DEVELOPER SHALL PROVIDE MAINTENANCE FOR ALL PLANT MATERIALS AND IRRIGATION WITHIN THE RIGHT-OF-WAY THROUGH A PRIVATE LANDSCAPE MAINTENANCE CONTRACTOR SUBSEQUENT TO INSTALLATION.


ALL WORK TO BE PERFORMED WITHIN THE PUBLIC RIGHT OF WAY

Y 1 2 3 4 5 6 7 8 9 10 11 12 13 14 15
26 65 17.84 1204

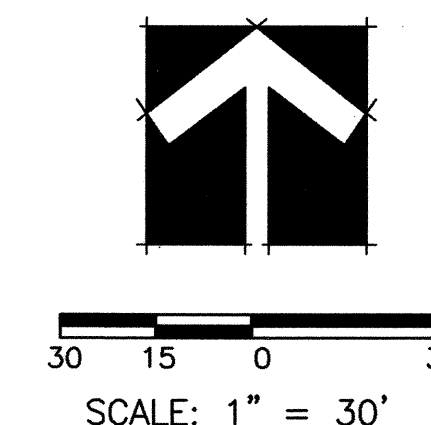


	CITY OF ALBUQUERQUE PUBLIC WORKS DEPARTMENT ENGINEERING DEVELOPMENT GROUP			
	JOURNAL CENTER 2—UNIT 2 PLANTING PLANS			
Design Review Committee APPROVED JAN 19 2004 DESIGN REVIEW COMMITTEE	City Engineer Approval APPROVED FEB - 2 2004 CITY ENGINEER	Last Design Update	Mo./Day/Yr. 	Mo./Day/Yr.
City Project No. 6517 84	Zone Map No. D-17	Sheet 12	Of 24	

AS-BUILT INFORMATION	
CONTRACTOR	DATE
WORK STARTED BY	DATE
INSPECTOR'S ASSISTANCE BY	DATE
FIELD VERIFICATION BY	DATE
DRAWINGS CORRECTED BY	DATE
MICRO-FILM INFORMATION	
RECORDED BY	DATE
NO.	


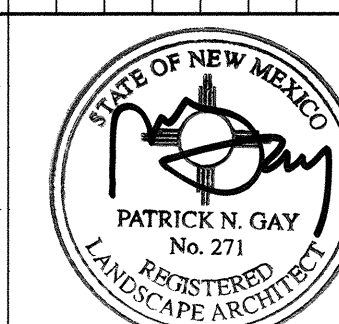
[illegible][illegible]

11.4.03

15									
4									
	No.	Date	REMARKS						BY
	DESIGN REVISIONS								
	DESIGN								
	Designed By: GRAD/P/GRAY								DATE: 11/04/03
	Drawn By: PA/CBD								DATE: 11/04/03
	Checked By: BCAY								DATE: 11/04/03

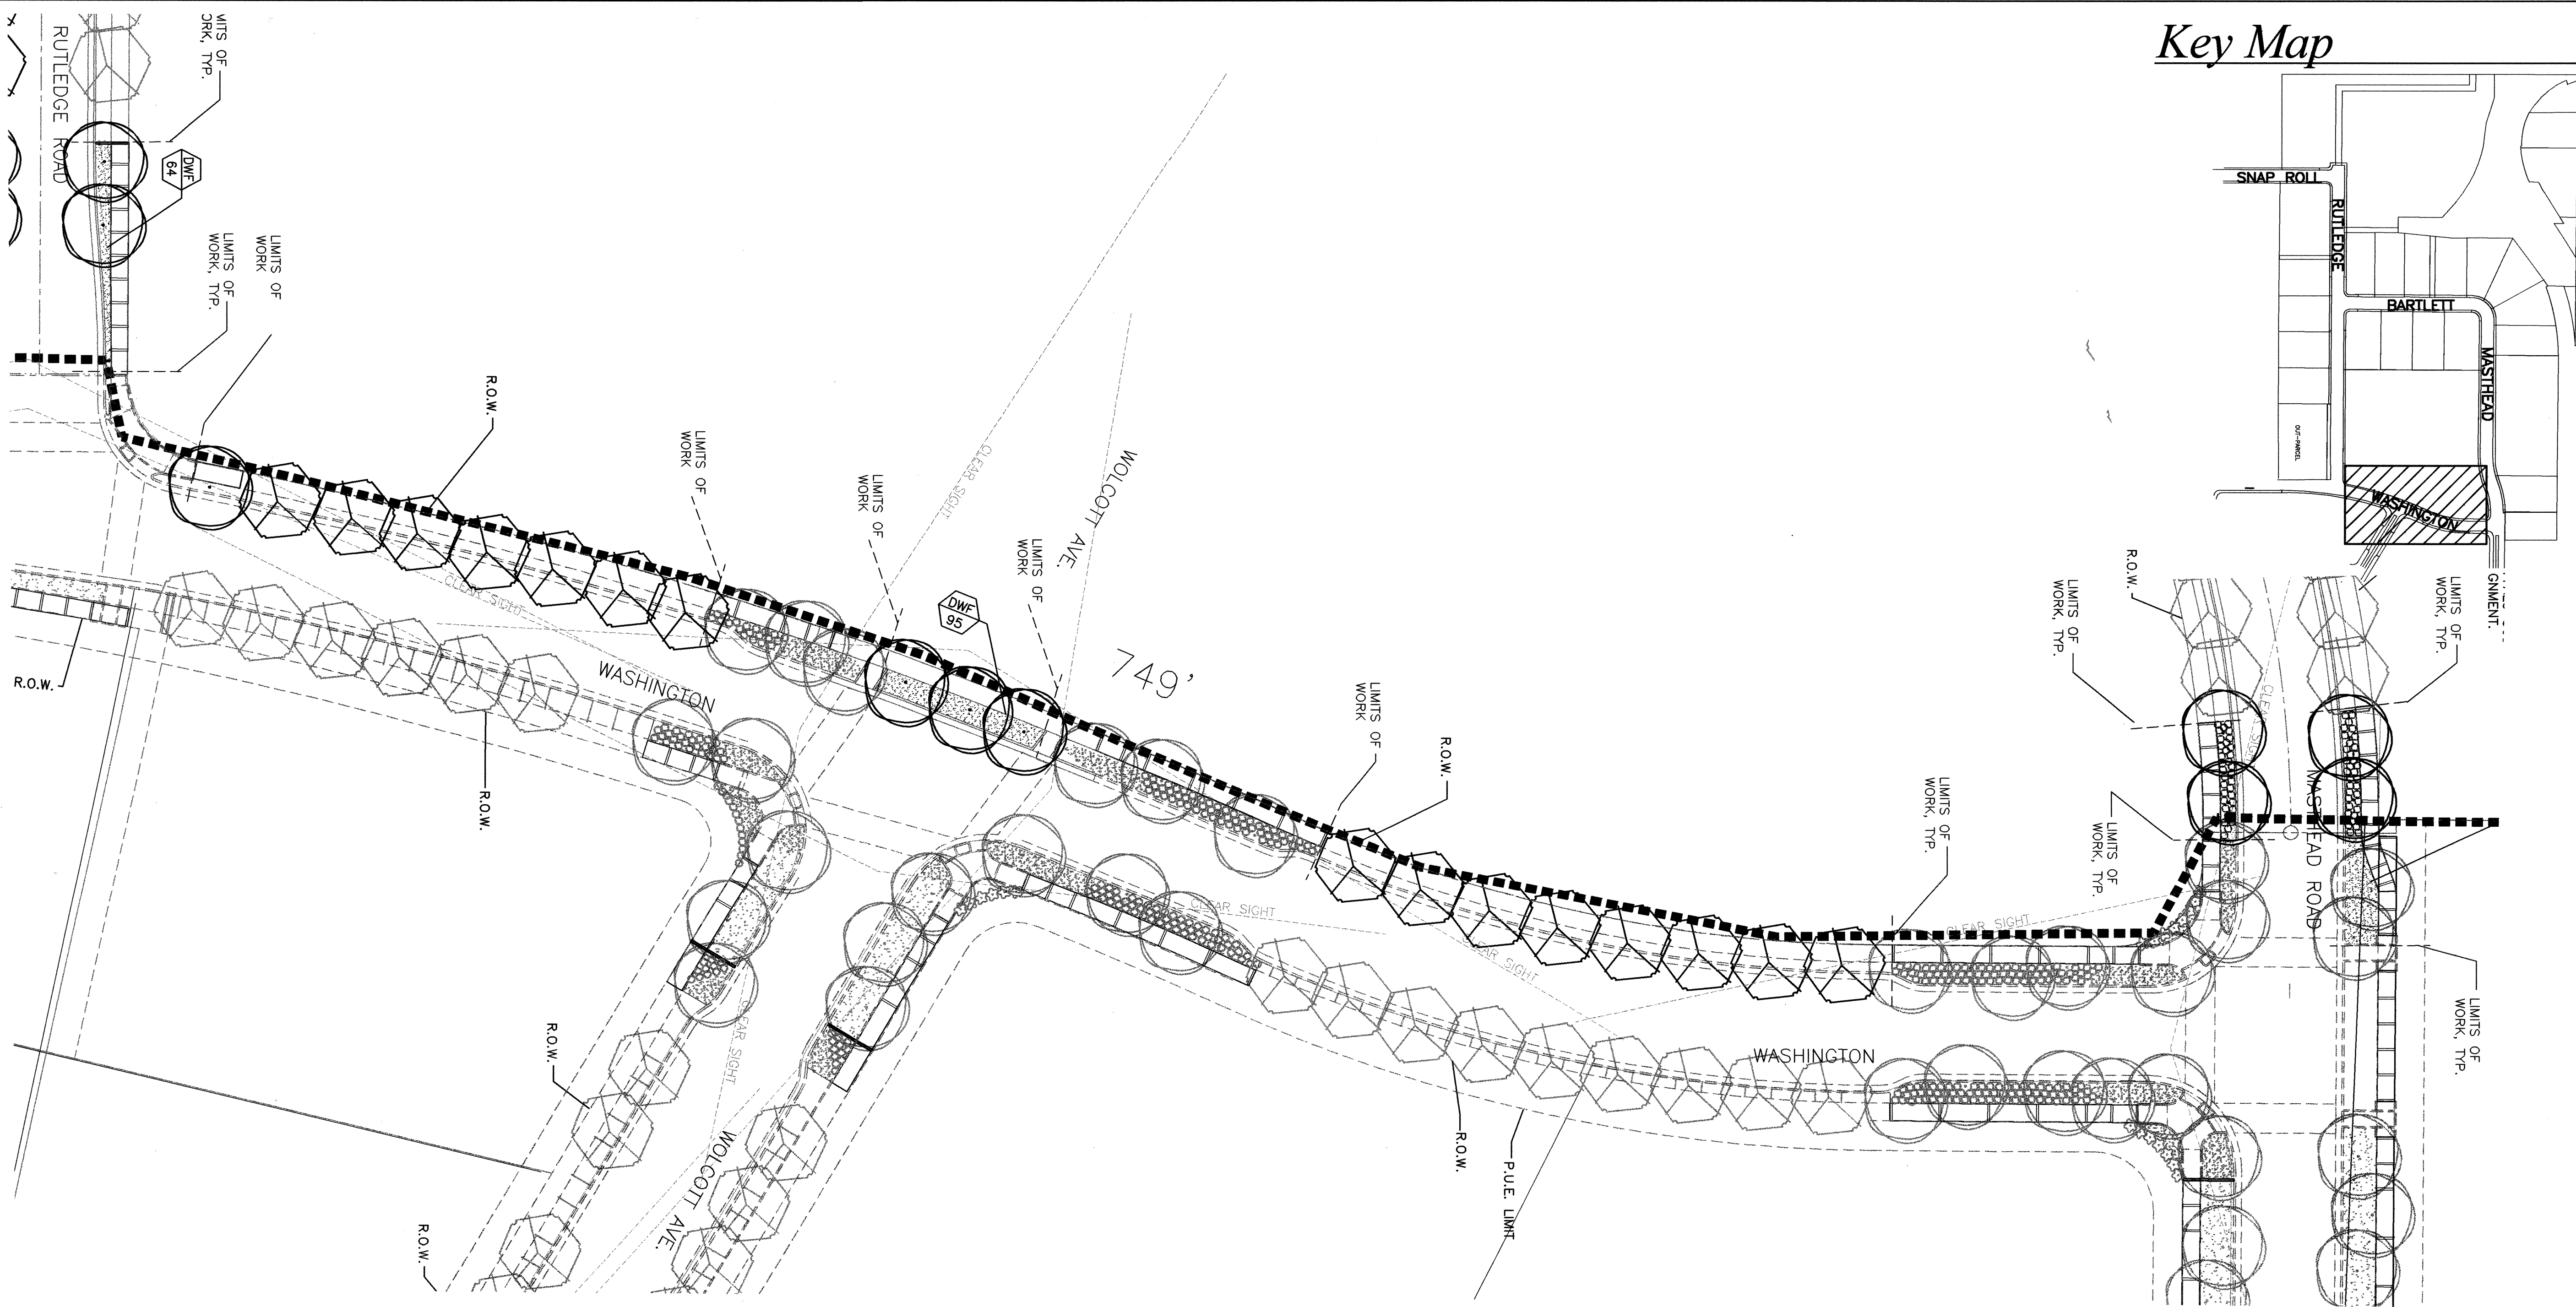


Plant Legend

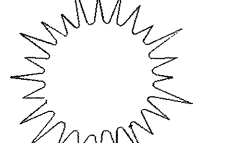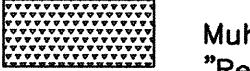SYMBOL	BOTANICAL NAME	COMMON NAME	QTY	SIZE	NOTES	MATURE SIZE HT x SPD	SYMBOL	BOTANICAL NAME	COMMON NAME	QTY	SPACING	SIZE	NOTES	MATURE SIZE HT x SPD
Trees-- Install as per C.O.A. Std Dwg # 2714 and 2715							Shrubs-- Install as per C.O.A. Std. Dwg # 2717							
	Pinus strobiformis	SOUTHWEST WHITE PINE	0	8'-10' HT		30' X 20'		Cercocarpus ledifolius	CURL-LEAF MOUNTAIN MAHOGANY	0	4.0' O.C.	5 GAL.		4' X 6'
	Fraxinus velutina 'Modesto' or	MODESTO ASH	15	2 1/2" CAL.		40' X 40'		Fallugia paradoxa	APACHE PLUME	0	5.0' O.C.	5 GAL.		5' X 5'
	Fraxinus velutina var. Berinda	BERINDA ASH	N.I.C	2 1/2" CAL.		30' X 30'	Ground Covers--Install as per C.O.A. Std. Dwg # 2718							
	Crataegus ambigua	RUSSIAN HAWTHORN	0	2 1/2" CAL.		20' X 25'		Lavendula angustifolia	ENGLISH LAVENDER	0	2.5' O.C.	1 GAL.		36" X 36"
	Celtis occidentalis	COMMON HACKBERRY	4	2 1/2" CAL.		40' X 40'		Pennisetum villosum	DWARF FOUNTAINGRASS	95	2.0' O.C.	1 GAL.		24" X 24"
	Quercus virginiana "Heritage"	HERITAGE LIVE OAK	0	6'-8' HT.		40' X 30'		Muhlenbergia capillaris "Regal Mist"	REGAL MIST	0	3.0' O.C.	5 GAL.		36" X 36"

Planting Notes

ALL WORK TO BE PERFORMED WITHIN THE PUBLIC RIGHT OF WAY

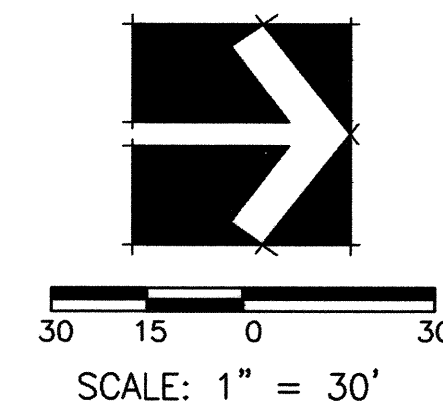


				CITY OF ALBUQUERQUE PUBLIC WORKS DEPARTMENT ENGINEERING DEVELOPMENT GROUP			
JOURNAL CENTER 2-UNIT 2 PLANTING PLANS							
Design Review Committee		City Engineer Approval		Last Design Update		Mo./Day/Yr.	
JAN 19 2004		FEB 2 2004					
City Project No. 6517.84		Zone Map No. D-17		Sheet 13		Of 24	


AS-BUILT INFORMATION		BENCH MARKS		SURVEY INFORMATION		LANDSCAPE ARCHITECT'S SEAL	
CONTRACTOR	DATE			NO.	BY	DATE	
WORKS BY	DATE						
INSPECTION BY	DATE						
ACCEPTANCE BY	DATE						
REVISION BY	DATE						
DRAWINGS BY	DATE						
CHECKED BY	DATE						
RECORDED BY	DATE						
NO.							

11-9-03

REVISIONS		BY	
No.	Date		
DESIGN			
Designed By: GRAD/PGAY		DATE: 11/04/03	
Drawn By: PACBD		DATE: 11/04/03	
Checked By: PGAY		DATE: 11/04/03	

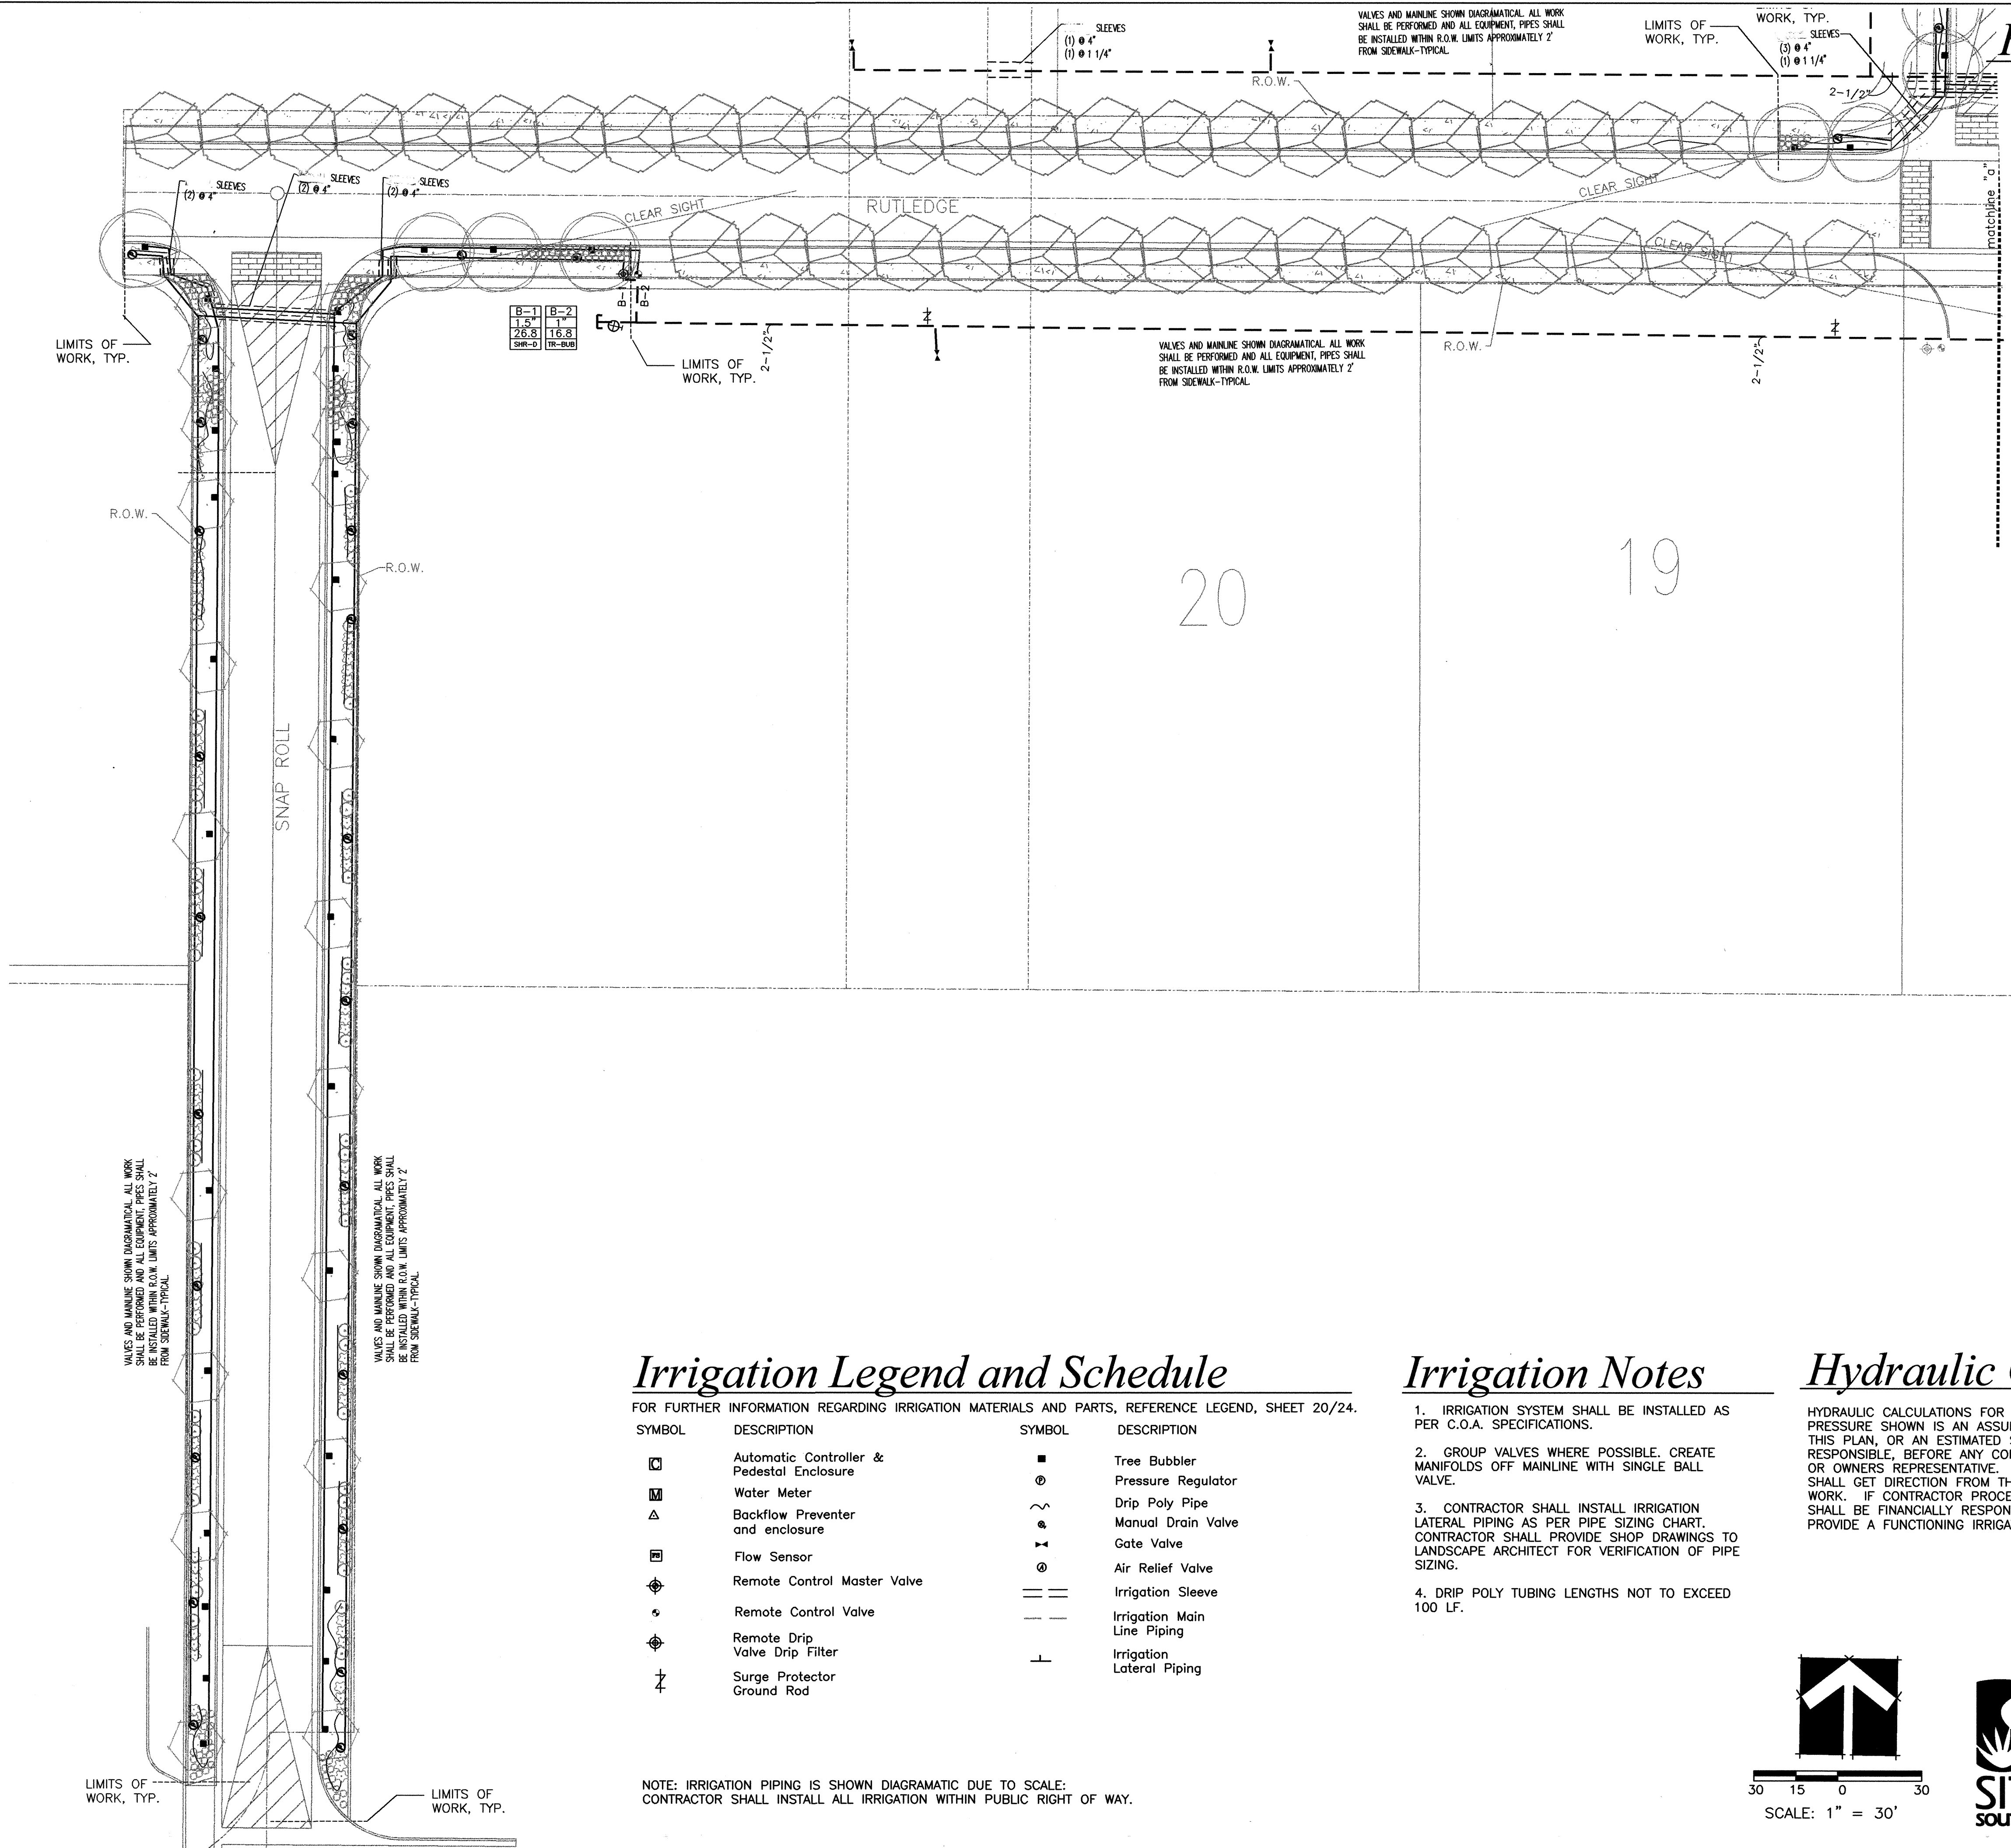

Key Map

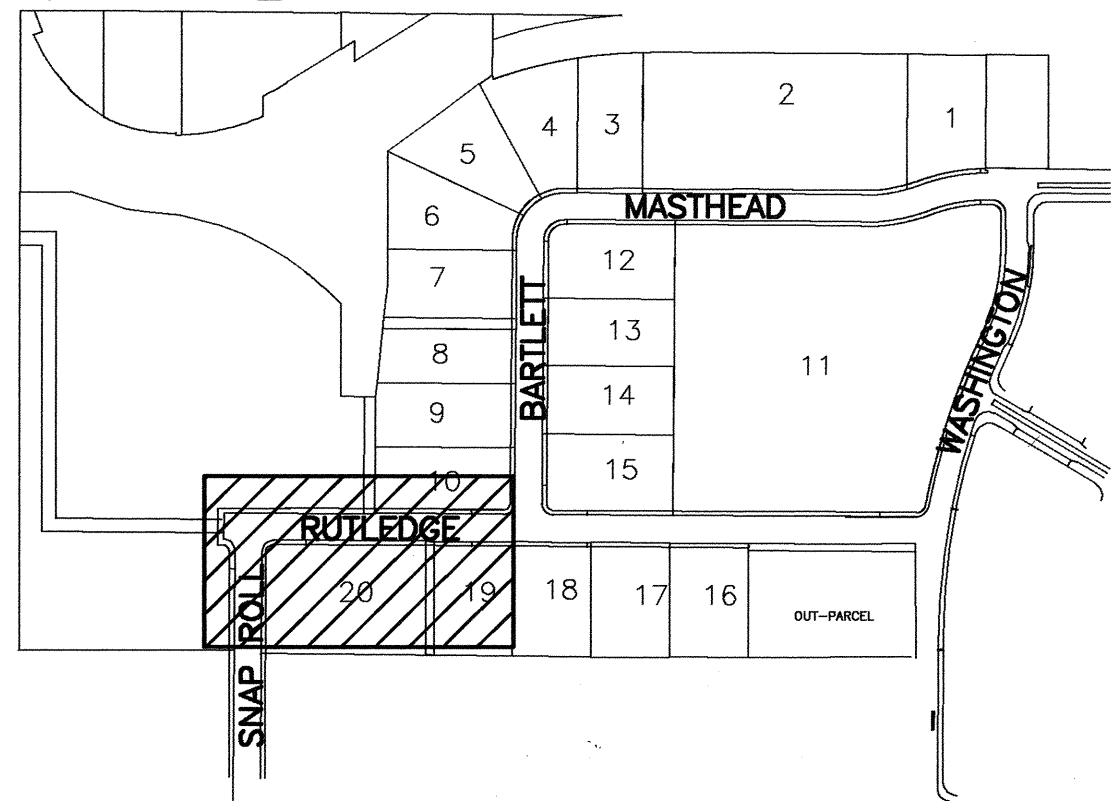

Hydraulic Calculations

ESTIMATED VALVE # A-34		
MAXIMUM GPM ESTIMATED	50	
STATIC PRESSURE	72	
METER	-1.9	
BACK FLOW PREVENTER	-13.5	
MASTER VALVE	-3.1	
MAINLINE	-8.81	
STATION VALVE	-3	
STATION ESTIMATION "AVERAGE"	-5	
GRADE CHANGES	+4.96	
10% FIXTURE LOSS	-3.5	
	-33.85	TOTAL LOSS
	72	DESIGN STATIC PRESSURE
	38.15	OPERATING PRESSURE

Valve Legend

VALVE/STATION NUMBER
VALVE SIZE
VALVE DEMAND
HEAD TYPE

PIPE SIZING CHART

LATERALS SHALL BE CLASS 200 PVC,
SIZED AS INDICATED BELOW.

MAXIMUM DEMAND

UP TO 10 GPM	3/4"
10 TO 16 GPM	1"
16 TO 26 GPM	1 1/4"
26 TO 35 GPM	1 1/2"
35 TO 55 GPM	2"
55 GPM AND UP	2 1/2"

Irrigation Legend and Schedule

FOR FURTHER INFORMATION REGARDING IRRIGATION MATERIALS AND PARTS, REFERENCE LEGEND, SHEET 20/24.

SYMBOL	DESCRIPTION	SYMBOL	DESCRIPTION
	Automatic Controller & Pedestal Enclosure		Tree Bubbler
	Water Meter		Pressure Regulator
	Backflow Preventer and enclosure		Drip Poly Pipe
	Flow Sensor		Manual Drain Valve
	Remote Control Master Valve		Gate Valve
	Remote Control Valve		Air Relief Valve
	Remote Drip Valve Drip Filter		Irrigation Sleeve
	Surge Protector Ground Rod		Irrigation Main Line Piping
			Irrigation Lateral Piping

NOTE: IRRIGATION PIPING IS SHOWN DIAGRAMATIC DUE TO SCALE.
CONTRACTOR SHALL INSTALL ALL IRRIGATION WITHIN PUBLIC RIGHT OF WAY.

Irrigation Notes

- IRRIGATION SYSTEM SHALL BE INSTALLED AS PER C.O.A. SPECIFICATIONS.
- GROUP VALVES WHERE POSSIBLE. CREATE MANIFOLDS OFF MAINLINE WITH SINGLE BALL VALVE.
- CONTRACTOR SHALL INSTALL IRRIGATION LATERAL PIPING AS PER PIPE SIZING CHART. CONTRACTOR SHALL PROVIDE SHOP DRAWINGS TO LANDSCAPE ARCHITECT FOR VERIFICATION OF PIPE SIZING.
- DRIP POLY TUBING LENGTHS NOT TO EXCEED 100 LF.

Hydraulic Calculation Notes


HYDRAULIC CALCULATIONS FOR THIS PLAN ARE BASED ON 72 PSI STATIC PRESSURE. THE STATIC PRESSURE SHOWN IS AN ASSUMED PRESSURE, OR A PRESSURE TAKEN PRIOR TO THE GENERATION OF THIS PLAN, OR AN ESTIMATED STATIC PRESSURE FROM THE COUNTY OR CITY. THE CONTRACTOR IS RESPONSIBLE, BEFORE ANY CONSTRUCTION COMMENCES, TO VERIFY STATIC PSI IN WRITING TO OWNER OR OWNERS REPRESENTATIVE. IF STATIC PSI VARIES BY 2 PSI IN ANY DIRECTION, THE CONTRACTOR SHALL GET DIRECTION FROM THE OWNER OR OWNERS REPRESENTATIVE BEFORE PROCEEDING WITH WORK. IF CONTRACTOR PROCEEDS WITH WORK WITH OUT NOTIFICATION TO OWNER, THE CONTRACTOR SHALL BE FINANCIALLY RESPONSIBLE TO CHANGE ANY ITEMS OR MATERIALS THAT MAY BE REQUIRED TO PROVIDE A FUNCTIONING IRRIGATION SYSTEM.


26 6517.84 7404

CITY OF ALBUQUERQUE
PUBLIC WORKS DEPARTMENT
ENGINEERING DEVELOPMENT GROUP


JOURNAL CENTER 2-UNIT 2 IRRIGATION PLANS

Design/Review Committee	City Engineer Approval	Mo./Day/Yr.	Mo./Day/Yr.
JAN 1 2004	FEB - 2 2004		
City Project No.	Zone Map No.	Sheet	Of
6517.84	D-17	14	24

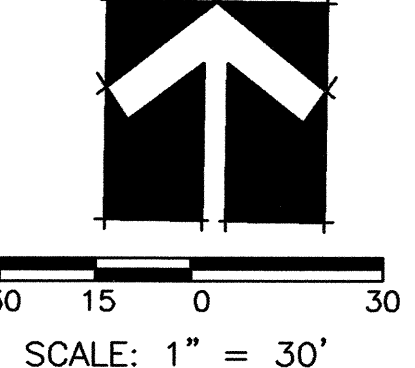

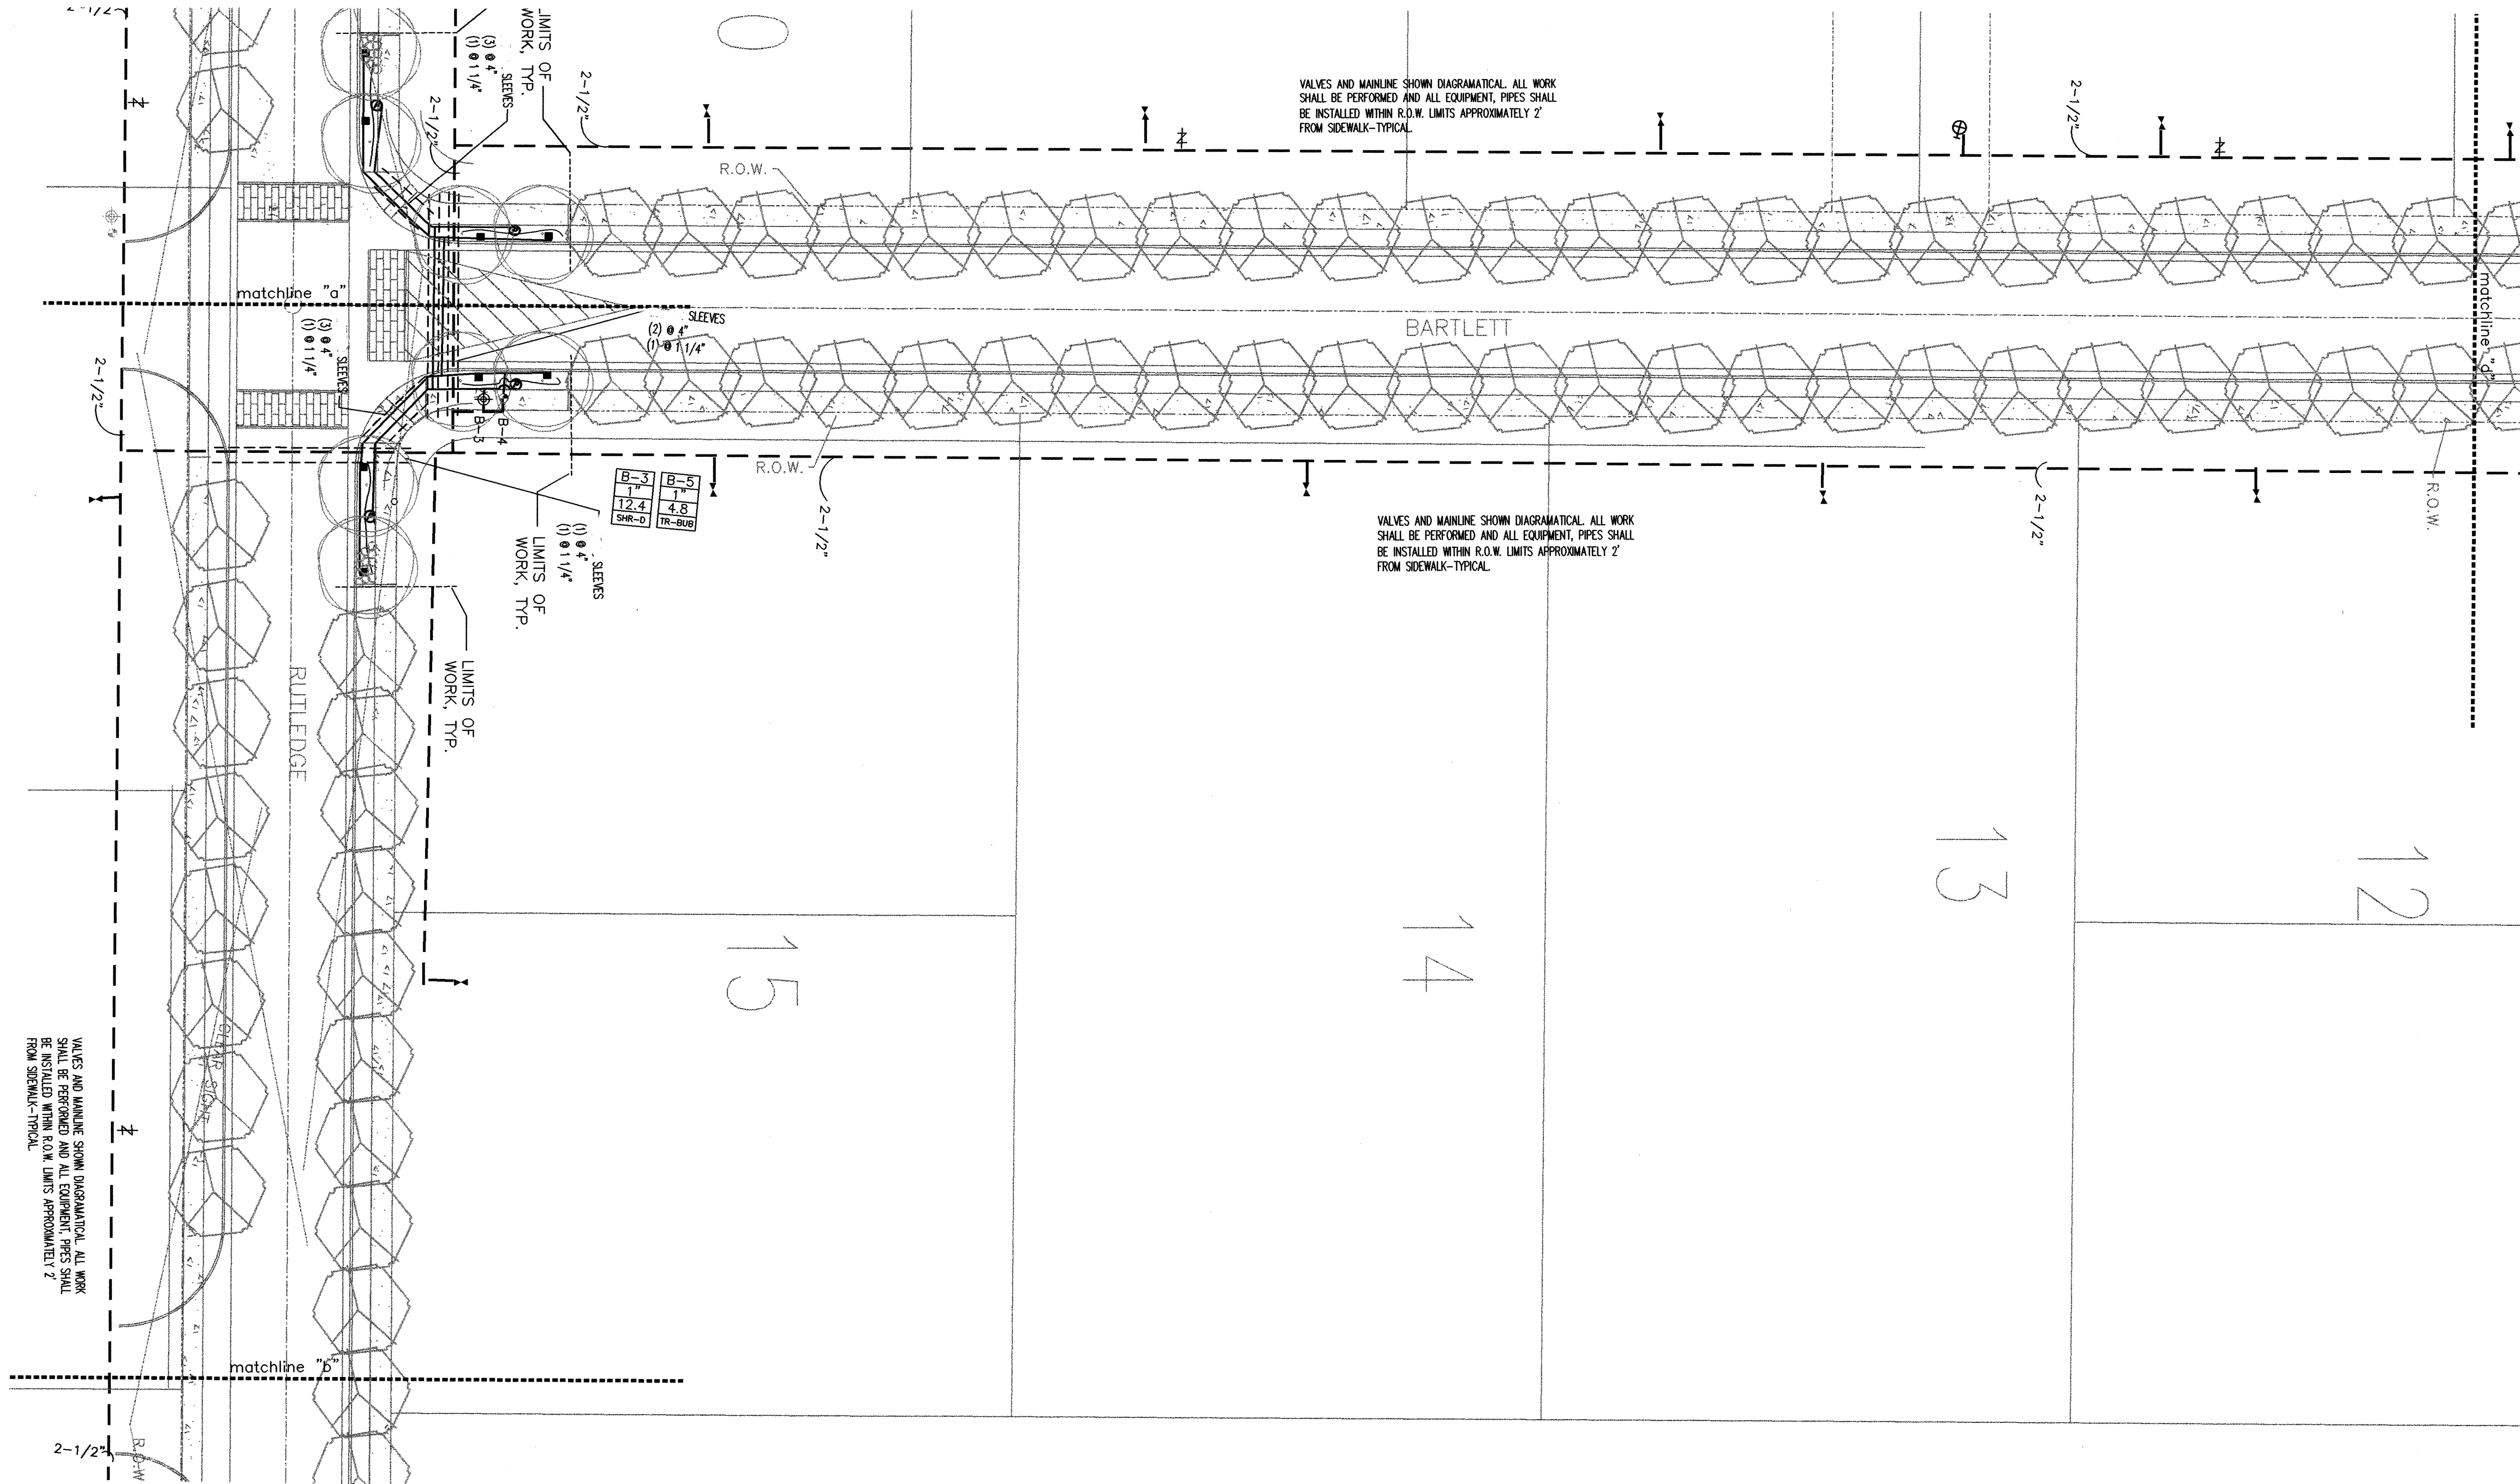

Key Map

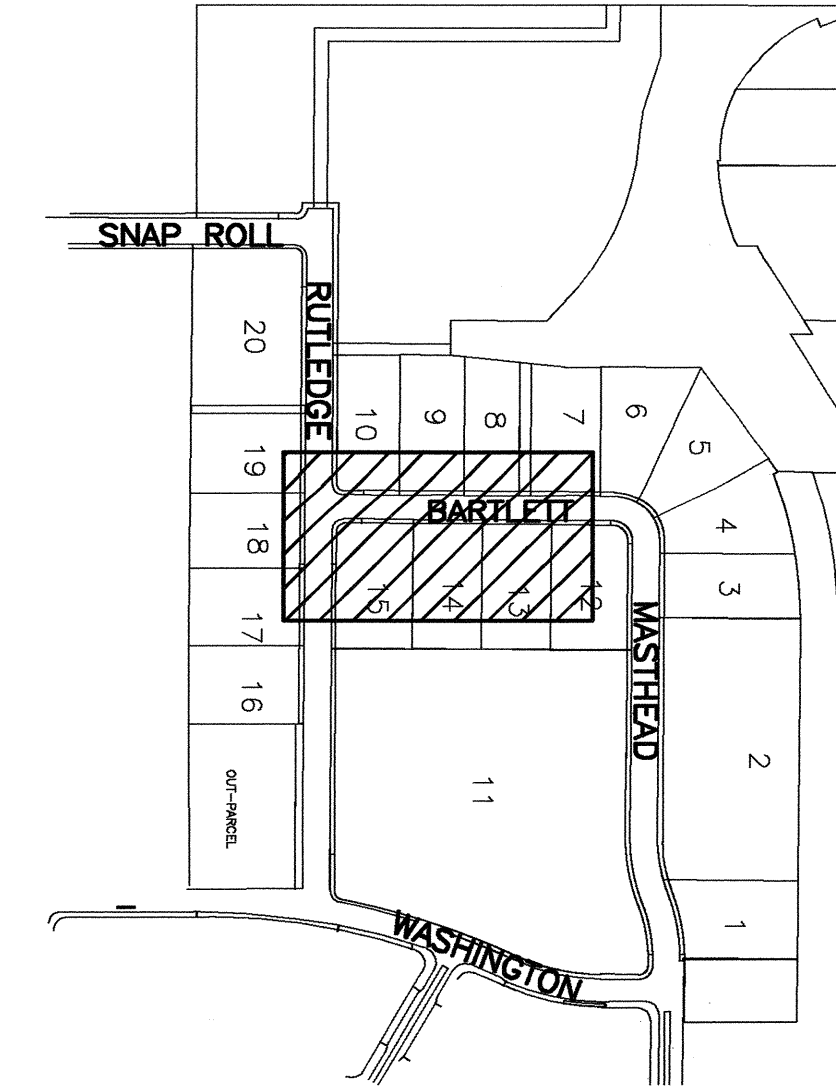

AS-BUILT INFORMATION		BENCH MARKS		SURVEY INFORMATION		LANDSCAPE ARCHITECT'S SEAL		REVISIONS		DESIGN	
CONTRACTOR	DATE	NO.	BY	NO.	DATE	STATE OF NEW MEXICO	DATE: 11/04/03	NO.	DATE	BY	DATE
STAKED BY	DATE					PATRICK N. GAY	DATE: 11/04/03				DATE: 11/04/03
INSPECTOR'S	DATE					No. 271	DATE: 11/04/03				DATE: 11/04/03
FIELD	DATE					REGISTERED	DATE: 11/04/03				DATE: 11/04/03
VERIFICATION BY	DATE					LANDSCAPE ARCHITECT	DATE: 11/04/03				DATE: 11/04/03
CORRECTED BY	DATE										
MICRO-FILM INFORMATION	DATE										
RECORDED BY	DATE										
NO.											

Irrigation Legend and Schedule

FOR FURTHER INFORMATION REGARDING IRRIGATION MATERIALS AND PARTS, REFERENCE LEGEND, SHEET 20/24.

SYMBOL	DESCRIPTION	SYMBOL	DESCRIPTION
	Automatic Controller & Pedestal Enclosure		Tree Bubbler
	Water Meter		Pressure Regulator
	Backflow Preventer and enclosure		Drip Poly Pipe
	Flow Sensor		Manual Drain Valve
	Remote Control Master Valve		Gate Valve
	Remote Control Valve		Air Relief Valve
	Remote Drip Valve Drip Filter		Irrigation Sleeve
	Surge Protector Ground Rod		Irrigation Main Line Piping
			Irrigation Lateral Piping

NOTE: IRRIGATION PIPING IS SHOWN DIAGRAMATIC DUE TO SCALE. CONTRACTOR SHALL INSTALL ALL IRRIGATION WITHIN PUBLIC RIGHT OF WAY.

Irrigation Notes

- IRRIGATION SYSTEM SHALL BE INSTALLED AS PER C.O.A. SPECIFICATIONS.
- GROUP VALVES WHERE POSSIBLE. CREATE MANIFOLDS OFF MAINLINE WITH SINGLE BALL VALVE.
- CONTRACTOR SHALL INSTALL IRRIGATION LATERAL PIPING AS PER PIPE SIZING CHART. CONTRACTOR SHALL PROVIDE SHOP DRAWINGS TO LANDSCAPE ARCHITECT FOR VERIFICATION OF PIPE SIZING.
- DRIP POLY TUBING LENGTHS NOT TO EXCEED 100 LF.

PIPE SIZING CHART


LATERALS SHALL BE CLASS 200 PVC, SIZED AS INDICATED BELOW.

MAXIMUM DEMAND



UP TO 10 GPM	3/4"
10 TO 16 GPM	1"
16 TO 26 GPM	1 1/4"
26 TO 35 GPM	1 1/2"
35 TO 55 GPM	2"
55 GPM AND UP	2 1/2"


Valve Legend

VALVE/STATION NUMBER
VALVE SIZE
VALVE DEMAND
HEAD TYPE

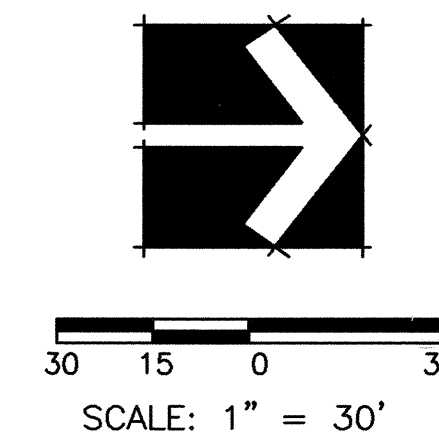

CITY OF ALBUQUERQUE PUBLIC WORKS DEPARTMENT ENGINEERING DEVELOPMENT GROUP	
JOURNAL CENTER 2-UNIT 2 IRRIGATION PLANS	
Design Review Committee JAN 1 9 2004 DESIGN REVIEW COMMITTEE	City Engineer Approval FEB - 2 2004 CITY ENGINEER
City Project No. 6517.84	Zone Map No. D-17
Sheet 15	Of 24

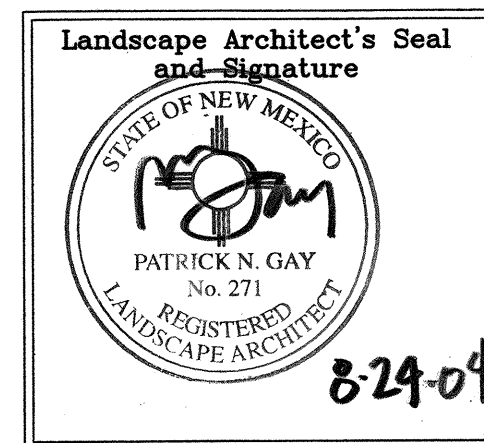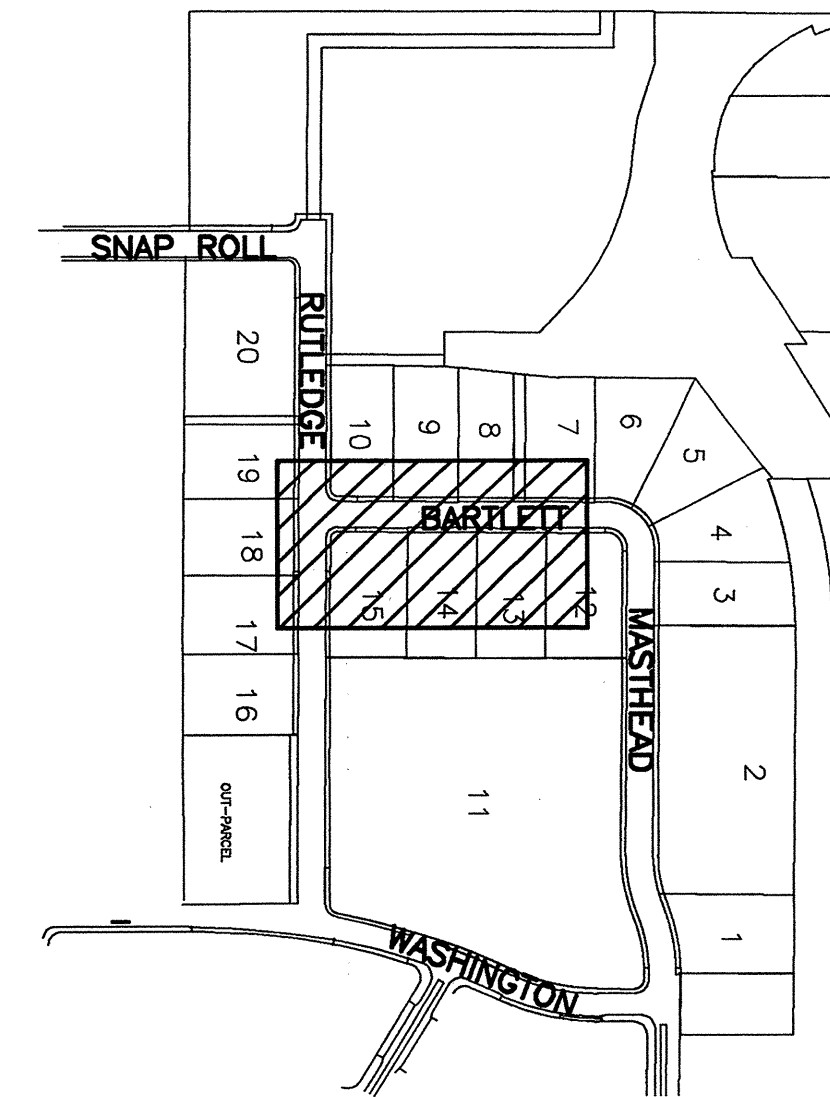

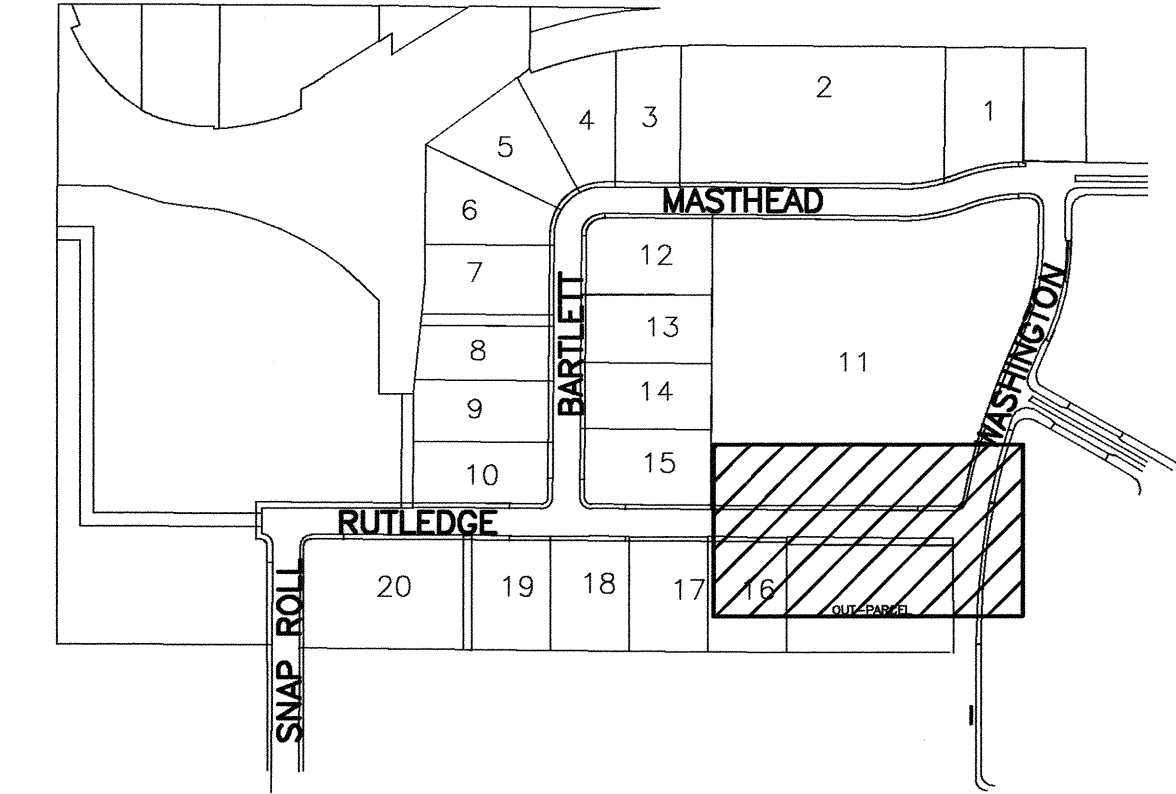



1	2	3	4	5	6	7	8	9	10	11	12	13	14	15
26	65	17	84	16	04									



Mo./Day/Yr.	Mo./Day/Yr.



Sheet	Of
16	24

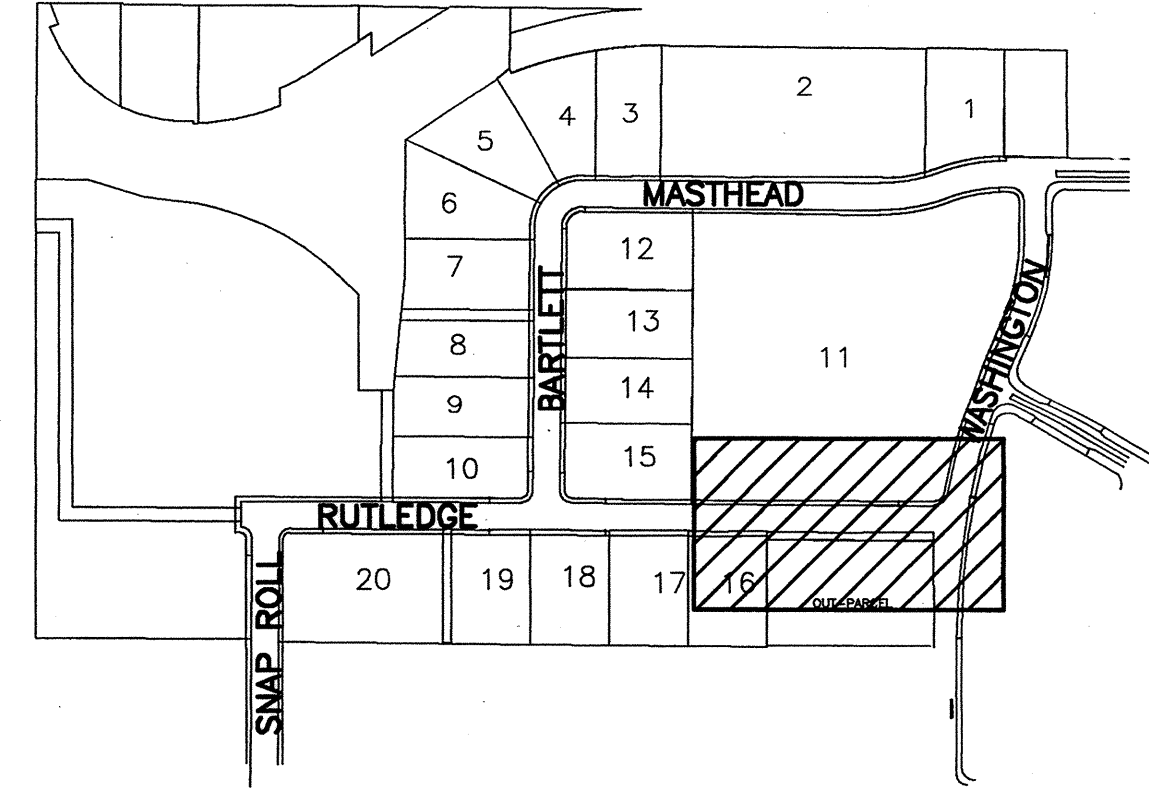[illegible]

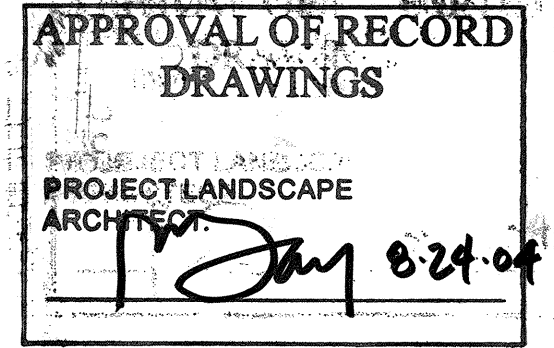

Sheet **17A** Of **24**

Key Map

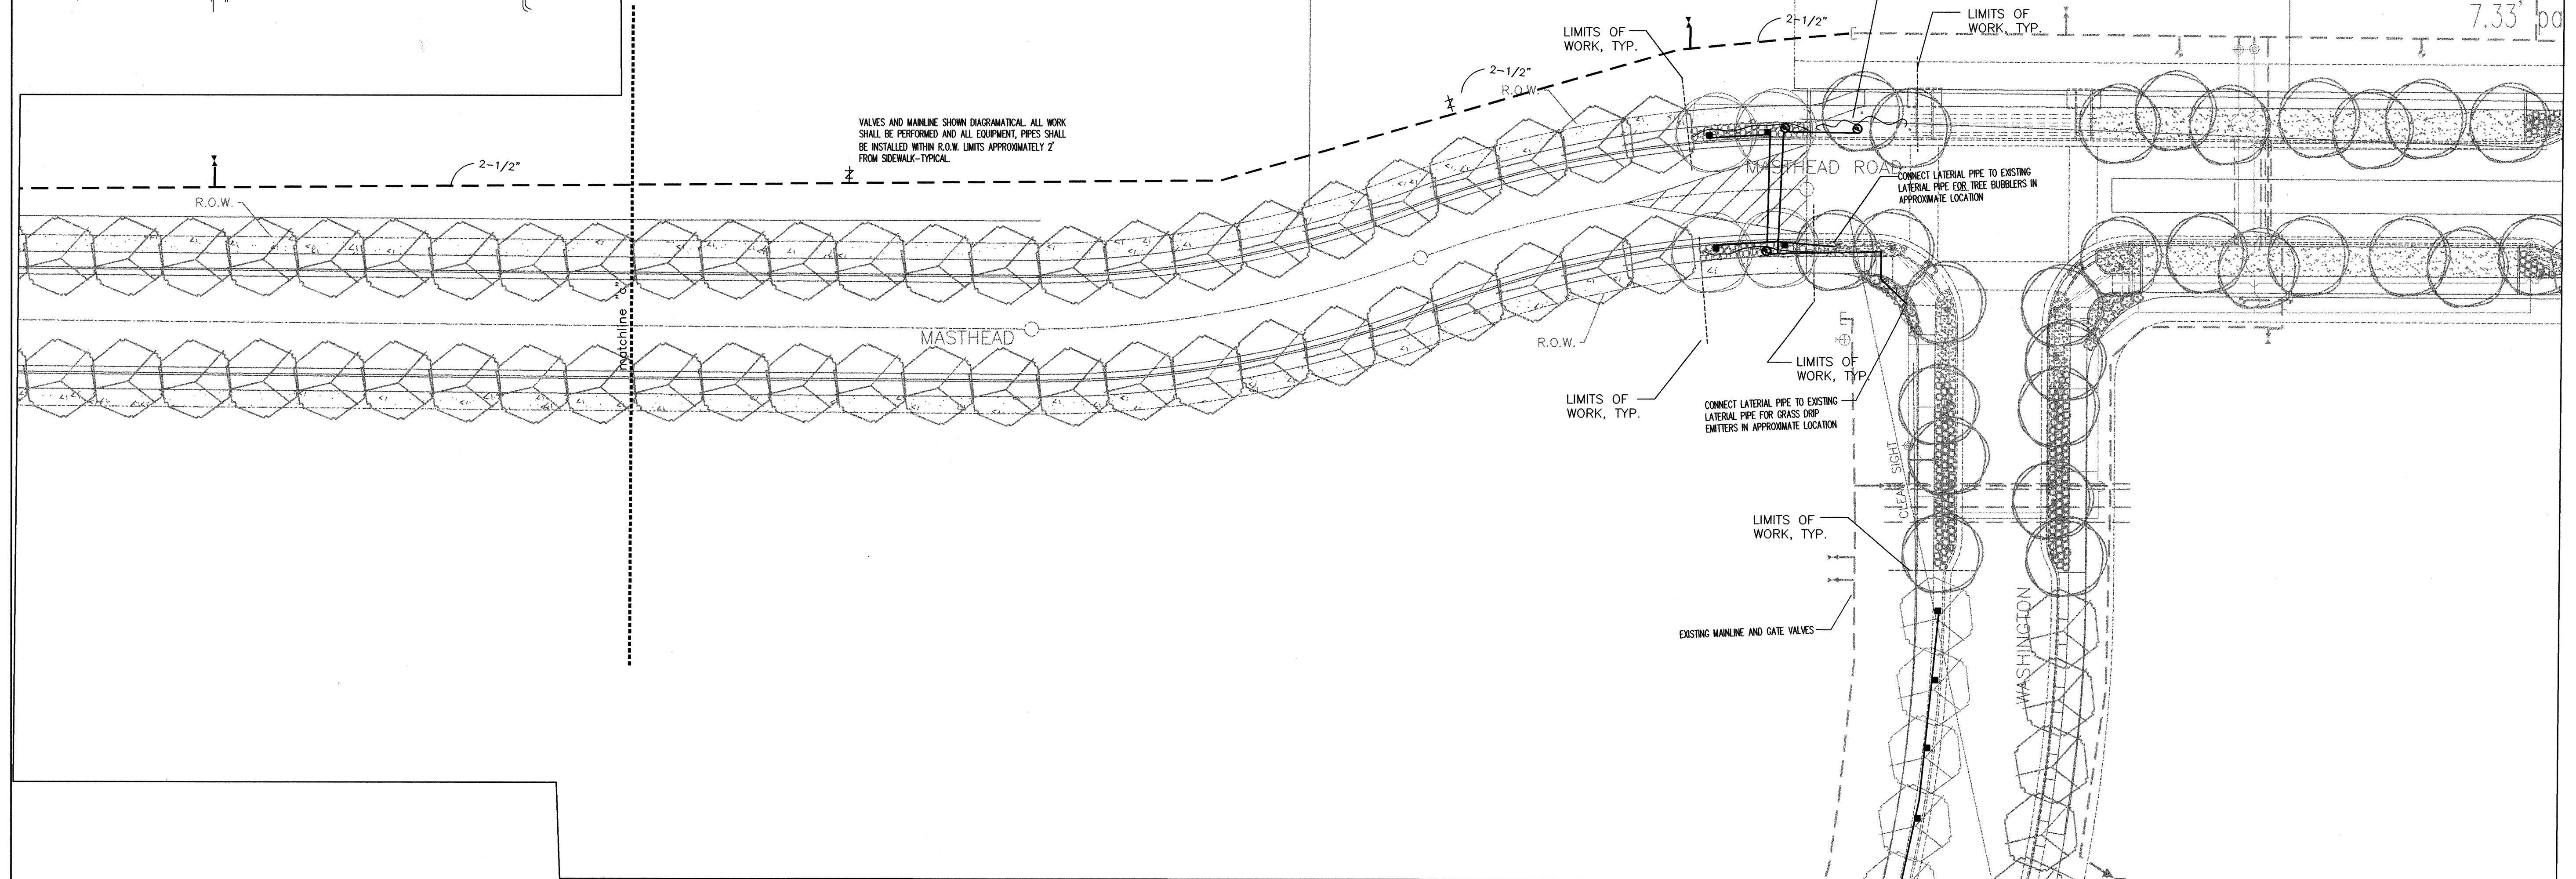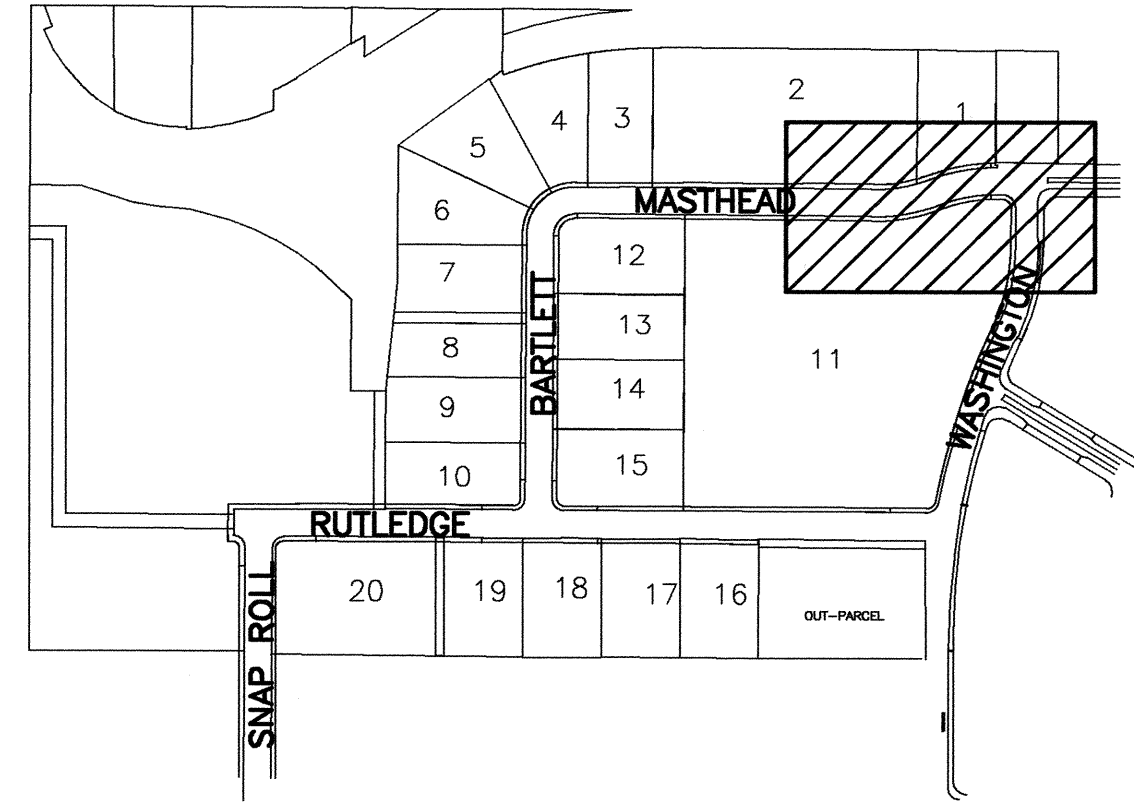

Irrigation Legend and Schedule

FOR FURTHER INFORMATION REGARDING IRRIGATION MATERIALS AND PARTS, REFERENCE LEGEND, SHEET 20/24.

SYMBOL	DESCRIPTION	SYMBOL	DESCRIPTION
	Automatic Controller & Pedestal Enclosure		Tree Bubbler
	Water Meter		Pressure Regulator
	Backflow Preventer and enclosure		Drip Poly Pipe
	Flow Sensor		Manual Drain Valve
	Remote Control Master Valve		Gate Valve
	Remote Control Valve		Air Relief Valve
	Remote Drip Valve Drip Filter		Irrigation Sleeve
	Surge Protector Ground Rod		Irrigation Main Line Piping
			Irrigation Lateral Piping

NOTE: IRRIGATION PIPING IS SHOWN DIAGRAMATIC DUE TO SCALE:
CONTRACTOR SHALL INSTALL ALL IRRIGATION WITHIN PUBLIC RIGHT OF WAY.

Irrigation Notes

- IRRIGATION SYSTEM SHALL BE INSTALLED AS PER C.O.A. SPECIFICATIONS.
- GROUP VALVES WHERE POSSIBLE. CREATE MANIFOLDS OFF MAINLINE WITH SINGLE BALL VALVE.
- CONTRACTOR SHALL INSTALL IRRIGATION LATERAL PIPING AS PER PIPE SIZING CHART. CONTRACTOR SHALL PROVIDE SHOP DRAWINGS TO LANDSCAPE ARCHITECT FOR VERIFICATION OF PIPE SIZING.
- DRIP POLY TUBING LENGTHS NOT TO EXCEED 100 LF.

PIPE SIZING CHART



LATERALS SHALL BE CLASS 200 PVC, SIZED AS INDICATED BELOW.

MAXIMUM DEMAND

UP TO 10 GPM	3/4"
10 TO 16 GPM	1"
16 TO 26 GPM	1 1/4"
26 TO 35 GPM	1 1/2"
35 TO 55 GPM	2"
55 GPM AND UP	2 1/2"

Valve Legend

VALVE/STATION NUMBER
VALVE SIZE
VALVE DEMAND
HEAD TYPE

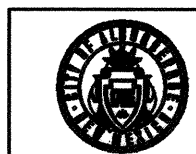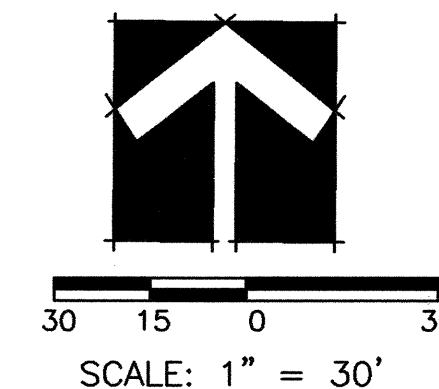

CITY OF ALBUQUERQUE
PUBLIC WORKS DEPARTMENT
ENGINEERING DEVELOPMENT GROUP

JOURNAL CENTER 2-UNIT 2 IRRIGATION PLANS

Design Review Committee APPROVED JAN 10 2004 DESIGN REVIEW COMMITTEE	City Engineer Approval APPROVED FEB - 2 2004 CITY	Mo./Day/Yr. Mo./Day/Yr.
City Project No. 6517.84	Zone Map No. D-17	Sheet 18
		Of 24


AS-BUILT INFORMATION	
CONTRACTOR	DATE
INSPECTOR'S	DATE
FIELD	DATE
VERIFICATION BY	DATE
CORRECTED BY	DATE
MICRO-FILM INFORMATION	
RECORDED BY	DATE
NO.	

BENCH MARKS

SURVEY INFORMATION


NO.	BY	DATE

LANDSCAPE ARCHITECT'S SEAL

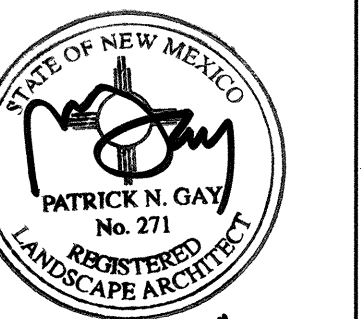

11.9.03

No.	Date	REMARKS	BY
REVISIONS			
DESIGN			
Designed By:	GRAD	DATE: 11/04/03	
Drawn By:	CBD	DATE: 11/04/03	
Checked By:	PGAY	DATE: 11/04/03	

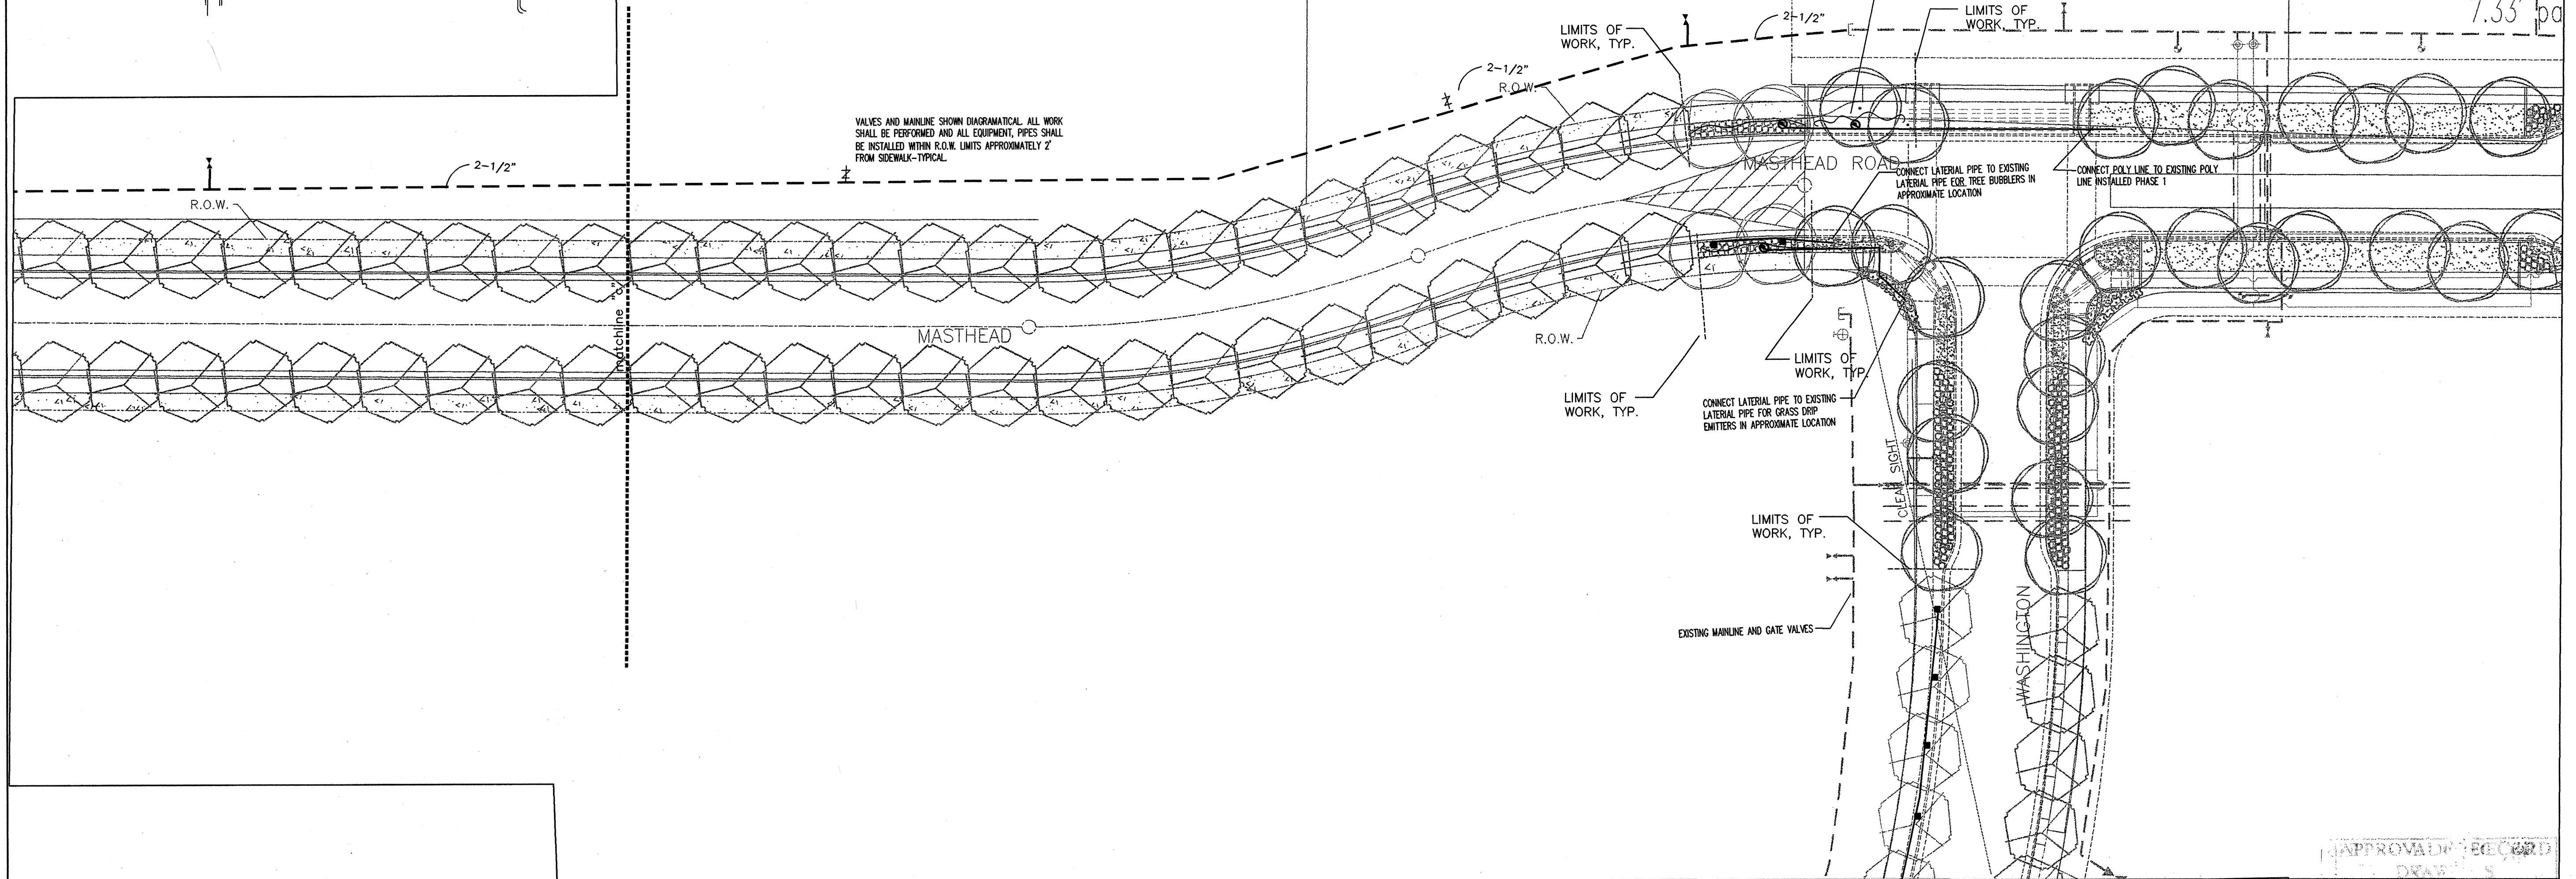

FOR FURTHER INFORMATION REGARDING IRRIGATION MATERIALS AND PARTS, REFERENCE LEGEND, SHEET 20/24.

SYMBOL	DESCRIPTION	SYMBOL	DESCRIPTION
	Automatic Controller & Pedestal Enclosure		Tree Bubbler
	Water Meter		Pressure Regulator
	Backflow Preventer and enclosure		Drip Poly Pipe
	Flow Sensor		Manual Drain Valve
	Remote Control Master Valve		Gate Valve
	Remote Control Valve		Air Relief Valve
	Remote Drip Valve Drip Filter		Irrigation Sleeve
	Surge Protector Ground Rod		Irrigation Main Line Piping
			Irrigation Lateral Piping

1. IRRIGATION SYSTEM SHALL BE INSTALLED AS PER C.O.A. SPECIFICATIONS.

2. GROUP VALVES WHERE POSSIBLE. CREATE MANIFOLDS OFF MAINLINE WITH SINGLE BALL VALVE.
3. CONTRACTOR SHALL INSTALL IRRIGATION LATERAL PIPING AS PER PIPE SIZING CHART. CONTRACTOR SHALL PROVIDE SHOP DRAWINGS TO LANDSCAPE ARCHITECT FOR VERIFICATION OF PIPE SIZING.
4. DRIP POLY TUBING LENGTHS NOT TO EXCEED 100 LF.

PIPE SIZING CHART

LATERALS SHALL BE CLASS 200 PVC,
SIZED AS INDICATED BELOW.



MAXIMUM DEMAND

UP TO 10 GPM	3/4"
10 TO 16 GPM	1"
16 TO 26 GPM	1 1/4"
26 TO 35 GPM	1 1/2"
35 TO 55 GPM	2"
55 GPM AND UP	2 1/2"


VALVE/STATION NUMBER
VALVE SIZE
VALVE DEMAND
HEAD TYPE

CERTIFICATE OF SUBSTANTIAL COMPLIANCE ON PLANS

1. Patrick Gay of the firm of Sites Southwest, a Registered Professional Landscape Architect in the State of New Mexico, do hereby certify, that the best of my knowledge and belief, that the structure installed as part of this project has been inspected by me or a qualified person under my direct supervision and has been constructed in accordance with the plans and specifications approved by the City Engineer and that the original design intent of the approved plans has been met, except as noted by me on the as-built construction drawings. This Certification is based on site inspections by me or personnel under my direction.

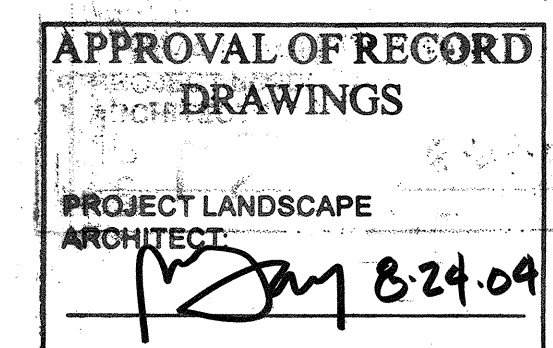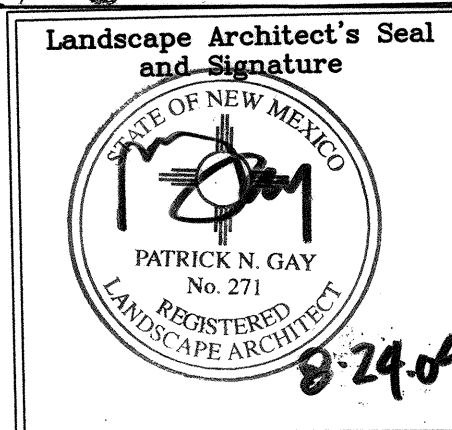

NOTE: IRRIGATION PIPING IS SHOWN DIAGRAMATIC DUE TO SCALE:
CONTRACTOR SHALL INSTALL ALL IRRIGATION WITHIN PUBLIC RIGHT OF WAY.

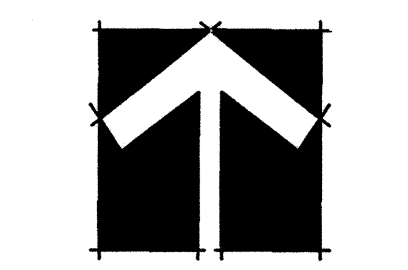

30 15 0



SCALE: 1" = 30'



CITY OF ALBUQUERQUE
PUBLIC WORKS DEPARTMENT
ENGINEERING DEVELOPMENT GROUP

JOURNAL CENTER 2-UNIT 2
IRRIGATION PLAN AS-BUILTS

Design Review Committee	City Engineer Approval	Last Design Update	Mo./Day/Yr.	Mo./Day/Yr.
City Project No. 6517.84		Zone Map No. D-17	Sheet 18A Of 24	

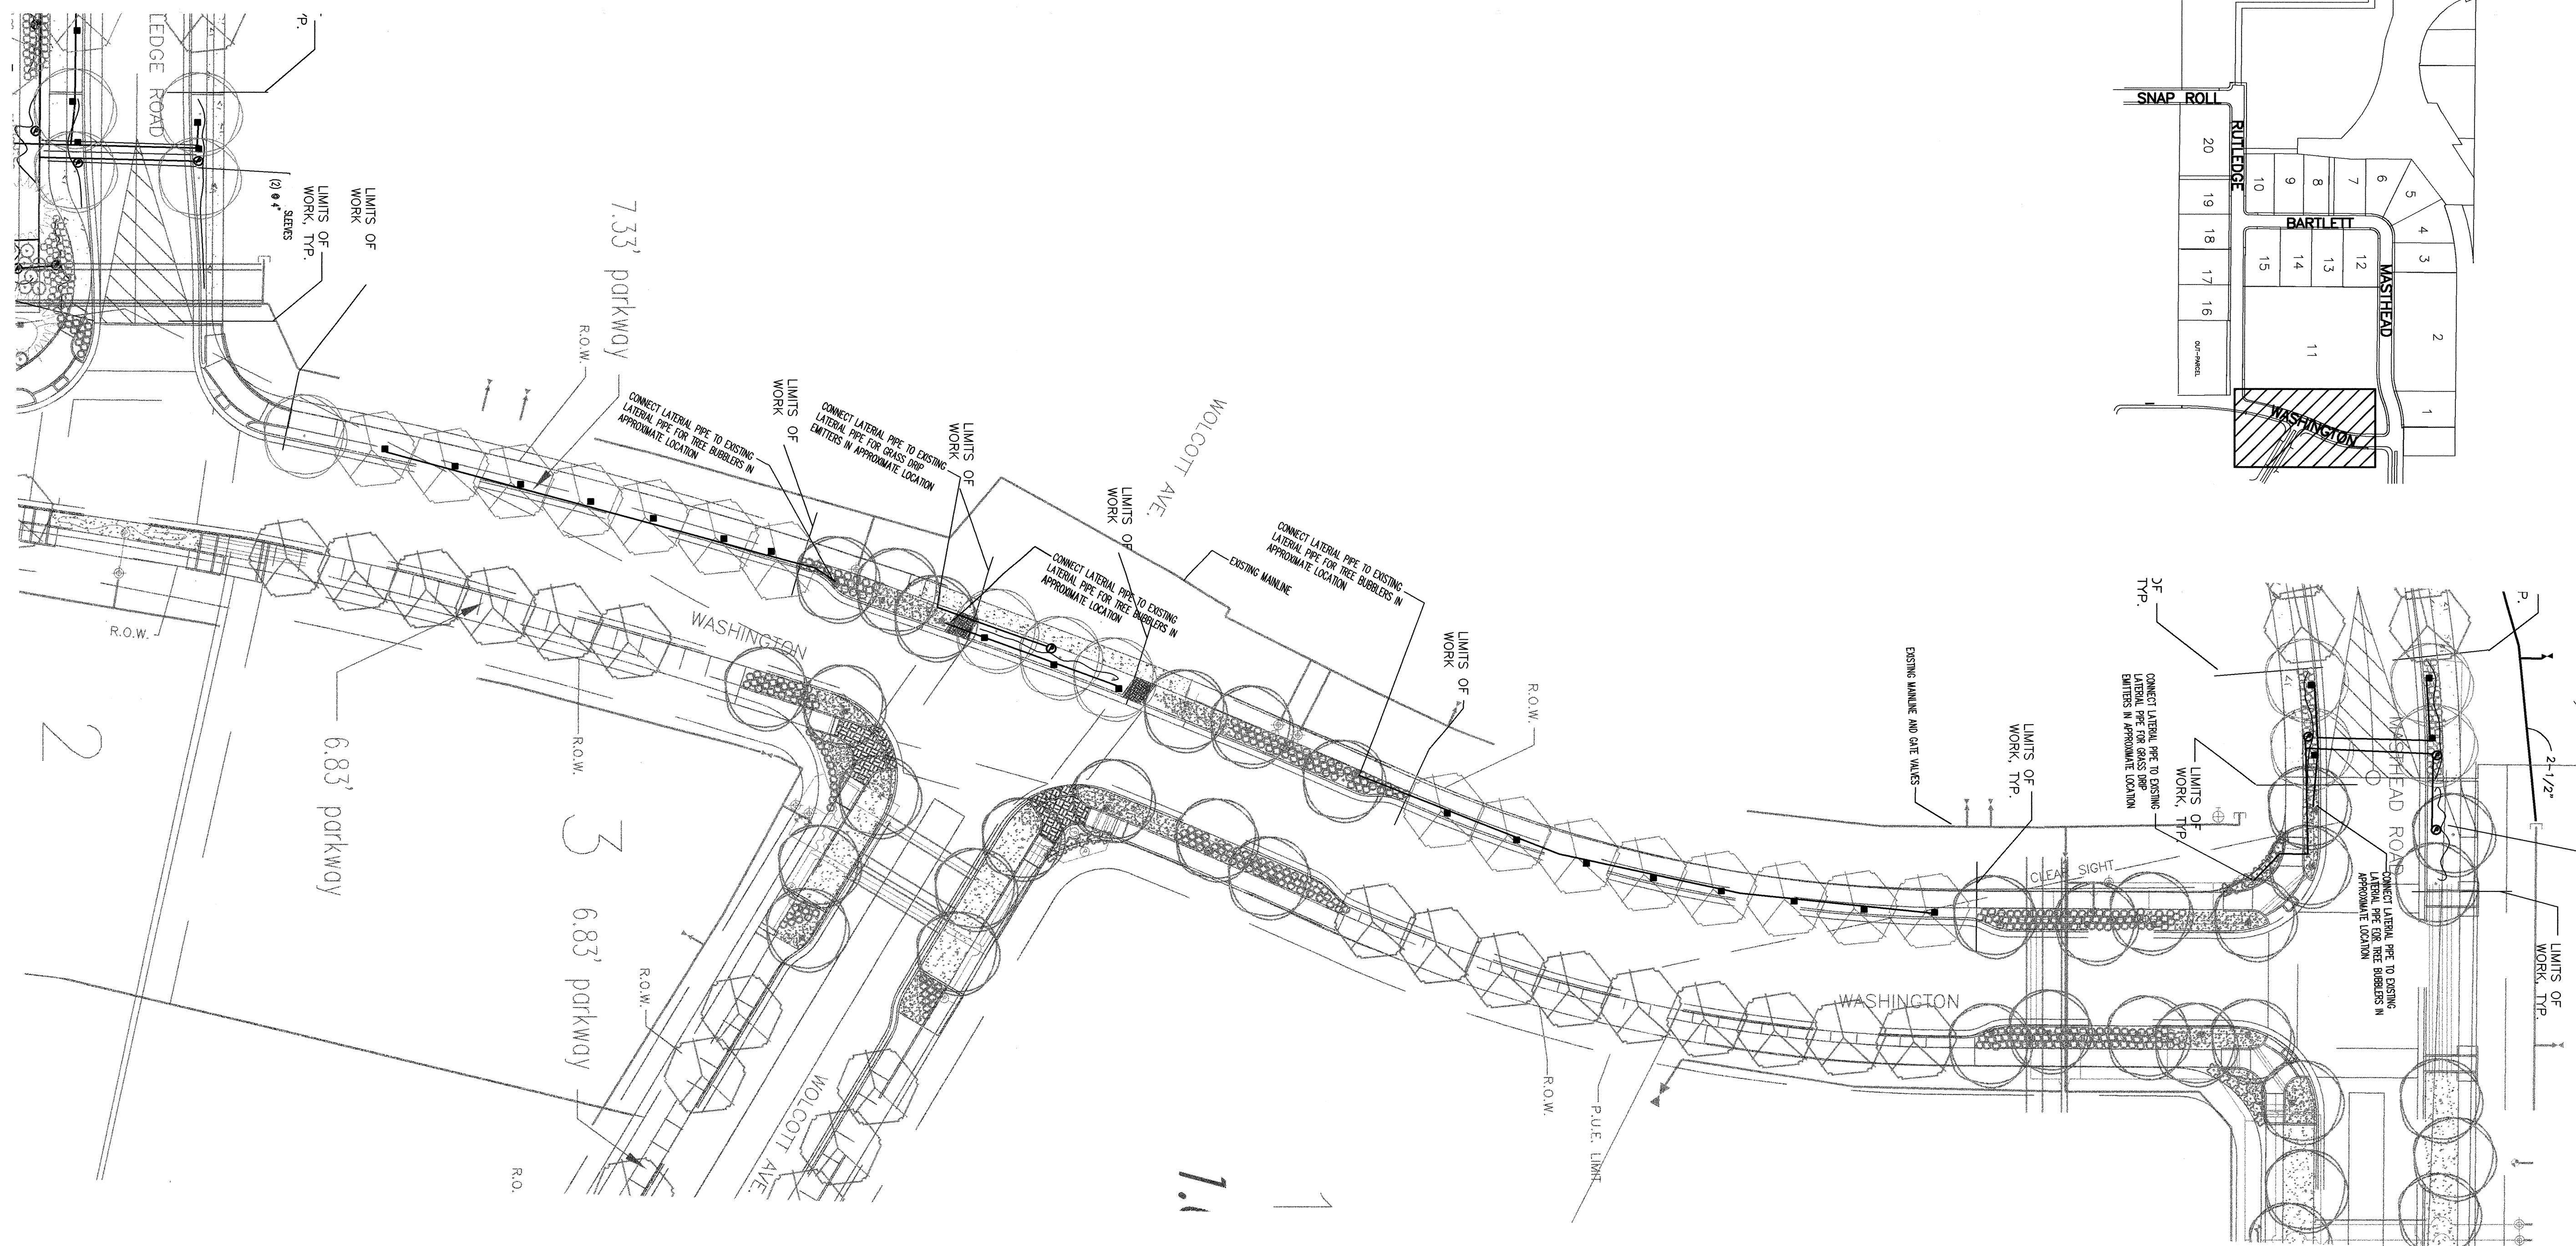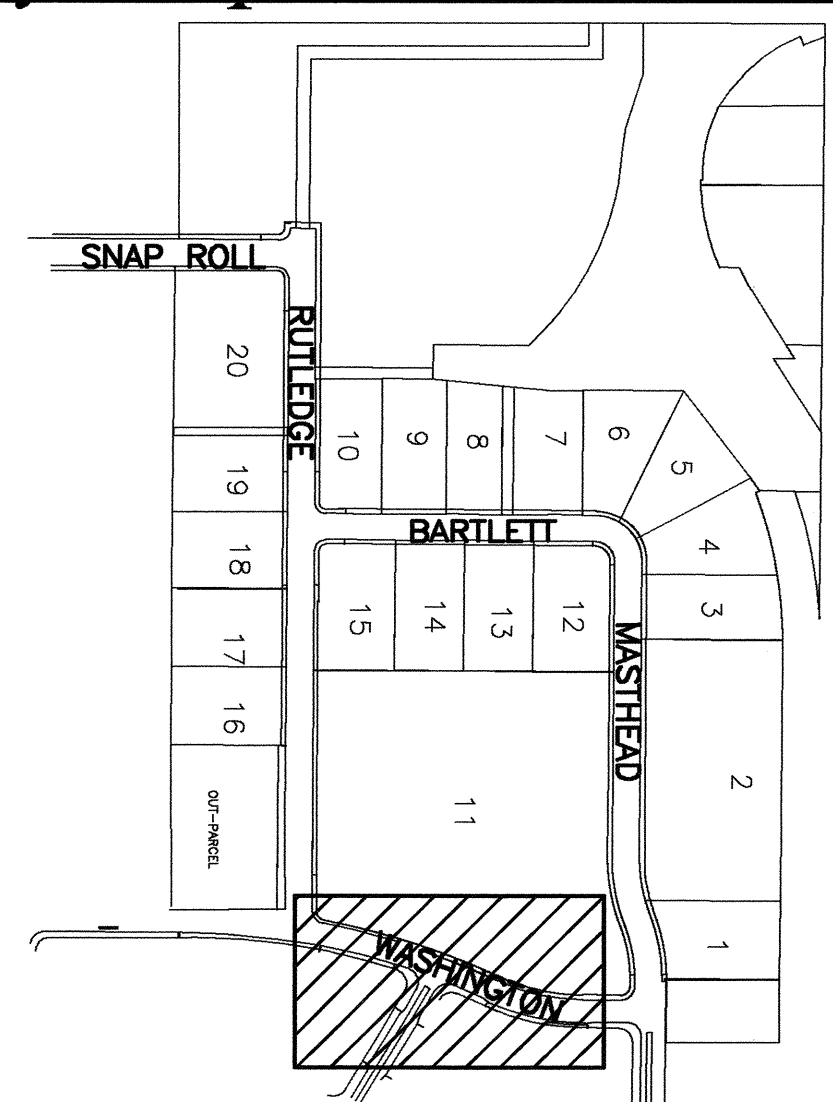

Irrigation Legend and Schedule

FOR FURTHER INFORMATION REGARDING IRRIGATION MATERIALS AND PARTS, REFERENCE LEGEND, SHEET 20/24.

SYMBOL	DESCRIPTION	SYMBOL	DESCRIPTION
	Automatic Controller & Pedestal Enclosure		Tree Bubbler
	Water Meter		Pressure Regulator
	Backflow Preventer and enclosure		Drip Poly Pipe
	Flow Sensor		Manual Drain Valve
	Remote Control Master Valve		Gate Valve
	Remote Control Valve		Air Relief Valve
	Remote Drip Valve Drip Filter		Irrigation Sleeve
	Surge Protector Ground Rod		Irrigation Main Line Piping
			Irrigation Lateral Piping

Irrigation Notes

1. IRRIGATION SYSTEM SHALL BE INSTALLED AS PER C.O.A. SPECIFICATIONS.
2. GROUP VALVES WHERE POSSIBLE, CREATE MANIFOLDS OFF MAINLINE WITH SINGLE BALL VALVE.
3. CONTRACTOR SHALL INSTALL IRRIGATION LATERAL PIPING AS PER PIPE SIZING CHART. CONTRACTOR SHALL PROVIDE SHOP DRAWINGS TO LANDSCAPE ARCHITECT FOR VERIFICATION OF PIPE SIZING.
4. DRIP POLY TUBING LENGTHS NOT TO EXCEED 100 LF.

Valve Legend

VALVE/STATION NUMBER
VALVE SIZE
VALVE DEMAND
HEAD TYPE

PIPE SIZING CHART

LATERALS SHALL BE CLASS 200 PVC,
SIZED AS INDICATED BELOW.

MAXIMUM DEMAND


UP TO 10 GPM	3/4"
10 TO 16 GPM	1"
16 TO 26 GPM	1 1/4"
26 TO 35 GPM	1 1/2"
35 TO 55 GPM	2"
55 GPM AND UP	2 1/2"

1 2 3 4 5 6 7 8 9 10 11 12 13 14 15
26 6517.84 1904


JOURNAL CENTER 2-UNIT 2
IRRIGATION PLANS

IRRIGATION PLANS

Design Review Committee	City Engineer Approval	Last Design Update	Mo./Day/Yr.	Mo./Day/Yr.
APPROVE	APPROVE			
JAN 19 2004	FEB - 2 2004			

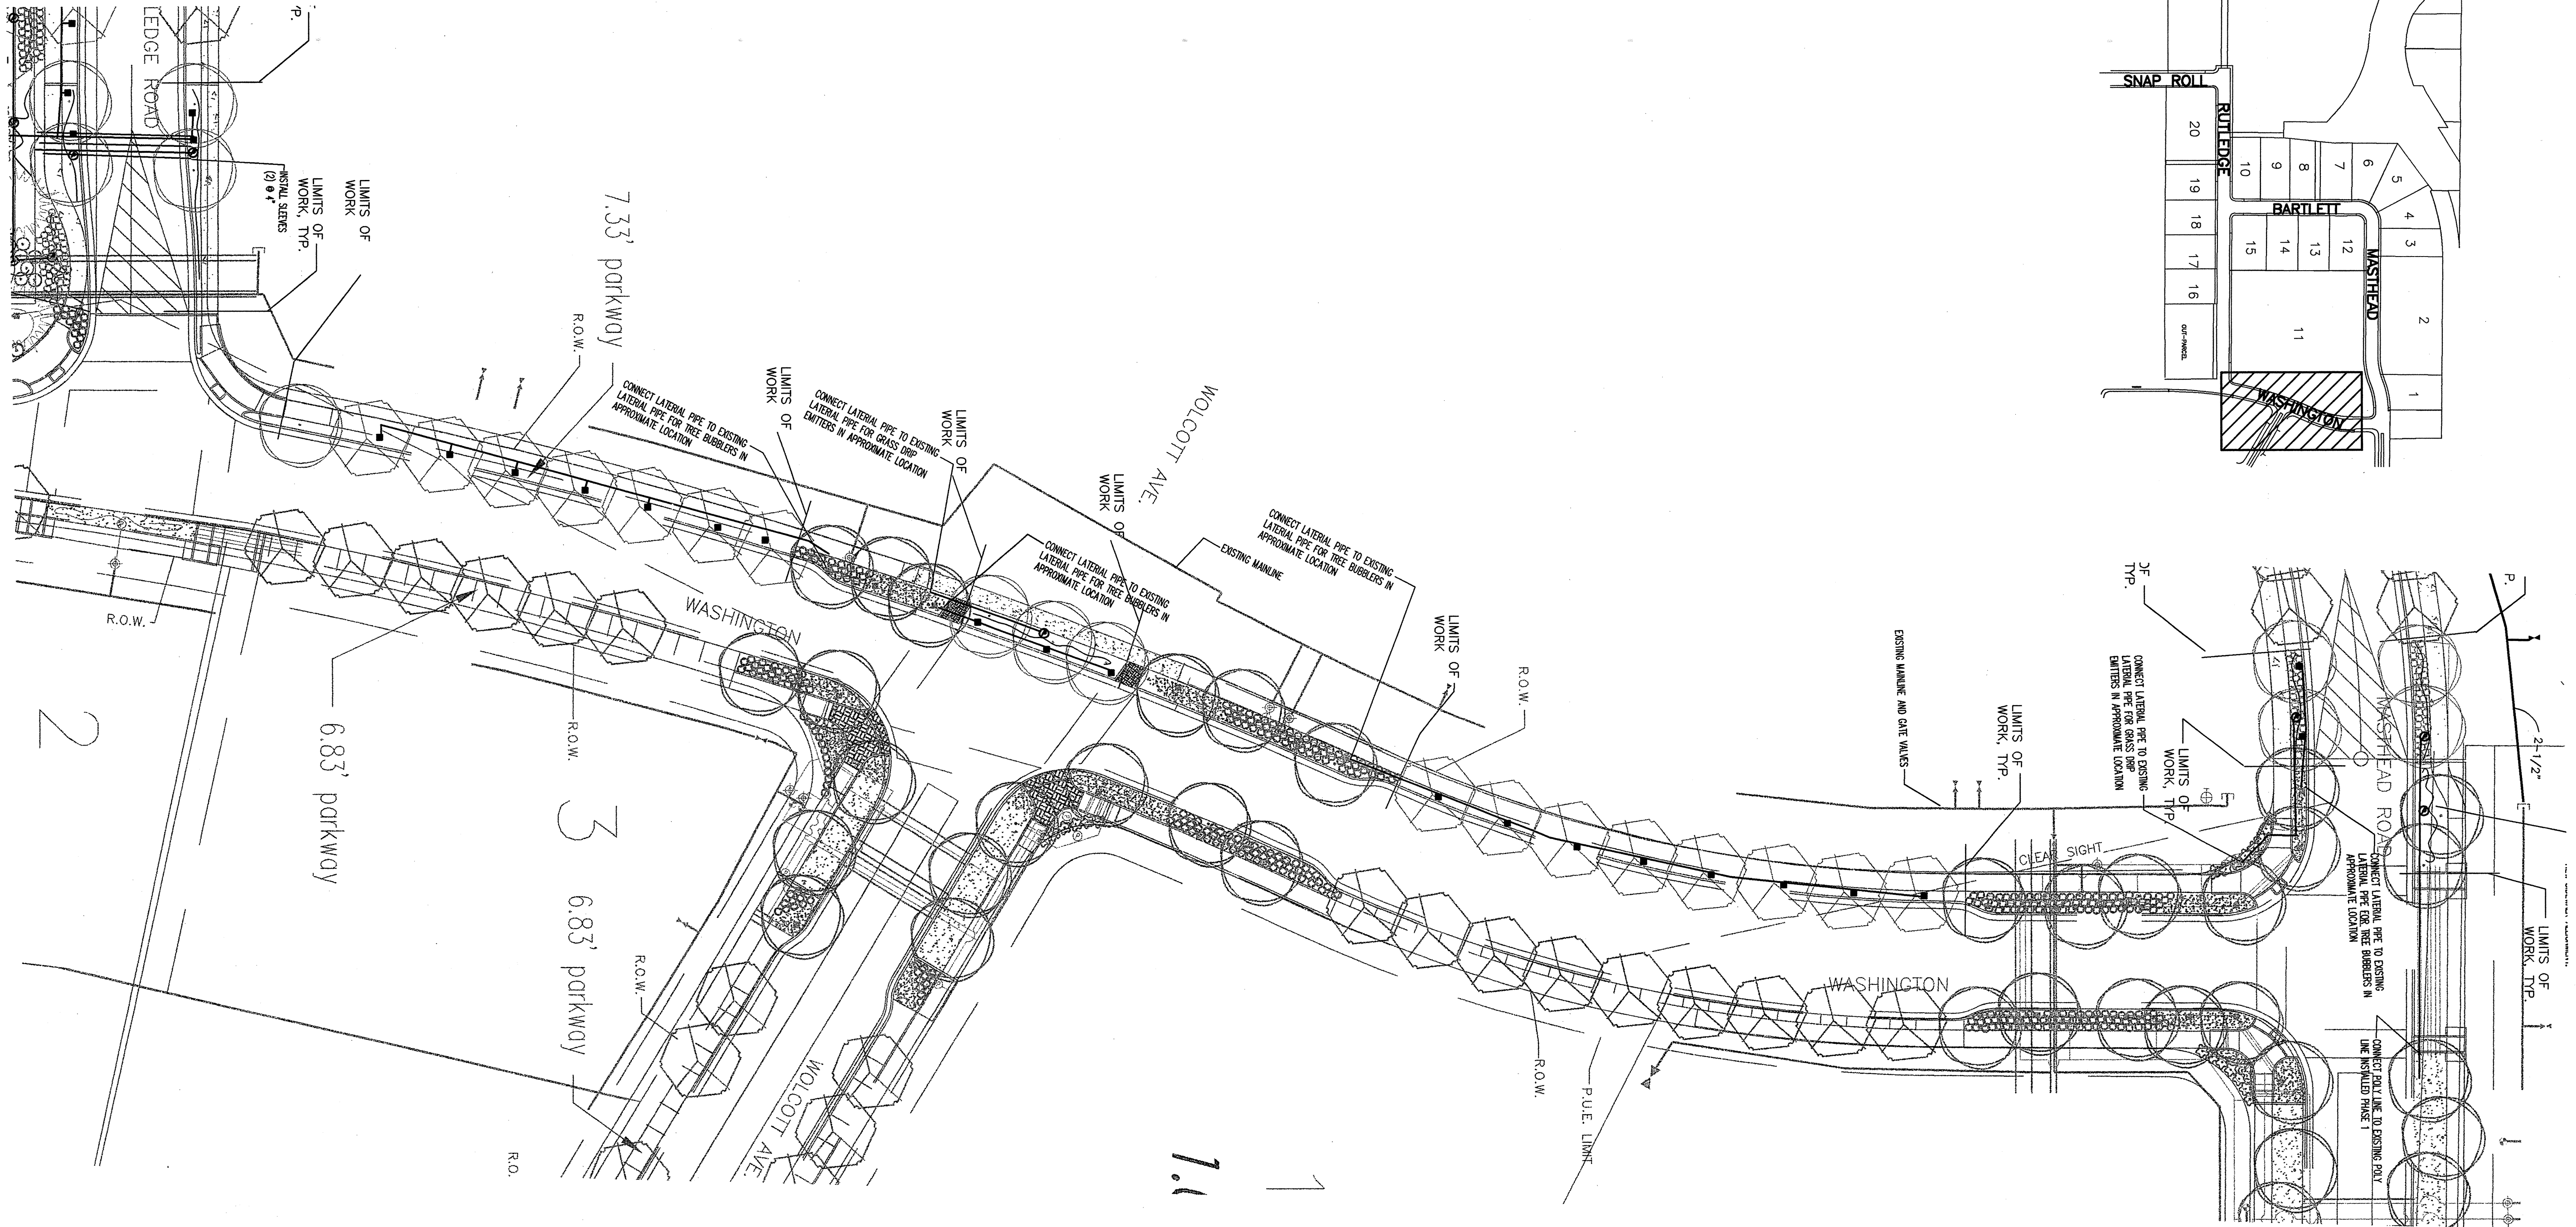

Key map

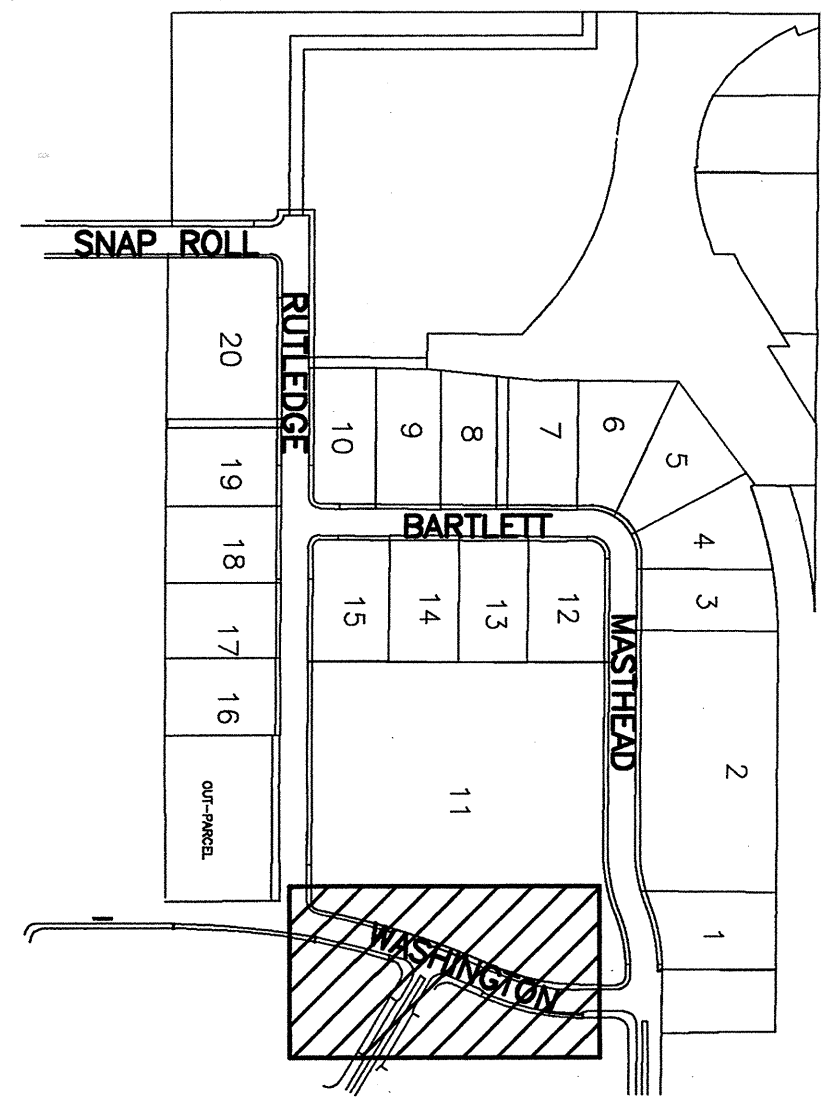

Irrigation Legend and Schedule

FOR FURTHER INFORMATION REGARDING IRRIGATION MATERIALS AND PARTS, REFERENCE LEGEND, SHEET 20/24.


SYMBOL	DESCRIPTION	SYMBOL	DESCRIPTION
	Automatic Controller & Pedestal Enclosure		Tree Bubbler
	Water Meter		Pressure Regulator
	Backflow Preventer and enclosure		Drip Poly Pipe
	Flow Sensor		Manual Drain Valve
	Remote Control Master Valve		Gate Valve
	Remote Control Valve		Air Relief Valve
	Remote Drip Valve Drip Filter		Irrigation Sleeve
	Surge Protector Ground Rod		Irrigation Main Line Piping
			Irrigation Lateral Piping

NOTE: IRRIGATION PIPING IS SHOWN DIAGRAMATIC DUE TO SCALE:
CONTRACTOR SHALL INSTALL ALL IRRIGATION WITHIN PUBLIC RIGHT OF WAY.

Irrigation Notes

- IRRIGATION SYSTEM SHALL BE INSTALLED AS PER C.O.A. SPECIFICATIONS.
- GROUP VALVES WHERE POSSIBLE. CREATE MANIFOLDS OFF MAINLINE WITH SINGLE BALL VALVE.
- CONTRACTOR SHALL INSTALL IRRIGATION LATERAL PIPING AS PER PIPE SIZING CHART. CONTRACTOR SHALL PROVIDE SHOP DRAWINGS TO LANDSCAPE ARCHITECT FOR VERIFICATION OF PIPE SIZING.
- DRIP POLY TUBING LENGTHS NOT TO EXCEED 100 LF.

CERTIFICATE OF SUBSTANTIAL COMPLIANCE ON PLANS
I, Patrick Gay of the firm of Sites Southwest, a Registered Professional Landscape Architect in the State of New Mexico, do hereby certify, to the best of my knowledge and belief, that the infrastructure installed as part of this project has been inspected by me or a qualified person under my direct supervision and has been constructed in accordance with the plans and specifications approved by the City Engineer and that the original design intent of the approved plans has been met, except as noted by me on the as-built construction drawings. This Certification is based on site inspections by me or personnel under my direction.

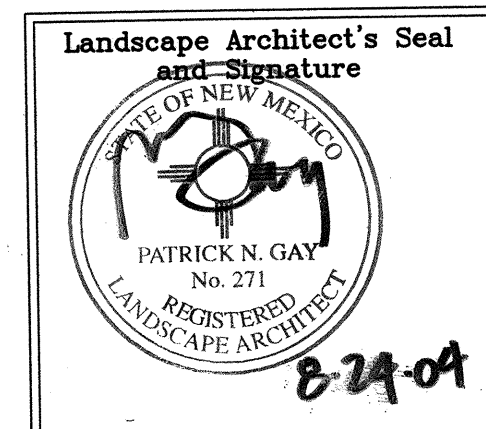

PIPE SIZING CHART

LATERALS SHALL BE CLASS 200 PVC, SIZED AS INDICATED BELOW.


MAXIMUM DEMAND	SIZE
UP TO 10 GPM	3/4"
10 TO 16 GPM	1"
16 TO 26 GPM	1 1/4"
26 TO 35 GPM	1 1/2"
35 TO 55 GPM	2"
55 GPM AND UP	2 1/2"

APPROVAL OF RECORD DRAWINGS


PROJECT LANDSCAPE ARCHITECT:
Patrick N. Gay 8-24-04

Valve Legend

VALVE/STATION NUMBER
VALVE SIZE
VALVE DEMAND
HEAD TYPE

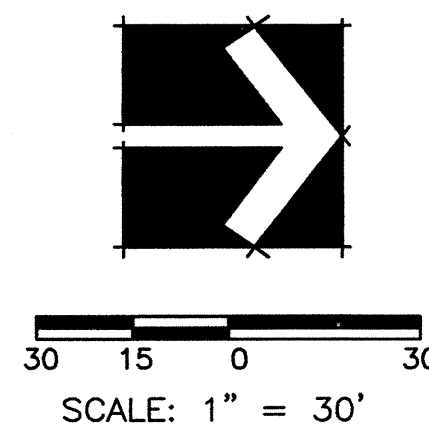


CITY OF ALBUQUERQUE PUBLIC WORKS DEPARTMENT ENGINEERING DEVELOPMENT GROUP	
JOURNAL CENTER 2-UNIT 2 IRRIGATION PLAN AS-BUILTS	
Design Review Committee	City Engineer Approval
City Project No. 6517.84	Zone Map No. D-17
Sheet 19A	Of 24

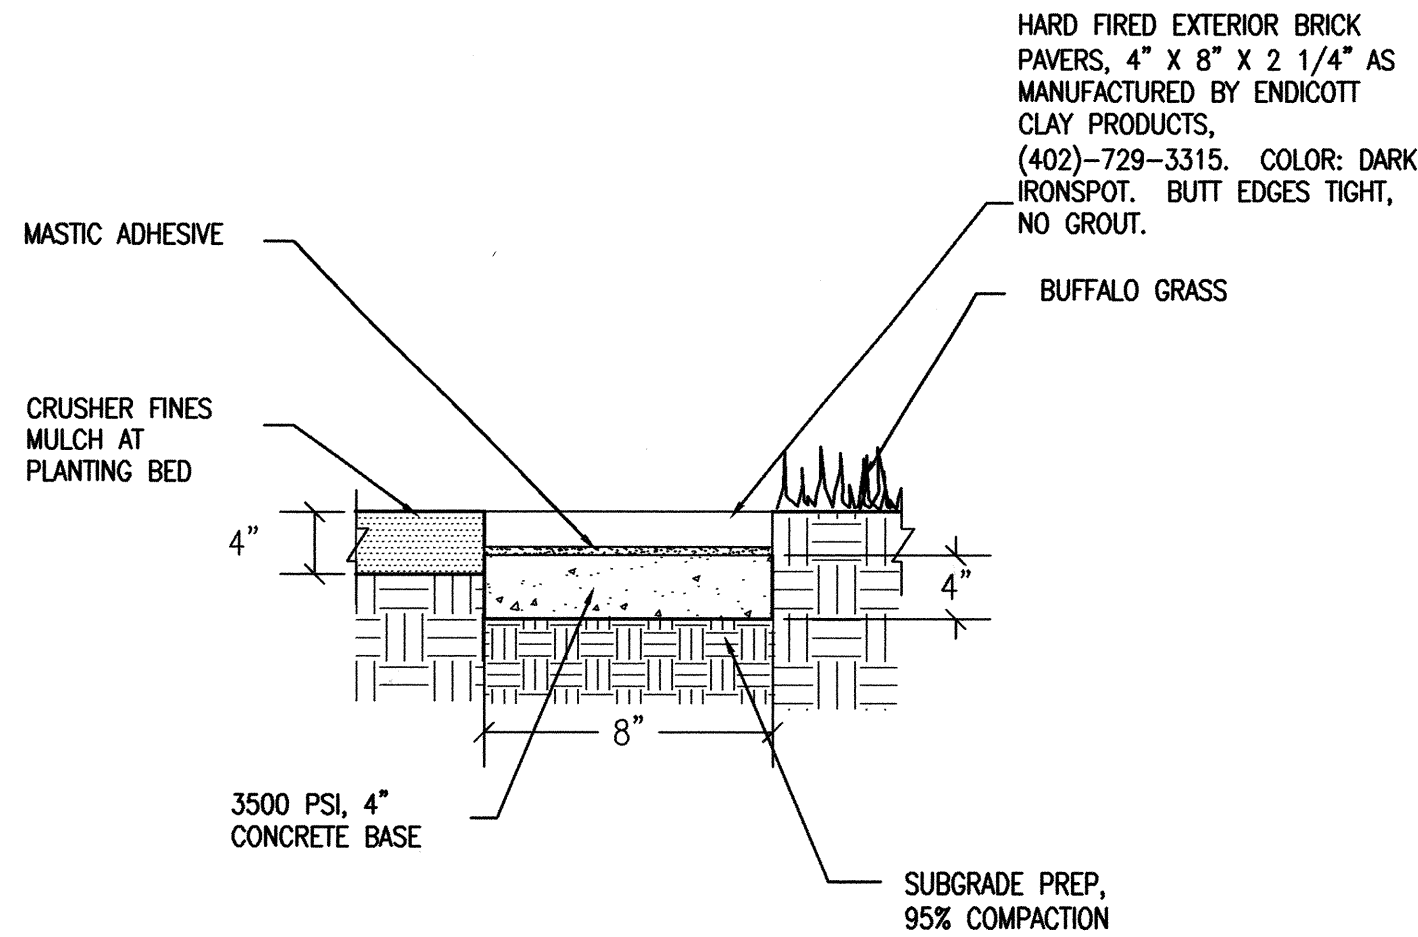


SECTION

A
20
BRICK MOWSTRIP

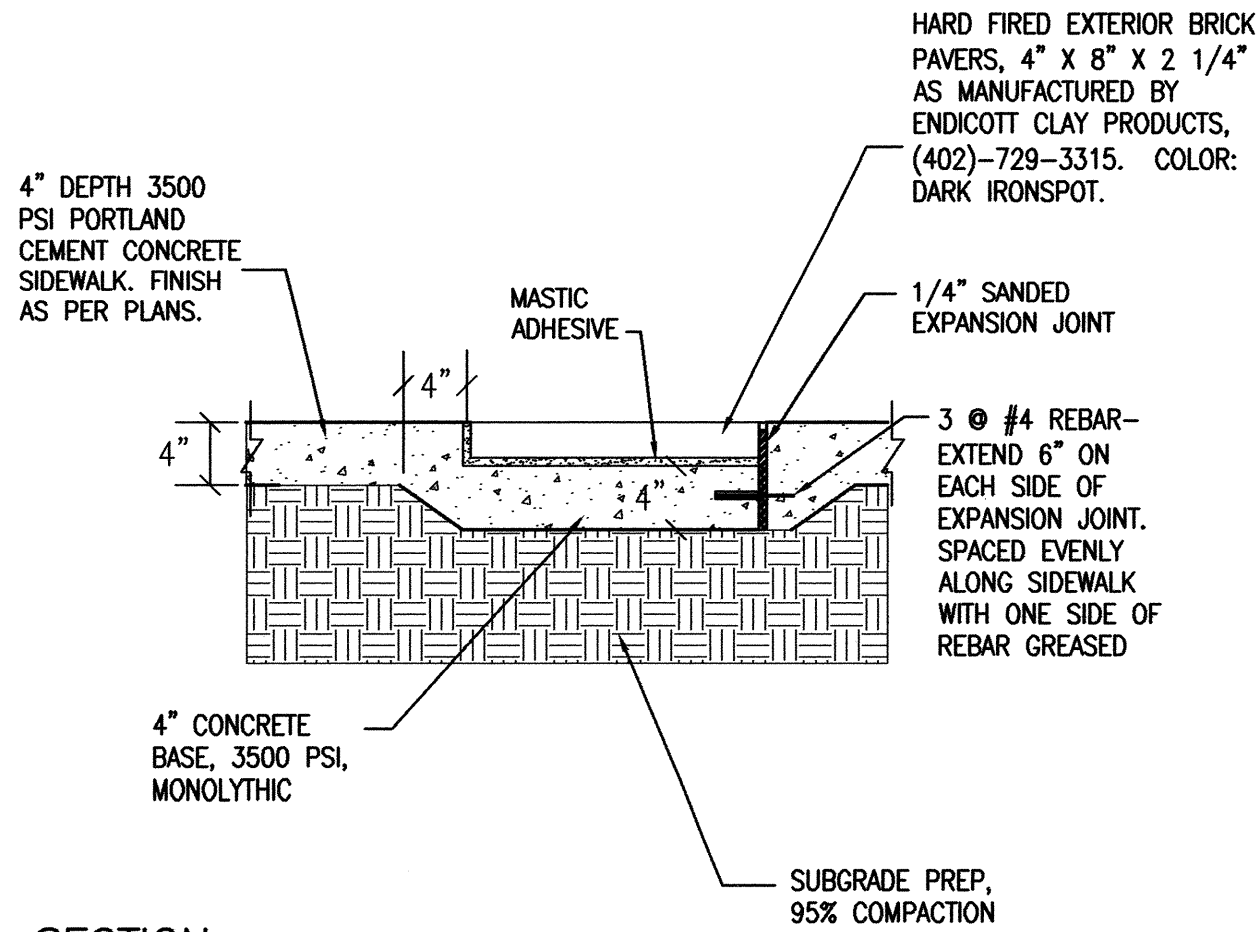


SECTION

B
20
BRICK IN MORTAR/SIDEWALK

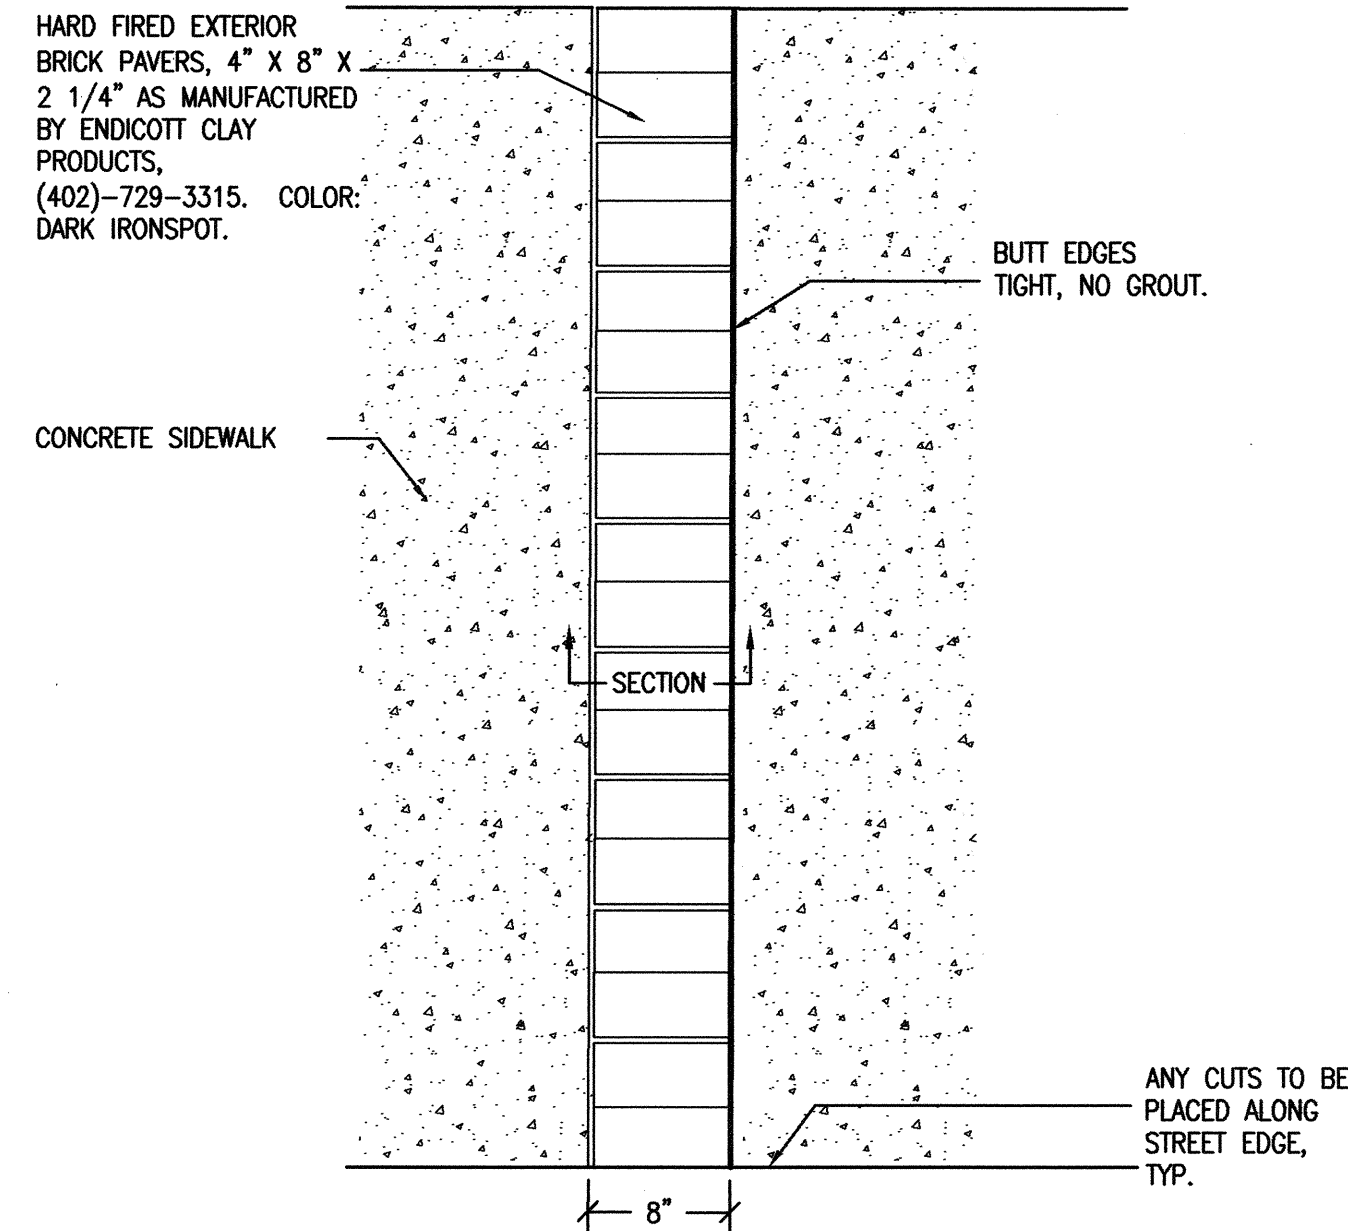


PLAN

D
20
PARKWAY SWALE

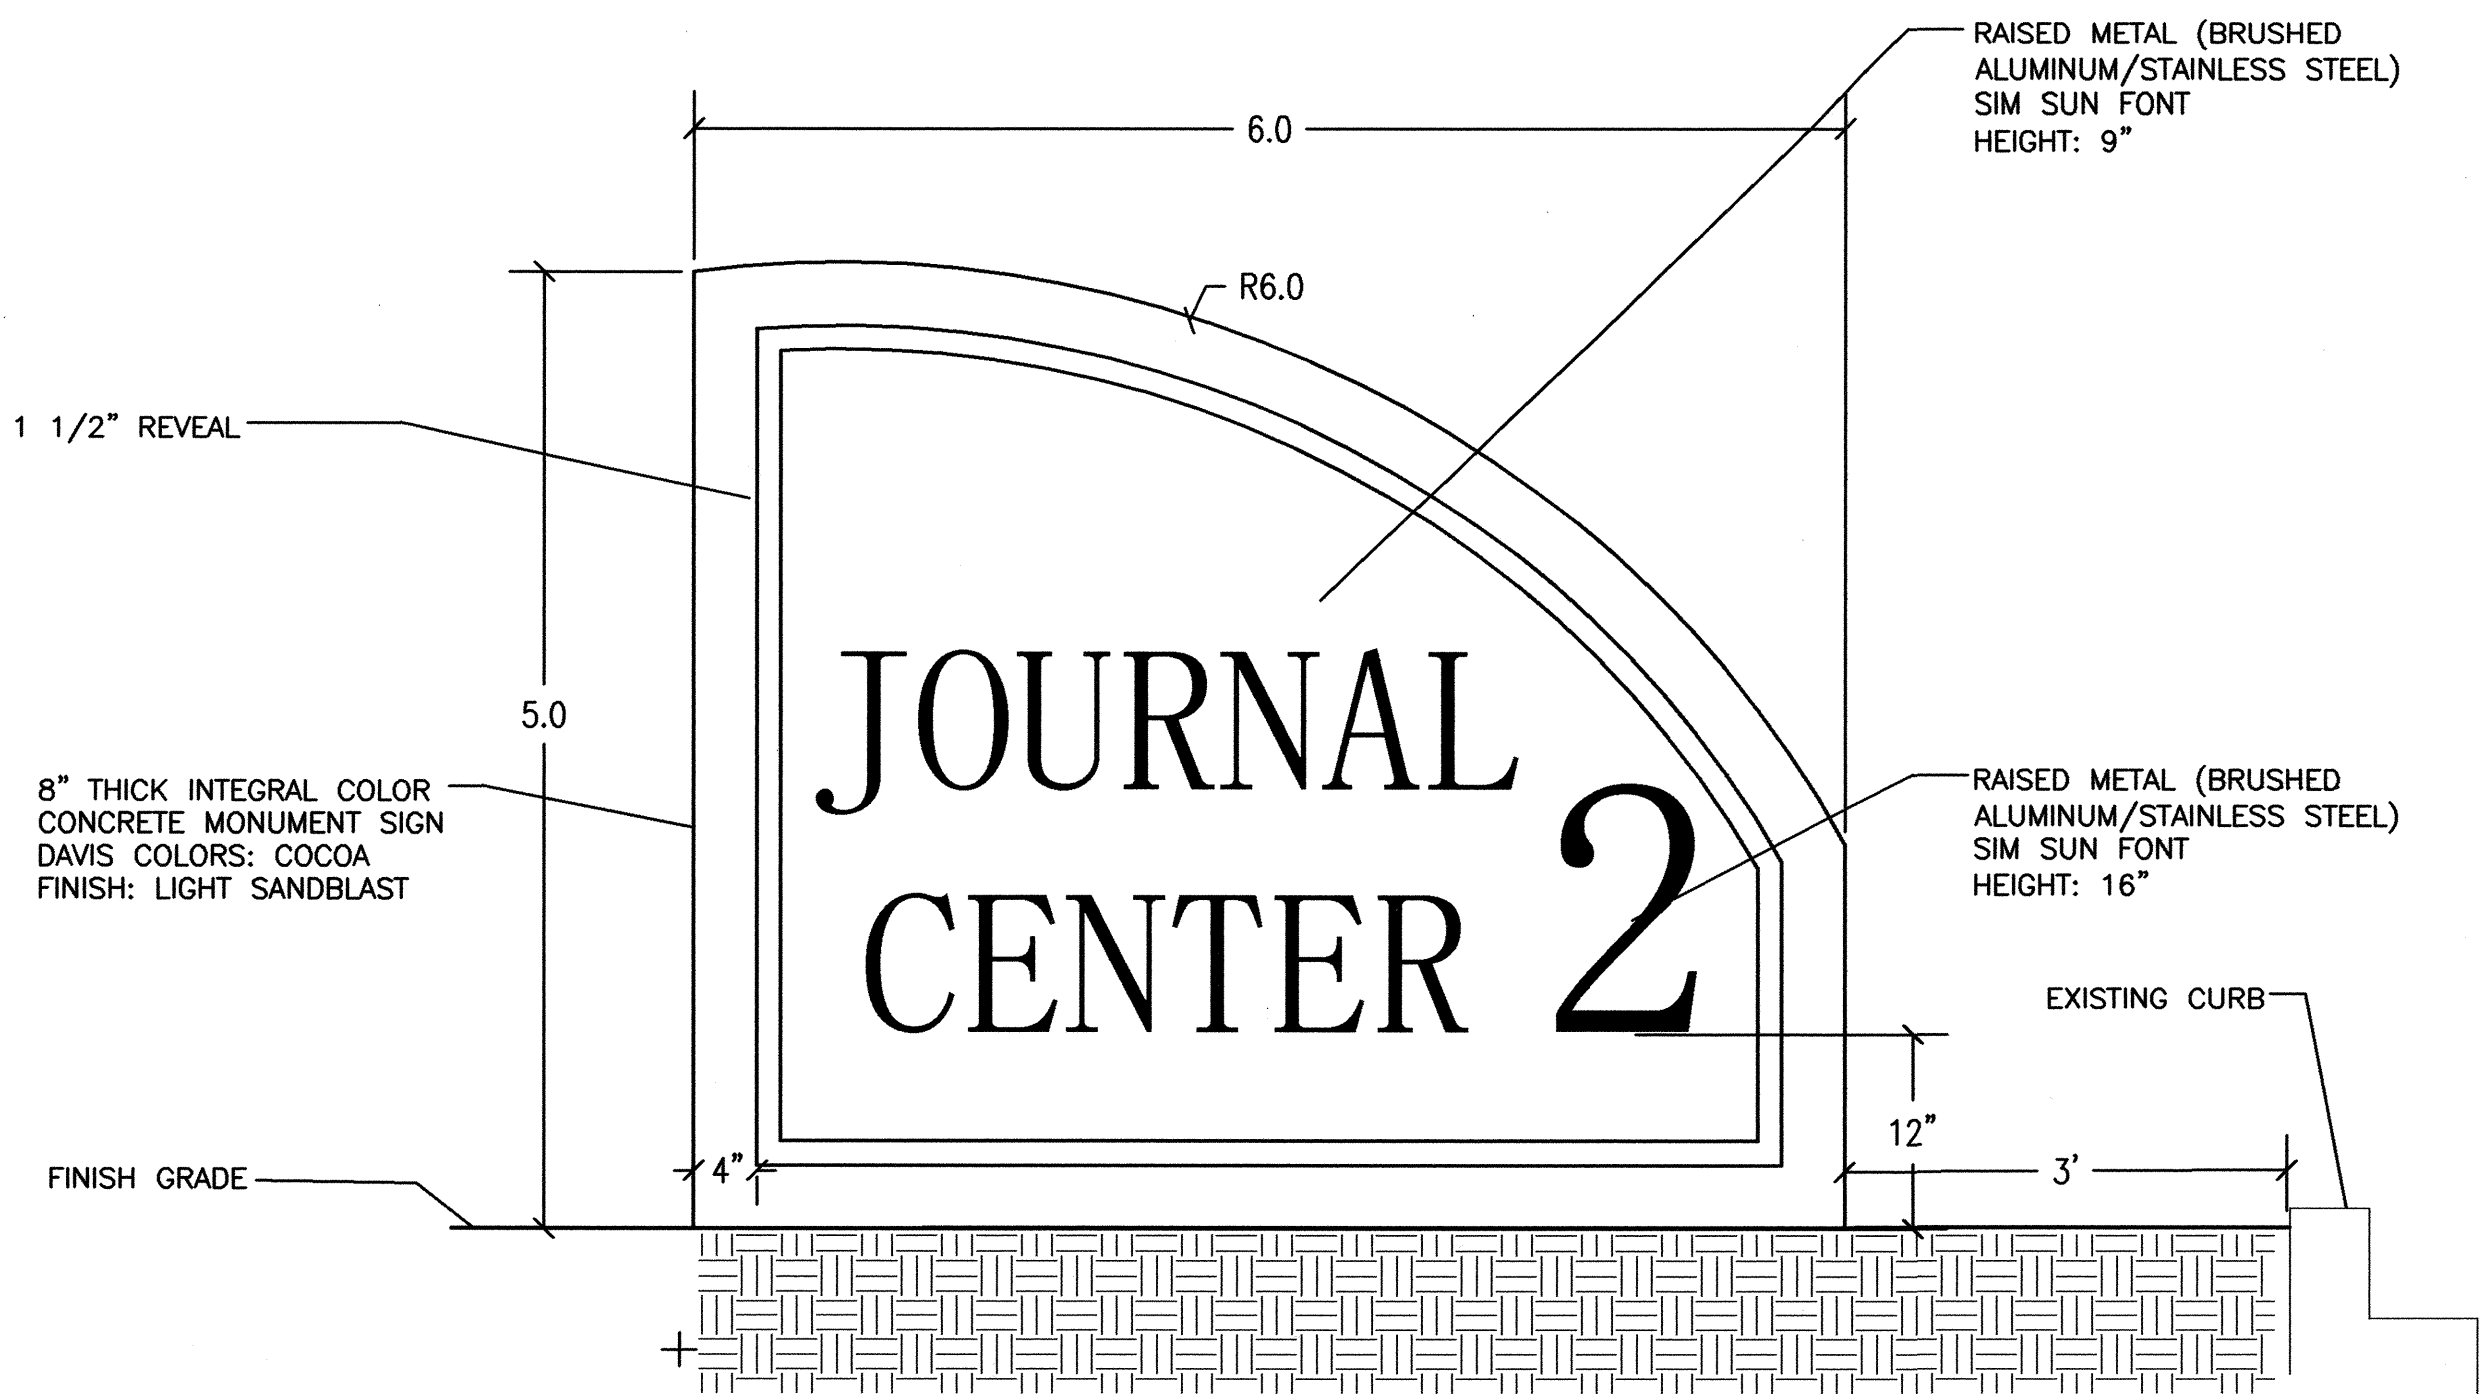


ELEVATION


D
20
ENTRY MONUMENT SIGN

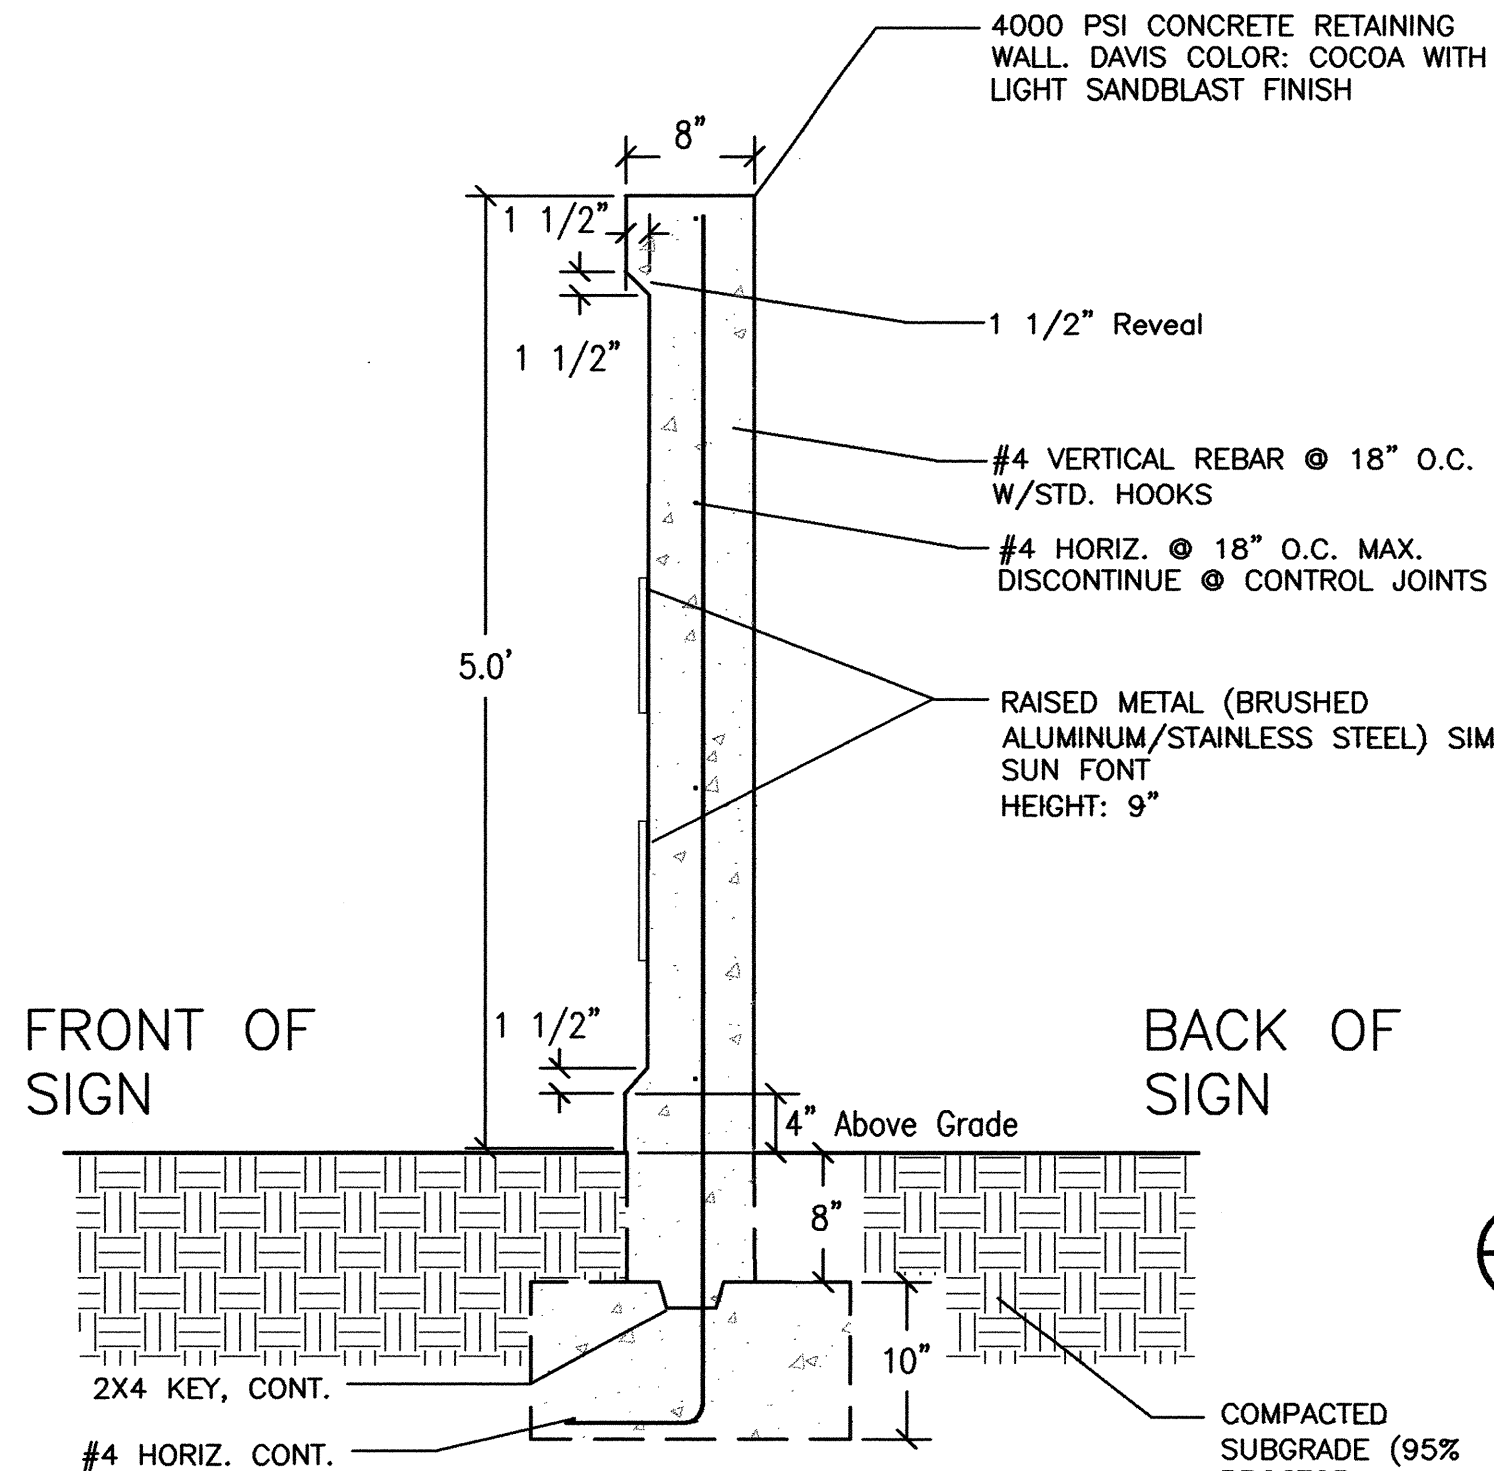


SECTION

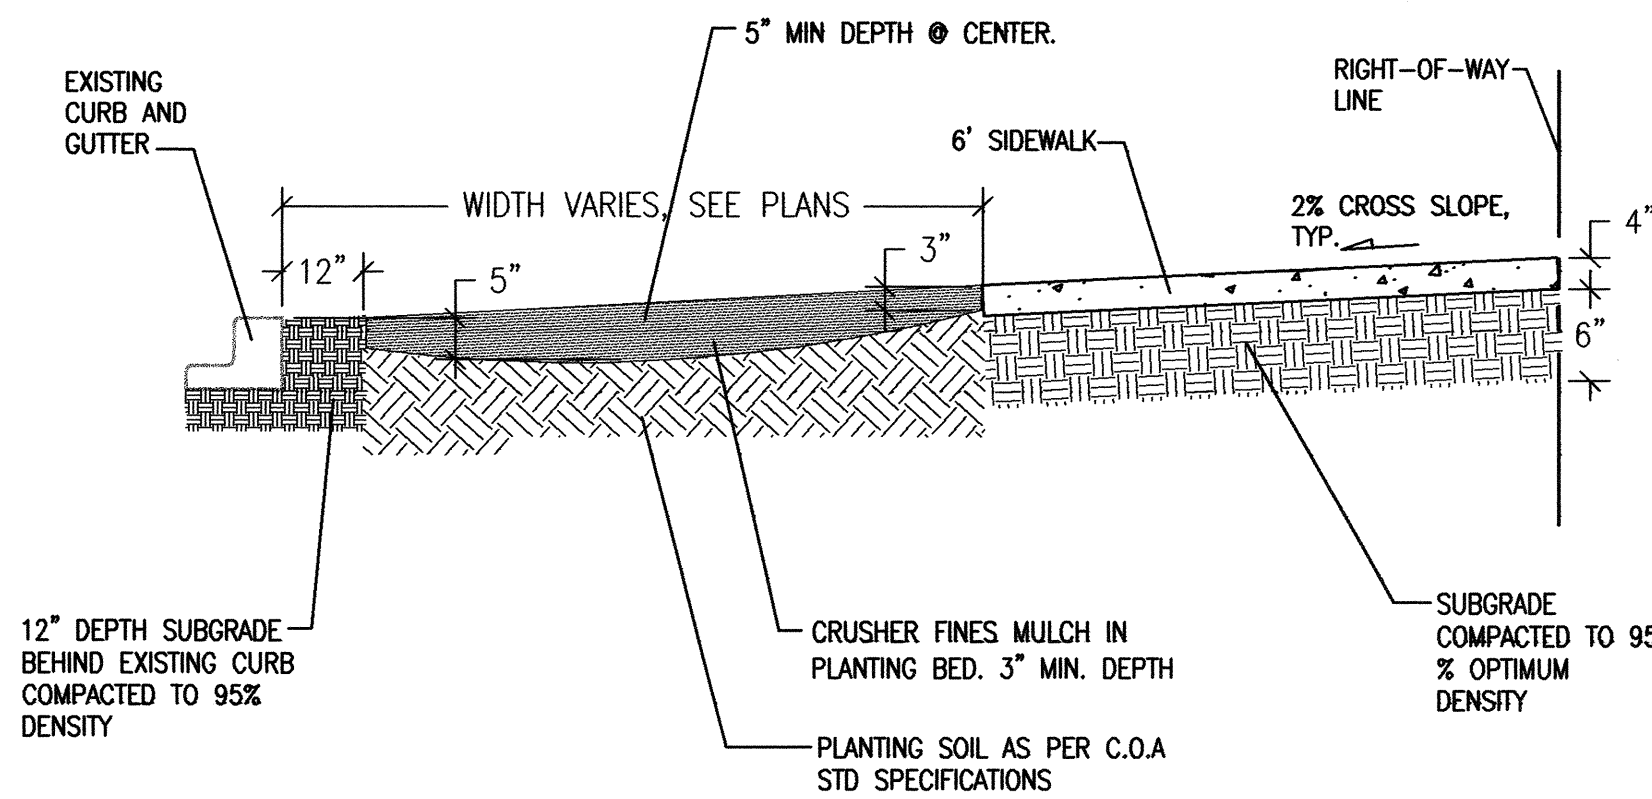

AS-BUILT INFORMATION		BENCH MARKS		SURVEY INFORMATION		FIELD NOTES		LANDSCAPE ARCHITECT'S SEAL	
CONTRACTOR	DATE	NO.	DATE	NO.	DATE	NO.	DATE	NO.	DATE

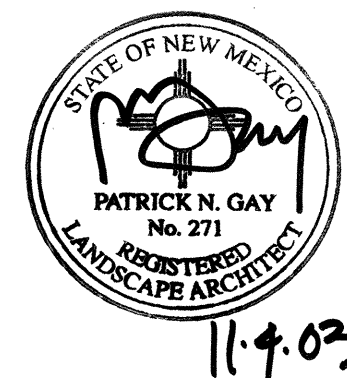

REVISIONS		DESIGN		DATE	
NO.	DATE	BY	REMARKS	DATE	BY

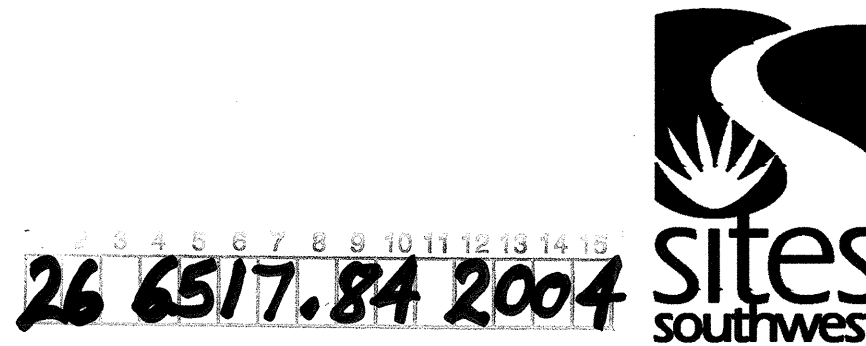

CITY OF ALBUQUERQUE PUBLIC WORKS DEPARTMENT ENGINEERING DEVELOPMENT GROUP			
JOURNAL CENTER 2-UNIT 2 CONSTRUCTION DETAILS			
Design Review Committee 	City Engineer Approval 	Mo./Day/Yr. JAN 1 9 2004	Mo./Day/Yr. FEB 2 2004
City Project No. 6517.84	Zone Map No. D-17	Sheet 20	Of 24

IRRIGATION LEGEND and SCHEDULE

SYMBOL	DESCRIPTION	MANUFACTURER	MODEL	SIZE/NOZZLE	NOTES
	Automatic Controller & Pedest. Enclosure	TUCOR STRONBOX	TWC-100-C SB-2455	Refer to Drawing	Pedestal mount with Rain Stat and Penn A-19ANC-1 Temperature Sensor
	Water Meter		Per Code	2"	by owner
	Backflow Preventer and enclosure	WILKINS Strongbox	975 RPBA SBBC-60 ALHP	2"	Install per City of Albu. standard detail. Drawing number 2701 and 2389
	Flow Sensor Master Valve	Tucor Bermad	FS-200 910-P	2"	Install per detail in 12" x 17" rectangular valve box w/ bolt down lid.
	Remote Control Master Valve	Rainbird	PEB	2"	Install per City of Albu. standard detail. Drawing number 2703
	Remote Control Valve	Rainbird	PEB	Refer to Drawing for Size	Install per City of Albu. standard detail. Drawing number 2703
	Buffalo Grass Turf Bubbler	Hunter	Institutional 4" PCN-20	PCN-20 2 GPM	Install per Bubbler detail, this sheet.
	Tree Bubbler	Rainbird	1803-5H-PCS060	.60 gpm	Install per City of Albu. standard detail. Drawing number 2710, mulch as per plan.
	Drip Poly Pipe	Toro	Toro EZ Drip Tubing EZH-50	1/2"	Install (2) EZ-2-20 2 gph emitters per shrub or perennial, (12) EZ-2-40 4 gph emitters per tree.
	Pressure Regulator	Rainbird	PSI-L30x-075	3/4"	See detail this sheet.
	Remote Drip Valve Disc Filter	Rainbird Netafim	PEB 1" DF100-200 or	Size as per plan 1 1/2" DF150S-200	Install per City of Albu. standard detail. Drawing number 2703
	Manual Drain Valve	Nibco	Nibco 1"	1"	Install at low point of system as shown in plans. Place in 12" x 17" plastic valve box. Field verify.
	Gate Valve	Nibco	Nibco 2"	2"	Install per City of Albu. standard detail. Drawing number 2706
	Air Relief Valve	Crispin	Crispin UL 10.0 1" Universal air release valve	1"	Install per City of Albu. standard detail. Drawing number 2705. Install at high points and saddles.
	Surge Protector with Ground Rod	Tucor	SP 100	Size as per plan	Install a 300' radius including branching Install as per manufactures specification
	Irrigation Sleeve		Class 200 w/ 12 ga. Pull Wire in Sleeve	2 sizes larger than total pipe to be sleeved	Paving sleeve(s) installed by General Contractor. Driveway and sidewalk sleeve(s) by Irrigation Contractor. All Controller wire sleeved separately in 1-1/4" sleeve.
	Irrigation Main Line Piping		Sch 40 PVC	Refer to Drawing for Size	See Specifications
	Irrigation Lateral Piping		Class 200 PVC	Refer to Drawing for Size	18" minimum cover over pipe


AUTOMATIC CONTROLLER DETAILS ARE PROVIDED ON THIS DETAIL SHEET DIRECTLY FROM THE MANUFACTURER'S RECOMMENDED DETAILS. SITES SOUTHWEST PROVIDED THESE DETAILS FOR CONTRACTOR CONVENIENCE AND ALL DIRECT QUESTIONS FOR THE TUCOR SYSTEM SHOULD BE DIRECTED TO TONY PAVLOVIC OF TUCOR, PHONE NUMBER " (724) 935-6850.

IRRIGATION NOTES:

1. Provide a complete, functioning automatic irrigation system including labor, materials, fees, taxes, equipment and other costs incidental to accomplishing the work.
2. Contractor shall maintain and provide all licensed requirements necessary to complete said scope of work.
3. Acquire written approval from Landscape Architect for material substitutes prior to commencing work.
4. Locate existing underground utilities and obstacles prior to commencing work. Repair damage to utilities or finishes resulting from work at no additional expense to Owner.
5. Install work in accordance with applicable local codes and ordinances.
6. Coordinate installation with General Contractor, landscape contractor and other trades as required.
7. Coordinate sleeve and conduit requirements with General Contractor.
8. Extend control valve wires to farthest valve from controller(s) and adjacent to all valves shown.
9. All control valve wiring shall be direct burial, 600 volt, single conductor, solid copper, plastic insulated cable, rated for direct burial applications, U.F. and U.L. approved, 14 gauge minimum lead and 14 gauge minimum common ground wire. Verify wire size with manufacturer's requirements based upon wire lengths prior to installing. Use Tucor wire specs.
10. Connect remote sensor(s) to controller(s) with common ground wire in series prior to connecting to remote control valves. Use Tucor wire spec.
11. Make final electrical connection of controller(s) and backflow preventer per local electrical code. Provide all necessary fuse boxes, conduit, connector or other electrical devices to make connection.
12. Owner or Landscape Architect shall determine final controller location(s).
13. All construction shall conform to City of Albuquerque standard specifications. Unless otherwise approved on this plan set.


A-1	Program and Station Number for Automatic Controller
2"	Valve Size in Inches
0.00	Gallons Per Minute Per Valve
AAA	Type Of Head

Ten days prior to commencing installation, verify static pressure. If static pressure is less than 75 PSI, do not start work until notified in writing to proceed from Owner. Adjust system as required to provide 100% coverage and to minimize over-spray onto paving and structure(s).

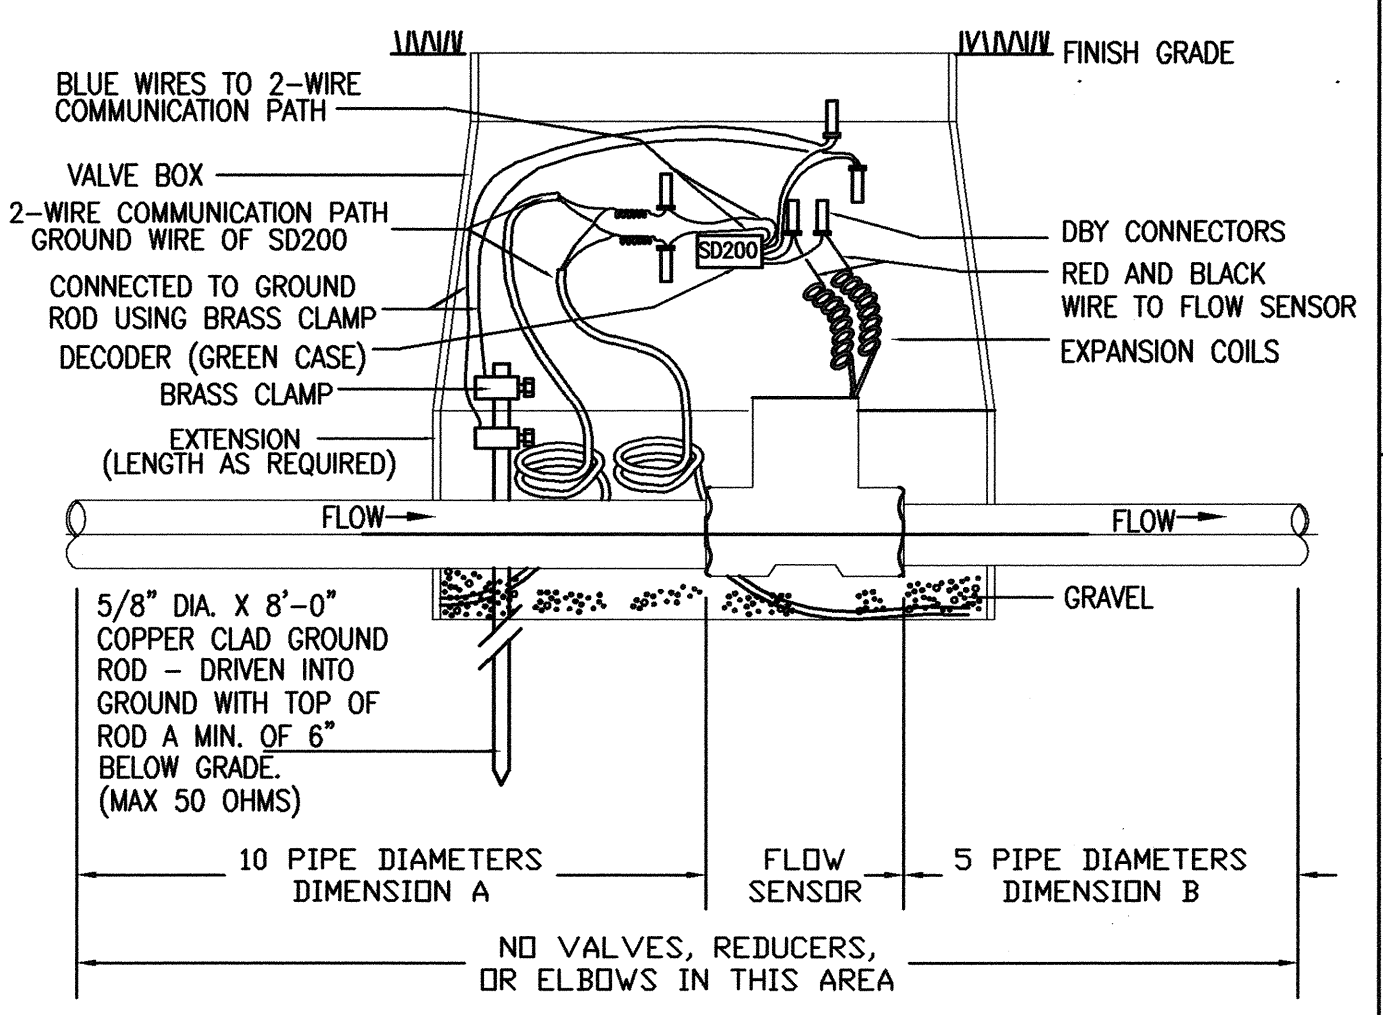


EXAMPLE: for 3" flow sensor:
Dimension A = Minimum 30" & Dimension B = Minimum 15"

FLOW SENSOR INSTALLATION

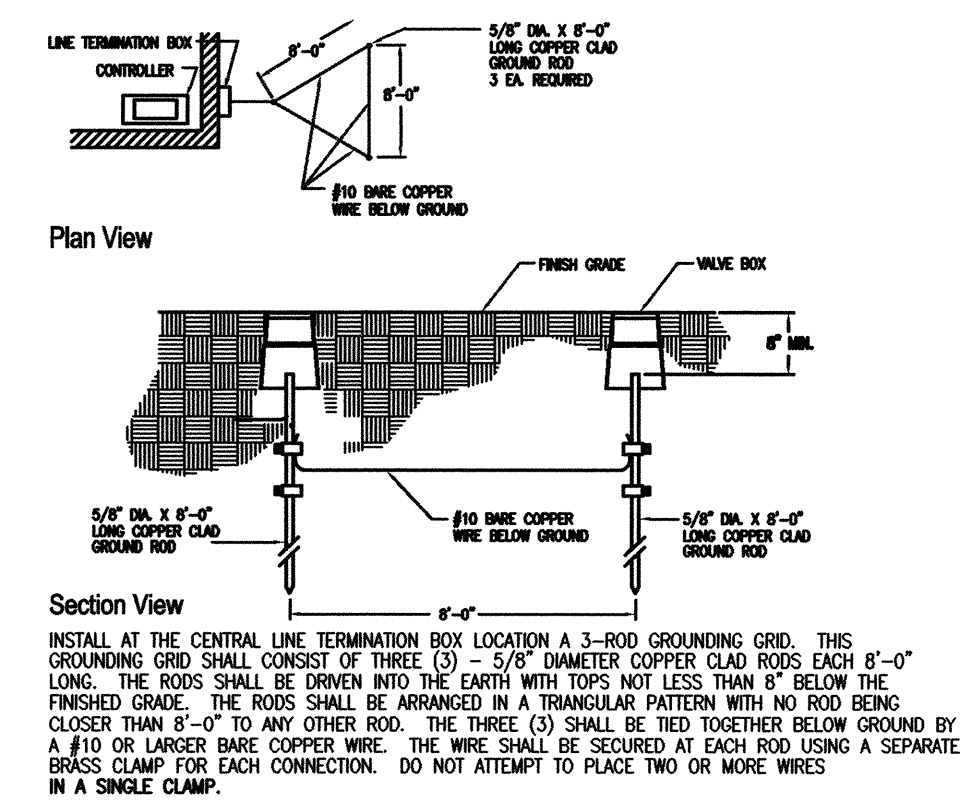

INSTALL AT THE CENTRAL LINE TERMINATION BOX LOCATION A 3-ROD GROUNDING GRID. THIS GROUNDING GRID SHALL CONSIST OF THREE (3) - 5/8" DIAMETER COPPER CLAD RODS EACH 8'-0" LONG. THE RODS SHALL BE DRIVEN INTO THE EARTH WITH TOPS NOT LESS THAN 8" BELOW THE FINISHED GRADE. THE RODS SHALL BE ARRANGED IN A TRIANGULAR PATTERN WITH NO ROD BEING CLOSER THAN 8'-0" TO ANY OTHER ROD. THE THREE (3) SHALL BE TIED TOGETHER BELOW GROUND BY A #10 OR LARGER BARE COPPER WIRE. THE WIRE SHALL BE SECURED AT EACH ROD USING A SEPARATE BRASS CLAMP FOR EACH CONNECTION. DO NOT ATTEMPT TO PLACE TWO OR MORE WIRES IN A SINGLE CLAMP.

GROUNDING GRID NETWORK

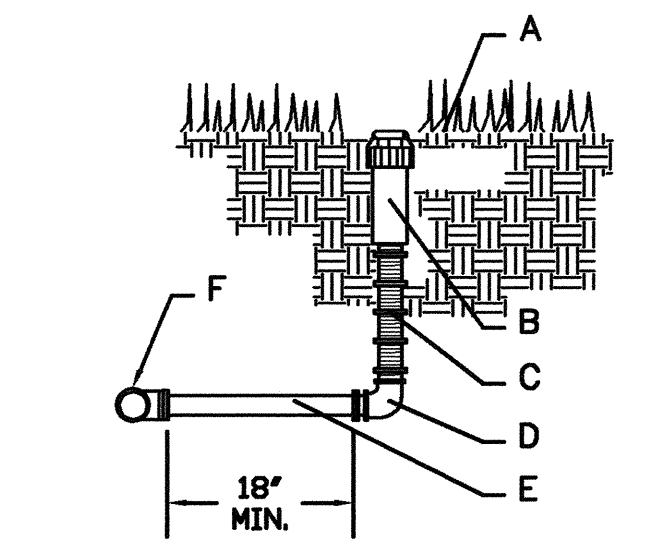


GENERAL NOTES:
SET TOP OF HEAD FLUSH WITH FINISH GRADE.

CONSTRUCTION NOTES:

- A. FINISH GRADE
- B. SPRINKLER HEAD (SEE PLAN)
- C. CUT OFF RISER
- D. SCH 40 PVC THREADED ELL (SxT)
- E. PVC FLEXIBLE VINYL PIPE, STD IPS FROM AGRICULTURAL PRODUCTS
- F. SCH 40 PVC TEE


Note: bubblers are used in the turf areas to adhere to requirements of not using spray heads along back of curb. Contractor is to fine grade planting areas so that the water flow from the flood bubblers can evenly flow across the planting area. If field situations occur that prevent the grading from being constructed and will not allow the water to flow as describe, contact the Landscape Architect for direction.

BUBBLER

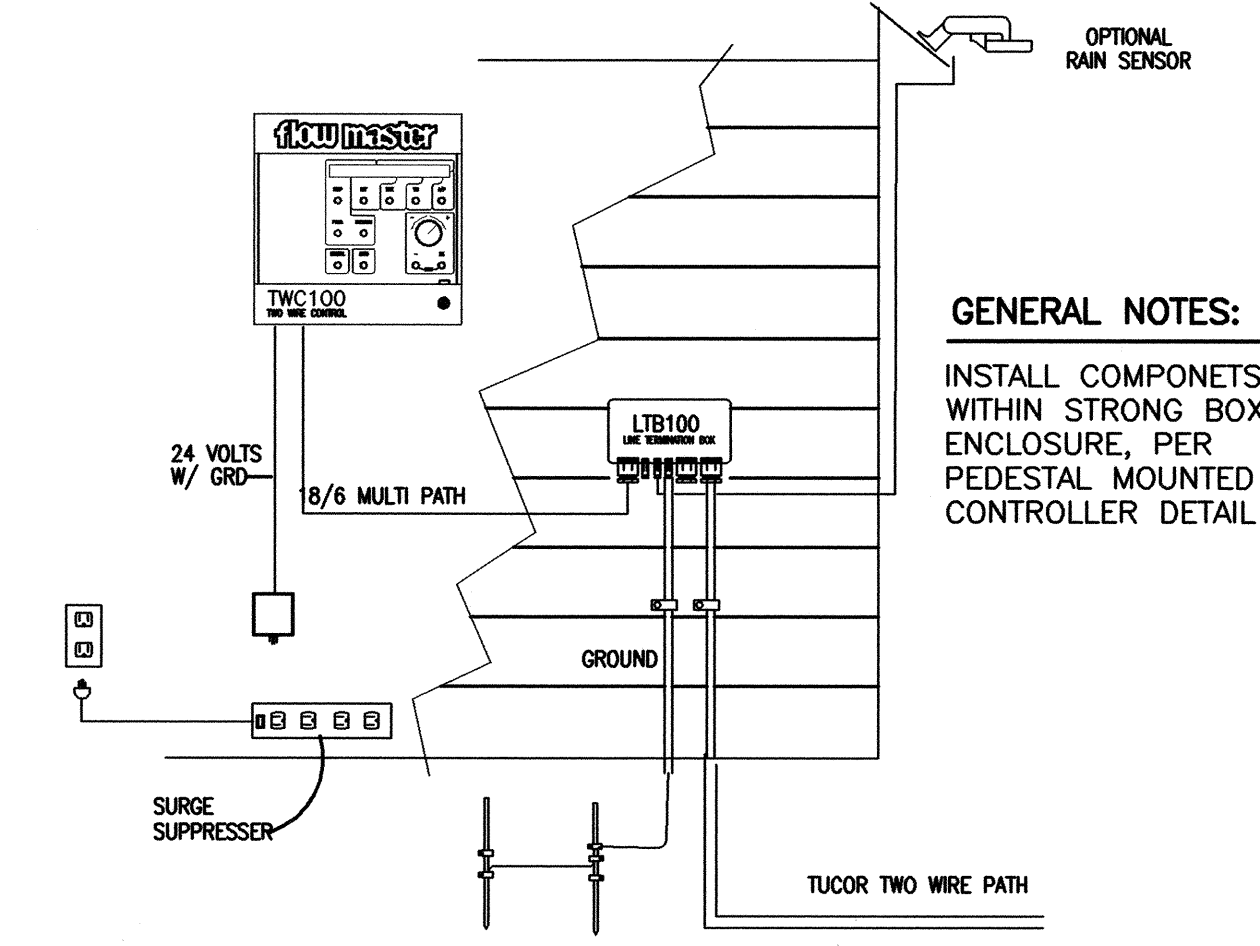


GENERAL NOTES:
INSTALL COMPONENTS WITHIN STRONG BOX ENCLOSURE, PER PEDESTAL MOUNTED CONTROLLER DETAIL

CONTROLLER TUCOR TWC 50

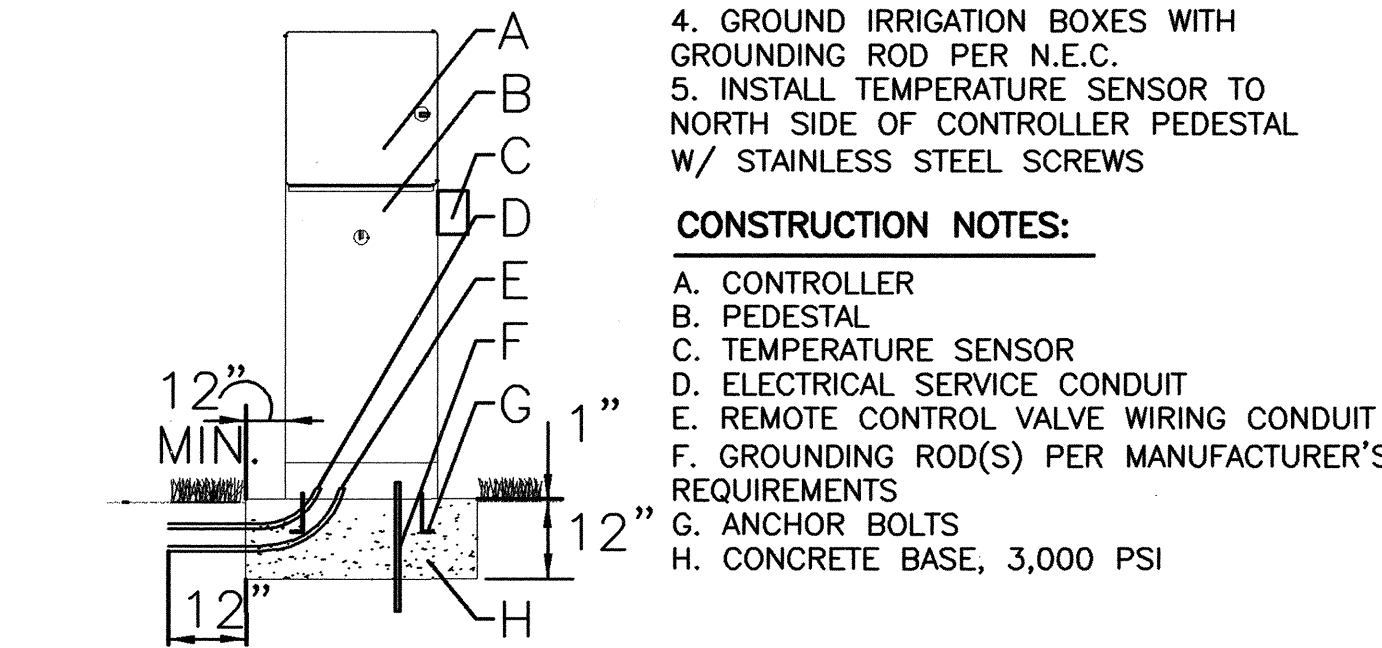

PEDESTAL MOUNTED CONTROLLER

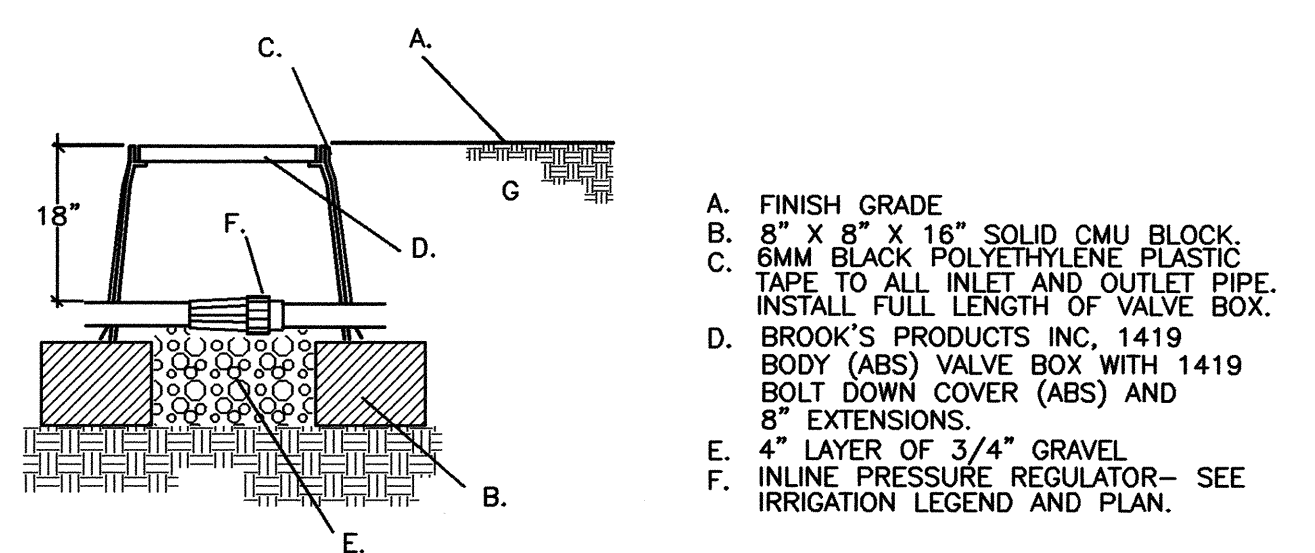

INLINE PRESSURE REGULATOR


GENERAL NOTES:

PRESSURE REGULATORS ARE IN PLANTING AREAS FOR FLEXIBILITY OF PLACING DRIP LINE IN THE FIELD. CONTRACTOR IS TO PLACE DRIP LINE AROUND PLANT MATERIAL IN THE BEST MANNER POSSIBLE THAT WILL ADEQUATE WATER TO THE PLANT MATERIAL TO SUSTAIN PLANT GROWTH. DO NOT EXCEED DRIP LINE RUNS OF 170'.

CONSTRUCTION NOTES:

- A. 3" LAYER OF CRUSHER FINES
- B. DRIP LINE
- C. SOIL


DRIP LINE / CRUSHER FINES

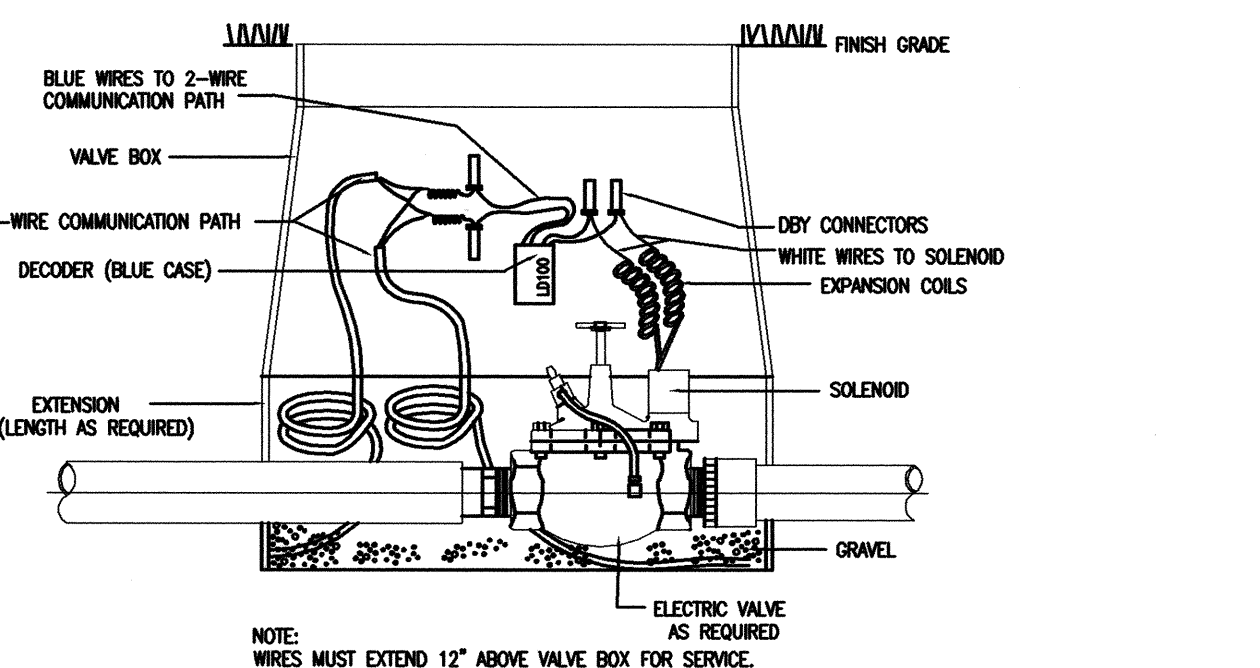


Valve & Decoder Detail

NOTE: INSTALL THE AUTOMATIC VALVE PER THE CITY OF ALBUQUERQUE STANDARD DETAIL. THIS DETAIL IS TO CLARIFY THE WIRING CRITERIA ONLY.


DECODER TO VALVE WIRING

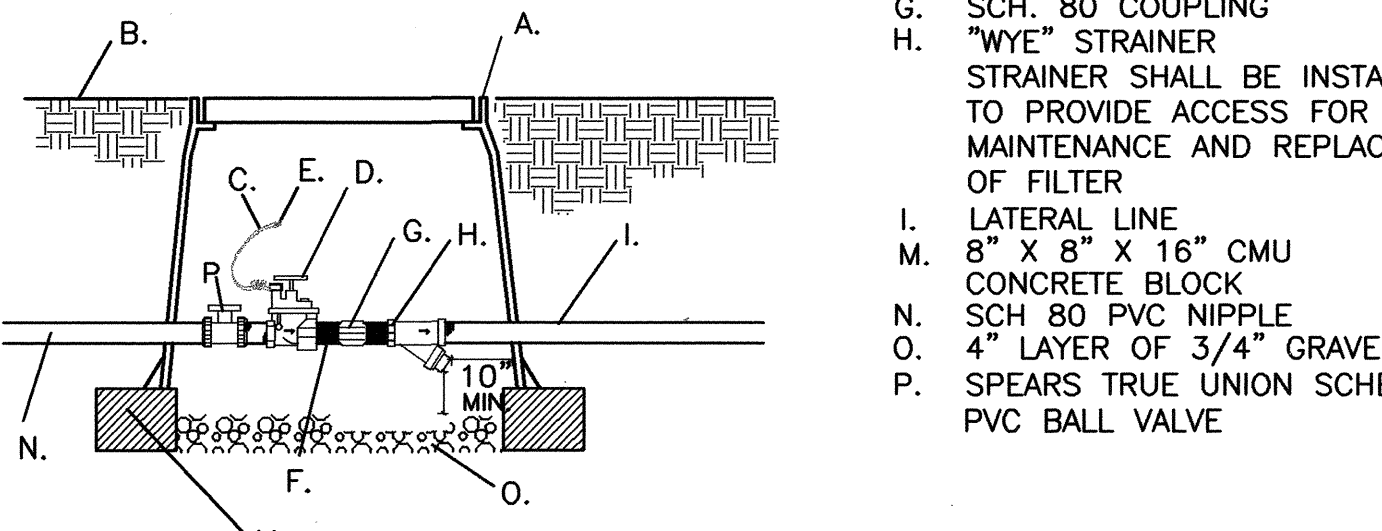


DRIP VALVE/FILTER ASSEMBLY

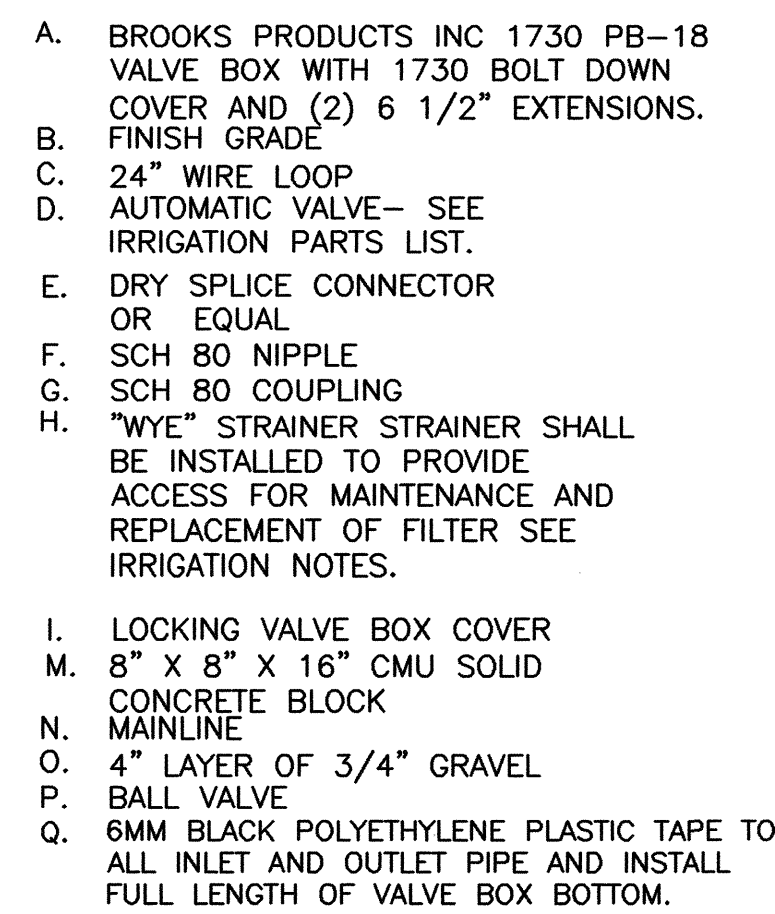


NOT TO SCALE

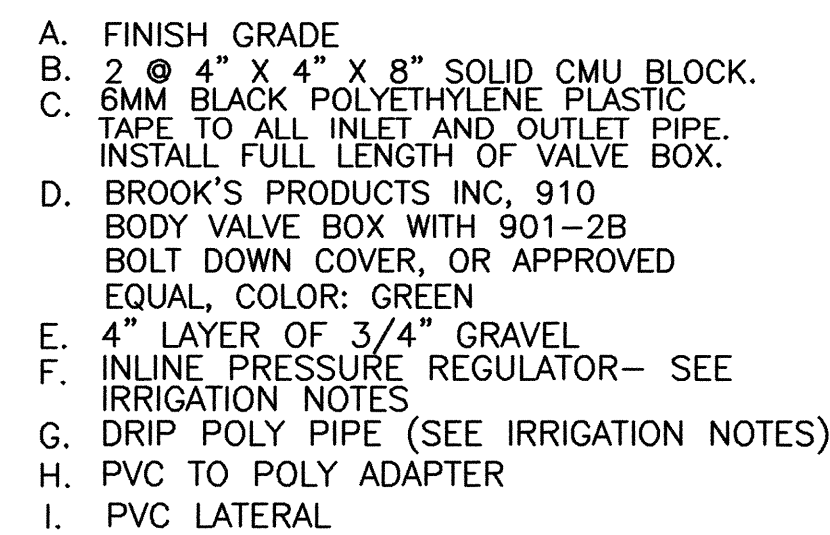

NOT TO SCALE

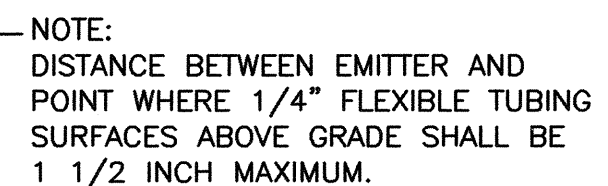

NOT TO SCALE

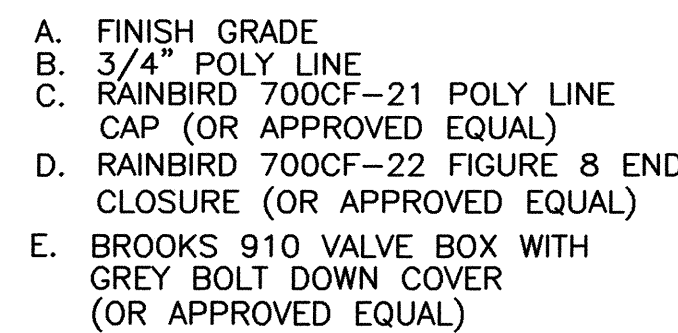

NOT TO SCALE

LATERALS SHALL BE CLASS 200 PVC,
SIZED AS INDICATED BELOW.
MAXIMUM DEMANDAND%%

UP TO 10 GPM	3/4"
10 TO 16 GPM	1"
16 TO 26 GPM	1 1/4"
26 TO 35 GPM	1 1/2"
35 TO 55 GPM	2"
55 GPM AND UP	2 1/2"

THE CONTRACTOR SHALL BE FAMILIAR WITH THESE DETAILS AND SPECIFICATIONS AS THEY PERTAIN TO THE SITE. IT SHALL BE THE CONTRACTOR'S RESPONSIBILITY TO NOTIFY THE OWNER'S REPRESENTATIVE OF ANY ITEMS THAT ARE IN CONFLICT WITH THE PROPOSED CONTRACT.

WHERE EVER APPLICABLE, PLACE MAINLINE AND LATERAL PIPING WITHIN TWO (2') FEET OF FACE OF CURB (F.O.C.) ALL VALVES SHALL BE LOCATED IN PLANTING AREAS WHERE SHOWN AND ALL PIPING SHALL BE INSTALLED PRIOR TO PLANTING. NO TEES, ELLS OR OTHER TURNS IN PIPING SHALL BE LOCATED UNDER PAVING. CAP ALL ENDS HAND TIGHT PRIOR TO BACKFILL. ALL IRRIGATION SHALL BE INSTALLED WITHIN APPLICABLE RIGHT OF WAYS.

DRIP SUPPLY PIPING SHALL BE LOW DENSITY 3/4" POLYETHYLENE TUBING. DEPTH OF BURY SHALL BE 8". MAXIMUM RUN OF PIPE FROM POINT OF CONNECTION AT PRESSURE REGULATOR SHALL BE 150 LINEAR FEET. MAXIMUM FLOW FROM POINT OF CONNECTION AT PRESSURE REGULATOR SHALL BE 5 GPM. DISTRIBUTION TUBING SHALL BE 1/4" FLEXIBLE POLYVINYL TUBING. MAXIMUM LENGTH OF DISTRIBUTION TUBING SHALL BE EIGHT FEET.

ALL DRIP SUPPLY FITTINGS SHALL BE COMPRESSION TYPE FITTINGS. ALL DISTRIBUTION TUBING FITTINGS SHALL BE BARBED TYPE CONNECTIONS.

EACH SHRUB WITH 2 FI OR GREATER ON CENTER SPACING SHALL BE DRIP IRRIGATED WITH (2) TWO PRESSURE COMPENSATING 2 GPH XB-20 RAINBIRD EMITTERS (OR APPROVED EQUAL). EACH SHRUB WITH LESS THAN 2 FT. ON CENTER SPACING SHALL BE DRIP IRRIGATED WITH (1) ONE 2 GPH XB-20 RAINBIRD EMITTERS (OR APPROVED EQUAL).

DRIP ZONE AUTOMATIC VALVES SHALL BE ACCOMPANIED BY A 150 MESH ROTARY DISK FILTER- RAINBIRD RAPIDCLEAN MODEL (OR APPROVED EQUAL). SIZE AS ZONE DEMAND REQUIRES. REFERENCE PIPE SIZING CHART AND MANUFACTURER'S SPECIFICATIONS.

HARD PIPE TO POLY PIPE TRANSITION SHALL BE MADE AT PRESSURE REGULATOR AS PER THE DETAILS. PRESSURE REGULATOR SHALL REDUCE OPERATING PRESSURE TO 30 PSI AT THE REQUIRED FLOW FOR EACH DRIP ZONE- RAINBIRD PSI-L30X (OR APPROVED EQUAL).

IF THE CONTRACT DRAWINGS AND/OR SPECIFICATIONS DO NOT THOROUGHLY DESCRIBE THE METHOD OR TECHNIQUES TO BE USED FOR INSTALLATION, THEN THE CONTRACTOR SHALL FOLLOW THE INSTALLATION METHODS RECOMMENDED BY THE MANUFACTURER.


ALL PLANT MATERIALS INSTALLED SHALL HAVE THE AUTOMATIC IRRIGATION SYSTEM FULLY OPERABLE AT THE TIME OF PLANT INSTALLATION.

WARRANTY AND MAINTENANCE

THE CONTRACTOR SHALL FURNISH A CERTIFICATE OF WARRANTY AND A GUARANTEE OF WORK AND MATERIALS FOR A ONE YEAR PERIOD FROM DATE OF FINAL ACCEPTANCE. FINAL PAYMENT FOR THE SYSTEM SHALL NOT BE MADE UNLESS THIS CERTIFICATE IS PRESENTED TO THE OWNER.




THE CONTRACTOR SHALL MAINTAIN THE IRRIGATION SYSTEM, IN SATISFACTORY WORKING ORDER, DURING THE TIME OF CONTRACT WORK.

THE CONTRACTOR SHALL BE LIABLE FOR ANY LOSS OR DAMAGE TO ANY WORK OR MATERIALS, SUPPLIES AND EQUIPMENT ON THE JOB SITE CAUSED BY THE CONTRACTOR, ITS EMPLOYEES OR ANY OTHER UNFORESEEN CAUSE UNTIL FINAL ACCEPTANCE OF PROJECT WITH THE OWNER'S REPRESENTATIVE.

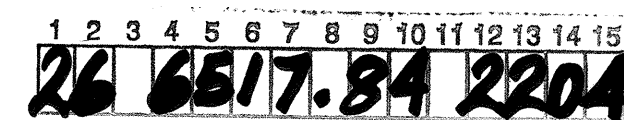[illegible]

CITY OF ALBUQUERQUE
PUBLIC WORKS DEPARTMENT
ENGINEERING DEVELOPMENT GROUP

JOURNAL CENTER 2-UNIT 2
IRRIGATION DETAILS

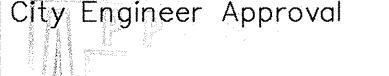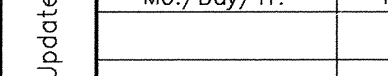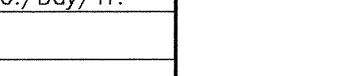Design Review Committee 		City Engineer Approval 		Last Design Update 		Mo./Day/Yr. 		Mo./Day/Yr. 	
City Project No. 6517.84		Zone Map No. D-17		Sheet 22		Of 24			

CONSTRUCTION TRAFFIC CONTROL GENERAL NOTES

1. CONTRACTOR MUST OBTAIN FROM CONSTRUCTION COORDINATION AN EXCAVATION/BARRICADING PERMIT BEFORE ENGAGING IN ANY CONSTRUCTION, MAINTENANCE OR REPAIR WORK IN ANY OF THE CITY OF ALBUQUERQUE'S RIGHTS-OF-WAY. EMERGENCY WORK THAT WOULD PRESERVE LIFE OR PROPERTY IS EXCLUDED WITH THE UNDERSTANDING, THAT A PERMIT SHALL BE OBTAINED WITHIN 24 TO 48 HOURS.

2. CONTRACTOR SHALL AT THE TIME OF PERMIT REQUEST, SUBMIT FOR APPROVAL BY CONSTRUCTION COORDINATION, A TRAFFIC CONTROL PLAN DETAILING ALL EXISTING TOPOGRAPHY SUCH AS LANE WIDTHS, DRIVEWAYS, AND BUSINESS/RESIDENTIAL ACCESSES. THE TRAFFIC CONTROL PLAN SHALL INCLUDE ALL PHASES OF WORK AND SCHEDULES INVOLVED IN THE CONSTRUCTION PROJECT. ANY SEPARATE PHASES OF A CONSTRUCTION PROJECT SHALL BE GIVEN AN INDIVIDUAL PERMIT EACH. BLANKET PERMITS WILL NOT BE ISSUED.

3. THESE TYPICAL TRAFFIC CONTROL PLANS DO NOT REFLECT THE EXISTING TOPOGRAPHY SUCH AS DRIVEWAYS, LANE WIDTHS, AND BUSINESS/RESIDENTIAL ACCESSES. EVERY LOCATION THAT REQUIRES CONSTRUCTION TRAFFIC CONTROL SHALL HAVE A DETAILED TRAFFIC CONTROL PLAN SHOWING ALL EXISTING TOPOGRAPHY.

4. CONSTRUCTION SHALL NOT BEGIN UNLESS A TRAFFIC CONTROL PLAN HAS BEEN APPROVED AND VERIFIED BY CONSTRUCTION COORDINATION.

5. CONSTRUCTION COORDINATION SHALL BE NOTIFIED 48 HOURS PRIOR TO ANY TRAFFIC CONTROL CHANGES NEEDED BY CONTRACTOR, THAT WERE NOT PREVIOUSLY APPROVED. THESE TRAFFIC CONTROL CHANGES SHALL BE REQUESTED IN WRITING ACCOMPANIED WITH A TRAFFIC CONTROL PLAN REFLECTING SUCH CHANGES.

6. ALL CONSTRUCTION TRAFFIC CONTROL DEVICES SHALL COMPLY TO THE MANUAL ON UNIFORM TRAFFIC CONTROL DEVICES (MUTCD), LATEST EDITION. IT IS THE RESPONSIBILITY OF THE CONTRACTOR TO INSTALL, SERVICE AND MAINTAIN ALL TRAFFIC CONTROL DEVICES. TRAFFIC CONTROL DEVICES SHALL NOT BE REMOVED OR ALTERED IN ANY WAY WITHOUT THE APPROVAL OF CONSTRUCTION COORDINATION, PER SECTION 6A-4 OF THE MUTCD, LATEST EDITION.

7. THE CONSTRUCTION TRAFFIC CONTROL INITIAL SET-UP SHALL BE BY AN AMERICAN TRAFFIC SAFETY SERVICES ASSOCIATION (ATSSA) CERTIFIED WORKSITE TRAFFIC SUPERVISOR. THE MAINTENANCE AND SERVICING SHALL ALSO BE DONE BY AN ATSSA CERTIFIED WORKSITE TRAFFIC SUPERVISOR OR EQUIVALENT.

8. CONTRACTOR IS RESPONSIBLE TO MAINTAIN AND SERVICE ALL TRAFFIC CONTROL DEVICES 24 HOURS A DAY, 7 DAYS A WEEK THROUGHOUT LENGTH OF PROJECT. CONTRACTOR IS RESPONSIBLE THAT ALL TRAFFIC CONTROL DEVICES COMPLY WITH THE MUTCD, LATEST EDITION.

9. ALL ADVANCE WARNING SIGNS SHALL BE DOUBLE INDICATED WHENEVER THERE ARE MULTI-LANE TRAFFIC IN ANY ONE GIVEN DIRECTION AND THERE IS SUFFICIENT MEDIAN SPACE.

10. ALL BARRICADES IN ALL TAPERS AND TANGENTS SHALL BE PLACED APART, A DISTANCE MEASURED IN FEET, EQUAL TO THAT OF THE POSTED SPEED LIMIT. NO EXCEPTIONS UNLESS APPROVED BY CONSTRUCTION COORDINATION PER MUTCD SECTION 6A-4.

11. ALL WORK IN ARTERIAL ROADWAYS SHALL BE ON A CONTINUOUS 24 HOUR PER DAY BASIS UNTIL COMPLETED.

12. CONTRACTOR IS RESPONSIBLE TO PROVIDE CONSTRUCTION COORDINATION, A WEEKLY LOG OF DAILY INSPECTIONS OF BARRICADE AND MAINTENANCE SCHEDULES ON PROJECTS THAT ARE OVER ONE WEEK DURATION.

13. EQUIPMENT OR MATERIALS SHALL NOT BE STORED WITHIN 15 FEET OF A TRAVELED TRAFFIC LANE DURING NON-WORKING HOURS WITHOUT THE APPROVAL OF CONSTRUCTION COORDINATION.

14. CONTRACTOR SHALL PROVIDE AND MAINTAIN A SAFE AND ADEQUATE MEANS OF CHANNELIZING PEDESTRIAN TRAFFIC AROUND AND THROUGH THE CONSTRUCTION AREA.

15. CONTRACTOR IS RESPONSIBLE FOR OBLITERATION OF ANY CONFLICTING STRIPING AND RESPONSIBLE FOR ALL TEMPORARY STRIPING.

16. CONTRACTOR SHALL MAINTAIN ACCESS TO ALL FACILITIES, BUSINESSES AND/OR RESIDENTS AT ALL TIMES.

17. CONTRACTOR SHALL PROVIDE ACCESS SIGNS FOR BUSINESSES LOCATED WITHIN THE CONSTRUCTION AREA UNDER THE SUPERVISION OF CONSTRUCTION COORDINATION. EACH ACCESS SIGN SHALL HAVE 5 INCH, WHITE OPAQUE LETTERING ON BLUE REFLECTORIZED BACKGROUND. ACCESS SIGNS SHALL BE CONSIDERED INCIDENTAL OF THE BID AND NOT PART OF THE CONTRACT UNLESS OTHERWISE STATED. NO MORE THAN 3 BUSINESSES SHALL BE LISTED ON A ACCESS SIGN. SHOPPING CENTERS AND MALLS SHALL BE LISTED AS SUCH.

18. ALL ADVANCE WARNING SIGNS SHALL MEET THE MINIMUM REFLECTIVE INTENSITY REQUIREMENTS SET FORTH BY THE CITY OF ALBUQUERQUE. CONSTRUCTION COORDINATION SHALL DETERMINE ALL REQUIREMENTS AND APPROVE OR DISAPPROVE ANY ADVANCE WARNING SIGN PER SECTION 6A-4 OF THE MUTCD, LATEST EDITION.

19. 48 HOURS PRIOR TO OCCUPYING OR CLOSING OF A RIGHT-OF-WAY, CONTRACTOR SHALL NOTIFY: POLICE, FIRE DEPARTMENT, SCHOOLS, HOSPITALS, TRANSIT AUTHORITY, BUSINESSES AND/OR RESIDENTS THAT WILL BE AFFECTED BY THE CONSTRUCTION.

20. ANY FIELD ADJUSTMENTS SHALL BE APPROVED BY CONSTRUCTION COORDINATION.

21. EXCAVATIONS SHALL BE PLATED, TEMPORARILY PATCHED OR RESURFACED PRIOR TO OPENING OF TRAFFIC. A MINIMUM OF 11 FEET SHALL BE PROVIDED FOR TRAFFIC IN ANY GIVEN DIRECTION. CONTRACTOR IS RESPONSIBLE FOR ANY WORK INVOLVED IN SATISFYING THESE REQUIREMENTS.

22. CONTRACTOR SHALL AT ALL TIMES COMPLY WITH THE FOLLOWING:
1. STANDARDS AND REQUIREMENTS SET FORTH IN THE MANUAL ON UNIFORM TRAFFIC CONTROL DEVICES, LATEST EDITION.
2. THE CITY OF ALBUQUERQUE TRAFFIC CODE, LATEST EDITION.
3. SECTION 19 OF THE CITY OF ALBUQUERQUE'S STANDARD SPECIFICATIONS FOR PUBLIC WORK CONSTRUCTION, AS WELL AS OTHER SECTIONS.



23. FAILURE TO COMPLY WITH ANY OF THE ABOVE MENTIONED, WILL BE ADEQUATE CAUSE TO CEASE ALL WORK ON ANY CONSTRUCTION PROJECT. WORK WILL NOT RESUME UNTIL ALL REQUIREMENTS ARE ADDRESSED AND APPROVED BY CONSTRUCTION COORDINATION.

24. ALL TRAFFIC CONTROL DEVICES SHALL BE KEPT IN NEW-CLEAN CONDITION, WASHING OF EQUIPMENT IS INCIDENTAL TO IT'S PLACEMENT AND MAINTENANCE.


25. TRAFFIC CONTROL STANDARDS APPLY ONLY WHERE THE CONSTRUCTION TRAFFIC CONTROL PLANS ARE NOT SPECIFIC.

26. ADVANCE WARNING SIGNS SHALL BE 36"x36" MIN. WITH SUPER ENGINEERING GRADE SHEETING OR BETTER. MOUNTING HEIGHT AT TOP OF SIGN SHALL BE THE SAME AS FOR A 48" SIGN AS INDICATED IN THE M.U.T.C.D.

27. CONTRACTOR SHALL MAINTAIN A GRAFFITI-FREE WORKSITE. ALL GRAFFITI SHALL BE PROMPTLY REMOVED FROM ALL EQUIPMENT, BOTH PERMANENT AND TEMPORARY.

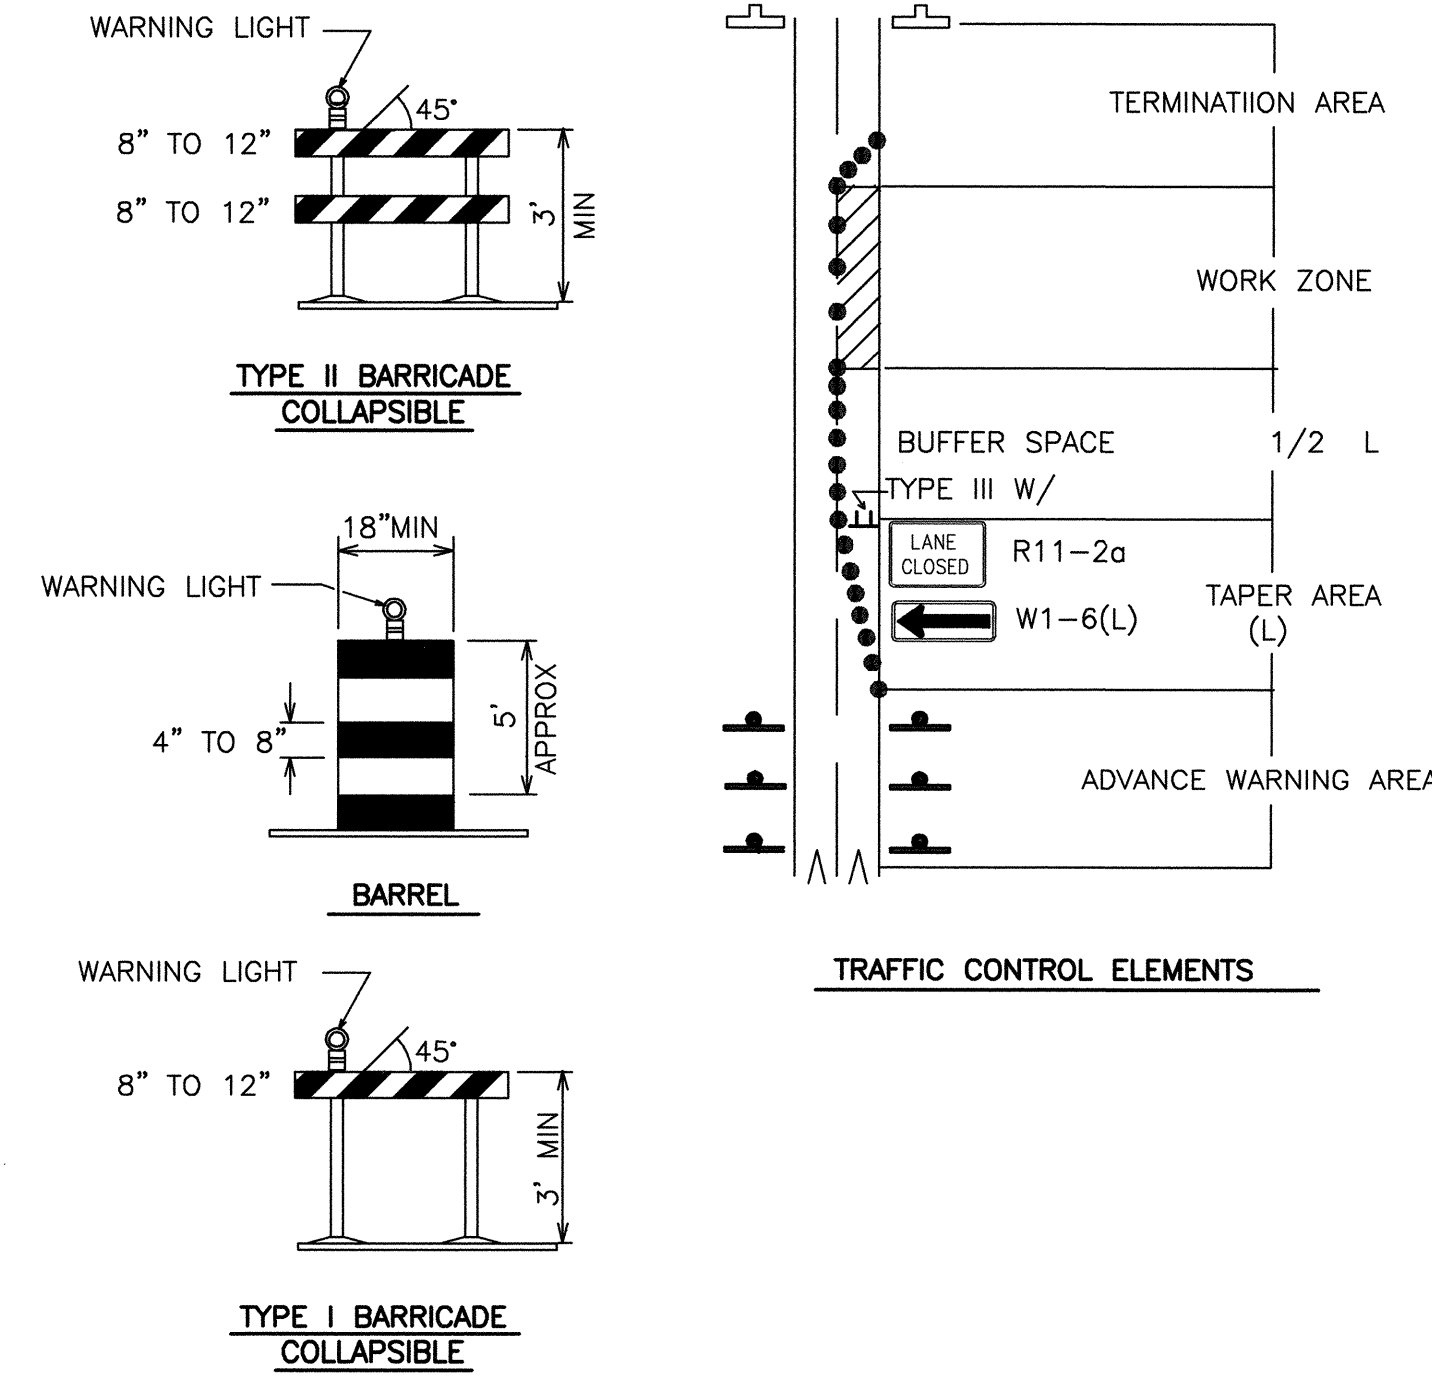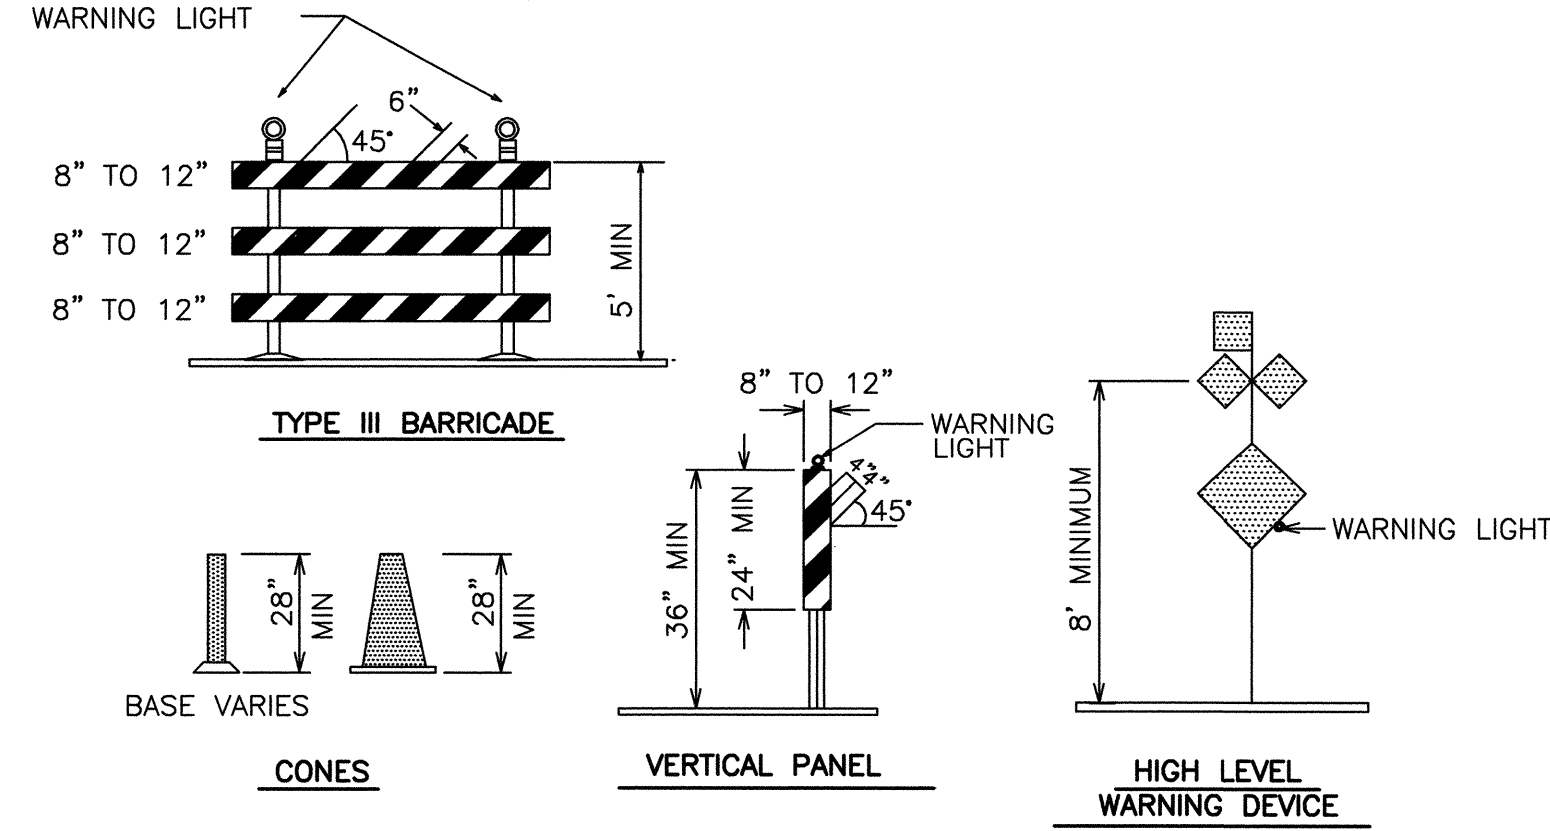

SIGN FACE DETAILS

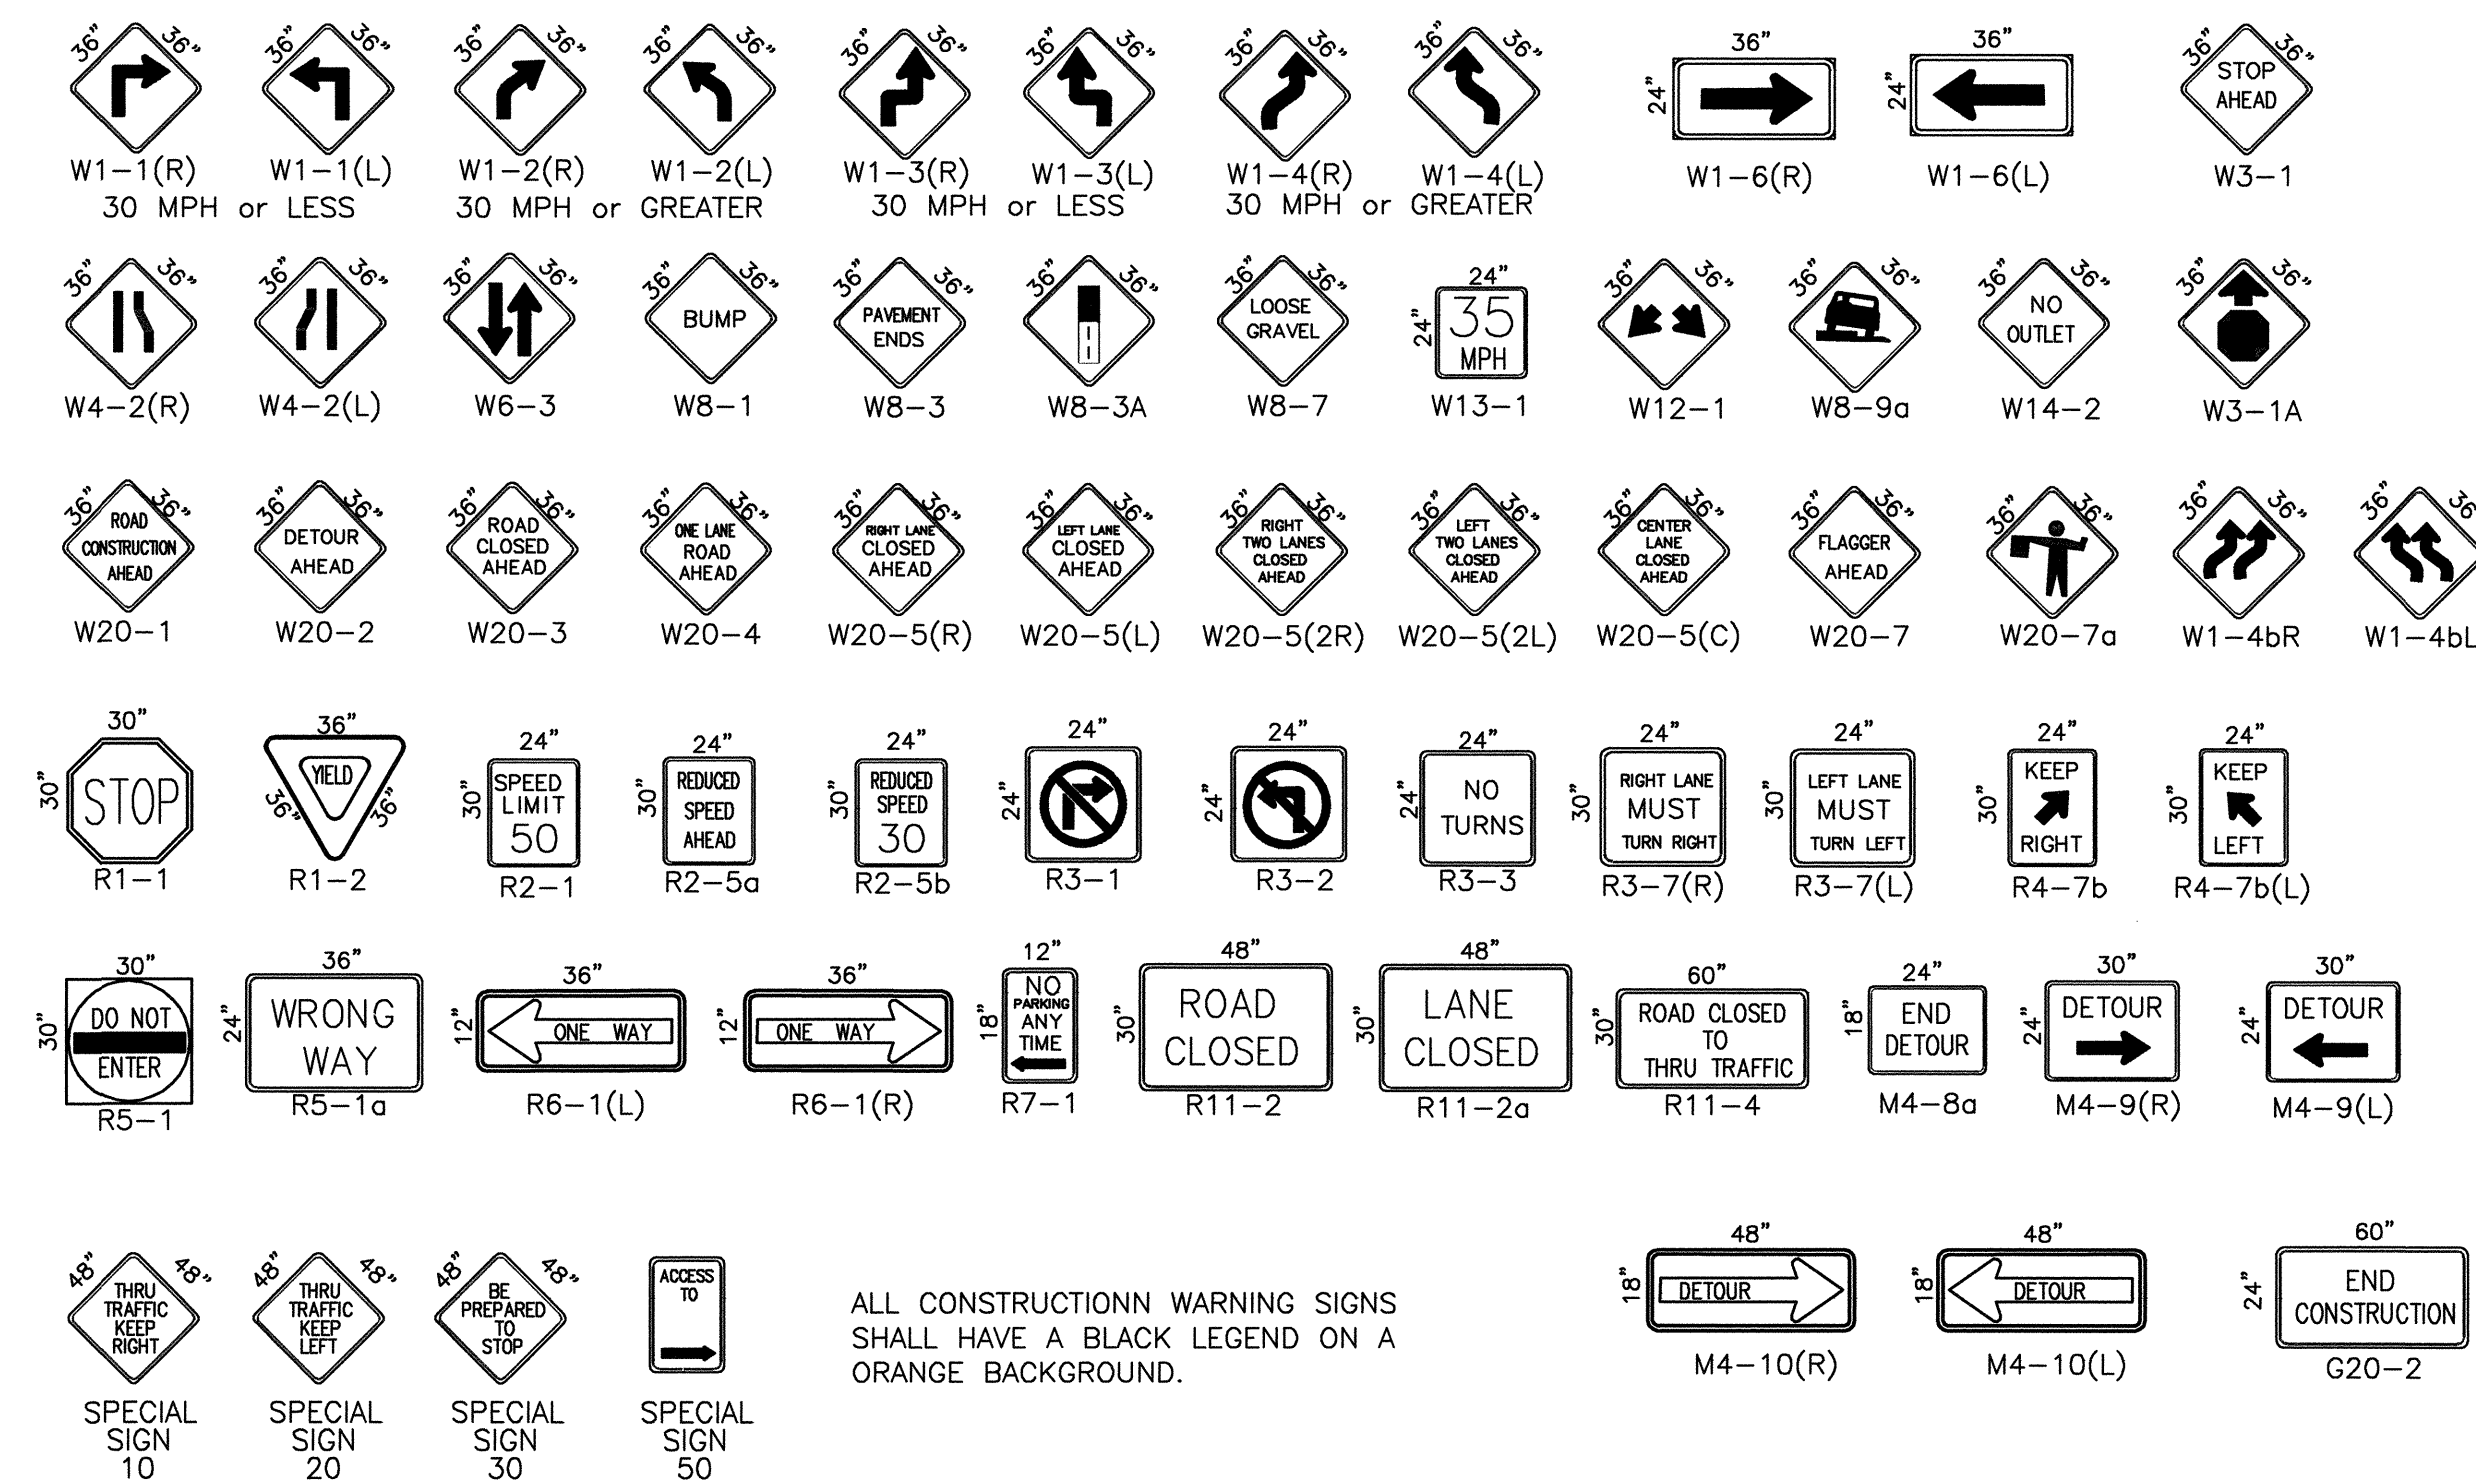

ALL CONSTRUCTION WARNING SIGNS SHALL HAVE A BLACK LEGEND ON A ORANGE BACKGROUND.

LEGEND

- WORK AREA
 - BARRICADE - TYPE I, TYPE II, OR BARREL
 - BARRICADE - TYPE III
 - VERTICAL PANEL
 - WARNING SIGN
 - DISTANCE BETWEEN SIGNS - A DISTANCE MEASURED IN FEET EQUAL TO A VALUE OF TEN TIMES THE SPEED LIMIT OF THE STREET
 - FLAGMAN POSITION
 - SPACING BETWEEN BARRICADES - A DISTANCE MEASURED IN FEET EQUAL TO THE STREET LIMIT OF THE STREET
 - TAPER LENGTH - SEE CHART BELOW
- THE TANGENT LENGTH IS EQUAL TO THE TAPER LENGTH FOR A GIVEN STREET.

TAPER REQUIREMENT

SPEED LIMIT (MPH)	TAPER LENGTH(L) (FEET)			MINIMUM NUMBER OF DEVICES FOR TAPER	MAXIMUM DEVICE SPACING IN FEET	
	10' LANE	11' LANE	12' LANE		ALONG TAPER	AFTER TAPER
20	70	75	80	5	20	20
25	105	115	125	6	25	25
30	150	165	180	7	30	30
35	205	225	245	8	35	35
40	270	295	320	9	40	40
45	450	495	540	13	45	45
50	500	550	600	13	50	50
55	550	605	660	13	55	55

RECOMMENDED SIGN SPACING(D) FOR ADVANCE WARNING SIGN SERIES

SPEED MILES PER HOUR	MINIMUM DISTANCE BETWEEN SIGNS	FROM LAST SIGN TO TAPER
0-20	10 X SPEED LIMIT	10 X SPEED LIMIT
25-30	10 X SPEED LIMIT	10 X SPEED LIMIT
30-35	10 X SPEED LIMIT	10 X SPEED LIMIT
40-45	10 X SPEED LIMIT	10 X SPEED LIMIT
50-60	10 X SPEED LIMIT	10 X SPEED LIMIT

TAPER CRITERIA

TYPE OF TAPER	TAPER LENGTH
UPSTREAM TAPER:	
MERGING TAPER	L MINIMUM
SHIFTING TAPER	1/2 L MINIMUM
SHOULDER TAPER	1/2 L MINIMUM
TWO-WAY TRAFFIC TAPER	100 FEET MAXIMUM
DOWNSTREAM TAPERS	100 FEET PER LANE

TAPER LENGTH COMPUTATION

SPEED LIMIT	
40 MPH OR LESS	$L = \frac{WS^2}{60}$
40 MPH OR GREATER	$L = W \times S$






L = TAPER LENGTH
W = WIDTH OF OFFSET IN FEET
S = POSTED SPEED OR OFF-PEAK 85-PERCENTILE SPEED IN MPH

26 6517.84 2304

CITY OF ALBUQUERQUE
PUBLIC WORKS DEPARTMENT
ENGINEERING DEVELOPMENT GROUP


TITLE: TRAFFIC CONTROL
SIGNING AND CONSTRUCTION TRAFFIC CONTROL STANDARDS

DESIGN REVIEW COMMITTEE	CITY ENGINEER APPROVAL	MO./DAY/YR.	MO./DAY/YR.
COA	STD		
CITY PROJECT NO.	ZONE MAP NO.	SHEET	OF
6517.84	D-17	23	24

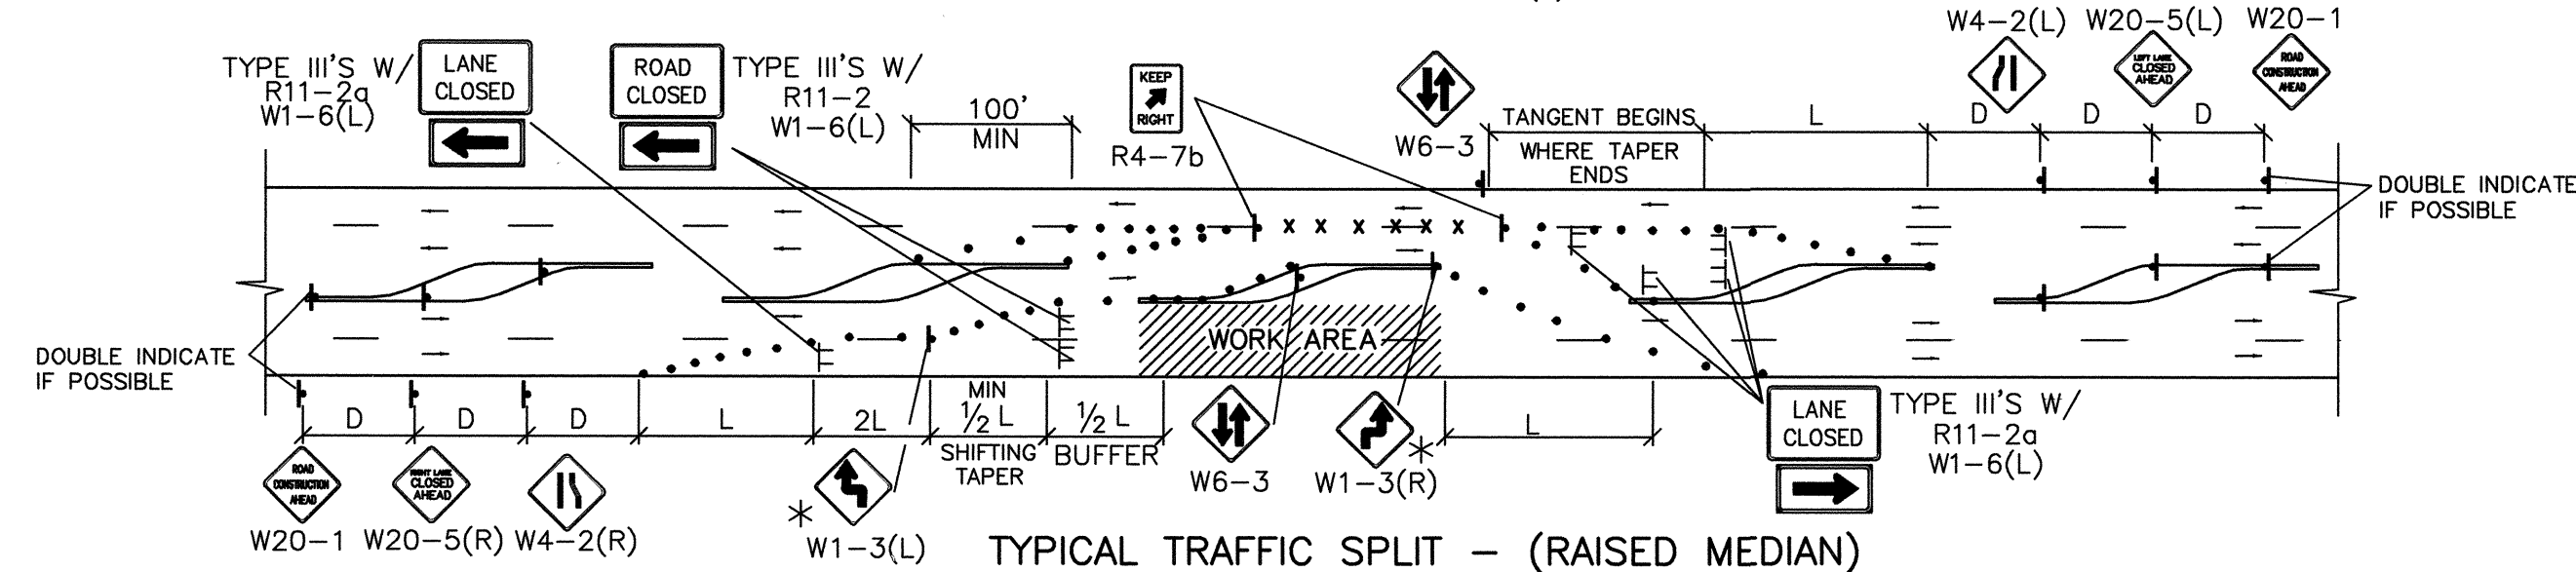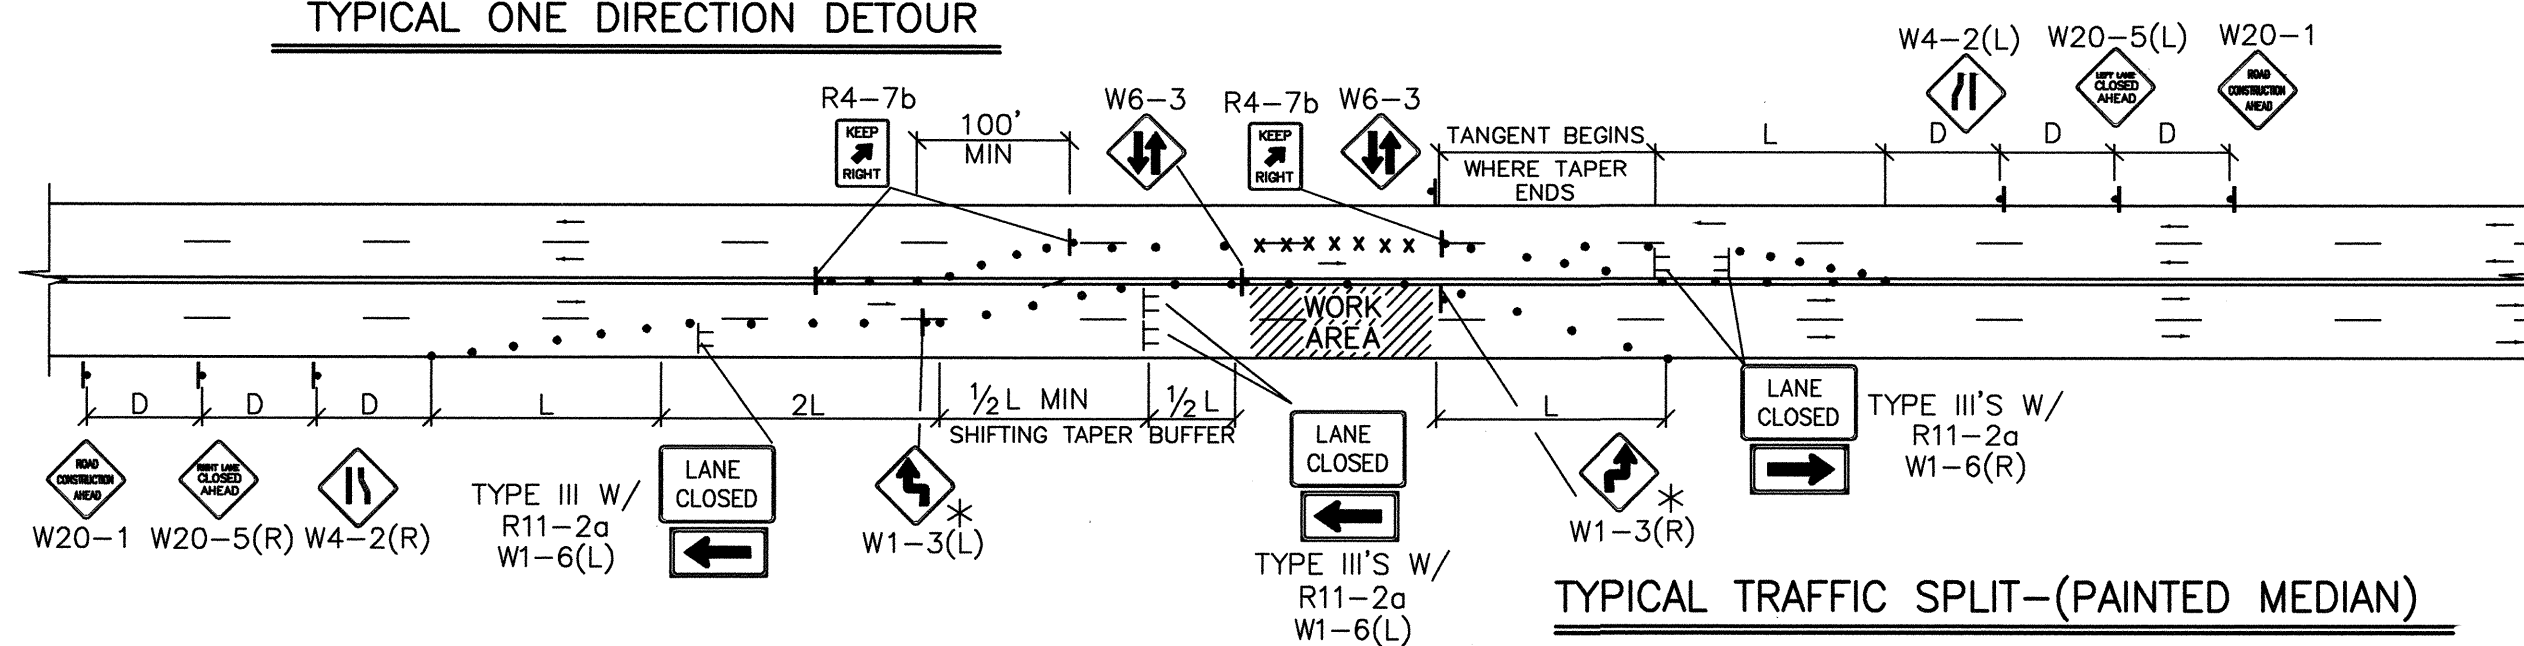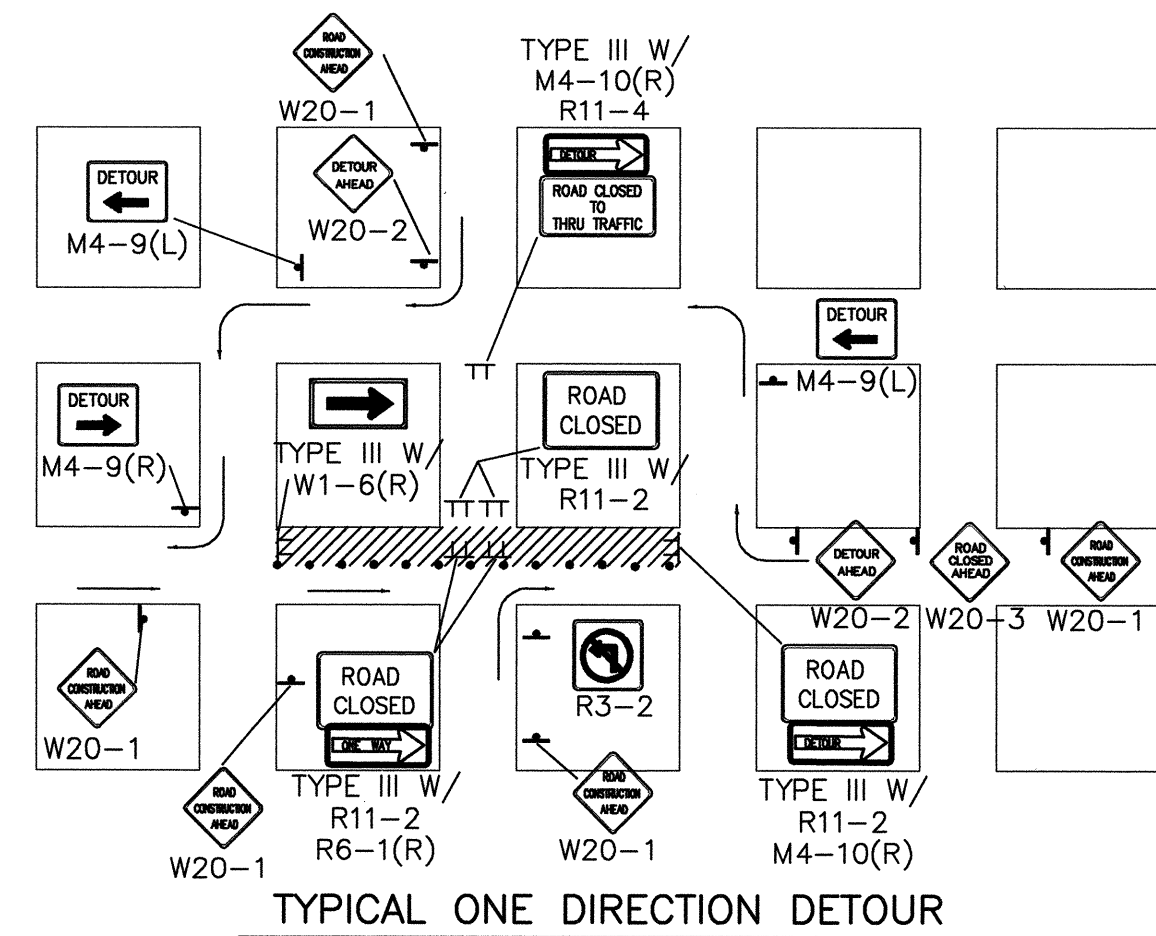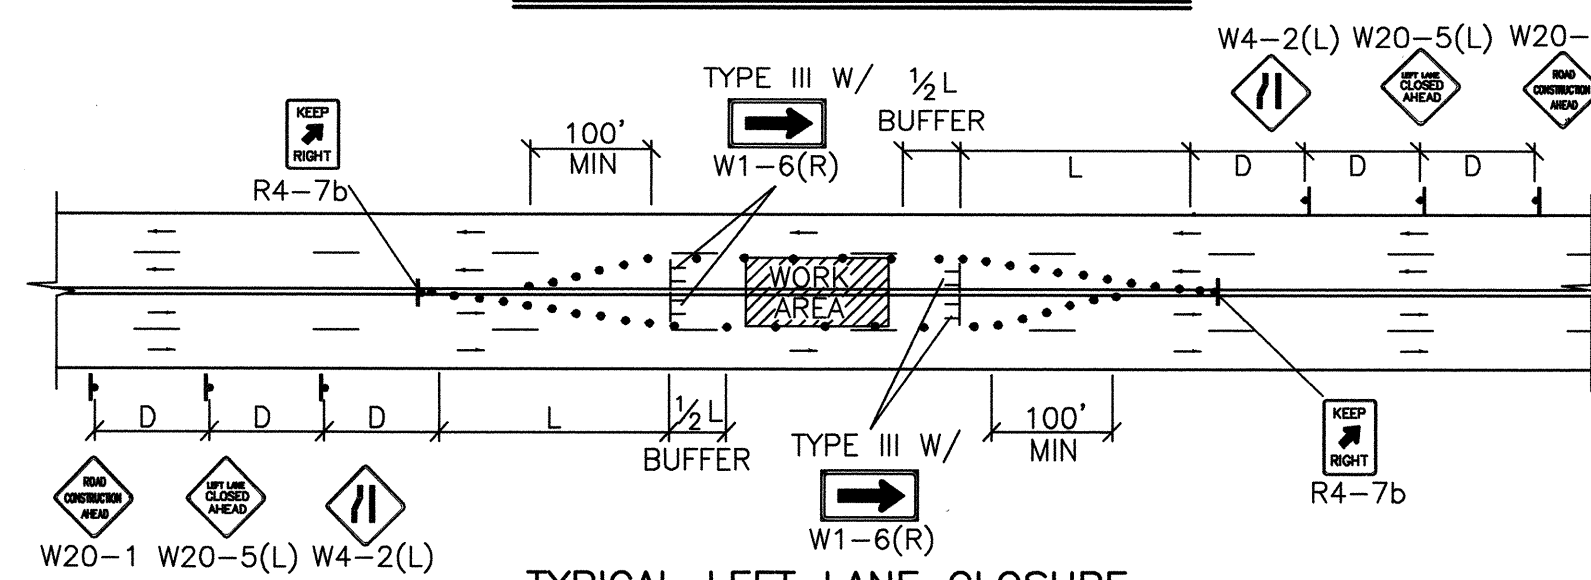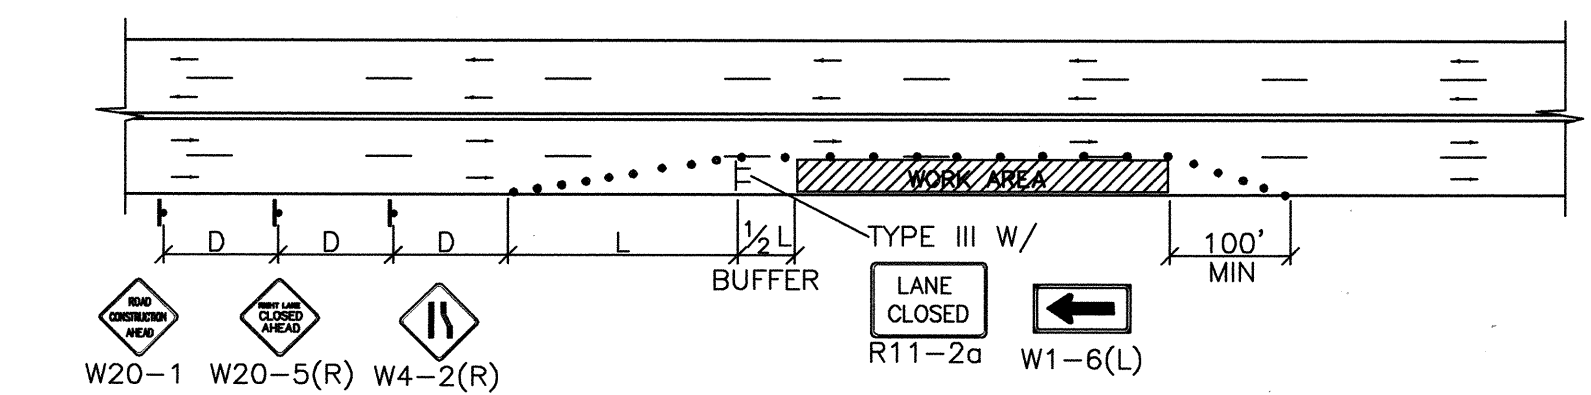

- TRAFFIC SPLIT NOTES:



- TRAFFIC SPLIT NOTES:**
1. THE OFFSET DISTANCE MUST BE CALCULATED IN ALL SHIFTING TAPERS. THE OFFSET DISTANCES SHALL INCLUDE LANE WIDTHS PLUS MEDIAN WIDTHS.
 2. $1/2 L$ IS THE MINIMUM DISTANCE FOR SHIFTING TAPERS.
 3. REVERSE CURVES MAY BE REQUIRED. ALL CURVE DATA SHALL BE CALCULATED.
 4. MEDIAN REMOVAL SHALL BE REQUIRED AT $1/2 L$ OR REVERSE CURVE IS NOT SUFFICIENT. MEDIAN REMOVAL SHALL TAKE PLACE BEFORE SPLITS.
 5. REDUCED SPEED MAY BE CONSIDERED.
 6. * USE $W1-3$ FOR 30 MPH OR LESS, $W1-4$ FOR SPEED 35 MPH OR GREATER.

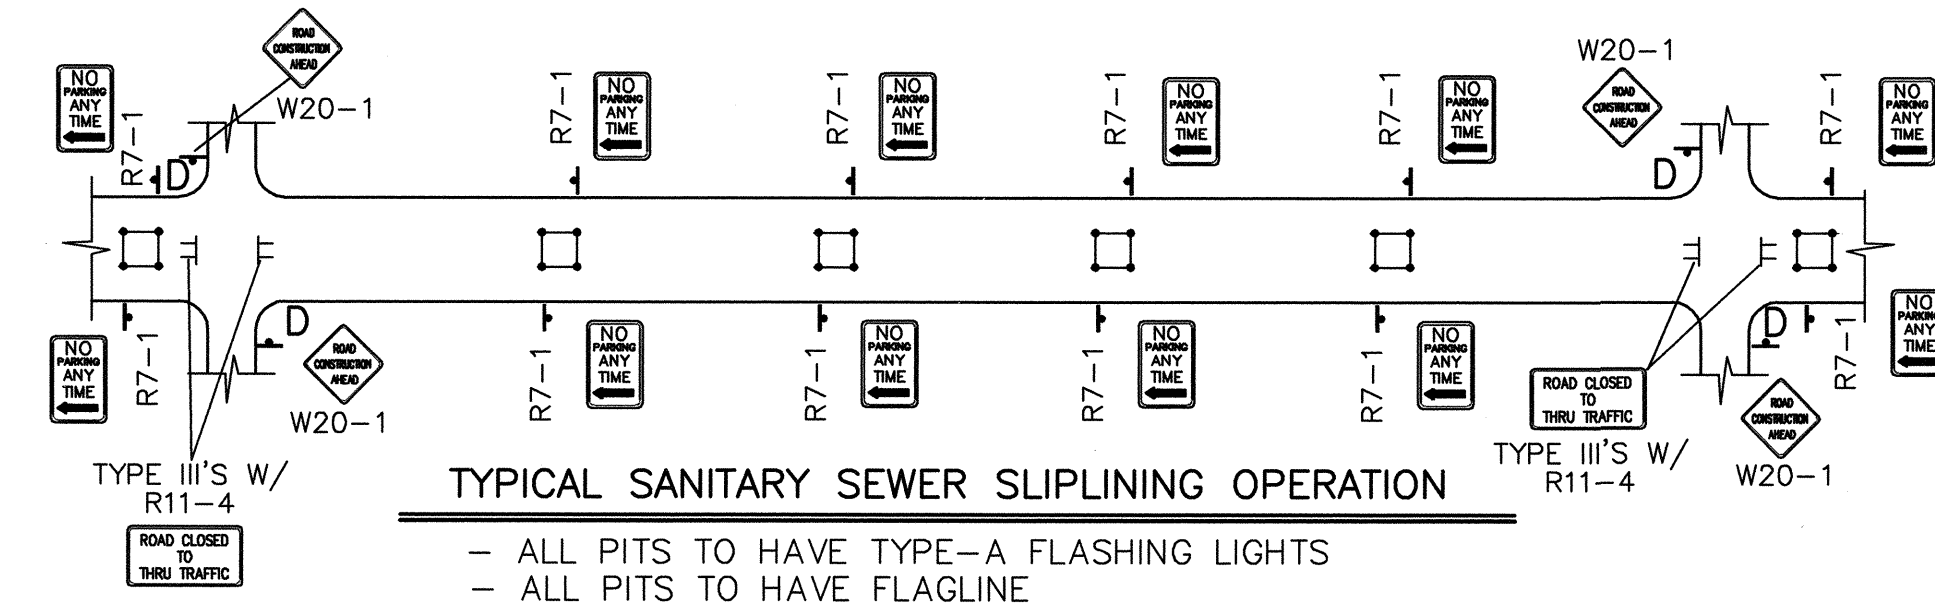

GENERAL NOTE:


ALL CONSTRUCTION WARNING
SIGNS SHALL HAVE A BLACK
LEGEND ON A ORANGE
BACKGROUND.

① ALL ADVANCE WARNING SIGNS SHALL BE A MINIMUM OF 36" THIRTY SIX INCHES BY 36" THIRTY SIX INCHES IN SIZE AND SHALL HAVE ONE WARNING LIGHT.

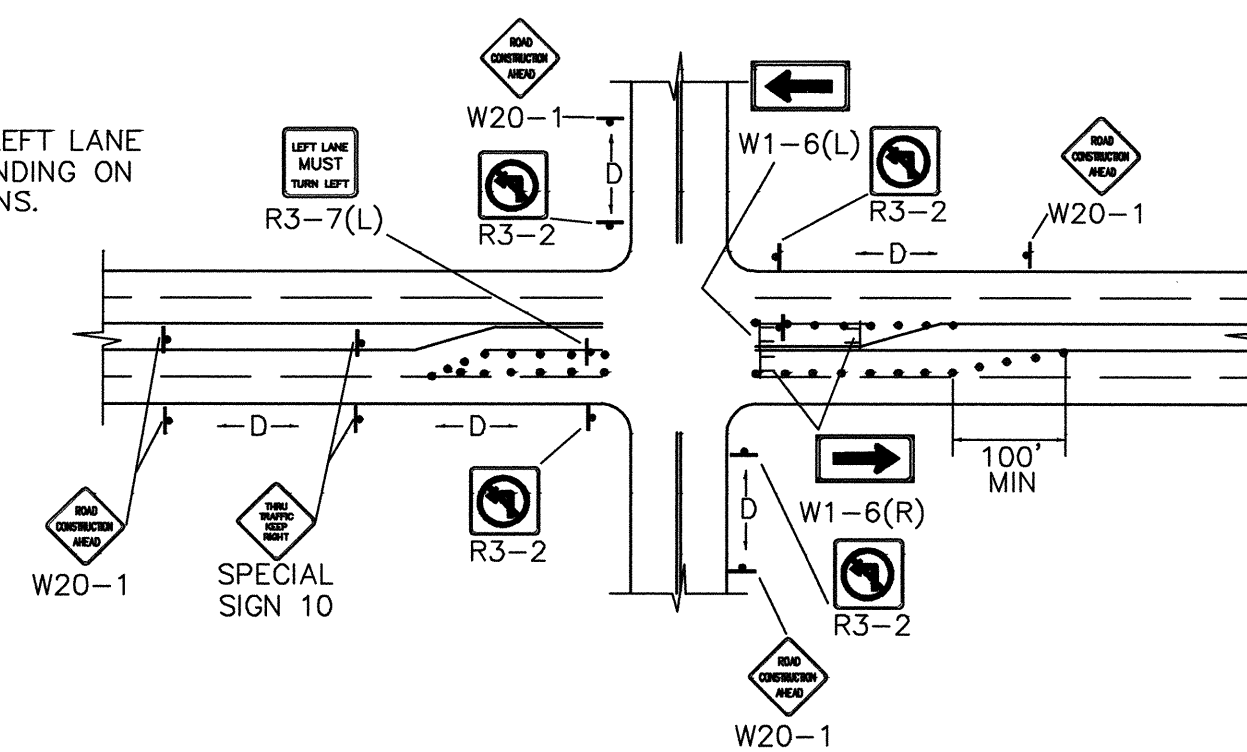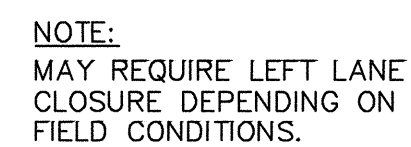


TYPICAL LANE CLOSURE AT INTERSECTION

NOTE: DEPENDING ON WORK ZONE LOCATION.

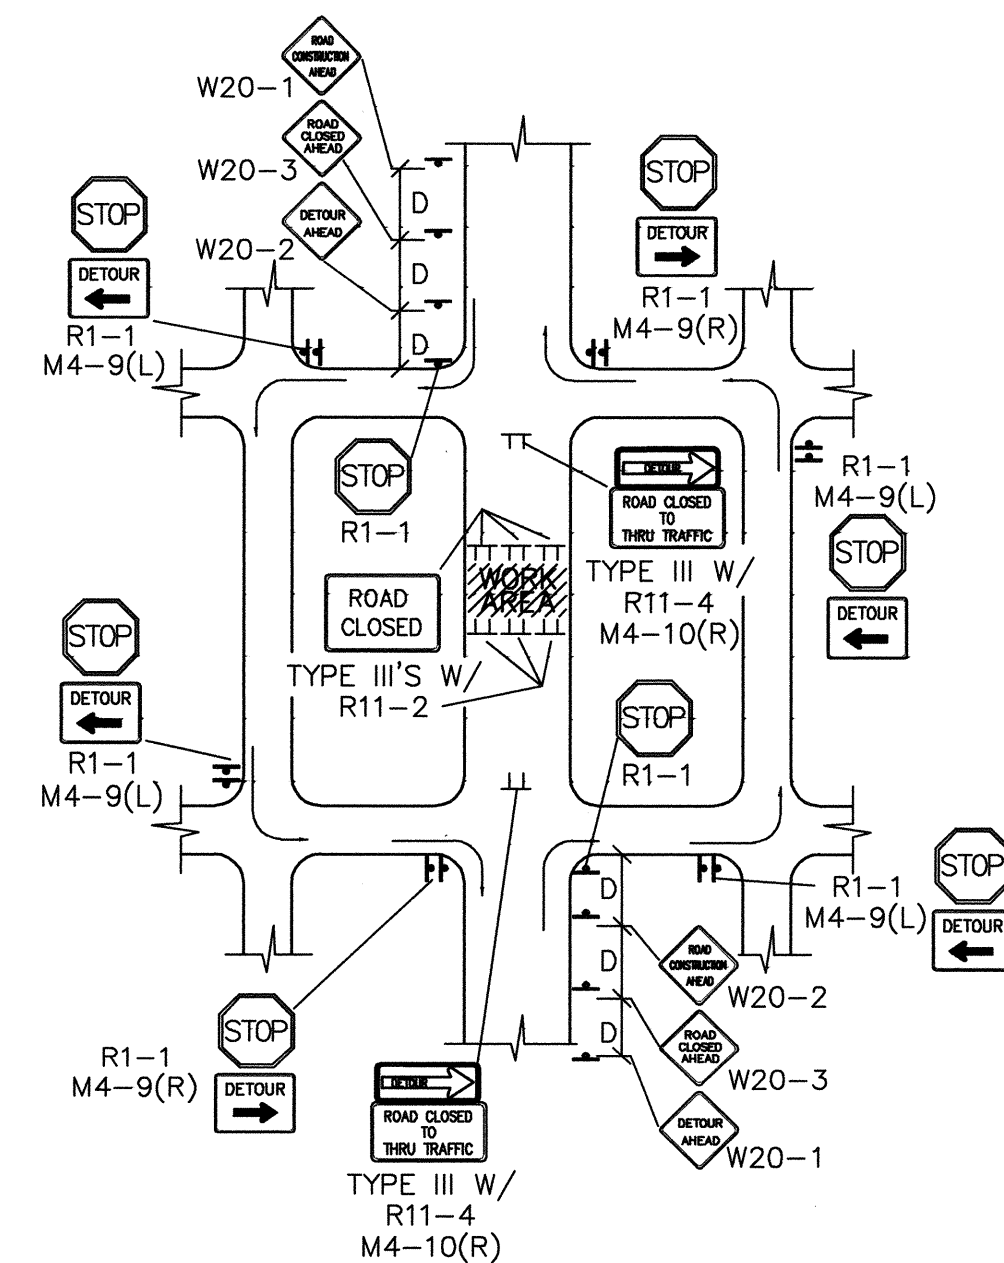





TYPICAL MID-BLOCK CLOSURE

NOTE: (R1-1) BASED ON FIELD CONDITIONS.

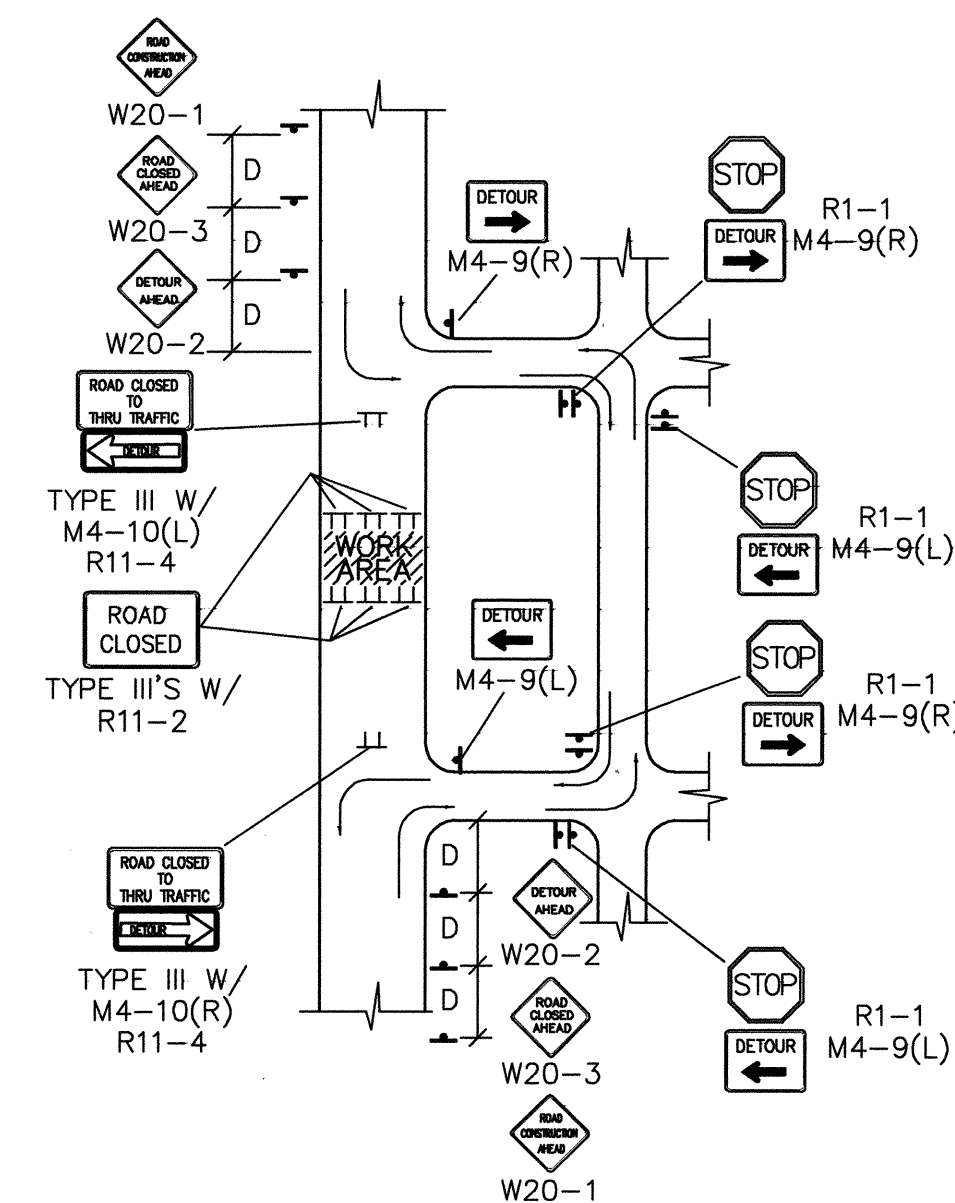

TYPICAL STREET CLOSURE

NOTE: (R1-1) BASED ON FIELD CONDITIONS.

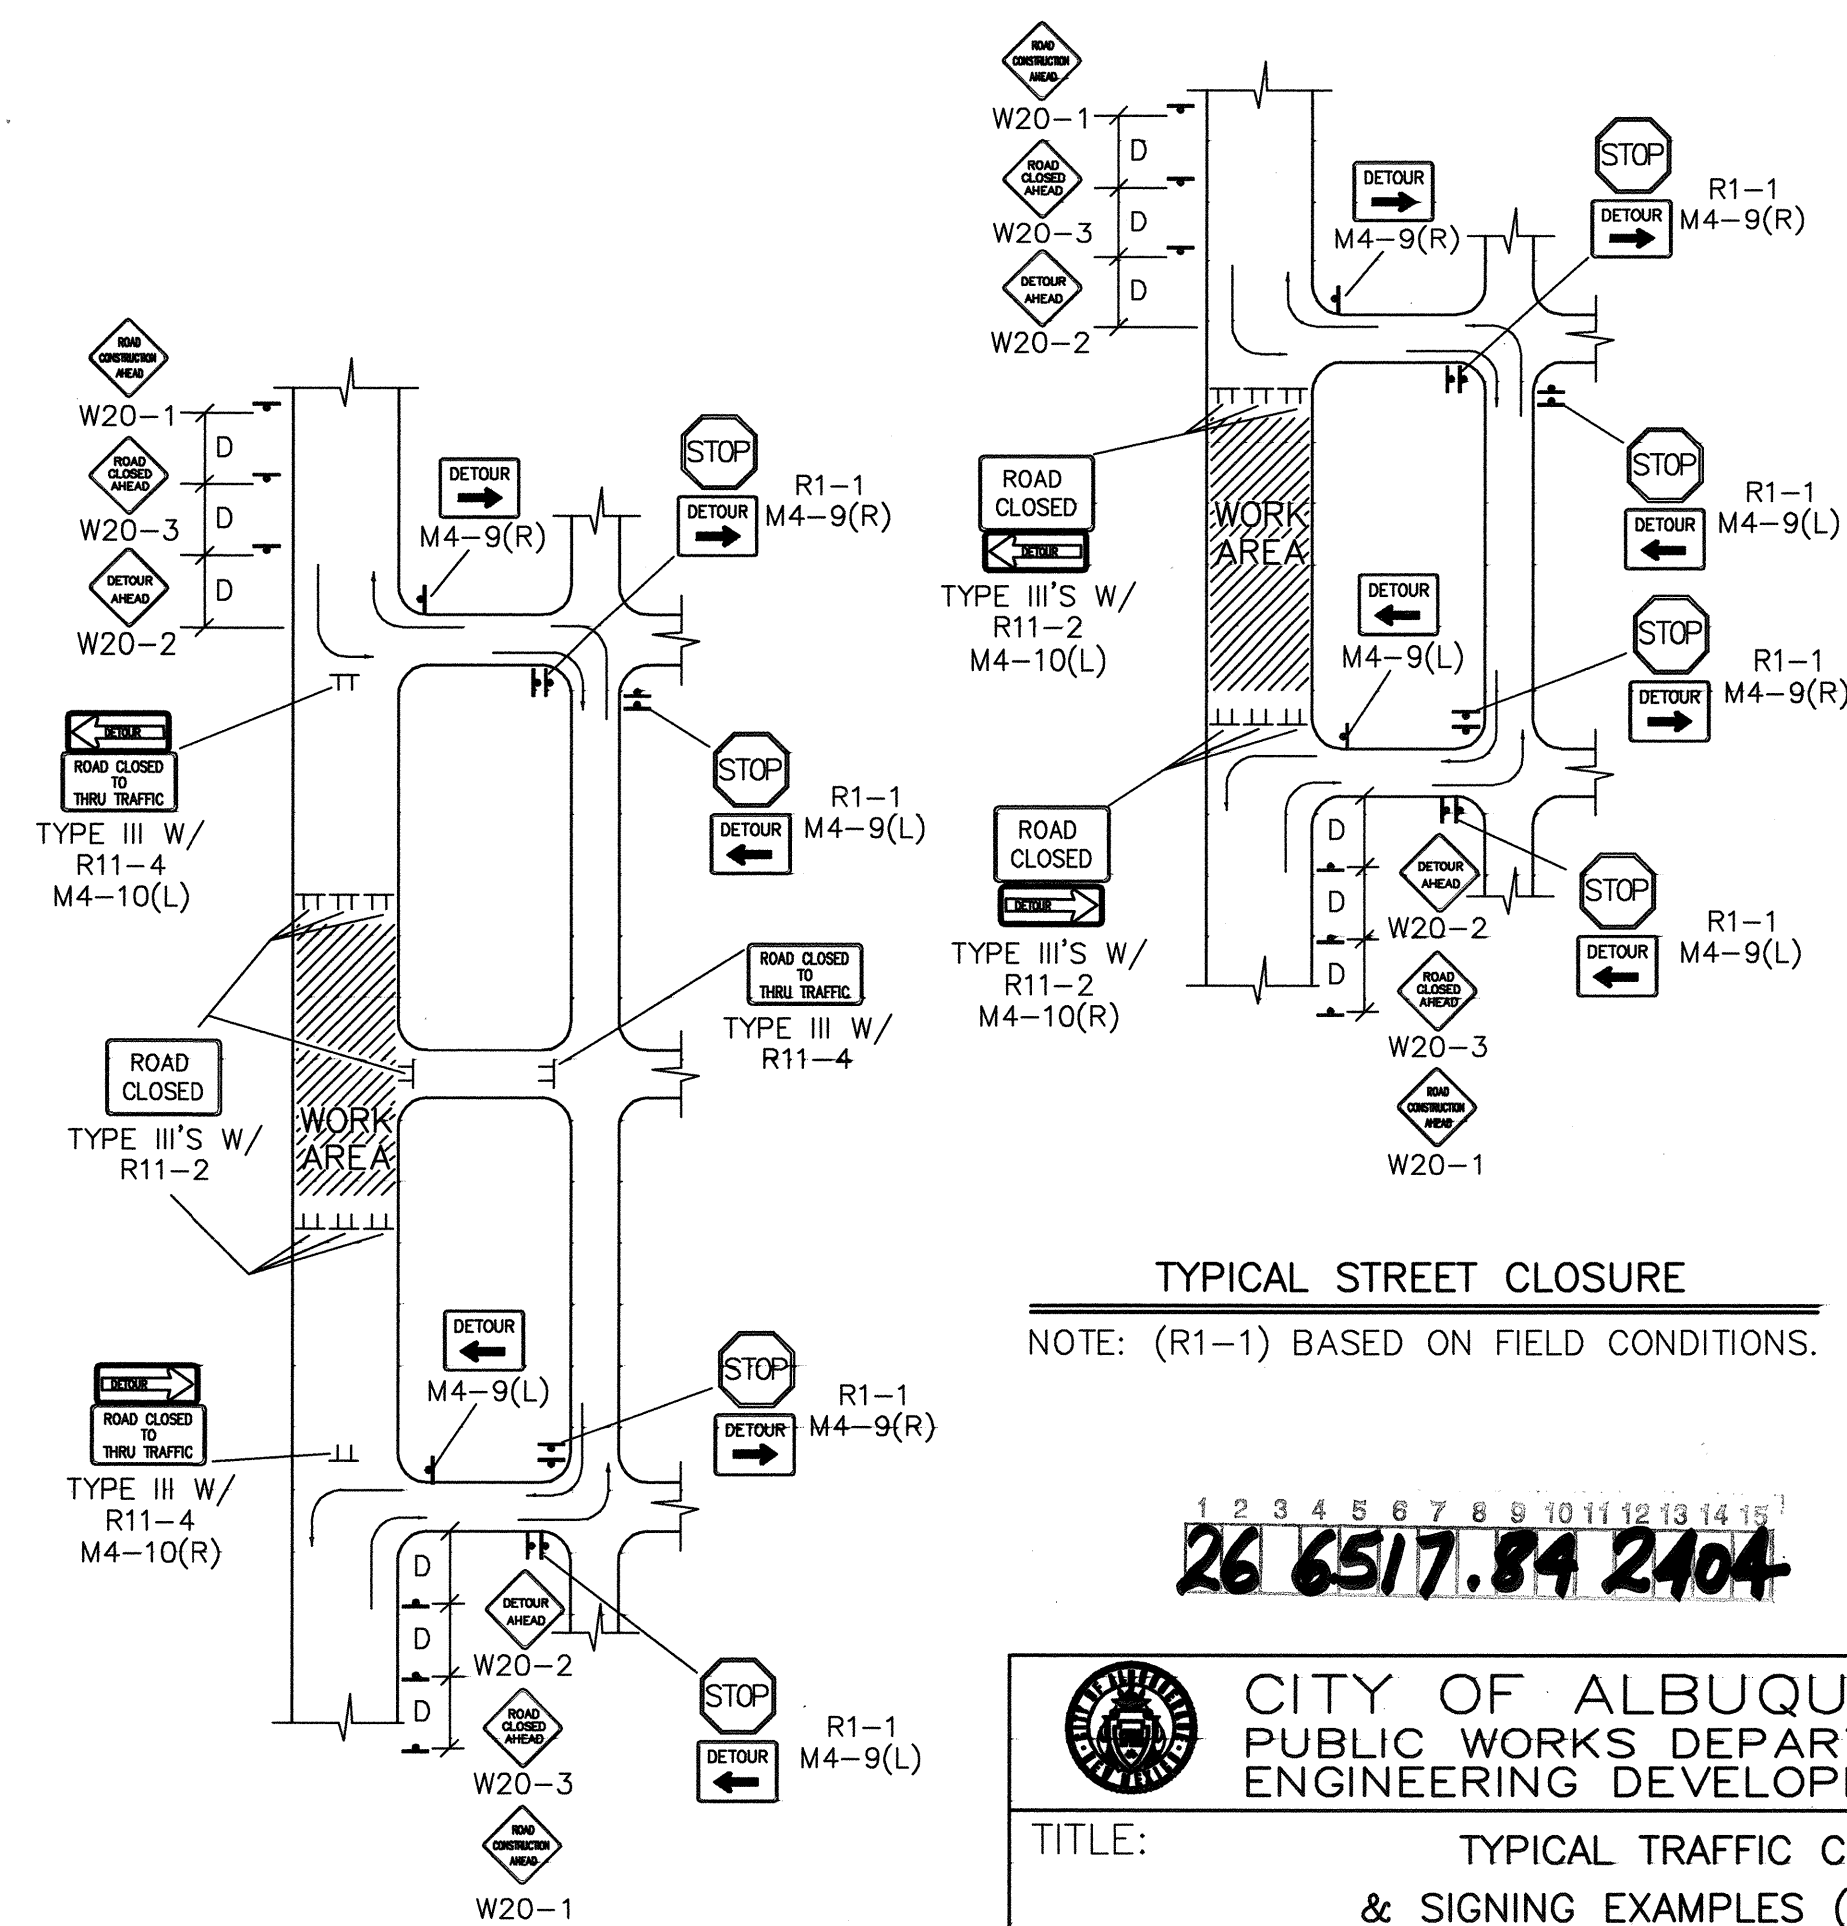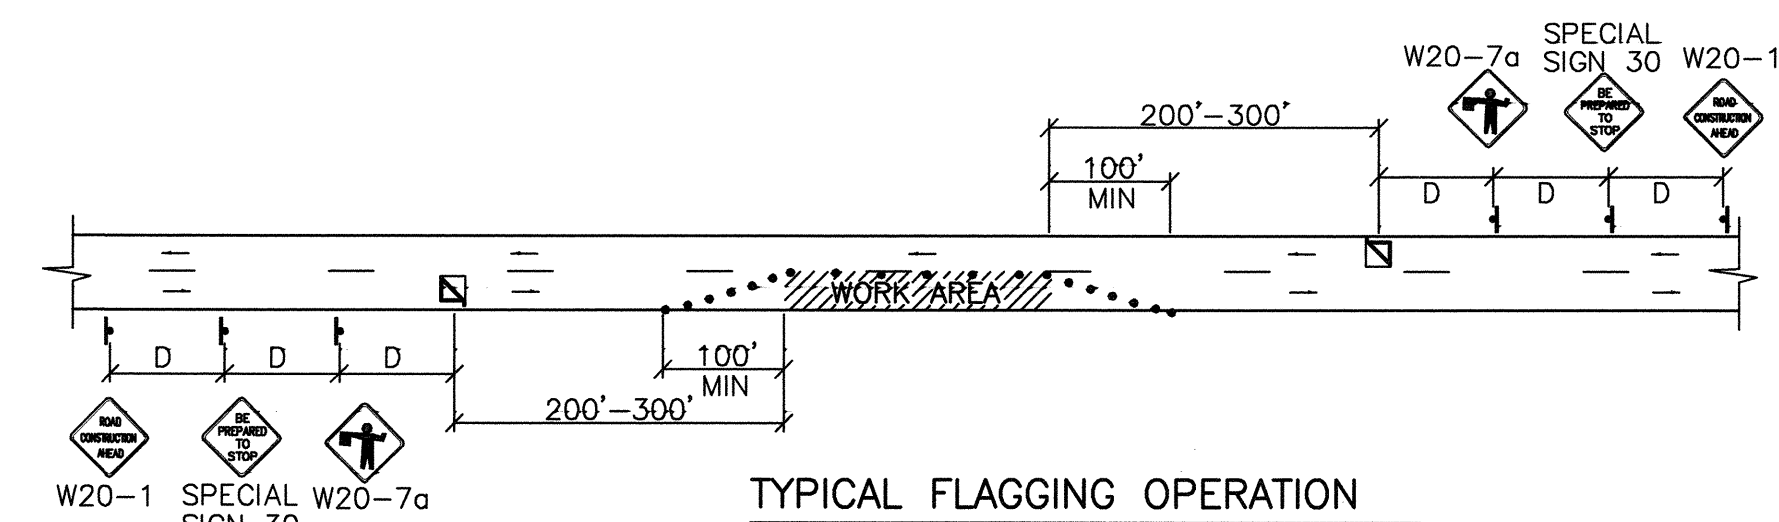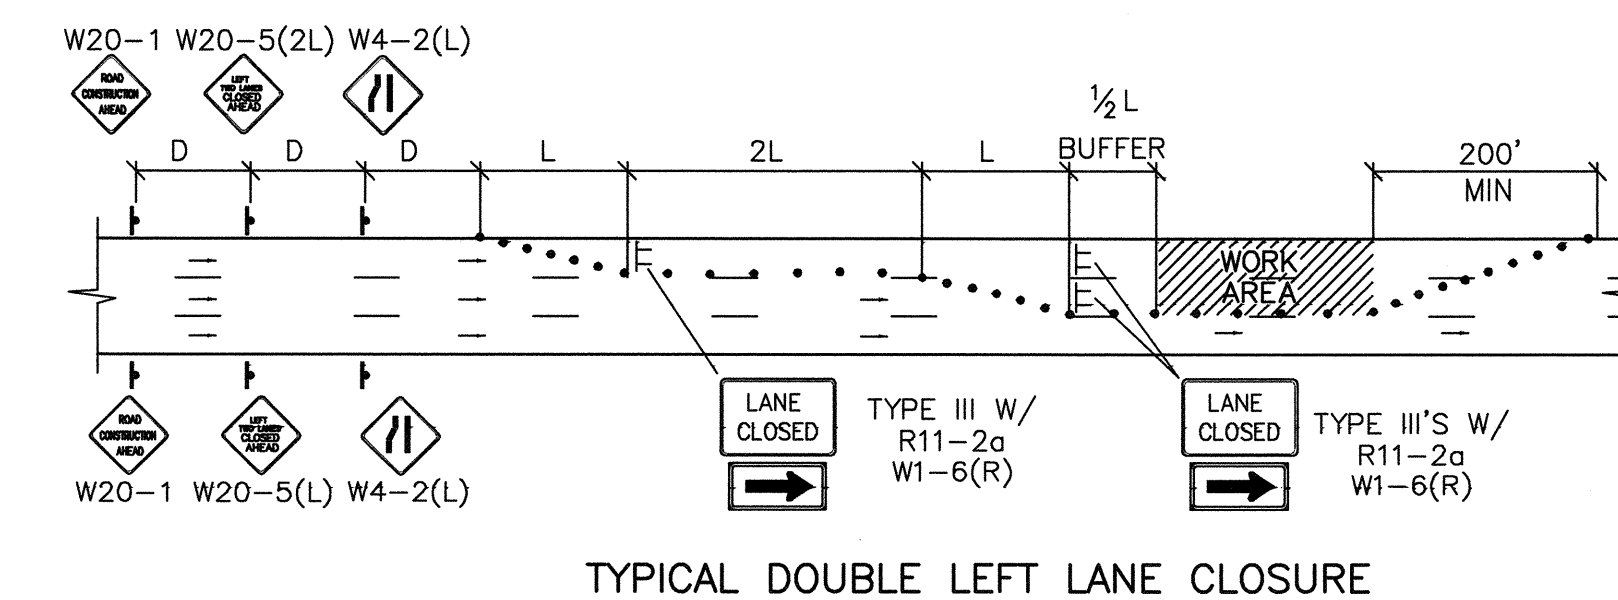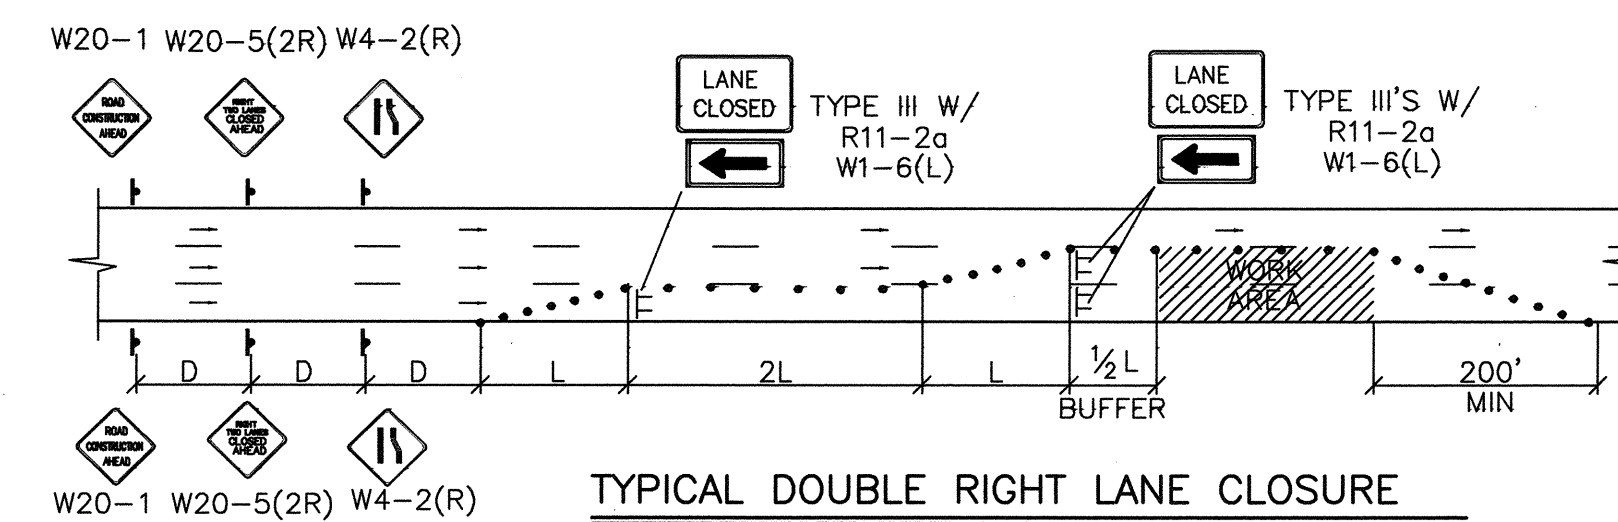

TYPICAL STREET CLOSURE

NOTE: (R1-1) BASED ON FIELD CONDITIONS.

1	2	3	4	5	6	7	8	9	10	11	12	13	14	15
26	65	17	.	84	24	04								

	CITY OF ALBUQUERQUE PUBLIC WORKS DEPARTMENT ENGINEERING DEVELOPMENT GROUP			
TITLE: TYPICAL TRAFFIC CONTROL & SIGNING EXAMPLES (REF MUTCD)				
DESIGN REVIEW COMMITTEE	CITY ENGINEER APPROVAL	LAST DESIGN UPDATE	MO./DAY/YR.	MO./DAY/YR.
<i>COA</i>	<i>STD</i>			
CITY PROJECT NO.		ZONE MAP NO.	SHEET	OF
6517.84		D-17	24	24