

PLANS FOR CONSTRUCTION OF

EMCORE ATR PAVING IMPROVEMENTS

ALBUQUERQUE, NEW MEXICO

JULY 13, 2001


INDEX TO DRAWINGS

SHEET	TITLE
1.	TITLE SHEET
2.	BOUNDARY SURVEY
3.	GRADING & DRAINAGE PLAN
4.	STREET LAYOUT PLAN
STREET PLAN & PROFILES	
5.	EUBANK BLVD PLAN AND PROFILE
6.	EASMENT RD PLAN AND PROFILE
7.	EUBANK CONCEPTIONAL FUTURE PROFILE
DETAILS	
8.	STREET PAVING DETAILS
9.	TRAFFIC CONTROL PLAN
10.	TRAFFIC CONTROL PLAN

CERTIFICATE OF SUBSTANTIAL COMPLIANCE ON PLANS


I, Steven K. Morrow, of the firm of Brasher and Lorenz, Inc., a Registered Professional Engineer in the State of New Mexico, do hereby certify, to the best of my knowledge and belief, that the infrastructure installed as part of this project has been inspected by me or by a qualified person under my direct supervision and has been constructed in accordance with the plans and specifications approved by the City Engineer and that the original design intent of the approved plans has been met, except as noted by me on the as-built construction drawings. This Certification is based on site inspections by me or personnel under my direction and survey information provided by KEVIN DALY, NMPS# 11008.

APPROVED AS RECORD DRAWINGS
DESIGN REVIEW SECTION
CITY CONSTRUCTION ENGINEER
DATE: 7/16/01

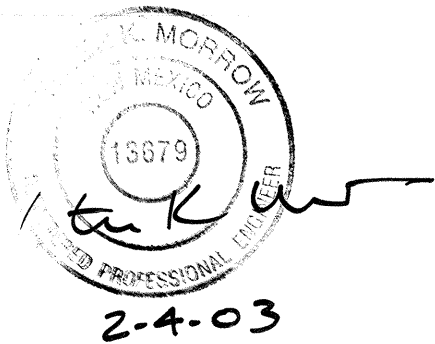

PROJ NO. 1000554
DRB NO. 00450-00000-01483

BRASHER & LORENZ
CONSULTING ENGINEERS
2201 San Pedro NE, Building 1, Suite 220
Albuquerque, New Mexico 87110
Ph: 505-888-6088 Fax: 505-888-6188

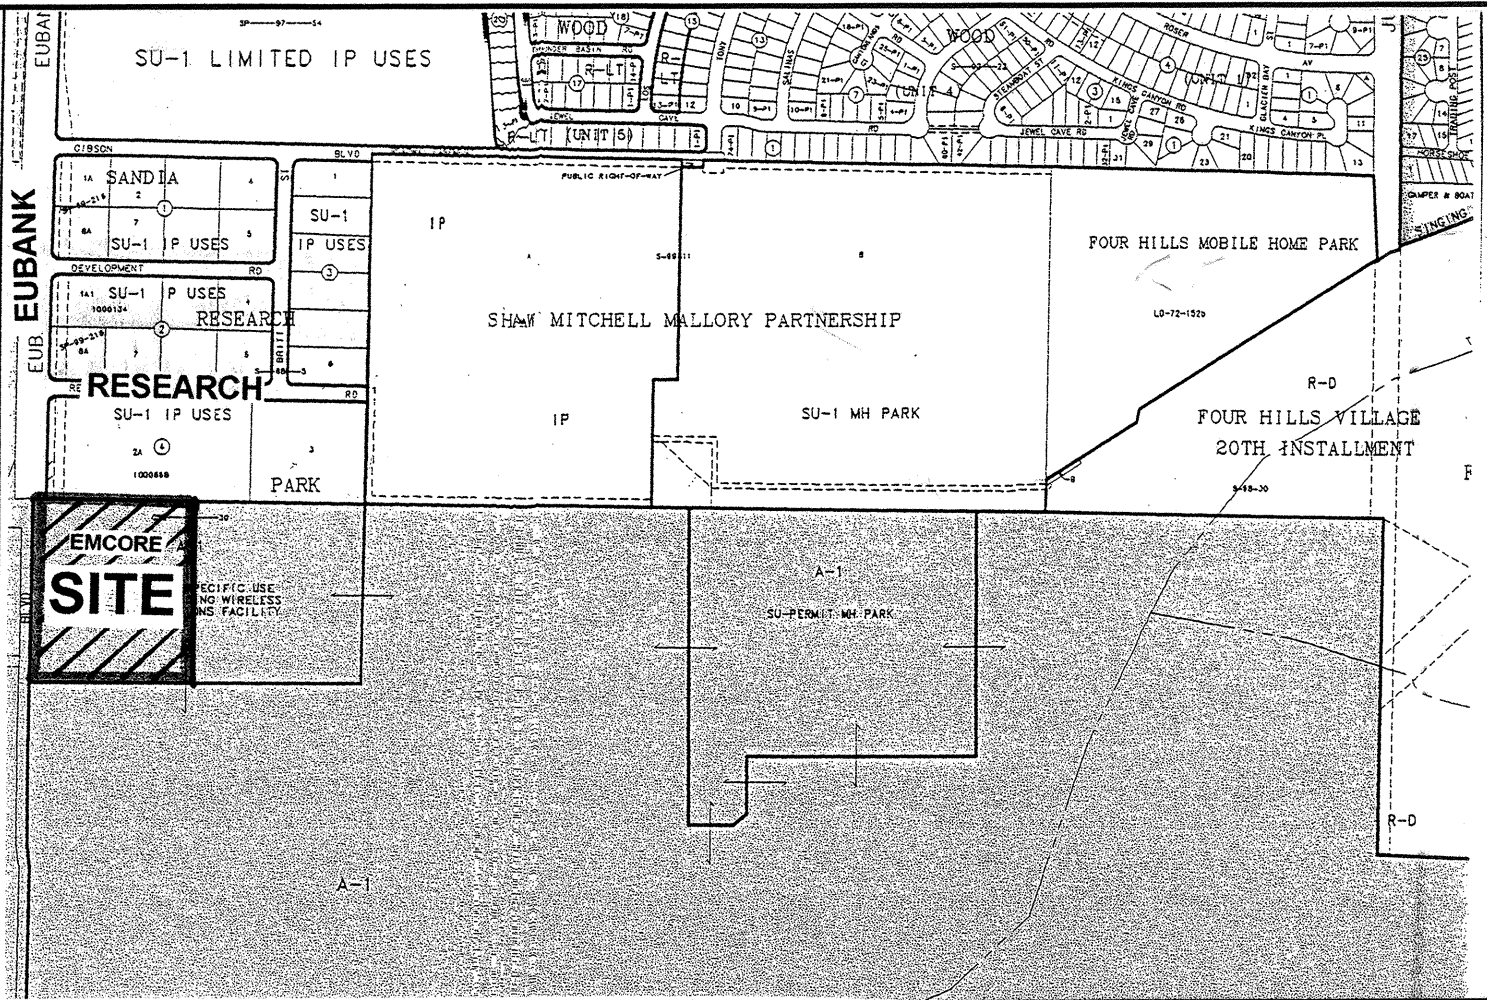

VICINITY MAP: M-21



SCALE: NTS

GENERAL NOTES:

- CITY OF ALBUQUERQUE SPECIFICATIONS FOR PUBLIC WORKS CONSTRUCTION, 1986 EDITION AS AMENDED THROUGH UPDATE 6, WILL BE REFERRED TO HEREIN AS THE "STANDARD SPECIFICATIONS." ALL WORK DETAILED ON THESE PLANS TO BE PERFORMED UNDER CONTRACT SHALL, EXCEPT AS OTHERWISE STATED OR PROVIDED FOR HEREON BE CONSTRUCTED IN ACCORDANCE WITH THE STANDARD SPECIFICATIONS
- THREE WORKING DAYS PRIOR TO ANY EXCAVATION, CONTRACTOR MUST CONTACT NEW MEXICO ONE CALL SYSTEM (280-1990) AND DETERMINE LOCATION OF EXISTING UTILITIES.
- PRIOR TO ANY CONSTRUCTION, THE CONTRACTOR SHALL EXCAVATE AND VERIFY THE HORIZONTAL AND VERTICAL LOCATIONS OF ALL OBSTRUCTIONS. SHOULD A CONFLICT EXIST, THE CONTRACTOR SHALL NOTIFY THE ENGINEER OR THE SURVEYOR SO THAT THE CONFLICT CAN BE RESOLVED WITHOUT DELAY.
- ALL EXISTING SIGNS, MARKERS, DELINEATORS, ETC., WITHIN THE CONSTRUCTION LIMITS SHALL BE REMOVED, STORED AND RE-SET BY THE CONTRACTOR.
- THE CONTRACTOR SHALL NOTIFY THE ENGINEER NOT LESS THAN SEVEN (7) WORKING DAYS PRIOR TO STARTING WORK IN ORDER THAT THE ENGINEER MAY TAKE NECESSARY MEASURES TO INSURE THE PRESERVATION OF SURVEY MONUMENTS. THE CONTRACTOR SHALL NOT DISTURB PERMANENT SURVEY MONUMENTS WITHOUT THE CONSENT OF THE ENGINEER AND BEAR THE EXPENSE OF REPLACING ANY THAT MAY BE DISTURBED WITHOUT PERMISSION. REPLACEMENT SHALL BE DONE ONLY BY THE CITY SURVEYOR. WHEN A CHANGE IS MADE IN THE FINISHED ELEVATIONS OF THE PAVEMENT OF ANY ROADWAY IN WHICH A PERMANENT SURVEY MARKER IS LOCATED, CONTRACTOR SHALL, AT HIS OWN EXPENSE, ADJUST THE MONUMENT COVER TO THE NEW GRADE UNLESS OTHERWISE SPECIFIED. REFER TO SECTION 4.4 OF THE GENERAL CONDITIONS OF THE STANDARD SPECIFICATIONS.
- FIVE (5) WORKING DAYS PRIOR TO BEGINNING CONSTRUCTION THE CONTRACTOR SHALL SUBMIT TO THE CONSTRUCTION COORDINATION DIVISION A DETAILED CONSTRUCTION SCHEDULE. TWO (2) WORKING DAYS PRIOR TO CONSTRUCTION THE CONTRACTOR SHALL OBTAIN A BARRICADING PERMIT FROM THE CONSTRUCTION COORDINATION DIVISION. CONTRACTOR SHALL NOTIFY BARRICADE ENGINEER (768-2551) PRIOR TO OCCUPYING AN INTERSECTION. REFER TO SECTION 19 OF THE STANDARD SPECIFICATIONS.
- ANY WORK OCCURRING WITHIN AN ARTERIAL ROADWAY REQUIRES 24 HOUR CONSTRUCTION.
- ALL UTILITIES AND UTILITY SERVICE LINES SHALL BE INSTALLED PRIOR TO PAVING.
- ALL STREET STRIPING ALTERED OR DESTROYED SHALL BE REPLACED BY THE CONTRACTOR WITH HOT THERMOPLASTIC REFLECTORIZED PAVEMENT MARKING. ALL NEW STRIPING SHALL BE HOT THERMOPLASTIC REFLECTORIZED PAVEMENT MARKING.
- THE CONTRACTOR SHALL ASSUME RESPONSIBILITY FOR ANY DAMAGE TO EXISTING PAVEMENTS, PAVEMENT MARKINGS, CURB AND GUTTER, DRIVEPADS, WHEELCHAIR RAMPS AND SIDEWALKS DURING CONSTRUCTION, APART FROM THOSE SECTIONS INDICATED FOR REMOVAL ON THE PLANS AND SHALL REPAIR OR REPLACE PER THE STANDARD SPECIFICATIONS AT HIS OWN EXPENSE.
- EXISTING UTILITY LINES AND PIPELINES SHOWN ON THESE DRAWINGS ARE SHOWN IN APPROXIMATE LOCATIONS ONLY. UTILITIES MAY EXIST WHERE NONE ARE SHOWN. THE ENGINEER HAS UNDERTAKEN NO FIELD VERIFICATION OF THE LOCATION, DEPTH, SIZE OR TYPE OF EXISTING UTILITY LINES AND PIPELINES. THE CONTRACTOR IS FULLY RESPONSIBLE FOR DAMAGE CAUSED BY FAILURE TO LOCATE AND PRESERVE EXISTING UTILITY LINES AND PIPELINES.
- THE CONTRACTOR SHALL SECURE A "TOPSOIL DISTURBANCE PERMIT" PRIOR TO BEGINNING CONSTRUCTION.
- THE CONTRACTOR SHALL ASSIST THE ENGINEER/INSPECTOR IN THE RECORDING OF DATA ON ALL UTILITY LINES AND ACCESSORIES AS REQUIRED BY THE OWNERS FOR THE PREPARATION OF "RECORD DRAWINGS." THE CONTRACTOR SHALL NOT COVER UTILITY LINES AND ACCESSORIES UNTIL ALL DATA HAS BEEN RECORDED.
- ALL CONSTRUCTION WITHIN CITY RIGHT-OF-WAY OR EASEMENTS MUST BE DONE FROM APPROVED WORK ORDER DOCUMENTS FROM THE CITY AND PREPARED BY BRASHER AND LORENZ, INC.
- THE CONTRACTOR SHALL DETERMINE IN ADVANCE OF HIS CONSTRUCTION IF OVERHEAD UTILITY LINES, SUPPORT STRUCTURES, POLES, GUYS, ETC. ARE AN OBSTRUCTION TO CONSTRUCTION OPERATIONS. IF ANY OBSTRUCTION TO CONSTRUCTION OPERATIONS IS EVIDENT, THE CONTRACTOR SHALL BE RESPONSIBLE FOR COORDINATING WITH THE APPROPRIATE UTILITY OWNER TO REMOVE OR SUPPORT THE UTILITY OBSTRUCTION. ANY COST ASSOCIATED WITH THIS EFFORT SHALL BE THE RESPONSIBILITY OF THE CONTRACTOR.
- THE CONTRACTOR IS TO SUPPORT AND MAINTAIN THE INTEGRITY OF ALL UNDERGROUND TELEPHONE, ELECTRIC CABLES AND CABLE TELEVISION UTILITIES AT NO ADDITIONAL COST THE OWNER. CABLE IS TO BE SUPPORTED EVERY 15 FEET (MINIMUM). CONTRACTOR SHALL COORDINATE WITH AND MAKE NECESSARY PAYMENT (IF ANY) TO UTILITY OWNER FOR DE-ENERGIZATION OF CABLES OR SUPPORT OF CABLES BY THE UTILITY OWNER.

REV.	SHEETS	CITY	ENGINEER	DATE	USER	DEPARTMENT	DATE	USER	DEPARTMENT	DATE
ENGINEERS STAMP & SIGNATURE		APPROVALS		ENGINEER		DATE	*****			
		DRC Chairman			6-6-02	APPROVED FOR CONSTRUCTION City Engineer Date 10/3/02				
		Transportation			5/23/02					
		Water/Wastewater			9/06/01					
		Hydrology			9/06/01					
		CIP								
		Constr. Mngmt.			6-6-02					
		Constr. Coord.			6-6-02					
CITY PROJECT NO.						654882		SHEET		OF
						1				10

BLOCK 4

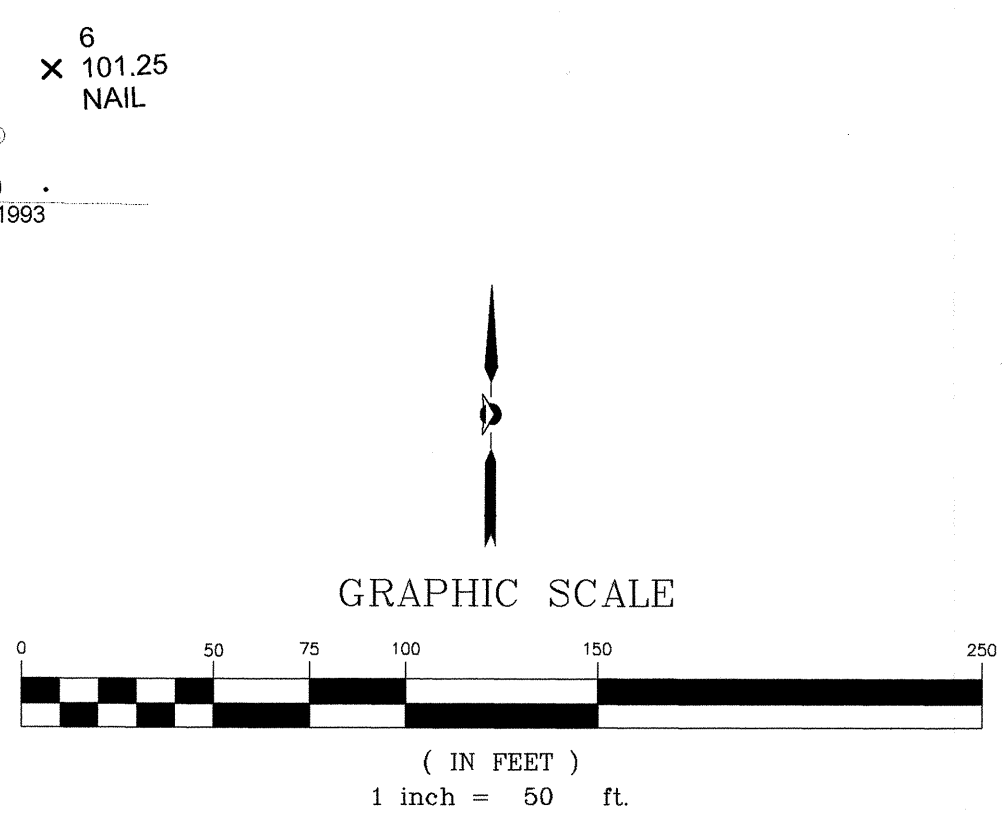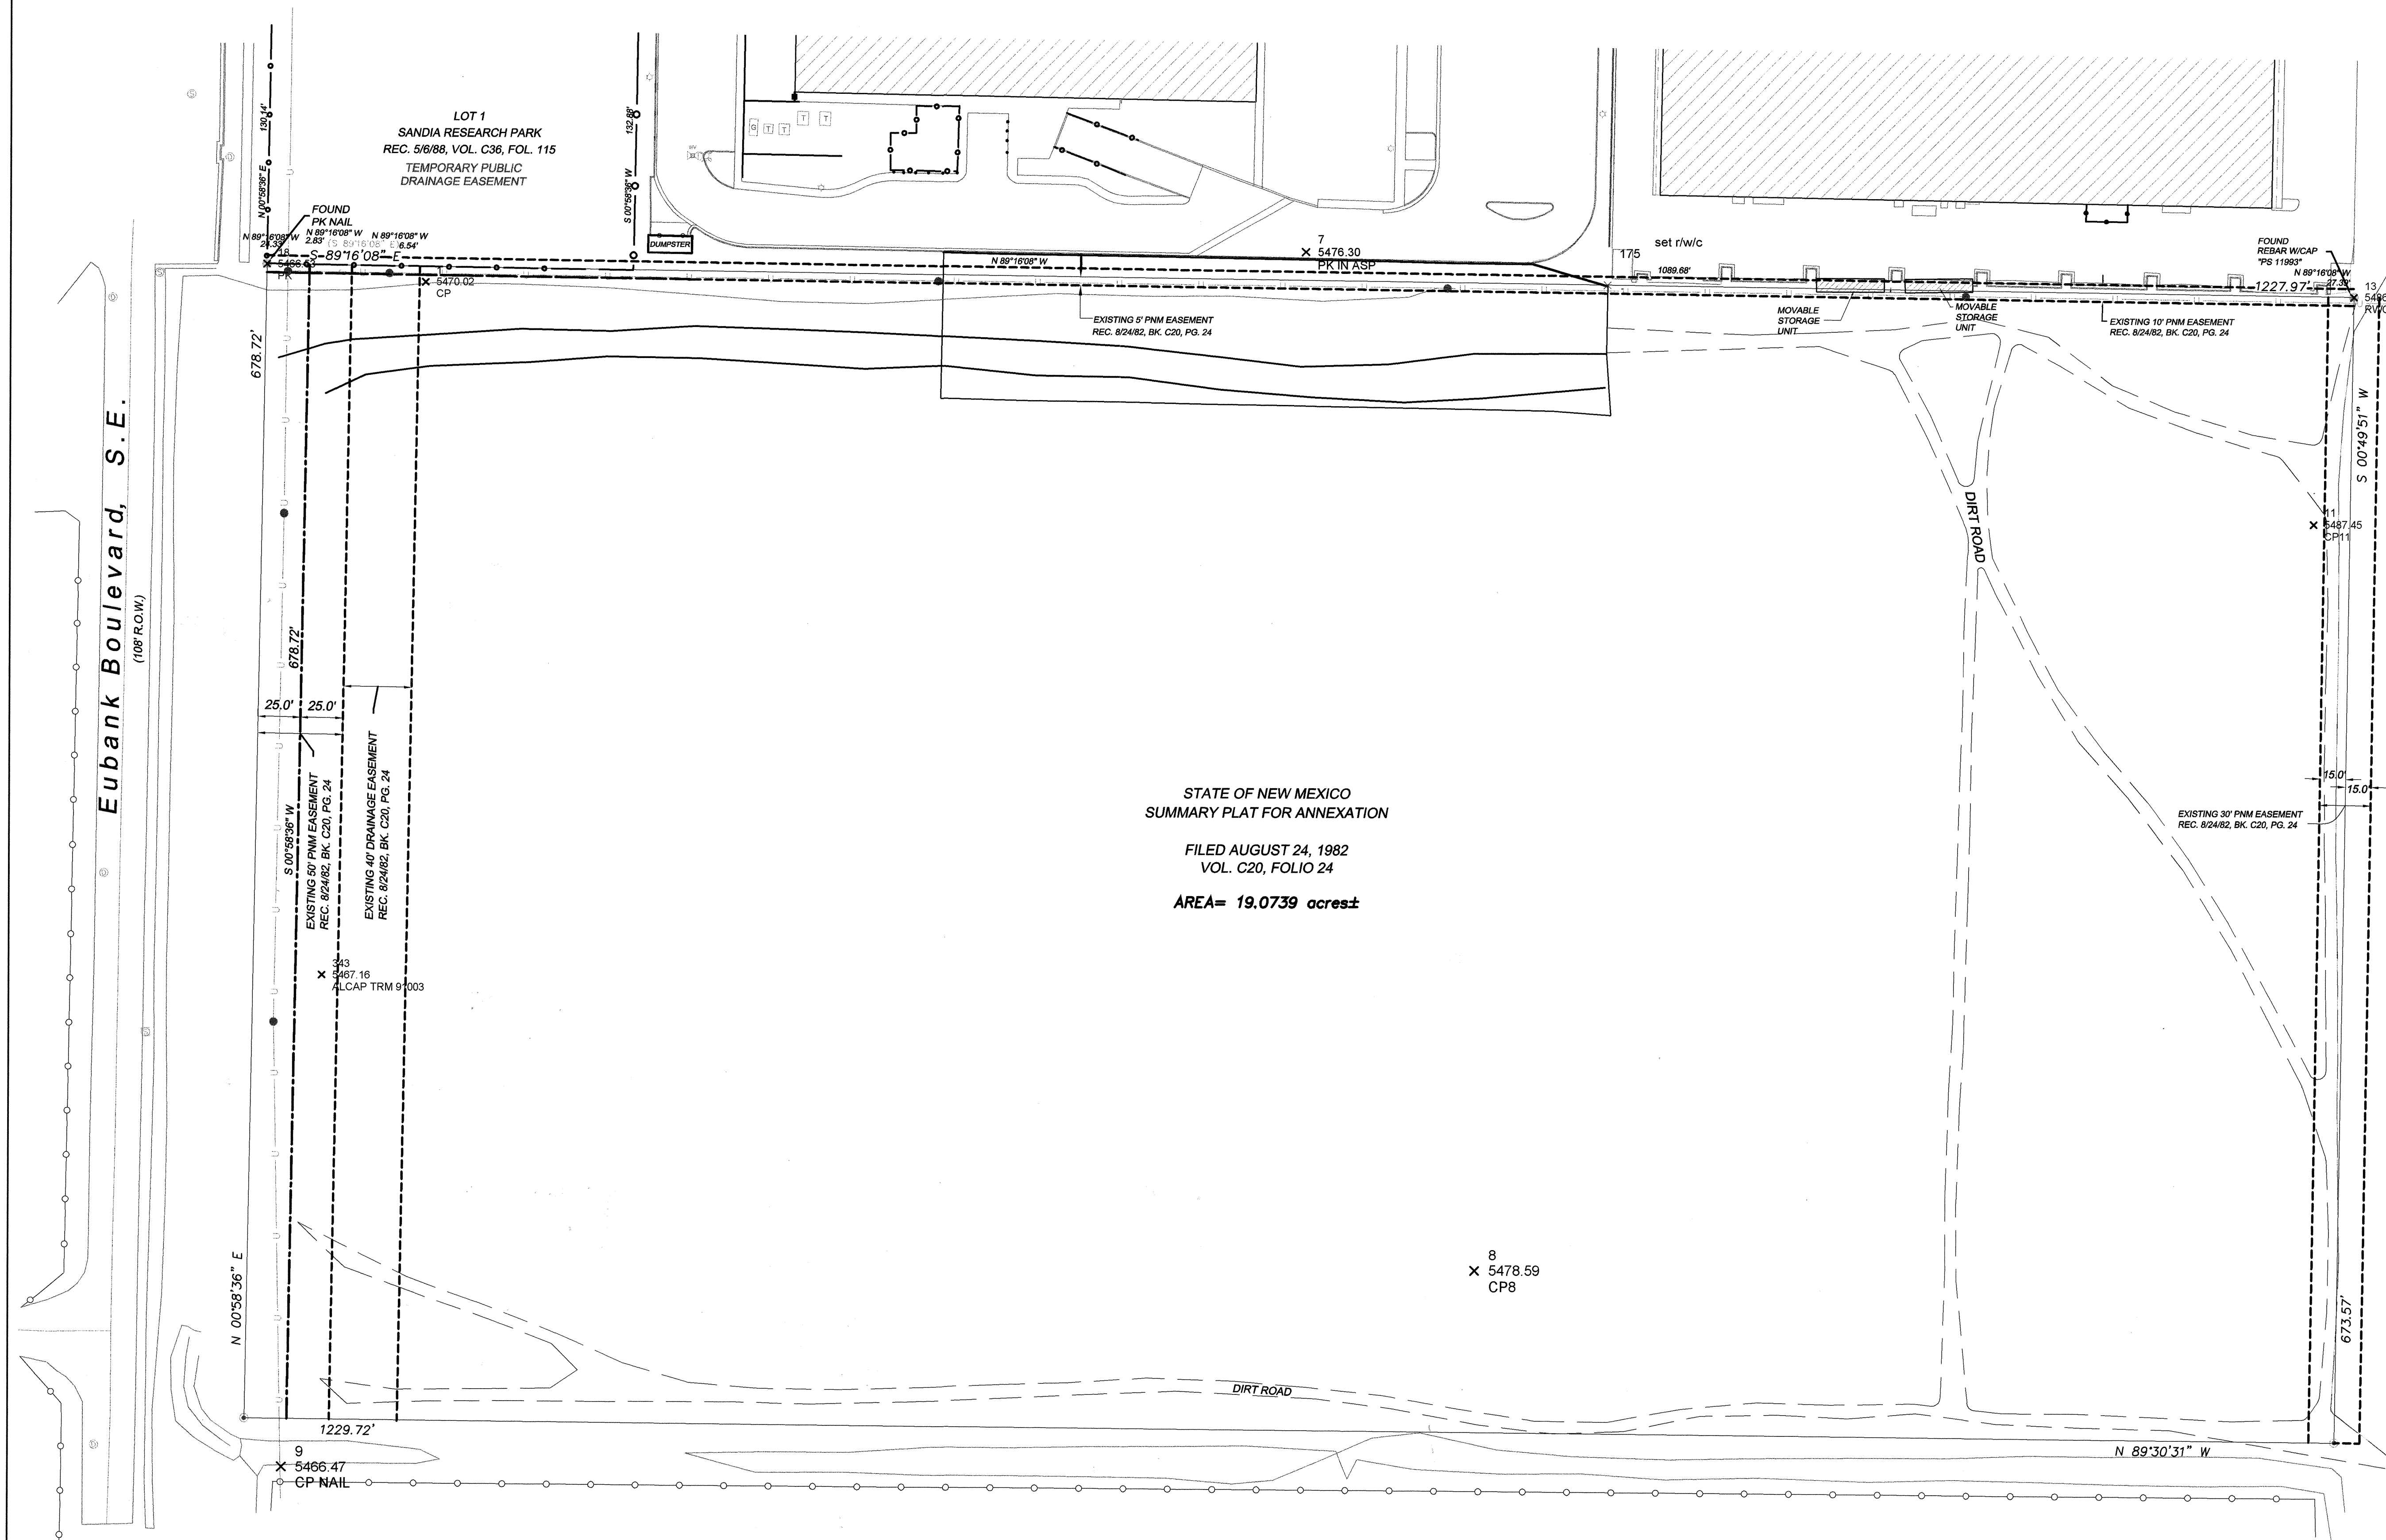



ALBUQUERQUE PUBLIC SCHOOLS
BOARD OF EDUCATION
SUMMARY PLAT FOR ANNEXATION
FILED AUGUST 24, 1982
VOL. C20, FOLIO 24

Legend

(N 90°00'00" E)	RECORD BEARINGS AND DISTANCES SHOWN IN PARENTHESIS
N 90°00'00" E	MEASURED BEARING AND DISTANCES
○	FOUND AND USED MONUMENT AS DESIGNATED
—	BLOCK WALL
●	UTILITY POLE
⊙	WATER METER
⊙	GAS METER
⊙	ELECTRIC METER
—U—	OVERHEAD UTILITY LINES

EMCORE
BOUNDARY SURVEY
SHT 2/10

654882

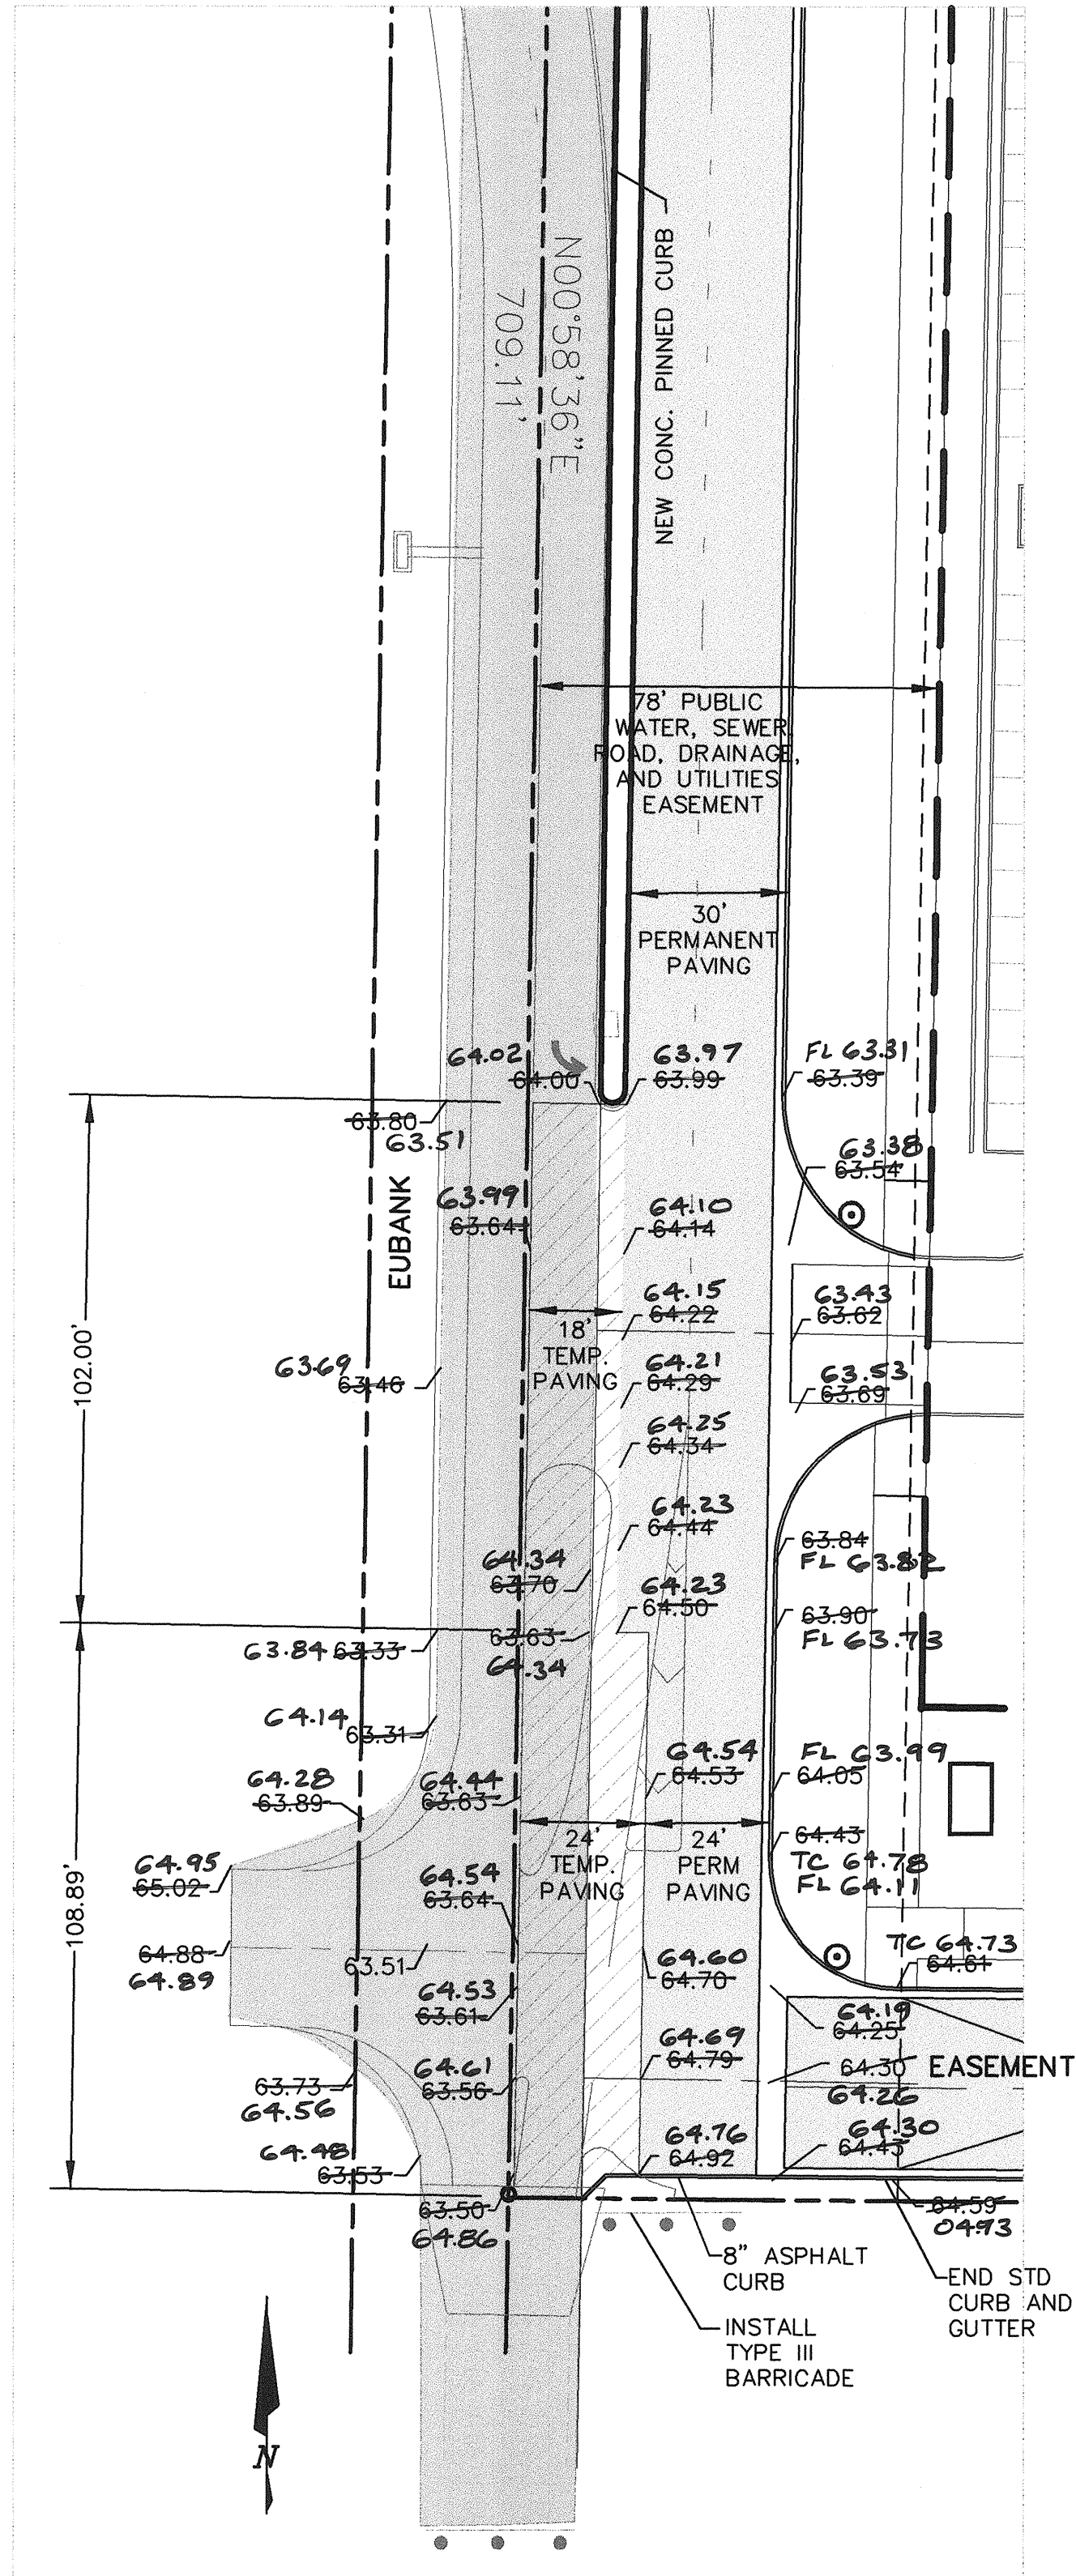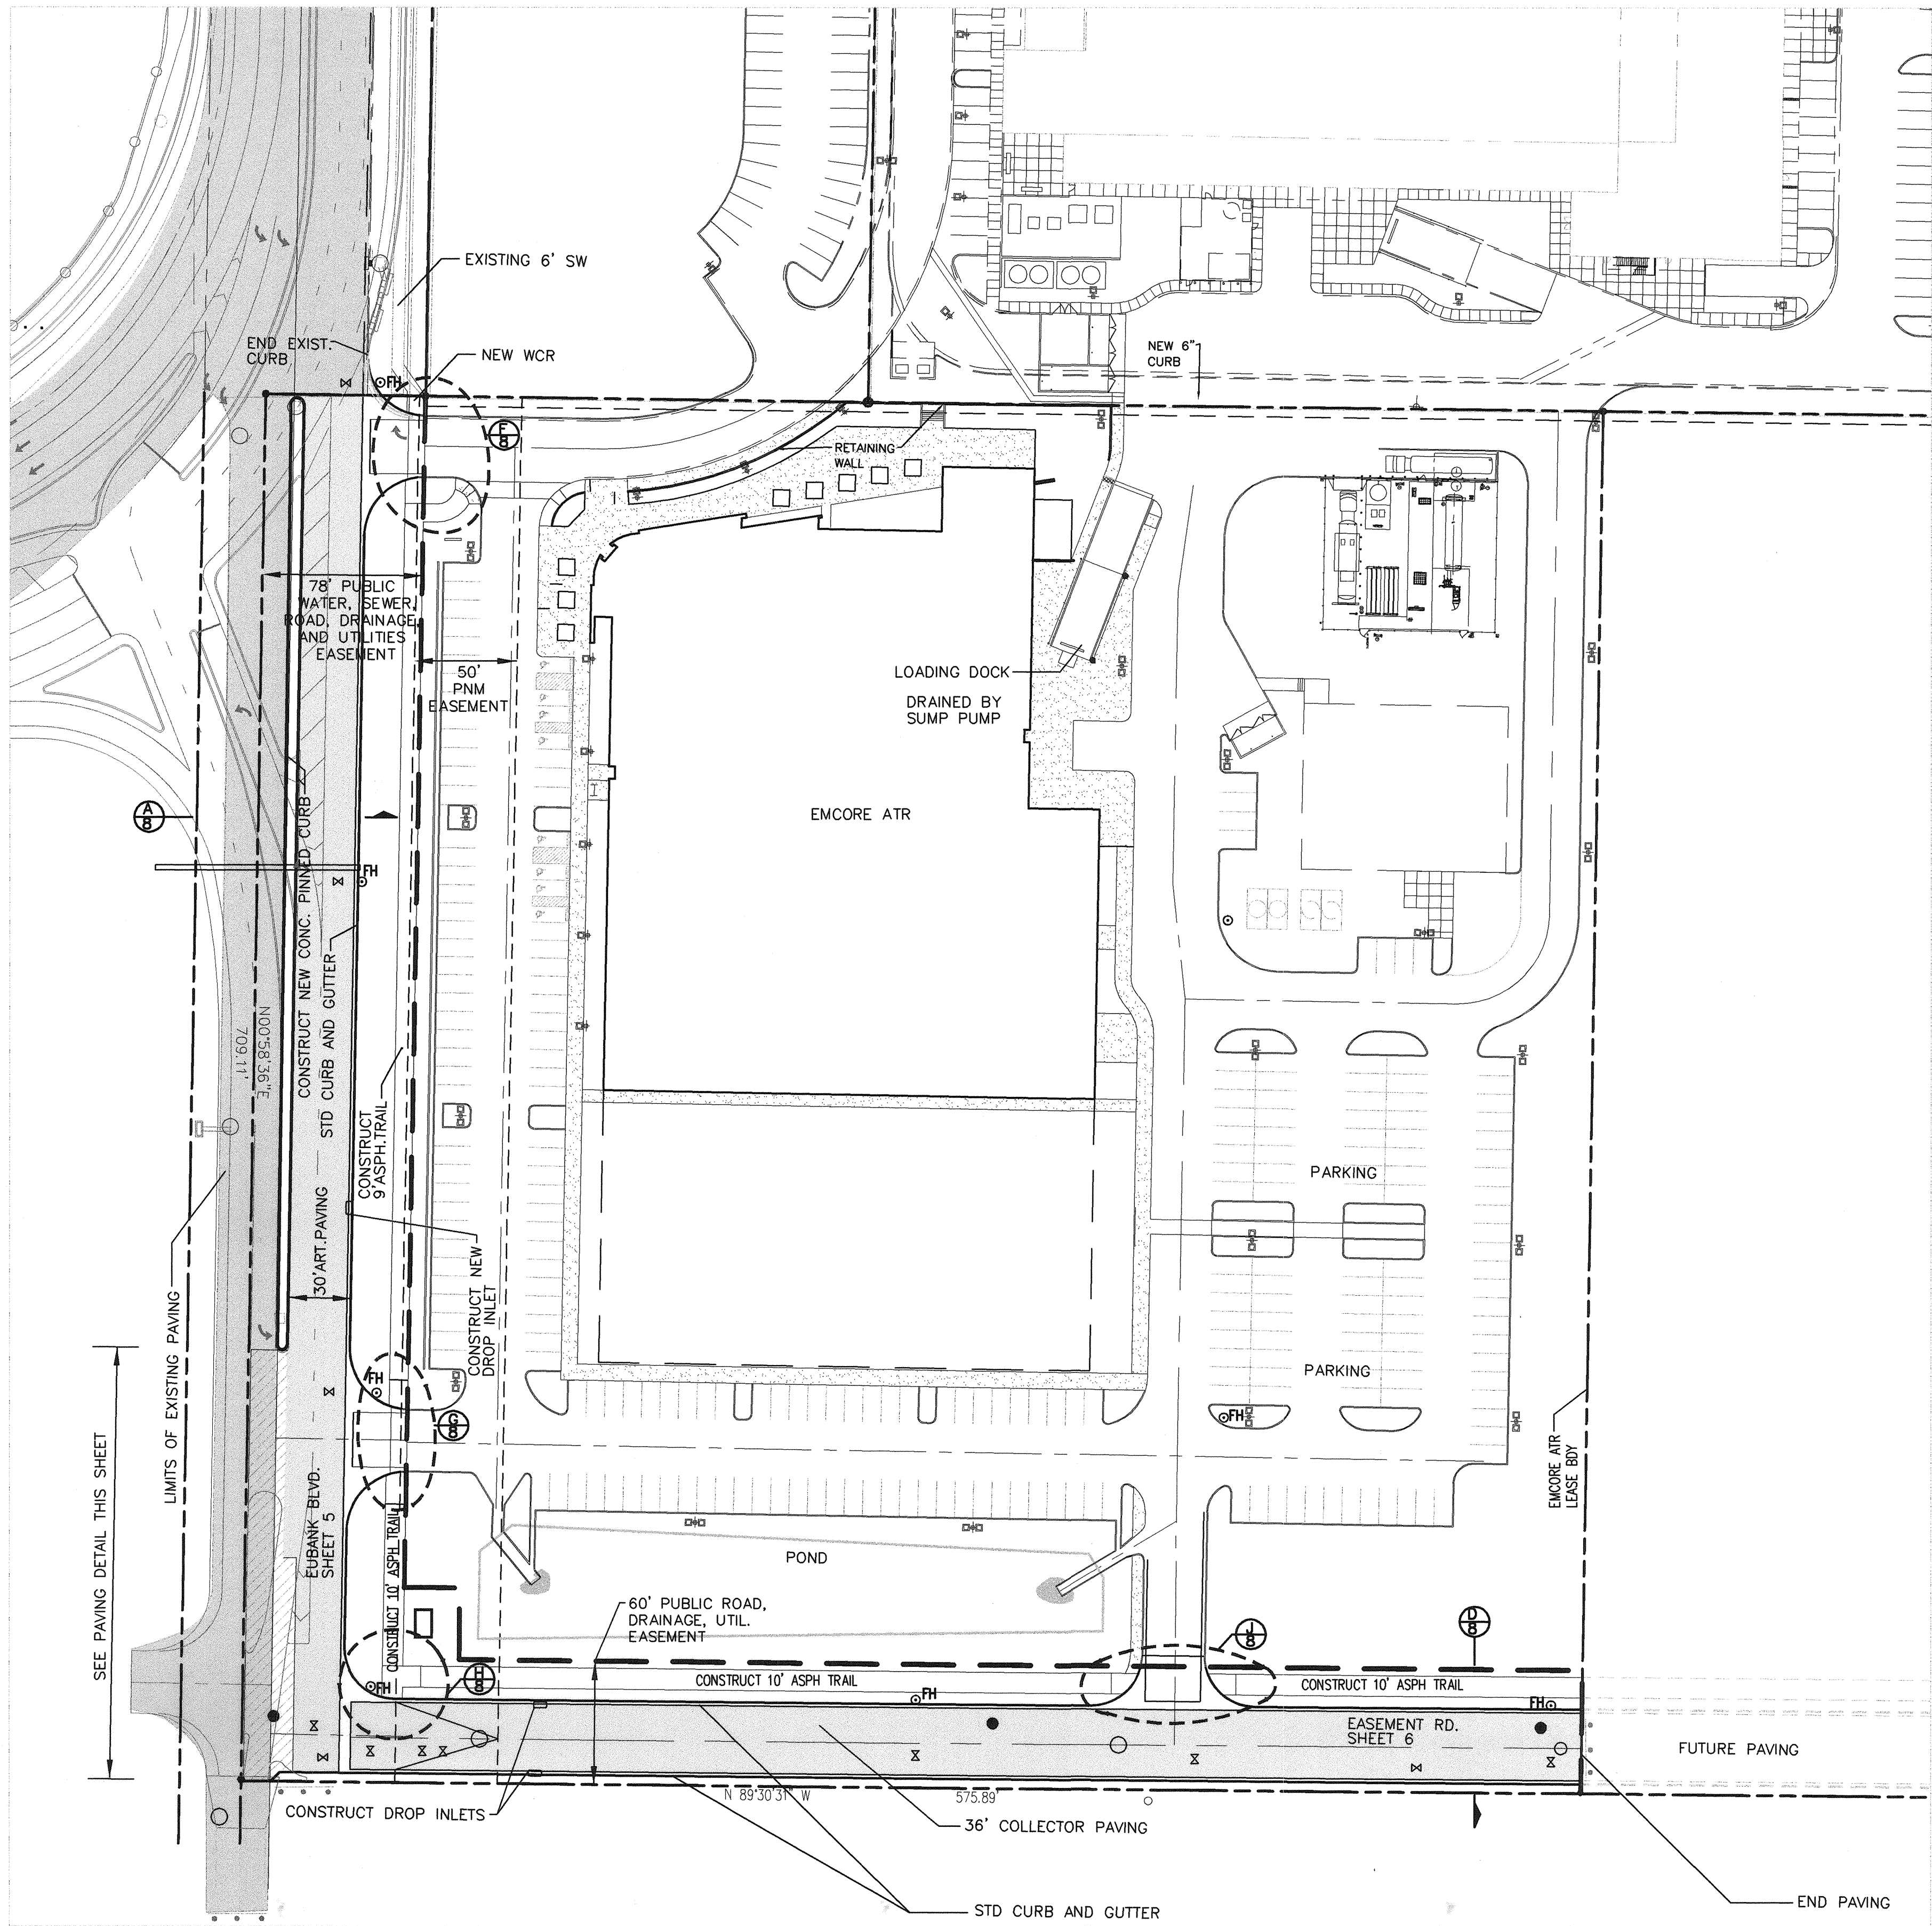

PAVING PLAN
SCALE 1"=30'

- LEGEND**
- 6001 --- EXISTING CONTOUR ELEVATION
 - 02.5 x EXISTING SPOT ELEVATION
 - 01 --- PROPOSED CONTOUR ELEVATION
 - -- PROPERTY LINE
 - 01.5 x PROPOSED SPOT ELEVATION
 - > DIRECTION OF FLOW
 - DRAINAGE SWALE
 - DRAINAGE BASIN DIVIDE
 - HEC 2 SECTION I.D.
 - WATER BLOCK
 - EXISTING STS MH
 - EXISTING SAS MH
 - x EXISTING WATER VALVE
 - EXISTING FH
 - NEW PERMANENT PAVING
 - EXISTING PAVING TO REMAIN
 - NEW TEMP. PAVING

NOTE: PUBLIC WATER, SEWER, ROAD, DRAINAGE, AND UTILITY EASEMENT FILED 5-25-01, BOOK A-19, PG 8578

PAVING UNDER PROJECT 6548.82 CONSISTS OF:

- 30' PERMANENT ARTERIAL PAVING
- 24' TEMPORARY PAVING, AS SHOWN


STD. CURB AND GUTTER ON EAST SIDE OF EUBANK, AS SHOWN

DRIVE ENTRANCES ON EAST SIDE EUBANK WITH CONNECTION TO EASEMENT RD (INNOVATION PARKWAY)

ASPHALT CURB IN MEDIAN OF EUBANK

PAVING IMPROVEMENTS TO EASEMENT RD. (INNOVATION PARKWAY, AS SHOWN)

ALL OTHER EUBANK PAVING AND STRIPING IMPROVEMENTS SHOWN ARE FOR REFERENCE, PER CONSTRUCTION DRAWINGS FOR G-AVENUE IMPROVEMENTS

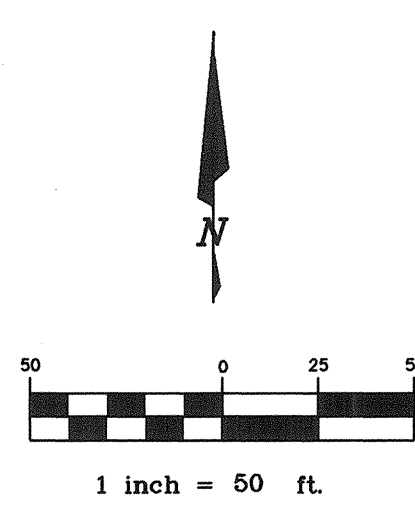

BRASHER & LORENZ
CONSULTING ENGINEERS
2201 San Pedro NE Building 1 Suite 220
Albuquerque, New Mexico 87110
Ph: 505-888-6088 Fax: 505-888-6188


CITY OF ALBUQUERQUE
PUBLIC WORKS DEPARTMENT
ENGINEERING DEVELOPMENT GROUP

TITLE: **EMCORE ATR STREET LAYOUT**

Design Review Committee	City Engineer Approval	No./Day/Yr.	No./Day/Yr.
APPROVED 6-6-2002 REVIEW COMMITTEE	APPROVED CITY ENGINEER		
City Project No.	Zone Map No.	Sheet	Of
6548.82	M-21	4	10


BENCH MARKS		AS BUILT INFORMATION	
ACS 7-120 A SQUARE CHISELED ON TOP OF THE CONCRETE BASE OF A METALIC POWERLINE Pylon. LOCATED ALONG AN ELECTRIC POWERLINE, ABOUT 55 FT WEST OF THE CENTERLINE OF EUBANK BLVD. 0.95 MILES SOUTH OF THE INTERSECTION WITH CENTRAL AVE. ELEVATION = 5488.80 (VERTICAL DATUM 1929)	DATE	CONTRACTOR	AUT. ALBY Underground
	BY	STAMPED BY	DATE 11-03
	NO.	FIELD ACCEPTANCE BY	DATE 2-3-03
		REVISIONS	DATE 2-3-03
		DESIGNED BY	DATE 2-3-03
		DRAWN BY	DATE 2-3-03
		CHECKED BY	DATE 2-3-03
		RECORDED BY	DATE
		NO.	DATE

SURVEY INFORMATION		ENGINEER'S SEAL	
FIELD NOTES	DATE		
BY	NO.		
NO.	DATE	REVISIONS	BY
		DESIGN	
		DATE 5 - 2002	DATE 5 - 2002
		DRAWN BY R.M.	DATE 5 - 2002
		CHECKED BY P.B.	DATE 5 - 2002

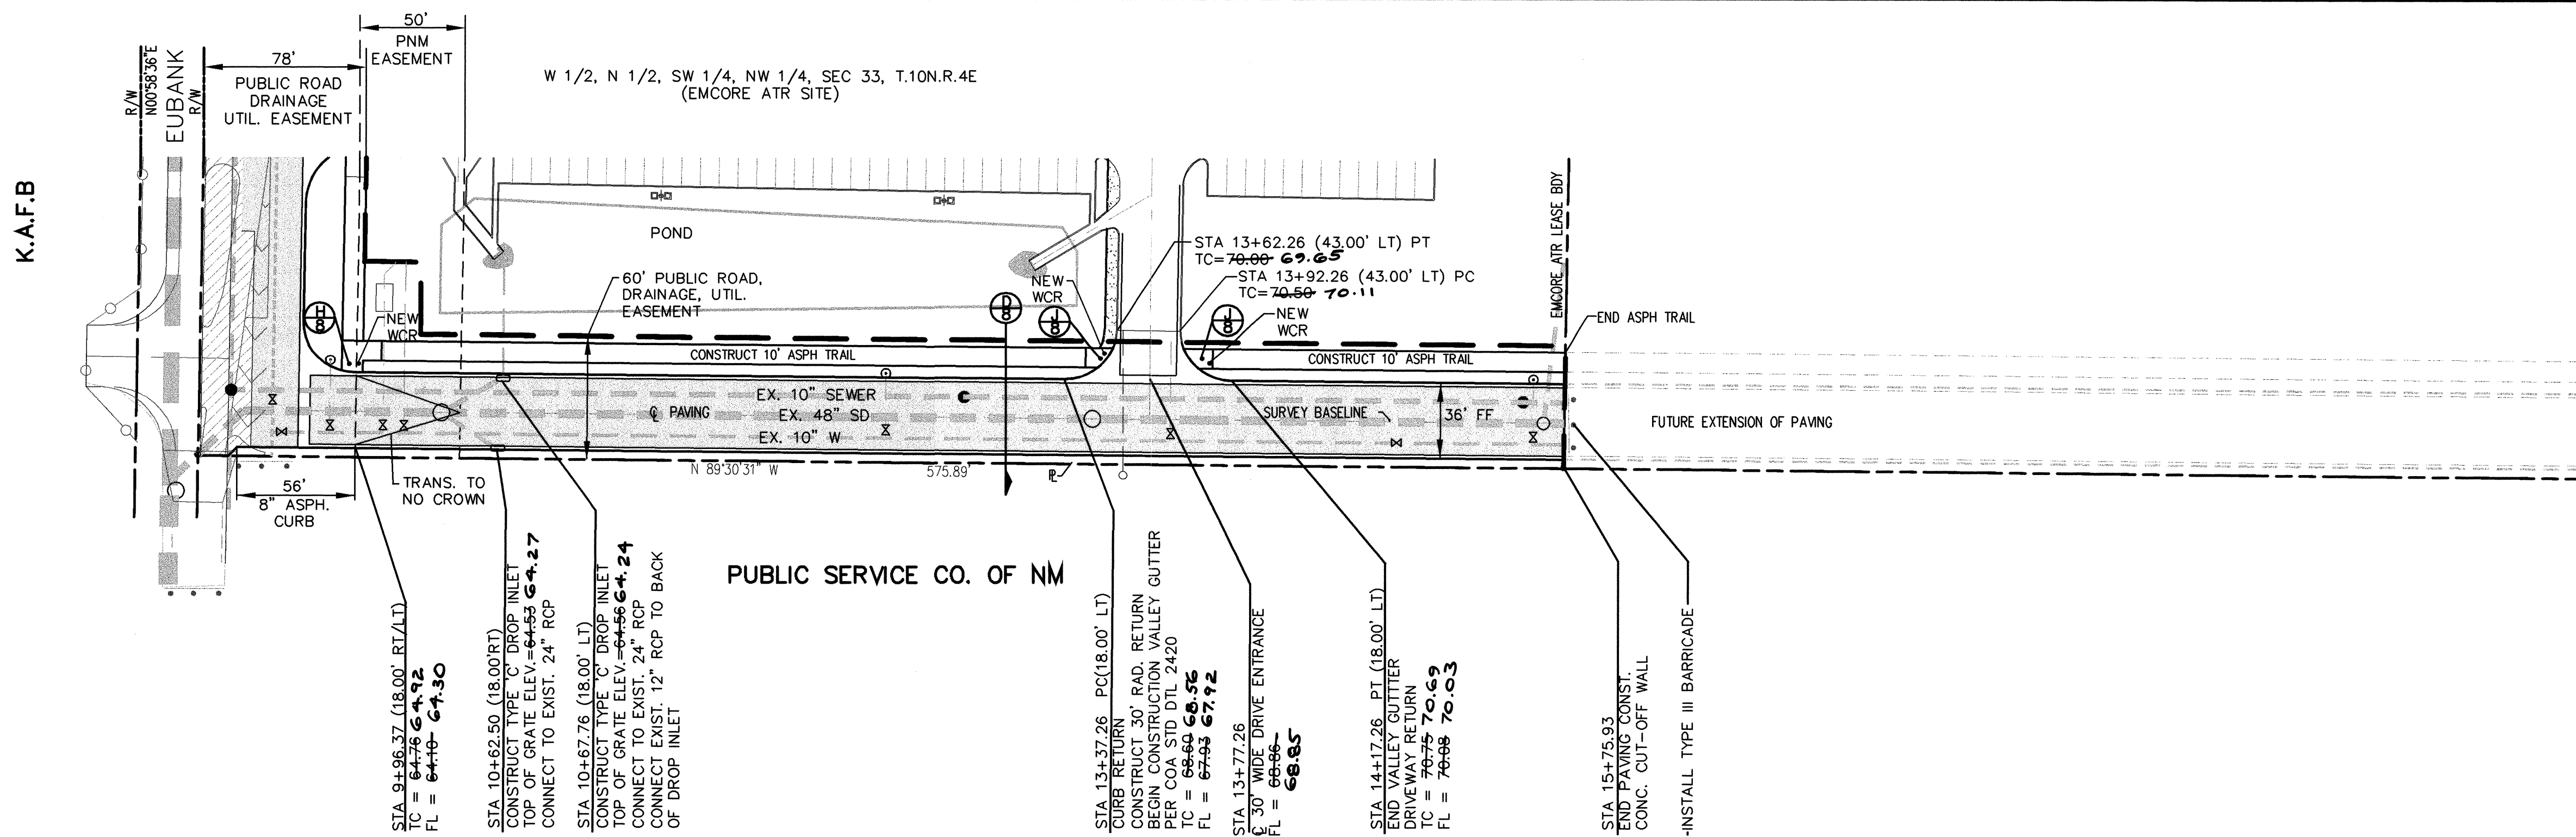

EASEMENT

1" = 50' (H)
1" = 5' (V)

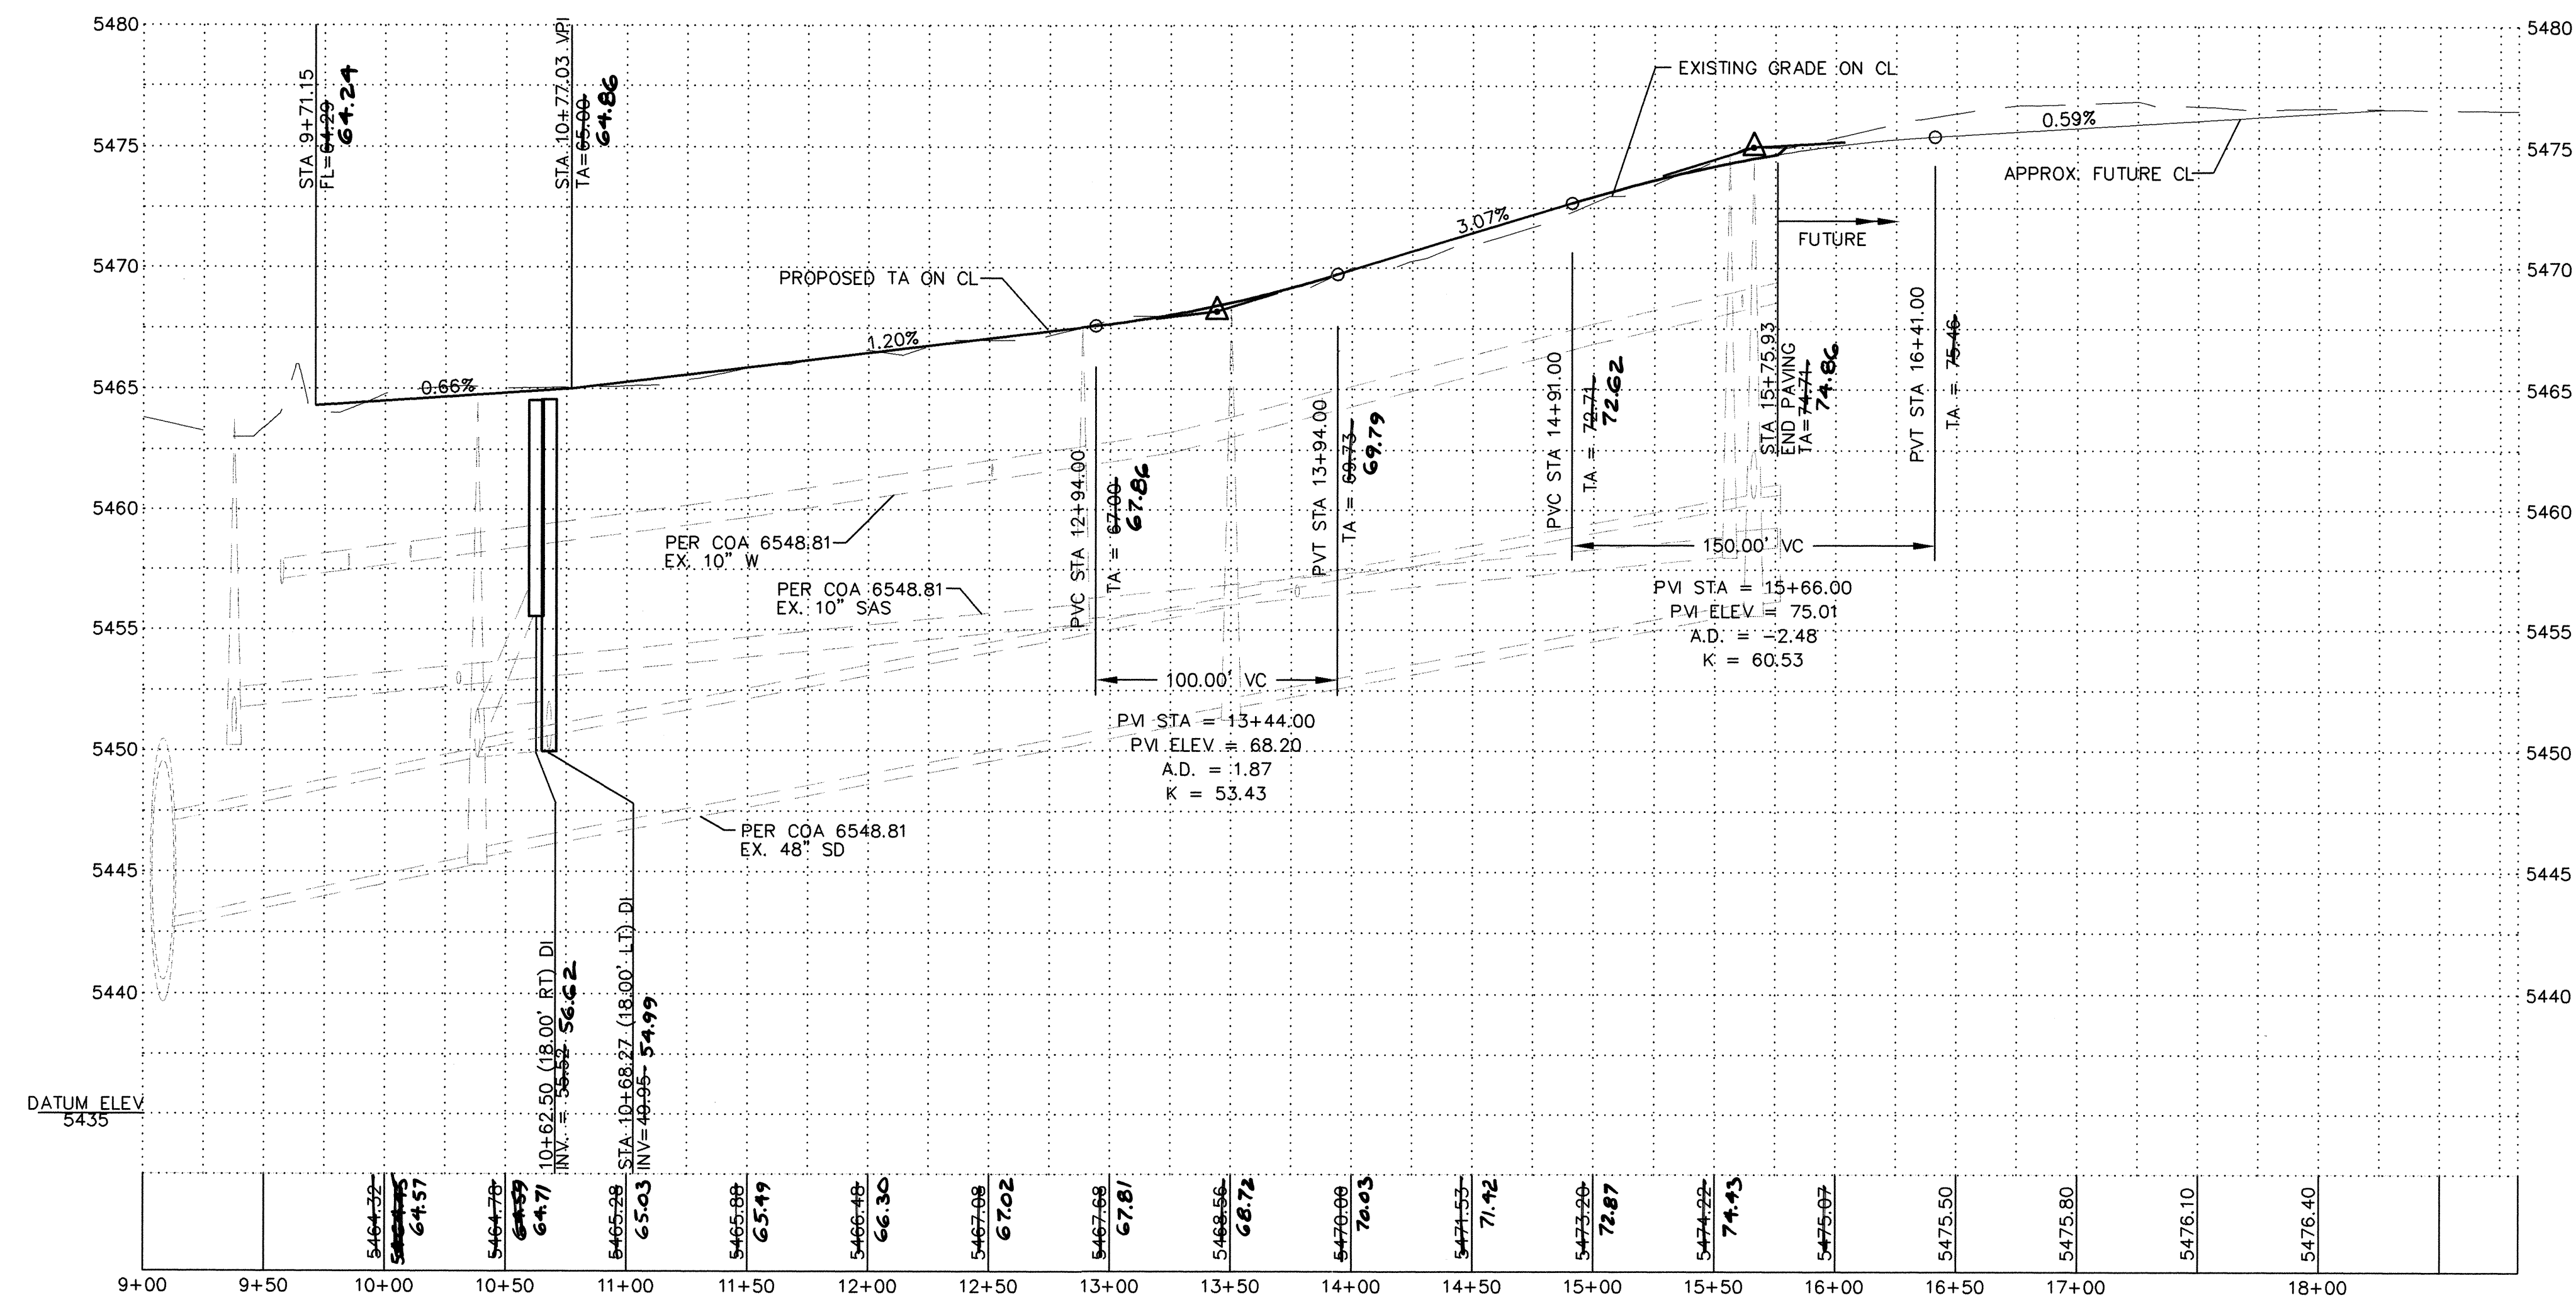


LEGEND

- 6001 — EXISTING CONTOUR ELEVATION
- 02.5 X EXISTING SPOT ELEVATION
- 01 — PROPOSED CONTOUR ELEVATION
- . . . — PROPERTY LINE
- 01.5 EX. PROPOSED SPOT ELEVATION
- ← DIRECTION OF FLOW
- DRAINAGE SWALE
- DRAINAGE BASIN DIVIDE
- ② HEC 2 SECTION I.D.
- WATER BLOCK
- EXISTING STS MH
- EXISTING SAS MH
- ⊗ EXISTING WATER VALVE
- EXISTING FH
- NEW PERMANENT PAVING
- EXISTING PAVING TO REMAIN
- NEW TEMP. PAVING

SURVEY BASELINE IS 6' PAVING
BASIS OF BEARING IS SOUTH PL N 1/2, SW 1/4, SEC 33
T 10N R4E

CONTRACTOR SHALL FIELD VERIFY HORIZONTAL
AND VERTICAL LOCATIONS OF EXISTING STORM
SEWER CONNECTOR LINES BEFORE
CONSTRUCTING NEW DROP INLETS.

NOTE: 60' PUBLIC WATER, SEWER, DRAINAGE,
ROAD, AND UTILITY EASEMENT GRANTED
05-25-01, BOOK A-19, PG 8578

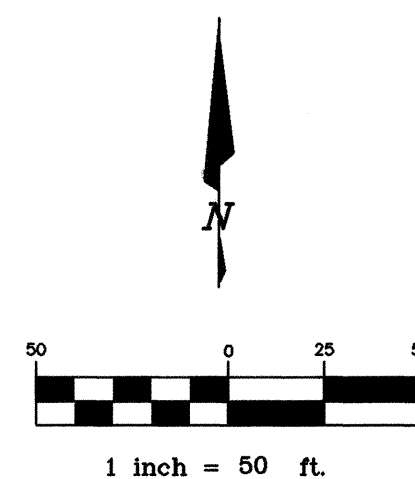

BRASHER & LORENZ
CONSULTING ENGINEERS
2201 San Pedro NE Building 1 Suite 220
Albuquerque, New Mexico 87110
Ph: 505-888-6088 Fax: 505-888-6188

CITY OF ALBUQUERQUE
PUBLIC WORKS DEPARTMENT
ENGINEERING DEVELOPMENT GROUP

TITLE: **EMCORE ATR
EASEMENT PAVING PLAN AND PROFILE**

Design Review Committee	City Engineer Approval	No. / Day / Yr.	No. / Day / Yr.
APPROVE JUN - 6 2002 DESIGN REVIEW COMMITTEE	APPROVE OCT - 3 2002 CITY ENGINEER		
City Project No.	Zone Map No.	Sheet	Of
6548.82	M-21	6	10

AS BUILT INFORMATION		BENCH MARKS		SURVEY INFORMATION		ENGINEER'S SEAL	
CONTRACTOR	AU I	AS 7-120 A SQUARE CHISELED ON TOP OF THE CONCRETE BASE	DATE	NO.	BY	NO.	BY
DATE	11/02	OF A METALLIC POWERLINE Pylon, LOCATED ALONG AN ELECTRIC					
WORKED BY	AU I	POWERLINE, ABOUT 55 FT WEST OF THE CENTERLINE OF EUBANK BLVD.,					
INTERPRETER	BRASHER & LORENZ	0.55 MILES SOUTH OF THE INTERSECTION WITH CENTRAL AVE.					
ACCEPTANCE BY	BRASHER & LORENZ	ELEVATION = 5468.80 (VERTICAL DATUM 1923)					
DATE	2/13/03						
VERIFICATION BY	BRASHER & LORENZ						
DATE	2/14/03						
CONTRACTOR	BRASHER & LORENZ						
DATE	2/14/03						
MICRO-FILM INFORMATION							
REPRODUCED BY	DATE						
NO.							


ENGINEER'S SEAL

P.L. BRASHER
NEW MEXICO
7882
REGISTERED PROFESSIONAL
5-31-02

NO.	DATE	REMARKS	BY
2	5/31/02	MODIFY STRIPING S. END EUBANK	
1	4/8/02	ADD G-AVENUE GEOMETRY	
REVISIONS			
DESIGN			
DESIGNED BY	P.B.	DATE	5 - 2002
DRAWN BY	L.A.N.	DATE	5 - 2002
CHECKED BY	P.B.	DATE	5 - 2002



This plan view shows the proposed road extension project. The road is shown as a solid line with a dashed centerline, extending from the left side of the image towards the right. The road is labeled "FLOWLINE" and "END PROJECT 6548.82". The road is shown crossing over a "SANDIA RESEARCH PARK" area, which is labeled "EMCORE ATR". The road is shown crossing over a "PNM" area, which is labeled "STATE OF NM". The road is shown crossing over a "EXISTING PAVING" area, which is labeled "EXISTING PAVING". The road is shown crossing over a "EXTENSION OF CURB AND GUTTER" area, which is labeled "EXTENSION OF CURB AND GUTTER". The road is shown crossing over a "SANDIA RESEARCH PARK" area, which is labeled "SANDIA RESEARCH PARK". The road is shown crossing over a "PNM" area, which is labeled "PNM". The road is shown crossing over a "STATE OF NM" area, which is labeled "STATE OF NM". The road is shown crossing over a "EXISTING PAVING" area, which is labeled "EXISTING PAVING". The road is shown crossing over a "EXTENSION OF CURB AND GUTTER" area, which is labeled "EXTENSION OF CURB AND GUTTER".


1" = 100' (H)
1" = 10' (V)

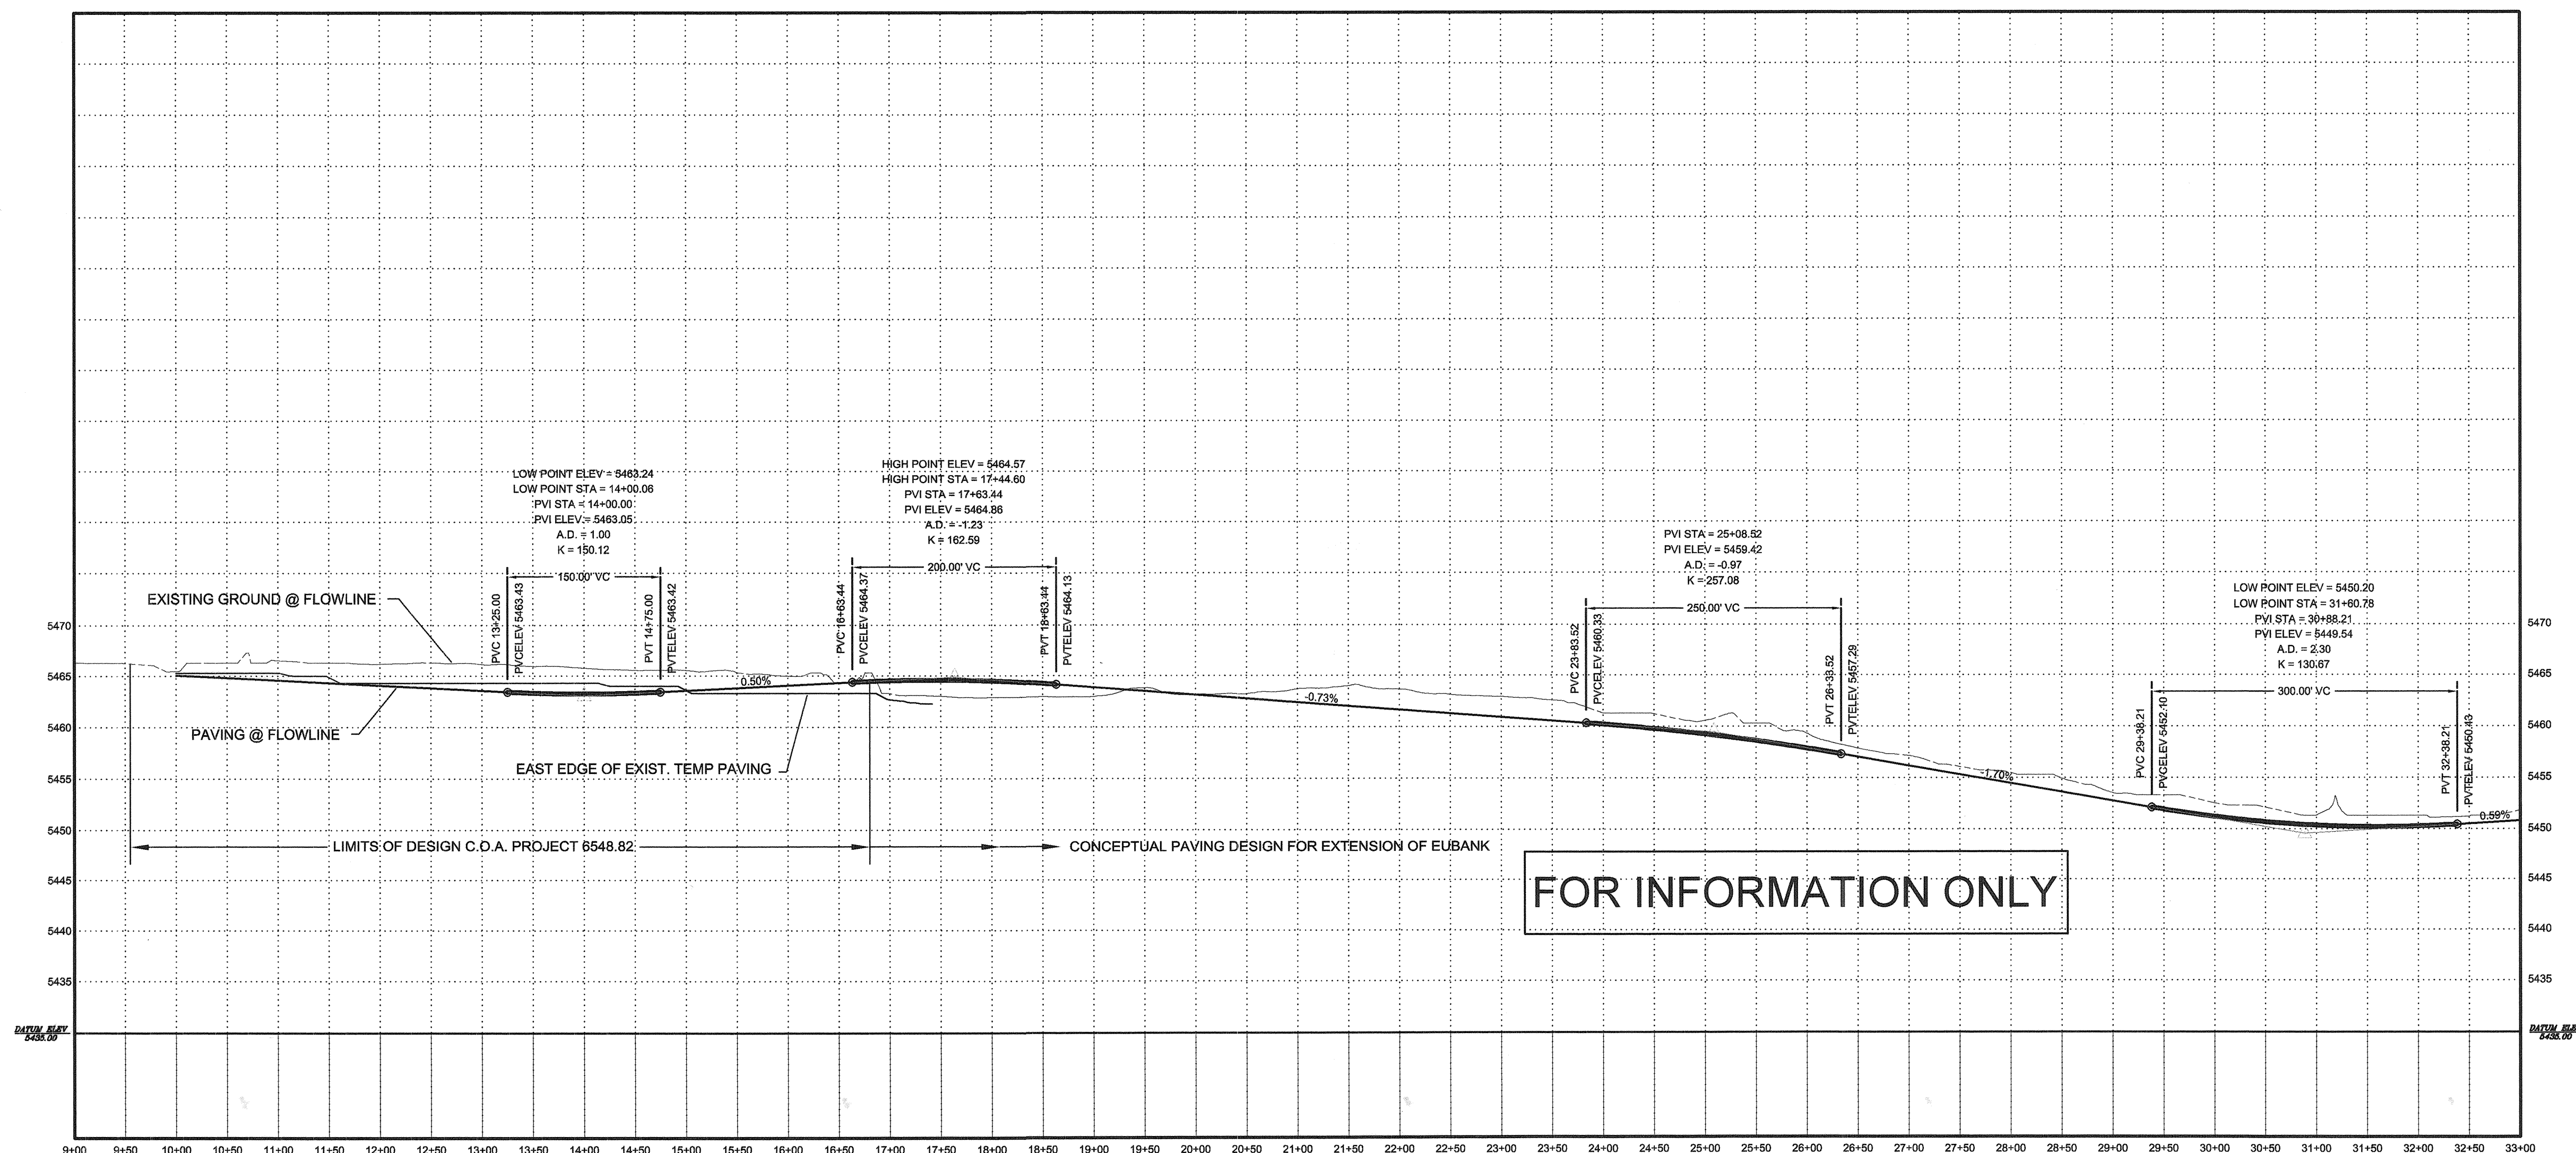

-- -- 600' ---	EXISTING CONTOUR ELEVATION
02.5 X	EXISTING SPOT ELEVATION
— 01 —	PROPOSED CONTOUR ELEVATION
— • • —	PROPERTY LINE
01.5 +	PROPOSED SPOT ELEVATION
←	DIRECTION OF FLOW
—	DRAINAGE SWALE
— - - -	DRAINAGE BASIN DIVIDE
② —	HEC 2 SECTION I.D.
~~~~~	WATER BLOCK
	EXISTING PAVING
○	EXISTING STS MH
●	EXISTING SAS MH
⋈	EXISTING WATER VALVE
○	EXISTING FH

[illegible]

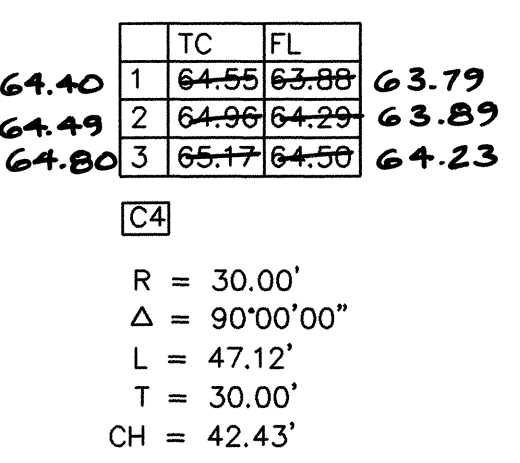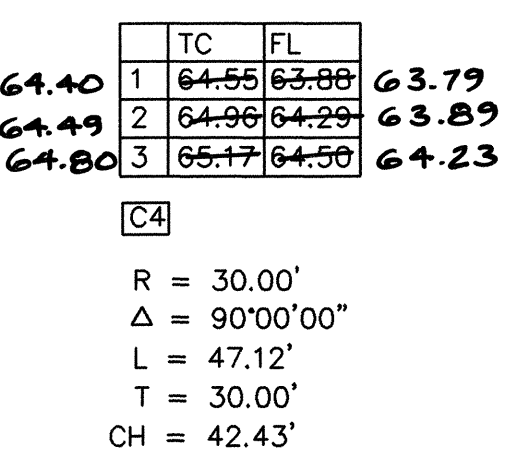

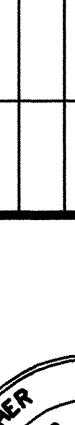		<b>ENGINEER'S SEAL</b>																			
<table border="1" style="width: 100%; border-collapse: collapse;"> <tr> <th colspan="2" style="text-align: center;">SURVEY INFORMATION</th> </tr> <tr> <th style="text-align: center;">FIELD NOTES</th> <th style="text-align: center;">BY</th> </tr> <tr> <td style="height: 100px; vertical-align: top;">  ACS 7-120 A SQUARE CHEELED ON TOP OF THE CONCRETE BASE OF A METALLIC POWERLINE Pylon. LOCATED ALONG AN ELECTRIC POWERLINE, ABOUT 55 FT WEST OF THE CENTERLINE OF EURANK BLVD. 0.95 MILES SOUTH OF THE INTERSECTION WITH CENTRAL AVE. ELEVATION = 5468.80 (VERTICAL DATUM 1929)  </td> <td style="vertical-align: top;">  DATE  </td> </tr> </table>		SURVEY INFORMATION		FIELD NOTES	BY	ACS 7-120 A SQUARE CHEELED ON TOP OF THE CONCRETE BASE OF A METALLIC POWERLINE Pylon. LOCATED ALONG AN ELECTRIC POWERLINE, ABOUT 55 FT WEST OF THE CENTERLINE OF EURANK BLVD. 0.95 MILES SOUTH OF THE INTERSECTION WITH CENTRAL AVE. ELEVATION = 5468.80 (VERTICAL DATUM 1929)	DATE	<table border="1" style="width: 100%; border-collapse: collapse;"> <tr> <th colspan="2" style="text-align: center;">BENCH MARKS</th> </tr> <tr> <th style="text-align: center;">CONTRACTOR</th> <th style="text-align: center;">A.U.I.</th> </tr> <tr> <td style="height: 100px; vertical-align: top;">  SPONSORED BY ACCEPTANCE BY FIELD LOCATION BY DRAWINGS CORRECTED BY  </td> <td style="vertical-align: top;">  DATE DATE DATE DATE DATE  </td> </tr> </table>		BENCH MARKS		CONTRACTOR	A.U.I.	SPONSORED BY ACCEPTANCE BY FIELD LOCATION BY DRAWINGS CORRECTED BY	DATE DATE DATE DATE DATE						
SURVEY INFORMATION																					
FIELD NOTES	BY																				
ACS 7-120 A SQUARE CHEELED ON TOP OF THE CONCRETE BASE OF A METALLIC POWERLINE Pylon. LOCATED ALONG AN ELECTRIC POWERLINE, ABOUT 55 FT WEST OF THE CENTERLINE OF EURANK BLVD. 0.95 MILES SOUTH OF THE INTERSECTION WITH CENTRAL AVE. ELEVATION = 5468.80 (VERTICAL DATUM 1929)	DATE																				
BENCH MARKS																					
CONTRACTOR	A.U.I.																				
SPONSORED BY ACCEPTANCE BY FIELD LOCATION BY DRAWINGS CORRECTED BY	DATE DATE DATE DATE DATE																				
<table border="1" style="width: 100%; border-collapse: collapse;"> <tr> <th colspan="2" style="text-align: center;">REVISIONS</th> </tr> <tr> <th style="text-align: center;">NO.</th> <th style="text-align: center;">DATE</th> <th style="text-align: center;">REMARKS</th> <th style="text-align: center;">BY</th> </tr> <tr> <td style="text-align: center;">1</td> <td style="text-align: center;">4/8/02</td> <td style="text-align: center;">ADD SLOPE INFO TO MCR'S</td> <td></td> </tr> </table>		REVISIONS		NO.	DATE	REMARKS	BY	1	4/8/02	ADD SLOPE INFO TO MCR'S		<table border="1" style="width: 100%; border-collapse: collapse;"> <tr> <th colspan="2" style="text-align: center;">DESIGN</th> </tr> <tr> <td style="text-align: center;">DESIGNED BY</td> <td style="text-align: center;">DATE</td> </tr> <tr> <td style="text-align: center;">DRAWN BY</td> <td style="text-align: center;">DATE</td> </tr> <tr> <td style="text-align: center;">CHECKED BY</td> <td style="text-align: center;">DATE</td> </tr> </table>		DESIGN		DESIGNED BY	DATE	DRAWN BY	DATE	CHECKED BY	DATE
REVISIONS																					
NO.	DATE	REMARKS	BY																		
1	4/8/02	ADD SLOPE INFO TO MCR'S																			
DESIGN																					
DESIGNED BY	DATE																				
DRAWN BY	DATE																				
CHECKED BY	DATE																				
<b>AS BUILT INFORMATION</b>																					
<table border="1" style="width: 100%; border-collapse: collapse;"> <tr> <th colspan="2" style="text-align: center;">MICRO-FILM INFORMATION</th> </tr> <tr> <td style="text-align: center;">RECORDED BY</td> <td style="text-align: center;">DATE</td> </tr> <tr> <td style="text-align: center;">NO.</td> <td></td> </tr> </table>				MICRO-FILM INFORMATION		RECORDED BY	DATE	NO.													
MICRO-FILM INFORMATION																					
RECORDED BY	DATE																				
NO.																					

CONSTRUCTION TRAFFIC CONTROL GENERAL NOTES

1. CONTRACTOR MUST OBTAIN FROM CONSTRUCTION COORDINATION AN EXCAVATION/BARRICADING PERMIT BEFORE ENGAGING IN ANY CONSTRUCTION, MAINTENANCE OR REPAIR WORK IN ANY OF THE CITY OF ALBUQUERQUE'S RIGHTS-OF-WAY. EMERGENCY WORK THAT WOULD PRESERVE LIFE OR PROPERTY IS EXCLUDED WITH THE UNDERSTANDING, THAT A PERMIT SHALL BE OBTAINED WITHIN 24 TO 48 HOURS.

2. CONTRACTOR SHALL AT THE TIME OF PERMIT REQUEST, SUBMIT FOR APPROVAL BY CONSTRUCTION COORDINATION, A TRAFFIC CONTROL PLAN DETAILING ALL EXISTING TOPOGRAPHY SUCH AS LANE WIDTHS, DRIVEWAYS, AND BUSINESS/RESIDENTIAL ACCESSES. THE TRAFFIC CONTROL PLAN SHALL INCLUDE ALL PHASES OF WORK AND SCHEDULES INVOLVED IN THE CONSTRUCTION PROJECT. ANY SEPARATE PHASES OF A CONSTRUCTION PROJECT SHALL BE GIVEN AN INDIVIDUAL PERMIT EACH. BLANKET PERMITS WILL NOT BE ISSUED.

3. THESE TYPICAL TRAFFIC CONTROL PLANS DO NOT REFLECT THE EXISTING TOPOGRAPHY SUCH AS DRIVEWAYS, LANE WIDTHS, AND BUSINESS/RESIDENTIAL ACCESSES. EVERY LOCATION THAT REQUIRES CONSTRUCTION TRAFFIC CONTROL SHALL HAVE A DETAILED TRAFFIC CONTROL PLAN SHOWING ALL EXISTING TOPOGRAPHY.

4. CONSTRUCTION SHALL NOT BEGIN UNLESS A TRAFFIC CONTROL PLAN HAS BEEN APPROVED AND VERIFIED BY CONSTRUCTION COORDINATION.

5. CONSTRUCTION COORDINATION SHALL BE NOTIFIED 48 HOURS PRIOR TO ANY TRAFFIC CONTROL CHANGES NEEDED BY CONTRACTOR, THAT WERE NOT PREVIOUSLY APPROVED. THESE TRAFFIC CONTROL CHANGES SHALL BE REQUESTED IN WRITING ACCOMPANIED WITH A TRAFFIC CONTROL PLAN REFLECTING SUCH CHANGES.

6. ALL CONSTRUCTION TRAFFIC CONTROL DEVICES SHALL COMPLY TO THE MANUAL ON UNIFORM TRAFFIC CONTROL DEVICES (MUTCD), LATEST EDITION. IT IS THE RESPONSIBILITY OF THE CONTRACTOR TO INSTALL, SERVICE AND MAINTAIN ALL TRAFFIC CONTROL DEVICES. TRAFFIC CONTROL DEVICES SHALL NOT BE REMOVED OR ALTERED IN ANY WAY WITHOUT THE APPROVAL OF CONSTRUCTION COORDINATION, PER SECTION 6A-4 OF THE MUTCD, LATEST EDITION.

7. THE CONSTRUCTION TRAFFIC CONTROL INITIAL SET-UP SHALL BE BY AN AMERICAN TRAFFIC SAFETY SERVICES ASSOCIATION (ATSSA) CERTIFIED WORKSITE TRAFFIC SUPERVISOR. THE MAINTENANCE AND SERVICING SHALL ALSO BE DONE BY AN ATSSA CERTIFIED WORKSITE TRAFFIC SUPERVISOR OR EQUIVALENT.

8. CONTRACTOR IS RESPONSIBLE TO MAINTAIN AND SERVICE ALL TRAFFIC CONTROL DEVICES 24 HOURS A DAY, 7 DAYS A WEEK THROUGHOUT LENGTH OF PROJECT. CONTRACTOR IS RESPONSIBLE THAT ALL TRAFFIC CONTROL DEVICES COMPLY WITH THE MUTCD, LATEST EDITION.

9. ALL ADVANCE WARNING SIGNS SHALL BE DOUBLE INDICATED WHENEVER THERE ARE MULTI-LANE TRAFFIC IN ANY ONE GIVEN DIRECTION AND THERE IS SUFFICIENT MEDIAN SPACE.

10. ALL BARRICADES IN ALL TAPERS AND TANGENTS SHALL BE PLACED APART, A DISTANCE MEASURED IN FEET, EQUAL TO THAT OF THE POSTED SPEED LIMIT. NO EXCEPTIONS UNLESS APPROVED BY CONSTRUCTION COORDINATION PER MUTCD SECTION 6A-4.

11. CONTRACTOR SHALL NOT BEGIN WORK BEFORE 7:00 A.M. OR END WORK AFTER 7:00 P.M. WITHOUT THE APPROVAL OF CONSTRUCTION COORDINATION.

12. CONTRACTOR IS RESPONSIBLE TO PROVIDE CONSTRUCTION COORDINATION, A WEEKLY LOG OF DAILY INSPECTIONS OF BARRICADE AND MAINTENANCE SCHEDULES ON PROJECTS THAT ARE OVER ONE WEEK DURATION.

13. EQUIPMENT OR MATERIALS SHALL NOT BE STORED WITHIN 15 FEET OF A TRAVELLED TRAFFIC LANE DURING NON-WORKING HOURS WITHOUT THE APPROVAL OF CONSTRUCTION COORDINATION.

14. CONTRACTOR SHALL PROVIDE AND MAINTAIN A SAFE AND ADEQUATE MEANS OF CHANNELIZING PEDESTRIAN TRAFFIC AROUND AND THROUGH THE CONSTRUCTION AREA.

15. CONTRACTOR IS RESPONSIBLE FOR OBLITERATION OF ANY CONFLICTING STRIPING AND RESPONSIBLE FOR ALL TEMPORARY STRIPING.

16. CONTRACTOR SHALL MAINTAIN ACCESS TO ALL FACILITIES, BUSINESSES AND/OR RESIDENTS AT ALL TIMES.

17. CONTRACTOR SHALL PROVIDE ACCESS SIGNS FOR BUSINESSES LOCATED WITHIN THE CONSTRUCTION AREA UNDER THE SUPERVISION OF CONSTRUCTION COORDINATION. EACH ACCESS SIGN SHALL HAVE 5 INCH, WHITE OPAQUE LETTERING ON BLUE REFLECTORIZED BACKGROUND. ACCESS SIGNS SHALL BE CONSIDERED INCIDENTAL TO THE BID AND NOT PART OF THE CONTRACT UNLESS OTHERWISE STATED. NO MORE THAN 3 BUSINESSES SHALL BE LISTED ON A ACCESS SIGN. SHOPPING CENTERS AND MALLS SHALL BE LISTED AS SUCH.

18. ALL ADVANCE WARNING SIGNS SHALL MEET THE MINIMUM REFLECTIVE INTENSITY REQUIREMENTS SET FORTH BY THE CITY OF ALBUQUERQUE. CONSTRUCTION COORDINATION SHALL DETERMINE ALL REQUIREMENTS AND APPROVE OR DISAPPROVE ANY ADVANCE WARNING SIGN PER SECTION 6A-4 OF THE MUTCD, LATEST EDITION.

19. 24 HOURS PRIOR TO OCCUPANCY OR CLOSING OF A RIGHT-OF-WAY, CONTRACTOR SHALL NOTIFY: POLICE, FIRE DEPARTMENT, SCHOOLS, HOSPITALS, TRANSIT AUTHORITY, BUSINESSES AND/OR RESIDENTS THAT WILL BE AFFECTED BY THE CONSTRUCTION.

20. ANY FIELD ADJUSTMENTS SHALL BE APPROVED BY CONSTRUCTION COORDINATION.

21. EXCAVATIONS SHALL BE PLATED, TEMPORARILY PATCHED OR RESURFACED PRIOR TO OPENING OF TRAFFIC. A MINIMUM OF 11 FEET SHALL BE PROVIDED FOR TRAFFIC IN ANY GIVEN DIRECTION. CONTRACTOR IS RESPONSIBLE FOR ANY WORK INVOLVED IN SATISFYING THESE REQUIREMENTS.


22. CONTRACTOR SHALL AT ALL TIMES COMPLY WITH THE FOLLOWING:  
1. STANDARDS AND REQUIREMENTS SET FORTH IN THE MANUAL ON UNIFORM TRAFFIC CONTROL DEVICES, LATEST EDITION.  
2. THE CITY OF ALBUQUERQUE TRAFFIC CODE, LATEST EDITION.  
3. SECTION 19 OF THE CITY OF ALBUQUERQUE'S STANDARD SPECIFICATIONS FOR PUBLIC WORK CONSTRUCTION, AS WELL AS OTHER SECTIONS.

23. FAILURE TO COMPLY WITH ANY OF THE ABOVE MENTIONED, WILL BE ADEQUATE CAUSE TO CEASE ALL WORK ON ANY CONSTRUCTION PROJECT. WORK WILL NOT RESUME UNTIL ALL REQUIREMENTS ARE ADDRESSED AND APPROVED BY CONSTRUCTION COORDINATION.


24. ALL TRAFFIC CONTROL DEVICES SHALL BE KEPT IN NEW-CLEAN CONDITION. WASHING OF EQUIPMENT IS INCIDENTAL TO IT'S PLACEMENT AND MAINTENANCE.

25. TRAFFIC CONTROL STANDARDS APPLY ONLY WHERE THE CONSTRUCTION TRAFFIC CONTROL PLANS ARE NOT SPECIFIC.

26. ADVANCE WARNING SIGNS SHALL BE 36"x36" WITH SUPER ENGINEERING GRADE SHEETING OR BETTER.

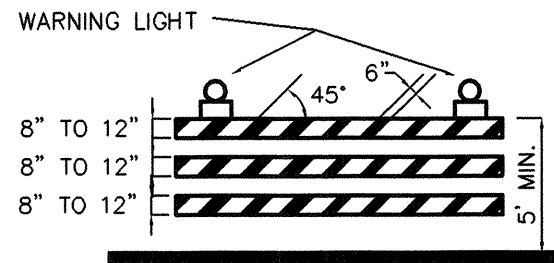


TYPE III BARRICADE

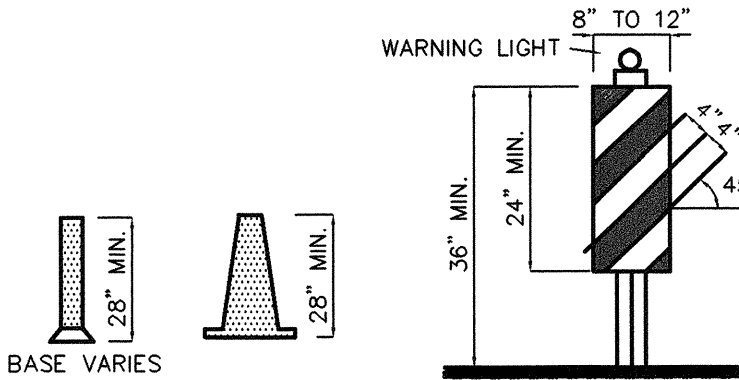

VERTICAL PANEL



CONES

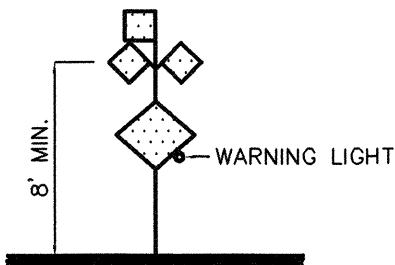

HIGH LEVEL WARNING DEVICE

LEGEND



WORK AREA

BARRICADE - TYPE I, TYPE II, OR BARREL

BARRICADE - TYPE III

VERTICAL PANEL

WARNING SIGN

DISTANCE BETWEEN SIGNS - A DISTANCE MEASURED IN FEET EQUAL TO A VALUE OF TEN TIMES THE SPEED LIMIT OF THE STREET

FLAGMAN POSITION

SPACING BETWEEN BARRICADES- A DISTANCE MEASURED IN FEET EQUAL TO THE SPEED LIMIT OF THE STREET

L TAPER LENGTH - SEE CHART BELOW

THE TANGENT LENGTH IS EQUAL TO THE TAPER LENGTH FOR A GIVEN STREET.

TAPER REQUIREMENTS

SPEED LIMIT (MPH)	TAPER LENGTH (L) (FEET)			MINIMUM NUMBER OF DEVICES FOR TAPER	MAXIMUM DEVICE SPACING IN FEET	
	10' LANE	11' LANE	12' LANE		ALONG TAPER	AFTER TAPER
20	70	75	80	5	20	20
25	105	115	125	6	25	25
30	150	165	180	7	30	30
35	205	225	245	8	35	35
40	270	295	320	9	40	40
45	450	495	540	13	45	45
50	500	550	600	13	50	50
55	550	605	660	13	55	55

RECOMMENDED SIGN SPACING(D) FOR ADVANCE WARNING SIGN SERIES

SPEED MILES PER HOUR	MINIMUM DISTANCE IN FEET	
	BETWEEN SIGNS	FROM LAST SIGN TO TAPER
0-20	10 X SPEED LIMIT	10 X SPEED LIMIT
25-30	10 X SPEED LIMIT	10 X SPEED LIMIT
30-35	10 X SPEED LIMIT	10 X SPEED LIMIT
40-45	10 X SPEED LIMIT	10 X SPEED LIMIT
50-60	10 X SPEED LIMIT	10 X SPEED LIMIT

TAPER CRITERIA


TYPE OF TAPER	TAPER LENGTH
UPSTREAM TAPER:	
MERGING TAPER	L MINIMUM
SHIFTING TAPER	1/2 L MINIMUM
SHOULDER TAPER	1/2 L MINIMUM
TWO-WAY TRAFFIC TAPER	100 FEET MAXIMUM
DOWNSTREAM TAPERS	100 FEET PER LANE

TAPER LENGTH COMPUTATION

SPEED LIMIT	
40 MPH OR LESS	$L = \frac{WS^2}{60}$
45 MPH OR GREATER	$L = W \times S$

L = TAPER LENGTH  
W = WIDTH OF OFFSET IN FEET  
S = POSTED SPEED OR OFF-PEAK 85-PERCENTILE SPEED IN MPH

SIGN FACE DETAILS

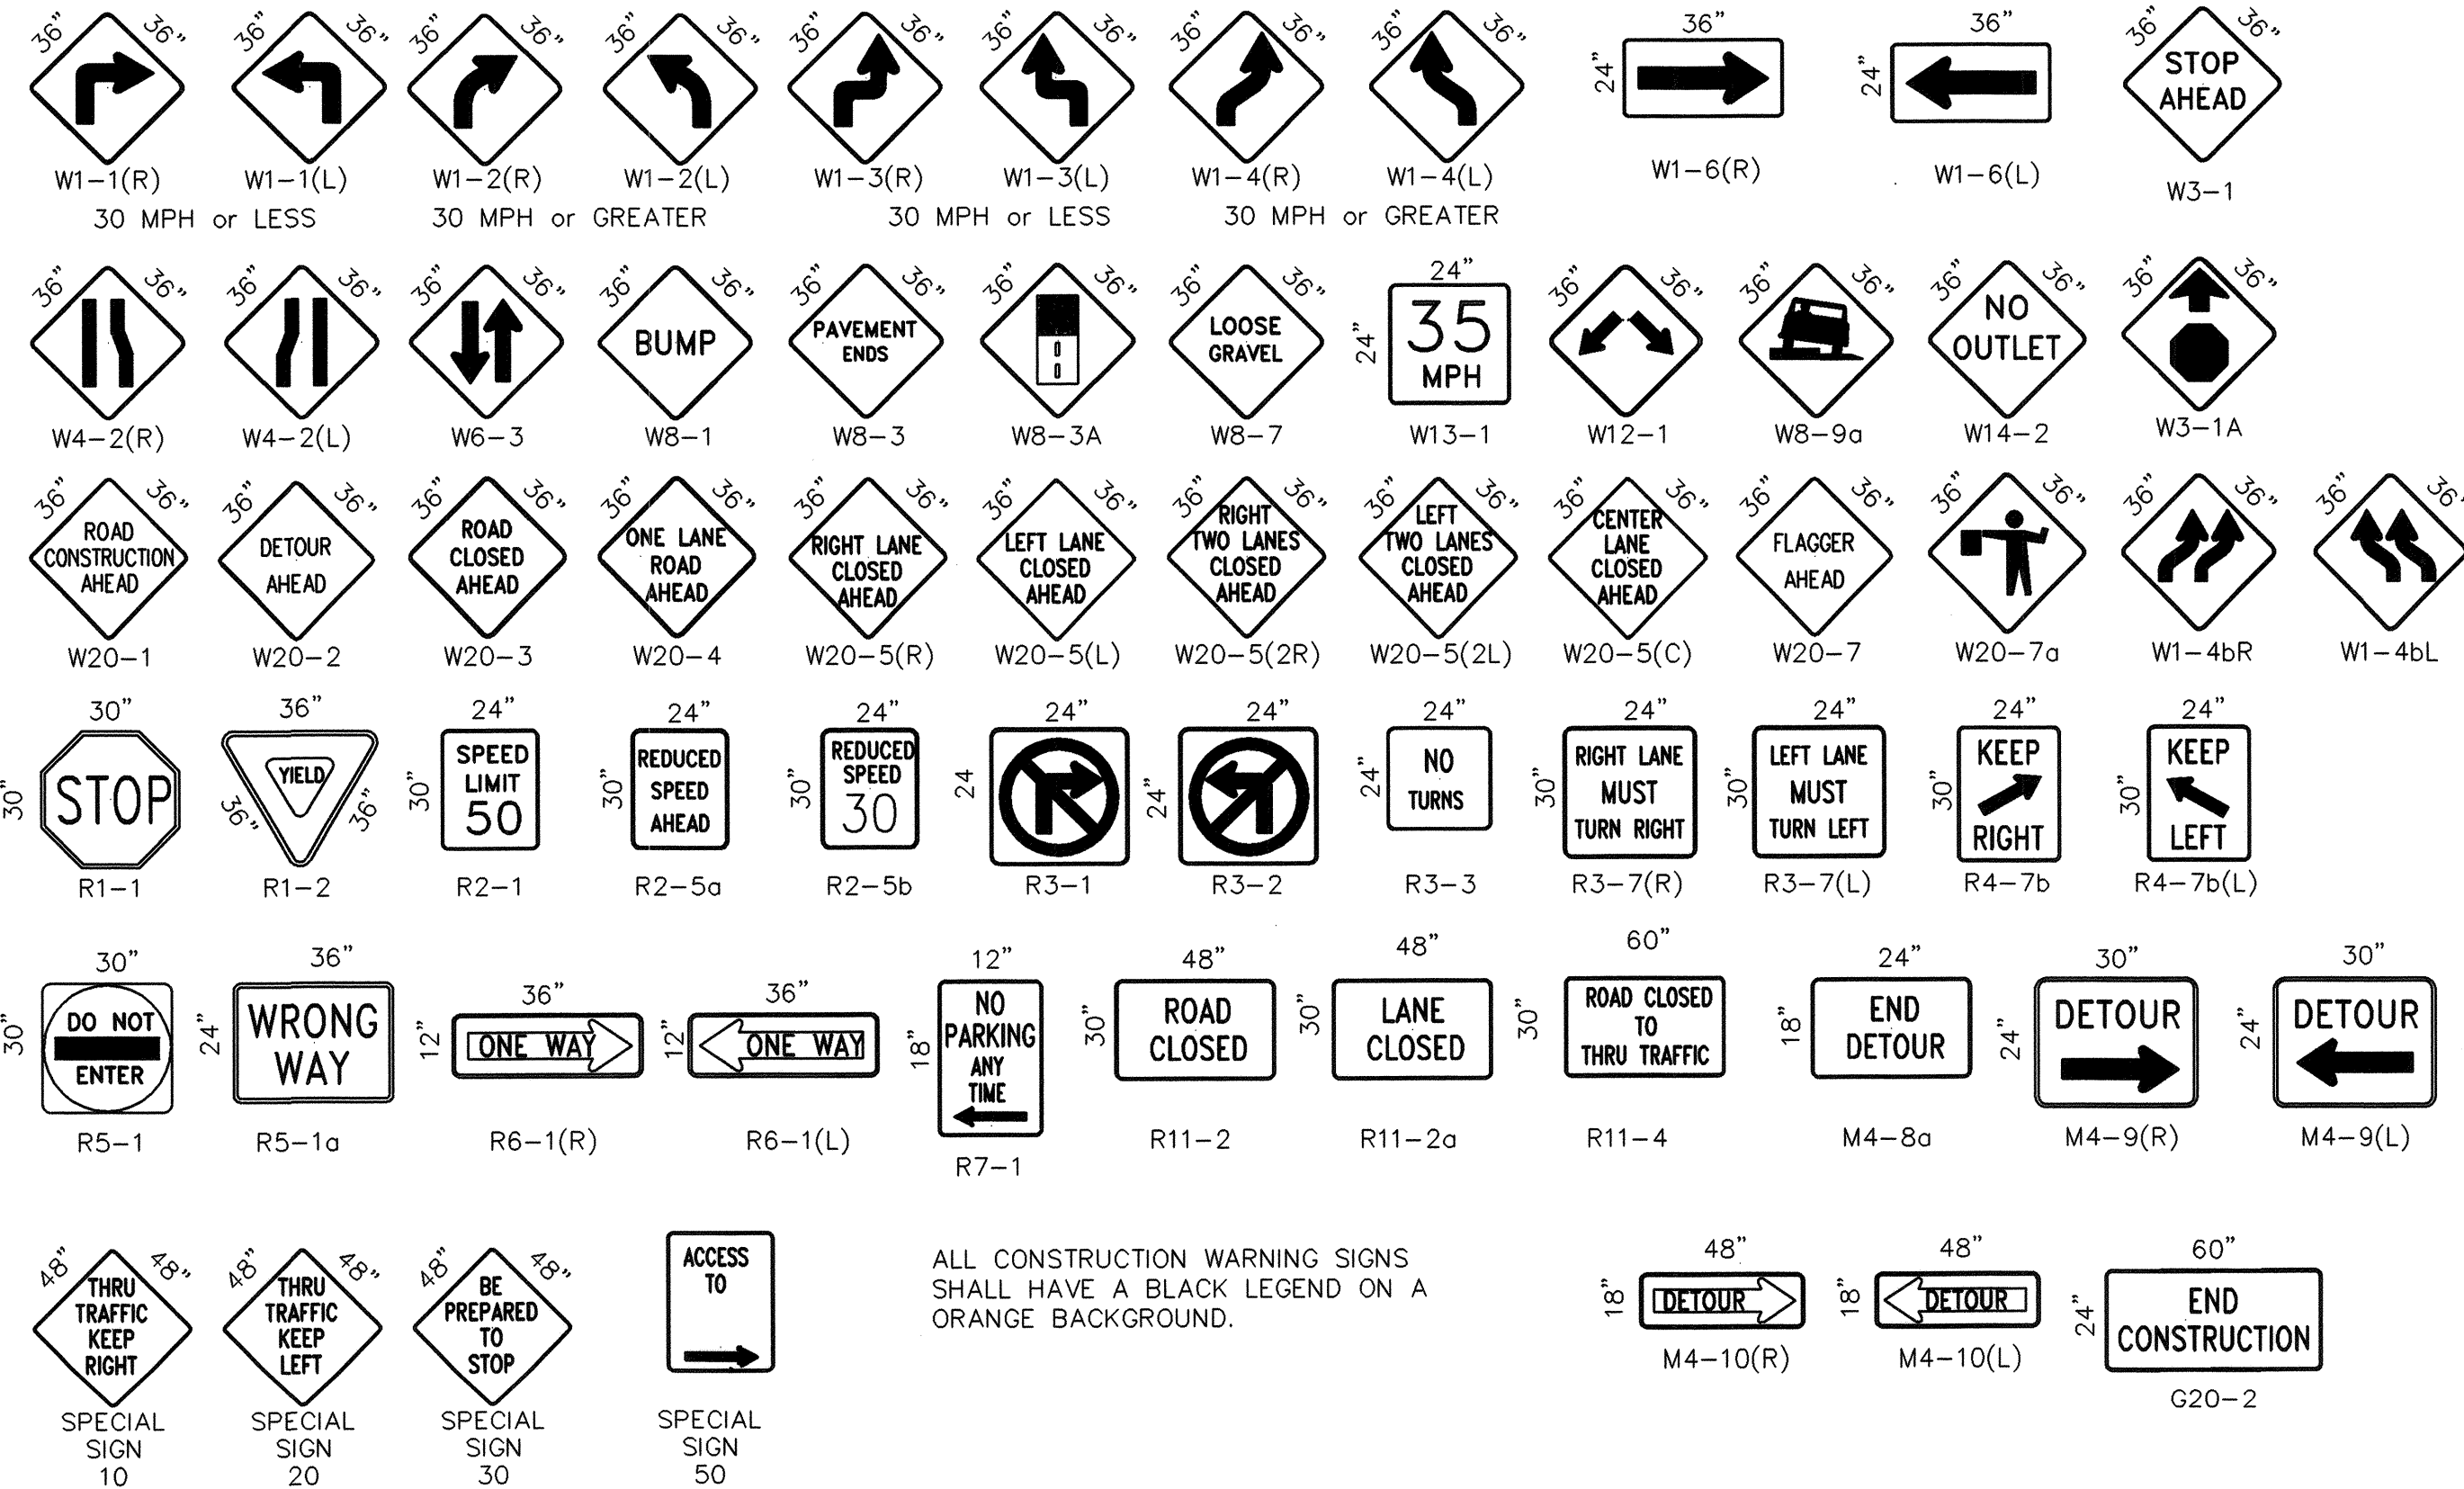

ALL CONSTRUCTION WARNING SIGNS SHALL HAVE A BLACK LEGEND ON A ORANGE BACKGROUND.

AS BUILT INFORMATION		BENCH MARKS		SURVEY INFORMATION		ENGINEER'S SEAL		REMARKS	
CONTRACTOR	DATE	NO.	BY	NO.	BY	NO.	BY	NO.	BY
WORK STAGED BY	DATE	DATE	DATE	DATE	DATE	DATE	DATE	DATE	DATE
FIELD ACCEPTANCE BY	DATE	DATE	DATE	DATE	DATE	DATE	DATE	DATE	DATE
FIELD ACCEPTANCE BY	DATE	DATE	DATE	DATE	DATE	DATE	DATE	DATE	DATE
CORRECTED BY	DATE	DATE	DATE	DATE	DATE	DATE	DATE	DATE	DATE
MICRO-FILM INFORMATION	DATE	DATE	DATE	DATE	DATE	DATE	DATE	DATE	DATE
RECORDED BY	DATE	DATE	DATE	DATE	DATE	DATE	DATE	DATE	DATE
NO.	DATE	DATE	DATE	DATE	DATE	DATE	DATE	DATE	DATE

CITY OF ALBUQUERQUE PUBLIC WORKS DEPARTMENT ENGINEERING DEVELOPMENT GROUP			
TITLE: EMCORE ATR TRAFFIC CONRTOL DETAILS			
DESIGN REVIEW COMMITTEE	CITY ENGINEER APPROVAL	MO./DAY/YR.	MO./DAY/YR.
COA	STD		
PROJECT NO. 654882	MAP NO. M-21	SHEET 9	OF 10

