


**48 HOURS PRIOR TO ANY
EXCAVATION, CONTRACTOR
MUST CONTACT LINE AND
CABLE LOCATING SERVICE
765-1234, FOR LOCATION
OF EXISTING UTILITIES.**



 Area to be removed and paved
 Remove paving and install valley gutter
 Curb and gutter to be removed and replaced
 Existing curb and gutter

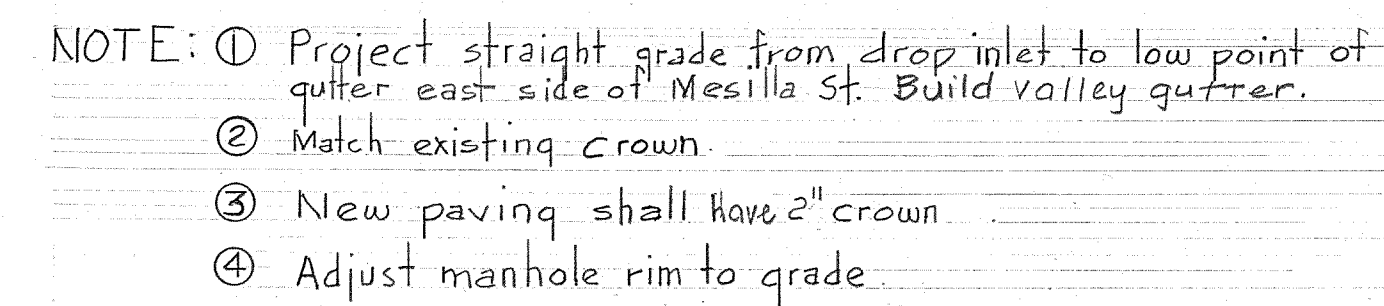

APPROVAL OF AS BUILT DRAWINGS
ASST. CITY ENGINEER - FIELD
[Signature]
DATE *12-8-88*

SHEET OF