

T:\PROJECTS\X0218001\1A\SHEETS\DRG\8001\COV.DWG\2-20-01\MOG

SCANNED BY
MESA REPRO


LOWE'S OF EAST ALBUQUERQUE

CONSTRUCTION PLANS FOR PUBLIC INFRASTRUCTURE IMPROVEMENTS

INDEX

SHEET NO.	DESCRIPTION
1	COVER SHEET
2	PLAT
3	SITE PLAN
4	GRADING AND DRAINAGE PLAN
5	JUAN TABO BOULEVARD PAVING AND UTILITY PLAN & PROFILE
6	CANDELARIA ROAD PAVING AND UTILITY PLAN & PROFILE
7	20' PUBLIC RIGHT-OF-WAY
8	EAST WATERLINE PLAN
9	MISCELLANEOUS DETAILS
10	SIGNING AND CONSTRUCTION TRAFFIC CONTROL STANDARDS
11	TRAFFIC CONTROL SIGNING EXAMPLES

PROJECT LOCATION

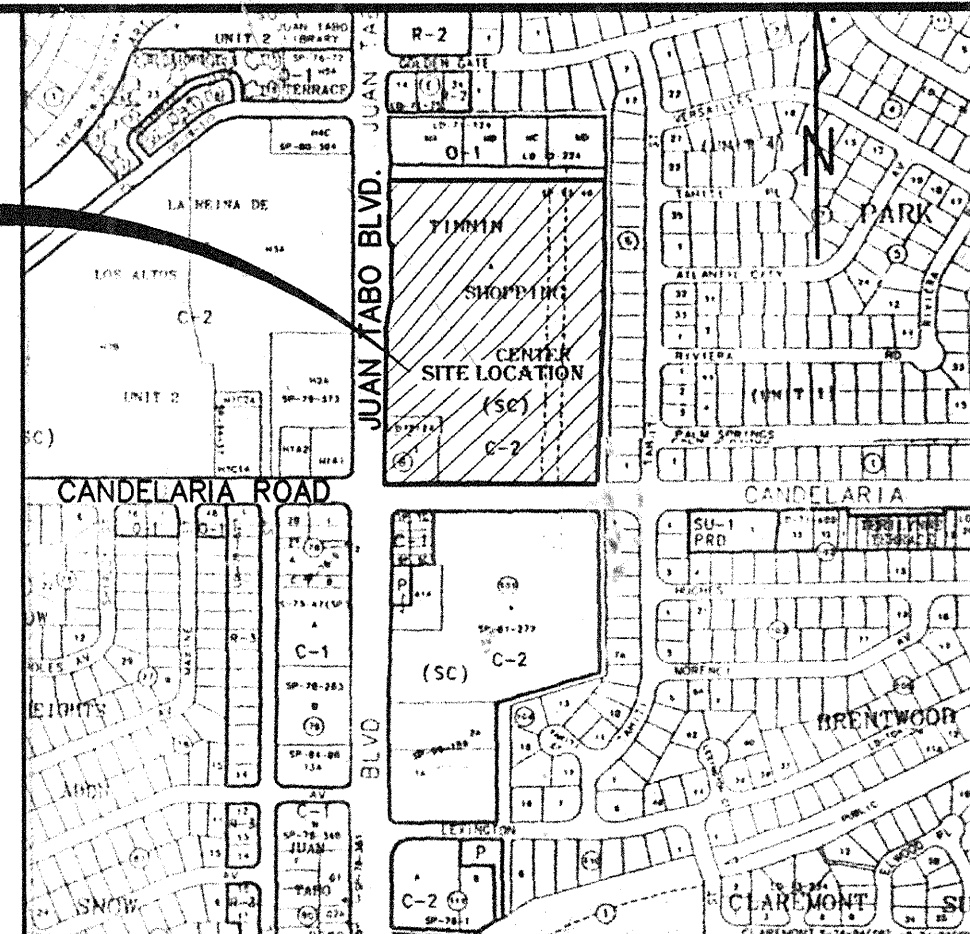

VICINITY MAP
ZONE ATLAS MAP NO. G-22

NOTES

ALL WORK DETAILED ON THESE PLANS TO BE PERFORMED UNDER CONTRACT SHALL, EXCEPT AS OTHERWISE STATED OR PROVIDED FOR HEREON, BE CONSTRUCTED IN ACCORDANCE WITH THE CITY OF ALBUQUERQUE STANDARD SPECIFICATIONS FOR PUBLIC WORKS CONSTRUCTION, 1986 EDITION, AS AMENDED THROUGH UPDATE #6.

THE CONTRACTOR WILL BE RESPONSIBLE FOR COORDINATING THE EXECUTION OF THE WATER VALVE SHUT-OFF PLAN WITH THE WATER SYSTEMS DIVISION (857-8200) FIVE (5) WORKING DAYS IN ADVANCE OF ANY WORK THAT MAY AFFECT EXISTING PUBLIC WATER UTILITIES.

TWO (2) WORKING DAYS PRIOR TO ANY EXCAVATION, THE CONTRACTOR MUST CONTACT NEW MEXICO ONE CALLS SYSTEM (260-1990) FOR LOCATION OF EXISTING UTILITIES.

PRIOR TO CONSTRUCTION, THE CONTRACTOR SHALL EXCAVATE AND VERIFY THE HORIZONTAL AND VERTICAL LOCATIONS OF ALL OBSTRUCTIONS. SHOULD A CONFLICT EXIST, THE CONTRACTOR SHALL NOTIFY THE ENGINEER OR SURVEYOR IMMEDIATELY SO THAT THE CONFLICT CAN BE RESOLVED WITH A MINIMUM AMOUNT OF DELAY.

FIVE (5) WORKING DAYS PRIOR TO BEGINNING CONSTRUCTION, THE CONTRACTOR SHALL SUBMIT TO CONSTRUCTION COORDINATIONS DIVISION A DETAILED CONSTRUCTION SCHEDULE. TWO (2) WORKING DAYS PRIOR TO CONSTRUCTION, THE CONTRACTOR SHALL OBTAIN A BARRICADING PERMIT FROM THE CONST. COORDINATION DIVISION. CONTRACTOR SHALL NOTIFY BARRICADE ENGINEER (768-2551) PRIOR TO OCCUPANCY OF INTERSECTION. REFER TO SECTION 19 OF THE GENERAL CONDITIONS OF THE STANDARD SPECIFICATIONS.

ALL STREET STRIPING ALTERED OR DESTROYED SHALL BE REPLACED WITH PLASTIC REFLECTORIZED PAVEMENT MARKINGS BY CONTRACTOR TO LOCATION AS EXISTING OR AS INDICATED BY THIS PLAN SET.

CONTRACTOR SHALL NOTIFY THE ENGINEER NOT LESS THAN SEVEN (7) DAYS PRIOR TO STARTING WORK IN ORDER THAT THE ENGINEER MAY TAKE NECESSARY MEASURES TO INSURE THE PRESERVATION OF SURVEY MONUMENTS. CONTRACTOR SHALL NOT DISTURB PERMANENT SURVEY MONUMENTS WITHOUT THE CONSENT OF THE ENGINEER AND SHALL NOTIFY THE ENGINEER AND BEAR THE EXPENSE OF REPLACING ANY THAT MAY BE DISTURBED WITHOUT PERMISSION. REPLACEMENT SHALL BE DONE ONLY BY THE CITY SURVEYOR. WHEN A CHANGE IS MADE IN THE FINISHED ELEVATIONS OF THE PAVEMENT OF ANY ROADWAY IN WHICH A PERMANENT SURVEY MONUMENT IS LOCATED, CONTRACTOR SHALL, AT HIS OWN EXPENSE, ADJUST THE MONUMENT COVER TO THE NEW GRADE UNLESS OTHERWISE SPECIFIED. REFER TO SECTION 4.4 OF THE GENERAL CONDITIONS OF THE STANDARD SPECIFICATIONS.

ANY WORK AFFECTING AN ARTERIAL ROADWAY REQUIRES TWENTY-FOUR (24) CONSTRUCTION.

CONTRACTOR SHALL MAINTAIN A GRAFFITI-FREE WORK SITE. CONTRACTOR SHALL PROMPTLY REMOVE ANY GRAFFITI FROM ALL EQUIPMENT, WHETHER PERMANENT OR TEMPORARY.

THE FOLLOWING NOTES ALSO APPLY WHEN CHECKED:

- ☒ ALL UTILITIES AND UTILITY SERVICE LINES SHALL BE INSTALLED PRIOR TO PAVING.
- ☒ BACKFILL COMPACTION SHALL BE ACCORDING TO SPECIFIED STREET USE.
- ☒ TACK COAT REQUIREMENTS SHALL BE DETERMINED BY THE CITY ENGINEER.
- ☒ SIDEWALKS AND WHEELCHAIR RAMPS WITHIN THE CURB RETURNS SHALL BE CONSTRUCTED WHEREVER A NEW CURB RETURN IS CONSTRUCTED.
- ☒ IF CURB IS DEPRESSIONED FOR A DRIVEPAD, THE DRIVEPAD SHALL BE CONSTRUCTED PRIOR TO ACCEPTANCE OF CURB AND CUTTER.
- ☒ ALL STORM DRAINAGE FACILITIES SHALL BE COMPLETED PRIOR TO FINAL ACCEPTANCE.

I, L. BRADFORD SUMRALL, P.E., DO HEREBY CERTIFY THAT THIS PROJECT HAS BEEN CONSTRUCTED AND WILL FUNCTION IN SUBSTANTIAL COMPLIANCE WITH THE DESIGN INTENT AND THE APPROVED PLANS. I CERTIFY THAT THE RECORD DRAWINGS REPRESENT THE AS-BUILT CONDITIONS AS AND FIELD VERIFIED.

L. BRADFORD SUMRALL, P.E.
NMPE NO. 14098

APPROVED AS RECORD DRAWINGS
DESIGN REVIEW SECTION
CITY CONSTRUCTION ENGINEER
DATE 8/14/02

WILSON & COMPANY

2600 THE AMERICAN ROAD SE, SUITE 100
RIO RANCHO, NEW MEXICO 87124
(505) 898-8021

REV	SHEETS	CITY ENGINEER	DATE	USER DEPARTMENT	DATE	USER DEPARTMENT	DATE
2	6	And J. Capin	8/17/01	DRG	8-17-01		
1	2 and 8	And J. Capin	8/17/01	DRG	8/17/01		

ENGINEERS STAMP & SIGNATURE		APPROVALS	ENGINEER	DATE	APPROVED FOR CONSTRUCTION		
		DRG Chairman	And J. Capin	8-17-2001			
		Transportation	And J. Capin	3-29-01			
		Water/Wastewater	And J. Capin	4-03-01			
		Hydrology	And J. Capin	4-5-01			
		Parks	And J. Capin	4-5-01			
		City Project No.	657881	Sheet	1	Of	11

1 2 3 4 5 6 7 8 9 10 11 12 13 14 15
26 65788.81 0102

DRB NO. 1000769
WCEA FILE NO. X0218001



SCANNED BY
MESA REPRO

GRAPHIC SCALE

(IN FEET)


1 inch = 60 ft.

LINE	TABLE	1	2	3	100																																																																																																																																																																																																																																																																																																																																																																																																																																																																																																																																																																																																																																																																																																																																																																																																																																																																																																																																																																																																																										
L3	N10°05'25"E	44.53'	L7	N09°47'39"W	20.00'	L11	N00°00'00"E	66.68'	L15	S00°12'21"W	5.00'	L19	N09°47'39"W	25.44'	L23	N00°38'56"W	9.00'	L27	N00°00'00"E	66.68'	L31	S00°12'21"W	5.00'	L35	N09°47'39"W	25.44'	L39	N00°38'56"W	9.00'	L43	N00°00'00"E	66.68'	L47	S00°12'21"W	5.00'	L51	N09°47'39"W	25.44'	L55	N00°38'56"W	9.00'	L59	N00°00'00"E	66.68'	L63	S00°12'21"W	5.00'	L67	N09°47'39"W	25.44'	L71	N00°38'56"W	9.00'	L75	N00°00'00"E	66.68'	L79	S00°12'21"W	5.00'	L83	N09°47'39"W	25.44'	L87	N00°38'56"W	9.00'	L91	N00°00'00"E	66.68'	L95	S00°12'21"W	5.00'	L99	N09°47'39"W	25.44'	L103	N00°38'56"W	9.00'	L107	N00°00'00"E	66.68'	L111	S00°12'21"W	5.00'	L115	N09°47'39"W	25.44'	L119	N00°38'56"W	9.00'	L123	N00°00'00"E	66.68'	L127	S00°12'21"W	5.00'	L131	N09°47'39"W	25.44'	L135	N00°38'56"W	9.00'	L139	N00°00'00"E	66.68'	L143	S00°12'21"W	5.00'	L147	N09°47'39"W	25.44'	L151	N00°38'56"W	9.00'	L155	N00°00'00"E	66.68'	L159	S00°12'21"W	5.00'	L163	N09°47'39"W	25.44'	L167	N00°38'56"W	9.00'	L171	N00°00'00"E	66.68'	L175	S00°12'21"W	5.00'	L179	N09°47'39"W	25.44'	L183	N00°38'56"W	9.00'	L187	N00°00'00"E	66.68'	L191	S00°12'21"W	5.00'	L195	N09°47'39"W	25.44'	L199	N00°38'56"W	9.00'	L203	N00°00'00"E	66.68'	L207	S00°12'21"W	5.00'	L211	N09°47'39"W	25.44'	L215	N00°38'56"W	9.00'	L219	N00°00'00"E	66.68'	L223	S00°12'21"W	5.00'	L227	N09°47'39"W	25.44'	L231	N00°38'56"W	9.00'	L235	N00°00'00"E	66.68'	L239	S00°12'21"W	5.00'	L243	N09°47'39"W	25.44'	L247	N00°38'56"W	9.00'	L251	N00°00'00"E	66.68'	L255	S00°12'21"W	5.00'	L259	N09°47'39"W	25.44'	L263	N00°38'56"W	9.00'	L267	N00°00'00"E	66.68'	L271	S00°12'21"W	5.00'	L275	N09°47'39"W	25.44'	L279	N00°38'56"W	25.44'	L1367	N00°38'56"W	9.00'	L1371	N00°00'00"E	66.68'	L1375	S00°12'21"W	5.00'	L1379	N09°47'39"W	25.44'	L1383	N00°38'56"W	9.00'	L1387	N00°00'00"E	66.68'	L1391	S00°12'21"W	5.00'	L1395	N09°47'39"W	25.44'	L1399	N00°38'56"W	9.00'	L1403	N00°00'00"E	66.68'	L1407	S00°12'21"W	5.00'	L1411	N09°47'39"W	25.44'	L1415	N00°38'56"W	9.00'	L1419	N00°00'00"E	66.68'	L1423	S00°12'21"W	5.00'	L1427	N09°47'39"W	25.44'	L1431	N00°38'56"W	9.00'	L1435	N00°00'00"E	66.68'	L1439	S00°12'21"W	5.00'	L1443	N09°47'39"W	25.44'	L1447	N00°38'56"W	9.00'	L1451	N0

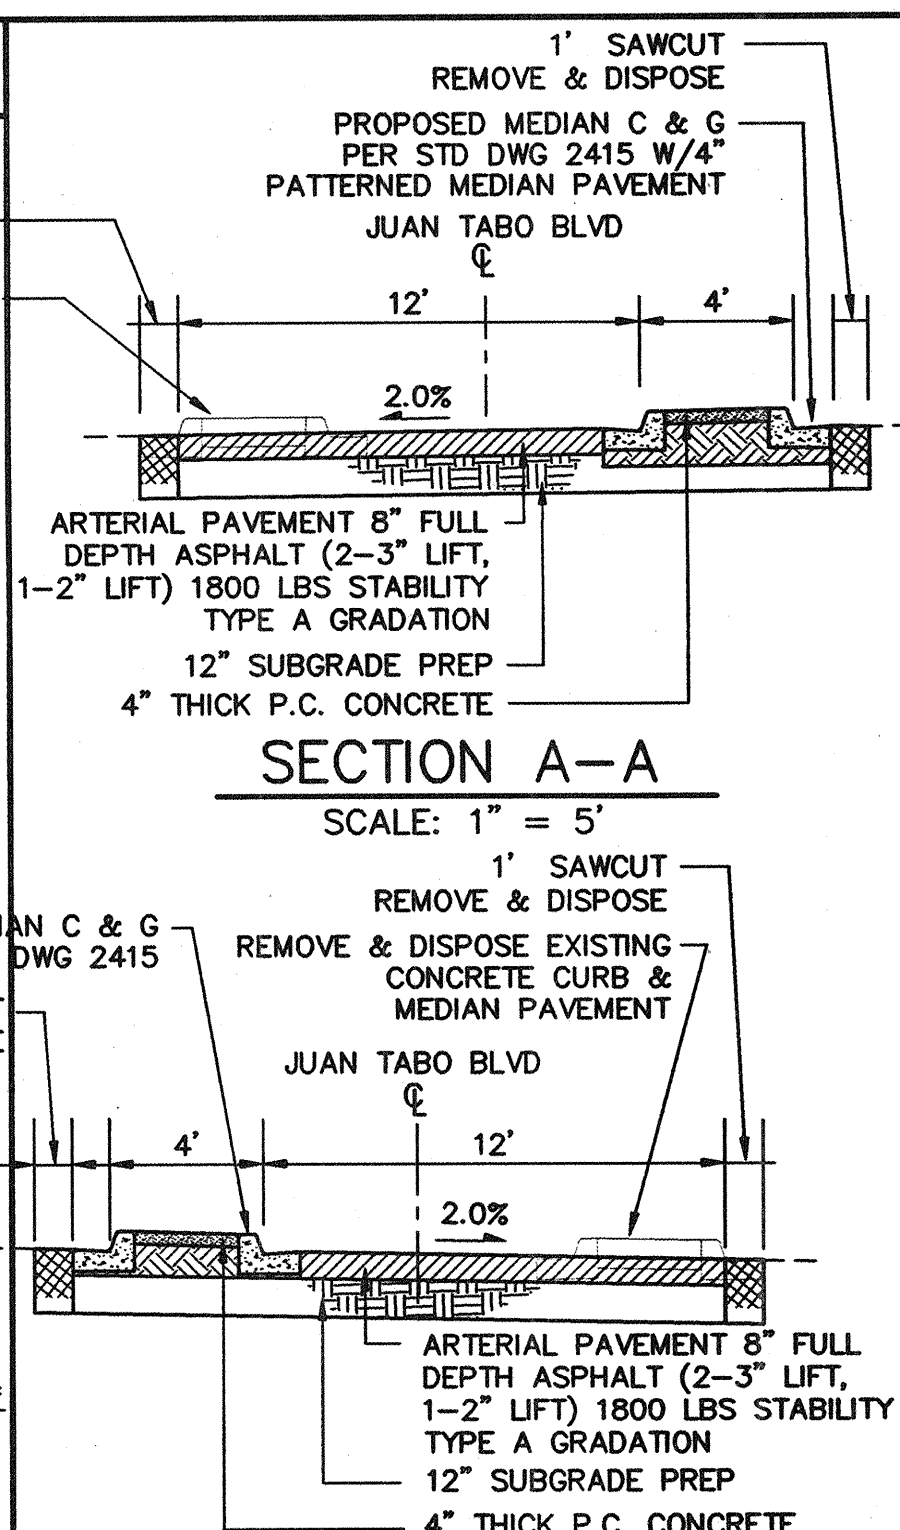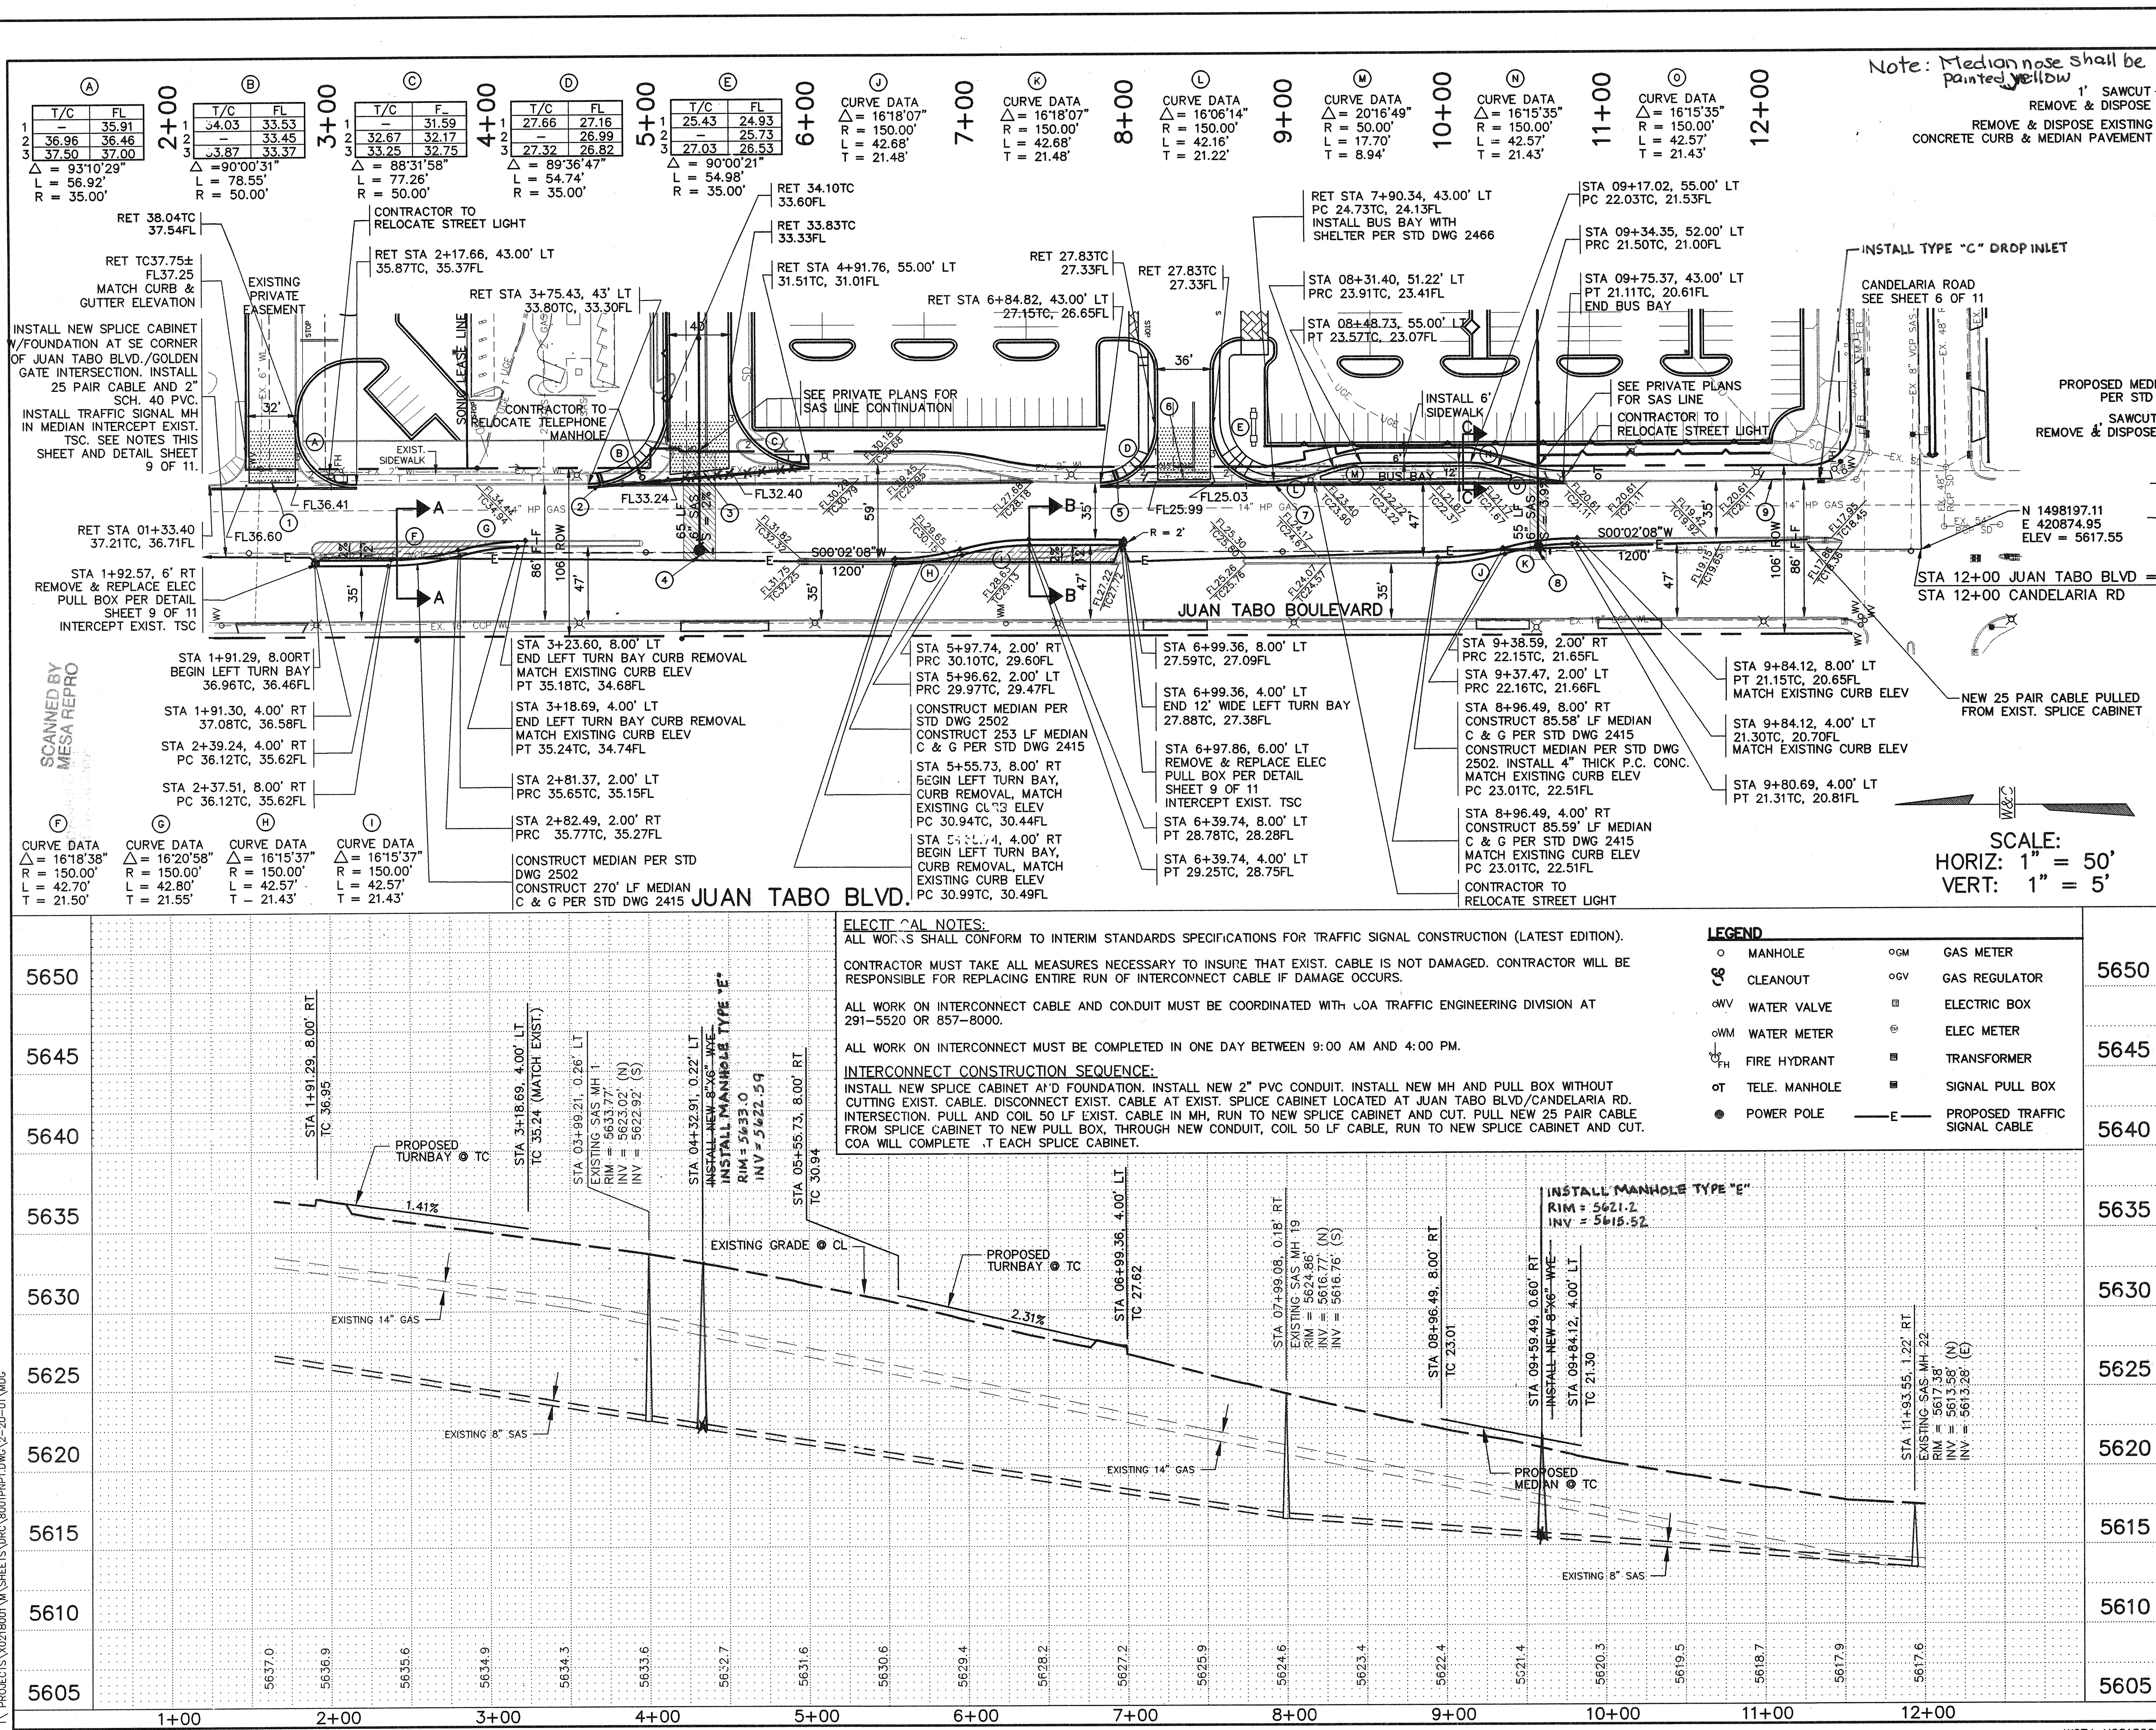

NOTES

- STA 01+64.75 MAKE NEAT CUT IN EXIST. PAVEMENT 1' FROM GUTTER LIP. REMOVE & DISPOSE 225 SY EXIST. PAVEMENT, 34 LF EXIST. C & G, 44 SY EXIST. SIDEWALK & WCR. CONSTRUCT VALLEY GUTTER PER STD DWG 2420. CONSTRUCT 32' WIDE PRIVATE ENTRANCE PER STD DWG 2426. SEE SHEET 9 OF 11 FOR HEAVY DUTY PAVEMENT DETAIL.
- STA 03+71.69 INSTALL 12" SIDEWALK CULVERT PER STD DWG 2236. FL INV 33.33, TC 33.83.
- STA 04+32.94 MAKE NEAT CUT IN EXIST. PAVEMENT 1' FROM GUTTER LIP. REMOVE & DISPOSE 211 SY EXIST. PAVEMENT, 120 LF EXIST. C & G, 58 SY EXIST. SIDEWALK & WCR. CONSTRUCT VALLEY GUTTER PER STD DWG 2420. CONSTRUCT 40' WIDE PRIVATE ENTRANCE PER STD DWG 2426. SEE SHEET 9 OF 11 FOR HEAVY DUTY PAVEMENT DETAIL.
- STA 04+32.91 INSTALL NEW 8"x6" WYE WITH 45° ELBOW ON BRANCH LINE WITH RESTRAINED JOINTS. REMOVE & REPLACE 55 SY EXIST. ARTERIAL PAVEMENT PER STD DWG 2465. INSTALL MANHOLE TYPE "E" RIM = 5633.0 INV = 5622.59
- STA 06+95.42 INSTALL 12" SIDEWALK CULVERT PER STD DWG 2236. FL INV 26.75 TC 27.25.
- STA 07+37.29 MAKE NEAT CUT IN EXIST. PAVEMENT 1' FROM GUTTER LIP. REMOVE & DISPOSE 130 SY EXIST. SIDEWALK, 36 SY DRIVEPAD. CONSTRUCT VALLEY GUTTER PER STD DWG 2420. CONSTRUCT 36' WIDE PRIVATE ENTRANCE PER STD DWG 2426. SEE SHEET 9 OF 11 FOR HEAVY DUTY PAVEMENT DETAIL.
- STA 07+90.34 MAKE NEAT CUT IN EXIST. PAVEMENT 1' FROM GUTTER LIP. REMOVE & DISPOSE 20 SY EXIST. PAVEMENT, 95 SY EXIST. SIDEWALK, 36 SY DRIVEPAD. 140 LF EXIST. C & G. INSTALL BUS BAY WITH SHELTER PER STD DWG 2466. SEE SHEET 9 OF 11 FOR SECTION C-C.
- STA 09+59.49 INSTALL NEW 8"x6" WYE WITH 45° ELBOW ON BRANCH LINE WITH RESTRAINED JOINTS. REMOVE & REPLACE 65 SY EXIST. ARTERIAL PAVEMENT PER STD DWG 2465. INSTALL MANHOLE TYPE "E" RIM = 5621.2 INV = 5615.52
- REMOVE & DISPOSE EXIST. DRIVEPAD. INSTALL STD C & G AND 4" SIDEWALK.

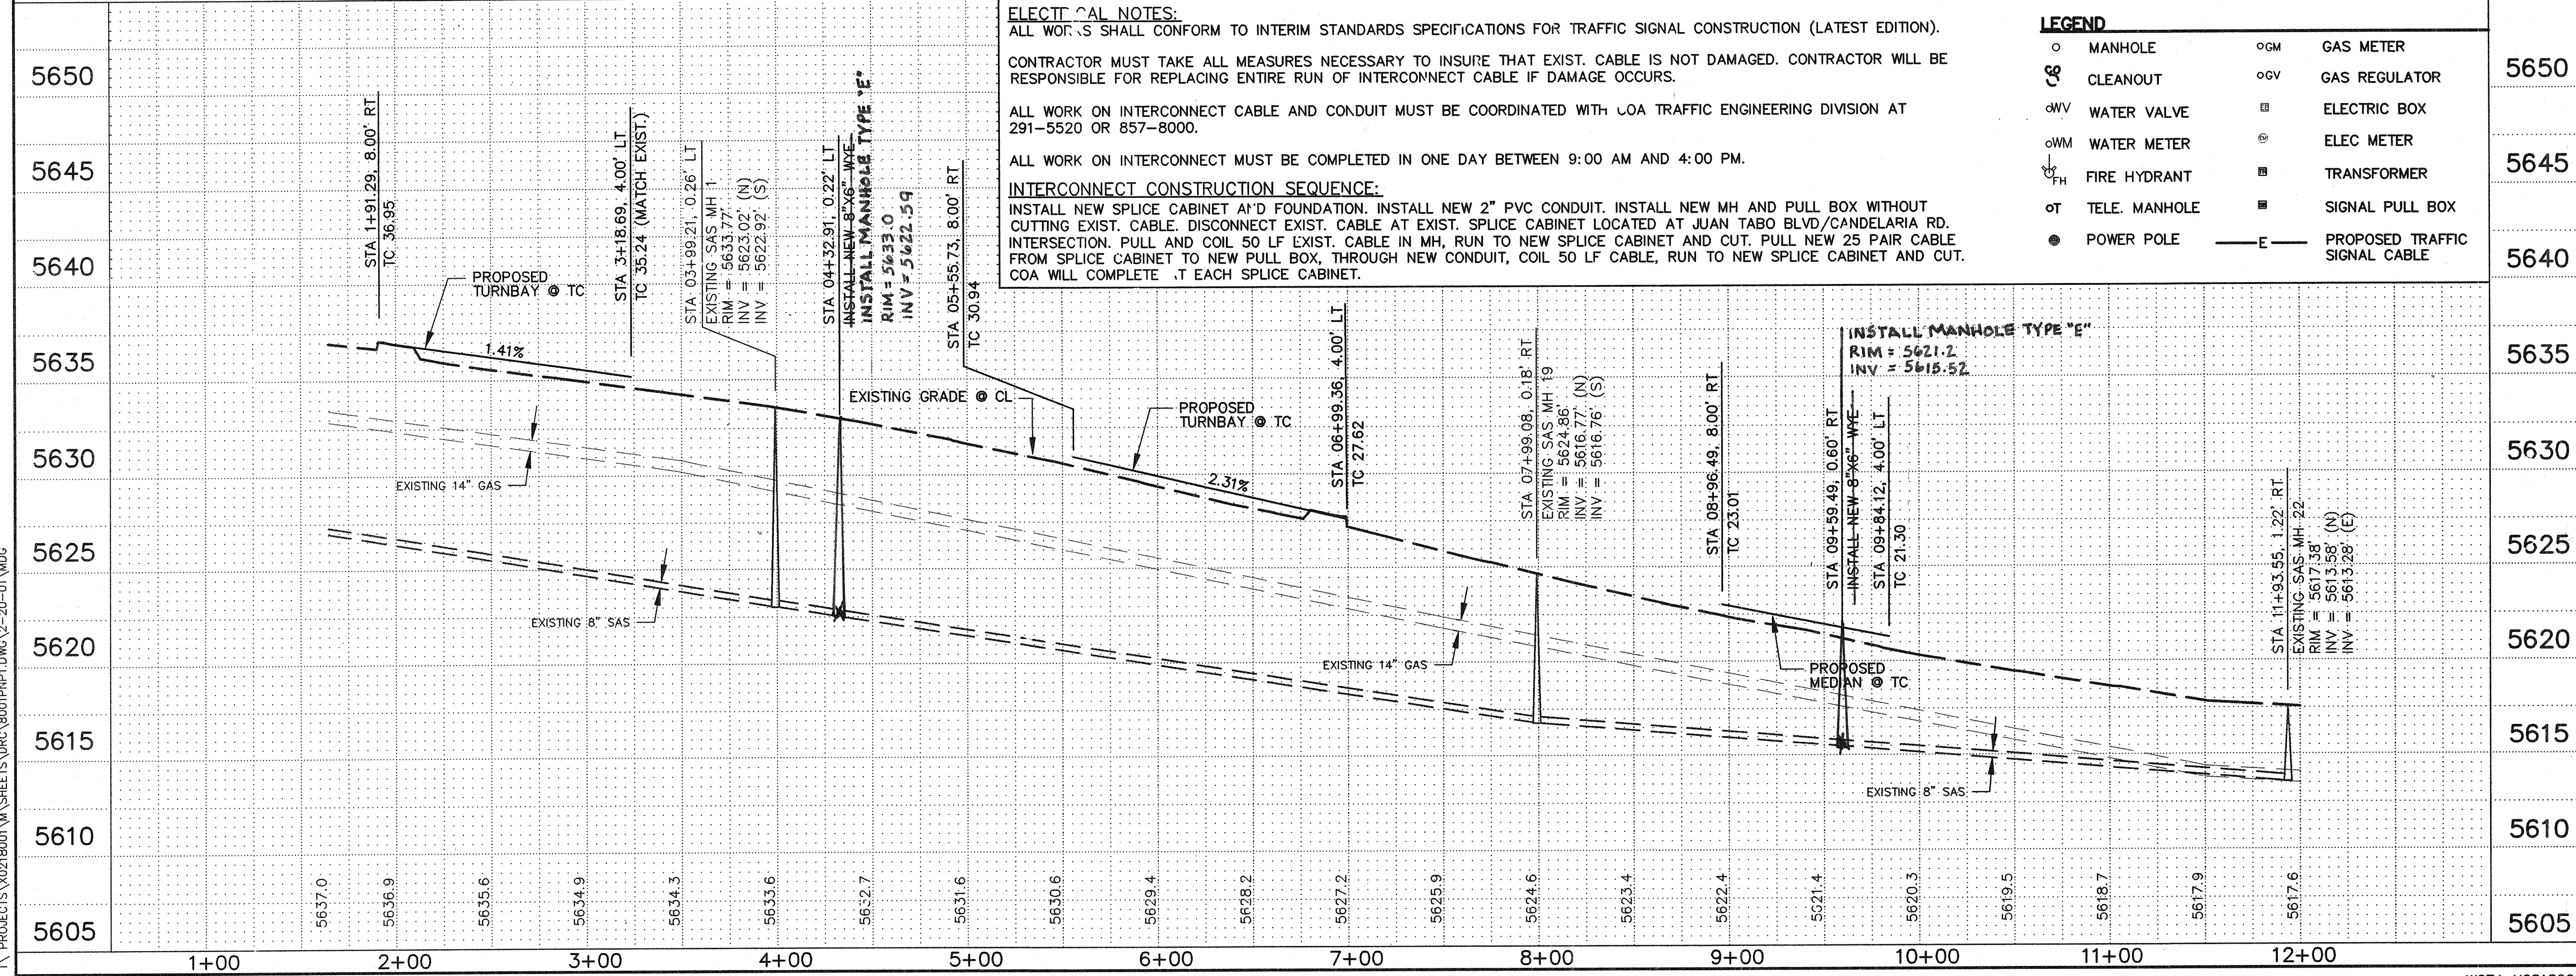

PROJECTS	NO.	DATE	BY	REVISIONS	DATE	BY	REMARKS
WILSON & COMPANY, ENGINEERS & ARCHITECTS	DESIGNED BY	BMS	DATE FEB 2001				
	DRAWN BY	MDG	DATE FEB 2001				
	CHECKED BY	LBS	DATE FEB 2001				

City Project No.

657881

Zone Map No.

G-22

Sheet

5

Of

11

AS-BUILT INFORMATION

CONTRACTOR

WCEA

DATE

07/2002

VERIFIED BY

WCEA

DATE

07/2002

RECORDED BY

WCEA

DATE

07/2002

BENCH MARKS

THE STATION IS LOCATED 8.3 MILES NORTHEAST OF JUAN TABO BOULEVARD AT THE INTERSECTION OF JUAN TABO BOULEVARD, N.E. & COMANCHE RD. N.E. TO REACH THE STATION FROM THE INTERCHANGE AT I-40 AND JUAN TABO BOULEVARD, GO NORTH ON JUAN TABO 3.2 MILES TO THE STATION ON THE WALL. THE STATION MARK IS A STANDARD ACS BRASS TABLET STAMPED "ACS 2-621-A 1978", DILLED INTO THE TOP OF THE CONCRETE CURB.

ELEVATION = 5666.13 FT

ENGINEER'S SEAL

NEW MEXICO

REGISTERED PROFESSIONAL ENGINEER

14986

3/1/01

CITY OF ALBUQUERQUE

PUBLIC WORKS DEPARTMENT

ENGINEERING GROUP

LOWE'S OF EAST ALBUQUERQUE

PAVING AND UTILITY PLAN & PROFILE

JUAN TABO BOULEVARD

Design Review Committee

City Engineer Approval

Last Design Update

Mo./Day/Yr.

Mo./Day/Yr.

City Project No.

657881

Zone Map No.

G-22

Sheet




5

Of



11


WILSON & COMPANY

26 6578.81 0502

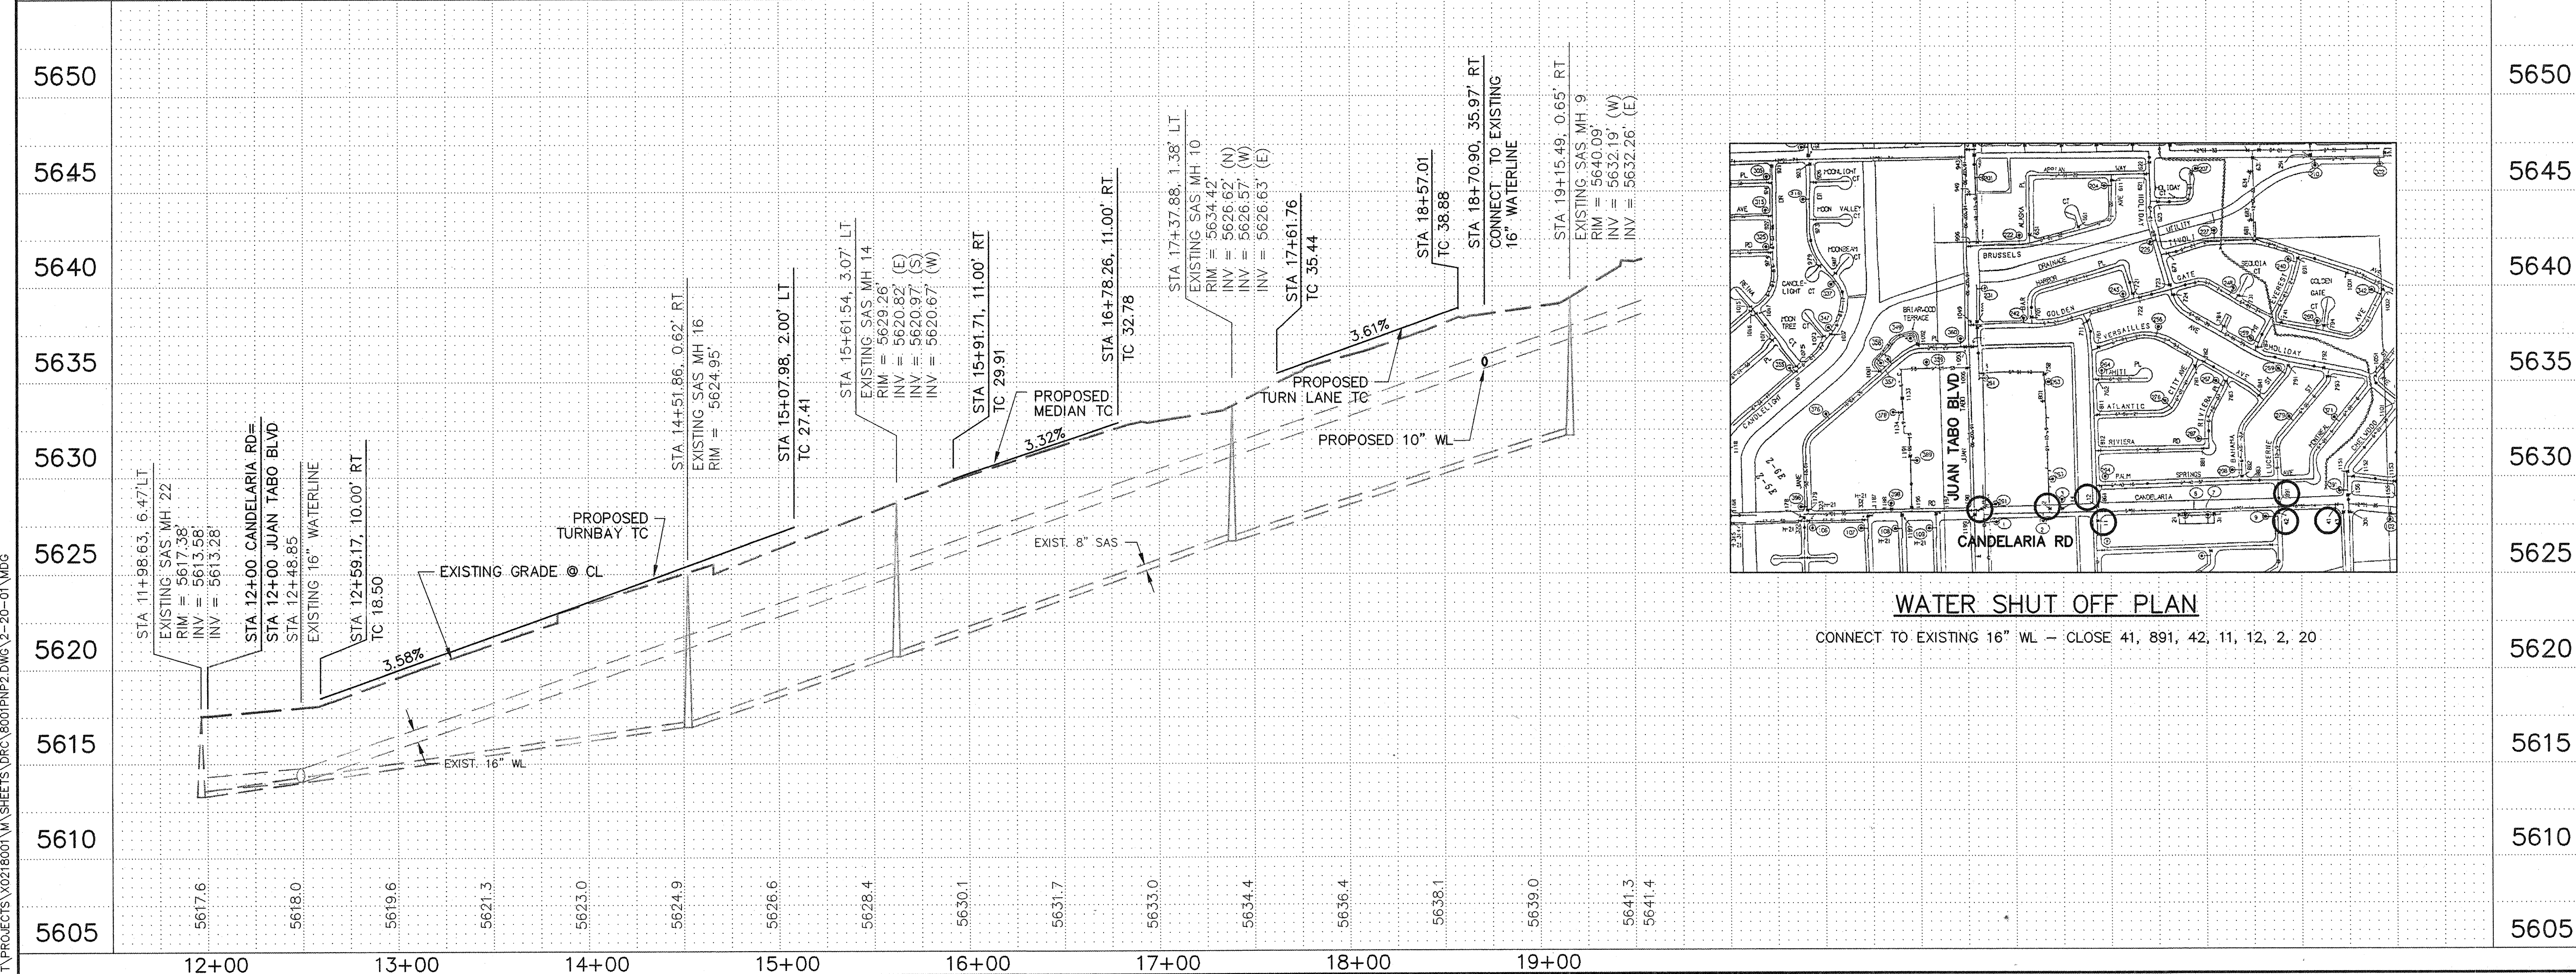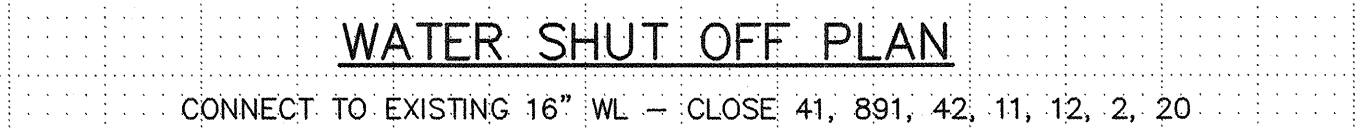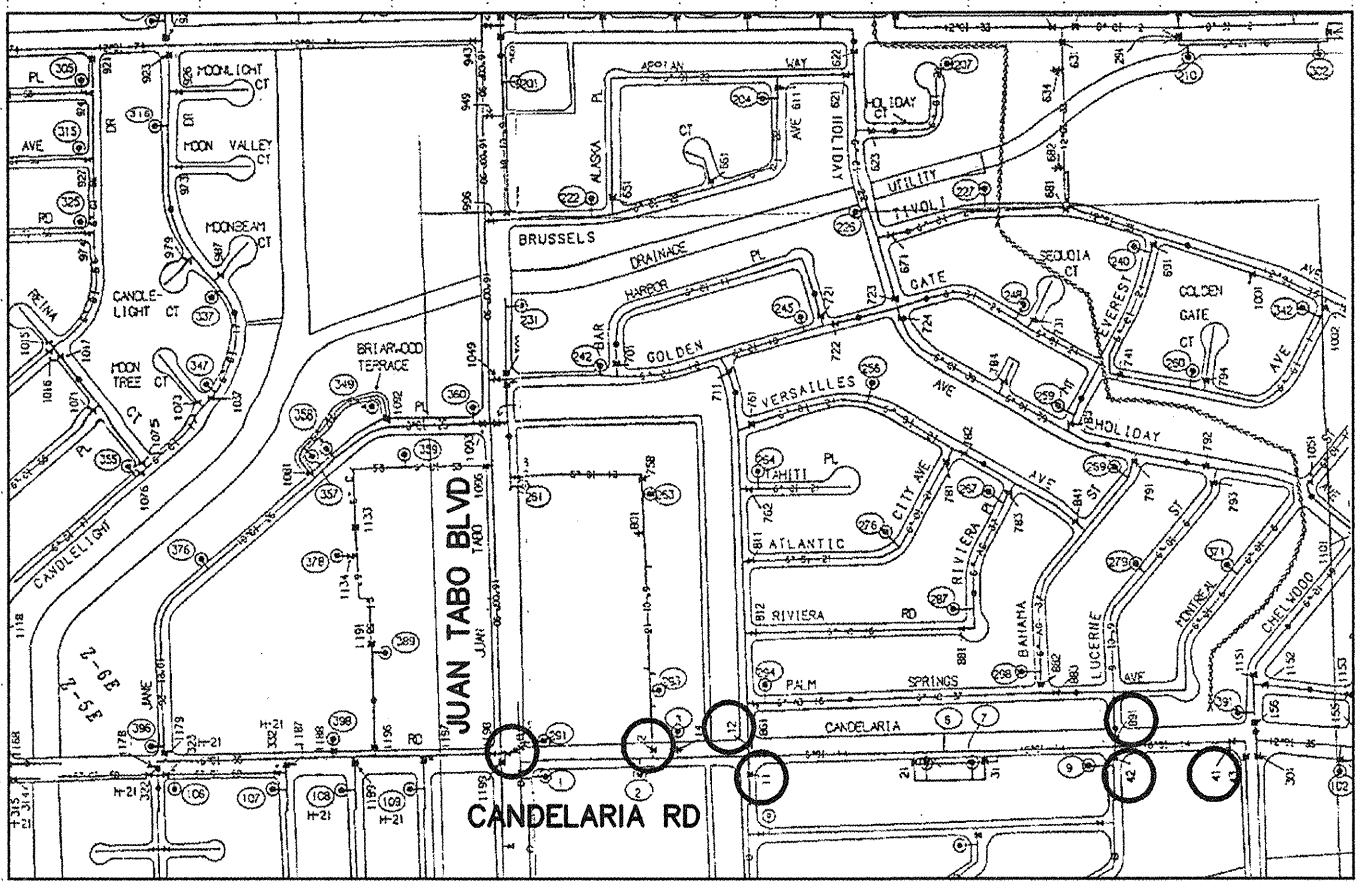


NOTES																
①	REMOVE AND DISPOSE EXIST. DRIVEPAD. INSTALL STD C & G AND 4" SIDEWALK PER STD DWG 2430.		AS-BUILT INFORMATION				CONTRACTOR	GERALD MARTIN			DATE	07/20/2001				
②	CONSTRUCT MEDIAN PER STD DWG 2502. CONSTRUCT 257 LF MEDIAN C & G PER STD DWG 2415.						INSPECTED BY	WCEA			DATE	07/20/2001				
③	STA 15+43.39 MAKE NEAT CUT IN EXIST. PAVEMENT 1' FROM GUTTER LIP. REMOVE & DISPOSE 102 SY EXIST. PAVEMENT, 95 LF EXIST. C & G, 64 SY EXIST. SIDEWALK. CONSTRUCT VALLEY GUTTER PER STD DWG 2420. CONSTRUCT 36' WIDE PRIVATE ENTRANCE PER STD DWG 2426. SEE SHEET 9 OF 11 FOR HEAVY DUTY PAVEMENT. INSTALL TYPE "D" (DOUBLE) INLET						FIELD ENGINEER BY	<i>COAL Rance</i>			DATE	07/20/2001				
④	REMOVE & DISPOSE TYPE "C" INLET. CONNECT PROPOSED 18" RCP SD. TO EXIST. 18" RCP SD WITH 20 LF CONCRETE ENGAGEMENT PER STD DWG 2146. INV ELEV = 5621.72'						TRANSMITTED BY	WCEA			DATE	07/20/2001				
⑤	REMOVE AND DISPOSE 880 LF EXISTING ASPHALT C & G AND 645 SY MEDIAN PAVEMENT. REPLACE ASPHALT PER DETAIL SECTION D-D.		BENCH MARKS				THE STATION IS LOCATED 8.3 MILES NORTHEAST OF TOWN ALBUQUERQUE AT THE INTERSECTION OF JUAN TABO BLVD. N.E. & COMANCHE RD. N.E. TO REACH THE STATION FROM THE INTERCHANGE AT I-40 AND JUAN TABO BLVD. GO NORTH ON JUAN TABO 3.2 MILES TO THE STATION ON THE MALL. THE STATION MARK IS A STANDARD ACS BRASS TABLET STAMPED "ACS 2-G21-A 1978", FILLED INTO THE TOP OF THE CONCRETE CURB. ELEVATION = 5666.13 FT									
⑥	STA 16+12.21, 34' LT REMOVE & DISPOSE TYPE "C" INLET. INSTALL TYPE "D" (DOUBLE) INLET.										SURVEY INFORMATION		FIELD NOTES		ENGINEER'S SEAL	
⑦	STA 16+17.90, 45' LT INSTALL TYPE "C" DOUBLE STORM INLET PER STD DWG 2265. TC ELEV = 5629.83' INV ELEV = 5624.80'															
⑧	STA 16+67.91, 45' LT INSTALL TYPE "C" DOUBLE STORM INLET PER STD DWG 2265. TC ELEV = 5631.57' INV ELEV = 5625.90' END 45 LF 18" RCP SD.															
⑨	CONSTRUCT MEDIAN PER SECTION E-E. CONSTRUCT 242 LF MEDIAN C & G PER STD DWG 2415. PAVE MEDIAN UP TO 5' WIDE W/4" P.C. CONCRETE. BACKFILL W/DIRT TO TOP OF CURB.		REVISIONS		NO. DATE		REMARKS		DESIGNED BY		DATE FEB 2001					
⑩	STA 17+17.37, 43' LT INSTALL TYPE "C" DOUBLE INLET PER STD DWG 2265. TC ELEV = 5633.52' INV ELEV = 5627.75'															
⑪	STA 17+28.22, 43.00' LT INSTALL 6" CAP WITH RESTRAINED JOINTS. ABANDON 6" WL IN PLACE.															
⑫	STA 17+38.36, 43.00' LT INSTALL 8" CAP WITH RESTRAINED JOINTS. ABANDON 8" SAS IN PLACE.		REVISIONS		NO. DATE		REMARKS		DESIGNED BY		DATE FEB 2001					
⑬	REMOVE AND DISPOSE EXIST. ASPHALT C & G AND MEDIAN PAVEMENT. SEE SHEET 9 OF 11 FOR SECTION G-G. STRIPE TURN LANES WITH SOLID WHITE LINE AND WHITE TURN ARROWS.															
⑭	REMOVE AND DISPOSE 35 LF EXIST. C & G AND 13 SY SIDEWALK. SEE SHEET 7 OF 11 FOR DRIVE PAD DETAIL.															
⑮	STA 18+77.34 MAKE NEAT CUT IN EXIST. PAVEMENT 1' FROM GUTTER LIP. REMOVE & DISPOSE 12 SY EXIST. PAVEMENT, 42 SY EXIST. SIDEWALK. CONSTRUCT VALLEY GUTTER PER STD DWG 2420. CONSTRUCT 40' WIDE PRIVATE ENTRANCE PER STD DWG 2426. SEE SHEET 9 OF 11 FOR HEAVY DUTY PAVEMENT DETAIL.		REVISIONS		NO. DATE		REMARKS		DESIGNED BY		DATE FEB 2001					
⑯	STA 18+70.90, 35.97' RT REMOVE AND REPLACE 75 SY OF ARTERIAL PAVEMENT PER STD DWG 2465. INSTALL 1 - PRESSURE CONNECTION, 1 - 16"x16"x10" TEE W/BLOCKING, 1 - 10" GATE VALVE WITH TYPE "A" BOX, 80 LF 10" WL WITH RESTRAINED JOINTS.															
⑰	LEGEND															
○	MANHOLE	○GM	GAS METER	REVISIONS		NO. DATE		REMARKS		DESIGNED BY		DATE FEB 2001				
○	CLEANOUT	○GV	GAS REGULATOR													
○WV	WATER VALVE	⊞	ELECTRIC BOX													
○WM	WATER METER	⊞	ELEC METER													
○FH	FIRE HYDRANT	⊞	TRANSFORMER	REVISIONS		NO. DATE		REMARKS		DESIGNED BY		DATE FEB 2001				
○OT	TELE. MANHOLE	⊞	SIGNAL PULL BOX													
●	POWER POLE															
CITY OF ALBUQUERQUE PUBLIC WORKS DEPARTMENT ENGINEERING GROUP																
LOWE'S OF EAST ALBUQUERQUE PAVING AND UTILITY PLAN & PROFILE CANDELARIA ROAD																
Design Review Committee				City Engineer Approval				Last Design Update		Mo./Day/Yr.		Mo./Day/Yr.				
AUG 17 2001								Mo./Day/Yr.		Mo./Day/Yr.						
								Mo./Day/Yr.		Mo./Day/Yr.						
								Mo./Day/Yr.		Mo./Day/Yr.						
								Mo./Day/Yr.		Mo./Day/Yr.						
City Project No.				Zone Map No.				Sheet		Of						
657881				G--22				6		11						

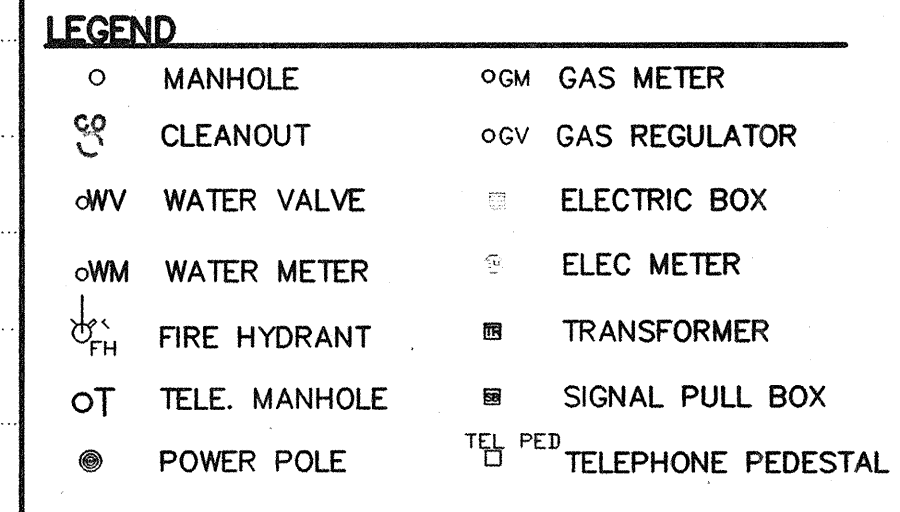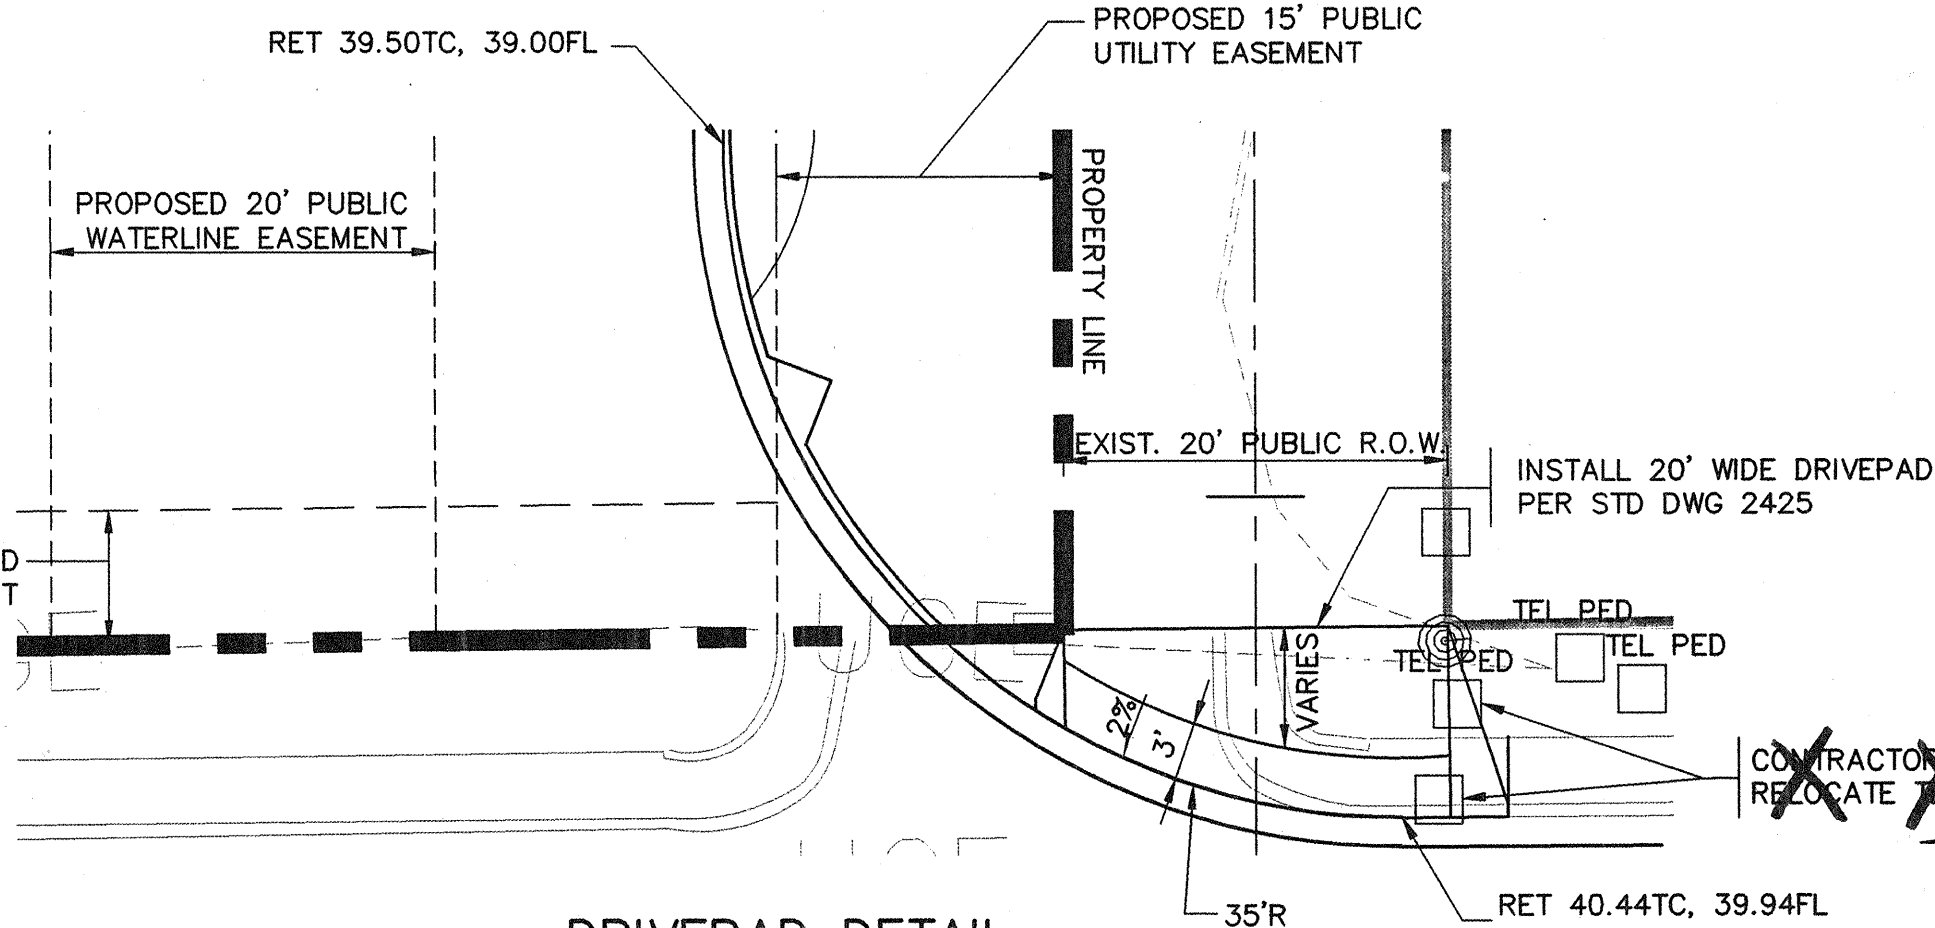


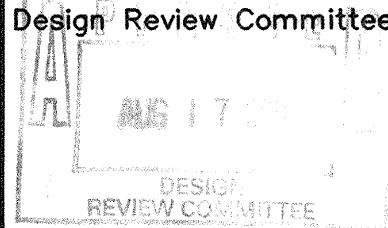CITY OF ALBUQUERQUE PUBLIC WORKS DEPARTMENT ENGINEERING GROUP				
LOWE'S OF EAST ALBUQUERQUE PAVING PLAN & PROFILE 20' PUBLIC RIGHT-OF-WAY				
	City Engineer Approval	Last Design Update	Mo./Day/Yr.	Mo./Day/Yr.
City Project No. 657881	Zone Map No. G-22	Sheet 7	Of 11	


T:\PROJECTS\X0218001\AS SHEETS\DRG\001DET.DWG (2-20-01) MDG

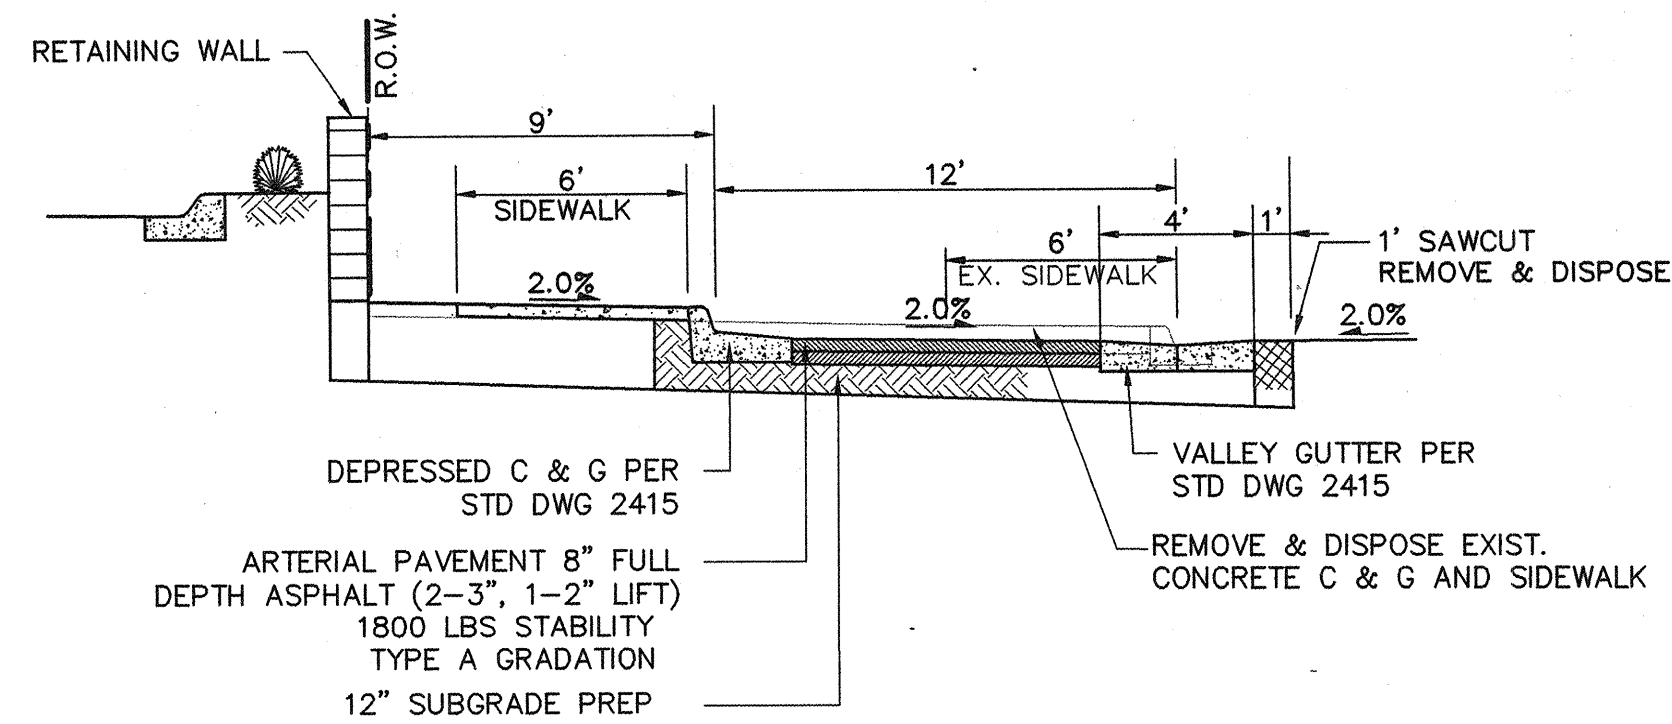


SECTION C-C
BUS BAY TYPICAL SECTION
SCALE: 1" = 50'

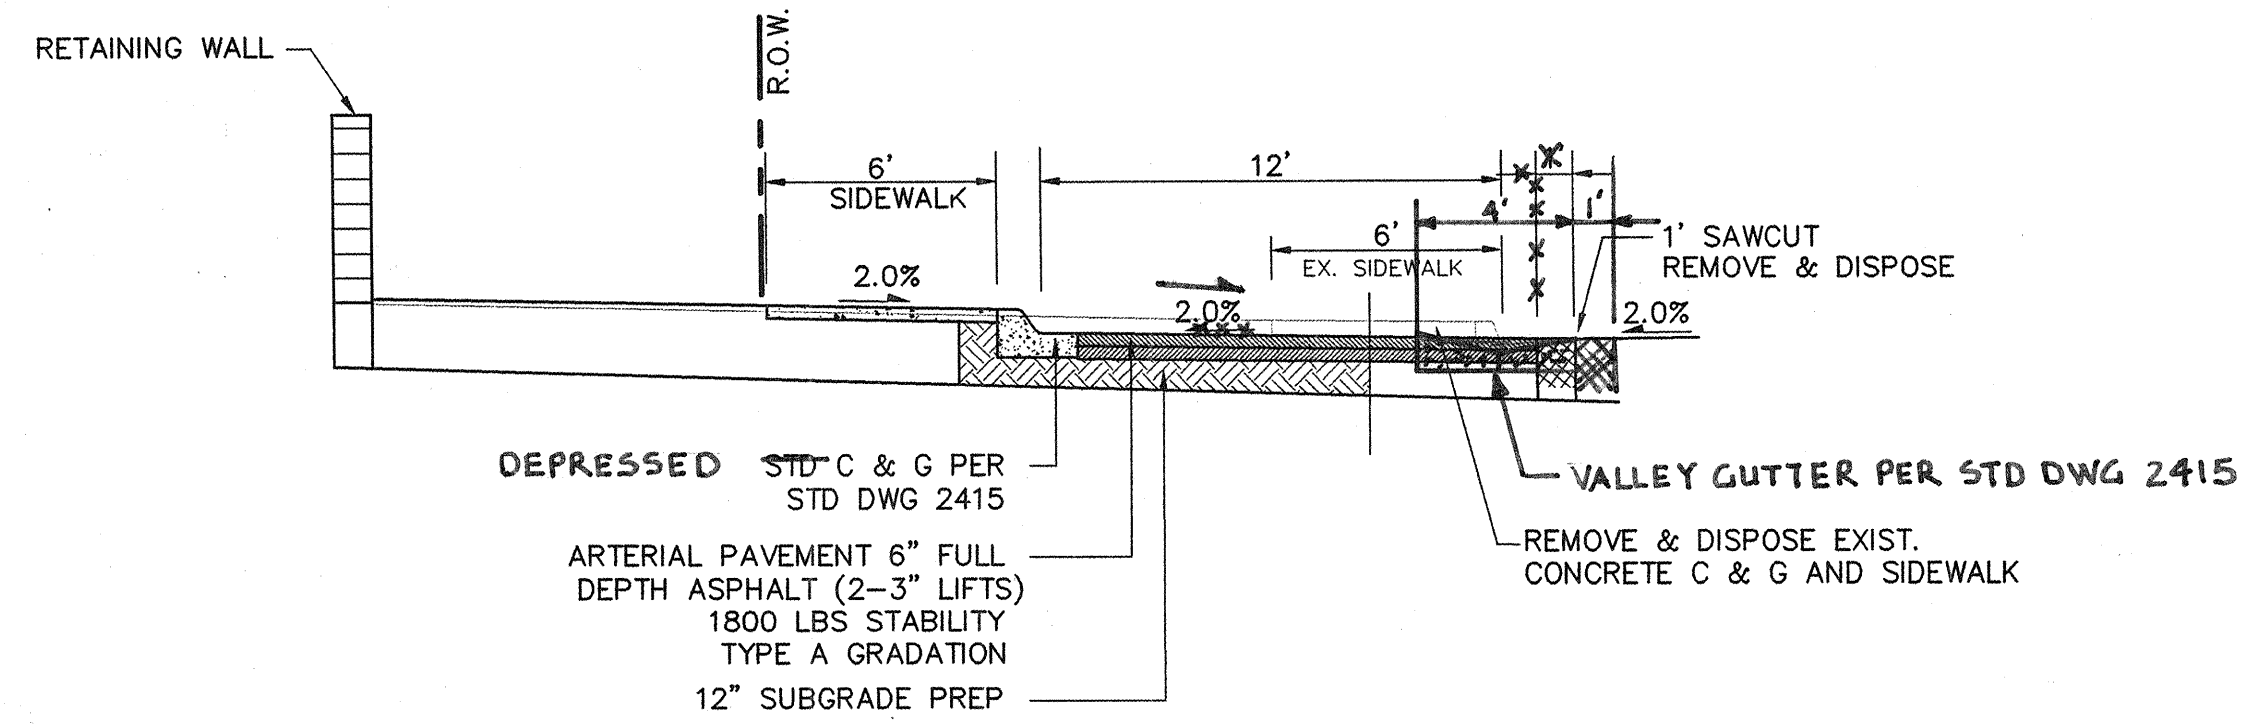

SECTION F-F
DECELERATION LANE
SCALE: 1" = 50'

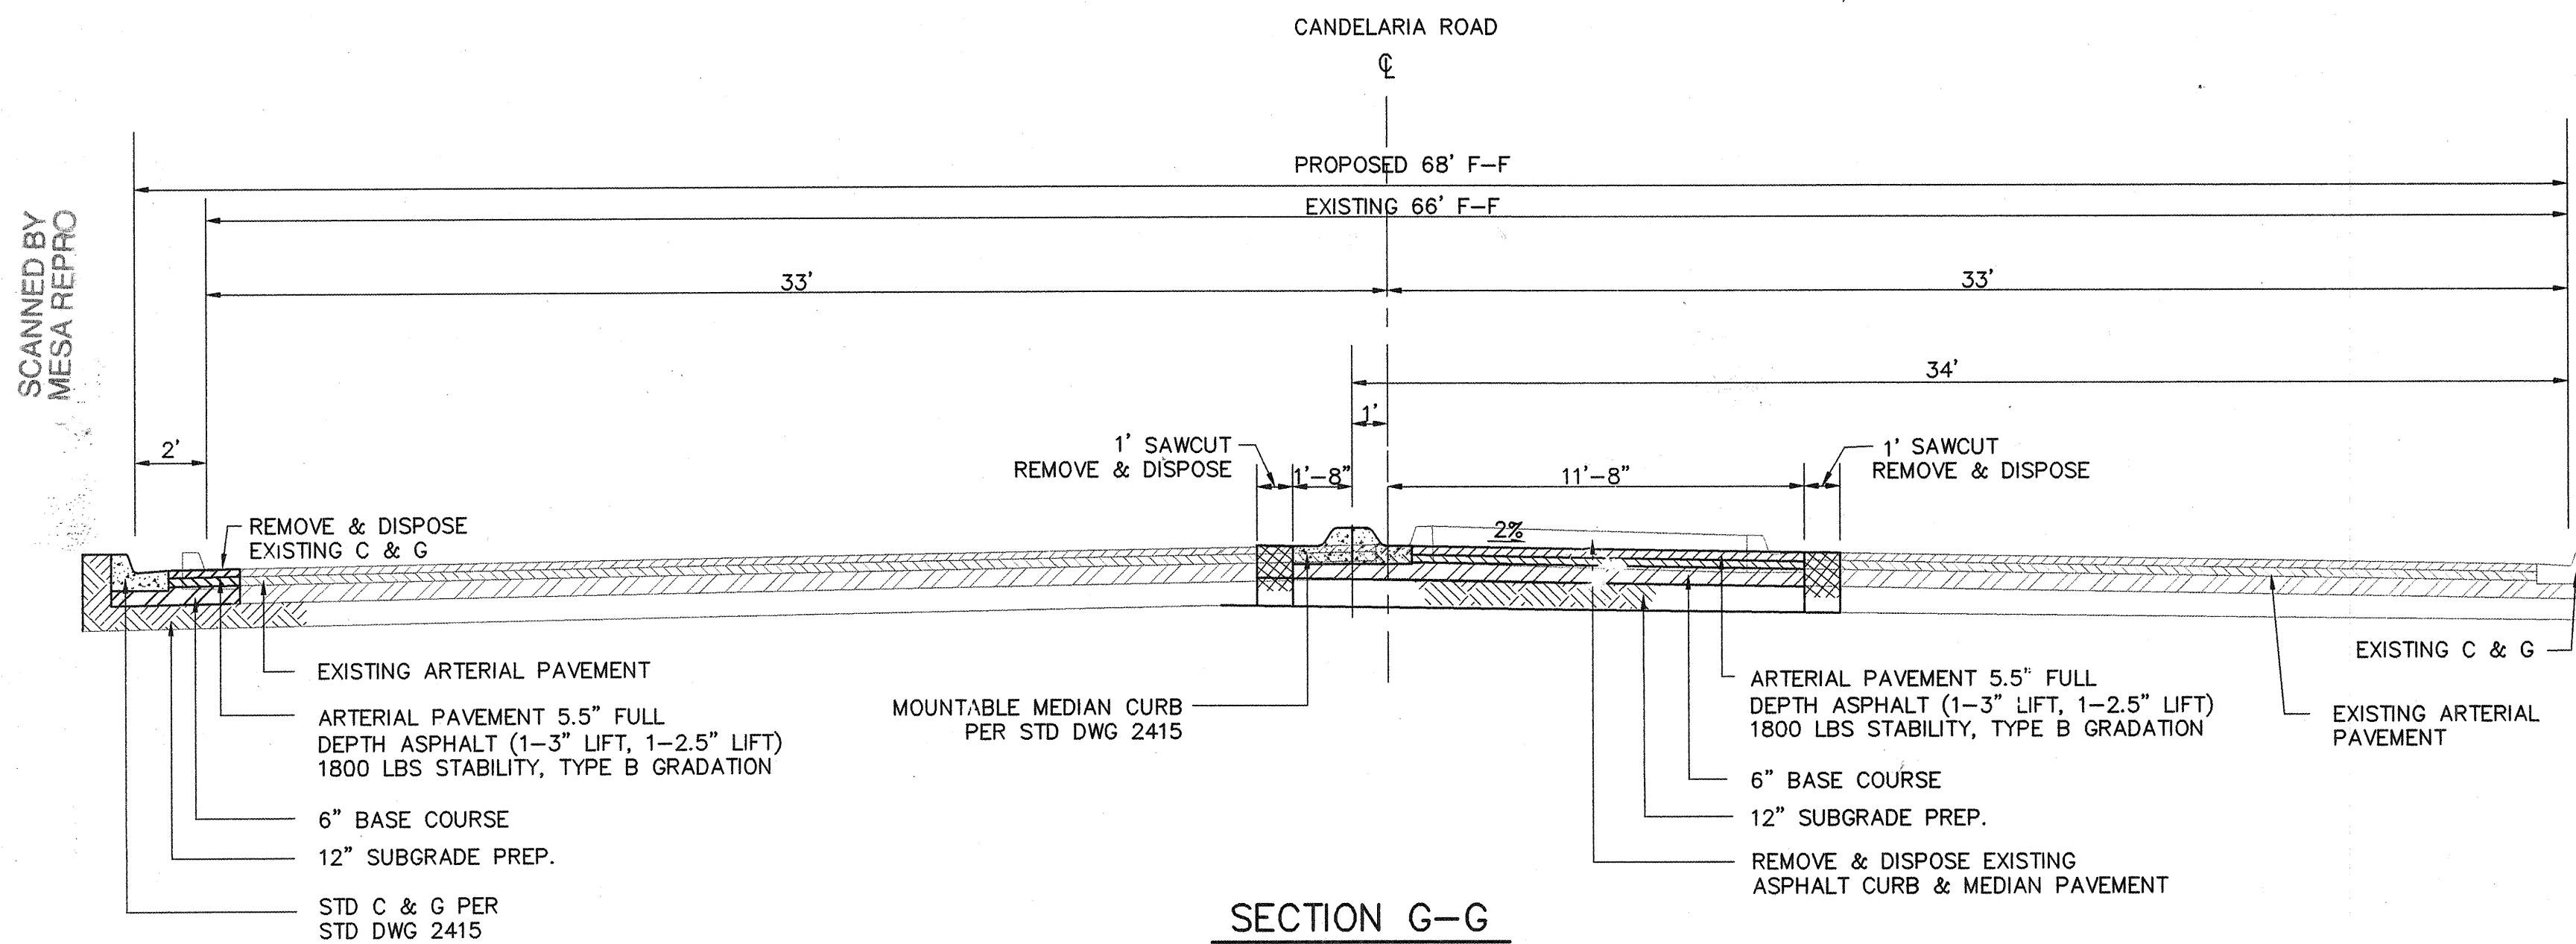


SECTION G-G
SCALE: 1" = 40'

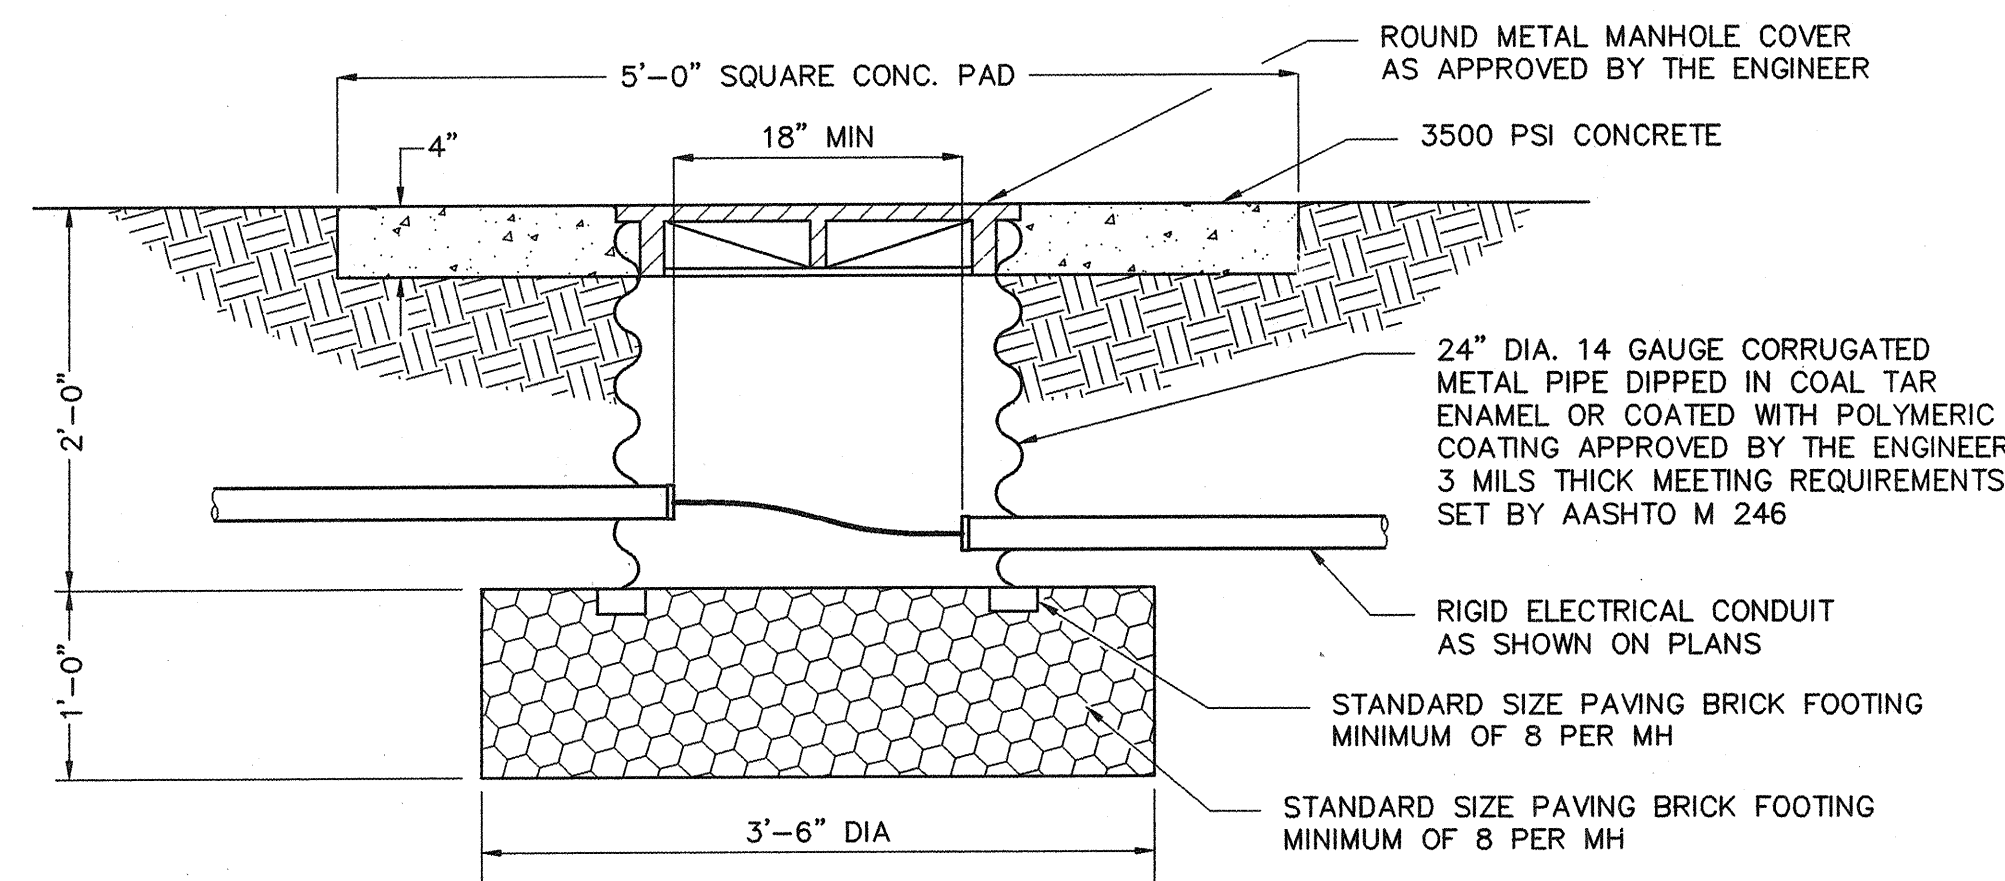


TRAFFIC SIGNAL MANHOLE (TYPICAL)
SCALE: 1" = 1'

NOTES FOR HEAVY DUTY REINFORCED POLYMER MORTAR PULL BOXES AND COVERS

1. MATERIAL TO BE AN AGGREGATE CONSISTING OF SAND AND GRAVEL BOUND TOGETHER WITH A POLYMER AND REINFORCED WITH CONTINUOUS WOVEN GLASS STRANDS. THE MATERIAL MUST HAVE THE FOLLOWING MECHANICAL PROPERTIES: COMPRESSIVE STRENGTH - 11000 PSI FLEXURAL STRENGTH - 7500 PSI
2. ALL PULL BOX COVERS SHALL BE HEAVY DUTY REINFORCED POLYMER MORTAR, HAVING A SERVICE LOAD OF 22568 LBS OVER 10" SQUARE (225 PSI).
3. PULL BOX TYPE AND LOGO SHALL BE APPROVED BY THE PROJECT MANAGER.
4. THE DIMENSIONS OF THE PULL BOX SHOWN ARE NOMINAL DIMENSIONS AND MAY VARY AS TO THE MANUFACTURER'S RECOMMENDATIONS. ALL DIMENSIONS SHALL BE VERIFIED BY THE PROJECT MANAGER.

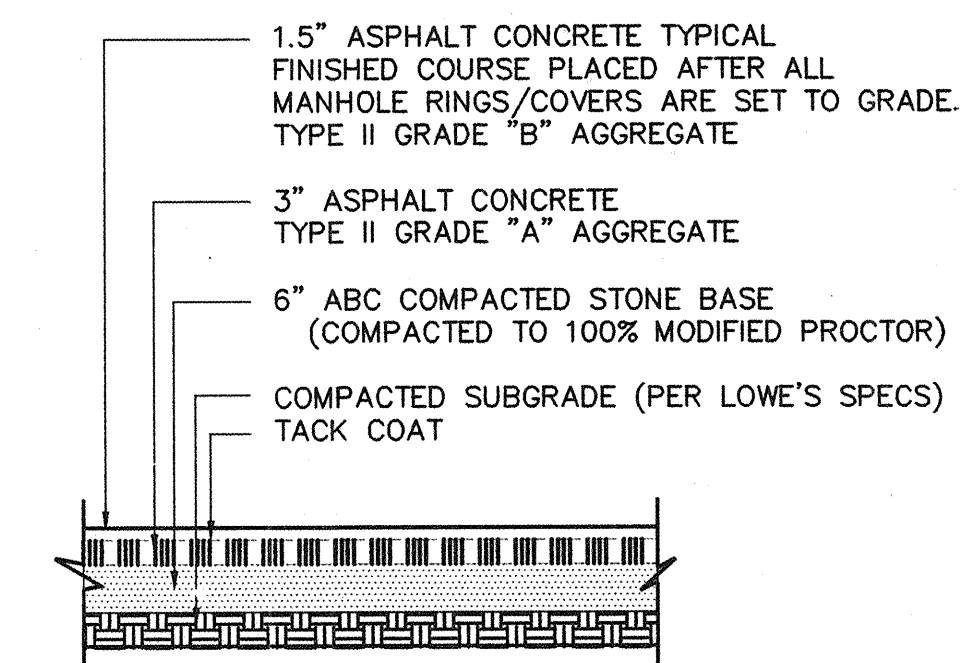

HEAVY DUTY ASPHALT PAVING
SCALE: 1" = 1'

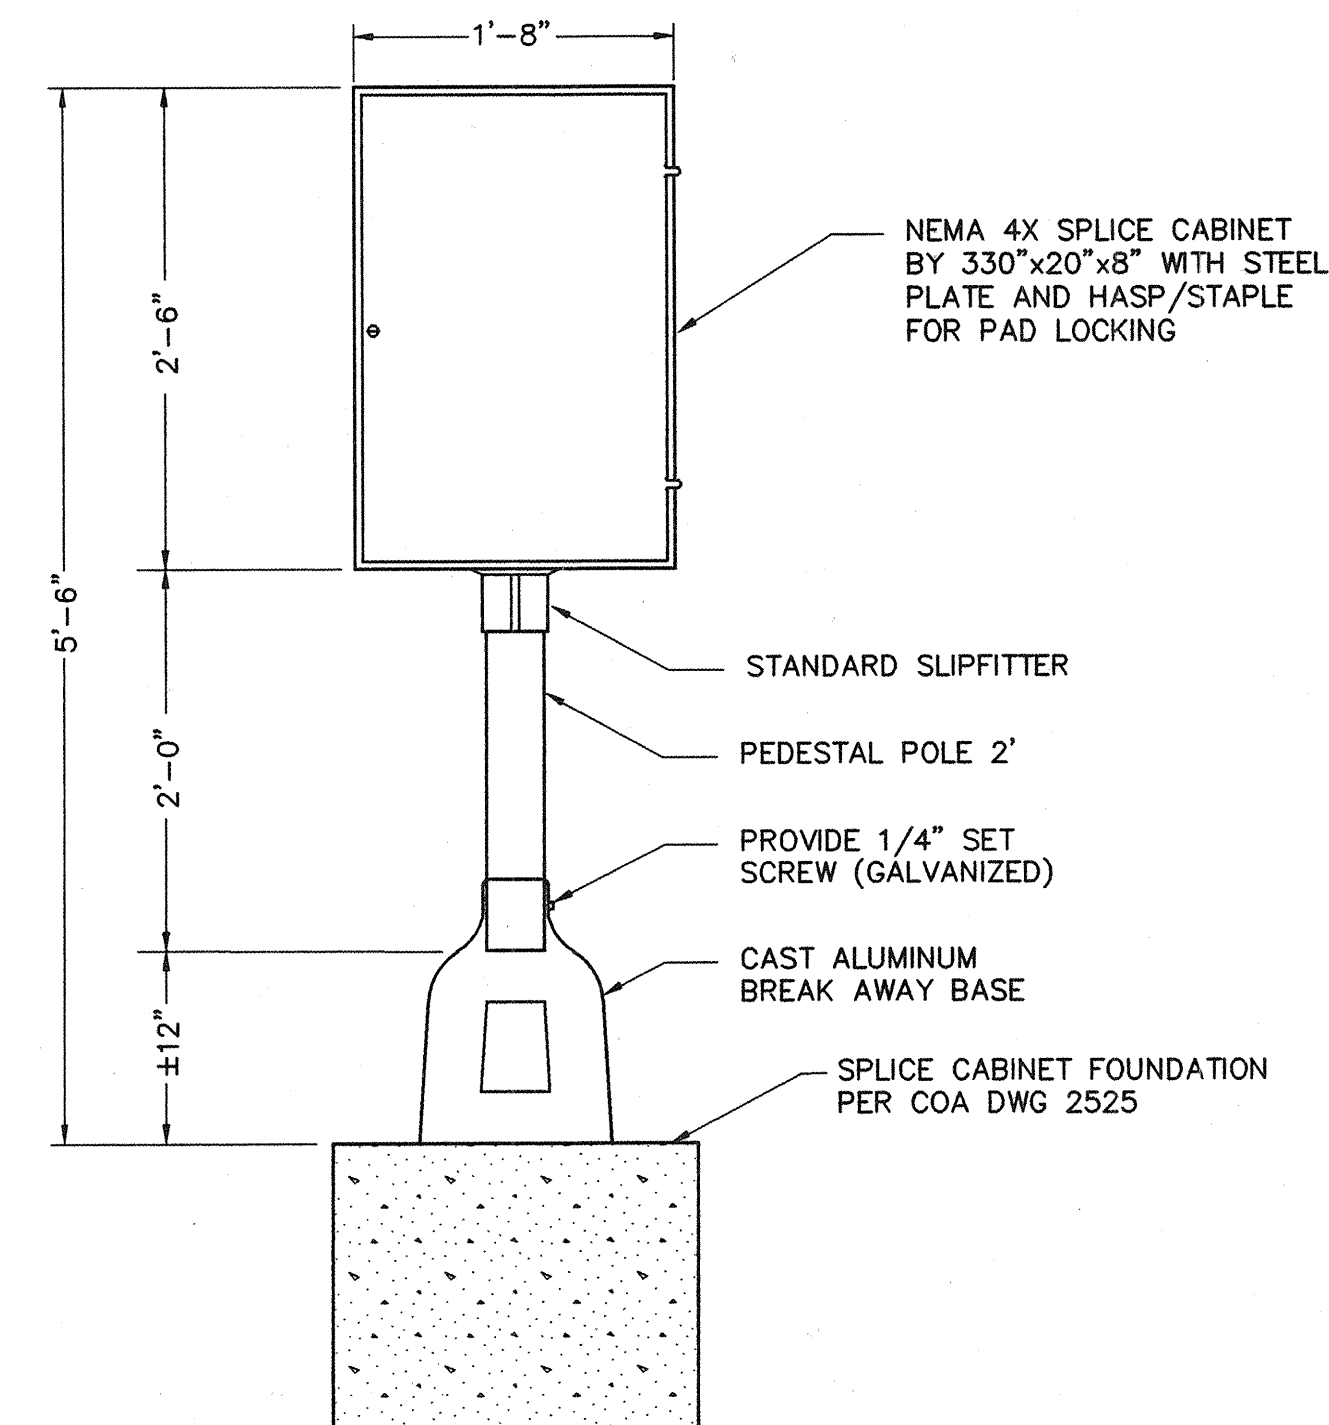

TRAFFIC SIGNAL
SPLICE CABINET DETAIL
SCALE: 1" = 1'

AS-BUILT INFORMATION		BENCH MARKS		SURVEY INFORMATION		ENGINEER'S SEAL	
CONTRACTOR	GERALD MARTIN	THE STATION IS LOCATED 8.3 MILES NORTHEAST OF DOWNTOWN ALBUQUERQUE AT THE INTERSECTION OF JUAN TABO BLVD. N.E. & COMANCHE RD. N.E. TO REACH THE STATION FROM THE INTERCHANGE AT I-40 AND JUAN TABO BLVD. GO NORTH ON JUAN TABO 3.2 MILES TO THE STATION ON THE WALL. THE STATION MARK IS A STANDARD ACS BRASS TABLET STAMPED "ACS 2-621-A 1978", DILLED INTO THE TOP OF THE CONCRETE CURB.	DATE	DATE	DATE	DATE	DATE
WORK	WCEA	DATE	DATE	DATE	DATE	DATE	DATE
INSPECTOR	WCEA	DATE	DATE	DATE	DATE	DATE	DATE
ACCEPTANCE BY COA	WCEA	DATE	DATE	DATE	DATE	DATE	DATE
VERIFICATION BY WCEA	WCEA	DATE	DATE	DATE	DATE	DATE	DATE
DESIGNED BY	WCEA	DATE	DATE	DATE	DATE	DATE	DATE
DRAWN BY	WCEA	DATE	DATE	DATE	DATE	DATE	DATE
CHECKED BY	WCEA	DATE	DATE	DATE	DATE	DATE	DATE
REVISIONS							
NO.	DATE	BY	REMARKS				
1	DATE	BY	REMARKS				
2	DATE	BY	REMARKS				
CITY OF ALBUQUERQUE PUBLIC WORKS DEPARTMENT ENGINEERING GROUP	
LOWE'S OF EAST ALBUQUERQUE MISCELLANEOUS DETAILS	
Design Review Committee	City Engineer Approval
City Project No. 657881	Zone Map No. G-22
Sheet 9	Of 11

1 2 3 4 5 6 7 8 9 10 11 12 13 14 15
26 65788.81 0902

WILSON
& COMPANY

1. CONTRACTOR MUST OBTAIN FROM CONSTRUCTION COORDINATION AN EXCAVATION/BARRICADING PERMIT BEFORE ENGAGING IN ANY CONSTRUCTION, MAINTENANCE OR REPAIR WORK IN ANY OF THE CITY OF ALBUQUERQUE'S RIGHTS-OF-WAY. EMERGENCY WORK THAT WOULD PRESERVE LIFE OR PROPERTY IS EXCLUDED WITH THE UNDERSTANDING, THAT A PERMIT SHALL BE OBTAINED WITHIN 24 TO 48 HOURS.

2. CONTRACTOR SHALL AT THE TIME OF PERMIT REQUEST, SUBMIT FOR APPROVAL BY CONSTRUCTION COORDINATION, A TRAFFIC CONTROL PLAN DETAILING ALL EXISTING TOPOGRAPHY SUCH AS LANE WIDTHS, DRIVEWAYS, AND BUSINESS/RESIDENTIAL ACCESSES. THE TRAFFIC CONTROL PLAN SHALL INCLUDE ALL PHASES OF WORK AND SCHEDULES INVOLVED IN THE CONSTRUCTION PROJECT. ANY SEPARATE PHASES OF A CONSTRUCTION PROJECT SHALL BE GIVEN AN INDIVIDUAL PERMIT EACH. BLANKET PERMITS WILL NOT BE ISSUED.

3. THESE TYPICAL TRAFFIC CONTROL PLANS DO NOT REFLECT THE EXISTING TOPOGRAPHY SUCH AS DRIVEWAYS, LANE WIDTHS, AND BUSINESS/RESIDENTIAL ACCESSSES. EVERY LOCATION THAT REQUIRES CONSTRUCTION TRAFFIC CONTROL SHALL HAVE A DETAILED TRAFFIC CONTROL PLAN SHOWING ALL EXISTING TOPOGRAPHY.

4. CONSTRUCTION SHALL NOT BEGIN UNLESS A TRAFFIC CONTROL PLAN HAS BEEN APPROVED AND VERIFIED BY CONSTRUCTION COORDINATION.

5. CONSTRUCTION COORDINATION SHALL BE NOTIFIED 48 HOURS PRIOR TO ANY TRAFFIC CONTROL CHANGES NEEDED BY CONTRACTOR, THAT WERE NOT PREVIOUSLY APPROVED. THESE TRAFFIC CONTROL CHANGES SHALL BE REQUESTED IN WRITING ACCOMPANIED WITH A TRAFFIC CONTROL PLAN REFLECTING SUCH CHANGES.

6. ALL CONSTRUCTION TRAFFIC CONTROL DEVICES SHALL COMPLY TO THE MANUAL ON UNIFORM TRAFFIC CONTROL DEVICES (MUTCD), LATEST EDITION. IT IS THE RESPONSIBILITY OF THE CONTRACTOR TO INSTALL, SERVICE AND MAINTAIN ALL TRAFFIC CONTROL DEVICES. TRAFFIC CONTROL DEVICES SHALL NOT BE REMOVED OR ALTERED IN ANY WAY WITHOUT THE APPROVAL OF CONSTRUCTION COORDINATION, PER SECTION 6A-4 OF THE MUTCD, LATEST EDITION.

7. THE CONSTRUCTION TRAFFIC CONTROL INITIAL SET-UP SHALL BE BY AN AMERICAN TRAFFIC SAFETY SERVICES ASSOCIATION (ATSSA) CERTIFIED WORK SITE TRAFFIC SUPERVISOR. THE MAINTENANCE AND SERVICING SHALL ALSO BE DONE BY AN ATSSA CERTIFIED WORKSITE TRAFFIC SUPERVISOR OR EQUIVALENT.

8. CONTRACTOR IS RESPONSIBLE TO MAINTAIN AND SERVICE ALL TRAFFIC CONTROL DEVICES 24 HOURS A DAY, 7 DAYS A WEEK THROUGHOUT LENGTH OF PROJECT. CONTRACTOR IS RESPONSIBLE THAT ALL TRAFFIC CONTROL DEVICES COMPLY WITH THE MUTCD, LATEST EDITION.

9. ALL ADVANCE WARNING SIGNS SHALL BE DOUBLE INDICATED WHENEVER THERE ARE MULTI-LANE TRAFFIC IN ANY ONE GIVEN DIRECTION AND THERE IS SUFFICIENT MEDIAN SPACE.

10. ALL BARRICADES IN ALL TAPERS AND TANGENTS SHALL BE PLACED APART, A DISTANCE MEASURED IN FEET, EQUAL TO THAT OF THE POSTED SPEED LIMIT. NO EXCEPTIONS UNLESS APPROVED BY CONSTRUCTION COORDINATION PER MUTCD SECTION 6A-4.

11. CONTRACTOR SHALL NOT BEGIN WORK BEFORE 7:00 A.M. OR END WORK AFTER 7:00 P.M. WITHOUT THE APPROVAL OF CONSTRUCTION COORDINATION.

12. CONTRACTOR IS RESPONSIBLE TO PROVIDE CONSTRUCTION COORDINATION, A WEEKLY LOG OF DAILY INSPECTIONS OF BARRICADE AND MAINTENANCE SCHEDULES ON PROJECTS THAT ARE OVER ONE WEEK DURATION.

13. EQUIPMENT OR MATERIALS SHALL NOT BE STORED WITHIN 15 FEET OF A TRAVELED TRAFFIC LANE DURING NON-WORKING HOURS WITHOUT THE APPROVAL OF CONSTRUCTION COORDINATION.

14. CONTRACTOR SHALL PROVIDE AND MAINTAIN A SAFE AND ADEQUATE MEANS OF CHANNELIZING PEDESTRIAN TRAFFIC AROUND AND THROUGH THE CONSTRUCTION AREA.

15. CONTRACTOR IS RESPONSIBLE FOR OBLITERATION OF ANY CONFLICTING STRIPING AND RESPONSIBLE FOR ALL TEMPORARY STRIPING.

16. CONTRACTOR SHALL MAINTAIN ACCESS TO ALL FACILITIES, BUSINESSES AND/OR RESIDENTS AT ALL TIMES.

17. CONTRACTOR SHALL PROVIDE ACCESS SIGNS FOR BUSINESSES LOCATED WITHIN THE CONSTRUCTION AREA UNDER THE SUPERVISION OF CONSTRUCTION COORDINATION. EACH ACCESS SIGN SHALL HAVE 5 INCH, WHITE OPAQUE LETTERING ON BLUE REFLECTORIZED BACKGROUND. ACCESS SIGNS SHALL BE CONSIDERED INCIDENTAL TO THE BID AND NOT PART OF THE CONTRACT UNLESS OTHERWISE STATED. NO MORE THAN 3 BUSINESSES SHALL BE LISTED ON A ACCESS SIGN. SHOPPING CENTERS AND MALLS SHALL BE LISTED AS SUCH.

18. ALL ADVANCE WARNING SIGNS SHALL MEET THE MINIMUM REFLECTIVE INTENSITY REQUIREMENTS SET FORTH BY THE CITY OF ALBUQUERQUE. CONSTRUCTION COORDINATION SHALL DETERMINE ALL REQUIREMENTS AND APPROVE OR DISAPPROVE ANY ADVANCE WARNING SIGN PER SECTION 6A-4 OF THE MUTCD, LATEST EDITION.

19. 24 HOURS PRIOR TO OCCUPYING OR CLOSING OF A RIGHT-OF-WAY, CONTRACTOR SHALL NOTIFY: POLICE, FIRE DEPARTMENT, SCHOOLS, HOSPITALS, TRANSIT AUTHORITY, BUSINESSES AND/OR RESIDENTS THAT WILL BE AFFECTED BY THE CONSTRUCTION.

20. ANY FIELD ADJUSTMENTS SHALL BE APPROVED BY CONSTRUCTION COORDINATION.

21. EXCAVATIONS SHALL BE PLATED, TEMPORARILY PATCHED OR RESURFACED PRIOR TO OPENING OF TRAFFIC. A MINIMUM OF 11 FEET SHALL BE PROVIDED FOR TRAFFIC IN ANY GIVEN DIRECTION. CONTRACTOR IS RESPONSIBLE FOR ANY WORK INVOLVED IN SATISFYING THESE REQUIREMENTS.

22. CONTRACTOR SHALL AT ALL TIMES COMPLY WITH THE FOLLOWING:

1. STANDARDS AND REQUIREMENTS SET FORTH IN THE MANUAL ON UNIFORM TRAFFIC CONTROL DEVICES, LATEST EDITION.
2. THE CITY OF ALBUQUERQUE TRAFFIC CODE, LATEST EDITION.
3. SECTION 19 OF THE CITY OF ALBUQUERQUE'S STANDARD SPECIFICATIONS FOR PUBLIC WORK CONSTRUCTION, AS WELL AS OTHER SECTIONS.

23. FAILURE TO COMPLY WITH ANY OF THE ABOVE MENTIONED, WILL BE ADEQUATE CAUSE TO CEASE ALL WORK ON ANY CONSTRUCTION PROJECT. WORK WILL NOT RESUME UNTIL ALL REQUIREMENTS ARE ADDRESSED AND APPROVED BY CONSTRUCTION COORDINATION.

24. ALL TRAFFIC CONTROL DEVICES SHALL BE KEPT IN NEW-CLEAN CONDITION, WASHING OF EQUIPMENT IS INCIDENTAL TO IT'S PLACEMENT AND MAINTENANCE.



25. TRAFFIC CONTROL STANDARDS APPLY ONLY WHERE THE CONSTRUCTION TRAFFIC CONTROL PLANS ARE NOT SPECIFIC.

26. ADVANCE WARNING SIGNS SHALL BE 36"x36" WITH SUPER ENGINEERING GRADE SHEETING OR BETTER.

1. ALL BARRICADING AND LANE CLOSURES IN JUAN TABO BLVD. AND CANDELARIA ROAD ARE SUBJECT TO ROAD RESTORATION FEES.
2. CONTRACTOR SHALL PERFORM AS MUCH WORK AS POSSIBLE (SUCH AS BUS BAY CONSTRUCTION) PRIOR TO CLOSING TRAFFIC LANES ON EITHER JUAN TABO BLVD. OR CANDELARIA ROAD.
3. DOUBLE LANE CLOSURES ON JUAN TABO BLVD. FOR THE WATER AND SANITARY SEWER CONNECTIONS WILL ONLY BE ALLOWED BETWEEN THE HOURS FROM 7:00 P.M. TO 5:00 A.M. CONTRACTOR MUST MAINTAIN AT LEAST TWO LANES OPEN IN BOTH DIRECTIONS ON JUAN TABO BLVD. OUTSIDE THESE HOURS. DOUBLE LANE CLOSURES WILL NOT BE ALLOWED FOR ANY OTHER OPERATION. NO DOUBLE LANE CLOSURES ON JUAN TABO BLVD. WILL BE ALLOWED ON FRIDAY OR SATURDAY NIGHTS.
4. CONTRACTOR IS ALLOWED SINGLE LEFT OR SINGLE RIGHT LANE CLOSURES ON JUAN TABO BLVD. OR CANDELARIA ROAD FOR CURB, GUTTER, AND PAVING OPERATIONS. HOWEVER, CONTRACTOR MUST WORK MINIMUM HOURS FROM 7:00 A.M. TO 10:00 P.M. WHEN ANY LANES ARE CLOSED TO TRAFFIC.
5. WHEN BEGINNING A NEW CONSTRUCTION OPERATION, SOUTHBOUND LANE CLOSURES ON JUAN TABO BLVD. AND WESTBOUND LANE CLOSURES ON CANDELARIA ROAD SHALL NOT BE IN PLACE PRIOR TO 9:00 A.M. ON THE INITIAL DAY OF THAT OPERATION.
6. CONTRACTOR MUST OPEN ALL LANES TO TRAFFIC UPON COMPLETION OF EACH WORK SHIFT IF SAFE TO DO SO, OR WORK THE HOURS SPECIFIED IN NOTE 4 ABOVE.
7. CONTRACTOR IS NOT ALLOWED TO HAVE BOTH NORTHBOUND AND SOUTHBOUND LANE CLOSURES ON JUAN TABO BLVD. AT THE SAME TIME EXCEPT WHEN INSTALLING MEDIAN IMPROVEMENTS.
8. CONTRACTOR IS NOT ALLOWED TO HAVE BOTH EASTBOUND AND WESTBOUND LANE CLOSURES ON CANDELARIA ROAD AT THE SAME TIME EXCEPT WHEN INSTALLING MEDIAN IMPROVEMENTS.

 W1-1(R) 30 MPH or LESS	 W1-1(L) 30 MPH or LESS	 W1-2(R) 30 MPH or GREATER	 W1-2(L) 30 MPH or GREATER	 W1-3(R) 30 MPH or LESS	 W1-3(L) 30 MPH or LESS	 W1-4(R) 30 MPH or GREATER	 W1-4(L) 30 MPH or GREATER	 W1-6(R)	 W1-6(L)	 W3-1	
 W4-2(R)	 W4-2(L)	 W6-3	 W8-1	 W8-3	 W8-3A	 W8-7	 W13-1	 W12-1	 W8-9a	 W14-2	
 W20-1	 W20-2	 W20-3	 W20-4	 W20-5(R)	 W20-5(L)	 W20-5(2R)	 W20-5(2L)	 W20-5(C)	 W20-7	 W20-7a	
 W1-4bR	 W1-4bL	 R1-1	 R1-2	 R2-1	 R2-5a	 R2-5b	 R3-1	 R3-2	 R3-3	 R3-7(R)	
 R3-7(L)	 R4-7b	 R4-7b(L)	 R5-1	 R5-1a	 R6-1(L)	 R6-1(R)	 R7-1	 R11-2	 R11-2a	 R11-4	
 M4-8a	 M4-9(R)	 M4-9(L)	 SPECIAL SIGN	 SPECIAL SIGN	 SPECIAL SIGN	 SPECIAL SIGN	ALL CONSTRUCTION WARNING SIGNS SHALL HAVE A BLACK LEGEND ON A ORANGE BACKGROUND.				
 M4-10(R)	 M4-10(L)	 G20-2									

ALL CONSTRUCTION WARNING SIGNS SHALL HAVE A BLACK LEGEND ON A ORANGE BACKGROUND.

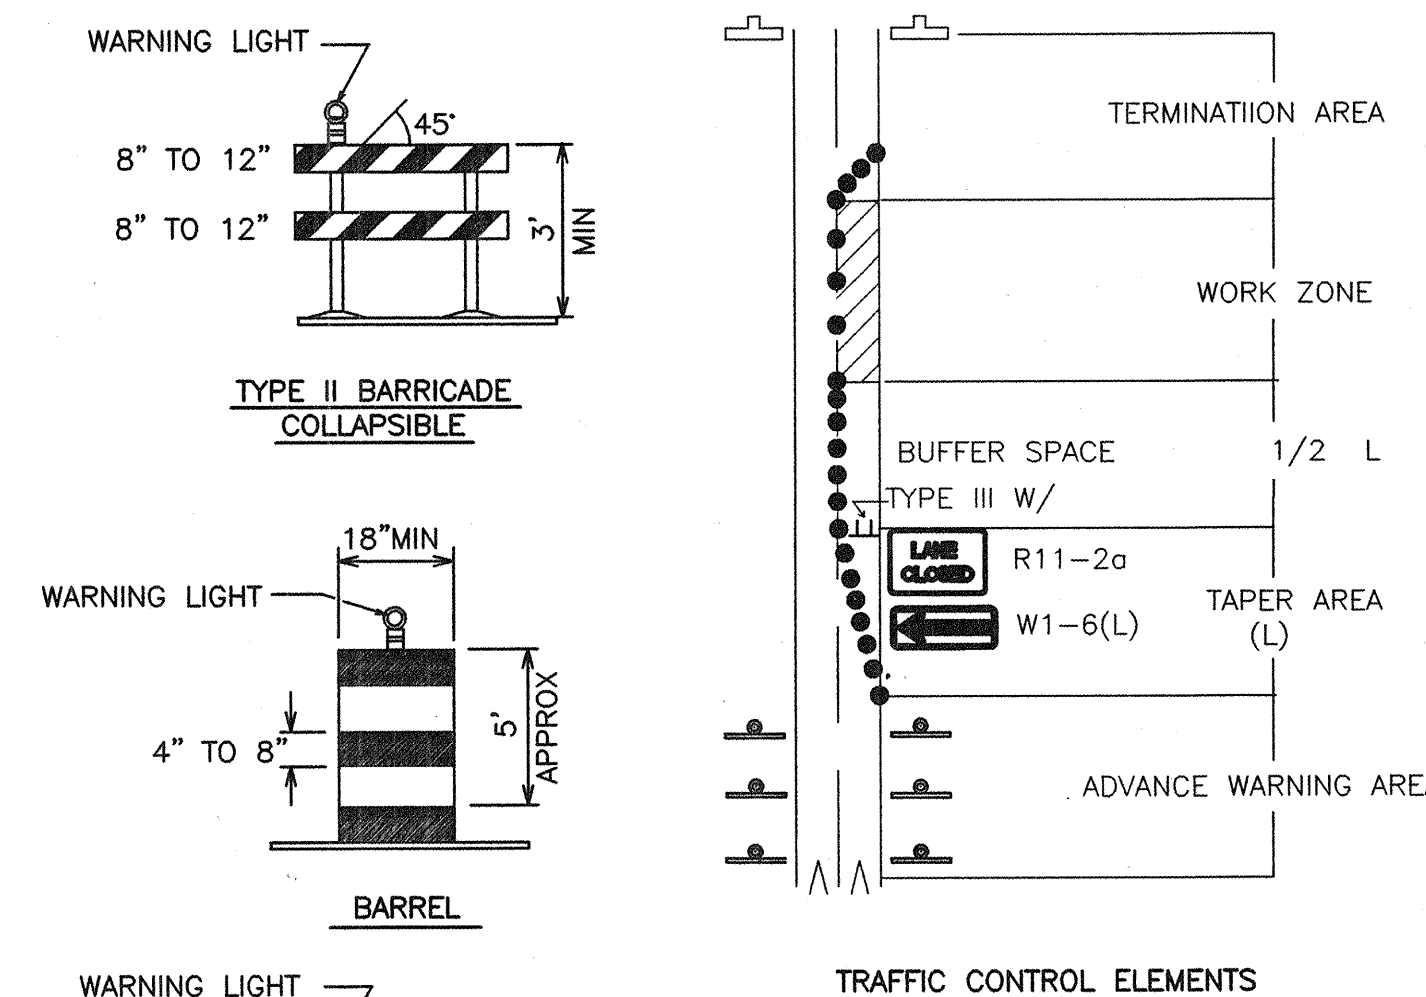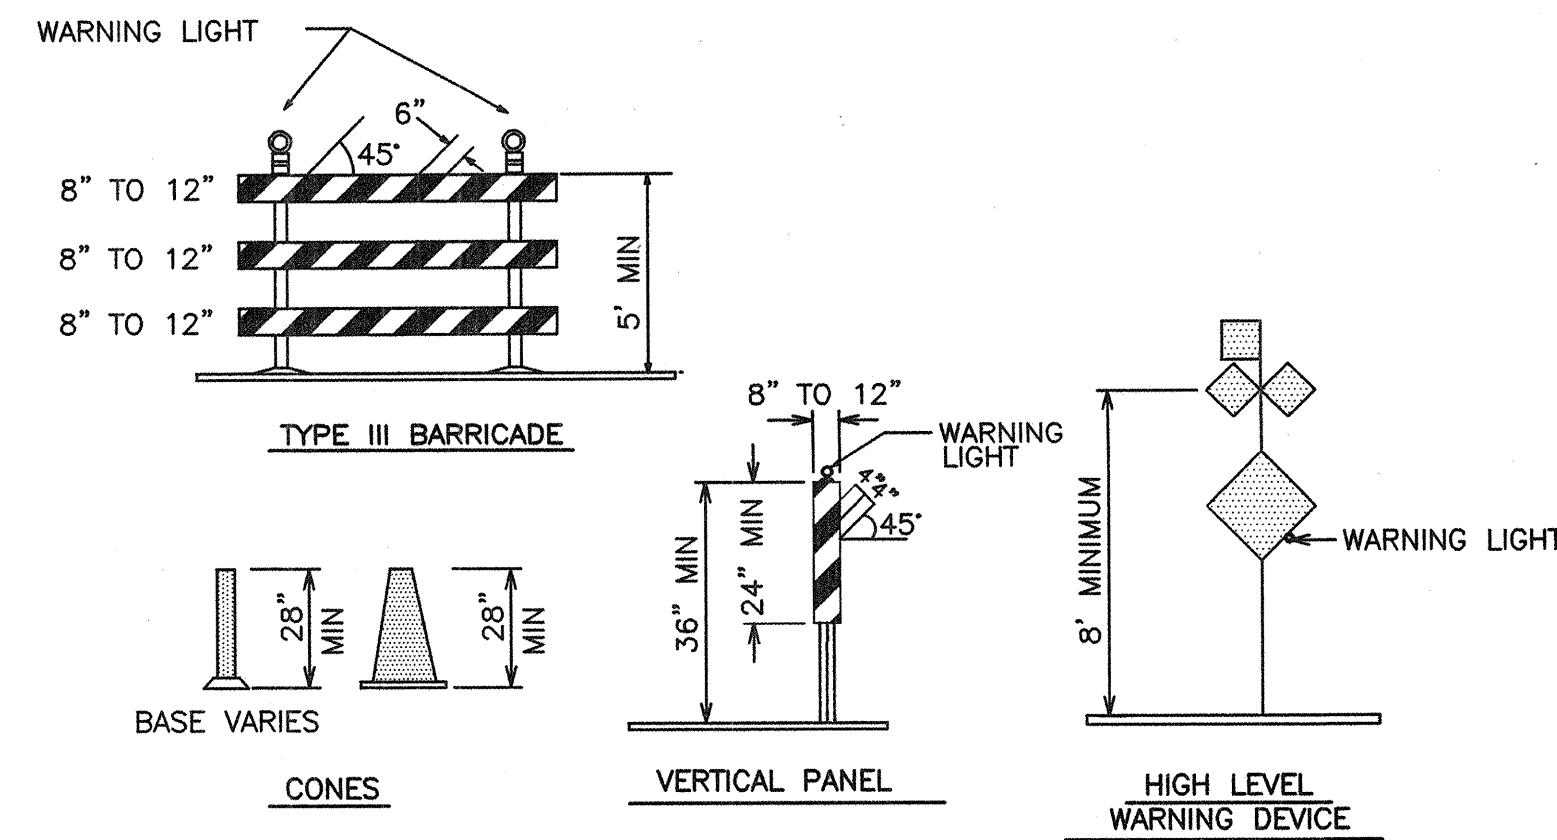

	WORK AREA
•	BARRICADE — TYPE I, TYPE II, OR BARREL
⊥	BARRICADE — TYPE III
×	VERTICAL PANEL
⚡	WARNING SIGN
D	DISTANCE BETWEEN SIGNS — A DISTANCE MEASURED IN FEET EQUAL TO A VALUE OF TEN TIMES THE SPEED LIMIT OF THE STREET
	FLAGMAN POSITION
S	SPACING BETWEEN BARRICADES — A DISTANCE MEASURED IN FEET EQUAL TO THE STREET LIMIT OF THE STREET
L	TAPER LENGTH — SEE CHART BELOW

THE TANGENT LENGTH IS EQUAL TO THE TAPER LENGTH FOR A GIVEN STREET.

SPEED LIMIT (MPH)	TAPER LENGTH(L) (FEET)			MINIMUM NUMBER OF DEVICES FOR TAPER	MAXIMUM DEVICE SPACING IN FEET	
	10' LANE	11' LANE	12' LANE		ALONG TAPER	AFTER TAPER
20	70	75	80	5	20	20
25	105	115	125	6	25	25
30	150	165	180	7	30	30
35	205	225	245	8	35	35
40	270	295	320	9	40	40
45	450	495	540	13	45	45
50	500	550	600	13	50	50
55	550	605	660	13	55	55






SPEED MILES PER HOUR	MINIMUM BETWEEN SIGNS	DISTANCE IN FEET FROM LAST SIGN TO TAPER
0-20	10 X SPEED LIMIT	10 X SPEED LIMIT
25-30	10 X SPEED LIMIT	10 X SPEED LIMIT
30-35	10 X SPEED LIMIT	10 X SPEED LIMIT
40-45	10 X SPEED LIMIT	10 X SPEED LIMIT
50-60	10 X SPEED LIMIT	10 X SPEED LIMIT

TYPE OF TAPER	TAPER LENGTH
UPSTREAM TAPER:	
MERGING TAPER	L MINIMUM
SHIFTING TAPER	1/2 L MINIMUM
SHOULDER TAPER	1/2 L MINIMUM
TWO-WAY TRAFFIC TAPER	100 FEET MAXIMUM
DOWNSTREAM TAPERS	100 FEET PER LANE


<u>SPEED LIMIT</u>	
40 MPH OR LESS	$L = \frac{WS^2}{60}$
40 MPH OR GREATER	$L = W \times S$

L = TAPER LENGTH
W = WIDTH OF OFFSET IN FEET
S = POSTED SPEED OR OFF-PEAK
85--PERCENTILE SPEED IN MPH

CITY OF ALBUQUERQUE PUBLIC WORKS DEPARTMENT ENGINEERING GROUP					
LOWE'S OF EAST ALBUQUERQUE SIGNING AND CONSTRUCTION TRAFFIC CONTROL STANDARDS					
APPROVALS	ENGINEER	DATE	APPROVALS	ENGINEER	DATE
DRC CHAIRMAN			WATER		
TRANSPORTATION			WASTE WATER		
HYDROLOGY					
Project No.		Map No.		SHEET OF	
657881		G-22		10 11	

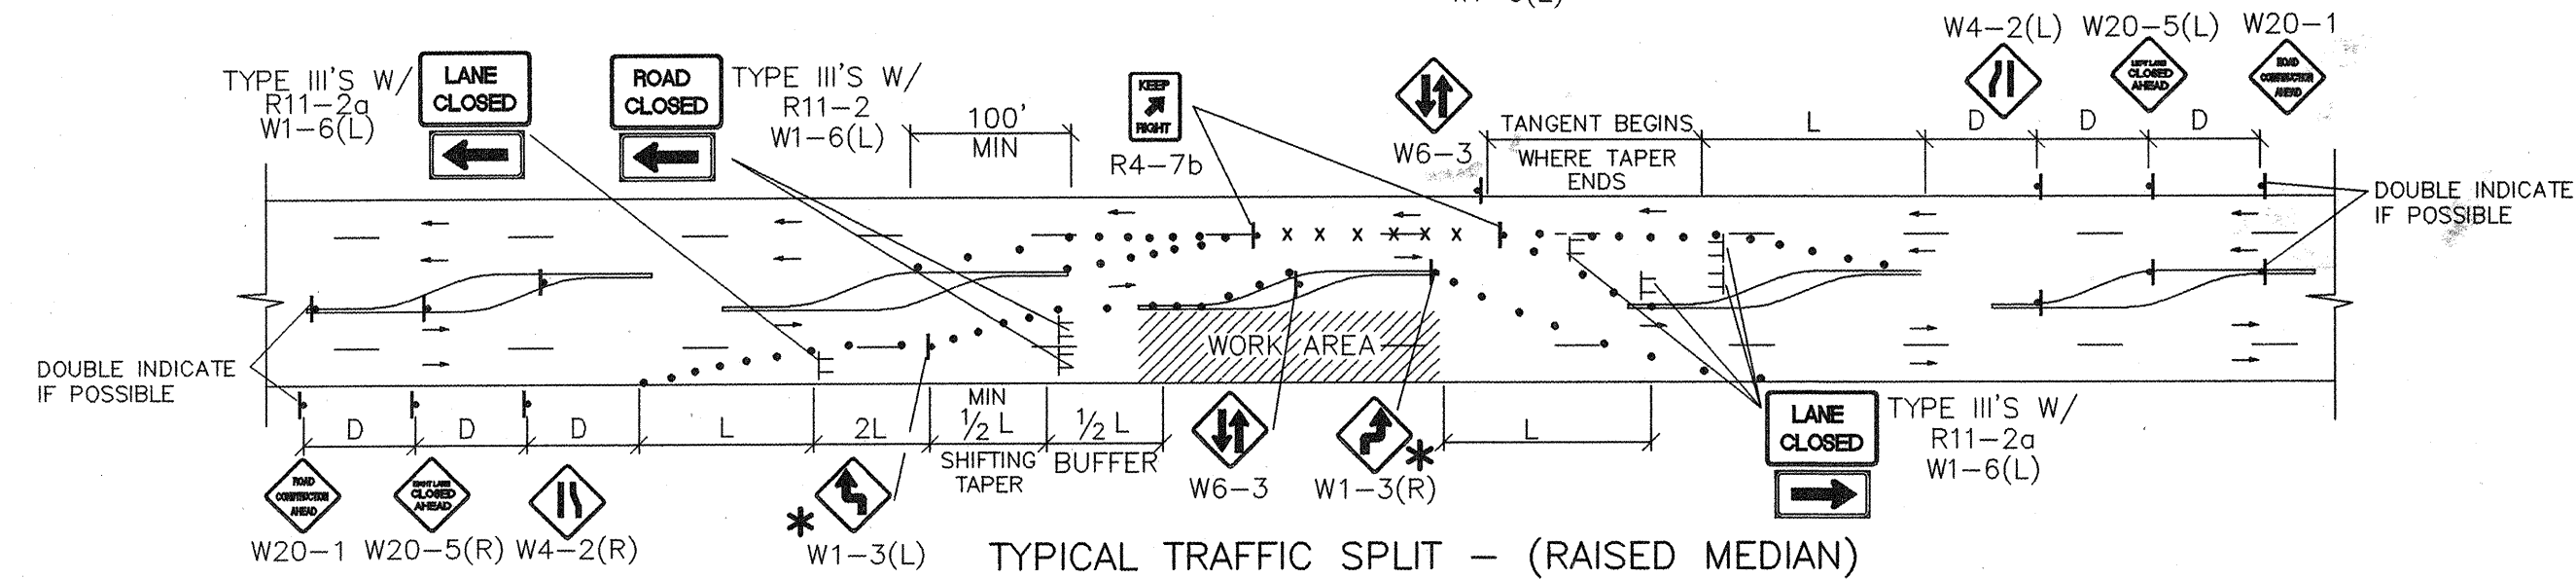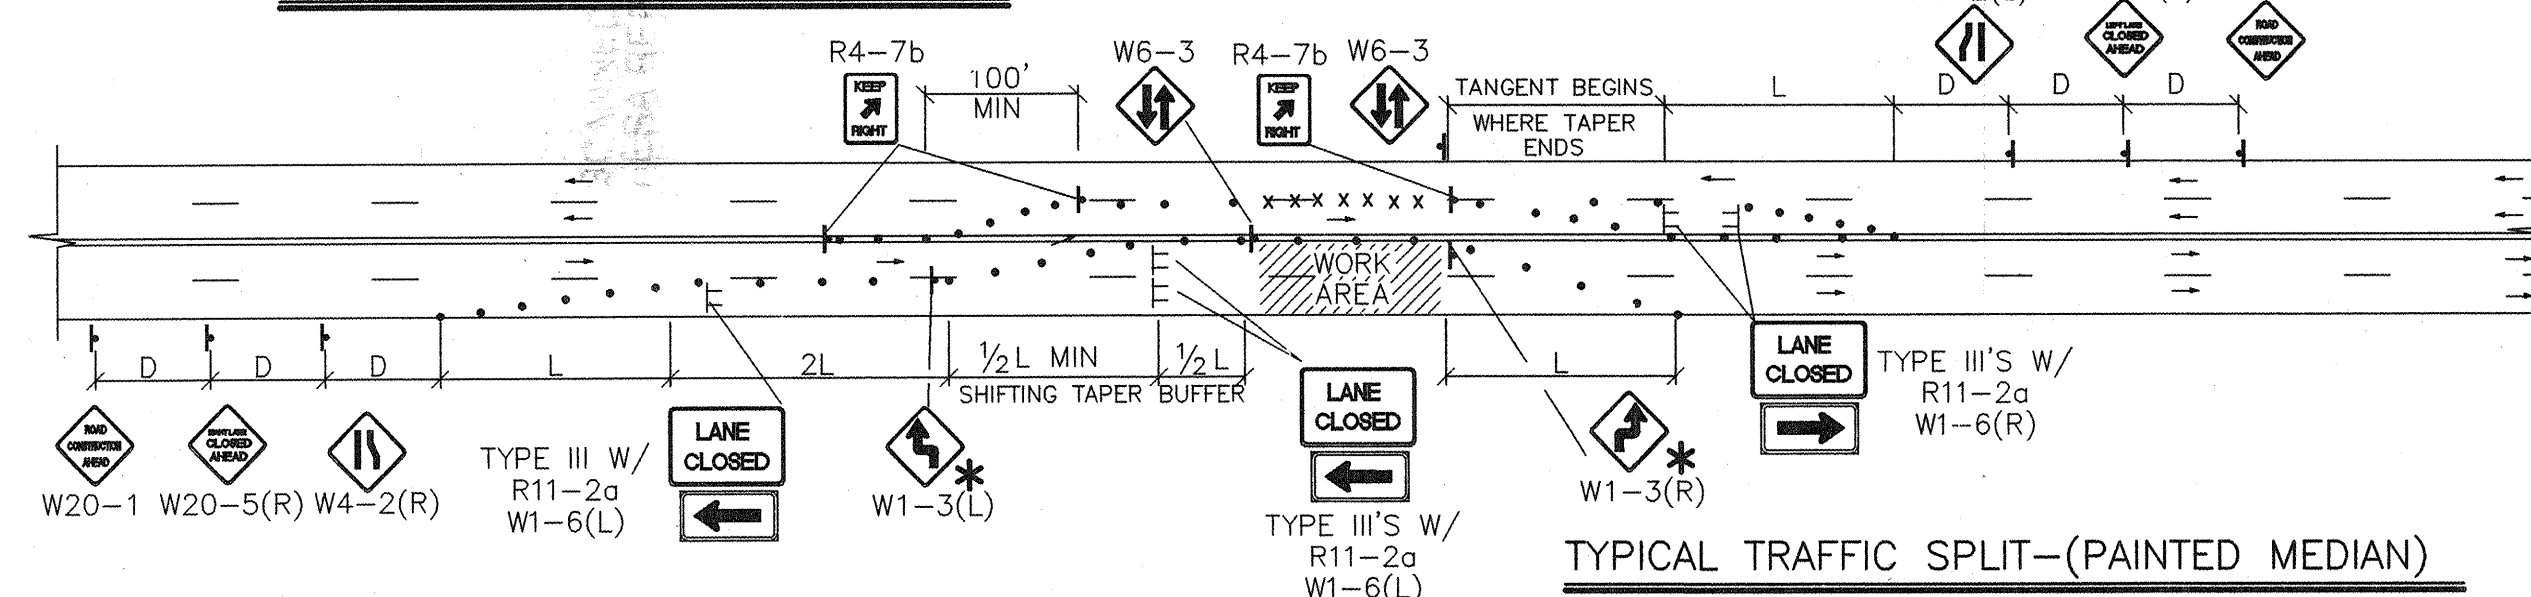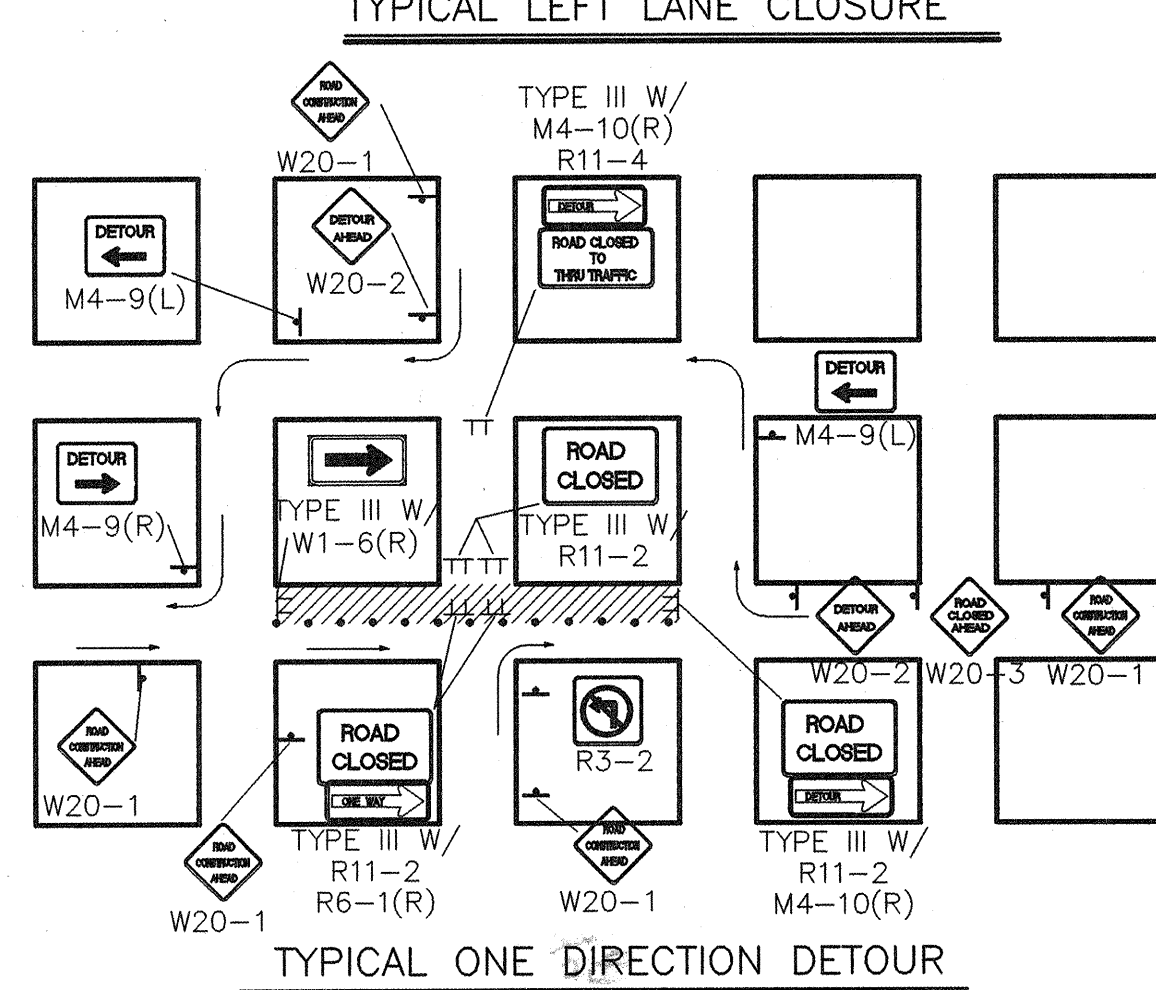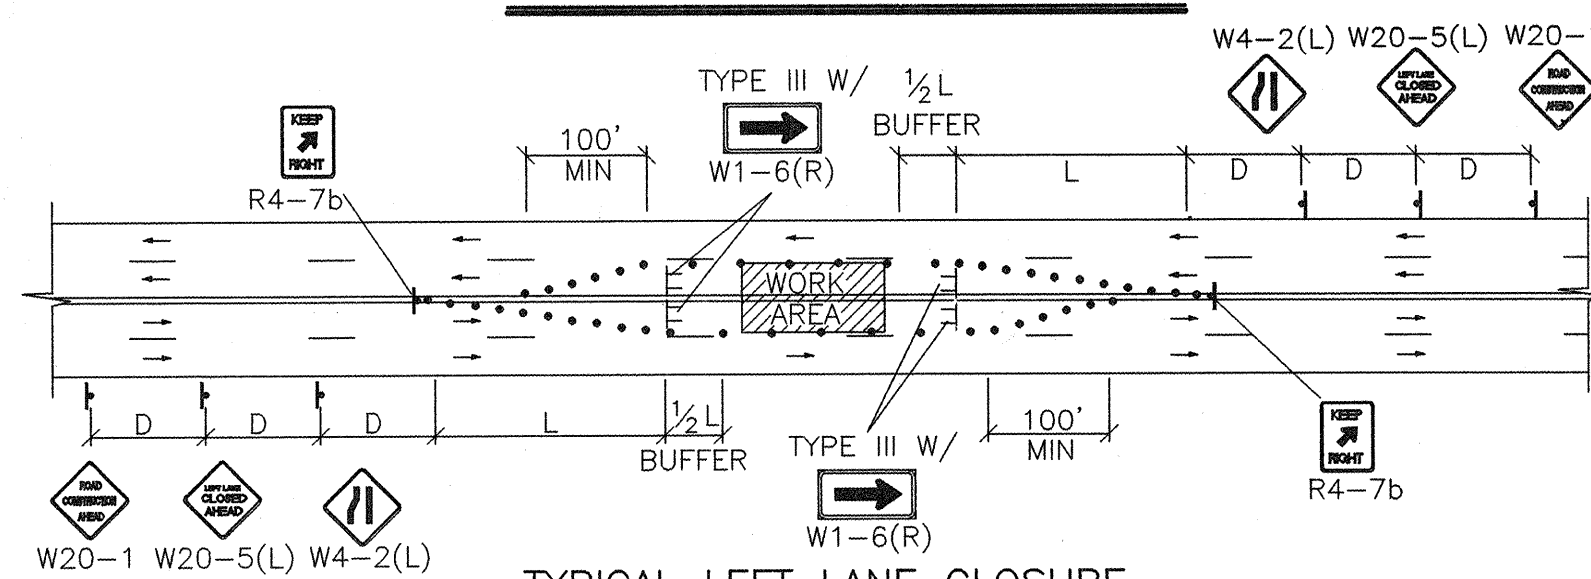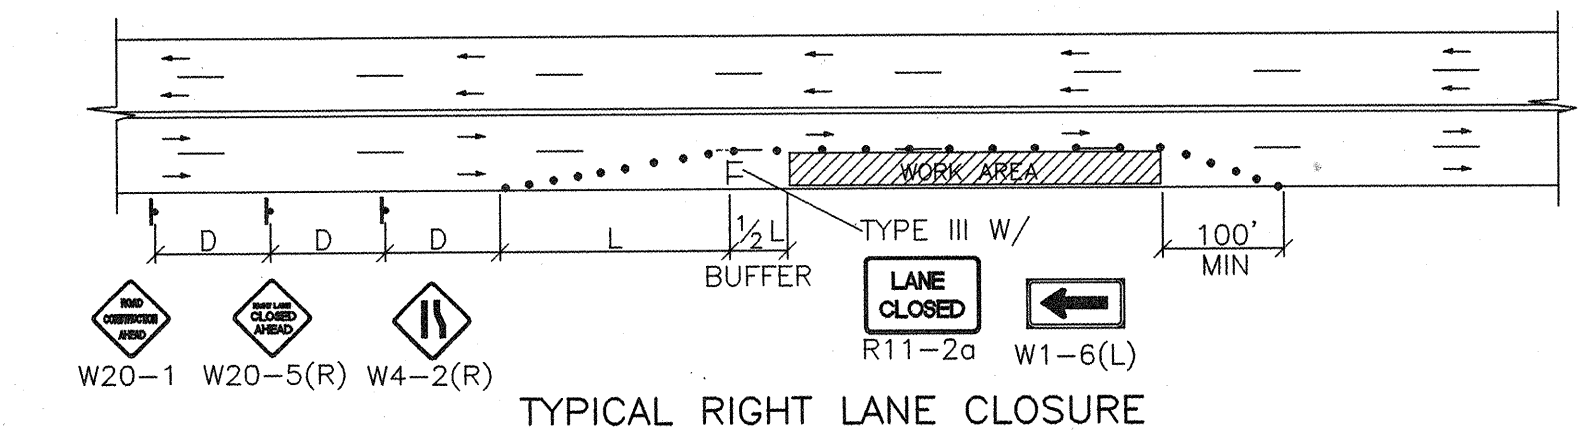

- TRAFFIC SPLIT NOTES:**
1. THE OFFSET DISTANCE MUST BE CALCULATED IN ALL SHIFTING TAPERS. THE OFFSET DISTANCES SHALL INCLUDE LANE WIDTHS PLUS MEDIAN WIDTHS.
 2. 1/2 L IS THE MINIMUM DISTANCE FOR SHIFTING TAPERS.
 3. REVERSE CURVES MAY BE IMPLEMENTED. ALL CURVE DATA SHALL BE CALCULATED.
 4. MEDIAN REMOVAL SHALL BE REQUIRED IF 1/2 L OR REVERSE CURVE IS NOT SUFFICIENT FOR MEDIAN REMOVAL. TAKE PLACE BEFORE SPLITS.
 5. REDUCED SPEED MAY BE CONSIDERED.
 6. * USE W1-3 FOR 30 MPH OR LESS, W1-4 FOR SPEED 35 MPH OR GREATER.

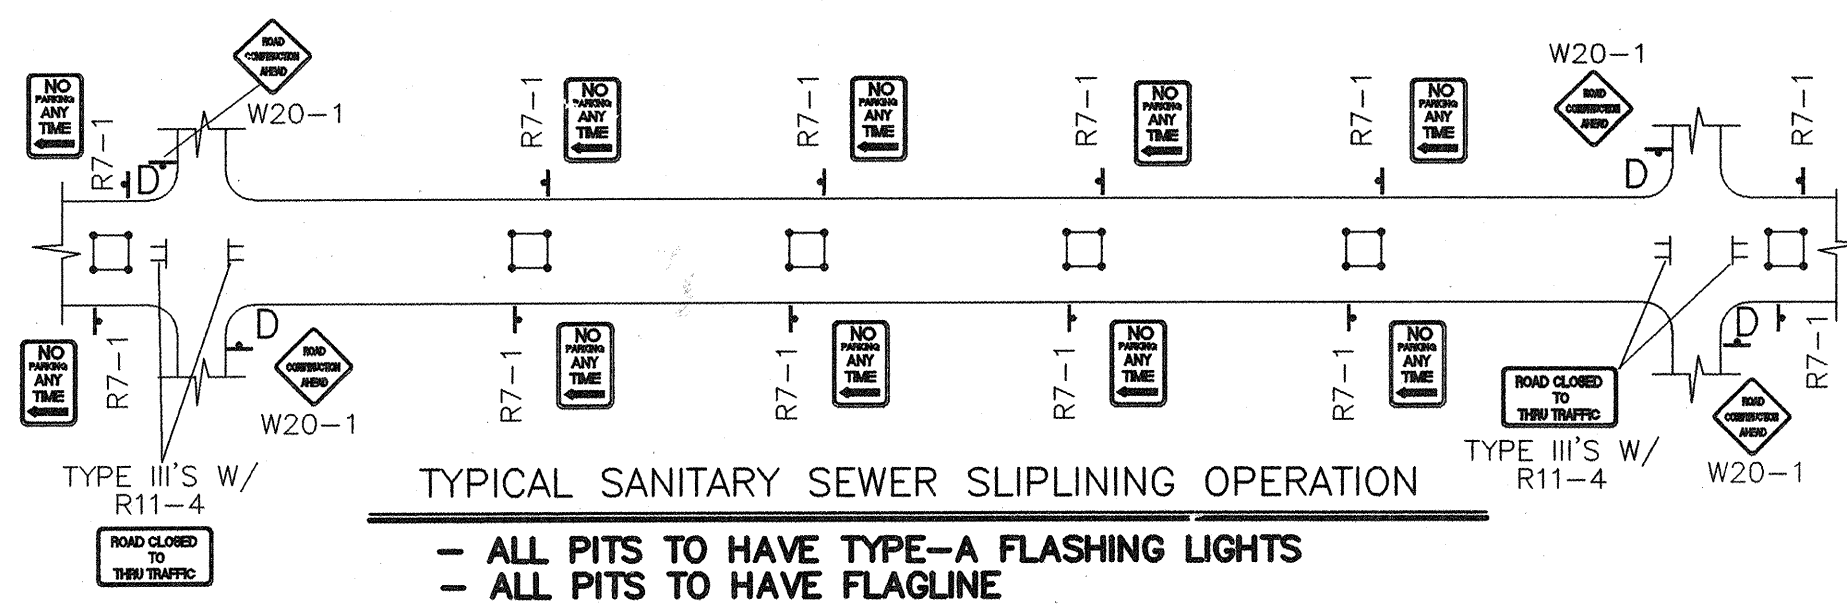


GENERAL NOTE:


ALL CONSTRUCTION WARNING SIGNS SHALL HAVE A BLACK LEGEND ON A ORANGE BACKGROUND.

ALL ADVANCE WARNING SIGNS SHALL BE A MINIMUM OF FORTY EIGHT (48) INCHES BY FORTY EIGHT (48) INCHES IN SIZE AND SHALL HAVE ONE WARNING LIGHT.

NOTE:
MAY REQUIRE LEFT LANE
CLOSURE DEPENDING ON
FIELD CONDITIONS.

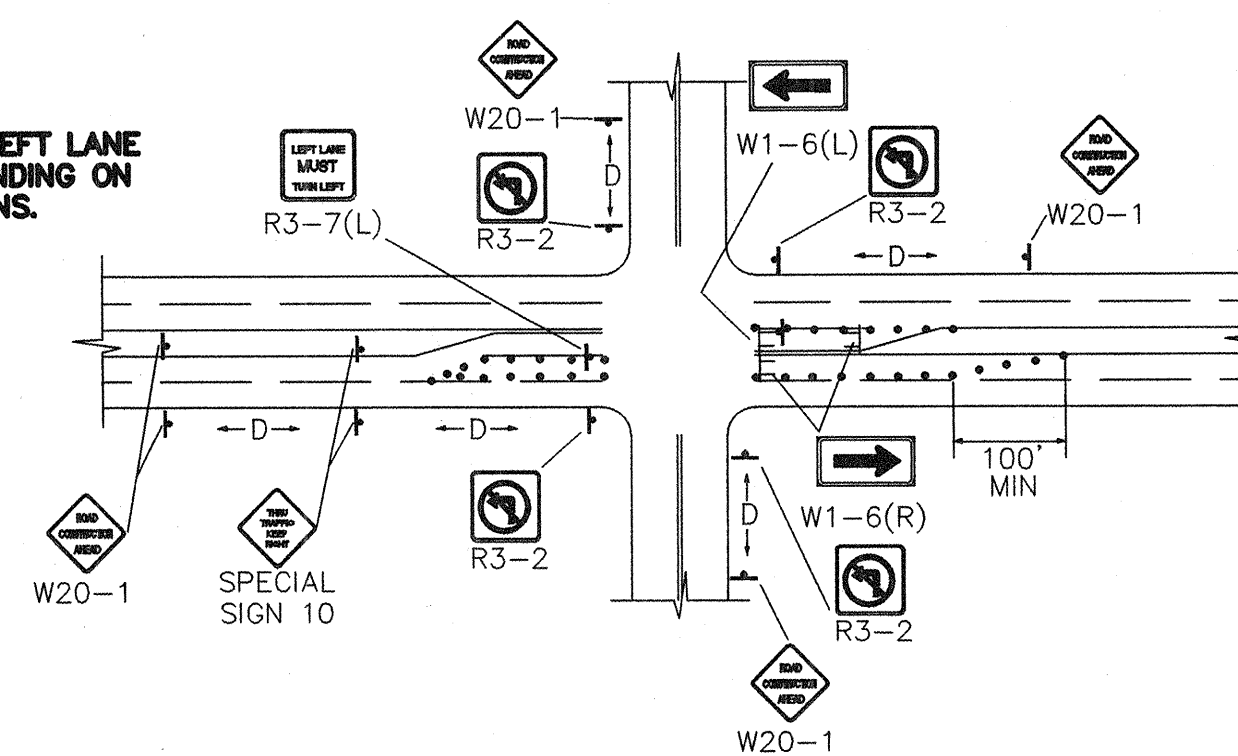


TYPICAL LANE CLOSURE AT INTERSECTION
NOTE: DEPENDING ON WORK ZONE LOCATION.

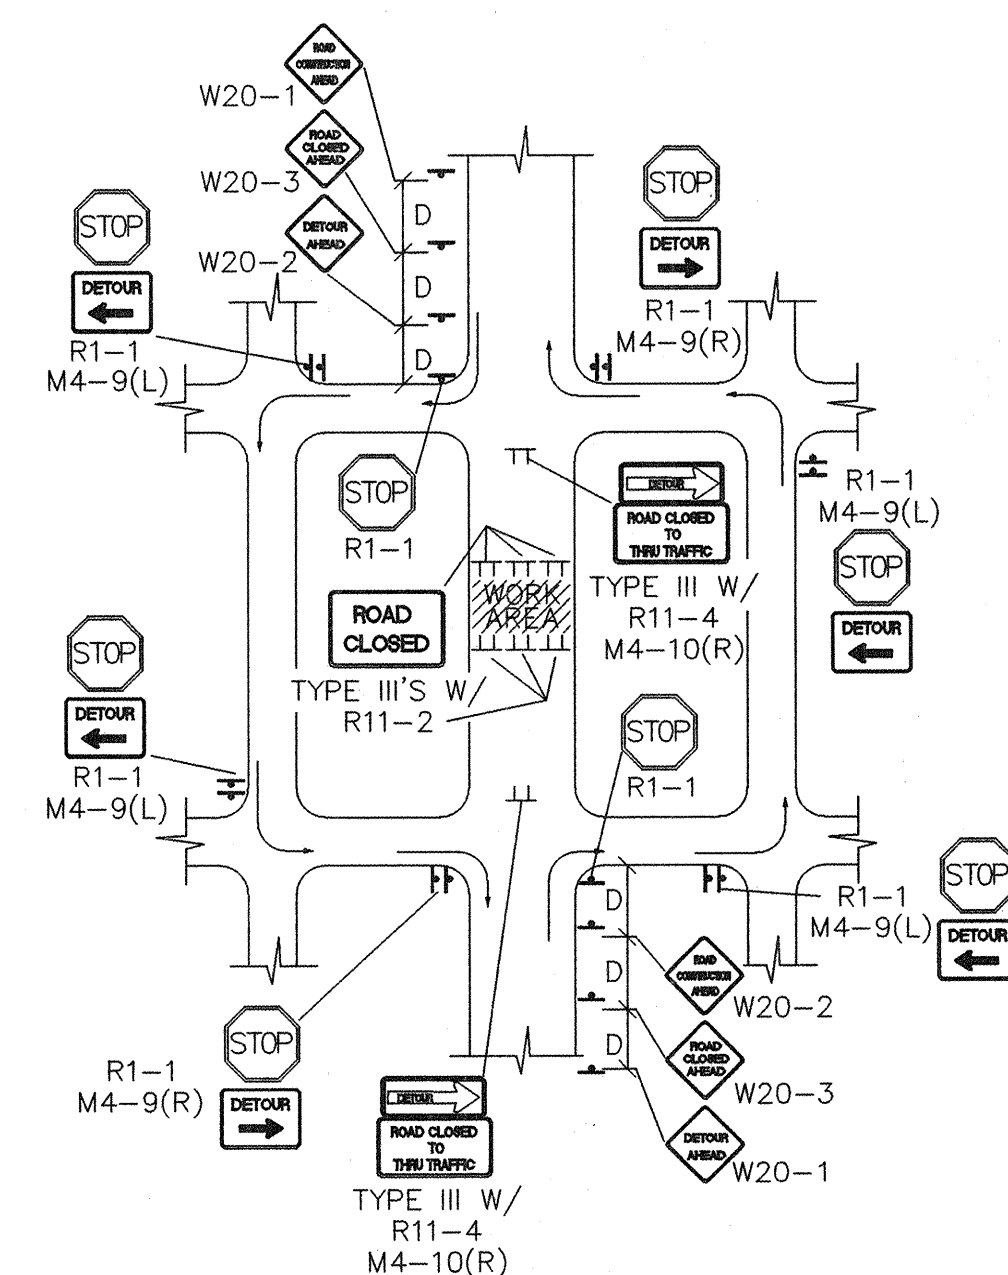





TYPICAL MID-BLOCK CLOSURE

NOTE: (R1-1) BASED ON FIELD CONDITIONS

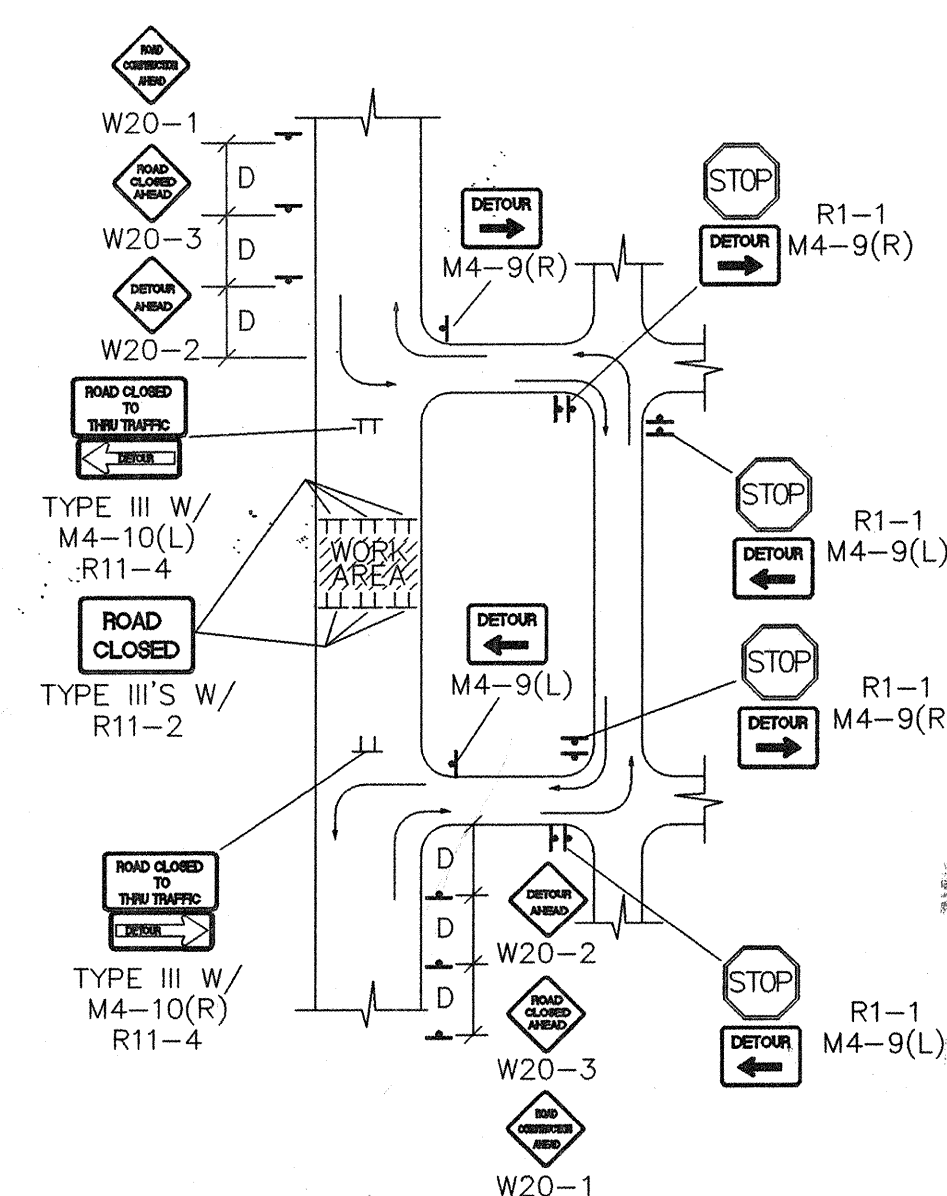

TYPICAL STREET CLOSURE

NOTE: (R1-1) BASED ON FIELD CONDITIONS

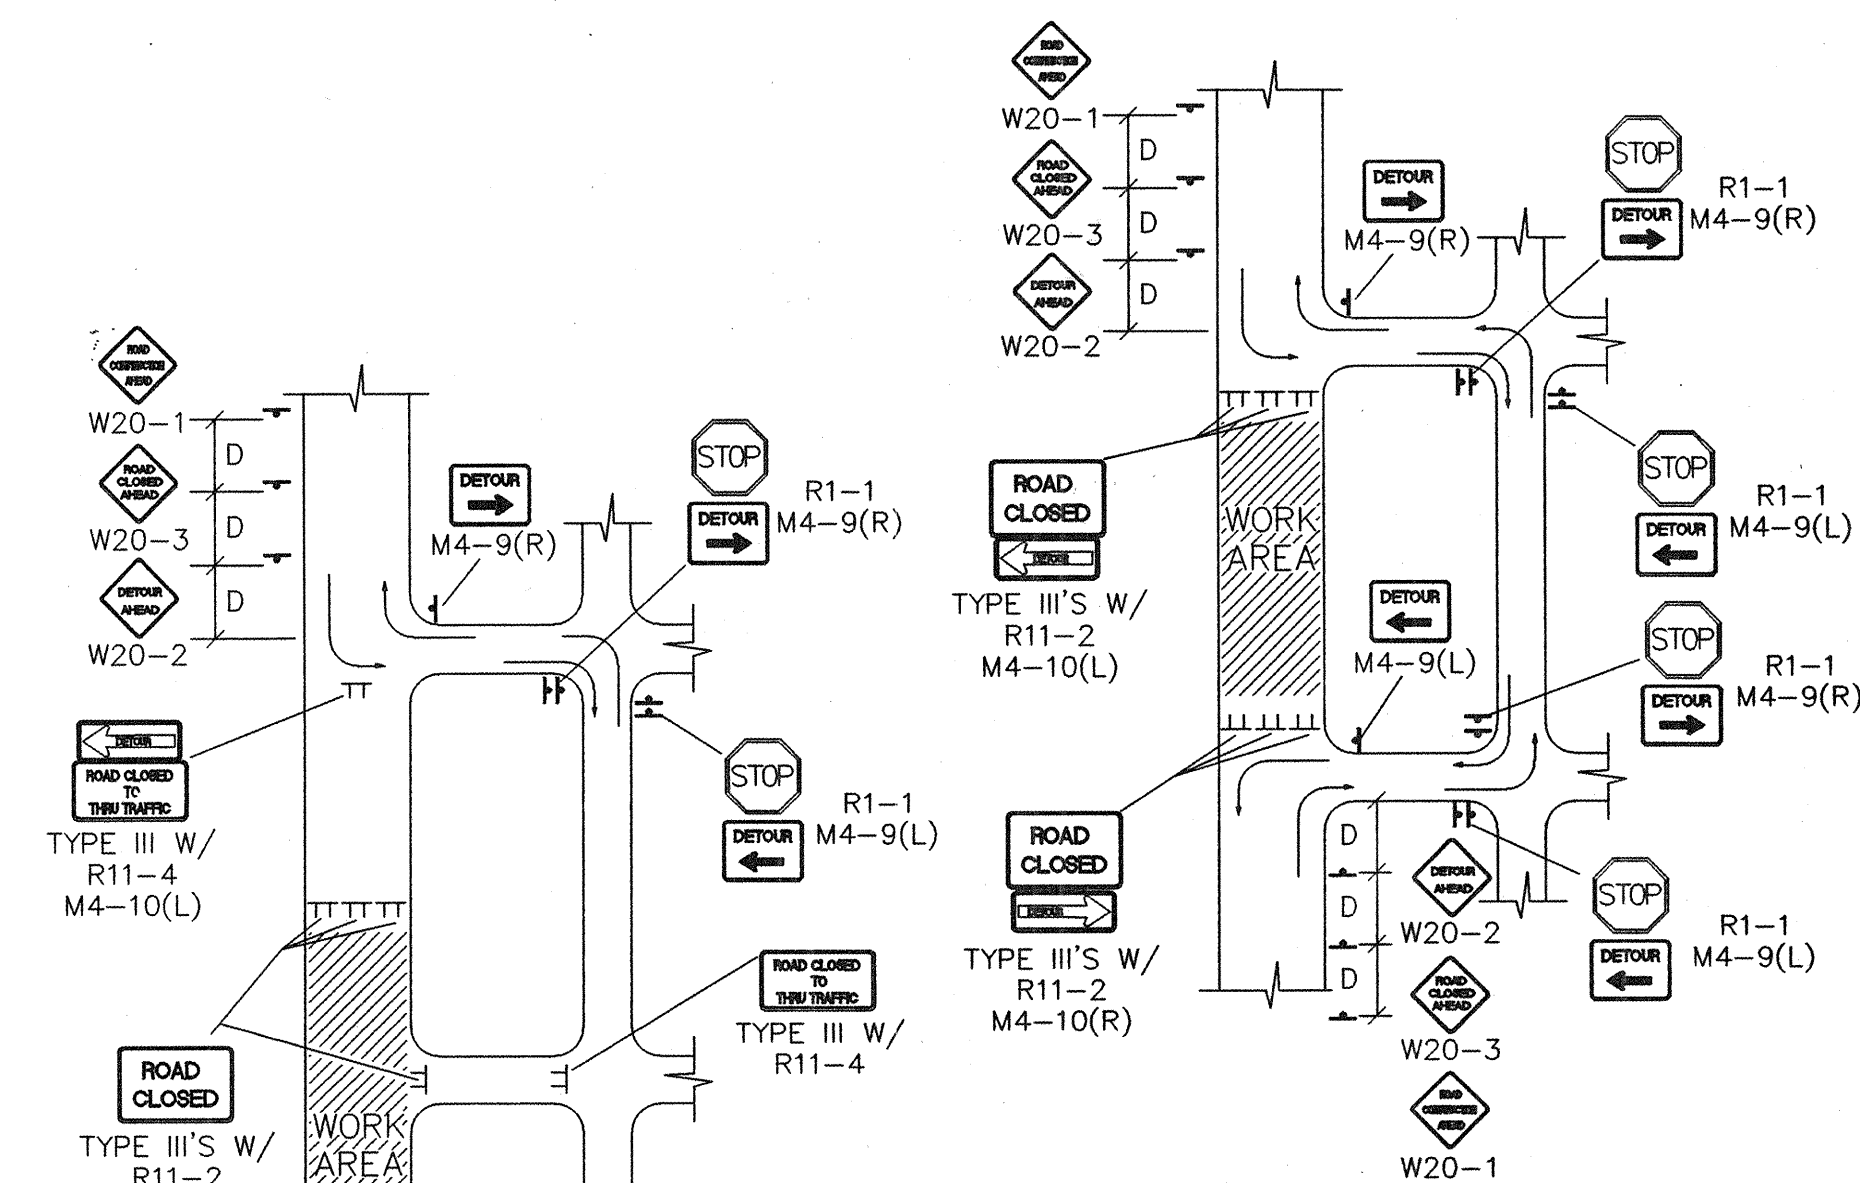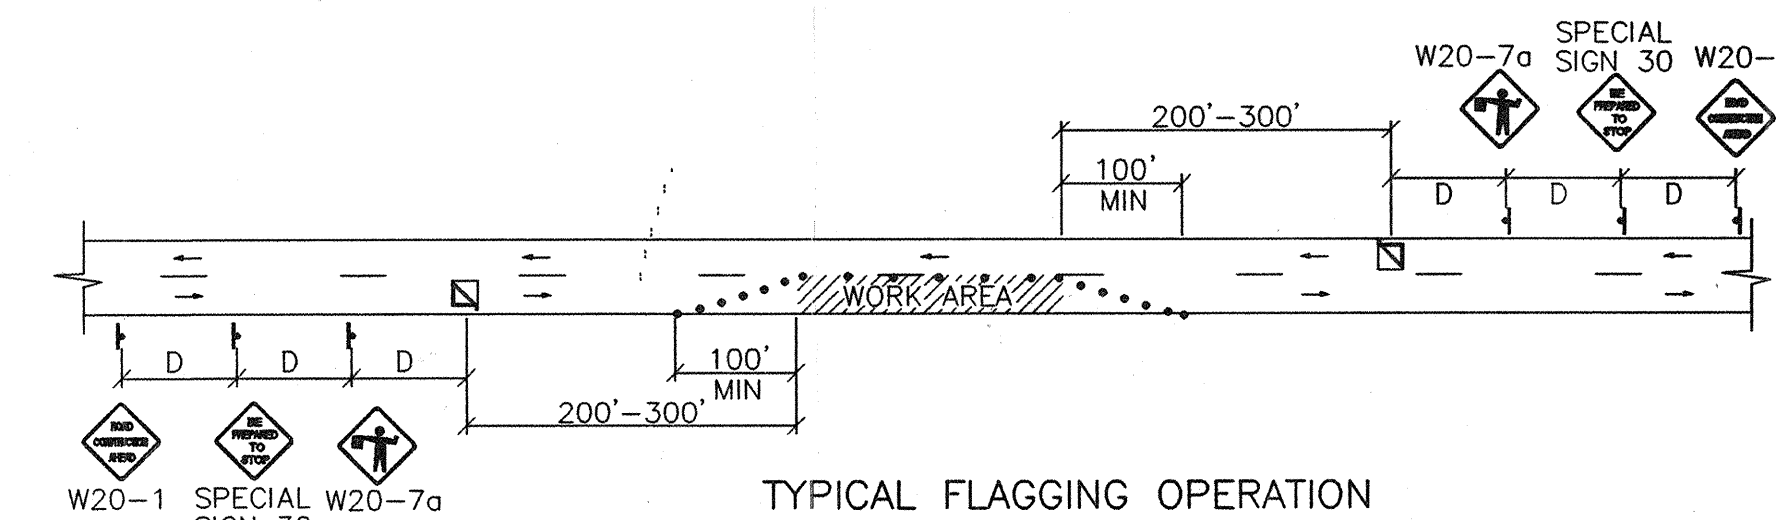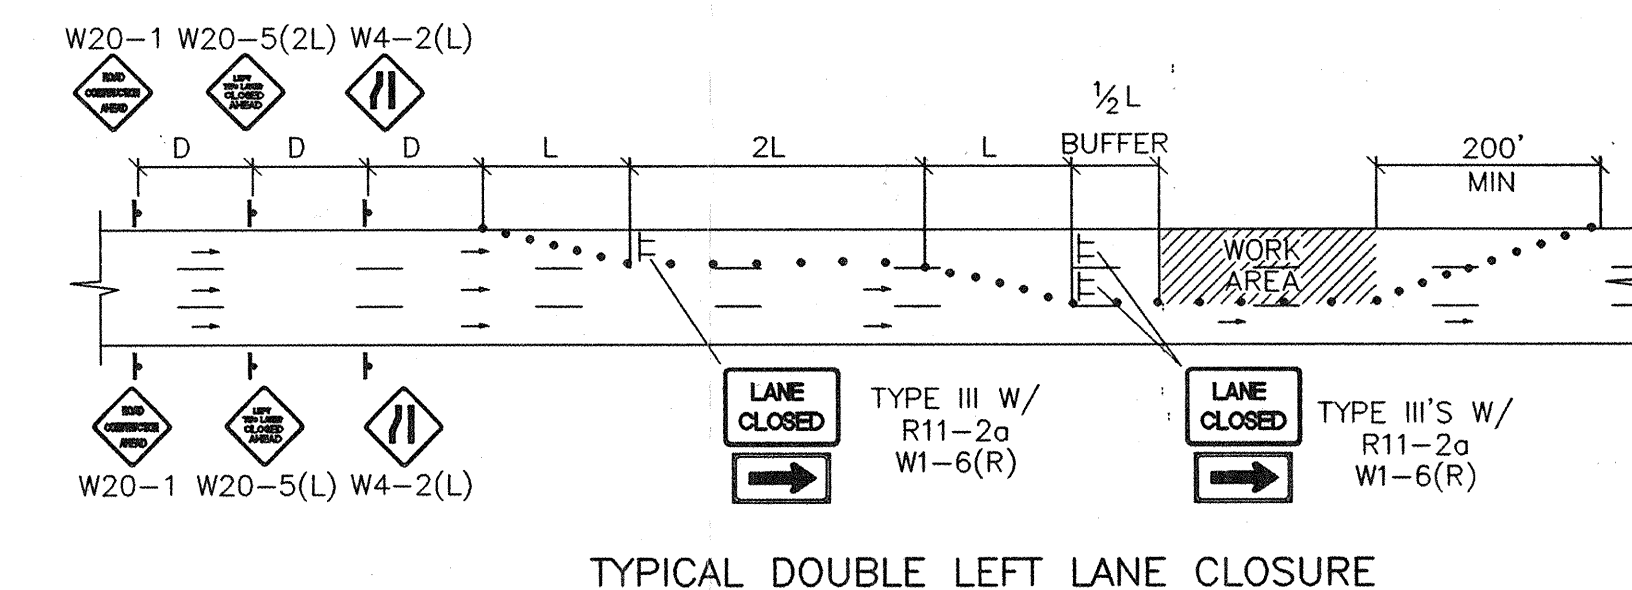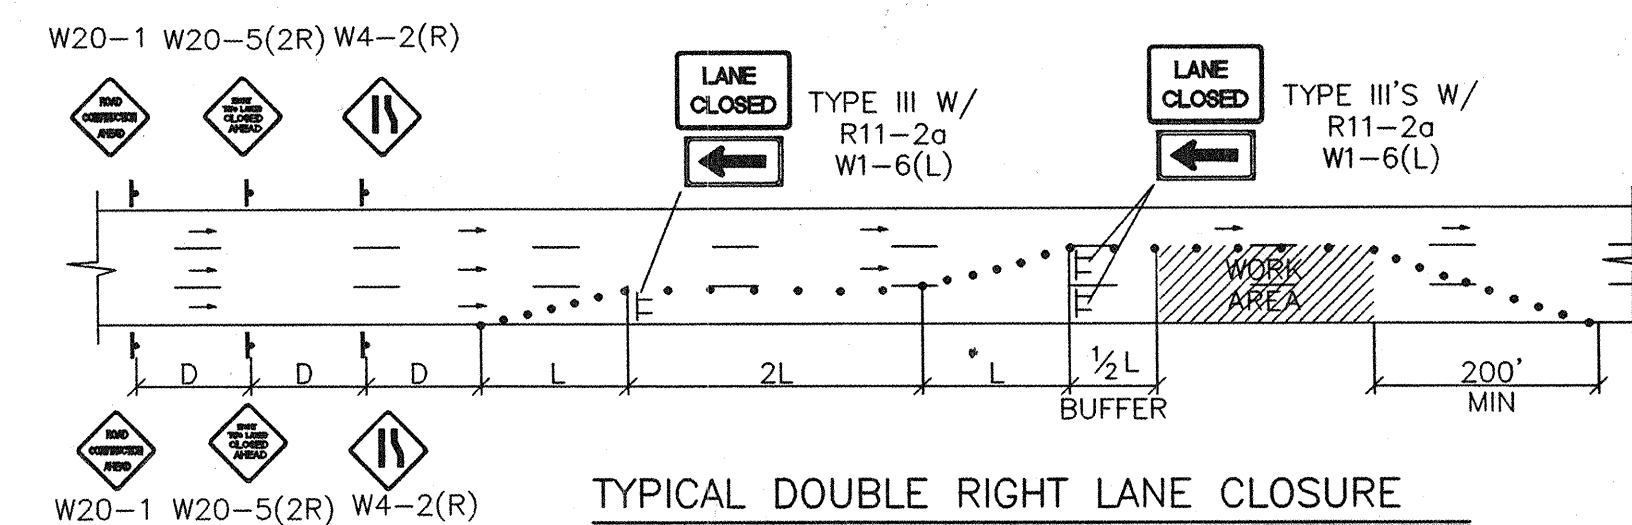

TYPICAL STREET CLOSURE

NOTE: (R1-1) BASED ON FIELD CONDITIONS.

CITY OF ALBUQUERQUE PUBLIC WORKS DEPARTMENT ENGINEERING GROUP					
LOWE'S OF EAST ALBUQUERQUE TRAFFIC CONTROL SIGNING EXAMPLES					
APPROVALS	ENGINEER	DATE	APPROVALS	ENGINEER	DATE
DRC CHAIRMAN			WATER		
TRANSPORTATION			WASTE WATER		
HYDROLOGY					
Project No.		Map No.		SHEET OF	
657881		G-22		11 11	