

CONSTRUCTION PLANS FOR
PIÑON POINTE II AT VENTANA RANCH
OFF-SITE IMPROVEMENTS
(A PORTION OF LAS VENTANAS ROAD)
ALBUQUERQUE, NEW MEXICO

INDEX

SHEET NUMBER	DESCRIPTION
1	TITLE SHEET
2	SITE DESCRIPTION PLAN
3	OVERALL PAVING PLAN
3A	FOR INFORMATION ONLY -
4-5	PAVING PLAN AND PROFILE SHEETS LAS VENTANAS ROAD
6	OVERALL UTILITY PLAN
7	UTILITY PLAN AND PROFILE SHEETS LAS VENTANAS ROAD
8	SIGNING AND CONSTRUCTION TRAFFIC CONTROL STANDARDS
9	TYPICAL TRAFFIC CONTROL AND SIGNING EXAMPLES (REF. M.U.T.C.D.)
10	LANDSCAPE PLAN FOR LAS VENTANAS RD FRONTAGE (STA. 44+00.00 TO STA. 52+00.00)



"RECORD DRAWINGS"


I CERTIFY THAT THE INFORMATION CONTAINED ON THESE DRAWINGS HAS BEEN REVISED IN ACCORDANCE WITH THE INFORMATION FURNISHED BY THE CONTRACTOR, SUNDANCE MECHANICAL. ALDRIDGE LAND SURVEYING PROVIDED THE CONSTRUCTION STAKING FOR THE PROJECT AND THIS SURVEY INFORMATION REFLECTS THE CONSTRUCTION AS ACTUALLY ACCOMPLISHED WHILE A CONSTRUCTION OBSERVER FROM SMITH ENGINEERING WAS PRESENT. THESE PLAN DRAWINGS, AS CONSTRUCTED, ARE IN SUBSTANTIAL COMPLIANCE WITH THE APPROVED PLAN DRAWINGS.

[Signature] 10/20/02
PATRICK J. CONLEY, PE 10141 DATE



SURVEYOR'S CERTIFICATION

"I, Timothy Aldrich, a duly qualified Registered Professional Land Surveyor under the laws of the State of New Mexico, do hereby certify that the 'as-built' information shown on these drawings was obtained from field construction and 'as-built' surveys performed by me or under my supervision, that the 'as-built' information shown on these drawings was added by me or under my supervision, and that this 'as-built' information is true and correct to the best of my knowledge and belief." Aldrich Land Surveying is not responsible for any of the design concepts, calculations, engineering, or intent of the record drawings.

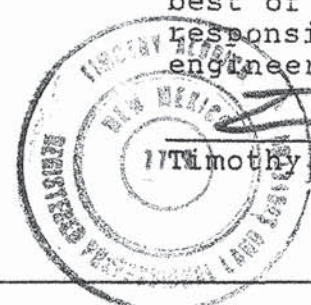


[Signature] 10-22-02
Timothy Aldrich, P.S. No. 7719 Date

1 2 3 4 5 6 7 8 9 10 11 12 13 14 15
26 6586 82 02

Bohannon & Huston

Courtyard One 7500 JEFFERSON NE Albuquerque NEW MEXICO 87109

ENGINEERS PLANNERS PHOTOGRAMMETRISTS SURVEYORS SOFTWARE DEVELOPERS

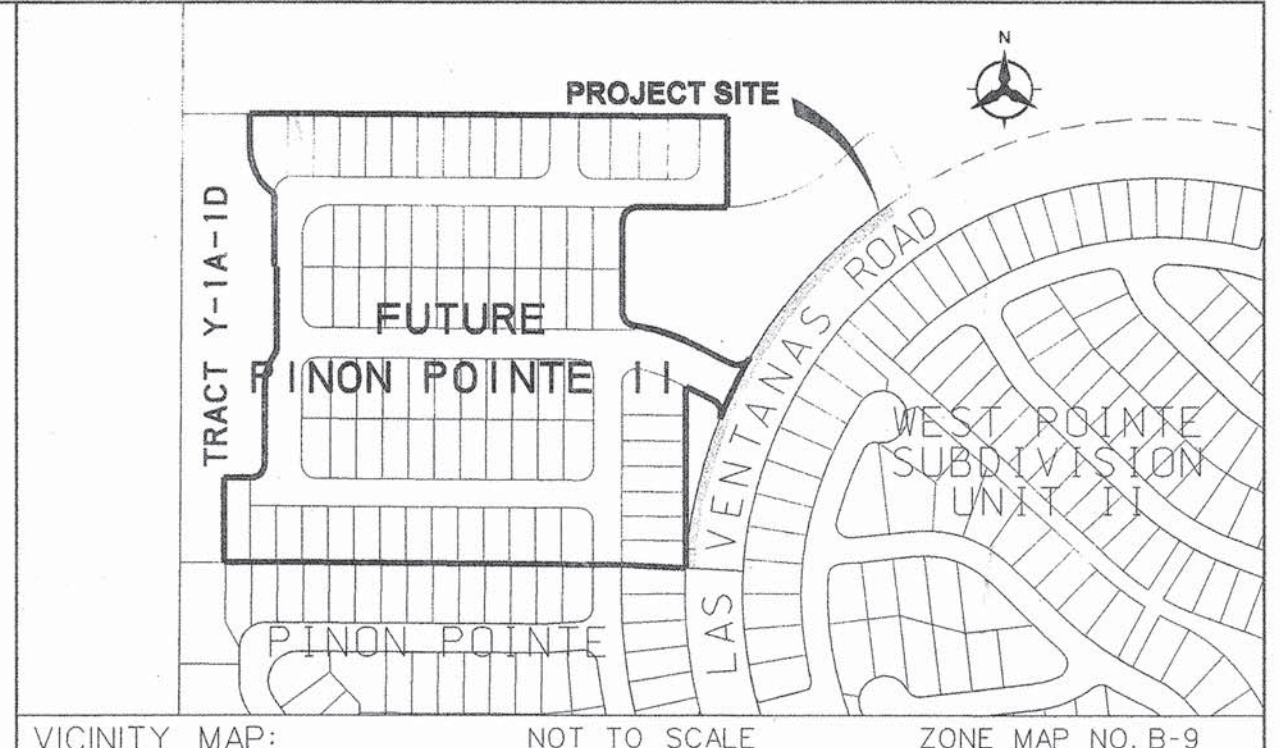

NOTICE TO CONTRACTORS

- ALL WORK DETAILED ON THESE PLANS TO BE PERFORMED UNDER CONTRACT SHALL, EXCEPT AS OTHERWISE STATED OR PROVIDED FOR HEREON, BE CONSTRUCTED IN ACCORDANCE WITH THE CITY OF ALBUQUERQUE STANDARD SPECIFICATIONS FOR PUBLIC WORKS CONSTRUCTION, 1986 EDITION AND SHALL INCLUDE UPDATE No. 6.
- TWO WORKING DAYS PRIOR TO ANY EXCAVATION, THE CONTRACTOR MUST CONTACT NEW MEXICO ONE CALL SYSTEM (260-1990) FOR LOCATION OF EXISTING UTILITIES.
- PRIOR TO CONSTRUCTION, THE CONTRACTOR SHALL EXCAVATE AND VERIFY THE HORIZONTAL AND VERTICAL LOCATIONS OF ALL OBSTRUCTIONS, SHOULD A CONFLICT EXIST, THE CONTRACTOR SHALL NOTIFY THE ENGINEER OR SURVEYOR IMMEDIATELY, SO THAT THE CONFLICT CAN BE RESOLVED WITH A MINIMUM AMOUNT OF DELAY.
- FIVE (5) WORKING DAYS PRIOR TO BEGINNING CONSTRUCTION, THE CONTRACTOR SHALL SUBMIT TO CONSTRUCTION COORDINATION DIVISION A DETAILED CONSTRUCTION SCHEDULE TWO (2) WORKING DAYS PRIOR TO CONSTRUCTION, THE CONTRACTOR SHALL OBTAIN A BARRICADING PERMIT FROM THE CONST. COORDINATION DIVISION. CONTRACTOR SHALL NOTIFY BARRICADE ENGINEER (768-2551) PRIOR TO OCCUPYING AN INTERSECTION. REFER TO SECTION 19 OF THE GENERAL CONDITIONS OF THE STANDARD SPECIFICATIONS.
- ALL PERMANENT STREET STRIPING ALTERED OR DESTROYED SHALL BE REPLACED W/ PLASTIC REFLECTORIZED PAVEMENT MARKING BY CONTRACTOR TO LOCATION AS EXISTING OR AS INDICATED BY THIS PLAN SET.
- CONTRACTOR SHALL NOTIFY THE ENGINEER NOT LESS THAN SEVEN (7) DAYS PRIOR TO STARTING WORK IN ORDER THAT THE CITY SURVEYOR MAY TAKE NECESSARY MEASURES TO INSURE THE PRESERVATION OF SURVEY MONUMENTS. CONTRACTOR SHALL NOT DISTURB PERMANENT SURVEY MONUMENTS WITHOUT THE CONSENT OF THE CITY SURVEYOR AND SHALL NOTIFY THE CITY SURVEYOR AND BEAR THE EXPENSE OF REPLACING ANY THAT MAY BE DISTURBED WITHOUT PERMISSION. REPLACEMENT SHALL BE DONE ONLY BY THE CITY SURVEYOR. WHEN A CHANGE IS MADE IN THE FINISHED ELEVATIONS OF THE PAVEMENT OF ANY ROADWAY IN WHICH A PERMANENT SURVEY MONUMENT IS LOCATED, CONTRACTOR SHALL, AT HIS OWN EXPENSE, ADJUST THE MONUMENT COVER TO THE NEW GRADE, UNLESS OTHERWISE SPECIFIED. REFER TO SECTION 4.4 OF THE GENERAL CONDITIONS OF THE STANDARD SPECIFICATIONS.
- ANY WORK WITHIN AN ARTERIAL ROADWAY REQUIRES TWENTY-FOUR HOUR CONSTRUCTION.
- ALL UTILITY WORK SHALL BE CONSTRUCTED IN ACCORDANCE WITH NEW MEXICO UTILITIES, INC. SPECIFICATIONS FOR WATER AND WASTEWATER FACILITIES (MOST RECENT REVISIONS).
- THE CONTRACTOR SHALL NOTIFY NEW MEXICO UTILITIES, (898-2661) THREE WORKING DAYS PRIOR TO BEGINNING THE CONSTRUCTION OF THE UTILITIES.
- CONTRACTOR SHALL MAINTAIN A GRAFFITI-FREE WORK SITE. CONTRACTOR SHALL PROMPTLY REMOVE ANY GRAFFITI FROM ALL EQUIPMENT, WHETHER PERMANENT OR TEMPORARY.
- FOR STORM DRAIN CONSTRUCTION, RCP PIPE JOINTS SHALL NOT BE GROUTED PRIOR TO FINAL INSPECTION. FINAL INSPECTION WILL DETERMINE JOINTS TO BE GROUTED FOR FINAL ACCEPTANCE OF THE CONSTRUCTION.

THE FOLLOWING NOTES ALSO APPLY WHEN CHECKED

- ☒ ALL UTILITIES AND UTILITY SERVICE LINES SHALL BE INSTALLED PRIOR TO PAVING.
- ☒ BACKFILL COMPACTION SHALL BE ACCORDING TO SPECIFIED STREET USE.
- ☐ TACK COAT REQUIREMENTS SHALL BE DETERMINED BY THE CITY ENGINEER.
- ☒ SIDEWALKS AND WHEELCHAIR RAMPS WITHIN THE CURB RETURNS SHALL BE CONSTRUCTED WHEREVER A NEW CURB RETURN IS CONSTRUCTED.
- ☐ IF CURB IS DEPRESSED FOR A DRIVEPAD, THE DRIVEPAD SHALL BE CONSTRUCTED PRIOR TO ACCEPTANCE OF CURB AND GUTTER.
- ☒ ALL STORM DRAINAGE FACILITIES SHALL BE COMPLETED PRIOR TO FINAL ACCEPTANCE.
- ☒ THE REQUESTOR OR DEVELOPER SHALL BE RESPONSIBLE FOR REPAIR OR REPLACEMENT OF ALL CURB AND GUTTER OR SIDEWALK DAMAGED AFTER APPROVAL BY THE CITY ENGINEER OF WORK COMPLETED BY THE CONTRACTOR.

REV.	SHEETS	CITY ENGINEER	DATE	USER DEPARTMENT	DATE	USER DEPARTMENT	DATE
ENGINEERS STAMP & SIGNATURE		APPROVALS		ENGINEER	DATE	*****	
		DRC Chairman	<i>[Signature]</i>	3-28-02	APPROVED FOR CONSTRUCTION		
		Transportation	<i>[Signature]</i>	2/19/02			
		Water/Wastewater	<i>[Signature]</i>	2/19/02			
		Hydrology	<i>[Signature]</i>	2/19/02			
		CIP					
Const. Mngmt.					City Engineer <i>[Signature]</i> 4/25/02 Date		
Const. Coord.		<i>[Signature]</i>	3-28-02				
NMUI		<i>[Signature]</i>	2-26-02				
DRB Case Number		City Project No.		Sheet		Of	
1001413		658682		1		10	

**FUTURE PINON POINTE II
Y-1A-1C
COA PROJECT #658683**

Y-1A-1B

LAS VENTANAS ROAD

BUILD 10' ASPHALT TRAIL AS PER DETAIL THIS SHEET

WEST EDGE OF NEW PAVEMENT

SHADE AREA WILL BE BUILT UNDER THIS WORK ORDER

TRACT 15
WEST POINT SUBDIVISION
FILED: AUGUST 31, 2000
(200CC-226)

PINON POINT SUBDIVISION
FILED: MAY 4, 2001
(200IC-127)

EXISTING COA #617682

THIS PROJECT

EXISTING COA #617682

THIS PROJECT

10' ASPHALT TRAIL TO BE BUILT WITH FUTURE DEVELOPMENT

STATIONING: 00+00, 00+10, 00+20, 00+4320,

LAS VENTANAS ROAD
COA PROJECT NO. 617682

Diagram illustrating the plan view of the proposed section, showing stationing and various offsets:

- Overall width: 100' R/W
- Stationing: 50' (left), 50' (right)
- Offset of Road: 60' (left), 40' (right)
- Offset of R/W: 42' (left), 36' (right)
- Proposed Section: 8' (left), 4' (right)
- Temp. Curb to be Removed: 24' (left), 18' (right)
- Existing Std. Curb & Existing 10' Asphalt Trail: 22' (right)
- Grades: 2% (left), 0.91% (right)
- Labels: PROPOSED 10' ASPHALT TRAIL, STD. CURB & GUTTER, TEMP. CURB TO BE REMOVED, EXISTING STD. CURB & EXISTING 10' ASPHALT TRAIL

4" CONCRETE SIDEWALK

ASPHALT TRANSITION FROM 4" SIDEWALK TO 10" ASPHALT TRAIL

R/W LINE

NO HEADER CURB

10" ASPHALT TRAIL

MIN

MIN

2" BIKE ASPHALT, TYPE "C" GRADATION

2%

SLOPE TRAIL 2% TOWARDS CURB

8" SUBGRADE COMPACTED AT 95%

10'

A cross-sectional diagram of a standard curb and gutter. It shows a concrete curb on the left, a gutter with a sloped bottom, and a road surface on the right. A dimension line above the curb indicates a width of 12". A label with an arrow points to the gutter area, stating "STANDARD CURB AND GUTTER". The road surface is shown with diagonal hatching.

 
 
FINISH SURFACES OF SUBGRADE SHALL BE MOISTURE CONTROLLED AT THE COMPACTION MOISTURE RANGE, OR A PRIME SOIL APPD AS REQUIRED BY THE ENGINEER UNTIL NEXT/ FINAL SURFACING IS COMPLETED. SUBGRADE PREPARATION SHALL BE PERFORMED AFTER ALL SUBSURFACE R/W UTILITIES CONSTRUCTION ARE COMPLETED.

95% MINIMUM COMPACTION

1" SUBGRADE SOIL, R-VALUE 50. PLACED IN 2-6" LIFTS. 95% MIN. COMPACTION. AT OPT MOISTURE +/-2.0%. ASTM D698 FOR SOIL W/35% OR MORE PASSING THE 200 SIEVE.

LAS VENTANAS ROAD PAVEMENT SECTION
(MATCH COA PROJECT #617682)
NOT TO SCALE MINOR ARTERIAL
(DESIGNED UNDER PROJECT #5750.56)

NOTE:
"SOIL NOT HAVING THE MINIMUM R-VALUE OF 50, SHALL
BE REMOVED TO A DEPTH OF 2 FEET AND REPLACED,
BY THE CONTRACTOR, WITH SUITABLE MATERIAL OR PAVEMENT
SECTION SHALL BE DESIGNED, BY THE CONSULTANT ACCOMMODATING
THE EXISTING R-VALUE PER COA STANDARD SPECIFICATIONS."

PROPOSED CURB AND GUTTER	
EXISTING CURB AND GUTTER	
FUTURE CURB AND GUTTER	
PROPOSED STORM DRAIN MANHOLE	
EXISTING STORM DRAIN MANHOLE	
PROPOSED SANITARY SEWER MANHOLE	
EXISTING SANITARY SEWER MANHOLE	
PROPOSED FIRE HYDRANT	
PROPOSED GATE VALVE	
EXISTING GATE VALVE	
PROPOSED STREET LIGHT	
10' ASPHALT TRAIL	
CROWN FLATTENING	

 Courtyard One 7500 JEFFERSON NE Albuquerque NEW MEXICO 87109

ENGINEERS PLANNERS PHOTOGRAMMETRISTS SURVEYORS SOFTWARE DEVELOPERS

CITY OF ALBUQUERQUE
PUBLIC WORKS DEPARTMENT
ENGINEERING DEVELOPMENT GROUP
PINON POINTE II SUBDIVISION AT VENTANA RANCH
OFF SITE IMPROVEMENTS
OVERALL OFFSITE PAVING PLAN



DESIGN REVIEW COMMITTEE	CITY ENGINEER
APPROVED	APPROVED
MAR 28 2002	APR 25 2002
DESIGN REVIEW COMMITTEE	CITY ENGINEER

CITY PROJECT NO.	658682	ZONE MAP NO.	B-9	SHEET	3	OF	10
------------------	--------	--------------	-----	-------	---	----	----

SURVEY INFORMATION		BENCH MARKS		AS-BUILT INFORMATION	
NO.	DATE	BY	NOTES	CONTRACTOR	DATE
			ACS BRASS TABLE STAMPED "1-B9 1980"	WORKED BY	11/15/2012
			GEOGRAPHIC POSITION (NAD 1927)	INSPECTOR'S	11/15
			N.M. STATE PLANE COORDINATES	ACCEPTANCE BY	10/1
			(CENTRAL ZONE) X=355-077.00	VERIFICATION BY	11/15
			Y=1-529-056.93	DRAWINGS	11/15
				CORRECTED BY	11/15
			GROUND-TO-GRID FACTOR = .99866334	MICRO-FILM INFORMATION	
			DELTA ALPHA -00° 16' 47"	RECORDED BY	DATE
			NVD 1929 ELEVATION = 5450.51	NO.	
				C. SHENGO - C.O.A. 7/29/91	

[illegible]

QUERQUE	
TMENT	
PMENT GROUP	
VENTANA RANCH	
ENTS	
PLAN	
MO./DAY/YR.	MO./DAY/YR.
SHEET	OF
3	10

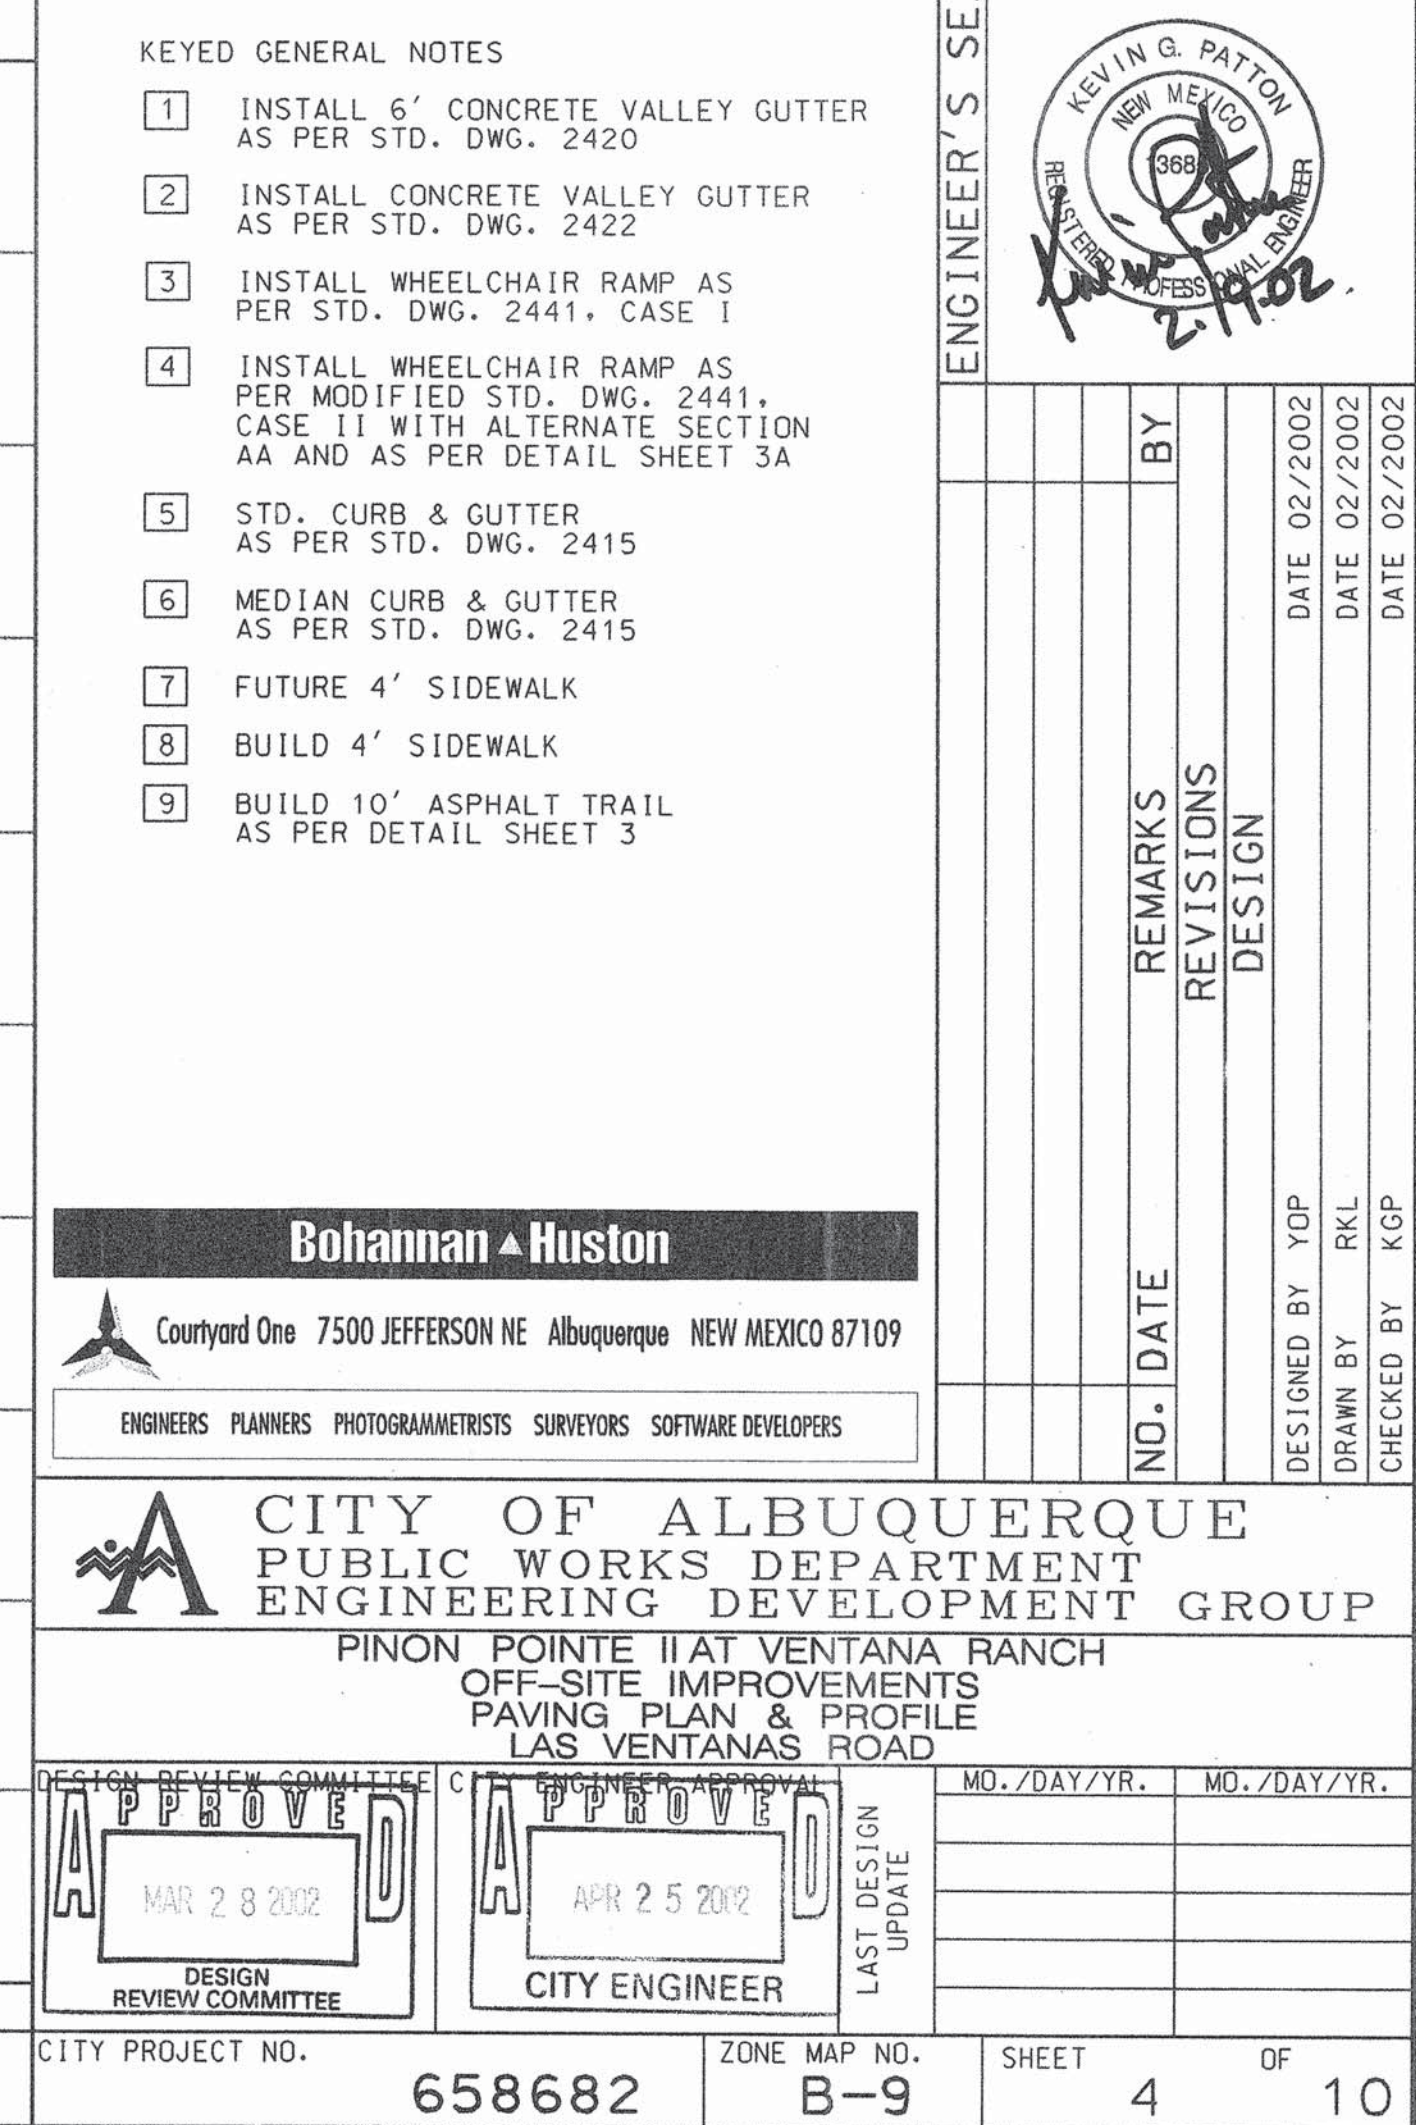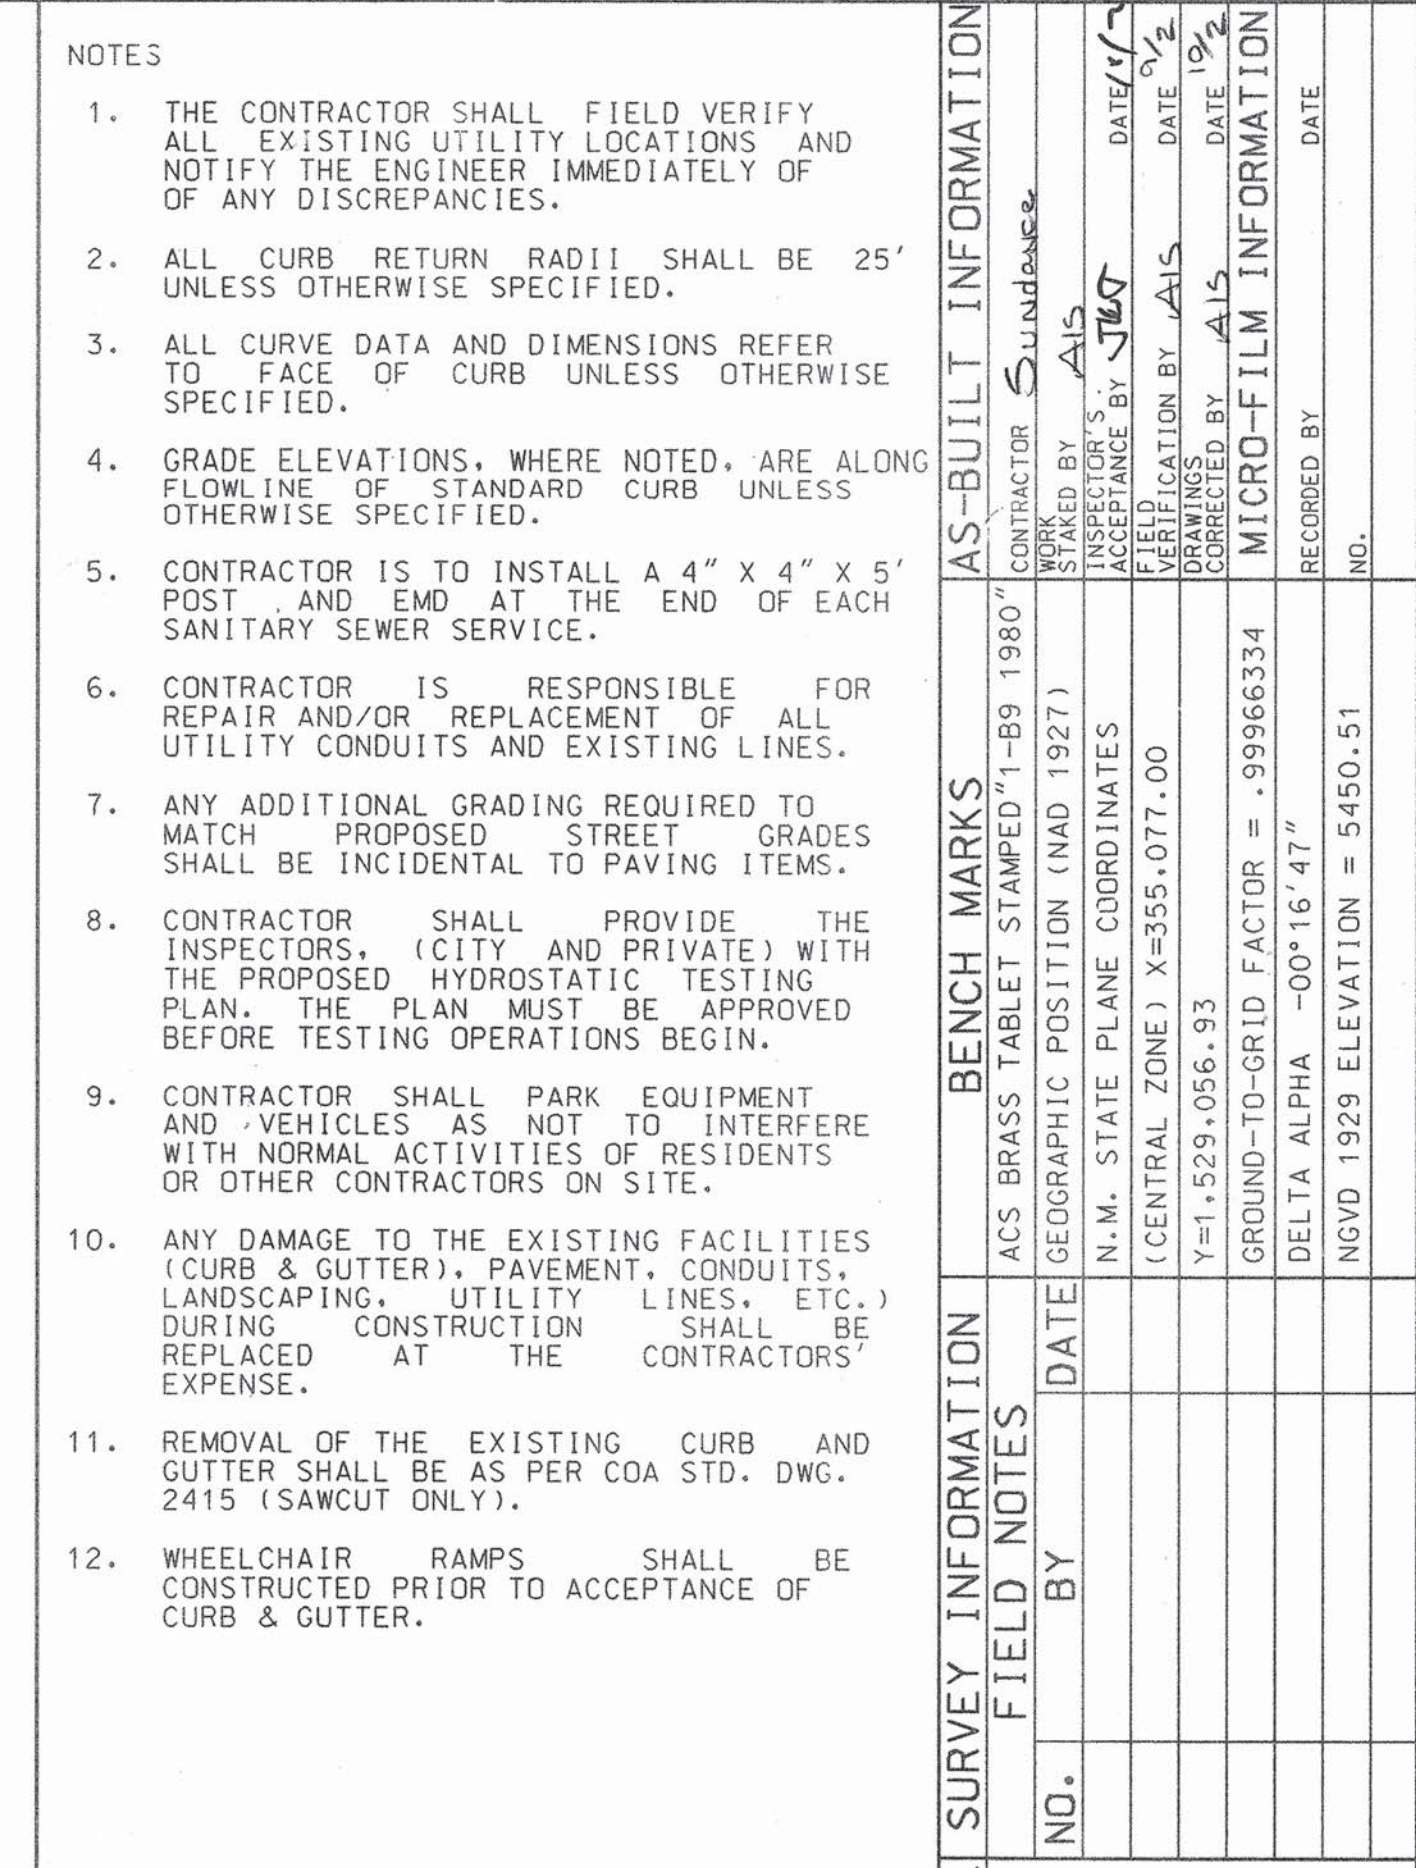

CL TANGENT TABLE

ID	BEARING	LENGTH
T3	S70°00'00"E	213.82'

CL Curve Table

ID	ARC	RADIUS	DELTA	TANGENT
C2	1448.35'	775.00'	107°04'36"	1048.88'

SD TANGENT TABLE


ID	BEARING	LENGTH
T4	S28°43'16"E	30.00'
T5	S70°00'00"E	12.00'
T6	S25°00'00"E	8.00'
T7	S20°00'00"E	16.00'

SD Curve Table

ID	ARC	RADIUS	DELTA	TANGENT
C3	327.69'	795.00'	23°37'01"	166.21'
C4	206.59'	795.00'	14°53'21"	103.88'

SD FLOW TABLE

NUMBER	(D/Gfs)	(V/Gfs)	DEPTH	LENGTH	SIZE	SLOPE
T4	198.00	18.20	38.76"	30.00'	48"	1.84 %
T5	198.00	19.10	31.32"	12.00'	60"	2.00 %
C3	198.00	18.20	38.76"	327.69'	48"	1.95 %
C4	198.00	14.77	42.48"	206.59'	54"	1.10 %

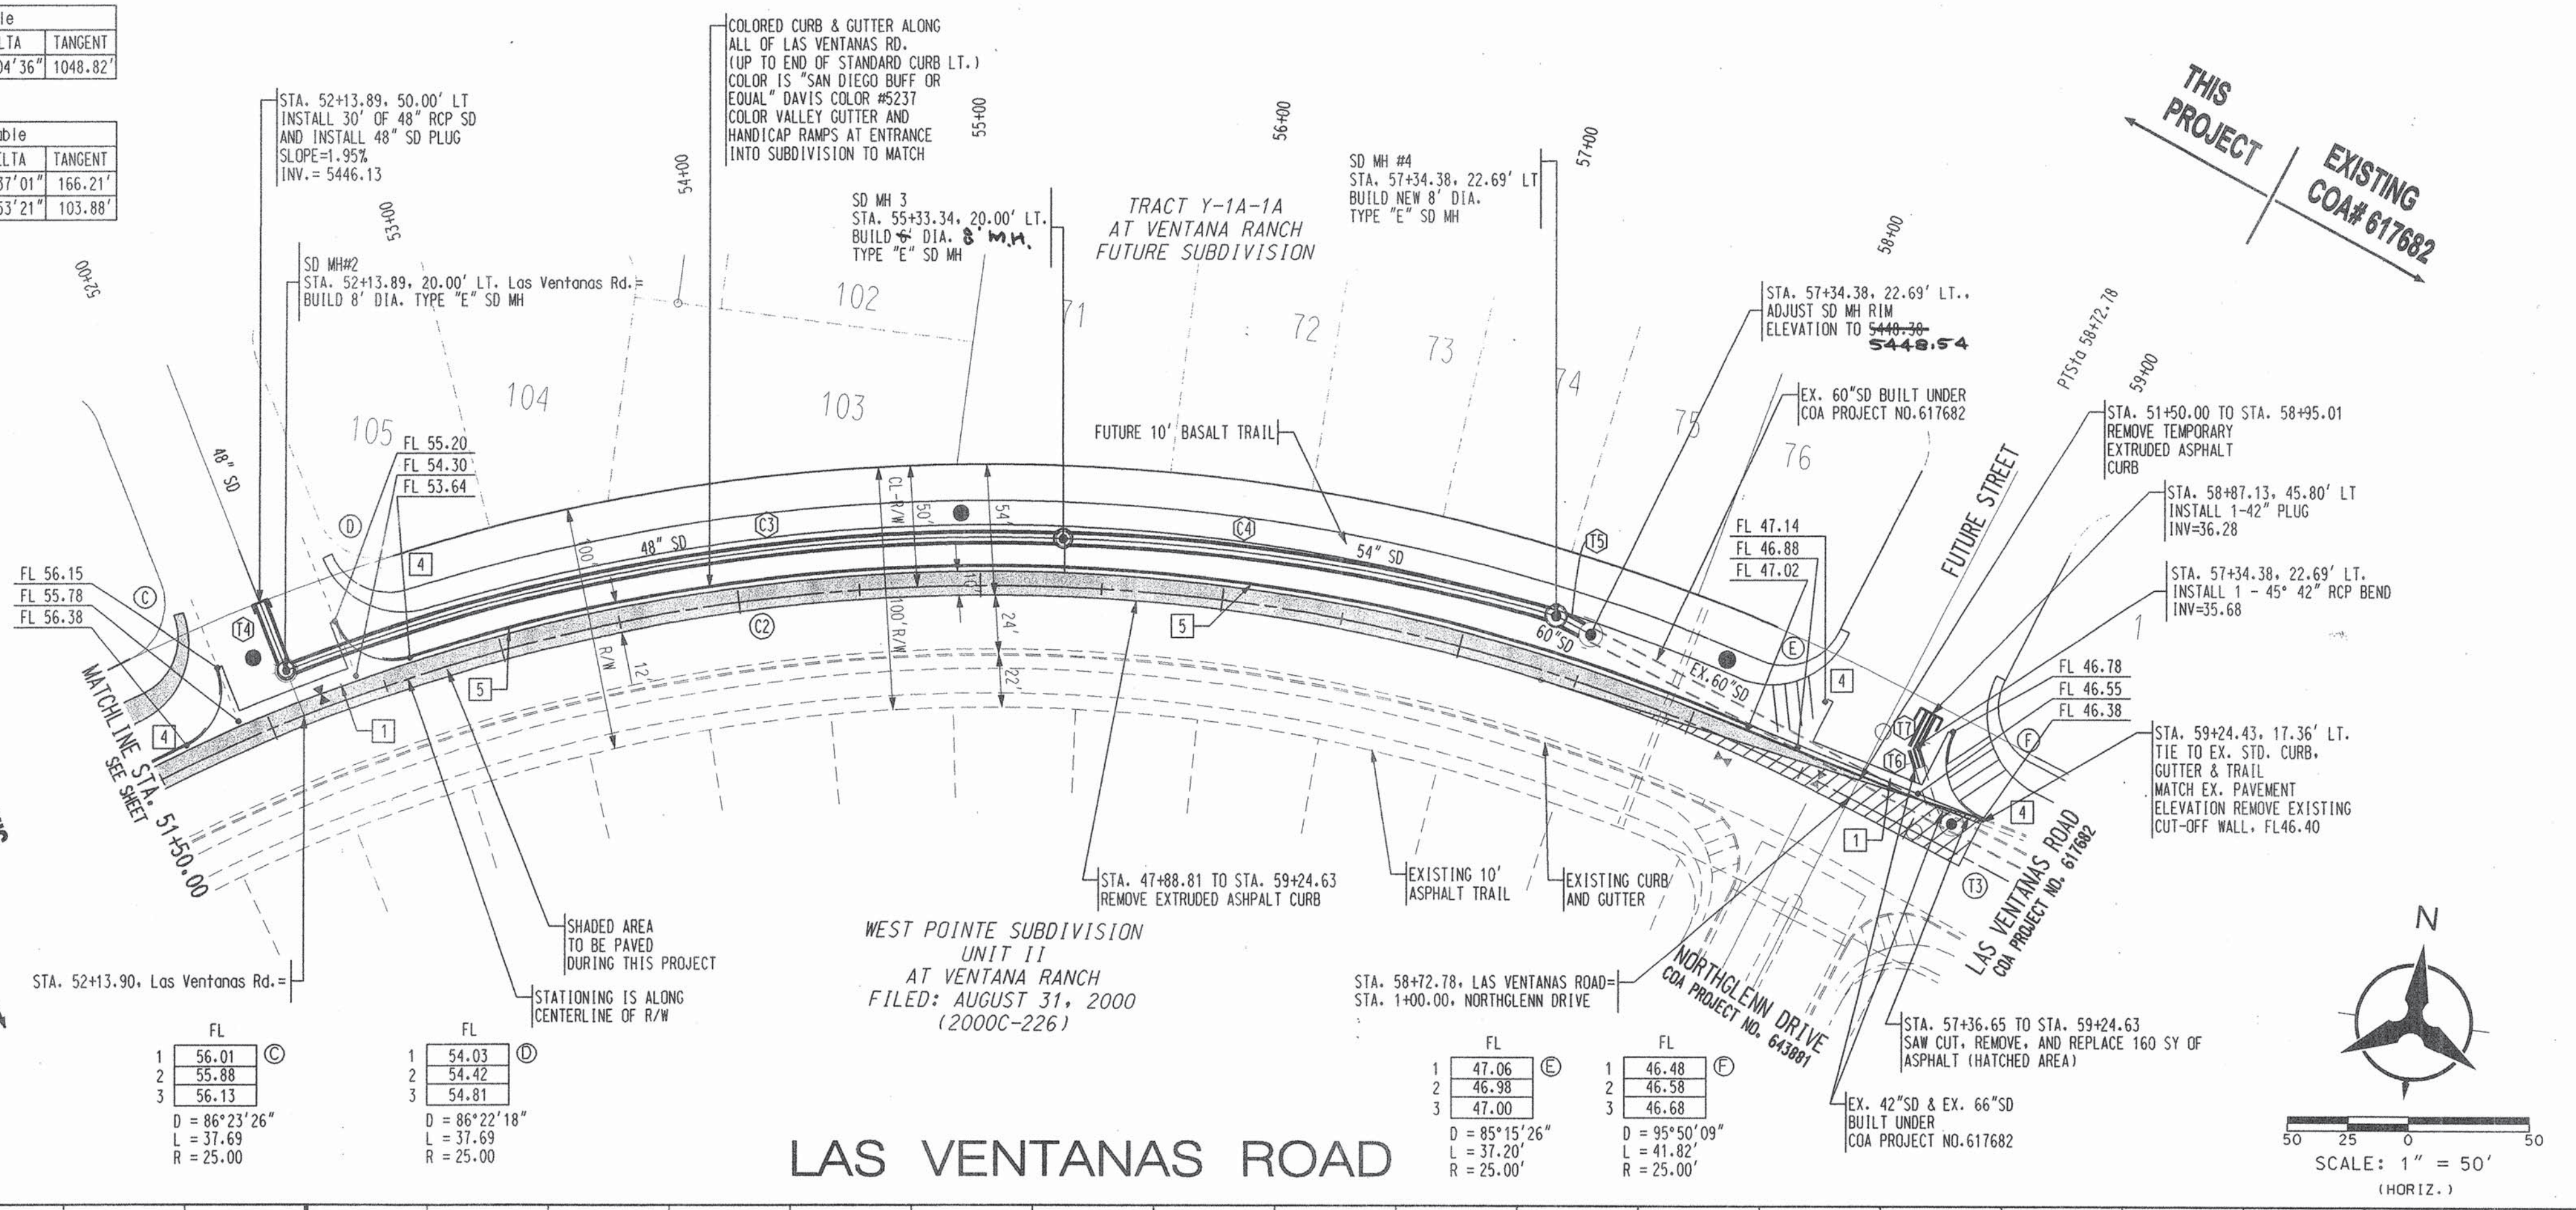

- NOTES
- THE CONTRACTOR SHALL FIELD VERIFY ALL EXISTING UTILITY LOCATIONS AND NOTIFY THE ENGINEER IMMEDIATELY OF ANY DISCREPANCIES.
 - ALL CURB RETURN RADII SHALL BE 25' UNLESS OTHERWISE SPECIFIED.
 - ALL CURVE DATA AND DIMENSIONS REFER TO FACE OF CURB UNLESS OTHERWISE SPECIFIED.
 - GRADE ELEVATIONS, WHERE NOTED, ARE ALONG FLOWLINE OF STANDARD CURB UNLESS OTHERWISE SPECIFIED.
 - CONTRACTOR IS TO INSTALL A 4" X 4" X 5' POST AND EMD AT THE END OF EACH SANITARY SEWER SERVICE.
 - CONTRACTOR IS RESPONSIBLE FOR REPAIR AND/OR REPLACEMENT OF ALL UTILITY CONDUITS AND EXISTING LINES.
 - ANY ADDITIONAL GRADING REQUIRED TO MATCH PROPOSED STREET GRADES SHALL BE INCIDENTAL TO PAVING ITEMS.
 - CONTRACTOR SHALL PROVIDE THE INSPECTORS, (CITY AND PRIVATE) WITH THE PROPOSED HYDROSTATIC TESTING PLAN. THE PLAN MUST BE APPROVED BEFORE TESTING OPERATIONS BEGIN.
 - CONTRACTOR SHALL PARK EQUIPMENT AND VEHICLES AS NOT TO INTERFERE WITH NORMAL ACTIVITIES OF RESIDENTS OR OTHER CONTRACTORS ON SITE.
 - ANY DAMAGE TO THE EXISTING FACILITIES (CURB & GUTTER), PAVEMENT, CONDUITS, LANDSCAPING, UTILITY LINES, ETC.) DURING CONSTRUCTION SHALL BE REPLACED AT THE CONTRACTORS' EXPENSE.
 - REMOVAL OF THE EXISTING CURB AND GUTTER SHALL BE AS PER COA STD. DWG. 2415 (SAWCUT ONLY).
 - WHEELCHAIR RAMPS SHALL BE CONSTRUCTED PRIOR TO ACCEPTANCE OF CURB & GUTTER.

- KEYED GENERAL NOTES
- INSTALL 6" CONCRETE VALLEY GUTTER AS PER STD. DWG. 2420
 - INSTALL CONCRETE VALLEY GUTTER AS PER STD. DWG. 2422
 - INSTALL WHEELCHAIR RAMP AS PER STD. DWG. 2441, CASE I
 - INSTALL WHEELCHAIR RAMP AS PER MODIFIED STD. DWG. 2441, CASE II WITH ALTERNATE SECTION AA AND AS PER DETAIL SHEET 3A
 - STD. CURB & GUTTER AS PER STD. DWG. 2415
 - MEDIAN CURB & GUTTER AS PER STD. DWG. 2415
 - FUTURE 4' SIDEWALK
 - BUILD 4' SIDEWALK
 - BUILD 10' ASPHALT TRAIL AS PER DETAIL SHEET 3

Bohannon & Huston
Courtyard One 7500 JEFFERSON NE Albuquerque NEW MEXICO 87109
ENGINEERS PLANNERS PHOTOGRAMMETRISTS SURVEYORS SOFTWARE DEVELOPERS


CITY OF ALBUQUERQUE
PUBLIC WORKS DEPARTMENT
ENGINEERING DEVELOPMENT GROUP
PINON POINTE II AT VENTANA RANCH
OFF-SITE IMPROVEMENTS
PAVING PLAN & PROFILE
LAS VENTANAS ROAD

DESIGN REVIEW COMMITTEE CITY ENGINEER APPROVAL
APPROVED MAR 28 2002
DESIGN REVIEW COMMITTEE CITY ENGINEER
APPROVED APR 25 2002

LAST DESIGN UPDATE

CITY PROJECT NO. 658682 ZONE MAP NO. B-9 SHEET 5 OF 10

AS-BUILT INFORMATION		BENCH MARKS		ENGINEER'S SEAL		SURVEY INFORMATION		FIELD NOTES		NO. BY DATE		REMARKS		REVISIONS		DESIGN		NO. DATE		YOP		RKL		KGP	
CONTRACTOR: Sundance		CONTRACTOR: Sundance		ENGINEER'S SEAL		SURVEY INFORMATION		FIELD NOTES		NO. BY DATE		REMARKS		REVISIONS		DESIGN		NO. DATE		YOP		RKL		KGP	
WORK STARTED BY: AJS		WORK STARTED BY: AJS		ENGINEER'S SEAL		SURVEY INFORMATION		FIELD NOTES		NO. BY DATE		REMARKS		REVISIONS		DESIGN		NO. DATE		YOP		RKL		KGP	
ACCEPTANCE BY: AJS		ACCEPTANCE BY: AJS		ENGINEER'S SEAL		SURVEY INFORMATION		FIELD NOTES		NO. BY DATE		REMARKS		REVISIONS		DESIGN		NO. DATE		YOP		RKL		KGP	
DATE: 10/1/01		DATE: 10/1/01		ENGINEER'S SEAL		SURVEY INFORMATION		FIELD NOTES		NO. BY DATE		REMARKS		REVISIONS		DESIGN		NO. DATE		YOP		RKL		KGP	
DATE: 10/1/01		DATE: 10/1/01		ENGINEER'S SEAL		SURVEY INFORMATION		FIELD NOTES		NO. BY DATE		REMARKS		REVISIONS		DESIGN		NO. DATE		YOP		RKL		KGP	
DATE: 10/1/01		DATE: 10/1/01		ENGINEER'S SEAL		SURVEY INFORMATION		FIELD NOTES		NO. BY DATE															


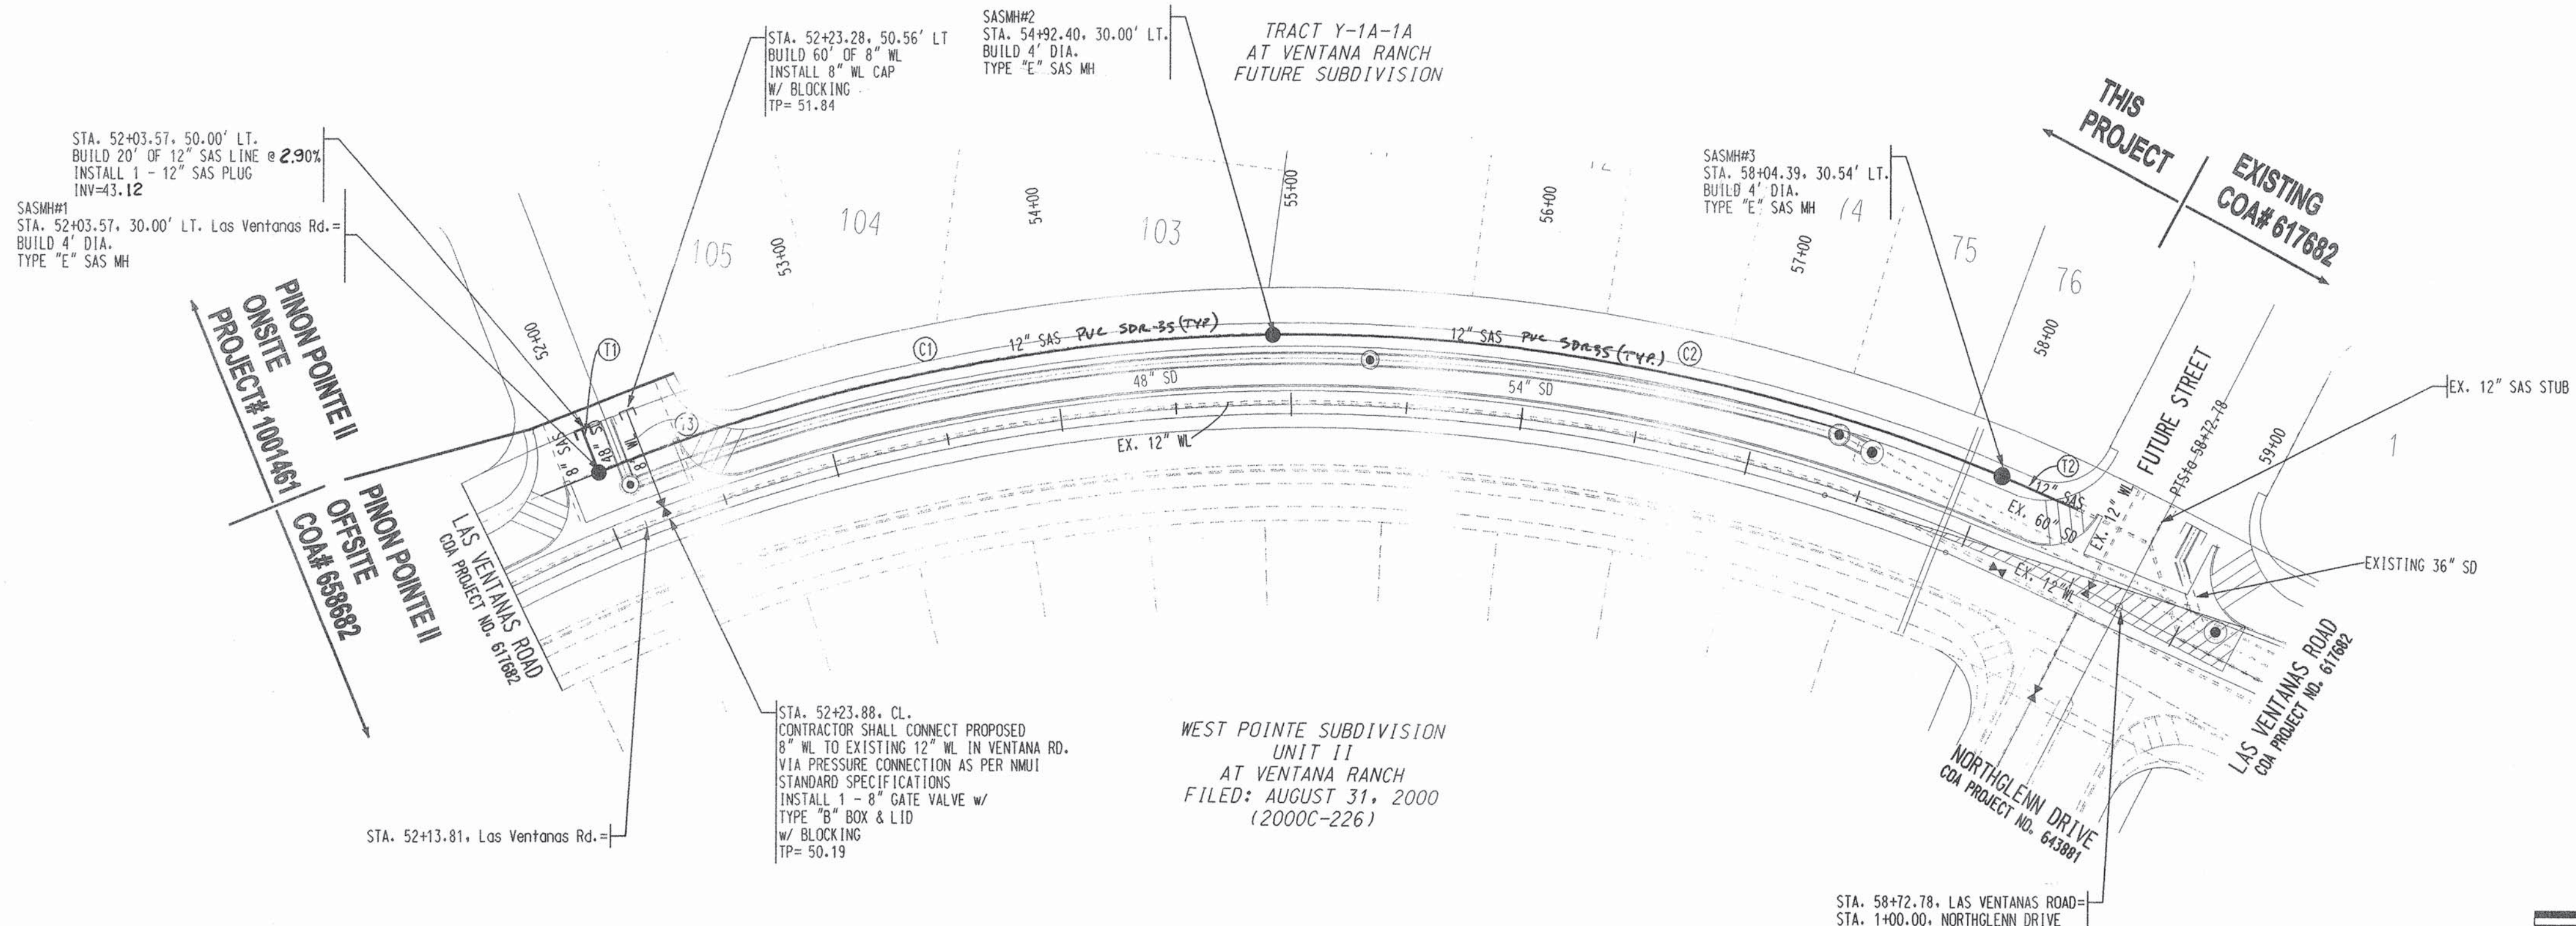


SAS Tangent Table		
ID	BEARING	LENGTH
T1	S29°28'28"E	20.00'
T2	S73°46'13"E	35.96'

SAS Curve Table				
ID	ARC	RADIUS	DELTA	TANGENT
C1	300.00'	805.00'	21°21'09"	151.76'
C2	324.15'	805.00'	23°04'17"	164.30'

WL Tangent Table		
ID	BEARING	LENGTH
T1	S28°43'17"E	49.57'

- NOTES
1. THE CONTRACTOR SHALL FIELD VERIFY ALL EXISTING UTILITY LOCATIONS AND NOTIFY THE ENGINEER IMMEDIATELY OF ANY DISCREPANCIES.
 2. ALL CURB RETURN RADII SHALL BE 25' UNLESS OTHERWISE SPECIFIED.
 3. ALL CURVE DATA AND DIMENSIONS REFER TO FACE OF CURB UNLESS OTHERWISE SPECIFIED.
 4. GRADE ELEVATIONS, WHERE NOTED, ARE ALONG FLOWLINE OF STANDARD CURB UNLESS OTHERWISE SPECIFIED.
 5. CONTRACTOR IS TO INSTALL A 4" X 4" X 5' POST AND END AT THE END OF EACH SANITARY SEWER SERVICE.
 6. CONTRACTOR IS RESPONSIBLE FOR REPAIR AND/OR REPLACEMENT OF ALL UTILITY CONDUITS AND EXISTING LINES.
 7. ANY ADDITIONAL GRADING REQUIRED TO MATCH PROPOSED STREET GRADES SHALL BE INCIDENTAL TO PAVING ITEMS.
 8. CONTRACTOR SHALL PROVIDE THE INSPECTORS, (CITY AND PRIVATE) WITH THE PROPOSED HYDROSTATIC TESTING PLAN. THE PLAN MUST BE APPROVED BEFORE TESTING OPERATIONS BEGIN.
 9. CONTRACTOR SHALL PARK EQUIPMENT AND VEHICLES AS NOT TO INTERFERE WITH NORMAL ACTIVITIES OF RESIDENTS OR OTHER CONTRACTORS ON SITE.
 10. ANY DAMAGE TO THE EXISTING FACILITIES (CURB & GUTTER), PAVEMENT, CONDUITS, LANDSCAPING, UTILITY LINES, ETC.) DURING CONSTRUCTION SHALL BE REPLACED AT THE CONTRACTORS' EXPENSE.
 11. REMOVAL OF THE EXISTING CURB AND GUTTER SHALL BE AS PER COA STD. DWG. 2415 (SAWCUT ONLY).
 12. WHEELCHAIR RAMPS SHALL BE CONSTRUCTED PRIOR TO ACCEPTANCE OF CURB & GUTTER.

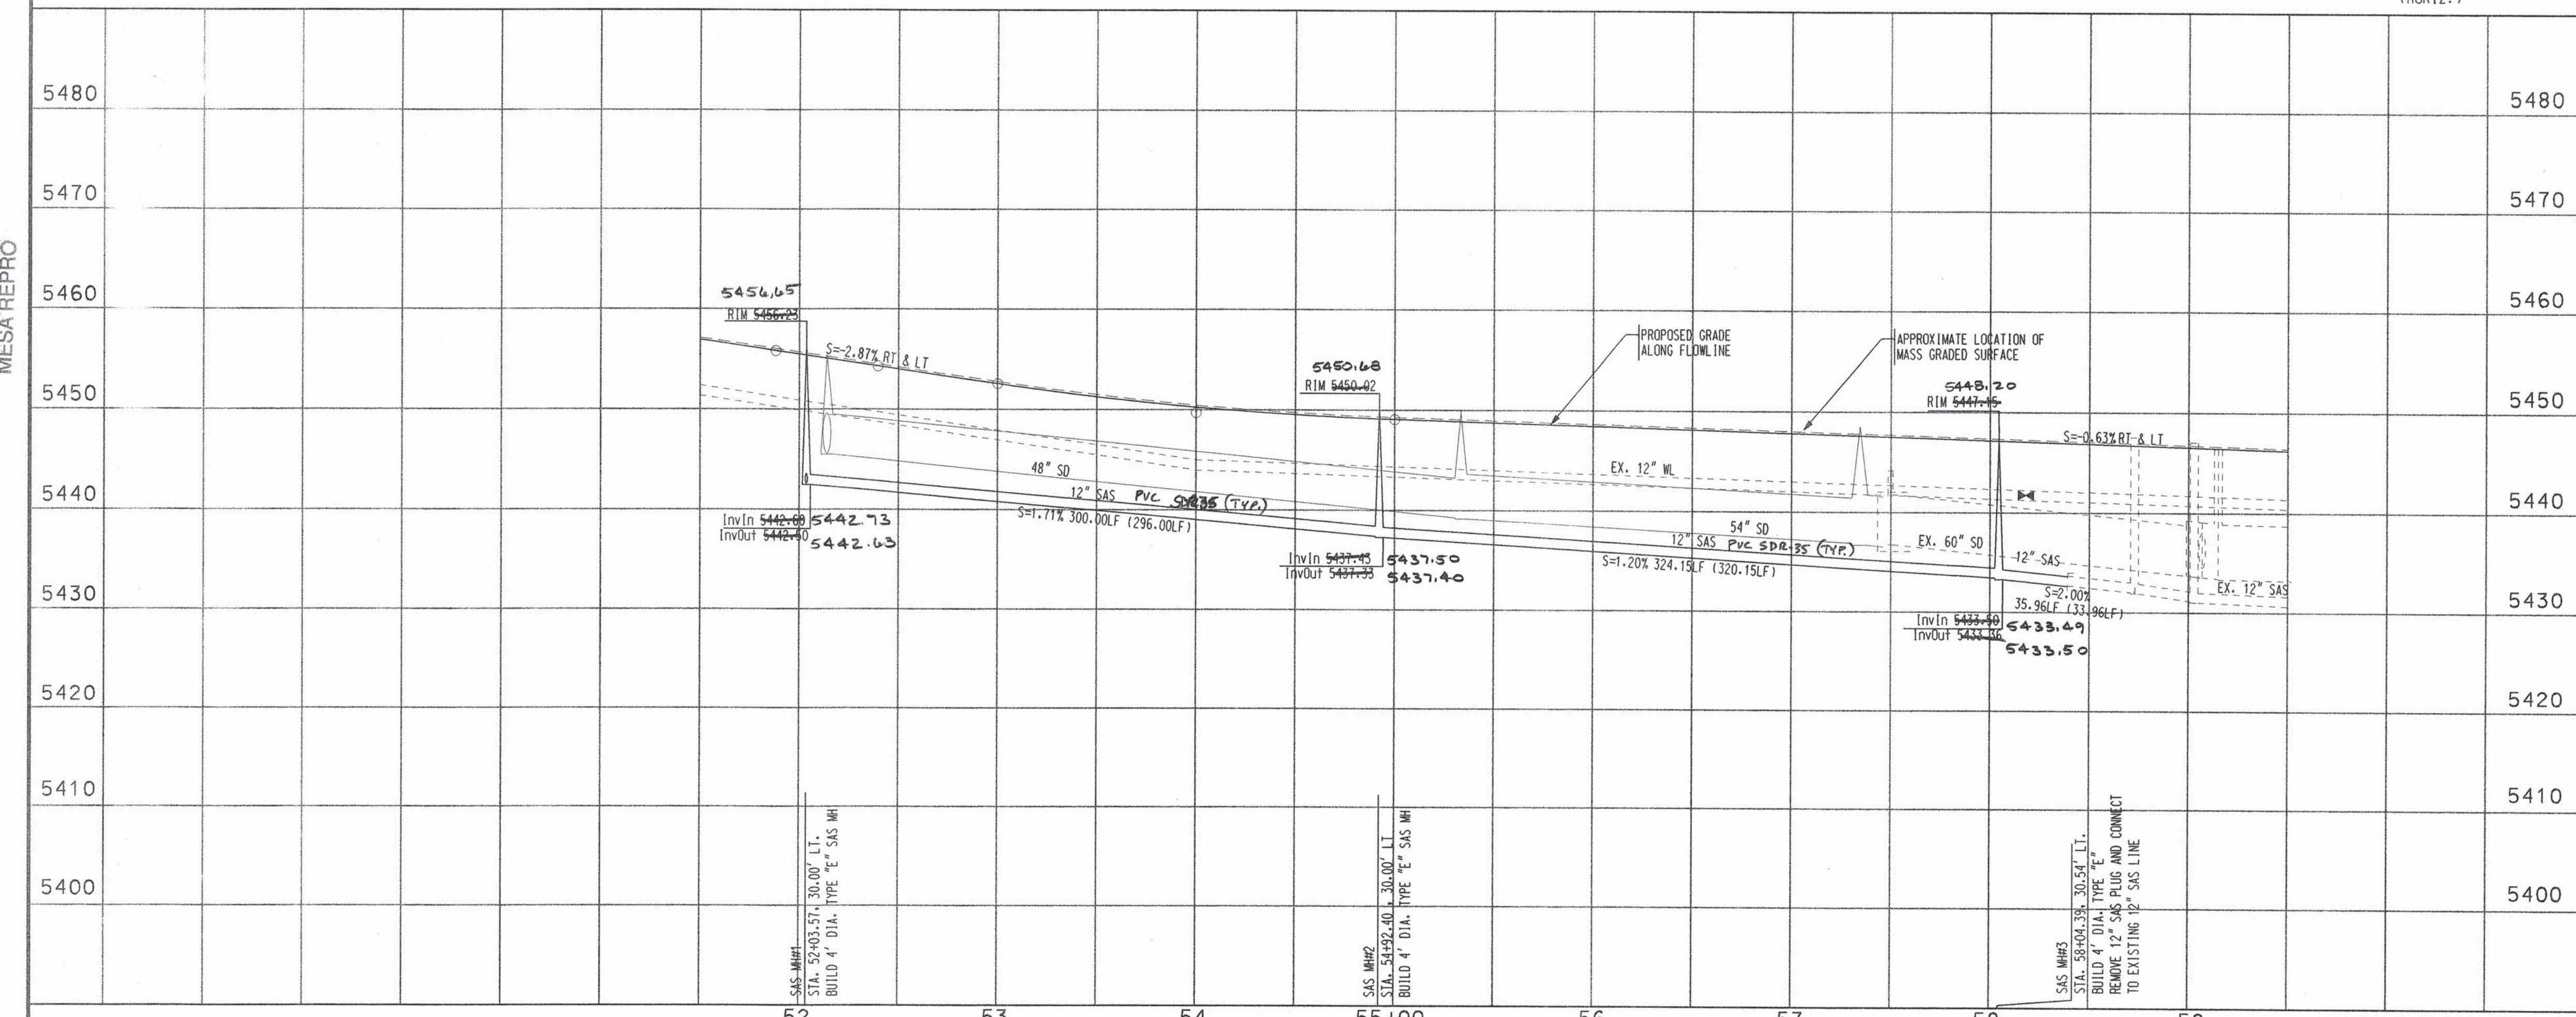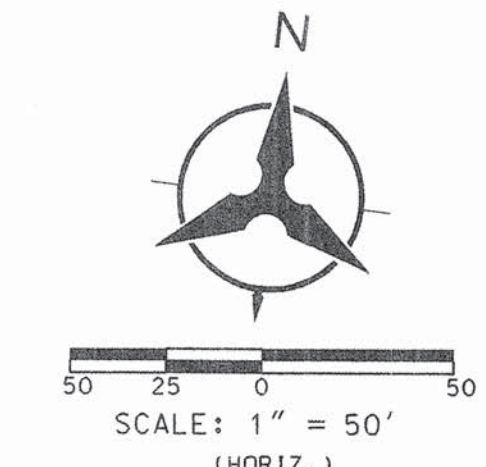

APPROVED BY NMUI 2-26-02 DATE

Bohannon & Huston
Courtney One 7500 JEFFERSON NE Albuquerque NEW MEXICO 87109
ENGINEERS PLANNERS PHOTOGRAMMETRISTS SURVEYORS SOFTWARE DEVELOPERS

CITY OF ALBUQUERQUE
PUBLIC WORKS DEPARTMENT
ENGINEERING DEVELOPMENT GROUP
PINON PONTE II AT VENTANA RANCH
OFF-SITE IMPROVEMENTS
UTILITY PLAN & PROFILE
LAS VENTANAS ROAD

DESIGN REVIEW COMMITTEE APPROVED MAR 28 2002
CITY ENGINEER APPROVED APR 25 2002

LAST DESIGN UPDATE

MO./DAY/YR. MO./DAY/YR.

SCANNED BY
MESA REPRO

Y-1A-1D

Y-1A-1A

FUTURE PARK
Y-1A-1B

FUTURE PINON POINTE II
Y-1A-1C (BY OTHERS)
COA PROJECT #658683

WOODSTAR AVENUE

BUTTON QUAIL AVENUE

GOSHAWK AVENUE

SHAWNA STREET

LAS VENTANAS ROAD

TRACT Y-1A-1A
AT VENTANA RANCH
FUTURE SUBDIVISION

FUTURE
PROJECT
THIS
PROJECT

SEE THIS SHEET FOR CONTINUATION
LAS VENTANAS ROAD

SEE THIS SHEET FOR CONTINUATION
LAS VENTANAS ROAD

NOTE:
ALL EXISTING UTILITIES AND
STORM DRAIN THIS AREA BUILT
UNDER COA PROJECT NO. 617682



TRACT 15
WEST POINT SUBDIVISION
FILED: AUGUST 31, 2000
(200CC-226)

PEDESTRIAN ACCESS
AND PUBLIC STORM DRAIN
FILED: DECEMBER 10, 2001
BOOK 2001C, PAGE 322

NOTE:
THE CONTRACTOR SHALL FIELD VERIFY
ALL EXISTING UTILITY LOCATIONS AND
NOTIFY THE ENGINEER IMMEDIATELY OF
ANY DISCREPANCIES.

PINON POINT SUBDIVISION
FILED: MAY 4, 2001
(2001C-127)

Crossings					
DES	SAS	SD	WL	Clearance	
1	12" TP 43.38	48" TP 50.22		1.88	
	12" INV 42.32	48" INV 45.26			
2	12" TP 43.21	8" TP 51.15		7.24	
	12" INV 42.15	8" INV 50.45			
3	48" TP 49.84	8" TP 51.15		0.65	
	48" INV 44.88	8" INV 50.49			

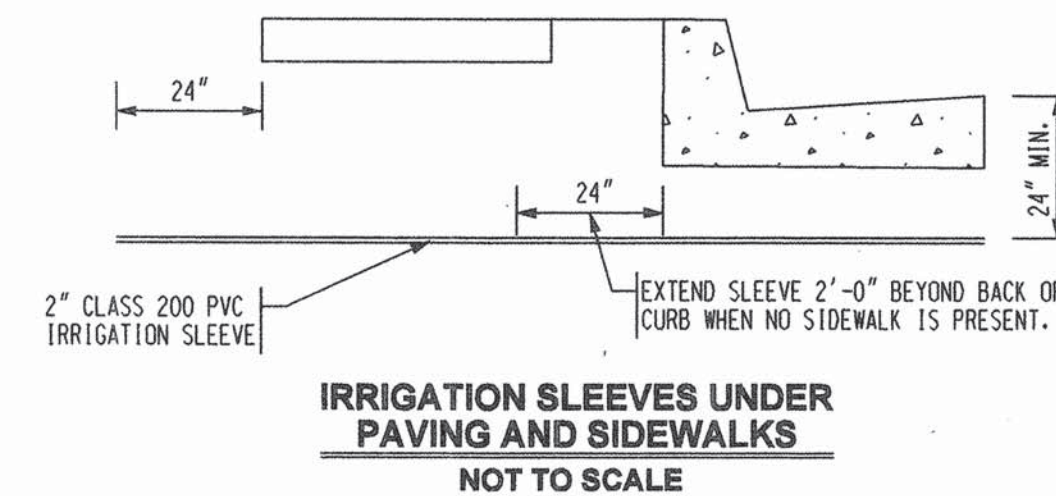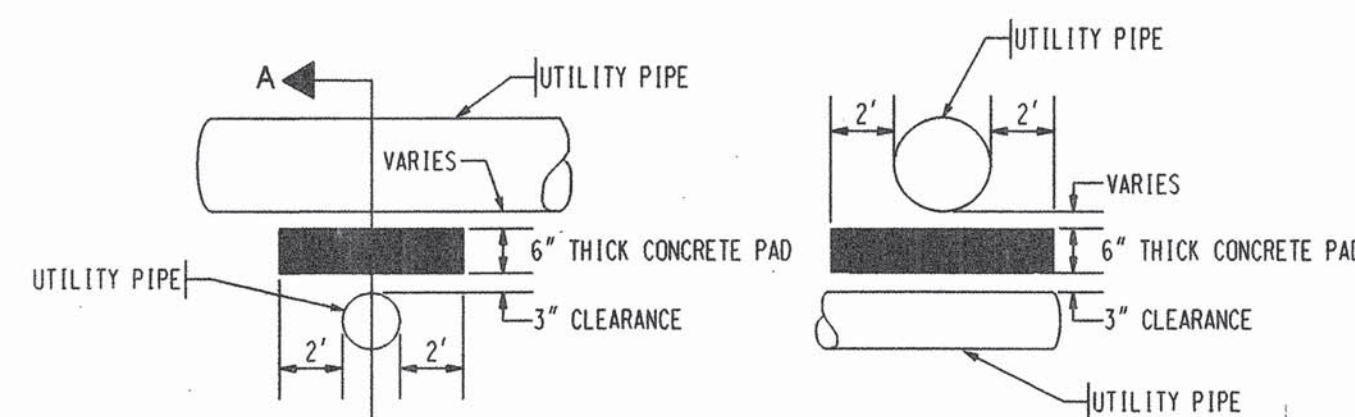

LEGEND

PROPOSED SANITARY SEWER MANHOLE	●
EXISTING SANITARY SEWER MANHOLE	○
PROPOSED FIRE HYDRANT	●
EXISTING FIRE HYDRANT	○
PROPOSED GATE VALVE	⊗
EXISTING GATE VALVE	⊙
PROPOSED SANITARY SEWER LINE	SAS
EXISTING SANITARY SEWER LINE	SAS
PROPOSED WATER LINE	W
EXISTING WATER LINE	W
PROPOSED SANITARY SEWER SERVICE	—
PROPOSED WATER METER SERVICE	—
PROPOSED STREET LIGHT	★

Bohannon & Huston


Courtyard One 7500 JEFFERSON NE Albuquerque NEW MEXICO 87109

ENGINEERS PLANNERS PHOTOGRAMMETRISTS SURVEYORS SOFTWARE DEVELOPERS

CITY OF ALBUQUERQUE
PUBLIC WORKS DEPARTMENT
ENGINEERING DEVELOPMENT GROUP
PINON POINTE II SUBDIVISION AT VENTANA RANCH
OFF-SITE IMPROVEMENTS
OVERALL OFFSITE PAVING PLAN

DESIGN REVIEW COMMITTEE	CITY ENGINEER APPROVAL	MO./DAY/YR.	MO./DAY/YR.
APPROVED MAR 28 2002 DESIGN REVIEW COMMITTEE	APPROVED APR 25 2002 CITY ENGINEER		
LAST DESIGN UPDATE			


CITY PROJECT NO.	658682	ZONE MAP NO.	B-9	SHEET	6	OF	10
------------------	--------	--------------	-----	-------	---	----	----

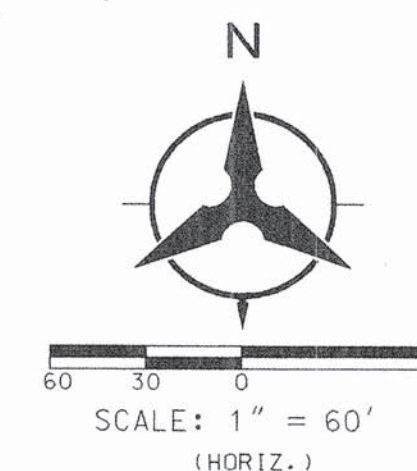


BHI JOB NO. 020066

P:\020066\CDP\GENERAL\020066OFF-UTIL.DGN


16:22

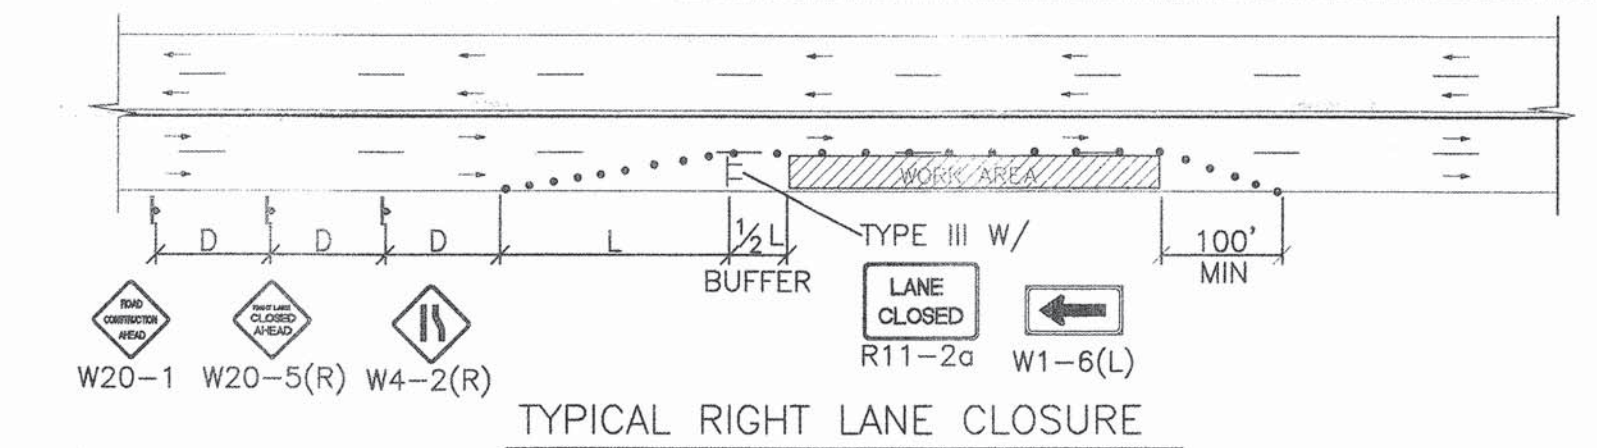


TYPICAL RIGHT LANE CLOSURE

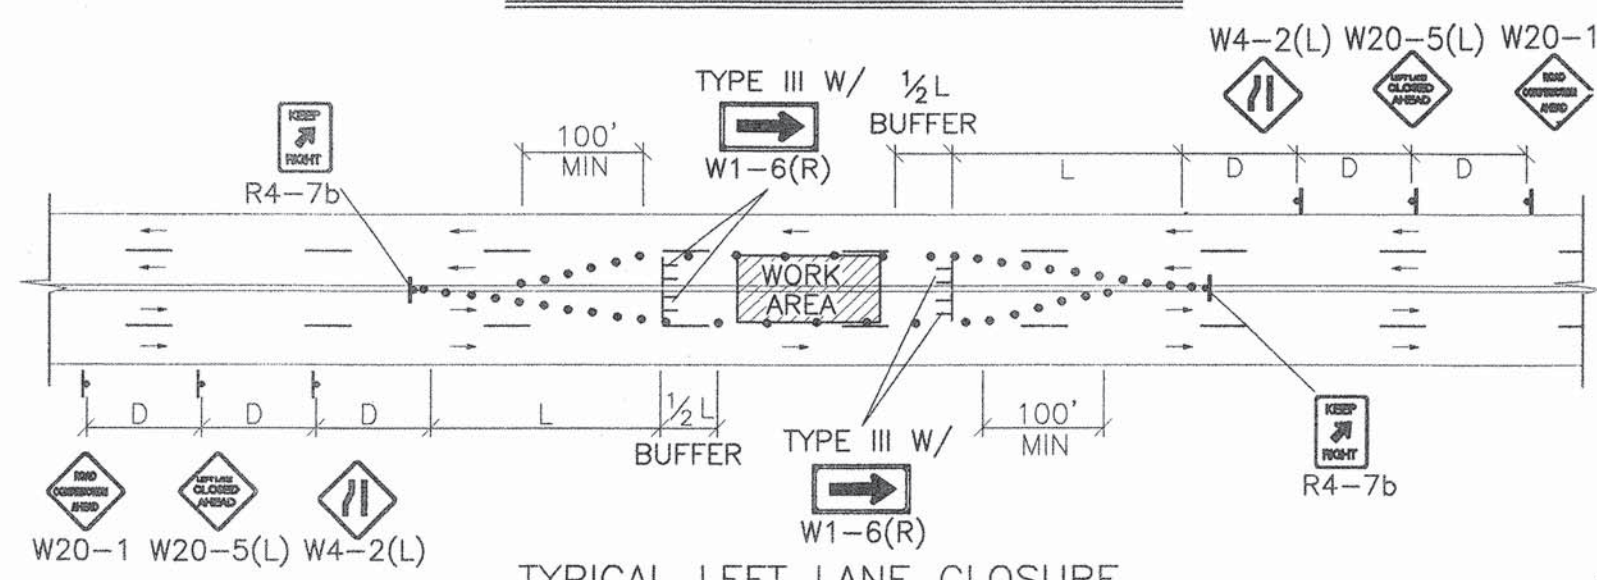


TYPICAL LEFT LANE CLOSURE

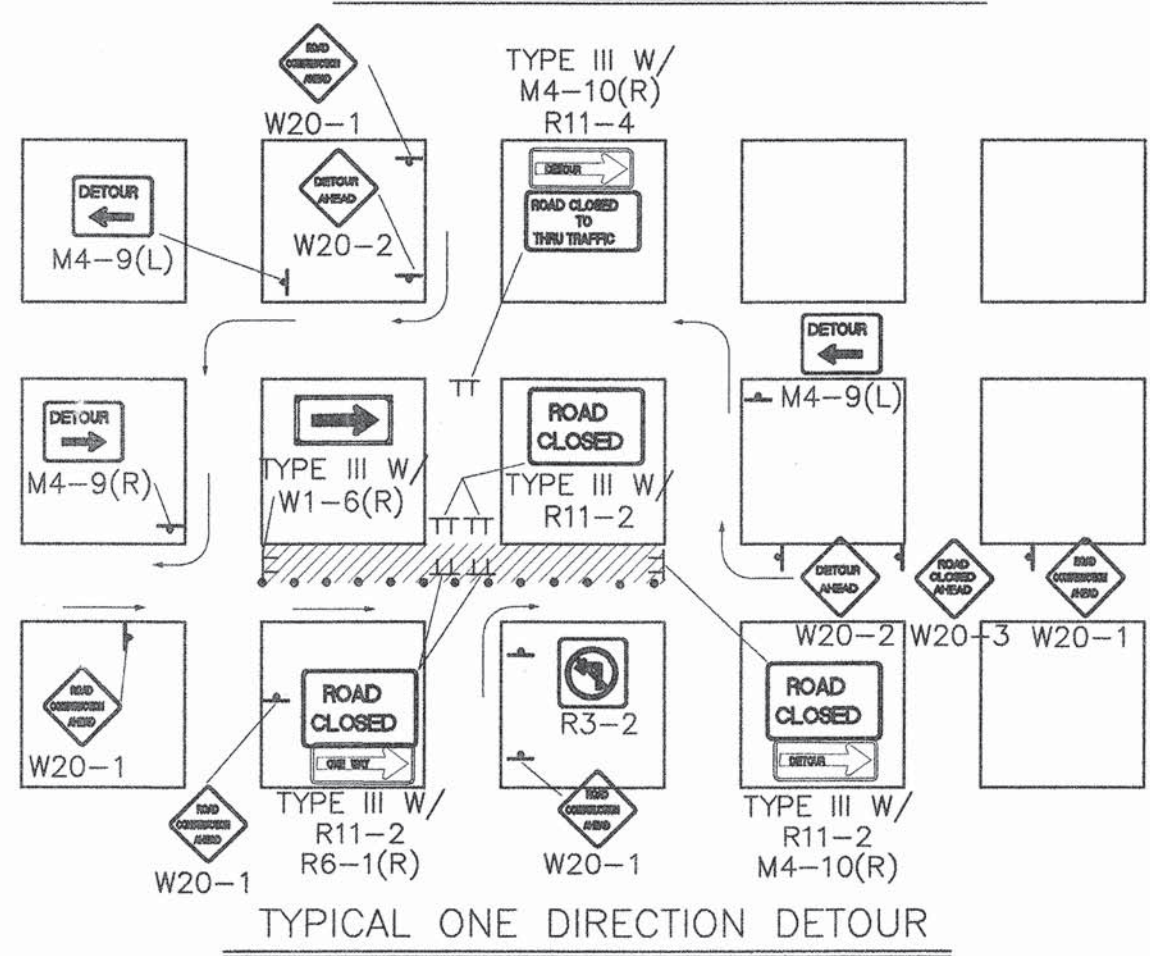

TYPICAL ONE DIRECTION DETOUR

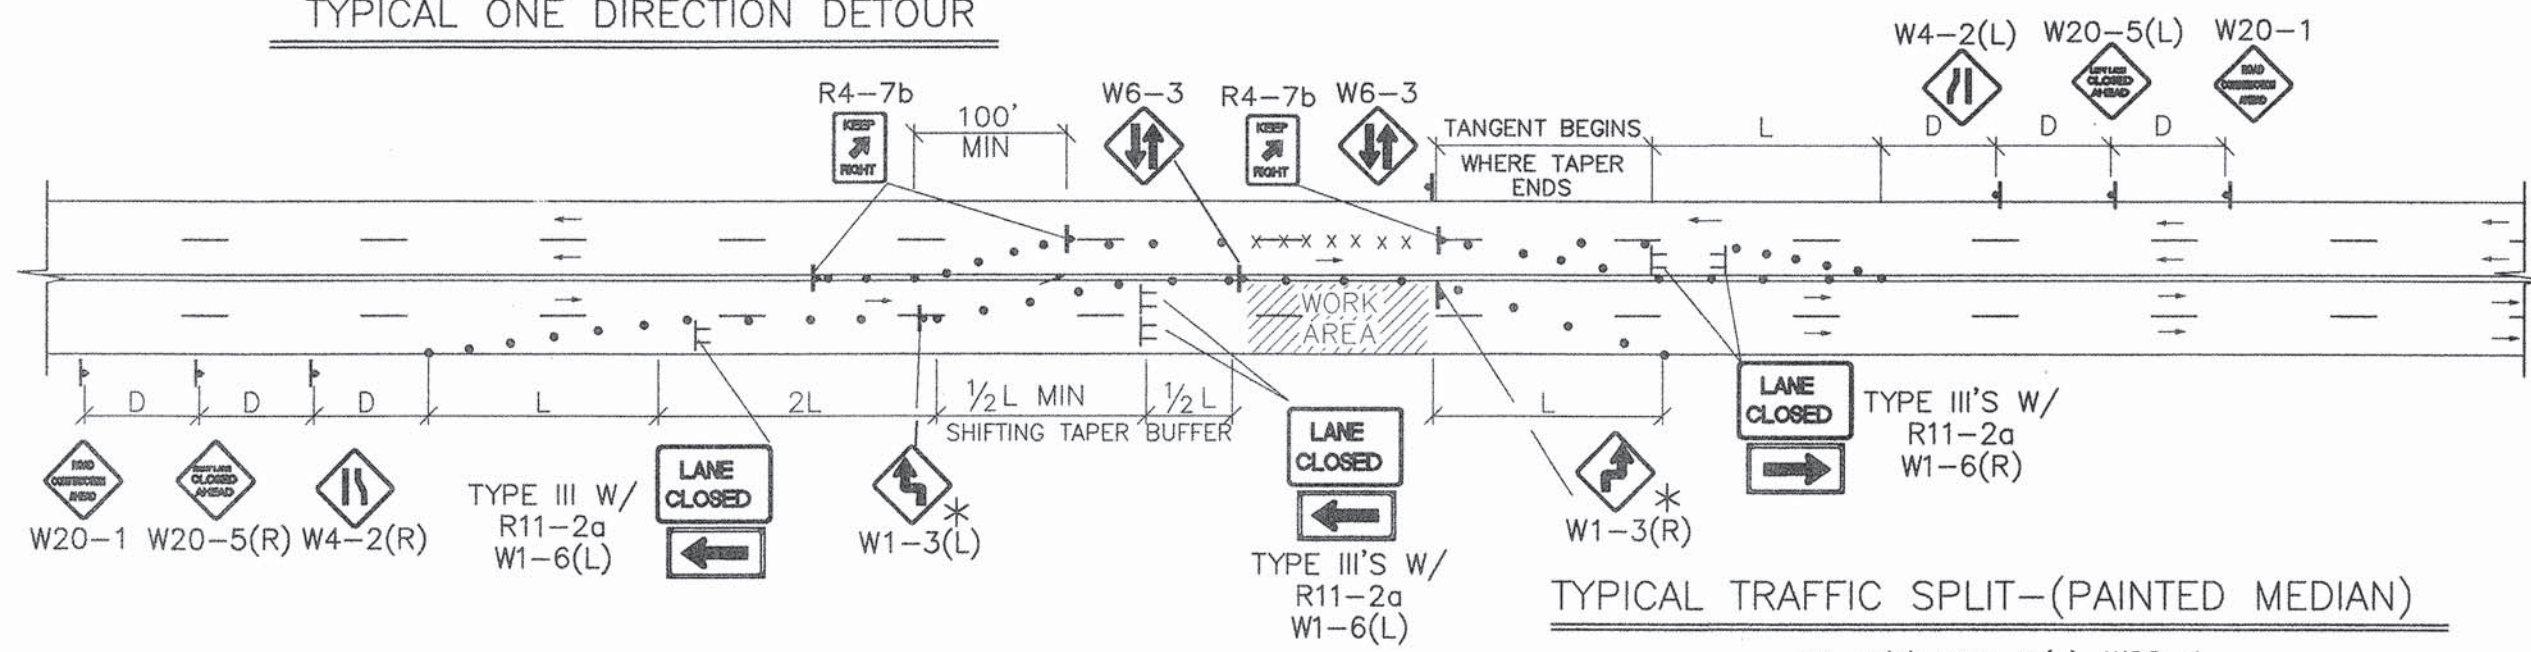


TYPICAL TRAFFIC SPLIT - (PAINTED MEDIAN)

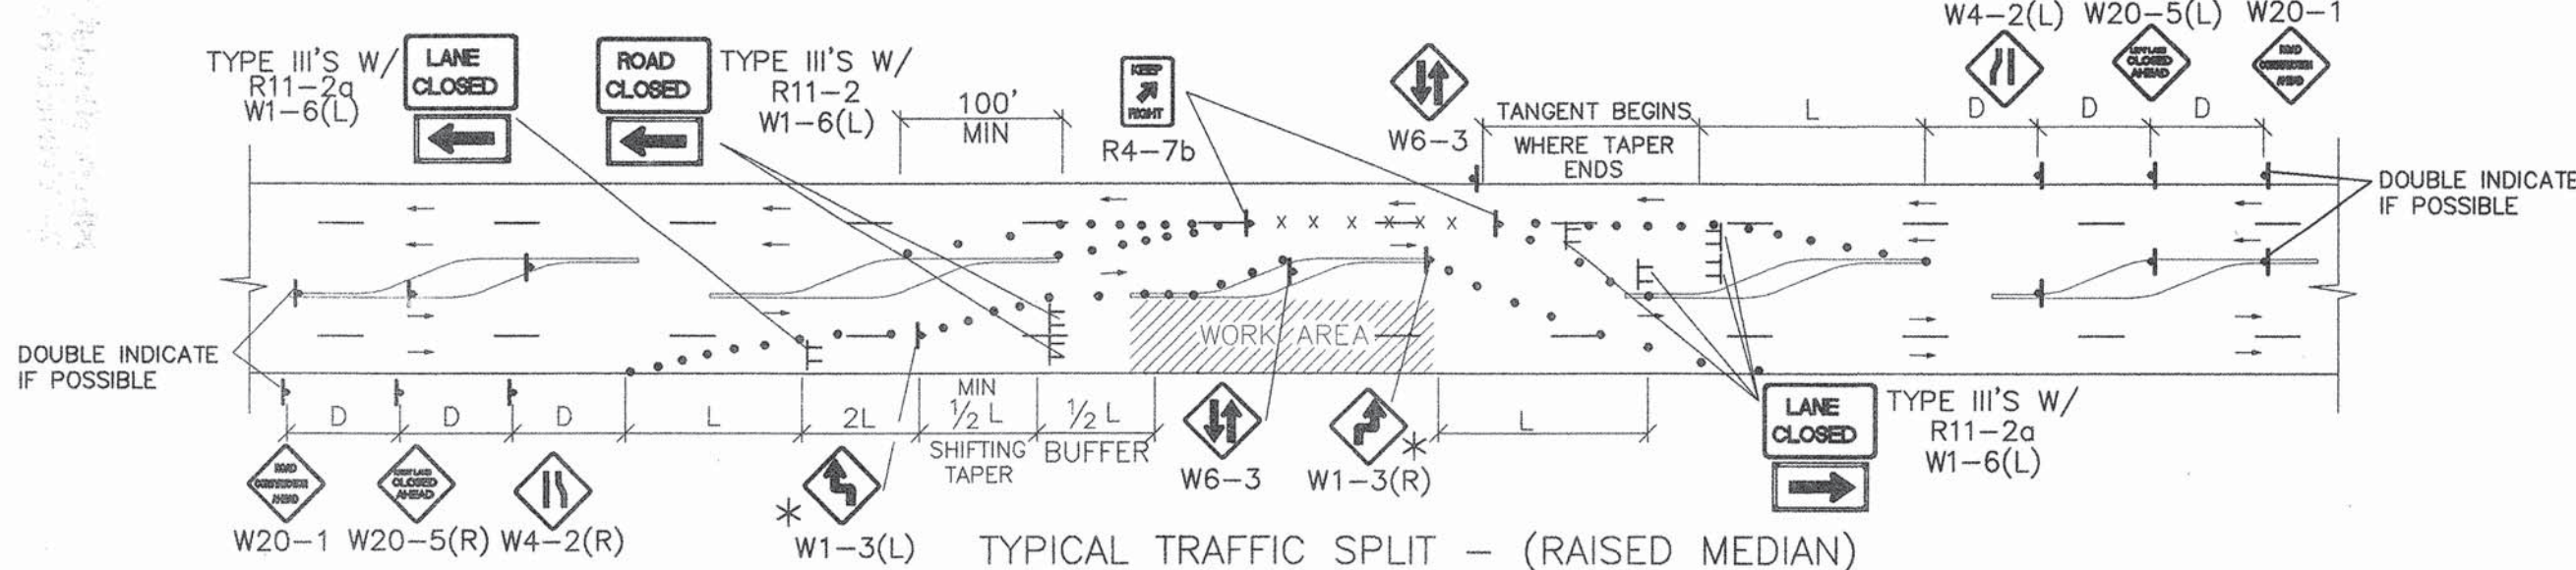

TYPICAL TRAFFIC SPLIT - (RAISED MEDIAN)

TRAFFIC SPLIT NOTES:


1. THE OFFSET DISTANCE MUST BE CALCULATED IN ALL SHIFTING TAPERS. THE OFFSET DISTANCES SHALL INCLUDE LANE WIDTHS PLUS MEDIAN WIDTHS.
2. 1/2 L IS THE MINIMUM DISTANCE FOR SHIFTING TAPERS.
3. REVERSE CURVES MAY BE IMPLEMENTED. ALL CURVE DATA SHALL BE CALCULATED.
4. MEDIAN REMOVAL SHALL BE REQUIRED IF 1/2 L OR REVERSE CURVE IS NOT SUFFICIENT. MEDIAN REMOVAL SHALL TAKE PLACE BEFORE SPLITS.
5. REDUCED SPEED MAY BE CONSIDERED.
6. * USE W1-3 FOR 30 MPH OR LESS, W1-4 FOR SPEED 35 MPH OR GREATER.

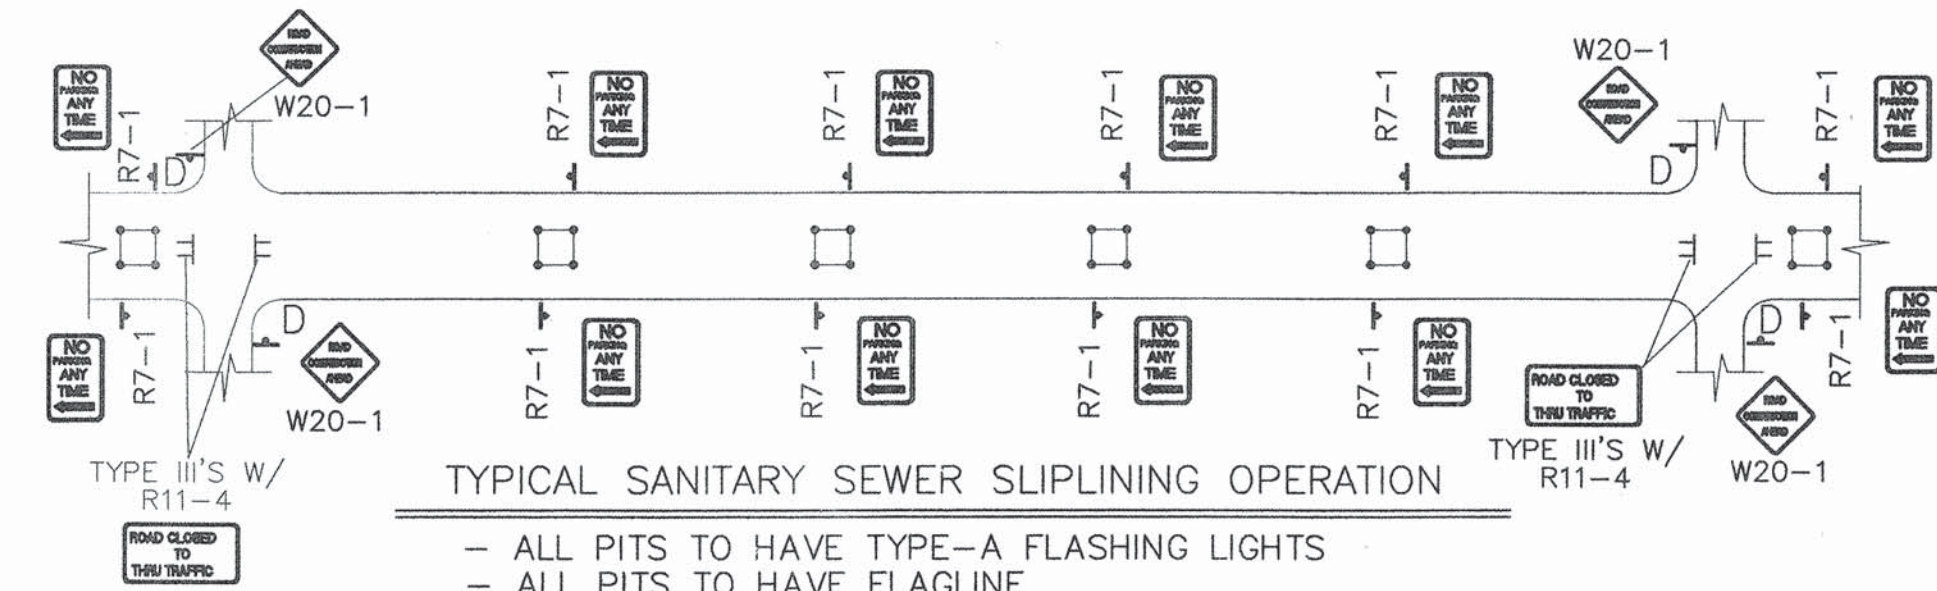


TYPICAL SANITARY SEWER SLIPLINING OPERATION

- ALL PITS TO HAVE TYPE-A FLASHING LIGHTS
- ALL PITS TO HAVE FLAGLINE


NOTE:
MAY REQUIRE LEFT LANE
CLOSURE DEPENDING ON
FIELD CONDITIONS.

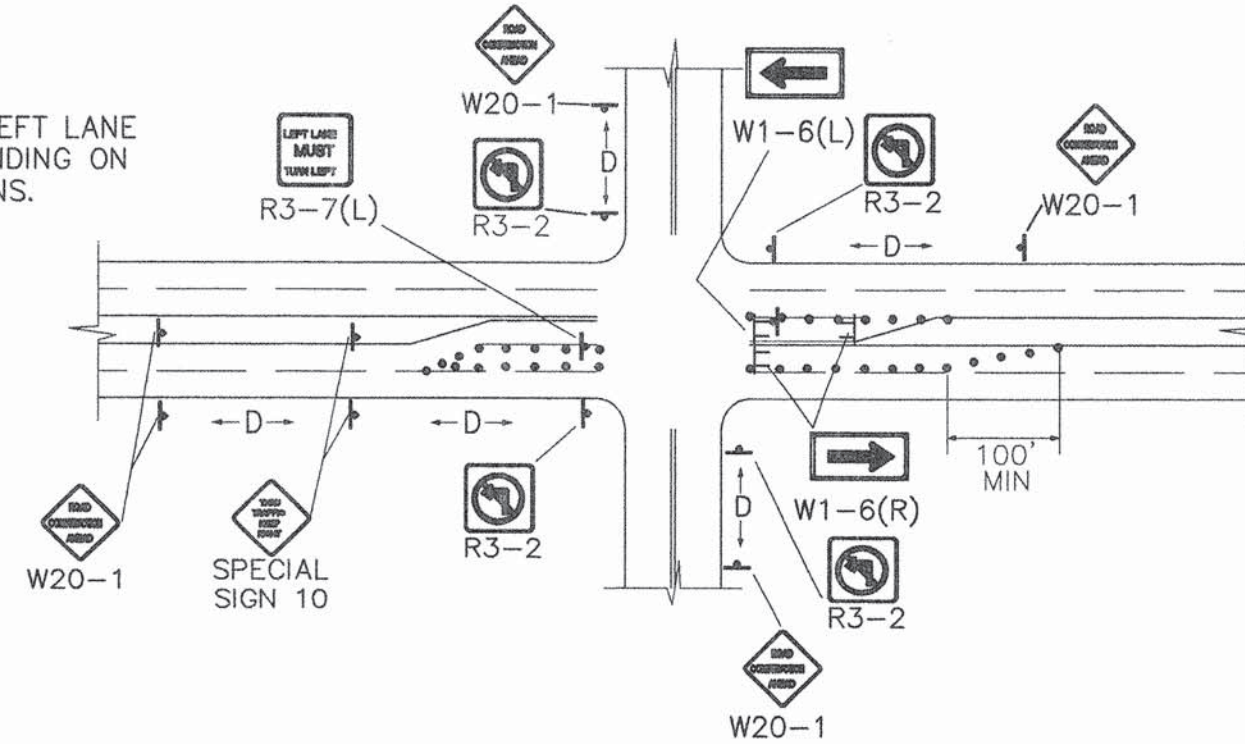


TYPICAL LANE CLOSURE AT INTERSECTION
NOTE: DEPENDING ON WORK ZONE LOCATION.

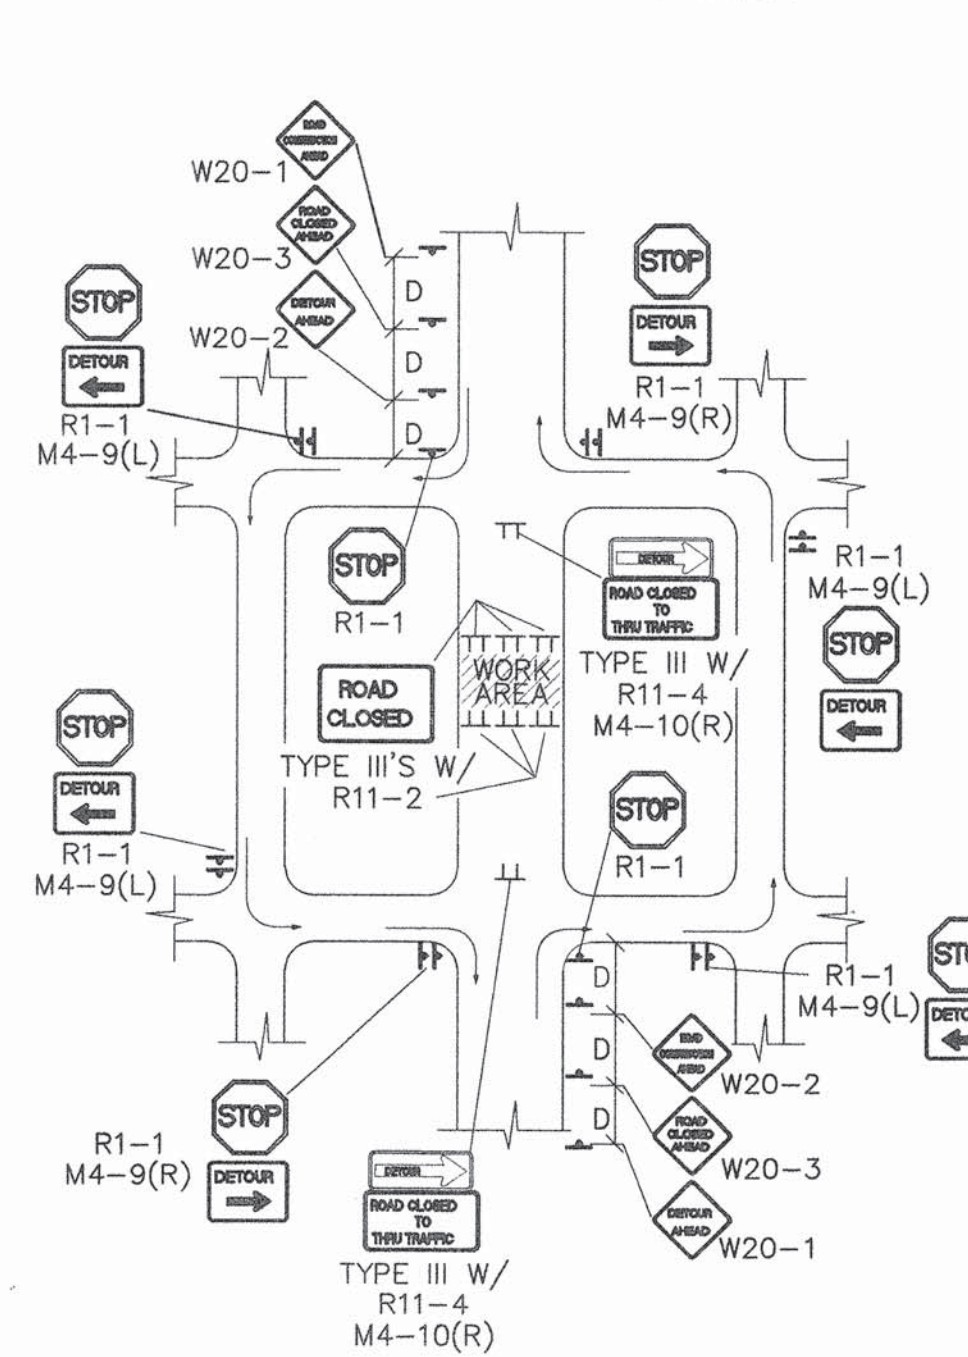

TYPICAL MID-BLOCK CLOSURE
NOTE: (R1-1) BASED ON FIELD CONDITIONS.

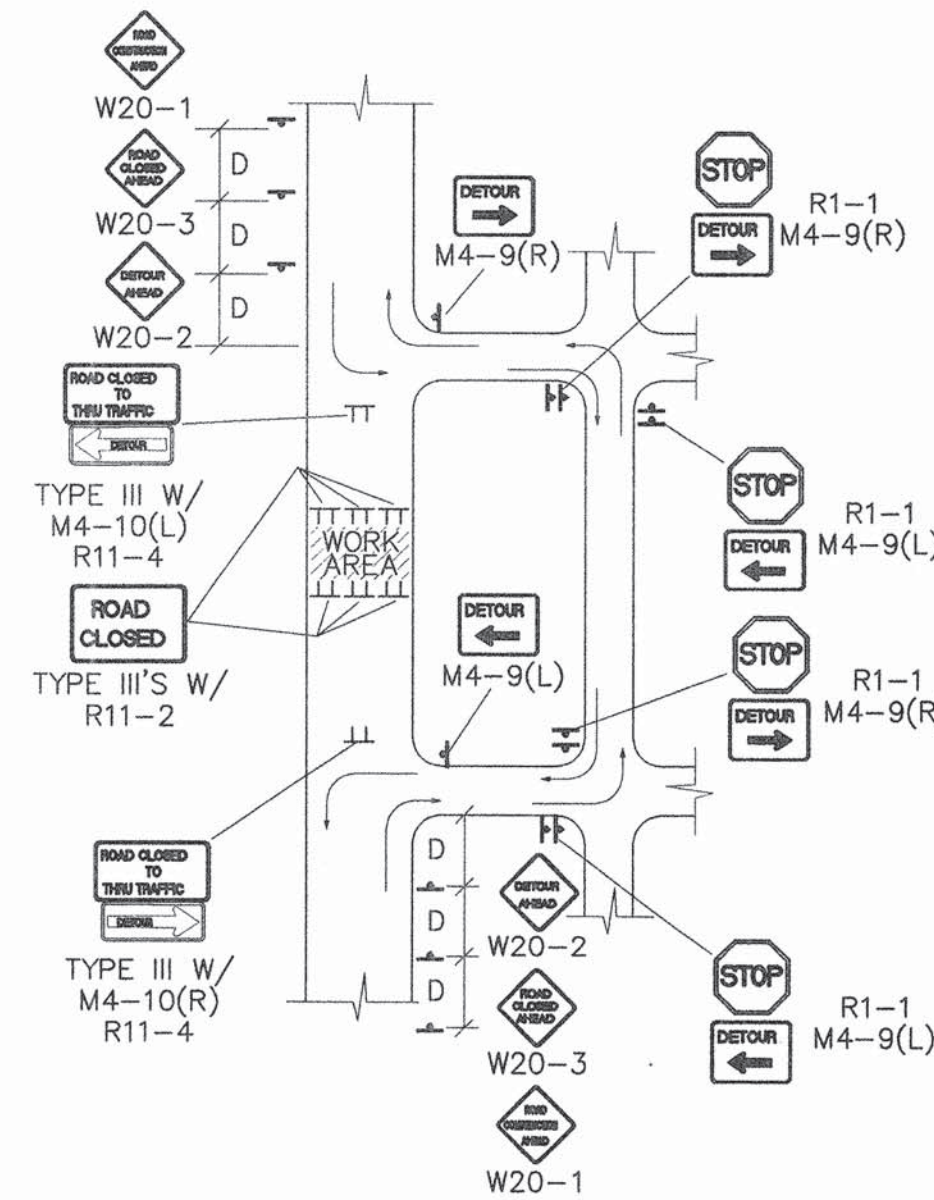

TYPICAL STREET CLOSURE
NOTE: (R1-1) BASED ON FIELD CONDITIONS.

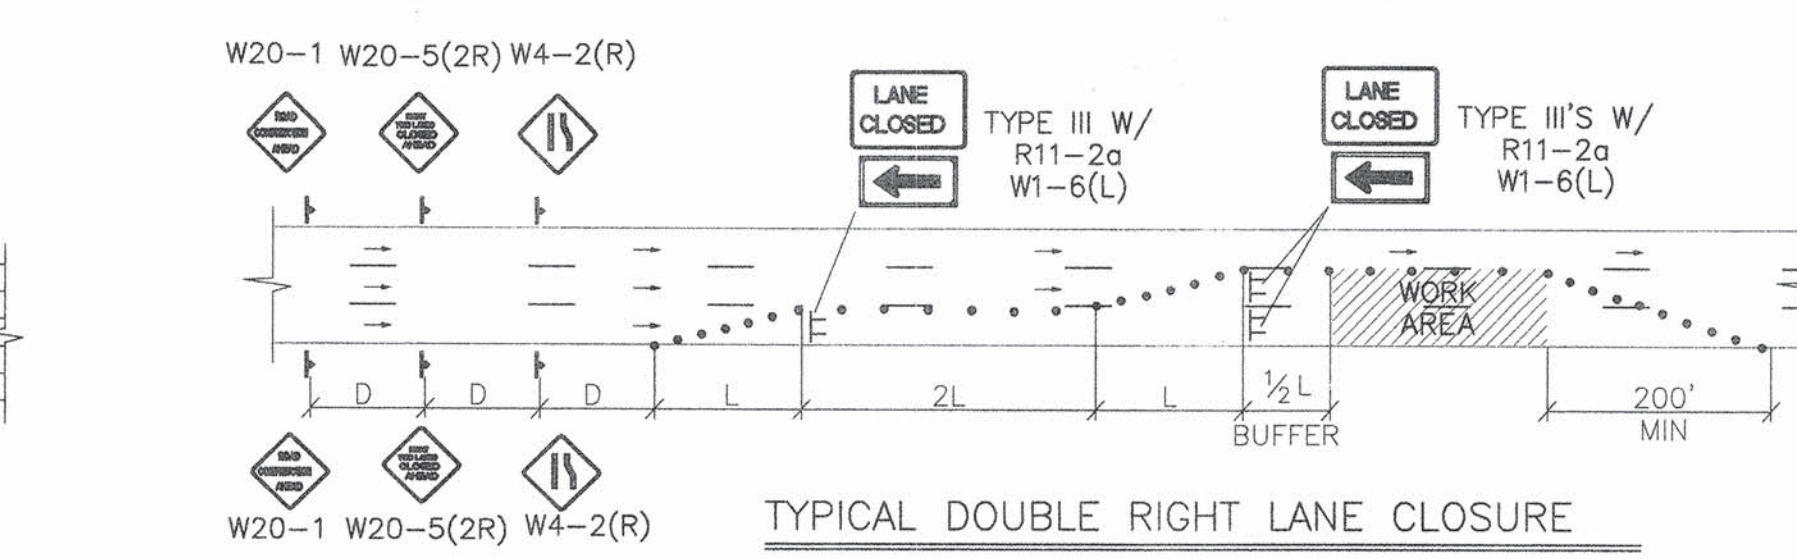

CONSTRUCTION TRAFFIC CONTROL GENERAL NOTES

1. CONTRACTOR MUST OBTAIN FROM CONSTRUCTION COORDINATION AN EXCAVATION/BARRICADING PERMIT BEFORE ENGAGING IN ANY CONSTRUCTION, MAINTENANCE OR REPAIR WORK IN ANY OF THE CITY OF ALBUQUERQUE'S RIGHTS-OF-WAY. EMERGENCY WORK THAT WOULD PRESERVE LIFE OR PROPERTY IS EXCLUDED WITH THE UNDERSTANDING, THAT A PERMIT SHALL BE OBTAINED WITHIN 24 TO 48 HOURS.

2. CONTRACTOR SHALL AT THE TIME OF PERMIT REQUEST, SUBMIT FOR APPROVAL BY CONSTRUCTION COORDINATION, A TRAFFIC CONTROL PLAN DETAILING ALL EXISTING TOPOGRAPHY SUCH AS LANE WIDTHS, DRIVEWAYS, AND BUSINESS/RESIDENTIAL ACCESSSES. THE TRAFFIC CONTROL PLAN SHALL INCLUDE ALL PHASES OF WORK AND SCHEDULES INVOLVED IN THE CONSTRUCTION PROJECT. ANY SEPERATE PHASES OF A CONSTRUCTION PROJECT SHALL BE GIVEN AN INDIVIDUAL PERMIT EACH. BLANKET PERMITS WILL NOT BE ISSUED.

3. THESE TYPICAL TRAFFIC CONTROL PLANS DO NOT REFLECT THE EXISTING TOPOGRAPHY SUCH AS DRIVEWAYS, LANE WIDTHS, AND BUSINESS/RESIDENTIAL ACCESSSES. EVERY LOCATION THAT REQUIRES CONSTRUCTION TRAFFIC CONTROL SHALL HAVE A DETAILED TRAFFIC CONTROL PLAN SHOWING ALL EXISTING TOPOGRAPHY.

4. CONSTRUCTION SHALL NOT BEGIN UNLESS A TRAFFIC CONTROL PLAN HAS BEEN APPROVED AND VERIFIED BY CONSTRUCTION COORDINATION.

5. CONSTRUCTION COORDINATION SHALL BE NOTIFIED 48 HOURS PRIOR TO ANY TRAFFIC CONTROL CHANGES NEEDED BY CONTRACTOR, THAT WERE NOT PREVIOUSLY APPROVED. THESE TRAFFIC CONTROL CHANGES SHALL BE REQUESTED IN WRITING ACCOMPANIED WITH A TRAFFIC CONTROL PLAN REFLECTING SUCH CHANGES.

6. ALL CONSTRUCTION TRAFFIC CONTROL DEVICES SHALL COMPLY TO THE MANUAL ON UNIFORM TRAFFIC CONTROL DEVICES (MUTCD), LATEST EDITION. IT IS THE RESPONSIBILITY OF THE CONTRACTOR TO INSTALL, SERVICE AND MAINTAIN ALL TRAFFIC CONTROL DEVICES. TRAFFIC CONTROL DEVICES SHALL NOT BE REMOVED OR ALTERED IN ANY WAY WITHOUT THE APPROVAL OF CONSTRUCTION COORDINATION, PER SECTION 6A-4 OF THE MUTCD, LATEST EDITION.

7. THE CONSTRUCTION TRAFFIC CONTROL INITIAL SET-UP SHALL BE BY AN AMERICAN TRAFFIC SAFETY SERVICES ASSOCIATION (ATSSA) CERTIFIED WORKSITE TRAFFIC SUPERVISOR. THE MAINTENANCE AND SERVICING SHALL ALSO BE DONE BY AN ATSSA CERTIFIED WORKSITE TRAFFIC SUPERVISOR OR EQUIVALENT.

8. CONTRACTOR IS RESPONSIBLE TO MAINTAIN AND SERVICE ALL TRAFFIC CONTROL DEVICES 24 HOURS A DAY, 7 DAYS A WEEK THROUGHOUT LENGTH OF PROJECT. CONTRACTOR IS RESPONSIBLE THAT ALL TRAFFIC CONTROL DEVICES COMPLY WITH THE MUTCD, LATEST EDITION.

9. ALL ADVANCE WARNING SIGNS SHALL BE DOUBLE INDICATED WHENEVER THERE ARE MULTI-LANE TRAFFIC IN ANY ONE GIVEN DIRECTION AND THERE IS SUFFICIENT MEDIAN SPACE.

10. ALL BARRICADES IN ALL TAPERS AND TANGENTS SHALL BE PLACED APART, A DISTANCE MEASURED IN FEET, EQUAL TO THAT OF THE POSTED SPEED LIMIT. NO EXCEPTIONS UNLESS APPROVED BY CONSTRUCTION COORDINATION PER MUTCD SECTION 6A-4.

11. ALL WORK IN ARTERIAL ROADWAYS SHALL BE ON A CONTINUOUS 24 HOUR PER DAY BASIS UNTIL COMPLETED.

12. CONTRACTOR IS RESPONSIBLE TO PROVIDE CONSTRUCTION COORDINATION, A WEEKLY LOG OF DAILY INSPECTIONS OF BARRICADE AND MAINTENANCE SCHEDULES ON PROJECTS THAT ARE OVER ONE WEEK DURATION.

13. EQUIPMENT OR MATERIALS SHALL NOT BE STORED WITHIN 15 FEET OF A TRAVELED TRAFFIC LANE DURING NON-WORKING HOURS WITHOUT THE APPROVAL OF CONSTRUCTION COORDINATION.

14. CONTRACTOR SHALL PROVIDE AND MAINTAIN A SAFE AND ADEQUATE MEANS OF CHANNELIZING PEDESTRIAN TRAFFIC AROUND AND THROUGH THE CONSTRUCTION AREA.

15. CONTRACTOR IS RESPONSIBLE FOR OBLITERATION OF ANY CONFLICTING STRIPING AND RESPONSIBLE FOR ALL TEMPORARY STRIPING.

16. CONTRACTOR SHALL MAINTAIN ACCESS TO ALL FACILITIES, BUSINESSES AND/OR RESIDENTS AT ALL TIMES.

17. CONTRACTOR SHALL PROVIDE ACCESS SIGNS FOR BUSINESSES LOCATED WITHIN THE CONSTRUCTION AREA UNDER THE SUPERVISION OF CONSTRUCTION COORDINATION. EACH ACCESS SIGN SHALL HAVE 5 INCH, WHITE OPAQUE LETTERING ON BLUE REFLECTORIZED BACKGROUND. ACCESS SIGNS SHALL BE CONSIDERED INCIDENTAL TO THE BID AND NOT PART OF THE CONTRACT UNLESS OTHERWISE STATED. NO MORE THAN 3 BUSINESSES SHALL BE LISTED ON A ACCESS SIGN. SHOPPING CENTERS AND MALLS SHALL BE LISTED AS SUCH.

18. ALL ADVANCE WARNING SIGNS SHALL MEET THE MINIMUM REFLECTIVE INTENSITY REQUIREMENTS SET FORTH BY THE CITY OF ALBUQUERQUE. CONSTRUCTION COORDINATION SHALL DETERMINE ALL REQUIREMENTS AND APPROVE OR DISAPPROVE ANY ADVANCE WARNING SIGN PER SECTION 6A-4 OF THE MUTCD, LATEST EDITION.

19. 48 HOURS PRIOR TO OCCUPYING OR CLOSING OF A RIGHT-OF-WAY, CONTRACTOR SHALL NOTIFY: POLICE, FIRE DEPARTMENT, SCHOOLS, HOSPITALS, TRANSIT AUTHORITY, BUSINESSES AND/OR RESIDENTS THAT WILL BE AFFECTED BY THE CONSTRUCTION.

20. ANY FIELD ADJUSTMENTS SHALL BE APPROVED BY CONSTRUCTION COORDINATION.

21. EXCAVATIONS SHALL BE PLATED, TEMPORARILY PATCHED OR RESURFACED PRIOR TO OPENING OF TRAFFIC. A MINIMUM OF 11 FEET SHALL BE PROVIDED FOR TRAFFIC IN ANY GIVEN DIRECTION. CONTRACTOR IS RESPONSIBLE FOR ANY WORK INVOLVED IN SATISFYING THESE REQUIREMENTS.

22. CONTRACTOR SHALL AT ALL TIMES COMPLY WITH THE FOLLOWING:
1. STANDARDS AND REQUIREMENTS SET FORTH IN THE MANUAL ON UNIFORM TRAFFIC CONTROL DEVICES, LATEST EDITION.
2. THE CITY OF ALBUQUERQUE TRAFFIC CODE, LATEST EDITION.
3. SECTION 19 OF THE CITY OF ALBUQUERQUE'S STANDARD SPECIFICATIONS FOR PUBLIC WORK CONSTRUCTION, AS WELL AS OTHER SECTIONS.


23. FAILURE TO COMPLY WITH ANY OF THE ABOVE MENTIONED, WILL BE ADEQUATE CAUSE TO CEASE ALL WORK ON ANY CONSTRUCTION PROJECT. WORK WILL NOT RESUME UNTIL ALL REQUIREMENTS ARE ADDRESSED AND APPROVED BY CONSTRUCTION COORDINATION.

24. ALL TRAFFIC CONTROL DEVICES SHALL BE KEPT IN NEW-CLEAN CONDITION, WASHING OF EQUIPMENT IS INCIDENTAL TO ITS PLACEMENT AND MAINTENANCE.

25. TRAFFIC CONTROL STANDARDS APPLY ONLY WHERE THE CONSTRUCTION TRAFFIC CONTROL PLANS ARE NOT SPECIFIC.

26. ADVANCE WARNING SIGNS SHALL BE 36"x36" MIN. WITH SUPER ENGINEERING GRADE SHEETING OR BETTER. MOUNTING HEIGHT AT TOP OF SIGN SHALL BE THE SAME AS FOR A 48" SIGN AS INDICATED IN THE M.U.T.C.D.

27. CONTRACTOR SHALL MAINTAIN A GRAFFITI-FREE WORKSITE. ALL GRAFFITI SHALL BE PROMPTLY REMOVED FROM ALL EQUIPMENT, BOTH PERMANENT AND TEMPORARY.

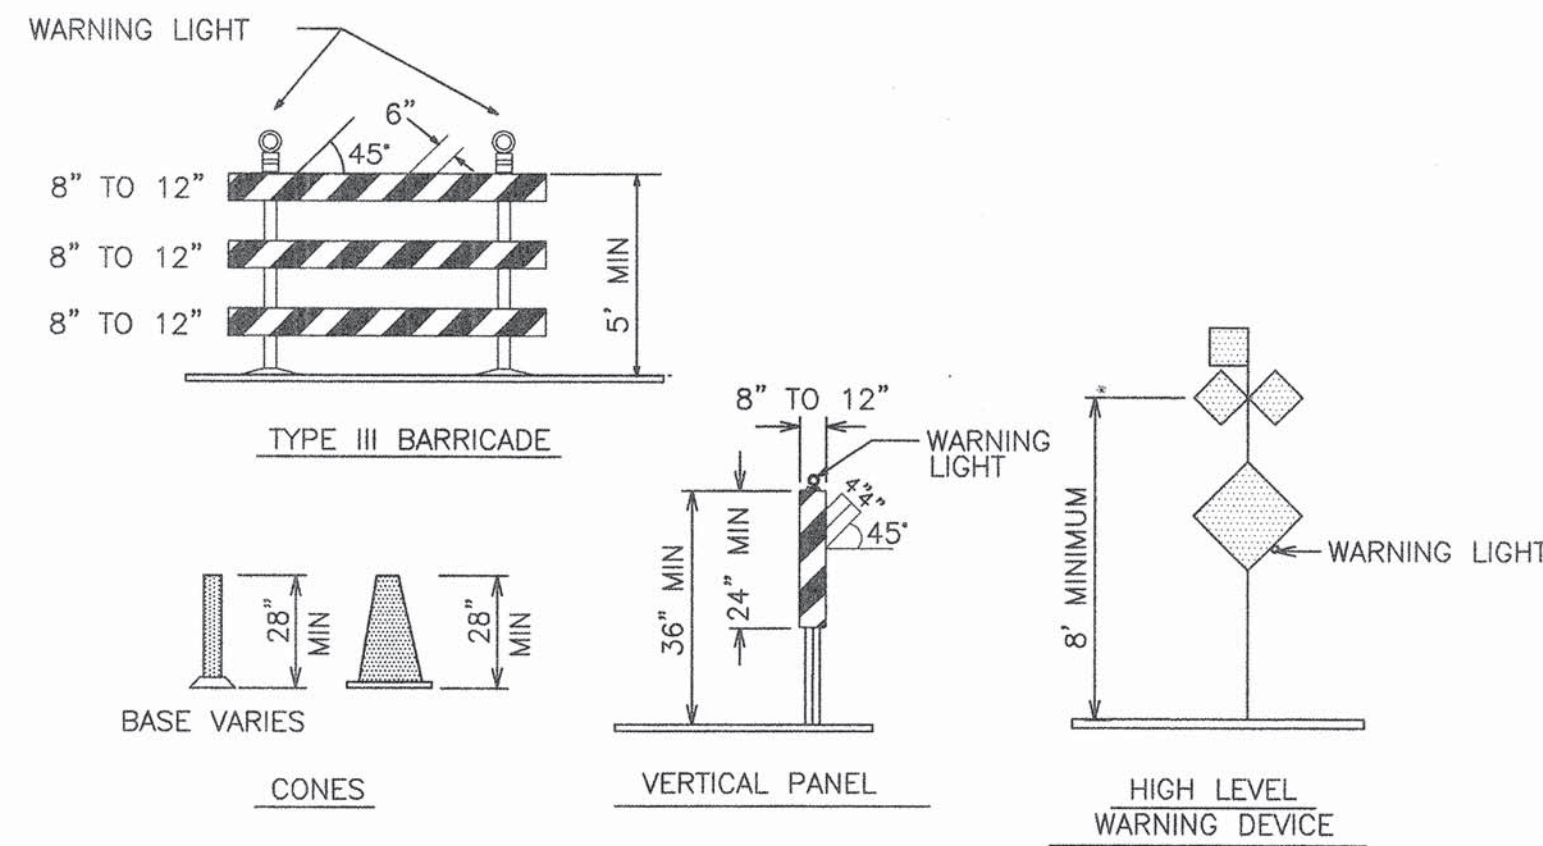

LEGEND

- WORK AREA
- BARRICADE - TYPE I, TYPE II, OR BARREL
- BARRICADE - TYPE III
- VERTICAL PANEL
- WARNING SIGN
- DISTANCE BETWEEN SIGNS - A DISTANCE MEASURED IN FEET EQUAL TO A VALUE OF TEN TIMES THE SPEED LIMIT OF THE STREET
- FLAGMAN POSITION
- SPACING BETWEEN BARRICADES - A DISTANCE MEASURED IN FEET EQUAL TO THE STREET LIMIT OF THE STREET
- TAPER LENGTH - SEE CHART BELOW

THE TANGENT LENGTH IS EQUAL TO THE TAPER LENGTH FOR A GIVEN STREET.

TAPER REQUIREMENT

SPEED LIMIT (MPH)	TAPER LENGTH(L) (FEET)			MINIMUM NUMBER OF DEVICES FOR TAPER	MAXIMUM DEVICE SPACING IN FEET	
	10' LANE	11' LANE	12' LANE		ALONG TAPER	AFTER TAPER
20	70	75	80	5	20	20
25	105	115	125	6	25	25
30	150	165	180	7	30	30
35	205	225	245	8	35	35
40	270	295	320	9	40	40
45	450	495	540	13	45	45
50	500	550	600	13	50	50
55	550	605	660	13	55	55

RECOMMENDED SIGN SPACING(D) FOR ADVANCE WARNING SIGN SERIES

SPEED LIMIT (MPH)	MINIMUM DISTANCE BETWEEN SIGNS	DISTANCE IN FEET FROM LAST SIGN TO TAPER
0-20	10 X SPEED LIMIT	10 X SPEED LIMIT
25-30	10 X SPEED LIMIT	10 X SPEED LIMIT
30-35	10 X SPEED LIMIT	10 X SPEED LIMIT
40-45	10 X SPEED LIMIT	10 X SPEED LIMIT
50-60	10 X SPEED LIMIT	10 X SPEED LIMIT

TAPER CRITERIA


TYPE OF TAPER	TAPER LENGTH
UPSTREAM TAPER:	
MERGING TAPER	L MINIMUM
SHIFTING TAPER	1/2 L MINIMUM
SHOULDER TAPER	1/2 L MINIMUM
TWO-WAY TRAFFIC TAPER	100 FEET MAXIMUM
DOWNSTREAM TAPERS	100 FEET PER LANE

TAPER LENGTH COMPUTATION

SPEED LIMIT	L = WS ² / 60
40 MPH OR LESS	
40 MPH OR GREATER	L = W x S

L = TAPER LENGTH
W = WIDTH OF OFFSET IN FEET
S = POSTED SPEED OR OFF-PEAK 85-PERCENTILE SPEED IN MPH

SIGN FACE DETAILS

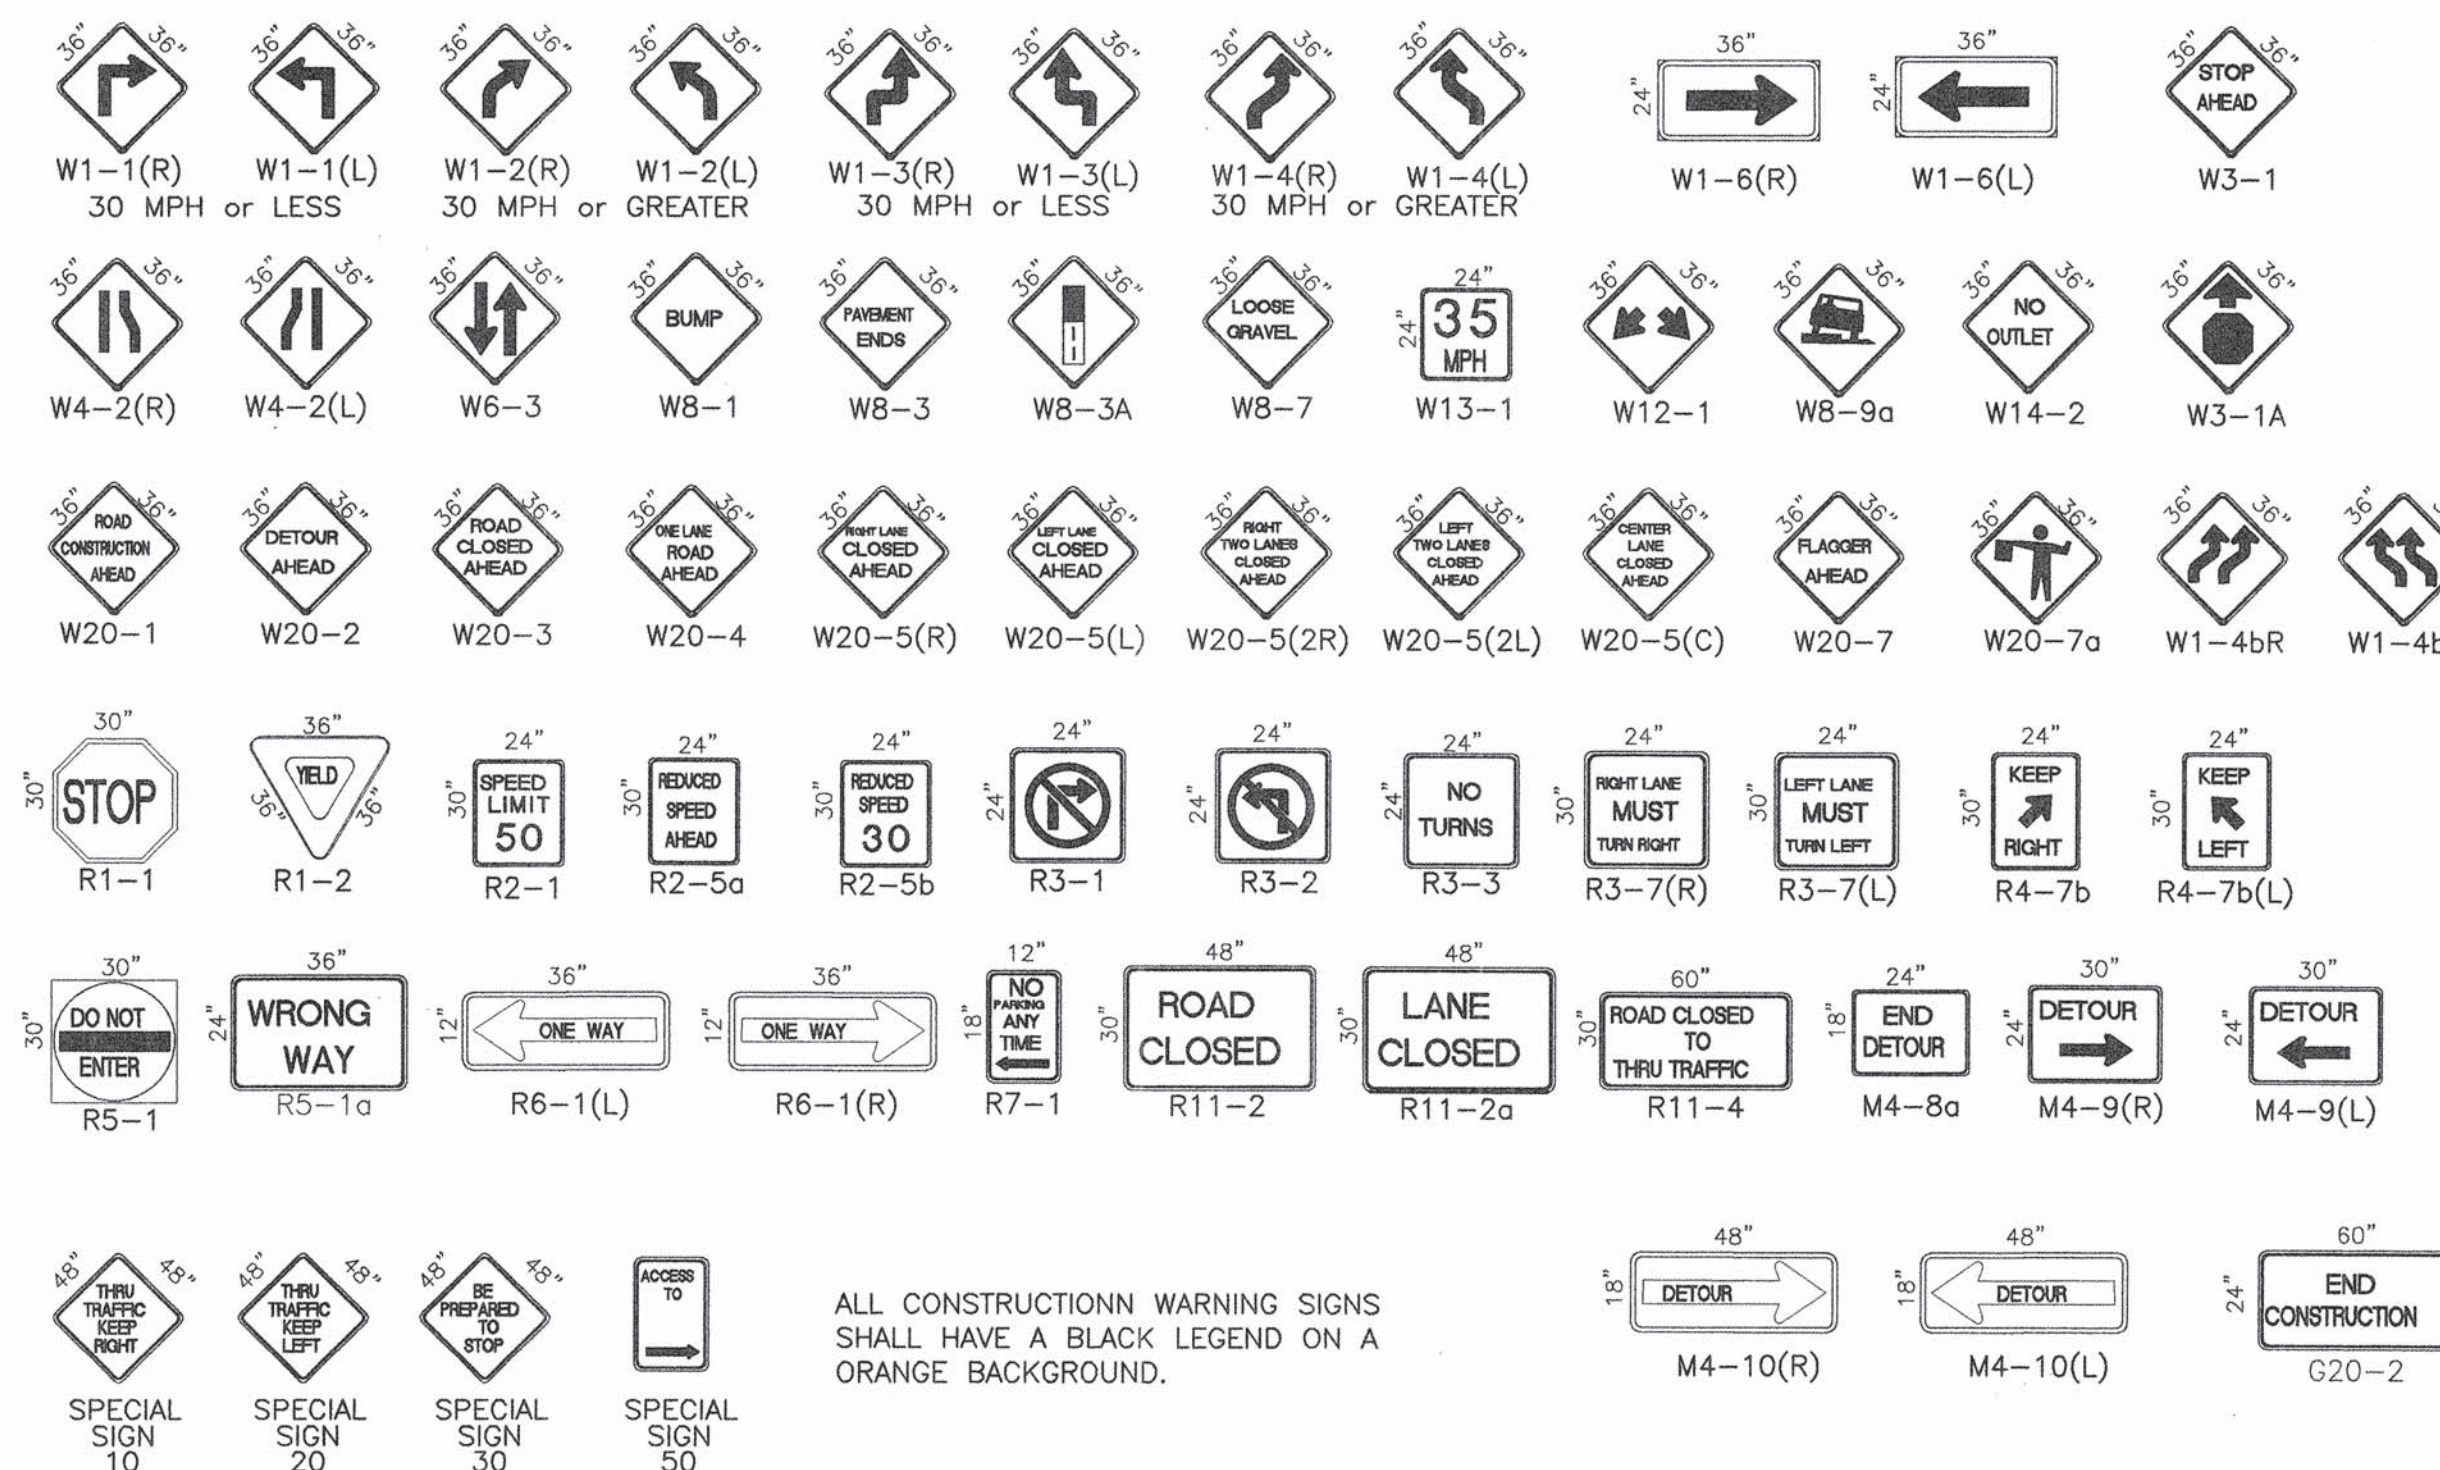

ALL CONSTRUCTION WARNING SIGNS SHALL HAVE A BLACK LEGEND ON A ORANGE BACKGROUND.

Bohannon & Huston
 Courtyard One 7500 JEFFERSON NE Albuquerque NEW MEXICO 87109
 ENGINEERS PLANNERS PHOTOGRAMMETRISTS SURVEYORS SOFTWARE DEVELOPERS

CITY OF ALBUQUERQUE PUBLIC WORKS DEPARTMENT
PINON POINTE II AT VENTANA RANCH OFFSITE IMPROVEMENTS
SIGNING & CONSTRUCTION TRAFFIC CONTROL STANDARDS
 Design Review Committee City Engineer Approval
 COA STD
 City Project No. 658682 Zone Map No. B-9 Sheet 9 Of 10

SCANNED BY MESA REPRO

IBD SUBD

46 47 48

LAS VENTANAS


WEST POIN


The Hilltop

LANDSCAPE ARCHITECTS & CONTRACTORS
Cont. Lic. #26458
7909 Edith N.E.
Albuquerque, NM 87184
Ph. (505) 898-9690
Fax (505) 898-7737
it@hilltoplandscaping.com

1. ALL LANDSCAPE TO BE MAINTAINED BY THE VENTANA RANCH COMMUNITY ASSOCIATION.
2. NO TREES SHALL BE PLANTED WITHIN 8' OF CURBS OR SIDEWALKS.

SYMBOL	SIZE	NAME	HEIGHT
--------	------	------	--------

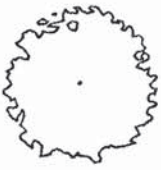PROPOSED PARK TREE			
	2" Cal.	SHADE TREE	TO 35'
	2" Cal.	ORNAMENTAL TREE	TO 35'
	20 Gal.	PINON PINE	TO 25'
	15 Gal.	WASHINGTON HAWTHORN	16" TO 18"
	15 Gal.	DESERT WILLOW	16" TO 18"
		PALM YUCCA	TO 13'
	5 Gal.	SHRUB/MAIDENGRASS	TO 2'
	1 Gal.	VINE	TO 1'
	1 Gal.	GROUND COVER	TO 24"
	1 Gal.	CATMINT	8" TO 12"
		OVERSIZED GRAVEL AND BASALT BOULDERS	
		SANTA ANA TAN GRAVEL WITH FF, SIDEWALK TO PROPERTY LINE	
		BROWN GRAVEL WITH FF, SIDEWALK TO CURB AND MEDIANS	

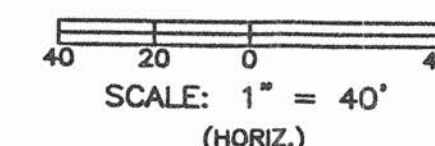

Bohannon ▲ Huston


 Courtyard One 7500 JEFFERSON NE Albuquerque NEW MEXICO 87110

ENGINEERS	PLANNERS	PHOTOGRAMMETRISTS	SURVEYORS	SOFTWARE DEVELOPERS
-----------	----------	-------------------	-----------	---------------------

CITY OF ALBUQUERQUE
PUBLIC WORKS DEPARTMENT
ENGINEERING DEVELOPMENT GROUP
PINON POINTE 2 SUBDIVISION AT VENTANA RANCH
LANDSCAPE PLAN

DESIGN REVIEW COMMITTEE	CITY ENGINEER APPROVAL
APPROVED	APPROVED
MAR 28 2002	APR 25 2002
DESIGN REVIEW COMMITTEE	CITY ENGINEER

CITY PROJECT NO.	ZONE MAP
658682	B-9

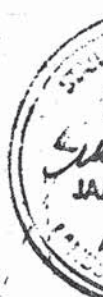ENGINEER'S SEAL		SURVEY INFORMATION		BENCH MARKS		AS-BUILT INFORMATION	
		FIELD NOTES		ACS BRASS TABLET STAMPED "1-B9 1980"		CONTRACTOR SUBSTANCE	
		NO.	BY DATE	GEOGRAPHIC POSITION (NAD 1927)	WORK SIGNED BY ACCEPTANCE BY	DATE	DATE
				N.M. STATE PLANE COORDINATES (CENTRAL ZONE) X=355,077.00 Y=1,529,056.93	FIELD DEFINITION BY CORRECTED BY	1/15 9/16 1/15	DATE DATE DATE
				GROUND-TO-GRID FACTOR = .99966334	MICRO-FILM INFORMATION		
				DELTA ALPHA -00°16'47"	RECORDED BY		DATE
				NGVD 1929 ELEVATION = 5450.51	NO.		

11/26/01	Revised LS Plan			
NO. DATE	REMARKS		BY	
REVISIONS				
DESIGN				
DESIGNED BY	Hilttop	DATE	11/01	
DRAWN BY	Hilttop	DATE	11/01	
CHECKED BY	Hilttop	DATE	11/01	

UPDATE	MO./DAY/YR.	MO./DAY/YR.
NO.	SHEET	OF
	10	10