

CONSTRUCTION PLANS FOR PINON POINTE UNIT II AT VENTANA RANCH ALBUQUERQUE, NEW MEXICO

INDEX

SHEET NUMBER	DESCRIPTION
1	TITLE SHEET
2	SITE DESCRIPTION PLAN
3	PLAT
4-8	FINAL GRADING PLAN
9	RETAINING WALL DETAIL NOT USED
10	OVERALL PAVING PLAN
	PAVING PLAN AND PROFILE SHEETS
11	SHAWNA STREET
12	GOSHAWK AVENUE
13	BUTTON QUAIL AVENUE
14	SNOWY OWL DRIVE
15	WOODSTAR AVENUE
16	WOODQUAIL DRIVE / GRIFFON DRIVE
17	OVERALL UTILITY PLAN
	UTILITY PLAN AND PROFILE SHEETS
18	SHAWNA STREET
19	GOSHAWK AVENUE
20	BUTTON QUAIL AVENUE
21	SNOWY OWL DRIVE 1+00.00 - 5+44.83
22	WOODSTAR AVENUE 5+44.83 - 14+00.00
23	WOODSTAR AVENUE 14+00.00 - 17+50.00 / NEW ENTRANCE
24	WOODQUAIL DRIVE / GRIFFON DRIVE
24A	LANDSCAPE PLAN
25	SIGNING AND CONSTRUCTION TRAFFIC CONTROL STANDARDS
26	TYPICAL TRAFFIC CONTROL AND SIGNING EXAMPLES (REF. M.U.T.C.D.)




"RECORD DRAWINGS"

I CERTIFY THAT THE INFORMATION CONTAINED ON THESE DRAWINGS HAS BEEN REVISED IN ACCORDANCE WITH THE INFORMATION FURNISHED BY THE CONTRACTOR, SUNDANCE MECHANICAL ALDRIDGE LAND SURVEYING PROVIDED THE CONSTRUCTION STAKING FOR THE PROJECT AND THIS SURVEY INFORMATION REFLECTS THE CONSTRUCTION AS ACTUALLY ACCOMPLISHED WHILE A CONSTRUCTION OBSERVER FROM SMITH ENGINEERING WAS PRESENT. THESE PLAN DRAWINGS, AS CONSTRUCTED, ARE IN SUBSTANTIAL COMPLIANCE WITH THE APPROVED PLAN DRAWINGS.

PATRICK J. CONLEY, PE 10141

DATE

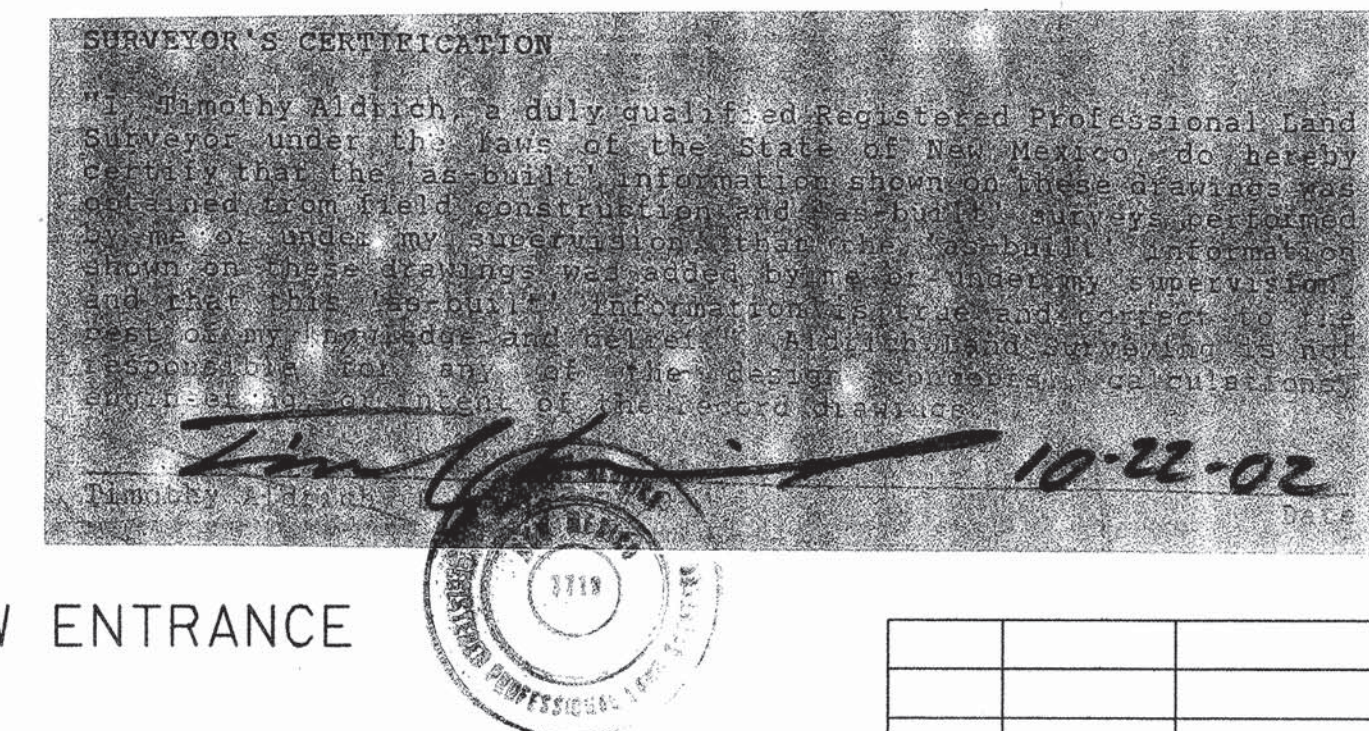


1 2 3 4 5 6 7 8 9 10 11 12 13 14 15
26 65861.83 0102

Bohannon & Huston

Courtyard One 7500 JEFFERSON NE Albuquerque NEW MEXICO 87109

ENGINEERS PLANNERS PHOTOGRAMMETRISTS SURVEYORS SOFTWARE DEVELOPERS

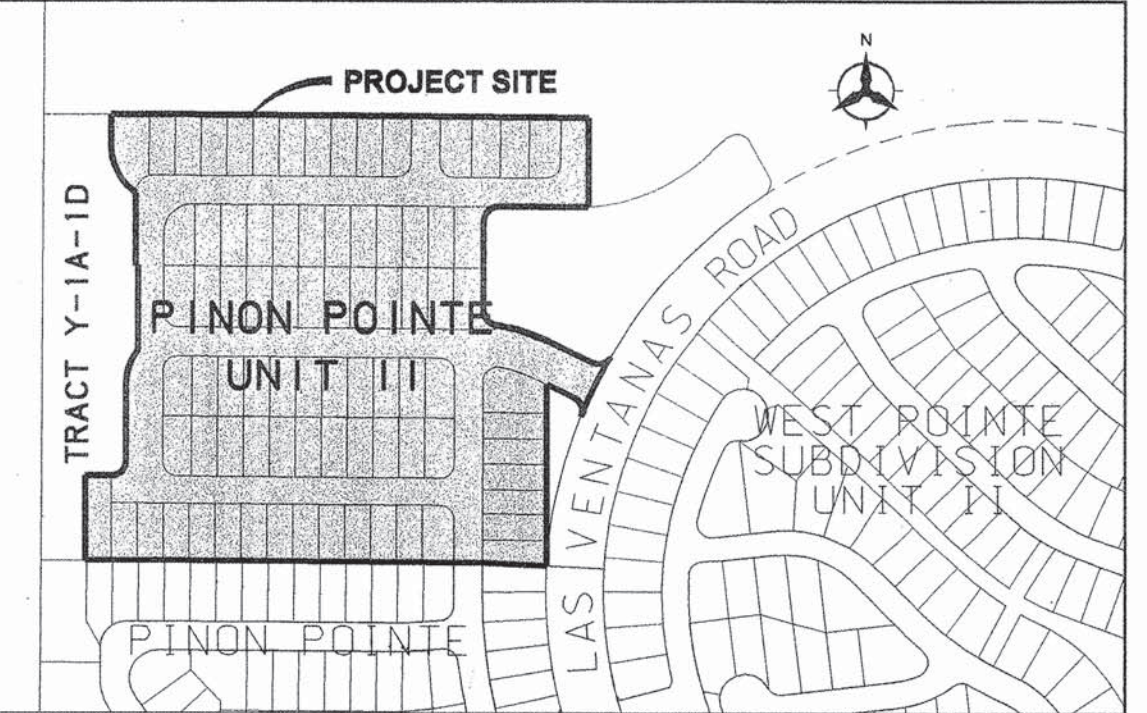



VICINITY MAP: NOT TO SCALE ZONE MAP NO. B-9

NOTICE TO CONTRACTORS


- ALL WORK DETAILED ON THESE PLANS TO BE PERFORMED UNDER CONTRACT SHALL, EXCEPT AS OTHERWISE STATED OR PROVIDED FOR HEREON, BE CONSTRUCTED IN ACCORDANCE WITH THE CITY OF ALBUQUERQUE STANDARD SPECIFICATIONS FOR PUBLIC WORKS CONSTRUCTION, 1986 EDITION, AND SHALL INCLUDE UPDATE No. 8.
- TWO WORKING DAYS PRIOR TO ANY EXCAVATION, THE CONTRACTOR MUST CONTACT NEW MEXICO ONE CALL SYSTEM (260-1990) FOR LOCATION OF EXISTING UTILITIES.
- PRIOR TO CONSTRUCTION, THE CONTRACTOR SHALL EXCAVATE AND VERIFY THE HORIZONTAL AND VERTICAL LOCATIONS OF ALL OBSTRUCTIONS. SHOULD A CONFLICT EXIST, THE CONTRACTOR SHALL NOTIFY THE ENGINEER OR SURVEYOR IMMEDIATELY SO THAT THE CONFLICT CAN BE RESOLVED WITH A MINIMUM AMOUNT OF DELAY.
- FIVE (5) WORKING DAYS PRIOR TO BEGINNING CONSTRUCTION, THE CONTRACTOR SHALL SUBMIT TO CONSTRUCTION COORDINATION DIVISION A DETAILED CONSTRUCTION SCHEDULE, TWO (2) WORKING DAYS PRIOR TO CONSTRUCTION, THE CONTRACTOR SHALL OBTAIN A BARRICADING PERMIT FROM THE CONST. COORDINATION DIVISION. CONTRACTOR SHALL NOTIFY BARRICADE ENGINEER (768-2551) PRIOR TO OCCUPYING AN INTERSECTION. REFER TO SECTION 19 OF THE GENERAL CONDITIONS OF THE STANDARD SPECIFICATIONS.
- ALL PERMANENT STREET STRIPING ALTERED OR DESTROYED SHALL BE REPLACED W/ PLASTIC REFLECTORIZED PAVEMENT MARKING BY CONTRACTOR TO LOCATION AS EXISTING OR AS INDICATED BY THIS PLAN SET.
- CONTRACTOR SHALL NOTIFY THE ENGINEER NOT LESS THAN SEVEN (7) DAYS PRIOR TO STARTING WORK IN ORDER THAT THE CITY SURVEYOR MAY TAKE NECESSARY MEASURES TO INSURE THE PRESERVATION OF SURVEY MONUMENTS. CONTRACTOR SHALL NOT DISTURB PERMANENT SURVEY MONUMENTS WITHOUT THE CONSENT OF THE CITY SURVEYOR AND SHALL NOTIFY THE CITY SURVEYOR AND BEAR THE EXPENSE OF REPLACING ANY THAT MAY BE DISTURBED WITHOUT PERMISSION. REPLACEMENT SHALL BE DONE ONLY BY THE CITY SURVEYOR WHEN A CHANGE IS MADE IN THE FINISHED ELEVATIONS OF THE PAVEMENT OF ANY ROADWAY IN WHICH A PERMANENT SURVEY MONUMENT IS LOCATED, CONTRACTOR SHALL, AT HIS OWN EXPENSE, ADJUST THE MONUMENT COVER TO THE NEW GRADE UNLESS OTHERWISE SPECIFIED. REFER TO SECTION 4.4 OF THE GENERAL CONDITIONS OF THE STANDARD SPECIFICATIONS.
- ANY WORK WITHIN AN ARTERIAL ROADWAY REQUIRES TWENTY-FOUR HOUR CONSTRUCTION.
- ALL UTILITY WORK SHALL BE CONSTRUCTED IN ACCORDANCE WITH NEW MEXICO UTILITIES, INC. SPECIFICATIONS FOR WATER AND WASTEWATER FACILITIES (MOST RECENT REVISIONS).
- THE CONTRACTOR SHALL NOTIFY NEW MEXICO UTILITIES, (898-2661) THREE WORKING DAYS PRIOR TO BEGINNING THE CONSTRUCTION OF THE UTILITIES.
- CONTRACTOR SHALL MAINTAIN A GRAFFITI-FREE WORK SITE. CONTRACTOR SHALL PROMPTLY REMOVE ANY GRAFFITI FROM ALL EQUIPMENT, WHETHER PERMANENT OR TEMPORARY.
- FOR STORM DRAIN CONSTRUCTION, RCP PIPE JOINTS SHALL NOT BE GROUTED PRIOR TO FINAL INSPECTION. FINAL INSPECTION WILL DETERMINE JOINTS TO BE GROUTED FOR FINAL ACCEPTANCE OF THE CONSTRUCTION.

THE FOLLOWING NOTES ALSO APPLY WHEN CHECKED

- ☒ ALL UTILITIES AND UTILITY SERVICE LINES SHALL BE INSTALLED PRIOR TO PAVING.
- ☒ BACKFILL COMPACTION SHALL BE ACCORDING TO SPECIFIED STREET USE.
- ☐ TACK COAT REQUIREMENTS SHALL BE DETERMINED BY THE CITY ENGINEER.
- ☒ SIDEWALKS AND WHEELCHAIR RAMPS WITHIN THE CURB RETURNS SHALL BE CONSTRUCTED WHEREVER A NEW CURB RETURN IS CONSTRUCTED.
- ☐ IF CURB IS DEPRESSED FOR A DRIVEPAD, THE DRIVEPAD SHALL BE CONSTRUCTED PRIOR TO ACCEPTANCE OF CURB AND GUTTER.
- ☒ ALL STORM DRAINAGE FACILITIES SHALL BE COMPLETED PRIOR TO FINAL ACCEPTANCE.
- ☒ THE REQUESTOR OR DEVELOPER SHALL BE RESPONSIBLE FOR REPAIR OR REPLACEMENT OF ALL CURB AND GUTTER OR SIDEWALK DAMAGED AFTER APPROVAL BY THE CITY ENGINEER OF WORK COMPLETED BY THE CONTRACTOR.

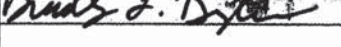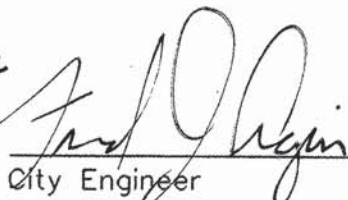REV.	SHEETS	CITY ENGINEER	DATE	USER DEPARTMENT	DATE	USER DEPARTMENT	DATE		
ENGINEERS STAMP & SIGNATURE		APPROVALS	ENGINEER	DATE	*****				
		DRC Chairman		4-12-02	APPROVED FOR CONSTRUCTION				
		Transportation		3/08/02					
		Water/Wastewater		3/06/2002					
		Hydrology		3/6/02					
		CIP		4-12-02					
		Const. Mngmt.		4-12-02	 4-26-02 City Engineer Date				
		Const. Coord.		3-7-02					
		NMUI		3-7-02					
DRB Case Number		City Project No.			Sheet Of				
1001461		658683			1 26				

SCANNED BY
MESA REPRO

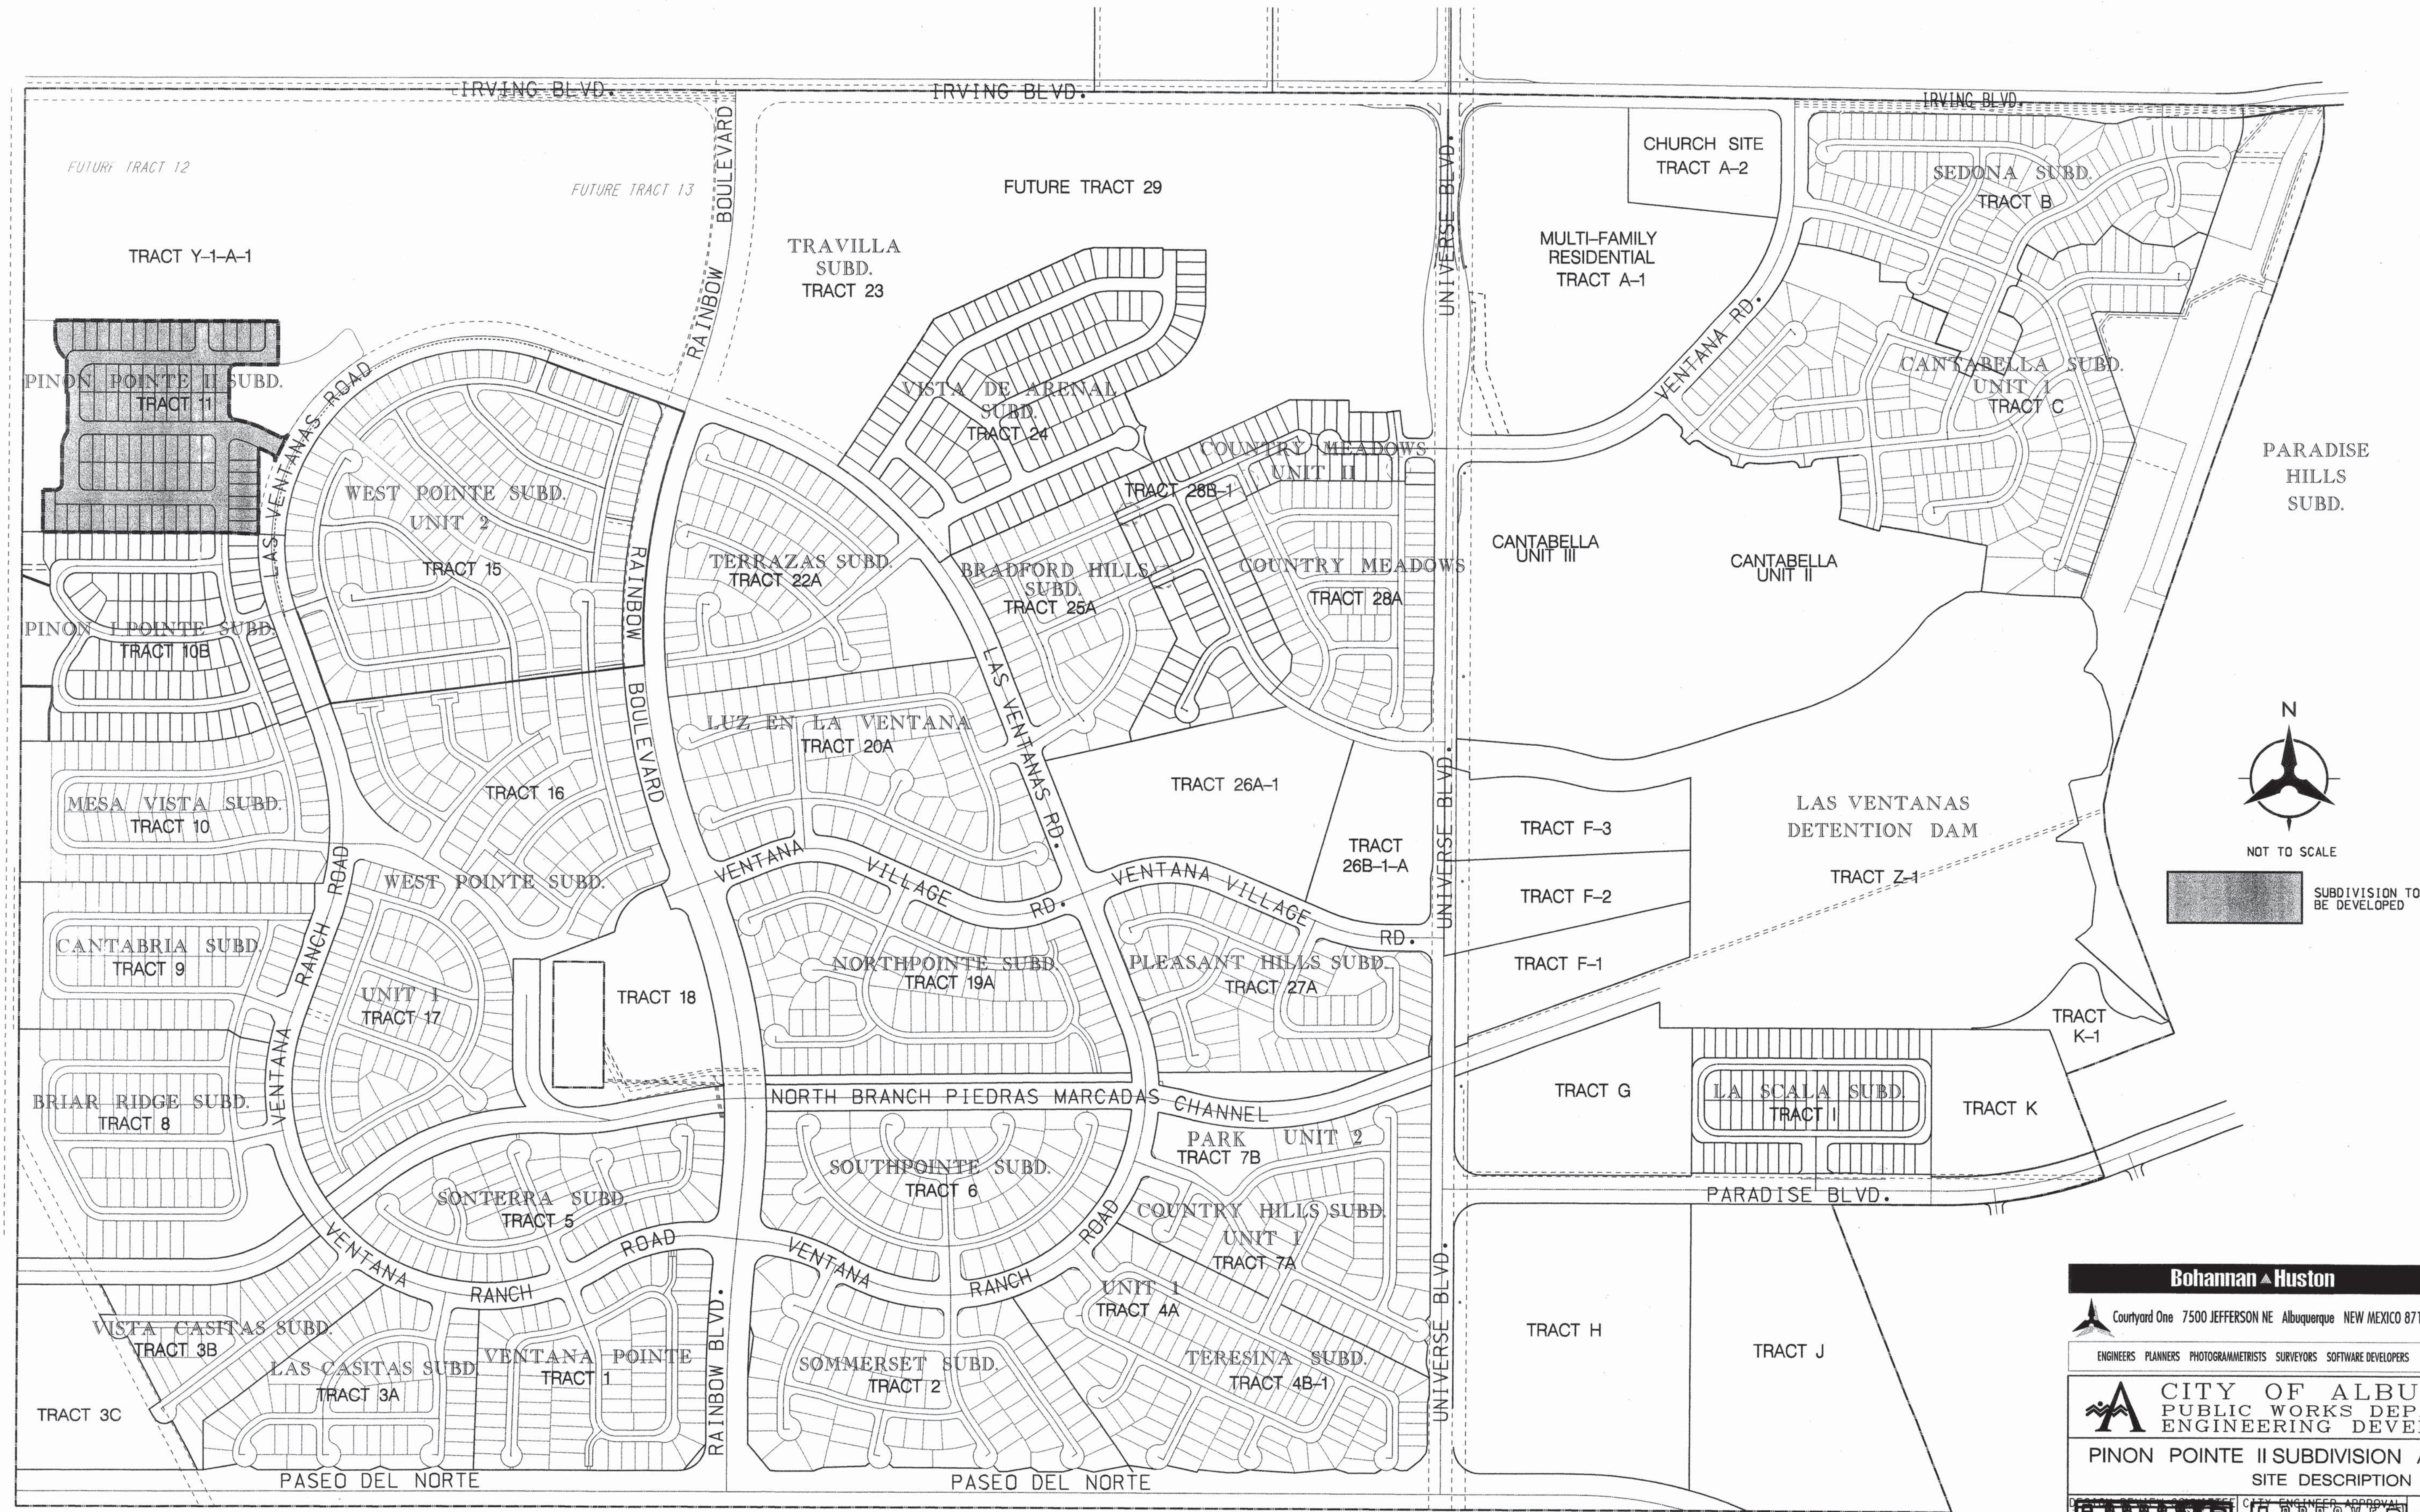

1 2 3 4 5 6 7 8 9 10 11 12 13 14 15
26 6586.83 0202

BHI JOB NO. 020066

Bohannon & Huston
Court yard One 7500 JEFFERSON NE Albuquerque NEW MEXICO 87109
ENGINEERS PLANNERS PHOTOGRAMMETRISTS SURVEYORS SOFTWARE DEVELOPERS

CITY OF ALBUQUERQUE
PUBLIC WORKS DEPARTMENT
ENGINEERING DEVELOPMENT GROUP

PINON POINTE II SUBDIVISION AT VENTANA RANCH
SITE DESCRIPTION PLAN

APPROVED APR 26 2002
CITY ENGINEER
LAST DESIGN UPDATE

CITY PROJECT NO. 658683 ZONE MAP NO. B-9 SHEET 2 OF 26

COPYRIGHT BOHANNAN-HUSTON, INC 2001


ENGINEER'S SEAL SURVEY INFORMATION		BENCH MARKS		AS-BUILT INFORMATION	
NO.	DATE	BY	DATE	NO.	DATE



REVISIONS		DESIGN	
NO.	DATE	BY	DATE

DESIGNED BY	YOP	DATE	08/2001
DRAWN BY	SAR	DATE	08/2001
CHECKED BY	KGP	DATE	08/2001

SCANNED BY
MESA REPRO

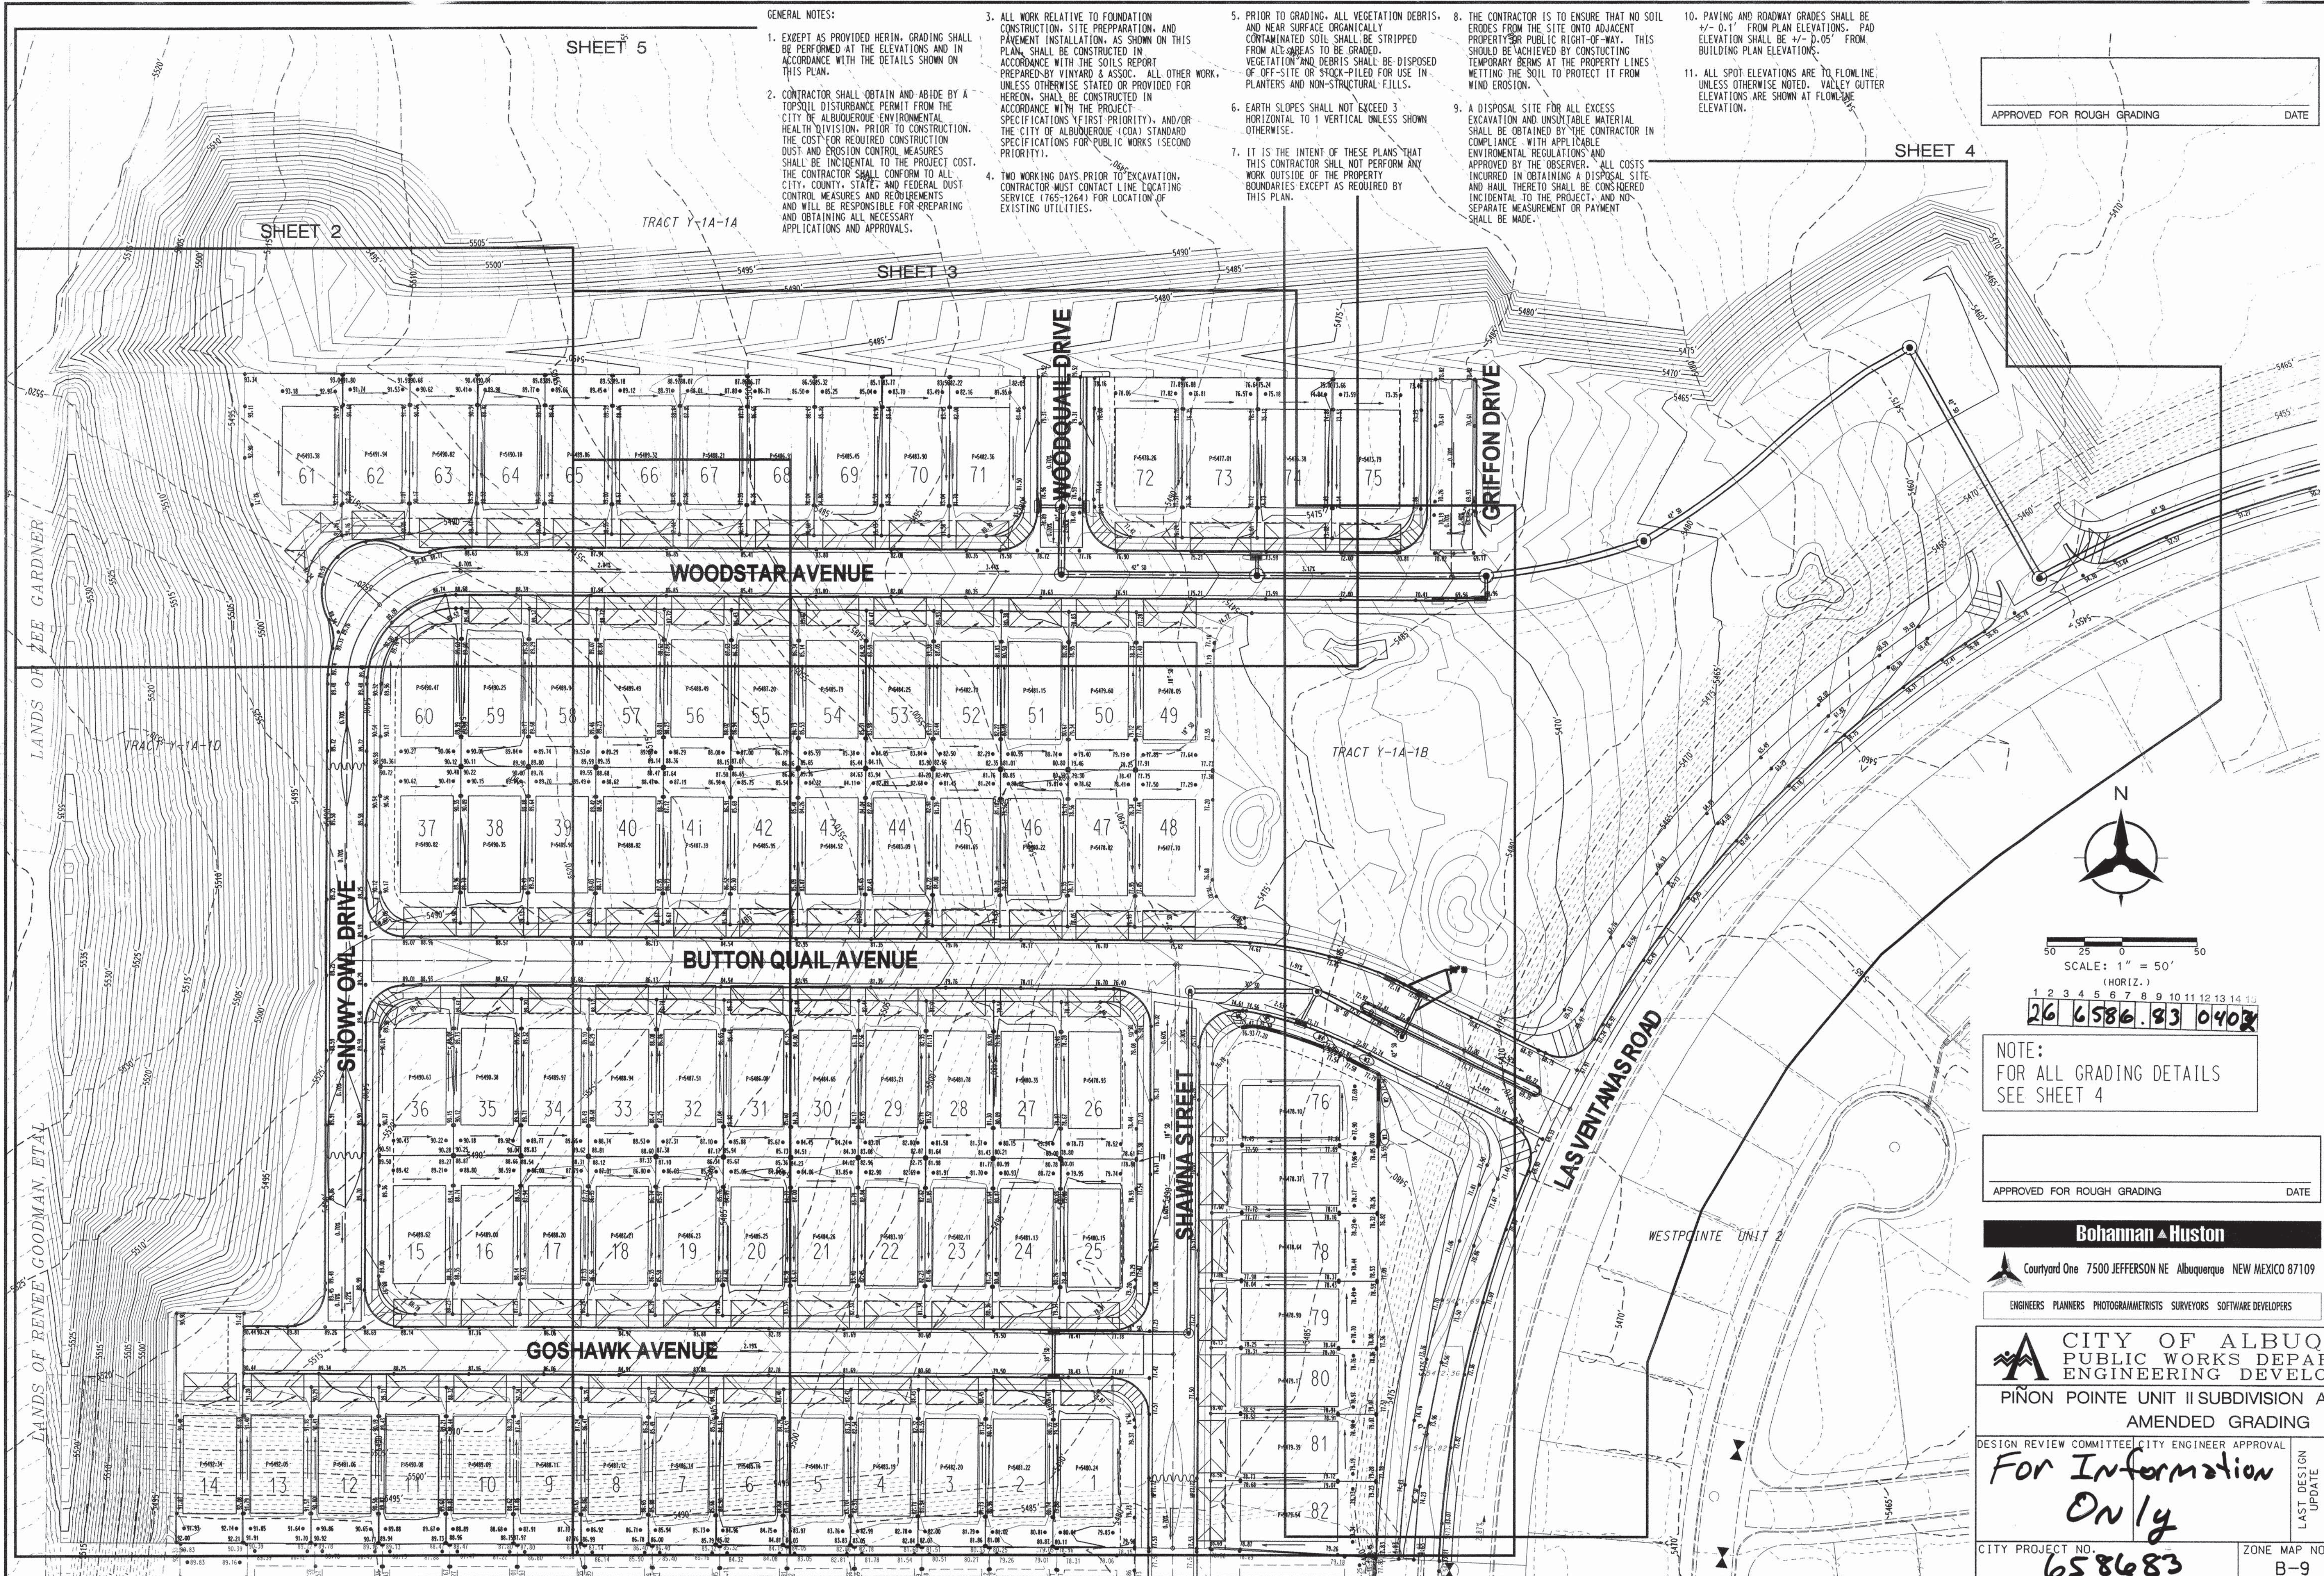

GENERAL NOTES:

- EXCEPT AS PROVIDED HEREIN, GRADING SHALL BE PERFORMED AT THE ELEVATIONS AND IN ACCORDANCE WITH THE DETAILS SHOWN ON THIS PLAN.
- CONTRACTOR SHALL OBTAIN AND ABIDE BY A TOPSOIL DISTURBANCE PERMIT FROM THE CITY OF ALBUQUERQUE ENVIRONMENTAL HEALTH DIVISION, PRIOR TO CONSTRUCTION. THE COST FOR REQUIRED CONSTRUCTION DUST AND EROSION CONTROL MEASURES SHALL BE INCIDENTAL TO THE PROJECT COST. THE CONTRACTOR SHALL CONFORM TO ALL CITY, COUNTY, STATE, AND FEDERAL DUST CONTROL MEASURES AND REQUIREMENTS AND WILL BE RESPONSIBLE FOR PREPARING AND OBTAINING ALL NECESSARY APPLICATIONS AND APPROVALS.
- ALL WORK RELATIVE TO FOUNDATION CONSTRUCTION, SITE PREPARATION, AND PAVEMENT INSTALLATION, AS SHOWN ON THIS PLAN, SHALL BE CONSTRUCTED IN ACCORDANCE WITH THE SOILS REPORT PREPARED BY WINYARD & ASSOC., ALL OTHER WORK, UNLESS OTHERWISE STATED OR PROVIDED FOR HEREON, SHALL BE CONSTRUCTED IN ACCORDANCE WITH THE PROJECT SPECIFICATIONS (FIRST PRIORITY), AND/OR THE CITY OF ALBUQUERQUE (COA) STANDARD SPECIFICATIONS FOR PUBLIC WORKS (SECOND PRIORITY).
- TWO WORKING DAYS PRIOR TO EXCAVATION, CONTRACTOR MUST CONTACT LINE LOCATING SERVICE (765-1264) FOR LOCATION OF EXISTING UTILITIES.
- PRIOR TO GRADING, ALL VEGETATION DEBRIS, AND NEAR SURFACE ORGANICALLY CONTAMINATED SOIL SHALL BE STRIPPED FROM ALL AREAS TO BE GRADED. VEGETATION AND DEBRIS SHALL BE DISPOSED OF OFF-SITE OR STOCK-PILED FOR USE IN PLANTERS AND NON-STRUCTURAL FILLS.
- EARTH SLOPES SHALL NOT EXCEED 3 HORIZONTAL TO 1 VERTICAL UNLESS SHOWN OTHERWISE.
- IT IS THE INTENT OF THESE PLANS THAT THIS CONTRACTOR SHALL NOT PERFORM ANY WORK OUTSIDE OF THE PROPERTY BOUNDARIES EXCEPT AS REQUIRED BY THIS PLAN.
- THE CONTRACTOR IS TO ENSURE THAT NO SOIL ERODES FROM THE SITE ON ADJACENT PROPERTY OR PUBLIC RIGHT-OF-WAY. THIS SHOULD BE ACHIEVED BY CONSTRUCTING TEMPORARY BENCHES AT THE PROPERTY LINES WETTING THE SOIL TO PROTECT IT FROM WIND EROSION.
- A DISPOSAL SITE FOR ALL EXCESS EXCAVATION AND UNSUITABLE MATERIAL SHALL BE OBTAINED BY THE CONTRACTOR IN COMPLIANCE WITH APPLICABLE ENVIRONMENTAL REGULATIONS AND APPROVED BY THE OBSERVER. ALL COSTS INCURRED IN OBTAINING A DISPOSAL SITE AND HAUL THERE TO SHALL BE CONSIDERED INCIDENTAL TO THE PROJECT, AND NO SEPARATE MEASUREMENT OR PAYMENT SHALL BE MADE.
- PAVING AND ROADWAY GRADES SHALL BE $\pm 0.1'$ FROM PLAN ELEVATIONS. PAD ELEVATIONS SHALL BE $\pm 0.05'$ FROM BUILDING PLAN ELEVATIONS.
- ALL SPOT ELEVATIONS ARE TO FLOWLINE UNLESS OTHERWISE NOTED. VALLEY GUTTER ELEVATIONS ARE SHOWN AT FLOWLINE ELEVATION.

APPROVED FOR ROUGH GRADING

DATE



SCALE: 1" = 50'

26 6586.83 0408

NOTE:
FOR ALL GRADING DETAILS
SEE SHEET 4

APPROVED FOR ROUGH GRADING

DATE

Bohannon & Huston

Courtyard One 7500 JEFFERSON NE Albuquerque NEW MEXICO 87109

ENGINEERS PLANNERS PHOTOGRAMMETRISTS SURVEYORS SOFTWARE DEVELOPERS



CITY OF ALBUQUERQUE
PUBLIC WORKS DEPARTMENT
ENGINEERING DEVELOPMENT GROUP

PIÑON POINTE UNIT II SUBDIVISION AT VENTANA RANCH
AMENDED GRADING PLAN

DESIGN REVIEW COMMITTEE/CITY ENGINEER APPROVAL

For Information
Only

CITY PROJECT NO.
658683

ZONE MAP NO. B-9 SHEET 4 OF 26

BHI JOB NO. 020066

COPYRIGHT BOHANNAN HUSTON 2001

AS-BUILT INFORMATION	
CONTRACTOR	Bohannon & Huston
WORK STARTED BY	DATE
WORK STOPPED BY	DATE
FIELD ACCEPTANCE BY	DATE
FIELD CORRECTION BY	DATE
FIELD CORRECTION BY	DATE
FIELD CORRECTION BY	DATE
FIELD CORRECTION BY	DATE

BENCH MARKS	
ACS BRASS TABLET STAMPED "1-B9 1980"	
GEODETIC POSITION (NAD 1927)	
N.M. STATE PLANE COORDINATES	
(CENTRAL ZONE) X=355,077.00	
Y=1,529,056.93	
GROUND-TO-GRID FACTOR = .99966334	
DELTA ALPHA = -00°16'47"	
NGVD 1929 ELEVATION = 5450.51	

ENGINEER'S SEAL SURVEY INFORMATION	
NO.	DATE
BY	


FIELD NOTES	
NO.	DATE
BY	

REVISIONS	
NO.	DATE
BY	
REMARKS	
DESIGNED BY	YOP
DRAWN BY	BS
CHECKED BY	KGP
DATE	8/01
DATE	8/01
DATE	8/01

LAST DESIGN UPDATE	
MO./DAY/YR.	MO./DAY/YR.


MICRO-FILM INFORMATION	
RECORDED BY	DATE
NO.	

G. SAENOS - COA INSP.


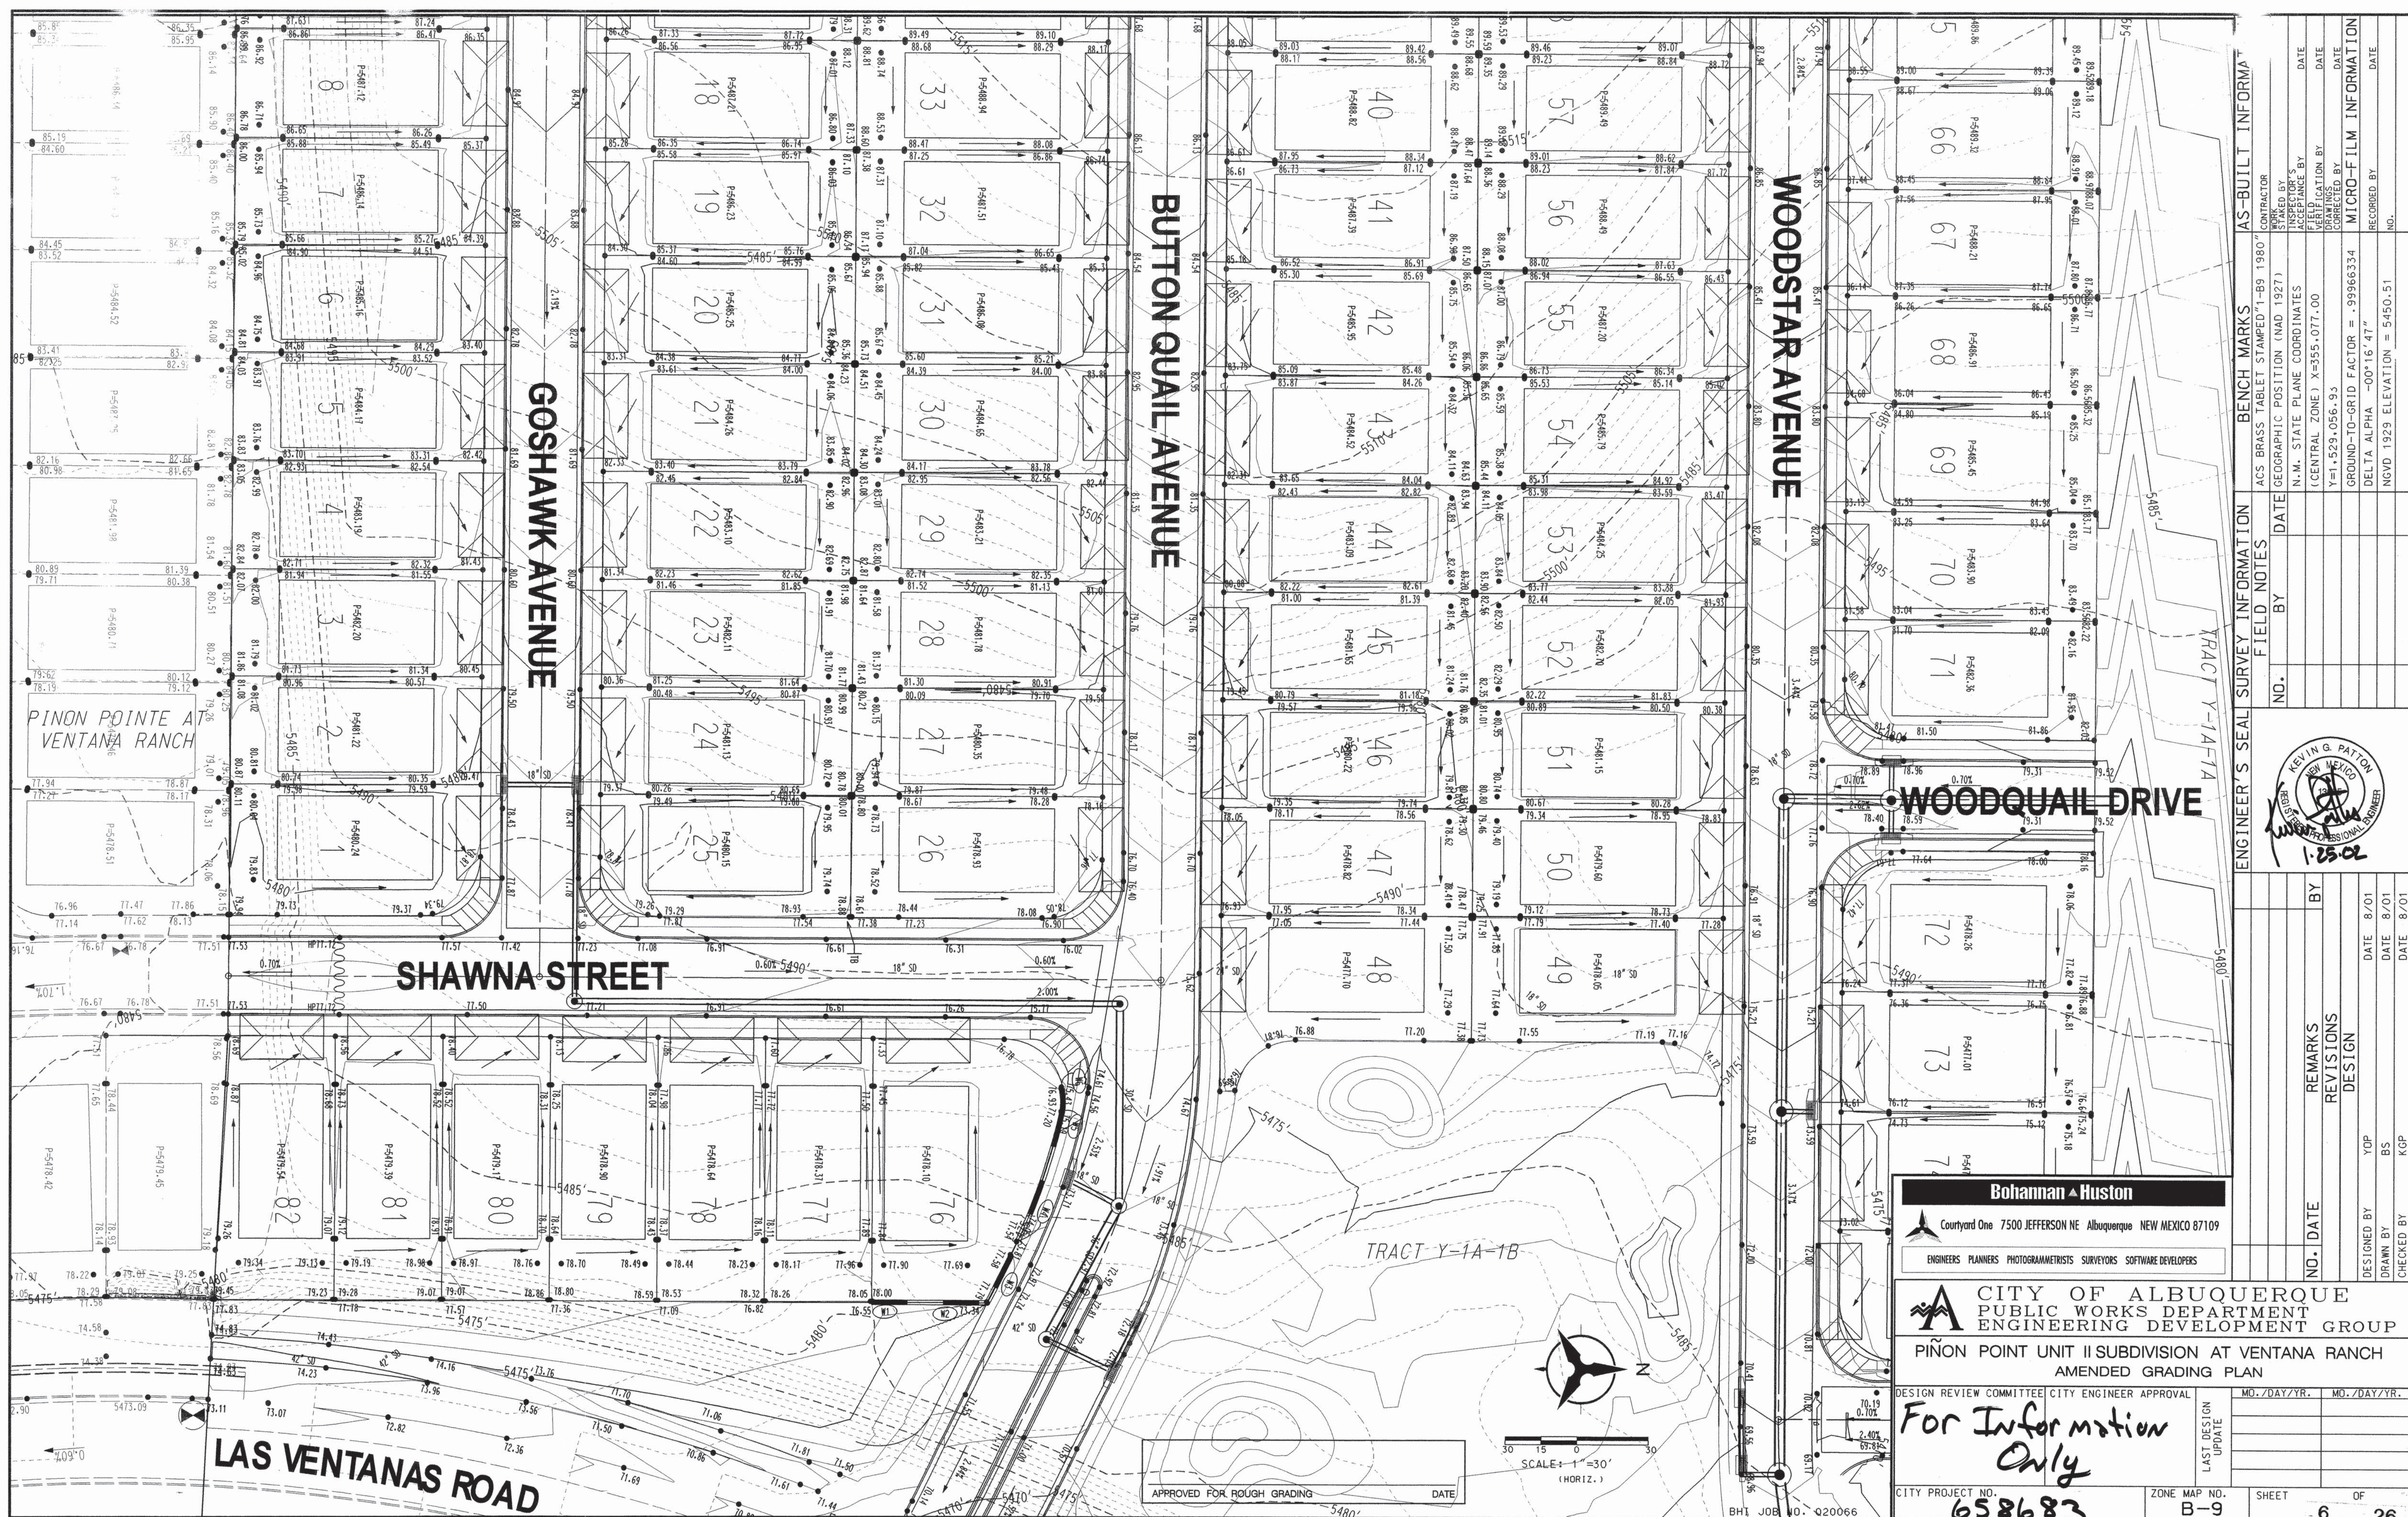


SCANNED BY
MESA REPRO

SCANNED BY
MESA REPRO

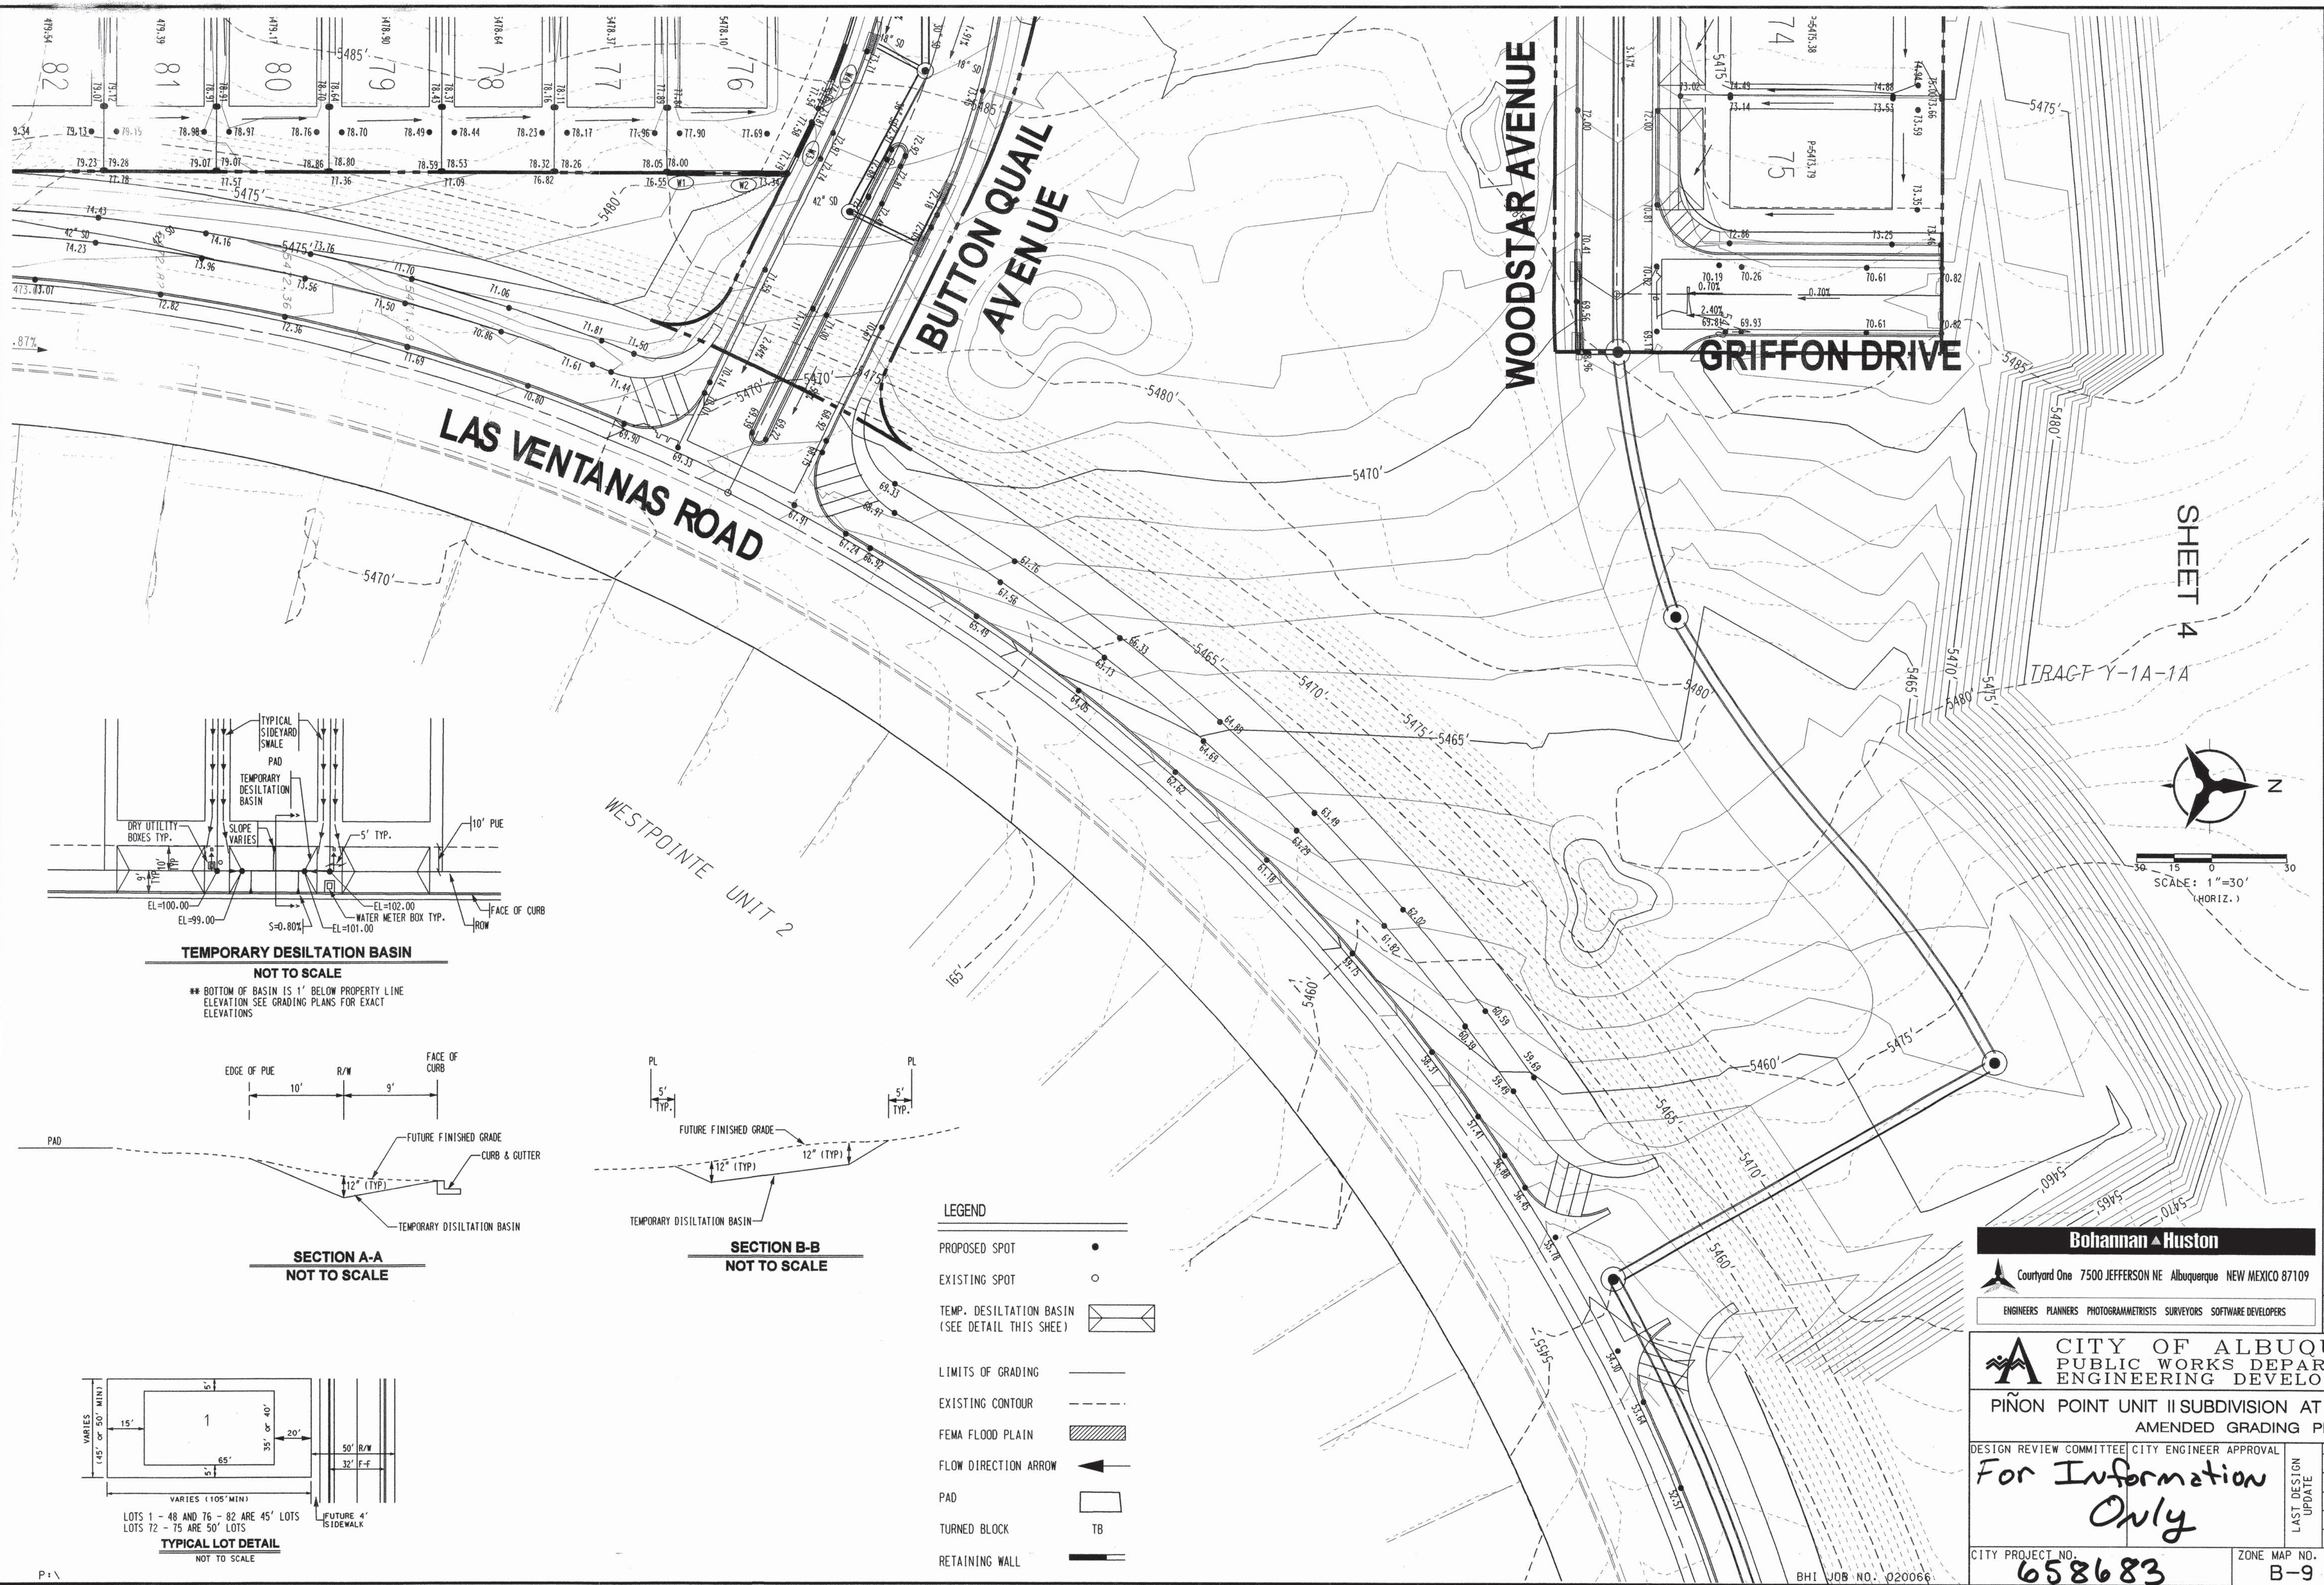
[illegible]

SCANNED BY
MESA REPRO

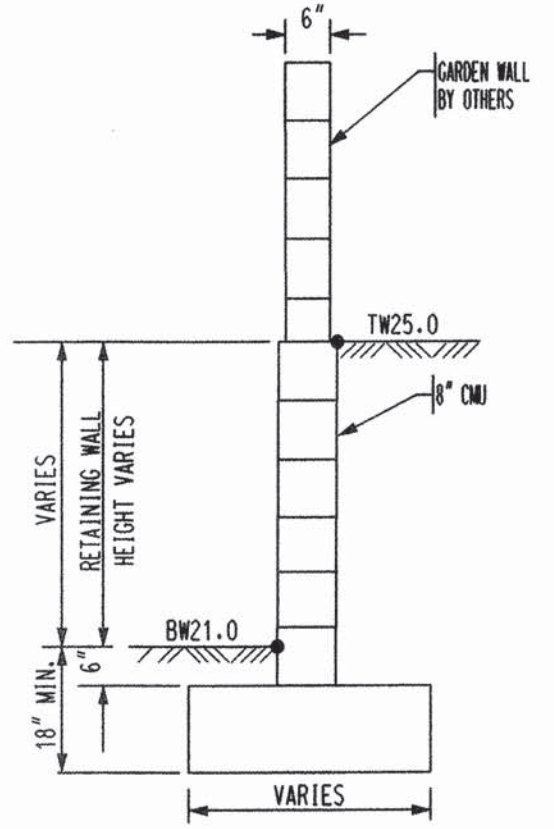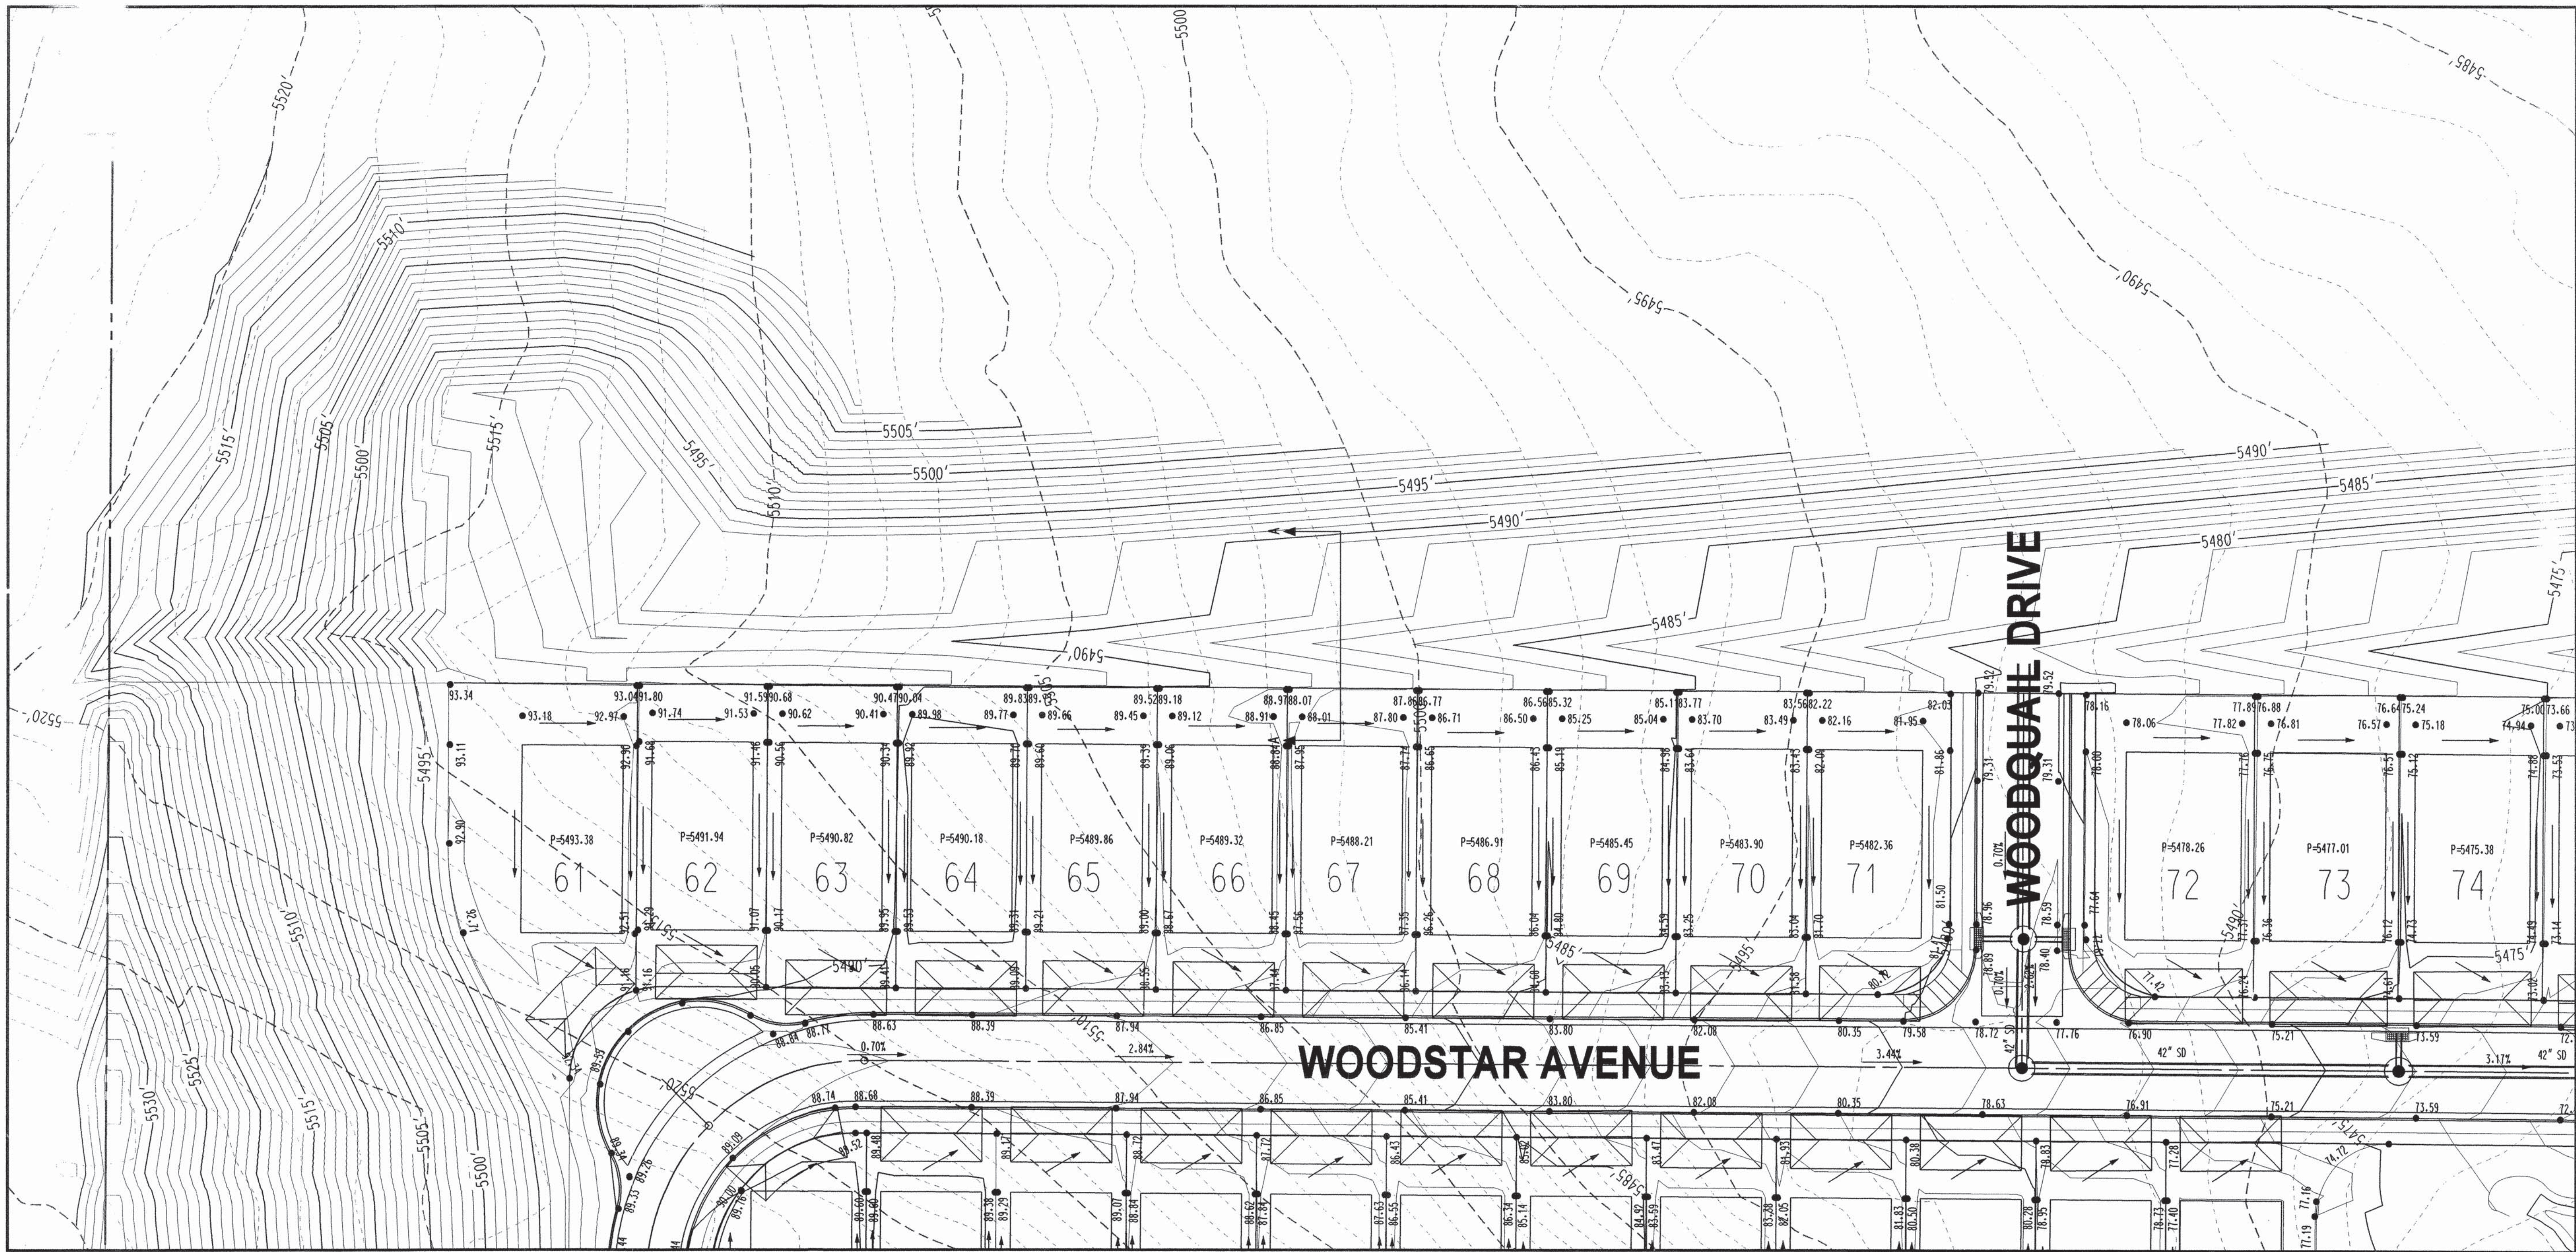


TYPICAL RETAINING WALL NOMENCLATURE
NOT TO SCALE
(RETAINING HEIGHT IS TAKEN TO BE DIFFERENCE IN FINISHED GRADES ON LEFT AND RIGHT SIDE OF WALL.)

Wall Point	TW Elev	BW Elev	Wall Ht	Approx Wall Length	Average Wall Height	Average Wall Type
1	78.05	76.55	1.50			
2	77.79	73.34	4.45	48.40	2.98	A
3	77.58	73.81	3.77	22.62	4.11	B
4	77.51	74.05	3.46	5.95	3.62	B
5	77.20	75.19	2.01	97.52	2.74	A
6	76.93	75.43	1.50	10.70	1.75	A

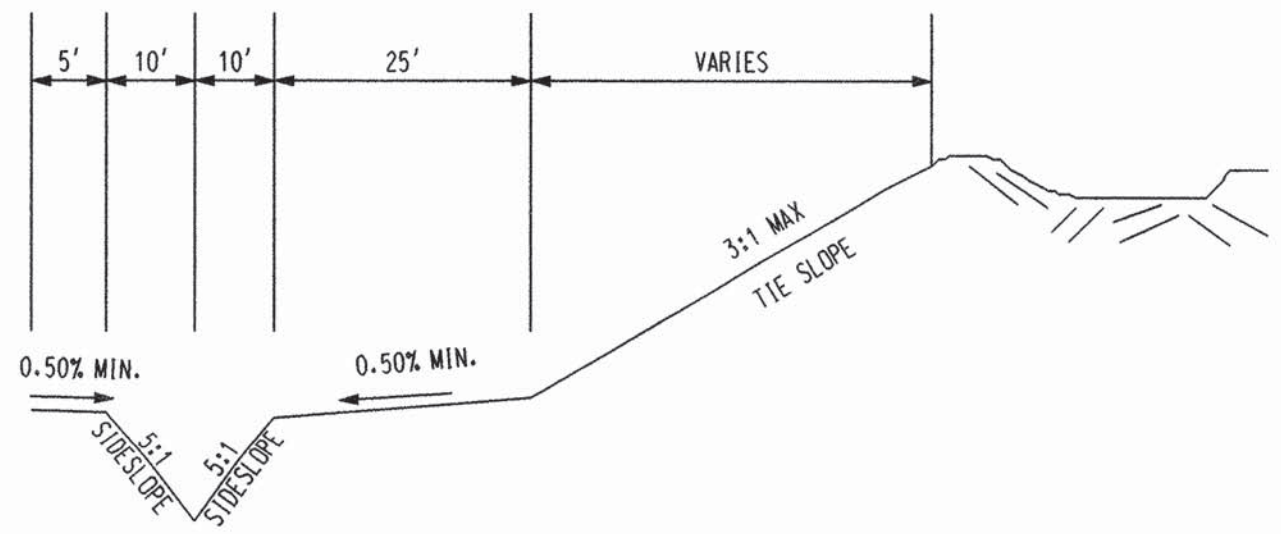

SWALE DETAIL SECTION A - A
NOT TO SCALE

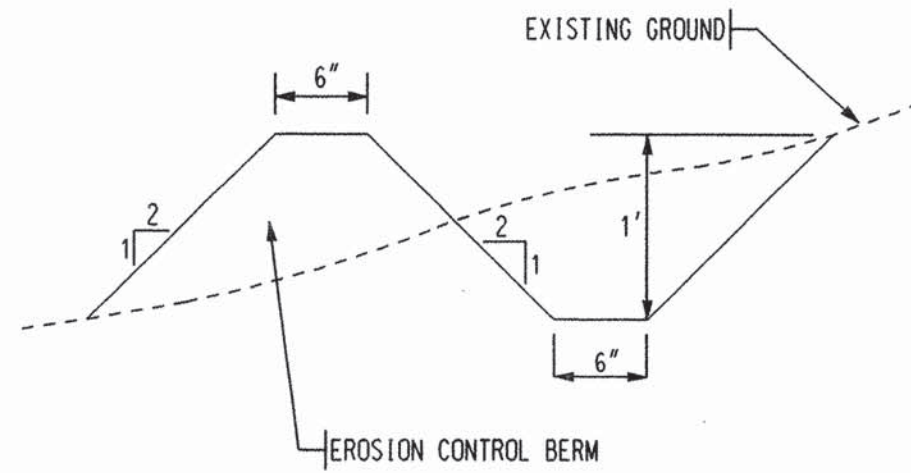

EROSION CONTROL PLAN
NOT TO SCALE

A BERM WITH THE DIMENSIONS SHOWN SHALL BE MAINTAINED DURING CONSTRUCTION UNTIL COMPLETION OF INDIVIDUAL HOMES WITHIN THE PROJECT



SCALE: 1"=30'
(HORIZ.)

26 6586.83 0802

BHI JOB NO. 020066

Bohannon & Huston
Courtyard One 7500 JEFFERSON NE Albuquerque NEW MEXICO 87109
ENGINEERS PLANNERS PHOTOGRAMMETRISTS SURVEYORS SOFTWARE DEVELOPERS


CITY OF ALBUQUERQUE
PUBLIC WORKS DEPARTMENT
ENGINEERING DEVELOPMENT GROUP
PIÑON POINT UNIT II SUBDIVISION AT VENTANA RANCH
AMENDED GRADING PLAN

DESIGN REVIEW COMMITTEE CITY ENGINEER APPROVAL	MO./DAY/YR.	MO./DAY/YR.
For Information Only	LAST DESIGN UPDATE	
CITY PROJECT NO. 658683	ZONE MAP NO. B-9	SHEET 8 OF 26

ENGINEER'S SEAL SURVEY INFORMATION		BENCH MARKS		AS-BUILT INFORMATION	
NO.	DATE	ACS BRASS TABLE STAMPED 1-B9 1980"	CONTRACTOR	DATE	
		GEOGRAPHIC POSITION (NAD 1927)	BY	DATE	
		N.M. STATE PLANE COORDINATES	ACCEPTANCE BY	DATE	
		(CENTRAL ZONE) X=555,077.00	DATE	DATE	
		Y=1,529,056.93	DATE	DATE	
		GROUND-TO-GRID FACTOR = .99966334	DATE	DATE	
		DELTA ALPHA = -00°16'47"	DATE	DATE	
		NGVD 1929 ELEVATION = 5450.51	DATE	DATE	



NO.	DATE	BY
REMARKS		
REVISIONS		
DESIGN		
DESIGNED BY	YOP	DATE 8/01
DRAWN BY	BS	DATE 8/01
CHECKED BY	KGP	DATE 8/01

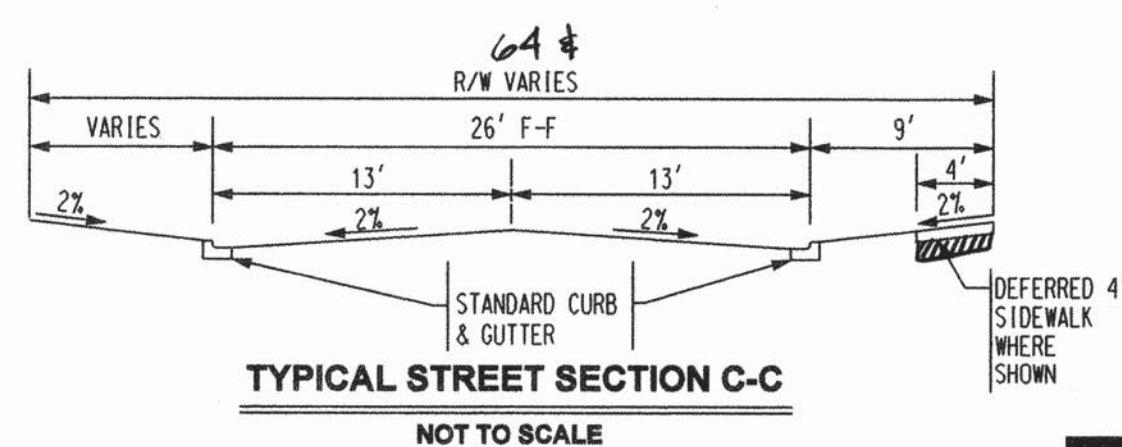



	CITY OF ALBUQUERQUE PUBLIC WORKS DEPARTMENT ENGINEERING DEVELOPMENT GROUP																
	PINON POINTE II SUBDIVISION AT VENTANA RANCH OVERALL PAVING PLAN																
DESIGN REVIEW COMMITTEE APPROVED APR 12 2002 DESIGN REVIEW COMMITTEE	CITY ENGINEER APPROVAL APPROVED MAY 26 2002 CITY ENGINEER	LAST DESIGN UPDATE	<table border="1" style="width: 100%; border-collapse: collapse;"> <tr> <th style="width: 50%;">MO./DAY/YR.</th> <th style="width: 50%;">MO./DAY/YR.</th> </tr> <tr><td> </td><td> </td></tr> <tr><td> </td><td> </td></tr> <tr><td> </td><td> </td></tr> <tr><td> </td><td> </td></tr> <tr><td> </td><td> </td></tr> <tr><td> </td><td> </td></tr> </table>	MO./DAY/YR.	MO./DAY/YR.												
MO./DAY/YR.	MO./DAY/YR.																
CITY PROJECT NO. 658683		ZONE MAP NO. B-9	SHEET 10 OF 26														

[illegible]

CENTERLINE CURVE TABLE			
NUMBER	ARC	RADIUS	DELTA
C1	135.60'	300.00'	25°53'52"
C2	135.60'	300.00'	25°53'52"

FACE OF CURB TRANSITION CURVE TABLE			
NUMBER	ARC	RADIUS	DELTA
C2	135.60'	300.00'	25°53'52"
C2	135.60'	300.00'	25°53'52"

CENTERLINE TANGENT TABLE		
NUMBER	BEARING	LENGTH
T1	S89°39'17"E	553.00'
T2	S63°45'25"E	147.60'

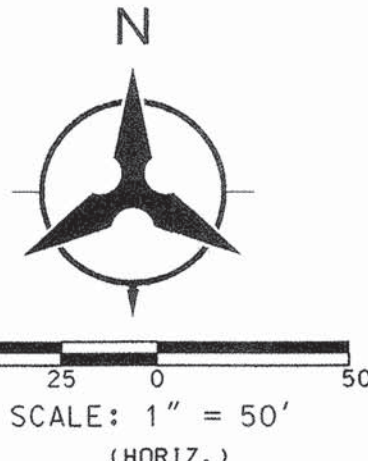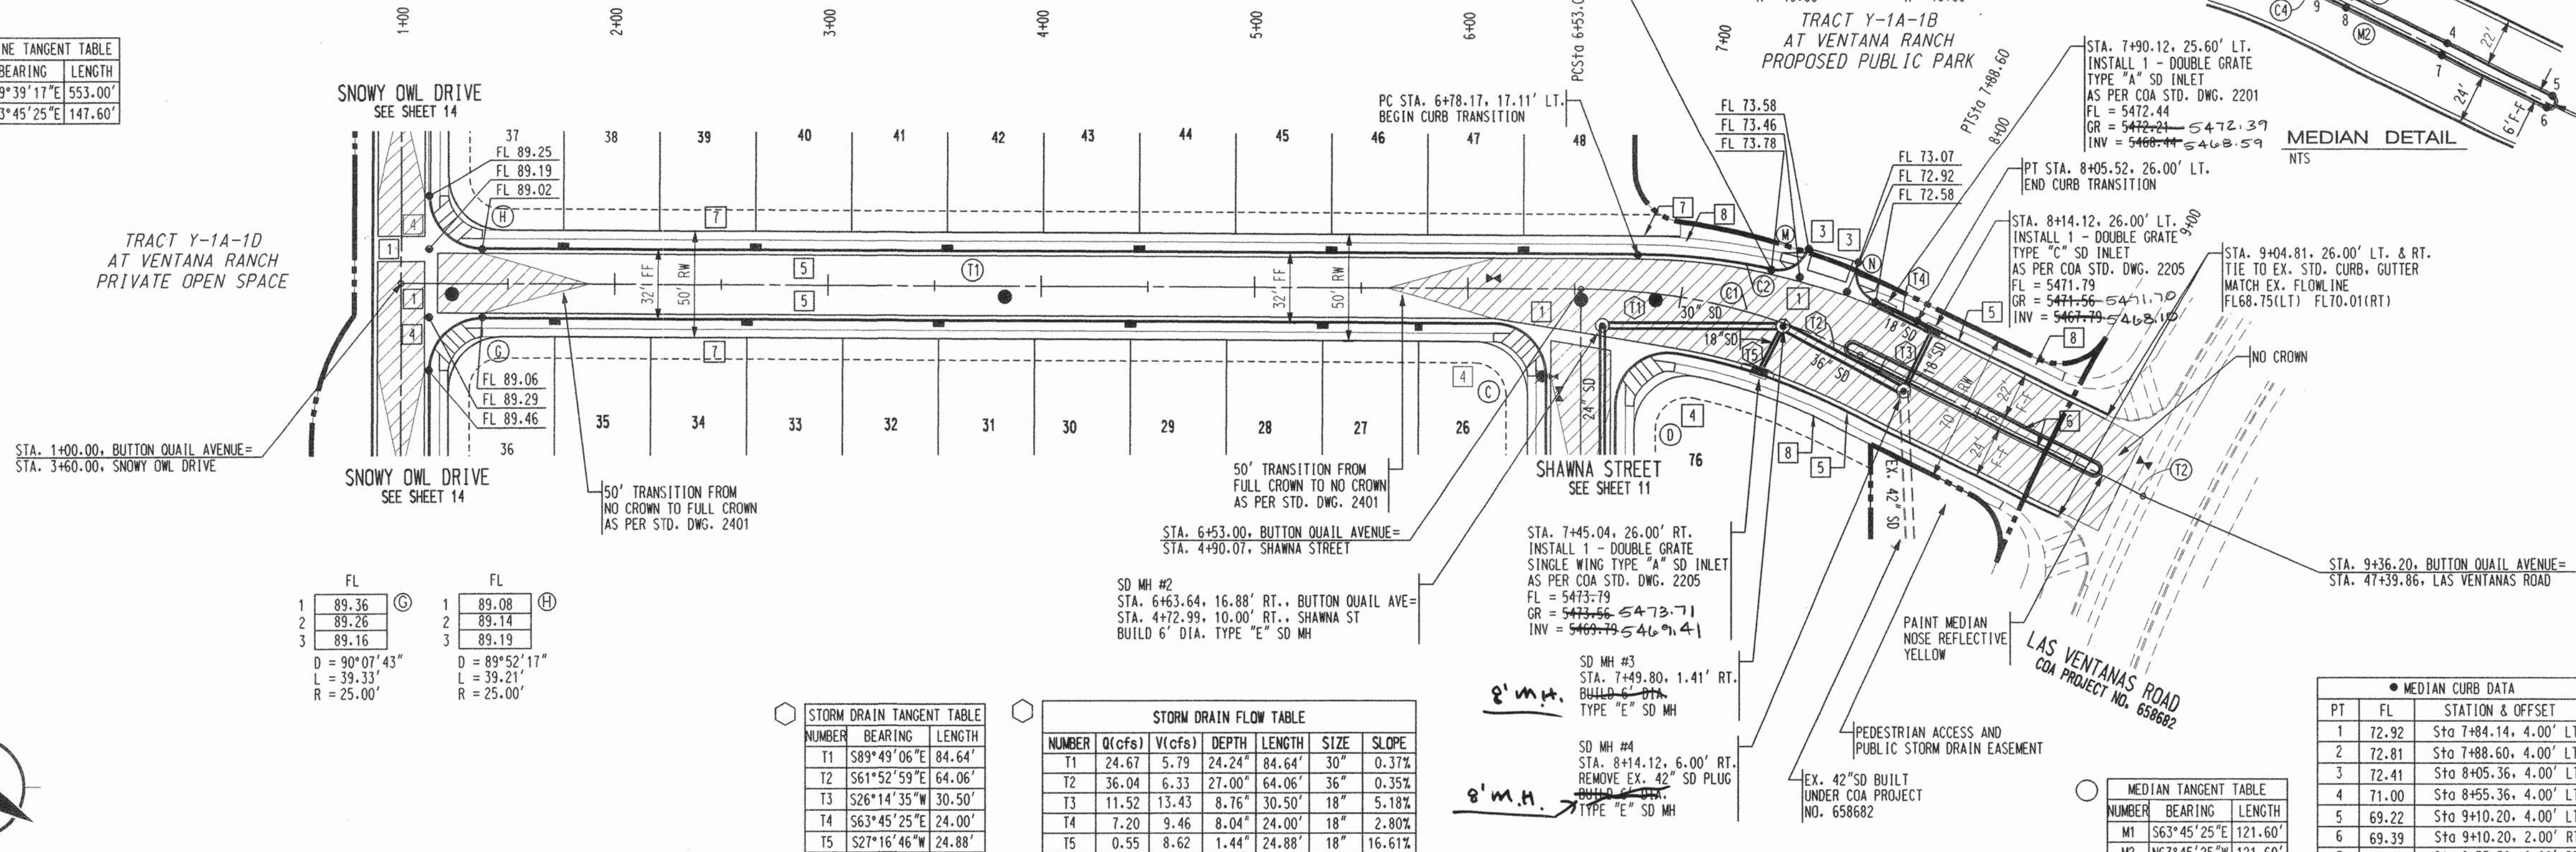

BUTTON QUAIL AVENUE

STORM DRAIN TANGENT TABLE		
NUMBER	BEARING	LENGTH
T1	S89°49'06"E	84.64'
T2	S61°52'59"E	64.06'
T3	S26°14'35"W	30.50'
T4	S63°45'25"E	24.00'
T5	S27°16'46"W	24.88'

STORM DRAIN FLOW TABLE						
NUMBER	Q(cfs)	V(cfs)	DEPTH	LENGTH	SIZE	SLOPE
T1	24.67	5.79	24.24"	84.64'	30"	0.37%
T2	36.04	6.33	27.00"	64.06'	36"	0.35%
T3	11.52	13.43	8.76"	30.50'	18"	5.18%
T4	7.20	9.46	8.04"	24.00'	18"	2.80%
T5	0.55	8.62	1.44"	24.88'	18"	16.61%

NOTE:
SEE SHEET 11 FOR QUARTER POINT FLOWLINE
ELEVATION TABLES FOR RETURNS C & D

MEDIAN CURB DATA		
PT	FL	STATION & OFFSET
1	72.92	Sta 7+84.14, 4.00' LT.
2	72.81	Sta 7+88.60, 4.00' LT.
3	72.41	Sta 8+05.36, 4.00' LT.
4	71.00	Sta 8+55.36, 4.00' LT.
5	69.22	Sta 9+10.20, 4.00' LT.
6	69.39	Sta 9+10.20, 2.00' RT.
7	71.11	Sta 8+55.36, 2.00' RT.
8	72.48	Sta 8+05.36, 2.00' RT.
9	72.88	Sta 7+88.60, 2.00' RT.
10	72.97	Sta 7+84.14, 2.00' RT.

MEDIAN TANGENT TABLE			
NUMBER	BEARING	LENGTH	
M1	S63°45'25"E	121.60'	
M2	N63°45'25"W	121.60'	

MEDIAN CURVE TABLE			
ID	ARC	RADIUS	DELTA
C3	4.52'	304.00'	00°51'06"
C4	4.44'	298.00'	00°51'15"

NOTES

- THE CONTRACTOR SHALL FIELD VERIFY ALL EXISTING UTILITY LOCATIONS AND NOTIFY THE ENGINEER IMMEDIATELY OF ANY DISCREPANCIES.
- ALL CURB RETURN RADII SHALL BE 25' UNLESS OTHERWISE SPECIFIED.
- ALL CURVE DATA AND DIMENSIONS REFER TO FACE OF CURB UNLESS OTHERWISE SPECIFIED.
- GRADE ELEVATIONS, WHERE NOTED, ARE ALONG FLOWLINE OF STANDARD CURB UNLESS OTHERWISE SPECIFIED.
- CONTRACTOR IS TO INSTALL A 4" X 4" X 5' POST AND EMD AT THE END OF EACH SANITARY SEWER SERVICE.
- CONTRACTOR IS RESPONSIBLE FOR REPAIR AND/OR REPLACEMENT OF ALL UTILITY CONDUITS AND EXISTING LINES.
- ANY ADDITIONAL GRADING REQUIRED TO MATCH PROPOSED STREET GRADES SHALL BE INCIDENTAL TO PAVING ITEMS.
- CONTRACTOR SHALL PROVIDE THE INSPECTORS, (CITY AND PRIVATE) WITH THE PROPOSED HYDROSTATIC TESTING PLAN. THE PLAN MUST BE APPROVED BEFORE TESTING OPERATIONS BEGIN.
- CONTRACTOR SHALL PARK EQUIPMENT AND VEHICLES AS NOT TO INTERFERE WITH NORMAL ACTIVITIES OF RESIDENTS OR OTHER CONTRACTORS ON SITE.
- ANY DAMAGE TO THE EXISTING FACILITIES (CURB & GUTTER), PAVEMENT, CONDUITS, LANDSCAPING, UTILITY LINES, ETC.) DURING CONSTRUCTION SHALL BE REPLACED AT THE CONTRACTORS' EXPENSE.
- REMOVAL OF THE EXISTING CURB AND GUTTER SHALL BE AS PER COA STD. DWG. 2415 (SAWCUT ONLY).
- WHEELCHAIR RAMPS SHALL BE CONSTRUCTED PRIOR TO ACCEPTANCE OF CURB & GUTTER.

KEYED GENERAL NOTES

- INSTALL 6' CONCRETE VALLEY GUTTER AS PER STD. DWG. 2420
- INSTALL CONCRETE VALLEY GUTTER AS PER STD. DWG. 2421
- INSTALL UNI-DIRECTIONAL WHEELCHAIR RAMP AS PER DETAIL SHEET 10 AS PER COA 2440
- INSTALL WHEELCHAIR RAMP AS PER MODIFIED STD. DWG. 2441, CASE II WITH ALTERNATE SECTION AA AND AS PER DETAIL SHEET 10
- STD. CURB & GUTTER AS PER STD. DWG. 2415
- MEDIAN CURB & GUTTER AS PER STD. DWG. 2415
- DEFERRED 4' SIDEWALK
- BUILD 4' SIDEWALK PER COA 2430
- TEMPORARY EXTRUDED ASPHALT CURB AS PER STD. DWG. 2415

26 6586.83 1302

Bohannon & Huston
 Courtyard One 7500 JEFFERSON NE ALBUQUERQUE NEW MEXICO 87109
 ENGINEERS PLANNERS PHOTOGRAMMETRISTS SURVEYORS SOFTWARE DEVELOPERS

CITY OF ALBUQUERQUE
 PUBLIC WORKS DEPARTMENT
 ENGINEERING DEVELOPMENT GROUP
 PINON POINTE II SUBDIVISION AT VENTANA RANCH
 PAVING PLAN & PROFILE
 BUTTON QUAIL AVENUE

DESIGN REVIEW COMMITTEE
 APR 12 2002
 CITY ENGINEER
 MAY 26 2002
 LAST DESIGN UPDATE

CITY PROJECT NO. 658683
 ZONE MAP NO. B-9
 SHEET 13 OF 26

NUMBER	BEARING	LENGTH
T1	N00°13'00"E	130.07'
T2	N00°13'00"E	260.00'



STA. 0+98.98, 16' LT. & RT. THIS PROJECT= STA. 8+51.01, 16' LT. & RT. COA PROJECT NO. 658681 REMOVE CUT-OFF WALL 16' LT. TO 16' RT. AND 2 - TYPE III BARRICADES. MATCH EXISTING CURB ELEVATIONS LT. & RT. FL 77.534/-

NUMBER	BEARING	LENGTH
T1	N00°13'00"E	228.24'

NUMBER	Q(cfs)	V(cfs)	DEPTH	LENGTH	SIZE	SLOPE
T1	6.65	3.44	14.16"	228.24'	24"	0.20 %

FL	(A)	FL	(B)	FL	(C)	FL	(D)
1	77.80	1	77.26	1	76.31	1	75.48
2	77.72	2	77.43	2	76.21	2	75.19
3	77.65	3	77.61	3	76.12	3	74.90
D = 89°52'17"				D = 89°52'17"			
L = 39.21				L = 39.21			
R = 25.00				R = 25.00			
D = 99°38'04"				D = 99°38'04"			
L = 43.47				L = 43.47			
R = 25.00				R = 25.00			

SHAWNA STREET

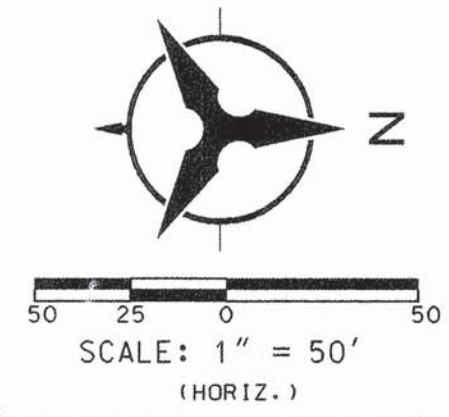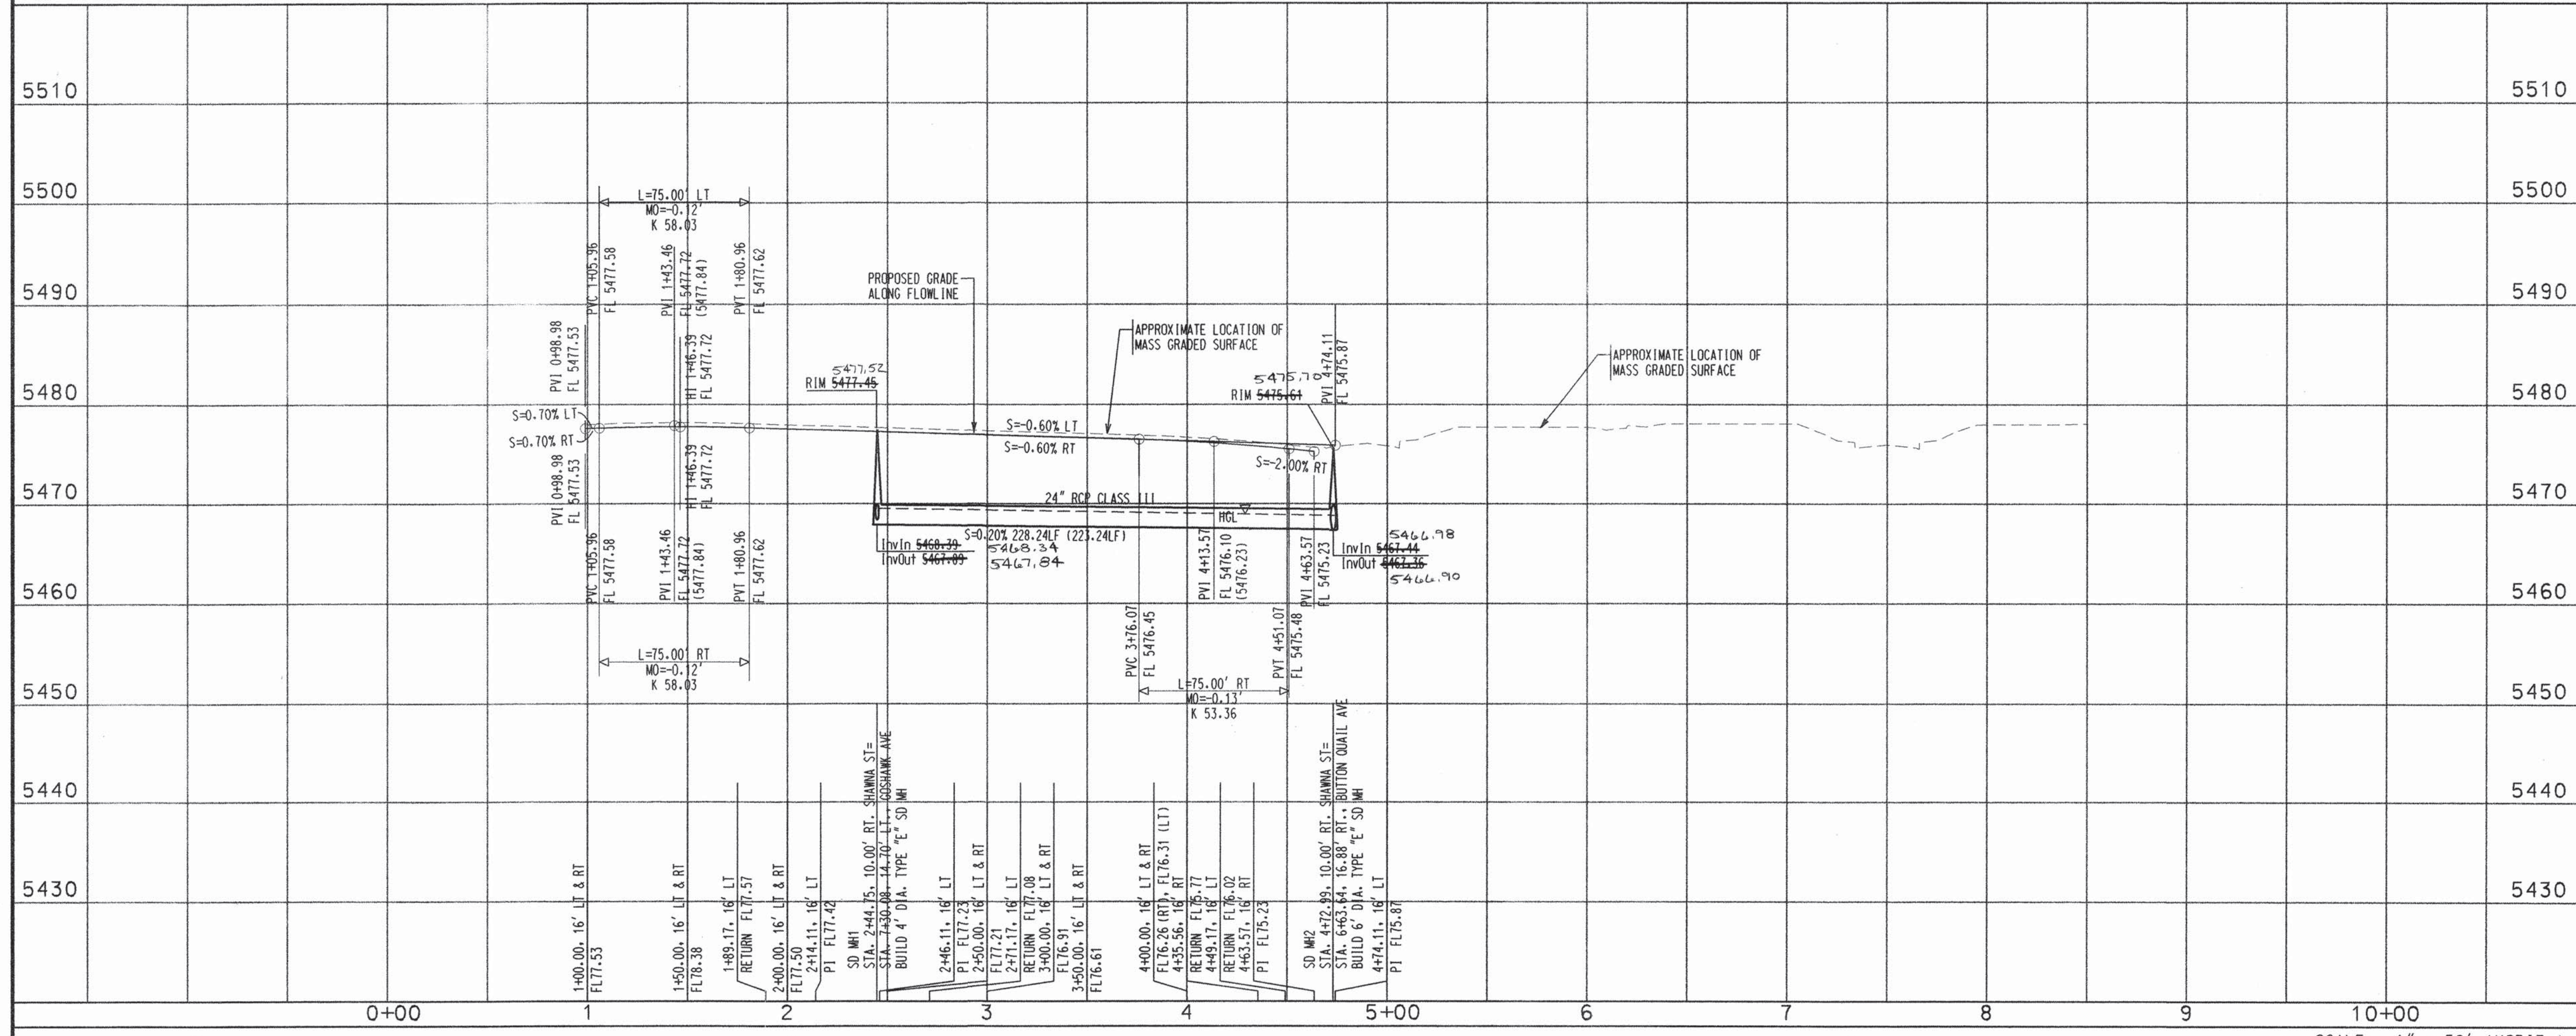

- NOTES
- THE CONTRACTOR SHALL FIELD VERIFY ALL EXISTING UTILITY LOCATIONS AND NOTIFY THE ENGINEER IMMEDIATELY OF ANY DISCREPANCIES.
 - ALL CURB RETURN RADII SHALL BE 25' UNLESS OTHERWISE SPECIFIED.
 - ALL CURVE DATA AND DIMENSIONS REFER TO FACE OF CURB UNLESS OTHERWISE SPECIFIED.
 - GRADE ELEVATIONS, WHERE NOTED, ARE ALONG FLOWLINE OF STANDARD CURB UNLESS OTHERWISE SPECIFIED.
 - CONTRACTOR IS TO INSTALL A 4" X 4" X 5' POST AND EMD AT THE END OF EACH SANITARY SEWER SERVICE.
 - CONTRACTOR IS RESPONSIBLE FOR REPAIR AND/OR REPLACEMENT OF ALL UTILITY CONDUITS AND EXISTING LINES.
 - ANY ADDITIONAL GRADING REQUIRED TO MATCH PROPOSED STREET GRADES SHALL BE INCIDENTAL TO PAVING ITEMS.
 - CONTRACTOR SHALL PROVIDE THE INSPECTORS (CITY AND PRIVATE) WITH THE PROPOSED HYDROSTATIC TESTING PLAN. THE PLAN MUST BE APPROVED BEFORE TESTING OPERATIONS BEGIN.
 - CONTRACTOR SHALL PARK EQUIPMENT AND VEHICLES AS NOT TO INTERFERE WITH NORMAL ACTIVITIES OF RESIDENTS OR OTHER CONTRACTORS ON SITE.
 - ANY DAMAGE TO THE EXISTING FACILITIES (CURB & GUTTER), PAVEMENT, CONDUITS, LANDSCAPING, UTILITY LINES, ETC.) DURING CONSTRUCTION SHALL BE REPLACED AT THE CONTRACTORS' EXPENSE.
 - REMOVAL OF THE EXISTING CURB AND GUTTER SHALL BE AS PER COA STD. DWG. 2415 (SAWCUT ONLY).
 - WHEELCHAIR RAMPS SHALL BE CONSTRUCTED PRIOR TO ACCEPTANCE OF CURB & GUTTER.

- KEYED GENERAL NOTES
- INSTALL 6' CONCRETE VALLEY GUTTER AS PER STD. DWG. 2420
 - INSTALL 4' CONCRETE VALLEY GUTTER AS PER STD. DWG. 2421
 - INSTALL UNI-DIRECTIONAL WHEELCHAIR RAMP AS PER DETAIL SHEET 10 AS PER COA 2440
 - INSTALL WHEELCHAIR RAMP AS PER MODIFIED STD. DWG. 2441, CASE II WITH ALTERNATE SECTION AA AND AS PER DETAIL SHEET 10
 - STD. CURB & GUTTER AS PER STD. DWG. 2415
 - MEDIAN CURB & GUTTER AS PER STD. DWG. 2415
 - DEFERRED 4' SIDEWALK
 - BUILD 4' SIDEWALK PER COA 2430
 - TEMPORARY EXTRUDED ASPHALT CURB AS PER STD. DWG. 2415

26 6586.83 1102

Bohannon & Huston
 Courtyard One 7500 JEFFERSON NE Albuquerque NEW MEXICO 87109
 ENGINEERS PLANNERS PHOTOGRAMMETRISTS SURVEYORS SOFTWARE DEVELOPERS


CITY OF ALBUQUERQUE
 PUBLIC WORKS DEPARTMENT
 ENGINEERING DEVELOPMENT GROUP

PINON POINTE II SUBDIVISION AT VENTANA RANCH
 PAVING PLAN & PROFILE
 SHAWNA STREET


DESIGN REVIEW COMMITTEE: APPROVED APR 12 2002
 CITY ENGINEER APPROVAL: APPROVED MAY 26 2002

MO./DAY/YR. SHEET 11 OF 26
 ZONE MAP NO. B-9
 CITY PROJECT NO. 658683

ID	BEARING	LENGTH
T1	S00°13'00"W	260.00
T2	S00°13'00"W	184.83

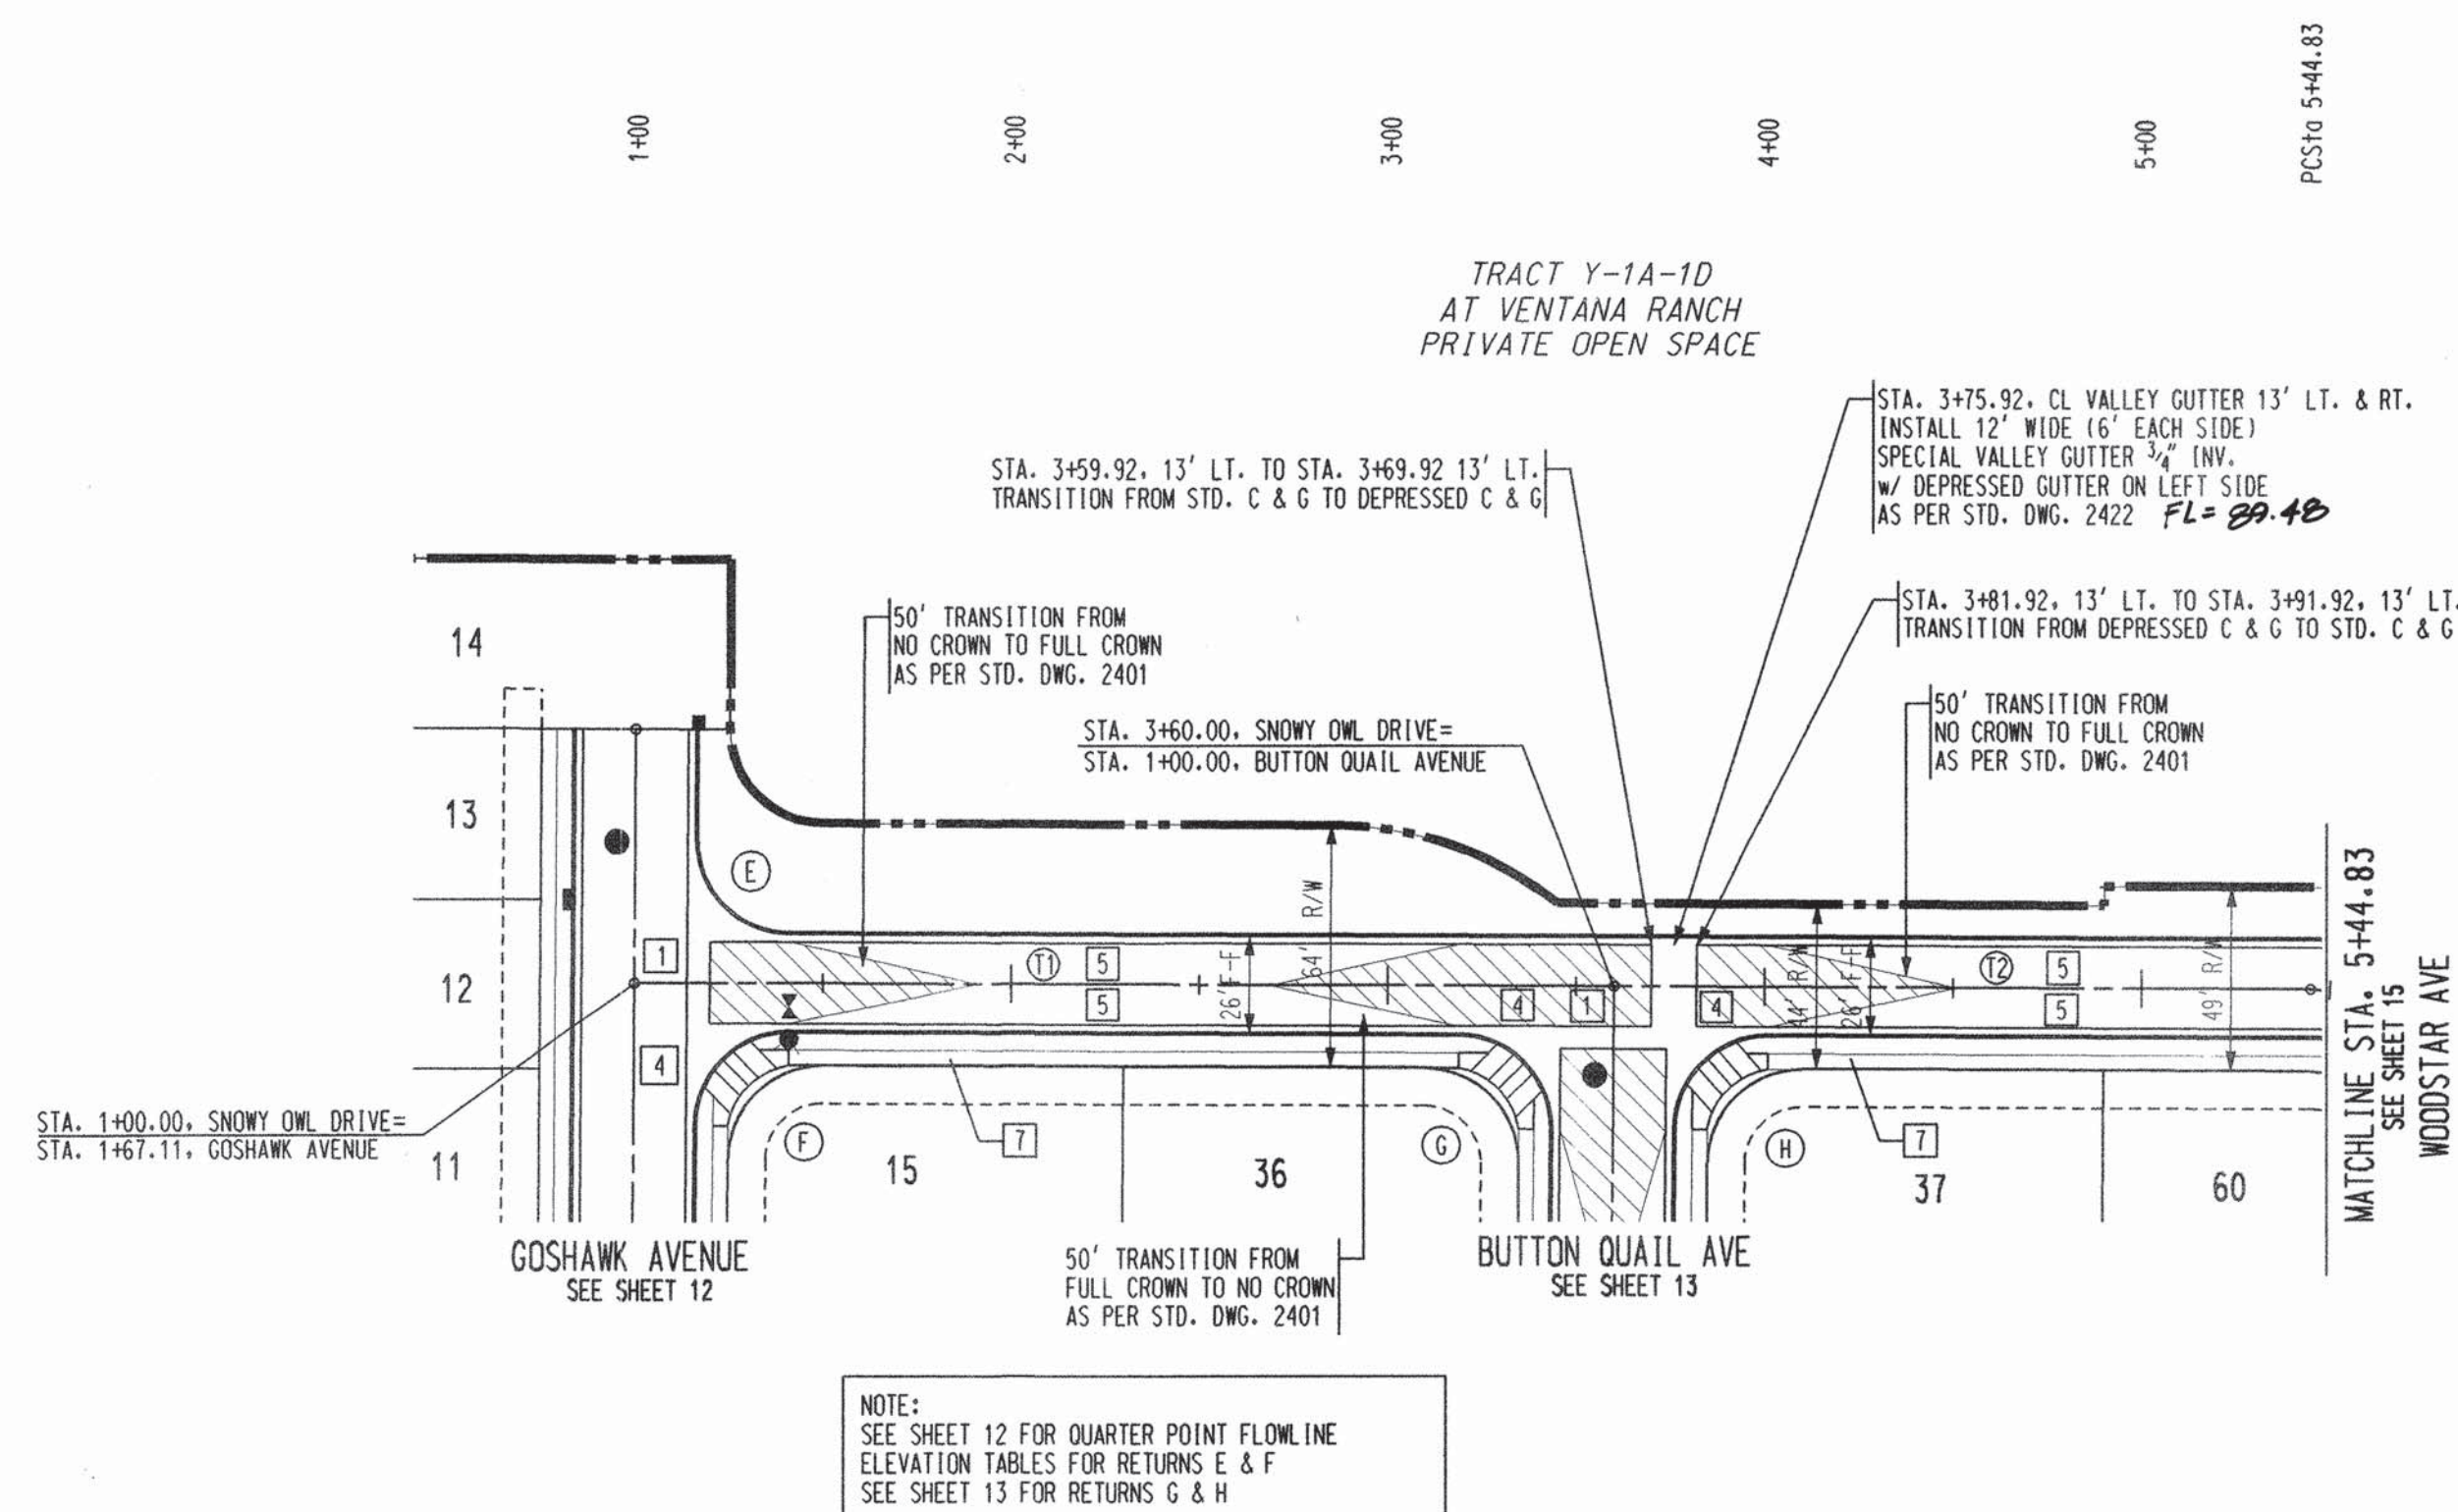

SNOWY OWL DRIVE STA 1+00.00 to 5+44.83

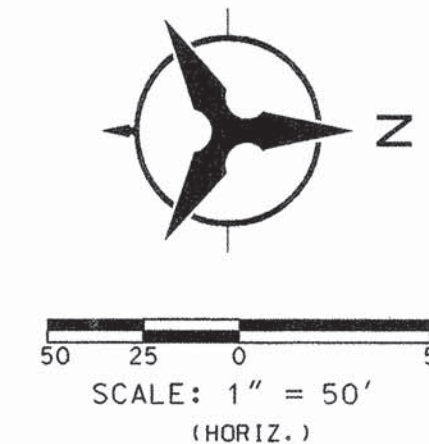[illegible]

NOTES

1. THE CONTRACTOR SHALL FIELD VERIFY ALL EXISTING UTILITY LOCATIONS AND NOTIFY THE ENGINEER IMMEDIATELY OF ANY DISCREPANCIES.
2. ALL CURB RETURN RADII SHALL BE 25' UNLESS OTHERWISE SPECIFIED.
3. ALL CURVE DATA AND DIMENSIONS REFER TO FACT OF CURB UNLESS OTHERWISE SPECIFIED.
4. GRADE ELEVATIONS, WHERE NOTED, ARE ALONG FLOWLINE OF STANDARD CURB UNLESS OTHERWISE SPECIFIED.
5. CONTRACTOR IS TO INSTALL A 4" X 4" X 5' POST AND END AT THE END OF EACH SANITARY SEWER SERVICE.
6. CONTRACTOR IS RESPONSIBLE FOR REPAIR AND/OR REPLACEMENT OF ALL UTILITY CONDUITS AND EXISTING LINES.
7. ANY ADDITIONAL GRADING REQUIRED TO MATCH PROPOSED STREET GRADES SHALL BE INCIDENTAL TO PAVING ITEMS.
8. CONTRACTOR SHALL PROVIDE THE INSPECTORS, (CITY AND PRIVATE) WITH THE PROPOSED HYDROSTATIC TESTING PLAN. THE PLAN MUST BE APPROVED BEFORE TESTING OPERATIONS BEGIN.
9. CONTRACTOR SHALL PARK EQUIPMENT AND VEHICLES AS NOT TO INTERFERE WITH NORMAL ACTIVITIES OF RESIDENTS OR OTHER CONTRACTORS ON SITE.
10. ANY DAMAGE TO THE EXISTING FACILITIES (CURB & GUTTER), PAVEMENT, CONDUITS, LANDSCAPING, UTILITY LINES, ETC.) DURING CONSTRUCTION SHALL BE REPLACED AT THE CONTRACTORS' EXPENSE.
11. REMOVAL OF THE EXISTING CURB AND GUTTER SHALL BE AS PER COA STD. DWG. 2415 (SAWCUT ONLY).
12. WHEELCHAIR RAMPS SHALL BE CONSTRUCTED PRIOR TO ACCEPTANCE OF CURB & GUTTER.

KEYED GENERAL NOTES

1. INSTALL 6' CONCRETE VALLEY GUTTER
AS PER STD. DWG. 2420
2. INSTALL CONCRETE VALLEY GUTTER
AS PER STD. DWG. 2421
3. INSTALL UNI-DIRECTIONAL WHEELCHAIR
RAMP AS PER DETAIL SHEET 10 **AS PER**
COA 2420
4. INSTALL WHEELCHAIR RAMP AS
PER MODIFIED STD. DWG. 2441,
SECTION 11 WITH ALUMINATE SECTION
AA AND AS PER DETAIL SHEET 10
5. STD. CURB & GUTTER
AS PER STD. DWG. 2415
6. MEDIAN CURB & GUTTER
AS PER STD. DWG. 2415
7. DEFERRED 4' SIDEWALK
8. BUILD 4' SIDEWALK **PER COA 2420**
9. TEMPORARY EXTRUDED ASPHALT CURB
AS PER STD. DWG. 2415

1	2	3	4	5	6	7	8	9	10	11	12	13	14	15	16
2	6		6	5	8	6	.	8	3		1	4	0	2	

Bohannon ▲ Huston

 Courtyard One 7500 JEFFERSON NE Albuquerque NEW MEXICO 87109

ENGINEERS PLANNERS PHOTOGRAMMETRISTS SURVEYORS SOFTWARE DEVELOPERS

 CITY OF ALBUQUERQUE
PUBLIC WORKS DEPARTMENT
ENGINEERING DEVELOPMENT GROUP

PINON POINTE II SUBDIVISION AT VENTANA RANCH
PAVING PLAN & PROFILE
SNOWY OWL DRIVE STA 1+00.00 - 5+44.83

SNOWT OWL DRIVE STA 1+00.00 = S+44.83				
DESIGN REVIEW COMMITTEE	CITY ENGINEER APPROVAL		MO./DAY/YR.	MO./DAY/YR.

APPROVED APR 12 2002 CITY DESIGN REVIEW COMMITTEE	APPROVED MAY 26 2002 CITY ENGINEER	LAST DESIGN UPDATE	DESIGN DATE	DESIGN BY

CITY PROJECT NO.		ZONE MAP NO.		SHEET		OF	
658683		B-9		14		26	

SCALE: 1" = 50' (HORIZ.)
1" = 10' (VERT.)

BHI JOB NO. 02 0066

P:\020066\CDP\PNP\ 020066PPNP06.DGM

P:\020066\cdp\pnp\020066ppnp06.dg
06-MAR-2002
14:34

PT	FL	STATION & OFFSET	PT	FL	STATION & OFFSET
1	89.33	5+65.25, 13.11' LT	5	89.38	6+19.48, 38.05' LT
2	89.44	5+78.92, 22.20' LT	6	89.05	6+31.77, 23.66' LT
3	89.58	5+90.94, 37.25' LT	7	88.77	6+45.46, 15.27' LT
4	89.72	6+05.17, 42.84' LT			

ID	ARC	RADIUS	DELTA	TANGENT
10	117.98	75.00	90°07'43"	75.17
C1	20.16	300.00	03°50'58"	10.08

ID	BEARING	LENGTH
13	S89°39'17"E	663.91
14	S45°32'49"E	22.77

ID	ARC	RADIUS	DELTA	TANGENT
C3	23.97	91.00	15°05'27"	12.05
C4	23.97	91.00	15°05'25"	12.05
C5	92.81	59.00	90°07'41"	59.13

FL	1	2	3
79.07	79.24	79.41	
D = 90°07'43"	D = 89°52'17"	D = 90°07'43"	
L = 39.33	L = 39.21	L = 39.33	
R = 25.00	R = 25.00	R = 25.00	

FL	1	2	3
77.17	77.58	77.98	
D = 90°07'43"	D = 89°52'17"	D = 90°07'43"	
L = 39.33	L = 39.21	L = 39.33	
R = 25.00	R = 25.00	R = 25.00	

FL	1	2	3
70.80	70.86	70.91	
D = 90°07'43"	D = 89°52'17"	D = 90°07'43"	
L = 39.33	L = 39.21	L = 39.33	
R = 25.00	R = 25.00	R = 25.00	

FL	1	2	3
68.64	69.11	69.57	
D = 90°07'43"	D = 89°52'17"	D = 90°07'43"	
L = 39.33	L = 39.21	L = 39.33	
R = 25.00	R = 25.00	R = 25.00	

ID	ARC	RADIUS	DELTA	TANGENT
C7	160.01	550.00	16°40'07"	80.57

ID	BEARING	LENGTH
T1	S89°39'17"E	130.37
T2	S89°44'22"E	144.09
T3	N00°15'06"E	16.00
T4	N89°53'58"W	48.00
T5	S00°15'44"W	16.00
T6	S89°44'22"E	31.33

NUMBER	Q(cfs)	V(cfs)	DEPTH	LENGTH	SIZE	SLOPE
T1	123.0	14.60	34.32	130.37	42"	1.50%
T2	125.9	15.08	34.02	144.09	42"	1.60%
T3	2.95	22.52	2.28	16.00	18"	64.43%
T4	3.50	8.47	5.11	48.00	18"	3.55%
T5	6.10	26.23	3.36	16.00	18"	54.17%
T6	135.0	16.00	34.44	160.01	42"	1.80%
C7	135.0	16.00	34.44	160.01	42"	1.80%

NOTES

- THE CONTRACTOR SHALL FIELD VERIFY ALL EXISTING UTILITY LOCATIONS AND NOTIFY THE ENGINEER IMMEDIATELY OF ANY DISCREPANCIES.
- ALL CURB RETURN RADII SHALL BE 25' UNLESS OTHERWISE SPECIFIED.
- ALL CURVE DATA AND DIMENSIONS REFER TO FACE OF CURB UNLESS OTHERWISE SPECIFIED.
- GRADE ELEVATIONS, WHERE NOTED, ARE ALONG FLOWLINE OF STANDARD CURB UNLESS OTHERWISE SPECIFIED.
- CONTRACTOR IS TO INSTALL A 4" X 4" X 5' POST AND EMO AT THE END OF EACH SANITARY SEWER SERVICE.
- CONTRACTOR IS RESPONSIBLE FOR REPAIR AND/OR REPLACEMENT OF ALL UTILITY CONDUITS AND EXISTING LINES.
- ANY ADDITIONAL GRADING REQUIRED TO MATCH PROPOSED STREET GRADES SHALL BE INCIDENTAL TO PAVING ITEMS.
- CONTRACTOR SHALL PROVIDE THE INSPECTORS, (CITY AND PRIVATE) WITH THE PROPOSED HYDROSTATIC TESTING PLAN. THE PLAN MUST BE APPROVED BEFORE TESTING OPERATIONS BEGIN.
- CONTRACTOR SHALL PARK EQUIPMENT AND VEHICLES AS NOT TO INTERFERE WITH NORMAL ACTIVITIES OF RESIDENTS OR OTHER CONTRACTORS ON SITE.
- ANY DAMAGE TO THE EXISTING FACILITIES (CURB & GUTTER), PAVEMENT, CONDUITS, LANDSCAPING, UTILITY LINES, ETC.) DURING CONSTRUCTION SHALL BE REPLACED AT THE CONTRACTORS' EXPENSE.
- REMOVAL OF THE EXISTING CURB AND GUTTER SHALL BE AS PER COA STD. DWG. 2415 (SAWCUT ONLY).
- WHEELCHAIR RAMPS SHALL BE CONSTRUCTED PRIOR TO ACCEPTANCE OF CURB & GUTTER.

KEYED GENERAL NOTES

- INSTALL 6' CONCRETE VALLEY GUTTER AS PER STD. DWG. 2420
- INSTALL 4' CONCRETE VALLEY GUTTER AS PER STD. DWG. 2421
- INSTALL UNIDIRECTIONAL WHEELCHAIR RAMP AS PER DETAIL SHEET 10 AS PER COA 2420
- INSTALL WHEELCHAIR RAMP AS PER MODIFIED STD. DWG. 2441, CASE 11 WITH ALTERNATE SECTION AA AND AS PER DETAIL SHEET 10
- STD. CURB & GUTTER AS PER STD. DWG. 2415
- MEDIAN CURB & GUTTER AS PER STD. DWG. 2415
- DEFERRED 4' SIDEWALK
- BUILD 4' SIDEWALK PER COA 2420
- TEMPORARY EXTRUDED ASPHALT CURB AS PER STD. DWG. 2415

1 2 3 4 5 6 7 8 9 10 11 12 13 14 15

Bohannon & Huston

Courtyard One 7500 JEFFERSON NE Albuquerque NEW MEXICO 87109

ENGINEERS PLANNERS PHOTOGRAMMETRISTS SURVEYORS SOFTWARE DEVELOPERS

CITY OF ALBUQUERQUE
PUBLIC WORKS DEPARTMENT
ENGINEERING DEVELOPMENT GROUP

PINON POINTE II SUBDIVISION AT VENTANA RANCH
PAVING PLAN & PROFILE
WOODSTAR AVENUE

DESIGN REVIEW COMMITTEE CITY ENGINEER APPROVAL


APPROVED APR 12 2002
APPROVED MAY 26 2002

CITY PROJECT NO. 658683

ZONE MAP NO. B-9

SHEET 15 OF 26

WOODSTAR AVENUE

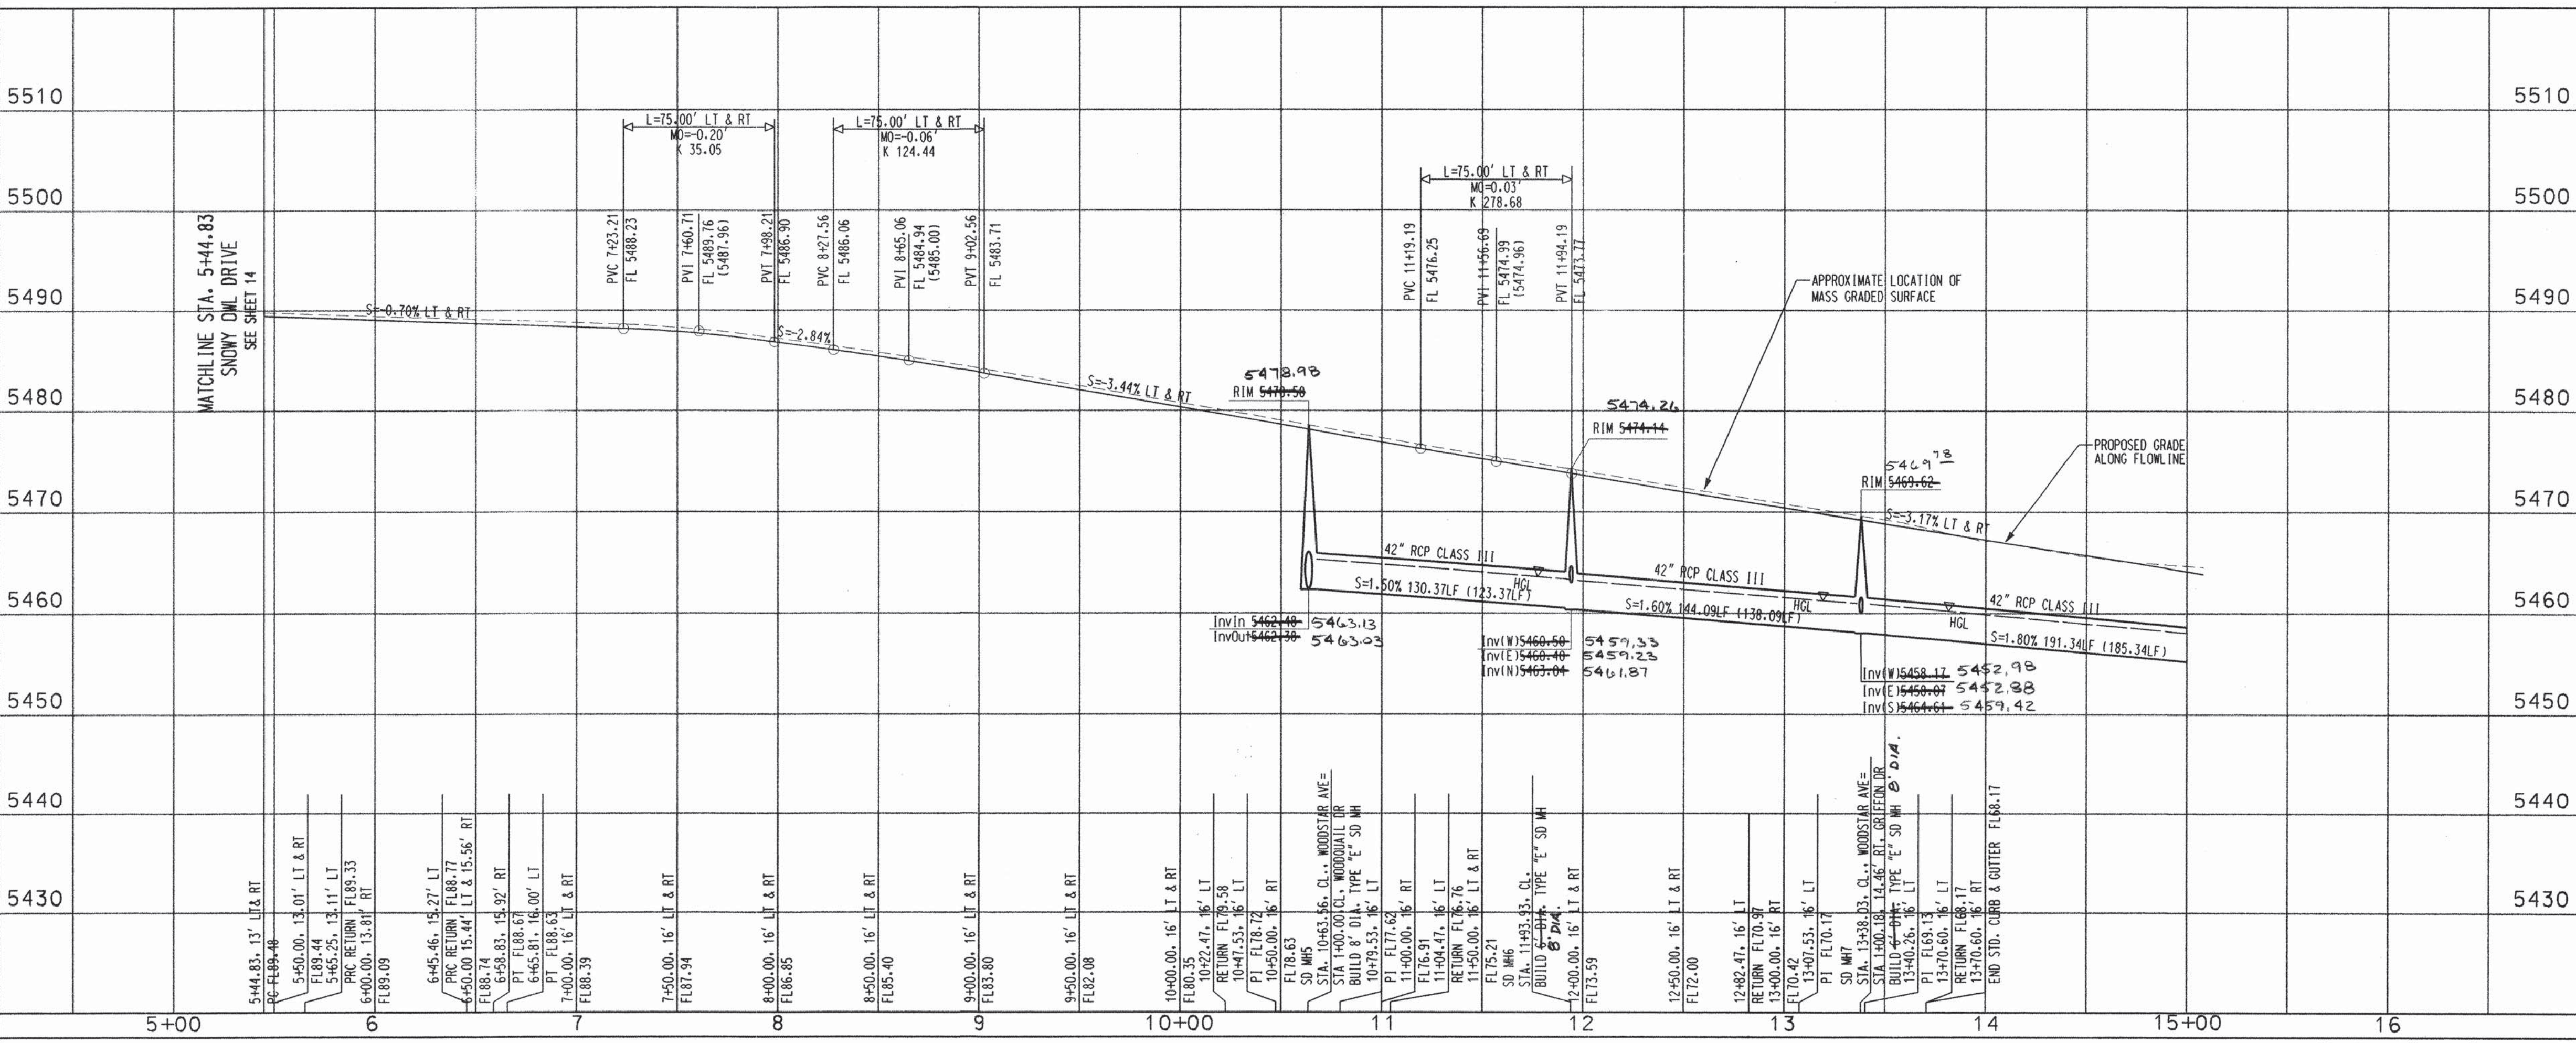


P:\020066\CDP\PNP\ 020066PPNP05.DGN


BHI JOB NO. 02 0066

SCALE: 1" = 50' (HORIZ.)
1" = 10' (VERT.)

16 OF 26

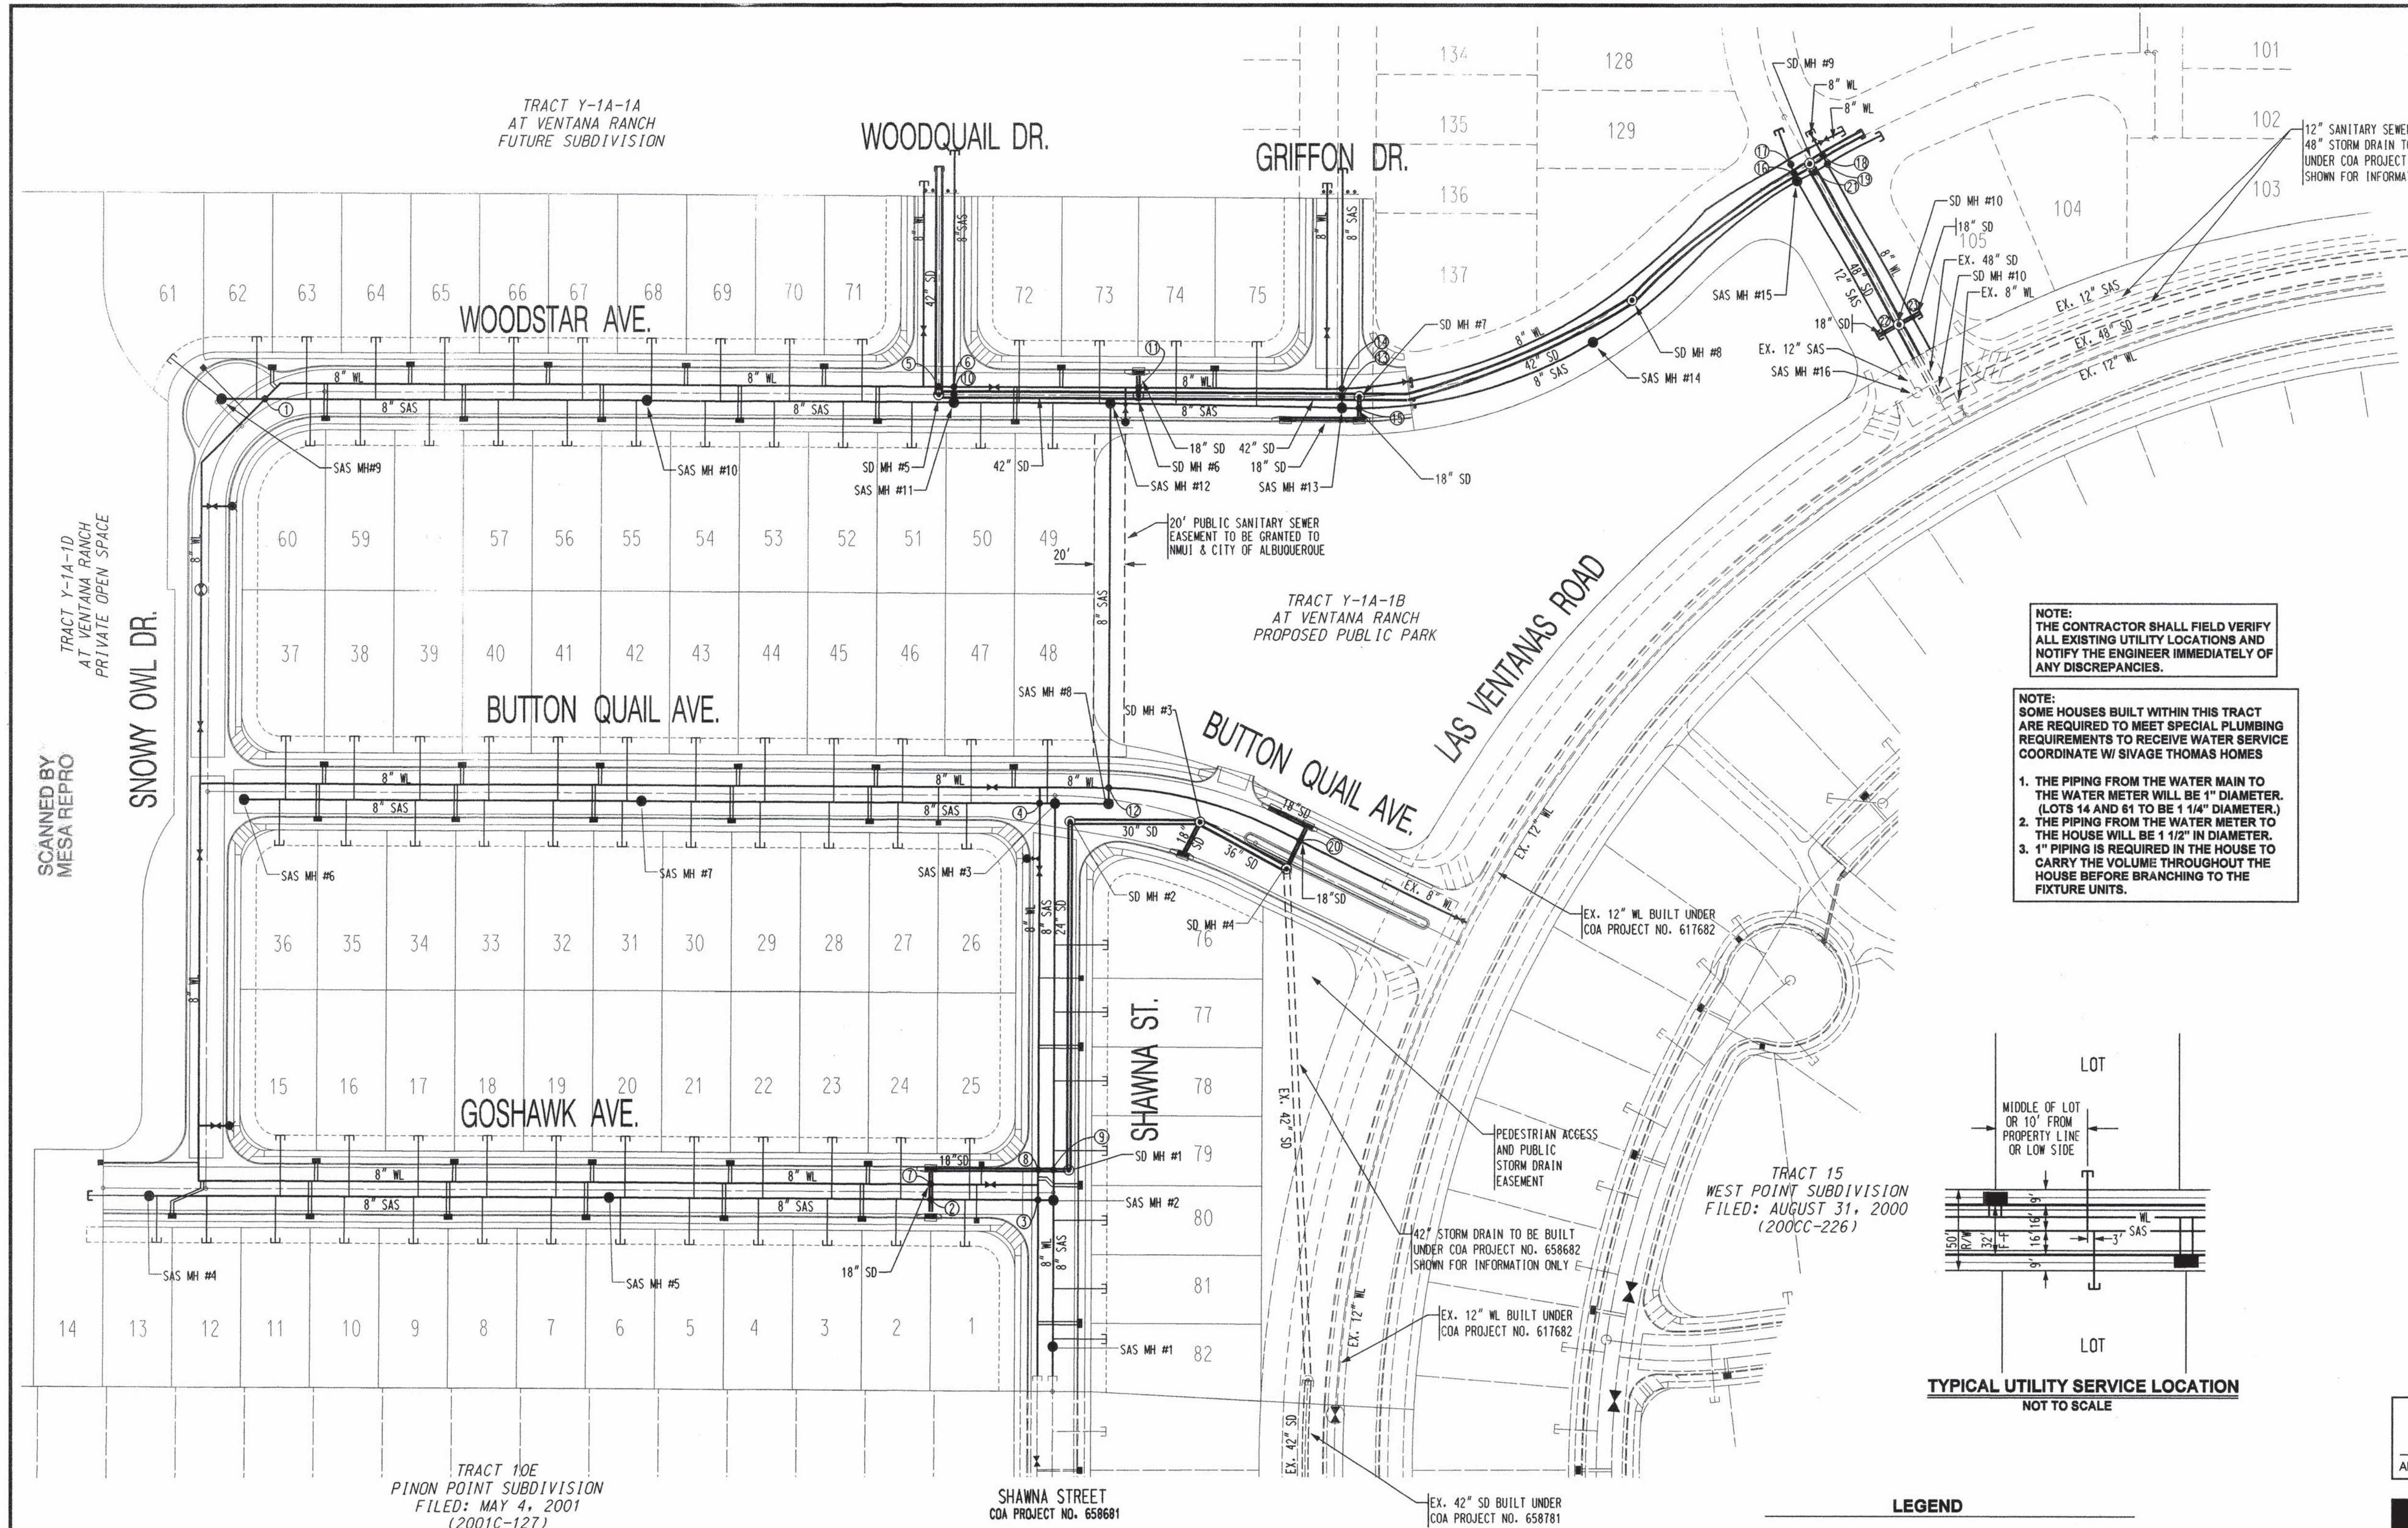

Crossings				
DES	SAS	SD	WL	Clearance
1	8" TP 82.80	8" TP 84.60	8" INV 84.06	1.25
2	8" TP 73.40	18" TP 71.02	8" INV 84.06	1.68
3	8" TP 71.96	8" INV 73.78	8" TP 73.78	1.09
4	8" TP 70.11	8" INV 73.06	8" TP 72.12	1.28
5	42" TP 66.45	8" TP 73.96	8" INV 73.96	6.79
6	8" TP 61.29	8" INV 73.64	8" TP 73.64	11.62
7	8" TP 70.11	8" INV 72.91	8" TP 74.54	3.29
8	8" TP 68.79	8" INV 74.00	8" TP 74.00	0.80
9	8" TP 71.52	8" TP 70.13	8" INV 70.98	0.68
10	8" INV 70.82	8" INV 68.22	8" TP 68.22	0.57
11	8" INV 60.56	42" INV 61.84	8" TP 61.84	3.08
12	8" TP 69.15	8" INV 64.12	8" TP 69.12	11.47
13	8" INV 68.45	8" INV 70.63	8" TP 70.63	11.00
14	8" TP 56.87	42" INV 62.25	8" TP 62.25	8.27
15	8" INV 56.16	42" INV 57.87	8" TP 57.87	6.58
16	8" TP 56.90	8" INV 65.89	8" TP 65.89	1.62
17	8" INV 56.19	8" INV 65.17	8" TP 65.17	5.94
18	8" TP 56.47	8" TP 63.82	8" INV 63.82	1.04
19	8" INV 55.77	8" INV 61.91	8" TP 61.91	0.41
20	8" TP 48.00	42" TP 53.23	8" INV 53.23	4.67
21	8" INV 47.29	42" INV 48.85	8" TP 48.85	0.72
22	8" TP 48.12	8" INV 55.43	8" TP 55.43	1.62
23	8" INV 47.42	8" INV 54.71	8" TP 54.71	5.94
24	8" TP 52.41	8" TP 54.61	8" INV 54.61	1.04
25	8" INV 48.62	8" TP 54.03	8" TP 54.03	0.41
26	8" TP 48.00	8" TP 53.94	8" INV 53.94	4.67
27	8" TP 69.02	8" TP 66.10	8" INV 66.10	0.72
28	8" INV 67.14	8" TP 65.43	8" TP 65.43	
29	8" TP 47.93	48" TP 52.80	8" INV 52.80	
30	8" INV 47.26	48" INV 48.34	8" TP 48.34	
31	12" TP 44.85	18" TP 51.44	8" INV 51.44	
32	12" INV 43.79	18" INV 49.52	8" TP 49.52	
33	18" TP 50.95	8" TP 52.39	8" INV 52.39	
34	18" INV 49.03	8" INV 51.67	8" TP 51.67	

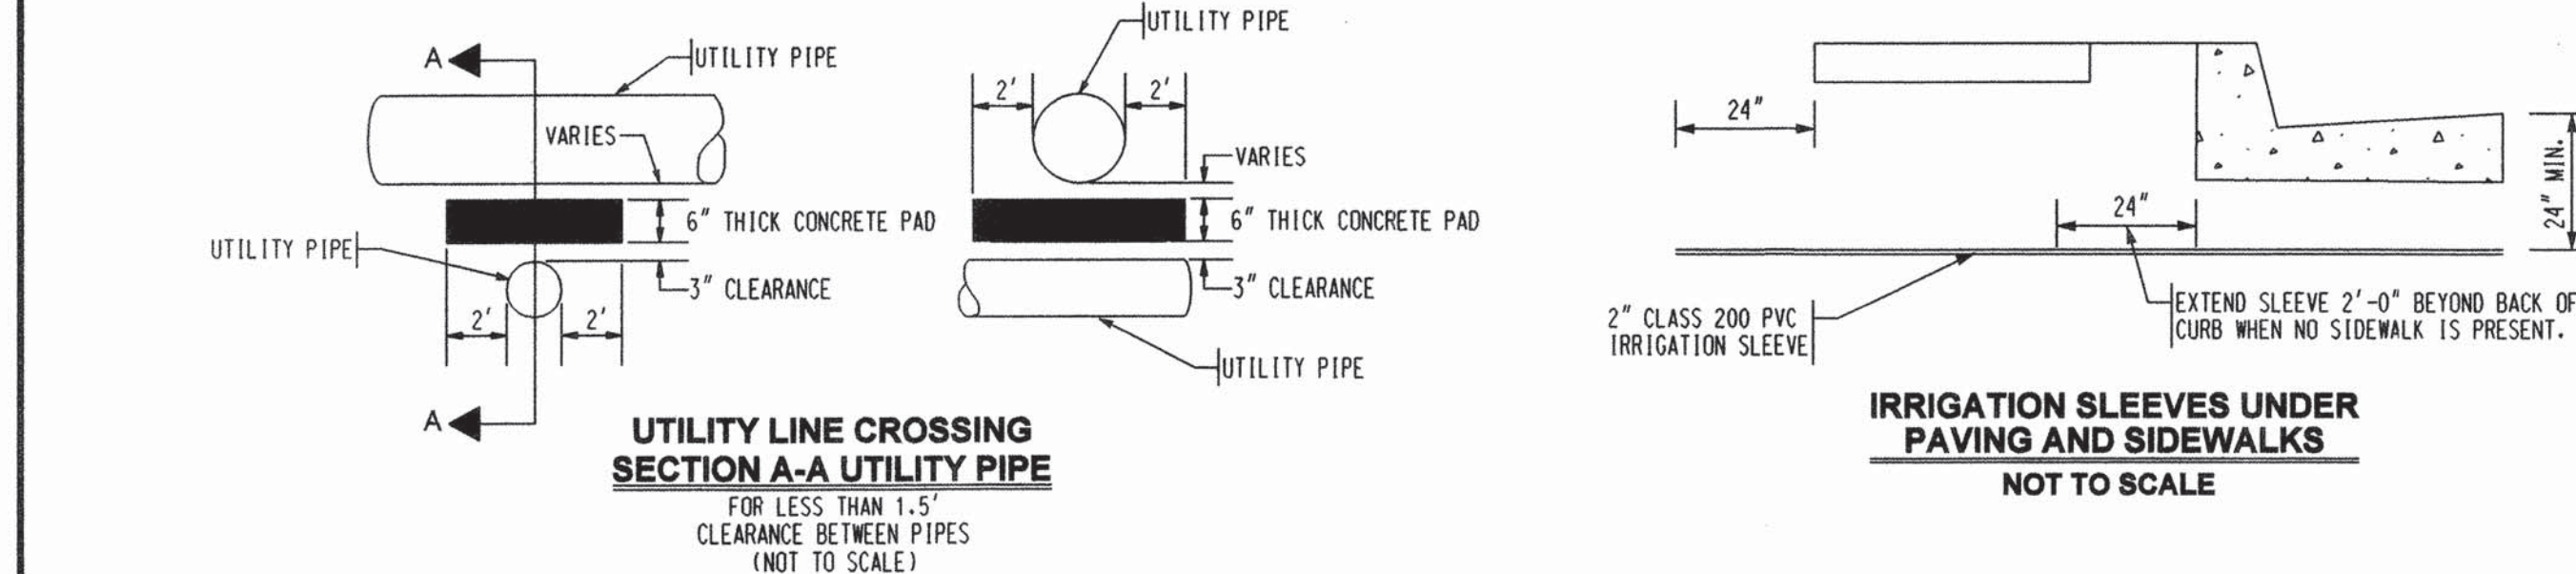

LEGEND

- PROPOSED SANITARY SEWER MANHOLE
- EXISTING SANITARY SEWER MANHOLE
- PROPOSED FIRE HYDRANT
- EXISTING FIRE HYDRANT
- PROPOSED GATE VALVE
- EXISTING GATE VALVE
- PROPOSED SANITARY SEWER LINE
- EXISTING SANITARY SEWER LINE
- PROPOSED WATER LINE
- EXISTING WATER LINE
- PROPOSED SANITARY SEWER SERVICE
- PROPOSED WATER METER SERVICE
- PROPOSED STREET LIGHT

APPROVED PLANS CHECKING OFFICE
924-6811
3/8/02

Bohannon & Huston
Courtney One 7500 JEFFERSON NE ALBUQUERQUE NEW MEXICO 87109
ENGINEERS PLANNERS PHOTOGRAMMETRISTS SURVEYORS SOFTWARE DEVELOPERS

CITY OF ALBUQUERQUE
PUBLIC WORKS DEPARTMENT
ENGINEERING DEVELOPMENT GROUP
PINON POINTE II SUBDIVISION AT VENTANA RANCH
OVERALL UTILITY PLAN

DESIGN REVIEW COMMITTEE
APR 12 2002
DESIGN REVIEW COMMITTEE

ENGINEER APPROVAL
MAY 26 2002
CITY ENGINEER

LAST DESIGN UPDATE

CITY PROJECT NO. 658683
ZONE MAP NO. B-9
SHEET 17 **OF** 26

SCALE: 1" = 60' (HORIZ.)

BHI JOB NO. 020066

BENCH MARKS		AS-BUILT INFORMATION	
CONTRACTOR	STAMPED	CONTRACTOR	STAMPED
INSPECTOR'S	DATE	INSPECTOR'S	DATE
VERIFICATION BY	DATE	VERIFICATION BY	DATE
CORRECTED BY	DATE	CORRECTED BY	DATE
RECORDED BY	DATE	RECORDED BY	DATE
NO.		NO.	

ENGINEER'S SEAL		SURVEY INFORMATION	
NO.	DATE	NO.	DATE
BY		BY	
REMARKS		REMARKS	
REVISIONS		REVISIONS	
DESIGN		DESIGN	
DATE 08/2001		DATE 08/2001	
DATE 08/2001		DATE 08/2001	
DESIGNED BY		DESIGNED BY	
DRAWN BY		DRAWN BY	
CHECKED BY		CHECKED BY	

SCANNED BY
MESA REPRO

SANITARY SEWER SERVICES			
LOT	SAS	LENGTH	TOP OF PIPE AT
ID	STATION & OFFSET	PLUG (W/RISE)	
76	3482.37, CL	35.00'	5470.46 (-)
77	3471.37, CL	35.00'	5470.78 (-)
78	3402.37, CL	35.00'	5471.09 (-)
79	2457.37, CL	35.00'	5471.42 (-)
80	2412.37, CL	35.00'	5471.79 (-)
81	1467.37, CL	35.00'	5472.06 (-)
82	1434.87, CL	35.00'	5472.26 (-)

NOTE: WATER METER LOCATIONS ARE DESIGNATED
BY STATIONING AT PROPERTY CORNERS.

SAS TANGENT TABLE		
NUMBER	BEARING	LENGTH
T1	N00°13'01"E	19.87'
T2	N00°13'00"E	95.20'
T3	N00°13'00"E	260.00'
T4	S89°39'17"E	35.00'
T5	N00°13'00"E	260.00'

WATERLINE TANGENT TABLE		
ID	BEARING	LENGTH
T6	N00°13'00"E	125.04'
T7	N00°13'00"E	260.00'



STA. 1+10.05, CL
REMOVE EXISTING 8" SAS
PLUG AND CONNECT
NEW 8" SAS TO
EXISTING 8" SAS
INV = 70.47

EXISTING
658681

THIS
PROJECT

SHAWNA STREET

PARK SAS

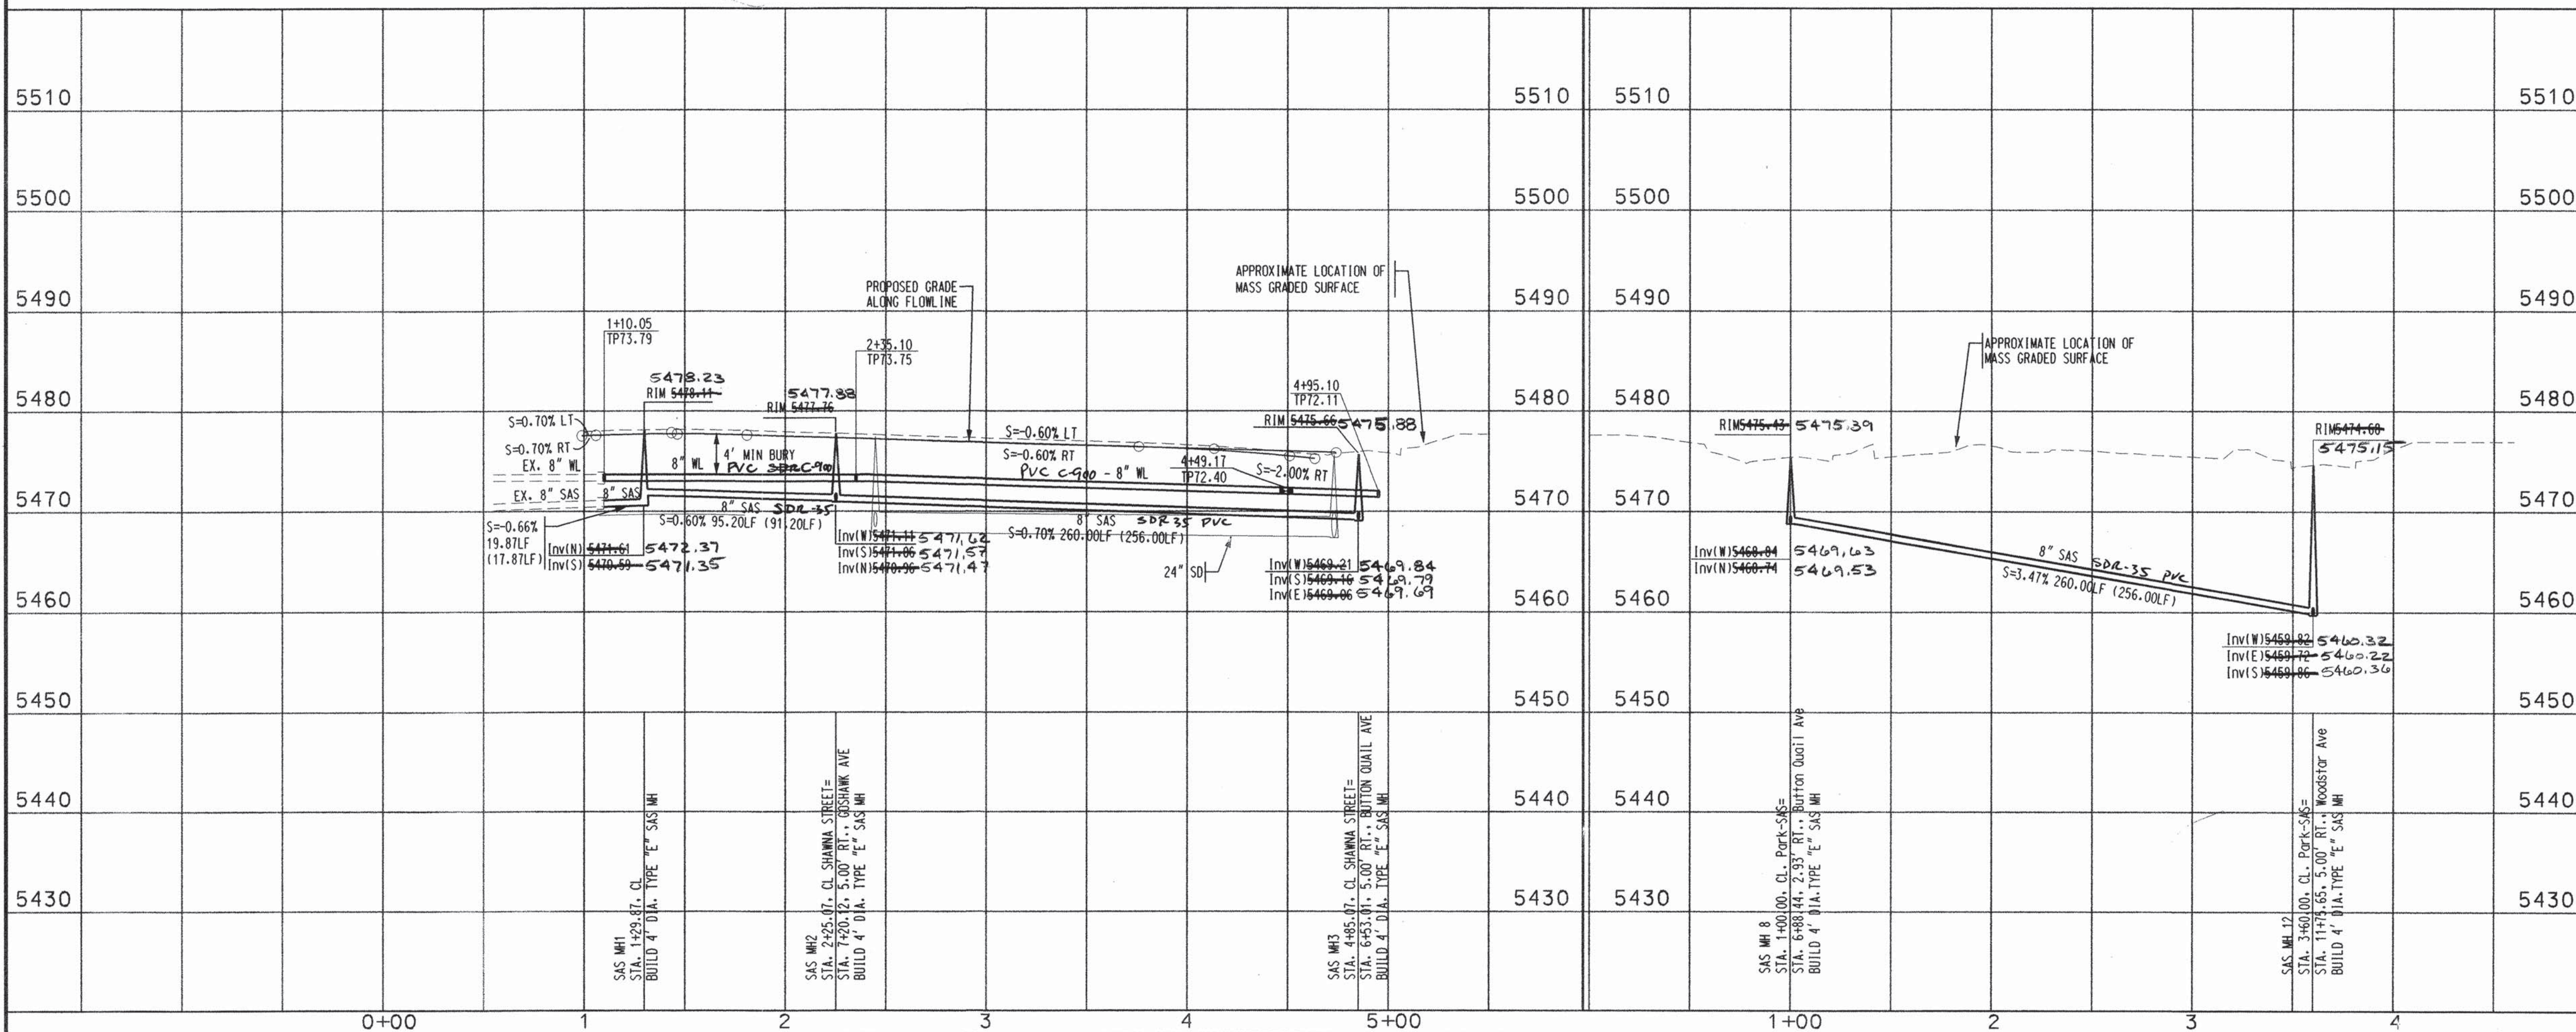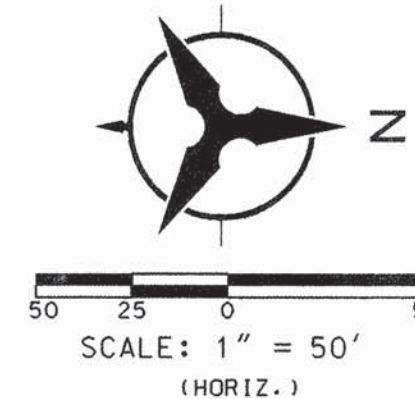

NOTES

1. THE CONTRACTOR SHALL FIELD VERIFY ALL EXISTING UTILITY LOCATIONS AND NOTIFY THE ENGINEER IMMEDIATELY OF ANY DISCREPANCIES.
2. ALL CURB RETURN RADII SHALL BE 25' UNLESS OTHERWISE SPECIFIED.
3. ALL CURVE DATA AND DIMENSIONS REFER TO FACE OF CURB UNLESS OTHERWISE SPECIFIED.
4. GRADE ELEVATIONS, WHERE NOTED, ARE ALONG FLOWLINE OF STANDARD CURB UNLESS OTHERWISE SPECIFIED.
5. CONTRACTOR IS TO INSTALL A 4" X 4" X 5' POST AND EMD AT THE END OF EACH SANITARY SEWER SERVICE.
6. CONTRACTOR IS RESPONSIBLE FOR REPAIR AND/OR REPLACEMENT OF ALL UTILITY CONDUITS AND EXISTING LINES.
7. ANY ADDITIONAL GRADING REQUIRED TO MATCH PROPOSED STREET GRADES SHALL BE INCIDENTAL TO PAVING ITEMS.
8. CONTRACTOR SHALL PROVIDE THE INSPECTORS, (CITY AND PRIVATE) WITH THE PROPOSED HYDROSTATIC TESTING PLAN. THE PLAN MUST BE APPROVED BEFORE TESTING OPERATIONS BEGIN.
9. CONTRACTOR SHALL PARK EQUIPMENT AND VEHICLES AS NOT TO INTERFERE WITH NORMAL ACTIVITIES OF RESIDENTS OR OTHER CONTRACTORS ON SITE.
10. ANY DAMAGE TO THE EXISTING FACILITIES (CURB & GUTTER), PAVEMENT, CONDUITS, LANDSCAPING, UTILITY LINES, ETC.) DURING CONSTRUCTION SHALL BE REPLACED AT THE CONTRACTORS' EXPENSE.
11. REMOVAL OF THE EXISTING CURB AND GUTTER SHALL BE AS PER COA STD. DWG. 2415 (SAWCUT ONLY).
12. WHEELCHAIR RAMPS SHALL BE CONSTRUCTED PRIOR TO ACCEPTANCE OF CURB & GUTTER.

26 6586.83 1802

APPROVED BY NMUI
3-8-02
DATE

Bohannon & Huston
Courtyard One 7500 JEFFERSON NE Albuquerque NEW MEXICO 87109
ENGINEERS PLANNERS PHOTOGRAMMETRISTS SURVEYORS SOFTWARE DEVELOPERS


CITY OF ALBUQUERQUE
PUBLIC WORKS DEPARTMENT
ENGINEERING DEVELOPMENT GROUP
PINON POINTE II SUBDIVISION AT VENTANA RANCH
UTILITY PLAN & PROFILE
SHAWNA STREET

DESIGN REVIEW COMMITTEE
APR 12 2002
CITY ENGINEER
MAY 26 2002
LAST DESIGN UPDATE



CITY PROJECT NO. 658683
ZONE MAP NO. B-9
SHEET 18 OF 26

NOTE: WATER METER LOCATIONS ARE DESIGNATED
BY STATIONING AT PROPERTY CORNERS.

WATERLINE TANGENT TABLE		
NUMBER	BEARING	LENGTH
T3	S89°39'17"E	548.00

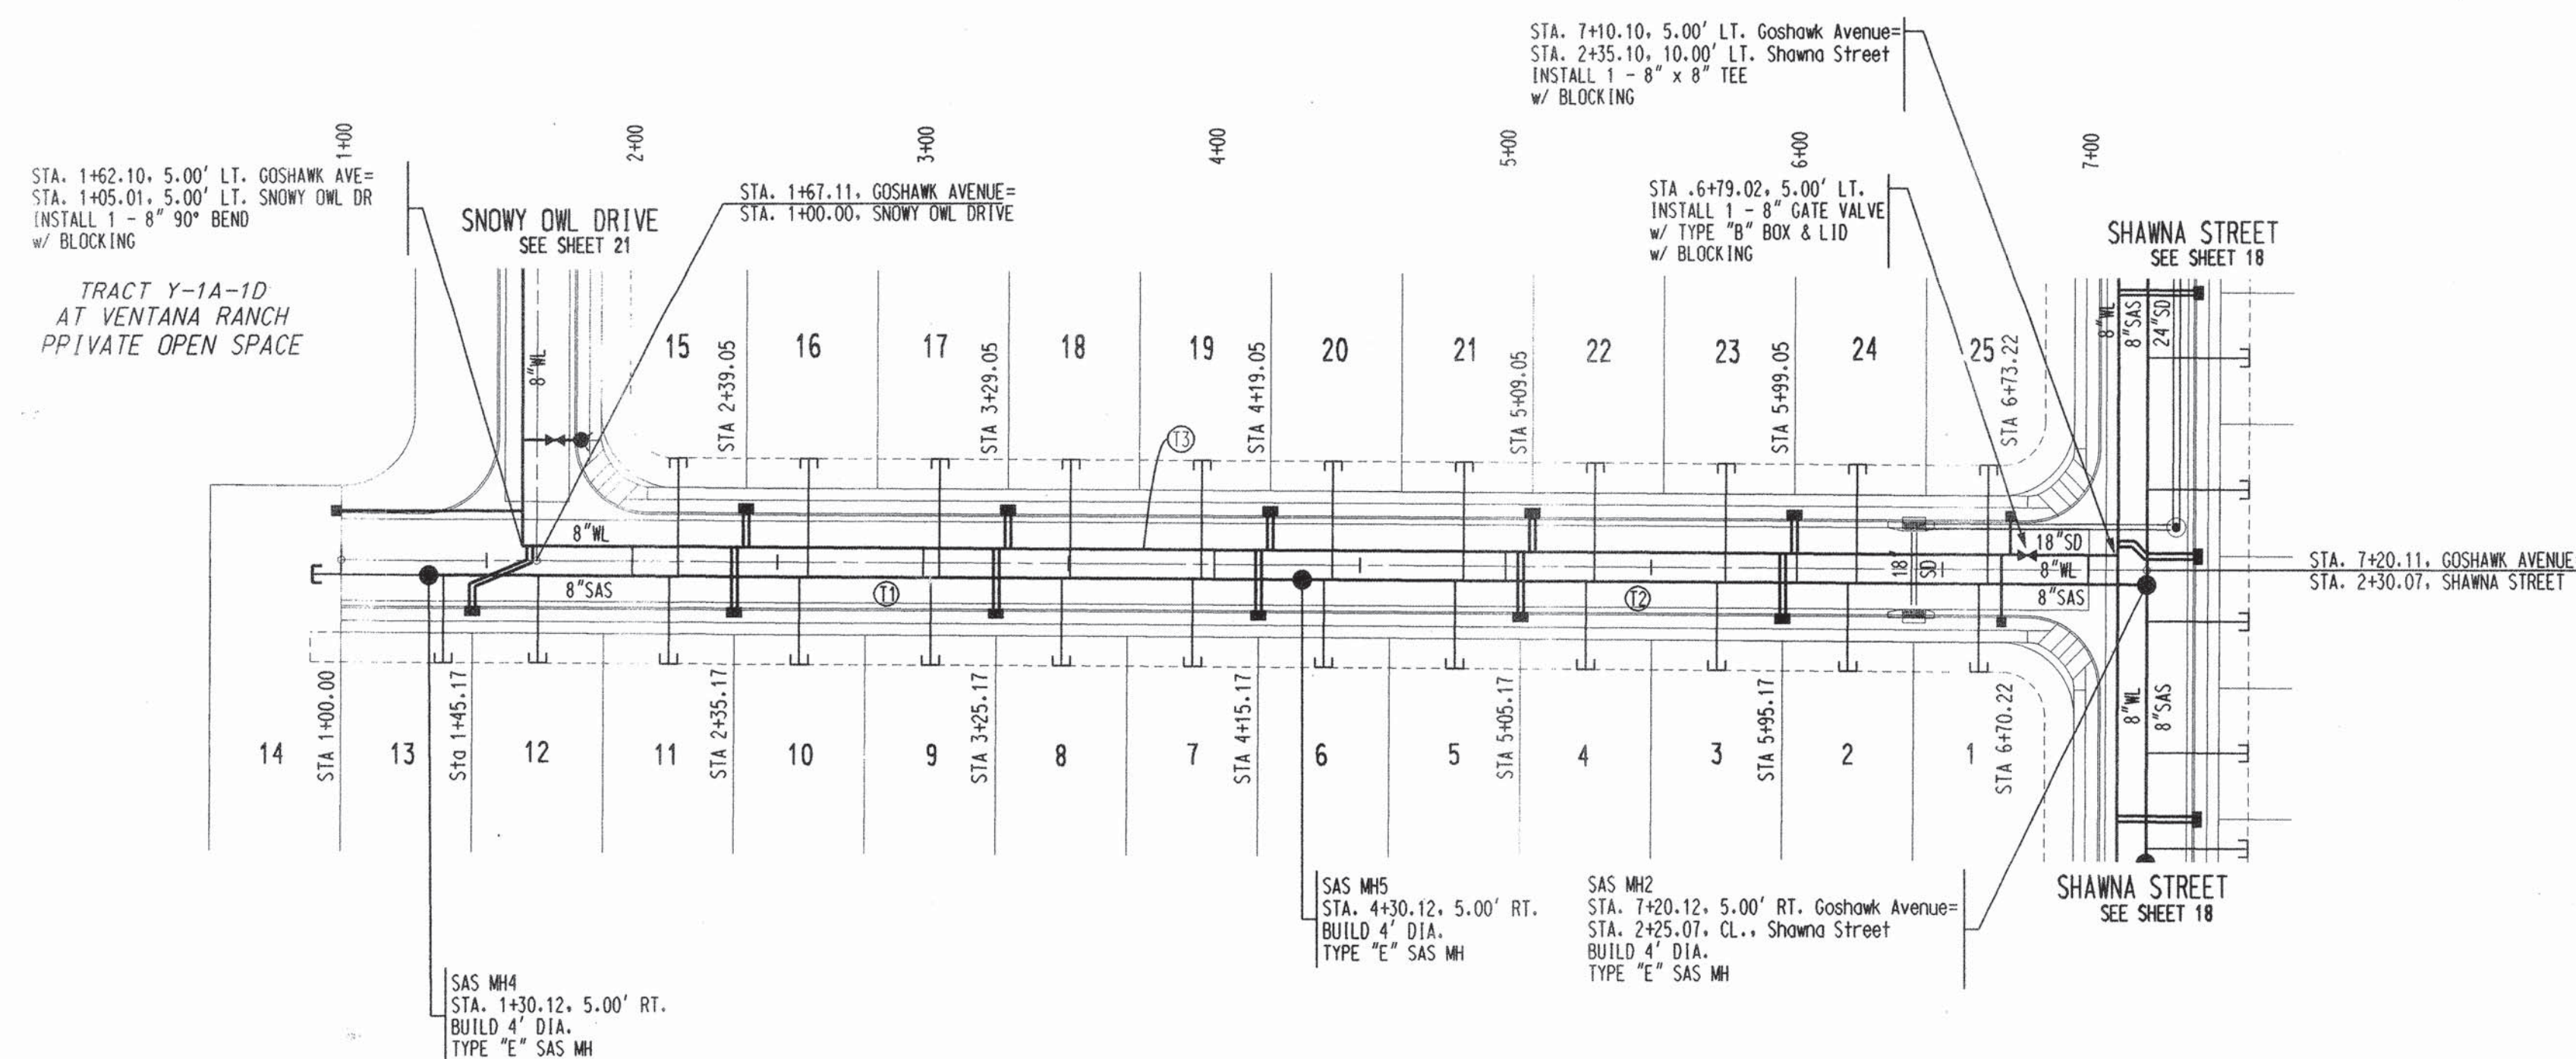

GOSHAWK AVENUE

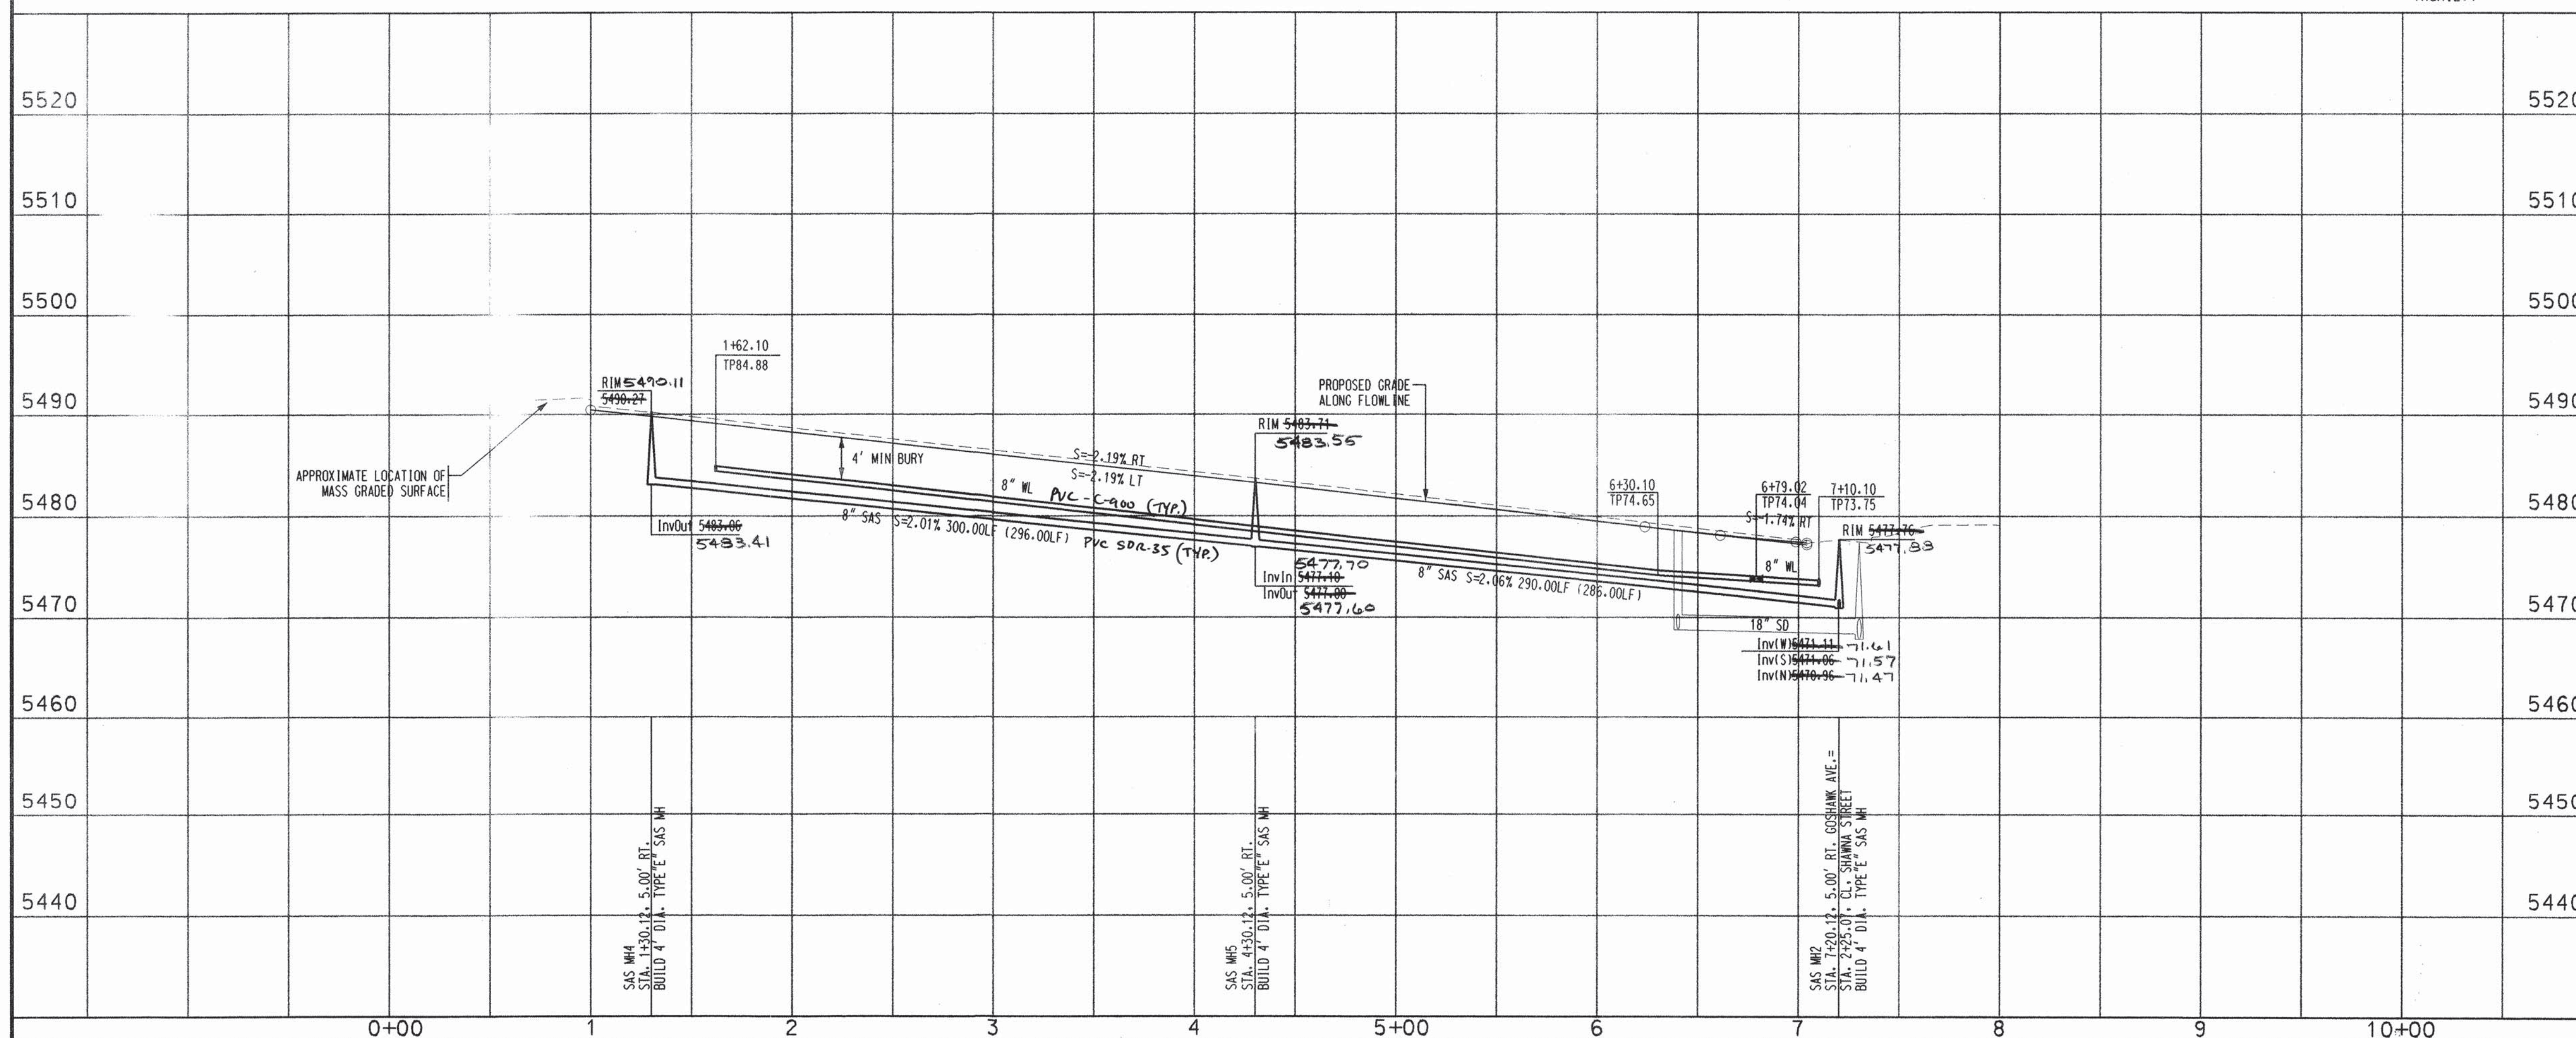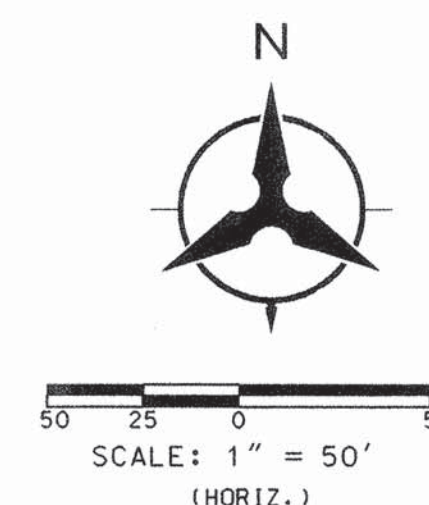

P:\020066\CDP\PNP\ 020066UPNP02.DGN

BHI JOB NO. 02 0066

SCALE: 1" = 50' (HORIZ.)
1" = 10' (VERT.)

CITY PROJECT NO.	
------------------	--

658683


ZONE MAP NO.

SHEET 19 OF 26

NOTES

1. THE CONTRACTOR SHALL FIELD VERIFY THE EXISTING UTILITY LOCATIONS AND NOTIFY THE ENGINEER IMMEDIATELY OF ANY DISCREPANCIES.
2. ALL CURB RETURN RADII SHALL BE 25' UNLESS OTHERWISE SPECIFIED.
3. ALL CURVE DATA AND DIMENSIONS REFER TO FACE OF CURB UNLESS OTHERWISE SPECIFIED.
4. GRADE ELEVATIONS, WHERE NOTED, ARE ALONG FLOWLINE OF STANDARD CURB UNLESS OTHERWISE SPECIFIED.
5. CONTRACTOR IS TO INSTALL A 4" X 4" X 5' POST AND END AT THE END OF EACH SANITARY SEWER SERVICE.
6. CONTRACTOR IS RESPONSIBLE FOR REPAIR AND/OR REPLACEMENT OF ALL UTILITY CONDUITS AND EXISTING LINES.
7. ANY ADDITIONAL GRADING REQUIRED TO MATCH PROPOSED STREET GRADES SHALL BE INCIDENTAL TO PAVING ITEMS.
8. CONTRACTOR SHALL PROVIDE THE INSPECTORS, (CITY AND PRIVATE) WITH THE PROPOSED HYDROSTATIC TESTING PLAN. THE PLAN MUST BE APPROVED BEFORE TESTING OPERATIONS BEGIN.
9. CONTRACTOR SHALL PARK EQUIPMENT AND VEHICLES AS NOT TO INTERFERE WITH NORMAL ACTIVITIES OF RESIDENTS OR OTHER CONTRACTORS ON SITE.
10. ANY DAMAGE TO THE EXISTING FACILITIES (CURB & GUTTER), PAVEMENT, CONDUITS, LANDSCAPING, UTILITY LINES, ETC.) DURING CONSTRUCTION SHALL BE REPLACED AT THE CONTRACTORS' EXPENSE.
11. REMOVAL OF THE EXISTING CURB AND GUTTER SHALL BE AS PER COA STD. DWG. 2415 (SAWCUT ONLY).
12. WHEELCHAIR RAMPS SHALL BE CONSTRUCTED PRIOR TO ACCEPTANCE OF CURB & GUTTER.

ENGINEER'S SEAL		SURVEY INFORMATION		FIELD NOTES		BENCH MARKS		AS-BUILT INFORMATION	
1368 NEW MEXICO KEVIN G. PATTON PROFESSIONAL ENGINEER 3802		NO.	BY	DATE	ACS BRASS TABLET STAMPED "1-B9 1980"		CONTRACTOR Sundance		
					GEOGRAPHIC POSITION (NAD 1927)		WORKED BY A/S		
					N.M. STATE PLANE COORDINATES		INSPECTOR'S A/S		
					(CENTRAL ZONE) X=355+077.00		ACCEPTANCE BY A/S		
					Y=1+529+056.33		VERIFICATION BY A/S		
						DRAWINGS CORRECTED BY A/S		DATE 10/2	
					GROUND-TO-GRID FACTOR = .99966334		MICRO-FILM INFORMATION		
					DELTA ALPHA -00°16'47"		DATE		
					NGVD 1923 ELEVATION = 5450.51		RECORDED BY		
							DATE		
							NO.		

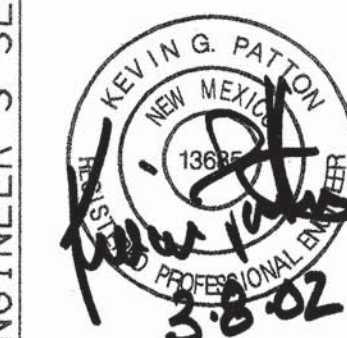[illegible]

APPROVED BY NIA  3-8-02 DATE



Bohannon & Huston

 Courtyard One 7500 JEFFERSON NE Albuquerque NEW MEXICO 87109

ENGINEERS PLANNERS PHOTOGRAMMETRISTS SURVEYORS SOFTWARE DEVELOPERS


CITY OF ALBUQUERQUE
PUBLIC WORKS DEPARTMENT
ENGINEERING DEVELOPMENT GROUP
PINON POINTE II SUBDIVISION AT VENTANA RANCH
UTILITY PLAN & PROFILE
GOSHAWK AVENUE

UPDATE	MO./DAY/YR.	MO./DAY/YR.

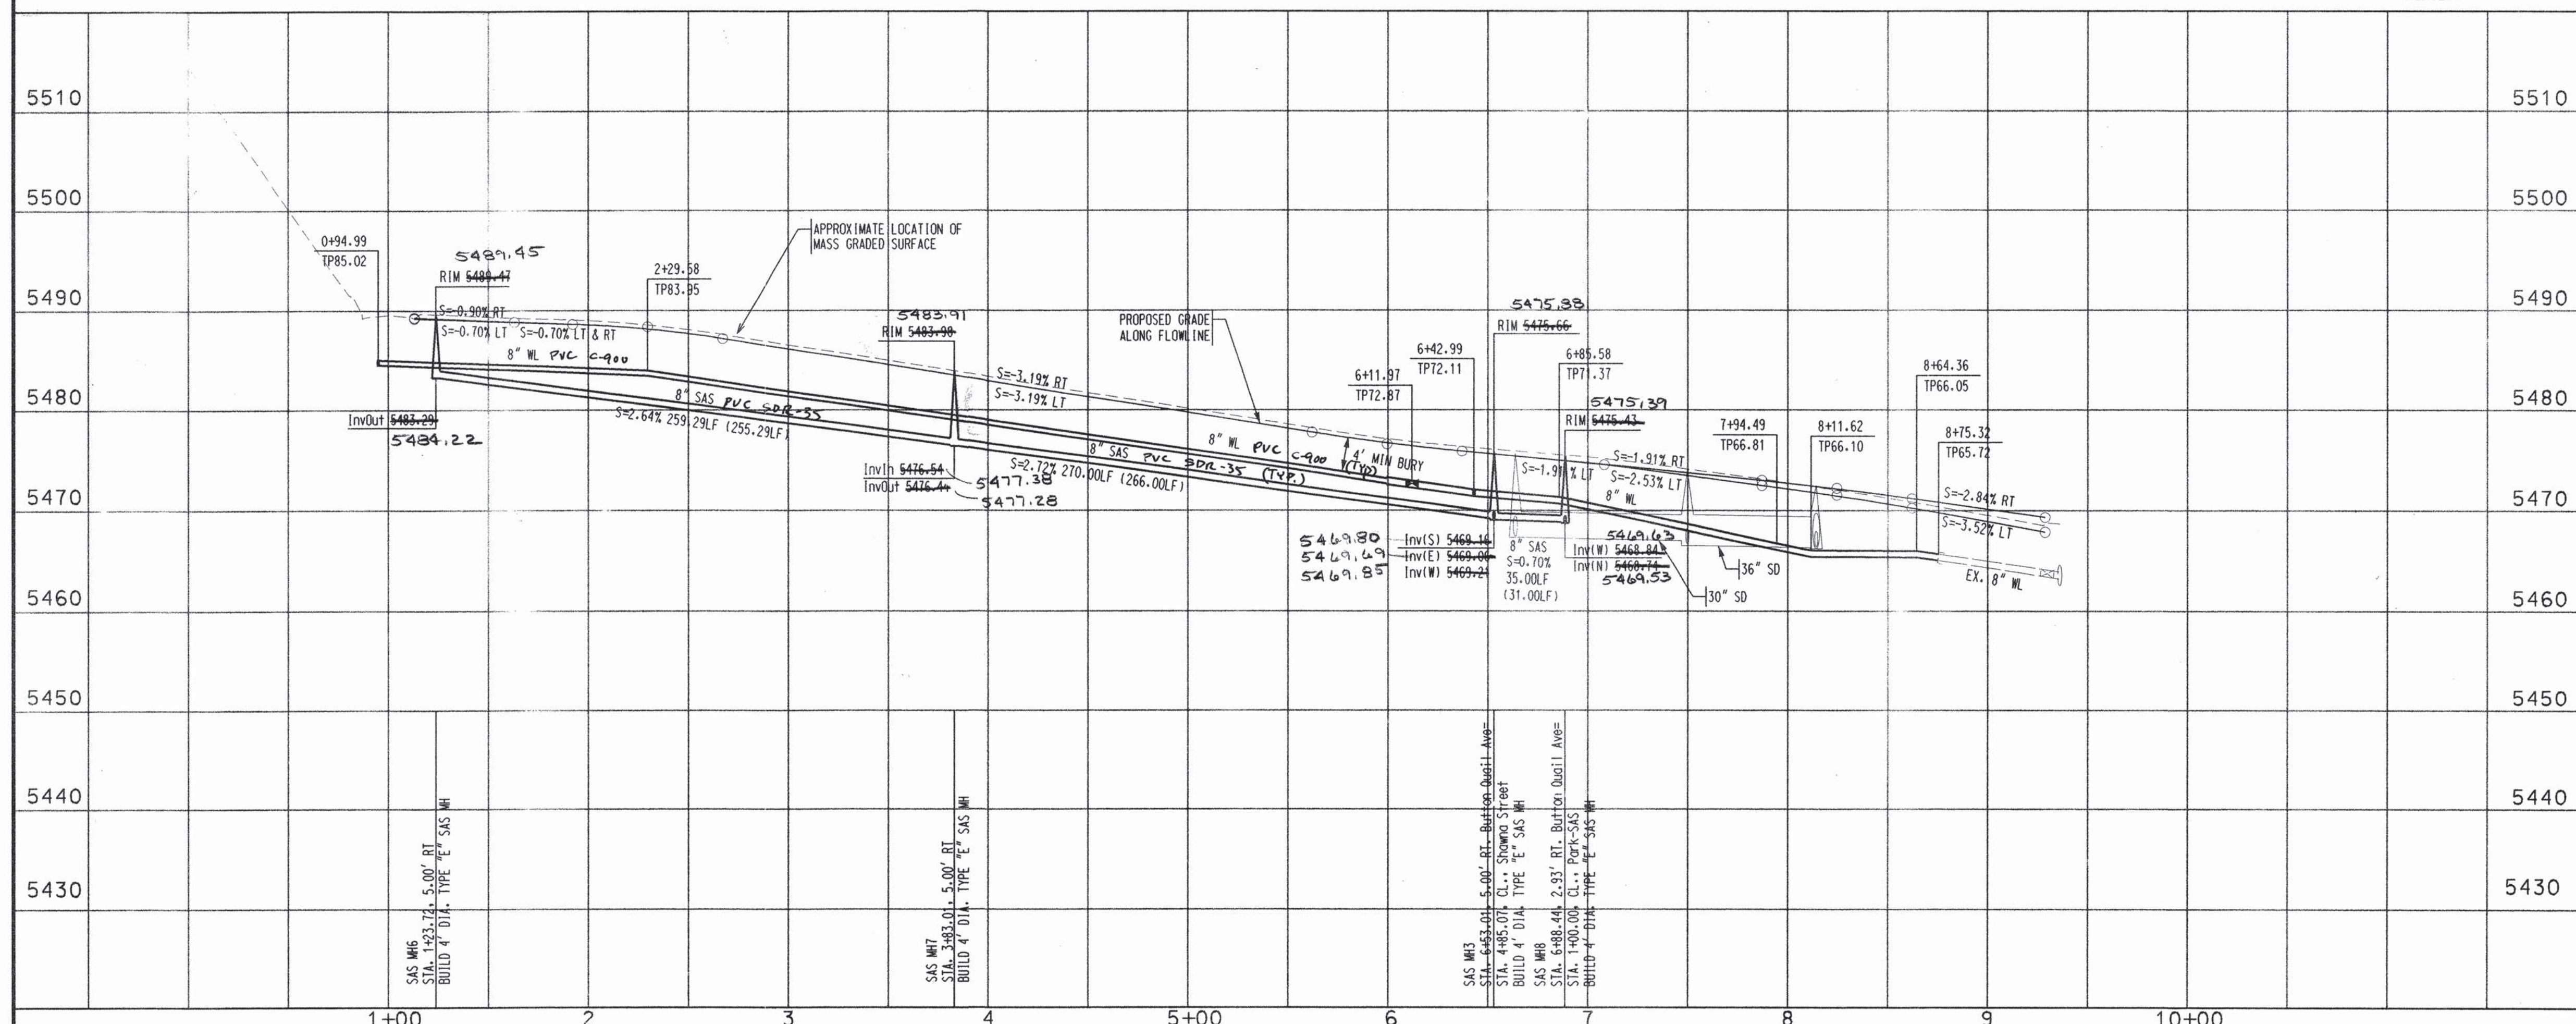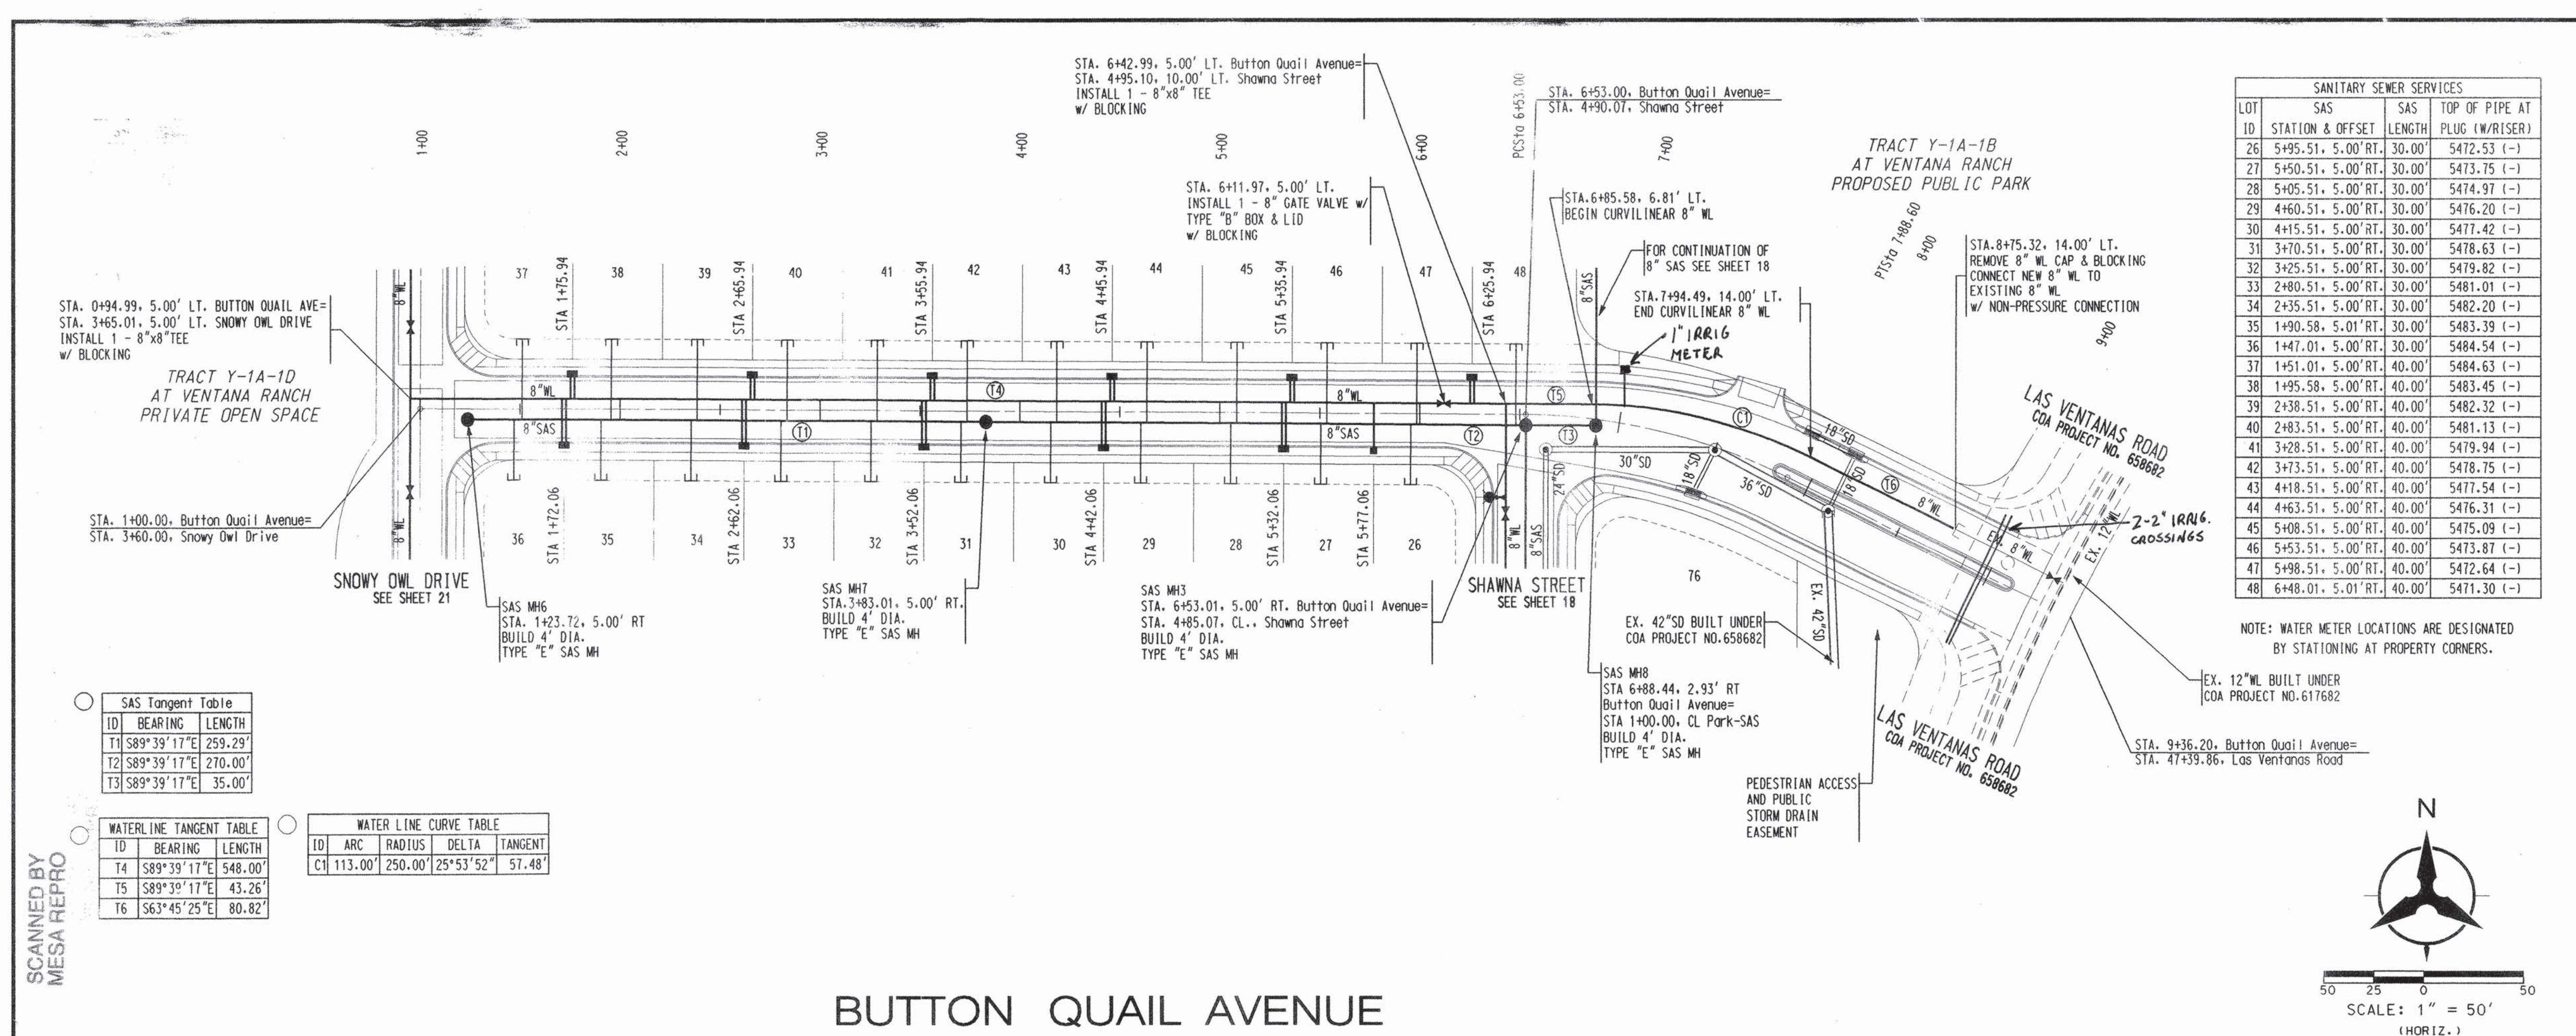

SANITARY SEWER SERVICES			
LOT	SAS	LENGTH	TOP OF PIPE AT PLUG (W/ RISER)
26	5495.51, 5.00' RT.	30.00'	5472.53 (-)
27	5495.51, 5.00' RT.	30.00'	5473.75 (-)
28	5495.51, 5.00' RT.	30.00'	5474.97 (-)
29	5495.51, 5.00' RT.	30.00'	5476.20 (-)
30	5495.51, 5.00' RT.	30.00'	5477.42 (-)
31	5495.51, 5.00' RT.	30.00'	5478.63 (-)
32	5495.51, 5.00' RT.	30.00'	5479.82 (-)
33	5495.51, 5.00' RT.	30.00'	5481.01 (-)
34	5495.51, 5.00' RT.	30.00'	5482.20 (-)
35	5495.51, 5.00' RT.	30.00'	5483.39 (-)
36	5495.51, 5.00' RT.	30.00'	5484.54 (-)
37	5495.51, 5.00' RT.	30.00'	5485.63 (-)
38	5495.51, 5.00' RT.	30.00'	5486.75 (-)
39	5495.51, 5.00' RT.	30.00'	5487.82 (-)
40	5495.51, 5.00' RT.	30.00'	5488.94 (-)
41	5495.51, 5.00' RT.	30.00'	5490.01 (-)
42	5495.51, 5.00' RT.	30.00'	5491.13 (-)
43	5495.51, 5.00' RT.	30.00'	5492.20 (-)
44	5495.51, 5.00' RT.	30.00'	5493.32 (-)
45	5495.51, 5.00' RT.	30.00'	5494.44 (-)
46	5495.51, 5.00' RT.	30.00'	5495.51 (-)
47	5495.51, 5.00' RT.	30.00'	5496.63 (-)
48	5495.51, 5.00' RT.	30.00'	5497.75 (-)

NOTES

- THE CONTRACTOR SHALL FIELD VERIFY ALL EXISTING UTILITY LOCATIONS AND NOTIFY THE ENGINEER IMMEDIATELY OF ANY DISCREPANCIES.
- ALL CURB RETURN RADIUS SHALL BE 25' UNLESS OTHERWISE SPECIFIED.
- ALL CURVE DATA AND DIMENSIONS REFER TO FACE OF CURB UNLESS OTHERWISE SPECIFIED.
- GRADE ELEVATIONS, WHERE NOTED, ARE ALONG FLOWLINE OF STANDARD CURB UNLESS OTHERWISE SPECIFIED.
- CONTRACTOR IS TO INSTALL A 4" X 4" X 5' POST AND EMD AT THE END OF EACH SANITARY SEWER SERVICE.
- CONTRACTOR IS RESPONSIBLE FOR REPAIR AND/OR REPLACEMENT OF ALL UTILITY CONDUITS AND EXISTING LINES.
- ANY ADDITIONAL GRADING REQUIRED TO MATCH PROPOSED STREET GRADES SHALL BE INCIDENTAL TO PAVING ITEMS.
- CONTRACTOR SHALL PROVIDE THE INSPECTORS (CITY AND PRIVATE) WITH THE PROPOSED HYDROSTATIC TESTING PLAN. THE PLAN MUST BE APPROVED BEFORE TESTING OPERATIONS BEGIN.
- CONTRACTOR SHALL PARK EQUIPMENT AND VEHICLES AS NOT TO INTERFERE WITH NORMAL ACTIVITIES OF RESIDENTS OR OTHER CONTRACTORS ON SITE.
- ANY DAMAGE TO THE EXISTING FACILITIES (CURB & GUTTER), PAVEMENT, CONDUITS, LANDSCAPING, UTILITY LINES, ETC.) DURING CONSTRUCTION SHALL BE REPLACED AT THE CONTRACTORS' EXPENSE.
- REMOVAL OF THE EXISTING CURB AND GUTTER SHALL BE AS PER COA STD. DWG. 2415 (SAWCUT ONLY).
- WHEELCHAIR RAMPS SHALL BE CONSTRUCTED PRIOR TO ACCEPTANCE OF CURB & GUTTER.

AS-BUILT INFORMATION

CONTRACTOR: **Bohannon & Huston**

DATE: **3-7-02**

BY: **KEVIN G. PLYTON**

NO. **26**

ENGINEER'S SEAL

DATE: **3-7-02**

BY: **KEVIN G. PLYTON**

NO. **26**

REVISIONS

NO.	DATE	REVISIONS
1	10/2001	DESIGN
2	10/2001	REVISION
3	10/2001	DESIGN

CITY OF ALBUQUERQUE

PUBLIC WORKS DEPARTMENT

ENGINEERING DEVELOPMENT GROUP

PINON POINTE II SUBDIVISION AT VENTANA RANCH

UTILITY PLAN & PROFILE

BUTTON QUAIL AVENUE

APPROVED

APR 1 2 2002

DESIGN REVIEW COMMITTEE

APPROVED

MAY 26 2002

CITY ENGINEER

LAST DESIGN UPDATE

MO./DAY/YR.

MO./DAY/YR.

CITY PROJECT NO. **658683**

ZONE MAP NO. **B-9**

SHEET **20** OF **26**

1405.01, 5.00' LT. SNOWY OWL DRIVE=
STA. 1462.10, 5.00' LT. GOSHAWK AVE
INSTALL 1 - 8" 90° BEND
w/ BLOCKING

STA. 1400.00, SNOWY OWL DRIVE=
STA. 1467.11, Goshawk Avenue

14
13
12
11

8" S&S
8" ML

GOSHAWK AVENUE
SEE SHEET 19

15 36 37 60

5" AIR/G. METER

1467.18

STA. 1400.95, 5.00' LT.
INSTALL 1 - 8"x6" TEE w/BLOCKING
APPROX. 20.13 LF OF 6" PVC
1 - 6" GATE VALVE w/ TYPE "B"
BOX & LID ON FH LEG
1 - FIRE HYDRANT 4" BURY
AS PER COA STD. DWG. 2340
FLANGE ELEV. = 90.16
w/ BLOCKING

1-6" extension

TRACT Y-1A-1D
AT VENTANA RANCH
PRIVATE OPEN SPACE

STA. 3460.00, SNOWY OWL DRIVE=
STA. 1400.00, Button Quail Avenue

STA. 3418.92, 5.00' LT.
INSTALL 1 - 8" GATE VALVE w/
TYPE "B" BOX & LID
w/ BLOCKING

8" ML

60

3465.01, 5.00' LT. SNOWY OWL DRIVE=
STA. 0494.99, 5.00' LT. Button Quail Avenue
INSTALL 1 - 8"x8" TEE
w/ BLOCKING

STA. 4400.92, 5.00' LT.
INSTALL 1 - 8" GATE VALVE w/
TYPE "B" BOX & LID
w/ BLOCKING


STA. 4489.99, 5.00' LT.
INSTALL 1 - 1" AIR RELEASE VALVE
VAL-MATIC 201-C OR APPROVED EQUAL
w/ BLOCKING

5444.83

MATCH LINE STA. 5444.83
SEE SHEET 22

WOODSTAR AVE

STA. 5444.83, 5.00' LT.
INSTALL 1 - 8"x6" TEE w/BLOCKING
APPROX. 20.13 LF OF 6" PVC
1 - 6" GATE VALVE w/ TYPE "B"
BOX & LID ON FH LEG
1 - FIRE HYDRANT 4" BURY
AS PER COA STD. DWG. 2340
FLANGE ELEV. = 90.16
w/ BLOCKING

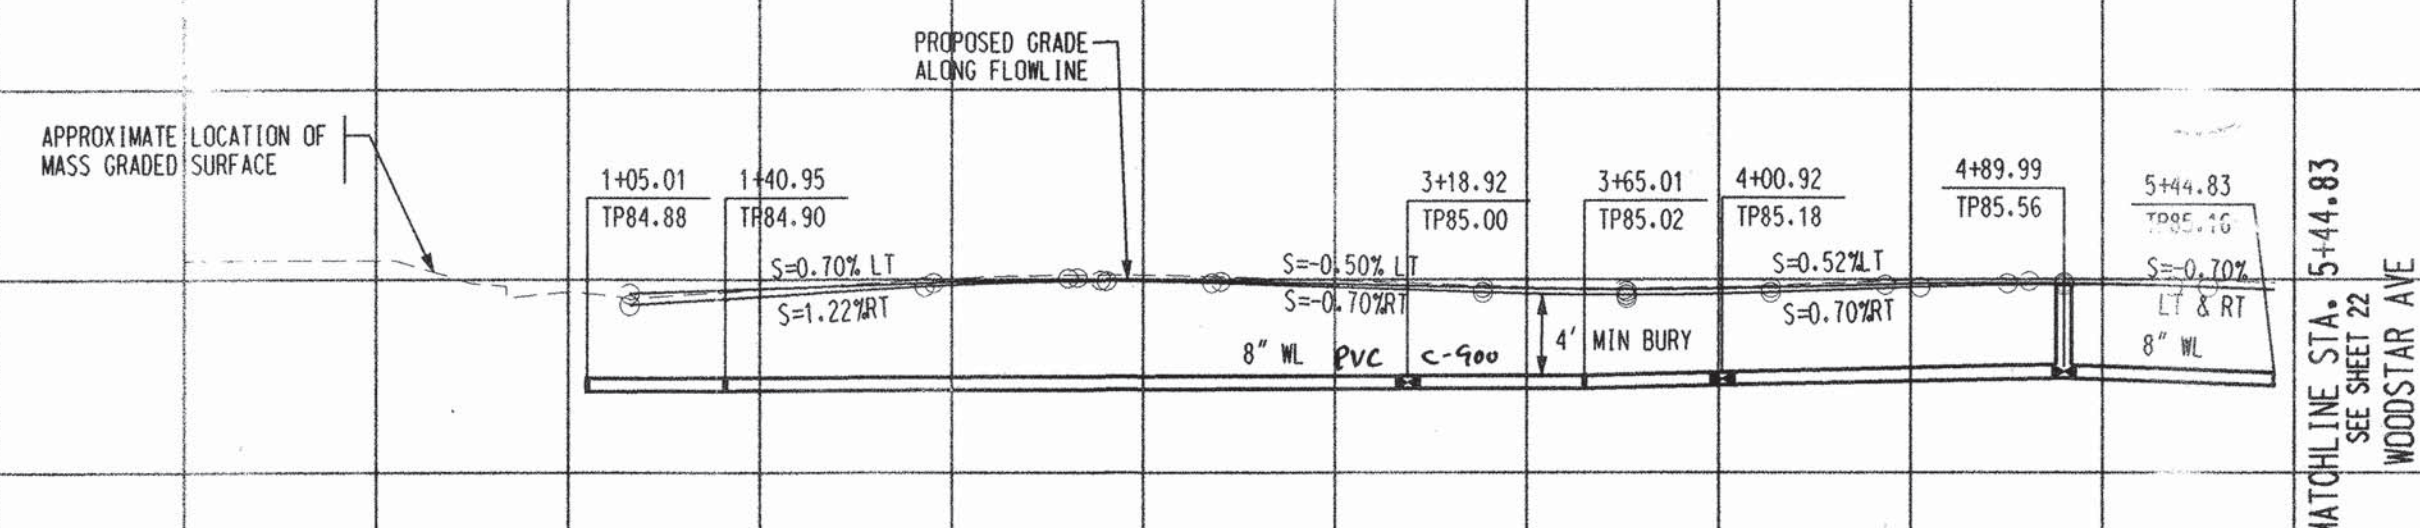

1. THE CONTRACTOR SHALL FIELD VERIFY ALL EXISTING UTILITY LOCATIONS AND NOTIFY THE ENGINEER IMMEDIATELY OF ANY DISCREPANCIES.
2. ALL CURB RETURN RADIII SHALL BE 25' UNLESS OTHERWISE SPECIFIED.
3. ALL CURVE DATA AND DIMENSIONS REFER TO FACE OF CURB UNLESS OTHERWISE SPECIFIED.
4. GRADE ELEVATIONS, WHERE NOTED, ARE ALONG FLOOR LINE OF STANDARD CURB UNLESS OTHERWISE SPECIFIED.
5. CONTRACTOR IS TO INSTALL A 4" X 4" X 5' POST AND END AT THE END OF EACH SANITARY SEWER SERVICE.
6. CONTRACTOR IS RESPONSIBLE FOR REPAIR AND/OR REPLACEMENT OF ALL UTILITY CONDUITS AND EXISTING LINES.
7. ANY ADDITIONAL GRADING REQUIRED TO MATCH PROPOSED STREET GRADES SHALL BE INCIDENTAL TO PAVING ITEMS.
8. CONTRACTOR SHALL PROVIDE THE INSPECTORS, (CITY AND PRIVATE) WITH THE PROPOSED HYDROSTATIC TESTING PLAN. THE PLAN MUST BE APPROVED BEFORE TESTING OPERATIONS BEGIN.
9. CONTRACTOR SHALL PARK EQUIPMENT AND VEHICLES AS NOT TO INTERFERE WITH NORMAL ACTIVITIES OF RESIDENTS OR OTHER CONTRACTORS ON SITE.
10. ANY DAMAGE TO THE EXISTING FACILITIES (CURB & GUTTER), PAVEMENT, CONDUITS, LANDSCAPING, UTILITY LINES, ETC.) DURING CONSTRUCTION SHALL BE REPLACED AT THE CONTRACTORS' EXPENSE.
11. REMOVAL OF THE EXISTING CURB AND GUTTER SHALL BE AS PER COA STD. DWG. 2415 (SAWCUT ONLY).
12. WHEELCHAIR RAMPS SHALL BE CONSTRUCTED PRIOR TO ACCEPTANCE OF CURB & GUTTER.

ENGINEER'S SEAL		SURVEY INFORMATION		BENCH MARKS		AS-BUILT INFORMATION	
NO.	DATE	BY	FIELD NOTES	ACCS BRASS TABLE STAMPED "1-B9 1980"	CONTRACTOR	INSPECTOR'S	DATE
				GEOGRAPHIC POSITION (NAD 1927)	<u>Sundance</u>	INSPECTION BY <u>AIS</u>	<u>10/1</u>
				N.M. STATE PLANE COORDINATES		ACCEPTANCE BY <u>WJF</u>	<u>9/2</u>
				(CENTRAL ZONE) X=355,077.00		VERIFICATION BY <u>AIS</u>	<u>9/2</u>
				Y=1,529,056.93		DRAWINGS CORRECTED BY <u>AIS</u>	<u>10/2</u>
				GROUND-TO-GRID FACTOR = .99966334		MICRO-FILM INFORMATION	
				DELTA ALPHA -00°16'47"		RECORDED BY	DATE
				NGVD 1929 ELEVATION = 5450.51		NO.	

Professional Engineer Seal for Kevin G. Patton, New Mexico, No. 13685. The seal is circular with the text "KEVIN G. PATTON", "NEW MEXICO", "13685", and "PROFESSIONAL ENGINEER" around the perimeter. A signature is written across the seal, and the date "3.8.02" is written below it.

[illegible]

APPROVED BY  3-7-02
DATE

Bohannon ▲ Huston

 Courtyard One 7500 JEFFERSON NE Albuquerque NEW MEXICO 87105

ENGINEERS PLANNERS PHOTOGRAMMETRISTS SURVEYORS SOFTWARE DEVELOPERS

CITY OF ALBUQUERQUE
PUBLIC WORKS DEPARTMENT
ENGINEERING DEVELOPMENT GROUP
PINON POINTE II SUBDIVISION AT VENTANA RANCH
UTILITY PLAN & PROFILE
SNOWY OWL DRIVE STA 1+00.00 - 5+44.83

DESIGN REVIEW COMMITTEE CITY ENGINEER APPROVAL		MO./DAY/YR.		MO./DAY/YR.					
APPROVED APR 12 2002 DESIGN REVIEW COMMITTEE	APPROVED MAY 26 2002 CITY ENGINEER	LAST DESIGN UPDATE							

CITY PROJECT NO.		ZONE	MAP NO.	SHEET	OF
658683			B-9	21	26

WATER LINE CURVE TABLE				
ID	ARC	RADIUS	DELTA	TANGENT
C1	277.42'	325.00'	48°54'27"	147.79'

WATER LINE TANGENT TABLE			
ID	BEARING	LENGTH	
T2	N00°13'00"E	208.33'	
T3	N45°00'00"E	72.64'	
T4	S89°39'18"E	419.75'	
T5	S89°39'18"E	186.06'	
T6	S89°39'18"E	77.08'	

TRACT Y-1A-1A
AT VENTANA RANCH
FUTURE SUBDIVISION

TRACT Y-1A-1D
AT VENTANA RANCH
PRIVATE OPEN SPACE

SAS MH9
STA. 6+05.46, 9.93' LT.
INSTALL 1-45" 8" WL BEND
W/ BLOCKING
TYPE "E" SAS MH

MATCHLINE STA. 5+44.83
SNOWY OWL DRIVE
SEE SHEET 21

STA. 6+36.72, 10.10' LT.
INSTALL 1-45" 8" BEND
W/ BLOCKING

STA. 10+53.55, 5.00' LT. WOODSTAR AVE.
STA. 1+05.02, 10.00' LT. WOODQUAIL DR
INSTALL 1-8"X8" TEE W/ BLOCKING

STA. 11+85.63, 5.00' LT.
INSTALL 1-8"X6" TEE W/ BLOCKING
APPROX. 22.5L' 6" PVC
1-6" GATE VALVE W/ TYPE "B"
BOX & LID ON FR LEG
1- FIRE HYDRANT 4" BURY
AS PER CDA STD. DWG. 2340
FLANGE ELEV. = 75.21
W/ BLOCKING

STA. 10+99.74, 5.00' LT.
INSTALL 1-8" GATE VALVE W/
TYPE "B" BOX & LID
W/ BLOCKING

STA. 13+16.69, 5.00' LT. WOODSTAR AVE.
STA. 1+05.02, 6.86' LT. GRIFFON DR
INSTALL 1-8"X8" TEE W/ BLOCKING
BEGIN CURVILINEAR 8" WL

TRACT Y-1A-1A
AT VENTANA RANCH
FUTURE SUBDIVISION

STA. 13+70.60, 7.00' LT.
INSTALL 1-8" GATE VALVE W/
TYPE "B" BOX AND LID
W/ BLOCKING

MATCHLINE STA. 14+00.00
SEE SHEET 23

SAS MH13
STA. 13+26.72, 7.03' RT. WOODSTAR AVE=
STA. 0+92.96, 3.14' RT. GRIFFON DR
BUILD 4" DIA. TYPE "E" SAS MH
BEGIN CURVILINEAR 8" SAS

FOR CONTINUATION OF
8" SAS SEE SHEET 18

STA. 13+23.57, Woodstar Avenue=
STA. 1+00.00, Griffon Dr

SAS MH12
STA. 11+75.65, 5.00' RT. RT.
WOODSTAR AVE=
STA. 3+60.00, CL Park-SAS
BUILD 4" DIA. TYPE "E" SAS MH

SAS MH11
STA. 10+73.58, 5.00' RT. WOODSTAR AVE=
STA. 0+94.98, 10.00' RT. WOODQUAIL DR
BUILD 4" DIA. TYPE "E" SAS MH

SAS MH10
STA. 8+73.15, 5.00' RT.
BUILD 4" DIA. TYPE "E" SAS MH

SAS MH9
STA. 6+05.46, 9.93' LT.
INSTALL 1-45" 8" WL BEND
W/ BLOCKING
TYPE "E" SAS MH

SAS MH8
STA. 4+05.46, 9.93' LT.
INSTALL 1-45" 8" WL BEND
W/ BLOCKING
TYPE "E" SAS MH

SAS MH7
STA. 2+05.46, 9.93' LT.
INSTALL 1-45" 8" WL BEND
W/ BLOCKING
TYPE "E" SAS MH

SAS MH6
STA. 0+05.46, 9.93' LT.
INSTALL 1-45" 8" WL BEND
W/ BLOCKING
TYPE "E" SAS MH

SAS MH5
STA. -2+05.46, 9.93' LT.
INSTALL 1-45" 8" WL BEND
W/ BLOCKING
TYPE "E" SAS MH

SAS MH4
STA. -4+05.46, 9.93' LT.
INSTALL 1-45" 8" WL BEND
W/ BLOCKING
TYPE "E" SAS MH

SAS MH3
STA. -6+05.46, 9.93' LT.
INSTALL 1-45" 8" WL BEND
W/ BLOCKING
TYPE "E" SAS MH

SAS MH2
STA. -8+05.46, 9.93' LT.
INSTALL 1-45" 8" WL BEND
W/ BLOCKING
TYPE "E" SAS MH

SAS MH1
STA. -10+05.46, 9.93' LT.
INSTALL 1-45" 8" WL BEND
W/ BLOCKING
TYPE "E" SAS MH

SAS MH0
STA. -12+05.46, 9.93' LT.
INSTALL 1-45" 8" WL BEND
W/ BLOCKING
TYPE "E" SAS MH

SAS MH-1
STA. -14+05.46, 9.93' LT.
INSTALL 1-45" 8" WL BEND
W/ BLOCKING
TYPE "E" SAS MH

W/ BLOCKING
TYPE "E" SAS MH

SAS MH-92
STA. -196+05.46, 9.93' LT.
INSTALL 1-45" 8" WL BEND
W/ BLOCKING
TYPE "E" SAS MH

SAS MH-93
STA. -198+05.46, 9.93' LT.
INSTALL 1-45" 8" WL BEND
W/ BLOCKING
TYPE "E" SAS MH

SAS MH-94
STA. -200+05.46, 9.93' LT.
INSTALL 1-45" 8" WL BEND
W/ BLOCKING
TYPE "E" SAS MH

SAS MH-95
STA. -202+05.46, 9.93' LT.
INSTALL 1-45" 8" WL BEND
W/ BLOCKING
TYPE "E" SAS MH


SAS MH-96
STA. -204+05.46, 9.93' LT.
INSTALL 1-45" 8" WL BEND
W/ BLOCKING
TYPE "E" SAS MH

SAS MH-97
STA. -206+05.46, 9.93' LT.
INSTALL 1-45" 8" WL BEND
W/ BLOCKING
TYPE "E" SAS MH

SAS MH-98
STA. -208+05.46, 9.93' LT.
INSTALL 1-45" 8" WL BEND
W/ BLOCKING
TYPE "E" SAS MH

SAS MH-99
STA. -210+05.46, 9.93' LT.
INSTALL 1-45"

ID	BEARING	LENGTH
T14	N29°28'28"W	139.00
T15	S60°31'32"W	31.50
T18	S20°12'06"E	35.93

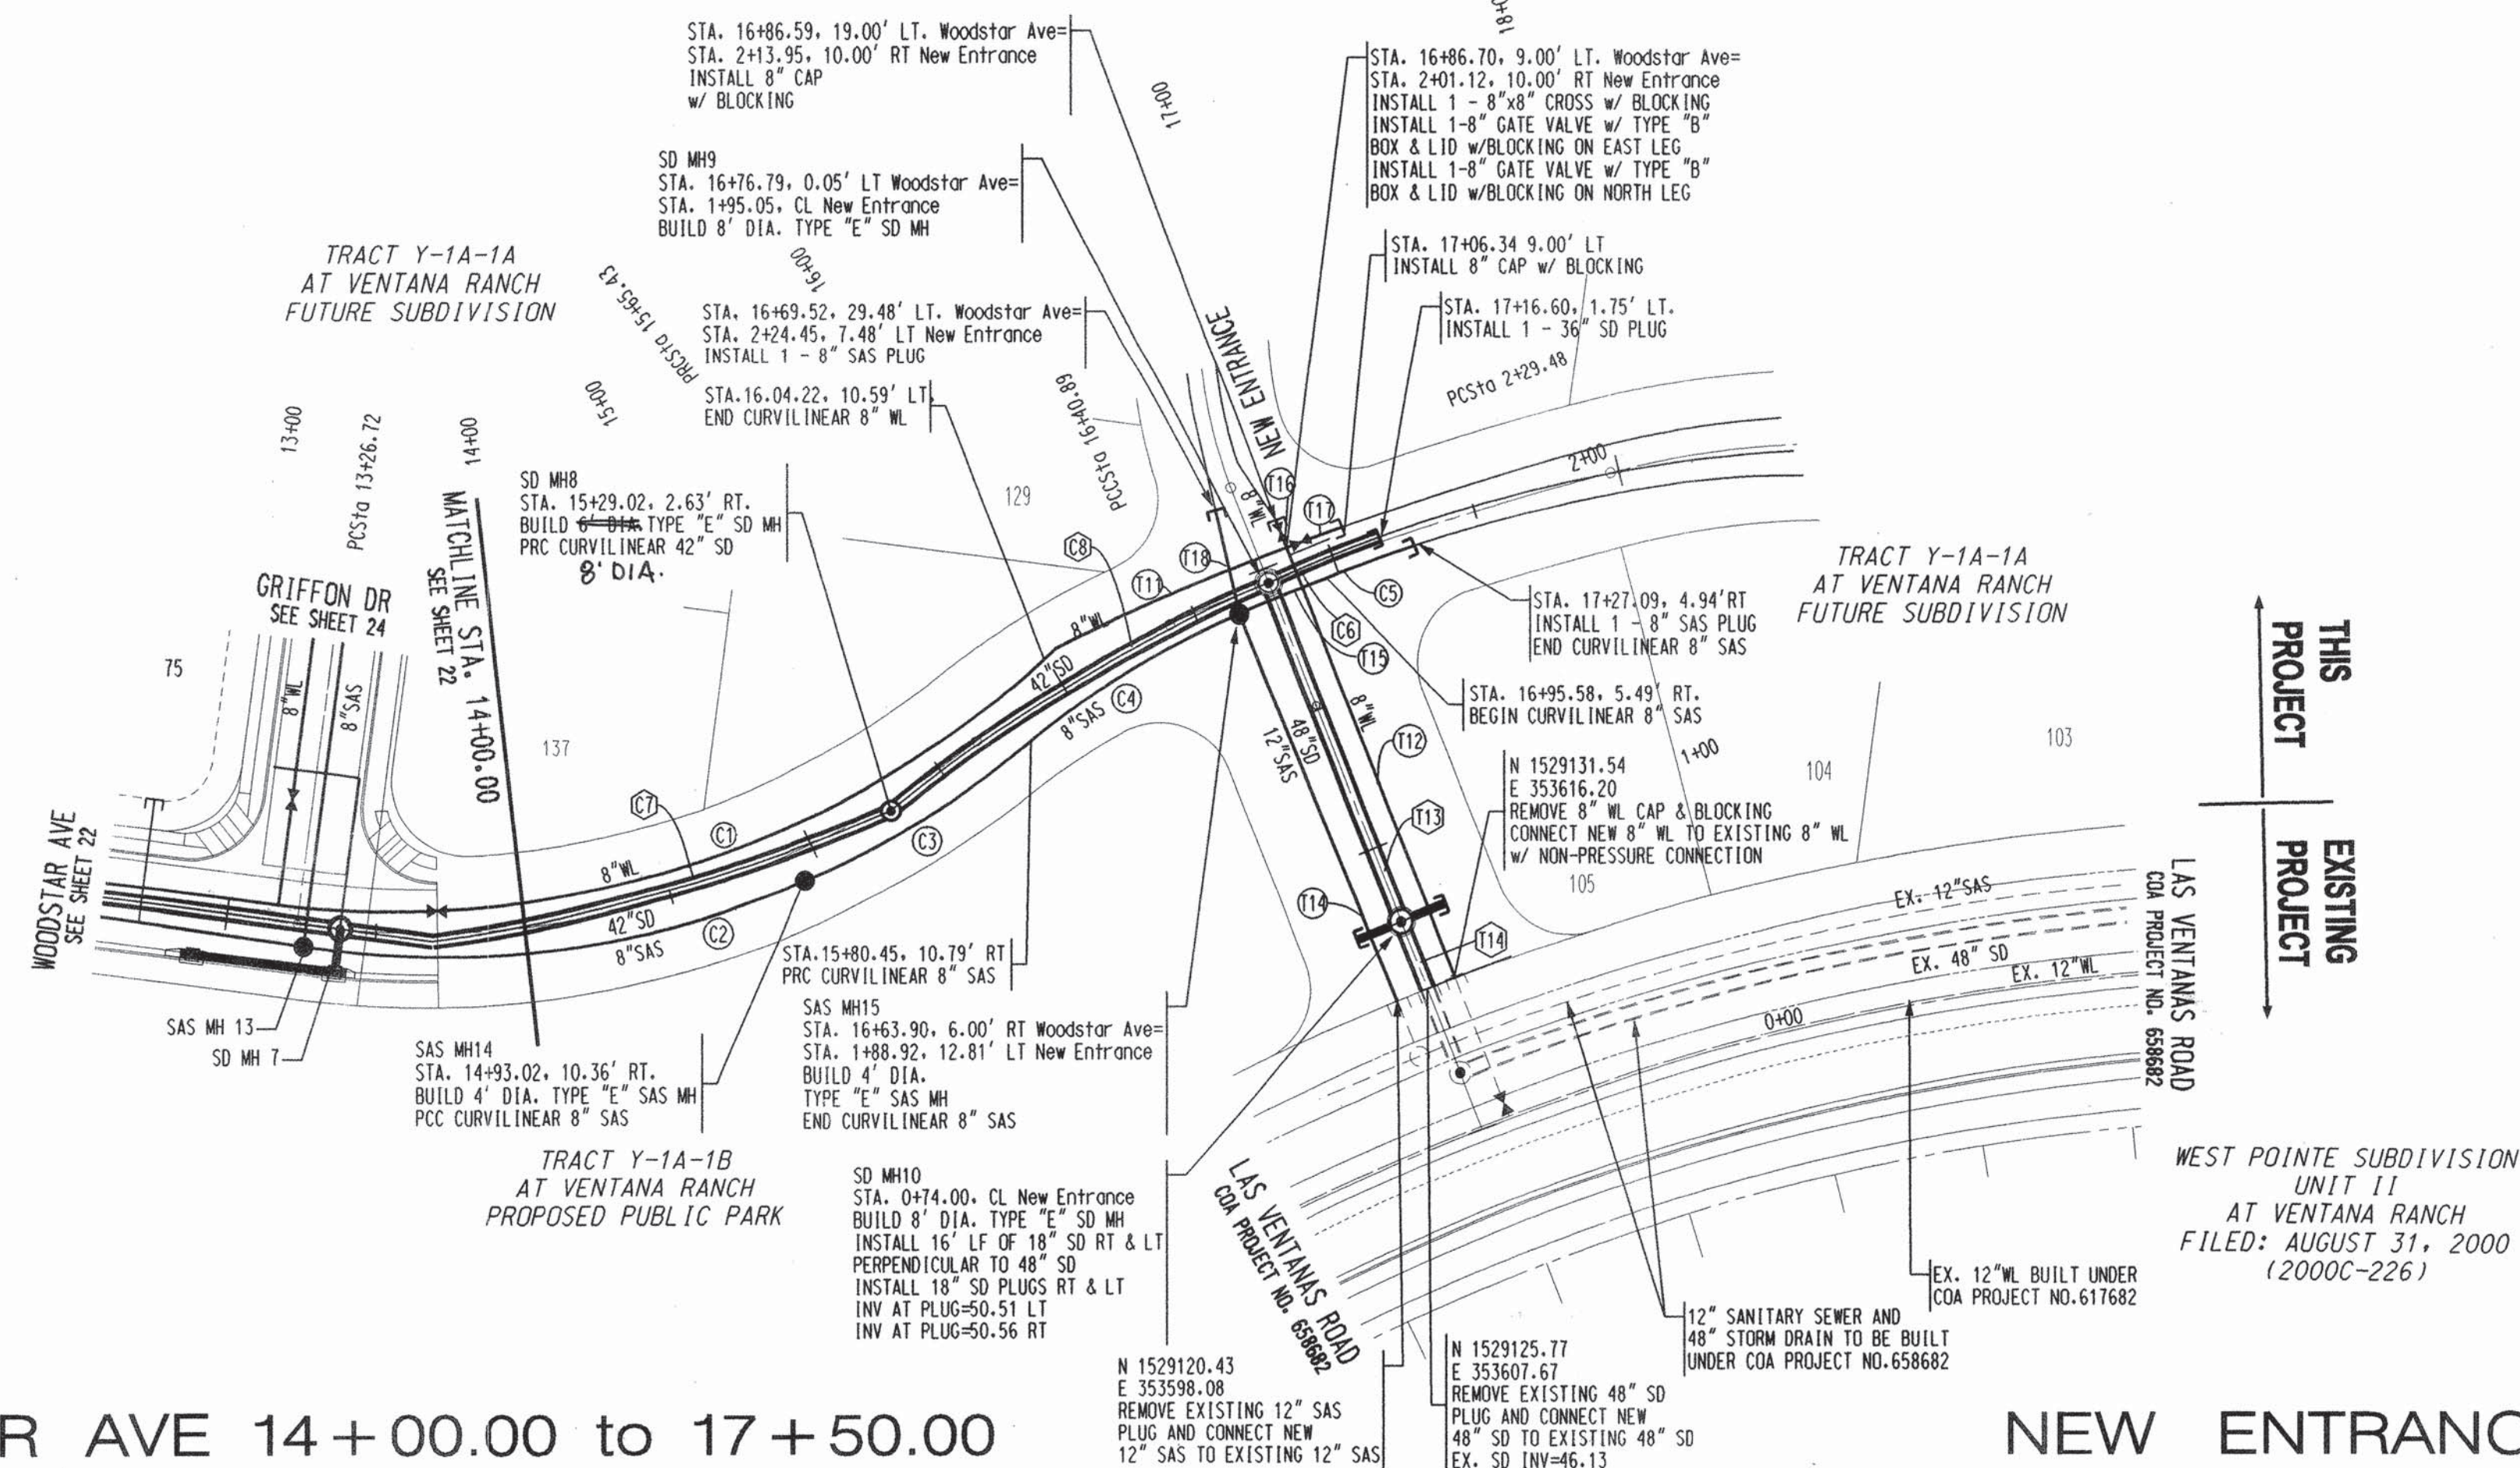


SD Curve Table				
ID	ARC	RADIUS	DELTA	TANG
C6	39.90'	469.00'	04°52'27"	19.90'
C7	160.01'	550.00'	16°40'07"	80.50'
C8	147.55'	544.00'	15°32'24"	74.50'

SD Tangent Table		
ID	BEARING	LENG
T13	S28°43'16"E	121.
T14	S28°43'16"E	24.

STORM DRAIN FLOW TABLE					
NUMBER	Q(cfs)	V(cfs)	DEPTH	LENGTH	SIZE
C6	57.0	9.32	29.04"	39.90"	36"
C7	135.0	15.99	34.43"	160.01"	42"
C8	135.0	22.51	25.08"	147.55"	42"
T13	192.0	18.18	37.56"	121.05"	48"
T14	192.0	18.18	37.56"	24.00"	48"

NOTE:
AFTER CONSTRUCTION IS COMPLETE GRADES
MUST BE RETURNED TO THEIR ORIGINAL STATE
SO SWALE IS NOT DISRUPTED

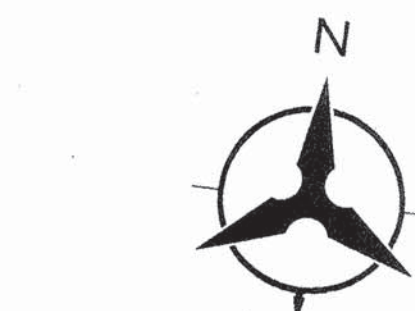

50 25 0
SCALE: 1" = 50'
(HORIZ.)

NOTES

1. THE CONTRACTOR SHALL FIELD VERIFY ALL EXISTING UTILITY LOCATIONS AND NOTIFY THE ENGINEER IMMEDIATELY OF ANY DISCREPANCIES.
2. ALL CURB RETURN RADII SHALL BE 25' UNLESS OTHERWISE SPECIFIED.
3. ALL CURVE DATA AND DIMENSIONS REFER TO FACE OF CURB UNLESS OTHERWISE SPECIFIED.
4. GRADE ELEVATIONS, WHERE NOTED, ARE ALONG FLOWLINE OF STANDARD CURB UNLESS OTHERWISE SPECIFIED.
5. CONTRACTOR IS TO INSTALL A 4" X 4" X 5' POST AND END AT THE END OF EACH SANITARY SEWER SERVICE.
6. CONTRACTOR IS RESPONSIBLE FOR REPAIR AND/OR REPLACEMENT OF ALL UTILITY CONDUITS AND EXISTING LINES.
7. ANY ADDITIONAL GRADING REQUIRED TO MATCH PROPOSED STREET GRADES SHALL BE INCIDENTAL TO PAVING ITEMS.
8. CONTRACTOR SHALL PROVIDE THE INSPECTORS, (CITY AND PRIVATE) WITH THE PROPOSED HYDROSTATIC TESTING PLAN. THE PLAN MUST BE APPROVED BEFORE TESTING OPERATIONS BEGIN.
9. CONTRACTOR SHALL PARK EQUIPMENT AND VEHICLES AS NOT TO INTERFERE WITH NORMAL ACTIVITIES OF RESIDENTS OR OTHER CONTRACTORS ON SITE.
10. ANY DAMAGE TO THE EXISTING FACILITIES (CURB & GUTTER), PAVEMENT, CONDUITS, LANDSCAPING, UTILITY LINES, ETC. DURING CONSTRUCTION SHALL BE REPLACED AT THE CONTRACTORS' EXPENSE.
11. REMOVAL OF THE EXISTING CURB AND GUTTER SHALL BE AS PER COA STD. DWG. 2415 (SAWCUT ONLY).
12. WHEELCHAIR RAMPS SHALL BE CONSTRUCTED PRIOR TO ACCEPTANCE OF CURB & GUTTER.

SURVEY INFORMATION		BENCH MARKS		AS-BUILT INFORMATION	
NO.	FIELD NOTES		CONTRACTOR		DATE
	BY	DATE	STARTED BY	ACCEPTANCE BY	
	ACS BRASS TABLET STAMPED "1-B9 1980"		CONTRACTOR <i>Sundt & Co.</i>		
	GEOGRAPHIC POSITION (NAD 1927)				
	N.M. STATE PLANE COORDINATES		ACCEPTED BY <i>ALS</i>		
	(CENTRAL ZONE) X=355.077-00		FIELD CHECKED BY <i>ALS</i>		DATE <i>9/12/02</i>
	Y=1,529,056.33		DRAWINGS		DATE <i>9/12/02</i>
	GROUND-TO-GRID FACTOR = .99966334		MICRO-FILM INFORMATION		
	DELTA ALPHA -00°16'47"		RECORDED BY		DATE
	NGVD 1929 ELEVATION = 5450.51		NO.		



				E
J.	DATE	REMARKS	BY	
		REVSIONS		
		DESIGN		
SIGNED BY	YOP	DATE	10/2001	
AWN BY	DM	DATE	10/2001	

	1	2	3	4	5	6	7	8	9	10	11	12	13	14
	2	6		6	5	8	6	.	8	3			2	3

APPROVED BY 

3-8-02

Bohannon ▲ Huston



 Courtyard One 7500 JEFFERSON NE Albuquerque NEW MEXICO 87

ENGINEERS PLANNERS PHOTOGRAMMETRISTS SURVEYORS SOFTWARE DEVELOPERS


CITY OF ALBUQUERQUE
PUBLIC WORKS DEPARTMENT
ENGINEERING DEVELOPMENT GROUP
PINON POINTE II SUBDIVISION AT VENTANA RANCH
UTILITY PLAN & PROFILE
WOODSTAR AVE 14+00.00 - 17+50.00 (NEW ENTRANCE)

DESIGN REVIEW COMMITTEE		CITY ENGINEER APPROVAL		MO./DAY/YR.	
APPROVED	APR 12 2002	APPROVED	MAY 26 2002	LAST DESIGN UPDATE	
	DESIGN REVIEW COMMITTEE		CITY ENGINEER		

CITY PROJECT NO.		ZONE MAP NO.	SHEET	OF
658683		B-9	23	26

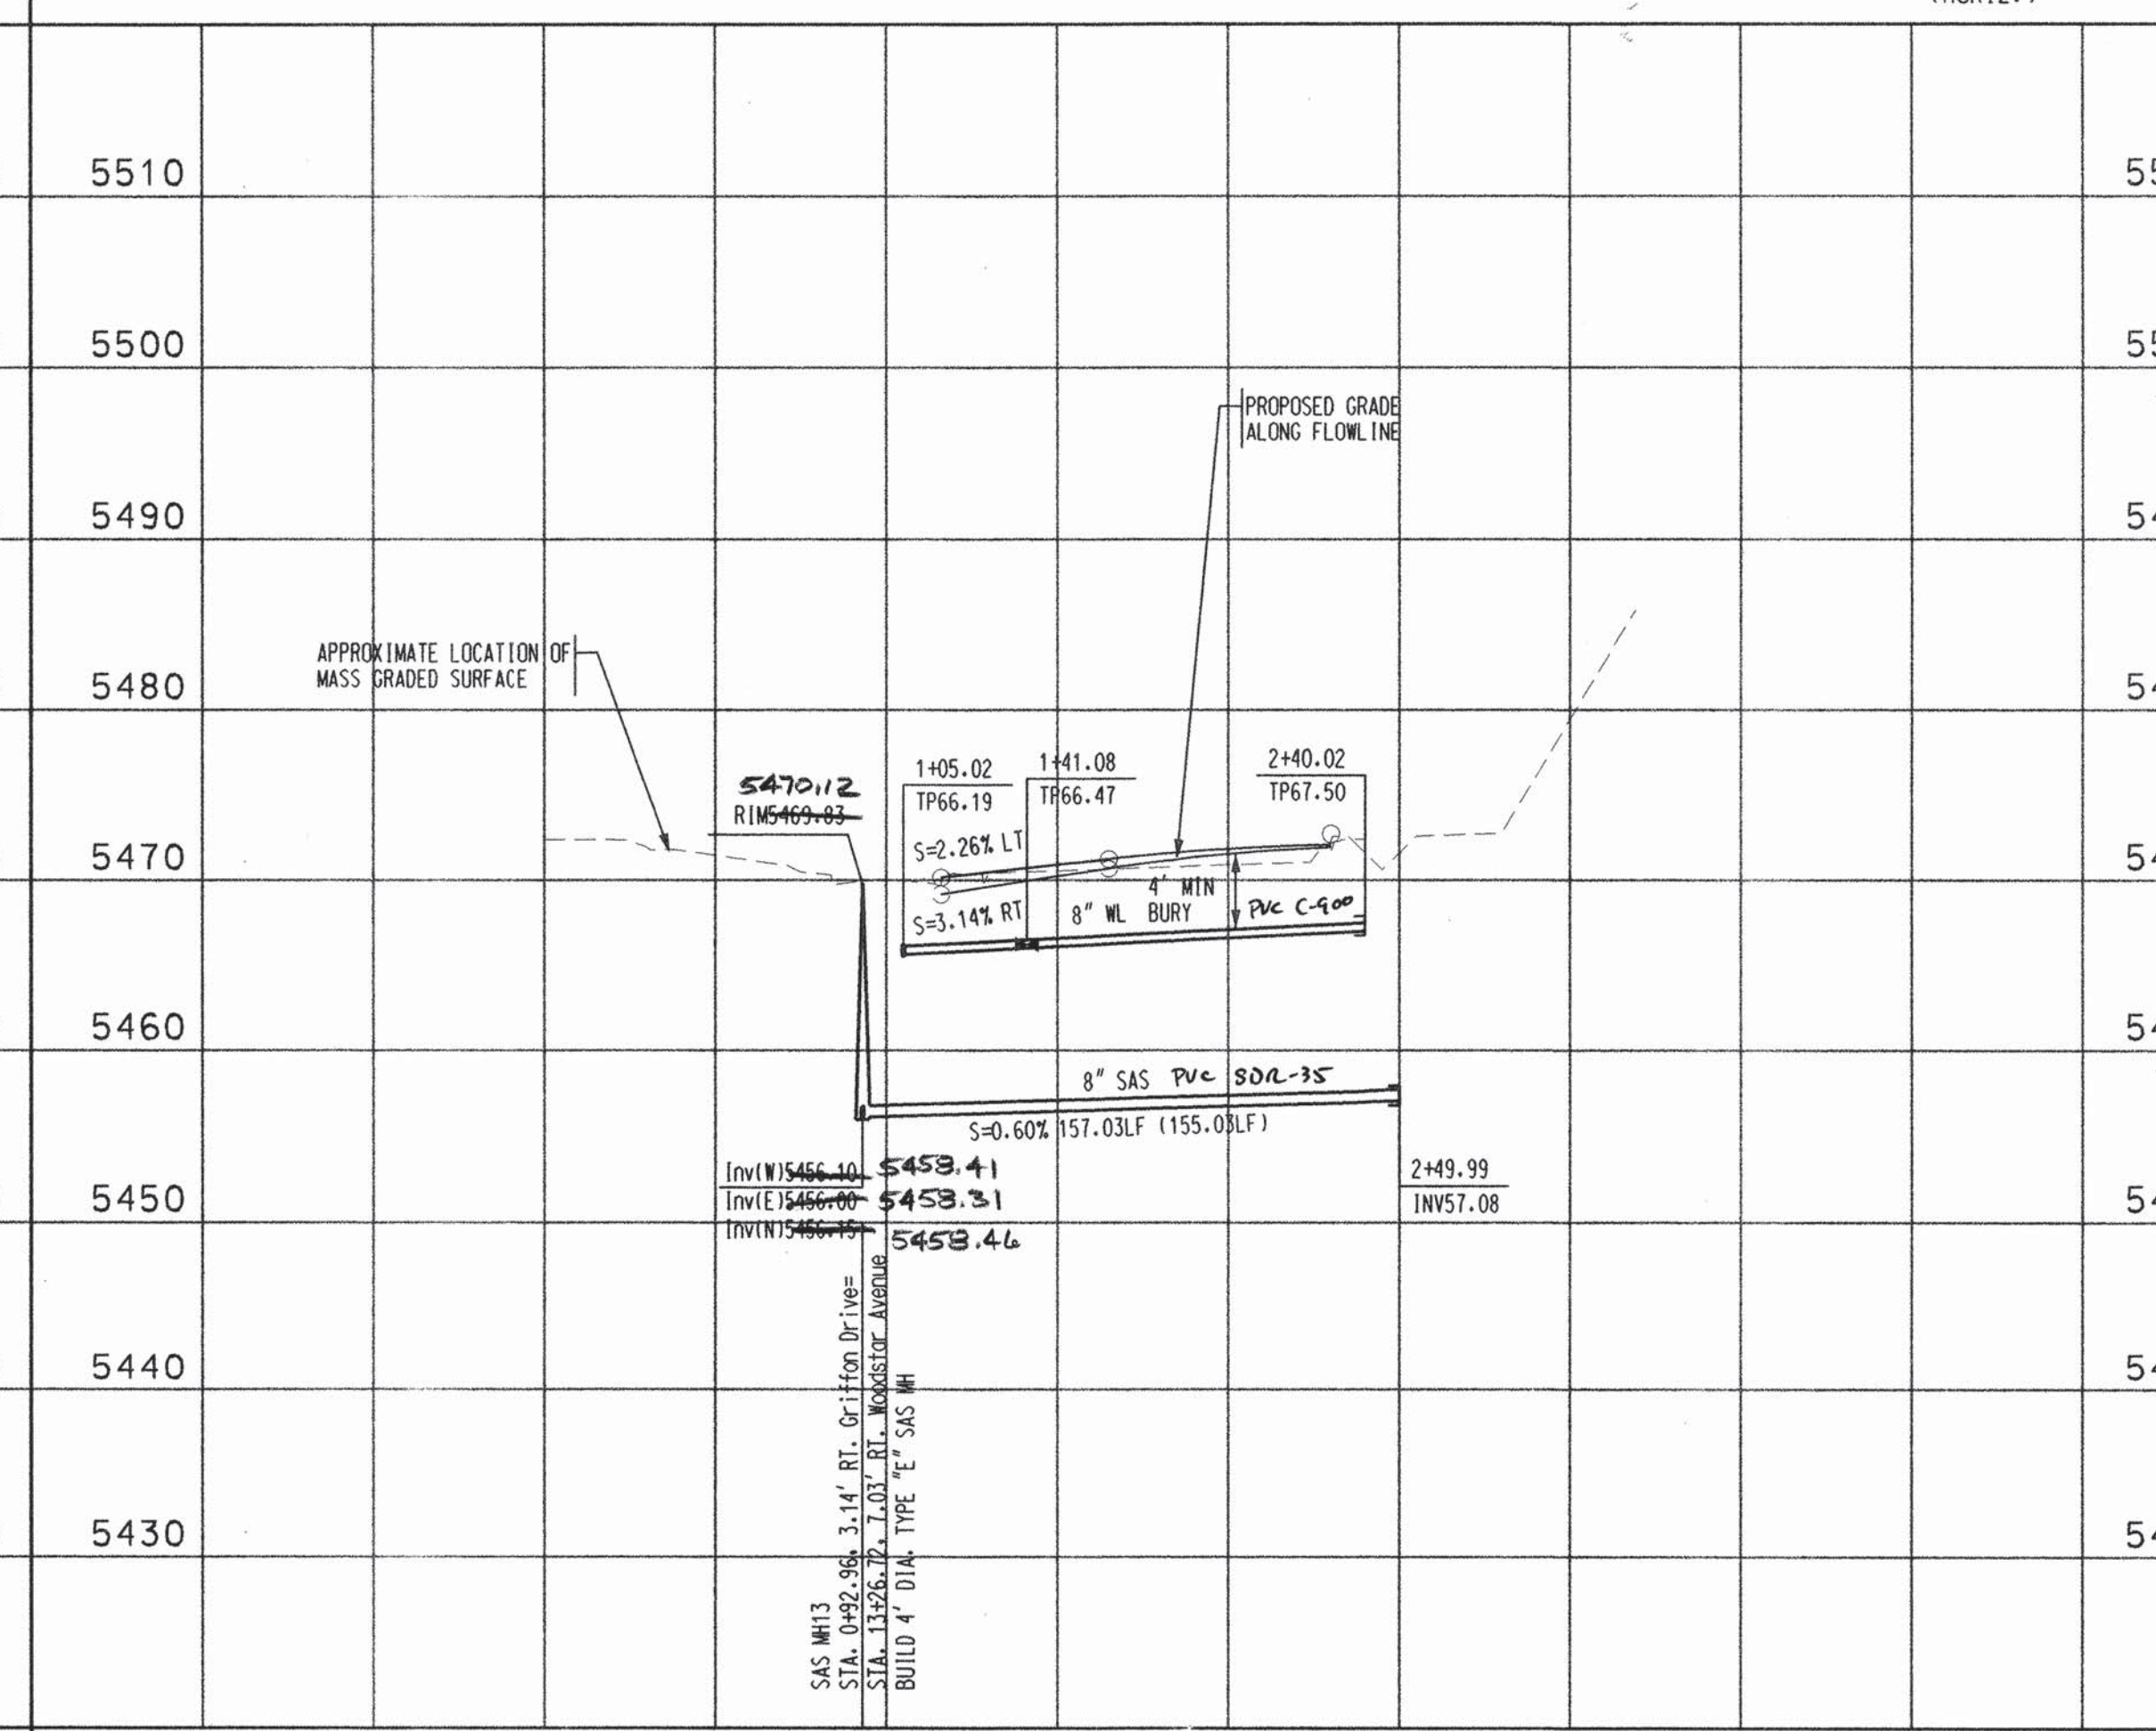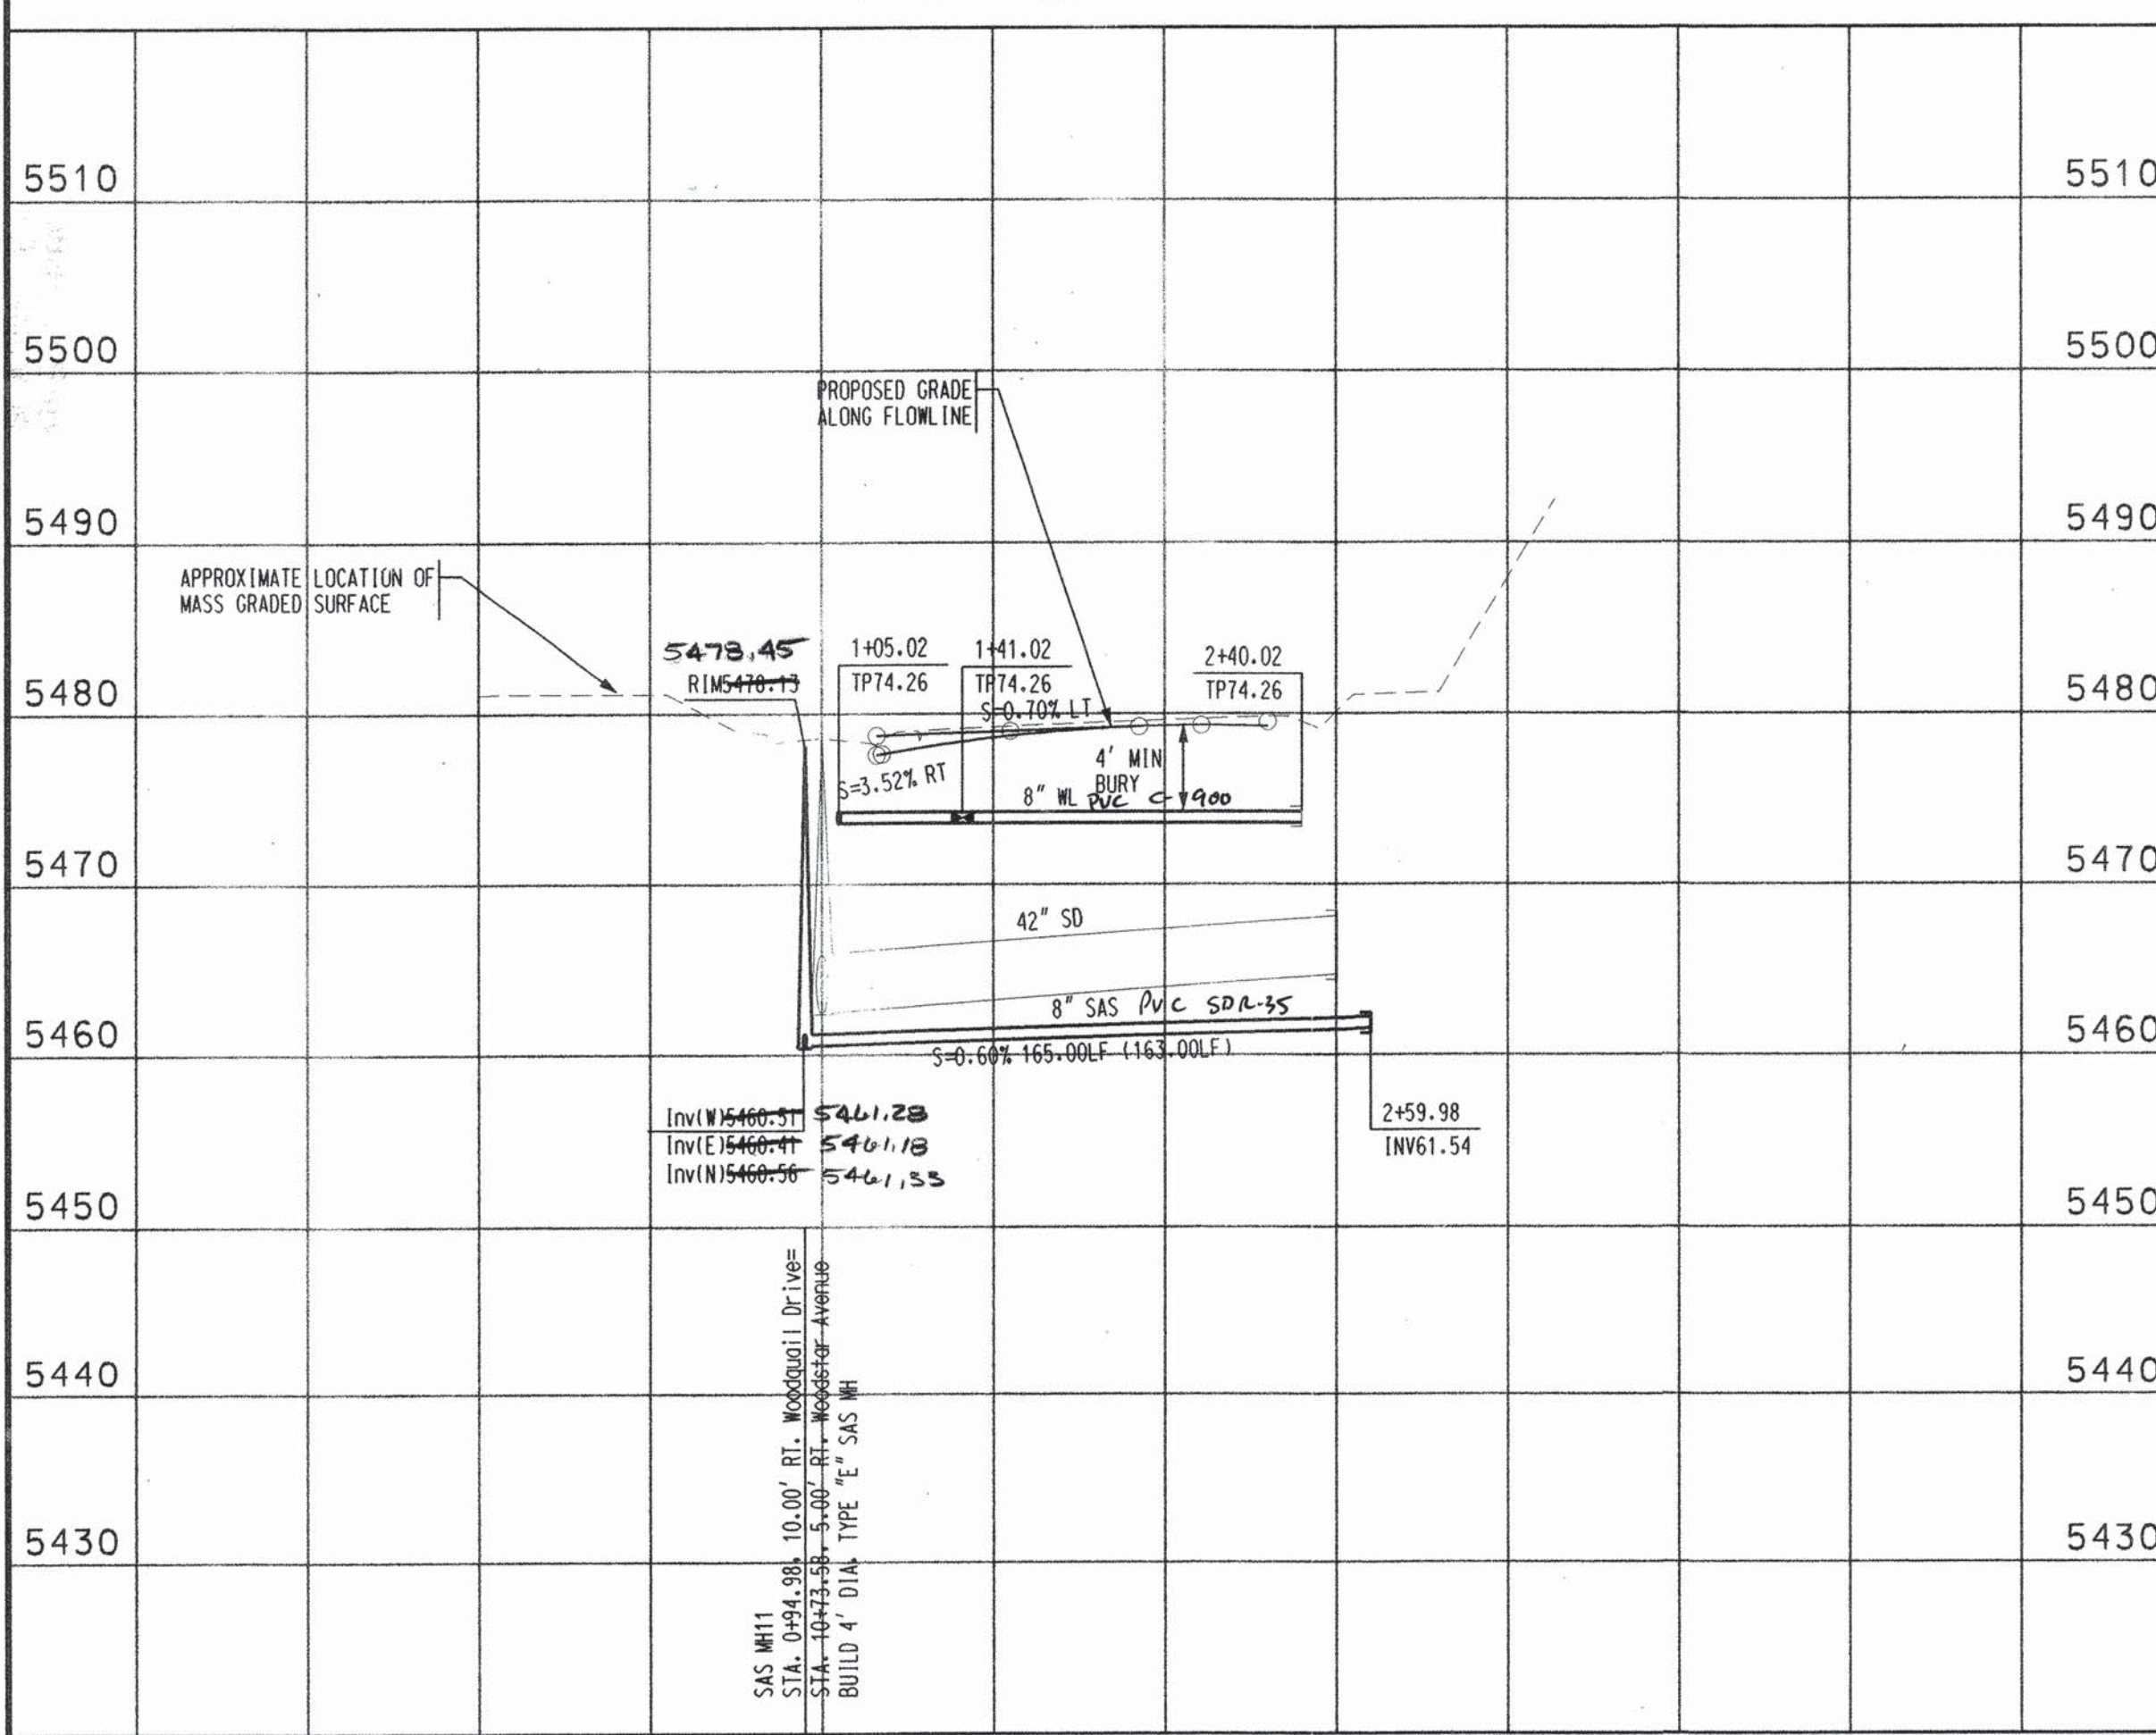

- | | | | | | | | | | | | | | | |
|----|---|---|---|---|---|---|---|---|----|----|----|----|----|----|
| 1 | 2 | 3 | 4 | 5 | 6 | 7 | 8 | 9 | 10 | 11 | 12 | 13 | 14 | 15 |
| 26 | 6 | 5 | 8 | 6 | . | 8 | 3 | 2 | 4 | 0 | 2 | | | |


 APPROVED BY NMU

3-T-2
 DATE

Bohannon ▲ Huston


Courtyard One 7500 JEFFERSON NE Albuquerque NEW MEXICO 87109

ENGINEERS PLANNERS PHOTOGRAMMETRISTS SURVEYORS SOFTWARE DEVELOPERS



CITY OF ALBUQU

PUBLIC WORKS DEPAR

ENGINEERING DEVELO

PINON POINTE II SUBDIVISION AT

UTILITY PLAN & PROFILE

WOODQUAIL DRIVE / GRIFFON

DESIGN REVIEW COMMITTEE

CITY ENGINEER APPROVAL

APPROVED

APR 12 2002

APPROVED

MAY 26 2002

LAST DESIGN UPDATE

LAST DESIGN UPDATE

--	--	
TRID SUBD

CT 11

FUTURE CITY PARK

LAS VENTANAS

WEST POINTE

CLEAR SITE TRIANGLE
NO PLANT MATERIAL OVER
2' IN THIS AREA

5825 SF
4593 SF
226 SF
226 SF
226 SF
12586 SF
442 SF


TheHilltop
LANDSCAPE ARCHITECTS & CONTRACTORS
Cont. Lic. #26458
7909 Edith N.E.
Albuquerque, NM 87184
Ph. (505) 898-9690
Fax (505) 898-7737
it@hilltoplandscaping.com

GENERAL NOTES

1. ALL LANDSCAPE TO BE MAINTAINED BY THE VENTANA RANCH COMMUNITY ASSOCIATION.
2. NO TREES SHALL BE PLANTED WITHIN 8' OF CURBS OR SIDEWALKS.

PLANTING LEGEND

SYMBOL	SIZE	NAME	HEIGHT
		PROPOSED PARK TREE	
	2" Cal.	SHADE TREE	TO 35'
	2" Cal.	ORNAMENTAL TREE	TO 35'
	20 Gal.	PINON PINE	TO 25'
	15 Gal.	WASHINGTON HAWTHORN	16' TO 18'
	15 Gal.	DESERT WILLOW	16' TO 18'
		PALM YUCCA	TO 13'
	5 Gal.	SHRUB/MAIDENGRASS	TO 2'
	1 Gal.	VINE	TO 1'
	1 Gal.	GROUNDCOVER	TO 24"
	1 Gal.	CATMINT	8" TO 12"
		OVERSIZED GRAVEL AND BASALT BOULDERS	
		SANTA ANA TAN GRAVEL WITH FF, SIDEWALK TO PROPERTY LINE	
		BROWN GRAVEL WITH FF, SIDEWALK TO CURB AND MEDIANS	

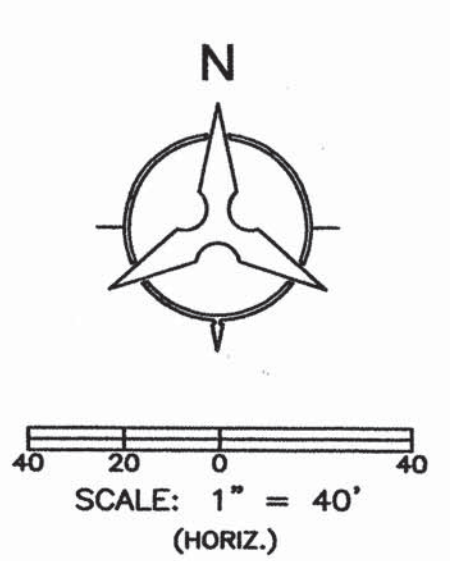

1 2 3 4 5 6 7 8 9 10 11 12 13 14 15
26 6586.83 24 A02

Bohannon & Huston
Court yard One 7500 JEFFERSON NE Albuquerque NEW MEXICO 87109
ENGINEERS PLANNERS PHOTOGRAMMETRISTS SURVEYORS SOFTWARE DEVELOPERS

CITY OF ALBUQUERQUE
PUBLIC WORKS DEPARTMENT
ENGINEERING DEVELOPMENT GROUP
PINON POINTE 2 SUBDIVISION AT VENTANA RANCH
LANDSCAPE PLAN

DESIGN REVIEW COMMITTEE APPROVAL APR 12 2002	CITY ENGINEER APPROVAL MAY 26 2002	MO./DAY/YR.	MO./DAY/YR.
DESIGN REVIEW COMMITTEE	CITY ENGINEER		
CITY PROJECT NO. 658683	ZONE MAP NO. B-9	SHEET 24 A	OF 26

AS-BUILT INFORMATION		BENCH MARKS		SURVEY INFORMATION		ENGINEER'S SEAL		Revised LS Plan	
CONTRACTOR	1-89 1980	ACS BRASS TABLET STAMPED	1-B9 1980	DATE	BY	NO.	DATE	11/26/01	
WORKED BY	1415	GEOGRAPHIC POSITION (NAD 1927)							
ACCEPTANCE BY	1415	N.M. STATE PLANE COORDINATES							
FIELD VERIFICATION BY	1415	(CENTRAL ZONE) X=355,077.00							
DATE	1415	Y=1,529,066.93							
DATE	1415	GROUND-TO-GRID FACTOR = .99966334							
DATE	1415	MICRO-FILM INFORMATION							
RECORDED BY		DELTA ALPHA -00°16'47"							
NO.		NGVD 1929 ELEVATION = 5450.51							

CONSTRUCTION TRAFFIC CONTROL GENERAL NOTES

1. CONTRACTOR MUST OBTAIN FROM CONSTRUCTION COORDINATION AN EXCAVATION/BARRICADING PERMIT BEFORE ENGAGING IN ANY CONSTRUCTION, MAINTENANCE OR REPAIR WORK IN ANY OF THE CITY OF ALBUQUERQUE'S RIGHTS-OF-WAY. EMERGENCY WORK THAT WOULD PRESERVE LIFE OR PROPERTY IS EXCLUDED WITH THE UNDERSTANDING, THAT A PERMIT SHALL BE OBTAINED WITHIN 24 TO 48 HOURS.

2. CONTRACTOR SHALL AT THE TIME OF PERMIT REQUEST, SUBMIT FOR APPROVAL BY CONSTRUCTION COORDINATION, A TRAFFIC CONTROL PLAN DETAILING ALL EXISTING TOPOGRAPHY SUCH AS LANE WIDTHS, DRIVEWAYS, AND BUSINESS/RESIDENTIAL ACCESSES. THE TRAFFIC CONTROL PLAN SHALL INCLUDE ALL PHASES OF WORK AND SCHEDULES INVOLVED IN THE CONSTRUCTION PROJECT. ANY SEPARATE PHASES OF A CONSTRUCTION PROJECT SHALL BE GIVEN AN INDIVIDUAL PERMIT EACH. BLANKET PERMITS WILL NOT BE ISSUED.

3. THESE TYPICAL TRAFFIC CONTROL PLANS DO NOT REFLECT THE EXISTING TOPOGRAPHY SUCH AS DRIVEWAYS, LANE WIDTHS, AND BUSINESS/RESIDENTIAL ACCESSES. EVERY LOCATION THAT REQUIRES CONSTRUCTION TRAFFIC CONTROL SHALL HAVE A DETAILED TRAFFIC CONTROL PLAN SHOWING ALL EXISTING TOPOGRAPHY.

4. CONSTRUCTION SHALL NOT BEGIN UNLESS A TRAFFIC CONTROL PLAN HAS BEEN APPROVED AND VERIFIED BY CONSTRUCTION COORDINATION.

5. CONSTRUCTION COORDINATION SHALL BE NOTIFIED 48 HOURS PRIOR TO ANY TRAFFIC CONTROL CHANGES NEEDED BY CONTRACTOR, THAT WERE NOT PREVIOUSLY APPROVED. THESE TRAFFIC CONTROL CHANGES SHALL BE REQUESTED IN WRITING ACCOMPANIED WITH A TRAFFIC CONTROL PLAN REFLECTING SUCH CHANGES.

6. ALL CONSTRUCTION TRAFFIC CONTROL DEVICES SHALL COMPLY TO THE MANUAL ON UNIFORM TRAFFIC CONTROL DEVICES (MUTCD), LATEST EDITION. IT IS THE RESPONSIBILITY OF THE CONTRACTOR TO INSTALL, SERVICE AND MAINTAIN ALL TRAFFIC CONTROL DEVICES. TRAFFIC CONTROL DEVICES SHALL NOT BE REMOVED OR ALTERED IN ANY WAY WITHOUT THE APPROVAL OF CONSTRUCTION COORDINATION, PER SECTION 6A-4 OF THE MUTCD, LATEST EDITION.

7. THE CONSTRUCTION TRAFFIC CONTROL INITIAL SET-UP SHALL BE BY AN AMERICAN TRAFFIC SAFETY SERVICES ASSOCIATION (ATSSA) CERTIFIED WORKSITE TRAFFIC SUPERVISOR. THE MAINTENANCE AND SERVICING SHALL ALSO BE DONE BY AN ATSSA CERTIFIED WORKSITE TRAFFIC SUPERVISOR OR EQUIVALENT.

8. CONTRACTOR IS RESPONSIBLE TO MAINTAIN AND SERVICE ALL TRAFFIC CONTROL DEVICES 24 HOURS A DAY, 7 DAYS A WEEK THROUGHOUT LENGTH OF PROJECT. CONTRACTOR IS RESPONSIBLE THAT ALL TRAFFIC CONTROL DEVICES COMPLY WITH THE MUTCD, LATEST EDITION.

9. ALL ADVANCE WARNING SIGNS SHALL BE DOUBLE INDICATED WHENEVER THERE ARE MULTI-LANE TRAFFIC IN ANY ONE GIVEN DIRECTION AND THERE IS SUFFICIENT MEDIAN SPACE.

10. ALL BARRICADES IN ALL TAPERS AND TANGENTS SHALL BE PLACED APART, A DISTANCE MEASURED IN FEET, EQUAL TO THAT OF THE POSTED SPEED LIMIT. NO EXCEPTIONS UNLESS APPROVED BY CONSTRUCTION COORDINATION PER MUTCD SECTION 6A-4.

11. ALL WORK IN ARTERIAL ROADWAYS SHALL BE ON A CONTINUOUS 24 HOUR PER DAY BASIS UNTIL COMPLETED.

12. CONTRACTOR IS RESPONSIBLE TO PROVIDE CONSTRUCTION COORDINATION, A WEEKLY LOG OF DAILY INSPECTIONS OF BARRICADE AND MAINTENANCE SCHEDULES ON PROJECTS THAT ARE OVER ONE WEEK DURATION.

13. EQUIPMENT OR MATERIALS SHALL NOT BE STORED WITHIN 15 FEET OF A TRAVELED TRAFFIC LANE DURING NON-WORKING HOURS WITHOUT THE APPROVAL OF CONSTRUCTION COORDINATION.

14. CONTRACTOR SHALL PROVIDE AND MAINTAIN A SAFE AND ADEQUATE MEANS OF CHANNELIZING PEDESTRIAN TRAFFIC AROUND AND THROUGH THE CONSTRUCTION AREA.

15. CONTRACTOR IS RESPONSIBLE FOR OBLITERATION OF ANY CONFLICTING STRIPING AND RESPONSIBLE FOR ALL TEMPORARY STRIPING.

16. CONTRACTOR SHALL MAINTAIN ACCESS TO ALL FACILITIES, BUSINESSES AND/OR RESIDENTS AT ALL TIMES.

17. CONTRACTOR SHALL PROVIDE ACCESS SIGNS FOR BUSINESSES LOCATED WITHIN THE CONSTRUCTION AREA UNDER THE SUPERVISION OF CONSTRUCTION COORDINATION. EACH ACCESS SIGN SHALL HAVE 5 INCH, WHITE OPAQUE LETTERING ON BLUE REFLECTORIZED BACKGROUND. ACCESS SIGNS SHALL BE CONSIDERED INCIDENTAL TO THE BID AND NOT PART OF THE CONTRACT UNLESS OTHERWISE STATED. NO MORE THAN 3 BUSINESSES SHALL BE LISTED ON A ACCESS SIGN. SHOPPING CENTERS AND MALLS SHALL BE LISTED AS SUCH.

18. ALL ADVANCE WARNING SIGNS SHALL MEET THE MINIMUM REFLECTIVE INTENSITY REQUIREMENTS SET FORTH BY THE CITY OF ALBUQUERQUE. CONSTRUCTION COORDINATION SHALL DETERMINE ALL REQUIREMENTS AND APPROVE OR DISAPPROVE ANY ADVANCE WARNING SIGN PER SECTION 6A-4 OF THE MUTCD, LATEST EDITION.

19. 48 HOURS PRIOR TO OCCUPYING OR CLOSING OF A RIGHT-OF-WAY, CONTRACTOR SHALL NOTIFY: POLICE, FIRE DEPARTMENT, SCHOOLS, HOSPITALS, TRANSIT AUTHORITY, BUSINESSES AND/OR RESIDENTS THAT WILL BE AFFECTED BY THE CONSTRUCTION.

20. ANY FIELD ADJUSTMENTS SHALL BE APPROVED BY CONSTRUCTION COORDINATION.

21. EXCAVATIONS SHALL BE PLATED, TEMPORARILY PATCHED OR RESURFACED PRIOR TO OPENING OF TRAFFIC. A MINIMUM OF 11 FEET SHALL BE PROVIDED FOR TRAFFIC IN ANY GIVEN DIRECTION. CONTRACTOR IS RESPONSIBLE FOR ANY WORK INVOLVED IN SATISFYING THESE REQUIREMENTS.

22. CONTRACTOR SHALL AT ALL TIMES COMPLY WITH THE FOLLOWING:
1. STANDARDS AND REQUIREMENTS SET FORTH IN THE MANUAL ON UNIFORM TRAFFIC CONTROL DEVICES, LATEST EDITION.
2. THE CITY OF ALBUQUERQUE TRAFFIC CODE, LATEST EDITION.
3. SECTION 19 OF THE CITY OF ALBUQUERQUE'S STANDARD SPECIFICATIONS FOR PUBLIC WORK CONSTRUCTION, AS WELL AS OTHER SECTIONS.


23. FAILURE TO COMPLY WITH ANY OF THE ABOVE MENTIONED, WILL BE ADEQUATE CAUSE TO CEASE ALL WORK ON ANY CONSTRUCTION PROJECT. WORK WILL NOT RESUME UNTIL ALL REQUIREMENTS ARE ADDRESSED AND APPROVED BY CONSTRUCTION COORDINATION.

24. ALL TRAFFIC CONTROL DEVICES SHALL BE KEPT IN NEW-CLEAN CONDITION, WASHING OF EQUIPMENT IS INCIDENTAL TO IT'S PLACEMENT AND MAINTENANCE.

25. TRAFFIC CONTROL STANDARDS APPLY ONLY WHERE THE CONSTRUCTION TRAFFIC CONTROL PLANS ARE NOT SPECIFIC.

26. ADVANCE WARNING SIGNS SHALL BE 36"x36" MIN. WITH SUPER ENGINEERING GRADE SHEETING OR BETTER. MOUNTING HEIGHT AT TOP OF SIGN SHALL BE THE SAME AS FOR A 48" SIGN AS INDICATED IN THE M.U.T.C.D.

27. CONTRACTOR SHALL MAINTAIN A GRAFFITI-FREE WORKSITE. ALL GRAFFITI SHALL BE PROMPTLY REMOVED FROM ALL EQUIPMENT, BOTH PERMANENT AND TEMPORARY.

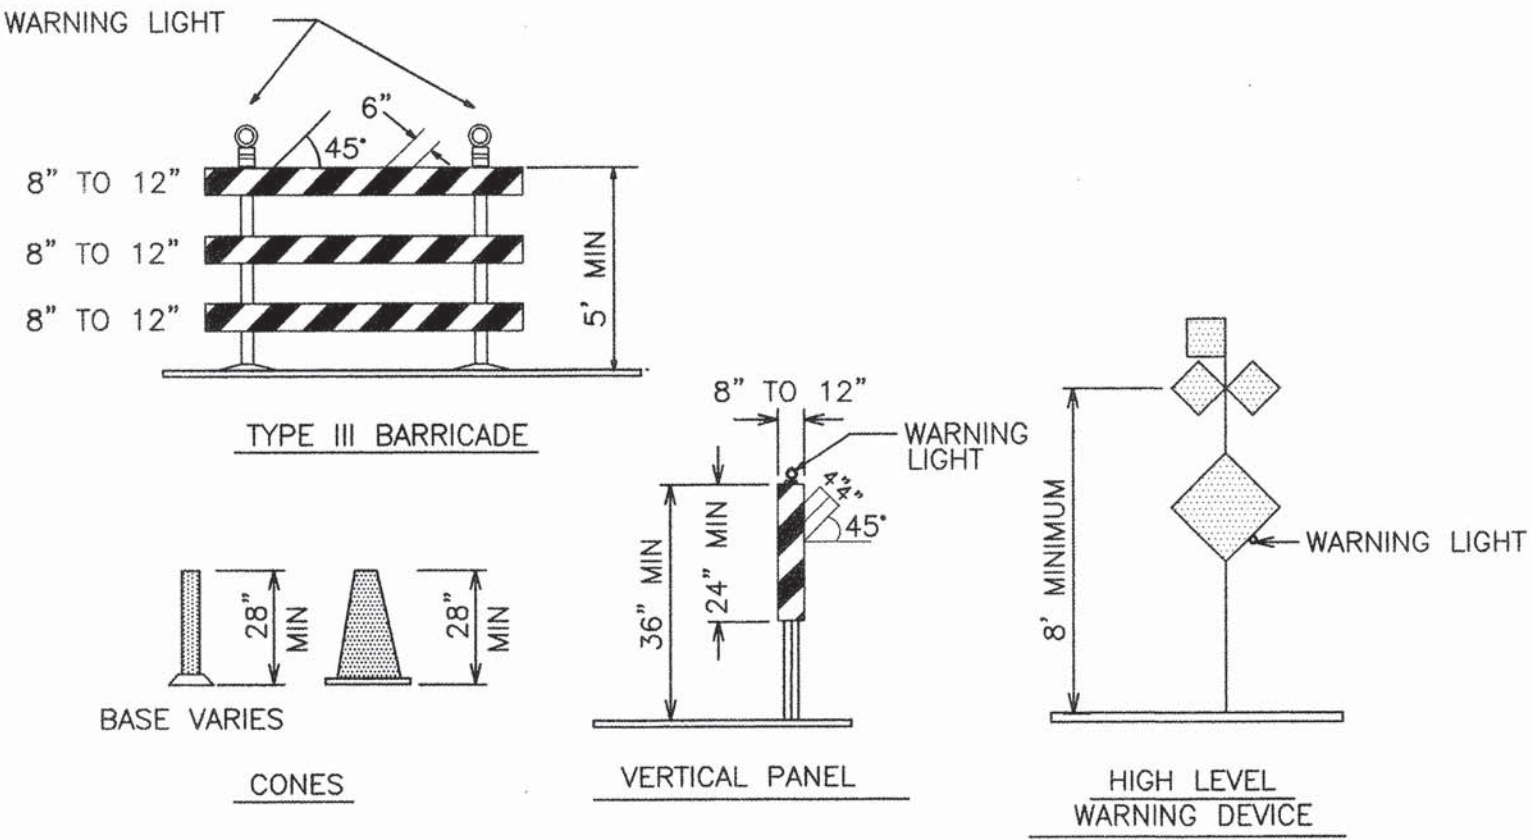

LEGEND
WORK AREA
BARRICADE - TYPE I, TYPE II, OR BARREL
BARRICADE - TYPE III
VERTICAL PANEL
WARNING SIGN
DISTANCE BETWEEN SIGNS - A DISTANCE MEASURED IN FEET EQUAL TO A VALUE OF TEN TIMES THE SPEED LIMIT OF THE STREET
FLAGMAN POSITION
SPACING BETWEEN BARRICADES - A DISTANCE MEASURED IN FEET EQUAL TO THE STREET LIMIT OF THE STREET
TAPER LENGTH - SEE CHART BELOW
THE TANGENT LENGTH IS EQUAL TO THE TAPER LENGTH FOR A GIVEN STREET.

TAPER REQUIREMENT

SPEED LIMIT (MPH)	TAPER LENGTH(L) (FEET)			MINIMUM NUMBER OF DEVICES FOR TAPER	MAXIMUM DEVICE SPACING IN FEET	
	10' LANE	11' LANE	12' LANE		ALONG TAPER	AFTER TAPER
20	70	75	80	5	20	20
25	105	115	125	6	25	25
30	150	165	180	7	30	30
35	205	225	245	8	35	35
40	270	295	320	9	40	40
45	450	495	540	13	45	45
50	500	550	600	13	50	50
55	550	605	660	13	55	55

RECOMMENDED SIGN SPACING(D) FOR ADVANCE WARNING SIGN SERIES

SPEED LIMIT (MPH)	MINIMUM DISTANCE IN FEET BETWEEN SIGNS		FROM LAST SIGN TO TAPER
	10' LANE	11' LANE	
0-20	10 X SPEED LIMIT	10 X SPEED LIMIT	10 X SPEED LIMIT
25-30	10 X SPEED LIMIT	10 X SPEED LIMIT	10 X SPEED LIMIT
30-35	10 X SPEED LIMIT	10 X SPEED LIMIT	10 X SPEED LIMIT
40-45	10 X SPEED LIMIT	10 X SPEED LIMIT	10 X SPEED LIMIT
50-60	10 X SPEED LIMIT	10 X SPEED LIMIT	10 X SPEED LIMIT

TAPER CRITERIA


TYPE OF TAPER	TAPER LENGTH
UPSTREAM TAPER:	
MERGING TAPER	L MINIMUM
SHIFTING TAPER	1/2 L MINIMUM
SHOULDER TAPER	1/2 L MINIMUM
TWO-WAY TRAFFIC TAPER	100 FEET MAXIMUM
DOWNSTREAM TAPERS	100 FEET PER LANE

TAPER LENGTH COMPUTATION

SPEED LIMIT	L = WS ² / 60
40 MPH OR LESS	
40 MPH OR GREATER	L = W x S

L = TAPER LENGTH
W = WIDTH OF OFFSET IN FEET
S = POSTED SPEED OR OFF-PEAK 85-PERCENTILE SPEED IN MPH

SIGN FACE DETAILS

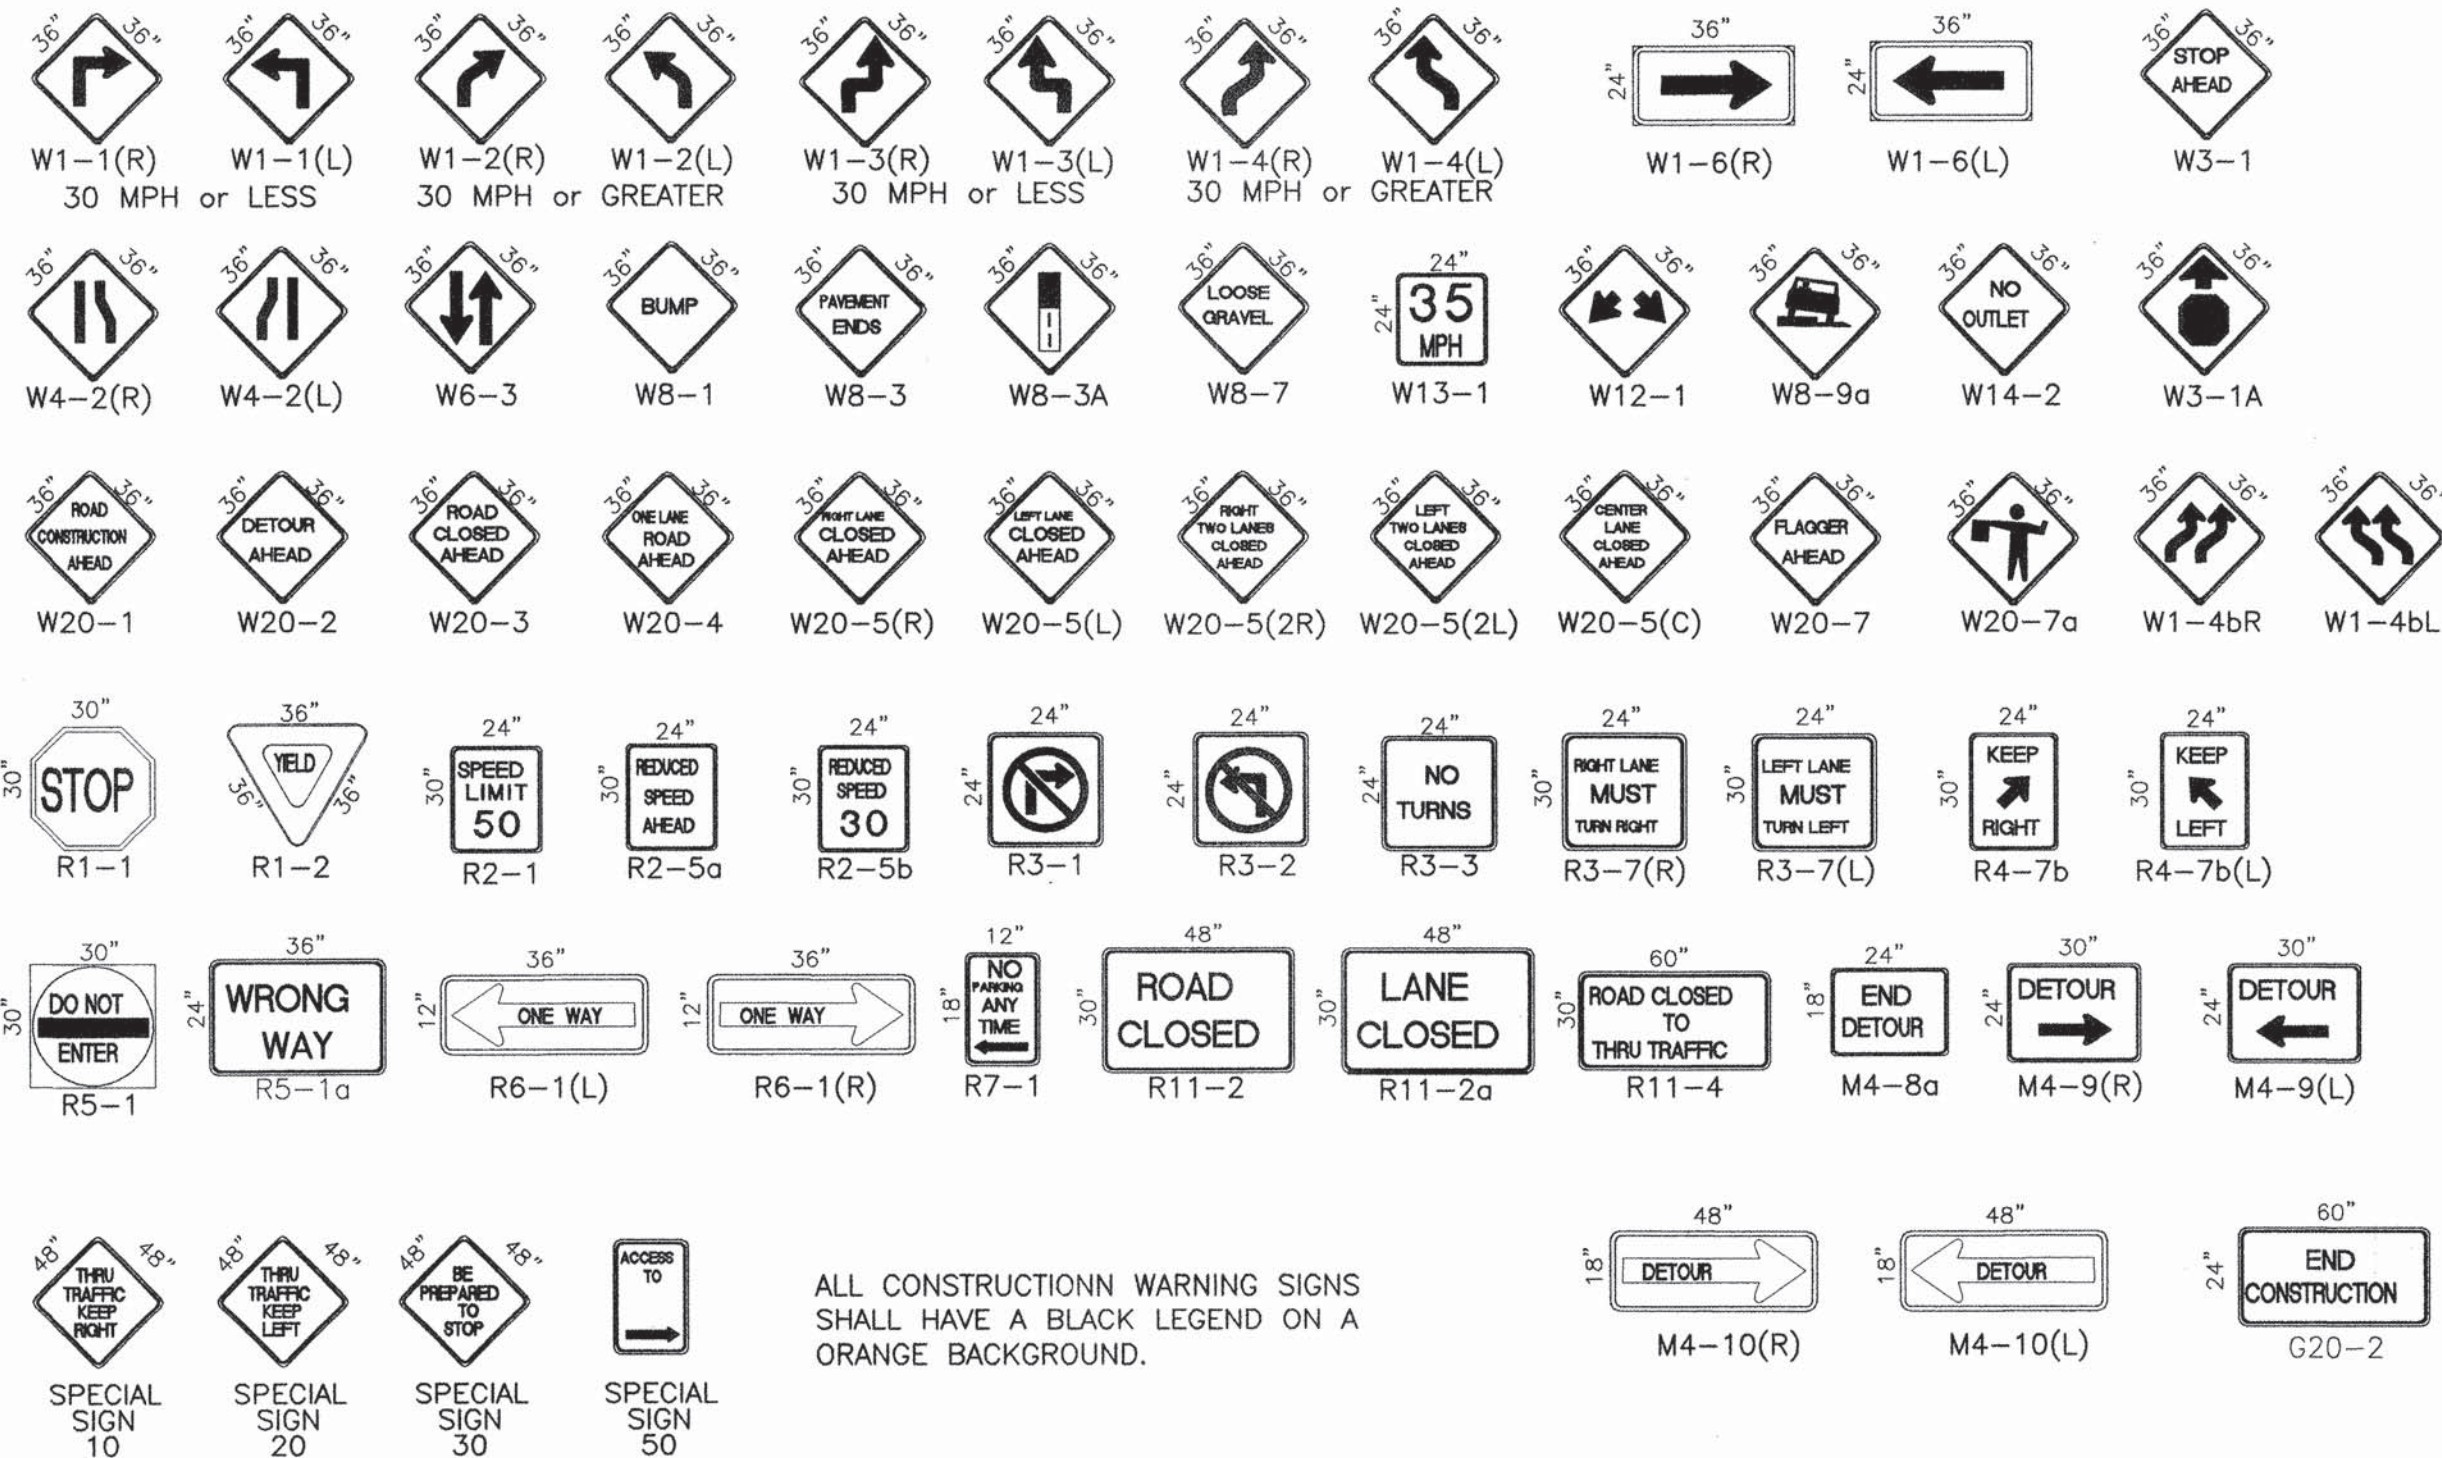

ALL CONSTRUCTION WARNING SIGNS SHALL HAVE A BLACK LEGEND ON A ORANGE BACKGROUND.

1 2 3 4 5 6 7 8 9 10 11 12 13 14 15
24 6586.83 2502

SCANNED BY
MESA REPRO

Bohannon & Huston
Courtney One 7500 JEFFERSON NE Albuquerque NEW MEXICO 87109
ENGINEERS PLANNERS PHOTOGRAMMETRISTS SURVEYORS SOFTWARE DEVELOPERS

CITY OF ALBUQUERQUE
PUBLIC WORKS DEPARTMENT
PINON POINTE II AT VENTANA RANCH
TRAFFIC CONTROL
SIGNING & CONSTRUCTION CONTROL STANDARDS
Design Review Committee City Engineer Approval
City Project No. 658683 Zone Map No. B-9 Sheet 25 Of 26
Last Design Update

