



CONSTRUCTION PLANS FOR
PIÑON POINTE UNIT IV
AT VENTANA RANCH
ALBUQUERQUE, NEW MEXICO

INDEX

SHEET NUMBER	DESCRIPTION
1	TITLE SHEET
2	SITE DESCRIPTION PLAN
3	PLAT
4-8	FINAL GRADING PLAN
8A	RETAINING WALL DETAILS
9	OVERALL PAVING PLAN
10	PAVING PLAN AND PROFILE SHEETS
11	JUNCO PLACE
12	KINGFISHER CT / KINGFISHER HAMMERHEAD
13	CEDAR WAXWING PL
14	OVERALL UTILITY PLAN
15	UTILITY PLAN AND PROFILE SHEETS
16	JUNCO PLACE
17	KINGFISHER CT / KINGFISHER HAMMERHEAD
18	CEDAR WAXWING
19	SIGNING AND CONSTRUCTION
20	TRAFFIC CONTROL STANDARDS
21	TYPICAL TRAFFIC CONTROL AND
22	SIGNING EXAMPLES (REF. M.U.T.C.D.)

RECORD DRAWINGS

I, PATRICK J. CONLEY of the firm of SMITH ENGR. CO.
A Registered Professional Engineer in the State of New Mexico, do hereby certify, to the best of my knowledge and belief, that the infrastructure installed as part of this project has been inspected by me or by a qualified person under my direct supervision and has been constructed in accordance with the plans and specifications, ~~which~~
~~which~~ Smith Engineering Company was approved by the City Engineer and that the original design intent of the approved plans has been met, except as noted by me on the as-built construction drawings. This Certification is based on site inspections by me or personnel under my direction and survey information provided by TIM ALDRICH, LS (Surveyor Name) NMPS number 7712 (PS #).

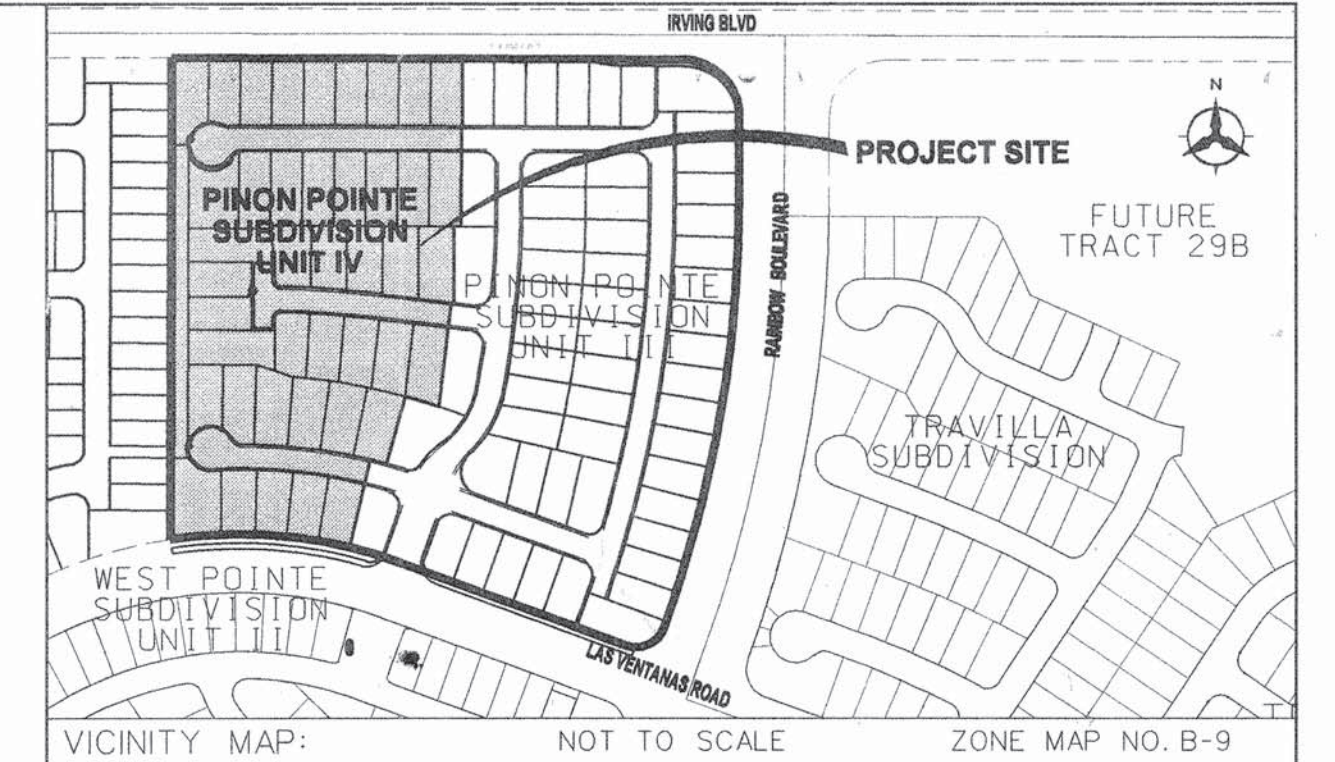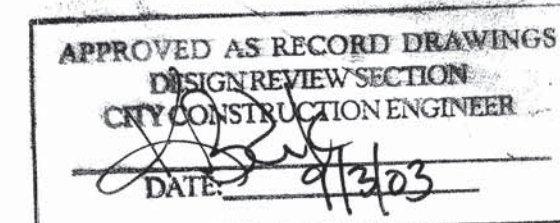

- NOTICE TO CONTRACTORS**
- ALL WORK DETAILED ON THESE PLANS TO BE PERFORMED UNDER CONTRACT SHALL, EXCEPT AS OTHERWISE STATED OR PROVIDED FOR HEREON, BE CONSTRUCTED IN ACCORDANCE WITH THE CITY OF ALBUQUERQUE STANDARD SPECIFICATIONS FOR PUBLIC WORKS CONSTRUCTION, 1986 EDITION AND SHALL INCLUDE UPDATE No. 6.
 - TWO WORKING DAYS PRIOR TO ANY EXCAVATION, THE CONTRACTOR MUST CONTACT NEW MEXICO ONE CALL SYSTEM (260-1990) FOR LOCATION OF EXISTING UTILITIES.
 - PRIOR TO CONSTRUCTION, THE CONTRACTOR SHALL EXCAVATE AND VERIFY THE HORIZONTAL AND VERTICAL LOCATIONS OF ALL OBSTRUCTIONS. SHOULD A CONFLICT EXIST, THE CONTRACTOR SHALL NOTIFY THE ENGINEER OR SURVEYOR IMMEDIATELY SO THAT THE CONFLICT CAN BE RESOLVED WITH A MINIMUM AMOUNT OF DELAY.
 - FIVE (5) WORKING DAYS PRIOR TO BEGINNING CONSTRUCTION, THE CONTRACTOR SHALL SUBMIT TO CONSTRUCTION COORDINATION DIVISION A DETAILED CONSTRUCTION SCHEDULE. TWO (2) WORKING DAYS PRIOR TO CONSTRUCTION, THE CONTRACTOR SHALL OBTAIN A BARRICADING PERMIT FROM THE CONST. COORDINATION DIVISION. CONTRACTOR SHALL NOTIFY BARRICADE ENGINEER PRIOR TO OCCUPYING AN INTERSECTION. REFER TO SECTION 19 OF THE GENERAL CONDITIONS OF THE STANDARD SPECIFICATIONS.
 - ALL PERMANENT STREET STRIPING ALTERED OR DESTROYED SHALL BE REPLACED WITH PLASTIC REFLECTORIZED PAVEMENT MARKING BY CONTRACTOR TO LOCATION AS EXISTING OR AS INDICATED BY THIS PLAN SET.
 - CONTRACTOR SHALL NOTIFY THE ENGINEER NOT LESS THAN SEVEN (7) DAYS PRIOR TO STARTING WORK IN ORDER THAT THE CITY SURVEYOR MAY TAKE NECESSARY MEASURES TO INSURE THE PRESERVATION OF SURVEY MONUMENTS. CONTRACTOR SHALL NOT DISTURB PERMANENT SURVEY MONUMENTS WITHOUT THE CONSENT OF THE CITY SURVEYOR AND SHALL NOTIFY THE CITY SURVEYOR AND BEAR THE EXPENSE OF REPLACING ANY THAT MAY BE DISTURBED WITHOUT PERMISSION. REPLACEMENT SHALL BE DONE ONLY BY THE CITY SURVEYOR. WHEN A CHANGE IS MADE IN THE FINISHED ELEVATIONS OF THE PAVEMENT OF ANY ROADWAY IN WHICH A PERMANENT SURVEY MONUMENT IS LOCATED, CONTRACTOR SHALL, AT HIS OWN EXPENSE, ADJUST THE MONUMENT COVER TO THE NEW GRADE UNLESS OTHERWISE SPECIFIED. REFER TO SECTION 4.4 OF THE GENERAL CONDITIONS OF THE STANDARD SPECIFICATIONS.
 - ANY WORK WITHIN AN ARTERIAL ROADWAY REQUIRES TWENTY-FOUR HOUR CONSTRUCTION.
 - ALL UTILITY WORK SHALL BE CONSTRUCTED IN ACCORDANCE WITH NEW MEXICO UTILITIES, INC. SPECIFICATIONS FOR WATER AND WASTEWATER FACILITIES (MOST RECENT REVISIONS).
 - THE CONTRACTOR SHALL NOTIFY NEW MEXICO UTILITIES, (898-2661) THREE WORKING DAYS PRIOR TO BEGINNING THE CONSTRUCTION OF THE UTILITIES.
 - CONTRACTOR SHALL MAINTAIN A GRAFFITI-FREE WORK SITE. CONTRACTOR SHALL PROMPTLY REMOVE ANY GRAFFITI FROM ALL EQUIPMENT, WHETHER PERMANENT OR TEMPORARY.
 - FOR STORM DRAIN CONSTRUCTION, RCP PIPE JOINTS SHALL NOT BE GROUTED PRIOR TO FINAL INSPECTION. FINAL INSPECTION WILL DETERMINE JOINTS TO BE GROUTED FOR FINAL ACCEPTANCE OF THE CONSTRUCTION.
- THE FOLLOWING NOTES ALSO APPLY WHEN CHECKED**
- ☒ ALL UTILITIES AND UTILITY SERVICE LINES SHALL BE INSTALLED PRIOR TO PAVING.
 - ☒ BACKFILL COMPACTION SHALL BE ACCORDING TO SPECIFIED STREET USE.
 - ☐ TACK COAT REQUIREMENTS SHALL BE DETERMINED BY THE ~~ENGINEER~~ ENGINEER.
 - ☒ SIDEWALKS AND WHEELCHAIR RAMP WITHIN THE CURB RETURNS SHALL BE CONSTRUCTED WHEREVER A NEW CURB RETURN IS CONSTRUCTED.
 - ☐ IF CURB IS DEPRESSED FOR A DRIVEPAD, THE DRIVEPAD SHALL BE CONSTRUCTED PRIOR TO ACCEPTANCE OF CURB AND GUTTER.
 - ☒ ALL STORM DRAINAGE FACILITIES SHALL BE COMPLETED PRIOR TO FINAL ACCEPTANCE.
 - ☒ THE REQUESTOR OR DEVELOPER SHALL BE RESPONSIBLE FOR REPAIR OR REPLACEMENT OF ALL CURB AND GUTTER OR SIDEWALK DAMAGED AFTER APPROVAL BY THE CITY ENGINEER OF WORK COMPLETED BY THE CONTRACTOR.

SURVEYOR'S CERTIFICATION
I, Timothy Aldrich, a duly qualified Registered Professional Land Surveyor under the laws of the State of New Mexico, do hereby certify that the "as-built" information shown on these drawings was obtained from field construction and "as-built" surveys performed by me or under my supervision, that the "as-built" information shown on these drawings was added by me or under my supervision, and that this "as-built" information is true and correct to the best of my knowledge and belief. Aldrich Land Surveying is not responsible for any of the design concepts, calculations, engineering, or content of the record drawings.
Timothy Aldrich, P.S. No. 7712
Date 06-09-03



Bohannon & Huston
Courtyard I 7500 Jefferson St. NE Albuquerque, NM 87109-4335
ENGINEERING • SPATIAL DATA • ADVANCED TECHNOLOGIES

REV.	SHEETS	CITY ENGINEER	DATE	USER DEPARTMENT	DATE	USER DEPARTMENT	DATE
ENGINEERS STAMP & SIGNATURE	APPROVALS	ENGINEER	DATE	*****	APPROVED FOR CONSTRUCTION		
	DRC Chairman		1/2-27-02				
	Transportation		11/23/02				
	Water/Wastewater		11/25/02				
	Hydrology		11/25/02				
	CIP						
	Const. Mngmt.						
	Const. Coord.		12-27-02				
	NMUI		11-22-02				
DRB Case Number	City Project No.						
1001916	658685						
Sheet	Of						
1	18						

[illegible]

1	2	3	4	5	6	7	8	9	10	11	12	13	14	15
2	6	5	8	6	.	8	5		0	2	0	3		

Bohannon  **Huston** 

Courtyard | 7500 Jefferson St. NE Albuquerque, NM 87109-4335

ENGINEERING  **SPATIAL DATA**  **ADVANCED TECHNOLOGIES**



CITY OF ALBUQUERQUE
 PUBLIC WORKS DEPARTMENT
 ENGINEERING DEVELOPMENT GROUP


PINON POINTE IV SUBDIVISION AT VENTANA RANCH
SITE DESCRIPTION PLAN

DESIGN REVIEW COMMITTEE		CITY ENGINEER APPROVAL		LAST DESIGN UPDATE	MO./DAY/YR.	MO./DAY/YR.
APPROVED DEC 27 2002 DESIGN REVIEW COMMITTEE	APPROVED MAR - 4 2003 CITY ENGINEER					

CITY PROJECT NO.	658685	ZONE MAP NO.	B-9	SHEET	2	OF	18
------------------	--------	--------------	-----	-------	---	----	----

COPYRIGHT BOHANNAN-HUSTON, INC 2001

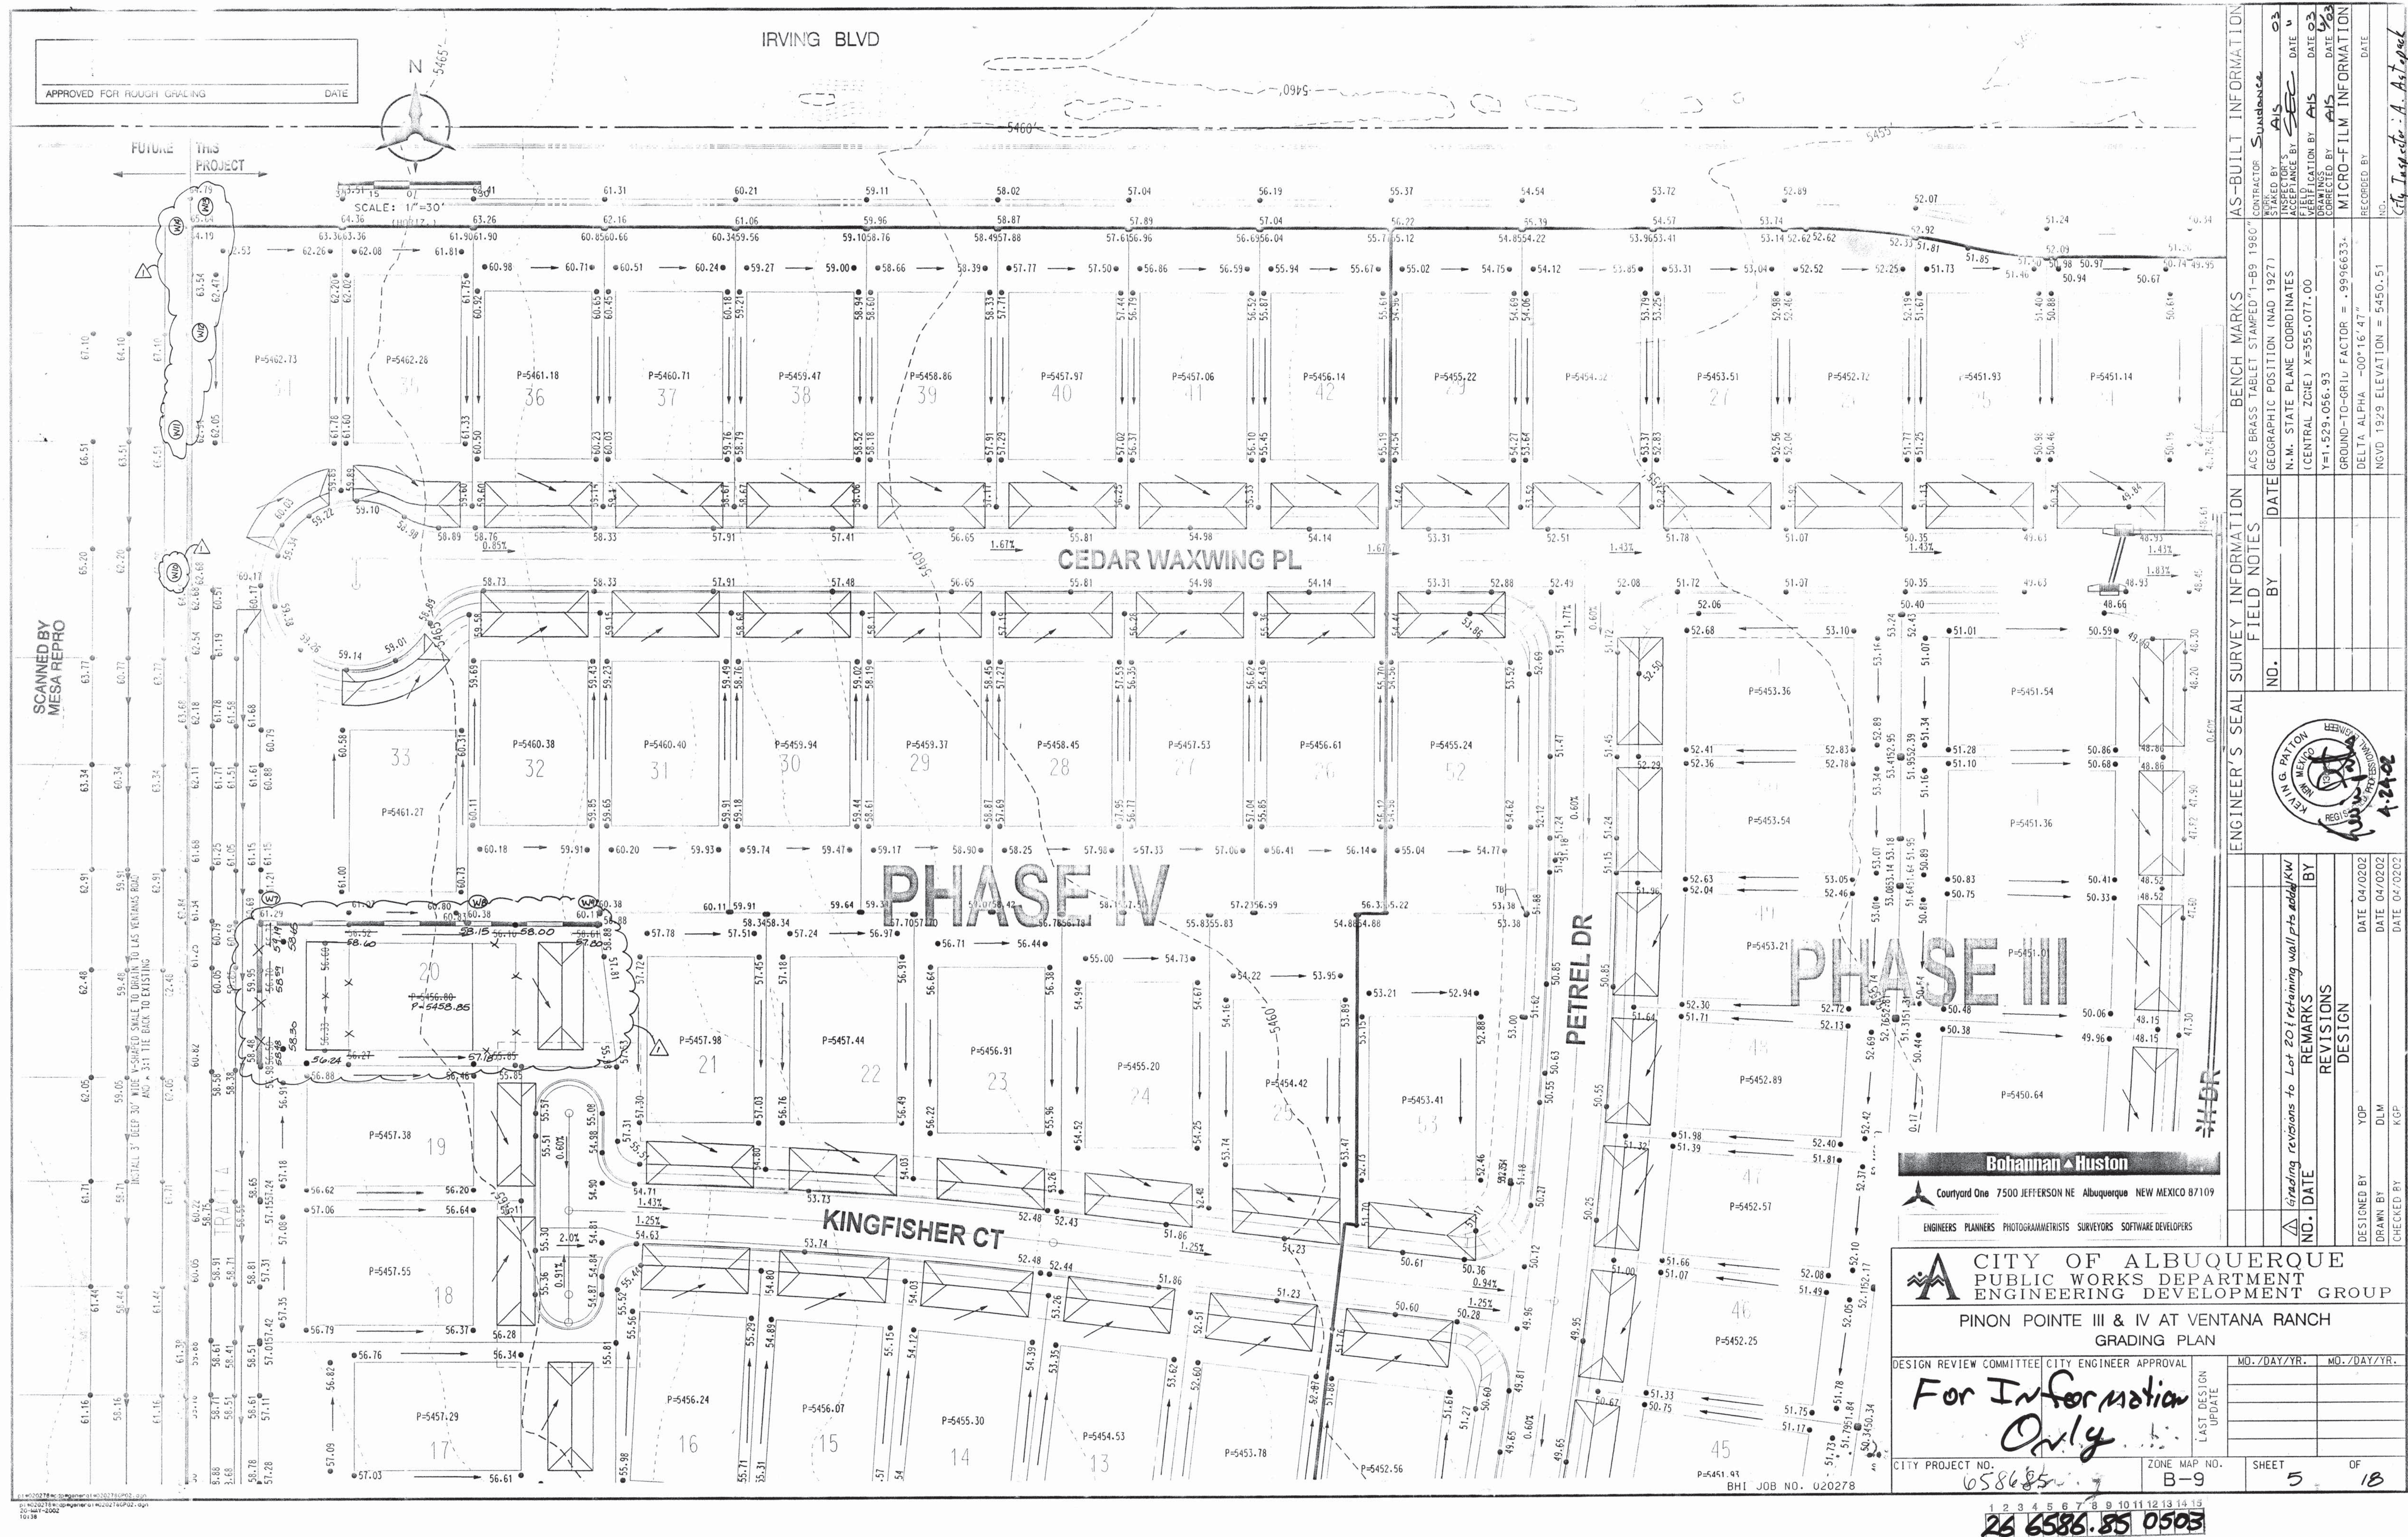

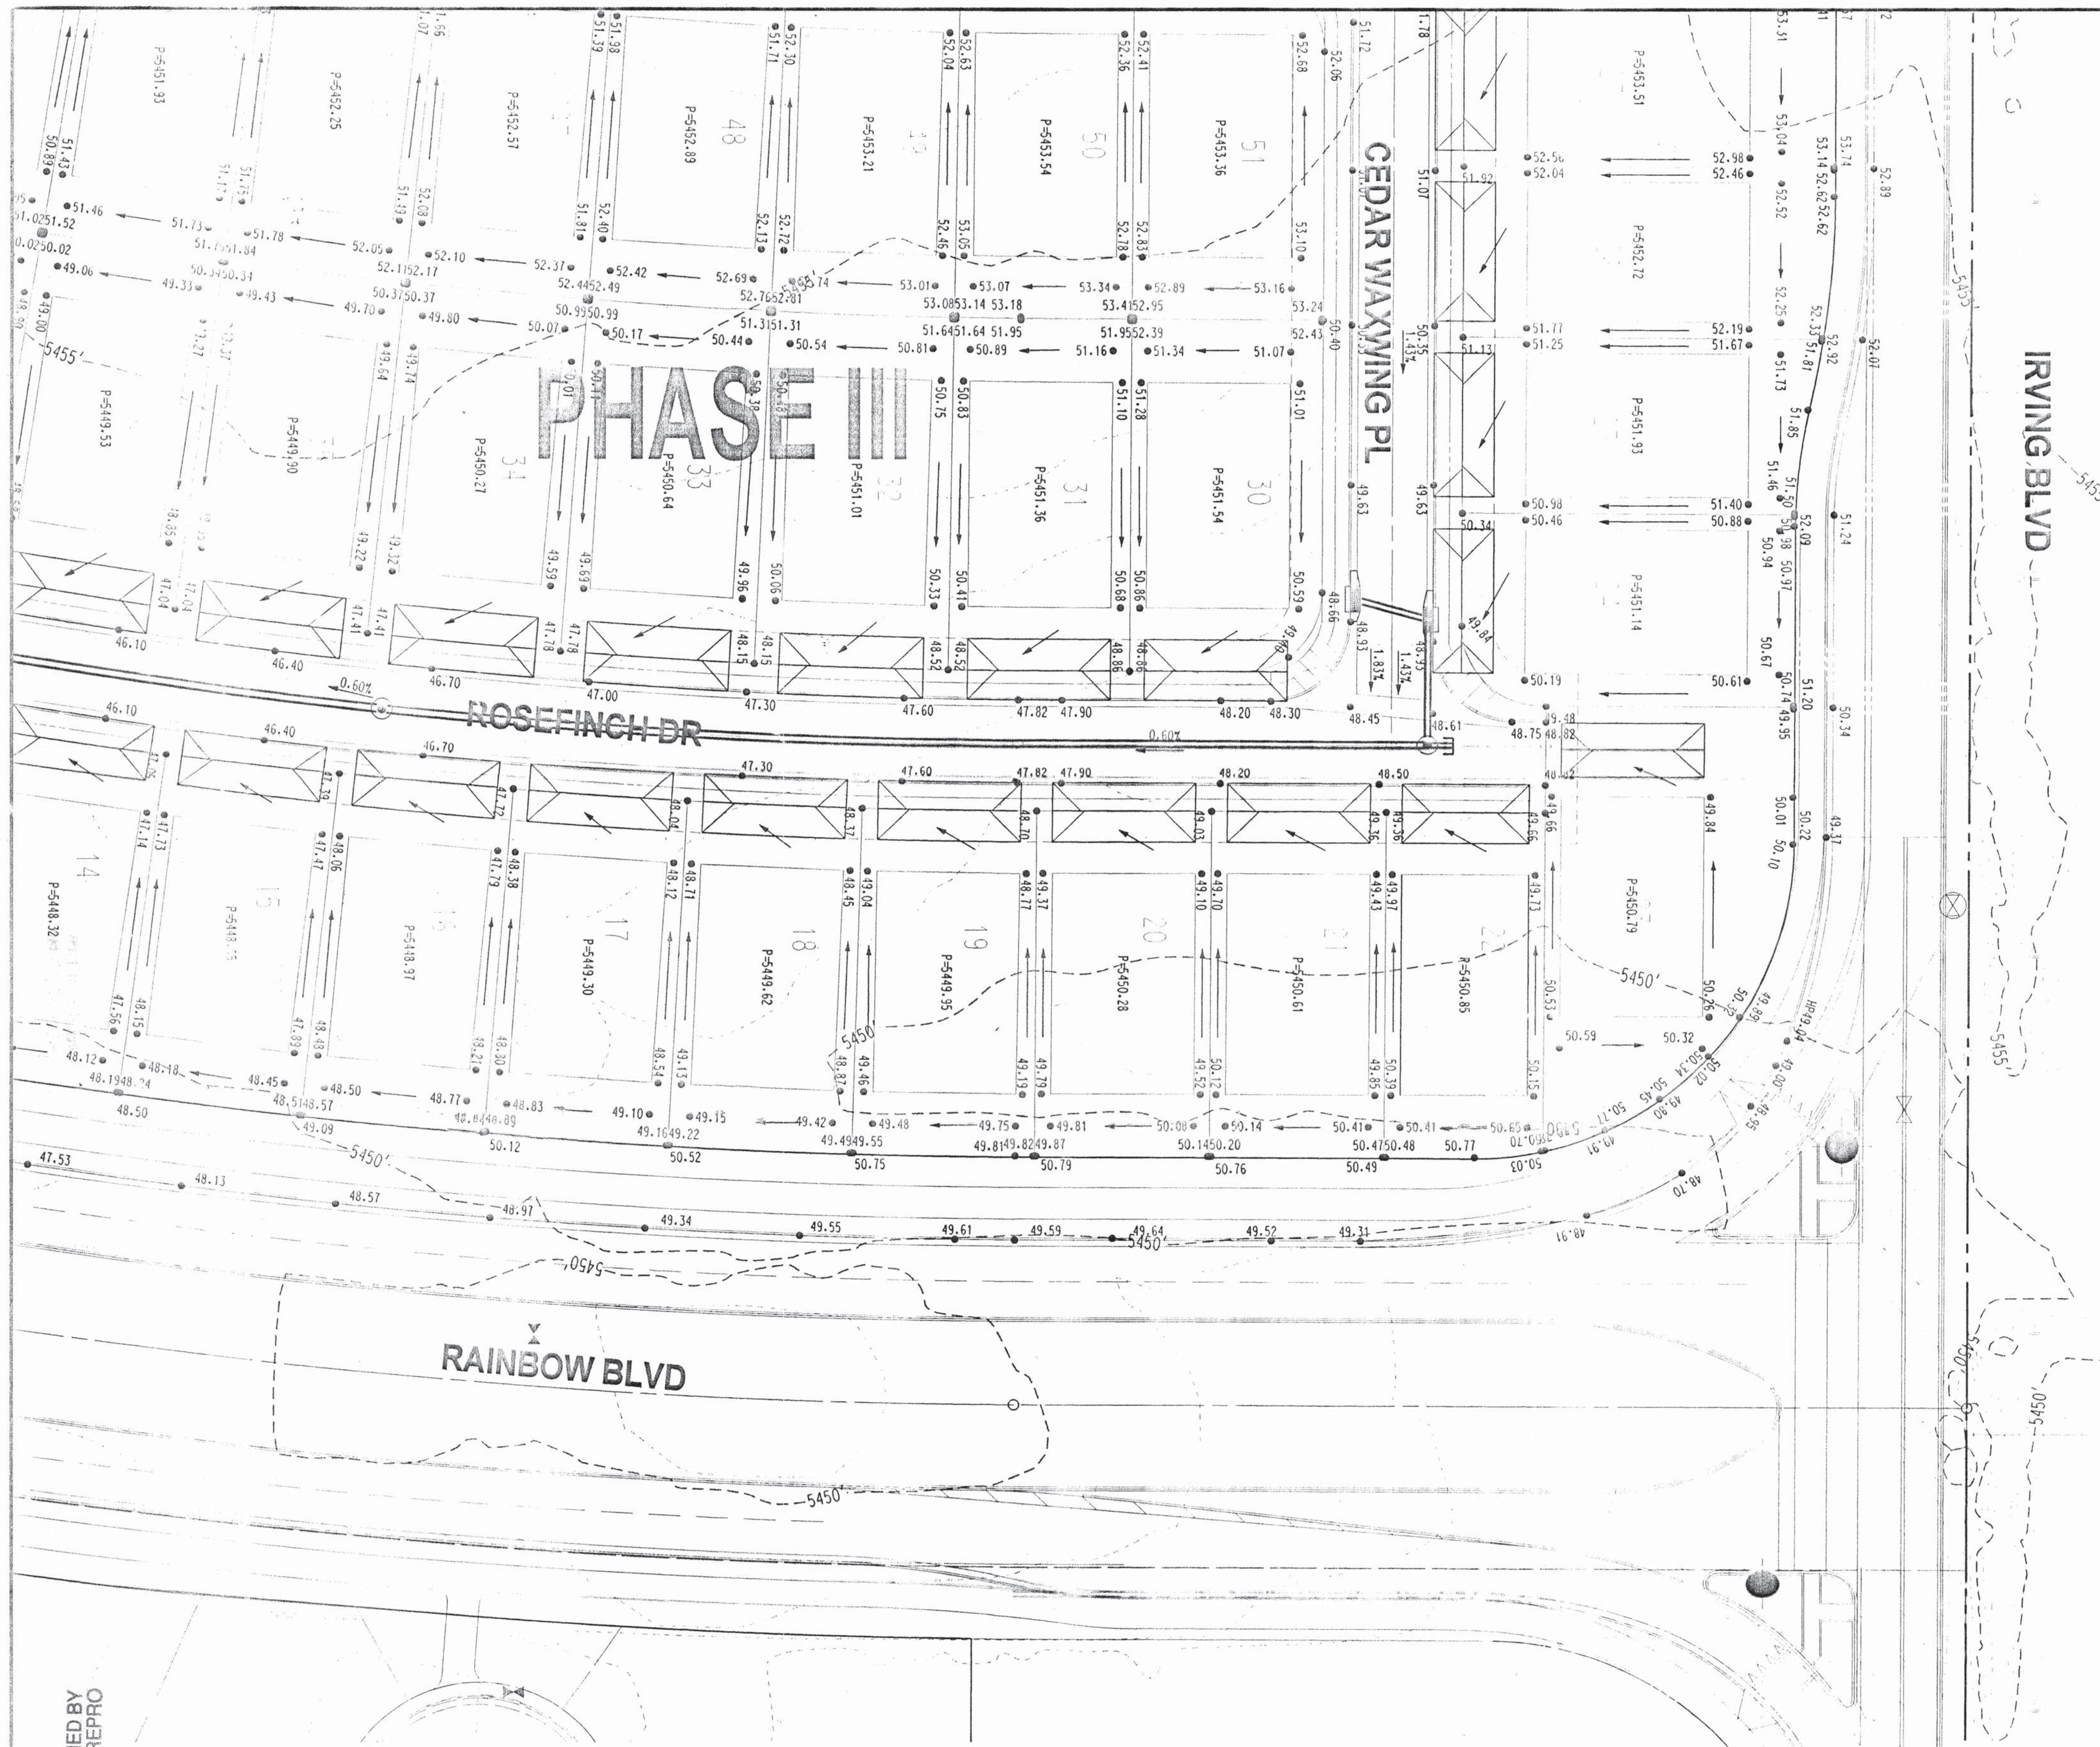

SCANNED BY
MESA REPRO



SCALE: 1"=30'
1 2 3 4 5 6 7 8 9 10 11 12 13 14 15
26 6586.85 0603
BHT JOB NO. 020278

APPROVED FOR ROUGH GRADING _____ DATE _____


Bohannon & Huston
Court yard One 7500 JEFFERSON NE Albuquerque NEW MEXICO 87109
ENGINEERS PLANNERS PHOTOGRAMMETRISTS SURVEYORS SOFTWARE DEVELOPERS

 CITY OF ALBUQUERQUE PUBLIC WORKS DEPARTMENT ENGINEERING DEVELOPMENT GROUP	
PINON POINTE III & IV AT VENTANA RANCH GRADING PLAN	
DESIGN REVIEW COMMITTEE	CITY ENGINEER APPROVAL
For Information Only	
CITY PROJECT NO. 658685	ZONE MAP NO. B-9
SHEET 6 OF 18	

ENGINEER'S SEAL SURVEY INFORMATION		BENCH MARKS		AS-BUILT INFORMATION	
NO.	BY	DATE	FIELD NOTES	ACS BRASS TABLET STAMPED "1-B9 1980"	CONTRACTOR
				GEOGRAPHIC POSITION (NAD 1927)	Sundance
				N.M. STATE PLANE COORDINATES (CENTRAL ZONE) X=355,077.00	DATE 03
				Y=1,529,056.93	DATE 03
				GROUND-TO-GRID FACTOR = .99966334	DATE 03
				DELTA ALPHA = 00°16'47"	DATE 03
				NGVD 1929 ELEVATION = 5450.51	DATE 03
				RECORDED BY	RECORDED BY
				NGVD 1929 ELEVATION = 5450.51	RECORDED BY




City Engineer A. Aschack

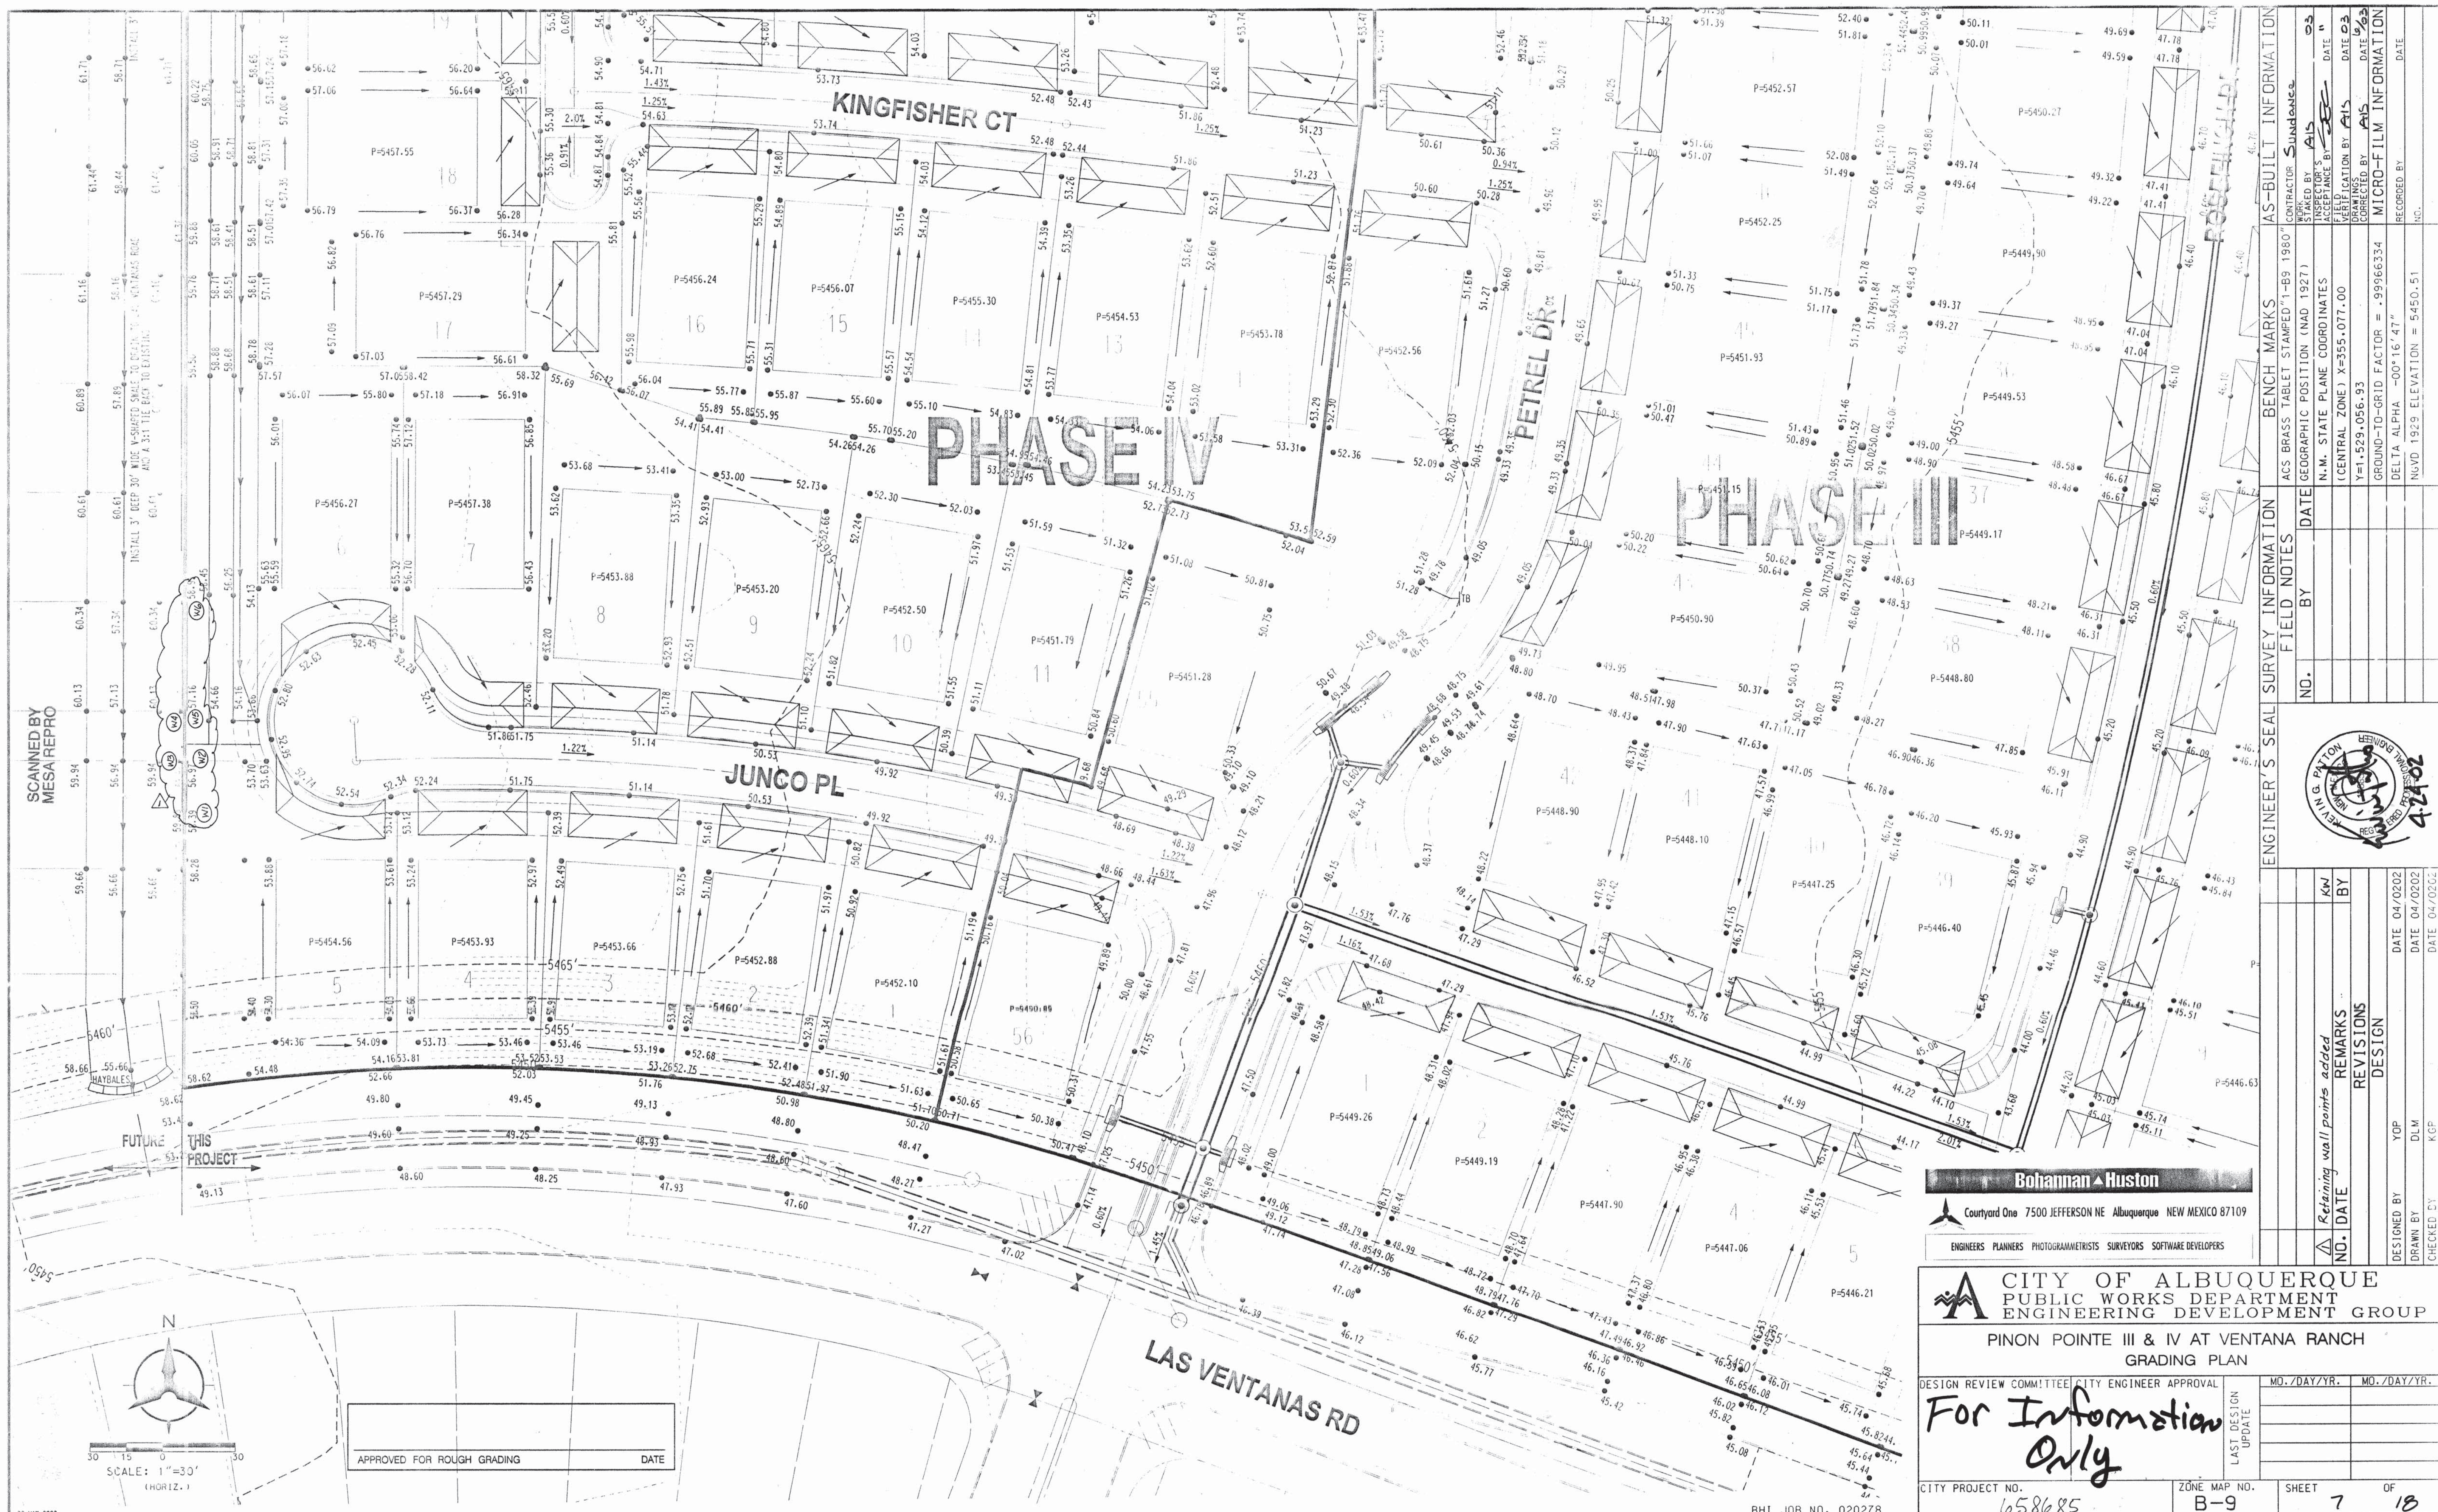



20-MAY-2002
p1#020278#cdp#gener#020278CP04.dg
p1#020278#cdp#gener#020278CP04.dg
20-MAY-2002
10:40

 CITY OF ALBUQUERQUE PUBLIC WORKS DEPARTMENT ENGINEERING DEVELOPMENT GROUP			
PINON POINTE III & IV AT VENTANA RANCH GRADING PLAN			
DESIGN REVIEW COMMITTEE CITY ENGINEER APPROVAL		MO./DAY/YR. MO./DAY/YR.	
For Information Only		LAST DESIGN UPDATE	
CITY PROJECT NO. 658685		ZONE MAP NO. B-9	
		SHEET OF 7 18	

1 2 3 4 5 6 7 8 9 10 11 12 13 14 15
26 6586.85 0703

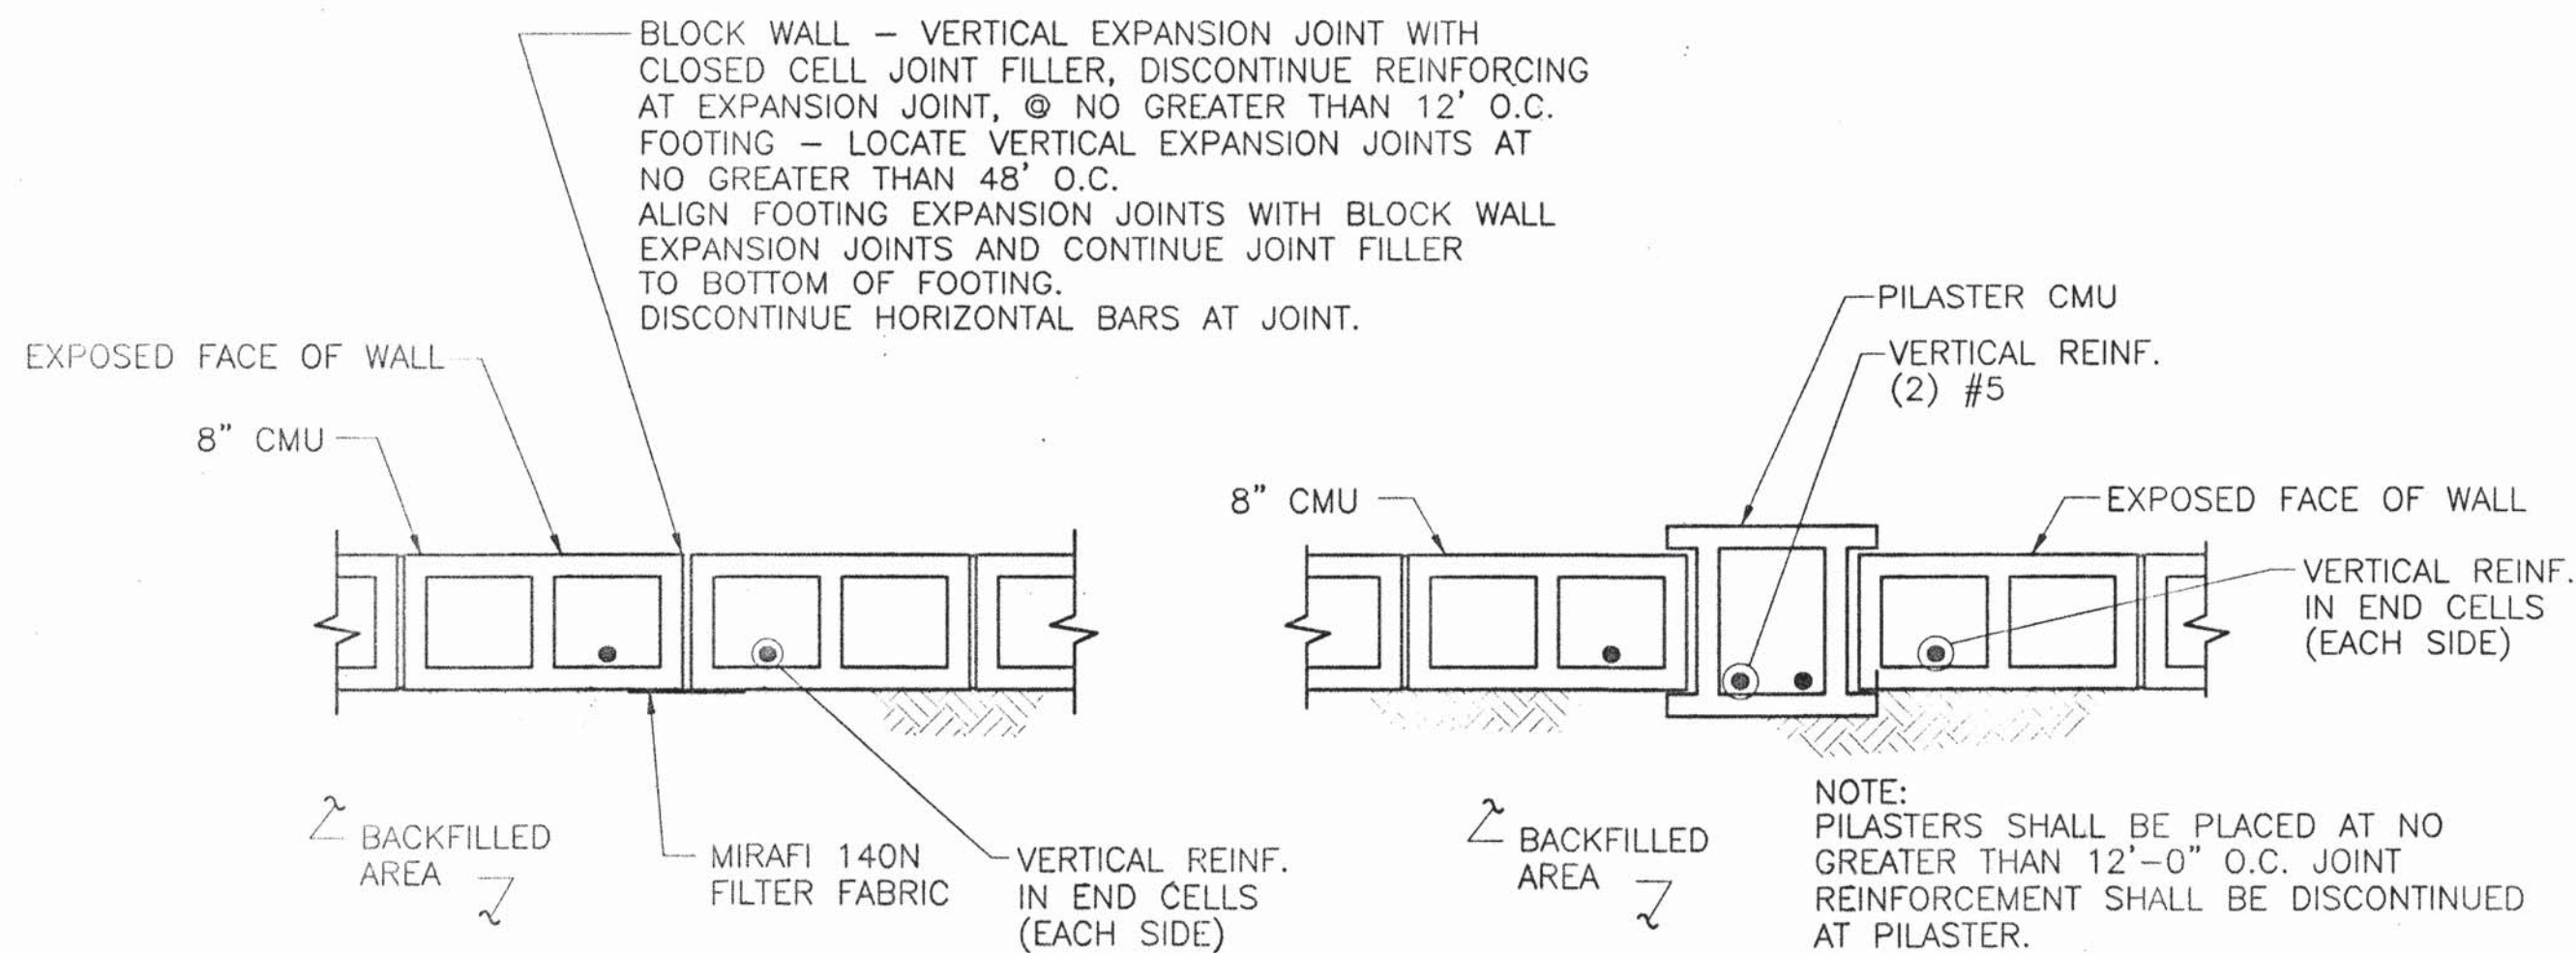

EXPANSION JOINT DETAILS
NO SCALE

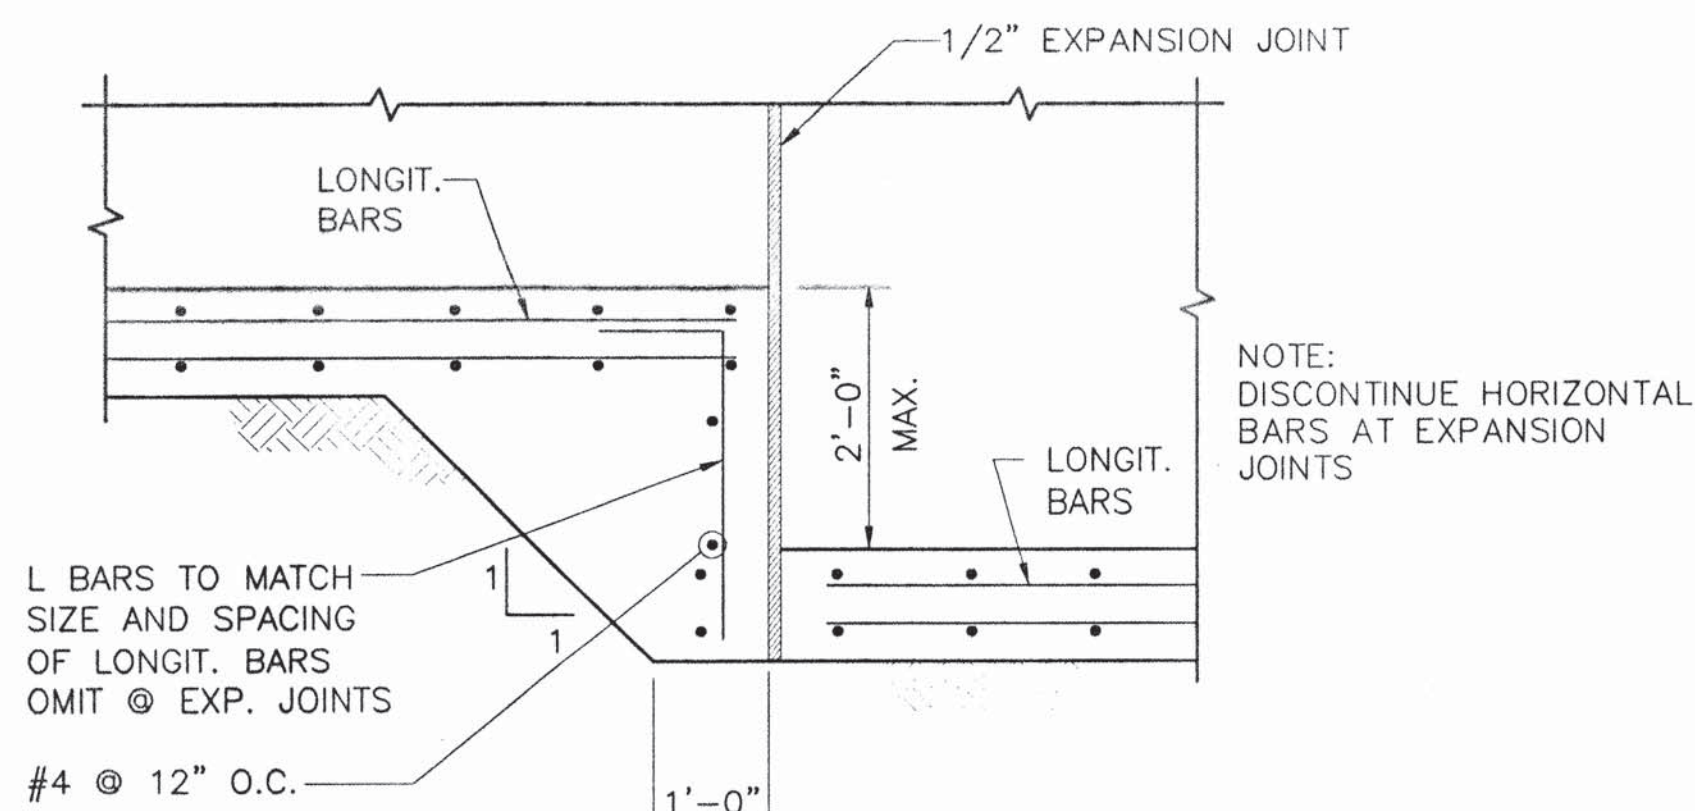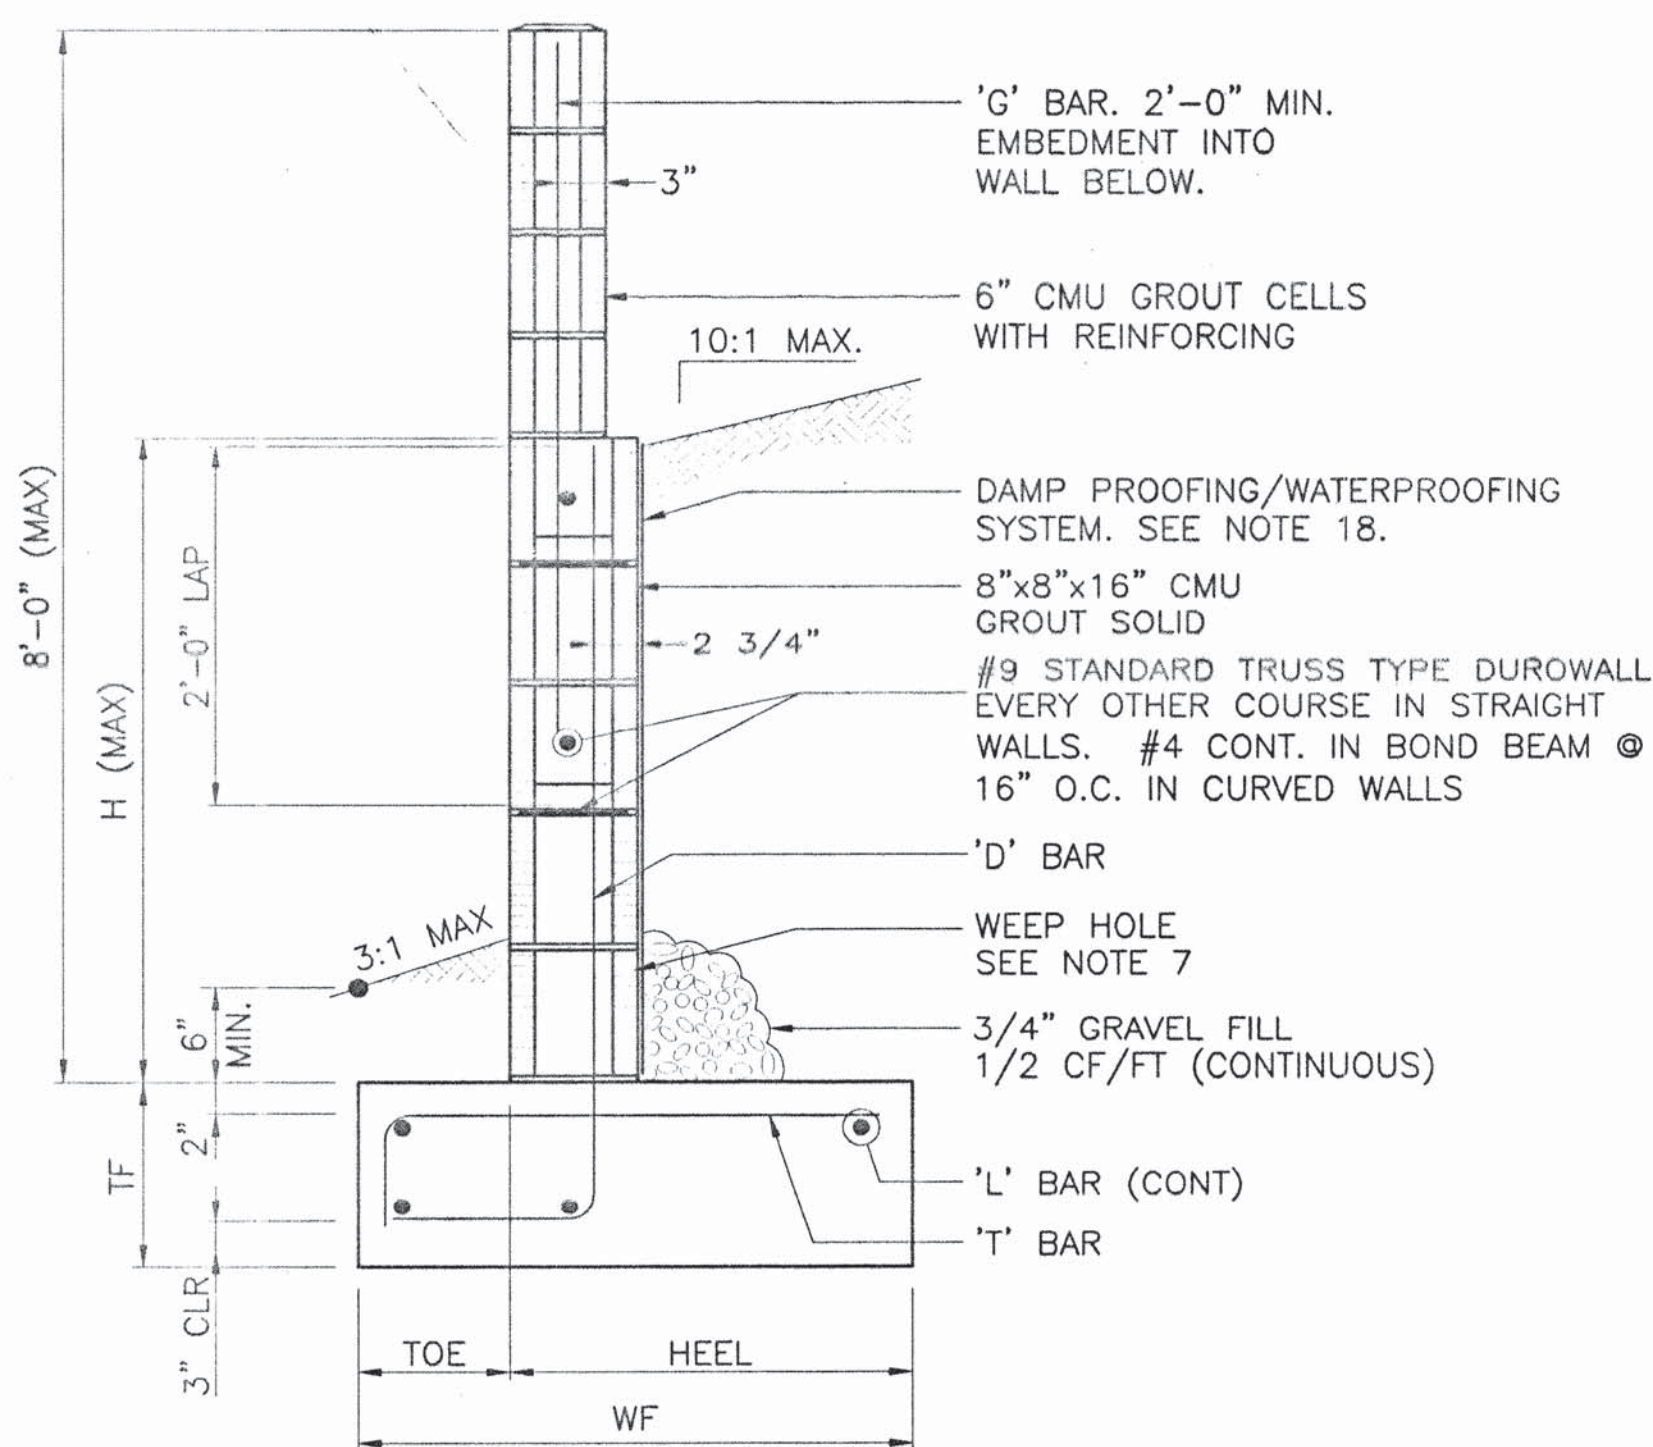

STEP FOOTING DETAIL
NO SCALE

2'-0" TO 4'-8" RETAINING/GARDEN WALL
NO SCALE SEE TABLE BELOW

DIMENSIONS					
WALL TYPE	H (MAX)	TF (IN)	TOE (IN)	HEEL (IN)	WF (IN)
A	3'-4"	10	9	18	27
B	4'-8"	10	12	23	35

REINFORCING							
WALL TYPE	D		G		T		L
	SIZE	SP (IN)	SIZE	SP (IN)	SIZE	SP (IN)	
A	4	32	4	48	4	16	4
B	5	24	4	48	4	18	4

SLOPING BACKFILL 3:1 MAX

NOTES FOR RETAINING WALLS

- WORKMANSHIP AND MATERIALS SHALL CONFORM TO THE CITY OF ALBUQUERQUE STANDARD SPECIFICATIONS FOR PUBLIC WORKS CONSTRUCTION, LATEST EDITION.
- STRUCTURAL CAST-IN-PLACE CONCRETE:** STRUCTURAL CONCRETE SHALL BE IN ACCORDANCE WITH SECTION 101, TABLE 101.C, HYDRAULIC STRUCTURES.
- REINFORCING STEEL:** STEEL REINFORCEMENT AND PLACEMENT SHALL BE IN ACCORDANCE WITH SECTION 102-STEEL REINFORCEMENT, AND SHALL CONFORM TO ASTM A615, GRADE 60. ALL LAP SPLICES SHALL BE AS SHOWN ON THE PLANS.
- SUBGRADE PREPARATION:** EXPOSED SOILS SHALL BE SCARIFIED TO A DEPTH OF 8", MOISTURE CONDITIONED TO A NEAR OPTIMUM ($\pm 3\%$) MOISTURE CONTENT AND COMPACTED TO A MINIMUM OF 95% OF MAXIMUM DENSITY AS DETERMINED BY ASTM D-1557 WITH A MINIMUM OF 20 PASSES BY A MINIMUM 20 TON VIBRATOR COMPACTOR. ANY SOFT OR "SPONGY" AREAS SHALL BE REMOVED. DURING BACKFILLING, THE CONTRACTOR SHALL BE LIMITED TO THE USE OF HAND OPERATED COMPACTION EQUIPMENT WITHIN A ZONE OF FIVE FEET HORIZONTALLY FROM THE BACK OF THE WALL. THE BACKFILL SHALL BE IN LIFTS NOT TO EXCEED EIGHT INCHES, WATERED AS NECESSARY AND COMPACTED.
- RETAINING WALL SHALL NOT BE BACK-FILLED UNTIL AT LEAST 7 DAYS AFTER PLACING OF FINAL GROUT LEVEL. CARE SHOULD BE TAKEN TO AVOID EXERTING IMPACT FORCES ON THE WALL AS COULD BE CAUSED BY A LARGE MASS OF MOVING EARTH. SLOPES UP AWAY FROM WALLS SHOULD NOT EXCEED 10:1.
- THE CONTRACTOR SHALL BE RESPONSIBLE FOR PROVIDING SAFE AND ADEQUATE SHORING FOR ALL PARTS OF THE WALL AND ANY ADJACENT STRUCTURES DURING CONSTRUCTION, AS WELL AS WORKER SAFETY AND COMPLIANCE WITH OSHA OR OTHER AGENCY SAFETY GUIDELINES.
- WEEP HOLES: PLACE A 2'x1' PIECE OF MIRAFI 140N FILTER FABRIC ON THE BACK OF WALL AT EACH WEEP LOCATION. OMIT HEAD JOINT ON BOTTOM TWO COURSES AT 48" O.C.
- VERTICAL EXPANSION AND VERTICAL CONTRACTION JOINTS SHALL BE PLACED AS SHOWN IN THE EXPANSION JOINT DETAILS.
- THE CONTRACTOR SHALL NOTIFY THE ENGINEER PRIOR TO THE CONCRETE FOOTING PLACEMENT, FOR THE INSPECTION OF COMPACTION UNDER THE FOOTING, FOOTING DEPTH AND WIDTH, THE WALL STEEL SPACING. FINAL INSPECTION OF THE FOOTING AND WALL WILL BE REQUIRED.
- THE CONTRACTOR SHALL BE RESPONSIBLE FOR CODE ADMINISTRATION APPROVAL AND FEES ASSOCIATED WITH IT.
- THE CONTRACTOR SHALL BE RESPONSIBLE TO SEE THAT ALL REBAR IS PROPERLY ALIGNED AND TIED IN PLACE BEFORE PLACING CONCRETE. ALL STEEL SHALL BE ACCURATELY LOCATED AND SECURED IN PLACE SO THAT IT REMAINS IN POSITION DURING THE PLACEMENT OF THE CONCRETE. ANY REBAR IMPROPERLY INSTALLED SHALL BE CORRECTED AT NO ADDITIONAL COST TO THE OWNER.
- MINIMUM LAP SPICE ON REINFORCING BARS IN MASONRY WALLS SHALL BE 40 BAR DIAMETERS (2' -0" MINIMUM). REINFORCEMENT OF A SIZE AND SPACING OTHER THAN THAT GIVEN IN THE TABLES MAY BE USED PROVIDING SUCH OTHER REINFORCEMENT FURNISHES AN AREA OF STEEL AREA AT LEAST EQUAL TO THAT GIVEN IN THE TABLE. LAP ALL DUROWALL JOINT REINFORCEMENT 8" MINIMUM.
- THE FIRST COURSE OF CMU BLOCK MAY BE PLACED IN FRESH FOOTING CONCRETE. SUBSEQUENT COURSES OF CMU BLOCK SHALL NOT BE PLACED UNTIL 7 DAYS AFTER THE FOOTING IS CAST.
- THE CONTRACTOR SHALL COORDINATE COLOR/FINISH OF ALL EXPOSED CMU BLOCK WITH THE OWNER.
- ALL CMU BLOCK JOINTS SHALL BE TOOLED.
- MIRAFI 140N FILTER FABRIC, 1 FOOT WIDE SHALL BE PLACED ON THE BACK OF THE WALL AT EACH EXPANSION JOINT. THE FABRIC SHALL EXTEND DOWN FROM THE TOP OF THE WALL EXTENDING 6" OVER THE TOP OF THE FOOTING.
- THE CONTRACTOR SHALL CLEAN ALL CONSTRUCTION DEBRIS FROM THE AREA.
- THE EARTH SIDE OF RETAINING WALLS SHALL BE WATERPROOFED AT IRRIGATED AREAS AND DAMP PROOFED AT ALL OTHER AREAS. WATERPROOFING SHALL BE CONWRAP BARRIER CS-212 AS MANUFACTURED BY CONCRETE SEALANTS, INC. (MEMBRANE THICKNESS 0.100 INCHES MINIMUM) OR ENGINEER APPROVED SUBSTITUTION. DAMP PROOFING SHALL BE HYDROCODE 700B OR ENGINEER APPROVED SUBSTITUTION.

RETAINING WALL TABLE

Wall Point	TW Elev	BW Elev	Top of Footer	Wall Ht	Approx Wall Length	Average Wall Height	Average Wall Type
1	59.89	58.39	57.56	2.67	20.67	3.33	A
2	59.99	56.97	56.14	4.00	2.00	4.00	B
3	59.99	56.97	56.14	4.00			
4	60.18	57.16	56.33	4.00	2.00	4.00	B
5	60.18	57.16	56.33	4.00	45.33	3.33	A
6	60.45	58.95	58.11	2.67			
7	61.29	59.19	58.36	3.33	20.67	4.00	B
8	60.83	58.15	57.32	4.00	18.93	4.00	B
9	60.11	57.80	56.97	3.33			
10	64.18	62.68	61.85	2.67	60.00	4.00	B
11	66.94	62.94	62.11	4.83	45.33	4.83	B
12	67.43	63.43	62.60	4.83	45.33	4.75	B
13	67.64	64.19	63.36	4.67	2.00	4.00	B
14	67.64	65.64	64.81	3.33			

DESIGN LOADS

EFP (ACTIVE) =34 PCF
EFP (PASSIVE) =300 PCF
SOIL UNIT WEIGHT =110 PCF
ALLOWABLE BEARING PRESSURE =1500 PSF
COEFFICIENT OF FRICTION FOR SLIDING =0.40

26 6586.85 8A03

Bohannon & Huston
Courtney One 7500 JEFFERSON NE Albuquerque NEW MEXICO 87109
ENGINEERS PLANNERS PHOTOGRAMMETRISTS SURVEYORS SOFTWARE DEVELOPERS

CITY OF ALBUQUERQUE
PUBLIC WORKS DEPARTMENT


PINON POINTE IV AT VENTANA RANCH
RETAINING WALL DETAILS

Design Review Committee	City Engineer Approval	Mo./Day/Yr.	Mo./Day/Yr.
For Information Only		Last Design Update	
City Project No.	Zone Map No.	Sheet	Of
658685	B-9	8A	18

SCANNED BY
MESA REPRO

SCANNED BY
MESA REPRO

CONTRACTOR SHALL CONSTRUCT
SIDEWALK AROUND ANY AND ALL
FIRE HYDRANTS AND LIGHT POLES

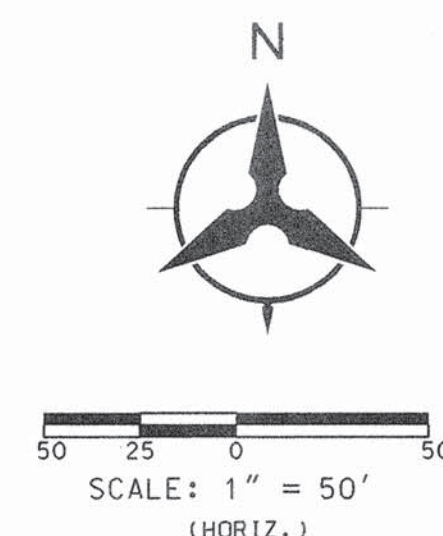

1. THE CONTRACTOR SHALL FIELD VERIFY ALL EXISTING UTILITY LOCATIONS AND NOTIFY THE ENGINEER IMMEDIATELY OF ANY DISCREPANCIES.
2. ALL CURB RETURN RADII SHALL BE 25' UNLESS OTHERWISE SPECIFIED.
3. ALL CURVE DATA AND DIMENSIONS REFER TO FACE OF CURB UNLESS OTHERWISE SPECIFIED.
4. GRADE ELEVATIONS, WHERE NOTED, ARE ALONG FLOWLINE OF STANDARD CURB UNLESS OTHERWISE SPECIFIED.
5. CONTRACTOR IS TO INSTALL A 4" X 4" X 5' POST AND END AT THE END OF EACH SANITARY SEWER SERVICE.
6. CONTRACTOR IS RESPONSIBLE FOR REPAIR AND/OR REPLACEMENT OF ALL UTILITY CONDUITS AND EXISTING LINES.
7. ANY ADDITIONAL GRADING REQUIRED TO MATCH PROPOSED STREET GRADES SHALL BE INCIDENTAL TO PAVING ITEMS.
8. CONTRACTOR SHALL PROVIDE THE INSPECTORS, (CITY AND PRIVATE) WITH THE PROPOSED HYDROSTATIC TESTING PLAN. THE PLAN MUST BE APPROVED BEFORE TESTING OPERATIONS BEGIN.
9. CONTRACTOR SHALL PARK EQUIPMENT AND VEHICLES AS NOT TO INTERFERE WITH NORMAL ACTIVITIES OF RESIDENTS OR OTHER CONTRACTORS ON SITE.
10. ANY DAMAGE TO THE EXISTING FACILITIES (CURB & GUTTER), PAVEMENT, CONDUITS, LANDSCAPING, UTILITY LINES, ETC.) DURING CONSTRUCTION SHALL BE REPLACED AT THE CONTRACTORS' EXPENSE.
11. REMOVAL OF THE EXISTING CURB AND GUTTER SHALL BE AS PER CDA STD. DWG. 2415 (SAWCUT ONLY).
12. WHEELCHAIR RAMPS SHALL BE CONSTRUCTED PRIOR TO ACCEPTANCE OF CURB & GUTTER.

- 1 INSTALL 6' CONCRETE VALLEY GUTTER
AS PER STD. DWG. 2420
- 2 INSTALL 12' CONCRETE VALLEY GUTTER
AS PER STD. DWG. 2422
- 3 MEDIAN CURB & GUTTER AS
PER STD DWG 2415
- 4 INSTALL WHEELCHAIR RAMP AS
PER MODIFIED STD. DWG. 2441,
CASE 11 WITH ALTERNATE SECTION
AA AND AS PER DETAIL SHEET 10
- 5 STD. CURB & GUTTER
AS PER STD. DWG. 2415
- 6 ROLL CURB & GUTTER
AS PER STD. DWG. 2415
- 7 DEFERRED 4' SIDEWALK
- 8 BUILD 4' SIDEWALK PER STD DWG 2430
- 9 DEPRESSURE CURB & GUTTER
AS PER STD. DWG 2415

1	2	3	4	5	6	7	8	9	10	11	12	13	14	15
26		6	5	8	6	.	8	5			1	0	0	3





Bohannon  **Huston** 
Courtyard | 7500 Jefferson St. NE Albuquerque, NM 87109
ENGINEERING  SPATIAL DATA  ADVANCED TECHNOLOGY


CITY OF ALBUQUERQUE
PUBLIC WORKS DEPARTMENT
ENGINEERING DEVELOPMENT GROUP

PINON POINTE IV SUBDIVISION AT VENTANA RANCH
PAVING PLAN & PROFILE
CEDAR WAXWING PLACE

DESIGN REVIEW COMMITTEE		CITY ENGINEER-APPROVAL	LAST DESIGN UPDATE	MO./DAY/YR.	MO./DAY/YR.

CITY PROJECT NO.	658685	ZONE MAP NO.	B-9	SHEET	10	OF	18
------------------	--------	--------------	-----	-------	----	----	----

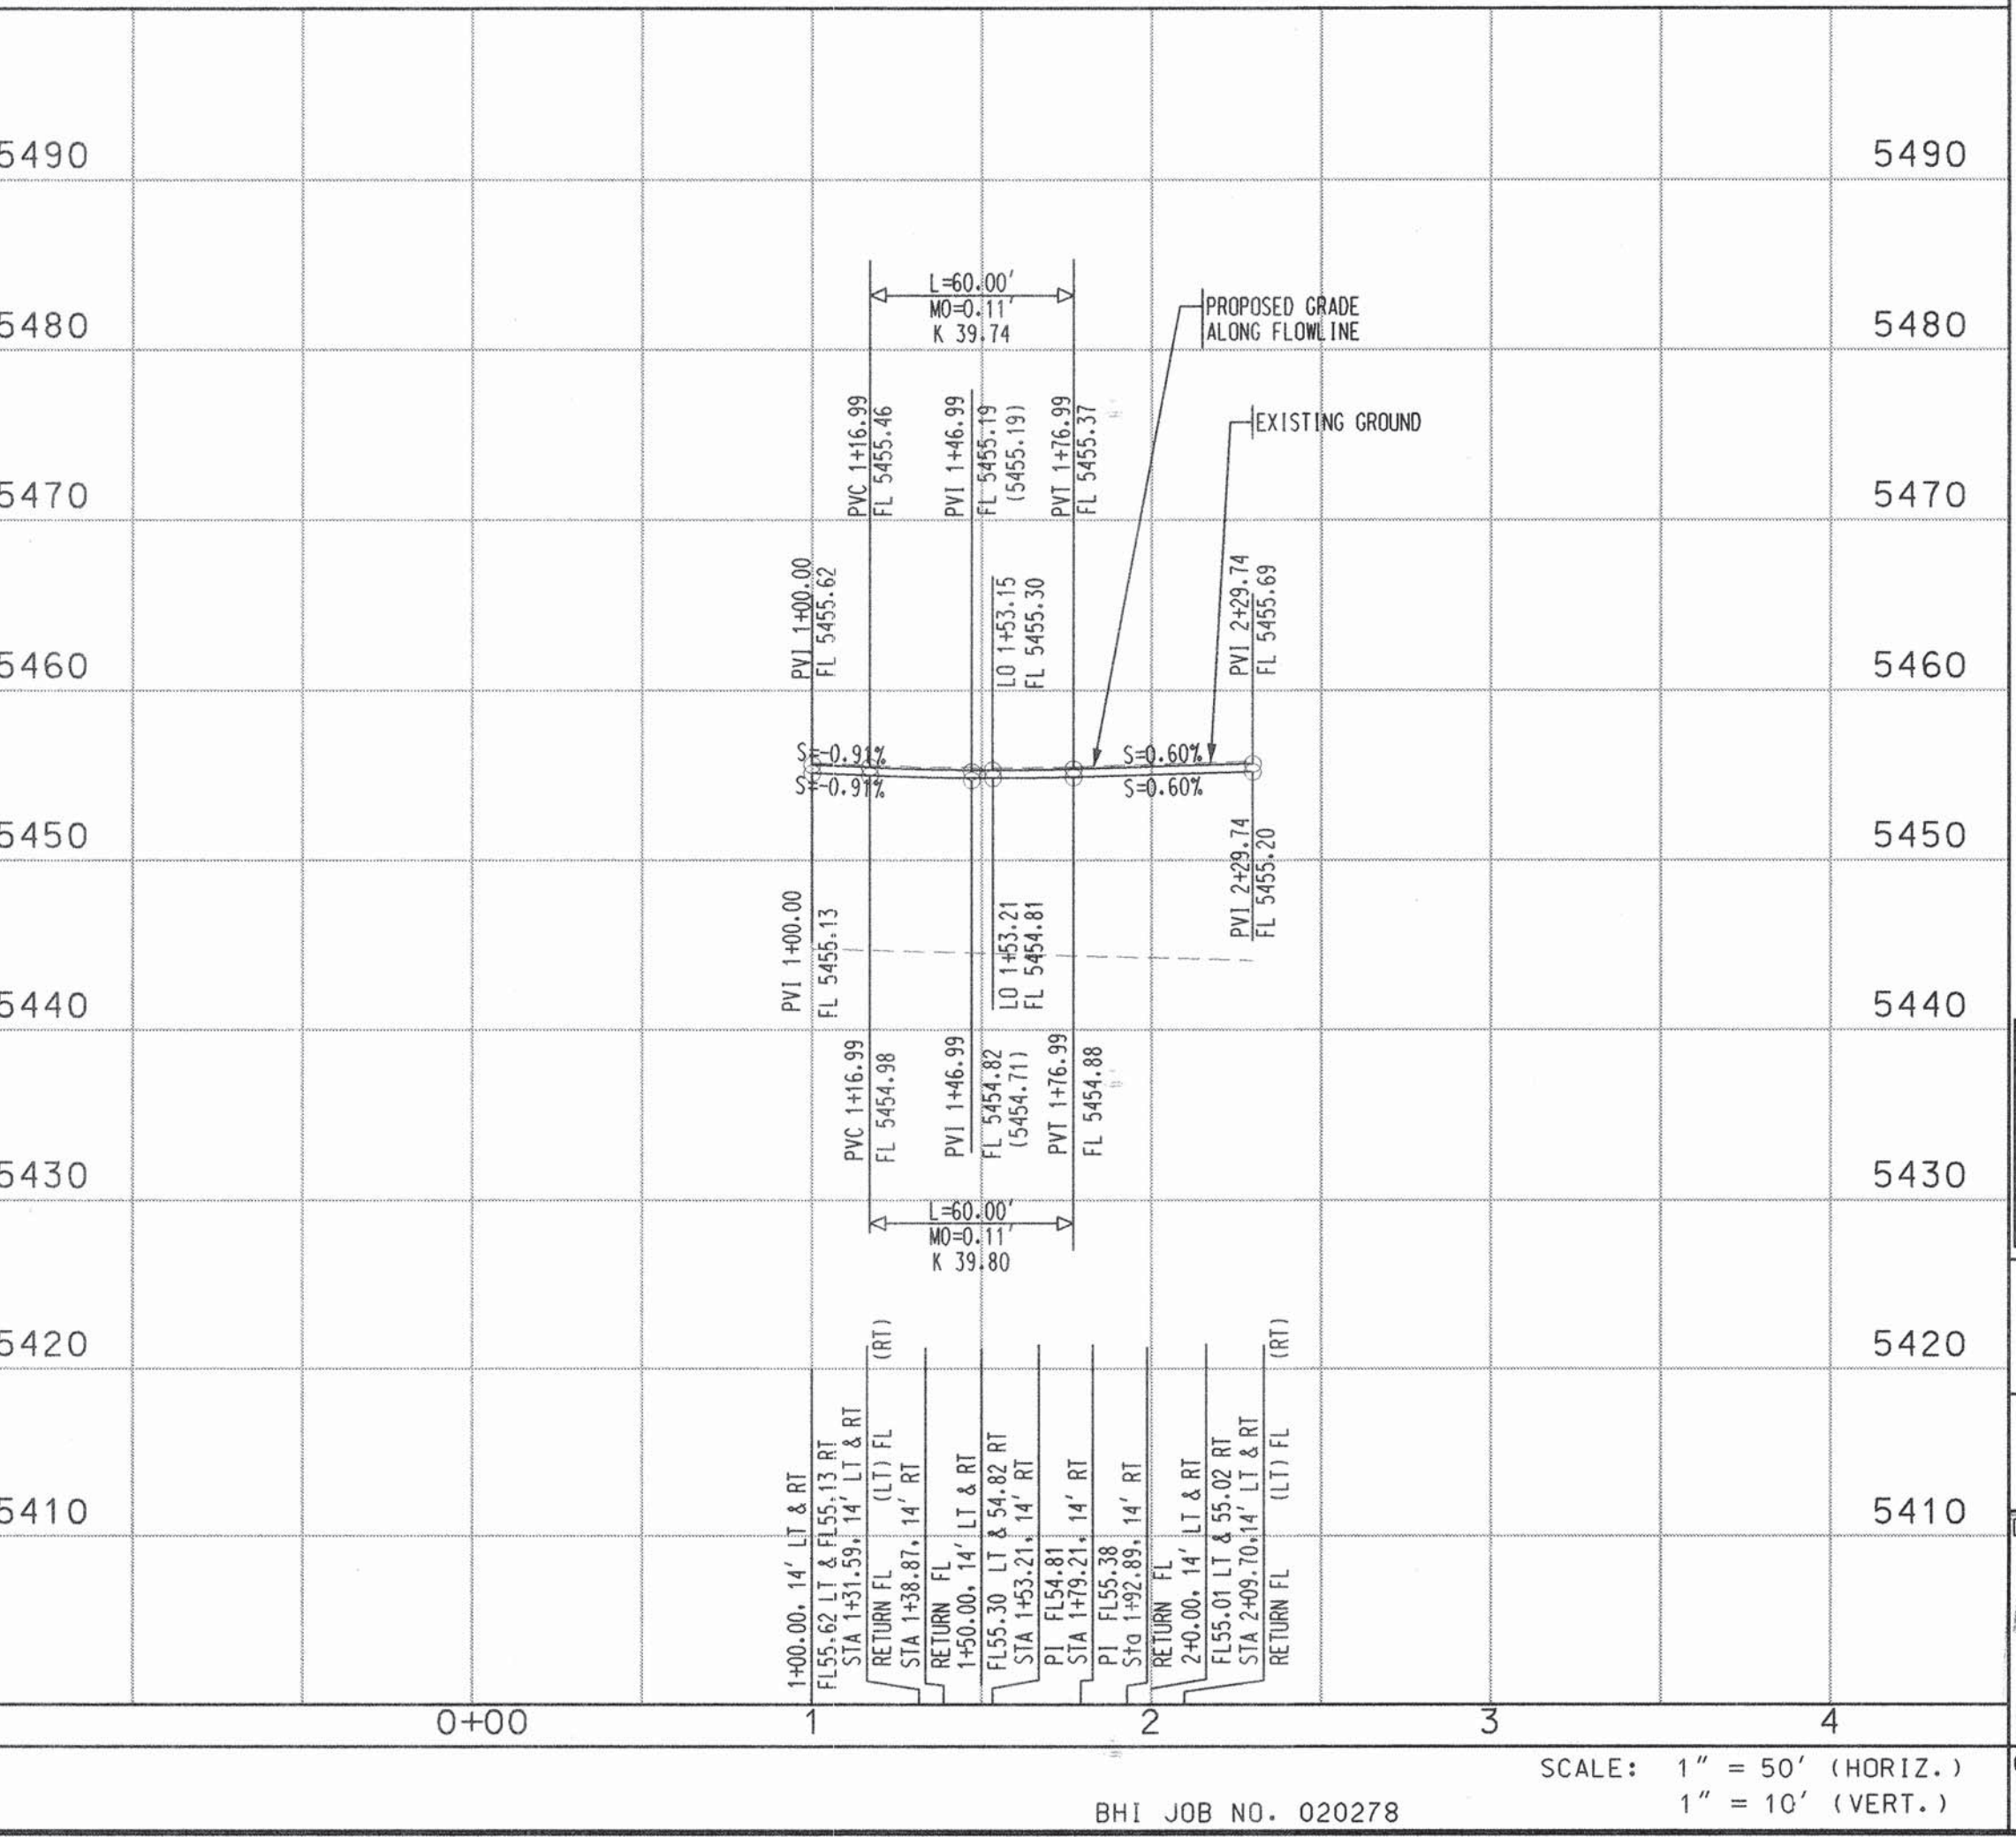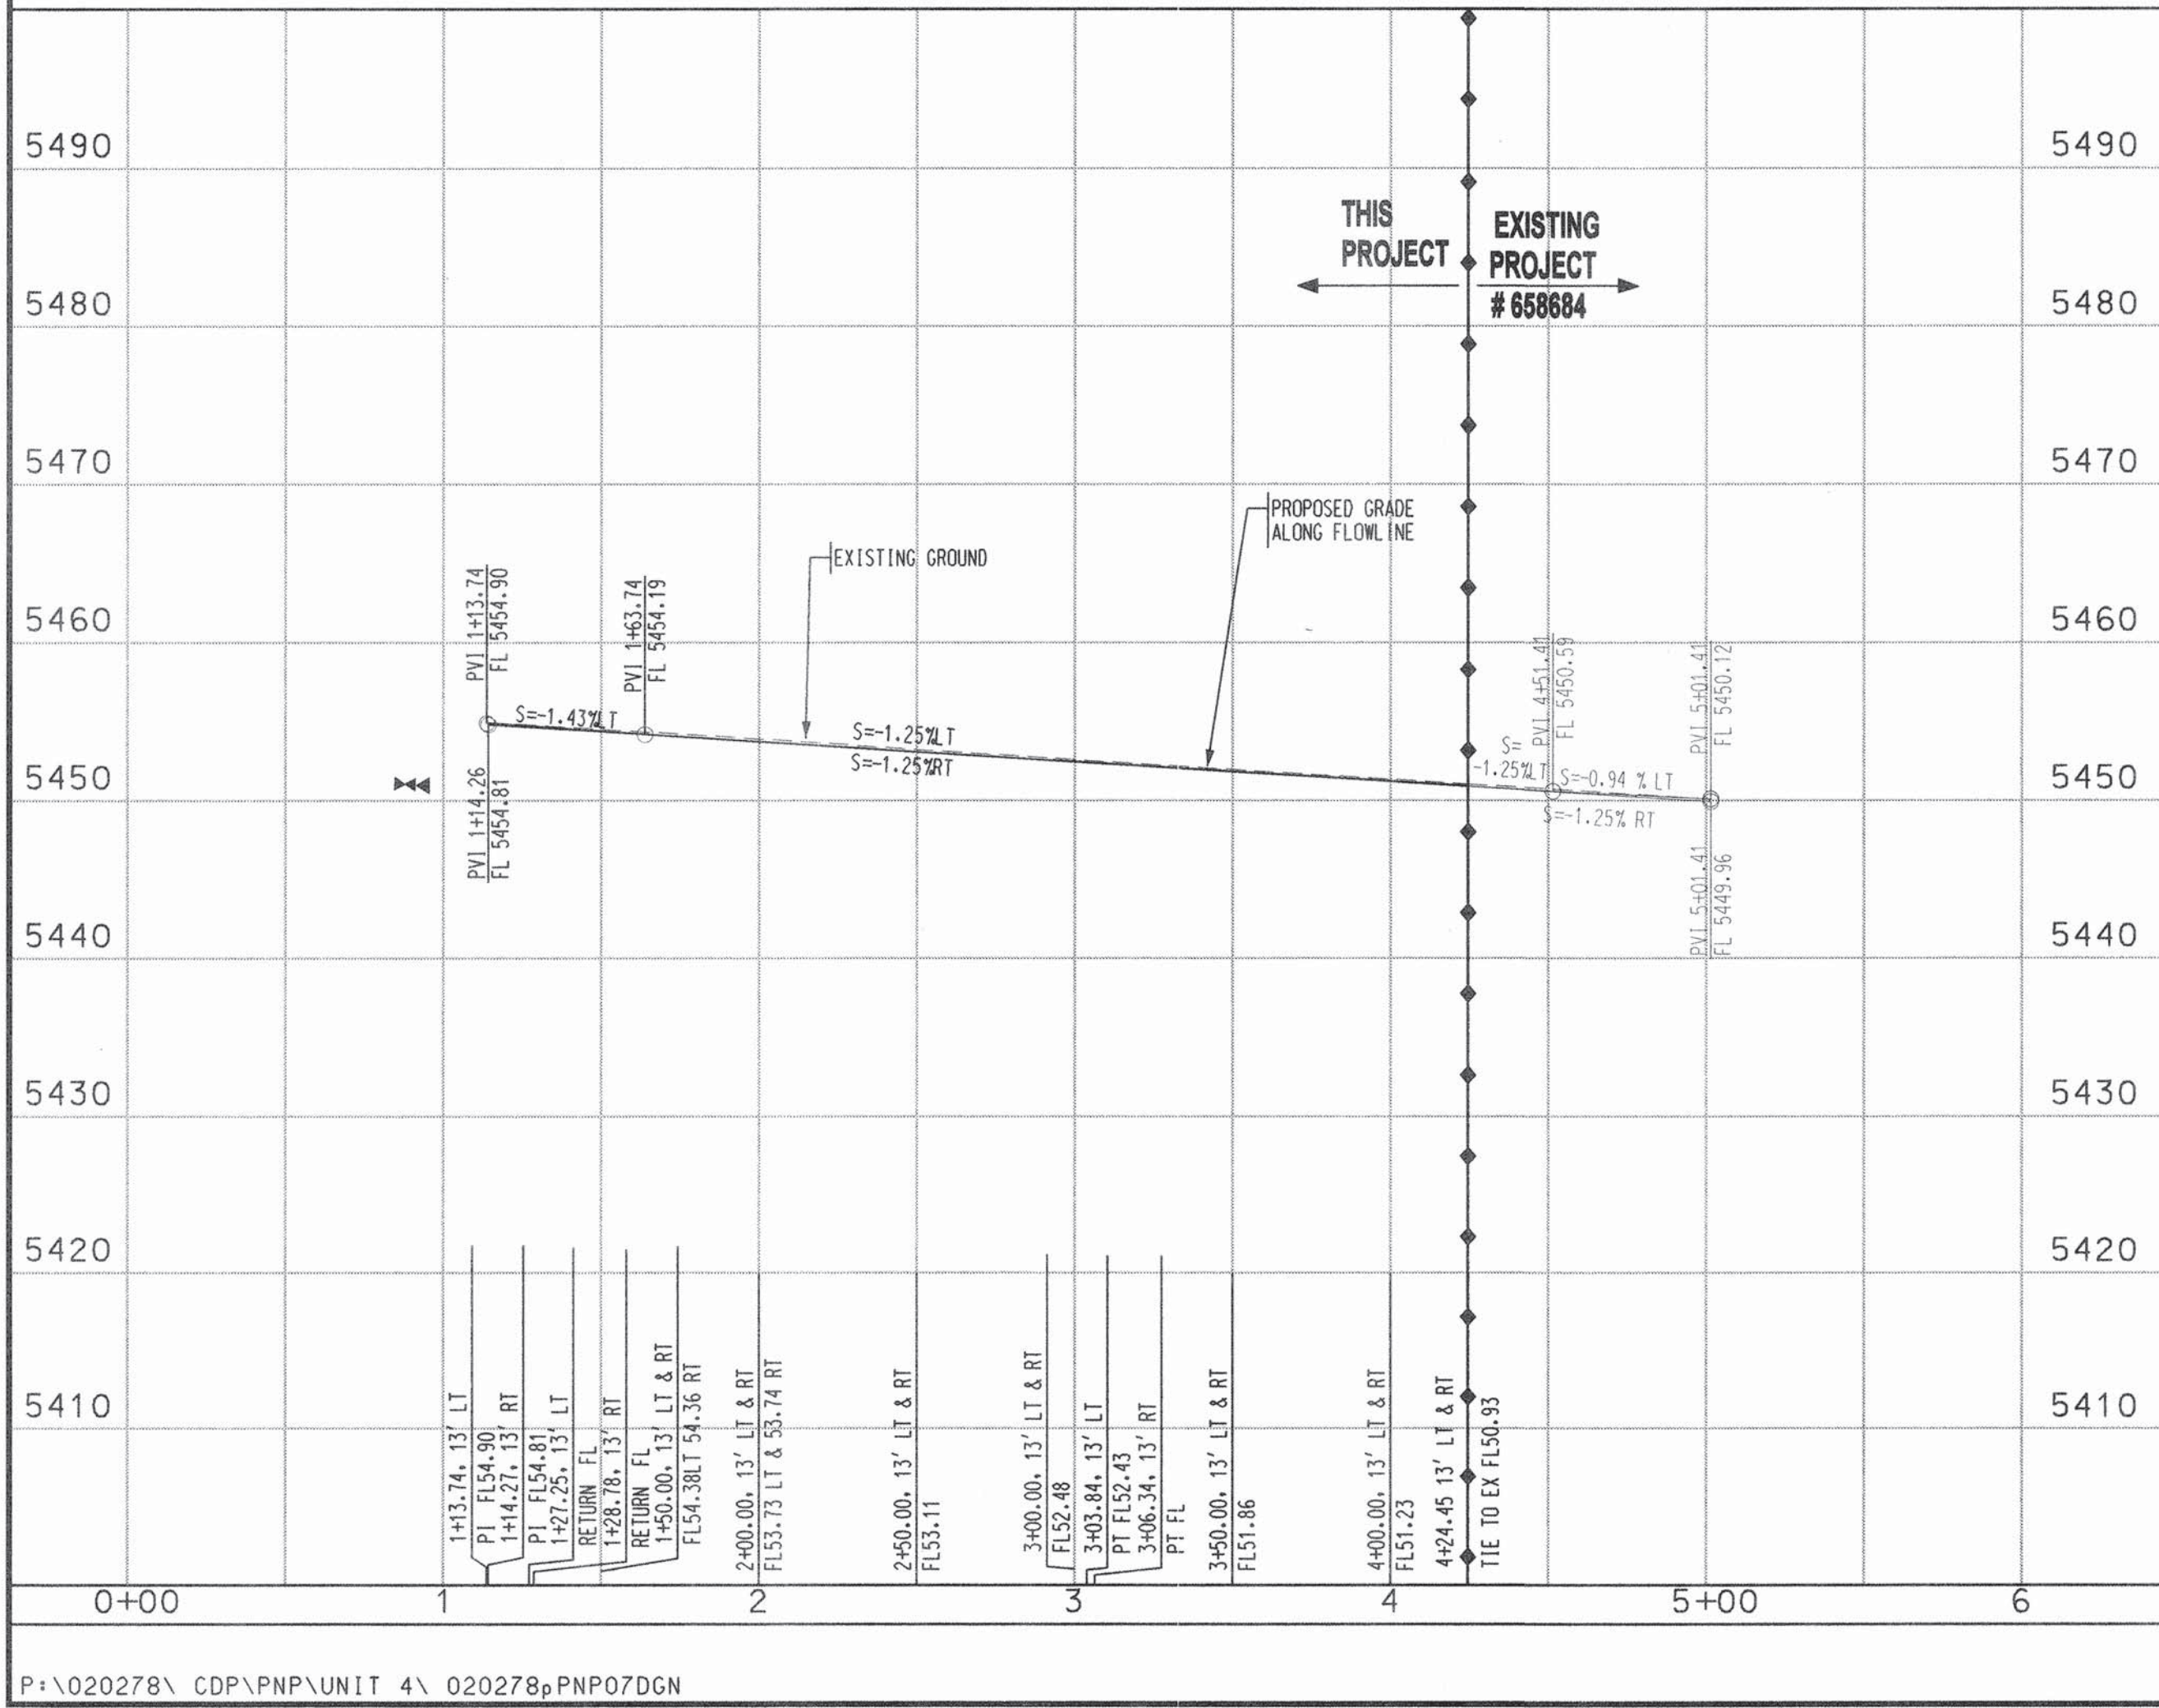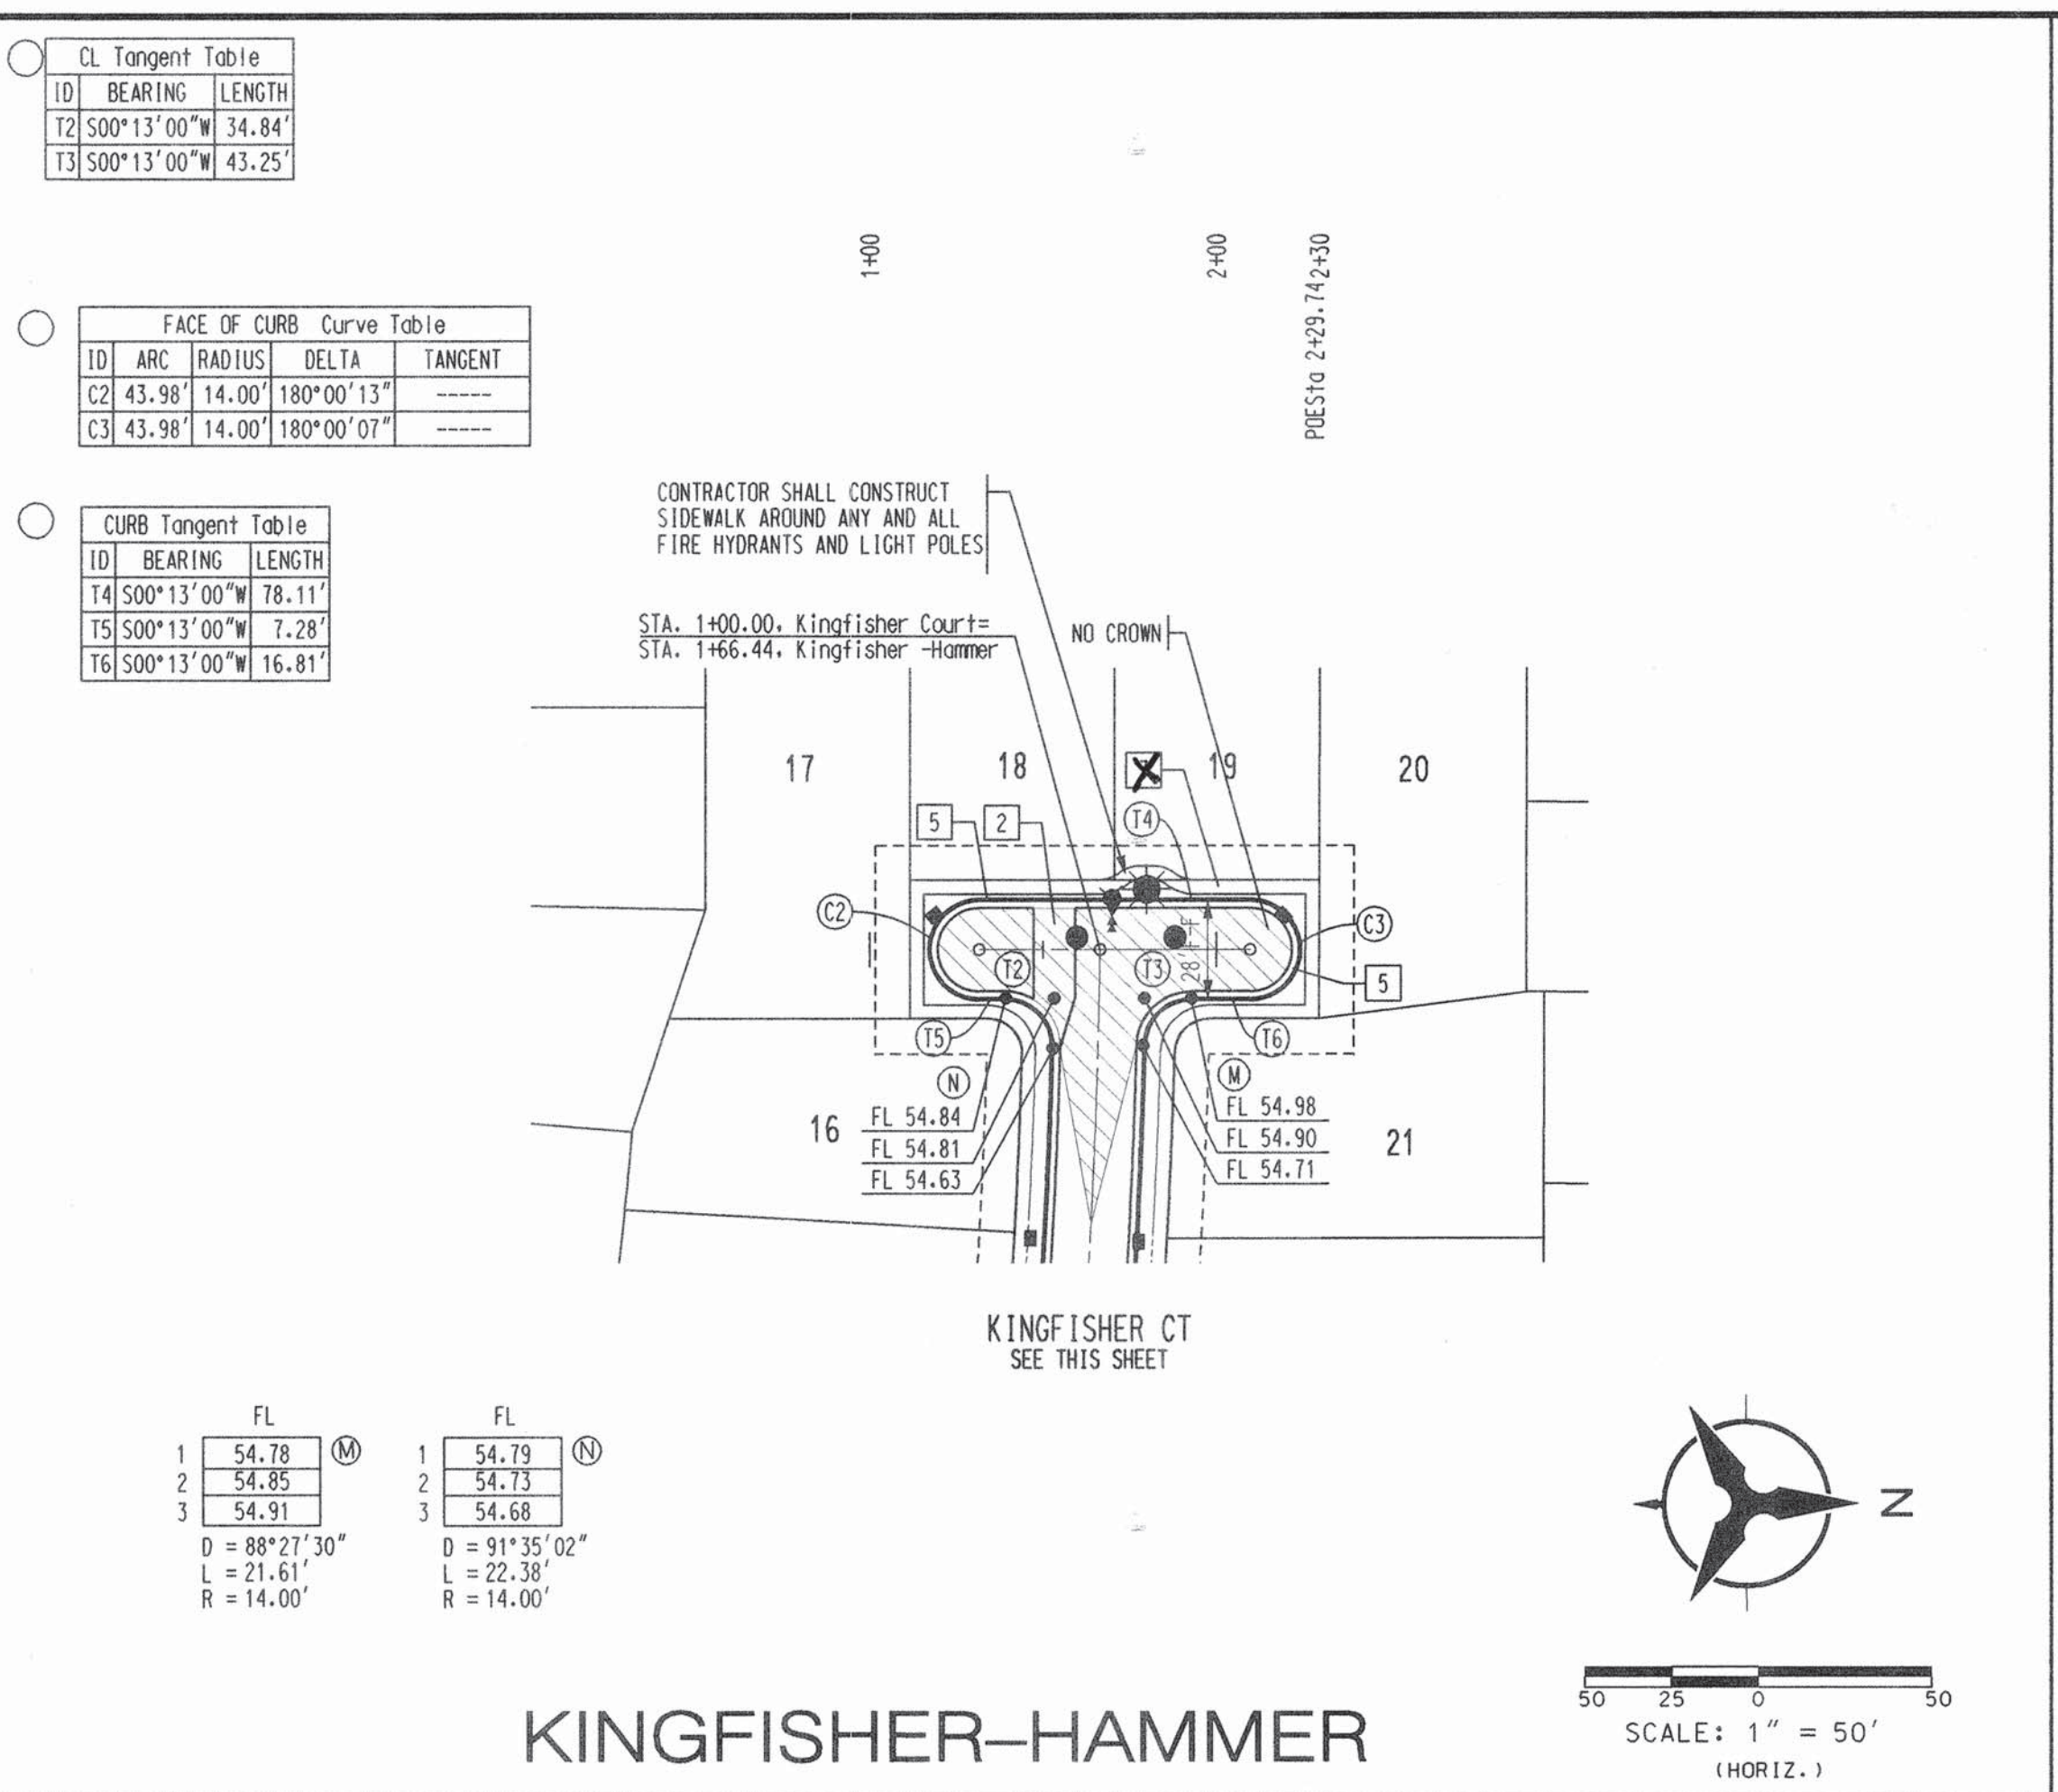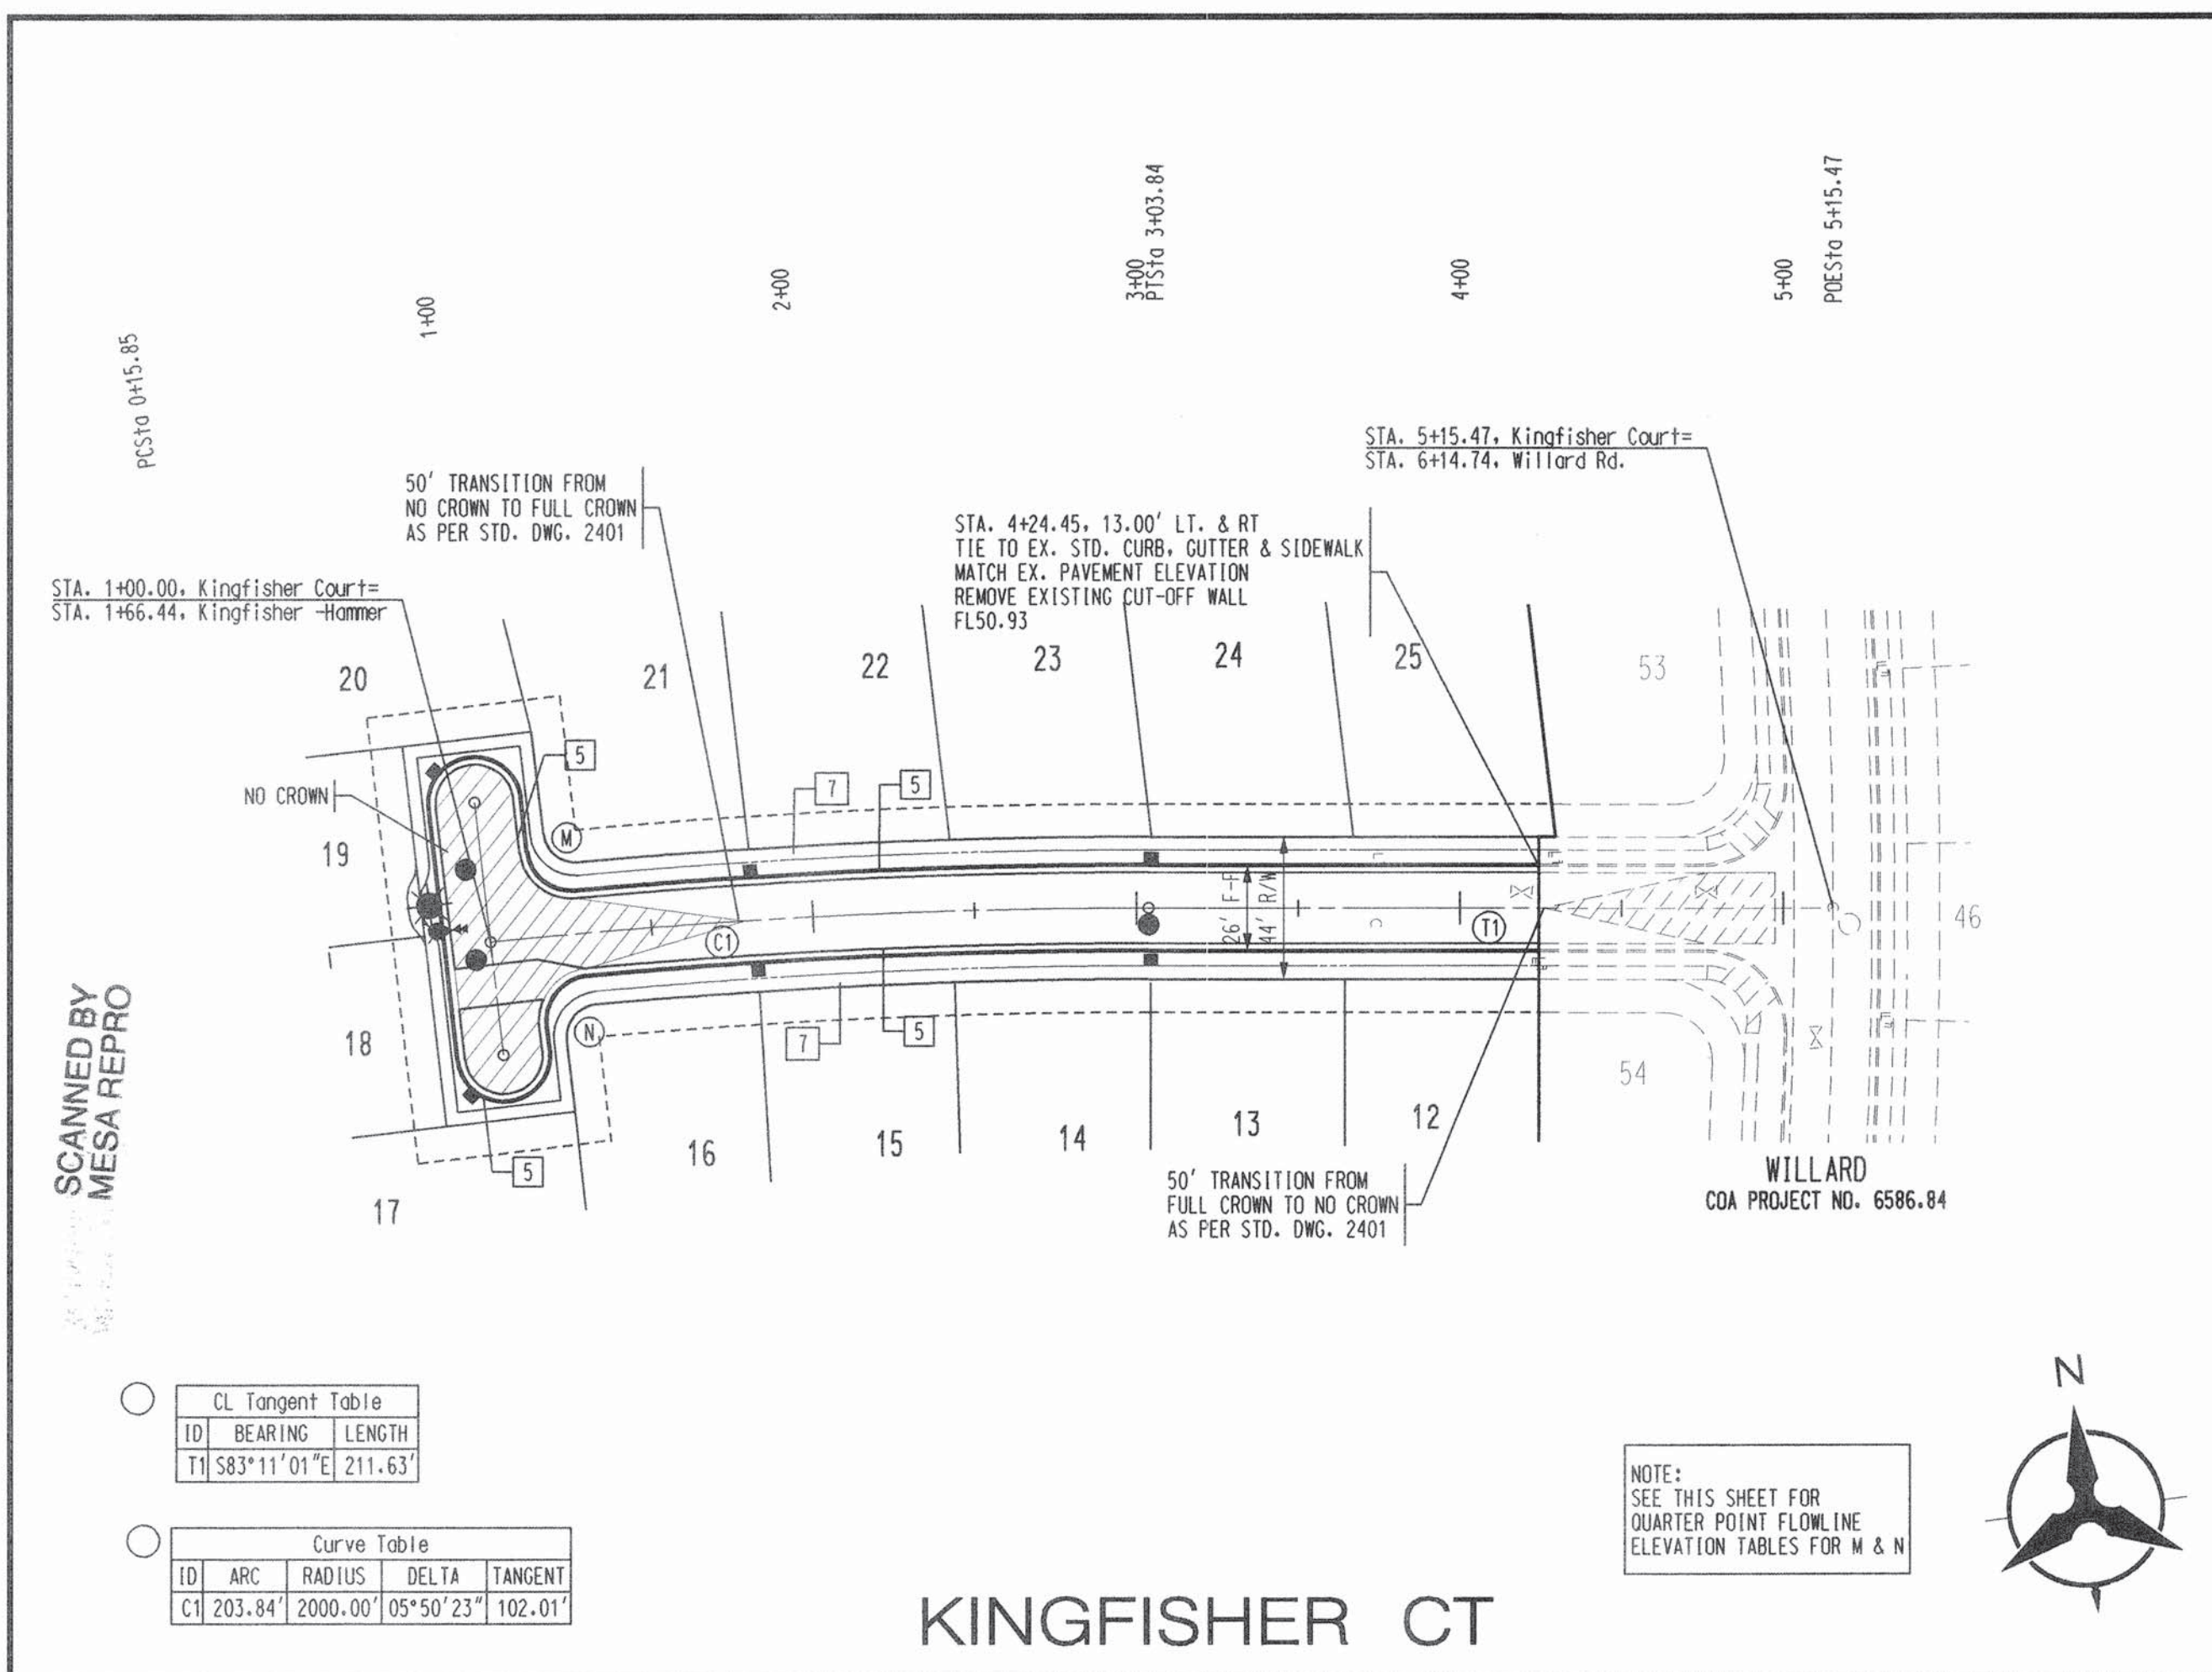

NOTES

- THE CONTRACTOR SHALL FIELD VERIFY ALL EXISTING UTILITY LOCATIONS AND NOTIFY THE ENGINEER IMMEDIATELY OF ANY DISCREPANCIES.
- ALL CURB RETURN RADIUS SHALL BE 25' UNLESS OTHERWISE SPECIFIED.
- ALL CURVE DATA AND DIMENSIONS REFER TO FACE OF CURB UNLESS OTHERWISE SPECIFIED.
- GRADE ELEVATIONS, WHERE NOTED, ARE ALONG FLOWLINE OF STANDARD CURB UNLESS OTHERWISE SPECIFIED.
- CONTRACTOR IS TO INSTALL A 4" X 4" X 5' POST AND EMD AT THE END OF EACH SANITARY SEWER SERVICE.
- CONTRACTOR IS RESPONSIBLE FOR REPAIR AND/OR REPLACEMENT OF ALL UTILITY CONDUITS AND EXISTING LINES.
- ANY ADDITIONAL GRADING REQUIRED TO MATCH PROPOSED STREET GRADES SHALL BE INCIDENTAL TO PAVING ITEMS.
- CONTRACTOR SHALL PROVIDE THE INSPECTORS (CITY AND PRIVATE) WITH THE PROPOSED HYDROSTATIC TESTING PLAN. THE PLAN MUST BE APPROVED BEFORE TESTING OPERATIONS BEGIN.
- CONTRACTOR SHALL PARK EQUIPMENT AND VEHICLES AS NOT TO INTERFERE WITH NORMAL ACTIVITIES OF RESIDENTS OR OTHER CONTRACTORS ON SITE.
- ANY DAMAGE TO THE EXISTING FACILITIES (CURB & GUTTER), PAVEMENT, CONDUITS, LANDSCAPING, UTILITY LINES, ETC.) DURING CONSTRUCTION SHALL BE REPLACED AT THE CONTRACTORS' EXPENSE.
- REMOVAL OF THE EXISTING CURB AND GUTTER SHALL BE AS PER COA STD. DWG. 2415 (SAWCUT ONLY).
- WHEELCHAIR RAMPS SHALL BE CONSTRUCTED PRIOR TO ACCEPTANCE OF CURB & GUTTER.

KEYED GENERAL NOTES

- INSTALL 6" CONCRETE VALLEY GUTTER AS PER STD. DWG. 2420
- INSTALL 12" CONCRETE VALLEY GUTTER AS PER STD. DWG. 2422
- MEDIAN CURB & GUTTER AS PER STD DWG 2415
- INSTALL WHEELCHAIR RAMP AS PER MODIFIED STD. DWG. 2441, CASE II WITH ALTERNATE SECTION AA AND AS PER DETAIL SHEET 10
- STD. CURB & GUTTER AS PER STD. DWG. 2415
- ROLL CURB & GUTTER AS PER STD. DWG. 2415
- DEFERRED 4' SIDEWALK
- BUILD 4' SIDEWALK PER STD DWG 2430
- DEPRESSED CURB & GUTTER AS PER STD. DWG 2415

BOHANNAN HUSTON
Engineering • Spatial Data • Advanced Technologies
Courtney | 7500 Jefferson St. NE Albuquerque, NM 87109-4335

CITY OF ALBUQUERQUE
PUBLIC WORKS DEPARTMENT
ENGINEERING DEVELOPMENT GROUP
PINON POINTE IV SUBDIVISION AT VENTANA RANCH
PAVING PLAN & PROFILE
KINGFISHER CT & HAMMER

DESIGN REVIEW COMMITTEE
CITY ENGINEER APPROVAL
MO./DAY/YR. MO./DAY/YR.

REVISIONS

NO.	DATE	REMARKS
1	10/02	DESIGNED BY YOP
2	10/02	DRAWN BY DLM
3	10/02	CHECKED BY KGP

AS-BUILT INFORMATION

CONTRACTOR	DATE	BY
SEC	03	SEC

FIELD NOTES

NO.	DATE	BY

ENGINEER'S SEAL

APPROVALS


DESIGN REVIEW COMMITTEE
CITY ENGINEER
LAST DESIGN UPDATE

CITY PROJECT NO. 658685 **ZONE MAP NO.** B-9 **SHEET** 11 **OF** 18


CUL-DE-SAC CURB DATA		
STATION	OFFSET	ELEVATION
1+50.01	15.16' RT.	5452.34
1+29.29	17.31' RT.	5452.54
1+11.18	7.46' RT.	5452.74
1+01.75	10.81' LT.	5452.95
1+04.27	31.32' LT.	5452.80
1+17.87	46.81' LT.	5452.63
1+37.75	51.96' LT.	5452.45
1+56.28	45.21' LT.	5452.28
1+68.37	28.86' LT.	5452.11

CL Curve Table				
ID	ARC	RADIUS	DELTA	TANGENT
C1	380.99'	958.00'	22°47'11"	193.05'

CL Tangent Table		
ID	BEARING	LENGTH
T1	S02°47'11"E	17.00'

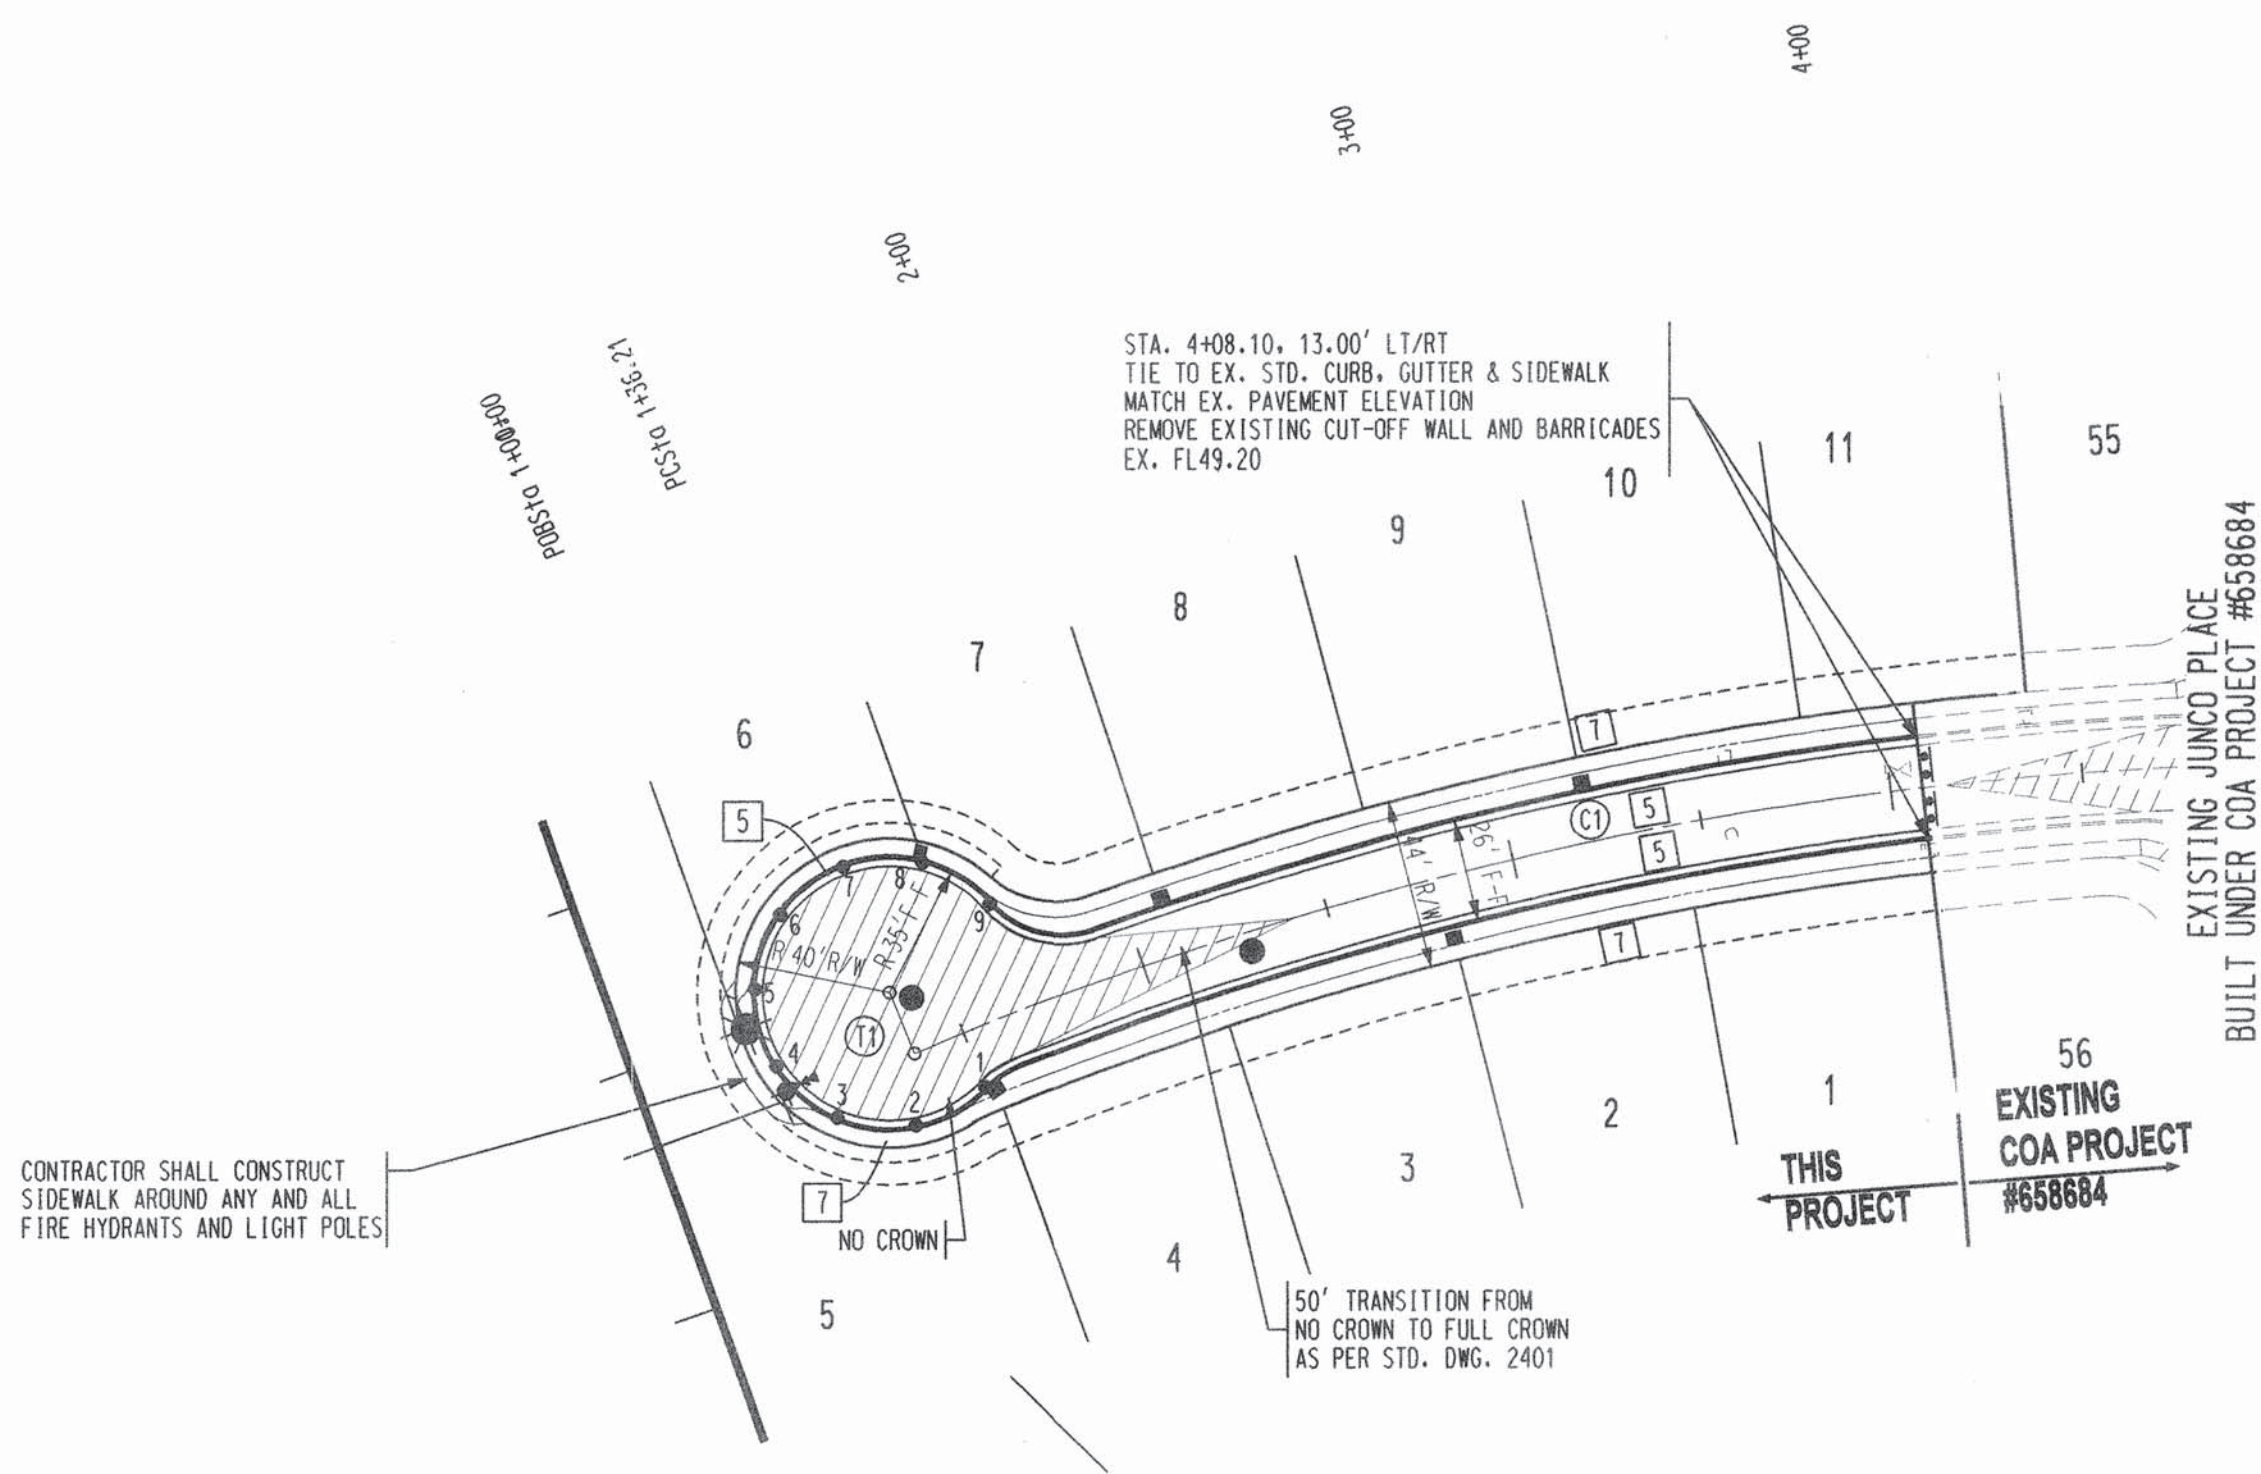

JUNCO PLACE

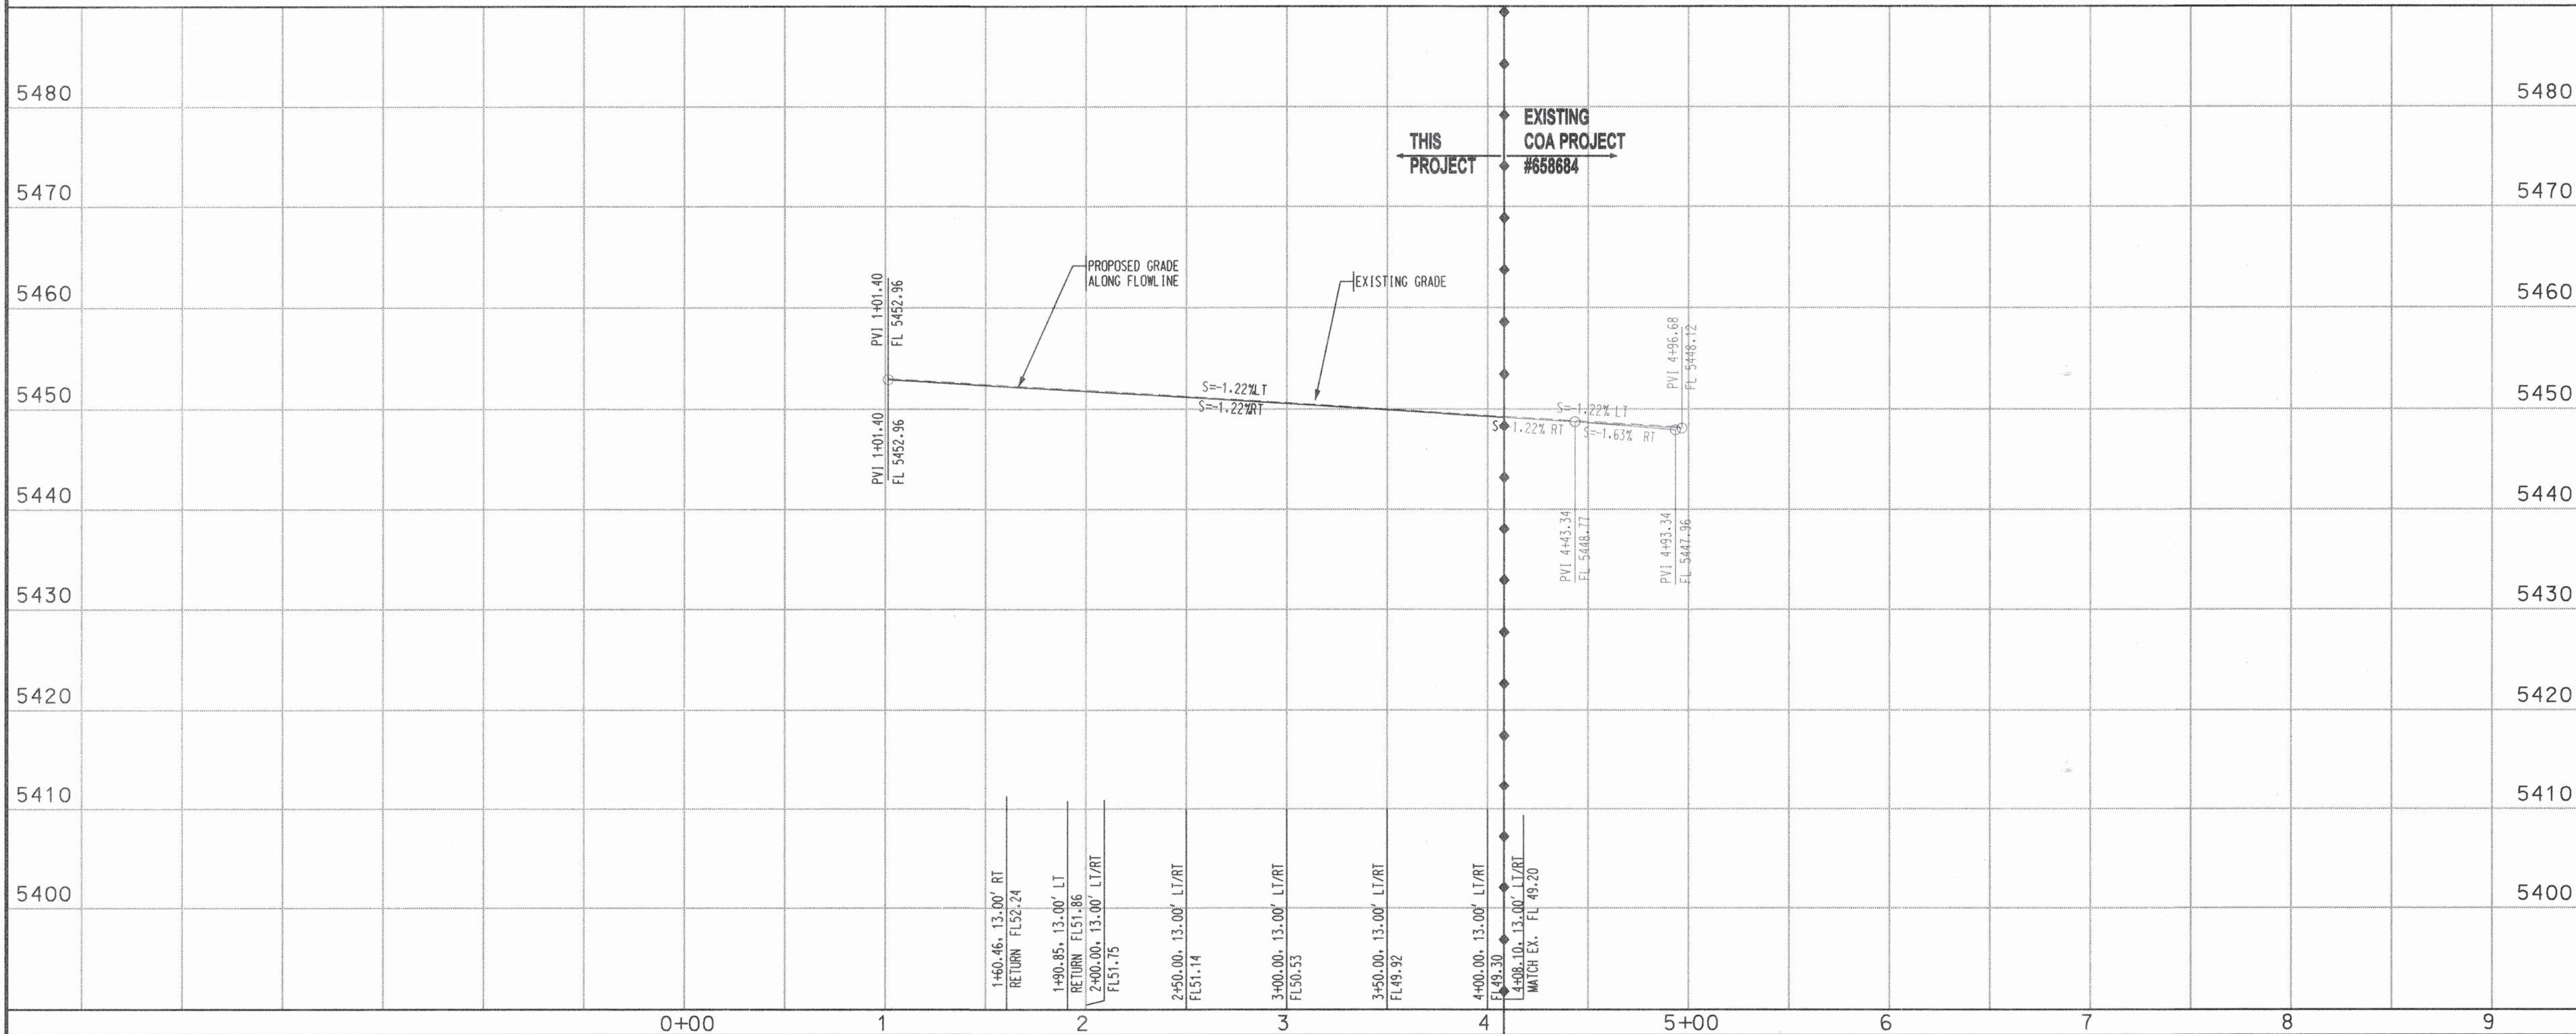

- NOTES
- THE CONTRACTOR SHALL FIELD VERIFY ALL EXISTING UTILITY LOCATIONS AND NOTIFY THE ENGINEER IMMEDIATELY OF ANY DISCREPANCIES.
 - ALL CURB RETURN RADIUS SHALL BE 25' UNLESS OTHERWISE SPECIFIED.
 - ALL CURVE DATA AND DIMENSIONS REFER TO FACE OF CURB UNLESS OTHERWISE SPECIFIED.
 - GRADE ELEVATIONS, WHERE NOTED, ARE ALONG FLOWLINE OF STANDARD CURB UNLESS OTHERWISE SPECIFIED.
 - CONTRACTOR IS TO INSTALL A 4" X 4" X 5' POST AND EMD AT THE END OF EACH SANITARY SEWER SERVICE.
 - CONTRACTOR IS RESPONSIBLE FOR REPAIR AND/OR REPLACEMENT OF ALL UTILITY CONDUITS AND EXISTING LINES.
 - ANY ADDITIONAL GRADING REQUIRED TO MATCH PROPOSED STREET GRADES SHALL BE INCIDENTAL TO PAVING ITEMS.
 - CONTRACTOR SHALL PROVIDE THE INSPECTORS (CITY AND PRIVATE) WITH THE PROPOSED HYDROSTATIC TESTING PLAN. THE PLAN MUST BE APPROVED BEFORE TESTING OPERATIONS BEGIN.
 - CONTRACTOR SHALL PARK EQUIPMENT AND VEHICLES AS NOT TO INTERFERE WITH NORMAL ACTIVITIES OF RESIDENTS OR OTHER CONTRACTORS ON SITE.
 - ANY DAMAGE TO THE EXISTING FACILITIES (CURB & GUTTER), PAVEMENT, CONDUITS, LANDSCAPING, UTILITY LINES, ETC.) DURING CONSTRUCTION SHALL BE REPLACED AT THE CONTRACTORS' EXPENSE.
 - REMOVAL OF THE EXISTING CURB AND GUTTER SHALL BE AS PER COA STD. DWG. 2415 (SAWCUT ONLY).
 - WHEELCHAIR RAMPS SHALL BE CONSTRUCTED PRIOR TO ACCEPTANCE OF CURB & GUTTER.



- KEYED GENERAL NOTES
- INSTALL 6' CONCRETE VALLEY GUTTER AS PER STD. DWG. 2420
 - INSTALL 12' CONCRETE VALLEY GUTTER AS PER STD. DWG. 2422
 - MEDIAN CURB & GUTTER AS PER STD DWG 2415
 - INSTALL WHEELCHAIR RAMP AS PER MODIFIED STD. DWG. 2441, CASE II WITH ALTERNATE SECTION AA AND AS PER DETAIL SHEET 10
 - STD. CURB & GUTTER AS PER STD. DWG. 2415
 - ROLL CURB & GUTTER AS PER STD. DWG. 2415
 - DEFERRED 4' SIDEWALK
 - BUILD 4' SIDEWALK PER STD DWG 2430
 - DEPRESSED CURB & GUTTER AS PER STD. DWG 2415

26 6586.85 1203


Bohannon & Huston
Courtney | 7500 Jefferson St. NE Albuquerque, NM 87109-4335
ENGINEERING • SPATIAL DATA • ADVANCED TECHNOLOGIES

CITY OF ALBUQUERQUE PUBLIC WORKS DEPARTMENT ENGINEERING DEVELOPMENT GROUP	
PINON POINTE IV SUBDIVISION AT VENTANA RANCH PAVING PLAN & PROFILE JUNCO PLACE	
DESIGN REVIEW COMMITTEE	CITY ENGINEER APPROVAL
APPROVED DEC 27 2002	APPROVED MAR - 4 2003
DESIGN REVIEW COMMITTEE	CITY ENGINEER
CITY PROJECT NO.	ZONE MAP NO.
658685	B-9
SHEET	OF
12	18

SCANNED BY
MESA REPRO

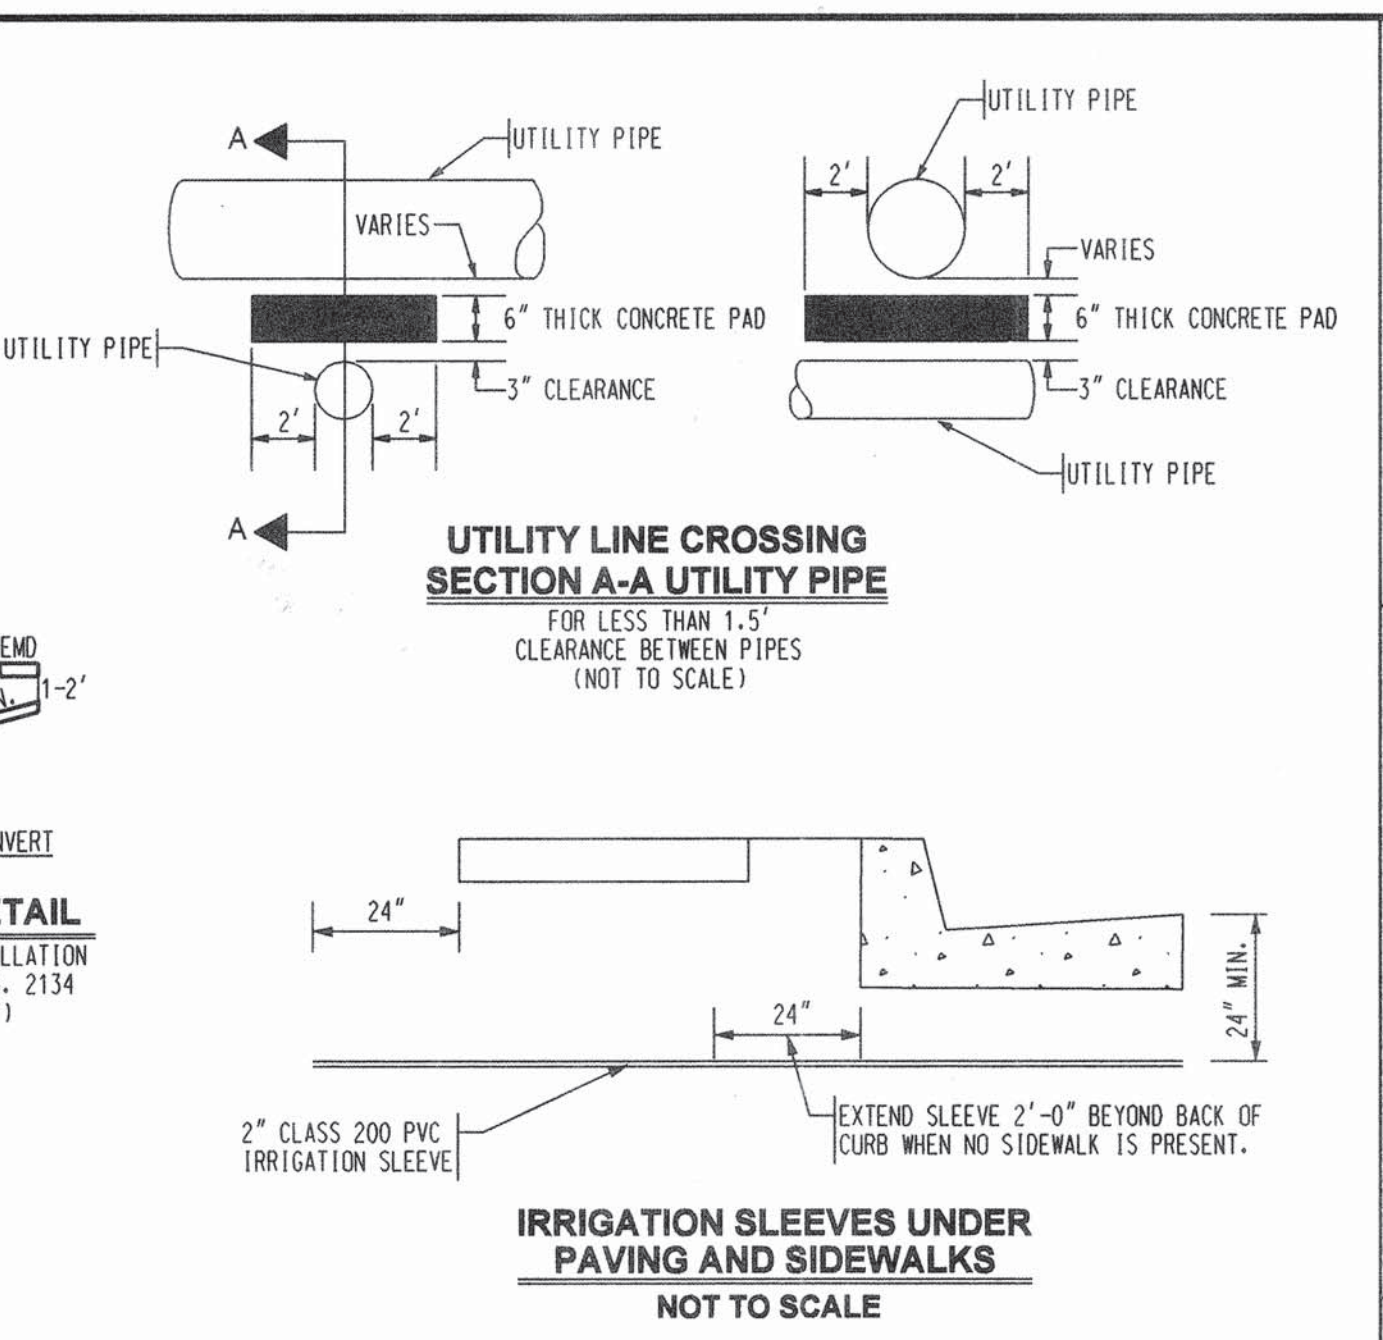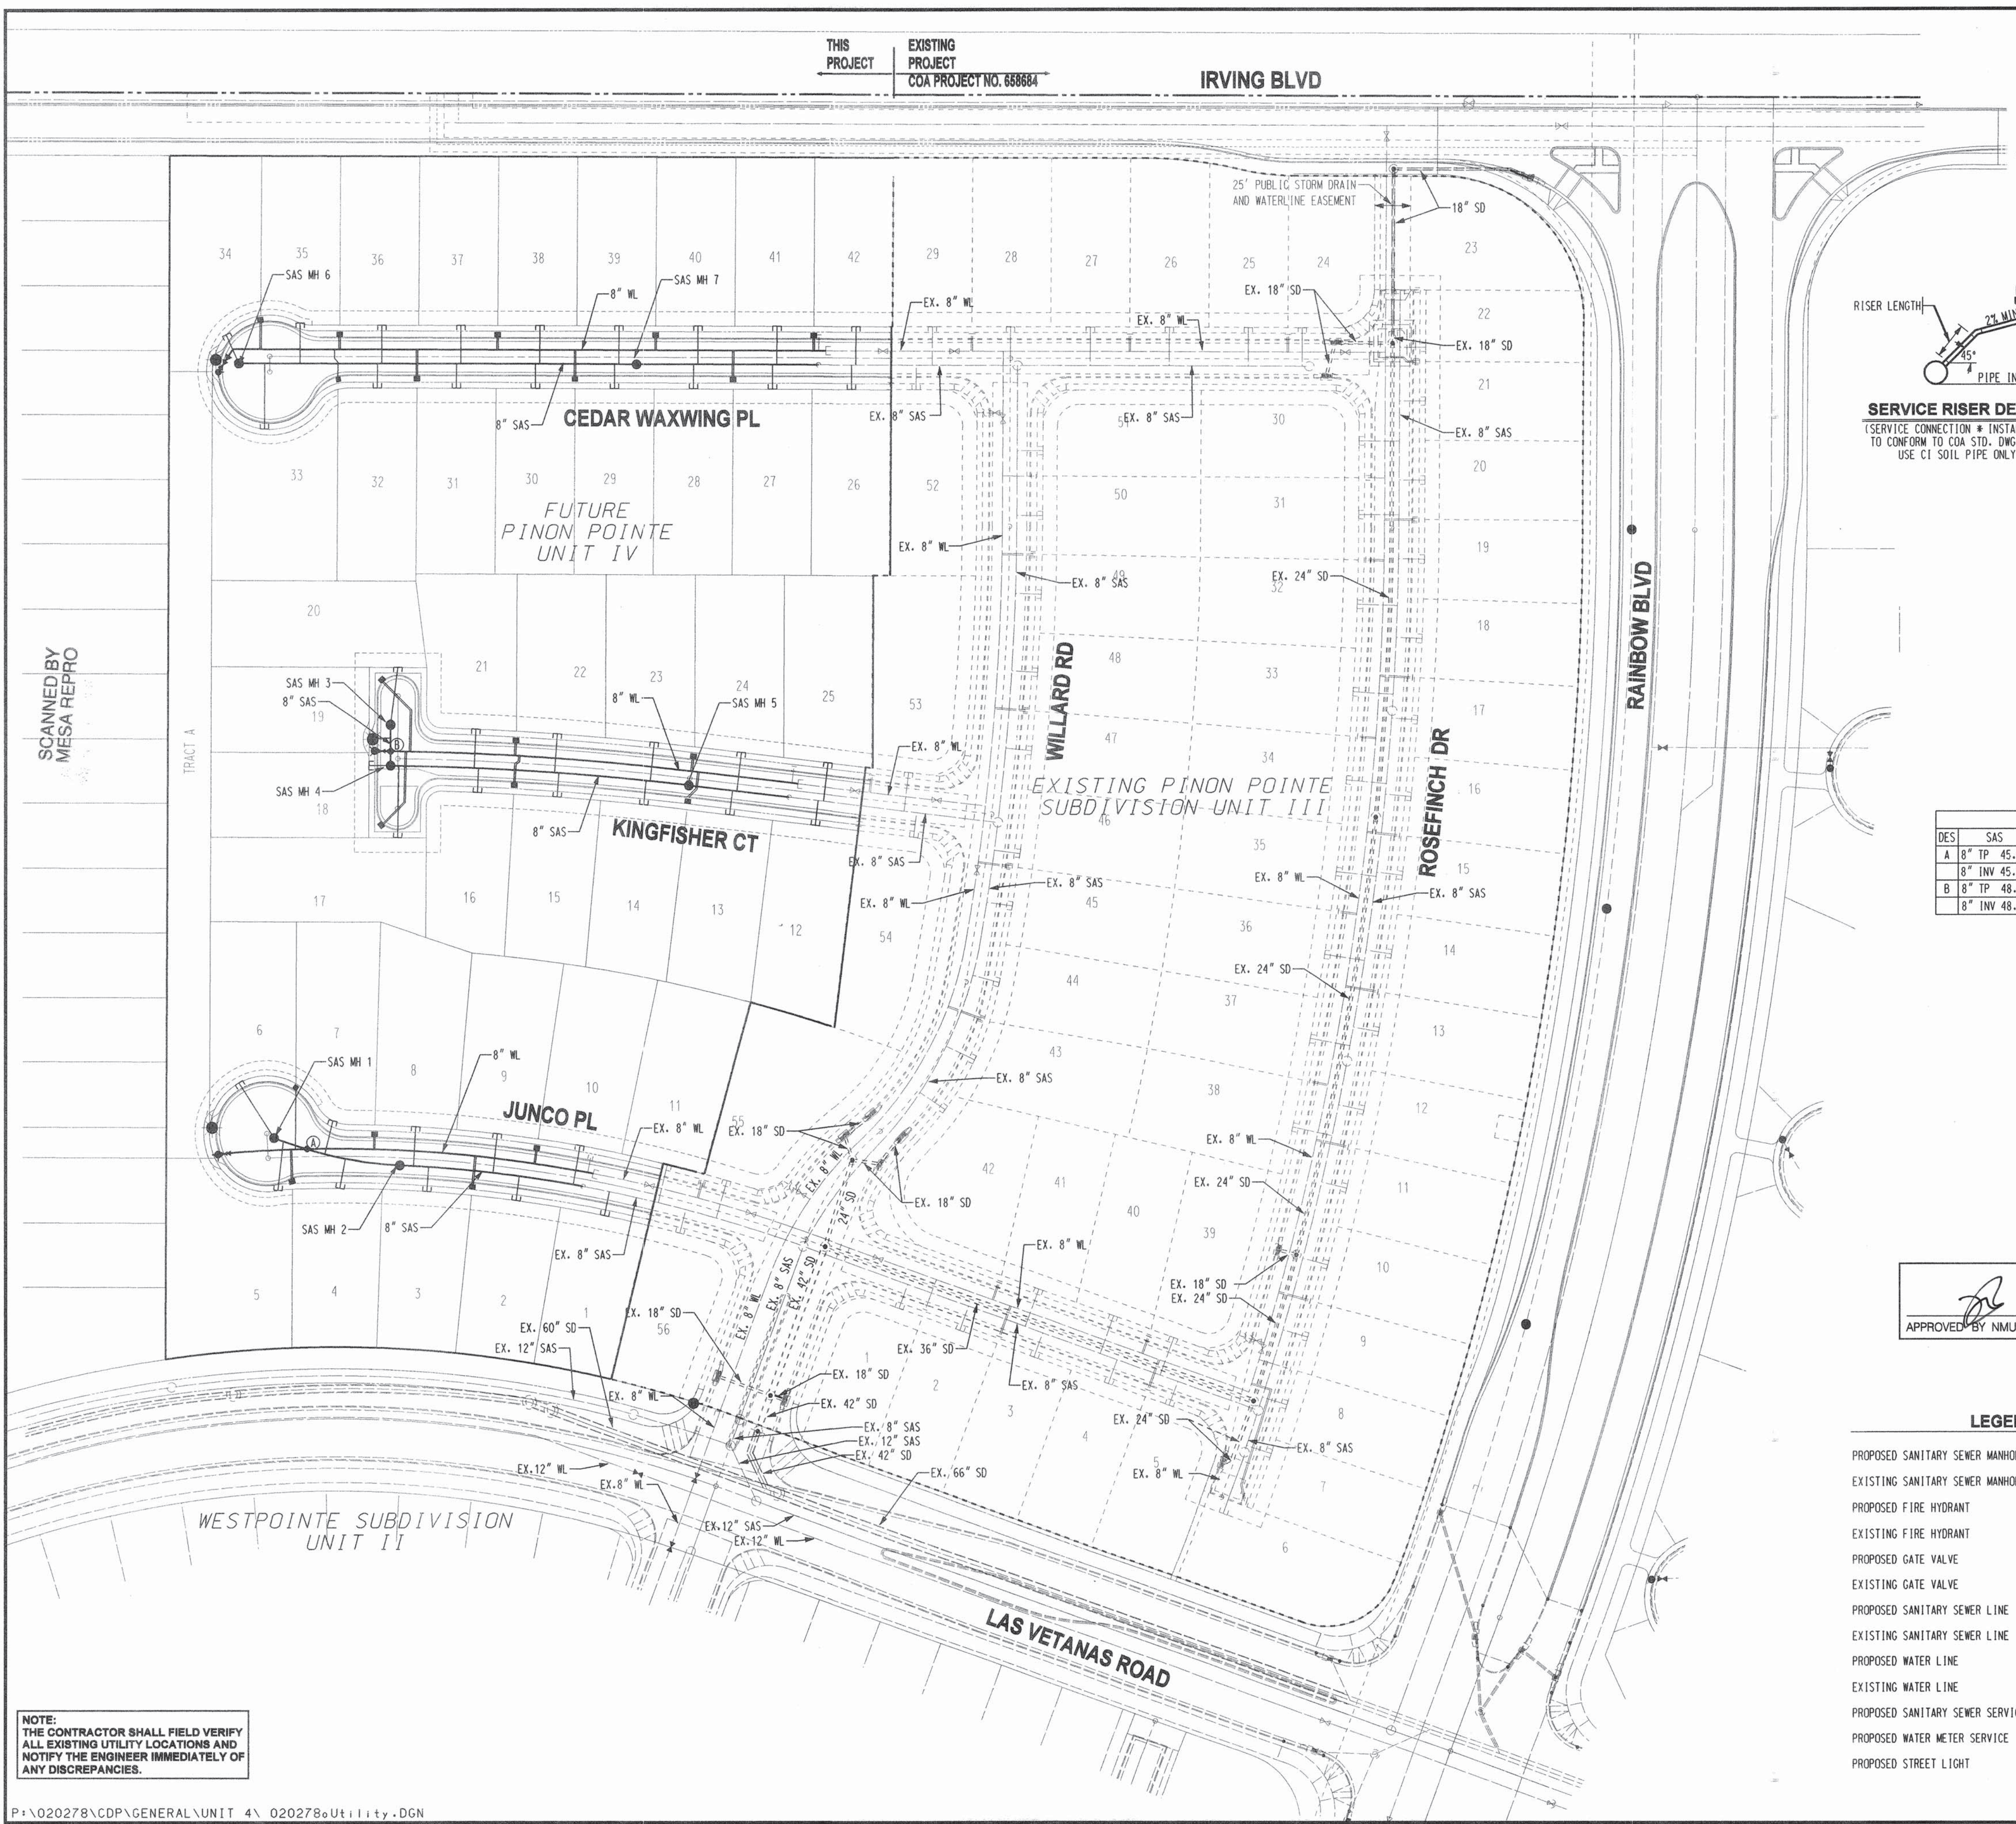

Crossings				
DES	SAS	SD	WL	Clearance
A	8" TP 45.97	8" TP 48.24	8" TP 48.24	1.54
B	8" INV 45.26	8" INV 47.51	8" INV 47.51	
C	8" TP 48.91	8" TP 51.24	8" TP 51.24	1.61
D	8" INV 48.21	8" INV 50.52	8" INV 50.52	

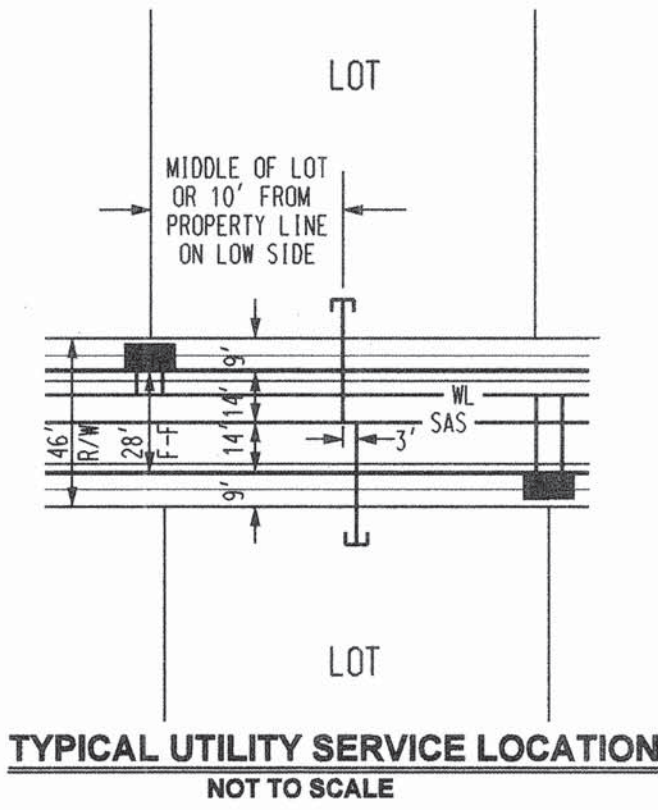

APPROVED BY NMUI
DATE 11-22-02

26 6586.85 / 1303
SCALE: 1" = 60'
(HORIZ.)

- LEGEND**
- PROPOSED SANITARY SEWER MANHOLE
 - EXISTING SANITARY SEWER MANHOLE
 - PROPOSED FIRE HYDRANT
 - EXISTING FIRE HYDRANT
 - PROPOSED GATE VALVE
 - EXISTING GATE VALVE
 - PROPOSED SANITARY SEWER LINE
 - EXISTING SANITARY SEWER LINE
 - PROPOSED WATER LINE
 - EXISTING WATER LINE
 - PROPOSED SANITARY SEWER SERVICE
 - PROPOSED WATER METER SERVICE
 - PROPOSED STREET LIGHT

Bohannon & Huston
Courtyard I 7500 Jefferson St. NE Albuquerque, NM 87109-4335
ENGINEERING • SPATIAL DATA • ADVANCED TECHNOLOGIES


CITY OF ALBUQUERQUE
PUBLIC WORKS DEPARTMENT
ENGINEERING DEVELOPMENT GROUP
PINON POINTE IV SUBDIVISION AT VENTANA RANCH
OVERALL UTILITY PLAN

DESIGN REVIEW COMMITTEE
CITY ENGINEER APPROVAL
MO./DAY/YR.
MO./DAY/YR.

CITY PROJECT NO. 658685
ZONE MAP NO. B-9
SHEET 13 OF 18

AS-BUILT INFORMATION		BENCH MARKS		SURVEY INFORMATION		FIELD NOTES		ENGINEER'S SEAL		REMARKS		REVISIONS		DESIGN		YOP		DLM		KGP		DATE		DATE		DATE	
CONTRACTOR	Sundance	ACCS BRASS TABLET STAMPED 1-B9 1980		NO.	BY	DATE																					
STAKED BY	AS	GEOGRAPHIC POSITION (NAD 1927)																									
ACCEPTANCE BY	AS	N.M. STATE PLANE COORDINATES																									
FIELD CATCH BY	AS	(CENTRAL ZONE) X=355,077.00																									
DATE	02	Y=1,529,056.93																									
DATE	03	GROUND-TO-GRID FACTOR = .99966334																									
DATE	03	DELTA ALPHA -00°16'47"																									
DATE	03	RECORDED BY																									
DATE	03	NO.																									

NOTE:
THE CONTRACTOR SHALL FIELD VERIFY
ALL EXISTING UTILITY LOCATIONS AND
NOTIFY THE ENGINEER IMMEDIATELY OF
ANY DISCREPANCIES.

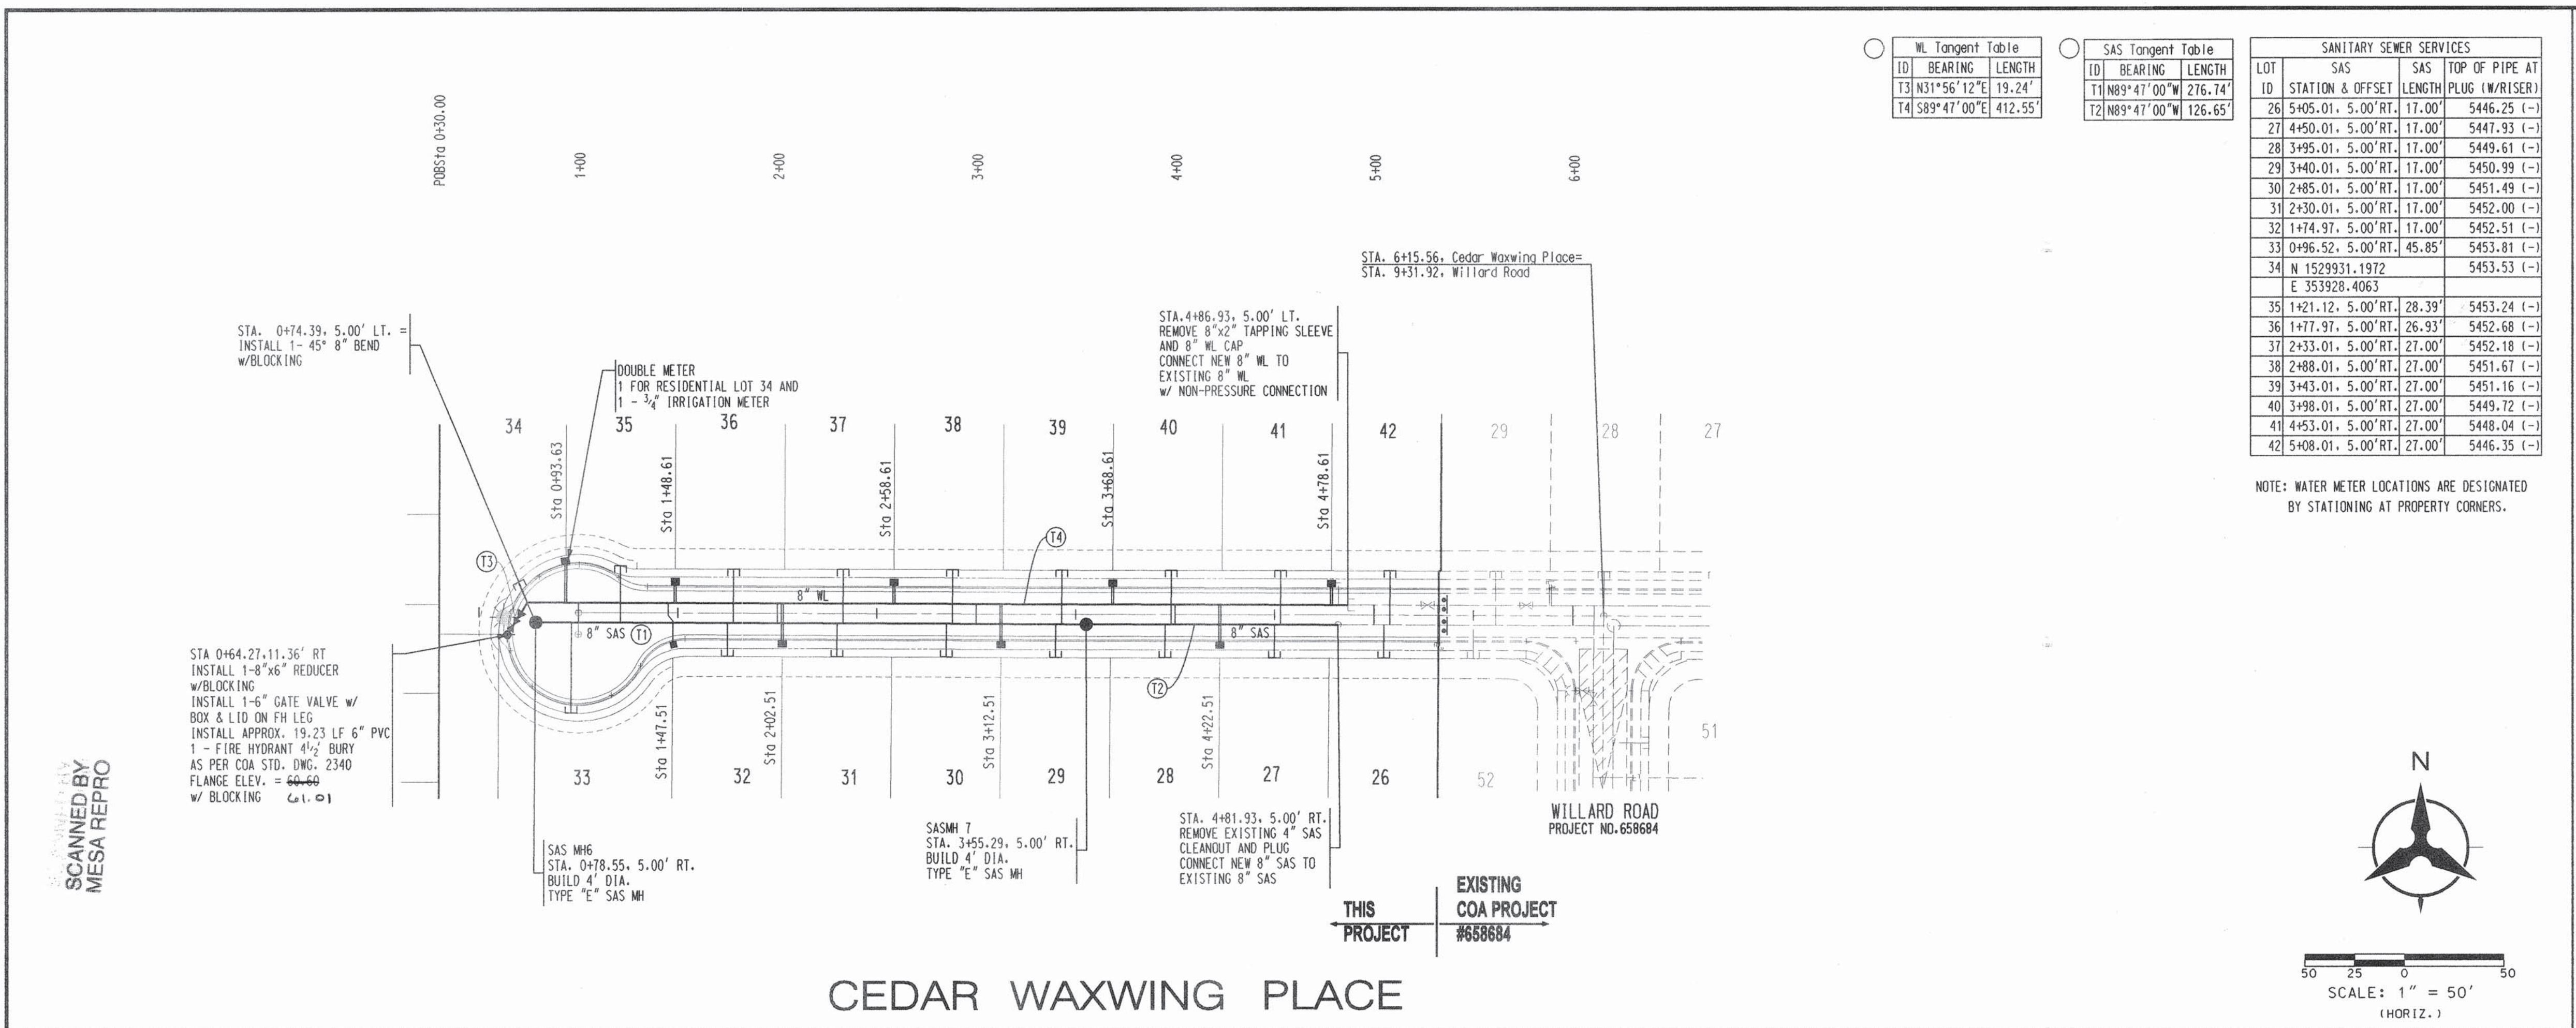


W. Tangent Table			SAS Tangent Table		
ID	BEARING	LENGTH	ID	BEARING	LENGTH
13	N31°56'12"E	19.24'	T1	N89°47'00"W	276.74'
14	S89°47'00"E	412.55'	T2	N89°47'00"W	126.65'

SANITARY SEWER SERVICES			
LOT	SAS	SAS TOP OF PIPE AT	
ID	STATION & OFFSET	LENGTH	PLUG (W/RISER)
26	5405.01, 5.00' RT.	17.00'	5446.25 (-)
27	4450.01, 5.00' RT.	17.00'	5447.93 (-)
28	3495.01, 5.00' RT.	17.00'	5449.61 (-)
29	3440.01, 5.00' RT.	17.00'	5450.99 (-)
30	2485.01, 5.00' RT.	17.00'	5451.49 (-)
31	2430.01, 5.00' RT.	17.00'	5452.00 (-)
32	1474.97, 5.00' RT.	17.00'	5452.51 (-)
33	0496.52, 5.00' RT.	45.85'	5453.81 (-)
34	N 1529931.1972		5453.53 (-)
	E 353928.4063		
35	1421.12, 5.00' RT.	28.39'	5453.24 (-)
36	1477.97, 5.00' RT.	26.93'	5452.68 (-)
37	2433.01, 5.00' RT.	27.00'	5452.18 (-)
38	2488.01, 5.00' RT.	27.00'	5451.67 (-)
39	3443.01, 5.00' RT.	27.00'	5451.16 (-)
40	3498.01, 5.00' RT.	27.00'	5449.72 (-)
41	4453.01, 5.00' RT.	27.00'	5448.04 (-)
42	5408.01, 5.00' RT.	27.00'	5446.35 (-)

NOTE: WATER METER LOCATIONS ARE DESIGNATED BY STATIONING AT PROPERTY CORNERS.

- NOTES
- THE CONTRACTOR SHALL FIELD VERIFY ALL EXISTING UTILITY LOCATIONS AND NOTIFY THE ENGINEER IMMEDIATELY OF ANY DISCREPANCIES.
 - ALL CURB RETURN RADI SHALL BE 25' UNLESS OTHERWISE SPECIFIED.
 - ALL CURVE DATA AND DIMENSIONS REFER TO FACE OF CURB UNLESS OTHERWISE SPECIFIED.
 - GRADE ELEVATIONS, WHERE NOTED, ARE ALONG FLOWLINE OF STANDARD CURB UNLESS OTHERWISE SPECIFIED.
 - CONTRACTOR IS TO INSTALL A 4" X 4" X 5' POST AND EMD AT THE END OF EACH SANITARY SEWER SERVICE.
 - CONTRACTOR IS RESPONSIBLE FOR REPAIR AND/OR REPLACEMENT OF ALL UTILITY CONDUITS AND EXISTING LINES.
 - ANY ADDITIONAL GRADING REQUIRED TO MATCH PROPOSED STREET GRADES SHALL BE INCIDENTAL TO PAVING ITEMS.
 - CONTRACTOR SHALL PROVIDE THE INSPECTORS (CITY AND PRIVATE) WITH THE PROPOSED HYDROSTATIC TESTING PLAN. THE PLAN MUST BE APPROVED BEFORE TESTING OPERATIONS BEGIN.
 - CONTRACTOR SHALL PARK EQUIPMENT AND VEHICLES AS NOT TO INTERFERE WITH NORMAL ACTIVITIES OF RESIDENTS OR OTHER CONTRACTORS ON SITE.
 - ANY DAMAGE TO THE EXISTING FACILITIES (CURB & GUTTER), PAVEMENT, CONDUITS, LANDSCAPING, UTILITY LINES, ETC.) DURING CONSTRUCTION SHALL BE REPLACED AT THE CONTRACTORS' EXPENSE.
 - REMOVAL OF THE EXISTING CURB AND GUTTER SHALL BE AS PER COA STD. DWG. 2415 (SAWCUT ONLY).
 - WHEELCHAIR RAMPS SHALL BE CONSTRUCTED PRIOR TO ACCEPTANCE OF CURB & GUTTER.
 - ALL EXCAVATION, TRENCHING, AND SHORING ACTIVITIES MUST BE CARRIED OUT IN ACCORDANCE WITH OSHA 29 CFR 1926.650 Subpart P. (typical)

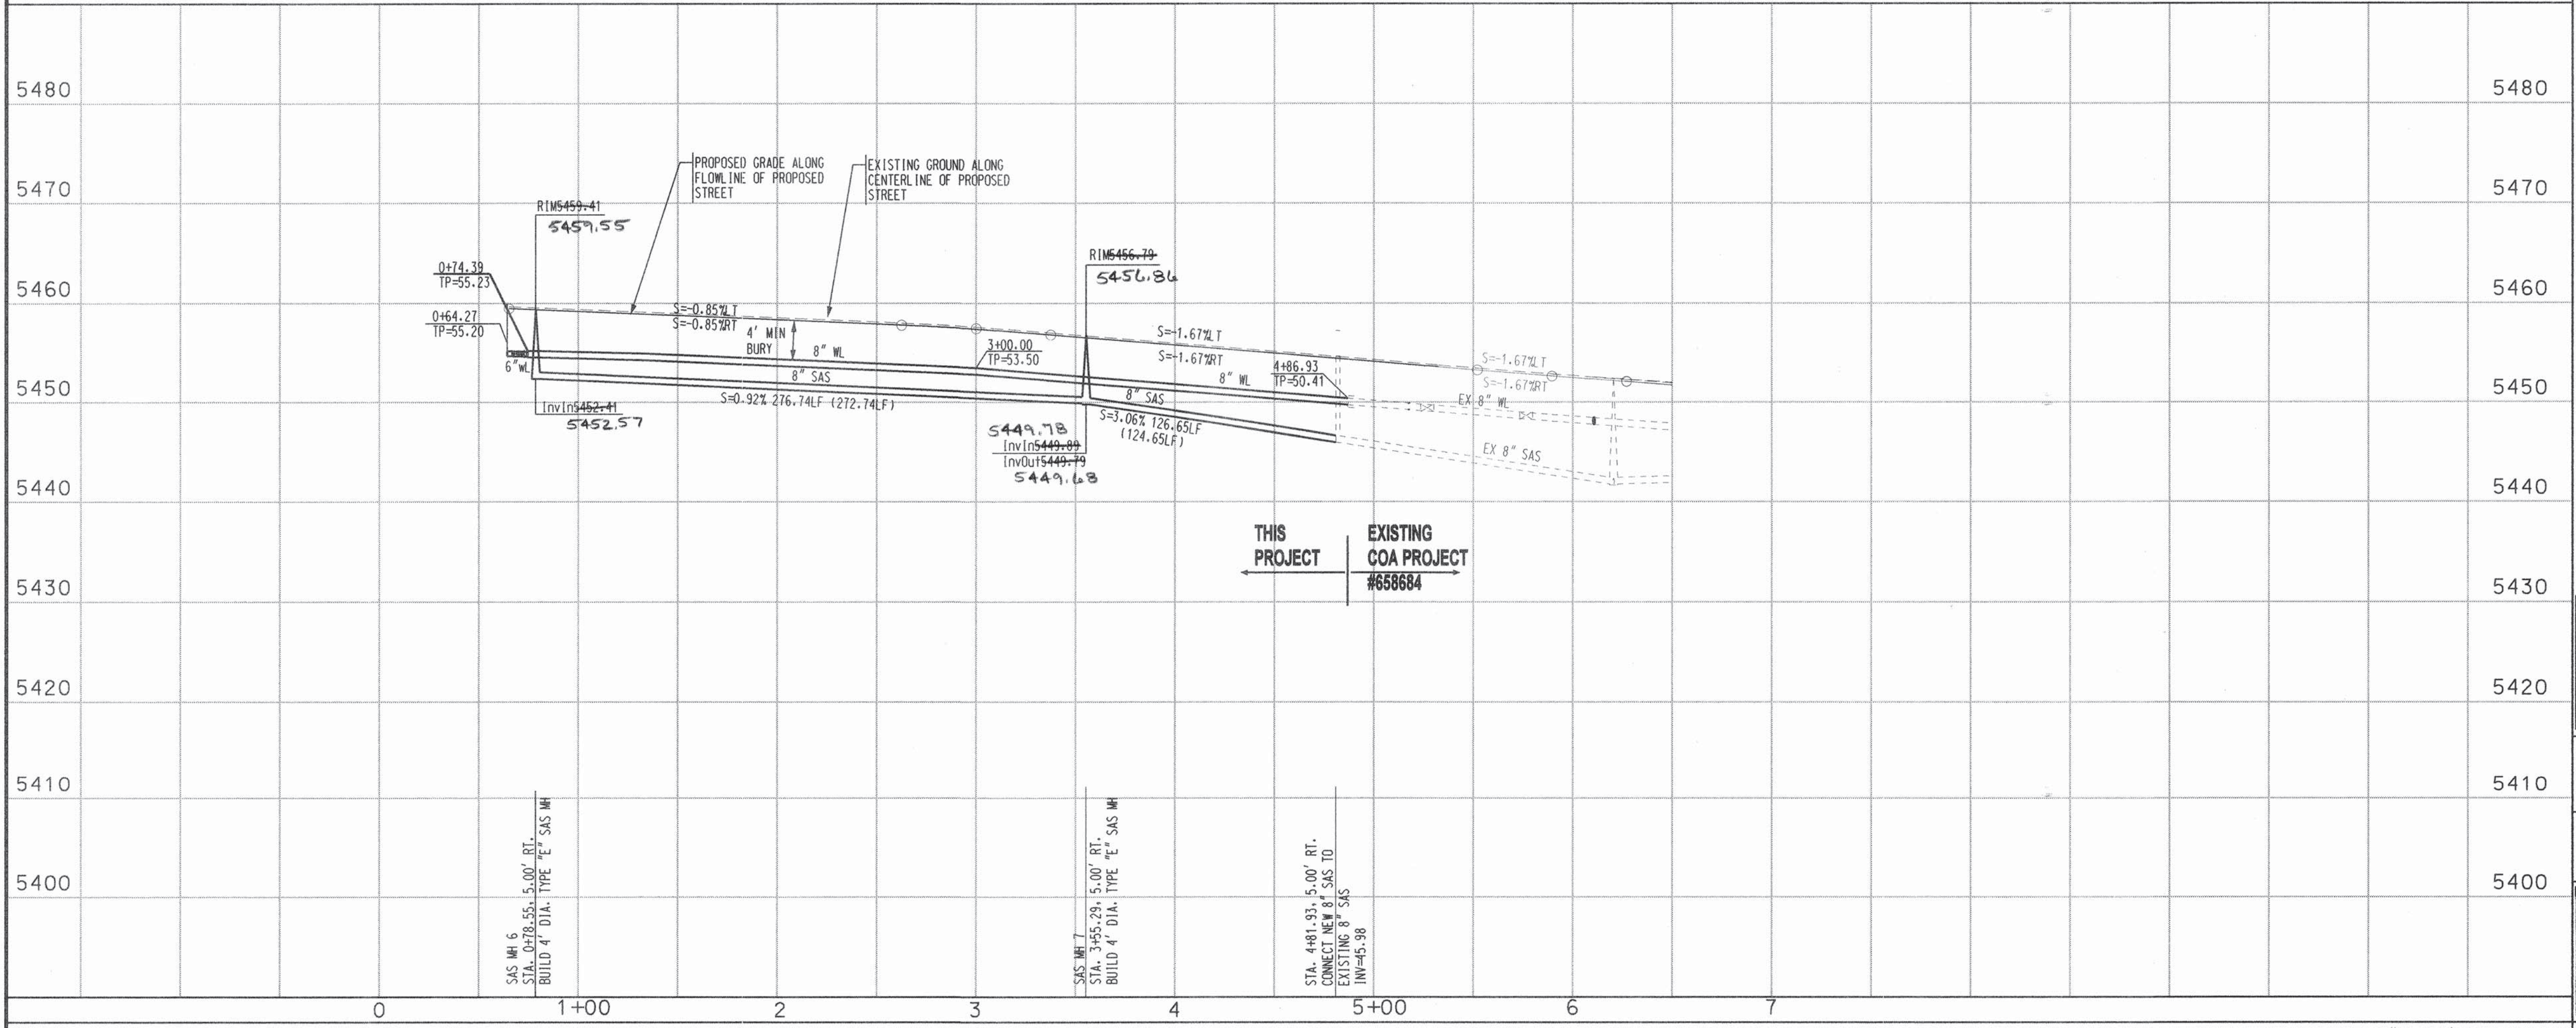

ENGINEER'S SEAL

APPROVED BY NMUI DATE 11-22-2

Bohannan & Huston

Courtyard | 7500 Jefferson St. NE | Albuquerque, NM 87109-4335

ENGINEERING • SPATIAL DATA • ADVANCED TECHNOLOGIES

CITY OF ALBUQUERQUE

PUBLIC WORKS DEPARTMENT

ENGINEERING DEVELOPMENT GROUP

PINON POINTE IV SUBDIVISION AT VENTANA RANCH

UTILITY PLAN & PROFILE

CEDAR WAXWING PLACE

DESIGN REVIEW COMMITTEE CITY ENGINEER APPROVAL

APPROVED DEC 27 2002

APPROVED MAR - 4 2013

LAST DESIGN UPDATE

CITY PROJECT NO. 658685


ZONE MAP NO. B-9

SHEET 14 OF 18

AS-BUILT INFORMATION		BENCH MARKS		SURVEY INFORMATION		FIELD NOTES	
CONTRACTOR	Sundance	ACS BRASS TABLET STAMPED "1-B9 1380"		NO.	BY	DATE	DATE
WORK	11-22-2	GEOGRAPHIC POSITION (NAD 1927)					
STAKED BY	AKS	N.M. STATE PLANE COORDINATES					
ACCEPTANCE BY	AKS	(CENTRAL ZONE) X=355+077.00					
FIELD	AKS	Y=1529+086.93					
ADJUSTMENT BY	AKS	DELTA TO-GRID FACTOR = .99966334					
DATE	11-22-2	DELTA ALPHA -00°16'47"					
RECORDED BY	AKS	GROUND TO-GRID FACTOR = .99966334					
NO.		NOVD 1929 ELEVATION = 5450.51					

SAS Curve Table				
ID	ARC	RADIUS	DELTA	TANGENT
C1	208.27'	1995.00'	05°58'53"	104.23'

SAS Tangent Table		
ID	BEARING	LENGTH
T1	N83°11'01"W	70.20'

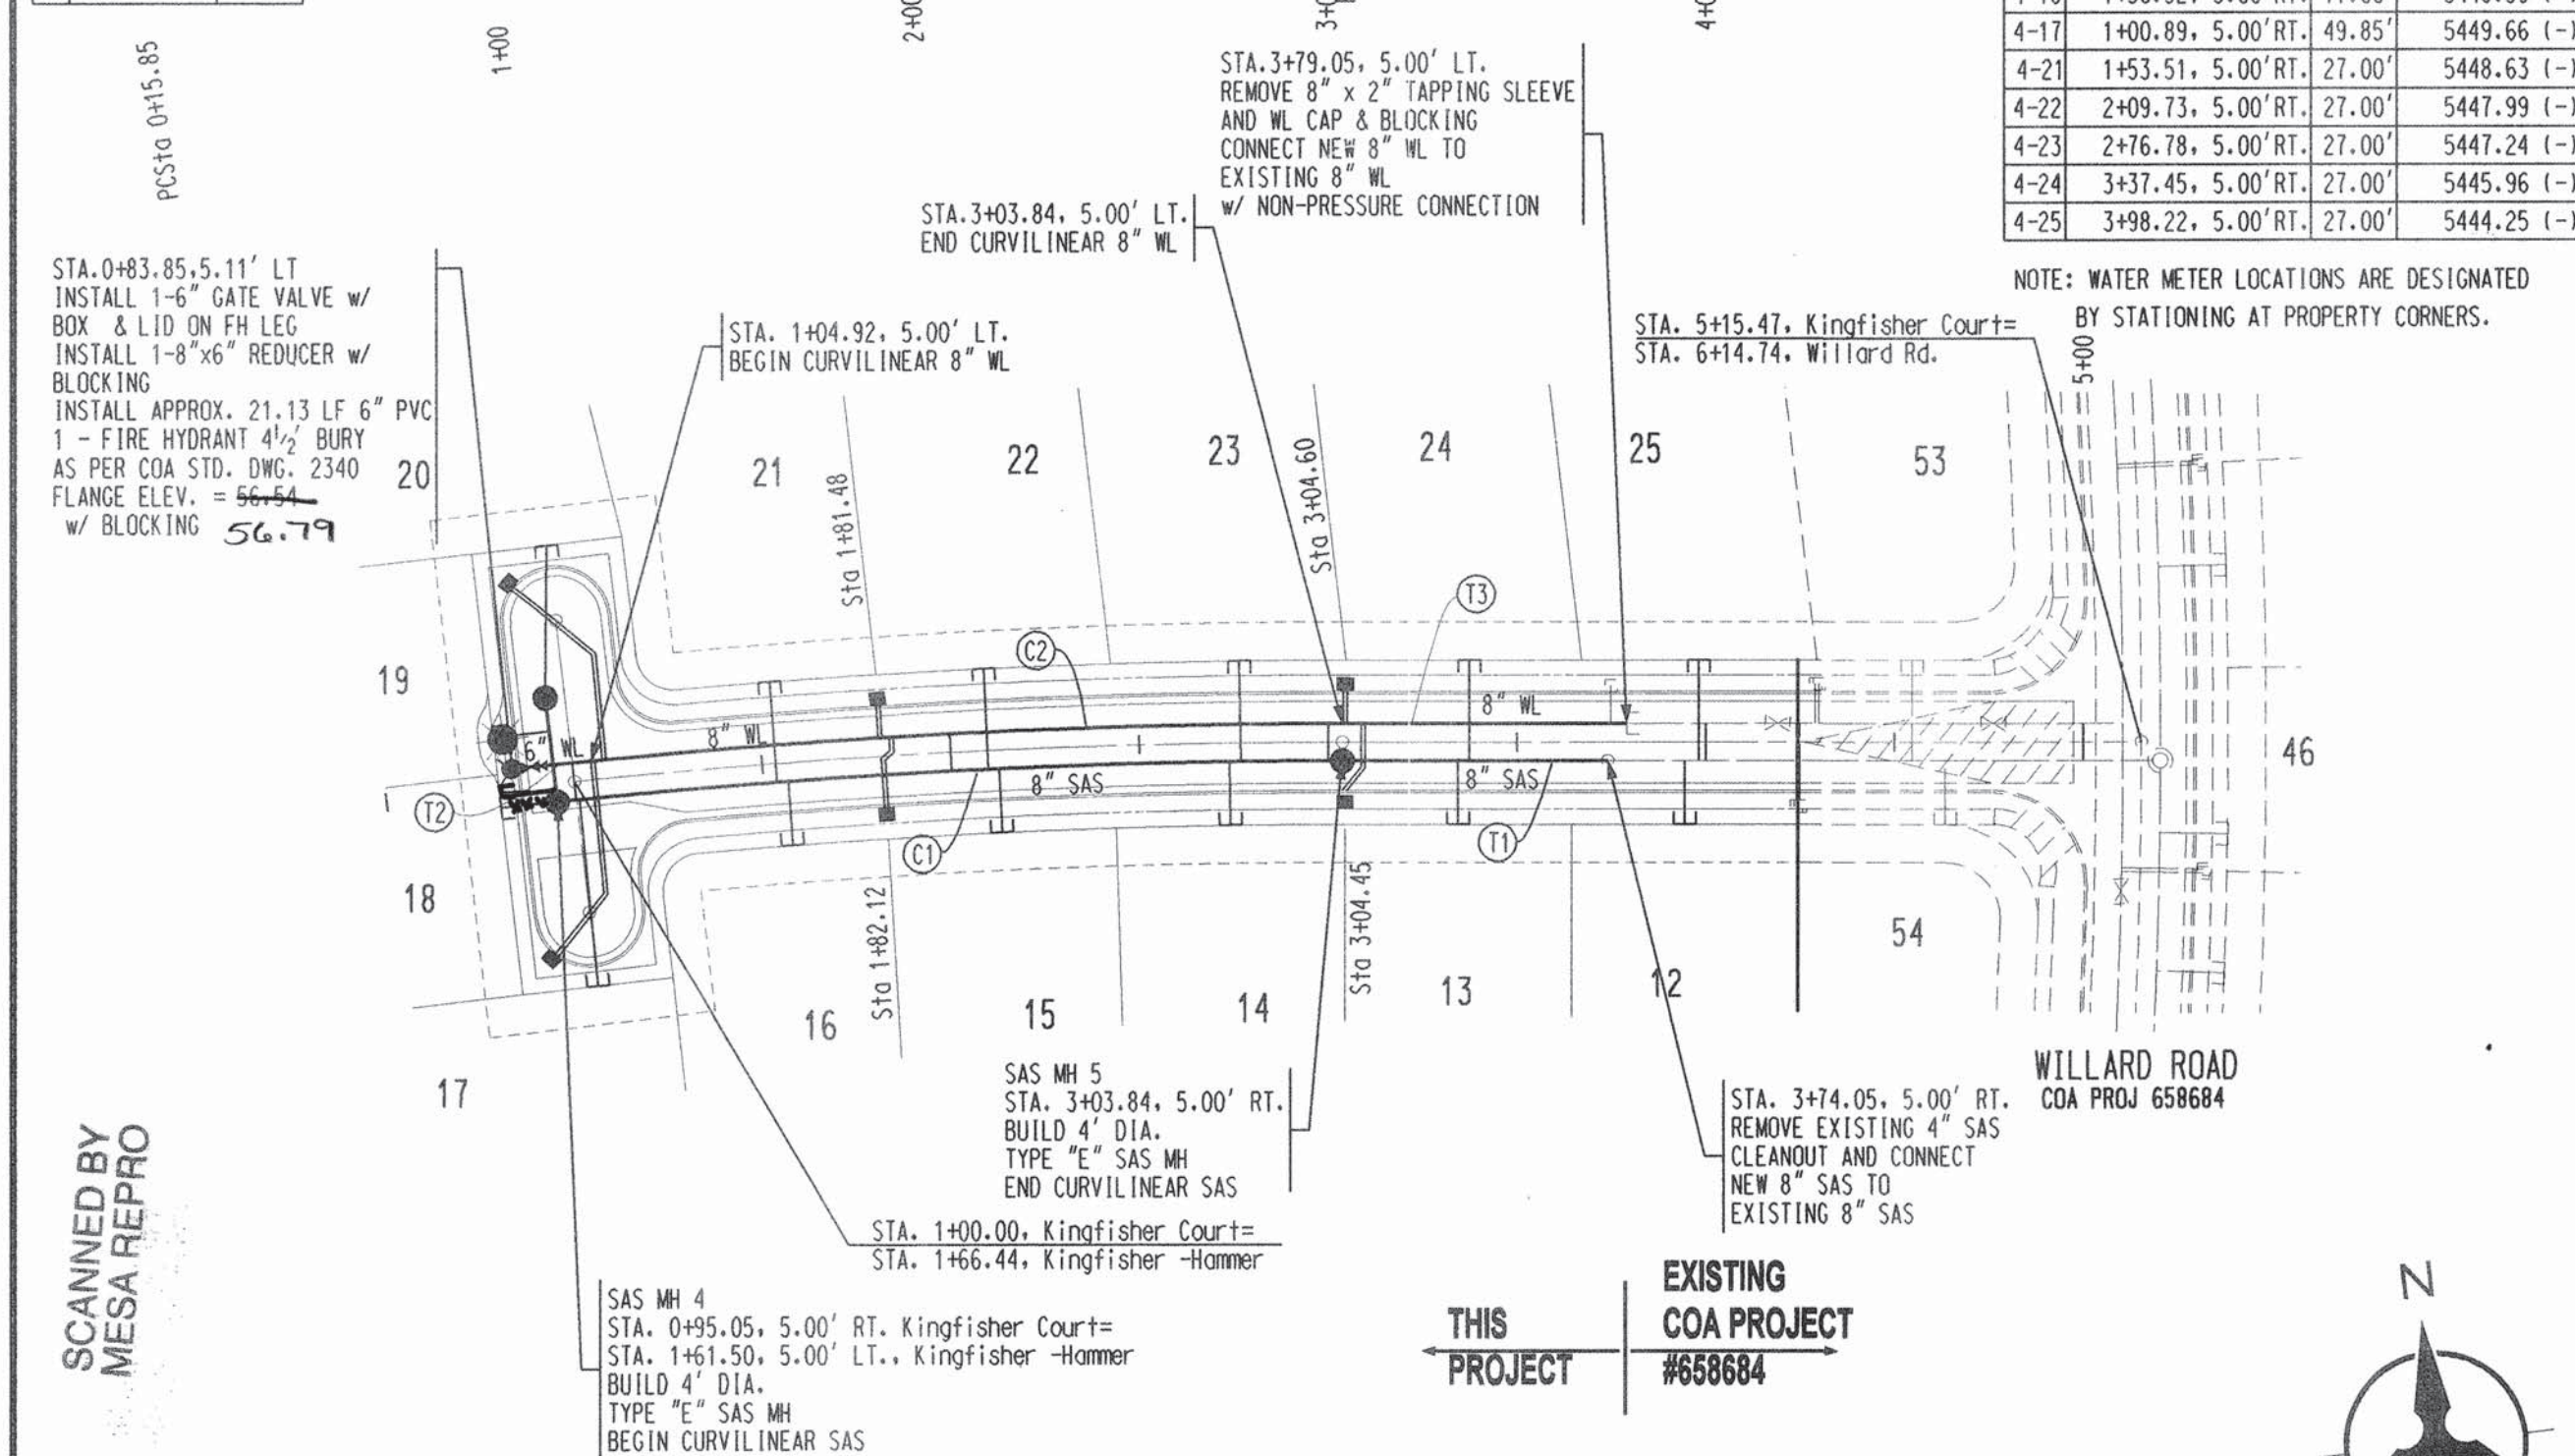


KINGFISHER CT


ID	BEARING	LENGTH
T3	S00°13'00"W	34.91
T4	N00°13'00"E	28.20

SANITARY SEWER SERVICES			
LOT ID	SAS STATION & OFFSET	SAS LENGTH	TOP OF PIPE PLUG (W/RISE)
18	1+66.50, 5.00' IT.	15.00'	5449.50 (
19	1+80.59, 5.00' IT.	15.00'	5449.60 (
20	N 1529699.5655		5450.25 (
	E 354047.7311		

NOTE: WATER METER LOCATIONS ARE DESIGNATED
BY STATIONING AT PROPERTY CORNERS.

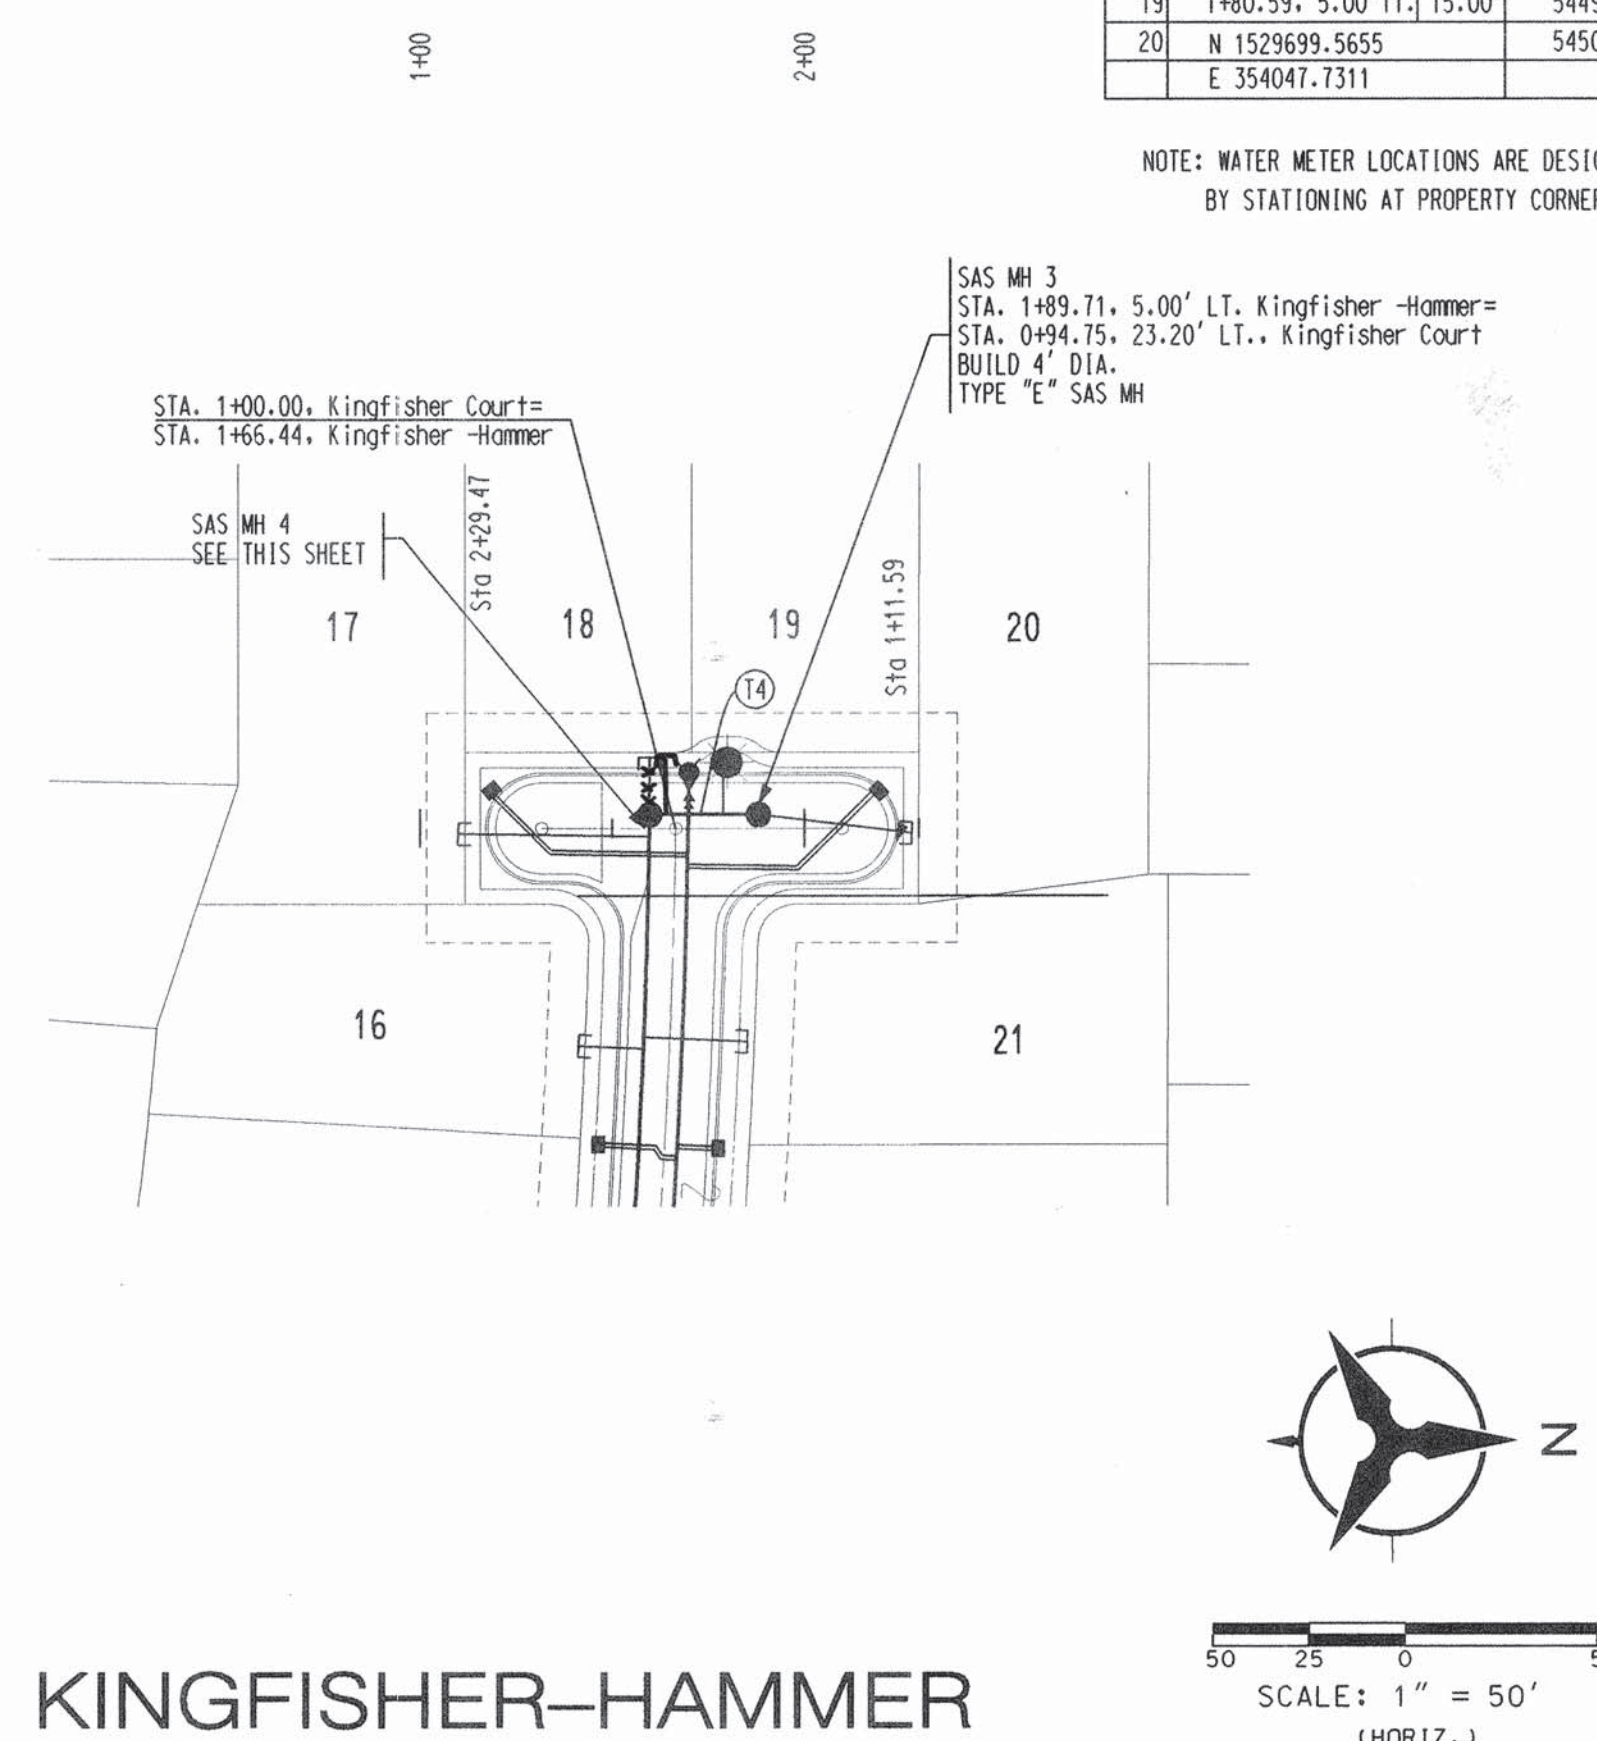

KINGFISHER-HAMMER

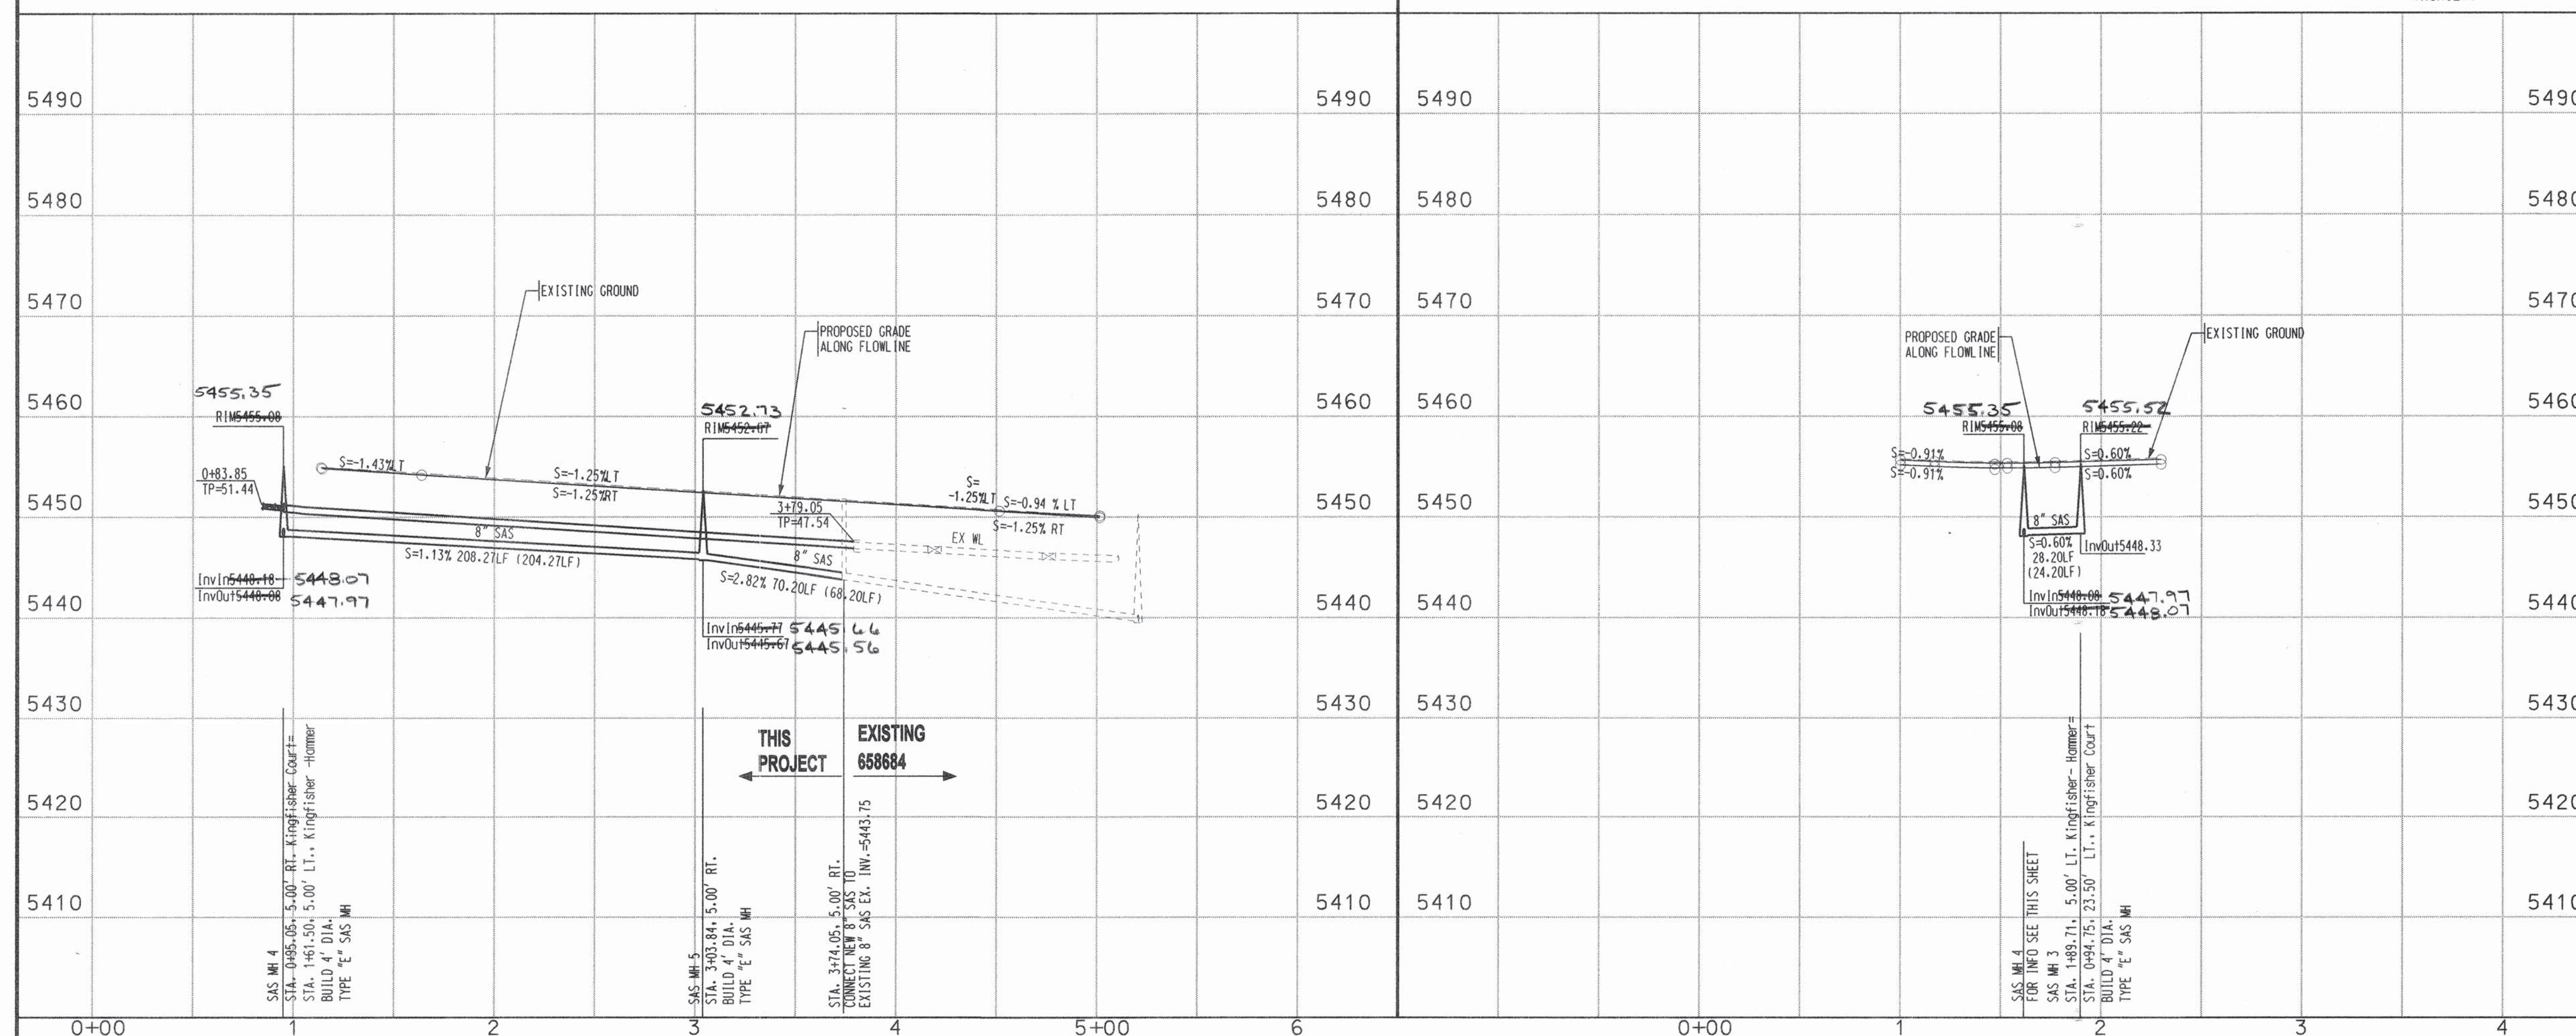

P:\020278\ CDP\PNP\UNIT 4\ 020278UPNP07.DGN

BHI JOB NO. 020278

SCALE: 1" = 50' (HORIZ.)
1" = 10' (VERT.)

NOTES

1. THE CONTRACTOR SHALL FIELD VERIFY ALL EXISTING UTILITY LOCATIONS AND NOTIFY THE ENGINEER IMMEDIATELY OF ANY DISCREPANCIES.
2. ALL CURB RETURN RADII SHALL BE 25' UNLESS OTHERWISE SPECIFIED.
3. ALL CURVE DATA AND DIMENSIONS REFER TO FACE OF CURB UNLESS OTHERWISE SPECIFIED.
4. GRADE ELEVATIONS, WHERE NOTED, ARE ALONG FLOWLINE OF STANDARD CURB UNLESS OTHERWISE SPECIFIED.
5. CONTRACTOR IS TO INSTALL A 4" X 4" X 5' POST AND END AT THE END OF EACH SANITARY SEWER SERVICE.
6. CONTRACTOR IS RESPONSIBLE FOR REPAIR AND/OR REPLACEMENT OF ALL UTILITY CONDUITS AND EXISTING LINES.
7. ANY ADDITIONAL GRADING REQUIRED TO MATCH PROPOSED STREET GRADES SHALL BE INCIDENTAL TO PAVING ITEMS.
8. CONTRACTOR SHALL PROVIDE THE INSPECTORS, (CITY AND PRIVATE) WITH THE PROPOSED HYDROSTATIC TESTING PLAN. THE PLAN MUST BE APPROVED BEFORE TESTING OPERATIONS BEGIN.
9. CONTRACTOR SHALL PARK EQUIPMENT AND VEHICLES AS NOT TO INTERFERE WITH NORMAL ACTIVITIES OF RESIDENTS OR OTHER CONTRACTORS ON SITE.
10. ANY DAMAGE TO THE EXISTING FACILITIES (CURB & GUTTER), PAVEMENT, CONDUITS, LANDSCAPING, UTILITY LINES, ETC.) DURING CONSTRUCTION SHALL BE REPLACED AT THE CONTRACTORS' EXPENSE.
11. REMOVAL OF THE EXISTING CURB AND GUTTER SHALL BE AS PER COA STD. DWG. 2415 (SAWCUT RAMP).
12. WHEELCHAIR RAMPS SHALL BE CONSTRUCTED PRIOR TO ACCEPTANCE OF CURB & GUTTER.

SURVEY INFORMATION		BENCH MARKS		AS-BUILT INFORMATION	
NO.	FIELD NOTES	DATE	BY	CONTRACTOR	DATE
	ACS BRASS TABLE STAMPED "1-B9 1980"			Sundeen	
	GEOGRAPHIC POSITION (NAD 1927)			WORKED BY A15	03
	N.M. STATE PLANE COORDINATES			INSPECTOR'S ACCEPTANCE BY SEC	DATE 11
	(CENTRAL ZONE) X=355.077.00			FIELD LIGATION BY A15	DATE 03
	Y=1.529.056.93			DRAWINGS CORRECTED BY A15	DATE 10/03
	GROUND-TO-GRID FACTOR = .99966334			MICRO-FILM INFORMATION	
	DELTA ALPHA = -00° 16' 47"			RECORDED BY	DATE
	NVD 1929 ELEVATION = 5450.51				
				NO.	

[illegible]

1	2	3	4	5	6	7	8	9	10	11	12	13	14	15
26	6	5	8	6	.	8	5		1	5	0	3		

APPROVED BY NMUI  11-22-02

Bohannon ▲ Huston

Courtyard I 7500 Jefferson St. NE Albuquerque, NM 87109-4335
ENGINEERING • SPATIAL DATA • ADVANCED TECHNOLOGIES



CITY OF ALBUQUERQUE
PUBLIC WORKS DEPARTMENT
ENGINEERING DEVELOPMENT GROUP

PINON POINTE IV SUBDIVISION AT VENTANA RANCH
UTILITY PLAN & PROFILE
KINGFISHER CT & HAMMER

DESIGN REVIEW COMMITTEE		CITY ENGINEER APPROVAL		MO./DAY/YR.		MO./DAY/YR.	
APPROVED DEC 27 2002 DESIGN REVIEW COMMITTEE		APPROVED MAR - 4 2003 CITY ENGINEER		LAST DESIGN UPDATE			

CITY PROJECT NO.	658685	ZONE MAP NO.	B-9	SHEET	15	OF	18
------------------	--------	--------------	-----	-------	----	----	----

ID	ARC	RADIUS	DELTA	TANGENT
C1	89.90'	275.00'	18°43'49"	45.35'
C2	128.36'	953.00'	07°43'03"	64.28'

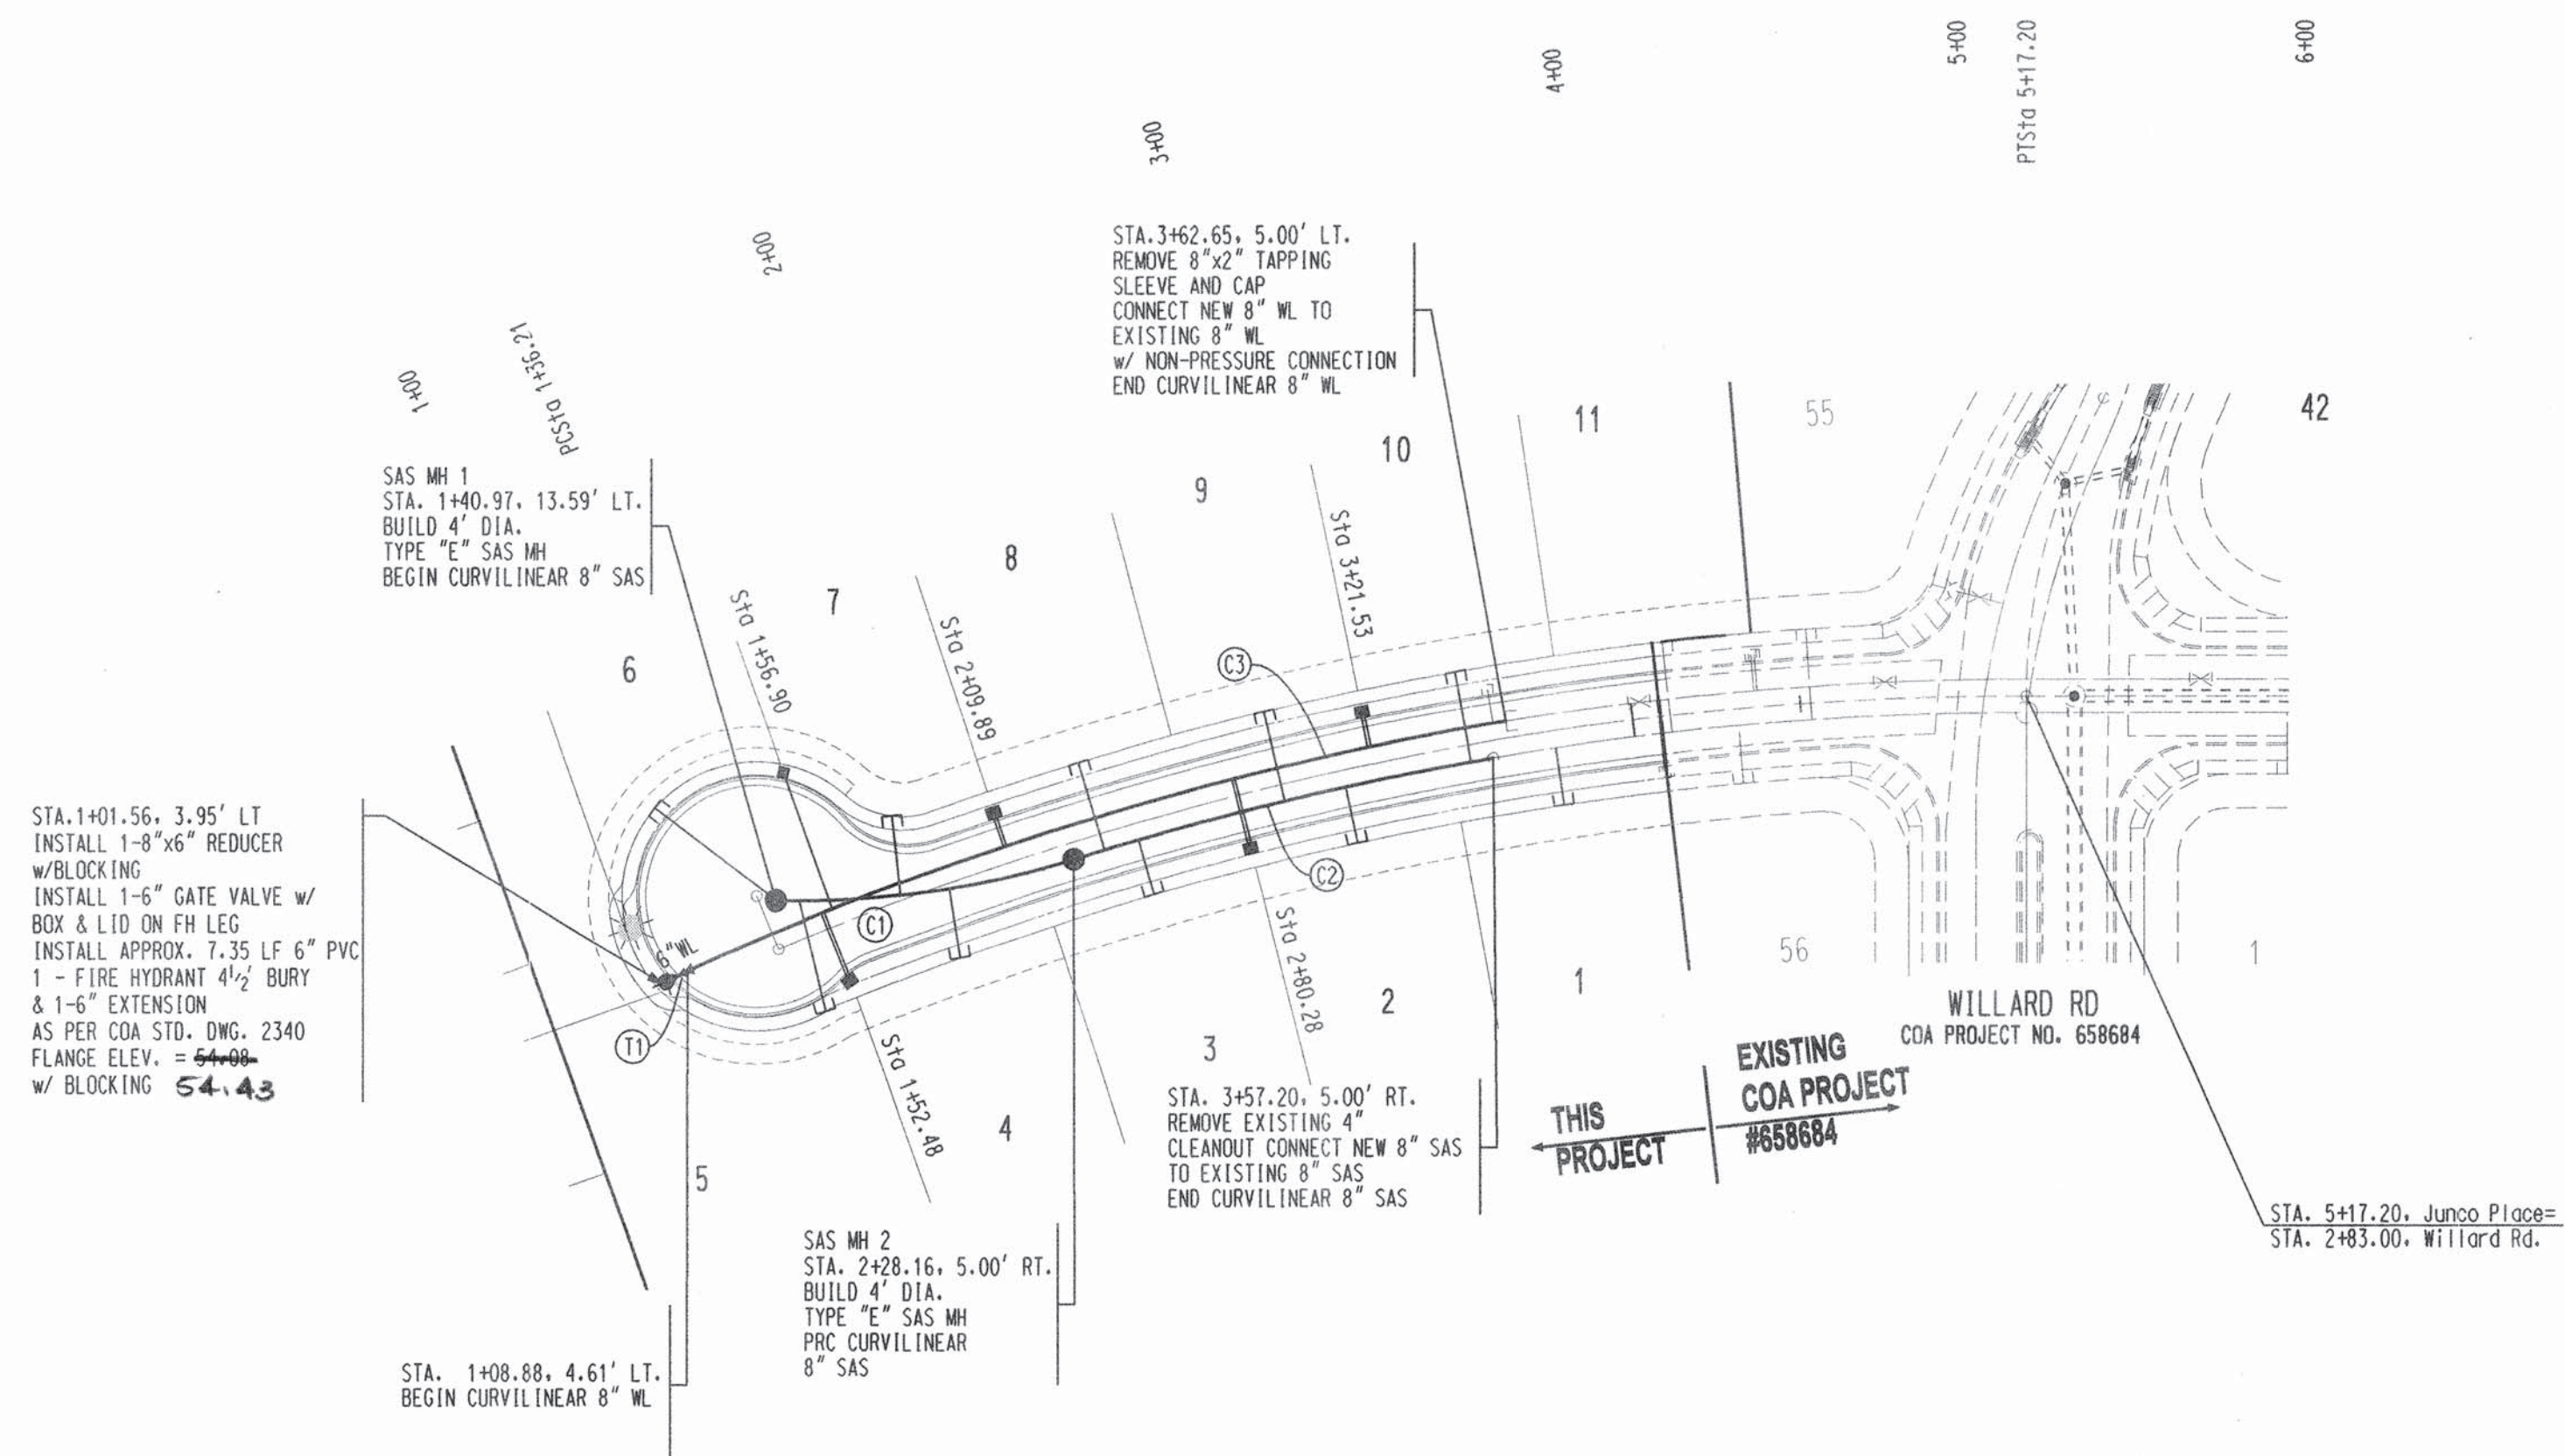

SANITARY SEWER SERVICES				
LOT 10	SAS STATION & OFFSET	SAS LENGTH	TOP OF PIPE AT PLUG (W/RISE)	
1	3+50.40, 5.00' RT.	16.29'	5442.57 (2')	
10	3+50.40, 5.00' RT.	27.00'	5443.11 (2')	
2	3+12.23, 5.00' RT.	17.00'	5442.31 (-)	
3	2+48.32, 5.00' RT.	17.00'	5444.16 (-)	
4	1+90.09, 1.61' RT.	20.73'	5446.17 (-)	
5	1+53.88, 8.28' LT.	32.94'	5446.85 (-)	
6	1+40.97, 13.59' LT.	45.30'	5445.97 (-)	
7	1+75.78, 1.48' LT.	23.76'	5446.41 (-)	
8	2+37.80, 5.00' RT.	27.00'	5444.78 (-)	
9	2+39.62, 5.00' RT.	27.00'	5443.27 (-)	

NOTE: WATER METER LOCATIONS ARE DESIGNATED
BY STATIONING AT PROPERTY CORNERS.




50 25 0 50
SCALE: 1" = 50'
(HORIZ.)

NOTES

1. THE CONTRACTOR SHALL FIELD VERIFY ALL EXISTING UTILITY LOCATIONS AND NOTIFY THE ENGINEER IMMEDIATELY OF ANY DISCREPANCIES.
2. ALL CURB RETURN RADII SHALL BE 25' UNLESS OTHERWISE SPECIFIED.
3. ALL CURVE DATA AND DIMENSIONS REFER TO FACE OF CURB UNLESS OTHERWISE SPECIFIED.
4. GRADE ELEVATIONS, WHERE NOTED, ARE ALONG FLOWLINE OF STANDARD CURB UNLESS OTHERWISE SPECIFIED.
5. CONTRACTOR IS TO INSTALL A 4" X 4" X 5' POST AND END AT THE END OF EACH SANITARY SEWER SERVICE.
6. CONTRACTOR IS RESPONSIBLE FOR REPAIR AND/OR REPLACEMENT OF ALL UTILITY CONDUITS AND EXISTING LINES.
7. ANY ADDITIONAL GRADING REQUIRED TO MATCH PROPOSED STREET GRADES SHALL BE INCIDENTAL TO PAVING ITEMS.
8. CONTRACTOR SHALL PROVIDE THE INSPECTORS, (CITY AND PRIVATE) WITH THE PROPOSED HYDROSTATIC TESTING PLAN. THE PLAN MUST BE APPROVED BEFORE TESTING OPERATIONS BEGIN.
9. CONTRACTOR SHALL PARK EQUIPMENT AND VEHICLES AS NOT TO INTERFERE WITH NORMAL ACTIVITIES OF RESIDENTS OR OTHER CONTRACTORS ON SITE.
10. ANY DAMAGE TO THE EXISTING FACILITIES (CURB & GUTTER), PAVEMENT, CONDUITS, LANDSCAPING, UTILITY LINES, ETC.) DURING CONSTRUCTION SHALL BE REPLACED AT THE CONTRACTORS' EXPENSE.
11. REMOVAL OF THE EXISTING CURB AND GUTTER SHALL BE AS PER COA STD. DWG. 2415 (SAWCUT RAMP).
12. WHEELCHAIR RAMPS SHALL BE CONSTRUCTED PRIOR TO ACCEPTANCE OF CURB & GUTTER.

SCANNED BY
MESA REPRO

JUNCO PLACE

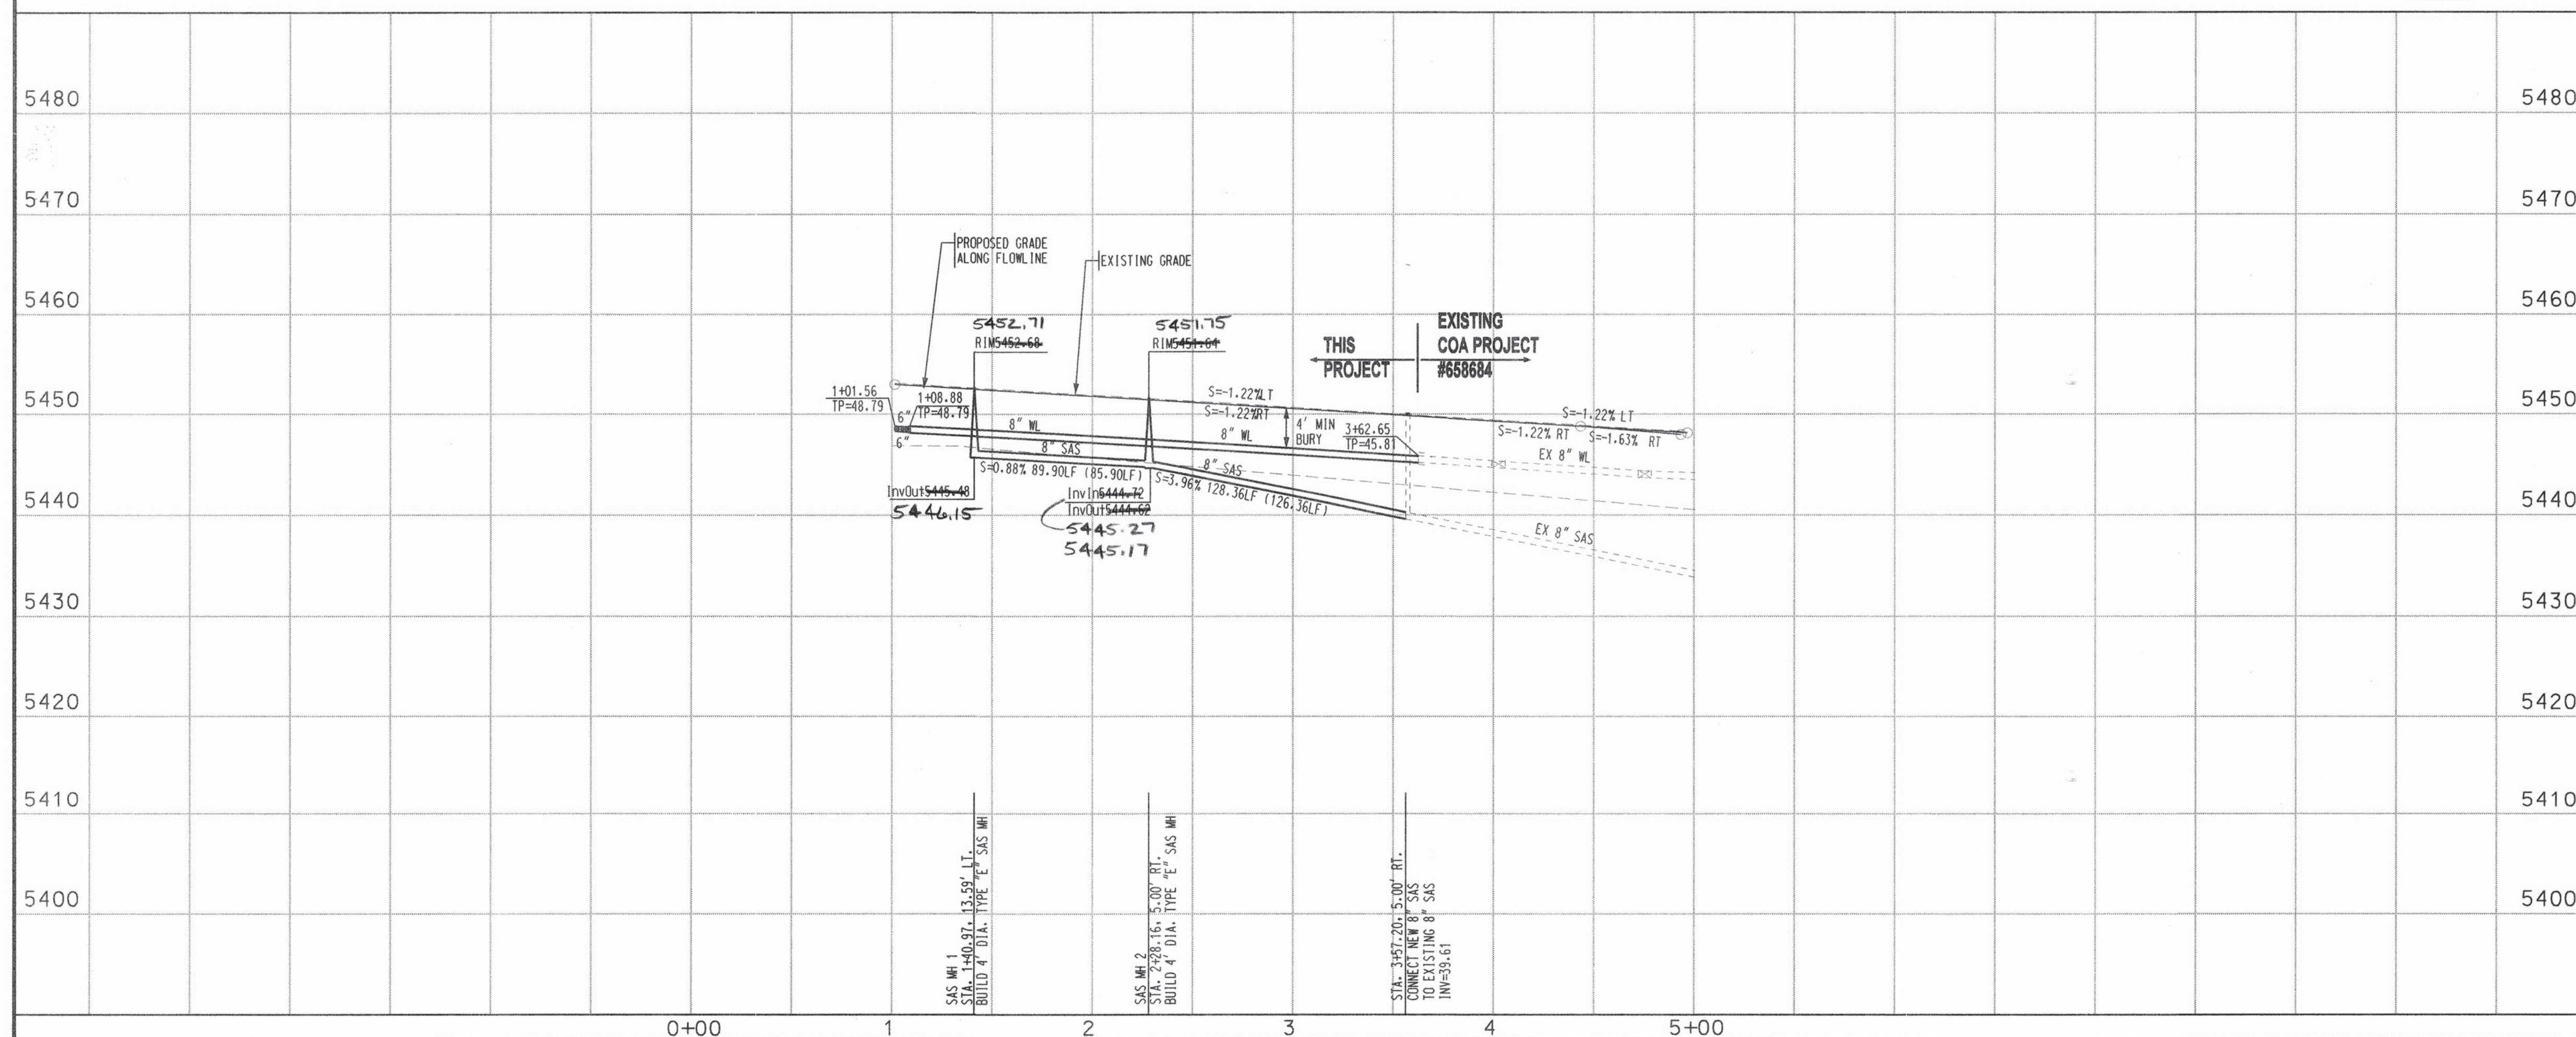

P:\020278\ CDP\PNP\unit 4\ 020278UPNP08.DGN

BHI JOB NO. 020278

SCALE: 1" = 50' (HORIZ.)
1" = 10' (VERT.)

CITY PROJECT NO.

658685

NE MAP NO.
B-9

SHEET 16 OF 18

CITY PROJECT NO.

658685

NE MAP NO.
B-9

SHEET 16 OF 18

CITY PROJECT NO.

658685

NE MAP NO.
B-9

SHEET 16 OF 18

CONSTRUCTION TRAFFIC CONTROL GENERAL NOTES

1. CONTRACTOR MUST OBTAIN FROM CONSTRUCTION COORDINATION AN EXCAVATION/BARRICADING PERMIT BEFORE ENGAGING IN ANY CONSTRUCTION, MAINTENANCE OR REPAIR WORK IN ANY OF THE CITY OF ALBUQUERQUE'S RIGHTS-OF-WAY. EMERGENCY WORK THAT WOULD PRESERVE LIFE OR PROPERTY IS EXCLUDED WITH THE UNDERSTANDING, THAT A PERMIT SHALL BE OBTAINED WITHIN 24 TO 48 HOURS.

2. CONTRACTOR SHALL AT THE TIME OF PERMIT REQUEST, SUBMIT FOR APPROVAL BY CONSTRUCTION COORDINATION, A TRAFFIC CONTROL PLAN DETAILING ALL EXISTING TOPOGRAPHY SUCH AS LANE WIDTHS, DRIVEWAYS, AND BUSINESS/RESIDENTIAL ACCESSES. THE TRAFFIC CONTROL PLAN SHALL INCLUDE ALL PHASES OF WORK AND SCHEDULES INVOLVED IN THE CONSTRUCTION PROJECT. ANY SEPERATE PHASES OF A CONSTRUCTION PROJECT SHALL BE GIVEN AN INDIVIDUAL PERMIT EACH. BLANKET PERMITS WILL NOT BE ISSUED.

3. THESE TYPICAL TRAFFIC CONTROL PLANS DO NOT REFLECT THE EXISTING TOPOGRAPHY SUCH AS DRIVEWAYS, LANE WIDTHS, AND BUSINESS/RESIDENTIAL ACCESSES. EVERY LOCATION THAT REQUIRES CONSTRUCTION TRAFFIC CONTROL SHALL HAVE A DETAILED TRAFFIC CONTROL PLAN SHOWING ALL EXISTING TOPOGRAPHY.

4. CONSTRUCTION SHALL NOT BEGIN UNLESS A TRAFFIC CONTROL PLAN HAS BEEN APPROVED AND VERIFIED BY CONSTRUCTION COORDINATION.

5. CONSTRUCTION COORDINATION SHALL BE NOTIFIED 48 HOURS PRIOR TO ANY TRAFFIC CONTROL CHANGES NEEDED BY CONTRACTOR, THAT WERE NOT PREVIOUSLY APPROVED. THESE TRAFFIC CONTROL CHANGES SHALL BE REQUESTED IN WRITING ACCOMPANIED WITH A TRAFFIC CONTROL PLAN REFLECTING SUCH CHANGES.

6. ALL CONSTRUCTION TRAFFIC CONTROL DEVICES SHALL COMPLY TO THE MANUAL ON UNIFORM TRAFFIC CONTROL DEVICES (MUTCD), LATEST EDITION. IT IS THE RESPONSIBILITY OF THE CONTRACTOR TO INSTALL, SERVICE AND MAINTAIN ALL TRAFFIC CONTROL DEVICES. TRAFFIC CONTROL DEVICES SHALL NOT BE REMOVED OR ALTERED IN ANY WAY WITHOUT THE APPROVAL OF CONSTRUCTION COORDINATION, PER SECTION 6A-4 OF THE MUTCD, LATEST EDITION.

7. THE CONSTRUCTION TRAFFIC CONTROL INITIAL SET-UP SHALL BE BY AN AMERICAN TRAFFIC SAFETY SERVICES ASSOCIATION (ATSSA) CERTIFIED WORKSITE TRAFFIC SUPERVISOR. THE MAINTENANCE AND SERVICING SHALL ALSO BE DONE BY AN ATSSA CERTIFIED WORKSITE TRAFFIC SUPERVISOR OR EQUIVALENT.

8. CONTRACTOR IS RESPONSIBLE TO MAINTAIN AND SERVICE ALL TRAFFIC CONTROL DEVICES 24 HOURS A DAY, 7 DAYS A WEEK THROUGHOUT LENGTH OF PROJECT. CONTRACTOR IS RESPONSIBLE THAT ALL TRAFFIC CONTROL DEVICES COMPLY WITH THE MUTCD, LATEST EDITION.

9. ALL ADVANCE WARNING SIGNS SHALL BE DOUBLE INDICATED WHENEVER THERE ARE MULTI-LANE TRAFFIC IN ANY ONE GIVEN DIRECTION AND THERE IS SUFFICIENT MEDIAN SPACE.

10. ALL BARRICADES IN ALL TAPERS AND TANGENTS SHALL BE PLACED APART, A DISTANCE MEASURED IN FEET, EQUAL TO THAT OF THE POSTED SPEED LIMIT. NO EXCEPTIONS UNLESS APPROVED BY CONSTRUCTION COORDINATION PER MUTCD SECTION 6A-4.

11. ALL WORK IN ARTERIAL ROADWAYS SHALL BE ON A CONTINUOUS 24 HOUR PER DAY BASIS UNTIL COMPLETED.

12. CONTRACTOR IS RESPONSIBLE TO PROVIDE CONSTRUCTION COORDINATION, A WEEKLY LOG OF DAILY INSPECTIONS OF BARRICADE AND MAINTENANCE SCHEDULES ON PROJECTS THAT ARE OVER ONE WEEK DURATION.

13. EQUIPMENT OR MATERIALS SHALL NOT BE STORED WITHIN 15 FEET OF A TRAVELED TRAFFIC LANE DURING NON-WORKING HOURS WITHOUT THE APPROVAL OF CONSTRUCTION COORDINATION.

14. CONTRACTOR SHALL PROVIDE AND MAINTAIN A SAFE AND ADEQUATE MEANS OF CHANNELIZING PEDESTRIAN TRAFFIC AROUND AND THROUGH THE CONSTRUCTION AREA.

15. CONTRACTOR IS RESPONSIBLE FOR OBLITERATION OF ANY CONFLICTING STRIPING AND RESPONSIBLE FOR ALL TEMPORARY STRIPING.

16. CONTRACTOR SHALL MAINTAIN ACCESS TO ALL FACILITIES, BUSINESSES AND/OR RESIDENTS AT ALL TIMES.

17. CONTRACTOR SHALL PROVIDE ACCESS SIGNS FOR BUSINESSES LOCATED WITHIN THE CONSTRUCTION AREA UNDER THE SUPERVISION OF CONSTRUCTION COORDINATION. EACH ACCESS SIGN SHALL HAVE 5 INCH, WHITE OPAQUE LETTERING ON BLUE REFLECTORIZED BACKGROUND. ACCESS SIGNS SHALL BE CONSIDERED INCIDENTAL TO THE BID AND NOT PART OF THE CONTRACT UNLESS OTHERWISE STATED. NO MORE THAN 3 BUSINESSES SHALL BE LISTED ON A ACCESS SIGN. SHOPPING CENTERS AND MALLS SHALL BE LISTED AS SUCH.

18. ALL ADVANCE WARNING SIGNS SHALL MEET THE MINIMUM REFLECTIVE INTENSITY REQUIREMENTS SET FORTH BY THE CITY OF ALBUQUERQUE. CONSTRUCTION COORDINATION SHALL DETERMINE ALL REQUIREMENTS AND APPROVE OR DISAPPROVE ANY ADVANCE WARNING SIGN PER SECTION 6A-4 OF THE MUTCD, LATEST EDITION.

19. 48 HOURS PRIOR TO OCCUPYING OR CLOSING OF A RIGHT-OF-WAY, CONTRACTOR SHALL NOTIFY: POLICE, FIRE DEPARTMENT, SCHOOLS, HOSPITALS, TRANSIT AUTHORITY, BUSINESSES AND/OR RESIDENTS THAT WILL BE AFFECTED BY THE CONSTRUCTION.

20. ANY FIELD ADJUSTMENTS SHALL BE APPROVED BY CONSTRUCTION COORDINATION.

21. EXCAVATIONS SHALL BE PLATED, TEMPORARILY PATCHED OR RESURFACED PRIOR TO OPENING OF TRAFFIC. A MINIMUM OF 11 FEET SHALL BE PROVIDED FOR TRAFFIC IN ANY GIVEN DIRECTION. CONTRACTOR IS RESPONSIBLE FOR ANY WORK INVOLVED IN SATISFYING THESE REQUIREMENTS.

22. CONTRACTOR SHALL AT ALL TIMES COMPLY WITH THE FOLLOWING:
1. STANDARDS AND REQUIREMENTS SET FORTH IN THE MANUAL ON UNIFORM TRAFFIC CONTROL DEVICES, LATEST EDITION.
2. THE CITY OF ALBUQUERQUE TRAFFIC CODE, LATEST EDITION.
3. SECTION 19 OF THE CITY OF ALBUQUERQUE'S STANDARD SPECIFICATIONS FOR PUBLIC WORK CONSTRUCTION, AS WELL AS OTHER SECTIONS.


23. FAILURE TO COMPLY WITH ANY OF THE ABOVE MENTIONED, WILL BE ADEQUATE CAUSE TO CEASE ALL WORK ON ANY CONSTRUCTION PROJECT. WORK WILL NOT RESUME UNTIL ALL REQUIREMENTS ARE ADDRESSED AND APPROVED BY CONSTRUCTION COORDINATION.

24. ALL TRAFFIC CONTROL DEVICES SHALL BE KEPT IN NEW-CLEAN CONDITION, WASHING OF EQUIPMENT IS INCIDENTAL TO IT'S PLACEMENT AND MAINTENANCE.

25. TRAFFIC CONTROL STANDARDS APPLY ONLY WHERE THE CONSTRUCTION TRAFFIC CONTROL PLANS ARE NOT SPECIFIC.

26. ADVANCE WARNING SIGNS SHALL BE 36"x36" MIN. WITH SUPER ENGINEERING GRADE SHEETING OR BETTER. MOUNTING HEIGHT AT TOP OF SIGN SHALL BE THE SAME AS FOR A 48" SIGN AS INDICATED IN THE M.U.T.C.D.

27. CONTRACTOR SHALL MAINTAIN A GRAFFITI-FREE WORKSITE. ALL GRAFFITI SHALL BE PROMPTLY REMOVED FROM ALL EQUIPMENT, BOTH PERMANENT AND TEMPORARY.

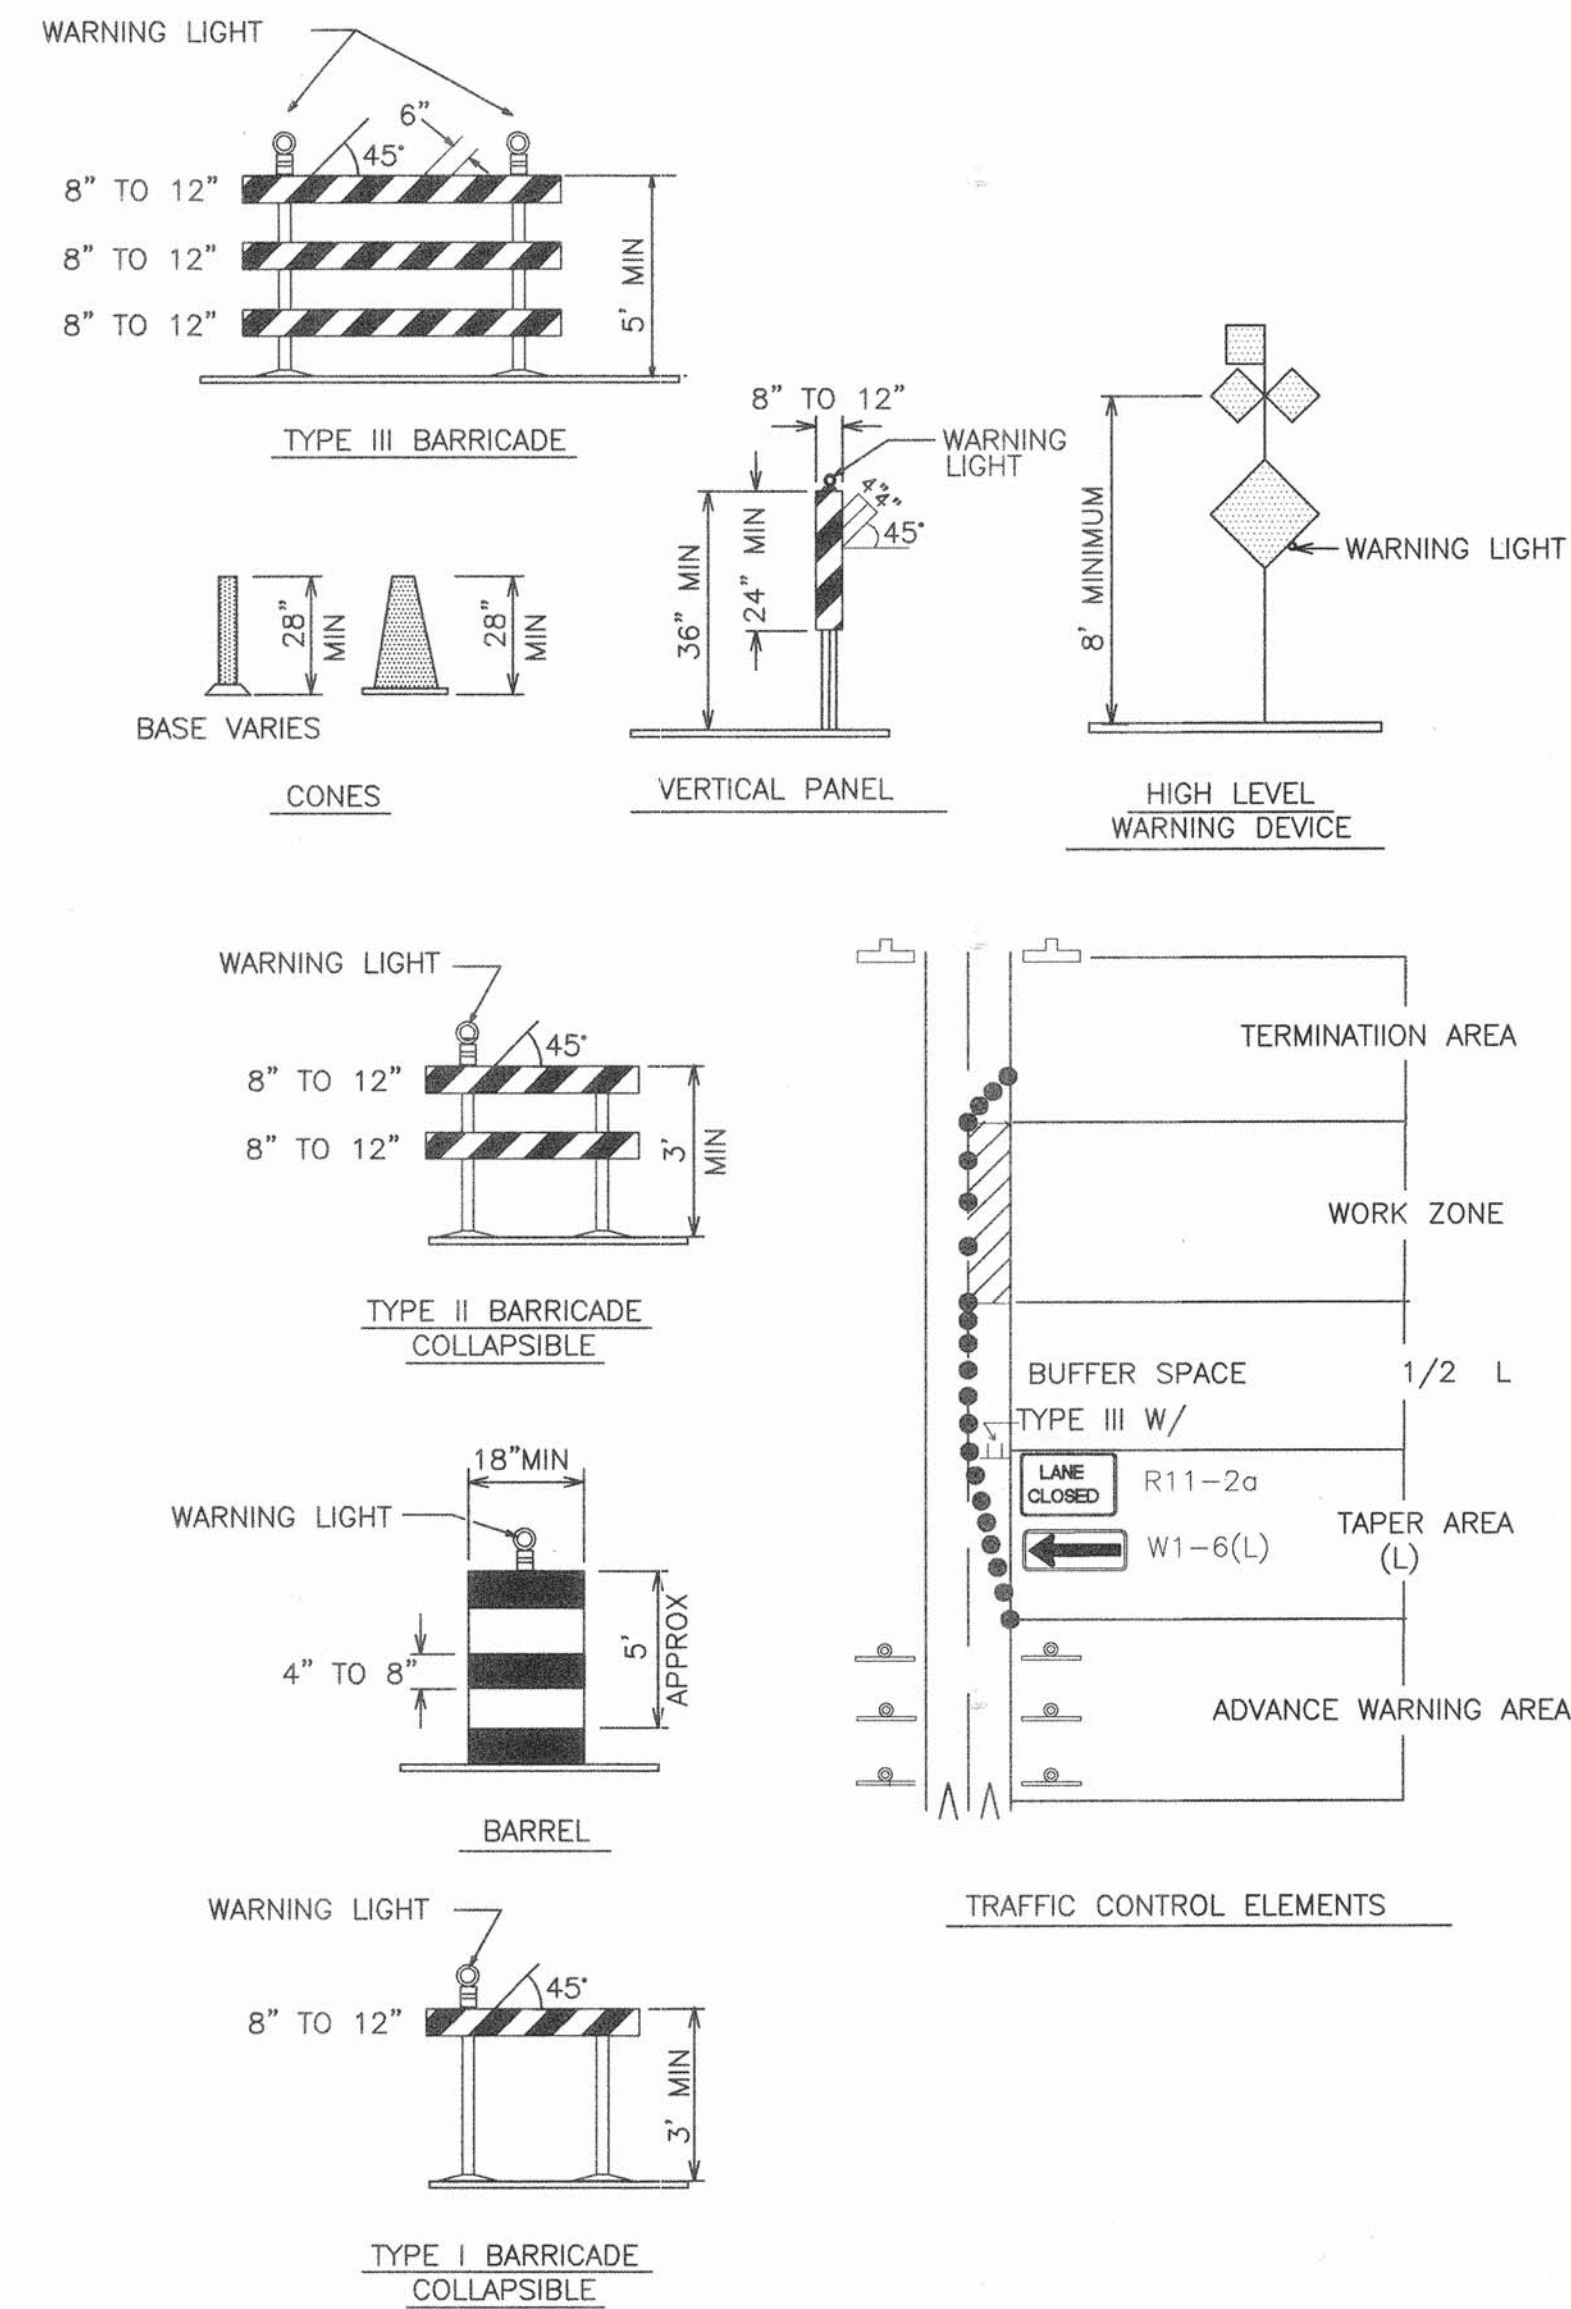

LEGEND

- WORK AREA
- BARRICADE - TYPE I, TYPE II, OR BARREL
- BARRICADE - TYPE III
- VERTICAL PANEL
- WARNING SIGN
- DISTANCE BETWEEN SIGNS - A DISTANCE MEASURED IN FEET EQUAL TO A VALUE OF TEN TIMES THE SPEED LIMIT OF THE STREET
- FLAGMAN POSITION
- SPACING BETWEEN BARRICADES - A DISTANCE MEASURED IN FEET EQUAL TO THE STREET LIMIT OF THE STREET
- TAPER LENGTH - SEE CHART BELOW

THE TANGENT LENGTH IS EQUAL TO THE TAPER LENGTH FOR A GIVEN STREET.

TAPER REQUIREMENT

SPEED LIMIT (MPH)	TAPER LENGTH(L) (FEET)			MINIMUM NUMBER OF DEVICES FOR TAPER	MAXIMUM DEVICE SPACING IN FEET	
	10' LANE	11' LANE	12' LANE		ALONG TAPER	AFTER TAPER
20	70	75	80	5	20	20
25	105	115	125	6	25	25
30	150	165	180	7	30	30
35	205	225	245	8	35	35
40	270	295	320	9	40	40
45	450	495	540	13	45	45
50	500	550	600	13	50	50
55	550	605	660	13	55	55

RECOMMENDED SIGN SPACING(D) FOR ADVANCE WARNING SIGN SERIES

SPEED LIMIT (MPH)	MINIMUM DISTANCE IN FEET BETWEEN SIGNS	
	FROM LAST SIGN TO TAPER	FROM TAPER TO LAST SIGN
0-20	10 X SPEED LIMIT	10 X SPEED LIMIT
25-30	10 X SPEED LIMIT	10 X SPEED LIMIT
30-35	10 X SPEED LIMIT	10 X SPEED LIMIT
40-45	10 X SPEED LIMIT	10 X SPEED LIMIT
50-60	10 X SPEED LIMIT	10 X SPEED LIMIT

TAPER CRITERIA


TYPE OF TAPER	TAPER LENGTH
UPSTREAM TAPER:	
MERGING TAPER	L MINIMUM
SHIFTING TAPER	1/2 L MINIMUM
SHOULDER TAPER	1/2 L MINIMUM
TWO-WAY TRAFFIC TAPER	100 FEET MAXIMUM
DOWNSTREAM TAPERS	100 FEET PER LANE

TAPER LENGTH COMPUTATION

SPEED LIMIT	
40 MPH OR LESS	$L = \frac{WS^2}{60}$
40 MPH OR GREATER	$L = W \times S$

L = TAPER LENGTH
W = WIDTH OF OFFSET IN FEET
S = POSTED SPEED OR OFF-PEAK 85-PERCENTILE SPEED IN MPH

SIGN FACE DETAILS

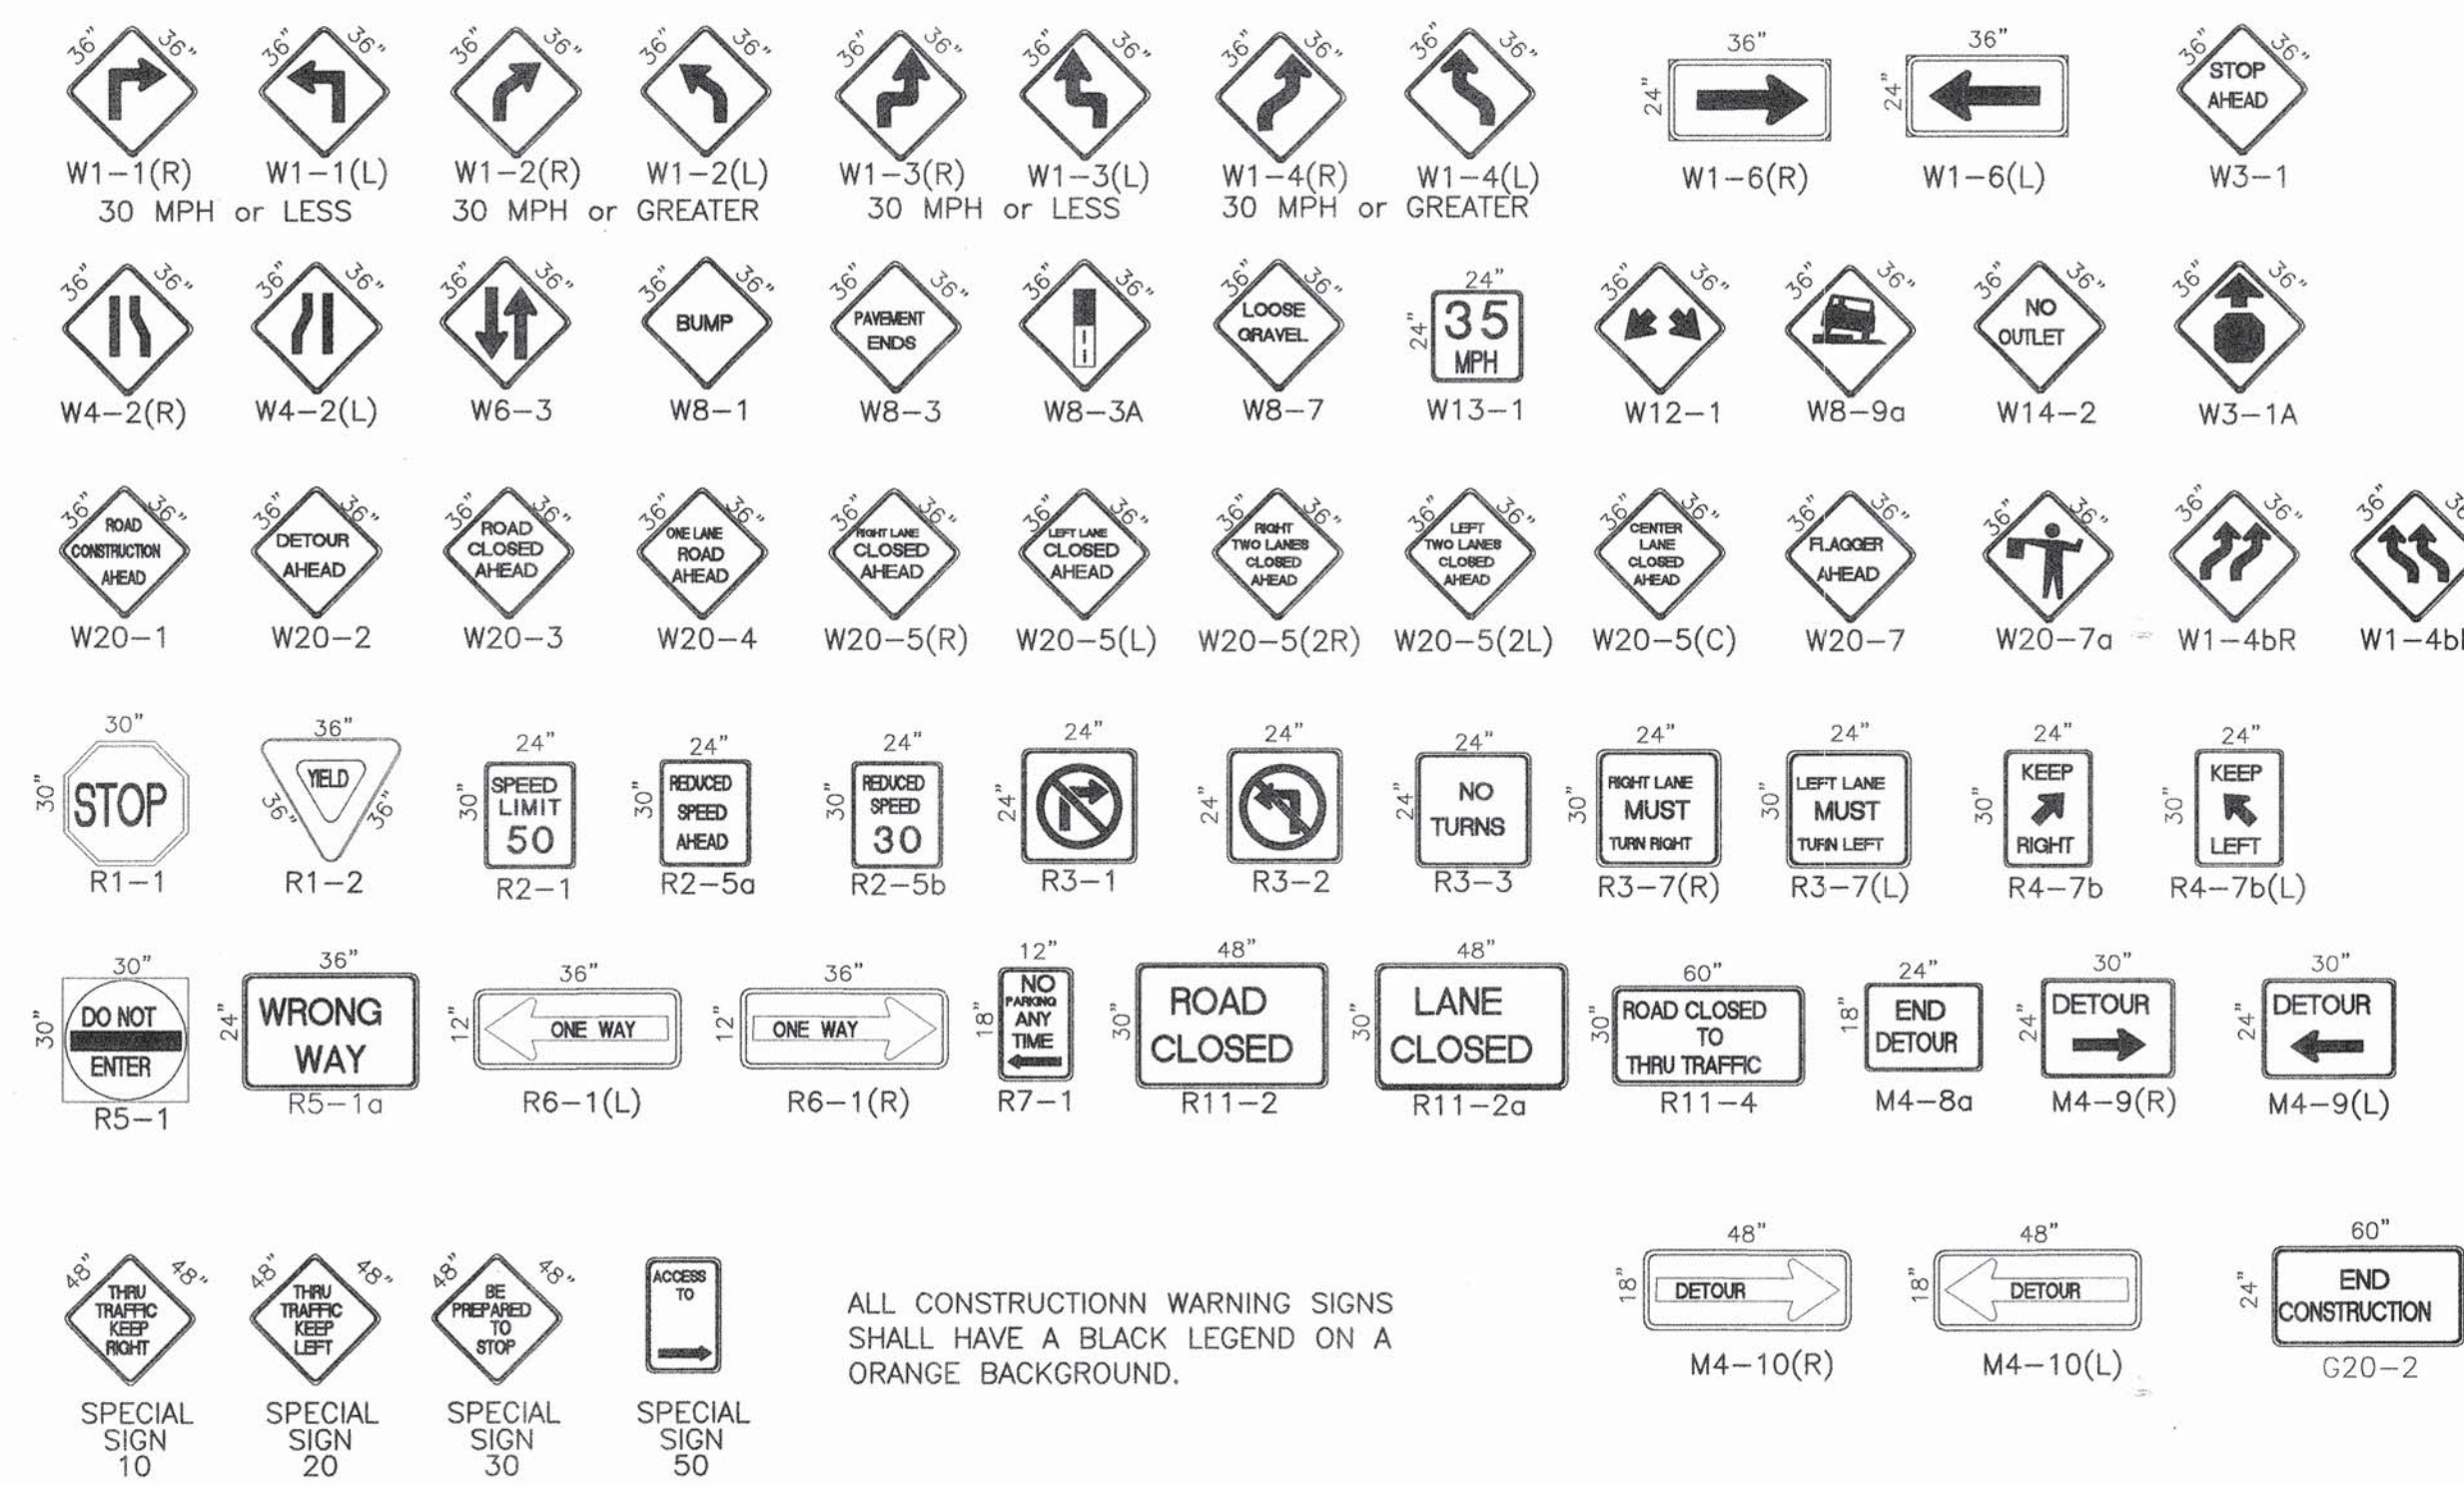

ALL CONSTRUCTION WARNING SIGNS SHALL HAVE A BLACK LEGEND ON A ORANGE BACKGROUND.

26 6586 85 1703

Bohannon & Huston
7500 Jefferson St. NE Albuquerque, NM 87109-4335
ENGINEERING • SPATIAL DATA • ADVANCED TECHNOLOGIES

CITY OF ALBUQUERQUE PUBLIC WORKS DEPARTMENT
PINON POINTE IV AT VENTANA RANCH SIGNING & CONSTRUCTION TRAFFIC CONTROL STANDARDS
Design Review Committee: **COA**
City Engineer Approval: **STD**
City Project No. B-9
Zone Map No. B-9
Sheet 17 Of 18
Last Design Update: Mo./Day/Yr.
Designed By: COA
Checked By: COA
DATE: 10/01
DATE: 10/01
DATE: 10/01

