

CONSTRUCTION PLANS
FOR
PAINTED SKY
SUBDIVISION - UNIT 5
ALBUQUERQUE, NEW MEXICO


SCANNED BY
MESA REPRO

CERTIFICATE OF SUBSTANTIAL COMPLIANCE ON PLANS

I, James D. Hughes, NMPE 11674, of the firm Mark Goodwin & Associates, P.A., a Registered Professional Engineer in the State of New Mexico, do hereby certify, to the best of my knowledge and belief, that the infrastructure installed as part of this project has been inspected by me or by a qualified person under my direct supervision, and has been constructed in accordance with the plans and specifications approved by the City Engineer and that the original design intent of the approved plans has been met, except as noted by the surveyor on the as-built construction drawings. This Certification is based on site inspections by me or personnel under my direction, and survey information provided by Precision Surveys, Inc., NMPS number 11993.

James D. Hughes
James D. Hughes NMPE 11674

7-22-03


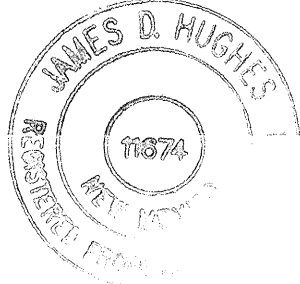


AS BUILT CERTIFICATION

I, LARRY W. MEDRANO, DO HEREBY ATTEST TO THE FACT THAT THE AS-BUILT INFORMATION SHOWN HEREON IS THE RESULT OF A FIELD SURVEY PERFORMED BY ME OR UNDER MY DIRECT SUPERVISION, AND THAT THE SAME ARE TRUE AND CORRECT TO THE BEST OF MY KNOWLEDGE AND BELIEF.

Larry W. Medrano DATE: 4/28/03
LARRY W. MEDRANO
NEW MEXICO PROFESSIONAL
LAND SURVEYOR NO. 11993

PRECISION SURVEYS, INC.
8414-D JEFFERSON STREET, N.E.
ALBUQUERQUE, NM 87113
(505) 856-5700

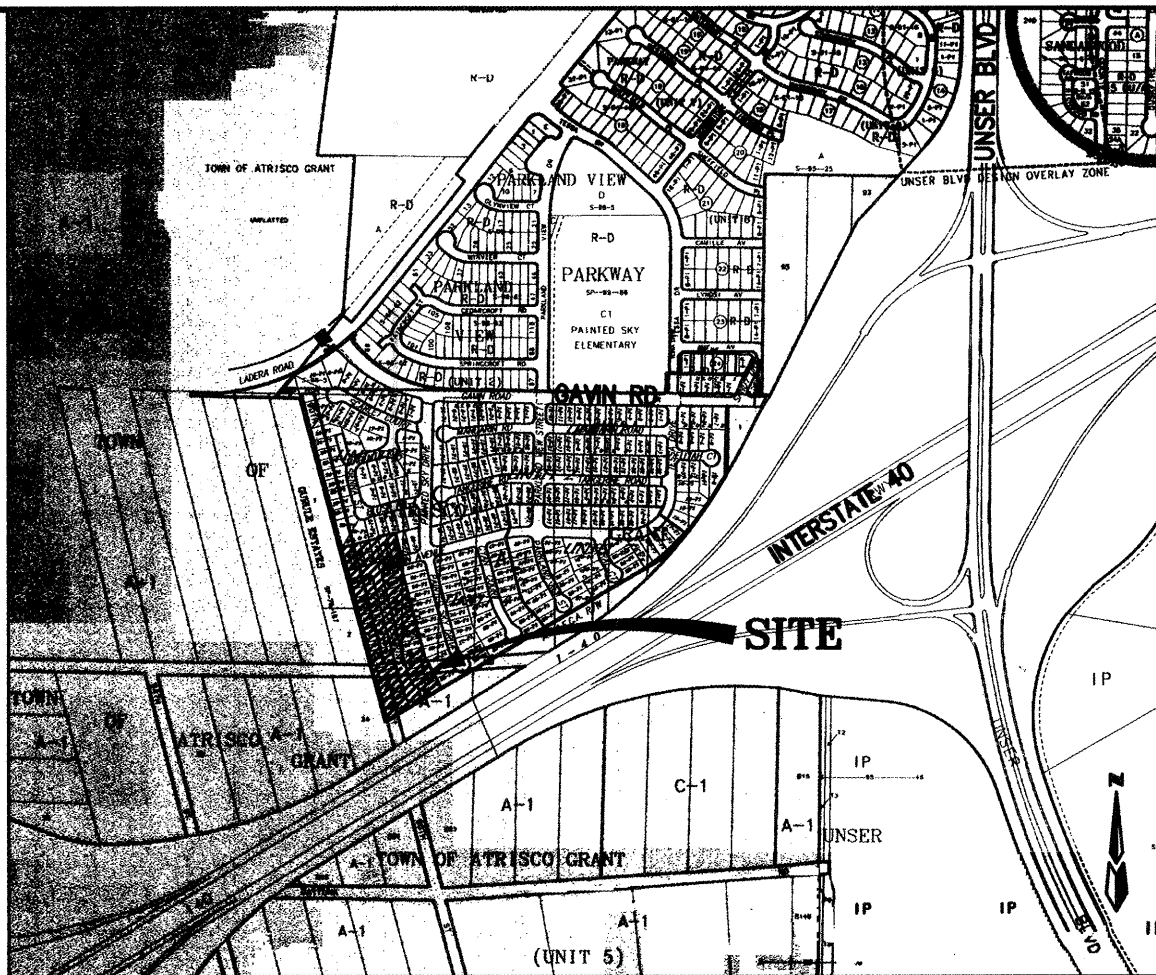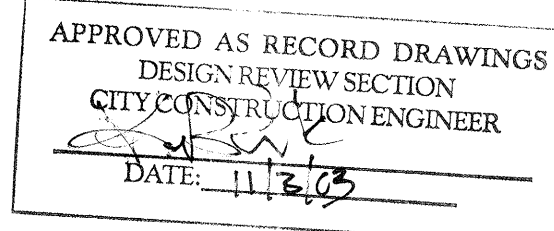

VICINITY MAP ZONE ATLAS J-9

GENERAL NOTES

NOTICE TO CONTRACTORS

1. AN EXCAVATION/CONSTRUCTION PERMIT WILL BE REQUIRED BEFORE BEGINNING ANY WORK WITHIN THE CITY RIGHT-OF-WAY.
2. ALL WORK DETAILED ON THESE PLANS TO BE PERFORMED UNDER CONTRACT SHALL, EXCEPT AS OTHERWISE STATED OR PROVIDED FOR HEREON, BE CONSTRUCTED IN ACCORDANCE WITH THE CITY OF ALBUQUERQUE STANDARD SPECIFICATIONS FOR PUBLIC WORKS CONSTRUCTION, 1986 EDITION AS REVISED THROUGH UPDATE #6.
3. TWO WORKING DAYS PRIOR TO ANY EXCAVATION, THE CONTRACTOR MUST CONTACT NEW MEXICO ONE CALL SYSTEM (260-1990) FOR LOCATION OF EXISTING UTILITIES.
4. PRIOR TO CONSTRUCTION, THE CONTRACTOR SHALL EXCAVATE AND VERIFY THE HORIZONTAL AND VERTICAL LOCATIONS OF ALL OBSTRUCTIONS. SHOULD A CONFLICT EXIST, THE CONTRACTOR SHALL NOTIFY THE ENGINEER IMMEDIATELY SO THAT THE CONFLICT CAN BE RESOLVED WITH A MINIMUM AMOUNT OF DELAY.
5. FIVE (5) WORKING DAYS PRIOR TO BEGINNING OF CONSTRUCTION, THE CONTRACTOR SHALL SUBMIT TO CONSTRUCTION COORDINATION DIVISION A DETAILED CONSTRUCTION SCHEDULE. TWO (2) WORKING DAYS PRIOR TO THE START OF CONSTRUCTION, THE CONTRACTOR SHALL OBTAIN A BARRICADING PERMIT FROM THE CONSTRUCTION COORDINATION DIVISION. CONTRACTOR SHALL NOTIFY THE CONSTRUCTION COORDINATION ENGINEER (768-2551) PRIOR TO OCCUPYING AN INTERSECTION. REFER TO SECTION 19 OF THE GENERAL CONDITIONS OF THE STANDARD SPECIFICATIONS.
6. ALL WORK AFFECTING ARTERIAL ROADWAYS REQUIRES TWENTY-FOUR HOUR CONSTRUCTION.
7. ALL STREET STRIPING ALTERED OR DESTROYED SHALL BE REPLACED WITH PLASTIC REFLECTORIZED PAVEMENT MARKING BY CONTRACTOR TO THE SAME LOCATION AS WAS EXISTING, OR AS INDICATED BY THIS PLAN SET.
8. CONTRACTOR SHALL NOTIFY THE ENGINEER NOT LESS THAN SEVEN (7) DAYS PRIOR TO STARTING WORK IN ORDER THAT THE CITY SURVEYOR MAY TAKE NECESSARY MEASURES TO INSURE THE PRESERVATION OF SURVEY MONUMENTS. CONTRACTOR SHALL NOT DISTURB PERMANENT SURVEY MONUMENTS WITHOUT THE CONSENT OF THE CITY SURVEYOR AND SHALL NOTIFY THE CITY SURVEYOR AND BEAR THE EXPENSE OF REPLACING ANY THAT MAY BE DISTURBED WITHOUT PERMISSION. REPLACEMENT SHALL BE DONE ONLY BY THE CITY SURVEYOR. WHEN A CHANGE IS MADE IN THE FINISHED ELEVATIONS OF THE PAVEMENT OF ANY ROADWAY IN WHICH A PERMANENT SURVEY MONUMENT IS LOCATED, CONTRACTOR SHALL, AT HIS OWN EXPENSE, ADJUST THE MONUMENT TO COVER THE NEW GRADE UNLESS OTHERWISE SPECIFIED. REFER TO SECTION 4.4 OF THE GENERAL CONDITIONS OF THE STANDARD SPECIFICATIONS.
9. CONTRACTOR SHALL RECORD DATA ON ALL UTILITY LINES AND ACCESSORIES AS REQUIRED BY THE CITY OF ALBUQUERQUE FOR THE PREPARATION OF "AS CONSTRUCTED" DRAWINGS. CONTRACTOR SHALL NOT COVER UTILITY LINES AND ACCESSORIES UNTIL ALL DATA HAVE BEEN RECORDED.
10. CONTRACTOR SHALL MAINTAIN A GRAFFITI-FREE WORK SITE. CONTRACTOR SHALL PROMPTLY REMOVE ANY GRAFFITI FROM ALL EQUIPMENT, WHETHER PERMANENT OR TEMPORARY.
11. CONTRACTOR SHALL COORDINATE WITH THE CITY OF ALBUQUERQUE WATER SYSTEMS DIVISION (857-8200) ~~THREE (3)~~ ^{SEVEN (7)} WORKING DAYS IN ADVANCE OF ANY WORK THAT MAY AFFECT EXISTING PUBLIC WATER OR SEWER UTILITIES. EXISTING VALVES TO BE OPERATED BY CITY PERSONNEL ONLY. CONTRACTOR SHALL CONTACT THE WATER SYSTEMS DIVISION ~~THREE (3)~~ ^{SEVEN (7)} WORKING DAYS PRIOR TO NEEDING VALVES TURNED ON OR OFF.
12. FOR STORM DRAIN CONSTRUCTION, RCP JOINTS SHALL NOT BE GROUTED PRIOR TO FINAL INSPECTION. FINAL INSPECTION WILL DETERMINE JOINTS TO BE GROUTED FOR FINAL ACCEPTANCE BY CITY.

THE FOLLOWING NOTES ALSO APPLY WHEN CHECKED

- ☒ ALL UTILITIES AND UTILITY SERVICE LINES SHALL BE INSTALLED PRIOR TO PAVING.
- ☒ BACKFILL COMPACTION SHALL BE ACCORDING TO SPECIFIED STREET USE.
- ☐ TACK COAT REQUIREMENTS SHALL BE DETERMINED BY THE ~~CITY~~ ENGINEER.
- ☒ SIDEWALK AND WHEELCHAIR RAMPS WITHIN THE CURB RETURNS SHALL BE CONSTRUCTED WHEREVER A NEW CURB RETURN IS CONSTRUCTED.
- ☐ IF CURB IS DEPRESSIONED FOR A DRIVEPAD, THE DRIVEPAD SHALL BE CONSTRUCTED PRIOR TO ACCEPTANCE OF CURB AND GUTTER.
- ☒ ALL STORM DRAINAGE FACILITIES SHALL BE COMPLETED PRIOR TO FINAL ACCEPTANCE.

CAUTION:

NOTE THAT ALL EXISTING UTILITIES MAY NOT BE SHOWN. ALL EXISTING SERVICE CONNECTIONS ARE NOT SHOWN. ANY EXISTING UTILITIES THAT ARE SHOWN ARE APPROXIMATE LOCATION ONLY. IT SHALL BE THE SOLE RESPONSIBILITY OF THE CONTRACTOR TO CONTACT ALL THE UTILITY OWNERS AND TO CONDUCT ALL NECESSARY FIELD INVESTIGATIONS PRIOR TO ANY EXCAVATIONS TO DETERMINE THE ACTUAL LOCATION OF UTILITIES AND OTHER IMPROVEMENTS.

dmg D. MARK GOODWIN & ASSOCIATES, P.A.
CONSULTING ENGINEERS
P. O. BOX 90606
ALBUQUERQUE, NEW MEXICO 87199
(505) 828-2200, FAX (505) 737-8539


INDEX TO DRAWINGS

SHEET NO.	SHEET
1	TITLE SHEET
2-5	PLAT
6-7	GRADING AND DRAINAGE PLAN
8	MASTER PAVING PLAN
9-10	PAVING IMPROVEMENTS
11	MASTER UTILITY PLAN
12-14	UTILITY IMPROVEMENTS
15-16	TRAFFIC CONTROL

1 2 3 4 5 6 7 8 9 10 11 12 13 14
26 65888 85 03

DRB - 1000217

REV.	SHEETS	CITY ENGINEER	DATE	USER DEPARTMENT	DATE	USER DEPARTMENT	DATE
ENGINEERS STAMP & SIGNATURE		APPROVALS	ENGINEER	DATE	*****		
		DRC CHAIRMAN	<u>James D. Hughes</u>	9-4-02	APPROVED FOR CONSTRUCTION		
		TRANSPORTATION	<u>Mark Goodwin</u>	8/27/02			
		WATER/WASTEWATER	<u>Nancy Musinski</u>	8/27/02			
		HYDROLOGY	<u>Bradley D. Hughes</u>	8/27/02			
		GIP AMATECA	<u>Larry W. Medrano</u>	8-30-02			
		CONSTR. MNGMT.	<u>James D. Hughes</u>	9-4-02	CITY ENGINEER DATE		
		CONSTR. COORD.	<u>James D. Hughes</u>	9-4-02			
		CITY PROJECT NO.	658885		SHEET OF		
					1 16		

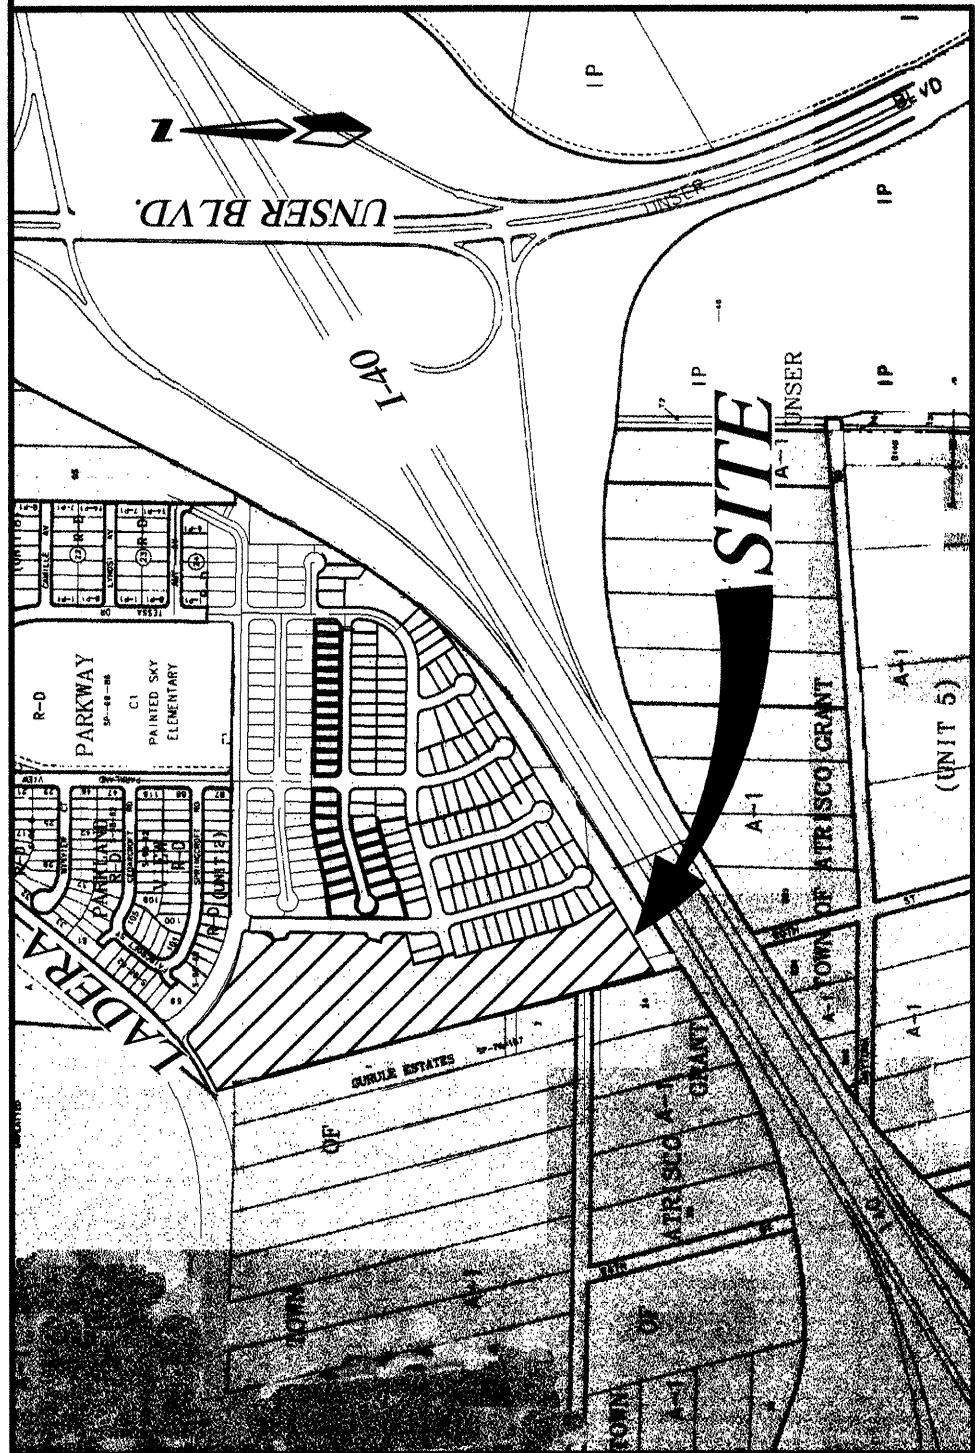

LEGAL DESCRIPTION (SEE SHEET 2)

NOTES (SEE SHEET 2)

PURPOSE OF PLAT

- Subdivide Parcel Numbered "2-A-1-A" of the Painted Sky Subdivision, Unit 4 into 31 residential Lots and 1 Tract.
- Dedicate new Rights-of-way as shown hereon.
- Grant easements as shown hereon.
- Vacate portion of Existing Drainage Easement as shown hereon.

LOCATION MAP

ZONE ATLAS J-9-Z

SCALE: NONE

SUBDIVISION DATA

Plat Case No.'s..... Project # 1000217

Case #.....

Gross acreage..... 13.8363 AC

Zone Atlas No..... J-9-Z

No. of existing Parcels/Tracts..... 1 Parcel/0 Lots

No. of Parcels/Lots created..... 1 Tract/ 31 Lots

No. of Parcels/Lots eliminated..... 1 Parcel

Miles of full width streets created..... 0.08

Area dedicated to the City of Albuquerque..... 1.0064 AC

Date of Survey..... March 2, 1999

Utility Control Location System Log Number..... 2002211606

FREE CONSENT AND DEDICATION:

The subdivision hereon described is with the free consent and in accordance with the desires of the undersigned owner(s) and/or proprietor(s) thereof and said owner(s) and/or proprietor(s) do hereby dedicate all streets, public right-of-ways shown hereon to the City of Albuquerque in fee simple with warranty covenants and do hereby grant: all access, utility and drainage easements shown hereon including the right to construct, operate, inspect, and maintain facilities therein, and all public utility easements shown hereon for the common and joint use of gas, electrical power and communication services for buried distribution lines, conduits, and pipes for underground utilities where shown or indicated, and including the right of ingress and egress for construction and maintenance, and the right to trim interfering trees and shrubs. Said owner(s) and/or proprietor(s) do hereby consent to all of the foregoing and do hereby certify that this subdivision is their free act and deed. Said owner(s) warrant that they hold among them complete and indefeasible title to the land subdivided.

Owner: Westland Development Co., Inc.
By: Barbara Page
President & C.E.O., Westland Development Co., Inc.

BY: Barbara Page

DATE

OWNER'S ACKNOWLEDGMENT

STATE OF NEW MEXICO SS
COUNTY OF BERNALILLO

This instrument was acknowledged before me on _____
By: Barbara Page, President & C.E.O., Westland Development Co., Inc. A New Mexico Corporation on behalf of said corporation

NOTARY PUBLIC

MY COMMISSION EXPIRES

LEGAL DESCRIPTION

A Tract of land lying and situate within Projected Section 16, Township 10 North, Range 2 East, New Mexico Principal Meridian, Town of Atrisco Grant, City of Albuquerque, Bernalillo County, New Mexico comprised of all of Parcel numbered "2-A-1-A" of the Painted Sky Subdivision, Unit 4 as the same is shown and designated on the plat thereof, filed in the office of the County Clerk of Bernalillo County, New Mexico on _____, Page _____, containing 13.8363 acres, more or less.

NOTES

- Field survey performed from November 1999 to August 2000.
- All bearings are grid bearings. N.M. State Plane Coordinates, Central Zone-NAD 1927.
- All distances are ground distances: U.S. Survey Foot.
- This property lies within projected section 16, Township 10 North, Range 2 East, New Mexico Principal Meridian, Town of Atrisco Grant, Bernalillo County, New Mexico
- Plat shows all easement of record.
- As to the Title matters shown hereon, Precision Surveys, Inc. has relied solely on the "certificate as to the state of the record" prepared by First American Title Insurance Company, GF number 01994023-F(CW)11, Dated January 21, 2000. Precision Surveys, Inc. makes no statement as to the accuracy or completeness of the subject title report.
- UPC # 1-009-058-184-175-30701
- Unless otherwise noted all points are set 1/2" rebar with cap " LS 11993".

CITY PROJECT NO.

658885

ZONE MAP NO.

J-9

SHEET 2 OF 16

PLAT FOR
PAINTED SKY
SUBDIVISION, UNIT 5
WITHIN THE
TOWN OF ATRISCO GRANT
PROJECTED SECTION 16
TOWNSHIP 10 NORTH, RANGE 2 EAST, NMPM
CITY OF ALBUQUERQUE
BERNALILLO COUNTY, NEW MEXICO
JUNE, 2002

APPROVED AND ACCEPTED BY:

APPROVAL AND CONDITIONAL ACCEPTANCE as specified by the Albuquerque subdivision Ordinance, Chapter 14 Article 14 of the Revised Ordinances of Albuquerque, New Mexico, 1994.

Subdivision Case No. _____

Planning Director, City of Albuquerque, N.M. _____ Date _____

City Engineer, City of Albuquerque, N.M. _____ Date _____

Albuquerque Metropolitan Arroyo Flood Control Authority _____ Date _____

Transportation Development, City of Albuquerque, N.M. _____ Date _____

Utility Development Division, City of Albuquerque, N.M. _____ Date _____

Parks and Recreation _____ Date _____

City Surveyor, City of Albuquerque, N.M. _____ Date _____

Property Management, City of Albuquerque, N.M. _____ Date _____

PNM Gas _____ Date _____

PNM Electric _____ Date _____


Qwest Telecommunications _____ Date _____

Comcast Cable _____ Date _____

SURVEYOR'S CERTIFICATION

"I, Larry W. Medrano, a duly qualified Registered Professional Land Surveyor under the laws of the State of New Mexico, do hereby certify that this plat and description were prepared by me or under my supervision, shows all easements as shown on the plat of record or made known to me by the owners and/or proprietors of the subdivision shown hereon, utility companies and other parties expressing an interest and meets the minimum requirements for monumentation and surveys of the Albuquerque Subdivision Ordinance, and further meets the Minimum Standards for Land Surveying in the State of New Mexico, and is true and correct to the best of my knowledge and belief."

Larry W. Medrano N.M.P.S. No. 11993

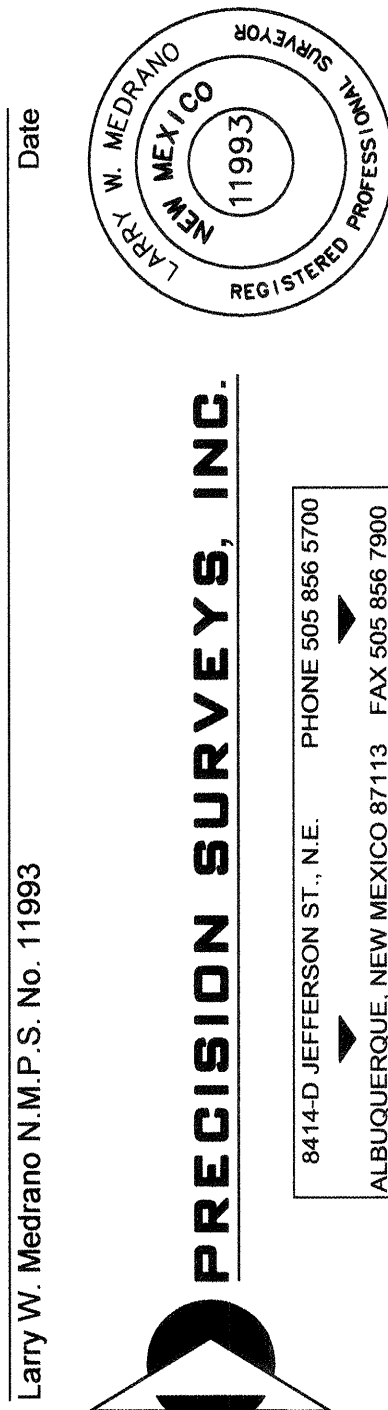

Dwg: USCOVER.dwg
Scale: 1:1

Drawn: RICHARD
Date: 07/24/02

Checked: LWM
Job: A02025 (99049)

Sheet 1 of 5

PLAT FOR
PAINTED SKY
SUBDIVISION
UNIT 5
WITHIN THE
TOWN OF ATRISCO GRANT
PROJECTED SECTION 16
TOWNSHIP 10 NORTH, RANGE 2 EAST, NMPM
CITY OF ALBUQUERQUE
BERNALILLO COUNTY, NEW MEXICO
JUNE, 2002

PUBLIC UTILITY EASEMENTS

PUBLIC UTILITY EASEMENTS shown on this plat are granted for the common and joint use of:

- The PNM Electric Services Division for the installation, maintenance and service of underground electrical lines, transformers, poles and any other equipment, fixtures, structures and related facilities reasonably necessary to provide electrical services.
- The PNM Gas Services Division for installation, maintenance and services of natural gas lines, valves and other equipment and facilities reasonably necessary to provide natural gas.
- Qwest for installation, maintenance and service of all buried communication lines and other related equipment and facilities reasonably necessary to provide communication services, including but not limited to above ground pedestals and closures.
- Comcast cable for installation, maintenance and service of such lines, cable and other related equipment and facilities reasonably necessary to provide Cable TV service.

Included, is the right to build, rebuild, construct, reconstruct, locate, relocate, change, remove,

Modify, renew, operate and maintain facilities for the purposes described above, together with free access to, from and over said easement, including sufficient working area, space for electric transformers, with the right and privilege to trim and remove trees, shrubs or bushes which interfere with the purposes set forth herein. No building, sign, pool (above ground or subsurface), hot tub, concrete or wood pool decking, or other structure shall be erected or constructed on said easements, nor shall any well be drilled or operated thereon. Property owners shall be solely responsible for correcting any violations of National Electrical Safety Code caused by construction of pools, decking or any structures adjacent to within or near easements shown on this plat.

In approving this plat, the utility companies did not conduct a Title Search of the properties shown hereon. Consequently, the utility companies do not waive or release any easement or easement rights which may have been granted by prior plat, replat or other document and which are not shown on this plat.

Easements for electric transformers/switchgears, as installed, shall extend ten feet (10') in front of transformer/switchgear doors and five feet (5') on each side.



PRECISION SURVEYS, INC.

8414-D JEFFERSON ST., N.E. ALBUQUERQUE, NEW MEXICO 87113
PHONE 505-856-5700
FAX 505-856-7900




Dwg: USCOVER.dwg
Scale: 1"=200'

Drawn: RICHARD
Date: 07/24/02

Checked: LWM
Job: A02025 (99049)

Sheet 2 of 5

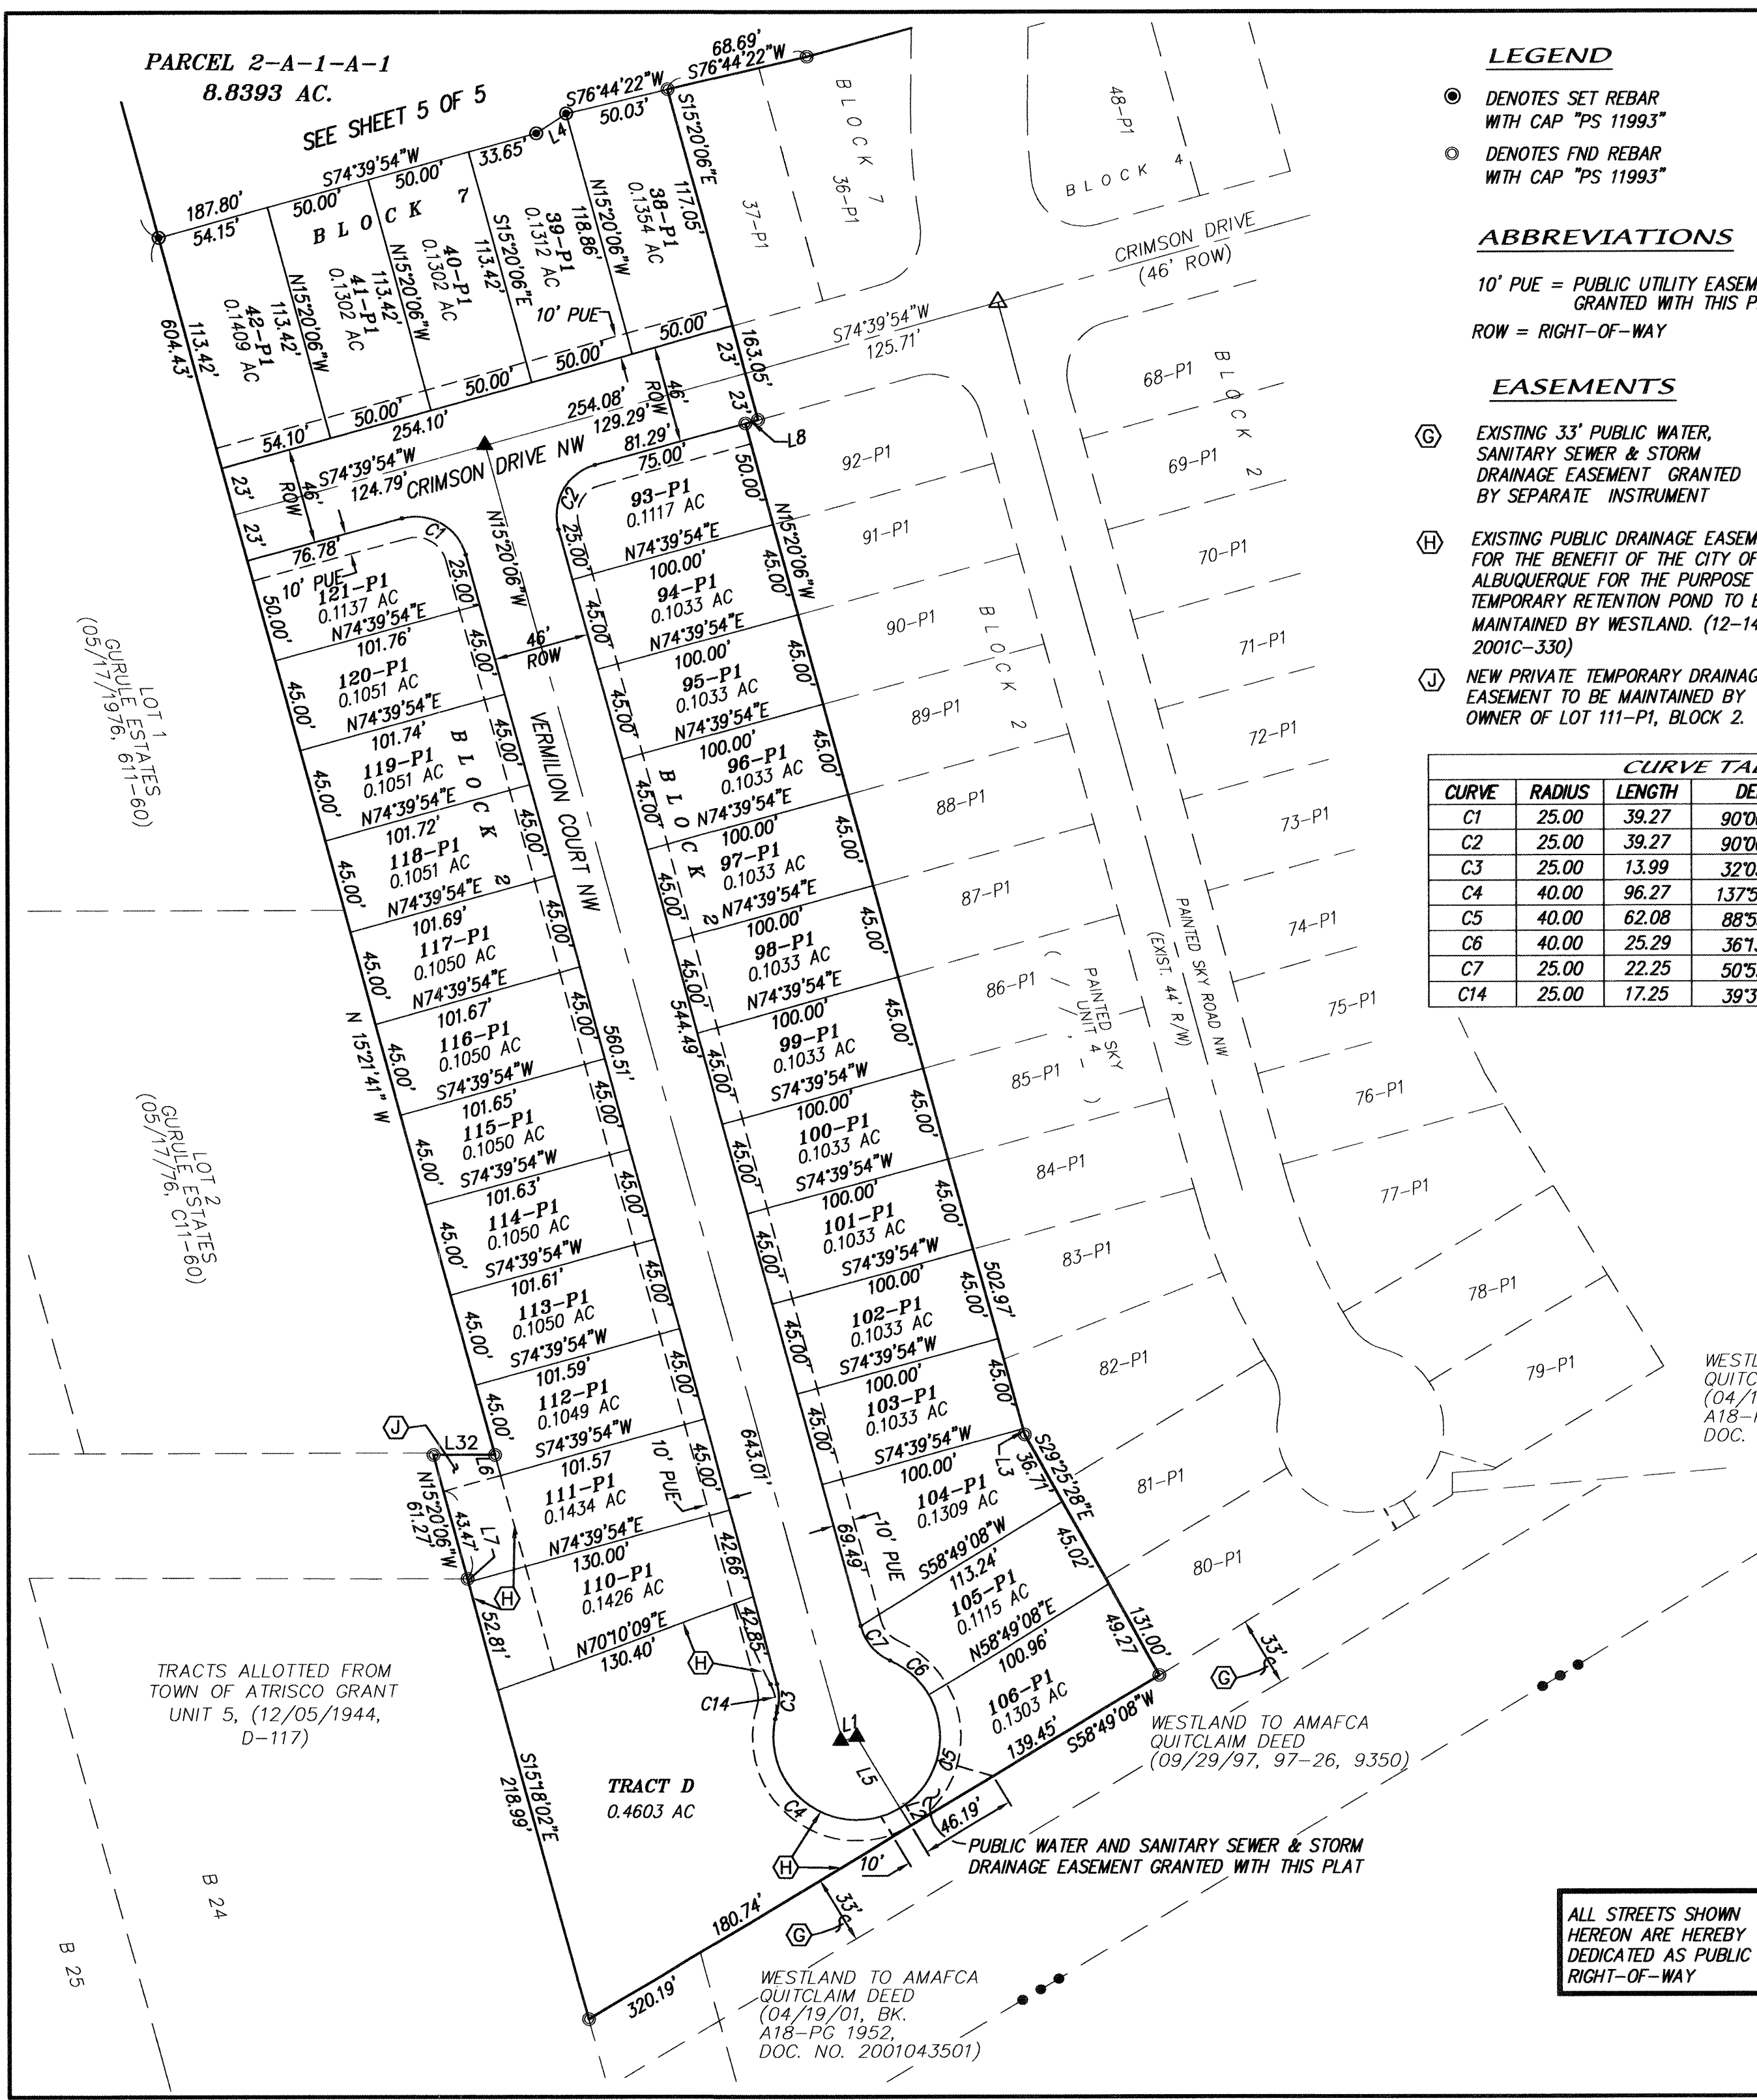

LEGEND

- DENOTES SET REBAR WITH CAP "PS 11993"
- DENOTES FND REBAR WITH CAP "PS 11993"

ABBREVIATIONS

10' PUE = PUBLIC UTILITY EASEMENTS GRANTED WITH THIS PLAT
ROW = RIGHT-OF-WAY

EASEMENTS

- Ⓔ EXISTING 33' PUBLIC WATER, SANITARY SEWER & STORM DRAINAGE EASEMENT GRANTED BY SEPARATE INSTRUMENT
- Ⓗ EXISTING PUBLIC DRAINAGE EASEMENT FOR THE BENEFIT OF THE CITY OF ALBUQUERQUE FOR THE PURPOSE OF TEMPORARY RETENTION POND TO BE MAINTAINED BY WESTLAND. (12-14-01, 2001C-330)
- Ⓙ NEW PRIVATE TEMPORARY DRAINAGE EASEMENT TO BE MAINTAINED BY OWNER OF LOT 111-P1, BLOCK 2.

CURVE TABLE ~ SHEET 4						
CURVE	RADIUS	LENGTH	DELTA	TANGENT	CHORD BRG	CHORD
C1	25.00	39.27	90°00'00"	25.00	N60°20'06"W	35.36
C2	25.00	39.27	90°00'00"	25.00	S29°39'54"W	35.36
C3	25.00	13.99	32°03'22"	7.18	N00°41'35"E	13.81
C4	40.00	96.27	137°54'08"	103.94	S52°13'48"E	74.66
C5	40.00	62.08	88°55'15"	39.25	N14°21'30"E	56.03
C6	40.00	25.29	36°13'39"	13.08	N48°12'57"W	24.87
C7	25.00	22.25	50°59'40"	11.92	S40°49'56"E	21.52
C14	25.00	17.25	39°31'36"	8.98	S07°29'01"E	16.91

LINE TABLE		
LINE ID	LENGTH	BEARING
L1	7.09	S74°39'54"W
L2	10.00	S31°10'52"E
L3	2.97	S15°20'06"E
L4	17.24	N56°14'13"E
L5	40.00	S31°10'52"E
L6	9.98	N15°21'41"W
L7	1.53	N15°18'02"W
L8	6.29	S74°39'54"W

WESTLAND TO AMAFCA
QUITCLAIM DEED
(04/19/01, BK.
A18-PG 1952,
DOC. NO. 2001043501)


WESTLAND TO AMAFCA
QUITCLAIM DEED
(09/29/97, 97-26, 9350)

WESTLAND TO AMAFCA
QUITCLAIM DEED
(04/19/01, BK.
A18-PG 1952,
DOC. NO. 2001043501)

PUBLIC WATER AND SANITARY SEWER & STORM
DRAINAGE EASEMENT GRANTED WITH THIS PLAT


ALL STREETS SHOWN
HEREON ARE HEREBY
DEDICATED AS PUBLIC
RIGHT-OF-WAY

PLAT FOR
**PAINTED SKY
SUBDIVISION, UNIT 5**
WITHIN THE
TOWN OF ATRISCO GRANT
PROJECTED SECTION 16
TOWNSHIP 10 NORTH, RANGE 2 EAST, NMPM
CITY OF ALBUQUERQUE
BERNALILLO COUNTY, NEW MEXICO
JUNE, 2002

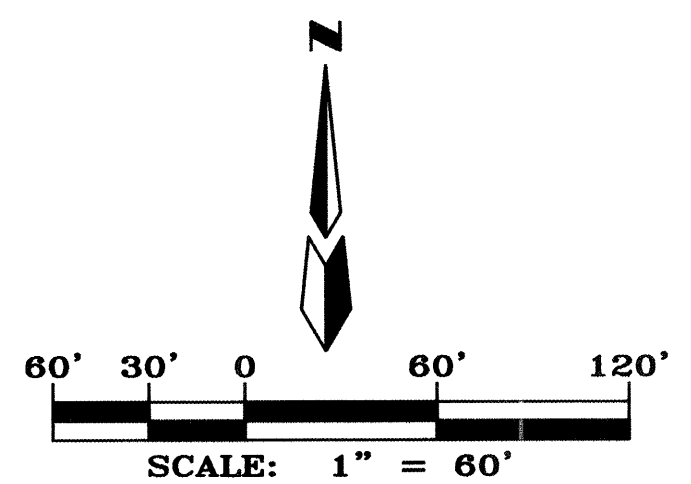


NOTE: ▲
CENTERLINE (IN LIEU OF R/W) MONUMENTATION IS TO BE INSTALLED
AT ALL CENTERLINE PC'S, PT'S, ANGLE POINTS AND STREET
INTERSECTIONS AS SHOWN HEREON, AND WILL CONSIST OF A FOUR
INCH (4") ALUMINUM ALLOY CAP STAMPED "CITY OF ALBUQUERQUE",
"CENTERLINE MONUMENT", "DO NOT DISTURB", "NMP # 11993".

TYPICAL LOT DETAIL

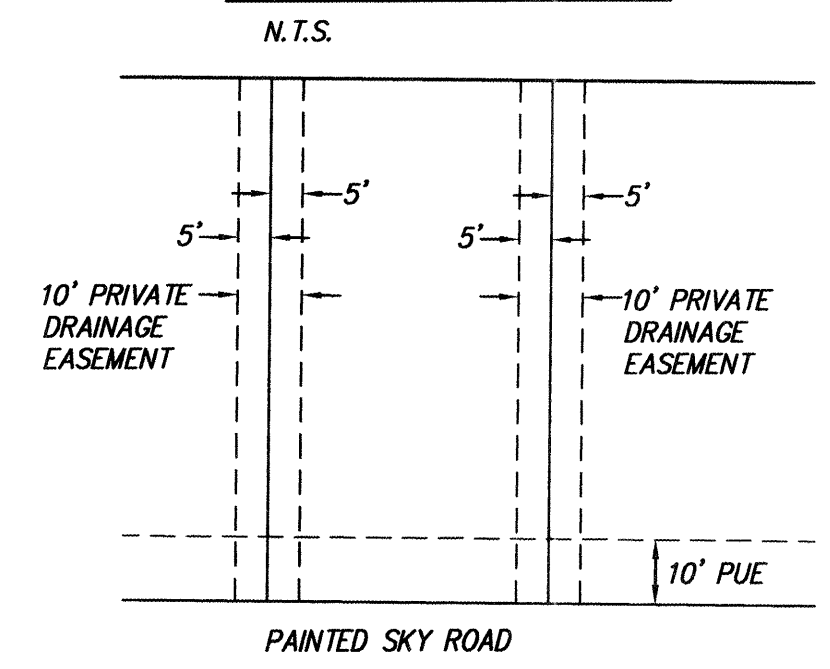

A 10' PRIVATE DRAINAGE EASEMENT IS
CENTERED ON ALL COMMON SIDE LOT LINES
AND ON REAR LOT LINES WHERE THEY
ABUT THE SIDE YARD OF THE ADJACENT
LOT. (SEE TYPICAL LOT DETAIL)

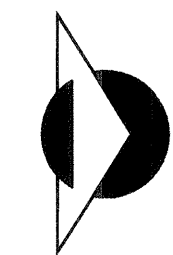

PRECISION SURVEYS, INC.

8414-D JEFFERSON ST., N.E. PHONE 505 856 5700
ALBUQUERQUE, NEW MEXICO 87113 FAX 505 856 7900



Dwg: UN5SHT4.dwg	Drawn: RICHARD	Checked: LWK	Sheet 4 of 5
Scale: 1"=60'	Date: 07/24/02	Job: A02025 (99049)	


PLAT FOR
PAINTED SKY
SUBDIVISION, UNIT 5
WITHIN THE
TOWN OF ATRISCO GRANT
PROJECTED SECTION 16
TOWNSHIP 10 NORTH, RANGE 2 EAST, NMPM
CITY OF ALBUQUERQUE
BERNALILLO COUNTY, NEW MEXICO
JUNE, 2002

LEGEND


- ⊙ ACS CONTROL MONUMENT
● DENOTES SET REBAR
WITH CAP "PS 11993"
○ DENOTES END REBAR
WITH CAP "PS 11993"

ABBREVIATIONS

10' PUE = PUBLIC UTILITY EASEMENTS
GRANTED WITH THIS PLAT
ROW = RIGHT-OF-WAY

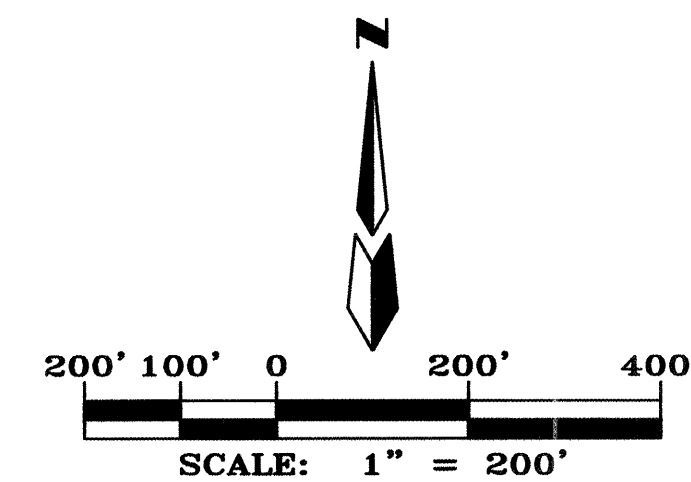

ACS MONUMENT "ANDY" N.M.
STATE PLANE COORDINATES
(CENTRAL ZONE) NAD 27
X=347212.94 Y=1493629.17
DELTA ALPHA = -077.38"
G-G = 0.99966057
ELEVATION = 5564.45

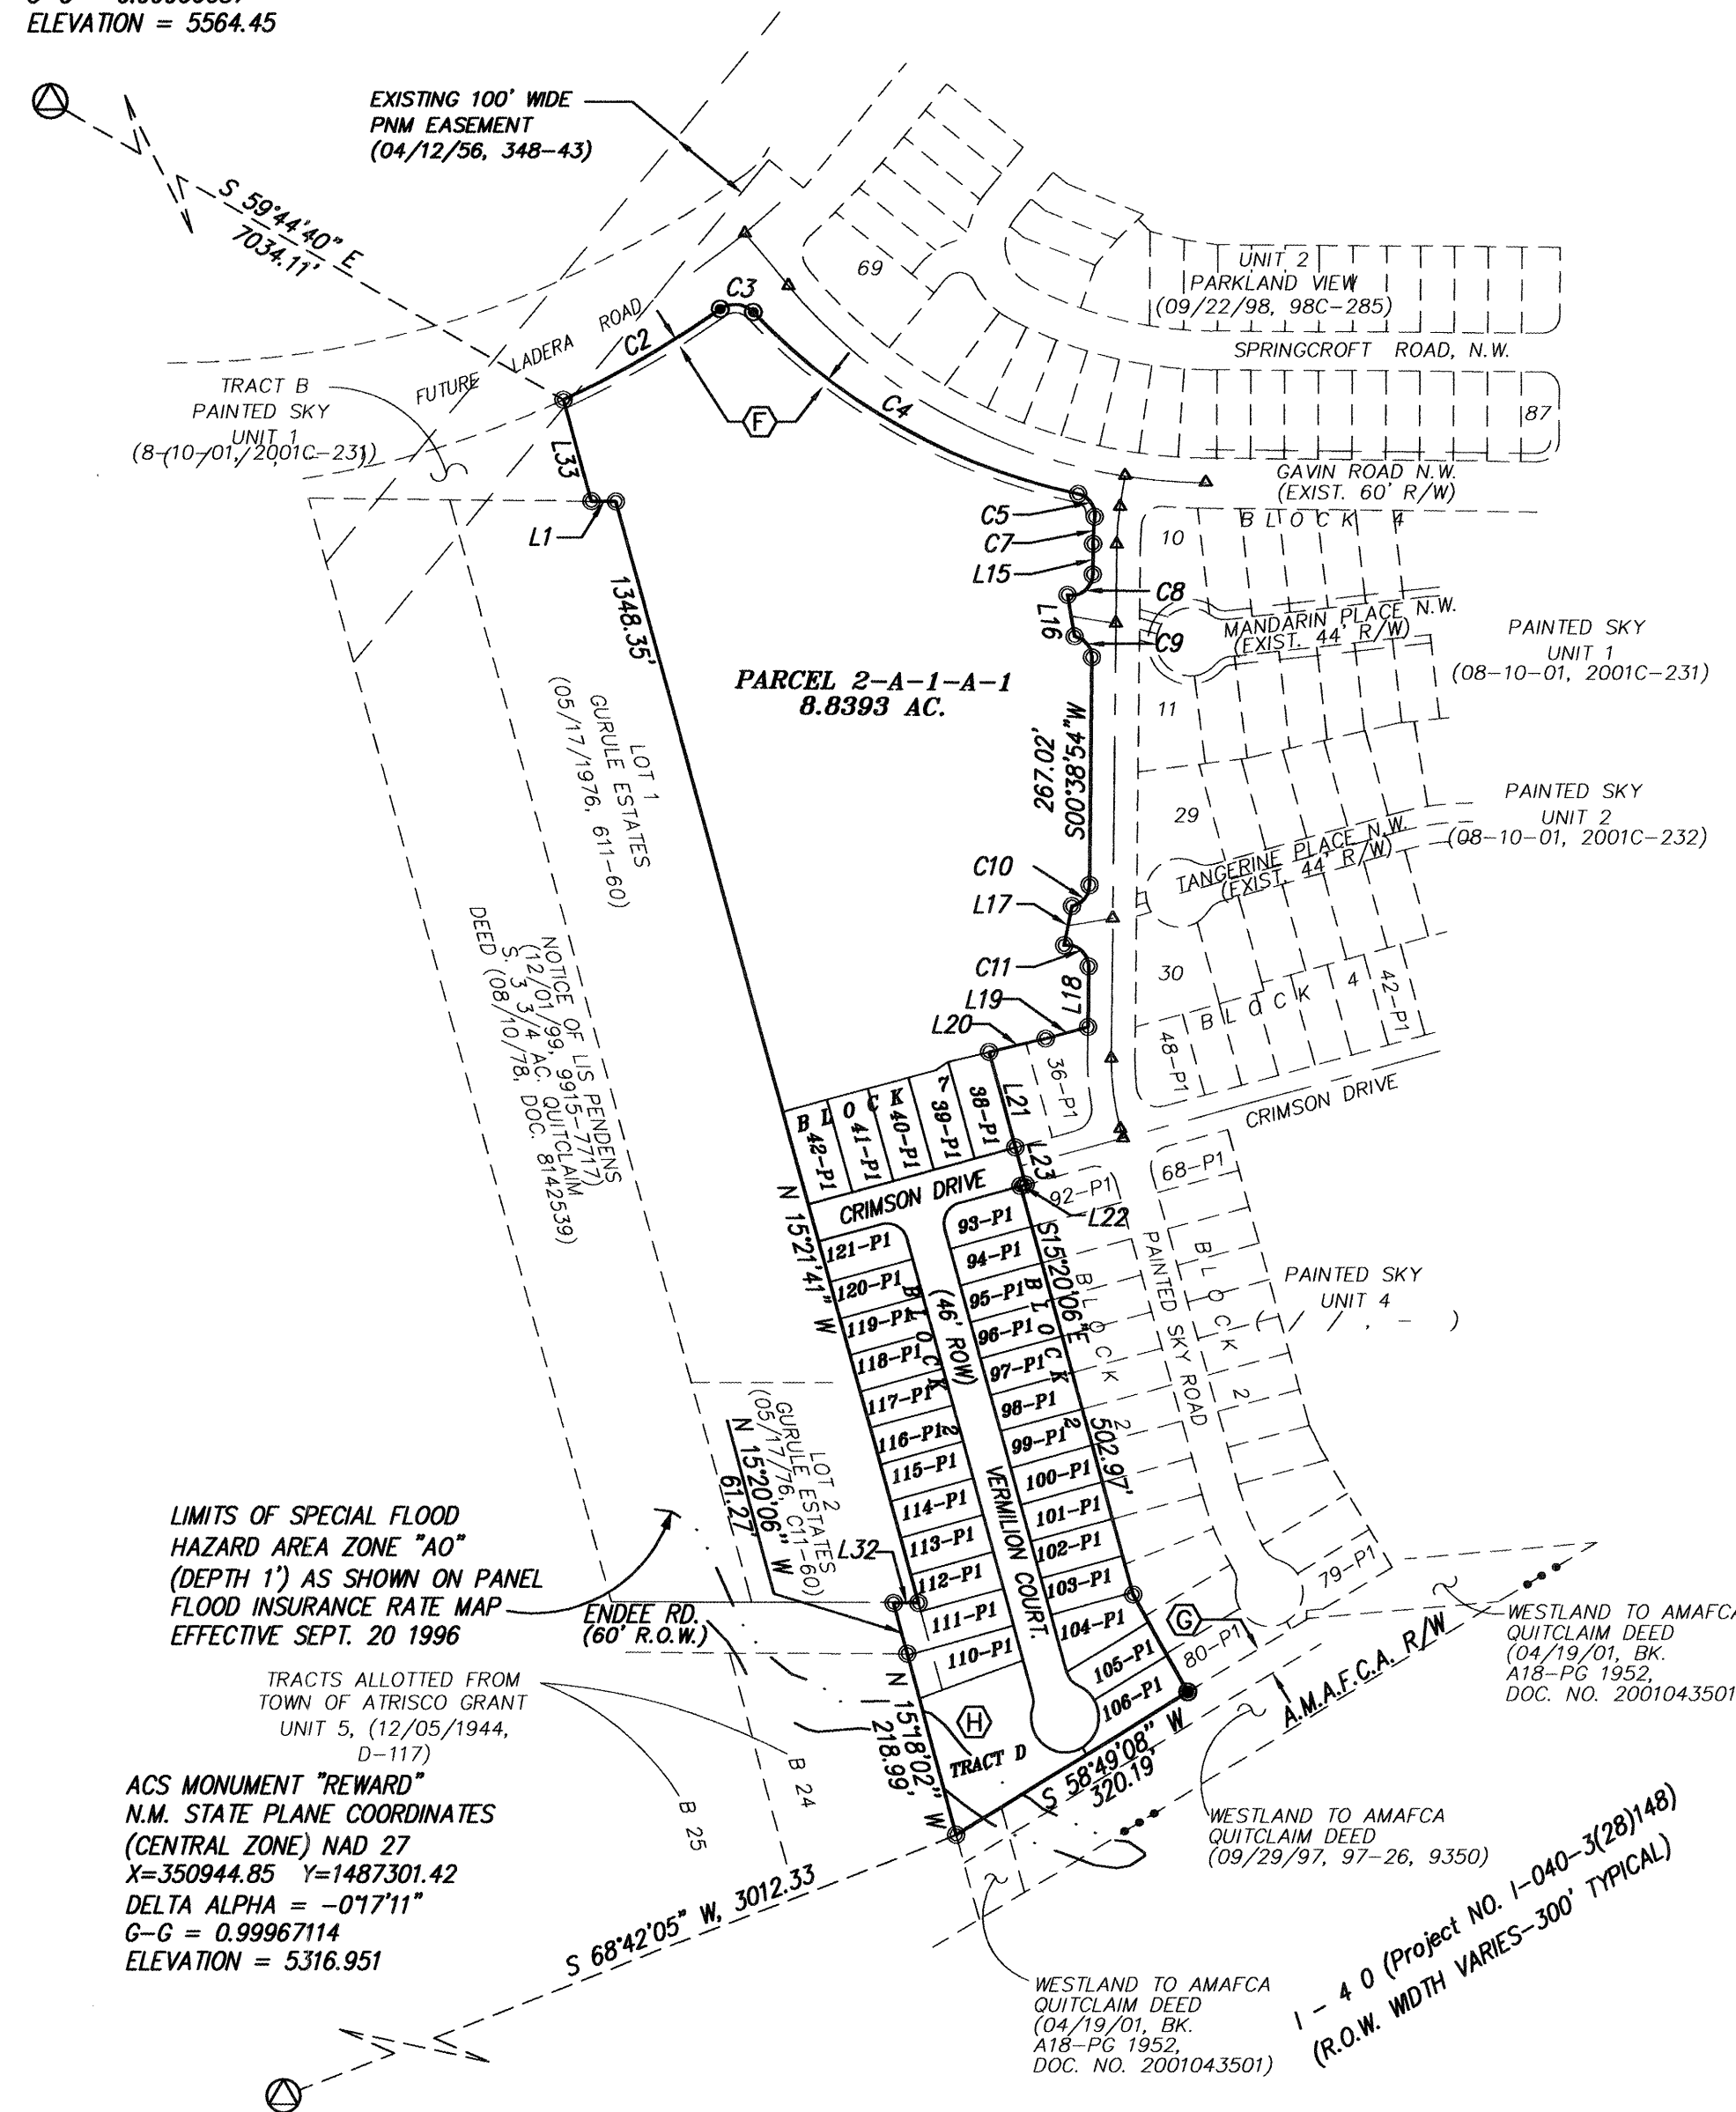

LINE TABLE

NUMBER	DIRECTION	DISTANCE
L1	N 89°21'06" W	28.92'
L15	S 00°38'54" W	36.37'
L16	S 09°44'25" E	49.14'
L17	S 11°17'23" W	47.02'
L18	S 00°38'54" W	70.57'
L19	S 74°39'54" W	51.96'
L20	S 76°44'22" W	68.69'
L21	S 15°20'06" E	117.05'
L22	S 74°39'54" W	6.29'
L23	S 15°25'38" E	46.00'
L24	S 29°25'28" E	131.00'
L25	N 74°39'54" E	120.00'
L26	S 15°20'06" E	63.05'
L27	S 31°10'52" E	10.00'
L28	S 80°38'54" W	53.82'
L32	S 89°57'38" E	29.48'
L33	N 15°20'06" W	125.23'

CURVE TABLE

NUMBER	R = '	L = '	D = "	T = "	CH BEARING=	CHORD LE='
C2	1153.00	215.42	10°42'18"	108.03	N 59°39'39" E	215.11
C3	30.00	43.10	82°19'06"	26.23	N 84°31'57" W	39.49
C4	746.78	447.75	34°21'11"	230.83	N 60°33'00" W	441.08
C5	25.00	36.66	84°00'26"	22.51	N 35°43'22" W	33.46
C7	328.00	32.24	05°37'57"	16.13	S 03°27'52" W	32.23
C8	25.00	43.97	100°45'53"	30.20	N 51°01'50" E	38.52
C9	25.00	35.06	80°20'54"	21.11	N 39°31'33" W	32.26
C10	25.00	34.91	80°00'00"	20.98	N 40°38'54" E	32.14
C11	25.00	43.63	100°00'00"	29.79	N 49°21'06" W	38.30
C13	323.00	67.15	11°54'43"	33.70	S 21°17'28" E	67.03
C14	25.00	17.25	39°31'36"	8.98	S 07°29'01" E	16.91
C15	40.00	93.17	133°27'39"	93.01	S 54°27'03" E	73.49

EXISTING EASEMENTS

- (E) EXISTING 10' PUBLIC UTILITY EASEMENT (PUE) PAINTED SKY, UNIT 3 (12-14-01, 2001C-330)
(G) EXISTING 33' PUBLIC WATER, SANITARY SEWER & STORM DRAINAGE EASEMENT GRANTED BY SEPARATE INSTRUMENT
(H) EXISTING PUBLIC DRAINAGE EASEMENT FOR THE BENEFIT OF THE CITY OF ALBUQUERQUE FOR THE PURPOSE OF TEMPORARY RETENTION POND TO BE MAINTAINED BY WESTLAND. (12-14-01, 2001C-330)




PRECISION SURVEYS, INC.

8414-D JEFFERSON ST., N.E. PHONE 505 856 5700
ALBUQUERQUE, NEW MEXICO 87113 FAX 505 856 7900




Dwg: UN5SHT5.dwg Drawn: RICHARD Checked: LWM
Scale: 1"=200' Date: 07/24/02 Job: A02025 (99049)

Sheet 5 of 5

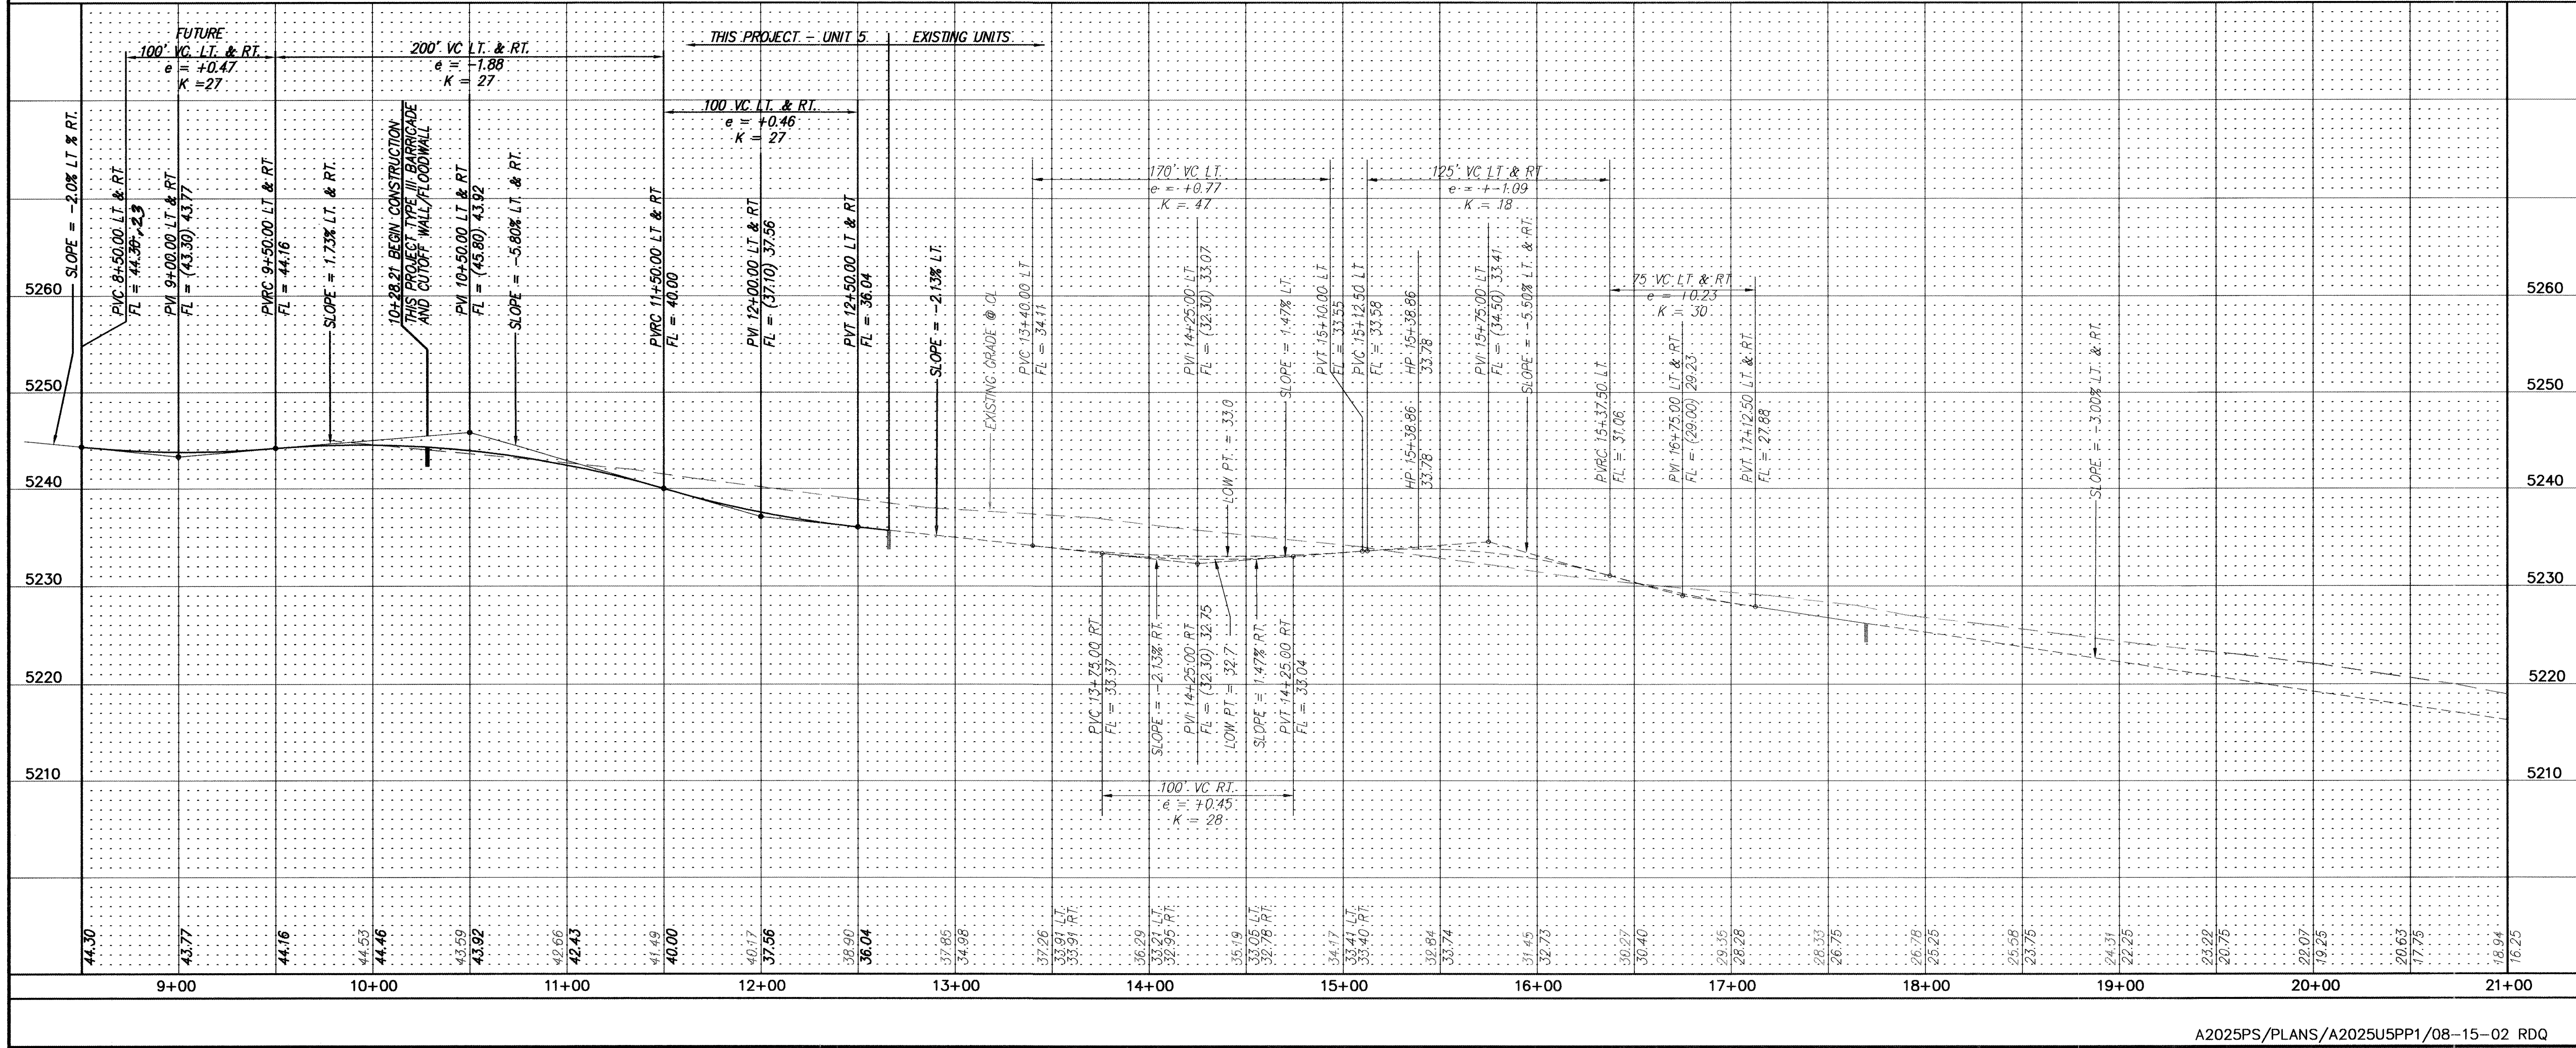

SCANNED BY
MESA REPRO

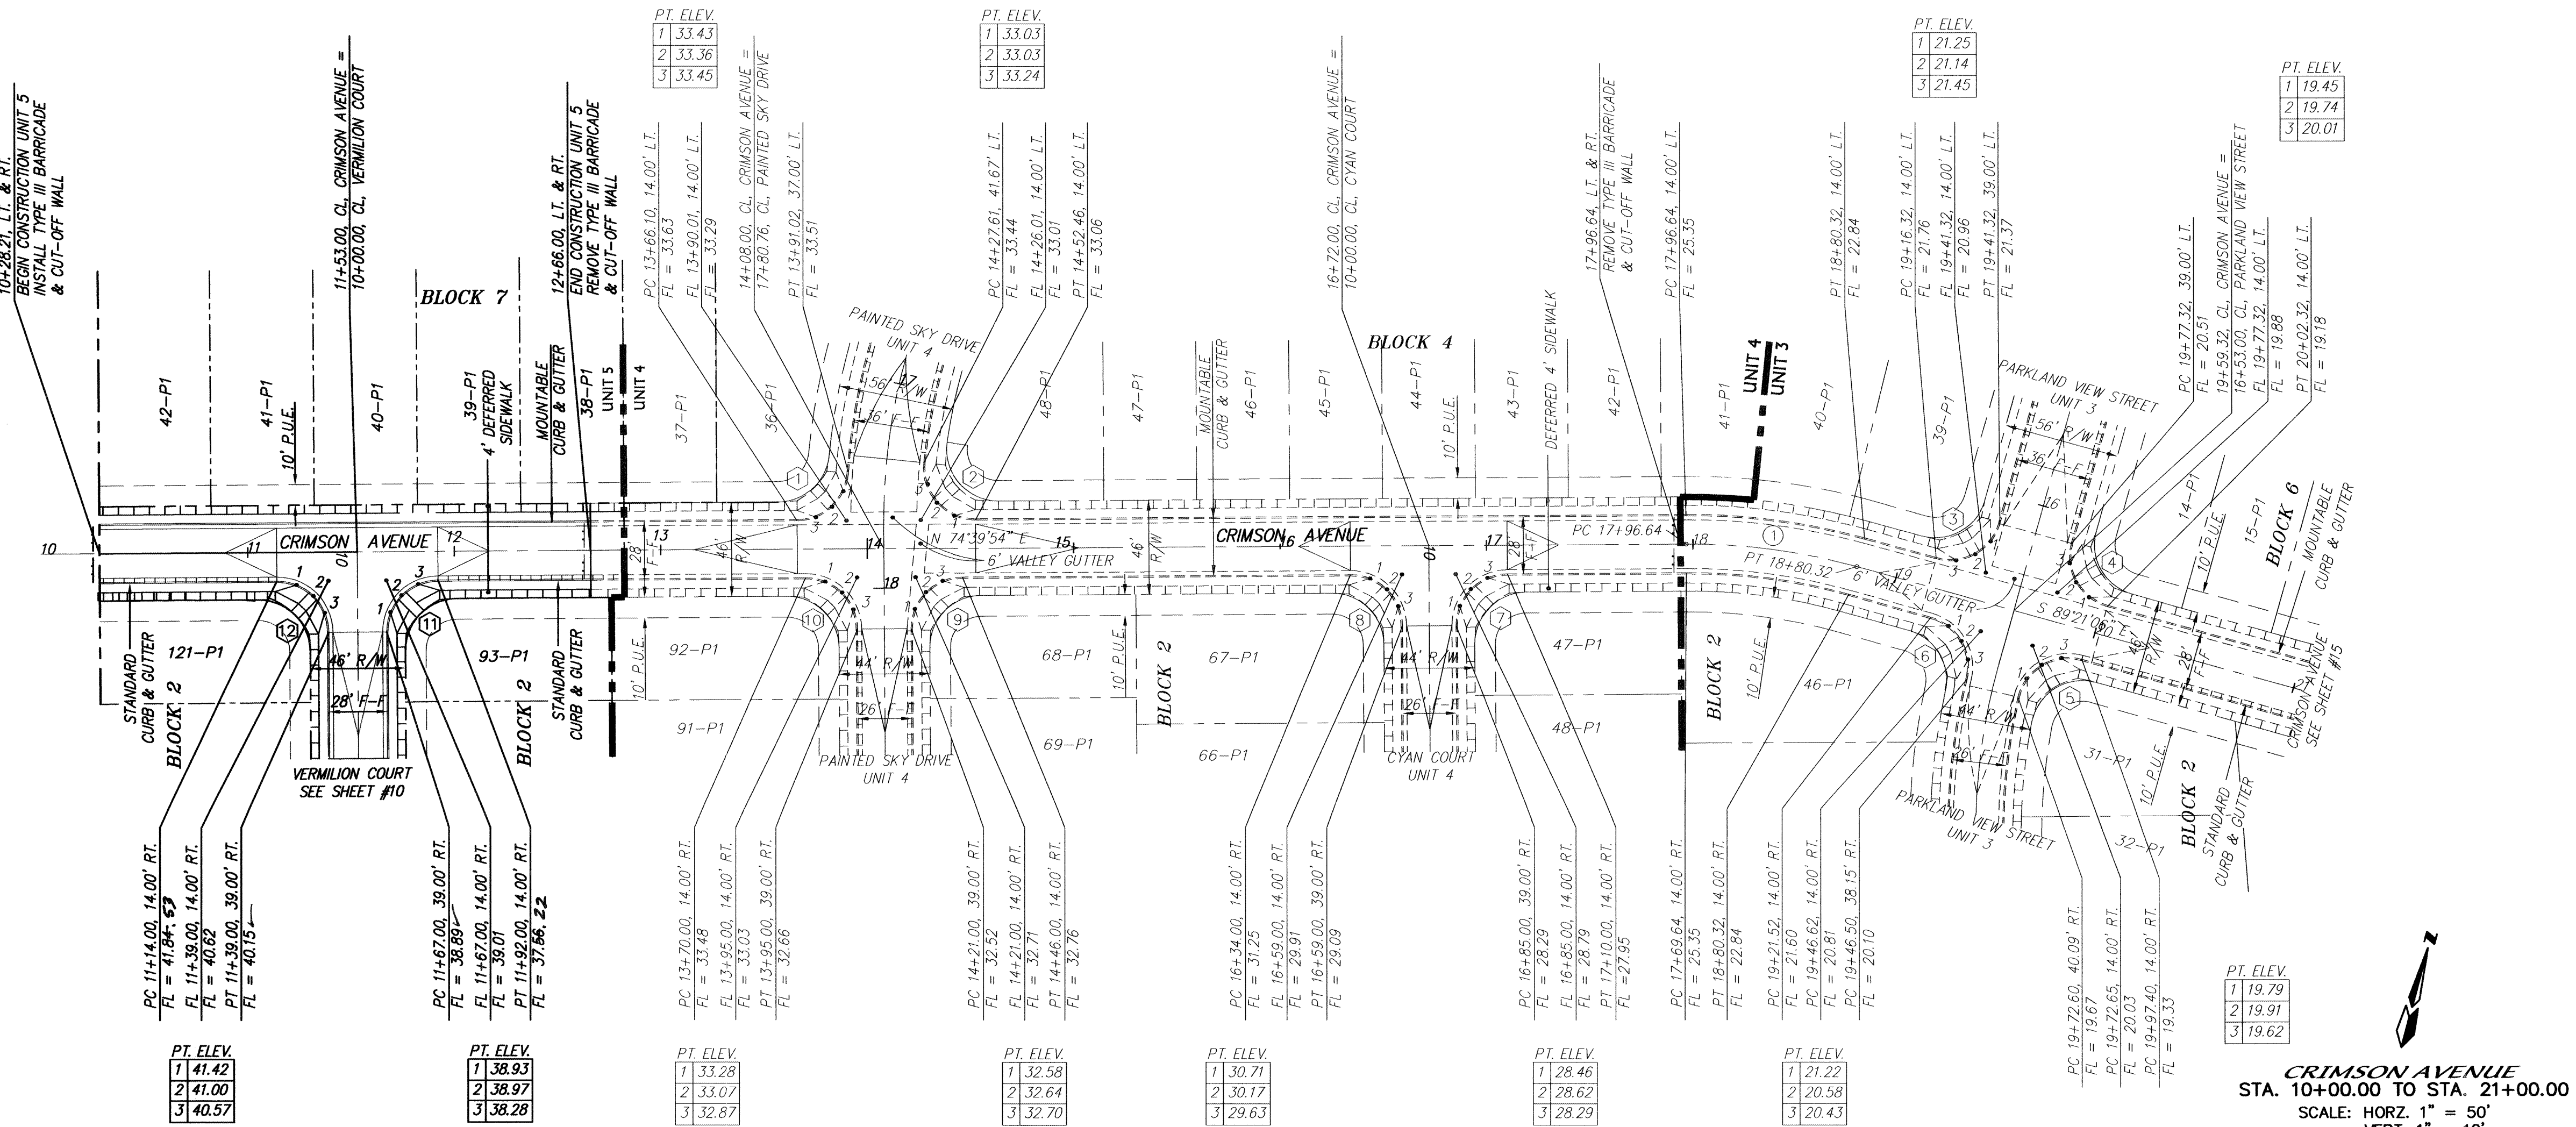

NOTES

1. ALL STATIONING IS CENTERLINE STATIONING.


CURVE DATA - DESCRIBES CENTERLINE

$$\begin{aligned} \textcircled{1} \quad \Delta &= 15^{\circ}59'00'' \\ R &= 300.00' \\ T &= 42.12' \\ L &= 83.69' \end{aligned}$$

CURVE DATA - DESCRIBES FACE OF NEW CURB

- ① $\Delta = 85^{\circ}24'43''$
 $R = 25.00''$
 $T = 23.07''$
 $L = 37.27''$
- ② $\Delta = 96^{\circ}07'42''$
 $R = 25.00''$
 $T = 27.83''$
 $L = 41.94''$
- ③ $\Delta = 90^{\circ}00'00''$
 $R = 25.00''$
 $T = 25.00''$
 $L = 39.27''$
- ④ $\Delta = 90^{\circ}00'01''$
 $R = 25.00''$
 $T = 25.00''$
 $L = 39.27''$
- ⑤ $\Delta = 92^{\circ}30'03''$
 $R = 25.00''$
 $T = 26.12''$
 $L = 40.36''$
- ⑥ $\Delta = 88^{\circ}03'42''$
 $R = 25.00''$
 $T = 24.17''$
 $L = 38.42''$
- ⑦ $\Delta = 90^{\circ}00'00''$
 $R = 25.00''$
 $T = 25.00''$
 $L = 39.27''$
- ⑧ $\Delta = 90^{\circ}00'00''$
 $R = 25.00''$
 $T = 25.00''$
 $L = 39.27''$
- ⑨ $\Delta = 90^{\circ}00'00''$
 $R = 25.00''$
 $T = 25.00''$
 $L = 39.27''$
- ⑩ $\Delta = 90^{\circ}00'00''$
 $R = 25.00''$
 $T = 25.00''$
 $L = 39.27''$
- ⑪ $\Delta = 90^{\circ}00'00''$
 $R = 25.00''$
 $T = 25.00''$
 $L = 39.27''$
- ⑫ $\Delta = 90^{\circ}00'00''$
 $R = 25.00''$
 $T = 25.00''$
 $L = 39.27''$

Registered Professional
ge and belief, that the
person under my direct
is approved by the City
is noted by the surveyor
or personnel under my
11993.

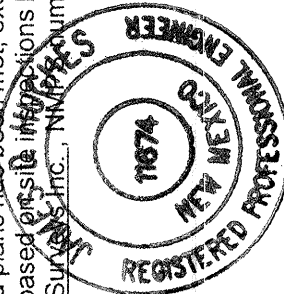

CERTIFICATE OF SUBSTANTIAL COMPLIANCE ON PLANS

CERTIFICATE

I, James D. Hughes, NMPE 11674,
Engineer in the State of New Mexico,
infrastructure installed as part of this project,
supervision, and has been constructed
Engineer and that the original design intent
on the as-built construction drawings. This
direction, and survey information provided

James D. Hughes 7/1/2014

James D. Hughes NMPE 11674

LEGEND

----- PHASE LINE

dmg

MARK GOODWIN & ASSOCIATES, P.A.
CONSULTING ENGINEERS
P.O. BOX 90606
ALBUQUERQUE, NEW MEXICO 87199
(505) 828-2200, FAX (505) 797-9539



CITY OF ALBUQUERQUE
PUBLIC WORKS DEPARTMENT

TITLE: ***PAINTED SKY SUBDIVISION - UNIT 5
PAVING IMPROVEMENTS***

DESIGN REVIEW COMMITTEE

SEP - 4 2002
REVIEW COMMITTEE

CITY ENGINEER APPROVAL

APPROVE
NOV 20 2002
CITY ENGINEER

TE

	MO./DAY/YR.	MO./DAY/YR.

CITY PROJECT NO. _____


658885

ZONE MAP NO.

AP NO.
J-9

SHEET	OF
-------	----

OF
9 1e

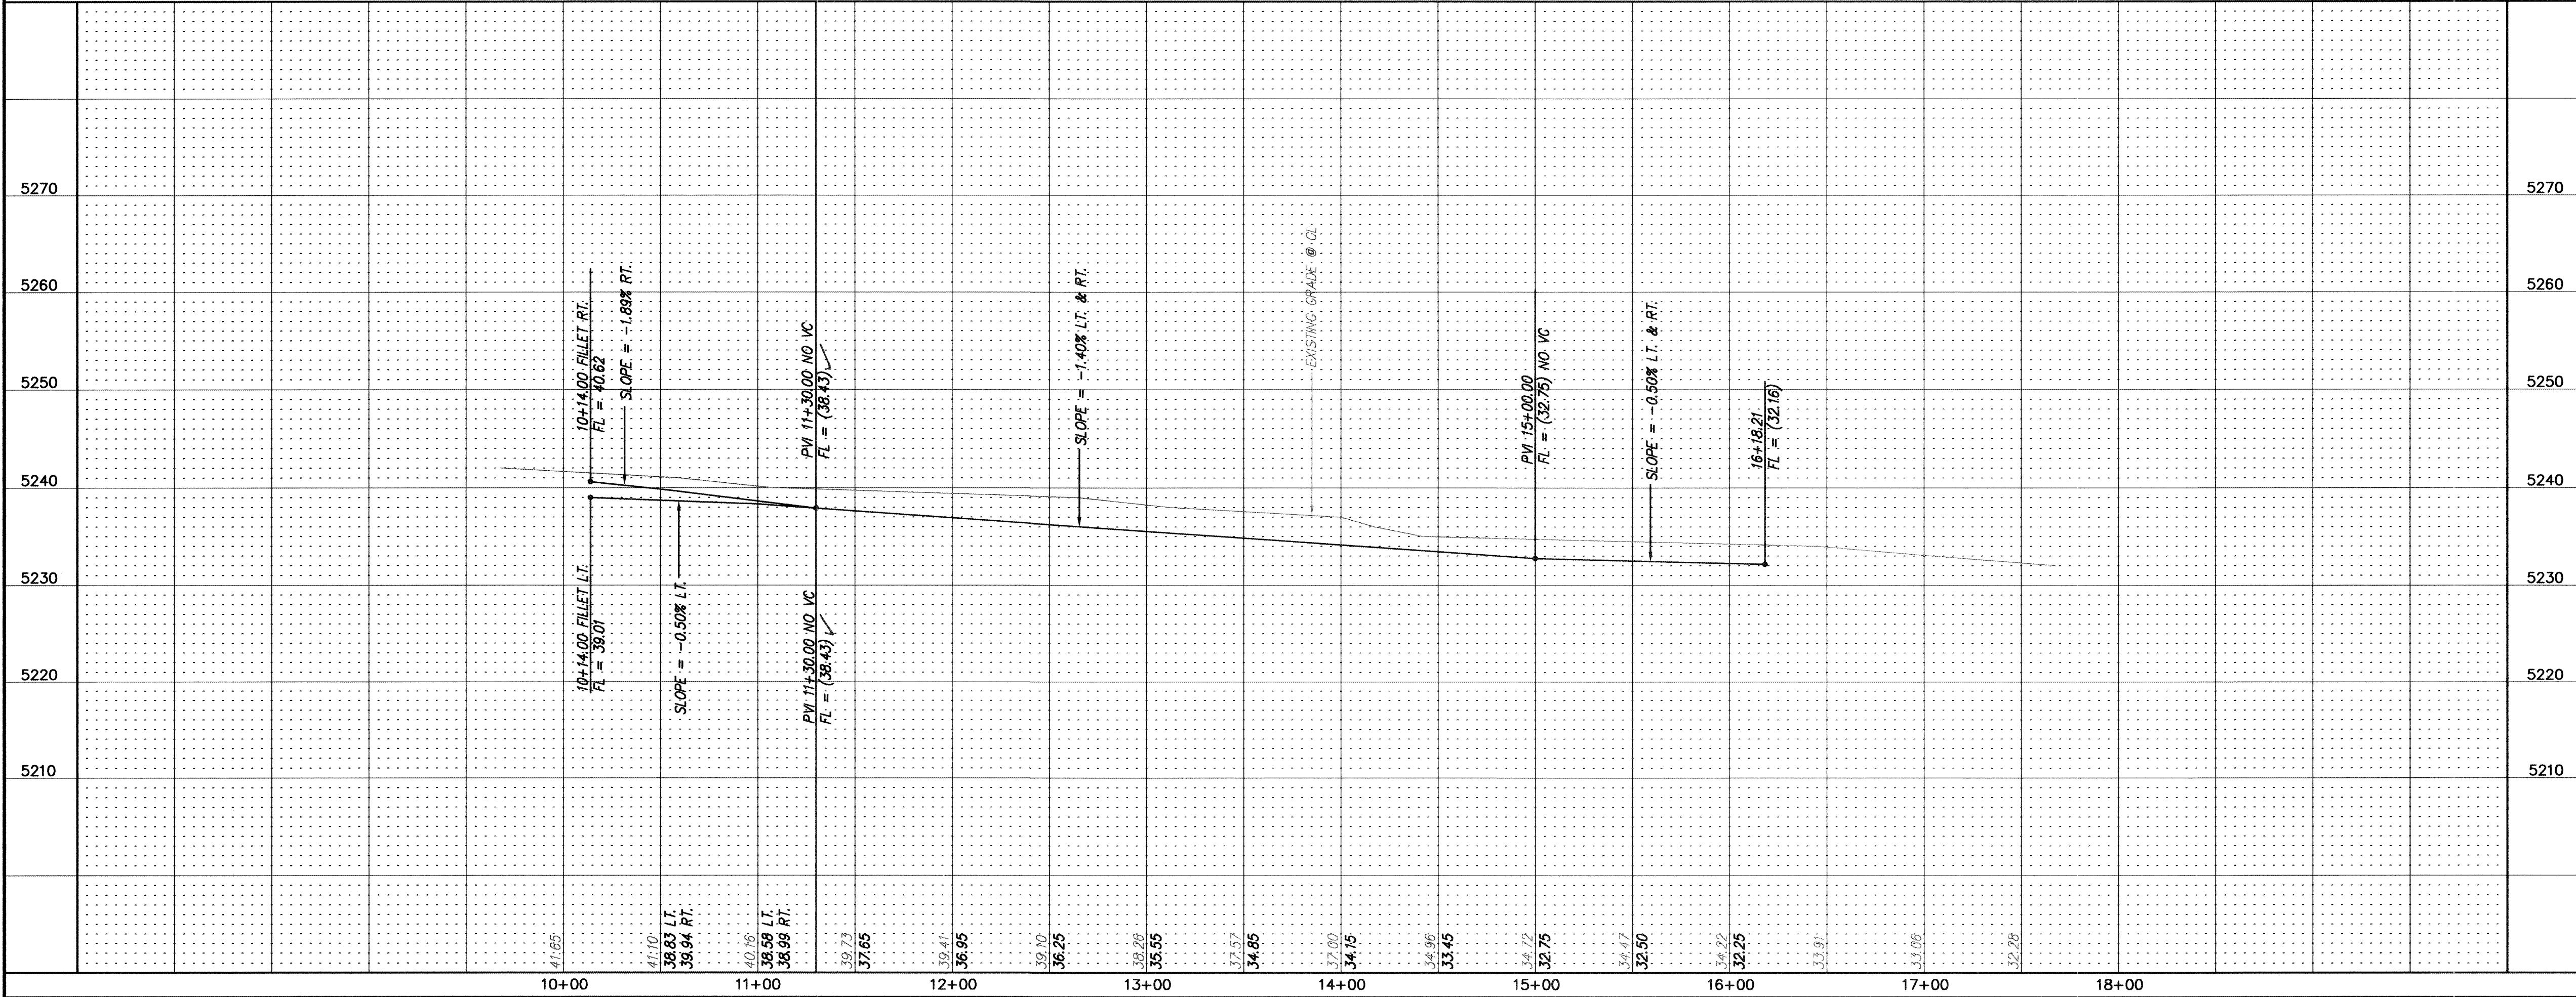

SCANNED BY
MESA REPRO

VERMILION COURT
STA. 10+00.00 TO STA. 16+44.85
SCALE: HORIZ. 1" = 50'
VERT. 1" = 10'

NOTES

1. ALL STATIONING IS CENTERLINE STATIONING.


CURVE DATA - DESCRIBES CENTERLINE

①

CURVE DATA - DESCRIBES FACE OF NEW CURB

- ① $\Delta = 90^{\circ}00'00''$
 $R = 25.00'$
 $T = 25.00'$
 $L = 39.27'$
- ② $\Delta = 57^{\circ}52'12''$
 $R = 25.00'$
 $T = 13.82'$
 $L = 25.25'$
- ③ $\Delta = 277^{\circ}40'53''$
 $R = 35.00'$
 $T = 30.60'$
 $L = 169.63'$
- ④ $\Delta = 39^{\circ}48'41''$
 $R = 25.00'$
 $T = 9.05'$
 $L = 17.37'$
- ⑤ $\Delta = 90^{\circ}00'00''$
 $R = 25.00'$
 $T = 25.00'$
 $L = 39.27'$

CERTIFICATE OF SUBSTANTIAL COMPLIANCE ON PLANS
I, James D. Hughes, NMPE 11674, of the firm, Mark Goodwin & Associates, P.A., a Registered Professional Engineer in the State of New Mexico, do hereby certify, to the best of my knowledge and belief, that the infrastructure installed as part of this project has been inspected by me or by a qualified person under my direct supervision, and has been constructed in accordance with the plans and specifications approved by the City Engineer and that the original design intent of the approved plans has been met, except as noted by the surveyor on the as-built construction drawings. This Certification is based on site inspections by me or personnel under my direction, and any information provided by Precision Surveys, Inc., dated 11/15/02.

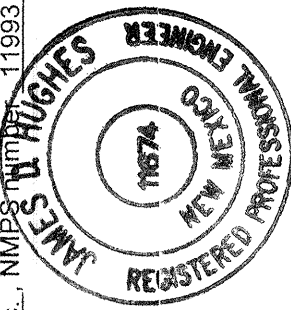

James D. Hughes
NMPE 11674
7-22-03



MARK GOODWIN & ASSOCIATES, P.A.
CONSULTING ENGINEERS
P.O. BOX 90606
ALBUQUERQUE, NEW MEXICO 87199
(505) 828-2200, FAX (505) 797-9539



CITY OF ALBUQUERQUE
PUBLIC WORKS DEPARTMENT

TITLE: PAINTED SKY SUBDIVISION - UNIT 5
PAVING IMPROVEMENTS

DESIGN REVIEW COMMITTEE
NOV - 4 2002

CITY ENGINEER APPROVAL
NOV 20 2002
CITY ENGINEER

LAST DESIGN UPDATE

MO./DAY/YR.
MO./DAY/YR.


CITY PROJECT NO.

ZONE MAP NO.

SHEET OF






1. James D. Hughes, NMPE #11674, of the firm Mark Goodwin & Associates, PA, a Registered Professional Engineer in the State of New Mexico, do hereby certify, to the best of my knowledge and belief, that the infrastructure installed as part of this project has been inspected by me or by a qualified person under my direct supervision, and has been constructed in accordance with the plans and specifications approved by the City Engineer and that the original design intent of the approved plans has been met, except as noted by the surveyor on the as-built construction drawings. This Certification is based on site inspections by me or personnel under my direction, and survey information provided by Precision Surveys Inc., NMPS number 11993.

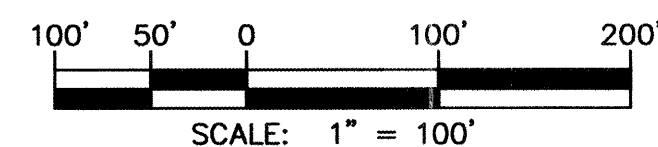

1. ALL FIRE HYDRANTS ARE 4' BURY UNLESS OTHERWISE SPECIFIED.
2. SEWER SERVICES WILL BE TERMINATED AT RIGHT-OF-WAY LINE UNLESS OTHERWISE DIRECTED BY OWNER.
3. ALL New Water and GAS Lines ARE P.V.C. PIPE

1. CONTRACTOR WILL CONTACT WATER SYSTEMS AT 857-8200, ~~FIVE (5)~~ SEVEN (7) DAYS PRIOR TO NECESSARY SHUT-OFF.
2. VALVES SHALL ONLY BE OPERATED BY CITY WATER EMPLOYEES.
3. NON-PRESSURE CONNECTIONS ARE TO BE MADE TO THE EXISTING 6" WATER STUBS IN CRIMSON AVENUE AND A.M.A.F.C.A. RIGHT-OF-WAY.
4. Shut off valves 'A' and 'B' for emergency.

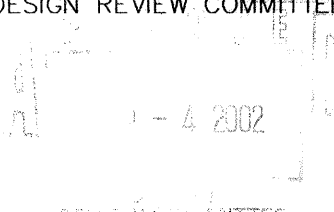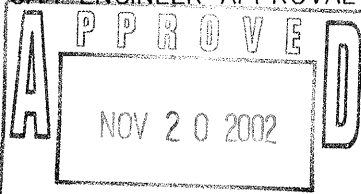
	MARK GOODWIN & ASSOCIATES, P.A. CONSULTING ENGINEERS P.O. BOX 90606 ALBUQUERQUE, NEW MEXICO 87199 (505) 828-2200, FAX (505) 797-9539					NO.	DATE	DESIGNED BY	DRAWN BY	CHECKED BY
 CITY OF ALBUQUERQUE PUBLIC WORKS DEPARTMENT										
TITLE: <i>PAINTED SKY SUBDIVISION - UNIT 5</i> <i>MASTER UTILITY PLAN</i>										
DESIGN REVIEW COMMITTEE 	CITY ENGINEER APPROVAL 		LAST DESIGN UPDATE 		MO./DAY/YR. 		MO./DAY/YR. 			
CITY PROJECT NO. <i>658885</i>	ZONE MAP NO. <i>J-9</i>				SHEET <i>11</i> OF <i>16</i>					

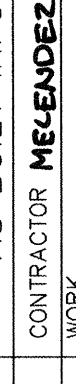	SURVEY INFORMATION		BENCH MARKS		AS BUILT INFORMATION	
	NO.	FIELD NOTES BY DATE	STATION "REAR" IS LOCATED ABOUT 5 MILES WEST OF DOWNTOWN ALBUQUERQUE TO REACH THE STATION FROM INTERSECTION OF CENTRAL AVE. AND STATE RD. 448 GO WEST ON CENTRAL 1.8 MI. TO MOLASCO RD. ON RT. 198TH ST. ON LT., THEN NORTH ALONG MOLASCO RD. CROSSING OVER US 1-40, 1.0 MI. TO TRACK RD. LEFT (SW) THEN TAKE TRACK ROAD 0.1 MI. TO PHILON #PM 88 AND STATION TO LEFT. STATION IS STANDARD USGS BRASS TAPEST STAMPED "REAR 1989", SET IN TOP OF A CONCRETE PILE PROJECTING 0.3 FT. ABOVE GROUND. X= -350.944.85 Y= -1487.301.42 (NAD 1983) ELEV.= 5316.651 (NGVD 1928)		CONTRACTOR MELLENDEZ CONCO.	WORKED BY INSPECTOR'S FIGURE BY DATE PRECISION SURVEY DATE 2/03

ENGINEER'S SEAL

F:\A02\05\A2025PS\PLANS\UNIT 5\A2025U5UP16.dwg, 08/15/02 01:55:11 PM, MARK GOODWIN & ASSOCIATES, PLOTTED BY: RDQ

SCANNED BY
MESA REPRO

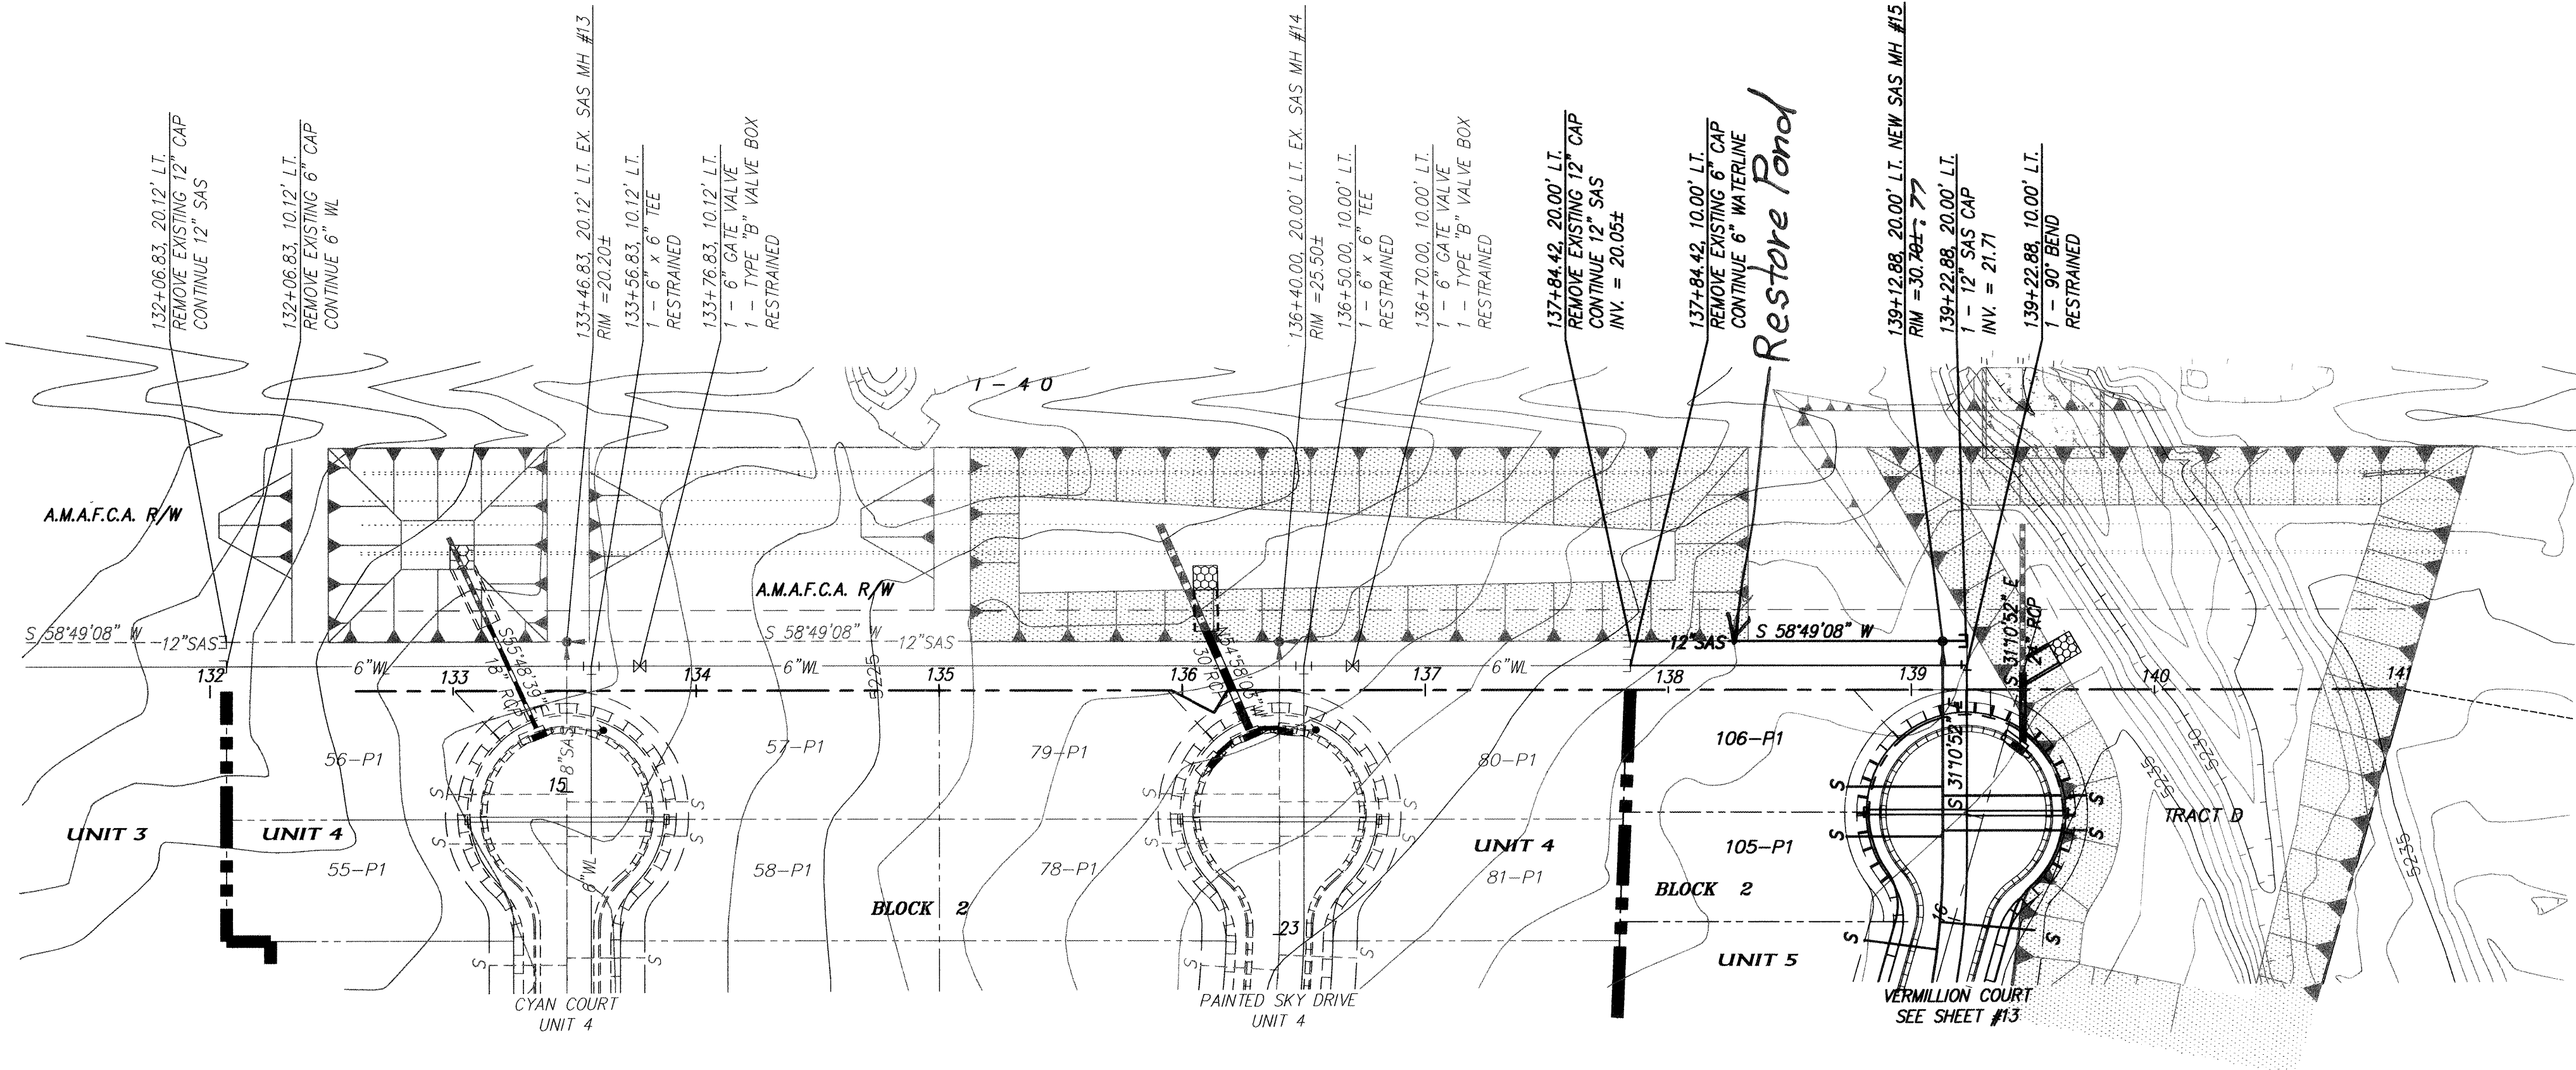

CERTIFICATE OF SUBSTANTIAL COMPLIANCE ON PLANS

I, James D. Hughes, NMPE 11674, of the firm Mark Goodwin & Associates, P.A., a Registered Professional Engineer in the State of New Mexico, do hereby certify, to the best of my knowledge and belief, that the infrastructure installed as part of this project has been inspected by me or by a qualified person under my direct supervision, and has been constructed in accordance with the plans and specifications approved by the City Engineer and that the original design intent of the approved plans has been met, except as noted by the surveyor on the as-built construction drawings. This Certification is based on site inspections by me or personnel under my direction, and survey information provided by Precision Surveys Inc., NMPS number 11993.

James D. Hughes 7-22-03
James D. Hughes NMPE 11674

OFFSITE UTILITIES
STA. 132+96.02 TO STA. 141+08.78
SCALE: HORIZ. 1" = 50'
VERT. 1" = 10'

NOTES

1. BASELINE FOR STATIONING IS SOUTH PROPERTY LINE.

RESTRAINED JOINT LENGTH FOR BENDS, VALVES, DEAD ENDS (FT.)

PIPE SIZE	90°	45°	22.5°	11.25°	VALVE
4"	12'	5'	2'	1'	32'
6"	17'	7'	3'	2'	46'
12"	30'	12'	6'	3'	85'

LENGTH OF RESTRAINED PIPE ON EACH SIDE OF THE BEND. RESTRAIN BRANCH AT FITTING ONLY MINIMUM ATTACHED PIPE LENGTH, RUN SIDE OF TEE: 10.00 FEET.

RESTRAINED JOINT LENGTH FOR TEES (FT.)

PIPE SIZE	RUN	BRANCH
12"x12"x6"	5'	1'
6"x6"x6"	10'	2'
6"x6"x4"	4'	7'

dmg MARK GOODWIN & ASSOCIATES, P.A.
CONSULTING ENGINEERS
P.O. BOX 90606
ALBUQUERQUE, NEW MEXICO 87199
(505) 828-2200, FAX (505) 797-9539

CITY OF ALBUQUERQUE
PUBLIC WORKS DEPARTMENT
ENGINEERING DEVELOPMENT GROUP

TITLE: **PAINTED SKY SUBDIVISION - UNIT 5
OFFSITE UTILITY IMPROVEMENTS**

DESIGN REVIEW COMMITTEE
APPROVE
SEP - 4 2002

CITY ENGINEER APPROVAL
APPROVE
NOV 20 2002

LAST DESIGN UPDATE

CITY PROJECT NO.

ZONE MAP NO.

SHEET







OF










A2025PS/UNIT 5 PLANS/9049U5UP16/8-12-02 NHM RDQ

658885

J-9

14 16

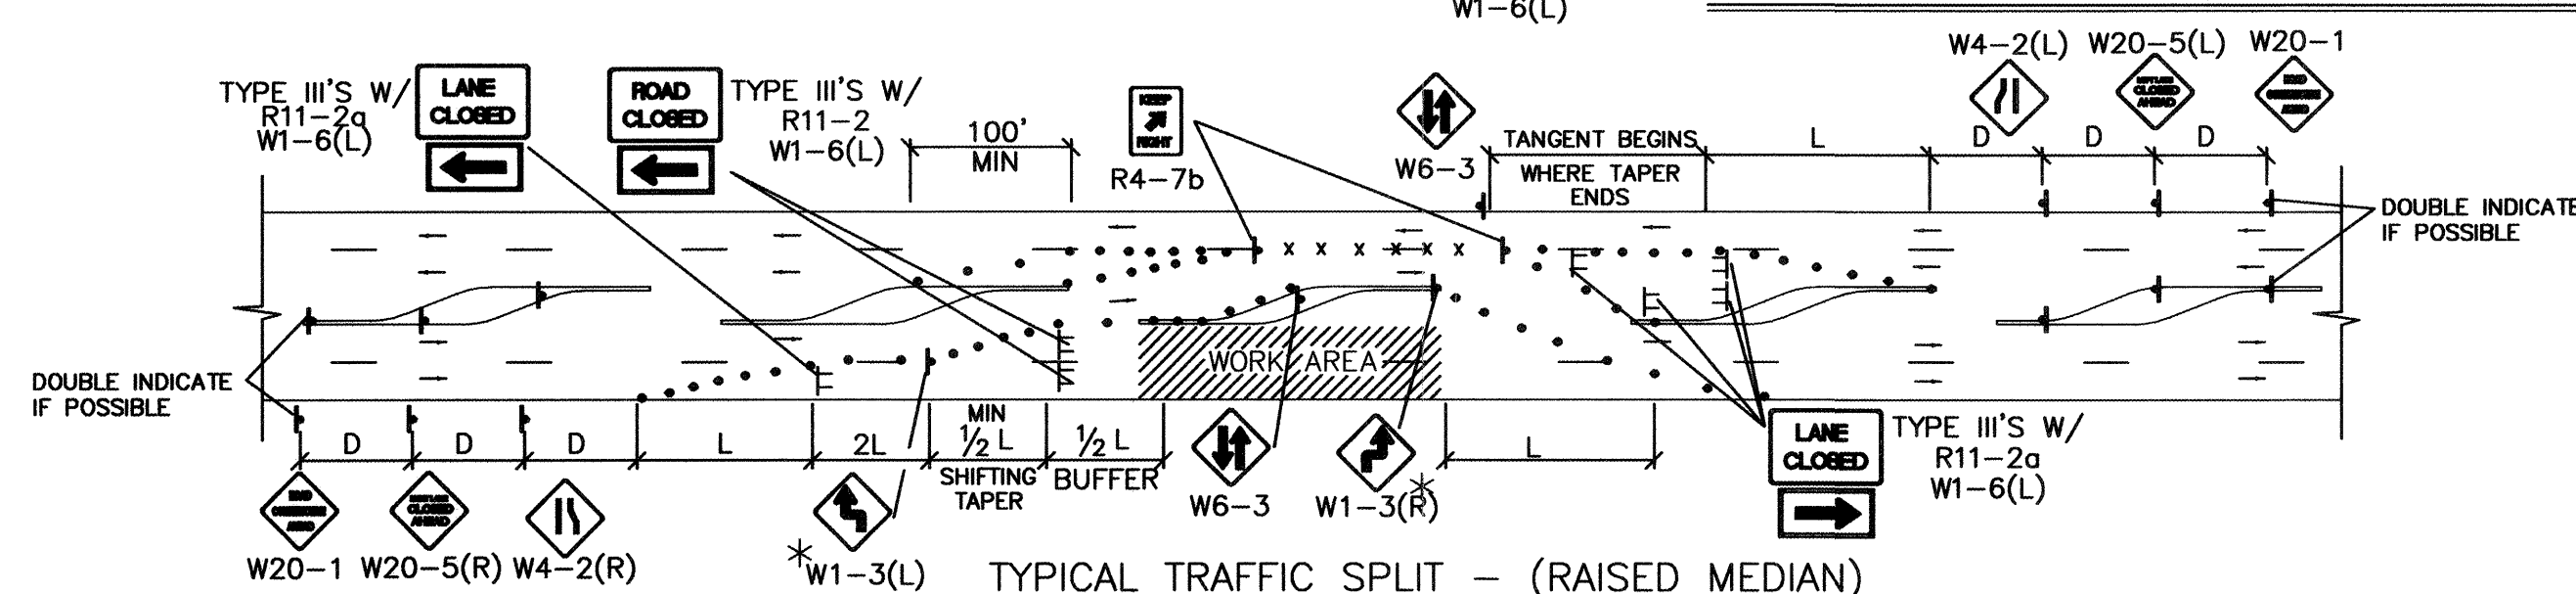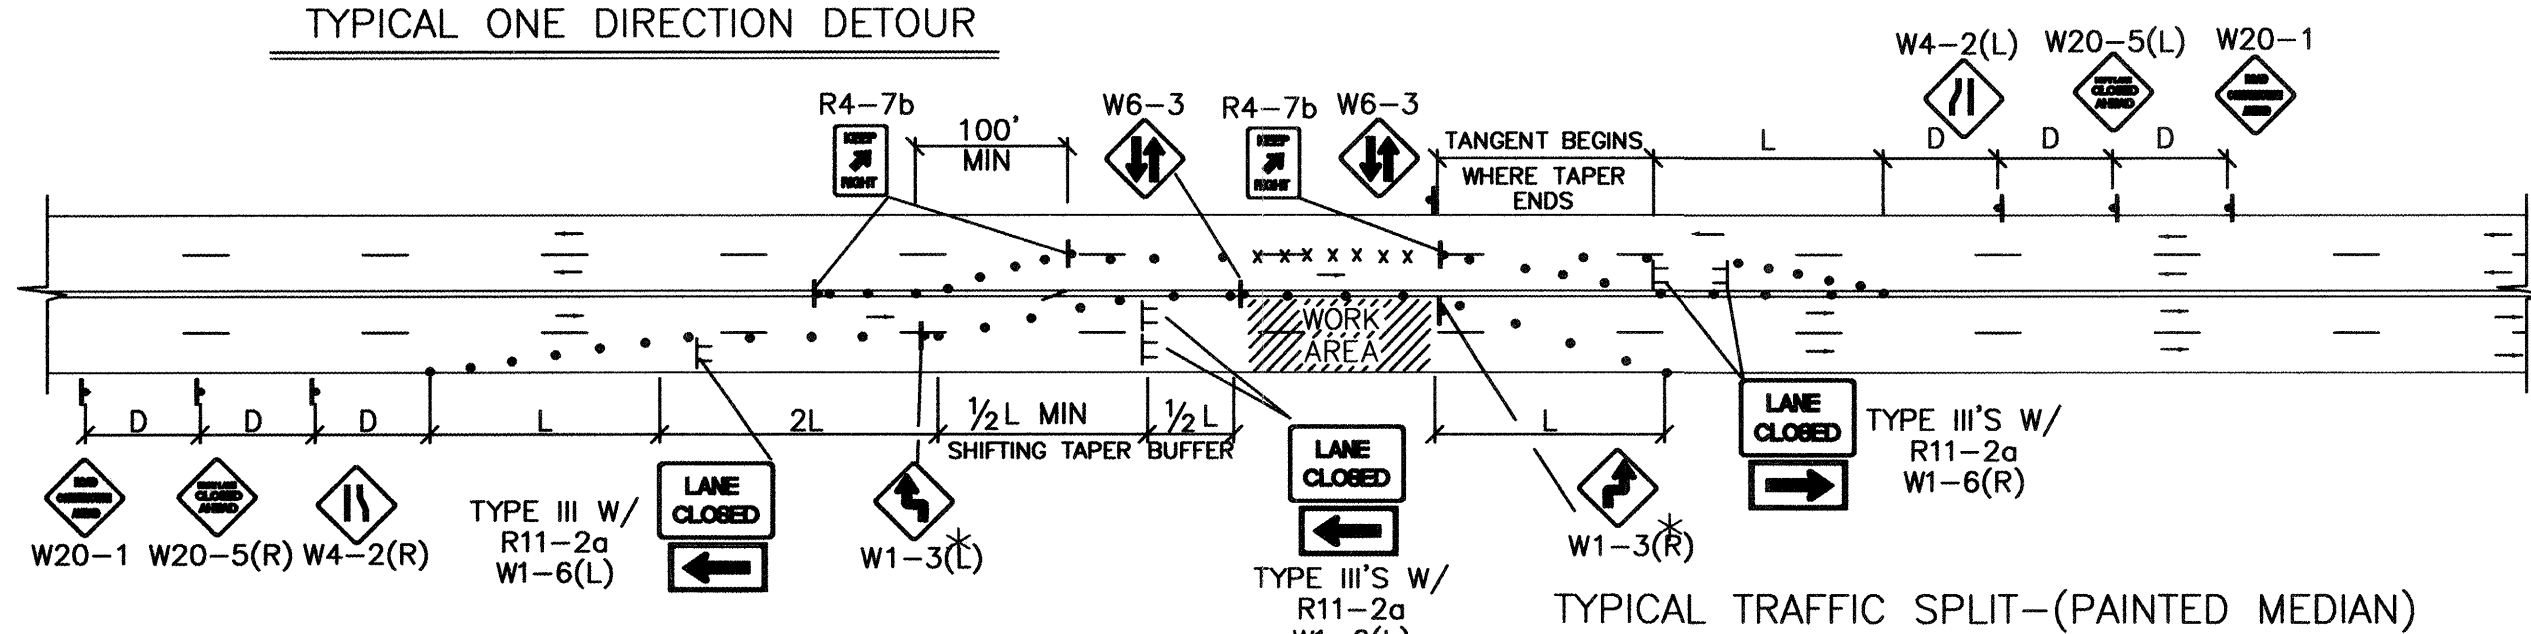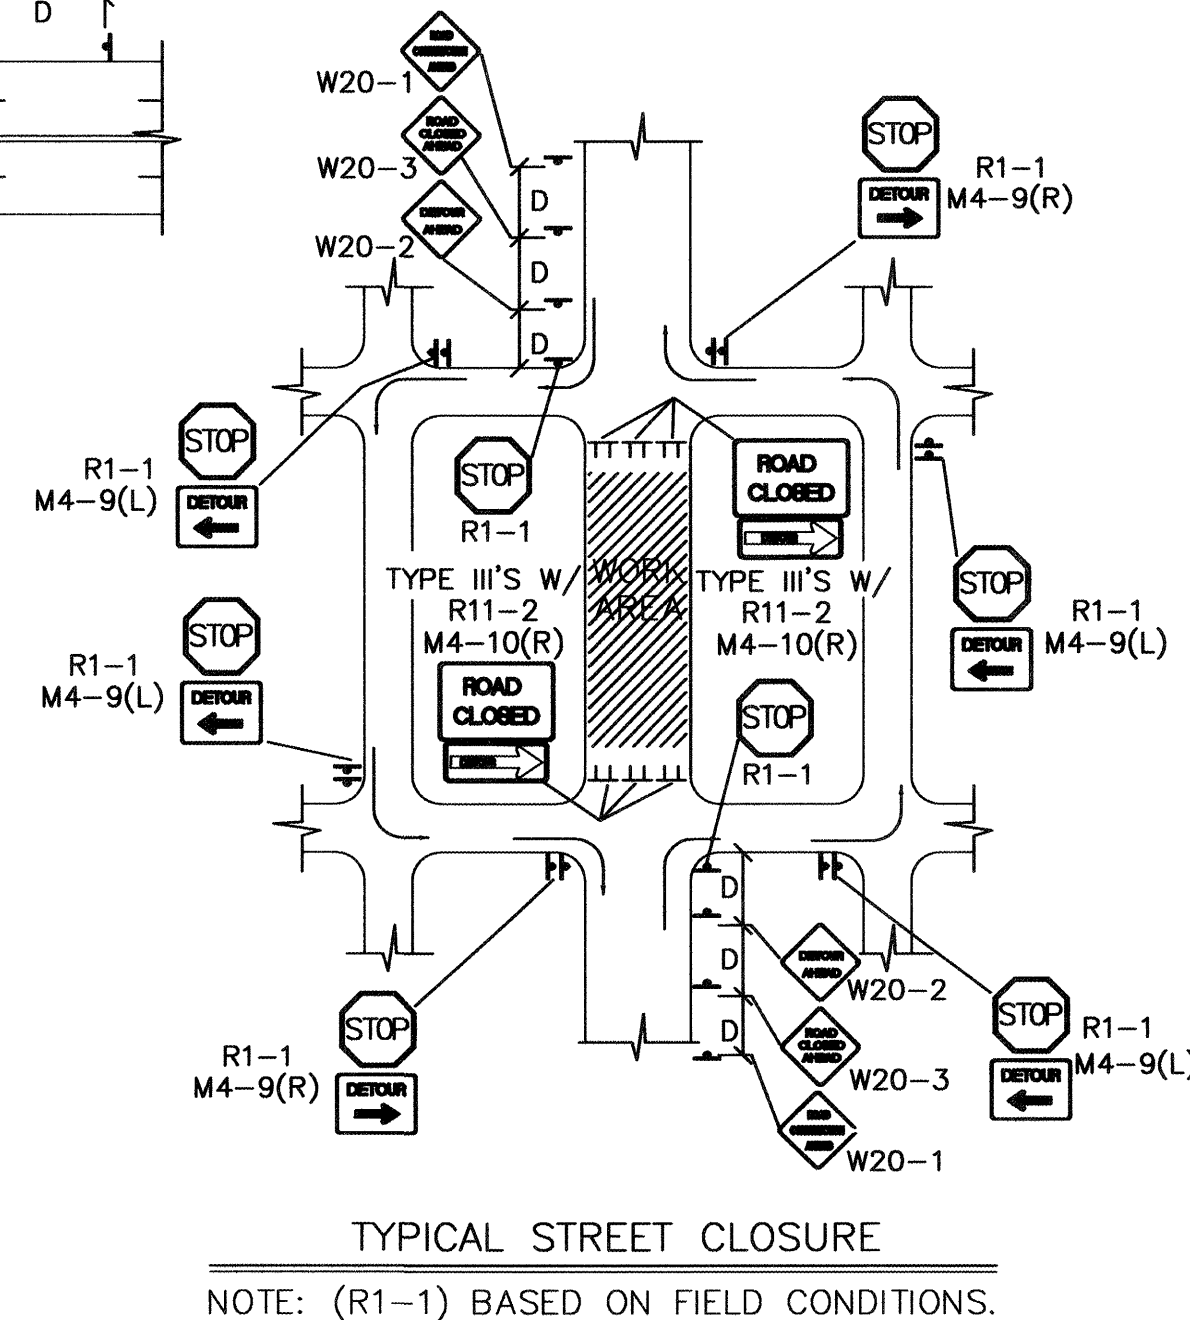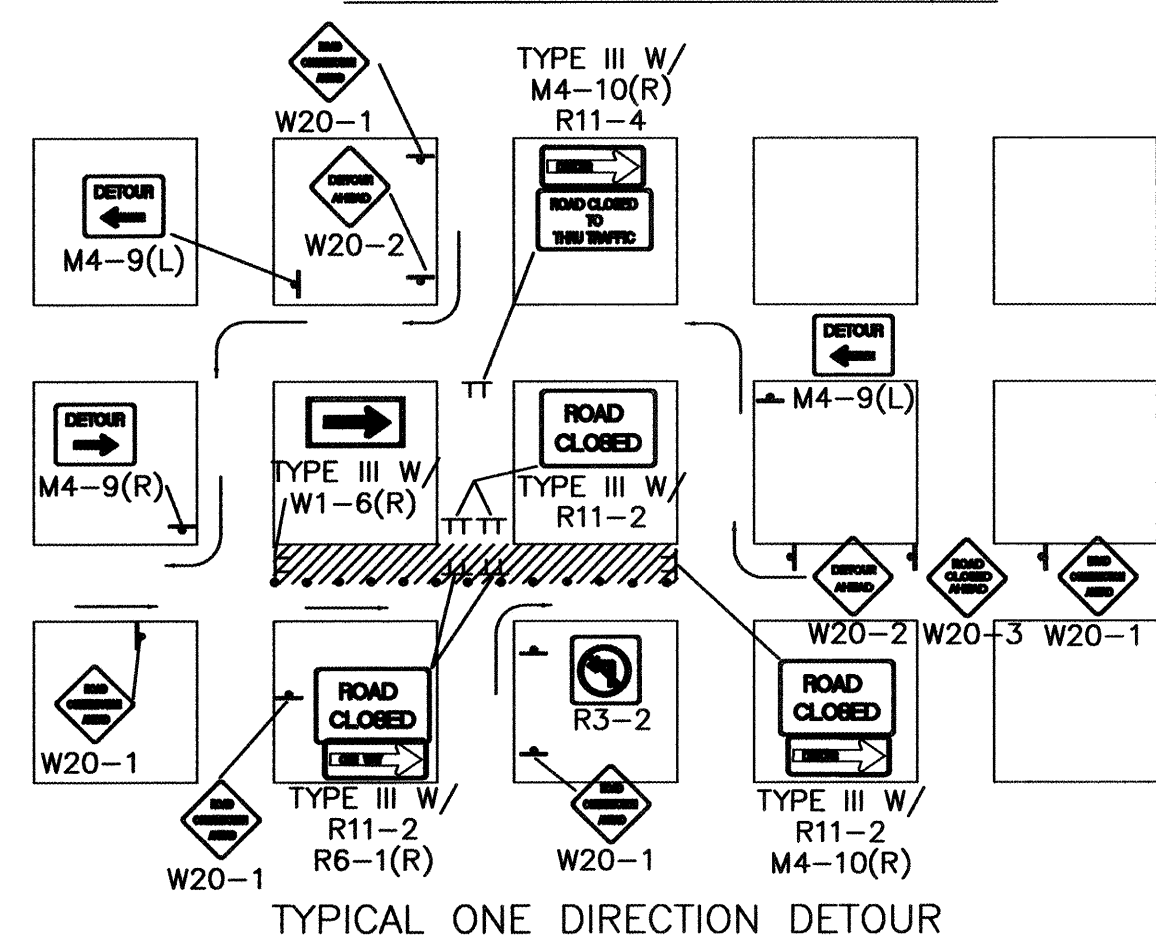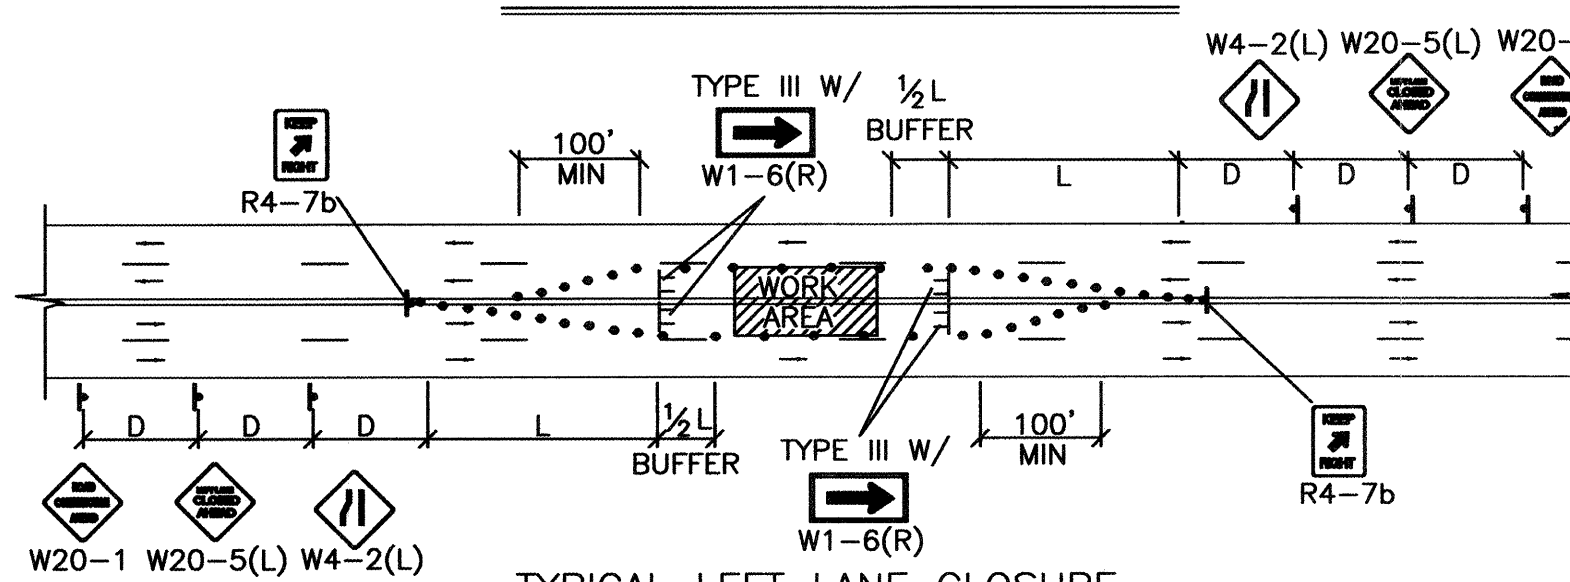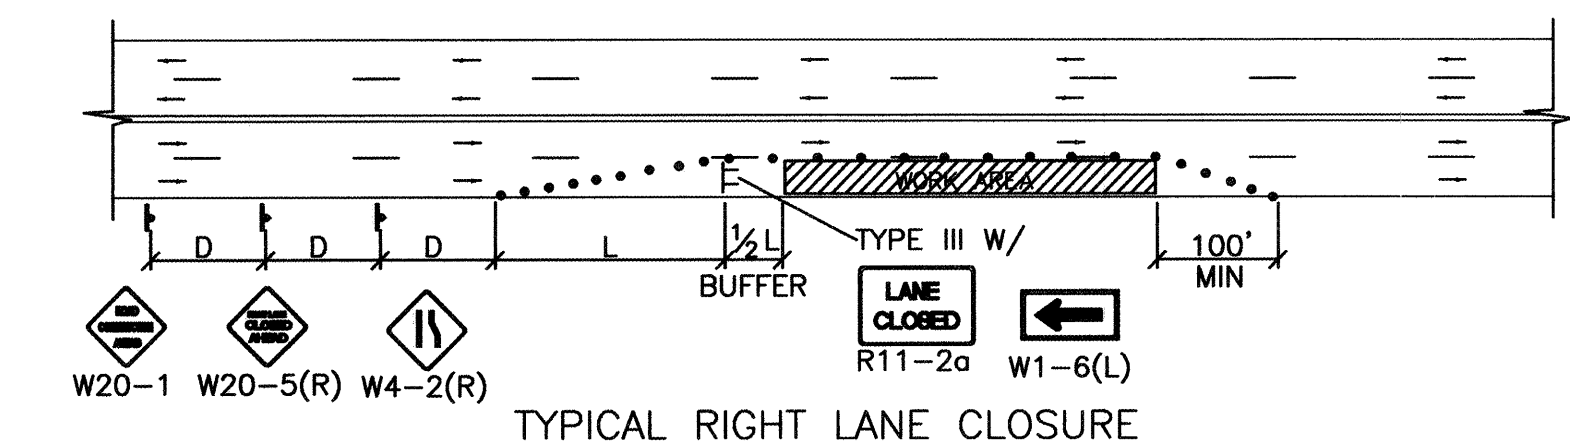

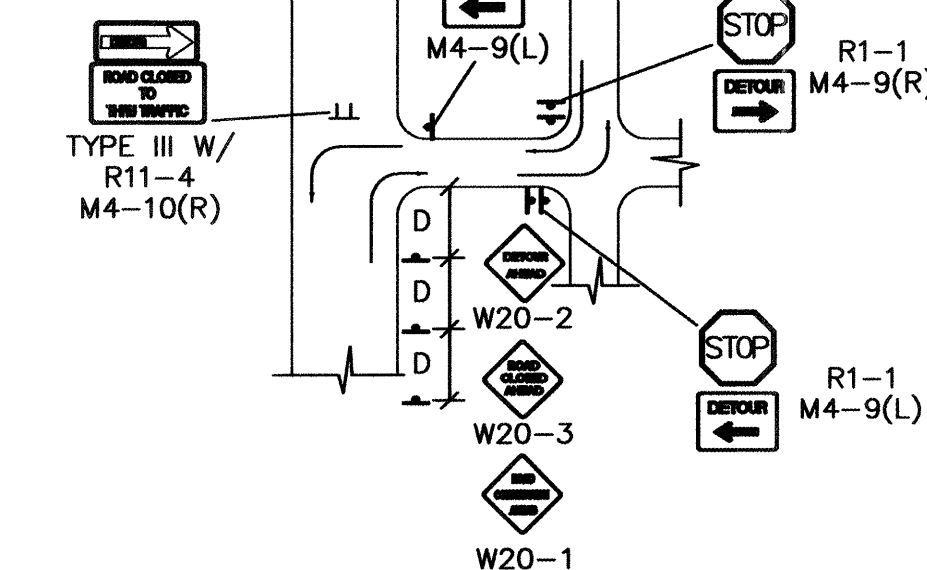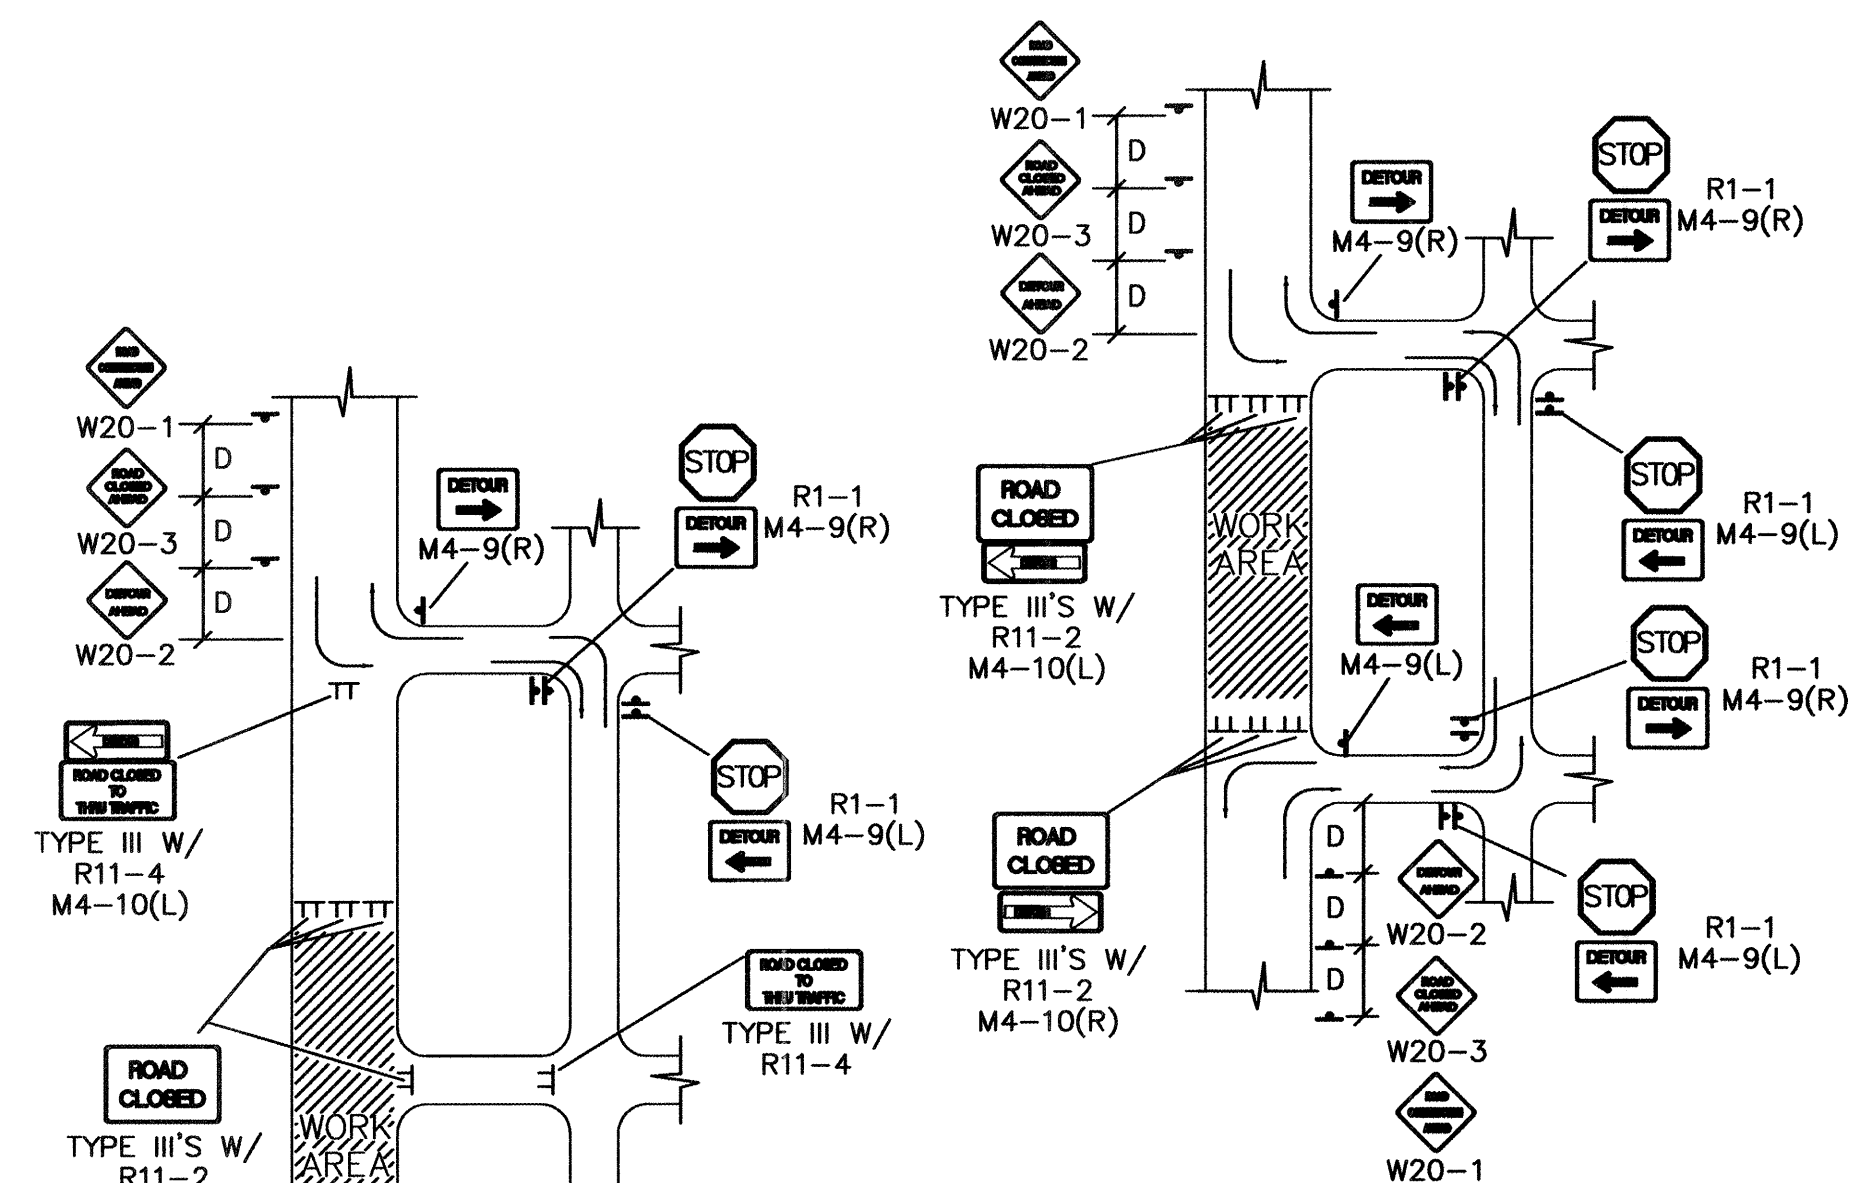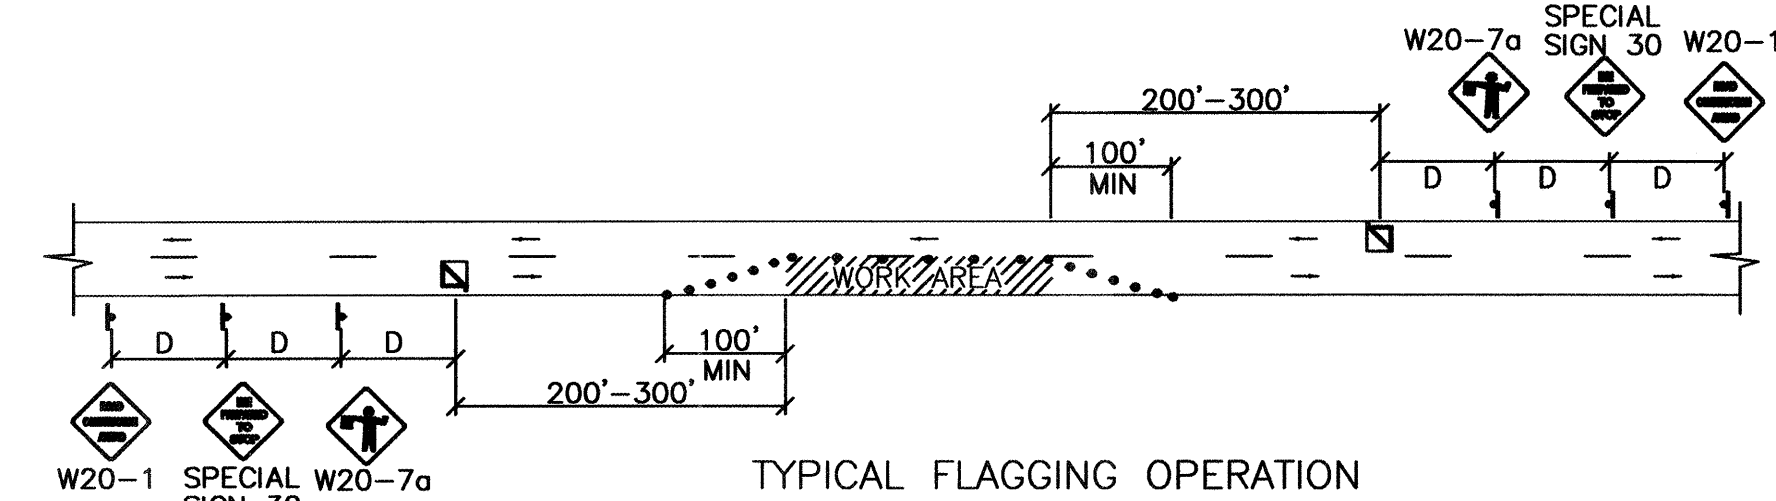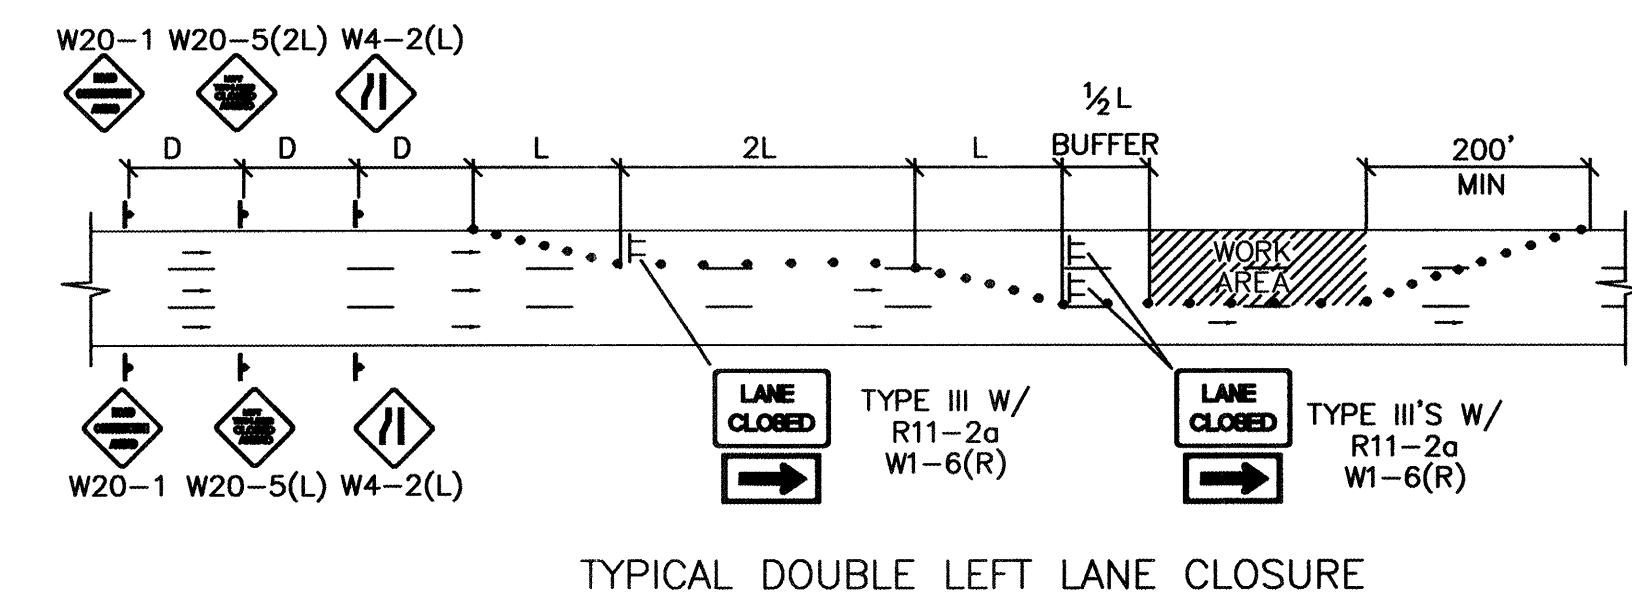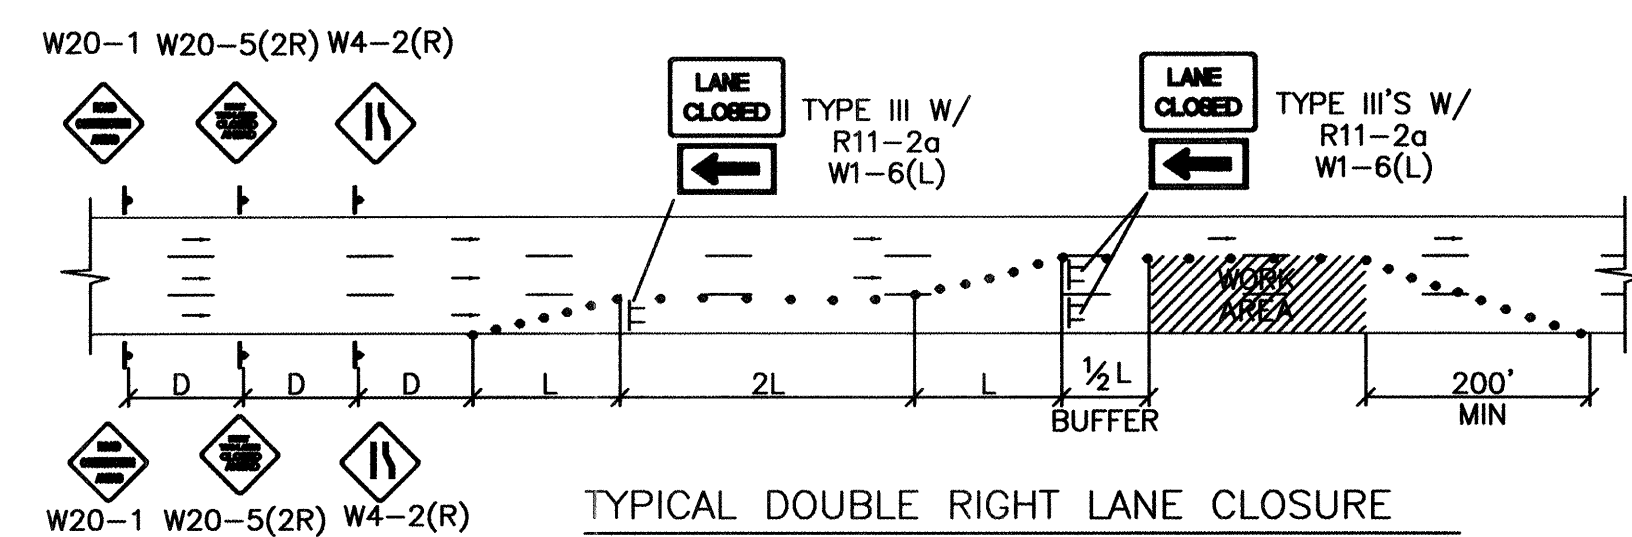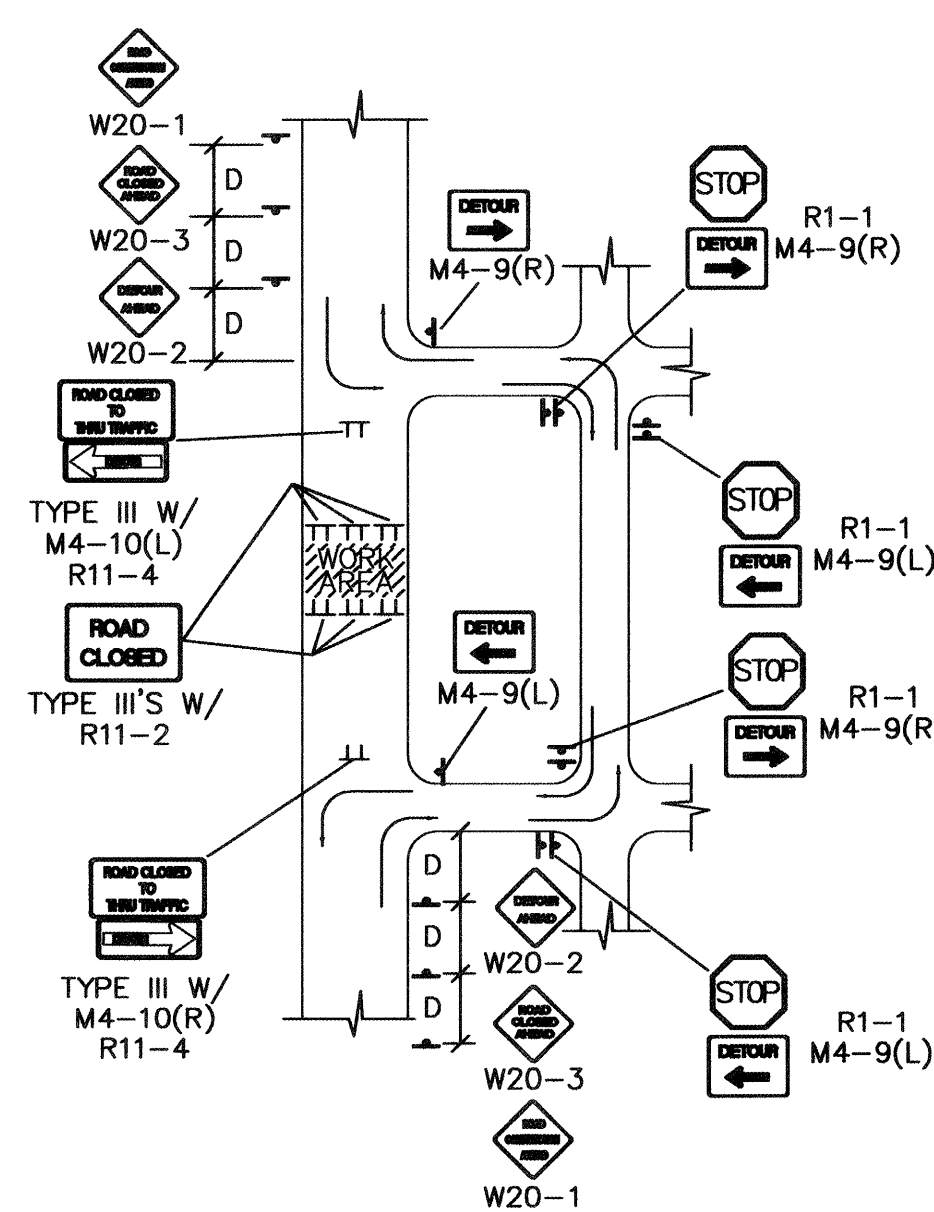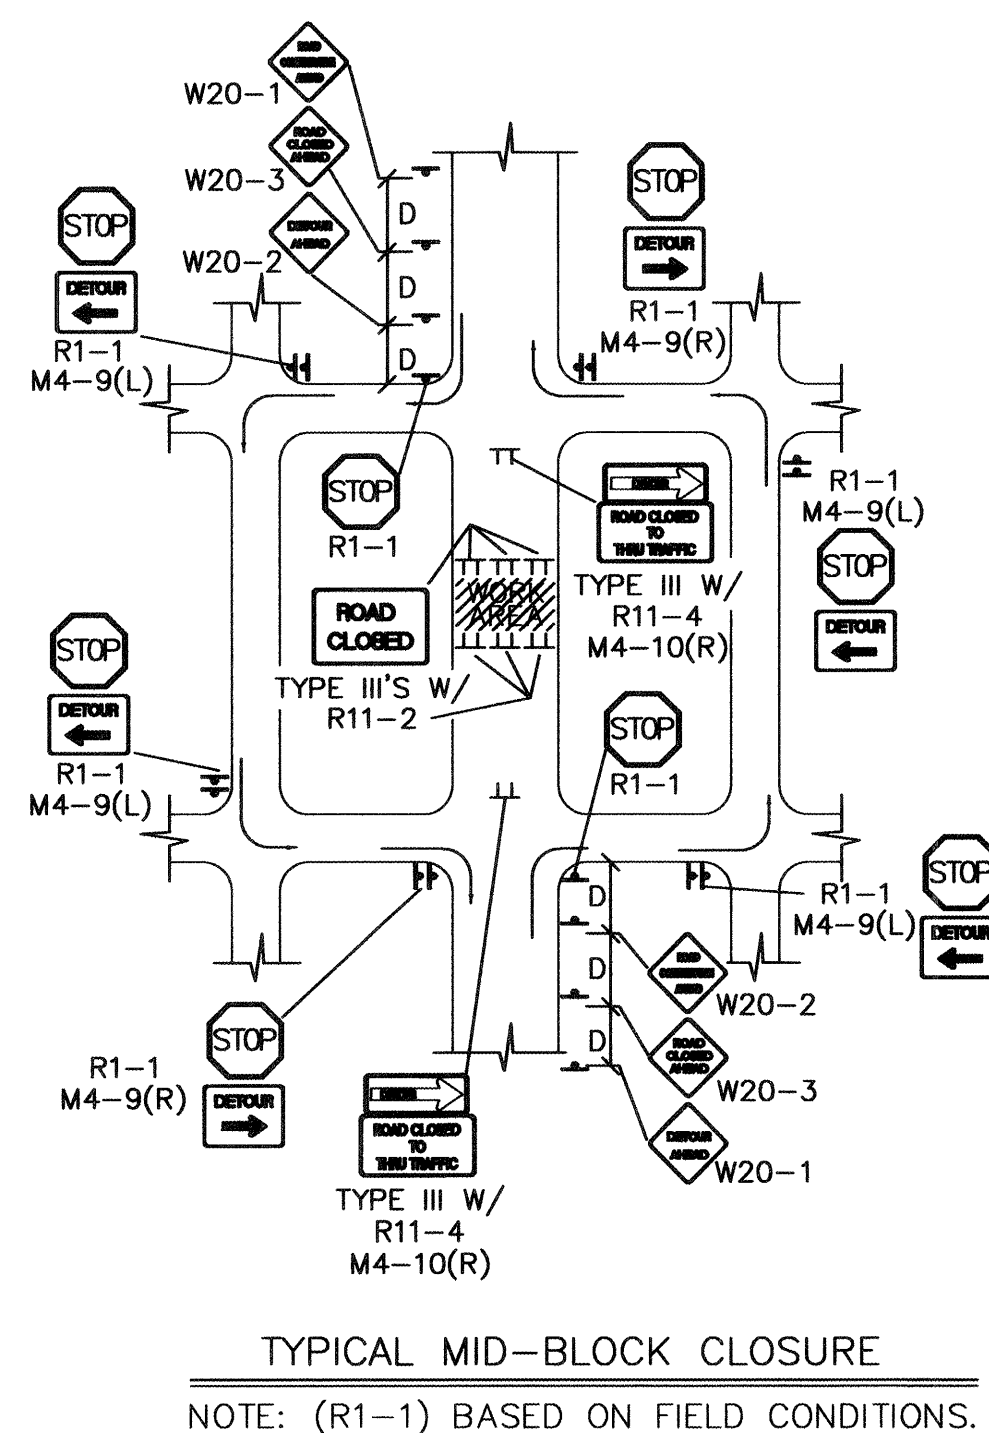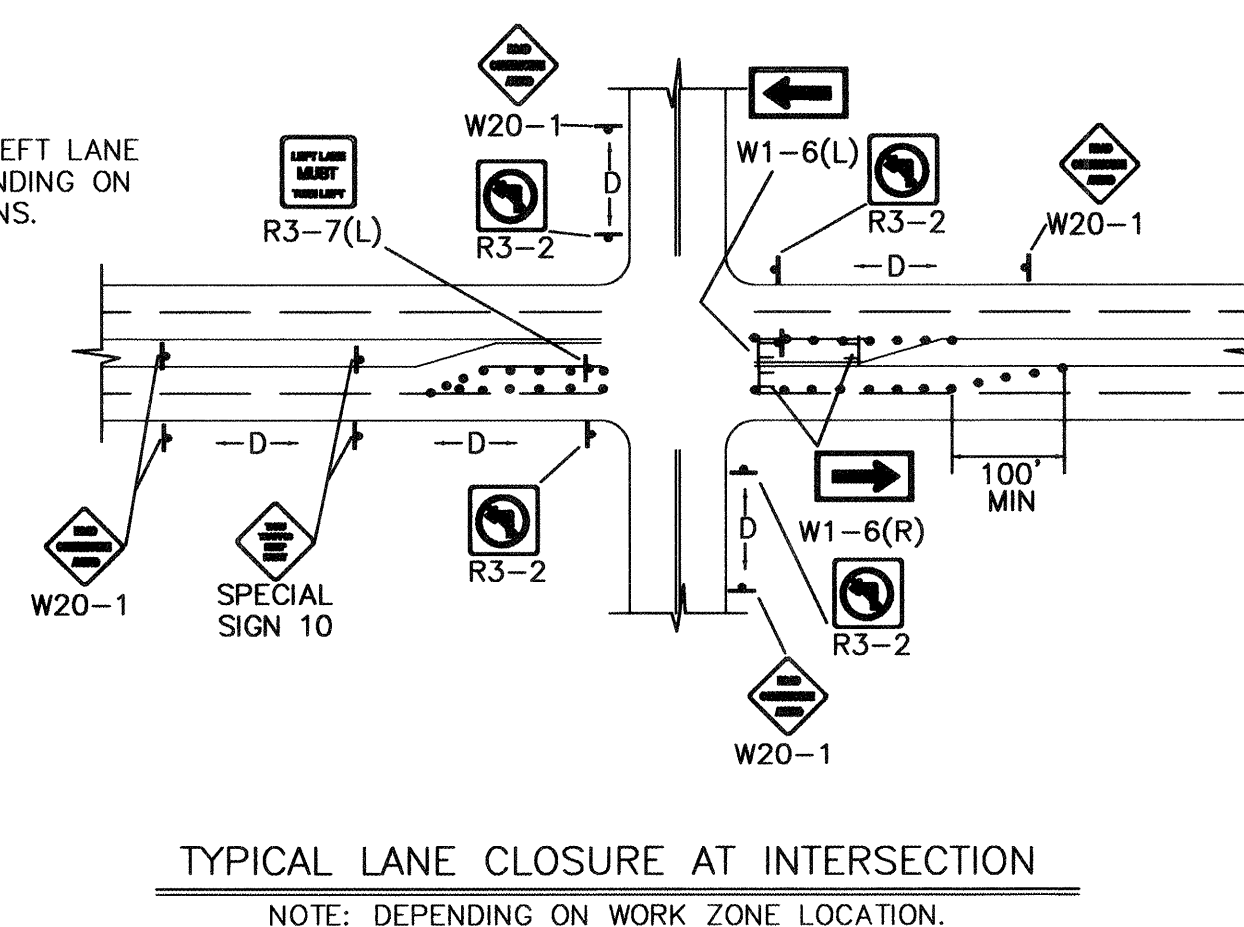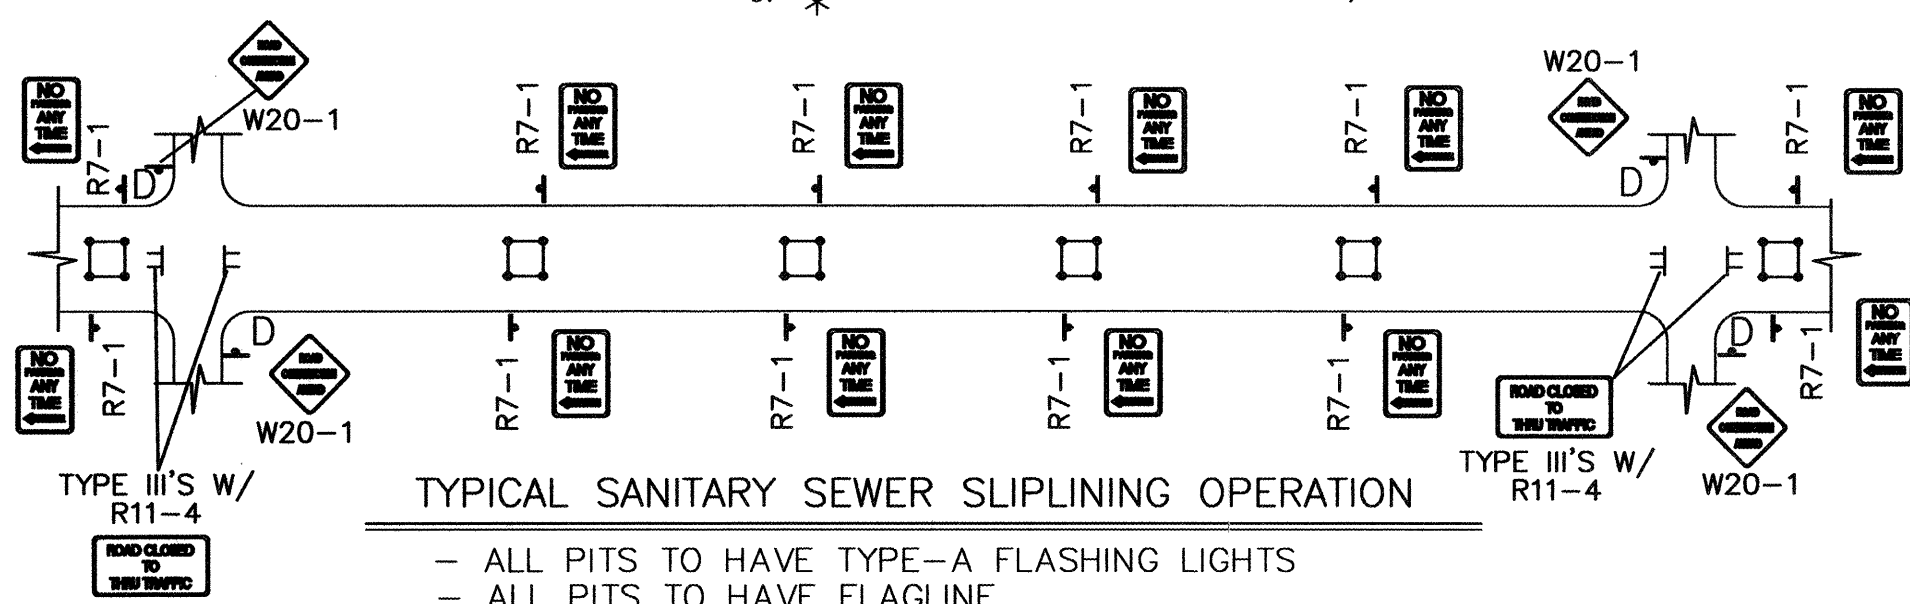

SCANNED BY
MESA REPRO

- ## SIGN FACE DETAILS



THE TANGENT LENGTH IS EQUAL TO THE TAPER LENGTH FOR A GIVEN STREET.

SPEED LIMIT (MPH)	TAPER LENGTH(L) (FEET)			MINIMUM NUMBER OF DEVICES FOR TAPER	MAXIMUM DEVICE SPACING IN FEET	
	10' LANE	11' LANE	12' LANE		ALONG TAPER	AFTER TAPER
20	70	75	80	5	20	20
25	105	115	125	6	25	25
30	150	165	180	7	30	30
35	205	225	245	8	35	35
40	270	295	320	9	40	40
45	450	495	540	13	45	45
50	500	550	600	13	50	50
55	550	605	660	13	55	55

SPEED MILES PER HOUR	MINIMUM BETWEEN SIGNS	DISTANCE IN FEET FROM LAST SIGN TO TAPER
0-20	10 X SPEED LIMIT	10 X SPEED LIMIT
25-30	10 X SPEED LIMIT	10 X SPEED LIMIT
30-35	10 X SPEED LIMIT	10 X SPEED LIMIT
40-45	10 X SPEED LIMIT	10 X SPEED LIMIT
50-60	10 X SPEED LIMIT	10 X SPEED LIMIT

TYPE OF TAPER	TAPER LENGTH
UPSTREAM TAPER:	
MERGING TAPER	L MINIMUM
SHIFTING TAPER	1/2 L MINIMUM
SHOULDER TAPER	1/2 L MINIMUM
TWO-WAY TRAFFIC TAPER	100 FEET MAXIMUM
DOWNSTREAM TAPERS	100 FEET PER LANE

SPEED LIMIT	
40 MPH OR LESS	$L = \frac{WS^2}{60}$
40 MPH OR GREATER	$L = W \times S$

L = TAPER LENGTH
W = WIDTH OF OFFSET IN FEET
S = POSTED SPEED OR OFF-PEAK 85-PERCENTILE SPEED IN MPH

CITYSIGN.DWG 6-11-97