

CONSTRUCTION PLANS FOR PROSPERITY CT., WILLIAM ST., & RIO ABAJO RD.




SEWER LINE IMPROVEMENTS




COUNTY OF BERNALILLO
&
CITY OF ALBUQUERQUE
NEW MEXICO
APRIL 2001

INDEX TO DRAWINGS

1. TITLE SHEET
2. PORTION OF PROSPERITY COURT /
KINNEY BRICK SEWER LINE EXTENSION PHASE III
3. WILLIAM STREET SE
4. RIO ABAJO ROAD SE

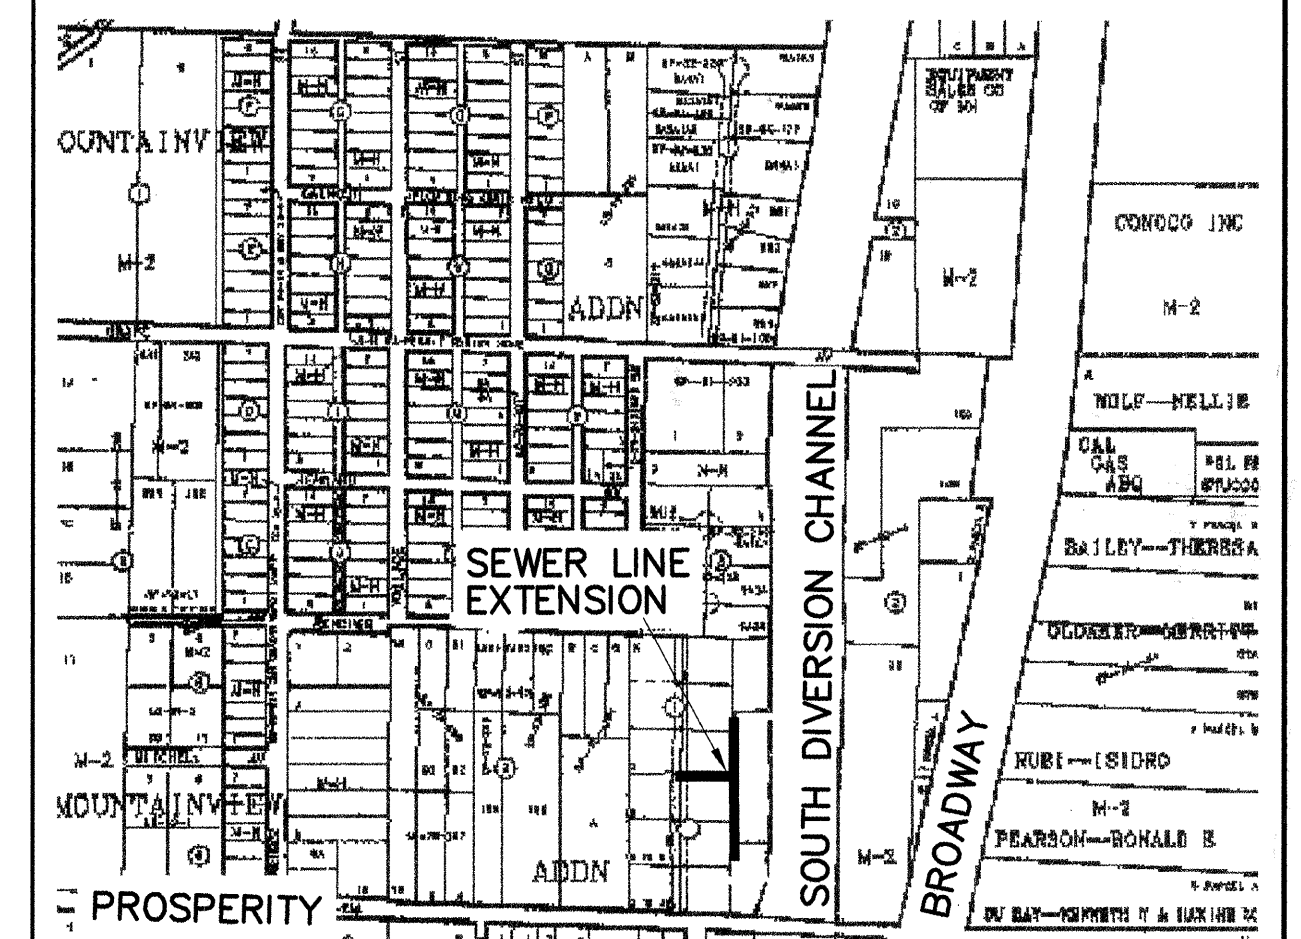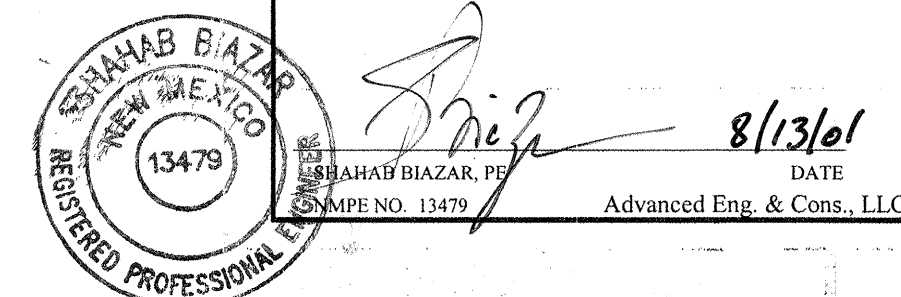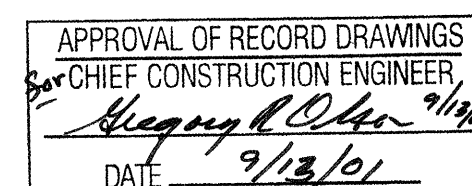

VICINITY MAP ZONE ATLAS P-14-Z

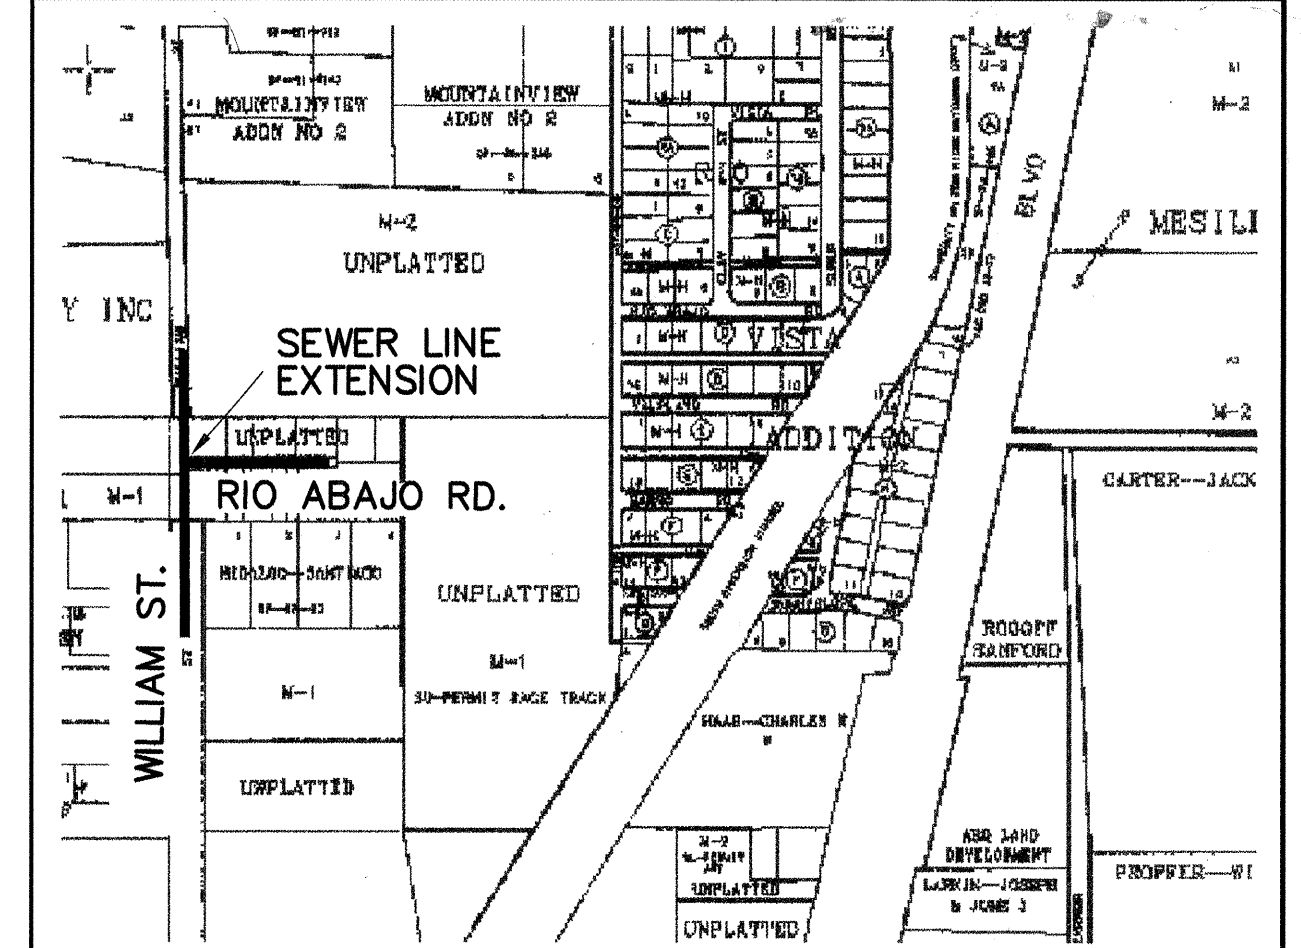

VICINITY MAP ZONE ATLAS Q-14-Z


NOTICE TO CONTRACTORS




1. ALL WORK DETAILED ON THESE PLANS TO BE PERFORMED UNDER CONTRACT SHALL, EXCEPT AS OTHERWISE STATED OR PROVIDED FOR HEREON, BE CONSTRUCTED IN ACCORDANCE WITH THE CITY OF ALBUQUERQUE STANDARD SPECIFICATIONS FOR PUBLIC WORKS CONSTRUCTION, 1986 EDITION (UPDATE #6).
2. TWO WORKING DAYS PRIOR TO ANY EXCAVATION, THE CONTRACTOR MUST CONTACT NEW MEXICO ONE CALL SYSTEM (260-1990) FOR LOCATION OF EXISTING UTILITIES.
3. ANY WORK AFFECTING AN ARTERIAL ROADWAY REQUIRES 24-HOUR CONSTRUCTION.
4. PRIOR TO CONSTRUCTION, THE CONTRACTOR SHALL EXCAVATE AND VERIFY THE HORIZONTAL AND VERTICAL LOCATIONS OF ALL OBSTRUCTIONS. SHOULD A CONFLICT EXIST, THE CONTRACTOR SHALL NOTIFY THE ENGINEER OR SURVEYOR IMMEDIATELY SO THAT THE CONFLICT CAN BE RESOLVED WITH A MINIMUM AMOUNT OF DELAY.
5. FIVE (5) WORKING DAYS PRIOR TO BEGINNING OF CONSTRUCTION, THE CONTRACTOR SHALL SUBMIT TO THE CONSTRUCTION COORDINATION DIVISION A DETAILED CONSTRUCTION SCHEDULE. TWO(2) WORKING DAYS PRIOR TO CONSTRUCTION, THE CONTRACTOR SHALL OBTAIN A BARRICADE PERMIT FROM THE CONST. COORDINATION DIVISION. CONTRACTOR SHALL NOTIFY BARRICADE ENGINEER (768-2551) PRIOR TO OCCUPYING AN INTERSECTION. REFER TO STANDARD SPECIFICATIONS.
6. ALL STREET STRIPING ALTERED OR DESTROYED SHALL BE REPLACED WITH PLASTIC REFLECTORIZED PAVEMENT MARKINGS BY THE CONTRACTOR TO LOCATION AS EXISTING OR AS INDICATED BY THIS PLAN SET AT THE COUNTY'S EXPENSE.
7. ALL BACKFILL MUST BE COMPACTED TO 95% OF OPTIMUM IN COUNTY ROW AND PRIVATE EASEMENTS.
8. ALL EXCAVATION, TRENCHING AND SHORING ACTIVITIES MUST BE CARRIED-OUT IN ACCORDANCE WITH OSHA 29 CFR 1926.650 SUBPART P.
7. CONTRACTOR SHALL NOTIFY THE ENGINEER NOT LESS THAN SEVEN (7) DAYS PRIOR TO STARTING WORK IN ORDER THAT THE ENGINEER MAY TAKE NECESSARY MEASURES TO INSURE THE PRESERVATION OF SURVEY MONUMENTS. CONTRACTOR SHALL NOT DISTURB PERMANENT SURVEY MONUMENTS WITHOUT THE CONSENT OF THE ENGINEER AND SHALL NOTIFY THE ENGINEER AND BEAR THE EXPENSE OF REPLACING ANY THAT MAY BE DISTURBED WITHOUT PERMISSION. REPLACEMENT SHALL BE DONE ONLY BY THE CITY SURVEYOR. WHEN A CHANGE IS MADE IN THE FINISHED ELEVATIONS OF THE PAVEMENT OF ANY ROADWAY IN WHICH A PERMANENT SURVEY MONUMENT IS LOCATED, CONTRACTOR SHALL, AT HIS OWN EXPENSE, ADJUST THE MONUMENT COVER TO THE NEW GRADE UNLESS OTHERWISE SPECIFIED. REFER TO SECTION 4.4 OF THE GENERAL CONDITIONS OF THE STANDARD SPECIFICATIONS. ANY PERMANENT SURVEY MONUMENT LOCATED WITHIN 50' OF THIS PROJECT THAT IS NOT SHOWN ON THE PLAN AND IS DESTROYED DURING CONSTRUCTION WILL BE REPLACED AT THE DESIGNER'S EXPENSE.

THE FOLLOWING NOTES ALSO APPLY WHEN CHECKED


- ☐ ALL UTILITIES AND UTILITY SERVICE LINES SHALL BE INSTALLED PRIOR TO PAVING.
- ☐ BACKFILL COMPACTION SHALL BE ACCORDING TO SPECIFIED STREET USE.
- ☐ TACK COAT REQUIREMENTS SHALL BE DETERMINED BY THE CITY ENGINEER.
- ☐ SIDEWALKS AND WHEELCHAIR RAMPS WITHIN THE CURB RETURNS SHALL BE CONSTRUCTED WHEREVER A NEW CURB RETURN IS CONSTRUCTED.
- ☐ IF CURB IS DEEPENED FOR A DRIVEPAD, THE DRIVEPAD SHALL BE CONSTRUCTED PRIOR TO ACCEPTANCE OF CURB AND GUTTER.
- ☐ ALL STORM DRAINAGE FACILITIES SHALL BE COMPLETED PRIOR TO FINAL ACCEPTANCE.

--	--	

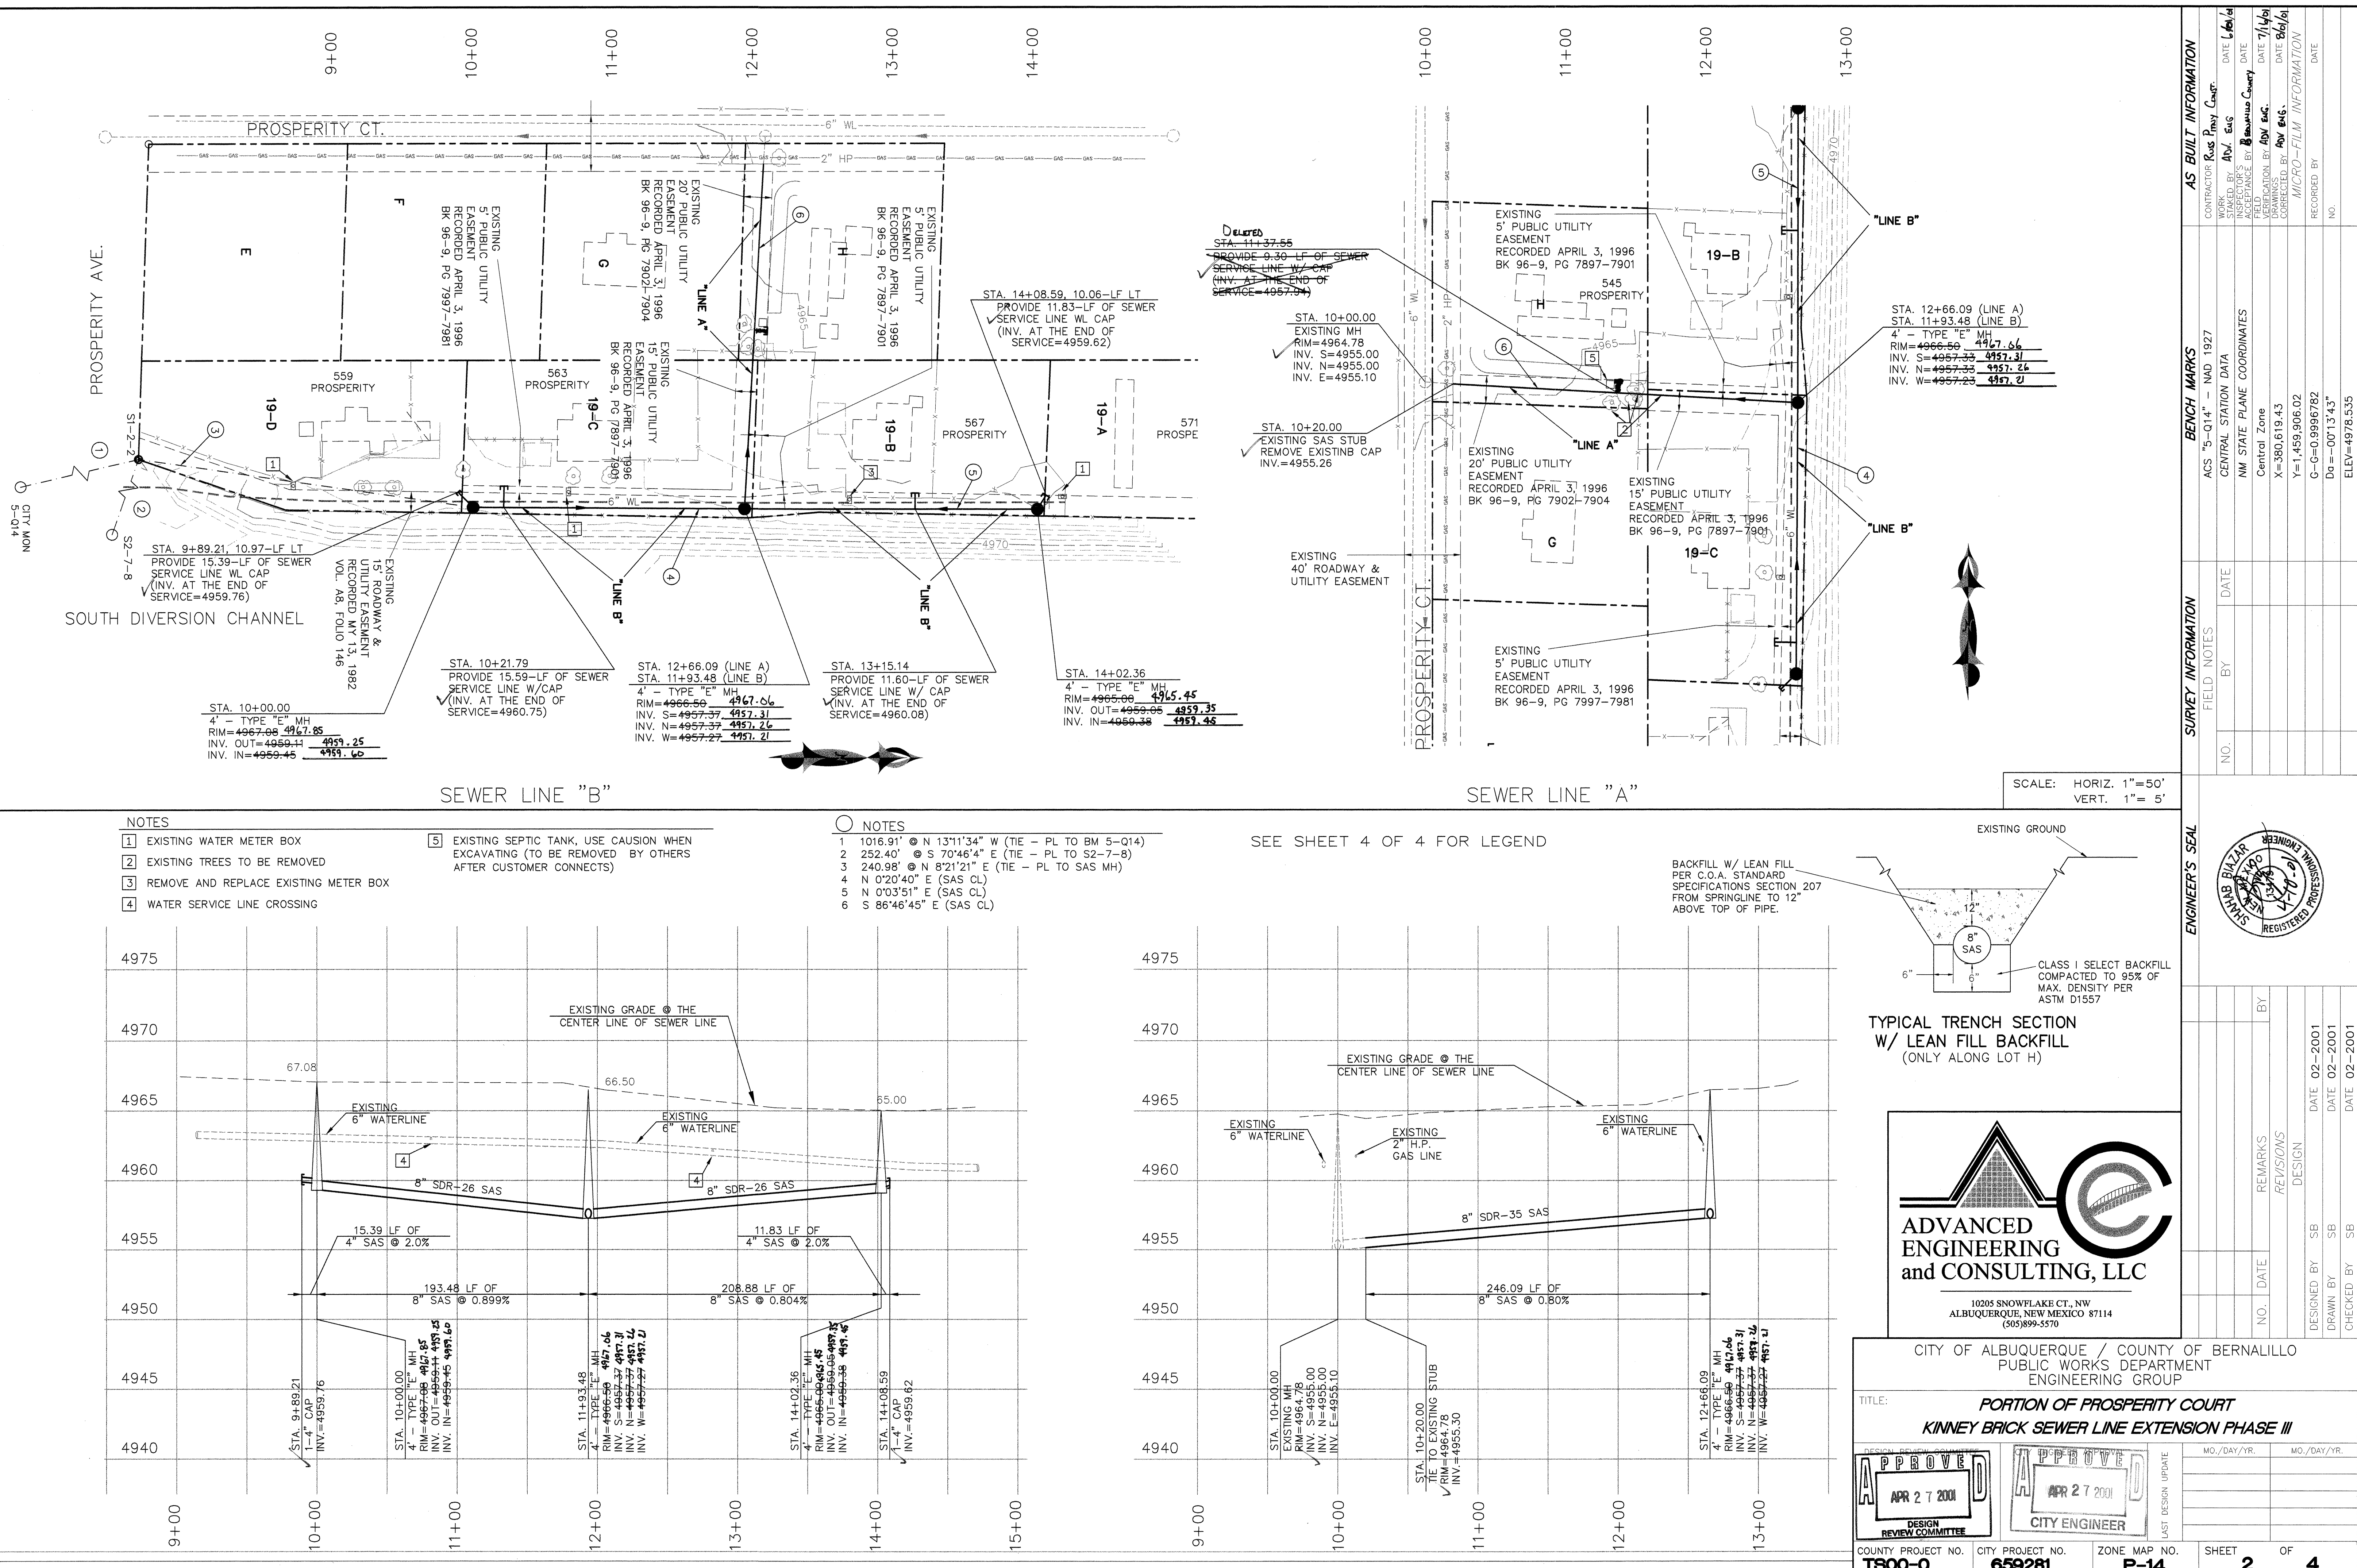


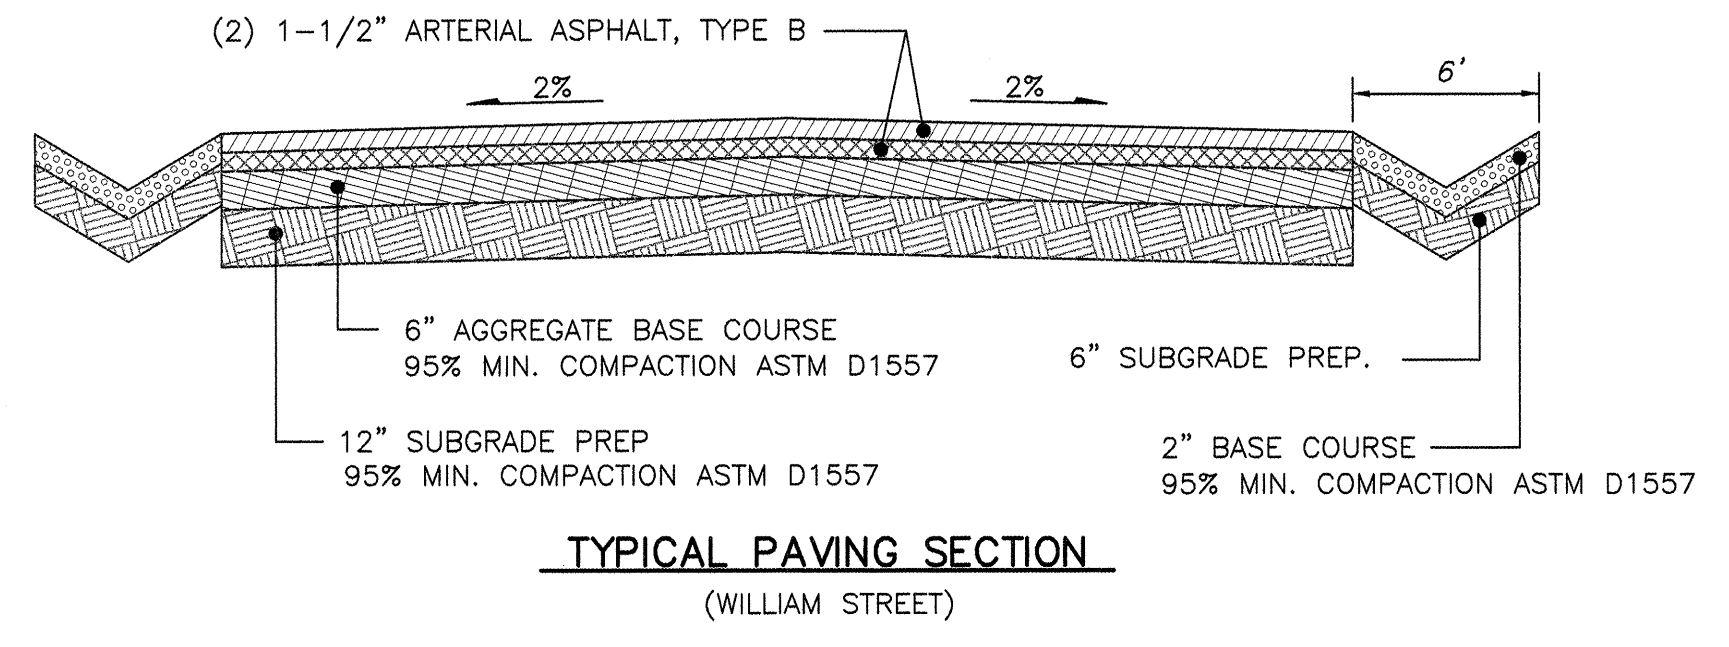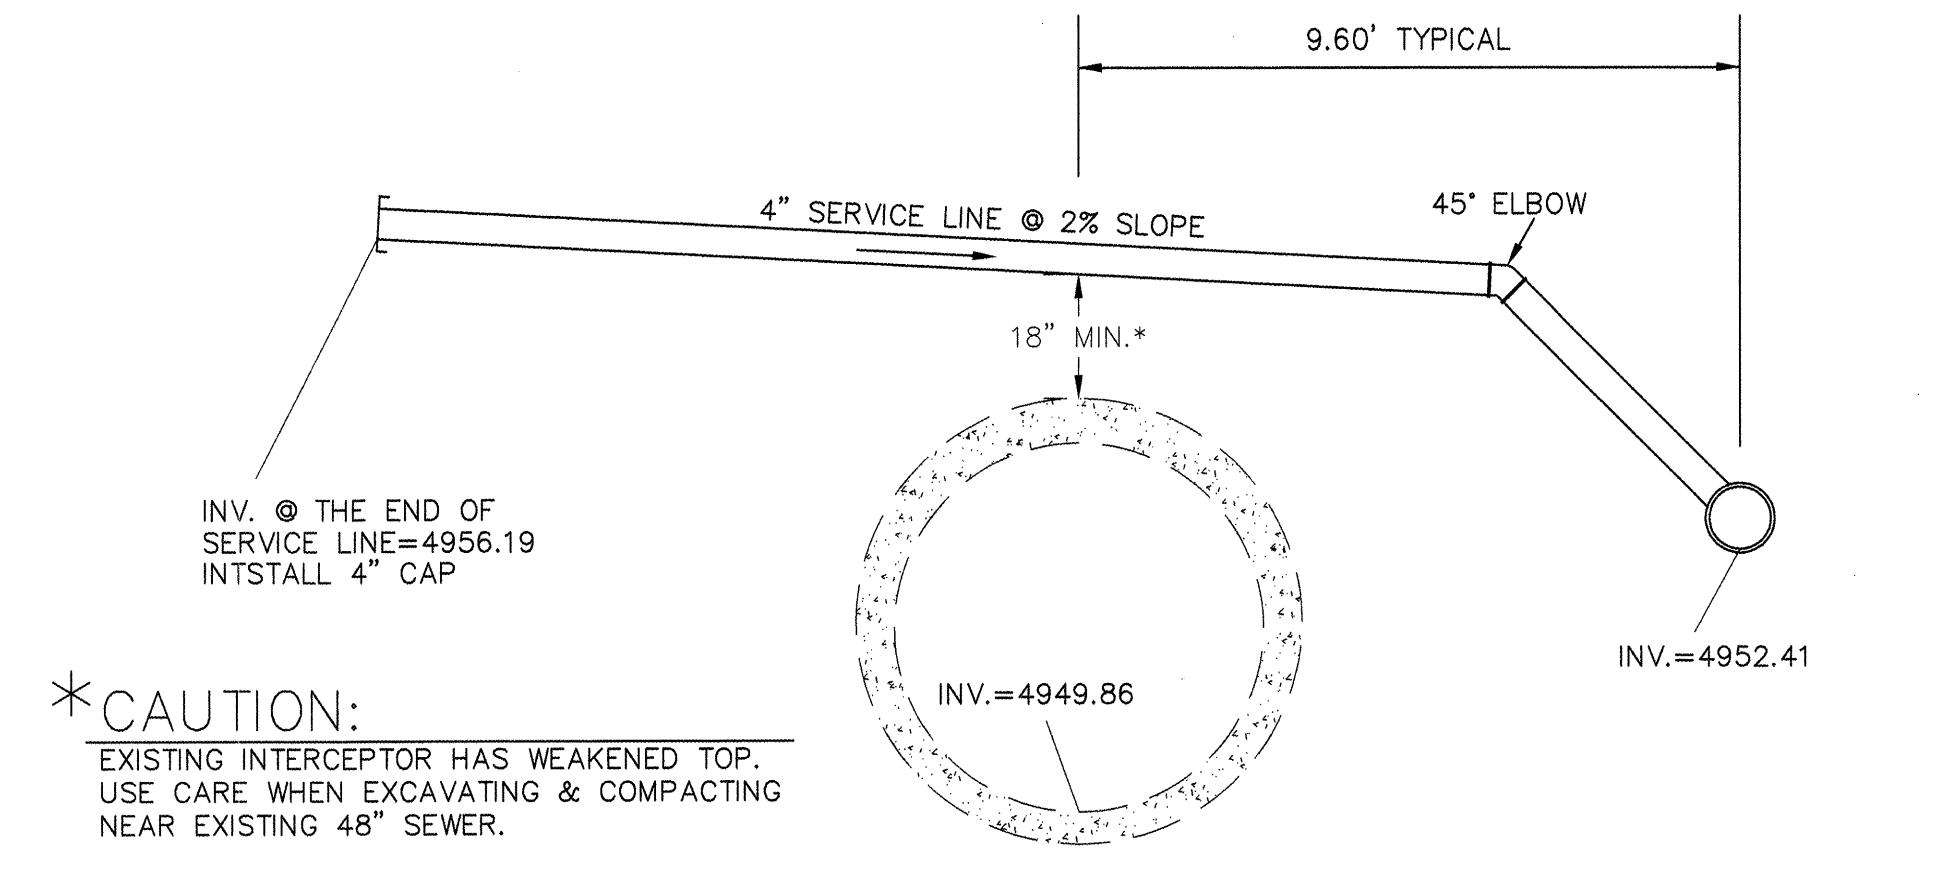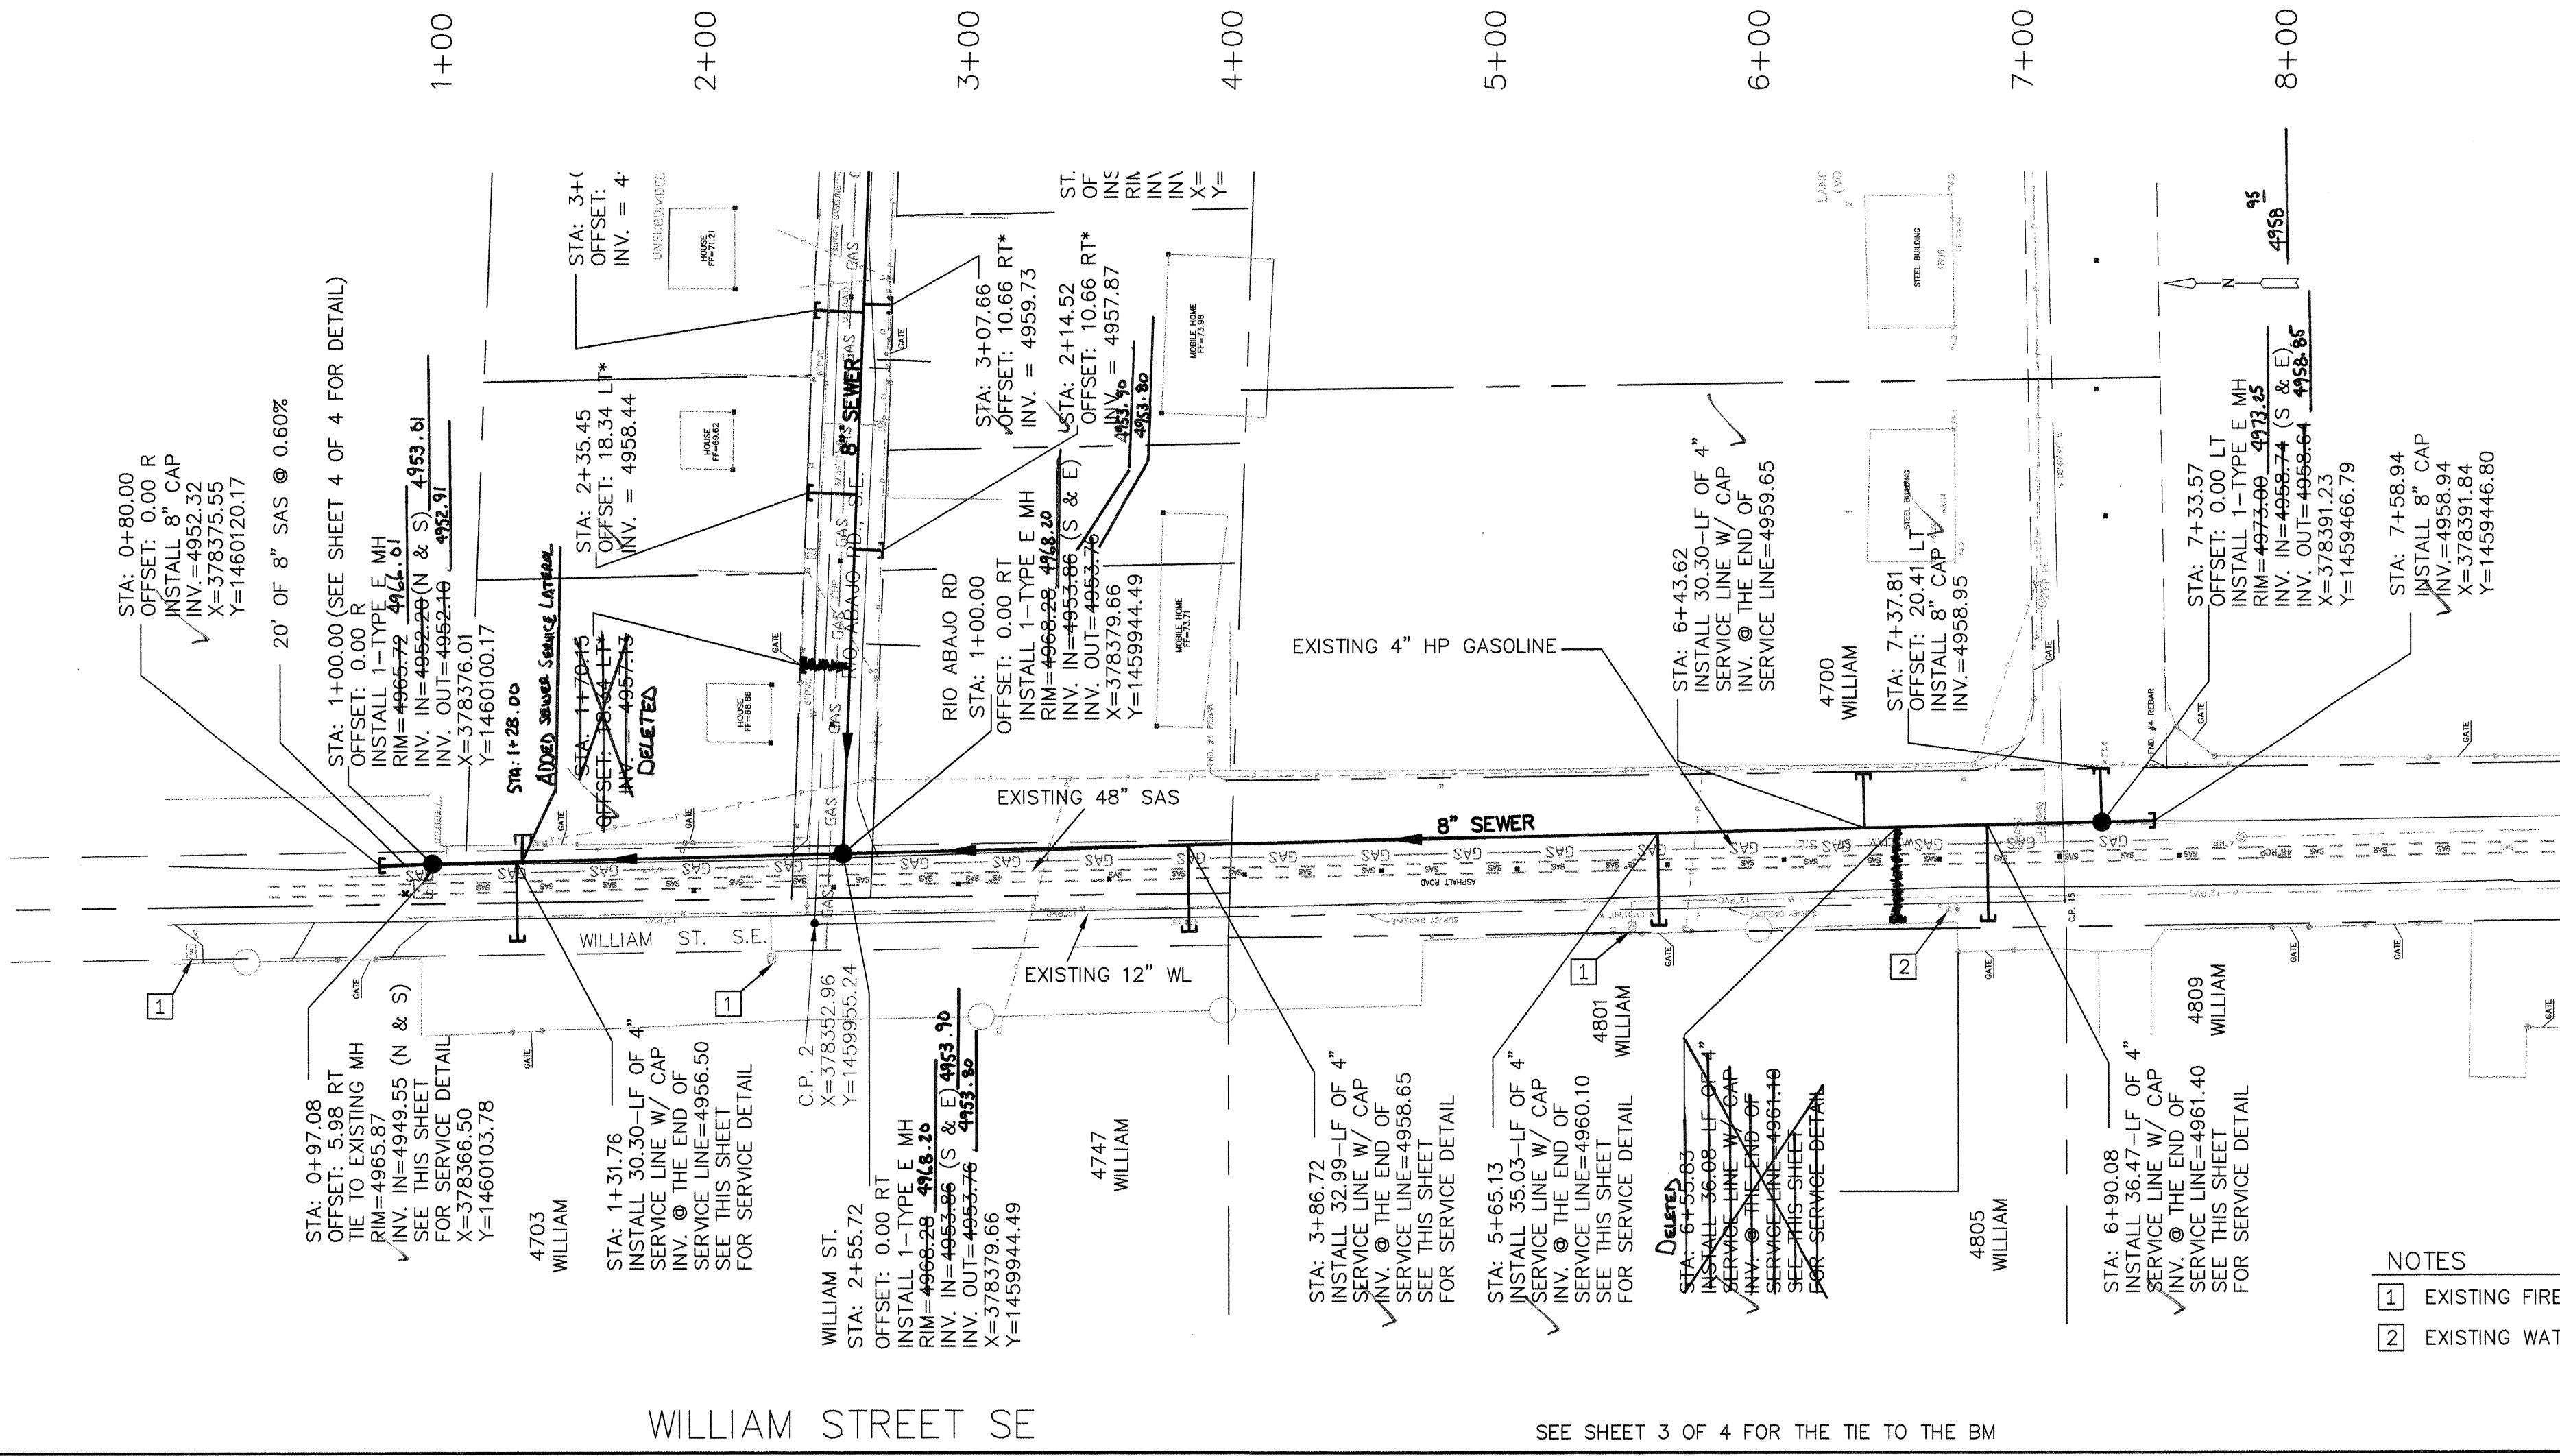

- NOTES
- 1 EXISTING FIRE HYDRANT
 - 2 EXISTING WATER METER

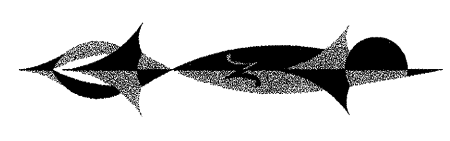

SCALE: HORIZ. 1"=50'
VERT. 1"= 5'

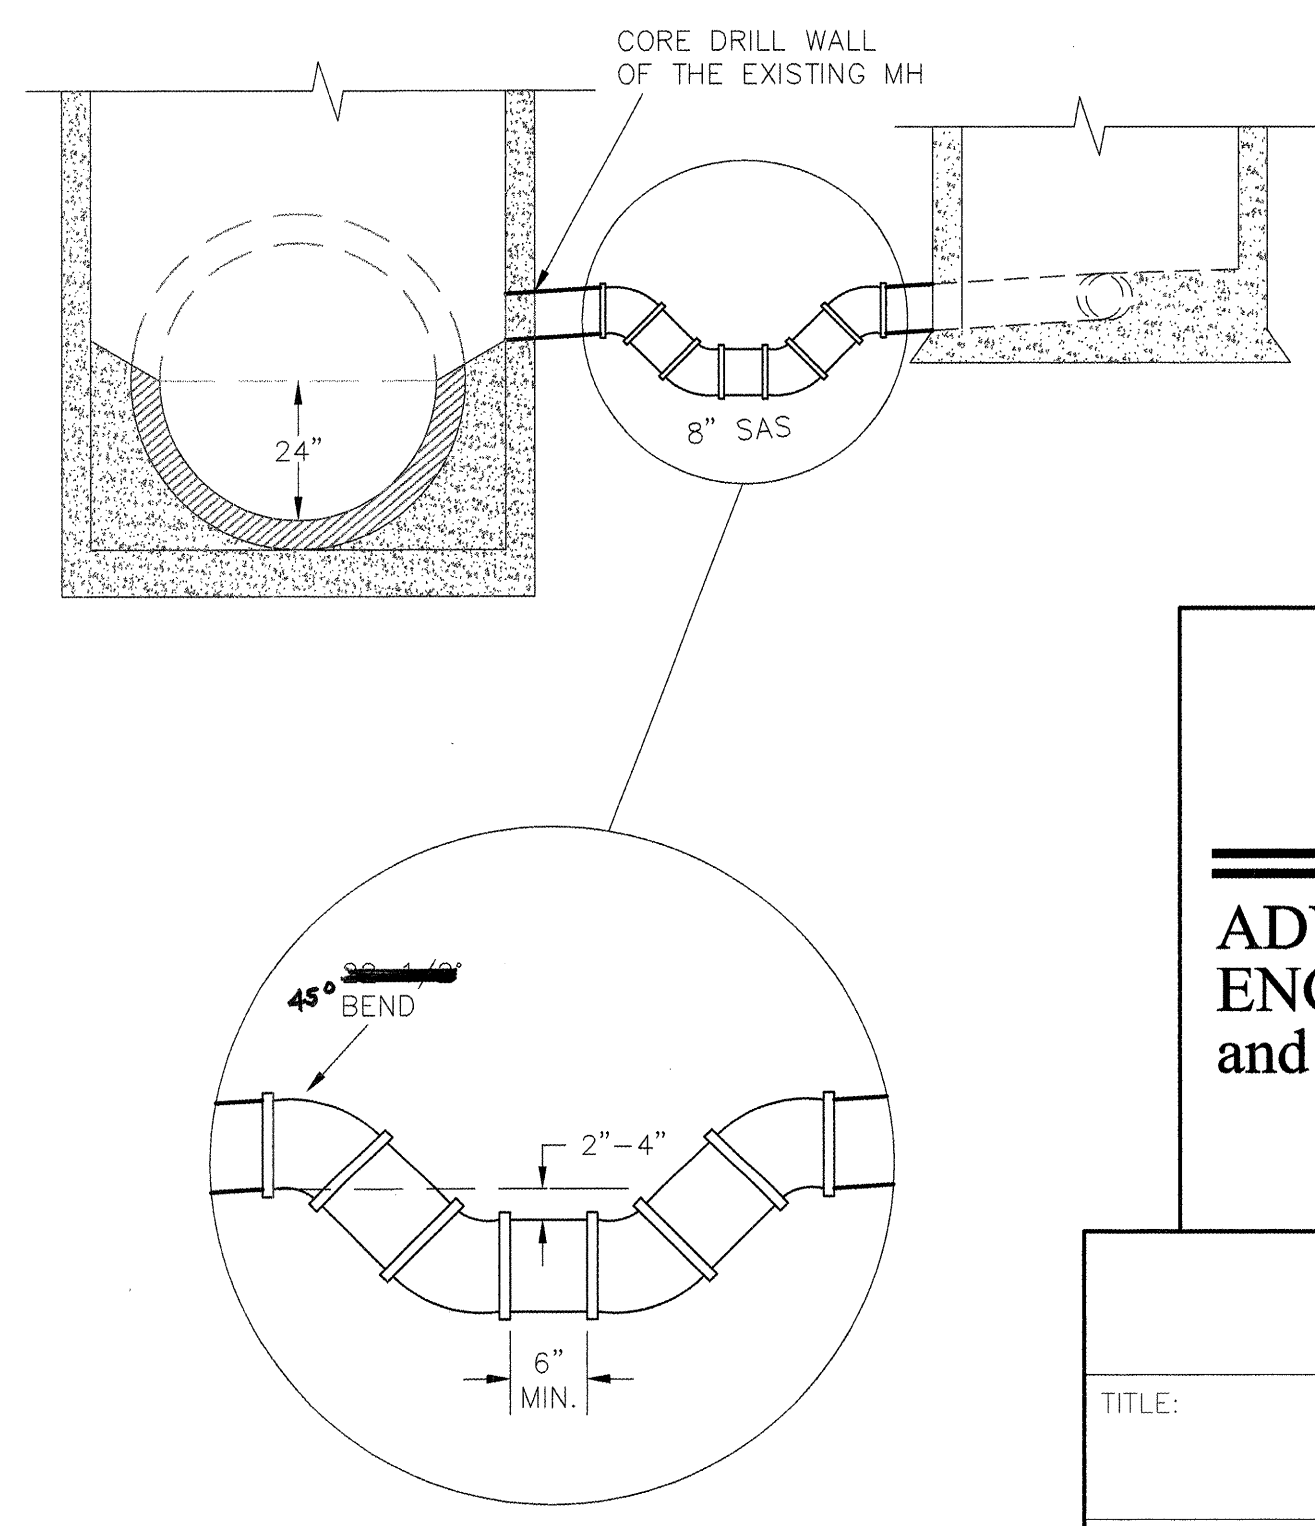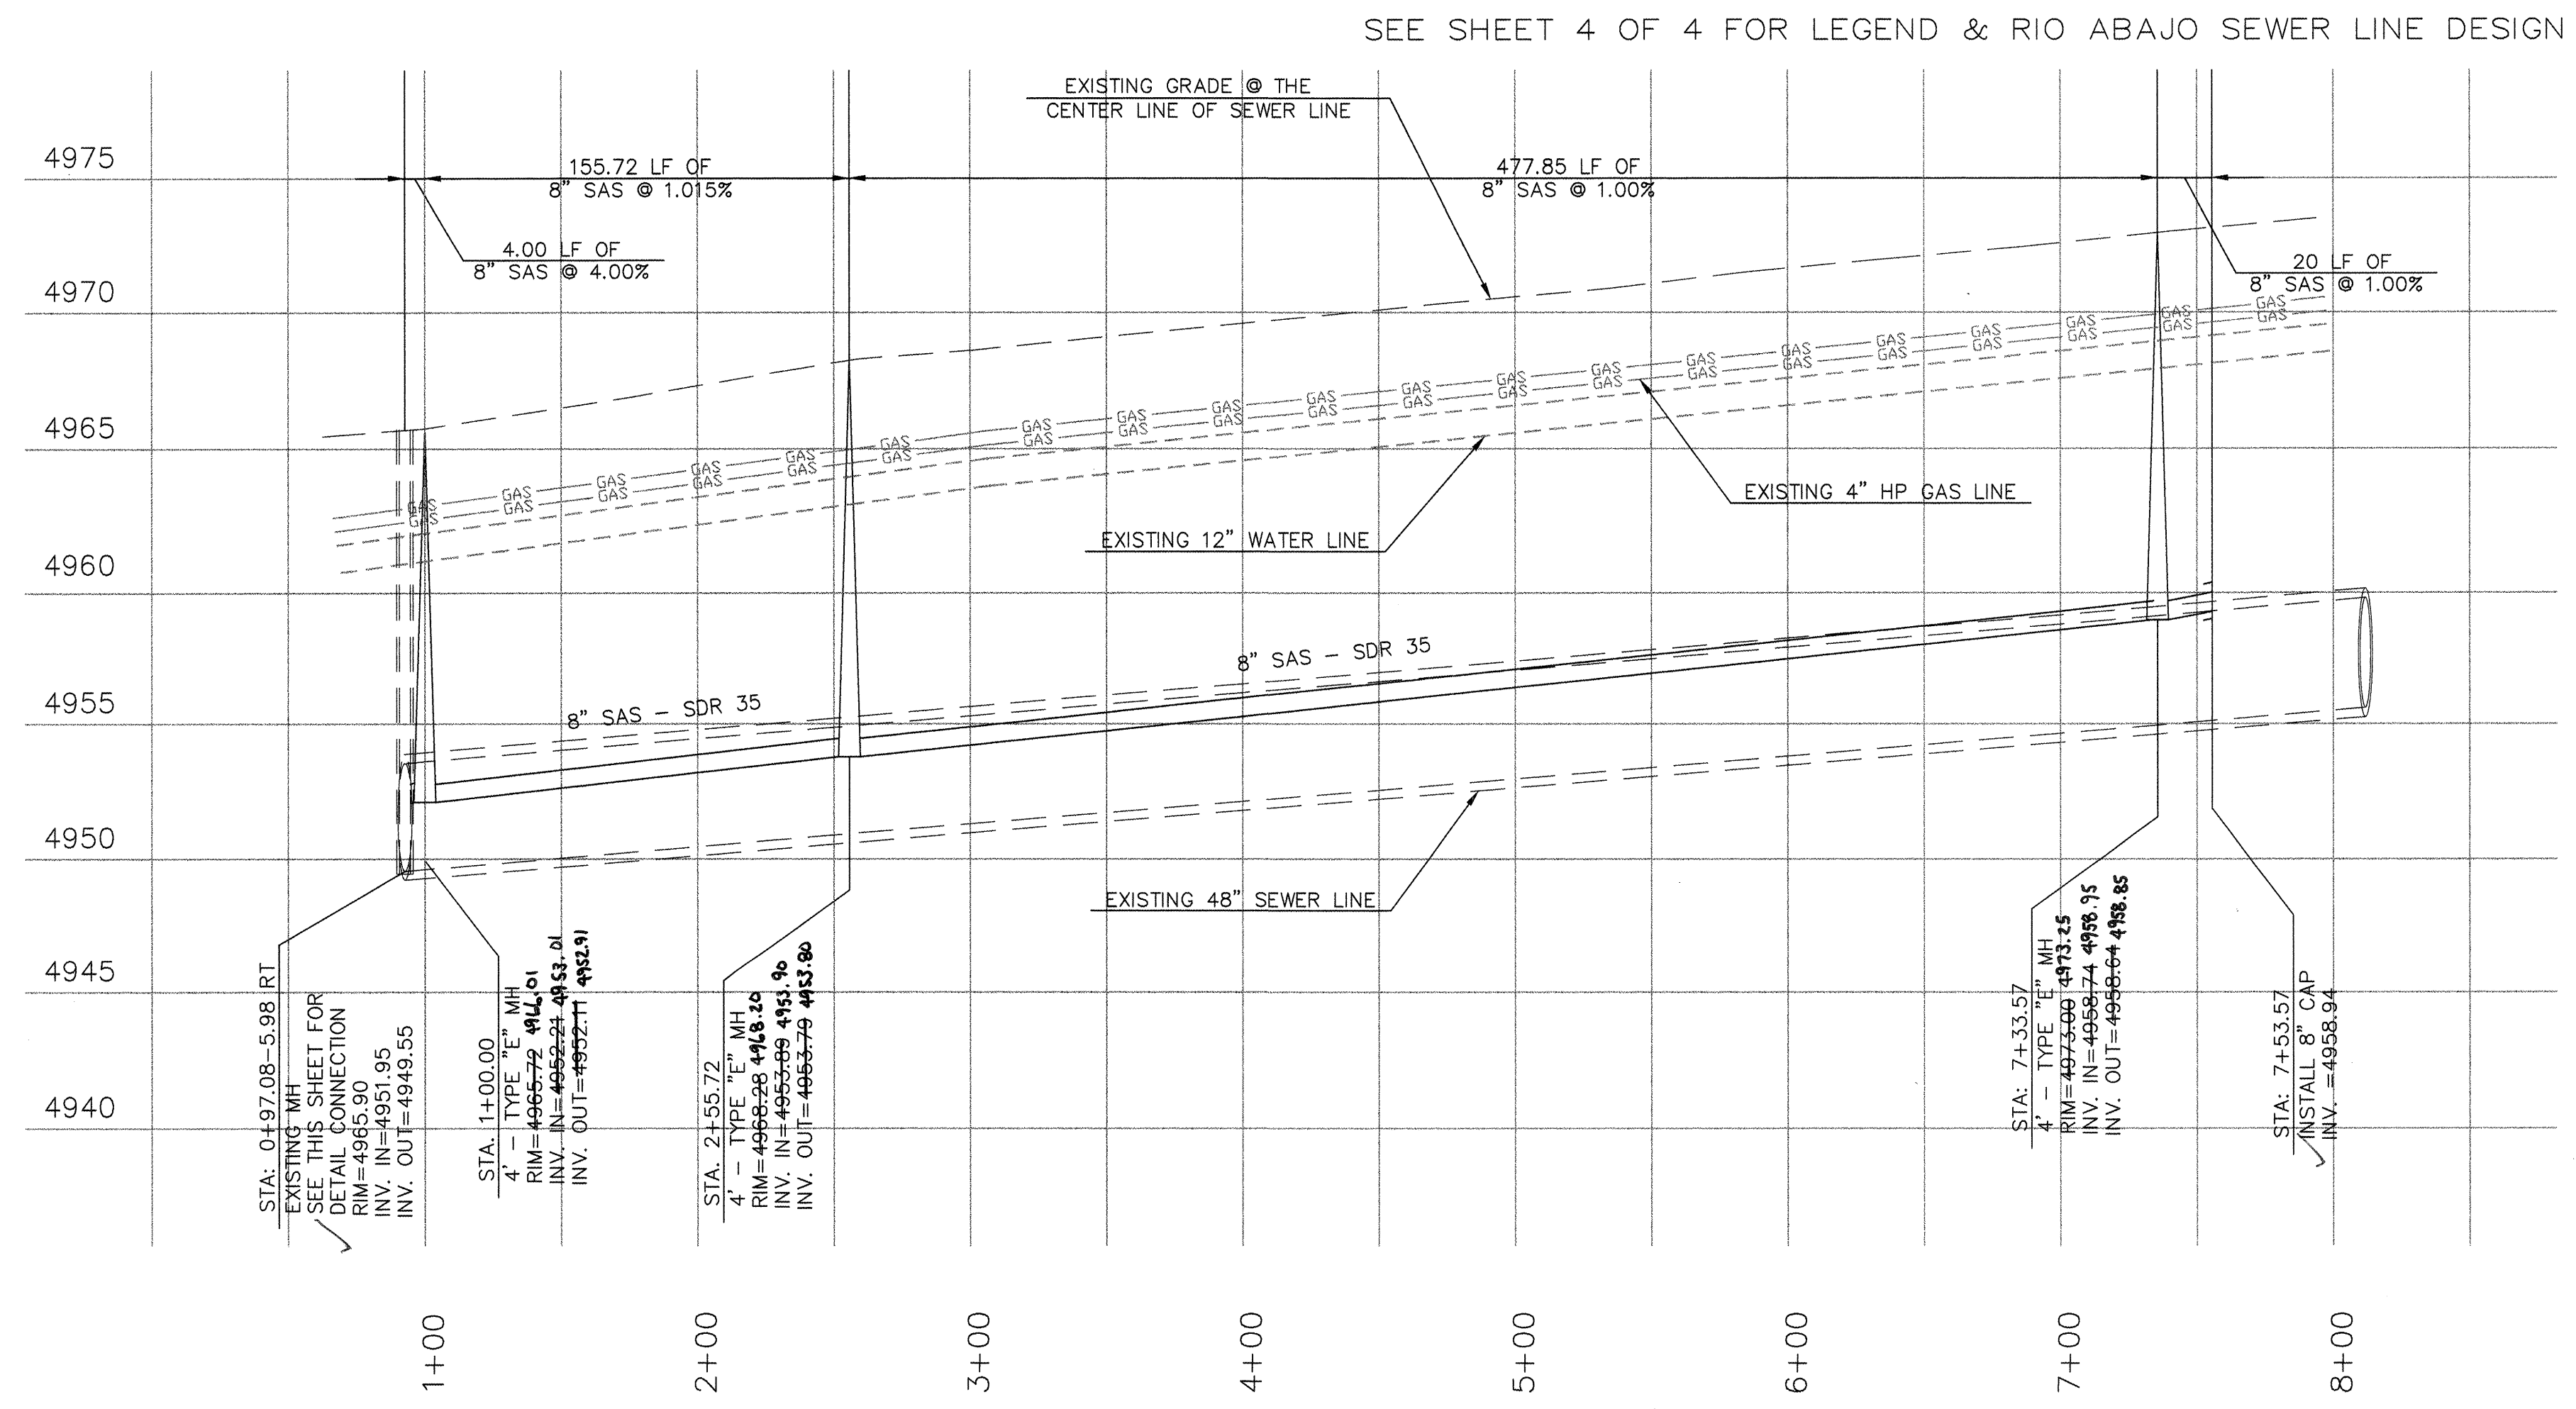

TYPICAL INVERTED SIPHON
NTS
(SEE SHEET 4 OF 4 FOR THE PLAN
VIEW DETAIL OF THE MH)

ENGINEER'S SEAL

ADVANCED
ENGINEERING
and CONSULTING, LLC

10205 SNOWFLAKE CT., NW
ALBUQUERQUE, NEW MEXICO 87114
(505) 899-5570

REVISIONS		REMARKS		DATE	
NO.	DATE	NO.	DATE	NO.	DATE

COUNTY OF BERNALILLO
PUBLIC WORKS DEPARTMENT
ENGINEERING GROUP

TITLE: **WILLIAM STREET SE
SEWER LINE EXTENSION**

DESIGN REVIEW COMMITTEE

APPROVED


APR 27 2001

CITY ENGINEER APPROVAL

APPROVED

APR 27 2001

COUNTY PROJECT NO. **TS00-0** CITY PROJECT NO. **659281** ZONE MAP NO. **Q-14** SHEET **3** OF **4**

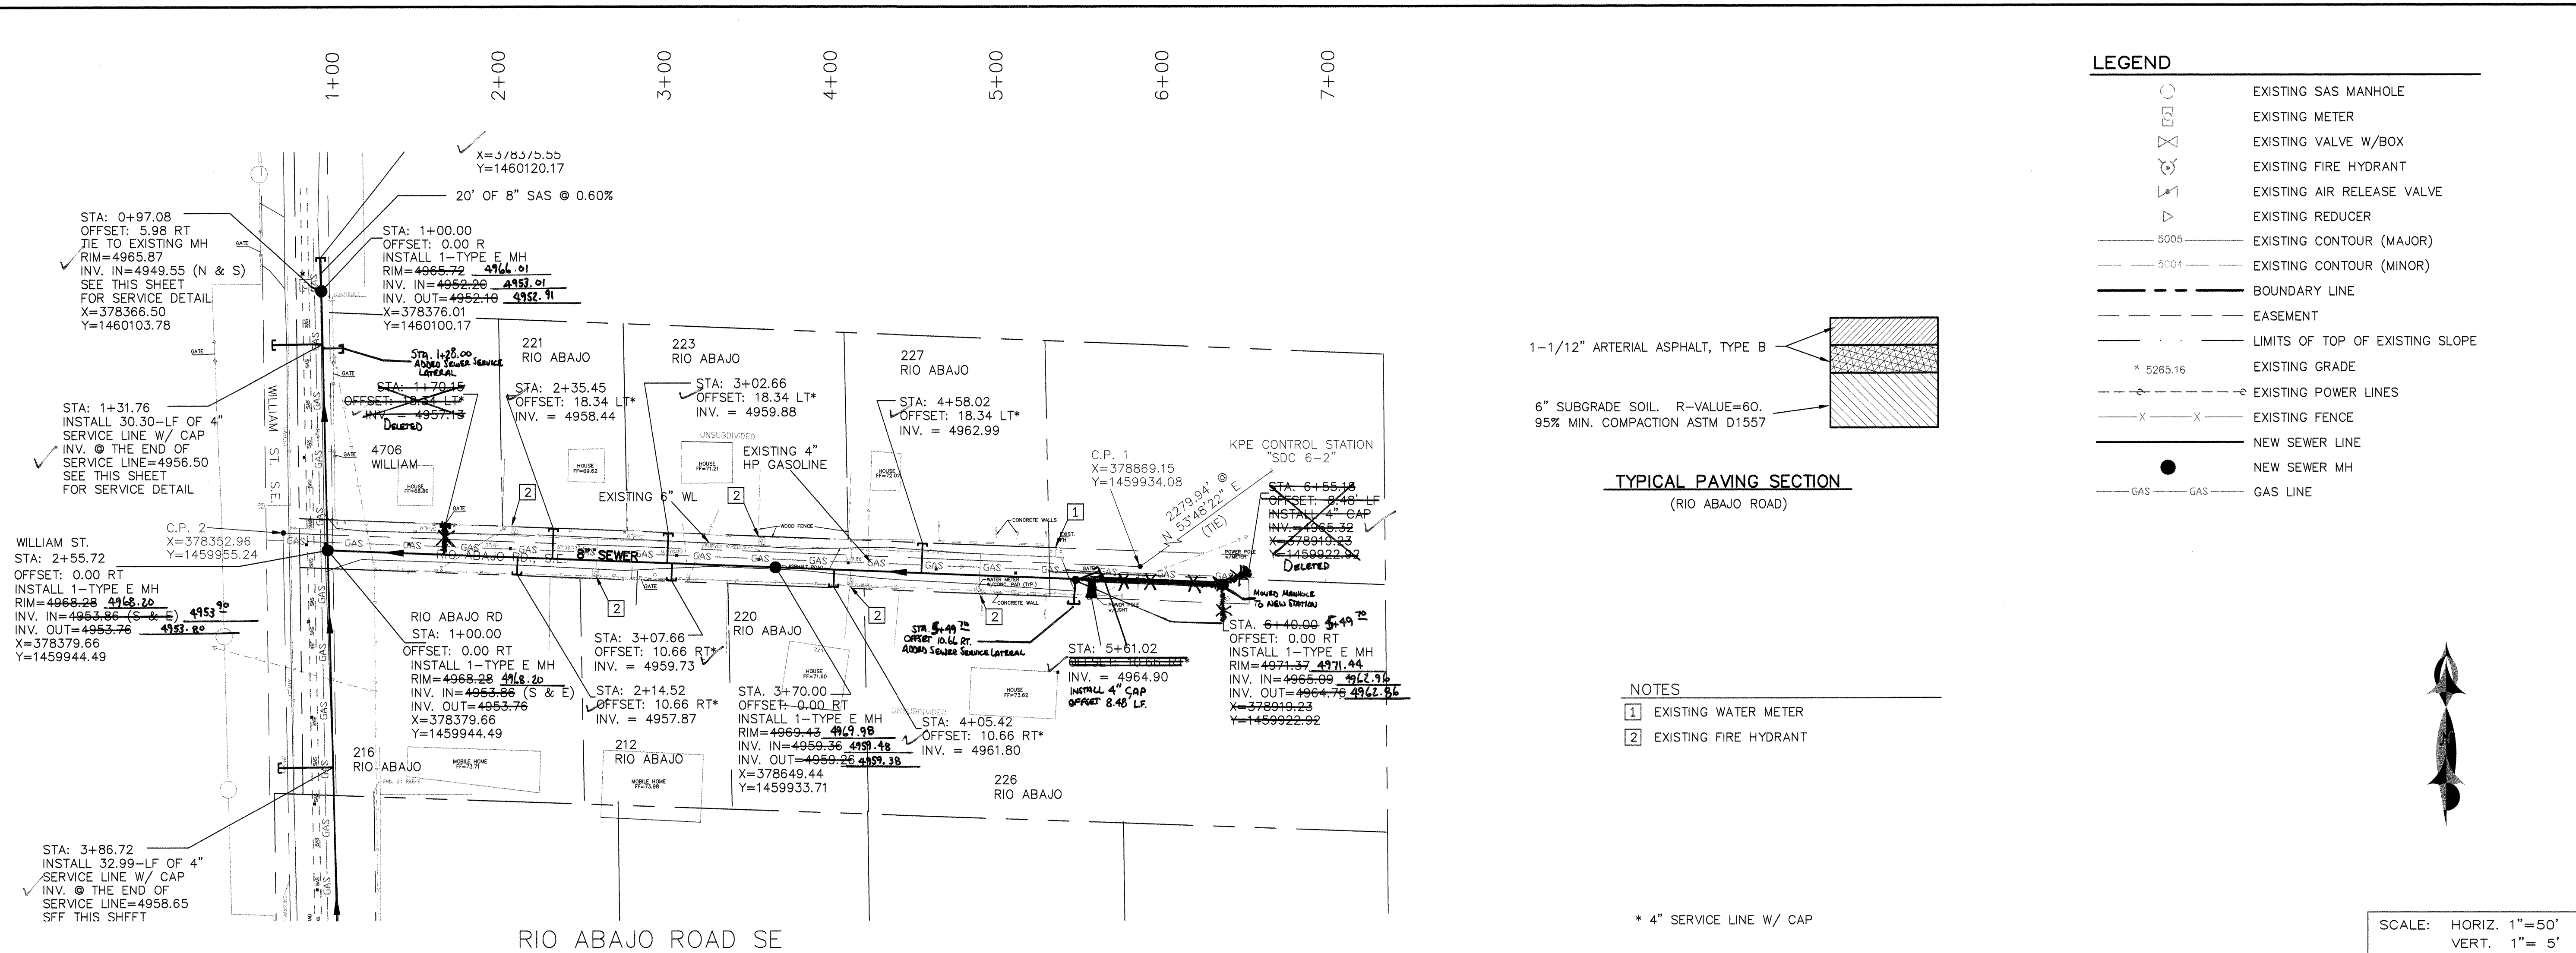

SURVEY INFORMATION		BENCH MARKS		AS BUILT INFORMATION	
FIELD NOTES				CONTRACTOR <i>Rest Pave, Inc.</i>	
NO.	BY	DATE		WORK ORDER BY <i>ADU Eng</i>	DATE <i>6/17/14</i>
			CENTRAL STATION DATA	INSPECTOR'S ACCEPTANCE BY	DATE
			NM STATE PLANE COORDINATES	FIELD VERIFICATION BY <i>Benjamin Cherry</i>	DATE
			Central Zone	DRAWINGS CORRECTED BY <i>ADU Eng</i>	DATE <i>7/14/14</i>
			X=380,619.43	<i>MICRO-FILM INFORMATION</i>	
			Y=1,459,906.02	RECORDED BY	DATE
			G-C=0.9996782		
			Dg = -00°13'43"	NO.	
			ELEV=4978.535		