

PLANS FOR CONSTRUCTION OF

BLUEWATER ROAD NW

ALBUQUERQUE, NEW MEXICO

APRIL, 2001

INDEX TO DRAWINGS

SHEET	TITLE
1.	TITLE SHEET
2.	PLAT
3.	PLAT
4.	BLUEWATER RD. PAVING & STORM DRAIN LAYOUT PLAN
5.	BLUEWATER RD. UTILITIES LAYOUT PLAN
6.	BLUEWATER RD. STREET PAVING PLAN & PROFILE
7.	BLUEWATER RD. WATER & SANITARY SEWER PLAN & PROFILE
8.	BLUEWATER RD. STORM DRAIN PLAN & PROFILE
9.	STREET PAVING DETAILS
10.	TRAFFIC CONTROL DETAILS
11.	TRAFFIC CONTROL DETAILS

FOR INFORMATION ONLY

APPROVAL OF RECORD DRAWINGS
CHIEF CONSTRUCTION ENGINEER
<i>Peter Chang</i>
DATE 8/25/04

1 2 3 4 5 6 7 8 9 10 11 12 13 14 15
26 663881 81 64

DRB- 98-50

BRASHER & LORENZ
CONSULTING ENGINEERS
2201 San Pedro NE Building 1 Suite 220
Albuquerque, New Mexico 87110
Ph: 505-888-6088 Fax: 505-888-6188

THESE DRAWINGS DO NOT INCLUDE NECESSARY
COMPONENTS FOR THE CONSTRUCTION SAFETY WHICH
SHALL REMAIN THE RESPONSIBILITY OF THE
CONTRACTOR.



VICINITY MAP: K-9









































































































SCALE: NTS

GENERAL NOTES:

- CITY OF ALBUQUERQUE SPECIFICATIONS FOR PUBLIC WORKS CONSTRUCTION, 1986 EDITION AS AMENDED THROUGH UPDATE 6, WILL BE REFERRED TO HEREIN AS THE "STANDARD SPECIFICATIONS." ALL WORK DETAILED ON THESE PLANS TO BE PERFORMED UNDER CONTRACT SHALL, EXCEPT AS OTHERWISE STATED OR PROVIDED FOR HEREON BE CONSTRUCTED IN ACCORDANCE WITH THE STANDARD SPECIFICATIONS
- THREE WORKING DAYS PRIOR TO ANY EXCAVATION, CONTRACTOR MUST CONTACT NEW MEXICO ONE CALL SYSTEM (260-1990) AND DETERMINE LOCATION OF EXISTING UTILITIES.
- PRIOR TO ANY CONSTRUCTION, THE CONTRACTOR SHALL EXCAVATE AND VERIFY THE HORIZONTAL AND VERTICAL LOCATIONS OF ALL OBSTRUCTIONS. SHOULD A CONFLICT EXIST, THE CONTRACTOR SHALL NOTIFY THE ENGINEER OR THE SURVEYOR SO THAT THE CONFLICT CAN BE RESOLVED WITHOUT DELAY.
- ALL EXISTING SIGNS, MARKERS, DELINEATORS, ETC., WITHIN THE CONSTRUCTION LIMITS SHALL BE REMOVED, STORED AND RE-SET BY THE CONTRACTOR.
- THE CONTRACTOR SHALL NOTIFY THE ENGINEER NOT LESS THAN SEVEN (7) WORKING DAYS PRIOR TO STARTING WORK IN ORDER THAT THE ENGINEER MAY TAKE NECESSARY MEASURES TO INSURE THE PRESERVATION OF SURVEY MONUMENTS. THE CONTRACTOR SHALL NOT DISTURB PERMANENT SURVEY MONUMENTS WITHOUT THE CONSENT OF THE ENGINEER AND BEAR THE EXPENSE OF REPLACING ANY THAT MAY BE DISTURBED WITHOUT PERMISSION. REPLACEMENT SHALL BE DONE ONLY BY THE CITY SURVEYOR. WHEN A CHANGE IS MADE IN THE FINISHED ELEVATIONS OF THE PAVEMENT OF ANY ROADWAY IN WHICH A PERMANENT SURVEY MARKER IS LOCATED, CONTRACTOR SHALL, AT HIS OWN EXPENSE, ADJUST THE MONUMENT COVER TO THE NEW GRADE UNLESS OTHERWISE SPECIFIED. REFER TO SECTION 4.4 OF THE GENERAL CONDITIONS OF THE STANDARD SPECIFICATIONS.
- FIVE (5) WORKING DAYS PRIOR TO BEGINNING CONSTRUCTION THE CONTRACTOR SHALL SUBMIT TO THE CONSTRUCTION COORDINATION DIVISION A DETAILED CONSTRUCTION SCHEDULE. TWO (2) WORKING DAYS PRIOR TO CONSTRUCTION THE CONTRACTOR SHALL OBTAIN A BARRICADING PERMIT FROM THE CONSTRUCTION COORDINATION DIVISION. CONTRACTOR SHALL NOTIFY BARRICADE ENGINEER (768-2551) PRIOR TO OCCUPYING AN INTERSECTION. REFER TO SECTION 19 OF THE STANDARD SPECIFICATIONS.
- ANY WORK OCCURRING WITHIN AN ARTERIAL ROADWAY REQUIRES 24 HOUR CONSTRUCTION.
- ALL UTILITIES AND UTILITY SERVICE LINES SHALL BE INSTALLED PRIOR TO PAVING.
- ALL STREET STRIPING ALTERED OR DESTROYED SHALL BE REPLACED BY THE CONTRACTOR WITH HOT THERMOPLASTIC REFLECTORIZED PAVEMENT MARKING. ALL NEW STRIPING SHALL BE HOT THERMOPLASTIC REFLECTORIZED PAVEMENT MARKING.
- THE CONTRACTOR SHALL ASSUME RESPONSIBILITY FOR ANY DAMAGE TO EXISTING PAVEMENTS, PAVEMENT MARKINGS, CURB AND GUTTER, DRIVEPADS, WHEELCHAIR RAMPS AND SIDEWALKS DURING CONSTRUCTION, APART FROM THOSE SECTIONS INDICATED FOR REMOVAL ON THE PLANS AND SHALL REPAIR OR REPLACE PER THE STANDARD SPECIFICATIONS AT HIS OWN EXPENSE.
- EXISTING UTILITY LINES AND PIPELINES SHOWN ON THESE DRAWINGS ARE SHOWN IN APPROXIMATE LOCATIONS ONLY. UTILITIES MAY EXIST WHERE NONE ARE SHOWN. THE ENGINEER HAS UNDERTAKEN NO FIELD VERIFICATION OF THE LOCATION, DEPTH, SIZE OR TYPE OF EXISTING UTILITY LINES AND PIPELINES. THE CONTRACTOR IS FULLY RESPONSIBLE FOR DAMAGE CAUSED BY FAILURE TO LOCATE AND PRESERVE EXISTING UTILITY LINES AND PIPELINES.
- THE CONTRACTOR SHALL SECURE A "TOPSOIL DISTURBANCE PERMIT" PRIOR TO BEGINNING CONSTRUCTION.
- THE CONTRACTOR SHALL ASSIST THE ENGINEER/INSPECTOR IN THE RECORDING OF DATA ON ALL UTILITY LINES AND ACCESSORIES AS REQUIRED BY THE OWNERS FOR THE PREPARATION OF "RECORD DRAWINGS." THE CONTRACTOR SHALL NOT COVER UTILITY LINES AND ACCESSORIES UNTIL ALL DATA HAS BEEN RECORDED.
- ALL CONSTRUCTION WITHIN CITY RIGHT-OF-WAY OR EASEMENTS MUST BE DONE FROM APPROVED WORK ORDER DOCUMENTS FROM THE CITY AND PREPARED BY BRASHER AND LORENZ, INC.
- THE CONTRACTOR SHALL DETERMINE IN ADVANCE OF HIS CONSTRUCTION IF OVERHEAD UTILITY LINES, SUPPORT STRUCTURES, POLES, GUYS, ETC. ARE AN OBSTRUCTION TO CONSTRUCTION OPERATIONS. IF ANY OBSTRUCTION TO CONSTRUCTION OPERATIONS IS EVIDENT, THE CONTRACTOR SHALL BE RESPONSIBLE FOR COORDINATING WITH THE APPROPRIATE UTILITY OWNER TO REMOVE OR SUPPORT THE UTILITY OBSTRUCTION. ANY COST ASSOCIATED WITH THIS EFFORT SHALL BE THE RESPONSIBILITY OF THE CONTRACTOR.
- THE CONTRACTOR IS TO SUPPORT AND MAINTAIN THE INTEGRITY OF ALL UNDERGROUND TELEPHONE, ELECTRIC CABLES AND CABLE TELEVISION UTILITIES AT NO ADDITIONAL COST THE OWNER. CABLE IS TO BE SUPPORTED EVERY 15 FEET (MINIMUM). CONTRACTOR SHALL COORDINATE WITH AND MAKE NECESSARY PAYMENT (IF ANY) TO UTILITY OWNER FOR DE-ENERGIZATION OF CABLES OR SUPPORT OF CABLES BY THE UTILITY OWNER.
- FOR STORM DRAIN CONSTRUCTION, RCP PIPE JOINTS SHALL NOT BE GROUTED PRIOR TO FINAL INSPECTION. FINAL INSPECTION WILL DETERMINE JOINTS TO BE GROUTED FOR FINAL ACCEPTANCE OF THE CONSTRUCTION.



5-3-01

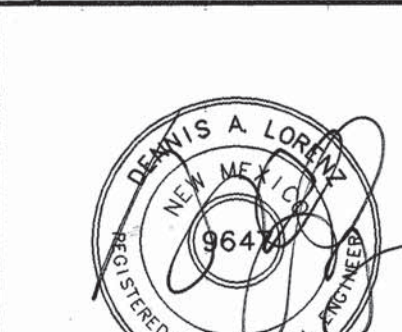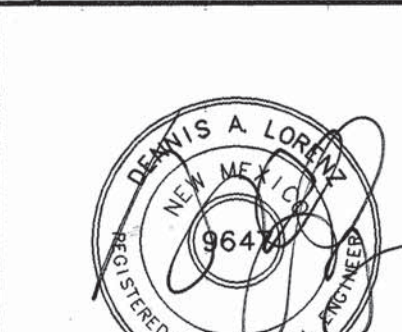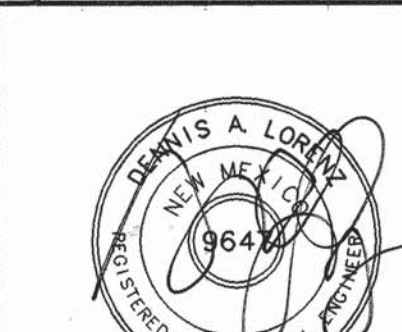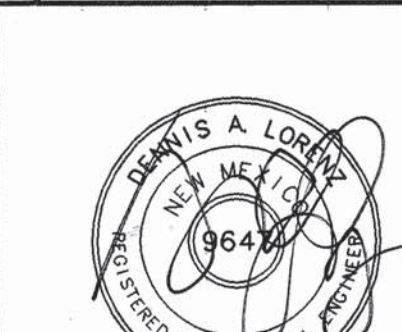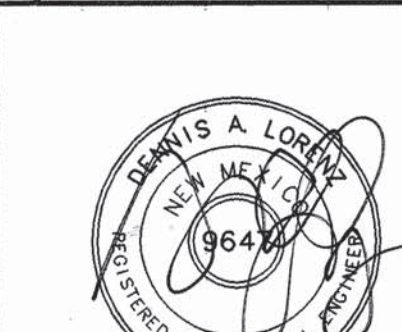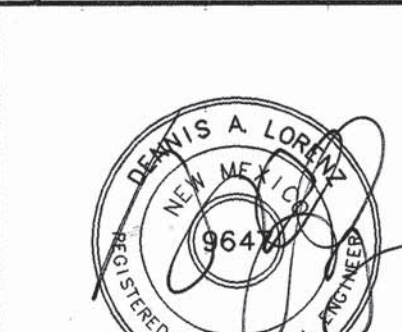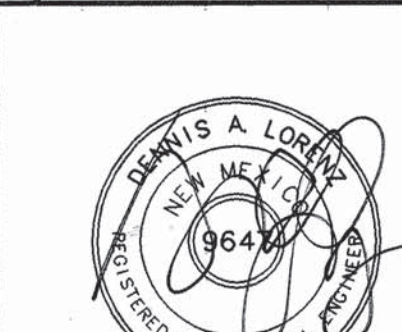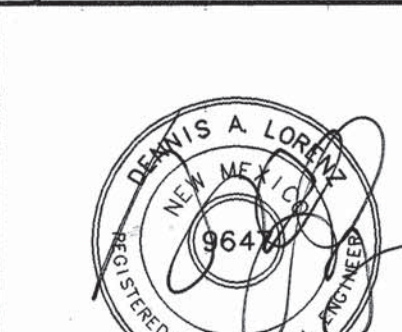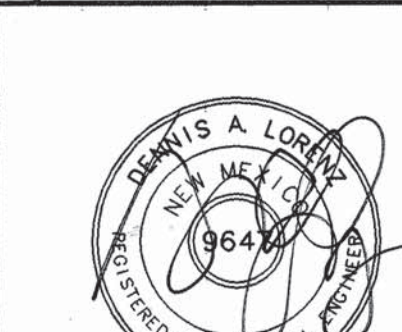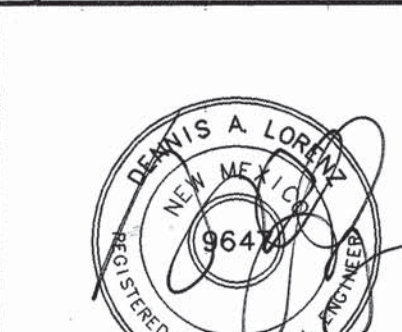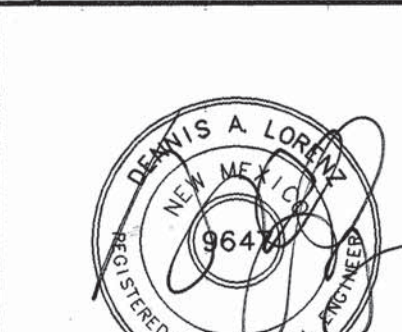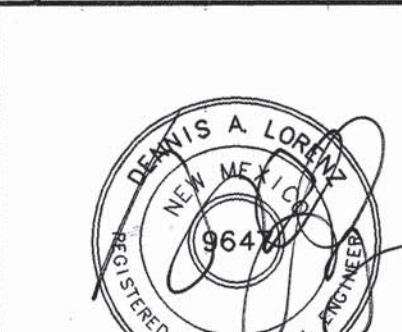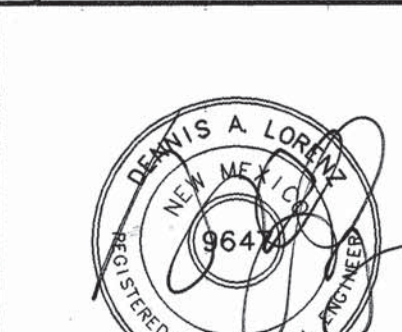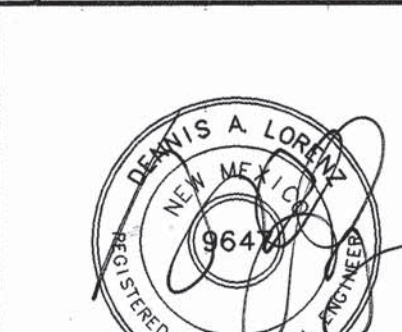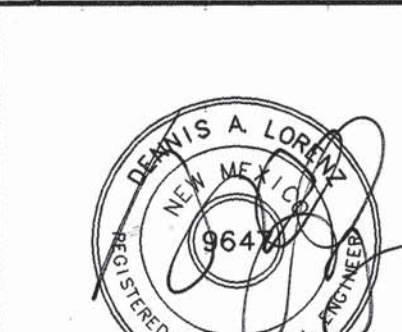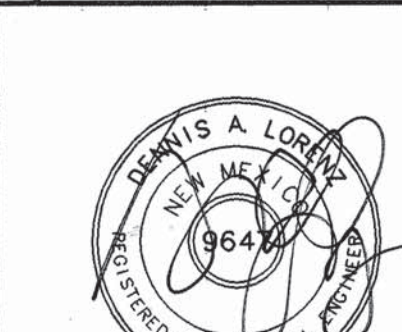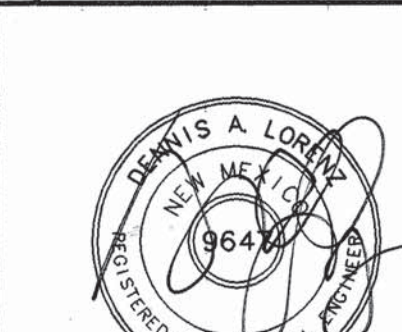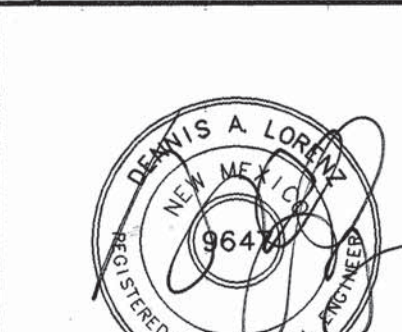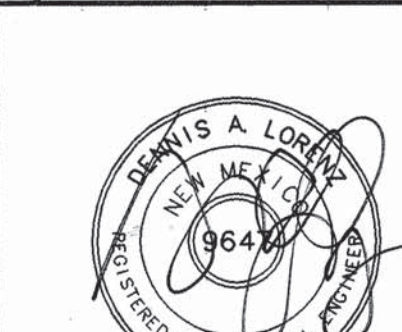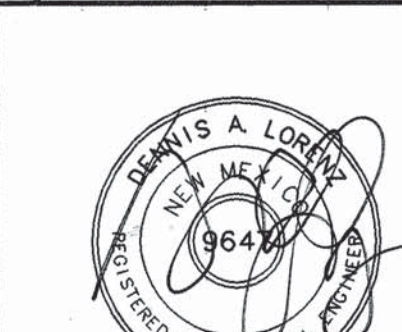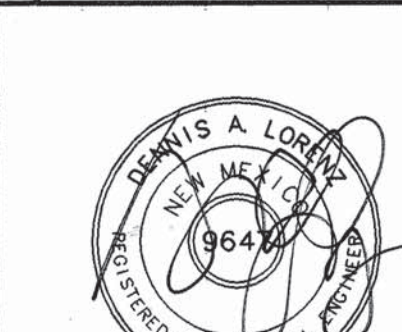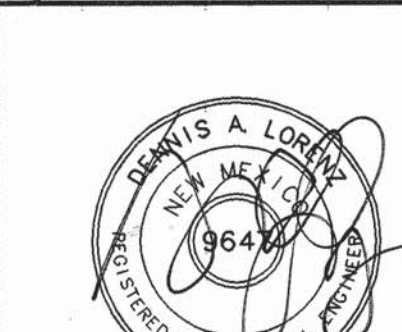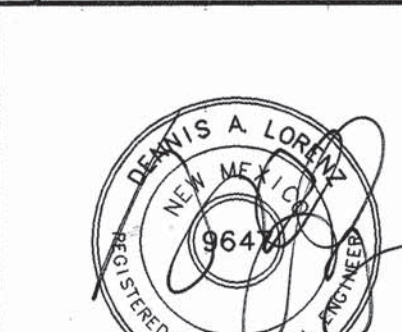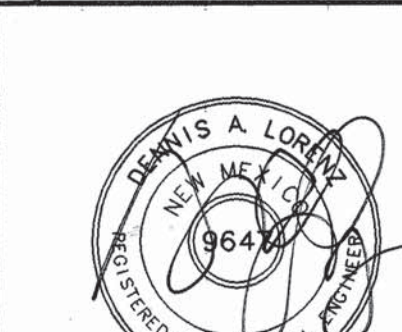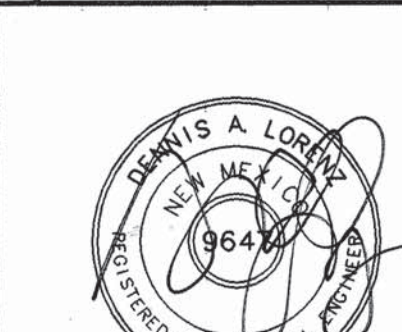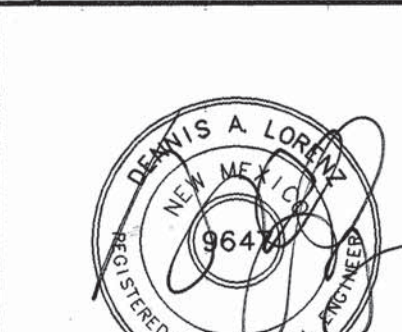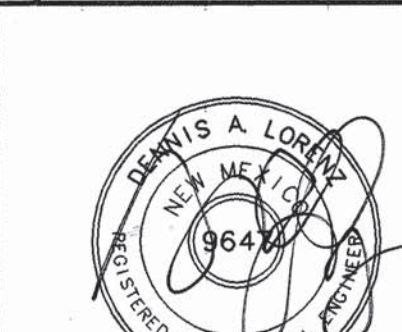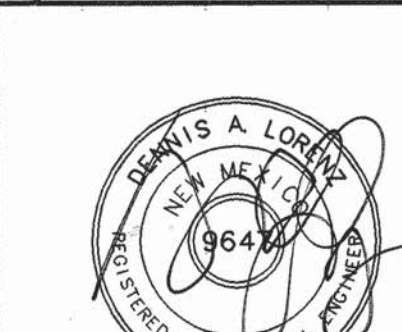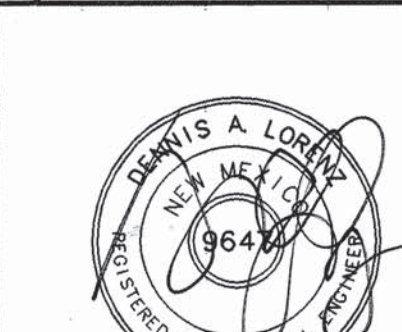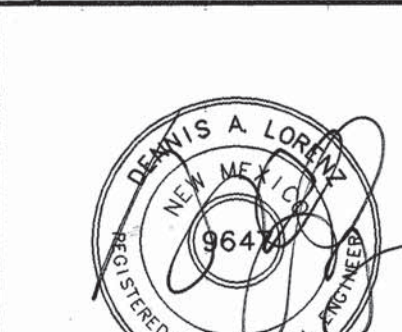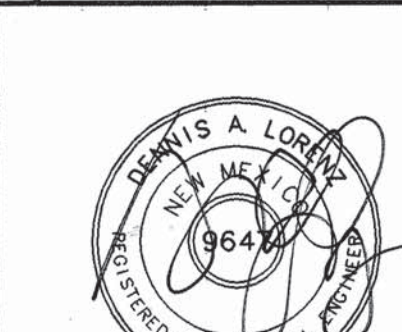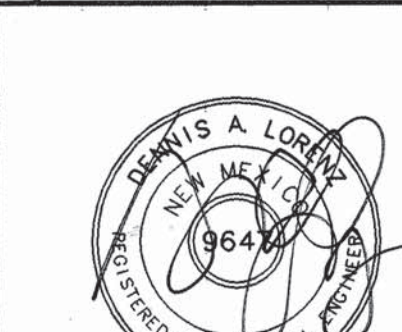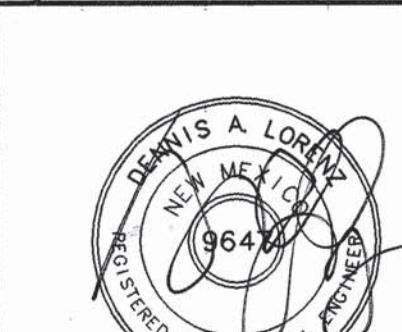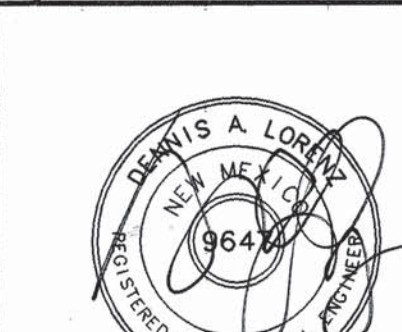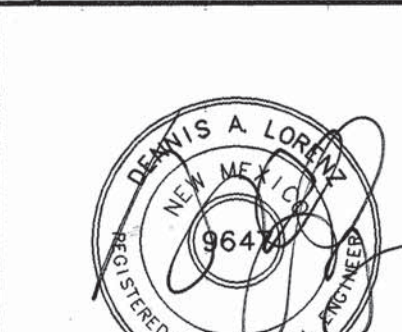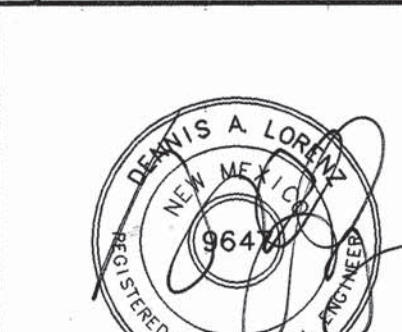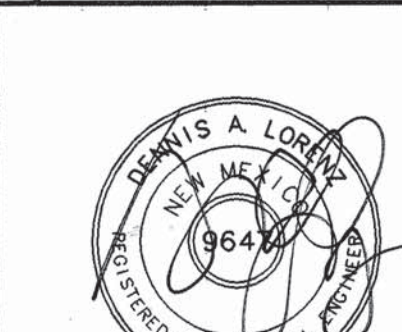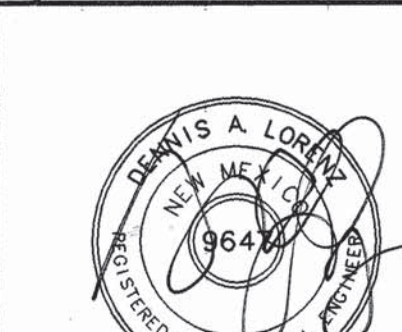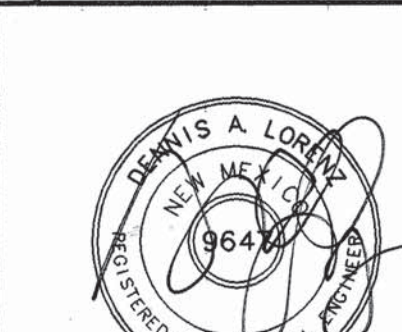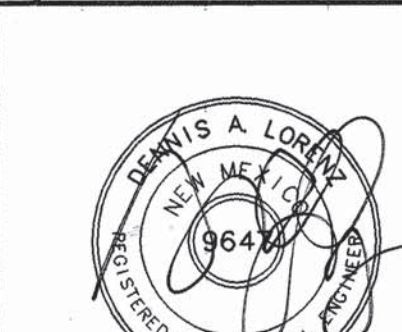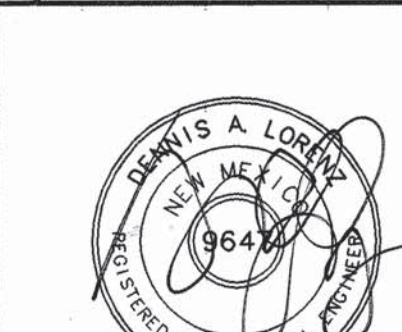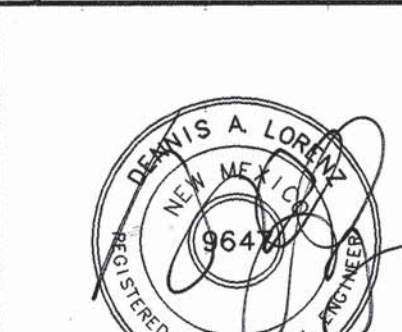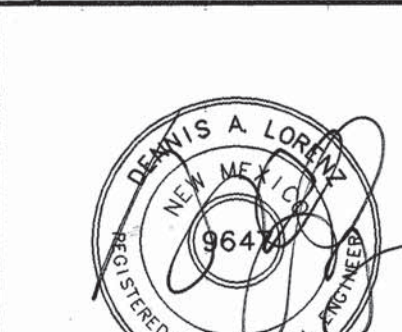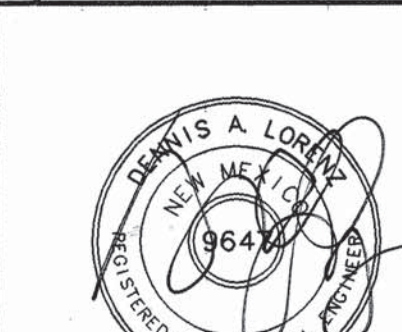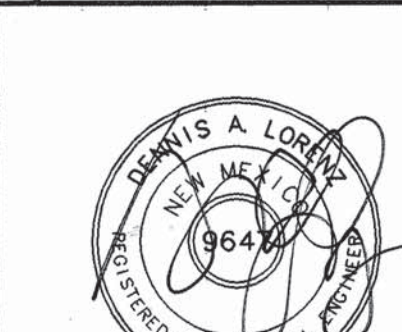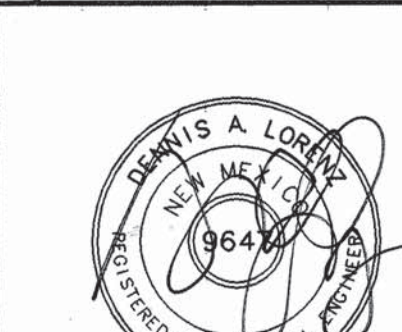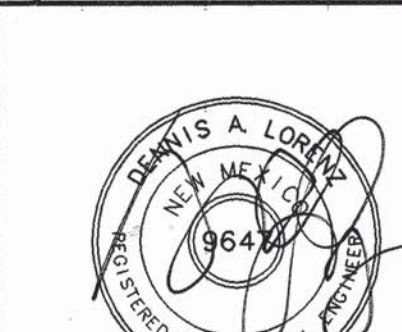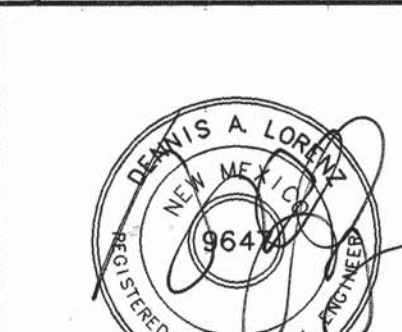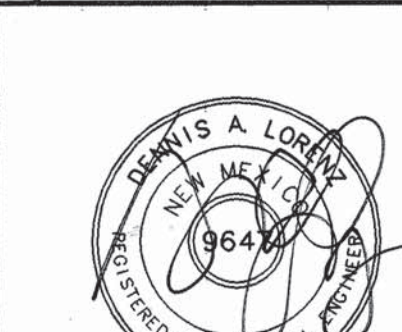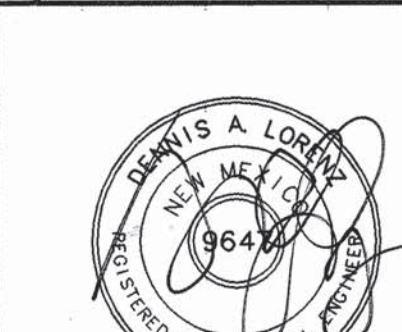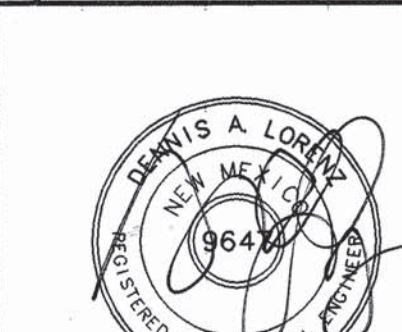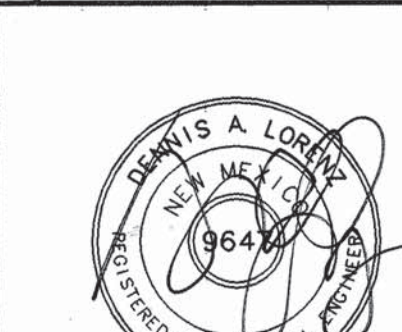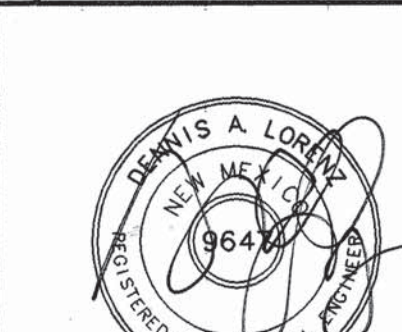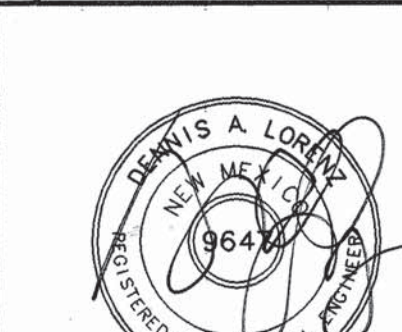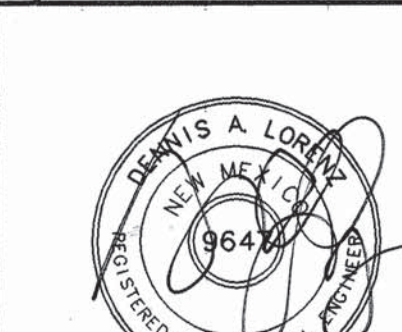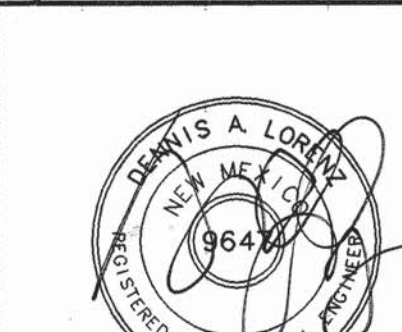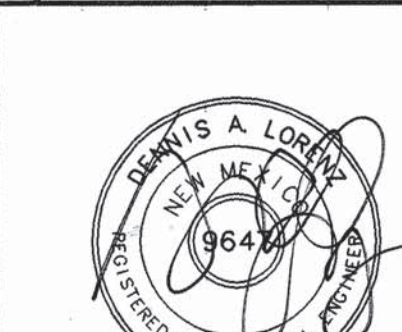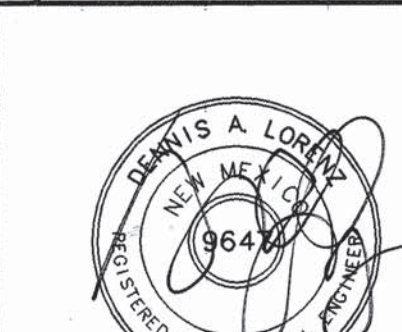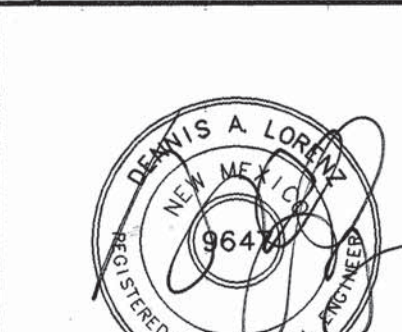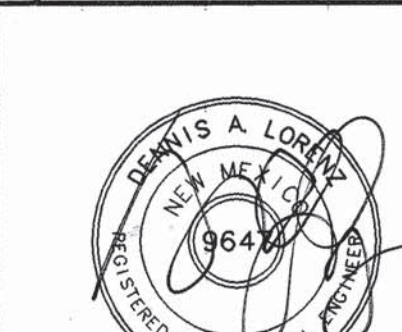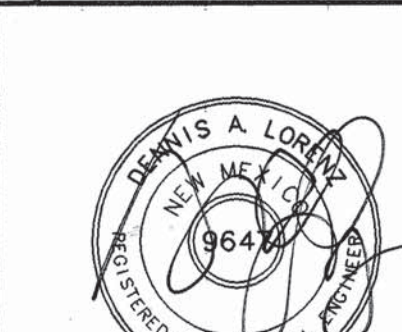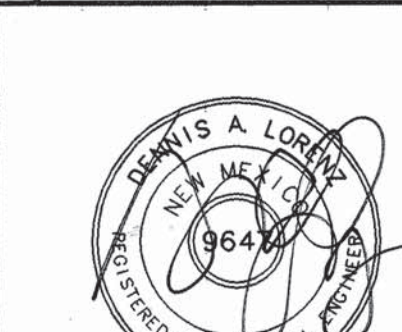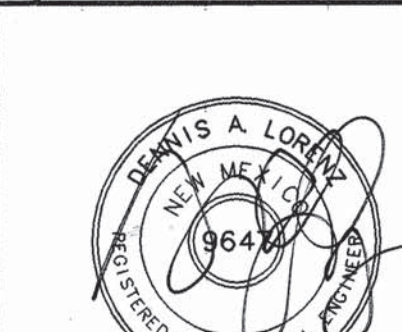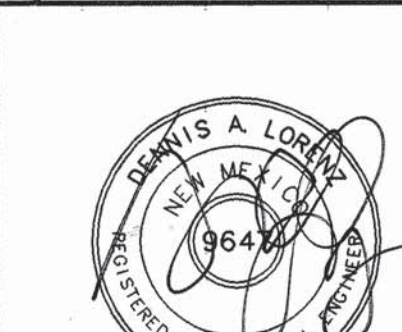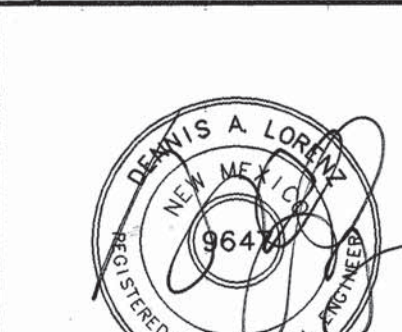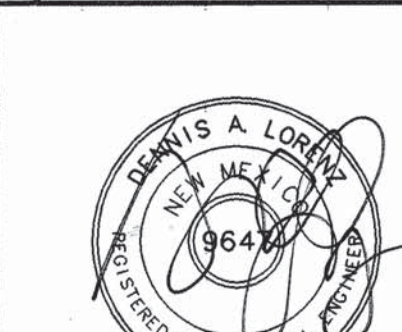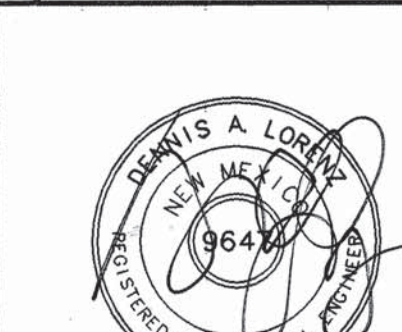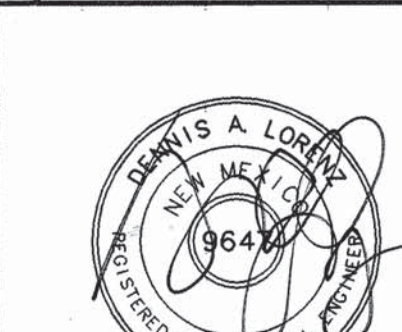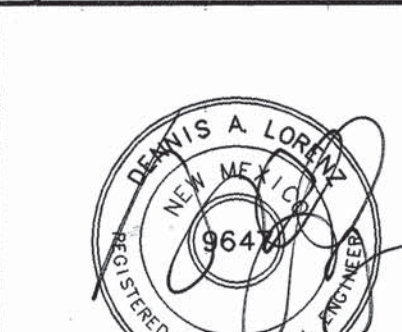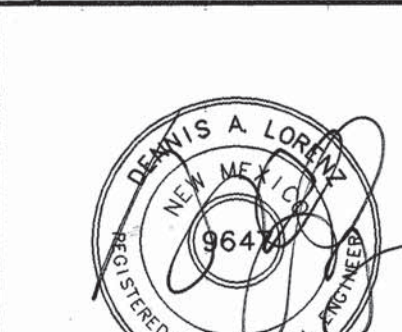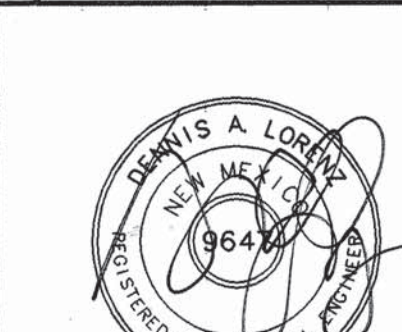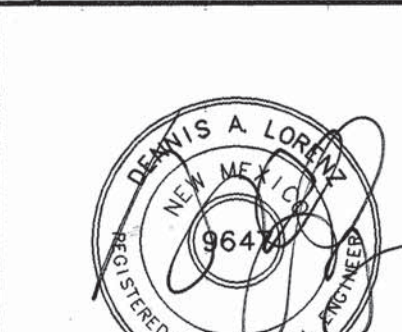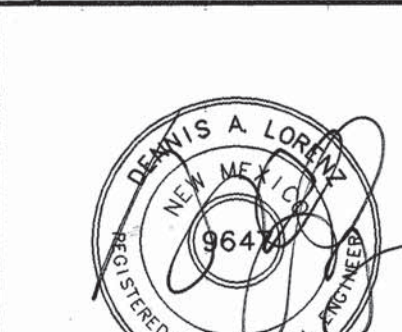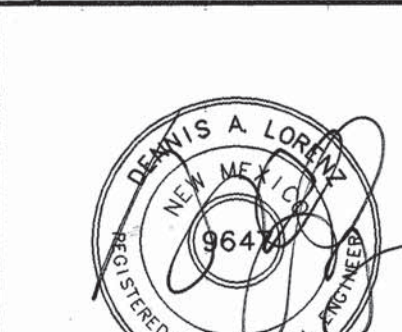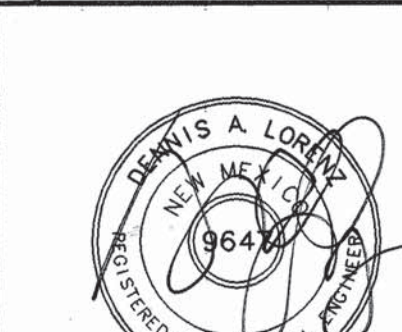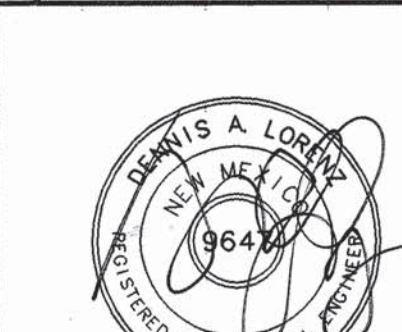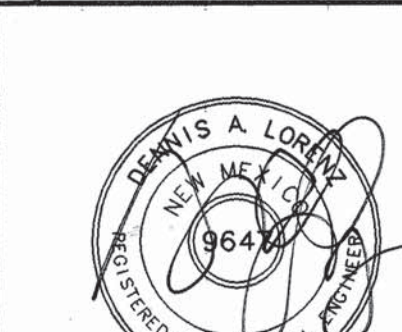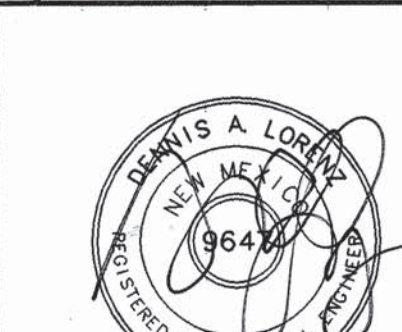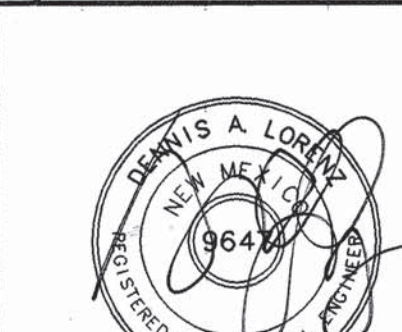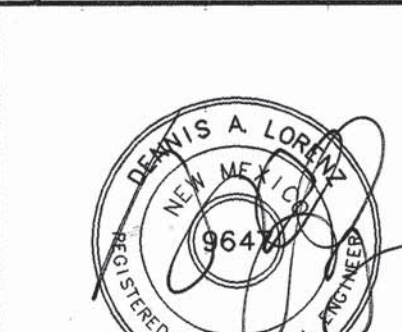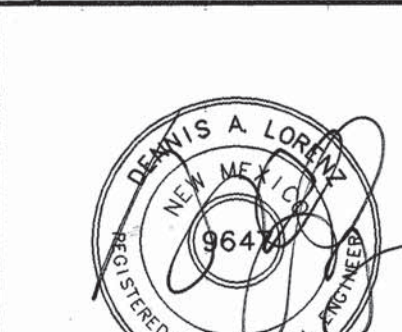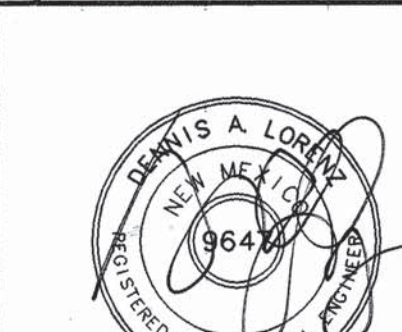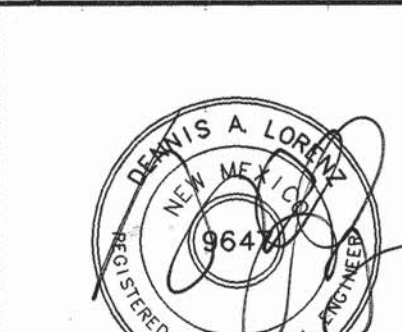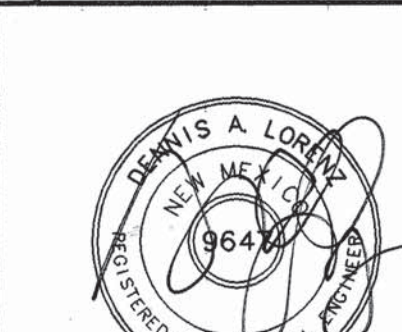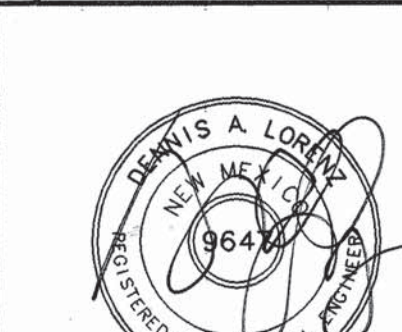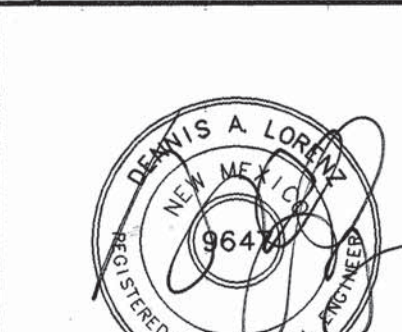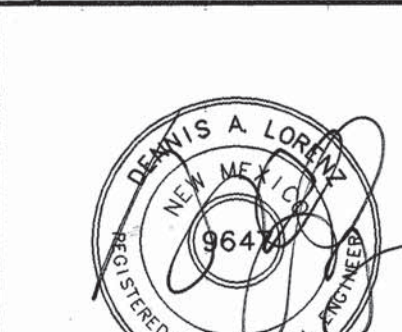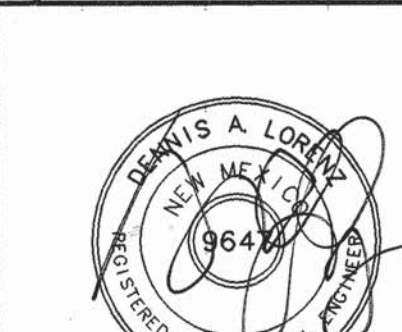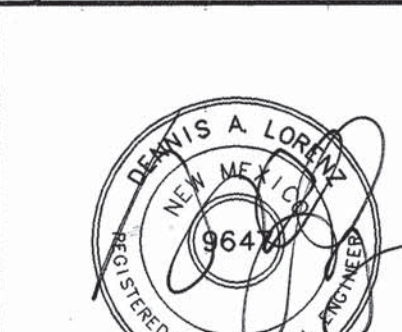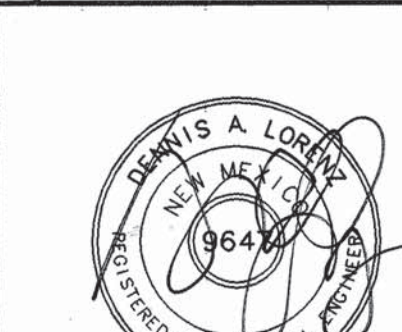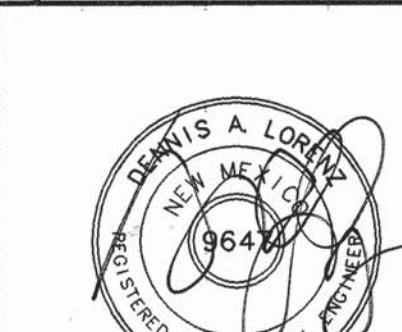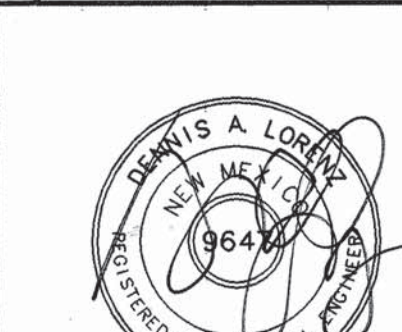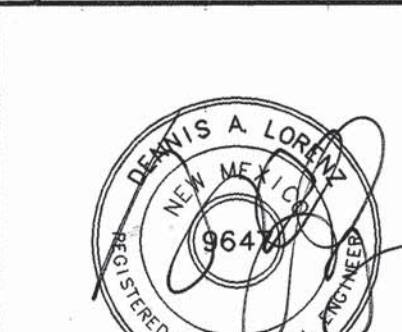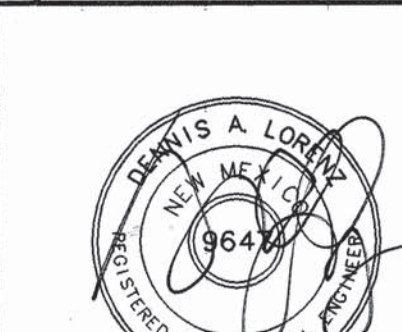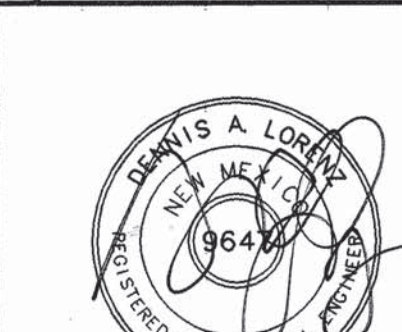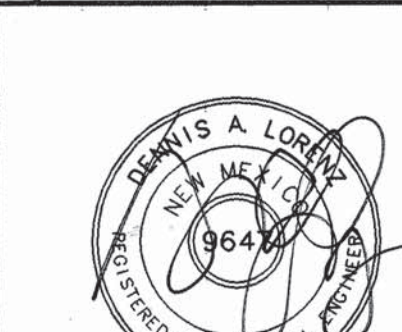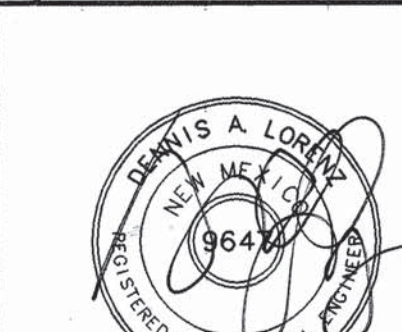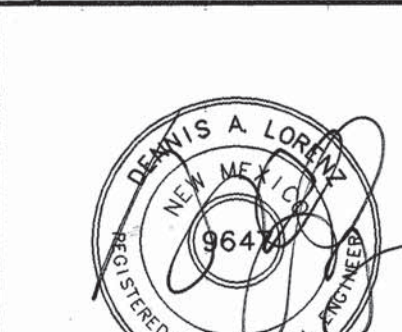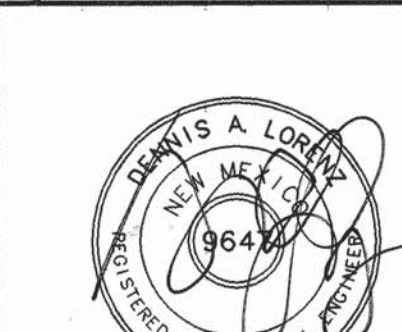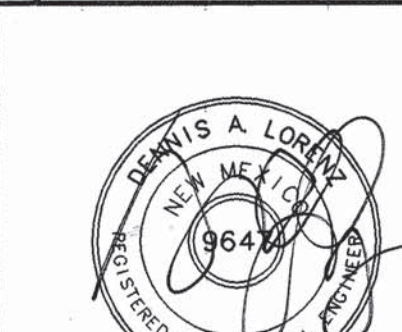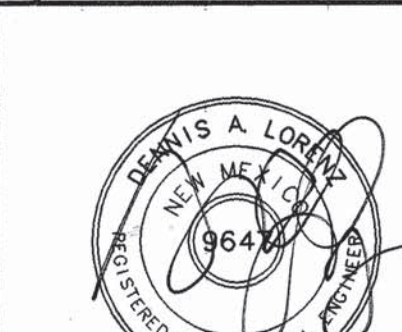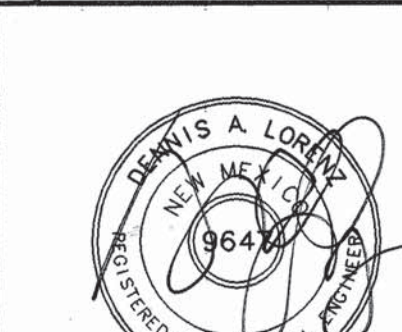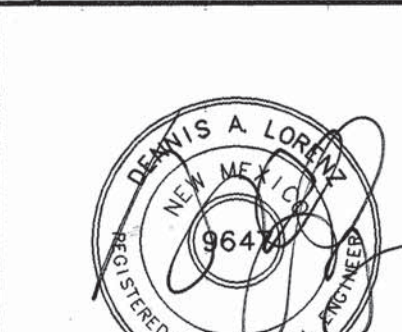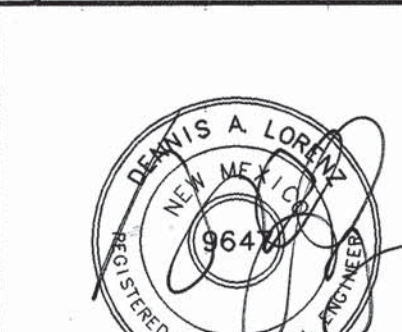

PLAT OF
AVALON SUBDIVISION
UNIT 2

ALBUQUERQUE, BERNALILLO COUNTY, NEW MEXICO
JANUARY 1999

CURVE TABLE

BEING THAT CERTAIN PARCEL OF LAND SITUATED WITHIN THE TOWN OF AYRISO GRANT, WITHIN SECTION 21 (AS PROJECTED), TOWNSHIP 10 NORTH, RANGE 2 EAST, NEW MEXICO PRINCIPAL MERIDIAN, CITY OF ALBUQUERQUE, BERNALILLO COUNTY, NEW MEXICO, BEING IDENTIFIED AS TRACT B-1A, AVALON SUBDIVISION, UNIT 2, FILED IN THE OFFICE OF THE COUNTY CLERK, BERNALILLO COUNTY, NEW MEXICO, ON JUNE 3, 1999, IN VOLUME 99C, FOLIO 134, AND BEING MORE PARTICULARLY DESCRIBED AS FOLLOWS)

BEGINNING AT THE NORTHEAST CORNER OF THE PLOT OF LAND HEREIN DESCRIBED BEING IN THE INTERSECTION OF THE SOUTHERLY RIGHT-OF-WAY LINE OF "E" AVE. (EATER ROAD) AND THE SOUTHERLY RIGHT-OF-WAY LINE OF "F" AVE. (EATER ROAD), THE FIRST BEARING TO THE POINT OF THE A.C.S. CONTROL STATION, 10°-40' BEARS N 60° 15' 30" E, 338.93 FEET DISTANCE; THENCE SOUTHERLY, 36.20 FEET DISTANCE ALONG THE ARC OF A CURVE BEARING TO THE POINT (SAID POINT BEING THE POINT OF TANGENCY), A CENTRAL ANGLE OF 83°01'48" AND A CHORD HAVING A RADIUS OF 684.00 FEET, TO THE POINT OF REVERSE CURVATURE, THENCE SOUTHERLY, 87.51 FEET DISTANCE ALONG THE ARC OF A CURVE BEARING TO THE LEFT (SAID ARC HAVING A RADIUS OF 684.00 FEET), A CENTRAL ANGLE OF 07°19'48" AND A CHORD HAVING A RADIUS OF 684.00 FEET, 87.45 FEET DISTANCE TO THE POINT OF TANGENCY, THENCE S 14°38'50" E, 487.75 FEET DISTANCE TO THE POINT OF CURVATURE, THENCE

SOUTHWESTERLY, 39.27 FEET DISTANCE ALONG THE ARC OF A CURVE BEARING TO THE RIGHT (SAY
ARC HAVING A RADIUS OF 25.00 FEET, A CENTRAL ANGLE OF 30°00'00" AND A CHORD WHICH
BEARS S 30°01'40" W, 35.36 FEET DISTANCE TO A POINT) THENCE,
S 19°15'06" E, 58.18 FEET DISTANCE TO A POINT (ON CURVE) THENCE,

SOUTHEASTERLY, 34.91 FEET DISTANCE ALONG THE ARC OF A CURVE BEARING TO THE RIGHT (SAID ARC HAVING A RADIUS OF 25.00 FEET, A CENTRAL ANGLE OF 80°00'00" AND A CHORD WHICH BEARS S 54°58'20" E, 32.14 FEET DISTANCE) TO THE POINT OF TANGENCY; THENCE,

S 14°58'20" E, 55.14 FEET DISTANCE TO THE POINT OF CURVATURE), THENCE, SOUTHEASTERLY, 164.49 FEET DISTANCE ALONG THE ARC OF A CURVE BEARING TO THE RIGHT (SAID ARC HAVING A RADIUS OF 616.00 FEET, A CENTRAL ANGLE OF 15°18'00" AND A CHORD WHICH BEARS S 07°19'20" E, 164.01 FEET DISTANCE TO THE POINT OF TANGENCY), THENCE, S 00°19'40" W, 99.07 FEET DISTANCE TO THE SOUTHEAST CORNER OF THE PARCEL OF LAND HEREIN DESCRIBED, THENCE,

N 89°40'20" V, 32.28 FEET DISTANCE TO A POINT) THENCE,
S 0°19'40" V, 23.38 FEET DISTANCE TO A POINT AT THE INTERSECTION OF THE WESTERLY
RIGHT-OF-WAY LINE OF 90TH STREET AND THE SOUTHERLY LINE OF VACATED AVALIN ROAD NW
(VACATION V-98-57) THENCE,

N 89°40'20" V, 1,320.00 FEET DISTANCE TO THE SOUTHWEST CORNER OF THE PARCEL OF LAND HEREIN DESCRIBED BEING A POINT AT THE INTERSECTION OF THE SOUTHERLY LINE OF VACATED AVALON ROAD NW (VACATION V-98-57) AND THE EASTERLY TERMINUS OF EXISTING 60' AVALON ROAD NW (RIGHT-OF-WAY); THENCE,
N 00°19'40" E, 23.38 FEET DISTANCE TO A POINT; THENCE,

S 89° 40' 20" E, 313.96 FEET DISTANCE TO A POINT AT THE INTERSECTION OF THE NORTHERLY LINE OF VACATED ARLING ROAD NW (VACATION V-98-57) AND THE WESTERLY LINE OF VACATED 94TH STREET NW (VACATION V-98-57); THENCE,

NORTHEASTERLY, 889.97 FEET DISTANCE ALONG THE ARC OF A CURVE BEARING TO THE RIGHT (SAID ARC HAVING A RADIUS OF 1,290.17 FEET, A CENTRAL ANGLE OF $39^{\circ}31'24''$ AND A CHORD WHICH BEARS N $70^{\circ}33'58''$ E, 872.43 FEET DISTANCE) TO THE POINT OF TANGENCY) THENCE,

S 89° 40' 20" E, 180.85 FEET DISTANCE TO THE POINT OF CURVATURE), THENCE, NORTHEASTERLY, 11.92 FEET DISTANCE ALONG THE ARC OF A CURVE BEARING TO THE LEFT (SAID ARC HAVING A RADIUS OF 684.00 FEET, A CENTRAL ANGLE OF 00° 59' 55" AND A CHORD WHICH BEARS N 89° 42' E, 11.92 FEET DISTANCE) TO THE NORTHEAST CORNER AND A POINT BEING THE BEGINNING OF THE PARCEL OF LAND HEREIN DESCRIBED AND CONTAINING 1,039,947 SQUARE FEET (C.E. 8739 ACRES), MORE OR LESS.

CURVE TABLE

[illegible]

LINE TABLE

LINE	AS-BUILD	AS-BUILD
LINE	1/15/15	5/1/18
1	5	5
2	10	10
3	15	15
100	500	500

LOT AREAS-BLOCK G

LOT NO.	LOT AREA (ACRES)
1	4.80
2	5.68
3	5.20
4	5.20
5	5.20
6	5.20
7	5.20
8	5.20
9	5.19
10	5.19
11	5.19
12	5.20
13	5.20
14	5.20
15	5.20
16	5.20
17	5.20
18	5.68
19	5.68
20	5.68
21	5.68
22	5.68
23	4.11
24	4.11
51	5.27

LOT AREAS-BLOCK H



LOT NO.	LOT AREA (ACR.)
1	25.72
2	27.49
3	26.18
4	24.14
5	46.08
6	46.08
7	35.82
8	24.69
9	24.69
10	33.38
11	33.38
12	54.94
13	48.89
14	48.89
15	47.51
16	46.75
17	46.75
18	45.38
19	46.60
20	46.60
21	53.82
22	53.82
23	81.32
24	81.32
25	50.20
26	50.20
LOT AREAS-BLOCK F

LOT NO.	LOT AREA (sq.ft.)
1	6681
2	5474
3	5430
4	5430
5	5430
6	5430
7	5430
8	5399
9	5228
10	5407
11	8632
12	5619
13	5433
14	5460
15	5460
16	5460
17	5460
18	5460
19	5971
20	5737
21	7361

SCANNED BY
MESA REPRO

UNPLATTED LANDS WITHIN
TOWN OF ATRISCO GRANT

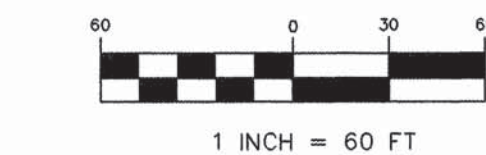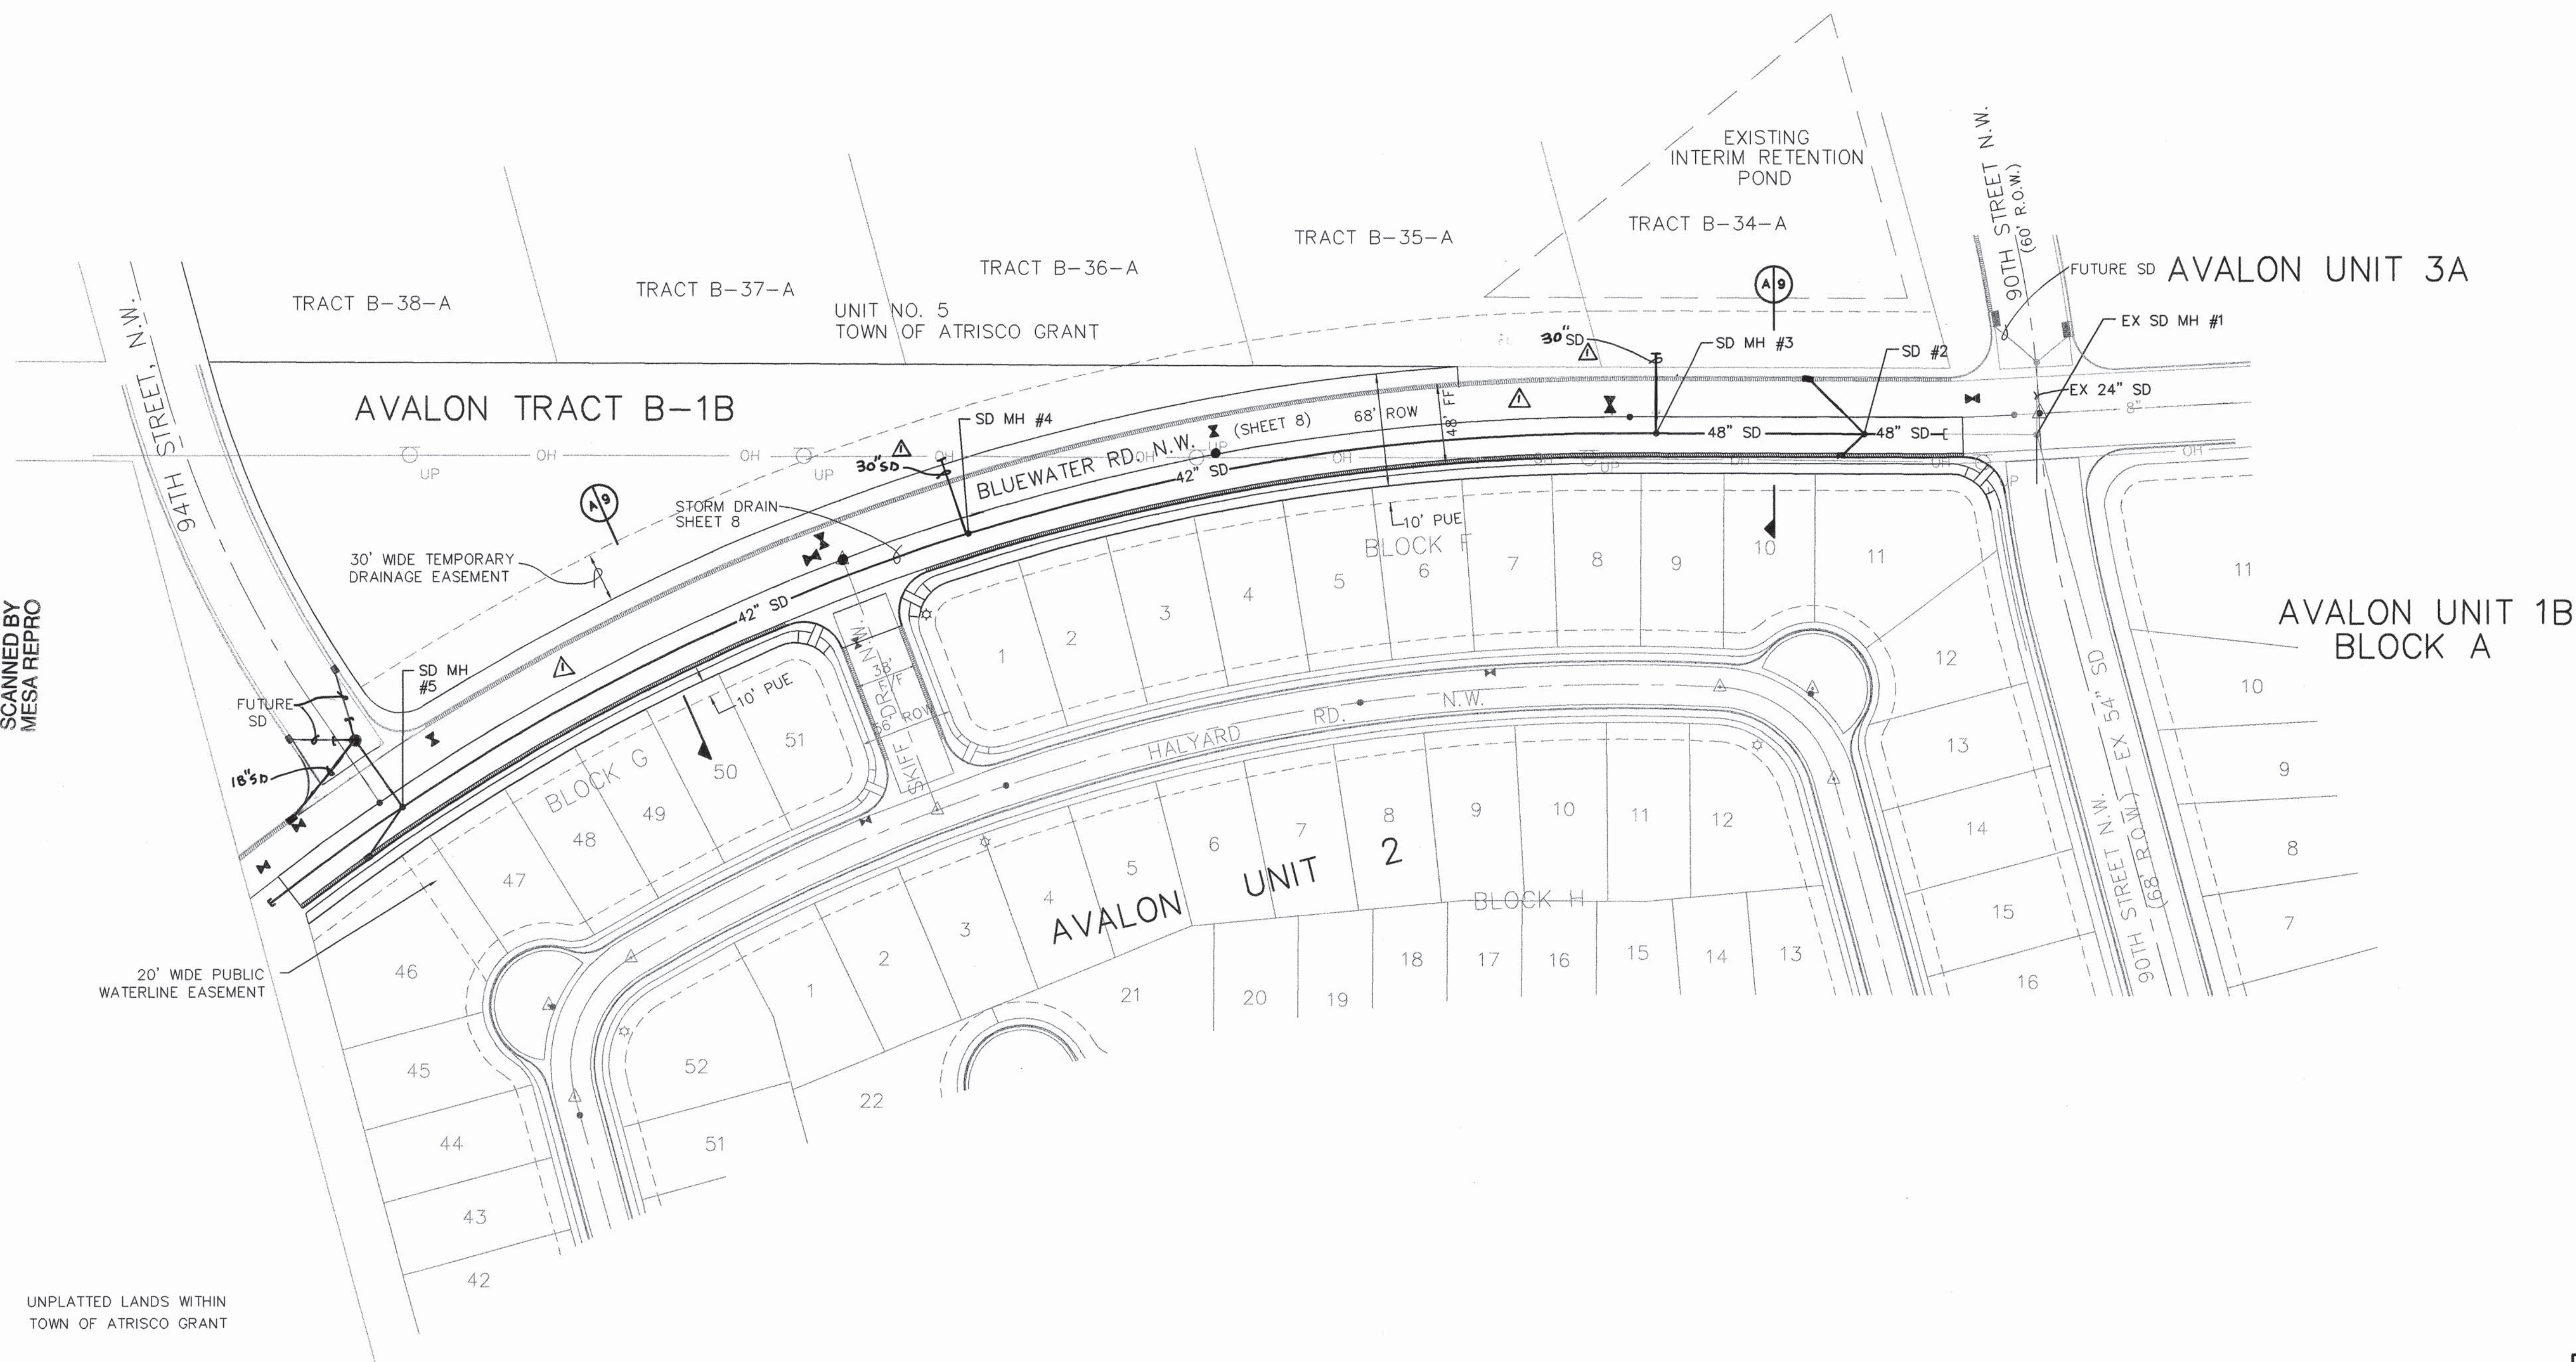

BRASHER & LORENZ
CONSULTING ENGINEERS
2201 San Pedro NE Building 1 Suite 220
Albuquerque, New Mexico 87110
Ph: 505-888-6088 Fax: 505-888-6188

CITY OF ALBUQUERQUE
PUBLIC WORKS DEPARTMENT
ENGINEERING DEVELOPMENT GROUP

TITLE: **BLUEWATER ROAD NW
& STORM DRAIN LAYOUT PLAN**

Design Review Committee	City Engineer Approval	Mo./Day/Yr.	Mo./Day/Yr.
City Project No.	Zone Map No.	Sheet	Of
663881	K-9	4	11

City Project No. 663881 Zone Map No. K-9 Sheet 4 Of 11

LEGEND


ITEM	EXISTING	PROPOSED
WATERLINE	6" W	6" W
SANITARY SEWER	8" SAS	8" SAS
STORM SEWER	36" SD	24" SD
FIRE HYDRANT		
VALVE		
WATER SERVICE (SINGLE)		
WATER SERVICE (DOUBLE)		
MANHOLE		
MOUNTABLE CURB		
STD CURB & GUTTER		
DROP INLET		
OVERHEAD ELEC.	OHE	OHE
UNDERGROUND ELEC.	UGT	UGT
GAS, TEL, TV		
FLOWLINE ELEV.	FL 0.14	FL 0.14
TOP OF CURB ELEV.	99.3	99.31
SPOT ELEV.	16.7	16.7
SEWER SERVICE		
RIGHT OF WAY		
POWER POLE (GUYED)	PP	PP
CHAIN LINK FENCE		
CENTERLINE		
TOP OF ASPHALT ELEV.	TA 16.2	TA 16.2
50' CROWN TRANSITION		
LIGHT POLE		

AS BUILT INFORMATION		BENCH MARKS		SURVEY INFORMATION		FIELD NOTES		ENGINEER'S SEAL		REVISIONS		DESIGN	
CONTRACTOR	NEW CONCEPTS	ACCS 10-K10 ACS 3 1/4" ALUM CAP 54" EAST	DATE	NO.	BY	DATE	NO.	ENGINEER'S SEAL	DATE	NO.	DATE	DESIGNED BY	DATE
INSPECTOR	N/A	CENTERLINE OF UNSUB. BLVD. AND 20.4" SOUTH	DATE						4/2001		4/2001	DRAWN BY	DATE
ACCEPTANCE BY	HERMAN RAY SACA [COA]	OF NORTH END OF BACK OF CURB OF TRAFFIC	DATE						4/2001		4/2001	CHECKED BY	DATE
VERIFICATION BY	HERMAN RAY SACA [COA]	ISLAND ON LOS VOLCANES RD. THE STATION	DATE										
DRAWINGS	N/A	IS SET FLUSH IN THE TOP OF CURB AND IS	DATE										
CONNECTED BY	MICRO-FILM INFORMATION	STAMPED "10-K10, 1989"	DATE										
RECORDED BY		ELEVATION = 5142.79 FEET	DATE										
NO.		VERTICAL DATUM SLD 1929	NO.										



ADDED PAVING, WATER, SAN. SEWER & SD TO N1/2 BLUEWATER BL.	DL.	BY	DATE
CHANGE ORDER No. 1.	DL.	BY	DATE
REVISIONS	NO.	DATE	
DESIGN	NO.	DATE	
DESIGNED BY	DAL	DATE	4/2001
DRAWN BY	R.M.	DATE	4/2001
CHECKED BY	DAL	DATE	4/2001

SCANNED BY
MESA REPRO

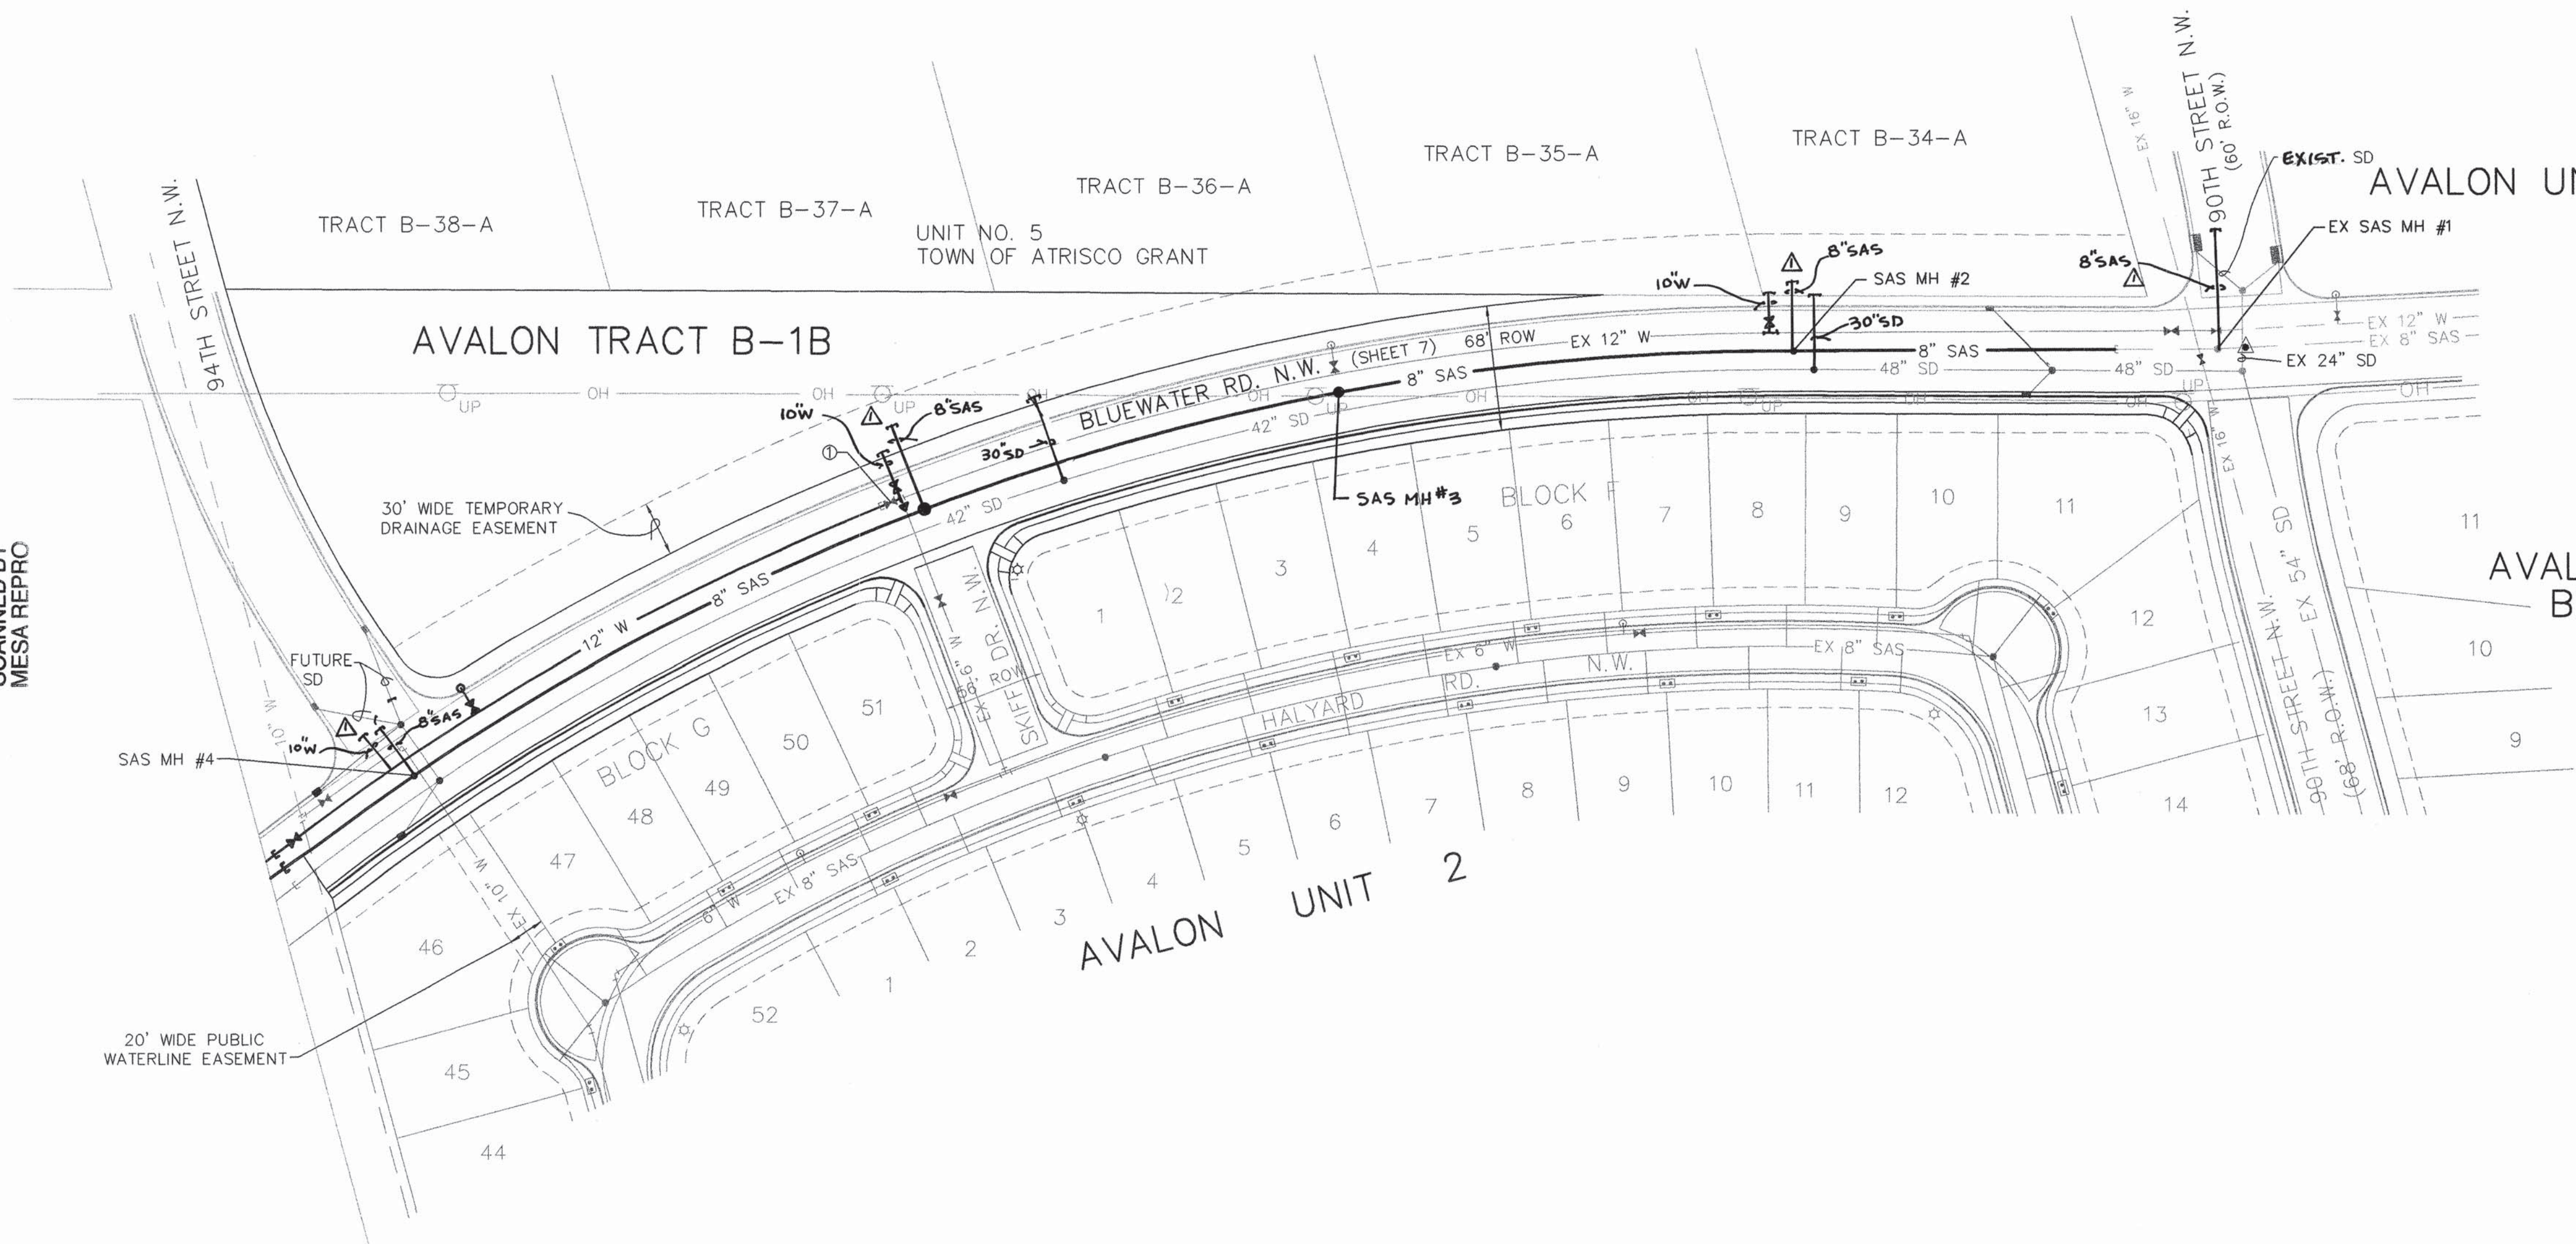


LEGEND		
ITEM	EXISTING	PROPOSED
WATERLINE	6" W	6" W
SANITARY SEWER	8" SAS	8" SAS
STORM SEWER	36" SD	24" SD
FIRE HYDRANT		
VALVE		
WATER SERVICE (SINGLE)		
WATER SERVICE (DOUBLE)		
MANHOLE		
MOUNTABLE CURB		
STD CURB & GUTTER		
DROP INLET		
OVERHEAD ELEC	OHE	OHE
UNDERGROUND ELEC, GAS, TEL, TV	UGT	UGT
FLOWLINE ELEV.	FL 0.14	FL 0.14
TOP OF CURB ELEV.	99.3	99.31
SPOT ELEV.	16.7	16.7
SEWER SERVICE		
RIGHT OF WAY		
POWER POLE (GUYPED)	PP	PP
CHAIN LINK FENCE		
CENTERLINE		
TOP OF ASPHALT ELEV.	TA 16.2	TA 16.2
50' CROWN TRANSITION		
LIGHT POLE		



1. VALVES, HYDRANTS, AND APPURTENANCES OF THE CITY WATER SYSTEM SHALL BE OPERATED BY CITY PERSONNEL ONLY.
2. THE CONTRACTOR SHALL PROVIDE THE CITY 5 DAYS ADVANCE NOTICE OF NEED FOR SYSTEM SHUTDOWN.
3. SYSTEM SHUTDOWN SHALL BE ACCOMPLISHED BY CLOSING VALVE ① LOCATED AT BLUEWATER / SKIFF AS SHOWN ON THE PLAN
4. NO SYSTEM SHUTDOWN IS ANTICIPATED

WATER SHUT-OFF PLAN

NOTES: THE 10" WATERLINE IS A WELL COLLECTOR LINE - NO CONNECTIONS FOR SERVICE OR FIRE PROTECTION SHALL BE MADE. THE 10" WELL COLLECTOR IS NOT CONNECTED TO THE DISTRIBUTION SYSTEM.

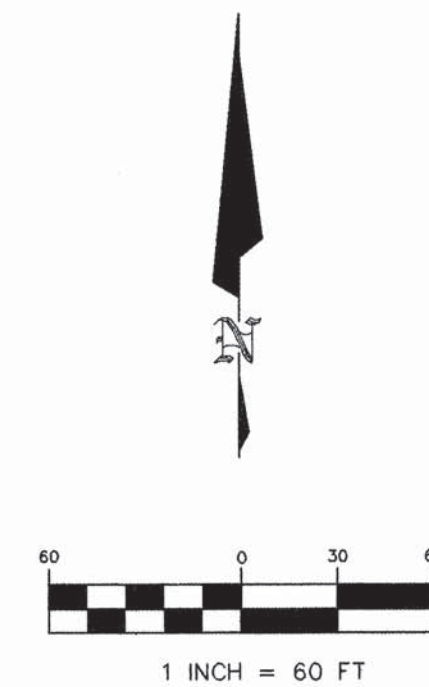

BRASHER & LORENZ CONSULTING ENGINEERS 2201 San Pedro NE Building 1 Suite 220 Albuquerque, New Mexico 87110 Ph: 505-888-6088 Fax: 505-888-6188	
CITY OF ALBUQUERQUE PUBLIC WORKS DEPARTMENT ENGINEERING DEVELOPMENT GROUP	
TITLE: BLUEWATER ROAD NW UTILITIES LAYOUT PLAN	
Design Review Committee MAY 2 3 2001 DESIGN REVIEW COMMITTEE	City Engineer Approval
City Project No. 663881	Zone Map No. K-9
Sheet 5	Of 11

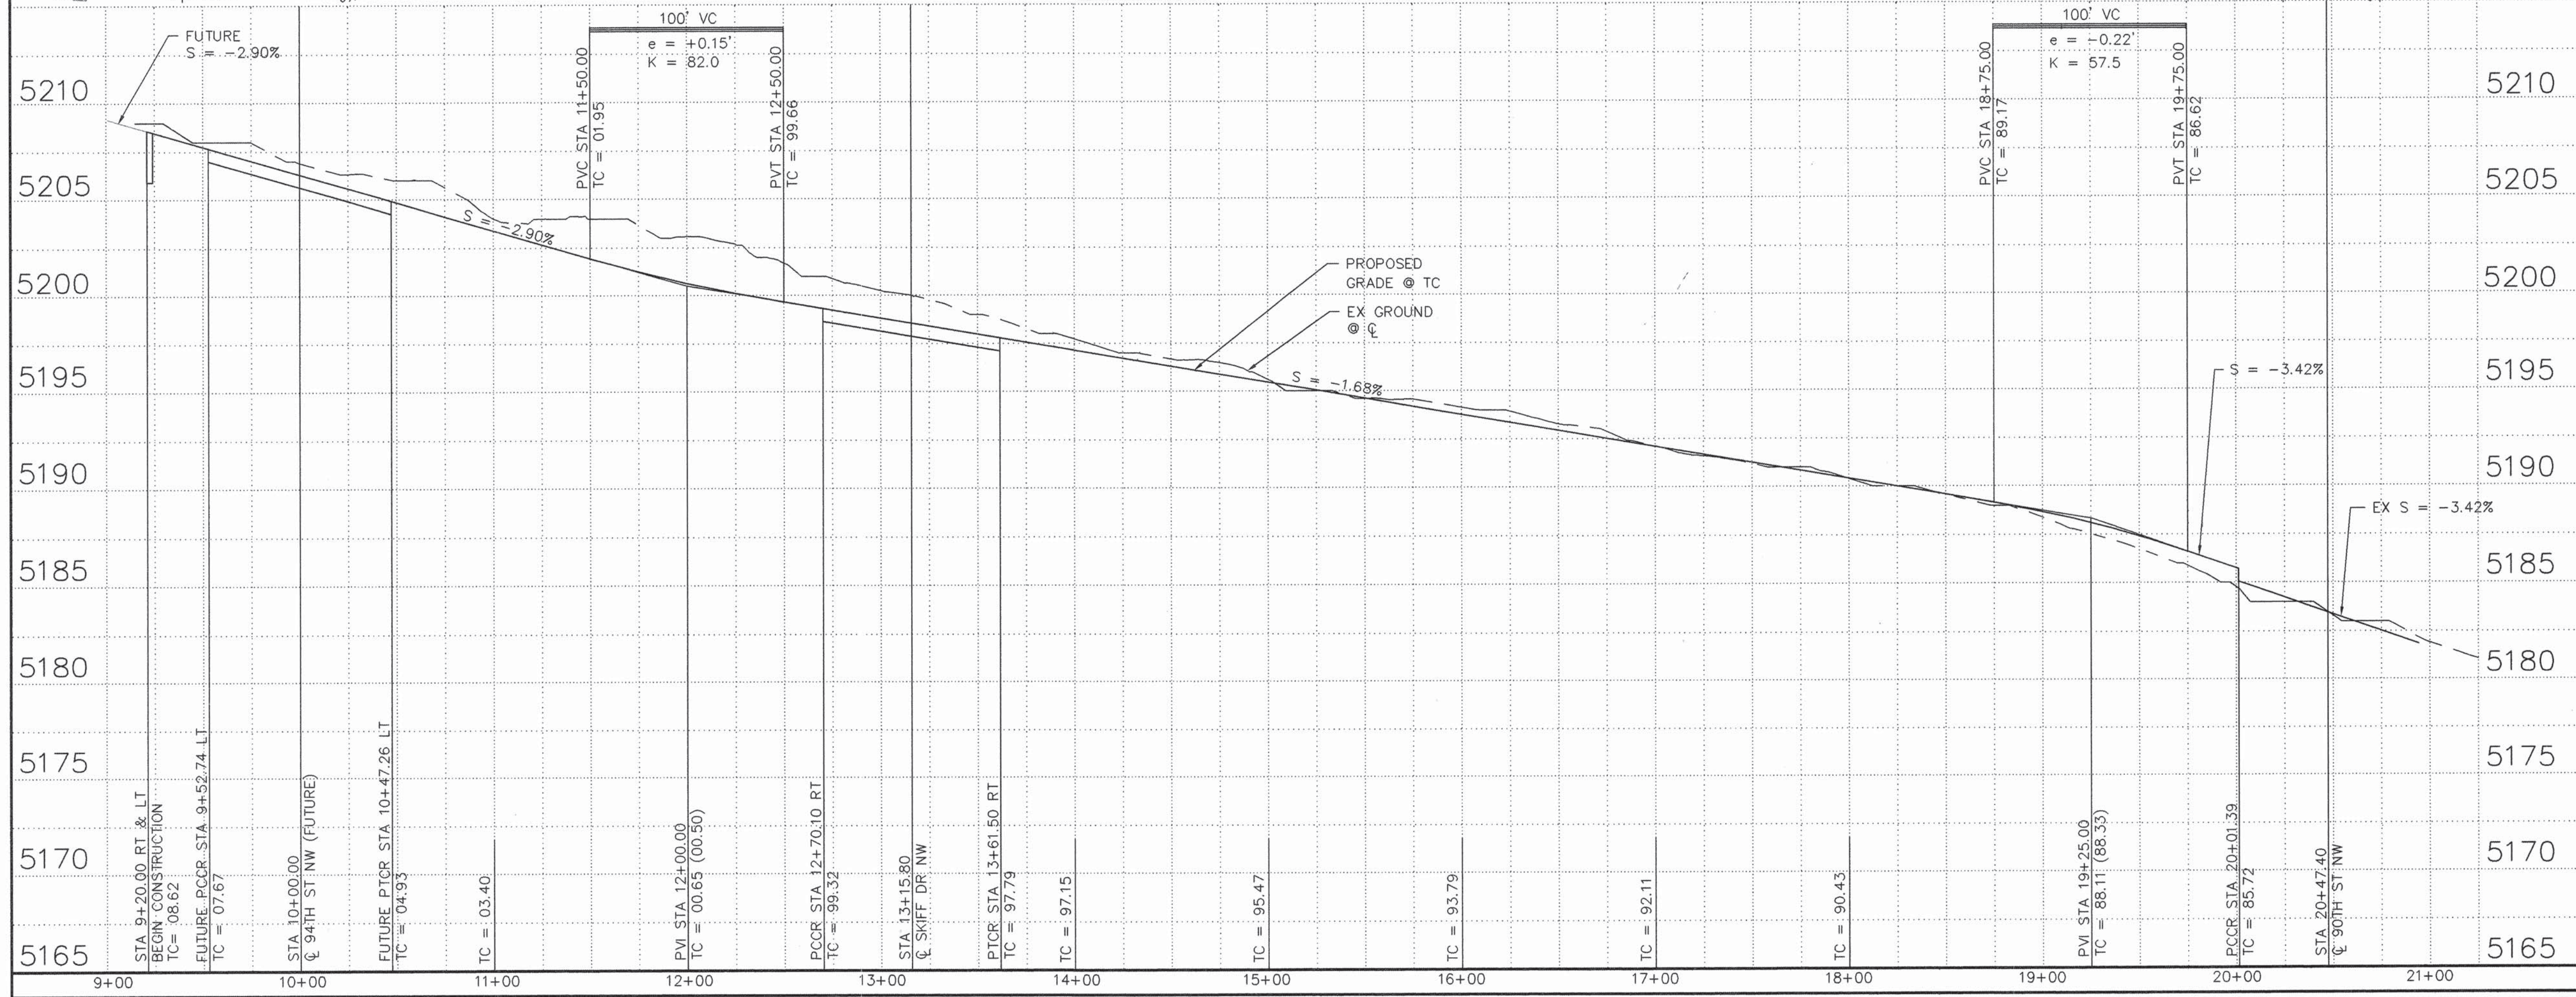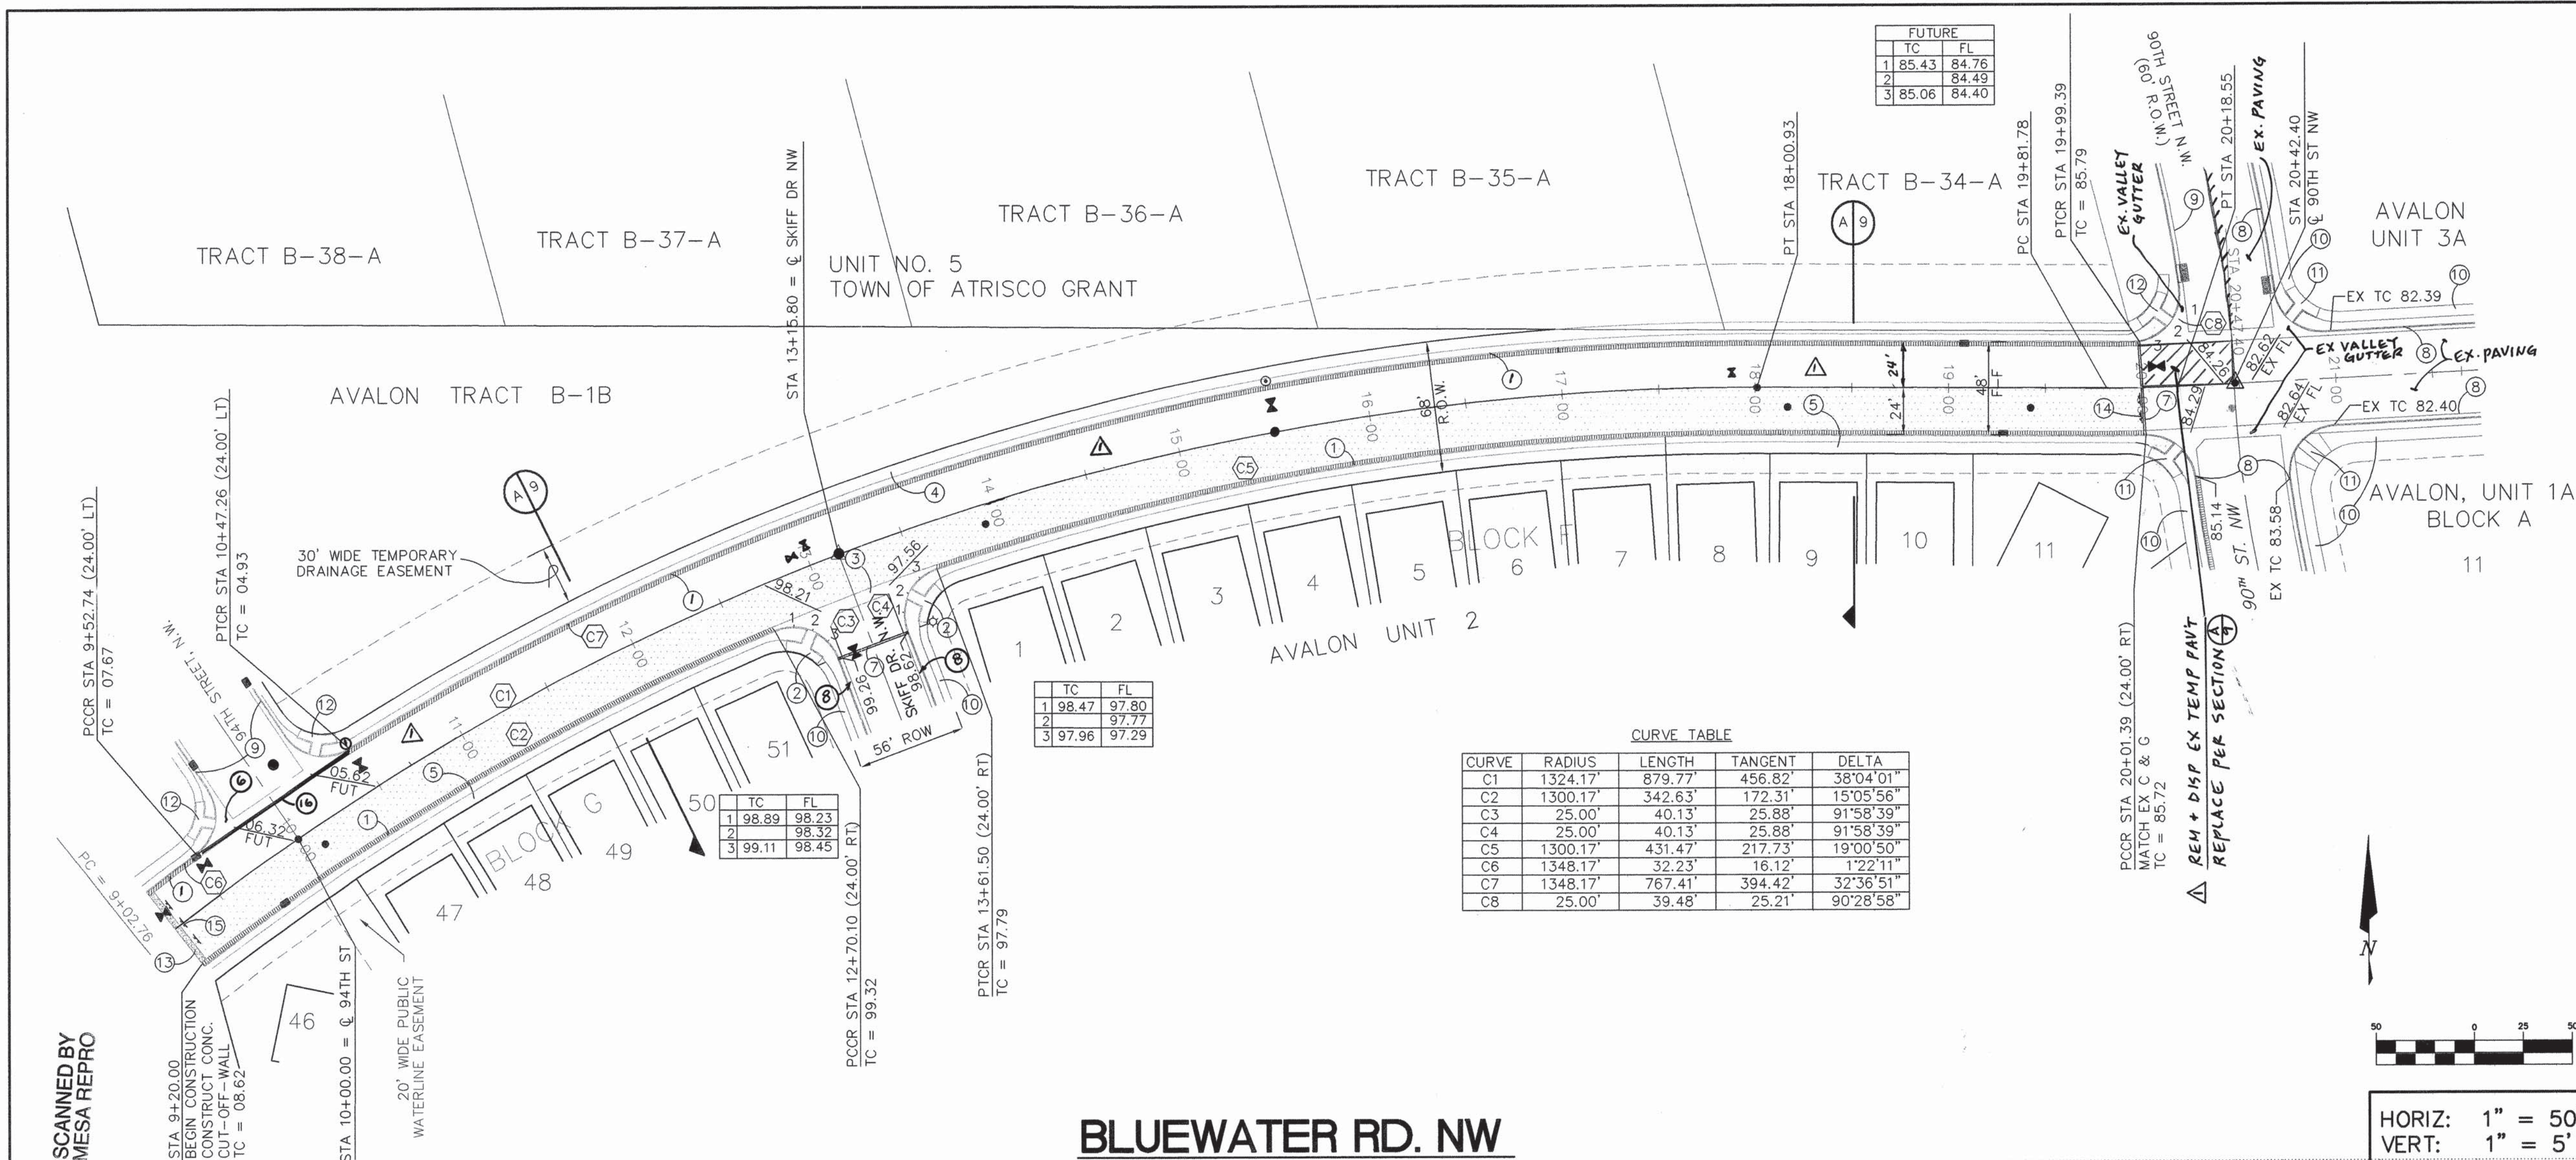

LEGEND

ITEM	EXISTING	PROPOSED
WATERLINE	6" W	6" W
SANITARY SEWER	8" SAS	8" SAS
STORM SEWER	36" SD	24" SD
FIRE HYDRANT		
VALVE		
WATER SERVICE (SINGLE)		
WATER SERVICE (DOUBLE)		
MANHOLE		
MOUNTABLE CURB		
STD CURB & GUTTER		
DROP INLET		
OVERHEAD ELEC	OHE	OHE
UNDERGROUND ELEC, GAS, TEL, TV	UGT	UGT
FLOWLINE ELEV.	FL 0.14	FL 0.14
TOP OF CURB ELEV.	99.3	99.31
SPOT ELEV.	x 16.7	16.7
SEWER SERVICE		
RIGHT OF WAY		
POWER POLE (GUYED)	PB	PB
CHAIN LINK FENCE	x	x
CENTERLINE		
RETAINING WALL		
TOP OF ASPHALT ELEV.	TA 16.2	TA 16.2
NEW PAVEMENT		
STREET LIGHT	*	*

KEYED NOTES

- CONSTRUCT STANDARD C&G PER STD DWG 2415
- CONSTRUCT CURB ACCESS RAMP PER DETAIL (C9)
- CONSTRUCT CONCRETE VALLEY GUTTER PER STD DWG 2420
- FUTURE 4' SIDEWALK
- CONSTRUCT 4' SIDEWALK PER COA STD DWG 2430
- FUTURE VALLEY GUTTER**
- REMOVE & DISPOSE EXISTING CONC. CUT-OFF WALL. MATCH EXIST. PAVING
- EXISTING STD. CURB AND GUTTER
- FUTURE STD. CURB AND GUTTER
- EXISTING 4' SIDEWALK
- EXISTING HANDICAP RAMP
- FUTURE HANDICAP RAMP
- CONSTRUCT CONC. CUT OFF WALL PER STD. DWG 2415
- REMOVE EXISTING BARRICADES RELOCATE TO STA 9+20.00
- RELOCATED BARRICADES
- CONSTR 6" TEMP AC CURB PER STD DWG 2415.**

BRASHER & LORENZ
CONSULTING ENGINEERS
2201 San Pedro NE Building 1 Suite 220
Albuquerque, New Mexico 87110
Ph: 505-888-6088 Fax: 505-888-6188

CITY OF ALBUQUERQUE
PUBLIC WORKS DEPARTMENT
ENGINEERING DEVELOPMENT GROUP

TITLE: BLUEWATER ROAD NW STREET PAVING PLAN & PROFILE

Design Review Committee	City Engineer Approval	Mo./Day/Yr.	Mo./Day/Yr.
City Project No.	Zone Map No.	Sheet	Of
663881	K-9	6	11

AS BUILT INFORMATION

CONTRACTOR	DATE
WORK BY	
INSPECTED BY	
ACCEPTANCE BY	
VERIFICATION BY	
DRAWINGS CORRECTED BY	
RECORDED BY	
NO.	

BENCH MARKS

CONTRACTOR	DATE
ACCS 10-K10 ACS 3 1/4" ALUM CAP 54" EAST	
CENTERLINE OF UNSER BLVD. AND 20.4" SOUTH	
OF NORTH END OF BACK OF CURB OF TRAFFIC	
ISLAND ON LOS VOLCANES RD. THE STATION	
IS SET FLUSH IN THE TOP OF CURB AND IS	
STAMPED "10-K10, 1989."	
ELEVATION = 5142.79 FEET	
VERTICAL DATUM SLD 1929	

SURVEY INFORMATION

FIELD NOTES	DATE
NO.	
BY	

ENGINEER'S SEAL

5-3-01

REVISIONS	DATE
DESIGN	4/2001
REMARKS	4/2001
BY	4/2001
PL	4/2001
DL	4/2001

ADDED PAVING, WATER, SAS + SD STUBS TO N 1/2 BLUEWATER

CHANGE ORDER No 1

REVISIONS

DESIGN

REMARKS

BY

PL

DL

NO.

DATE

DESIGNED BY


DRAWN BY

CHECKED BY


DATE

DATE

DATE

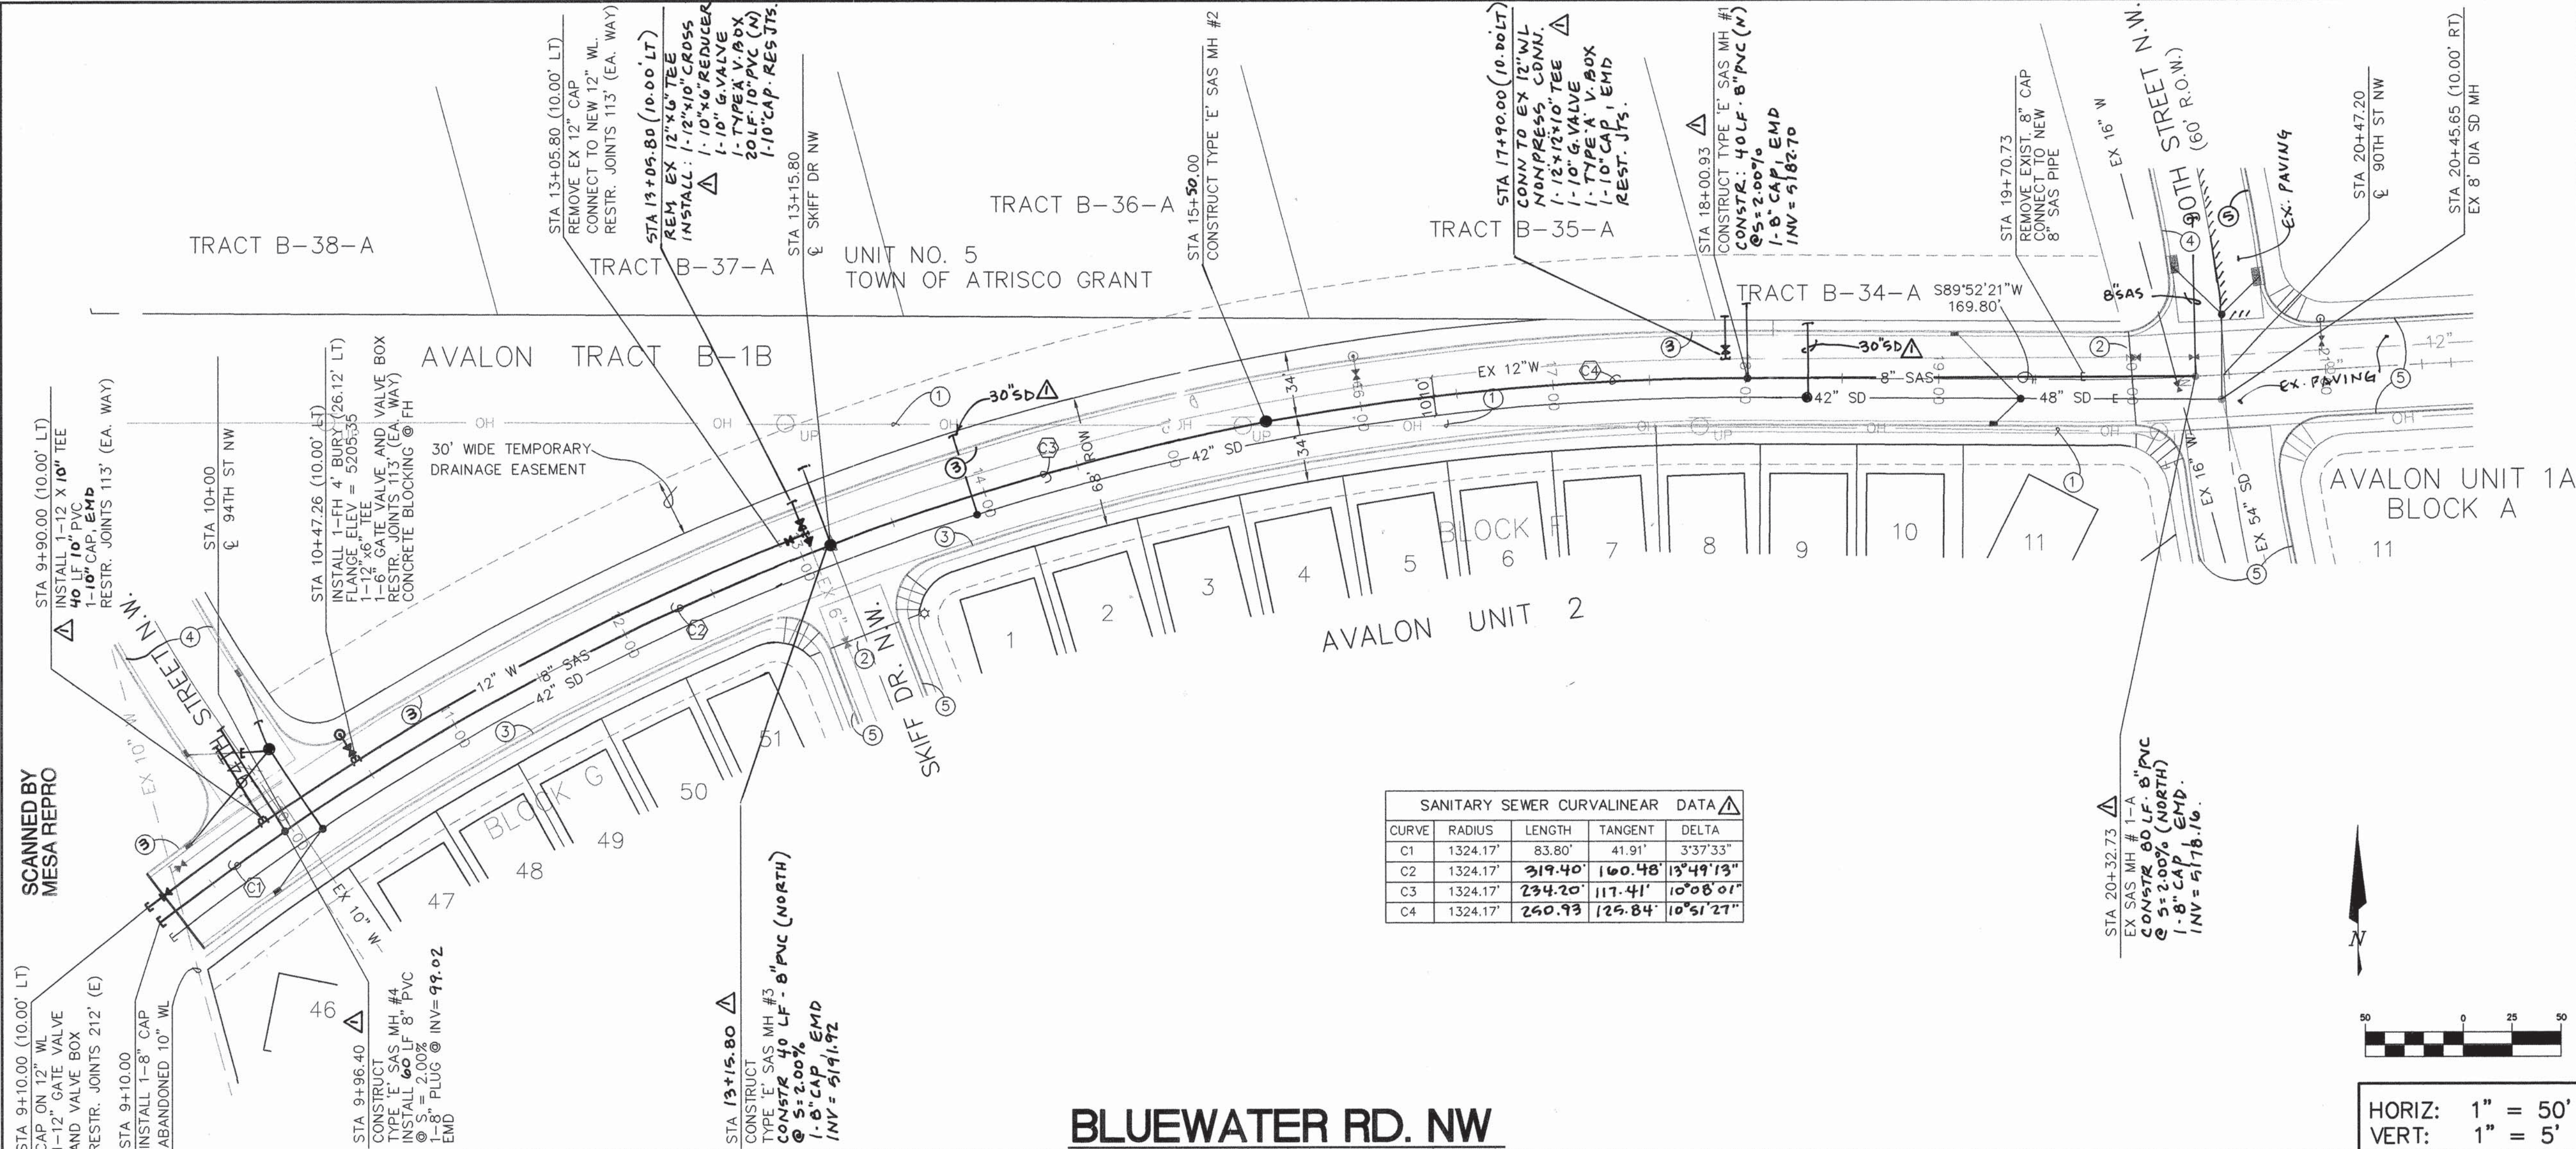

SANITARY SEWER CURVILINEAR DATA				
CURVE	RADIUS	LENGTH	TANGENT	DELTA
C1	1324.17'	83.80'	41.91'	3°37'33"
C2	1324.17'	319.40'	160.48'	13°49'13"
C3	1324.17'	234.20'	117.41'	10°06'01"
C4	1324.17'	240.93'	126.84'	10°51'27"

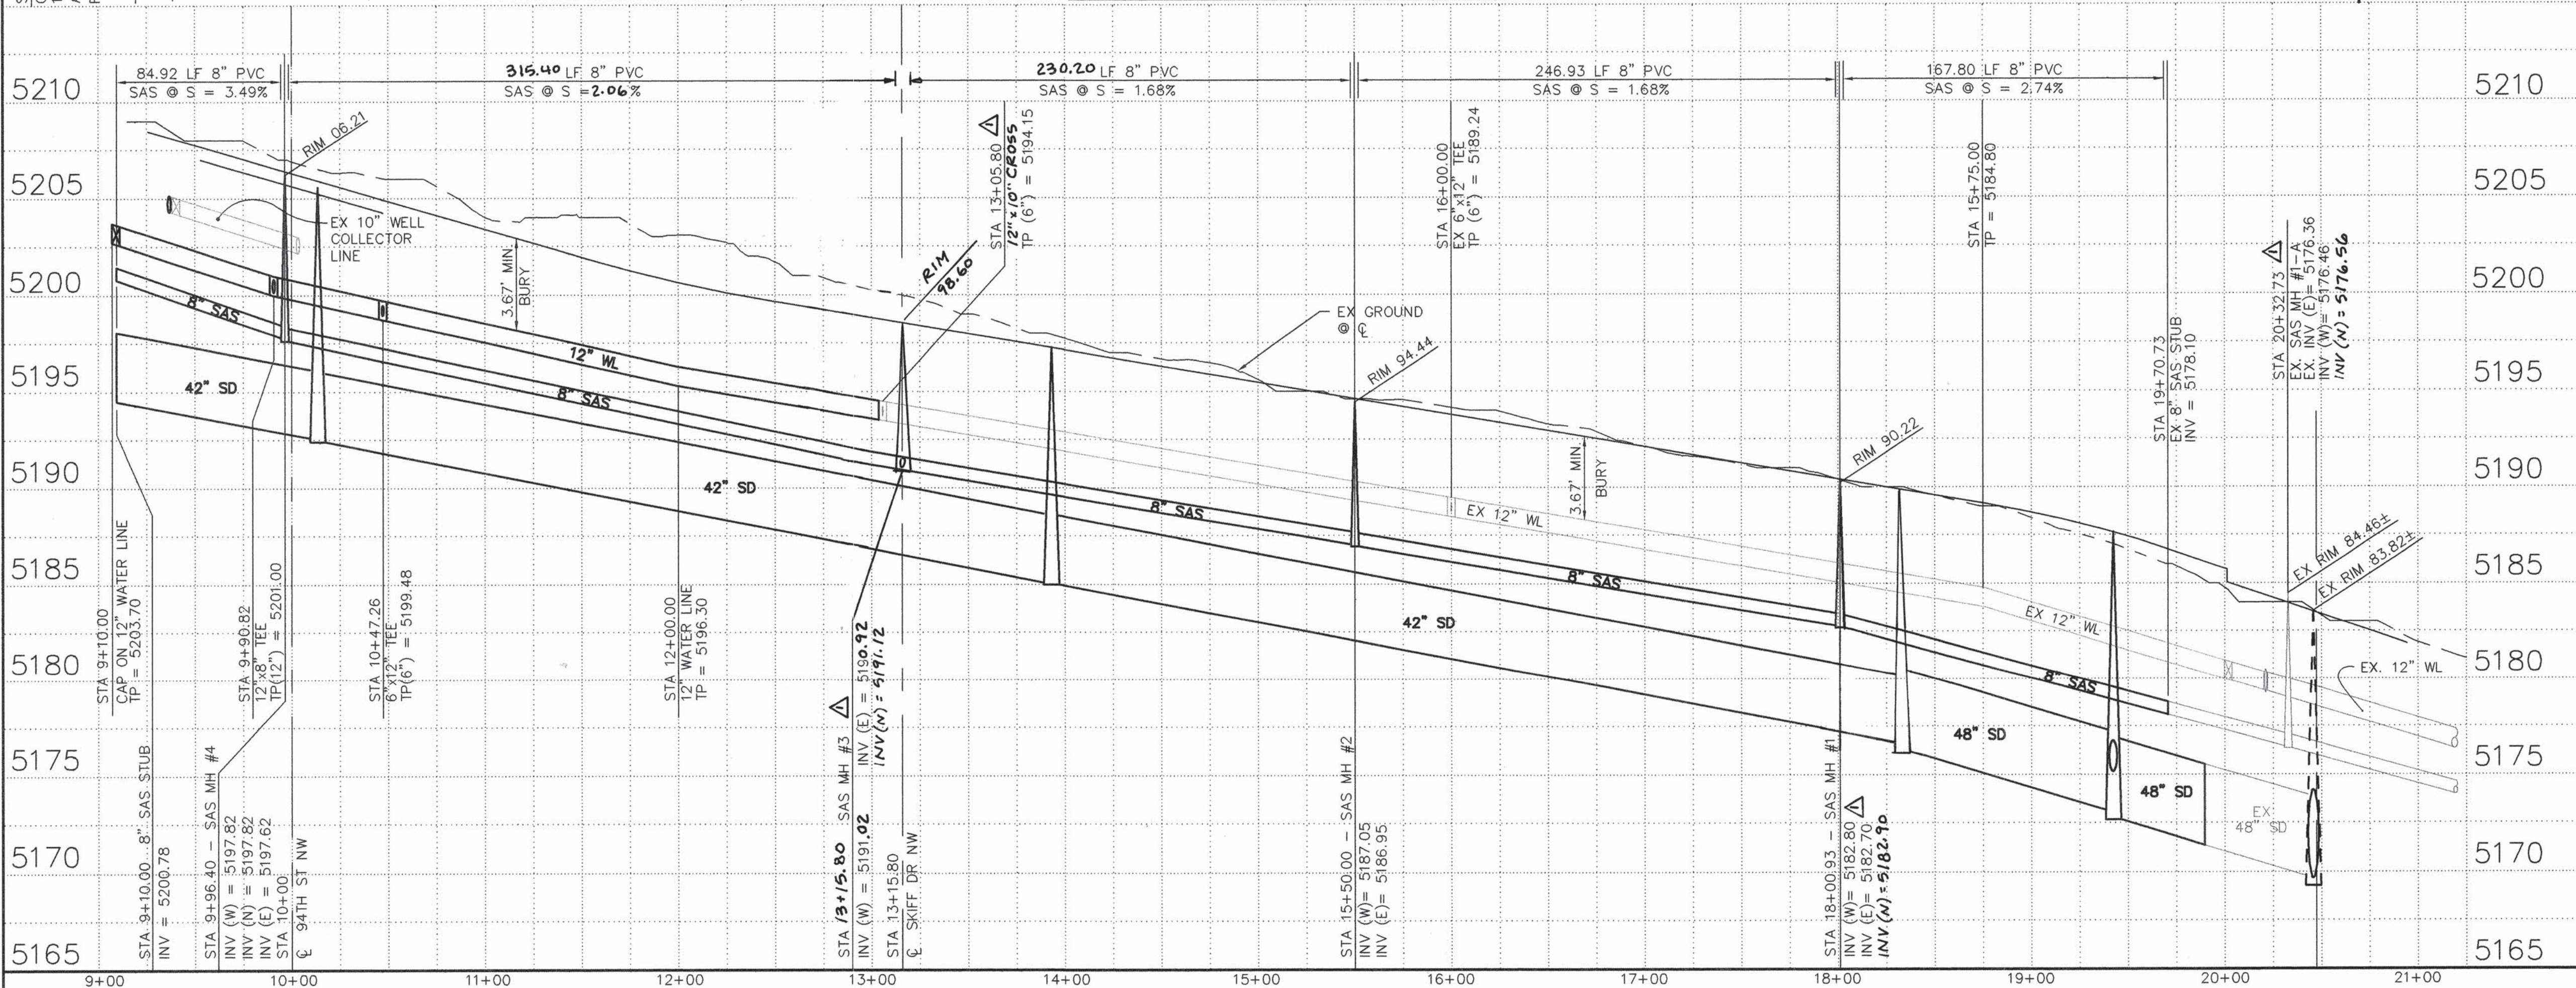

LEGEND

ITEM	EXISTING	PROPOSED
WATERLINE	6" W	6" W
SANITARY SEWER	8" SAS	8" SAS
STORM SEWER	36" SD	24" SD
FIRE HYDRANT		
VALVE		
WATER SERVICE (SINGLE)		
WATER SERVICE (DOUBLE)		
MANHOLE		
MOUNTABLE CURB		
STD CURB & GUTTER		
DROP INLET		
OVERHEAD ELEC	OHE	
UNDERGROUND ELEC, GAS, TEL, TV	UGT	
FLOWLINE ELEV.	FL 0.14	FL 0.14
TOP OF CURB ELEV.	99.3	99.31
SPOT ELEV.	x 16.7	16.7
SEWER SERVICE		
RIGHT OF WAY		
POWER POLE (GUYED)	PP	
CHAIN LINK FENCE		
CENTERLINE		
RETAINING WALL		
TOP OF ASPHALT ELEV.	TA 16.2	TA 16.2
TEMP. PAVEMENT		
STREET LIGHT		

STATIONING IS BASED ON CENTERLINE OF RIGHT OF WAY UNLESS NOTED OTHERWISE.

1

EXISTING OVERHEAD ELECTRIC TO BE RELOCATED BY PNM

2

EXISTING EDGE OF PAVEMENT

3

NEW STD C & G

4

FUTURE STD. C & G

5

EXISTING STD. C & G

AS BUILT INFORMATION

CONTRACTOR	DATE

SURVEY INFORMATION

FIELD NOTES	DATE

ENGINEER'S SEAL

BRASHER & LORENZ CONSULTING ENGINEERS

2201 San Pedro NE Building 1 Suite 220 Albuquerque, New Mexico 87110 Ph: 505-888-6068 Fax: 505-888-6188

CITY OF ALBUQUERQUE PUBLIC WORKS DEPARTMENT ENGINEERING DEVELOPMENT GROUP

TITLE: BLUEWATER ROAD NW WATER & SANITARY SEWER PLAN & PROFILE

Design Review Committee

City Engineer Approval

Mo./Day/Yr.

Mo./Day/Yr.

REVISIONS

NO.	DATE	REMARKS
1	11-01	ADDED PAVING, WATER, SAS & SD STUDS TO N 1/2 BLUEWATER
2	11-01	CHANGE ORDER NO 1

DESIGNED BY DAL

DATE 4/2001

DRAWN BY R.M

DATE 4/2001

CHECKED BY DAL


DATE 4/2001

01511-WS.DWG 5/3/2001 1=50

663881

K-9

Sheet 7 Of 11

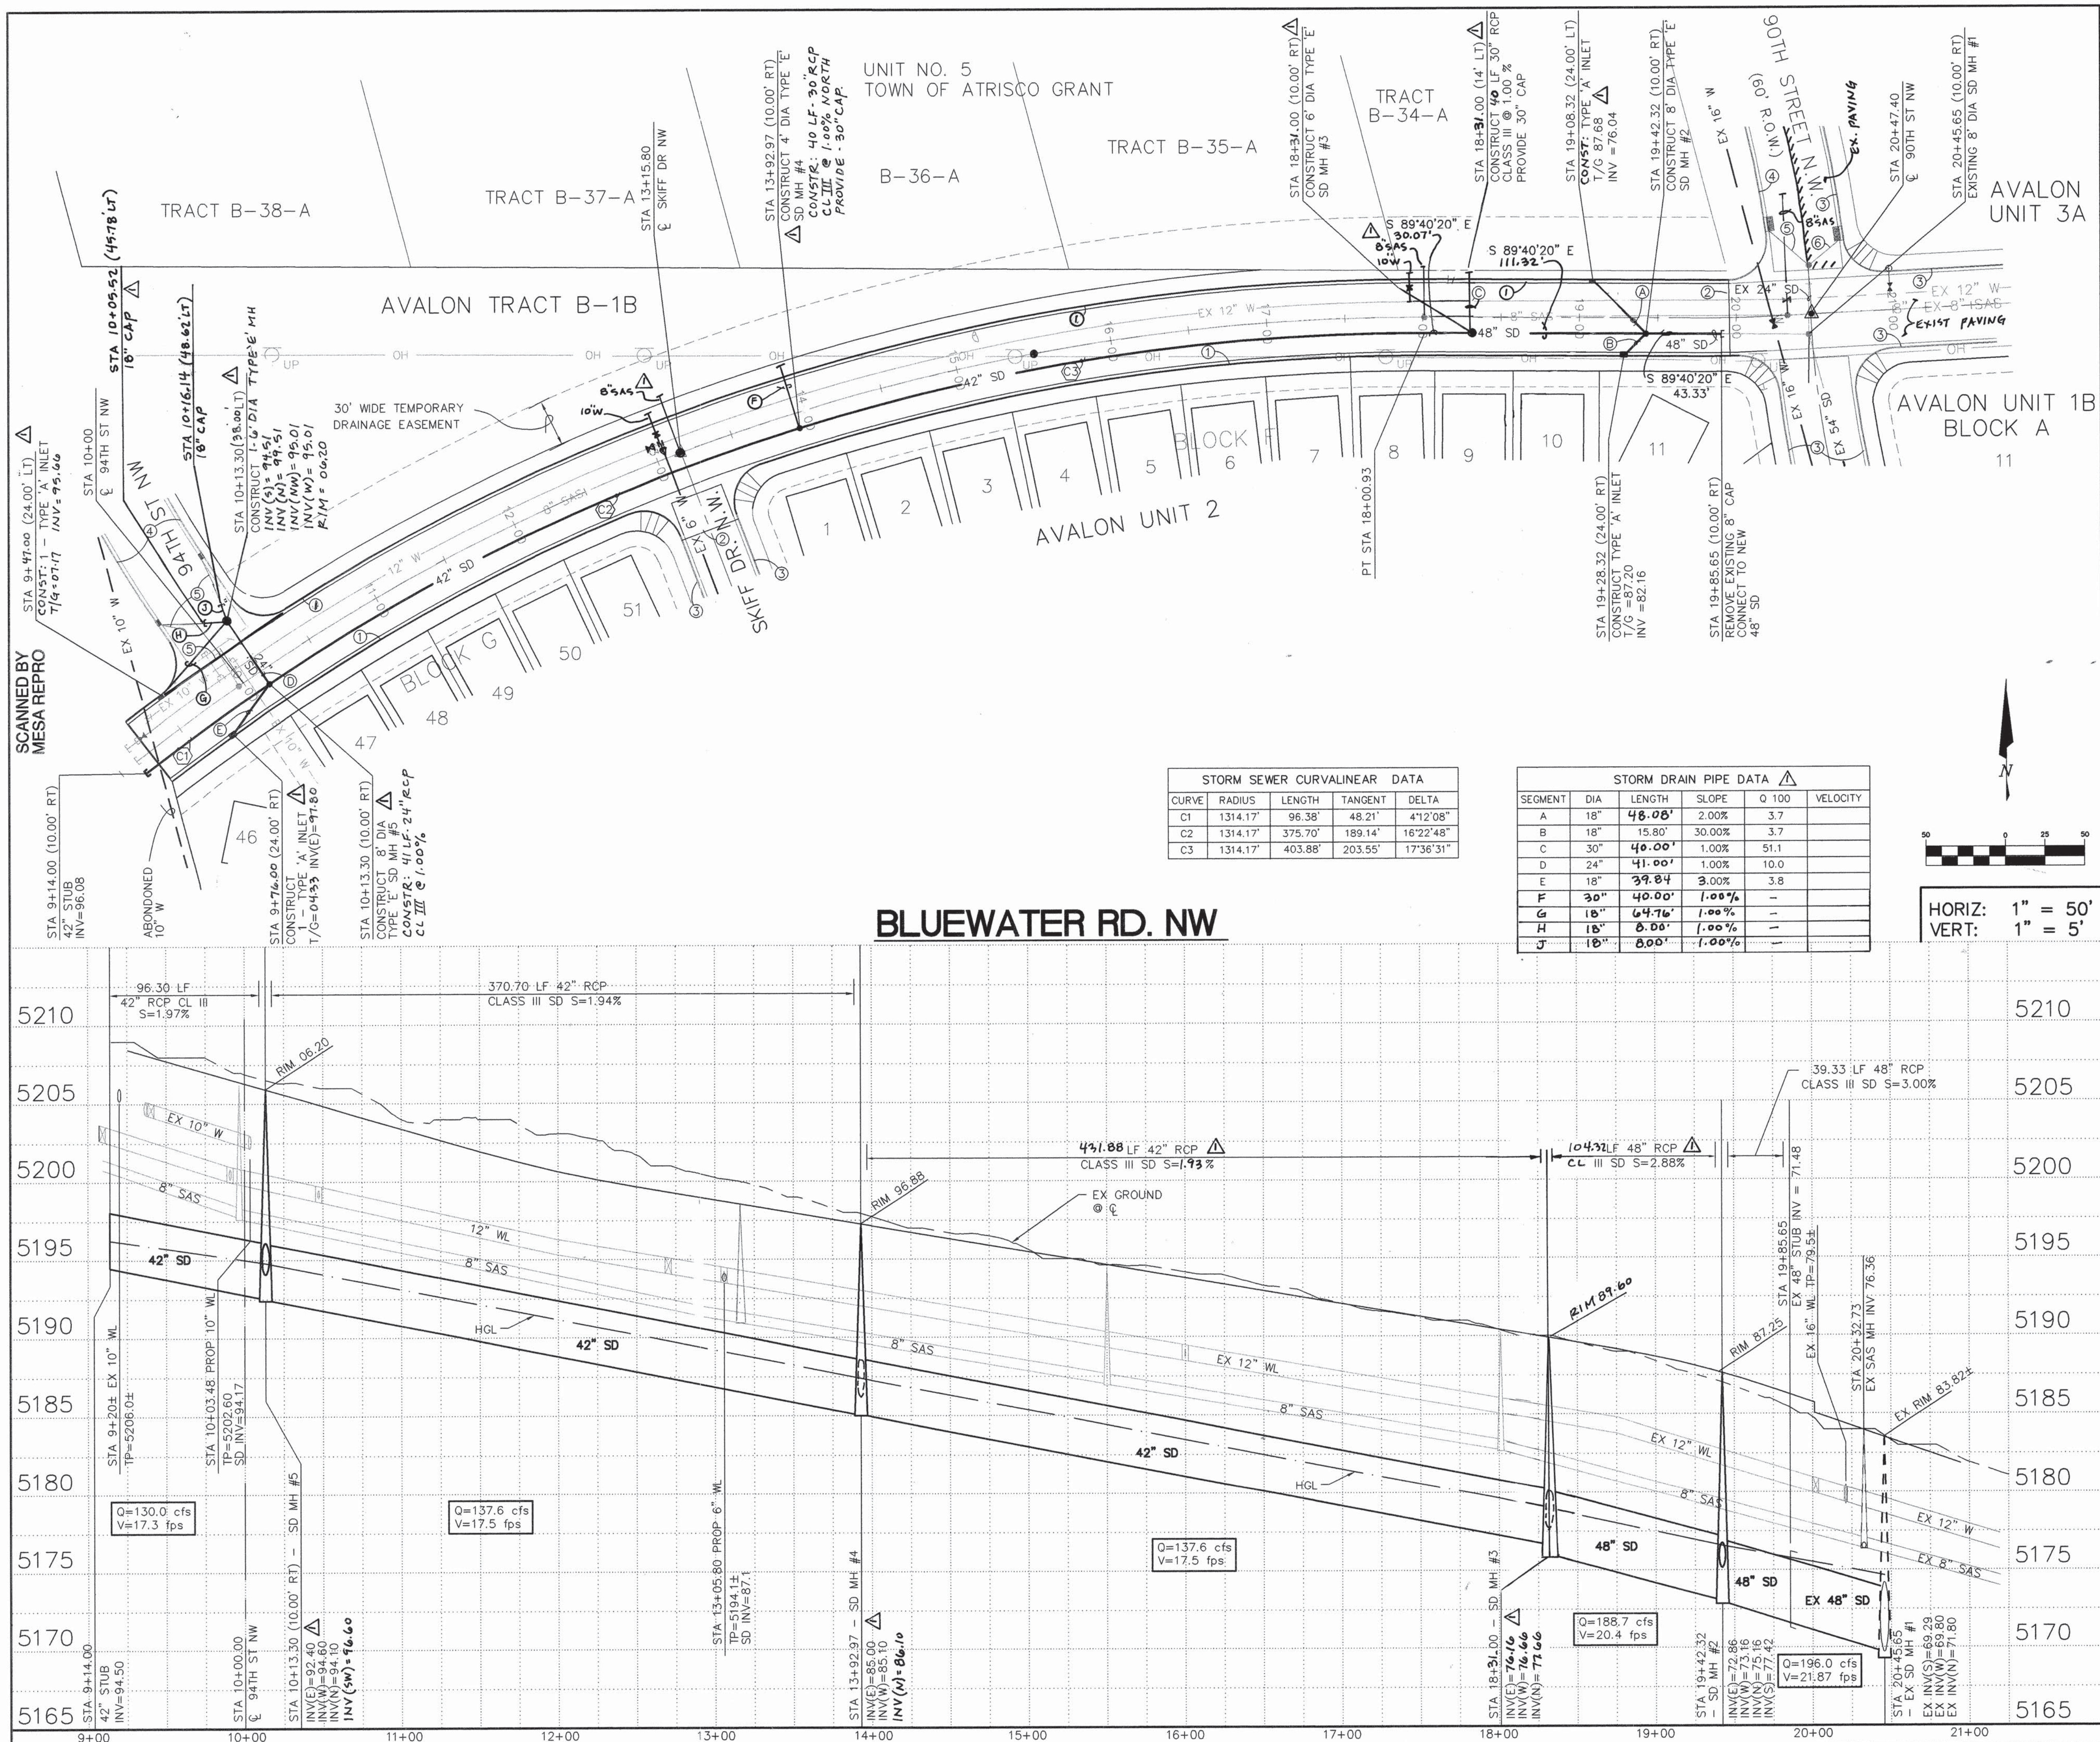

LEGEND		AS BUILT INFORMATION		BENCH MARKS		SURVEY INFORMATION		ENGINEER'S SEAL	
ITEM	EXISTING	PROPOSED	CONTRACTOR	NO.	BY	DATE	NO.	BY	DATE
WATERLINE	— 6" W —	— 6" W —	STARTED BY						
SANITARY SEWER	— 8" SAS —	— 8" SAS —	RECORDED BY						
STORM SEWER	— 36" SD —	— 24" SD —	FIELD ACCEPTANCE BY						
FIRE HYDRANT	⊙	⊙	FIELD MEASUREMENT BY						
VALVE	⋈	⋈	DRAWINGS						
WATER SERVICE (SINGLE)	— — —	— — —	CORRECTED BY						
WATER SERVICE (DOUBLE)	— — —	— — —	RECORDED BY						
MANHOLE	— ○ —	— ● —	NO.						
MOUNTABLE CURB	— — —	— — —	DATE						
STD CURB & GUTTER			IS SET FLUSH IN THE TOP OF CURB AND IS						
DROP INLET	— — —	— — —	STAMPED "10-K10, 1989"						
OVERHEAD ELEC	— OHE —	— — —	ELEVATION = 5142.79 FEET						
UNDERGROUND ELEC.	— UGT —	— — —	VERTICAL DATUM SLD 1929						
GAS, TEL, TV	— — —	— — —							
FLOWLINE ELEV.	— FL 0.14 —	— FL 0.14 —							
TOP OF CURB ELEV.	— 99.3 —	— 99.31 —							
SPOT ELEV.	× 16.7	⬤ 16.7							
SEWER SERVICE	— — —	— — —							
RIGHT OF WAY	— — —	— — —							
POWER POLE (GUyed)	● — —	— — —							
CHAIN LINK FENCE	— — —	— — —							
CENTERLINE	— — —	— — —							
RETAINING WALL	— — —	— — —							
TOP OF ASPHALT ELEV.	— TA 16.2 —	— TA 16.2 —							
TEMP. PAVEMENT									
STREET LIGHT		☆							

STATIONING IS BASED ON CENTERLINE OF RIGHT OF WAY UNLESS NOTED OTHERWISE.

1. NEW STD C & G
 2. EXISTING EDGE OF PAVING
 3. EXISTING STD C & G
 4. FUTURE STD C & G
 5. FUTURE SD
 6. EXISTING SD

NOTE:
 STORM INLETS ARE TO BE BLOCKED BY PLACING PLYWOOD OVER LATERAL PIPE AND BACKFILLING INLET WITH SANDBAGS TO WITHIN 6-INCHES OF STREET GRADE. BACKFILL OVER SANDBAGS WITH CLEAN SAND AND PAVE WITH 2-INCHES TEMPORARY ASPHALT. INLET GRATES SHALL BE DELIVERED TO CITY STORM MAINTENANCE, 9805 CENTRAL AVE NE (235-8016).

BRASHER & LORENZ
 CONSULTING ENGINEERS
 2201 San Pedro NE Building 1 Suite 220
 Albuquerque, New Mexico 87110
 Ph: 505-888-6088 Fax: 505-888-6188

ENGINEER'S SEAL		REVISIONS	
NO.	DATE	REMARKS	DESIGN
11-01		ADDED PAVING WATER SAS + SD STUDS TO N 1/2 BLUEWATER	DATE 4/2001
11-01		CHANGE ORDER NO 1	DATE 4/2001
NO. DATE			
DESIGNED BY	DAL		
DRAWN BY	R.M		
CHECKED BY	DAL		

CITY OF ALBUQUERQUE
PUBLIC WORKS DEPARTMENT
ENGINEERING DEVELOPMENT GROUP


TITLE:		BLUEWATER ROAD NW	
		STORM DRAIN PLAN & PROFILE	
Design Review Committee	City Engineer Approval	Mo./Day/Yr.	Mo./Day/Yr.
MAY 25 2001 DESIGN REVIEW COMMITTEE			

City Project No. **663881**

Zone Map No. **K-9**

Sheet **8** Of **11**

SCANNED BY
MESA REPRO




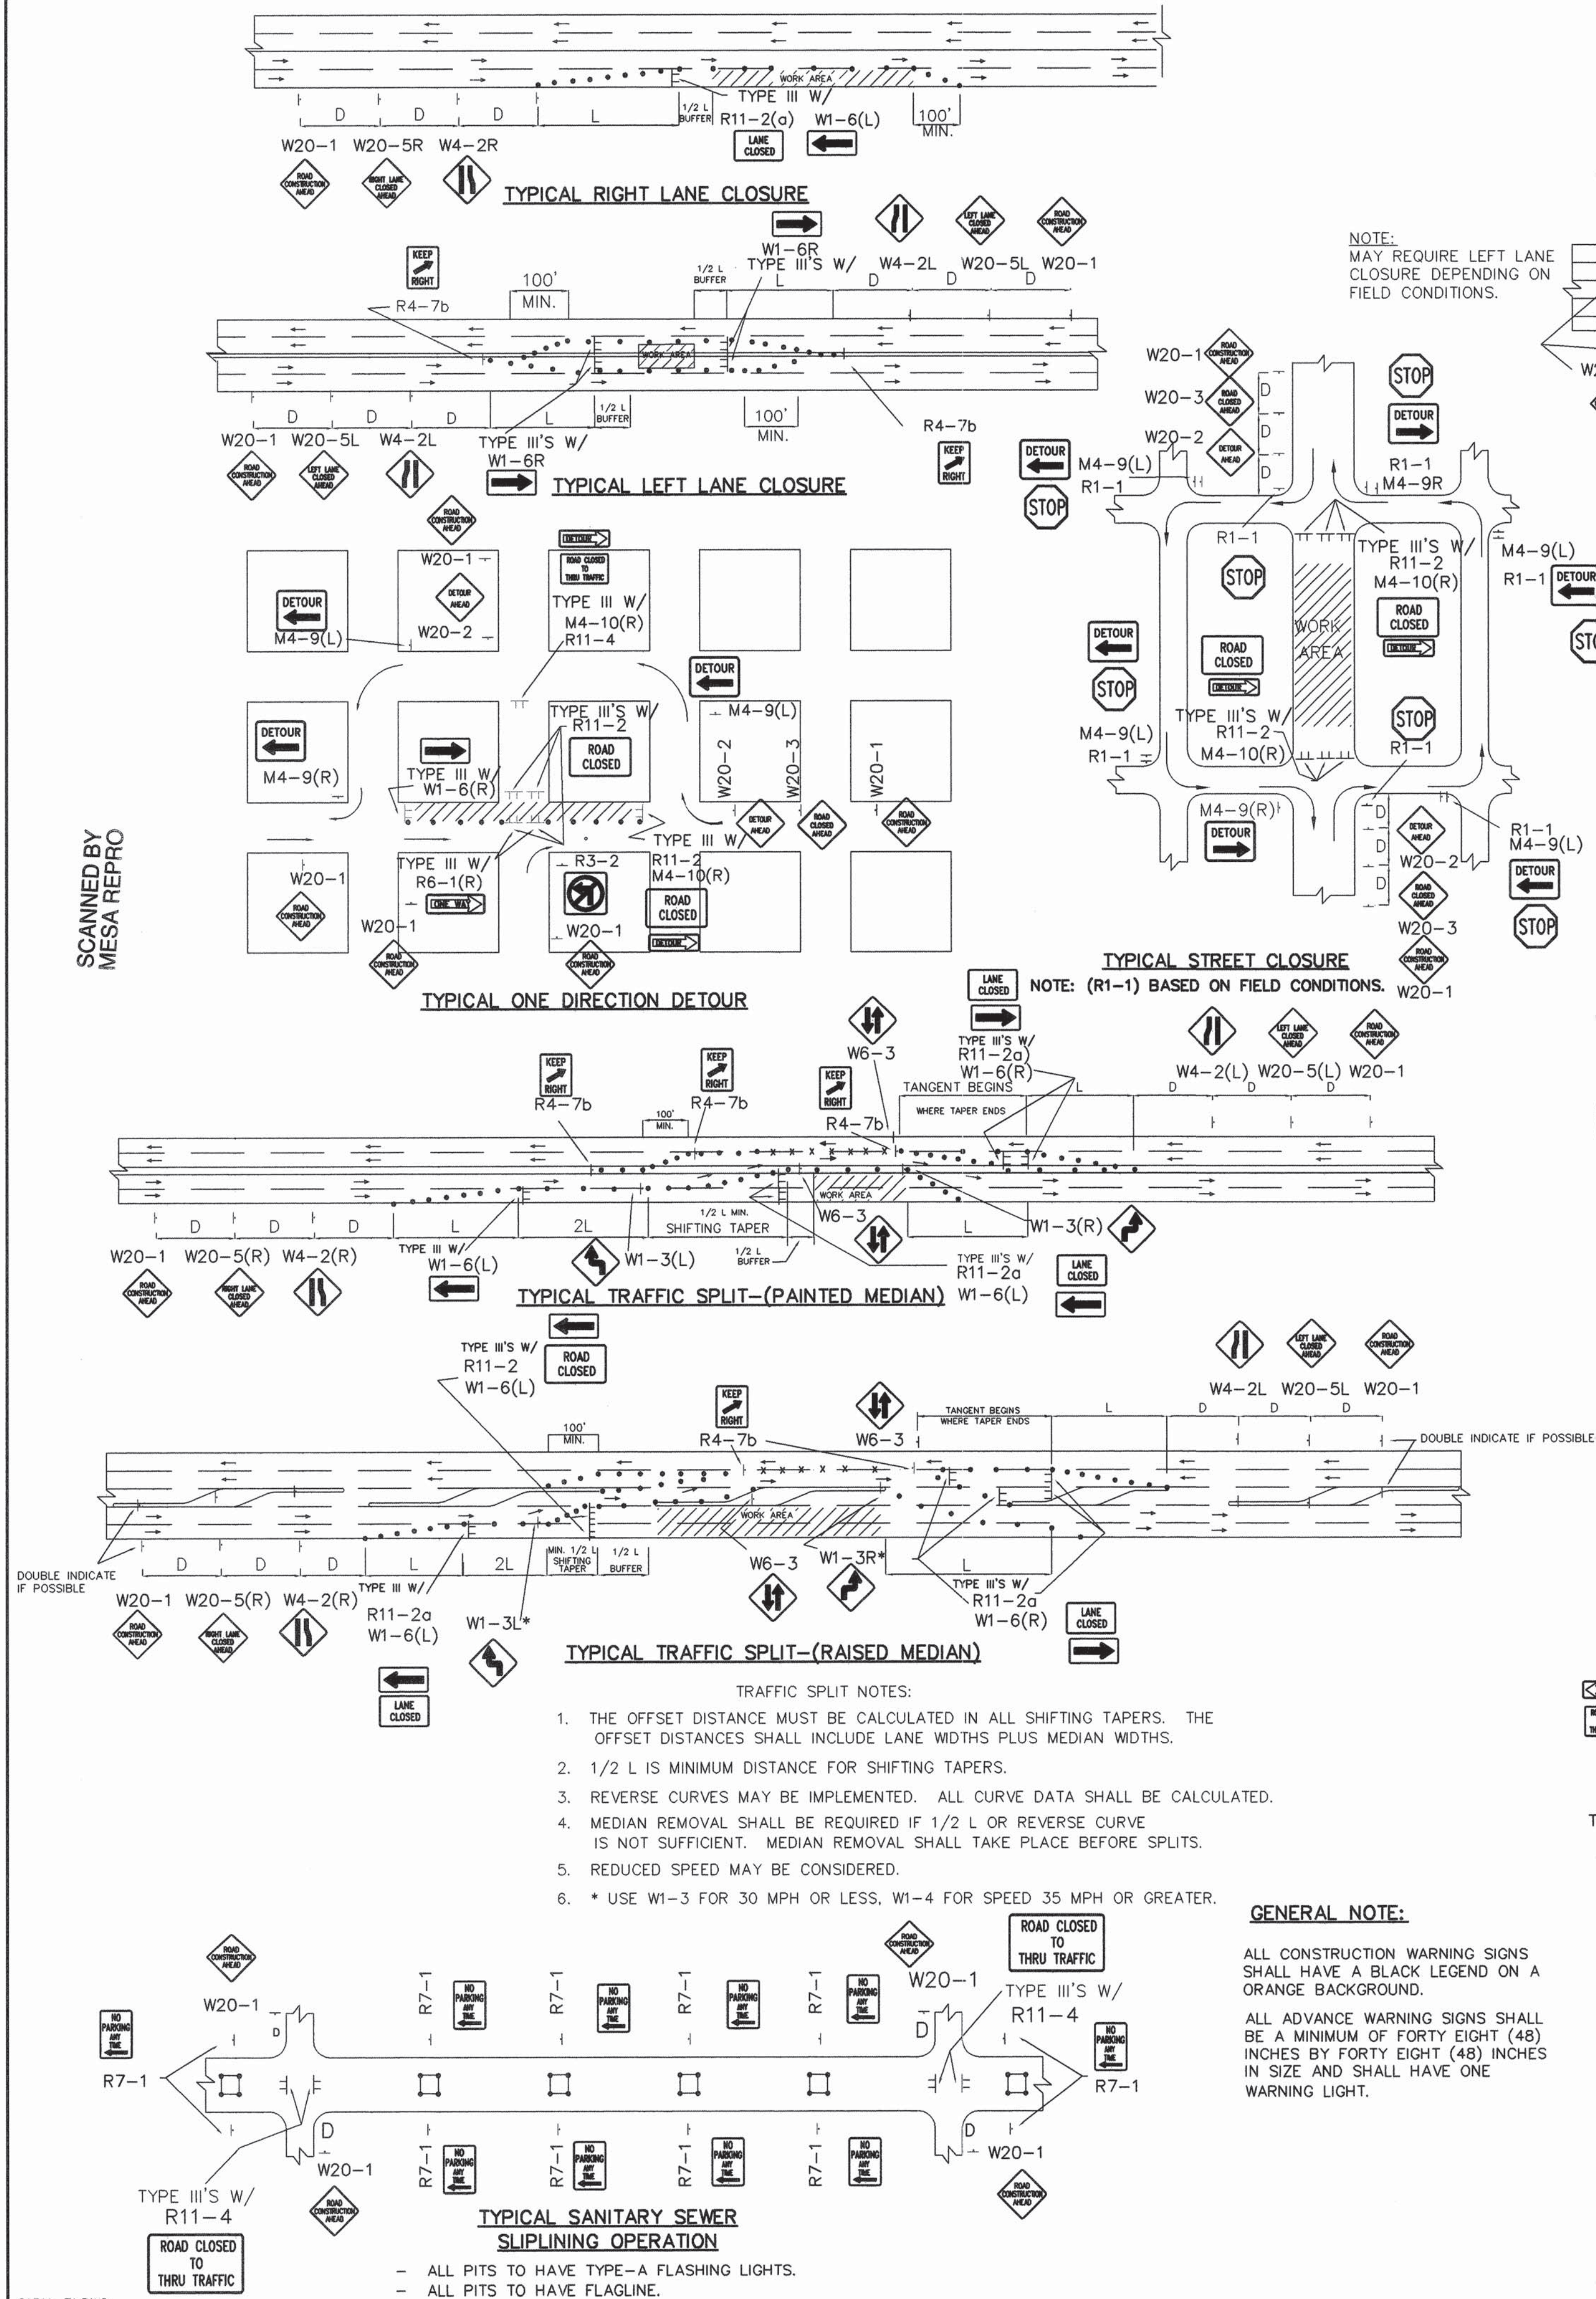


NOTE:
MAY REQUIRE LEFT LANE
CLOSURE DEPENDING ON
FIELD CONDITIONS.

TYPICAL LANE CLOSURE AT INTERSECTION
NOTE: DEPENDING ON WORK ZONE LOCATION

TYPICAL MID-BLOCK CLOSURE
NOTE: (R1-1) BASED ON FIELD CONDITIONS.

TYPICAL STREET CLOSURE
NOTE: (R1-1) BASED ON FIELD CONDITIONS.

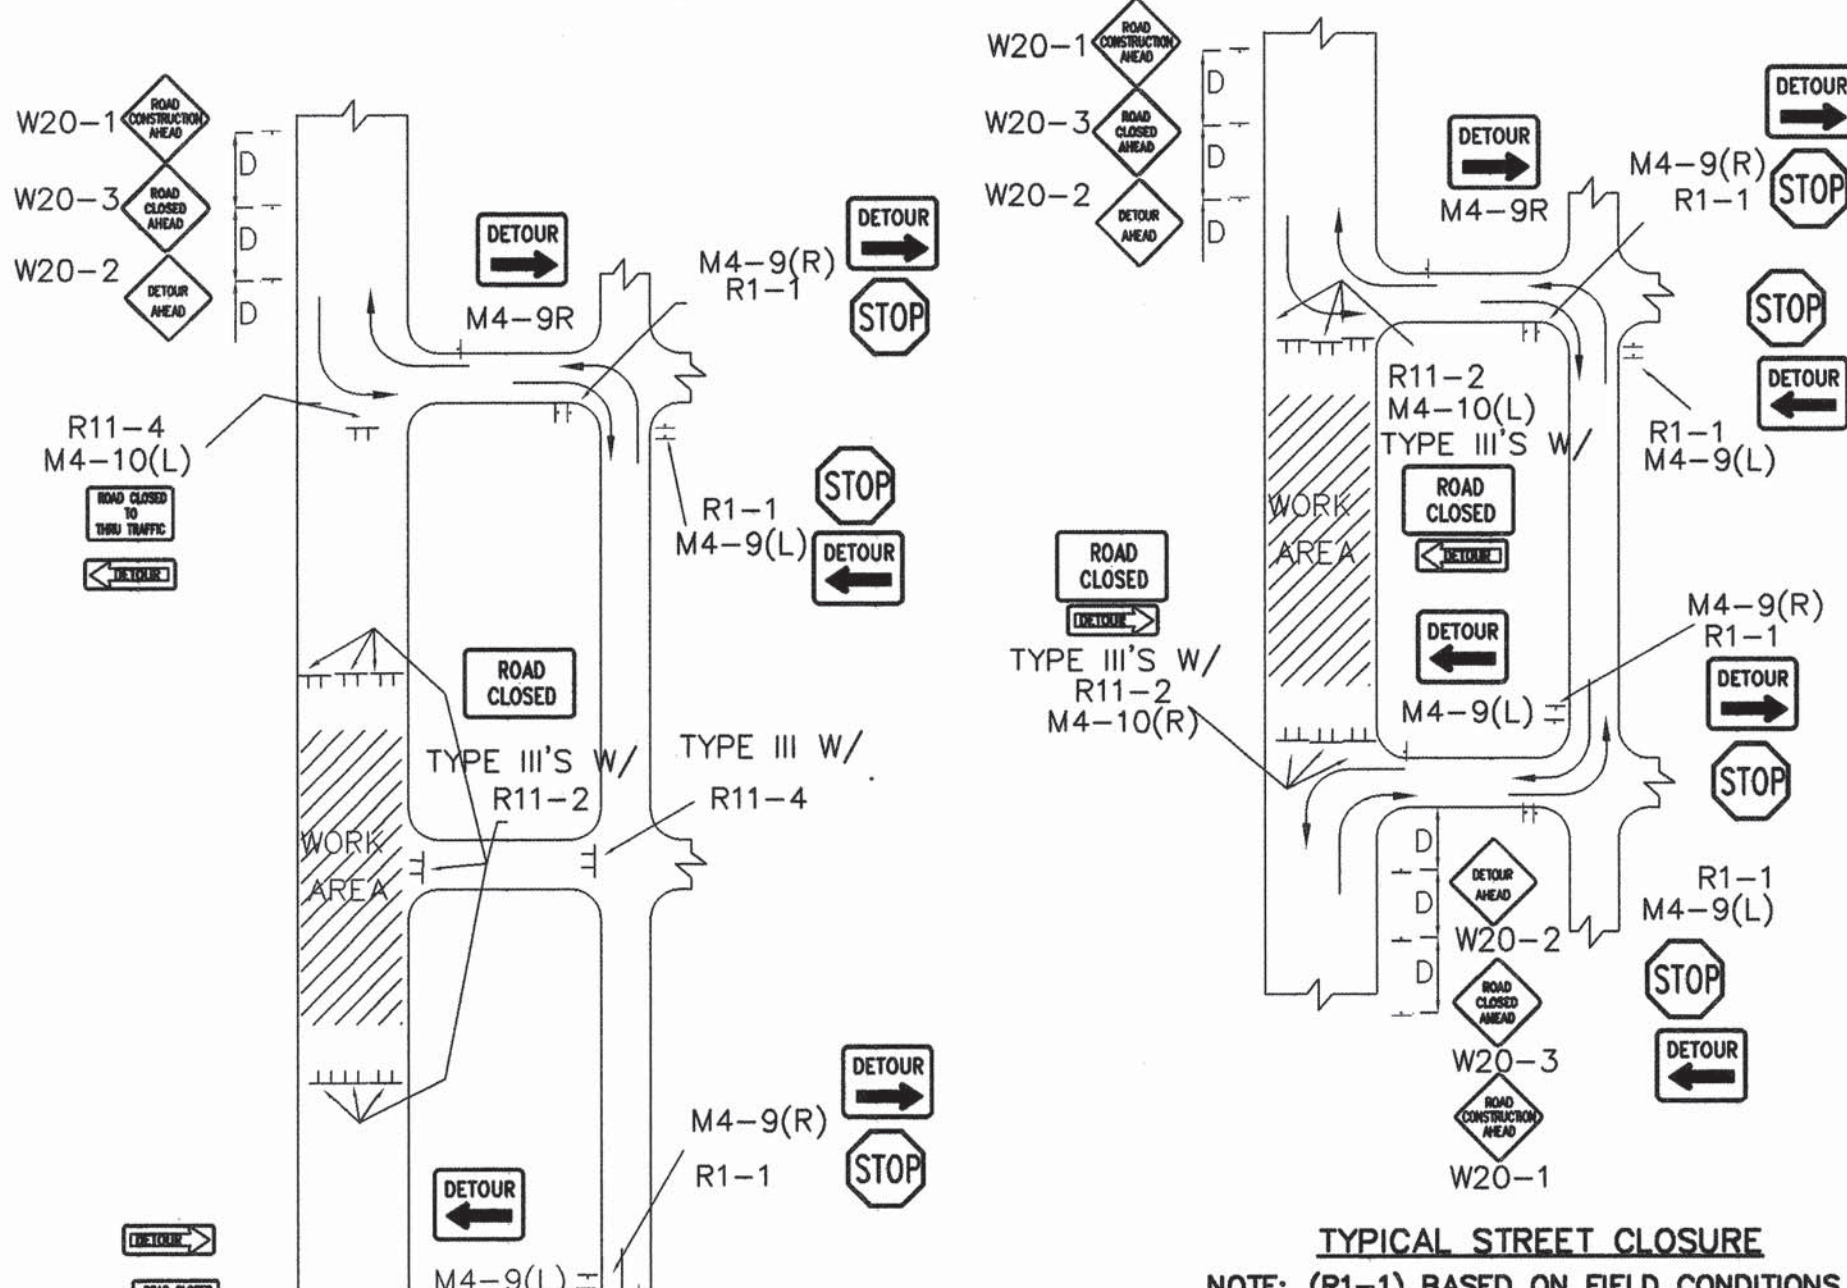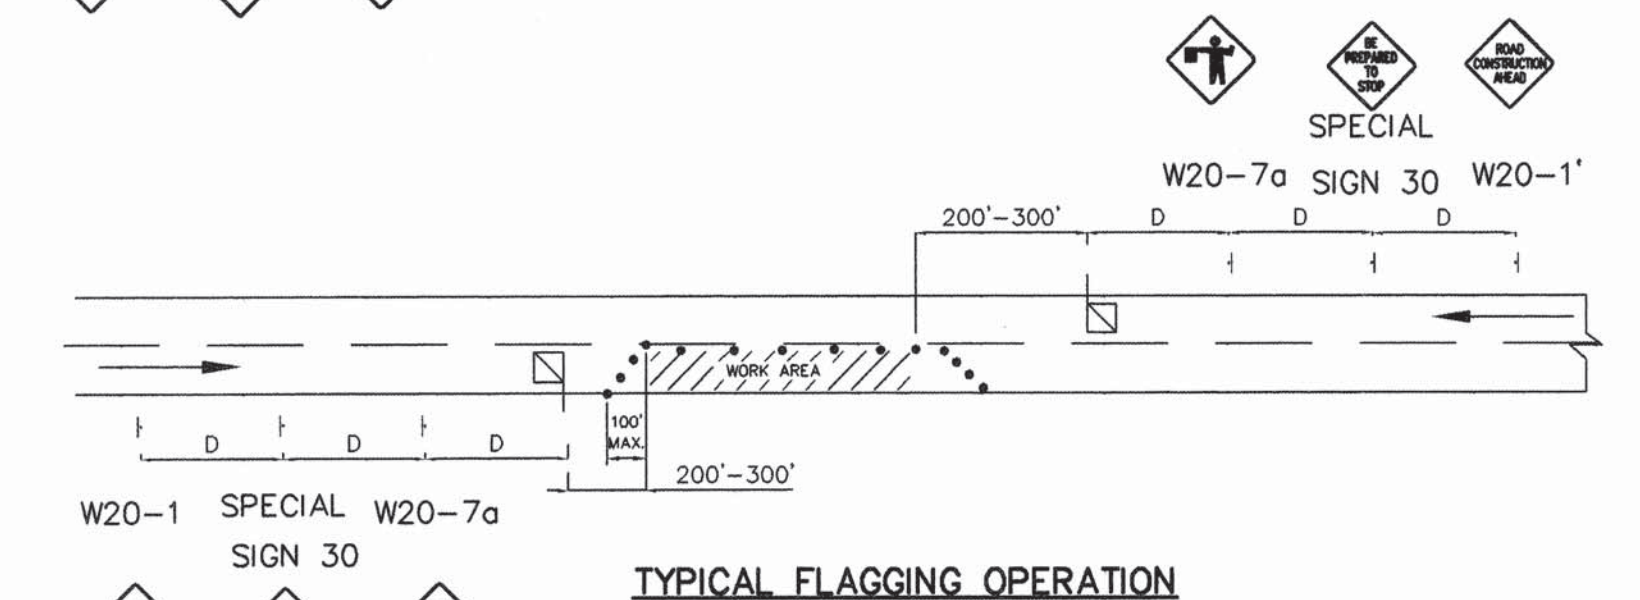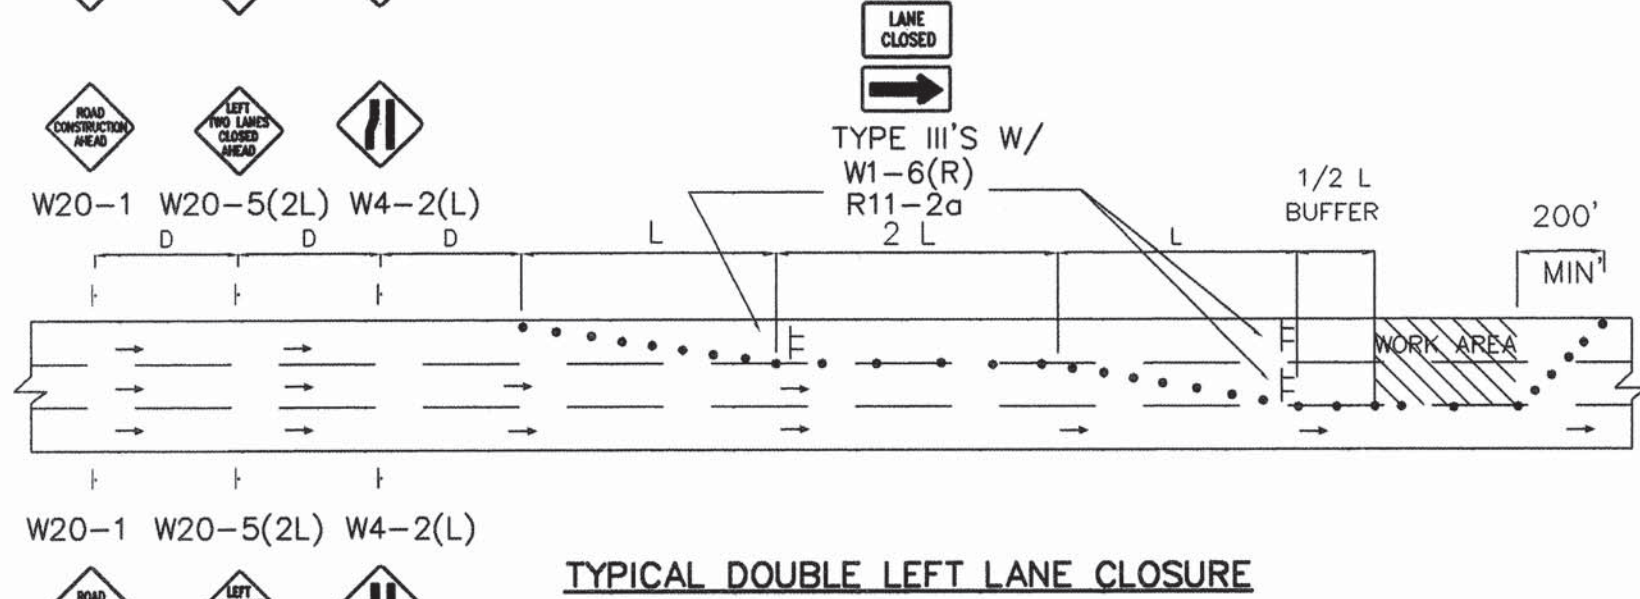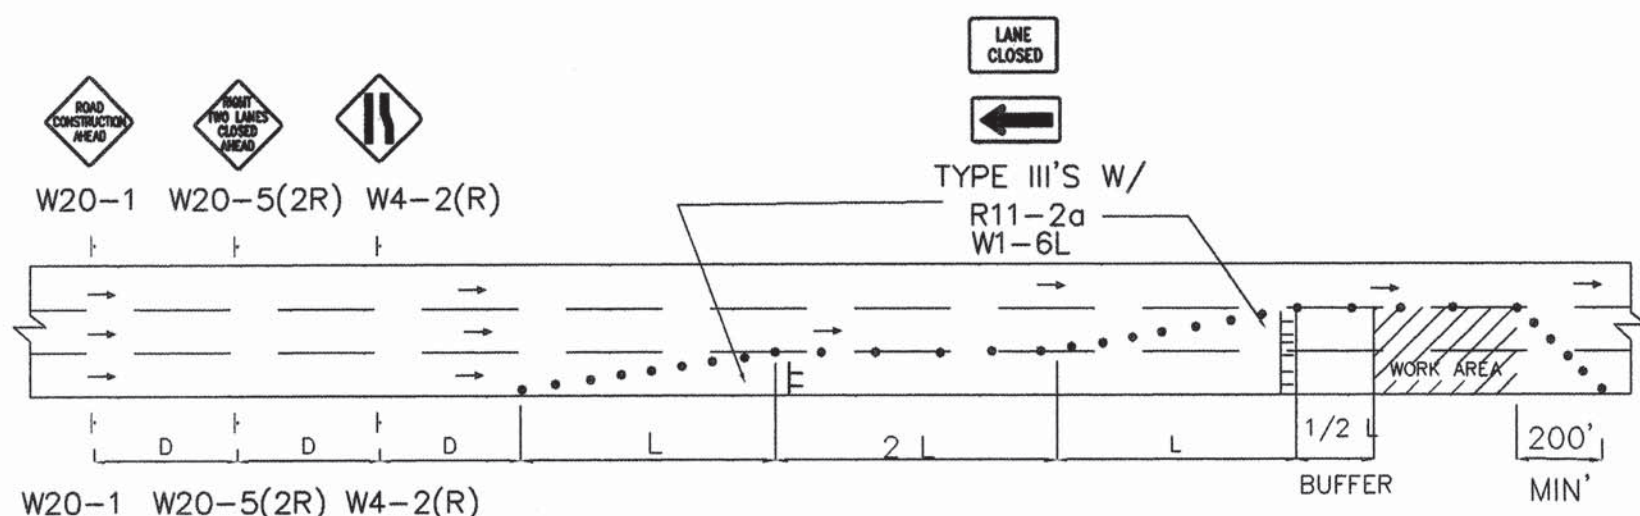

CITY OF ALBUQUERQUE PUBLIC WORKS DEPARTMENT ENGINEERING DEVELOPMENT GROUP			
TITLE: BLUEWATER ROAD NW TRAFFIC CONTROL DETAILS			
DESIGN REVIEW COMMITTEE	CITY ENGINEER APPROVAL	LAST UPDATE	MO./DAY/YR.
COA	STANDARD		
PROJECT NO. 663881	MAP NO. K-9	SHEET 10	OF 11

		ENGINEER'S SEAL		SURVEY INFORMATION		BENCH MARKS		AS BUILT INFORMATION	
				FIELD NOTES		ACS 10-K10 ACS 3 1/4" ALUM CAP 54" EAST		CONTRACTOR	DATE
				NO.	BY	DATE	CENTERLINE OF UNSER BLVD. AND 20.4' SOUTH	WORK SCHEDULED BY	DATE
							OF NORTH END OF BACK OF CURB OF TRAFFIC	INSPECTOR'S FIELD	DATE
							ISLAND ON LOS VOLCANES RD. THE STATION	VERIFICATION BY	DATE
NO.	DATE	REMARKS	BY				IS SET FLUSH IN THE TOP OF CURB AND IS	CORRECTED BY	DATE
				CITY STANDARD			STAMPED "10-K10, 1989."	MICRO-FILM INFORMATION	
DESIGNED BY	STAFF	DATE 4/2001					ELEVATION = 5142.79 FEET	RECORDED BY	DATE
DRAWN BY	STAFF	DATE 4/2001					VERTICAL DATUM SLD 1929	NO.	
CHECKED BY	D.A.L.	DATE 4/2001							

CONSTRUCTION TRAFFIC CONTROL GENERAL NOTES

1. CONTRACTOR MUST OBTAIN FROM CONSTRUCTION COORDINATION AN EXCAVATION/BARRICADING PERMIT BEFORE ENGAGING IN ANY CONSTRUCTION, MAINTENANCE OR REPAIR WORK IN ANY OF THE CITY OF ALBUQUERQUE'S RIGHTS-OF-WAY. EMERGENCY WORK THAT WOULD PRESERVE LIFE OR PROPERTY IS EXCLUDED WITH THE UNDERSTANDING, THAT A PERMIT SHALL BE OBTAINED WITHIN 24 TO 48 HOURS.
2. CONTRACTOR SHALL AT THE TIME OF PERMIT REQUEST, SUBMIT FOR APPROVAL BY CONSTRUCTION COORDINATION, A TRAFFIC CONTROL PLAN DETAILING ALL EXISTING TOPOGRAPHY SUCH AS LANE WIDTHS, DRIVEWAYS, AND BUSINESS/RESIDENTIAL ACCESSES. THE TRAFFIC CONTROL PLAN SHALL INCLUDE ALL PHASES OF WORK AND SCHEDULES INVOLVED IN THE CONSTRUCTION PROJECT. ANY SEPARATE PHASES OF A CONSTRUCTION PROJECT SHALL BE GIVEN AN INDIVIDUAL PERMIT EACH. BLANKET PERMITS WILL NOT BE ISSUED.
3. THESE TYPICAL TRAFFIC CONTROL PLANS DO NOT REFLECT THE EXISTING TOPOGRAPHY SUCH AS DRIVEWAYS, LANE WIDTHS, AND BUSINESS/RESIDENTIAL ACCESSES. EVERY LOCATION THAT REQUIRES CONSTRUCTION TRAFFIC CONTROL SHALL HAVE A DETAILED TRAFFIC CONTROL PLAN SHOWING ALL EXISTING TOPOGRAPHY.
4. CONSTRUCTION SHALL NOT BEGIN UNLESS A TRAFFIC CONTROL PLAN HAS BEEN APPROVED AND VERIFIED BY CONSTRUCTION COORDINATION.
5. CONSTRUCTION COORDINATION SHALL BE NOTIFIED 48 HOURS PRIOR TO ANY TRAFFIC CONTROL CHANGES NEEDED BY CONTRACTOR, THAT WERE NOT PREVIOUSLY APPROVED. THESE TRAFFIC CONTROL CHANGES SHALL BE REQUESTED IN WRITING ACCOMPANIED WITH A TRAFFIC CONTROL PLAN REFLECTING SUCH CHANGES.
6. ALL CONSTRUCTION TRAFFIC CONTROL DEVICES SHALL COMPLY TO THE MANUAL ON UNIFORM TRAFFIC CONTROL DEVICES (MUTCD), LATEST EDITION. IT IS THE RESPONSIBILITY OF THE CONTRACTOR TO INSTALL, SERVICE AND MAINTAIN ALL TRAFFIC CONTROL DEVICES. TRAFFIC CONTROL DEVICES SHALL NOT BE REMOVED OR ALTERED IN ANY WAY WITHOUT THE APPROVAL OF CONSTRUCTION COORDINATION, PER SECTION 6A-4 OF THE MUTCD, LATEST EDITION.
7. THE CONSTRUCTION TRAFFIC CONTROL INITIAL SET-UP SHALL BE BY AN AMERICAN TRAFFIC SAFETY SERVICES ASSOCIATION (ATSSA) CERTIFIED WORKSITE TRAFFIC SUPERVISOR. THE MAINTENANCE AND SERVICING SHALL ALSO BE DONE BY AN ATSSA CERTIFIED WORKSITE TRAFFIC SUPERVISOR OR EQUIVALENT.
8. CONTRACTOR IS RESPONSIBLE TO MAINTAIN AND SERVICE ALL TRAFFIC CONTROL DEVICES 24 HOURS A DAY, 7 DAYS A WEEK THROUGHOUT LENGTH OF PROJECT. CONTRACTOR IS RESPONSIBLE THAT ALL TRAFFIC CONTROL DEVICES COMPLY WITH THE MUTCD, LATEST EDITION.
9. ALL ADVANCE WARNING SIGNS SHALL BE DOUBLE INDICATED WHENEVER THERE ARE MULTI-LANE TRAFFIC IN ANY ONE GIVEN DIRECTION AND THERE IS SUFFICIENT MEDIAN SPACE.
10. ALL BARRICADES IN ALL TAPERS AND TANGENTS SHALL BE PLACED APART, A DISTANCE MEASURED IN FEET, EQUAL TO THAT OF THE POSTED SPEED LIMIT. NO EXCEPTIONS UNLESS APPROVED BY CONSTRUCTION COORDINATION PER MUTCD SECTION 6A-4.
11. CONTRACTOR SHALL MAINTAIN A GRAFFITI FREE SITE
12. CONTRACTOR IS RESPONSIBLE TO PROVIDE CONSTRUCTION COORDINATION, A WEEKLY LOG OF DAILY INSPECTIONS OF BARRICADE AND MAINTENANCE SCHEDULES ON PROJECTS THAT ARE OVER ONE WEEK DURATION.
13. EQUIPMENT OR MATERIALS SHALL NOT BE STORED WITHIN 15 FEET OF A TRAVELLED TRAFFIC LANE DURING NON-WORKING HOURS WITHOUT THE APPROVAL OF CONSTRUCTION COORDINATION.
14. CONTRACTOR SHALL PROVIDE AND MAINTAIN A SAFE AND ADEQUATE MEANS OF CHANNELIZING PEDESTRIAN TRAFFIC AROUND AND THROUGH THE CONSTRUCTION AREA.
15. CONTRACTOR IS RESPONSIBLE FOR OBLITERATION OF ANY CONFLICTING STRIPING AND RESPONSIBLE FOR ALL TEMPORARY STRIPING.
16. CONTRACTOR SHALL MAINTAIN ACCESS TO ALL FACILITIES, BUSINESSES AND/OR RESIDENTS AT ALL TIMES.
17. CONTRACTOR SHALL PROVIDE ACCESS SIGNS FOR BUSINESSES LOCATED WITHIN THE CONSTRUCTION AREA UNDER THE SUPERVISION OF CONSTRUCTION COORDINATION. EACH ACCESS SIGN SHALL HAVE 5 INCH, WHITE OPAQUE LETTERING ON BLUE REFLECTORIZED BACKGROUND. ACCESS SIGNS SHALL BE CONSIDERED INCIDENTAL TO THE BID AND NOT PART OF THE CONTRACT UNLESS OTHERWISE STATED. NO MORE THAN 3 BUSINESSES SHALL BE LISTED ON A ACCESS SIGN. SHOPPING CENTERS AND MALLS SHALL BE LISTED AS SUCH.
18. ALL ADVANCE WARNING SIGNS SHALL MEET THE MINIMUM REFLECTIVE INTENSITY REQUIREMENTS SET FORTH BY THE CITY OF ALBUQUERQUE. CONSTRUCTION COORDINATION SHALL DETERMINE ALL REQUIREMENTS AND APPROVE OR DISAPPROVE ANY ADVANCE WARNING SIGN PER SECTION 6A-4 OF THE MUTCD, LATEST EDITION.
19. 24 HOURS PRIOR TO OCCUPYING OR CLOSING OF A RIGHT-OF-WAY, CONTRACTOR SHALL NOTIFY: POLICE, FIRE DEPARTMENT, SCHOOLS, HOSPITALS, TRANSIT AUTHORITY, BUSINESSES AND/OR RESIDENTS THAT WILL BE AFFECTED BY THE CONSTRUCTION.
20. ANY FIELD ADJUSTMENTS SHALL BE APPROVED BY CONSTRUCTION COORDINATION.

21. EXCAVATIONS SHALL BE PLATED, TEMPORARILY PATCHED OR RESURFACED PRIOR TO OPENING OF TRAFFIC. A MINIMUM OF 11 FEET SHALL BE PROVIDED FOR TRAFFIC IN ANY GIVEN DIRECTION. CONTRACTOR IS RESPONSIBLE FOR ANY WORK INVOLVED IN SATISFYING THESE REQUIREMENTS.


22. CONTRACTOR SHALL AT ALL TIMES COMPLY WITH THE FOLLOWING:
1. STANDARDS AND REQUIREMENTS SET FORTH IN THE MANUAL ON UNIFORM TRAFFIC CONTROL DEVICES, LATEST EDITION.
 2. THE CITY OF ALBUQUERQUE TRAFFIC CODE, LATEST EDITION.
 3. SECTION 19 OF THE CITY OF ALBUQUERQUE'S STANDARD SPECIFICATIONS FOR PUBLIC WORK CONSTRUCTION, AS WELL AS OTHER SECTIONS.

23. FAILURE TO COMPLY WITH ANY OF THE ABOVE MENTIONED, WILL BE ADEQUATE CAUSE TO CEASE ALL WORK ON ANY CONSTRUCTION PROJECT. WORK WILL NOT RESUME UNTIL ALL REQUIREMENTS ARE ADDRESSED AND APPROVED BY CONSTRUCTION COORDINATION.


24. ALL TRAFFIC CONTROL DEVICES SHALL BE KEPT IN NEW-CLEAN CONDITION. WASHING OF EQUIPMENT IS INCIDENTAL TO IT'S PLACEMENT AND MAINTENANCE.

25. TRAFFIC CONTROL STANDARDS APPLY ONLY WHERE THE CONSTRUCTION TRAFFIC CONTROL PLANS ARE NOT SPECIFIC.


26. ADVANCE WARNING SIGNS SHALL BE 36"x36" WITH SUPER ENGINEERING GRADE SHEETING OR BETTER.

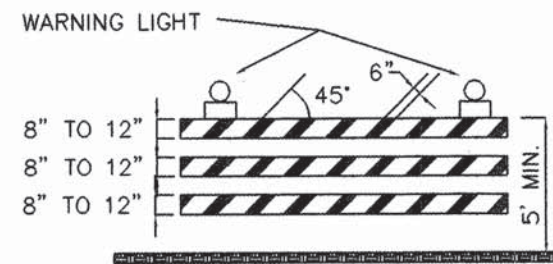


TYPE III BARRICADE

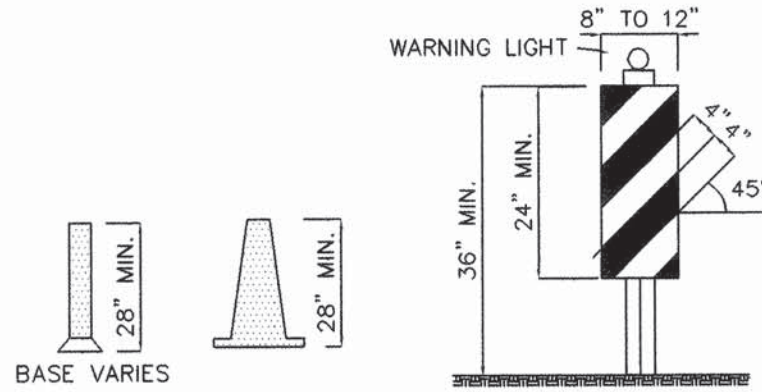

VERTICAL PANEL

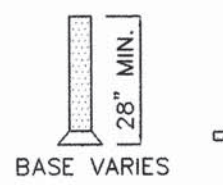


CONES

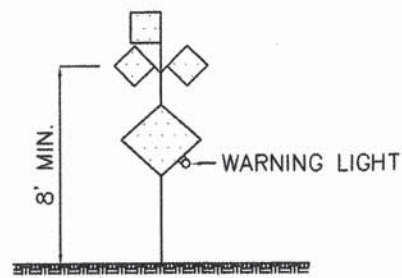


HIGH LEVEL WARNING DEVICE

LEGEND


- WORK AREA
- BARRICADE - TYPE I, TYPE II, OR BARREL
- BARRICADE - TYPE III
- VERTICAL PANEL
- WARNING SIGN
- DISTANCE BETWEEN SIGNS - A DISTANCE MEASURED IN FEET EQUAL TO A VALUE OF TEN TIMES THE SPEED LIMIT OF THE STREET
- FLAGMAN POSITION
- SPACING BETWEEN BARRICADES- A DISTANCE MEASURED IN FEET EQUAL TO THE SPEED LIMIT OF THE STREET
- TAPER LENGTH - SEE CHART BELOW
- THE TANGENT LENGTH IS EQUAL TO THE TAPER LENGTH FOR A GIVEN STREET.

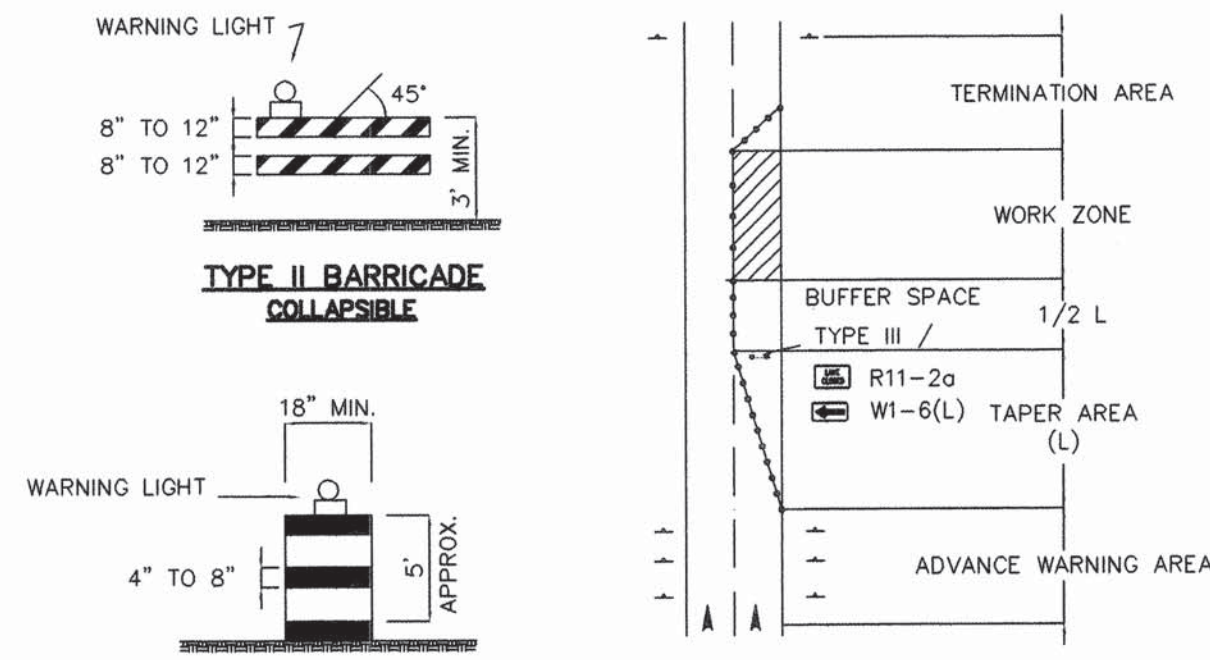


TYPE II BARRICADE COLLAPSIBLE

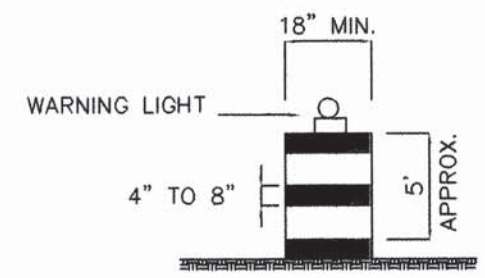

BARREL

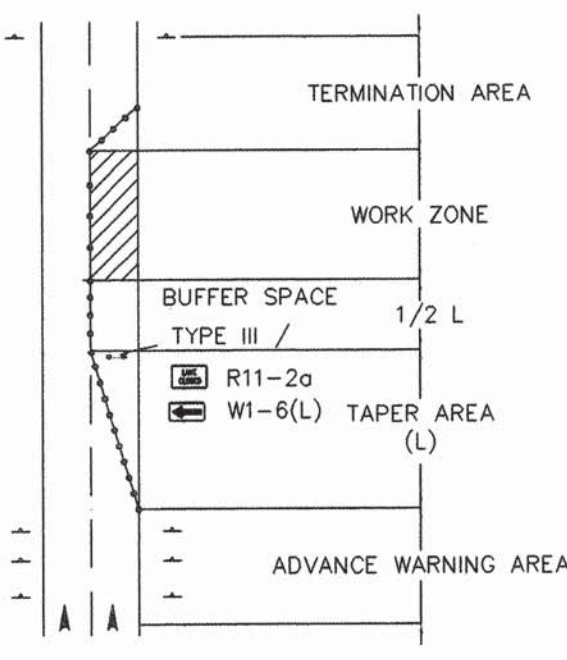

TRAFFIC CONTROL ELEMENTS

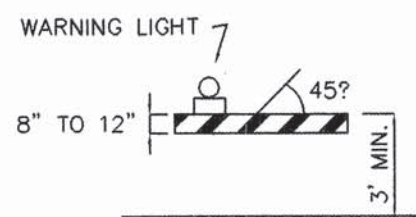

TYPE I BARRICADE COLLAPSIBLE

TAPER REQUIREMENTS

SPEED LIMIT (MPH)	TAPER LENGTH (L) (FEET)			MINIMUM NUMBER OF DEVICES FOR TAPER	MAXIMUM DEVICE SPACING IN FEET	
	10' LANE	11' LANE	12' LANE		ALONG TAPER	AFTER TAPER
20	70	75	80	5	20	20
25	105	115	125	6	25	25
30	150	165	180	7	30	30
35	205	225	245	8	35	35
40	270	295	320	9	40	40
45	450	495	540	13	45	45
50	500	550	600	13	50	50
55	550	605	660	13	55	55

RECOMMENDED SIGN SPACING(D) FOR ADVANCE WARNING SIGN SERIES

SPEED MILES PER HOUR	MINIMUM DISTANCE BETWEEN SIGNS	FROM LAST SIGN TO TAPER
0-20	10 X SPEED LIMIT	10 X SPEED LIMIT
25-30	10 X SPEED LIMIT	10 X SPEED LIMIT
30-35	10 X SPEED LIMIT	10 X SPEED LIMIT
40-45	10 X SPEED LIMIT	10 X SPEED LIMIT
50-60	10 X SPEED LIMIT	10 X SPEED LIMIT

TAPER CRITERIA


TYPE OF TAPER	TAPER LENGTH
UPSTREAM TAPER:	
MERGING TAPER	L MINIMUM
SHIFTING TAPER	1/2 L MINIMUM
SHOULDER TAPER	1/2 L MINIMUM
TWO-WAY TRAFFIC TAPER	100 FEET MAXIMUM
DOWNSTEAM TAPERS	100 FEET PER LANE

TAPER LENGTH COMPUTATION

SPEED LIMIT	
40 MPH OR LESS	$L = \frac{WS^2}{60}$
45 MPH OR GREATER	$L = W \times S$

L = TAPER LENGTH
W = WIDTH OF OFFSET IN FEET
S = POSTED SPEED OR OFF-PEAK 85-PERCENTILE SPEED IN MPH

SIGN FACE DETAILS

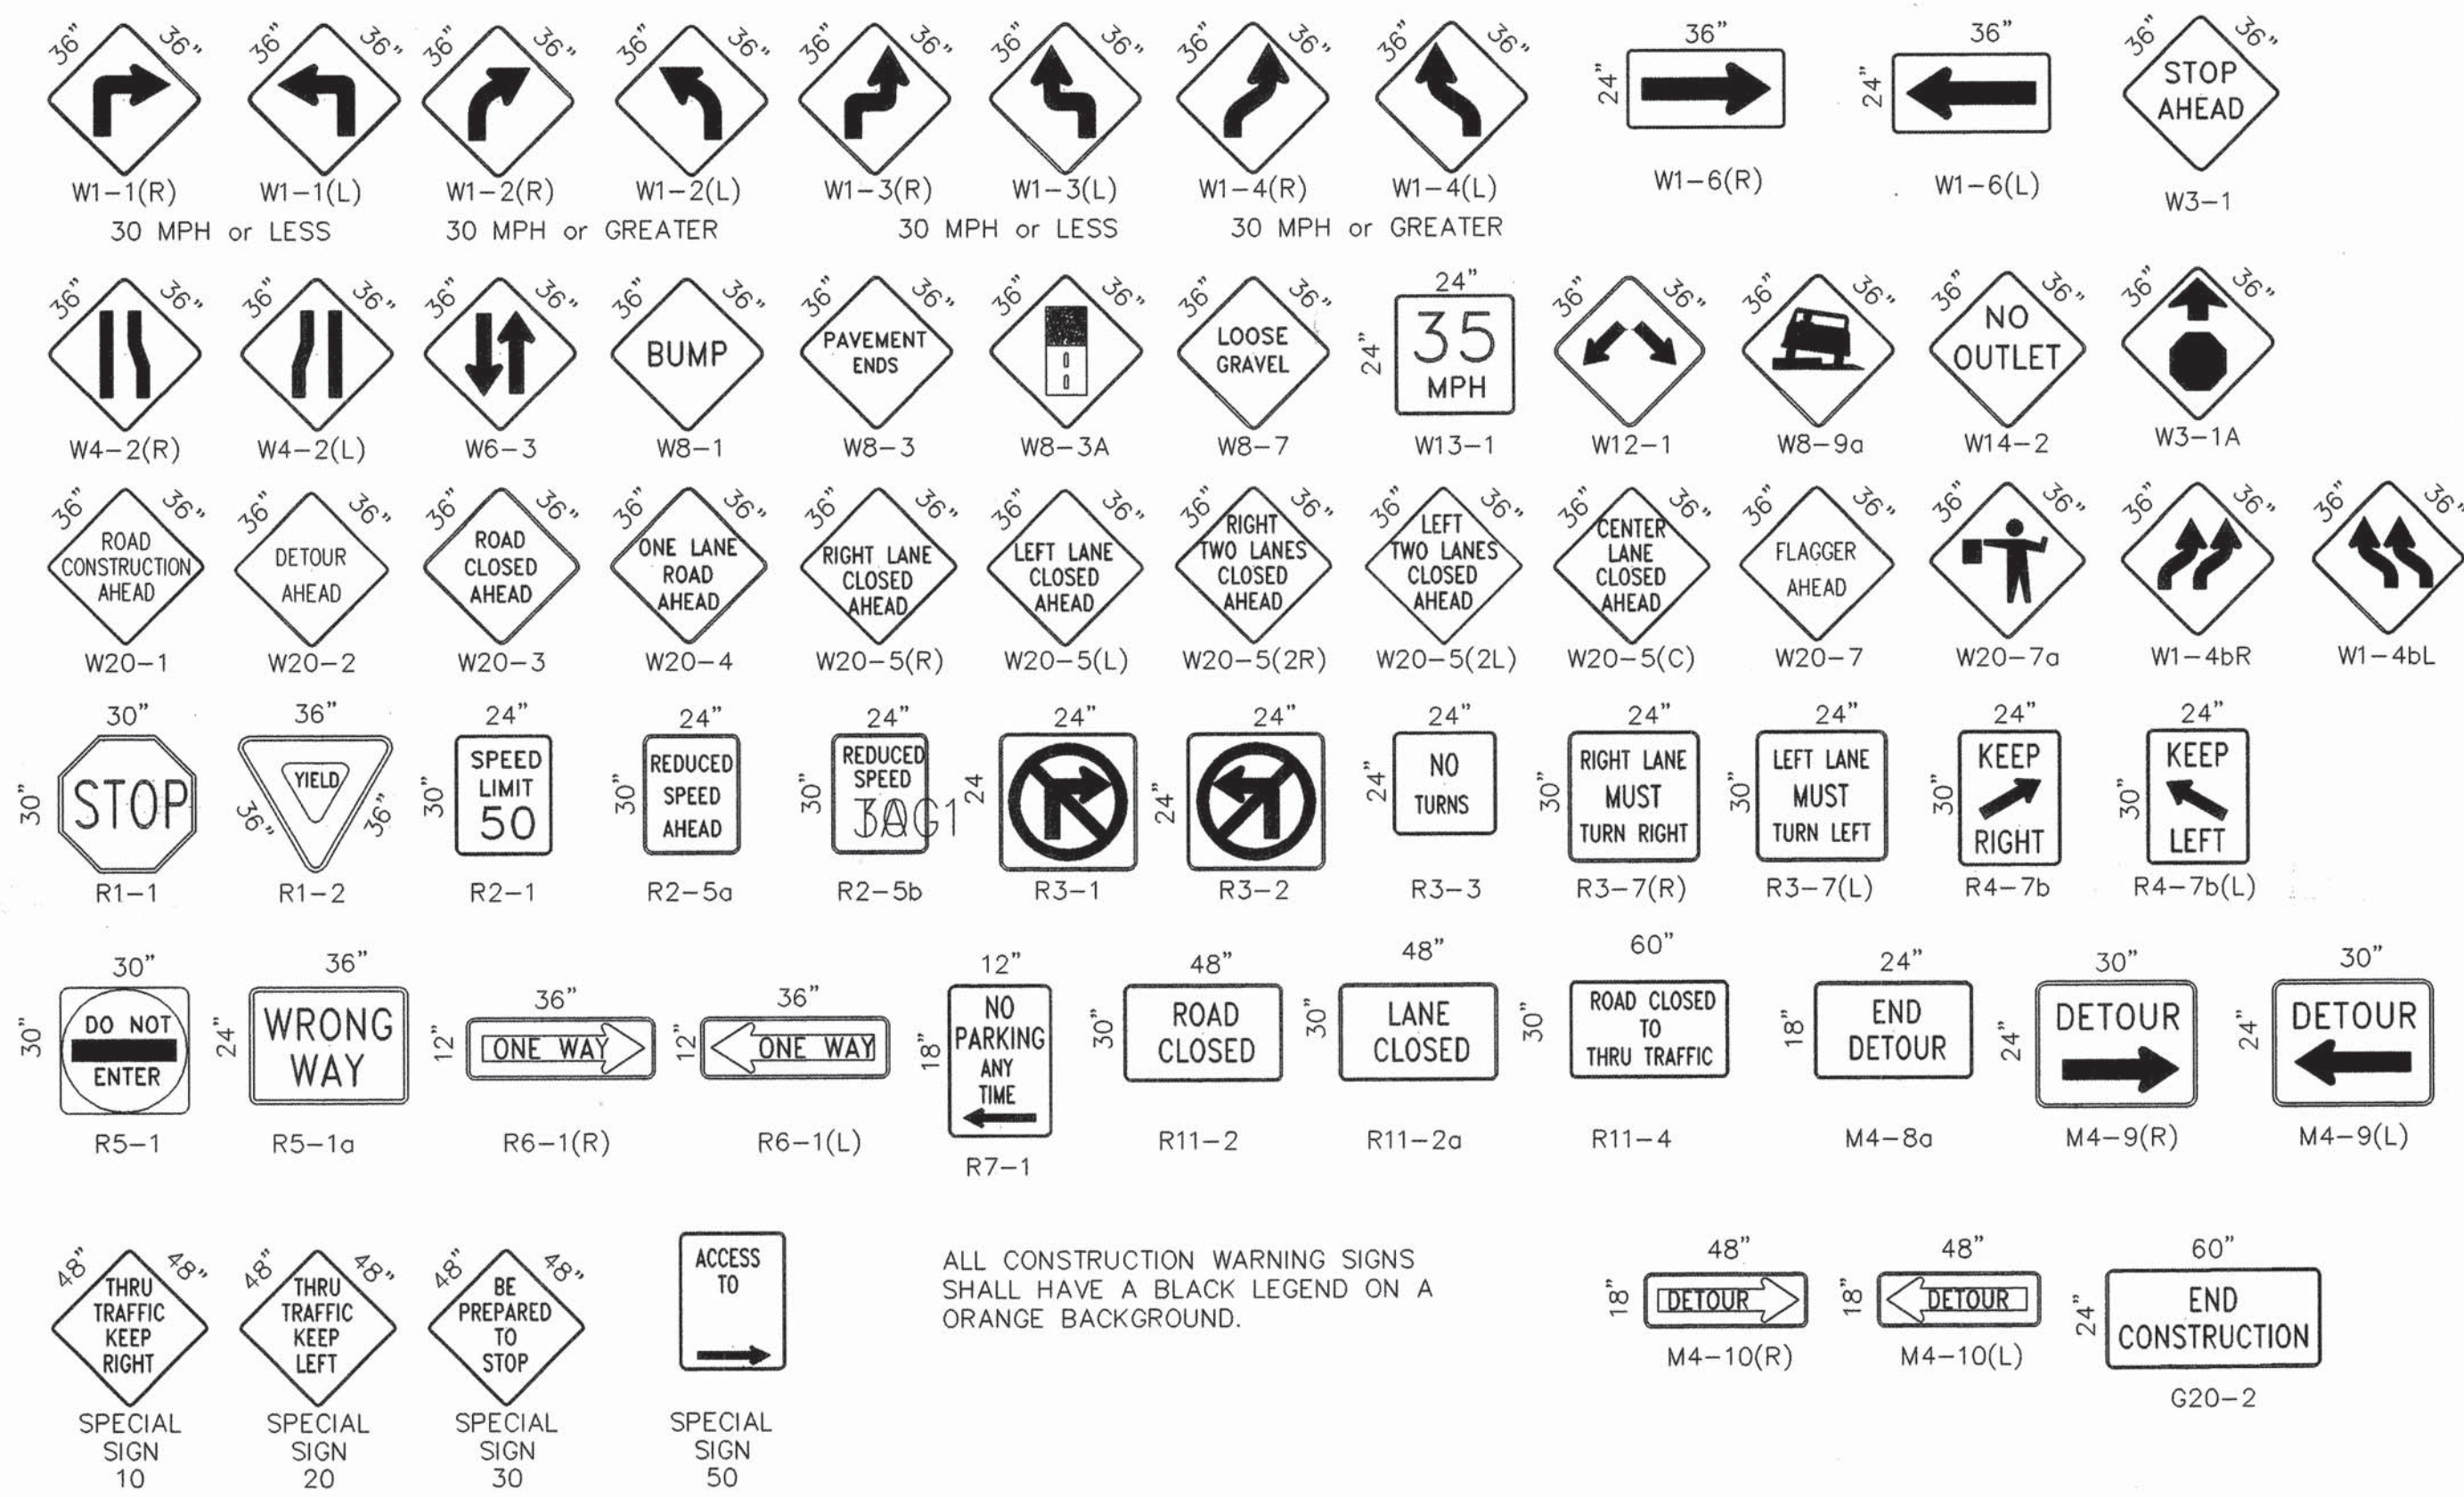

ALL CONSTRUCTION WARNING SIGNS SHALL HAVE A BLACK LEGEND ON A ORANGE BACKGROUND.

CITY OF ALBUQUERQUE PUBLIC WORKS DEPARTMENT ENGINEERING DEVELOPMENT GROUP			
TITLE: BLUEWATER ROAD NW TRAFFIC CONTROL DETAILS			
DESIGN REVIEW COMMITTEE	CITY ENGINEER APPROVAL	MO./DAY/YR.	MO./DAY/YR.
COA	STANDARD		
PROJECT NO. 663881	MAP NO. K-9	SHEET 11	OF 11