

FROM ZONE MAP K-15


**CITY OF ALBUQUERQUE**  
**PUBLIC WORKS DEPARTMENT**  
**TRAFFIC ENGINEERING OPERATIONS**  
**COAL AVE. - TVI PEDESTRIAN IMPROVEMENTS**  
**COAL AVE., FROM UNIVERSITY BLVD. TO BUENA VISTA DR. SE**

Caltrans: TLC  
Inspector: Ron Rutledge  
Staking: COA John Maliceball  
Acceptance: Rick Drai

**DRAWING LIST**

- 1 - TITLE SHEET
- 2 - OVERVIEW AND GENERAL NOTES
- 3 - INTERSECTION PLAN - COAL AVE. AND UNIVERSITY BLVD.
- 4 - CROSSING IMPROVEMENTS PLAN, COAL AVE., UNIVERSITY BLVD. TO BUENA VISTA DR. SE
- 5 - WHEELCHAIR RAMP DETAILS
- 6 - TYPICAL TRAFFIC CONTROL & SIGNING EXAMPLES (REF. M.U.T.C.D.)
- 7 - SIGNING AND CONSTRUCTION TRAFFIC CONTROL STANDARDS

APPROVAL OF RECORD DRAWINGS	
CHIEF CONSTRUCTION ENGINEER	
<i>[Signature]</i>	
DATE	2/9/04

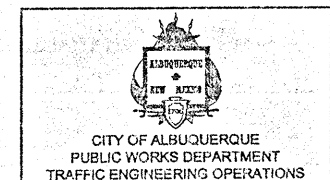

AS BUILTS							
REV.	SHEETS	CITY ENGINEER	DATE	USER DEPARTMENT	DATE	USER DEPARTMENT	DATE
ENGINEERS STAMP & SIGNATURE		APPROVALS	ENGINEER	DATE	*****		
		DRC Chairman			APPROVED FOR CONSTRUCTION		
		Transportation					
		Water/Wastewater					
		Hydrology					
		Parks					
		Constr. Mngmt.			City Engineer      Date		
		City Project No.	6675.08			Sheet 1 of 7	



1. ALL WORK DETAILED ON THESE DRAWINGS TO BE PERFORMED UNDER THIS CONTRACT SHALL, EXCEPT AS OTHERWISE STATED, BE CONSTRUCTED IN ACCORDANCE WITH THE CITY OF ALBUQUERQUE STANDARD SPECIFICATIONS FOR PUBLIC WORKS CONSTRUCTION, 1986 (INCLUDING UPDATES 1 THRU 6) AS HEREBY REFERRED TO AS THE SPECIFICATIONS. REFERENCES MADE TO STANDARD DRAWINGS IMPLY THAT SECTION OF THE SPECIFICATIONS WHICH INCLUDES MISCELLANEOUS STANDARD DETAILS.

- ### GENERAL NOTES

- ALL SIGNAGE AND MARKINGS TO BE INSTALLED IN ACCORDANCE WITH MUTCD SPECIFICATIONS.


- ALL PORTLAND CEMENT CONCRETE FOR PAVEMENT, DRIVEPADS, CURB & GUTTER SECTIONS, VALLEY GUTTERS, SANITARY SEWER STRUCTURES, AND SANITARY SEWER MANHOLE BASES TO BE 4000 PSI FLY ASH. ALL PORTLAND CEMENT CONCRETE FOR EXTERIOR STRUCTURES, EXTERIOR SLAB ON GRADE (SIDEWALKS, STEPS), STORM DRAIN MANHOLE BASES AND MISCELLANEOUS CONCRETE TO BE 3500 PSI FLY ASH. REFER TO SECTION 101 OF THE SPECIFICATIONS.

TRAFFIC SIGN

CURB & GUTTER W/  
DRIVEWAY

EXISTING


PROPOSED

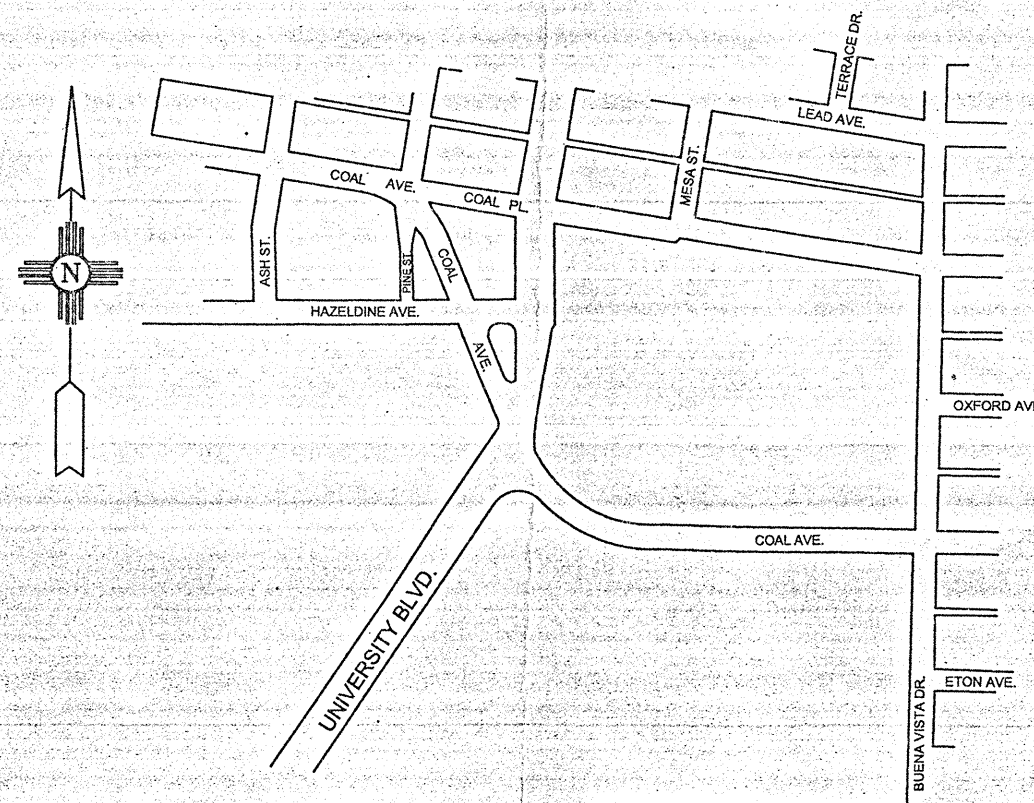

# LOCATION PLAN




## FROM ZONE MAP K-15

### EXPLANATION OF DETAIL NOTATION

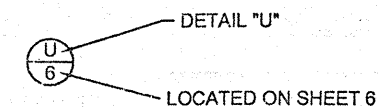

CITY OF ALBUQUERQUE PUBLIC WORKS DEPARTMENT TRAFFIC ENGINEERING OPERATIONS			
TITLE:		COORS CORRIDOR PROJECT OVERVIEW AND GENERAL NOTES	
DESIGN REVIEW COMMITTEE	CITY ENGINEER APPROVAL	MO./DAY/YR.	MO./DAY/YR.
City Project No.		Zone Map No. K-15	Sheet 2 of 7









[illegible]

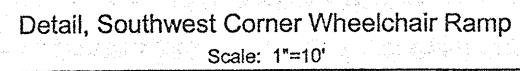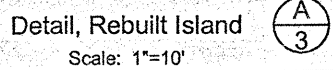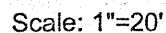

- [illegible]





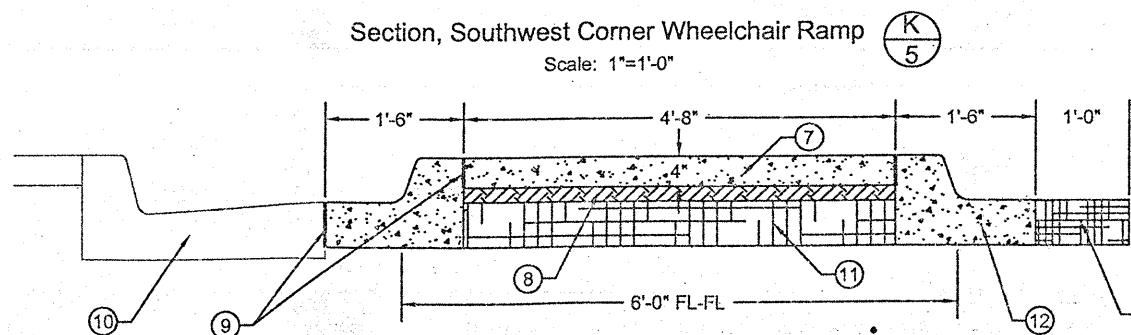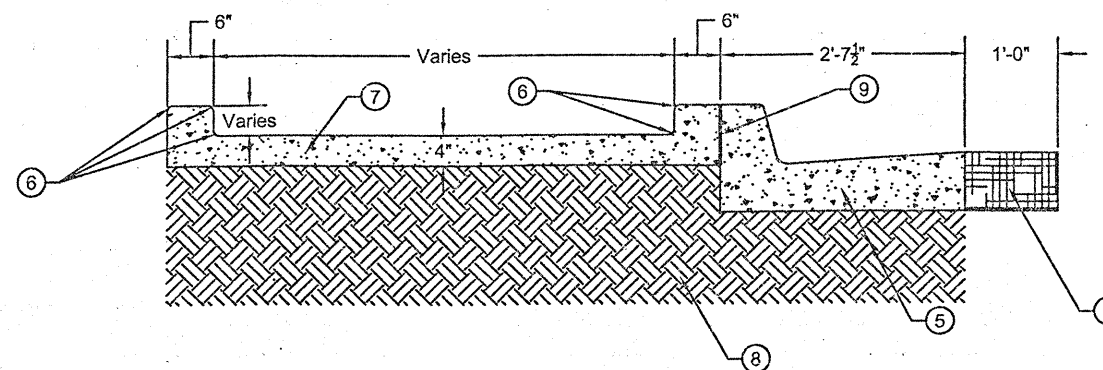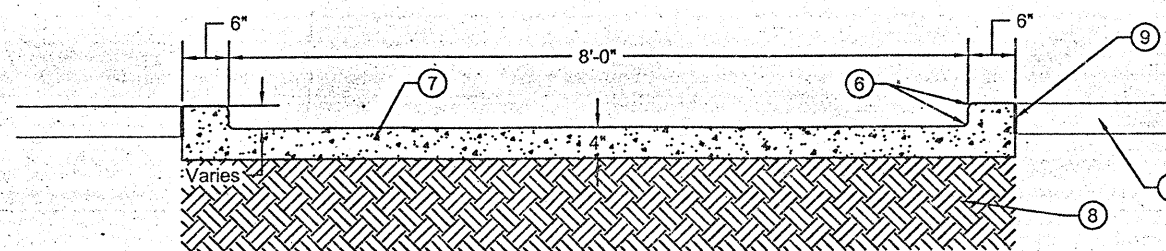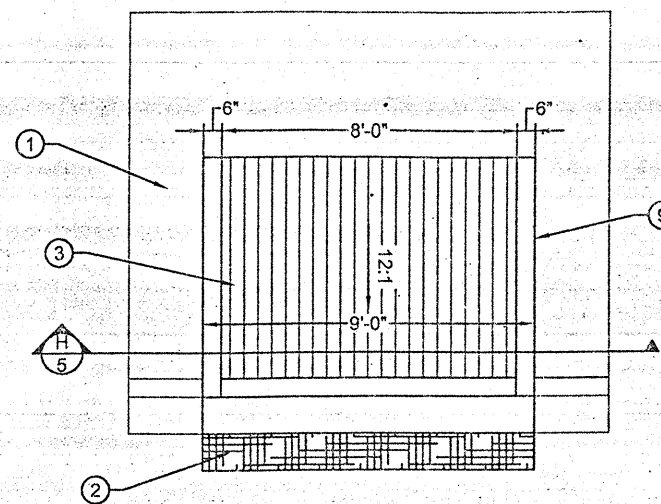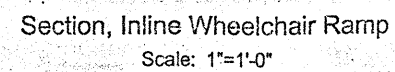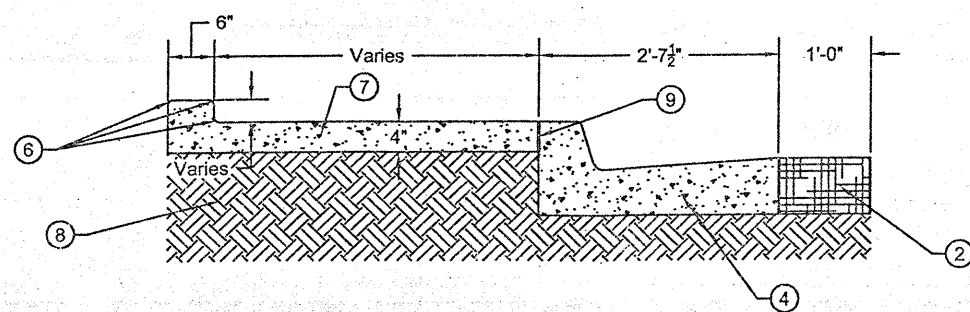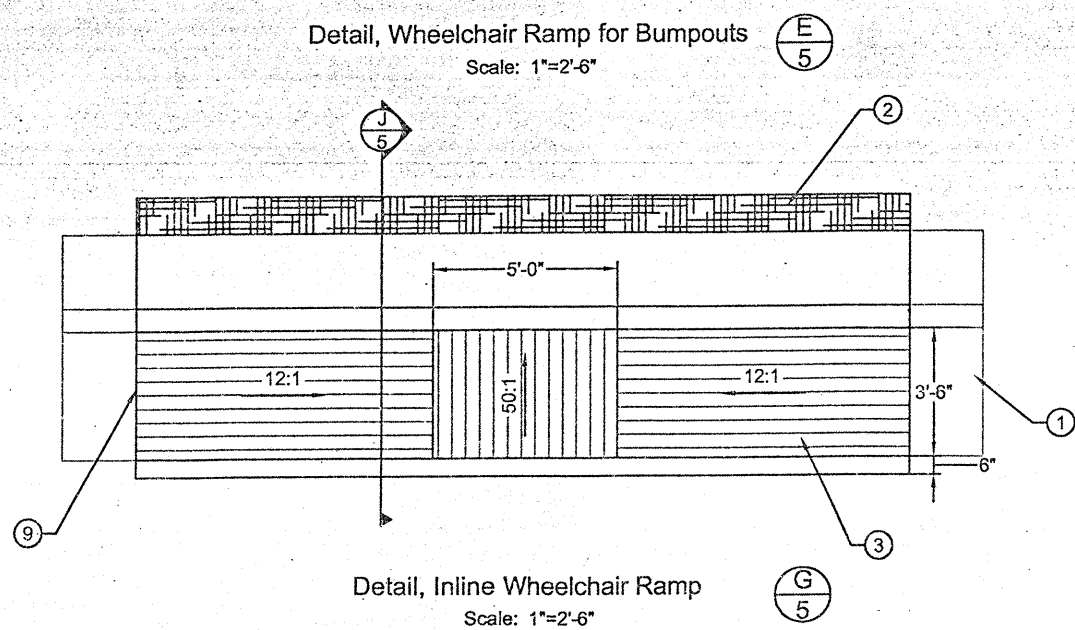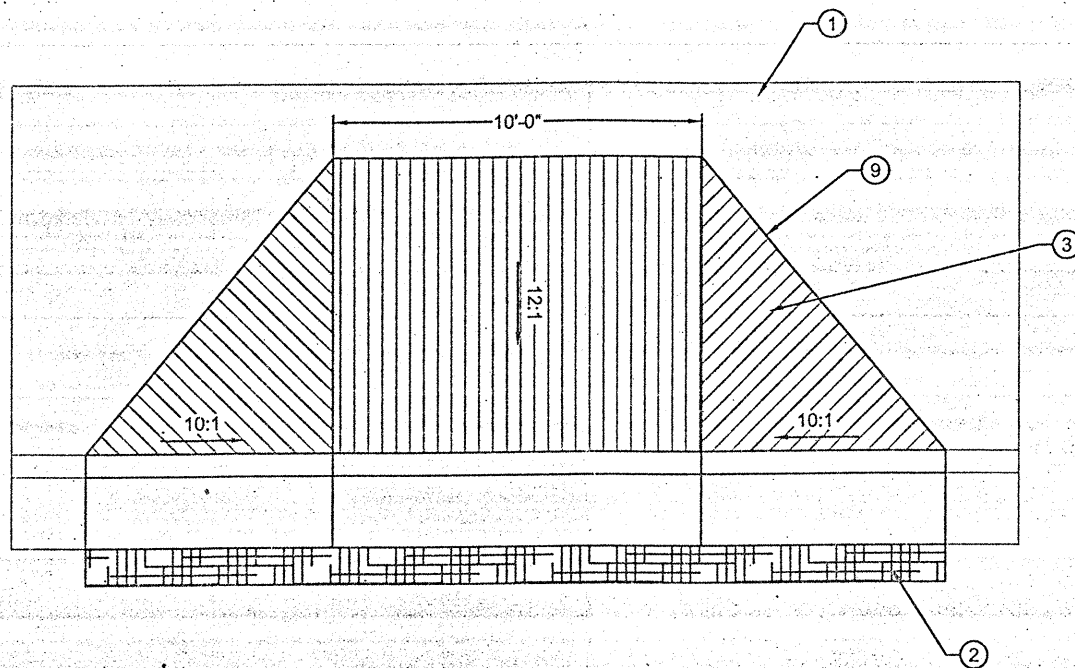

- ### Keyed Notes

- ① - Existing Sidewalk
- ② - Remove & Replace Existing Asphalt Concrete Pavement (Arterial Type)
- ③ - Slopes to have coarse-brushed pattern running parallel to slope
- ④ - Standard Curb & Gutter, Modified to be Flush with Ramp Surface
- ⑤ - Standard Curb & Gutter as per City Std. Dwg. 2415
- ⑥ -  $\frac{3}{4}$ " Radius
- ⑦ - 4000 psi Fly Ash Concrete
- ⑧ - Compacted Subgrade as per Section 301 of the Specifications
- ⑨ -  $\frac{1}{2}$ " Expansion Joint
- ⑩ - Existing Curb & Gutter
- ⑪ - Existing Asphalt Pavement
- ⑫ - Median Curb & Gutter as per City Std. Dwg. 2415

[illegible]