

# PUBLIC IMPROVEMENT PLANS FOR RANCHO ROBERTO N.W. ALBUQUERQUE, NEW MEXICO

JULY 2001

PREPARED FOR:  
**ROBERT GUTIERREZ**  
114 VERONICA COURT  
CORRALES, NM 87048

PREPARED BY:  
**ISAACSON & ARFMAN, P.A.**  
128 MONROE ST. NE  
ALBUQUERQUE, NM 87108

## INDEX TO DRAWINGS

| SHEET NO. | TITLE   |
|-----------|---|
| 1         | COVER SHEET   |
| 2         | GRADING & DRAINAGE PLAN<br>PAVING PLAN & PROFILE SHEETS |
| 3         | RANCHO ROBERTO N.W.<br>UTILITY PLAN & PROFILE SHEETS    |
| 4         | RANCHO ROBERTO N.W.                                     |



### SURVEYOR'S CERTIFICATION

"I, Timothy Aldrich, a duly qualified Registered Professional Land Surveyor under the laws of the State of New Mexico, do hereby certify that the 'as-built' information shown on these drawings was obtained from field construction and 'as-built' surveys performed by me or under my supervision, that the 'as-built' information shown on these drawings was added by me or under my supervision, and that this 'as-built' information is true and correct to the best of my knowledge and belief. Aldrich Land Surveying is not responsible for any of the design concepts, calculations, engineering, or intent of the record drawings."





APPROVED FOR  
CONSTRUCTION  
**Robert Benthala**  
COUNTY OF BERNALILLO PUBLIC WORKS

PROJECT NO. **PWCO# 10003**

I, Fred C. Arfman, a registered Professional Engineer under the laws of the State of New Mexico, do hereby certify that these plans comply with all applicable laws, ordinances and regulations to the best of my knowledge and belief.



**Fred C. Arfman** 571301  
Fred C. Arfman NMPE #7322

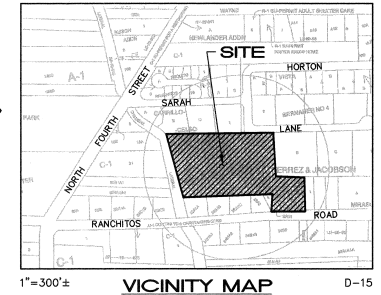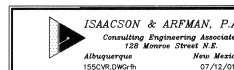

## GENERAL NOTES

- ALL WORK DETAILED ON THESE PLANS TO BE PERFORMED UNDER CONTRACT SHALL, EXCEPT AS OTHERWISE STATED OR PROVIDED FOR HEREON, BE CONSTRUCTED IN ACCORDANCE WITH THE CITY OF ALBUQUERQUE STANDARD SPECIFICATIONS FOR PUBLIC WORKS CONSTRUCTION 1986 EDITION AS AMENDED WITH UPDATE NO. 6.
- ALL WORK ON THIS PROJECT SHALL BE PERFORMED IN ACCORDANCE WITH APPLICABLE FEDERAL, STATE, AND LOCAL LAWS, RULES, AND REGULATIONS CONCERNING CONSTRUCTION SAFETY AND HEALTH.
- PRIOR TO CONSTRUCTION, THE CONTRACTOR SHALL EXCAVATE & VERIFY THE HORIZONTAL AND VERTICAL LOCATIONS OF ALL EXISTING OBSTRUCTIONS. SHOULD A CONFLICT EXIST, THE CONTRACTOR SHALL NOTIFY THE ENGINEER SO THAT THE CONFLICT CAN BE RESOLVED WITH MINIMUM DELAY.
- TWO (2) WORKING DAYS PRIOR TO ANY EXCAVATION, CONTRACTOR MUST CONTACT NEW MEXICO ONE CALL SYSTEM @ 260-1990 FOR LOCATION OF EXISTING UTILITIES.
- CONTRACTOR SHALL CONDUCT HIS OPERATIONS IN A MANNER WHICH SHALL COMPLY WITH ALL APPLICABLE LAWS, ORDINANCES, RULES, REGULATIONS, AND ORDERS OF ANY PUBLIC BODY HAVING JURISDICTION FOR THE SAFETY OF PERSONS OR PROPERTY, AND TO PROTECT THEM FROM DAMAGE, INJURY, OR LOSS. CONTRACTOR SHALL ERECT AND MAINTAIN, AS REQUIRED BY THE CONDITIONS AND PROGRESS OF THE WORK, ALL NECESSARY SAFEGUARDS FOR SAFETY CONTINUOUSLY AND NOT LIMITED TO NORMAL WORKING HOURS, THROUGHOUT THE DURATION OF THE PROJECT. CONTRACTOR SHALL ADHERE TO SECTION 19 OF THE GENERAL CONDITIONS OF THE CITY OF ALBUQUERQUE STANDARD SPECIFICATIONS FOR PUBLIC WORKS CONSTRUCTION, 1986, AS AMENDED WITH UPDATE NO. 6.
- THE CONTRACTOR AGREES THAT HE SHALL ASSUME THE SOLE AND COMPLETE RESPONSIBILITY FOR THE JOB SITE CONDITIONS DURING THE COURSE OF CONSTRUCTION OF THIS PROJECT, INCLUDING SAFETY OF ALL PERSONS AND PROPERTY; THAT THIS REQUIREMENT SHALL APPLY CONTINUOUSLY AND NOT BE LIMITED TO NORMAL WORKING HOURS; AND THAT THE CONTRACTOR SHALL DEFEND, INDEMNIFY, AND HOLD HARMLESS THE OWNER & ENGINEER FROM ANY AND ALL LIABILITY REAL OR ALLEGED, IN CONNECTION WITH THE PERFORMANCE OF WORK ON THIS PROJECT, EXCEPTING LIABILITY ARISING FROM THE SOLE NEGLIGENCE OF THE OWNER OR ENGINEER.
- TRAFFIC CONTROL: FIVE (5) WORKING DAYS PRIOR TO BEGINNING CONSTRUCTION THE CONTRACTOR SHALL SUBMIT TO THE CONSTRUCTION COORDINATION DIVISION A DETAILED CONSTRUCTION SCHEDULE. TWO WORKING DAYS PRIOR TO CONSTRUCTION, THE CONTRACTOR SHALL OBTAIN A BARRICADE PERMIT FROM THE CONSTRUCTION COORDINATION DIVISION. CONTRACTOR SHALL NOTIFY BARRICADE ENGINEER (226-2551) PRIOR TO OCCUPANCY AN INTERSECTION. SECTION 19 OF THE SPECIFICATIONS. ALL STREET SIGNAGE ALTERED OR DESTROYED SHALL BE REPLACED WITH PLAS-TIC REFLECTORIZED PAVEMENT MARKINGS BY CONTRACTOR TO NEARLY AS EXISTING OR AS SHOWN IN THIS PLAN SET.
- WHEN ABUTTING EXISTING PAVEMENT TO NEW, SAWCUT EXISTING PAVEMENT TO A STRAIGHT EDGE AND AT A RIGHT ANGLE, OR AS APPROVED BY THE FIELD ENGINEER. REMOVAL OF BROKEN OR CRACKED PAVEMENT WILL ALSO BE REQUIRED.
- EXISTING CURB AND GUTTER NOT TO BE REMOVED UNDER THE CONTRACT WHICH IS DAMAGED OR DISPLACED BY THE CONTRACTOR SHALL BE REMOVED AND REPLACED BY THE CONTRACTOR AT HIS EXPENSE.
- ALL FINAL BACKFILL FOR TRENCHES SHALL BE COMPACTED TO A MINIMUM 90% MAXIMUM DENSITY PER ASTM D-1557 AND AS DIRECTED BY SECTION 701.14.2 AND STANDARD DRAWING NUMBER 2315.
- THE CONTRACTOR SHALL PROMPTLY CLEAN UP ANY MATERIAL EXCAVATED WITHIN THE PUBLIC RIGHT-OF-WAY OR PRIVATE ROADWAY EASEMENTS SO THAT THE EXCAVATED MATERIAL IS NOT SUSCEPTIBLE TO BEING WASHED DOWN THE STREET OR INTO ANY PUBLIC DRAINAGE FACILITY.
- PROPOSED WATERLINE MATERIALS SHALL BE EITHER PVC PIPE MEETING AWWA C900 REQUIREMENTS (6"-12") OR DUCTILE IRON PIPE, THICKNESS CLASS 50 (6"-16").
- ALL SANITARY SEWER LINE STATIONING REFERS TO SANITARY SEWER CENTERLINE STATIONING.
- ALL FITTINGS ON WATERLINES SHALL HAVE RESTRAINED JOINTS AS NOTED ON THE PLANS.
- CONTRACTOR SHALL SUPPORT ALL EXISTING, UNDERGROUND UTILITY LINES WHICH BECOME EXPOSED DURING CONSTRUCTION. PAYMENT FOR SUPPORTING WORK SHALL BE INCIDENTAL TO WATER-LINE AND/OR SEWERLINE COSTS.
- CONTRACTOR SHALL ASSIST THE ENGINEER/INSPECTOR IN THE RECORDING OF DATA ON ALL UTILITY LINES AND ACCESSORIES AS REQUIRED BY THE CITY OF ALBUQUERQUE FOR THE PREPARATION OF RECORD DRAWINGS. CONTRACTOR SHALL NOT COVER UTILITY LINES AND ACCESSORIES UNTIL ALL DATA HAS BEEN RECORDED.
- THE CONTRACTOR SHALL NOTIFY THE ENGINEER NOT LESS THAN SEVEN (7) DAYS PRIOR TO STARTING WORK IN ORDER THAT THE ENGINEER MAY TAKE NECESSARY MEASURES TO INSURE THE PRESERVATION OF SURVEY MONUMENTS. CONTRACTOR SHALL NOT DISTURB PERMANENT SURVEY MONUMENTS WITHOUT THE CONSENT OF THE ENGINEER AND SHALL NOTIFY THE ENGINEER AND BEAR THE EXPENSE OF REPLACING ANY THAT MAY BE DISTURBED WITHOUT PERMISSION. REPLACEMENT SHALL BE DONE ONLY BY THE CITY SURVEYOR. WHEN A CHANGE IS MADE IN THE FINISHED ELEVATIONS OF THE PAVEMENT OF ANY ROADWAY IN WHICH A PERMANENT SURVEY MONUMENT IS LOCATED, CONTRACTOR SHALL, AT HIS OWN EXPENSE, ADJUST THE MONUMENT COVER TO THE NEW GRADE UNLESS OTHERWISE SPECIFIED. REFER TO SECTION 4.4 OF THE GENERAL CONDITIONS OF THE STANDARD SPECIFICATIONS.
- PWM WILL PROVIDE AT NO COST TO THE CITY OR THE CONTRACTOR THE REQUIRED PERSONNEL FOR INSPECTION OR OBSERVATION DEEMED NECESSARY BY PWM WHILE THE CONTRACTOR IS EXPOSING PWM'S CABLES. HOWEVER, THE CONTRACTOR SHALL BE CHARGED THE TOTAL COST ASSOCIATED WITH REPAIRS TO ANY DAMAGED CABLES OR FOR ANY COST ASSOCIATED WITH SUPPORTING OR RELOCATING THE POLES AND CABLES DURING CONSTRUCTION.
- WARNING--EXISTING UTILITY LINE LOCATIONS ARE SHOWN IN AN APPROXIMATE MANNER ONLY, AND SUCH LINES MAY EXIST WHERE NONE ARE SHOWN. THE LOCATION OF ANY SUCH EXISTING LINES IS BASED UPON INFORMATION PROVIDED BY THE UTILITY COMPANY, THE OWNER, OR BY OTHERS, AND THE INFORMATION MAY BE INCOMPLETE OR MAY BE OBSOLETE BY THE TIME CONSTRUCTION COMMENCES.
- THE ENGINEER HAS UNDERTAKEN NO FIELD VERIFICATION OF THE LOCATION, DEPTH, SIZE, OR TYPE OF EXISTING UNDERGROUND UTILITY LINES. MAKES NO REPRESENTATION PERTAINING THERETO, AND ASSUMES NO RESPONSIBILITY OR LIABILITY THEREFOR. THE CONTRACTOR SHALL INFORM ITSELF OF THE LOCATION OF ANY UTILITY LINE IN OR NEAR THE AREA OF THE WORK IN ADVANCE OF AND DURING EXCAVATION WORK. THE CONTRACTOR IS FULLY RESPONSIBLE FOR ANY AND ALL DAMAGE CAUSED BY ITS FAILURE TO LOCATE, IDENTIFY, AND PRESERVE ANY AND ALL EXISTING UTILITIES. THE CONTRACTOR SHALL COMPLY WITH STATE STATUTES, MUNICIPAL AND LOCAL ORDINANCES, RULES AND REGULATIONS PERTAINING TO THE LOCATION OF THESE LINES AND FACILITIES, IN PLANNING AND CONDUCTING EXCAVATION, WHETHER BY CALLING OR NOTIFYING THE UTILITIES, COMPLYING WITH "BLUE STAKES" PROCEDURES, OR OTHERWISE.
- ALL EXCAVATION, TRENCHING AND SHORING ACTIVITIES MUST BE ACCOMPLISHED IN ACCORDANCE WITH OSHA 29CFR 1926.650 SUBPART P.
- CONTRACTOR SHALL MAINTAIN A GRAFFITI-FREE WORK SITE. CONTRACTOR SHALL PROMPTLY REMOVE ANY AND ALL GRAFFITI FROM EQUIPMENT, WHETHER PERMANENT OR TEMPORARY.
- CONTRACTOR SHALL COORDINATE WITH WATER SYSTEMS DIVISION (857-2000) FIVE (5) WORKING DAYS PRIOR TO ANY WORK THAT MAY AFFECT EXISTING CITY PUBLIC WATER OR SEWER UTILITIES. CONTRACTOR SHALL BE RESPONSIBLE FOR TING AND COORDINATION OF WATER SHUT OFF. EXISTING CITY VALVES TO BE OPERATED BY CITY PERSONNEL ONLY.

| |
|---|
| |
|---|

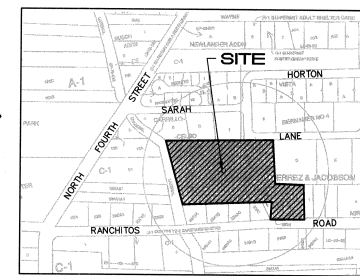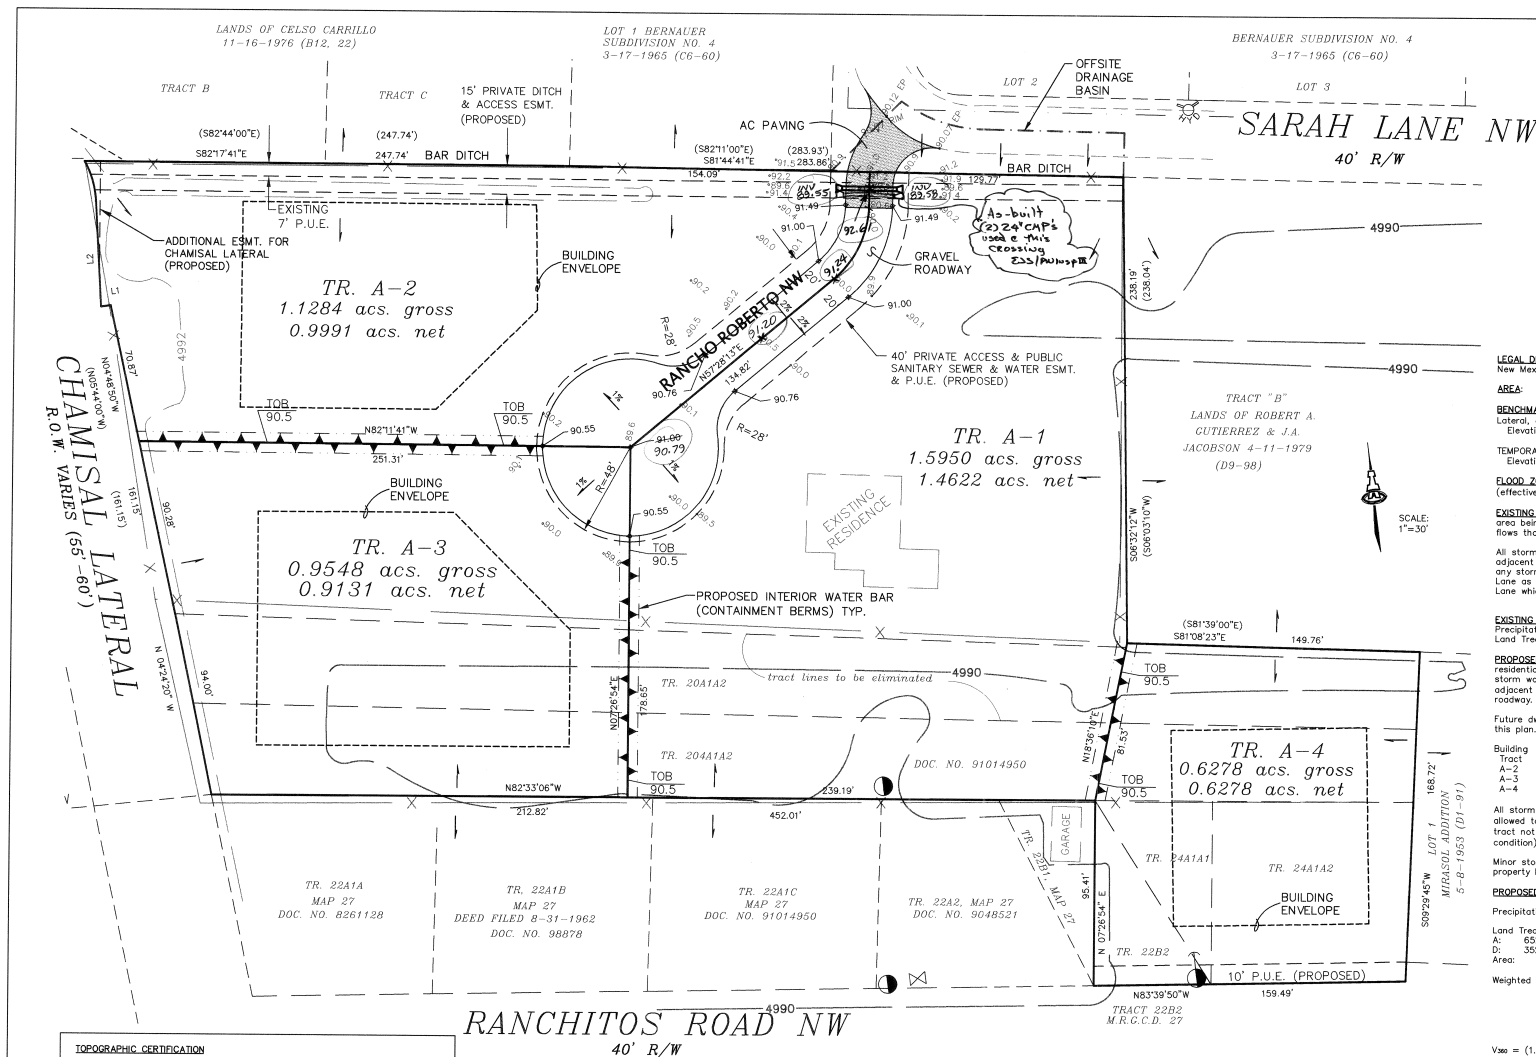

**LEGAL DESCRIPTION:** LANDS OF ROBERT A. GUTIERREZ AND J.A. JACOBSON filed in Bernalillo County, New Mexico on April 11, 1969 in Plot Book D9, Page 98.

#### AREA:

**BENCHMARK:** ACS Monument "11-015" located on the east side of 4th Street at the Chamisal Lateral, a cut on top of the southerly wing wall.  
Elevation = 4993.29

**TEMPORARY BENCHMARK (TBM):** Set hub at fence corner at northeast corner of property.  
Elevation = 4990.88

**FLOOD ZONE DESIGNATION:** Site is not within a flood zone as designated on Map No. 3500160117 (effective date: September 20, 1996) of the Flood Insurance Rate Map of FEMA.

**EXISTING CONDITIONS:** Site consists of a single dwelling (on future Tract A-1) and the remaining area being cultivated farmland. No offsite storm waters flow onto the property except those minor flows that sheetflow off of the adjacent public roads.

All storm waters generated on the property are confined to the property limits due to built-up adjacent roadways, irrigation laterals, and neighboring irrigation berms. The site does not accept any storm water runoff from adjacent properties except for approximately 3500 SF area on Sarah Lane as designated herein. Those storm water volumes are captured in a bar ditch south of Sarah Lane which is situated along and over the south right-of-way line of Sarah Lane.

#### EXISTING HYDROLOGY:

Precipitation Zone: 2

Land Treatment: A= 96%, D= 4%

**PROPOSED CONDITIONS:** The property is planned to be assembled and re-subdivided into four (4) residential tracts. A gravel cul-de-sac is programmed to serve Tracts A-1, A-2, and A-3. All storm waters generated by the road shall be allowed to sheetflow off onto the newly created adjacent lots, which shall remain depressed within a forty foot (40') offset from the edge of roadway. Storm waters shall be retained in the forty foot depressed zone.

Future dwelling units shall be constructed within the building envelope shown and designated on this plan. Future building pads shall be established for each undeveloped tract as follows:

| Building Tract | Pad Elevation |
|----------------|---------------|
| A-2            | 4991.1        |
| A-3            | 4991.1        |
| A-4            | 4990.3        |

All storm waters generated on the future tracts shall be directed away from the structure(s) and allowed to surface pond no closer than fifteen feet (15') from the building. The areas on each tract not being utilized for buildings, access drive or out structures should remain level (natural condition) to spread the storm waters over a larger area.

Minor storm water containment berms or solid walls should be placed along the interior side property lines to prevent the migration of storm waters from one property to another.

#### PROPOSED HYDROLOGY: (TOTAL SITE)

Precipitation Zone: 2

Land Treatment Excess Precipitation  
A: 65% 0.53  
D: 35% 2.12

Area: 4,306 Ac.

Weighted E =  $(4.31 \times 0.65 \times 0.53) + (4.31 \times 0.35 \times 2.12)$   
4.31

=  $\frac{1.68 + 3.20}{4.31}$   
1.09

$V_{50} = (1.09 \times 4.31) / 12 \text{ in/ft} = 0.3915 \text{ ac-ft}$   
= 17,053 cu/ft

The computed volume of 17,053 cu/ft equate to an average stormwater depth over reserve retention area (4.31 x 0.65% = 2.80 Ac) at 0.14 feet (average).

#### TOPOGRAPHIC CERTIFICATION

I, Fred C. Arfman, P.E. No. 7322, a registered professional engineer under the laws of the State of New Mexico, do hereby certify that the existing grades shown on this plan have not been altered and are true and correct to best of my knowledge and belief.

Fred C. Arfman, NMPE No. 7322

Date

#### LEGEND

- 5200 — EXISTING CONTOUR
- 52 — PROPOSED CONTOUR
- ◆ 78.3 PROPOSED SPOT ELEVATION
- FLOW ARROW
- PG=6881.0 PAD GRADE ELEVATION
- SIDEWALK CULVERT
- TOP OF CURB ELEVATION
- FL=81.45 FLOWLINE
- ⊙ EXISTING SEWER MANHOLE
- ⊙ EXISTING FIRE HYDRANT
- EXISTING CONTOUR
- EXISTING SPOT ELEVATION
- EXISTING FENCE

#### PROPOSED HYDROLOGY: (TRACT-3)

Precipitation Zone: 2  
Land Treatments: % Area Excess Precipitation  
A: (19,900) 50% 0.53  
B: (4,780) 12% 0.78  
C: (6,100) 15% 1.13  
D: (9,000) 23% 2.12

NOTE: The above individual land treatment areas are based on the following construction projections.

- Building pad = 4,000 SF
- Paved drive = 3,000 SF
- Patio & out structures = 2,000 SF
- Gravel roadway = 6,000 SF
- Remaining 62% being grass, crops, etc. (Typical of valley properties)

COMPUTED RUNOFF FOR 10 DAY/100 YR EVENT:

$V_{50} = V_{50} + A_d(P_{50} - P_{50}) / 12 \text{ in/ft}$

Therefore:

$V_{50} = \text{Weighted E (A + B + C + D)}$

Weighted E =  $(0.46 \times 0.53 + 0.11 \times 0.78 + 0.14 \times 1.13 + 0.21 \times 2.12)$

= 1.02

$V_{50} = 1.02 (0.9131) / 12 \text{ in/ft}$   
= 0.0778 ac-ft or 3,587 cu/ft

$V_{50} = V_{50} + A_d(P_{50} - P_{50}) / 12 \text{ in/ft}$

=  $0.0778 + 0.21(2.6 - 2.25) / 12 \text{ in/ft}$


= 0.0778 + 0.0061 ac-ft

= 0.0900 ac-ft = 3,921 cu/ft

Lot A-2 will pond the 10 day volume of 3,921 cu/ft over the Type A treatment property outside of the building envelope. The area of A treatment as computed above is 19,900 SF, which will result in a maximum depth of 0.197 ft (2.36 in) over the grassed/cultivated fields.

All building envelopes have been raised a minimum of one foot above the maximum water surface elevation of the  $V_{50}$ -w event.

#### LANDS OF RANCHO ROBERTO GRADING & DRAINAGE PLAN

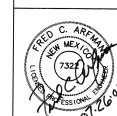

**ISAACSON & ARFMAN, P.A.**  
Consulting Engineering Associates  
128 Monroe Street N.E.  
Albuquerque, New Mexico

155GRD.DWG-11 07/12/01

**SHEET 2 OF 4**

CP# 669381



