


SCANNED BY
MESA REPRO

APPROVAL OF AS BUILT DRAWINGS
CHIEF CONSTRUCTION ENGINEER
Peter Chang
DATE 3/8/01

☒	ALL UTILITIES AND UTILITY SERVICE LINES SHALL BE INSTALLED PRIOR TO PAVING.
☒	BACKFILL COMPACTION SHALL BE ACCORDING TO SPECIFIED STREET USE.
☐	TACK COAT REQUIREMENTS SHALL BE DETERMINED BY THE CITY ENGINEER.
☒	SIDEWALK AND WHEELCHAIR RAMPS WITHIN THE CURB RETURNS SHALL BE CONSTRUCTED WHEREVER A NEW CURB RETURN IS CONSTRUCTED.
☐	IF CURB IS DERESSED FOR A DRIVEPAD, THE DRIVEPAD SHALL BE CONSTRUCTED PRIOR TO ACCEPTANCE OF CURB AND GUTTER.
☒	ALL STORM DRAINAGE FACILITIES SHALL BE COMPLETED PRIOR TO FINAL ACCEPTANCE.

PLAT FOR
STONEBROOKE ESTATES
SUBDIVISION

WITHIN THE
ELENA GALLEGOS GRANT
PROJECTED SECTION 18
TOWNSHIP 11 NORTH, RANGE 4 EAST, NM6M
CITY OF ALBUQUERQUE
BERNALILLO COUNTY, NEW MEXICO
JULY, 1999

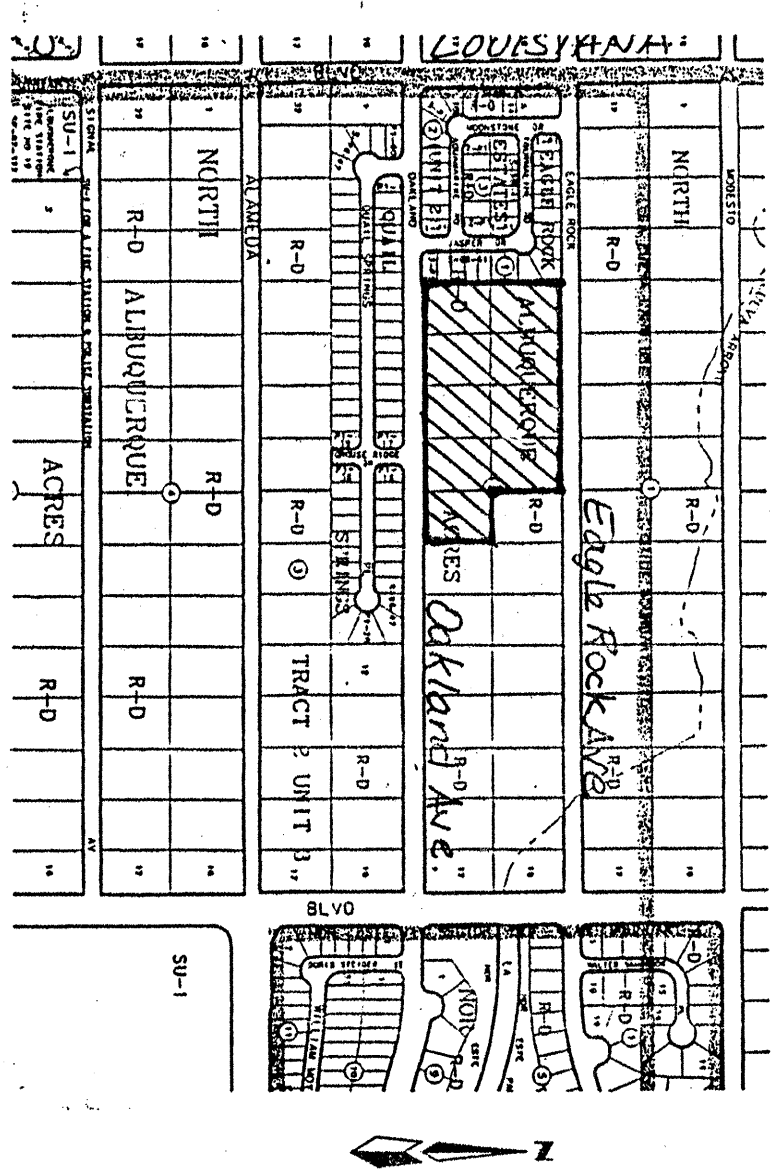

LOCATION MAP C-19-Z

SCALE: NONE


SUBDIVISION DATA

PLAT CASE NOS.: DRB. 99-143. S V.
GROSS ACREAGE: 8,9886 AC. C-19-Z
ZONE ATLAS NO.: C-19-Z
NO. OF EXISTING TRACTS/LOTS: 9 LOTS
NO. OF TRACTS/LOTS CREATED: 45 LOTS
NO. OF TRACTS/LOTS ELIMINATED: 9 LOTS
MILES OF FULL WIDTH STREETS CREATED: 0.25
AREA DEDICATED TO CITY OF ALBUQUERQUE: 2.4051 ACRES
DATE OF SURVEY: APRIL 1999
UTILITY CONTROL LOCATION SYSTEM LOG NUMBER: 99042813340427

SURVEYOR'S CERTIFICATION

"I, Timothy Aldrich, a duly qualified Registered Professional Land Surveyor under the laws of the State of New Mexico, do hereby certify that this plat and description were prepared by me or under my supervision, shows all easements as shown on the plat of record or made known to me by the owners and/or proprietors of the subdivision shown herein, utility companies and other parties expressing an interest therein, the minimum Subdivision Ordinance, and further meets the Minimum Standards for Land Surveying in the State of New Mexico (Effective November 1, 1989 and revisions effective December 25, 1991 and February 2, 1994), and is true and correct to the best of my knowledge and belief."

TIMOTHY ALDRICH, P.S. No. 7719 DATE 07-20-99

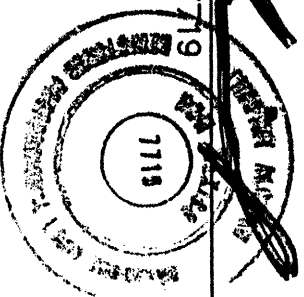

LEGAL DESCRIPTION

A tract of land situate within the Elena Gallegos Grant, projected Section 18, Township 11 North, Range 4 East, New Mexico Principal Meridian, City of Albuquerque, Bernalillo County, New Mexico being all of LOTS 5 THRU 8 and LOTS 24 THRU 28, BLOCK 2, TRACT 2, UNIT 3, NORTH ALBUQUERQUE ACRES as the same is shown and designated on said plat filed for record in the office of the County Clerk of Bernalillo County, New Mexico on September 10, 1931 in Volume D1, Folio 20 to a point, said point being common with the southwest corner of said LOT 9;

THENCE S 89°37'07" E, 164.59 feet along a line common with the south line of said LOT 9 to a point, said point being common with the southeast corner of said LOT 9 and further being common with the northwest corner of LOT 23, BLOCK 2, TRACT 2, UNIT 3, NORTH ALBUQUERQUE ACRES as the same is shown and designated on said plat filed for record in the office of the County Clerk of Bernalillo County, New Mexico on September 10, 1931 in Volume D1, Folio 20;

THENCE S 00°09'58" W, 264.10 feet along a line common with the west line of said LOT 23 to the southeast corner, said point being on the centerline of Oakland Avenue N.E.;

THENCE along said centerline N 89°35'40" W, 824.57 feet to the southwest corner;

THENCE leaving said centerline S 00°15'00" W, 263.62 feet along a line common with the west line of LOT 9, BLOCK 2, TRACT 2, UNIT 3, NORTH ALBUQUERQUE ACRES as the same is shown and designated on said plat filed for record in the office of the County Clerk of Bernalillo County, New Mexico on September 10, 1931 in Volume D1, Folio 20 to the point of beginning and containing 8,9886 acres more or less.

NOTES

1. Bearings are New Mexico State Plane Grid Bearings (Central Zone).
2. Distances are ground distances.
3. Bearings and Distances in parenthesis are record.
4. Basis of boundary are the following plats of record entitled:

"NORTH ALBUQUERQUE ACRES, TRACT 2, UNIT 3", (09-10-31, D1-20)
"EAGLE ROCK ESTATES UNIT II", (06-29-98, 98C-175)

records of Bernalillo County, New Mexico.

FREE CONSENT AND DEDICATION

The subdivision herein described is with the free consent and in accordance with the desires of the undersigned owner(s) and/or proprietor(s) thereof and said owner(s) and/or proprietor(s) do hereby dedicate all streets and public right-of-ways shown herein to the City of Albuquerque in fee simple with warranty covenants and do hereby grant: all access, utility and drainage easements shown herein including the right to construct, operate, inspect, and maintain facilities therein; and all public utility easements shown herein for the common and joint use of gas, electrical power and communication services for buried distribution lines, conduits, and pipes for underground utilities where shown or indicated, and including the right of ingress and egress for construction and maintenance, and the right to then interfering trees and shrubs. Said owner(s) and/or proprietor(s) do hereby consent to all of the foregoing and do hereby certify that this subdivision is their free act and deed.


Randal Schulte, Managing Partner
RANDALL SCHULTE
MANAGING PARTNER
RANDALL HOMES, LLC
DATE 7-20-99

OWNER'S ACKNOWLEDGMENT

STATE OF NEW MEXICO } ss
COUNTY OF BERNALILLO }

This instrument was acknowledged before me on 7-20-99

SUSAN BARROR
NOTARY PUBLIC
NOTARY PUBLIC STATE OF NEW MEXICO
MY COMMISSION EXPIRES 0-3-2000

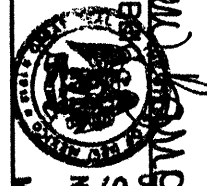

PURPOSE OF PLAT

1. SUBDIVIDE LOTS 5 THRU 8 AND LOTS 24 THRU 28, BLOCK 2, TRACT 2, UNIT 3, NORTH ALBUQUERQUE ACRES INTO 45 RESIDENTIAL LOTS.
2. DEDICATE PUBLIC STREET RIGHT-OF-WAY AS SHOWN HEREON
3. GRANT PUBLIC UTILITY EASEMENTS AS SHOWN HEREON.
4. GRANT SANITARY SEWER AND DRAINAGE EASEMENT AS SHOWN HEREON.
5. VACATE PUBLIC R/W AND UTILITY EASEMENT.

APPROVED AND ACCEPTED BY:

APPROVAL AND CONDITIONAL ACCEPTANCE as specified by the Albuquerque Subdivision Ordinance, Article XI of Chapter 7 of the Revised Ordinances of Albuquerque, New Mexico.


Planning Director, City of Albuquerque, N.M. Date
City Engineer, City of Albuquerque, N.M. Date
Albuquerque Metropolitan Arroyo Flood Control Authority Date
Transportation Development, City of Albuquerque, N.M. Date
Utility Development Division, City of Albuquerque, N.M. Date
Public Design and Development, C.I.P., City of Albuquerque, N.M. Date
City Surveyor, City of Albuquerque, N.M. Date 07/19/99

Property Management, City of Albuquerque, N.M. Date
P.N.M. GAS Date
U.S. West Telecommunications Date
P.N.M. ELECTRIC Date
Jones Interchange, Inc. Date


dwg: PLAT/DWG Drawn: SPS Checked: ALS Sheet 2 of 4
Scale: 1" = 100' Date: JULY 1, 99 Job: 99050

PLAT FOR
STONEBROOKE ESTATES
SUBDIVISION
WITHIN THE
ELENA GALLEGOS GRANT
PROJECTED SECTION 18
TOWNSHIP 11 NORTH, RANGE 4 EAST, NM6M
CITY OF ALBUQUERQUE
BERNALILLO COUNTY, NEW MEXICO
JULY, 1999

EAGLE ROCK ESTATES UNIT II
BLOCK 1
(06-29-98, 98C-175)

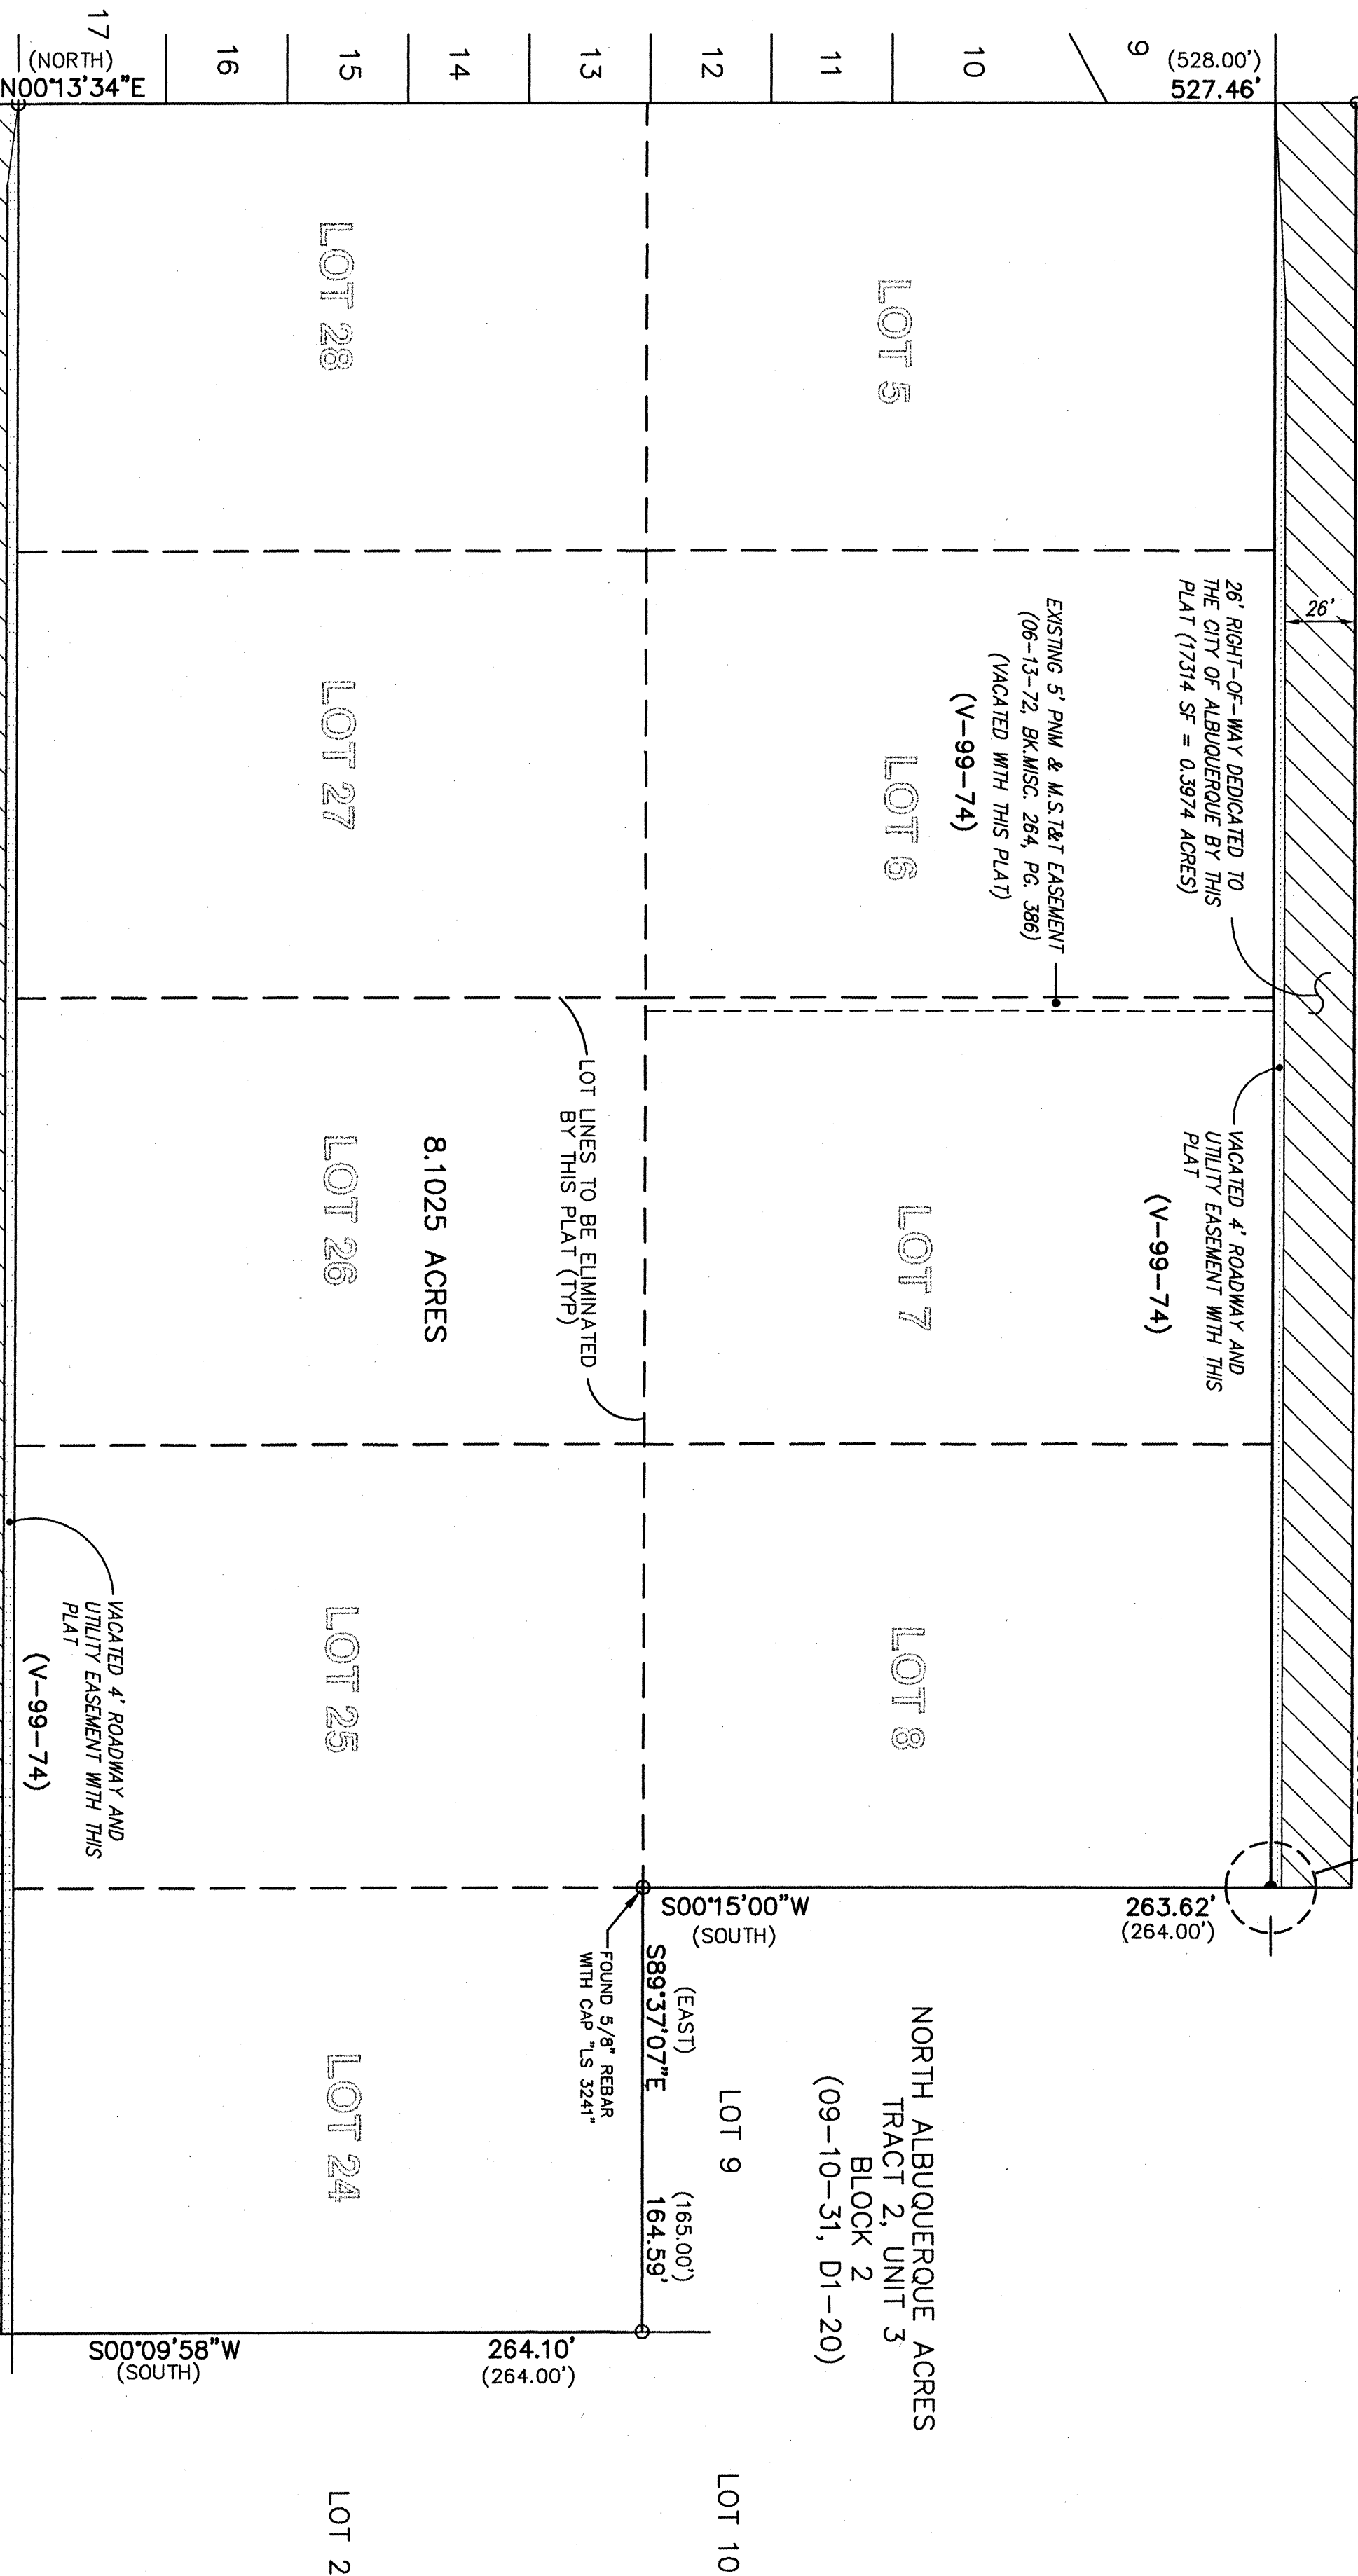



ACS MONUMENT
11-C18
N=1524061.45
Y=1524061.45
X=402319.45
G=0-0.9996563
AZ=0-0011100
ELEVATION=5219.41

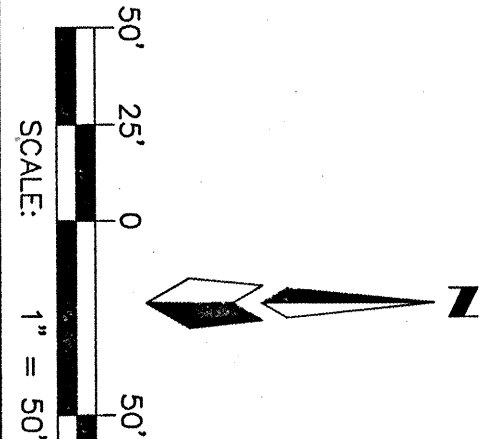

SCANNED BY
MESA REPRO

PLAT FOR
STONEBROOKE ESTATES
SUBDIVISION

WITHIN THE
ELENA GALLEGOS GRANT
PROJECTED SECTION 18
TOWNSHIP 11 NORTH, RANGE 4 EAST, NMPM
CITY OF ALBUQUERQUE
BERNALILLO COUNTY, NEW MEXICO
AUGUST, 1999

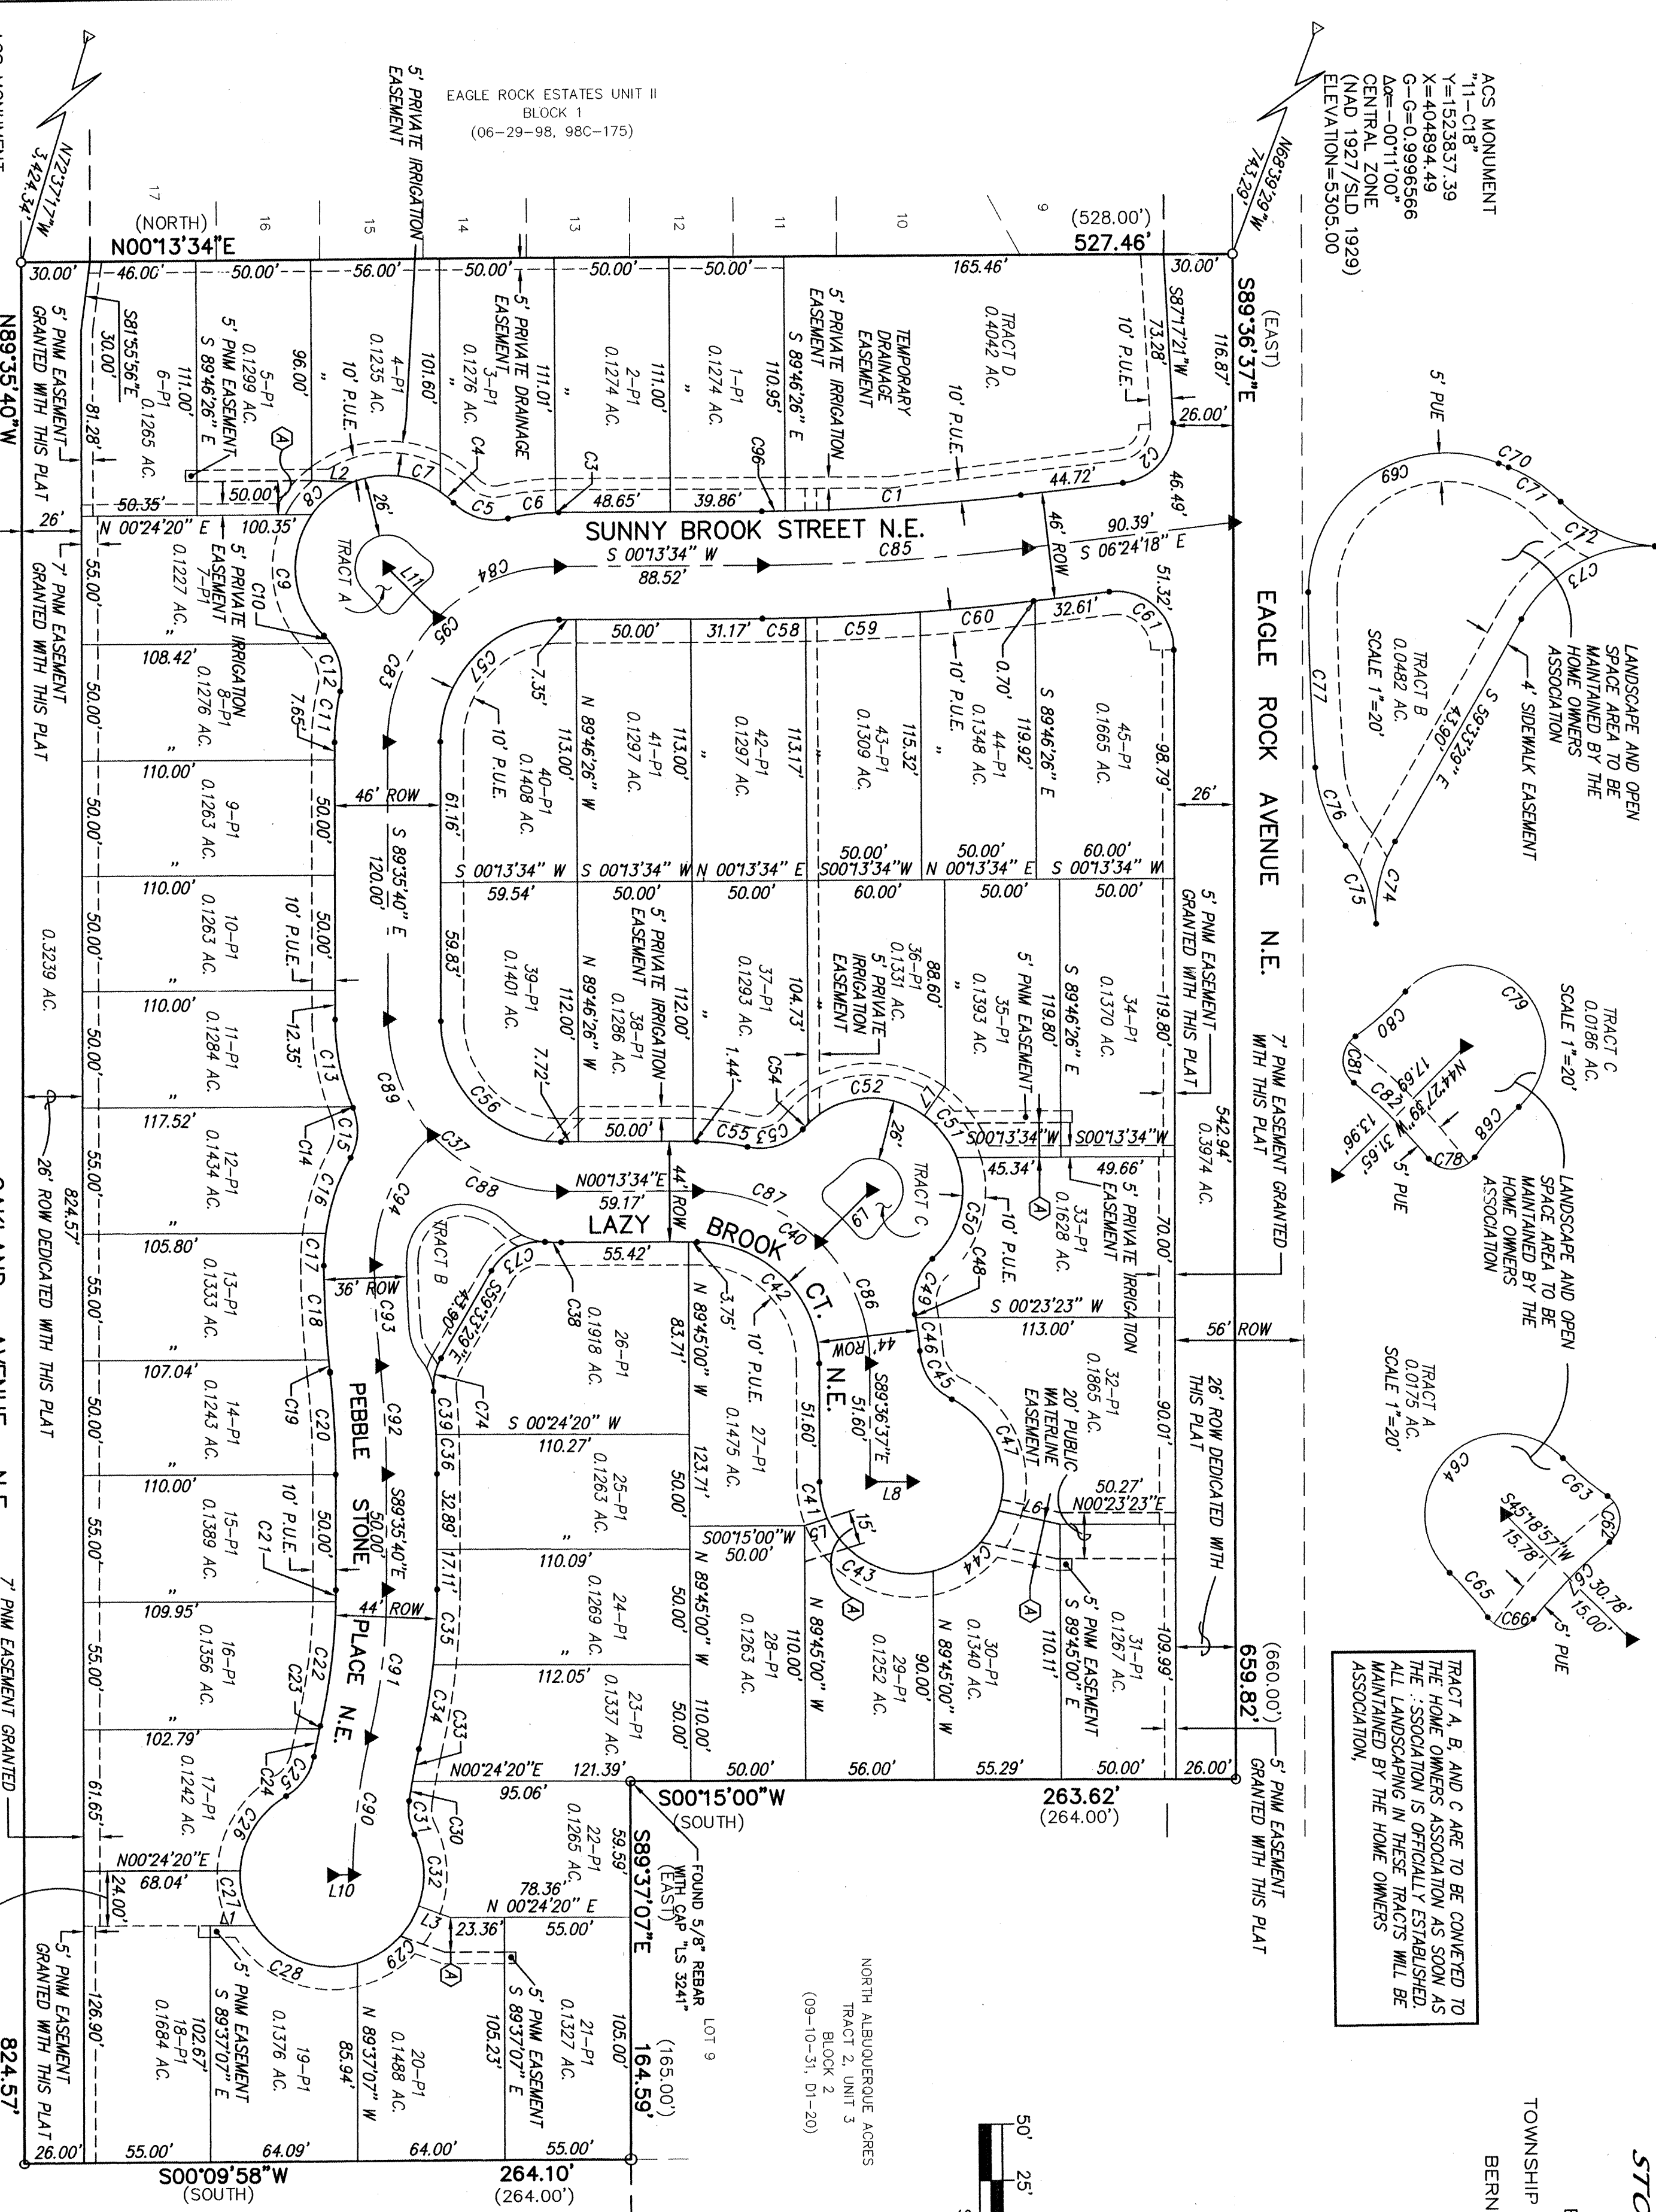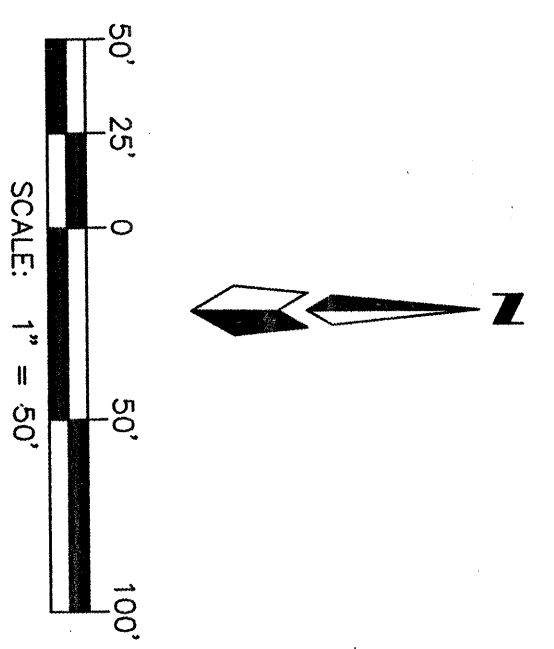

NUMBER	DIRECTION	DISTANCE
L1	S 00°24'20" W	19.68'
L2	S 02°50'16" E	18.13'
L3	N 00°30'07" E	15.00'
L4	S 17°03'55" E	10.47'
L5	N 12°48'38" E	15.97'
L6	N 00°23'05" E	16.00'
L7	N 44°27'39" E	51.85'
L8	S 00°22'33" W	8.99'
L9	S 45°18'57" W	30.78'

NOTE: SEE SHEET 4 OF 4 FOR CURVE TABLE
ABBREVIATIONS
P.U.E. = PUBLIC UTILITY EASEMENT
A.C. = ACREAGE
15' PRIVATE ACCESS, WATER AND SANITARY SEWER EASEMENT GRANTED WITH THIS PLAT

DWG:	PLATTING	Drawn:	SPS	Checked:	ALS	Sheet	3	of	4
Scale:	1" = 100'	Date:	8-26-99	Job:	99050				

PLAT FOR
STONEBROOKE ESTATES
SUBDIVISION

WITHIN THE
ELENA GALLEGOS GRANT
PROJECTED SECTION 18
TOWNSHIP 11 NORTH, RANGE 4 EAST, NMPM
CITY OF ALBUQUERQUE
BERNALILLO COUNTY, NEW MEXICO
AUGUST, 1999

PUBLIC UTILITY EASEMENTS:

- PUBLIC UTILITY EASEMENTS shown on this plat are granted for the common and joint use of:
1. The PNM Electric Services Division for the installation, maintenance and service of overhead and underground electrical lines, transformers, poles and any other equipment, fixtures, structures and related facilities reasonably necessary to provide electric services.
 2. The PNM Gas Services Division for installation, maintenance and service of natural gas lines, valves and other equipment and facilities reasonably necessary to provide natural gas.
 3. U.S. West for installation, maintenance and service of all buried and aerial communication lines and other related equipment and facilities reasonably necessary to provide communication services, including but not limited to above ground pedestals and closures.
 4. Jones Interchange for installation, maintenance and service of such lines, cable and other related equipment and facilities reasonably necessary to provide Cable TV service.

CURVE TABLE

CURVE NUMBER	DELTA	RADIUS	ARC LENGTH	TANGENT LENGTH	CHORD BEARING	CHORD LENGTH
C1	06°02'12"	97.00	102.94	51.52	N 03°23'12" W	102.89
C2	06°18'21"	25.00	37.66	21.51	N 49°33'29" W	34.20
C3	00°47'15"	98.00	1.35	0.67	S 00°10'03" E	1.35
C4	10°35'35"	40.00	7.40	3.71	S 41°12'32" E	7.39
C5	59°17'46"	25.00	25.87	14.23	N 16°31'26" E	24.23
C6	12°14'46"	98.00	20.92	10.50	S 06°40'34" E	20.88
C7	57°01'15"	40.00	38.91	21.73	S 02°34'07" E	38.19
C8	33°24'60"	40.00	23.33	12.01	S 37°49'07" E	23.00
C9	81°20'55"	40.00	36.79	24.57	N 04°48'02" E	52.14
C10	10°25'08"	25.00	4.35	2.28	S 49°20'08" E	4.54
C11	1°10'01"	98.00	22.26	11.18	S 83°05'10" E	22.22
C12	46°52'58"	25.00	21.33	11.56	S 78°59'01" W	20.69
C13	22°52'55"	98.00	38.64	19.58	N 79°06'32" E	38.39
C14	00°14'47"	98.00	0.42	0.21	N 67°41'21" E	0.42
C15	51°18'21"	25.00	22.39	12.01	N 66°46'52" W	21.65
C16	20°57'10"	97.00	34.81	17.64	S 71°26'17" E	34.72
C17	08°16'12"	459.00	14.00	7.01	S 85°52'58" E	13.99
C18	05°07'54"	459.00	41.11	20.57	N 87°24'59" E	41.10
C19	00°36'52"	415.00	5.19	2.59	N 84°31'56" E	5.19
C20	06°12'10"	253.00	44.83	22.49	S 82°18'15" W	44.80
C21	10°13'57"	253.00	5.00	2.50	N 89°01'42" W	5.00
C22	12°16'47"	253.00	54.22	27.22	S 76°18'47" E	54.12
C23	12°16'47"	253.00	1.38	0.68	S 76°18'47" E	1.35
C24	02°21'26"	287.00	12.22	6.11	S 77°37'07" E	12.22
C25	49°21'53"	25.00	21.54	11.49	N 54°07'05" W	20.88
C26	57°17'28"	40.00	40.00	21.65	N 58°04'53" W	38.35
C27	36°13'42"	40.00	25.29	13.08	N 75°09'32" E	24.61
C28	72°57'33"	40.00	30.70	28.40	N 20°43'55" E	47.58
C29	53°55'07"	40.00	37.64	20.35	N 42°32'26" W	38.27
C30	01°55'26"	253.00	8.50	4.25	S 80°24'01" E	8.49
C31	34°27'33"	25.00	15.04	7.75	N 81°24'30" E	14.81
C32	46°19'17"	40.00	32.34	17.11	S 87°20'22" W	31.46
C33	03°15'21"	253.00	14.39	7.19	S 77°48'37" E	14.37
C34	07°03'15"	297.00	35.57	18.31	N 79°42'34" W	36.54
C35	06°21'29"	297.00	32.96	16.50	N 86°24'56" W	32.94
C36	02°18'11"	459.00	12.11	6.26	S 89°20'14" W	12.11
C37	50°10'45"	75.00	118.04	75.24	S 43°18'57" E	106.23
C38	04°10'55"	97.00	7.08	3.54	N 02°19'02" E	7.08
C39	02°21'56"	459.00	18.91	9.45	S 87°05'21" W	18.91
C40	09°09'46"	75.00	18.02	75.21	S 45°18'21" W	106.22
C41	33°24'41"	40.00	16.33	8.29	N 78°41'00" E	16.33
C42	80°15'24"	40.00	36.03	33.72	N 26°30'53" E	75.08
C43	57°47'36"	40.00	40.33	22.08	N 42°10'36" W	38.66
C44	60°33'04"	25.00	26.42	14.59	N 56°38'59" E	28.21
C45	08°38'33"	97.00	14.63	7.33	S 82°56'12" W	14.62
C46	82°13'09"	40.00	57.40	34.91	S 67°49'02" W	32.60
C47	00°55'52"	97.00	1.58	0.79	S 76°09'03" W	1.58


CURVE TABLE

CURVE NUMBER	DELTA	RADIUS	ARC LENGTH	TANGENT LENGTH	CHORD BEARING	CHORD LENGTH
C49	60°48'41"	25.00	26.53	14.67	S 71°54'33" E	25.37
C50	60°48'41"	40.00	46.21	27.52	N 76°02'01" W	45.35
C51	33°25'14"	40.00	23.33	12.01	S 52°43'32" W	23.00
C52	78°45'51"	40.00	54.99	32.84	S 03°22'00" E	50.76
C53	60°48'41"	25.00	26.53	14.67	N 77°00'45" W	25.37
C54	04°40'10"	40.00	3.26	1.63	S 45°05'00" E	3.26
C55	13°10'02"	97.00	82.89	11.20	S 08°46'35" W	22.24
C56	50°10'45"	52.00	81.52	52.17	N 45°18'57" E	73.66
C57	88°49'15"	52.00	81.52	51.84	S 44°41'03" E	73.42
C58	07°13'17"	102.100	18.83	9.42	N 00°18'04" W	18.83
C59	02°46'12"	102.100	50.05	24.26	N 08°13'49" W	50.05
C60	02°46'12"	102.100	48.52	24.26	S 41°59'33" W	49.51
C61	96°41'42"	25.00	42.23	28.16	S 88°11'04" W	37.39
C62	06°11'51"	5.00	0.27	0.14	S 88°11'04" W	8.00
C63	11°28'11"	5.00	10.16	5.10	S 44°41'03" E	10.15
C64	18°22'45"	14.00	44.56	—	S 44°41'03" E	22.89
C65	11°25'11"	5.00	10.16	5.10	N 48°50'10" E	10.15
C66	106°11'51"	5.00	9.27	6.66	N 02°26'50" E	18.71
C67	11°56'04"	50.00	18.75	9.41	S 44°41'03" E	11.36
C68	13°02'36"	51.00	11.61	5.83	S 48°01'30" E	11.36
C69	13°02'36"	50.00	18.75	9.41	S 44°41'03" E	11.36
C70	11°23'11"	24.00	42.15	35.85	S 33°27'41" E	39.92
C71	25°14'08"	25.00	11.01	5.60	S 34°14'52" W	10.92
C72	42°27'27"	25.00	18.53	9.71	N 25°38'13" E	18.10
C73	63°57'58"	25.00	27.91	15.61	S 27°54'30" E	26.48
C74	33°59'43"	25.00	15.07	7.77	S 76°49'28" E	14.84
C75	33°59'43"	25.00	14.79	7.56	N 69°44'41" E	14.84
C76	33°59'43"	25.00	14.79	7.56	N 69°44'41" E	14.84
C77	06°13'33"	42.100	30.09	15.05	N 68°11'26" E	30.08
C78	06°13'33"	5.00	9.28	6.64	S 45°32'21" W	22.96
C79	185°34'53"	14.00	44.53	—	S 45°32'21" W	11.58
C80	12°02'22"	5.00	11.01	5.83	S 87°24'12" E	11.58
C81	106°03'26"	5.00	9.28	6.64	S 87°24'12" E	11.58
C82	11°56'33"	69.00	18.55	9.37	S 45°32'21" W	18.52
C83	44°54'37"	75.00	58.79	31.00	S 67°08'22" E	57.28
C84	44°54'37"	75.00	58.79	31.00	S 27°13'44" E	57.28
C85	06°57'52"	1000.00	115.74	57.93	N 03°05'22" W	115.67
C86	44°51'01"	75.00	58.71	30.95	S 67°57'52" W	57.22
C87	45°18'47"	75.00	59.31	31.37	S 22°52'58" W	57.78
C88	48°29'58"	75.00	63.46	33.77	N 24°27'43" E	61.58
C89	41°41'36"	75.00	54.59	28.57	N 69°33'31" E	53.39
C90	12°35'36"	275.00	64.37	32.53	S 82°28'46" E	60.33
C91	13°34'43"	275.00	64.37	32.53	N 82°53'19" W	64.23
C92	05°12'10"	437.00	47.31	23.68	S 87°18'15" W	47.29
C93	05°16'46"	75.00	63.78	32.06	S 65°59'24" E	61.87
C94	48°43'20"	75.00	117.58	74.77	N 44°41'03" W	105.50
C95	89°49'15"	25.00	107.58	74.77	N 44°41'03" W	105.50
C96	00°35'40"	97.00	101.14	5.07	N 00°35'40" W	101.14




SCANNED BY
MESA REPRO

SCANNED BY
MESA REPRO


EAGLE ROCK ESTATES UNIT II
BLOCK 1
(06-29-98, 98C-175)

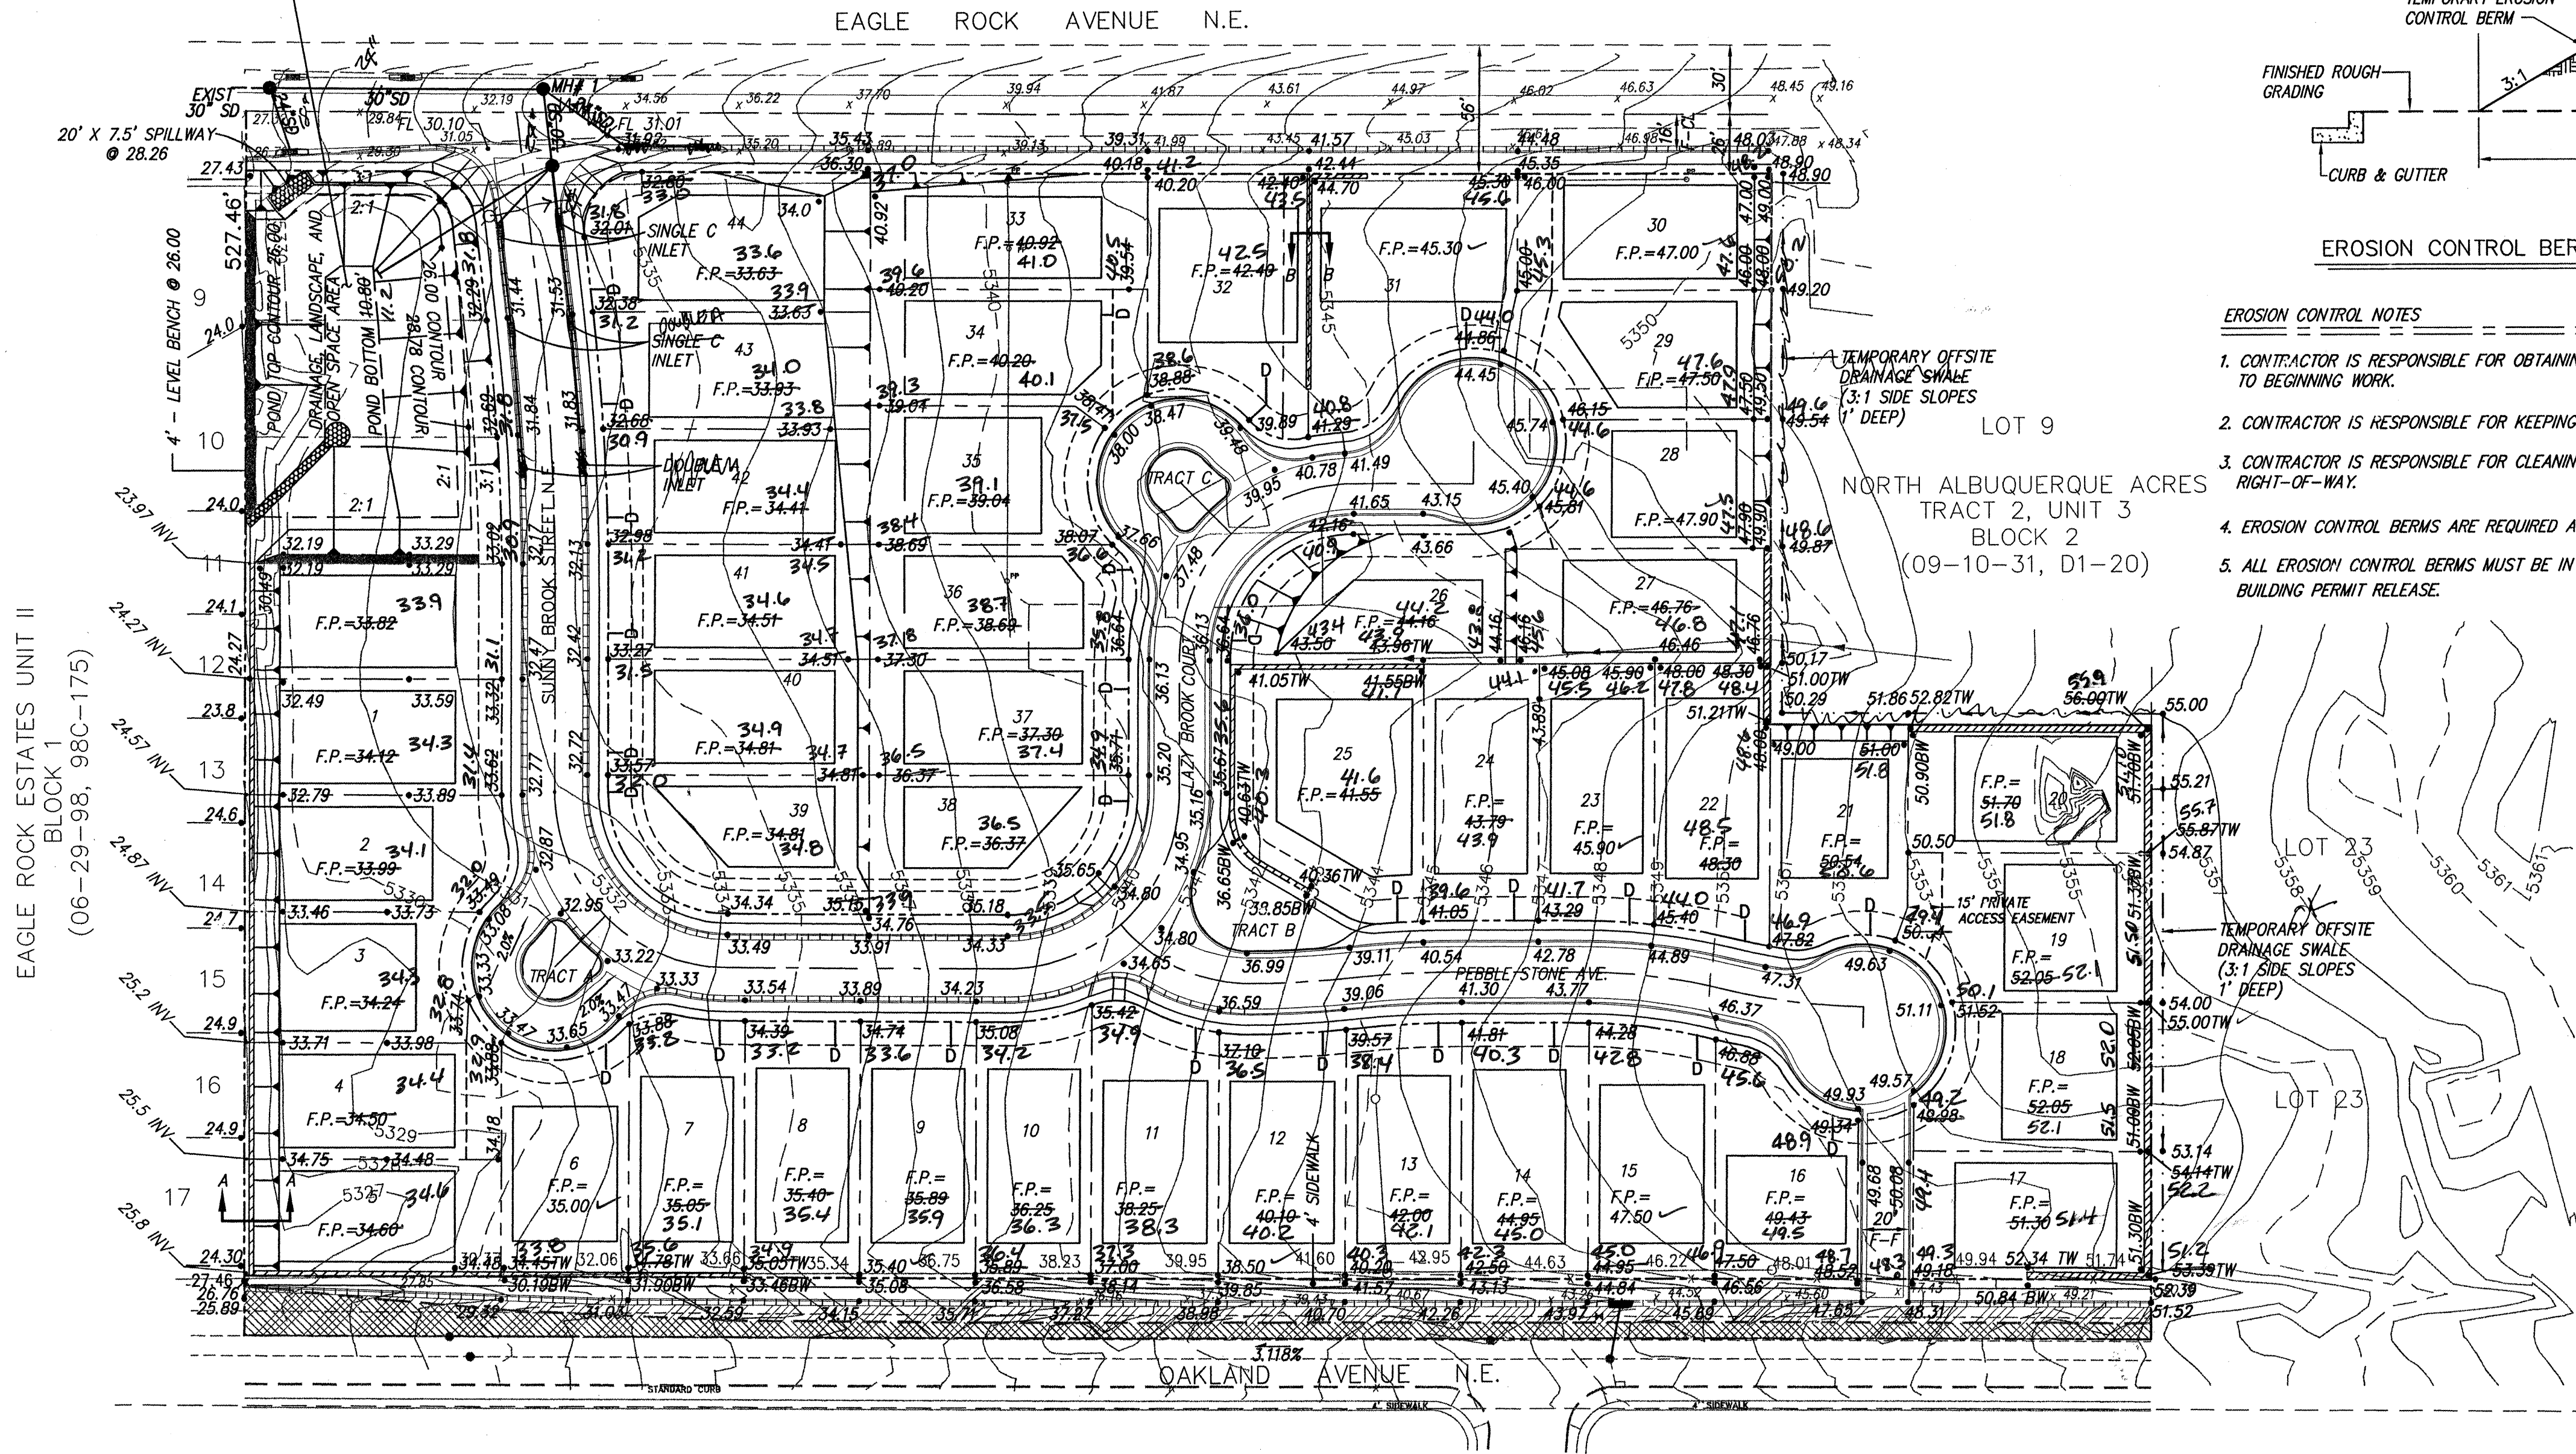


TEMPORARY RETENTION POND
REQ'D VOLUME = 2.31 AC. FT.
DESIGN VOLUME = 2.31 AC. FT.
2:1 MAXIMUM SIDE SLOPES
PROTECTED WITH 2" GRAVEL MULCH
TOP OF POND ELEVATION = 26.00
BOTTOM OF POND ELEVATION = 10.80
DEPTH OF POND = 15.20'

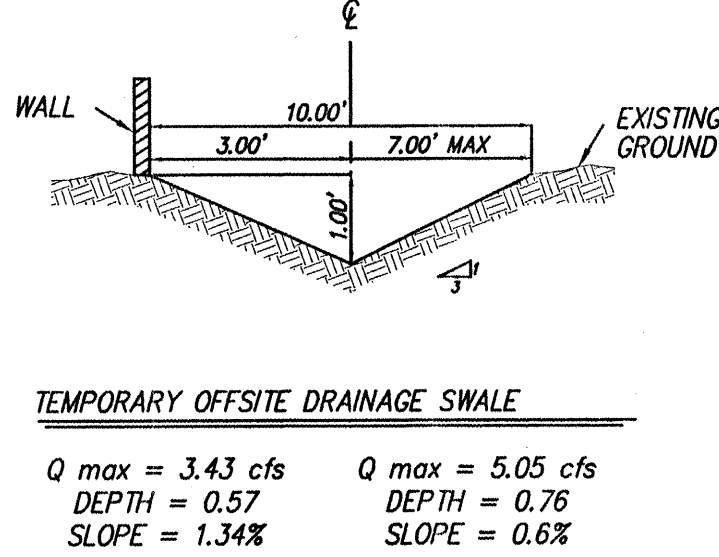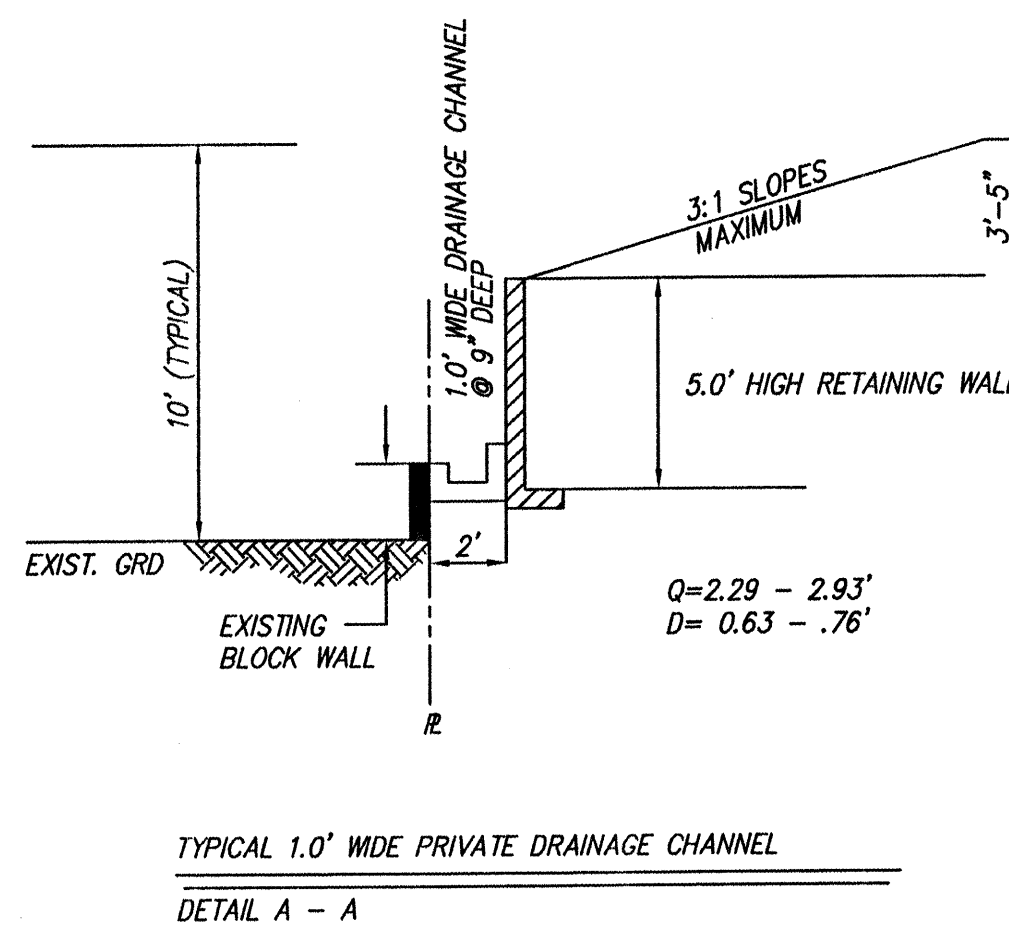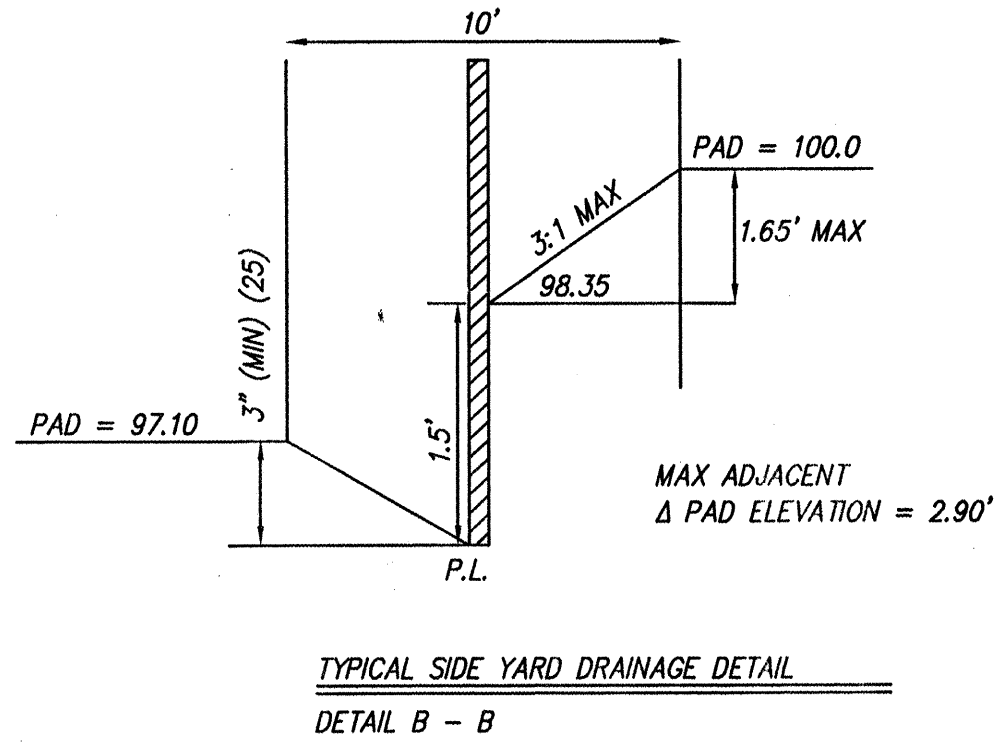

- NOTES
- OFFSITE FLOWS WILL BE ROUTED ALONG THE RETAINING WALL ON THE PROPERTY LINE TO THE R.O.W. OR ARROYO.
 - CONTRACTOR MUST OBTAIN A TOPSOIL DISTURBANCE PERMIT FROM THE ENVIRONMENTAL HEALTH DIVISION PRIOR TO CONSTRUCTION.
 - CITY OF ALBUQUERQUE STANDARD SPECIFICATIONS FOR PUBLIC WORKS CONSTRUCTION, LATEST EDITION SHALL GOVERN ALL WORK.
 - THE CONTRACTOR SHALL CONFORM TO ALL CITY, COUNTY, STATE AND FEDERAL DUST CONTROL MEASURES AND REQUIREMENTS AND WILL BE RESPONSIBLE FOR PREPARING AND OBTAINING ALL NECESSARY APPLICATIONS AND APPROVALS.
 - THE CONTRACTOR SHALL ENSURE THAT NO SOIL ERODES FROM THE LOTS INTO PUBLIC RIGHT-OF-WAY. THIS CAN BE ACHIEVED BY CONSTRUCTING TEMPORARY BERMS AND WETTING THE SOIL TO KEEP IT FROM BLOWING.

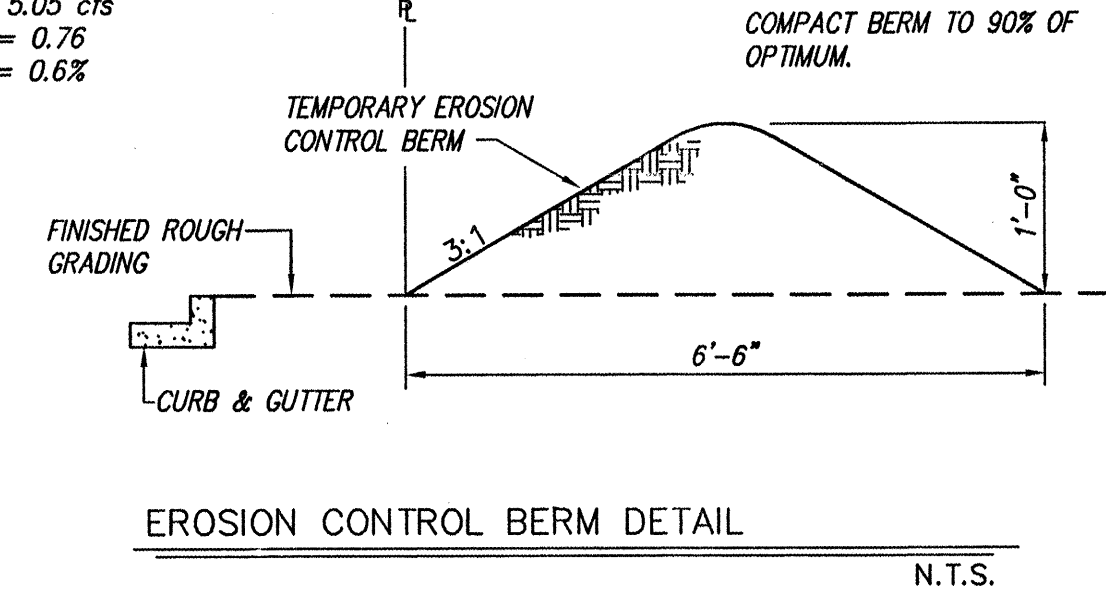

- EROSION CONTROL NOTES
- CONTRACTOR IS RESPONSIBLE FOR OBTAINING A TOPSOIL DISTURBANCE PERMIT PRIOR TO BEGINNING WORK.
 - CONTRACTOR IS RESPONSIBLE FOR KEEPING ALL SEDIMENT OUT OF EXISTING RIGHT-OF-WAY.
 - CONTRACTOR IS RESPONSIBLE FOR CLEANING UP ANY SEDIMENT THAT GETS INTO EXISTING RIGHT-OF-WAY.
 - EROSION CONTROL BERMS ARE REQUIRED AROUND THE ENTIRE SITE.
 - ALL EROSION CONTROL BERMS MUST BE IN PLACE AND ENGINEER CERTIFIED PRIOR TO BUILDING PERMIT RELEASE.

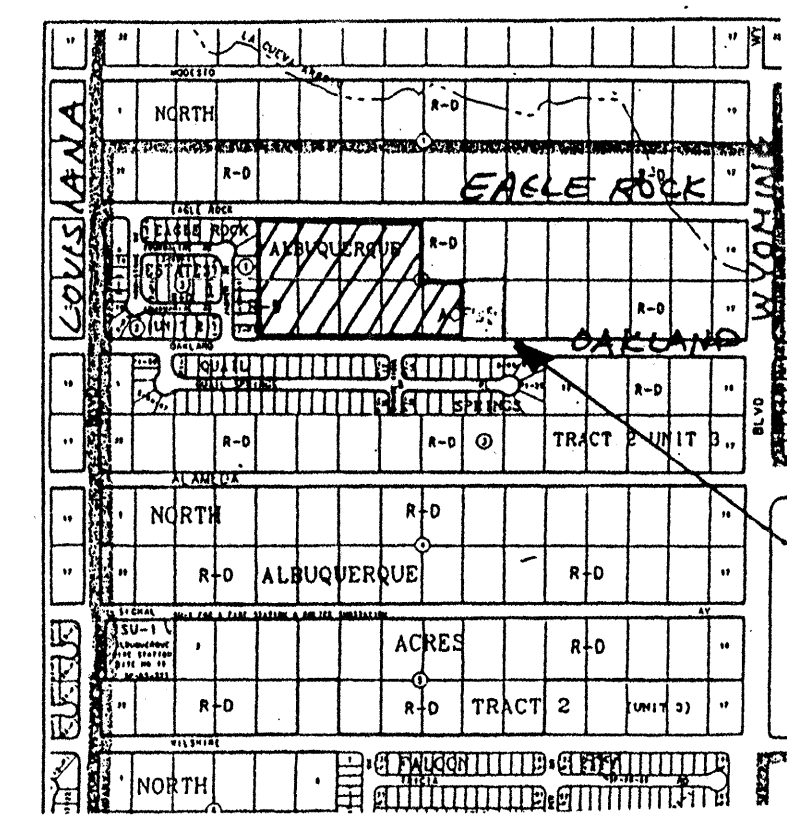


T B M (TEMPORARY BENCHMARK)

LEGAL DESCRIPTION

LOTS 5 - 8, 24 - 28, BLOCK 2, TRACT 2, UNIT 3 N.A.A.

- LEGEND
- NEW RETAINING WALL
 - 21.01 TW TOP OF WALL
 - 18.31 BW BOTTOM OF WALL
 - FP=76.98 FINISHED PAD ELEV.
 - STANDARD 8" CURB & GUTTER
 - 28.53* PROPOSED SPOT ELEV.
 - 3:1 SLOPE
 - EXIST. SANITARY SEWER MANHOLE
 - EXIST. WATER VALVE
 - EXIST. FIRE HYDRANT
 - EXIST. STORM SEWER MANHOLE
 - EXIST. CONTOUR
 - EXIST. CABLE T.V. PEDESTAL
 - EXIST. OVERHEAD ELECTRIC LINE
 - EXIST. OVERHEAD TELEPHONE LINE
 - EXIST. P.P.
 - SPOT ELEVATION
 - PROPOSED STORM DRAIN LINE
 - PROPOSED MANHOLE
 - BASIN BOUNDARY
 - PROPOSED STORM DRAIN INLET
 - EXIST. DROP INLET
 - EXIST. TOP OF CURB
 - FLOWLINE
 - SUGGESTED DRIVEWAY LOCATION

October 22, 1999
ROUGH GRADING APPROVAL DATE

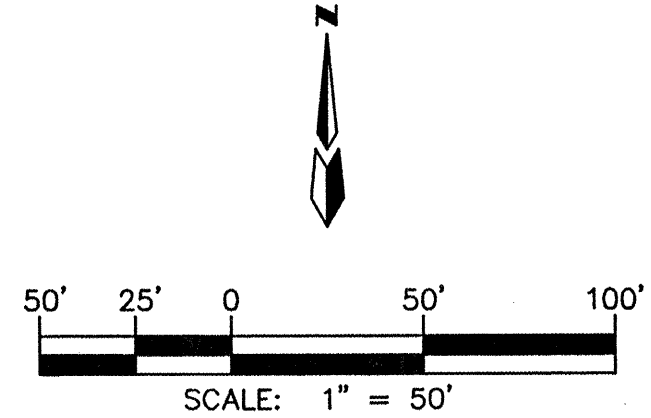

MARK GOODWIN & ASSOCIATES, P.A.
CONSULTING ENGINEERS
P.O. BOX 90606
ALBUQUERQUE, NEW MEXICO 87199
(505) 828-2200, FAX (505) 797-9539

CITY OF ALBUQUERQUE
PUBLIC WORKS DEPARTMENT
ENGINEERING DEVELOPMENT GROUP

TITLE: STONEBROOKE ESTATES SUBDIVISION
GRADING AND DRAINAGE PLAN

DESIGN REVIEW COMMITTEE CITY ENGINEER APPROVAL

APPROVED AS DRAFT

CITY PROJECT NO. 627281

ZONE MAP NO. C-19-Z

SHEET 4 OF 18

ENGINEER'S SEAL				SURVEY INFORMATION				BENCH MARKS				AS BUILT INFORMATION			
				NO.	BY	DATE		CITY OF ALBUQUERQUE OF CONTROL MONUMENT "11-C18"	CONTRACTOR						
				WALKER SURVEYING CO. 4-799				A STANDARD ALUMINUM CAP SET IN A 2 1/2" PIPE, LOCATED	WORKED BY						
								APPROXIMATELY 265 FEET NORTH OF THE CENTERLINE OF	INSPECTED BY						
								EAGLE ROCK AVE. AND 32 FEET WEST OF THE CENTER LINE	FIELD INFORMATION BY						
								OF LOUISIANA BLVD	DRAWINGS						
								ELEVATION 5305.0 FEET	CORRECTED BY						
									MICRO-FILM INFORMATION						
									RECORDED BY						
									NO.						

66-51-01


REGISTERED PROFESSIONAL ENGINEER

NEW MEXICO


1987

HOELZER

--	--	
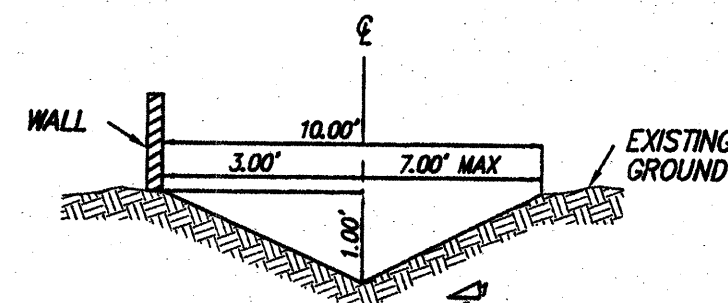

$Q \text{ max} = 3.43 \text{ cfs}$	$Q \text{ max} = 5.05 \text{ cfs}$
DEPTH = 0.57	DEPTH = 0.76
SLOPE = 1.34%	SLOPE = 0.6%

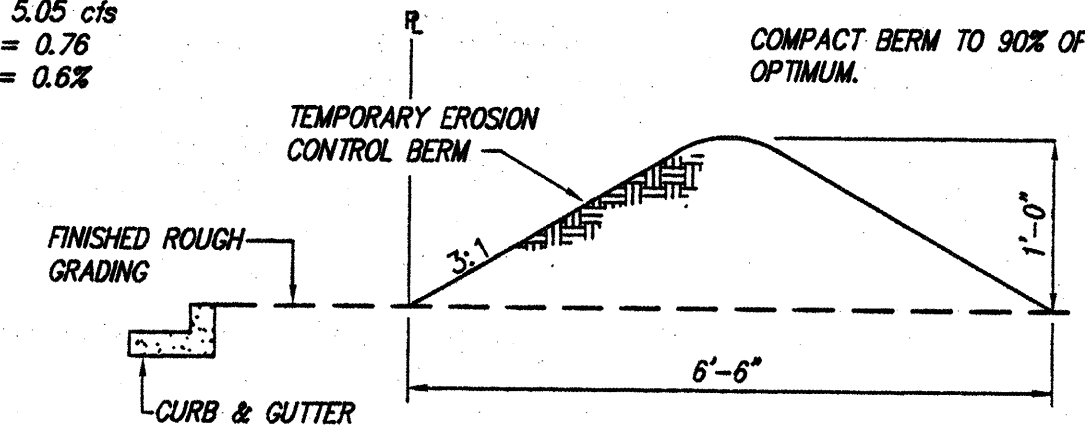

EROSION CONTROL BERM DETAIL

EROSION CONTROL NOTES

1. CONTRACTOR IS RESPONSIBLE FOR OBTAINING A TOPSOIL DISTURBANCE PERMIT PRIOR TO BEGINNING WORK.
2. CONTRACTOR IS RESPONSIBLE FOR KEEPING ALL SEDIMENT OUT OF EXISTING RIGHT-OF-WAY.
3. CONTRACTOR IS RESPONSIBLE FOR CLEANING UP ANY SEDIMENT THAT GETS INTO EXISTING RIGHT-OF-WAY.
4. EROSION CONTROL BERMS ARE REQUIRED AROUND THE ENTIRE SITE.
5. ALL EROSION CONTROL BERMS MUST BE IN PLACE AND ENGINEER CERTIFIED PRIOR TO BUILDING PERMIT RELEASE.

RECORD DRAWING

hereby certify that the information contained on this drawing has been revised in accordance with information furnished by the contractor, Salls Bros., and by the surveyor, Walker Surveying Co., and reflects the construction as actually accomplished. This plan as constructed is in substantial compliance with the

Approved Plan. Diane Hoelzer 5-7-01
Diane Hoelzer NMDE 11067

accomplished. This plan as constructed is in substantial compliance with the Approved Plan.

Mane Hoelzer 5-7-01
 Mane Hoelzer NMIDE 11067

7-9-10

ROUGH GRADING APPROVAL DATE _____

SCALE: 1" = 50'

9050SCH/9050GD4R.DWG / 02-9-00 / SPS M.I.R. D.L.H. W.V.

SCH/9050GD4R.DWG/ 02-9-00 / SPS M.I.R. DI H. W.V.

VICINITY MAP


ZONE MAP: C-19-Z

T B M (TEMPORARY BENCHMARK)

LEGAL DESCRIPTION

LOTS 5 - 8, 24 - 28, BLOCK 2, TRACT 2, UNIT 3 N.A.A.

LEGEND

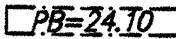- 
 POND BOTTOM ELEVATION

 21.01 TW
 18.31 BW
 FP=76.98

 28.53 *

 O EXIST. SANITARY SEWER MANHOLE
 " EXIST. WATER VALVE
 Φ EXIST. FIRE HYDRANT
 ⊗ EXIST. STORM SEWER MANHOLE
 -5135- EXIST. CONTOUR
 * EXIST. CABLE T.V. PEDESTAL
 —E— EXIST. OVERHEAD ELECTRIC LINE
 —T— EXIST. OVERHEAD TELEPHONE LINE
 O EXIST. P.P.
 x 00.00 SPOT ELEVATION
 —SD— PROPOSED STORM DRAIN LINE
 ● PROPOSED MANHOLE
 BASIN BOUNDARY
 PROPOSED STORM DRAIN INLET
 EXIST. DRAIN INLET
 TC= EXIST. TOP OF CURB
 FLOWLINE
 —SUG— SUGGESTED DRIVEWAY LOCATION

AS BUILT INFORMATION			
CONTRACTOR	WORK	DATE	DATE
INSPECTED BY	DATE		
ACCEPTANCE BY	DATE		
FIELD	DATE		
VERIFICATION BY	DATE		
DRAWINGS	DATE		
CORRECTED BY	DATE		
MICRO-FILM INFORMATION			
RECORDED BY	DATE		
NO.			

[illegible]

BENCH MARK'S
CITY OF ALBUQUERQUE OF CONTROL MONUMENTAL CAP SET IN A 2 1/2"
A STANDARD ALUMINUM CAP SET IN A 2 1/2"
APPROXIMATELY 285 FEET NORTH OF THE CENTER
EAGLE ROCK AVE. AND 32 FEET WEST OF THE
OF LOUISIANA BLVD
ELEVATION 5305.0 FEET

FIELD NOTES		SURVEY INFORMATION	
NO.	BY	DATE	
1	WALKER	SURVEYING CO.	4/30
2			
3			
4			
5			
6			
7			
8			
9			
10			

A circular seal of the American Society of Mechanical Engineers (ASME). The outer ring contains the text "AMERICAN SOCIETY OF MECHANICAL ENGINEERS" at the top and "REGISTERED" at the bottom. The inner circle contains the text "NEW MEXICO" and the year "1967". Handwritten annotations include "2" and "00-8-2" at the top, and "177-177" and "177-177" in the center, along with a signature "W. H. H." on the right.

[illegible]

	SIGNED BY	DH
	DRAWN BY	SPS, M
	CHECKED BY	DMG

 CITY OF ALBUQUERQUE
PUBLIC WORKS DEPARTMENT
ENGINEERING DEVELOPMENT GROUP







TITLE: **STONEBROOKE ESTATES SUBDIVISION
GRADING AND DRAINAGE PLAN**

DESIGN REVIEW COMMITTEE	CITY ENGINEER APPROVAL	DATE	MO./DAY/YR.	MO./DAY/YR.
-------------------------	------------------------	------	-------------	-------------




Approved F RB		IGN UPDA		

APP AT DIES		LAST DES		



CITY PROJECT NO. 627281	ZONE MAP NO. C-19-Z	SHEET 4A OF 18
-----------------------------------	-------------------------------	------------------------------

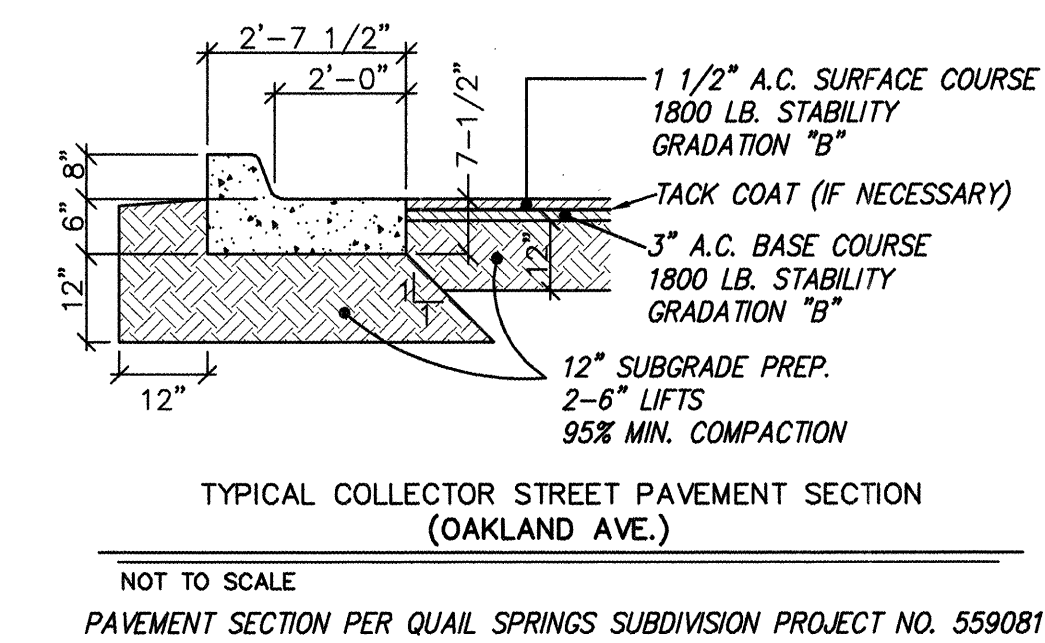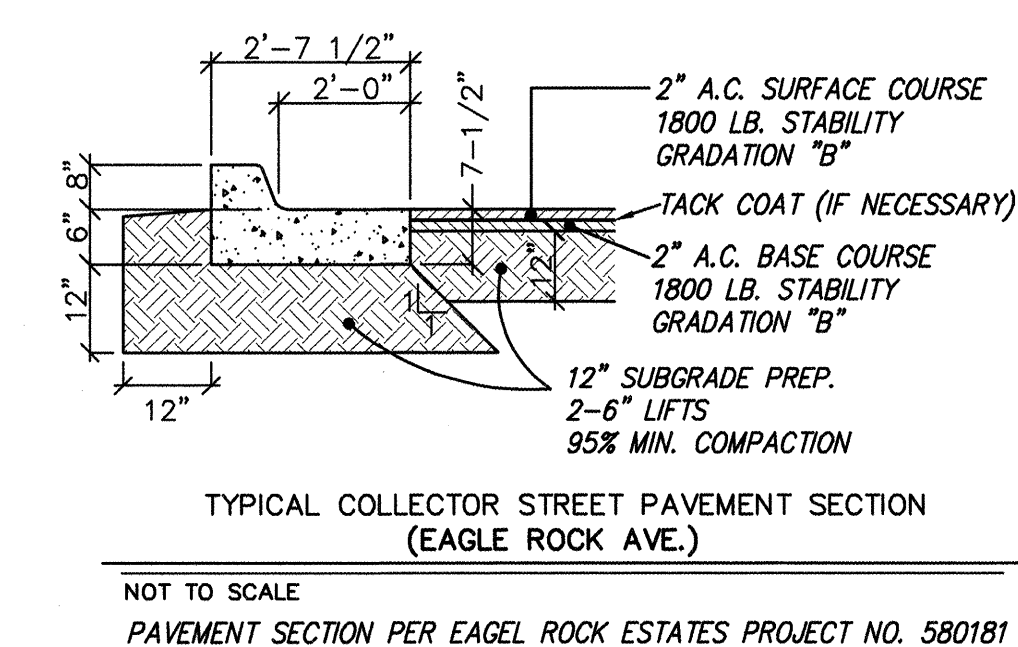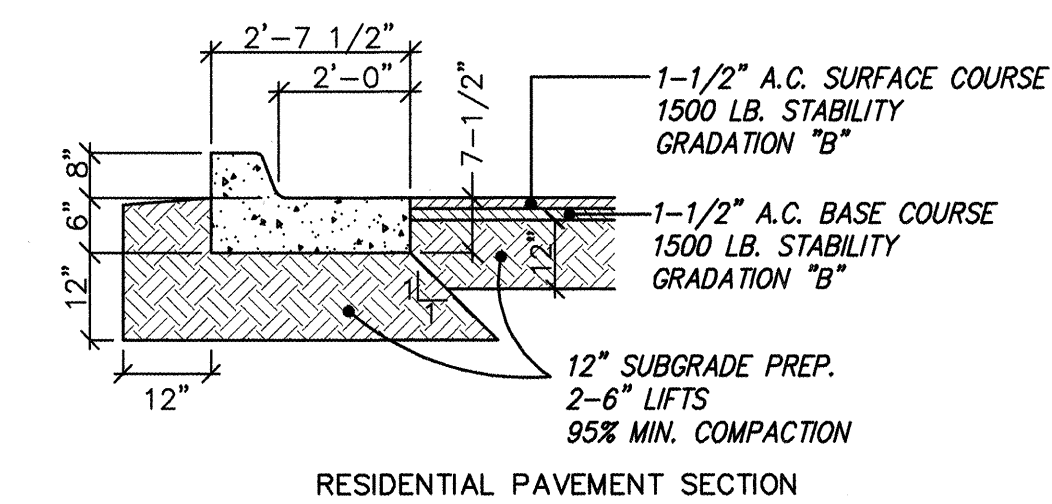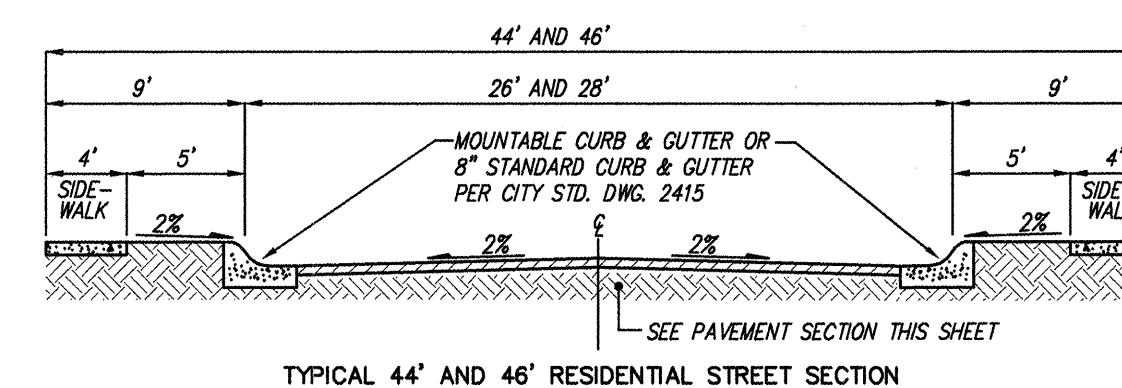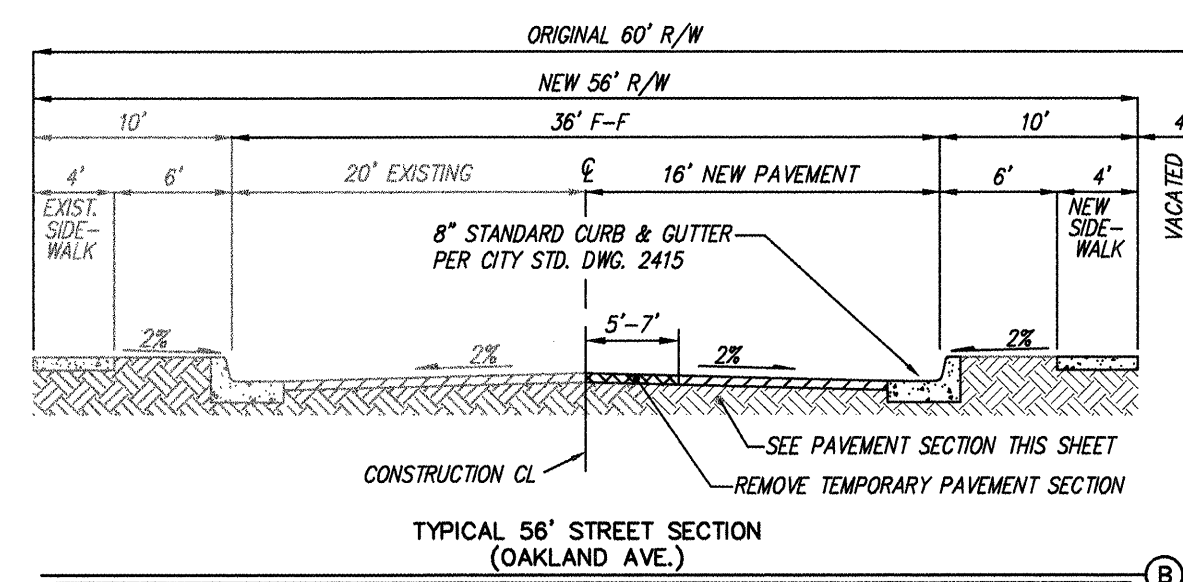
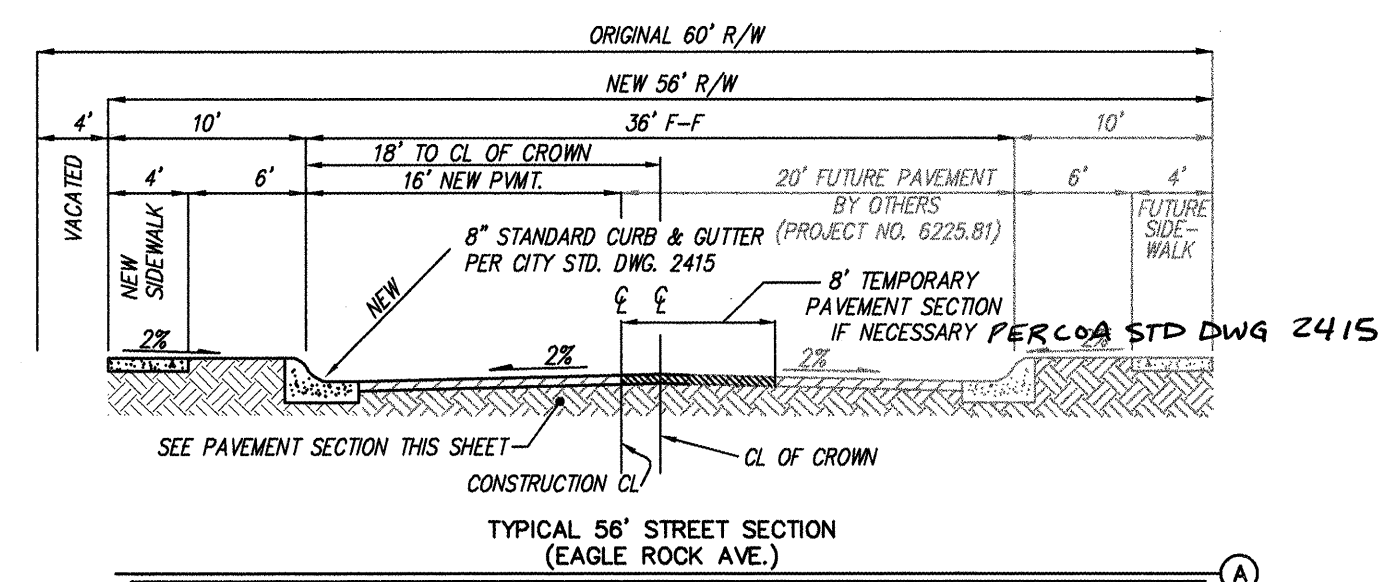


- # LEGEND

  
 
           	PROPERTY LINE NEW 8" STANDARD CURB NEW 8" DEPRESSIONED CURB NEW MOUNTABLE CURB NEW WHEELCHAIR RAMP PER COA STD DWG 2441 CASE II 50° CROWN TRANSITION (TYP) NEW STREET LIGHT NEW DEFERRED SIDEWALK RETAINING WALL NEW OFFSITE PAVEMENT SEE P.W.M.T. SECTIONS THIS SHEET REMOVE EXISTING PAVEMENT TEMPORARY PAVEMENT EXISTING PAVEMENT
--	---

- # N O T E S
-
1. ALL SIDEWALKS PER CITY OF ALBUQUERQUE STANDARD DRAWING 2430.
 2. ALL 6' VALLEY GUTTERS PER COA STANDARD DWG 2420.
ALL 10' VALLEY GUTTERS PER COA STANDARD DWG 2422.
 3. ALL 4' VALLEY GUTTERS PER COA STANDARD DWG 2421.
 4. ALL VALLEY GUTTERS ARE TO HAVE 3/4" INVERT.
 5. ALL 4' INTERIOR SIDEWALKS ARE DEFERRED.
 6. ALL HANDICAP RAMPS TO BE CASE 2 PER CITY OF ALBUQUERQUE STANDARD DRAWING 2441.
 7. TRANSITION FROM MOUNTABLE TO STANDARD CURB SHALL BE PER CITY OF ALBUQUERQUE STANDARD DRAWING 2418.
 8. 50' MINIMUM TRANSITION SECTION FROM FULL CROWN TO NO CROWN SECTION.
 9. ALL STANDARD CURB AND GUTTER SHALL BE 8" PER CITY OF ALBUQUERQUE STANDARD DRAWING 2415.
 10. 45 RESIDENTIAL LOTS TO BE CONSTRUCTED THIS PROJECT.

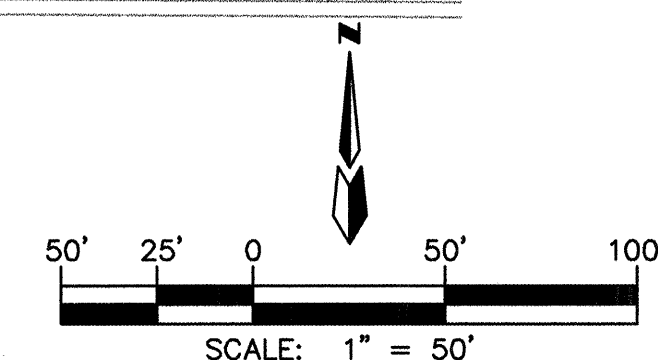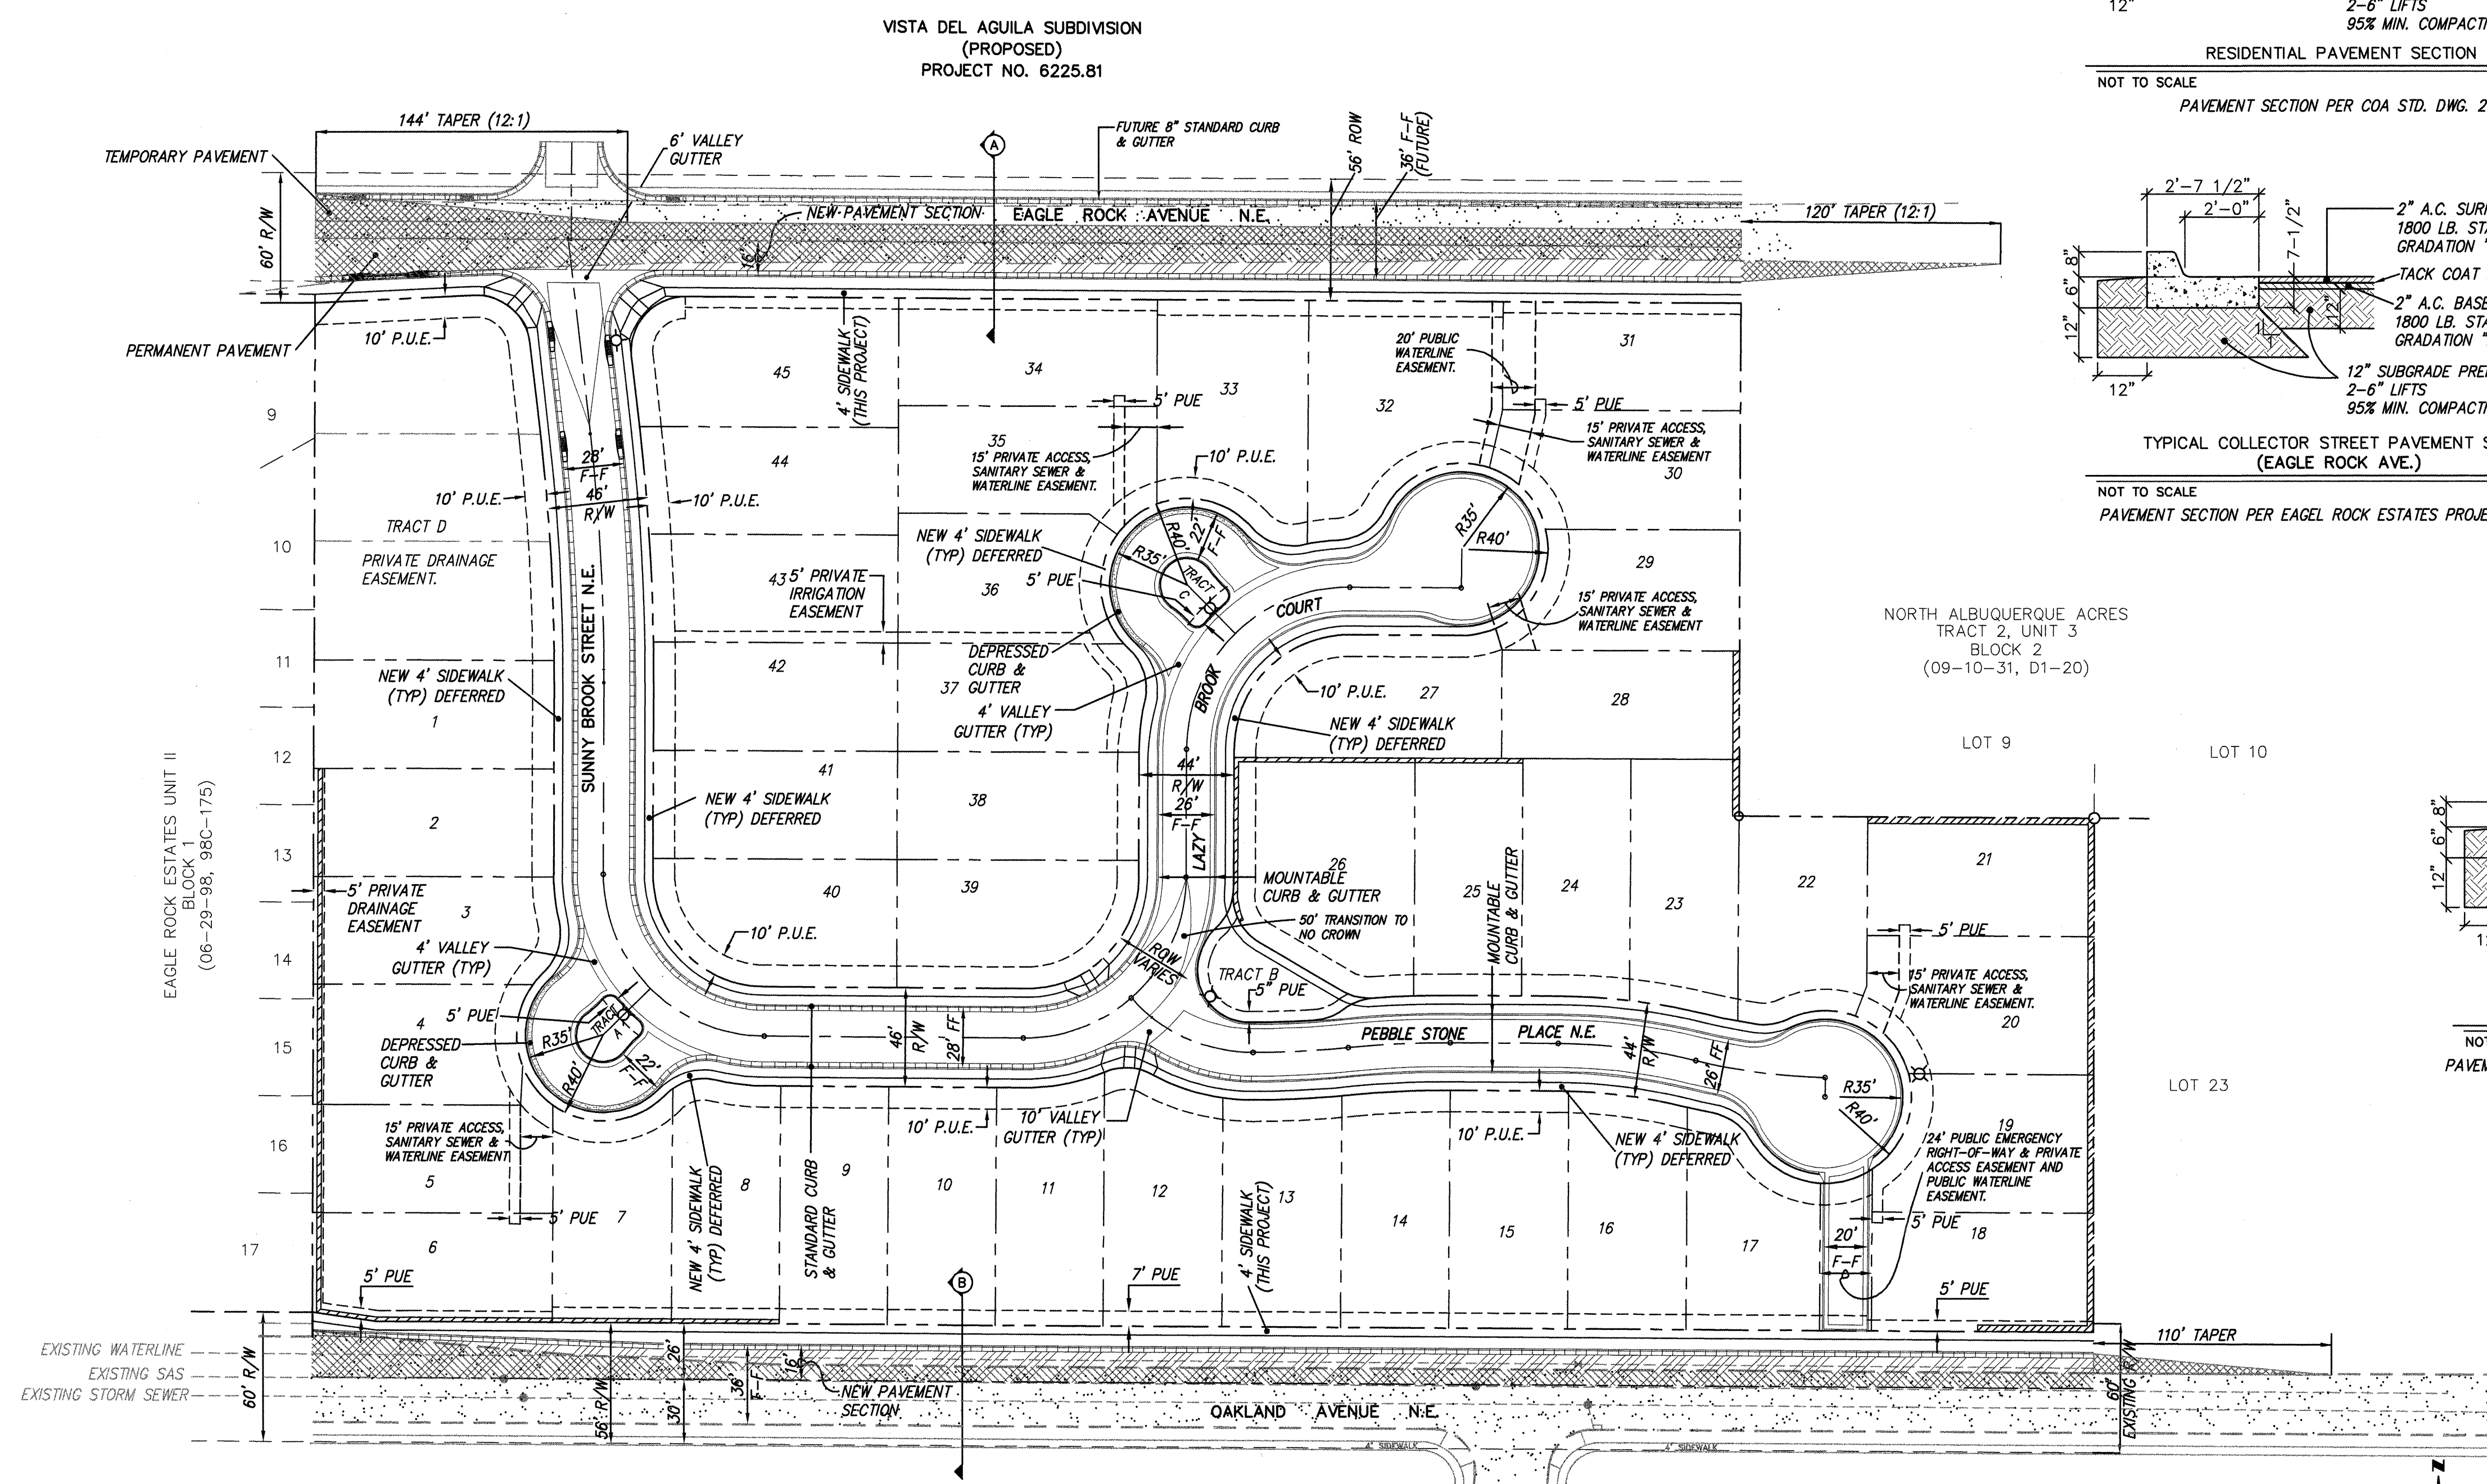

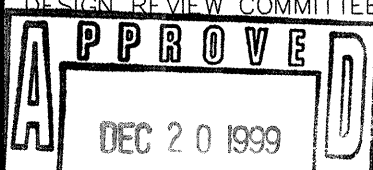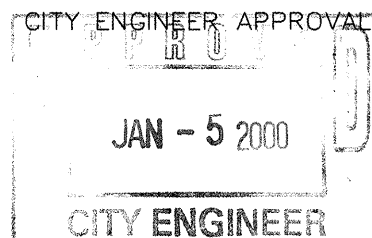	D. MARK GOODWIN & ASSOCIATES, P.A. CONSULTING ENGINEERS P.O. BOX 90606 ALBUQUERQUE, NEW MEXICO 87199 (505) 828-2200		NO.	DATE	DESIGNED BY
 CITY OF ALBUQUERQUE PUBLIC WORKS DEPARTMENT ENGINEERING DEVELOPMENT GROUP					
TITLE: STONEBROOKE ESTATES MASTER PAVING PLAN					
DESIGN REVIEW COMMITTEE 		CITY ENGINEER APPROVAL 		LAST DESIGN UPDATE 	MO./DAY/YR.
DESIGN REVIEW COMMITTEE CITY PROJECT NO. 627281		ZONE MAP NO. C-19-Z		SHEET 5	OF

SCANNED BY
MESA REPRO

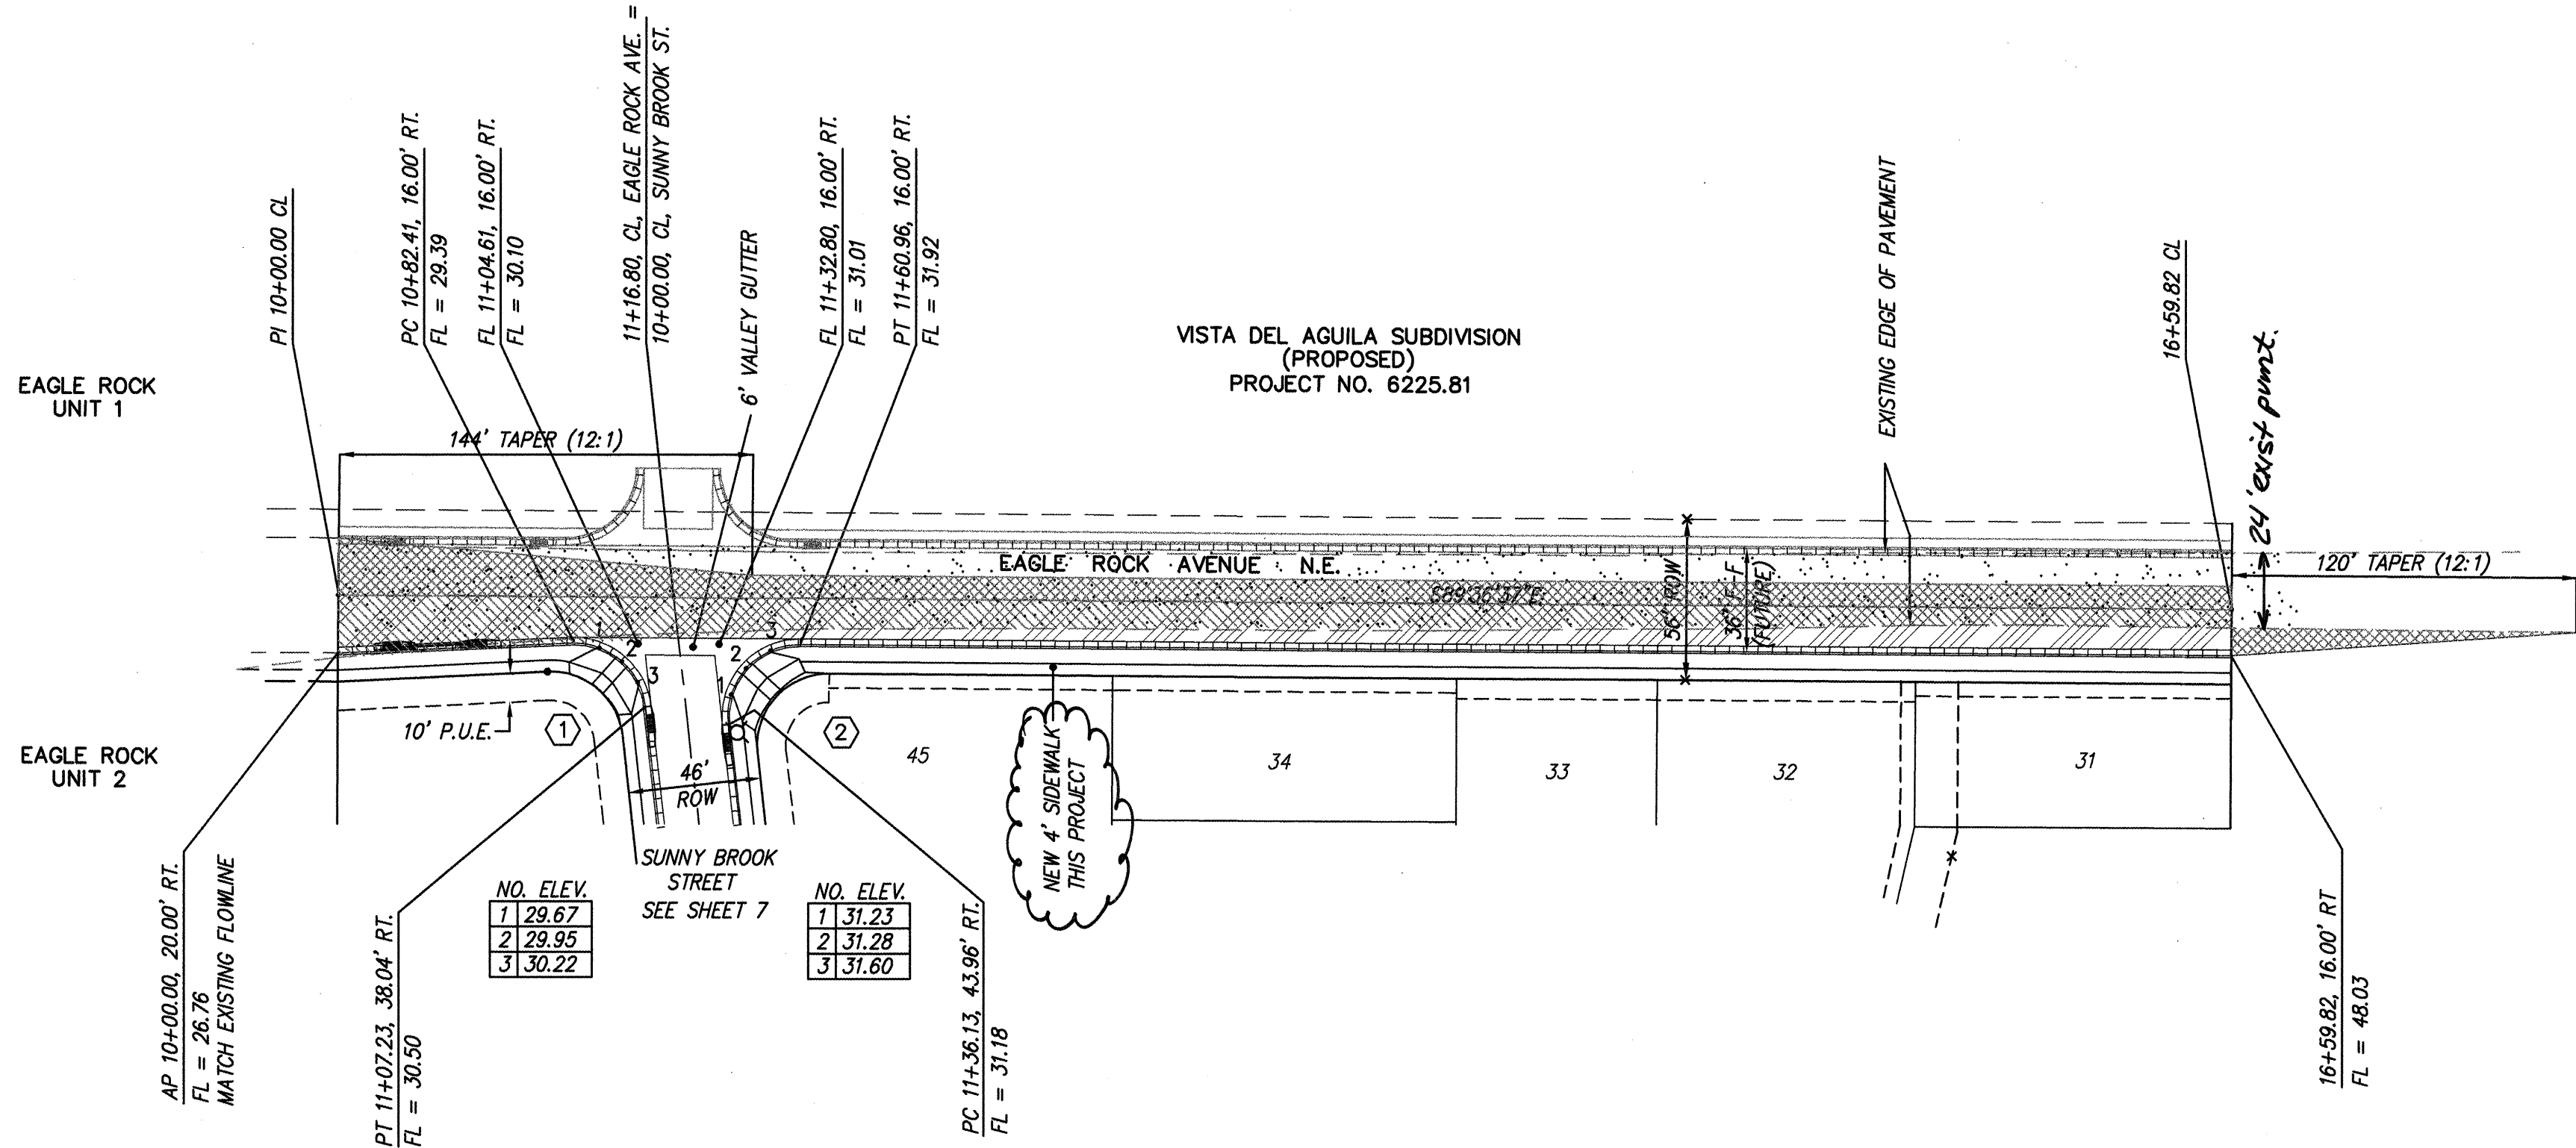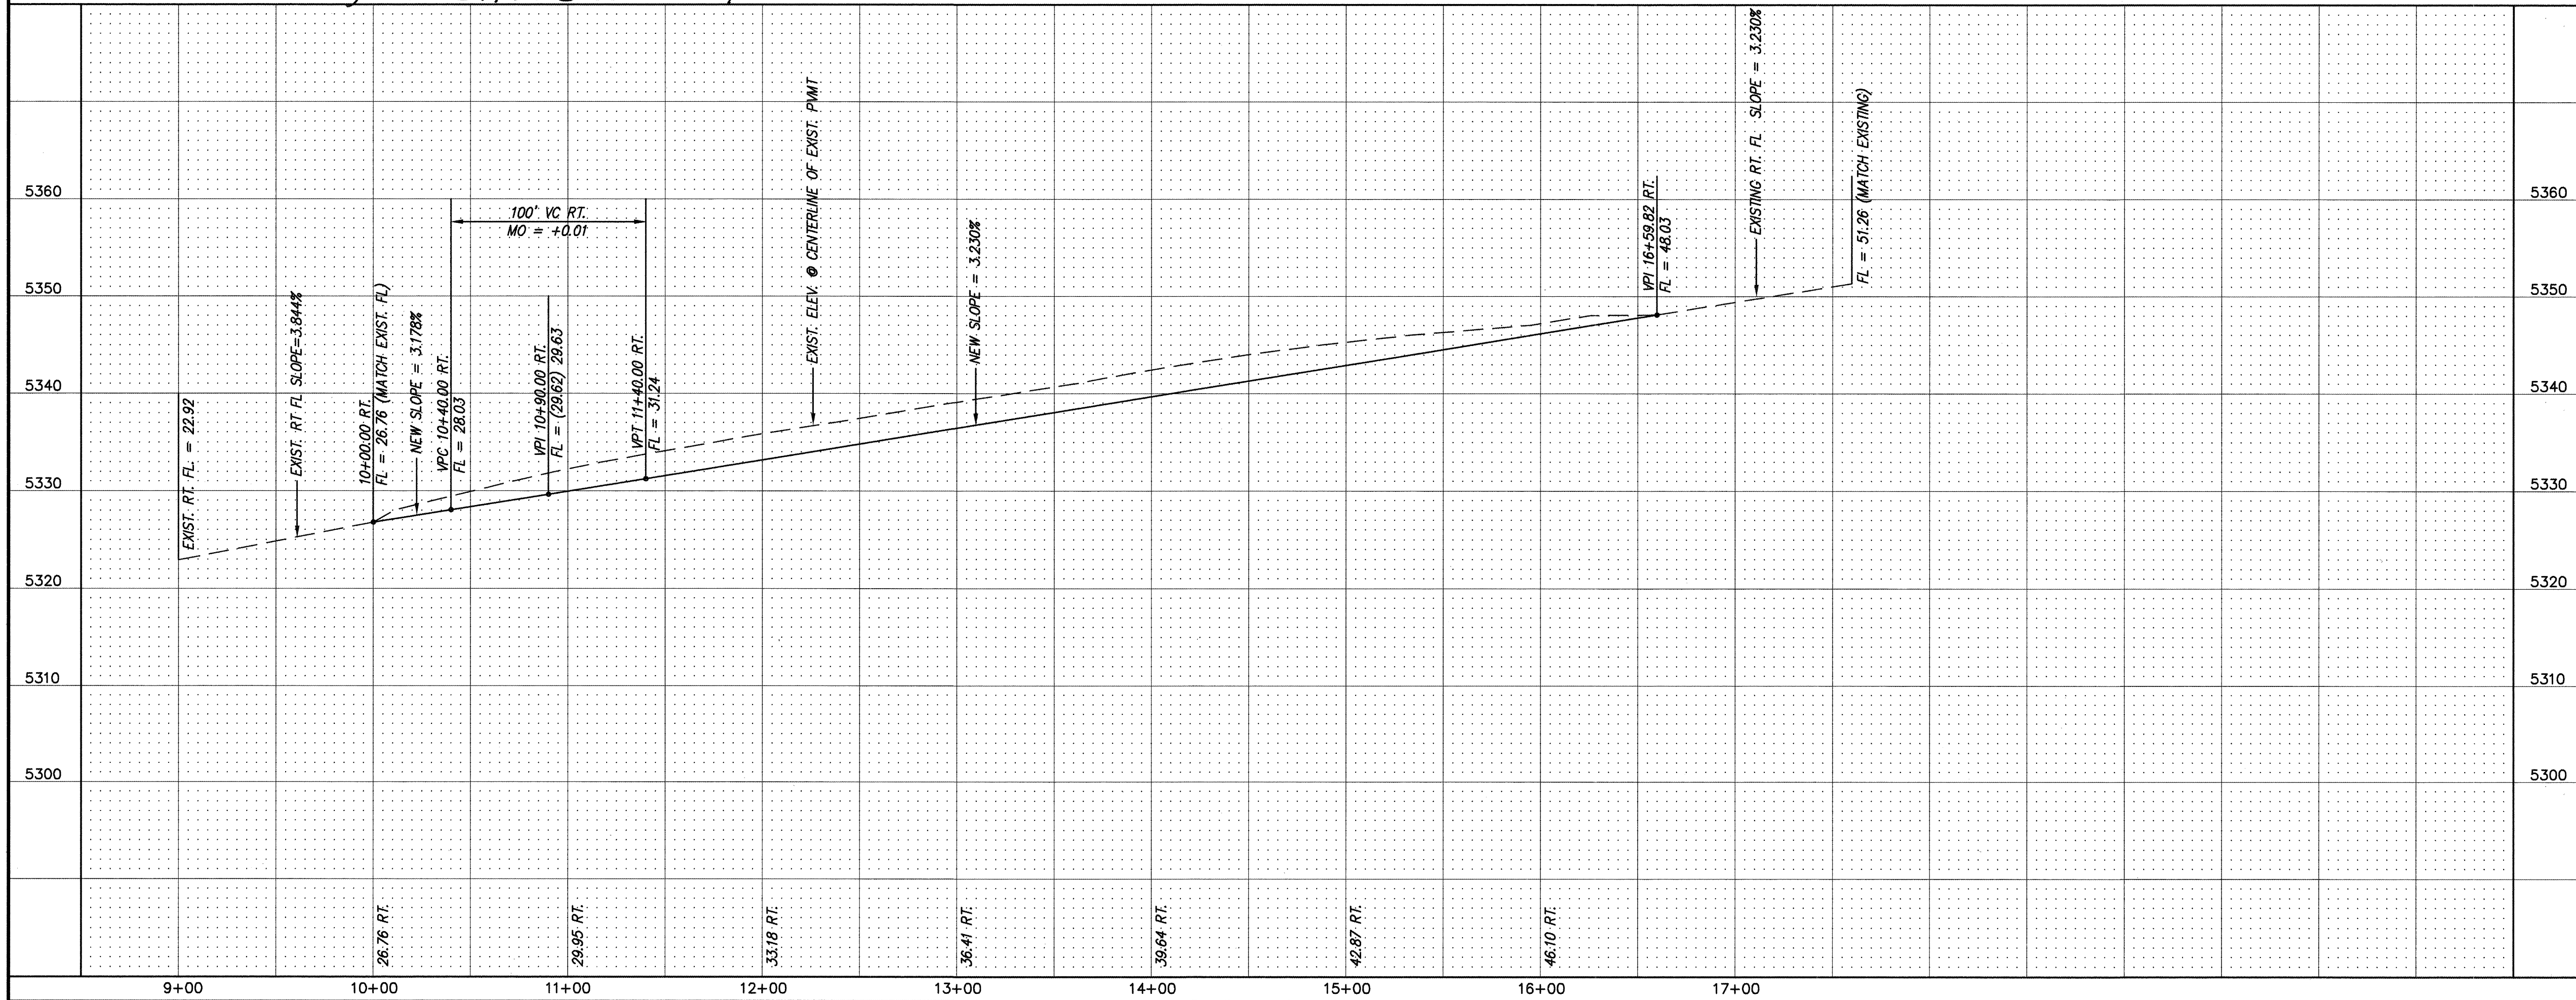

LEGEND

- PERMANENT PAVEMENT
- REMOVE EXISTING PAVEMENT
- NEW TEMPORARY PAVEMENT

EAGLE ROCK AVENUE N.E.
STA. 8+83.87 TO STA. 15+42.94
SCALE: HORIZ. 1" = 50'
VERT. 1" = 10'

NOTES

- ALL 4' VALLEY GUTTERS PER CITY OF ALBUQUERQUE STANDARD DRAWING 2421 AT KNUCKLES AND 6' VALLEY GUTTERS PER CITY OF ALBUQUERQUE STANDARD DRAWING 2420 AT ALL INTERSECTIONS.
- ALL 4' INTERIOR SIDEWALKS ARE DEFERRED.
- ALL HANDICAP RAMPS TO BE CASE II PER CITY OF ALBUQUERQUE STANDARD DRAWING 2441. WHERE GRADES DO NOT PERMIT A MAXIMUM SLOPE OF 12:1 TO BE MAINTAINED WITHIN THE 7' LENGTH AS SPECIFIED, THEN THE "7" LENGTH AS SHOWN IN DRAWING 2441 MUST BE INCREASED TO MAINTAIN A SLOPE < 12:1.
- TRANSITION FROM MOUNTABLE CURB TO STANDARD CURB SHALL BE WITHIN 10' SECTION.
- TRANSITION SECTION FROM FULL CROWN TO NO CROWN TO BE A MINIMUM OF 50', PER CITY OF ALBUQUERQUE STANDARD DRAWING 2401.
- ALL INTERIOR SUBDIVISION STREETS ARE PRIVATE.

CURVE DATA - DESCRIBES FACE OF CURB

- ① $A = 83'12.19''$ $R = 25.00'$ $L = 36.31'$ $T = 22.20'$
- ② $A = 96'47.41''$ $R = 25.00'$ $L = 42.23'$ $T = 28.16'$

dmg MARK GOODWIN & ASSOCIATES, P.A.
CONSULTING ENGINEERS
P.O. BOX 90606
ALBUQUERQUE, NEW MEXICO 87199
(505) 828-2200, FAX (505) 797-9539


CITY OF ALBUQUERQUE
PUBLIC WORKS DEPARTMENT
ENGINEERING DEVELOPMENT GROUP

TITLE: **STONEBROOKE ESTATES
PAVING IMPROVEMENTS
EAGLE ROCK AVENUE**

DESIGN REVIEW COMMITTEE
DEC 20 1999

CITY ENGINEER APPROVAL
JAN - 5 2000
CITY ENGINEER



CITY PROJECT NO. **627281** ZONE MAP NO. **C-19-Z** SHEET **6** OF **18**

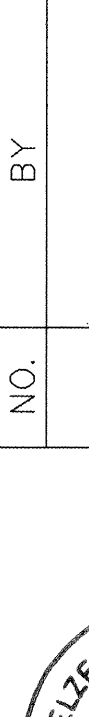ENGINEER'S SEAL				SURVEY INFORMATION			BENCH MARKS			AS BUILT INFORMATION		
				FIELD NOTES			CITY OF ALBUQUERQUE OF CONTROL MONUMENT "11-C18" A STANDARD ALUMINUM CAP SET IN A 2 1/2" PIPE, LOCATED APPROXIMATELY 265 FEET NORTH OF THE CENTERLINE OF EAGLE ROCK AVE. AND 32 FEET WEST OF THE CENTER LINE OF LOUISIANA BLVD ELEVATION 5305.0 FEET			CONTRACTOR		
				NO.	BY	DATE				STAKED BY Sundance		
REMARKS				BY			DATE			DATE		
DESIGNED BY DH				DATE 2/99			DATE			DATE		
DRAWN BY SP5				DATE 2/99			DATE			DATE		

DATE HOELTER & ASSOCIATES, P.A.
NEW MEXICO
REGISTERED PROFESSIONAL ENGINEER
NO. 11599

NO.	DATE	REMARKS	BY
		DESIGN	
		REVISIONS	
DESIGNED BY	DATE		
DRAWN BY	DATE		
CHECKED BY	DATE		


SCANNED BY
MESA REPRO

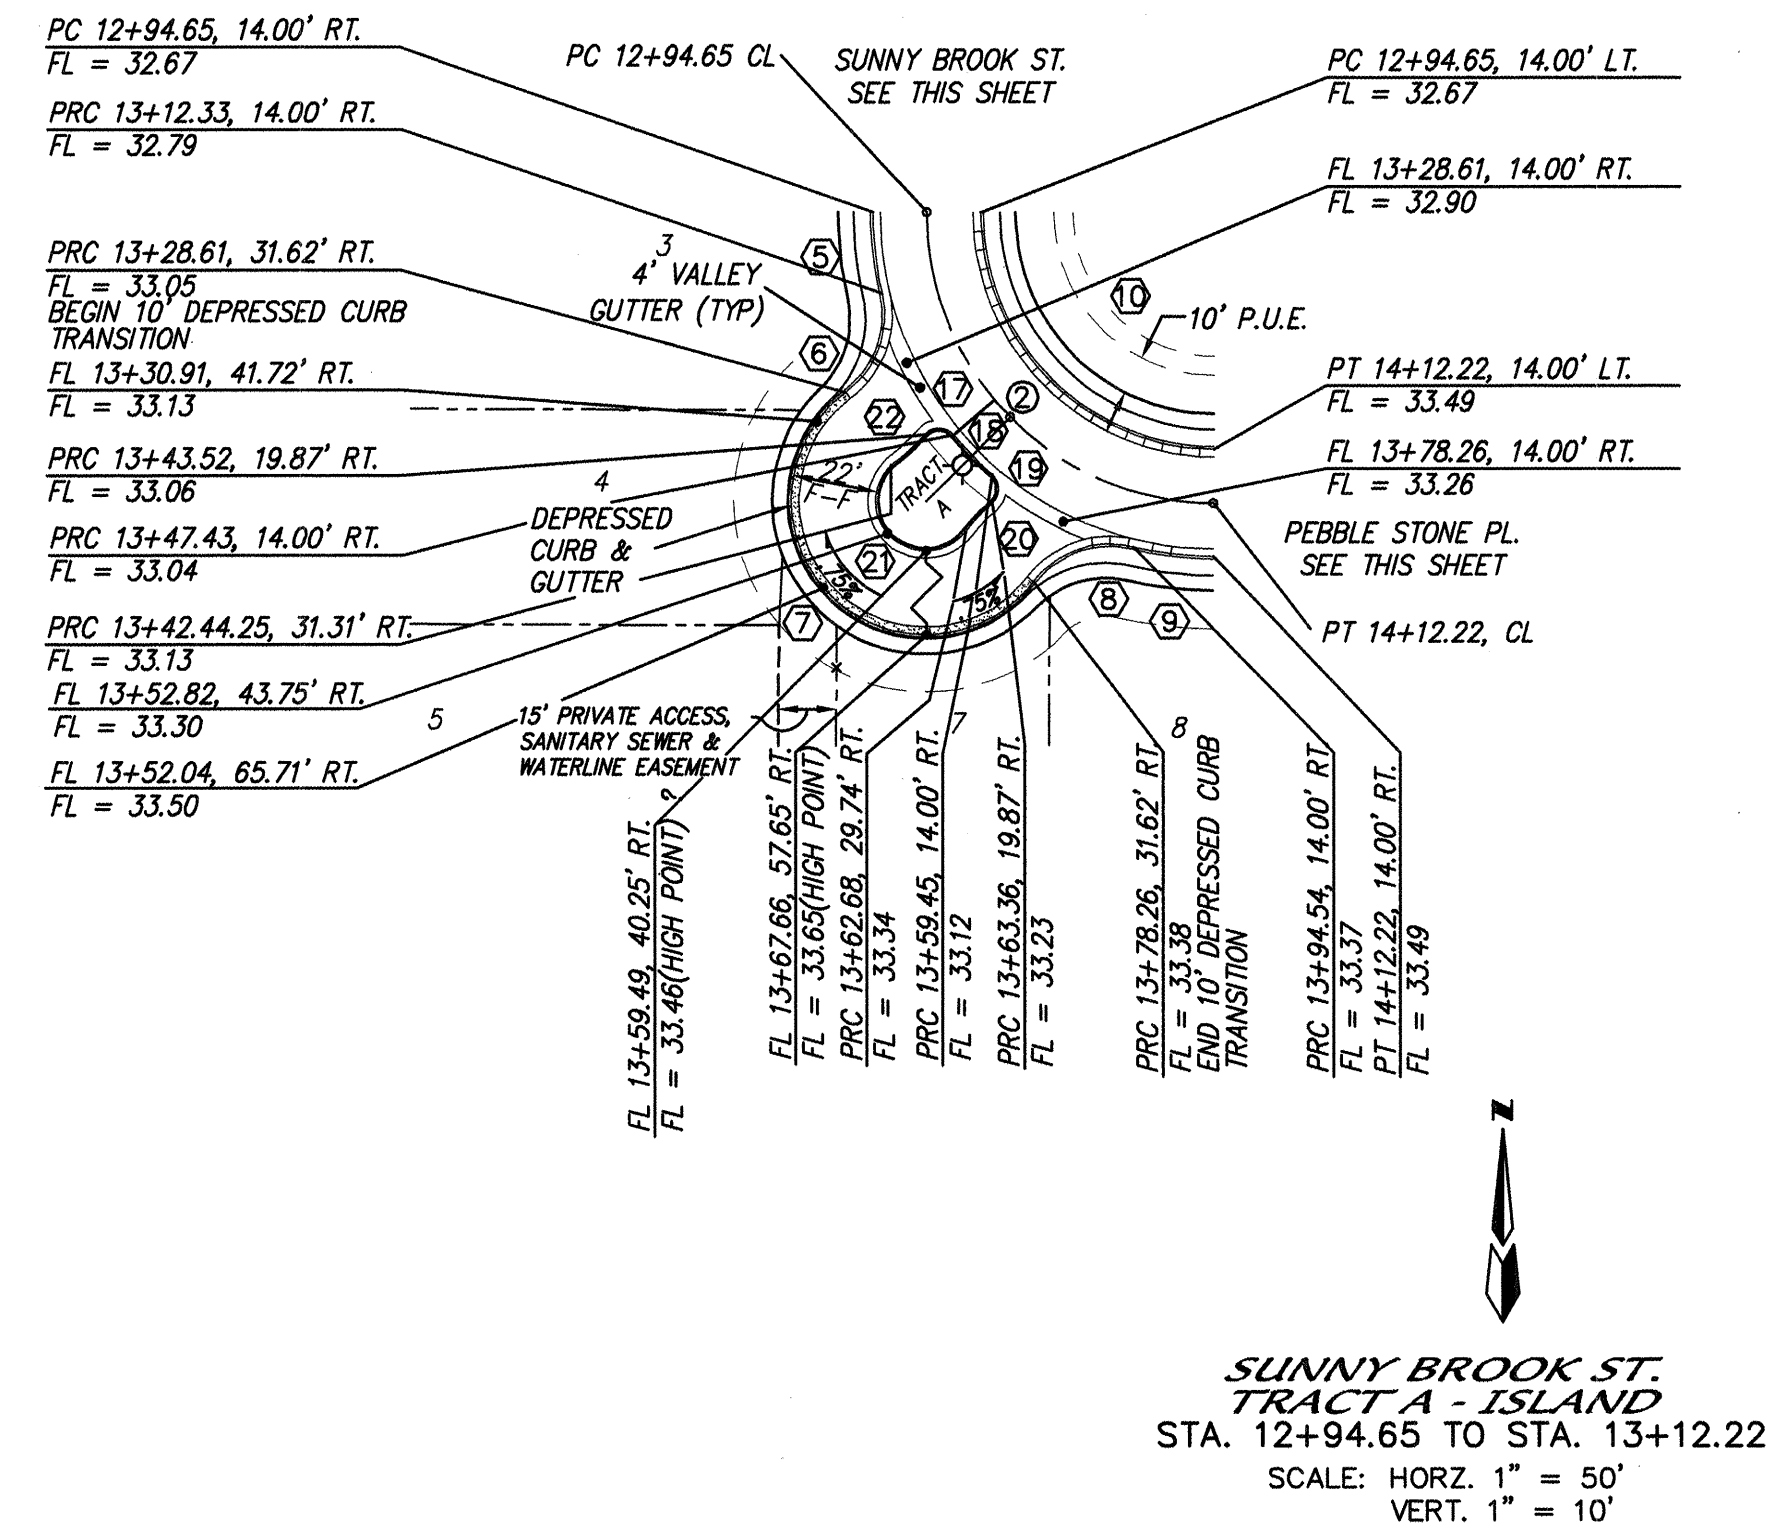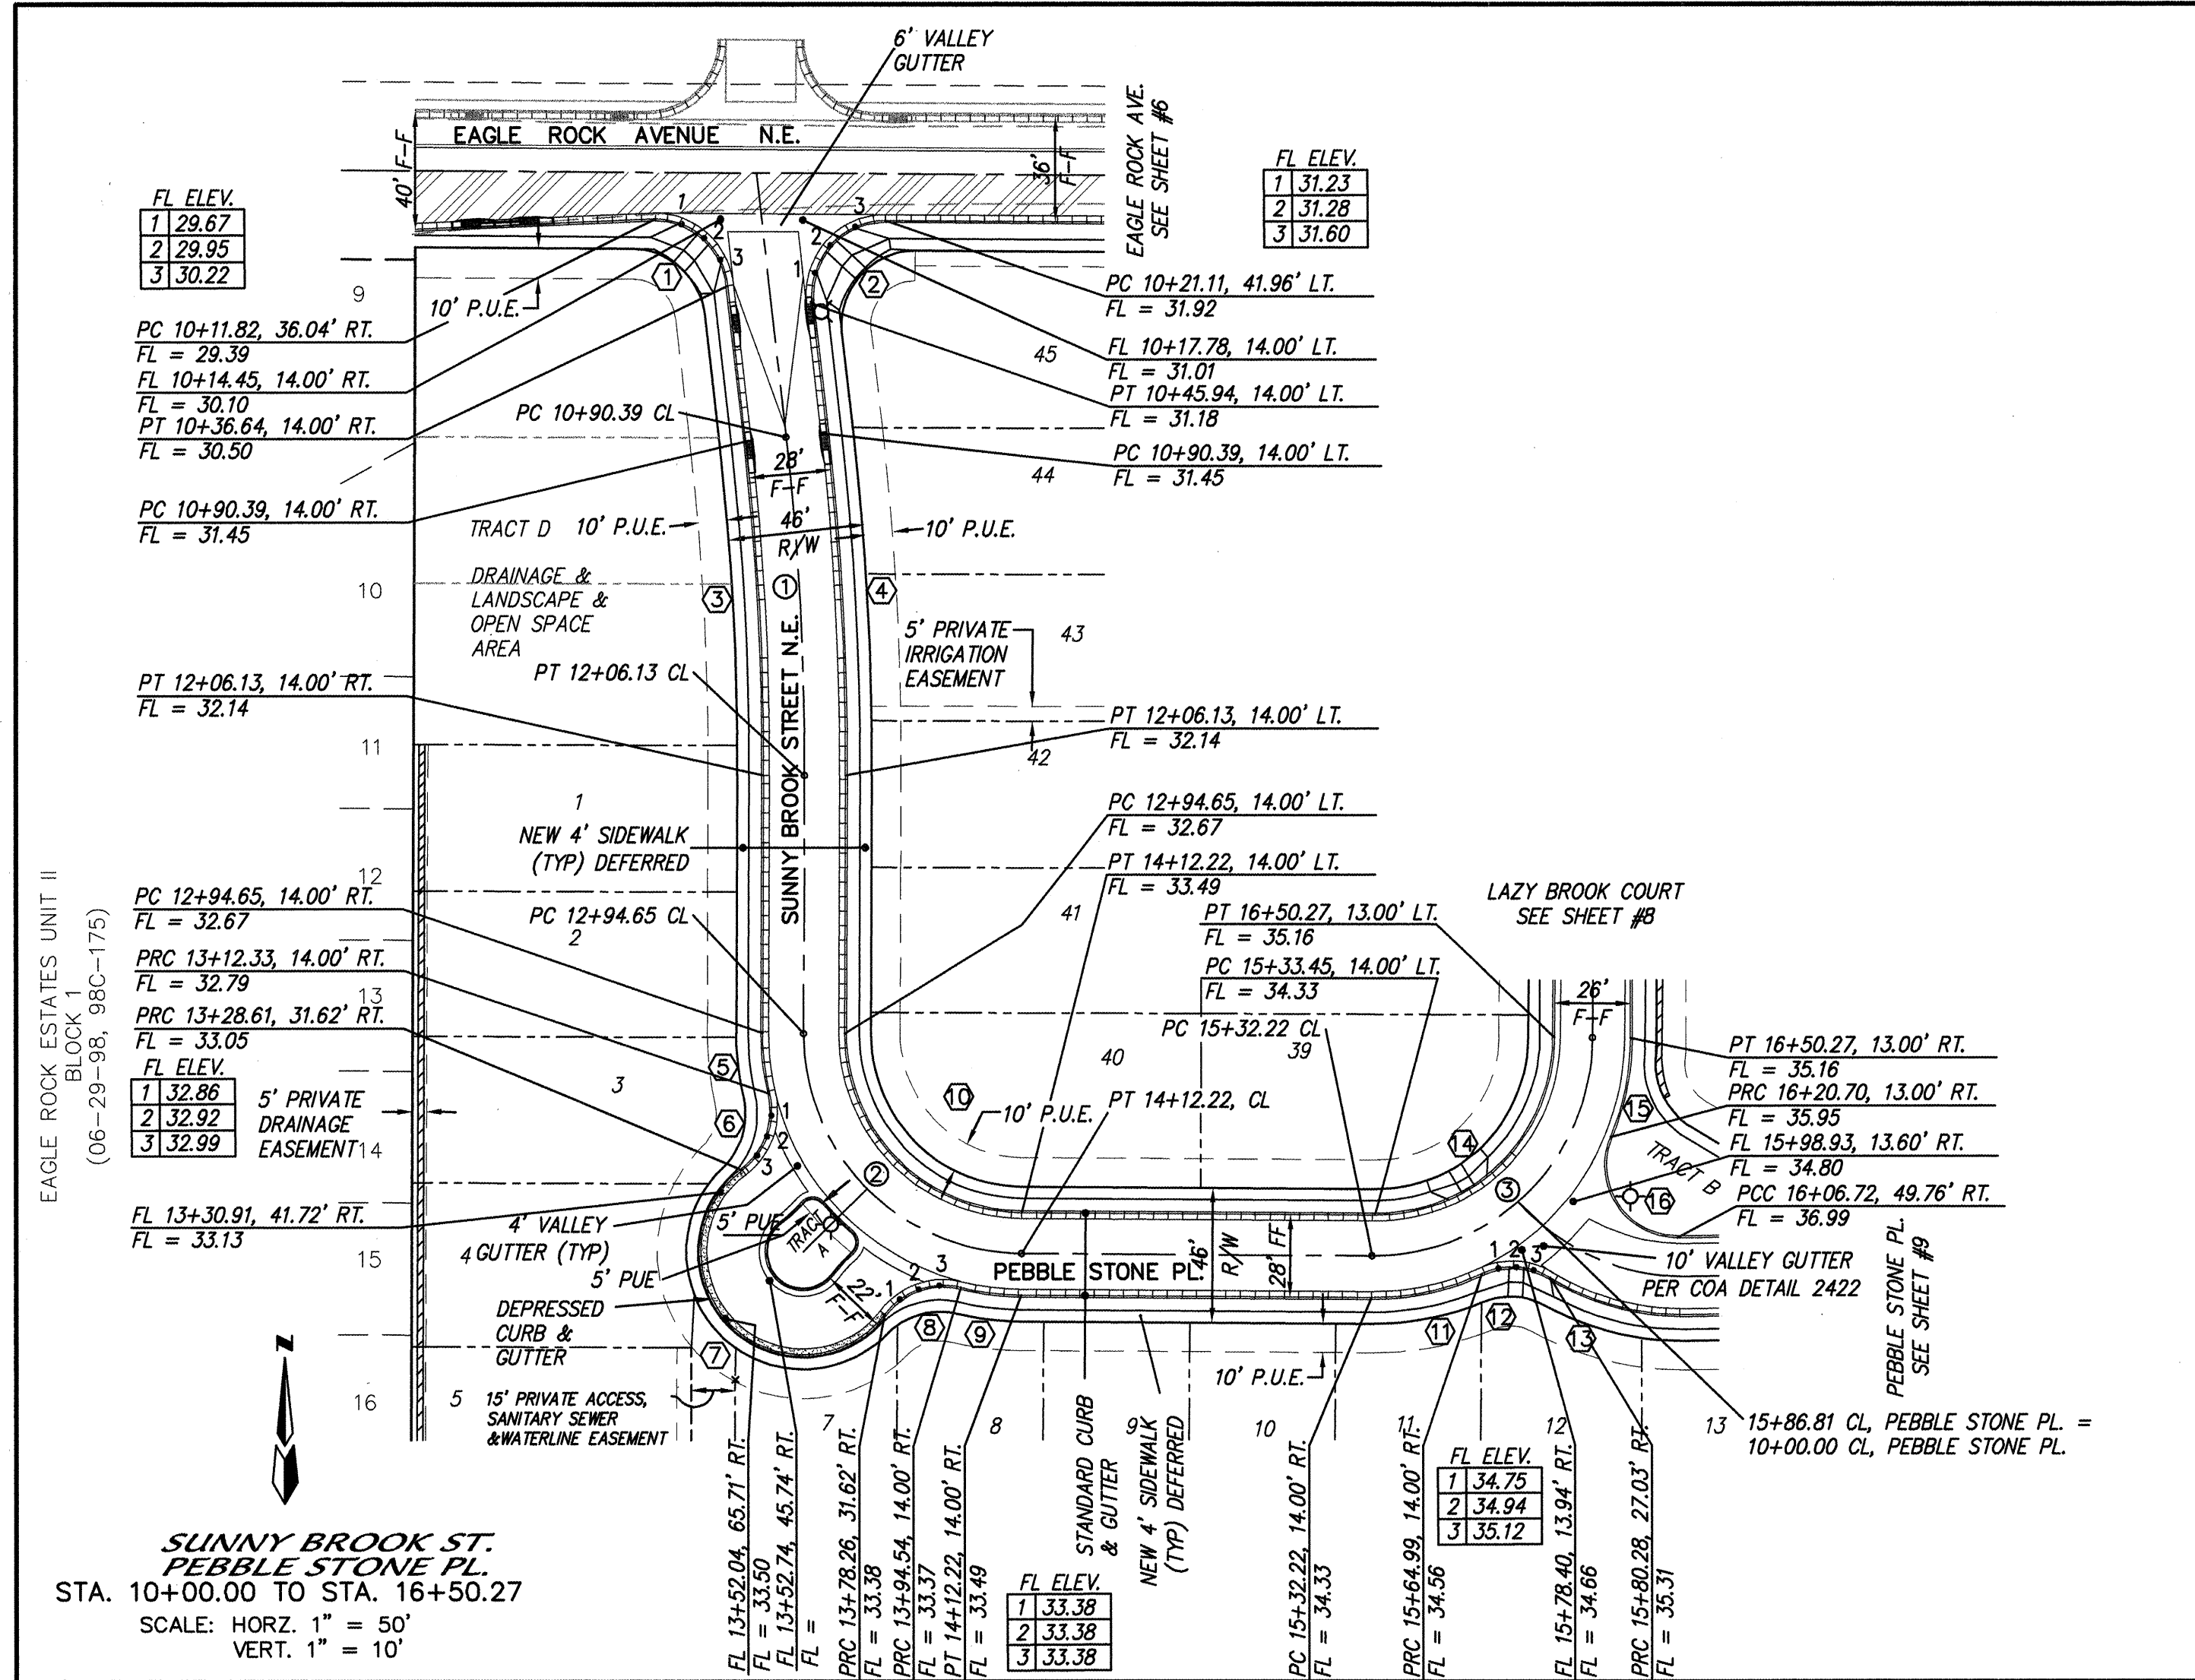

CURVE DATA - DESCRIBES FACE OF CURB			
① Δ = 83°12'19"	② Δ = 96°47'41"	③ Δ = 16°37'52"	④ Δ = 16°37'52"
R = 25.00'	R = 25.00'	L = 114.12'	L = 117.36'
L = 36.31'	L = 42.23'	T = 57.12'	T = 58.74'
T = 22.20'	T = 28.16'		
⑤ Δ = 13°30'31"	⑥ Δ = 16°43'14"	⑦ Δ = 196°14'42"	⑧ Δ = 66°43'14"
R = 89.00'	R = 25.00'	R = 35.00'	R = 25.00'
L = 20.98'	L = 29.11'	L = 119.88'	L = 29.11'
T = 10.54'	T = 16.46'	T = N/A	T = 16.46'
⑨ Δ = 13°30'31"	⑩ Δ = 89°49'15"	⑪ Δ = 25°01'58"	⑫ Δ = 55°42'41"
R = 89.00'	R = 61.00'	R = 89.00'	R = 25.00'
L = 20.98'	L = 95.63'	L = 38.88'	L = 24.31'
T = 10.54'	T = 60.81'	T = 19.76'	T = 13.21'
⑬ Δ = 31°06'07"	⑭ Δ = 90°10'45"	⑮ Δ = 22°35'31"	⑯ Δ = 112°33'11"
R = 88.00'	R = 61.00'	R = 88.00'	R = 25.00'
L = 47.77'	L = 96.01'	L = 34.69'	L = 49.11'
T = 24.49'	T = 61.19'	T = 17.58'	T = 37.45'
⑰ Δ = 98°33'55"	⑱ Δ = 09°10'52"	⑲ Δ = 98°33'55"	⑳ Δ = 12°05'50"
R = 5.00'	R = 89.00'	R = 5.00'	R = 47.00'
L = 8.60'	L = 14.26'	L = 8.60'	L = 9.92'
T = 5.81'	T = 7.15'	T = 5.81'	T = 4.98'
㉑ Δ = 196°14'42"	㉒ Δ = 12°05'50"	㉓ Δ = 90°10'45" LT.	
R = 13.00'	R = 47.00'	R = 75.00'	
L = 44.53'	L = 9.92'	L = 118.04'	
T = 91.09'	T = 4.98'	T = 75.24'	

CURVE DATA - DESCRIBES CENTERLINE			
① Δ = 06°37'52" RT.	② Δ = 89°49'15" LT.	③ Δ = 90°10'45" LT.	
R = 1000.00'	R = 75.00'	R = 75.00'	
L = 115.74'	L = 117.58'	L = 118.04'	
T = 57.93'	T = 74.77'	T = 75.24'	

NO PROFILE

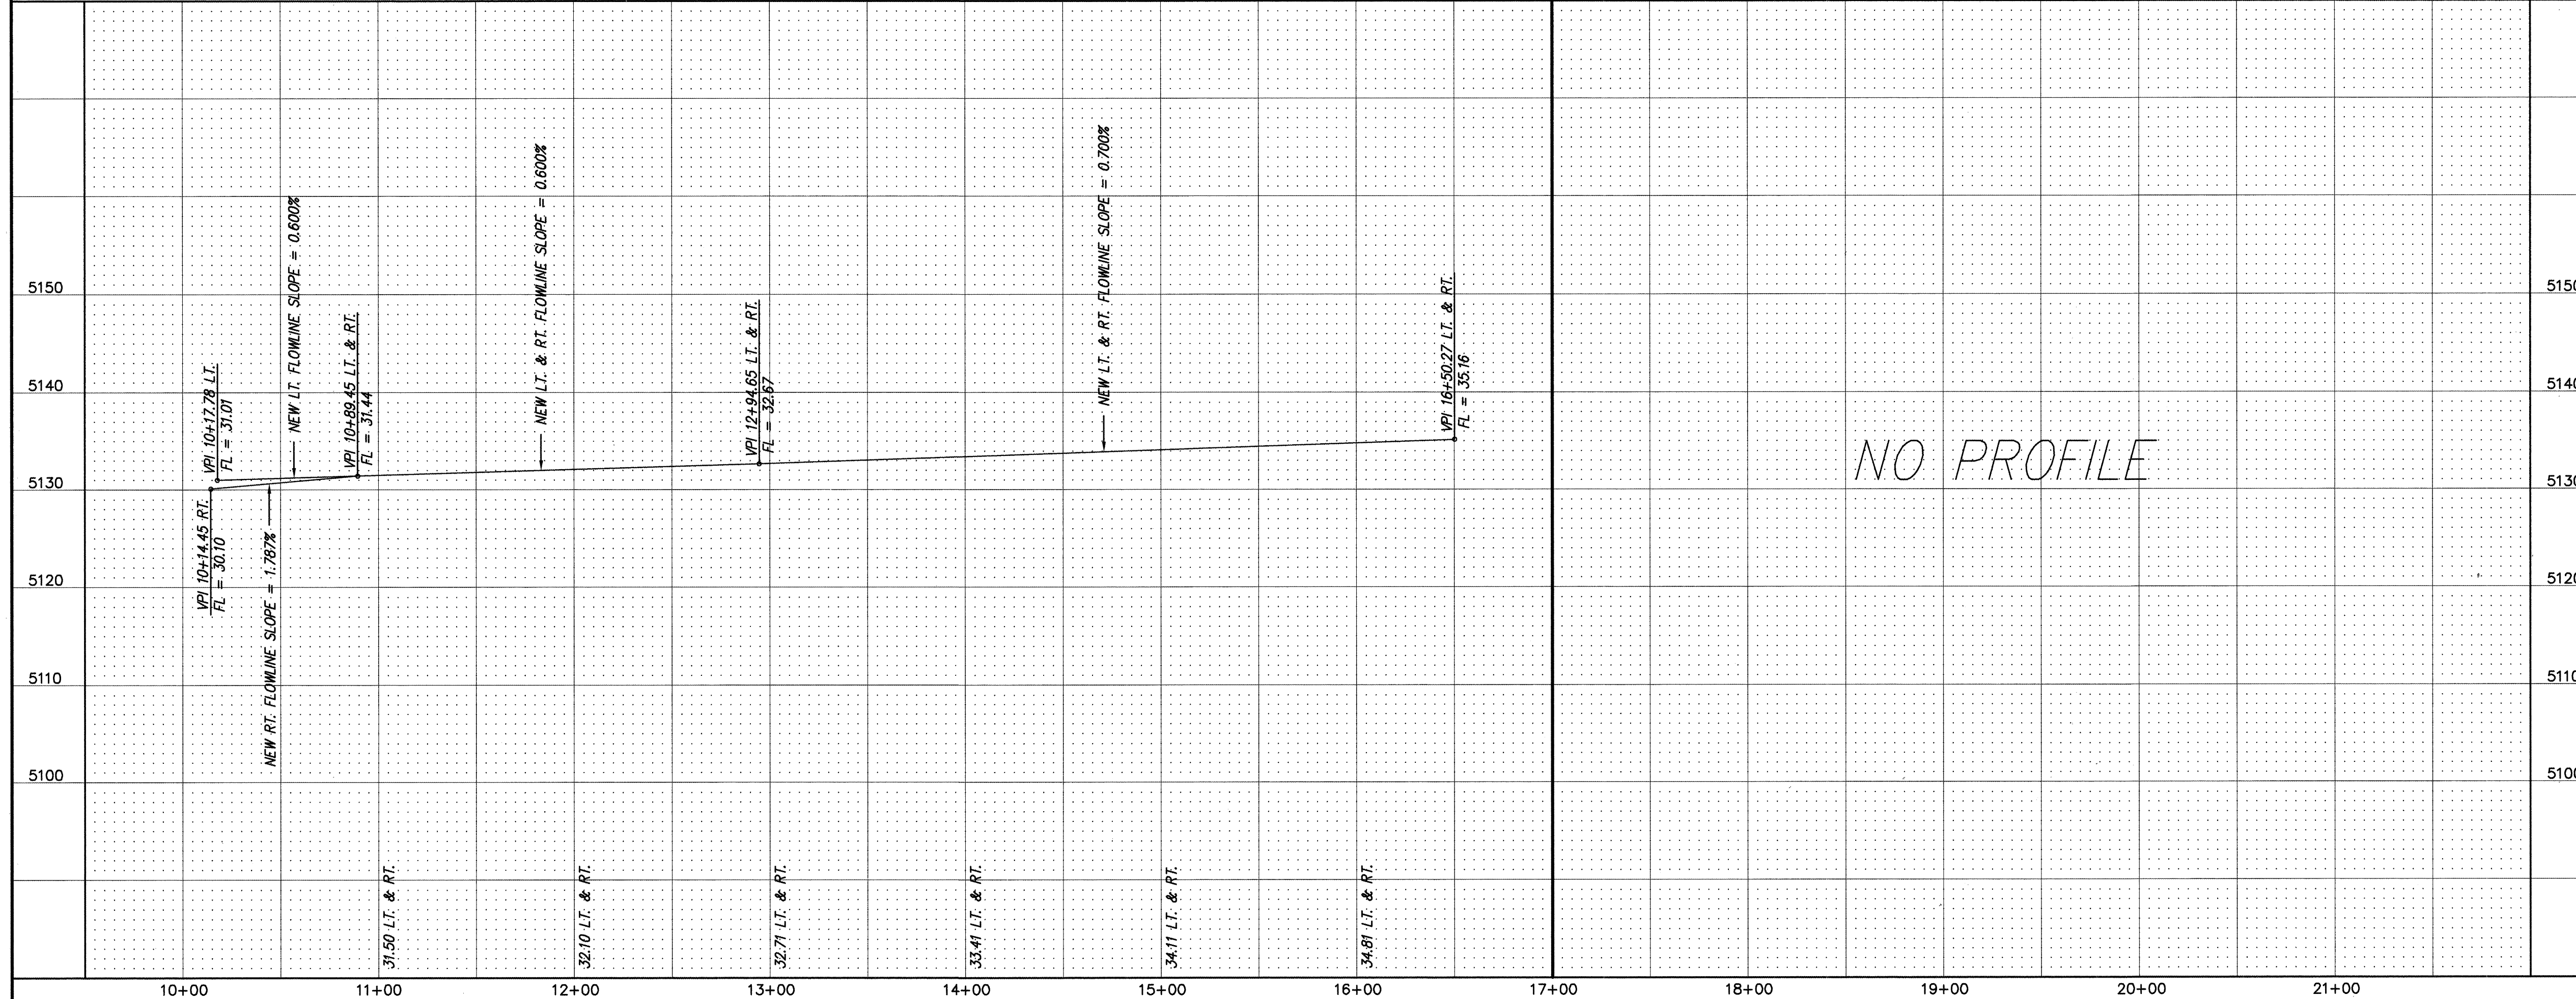

ENGINEER'S SEAL		SURVEY INFORMATION		AS BUILT INFORMATION	
CITY OF ALBUQUERQUE		CITY OF ALBUQUERQUE		CITY OF ALBUQUERQUE	
NO.		NO.		NO.	
BY		BY		BY	
DATE		DATE		DATE	
REMARKS		REMARKS		REMARKS	
DESIGN		DESIGN		DESIGN	
DRAWN BY		DRAWN BY		DRAWN BY	
DATE		DATE		DATE	
CHECKED BY		CHECKED BY		CHECKED BY	
DATE		DATE		DATE	
DESIGNED BY		DESIGNED BY		DESIGNED BY	
DATE		DATE		DATE	
DRAWN BY		DRAWN BY		DRAWN BY	
DATE		DATE		DATE	
CHECKED BY		CHECKED BY		CHECKED BY	
DATE		DATE		DATE	

APPROVED	APPROVED
DEC 20 1999	JAN 5 2000
DESIGN	CITY ENGINEER
REVIEW COMMITTEE	CITY ENGINEER

CITY PROJECT NO.	ZONE MAP NO.	SHEET	OF
627281	C-19-Z	7	18



MARK GOODWIN & ASSOCIATES, P.A.
CONSULTING ENGINEERS
P.O. BOX 90606
ALBUQUERQUE, NEW MEXICO 87199
(505) 828-2200, FAX (505) 797-9539

CITY OF ALBUQUERQUE
PUBLIC WORKS DEPARTMENT
ENGINEERING DEVELOPMENT GROUP
TITLE: STONEBROOK ESTATES
PAVING IMPROVEMENTS
SUNNY BROOK ST.

APPROVED
DEC 20 1999
DESIGN
REVIEW COMMITTEE

APPROVED
JAN 5 2000
CITY ENGINEER



HOELTER
NEW MEXICO
REGISTERED
11-15-99

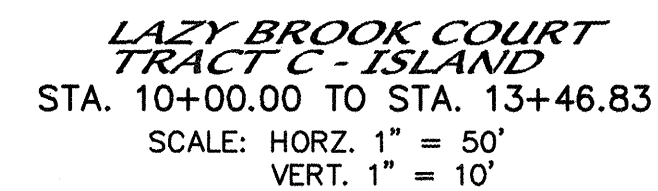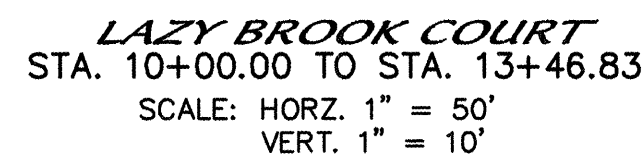

③ $\Delta = 90^{\circ}10'45''$ LT.
 $R = 75.00'$
 $L = 118.04'$
 $T = 75.24'$

④ $\Delta = 90^{\circ}09'48''$ LT.
 $R = 75.00'$
 $L = 118.02'$
 $T = 75.21'$

SHEET *8* OF *18*

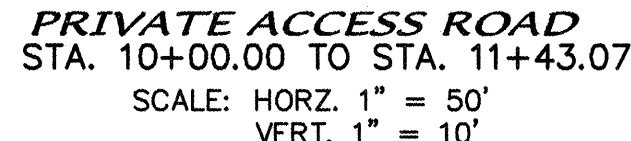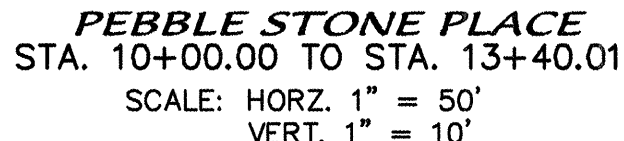

① $\Delta = 48^{\circ}58'32''$ LT. ② $\Delta = 05^{\circ}46'25''$ LT.
 $R = 74.64'$ $R = 437.43'$
 $L = 63.80'$ $L = 44.08'$
 $T = 33.99'$ $T = 22.06'$


④ $\Delta = 06^{\circ}11'31''$ RT. ⑤ $\Delta = 13^{\circ}24'44''$ RT.
 $R = 437.76'$ $R = 275.00'$
 $L = 47.31'$ $L = 64.37'$
 $T = 23.68'$ $T = 32.33'$

⑦ $\Delta = 14^{\circ}39'22''$ LT.
 $R = 275.40'$
 $L = 70.45'$
 $T = 35.42'$


CITY PROJECT NO.	ZONE MAP NO.	SHEET	OF
627281	C-19-Z	9	18

b6-S


C:\DWGS\9050SCH\9050util.dwg Thu Dec 02 08:18:08 1999 PLOTTED BY WILLIAM

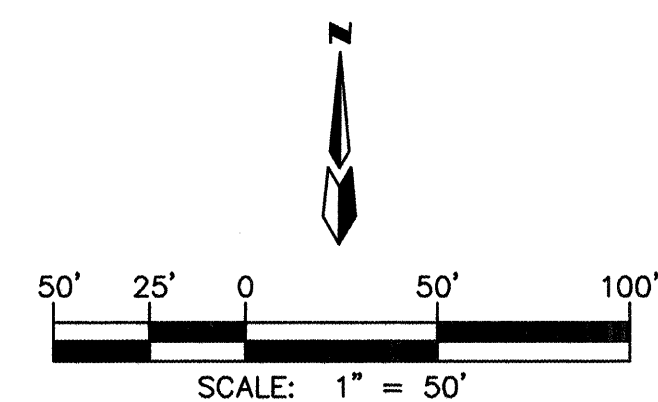

GROUP	
<i>TATES</i>	
<i>PLAN</i>	
MO./DAY/YR.	MO./DAY/YR.
SHEET	OF
7	11

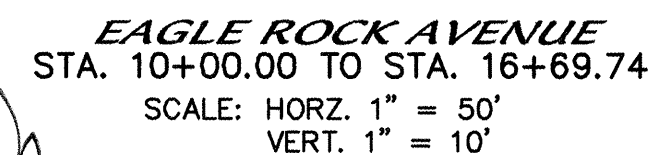

ALL UTILITIES (SAS, WL, SD) IN EAGLE ROCK AVENUE BUILT AS PART OF PROJECT NO. 622581 Vista Del Aguila

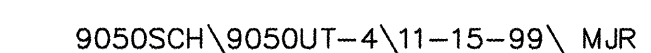

1. ALL STATIONING IS CENTERLINE STATIONING.

SURVEY INFORMATION			BENCH MARKS		AS BUILT INFORMATION		
NO.	FIELD NOTES	DATE	CITY OF ALBUQUERQUE OF CONTROL MONUMENT "11-C18"	CONTRACTOR	WORKED BY	DATE	
			A STANDARD ALUMINUM CAP SET IN A 2 1/2" PIPE, LOCATED APPROXIMATELY 265 FEET NORTH OF THE CENTERLINE OF EAGLE ROCK AVE. AND 32 FEET WEST OF THE CENTER LINE OF LOUISIANA BLVD	<i>Sundance</i>	<i>AL S</i>	<i>11/16/99</i>	
				INSPECTOR'S ACCEPTANCE BY	<i>MG A</i>	<i>4/10/00</i>	
				VERIFICATION BY	<i>AL S</i>	<i>4/10/00</i>	
			ELEVATION 5305.0 FEET	CORRECTED BY	<i>MG A</i>	<i>4/10/00</i>	
				MICRO-FILM INFORMATION			
				RECORDED BY		DATE	
				NO.			

ENGINEER'S SEAL

RESTRAINED JOINT LENGTH FOR BENDS, VALVES, DEAD ENDS (FT.)					
PIPE SIZE	90°	45°	22.5°	11.25°	VALVE
6"	17'	7'	3'	2'	46"
8"	22'	9'	4'	2'	60"
LENGTH OF RESTRAINED PIPE ON EACH SIDE OF THE BEND. RESTRAIN BRANCH AT FITTING ONLY MINIMUM ATTACHED PIPE LENGTH, RUN SIDE OF TEE: 10.00 FEET.					

RESTRAINED JOINT LENGTHS FOR REDUCERS (FT.)		
PIPE SIZE	LARGE SIDE	SMALL SIDE
8" x 6"	25'	33'

RESTRAINED JOINT LENGTH FOR TEES (FT.)		
PIPE SIZE	RUN	BRANCH
10"x10"x10"	—	—
8"x8"x6"	7'	5'
6"x6"x6"	10'	2'

dmg MARK GOODWIN & ASSOCIATES, P.A.
CONSULTING ENGINEERS
P.O. BOX 90606
ALBUQUERQUE, NEW MEXICO 87199
(505) 828-2200, FAX (505) 797-9539

CITY OF ALBUQUERQUE
PUBLIC WORKS DEPARTMENT
ENGINEERING DEVELOPMENT GROUP



TITLE: ***STONEBROOKE ESTATES***
UTILITY IMPROVEMENTS
EAGLE ROCK AVENUE

CITY PROJECT NO.	ZONE MAP NO.	SHEET OF
627281	C-19-Z	12 18

NO.		DATE	REMARKS	BY
REVISIONS				
DESIGN				
DESIGNED BY			DLH	DATE 9/99
DRAWN BY			MJR	DATE 9/99

SCANNED BY
MESA REPRO

PEBBLE STONE PLACE
STA. 10+00.00 TO STA. 13+44.24
SCALE: HORZ. 1" = 50'
VERT. 1" = 10'

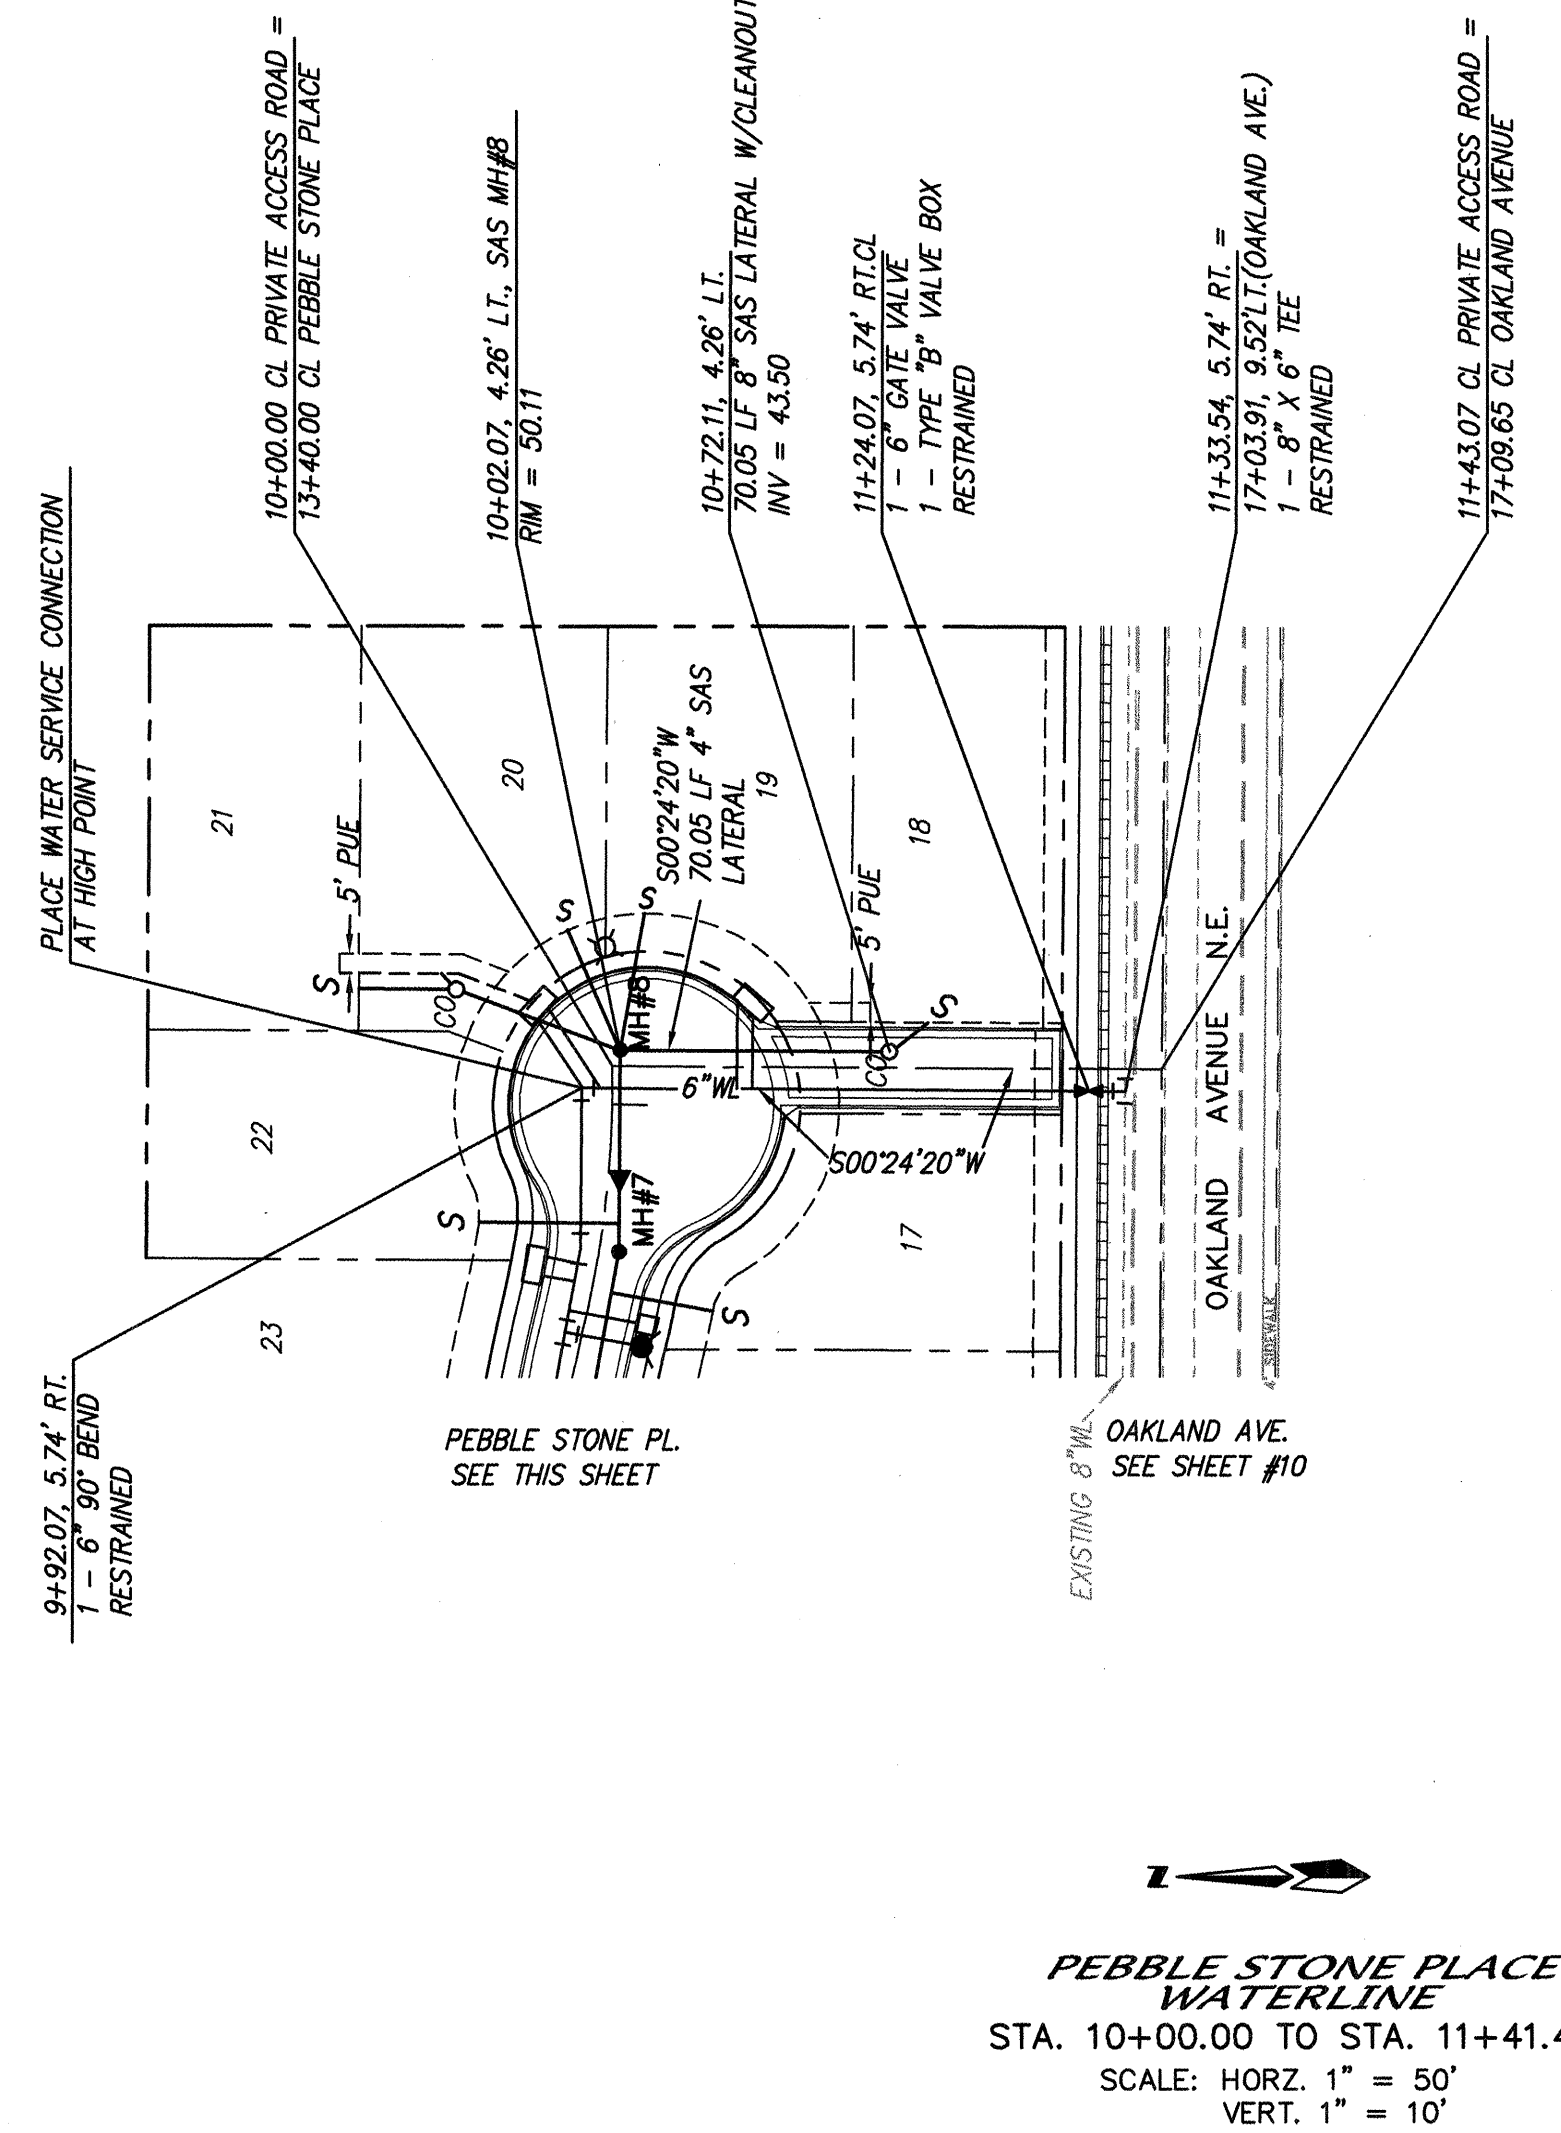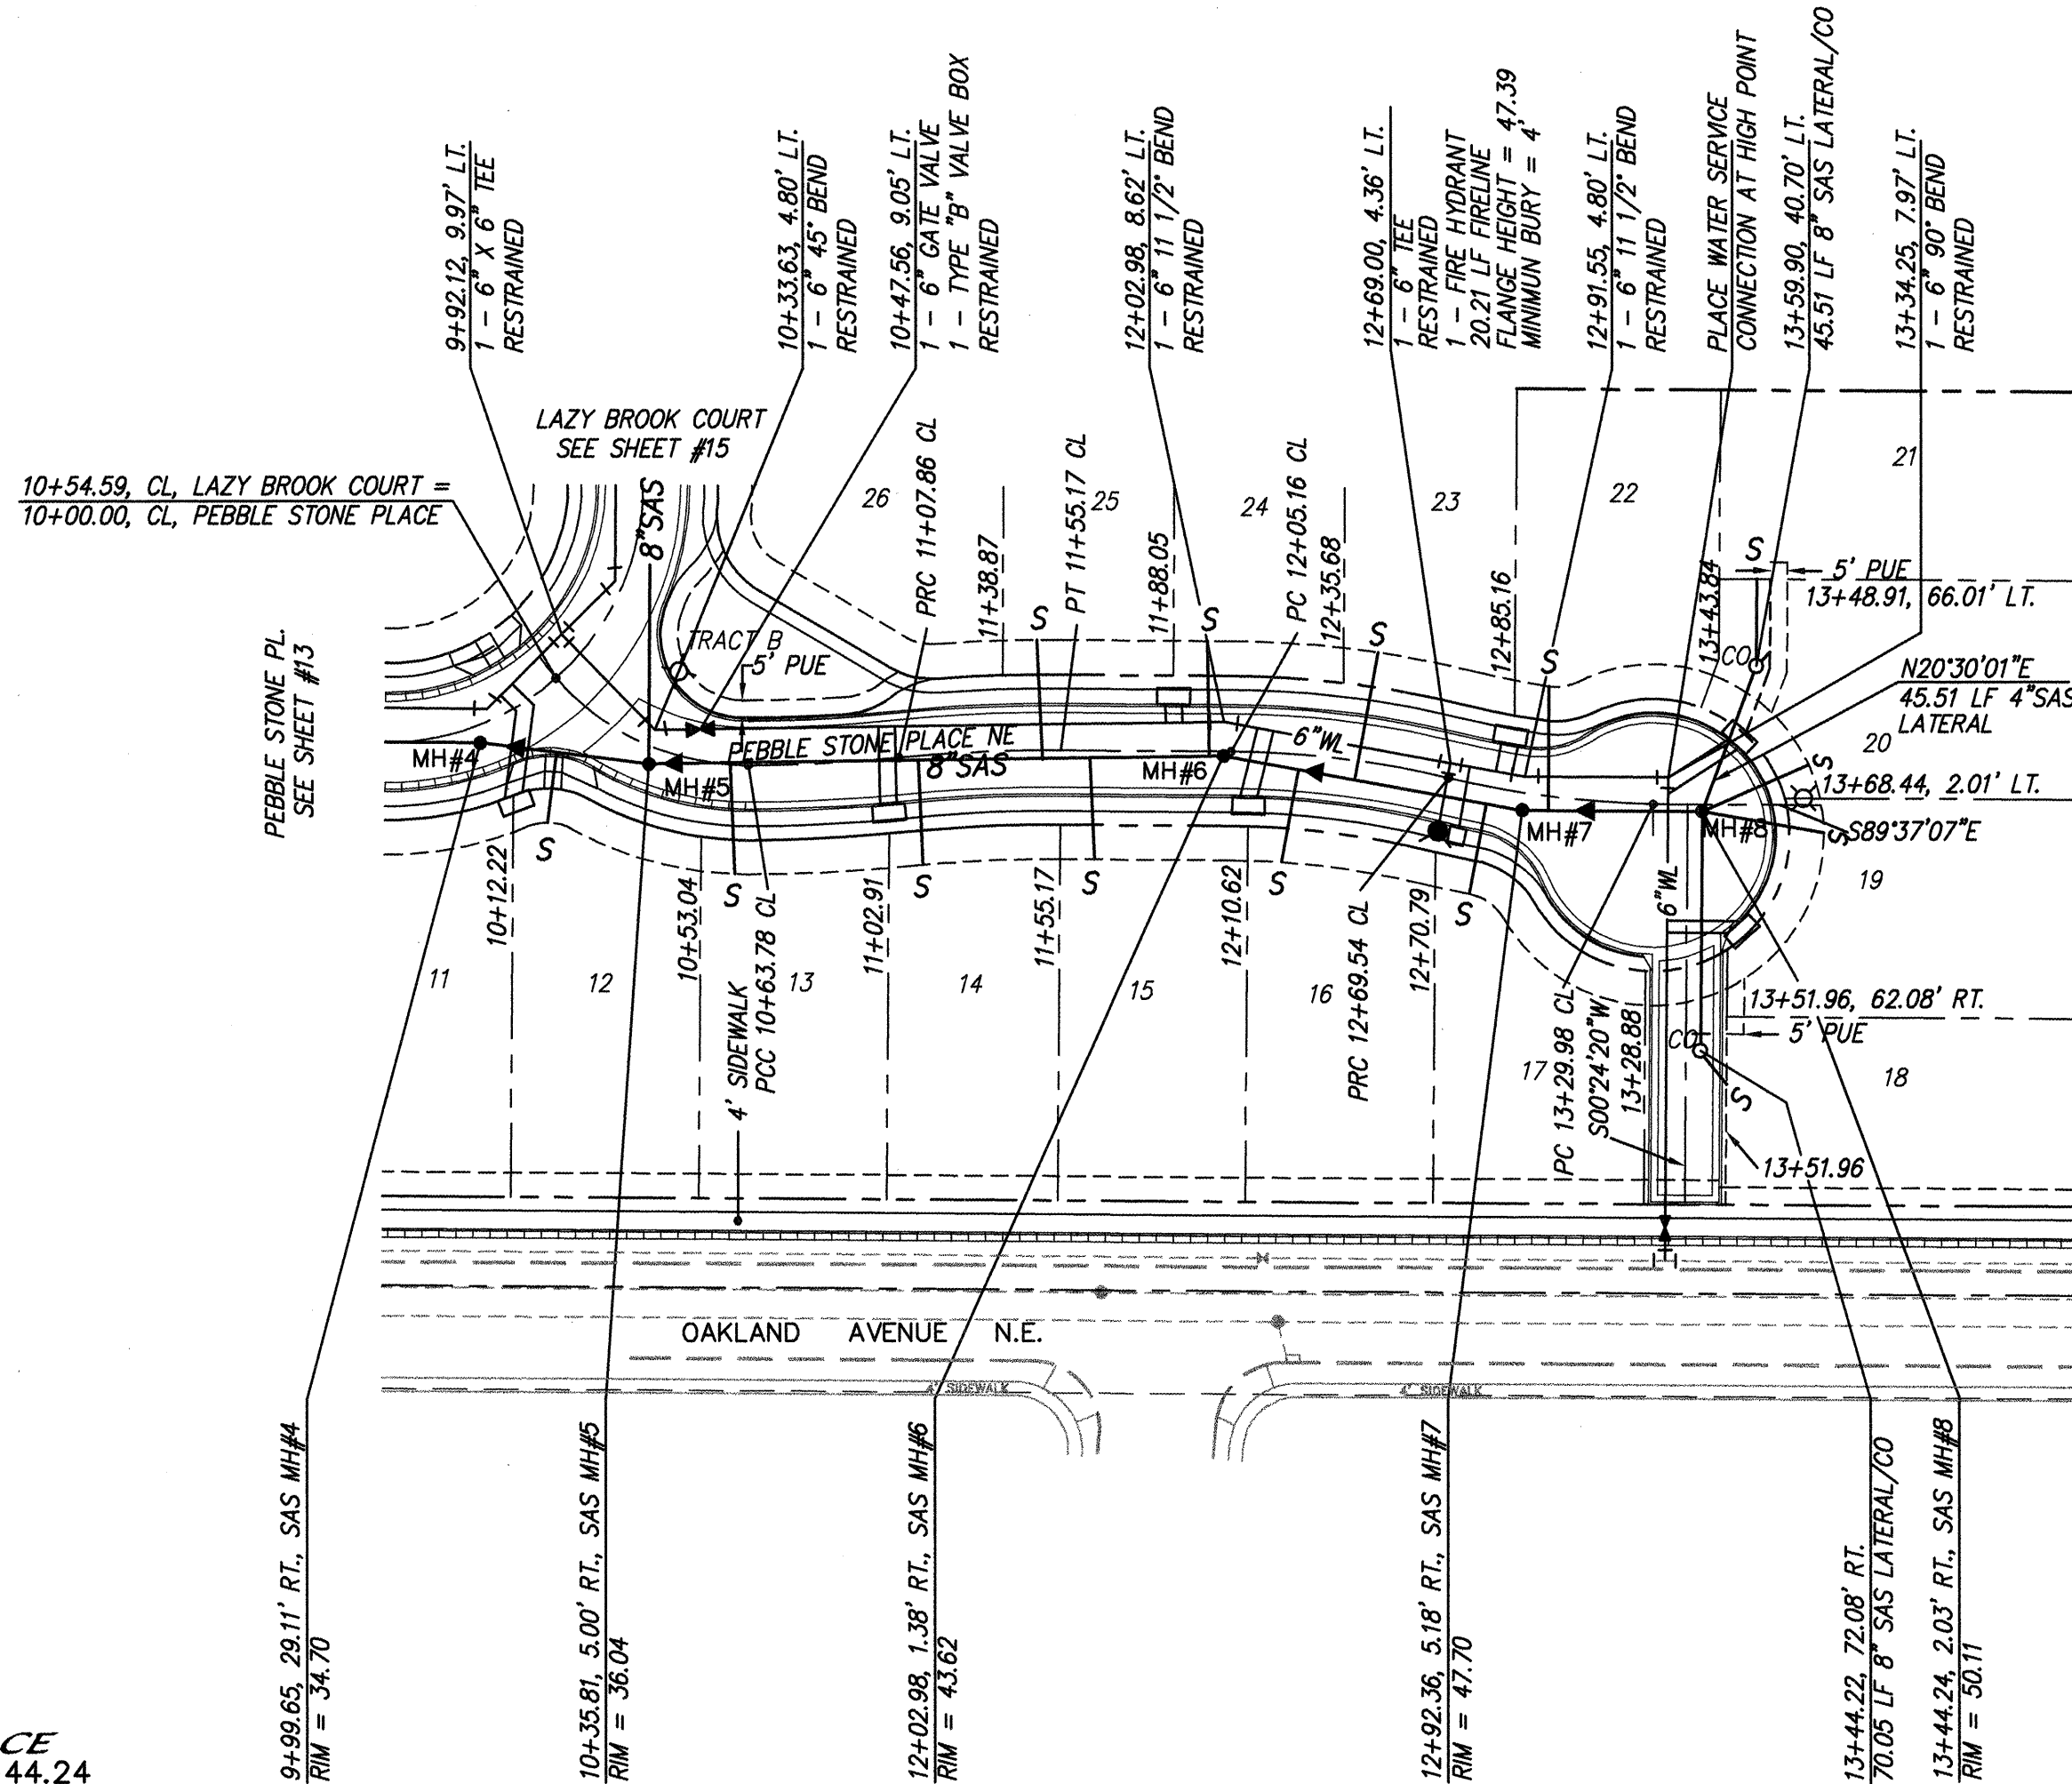

NOTES

1. ALL STATIONING IS CENTERLINE STATIONING.

SANITARY SEWER SERVICES

LOT	STATION AT PUE	INV. ELEV. AT PUE	LENGTH AT PUE
12	10+20.99	30.49	20.82
13	10+60.95	32.34	32.66
14	11+11.93	34.63	30.76
15	11+65.17	37.01	29.74
16	12+22.17	39.57	27.59
17	12+82.10	42.24	26.89
18	13+51.96, 82.08'R	45.08	12.14
19	13+79.97, 7.99'R	46.50	36.22
20	13+75.40, 12.01'L	46.50	34.14
21	13+59.91, 66.01'L	46.50	25.31
22	12+94.60	42.80	36.48
23	12+43.71	40.54	40.59
24	11+98.05	38.50	37.64
25	11+48.54	36.27	34.99

RESTRAINED JOINT LENGTH FOR BENDS, VALVES, DEAD ENDS (FT.)

PIPE SIZE	90°	45°	22.5°	11.25°	VALVE
6"	17'	7'	3'	2'	46'
8"	22'	9'	4'	2'	60'

LENGTH OF RESTRAINED PIPE ON EACH SIDE OF THE BEND. RESTRAIN BRANCH AT FITTING ONLY MINIMUM ATTACHED PIPE LENGTH, RUN SIDE OF TEE: 10.00 FEET.

RESTRAINED JOINT LENGTHS FOR REDUCERS (FT.)



PIPE SIZE	LARGE SIDE	SMALL SIDE
8" X 6"	25'	33'

RESTRAINED JOINT LENGTH FOR TEES (FT.)

PIPE SIZE	RUN	BRANCH
10"x10"x10"	-	-
8"x8"x6"	7'	5'
6"x6"x6"	10'	2'

MARK GOODWIN & ASSOCIATES, P.A.
CONSULTING ENGINEERS
P.O. BOX 90606
ALBUQUERQUE, NEW MEXICO 87199
(505) 828-2200, FAX (505) 797-9539

CITY OF ALBUQUERQUE
PUBLIC WORKS DEPARTMENT
ENGINEERING DEVELOPMENT GROUP
TITLE: **STONEBROOKE ESTATES
UTILITY IMPROVEMENTS
PEBBLE STONE PLACE**

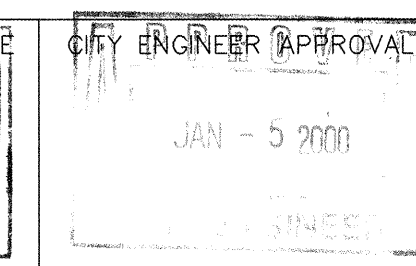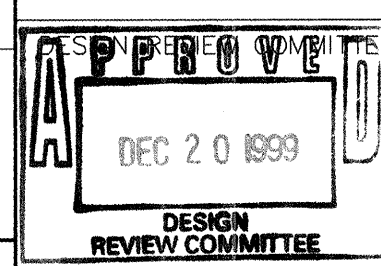

DESIGNED BY	DLH	DATE	9/99
DRAWN BY	MJR	DATE	9/99
CHECKED BY	DWG	DATE	9/99

NO.	DATE	REMARKS	BY

MO./DAY/YR.	MO./DAY/YR.

CITY PROJECT NO.	627281	ZONE MAP NO.	C-19-Z	SHEET	14	OF	18
------------------	--------	--------------	--------	-------	----	----	----

ENGINEER'S SEAL


SURVEY INFORMATION

BENCH MARKS


AS BUILT INFORMATION

CONTRACTOR	Sundance
STATIONED BY	ALS
INSPECTOR'S DATE	9/99
FIELD ENGINEER	MC-A
VERIFICATION BY	ALS
CORRECTED BY	MC-A
RECORDED BY	MC-A
DATE	9/99



CITY OF ALBUQUERQUE OF CONTROL MONUMENT "11-C18"	DATE	9/99
A STANDARD ALUMINUM CAP SET IN A 2 1/2" PIPE, LOCATED APPROXIMATELY 265 FEET NORTH OF THE CENTERLINE OF EAGLE ROCK AVE. AND 32 FEET WEST OF THE CENTER LINE OF LOUISIANA BLVD	DATE	9/99
ELEVATION 5305.0 FEET	DATE	9/99

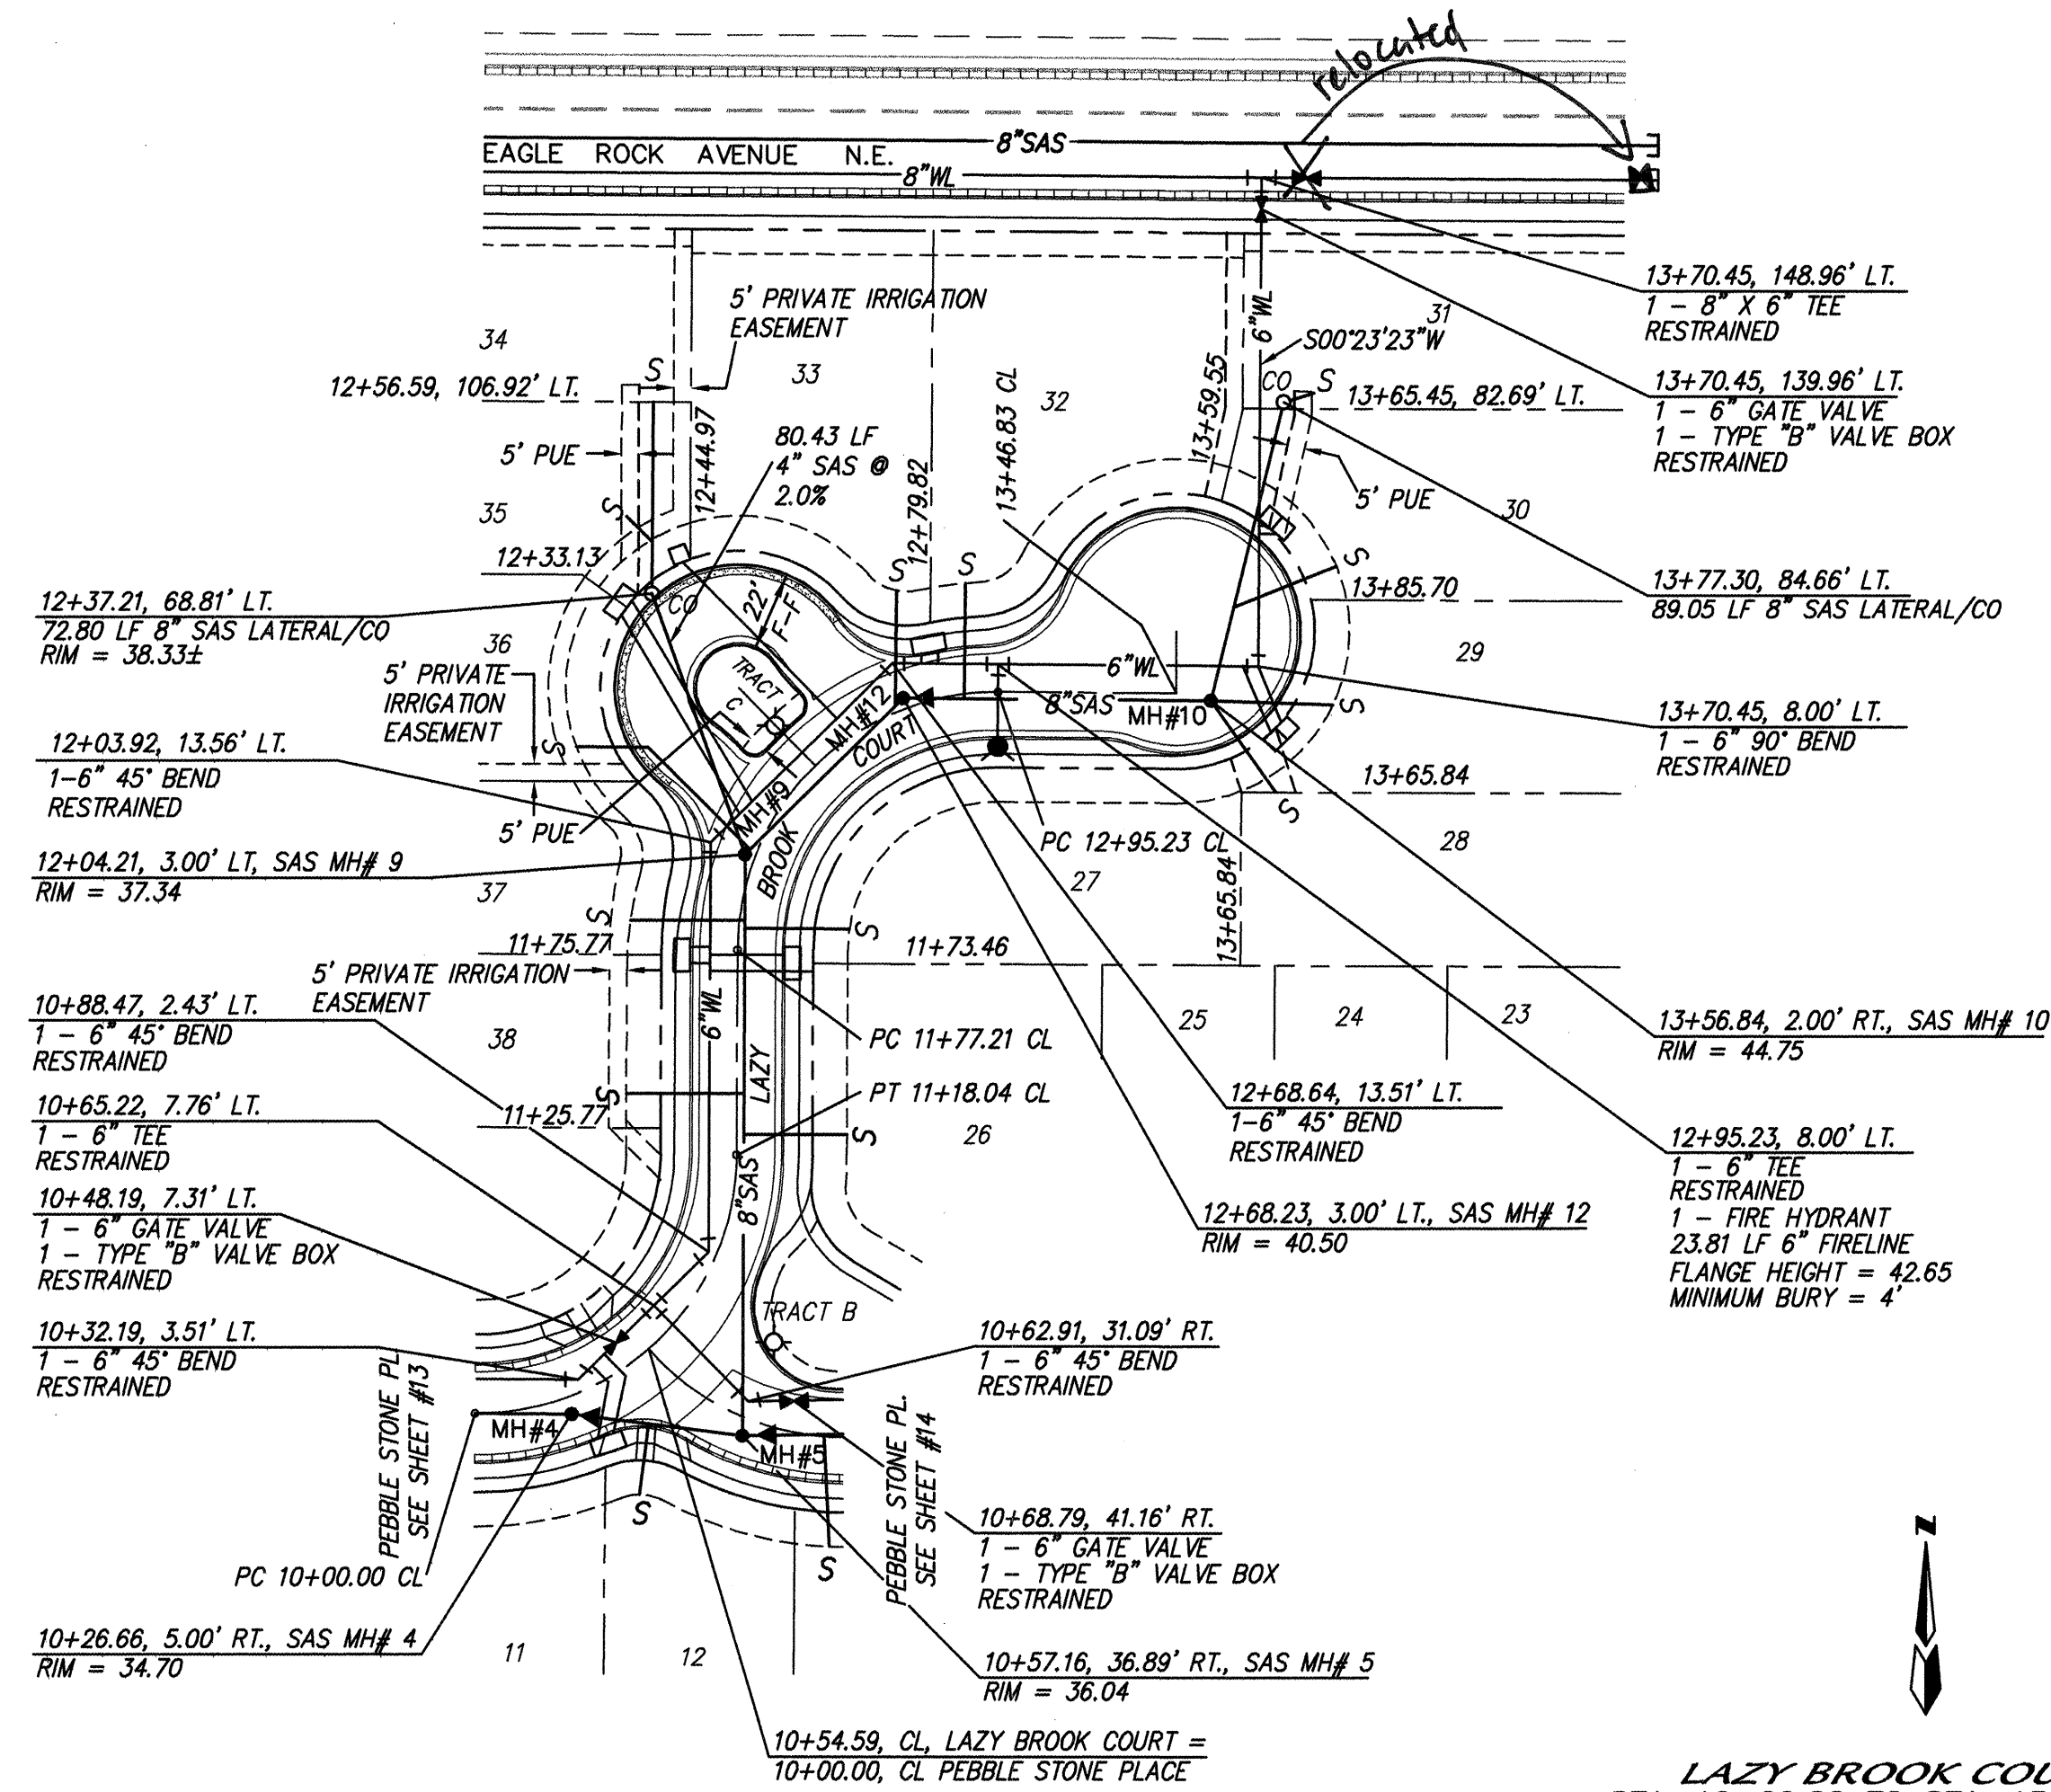

LAZY BROOK COURT
STA. 10+00.00 TO STA. 13+85.70
SCALE: HORIZ. 1" = 50'
VERT. 1" = 10'

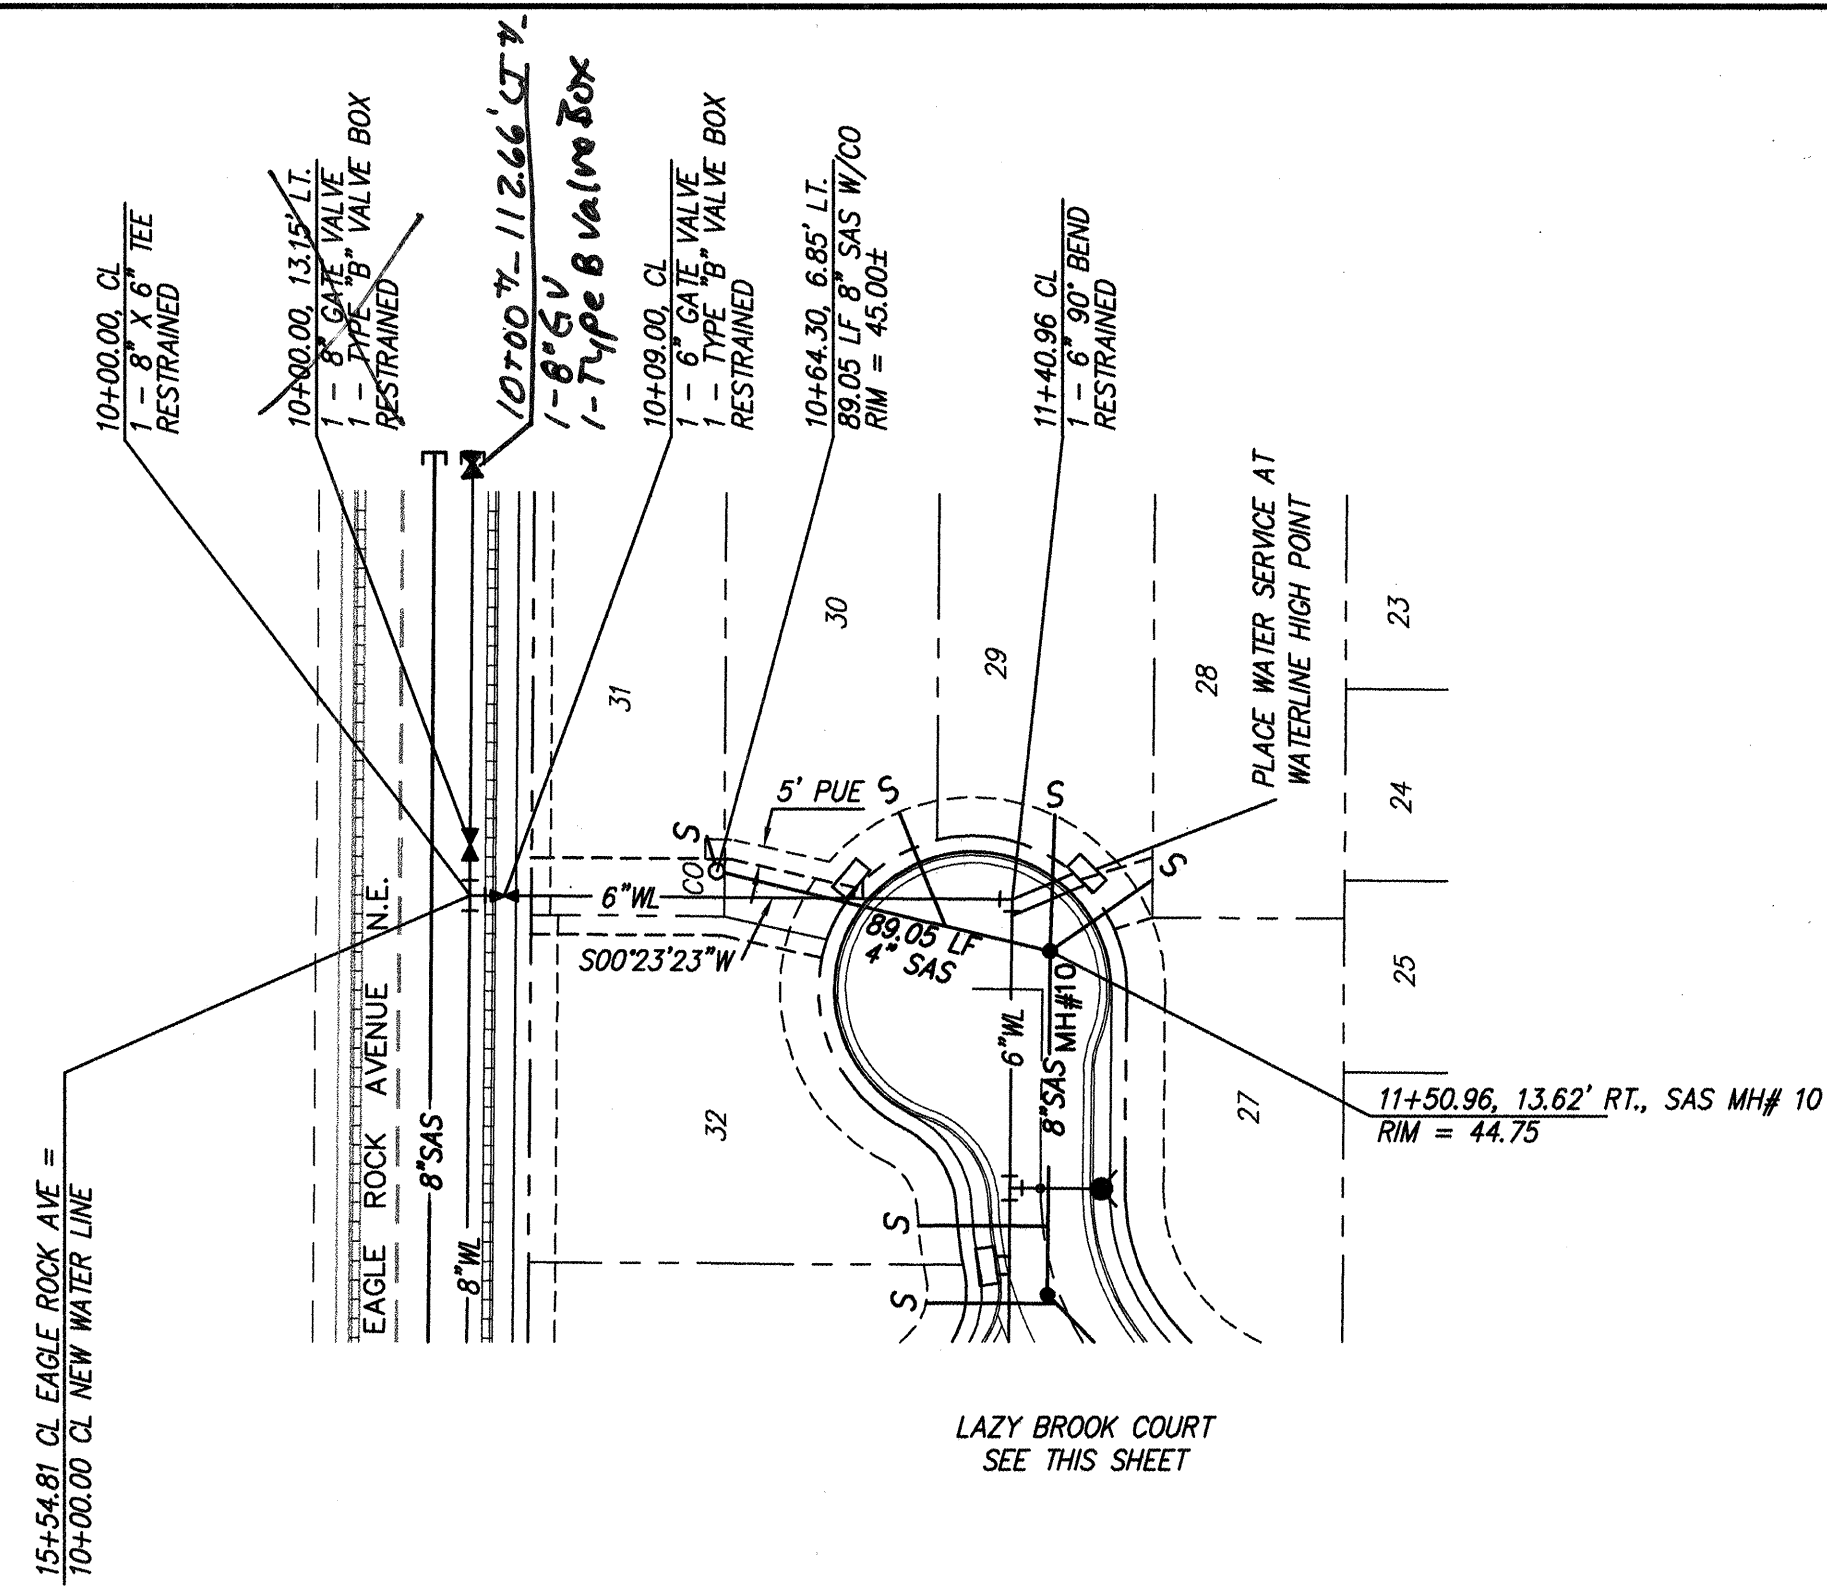

LAZY BROOK COURT WATERLINE
STA. 10+00.00 TO STA. 11+40.96
SCALE: HORIZ. 1" = 50'
VERT. 1" = 10'

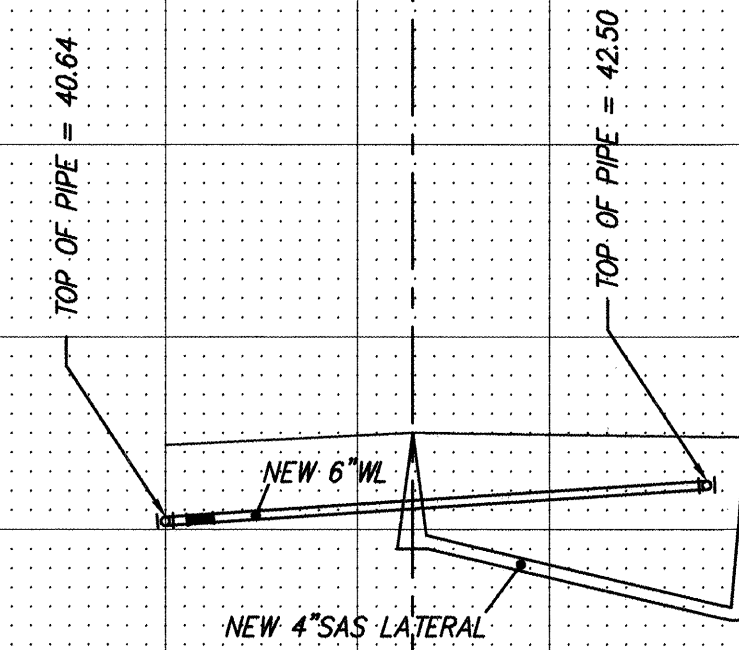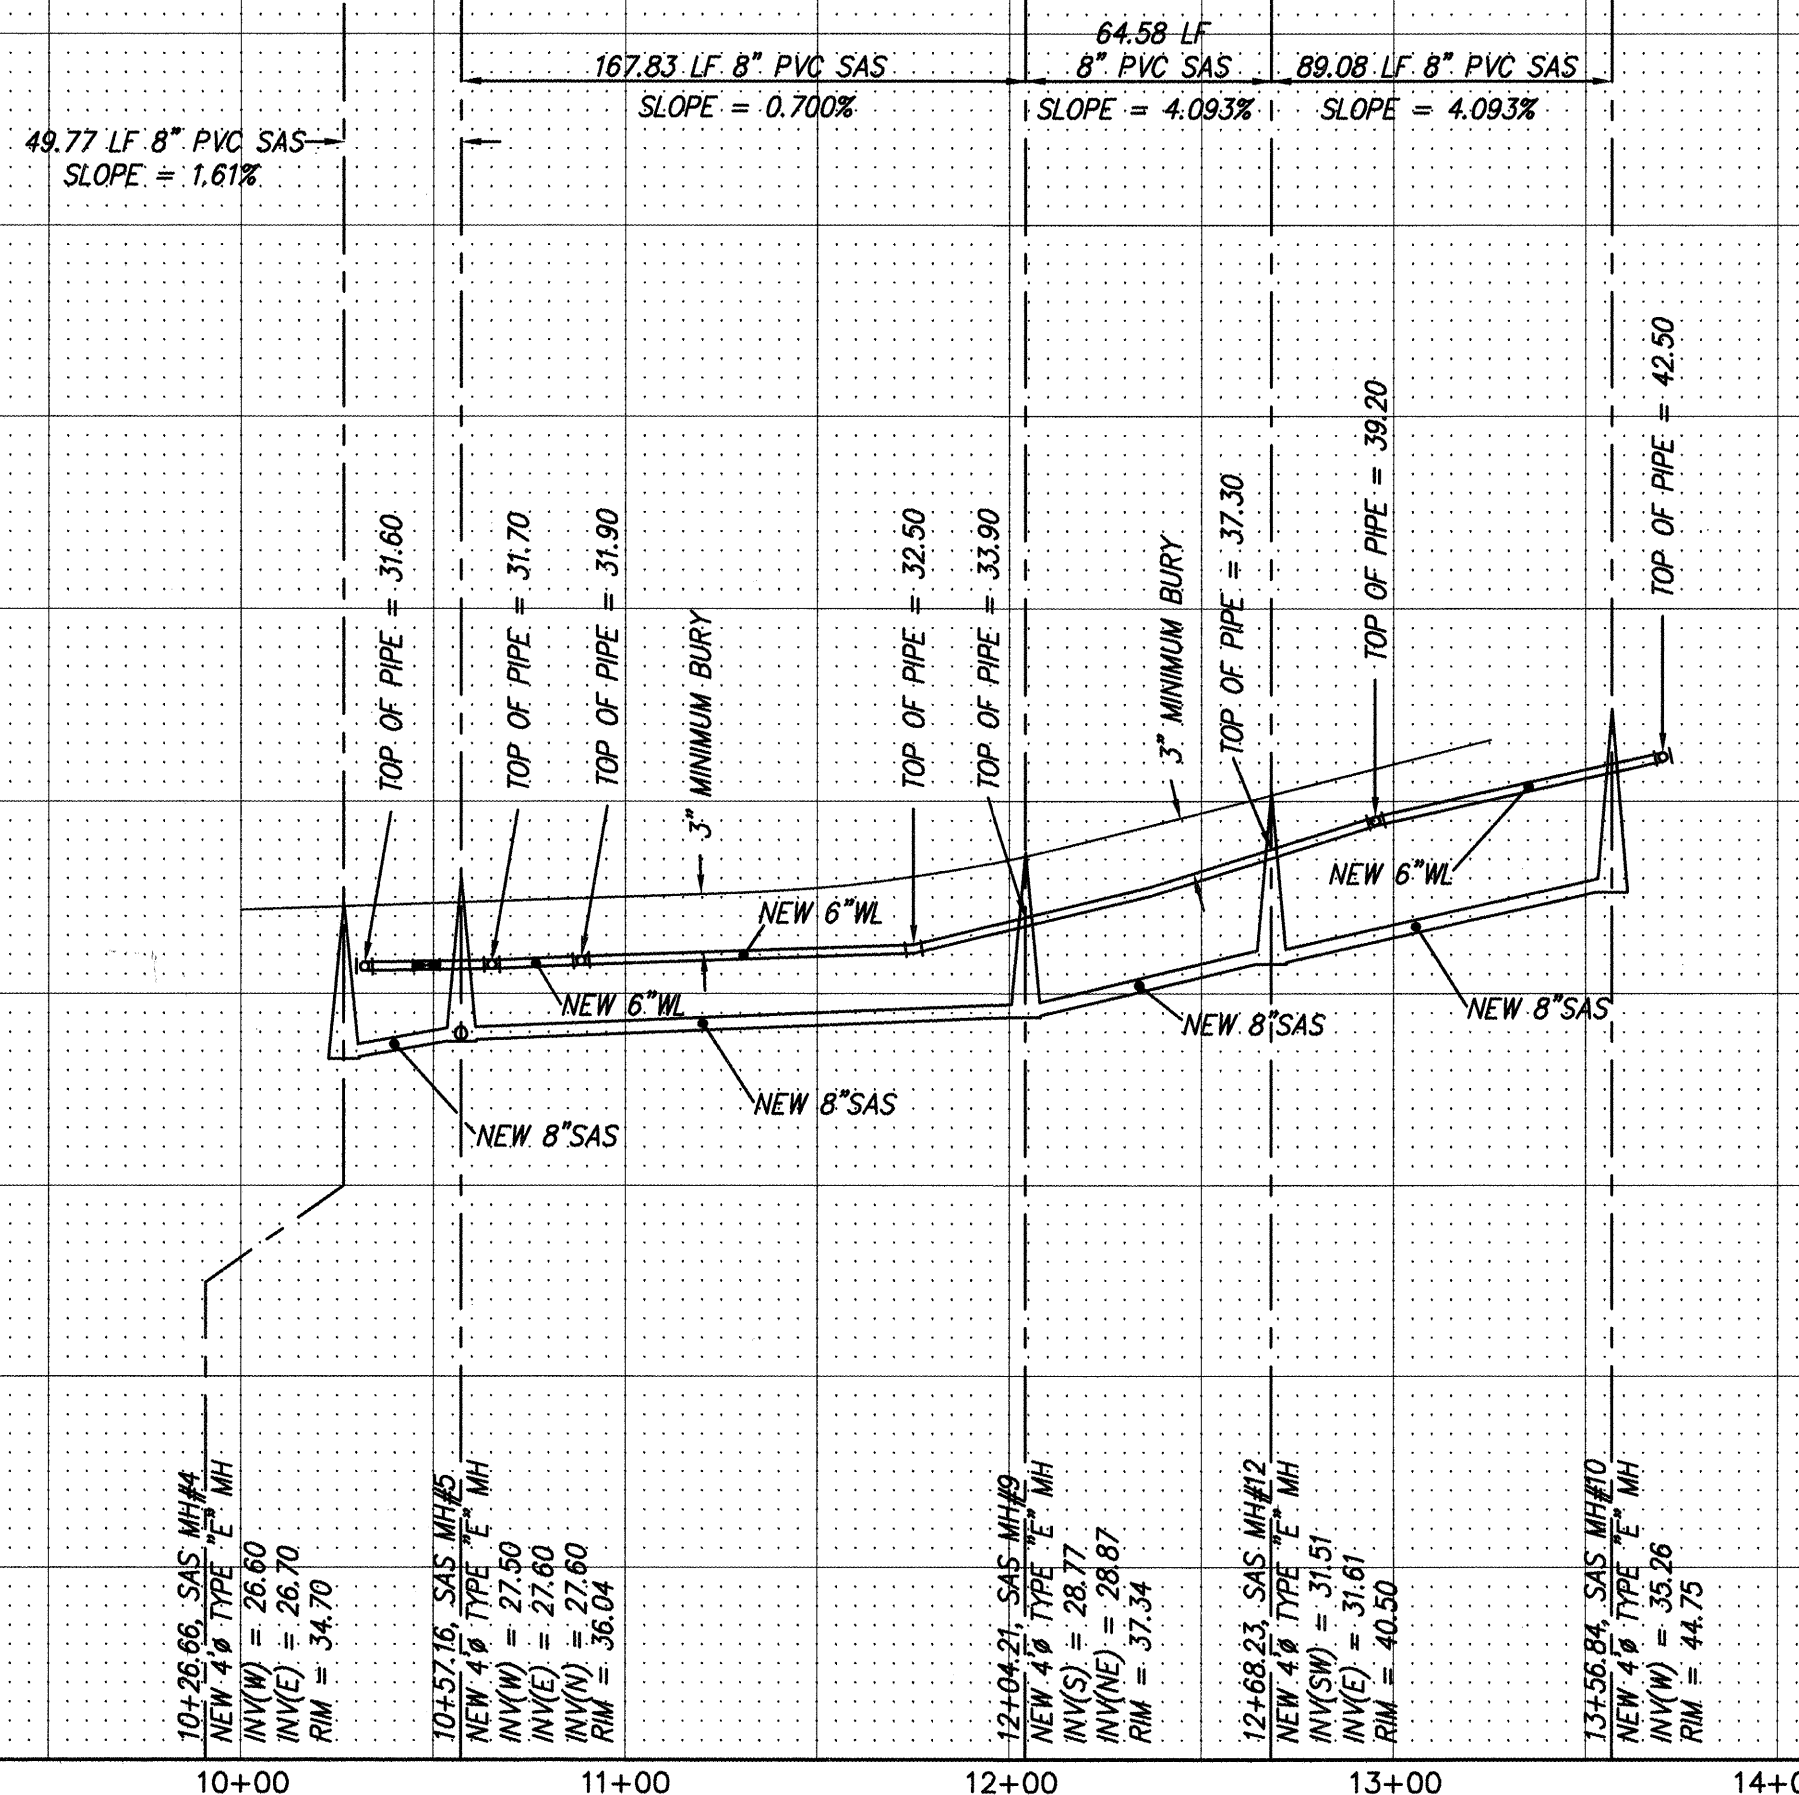

NOTES

1. ALL STATIONING IS CENTERLINE STATIONING.

SANITARY SEWER SERVICES

LOT	STATION AT PUE	INV. ELEV. AT PUE	LENGTH AT PUE
26	11+24.06	30.52	30.00
27	11+88.15	31.93	30.46
28	13+75.84, 28.57R	41.09	32.67
29	13+92.25, 2.91R	40.83	35.43
30	13+92.89, 37.47L	41.07	32.09
31	13+86.19, 87.31L	40.00	7.27
32	12+88.36	36.64	33.55
33	12+74.37	35.81	33.63
34	12+52.75, 112.56L	34.54	55.39
35	12+41.87, 90.40L	34.50	10.54
36	12+10.79	33.00	62.66
37	11+83.25	31.50	33.00
38	11+35.77	30.50	34.00

RESTRAINED JOINT LENGTH FOR BENDS, VALVES, DEAD ENDS (FT.)

PIPE SIZE	90°	45°	22.5°	11.25°	VALVE
6"	17'	7'	3'	2'	46'
8"	22'	9'	4'	2'	60'

LENGTH OF RESTRAINED PIPE ON EACH SIDE OF THE BEND. RESTRAIN BRANCH AT FITTING ONLY MINIMUM ATTACHED PIPE LENGTH, RUN SIDE OF TEE: 10.00 FEET.

RESTRAINED JOINT LENGTHS FOR REDUCERS (FT.)



PIPE SIZE	LARGE SIDE	SMALL SIDE
8" X 6"	25'	33'

RESTRAINED JOINT LENGTH FOR TEES (FT.)

PIPE SIZE	RUN	BRANCH
10"x10"x10"	-	-
8"x8"x6"	7'	5'
6"x6"x6"	10'	2'

dmg MARK GOODWIN & ASSOCIATES, P.A.
CONSULTING ENGINEERS
P.O. BOX 90606
ALBUQUERQUE, NEW MEXICO 87199
(505) 828-2200, FAX (505) 797-9539

CITY OF ALBUQUERQUE
PUBLIC WORKS DEPARTMENT
ENGINEERING DEVELOPMENT GROUP
TITLE: **STONEBROOKE ESTATES UTILITY IMPROVEMENTS LAZY BROOK COURT**



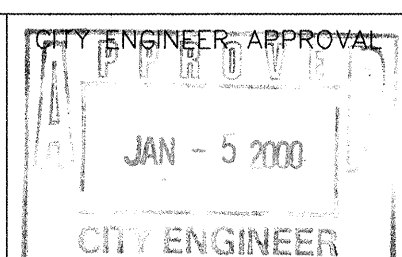
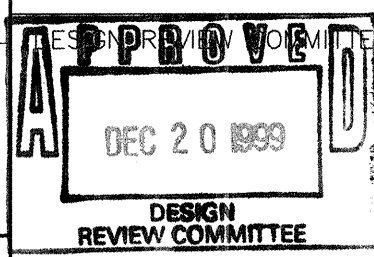



DESIGN REVIEW COMMITTEE: **DEC 20 1999**
CITY ENGINEER: **JAN - 5 2000**

LAST DESIGN UPDATE: **MO./DAY/YR.**

DESIGNED BY: **DLH** DATE: **9/99**
DRAWN BY: **NJR** DATE: **9/99**
CHECKED BY: **DMG** DATE: **9/99**

CITY PROJECT NO. **627281** ZONE MAP NO. **C-19-Z** SHEET **15** OF **18**

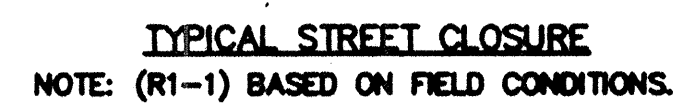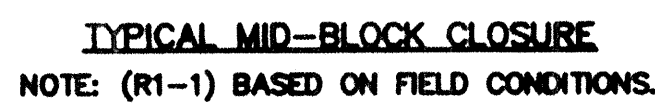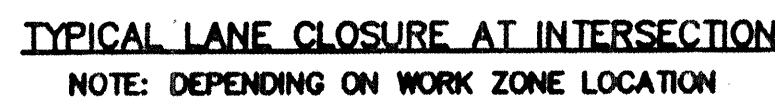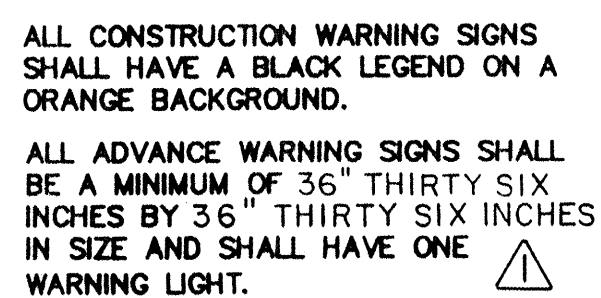


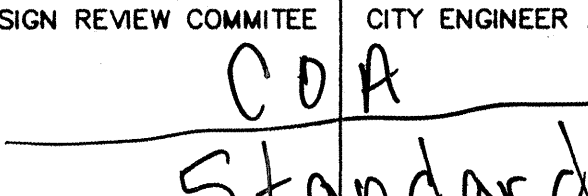CITY OF ALBUQUERQUE PUBLIC WORKS DEPARTMENT ENGINEERING DEVELOPMENT GROUP			
TITLE:		Stonebrooke Estates TYPICAL TRAFFIC CONTROL & SIGNING EXAMPLES (REF. M.U.T.C.D.)	
DESIGN REVIEW COMMITTEE	CITY ENGINEER APPROVAL	LAST UPDATE	MO./DAY/YR.
			
PROJECT NO.	627281	MAP NO.	C-19
		SHEET	OF 18

SCANNED BY
MESA REPRO

- CTCSTND1.DWG

- ### SIGN FACE DETAILS

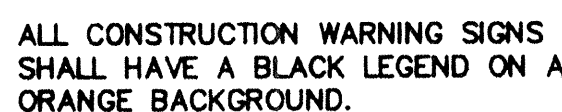

	WORK AREA
•	BARRICADE - TYPE I, TYPE II, OR BARREL
⊥	BARRICADE - TYPE III
x	VERTICAL PANEL
↑	WARNING SIGN
D	DISTANCE BETWEEN SIGNS - A DISTANCE MEASURED IN FEET EQUAL TO A VALUE OF TEN TIMES THE SPEED LIMIT OF THE STREET
	FLAGMAN POSITION
S	SPACING BETWEEN BARRICADES- A DISTANCE MEASURED IN FEET EQUAL TO THE SPEED LIMIT OF THE STREET
L	TAPER LENGTH - SEE CHART BELOW

THE TANGENT LENGTH IS EQUAL TO THE TAPER LENGTH FOR A GIVEN STREET.

SPEED LIMIT (MPH)	TAPER LENGTH (L) (FEET)			MINIMUM NUMBER OF DEVICES FOR TAPER	MAXIMUM DEVICE SPACING IN FEET	
	10' LANE	11' LANE	12' LANE		ALONG TAPER	AFTER TAPER
20	70	75	80	5	20	20
25	105	115	125	6	25	25
30	150	165	180	7	30	30
35	205	225	245	8	35	35
40	270	295	320	9	40	40
45	450	495	540	13	45	45
50	500	550	600	13	50	50
55	550	605	660	13	55	55

SPEED MILES PER HOUR	MINIMUM DISTANCE IN FEET	
	BETWEEN SIGNS	FROM LAST SIGN TO TAPER
0-20	10 X SPEED LIMIT	10 X SPEED LIMIT
25-30	10 X SPEED LIMIT	10 X SPEED LIMIT
30-35	10 X SPEED LIMIT	10 X SPEED LIMIT
40-45	10 X SPEED LIMIT	10 X SPEED LIMIT
50-60	10 X SPEED LIMIT	10 X SPEED LIMIT

TYPE OF TAPER	TAPER LENGTH
UPSTREAM TAPER:	
MERGING TAPER	L MINIMUM
SHIFTING TAPER	1/2 L MINIMUM
SHOULDER TAPER	1/2 L MINIMUM
TWO-WAY TRAFFIC TAPER	100 FEET MAXIMUM
DOWNSTREAM TAPERS	100 FEET PER LANE

SPEED LIMIT	
40 MPH OR LESS	$L = \frac{WS^2}{60}$
45 MPH OR GREATER	$L = W \times S$

L = TAPER LENGTH
 W = WIDTH OF OFFSET IN FEET
 S = POSTED SPEED OR OFF-PEAK
 85-PERCENTILE SPEED IN MPH

CITY OF ALBUQUERQUE															
PUBLIC WORKS DEPARTMENT															
ENGINEERING DEVELOPMENT GROUP															
TITLE: Stonebrooke Estates SIGNING AND CONSTRUCTION TRAFFIC CONTROL STANDARDS															
DESIGN REVIEW COMMITTEE	CITY ENGINEER APPROVAL	<table border="1"> <tr> <td>MO./DAY/YR.</td> <td>MO./DAY/YR.</td> </tr> <tr><td> </td><td> </td></tr> <tr><td> </td><td> </td></tr> <tr><td> </td><td> </td></tr> <tr><td> </td><td> </td></tr> <tr><td> </td><td> </td></tr> </table>		MO./DAY/YR.	MO./DAY/YR.										
MO./DAY/YR.	MO./DAY/YR.														
COA <u>Standard</u>		LAST UPDATE	<table border="1"> <tr><td> </td></tr> <tr><td> </td></tr> <tr><td> </td></tr> <tr><td> </td></tr> <tr><td> </td></tr> <tr><td> </td></tr> </table>												
PROJECT NO. 627281	MAP NO. C-19	SHEET 18 OF 18													