


CONSTRUCTION PLANS
FOR
MEADOWS AT ANDERSON HILLS
UNIT 4
ALBUQUERQUE, NEW MEXICO

SCANNED BY
MESA REPRO

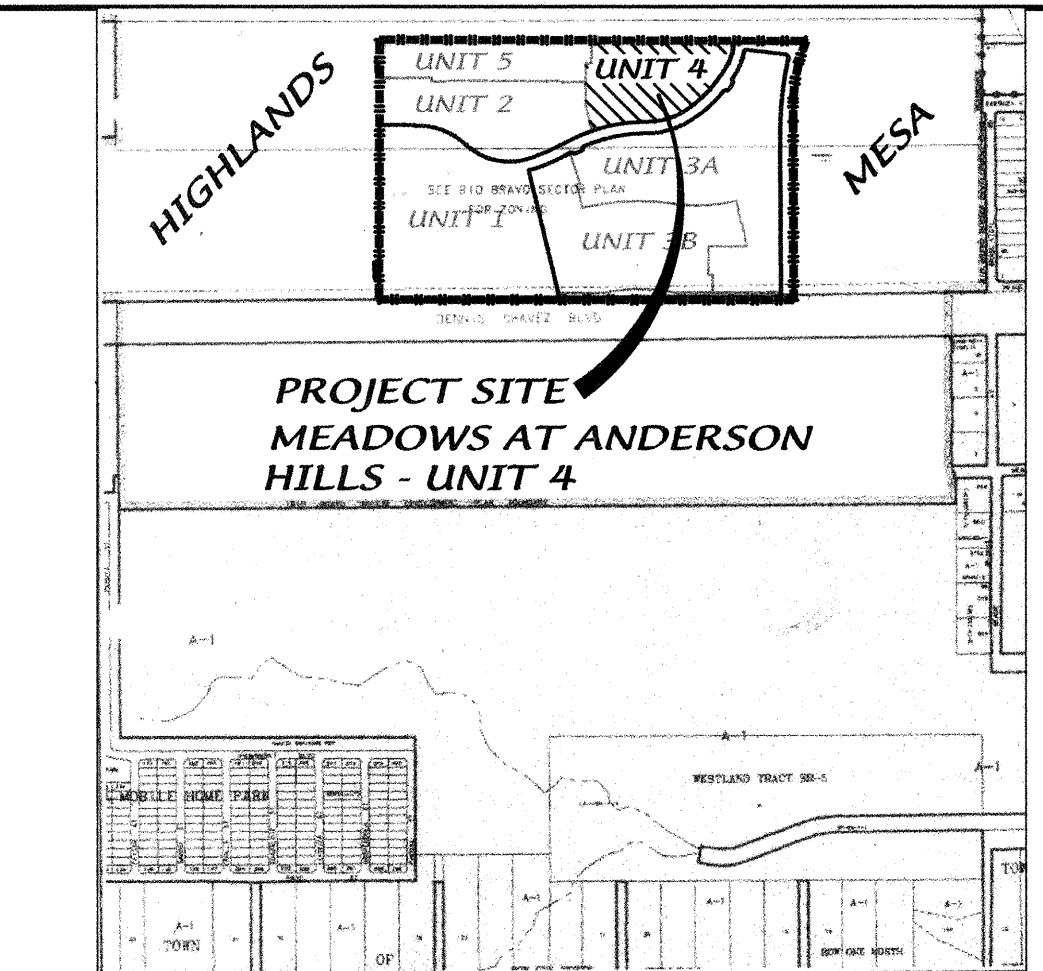

VICINITY MAP ZONE ATLAS P-9

SCALE: NONE

GENERAL NOTES

NOTICE TO CONTRACTORS

1. AN EXCAVATION/CONSTRUCTION PERMIT WILL BE REQUIRED BEFORE BEGINNING ANY WORK WITHIN THE CITY RIGHT-OF-WAY.
2. ALL WORK DETAILED ON THESE PLANS TO BE PERFORMED UNDER CONTRACT SHALL, EXCEPT AS OTHERWISE STATED OR PROVIDED FOR HEREON, BE CONSTRUCTED IN ACCORDANCE WITH THE CITY OF ALBUQUERQUE STANDARD SPECIFICATIONS FOR PUBLIC WORKS CONSTRUCTION, 1986 EDITION AS REVISED THROUGH UPDATE #7.
3. TWO WORKING DAYS PRIOR TO ANY EXCAVATION, THE CONTRACTOR MUST CONTACT NEW MEXICO ONE CALL SYSTEM (260-1990) FOR LOCATION OF EXISTING UTILITIES.
4. PRIOR TO CONSTRUCTION, THE CONTRACTOR SHALL EXCAVATE AND VERIFY THE HORIZONTAL AND VERTICAL LOCATIONS OF ALL OBSTRUCTIONS. SHOULD A CONFLICT EXIST, THE CONTRACTOR SHALL NOTIFY THE ENGINEER IMMEDIATELY SO THAT THE CONFLICT CAN BE RESOLVED WITH A MINIMUM AMOUNT OF DELAY.
5. FIVE (5) WORKING DAYS PRIOR TO BEGINNING OF CONSTRUCTION, THE CONTRACTOR SHALL SUBMIT TO CONSTRUCTION COORDINATION DIVISION A DETAILED CONSTRUCTION SCHEDULE. TWO (2) WORKING DAYS PRIOR TO THE START OF CONSTRUCTION, THE CONTRACTOR SHALL OBTAIN A BARRICADING PERMIT FROM THE CONSTRUCTION COORDINATION DIVISION. CONTRACTOR SHALL NOTIFY THE CONSTRUCTION COORDINATION ENGINEER (924-3400) PRIOR TO OCCUPYING AN INTERSECTION. REFER TO SECTION 19 OF THE GENERAL CONDITIONS OF THE STANDARD SPECIFICATIONS.
6. ALL WORK AFFECTING ARTERIAL ROADWAYS REQUIRES TWENTY-FOUR HOUR CONSTRUCTION.
7. ALL STREET STRIPING ALTERED OR DESTROYED SHALL BE REPLACED WITH PLASTIC REFLECTORIZING PAVEMENT MARKING BY CONTRACTOR TO THE SAME LOCATION AS WAS EXISTING, OR AS INDICATED BY THIS PLAN SET.
8. CONTRACTOR SHALL NOTIFY THE ENGINEER NOT LESS THAN SEVEN (7) DAYS PRIOR TO STARTING WORK IN ORDER THAT THE CITY SURVEYOR MAY TAKE NECESSARY MEASURES TO INSURE THE PRESERVATION OF SURVEY MONUMENTS. CONTRACTOR SHALL NOT DISTURB PERMANENT SURVEY MONUMENTS WITHOUT THE CONSENT OF THE CITY SURVEYOR AND SHALL NOTIFY THE CITY SURVEYOR AND BEAR THE EXPENSE OF REPLACING ANY THAT MAY BE DISTURBED WITHOUT PERMISSION. REPLACEMENT SHALL BE DONE ONLY BY THE CITY SURVEYOR. WHEN A CHANGE IS MADE IN THE FINISHED ELEVATIONS OF THE PAVEMENT OF ANY ROADWAY IN WHICH A PERMANENT SURVEY MONUMENT IS LOCATED, CONTRACTOR SHALL, AT HIS OWN EXPENSE, ADJUST THE MONUMENT TO COVER THE NEW GRADE UNLESS OTHERWISE SPECIFIED. REFER TO SECTION 4.4 OF THE GENERAL CONDITIONS OF THE STANDARD SPECIFICATIONS.
- CONTRACTOR SHALL RECORD DATA ON ALL UTILITY LINES AND ACCESSORIES AS REQUIRED BY THE CITY OF ALBUQUERQUE FOR THE PREPARATION OF "AS CONSTRUCTED" DRAWINGS. CONTRACTOR SHALL NOT COVER UTILITY LINES AND ACCESSORIES UNTIL ALL DATA HAVE BEEN RECORDED.
10. CONTRACTOR SHALL MAINTAIN A GRAFFITI-FREE WORK SITE. CONTRACTOR SHALL PROMPTLY REMOVE ANY GRAFFITI FROM ALL EQUIPMENT, WHETHER PERMANENT OR TEMPORARY.
11. CONTRACTOR SHALL COORDINATE WITH THE CITY OF ALBUQUERQUE WATER SYSTEMS DIVISION (857-8200) SEVEN (7) WORKING DAYS IN ADVANCE OF ANY WORK THAT MAY AFFECT EXISTING PUBLIC WATER OR SEWER UTILITIES. EXISTING VALVES TO BE OPERATED BY CITY PERSONNEL ONLY. CONTRACTOR SHALL CONTACT THE WATER SYSTEMS DIVISION SEVEN (7) WORKING DAYS PRIOR TO NEEDING VALVES TURNED ON OR OFF.
12. FOR STORM DRAIN CONSTRUCTION, RCP JOINTS SHALL NOT BE GROUTED PRIOR TO FINAL INSPECTION. FINAL INSPECTION WILL DETERMINE JOINTS TO BE GROUTED FOR FINAL ACCEPTANCE OF THE CONSTRUCTION.

THE FOLLOWING NOTES ALSO APPLY WHEN CHECKED

- ☒ ALL UTILITIES AND UTILITY SERVICE LINES SHALL BE INSTALLED PRIOR TO PAVING.
- ☒ BACKFILL COMPACTION SHALL BE ACCORDING TO SPECIFIED STREET USE.
- ☐ TACK COAT REQUIREMENTS SHALL BE DETERMINED BY THE ENGINEER.
- ☒ SIDEWALK AND WHEELCHAIR RAMPS WITHIN THE CURB RETURNS SHALL BE CONSTRUCTED WHEREVER A NEW CURB RETURN IS CONSTRUCTED.
- ☐ IF CURB IS DEPRESSIONED FOR A DRIVEPAD, THE DRIVEPAD SHALL BE CONSTRUCTED PRIOR TO ACCEPTANCE OF CURB AND GUTTER.
- ☒ ALL STORM DRAINAGE FACILITIES SHALL BE COMPLETED PRIOR TO FINAL ACCEPTANCE.



CAUTION:
NOTE THAT ALL EXISTING UTILITIES MAY NOT BE SHOWN. ALL EXISTING SERVICE CONNECTIONS ARE NOT SHOWN. ANY EXISTING UTILITIES THAT ARE SHOWN ARE APPROXIMATE LOCATION ONLY. IT SHALL BE THE SOLE RESPONSIBILITY OF THE CONTRACTOR TO CONTACT ALL THE UTILITY OWNERS AND TO CONDUCT ALL NECESSARY FIELD INVESTIGATIONS PRIOR TO ANY EXCAVATIONS TO DETERMINE THE ACTUAL LOCATION OF UTILITIES AND OTHER IMPROVEMENTS.

dmg D. MARK GOODWIN & ASSOCIATES, P.A.
CONSULTING ENGINEERS
P. O. BOX 90606
ALBUQUERQUE, NEW MEXICO 87199
(505) 825-2200, FAX (505) 797-9539

INDEX TO DRAWINGS

SHEET NO.	SHEET
1	TITLE SHEET
2-3	PLAT
4	GRADING AND DRAINAGE PLAN
5	MASTER PAVING PLAN
6-8	PAVING IMPROVEMENTS
9	MASTER UTILITY PLAN
10-12	UTILITY IMPROVEMENTS

SURVEYOR'S CERTIFICATION

"I, Timothy Aldrich, a duly qualified Registered Professional Land Surveyor under the laws of the State of New Mexico, do hereby certify that the 'as-built' information shown on these drawings was obtained from field construction and 'as-built' surveys performed by me or under my supervision, that the 'as-built' information shown on these drawings was added by me or under my supervision, and that this 'as-built' information is true and correct to the best of my knowledge and belief." Aldrich Land Surveying is not responsible for any of the design concepts, calculations, or engineering for any of the drawings.


Timothy Aldrich, P.L.S. No. 7719

01-18-05

CERTIFICATE OF SUBSTANTIAL COMPLIANCE ON PLANS

I, Diane Hoelzer, NMPE 11967, of the firm Mark Goodwin & Associates, P.A., a Registered Professional Engineer in the State of New Mexico, do hereby certify, to the best of my knowledge and belief, that the infrastructure installed as part of this project has been inspected by me or by a qualified person under my direct supervision, and has been constructed in accordance with the plans and specifications approved by the City Engineer and that the original design intent of the approved plans has been met, except as noted by me on the as-built construction drawings. This Certification is based on site inspections by me or personnel under my direction, and survey information provided by ALS, Inc., NMPS number 7719.


Diane Hoelzer 8-25-05

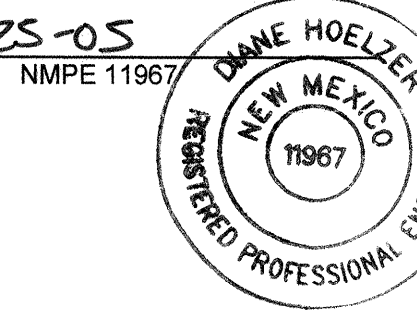

DRB NO.

1002856

REV.	9R & 10R	CITY ENGINEER	DATE	USER DEPARTMENT	DATE	USER DEPARTMENT	DATE
ENGINEERS STAMP & SIGNATURE		APPROVALS		ENGINEER		DATE	
		DRC CHAIRMAN		6-17-04		APPROVED FOR CONSTRUCTION	
		TRANSPORTATION		5/27/04			
		WATER/WASTEWATER		5/27/04			
		HYDROLOGY		5/27/04			
		CONSTR. MNGMT.					
CONSTR. COORD.		6-17-04				CITY ENGINEER DATE	
CITY PROJECT NO.		679586		SHEET OF		1 12	

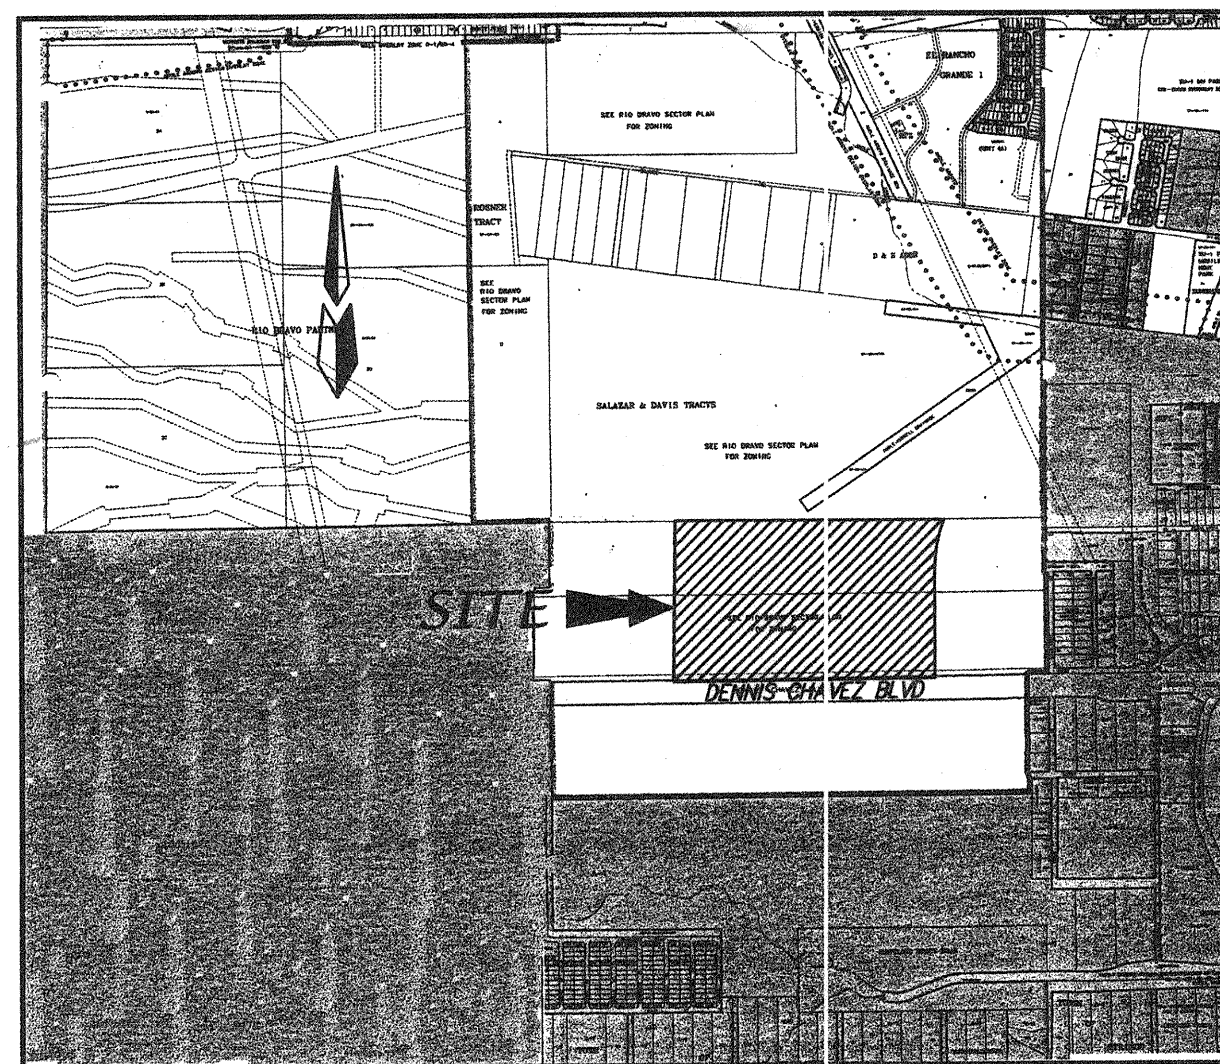

ZONE ATLAS: N-9-Z & P-9-Z

SITE BENCHMARK

ACS MONUMENT
"3-P10"
ELEVATION=4935.735
(SLD 1929)


ACS MONUMENT
"TRANS"
Y=1471822.67
X=354899.45
G-G=0.99967921
Δα=-00°16'42"
CENTRAL ZONE
(NAD 1927)

EASEMENTS

- EXISTING 156' PUBLIC WATERLINE EASEMENT (09-25-02, BK. A42, PG. 2469)
- EXISTING 156' PUBLIC WATERLINE EASEMENT (09-25-02, BK. A42, PG. 2470)
- EXISTING 156' PUBLIC C.O.A. WATERLINE EASEMENT (10-18-02, BK. A43, PG. 4894)
- EXISTING 7' LANDSCAPE EASEMENT & 7' PUE (01-09-04, 04C-9)
- EXISTING 156' PUBLIC INGRESS/EGRESS, WATER AND SANITARY SEWER EASEMENT (04-17-01, BK. A18 - PG. 457)
- EXISTING PUBLIC SANITARY SEWER AND WATERLINE EASEMENT (01-09-04, 04C-9)
- EXISTING PRIVATE ACCESS EASEMENT TO BENEFIT PARCEL 5 (01-09-04, 04C-9)
- EXISTING PUBLIC ROADWAY, DRAINAGE, WATER AND SANITARY SEWER EASEMENT (12-06-02, 02C-390)
- 40' PUBLIC SANITARY SEWER, WATERLINE & DRAINAGE EASEMENT (01-09-04, 04C-9)
- PROPOSED 78' PUBLIC RIGHT-OF-WAY (WITH UNIT 1)
- PROPOSED 15' PUBLIC WATERLINE EASEMENT (WITH UNIT 1 PLATTING)
- PROPOSED 25' PUBLIC WATERLINE EASEMENT AND PEDESTRIAN ACCESS EASEMENT (WITH UNIT 1 PLATTING)
- PROPOSED 20' PUBLIC DRAINAGE EASEMENT (WITH UNIT 1 PLATTING)
- PROPOSED 38' PUBLIC WATERLINE, SANITARY SEWER AND DRAINAGE EASEMENT (WITH UNIT 1 PLATTING)
- EXISTING 30' PUBLIC SANITARY SEWER AND WATERLINE EASEMENT (01-09-04, 04C-9)
- EXISTING PUBLIC WATERLINE, SANITARY SEWER AND DRAINAGE EASEMENT (01-09-04, 04C-9)
- EXISTING 25' PUBLIC SANITARY SEWER AND WATERLINE EASEMENT (01-09-04, 04C-9)
- 15' PUBLIC WATERLINE EASEMENT GRANTED WITH THIS PLAT
- 25' PUBLIC WATERLINE EASEMENT AND PEDESTRIAN ACCESS EASEMENT GRANTED WITH THIS PLAT
- 7' LANDSCAPE EASEMENT AND 7' PUE GRANTED WITH THIS PLAT
- EXISTING 60' PUBLIC ROADWAY, DRAINAGE, WATERLINE AND SANITARY SEWER EASEMENT (01-09-04, 04C-9)

SUBDIVISION DATA

GROSS ACREAGE 48.0729 AC
ZONE ATLAS NO. N-9-Z P-9-Z
NO. OF LOTS CREATED - UNIT 2 72 LOTS
NO. OF LOTS CREATED - UNIT 3B 118 LOTS
NO. OF LOTS CREATED - UNIT 4 42 LOTS
NO. OF LOTS CREATED - UNIT 5 46 LOTS
TOTAL NO. OF LOTS CREATED 278 LOTS
NO. OF TRACTS CREATED 4 TRACTS
NO. OF EXISTING PARCELS 3 PARCELS
NO. OF PARCELS ELIMINATED 3 PARCELS
AREA DEDICATED TO CITY 9.9399 AC±
PARK DEDICATION (UNIT 1) 2.5630 AC
ZONING RL
DATE OF SURVEY OCTOBER 2002

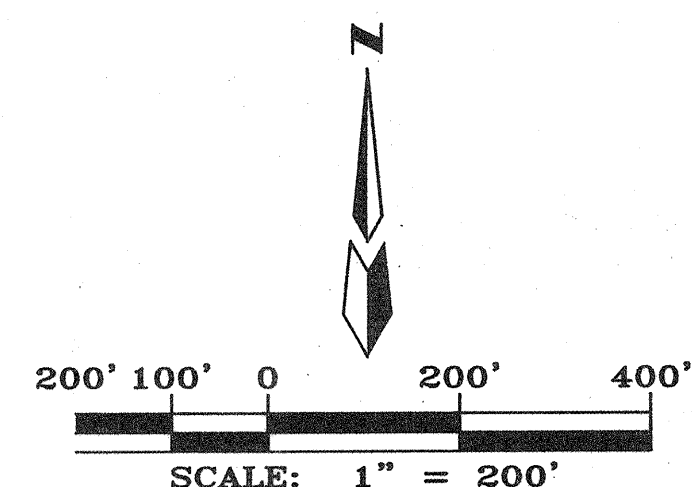

PRELIMINARY PLAT
THE MEADOWS AT ANDERSON HILLS
UNITS 2, 3B, 4 AND 5
WITHIN THE
TOWN OF ATRISCO GRANT
PROJECTED SECTIONS 8, 9 & 10
TOWNSHIP 9 NORTH, RANGE 2 EAST, NMPM
CITY OF ALBUQUERQUE
BERNALILLO COUNTY, NEW MEXICO
FEBRUARY, 2004

NOTES

- UNLESS OTHERWISE NOTED, ALL BOUNDARY CORNERS SHOWN SHALL BE MARKED BY A #5 REBAR W/CAP STAMPED "ALS LS 7719" (TYP.).
- ALL STREET CENTERLINE MONUMENTATION SHALL BE INSTALLED AT ALL CENTERLINE PC'S, PT'S, ANGLE POINTS, AND STREET INTERSECTIONS AND SHOWN THUS WILL BE MARKED BY A FOUR INCH (4") ALUMINUM CAP STAMPED:
"CITY OF ALBUQUERQUE CENTERLINE MONUMENTATION"
"DO NOT DISTURB"
PS#7719"
- BOUNDARY SHALL BE TIED TO THE NEW MEXICO STATE PLANE COORDINATE SYSTEM AS SHOWN.
- BASIS OF BEARING SHALL BE NEW MEXICO STATE PLANE GRID BEARINGS.
- ALL DISTANCES SHALL BE GROUND DISTANCES.
- MANHOLES WILL BE OFFSET AT ALL POINTS OF CURVATURE, POINTS OF TANGENCY, STREET INTERSECTIONS, AND ALL OTHER ANGLE POINTS TO ALLOW USE OF CENTERLINE MONUMENTATION.
- TRACTS O THRU T ARE FOR LANDSCAPE PURPOSES AND SHALL BE OWNED AND MAINTAINED BY THE HOMEOWNERS ASSOCIATION.
- TRACT KK IS HEREBY ENCUMBERED WITH PUBLIC SANITARY SEWER, WATER AND DRAINAGE EASEMENTS GRANTED TO THE CITY OF ALBUQUERQUE AND TO BE MAINTAINED BY THE CITY OF ALBUQUERQUE. TRACT KK IS HEREBY CREATED FOR UNRESTRICTED PRIVATE ACCESS TO ALL LOT OWNERS OF THIS SUBDIVISION AND IS TO BE OWNED AND MAINTAINED BY THE HOMEOWNER'S ASSOCIATION.
- DISCLOSURE STATEMENT FOR EXISTING PNM GAS LINE:
WITH THE EXCEPTION OF AREAS LOCATED WITHIN THE FUTURE RIGHTS-OF-WAY OF UNSER BOULEVARD, SW AND 98TH STREET, SW, THE SOUTHEAST CORNER OF TRACT H AND A FUTURE SANITARY SEWER CROSSING LOCATED APPROXIMATELY 470 FEET WEST OF THE SOUTHWEST CORNER OF TRACT 14, ANY IMPROVEMENTS ENCROACHING INTO EXISTING PNM NATURAL GAS LINE EASEMENTS SHALL NOT INTERFERE WITH NOR INHIBIT PNM'S ABILITY TO OPERATE AND MAINTAIN ITS GAS LINE FACILITIES. THE PROPERTY OWNER OR PERSON OR BUSINESS RESPONSIBLE FOR ANY ENCROACHMENT SHALL PAY FOR ALL PNM UTILITY RELOCATIONS OR MODIFICATIONS CAUSED BY SUCH EASEMENT ENCROACHMENTS.

DESCRIPTION

A tract of land situate within the Town of Atrisco Grant, projected Sections 8, 9, and 10, Township 9 North, Range 2 East, New Mexico Principal Meridian, Bernalillo County, New Mexico being all of PARCELS 1, 2 AND 5, MEADOWS AT ANDERSON HILLS as the same is shown and designated on said plat filed for record in the office of the County Clerk of Bernalillo County, New Mexico on January 5, 2004 in Book 2004C, Page 9 and containing 48.0729 acres more or less.

ENGINEERS

D. MARK GOODWIN & ASSOCIATES, P.A.
CONSULTING ENGINEERS
P.O. BOX 90606
ALBUQUERQUE, NEW MEXICO 87199
(505) 884-2200

OWNERS

ANDERSON HILLS, LLC
PO BOX 12317
ALBUQUERQUE, N.M. 87195
(505) 822-5562

SURVEYOR

ALDRICH LAND SURVEYING
P.O. BOX 30701
ALBUQUERQUE, N.M. 87190
(505) 884-1990

Robert Lupton
Manager, Anderson Hills, LLC
J. MARK FERGUSON
Division President, D.R. HORTON, INC.

APPROVED FOR MONUMENTATION AND STREET NAMES

City Surveyor, City of Albuquerque, N.M. Date 2-19-04

ALDRICH LAND SURVEYING
P.O. BOX 30701, ALBU., N.M. 87190
505-884-1990

PRELIMINARY PLAT
THE MEADOWS AT ANDERSON HILLS
UNITS 2, 3B, 4 AND 5
WITHIN THE
TOWN OF ATRISCO GRANT
PROJECTED SECTIONS 8, 9 & 10
TOWNSHIP 9 NORTH, RANGE 2 EAST, NMPM
CITY OF ALBUQUERQUE
BERNALILLO COUNTY, NEW MEXICO
FEBRUARY, 2004

SCALE: 1" = 100'

TRACT A
LANDS OF SALAZAR FAMILY TRUST
SALAZAR QUATRO TRUST
JSJ INVESTMENT COMPANY AND FALBA HANNET
(07-23-03, 03C-223)

- LEGEND**
- 1 LOT NUMBER
 - 11 BLOCK NUMBER
 - ▲ CENTER LINE MONUMENT
 - △ EXISTING CENTER LINE MONUMENT
 - RIGHT-OF-WAY
 - UNIT LINE
 - UNIT 2 UNIT NUMBER


EASEMENTS

- 1 EXISTING 156' PUBLIC WATERLINE EASEMENT (09-25-02, BK. A42, PG. 2469)
- 2 EXISTING 156' PUBLIC WATERLINE EASEMENT (09-25-02, BK. A42, PG. 2470)
- 3 EXISTING 156' PUBLIC C.O.A. WATERLINE EASEMENT (10-18-02, BK. A43, PG. 4894)
- 4 EXISTING 7' LANDSCAPE EASEMENT & 7' PUE (01-09-04, 04C-9)
- 5 EXISTING 156' PUBLIC INGRESS/EGRESS, WATER AND SANITARY SEWER EASEMENT (04-17-01, BK. A18 - PG. 457)
- 6 EXISTING PUBLIC SANITARY SEWER AND WATERLINE EASEMENT (01-09-04, 04C-9)
- 7 EXISTING PRIVATE ACCESS EASEMENT TO BENEFIT PARCEL 5 (01-09-04, 04C-9)
- 8 EXISTING PUBLIC ROADWAY, DRAINAGE, WATER AND SANITARY SEWER EASEMENT (12-06-02, 02C-390)
- 9 40' PUBLIC SANITARY SEWER, WATERLINE & DRAINAGE EASEMENT (01-09-04, 04C-9)
- 10 PROPOSED 78' PUBLIC ROADWAY, DRAINAGE, WATERLINE AND SANITARY SEWER EASEMENT (WITH UNIT 1 PLATTING)
- 11 PROPOSED 15' PUBLIC WATERLINE EASEMENT (WITH UNIT 1 PLATTING)
- 12 PROPOSED 25' PUBLIC WATERLINE EASEMENT AND PEDESTRIAN ACCESS EASEMENT (WITH UNIT 1 PLATTING)
- 13 PROPOSED 20' PUBLIC DRAINAGE EASEMENT (WITH UNIT 1 PLATTING)
- 14 PROPOSED 38' PUBLIC WATERLINE, SANITARY SEWER AND DRAINAGE EASEMENT (WITH UNIT 1 PLATTING)
- 15 EXISTING 30' PUBLIC SANITARY SEWER AND WATERLINE EASEMENT (01-09-04, 04C-9)
- 16 EXISTING PUBLIC WATERLINE, SANITARY SEWER AND DRAINAGE EASEMENT (01-09-04, 04C-9)
- 17 EXISTING 25' PUBLIC SANITARY SEWER AND WATERLINE EASEMENT (01-09-04, 04C-9)
- 18 15' PUBLIC WATERLINE EASEMENT GRANTED WITH THIS PLAT
- 19 25' PUBLIC WATERLINE EASEMENT AND PEDESTRIAN ACCESS EASEMENT GRANTED WITH THIS PLAT
- 20 7' LANDSCAPE EASEMENT AND 7' PUE GRANTED WITH THIS PLAT
- 21 EXISTING 60' PUBLIC ROADWAY, DRAINAGE, WATERLINE AND SANITARY SEWER EASEMENT (01-09-04, 04C-9)

ALDRICH LAND SURVEYING
P.O. BOX 30701, ALBUQUERQUE, N.M. 87190
505-884-1990

A2106ANH/DWG/MEADOWS/A2106-GD50-3A-3B-4REV.DWG, 01/08/04 01:48:33 PM, Mark Goodwin & Associates, Inc.

SCANNED BY
MESA REPRO

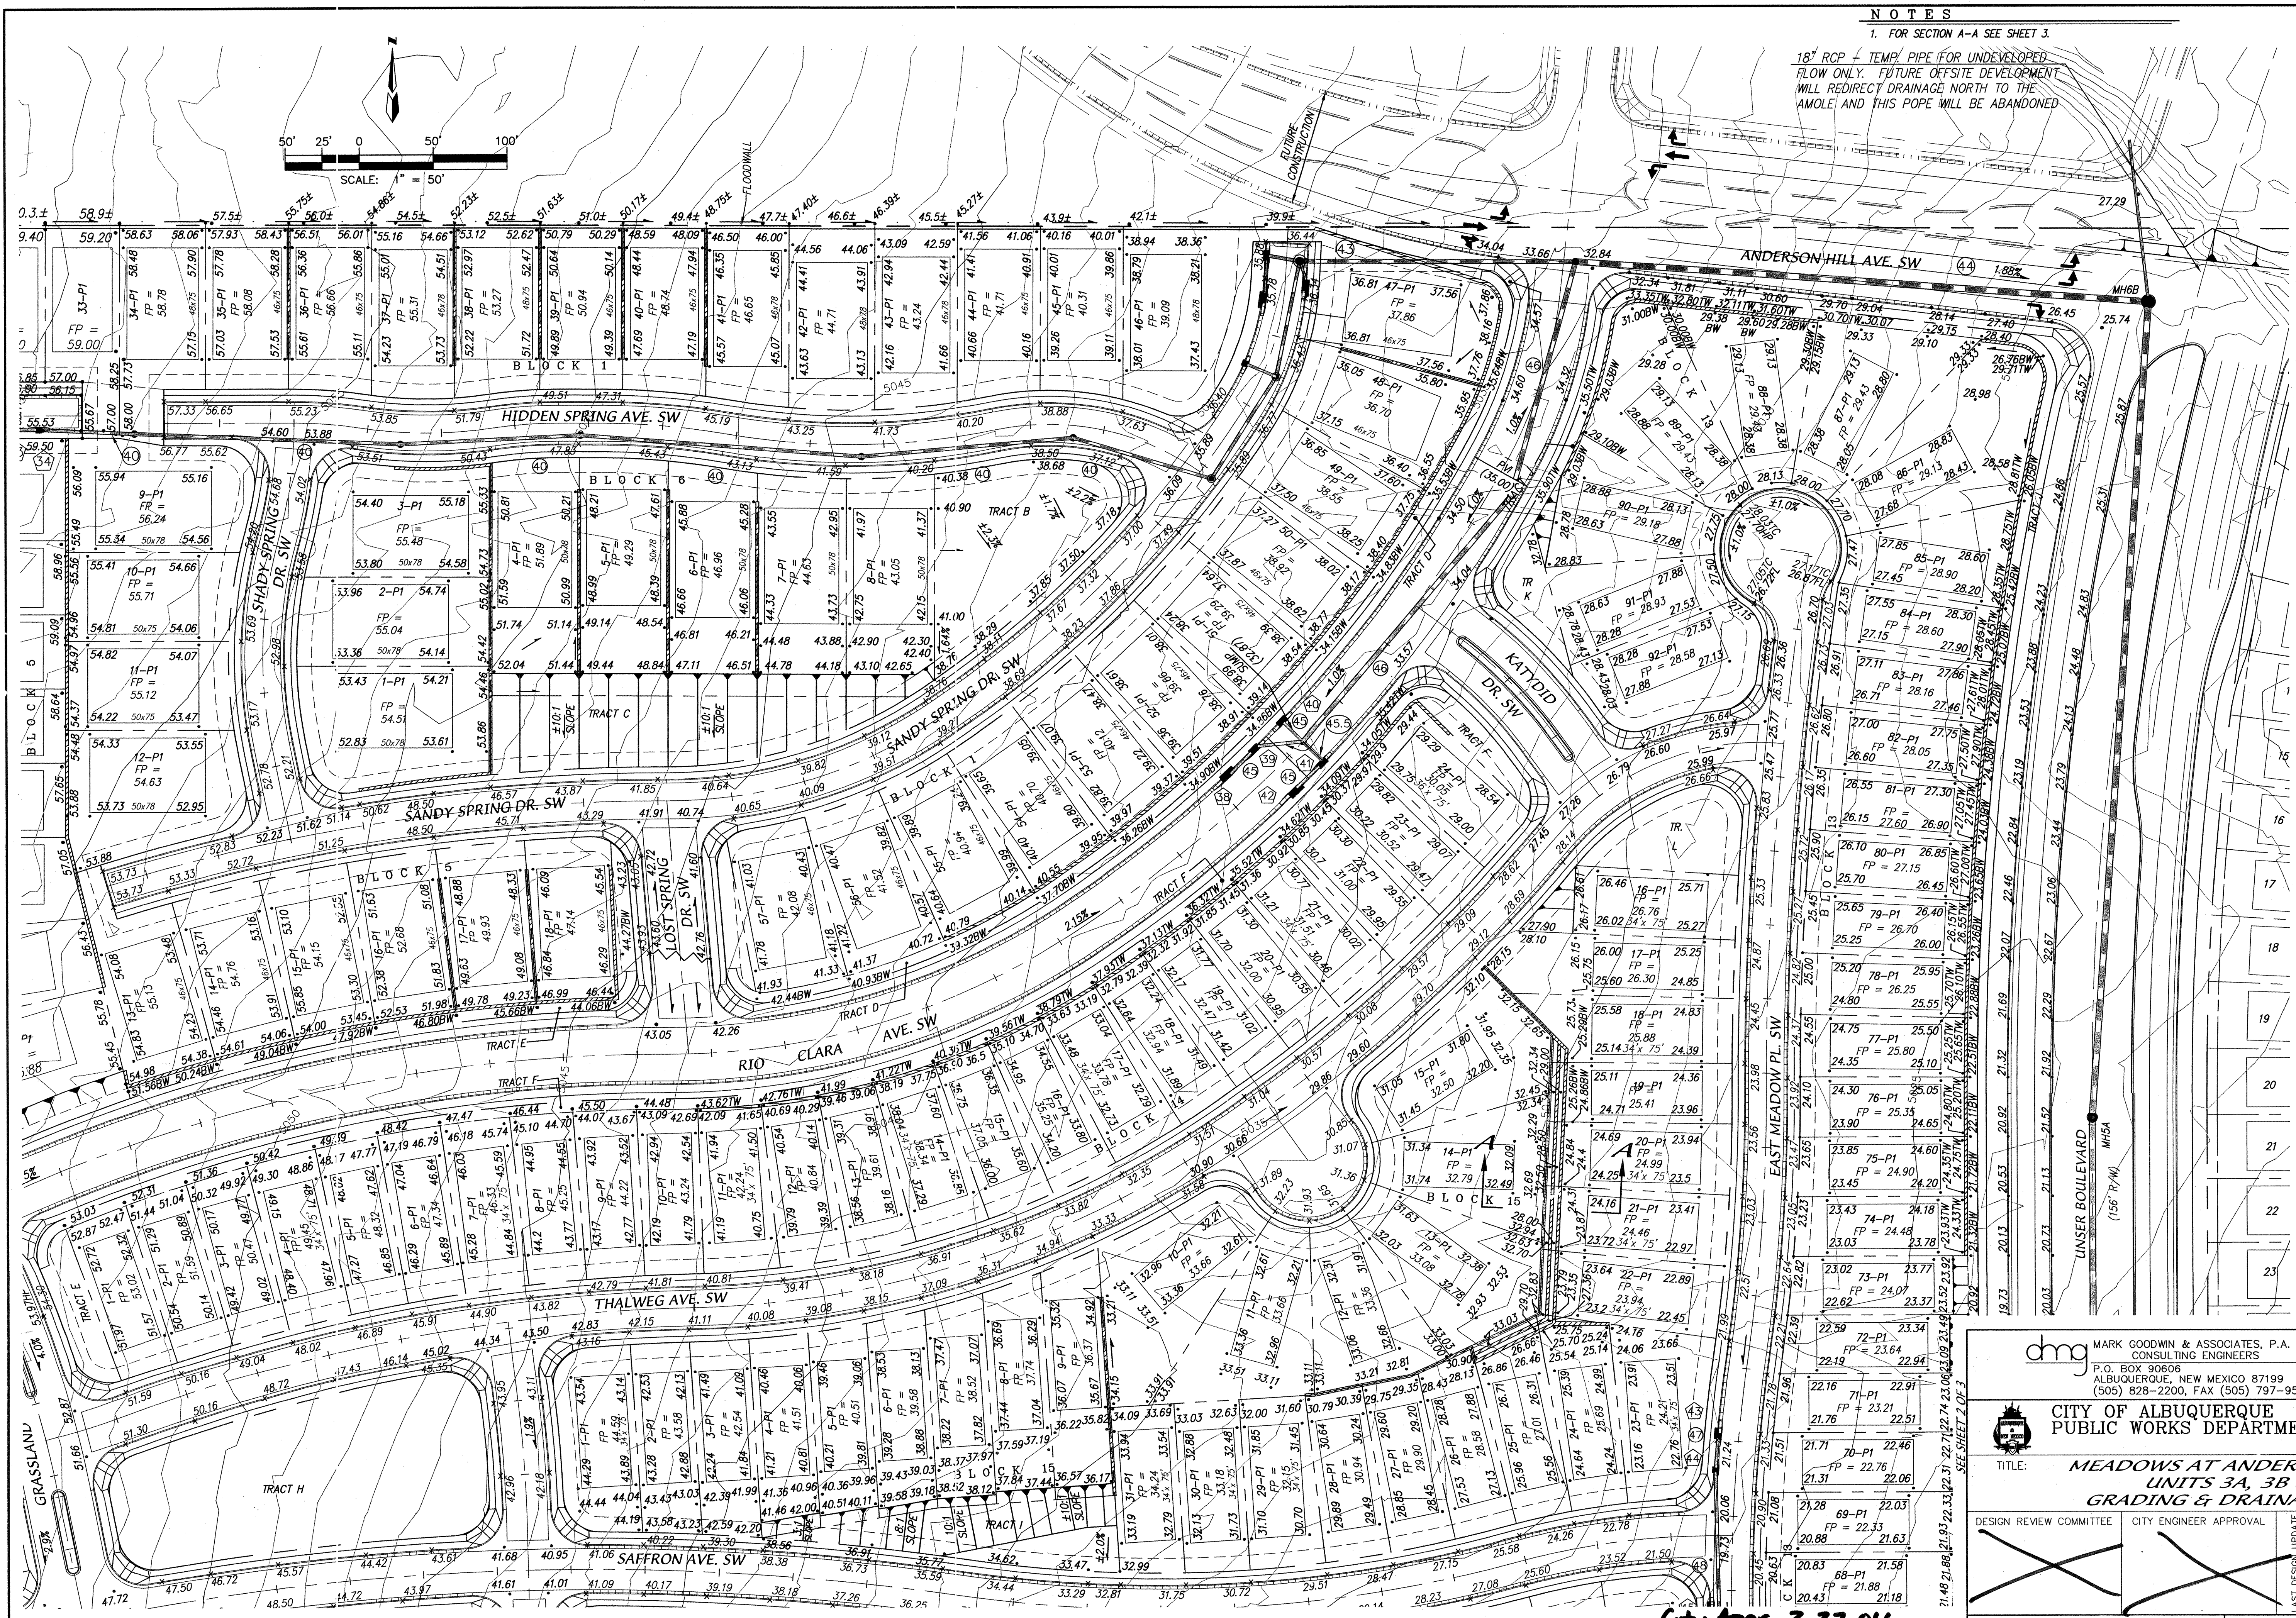


NOTES
1. FOR SECTION A-A SEE SHEET 3.
18" RCP + TEMP. PIPE FOR UNDEVELOPED
FLOW ONLY. FUTURE OFFSITE DEVELOPMENT
WILL REDIRECT DRAINAGE NORTH TO THE
AMOLE AND THIS POPE WILL BE ABANDONED

AS BUILT INFORMATION	
CONTRACTOR	MARK GOODWIN & ASSOCIATES, P.A.
INSPECTOR	ALBUQUERQUE, NEW MEXICO 87199
DATE	(505) 828-2200, FAX (505) 797-9539

BENCH MARKS	
STATION	STATION 2+00 IS LOCATED 4.9 MI. SW OF DOWNTOWN ALBUQUERQUE
DATE	TO REACH STATION FROM INT. OF COORS AND DENIS CHAVEZ BLVD.
BY	(FORMERLY RIO BRAVO), GO N. ON COORS 0.1 MI. TO FLORA VISTA
NO.	AND GO WEST ON FLORA VISTA 0.5 MI. TO CONDERSHIRE, THEN GO
REMARKS	S. ON CONDERSHIRE 0.4 MI. TO A POINT APPROX. 50 FT. W. OF THE
DESIGN	STATION. STATION MARK IS AN ACS 3 1/4" ALUM CAP STAMPED
REVISIONS	"2+00" RIVETED TO A PIPE PROJECTING 0.25 FT ABOVE THE
DATE	GROUND. X=35941.13, Y=1464349.24 (NAD 27) Z=4991 (NOV 20)

SURVEY INFORMATION	
FIELD NOTES	NO.
DATE	BY

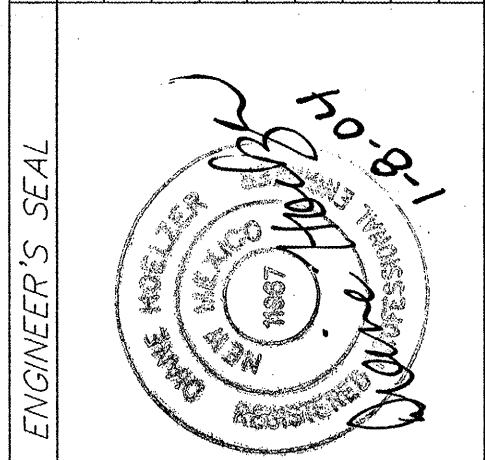

ENGINEER'S SEAL	
NO.	BY
REMARKS	DESIGN
DATE	1/03
DRAWN BY	NHE
CHECKED BY	DMG

dmg MARK GOODWIN & ASSOCIATES, P.A.
CONSULTING ENGINEERS
P.O. BOX 90606
ALBUQUERQUE, NEW MEXICO 87199
(505) 828-2200, FAX (505) 797-9539

**CITY OF ALBUQUERQUE
PUBLIC WORKS DEPARTMENT**


TITLE: **MEADOWS AT ANDERSON HILLS
UNITS 3A, 3B & 4
GRADING & DRAINAGE PLAN**

DESIGN REVIEW COMMITTEE	CITY ENGINEER APPROVAL	MO./DAY/YR.	MO./DAY/YR.
LAST DESIGN UPDATE			

CITY PROJECT NO. **679586** ZONE MAP NO. **P-9** SHEET **4 of 12**

City Appr. 2-27-04

A2106ANH/DWG/MEADOWS/A2106-GD50-3A-3B-4REV 1-07-04 ACH RDQ NHE

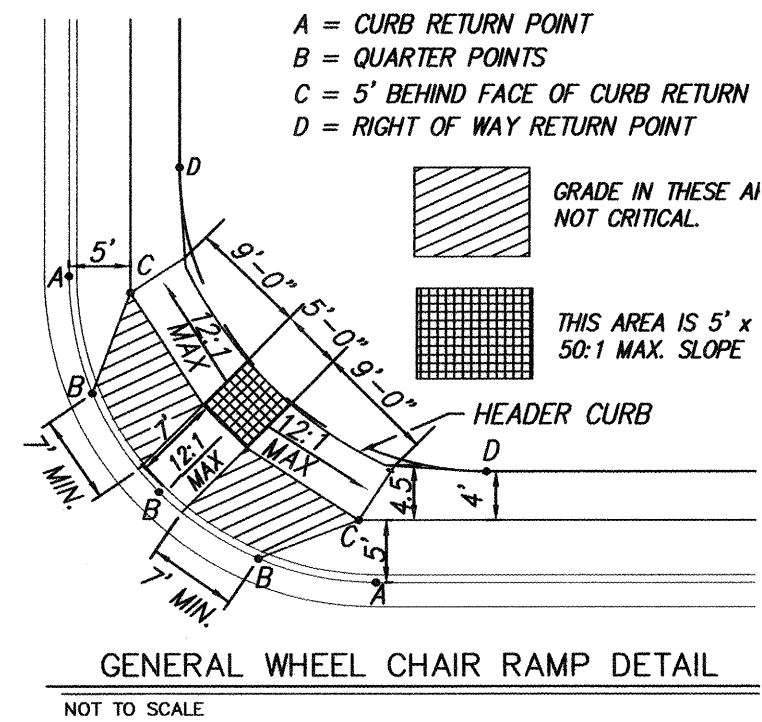


A circular professional engineer seal for Dane Hoelzer, New Mexico. The seal features the name "DANE HOELZER" in the outer ring, "NEW MEXICO" in the middle ring, and "11967" in the center. The text "REGISTERED PROFESSIONAL ENGINEER" is written along the bottom inner edge of the seal.

CITY PROJECT NO.	ZONE MAP NO.	SHEET	OF
632586	B.B.	5	

DESIGNED BY	<i>DLH</i>	DATE	<i>1/03</i>
DRAWN BY	<i>NHE</i>	DATE	<i>1/03</i>
CHECKED BY	<i>DMG</i>	DATE	<i>1/03</i>
DESIGN			
REVIEWS			
NO.	DATE	REMARKS	BY

	MO./DAY/YR.	MO./DAY/YR.
0.	SHEET	OF 5 13

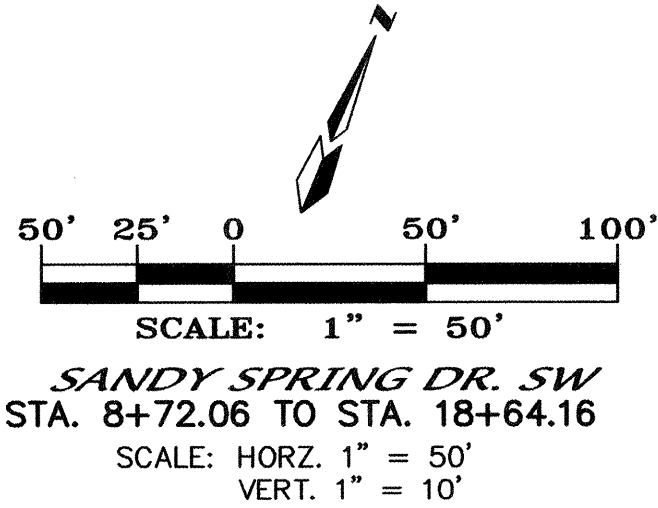

1. ALL STATIONING IS CENTERLINE STATIONING.

① $\Delta = 1716.56''$
 $R = 1273.05'$
 $T = 193.47'$
 $L = 384.00'$

② $\Delta = 3329.16''$
 $R = 329.00'$
 $T = 98.98'$
 $L = 192.29'$

③ $\Delta = 2312.35''$
 $R = 729.00'$
 $T = 149.71'$
 $L = 295.31'$

④ $\Delta = 3074.36''$
 $R = 180.00'$
 $T = 48.64'$
 $L = 95.01'$

① $\Delta = 4017''19$
 $R = 1283.00''$
 $T = 45.05''$
 $L = 90.06''$

② $\Delta = 8817''29$
 $R = 25.00''$
 $T = 24.27''$
 $L = 38.52''$

③ $\Delta = 8817''48$
 $R = 25.00''$
 $T = 24.27''$
 $L = 38.53''$

④ $\Delta = 949''16$
 $R = 27.00''$
 $T = 110.22''$
 $L = 220.61''$

⑤ $\Delta = 3329''16$
 $R = 315.00''$
 $T = 94.77''$
 $L = 184.11''$

⑥ $\Delta = 1525''23$
 $R = 715.00''$
 $T = 96.82''$
 $L = 192.47''$

⑦ $\Delta = 11415''30$
 $R = 25.00''$
 $T = 38.69''$
 $L = 49.85''$

⑧ $\Delta = 8007''07$
 $R = 25.00''$
 $T = 21.02''$
 $L = 34.96''$

⑨ $\Delta = 1701''20$
 $R = 715.00''$
 $T = 6.38''$
 $L = 12.76''$

⑩ $\Delta = 3014''36$
 $R = 166.00''$
 $T = 44.86''$
 $L = 87.62''$

⑪ $\Delta = 3014''36$
 $R = 194.00''$
 $T = 52.42''$
 $L = 102.40''$

⑫ $\Delta = 2312''35$
 $R = 743.00''$
 $T = 152.58''$
 $L = 300.98''$

⑬ $\Delta = 2557''38$
 $R = 343.00''$
 $T = 79.06''$
 $L = 155.41''$

⑭ $\Delta = 8727''26$
 $R = 25.00''$
 $T = 23.91''$
 $L = 38.16''$

⑮ $\Delta = 8656''11$
 $R = 25.00''$
 $T = 23.70''$
 $L = 37.93''$

⑯ $\Delta = 1520''37$
 $R = 1259.00''$
 $T = 169.59''$
 $L = 337.16''$

I, Diane Hoel, NMPE 11967, of the firm Mark Goodwin & Associates, PA, a Registered Professional Engineer in the State of New Mexico, do hereby certify, to the best of my knowledge and belief, that the infrastructure installed as part of this project has been inspected by me or by a qualified person under my direct supervision, and has been constructed in accordance with the plans and specifications approved by the City Engineer and that the original design intent of the approved plans has been met, except as noted by me on the as-built construction drawings. This Certification is based on site inspections by me or personnel under my direction, and survey information provided by ALS, Inc., NMPS number 7719.

Diane Hoelzer

 CITY OF ALBUQUERQUE
PUBLIC WORKS DEPARTMENT

DESIGN REVIEW COMMITTEE	CITY ENGINEER APPROVAL	ST DESIGN UPDATE	MO./DAY/YR.	MO./DAY/YR.
APPROVED JUN 17 2010	APPROVED JUN - 8 2010			

CITY PROJECT NO.	ZONE MAP NO.	SHEET	OF
------------------	--------------	-------	----


679586

P-9

6 12


2106ANH/DWG/MEADOWS/PLANSU4/SANDYSPRING-PP1 5-17-04 NHE/TAS

SCANNED BY
MESA REPRO

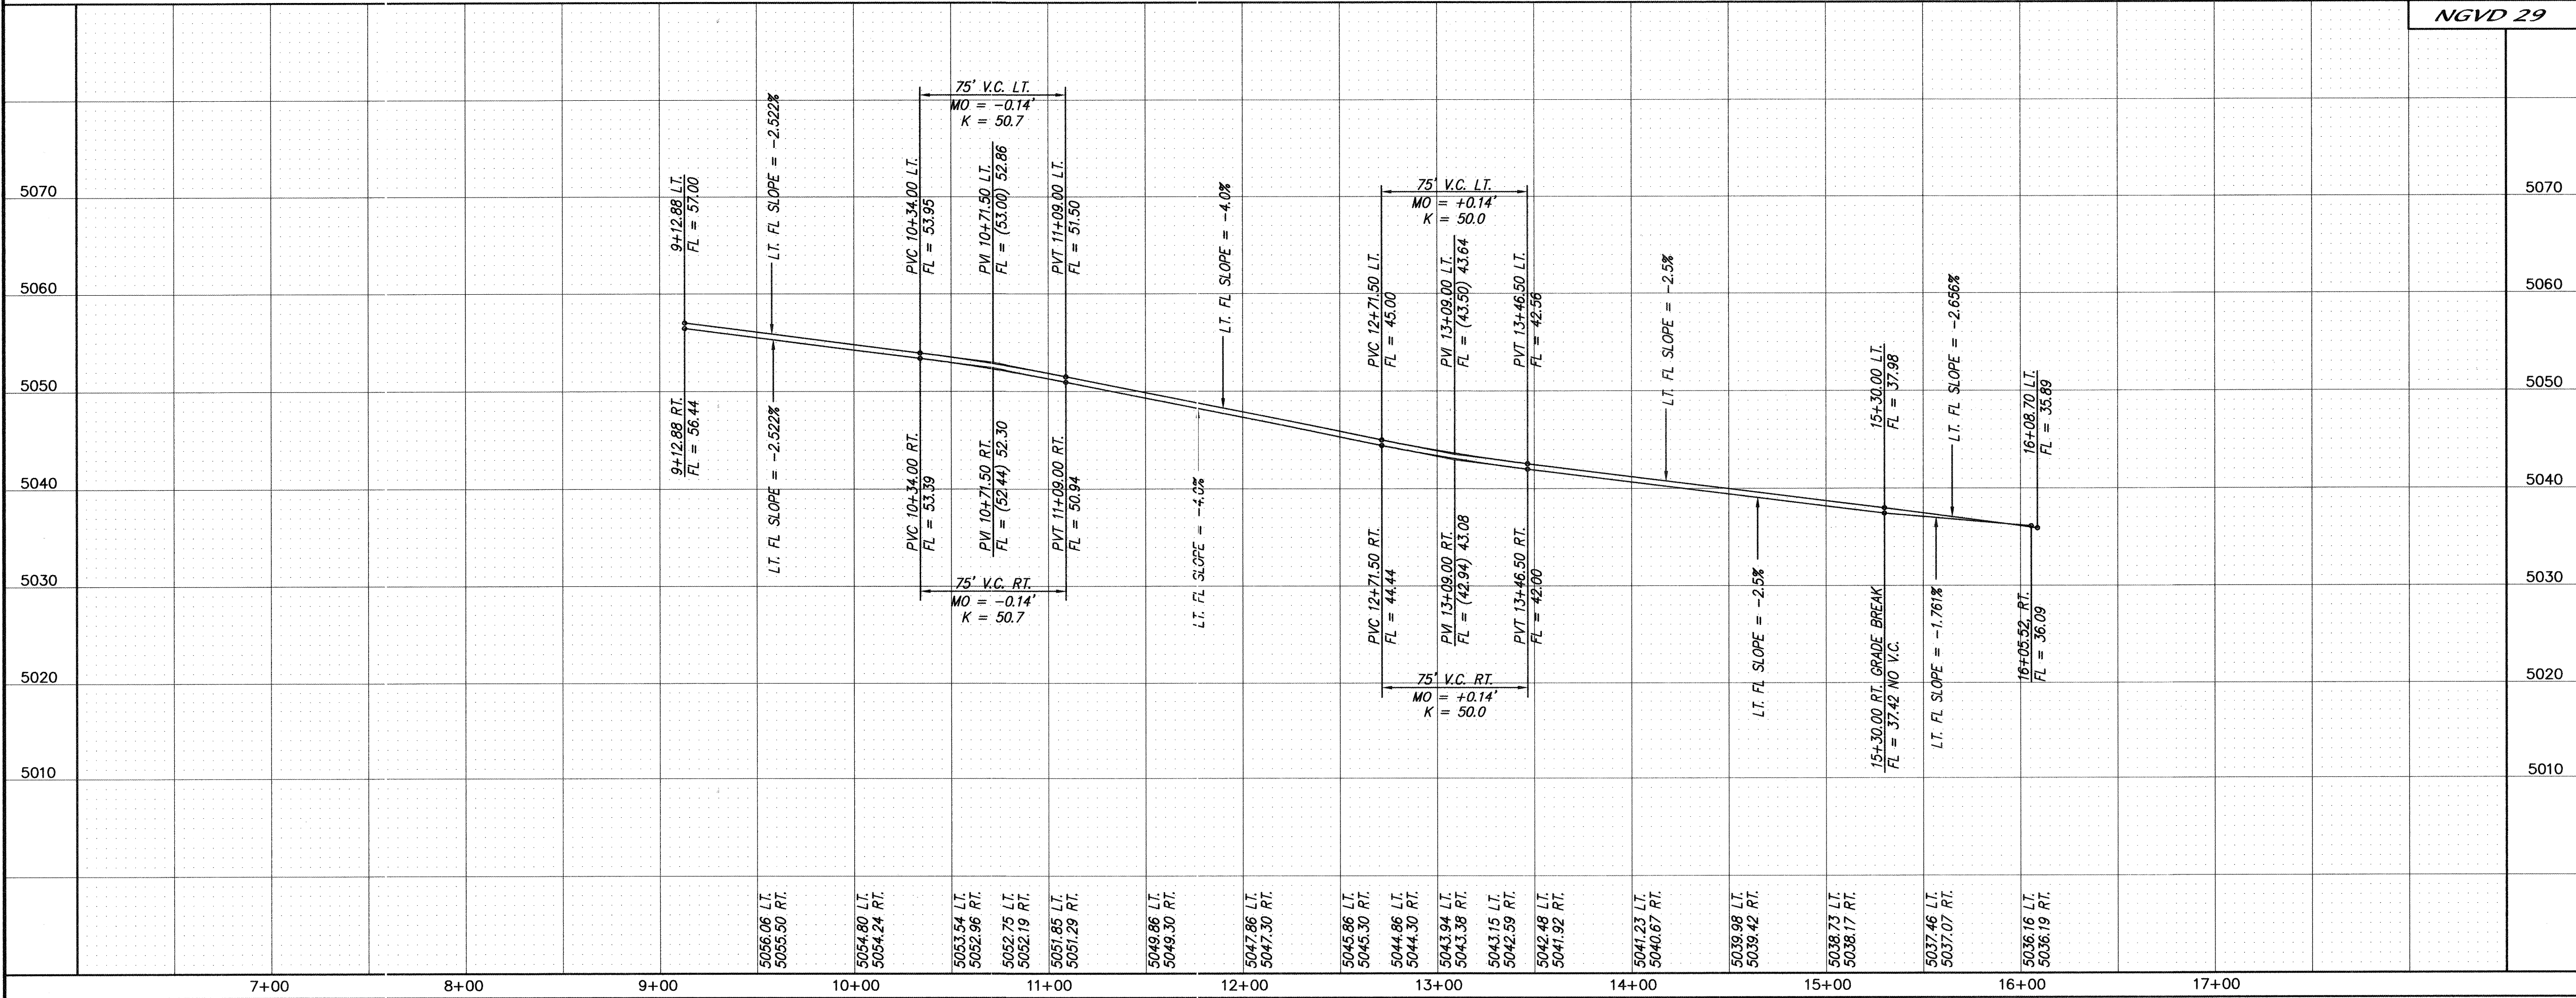

PT. ELEV.
1 35.89
2 36.04
3 36.19

PT. ELEV.
1 36.53
2 36.27
3 36.30

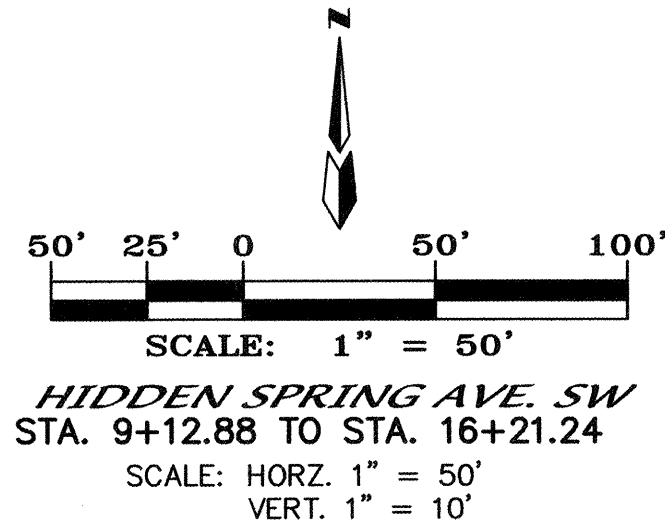

NOTES

1. ALL STATIONING IS CENTERLINE STATIONING.

CURVE DATA - DESCRIBES CENTERLINE

① Δ = 8'34'30" R = 300.00' T = 22.49' L = 44.90'	② Δ = 17'08'59" R = 300.00' T = 45.24' L = 89.80'	③ Δ = 8'34'30" R = 300.00' T = 22.49' L = 44.90'
④ Δ = 9'31'30" R = 500.00' T = 41.66' L = 83.12'	⑤ Δ = 21'04'55" R = 500.00' T = 93.04' L = 183.97'	⑥ Δ = 21'04'55" R = 500.00' T = 93.04' L = 183.97'

CURVE DATA - DESCRIBES FACE OF NEW CURB

① Δ = 8'34'30" R = 314.00' T = 23.54' L = 46.99'	② Δ = 17'08'59" R = 286.00' T = 43.13' L = 85.61'	③ Δ = 8'34'30" R = 314.00' T = 23.54' L = 46.99'
④ Δ = 9'31'30" R = 514.00' T = 42.82' L = 85.45'	⑤ Δ = 21'04'55" R = 486.00' T = 90.43' L = 178.82'	⑥ Δ = 35'57'17" R = 194.00' T = 62.95' L = 121.74'
⑦ Δ = 8'07'07" R = 25.00' T = 21.02' L = 34.96'	⑧ Δ = 11'41'53" R = 25.00' T = 38.69' L = 49.85'	⑨ Δ = 28'20'32" R = 166.00' T = 41.92' L = 82.11'
⑩ Δ = 21'04'55" R = 514.00' T = 95.64' L = 189.13'	⑪ Δ = 9'31'30" R = 486.00' T = 40.49' L = 80.79'	⑫ Δ = 8'34'30" R = 286.00' T = 21.44' L = 42.80'
⑬ Δ = 17'08'59" R = 314.00' T = 47.35' L = 93.99'	⑭ Δ = 0'32'55" R = 286.00' T = 1.37' L = 2.74'	⑮ Δ = 90'59'06" R = 25.00' T = 25.43' L = 39.70'
⑯ Δ = 9'74'24" R = 25.00' T = 28.61' L = 42.63'		

CERTIFICATE OF SUBSTANTIAL COMPLIANCE ON PLANS

I, Diane Hoelzer, NMPE 11967, of the firm Mark Goodwin & Associates, P.A., a Registered Professional Engineer in the State of New Mexico, do hereby certify, to the best of my knowledge and belief, that the infrastructure installed as part of this project has been inspected by me or by a qualified person under my direct supervision, and has been constructed in accordance with the plans and specifications approved by the City Engineer and that the original design intent of the approved plans has been met, except as noted by me on the as-built construction drawings. This Certification is based on site inspections by me or personnel under my direction, and survey information provided by ALS, Inc., NMPS number 7719.

Diane Hoelzer 8-23-05
Diane Hoelzer
NMPE 11967
REGISTERED PROFESSIONAL ENGINEER

dmg MARK GOODWIN & ASSOCIATES, P.A.
CONSULTING ENGINEERS
P.O. BOX 90606
ALBUQUERQUE, NEW MEXICO 87199
(505) 828-2200, FAX (505) 797-9539

CITY OF ALBUQUERQUE
PUBLIC WORKS DEPARTMENT
TITLE: MEADOW AT ANDERSON HILLS - UNIT 4
HIDDEN SPRINGS AVE. SW
PAVING IMPROVEMENTS







DESIGN REVIEW COMMITTEE	CITY ENGINEER APPROVAL	MO./DAY/YR.	MO./DAY/YR.
APPROVED	APPROVED		
REVIEW COMMITTEE	CITY		

CITY PROJECT NO. 679586 ZONE MAP NO. P-9 SHEET 7 OF 12

SURVEY INFORMATION		BENCH MARKS		AS BUILT INFORMATION	
NO.	BY	DATE	NO.	CONTRACTOR	DATE
				WORK PERFORMED BY	DATE
				INSPECTOR'S	DATE
				ACCEPTANCE BY	DATE
				VEGETATION BY	DATE
				DRAWINGS BY	DATE
				CORRECTIONS BY	DATE
				MICRO-FILM INFORMATION	DATE
				RECORDED BY	DATE
				NO.	

F:\A02\005\12106\NH\DWG\MEADOWS\PLANSU4\LostSpring-ShadySpring-pp1.dwg Tue May 18 07:36:04 2004 D. MARK GOODWIN & ASSOCIATES. PLOTTED BY: KJS

SCANNED BY
MESA REPRO

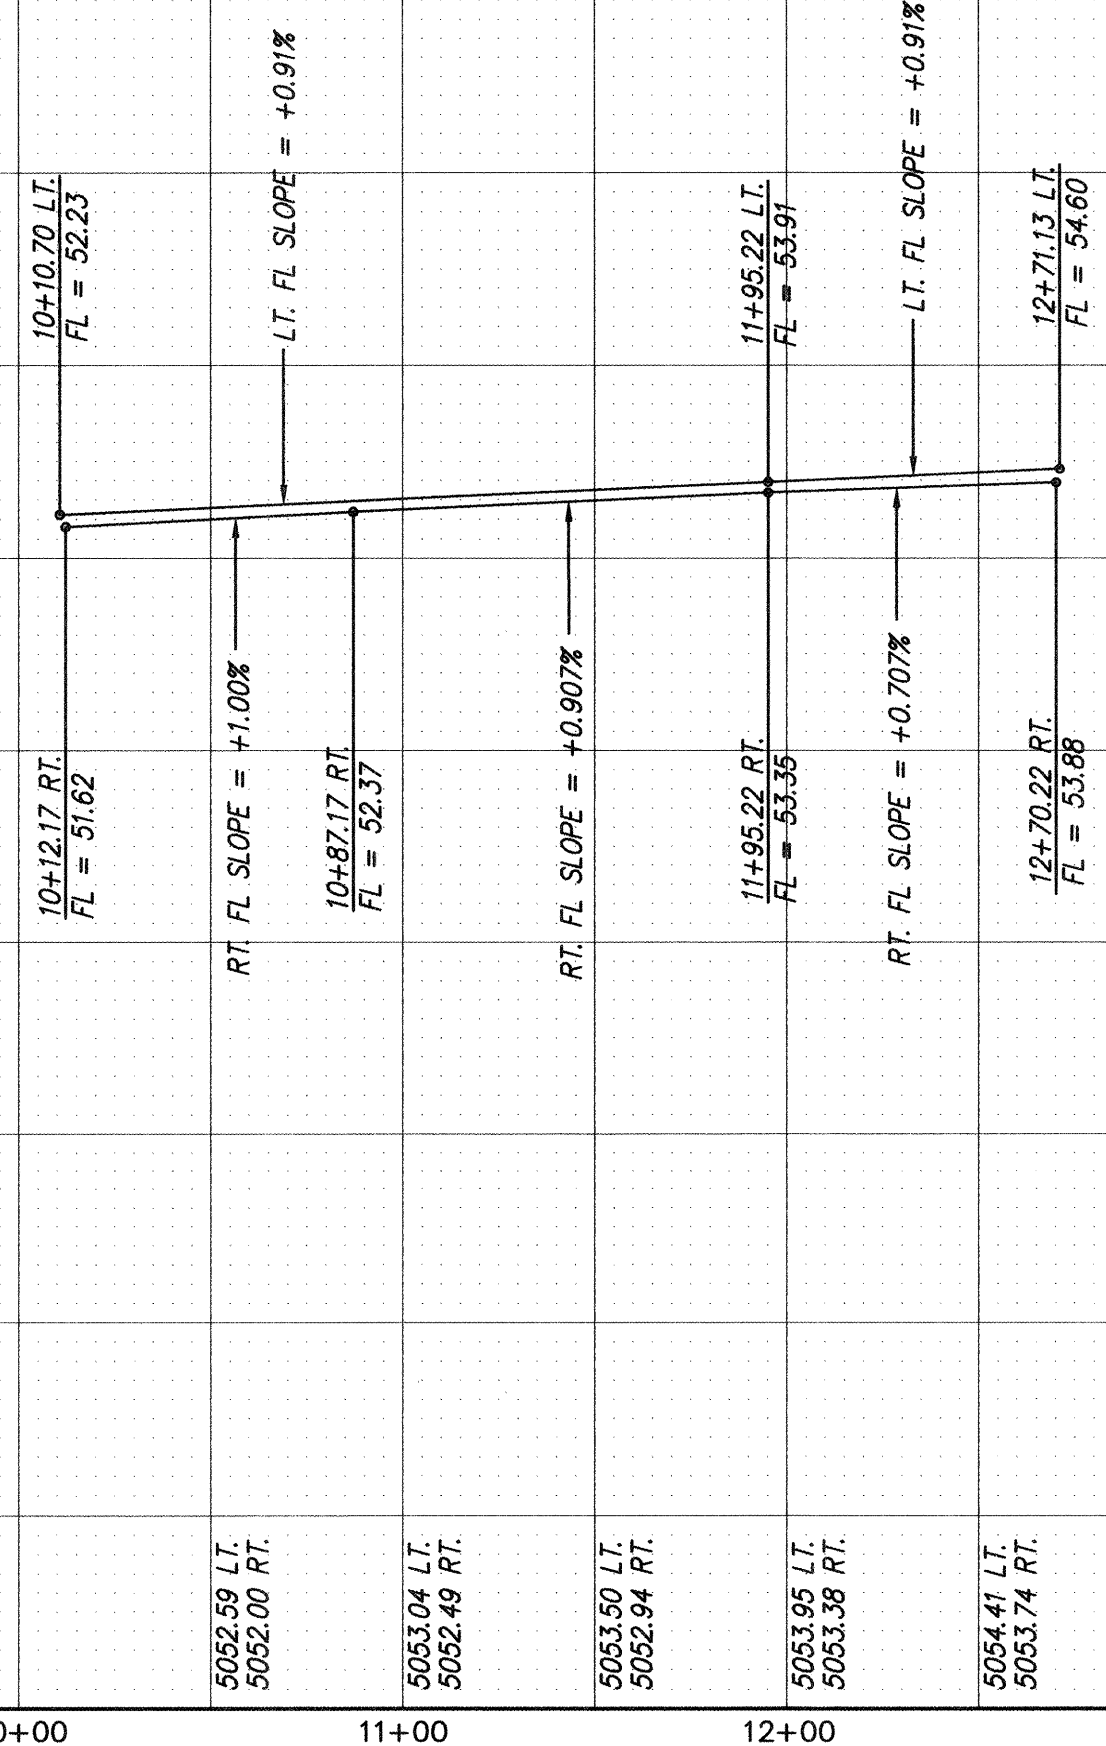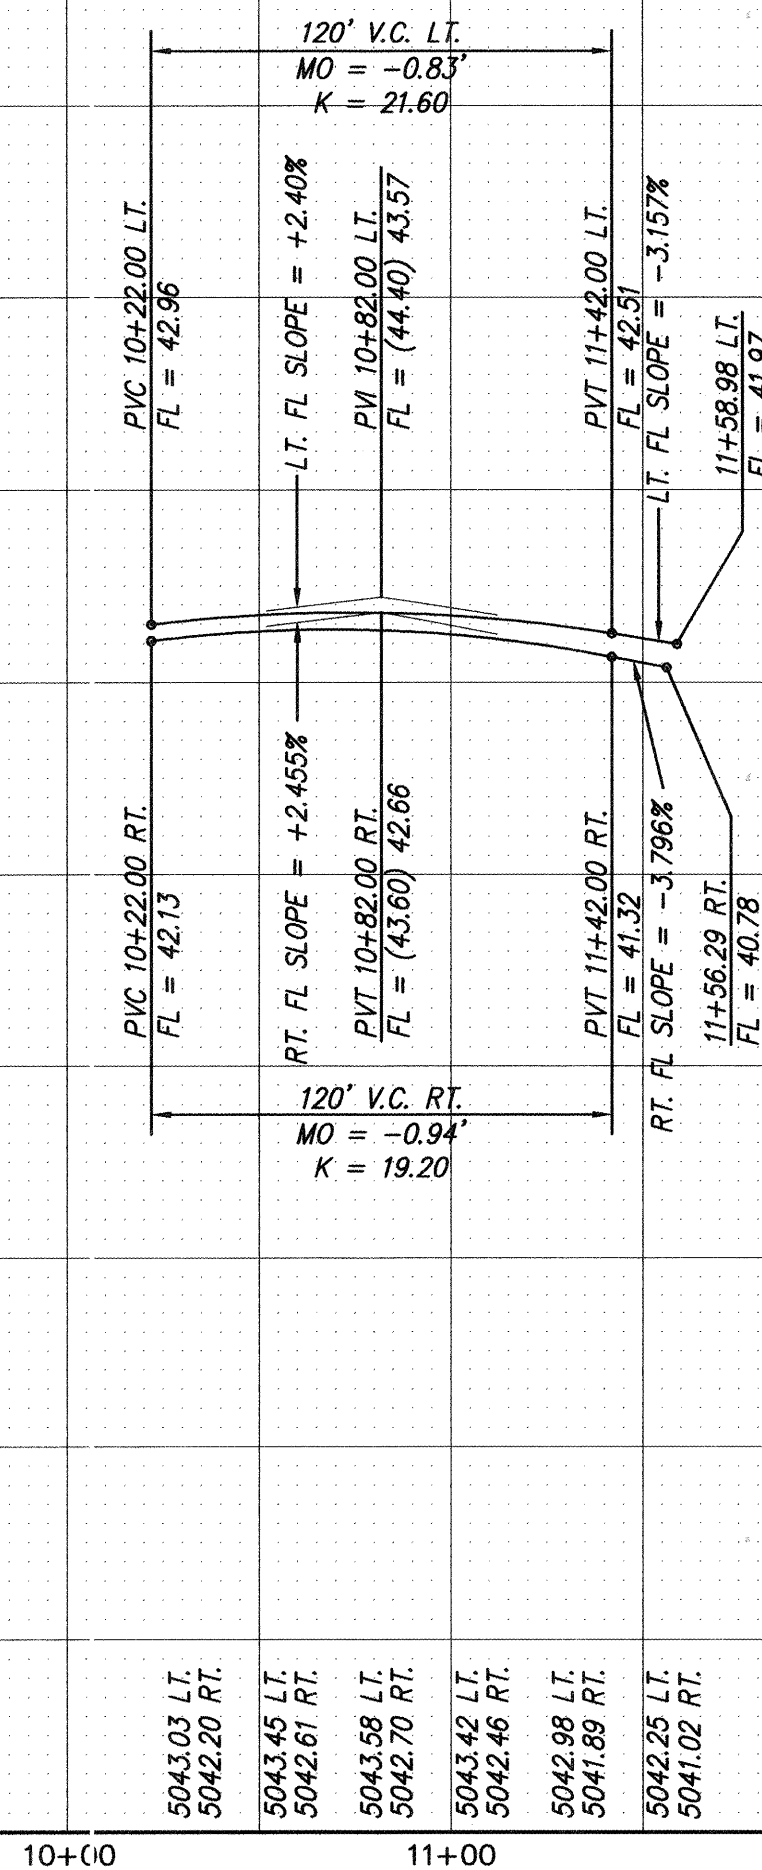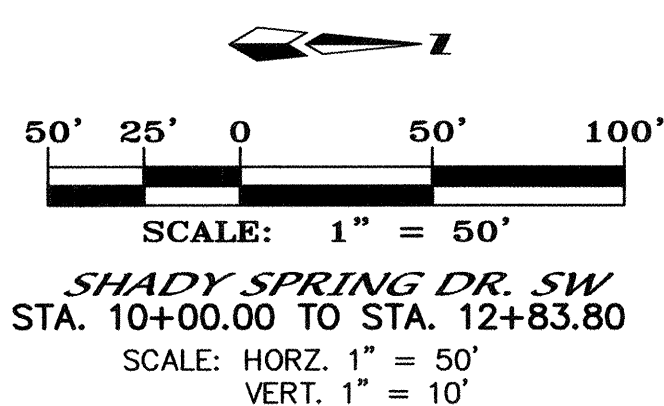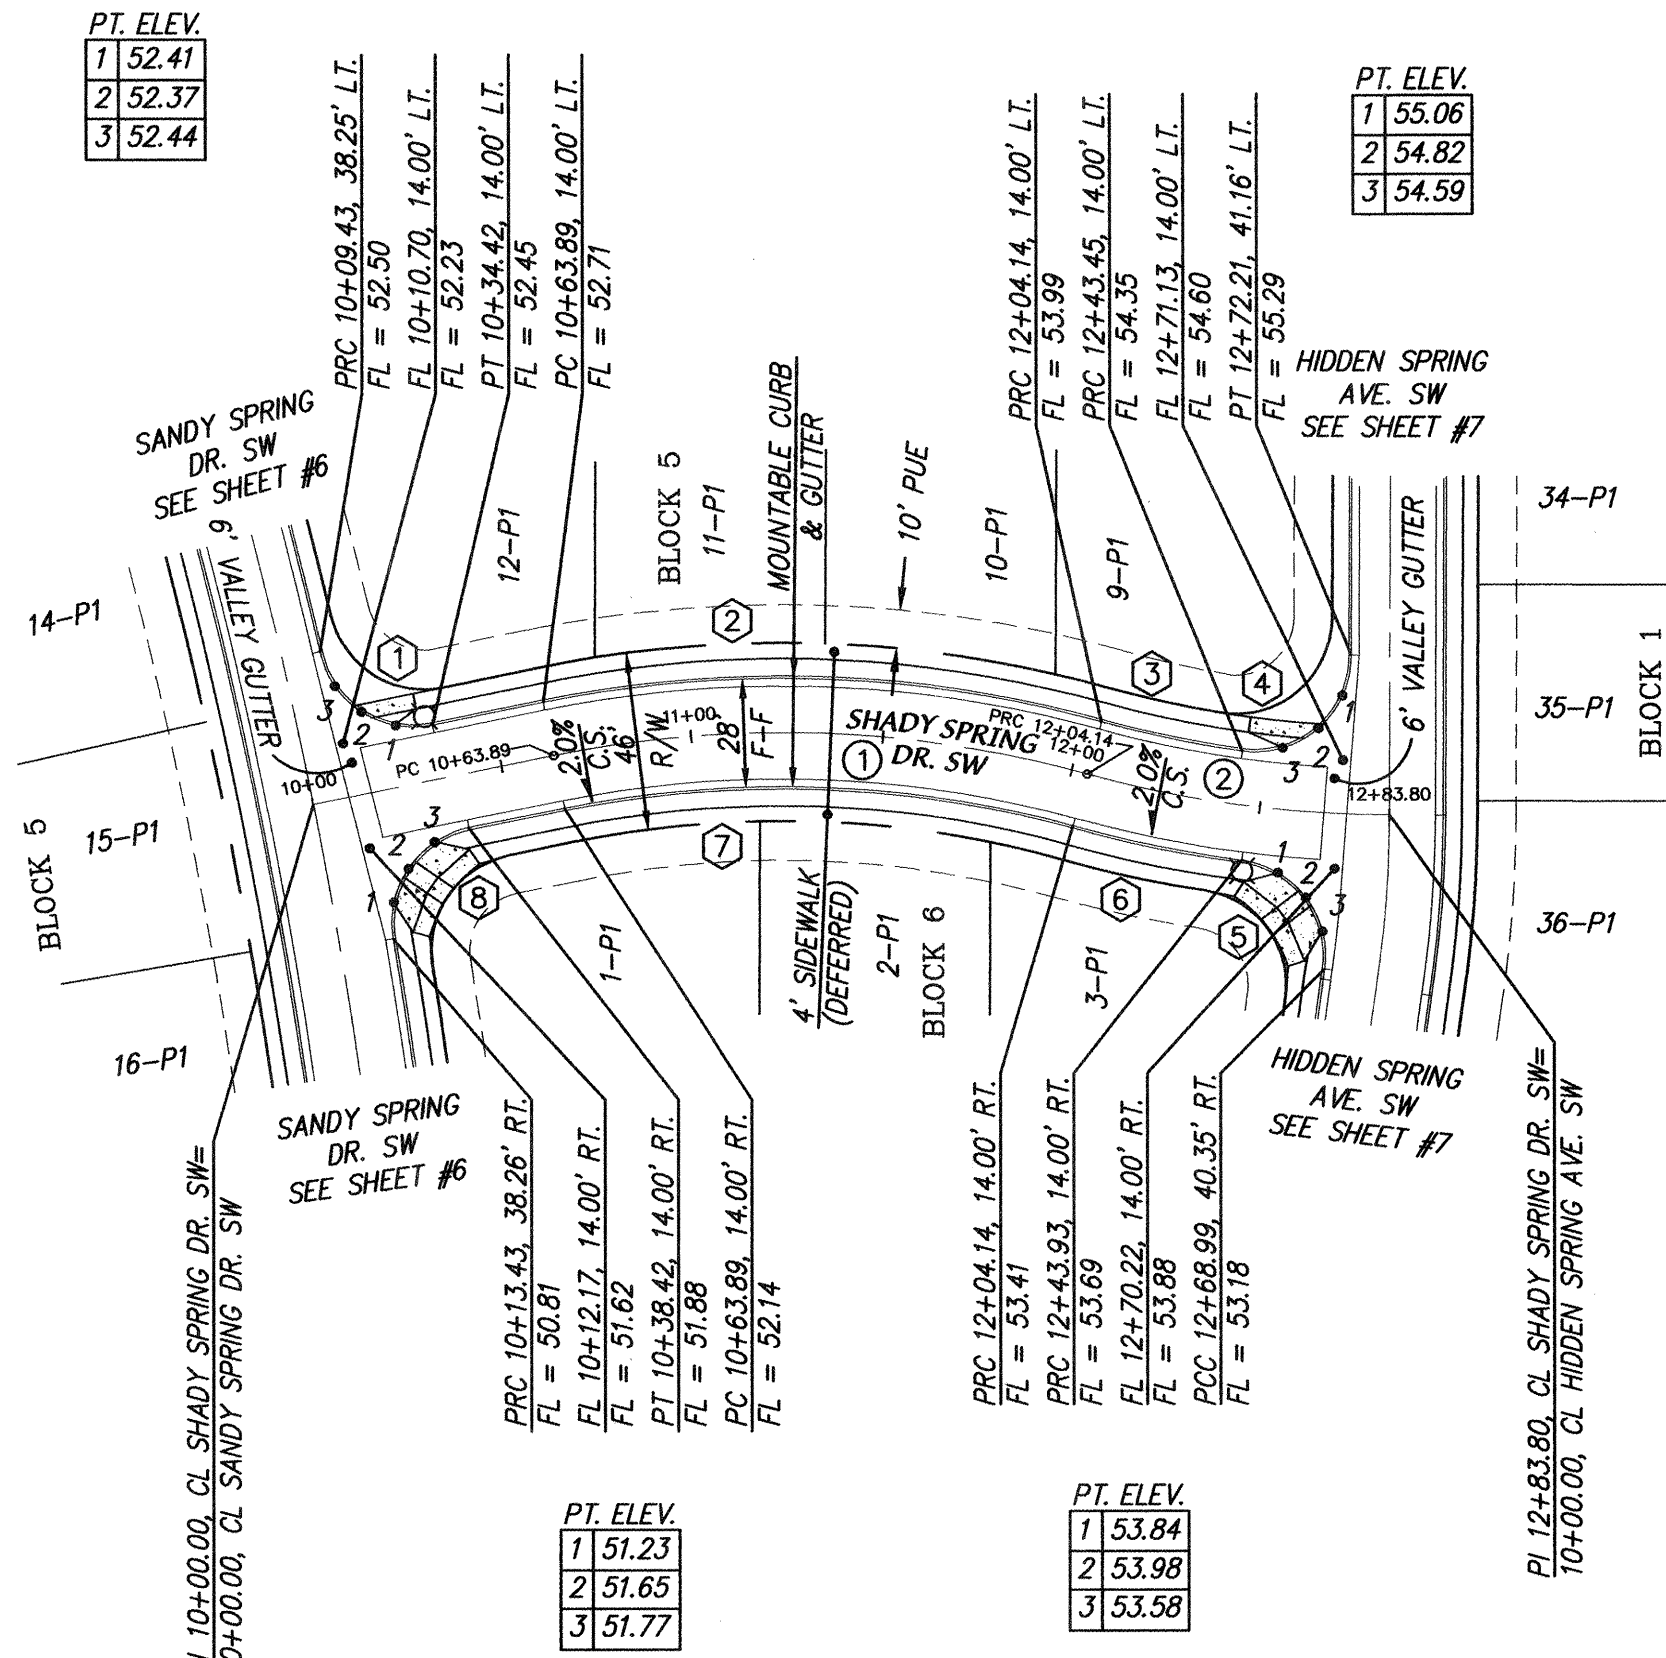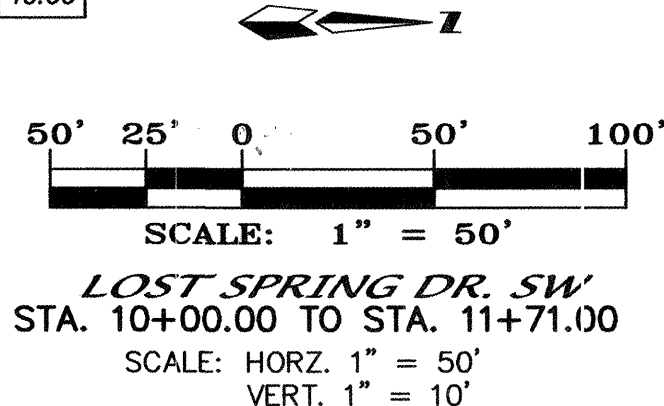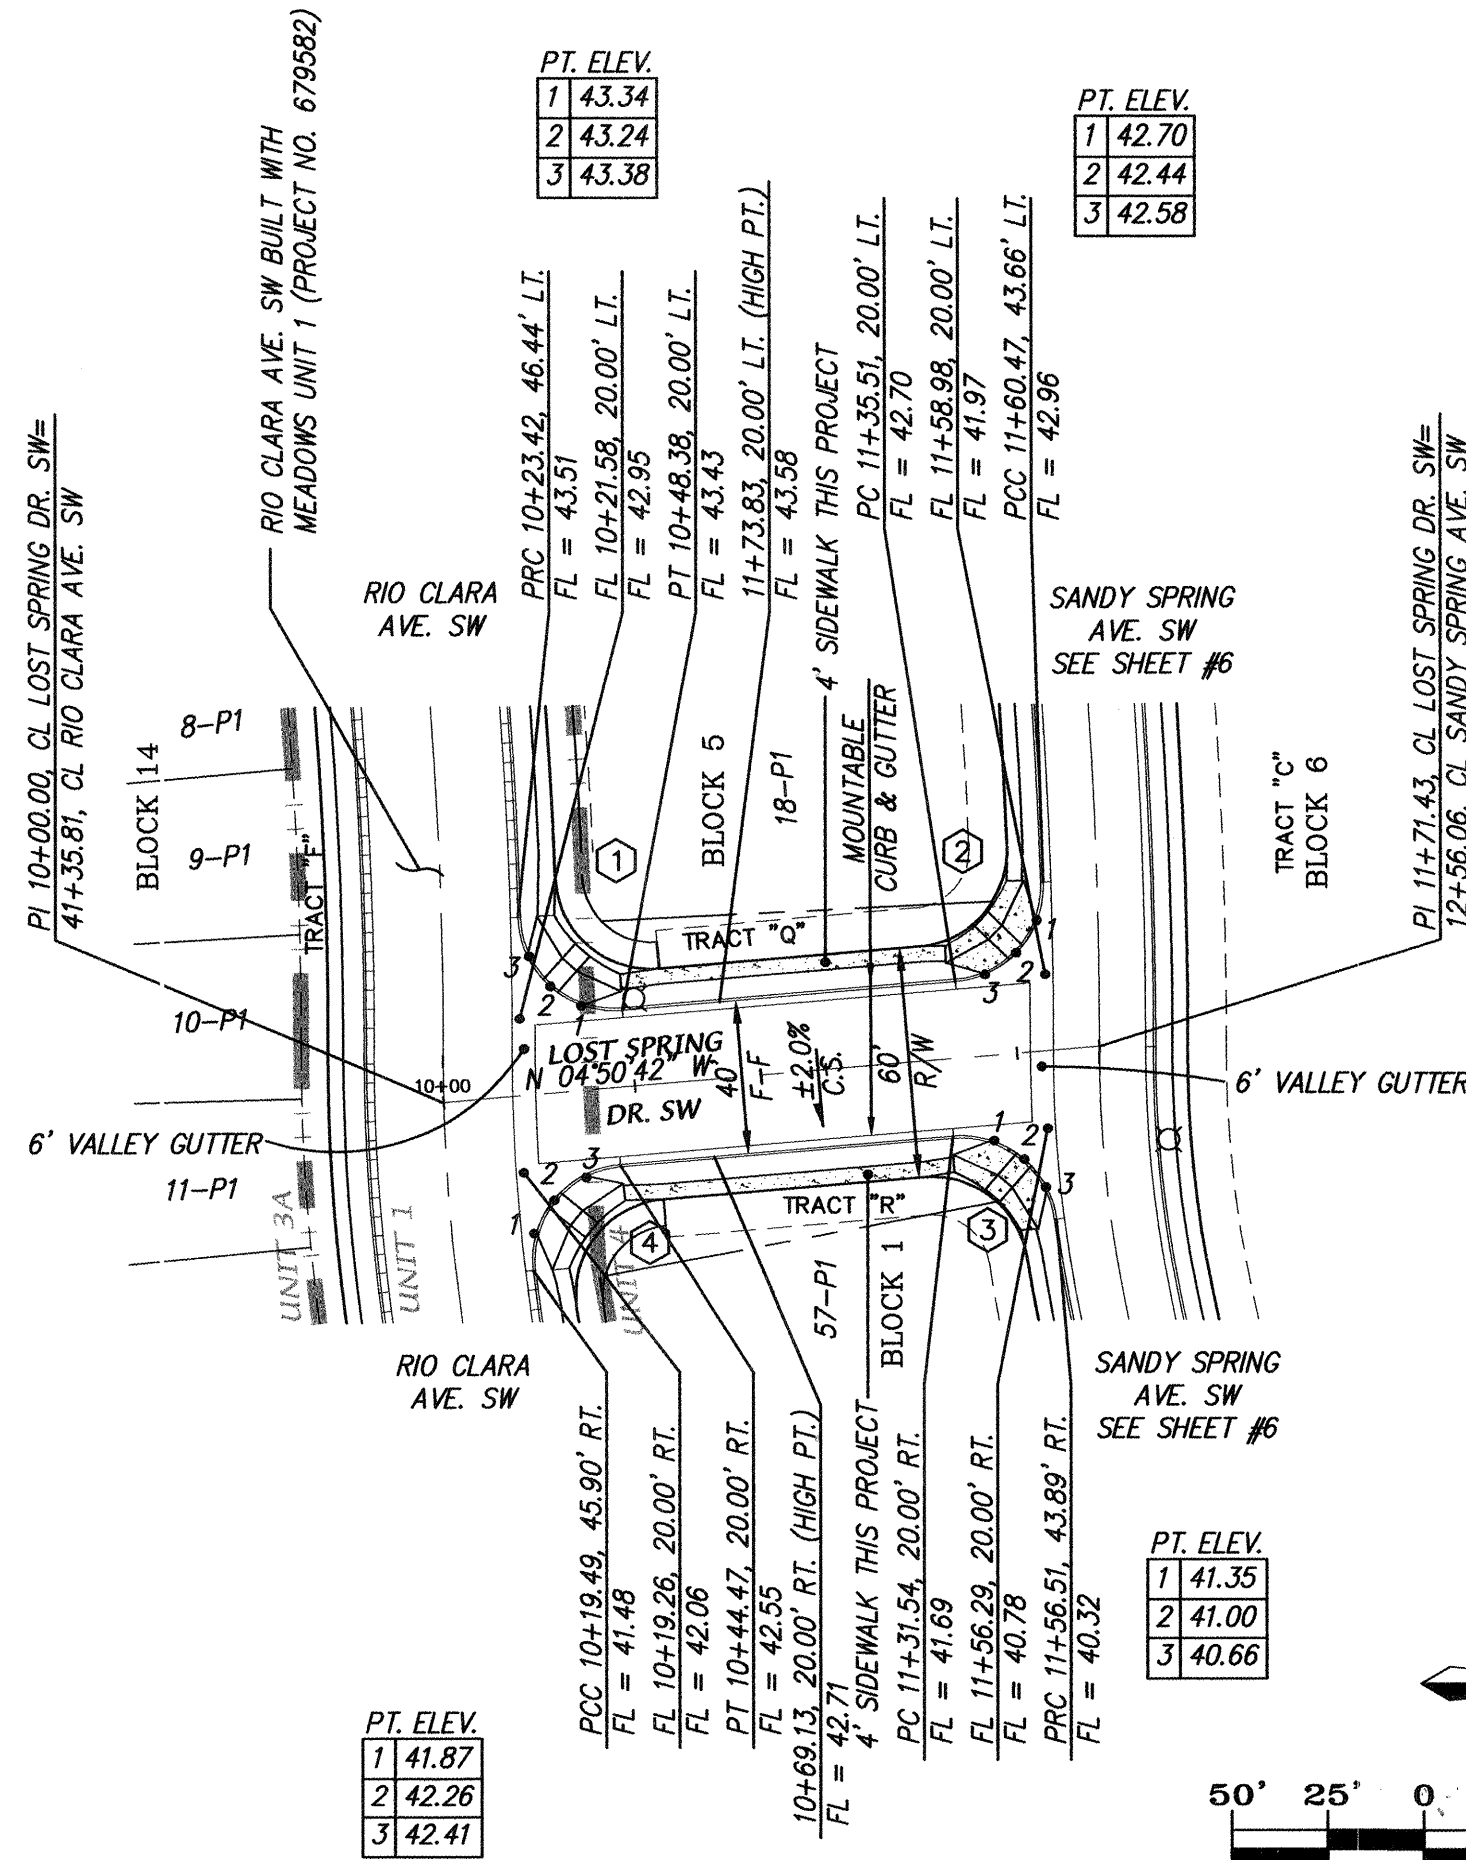

NOTES

1. ALL STATIONING IS CENTERLINE STATIONING.

LOST SPRINGS DRIVE SW

CURVE DATA - DESCRIBES FACE OF NEW CURB

- ① $\Delta = 93^{\circ}17'46''$ $R = 25.00'$ $T = 26.48'$ $L = 40.71'$
② $\Delta = 86^{\circ}56'11''$ $R = 25.00'$ $T = 23.70'$ $L = 37.93'$
③ $\Delta = 87^{\circ}27'26''$ $R = 25.00'$ $T = 23.91'$ $L = 38.16'$
④ $\Delta = 92^{\circ}03'23''$ $R = 25.00'$ $T = 25.91'$ $L = 40.17'$

SHADY SPRING DRIVE SW

CURVE DATA - DESCRIBES CENTERLINE

- ① $\Delta = 26^{\circ}47'08''$ $R = 300.00'$ $T = 71.43'$ $L = 140.25'$
② $\Delta = 15^{\circ}12'54''$ $R = 300.00'$ $T = 40.07'$ $L = 79.67'$

CURVE DATA - DESCRIBES FACE OF NEW CURB

- ① $\Delta = 88^{\circ}17'29''$ $R = 25.00'$ $T = 24.27'$ $L = 38.52'$
② $\Delta = 26^{\circ}47'08''$ $R = 314.00'$ $T = 74.76'$ $L = 146.79'$
③ $\Delta = 7^{\circ}30'31''$ $R = 286.00'$ $T = 18.77'$ $L = 37.48'$
④ $\Delta = 97^{\circ}42'24''$ $R = 25.00'$ $T = 28.61'$ $L = 42.63'$
⑤ $\Delta = 90^{\circ}59'06''$ $R = 25.00'$ $T = 25.43'$ $L = 39.70'$
⑥ $\Delta = 87^{\circ}02'25''$ $R = 314.00'$ $T = 22.44'$ $L = 44.79'$
⑦ $\Delta = 26^{\circ}47'08''$ $R = 286.00'$ $T = 68.10'$ $L = 133.70'$
⑧ $\Delta = 88^{\circ}17'48''$ $R = 25.00'$ $T = 24.27'$ $L = 38.53'$

CERTIFICATE OF SUBSTANTIAL COMPLIANCE ON PLANS

I, Diane Hoelzer, NMPE 11967, of the firm Mark Goodwin & Associates, P.A., a Registered Professional Engineer in the State of New Mexico, do hereby certify, to the best of my knowledge and belief, that the infrastructure installed as part of this project has been inspected by me or by a qualified person under my direct supervision, and has been constructed in accordance with the plans and specifications approved by the City Engineer and that the original design intent of the approved plans has been met, except as noted by me on the as-built construction drawings. This Certification is based on site inspections by me or personnel under my direction, and survey information provided by ALS, Inc., NMPS number 7719.

Diane Hoelzer
Diane Hoelzer
REGISTERED PROFESSIONAL ENGINEER
NEW MEXICO
11967

dmg MARK GOODWIN & ASSOCIATES, P.A.
CONSULTING ENGINEERS
P.O. BOX 90606
ALBUQUERQUE, NEW MEXICO 87199
(505) 828-2200, FAX (505) 797-9539

CITY OF ALBUQUERQUE
PUBLIC WORKS DEPARTMENT

TITLE: MEADOWS AT ANDERSON HILLS - UNIT 4
LOST SPRING DR. SW / SHADY SPRING DR. SW
PAVING IMPROVEMENTS

DESIGN REVIEW COMMITTEE	CITY ENGINEER APPROVAL	LAST DESIGN UPDATE	MO./DAY/YR.	MO./DAY/YR.
APR 17 2004	APR 17 2004			



CITY PROJECT NO. **679586** ZONE MAP NO. **P-9** SHEET **8** OF **12**

**PUBLIC WATERLINE,
SANITARY SEWER &
DRAINAGE EASEMENT**

1. ALL WATERLINE PIPE IS C-900 PVC PIPE AND ALL SAS PIPE IS SDR35 PVC PIPE UNLESS NOTED OTHERWISE.

	NEW MOUNTABLE CURB AND GUTTER
	FUTURE MOUNTABLE CURB AND GUTTER
	NEW STANDARD CURB AND GUTTER
	FUTURE STANDARD CURB AND GUTTER
	LOT LINE
	RIGHT-OF-WAY LINE
	CENTERLINE
	DRIVEWAY
	STORM DRAIN INLET THIS PROJECT
	EXISTING STORM DRAIN INLET
	PROPOSED STORM DRAIN
	PROPOSED STORM DRAIN MANHOLE
	PROPOSED SANITARY SEWER LINE
	PROPOSED SANITARY SEWER MANHOLE
	PROPOSED WATERLINE
	PROPOSED WATERLINE CROSS
	PROPOSED WATERLINE TEE
	PROPOSED WATERLINE REDUCER
	PROPOSED WATERLINE CAP
	PROPOSED FIRE HYDRANT
	PROPOSED GATE VALVE
	PROPOSED ADDRESS
	PROPOSED STREETLIGHT LOCATION

I, Diane Hoelzer, NMPS 11967, of the firm Mark Goodwin & Associates, PA, a Registered Professional Engineer in the State of New Mexico, do hereby certify, to the best of my knowledge and belief, that the infrastructure installed as part of this project has been inspected by me or by a qualified person under my direct supervision, and has been constructed in accordance with the plans and specifications approved by the City Engineer and that the original design intent of the approved plans has been met, except as noted by me on the as-built drawings. This certification is based on the direct observations by me or personnel under my direct supervision and survey information provided by ALS, Inc., NMPS number 779.
Diane Hoelzer 8-25-05
Diane Hoelzer NMPS 11967

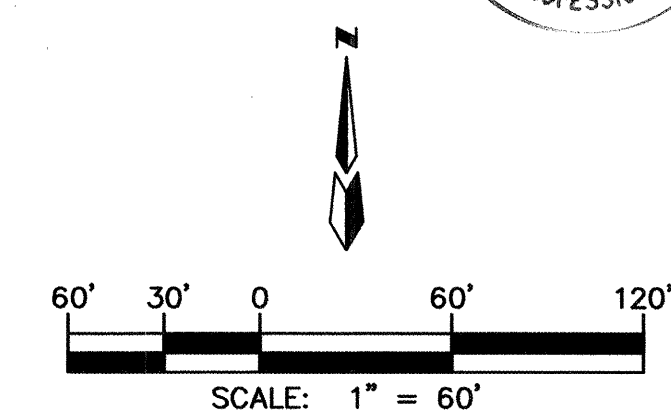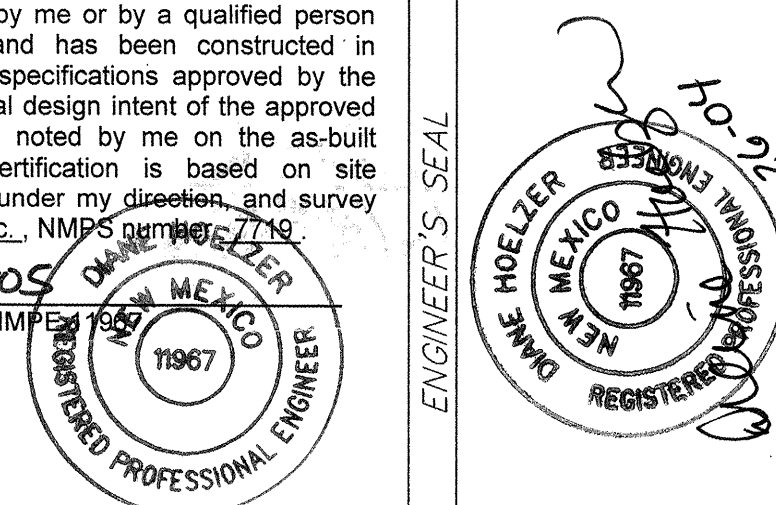

dmg MARK GOODWIN & ASSOCIATES, P.A.
CONSULTING ENGINEERS
P.O. BOX 90606
ALBUQUERQUE, NEW MEXICO 87199
(505) 828-2200, FAX (505) 797-9531




 CITY OF ALBUQUERQUE
PUBLIC WORKS DEPARTMENT

TITLE: **MEADOWS AT ANDERSON HILLS - UNIT 4
MASTER UTILITY PLAN**

DESIGN REVIEW COMMITTEE	CITY ENGINEER APPROVAL	DATE	MO./DAY/YR.	MO./DAY/YR.
-------------------------	------------------------	------	-------------	-------------

CITY PROJECT NO.	ZONE MAP NO.	SHEET OF
679586	P-9	9R

SCANNED BY
MESA REPRO

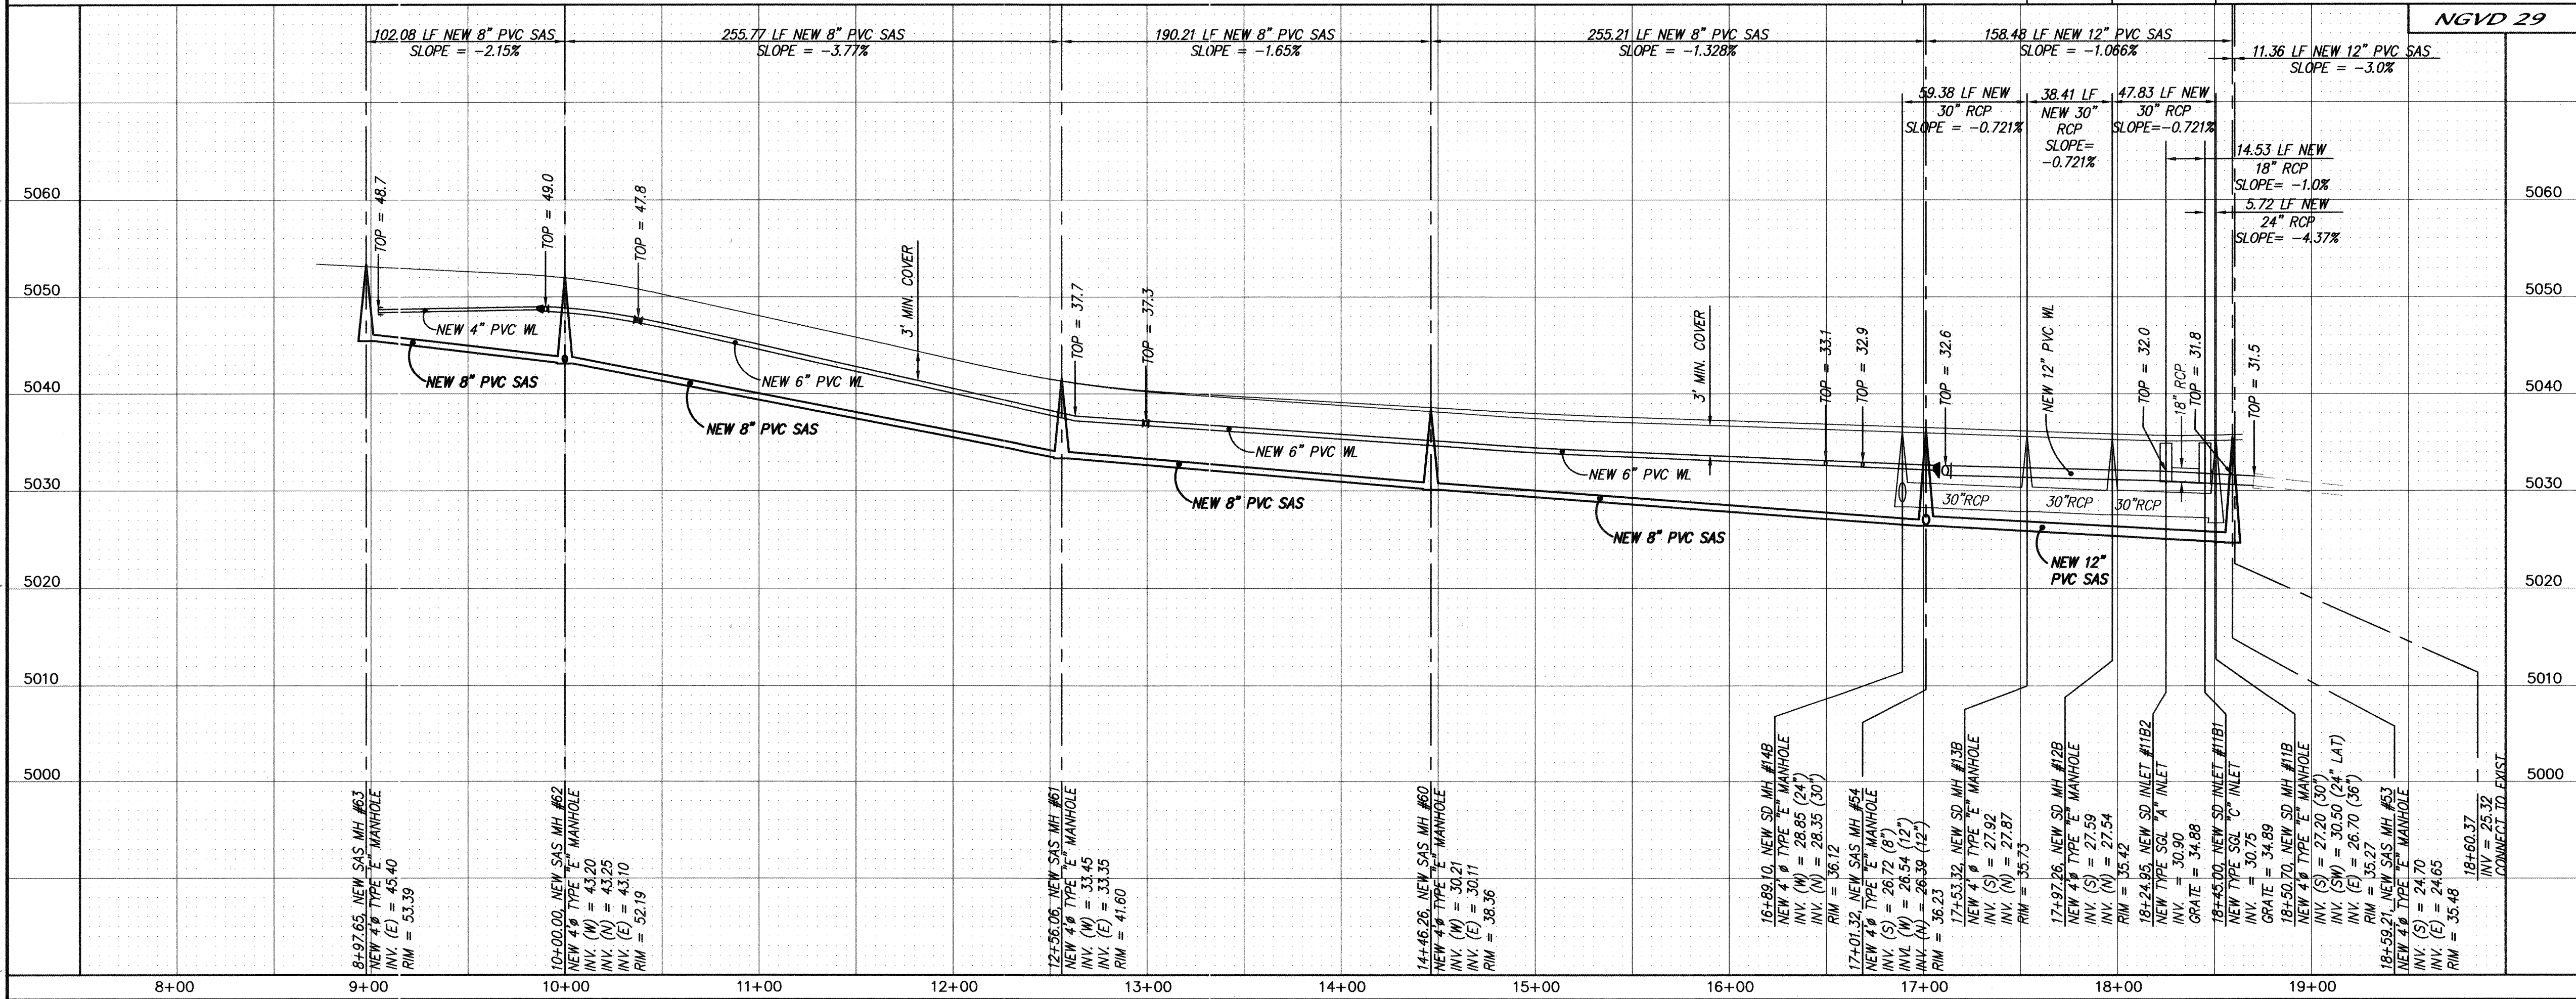

NOTES

1. ALL STATIONING IS CENTERLINE STATIONING.
2. ALL WATERLINE PIPE IS C-900 PVC PIPE AND ALL SAS PIPE IS SDR35 PVC PIPE UNLESS NOTED OTHERWISE.

SANITARY SEWER SERVICES

BLOCK	LOT	STATION AT PUE	INV. ELEV. AT PUE	LENGTH AT PUE
1	47-P1	18+36.31	5030.11	32.00'
1	48-P1	17+94.46	5030.28	32.00'
1	49-P1	17+49.43	5030.59	32.00'
1	50-P1	16+94.73	5030.97	32.16'
1	51-P1	16+44.89	5031.32	32.32'
1	52-P1	15+91.96	5031.70	32.50'
1	53-P1	15+39.03	5032.07	32.68'
1	54-P1	14+86.10	5032.59	32.87'
1	55-P1	14+34.04	5033.31	33.00'
1	56-P1	13+86.46	5033.97	33.00'
1	57-P1	13+34.89	5034.69	33.00'
5	13-P1	9+01.26	5048.10	28.97'
5	14-P1	9+62.78	5047.49	29.65'
5	15-P1	10+24.70	5046.23	30.35'
5	16-P1	10+86.42	5043.53	31.05'
5	17-P1	11+48.14	5040.75	31.75'
5	18-P1	12+01.96	5038.42	32.39'

CERTIFICATE OF SUBSTANTIAL COMPLIANCE ON PLANS

I, Diane Hoelzer, NMPE 11967, of the firm Mark Goodwin & Associates, P.A., a Registered Professional Engineer in the State of New Mexico, do hereby certify, to the best of my knowledge and belief, that the infrastructure installed as part of this project has been inspected by me or by a qualified person under my direct supervision, and has been constructed in accordance with the plans and specifications approved by the City Engineer and that the original design intent of the approved plans has been met, except as noted by me on the as-built construction drawings. This Certification is based on site inspections by me or personnel under my direction, and survey information provided by ALS, Inc., NMPS number 7719.

SEE REVISED SHEET 10R



RESTRAINED JOINT LENGTH FOR BENDS, VALVES, DEAD ENDS (FT.)				
PIPE SIZE	90°	45°	22.5°	11.25° VALVE
4"	12'	5'	2'	32'
6"	17'	7'	3'	46'
12"	30'	12'	6'	85'

LENGTH OF RESTRAINED PIPE ON EACH SIDE OF THE BEND. RESTRAIN BRANCH AT FITTING ONLY MINIMUM ATTACHED PIPE LENGTH, RUN SIDE OF TEE: 10.00 FEET.

RESTRAINED JOINT LENGTH FOR TEES (FT.)		
PIPE SIZE	RUN	BRANCH
12"x12"x6"	5'	1'
6"x6"x4"	4'	7'



MARK GOODWIN & ASSOCIATES, P.A.
CONSULTING ENGINEERS
P.O. BOX 90606
ALBUQUERQUE, NEW MEXICO 87199
(505) 828-2200, FAX (505) 797-9539




CITY OF ALBUQUERQUE
PUBLIC WORKS DEPARTMENT

TITLE: MEADOWS AT ANDERSON HILLS - UNIT 4
SANDY SPRING DR. SW
UTILITY IMPROVEMENTS

DESIGN REVIEW COMMITTEE	CITY ENGINEER APPROVAL	MO./DAY/YR.	MO./DAY/YR.
REVIEW COMMITTEE	CITY ENGINEER		

CITY PROJECT NO. 679586 ZONE MAP NO. P-9 SHEET 10 OF 12

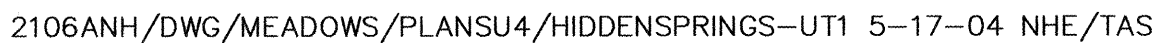

1. ALL STATIONING IS CENTERLINE STATIONING.
2. ALL WATERLINE PIPE IS C-900 PVC PIPE AND ALL SANITARY PIPE IS SDR35 PVC PIPE UNLESS NOTED OTHERWISE.

CERTIFICATE OF SUBSTANTIAL COMPLIANCE ON PLANS

I, Diana Hochstetzer, NMPDE 118927, of the firm Mark Goodrich & Associates, P.A., a Registered Professional Engineer in the State of New Mexico, do hereby certify, to the best of my knowledge and belief, that the infrastructure proposed in the above-captioned project has been inspected by me or by a qualified person under my direct supervision, and has been constructed in accordance with the plans and specifications approved by the City Engineer and that the original design intent of the approved plans has been met, except as noted by me on the above-captioned construction drawings. This Certification is based on site inspections by me or personnel under my direct supervision.

 MARK GOODWIN & ASSOCIATES, P.A.
CONSULTING ENGINEERS
P.O. BOX 90606
ALBUQUERQUE, NEW MEXICO 87199
(505) 828-2200, FAX (505) 797-9539

TITLE: **MEADOW AT ANDERSON HILLS - UNIT 4**
HIDDEN SPRINGS AVE. SW
UTILITY IMPROVEMENTS

CITY PROJECT NO. 679586	ZONE MAP NO. P-9	SHEET OF 11 12
-----------------------------------	----------------------------	--------------------------

ALL
VE.
EN

S. S. S. S.


$$\frac{W}{5}$$

IN

IT

4

[illegible]

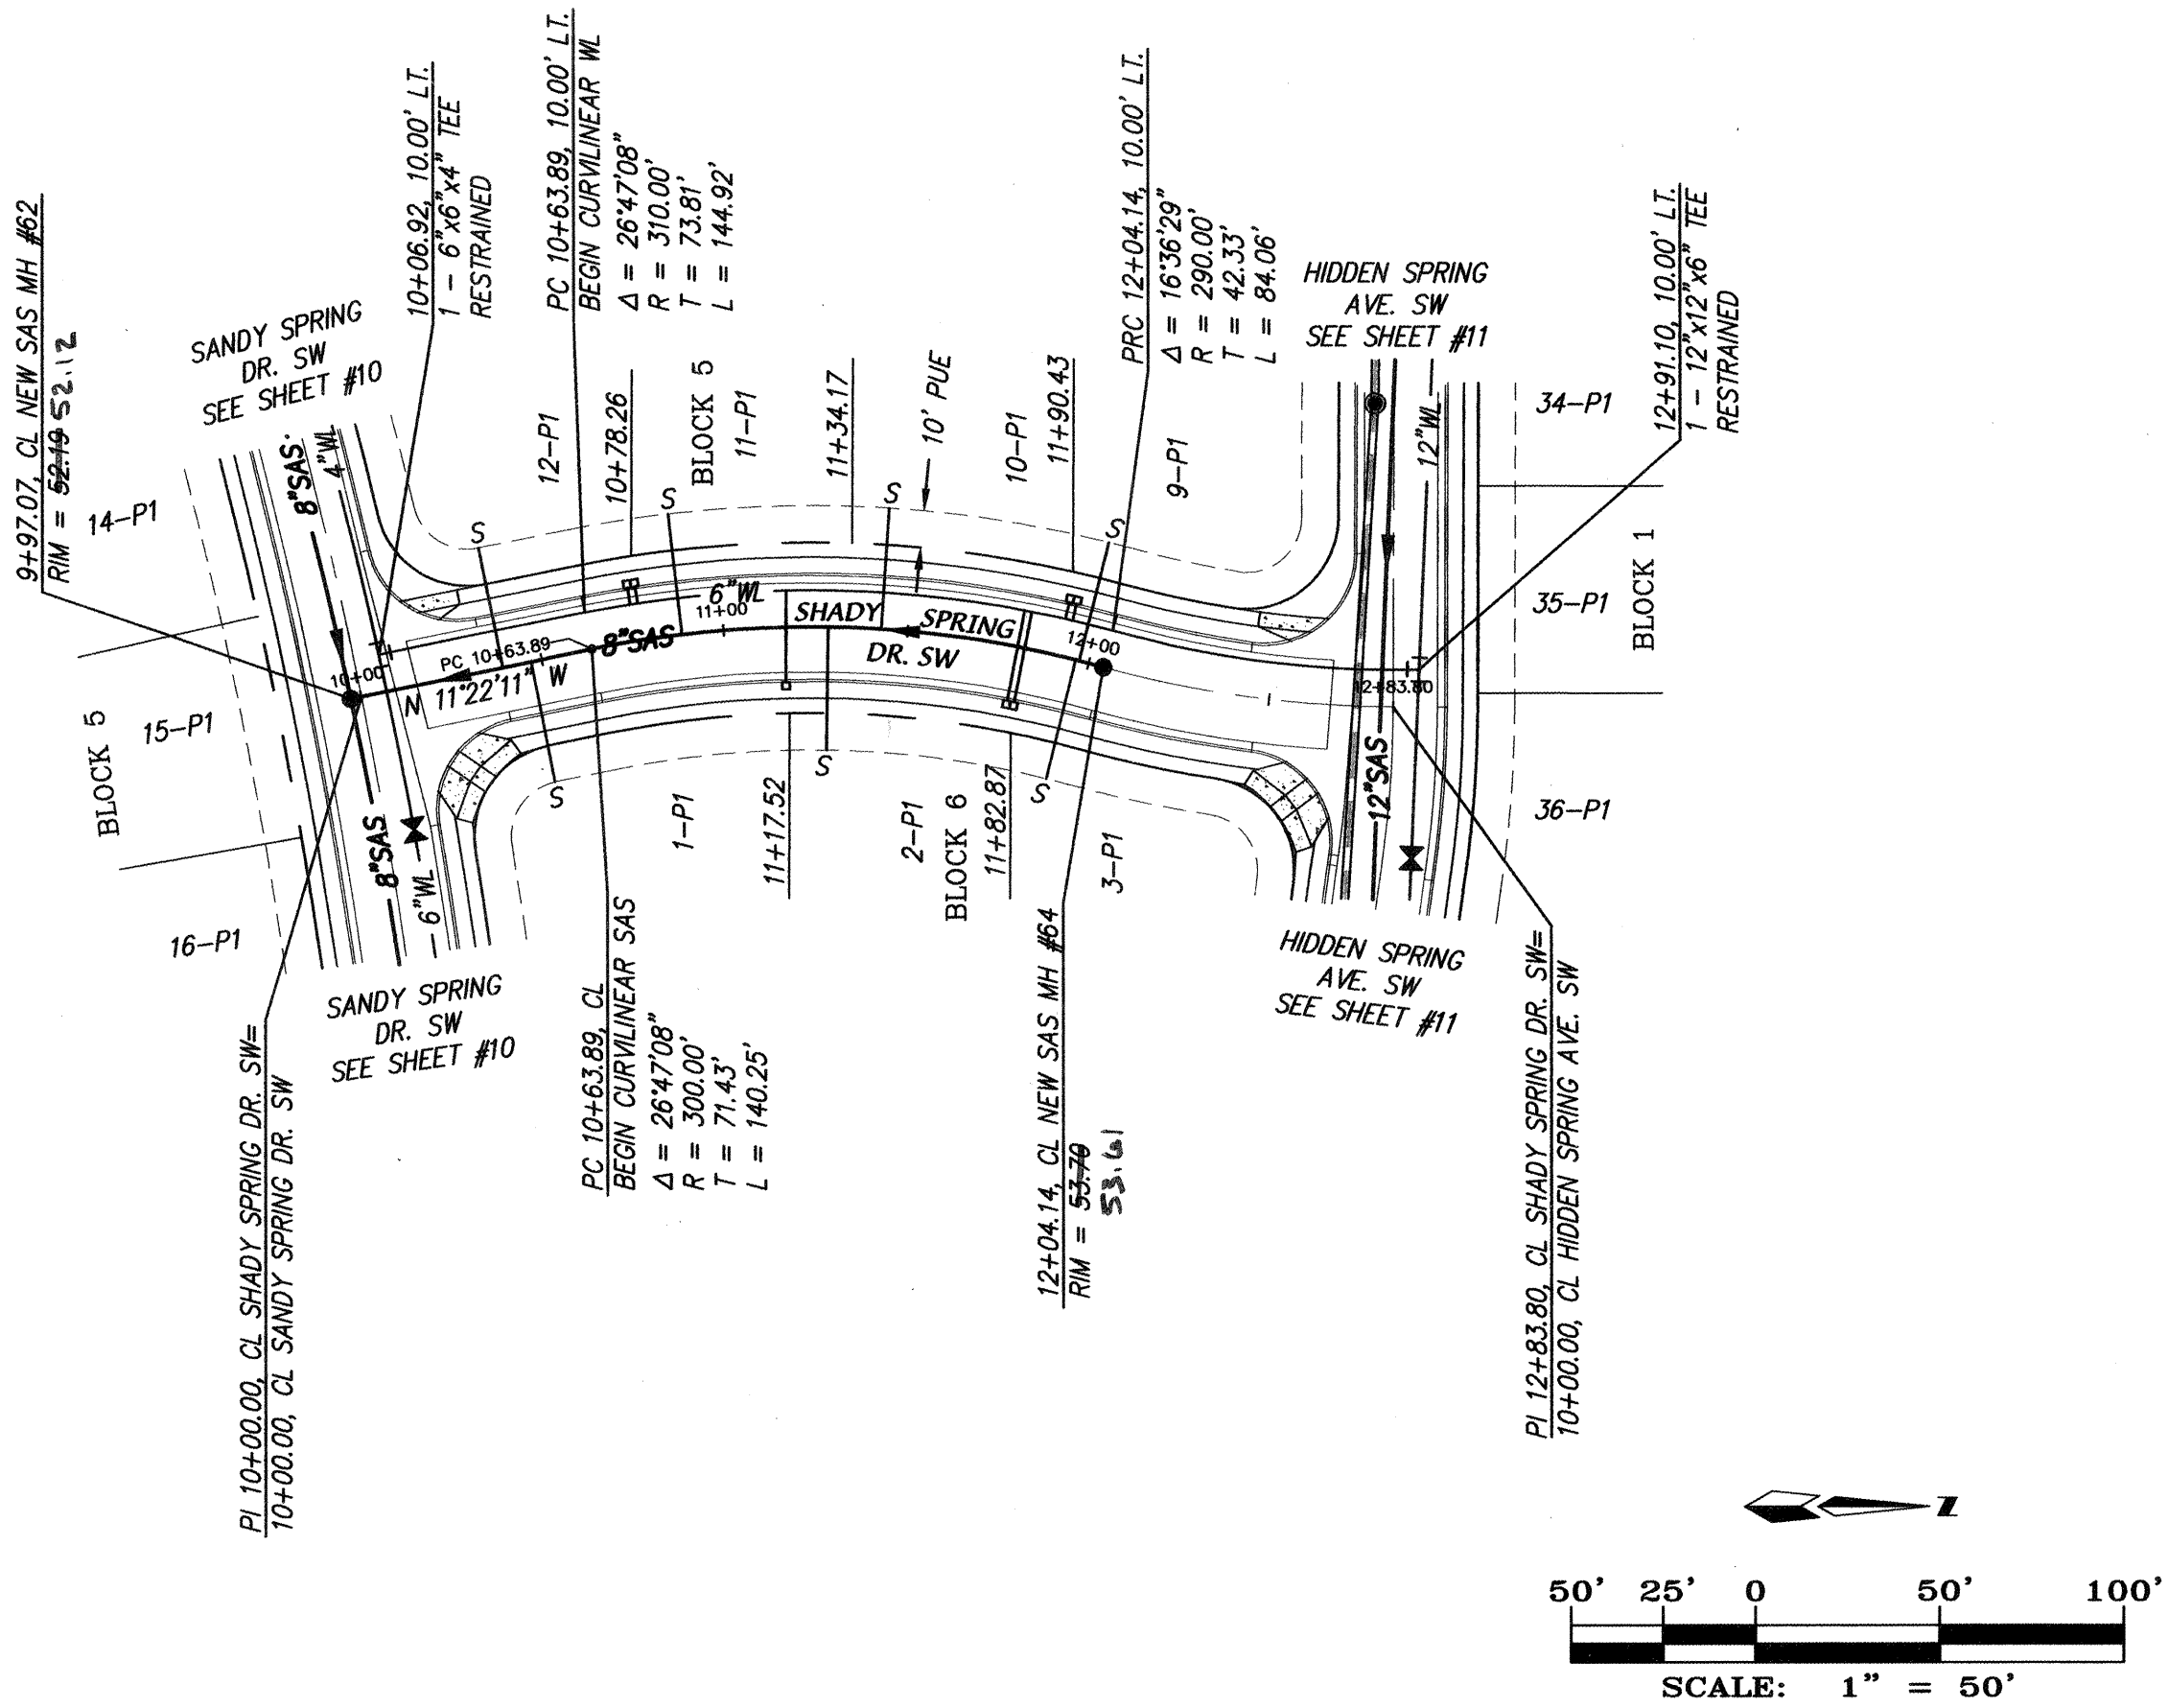

I, Diane Hostler, NMPE #11987, of the firm, Mark Goodwin & Associates, PA, a Registered Professional Engineer in the State of New Mexico, do hereby certify, to the best of my knowledge and belief, that the infrastructure installed on the as-built and specified by me or by a qualified person under my direct supervision, and has been constructed in accordance with the plans and specifications of the as-built and specified by me or by a qualified person under my direct supervision, and was designed in the design intent of the approved plans has been met, except as noted by me on the as-built construction drawings. This Certification is given in accordance with the provisions of the application, and survey information provided by A.L.S. Inc., NMPS number, 7719.

Diane Hostler 2-25-05
Diane Hostler NMPE 11987


Mark Goodwin 2-25-05
Mark Goodwin NMPE 11987

 MARK GOODWIN & ASSOCIATES, P.A.
CONSULTING ENGINEERS
P.O. BOX 90606
ALBUQUERQUE, NEW MEXICO 87199
(505) 828-2200, FAX (505) 797-9539

DESIGN REVIEW COMMITTEE	CITY ENGINEER APPROVAL	LAST DESIGN UPDATE
		

[illegible]

ALBUQUERQUE, NEW MEXICO

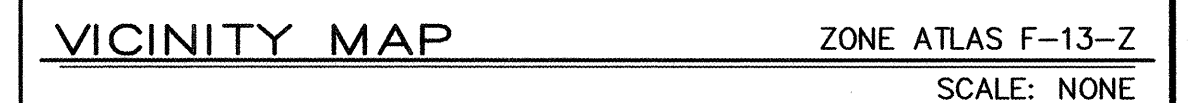

NOTICE TO CONTRACTORS

NOTICE TO CONTRACTORS

- ☒ ALL UTILITIES AND UTILITY SERVICE LINES SHALL BE INSTALLED PRIOR TO PAVING.
- ☒ BACKFILL COMPACTION SHALL BE ACCORDING TO SPECIFIED STREET USE.
- ☐ TACK COAT REQUIREMENTS SHALL BE DETERMINED BY THE ENGINEER.
- ☒ SIDEWALK AND WHEELCHAIR RAMPS WITHIN THE CURB RETURNS SHALL BE CONSTRUCTED WHEREVER A NEW CURB RETURN IS CONSTRUCTED.
- ☒ IF CURB IS DERESSED FOR A DRIVEPAD, THE DRIVEPAD SHALL BE CONSTRUCTED PRIOR TO ACCEPTANCE OF CURB AND GUTTER.
- ☒ ALL STORM DRAINAGE FACILITIES SHALL BE COMPLETED PRIOR TO FINAL ACCEPTANCE.

dmg D. MARK GOODWIN & ASSOCIATES, P.A.
CONSULTING ENGINEERS
P. O. BOX 90606
ALBUQUERQUE, NEW MEXICO 87199
(505) 828-2200, FAX (505) 797-9533

JOB \ TITLE \ DATE

APPROVED AS RECORD DRAWINGS
DESIGN REVIEW SECTION
CITY CONSTRUCTION ENGINEER
B. Wolfe
DATE: 11/16/05
Bryan Wolfe, P.E.


Timothy Aldrich

Mark Goodwin NMPE 8948




DRB NO. **1002565**

PLAT FOR
VILLA DE LA CAPILLA
WITHIN THE
ELENA GALLEGOS GRANT
AND
TOWN OF ALBUQUERQUE GRANT
PROJECTED SECTION 31
TOWNSHIP 11 NORTH, RANGE 3 EAST, N.M.P.M.
CITY OF ALBUQUERQUE
BERNALILLO COUNTY, NEW MEXICO
SEPTEMBER, 2003

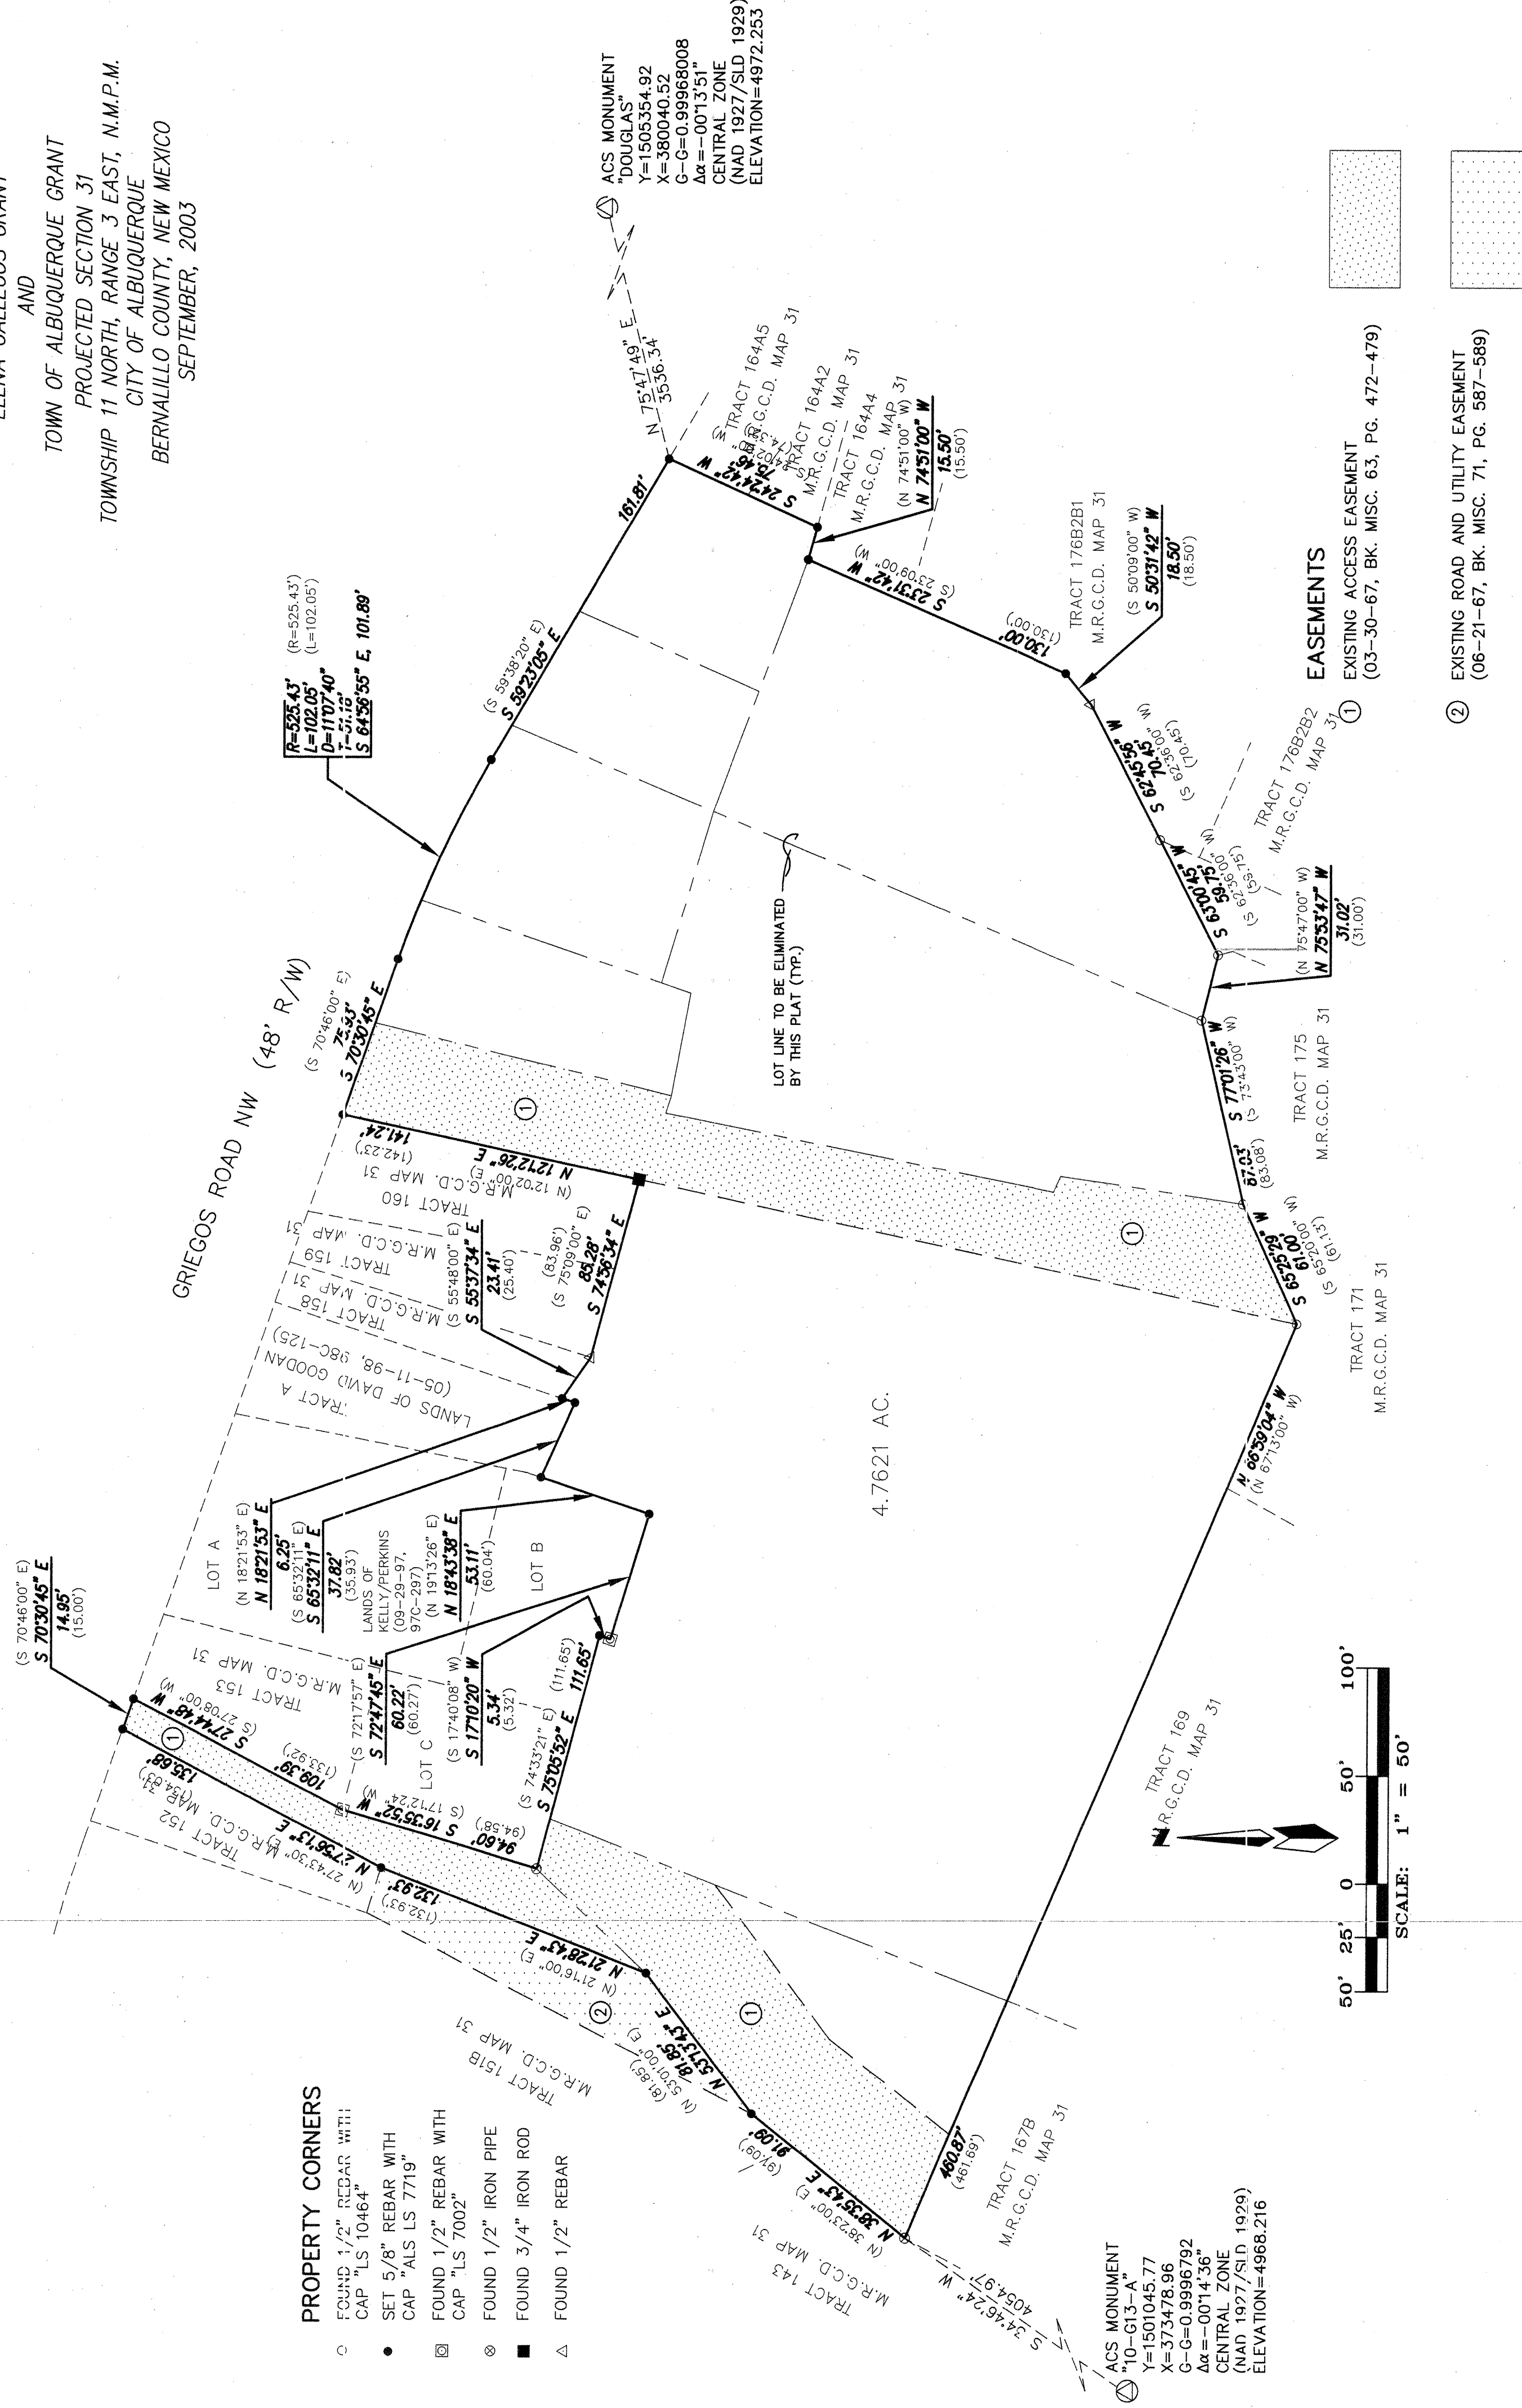

Dwg:	SHEET 2.dwg	Drawn:	STEPHEN	Checked:	ALS	Sheet	2	of	4
Scale:	AS SHOWN	Date:	01/26/04	Job:	A03027				

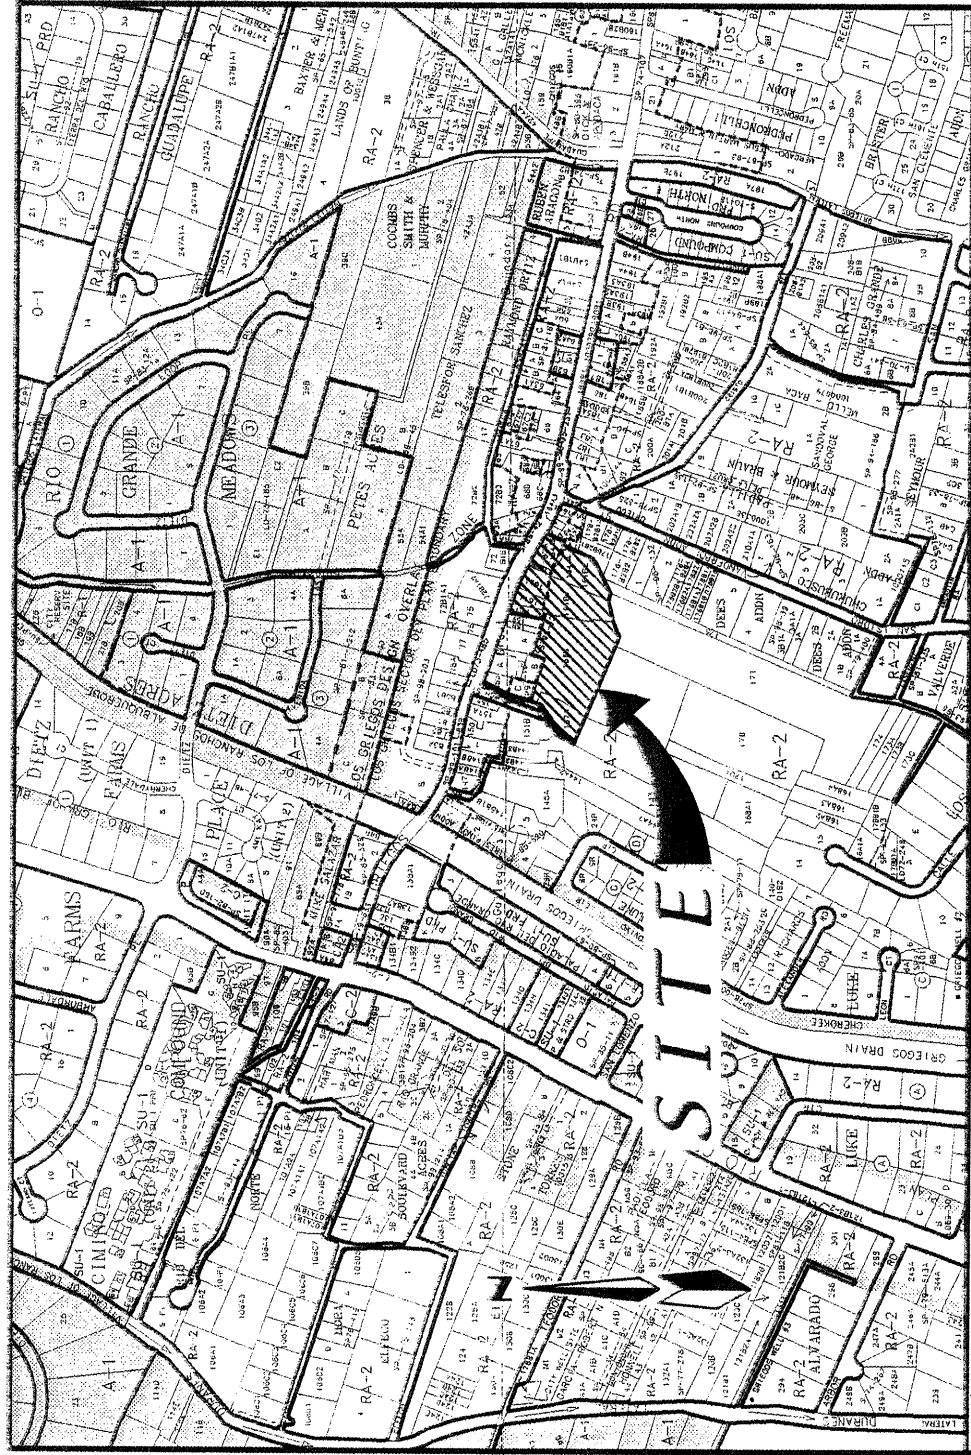

LOCATION MAP
ZONE ATLAS F-13-Z
SCALE: NONE

SUBDIVISION DATA

Gross acreage..... 4.7621 AC
Zone Atlas No..... F-13-Z
No. of existing Parcels..... 9
No. of Tracts/Lots created..... 3
No. of Tracts/Lots eliminated..... 9
Miles of full width streets created..... 0.20
Area dedicated to the City of Albuquerque..... 0.0022 AC
Date of Survey..... June, 2003
Utility Control Location System Log Number..... 2003272498
Zoning..... SU1 FOR PRD

FREE CONSENT AND DEDICATION:

The subdivision hereon described is with the free consent and in accordance with the desires of the undersigned owner(s) and/or proprietor(s) thereof and said owner(s) and/or proprietor(s) do hereby dedicate additional street, public right-of-ways shown hereon to the City of Albuquerque in fee simple with warranty covenants and do hereby grant: all access, utility and drainage easements shown hereon including the right to construct, operate, inspect, and maintain facilities therein, and all public utility easements shown hereon for the common and joint use of gas, electrical power and communication services for buried distribution lines, conduits, and pipes for underground utilities where shown or indicated, and including the right of ingress and egress for construction and maintenance, and the right to trim interfering trees and shrubs. Said owner(s) and/or proprietor(s) do hereby consent to all of the foregoing and do hereby certify that this subdivision is their free act and deed. Said owner(s) warrant that they hold among them complete and indefeasible title to the land subdivided.

OWNER: LOS GREGOS DEVELOPMENT LLC.


By: Ronald D. Brown, Managing member

Ronald D. Brown, Managing member

OWNER'S ACKNOWLEDGMENT

STATE OF NEW MEXICO
COUNTY OF BERNALILLO

This instrument was acknowledged before me on December 19, 2003
By Ronald D. Brown, Managing member, LOS GREGOS DEVELOPMENT LLC, A New Mexico Limited Liability Company on behalf of said Company

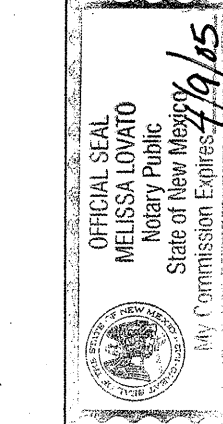

Notary Public
MY COMMISSION EXPIRES 4/19/05

LEGAL DESCRIPTION
(SEE SHEET 4 OF 4 FOR METES AND BOUNDS LEGAL DESCRIPTION)

NOTES

- Bearings are New Mexico State Plane Grid Bearings (Central Zone).
- Distances are ground distances.
- Bearings and distances in parenthesis are record.
- Basis of boundary are the following plats of record entitled:
PLAT OF "LANDS OF KELLY/PERKINS", (09-29-97, 97C-297)
PLAT OF "LANDS OF DAVID GOODAN", (05-11-98, 98C-125)
PLAT OF "GREGOS ROAD RW", (02-25-69, C7-45 & C7-46)
M.R.G.C.D. MAP 31
QUITCLAIM DEED (10-03-83, BK. D195A, PG. 533)
REAL ESTATE CONTRACT (08-23-84, BK. MISC. 148A, PG. 973-976)
WARRANTY DEED (04-11-94, BK. 94-11, PG. 6387-6388)
ROAD EASEMENT (06-21-87, BK. MISC. 71, PG. 587-589)
REAL ESTATE CONTRACT (03-30-67, BK. MISC. 63, PG. 472-479)
all being records of Bernalillo County, New Mexico.
- Field Survey performed on June, 2003.
- UTILITY COUNCIL LOCATION SYSTEM LOG NO.: 2003272498
- Title Report: Provided by Stewart Title of Albuquerque, L.L.C., Commitment No. 021001627C (Effective Date 10-09-02) Stewart Title of Albuquerque, L.L.C., Commitment No. 020704201Y (Effective Date 07-19-02)

PURPOSE OF PLAT

- Subdivide Nine Parcels into 24 residential Lots and 3 Tracts
- Grant easements shown hereon
- Dedicate Right-of-way shown hereon

OWNERS:

By: Danny N. Martinez and Mariorene S. Martinez (Husband and Wife)

Danny N. Martinez (Husband)

Mariorene S. Martinez (Wife)

OWNER'S ACKNOWLEDGMENT


STATE OF NEW MEXICO
COUNTY OF BERNALILLO

This instrument was acknowledged before me on December 19, 2003
By Danny N. Martinez and Mariorene S. Martinez, Husband and Wife.

Melissa Lovato

NOTARY PUBLIC

MY COMMISSION EXPIRES 4/19/05

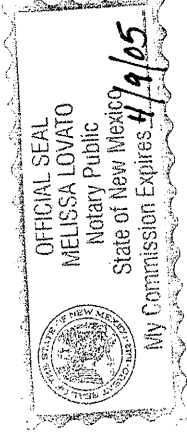

ALDRICH LAND
SURVEYING
P.O. BOX 30701, ALBU., N.M. 87190
505-684-1990

SURVEYOR'S CERTIFICATION

"I, Timothy Aldrich, a duly qualified Registered Professional Land Surveyor under the laws of the State of New Mexico, do hereby certify that this plat and description were prepared by me or under my supervision, shows all easements as shown on the plat of record or made known to me by the owners and/or proprietors of the subdivision shown hereon, utility companies and other parties expressing an interest and meets the minimum requirements for monumentation and surveys of the Albuquerque Subdivision Ordinance, and further meets the Minimum Standards for Land Surveying in the State of New Mexico, and is true and correct to the best of my knowledge and belief."

Timothy Aldrich P.S. No. 7719

Date

Sheet

1

of

4

CURVE TABLE				
CURVE	LENGTH	RADIUS	DELTA	TANGENT CH-BEARING-CH-DIST=
C1	54.44	525.43	5°56'13"	27.25 N67°32'39"W 54.42
C2	47.60	525.43	5°11'27"	23.82 N61°58'49"W 47.59
C3	23.93	45.63	30°33'08"	12.25 S79°17'44"W 23.66
C4	86.96	45.63	109°12'24"	64.21 N37°04'30"W 74.38
C5	43.77	45.63	54°57'37"	23.73 N31°00'30"E 42.11
C6	73.57	521.00	8°05'26"	36.85 N82°32'02"E 72.51
C7	51.59	521.00	5°40'25"	25.82 N89°24'58"E 51.57
C8	6.60	521.00	0°43'34"	3.30 S87°23'03"E 6.60
C9	43.71	171.00	14°38'43"	21.97 S79°41'55"E 43.59
C10	14.36	171.00	4°48'38"	7.18 S69°58'14"E 14.35
C11	14.55	25.00	33°21'18"	7.49 N84°14'34"W 14.35
C12	26.71	25.00	61°13'17"	14.79 S48°28'08"W 25.46
C13	36.38	45.00	48°50'28"	20.43 N42°16'44"E 37.21
C14	36.38	45.00	46°18'58"	19.25 N89°51'27"E 35.39
C15	17.12	25.00	39°13'53"	8.91 S86°36'01"E 16.79
C16	17.12	25.00	39°13'54"	8.91 N54°10'06"E 16.79
C17	61.62	45.00	78°27'47"	36.74 S72°47'02"W 55.22
C18	48.29	2023.00	1°22'04"	24.15 N18°32'31"E 48.29
C19	23.82	139.37	9°47'34"	11.94 S71°52'51"E 23.79
C20	37.25	25.00	85°21'52"	23.06 N60°32'26"E 33.90
C21	56.22	1977.00	1°37'45"	28.11 N18°40'22"E 56.21
C22	37.27	25.00	85°25'25"	23.08 S24°51'13"E 33.92
C23	5.65	133.00	2°25'57"	2.82 S68°46'53"E 5.65
C24	39.52	133.00	17°01'24"	19.90 S78°30'34"E 39.37
C25	12.09	483.00	1°26'02"	6.04 S87°44'17"E 12.09
C26	39.14	483.00	4°38'36"	19.58 N89°13'24"E 39.13
C27	34.91	25.00	80°00'14"	20.98 N46°54'00"E 43.80
C28	45.69	45.63	57°22'17"	24.96 S35°35'01"W 43.80
C29	14.79	2000.00	1°37'45"	28.44 N18°40'22"E 56.87
C30	20.30	150.00	7°45'11"	10.16 N71°26'30"W 20.28
C31	50.94	150.00	19°27'21"	25.72 S77°17'36"E 50.69
C32	126.45	500.00	1°12'26"	63.57 N85°44'01"E 126.12
C33	45.16	133.00	11°29'29"	22.80 S77°17'36"E 44.95
C34	58.07	171.00	19°27'21"	29.32 S77°17'36"E 57.79
C35	131.76	521.00	14°29'25"	66.23 N85°44'01"E 131.41
C36	51.23	483.00	6°04°38"	25.64 N89°56'25"E 51.21
C37	200.34	45.63	2°51'35"28"	63.27 N47°18'24"W 74.01
C38	41.27	25.00	94°34'35"	27.08 S65°08'47"W 36.74
C39	57.09	34.38	95°09'26"	37.62 N65°26'13"E 50.75
C40	74.74	45.00	95°09'26"	49.24 N65°26'13"E 66.44
C41	39.44	23.75	95°09'26"	25.99 N65°26'13"E 35.06
C42	34.24	25.00	95°09'26"	20.41 N73°47'02"E 31.62
C43	54.00	34.38	90°00'00"	34.37 S68°00'56"W 48.61
C45	74.61	23.75	180°00'00"	S23°00'56"W 47.50
C46	32.73	160.63	1°40'33"	16.42 S72°49'21"E 32.68
C47	30.57	150.00	1°40'33"	15.34 S72°49'21"E 30.51
C48	15.79	9.38	96°31'07"	10.51 N30°24'04"W 13.99
C49	21.89	25.00	50°10'37"	11.17 N44°34'33"E 21.20
C50	40.01	25.00	91°42'04"	25.75 N65°20'17"E 35.88
C51	18.12	25.00	41°31'28"	9.48 S89°34'25"E 17.72
C52	22.42	525.43	2°26'42"	11.21 N6°35'20"W 22.42
C53	32.87	25.00	7°51'9"57"	19.30 S20°38'10"E 30.55

LINE	BEARING	DISTANCE
L2	S25°43'50"E	31.42
L3	N04°19'18"E	11.16
L4	S66°38'41"E	8.12
L5	S68°00'56"W	14.14
L6	N16°12'58"W	44.27
L7	S78°39'37"E	40.48
L8	N75°19'06"W	16.05
L9	S67°33'55"E	30.27
L10	S11°30'41"E	24.63

DESCRIPTION

A tract of land situate within the Elena Gallegos Grant and Town of Albuquerque Grant, projected Section 31, Township 11 North, Range 3 East New Mexico Principal Meridian, City of Albuquerque, Bernalillo County, New Mexico, being all of TRACTS 161A, 161B1, 162A, 166A, 166B AND 167A, M.R.G.C.D. MAP 31, and being more particularly described as follows:

BEGINNING at the southwest corner of the herein described tract, from whence the Albuquerque Central Survey Monument "10-G13-A" bears S 34°46'24" W, 4054.97 feet;

THENCE N 38°35'43" E, 91.09 feet to a point;

THENCE N 53°13'43" E, 81.85 feet to a point;

THENCE N 27°28'43" E, 132.93 feet to a point;

THENCE N 27°56'13" E, 135.68 feet to the northwest corner;

THENCE S 70°30'45" E, 14.95 feet to a point;

THENCE S 27°44'48" W, 109.39 feet to a point;

THENCE S 16°35'52" W, 94.60 feet to a point;

THENCE S 75°05'52" E, 111.65 feet to a point;

THENCE S 17°10'20" W, 5.34 feet to a point;

THENCE S 72°47'45" E, 60.22 feet to a point;

THENCE N 18°43'38" E, 53.11 feet to a point;

THENCE S 65°32'11" E, 37.82 feet to a point;

THENCE N 18°21'53" E, 6.25 feet to a point;

THENCE S 55°37'34" E, 23.41 feet to a point;

THENCE S 74°56'34" E, 85.28 feet to a point;

THENCE N 12°12'26" E, 141.24 feet to a point;

THENCE S 70°30'45" E, 75.93 feet to a point of curvature;

THENCE 102.05 feet along a curve to the right, whose radius is 525.43 feet through a central angle of 110°7'40" and whose chord bears S 64°56'55" E, 101.89 feet to a point of tangency;

THENCE S 59°23'05" E, 161.81 feet to the northeast corner;

THENCE S 24°24'42" W, 75.46 feet to a point;

THENCE N 74°31'00" W, 15.50 feet to a point;

THENCE S 23°31'42" W, 130.00 feet to a point;

THENCE S 50°31'42" W, 18.50 feet to a point;

THENCE S 62°45'56" W, 70.45 feet to a point;

THENCE S 63°00'45" W, 58.75 feet to a point;

THENCE N 75°53'47" W, 31.02 feet to a point;

THENCE S 77°01'26" W, 87.03 feet to a point;

THENCE S 65°25'29" W, 61.00 feet to the southeast corner;

THENCE N 66°59'04" W, 460.87 feet to the point of beginning and containing (207.438s.1.) 4.7621 acres more or less.

PLAT FOR
VILLA DE LA CAPILLA
WITHIN THE
ELENA GALLEGOS GRANT
AND
TOWN OF ALBUQUERQUE GRANT
PROJECTED SECTION 31
TOWNSHIP 11 NORTH, RANGE 3 EAST, N.M.P.M.
CITY OF ALBUQUERQUE
BERNALILLO COUNTY, NEW MEXICO
DECEMBER, 2003

PUBLIC UTILITY EASEMENTS:

PUBLIC UTILITY EASEMENTS shown on this plat are granted for the common and joint use of :

1. The PNM Electric Services Division for the installation, maintenance and service of overhead and underground electrical lines, communication lines, transformers, poles and any other equipment, fixtures structures and related facilities reasonably necessary to provide electrical services.
2. The PNM Gas Services Division for installation, maintenance and services of natural gas lines, valves and other equipment and facilities reasonably necessary to provide natural gas.
3. Qwest for installation, maintenance and service of all buried and aerial communication lines and other related equipment and facilities reasonably necessary to provide communication services, including but not limited to above ground pedestals and closures.
4. Comcast cable for installation, maintenance and service of such lines, cable and other related equipment and facilities reasonably necessary to provide Cable TV service.
5. The New Mexico Utilities, Inc., for the installation, maintenance and service of water and sanitary sewer lines and any other equipment, fixtures, structures and related facilities reasonably necessary to provide water and sewer services.

Included, is the right to build, rebuild, construct, reconstruct, locate, relocate, change, remove, modify, renew, operate and maintain facilities for the purposes described above, together with free access to, from and over said easement, including sufficient working area space for electric transformers, with the right and privilege to trim and remove trees, shrubs or bushes which interfere with the purposes set forth herein.

No building, sign, pool (above ground or subsurface), hot tub, concrete or wood pool decking, or other structure shall be erected or operated on said easements, nor shall any well be drilled or operated thereon. Property owners shall be responsible for obtaining all necessary permits from the New Mexico Electrical Society Code caused by construction of pools, decking or any structures adjacent to within or near easements shown on this plat.

In approving this plat, the utility companies did not conduct a Title Search of the properties shown hereon. Consequently, the utility companies do not waive or release any easement or easement rights which may have been granted by prior plat, replat or other document and which are not shown on this plat.

Easements for electric transformers/switchgears, us included, shall extend ten feet (10') in front of transformer/switchgear doors and five feet (5') on each side.


ALDRICH LAND
SURVEYING

P.O. BOX 30701, ALBO., N.M. 87190
505-884-1990

Dwg:	BASE.dwg	Drawn:	STEPHEN	Checked:	ALS	Sheet	4
Scale:	AS SHOWN	Date:	01/27/04	Job:	A03027	of	4

PLAT FOR
VILLA DE LA CAPILLA
WITHIN THE
ELENA GALLEGOS GRANT
AND

TOWN OF ALBUQUERQUE GRANT
PROJECTED SECTION 31
TOWNSHIP 11 NORTH, RANGE 3 EAST, N.M.P.M.
CITY OF ALBUQUERQUE
BERNALILLO COUNTY, NEW MEXICO
DECEMBER, 2003

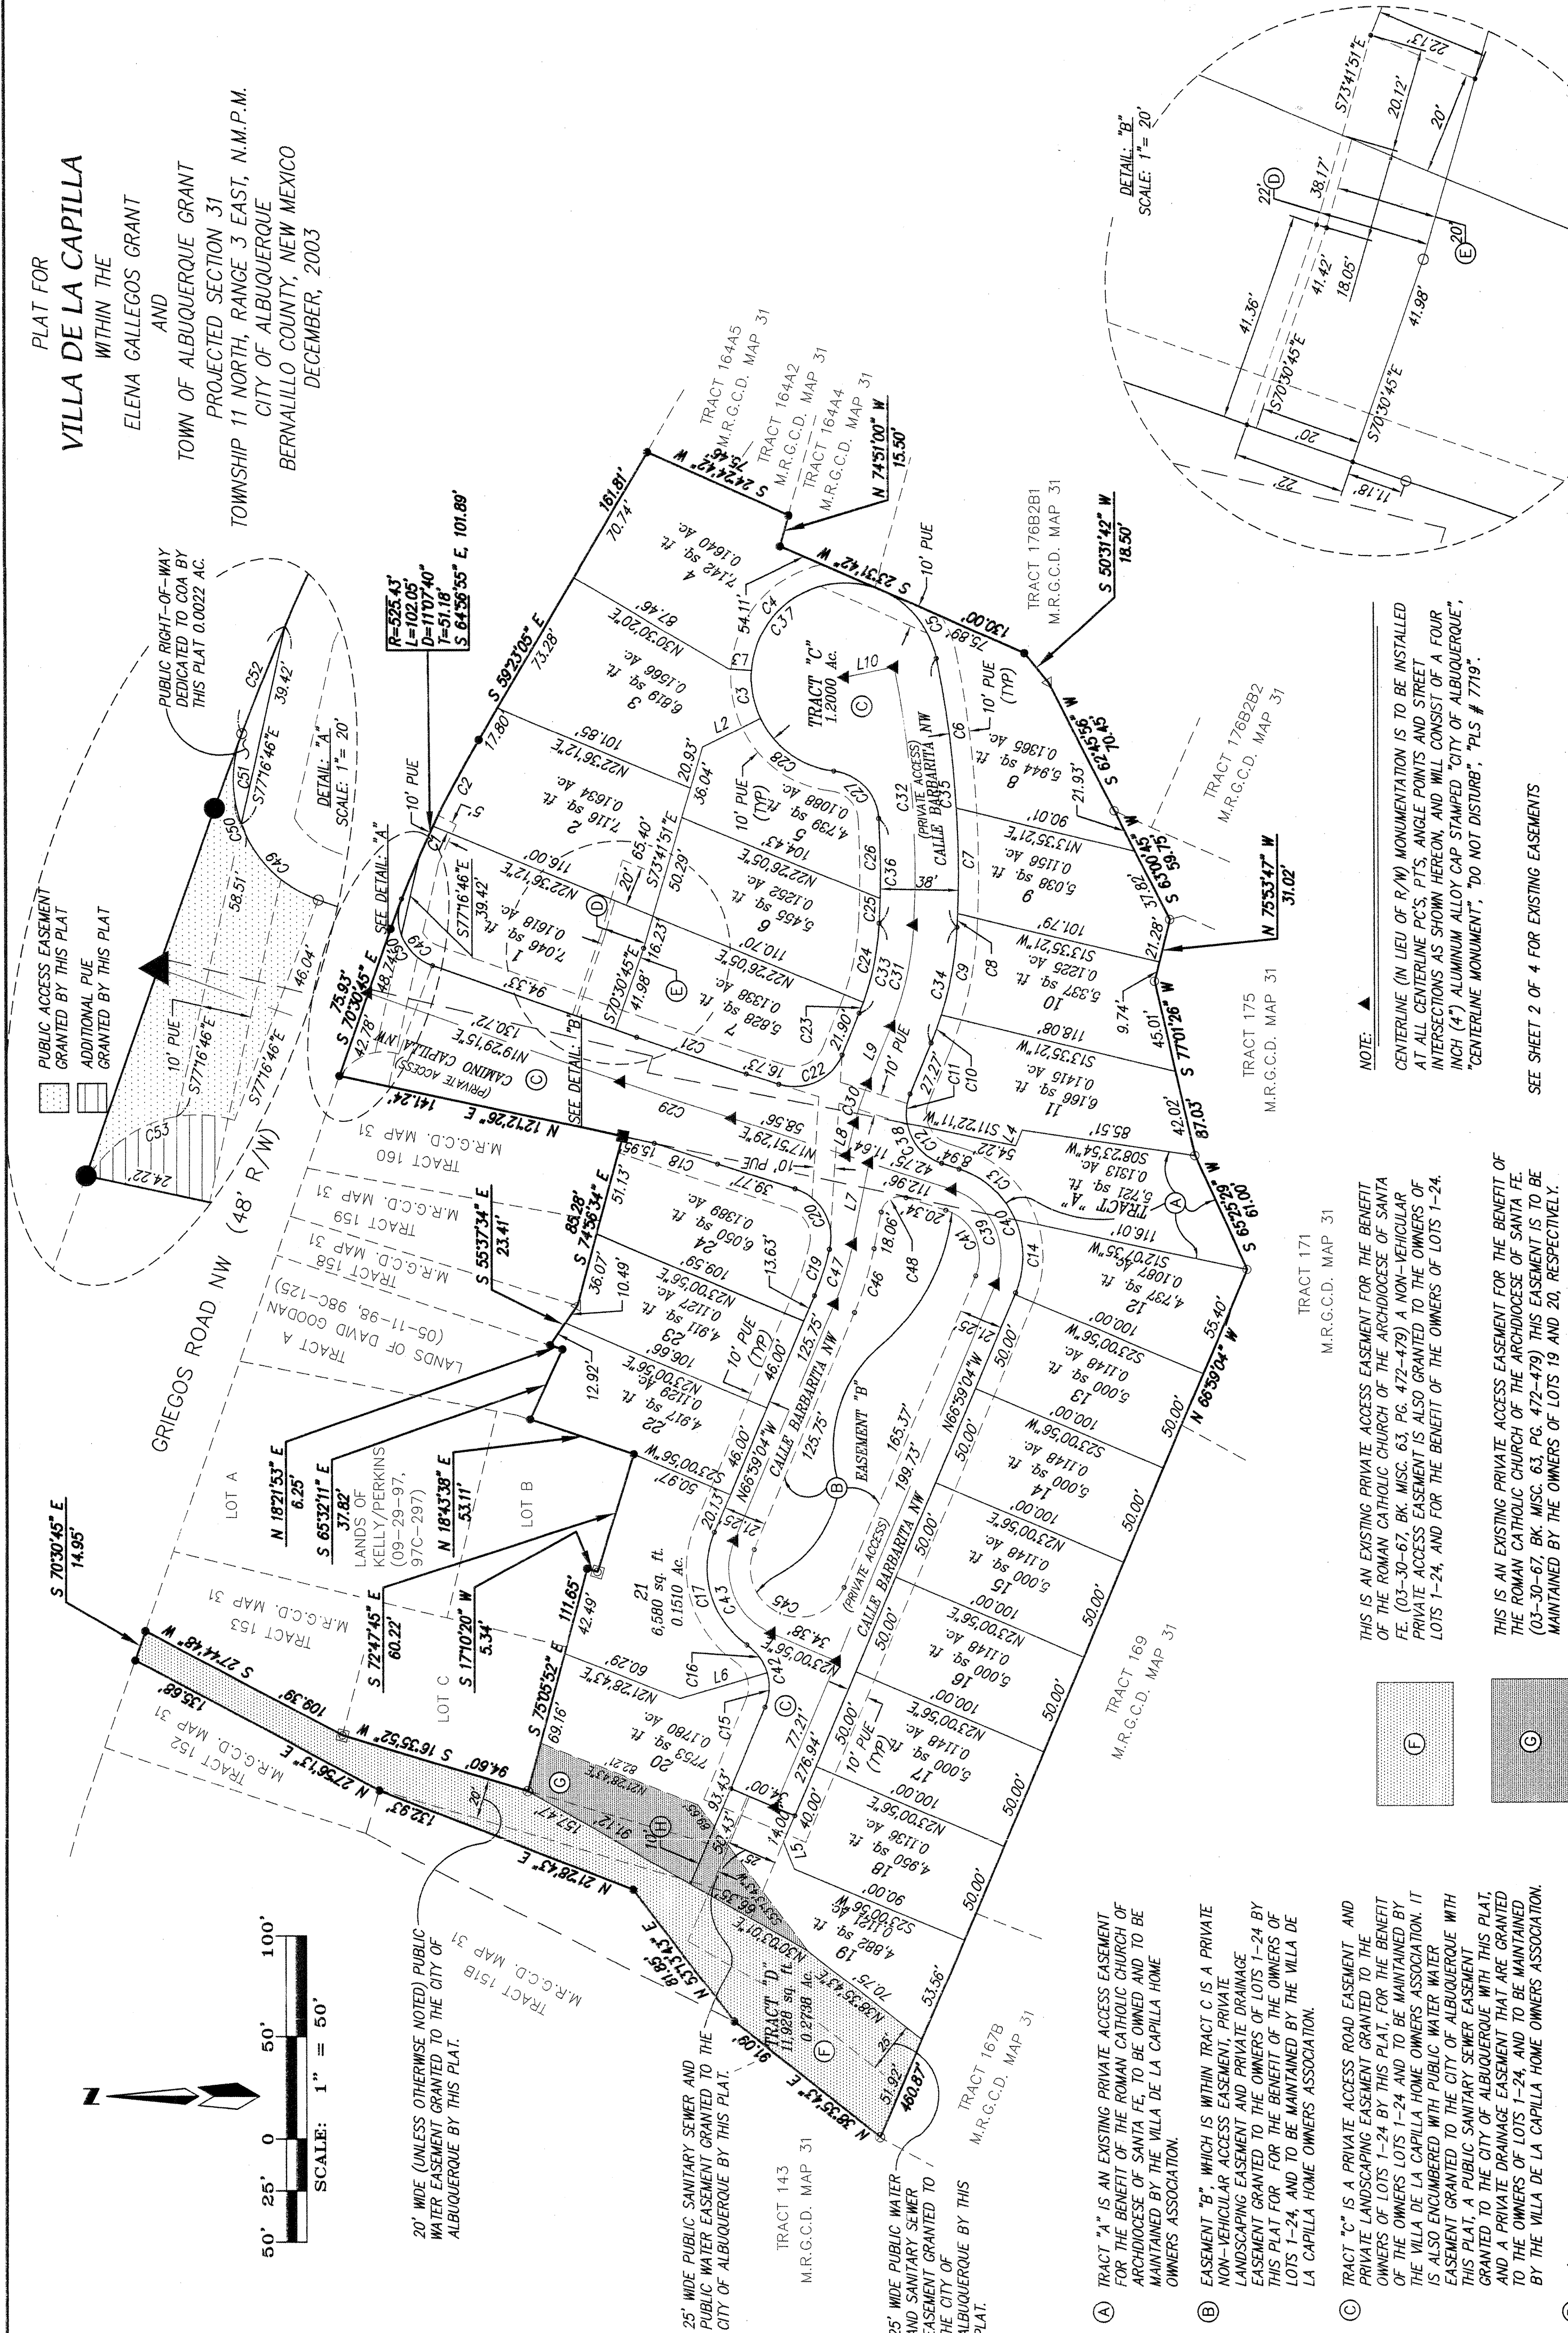

ALDRICH LAND
SURVEYING


P.O. BOX 30701, ALBO., N.M. 87190
505-884-1990

Dwg:	BASE.dwg	Drawn:	STEPHEN	Checked:	ALS	Sheet	3
Scale:	AS SHOWN	Date:	01/27/04	Job:	A03027	of	4




— 5190 —	CONTOUR (MAJOR)
— 5189 —	CONTOUR (MINOR)
	TOP CURB FLOWLINE
x 00.00	SPOT ELEV
	CHAIN LINK FENCE
	WOOD FENCE
	CURB AND GUTTER
	CONCRETE/SIDEWALK
	ADOBE WALL
o	WOOD BOLLARD
	TRAFFIC SIGN
	TREE
	SANITARY SEWER MANHOLE
o	CLEANOUT
	WATER VALVE
	FIRE HYDRANT
	WATER METER
— E&T —	OVERHEAD UTILITY LINES
	SERVICE POLE OVERHEAD ELECTRIC
	LIGHT POLE
	TELEPHONE MANHOLE
	TELEPHONE PEDESTAL
	GAS METER
	STORM DRAIN MANHOLE
	DROP INLET
	WHEEL CHAIR RAMP
00.00	NEW SPOT ELEVATION
FP = 0.00	FINISH PAD ELEVATION
18	LOT NUMBER
	FLOW DIRECTION
	STANDARD CURB & GUTTER
	NEW RETAINING WALL
71.00TW	TOP OF WALL ELEVATION
69.00TG	TOP OF GROUND ELEVATION
	MOUNTABLE CURB & GUTTER

② END OF PIPE TO HAVE REBAR SCREEN TO PREVENT ACCESS.

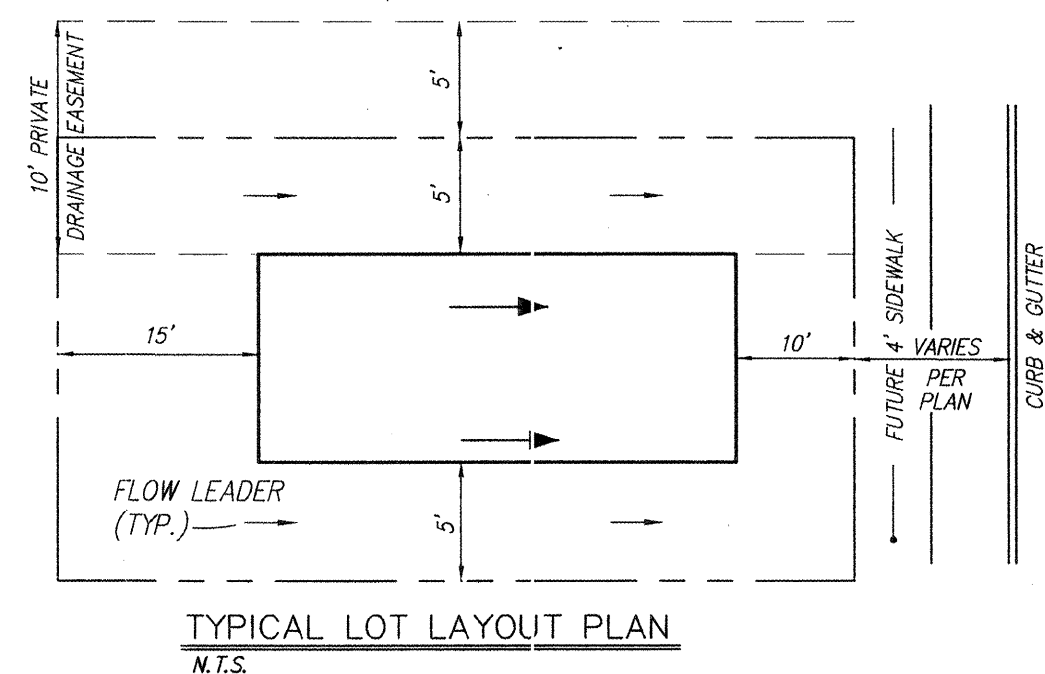

TYPICAL LOT LAYOUT PLAN
N.T.S.

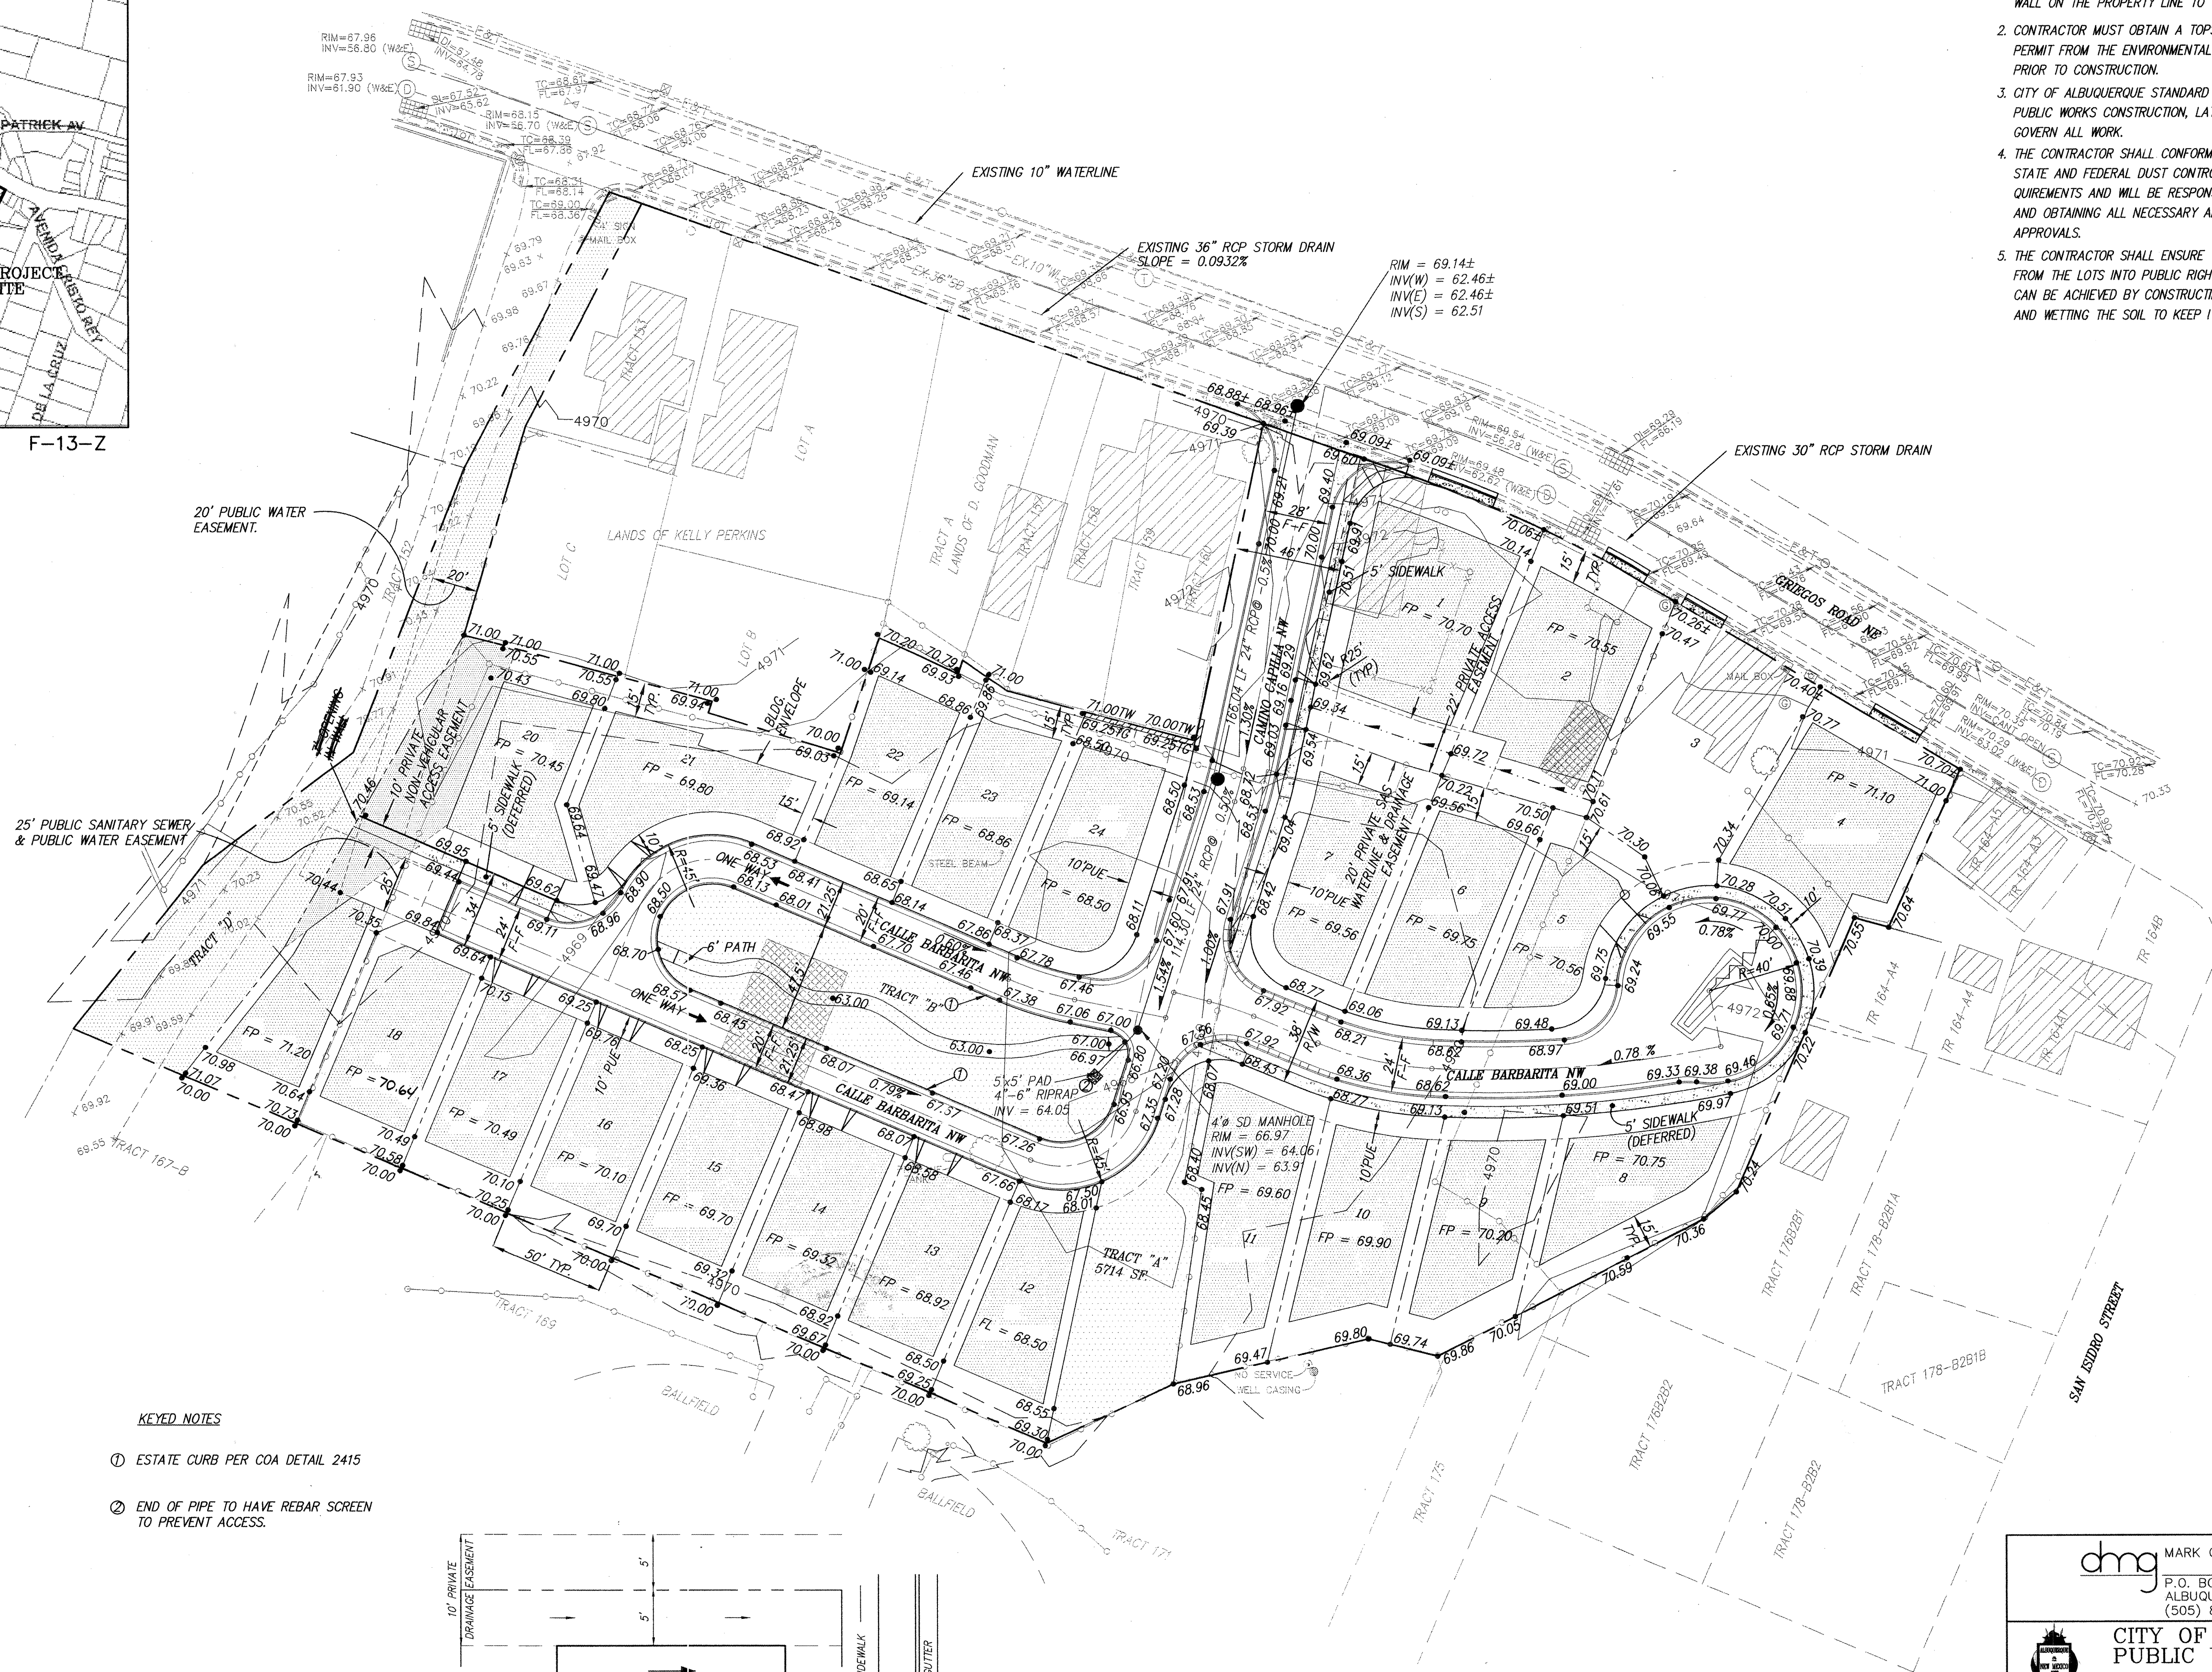

1. OFFSITE FLOWS WILL BE ROUTED ALONG THE RETAINING WALL ON THE PROPERTY LINE TO THE R.O.W. OR ARROYO.
2. CONTRACTOR MUST OBTAIN A TOPSOIL DISTURBANCE PERMIT FROM THE ENVIRONMENTAL HEALTH DIVISION PRIOR TO CONSTRUCTION.
3. CITY OF ALBUQUERQUE STANDARD SPECIFICATIONS FOR PUBLIC WORKS CONSTRUCTION, LATEST EDITION SHALL GOVERN ALL WORK.
4. THE CONTRACTOR SHALL CONFORM TO ALL CITY, COUNTY, STATE AND FEDERAL SUBSTANTIAL CONTROL MEASURES AND REQUIREMENTS AND WILL BE RESPONSIBLE FOR PREPARING AND OBTAINING ALL NECESSARY APPLICATIONS AND APPROVALS.
5. THE CONTRACTOR SHALL ENSURE THAT NO SOIL ERODES FROM THE LOTS INTO PUBLIC RIGHT-OF-WAY. THIS CAN BE ACHIEVED BY CONSTRUCTING TEMPORARY BERMS AND WETTING THE SOIL TO KEEP IT FROM BLOWING.

539								ENGINEER'S SEAL		SURVEY INFORMATION		BENCH MARKS		AS BUILT INFORMATION					
								 <i>[Signature]</i>		FIELD NOTES		THE STATION IS LOCATED 3.7 MILES NORTH OF DOWNTOWN ALBUQUERQUE, AT THE N.E. CORNER OF THE INTERSECTION OF GREGG ROAD NW AND RIO GRANDE BLVD NE. TO REACH THIS STATION FROM THE INTERCHANGE AT I-40 AND RIO GRANDE NW, GO NORTH ON RIO GRANDE 2.3 MILES TO THE STATION ON THE RT..		CONTRACTOR Sundance		WORK ORDERED BY ALS		DATE 1/05	
NO.		DATE		BY		DATE		INSPECTOR'S ACCEPTANCE BY		DATE		DRAWINGS PREPARED BY		DATE		MICRO-FILM INFORMATION			
REVISIONS		DESIGN		DESIGNED BY ALD		DATE 09/03		DRAWN BY NJR		DATE 11/03		RECORDED BY		DATE		mm CIA Inspector: Ron Rottke			

dmg MARK GOODWIN & ASSOCIATES, P.A.
CONSULTING ENGINEERS
P.O. BOX 90606
ALBUQUERQUE, NEW MEXICO 87199
(505) 828-2200. FAX (505) 797-9539




CITY OF ALBUQUERQUE
PUBLIC WORKS DEPARTMENT

TITLE: *VILLA DE LA CAPPILLA
GRADING AND DRAINAGE PLAN*

DESIGN REVIEW COMMITTEE	CITY ENGINEER APPROVAL	PLAST DESIGN INSTITUTE
For Information Only		

CITY PROJECT NO.	729981	ZONE MAP NO.	E-13-Z	SHEET	4	OF	11
------------------	--------	--------------	--------	-------	---	----	----

SCANNED BY
MESA REPRO

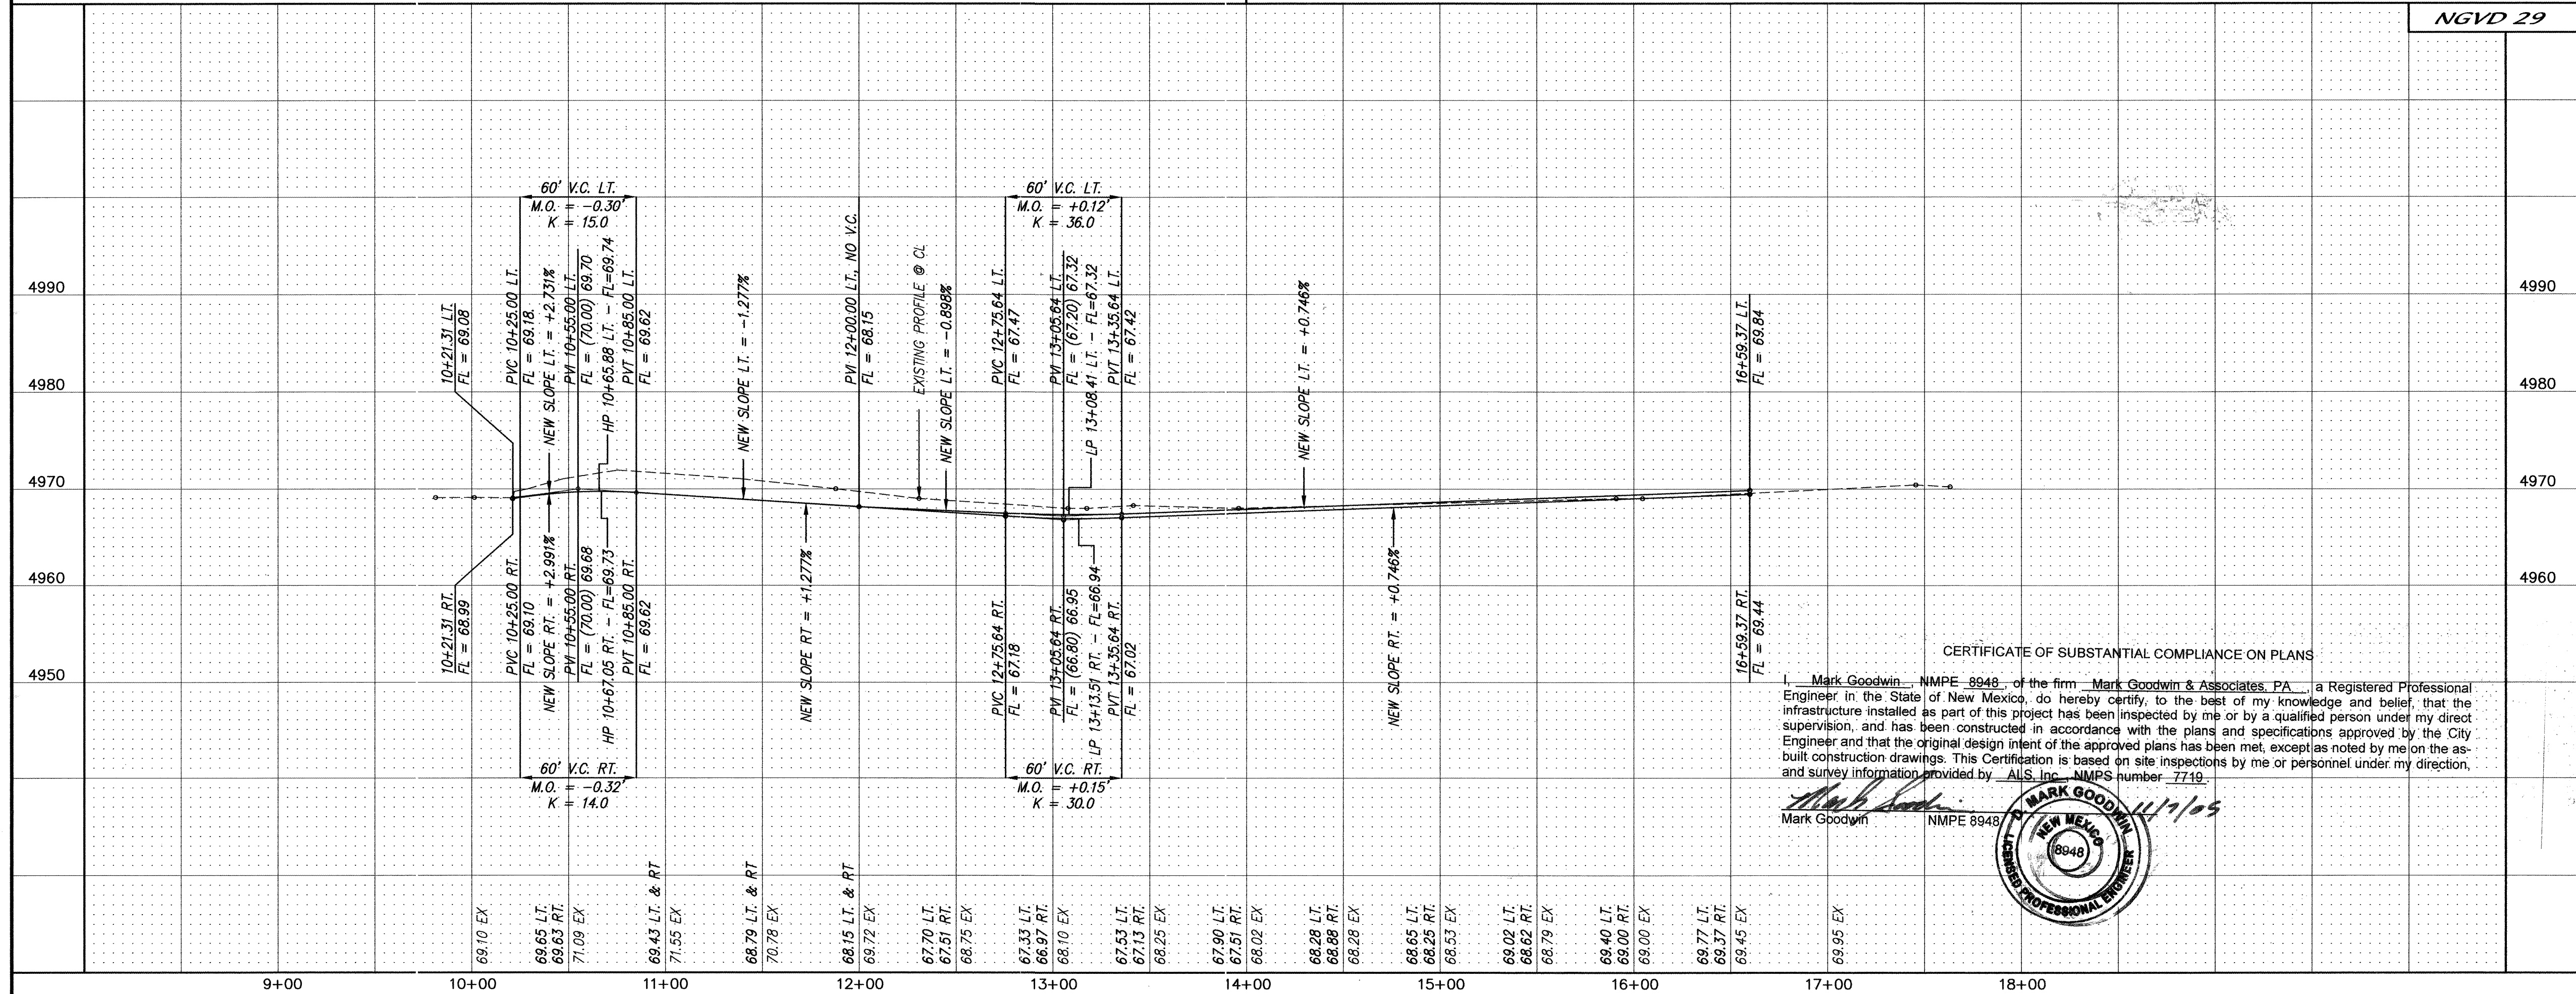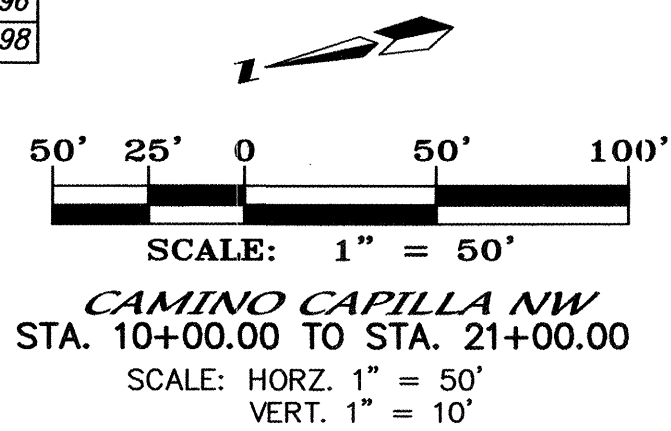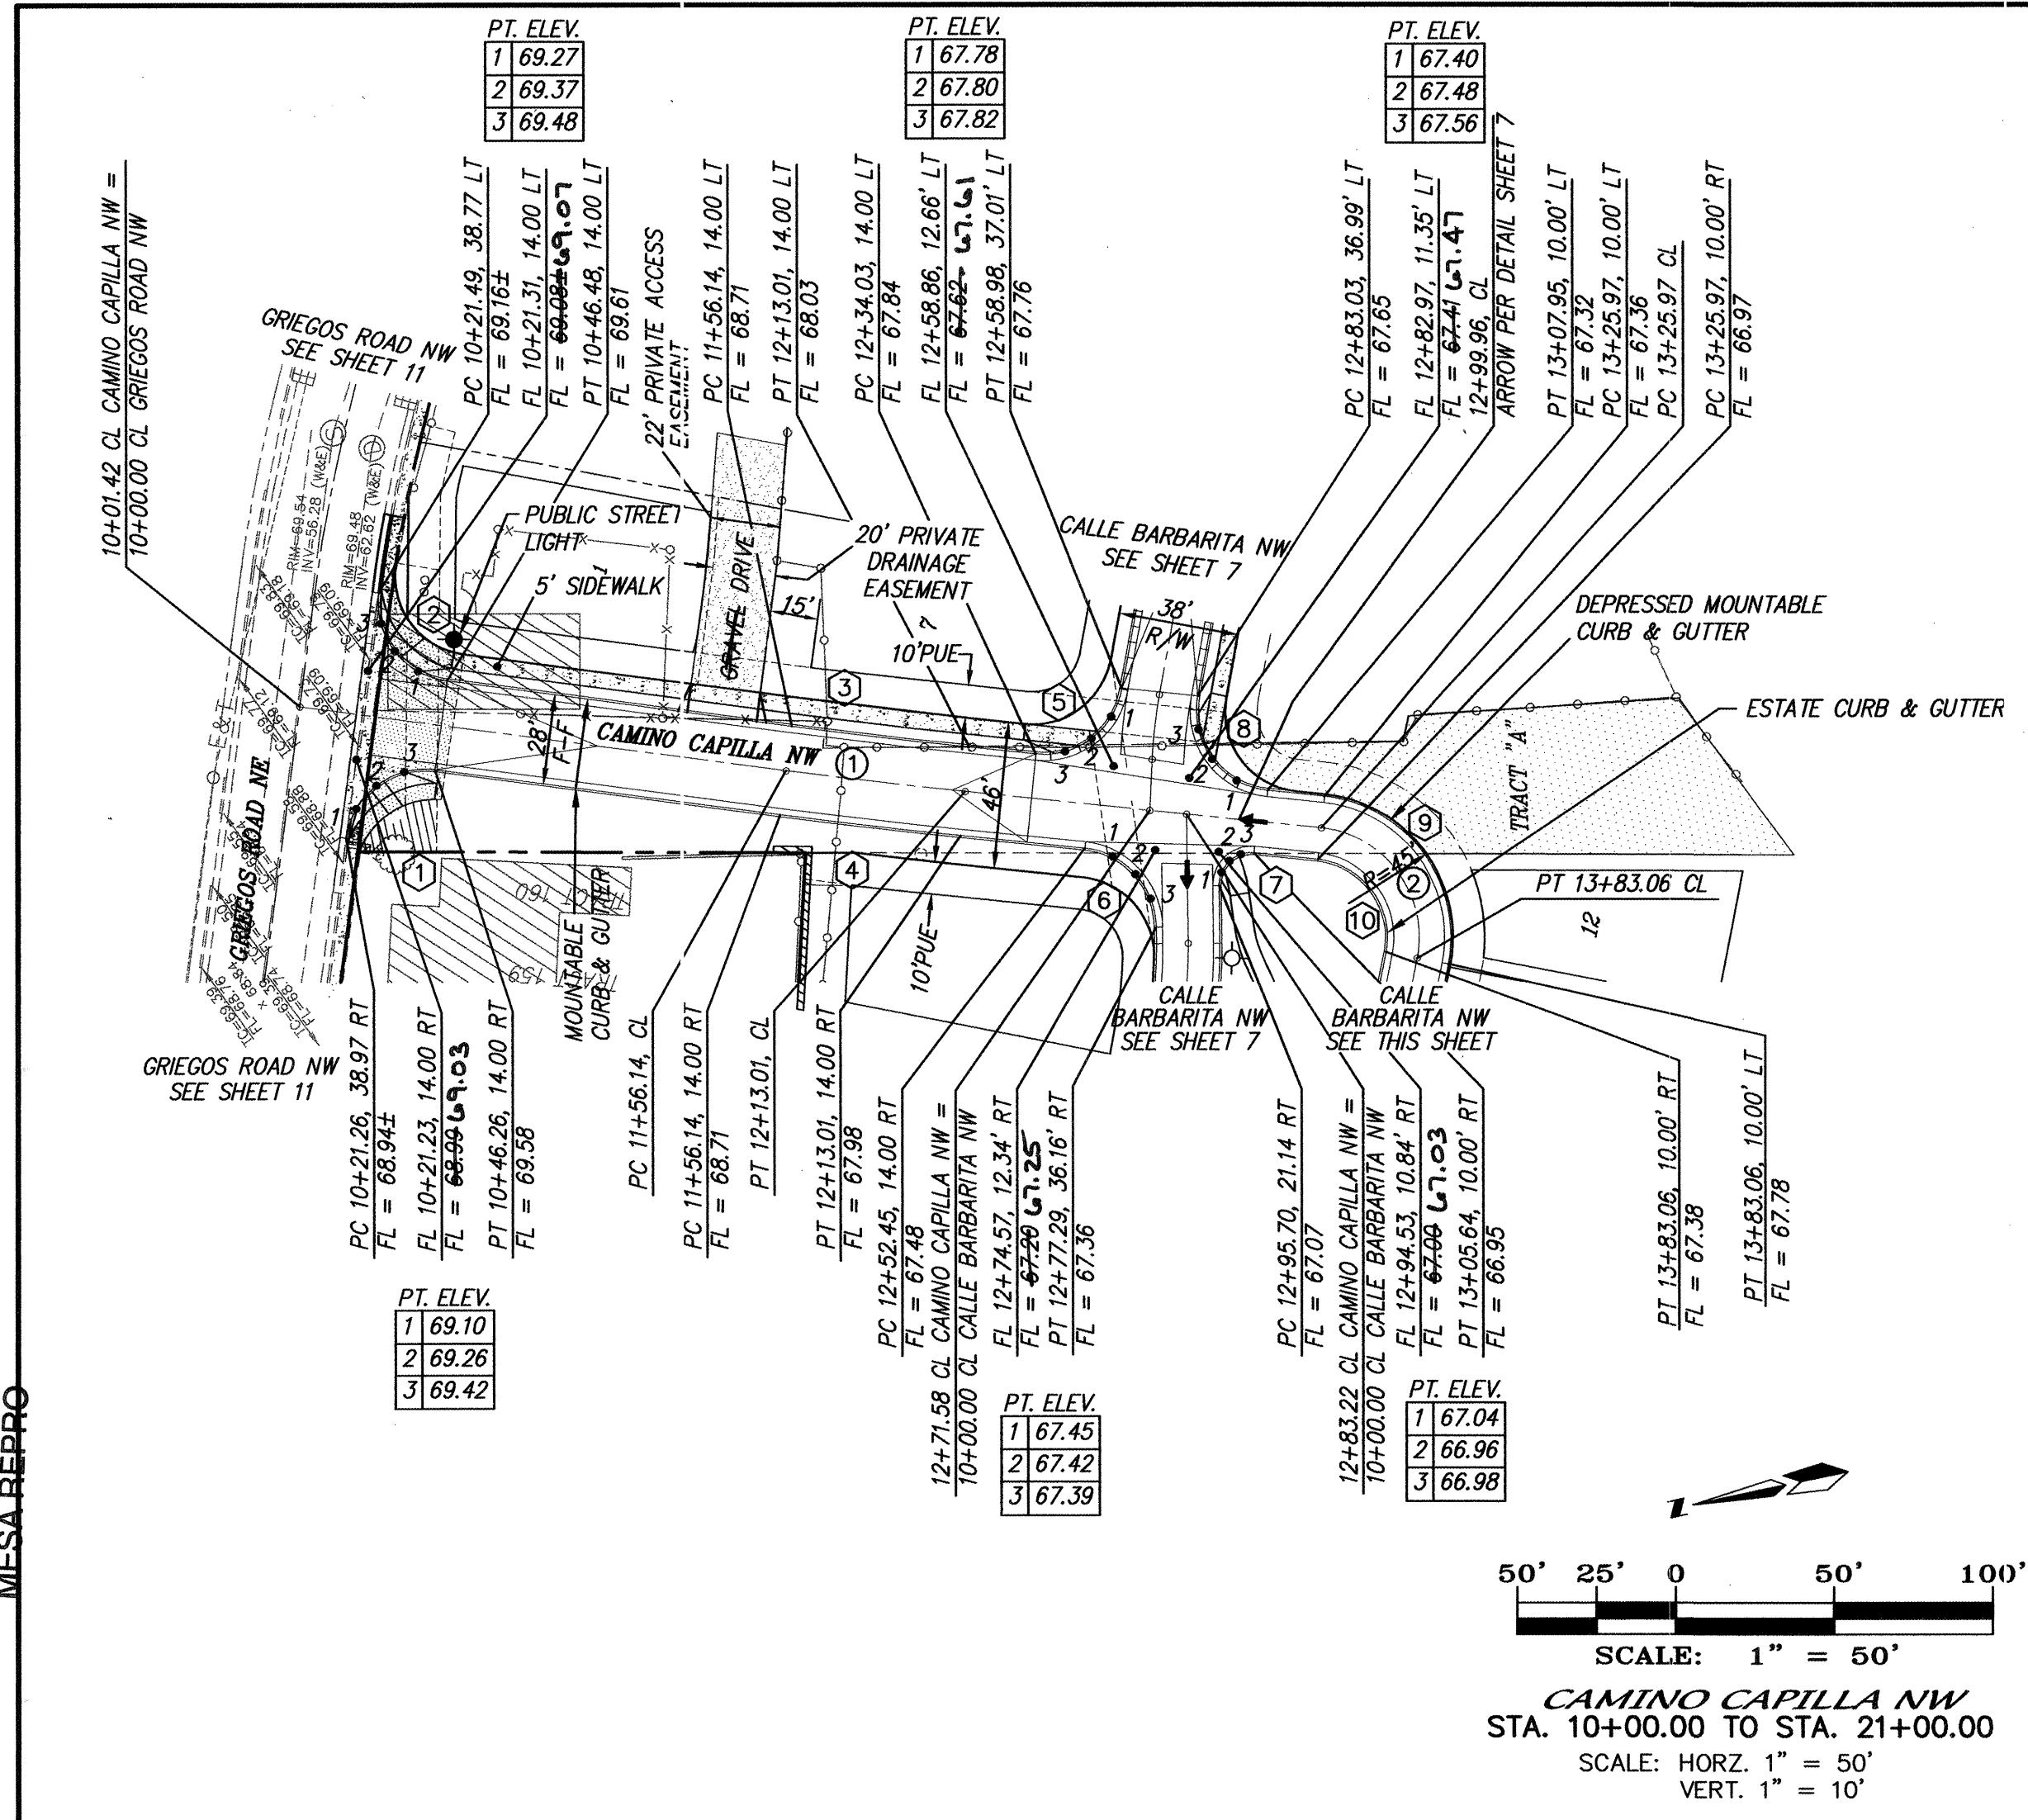

CERTIFICATE OF SUBSTANTIAL COMPLIANCE ON PLANS

I, Mark Goodwin, NMPE 8948, of the firm Mark Goodwin & Associates, P.A., a Registered Professional Engineer in the State of New Mexico, do hereby certify, to the best of my knowledge and belief, that the infrastructure installed as part of this project has been inspected by me or by a qualified person under my direct supervision, and has been constructed in accordance with the plans and specifications approved by the City Engineer and that the original design intent of the approved plans has been met, except as noted by me on the as-built construction drawings. This Certification is based on site inspections by me or personnel under my direction, and survey information provided by ALS, Inc., NMPS number 7719.

Mark Goodwin NMPE 8948



NOTES	
1. ALL STATIONING IS CENTERLINE STATIONING.	

CURVE DATA - DESCRIBES CENTERLINE	
① Δ = 01°37'45" R = 2000.00' L = 56.87' T = 28.44'	② Δ = 95°09'26" R = 34.38' L = 57.09' T = 37.62'

CURVE DATA - DESCRIBES FACE OF NEW CURB		
① Δ = 89°56'10" R = 25.00' L = 36.24' T = 24.97'	② Δ = 89°26'50" R = 25.00' L = 39.04' T = 24.77'	③ Δ = 01°37'45" R = 1986.00' L = 56.47' T = 28.24'
④ Δ = 01°37'45" R = 2014.00' L = 57.27' T = 28.64'	⑤ Δ = 85°26'25" R = 25.00' L = 37.27' T = 23.08'	⑥ Δ = 83°28'53" R = 25.00' L = 36.43' T = 22.31'
⑦ Δ = 96°31'07" R = 10.00' L = 16.85' T = 11.21'	⑧ Δ = 94°34'35" R = 25.00' L = 41.27' T = 27.08'	⑨ Δ = 95°09'26" R = 44.38' L = 73.70' T = 48.56'
⑩ Δ = 95°09'26" R = 24.38' L = 40.48' T = 26.67'	⑪ Δ = 180°00'00" R = 24.38' L = 76.58' T = N/A	⑫ Δ = 86°10'39" R = 25.00' L = 37.60' T = 23.39'





BENCH MARKS	
THE STATION IS LOCATED 3.7 MILES NORTH OF DOWNTOWN ALBUQUERQUE, AT THE N.E. CORNER OF THE INTERSECTION OF GRIEGOS ROAD NW AND RIO GRANDE BLVD. NE. TO REACH THIS STATION FROM THE INTERCHANGE AT I-40 AND RIO GRANDE NW, GO NORTH ON RIO GRANDE 2.3 MILES TO THE STATION ON THE RT. THE STATION IS A STAMPED ACS CAP STAMPED "11-FEB 1995". SET IN TOP OF SIDEWALK. ELEVATION = 4971.00 IN FEET. (SLD 1999)	

SURVEY INFORMATION	
FIELD NOTES	DATE
NO.	BY

ENGINEER'S SEAL	
NO.	DATE
REMARKS	BY
DESIGN	DATE
DRAWN BY	DATE
CHECKED BY	DATE

CITY OF ALBUQUERQUE PUBLIC WORKS DEPARTMENT	
TITLE: VILLA DE LA CAPILLA CAMINO CAPILLA NW & CALLE BARBARITA NW PAVING IMPROVEMENTS	
DESIGN REVIEW COMMITTEE	MO./DAY/YR.
APPROVED	MO./DAY/YR.
CITY ENGINEER	
CITY PROJECT NO.	ZONE MAP NO.
729981	F-13-Z
SHEET	OF
6	11

SCANNED BY
MESA REPRO

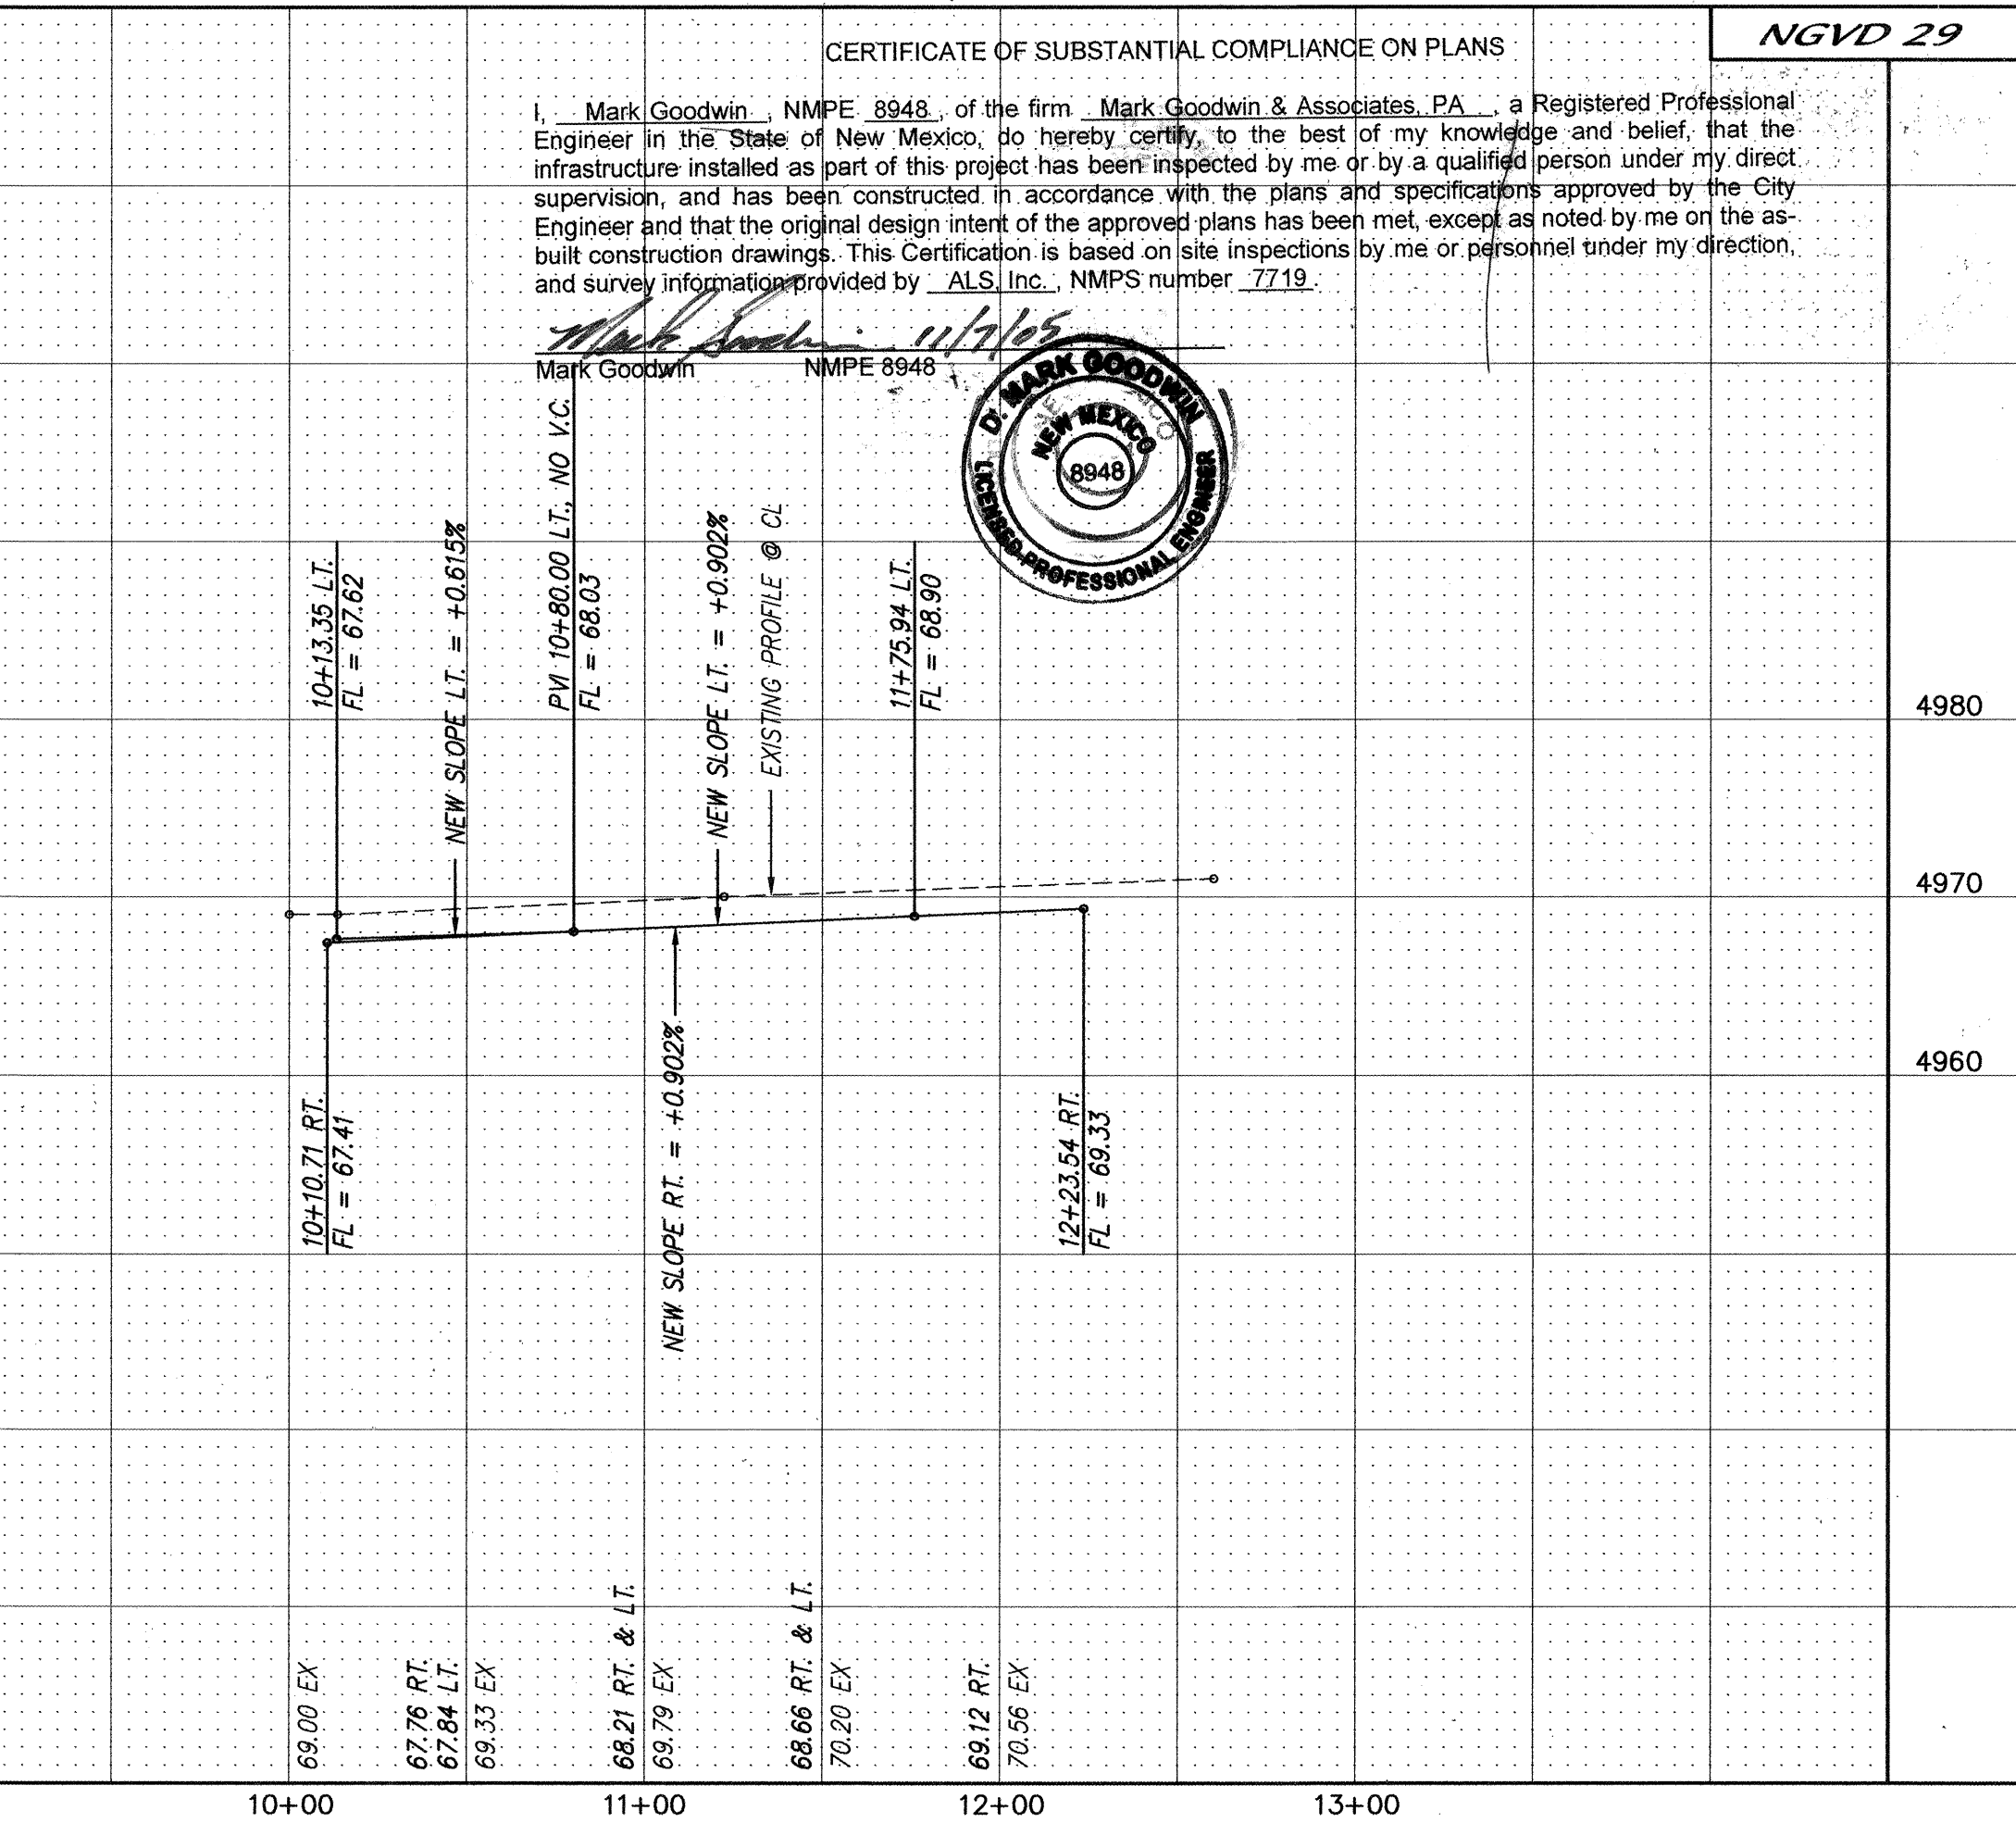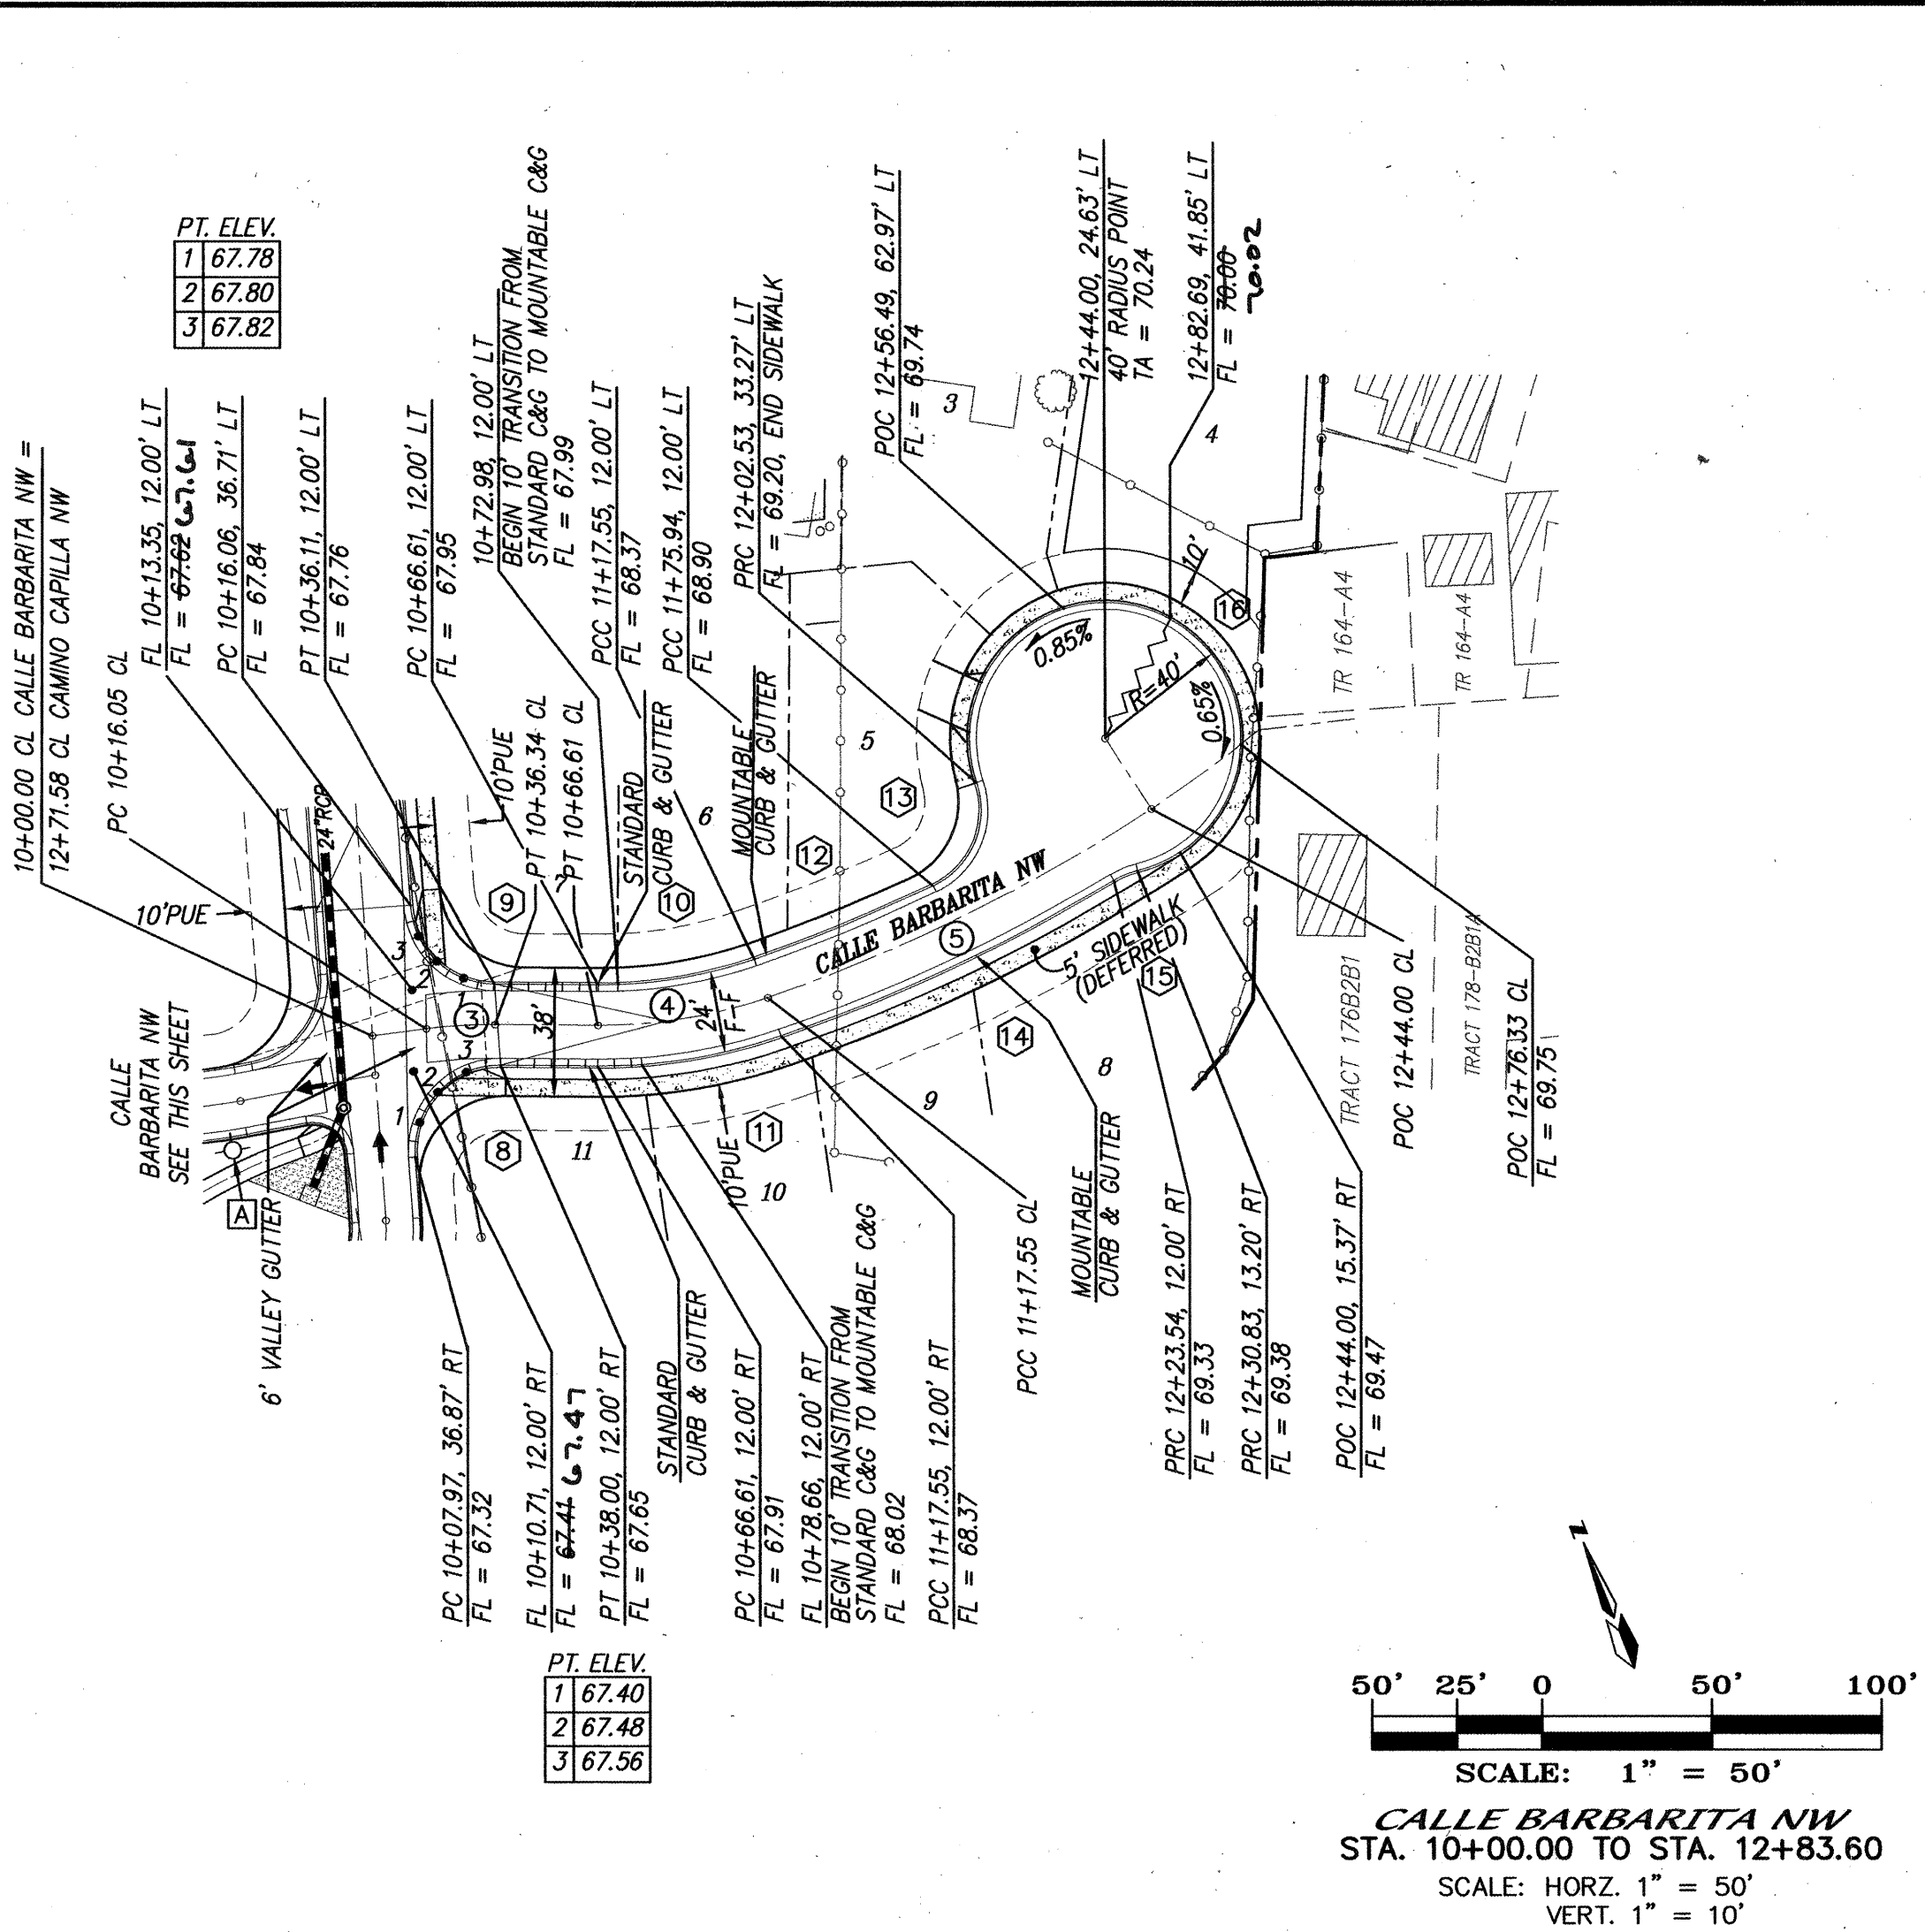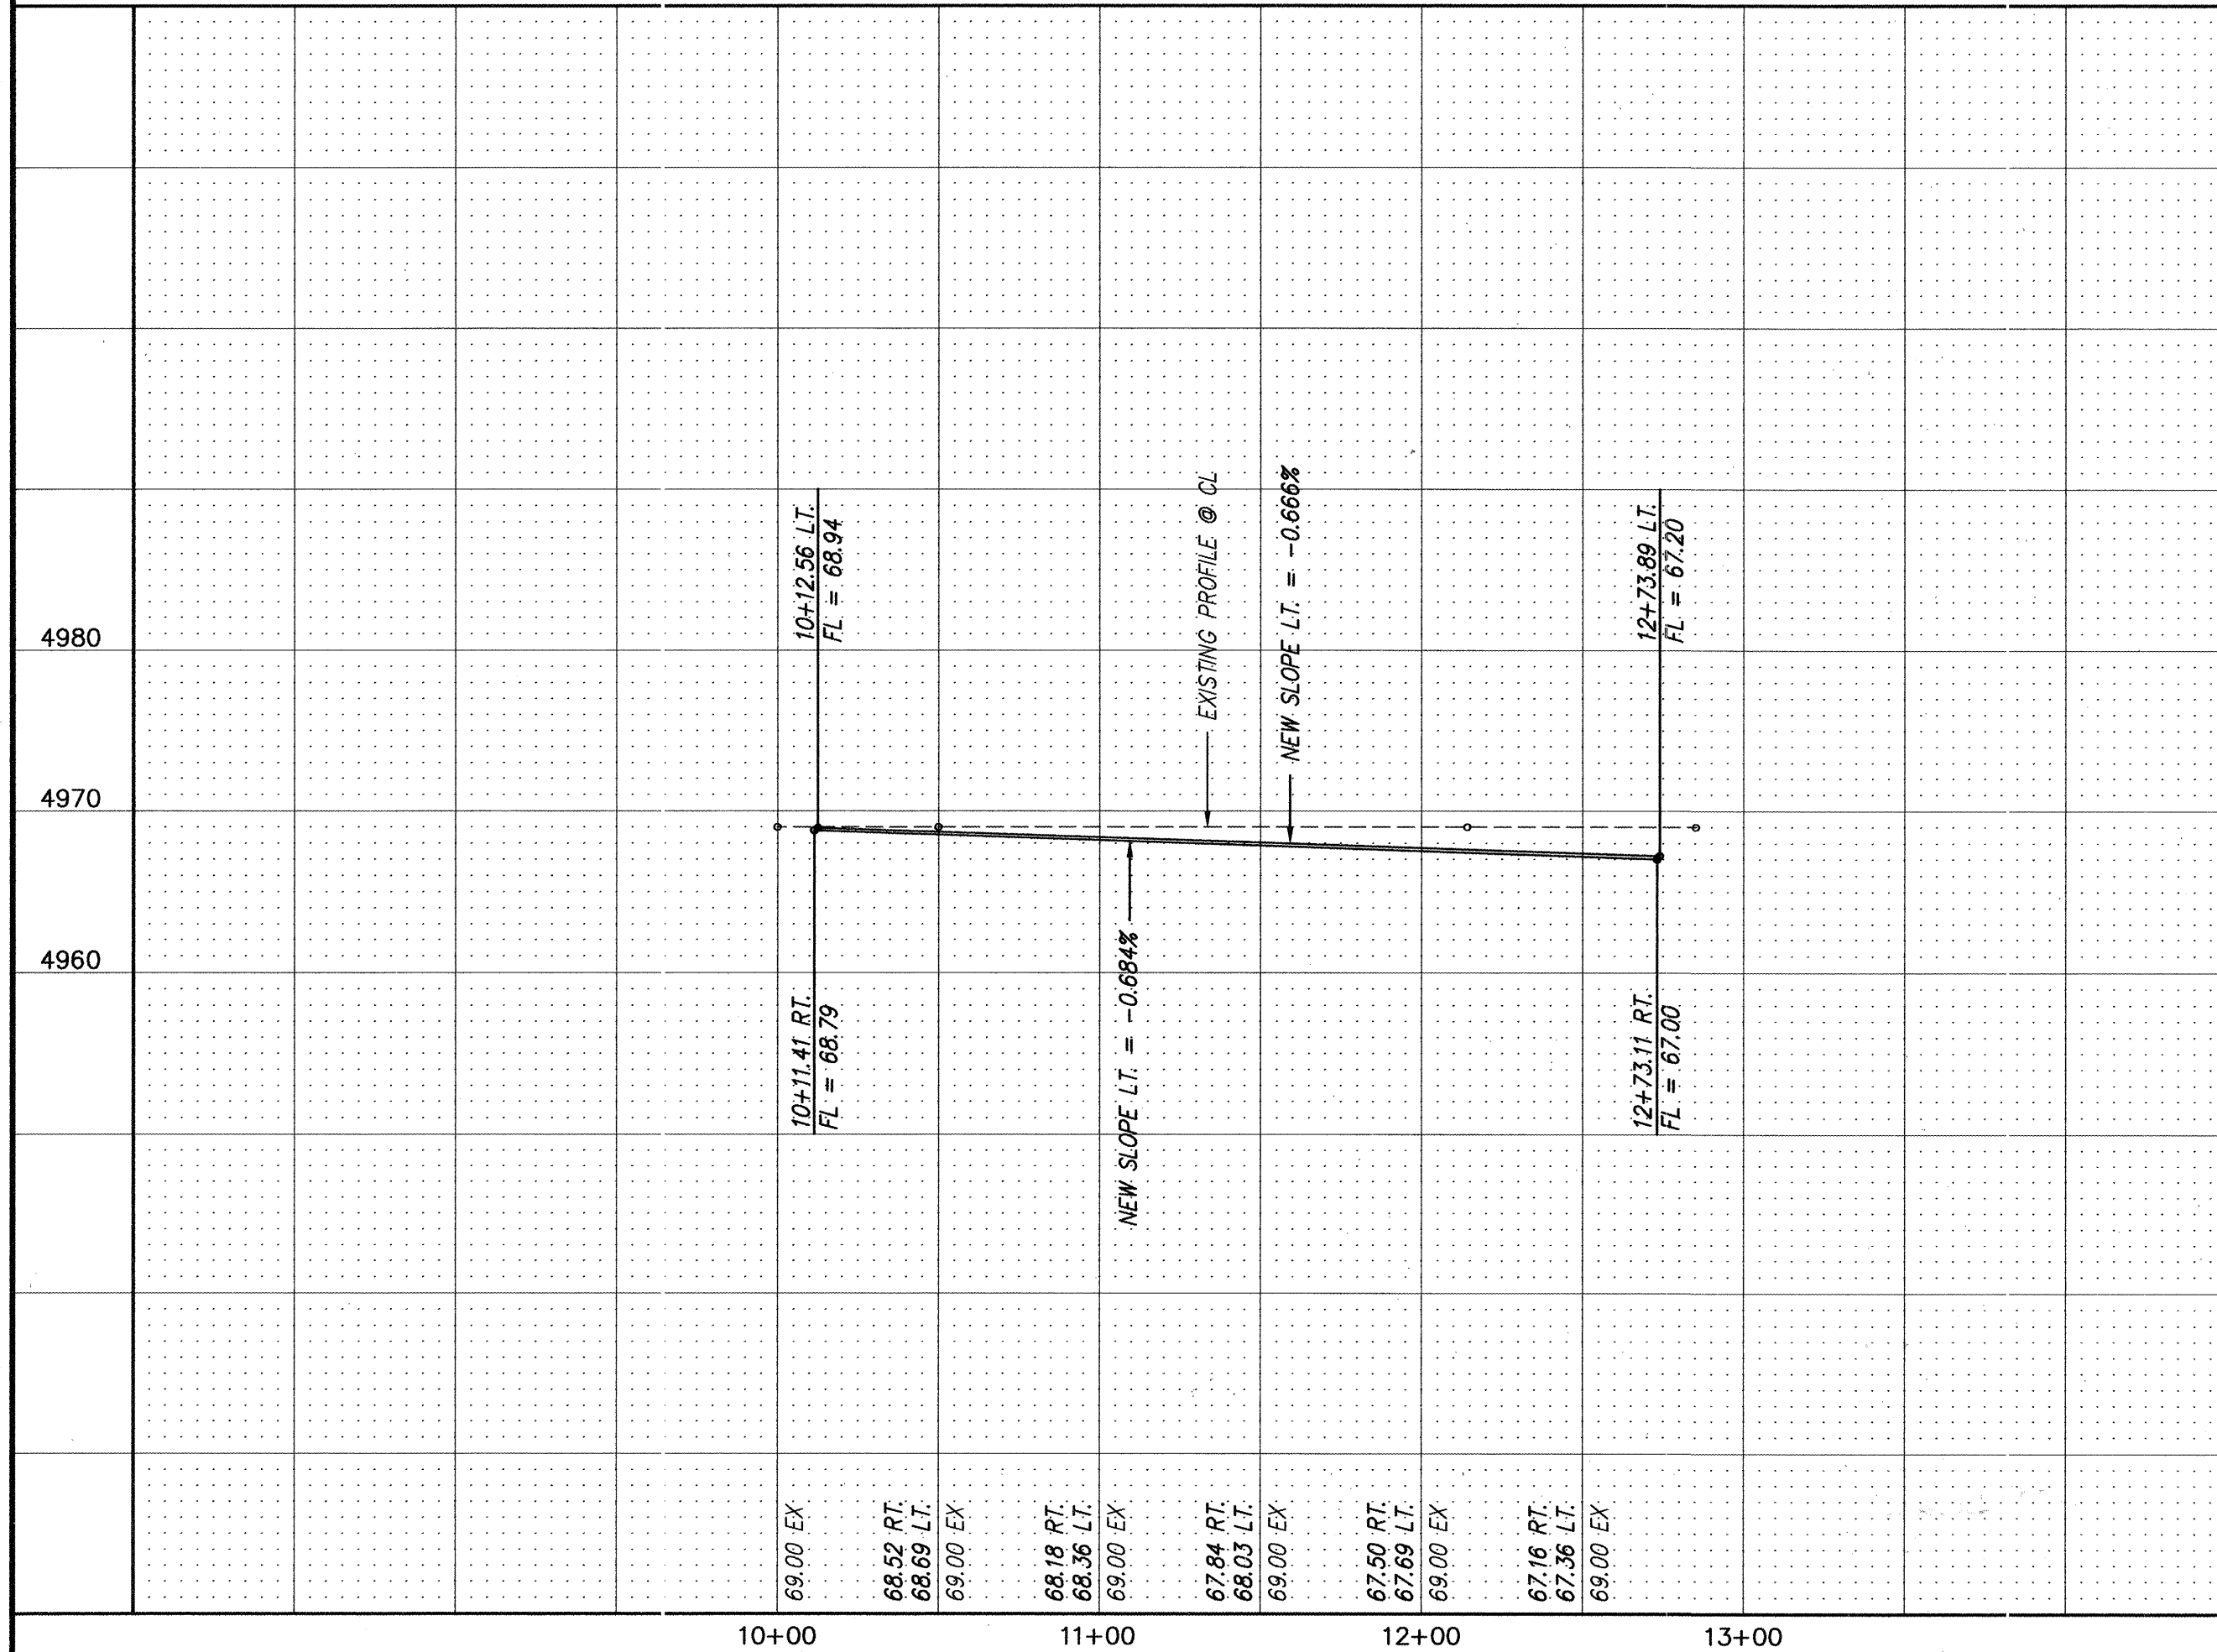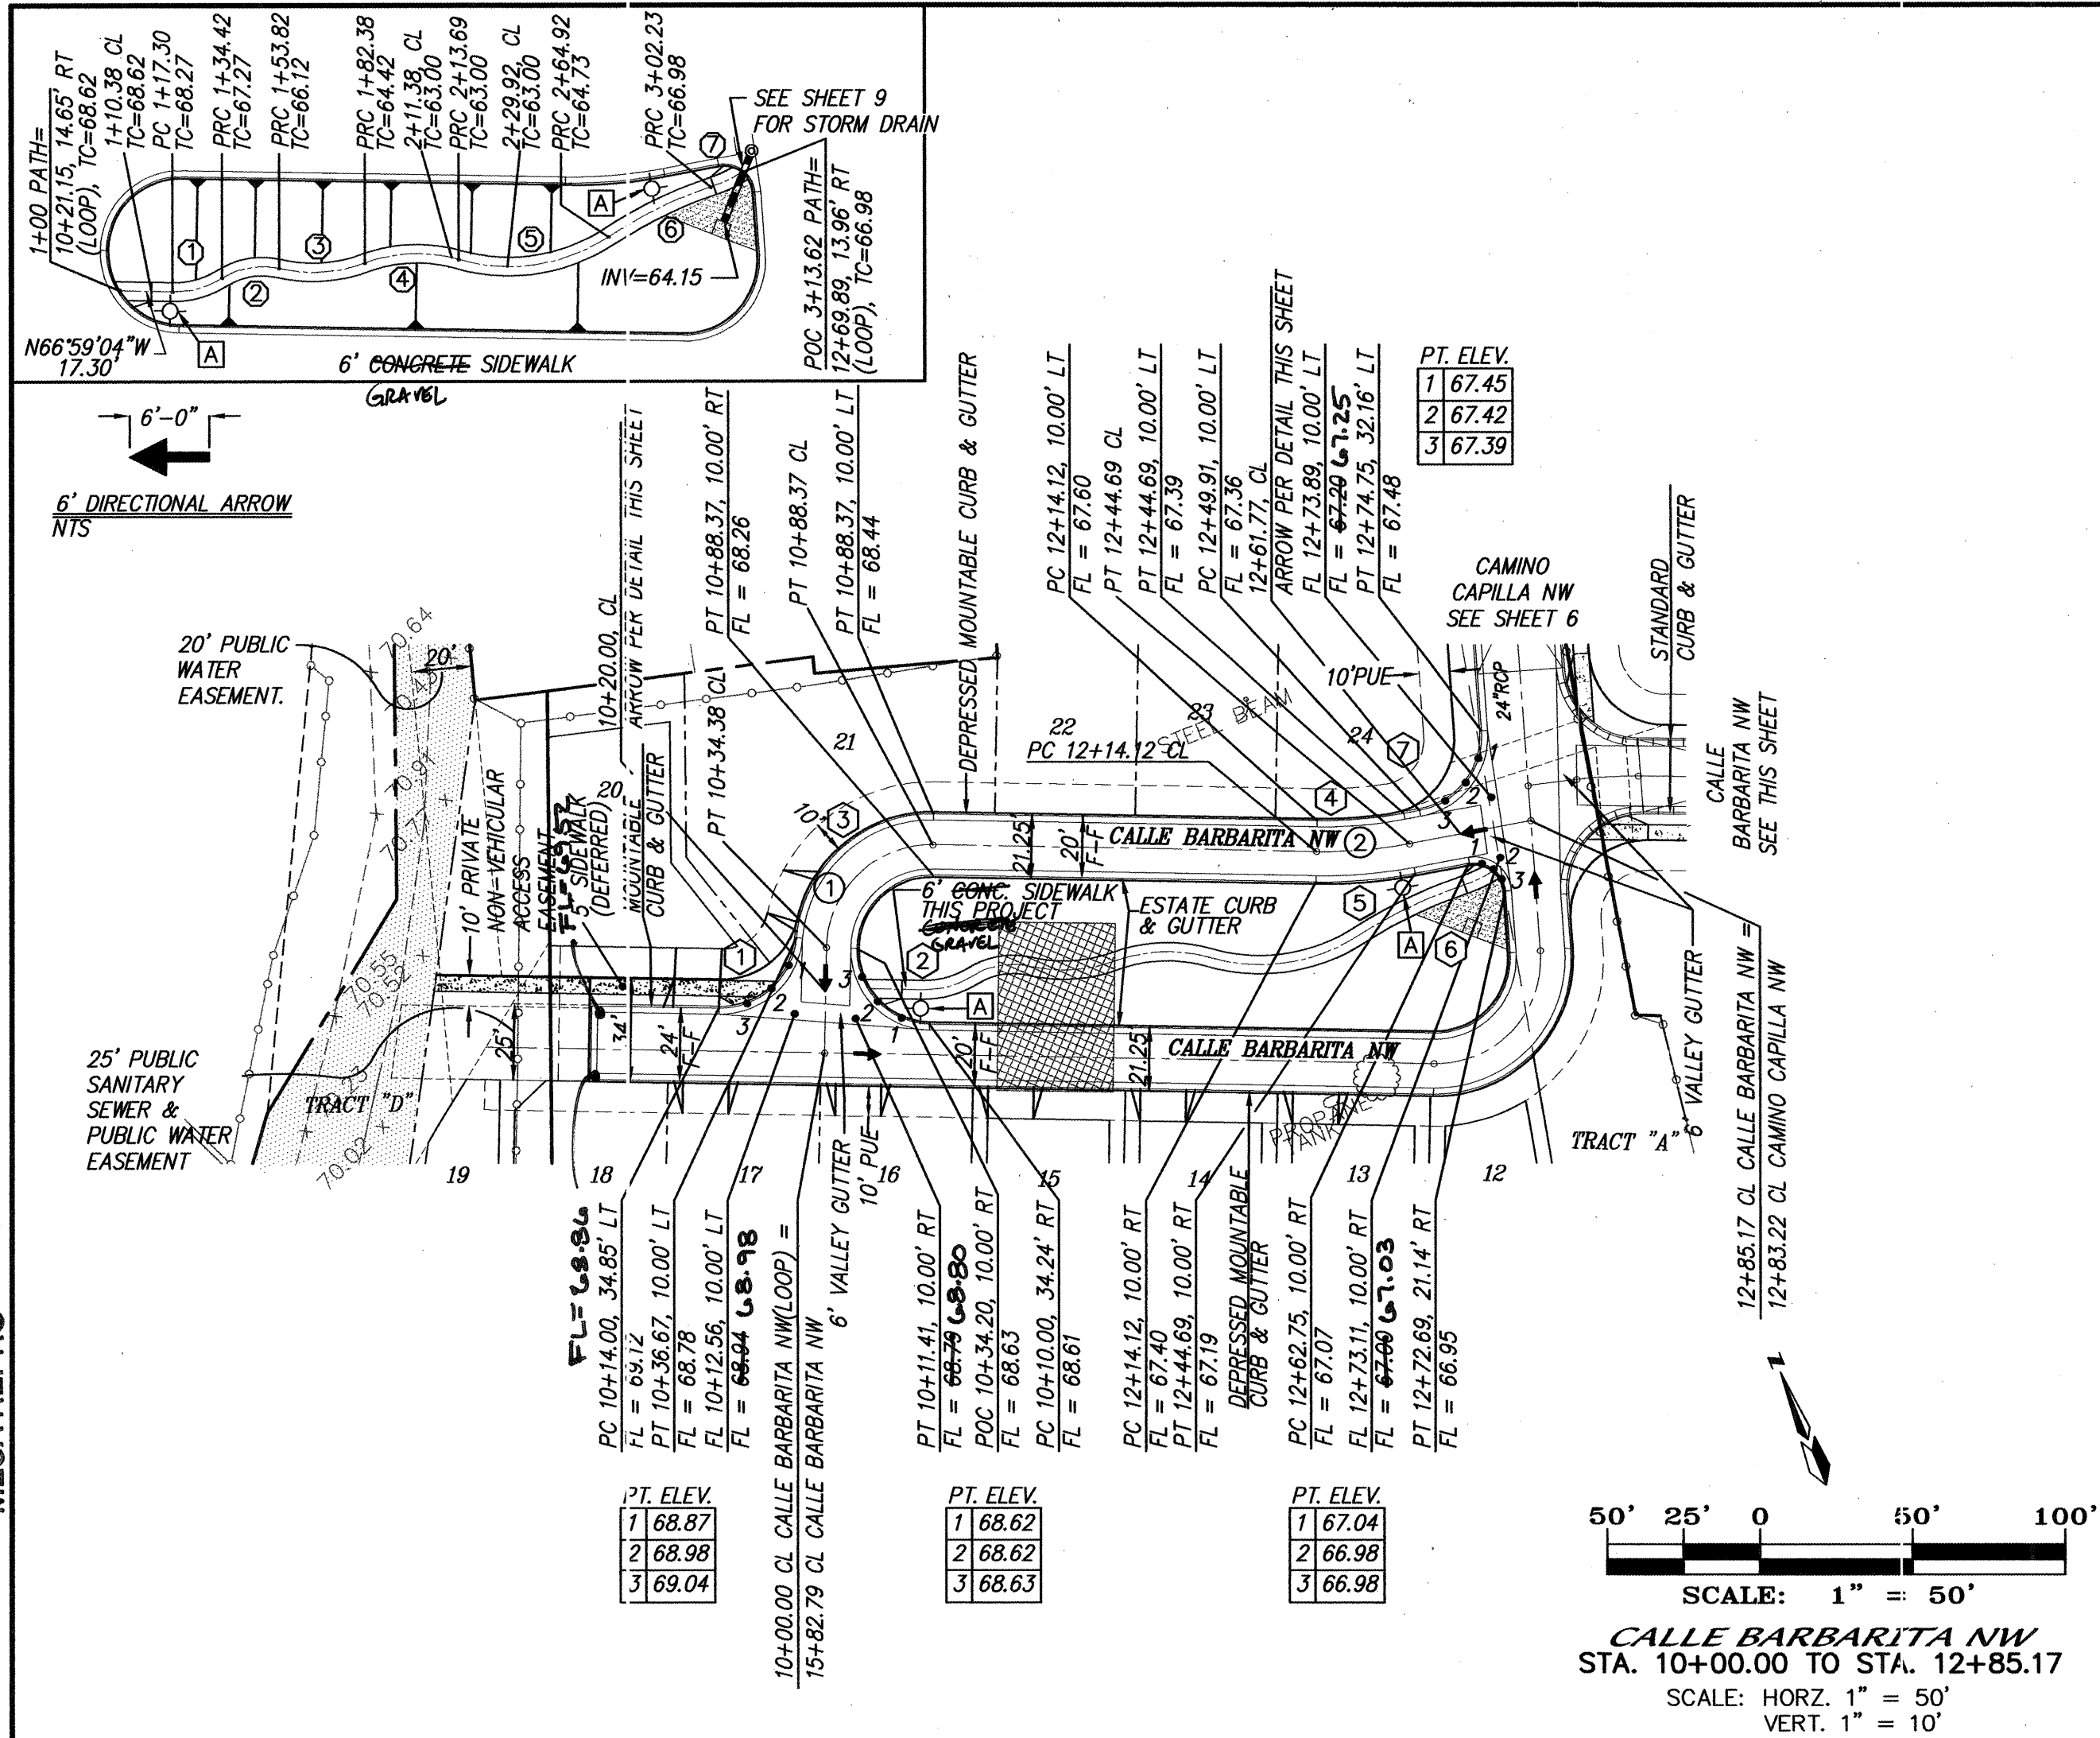

NOTES

1. ALL STATIONING IS CENTERLINE STATIONING.
2. PRIVATE STREET LIGHT

CURVE DATA - DESCRIBES CENTERLINE

1	$\Delta = 90^{\circ}00'00''$ $R = 34.38'$ $L = 54.00'$ $T = 34.38'$	2	$\Delta = 11^{\circ}40'33''$ $R = 150.00'$ $L = 30.57'$ $T = 15.34'$	3	$\Delta = 07^{\circ}45'11''$ $R = 150.00'$ $L = 20.30'$ $T = 10.16'$
4	$\Delta = 19^{\circ}27'21''$ $R = 150.00'$ $L = 50.94'$ $T = 25.72'$	5	$\Delta = 14^{\circ}29'25''$ $R = 500.00'$ $L = 126.45'$ $T = 63.57'$		

CURVE DATA - DESCRIBES FACE OF NEW CURB


1	$\Delta = 86^{\circ}10'39''$ $R = 25.00'$ $L = 37.60'$ $T = 23.39'$	2	$\Delta = 180^{\circ}00'00''$ $R = 24.39'$ $L = 24.39'$ $T = N/A$	3	$\Delta = 86^{\circ}10'39''$ $R = 25.00'$ $L = 37.60'$ $T = 23.39'$
4	$\Delta = 11^{\circ}40'33''$ $R = 140.00'$ $L = 28.53'$ $T = 14.31'$	5	$\Delta = 11^{\circ}40'33''$ $R = 160.00'$ $L = 36.43'$ $T = 17.21'$	6	$\Delta = 96^{\circ}31'07''$ $R = 10.00'$ $L = 16.85'$ $T = 11.21'$
7	$\Delta = 83^{\circ}28'53''$ $R = 25.00'$ $L = 36.43'$ $T = 22.31'$	8	$\Delta = 94^{\circ}34'35''$ $R = 25.00'$ $L = 41.27'$ $T = 27.08'$	9	$\Delta = 85^{\circ}25'25''$ $R = 25.00'$ $L = 37.27'$ $T = 23.08'$
10	$\Delta = 19^{\circ}27'21''$ $R = 138.00'$ $L = 46.86'$ $T = 23.66'$	11	$\Delta = 19^{\circ}27'21''$ $R = 162.00'$ $L = 55.01'$ $T = 27.77'$	12	$\Delta = 06^{\circ}41'28''$ $R = 488.00'$ $L = 56.99'$ $T = 28.53'$
13	$\Delta = 82^{\circ}57'00''$ $R = 25.00'$ $L = 36.19'$ $T = 22.10'$	14	$\Delta = 12^{\circ}08'45''$ $R = 512.00'$ $L = 108.54'$ $T = 54.47'$	15	$\Delta = 17^{\circ}24'29''$ $R = 25.00'$ $L = 7.60'$ $T = 3.83'$
16	$\Delta = 27^{\circ}54'12''$ $R = 40.00'$ $L = 191.92'$ $T = N/A$				

CURVE DATA - DESCRIBES CENTERLINE OF PATH

1	$\Delta = 32^{\circ}41'55''$ $R = 30.00'$ $L = 17.12'$ $T = 8.80'$	2	$\Delta = 44^{\circ}28'09''$ $R = 25.00'$ $L = 19.40'$ $T = 10.22'$	3	$\Delta = 32^{\circ}41'55''$ $R = 30.00'$ $L = 17.12'$ $T = 8.80'$
4	$\Delta = 36^{\circ}52'31''$ $R = 50.00'$ $L = 31.31'$ $T = 14.68'$	5	$\Delta = 48^{\circ}55'31''$ $R = 60.00'$ $L = 51.23'$ $T = 27.30'$	6	$\Delta = 141^{\circ}43'7''$ $R = 150.00'$ $L = 37.30'$ $T = 18.75'$
7	$\Delta = 13^{\circ}03'02''$ $R = 50.00'$ $L = 11.39'$ $T = 5.72'$				

CERTIFICATE OF SUBSTANTIAL COMPLIANCE ON PLANS

I, Mark Goodwin, NMPE 8948, of the firm Mark Goodwin & Associates, P.A., a Registered Professional Engineer in the State of New Mexico, do hereby certify, to the best of my knowledge and belief, that the infrastructure installed as part of this project has been inspected by me or by a qualified person under my direct supervision, and has been constructed in accordance with the plans and specifications approved by the City Engineer and that the original design intent of the approved plans has been met, except as noted by me on the as-built construction drawings. This Certification is based on site inspections by me or personnel under my direction, and survey information provided by A.L.S. Inc., NMPS number 7719.

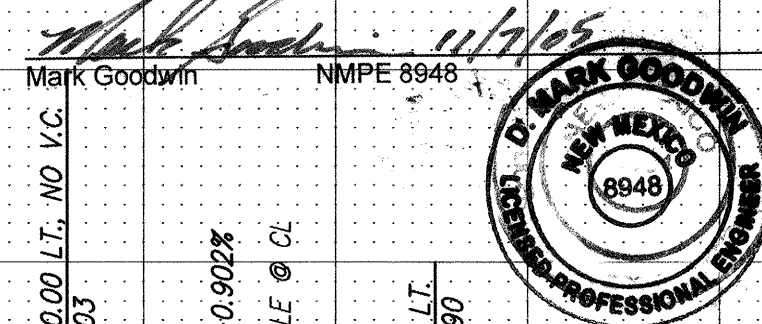


NGVD 29

MARK GOODWIN & ASSOCIATES, P.A.
CONSULTING ENGINEERS
P.O. BOX 90606
ALBUQUERQUE, NEW MEXICO 87199
(505) 828-2200, FAX (505) 797-9539

CITY OF ALBUQUERQUE
PUBLIC WORKS DEPARTMENT

TITLE: VILLA DE LA CAPILLA
CALLE BARBARITA NW
PAVING IMPROVEMENTS

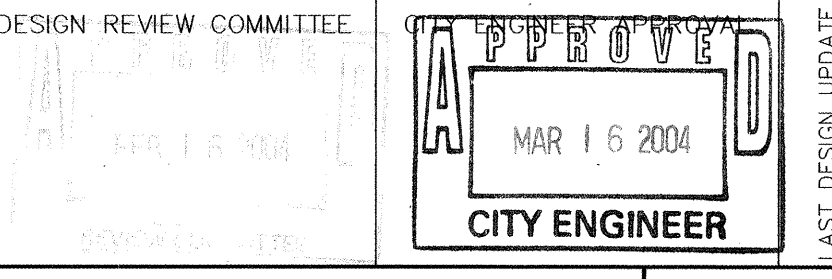

CITY PROJECT NO. 729981


ZONE MAP NO. F-13-Z

SHEET 7 OF 11

FILED 08/08/2020 05:40:02 PM A03027-M-UTIL-02-12-04/ M.J.R. DER

SCANNED BY
MESA REPRO

LEGEND	
-5190-	CONTOUR (MAJOR)
-5189-	CONTOUR (MINOR)
TC=	TOP CURB
FL=	FLOWLINE
x 00.00	SPOT ELEV
—○—	CHAIN LINK FENCE
—x—x—	WOOD FENCE
==	CURB AND GUTTER
	CONCRETE/SIDEWALK
=====	ADOBE WALL
•	WOOD BOLLARD
○	TRAFFIC SIGN
○	TREE
○	SANITARY SEWER MANHOLE
○	CLEANOUT
○	WATER VALVE
○	FIRE HYDRANT
○	WATER METER
---E&T---	OVERHEAD UTILITY LINES
○	SERVICE POLE OVERHEAD ELECTRIC
□	LIGHT POLE
○	TELEPHONE MANHOLE
□	TELEPHONE PEDESTAL
○	GAS METER
○	STORM DRAIN MANHOLE
□	DROP INLET
□	WHEEL CHAIR RAMP
•	NEW SAS MANHOLE
•	NEW SD MANHOLE
18	LOT NUMBER
—8"SAS—	NEW 8" SAS
—6"W—	NEW 6" WATERLINE
S	NEW SEWER SERVICE
□	NEW SINGLE WATER METER
□	NEW DOUBLE WATER METER
○	NEW STREET LIGHT
•	NEW FIRE HYDRANT
---	EXISTING SAS SERVICE(GRIEGOS RD.)
---	EXISTING WATER SERVICE(GRIEGOS RD.)

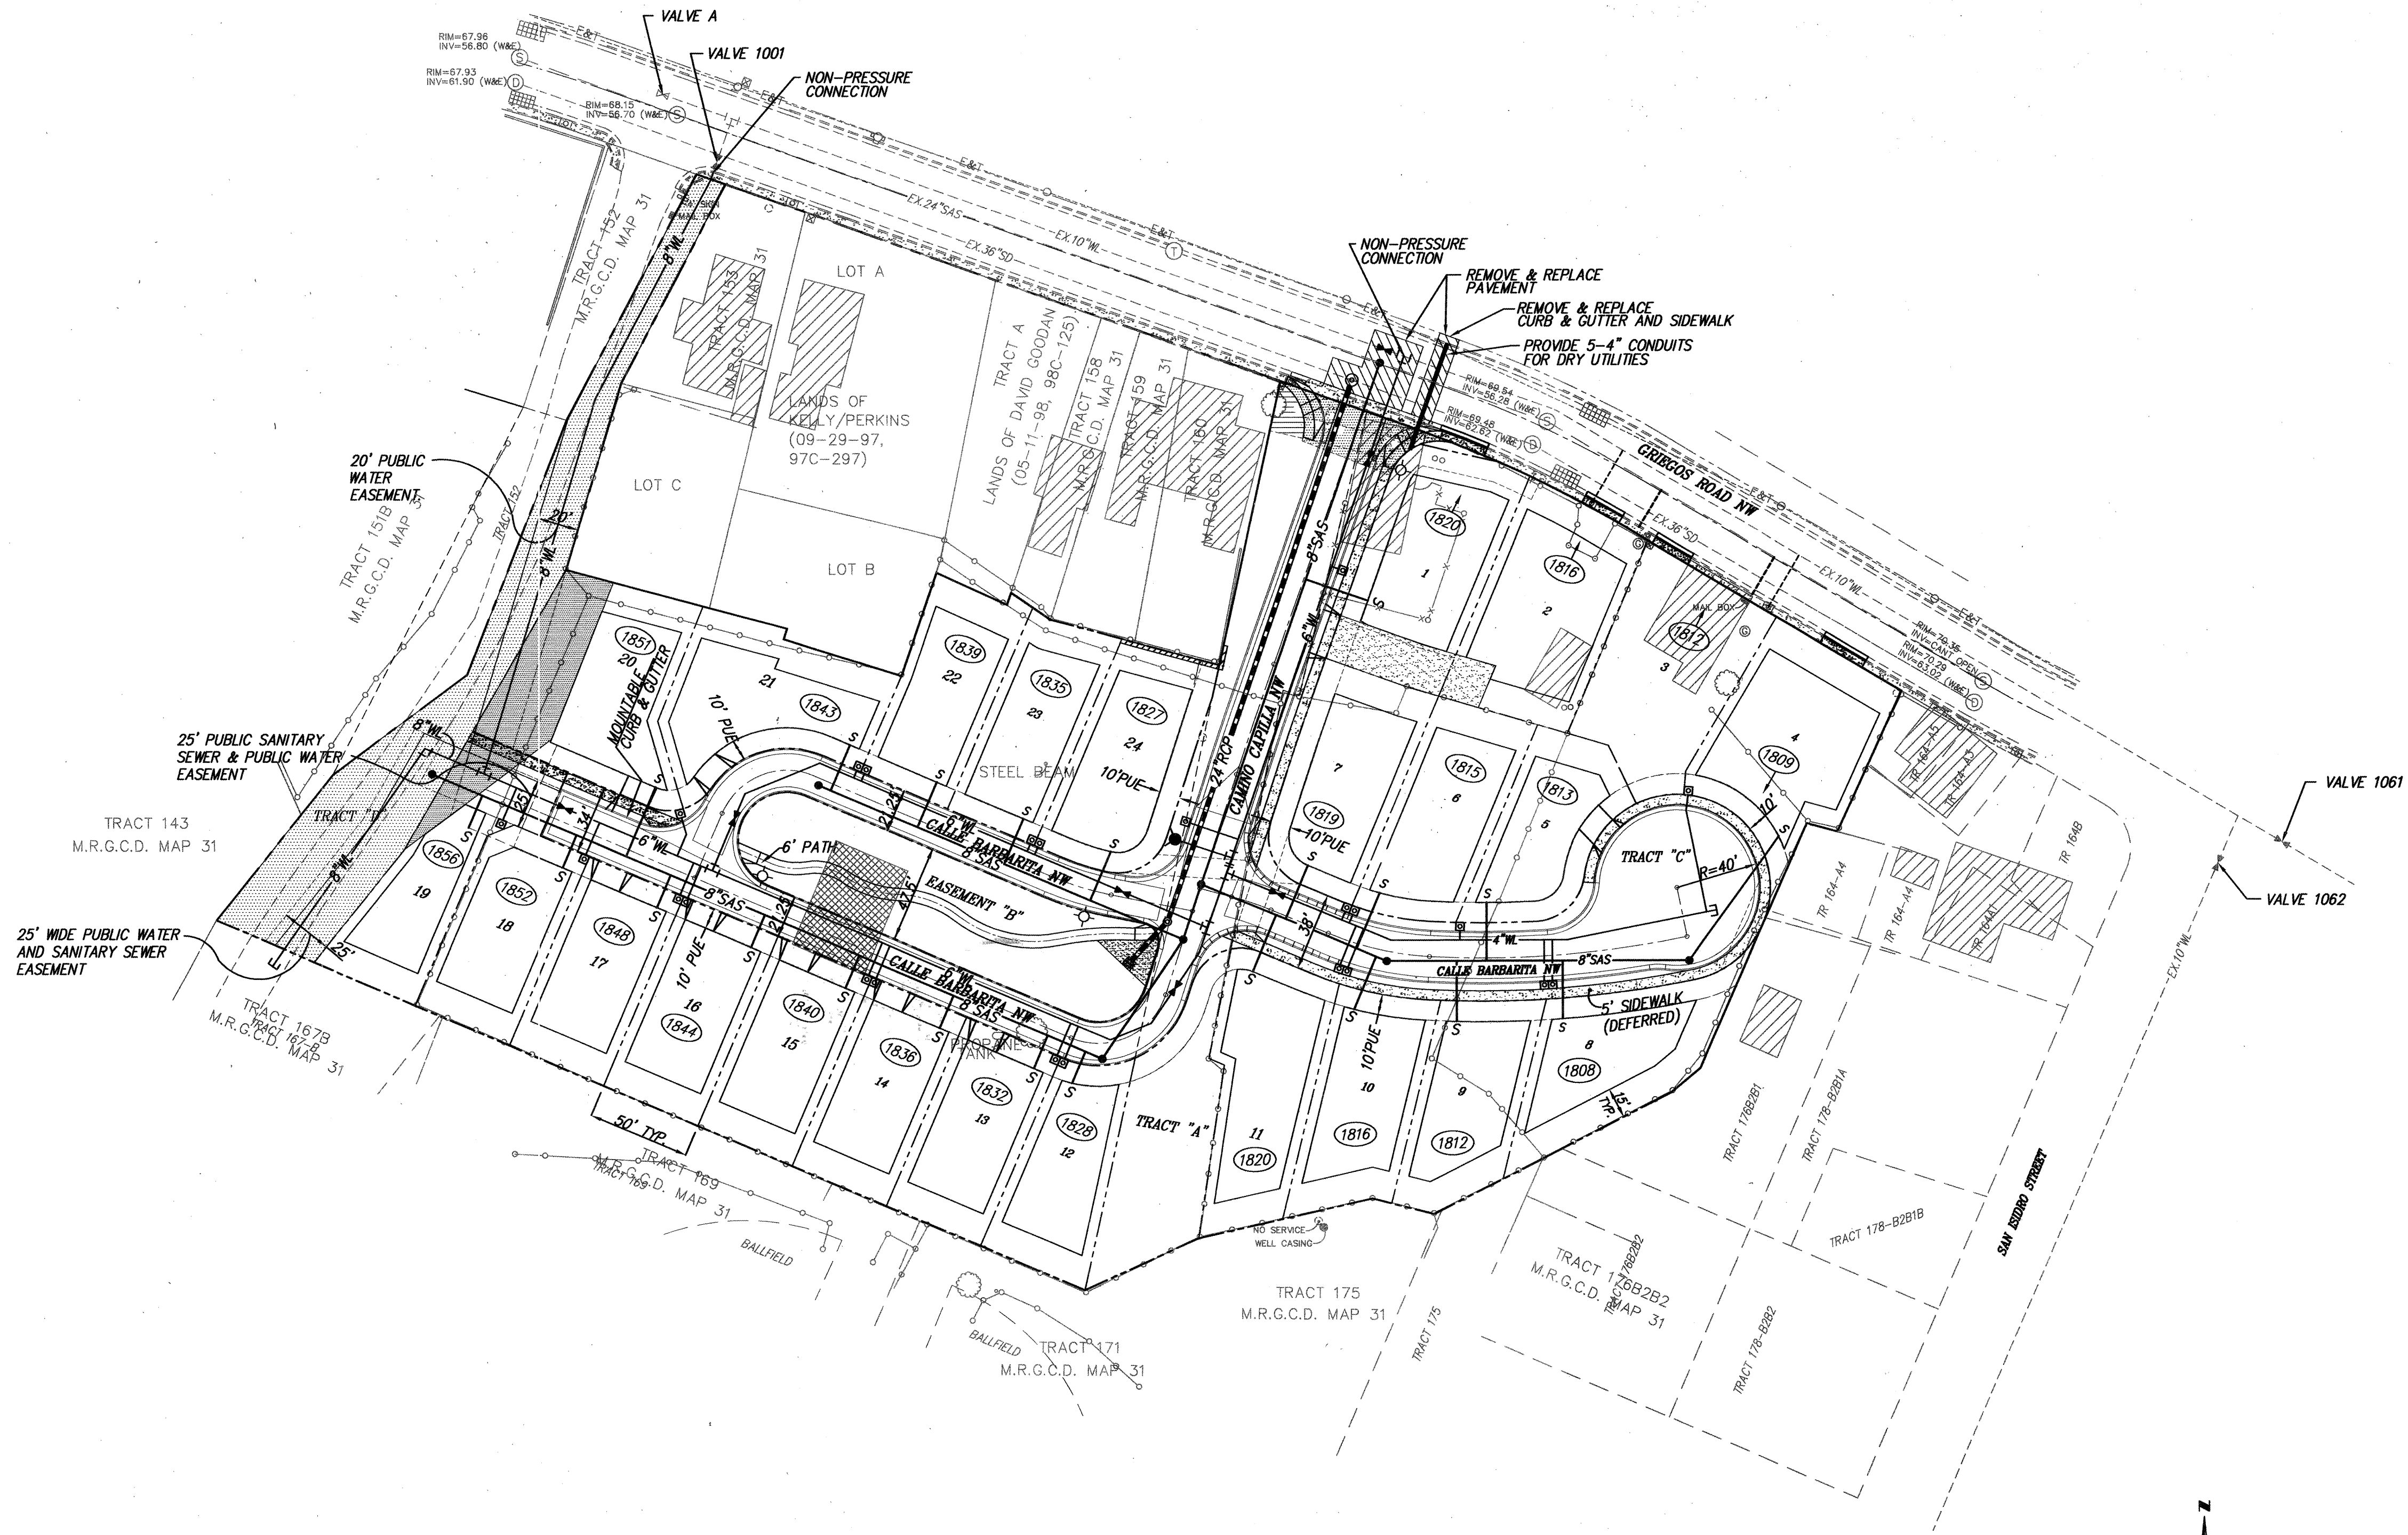

FOR ALL METERS:

1. INSTALL DUAL CHECK VALVES ON METER SETTER PER CITY SPEC 802-3.9.
2. INSTALL HEAVY WEIGHT COVER & LID PER STANDARD DWG #2369 AND INSTALL TRAFFIC RATED BOX.

CERTIFICATE OF SUBSTANTIAL COMPLIANCE ON PLANS


I, Mark Goodwin, NMPE 8948, of the firm Mark Goodwin & Associates, P.A., a Registered Professional Engineer in the State of New Mexico, do hereby certify, to the best of my knowledge and belief, that the infrastructure installed as part of this project has been inspected by me or by a qualified person under my direct supervision, and has been constructed in accordance with the plans and specifications approved by the City Engineer and that the original design intent of the approved plans has been met, except as noted by me on the as-built and survey information provided by ALS, Inc., NMPS number 7719.

Mark Goodwin
Mark Goodwin NMPE 8948



VALVE SHUT-OFF PLAN

1. CONTRACTOR WILL CONTACT WATER SYSTEMS AT 857-8200 7 DAYS PRIOR TO NECESSARY SHUT-OFF.
2. VALVES SHALL ONLY BE OPERATED BY CITY WATER EMPLOYEES. SEE THIS SHEET FOR VALVE NUMBERS AND LOCATIONS.
3. FOR CAMINO CAPILLA, NON-PRESSURE CONNECTION TO EXISTING 10" CAST IRON WATERLINE IN GRIEGOS. CLOSE VALVES 1061, 1062, 1001 AND A.
4. FOR STREET TO CHURCH, NON-PRESSURE CONNECTION TO EXISTING 8" WATERLINE TEE FROM GRIEGOS ROAD. CLOSE VALVE 1001.

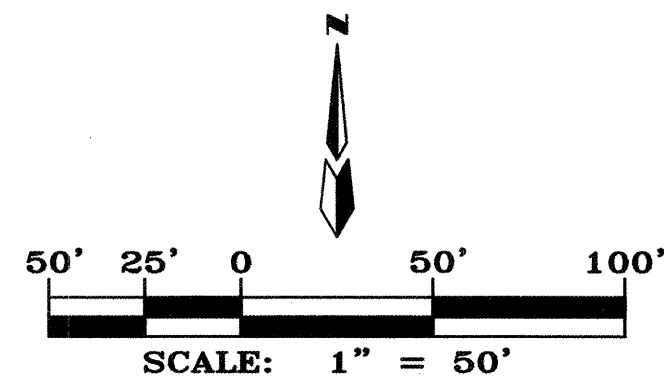


dmg MARK GOODWIN & ASSOCIATES, P.A. CONSULTING ENGINEERS P.O. BOX 90606 ALBUQUERQUE, NEW MEXICO 87199 (505) 828-2200, FAX (505) 797-9539	
CITY OF ALBUQUERQUE PUBLIC WORKS DEPARTMENT	
TITLE: VILLA DE LA CAPILLA MASTER UTILITY PLAN	
DESIGN REVIEW COMMITTEE APPROVED FEB 16 2004	CITY ENGINEER APPROVAL APPROVED MAR 16 2004 CITY ENGINEER
CITY PROJECT NO. 729981	ZONE MAP NO. F-13-Z
SHEET 8 OF 11	

AS BUILT INFORMATION	
CONTRACTOR	Sundance
WORK STAKED BY	ALS
DATE	DATE
FIELD ACCEPTANCE BY	ALS
DATE	DATE
FIELD LOCATION BY	ALS
DATE	DATE
DRAWINGS CORRECTED BY	ALS
DATE	DATE
MICRO-FILM INFORMATION	
RECORDED BY	NO.
DATE	DATE





BENCH MARKS	
THE STATION IS LOCATED 3.7 MILES NORTH OF DOWNTOWN ALBUQUERQUE, AT THE N.E. CORNER OF THE INTERSECTION OF GRIEGOS ROAD NW AND RIO GRANDE BLVD NE. TO REACH THIS STATION FROM THE INTERCHANGE AT I-40 AND RIO GRANDE NW, GO NORTH ON RIO GRANDE 2.3 MILES TO THE STATION ON THE RT. THE STATION IS A STAMPED ACS CAP STAMPED "11-FEB 1985". SET IN TOP OF SIDEWALK ELEVATION = 4971.00 IN FEET. (S.D. 1929)	

SURVEY INFORMATION	
FIELD NOTES	BY
NO.	DATE

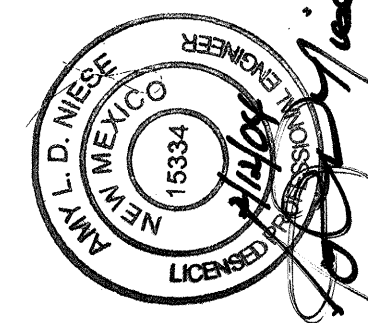

REVISIONS	NO.	DATE	BY
DESIGN	1	12/03	ALD
REVISIONS	2	12/03	AJR
DESIGN	3	12/03	DMG


SCANNED BY
MESA BEBBO

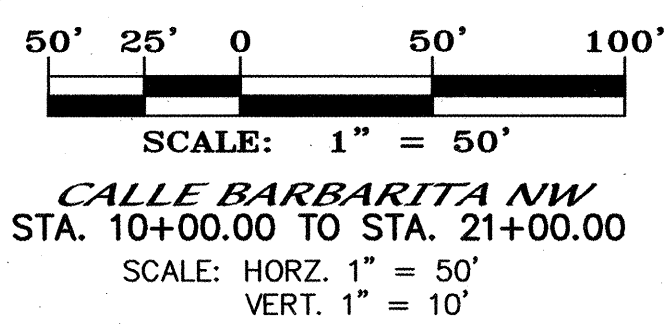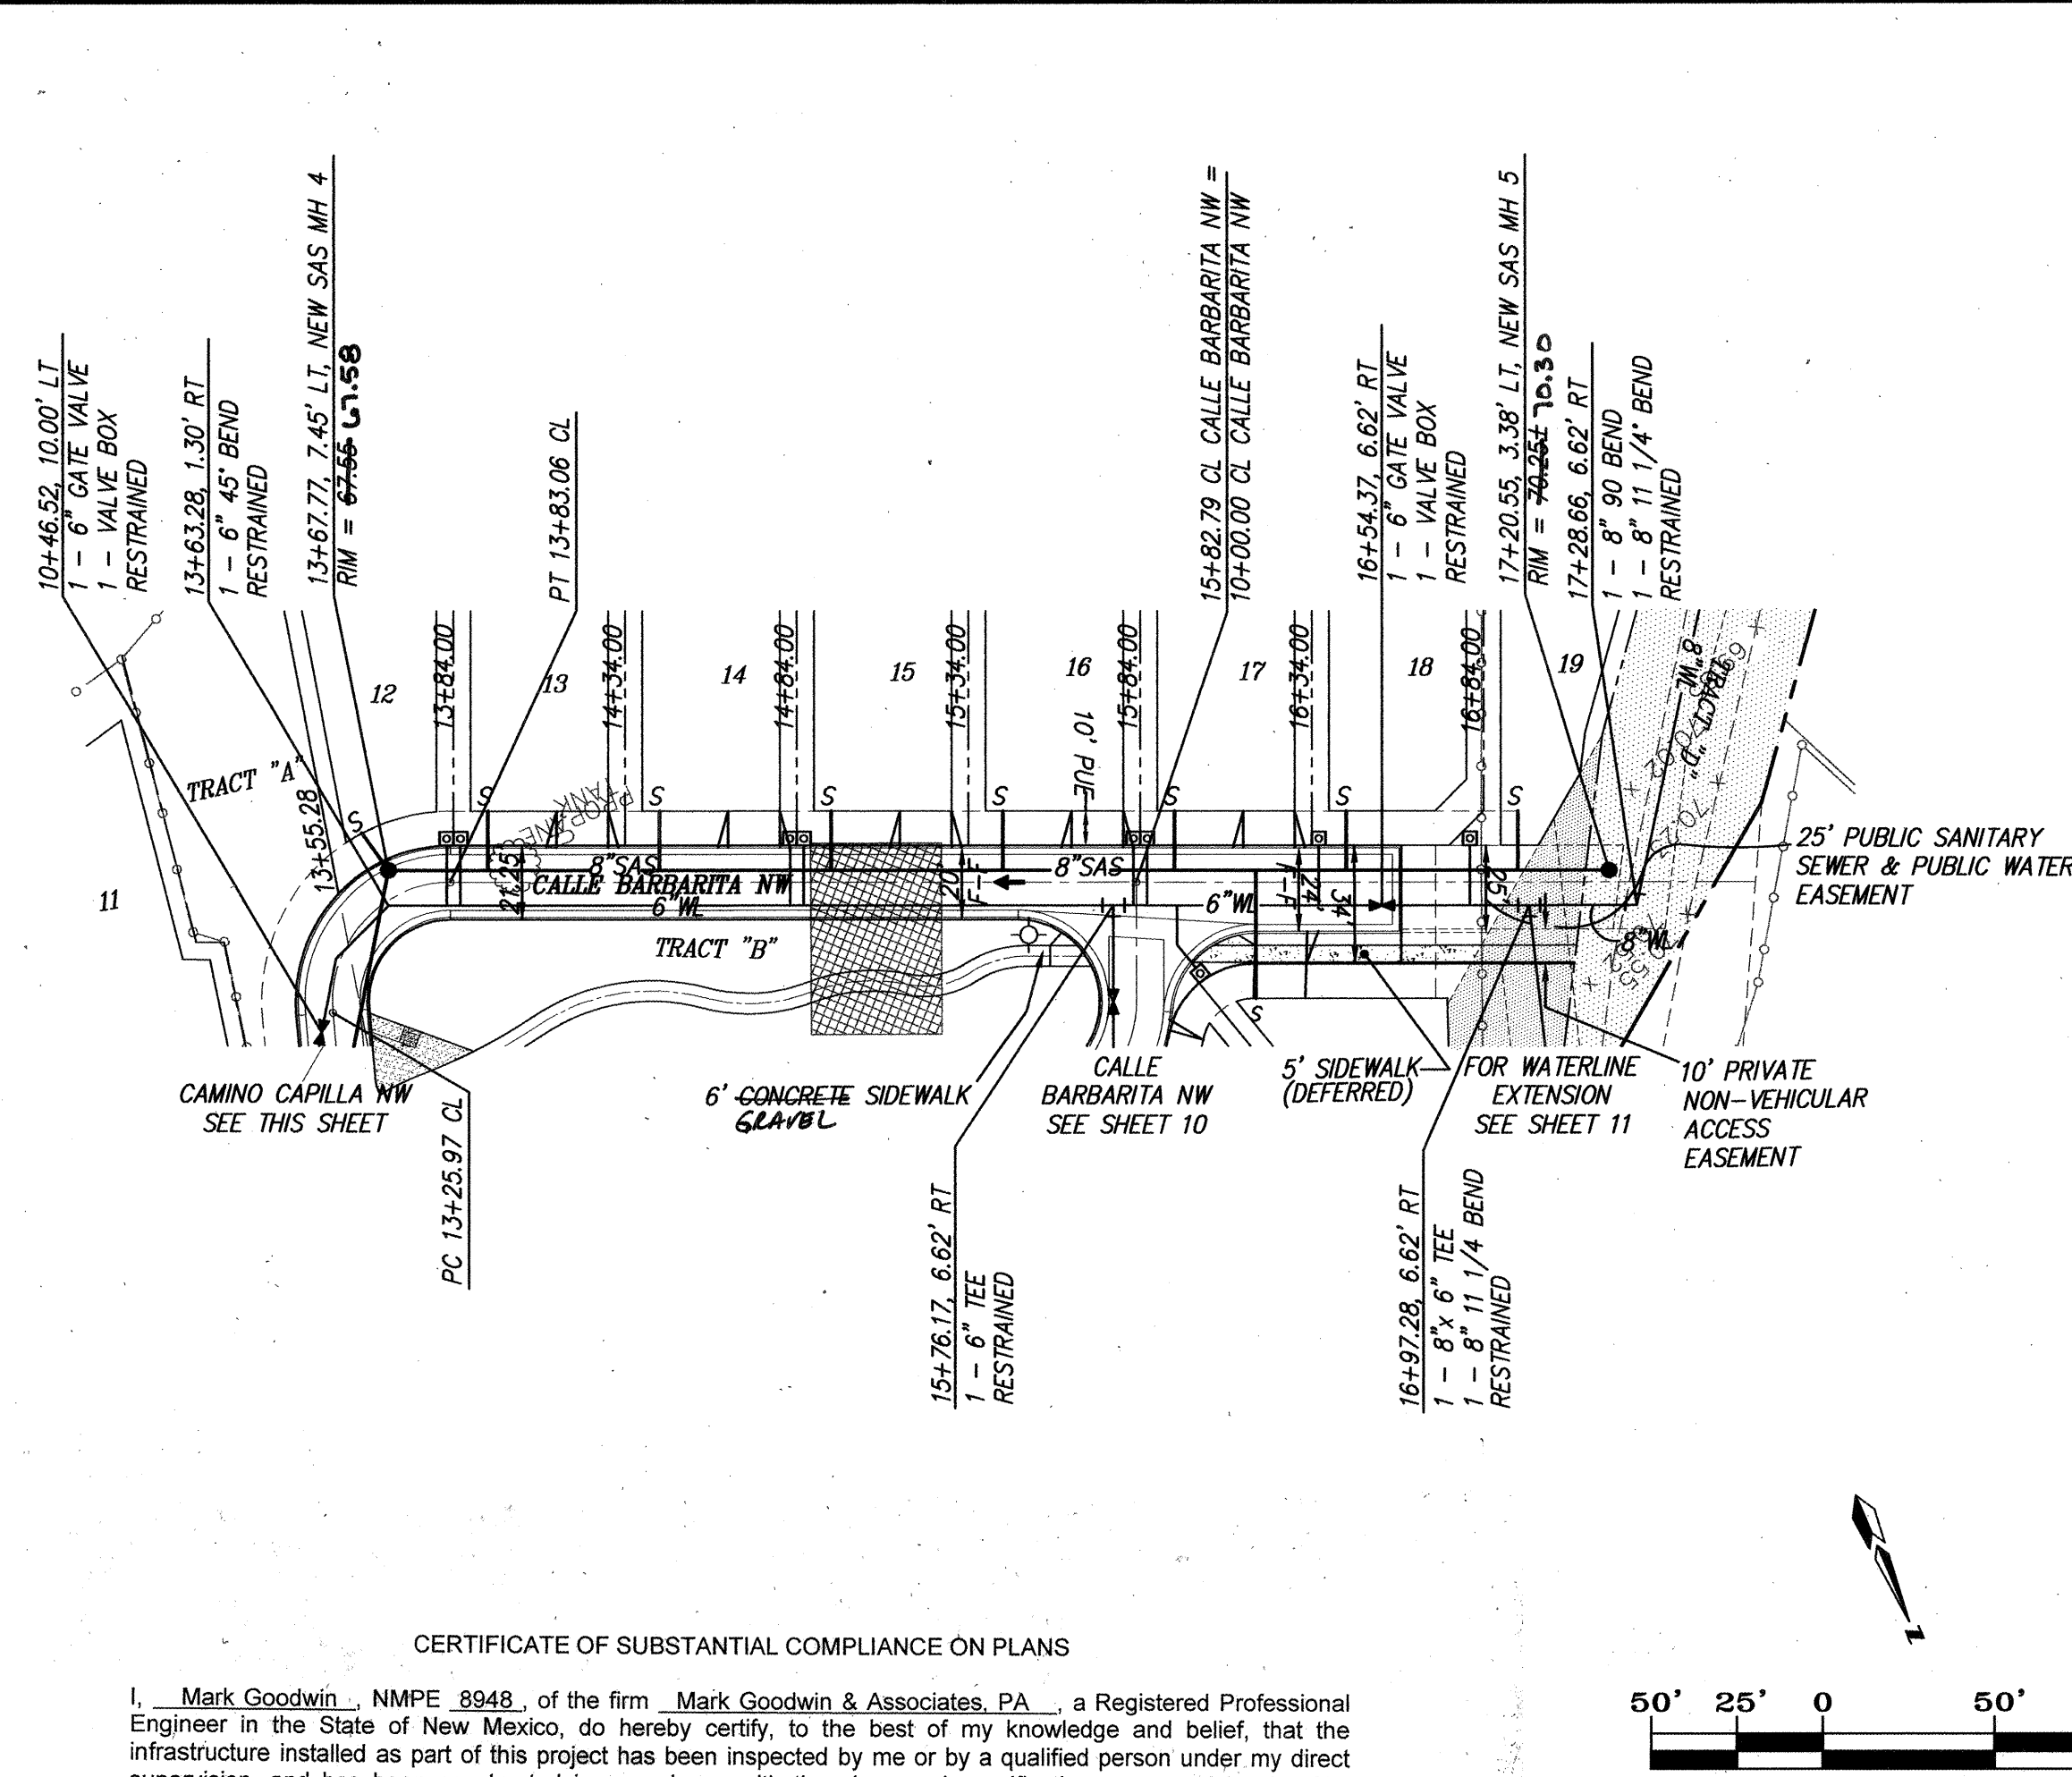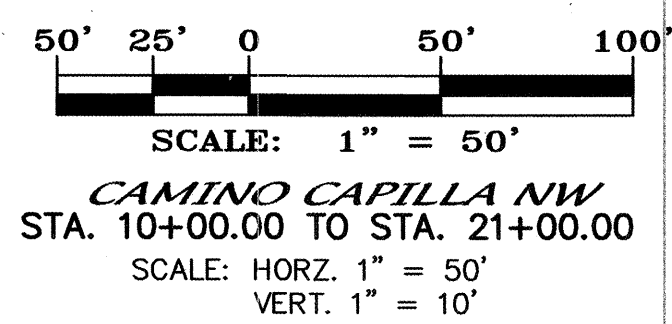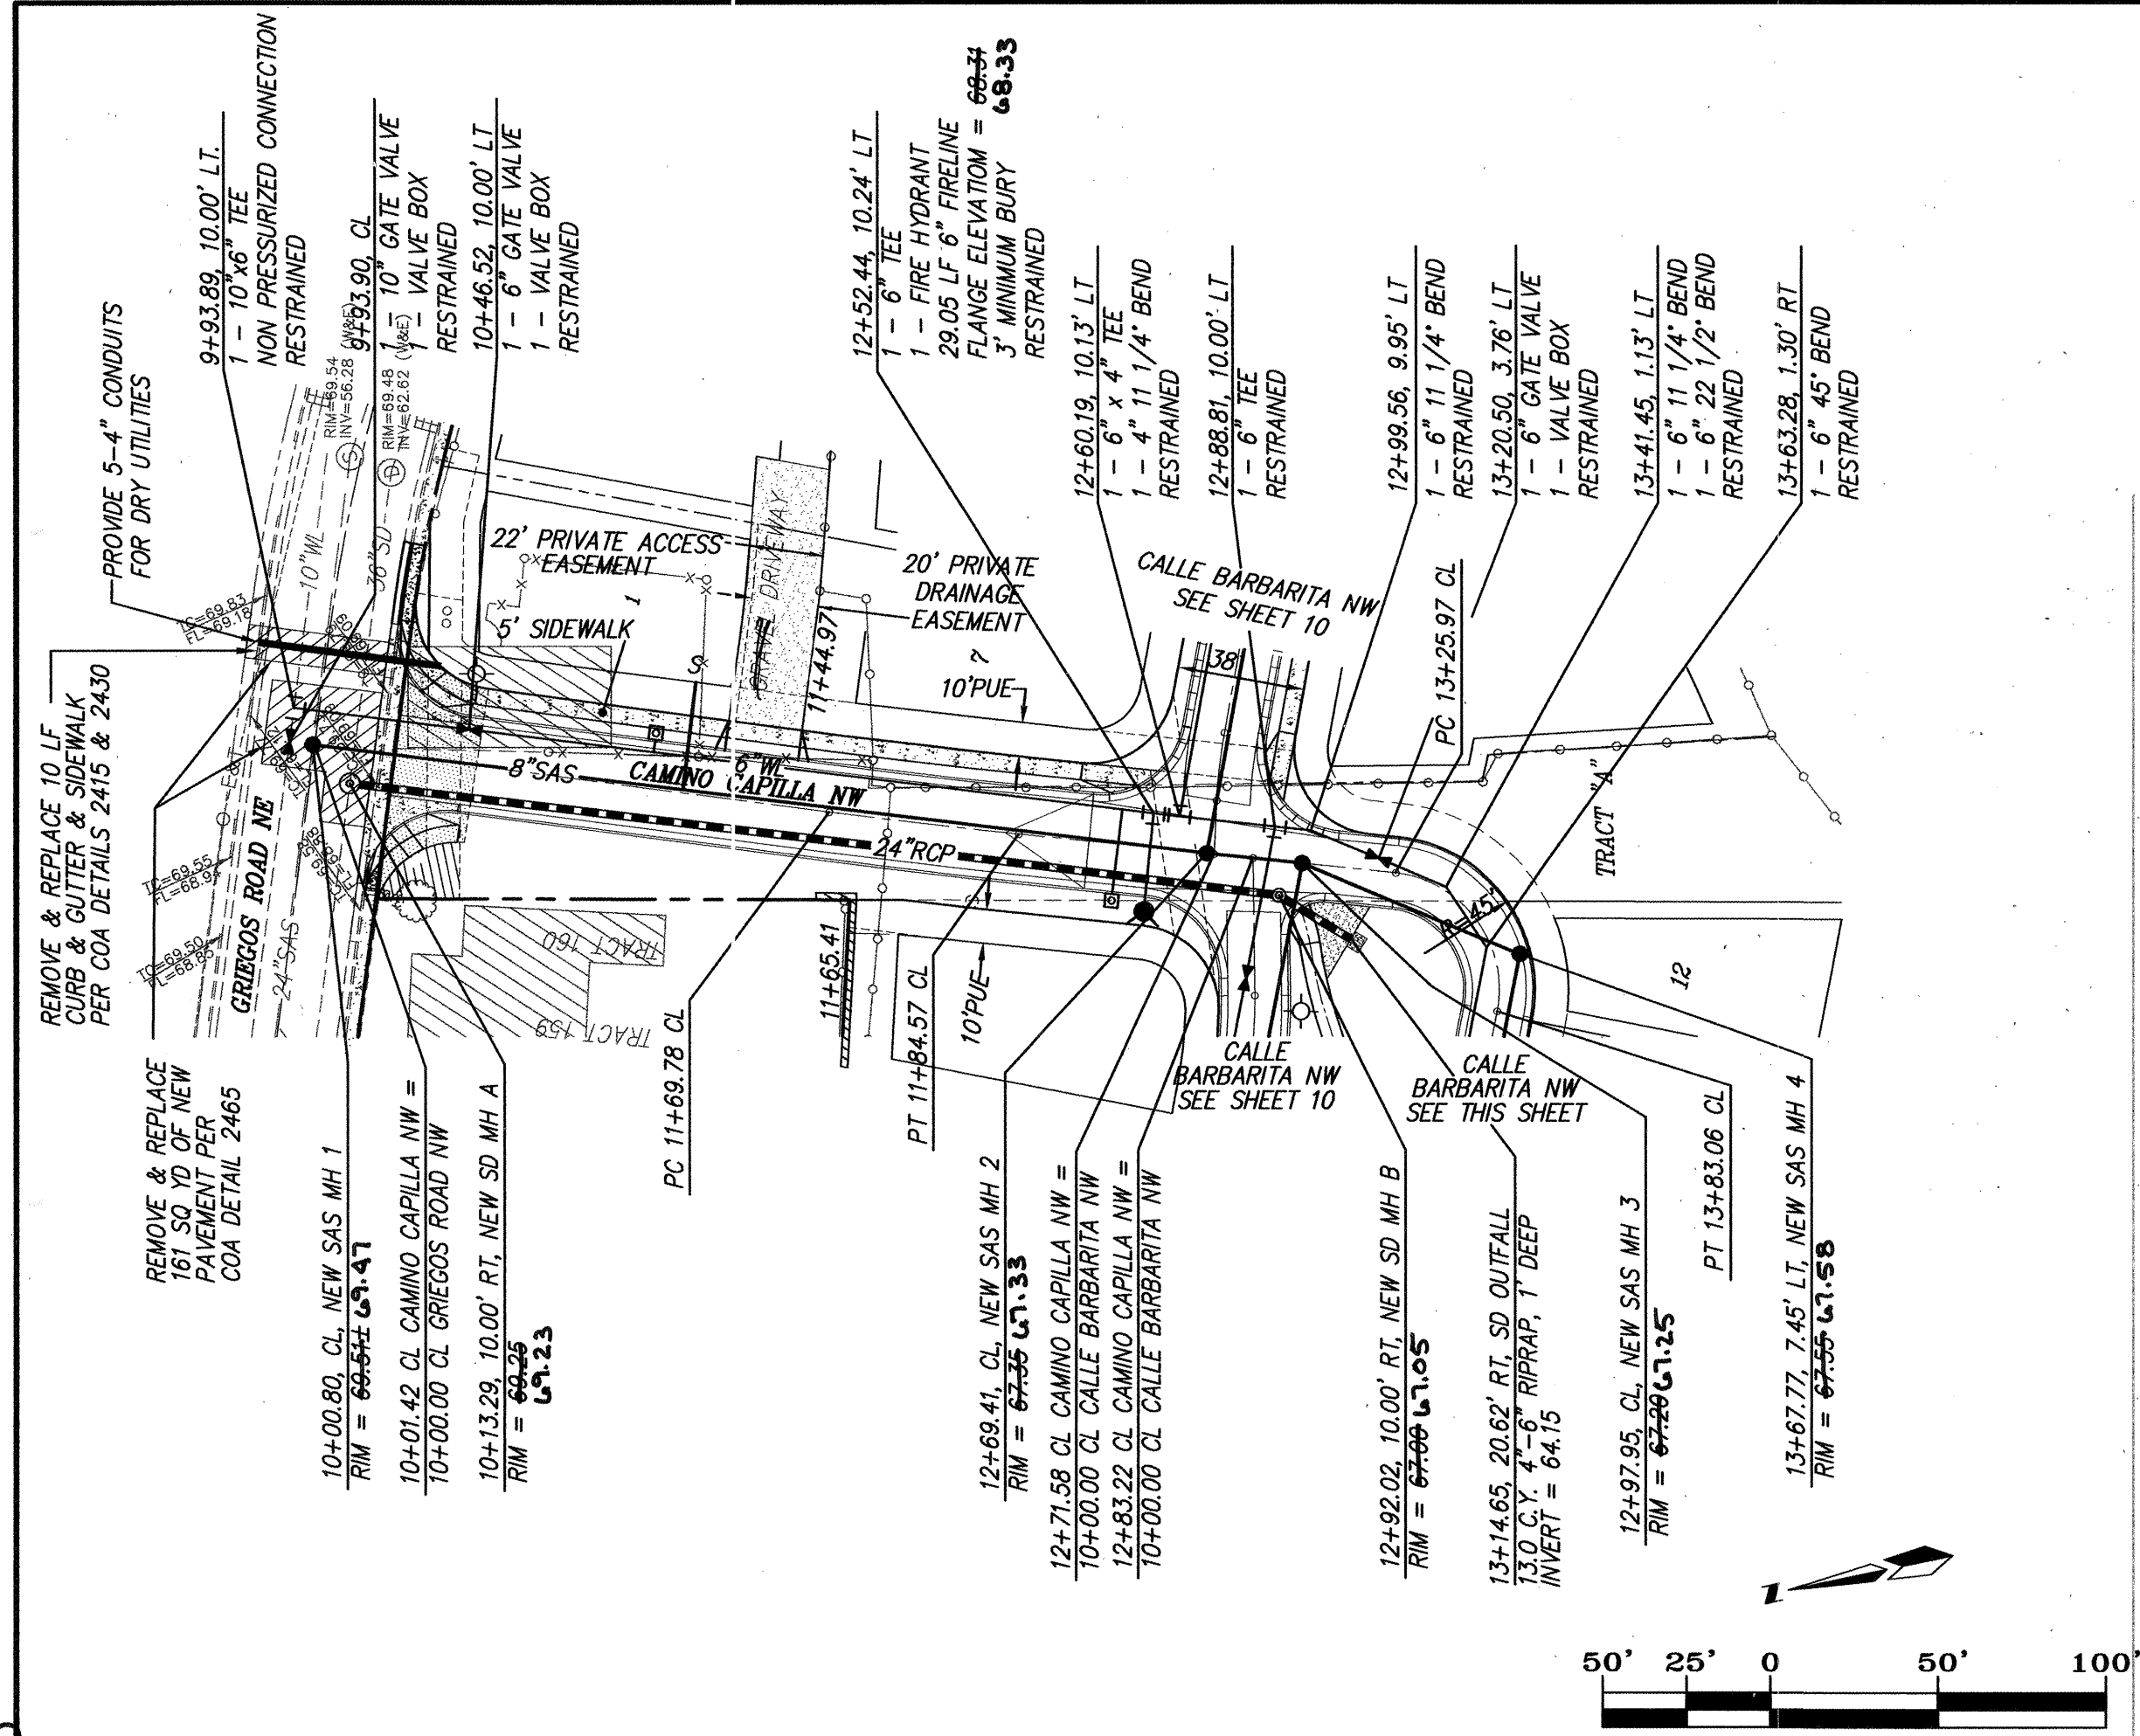

CERTIFICATE OF SUBSTANTIAL COMPLIANCE ON PLANS

I, Mark Goodwin, NMPE 8948, of the firm Mark Goodwin & Associates, P.A., a Registered Professional Engineer in the State of New Mexico, do hereby certify, to the best of my knowledge and belief, that the infrastructure installed as part of this project has been inspected by me or by a qualified person under my direct supervision, and has been constructed in accordance with the plans and specifications approved by the City Engineer and that the original design intent of the approved plans has been met, except as noted by me on the as-built construction drawings. This Certification is based on site inspections by me or personnel under my direction, and survey information provided by number 7719.

Mark Goodwin NMPE 8948

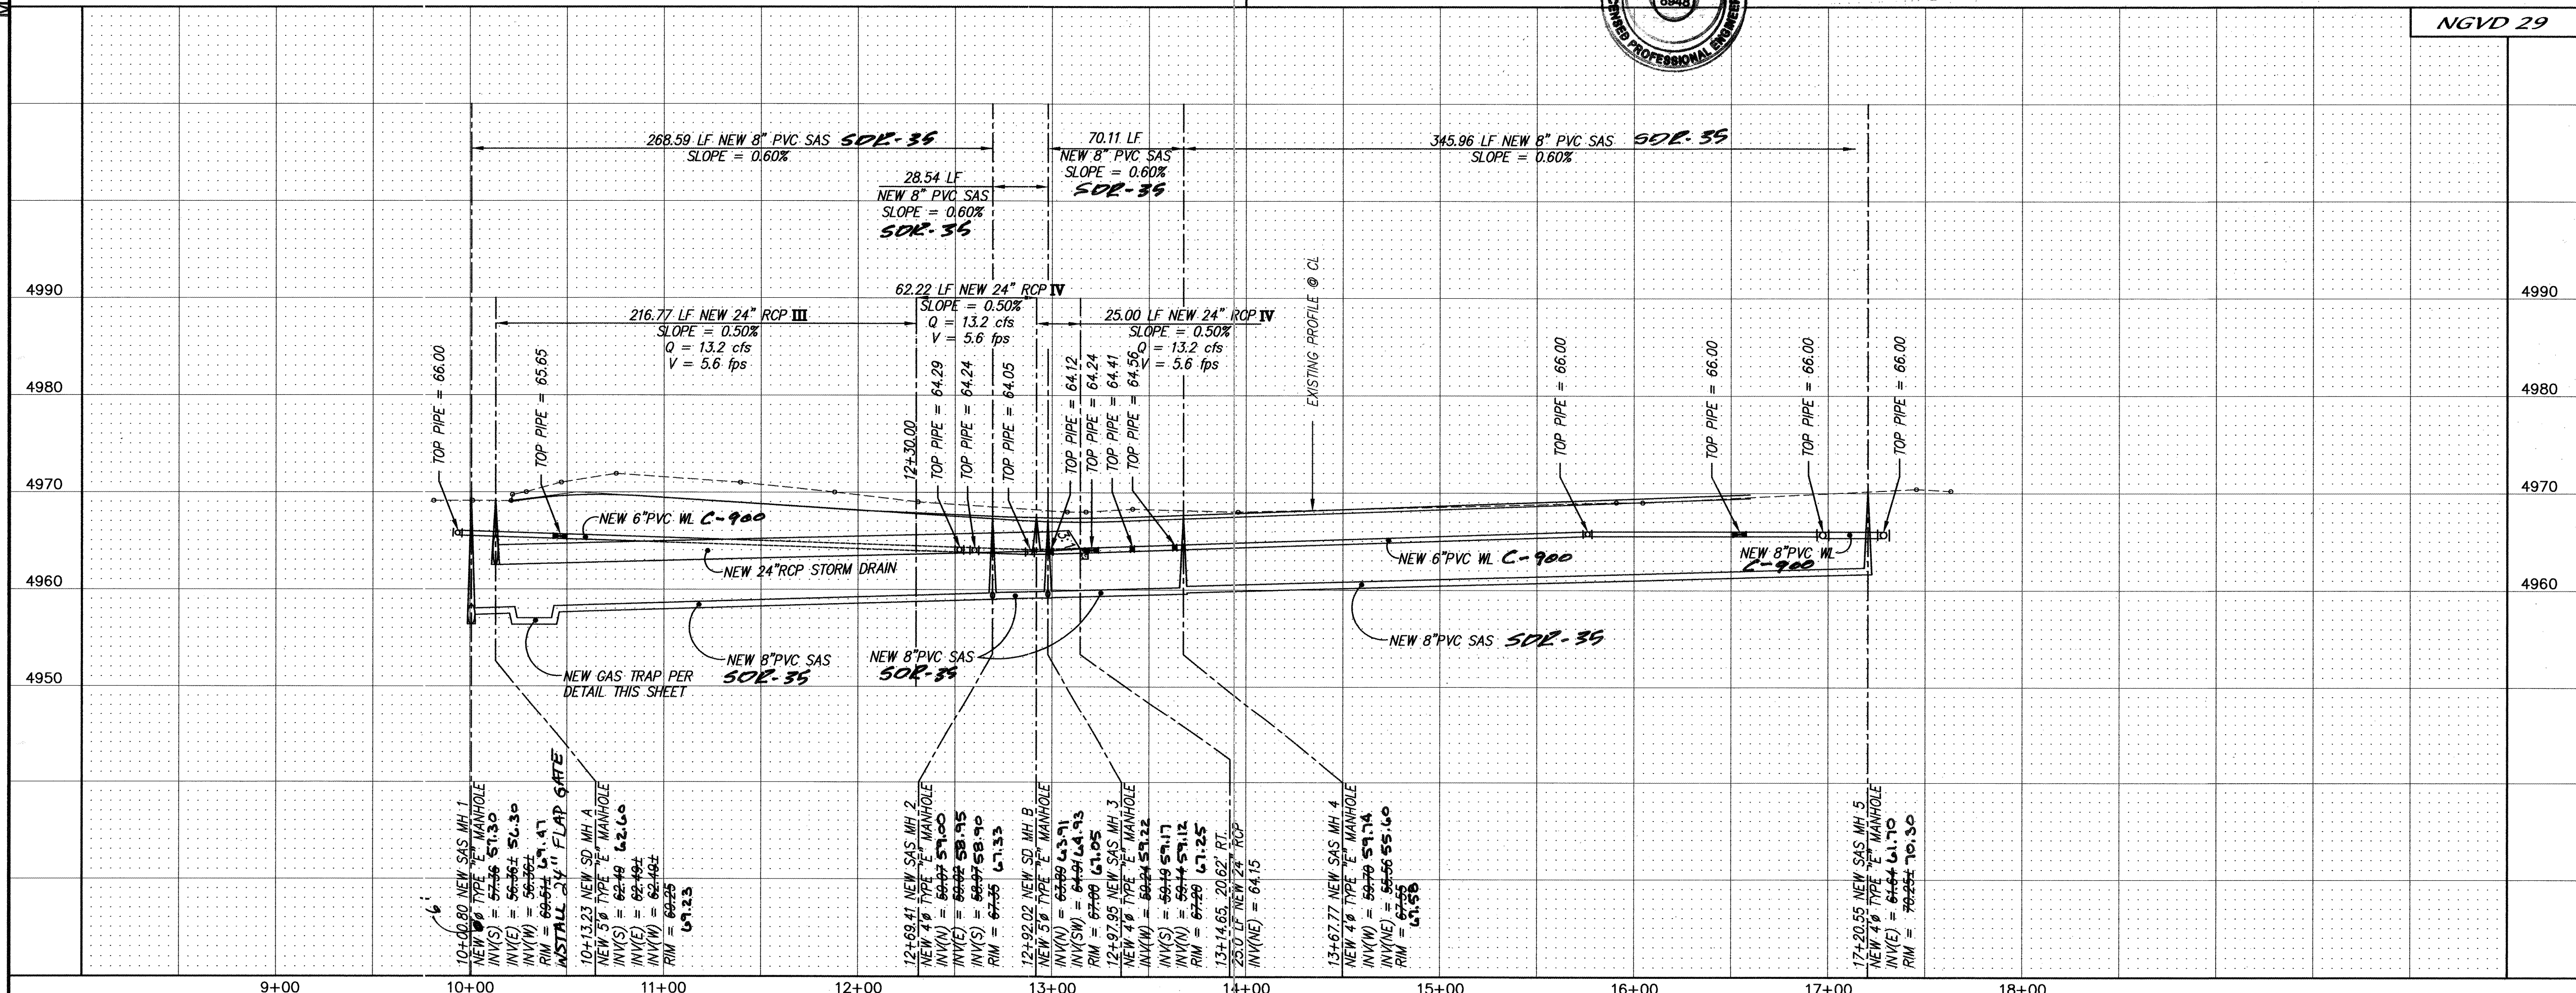

NOTES

1. ALL STATIONING IS CENTERLINE STATIONING.
2. 3" MINIMUM COVER ON ALL WATERLINES.

SANITARY SEWER SERVICES

BLOCK	LOT	STATION AT PUE	INV. ELEV. AT PUE	LENGTH AT PUE
	1	11+11.71	1	33.0'
	12	13+66.33	1	13.34'
	13	13+94.00	1	17.25'
	14	14+44.00	1	17.25'
	15	14+94.00	1	17.25'
	16	15+44.00	1	17.25'
	17	15+94.00	1	17.25'
	18	16+44.00	1	17.25'
	19	16+94.00	1	17.25'
	20	16+17.66	1	36.75'

PIPE SIZE	90"	45"	22.5"	11.25"	VALVE
4"	12'	5'	2'	1'	32'
6"	17'	7'	3'	2'	46'
8"	22'	9'	4'	2'	60'
10"	26'	11'	5'	3'	72'

LENGTH OF RESTRAINED PIPE ON EACH SIDE OF THE BEND. RESTRAIN BRANCH AT FITTING ONLY MINIMUM ATTACHED PIPE LENGTH, RUN SIDE OF TEE: 10.00 FEET.

PIPE SIZE	RUN	BRANCH
10"x10"x10"	15'	5'
10"x10"x6"	6'	1'
8"x8"x6"	7'	5'
6"x6"x6"	10'	2'
6"x6"x4"	4'	7'

MARK GOODWIN & ASSOCIATES, P.A.
CONSULTING ENGINEERS
P.O. BOX 90606
ALBUQUERQUE, NEW MEXICO 87199
(505) 828-2200, FAX (505) 797-9539

CITY OF ALBUQUERQUE
PUBLIC WORKS DEPARTMENT



TITLE: **VILLA DE LA CAPILLA
CAMINO CAPILLA NW & CALLE BARBARITA NW
UTILITY IMPROVEMENTS**

DESIGN REVIEW COMMITTEE: FEB 16 2004
CITY ENGINEER: MAR 16 2004

NO.	DATE	REMARKS	BY

DESIGNED BY: **ALD** DATE: **09/03**
DRAWN BY: **MJR** DATE: **09/03**
CHECKED BY: **DWG** DATE: **09/03**

CITY PROJECT NO. **729981** ZONE MAP NO. **F-13-Z** SHEET **9** OF **11**

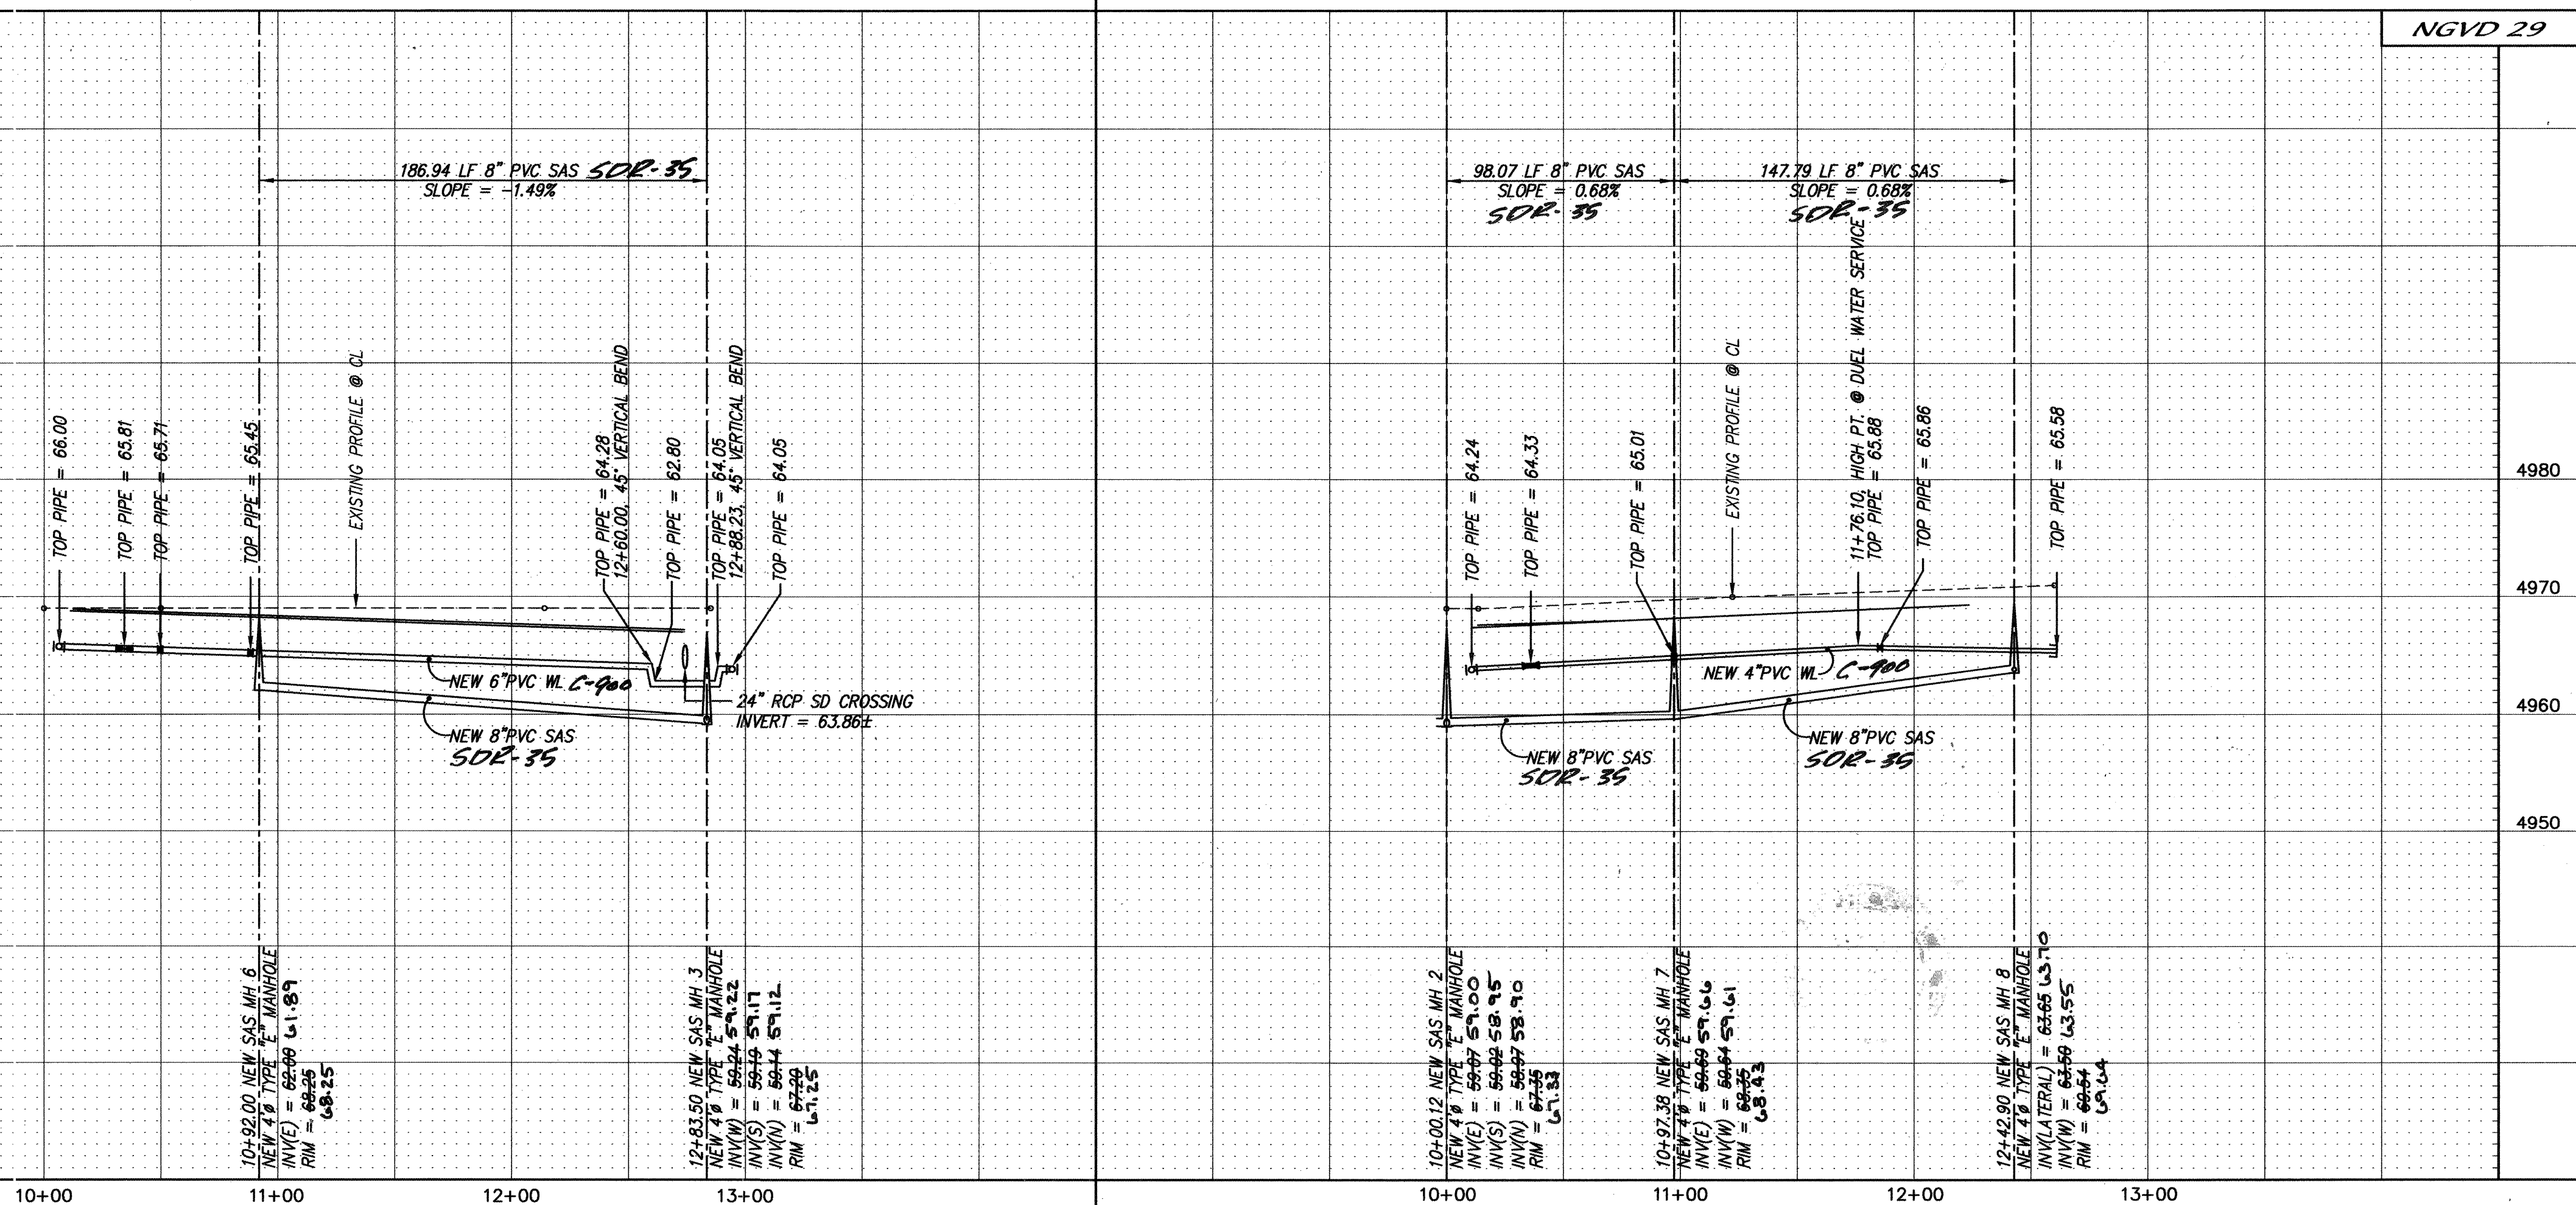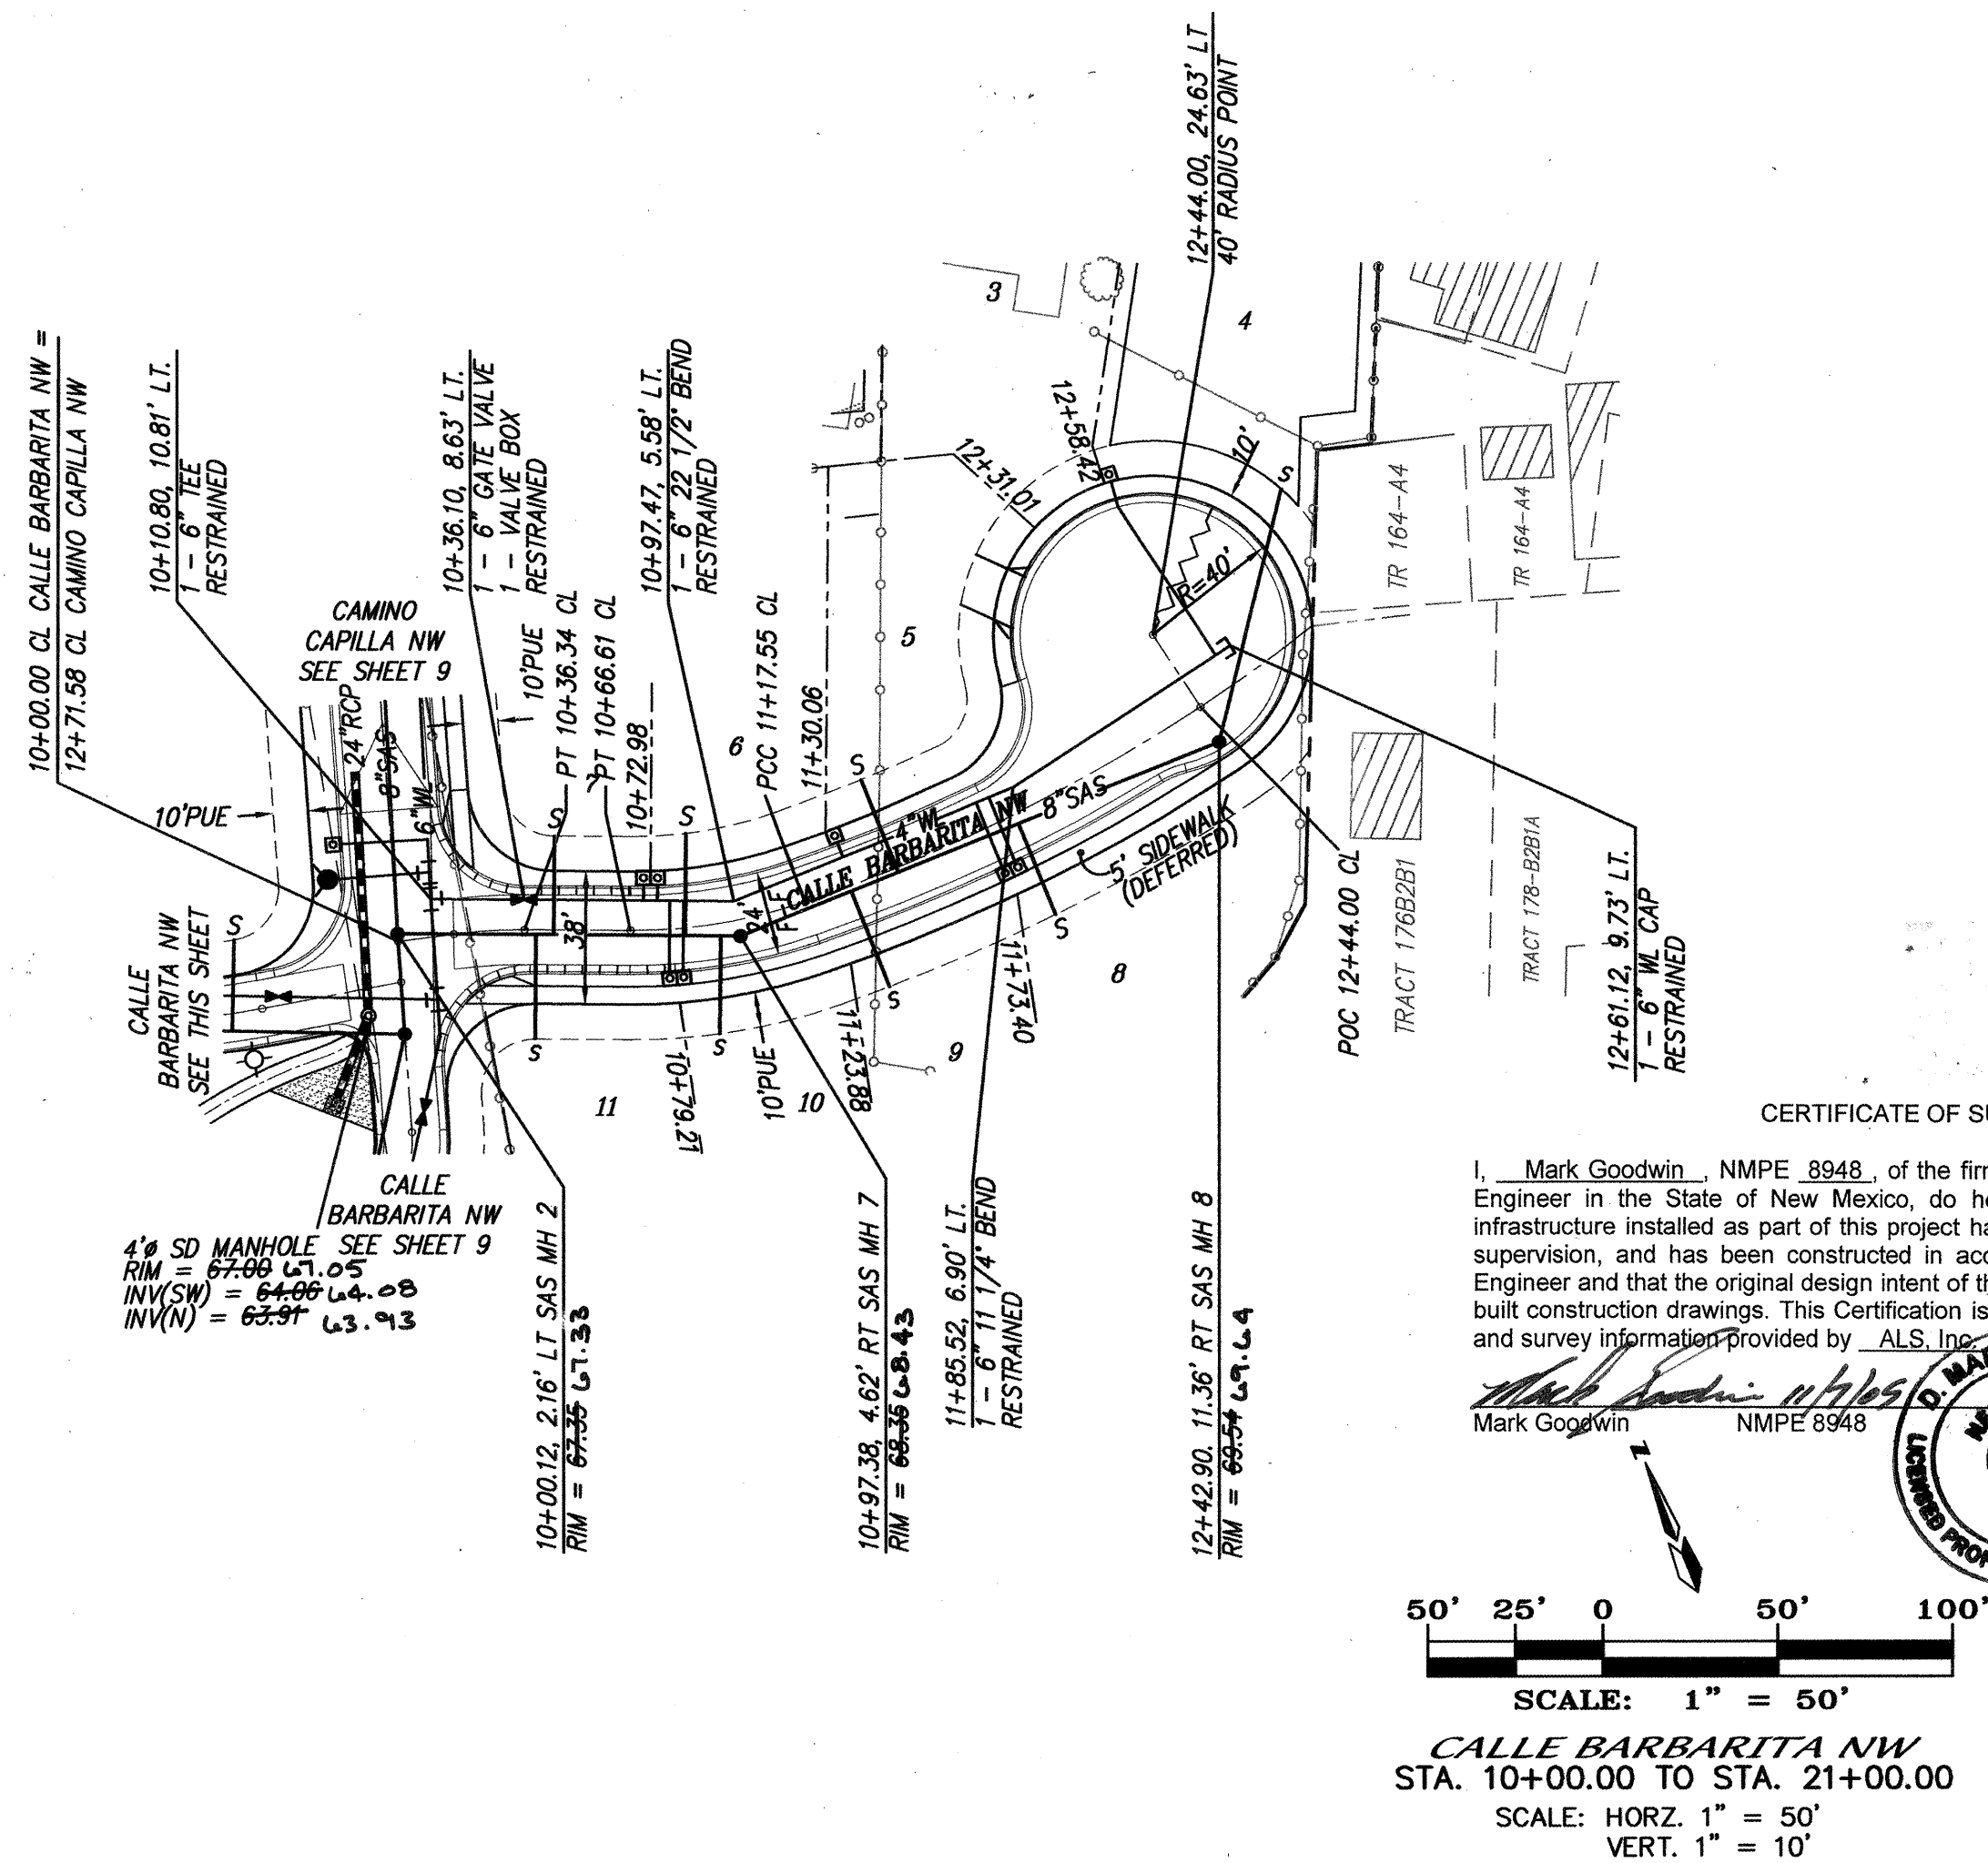

1. ALL STATIONING IS CENTERLINE STATIONING.
2. 3' MINIMUM COVER ON ALL WATERLINES.

SANITARY SEWER SERVICES				
BLOCK	LOT	STATION AT PUE	INV. AT ELEV. PUE	LENGTH AT PUE
	4	13+02.00.36.03	1	74.94'
	5	11+45.50	1	28.41'
	6	10+85.74	1	29.37'
	7	10+44.72	1	28.37'
	8	11+80.38	1	28.19'
	9	11+31.61	1	29.42'
	10	10+88.09	1	27.77'
	11	10+39.64	1	29.62'
	21	10+98.50	1	24.00'
	22	11+44.50	1	24.00'
	23	11+90.50	1	24.00'
	24	12+39.76	1	25.89'

I, Mark Goodwin, NMPE # 8948, of the firm Mark Goodwin & Associates, PA, a Registered Professional Engineer in the State of New Mexico, do hereby certify, to the best of my knowledge and belief, that the infrastructure installed as part of this project has been inspected by me or by a qualified person under my direct supervision, and has been constructed in accordance with the plans and specifications approved by the City Engineer and that the original design intent of the approved plans has been met, except as noted by me on the as-built construction drawings. This Certification is based on site inspections by me or personnel under my direction, and survey information provided by ALS Inc., NMPE number 7719.

Mark Goodwin NMPE 8948



50' 25' 0 50' 100'

SCALE: 1" = 50'

CALLE BARBARITA NW

STA. 10+00.00 TO STA. 21+00.00

SCALE: HORZ. 1" = 50'

VERT. 1" = 10'

PIPE SIZE	90°	45°	22.5°	11.25°	VALVE
4"	12'	5'	2'	1'	32'
6"	17'	7'	3'	2'	46'
8"	22'	9'	4'	2'	60'
10"	26'	11'	5'	3'	72'

LENGTH OF RESTRAINED PIPE ON EACH SIDE OF
THE BEND. RESTRAIN BRANCH AT FITTING ONLY
MINIMUM ATTACHED PIPE LENGTH, RUN SIDE
OF TEE: 10.00 FEET.

RESTRAINED JOINT LENGTH FOR TEES (FT.)		
PIPE SIZE	RUN	BRANCH
10"x10"x10"	15'	5'
10"x10"x6"	6'	1'
8"x8"x6"	7'	5'
6"x6"x6"	10'	2'
6"x6"x4"	4'	7'

MARK GOODWIN & ASSOCIATES, P.A.
CONSULTING ENGINEERS

P.O. BOX 90606
ALBUQUERQUE, NEW MEXICO 87199
(505) 828-2200, FAX (505) 797-9539



CITY OF ALBUQUERQUE
PUBLIC WORKS DEPARTMENT

TITLE:

**VILLA DE LA CAPILLA
CALLE BARBARITA NW
UTILITY IMPROVEMENTS**

DESIGN REVIEW COMMITTEE

APPROVE

FEB 16 2004

DESIGN REVIEW COMMITTEE

CITY ENGINEER APPROVAL

A P P R O V E

MAR 16 2004

CITY ENGINEER

LAST DESIGN UPDATE	MO./DAY/YR.	MO./DAY/YR.

CITY PROJECT NO

ZONE MAP NC

	SHEET	OF
--	-------	----

A03027LPG\A03027PLANS\A03027UT-2\02-12-04\ MJR DER


729981

F-13


10 11

NOTES

1. ALL STATIONING IS CENTERLINE STATIONING ALONG OFFSITE WATERLINE.
2. 3' MINIMUM COVER ON ALL WATERLINES.

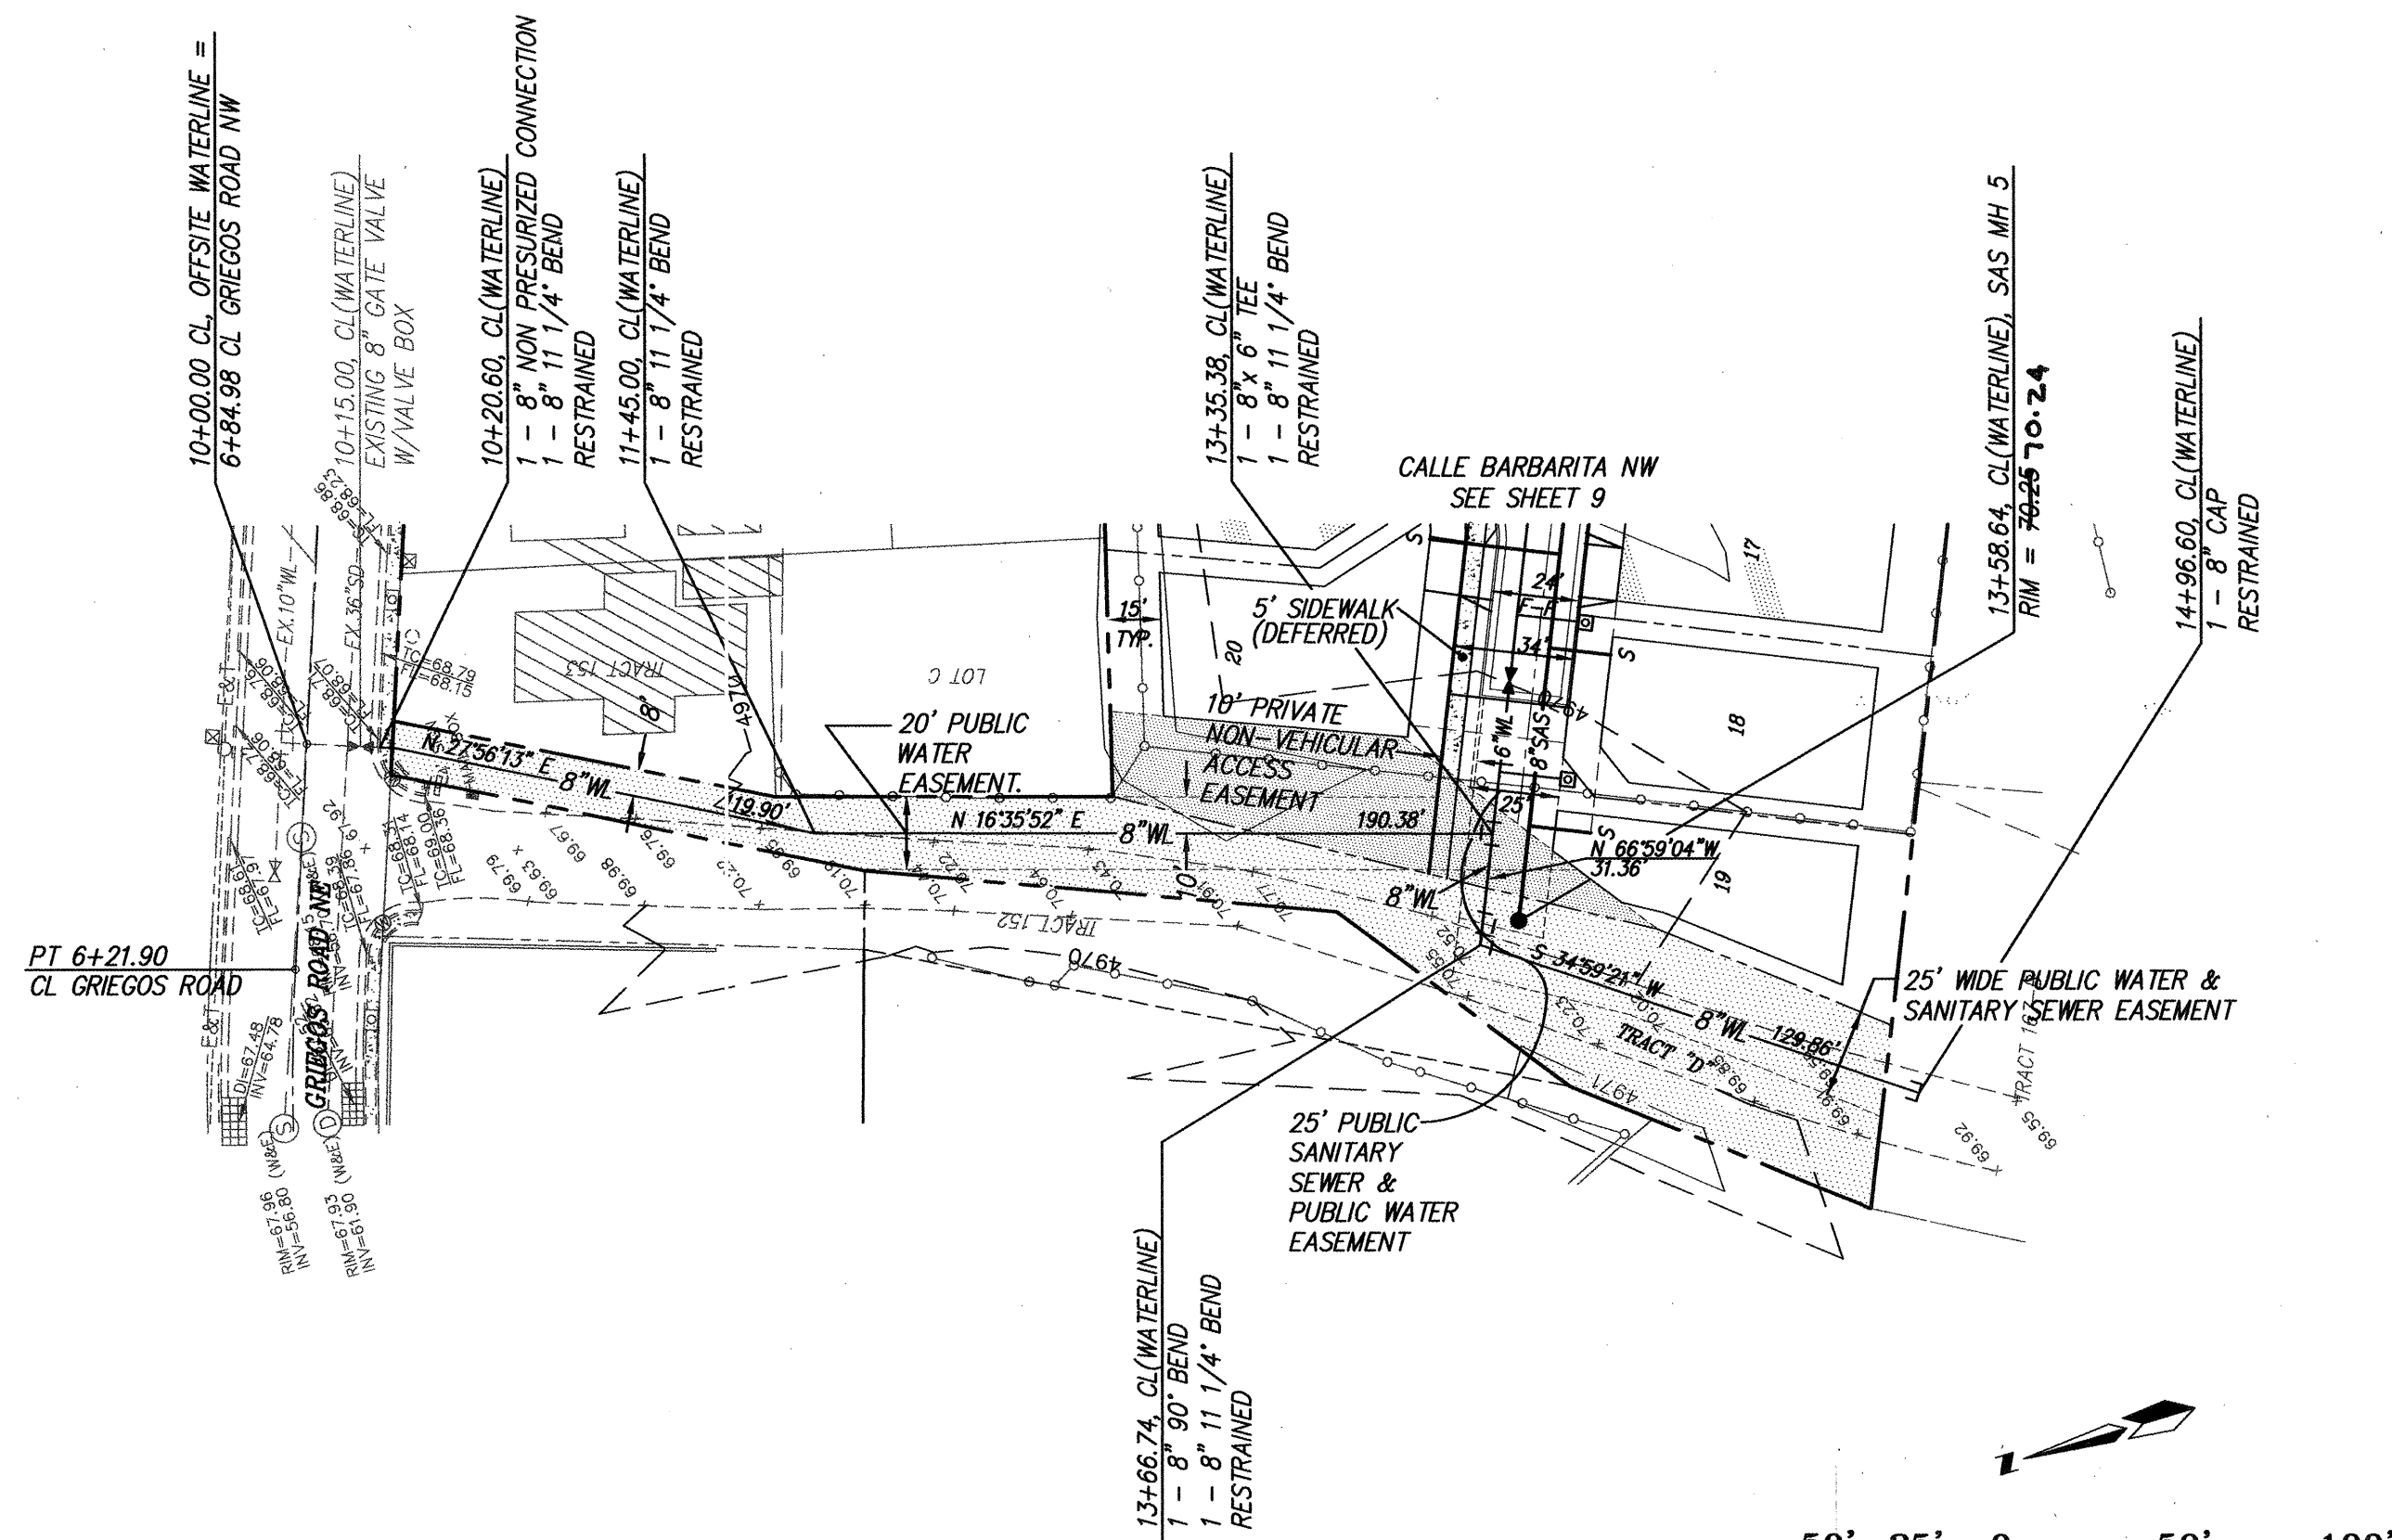


SCALE: 1" = 50'
WATERLINE CONNECTION
STA. 10+00.00 TO STA. 14+90.62
SCALE: HORIZ. 1" = 50'
VERT. 1" = 10'

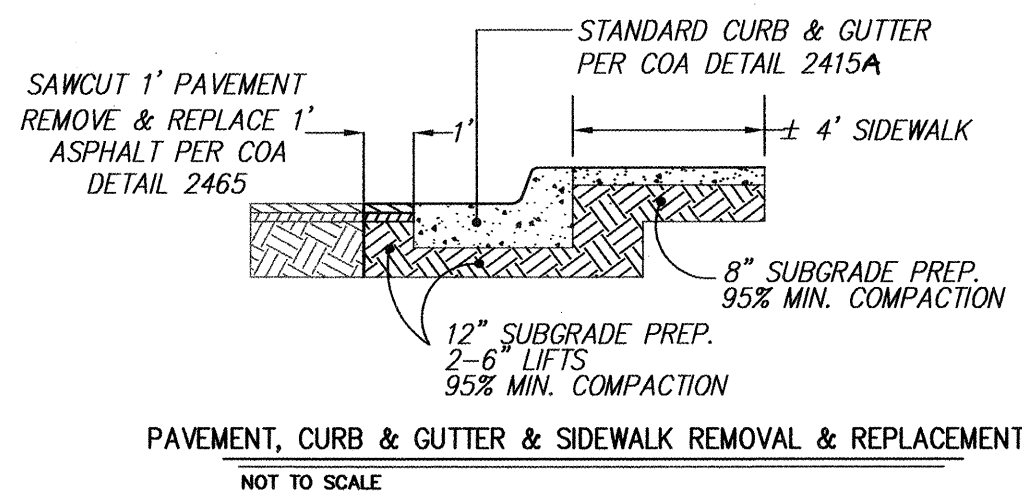

PAVEMENT, CURB & GUTTER & SIDEWALK REMOVAL & REPLACEMENT
NOT TO SCALE

NOTES

1. ALL STATIONING IS CENTERLINE STATIONING.
2. 3' MINIMUM COVER ON ALL WATERLINES.
3. CURB & GUTTER REMOVAL AND REPLACEMENT PER COA DETAIL 2415A AND 2430.

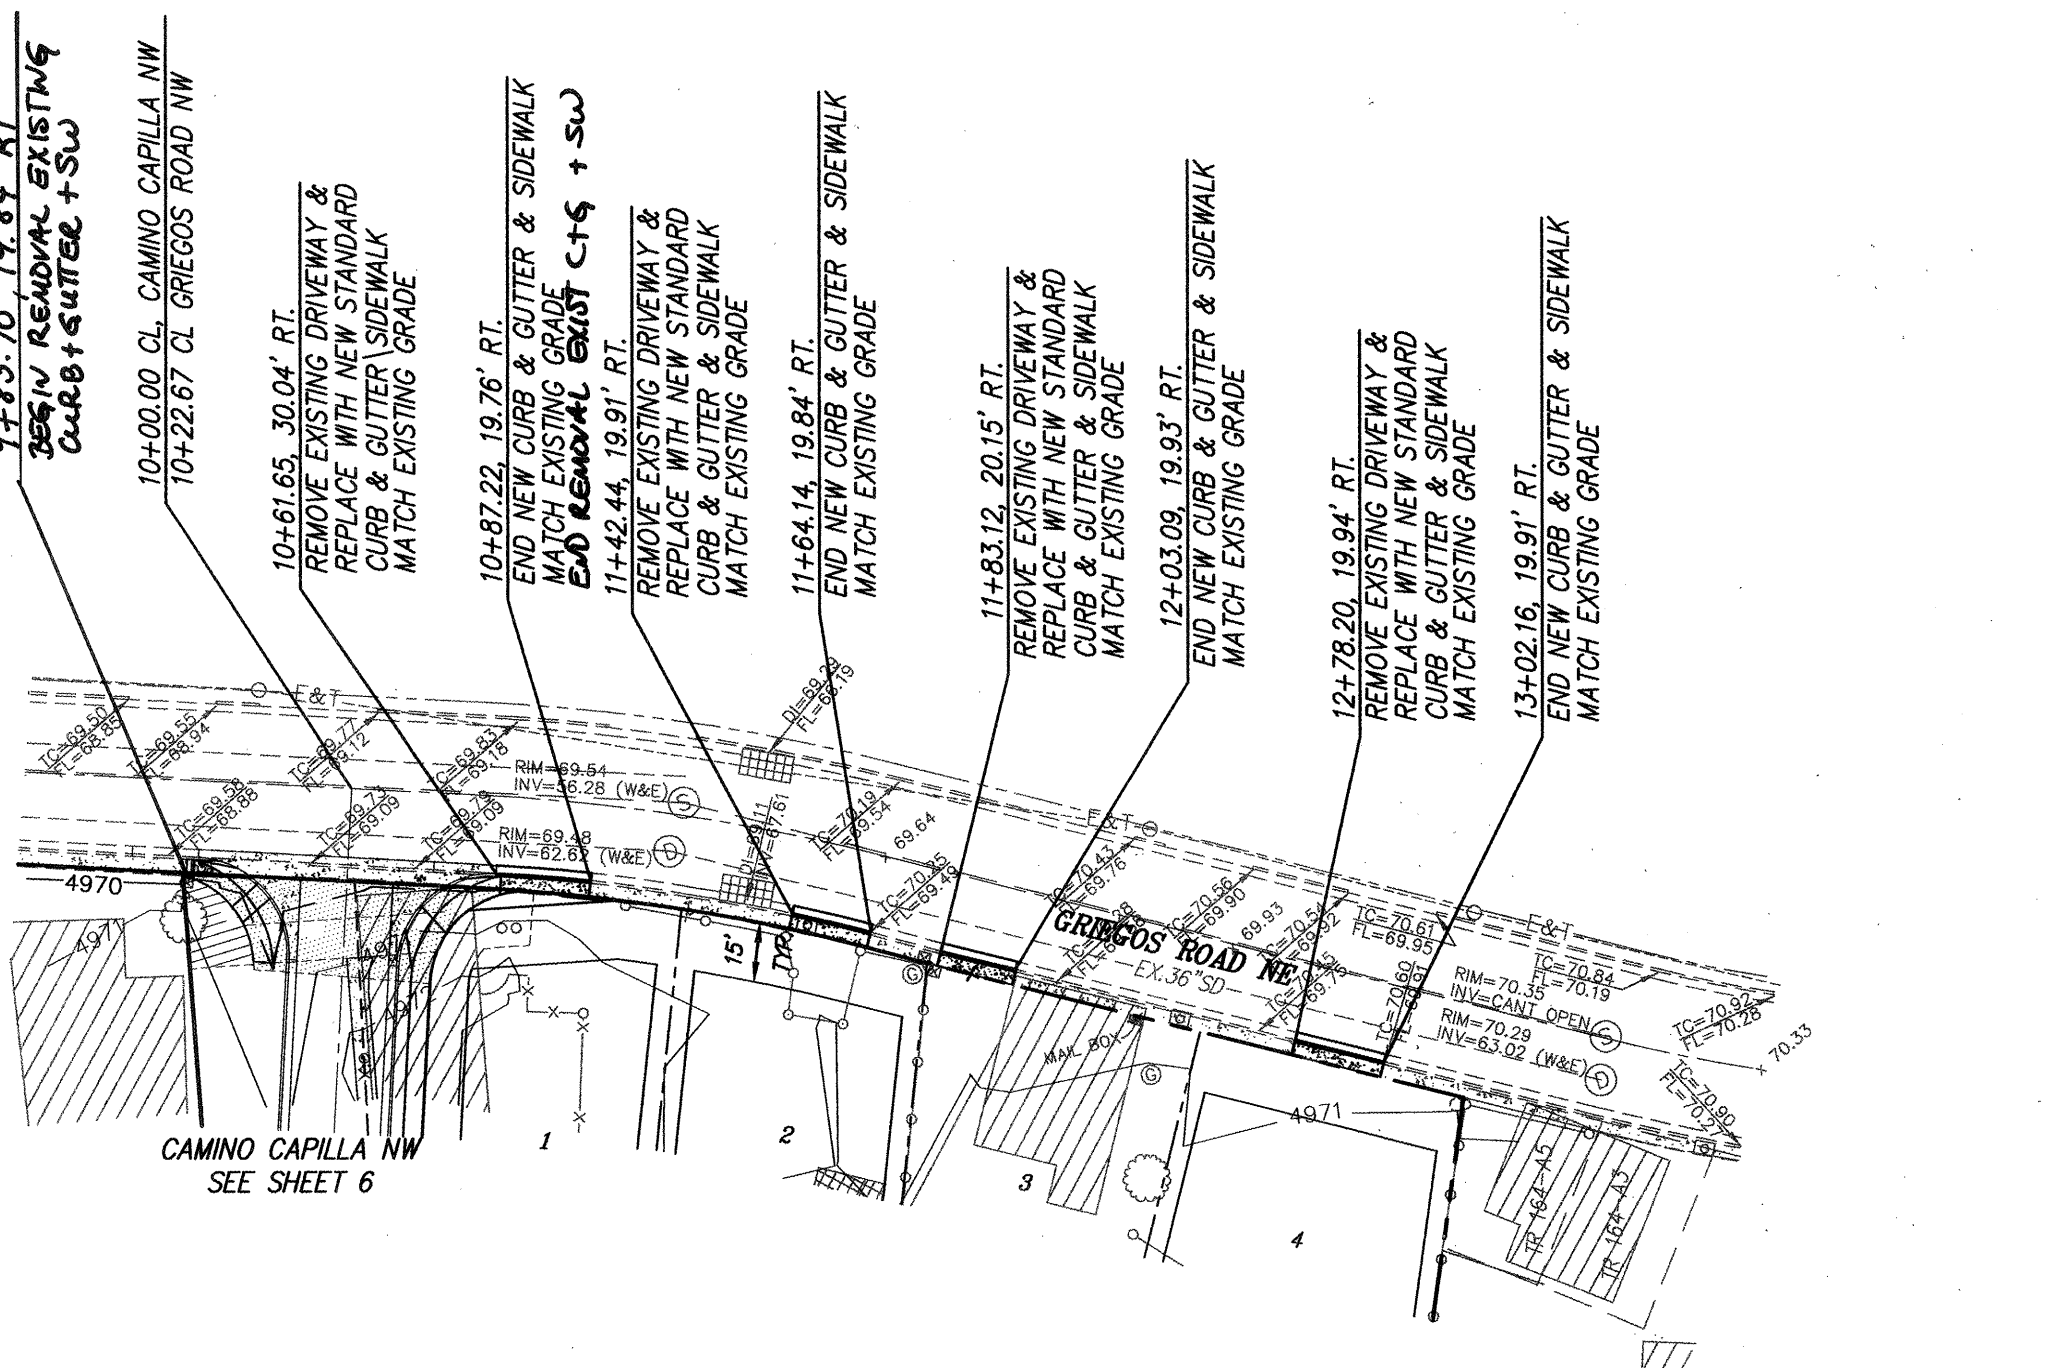


SCALE: 1" = 50'
GRIEGOS ROAD NW
STA. 10+00.00 TO STA. 13+02.16
SCALE: HORIZ. 1" = 50'
VERT. 1" = 10'

RESTRAINED JOINT LENGTH FOR BENDS, VALVES, DEAD ENDS (FT.)					
PIPE SIZE	90°	45°	22.5°	11.25°	VALVE
6"	17'	7'	-	-	46'
8"	22'	9'	4'	2'	60'
10"	-	11'	5'	3'	72'

LENGTH OF RESTRAINED PIPE ON EACH SIDE OF THE BEND, RESTRAIN BRANCH AT FITTING ONLY MINIMUM ATTACHED PIPE LENGTH, RUN SIDE OF TEE: 10.00 FEET.

RESTRAINED JOINT LENGTH FOR TEES (FT.)		
PIPE SIZE	RUN	BRANCH
10"x10"x10"	15'	5'
10"x10"x6"	6'	1'
8"x8"x6"	7'	5'
6"x6"x6"	10'	2'

CERTIFICATE OF SUBSTANTIAL COMPLIANCE ON PLANS
I, Mark Goodwin, NMPE 8842, of the firm Mark Goodwin & Associates, P.A., a Registered Professional Engineer in the State of New Mexico, do hereby certify, to the best of my knowledge and belief, that the infrastructure installed as part of this project has been inspected by me or by a qualified person under my direct supervision, and has been constructed in accordance with the plans and specifications approved by the City Engineer and that the original design intent of the approved plans has been met, except as noted by me on the as-built construction drawings. This Certification is based on site inspections by me or personnel under my direction, and survey information provided by ALS, Inc., NMPS number 7719.

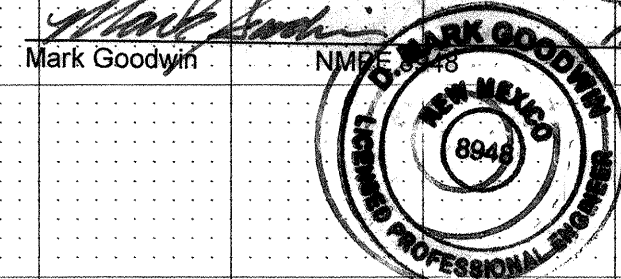

dmg MARK GOODWIN & ASSOCIATES, P.A.
CONSULTING ENGINEERS
P.O. BOX 90606
ALBUQUERQUE, NEW MEXICO 87199
(505) 828-2200, FAX (505) 797-9539

CITY OF ALBUQUERQUE
PUBLIC WORKS DEPARTMENT
TITLE: VILLA DE LA CAPILLA
OFFSITE WATERLINE CONNECTION
& GRIEGOS RD. DRIVEWAY CLOSURES

DESIGN REVIEW COMMITTEE	CITY ENGINEER APPROVAL	MO./DAY/YR.	MO./DAY/YR.
APPROVE FEB 16 2004	APPROVE MAR 16 2004		
DESIGN REVIEW COMMITTEE	CITY ENGINEER		

CITY PROJECT NO. 729981 ZONE MAP NO. F-13-Z SHEET 11 OF 11