

CONSTRUCTION PLANS
FOR
VISTA DEL NORTE - UNIT 5A
(VALLE GRANDE DEL NORTE UNIT 2)
ALBUQUERQUE, NEW MEXICO

SCANNED BY
MESA REPRO

INDEX TO DRAWINGS

SHEET NO.	SHEET
1	TITLE SHEET
2-3	PLAT
4	GRADING AND DRAINAGE PLAN
5	MASTER PAVING PLAN
6	CALLE FUERTE
7	CALLE MONTANA & VIA DE CALMA
8	VISTA DEL NORTE
9	MASTER UTILITY PLAN
10	CALLE FUERTE
11	CALLE MONTANA & VIA DE CALMA
12	VISTA DEL NORTE WATERLINE
13	WATER DETAIL
14-15	TRAFFIC CONTROL

SURVEYOR'S CERTIFICATION

"I, Timothy Aldrich, a duly qualified Registered Professional Land Surveyor under the laws of the State of New Mexico, do hereby certify that the 'as-built' information shown on these drawings was obtained from field construction and 'as-built' surveys performed by me or under my supervision, that the 'as-built' information shown on these drawings was added by me or under my supervision, and that this 'as-built' information is true and correct to the best of my knowledge and belief." Aldrich Land Surveying is not responsible for any of the design concepts, calculations, engineering, or intent of the record drawings.

Timothy Aldrich, P.S. No. 7719

Date

APPROVED AS RECORD DRAWINGS
DESIGN REVIEW SECTION
CITY CONSTRUCTION ENGINEER
DATE: 1-13-04

CERTIFICATE OF SUBSTANTIAL COMPLIANCE ON PLANS


I, Diane Hoelzer, NMPE 11967, of the firm Mark Goodwin & Associates, P.A., a Registered Professional Engineer in the State of New Mexico, do hereby certify, to the best of my knowledge and belief, that the infrastructure installed as part of this project has been inspected by me or by a qualified person under my direct supervision, and has been constructed in accordance with the plans and specifications approved by the City Engineer and that the original design intent of the approved plans has been met, except as noted by me on the as-built construction drawings. This Certification is based on site inspections by me or personnel under my direction, and survey information provided by ALS, Inc., NMPS number 7719.

Diane Hoelzer 10-29-03



DRB NO.

1001396

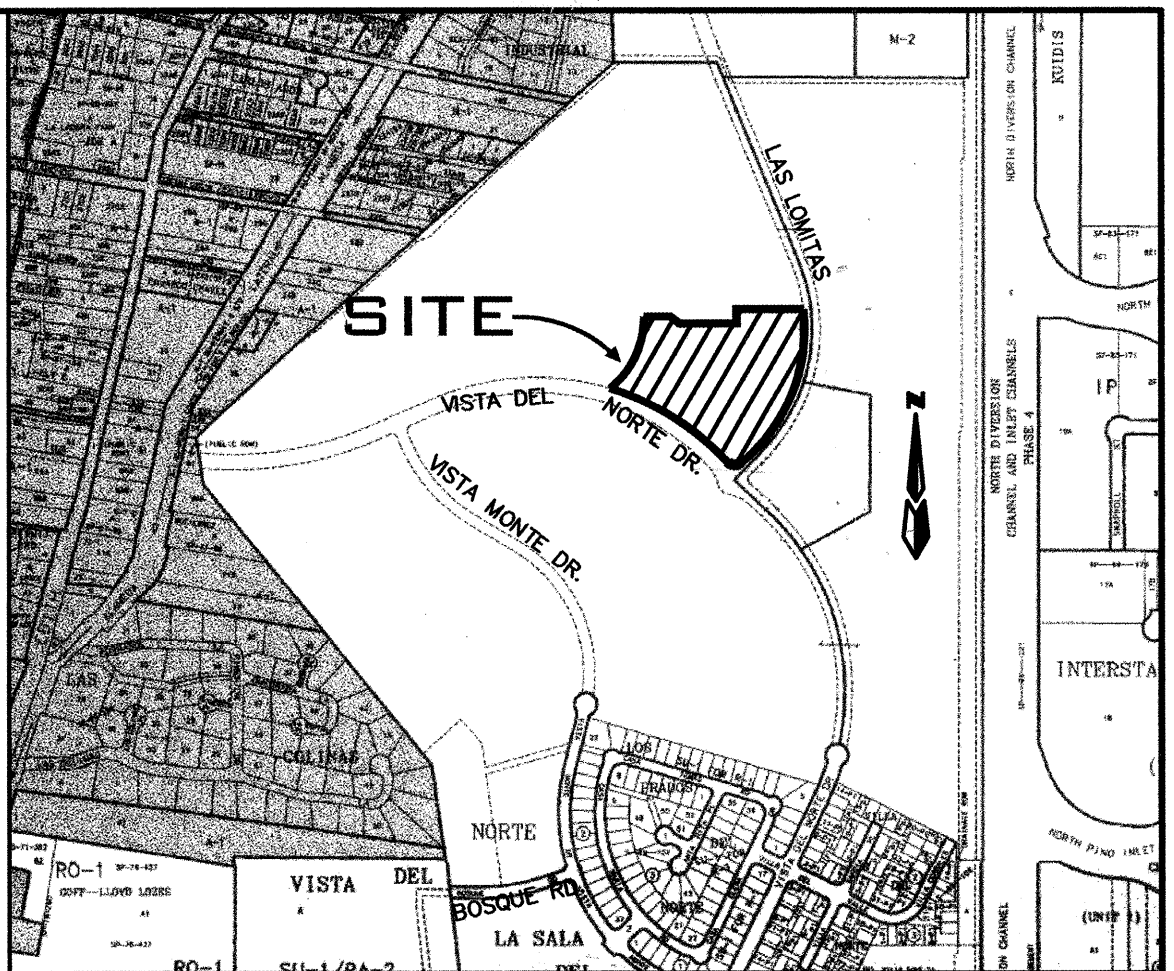

VICINITY MAP ZONE ATLAS D-16

SCALE: NONE

GENERAL NOTES

NOTICE TO CONTRACTORS

1. AN EXCAVATION/CONSTRUCTION PERMIT WILL BE REQUIRED BEFORE BEGINNING ANY WORK WITHIN THE CITY RIGHT-OF-WAY.
2. ALL WORK DETAILED ON THESE PLANS TO BE PERFORMED UNDER CONTRACT SHALL, EXCEPT AS OTHERWISE STATED OR PROVIDED FOR HEREON, BE CONSTRUCTED IN ACCORDANCE WITH THE CITY OF ALBUQUERQUE STANDARD SPECIFICATIONS FOR PUBLIC WORKS CONSTRUCTION, 1986 EDITION AS REVISED THROUGH UPDATE #6.
3. TWO WORKING DAYS PRIOR TO ANY EXCAVATION, THE CONTRACTOR MUST CONTACT NEW MEXICO ONE CALL SYSTEM (260-1990) FOR LOCATION OF EXISTING UTILITIES.
4. PRIOR TO CONSTRUCTION, THE CONTRACTOR SHALL EXCAVATE AND VERIFY THE HORIZONTAL AND VERTICAL LOCATIONS OF ALL OBSTRUCTIONS. SHOULD A CONFLICT EXIST, THE CONTRACTOR SHALL NOTIFY THE ENGINEER IMMEDIATELY SO THAT THE CONFLICT CAN BE RESOLVED WITH A MINIMUM AMOUNT OF DELAY.
5. SEVEN (7) WORKING DAYS PRIOR TO BEGINNING OF CONSTRUCTION, THE CONTRACTOR SHALL SUBMIT TO CONSTRUCTION COORDINATION DIVISION A DETAILED CONSTRUCTION SCHEDULE. SEVEN (7) WORKING DAYS PRIOR TO THE START OF CONSTRUCTION, THE CONTRACTOR SHALL OBTAIN A BARRICADING PERMIT FROM THE CONSTRUCTION COORDINATION DIVISION. CONTRACTOR SHALL NOTIFY THE CONSTRUCTION COORDINATION ENGINEER (924-3400) PRIOR TO OCCUPYING AN INTERSECTION. REFER TO SECTION 19 OF THE GENERAL CONDITIONS OF THE STANDARD SPECIFICATIONS.
6. ALL WORK AFFECTING ARTERIAL ROADWAYS REQUIRES TWENTY-FOUR HOUR CONSTRUCTION.
7. ALL STREET STRIPING ALTERED OR DESTROYED SHALL BE REPLACED WITH PLASTIC REFLECTORIZED PAVEMENT MARKING BY CONTRACTOR TO THE SAME LOCATION AS WAS EXISTING, OR AS INDICATED BY THIS PLAN SET.
8. CONTRACTOR SHALL NOTIFY THE ENGINEER NOT LESS THAN SEVEN (7) DAYS PRIOR TO STARTING WORK IN ORDER THAT THE CITY SURVEYOR MAY TAKE NECESSARY MEASURES TO INSURE THE PRESERVATION OF SURVEY MONUMENTS. CONTRACTOR SHALL NOT DISTURB PERMANENT SURVEY MONUMENTS WITHOUT THE CONSENT OF THE CITY SURVEYOR AND SHALL NOTIFY THE CITY SURVEYOR AND BEAR THE EXPENSE OF REPLACING ANY THAT MAY BE DISTURBED WITHOUT PERMISSION. REPLACEMENT SHALL BE DONE ONLY BY THE CITY SURVEYOR. WHEN A CHANGE IS MADE IN THE FINISHED ELEVATIONS OF THE PAVEMENT OF ANY ROADWAY IN WHICH A PERMANENT SURVEY MONUMENT IS LOCATED, CONTRACTOR SHALL, AT HIS OWN EXPENSE, ADJUST THE MONUMENT TO COVER THE NEW GRADE UNLESS OTHERWISE SPECIFIED. REFER TO SECTION 4.4 OF THE GENERAL CONDITIONS OF THE STANDARD SPECIFICATIONS. CONTRACTOR SHALL RECORD DATA ON ALL UTILITY LINES AND ACCESSORIES AS REQUIRED BY THE CITY OF ALBUQUERQUE FOR THE PREPARATION OF "AS CONSTRUCTED" DRAWINGS. CONTRACTOR SHALL NOT COVER UTILITY LINES AND ACCESSORIES UNTIL ALL DATA HAVE BEEN RECORDED.
10. CONTRACTOR SHALL MAINTAIN A GRAFFITI-FREE WORK SITE. CONTRACTOR SHALL PROMPTLY REMOVE ANY GRAFFITI FROM ALL EQUIPMENT, WHETHER PERMANENT OR TEMPORARY.
11. CONTRACTOR SHALL COORDINATE WITH THE CITY OF ALBUQUERQUE WATER SYSTEMS DIVISION (857-8200) SEVEN (7) WORKING DAYS IN ADVANCE OF ANY WORK THAT MAY AFFECT EXISTING PUBLIC WATER OR SEWER UTILITIES. EXISTING VALVES TO BE OPERATED BY CITY PERSONNEL ONLY. CONTRACTOR SHALL CONTACT THE WATER SYSTEMS DIVISION SEVEN (7) WORKING DAYS PRIOR TO NEEDING VALVES TURNED ON OR OFF.
12. FOR STORM DRAIN CONSTRUCTION, RCP JOINTS SHALL NOT BE GROUTED PRIOR TO FINAL INSPECTION. FINAL INSPECTION WILL DETERMINE JOINTS TO BE GROUTED FOR FINAL ACCEPTANCE BY CITY.
13. ALL EXCAVATION, TRENCHING AND SHORING ACTIVITIES MUST BE CARRIED-OUT IN ACCORDANCE WITH OSHA 29 CFR 1926.650 SUBPART P.

THE FOLLOWING NOTES ALSO APPLY WHEN CHECKED


- ☒ ALL UTILITIES AND UTILITY SERVICE LINES SHALL BE INSTALLED PRIOR TO PAVING.
- ☒ BACKFILL COMPACTION SHALL BE ACCORDING TO SPECIFIED STREET USE.
- ☐ TACK COAT REQUIREMENTS SHALL BE DETERMINED BY THE CITY ENGINEER.
- ☒ SIDEWALK AND WHEELCHAIR RAMPS WITHIN THE CURB RETURNS SHALL BE CONSTRUCTED WHEREVER A NEW CURB RETURN IS CONSTRUCTED.
- ☐ IF CURB IS DEPRESSED FOR A DRIVEPAD, THE DRIVEPAD SHALL BE CONSTRUCTED PRIOR TO ACCEPTANCE OF CURB AND GUTTER.
- ☒ ALL STORM DRAINAGE FACILITIES SHALL BE COMPLETED PRIOR TO FINAL ACCEPTANCE.

CAUTION:

NOTE THAT ALL EXISTING UTILITIES MAY NOT BE SHOWN. ALL EXISTING SERVICE CONNECTIONS ARE NOT SHOWN. ANY EXISTING UTILITIES THAT ARE SHOWN ARE APPROXIMATE LOCATION ONLY. IT SHALL BE THE SOLE RESPONSIBILITY OF THE CONTRACTOR TO CONTACT ALL THE UTILITY OWNERS AND TO CONDUCT ALL NECESSARY FIELD INVESTIGATIONS PRIOR TO ANY EXCAVATIONS TO DETERMINE THE ACTUAL LOCATION OF UTILITIES AND OTHER IMPROVEMENTS.

dmg D. MARK GOODWIN & ASSOCIATES, P.A.
CONSULTING ENGINEERS
P. O. BOX 90606
ALBUQUERQUE, NEW MEXICO 87199
(505) 828-2200, FAX (505) 797-9539

REV.	SHEETS	CITY ENGINEER	DATE	USER DEPARTMENT	DATE	USER DEPARTMENT	DATE
ENGINEERS STAMP & SIGNATURE		APPROVALS	ENGINEER	DATE	*****		
		DRC CHAIRMAN	Timothy Aldrich	2-7-03	APPROVED FOR CONSTRUCTION		
		TRANSPORTATION	Timothy Aldrich	1/23/03			
		WATER/WASTEWATER	Timothy Aldrich	1/23/03			
		HYDROLOGY	Bradley D. Byham	1/23/03			
		CIP					
		CONSTR. MGMT.			CITY ENGINEER DATE		
		CONSTR. COORD.					
		CITY PROJECT NO.		SHEET OF			
		682686		1		15	

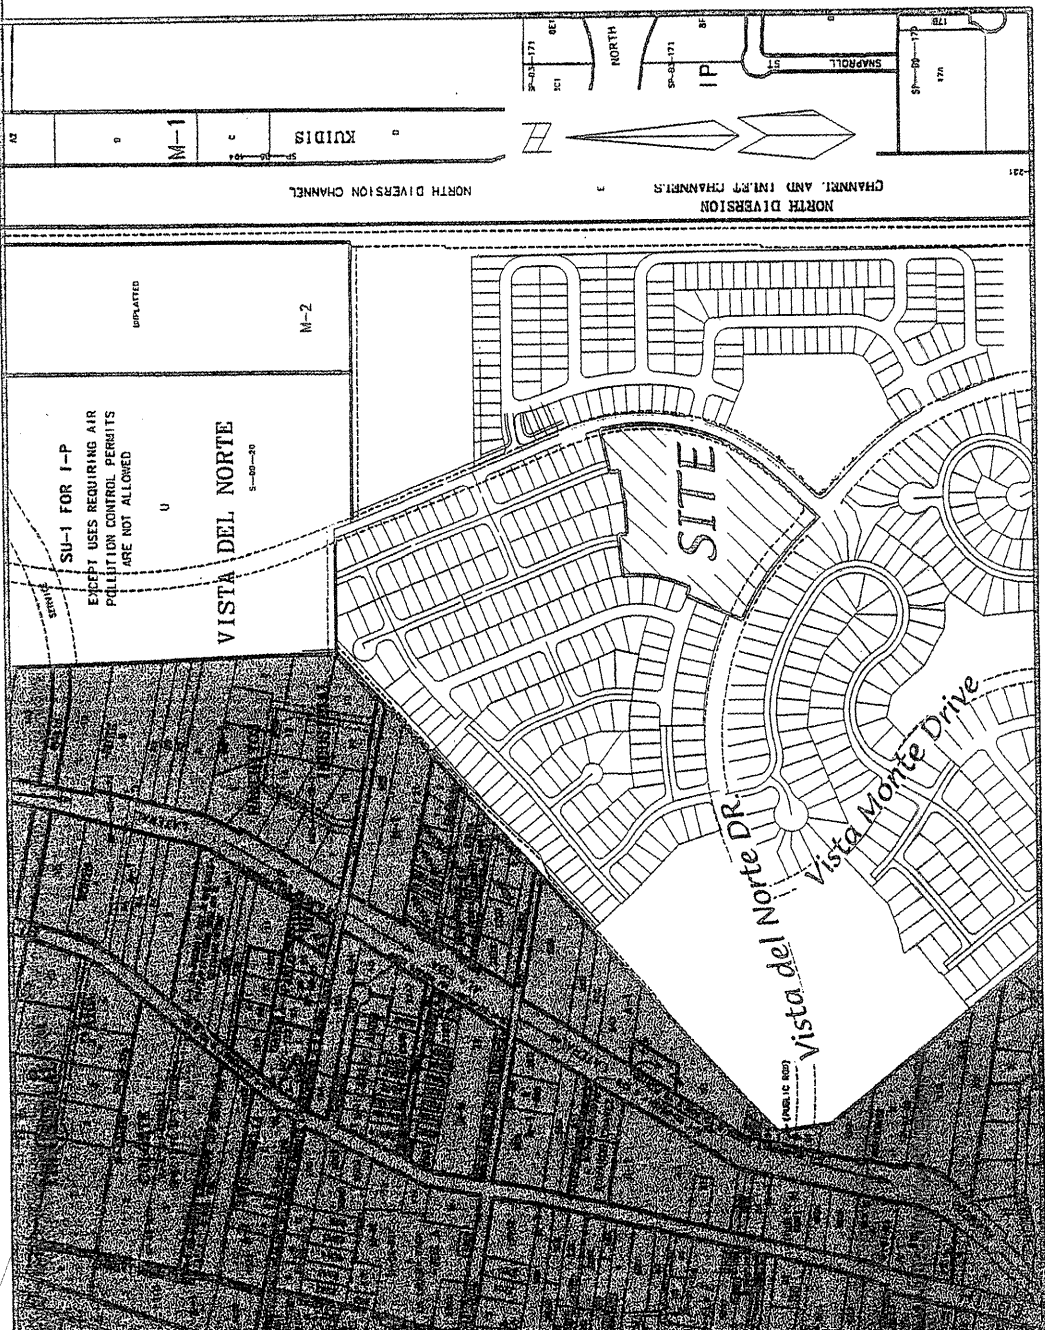

LOCATION MAP

SUBDIVISION DATA

Plat Case No's. Project #1001396
Gross acreage 8.70634 AC
Zone Atlas No. D-16-Z
No. of existing Tracts/Lots 1 TRACTS
No. of Tracts/Lots created 37 LOTS
No. of Tracts/Lots eliminated 1 TRACT
Miles of full width streets created 0.42
Area dedicated to the City of Albuquerque 2.7140 AC
Date of Survey NOVEMBER, 1998
Utility Control Location System Log Number 99092509100192

FREE CONSENT AND DEDICATION:

The subdivision hereon described is with the free consent and in accordance with the desires of the undersigned owner(s) and/or proprietor(s) thereof and said owner(s) and/or proprietor(s) do hereby dedicate all streets, public right-of-ways shown hereon to the City of Albuquerque in fee simple with warranty covenants and do hereby grant: all access, utility and drainage easements shown hereon, including the right to construct, operate, inspect, and maintain facilities therein; and all public utility easements shown hereon for the common and joint use of gas, electrical power and underground utilities where shown or indicated, and including the right of ingress and egress for construction and maintenance, and the right to trim interfering trees and shrubs. Said owner(s) and/or proprietor(s) do hereby consent to all of the foregoing and do hereby certify that this subdivision is their free act and deed. Said owner(s) warrant that they hold among them complete and indefeasible title to the land subdivided.

VISTA DEL NORTE DEVELOPMENT, LLC:
BY: JOHN A. MYERS, ASSISTANT MANAGER PRO TEM
DATE
JOHN A. MYERS, ASSISTANT MANAGER PRO TEM
DATE

OWNER'S ACKNOWLEDGMENT

STATE OF NEW MEXICO SS
COUNTY OF BERNALILLO

This instrument was acknowledged before me on
By John A. Myers, Assistant Manager pro tem Vista Del Norte Development, LLC
A New Mexico company on behalf of said company

NOTARY PUBLIC MY COMMISSION EXPIRES

LEGAL DESCRIPTION

A Tract of land situate within the Elena Gallegos Grant, Projected Section 22, Township 11 North, Range 3 East, New Mexico Principal Meridian, City of Albuquerque, Bernalillo County, New Mexico Being all of Tract T-2-A-1-A-1-A-1 Valle grande Del Norte Subdivision as the same is shown and designated on said plat filed for record in the office of the county clerk of Bernalillo County, New Mexico on _____ in Book 2003C, Page _____ and containing 6.7064 Acres.

NOTES

- Bearings are New Mexico State Plane Grid Bearings (Central Zone).
- Distances are ground distances.
- Bearings and distances are field and record.
- Basis of boundary are the following plats (and documents) of record entitled:
PLAT FOR "VALLE GRANDE DEL NORTE SUBDIVISION UNIT 1" (_____) PLAT FOR "MESETA DEL NORTE SUBDIVISION" (06-16-02, 2002C-173) PLAT FOR "MESETA DEL NORTE SUBDIVISION UNIT 2" (_____) BULK PLAT FOR "TRACTS T-2-A-1-A, T-2-A-1-B, T-2-A-1-C, T-2-A-1-D, T-3-A, AND T-3-B, VISTA DEL NORTE SUBDIVISION" (01-20-02, 2002C-31) PLAT FOR "TRACTS T-2-A-1, T-2-A-2 VISTA DEL NORTE SUBDIVISION", (06-19-01, 2001C-171) PLAT FOR "TRACTS T-2-A, T-2-B VISTA DEL NORTE SUBDIVISION", (02-22-01, 2001C-58) PLAT FOR "VISTA DEL NORTE", (03-16-99, 99C-57) PLAT FOR "VILLA DEL NORTE SUBDIVISION" (07-23-99, 99C-205) PLAT FOR "LOS PRADOS DEL NORTE SUBDIVISION" (08-18-99, 99C-233) PLAT FOR "TRACTS T-1, T-2, T-3 & T-4 VISTA DEL NORTE SUBDIVISION", (12-10-99, 99C-331) all being records of Bernalillo County, New Mexico.
- Field Survey performed November, 1998.
- Unless otherwise noted all point are SET 5/8" REBAR WITH CAP "ALS LS 7719" (TYP).

The City has the right to enter upon the grantors property at any time and perform whatever inspection, installation, maintenance, repair, modification or removal ("work") it deems appropriate without liability to the city. If the work effects any improvements or encroachments made by the grantor, the city will not be financially or otherwise responsible for rebuilding or repairing of improvements or encroachments. If in the opinion of the city, the work to be performed by the city could endanger the structural integrity or otherwise damage the improvements or encroachments, the grantor shall, at its own expense, take whatever protective measures are required to safeguard the improvements or encroachments.

PURPOSE OF PLAT

- Subdivide T-2-A-1-A-1-A-1, Valle grande Del Norte Subdivision into 37 Lots.
- Grant easements as shown.
- Dedicate right-of-way as shown.

SCANNED BY
MESA REPRO

PLAT FOR
VALLE GRANDE DEL NORTE
SUBDIVISION UNIT 2

WITHIN THE
ELENA GALLEGOS GRANT
PROJECTED SECTIONS 22 AND 27
TOWNSHIP 11 NORTH, RANGE 3 EAST, NMPM
CITY OF ALBUQUERQUE
BERNALILLO COUNTY, NEW MEXICO
JANUARY, 2003

APPROVED AND ACCEPTED BY:

APPROVAL AND CONDITIONAL ACCEPTANCE as specified by the Albuquerque subdivision Ordinance, Chapter 14 Article 14 of the Revised Ordinances of Albuquerque, New Mexico, 1994.

DRB Project No. 1001396

Application No. _____

Planning Director, City of Albuquerque, N.M. Date _____

City Engineer, City of Albuquerque, N.M. Date _____

Albuquerque Metropolitan Arroyo Flood Control Authority Date _____

Transportation Development, City of Albuquerque, N.M. Date _____

Utility Development Division, City of Albuquerque, N.M. Date _____

Parks and Recreation Date _____

City Surveyor, City of Albuquerque, N.M. Date _____

Property Management, City of Albuquerque, N.M. Date _____

PNM Gas Date _____

PNM Electric Date _____

Qwest Telecommunications Date _____


Comcast Cable Date _____

SURVEYOR'S CERTIFICATION

"I, Timothy Aldrich, a duly qualified Registered Professional Land Surveyor under the laws of the State of New Mexico, do hereby certify that this plat and description were prepared by me or under my supervision, shows all easements as shown on the plat of record or made known to me by the owners and/or proprietors of the subdivision shown hereon, utility companies and other parties expressing an interest and meets the minimum requirements for monumentation and surveys of the Albuquerque Subdivision Ordinance, and further meets the Minimum Standards for Land Surveying in the State of New Mexico, and is true and correct to the best of my knowledge and belief."


Timothy Aldrich P.S. No. 7719 Date _____

Dwg: COVER.dwg Drawn: STEPHEN Checked: ALS Sheet 1 of 4
Scale: 1"=1' Date: 01/09/03 Job: A01005

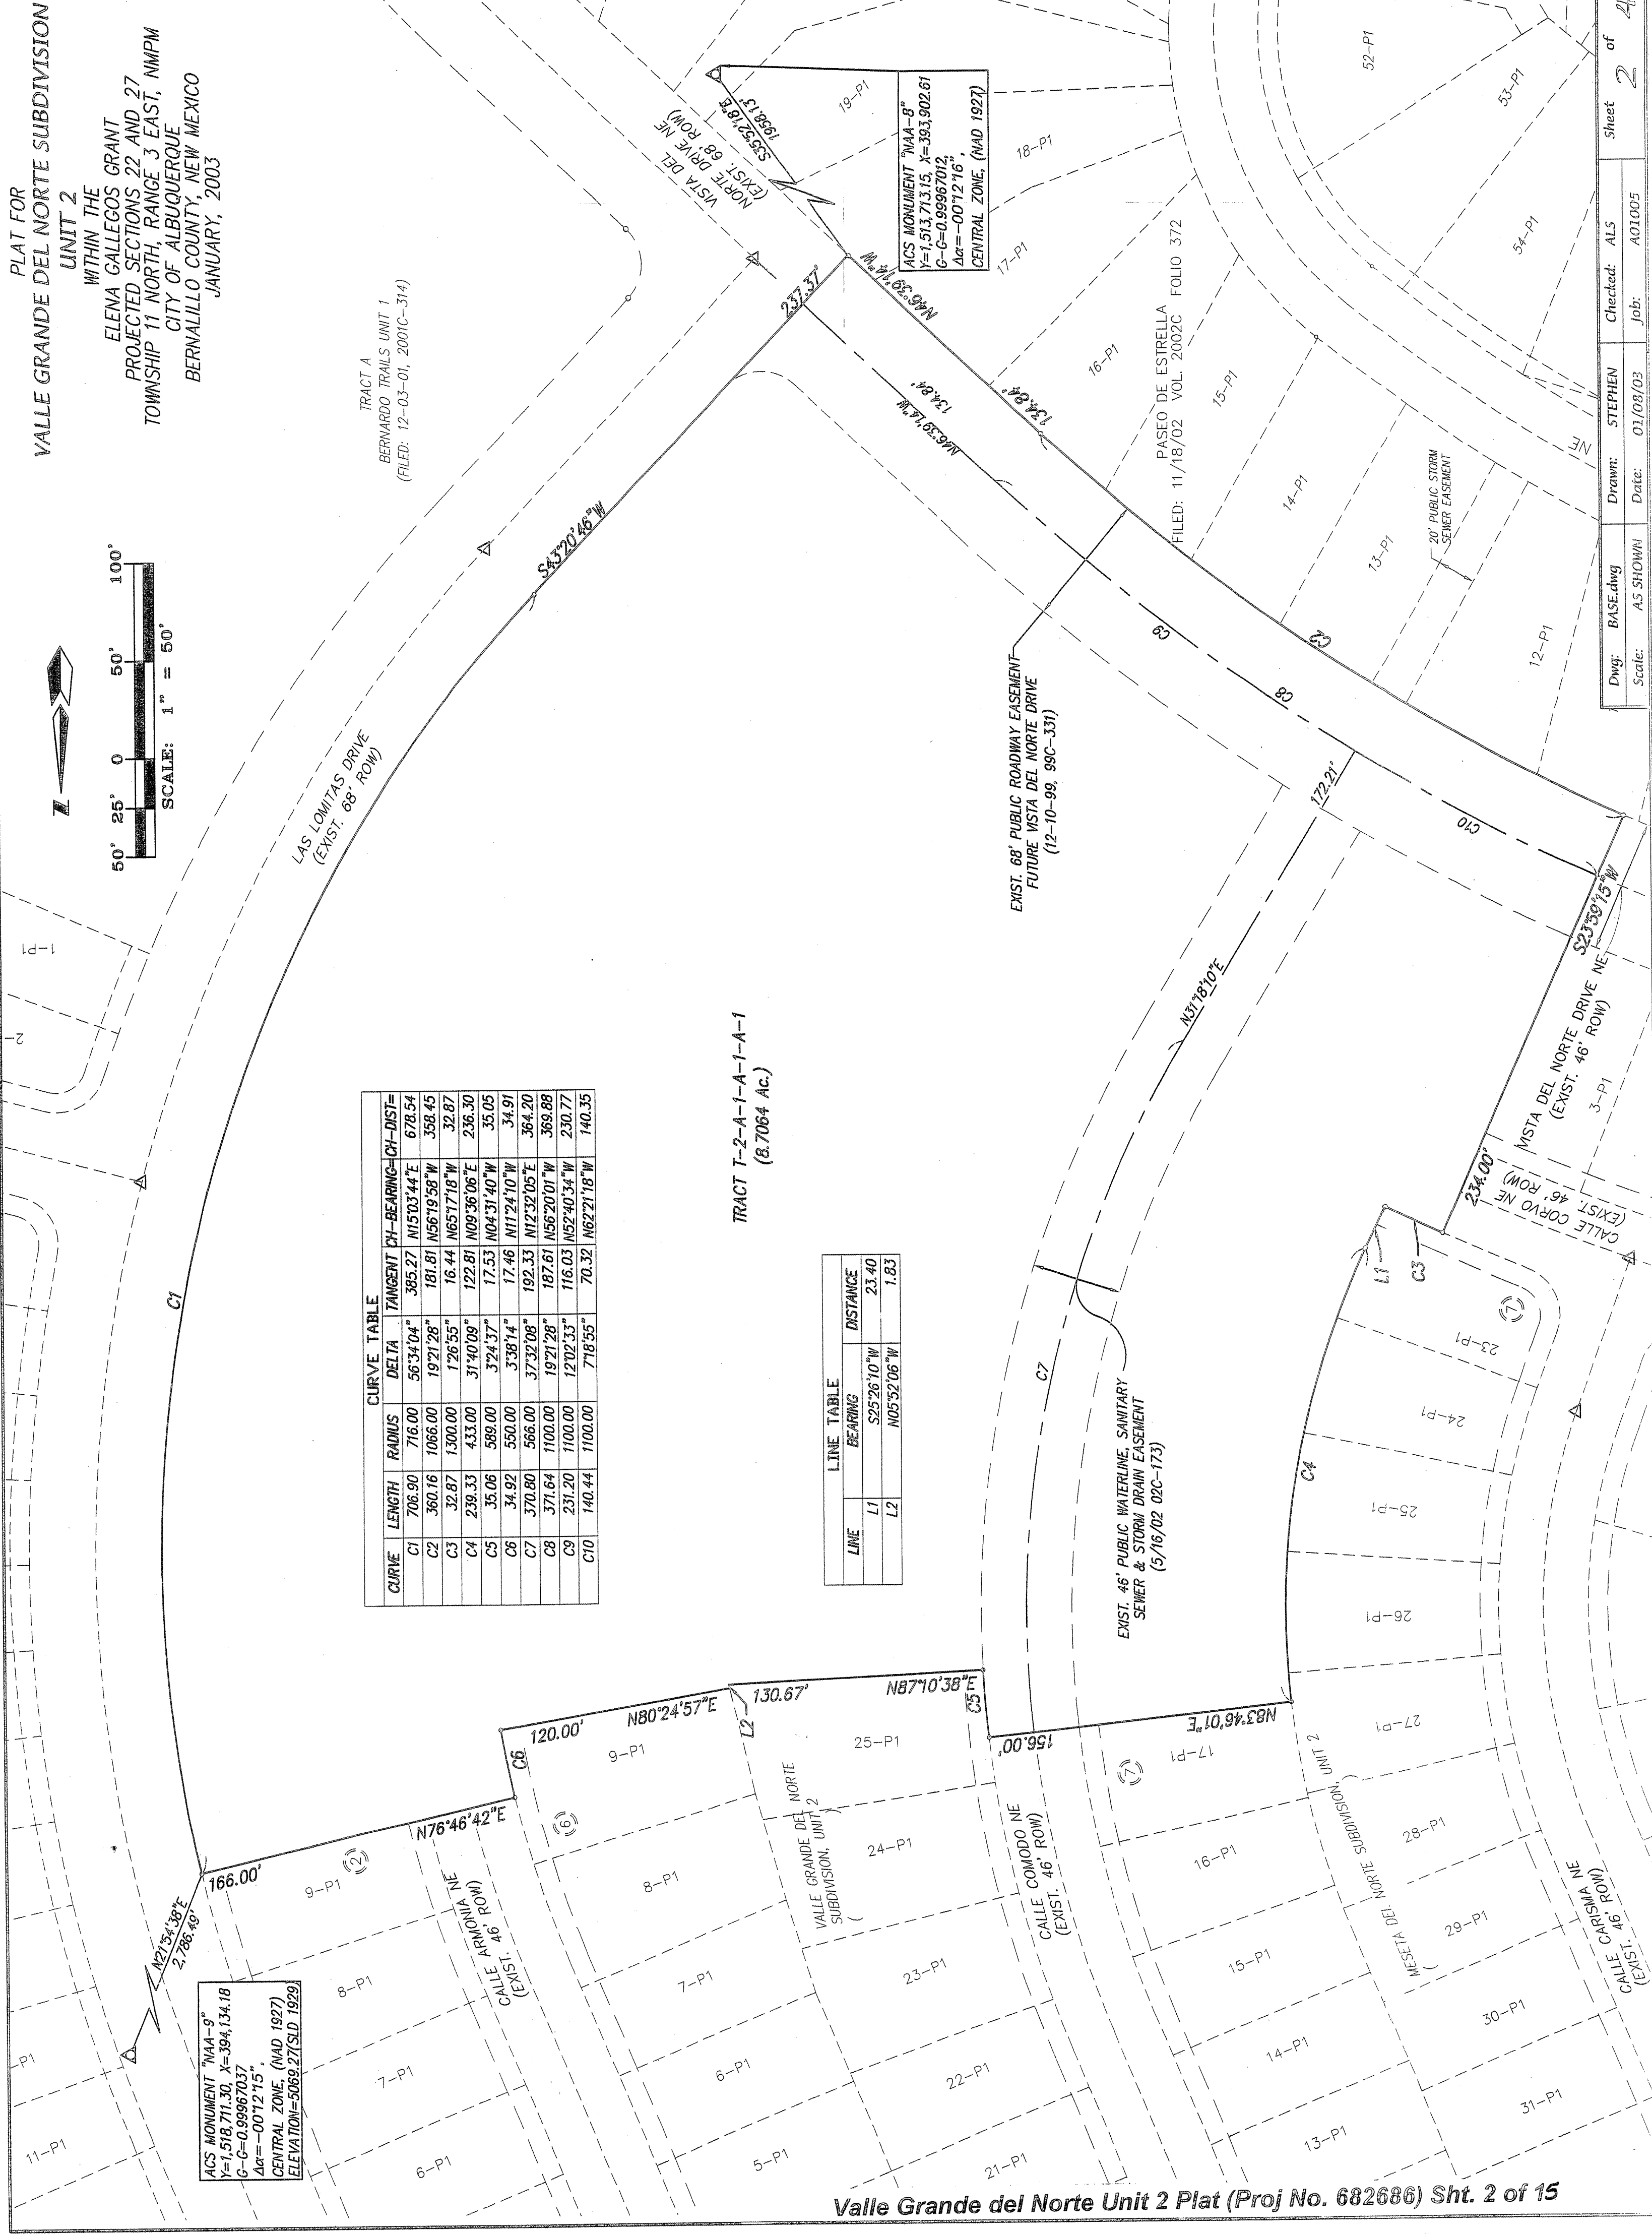

Valle Grande del Norte Unit 2 Plat (Proj No. 682686) Sht. 2 of 15

Dwg: BASE.dwg Drawn: STEPHEN Checked: ALS Sheet 2 of 4
Scale: AS SHOWN Date: 01/09/03 Job: A01005

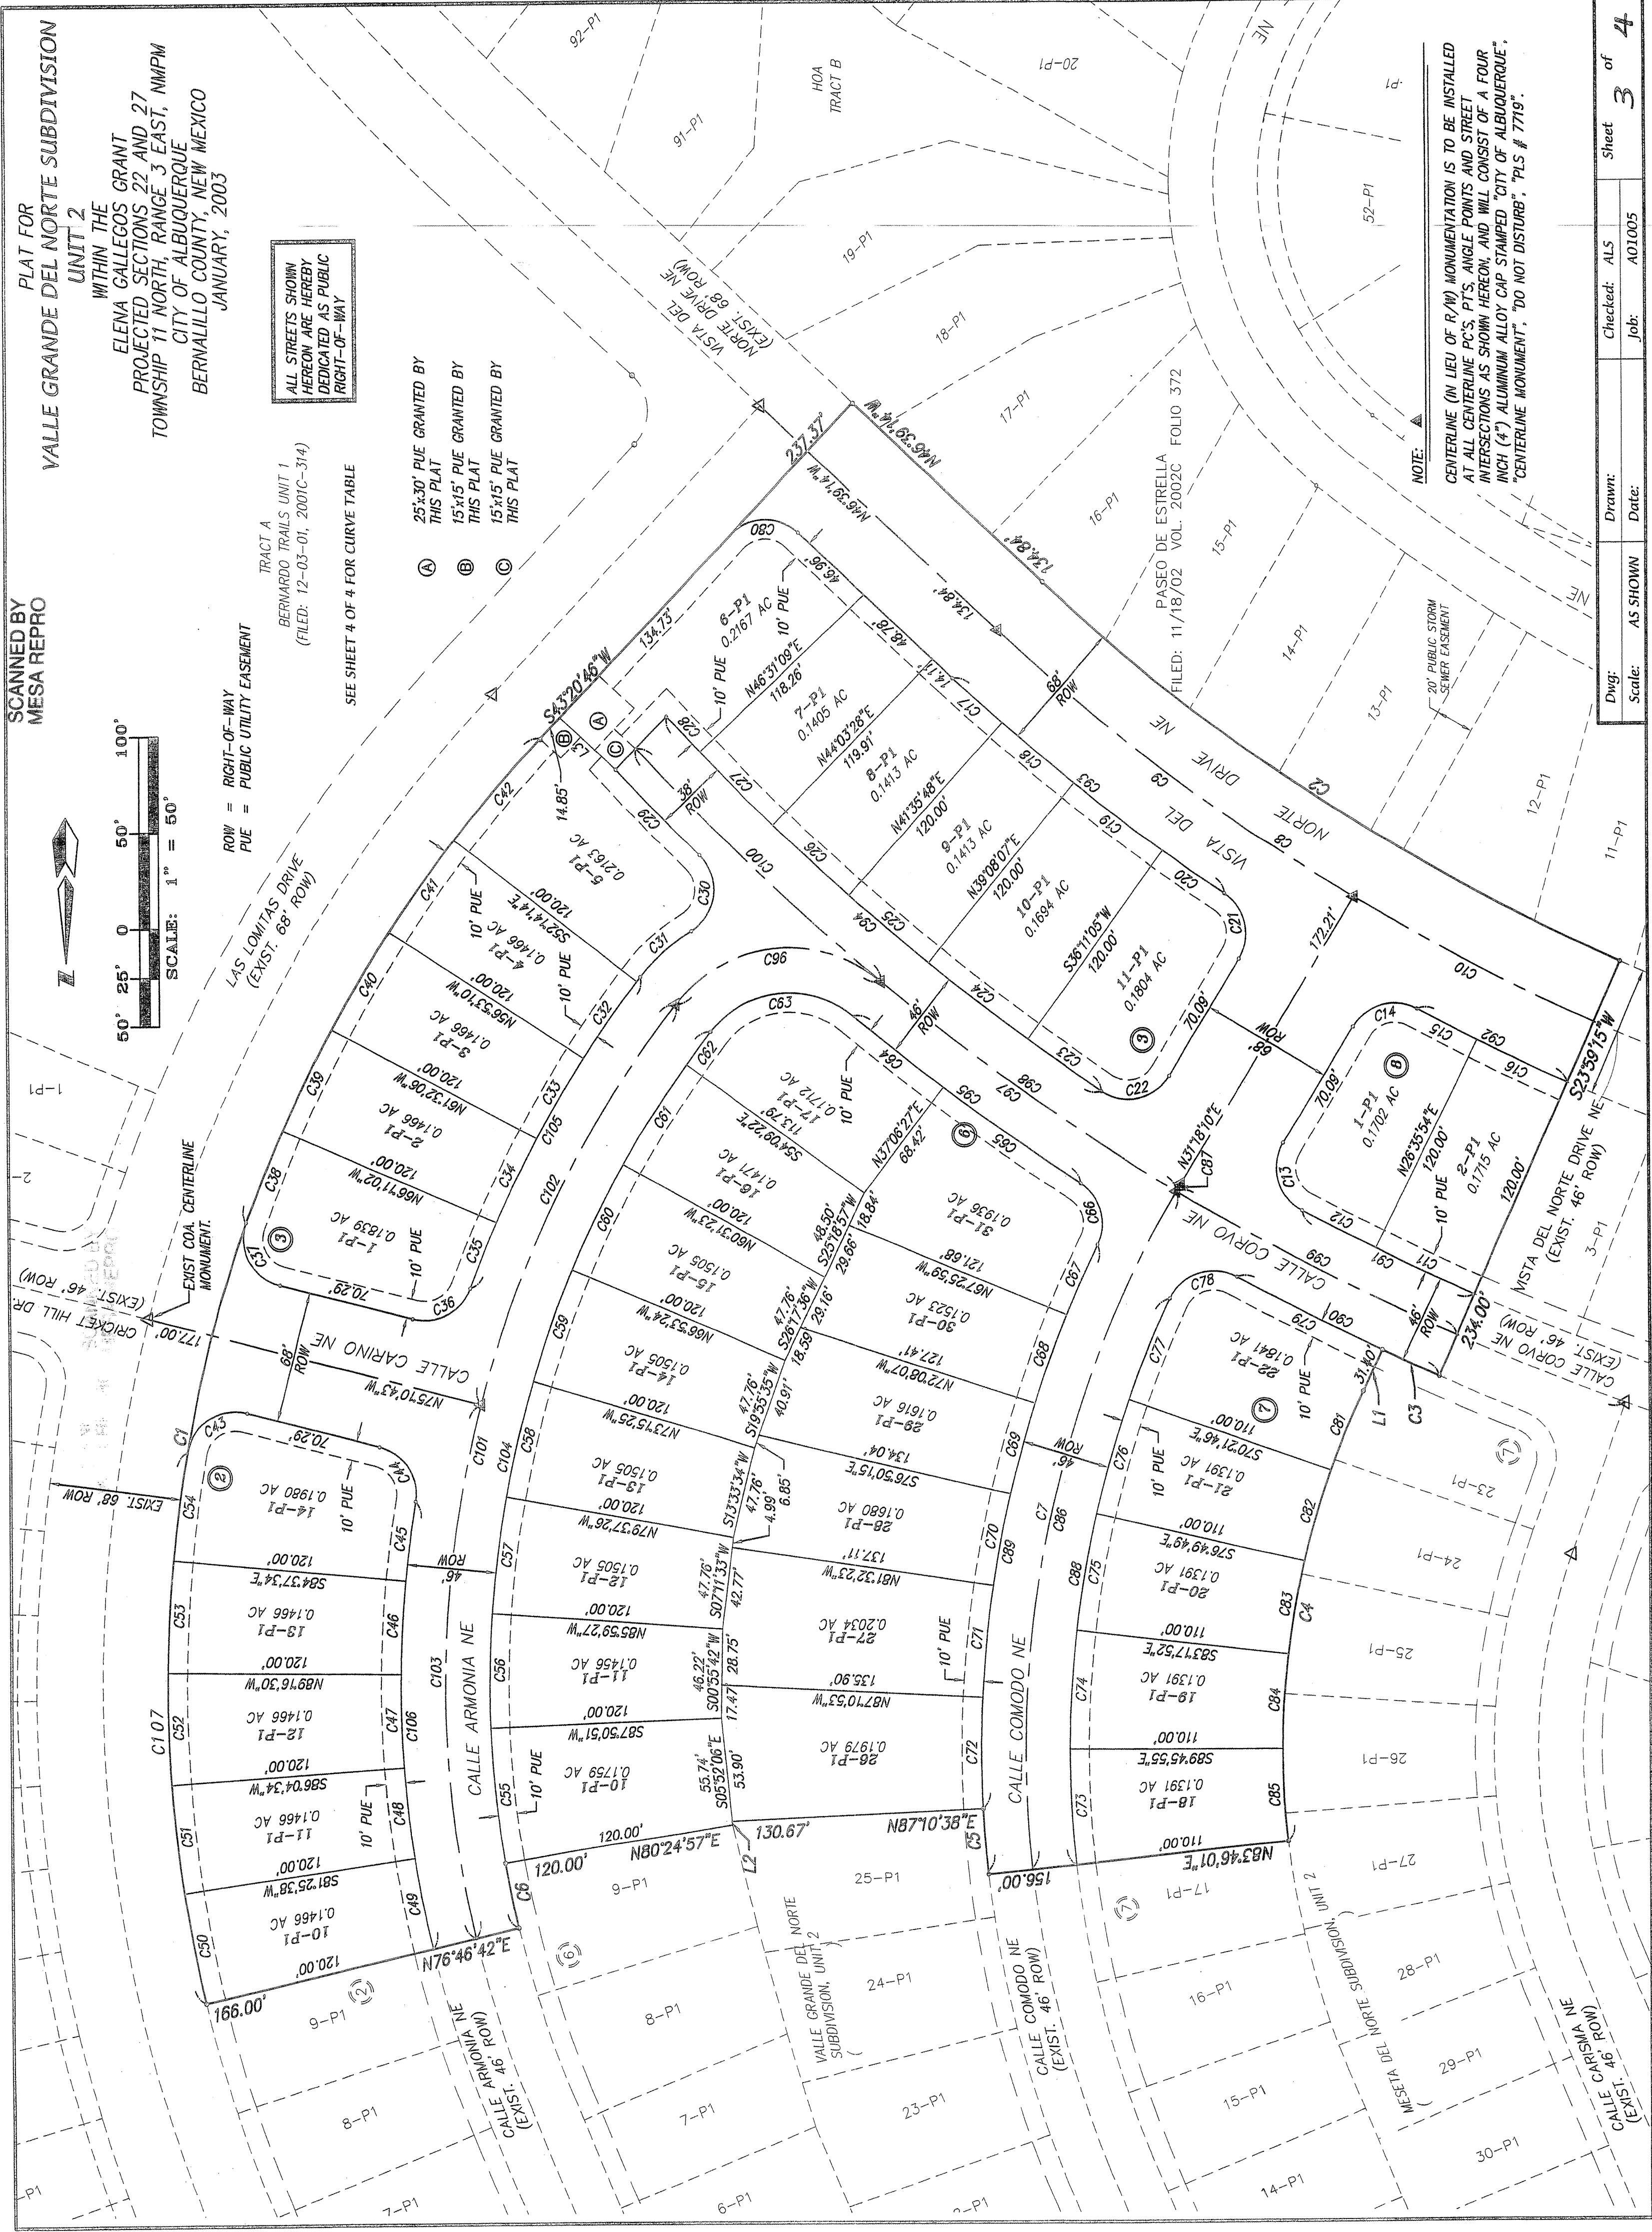

Dwg: AS SHOWN
Scale: 1" = 50'

Checked: ALS
Job: A01005

Drawn: Date:

Sheet 3 of 4

PLAT FOR VALLE GRANDE DEL NORTE SUBDIVISION UNIT 2

WITHIN THE ELENA CALLEGOS GRANT PROJECTED SECTIONS 22 AND 27 TOWNSHIP 11 NORTH, RANGE 3 EAST, NMPM CITY OF ALBUQUERQUE BERNALILLO COUNTY, NEW MEXICO JANUARY, 2003

CURVE	LENGTH	RADIUS	DELTA	TANGENT	CH-BEARING	CH-DIST
C81	43.82	433.00	5°47'56"	21.93	N22°32'12"E	43.80
C82	43.82	433.00	5°47'56"	21.93	N16°24'13"E	48.85
C83	48.88	433.00	6°28'03"	24.46	N09°56'09"E	48.85
C84	48.88	433.00	6°28'03"	24.46	N03°28'06"E	48.85
C85	48.88	433.00	6°28'03"	24.46	N00°29'57"W	48.85
C86	363.15	566.00	36°37'48"	188.18	N12°20'09"E	358.85
C87	4.79	566.00	0°29'06"	2.40	N01°50'37"E	4.78
C88	301.31	543.00	3°47'37"	154.65	N09°39'50"E	293.46
C89	334.20	596.00	3°30'35"	171.23	N00°17'22"E	328.74
C90	116.32	1300.00	5°07'36"	58.20	N63°26'57"W	116.28
C91	98.88	1254.00	4°33'49"	49.97	N63°43'51"W	98.86
C92	87.03	1134.00	4°23'50"	43.54	N63°48'50"W	87.01
C93	180.59	1134.00	9°07'28"	90.49	N51°13'01"W	180.40
C94	298.27	1254.00	13°37'42"	149.84	N49°07'54"W	297.57
C95	146.24	1300.00	6°26'43"	73.20	N63°29'39"W	146.16
C96	120.00	750.00	9°14'03"	77.23	N83°33'27"E	107.61
C97	526.37	1277.00	23°37'01"	266.98	N54°12'15"W	522.65
C98	187.82	1277.00	8°25'37"	94.08	N54°29'05"W	187.65
C99	163.02	1277.00	7°32'32"	81.62	N62°21'20"W	162.91
C100	175.53	1277.00	7°52'32"	87.90	N46°20'01"W	175.39
C101	512.79	573.00	51°16'29"	275.00	N12°24'57"E	495.84
C102	232.36	573.00	23°14'02"	117.80	N26°26'10"E	230.77
C103	280.43	573.00	28°02'27"	143.08	N00°47'56"E	277.64
C104	484.20	573.00	47°16'29"	263.96	N12°24'57"E	475.94
C105	164.97	596.00	17°46'55"	83.24	N29°09'44"E	164.23
C106	234.98	596.00	22°35'21"	119.03	N01°50'37"W	233.46
C107	288.21	716.00	23°08'35"	146.60	N01°59'00"W	287.25
C108	285.27	716.00	23°37'42"	148.77	N31°31'55"E	293.19

LINE	BEARING	DISTANCE
L1	S25°26'10"W	23.40
L2	N05°52'06"W	1.83
L3	N43°20'46"E	40.00

PUBLIC UTILITY EASEMENTS shown on this plat are granted for the common and joint use of:

- The PNM Electric Services Division for the installation, maintenance and service of overhead and underground electrical lines, transformers, poles and any other equipment, fixtures, structures and related facilities reasonably necessary to provide electrical services.
- The PNM Gas Services Division for installation, maintenance and services of natural gas lines, valves and other equipment and facilities reasonably necessary to provide natural gas.
- Qwest for installation, maintenance and service of all buried and aerial communication lines and other related equipment and facilities reasonably necessary to provide communication services, including but not limited to above ground pedestals and closures.
- Comcast cable for installation, maintenance and service of such lines, cable and other related equipment and facilities reasonably necessary to provide Cable TV service. Included, is the right to build, rebuild, construct, reconstruct, locate, relocate, change, remove, modify,

CURVE	LENGTH	RADIUS	DELTA	TANGENT	CH-BEARING	CH-DIST
C1	706.90	716.00	56°54'04"	385.27	N10°53'44"E	678.54
C2	360.16	1086.00	19°21'28"	181.81	N65°10'58"W	358.45
C3	322.97	1300.00	17°26'55"	164.41	N65°17'18"W	326.30
C4	238.33	430.00	31°40'08"	122.81	N69°36'06"E	236.30
C5	35.06	596.00	3°24'37"	17.53	N04°31'40"W	35.05
C6	34.92	550.00	3°38'14"	17.46	N07°24'10"W	34.91
C7	370.80	566.00	37°32'08"	192.33	N65°20'01"W	364.20
C8	371.64	1100.00	19°21'28"	187.61	N65°20'01"W	369.88
C9	231.20	1100.00	12°02'33"	116.03	N62°40'34"W	230.77
C10	140.44	1100.00	7°16'55"	70.32	N62°21'18"W	140.35
C11	57.14	1254.00	2°36'39"	28.59	N64°42'26"W	57.14
C12	42.74	1254.00	1°57'10"	21.37	N62°25'31"W	42.74
C13	40.47	25.00	92°45'06"	26.23	N15°04'23"W	36.19
C14	38.00	25.00	87°04'55"	23.76	N14°50'37"E	34.44
C15	35.36	1134.00	1°14'11"	17.68	N62°30'31"W	35.36
C16	51.67	1134.00	2°36'39"	25.84	N64°42'26"W	51.67
C17	34.61	1134.00	1°44'52"	17.31	N47°31'45"W	34.61
C18	48.71	1134.00	2°27'40"	24.36	N49°38'02"W	48.71
C19	58.40	1134.00	2°57'03"	29.21	N62°20'24"W	58.39
C20	38.87	1134.00	1°57'51"	19.44	N64°42'50"W	38.87
C21	38.00	25.00	87°04'55"	23.76	S17°41'18"E	34.44
C22	40.47	25.00	92°45'06"	26.23	S77°40'43"W	36.19
C23	46.63	1254.00	2°07'49"	23.32	N64°32'56"W	46.62
C24	64.96	1254.00	2°57'03"	32.30	N62°20'24"W	64.57
C25	53.87	1254.00	2°27'40"	26.94	N49°38'02"W	53.86
C26	53.87	1254.00	2°27'40"	26.94	N44°42'41"W	53.86
C27	53.87	1254.00	2°27'40"	26.94	N44°42'41"W	53.86
C28	25.46	1254.00	1°09'49"	12.73	N42°53'57"W	25.46
C29	102.43	1292.33	4°32'33"	51.24	N42°56'08"W	102.40
C30	45.37	25.00	103°56'59"	31.99	S06°47'06"W	38.40
C31	35.45	98.00	20°43'24"	17.92	N48°24'53"E	35.25
C32	48.36	596.00	4°38'56"	24.19	N35°26'19"E	48.34
C33	48.36	596.00	4°38'56"	24.19	N30°47'22"E	48.34
C34	48.36	596.00	4°38'56"	24.19	N06°08'26"E	48.34
C35	36.89	596.00	3°19'42"	18.44	N02°02'17"E	36.87
C36	36.89	25.00	84°33'00"	22.23	S02°32'46"W	33.63
C37	41.41	25.00	94°53'47"	27.23	N27°43'45"W	36.83
C38	51.22	716.00	4°05'54"	24.62	N27°46'07"E	51.21
C39	56.09	716.00	4°39'56"	28.06	N26°08'26"E	56.08
C40	56.09	716.00	4°39'56"	28.06	N30°47'22"E	56.08
C41	56.09	716.00	4°39'56"	28.06	N35°26'19"E	56.08
C42	69.77	716.00	5°33'00"	34.91	N40°33'16"E	69.75
C43	41.41	25.00	94°53'59"	27.23	N57°22'17"E	36.83
C44	36.89	25.00	84°32'47"	22.23	S32°54'20"E	33.63
C45	41.54	596.00	3°59'38"	20.78	N07°22'15"E	41.54
C46	48.36	596.00	4°38'56"	24.19	N03°02'58"E	48.34
C47	48.36	596.00	4°38'56"	24.19	N01°35'58"W	48.34
C48	48.36	596.00	4°38'56"	24.19	N06°14'54"W	48.34
C49	48.36	596.00	4°38'56"	24.19	N10°53'50"W	48.34
C50	56.09	716.00	4°39'56"	29.06	N10°53'50"W	56.08
C51	56.09	716.00	4°39'56"	29.06	N06°14'54"W	56.08
C52	56.09	716.00	4°39'56"	29.06	N01°35'58"W	56.08
C53	56.09	716.00	4°39'56"	29.06	N01°35'58"W	56.08
C54	56.83	716.00	4°39'52"	28.43	N07°58'32"E	56.82
C55	71.34	550.00	6°09'42"	35.72	N05°52'06"W	71.29
C56	59.15	550.00	5°33'12"	29.60	N00°55'42"E	59.12
C57	61.12	550.00	6°22'01"	30.59	N07°11'33"E	61.09
C58	61.12	550.00	6°22'01"	30.59	N13°33'34"E	61.09
C59	61.12	550.00	6°22'01"	30.59	N19°55'35"E	61.09
C60	61.12	550.00	6°22'01"	30.59	N26°17'36"E	61.09
C61	61.12	550.00	6°22'01"	30.59	N32°39'37"E	61.09
C62	21.21	550.00	2°12'54"	10.61	N36°56'55"E	21.21
C63	83.20	52.00	91°40'32"	53.54	N63°53'27"E	74.61
C64	59.47	1300.00	2°37'16"	29.74	N51°34'55"W	59.47
C65	66.77	1300.00	3°49'27"	43.40	N54°48'16"W	66.75
C66	36.29	25.00	83°09'40"	22.18	S10°08'10"E	33.18
C67	39.60	596.00	3°39'17"	19.91	N14°30'31"E	39.70
C68	48.34	596.00	4°43'08"	24.18	N20°12'57"E	48.33
C69	48.34	596.00	4°43'08"	24.18	N25°10'07"E	48.26
C70	48.34	596.00	4°43'08"	24.18	N30°48'01"E	48.33
C71	57.99	596.00	4°42'08"	29.00	N05°39'22"E	57.97
C72	57.99	596.00	5°38'29"	28.02	N00°00'00"W	57.97
C73	61.29	543.00	6°28'03"	30.66	N02°39'57"W	61.26
C74	61.29	543.00	6°28'03"	30.66	N03°28'06"E	61.26
C75	61.29	543.00	6°28'03"	30.66	N09°56'09"E	61.26
C76	61.29	543.00	6°28'03"	30.66	N16°24'13"E	61.26
C77	56.14	543.00	5°55'24"	28.09	N22°35'57"E	56.11
C78	40.82	25.00	93°33'12"	26.60	N72°20'15"E	36.43
C79	83.45	1300.00	3°40'41"	41.74	N62°43'30"W	83.44
C80	38.27	25.00	90°00'00"	25.00	S68°20'46"W	35.36


Dwg: AS SHOWN
Scale: 1" = 50'

Checked: ALS
Job: A01005

Drawn: Date:

Sheet 3 of 4

BERNARDO TRAILS SUBDIVISION
(UNDER CONSTRUCTION)

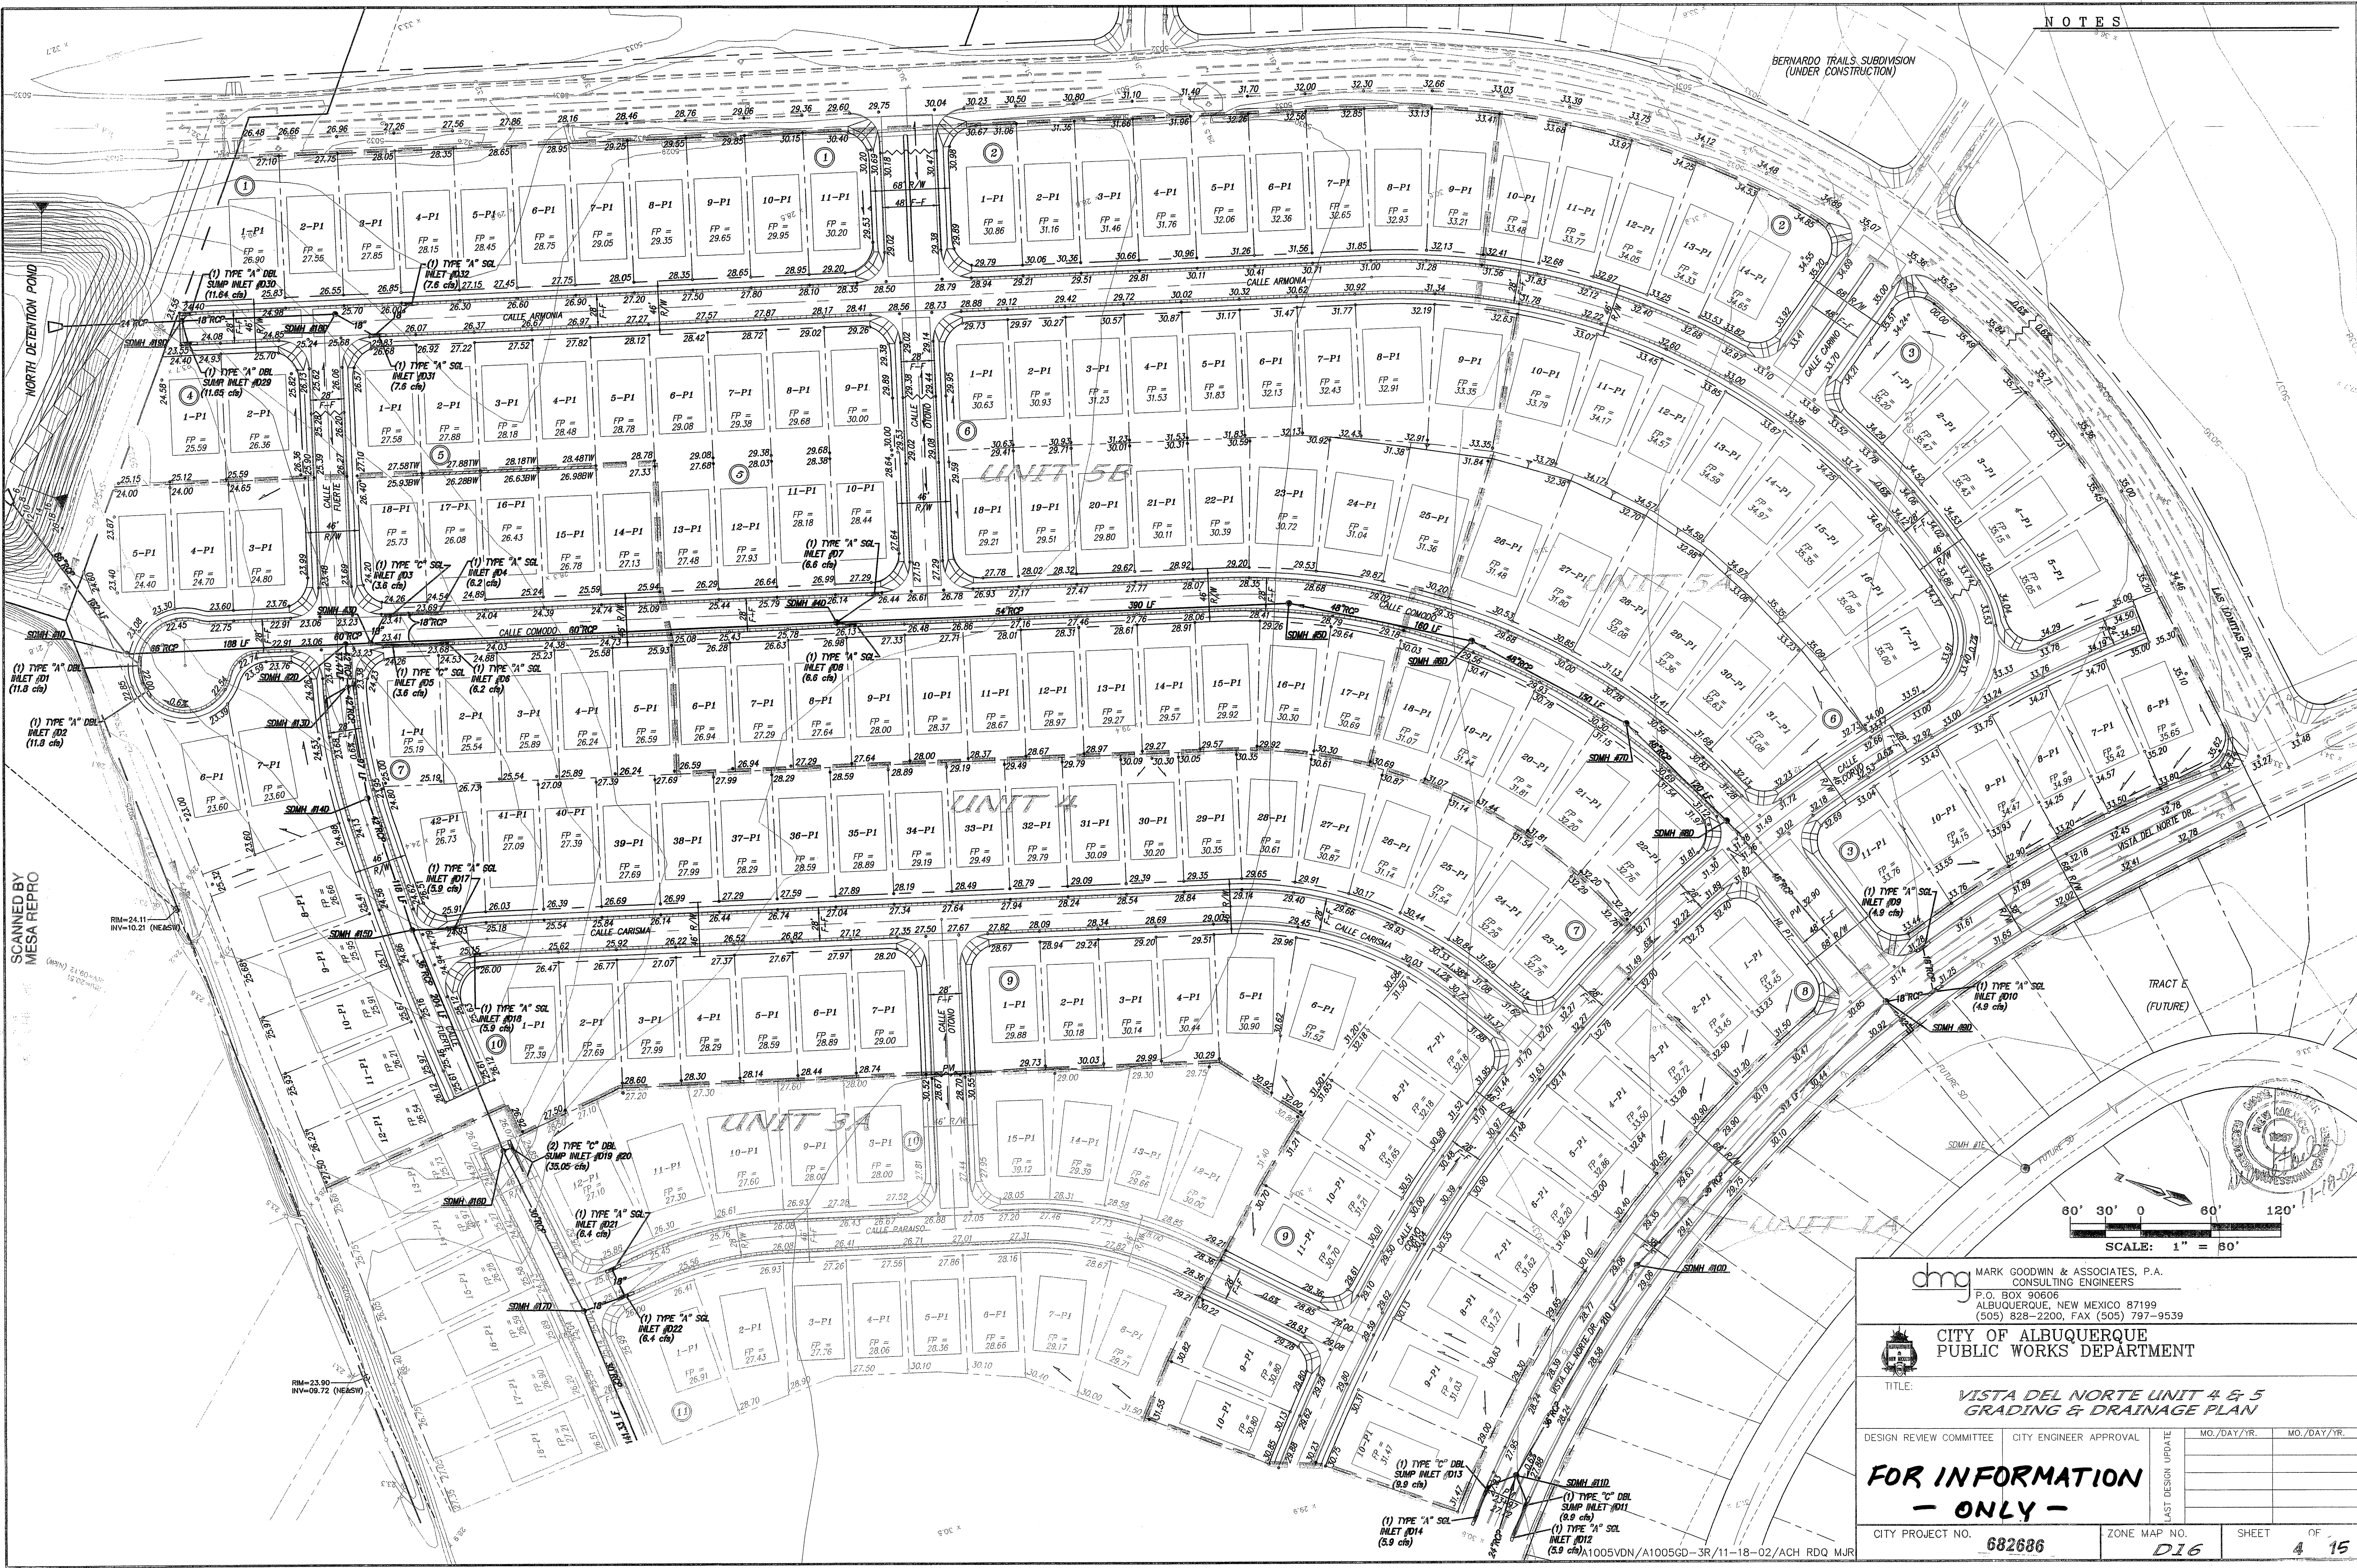

SCANNED BY
MESA REPRO




MARK GOODWIN & ASSOCIATES, P.A.
CONSULTING ENGINEERS
P.O. BOX 90606
ALBUQUERQUE, NEW MEXICO 87199
(505) 828-2200, FAX (505) 797-9539

**CITY OF ALBUQUERQUE
PUBLIC WORKS DEPARTMENT**


TITLE: **VISTA DEL NORTE UNIT 4 & 5
GRADING & DRAINAGE PLAN**

DESIGN REVIEW COMMITTEE	CITY ENGINEER APPROVAL	MO./DAY/YR.	MO./DAY/YR.
FOR INFORMATION - ONLY -			
CITY PROJECT NO. 682686	ZONE MAP NO. D16	SHEET 4	OF 15


1. ALL 4" VALLEY GUTTERS PER CITY OF ALBUQUERQUE STANDARD DRAWING 2421 AT KNUCKLES.
2. ALL 6" VALLEY GUTTERS PER CITY OF ALBUQUERQUE STANDARD DRAWING 2420 AT ALL INTERSECTIONS.
3. TRANSITION FROM MOUNTABLE CURB TO STANDARD CURB SHALL BE 10' PER COA STANDARD DRAWING 2418.
4. TRANSITION SECTION FROM FULL CROWN TO NO CROWN TO BE A MINIMUM OF 50', PER CITY OF ALBUQUERQUE STANDARD DRAWING 2401.
5. ALL SIDEWALKS PER COA STANDARD DRAWING 2430.
6. ALL CURB & GUTTER PER COA STD. DWG 2415.
7. WHEELCHAIR RAMPS PER COA STD. DWG 2441, CASE 1 SEE DETAIL AND NOTE THIS SHEET
8. ALL 4" INTERIOR SIDEWALKS ARE DEFERRED.

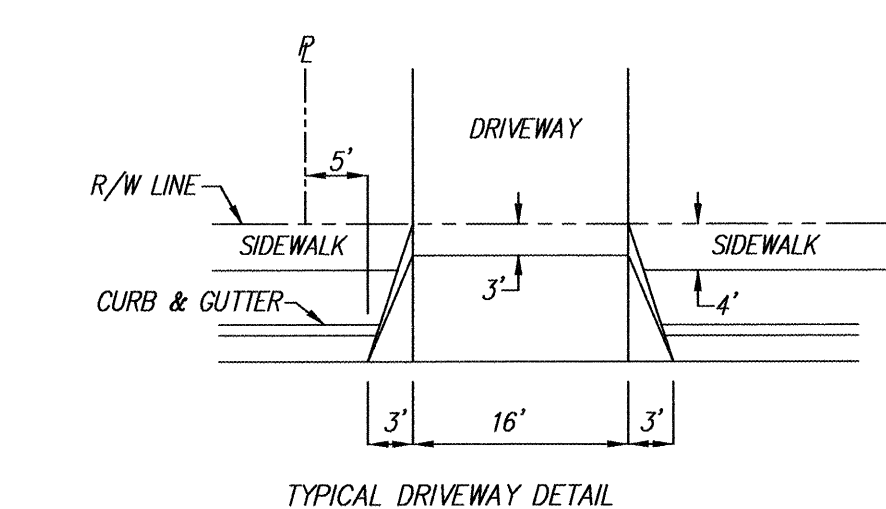

NTS CURB OPENING PER THIS PROJECT.
DRIVE PAD BY HOME BUILDER PER
COA STD. DWG. 2425.

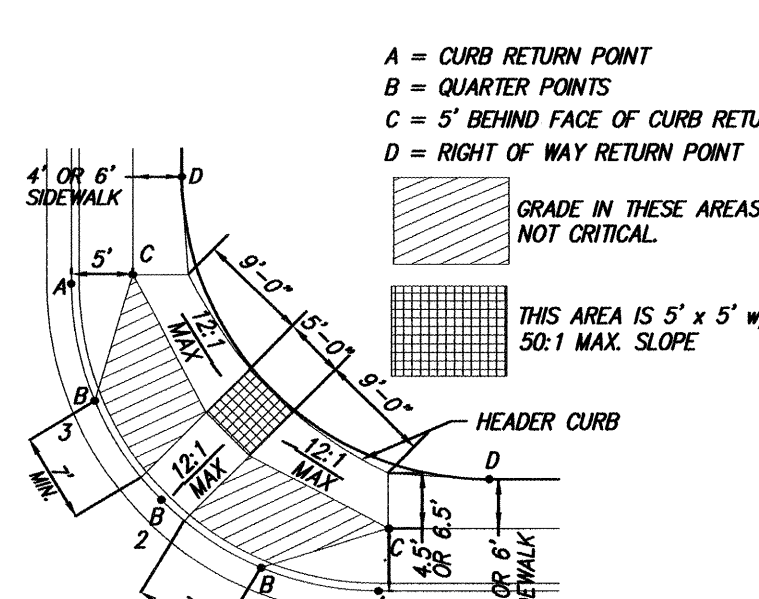

NON-ARTERIAL WHEEL CHAIR RAMP DETAIL - CASE II

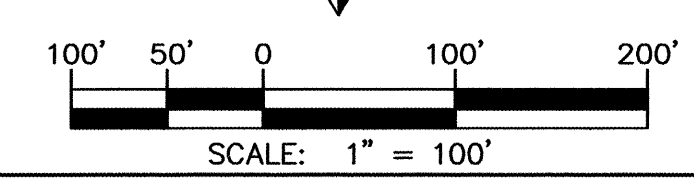

dmg MARK GOODWIN & ASSOCIATES, P.A.
CONSULTING ENGINEERS
P.O. BOX 90606
ALBUQUERQUE, NEW MEXICO 87199
(505) 828-2200, FAX (505) 797-9539



CITY OF ALBUQUERQUE
PUBLIC WORKS DEPARTMENT

TITLE: **VISTA DEL NORTE - UNIT 5
MASTER PAVING PLAN**

CITY ENGINEER APPROVAL

ZONE MAP NO.
D-16

SHEET	OF
5	15

[illegible]

F:\A01005\A1005VDN\Unit5A\A1005PP-8.dwg Fr1 Jan 10 08:34:30 2003 D. MARK GOODWIN & ASSOCIATES, PLTIED BY: ACH

SCANNED BY
MESA REPRO

UNIT 5B
EXISTING

UNIT 5A
THIS PROJECT

18+00

19+00

20+00

21+00

22+00


23+00

24+00

25+00


26+00

A1005VDN/UNIT 5A/A1005PP-8/01-07-03/ACH

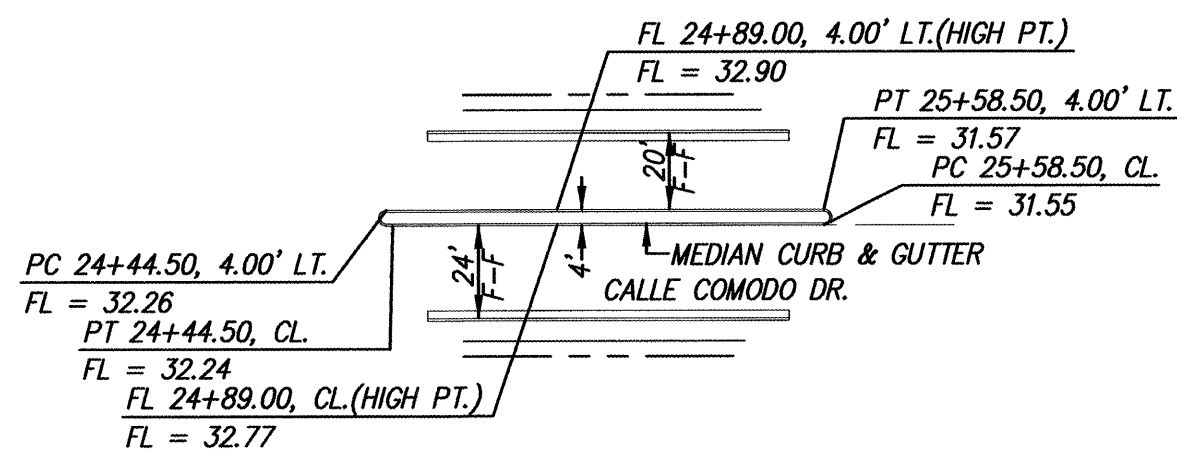

MEDIAN DETAIL

NTS

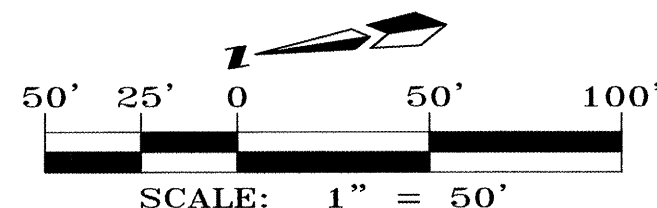

CALLE COMODO
STA. 19+10.41 TO STA. 25+92.30
SCALE: HORZ. 1" = 50'
VERT. 1" = 10'

NOTES

1. ALL STATIONING IS CENTERLINE STATIONING.

CURVE DATA - DESCRIBES FACE OF CURB

- | | |
|---|---|
| ① $\Delta = 49^{\circ}33'35''$
$R = 552.00'$
$L = 477.47'$
$T = 254.82'$ | ② $\Delta = 92^{\circ}29'43''$
$R = 25.00'$
$L = 40.36'$
$T = 26.11'$ |
| ③ $\Delta = 92^{\circ}16'06''$
$R = 25.00'$
$L = 40.26'$
$T = 26.01'$ | ④ $\Delta = 86^{\circ}30'07''$
$R = 25.00'$
$L = 37.74'$
$T = 23.52'$ |
| ⑤ $\Delta = 86^{\circ}28'55''$
$R = 25.00'$
$L = 37.73'$
$T = 23.51'$ | ⑥ $\Delta = 86^{\circ}28'55''$
$R = 25.00'$
$L = 40.26'$
$T = 26.01'$ |
| ⑦ $\Delta = 84^{\circ}16'08''$
$R = 25.00'$
$L = 36.77'$
$T = 22.62'$ | ⑧ $\Delta = 49^{\circ}43'18''$
$R = 580.00'$
$L = 503.33'$
$T = 268.75'$ |


CURVE DATA - DESCRIBES CENTERLINE

- ① $\Delta = 53^{\circ}49'19''$
 $R = 566.00'$
 $L = 531.68'$
 $T = 287.28'$

CERTIFICATE OF SUBSTANTIAL COMPLIANCE ON PLANS

I, Diane Hoelzer, NMPE 11967, of the firm Mark Goodwin & Associates, P.A., a Registered Professional Engineer in the State of New Mexico, do hereby certify, to the best of my knowledge and belief, that the infrastructure installed as part of this project has been inspected by me or by a qualified person under my direct supervision, and has been constructed in accordance with the plans and specifications approved by the City Engineer and that the original design intent of the approved plans has been met, except as noted by me on the as-built construction drawings. This Certification is based on site inspections by me or personnel under my direction, and survey information provided by ALS, Inc., NMPS number 7719.

Diane Hoelzer 10-29-03


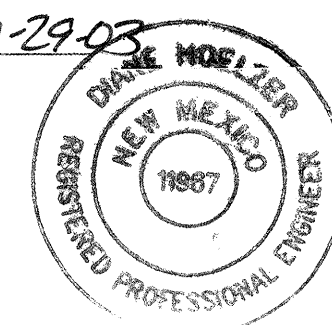


dmg MARK GOODWIN & ASSOCIATES, P.A.
CONSULTING ENGINEERS
P.O. BOX 90606
ALBUQUERQUE, NEW MEXICO 87199
(505) 828-2200, FAX (505) 797-9539



CITY OF ALBUQUERQUE
PUBLIC WORKS DEPARTMENT

TITLE: **VISTA DEL NORTE - UNIT 5A
CALLE COMODO
PAVING IMPROVEMENTS**

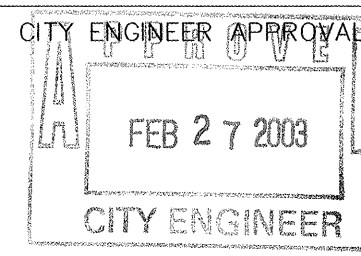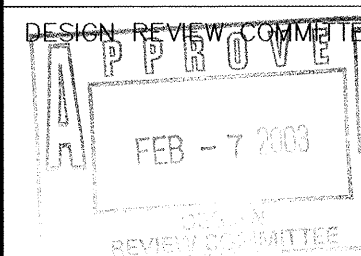

MO./DAY/YR.	MO./DAY/YR.

CITY PROJECT NO.

ZONE MAP NO.


SHEET OF

682686

D-16


6 15

SCANNED BY
MESA REPRO

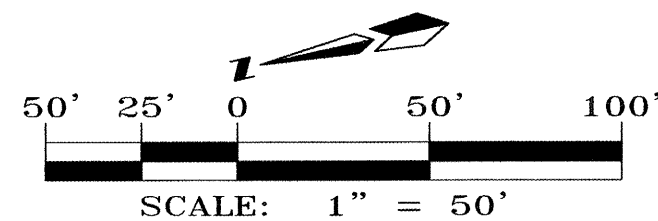


CALLE ARMONIA
STA. 19+94.76 TO STA. 25+07.55
SCALE: HORZ. 1" = 50'
VERT. 1" = 10'

**VISTA DEL NORTE
UNIT 5A**

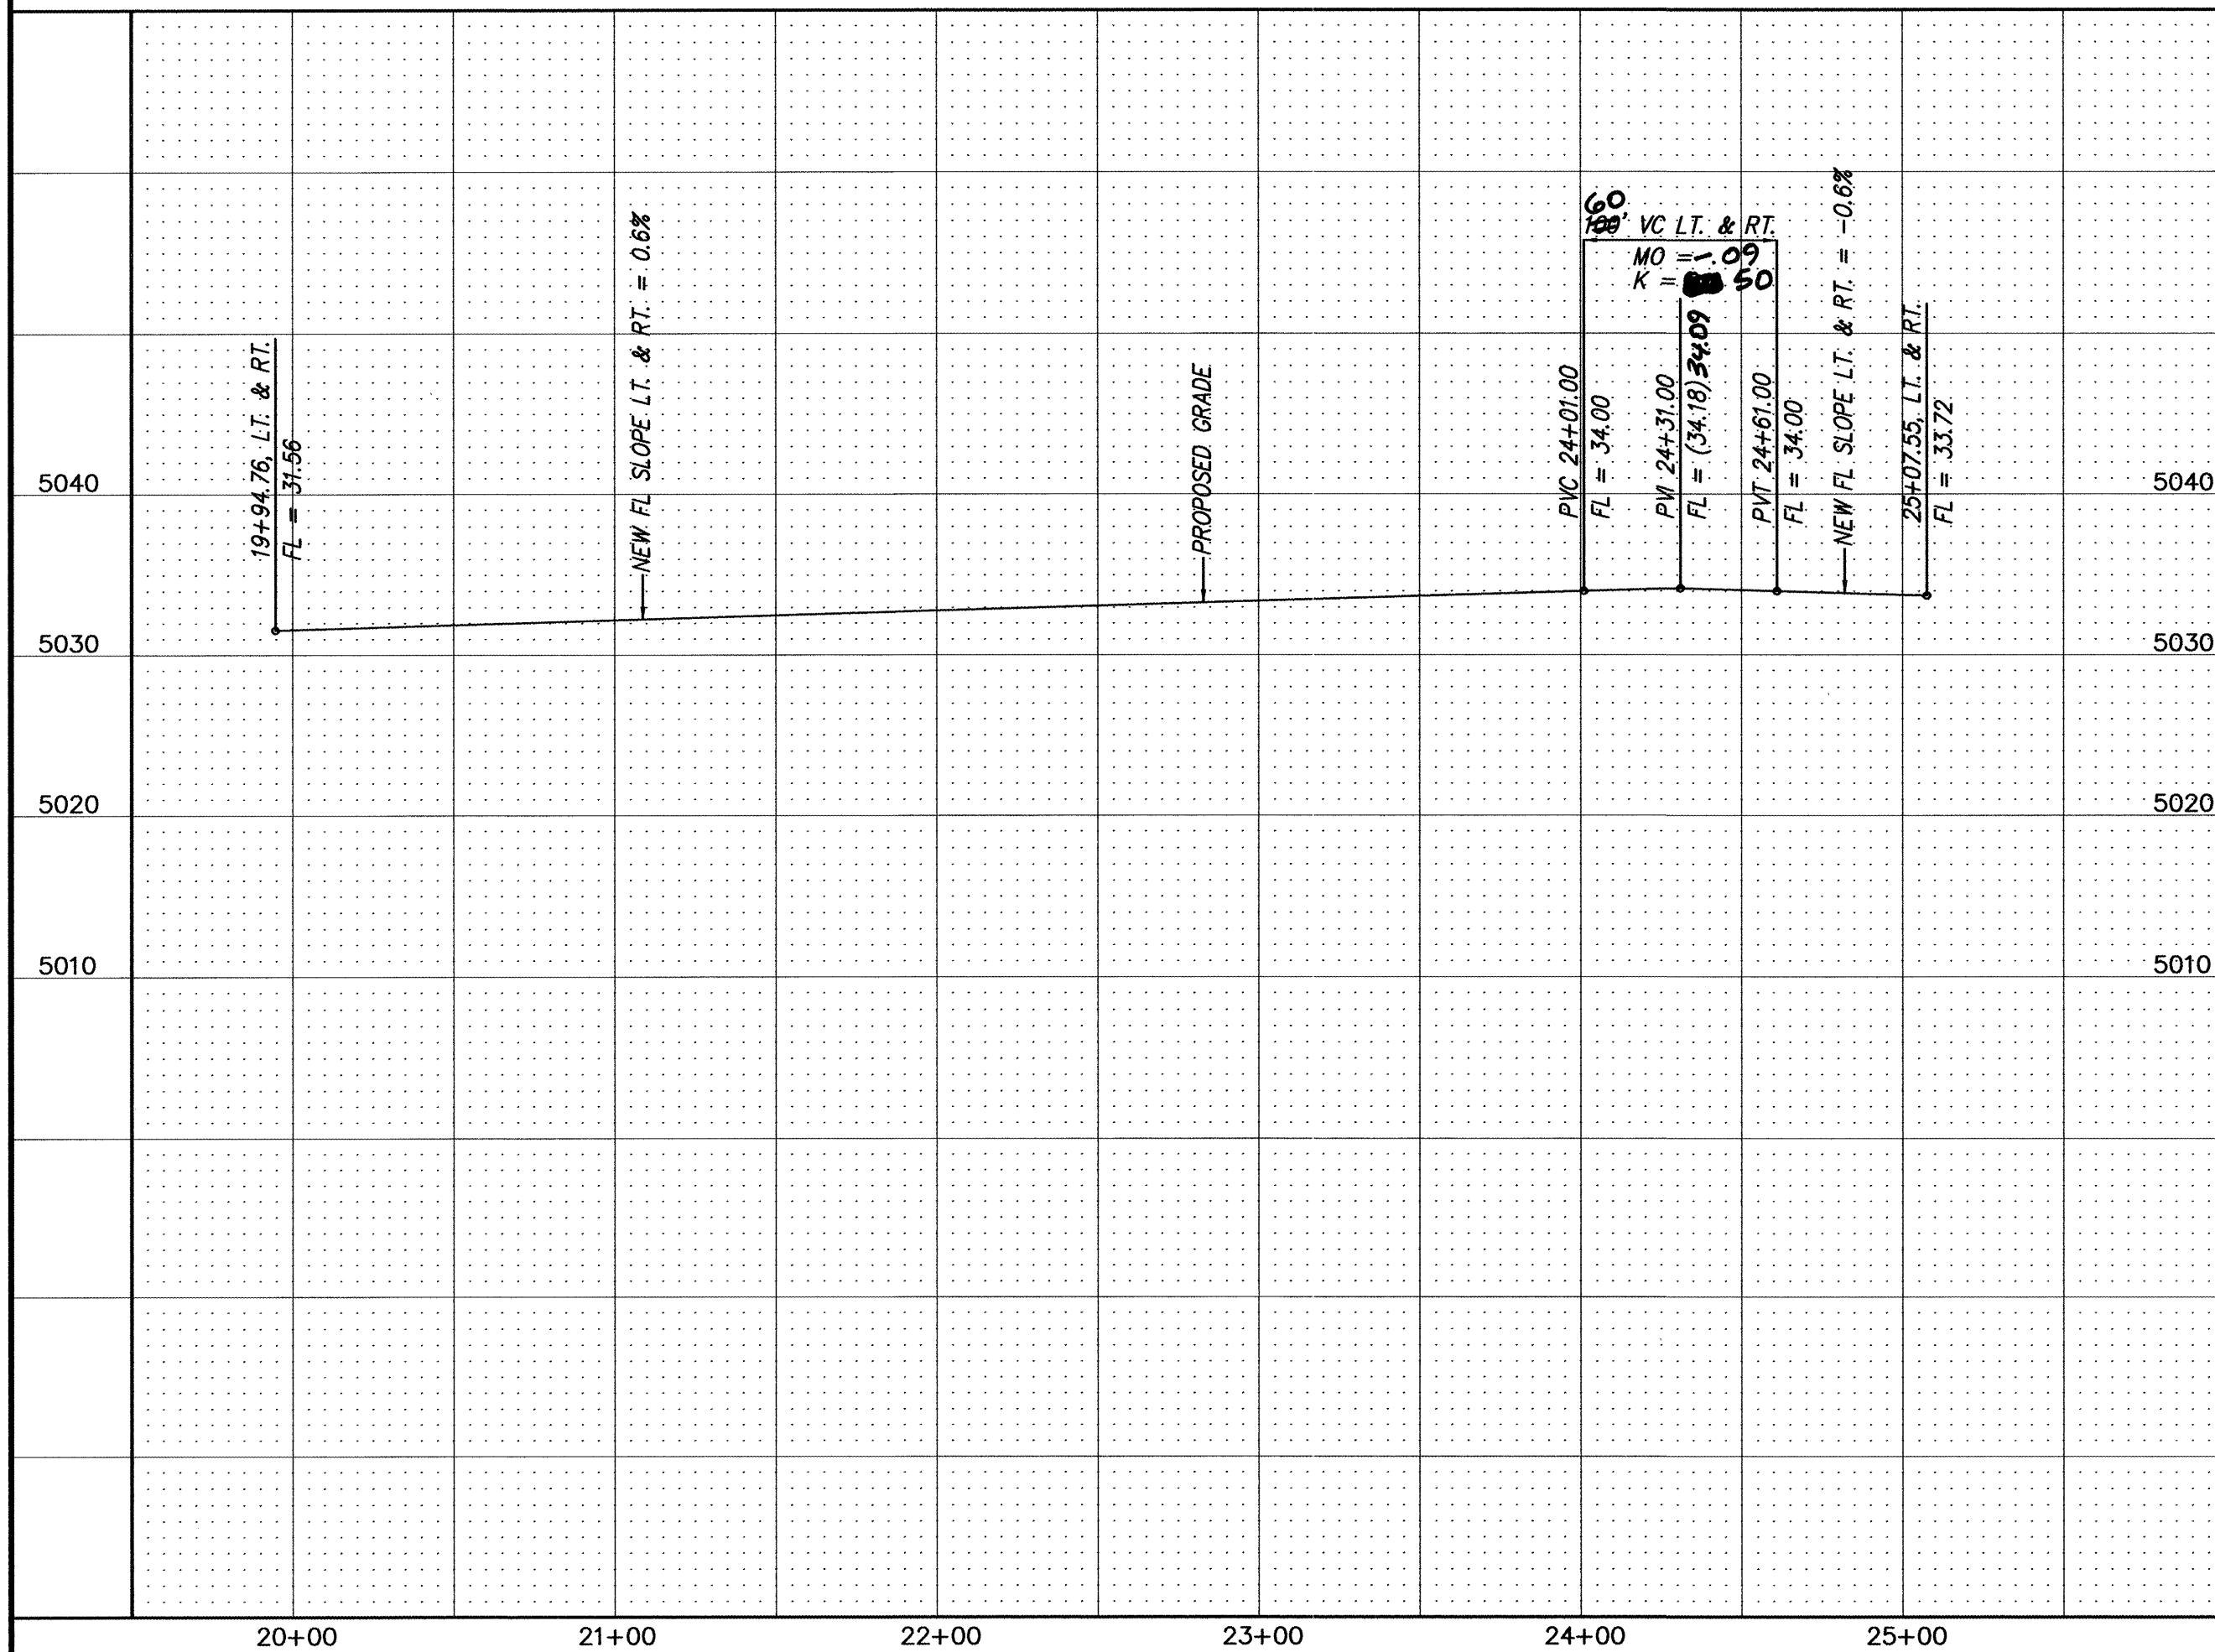

* EXIST. DESIGN FLOWLINE

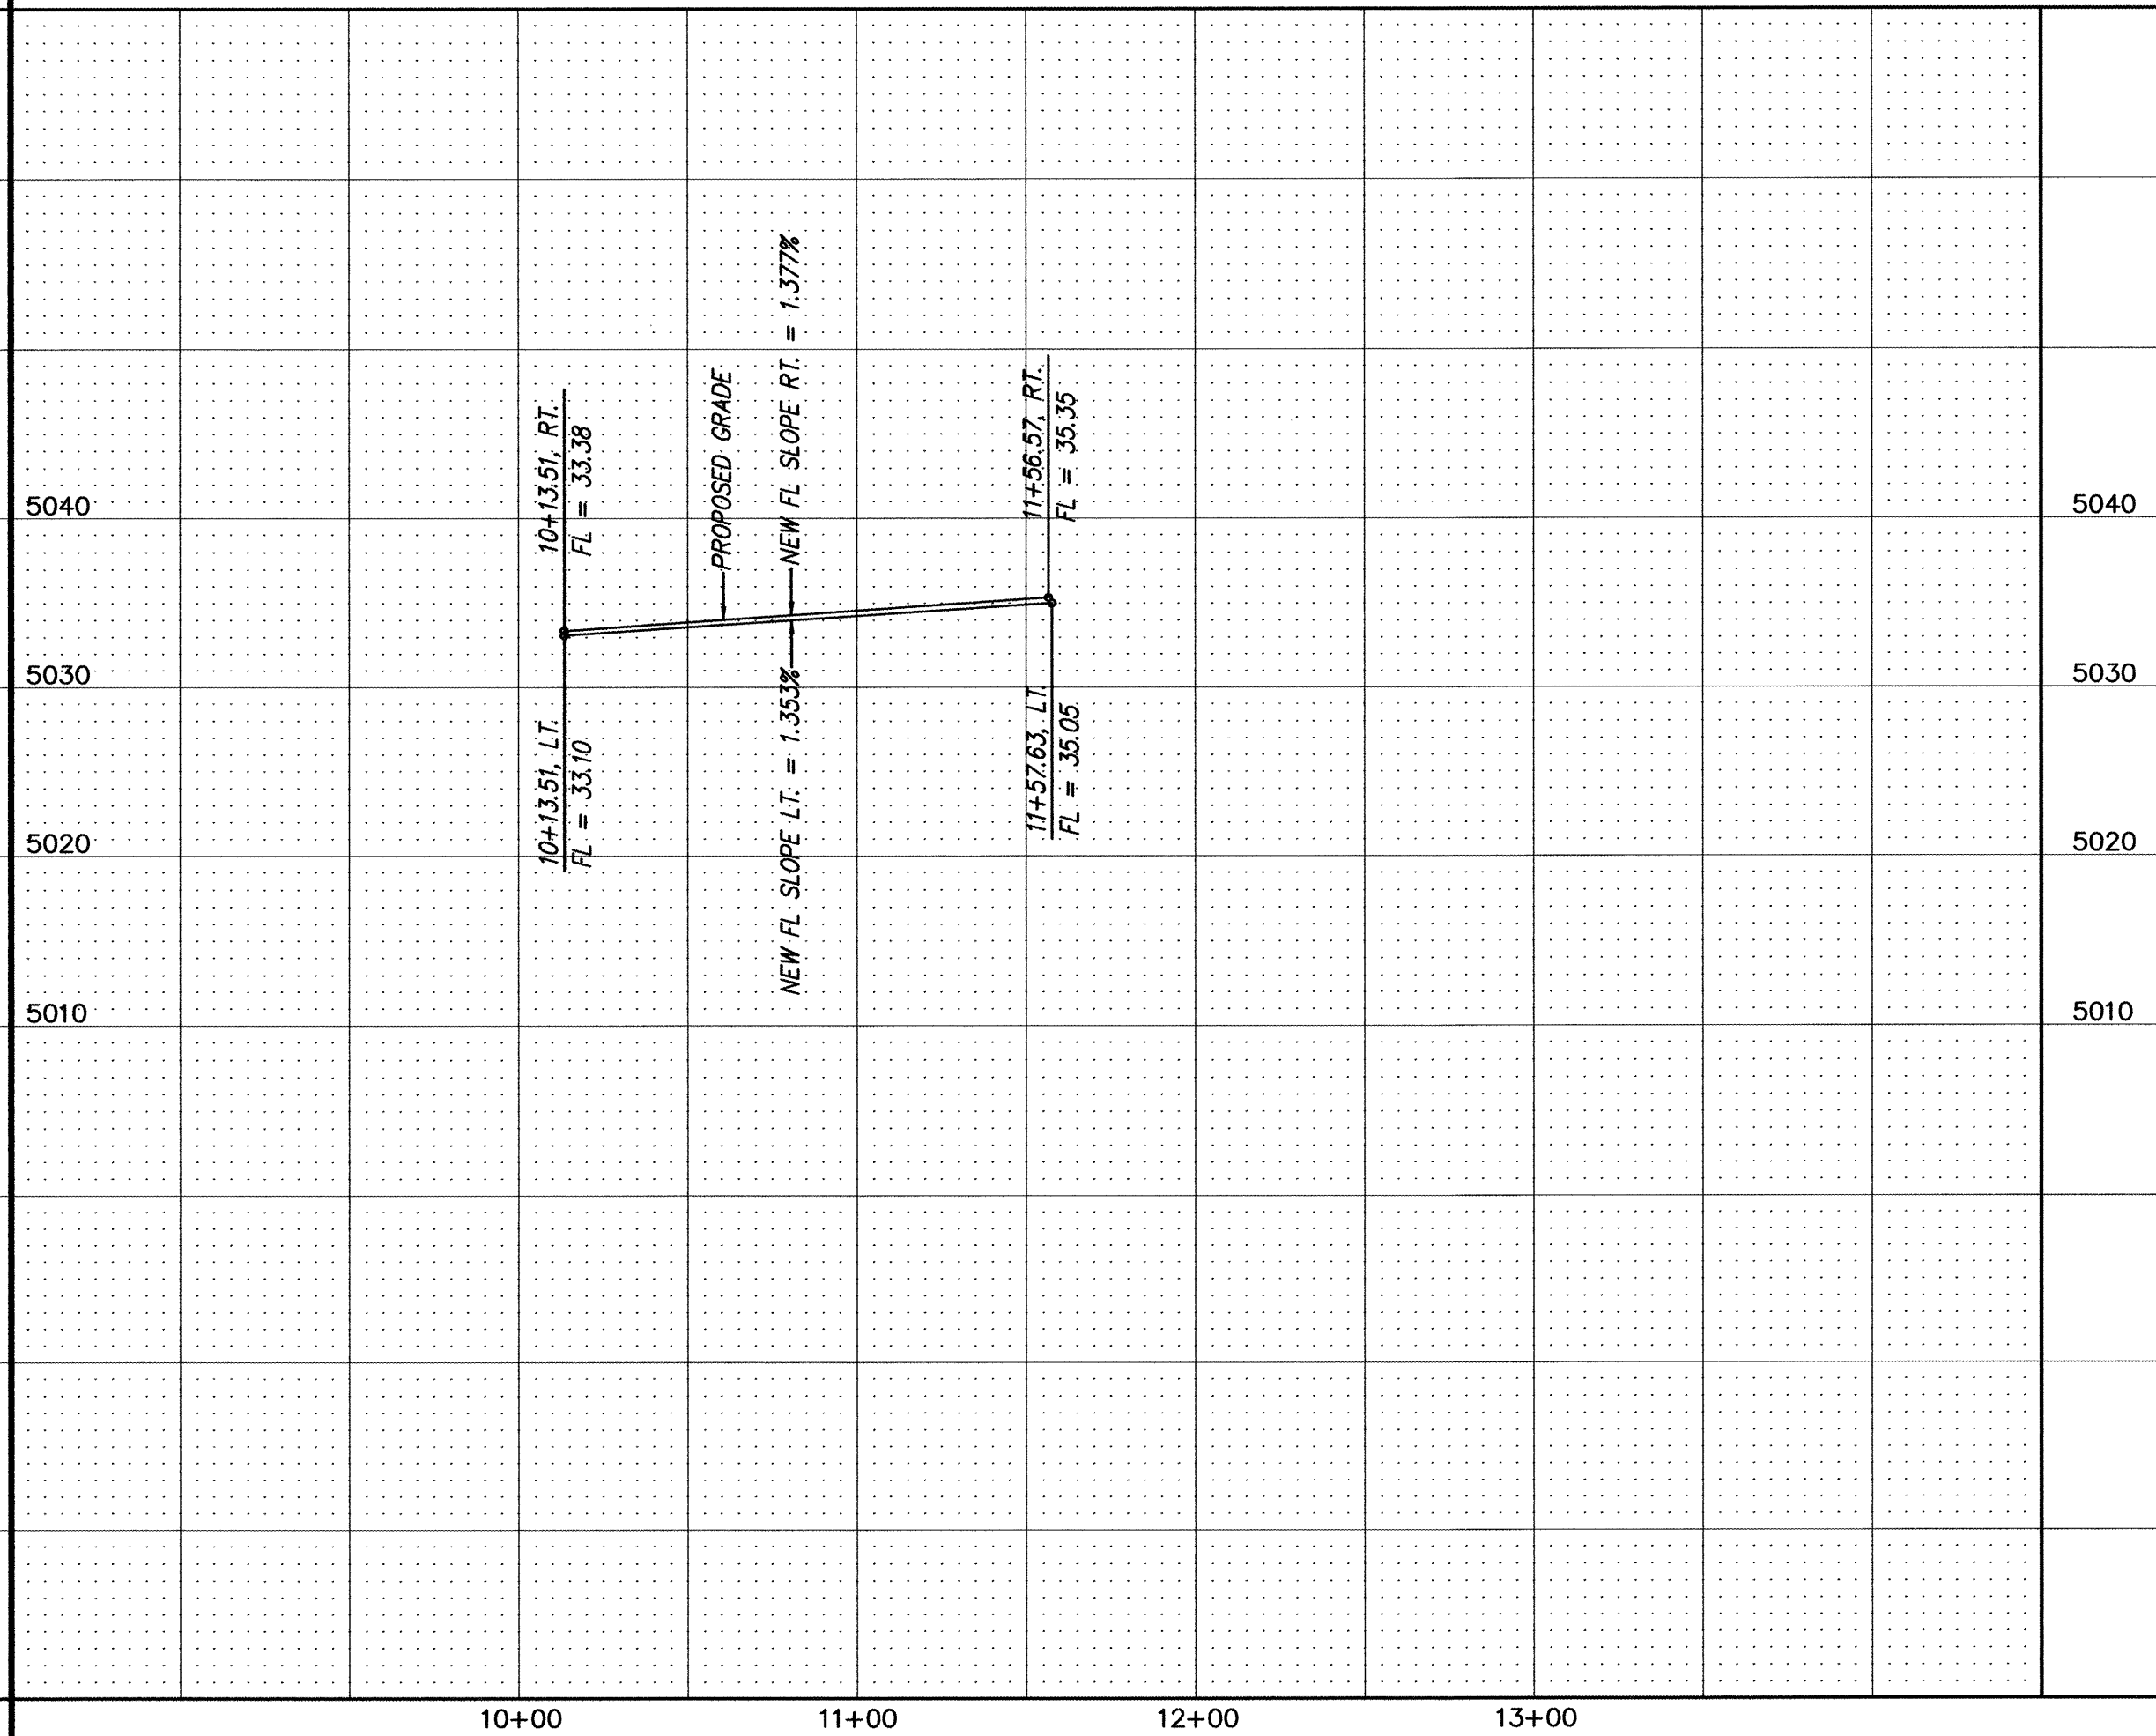

NOTES

1. ALL STATIONING IS CENTERLINE STATIONING.

CALLE ARMONIA

CURVE DATA - DESCRIBES FACE OF CURB

- | | |
|---|--|
| ① $\Delta = 60^{\circ}34'21''$
$R = 559.00'$
$L = 590.97'$
$T = 326.47'$ | ② $\Delta = 18^{\circ}38'29''$
$R = 587.00'$
$L = 190.98'$
$T = 96.34'$ |
| ③ $\Delta = 85^{\circ}24'34''$
$R = 25.00'$
$L = 37.27'$
$T = 23.07'$ | ④ $\Delta = 85^{\circ}24'34''$
$R = 25.00'$
$L = 37.27'$
$T = 23.07'$ |
| ⑤ $\Delta = 32^{\circ}44'47''$
$R = 587.00'$
$L = 335.49'$
$T = 172.46'$ | |

CURVE DATA - DESCRIBES CENTERLINE

- | |
|---|
| ① $\Delta = 90^{\circ}04'43''$
$R = 75.00'$
$L = 117.83'$
$T = 75.02'$ |
|---|

CALLE CARINO


CURVE DATA - DESCRIBES FACE OF CURB

- | | |
|--|--|
| ① $\Delta = 85^{\circ}24'34''$
$R = 25.00'$
$L = 37.27'$
$T = 23.07'$ | ② $\Delta = 93^{\circ}58'47''$
$R = 25.00'$
$L = 41.01'$
$T = 26.80'$ |
| ③ $\Delta = 93^{\circ}58'47''$
$R = 25.00'$
$L = 41.01'$
$T = 26.80'$ | ④ $\Delta = 85^{\circ}24'34''$
$R = 25.00'$
$L = 37.27'$
$T = 23.07'$ |
| ⑤ $\Delta = 180^{\circ}00'00''$
$R = 2.00'$
$L = 6.28'$
$T = 6.28'$ | ⑥ $\Delta = 180^{\circ}00'00''$
$R = 2.00'$
$L = 6.28'$
$T = 6.28'$ |

CERTIFICATE OF SUBSTANTIAL COMPLIANCE ON PLANS

I, Diane Hoelzer, NMPE 11967, of the firm Mark Goodwin & Associates, P.A., a Registered Professional Engineer in the State of New Mexico, do hereby certify, to the best of my knowledge and belief, that the infrastructure installed as part of this project has been inspected by me or by a qualified person under my direct supervision, and has been constructed in accordance with the plans and specifications approved by the City Engineer and that the original design intent of the approved plans has been met, except as noted by me on the as-built construction drawings. This Certification is based on site inspections by me or personnel under my direction, and survey information provided by ALS, Inc., NMPS number 7719.

Diane Hoelzer 10-29-03


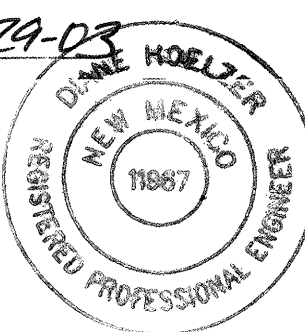


MARK GOODWIN & ASSOCIATES, P.A.
CONSULTING ENGINEERS
P.O. BOX 90606
ALBUQUERQUE, NEW MEXICO 87199
(505) 828-2200, FAX (505) 797-9539



**CITY OF ALBUQUERQUE
PUBLIC WORKS DEPARTMENT**


TITLE: **VISTA DEL NORTE - UNIT 5A
CALLE ARMONIA & CALLE CARINO
PAVING IMPROVEMENTS**

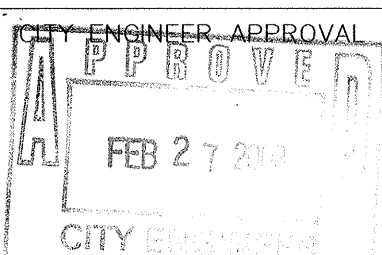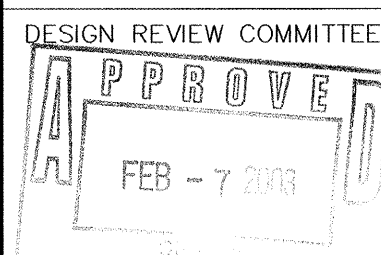


LAST DESIGN UPDATE

NO.	DATE	REVISIONS

CITY PROJECT NO. **682686** ZONE MAP NO. **D-16** SHEET **7** OF **15**

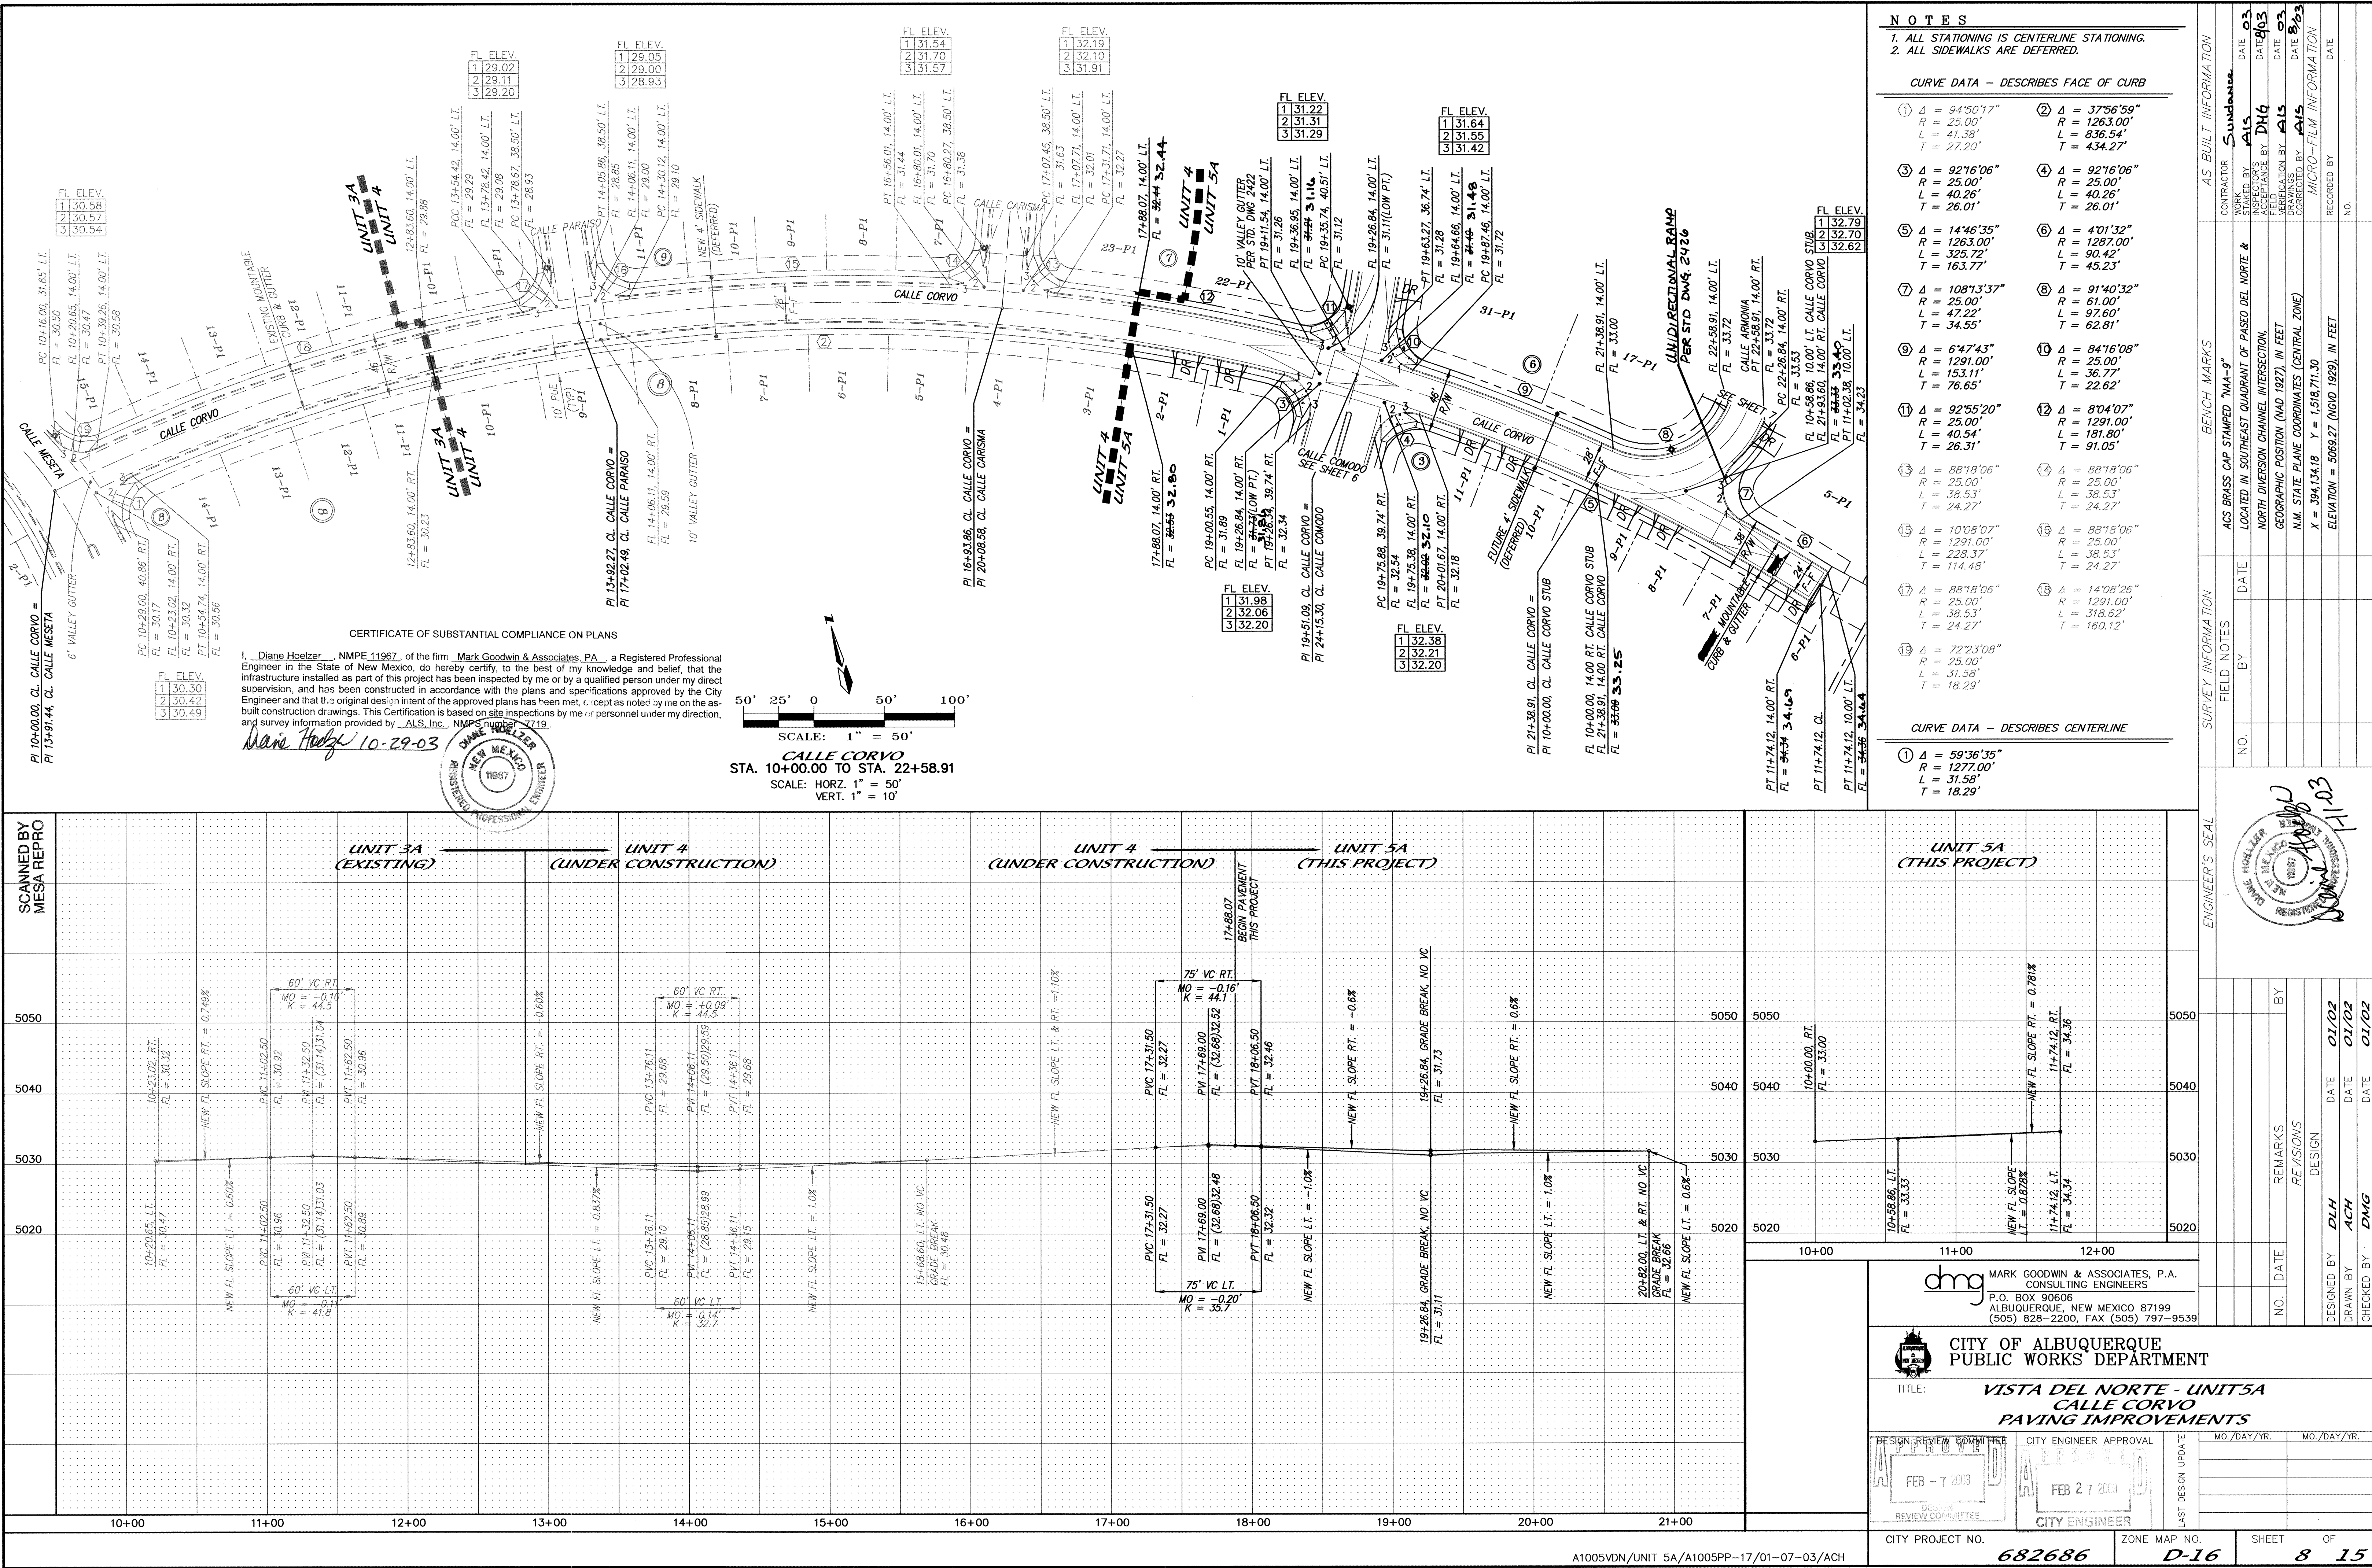


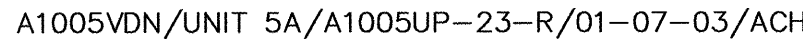


CERTIFICATE OF SUBSTANTIAL COMPLIANCE ON PLANS

I, Diane Hoelzer, NMPE 11967, of the firm Mark Goodwin & Associates, P.A., a Registered Professional Engineer in the State of New Mexico, do hereby certify, to the best of my knowledge and belief, that the infrastructure installed as part of this project has been inspected by me or by a qualified person under my direct supervision, and has been constructed in accordance with the plans and specifications approved by the City Engineer and that the original design intent of the approved plans has been met, except as noted by me on the as-built construction drawings. This Certification is based on site inspections by me or personnel under my direction, and survey information provided by ALS, Inc., NMPS number 7719.


Diane Hoelzer 10-29-03

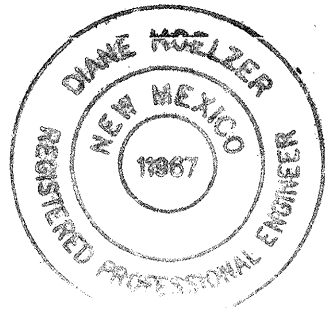

SCANNED BY
MESA REPRO

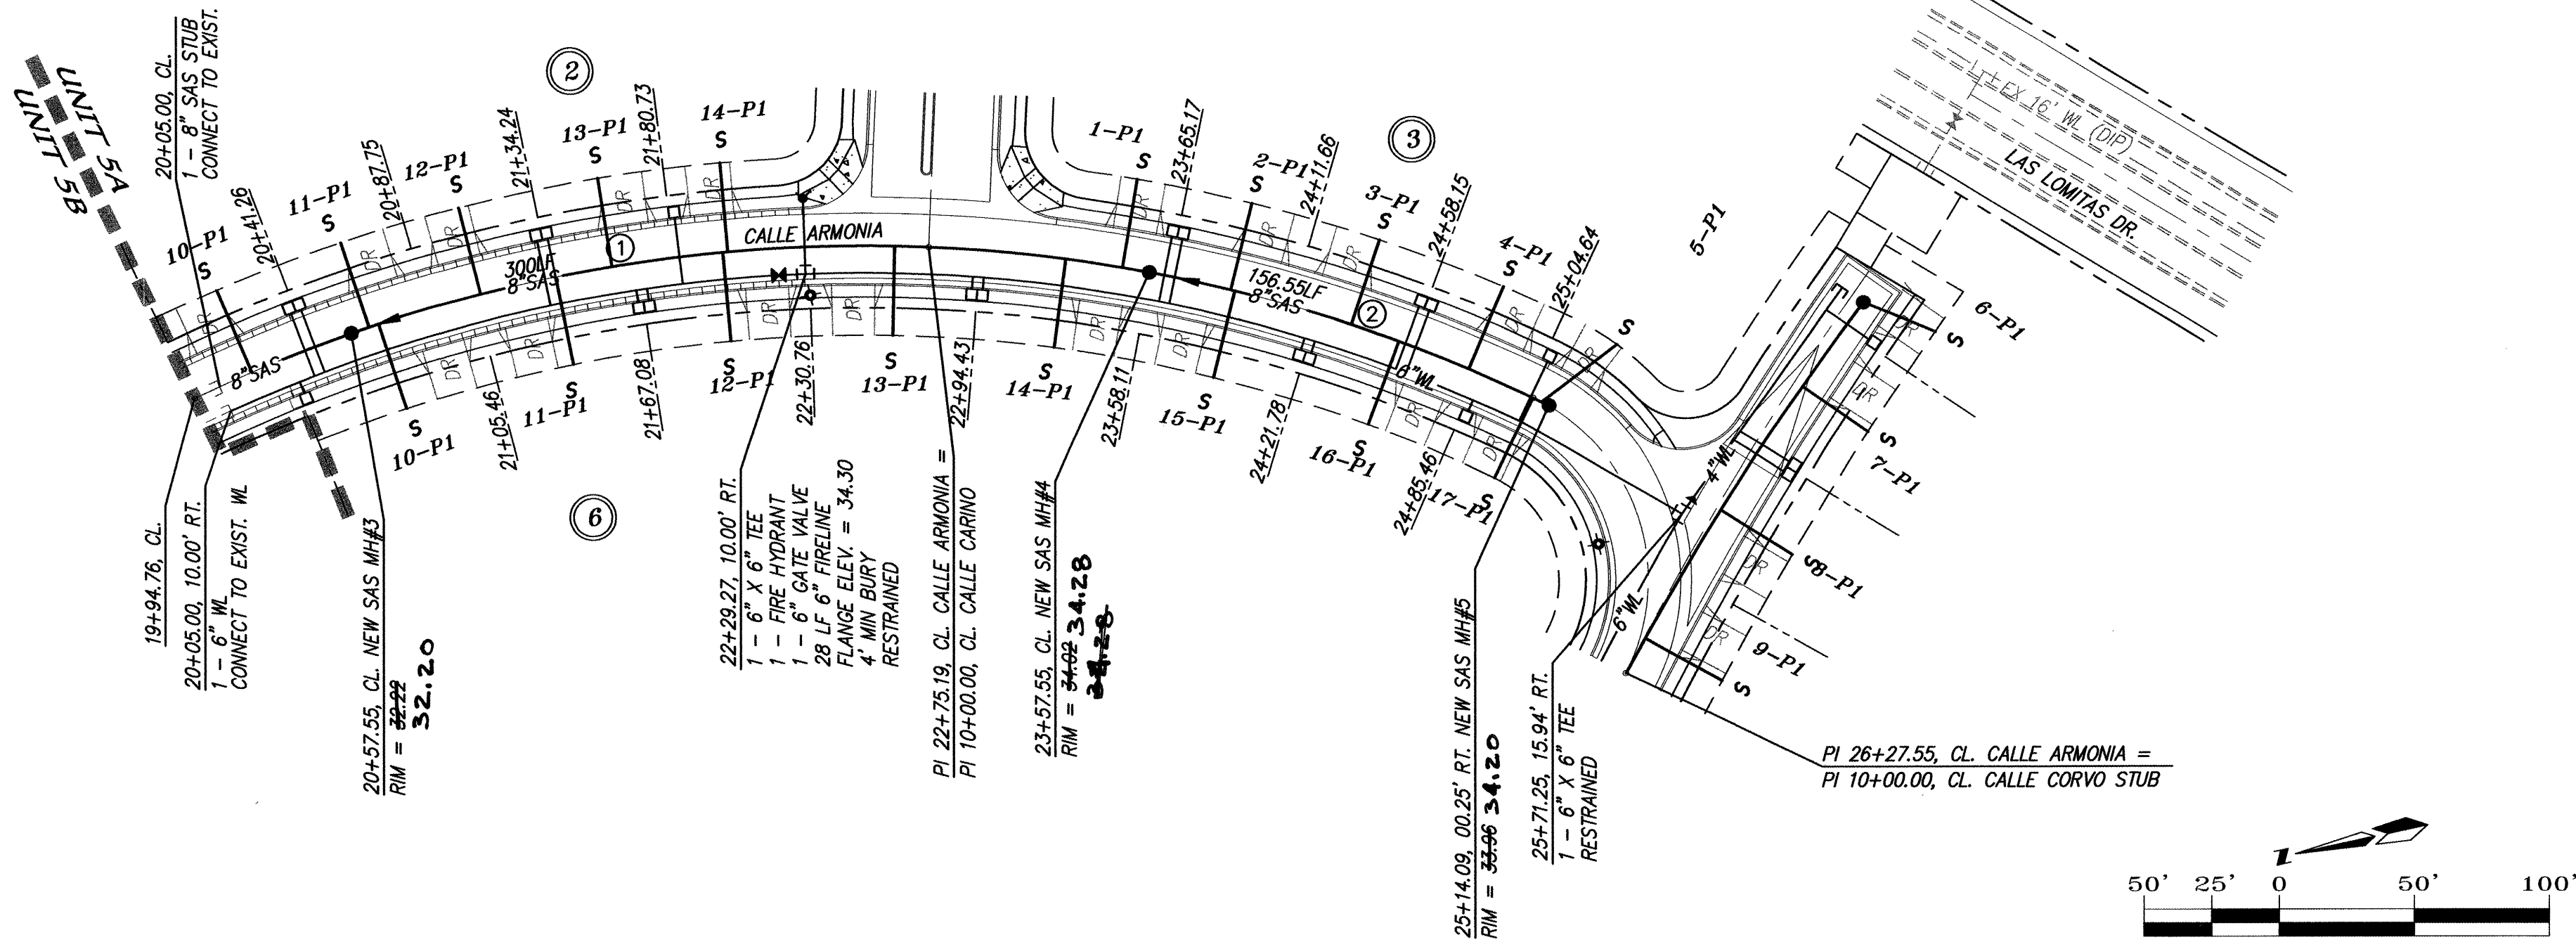

VISTA DEL NORTE
UNIT 5A

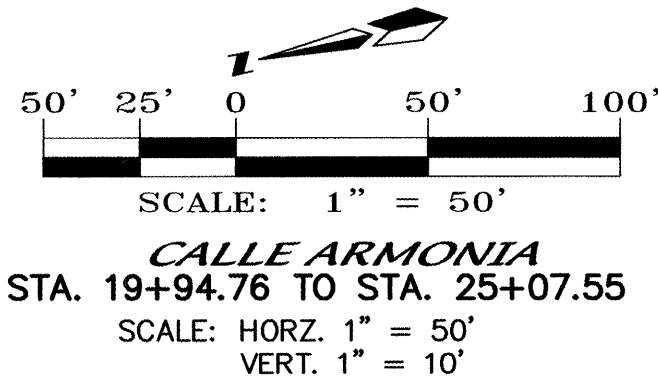

NOTES

1. ALL STATIONING IS CENTERLINE STATIONING.

CURVE DATA - DESCRIBES SAS

- ① $\Delta = 29^\circ 59' 52''$
 $R = 573.00'$
 $L = 300.00'$
 $T = 151.37'$
- ② $\Delta = 15^\circ 39' 15''$
 $R = 573.00'$
 $L = 156.55'$
 $T = 77.43'$

SANITARY SEWER SERVICES

BLOCK	LOT	STATION AT PUE	INV. AT PUE	LENGTH AT PUE
2	10	20+18.01	26.70'	33.00'
2	11	20+64.50	26.98'	33.00'
2	12	21+07.72	27.24'	33.00'
2	13	21+57.49	27.54'	33.00'
2	14	22+00.70	27.80'	33.00'
3	1	23+47.44	28.68'	33.00'
3	2	23+88.41	28.92'	33.00'
3	3	24+34.91	29.16'	33.00'
3	4	24+81.40	28.88'	33.00'
3	5	25+10.95	28.70'	35.11'
6	10	20+68.30	27.00'	33.00'
6	11	21+36.27	27.41'	33.00'
6	12	21+98.92	27.79'	33.00'
6	13	22+62.60	28.17'	33.00'
6	14	23+26.27	28.55'	33.00'
6	15	23+89.94	28.93'	33.00'
6	16	24+53.62	29.04'	33.00'
6	17	25+07.55	28.72'	33.00'

RESTRAINED JOINT LENGTH FOR BENDS, VALVES, DEAD ENDS (FT.)

PIPE SIZE	90°	45°	22.5°	11.25°	VALVE
6"	17'	7'	-	-	46'
10"	-	11'	5'	3'	72'

LENGTH OF RESTRAINED PIPE ON EACH SIDE OF THE BEND. RESTRAIN BRANCH AT FITTING ONLY MINIMUM ATTACHED PIPE LENGTH, RUN SIDE OF TEE: 10.00 FEET.

RESTRAINED JOINT LENGTHS FOR REDUCERS (FT.)

PIPE SIZE	LARGE SIDE	SMALL SIDE
10" x 6"	44'	-

RESTRAINED JOINT LENGTH FOR TEES (FT.)



PIPE SIZE	RUN	BRANCH
10"x10"x10"	15'	5'
10"x10"x6"	6'	1'
6"x6"x6"	10'	2'



MARK GOODWIN & ASSOCIATES, P.A.
CONSULTING ENGINEERS
P.O. BOX 90606
ALBUQUERQUE, NEW MEXICO 87199
(505) 828-2200, FAX (505) 797-9539






CITY OF ALBUQUERQUE
PUBLIC WORKS DEPARTMENT
TITLE: **VISTA DEL NORTE - UNIT 5A
CALLE ARMONIA
UTILITY IMPROVEMENTS**

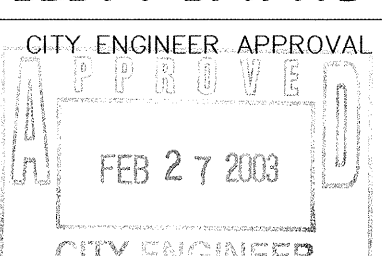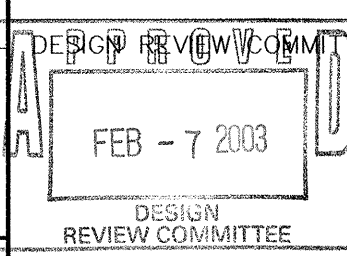

MO./DAY/YR.	MO./DAY/YR.

CITY PROJECT NO. **682686** ZONE MAP NO. **D-16** SHEET **12** OF **15**

A1005VDN/UNIT 5A/A1005UP-12/01-07-03/ACH

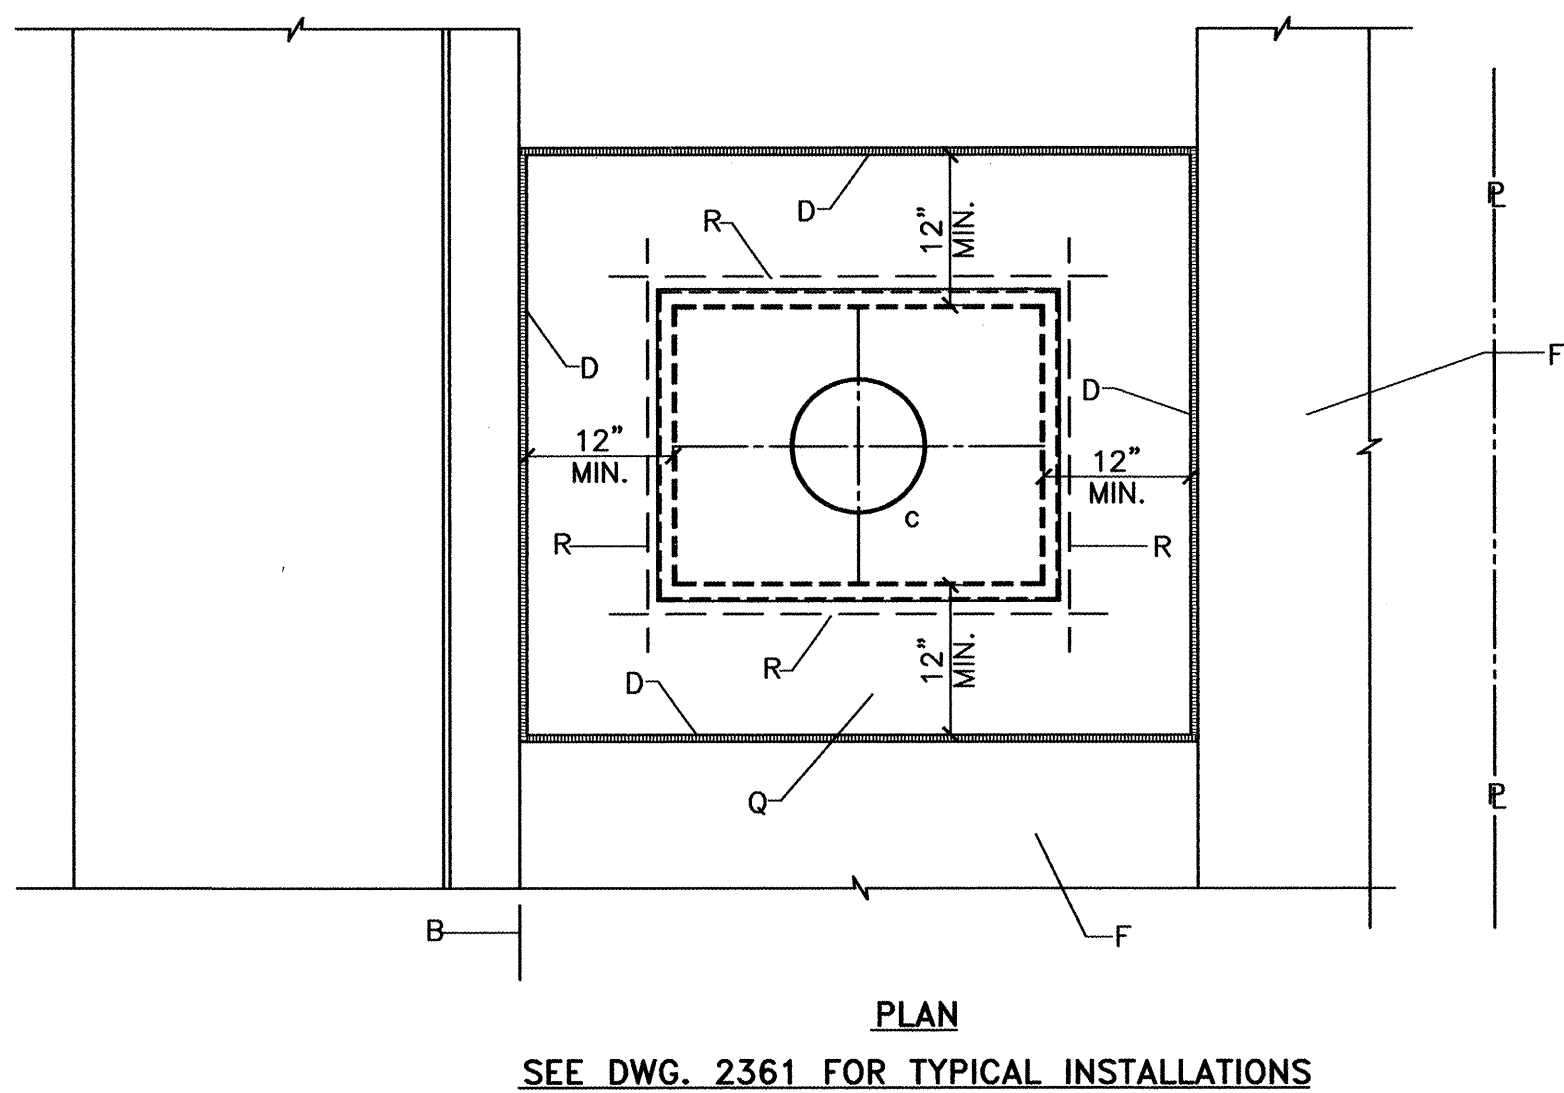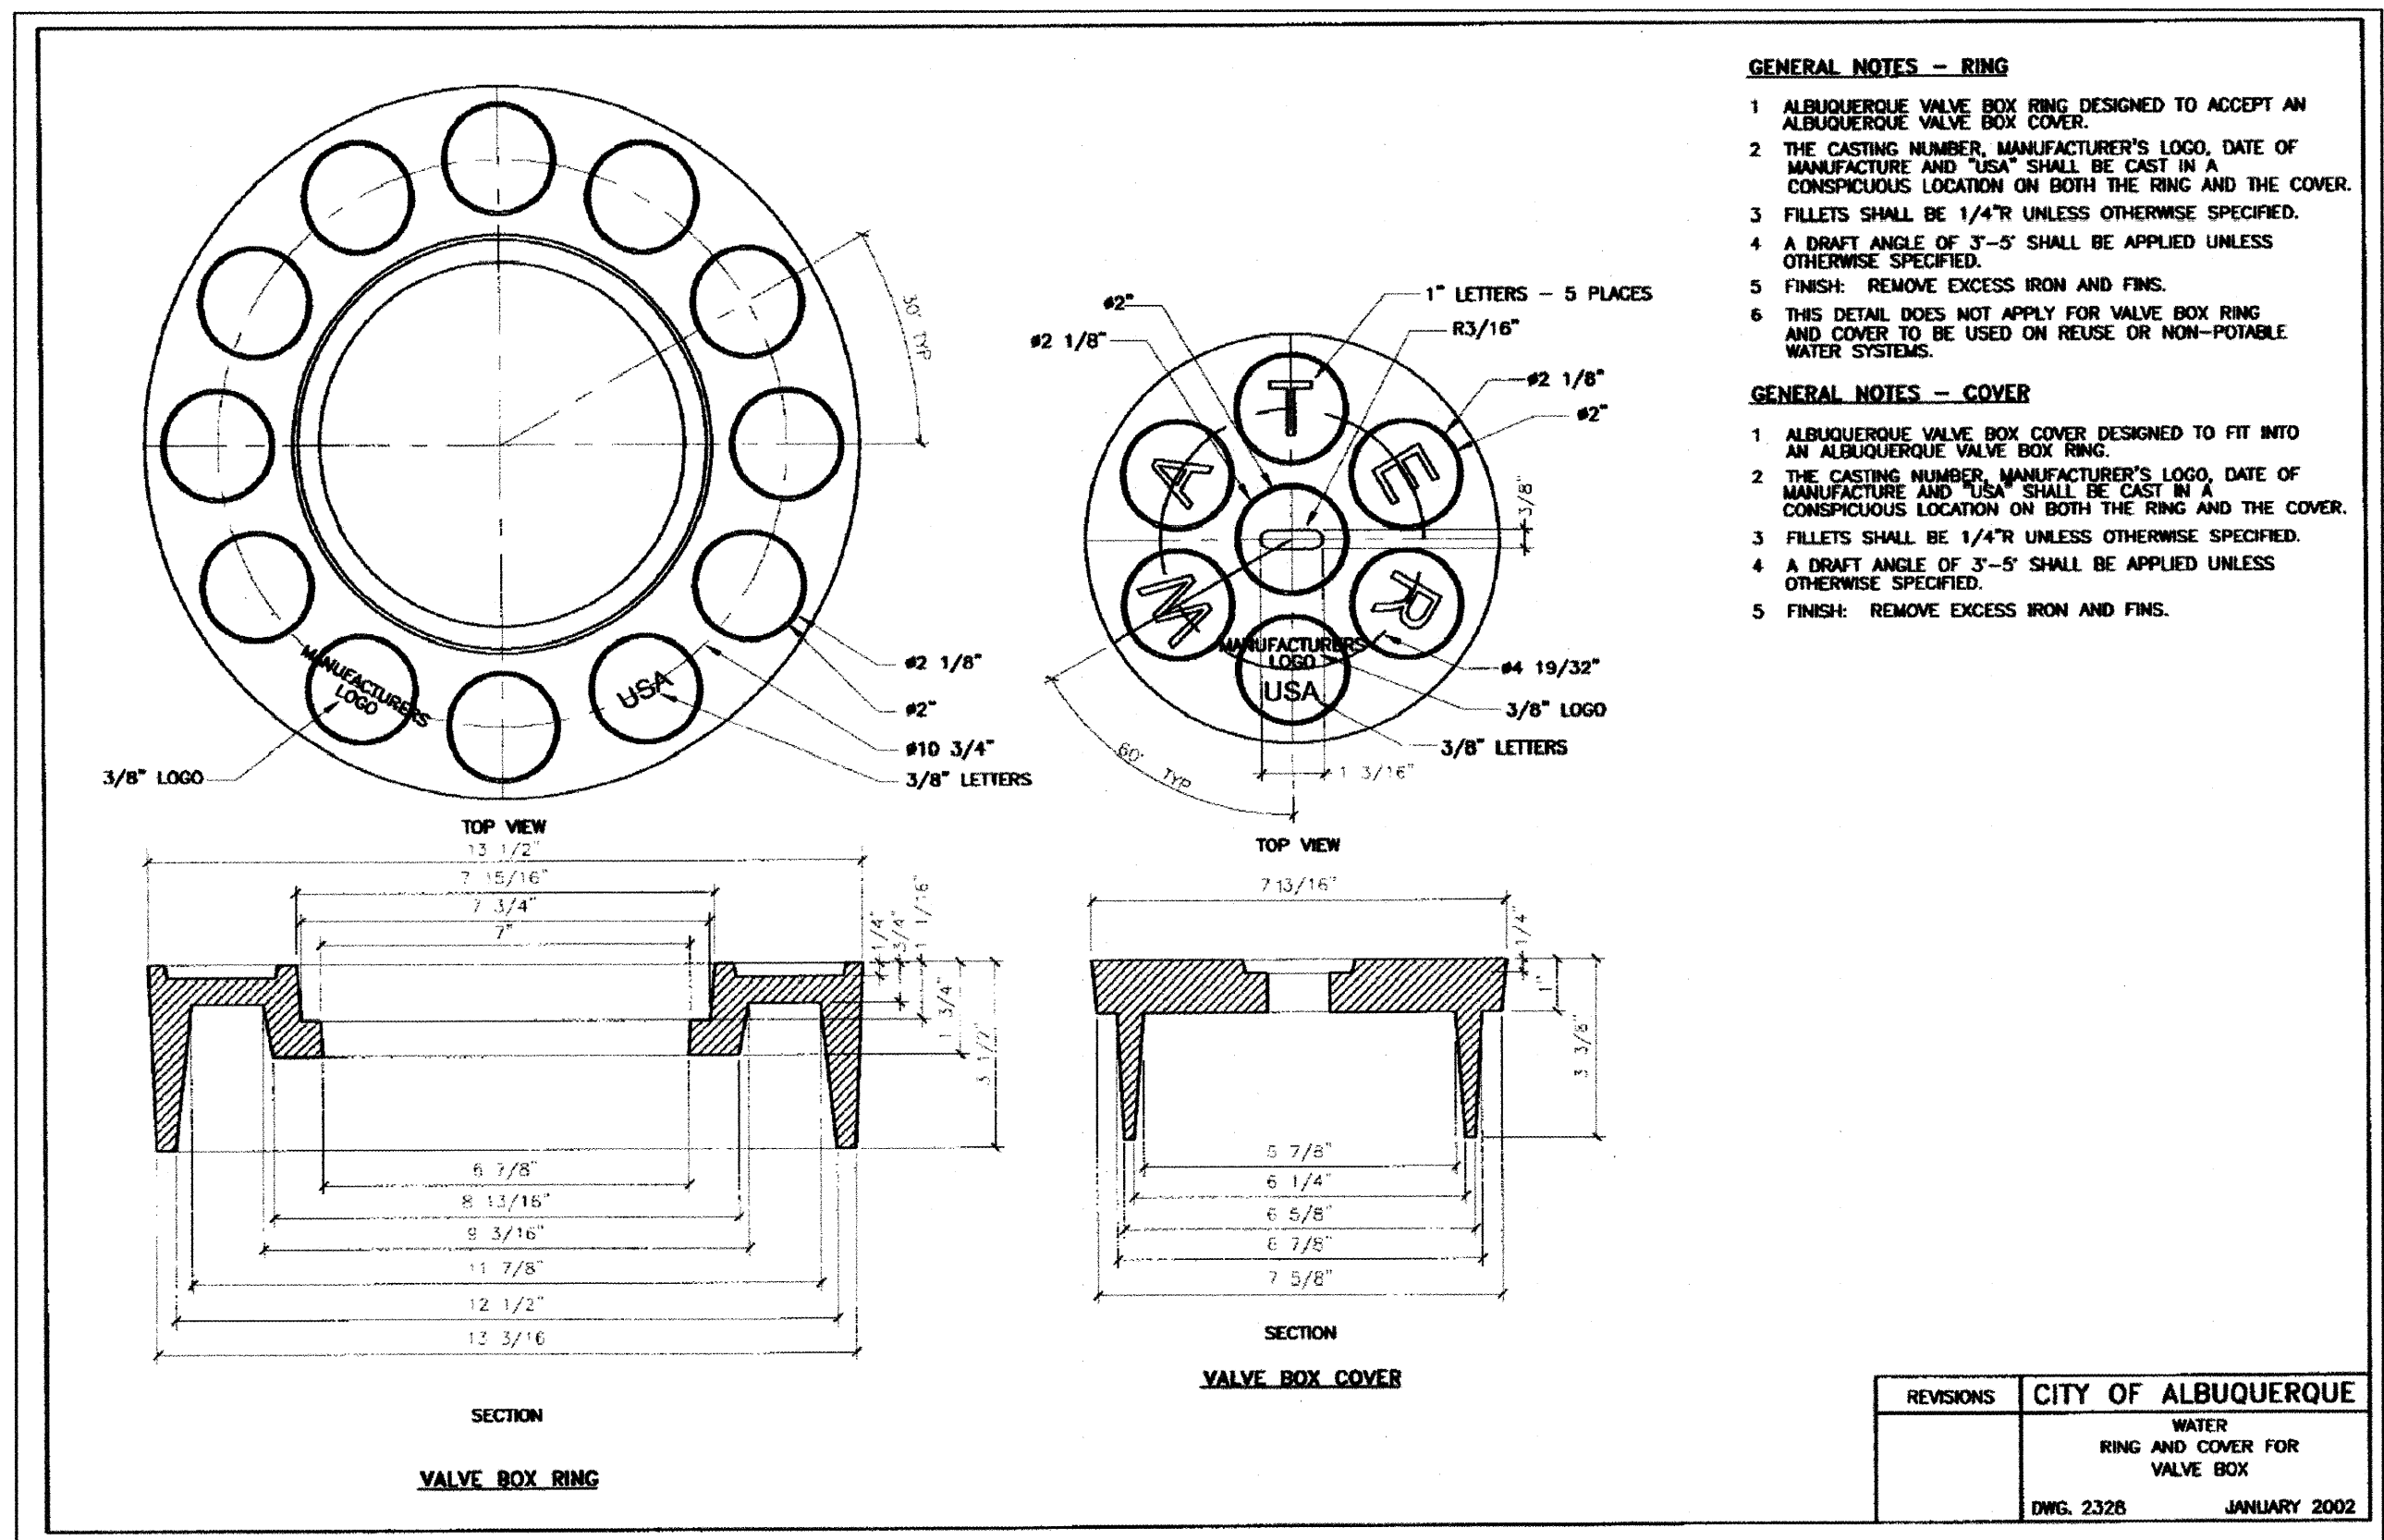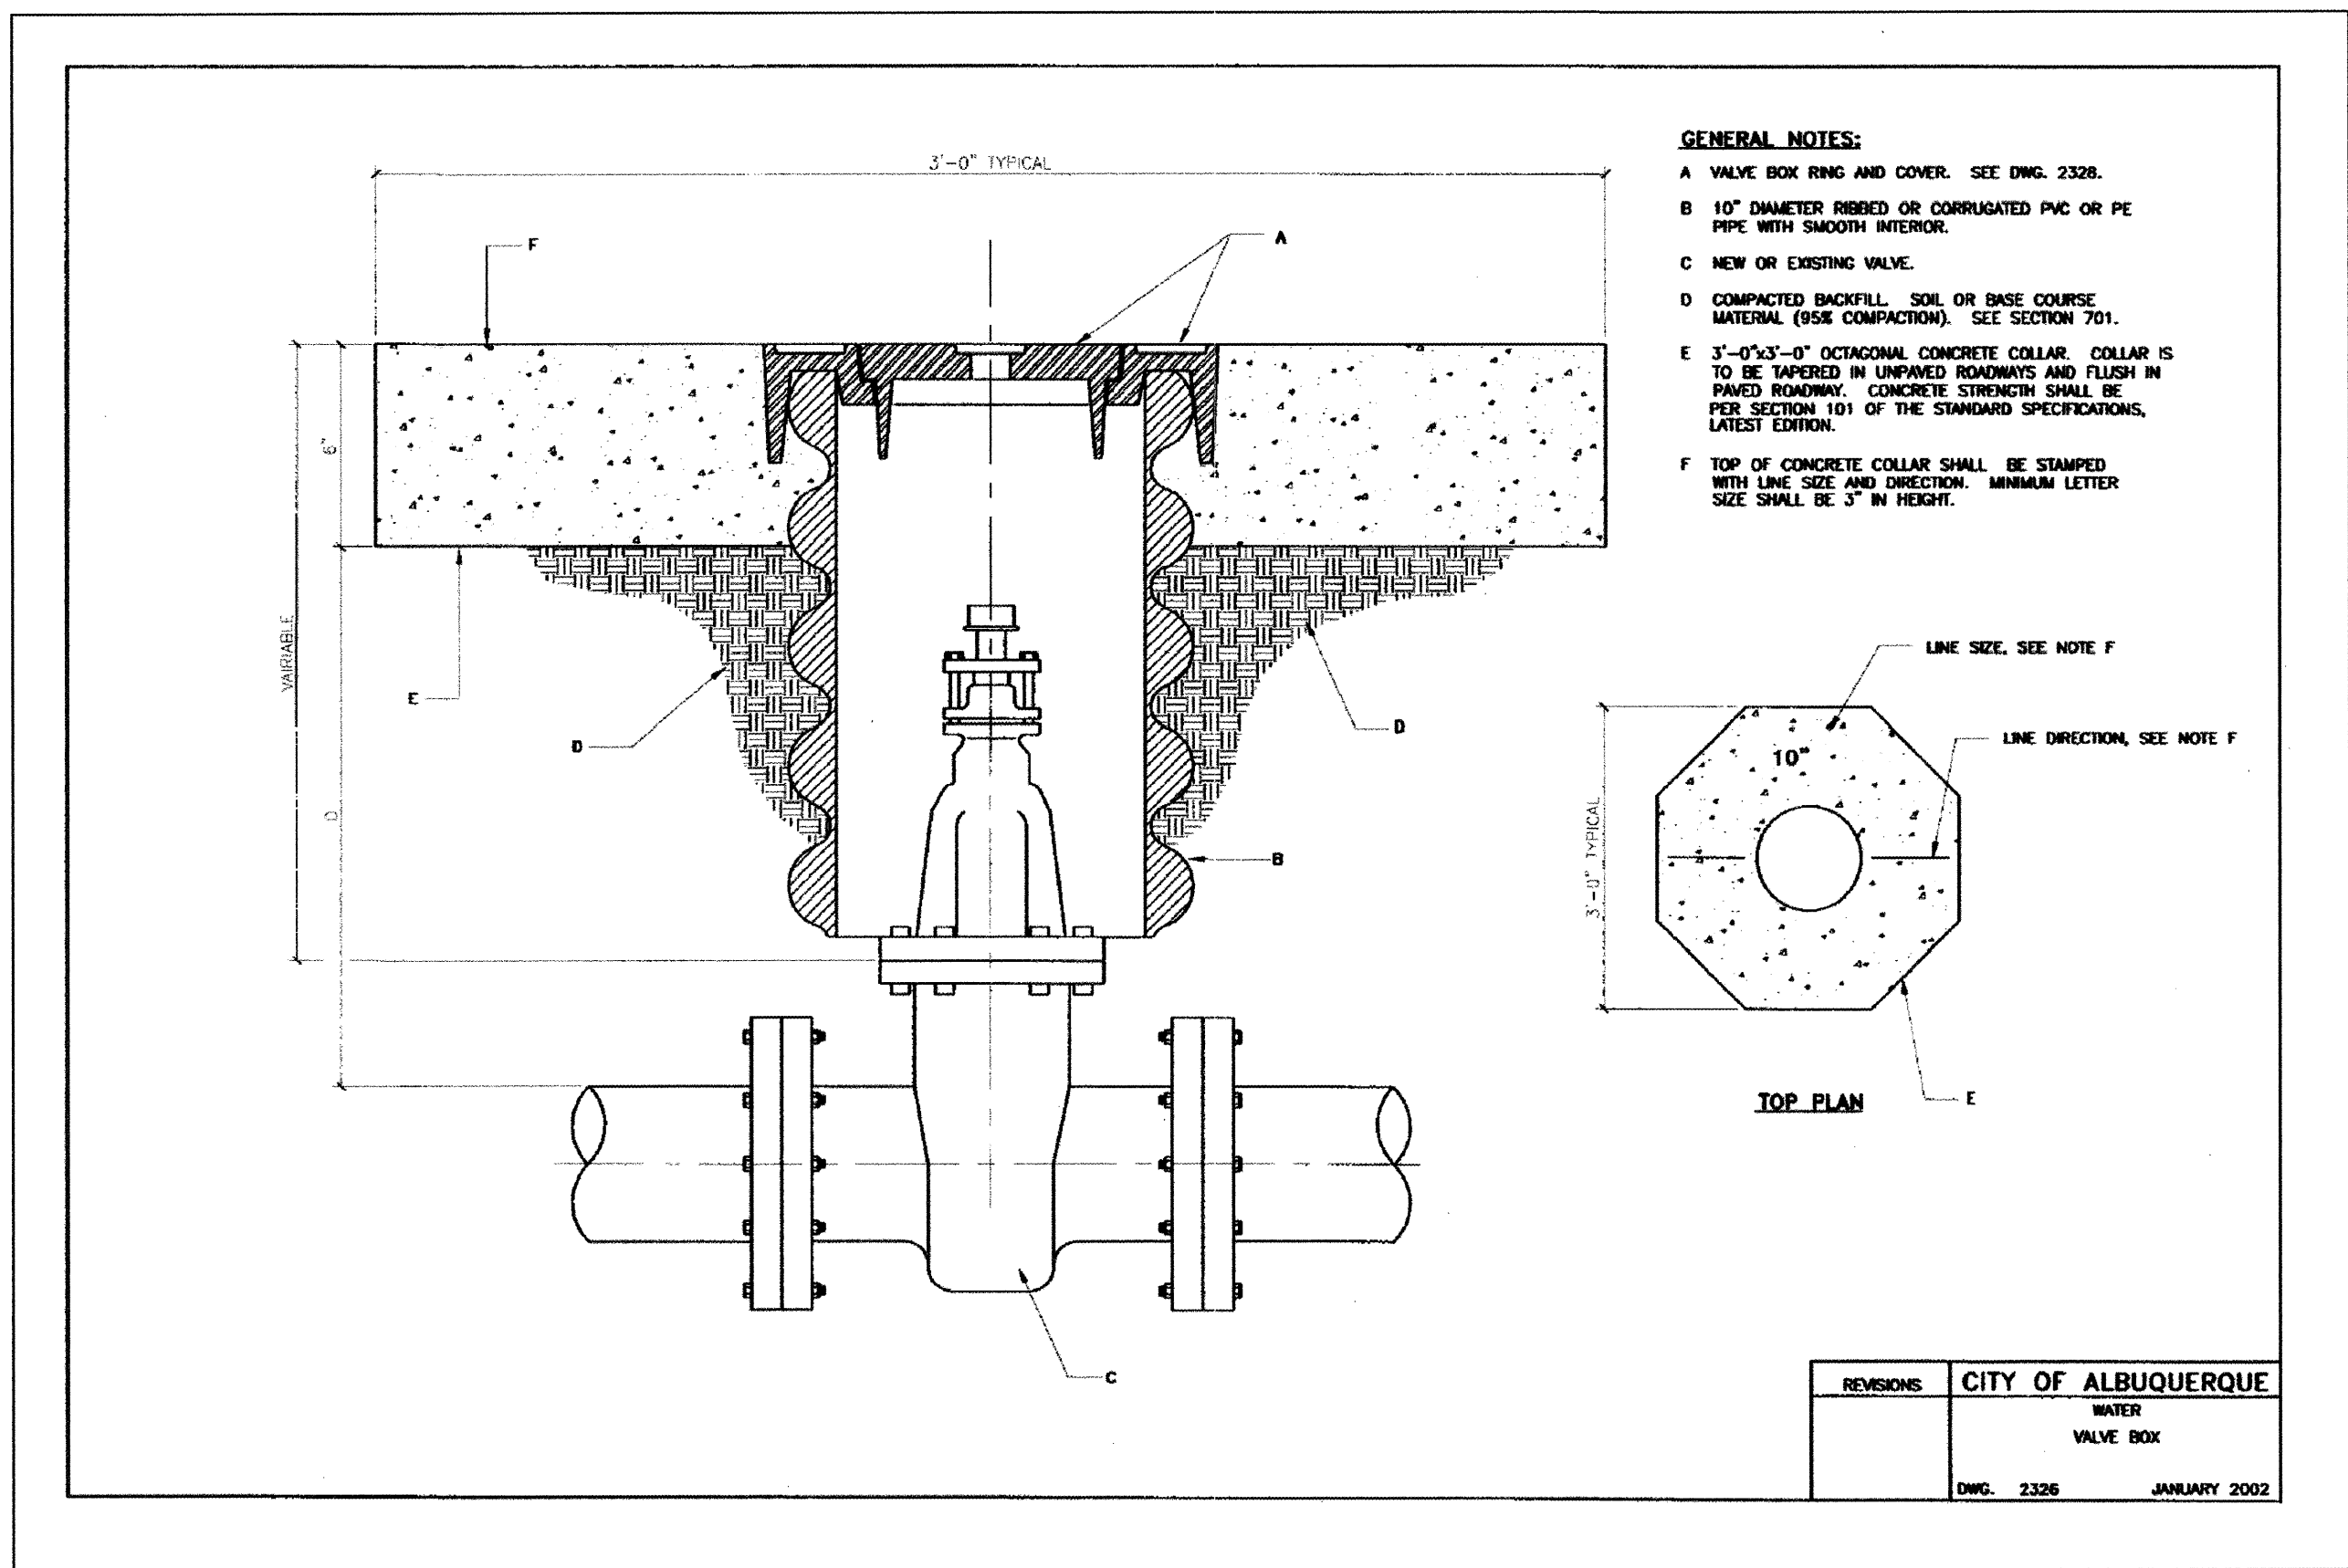

GENERAL NOTES:

- THE METER SHALL BE SET UTILIZING A COPPER-SETTER. COPPER-SETTER HEIGHT 10" FOR 1" METER. 7" FOR 3/4" METER.
- THE VALVE AND METER REGISTER BOX SHALL BE LOCATED UNDER THE LID OPENING. WHERE TWO METERS ARE TO BE INSTALLED IN A SINGLE METER BOX, THE METER REGISTERS SHALL BE WITHIN READING RANGE OF THE LID OPENING.
- METER BOX LOCATION TO CONFORM TO DWG. 2361.
- WHEN CONTRACTOR DOES NOT INSTALL METER, CONTRACTOR SHALL PROVIDE REMOVABLE PLUGS FOR END OF COPPER-SETTER.
- EXISTING CONCRETE TO BE SAWCUT.

CONSTRUCTION NOTES:

- STREET SURFACE.
- BACK OF CURB.
- CAST IRON METER BOX, COVER AND LID. SEE DWG. 2368 OR 2369.
- 1/2" EXPANSION JOINT.
- CURB STOP, LOCATE INSIDE METER BOX.
- SIDEWALK OR DRIVEPAD.
- METER. TOP OF METER TO BE 12"-18" BELOW COVER.
- CORP STOP.
- MAIN WATER LINE.
- TAPPING SADDLE.
- COPPER SERVICE LINE.
- COPPER SETTER.
- TAILPIECE TO PROPERTY LINE WITH INSTA-TITE I.P.T. CAPPED FITTING.
- CONCRETE PAD REQUIRED IN ALL AREAS.
- #4 REBAR CONTINUOUS ALL AROUND METER BOX.
- STABILIZER BAR. 12" LONG X 1/2" DIAMETER GALVANIZED STEEL PIPE.
- METER BOX LID SHALL BE FLUSH WITH SURROUNDING SIDEWALK.

dmg MARK GOODWIN & ASSOCIATES, P.A.
CONSULTING ENGINEERS
P.O. BOX 30606
ALBUQUERQUE, NEW MEXICO 87199
(505) 828-2200, FAX (505) 797-9539

CITY OF ALBUQUERQUE
PUBLIC WORKS DEPARTMENT

TITLE: VISTA DEL NORTE - UNIT 5A
WATER DETAILS

DESIGN REVIEW COMMITTEE CITY ENGINEER APPROVAL
C.O.A. STANDARD C.O.A. STANDARD
LAST DESIGN UPDATE


CITY PROJECT NO. 682686 ZONE MAP NO. D-16 SHEET 13 OF 15

AS-BUILT INFORMATION		BENCH MARKS		SURVEY INFORMATION		ENGINEER'S SEAL	
CONTRACTOR	DATE	NO.	BY	NO.	BY	NO.	BY
Sundance	03						
WORK	DATE						
STARTED BY	DATE						
STOPPED BY	DATE						
ACCEPTED BY	DATE						
FIELD	DATE						
LOCATION BY	DATE						
DRAWINGS	DATE						
CORRECTED BY	DATE						
RECORDED BY	DATE						
NO.							


DRAFT
C.O.A. STANDARD

DESIGNED BY	DATE	REVISIONS	DATE
DLH	01/02		
ACH	01/02		
DWG	01/02		


SCANNED BY
MESA REPRO

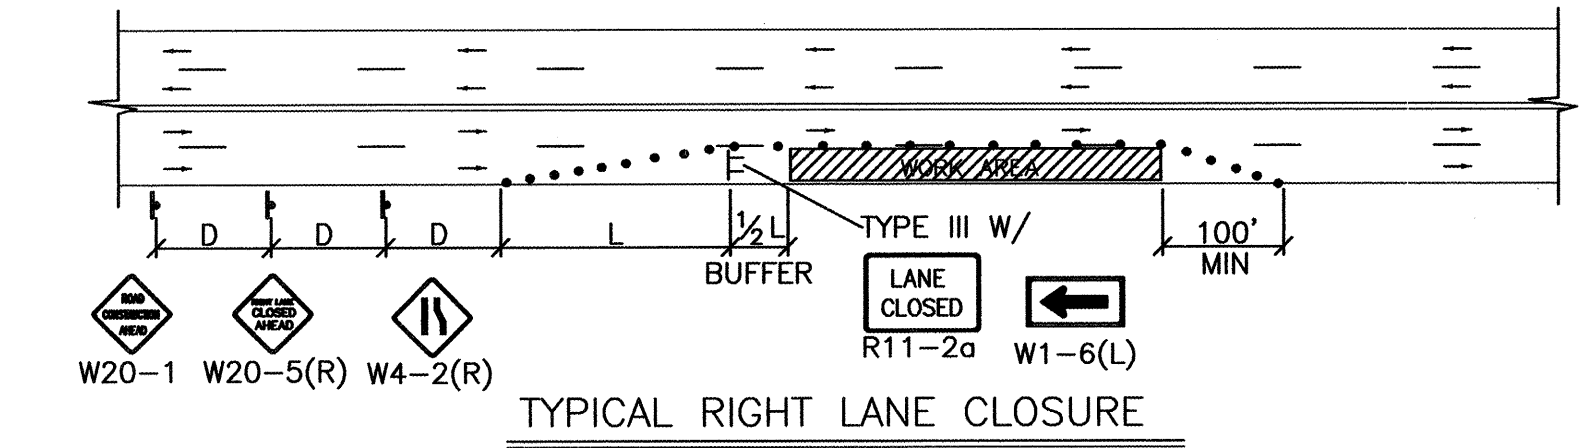


TYPICAL RIGHT LANE CLOSURE

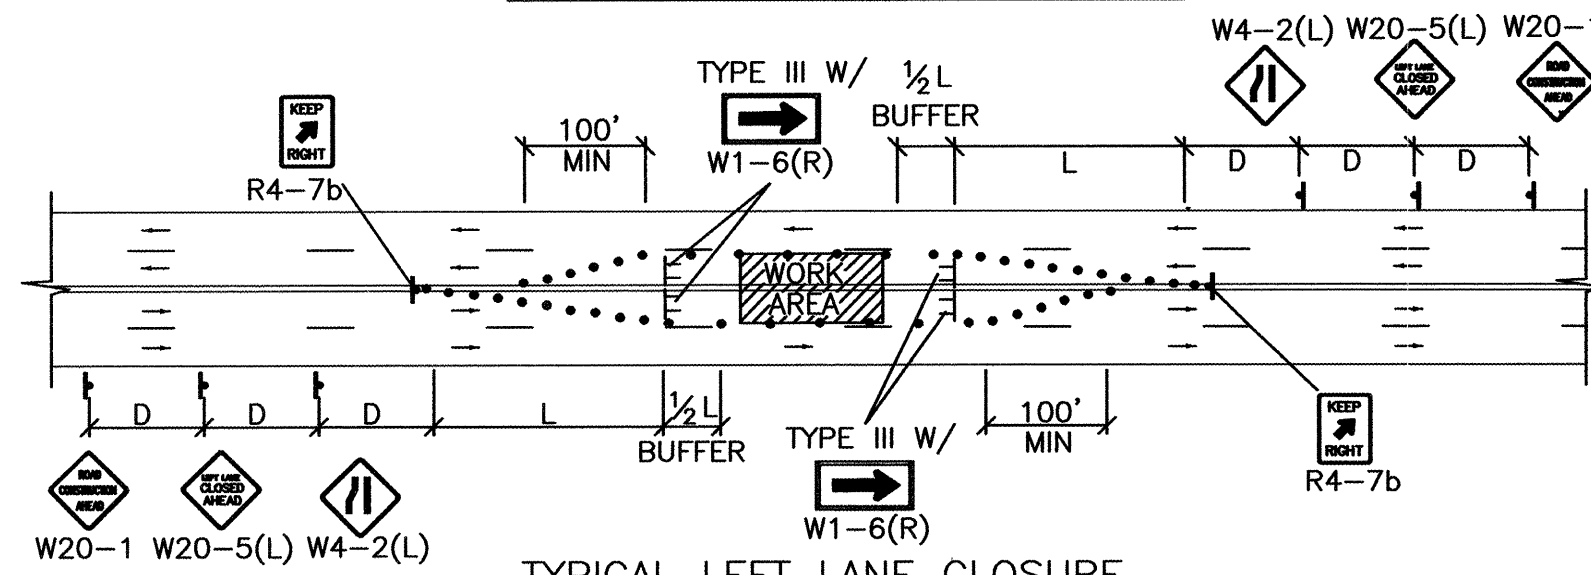


TYPICAL LEFT LANE CLOSURE

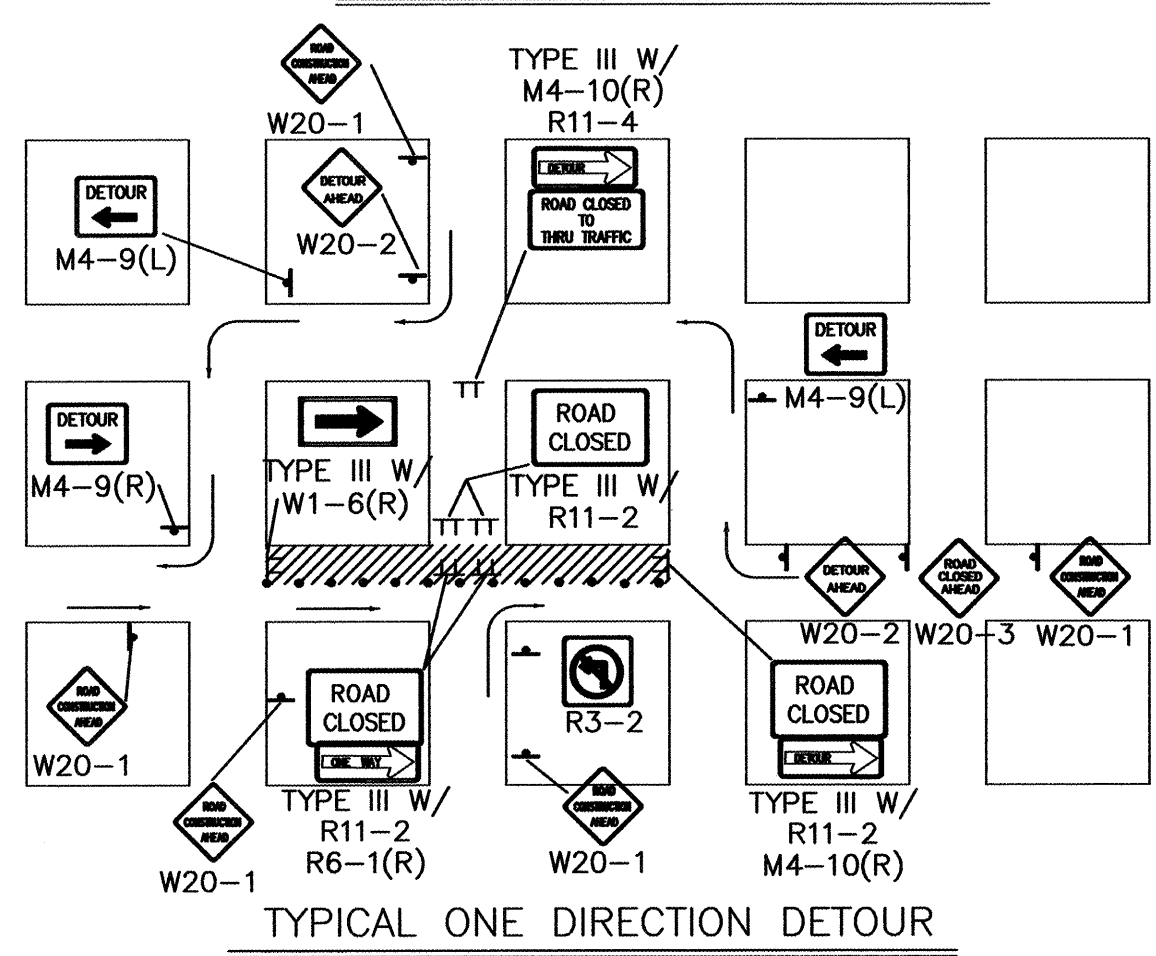

TYPICAL ONE DIRECTION DETOUR

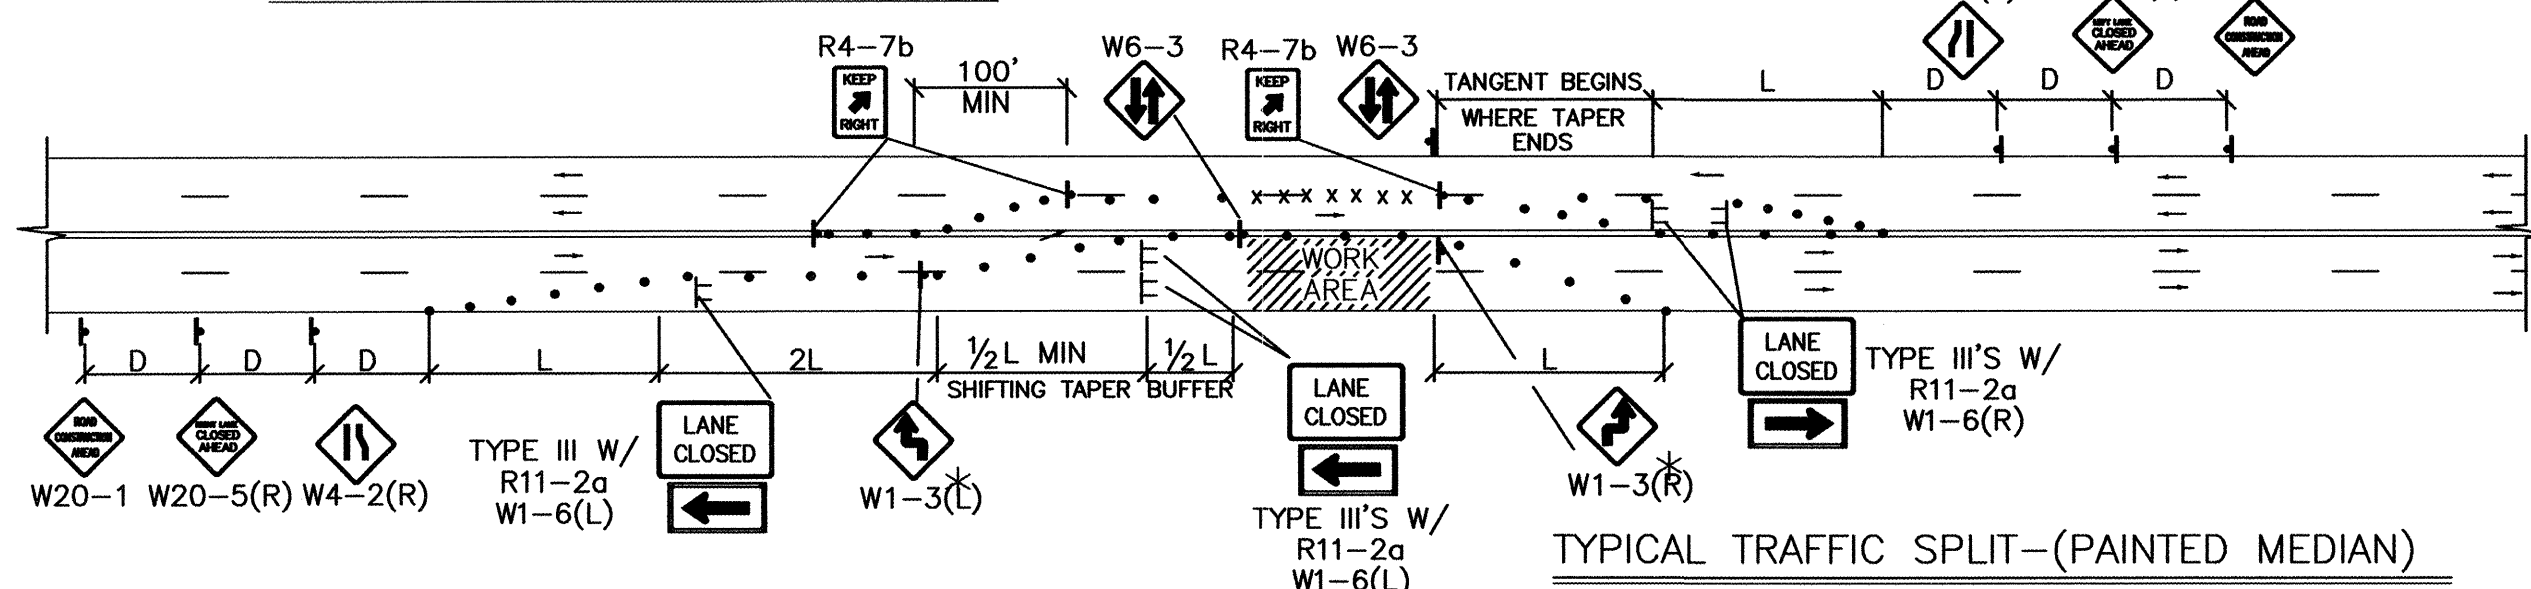

TYPICAL TRAFFIC SPLIT - (PAINTED MEDIAN)

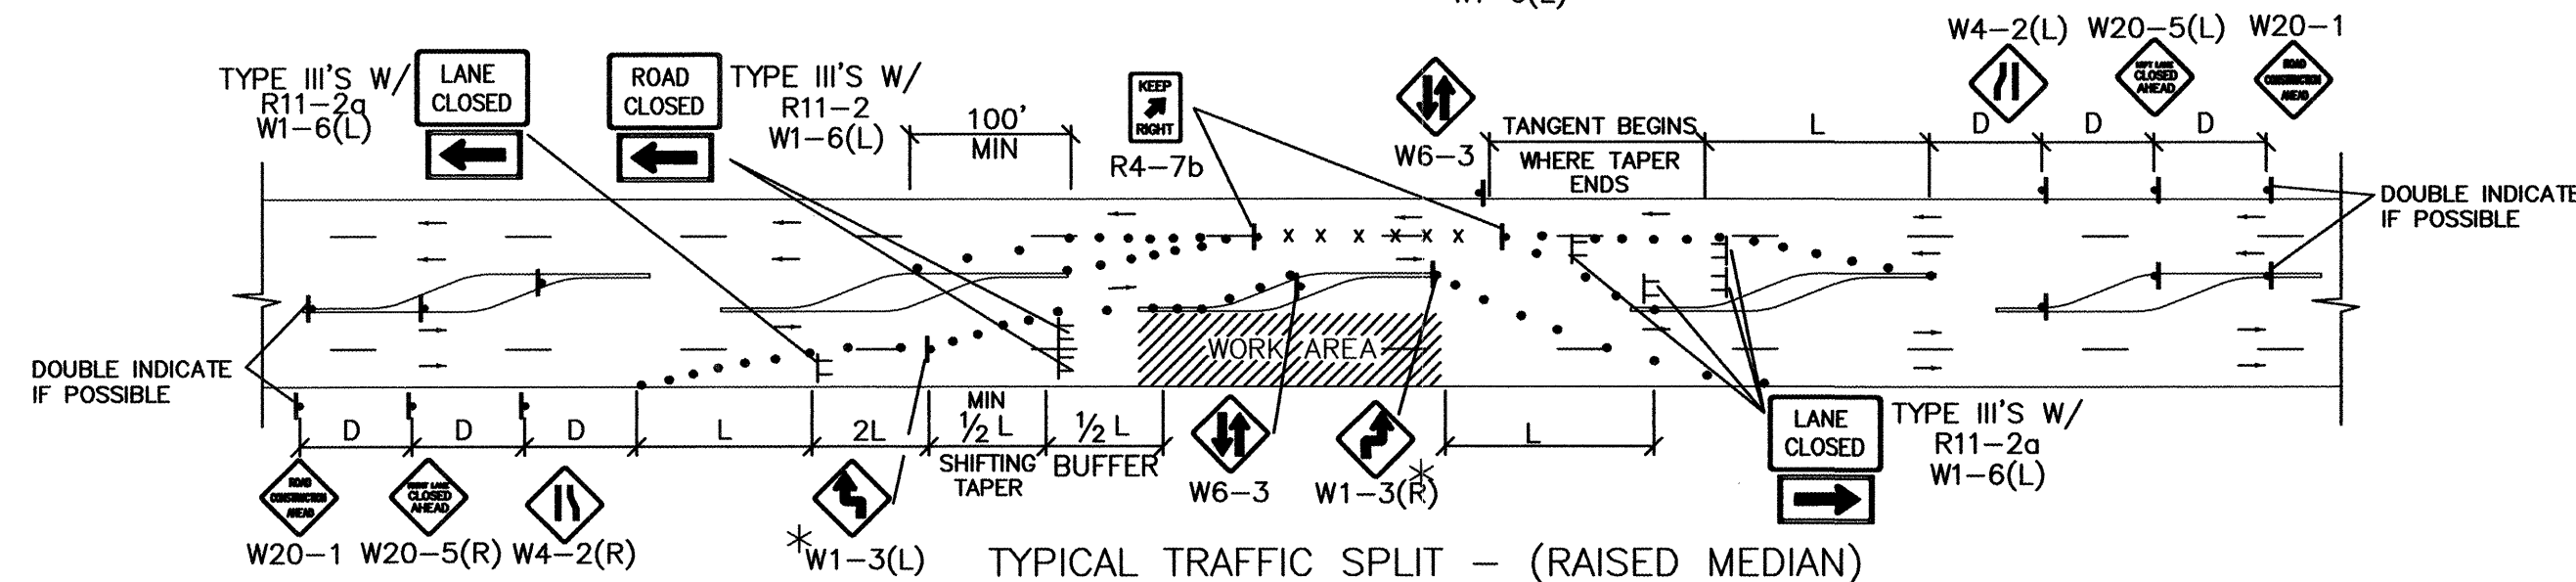

TRAFFIC SPLIT NOTES:

1. THE OFFSET DISTANCE MUST BE CALCULATED IN ALL SHIFTING TAPERS. THE OFFSET DISTANCES SHALL INCLUDE LANE WIDTHS PLUS MEDIAN WIDTHS.
2. $1/2 L$ IS THE MINIMUM DISTANCE FOR SHIFTING TAPERS.
3. REVERSE CURVES MAY BE IMPLEMENTED. ALL CURVE DATA SHALL BE CALCULATED.
4. MEDIAN REMOVAL SHALL BE REQUIRED IF $1/2 L$ OR REVERSE CURVE IS NOT SUFFICIENT. MEDIAN REMOVAL SHALL TAKE PLACE BEFORE SPLITS.
5. REDUCED SPEED MAY BE CONSIDERED.
6. * USE W1-3 FOR 30 MPH OR LESS, W1-4 FOR SPEED 35 MPH OR GREATER.

