

RIDGEVIEW VILLAGE
CITY OF ALBUQUERQUE, BERNALILLO COUNTY, NEW MEXICO
IMPROVEMENTS FOR
GRADING, PAVING AND UTILITIES
UNIT II

INDEX TO DRAWINGS


AS-BUILT DRAWING

SHEET NO.	DESCRIPTION
1	COVER SHEET, VICINITY MAP AND INDEX TO DRAWINGS
2	GENERAL NOTES
3-5	PLATS OF GEOMETRY
6-7	ULTIMATE DRAINAGE AND GRADING PLANS
8	EROSION CONTROL PLAN / ENVIRONMENTAL PROTECTION PLAN
9	TYPICAL TRAFFIC CONTROL AND SIGNING EXAMPLES
10	SIGNING AND CONSTRUCTION TRAFFIC CONTROL STANDARDS

PAVING PLAN & PROFILES

UTILITY PLAN & PROFILES

11	PAVING DETAILS	18	COMPOSITE UTILITY PLAN
12	COMPOSITE PAVING PLAN / SIDEWALK VARIANCE	19	WATER SHUTOFF / FLUSHING PLAN
13	PINON FLATS RD.	20	PINON FLATS RD.
14	PINON BLANCO RD.	21	PINON BLANCO RD.
15	DREAMY WAY DR. AND PINON DULCE RD.	22	PINON DULCE RD.
16	BANDELIER DR.	23	BANDELIER DR
17	PINON VERDE DR.	24	PINON VERDE DR.

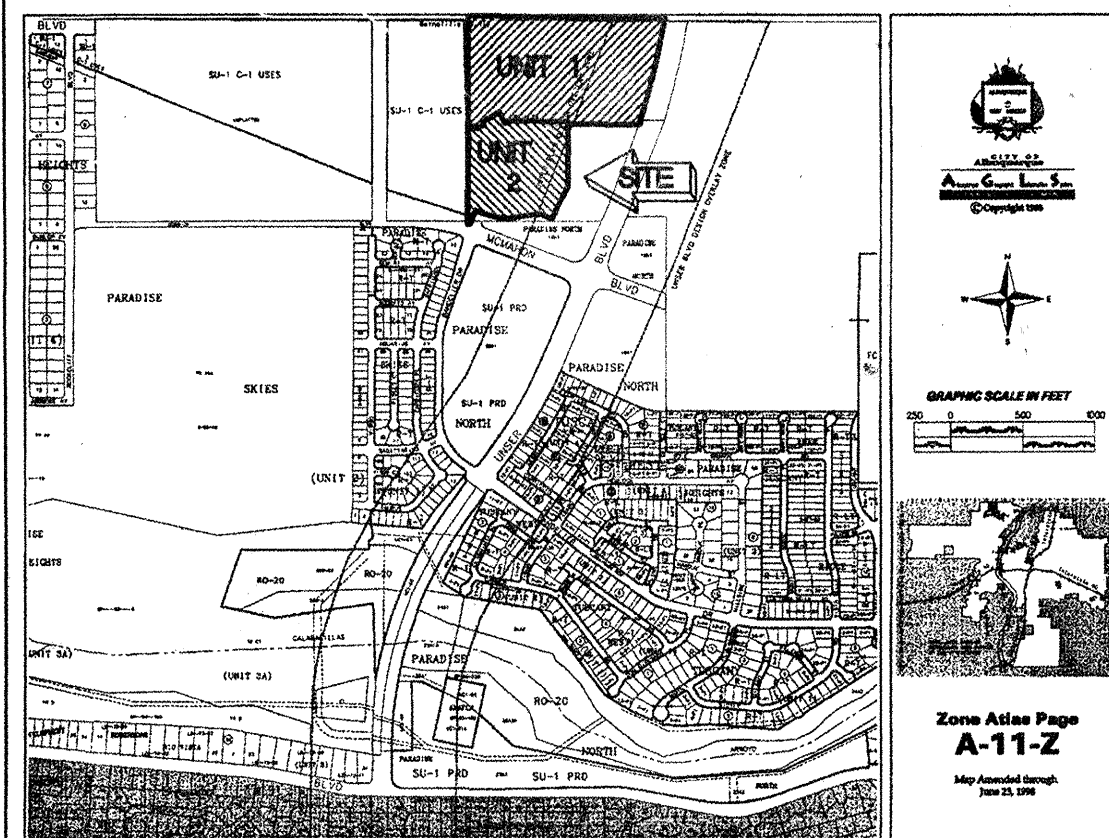

VICINITY MAP A-11-Z

CONSTRUCTION NOTES
ALL WORK DETAILED ON THESE PLANS TO BE PERFORMED UNDER CONTRACT SHALL, EXCEPT AS OTHERWISE STATED OR PROVIDED HEREON, BE CONSTRUCTED IN ACCORDANCE WITH THE C.O.A. STANDARD SPECIFICATIONS FOR PUBLIC WORKS CONSTRUCTION - 1986 EDITION AS AMENDED THROUGH UPDATE #6 (REFERRED TO HEREIN AS THE STANDARD SPECIFICATIONS).

TWO (2) WORKING DAYS PRIOR TO ANY EXCAVATION, CONTRACTOR MUST CONTACT NEW MEXICO ONE CALL SYSTEM, 260-1990, FOR LOCATION OF EXISTING UTILITIES.

PRIOR TO ANY CONSTRUCTION, THE CONTRACTOR SHALL EXCAVATE AND VERIFY THE HORIZONTAL AND VERTICAL LOCATIONS OF ALL OBSTRUCTIONS. SHOULD A CONFLICT EXIST, THE CONTRACTOR SHALL NOTIFY THE ENGINEER OR SURVEYOR SO THAT THE CONFLICT CAN BE RESOLVED WITHOUT DELAY.

THE CONTRACTOR SHALL NOTIFY THE ENGINEER NOT LESS THAN SEVEN (7) DAYS PRIOR TO STARTING WORK IN ORDER THAT THE ENGINEER MAY TAKE NECESSARY MEASURES TO INSURE THE PRESERVATION OF SURVEY MONUMENTS. CONTRACTOR SHALL NOT DISTURB PERMANENT SURVEY MONUMENTS WITHOUT THE CONSENT OF THE ENGINEER AND SHALL NOTIFY THE ENGINEER AND BEAR THE EXPENSE OF REPLACING ANY THAT MAY BE DISTURBED WITHOUT PERMISSION. REPLACEMENT SHALL BE DONE ONLY BY THE CITY SURVEYOR. WHEN A CHANGE IS MADE IN THE FINISHED ELEVATIONS OF THE PAVEMENT OF ANY ROADWAY IN WHICH A PERMANENT SURVEY MONUMENT IS LOCATED, CONTRACTOR SHALL, AT HIS OWN EXPENSE, ADJUST THE MONUMENT COVER TO THE NEW GRADE UNLESS OTHERWISE SPECIFIED. REFER TO SECTION 4.4 OF THE GENERAL CONDITIONS OF THE STANDARD SPECIFICATIONS.

ANY WORK OCCURRING WITHIN AN ARTERIAL ROADWAY REQUIRES 24 HOURS CONSTRUCTION.

BACKFILL COMPACTION WILL BE IN ACCORDANCE WITH SPECIFIED STREET USE.


ALL UTILITY WORK SHALL BE CONSTRUCTED IN ACCORDANCE WITH NEW MEXICO UTILITIES INC. SPECIFICATIONS FOR WATER AND WASTEWATER FACILITIES (MOST RECENT REVISIONS).

THE CONTRACTOR SHALL NOTIFY NEW MEXICO UTILITIES (898-2661) THREE WORKING DAYS PRIOR TO BEGINNING THE CONSTRUCTION OF THE UTILITIES.

CONTRACTOR SHALL MAINTAIN A GRAFFITI - FREE WORK SITE. CONTRACTOR SHALL PROMPTLY REMOVE ANY GRAFFITI FROM ALL EQUIPMENT, WHETHER PERMANENT OF TEMPORARY.

APPROVED AS RECORD DRAWINGS
DESIGN REVIEW SECTION
CITY CONSTRUCTION ENGINEER
DATE 2/25/02

CERTIFICATE OF SUBSTANTIAL COMPLIANCE ON PLANS

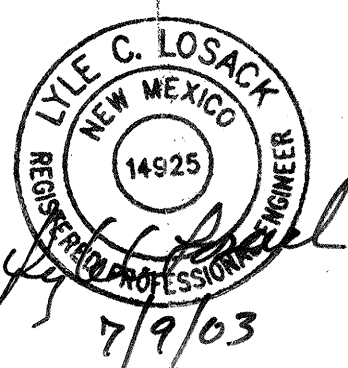



Lyle C. Losack of the firm of QuikDraw Engineering
a Registered Professional Engineer in the State of New Mexico, do hereby certify, to the best of my knowledge and belief, that the infrastructure installed as part of this project has been inspected by me or by a qualified person under my direct supervision and has been constructed in accordance with the plans and specifications approved by the City Engineer and that the original design intent of the approved plans has been met, except as noted by me on the as-built construction drawings. This Certification is based on site inspections by me or personnel under my direction and survey information provided by THOMAS W. PATRICK NMP's number 12651.

APPROVED FOR CONSTRUCTION															
NEW MEXICO UTILITIES		DATE: 10-31-02													
QuikDraw ENGINEERING, L.L.C. P.O. Box 729 Corrales, NM 87046 Office (505) 898-0309 Fax (505) 897-0309		Community Sciences Corporation LAND PLANNING P.O. Box 1328 ENGINEERING Corrales, N.M. 87046		DATE: 09/20/02 SCALE: N/A DESIGNED: REH DRAWN: RLS CHECKED BY: LCL		ENGINEERS STAMP & SIGNATURE Lyle C. Losack 14925 12/27/02		APPROVALS DRC Chairman: [Signature] 12-17-02 Transportation: [Signature] 12-20-02 Water/Wastewater: [Signature] 1/20/02 Hydrology: [Signature] 11/20/02 C.I.P.: Constr. Mngmt.: Constr. Coord.: [Signature] 12-17-02		DATE: 12-17-02 12-20-02 1/20/02 11/20/02 12-17-02		***** APPROVED FOR CONSTRUCTION [Signature] 12/29/02 City Engineer Date		Sheet 1 Of 24	
DRB 1000893		683082													

GENERAL NOTES


1. ALL RADII OF CURB RETURNS ARE SHOWN TO FLOWLINE.
2. UNLESS OTHERWISE SHOWN, ALL DIMENSIONS ARE TO FLOWLINE.
3. ALL FINISH GRADES AND PROFILES SHOWN ARE FLOWLINE GRADES, UNLESS OTHERWISE NOTED. MATCH FLOW LINES OF GUTTERS WHEN CONNECTING NEW CURB AND GUTTER TO EXISTING.
4. ALL UTILITY POLES ARE TO BE RELOCATED BY OTHERS.
5. CURB AND GUTTER SHOWN AS EXISTING AND NOT TO BE REMOVED UNDER THIS CONTRACT WHICH IS DAMAGED OR DISPLACED BY THE CONTRACTOR SHALL BE REMOVED AND REPLACED BY THE CONTRACTOR AT HIS EXPENSE.
6. WHEN ABUTTING NEW PAVEMENT TO EXISTING, SAW CUT EXISTING PAVEMENT TO A STRAIGHT LINE AS REQUIRED TO REMOVE ANY BROKEN OR CRACKED PAVEMENT AND MATCH NEW TO EXISTING.
7. WHEN REMOVAL OF EXISTING CURB AND GUTTER OR SIDEWALK IS REQUIRED, REMOVE BACK TO NEAREST JOINT.
8. ALL GAS VALVE BOXES, GAS MANHOLES, ELECTRICAL MANHOLES, AND TELEPHONE MANHOLES WILL BE ADJUSTED TO GRADE BY OTHERS.
9. TWO WORKING DAYS PRIOR TO ANY EXCAVATION, CONTRACTOR MUST CONTACT LINE & CABLE LOCATING SERVICE, NM ONE CALL, 260-1990, FOR LOCATION OF EXISTING UTILITIES.
10. CONTRACTOR IS TO EXERCISE DUE CARE TO AVOID DISTURBING ANY EXISTING UNDERGROUND UTILITIES. IT SHALL BE HIS RESPONSIBILITY TO COORDINATE WITH THE UTILITY COMPANIES IN ORDER TO PREVENT ANY SERVICE DISRUPTION THAT MIGHT RESULT FROM PROJECT CONSTRUCTION. IT SHALL BE HIS RESPONSIBILITY TO PROTECT AND PRESERVE UTILITY EQUIPMENT AFFECTED BY PROJECT CONSTRUCTION.
11. EXACT LOCATION OF DRIVE PADS AND WHEELCHAIR RAMPS WILL BE DETERMINED IN THE FIELD BY THE FIELD ENGINEER. LOCATIONS SHOWN ON PLANS AND PROFILE SHEETS ARE APPROXIMATE.
12. THE APPLICABLE CITY OF ALBUQUERQUE STANDARD DETAILS ARE INCLUDED AT THE BACK OF THE SPECIFICATIONS.
13. ALL WATER VALVE BOXES AND SEWER MANHOLES IN THE CONSTRUCTION AREA ARE TO BE ADJUSTED TO FINISH GRADE UNDER THIS CONTRACT, AND WILL BE PAID FOR AT CONTRACT UNIT PRICES.
14. SUB GRADE PREPARATION UNDER CURB AND GUTTERS, DRIVE PADS AND SIDEWALK SHALL BE CONSIDERED INCIDENTAL TO THE CONSTRUCTION OF SUCH AND SHALL BE INCLUDED IN THE BID PRICE FOR SUCH ITEMS.
15. A DISPOSAL SITE, COMPLYING WITH ALL CITY ORDINANCES, SHALL BE OBTAINED BY THE CONTRACTOR FOR THE DISPOSAL OF ALL EXCESS EXCAVATION MATERIAL, ASPHALTIC PAVEMENT (EXCEPT MILLED BITUMINOUS CONCRETE PAVEMENT) AND OTHER WASTE MATERIALS. THE CONTRACTOR SHALL NOTIFY THE CITY OF ALBUQUERQUE OF THE LOCATION OF THE DISPOSAL SITE PRIOR TO THE REMOVAL AND ACTUAL DISPOSAL OF THE MATERIAL. ALL COSTS IN OBTAINING A DISPOSAL SITE AND HAUL THERETO SHALL BE CONSIDERED INCIDENTAL TO CONSTRUCTION AND NO DIRECT PAYMENT WILL BE MADE THEREFOR.
16. THE CONTRACTOR WILL BE REQUIRED TO CONFINE HIS WORK WITHIN THE CONSTRUCTION LIMITS AND/OR R.O.W. TO PRESERVE EXISTING VEGETATION AND PRIVATE PROPERTY. OVERNIGHT PARKING OF CONSTRUCTION EQUIPMENT SHALL NOT OBSTRUCT DRIVEWAY OPENINGS OR DESIGNATED TRAFFIC LANES.
17. FIFTY (50) TON ROLLER OPERATION SHALL NOT BE USED IN THIS PROJECT WHERE UNDERGROUND UTILITIES ARE PRESENT. THE REQUIRED COMPACTION AT THESE LOCATIONS SHALL BE EFFECTED BY OTHER MEANS.
18. ALL EXCAVATIONS FOR STORM DRAINS, AND OTHER EXCAVATIONS AS NECESSARY, SHALL BE GOVERNED BY THE CONSTRUCTION SAFETY AND HEALTH STANDARDS (TITLE 29, CFR, PART 1926 AND PART 1910 AS APPLICABLE TO CONSTRUCTION WORK - PUBLISHED IN THE FEDERAL REGISTER ON FEBRUARY 9, 1979).
19. THE CONTRACTOR SHALL NOTIFY THE ALBUQUERQUE TRAFFIC ENGINEERING DIVISION 3 WORKING DAYS IN ADVANCE OF ANY WORK REQUIRED REGARDING ALL EXISTING REGULATORY SIGNS AND SIGNALS THAT NEED TO BE REMOVED, RELOCATED OR REINSTALLED. (CALL 764-1599)
20. WHERE PULL BOXES ABUT BACK OF CURB OR ARE LOCATED IN CONCRETE PAVED AREA, PROVIDE ½" EXPANSION MATERIAL. ALL PULL BOXES TO BE FLUSH WITH SURFACE OF CONCRETE.
21. CONTRACTOR WILL BE RESPONSIBLE FOR CONNECTING NEW CONDUIT TO EXISTING OR NEW TRAFFIC CONTROL FACILITIES. THIS WORK WILL BE CONSIDERED INCIDENTAL TO CONSTRUCTION AND NO SEPARATE PAYMENT WILL BE MADE THEREFOR.
22. PERMANENT SIGNING AND ALL STRIPING SHALL BE BY CITY FORCES. CONSTRUCTION SIGNING AND STRIPING SHALL BE BY CONTRACTOR.
23. THE CONTRACTOR SHALL ASSUME RESPONSIBILITY FOR ANY DAMAGE TO EXISTING PAVEMENT, PAVEMENT MARKINGS, CURB AND GUTTER, HANDICAP RAMPS AND SIDEWALK DURING CONSTRUCTION APART FROM THOSE SECTIONS INDICATED FOR REMOVAL ON THE PLANS AND SHALL REPAIR OR REPLACE, PER CITY OF ALBUQUERQUE STANDARDS, AT HIS OWN EXPENSE.
24. EXISTING MEDIAN CURB AND GUTTER AND STANDARD CURB AND GUTTER, NOT DISTURBED BY THE CONTRACTOR, AND THAT IS OUT OF ALIGNMENT OR DISPLACED VERTICALLY OR IS BADLY BROKEN OR DETERIORATED WILL BE REPLACED AS DIRECTED BY THE FIELD ENGINEER, AND WILL BE PAID FOR AT CONTRACT UNIT PRICES.
25. THE CONTRACTOR SHALL NOTIFY WATER SYSTEMS DIVISION AT LEAST 5 WORKING DAYS IN ADVANCE OR WHEN FIRE HYDRANTS WILL BE TAKEN OUT OF SERVICE AND RETURNED TO SERVICE.

8. ALL TRAFFIC CONTROL DEVICES SHALL COMPLY WITH THE CURRENT EDITION OF "MANUAL FOR UNIFORM TRAFFIC CONTROL DEVICES."
27. ALL TRAFFIC CONTROL SIGNS MUST BE INSTALLED BEFORE CONSTRUCTION BEGINS FOR EACH PHASE OF THE WORK AS DIRECTED BY THE FIELD ENGINEER. ALL SIGN LOCATIONS WILL BE SELECTED IN THE FIELD AND APPROVED BY THE FIELD ENGINEER. SIGN HEIGHT SHALL BE 7 FT. ABOVE THE SIDEWALK LEVEL TO THE BOTTOM OF SIGN.
28. ALL DRUMS USED FOR TRAFFIC CONTROL MAY BE FILLED WITH SAND OR WATER BALLAST LIMITED TO 100 LBS. MAXIMUM PER DRUM.
29. THE CONTRACTOR SHALL PROVIDE AND MAINTAIN A SAFE AND ADEQUATE MEANS OF CHANNELING PEDESTRIAN TRAFFIC AROUND ALL WORK AREAS THROUGHOUT THE CONSTRUCTION PERIOD.
30. FIVE (5) WORKING DAYS PRIOR TO BEGINNING CONSTRUCTION THE CONTRACTOR SHALL SUBMIT TO THE CONSTRUCTION COORDINATION DIVISION A DETAILED CONSTRUCTION SCHEDULE. TWO (2) WORKING DAYS PRIOR TO CONSTRUCTION THE CONTRACTOR SHALL OBTAIN A BARRICADING PERMIT FROM THE CONSTRUCTION COORDINATION DIVISION. CONTRACTOR SHALL NOTIFY BARRICADE ENGINEER (924-3400) PRIOR TO OCCUPYING AN INTERSECTION. SEE SECTION 19 OF THE SPECIFICATIONS. ALL STREET STRIPING ALTERED OR DESTROYED SHALL BE REPLACED WITH PLASTIC REFLECTORIZED PAVEMENT MARKINGS BY CONTRACTOR TO LOCATION AS EXISTING OR AS INDICATED BY THIS PLAN SET.
31. THE CONTRACTOR SHALL MAINTAIN CONTINUOUS ACCESS TO ALL PROPERTY EXCEPT DURING ACTUAL PAVING OPERATIONS. PRIOR TO ANY PAVING OPERATIONS THE CONTRACTOR SHALL NOTIFY THE PROPERTY OWNERS 3 DAYS IN ADVANCE.
32. THE CONCRETE PAVEMENT FOR WHEELCHAIR RAMPS IS INCLUDED IN THE BID ITEM, "4 INCH CONCRETE SIDEWALK INCLUDING 6 INCH SUB GRADE PREPARATION ."
33. ALL ADVANCE WARNING SIGNS AND ALL BARRICADES SHALL BE EQUIPPED WITH FLASHING WARNING LIGHTS, TYPE A, EXCEPT ALL CHANNELIZING BARRICADES SHALL HAVE STEADY BURNING WARNING LIGHTS, TYPE "C".
34. WHEELCHAIR RAMPS SHALL BE CONSTRUCTED AT ALL CURB RETURNS CONSTRUCTED ON THIS PROJECT AT LOCATION SHOWN ON THE PLANS, IN ACCORDANCE WITH CITY STANDARD DETAILS. WHEELCHAIR RAMPS SHALL BE MEASURED AND PAID AS CONCRETE SIDEWALK AND CONCRETE CURB AND GUTTER.
35. CONCRETE BLOCKING WILL BE INSTALLED AS REQUIRED AND IN ACCORDANCE WITH CITY OF ALBUQUERQUE STANDARD DRAWINGS OR AS DIRECTED BY THE ENGINEER.
36. MANHOLE RIM ELEVATIONS SHOWN ON THESE PLANS ARE APPROXIMATE AND WILL VARY IN ACCORDANCE WITH FINISHED PAVEMENT ELEVATIONS.
37. CONTRACTOR SHALL FIELD VERIFY LOCATION AND TYPE OF EXISTING UTILITIES TO BE ADJUSTED OR EXTENDED.
38. MILLED BITUMINOUS CONCRETE PAVEMENT WILL BE STOCKPILED FOR THE CITY AS DIRECTED BY ENGINEER.
39. CONTRACTOR TO VERIFY ALL FLANGE, PAD, VALVE BOX, RIM AND TOP OF PIPE ELEVATIONS IN FIELD. ELEVATIONS SHALL BE ADJUSTED TO COMPLY WITH REQUIREMENTS OF STANDARD CITY DETAILS.
40. THE CONTRACTOR WILL BE RESPONSIBLE FOR COORDINATING THE EXECUTION OF THE WATER VALVE SHUT-OFF PLAN WITH N.M. UTILITIES (898-2661) 5 WORKING DAYS IN ADVANCE OF ANY WORK THAT MAY AFFECT EXISTING PUBLIC WATER UTILITIES.
41. THE CONTRACTOR SHALL COORDINATE WITH QWEST ON RELOCATION OF ANY TELEPHONE BOXES.
42. THE CONTRACTOR SHALL ABIDE BY ALL LOCAL, STATE, AND FEDERAL LAWS, RULES AND REGULATIONS WHICH APPLY TO THE CONSTRUCTION OF THESE IMPROVEMENTS.
43. ALL ELECTRICAL, TELEPHONE, CABLE TV, GAS AND OTHER UTILITY LINES, CABLES AND APPURTENANCES ENCOUNTERED DURING CONSTRUCTION THAT REQUIRE RELOCATION, SHALL BE COORDINATED WITH THAT UTILITY. THE CONTRACTOR SHALL BE RESPONSIBLE FOR COORDINATION OF ALL NECESSARY UTILITY ADJUSTMENTS. NO ADDITIONAL COMPENSATION WILL BE ALLOWED FOR DELAYS OR INCONVENIENCES CAUSED BY UTILITY COMPANY WORK CREWS. THE CONTRACTOR MAY BE REQUIRED TO RESCHEDULE HIS ACTIVITIES TO ALLOW CREWS TO PERFORM THEIR REQUIRED WORK.
44. CONSTRUCTION ACTIVITY SHALL BE LIMITED TO THE PROPERTY AND/OR PROJECT LIMITS. ANY DAMAGE TO ADJACENT PROPERTIES RESULTING FROM THE CONSTRUCTION PROCESS IS THE RESPONSIBILITY OF THE CONTRACTOR. ANY COST INCURRED FOR REPAIRS SHALL BE THE COST OF THE CONTRACTOR.
45. THE CONTRACTOR SHALL OBTAIN ALL THE NECESSARY PERMITS FOR THE PROJECT PRIOR TO COMMENCING CONSTRUCTION (I.E. BARRICADING, SURFACE DISTURBANCE).
46. THE CONTRACTOR SHALL BE RESPONSIBLE TO REPLACE AT HIS EXPENSE ANY AND ALL PROPERTY CORNERS DESTROYED DURING CONSTRUCTION. ALL PROPERTY CORNERS MUST BE RESET BY A REGISTERED LAND SURVEYOR.
47. THE CONTRACTOR SHALL MAINTAIN ALL CONSTRUCTION BARRICADES AND SIGNING AT ALL TIMES. THE CONTRACTOR SHALL VERIFY THE PROPER LOCATION OR ALL BARRICADING AT THE END AND BEGINNING OF EACH DAY.
48. ALL SAWCUT PAVEMENT SHALL HAVE A UNIFORM EDGE AND BE SPRAYED WITH TACK.
49. WHEN ABUTTING NEW CURB AND GUTTER TO EXISTING PAVEMENT, A 1" WIDE SECTION OF EXISTING PAVEMENT ADJACENT TO THE CURB AND GUTTER SHALL BE SAWCUT, REMOVE, AND REPLACED AS PER THE STANDARD SPECIFICATIONS.
50. THE CONTRACTOR SHALL ASSUME RESPONSIBILITY FOR ANY DAMAGE TO EXISTING PAVEMENTS, PAVEMENT MARKINGS, CURB & GUTTER, DRIVE PADS, WHEELCHAIR RAMPS, AND SIDEWALK DURING CONSTRUCTION, APART FROM THOSE SECTIONS INDICATED FOR REMOVAL ON THE PLANS AND SHALL REPAIR OR REPLACE PER COA STANDARDS, AT HIS OWN EXPENSE.

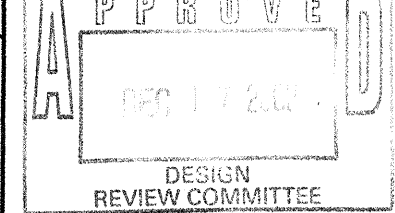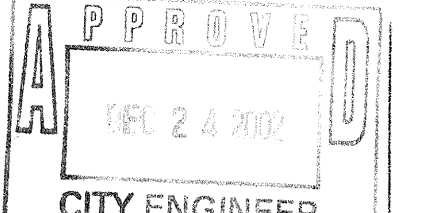JOB NO.: N291-33								NO	DESIGN	DRAW	CHECK
CITY OF ALBUQUERQUE PUBLIC WORKS DEPARTMENT ENGINEERING DEVELOPMENT GROUP											
TITLE: RIDGEVIEW VILLAGE UNIT II GENERAL NOTES											
Design Review Committee		City Engineer Approval				Mo./Day/Yr		Mo./Day/Yr			
											
City Project No. 683082		Zone Map No. A-11		Sheet 2 of 24							

NO AS-BUILT DATA ON THIS SHEET

SCANNED BY
MESA REPRO

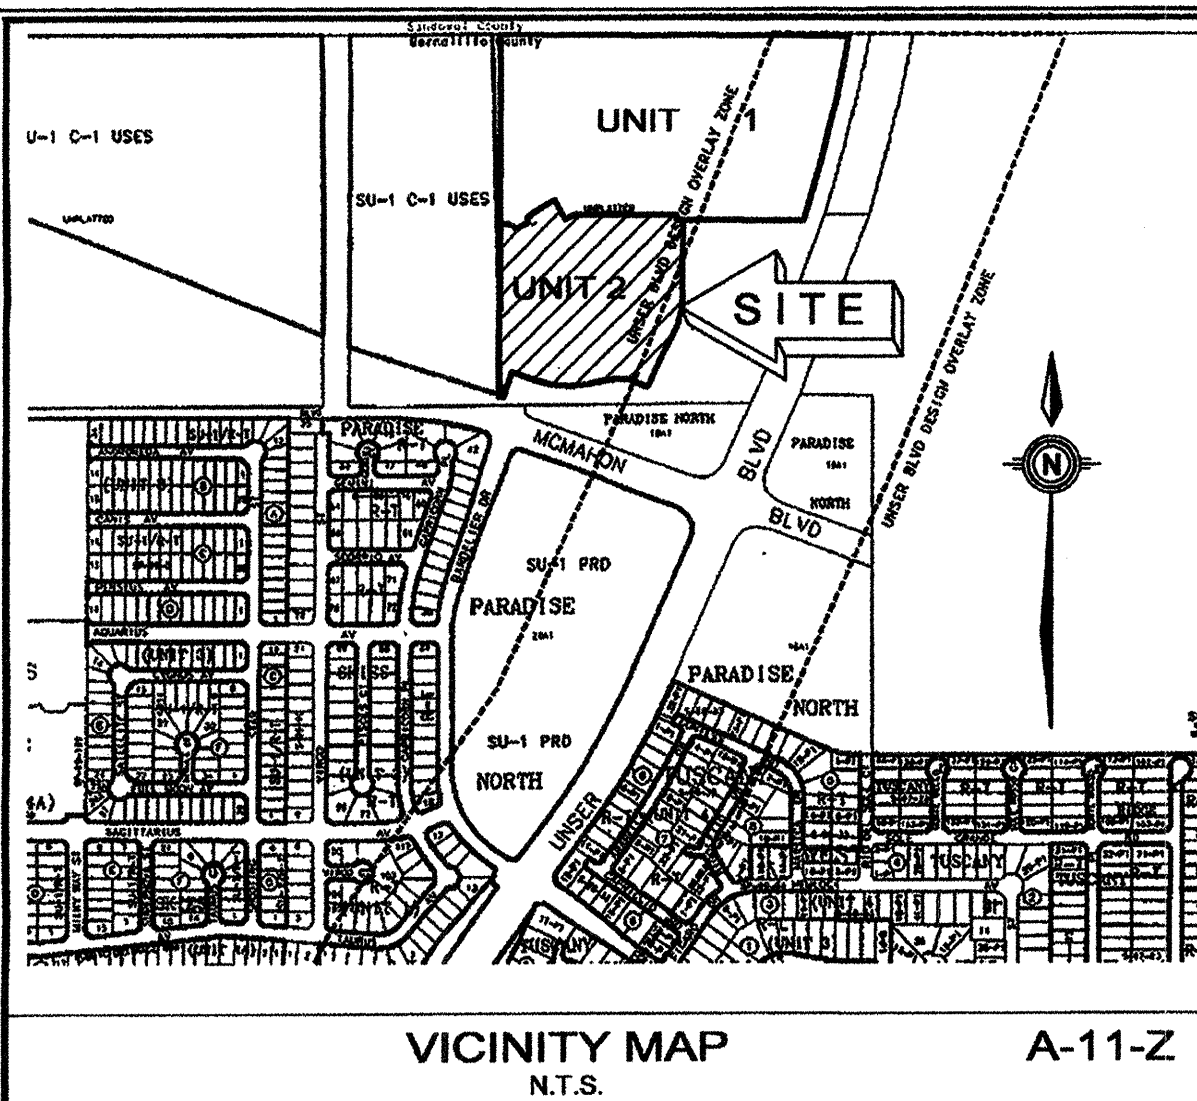**DISCLOSURE STATEMENT:**

THE PURPOSE OF THIS PLAT IS TO REPLAT TRACTS A-1-A, B-1-A, AND B-2-A OF THE PLAT FOR RIDGEVIEW VILLAGE, UNIT 1, AND TRACT B-3 OF THE CORRECTION PLAT No.1, BULK LAND PLAT, LANDS OF ZOLIN/KUNATH, TRES ESQUINAS, LLC AND CURB, INC., INTO 61 SINGLE FAMILY LOTS AND 1 TRACT. THIS PLAT ALSO DEDICATES PUBLIC RIGHT-OF-WAY TO THE CITY OF ALBUQUERQUE AND GRANTS PUBLIC EASEMENTS AS SHOWN.

SUBDIVISION DATA:

CASE NO.
GROSS SUBDIVISION ACREAGE 9.4372 AC
ZONE ATLAS INDEX NO. A-11-Z
NO. OF EXISTING BLOCKS 0
NO. OF EXISTING TRACTS 4
NO. OF LOTS CREATED 61
NO. OF BLOCKS CREATED 1
NO. OF TRACTS CREATED 0
MILES OF FULL-WIDTH STREETS CREATED 0.57 MILES
DATE OF SURVEY NOVEMBER, 2001
S.P. TALOS LOG NO. 2001441706

TREASURER'S CERTIFICATION

THIS IS TO CERTIFY THAT TAXES ARE CURRENT AND PAID ON PARCELS: TRACTS A-1-A, B-1-A, B-2-A AND B-3 WITH UPC NUMBERS 101106632949710550, 101106629742910540 AND 101106635142910510.

PROPERTY OWNER OF RECORD: CURB, INC.

BERNALILLO COUNTY TREASURER'S OFFICE:

BY: _____ DATE: _____


INDEX OF SHEETS

SHEET 1 PLAT APPROVALS, LEGAL DESCRIPTION
& SITE DATA
SHEET 2 PLAT GEOMETRY & EXISTING MONUMENTATION
EASEMENTS GRANTED & EASEMENTS VACATED
BY THIS PLAT.
SHEET 3 CURVE DATA

FREE CONSENT AND DEDICATION

THE SUBDIVISION SHOWN HEREON IS WITH THE FREE CONSENT AND IN ACCORDANCE WITH THE DESIRES OF THE UNDERSIGNED OWNER(S) AND/OR PROPRIETOR(S) THEREOF AND SAID OWNER(S) AND/OR PROPRIETOR(S) DO HEREBY DEDICATE ALL STREETS AND PUBLIC RIGHTS-OF-WAY SHOWN HEREON TO THE CITY OF ALBUQUERQUE IN FEE SIMPLE WITH WARRANTY COVENANTS AND DO HEREBY GRANT: ALL ACCESS, UTILITY AND DRAINAGE EASEMENTS SHOWN HEREON INCLUDING THE RIGHT TO CONSTRUCT, OPERATE, INSPECT, AND MAINTAIN FACILITIES THEREIN; AND ALL PUBLIC UTILITY EASEMENTS SHOWN HEREON FOR THE COMMON AND JOINT USE OF GAS, ELECTRICAL POWER AND COMMUNICATION SERVICES FOR BURIED AND/OR OVERHEAD DISTRIBUTION LINES, AND INCLUDING THE RIGHT OF INGRESS AND EGRESS FOR CONSTRUCTION AND MAINTENANCE, AND THE RIGHT TO TRIM INTERFERING TREES AND SHRUBS. SAID OWNER(S) AND/OR PROPRIETOR(S) DO HEREBY CONSENT TO ALL OF THE FOREGOING AND DO HEREBY CERTIFY THAT THIS SUBDIVISION IS THEIR FREE ACT AND DEED.

CURB, INC.

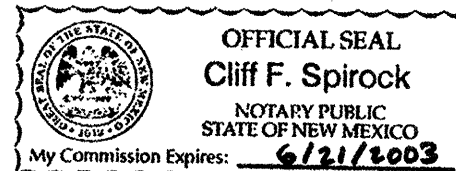BY: Charles G. Haegelin DATE: 12-19-01
CHARLES HAEGELINSTATE OF NEW MEXICO)
SS
COUNTY OF BERNALILLO)THIS INSTRUMENT WAS ACKNOWLEDGED BEFORE ME ON THIS 19TH DAY OF DECEMBER, 2001
BY CHARLES HAEGELINBY: _____
NOTARY PUBLICMY COMMISSION EXPIRES: 6/21/2003**LEGAL DESCRIPTION:**

A CERTAIN TRACT OF LAND CONSISTING OF TRACTS A-1-A, B-1-A, B-2-A OF THE PLAT FOR RIDGEVIEW VILLAGE, UNIT 1, AS THE SAME IS SHOWN AND DESIGNATED ON THE PLAT THEREOF RECORDED IN THE OFFICE OF THE COUNTY CLERK, BERNALILLO COUNTY, NEW MEXICO ON (UNRECORDED AT THIS TIME), AND TRACT B-3 OF THE CORRECTION PLAT No.1, BULK LAND PLAT, LANDS OF ZOLIN/KUNATH, TRES ESQUINAS, LLC AND CURB INC., AS THE SAME IS SHOWN AND DESIGNATED ON THE PLAT THEREOF RECORDED IN THE OFFICE OF THE COUNTY CLERK, BERNALILLO COUNTY, NEW MEXICO ON SEPTEMBER 18, 2001 IN BOOK 2001C, PAGE 261 AS DOCUMENT No. 2001109527.

NOTES:

1. THE BASIS OF BEARINGS FOR THIS PLAT IS NEW MEXICO STATE PLANE COORDINATE SYSTEM, CENTRAL ZONE, NAD 1927. ACS MONUMENTS "SANDBERN" AND "3-BIO" WERE HELD AS CONTROL FOR THE BASIS LINE. BEARINGS ARE GRID BEARINGS, AND DISTANCES ARE GROUND DISTANCES.
2. THE PLAT WAS CREATED USING AN ACTUAL FIELD SURVEY AND EXISTING RECORD DATA.
3. CENTERLINE (IN LIEU OF R/W) MONUMENTATION TO BE INSTALLED AT ALL CENTERLINE PC'S, PT'S, ANGLE POINTS AND STREET INTERSECTIONS PRIOR TO ACCEPTANCE OF SUBDIVISION STREET IMPROVEMENTS AND WILL CONSIST OF A FOUR INCH (ALUMINUM ALLOY CAP STAMPED "CITY OF ALBUQUERQUE CENTERLINE MONUMENTATION SURVEY MARKER DO NOT DISTURB P.L.S. 12651").
4. UNLESS OTHERWISE NOTED, ALL EXTERIOR BOUNDARY CORNERS AND INTERIOR LOT CORNERS SHALL BE MARKED BY A #5 REBAR WITH CAP STAMPED "PS #12651" UNLESS SET AT MASONRY WALL INTERSECTION, IN WHICH CASE A CONCRETE NAIL WITH BRASS TAG STAMPED "CSC PS 12651" WILL BE SET.
5. PUBLIC UTILITY EASEMENTS (P.U.E.) SHOWN ON THIS PLAT ARE GRANTED FOR THE COMMON AND JOINT USE OF:
A. PNM ELECTRIC SERVICES FOR THE INSTALLATION, MAINTENANCE, AND SERVICE OF OVERHEAD AND UNDERGROUND ELECTRICAL LINES, TRANSFORMERS, POLES AND OTHER EQUIPMENT AND RELATED FACILITIES REASONABLY NECESSARY TO PROVIDE ELECTRICAL SERVICE.
B. PNM GAS SERVICES FOR INSTALLATION, MAINTENANCE, AND SERVICE OF NATURAL GAS LINES, VALVES AND OTHER EQUIPMENT AND FACILITIES REASONABLY NECESSARY TO PROVIDE NATURAL GAS.
C. QWEST FOR THE INSTALLATION, MAINTENANCE AND SERVICE OF ALL BURIED COMMUNICATION LINES AND OTHER RELATED EQUIPMENT AND FACILITIES REASONABLY NECESSARY TO PROVIDE COMMUNICATION SERVICES, INCLUDING BUT NOT LIMITED TO ABOVE GROUND PEDESTALS AND D. COMCAST CABLE FOR THE INSTALLATION, MAINTENANCE, AND SERVICE OF SUCH LINES, CABLE, AND OTHER RELATED EQUIPMENT AND FACILITIES REASONABLY NECESSARY TO PROVIDE CABLE TV.
E. NEW MEXICO UTILITIES, INC. FOR THE INSTALLATION, MAINTENANCE AND SERVICE OF UNDERGROUND WATER AND SEWER LINES ACROSS THE EASEMENT (BUT NOT PARALLEL WITHIN) AND OTHER RELATED EQUIPMENT AND FACILITIES NECESSARY TO PROVIDE WATER AND SEWER SERVICE.

INCLUDED IS THE RIGHT TO BUILD, REBUILD, CONSTRUCT, RECONSTRUCT, LOCATE, RELOCATE, CHANGE, REMOVE, MODIFY, RENEW, OPERATE, AND MAINTAIN FACILITIES FOR THE PURPOSES DESCRIBED ABOVE, TOGETHER WITH FREE ACCESS TO, FROM, AND OVER SAID EASEMENTS, INCLUDING SUFFICIENT WORKING AREA SPACE FOR ELECTRIC TRANSFORMERS, WITH THE RIGHT AND PRIVILEGE TO TRIM AND REMOVE TREES, SHRUBS OR BUSHES WHICH INTERFERE WITH THE PURPOSES SET FORTH HEREIN. NO BUILDING, SIGN, POOL (ABOVE GROUND OR SUBSURFACE), HOT TUB, CONCRETE OR WOOD POOL DECKING, OR OTHER STRUCTURE SHALL BE ERRECTED OR CONSTRUCTED ON SAID EASEMENTS, NOR SHALL ANY WELL BE DRILLED OR OPERATED THEREON. PROPERTY OWNERS SHALL BE SOLELY RESPONSIBLE FOR CORRECTING ANY VIOLATIONS OF NATIONAL ELECTRICAL SAFETY CODE CAUSED BY CONSTRUCTION OF POOLS, DECKING, OR ANY STRUCTURES ADJACENT TO OR NEAR EASEMENTS SHOWN ON THIS PLAT.

EASEMENTS FOR ELECTRIC TRANSFORMERS/SWITCHGEARS, AS INSTALLED, SHALL EXTEND TEN (10) FEET IN FRONT OF TRANSFORMERS/SWITCHGEAR DOORS AND FIVE (5) FEET FROM THE OTHER THREE (3) SIDES OF THE TRANSFORMER/SWITCHGEAR, AS INSTALLED.

6. BERNALILLO COUNTY RECORDS HAVE NOT BEEN UPDATED TO ASSIGN NEW UPC NUMBERS TO THE TRACTS SHOWN ON THE BULK LAND PLAT (2001C-261).

7. THE PROPERTY IS WITHIN THE NEW MEXICO UTILITIES INC., (NMU, INC.) FRANCHISE AREA. WATER AND SANITARY SEWER SYSTEM CAPABILITIES ARE BASED ON NMU, INC.'S FACILITIES, NOT THE CITY OF ALBUQUERQUE.

8. DOCUMENTS USED:
CORRECTION PLAT No.1, BULK LAND PLAT, LANDS OF ZOLIN / KUNATH, TRES ESQUINAS, LLC, AND CURB, INC., RECORDED 9/18/2001, BK. 2001C, PG. 261. BEARINGS AND DISTANCES SHOWN ON THIS PLAT FOR RIDGEVIEW VILLAGE ARE IDENTICAL TO THOSE SHOWN ON SAID BULK LAND PLAT (2001C, 261).

9. ALL LOTS ARE DESIGNATED "P-1" AND WILL MEET THE OFF-STREET PARKING REGULATIONS CONTAINED IN THE CITY OF ALBUQUERQUE ZONING CODE, SECTION 14-16-3-1-A-24C.

10. THERE IS A 10' PRIVATE DRAINAGE EASEMENT CENTERED ON THE SIDE LOT LINES BETWEEN EACH LOT CREATED FOR THE JOINT USE BY EITHER OR BOTH PARTIES TO CONVEY LOCAL LOT DRAINAGE TO THE STREET FRONTING SAID LOTS.

**PLAT
FOR
RIDGEVIEW VILLAGE
UNIT 2**

BEING A REPLAT OF TRACTS A-1-A, B-1-A, AND B-2-A
OF THE PLAT FOR RIDGEVIEW VILLAGE, UNIT 1
AND
TRACT B-3 OF THE CORRECTION PLAT No.1,
BULK LAND PLAT, LANDS OF
ZOLIN/KUNATH, TRES ESQUINAS, LLC., AND CURB INC.

SITUATE WITHIN
PROJECTED SECTION 2, T11N, R2E, N.M.P.M.
TOWN OF ALAMEDA GRANT
CITY OF ALBUQUERQUE, BERNALILLO COUNTY, NEW MEXICO
DECEMBER 2001

APPROVALS:SUBDIVISION CASE NUMBER: PROJECT # 1000893S.P. TALOS LOG NUMBER: 2001441706

CITY PLANNER/ALBUQUERQUE, BERNALILLO CO. PLANNING DIVISION _____ DATE _____

PARKS DESIGN AND DEVELOPMENT _____ DATE _____

TRAFFIC ENGINEER, TRANSPORTATION DEPARTMENT _____ DATE _____

CITY ENGINEER, ENGINEERING DIVISION _____ DATE _____

ALBUQUERQUE METROPOLITAN ARROYO FLOOD CONTROL AUTHORITY _____ DATE _____

UTILITY DEVELOPMENT _____ DATE _____

CITY SURVEYOR, ENGINEERING DIVISION 12-19-01 DATE _____

PROPERTY MANAGEMENT _____ DATE _____

COMCAST CABLE 6-21-02 DATE _____

QWEST COMMUNICATIONS, INC. _____ DATE _____

PNM ELECTRIC AND GAS SERVICES 6-20-02 DATE _____NEW MEXICO UTILITIES, INC. 12-20-01 DATE _____

By approving this plat, PNM Electric Services and Gas Services (PNM) did not conduct a Title Search of the properties shown hereon. Consequently, PNM does not waive nor release any easement or easement rights to which it may be entitled.

SURVEYOR'S CERTIFICATION:

I, THOMAS W. PATRICK, A PROFESSIONAL SURVEYOR REGISTERED UNDER THE LAWS OF THE STATE OF NEW MEXICO, DO CERTIFY THAT THIS PLAT WAS PREPARED BY ME OR UNDER MY DIRECT SUPERVISION; SHOWS ACCURATE DIMENSIONS AND LAND AREAS; SHOWS ALL EASEMENTS AND RESTRICTIONS AS SHOWN ON THE PLAT OF RECORD OR MADE KNOWN TO ME BY THE OWNERS AND/OR PROPRIETORS OF THE SUBDIVISION SHOWN HEREON, TITLE COMPANIES, UTILITY COMPANIES OR OTHER PARTIES EXPRESSING AN INTEREST. I FURTHER CERTIFY THAT THIS PLAT MEETS THE MINIMUM REQUIREMENTS FOR MONUMENTATION AND SURVEYS OF THE ALBUQUERQUE SUBDIVISION ORDINANCE, MEETS THE "MINIMUM STANDARDS FOR LAND SURVEYS" AS DETERMINED BY THE NEW MEXICO BOARD OF REGISTRATION FOR PROFESSIONAL ENGINEERS AND SURVEYORS AND IS TRUE AND CORRECT TO THE BEST OF MY KNOWLEDGE AND BELIEF.

Thomas W. Patrick
THOMAS W. PATRICK
NEW MEXICO PROFESSIONAL SURVEYOR No. 12651

DATE: 12-19-2001

DATE: DECEMBER 2001
SCALE: N/A
DESIGNED BY: CAS / JTS
DRAWN BY: MS
JOB NO.: N291-33-120

SHEET 1 OF 3
community sciences corporation


QuikDraw
ENGINEERING, L.L.C.
P.O. Box 729
Corrales, NM 87048
Office (505) 898-0389 Fax (505) 897-0389
Community Sciences Corporation
LAND PLANNING ENGINEERING SURVEYING
P.O. Box 1328 Corrales, New Mexico 87048

JOB NO.: N291-33

CITY OF ALBUQUERQUE
PUBLIC WORKS DEPARTMENT
ENGINEERING DEVELOPMENT GROUP
TITLE: RIDGEVIEW VILLAGE UNIT II
PLATS OF GEOMETRY


Design Review Committee	City Engineer Approval	Mo./Day/Yr	Mo./Day/Yr
For Information Only			
City Project No. <u>683082</u>	Zone Map No. <u>A-11</u>	Sheet <u>3</u> of <u>24</u>	

COMMUNITY SCIENCES CORPORATION - CORRALES, NEW MEXICO - (505) 897-0000

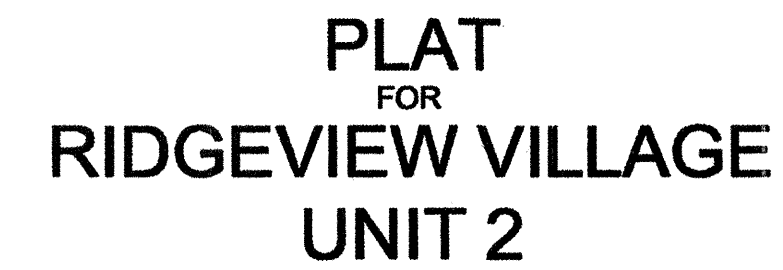

BEING A REPLAT OF TRACTS A-1-A, B-1-A, AND B-2-A
OF THE PLAT FOR RIDGEVIEW VILLAGE, UNIT 1
AND
TRACT B-3 OF THE CORRECTION PLAT No.1,
BULK LAND PLAT, LANDS OF
ZOLIN/KUNATH, TRES ESQUINAS, LLC., AND CURB INC.

SITUATE WITHIN
PROJECTED SECTION 2, T11N, R2E, N.M.P.M.
TOWN OF ALAMEDA GRANT
CITY OF ALBUQUERQUE, BERNALILLO COUNTY, NEW MEXICO
DECEMBER 2001

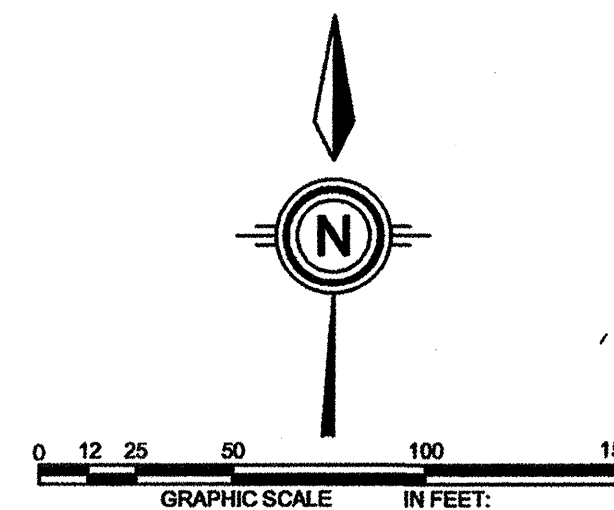

SCALE 1"=50'

MONUMENTATION LEGEND

- ❑ FOUND SURVEY MONUMENT AS DESCRIBED
- ✳ FOUND No.5 REBAR(S) WITH ALUMINUM CAP STAMPED "CSC PLS 12651"
- ⚠ SET CENTERLINE MONUMENT : FOUR INCH ALUMINUM ALLOY CAP STAMPED "CITY OF ALBUQUERQUE CENTERLINE MONUMENTATION SURVEY MARKER DO NOT DISTURB P.L.S. 12651".
- SET NO.5 REBAR WITH 2" ALUM. CAP STAMPED "CSC PLS 12651". INDIVIDUAL LOT CORNERS SET BUT NOT SHOWN HEREON.
- INTERIOR R/W AND EASEMENT CORNERS NOT MONUMENTED.

NOTES:

- A. PUBLIC WATER, SANITARY SEWER, DRAINAGE AND ROADWAY EASEMENTS GRANTED BY CORRECTION PLAT No.1, BULK LAND PLAT, LANDS OF ZOLIN / KUNATH, TRES ESQUINAS, LLC, AND CURRB, INC., RECORDED 9/18/2001, BK. 2001C, PG. 261.**
- B. PUBLIC WATER, SANITARY SEWER, DRAINAGE AND ROADWAY EASEMENTS PER PLAT FOR RIDGEVIEW VILLAGE, UNIT 1, RECORDED ON 05-20-02, BK. 2002C, PG. 180.**
- C. QUEST COMMUNICATION EASEMENT GRANTED BY THIS PLAT ACROSS LOT 159 P-1**

VERTICAL BENCHMARK:
ACS STATION 1-\$11
ELEV.= 5279.75 (NAVD 1929):

ACS 1 3/4" ALUMINUM DISK,
STAMPED "ACS BM, 1-\$11", EPOXIED
TO TOP OF CONCRETE CURB, EAST
SIDE OF UNSER BLVD. NW, 24 FT.
+/- NORTH OF THE BERNALILLO /
SANDOVAL COUNTY FENCE LINE, 210.1
FT. SOUTH OF "SPEED LIMIT 45"
SIGN, 50.7 FT. NORTH OF THE SOUTH
END OF CURB AND GUTTER.

DATE:	AUG. 2002
SCALE:	N/A
DESIGNED:	CAS / JTS
DRAWN:	MS
JOB NO.:	N291-33-120

SHEET 2 OF 3

*community
sciences
corporation*

QuikDraw
ENGINEERING, L.L.C.

P.O. Box 729
Corrales, NM 87048
Office (505) 898-0389 Fax (505) 897-0389

*Community
Sciences
Corporation*

LAND PLANNING ENGINEERING SURVEYING
P.O. Box 1328 Corrales, New Mexico 87048

[illegible]

JOB NO.: N291-33

CITY OF ALBUQUERQUE
PUBLIC WORKS DEPARTMENT
ENGINEERING DEVELOPMENT GROUP
RIDGEVIEW VILLAGE UNIT II
PLATS OF GEOMETRY

Design Review Committee		City Engineer Approval		Mo./Day/Yr		Mo./Day/Yr	
For Information Only							
City Project No. 683082		Zone Map No. A-11		Sheet 4		of 24	

SCANNED BY
MESA REPRO

COMMUNITY SCIENCES CORPORATION - CORRALES, NEW MEXICO - (505) 897-0000

CURVE TABLE						
CURVE	RADIUS	LENGTH	DELTA	TANGENT	CHORD BEARING	CHORD LENGTH
C63	177.00'	6.87'	213.31"	3.44'	S59°26'35"W	6.87'
C74	120.00'	66.93'	31°57'31"	34.36'	N74°18'35"E	66.07'
C75	120.00'	49.70'	23°43'55"	25.21'	N78°25'24"E	49.35'
C76	120.00'	17.23'	81°3'36"	8.63'	N62°26'38"E	17.22'
C77	143.00'	22.37'	8°57'44"	11.21'	N85°48'29"E	22.35'
C78	20.00'	24.32'	69°40'33"	13.92'	N63°50'08"W	22.85'
C79	20.00'	30.48'	87°19'40"	19.08'	S14°40'00"W	22.62'
C108	100.00'	51.13'	29°17'34"	26.13'	N14°21'03"W	50.57'
C109	125.00'	63.91'	29°17'34"	32.67'	N14°21'03"W	63.21'
C110	150.00'	62.88'	24°01'06"	31.91'	N16°59'17"W	62.42'
C111	150.00'	34.26'	13°05'10"	17.20'	N11°31'19"W	34.19'
C112	150.00'	28.62'	10°55'56"	14.35'	N23°31'52"W	28.58'
C113	20.00'	29.57'	84°43'32"	18.24'	S47°20'30"E	28.95'
C114	20.00'	31.42'	90°00'00"	20.00'	S45°17'44"W	28.28'
C115	143.00'	49.67'	19°53'59"	25.09'	N80°20'44"E	49.42'
C116	120.00'	41.68'	19°53'59"	21.05'	N80°20'44"E	41.47'
C117	97.00'	33.69'	19°53'59"	17.02'	N80°20'44"E	33.52'
C118	143.00'	41.99'	16°48'33"	21.15'	N81°52'57"E	41.84'
C119	143.00'	7.67'	3°04'26"	3.84'	N71°55'58"E	7.67'
C120	323.00'	112.65'	19°59'00"	56.90'	S80°23'14"W	112.08'
C121	300.00'	104.63'	19°59'00"	52.85'	S80°23'14"W	104.10'
C122	277.00'	96.81'	19°59'00"	48.80'	S80°23'14"W	96.12'
C123	277.00'	56.37'	11°39'37"	28.28'	S76°13'33"W	56.28'
C124	277.00'	40.24'	8°19'22"	20.15'	S86°13'03"W	40.20'
C125	323.00'	41.28'	7°19'20"	20.67'	S86°43'04"W	41.25'
C126	323.00'	50.93'	9°02'01"	25.52'	S78°32'24"W	50.87'
C127	323.00'	20.45'	5°37'38"	10.23'	S72°12'34"W	20.45'
C128	20.00'	31.44'	90°04'34"	20.03'	N45°20'27"E	28.30'
C129	20.00'	31.39'	89°55'26"	19.97'	N44°39'33"W	28.27'
C130	20.00'	31.45'	90°05'55"	20.03'	N45°21'07"E	28.31'
C131	20.00'	34.53'	98°55'05"	23.38'	N40°08'23"W	30.40'
C132	275.46'	96.11'	19°59'27"	48.55'	N19°18'53"E	95.62'
C133	275.46'	12.22'	2°32'31"	6.11'	N28°02'22"E	12.22'
C134	275.46'	63.69'	17°26'57"	42.27'	N18°02'38"E	63.52'
C135	223.00'	46.09'	11°35'05"	22.62'	S84°35'11"W	46.01'
C136	200.00'	40.44'	11°35'05"	20.29'	S84°35'11"W	40.37'
C137	177.00'	35.78'	11°35'00"	17.95'	S84°35'09"W	35.72'
C138	176.07'	17.94'	5°50'12"	8.98'	S87°19'15"W	17.93'
C139	177.00'	17.35'	5°36'56"	8.68'	S81°36'06"W	17.34'
C140	223.00'	29.01'	7°27'13"	14.53'	S82°31'15"W	28.99'
C141	223.00'	16.08'	4°07'53"	8.04'	S89°16'49"W	16.08'
C142	171.64'	35.48'	11°50'36"	17.80'	N84°22'28"E	35.42'
C143	194.64'	40.16'	11°49'21"	20.15'	N84°23'03"E	40.09'
C144	217.64'	44.84'	11°48'18"	22.50'	N84°23'35"E	44.76'
C145	217.64'	35.51'	9°20'56"	17.80'	N85°37'16"E	35.47'
C146	217.64'	9.33'	2°27'22"	4.67'	N79°43'07"E	9.33'
C147	20.00'	31.42'	90°00'00"	20.00'	S44°42'16"E	28.28'
C148	20.00'	31.42'	90°00'01"	20.00'	S45°17'44"W	28.28'
C149	146.50'	37.24'	14°33'56"	18.72'	N07°24'42"E	37.14'
C150	121.50'	45.41'	21°24'51"	22.87'	N11°00'09"E	45.15'
C151	30.00'	58.07'	110°53'55"	43.57'	S55°44'42"W	49.42'
C151A	97.00'	18.34'	10°49'58"	9.20'	N63°23'22"W	18.31'
C152	120.00'	8.92'	4°15'32"	4.46'	N66°40'35"W	8.92'
C152A	30.00'	48.16'	88°09'43"	29.05'	S24°43'30"E	41.74'
C153	30.00'	47.14'	90°01'45"	30.02'	S84°22'14"W	46.44'
C154	30.00'	44.78'	85°28'33"	27.72'	S27°52'36"E	40.72'
C155	146.50'	34.07'	13°19'29"	17.11'	N08°11'56"E	33.99'
C156	146.50'	3.17'	1°14'27"	1.59'	N00°54'58"E	3.17'
C157	277.79'	148.88'	30°42'31"	76.28'	S85°58'09"E	147.11'
C158	300.79'	161.23'	30°42'43"	82.60'	S85°58'15"E	159.31'
C159	323.79'	173.57'	30°42'54"	88.93'	S85°58'20"E	171.59'
C160	323.79'	16.46'	2°54'46"	8.23'	S72°04'16"E	16.46'
C161	323.79'	47.95'	8°29'08"	24.02'	S77°46'12"E	47.91'
C162	323.79'	47.99'	8°29'34"	24.04'	S86°15'32"E	47.95'
C163	323.79'	52.53'	9°17'41"	26.32'	N84°50'51"E	52.47'
C164	323.79'	8.64'	1°31'47"	4.32'	N79°26'07"E	8.64'
C165	277.79'	30.32'	6°15'14"	15.18'	N81°48'13"E	30.31'
C166	277.79'	77.99'	16°05'08"	39.25'	S87°01'36"E	77.73'
C167	277.79'	40.58'	8°22'08"	20.32'	S74°47'58"E	40.54'
C168	277.00'	47.27'	9°46'38"	23.69'	S83°28'51"W	47.21'
C169	300.00'	51.57'	9°50'56"	25.85'	S83°31'00"W	51.51'
C170	323.00'	55.88'	9°54'46"	28.01'	S83°32'55"W	55.81'
C171	323.00'	13.20'	2°20'29"	6.60'	S79°45'47"W	13.20'
C172	323.00'	42.68'	7°34'16"	21.37'	S84°43'10"W	42.65'
C173	224.71'	0.23'	0°33'35"	0.12'	N89°46'10"W	0.23'
C174	224.71'	85.25'	21°44'09"	43.14'	N78°55'53"W	84.74'
C175	201.71'	95.23'	27°02'57"	48.52'	N76°16'29"W	94.35'
C176	178.71'	59.07'	18°56'13"	29.81'	N80°19'51"W	58.80'
C177	20.00'	33.57'	98°10'26"	22.28'	N22°46'31"W	29.77'
C178	1225.00'	68.00'	3°10'50"	34.01'	S23°43'17"W	68.00'
C179	1200.00'	109.65'	5°14'07"	54.86'	S24°44'55"W	109.61'
C180	1200.00'	12.10'	0°34'39"	6.05'	S27°39'18"W	12.10'
C181	20.00'	29.32'	83°59'33"	18.01'	N69°58'24"E	28.76'
C182	224.71'	37.64'	9°35'53"	18.87'	N72°51'45"W	37.60'
C183	224.71'	47.60'	12°08'16"	23.89'	N83°43'50"W	47.51'

PLAT
FOR
RIDGEVIEW VILLAGE
UNIT 2

BEING A REPLAT OF TRACTS A-1-A, B-1-A, AND B-2-A
OF THE PLAT FOR RIDGEVIEW VILLAGE, UNIT 1
AND
TRACT B-3 OF THE CORRECTION PLAT No.1,
BULK LAND PLAT, LANDS OF
ZOLINKUNATH, TRES ESQUINAS, LLC., AND CURB INC.

SITUATE WITHIN
PROJECTED SECTION 2, T11N, R2E, N.M.P.M.
TOWN OF ALAMEDA GRANT
CITY OF ALBUQUERQUE, BERNALILLO COUNTY, NEW MEXICO
DECEMBER 2001

SHEET 3 OF 3

DATE	DECEMBER 2001
SCALE	N/A
DESIGNED	CAS / JTS
DRAWN	MS
JOB NO.	N291-33-120
LAND PLANNING	P.O. Box 1328
ENGINEERING	Corrales, N.M. 87048
SURVEYING	

QuikDraw
ENGINEERING, L.L.C.

P.O. Box 729
Corrales, NM 87048
Office (505) 698-0369 Fax (505) 697-0369

Community
Sciences
Corporation

LAND PLANNING ENGINEERING SURVEYING
P.O. Box 1328 Corrales, New Mexico 87048

AS BUILT INFORMATION

CONTRACTOR

WORK
STARTED BY

INSPECTOR'S
DATE

FIELD
DATE

VERIFICATION BY
DATE

CORRECTED BY
DATE

MICRO-FILM INFORMATION

RECORDED BY
NO.

NO.

[illegible]

DRAINAGE CERT W/ VERIFICATION BY ENGINEER OF RECORD
12/28/01

I, LYLE L. LOSACK, NPPE 14295 OF THE FIRM QUICKDRAW ENGINEERING L.L.C.,
HEREBY CERTIFY THAT THIS PROJECT HAS BEEN GRADED AND WILL DRAIN IN
SUBSTANTIAL COMPLIANCE WITH AND IN ACCORDANCE WITH THE DESIGN INTENT OF
THE APPROVED PLAN DATED 12/17/01. THE RECORD INFORMATION EDITED ON THE
ORIGINAL DESIGN DOCUMENT HAS BEEN OBTAINED BY ME OR UNDER MY DIRECT
SUPERVISION AND IS TRUE AND CORRECT TO THE BEST OF MY KNOWLEDGE AND BELIEF.
THIS CERTIFICATION IS SUBMITTED IN SUPPORT OF A REQUEST FOR
RIDGEVIEW VILLAGE - UNIT 11 DRB #100893

THE RECORD INFORMATION PRESENTED HEREON IS NOT NECESSARILY COMPLETE AND INTENDED ONLY TO VERIFY SUBSTANTIAL COMPLIANCE OF THE GRADING AND DRAINAGE ASPECTS OF THIS PROJECT. THOSE RELYING ON THIS RECORD DOCUMENT ARE ADVISED TO OBTAIN INDEPENDENT VERIFICATION OF ITS ACCURACY BEFORE USING IT FOR ANY OTHER PURPOSE.

LYLE C. LOSACK, NMPE #14925

DATE 7/9/03 MATCH LINE

GRADING NOTES:

1. CONTRACTOR SHALL FOLLOW THE RECOMMENDATION FOR SITE PREPARATION, VEGETATIVE REMOVAL, AND CONSTRUCTION OF STRUCTURAL FILL DETAILED IN THE PROJECT SOILS INVESTIGATION REPORT. ALL FILL SHALL COMPLY WITH GEOTECHNICAL SOILS REPORT REQUIREMENTS, OR AS DIRECTED BY THE GEOTECHNICAL ENGINEER IN THE FIELD.
2. CONTRACTOR IS RESPONSIBLE FOR MAINTAINING ADEQUATE WIND-BORN DUST CONTROL PER BERNALILLO COUNTY REGULATIONS.
3. CONTRACTOR MUST OBTAIN TOP SOIL DISTURBANCE PERMIT PRIOR TO MASS GRADING OPERATION.
4. INDIVIDUAL LOT DRAINAGE MUST BE DIRECTED TO DESIGNATED DRAINAGE FACILITIES OR TO THE PUBLIC STREET. NO DRAINAGE IS ALLOWED TO TRANSVERSE FROM ONE PRIVATE LOT TO ANOTHER EXCEPT AS NOTED ON THE GRADING PLAN VIA PRIVATE DRAINAGE EASEMENTS.
5. ALL SIDE AND REAR YARDS MUST BE GRADED IN ACCORDANCE WITH SECTION TYPICAL LOT DETAILS.
6. EROSION CONTROL BERMS ARE TO REMAIN IN PLACE ON INDIVIDUAL LOTS UNTIL FINAL GRADING FOR HOUSE CONSTRUCTION.

ENGINEER'S SEAL

(

14925

PROCESSED

121701

0 25 50 100 200
GRAPHIC SCALE IN FEET:

The map illustrates the Ridgeview Village Subdivision, which is situated between the Los Suenos Subdivision to the west and the Ridgeview Subdivision to the east. The subdivision is bounded by Paradise Blvd to the north and Under Blvd to the south. A large arrow points to the 'SITE' within the subdivision. The map also shows various lots, including SU-1, SU-1 PRO, and SU-1 PRN, and a north arrow.

VICINTY MAP
NTS

ROUGH GRADING - CONTRACTOR SPECIFICATION
FOR EROSION CONTROL AND FRONT-YARD EXCAVATION AREA

**TYPICAL LOT DETAIL
FOR SINGLE FAMILY DETACHED DWELLINGS**

LEGEND

- | | |
|------------|-------------------------------------|
| ● TC=98.43 | PROPOSED TOP OF CURB ELEVATION |
| ● 99.0 | PROPOSED SPOT ELEVATION |
| 909.0 | EXISTING SPOT ELEVATION (GRND & TC) |
| | PROPOSED CONCRETE VALLEY GUTTER |
| | TEMPORARY PAVING |
| | PROPOSED CURB & GUTTER |
| | FUTURE UNSEAL BLVD (BY OTHERS) |
| — 497.3 — | EXISTING CONTOUR W/ INDEX ELEVATION |
| | FLOW ARROW |
| | STORM DRAIN WITH MANHOLE & INLETS |
| | PROPOSED STORM DRAIN |
| | PROPOSED STORM SEWER CATCH BASIN |
| | PROPOSED WATER BLOCK |
| | BASIN BOUNDARY |
| | SUB BASIN BOUNDARY |
| | PHASE LINE |
| | RETAINING WALL |

DATE:	11/2001
SCALE:	1" = 50'
JOB NO.:	N201-33-13

*Community
Sciences
Corporation*

CITY OF ALBUQUERQUE
PUBLIC WORKS DEPARTMENT
ENGINEERING GROUP

TITLE: RIDGEVIEW VILLAGE SUBDIVISION
ULTIMATE GRADING AND DRAINAGE PLAN

Design Review Committee	City Engineer Approval
For Information Only	

PROJECT NO.
N291-33-130

MAP NO.	SHEET 7 of 24
---------	---------------

RIDGEVIEW VILLAGE


PHASE II

BEING A REPLAT OF TRACTS A-1, A-2, B-1 AND B-2
OF THE CORRECTION PLAT No.1, BULK LAND PLAT
LANDS OF ZOLIN/KUNATH, TRES ESQUINAS, LLC., AND CURB INC.


SITUATE WITHIN
PROJECTED SECTION 2, T11N, R2E, N.M.P.M.
TOWN OF ALAMEDA GRANT
CITY OF ALBUQUERQUE, BERNALILLO COUNTY, NEW MEXICO
FEBRUARY 2002



1. SET POSTS AND EXCAVATE A 4" X 4" TRENCH UPSLOPE ALONG THE LINE OF POSTS.

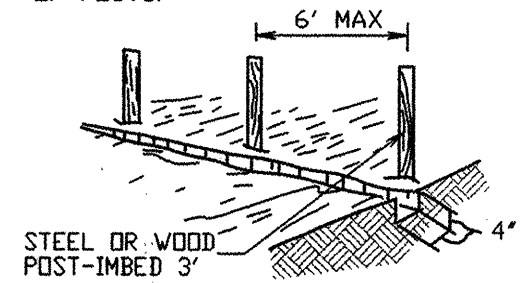

3. ATTACH THE FILTER FABRIC TO POSTS THE WIRE FENCE AND EXTEND INTO TRENCH.

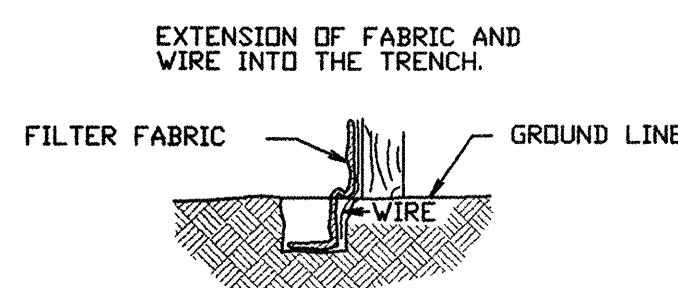

TEMPORARY SEDIMENT FENCE

NTS

EROSION CONTROL / ENVIRONMENTAL PROTECTION / STORM WATER POLLUTION PLAN

- THE CONTRACTOR SHALL CONFORM TO ALL CITY, COUNTY, STATE AND FEDERAL DUST AND EROSION CONTROL REGULATIONS. THE CONTRACTOR SHALL PREPARE AND OBTAIN ANY NECESSARY DUST OR EROSION CONTROL PERMITS FROM REGULATORY AGENCIES.
- THE CONTRACTOR SHALL PROMPTLY REMOVE ANY MATERIAL EXCAVATED WITHIN THE PUBLIC RIGHT-OF-WAY TO KEEP IT FROM WASHING OFF THE PROJECT SITE.
- THE CONTRACTOR SHALL ENSURE THAT NO SOIL ERODES FROM THE SITE ONTO OTHER PROPERTY BY CONSTRUCTING TEMPORARY EROSION CONTROL BERMS OR INSTALLING SILT FENCES AT THE PROPERTY LINES AND WETTING THE SOIL TO KEEP IT FROM BLOWING.
- THE CONTRACTOR SHALL MITIGATE EROSION OF TEMPORARY OR PERMANENT DIRT SWALES BY INSTALLING HAY BALES IN THE SWALES PERPENDICULAR TO THE DIRECTION OF FLOW, AND AT APPROPRIATE INTERVALS.
- WATERING AS REQUIRED FOR CONSTRUCTION AND DUST CONTROL, SHALL BE CONSIDERED INCIDENTAL TO CONSTRUCTION AND NO MEASUREMENT OR PAYMENT SHALL BE MADE THEREFOR. CONSTRUCTION AREAS SHALL BE WATERED FOR DUST CONTROL IN COMPLIANCE WITH GOVERNMENT ORDINANCES. THE CONTRACTOR SHALL BE RESPONSIBLE FOR LOCATING AND SUPPLYING WATER AS REQUIRED.
- ANY AREAS DISTURBED BY CONSTRUCTION AND NOT COVERED BY LANDSCAPING OR AN IMPERVIOUS SURFACE SHALL BE RE-VEGETATED WITH NATIVE GRASS SEEDING. THIS SHALL NOT INCLUDE RESIDENTIAL LOTS WHICH ARE TO BE OCCUPIED WITHIN 12 MONTHS.
- THE CONTRACTOR SHALL PROPERLY HANDLE AND DISPOSE OF ALL ASPHALT REMOVED ON THE PROJECT BY HAULING TO AN APPROVED LANDFILL IN ACCORDANCE WITH THE REQUIREMENTS OF THE NEW MEXICO SOLID WASTE ACT.
- ALL WASTE PRODUCTS FROM THE CONSTRUCTION SITE, INCLUDING ITEMS DESIGNATED FOR REMOVAL, CONSTRUCTION WASTE, CONSTRUCTION EQUIPMENT WASTE PRODUCTS (OIL, GAS, TIRES, ETC.) GARBAGE, GRUBBING EXCESS CUT MATERIAL, VEGETATIVE DEBRIS, ETC. SHALL BE APPROPRIATELY DISPOSED OF OFF SITE AT NO ADDITIONAL COST TO THE OWNER. IT SHALL BE THE CONTRACTOR'S RESPONSIBILITY TO OBTAIN PERMITS REQUIRED FOR HAUL OR DISPOSAL OF WASTE PRODUCTS. IT SHALL BE THE CONTRACTOR'S RESPONSIBILITY TO ENSURE THAT THE WASTE DISPOSAL SITE COMPLIES WITH GOVERNMENT REGULATIONS REGARDING THE ENVIRONMENT, ENDANGERED SPECIES AND ARCHAEOLOGICAL RESOURCES.
- THE CONTRACTOR SHALL BE RESPONSIBLE FOR THE CLEANUP AND REPORTING OF SPILLS OF HAZARDOUS MATERIALS ASSOCIATED WITH THE CONSTRUCTION SITE. HAZARDOUS MATERIALS INCLUDE GASOLINE, DIESEL FUEL, MOTOR OIL, SOLVENTS, CHEMICALS, PAINTS, ETC. WHICH MAY BE A THREAT TO THE ENVIRONMENT. THE CONTRACTOR SHALL REPORT THE DISCOVERY OF PAST OR PRESENT SPILLS TO THE NEW MEXICO ENVIRONMENT DEPARTMENT EMERGENCY RESPONSE AT 505-822-1558 OR 800-219-6157.
- THE CONTRACTOR SHALL COMPLY WITH ALL APPLICABLE REGULATIONS CONCERNING SURFACE AND UNDERGROUND WATER. CONTACT WITH SURFACE WATER BY CONSTRUCTION EQUIPMENT AND PERSONNEL SHALL BE MINIMIZED. EQUIPMENT MAINTENANCE AND REFUELING OPERATIONS SHALL BE PERFORMED IN AN ENVIRONMENTALLY SAFE MANNER IN COMPLIANCE WITH GOVERNMENT REGULATIONS.
- THE CONTRACTOR SHALL COMPLY WITH ALL APPLICABLE REGULATIONS CONCERNING CONSTRUCTION NOISE AND HOURS OF OPERATION.
- THE CONTRACTOR SHALL MAINTAIN A COPY OF THE STORM WATER POLLUTION PREVENTION PLAN ON SITE AT ALL TIMES.

LEGEND

- LOT LINES
- ROW
- SEDIMENT FENCE

QuikDraw
ENGINEERING, L.L.C.

P.O. Box 729
Corrales, NM 87048
Office (505) 896-0389 Fax (505) 897-0389

Community
Sciences
Corporation

LAND PLANNING ENGINEERING SURVEYING
P.O. Box 1328 Corrales, New Mexico 87048

JOB NO.: N291-33

CITY OF ALBUQUERQUE
PUBLIC WORKS DEPARTMENT
ENGINEERING DEVELOPMENT GROUP

TITLE: RIDGEVIEW VILLAGE UNIT II
EROSION CONTROL PLAN / ENVIRONMENTAL PROTECTION PLAN

Design Review Committee	City Engineer Approval	Mo./Day/Yr	Mo./Day/Yr


City Project No. 683082 Zone Map No. A-11 Sheet 8 of 24

AS BUILT INFORMATION				BENCH MARKS				SURVEY INFORMATION				ENGINEER'S SEAL			
CONTRACTOR	DATE	WORK	DATE	CONTRACTOR	DATE	WORK	DATE	NO.	DATE	BY	DATE	NO.	DATE	BY	DATE
NEW CONCEPTS	7/19/02			NEW CONCEPTS	7/19/02										
STARTED BY	DATE	ACCEPTED BY	DATE	STARTED BY	DATE	ACCEPTED BY	DATE	COMMUNITY SCIENCES CORP.	02/02						
FIELD	DATE	ACCEPTED BY	DATE	FIELD	DATE	ACCEPTED BY	DATE								
REVISIONS	DATE	REVISIONS	DATE	REVISIONS	DATE	REVISIONS	DATE								
CHECKED BY	DATE	CHECKED BY	DATE	CHECKED BY	DATE	CHECKED BY	DATE								
DESIGNED BY	DATE	DESIGNED BY	DATE	DESIGNED BY	DATE	DESIGNED BY	DATE								
DRAWN BY	DATE	DRAWN BY	DATE	DRAWN BY	DATE	DRAWN BY	DATE								
CHECKED BY	DATE	CHECKED BY	DATE	CHECKED BY	DATE	CHECKED BY	DATE								



NO AS-BUILT DATA ON THIS SHEET

SCANNED BY
MESA REPRO

SCANNED BY
MESA REPRO




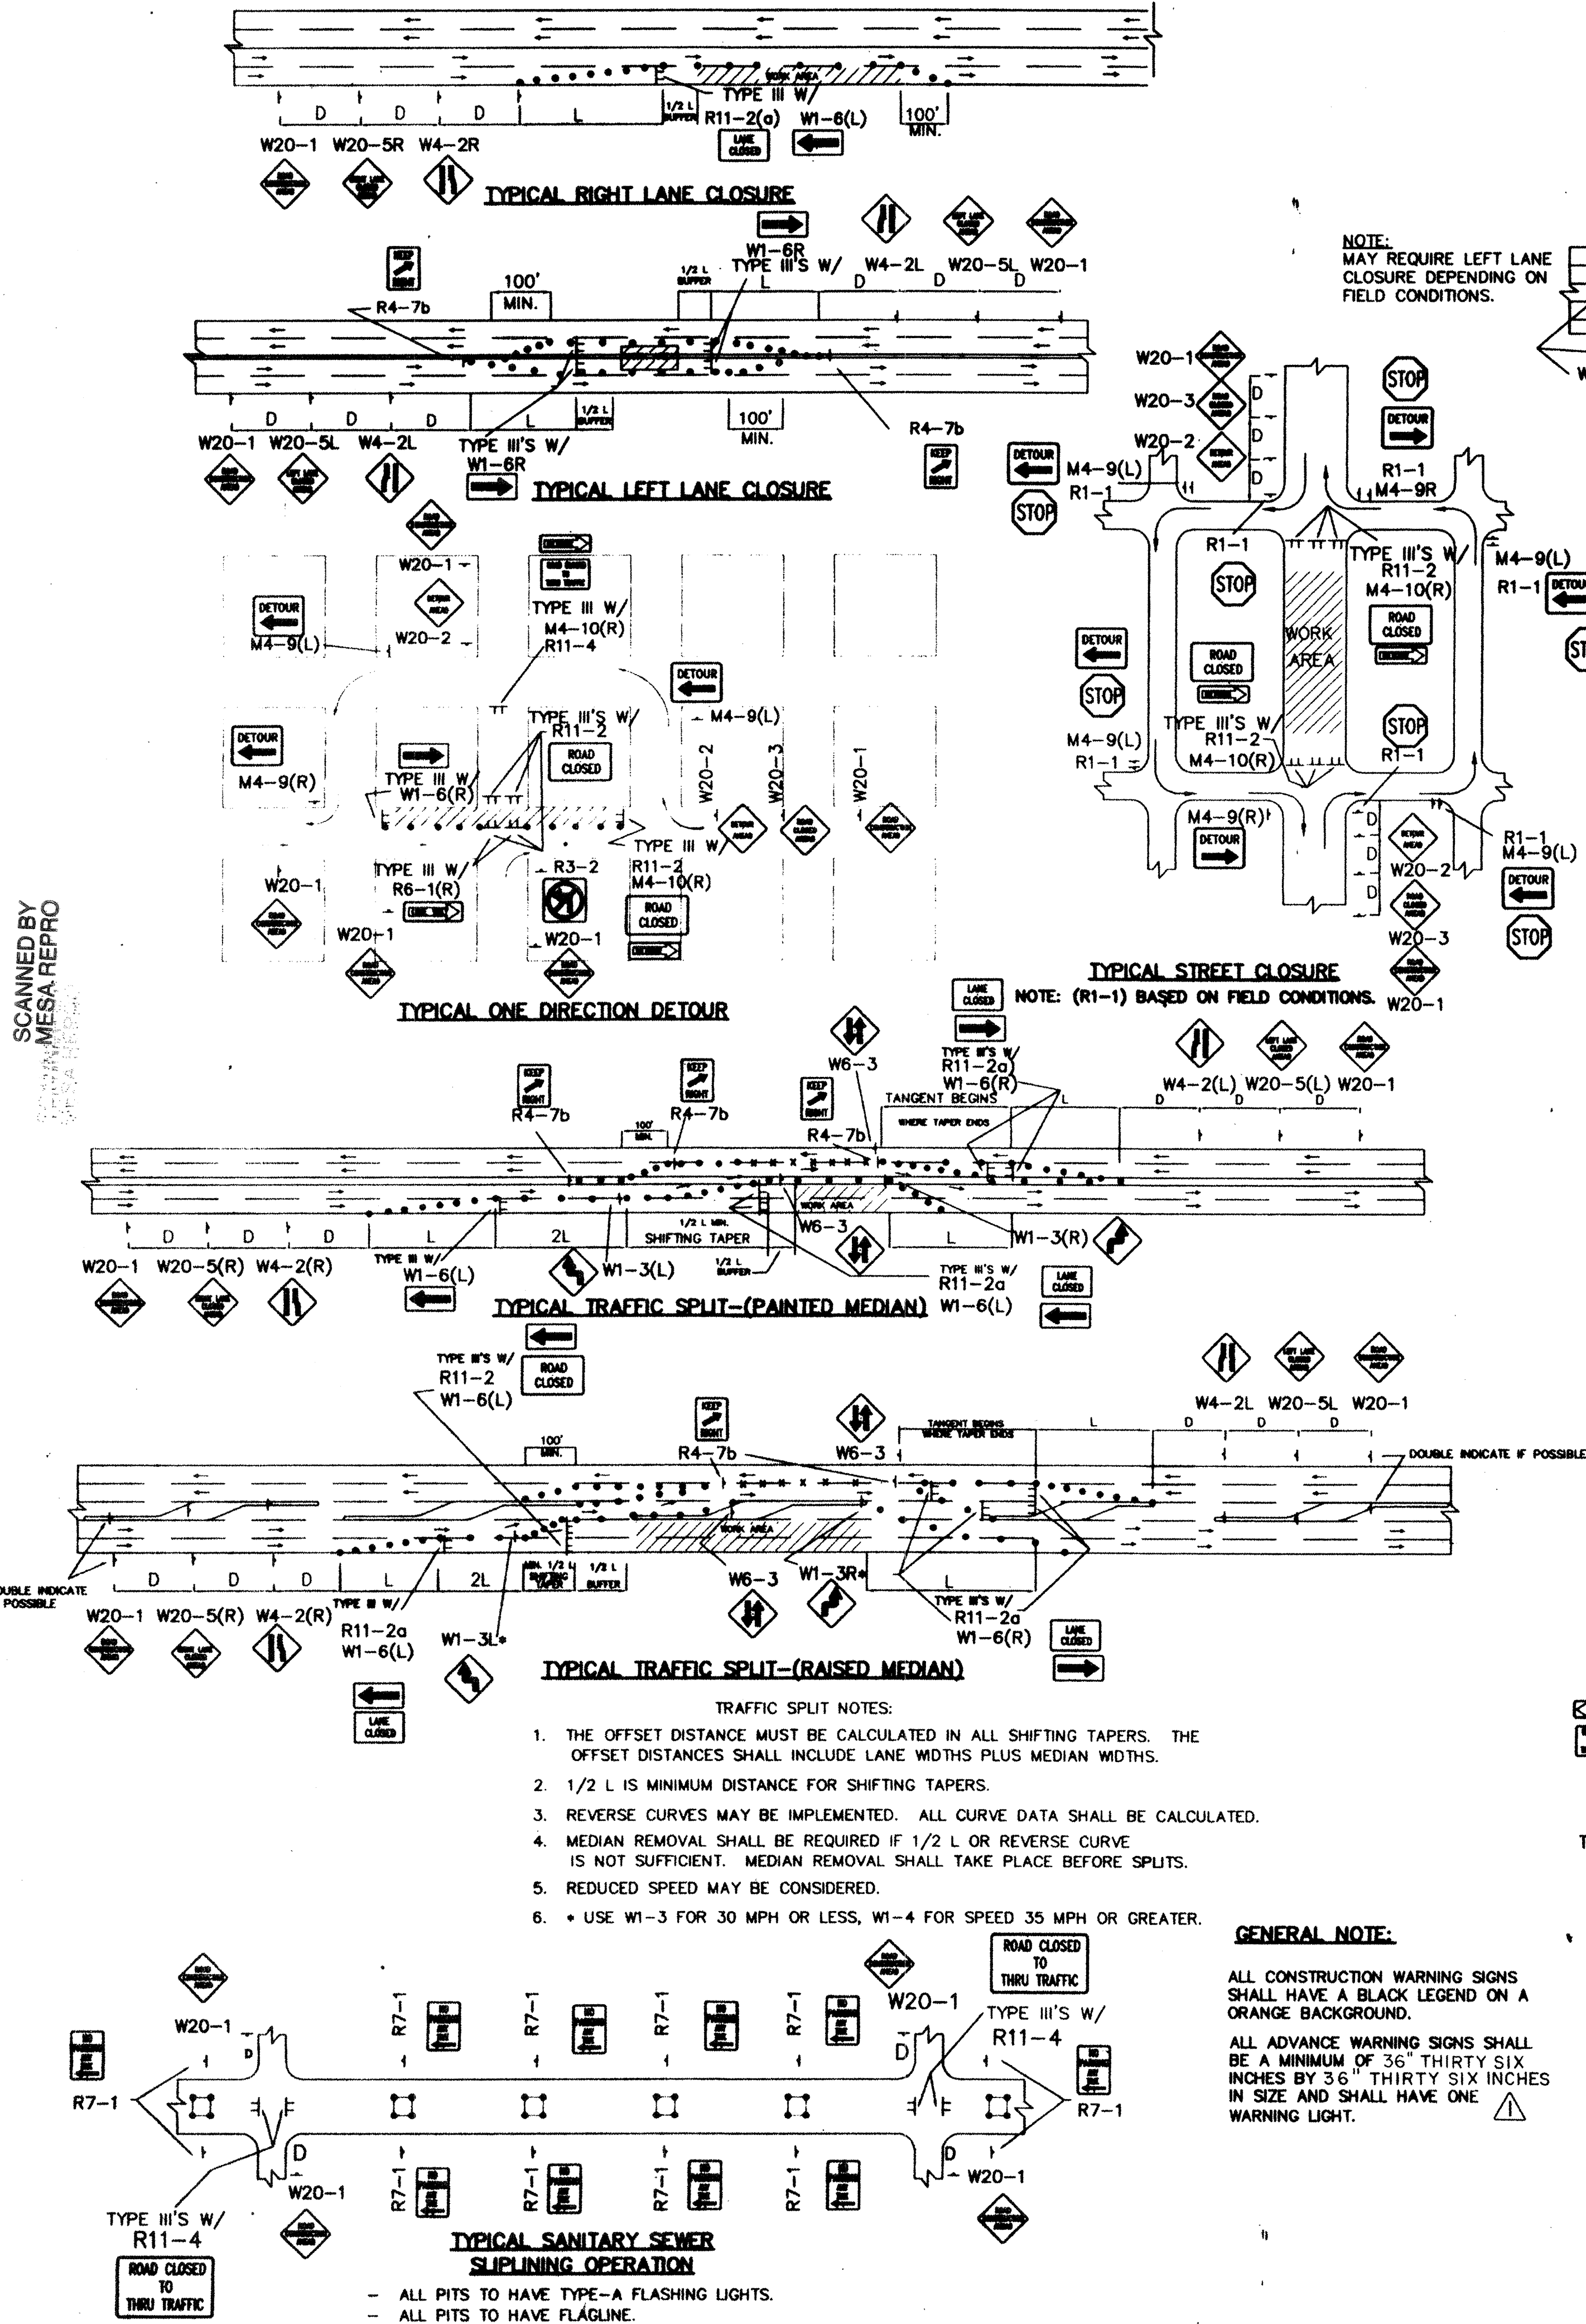


NOTE:
MAY REQUIRE LEFT LANE
CLOSURE DEPENDING ON
FIELD CONDITIONS.

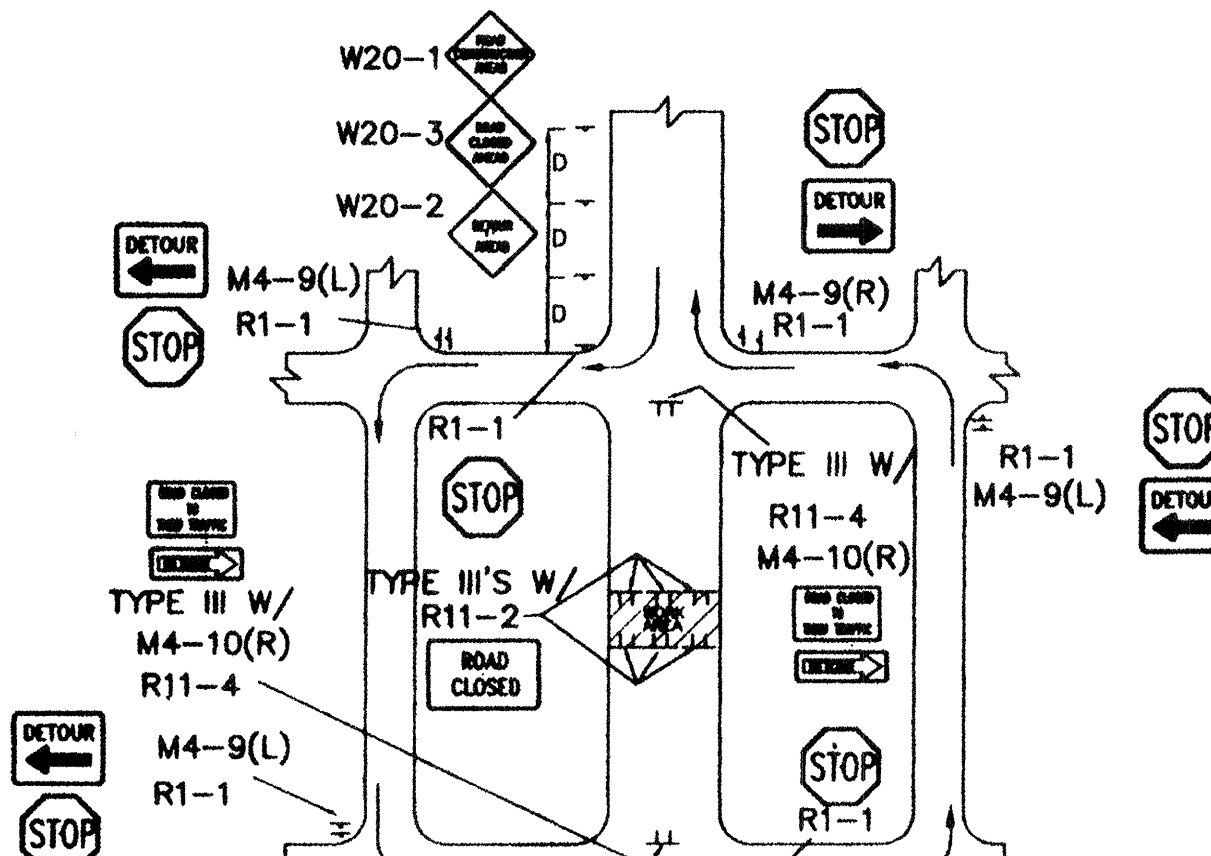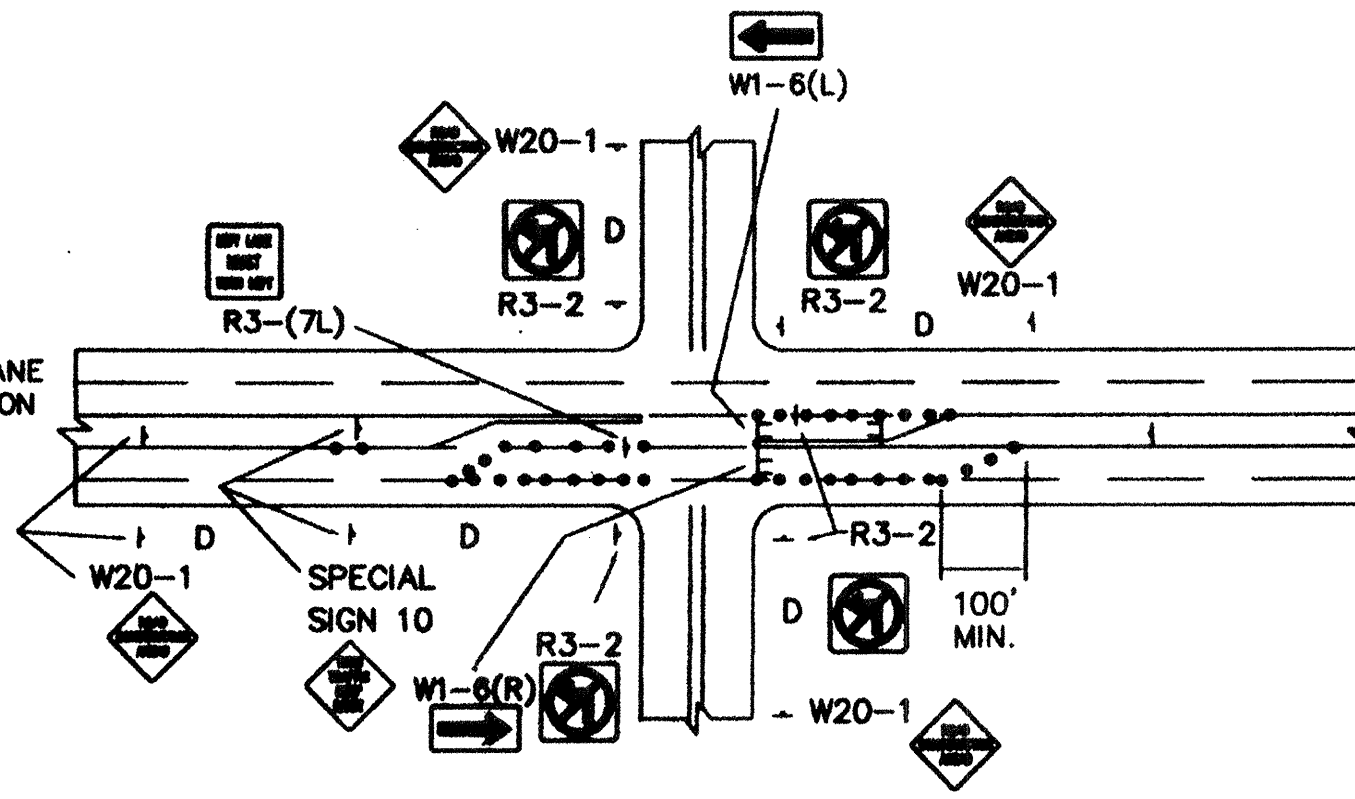

TYPICAL STREET CLOSURE
NOTE: (R1-1) BASED ON FIELD CONDITIONS.
W20-1 W20-3 W20-2 W20-1
M4-9(R) R1-1 M4-9(L) R1-1
TYPE III'S W/
R11-2

TYPICAL STREET CLOSURE
NOTE: (R1-1) BASED ON FIELD CONDITIONS.
W20-1 W20-3 W20-2 W20-1
M4-9(R) R1-1 M4-9(L) R1-1
TYPE III'S W/
R11-2

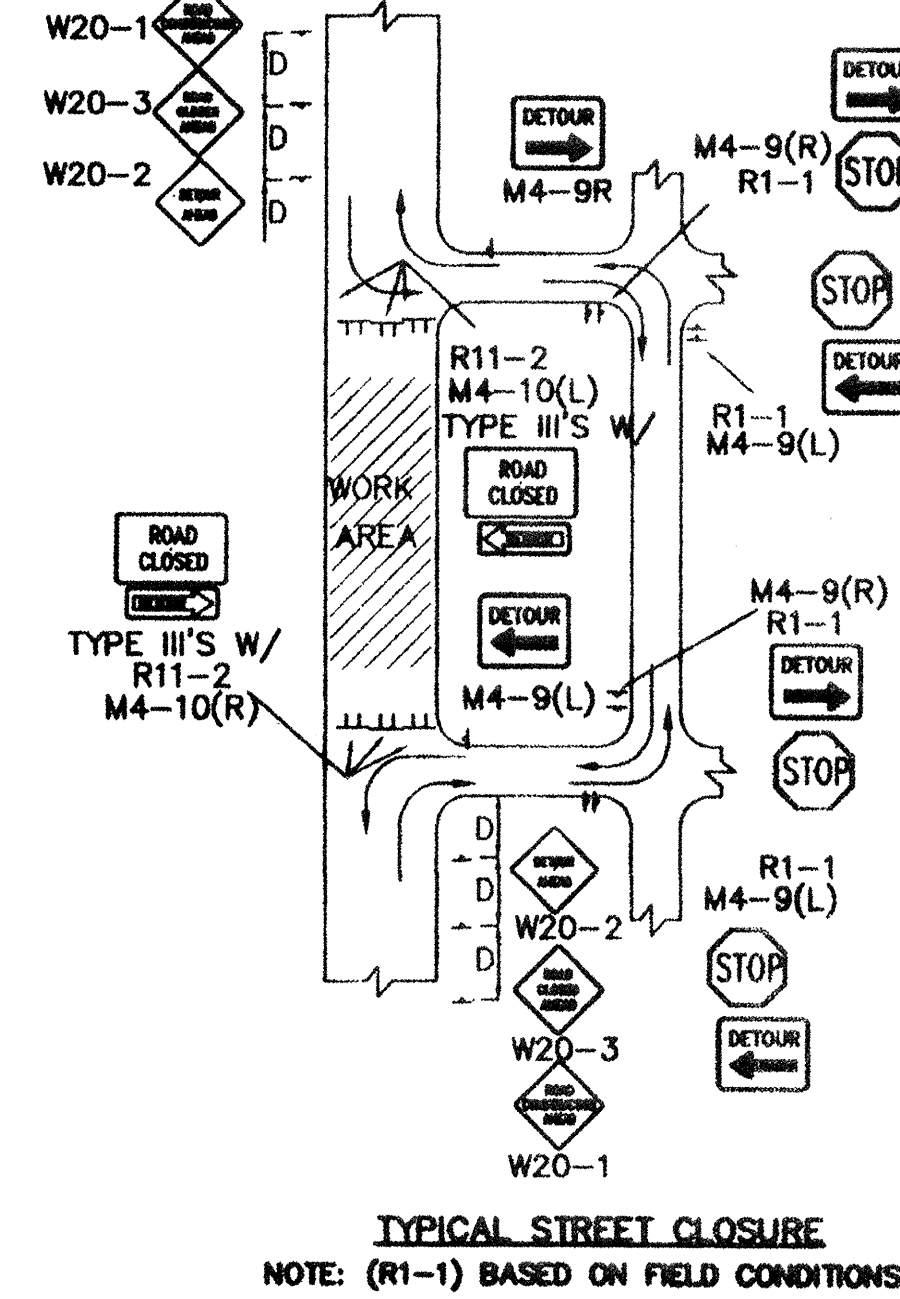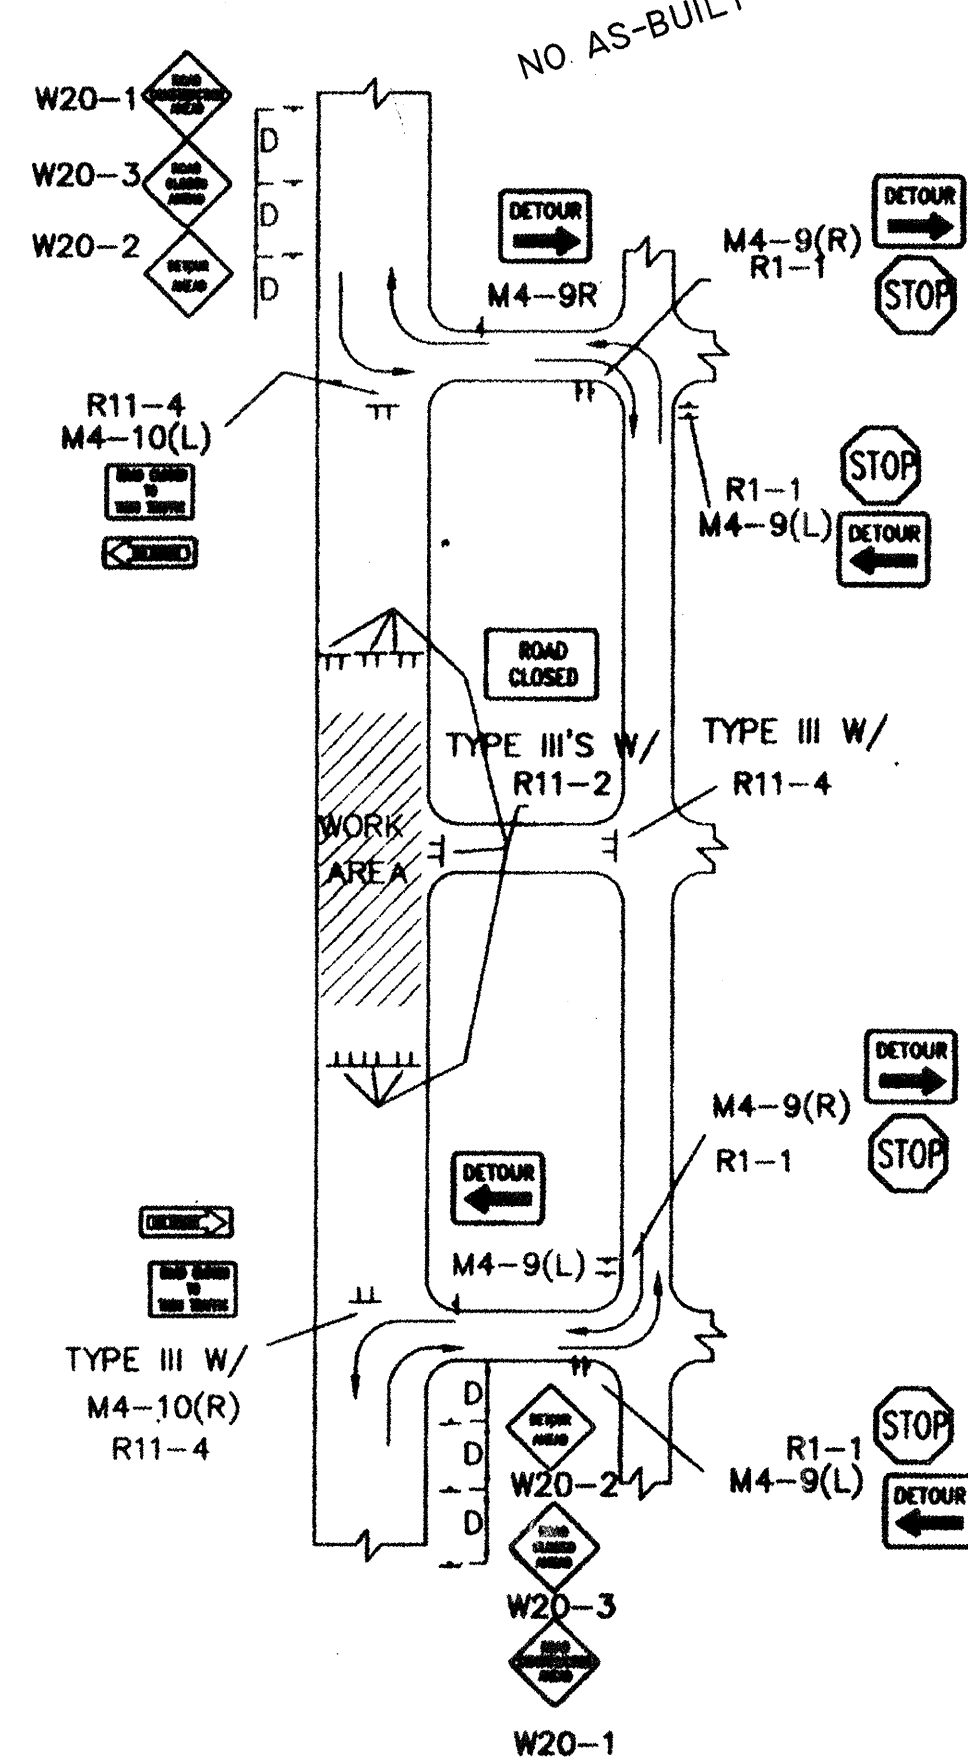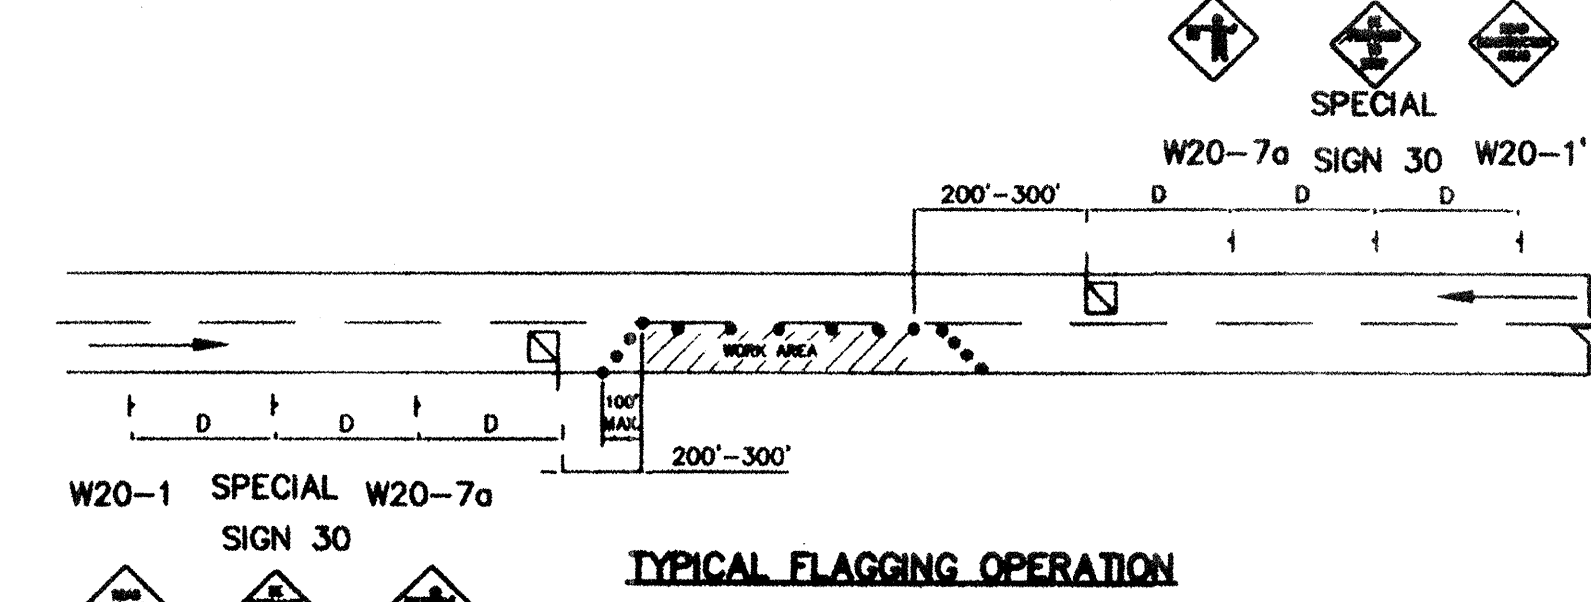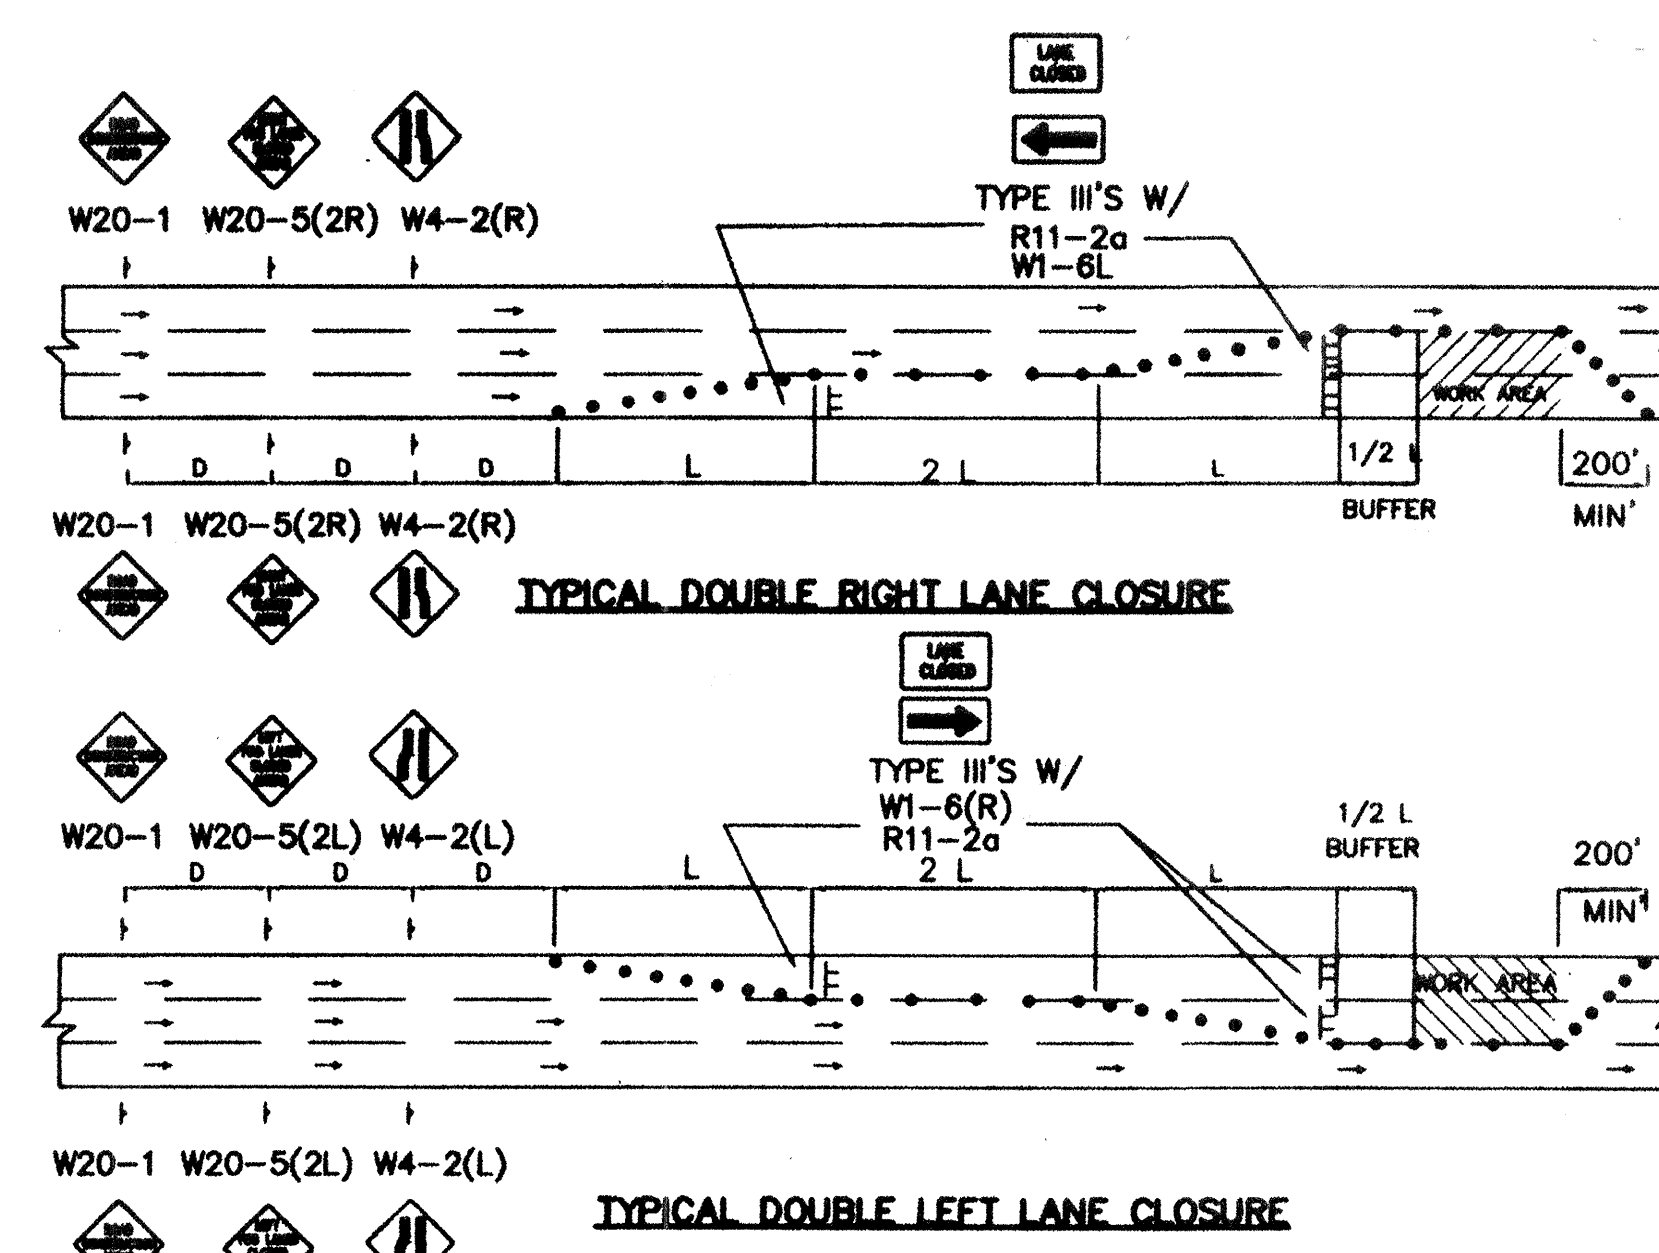

CITY OF ALBUQUERQUE PUBLIC WORKS DEPARTMENT ENGINEERING DEVELOPMENT GROUP			
TITLE: RIDGEVIEW VILLAGE UNIT II TYPICAL TRAFFIC CONTROL & SIGNING EXAMPLES (REF. M.U.T.C.D.)			
DESIGN REVIEW COMMITTEE	CITY ENGINEER APPROVAL	MO. DAY/YR.	MO. DAY/YR.
COA STD		LAST UPDATE	
PROJECT NO. 81.XXXXX	MAP NO. A-11-Z	SHEET 9	OF 24

AS BUILT INFORMATION		BENCH MARKS	
CONTRACTOR	DATE	NO.	DATE
STANDARD	DATE	BY	DATE
FIELD	DATE	NO.	DATE
REVISIONS	DATE	NO.	DATE
CORRECTED BY	DATE	NO.	DATE
RECORDED BY	DATE	NO.	DATE

SURVEY INFORMATION		FIELD NOTES	
NO.	DATE	NO.	DATE
ENGINEER'S SEAL		COA STD	
J.D.L.	BY	J.D.L.	BY
REVISIONS	DATE	REVISIONS	DATE
DESIGN	DATE	DESIGN	DATE
STANDARDS	DATE	STANDARDS	DATE
C.O.A.	DATE	C.O.A.	DATE

CONSTRUCTION TRAFFIC CONTROL GENERAL NOTES

CONTRACTOR MUST OBTAIN FROM CONSTRUCTION COORDINATION AN EXCAVATION/BARRICADING PERMIT BEFORE ENGAGING IN ANY CONSTRUCTION, MAINTENANCE OR REPAIR WORK IN ANY OF THE CITY OF ALBUQUERQUE'S RIGHTS-OF-WAY. EMERGENCY WORK THAT WOULD PRESERVE LIFE OR PROPERTY IS EXCLUDED WITH THE UNDERSTANDING, THAT A PERMIT SHALL BE OBTAINED WITHIN 24 TO 48 HOURS.

2. CONTRACTOR SHALL AT THE TIME OF PERMIT REQUEST, SUBMIT FOR APPROVAL BY CONSTRUCTION COORDINATION, A TRAFFIC CONTROL PLAN DETAILING ALL EXISTING TOPOGRAPHY SUCH AS LANE WIDTHS, DRIVEWAYS, AND BUSINESS/RESIDENTIAL ACCESSES. THE TRAFFIC CONTROL PLAN SHALL INCLUDE ALL PHASES OF WORK AND SCHEDULES INVOLVED IN THE CONSTRUCTION PROJECT. ANY SEPARATE PHASES OF A CONSTRUCTION PROJECT SHALL BE GIVEN AN INDIVIDUAL PERMIT EACH. BLANKET PERMITS WILL NOT BE ISSUED.

3. THESE TYPICAL TRAFFIC CONTROL PLANS DO NOT REFLECT THE EXISTING TOPOGRAPHY SUCH AS DRIVEWAYS, LANE WIDTHS, AND BUSINESS/RESIDENTIAL ACCESSES. EVERY LOCATION THAT REQUIRES CONSTRUCTION TRAFFIC CONTROL SHALL HAVE A DETAILED TRAFFIC CONTROL PLAN SHOWING ALL EXISTING TOPOGRAPHY.

4. CONSTRUCTION SHALL NOT BEGIN UNLESS A TRAFFIC CONTROL PLAN HAS BEEN APPROVED AND VERIFIED BY CONSTRUCTION COORDINATION.

5. CONSTRUCTION COORDINATION SHALL BE NOTIFIED 48 HOURS PRIOR TO ANY TRAFFIC CONTROL CHANGES NEEDED BY CONTRACTOR, THAT WERE NOT PREVIOUSLY APPROVED. THESE TRAFFIC CONTROL CHANGES SHALL BE REQUESTED IN WRITING ACCOMPANIED WITH A TRAFFIC CONTROL PLAN REFLECTING SUCH CHANGES.

6. ALL CONSTRUCTION TRAFFIC CONTROL DEVICES SHALL COMPLY TO THE MANUAL ON UNIFORM TRAFFIC CONTROL DEVICES (MUTCD), LATEST EDITION. IT IS THE RESPONSIBILITY OF THE CONTRACTOR TO INSTALL, SERVICE AND MAINTAIN ALL TRAFFIC CONTROL DEVICES. TRAFFIC CONTROL DEVICES SHALL NOT BE REMOVED OR ALTERED IN ANY WAY WITHOUT THE APPROVAL OF CONSTRUCTION COORDINATION, PER SECTION 6A-4 OF THE MUTCD, LATEST EDITION.

7. THE CONSTRUCTION TRAFFIC CONTROL INITIAL SET-UP SHALL BE BY AN AMERICAN TRAFFIC SAFETY SERVICES ASSOCIATION (ATSSA) CERTIFIED WORKSITE TRAFFIC SUPERVISOR. THE MAINTENANCE AND SERVICING SHALL ALSO BE DONE BY AN ATSSA CERTIFIED WORKSITE TRAFFIC SUPERVISOR OR EQUIVALENT.

8. CONTRACTOR IS RESPONSIBLE TO MAINTAIN AND SERVICE ALL TRAFFIC CONTROL DEVICES 24 HOURS A DAY, 7 DAYS A WEEK THROUGHOUT LENGTH OF PROJECT. CONTRACTOR IS RESPONSIBLE THAT ALL TRAFFIC CONTROL DEVICES COMPLY WITH THE MUTCD, LATEST EDITION.

9. ALL ADVANCE WARNING SIGNS SHALL BE DOUBLE INDICATED WHENEVER THERE ARE MULTI-LANE TRAFFIC IN ANY ONE GIVEN DIRECTION AND THERE IS SUFFICIENT MEDIAN SPACE.

10. ALL BARRICADES IN ALL TAPERS AND TANGENTS SHALL BE PLACED APART, A DISTANCE MEASURED IN FEET, EQUAL TO THAT OF THE POSTED SPEED LIMIT. NO EXCEPTIONS UNLESS APPROVED BY CONSTRUCTION COORDINATION PER MUTCD SECTION 6A-4.

11. ALL WORK IN ARTERIAL ROADWAYS SHALL BE ON A CONTINUOUS 24 HOUR PER DAY BASIS UNTIL COMPLETED.

12. CONTRACTOR IS RESPONSIBLE TO PROVIDE CONSTRUCTION COORDINATION, A WEEKLY LOG OF DAILY INSPECTIONS OF BARRICADE AND MAINTENANCE SCHEDULES ON PROJECTS THAT ARE OVER ONE WEEK DURATION.

13. EQUIPMENT OR MATERIALS SHALL NOT BE STORED WITHIN 15 FEET OF A TRAVELLED TRAFFIC LANE DURING NON-WORKING HOURS WITHOUT THE APPROVAL OF CONSTRUCTION COORDINATION.

14. CONTRACTOR SHALL PROVIDE AND MAINTAIN A SAFE AND ADEQUATE MEANS OF CHANNELIZING PEDESTRIAN TRAFFIC AROUND AND THROUGH THE CONSTRUCTION AREA.

15. CONTRACTOR IS RESPONSIBLE FOR OBLITERATION OF ANY CONFLICTING STRIPING AND RESPONSIBLE FOR ALL TEMPORARY STRIPING.

16. CONTRACTOR SHALL MAINTAIN ACCESS TO ALL FACILITIES, BUSINESSES AND/OR RESIDENTS AT ALL TIMES.

17. CONTRACTOR SHALL PROVIDE ACCESS SIGNS FOR BUSINESSES LOCATED WITHIN THE CONSTRUCTION AREA UNDER THE SUPERVISION OF CONSTRUCTION COORDINATION. EACH ACCESS SIGN SHALL HAVE 5 INCH, WHITE OPAQUE LETTERING ON BLUE REFLECTORIZED BACKGROUND. ACCESS SIGNS SHALL BE CONSIDERED INCIDENTAL TO THE BID AND NOT PART OF THE CONTRACT UNLESS OTHERWISE STATED. NO MORE THAN 3 BUSINESSES SHALL BE LISTED ON A ACCESS SIGN. SHOPPING CENTERS AND MALLS SHALL BE LISTED AS SUCH.

18. ALL ADVANCE WARNING SIGNS SHALL MEET THE MINIMUM REFLECTIVE INTENSITY REQUIREMENTS SET FORTH BY THE CITY OF ALBUQUERQUE. CONSTRUCTION COORDINATION SHALL DETERMINE ALL REQUIREMENTS AND APPROVE OR DISAPPROVE ANY ADVANCE WARNING SIGN PER SECTION 6A-4 OF THE MUTCD, LATEST EDITION.

19. 48 HOURS PRIOR TO OCCUPYING OR CLOSING OF A RIGHT-OF-WAY, CONTRACTOR SHALL NOTIFY: POLICE, FIRE DEPARTMENT, SCHOOLS, HOSPITALS, TRANSIT AUTHORITY, BUSINESSES AND/OR RESIDENTS THAT WILL BE AFFECTED BY THE CONSTRUCTION.

20. ANY FIELD ADJUSTMENTS SHALL BE APPROVED BY CONSTRUCTION COORDINATION.

21. EXCAVATIONS SHALL BE PLATED, TEMPORARILY PATCHED OR RESURFACED PRIOR TO OPENING OF TRAFFIC. A MINIMUM OF 11 FEET SHALL BE PROVIDED FOR TRAFFIC IN ANY GIVEN DIRECTION. CONTRACTOR IS RESPONSIBLE FOR ANY WORK INVOLVED IN SATISFYING THESE REQUIREMENTS.

22. CONTRACTOR SHALL AT ALL TIMES COMPLY WITH THE FOLLOWING:

1. STANDARDS AND REQUIREMENTS SET FORTH IN THE MANUAL ON UNIFORM TRAFFIC CONTROL DEVICES, LATEST EDITION.
2. THE CITY OF ALBUQUERQUE TRAFFIC CODE, LATEST EDITION.
3. SECTION 19 OF THE CITY OF ALBUQUERQUE'S STANDARD SPECIFICATIONS FOR PUBLIC WORK CONSTRUCTION, AS WELL AS OTHER SECTIONS.


23. FAILURE TO COMPLY WITH ANY OF THE ABOVE MENTIONED, WILL BE ADEQUATE CAUSE TO CEASE ALL WORK ON ANY CONSTRUCTION PROJECT. WORK WILL NOT RESUME UNTIL ALL REQUIREMENTS ARE ADDRESSED AND APPROVED BY CONSTRUCTION COORDINATION.

24. ALL TRAFFIC CONTROL DEVICES SHALL BE KEPT IN NEW-CLEAN CONDITION. WASHING OF EQUIPMENT IS INCIDENTAL TO ITS PLACEMENT AND MAINTENANCE.


25. TRAFFIC CONTROL STANDARDS APPLY ONLY WHERE THE CONSTRUCTION TRAFFIC CONTROL PLANS ARE NOT SPECIFIC.

26. ADVANCE WARNING SIGNS SHALL BE 36"x36" MIN. WITH SUPER ENGINEERING GRADE SHEETING OR BETTER. MOUNTING HEIGHT AT TOP OF SIGN SHALL BE THE SAME AS FOR A 48" SIGN AS INDICATED IN THE M.U.T.C.D.

27. CONTRACTOR SHALL MAINTAIN A GRAFFITI-FREE WORKSITE. ALL GRAFFITI SHALL BE PROMPTLY REMOVED FROM ALL EQUIPMENT, BOTH PERMANENT AND TEMPORARY.

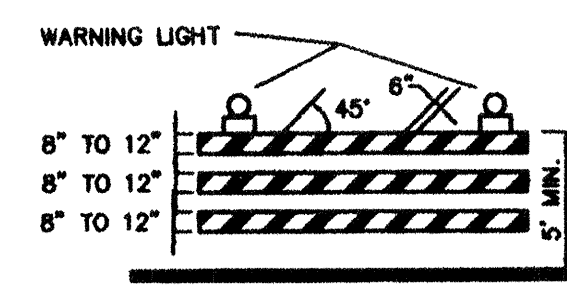


TYPE II BARRICADE

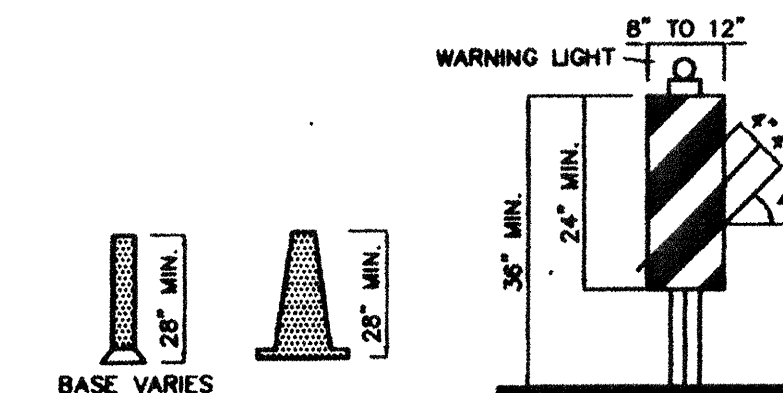


CONES

VERTICAL PANEL


HIGH LEVEL WARNING DEVICE

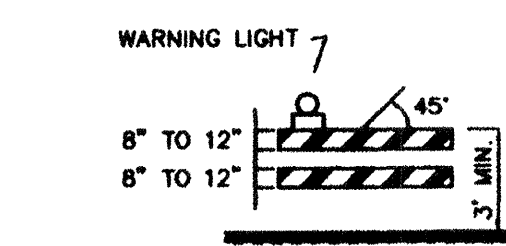


TYPE II BARRICADE

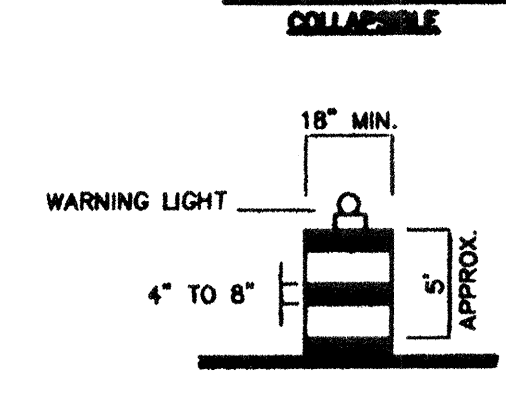

BARREL

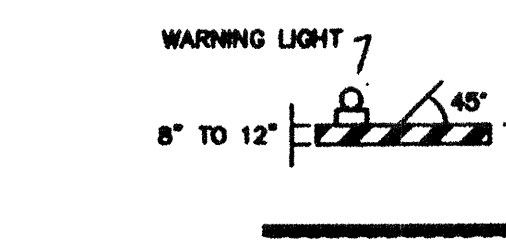

TYPE I BARRICADE

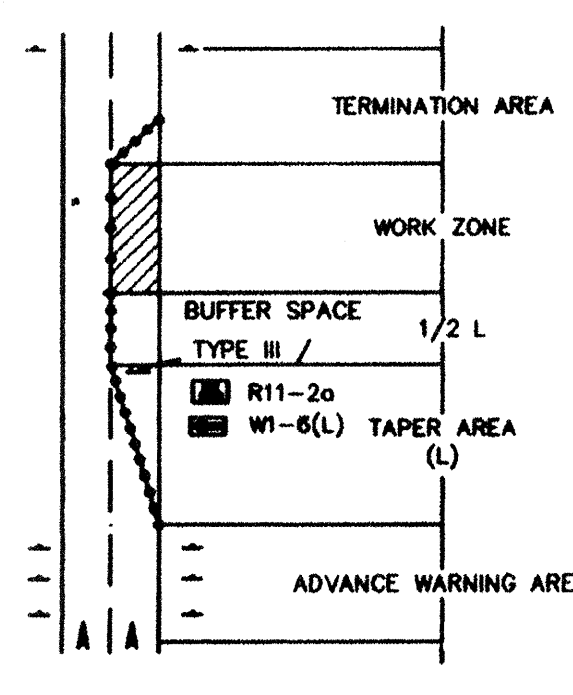

TRAFFIC CONTROL ELEMENTS

LEGEND

WORK AREA

BARRICADE - TYPE I, TYPE II, OR BARREL

BARRICADE - TYPE III

VERTICAL PANEL

WARNING SIGN

DISTANCE BETWEEN SIGNS - A DISTANCE MEASURED IN FEET EQUAL TO A VALUE OF TEN TIMES THE SPEED LIMIT OF THE STREET

FLAGMAN POSITION

SPACING BETWEEN BARRICADES - A DISTANCE MEASURED IN FEET EQUAL TO THE SPEED LIMIT OF THE STREET

L TAPER LENGTH - SEE CHART BELOW

THE TANGENT LENGTH IS EQUAL TO THE TAPER LENGTH FOR A GIVEN STREET.

TAPER REQUIREMENTS

SPEED LIMIT (MPH)	TAPER LENGTH (L) (FEET)			MINIMUM NUMBER OF DEVICES FOR TAPER	MAXIMUM DEVICE SPACING IN FEET	
	10' LANE	11' LANE	12' LANE		ALONG TAPER	AFTER TAPER
20	70	75	80	5	20	20
25	105	115	125	6	25	25
30	150	165	180	7	30	30
35	205	225	245	8	35	35
40	270	295	320	9	40	40
45	450	495	540	13	45	45
50	500	550	600	13	50	50
55	550	605	660	13	55	55

RECOMMENDED SIGN SPACING(D) FOR ADVANCE WARNING SIGN SERIES

SPEED LIMIT (MPH)	MINIMUM DISTANCE IN FEET	
	BETWEEN SIGNS	FROM LAST SIGN TO TAPER
0-20	10 X SPEED LIMIT	10 X SPEED LIMIT
25-30	10 X SPEED LIMIT	10 X SPEED LIMIT
30-35	10 X SPEED LIMIT	10 X SPEED LIMIT
40-45	10 X SPEED LIMIT	10 X SPEED LIMIT
50-60	10 X SPEED LIMIT	10 X SPEED LIMIT

TAPER CRITERIA

TYPE OF TAPER	TAPER LENGTH
UPSTREAM TAPER:	
MERGING TAPER	L MINIMUM
SHIFTING TAPER	1/2 L MINIMUM
SHOULDER TAPER	1/2 L MINIMUM
TWO-WAY TRAFFIC TAPER	100 FEET MAXIMUM
DOWNSTREAM TAPERS	100 FEET PER LANE

TAPER LENGTH COMPUTATION

SPEED LIMIT

40 MPH OR LESS

45 MPH OR GREATER

L = TAPER LENGTH

W = WIDTH OF OFFSET IN FEET


S = POSTED SPEED OR OFF-PEAK

85-PERCENTILE SPEED IN MPH

L = WS² / 60

L = W x S


SIGN FACE DETAILS

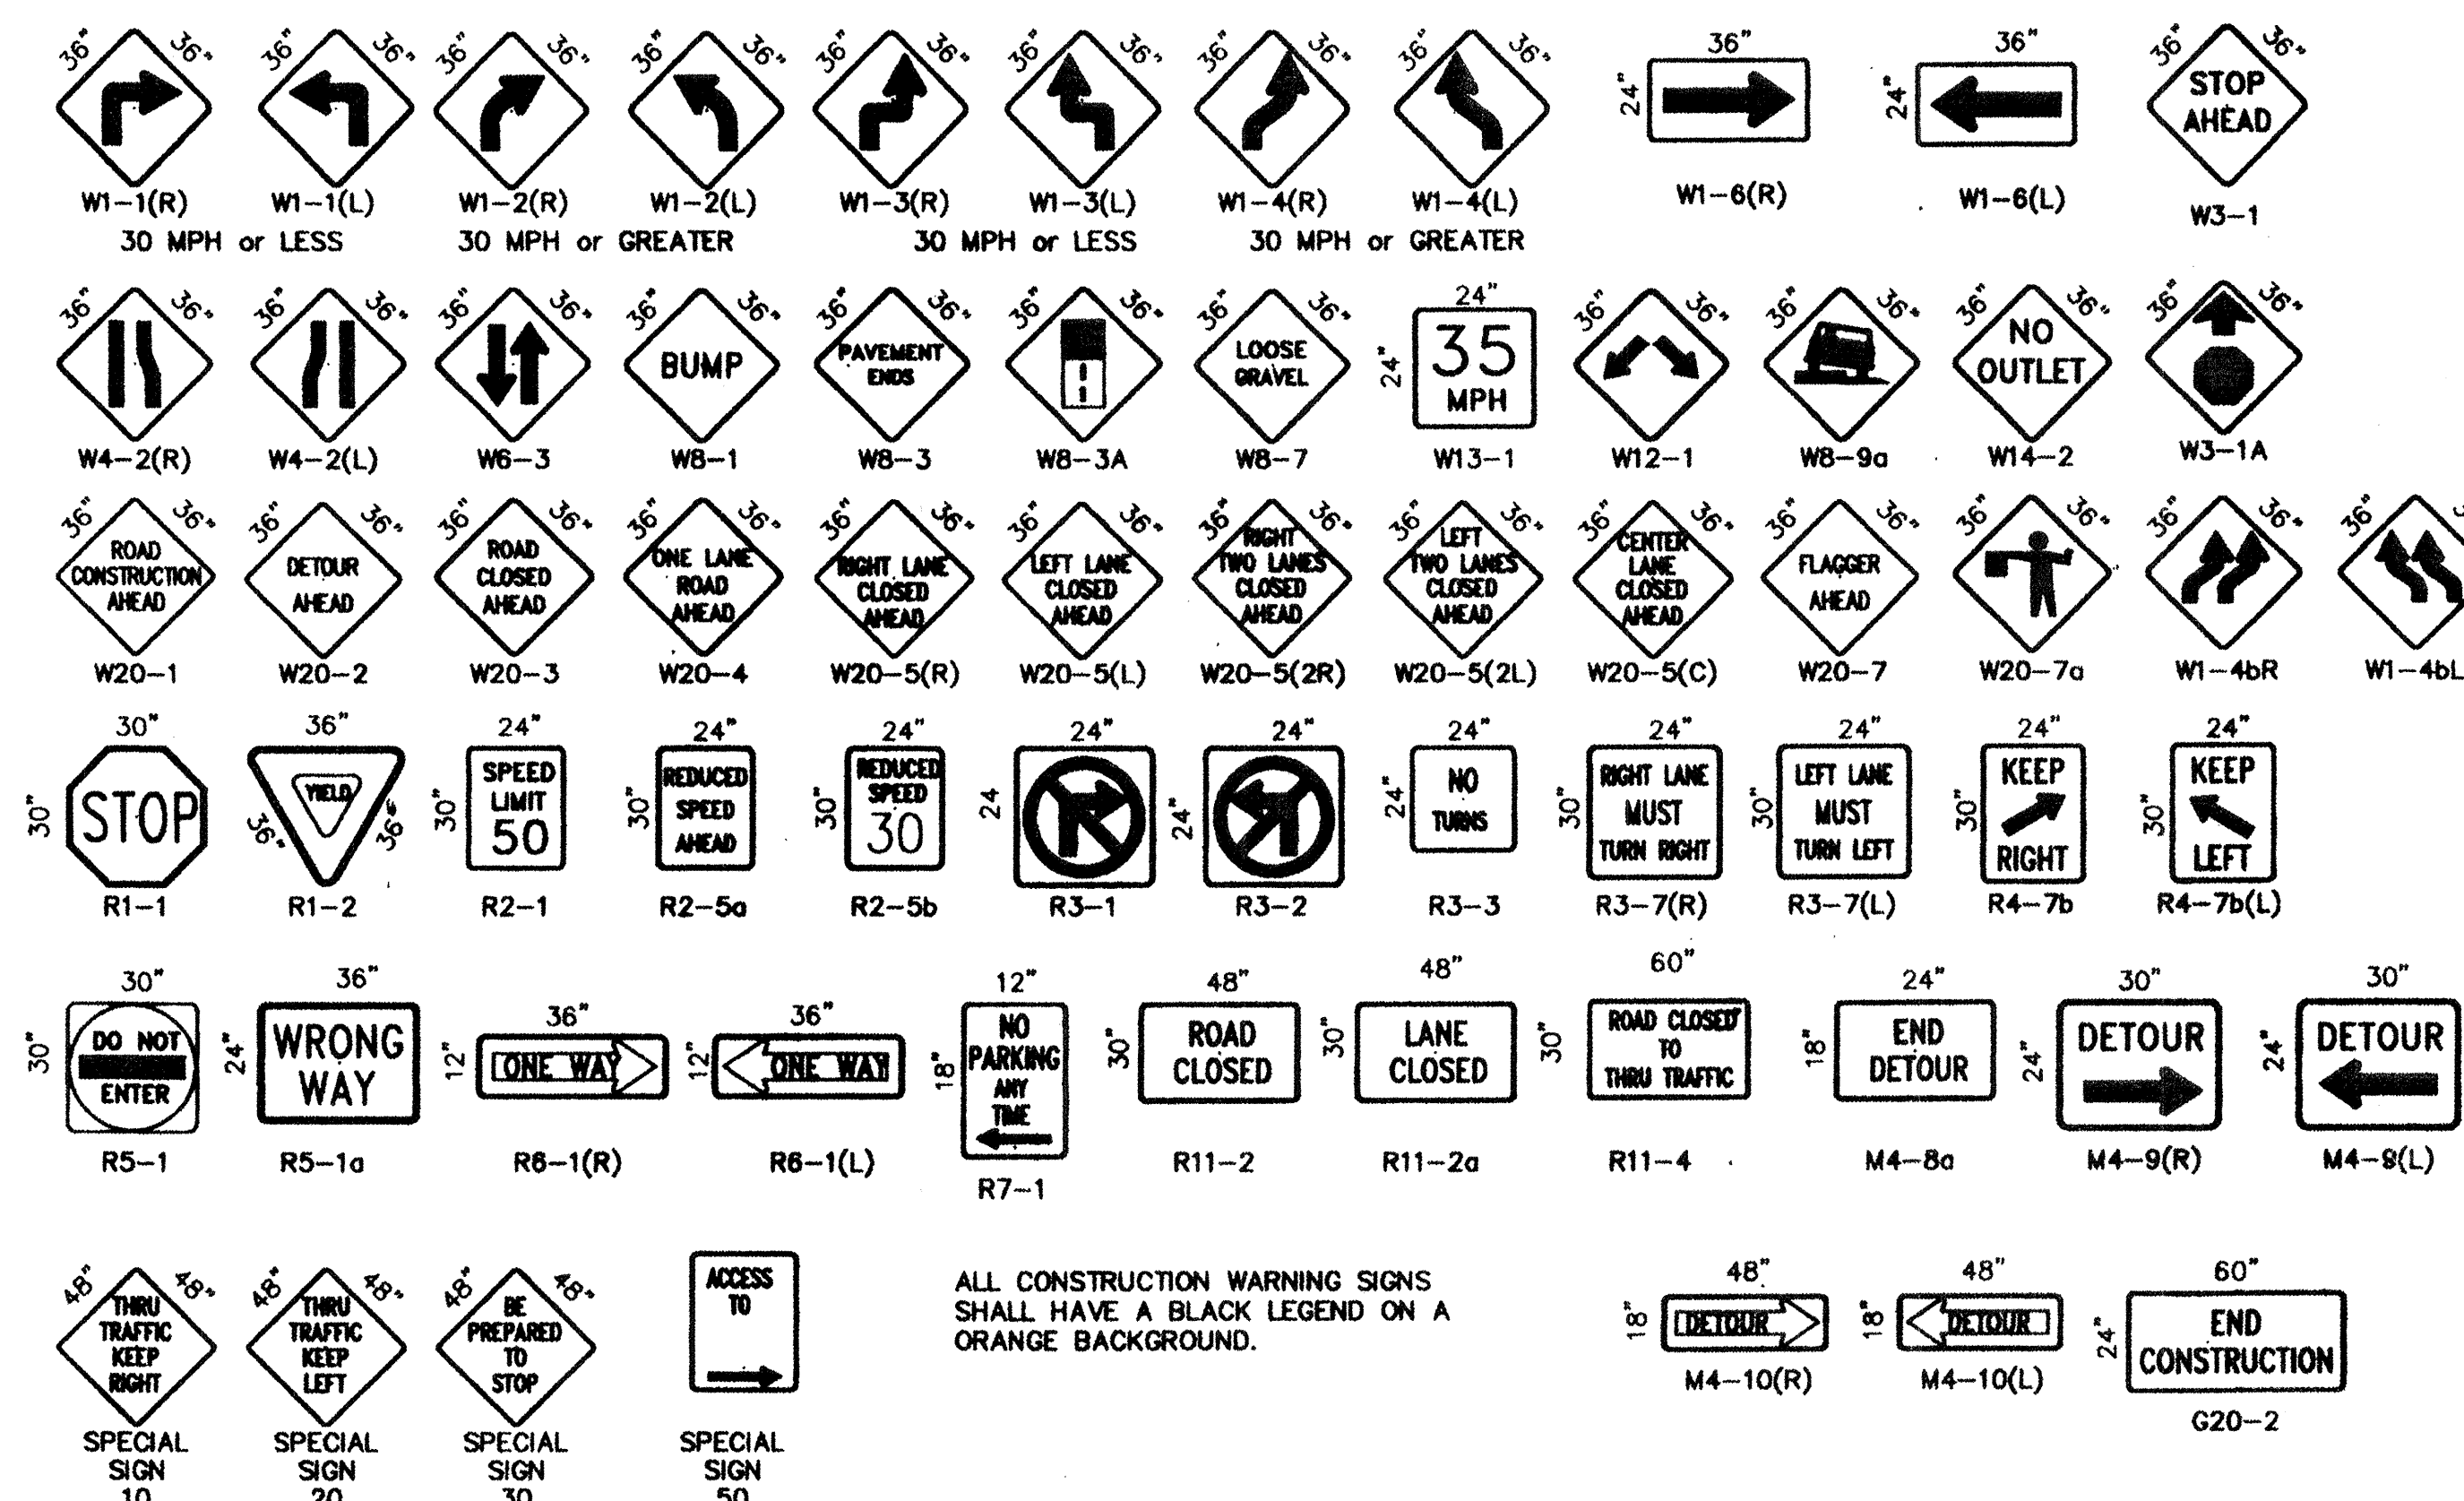

ALL CONSTRUCTION WARNING SIGNS SHALL HAVE A BLACK LEGEND ON A ORANGE BACKGROUND.


NO AS-BUILT DATA ON THIS SHEET

AS BUILT INFORMATION		BENCH MARKS		SURVEY INFORMATION		ENGINEER'S SEAL		COA STD	
CONTRACTOR	NEW CONCEPTS	DATE	DATE	NO.	BY	DATE	DATE	DATE	DATE
DESIGNED BY	DATE	DATE	DATE	DATE	DATE	DATE	DATE	DATE	DATE
CHECKED BY	DATE	DATE	DATE	DATE	DATE	DATE	DATE	DATE	DATE
APPROVED BY	DATE	DATE	DATE	DATE	DATE	DATE	DATE	DATE	DATE
REVISIONS									
NO.	DATE	DATE	DATE	DATE	DATE	DATE	DATE	DATE	DATE
CITY OF ALBUQUERQUE PUBLIC WORKS DEPARTMENT ENGINEERING DEVELOPMENT GROUP									
TITLE: RIDGEVIEW VILLAGE UNIT II									
SIGNING AND CONSTRUCTION TRAFFIC CONTROL STANDARDS									
DESIGN REVIEW COMMITTEE		CITY ENGINEER APPROVAL		LAST UPDATE		MO/DA/YR		MO/DA/YR	
COA		STD							
PROJECT NO. 81.XXXXX		MAP NO. A-11-Z		SHEET 10		OF 24			

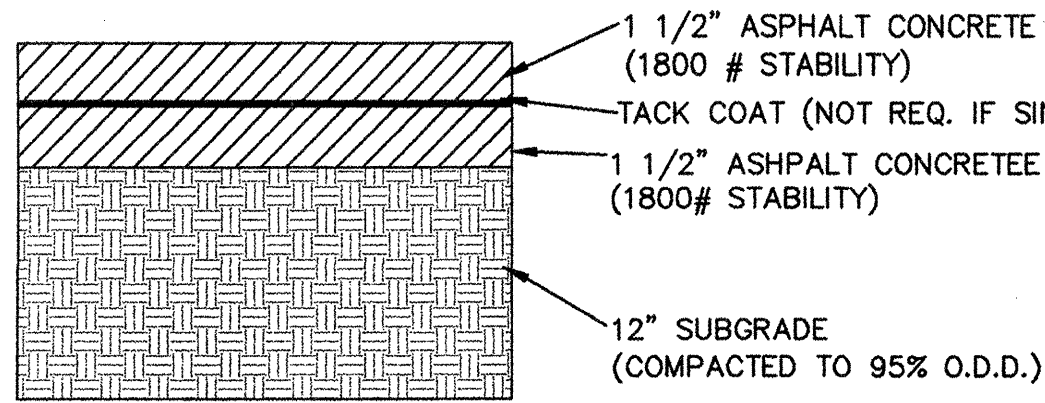


TYPICAL ROAD WAY PAVEMENT SECTION

NOT TO SCALE

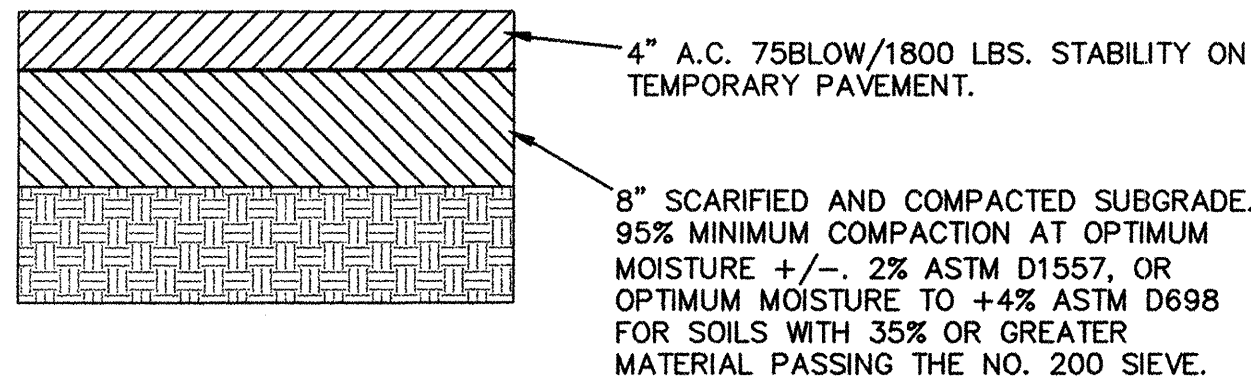


TEMPORARY PAVING SECTION

NOT TO SCALE

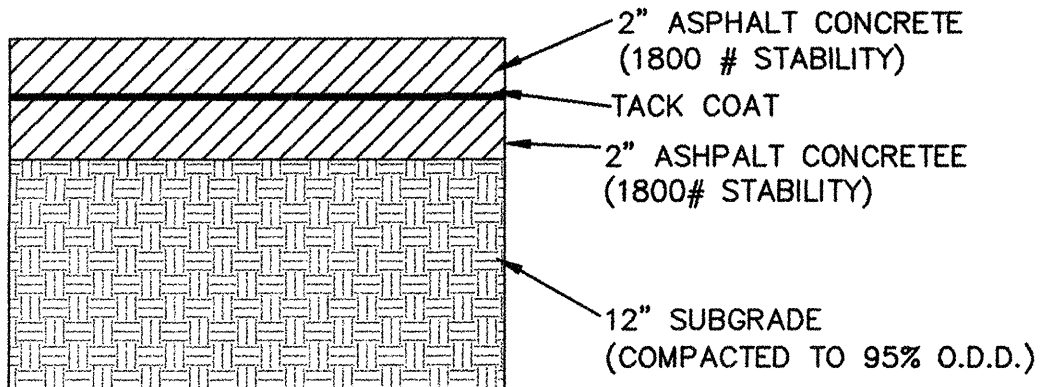


BANDELIER PAVEMENT SECTION

NOT TO SCALE

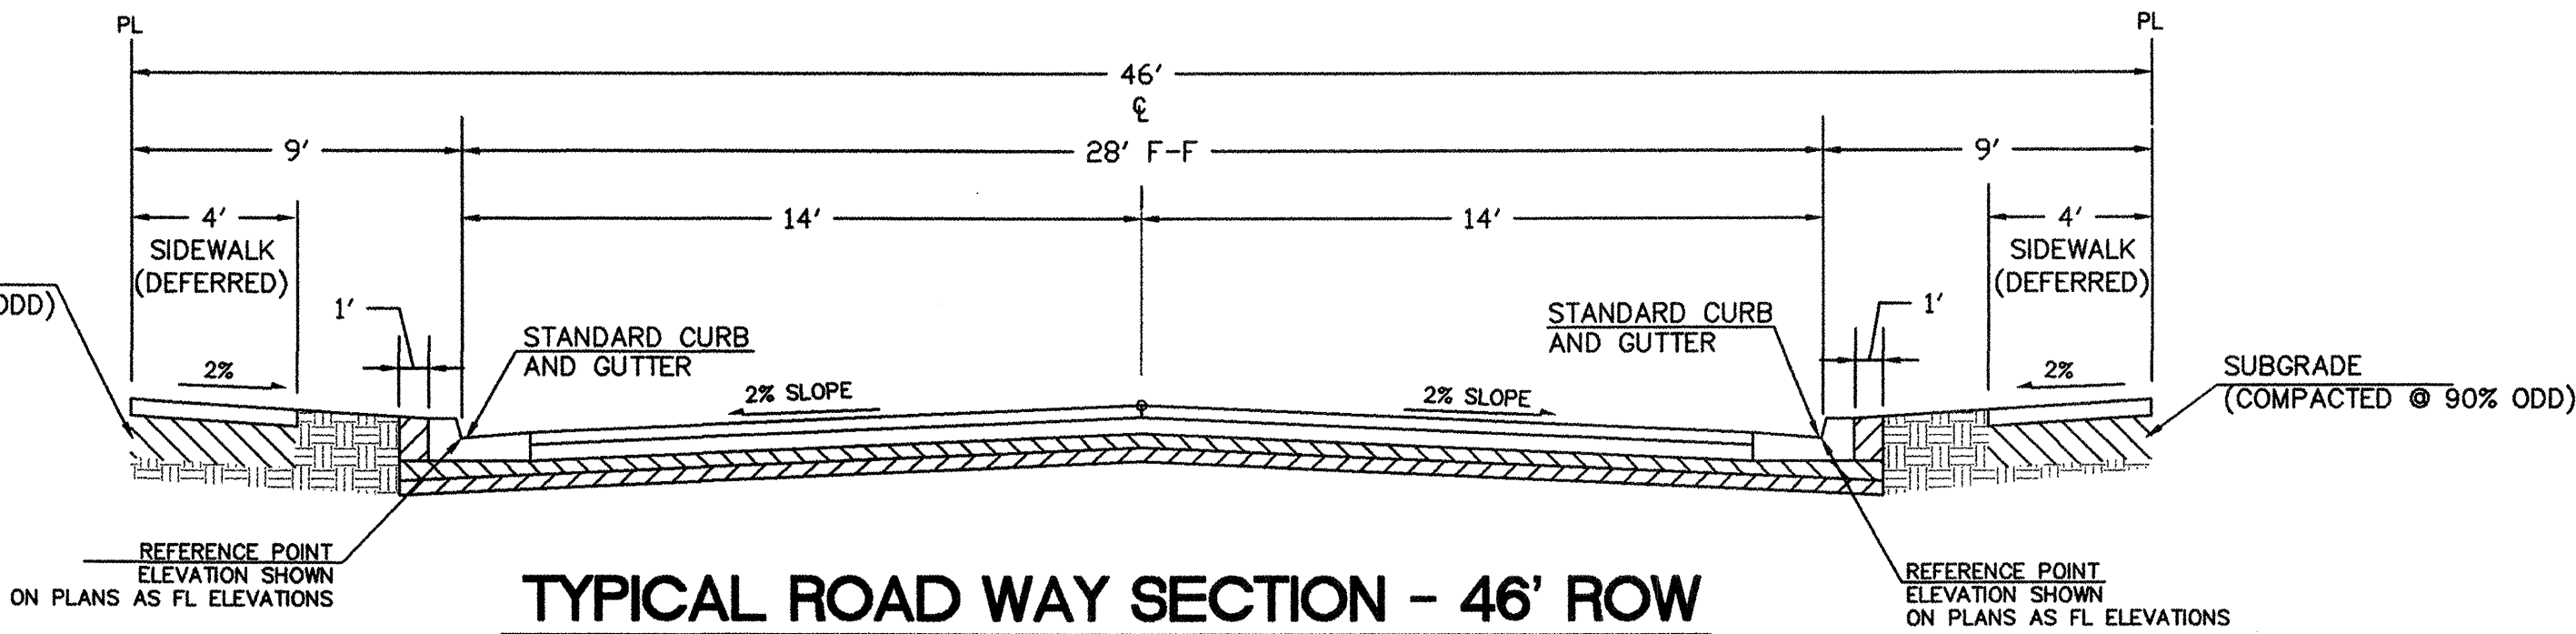


TYPICAL ROAD WAY SECTION - 46' ROW

NOT TO SCALE

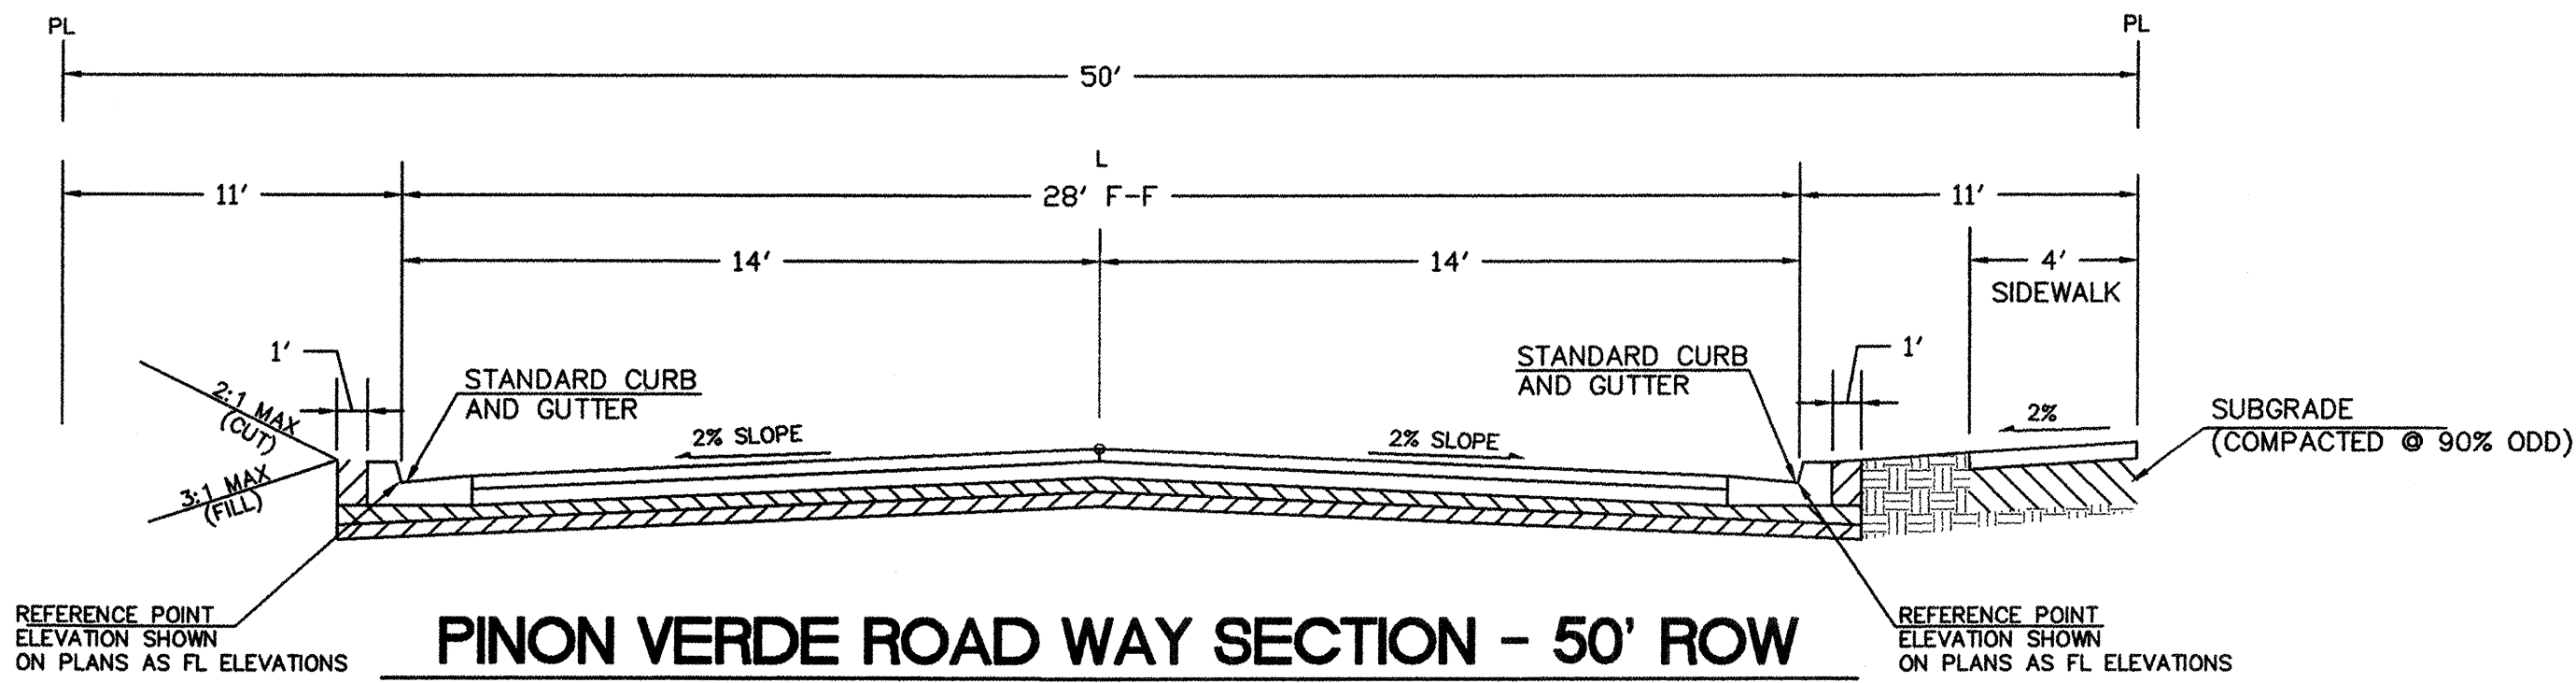


PINON VERDE ROAD WAY SECTION - 50' ROW

NOT TO SCALE

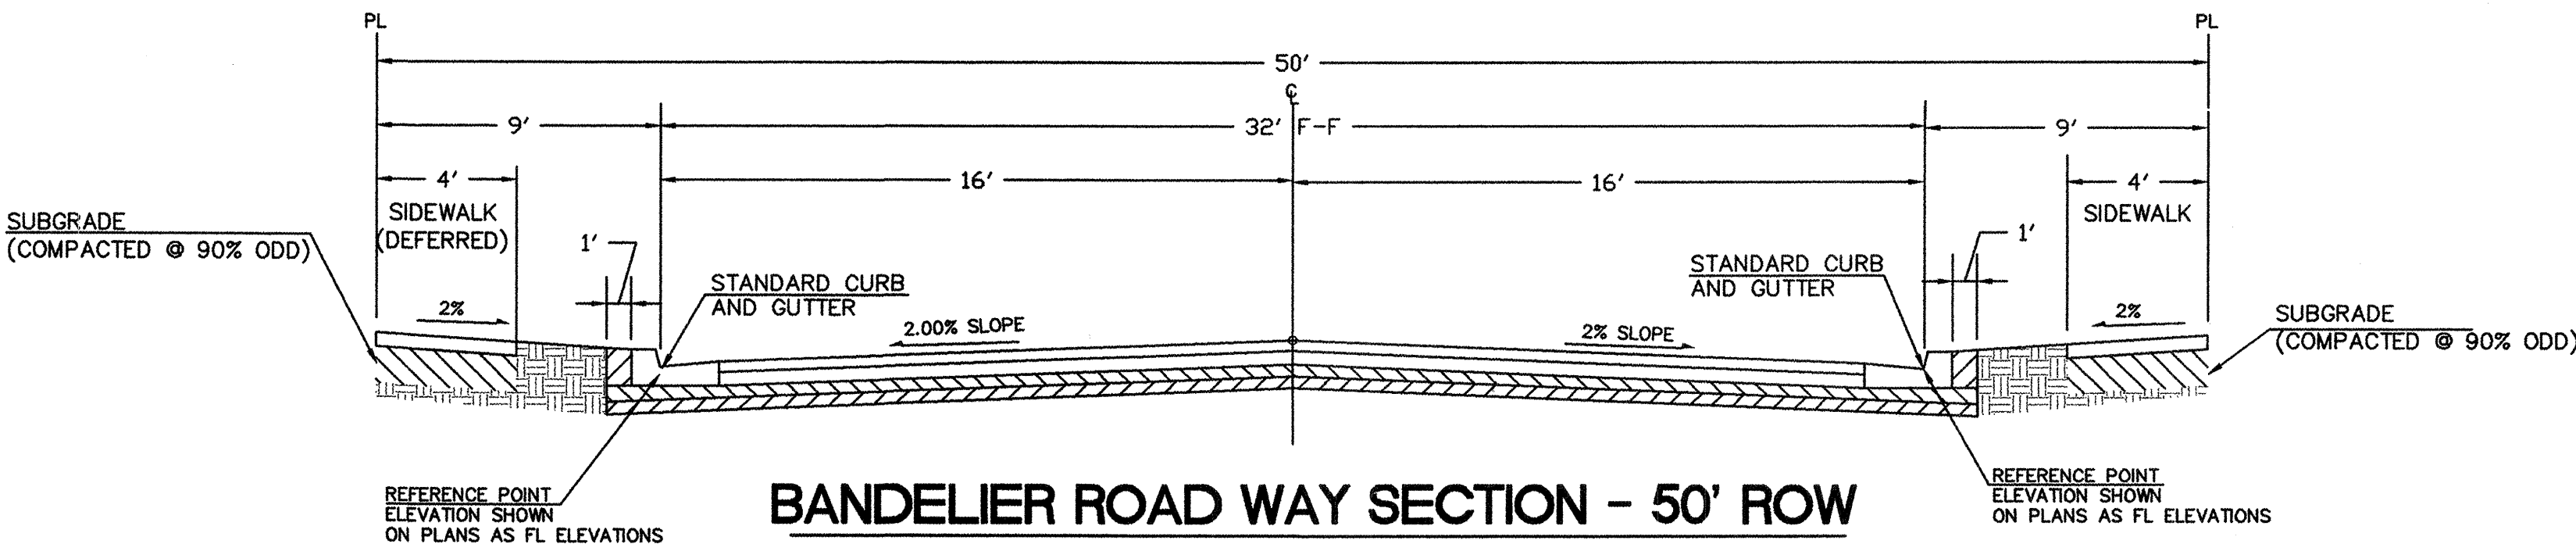

BANDELIER ROAD WAY SECTION - 50' ROW

NOT TO SCALE

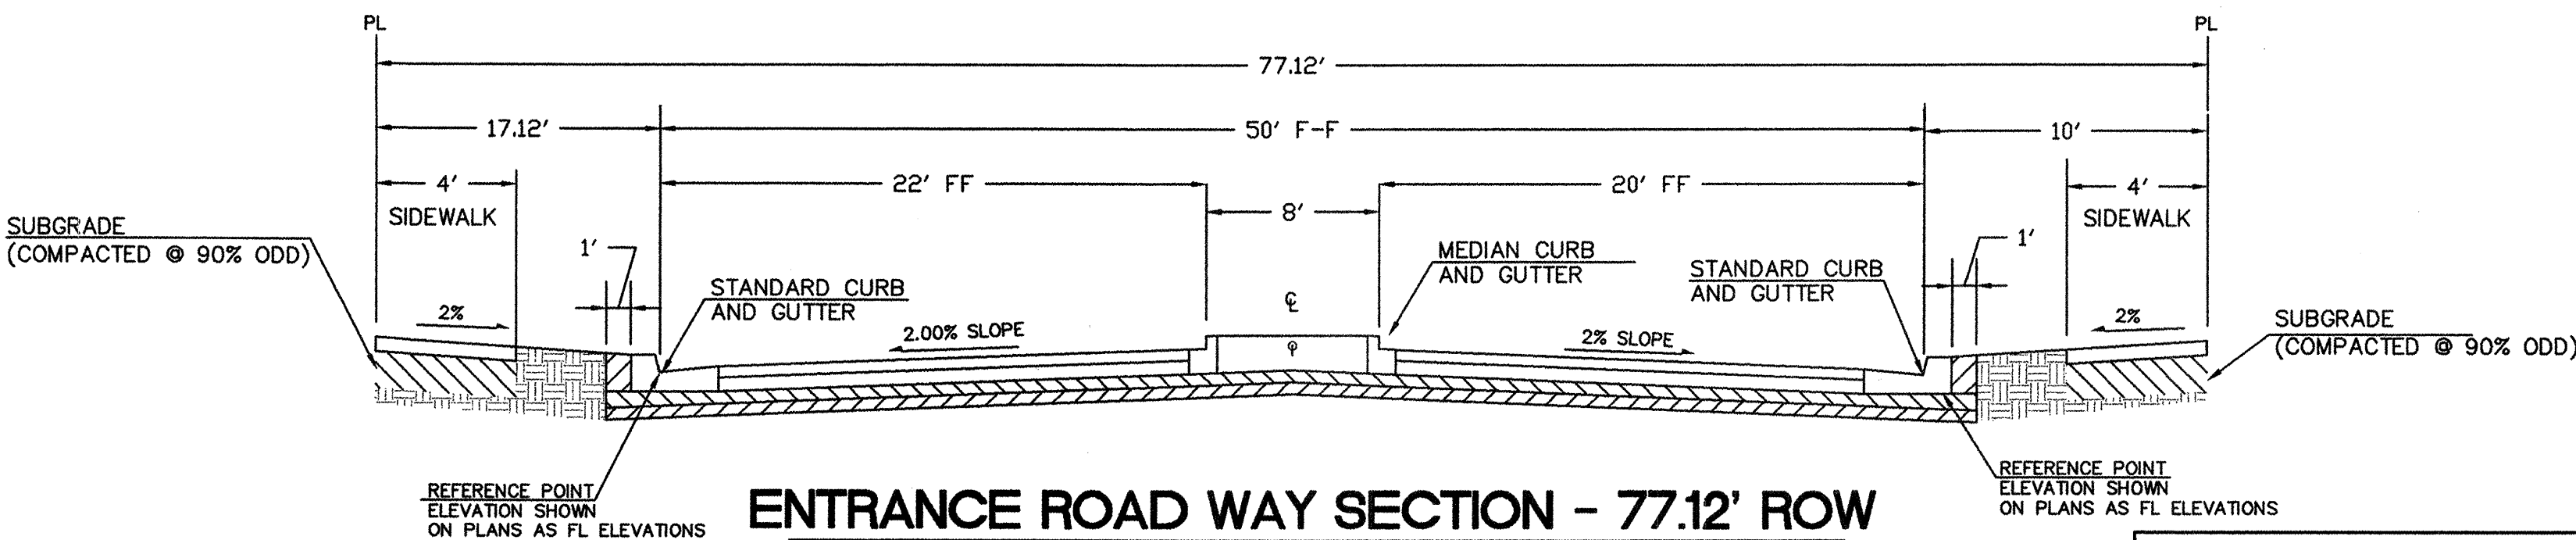

ENTRANCE ROAD WAY SECTION - 77.12' ROW

NOT TO SCALE

GRADING NOTES:


1. CONTRACTOR SHALL FOLLOW THE RECOMMENDATION FOR SITE PREPARATION, VEGETATIVE REMOVAL, AND CONSTRUCTION OF STRUCTURAL FILL DETAILED IN THE PROJECT SOILS INVESTIGATION REPORT. ALL FILL SHALL BE COMPACTED TO A MINIMUM OF 90% O.D.D. (MODIFIED), OR AS DIRECTED BY THE GEOTECHNICAL ENGINEER IN THE FIELD.
2. CONTRACTOR IS RESPONSIBLE FOR MAINTAINING ADEQUATE WIND-BORN DUST CONTROL PER C.O.A. AND COUNTY REGULATIONS.
3. CONTRACTOR MUST OBTAIN TOP SOIL DISTURBANCE PERMIT PRIOR TO MASS GRADING OPERATION.
4. INDIVIDUAL LOT DRAINAGE MUST BE DIRECTED TO DESIGNATED DRAINAGE FACILITIES OR TO THE PUBLIC STREET. NO DRAINAGE IS ALLOWED TO TRANSVERSE FROM ONE PRIVATE LOT TO ANOTHER EXCEPT AS NOTED ON THE GRADING PLAN VIA PRIVATE DRAINAGE EASEMENTS.

SPECIAL NOTE:

THIS GRADING PLAN IS INTENDED TO DESCRIBE THE CONDITION OF THE SITE FOLLOWING MASS GRADING OPERATIONS. PAD ELEVATIONS HAVE BEEN SET SUCH THAT THEY WILL ALLOW FOR PROPER DRAINAGE OF EACH LOT TO STREET AND/OR PUBLIC DRAINAGE FACILITIES. HOWEVER, THE DETAILS OF HOW LOTS WILL BE FINE GRADED TO ACCOMPLISH THIS OBJECTIVE CANNOT BE ESTABLISHED UNTIL SPECIFIC HOMES ARE SITED TO SPECIFIC LOTS. HOME BUILDERS ARE ADVISED TO PAY PARTICULAR NOTICE TO THE FINAL GRADING OF THEIR LOT(S) TO ENSURE THAT PROPER LOT DRAINAGE IS PROVIDED WHICH WILL MAINTAIN THE INTENDED DRAINAGE PATTERNS AND ALSO PROTECT THE INTEGRITY OF THE HOMES THEY BUILD. DRAINAGE FROM EACH LOT MUST BE DIRECTED TO STREETS AND/OR PUBLIC DRAINAGE FACILITIES WITHOUT ENTERING OR THREATENING ADJACENT PRIVATE PROPERTIES.

NO AS-BUILT DATA ON THIS SHEET

AS BUILT INFORMATION		BENCH MARKS		SURVEY INFORMATION	
CONTRACTOR	NEW CONCEPTS	ACCS 1 3/4" ALUMINUM DISK	STAMPED "ACS BM 1-11" EXPOSED TO TOP OF CONCRETE CURB, EAST SIDE OF UNSER BLVD. NW, 24 FT.	DATE	02/02
WORK	DATE	DATE	DATE	DATE	DATE
DESIGNED BY	DATE	DESIGNED BY	DATE	DESIGNED BY	DATE
DRAWN BY	DATE	DRAWN BY	DATE	DRAWN BY	DATE
CHECKED BY	DATE	CHECKED BY	DATE	CHECKED BY	DATE
RECORDED BY	DATE	RECORDED BY	DATE	RECORDED BY	DATE
NO.		NO.		NO.	

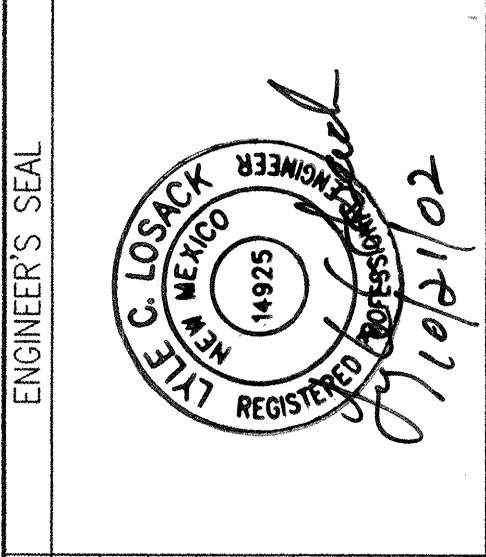

NO.	DATE	REVISIONS	DESIGN	REH	RLS	LCL
	09/2002					
	09/2002					
	09/2002					

QuikDraw
ENGINEERING, L.L.C.
P.O. Box 729
Corrales, NM 87048
Office (505) 898-0359 Fax (505) 897-0369

Community Sciences Corporation
LAND PLANNING ENGINEERING SURVEYING
P.O. Box 1328 Corrales, New Mexico 87048


JOB NO.: N291-33

CITY OF ALBUQUERQUE
PUBLIC WORKS DEPARTMENT
ENGINEERING DEVELOPMENT GROUP

TITLE: RIDGEVIEW VILLAGE UNIT II
PAVING DETAILS

Design Review Committee	City Engineer Approval	Mo./Day/Yr	Mo./Day/Yr
APPROVE SEP 17 2002	APPROVE SEP 24 2002		
DESIGN REVIEW COMMITTEE	CITY ENGINEER		
City Project No.	2002 Map No.	Sheet	of
683082	A-11	11	24

SCANNED BY
MESA REPRO

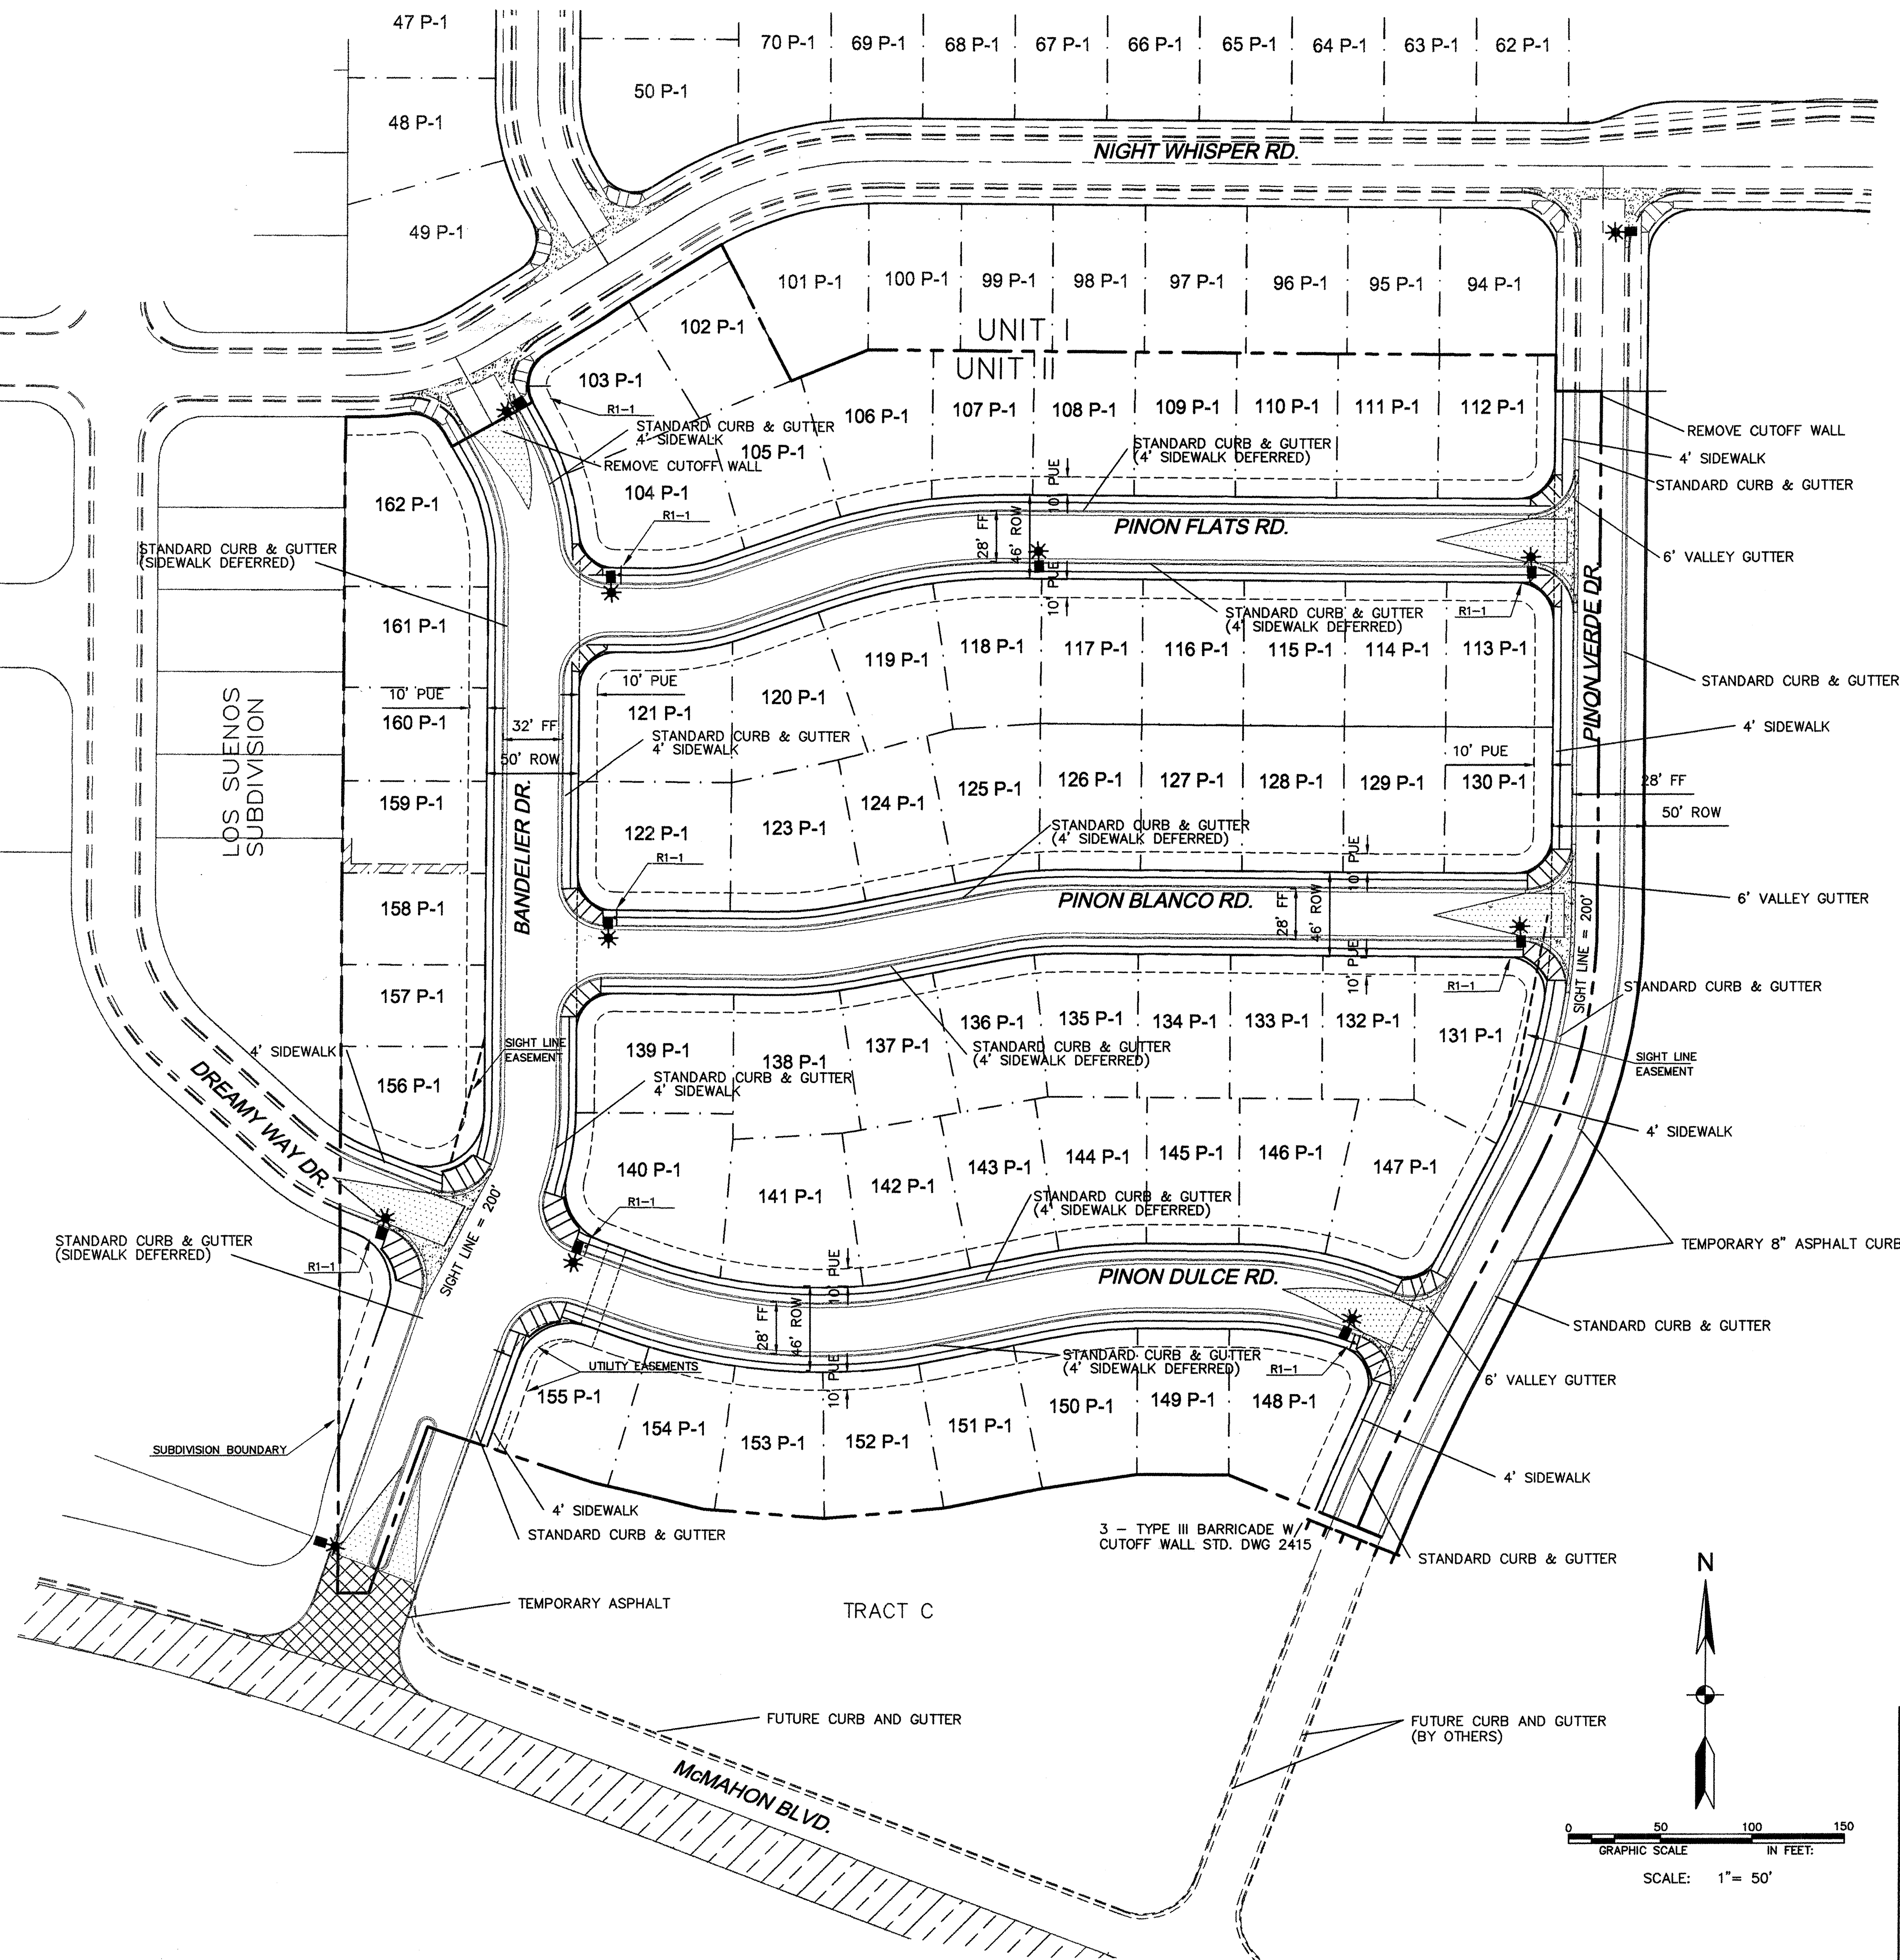

LEGEND:

PROPOSED	EXISTING	
---	---	ROW LINE
---	---	LOT LINE
---	---	PUBLIC UTILITY EASEMENT
---	---	ROW CENTER LINE
---	---	EDGE OF PAVEMENT
---	---	SUBDIVISION BOUNDARY
---	---	STANDARD CURB & GUTTER
---	---	TEMPORARY ASPHALT
---	---	CROWN TRANSITION
---	---	SIDEWALK & HANDICAP RAMPS
---	---	FL SPOT ELEVATIONS
---	---	DROP INLET
---	---	16 - STREET LIGHTS

NO AS-BUILT DATA ON THIS SHEET

AS BUILT INFORMATION		BENCH MARKS		SURVEY INFORMATION		ENGINEER'S SEAL		REVISIONS		DESIGN		CITY OF ALBUQUERQUE	
CONTRACTOR	DATE	ACS 1 3/4" ALUMINUM DISK	DATE	FIELD NOTES	DATE	REGISTERED PROFESSIONAL ENGINEER	NO.	BY	REMARKS	DATE	DESIGNED BY	DATE	CITY OF ALBUQUERQUE
INSPECTOR	DATE	STAMPED "ACS BM, 1-1/2" EXPOSED	DATE	BY	DATE	14925	NO.	BY	REMARKS	DATE	DRAWN BY	DATE	PUBLIC WORKS DEPARTMENT
ACCEPTANCE BY	DATE	TO TOP OF CONCRETE CURB, EAST	DATE	COMMUNITY SCIENCES CORP	02/02	REGISTERED PROFESSIONAL ENGINEER	NO.	BY	REMARKS	DATE	CHECKED BY	DATE	ENGINEERING DEVELOPMENT GROUP
REVISION BY	DATE	SIDE OF UNSUB. BLD. NW, 24 FT.	DATE				NO.	BY	REMARKS	DATE		DATE	
REVISION BY	DATE	+/- NORTH OF THE BERNALILLO /	DATE				NO.	BY	REMARKS	DATE		DATE	
REVISION BY	DATE	SANJOVAL COUNTY FENCE LINE, 210.1	DATE				NO.	BY	REMARKS	DATE		DATE	
REVISION BY	DATE	FT. SOUTH OF "SPEED LIMIT 45" SIGN,	DATE				NO.	BY	REMARKS	DATE		DATE	
REVISION BY	DATE	50.7 FT. NORTH OF THE SOUTH END OF CURB	DATE				NO.	BY	REMARKS	DATE		DATE	
REVISION BY	DATE	AND GUTTER, ELEV. = 5279.75, (NGVD 1929)	DATE				NO.	BY	REMARKS	DATE		DATE	

JOB NO.: N291-33

CITY OF ALBUQUERQUE
PUBLIC WORKS DEPARTMENT
ENGINEERING DEVELOPMENT GROUP

TITLE: RIDGEVIEW VILLAGE UNIT II
COMPOSITE PAVING PLAN / SIDEWALK VARIANCE


Design Review Committee: APPROVED 12/17/2002
City Engineer Approval: APPROVED 12/24/2002
CITY ENGINEER

City Project No. 683082 Zone Map No. A-11 Sheet 12 of 24


QuikDraw
ENGINEERING, L.L.C.
P.O. Box 729
Corrales, NM 87048
Office (505) 898-0389 Fax (505) 897-0389

Community Sciences Corporation
LAND PLANNING ENGINEERING SURVEYING
P.O. Box 1328 Corrales, New Mexico 87048

SCANNED BY
MESA REPRO

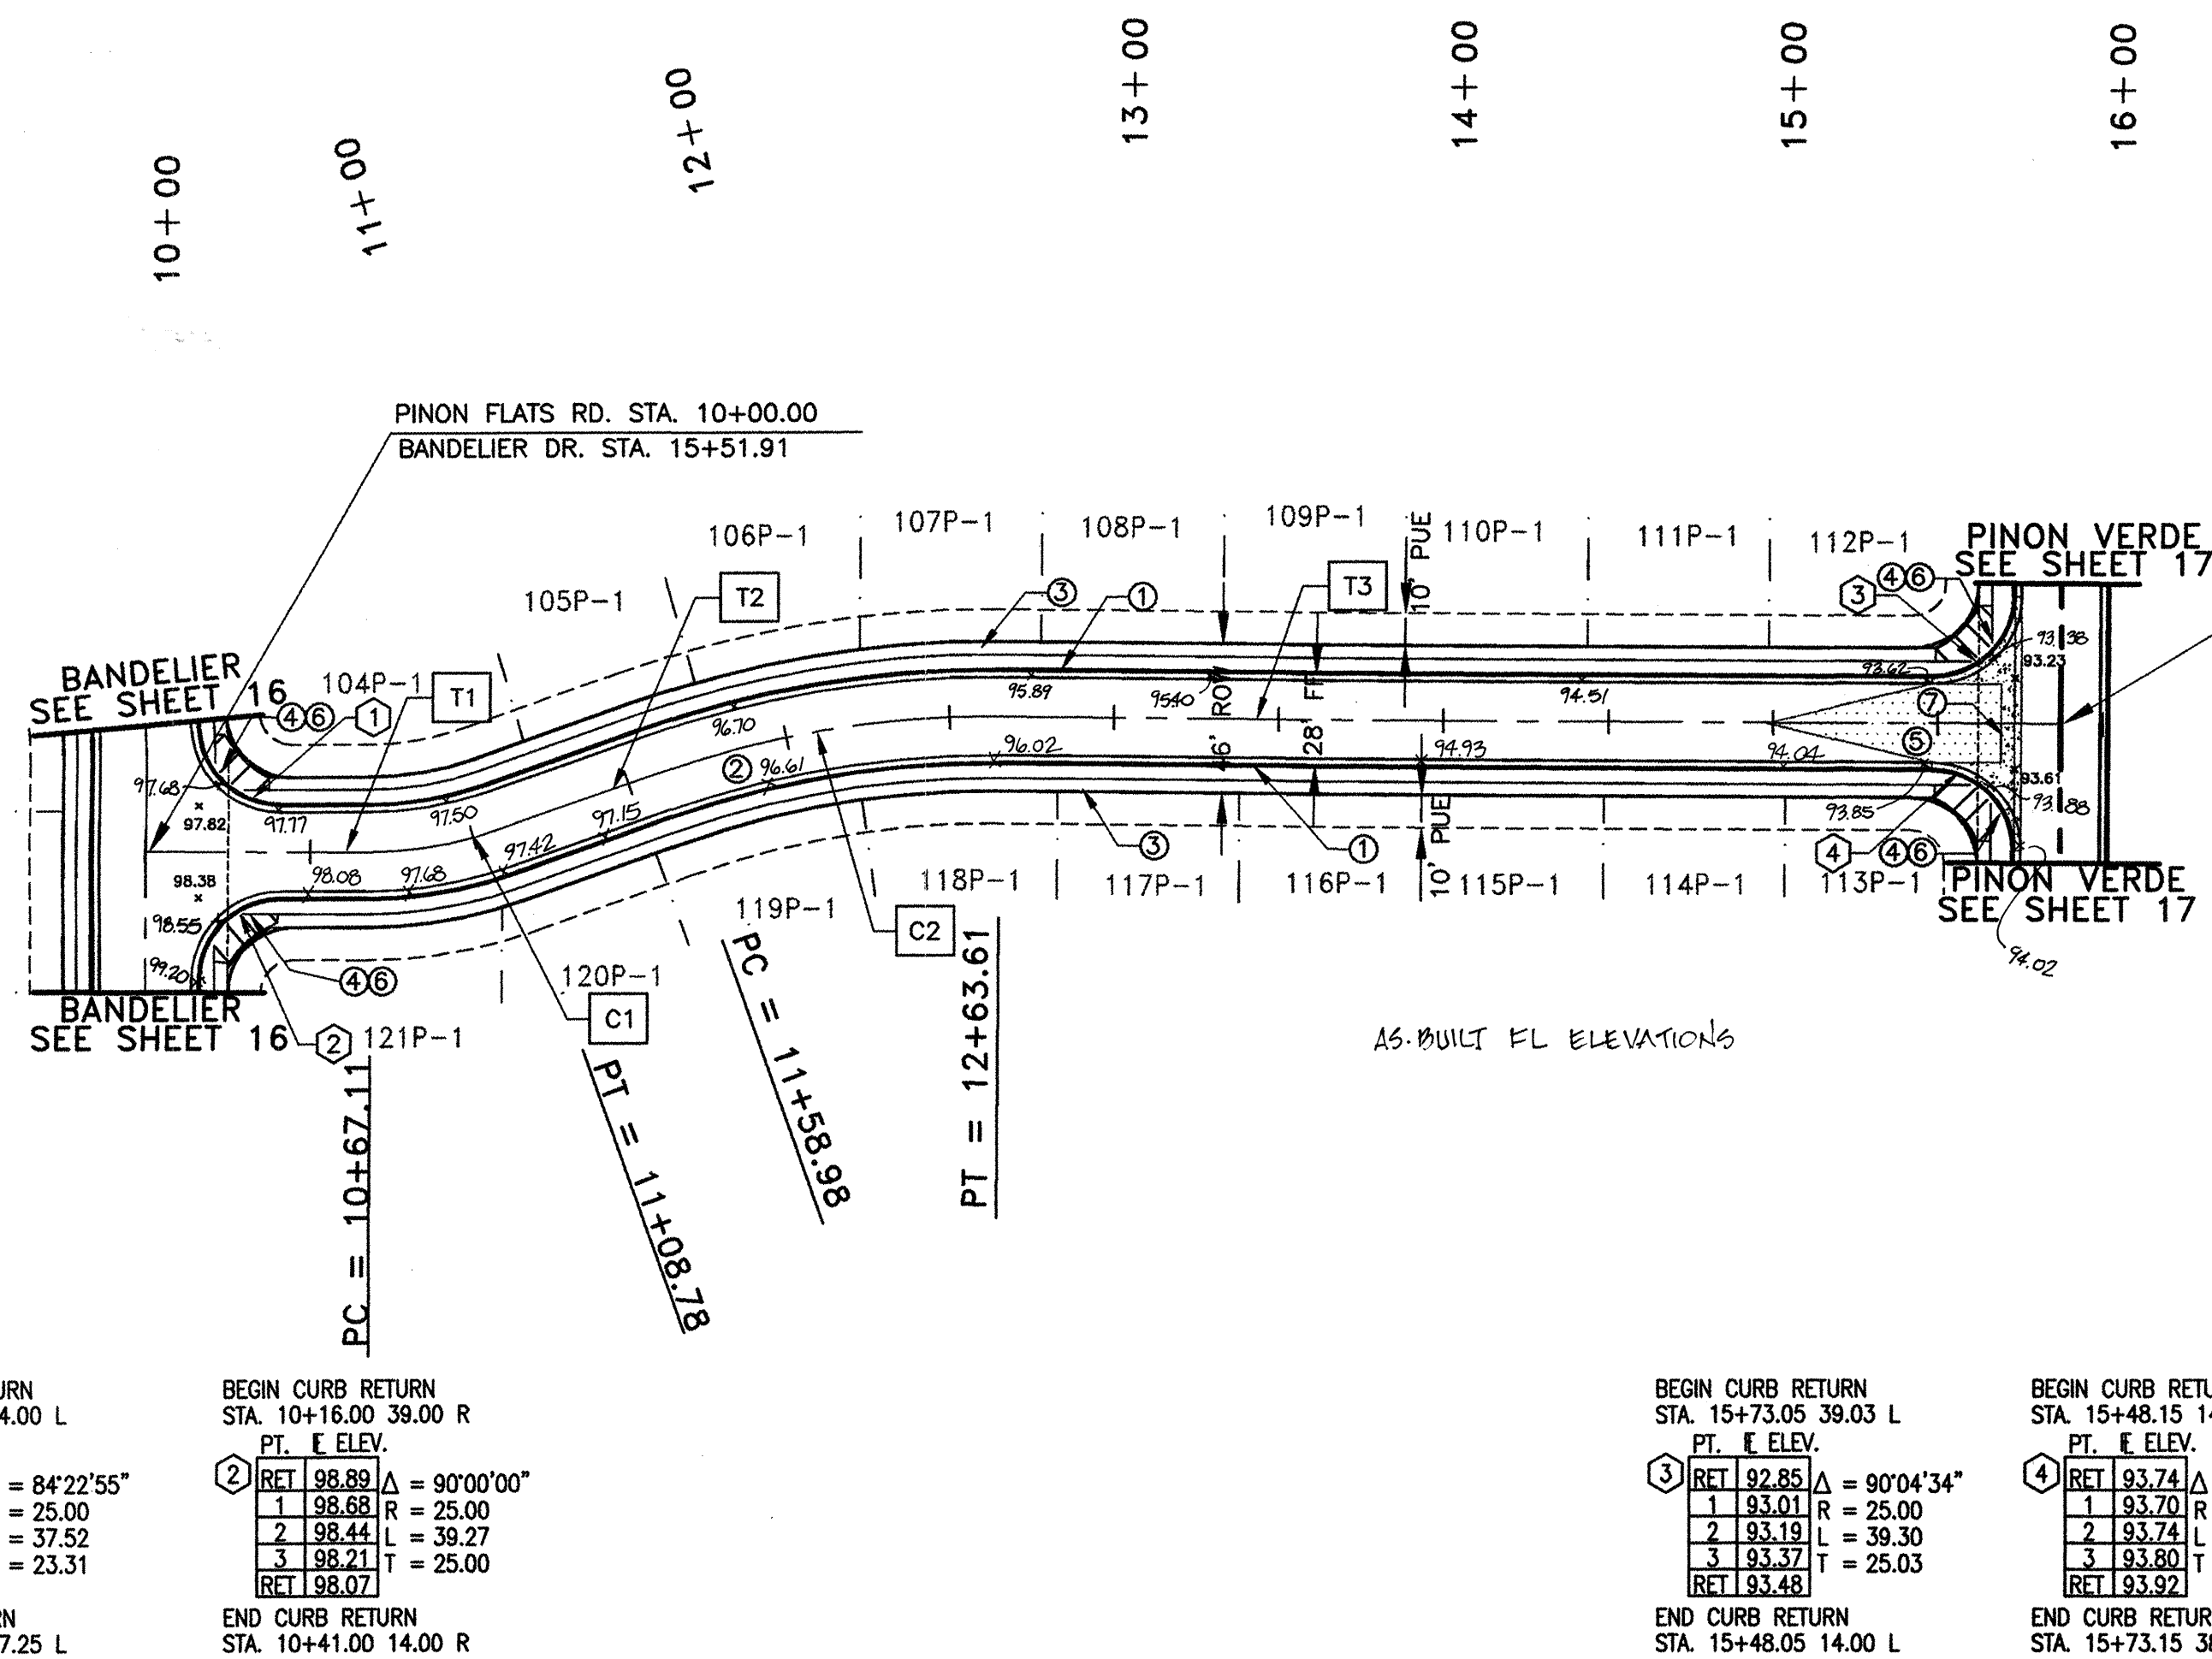

PINON FLATS RD.

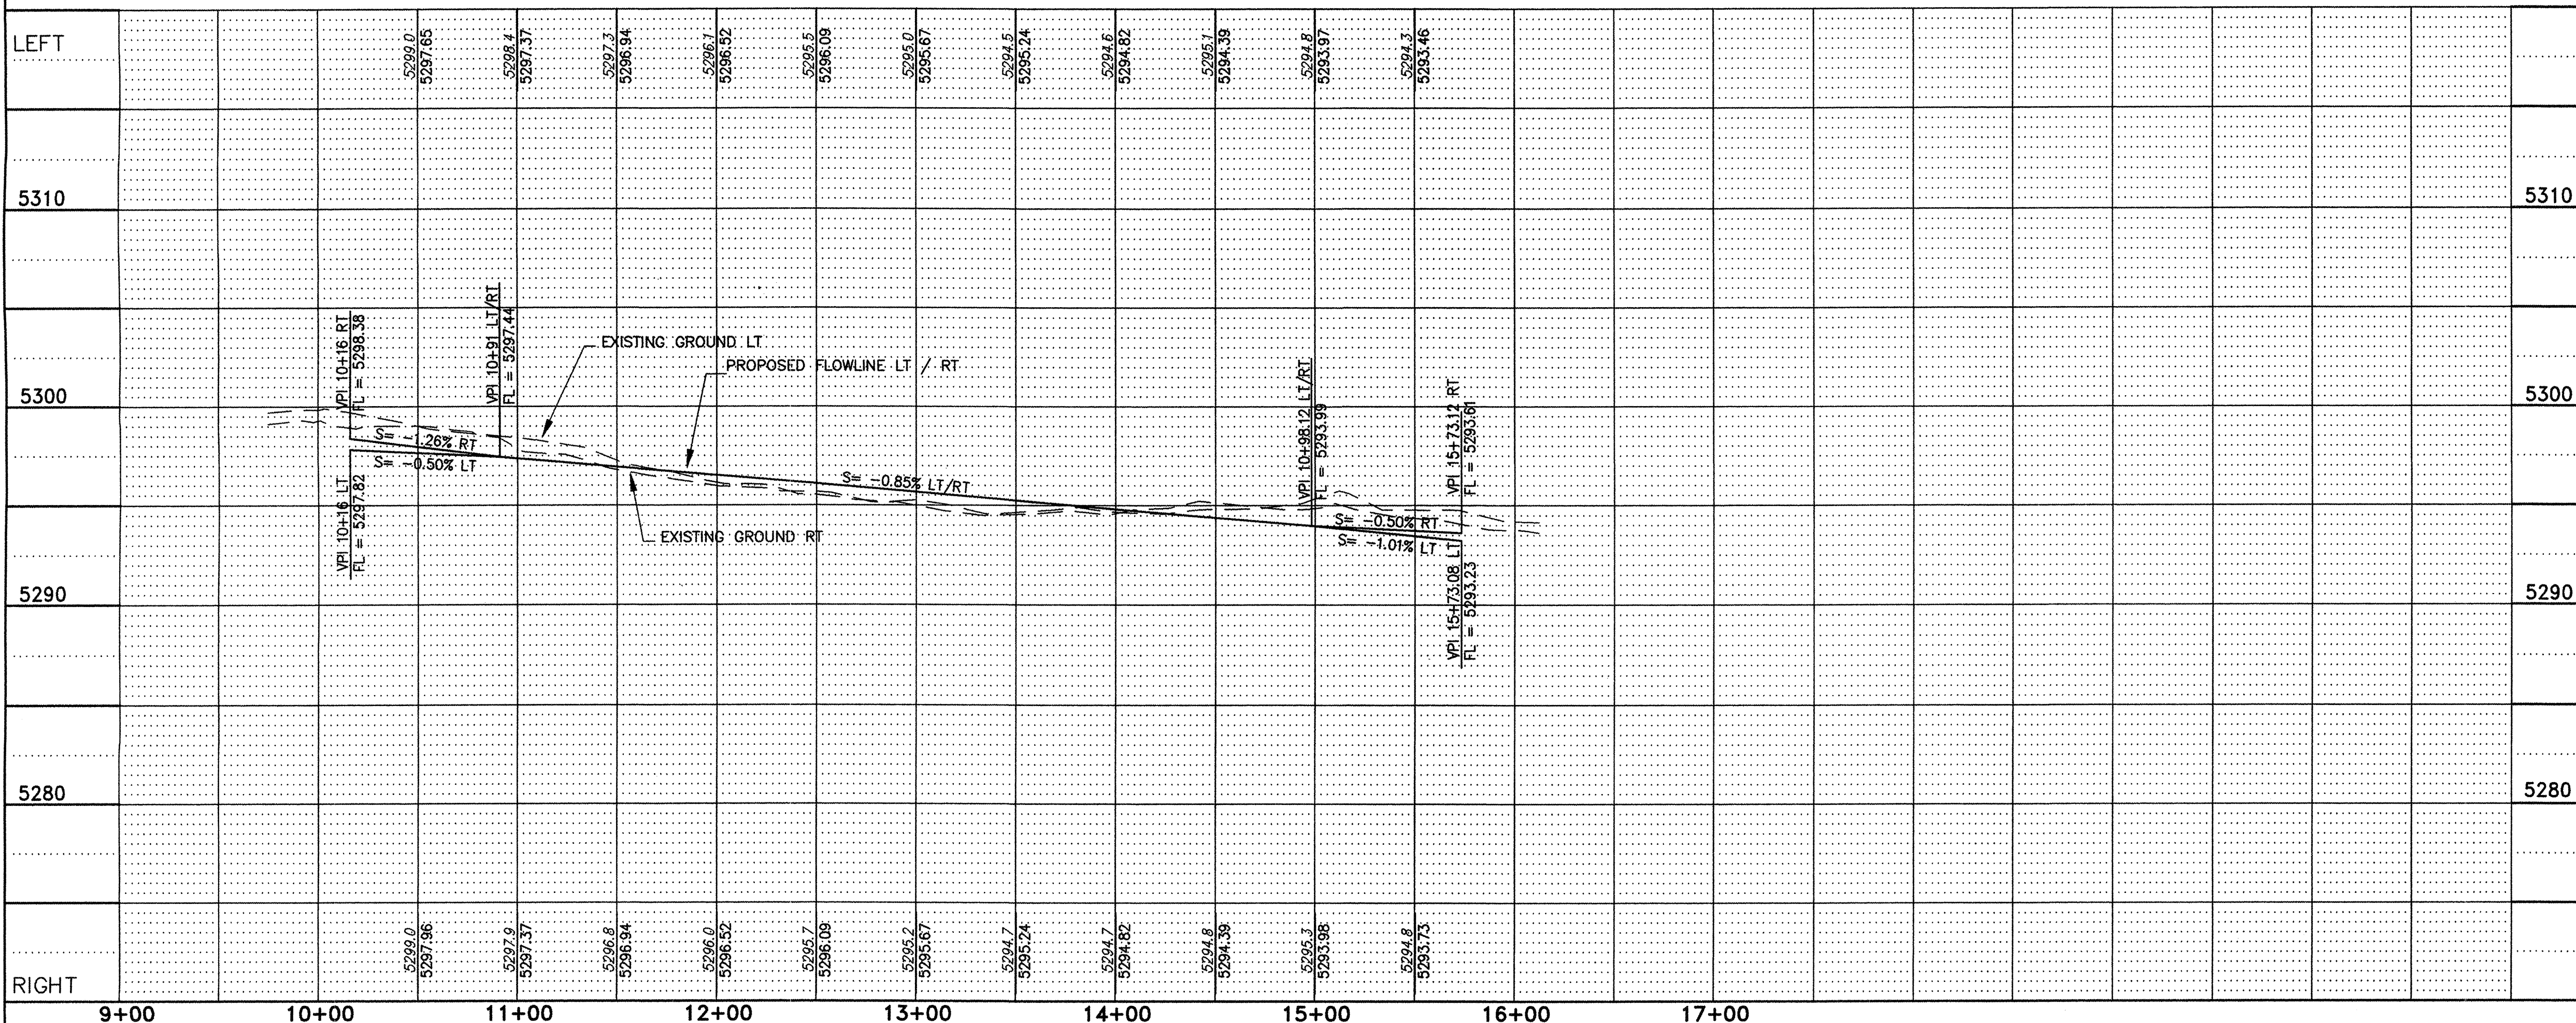


RIGHT

9+00 10+00 11+00 12+00 13+00 14+00 15+00 16+00 17+00

SURVEYOR'S CERTIFICATION

I, Thomas W. Patrick, a duly qualified Registered Professional Land Surveyor under the Laws of the State of New Mexico, do hereby certify that the "as-built" information shown on these drawings was obtained from field construction and "as-built" surveys performed by me, or under my supervision, that the "as-built" information shown on these drawings was added by me, or under my supervision and that this "as-built" information is true and correct to the best of my knowledge and belief. Community Sciences Corporation is not responsible for any of the design concepts, calculations, engineering and/or intent of the record drawings.

Thomas W. Patrick, N.M.P.S. 12651
Date: 6-18-2003

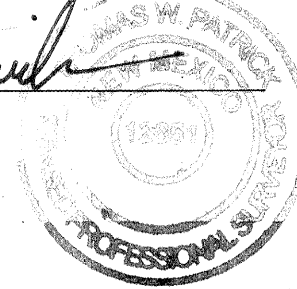

AS-BUILT DRAWING

LEGEND:


- ROW LINE
- LOT LINE
- PUBLIC UTILITY EASEMENT
- PROPOSED
- EXISTING
- ROW CENTER LINE
- EDGE OF PAVEMENT
- SUBDIVISION BOUNDARY
- STANDARD CURB & GUTTER
- TEMPORARY ASPHALT
- ASPHALT TRANSITION
- SIDEWALK & HANDICAP RAMPS
- FL SPOT ELEVATIONS

CONSTRUCTION NOTES:

- CONSTRUCT 8" CURB & GUTTER PER COA STANDARD #2415
- CONSTRUCT 3" ASPHALT CONCRETE PAVEMENT PER COA STANDARD #2405, SEE SHT 11
- CONSTRUCT 4" CONCRETE SIDEWALK PER COA STANDARD #2430 (DEFERRED)
- CONSTRUCT CURB RETURNS PER COA STANDARD #2420
- CONSTRUCT CROWN TRANSITION PER COA STANDARD #2401
- BUILD HANDICAP RAMP PER COA STANDARD #2441 CASE #2
- VALLEY GUTTER PER COA STANDARD #2420

GENERAL NOTES:

- ANY ADDITIONAL GRADING REQUIRED TO MATCH PROPOSED STREET GRADES SHALL BE INCIDENTAL TO PAVING ITEMS.
- ANY DAMAGE TO THE EXISTING FACILITIES, (C&G, PAVEMENT CONDUITS, LANDSCAPING, UTILITY LINES, ETC.) DURING CONSTRUCTION SHALL BE REPLACED AT THE CONTRACTOR'S EXPENSE.
- WHEELCHAIR RAMPS SHALL BE CONSTRUCTED PRIOR TO ACCEPTANCE OF CURB & GUTTER.
- DIMENSIONS SHOWN AS FF ARE FLOW LINE TO FLOW.

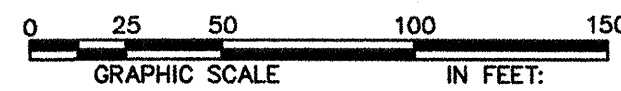

QuikDraw
ENGINEERING, L.L.C.

P.O. Box 729
Corrales, NM 87046
Office (505) 898-0309 Fax (505) 897-0309

Community
Sciences
Corporation

LAND PLANNING ENGINEERING SURVEYING
P.O. Box 1328 Corrales, New Mexico 87048


JOB NO.: N291-33

CITY OF ALBUQUERQUE
PUBLIC WORKS DEPARTMENT
ENGINEERING DEVELOPMENT GROUP

TITLE: RIDGEVIEW VILLAGE UNIT II
PAVING PLAN & PROFILES
PINON FLATS RD.

DESIGNED BY	REH	DATE	09/2002
DRAWN BY	RLS	DATE	09/2002
CHECKED BY	LCL	DATE	09/2002

SCANNED BY
MESA REPRO

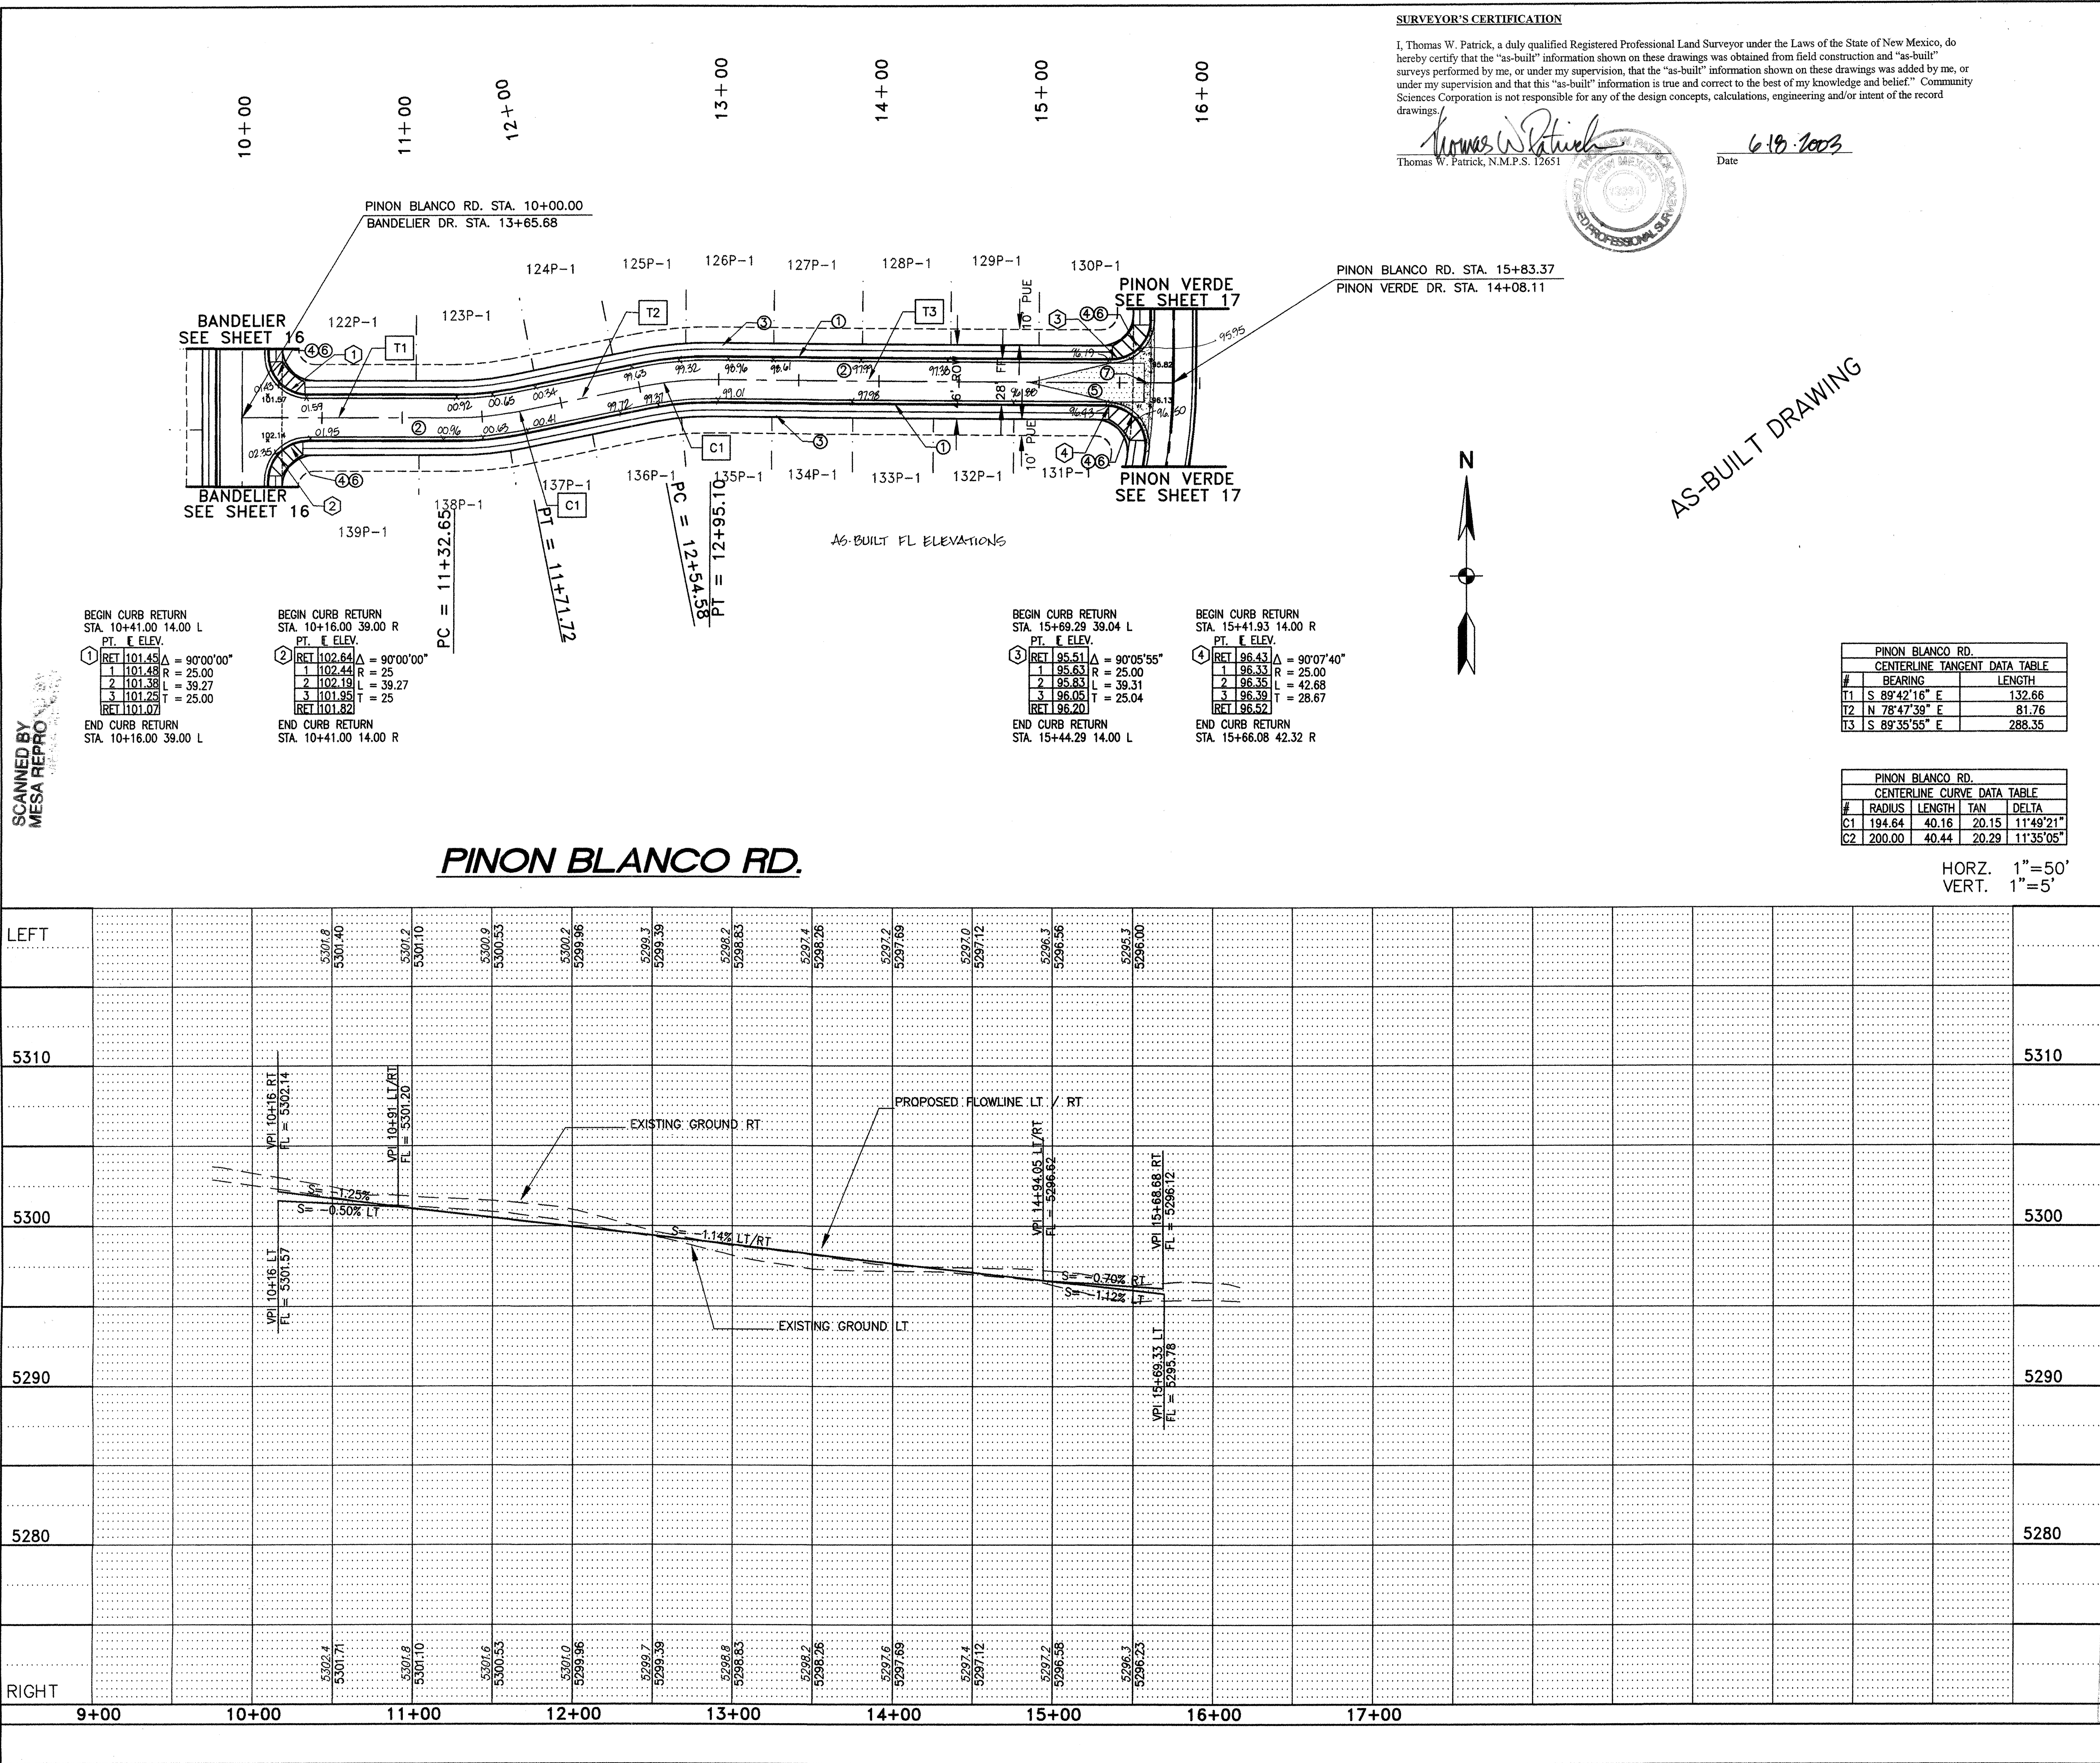


SURVEYOR'S CERTIFICATION

I, Thomas W. Patrick, a duly qualified Registered Professional Land Surveyor under the Laws of the State of New Mexico, do hereby certify that the "as-built" information shown on these drawings was obtained from field construction and "as-built" surveys performed by me, or under my supervision, that the "as-built" information shown on these drawings was added by me, or under my supervision and that this "as-built" information is true and correct to the best of my knowledge and belief. Community Sciences Corporation is not responsible for any of the design concepts, calculations, engineering and/or intent of the record drawings.

Thomas W. Patrick, N.M.P.S. 12651

Date 6-19-2003

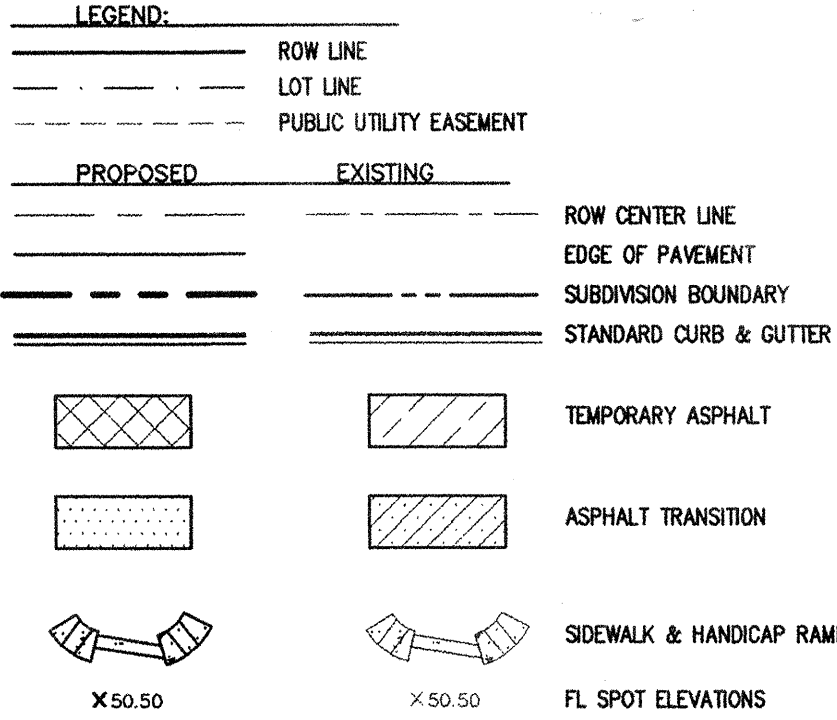

CONSTRUCTION NOTES:

- CONSTRUCT 8" CURB & GUTTER PER COA STANDARD #2415
- CONSTRUCT 3" ASPHALT CONCRETE PAVEMENT PER COA STANDARD #2405, SEE SHIT 11
- CONSTRUCT 4' CONCRETE SIDEWALK PER COA STANDARD #2430 (DEFERRED)
- CONSTRUCT CURB RETURNS PER COA STANDARD #2420
- CONSTRUCT CROWN TRANSITION PER COA STANDARD #2401
- BUILD HANDICAP RAMP PER COA STANDARD #2441 CASE #2
- VALLEY GUTTER PER COA STANDARD #2420

GENERAL NOTES:

- ANY ADDITIONAL GRADING REQUIRED TO MATCH PROPOSED STREET GRADES SHALL BE INCIDENTAL TO PAVING ITEMS.
- ANY DAMAGE TO THE EXISTING FACILITIES (C&G, PAVEMENT CONDUITS, LANDSCAPING, UTILITY LINES, ETC.) DURING CONSTRUCTION SHALL BE REPLACED AT THE CONTRACTOR'S EXPENSE.
- WHEELCHAIR RAMPS SHALL BE CONSTRUCTED PRIOR TO ACCEPTANCE OF CURB & GUTTER.
- DIMENSIONS SHOWN AS FF ARE FLOW LINE TO FLOW.



QuikDraw
ENGINEERING, L.L.C.

P.O. Box 729
Corrales, NM 87048
Office (505) 898-0389 Fax (505) 897-0389

Community Sciences Corporation

LAND PLANNING ENGINEERING SURVEYING
P.O. Box 1328 Corrales, New Mexico 87048


JOB NO.: N291-33



CITY OF ALBUQUERQUE
PUBLIC WORKS DEPARTMENT
ENGINEERING DEVELOPMENT GROUP

TITLE: RIDGEVIEW VILLAGE UNIT II
PAVING PLAN & PROFILES
PINON BLANCO RD.

DESIGN REVIEW COMMITTEE	CITY ENGINEER APPROVAL	Mo./Day/Yr	Mo./Day/Yr
APPROVED	APPROVED		
DESIGN REVIEW COMMITTEE	CITY ENGINEER		

City Project No. 683082 Zone Map No. A-11 Sheet 14 of 24

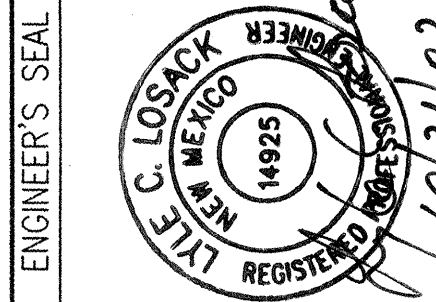

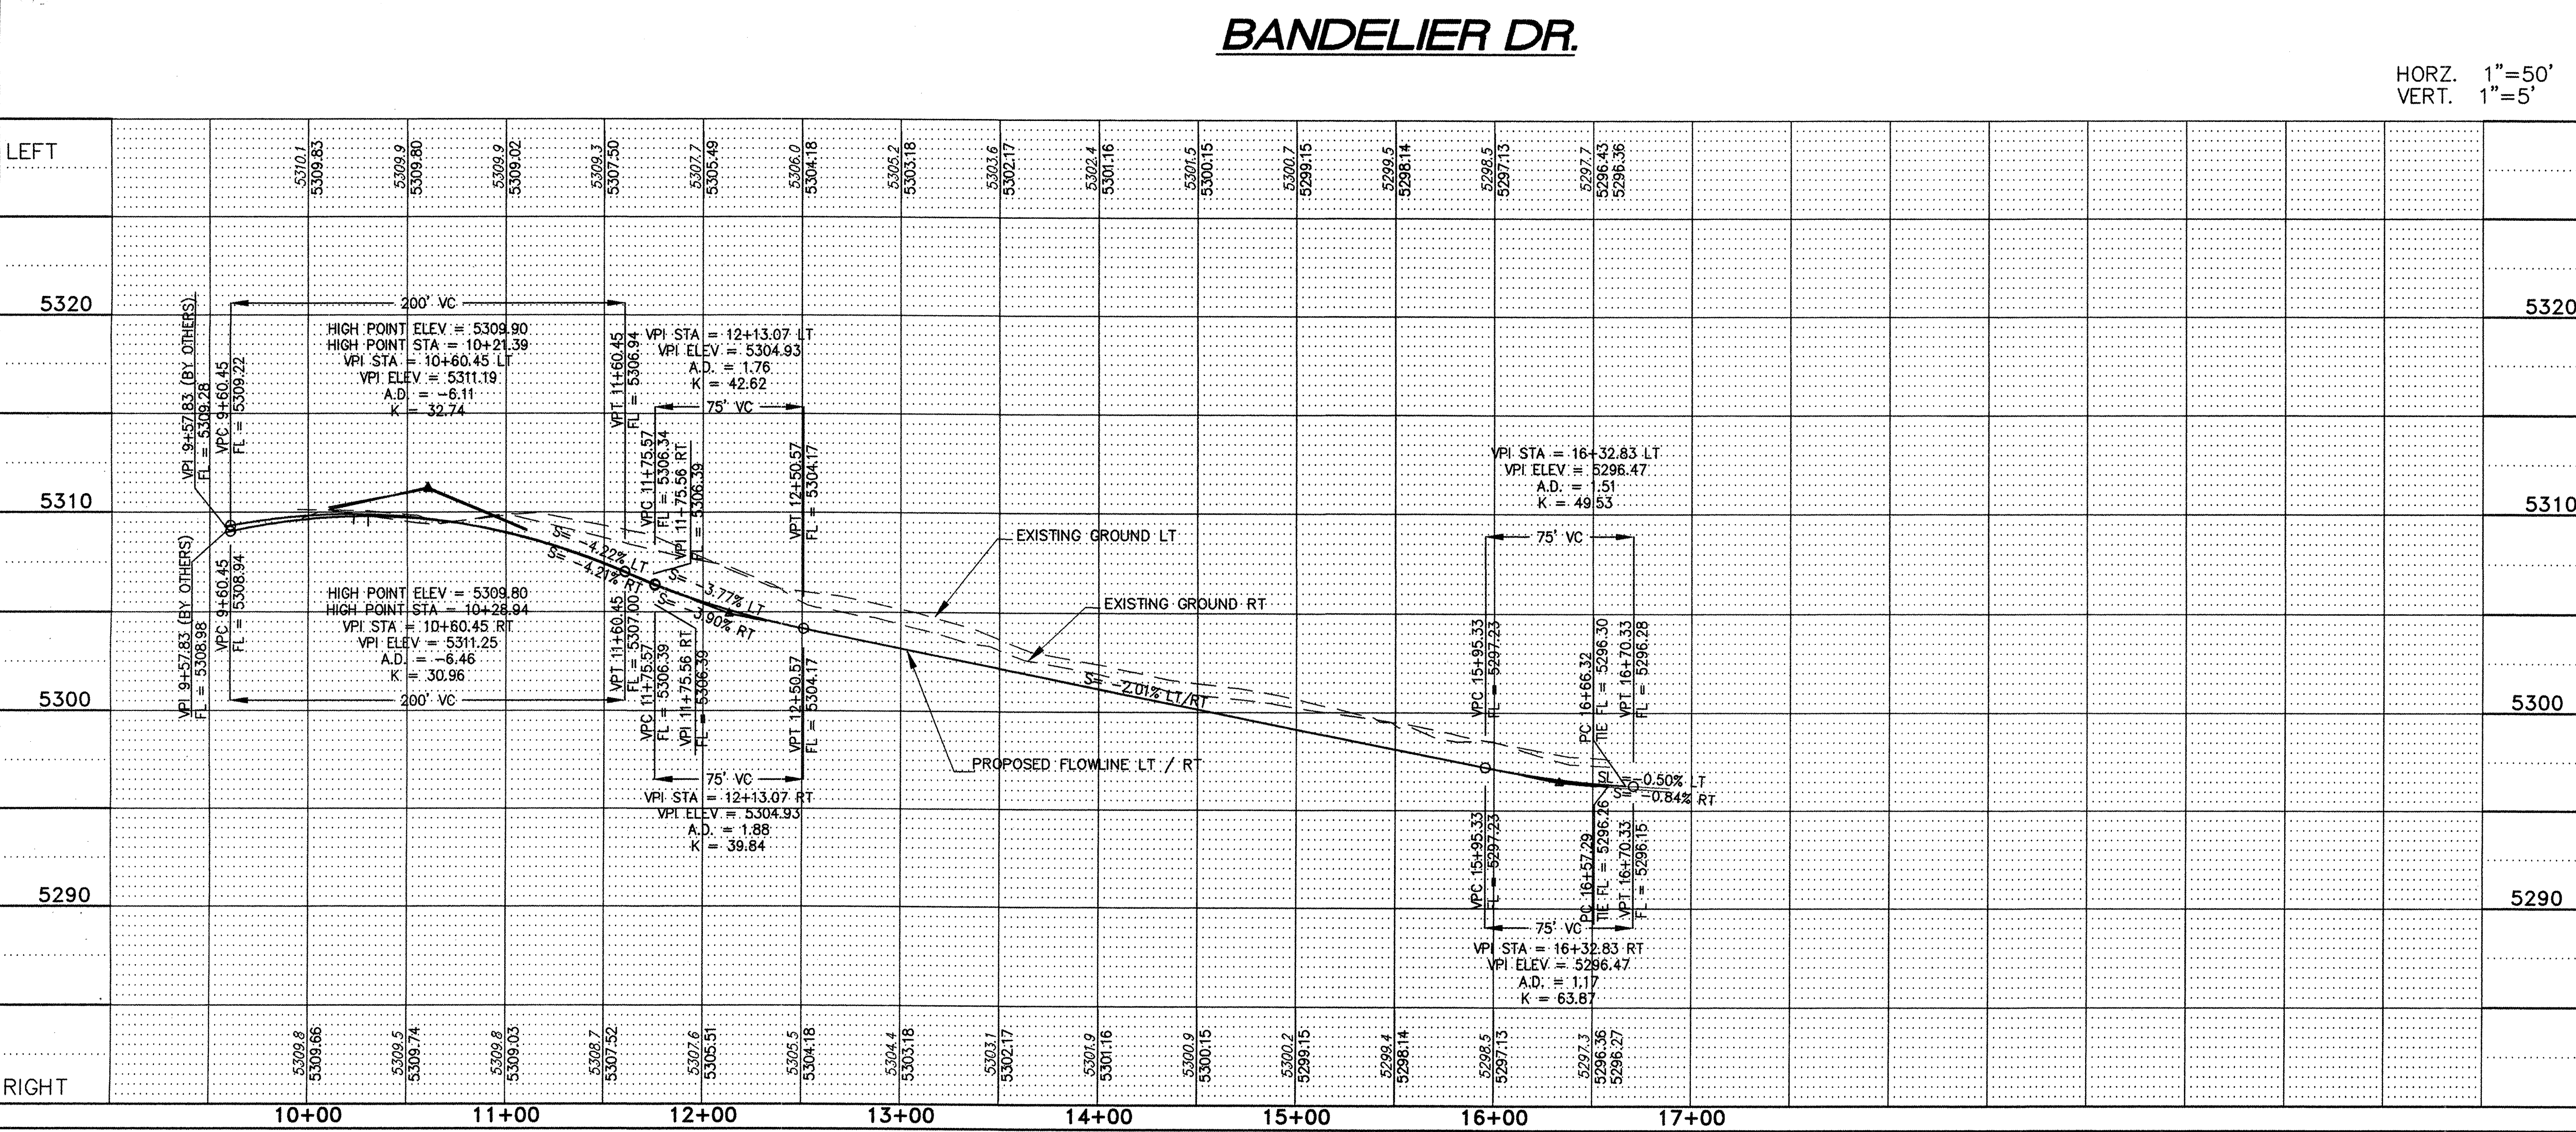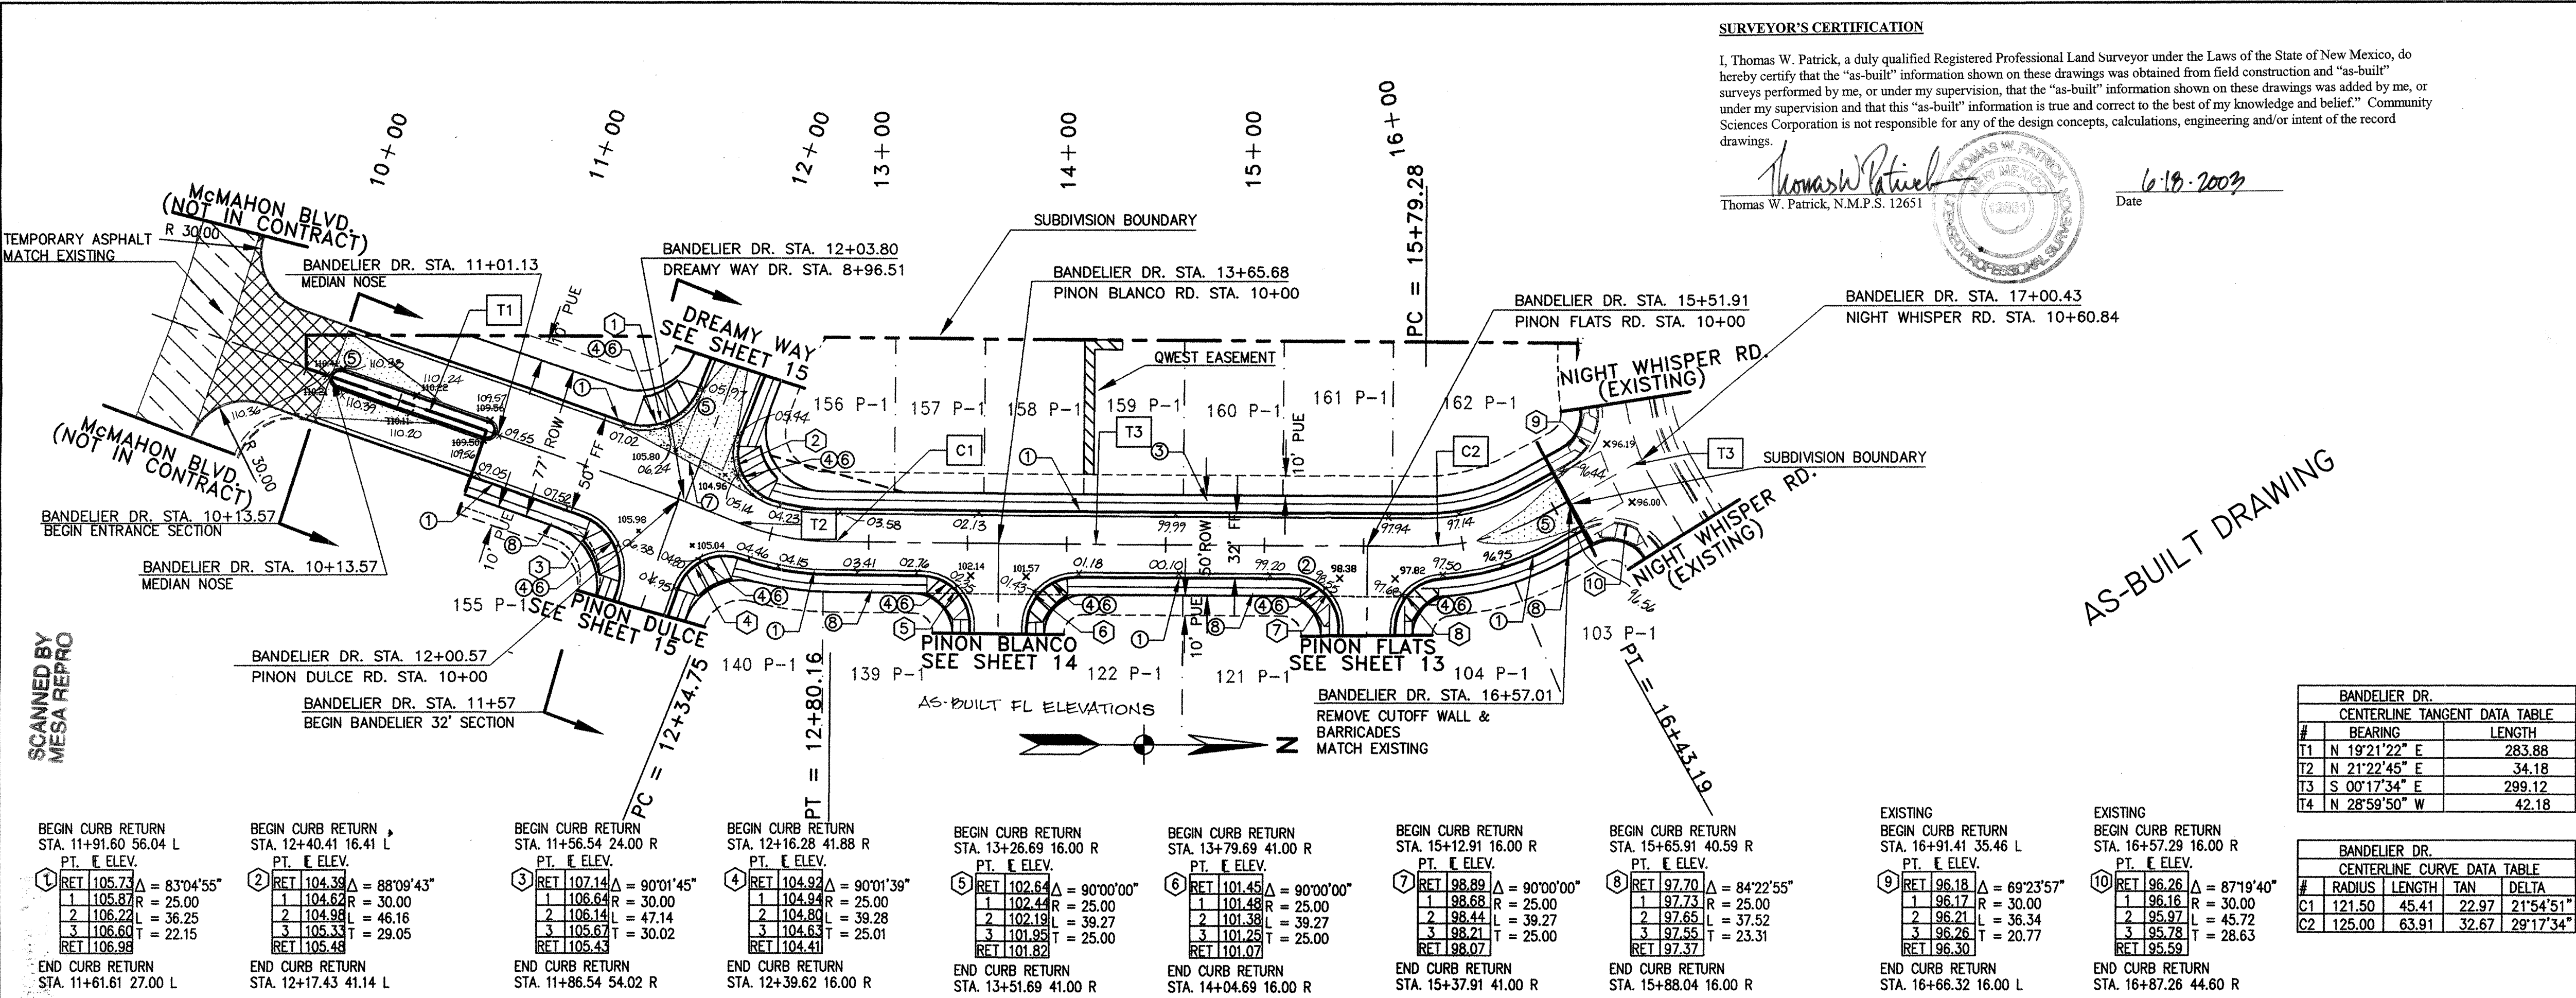

LEGEND:

- ROW LINE
- LOT LINE
- PUBLIC UTILITY EASEMENT
- PROPOSED
- EXISTING
- ROW CENTER LINE
- EDGE OF PAVEMENT
- SUBDIVISION BOUNDARY
- STANDARD CURB & GUTTER
- TEMPORARY ASPHALT
- ASPHALT TRANSITION
- SIDEWALK & HANDICAP RAMPS
- FL SPOT ELEVATIONS

CONSTRUCTION NOTES:

- CONSTRUCT 8" CURB & GUTTER PER COA STANDARD #2415
- CONSTRUCT 3" ASPHALT CONCRETE PAVEMENT PER COA STANDARD #2405, SEE SHT 11
- CONSTRUCT 4' CONCRETE SIDEWALK PER COA STANDARD #2430 (DEFERRED)
- CONSTRUCT CURB RETURNS PER COA STANDARD #2420
- CONSTRUCT CROWN TRANSITION PER COA STANDARD #2401
- BUILD HANDICAP RAMP PER COA STANDARD #2441 CASE #2
- VALLEY GUTTER PER COA STANDARD #2420
- CONSTRUCT 4' CONCRETE SIDEWALK PER COA STANDARD #2430

GENERAL NOTES:

- ANY ADDITIONAL GRADING REQUIRED TO MATCH PROPOSED STREET GRADES SHALL BE INCIDENTAL TO PAVING ITEMS.
- ANY DAMAGE TO THE EXISTING FACILITIES, (C&G, PAVEMENT CONDUITS, LANDSCAPING, UTILITY LINES, ETC.) DURING CONSTRUCTION SHALL BE REPLACED AT THE CONTRACTOR'S EXPENSE.
- WHEELCHAIR RAMPS SHALL BE CONSTRUCTED PRIOR TO ACCEPTANCE OF CURB & GUTTER.
- DIMENSIONS SHOWN AS FF ARE FLOW LINE TO FLOW.

AS-BUILT DRAWING

BANDELIER DR. CENTERLINE TANGENT DATA TABLE

#	BEARING	LENGTH
T1	N 19°21'22" E	283.88
T2	N 21°22'45" E	34.18
T3	S 00°17'34" E	299.12
T4	N 28°59'50" W	42.18

BANDELIER DR. CENTERLINE CURVE DATA TABLE

#	RADIUS	LENGTH	TAN	DELTA
C1	121.50	45.41	22.97	2154°51"
C2	125.00	63.91	32.67	29°17'34"

BEGIN CURB RETURN DATA:

STATION	PT. ELEV.	END CURB RETURN STA.	END CURB RETURN STA. ELEV.
11+91.60	56.04 L	11+61.61	27.00 L
12+40.41	16.41 L	12+17.43	41.14 L
11+56.54	24.00 R	11+86.54	54.02 R
12+28.68	41.88 R	12+39.62	16.00 R
13+79.89	41.00 R	13+51.69	41.00 R
15+12.91	16.00 R	14+04.69	16.00 R
15+65.91	40.59 R	15+37.91	41.00 R
16+91.41	35.46 L	16+66.32	16.00 L
16+57.29	16.00 R	16+87.26	44.60 R

GRAPHIC SCALE

0 25 50 100 150
IN FEET

QuikDraw ENGINEERING, L.L.C.

P.O. Box 729
Corrales, NM 87048
Office (505) 898-0389 Fax (505) 897-0389

Community Sciences Corporation

LAND PLANNING ENGINEERING SURVEYING
P.O. Box 1328 Corrales, New Mexico 87048

JOB NO. N291-33

CITY OF ALBUQUERQUE
PUBLIC WORKS DEPARTMENT
ENGINEERING DEVELOPMENT GROUP

TITLE: RIDGEVIEW VILLAGE UNIT II
PAVING PLAN & PROFILES
BANDIELIER DR.

DESIGN REVIEW COMMITTEE

CITY ENGINEER APPROVAL

Mo./Day/Yr


DESIGNED BY REF **DATE** 09/2002
DRAWN BY RLS **DATE** 09/2002
CHECKED BY LCL **DATE** 09/2002

City Project No. 683082


Zone Map No. A-11

Sheet 16 of 24


COMMUNITY SCIENCE

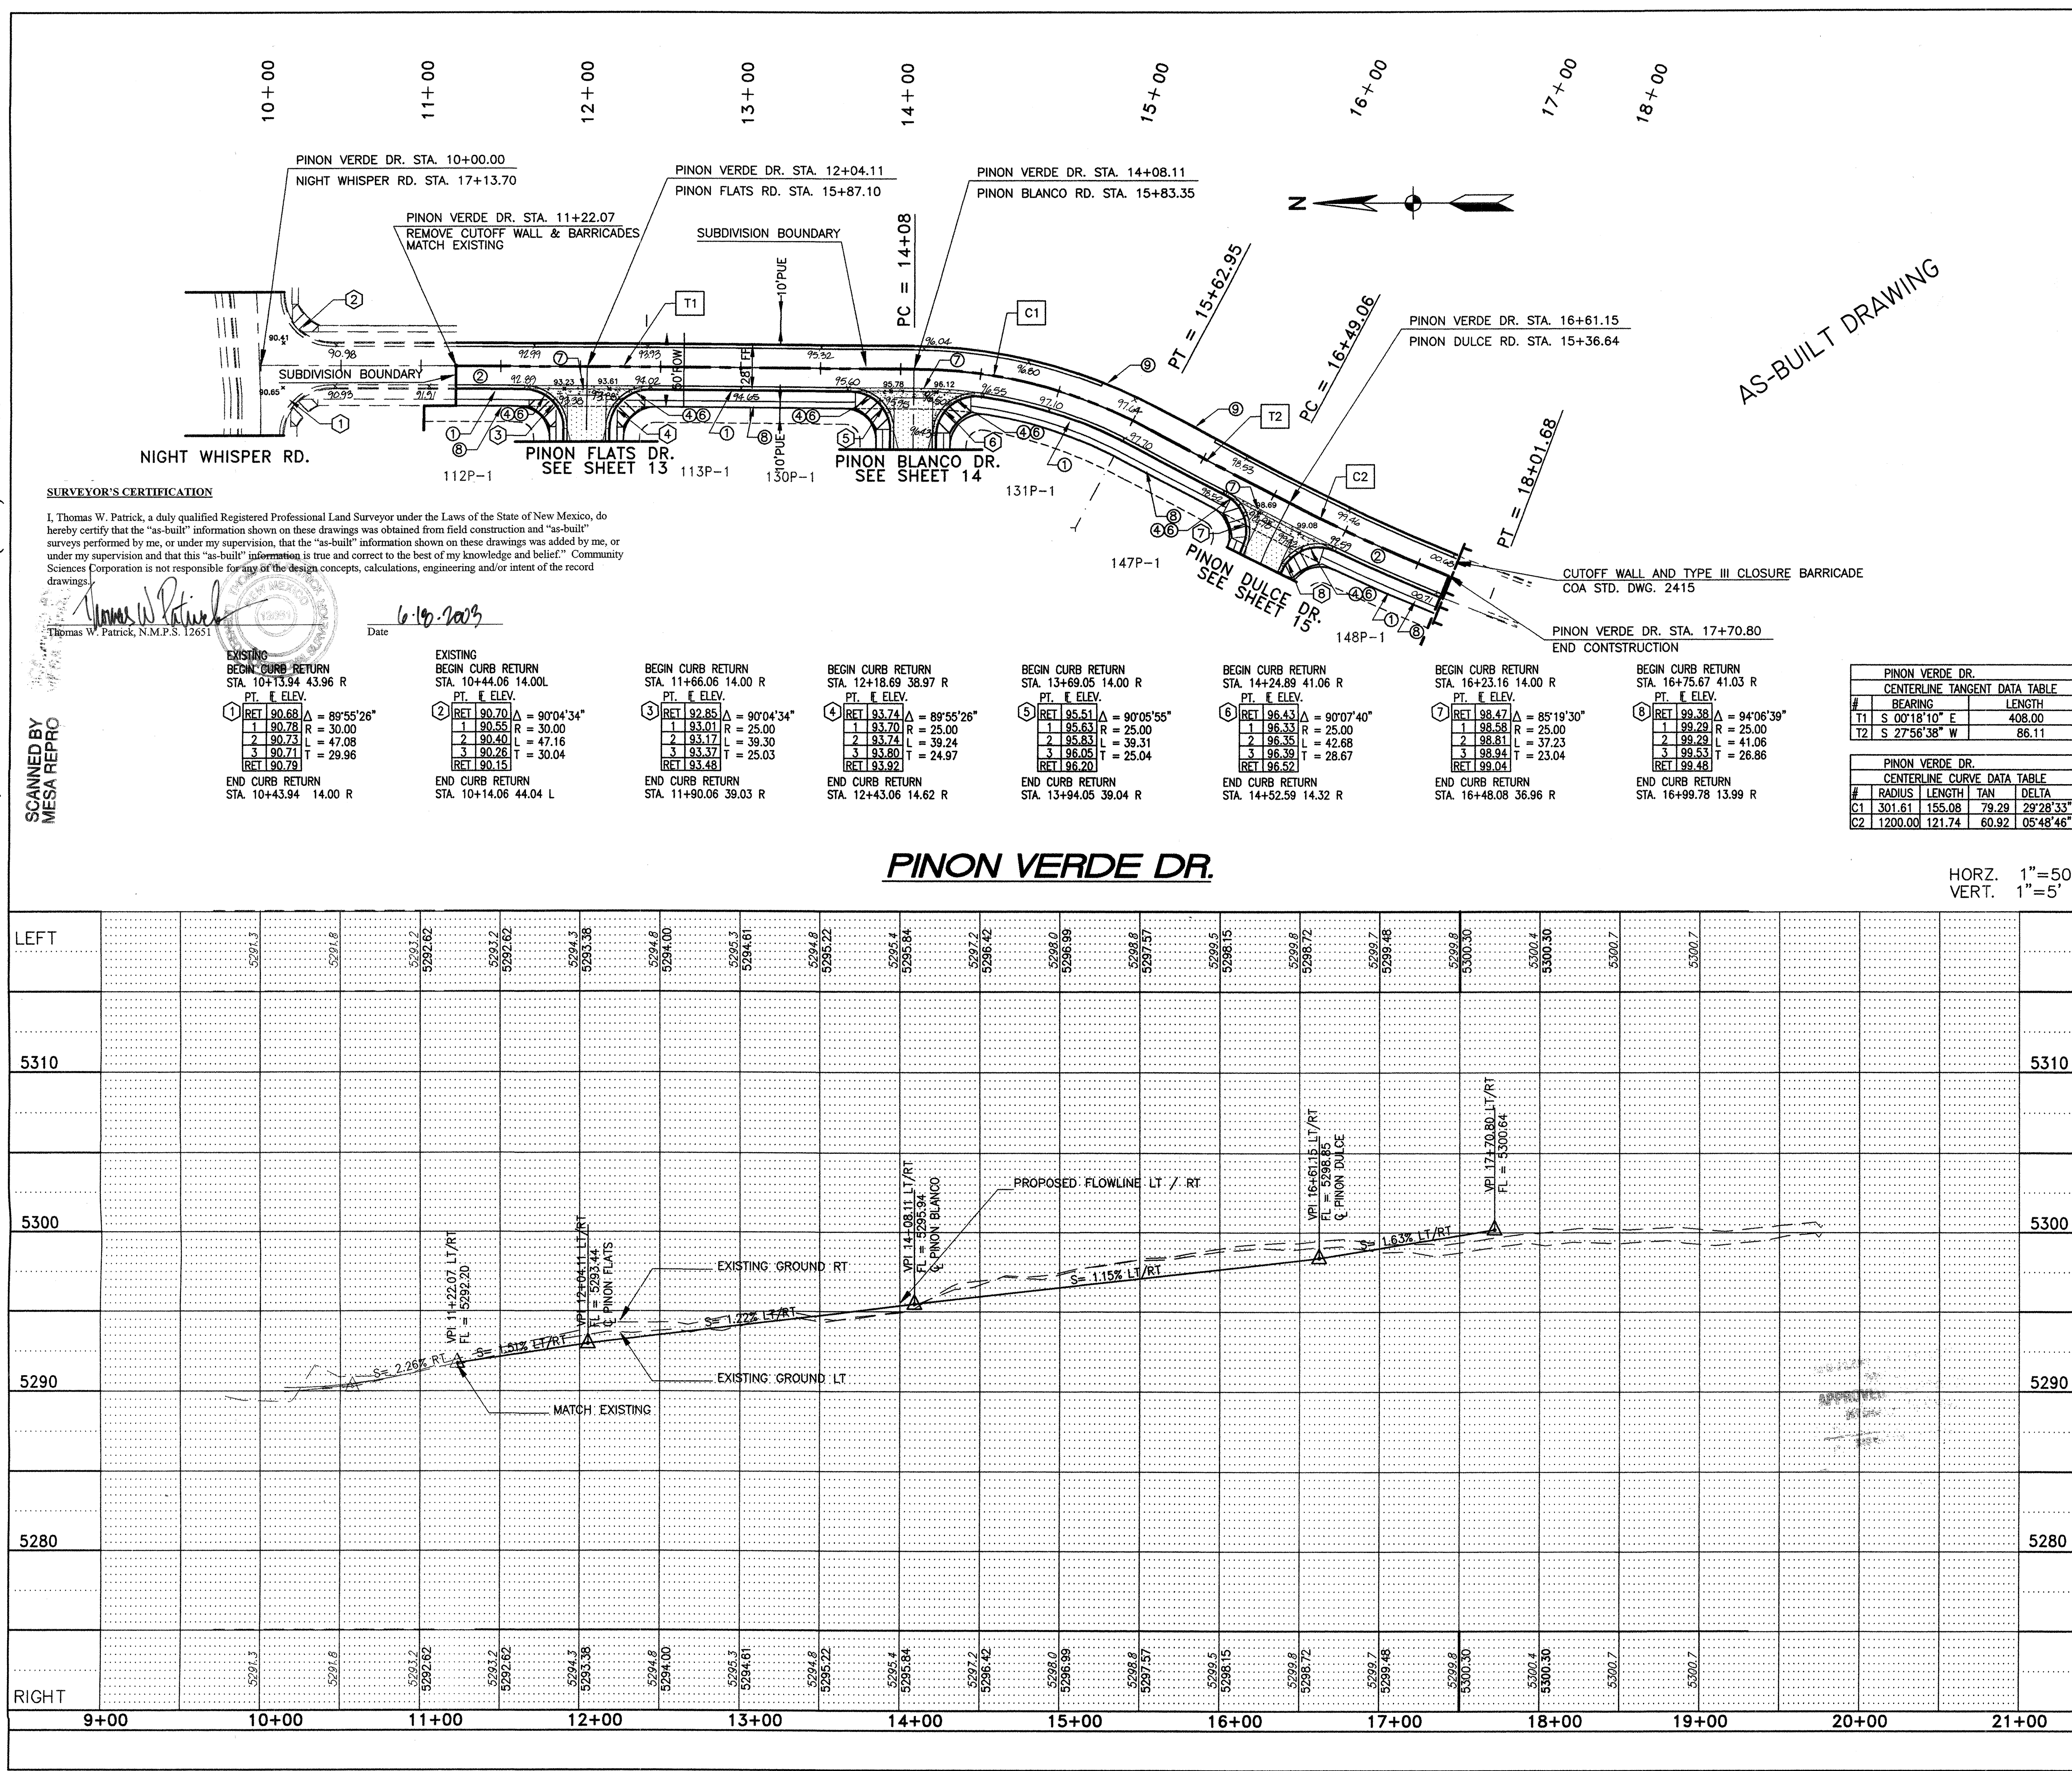

LEGEND:		ROW LINE LOT LINE PUBLIC UTILITY EASEMENT		PROPOSED EXISTING		ROW CENTER LINE EDGE OF PAVEMENT SUBDIVISION BOUNDARY STANDARD CURB & GUTTER		TEMPORARY ASPHALT ASPHALT TRANSITION SIDEWALK & HANDICAP RAMPS FL SPOT ELEVATIONS	
 X 50.50		 X 50.50		 X 50.50		 X 50.50		 X 50.50	
CONSTRUCTION NOTES: ① CONSTRUCT 8" CURB & GUTTER PER COA STANDARD #2415 ② CONSTRUCT 3" ASPHALT CONCRETE PAVEMENT PER COA STANDARD #2405, SEE SHT 11 ③ CONSTRUCT 4" CONCRETE SIDEWALK PER COA STANDARD #2430 (DEFERRED) ④ CONSTRUCT CURB RETURNS PER COA STANDARD #2420 ⑤ CONSTRUCT CROWN TRANSITION PER COA STANDARD #2401 ⑥ BUILD HANDICAP RAMP PER COA STANDARD #2441 CASE #2 ⑦ VALLEY GUTTER PER COA STANDARD #2420 ⑧ CONSTRUCT 4" CONCRETE SIDEWALK PER COA STANDARD #2430 ⑨ CONSTRUCT 8" TEMPORARY ASPHALT CURB PER COA STD #2415									
GENERAL NOTES: 1. ANY ADDITIONAL GRADING REQUIRED TO MATCH PROPOSED STREET GRADES SHALL BE INCIDENTAL TO PAVING ITEMS. 2. ANY DAMAGE TO THE EXISTING FACILITIES, (C&G, PAVEMENT CONDUITS, LANDSCAPING, UTILITY LINES, ETC.) DURING CONSTRUCTION SHALL BE REPLACED AT THE CONTRACTOR'S EXPENSE. 3. WHEELCHAIR RAMPS SHALL BE CONSTRUCTED PRIOR TO ACCEPTANCE OF CURB & GUTTER. 4. DIMENSIONS SHOWN AS FF ARE FLOW LINE TO FLOW.									
 GRAPHIC SCALE IN FEET:									
QuikDraw ENGINEERING, L.L.C. P.O. Box 729 Corrales, NM 87048 Office (505) 699-0389 Fax (505) 697-0389									
Community Sciences Corporation LAND PLANNING ENGINEERING SURVEYING P.O. Box 1328 Corrales, New Mexico 87048									
JOB NO.: N291-33									
CITY OF ALBUQUERQUE PUBLIC WORKS DEPARTMENT ENGINEERING DEVELOPMENT GROUP									
TITLE: RIDGEVIEW VILLAGE UNIT II PAVING PLAN & PROFILES PINON VERDE DR.									
Design Review Committee			City Engineer Approval			Mo./Day/Yr		Mo./Day/Yr	
DESIGN REVIEW COMMITTEE			CITY ENGINEER						
City Project No. 683082			Zone Map No. A-11			Sheet 17		of 24	

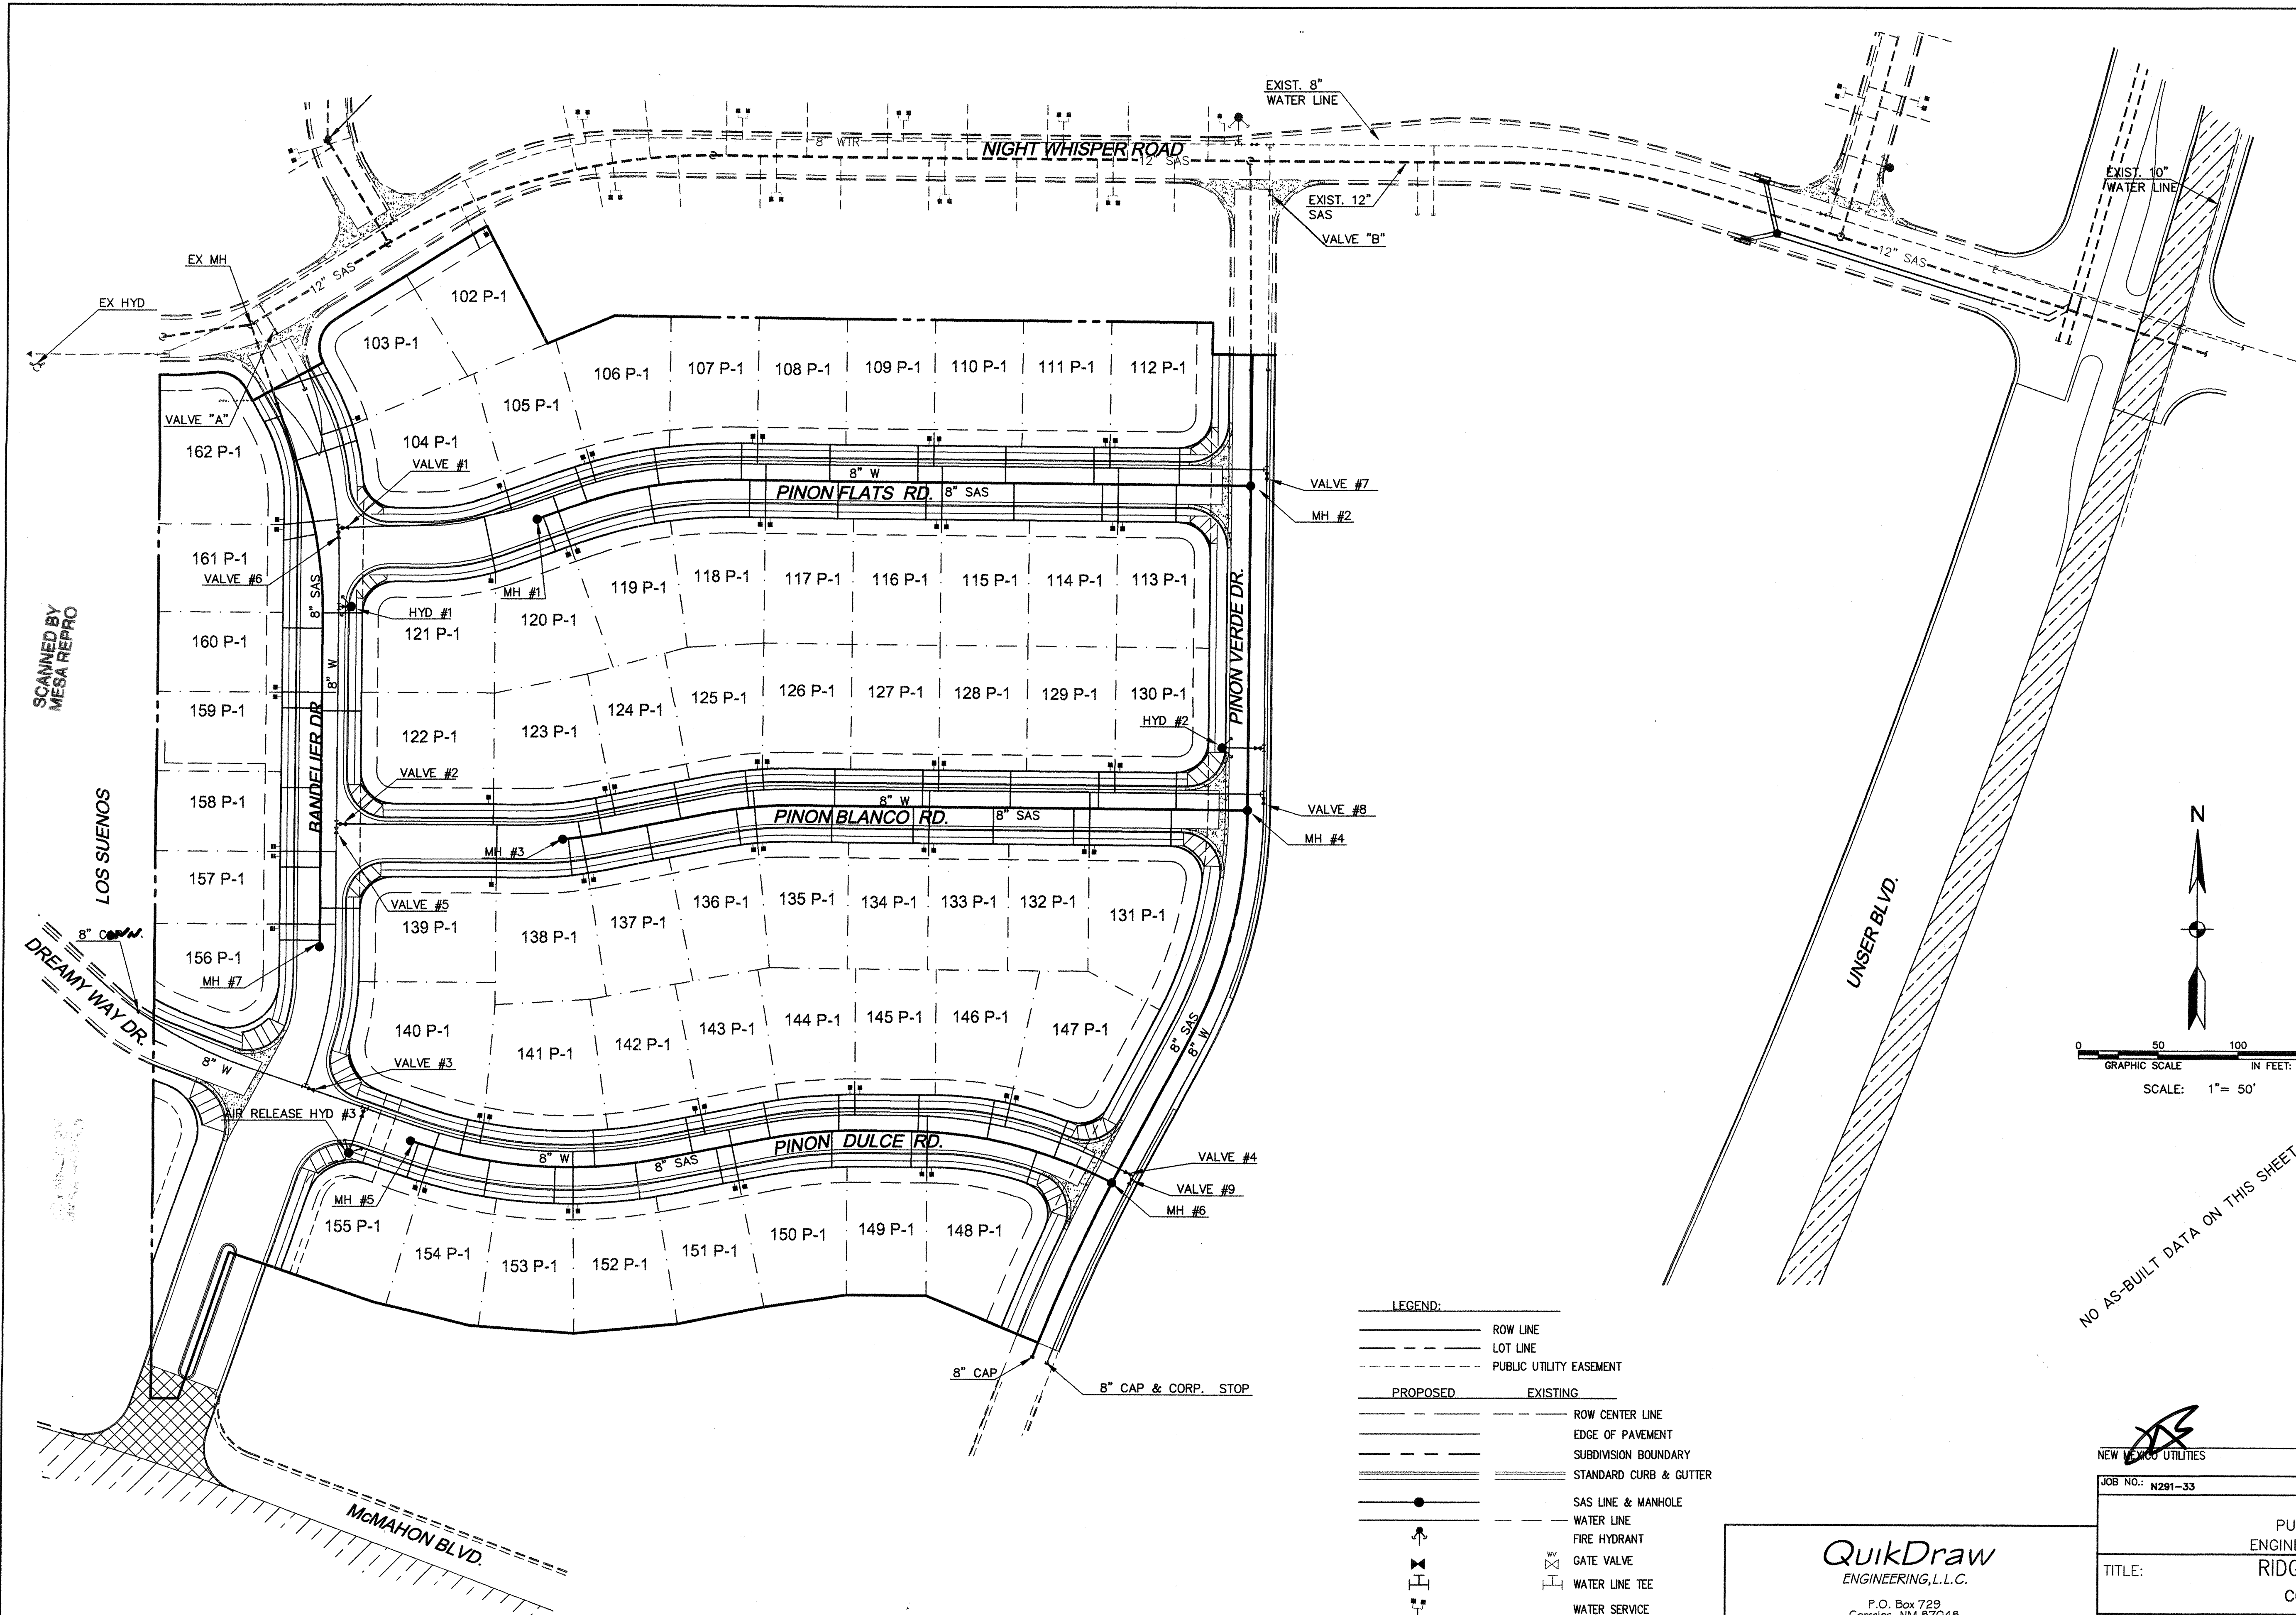

- LEGEND:
- ROW LINE
 - LOT LINE
 - PUBLIC UTILITY EASEMENT
- PROPOSED EXISTING
- ROW CENTER LINE
 - EDGE OF PAVEMENT
 - SUBDIVISION BOUNDARY
 - STANDARD CURB & GUTTER
 - SAS LINE & MANHOLE
 - WATER LINE
 - FIRE HYDRANT
 - GATE VALVE
 - WATER LINE TEE
 - WATER SERVICE
 - SAS SERVICE
 - STORM DRAIN
 - DROP INLET
 - CAP OR PLUG

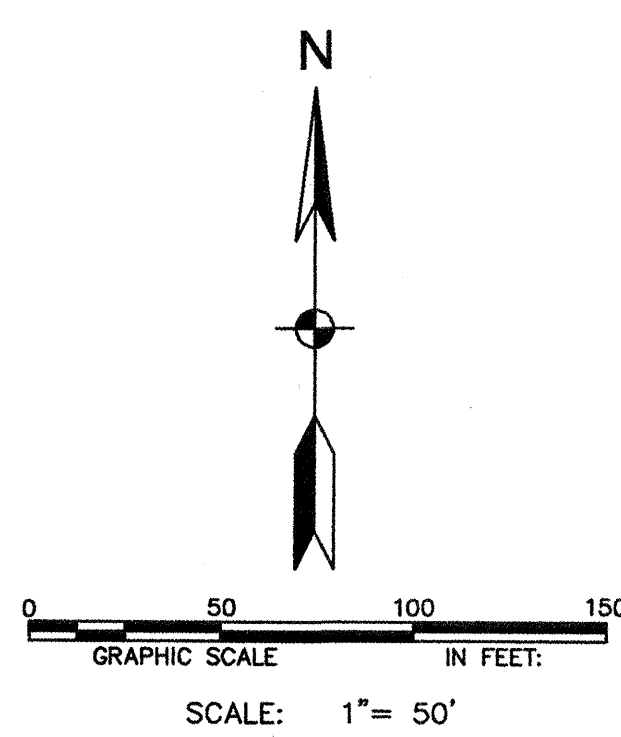

NO AS-BUILT DATA ON THIS SHEET

QuikDraw
ENGINEERING, L.L.C.
P.O. Box 729
Corrales, NM 87046
Office (505) 896-0369 Fax (505) 897-0369

Community Sciences Corporation
LAND PLANNING ENGINEERING SURVEYING
P.O. Box 1328 Corrales, New Mexico 87048

NEW MEXICO UTILITIES 10-21-02 DATE:

JOB NO.: N291-33

CITY OF ALBUQUERQUE
PUBLIC WORKS DEPARTMENT
ENGINEERING DEVELOPMENT GROUP



TITLE: RIDGEVIEW VILLAGE UNIT II
COMPOSITE UTILITY PLAN

DESIGN REVIEW COMMITTEE	CITY ENGINEER APPROVAL	Mo./Day/Yr	Mo./Day/Yr
DEC 17 2002	DEC 24 2002		
DESIGN REVIEW COMMITTEE	CITY ENGINEER		

City Project No. 683082 Zone Map No. A-11 Sheet 18 of 24

SURVEY INFORMATION		BENCH MARKS		AS BUILT INFORMATION	
NO.	BY	DATE	STAMPED "ACS BM. 1-811" EPOXIED TO TOP OF CONCRETE CURB, EAST SIDE OF UNSER BLVD. NW. 24 FT. +/- NORTH OF THE BERNALILLO / SANDOVAL COUNTY FENCE LINE, 210.1 FT. SOUTH OF "SPEED LIMIT 45" SIGN, AND GUTTER. ELEV. = 5279.75, (NSVD 1929)	CONTRACTOR	NEW CONCEPTS
1	COMMUNITY SCIENCES CORP	02/02		WORKS BY	CSC
				ACCEPTANCE BY	RLS
				VERIFICATION BY	NA
				DRAWINGS BY	NA
				CHECKED BY	NA
				RECORDED BY	NA

ENGINEER'S SEAL		REVISIONS		DESIGN	
		NO.	DATE	REH	DATE
				RLS	09/2002
				LCL	09/2002

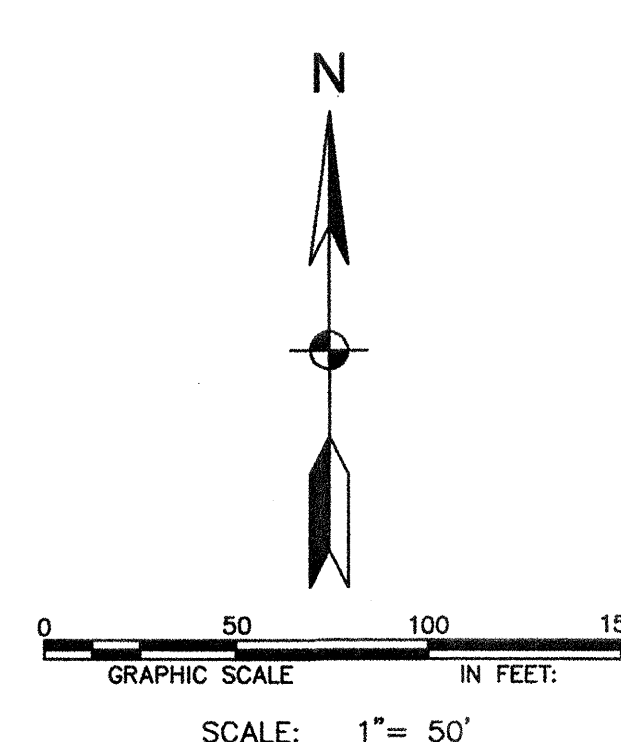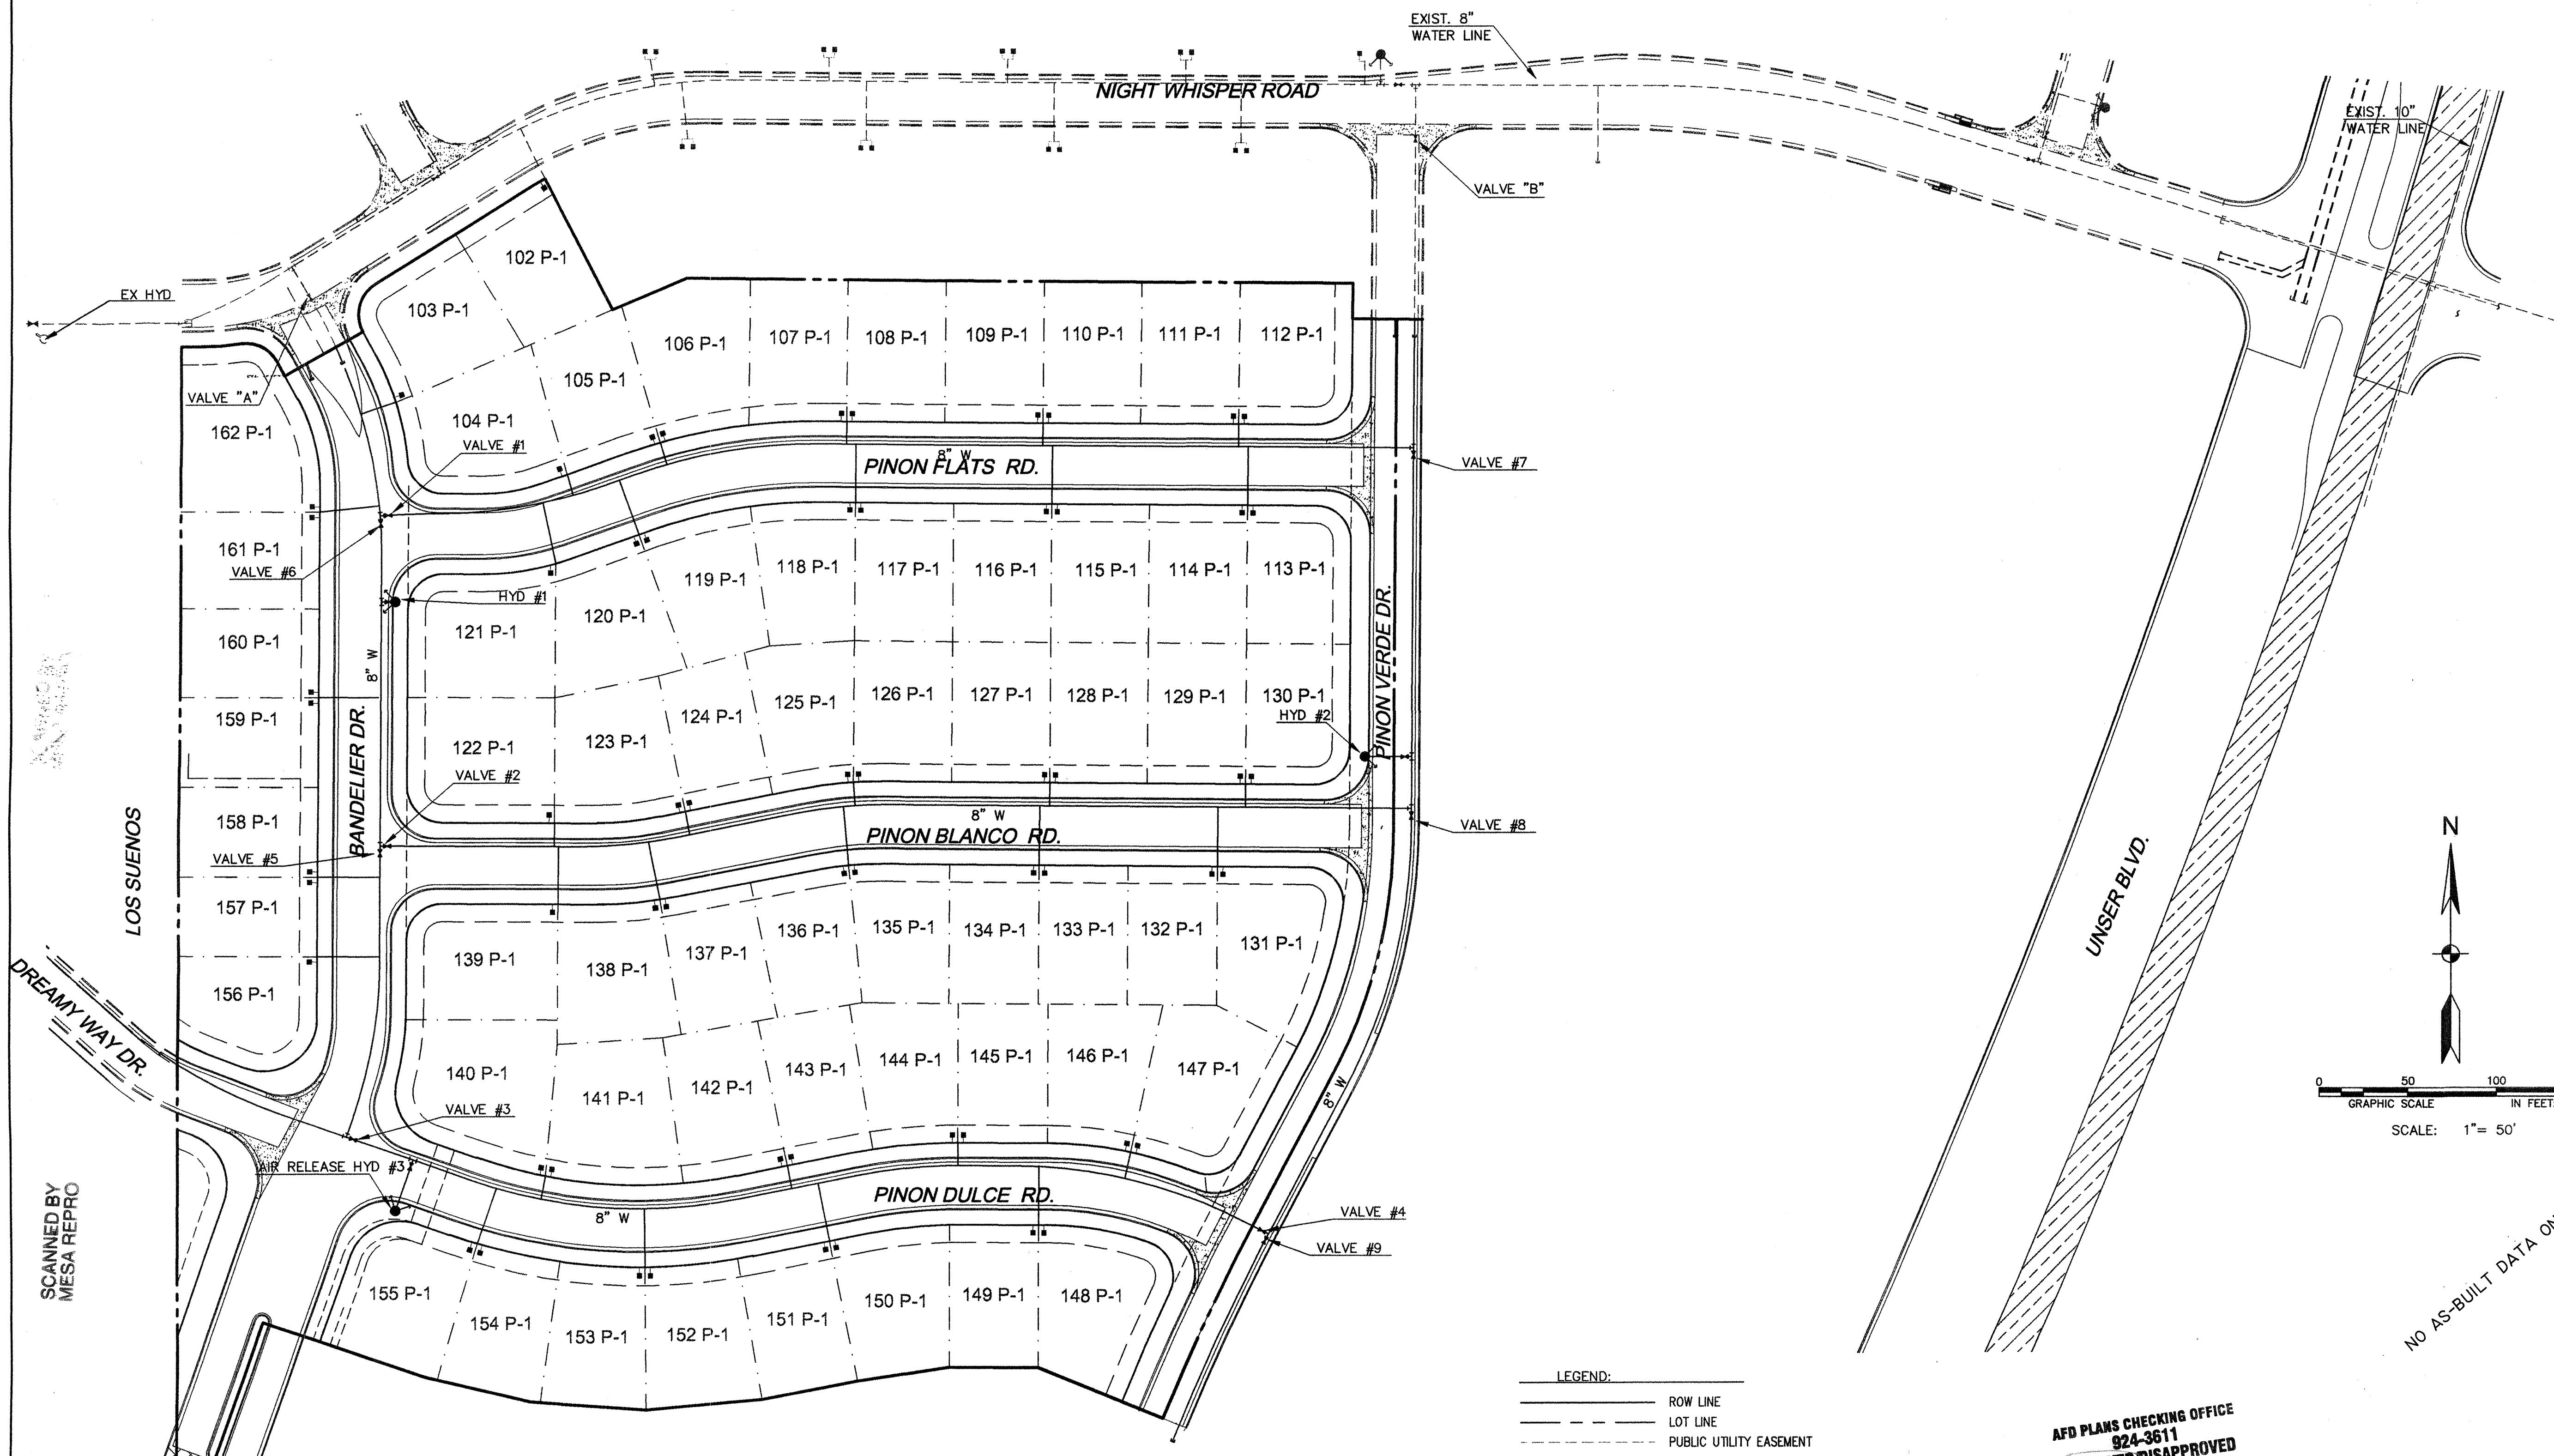

NO AS-BUILT DATA ON THIS SHEET

FLUSHING SCHEDULE	
1.	CLOSE ALL VALVES "A" through #12.
2.	OPEN HYD. #2 AND VALVES "B", #7.
3.	OPEN END LINE CORP. STOP AND VALVES #8 AND #9, CLOSE HYD. #2.
4.	OPEN HYD. #1 AND VALVES #1 AND #6, CLOSE CORP. STOP.
5.	OPEN HYD. #3 AND VALVES "A", #3 AND #5, CLOSE HYD #1, VALVE #1.
6.	OPEN VALVE #2, CLOSE VALVES "A" AND #6
7.	OPEN VALVE #4, CLOSE VALVES #2, #3 AND #5
8.	CLOSE HYD. #3 AND OPEN ALL VALVES.

- NOTES:
1. FLUSHING TO CONTINUE UNTIL ENTIRE VOLUME OF PIPE HAS BEEN REPLACED AND IS FREE OF CHLORINE ODOR.
 2. ALL VALVES TO BE IN CLOSED POSITION PRIOR TO FLUSHING.
 3. DEAD END VALVES TO BE FLUSHED VIA MOST REMOTE SERVICE TAP.

LEGEND:

---	ROW LINE
---	LOT LINE
---	PUBLIC UTILITY EASEMENT
---	PROPOSED
---	EXISTING
---	ROW CENTER LINE
---	EDGE OF PAVEMENT
---	SUBDIVISION BOUNDARY
---	STANDARD CURB & GUTTER
---	SAS LINE & MANHOLE
---	WATER LINE
---	FIRE HYDRANT
---	GATE VALVE
---	WATER LINE TEE
---	WATER SERVICE
---	CAP OR PLUG

AFD PLANS CHECKING OFFICE
924-3611
APPROVED/DISAPPROVED
HYDRANT(S) ONLY
Signature & Date
11/7/02

QuikDraw
ENGINEERING, L.L.C.
P.O. Box 729
Corrales, NM 87048
Office (505) 696-0369 Fax (505) 697-0369

Community Sciences Corporation
LAND PLANNING ENGINEERING SURVEYING
P.O. Box 1328 Corrales, New Mexico 87048

NEW MEXICO UTILITIES
DATE: 10-21-02


JOB NO.: N291-33

CITY OF ALBUQUERQUE
PUBLIC WORKS DEPARTMENT
ENGINEERING DEVELOPMENT GROUP
TITLE: RIDGEVIEW VILLAGE UNIT II
WATER SHUTOFF / FLUSHING PLAN

Design Review Committee	City Engineer Approval	Mo./Day/Yr	Mo./Day/Yr
APPROVED DEC 17 2002	APPROVED DEC 24 2002		
DESIGN REVIEW COMMITTEE	CITY ENGINEER		
City Engineer No.	Zone Map No.	Sheet	of
683082	A-11	19	24

SURVEY INFORMATION		BENCH MARKS		AS BUILT INFORMATION	
NO.	DATE	DATE	STAMPED "ACS BM, 1-1/2" EPOXY TO TOP OF CONCRETE CURB, EAST SIDE OF UNSER BLVD. NW, 24 FT. +/- NORTH OF THE BERNALILLO / SANDOVAL COUNTY FENCE LINE, 210.1 FT. SOUTH OF "SPEED LIMIT 45" SIGN, 50.7 FT. NORTH OF THE SOUTH END OF CURB AND GUTTER. ELEV. = 5278.75, (NGVD 1929)	CONTRACTOR	NEW CONCEPTS
1.	02/02	02/02		WORK STARTED BY	CSC
2.				FIELD ACCEPTANCE BY	LCL
3.				DESIGNED BY	NA
4.				CHECKED BY	NA
5.				REVIEWED BY	NA
6.				DATE	7/9/03
7.				DATE	
8.				DATE	
9.				DATE	
10.				DATE	

SCANNED BY
MESA REPRO

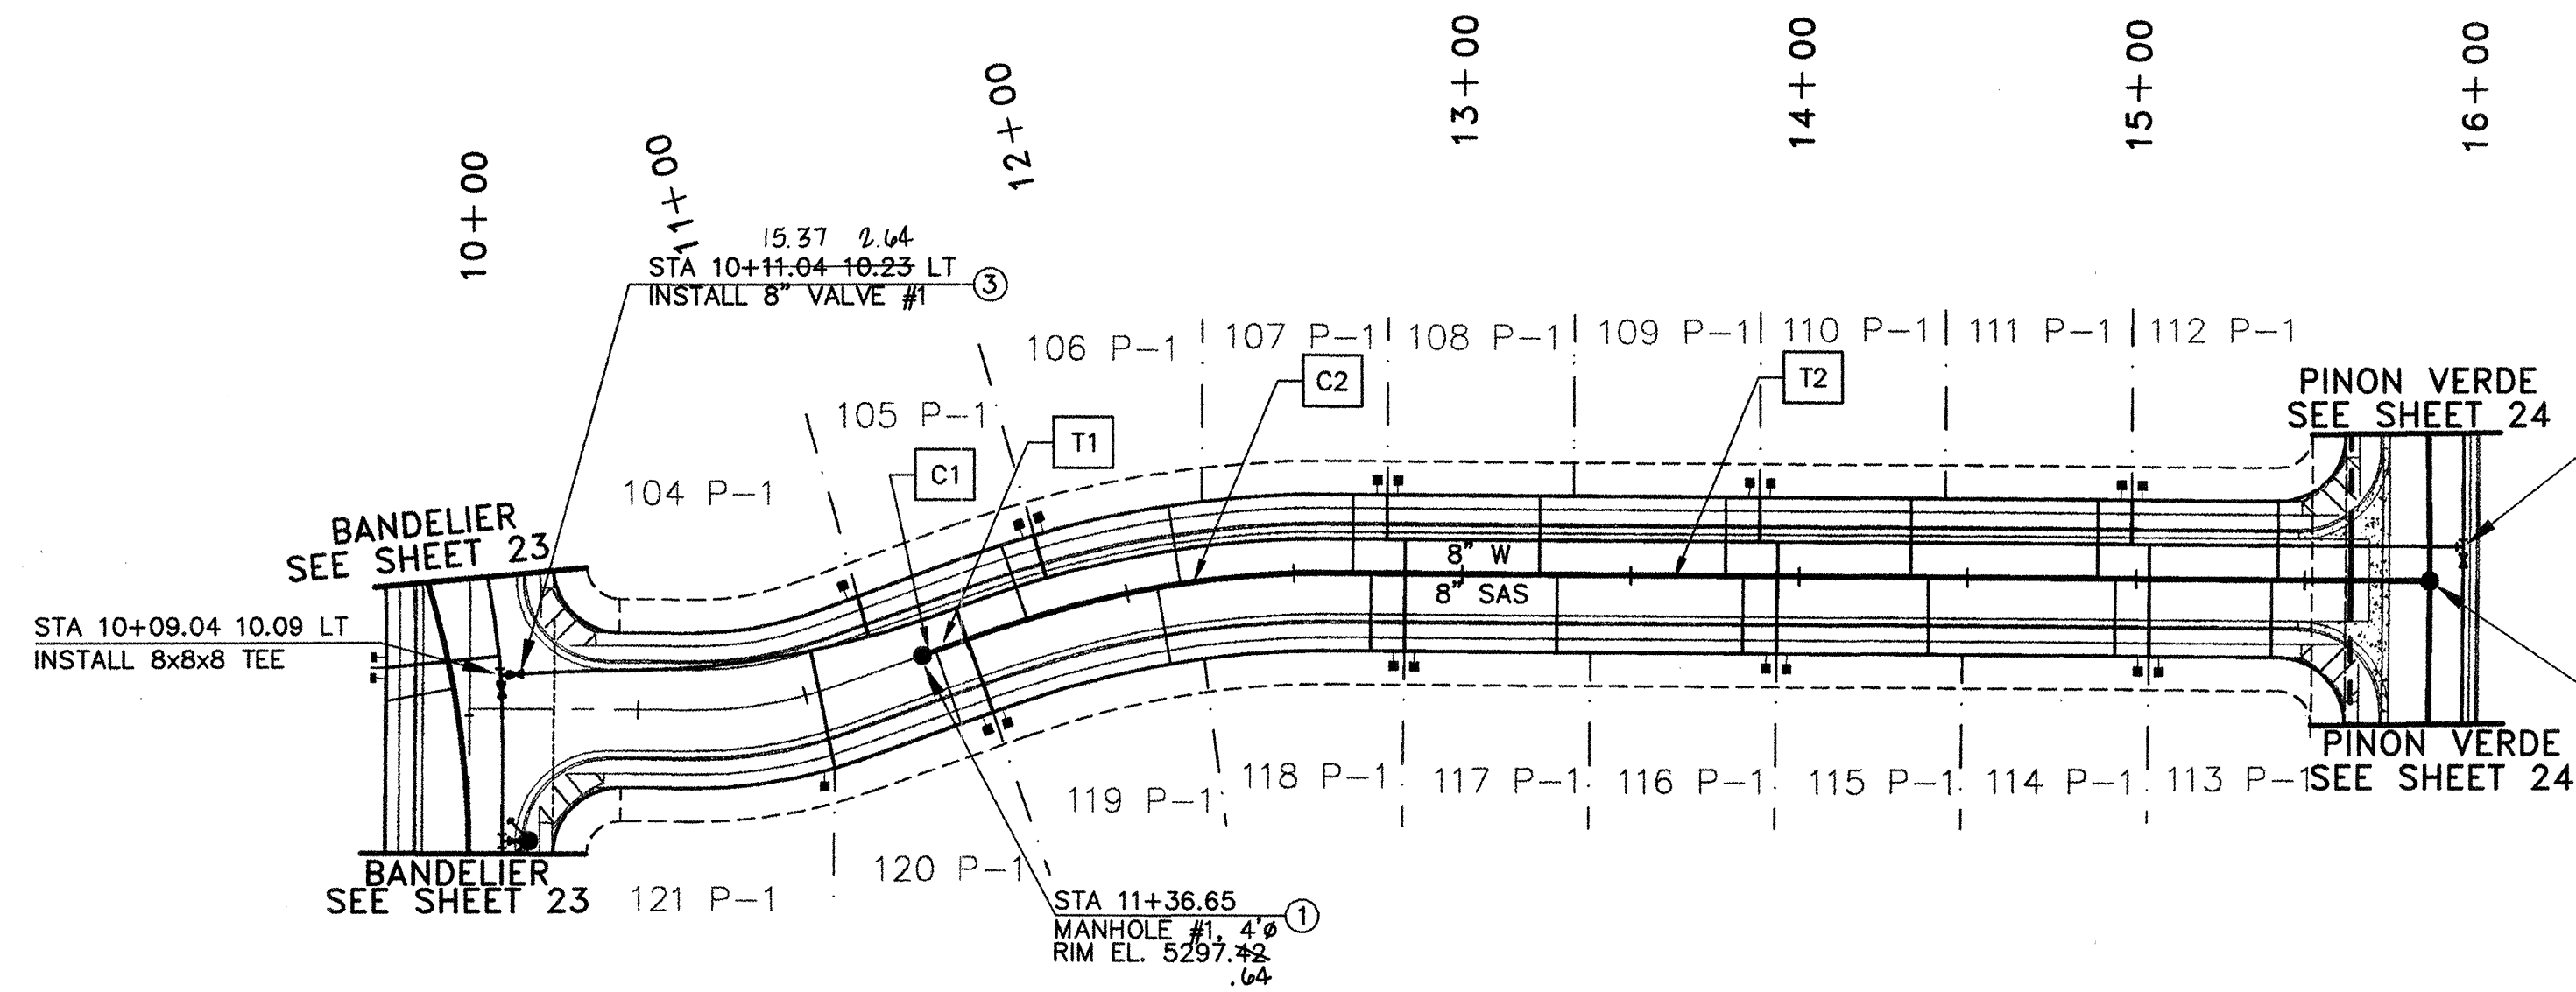

SANITARY SEWER SERVICES - PINON FLATS RD.				
LOT NO.	SAS STATION & OFFSET	SAS LENGTH	INV. BEGIN	TOP OF PIPE AT PLUG
105	11+68.68 23.00 L	23.00	5289.56	5291.62
106	12+15.99 23.00 L	23.15	5288.65	5291.22
107	12+67.65 23.00 L	23.00	5287.71	5290.78
108	13+22.85 23.00 L	23.00	5286.66	5290.31
109	13+78.05 23.00 L	23.00	5285.62	5289.84
110	14+33.25 23.00 L	23.00	5284.58	5289.37
111	14+88.45 23.00 L	23.00	5283.54	5288.90
112	15+42.04 23.00 L	23.00	5282.53	5288.38

NOTE: STATIONING IS AT PROPERTY LINE

WATER SERVICES - PINON FLATS ROAD			
LOT NO.	STATION & OFFSET	WL TYPE	WL
104	11+24.35 23.00L	SINGLE	
105	11+77.97 23.00L	DOUBLE	
106	12+77.65 23.00L	DOUBLE	
107	13+88.05 23.00L	DOUBLE	
108	14+98.45 23.00L	DOUBLE	

NOTE: STATIONING IS AT PROPERTY LINE

SANITARY SEWER SERVICES - PINON FLATS RD.				
LOT NO.	SAS STATION & OFFSET	SAS LENGTH	INV. BEGIN	TOP OF PIPE AT PLUG
120	11+40.65 23.00 R	23.00	5290.10	5291.85
119	12+09.20 23.00 R	23.00	5288.61	5291.27
118	12+73.00 23.00 R	23.00	5287.61	5290.73
117	13+28.20 23.00 R	23.00	5286.56	5290.26
116	13+83.40 23.00 R	23.00	5285.52	5289.79
115	14+38.60 23.00 R	23.00	5284.48	5289.32
114	14+93.80 23.00 R	23.00	5283.44	5288.86
113	15+40.16 23.00 R	23.00	5282.58	5288.61

NOTE: STATIONING IS AT PROPERTY LINE

WATER SERVICES - PINON FLATS RD.			
LOT NO.	STATION & OFFSET	WL TYPE	WL
121	11+02.35 23.00R	SINGLE	
120	11+50.65 23.00R	DOUBLE	
119	12+83.00 23.00R	DOUBLE	
118	13+93.40 23.00R	DOUBLE	
117	15+03.80 23.00R	DOUBLE	

NOTE: STATIONING IS AT PROPERTY LINE

PINON FLATS RD.			
#	BEARING	LENGTH	DELTA
T1	N 70°23'44" E	21.25	
T2	S 89°37'16" E	323.49	

PINON FLATS RD.			
#	RADIUS	LENGTH	DELTA
C1	285.00	1.08	0°13'01"
C2	300.00	104.63	19°59'00"

SURVEYOR'S CERTIFICATION

I, Thomas W. Patrick, a duly qualified Registered Professional Land Surveyor under the Laws of the State of New Mexico, do hereby certify that the "as-built" information shown on these drawings was obtained from field construction and "as-built" surveys performed by me, or under my supervision, that the "as-built" information shown on these drawings was added by me, or under my supervision and that this "as-built" information is true and correct to the best of my knowledge and belief. Community Sciences Corporation is not responsible for any of the design concepts, calculations, engineering and/or intent of the record drawings.

Thomas W. Patrick, N.M.P.S. 12651

STA 15+97.06 10.00 LT
INSTALL 8x8x8 TEE



AS-BUILT DRAWING


LEGEND:	
---	ROW LINE
---	LOT LINE
---	PUBLIC UTILITY EASEMENT
PROPOSED	
---	ROW CENTER LINE
---	EDGE OF PAVEMENT
---	SUBDIVISION BOUNDARY
---	STANDARD CURB & GUTTER
EXISTING	
---	SAS LINE & MANHOLE
---	WATER LINE
---	FIRE HYDRANT
---	GATE VALVE
---	WATER LINE TEE
---	WATER SERVICE
---	SAS SERVICE
---	STORM DRAIN
---	DROP INLET

CONSTRUCTION NOTES:

- BUILD SANITARY SEWER MANHOLE PER COA STANDARD #2101
- BUILD SANITARY SEWER SERVICE PER NMUI REQUIREMENTS
- BUILD 8" PVC GATE VALVE PER COA STANDARD #SERIES 2326
- BUILD FIRE HYDRANT ASSEMBLY PER COA STANDARD #2340 & 2347
- BUILD WATER SERVICE LATERALS AND TYPICAL UTILITY LAYOUT PER NMUI REQUIREMENTS

GENERAL NOTES:

- ALL CURVE DATA AND DIMENSIONS REFER CENTERLINE OF PIPE OR MANHOLE. ALL SAS SLOPES ARE FROM INVERT TO INVERT.
- CONTRACTOR IS RESPONSIBLE FOR REPAIR AND/OR REPLACEMENT OF ALL UTILITY CONDUITS AND EXISTING LINES.
- CONTRACTOR SHALL PROVIDE THE INSPECTORS WITH PROPOSED HYDROSTATIC TESTING PLAN. THE PLAN MUST BE APPROVED BEFORE TESTING OPERATIONS BEGIN.
- ANY DAMAGE TO THE EXISTING FACILITIES (CURB AND GUTTER, PAVEMENT, CONDUITS, LANDSCAPING, UTILITY LINES, ETC.) DURING CONSTRUCTION SHALL BE REPLACED AT THE CONTRACTORS' EXPENSE.
- CONTRACTOR TO BLOCK ALL JOINTS IN ACCORDANCE WITH STD. DWG. 2320
- WATER AND SEWER WILL BE CONSTRUCTED IN ACCORDANCE WITH NMUI REQUIREMENTS FOR ACCEPTANCE AND MAINTENANCE

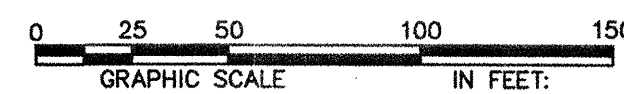

NEW MEXICO UTILITIES

10-21-02

QuikDraw
ENGINEERING, L.L.C.

P.O. Box 729
Corrales, NM 87048
Office (505) 898-0389 Fax (505) 897-0389



Community
Sciences
Corporation

LAND PLANNING ENGINEERING SURVEYING
P.O. Box 1328 Corrales, New Mexico 87048

JOB NO: N291-33

CITY OF ALBUQUERQUE
PUBLIC WORKS DEPARTMENT
ENGINEERING DEVELOPMENT GROUP

TITLE: RIDGEVIEW VILLAGE UNIT II
UTILITY IMPROVEMENTS
PINON FLATS RD.

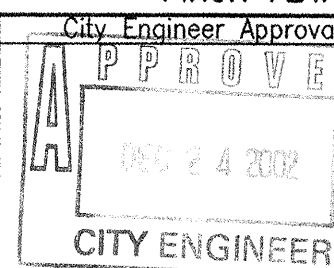
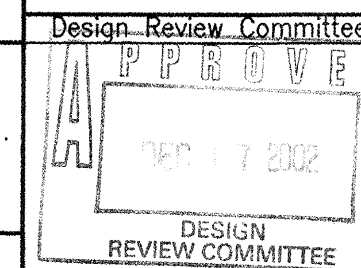


Mo./Day/Yr	Mo./Day/Yr

City Project No. 683082

Zone Map No. A-11

Sheet 20 of 24

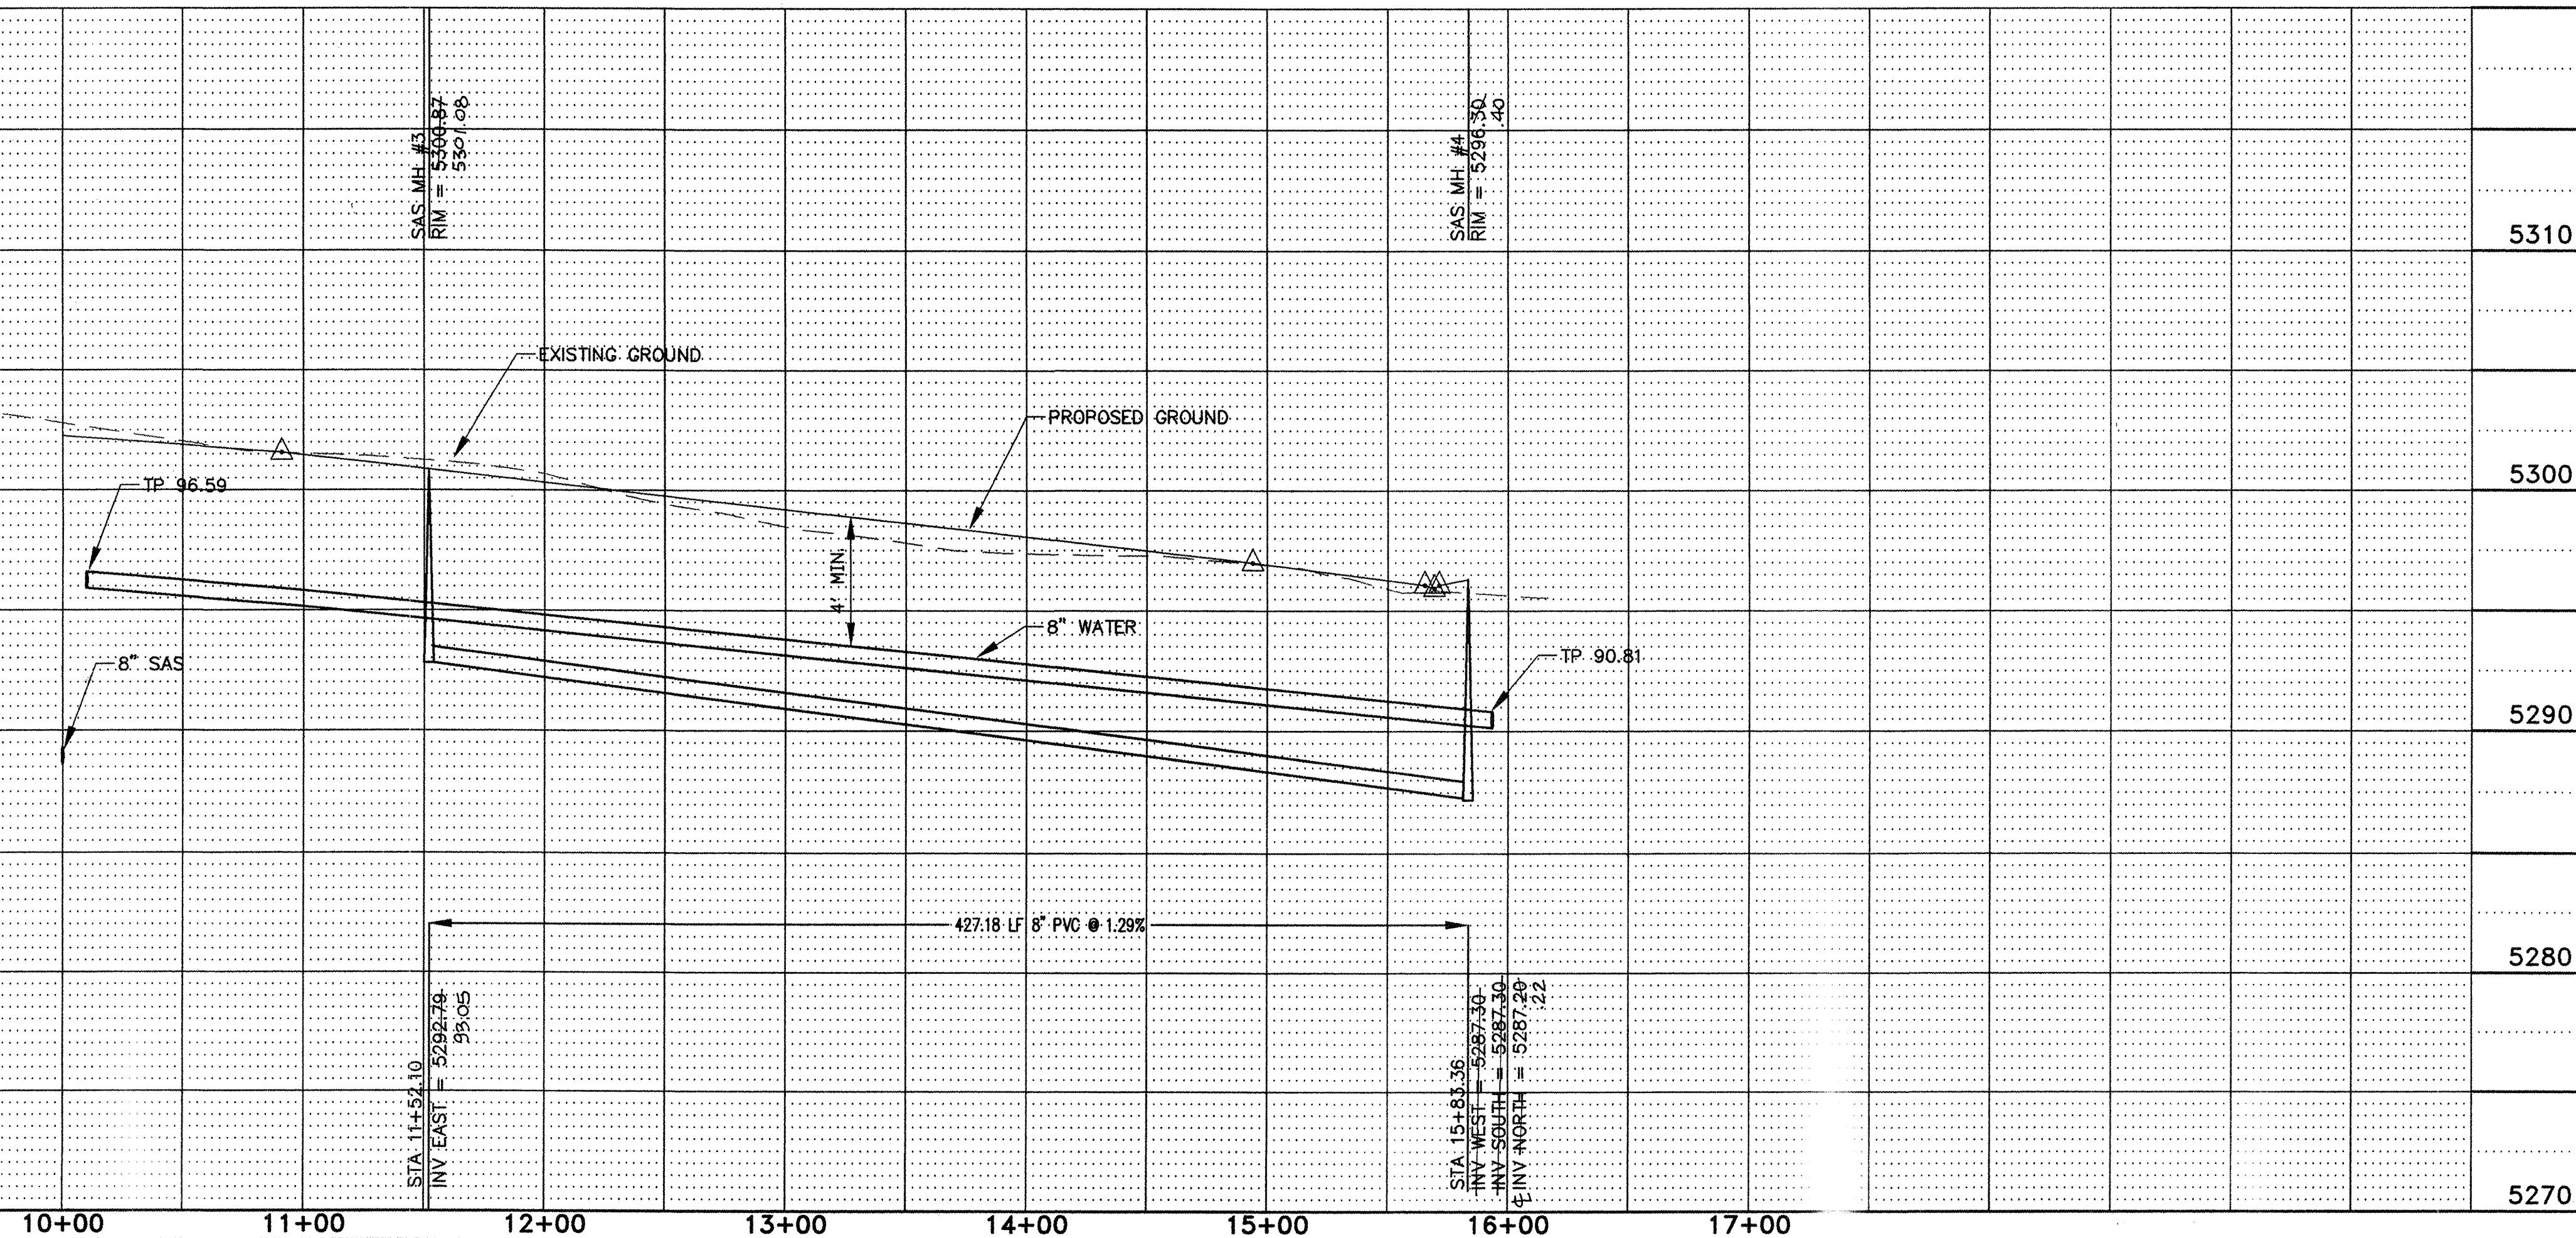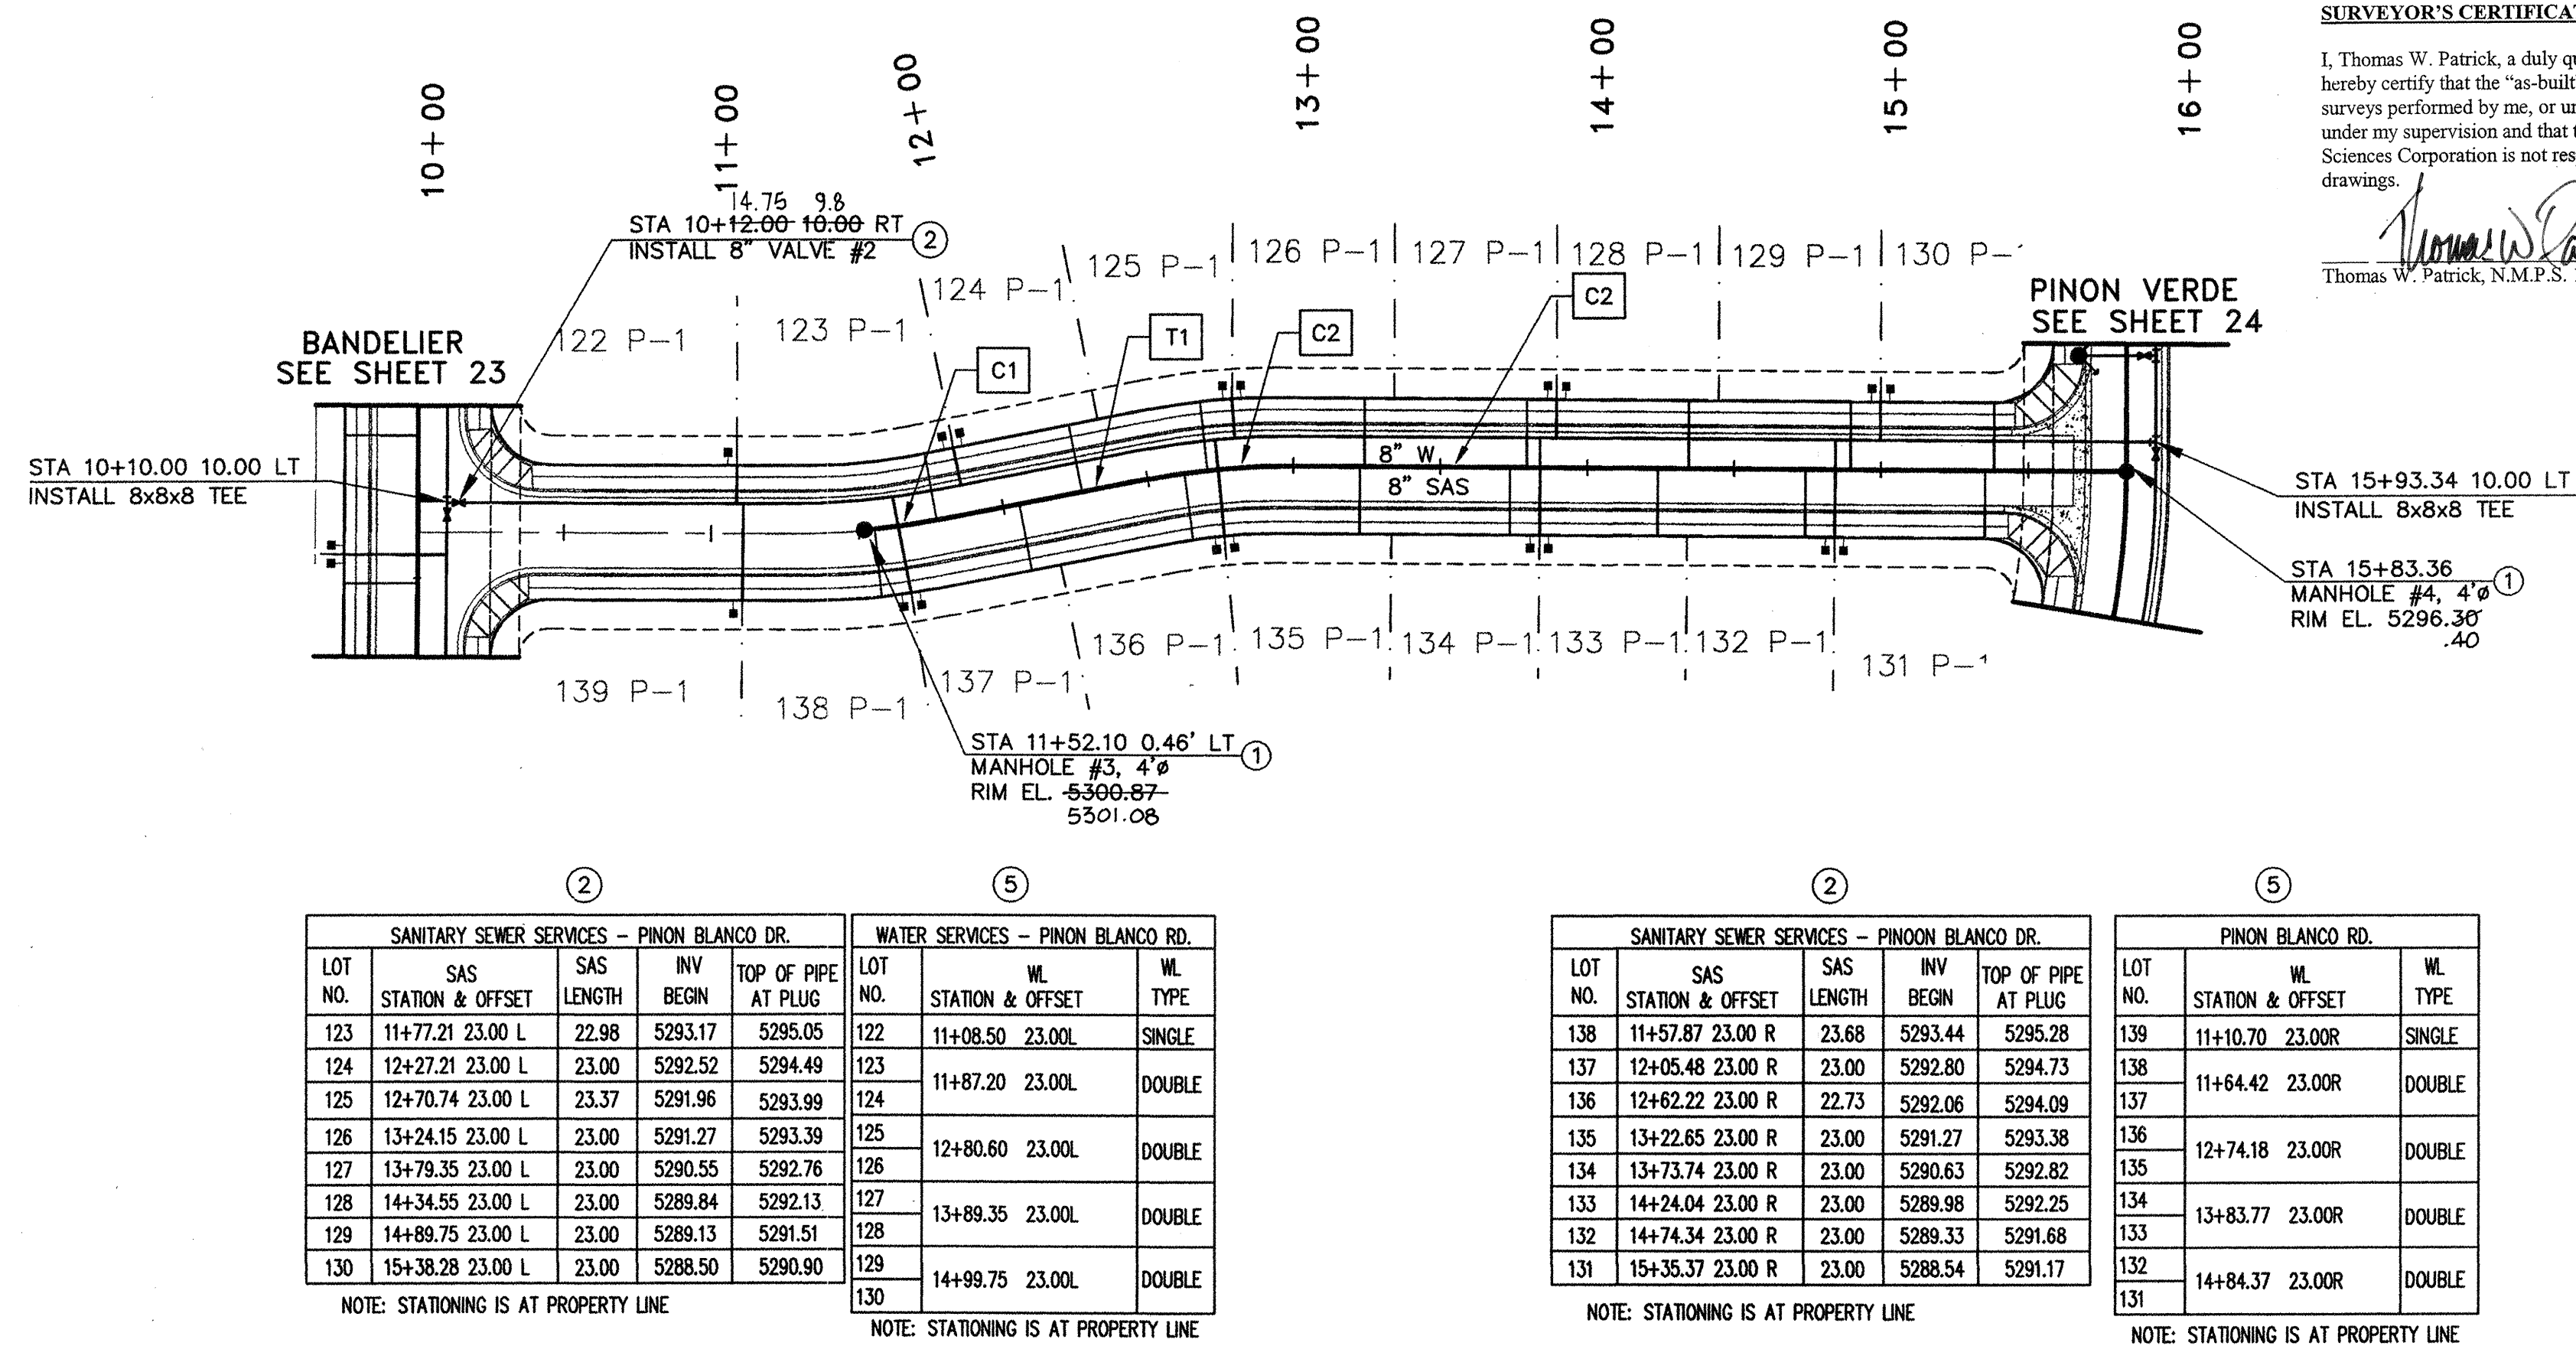SCANNED BY:
MESA REPRO.

LEGEND:

PROPOSED EXISTING

ROW LINE
EDGE OF PAVEMENT
SUBDIVISION BOUNDARY
STANDARD CURB & GUTTER
SAS LINE & MANHOLE
WATER LINE
FIRE HYDRANT
GATE VALVE
WATER LINE TEE
WATER SERVICE
SAS SERVICE
STORM DRAIN
DROP INLET

CONSTRUCTION NOTES:

① BUILD SANITARY SEWER MANHOLE PER COA STANDARD #2101

② BUILD SANITARY SEWER SERVICE PER NMUI REQUIREMENTS

③ BUILD 8" PVC GATE VALVE PER COA STANDARD #SERIES 2326

④ BUILD FIRE HYDRANT ASSEMBLY PER COA STANDARD #2340 & 2347

⑤ BUILD WATER SERVICE LATERALS AND TYPICAL UTILITY LAYOUT PER NMUI REQUIREMENTS

GENERAL NOTES:

1. ALL CURVE DATA AND DIMENSIONS REFER CENTERLINE OF PIPE OR MANHOLE. ALL SAS SLOPES ARE FROM INVERT TO INVERT.

2. CONTRACTOR IS RESPONSIBLE FOR REPAIR AND/OR REPLACEMENT OF ALL UTILITY CONDUITS AND EXISTING LINES.

3. CONTRACTOR SHALL PROVIDE THE INSPECTORS WITH PROPOSED HYDROSTATIC TESTING PLAN. THE PLAN MUST BE APPROVED BEFORE TESTING OPERATIONS BEGIN.

4. ANY DAMAGE TO THE EXISTING FACILITIES (CURB AND GUTTER, PAVEMENT, CONDUITS, LANDSCAPING, UTILITY LINES, ETC.) DURING CONSTRUCTION SHALL BE REPLACED AT THE CONTRACTORS' EXPENSE.

5. CONTRACTOR TO BLOCK ALL JOINTS IN ACCORDANCE WITH STD. DWG. 2320

6. WATER AND SEWER WILL BE CONSTRUCTED IN ACCORDANCE WITH NMUI REQUIREMENTS FOR ACCEPTANCE AND MAINTENANCE.

GRAPHIC SCALE

0 25 50 100 150
IN FEET

QuikDraw
ENGINEERING, L.L.C.
P.O. Box 729
Corrales, NM 87048
Office (505) 898-0389 Fax (505) 897-0389

Community Sciences Corporation
LAND PLANNING ENGINEERING SURVEYING
P.O. Box 1328 Corrales, New Mexico 87048

JOB NO.: N291-33

CITY OF ALBUQUERQUE
PUBLIC WORKS DEPARTMENT
ENGINEERING DEVELOPMENT GROUP

TITLE: RIDGEVIEW VILLAGE UNIT II
UTILITY IMPROVEMENTS
PINON BLANCO RD.

APPROVE
DESIGN REVIEW COMMITTEE
DEC 17 2002

APPROVE
CITY ENGINEER
DEC 24 2002

Mo./Day/Yr

DESIGNED BY: REH
DRAWN BY: RLS
CHECKED BY: LCL

DATE: 09/2002
DATE: 09/2002
DATE: 09/2002

REMARKS

NO.

DATE

BY

REVISIONS

DESIGN

AS BUILT INFORMATION

CONTRACTOR: NEW CONCEPTS
STAMPED BY: CSC
DATE: 7/9/03
INSPECTOR: CSC
DATE: 7/9/03
FIELD: JSG
DATE: 6/28/03
VERIFICATION: JSG
DATE: 6/28/03
CORRECTED BY: JSG
DATE: 6/28/03
MICRO-FILM INFORMATION

RECORDED BY: JSG
DATE: 6/28/03

NO.

50.7 FT. NORTH OF THE SOUTH END OF CURB AND GUTTER. ELEV. = 5278.75, (NGVD 1929)

City Project No.: 683082
Zone Map No.: A-11
Sheet: 21 of 24

SCANNED BY
MESA REPRO

DREAMY WAY DR.

PINON DULCE RD.


SURVEYOR'S CERTIFICATION

I, Thomas W. Patrick, a duly qualified Registered Professional Land Surveyor under the Laws of the State of New Mexico, do hereby certify that the "as-built" information shown on these drawings was obtained from field construction and "as-built" surveys performed by me, or under my supervision, that the "as-built" information shown on these drawings was added by me, or under my supervision and that this "as-built" information is true and correct to the best of my knowledge and belief. Community Sciences Corporation is not responsible for any of the design concepts, calculations, engineering and/or intent of the record drawings.

Thomas W. Patrick, N.M.P.S. 12651

Date: 6-10-2003

AS-BUILT DRAWING

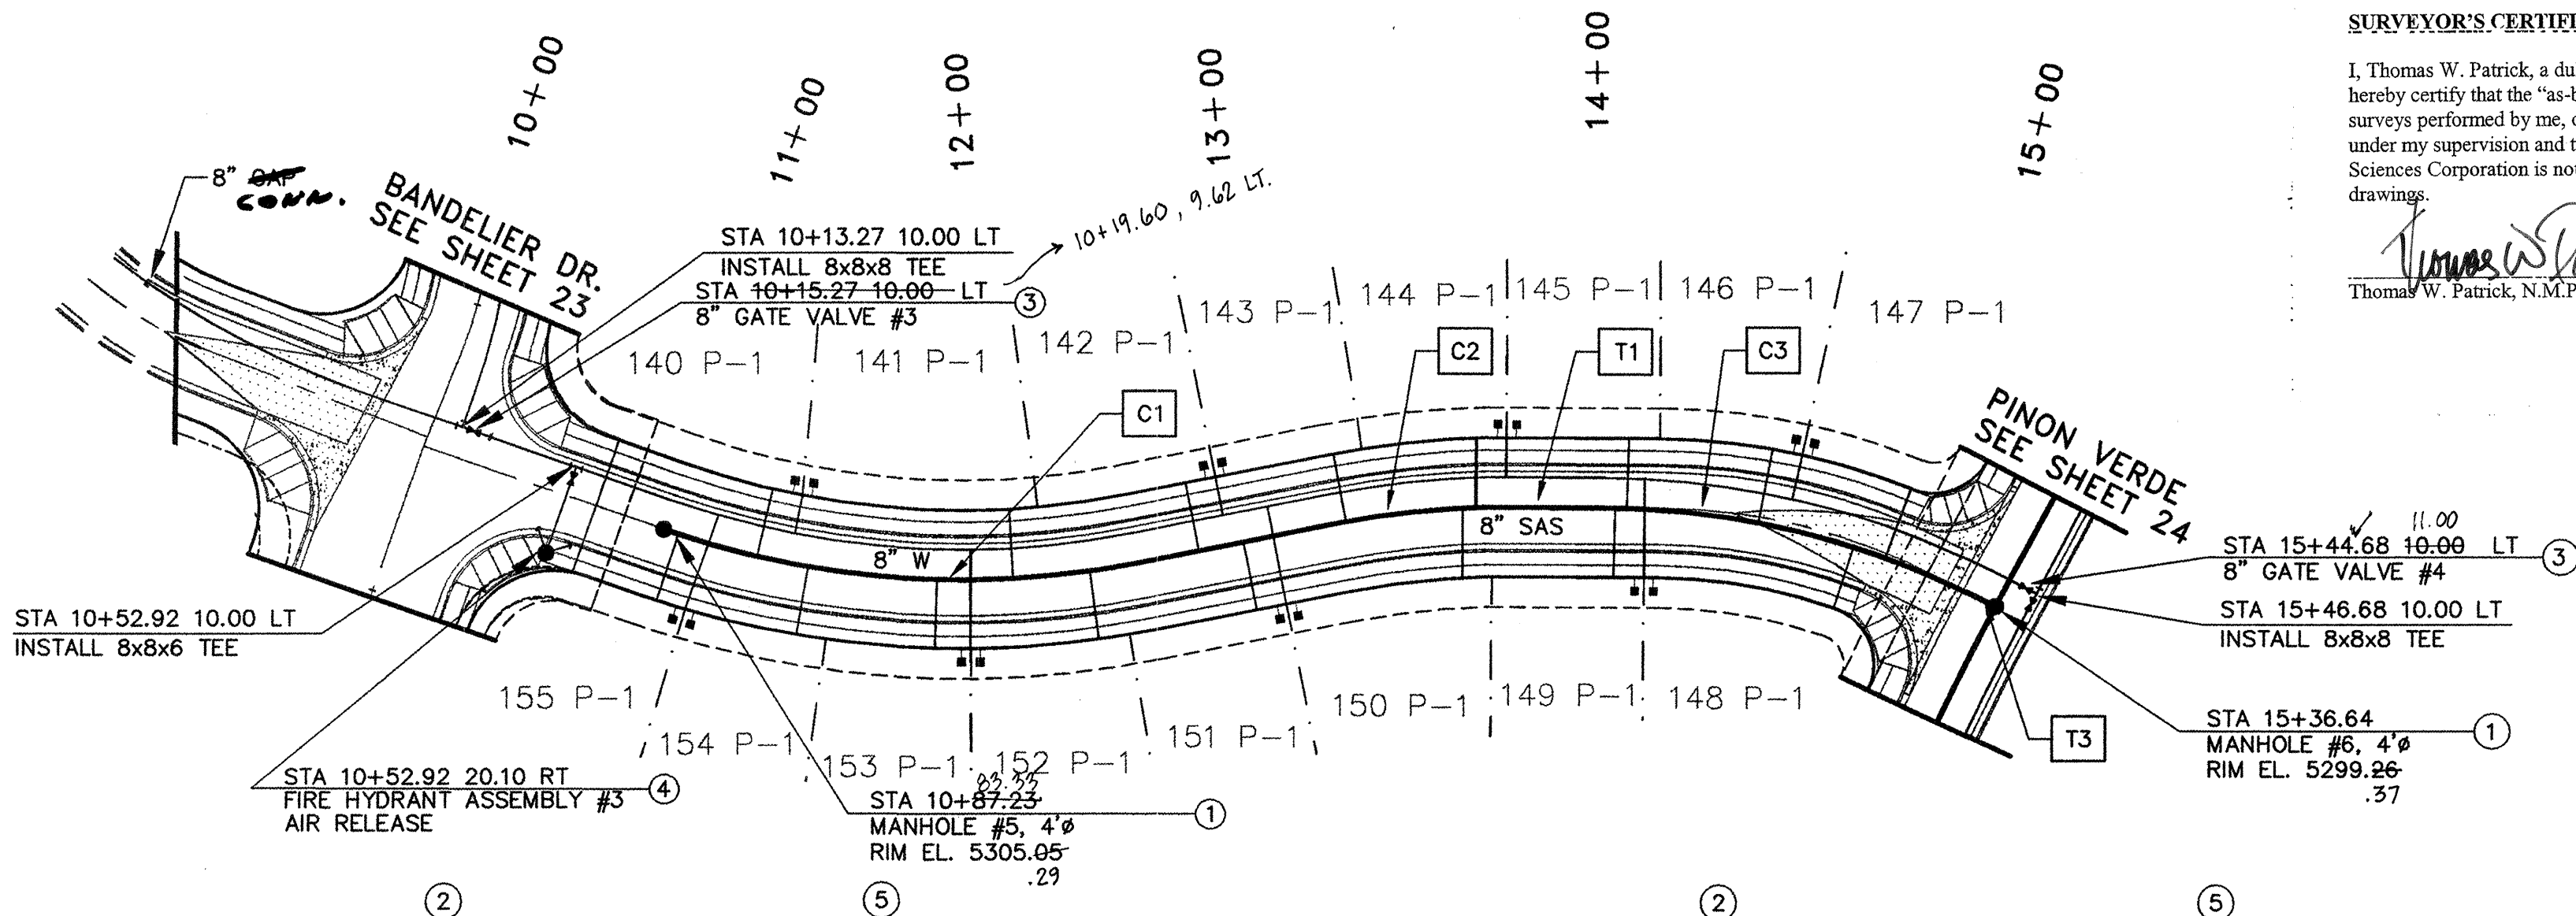

SANITARY SEWER SERVICES - NIGHT WHISPER ROAD					WATER SERVICES - NIGHT WHISPER ROAD				
LOT NO.	SAS STATION & OFFSET	SAS LENGTH	INV. BEGIN	TOP OF PIPE AT PLUG	LOT NO.	SAS STATION & OFFSET	WL TYPE		
140	11+19.36 23.00 L	23.00	5297.47	5299.22	140	11+30.19 23.00L	DOUBLE		
141	12+04.48 23.00 L	23.00	5296.44	5298.08	141	12+76.58 23.00L	DOUBLE		
142	12+66.58 23.00 L	23.00	5295.68	5297.22	142	12+76.58 23.00L	DOUBLE		
143	13+16.14 23.00 L	23.00	5295.08	5296.54	143	13+69.27 23.00L	DOUBLE		
144	13+60.29 23.00 L	23.00	5294.56	5295.93	144	13+69.27 23.00L	DOUBLE		
145	14+09.52 23.00 L	23.10	5293.98	5295.25	145	14+62.25 23.00L	DOUBLE		
146	14+53.27 23.00 L	24.97	5293.46	5294.63	146				
147	14+96.04 23.00 L	24.54	5292.92	5293.95	147				

NOTE: STATIONING IS AT PROPERTY LINE

NOTE: STATIONING IS AT PROPERTY LINE

SANITARY SEWER SERVICES - NIGHT WHISPER ROAD					WATER SERVICES - NIGHT WHISPER ROAD				
LOT NO.	SAS STATION & OFFSET	SAS LENGTH	INV. BEGIN	TOP OF PIPE AT PLUG	LOT NO.	SAS STATION & OFFSET	WL TYPE		
155	10+92.25 23.00 R	23.00	5297.79	5299.66	155	11+01.55 23.00R	DOUBLE		
154	11+36.30 23.00 R	23.00	5297.26	5299.02	154	11+90.68 23.00R	DOUBLE		
153	11+79.58 23.00 R	23.00	5296.47	5298.42	153	12+91.59 23.00R	DOUBLE		
152	12+29.92 23.00 R	23.00	5296.13	5297.73	152	12+91.59 23.00R	DOUBLE		
151	12+81.59 23.00 R	23.00	5295.50	5297.01	151	12+91.59 23.00R	DOUBLE		
150	13+53.50 23.00 R	23.00	5294.61	5296.02	150	14+14.68 23.00R	DOUBLE		
149	14+86.19 23.00 R	22.98	5294.03	5295.32	149				
148	14+76.55 23.00 R	21.12	5293.06	5294.31	148				


NOTE: STATIONING IS AT PROPERTY LINE

NOTE: STATIONING IS AT PROPERTY LINE

PINON DULCE RD.			
#	BEARING	LENGTH	
T1	S 89°47'57" E	37.46	
T3	S 62°38'01" E	3.78	

PINON DULCE RD.			
#	RADIUS	LENGTH	DELTA
C1	300.79	158.26	81.01
C2	300.00	51.57	25.85
C3	275.00	130.39	66.44

HORZ. 1"=50'
VERT. 1"=5'

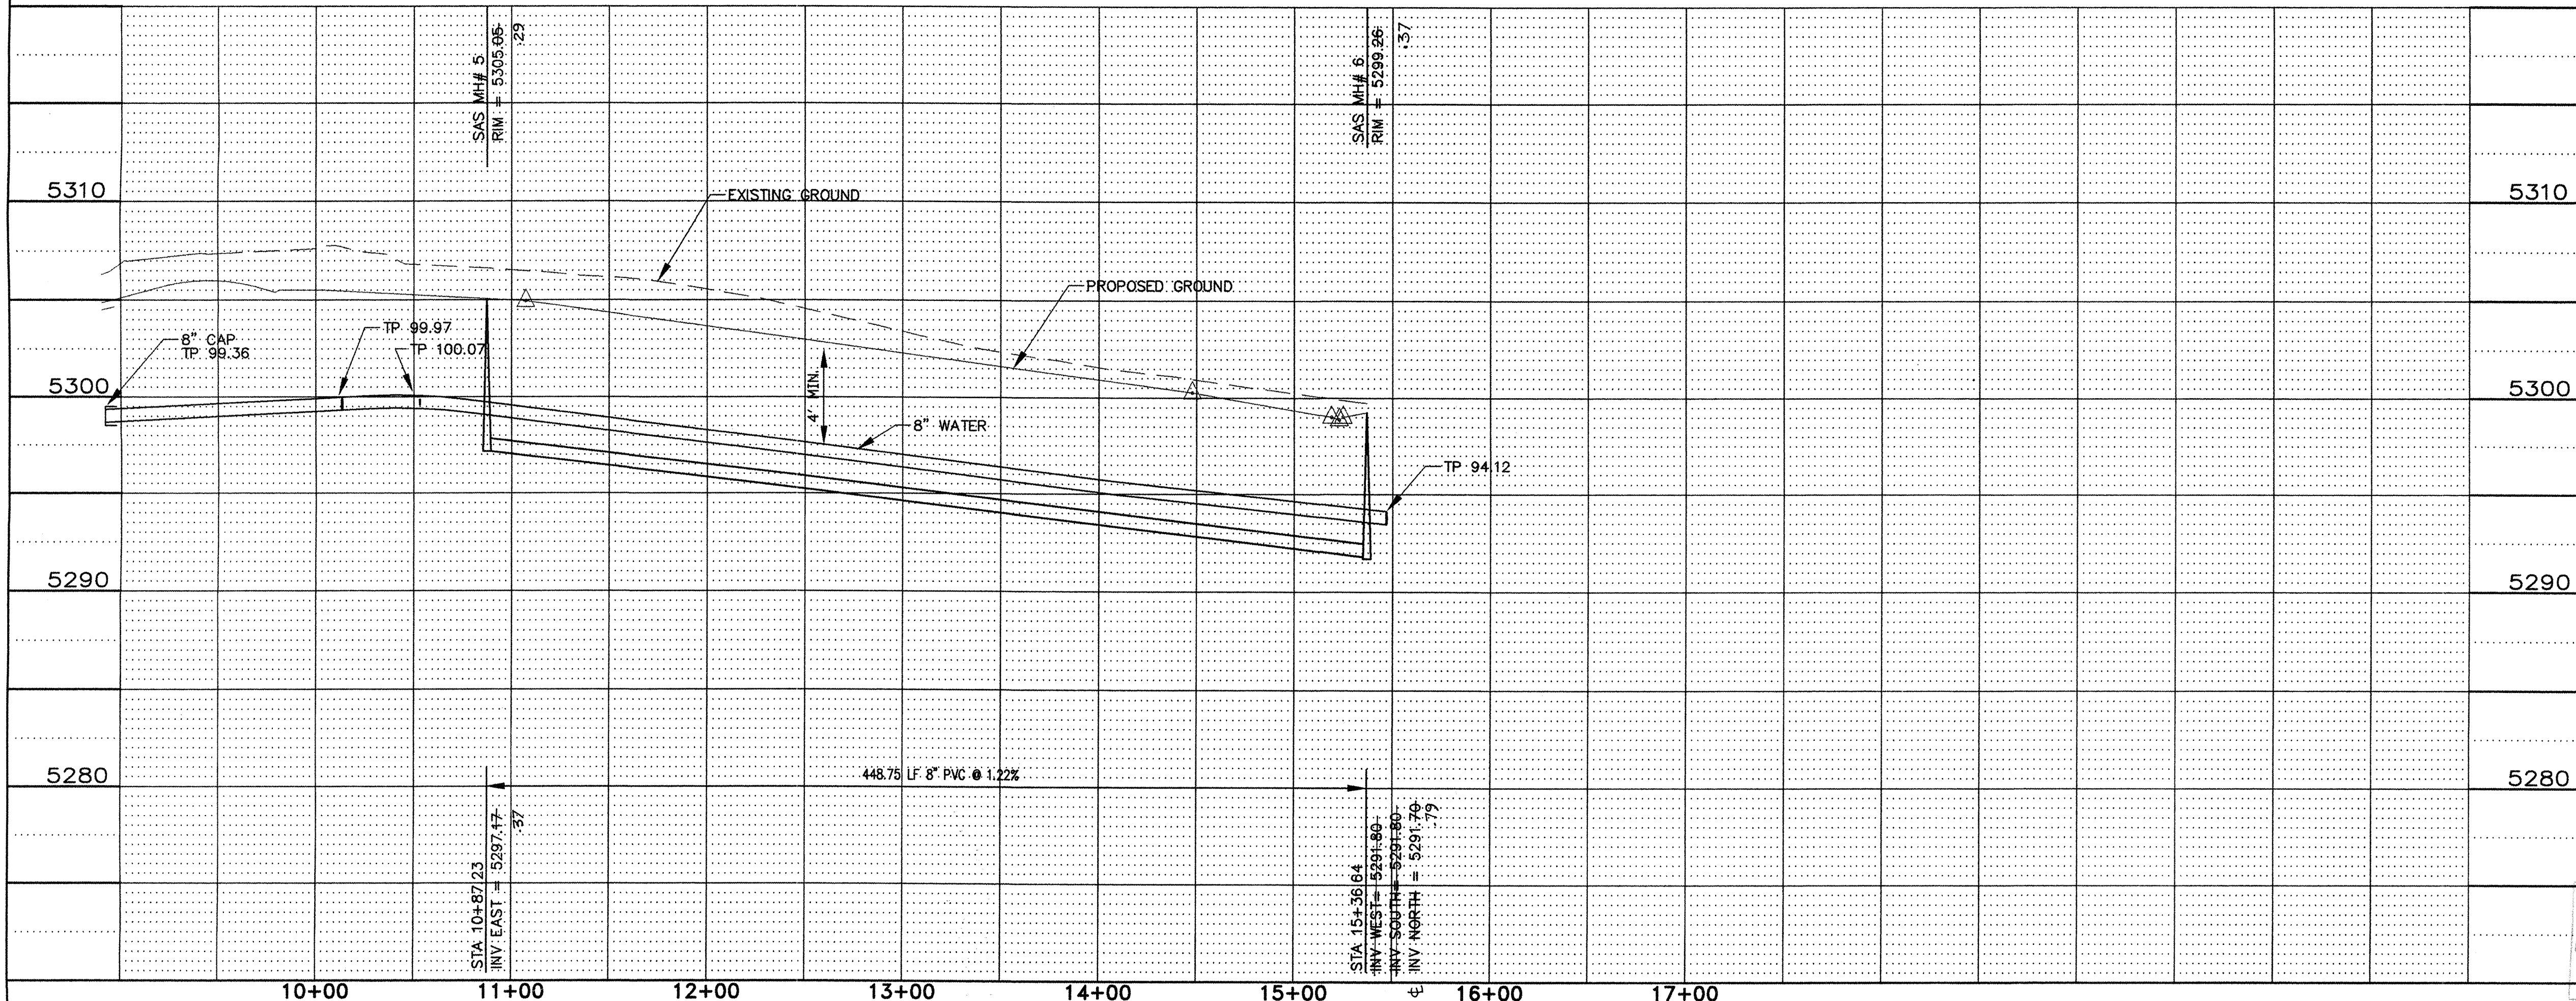

- CONSTRUCTION NOTES:**
- BUILD SANITARY SEWER MANHOLE PER COA STANDARD #2101
 - BUILD SANITARY SEWER SERVICE PER NMUI REQUIREMENTS
 - BUILD 8" PVC GATE VALVE PER COA STANDARD #SERIES 2326
 - BUILD FIRE HYDRANT ASSEMBLY PER COA STANDARD #2340 & 2347
 - BUILD WATER SERVICE LATERALS AND TYPICAL UTILITY LAYOUT PER NMUI REQUIREMENTS
- GENERAL NOTES:**
- ALL CURVE DATA AND DIMENSIONS REFER CENTERLINE OF PIPE OR MANHOLE. ALL SAS SLOPES ARE FROM INVERT TO INVERT.
 - CONTRACTOR IS RESPONSIBLE FOR REPAIR AND/OR REPLACEMENT OF ALL UTILITY CONDUITS AND EXISTING LINES.
 - CONTRACTOR SHALL PROVIDE THE INSPECTORS WITH PROPOSED HYDROSTATIC TESTING PLAN. THE PLAN MUST BE APPROVED BEFORE TESTING OPERATIONS BEGIN.
 - ANY DAMAGE TO THE EXISTING FACILITIES (CURB AND GUTTER, PAVEMENT, CONDUITS, LANDSCAPING, UTILITY LINES, ETC.) DURING CONSTRUCTION SHALL BE REPLACED AT THE CONTRACTORS' EXPENSE.
 - CONTRACTOR TO BLOCK ALL JOINTS IN ACCORDANCE WITH STD. DWG. 2320
 - WATER AND SEWER WILL BE CONSTRUCTED IN ACCORDANCE WITH NMUI REQUIREMENTS FOR ACCEPTANCE AND MAINTENANCE.

0 25 50 100 150
GRAPHIC SCALE IN FEET

QuikDraw
ENGINEERING, L.L.C.

P.O. Box 729
Corrales, NM 87048
Office (505) 898-0389 Fax (505) 897-0389

Community Sciences Corporation

LAND PLANNING ENGINEERING SURVEYING
P.O. Box 1328 Corrales, New Mexico 87048

JOB NO.: N291-33

CITY OF ALBUQUERQUE
PUBLIC WORKS DEPARTMENT
ENGINEERING DEVELOPMENT GROUP

TITLE: RIDGEVIEW VILLAGE UNIT II
UTILITY IMPROVEMENTS
PINON DULCE RD.

DESIGN REVIEW COMMITTEE
APPROVE
DEC 17 2002
DESIGN REVIEW COMMITTEE

CITY ENGINEER APPROVAL
APPROVE
DEC 24 2002
CITY ENGINEER

Mo./Day/Yr
Mo./Day/Yr

City Project No. 683082


Zone Map No. A-11

Sheet 22 of 24

AS BUILT INFORMATION			
CONTRACTOR	DATE	INSPECTOR'S NAME	DATE
NEW CONCEPTS	10/10/03	CSC	10/10/03
SURVEY INFORMATION			
FIELD NOTES	DATE	BY	NO.
ACCS 1 3/4" ALUMINUM DISK, STAMPED "ACCS BVI, 1-11" EPOXY TO TOP OF CONCRETE CURB, EAST SIDE OF UNISER BLVD. NW, 24 FT. +/- NORTH OF THE BERNALILLO / SANDOVAL COUNTY FENCE LINE, 210.1 FT. SOUTH OF "SPEED LIMIT 45" SIGN, 50.7 FT. NORTH OF THE SOUTH END OF CURB AND GUTTER. ELEV. = 5279.75, (NGVD 1929)	10/2001	COMMUNITY SCIENCES CORP.	

ENGINEER'S SEAL
LEON C. LOSACK
REGISTERED PROFESSIONAL LAND SURVEYOR
NEW MEXICO
14925
10/18/02

NO.	DATE	REMARKS	DESIGN
1	09/2002	REH	
2	09/2002	RLS	
3	09/2002	LCL	

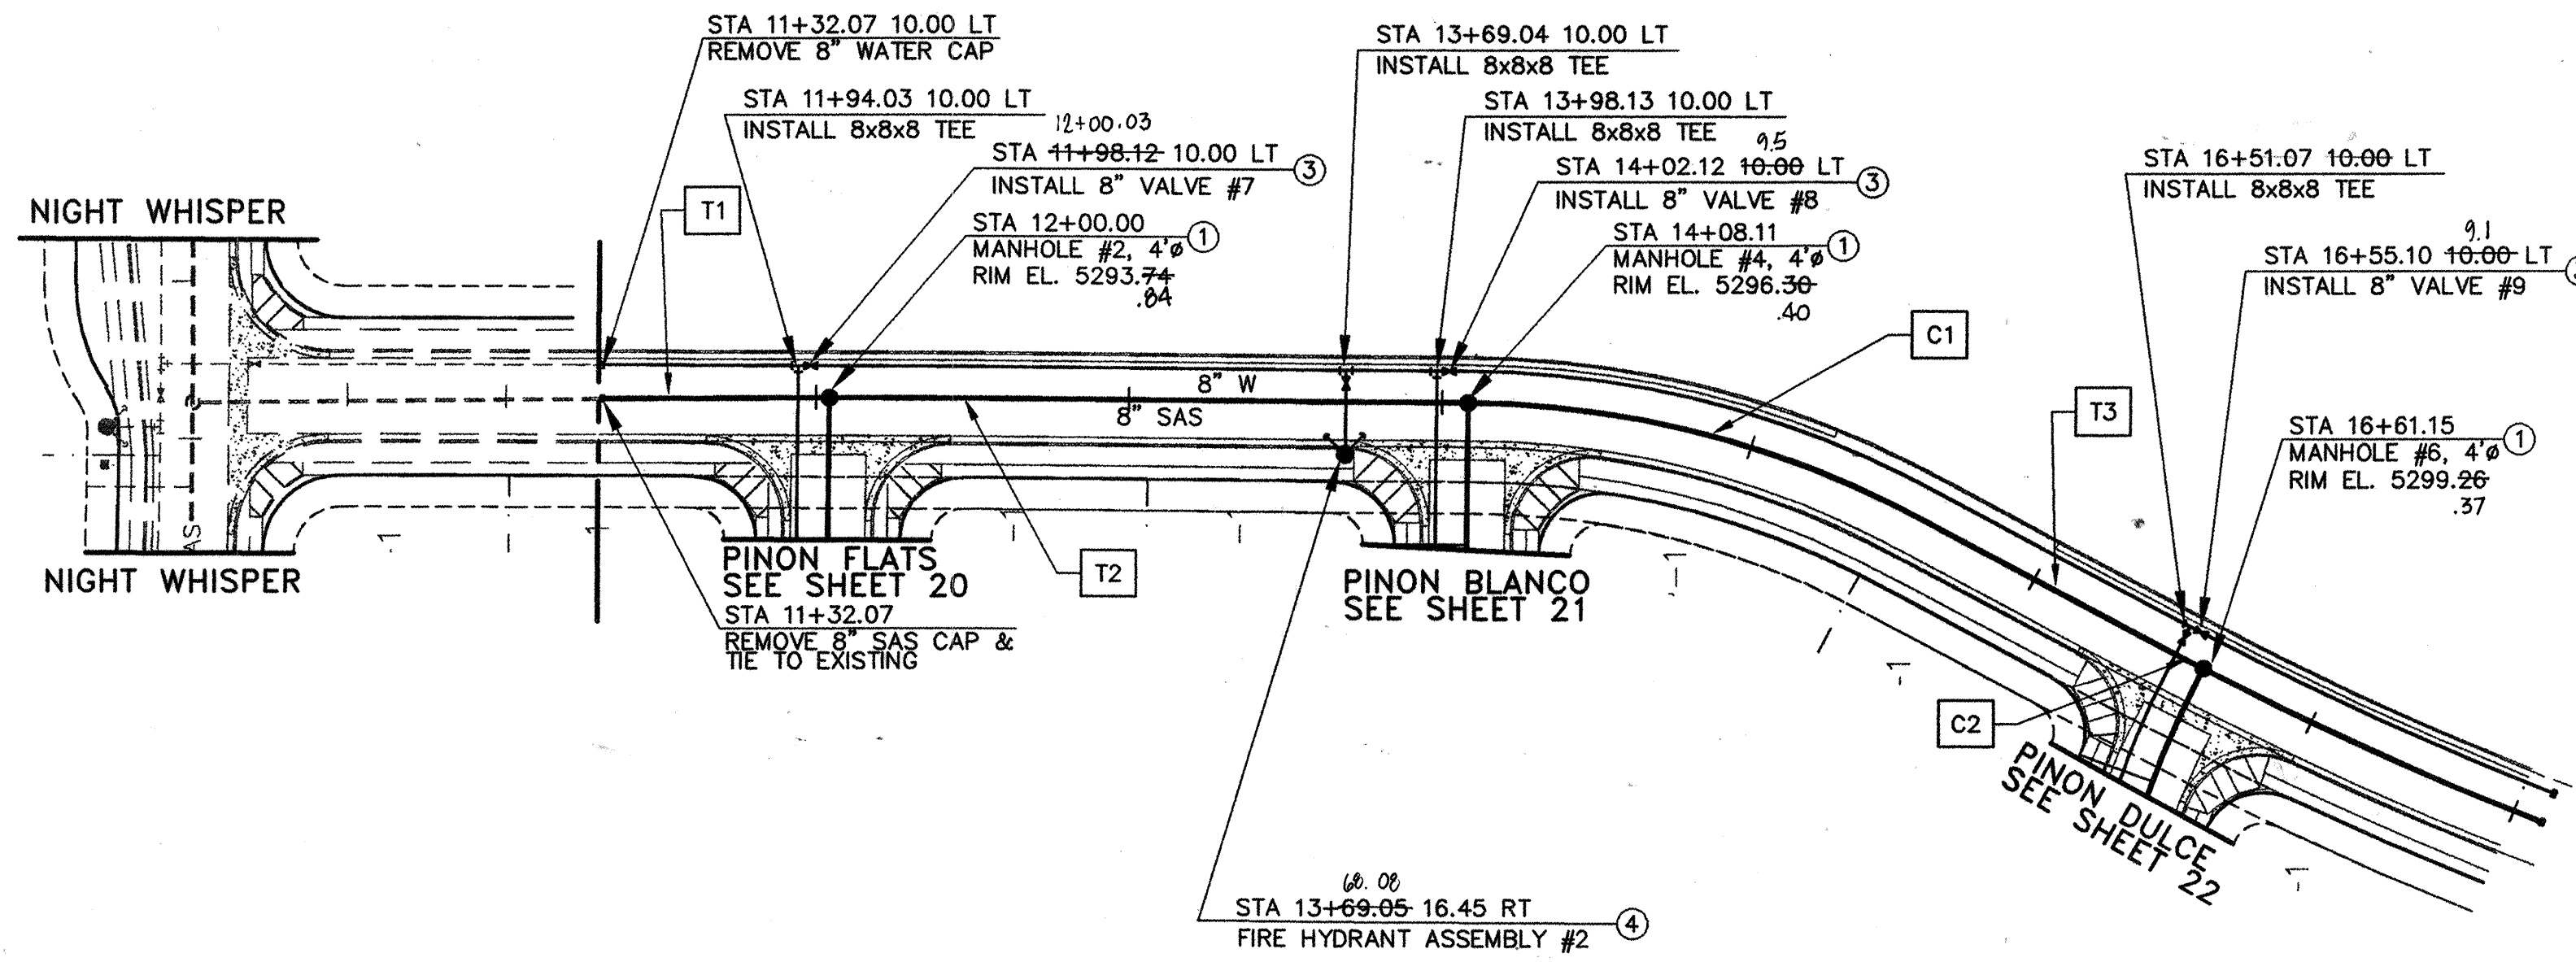SCANNED BY
MESA REPRO

SURVEYOR'S CERTIFICATION

I, Thomas W. Patrick, a duly qualified Registered Professional Land Surveyor under the Laws of the State of New Mexico, do hereby certify that the "as-built" information shown on these drawings was obtained from field construction and "as-built" surveys performed by me, or under my supervision, that the "as-built" information shown on these drawings was added by me, or under my supervision and that this "as-built" information is true and correct to the best of my knowledge and belief. Community Sciences Corporation is not responsible for any of the design concepts, calculations, engineering and/or intent of the record drawings.

Thomas W. Patrick
Thomas W. Patrick, N.M.P.S. 12651


Date 6-18-2003

BANDELER DR. PIPE TANGENT DATA TABLE			
#	BEARING	LENGTH	
T1	S 00°20'08" E	71.97	
T2	S 00°18'10" W	203.89	
T3	S 27°56'38" W	86.11	

BANDELER DR. PIPE CURVE DATA TABLE			
#	RADIUS	LENGTH	TAN DELTA
C1	312.85	154.95	79.10 28°22'41"
C2	1200.00	12.10	6.05 0°34'39"

HORZ. 1"=50'
VERT. 1"=5'

PINON VERDE DR.

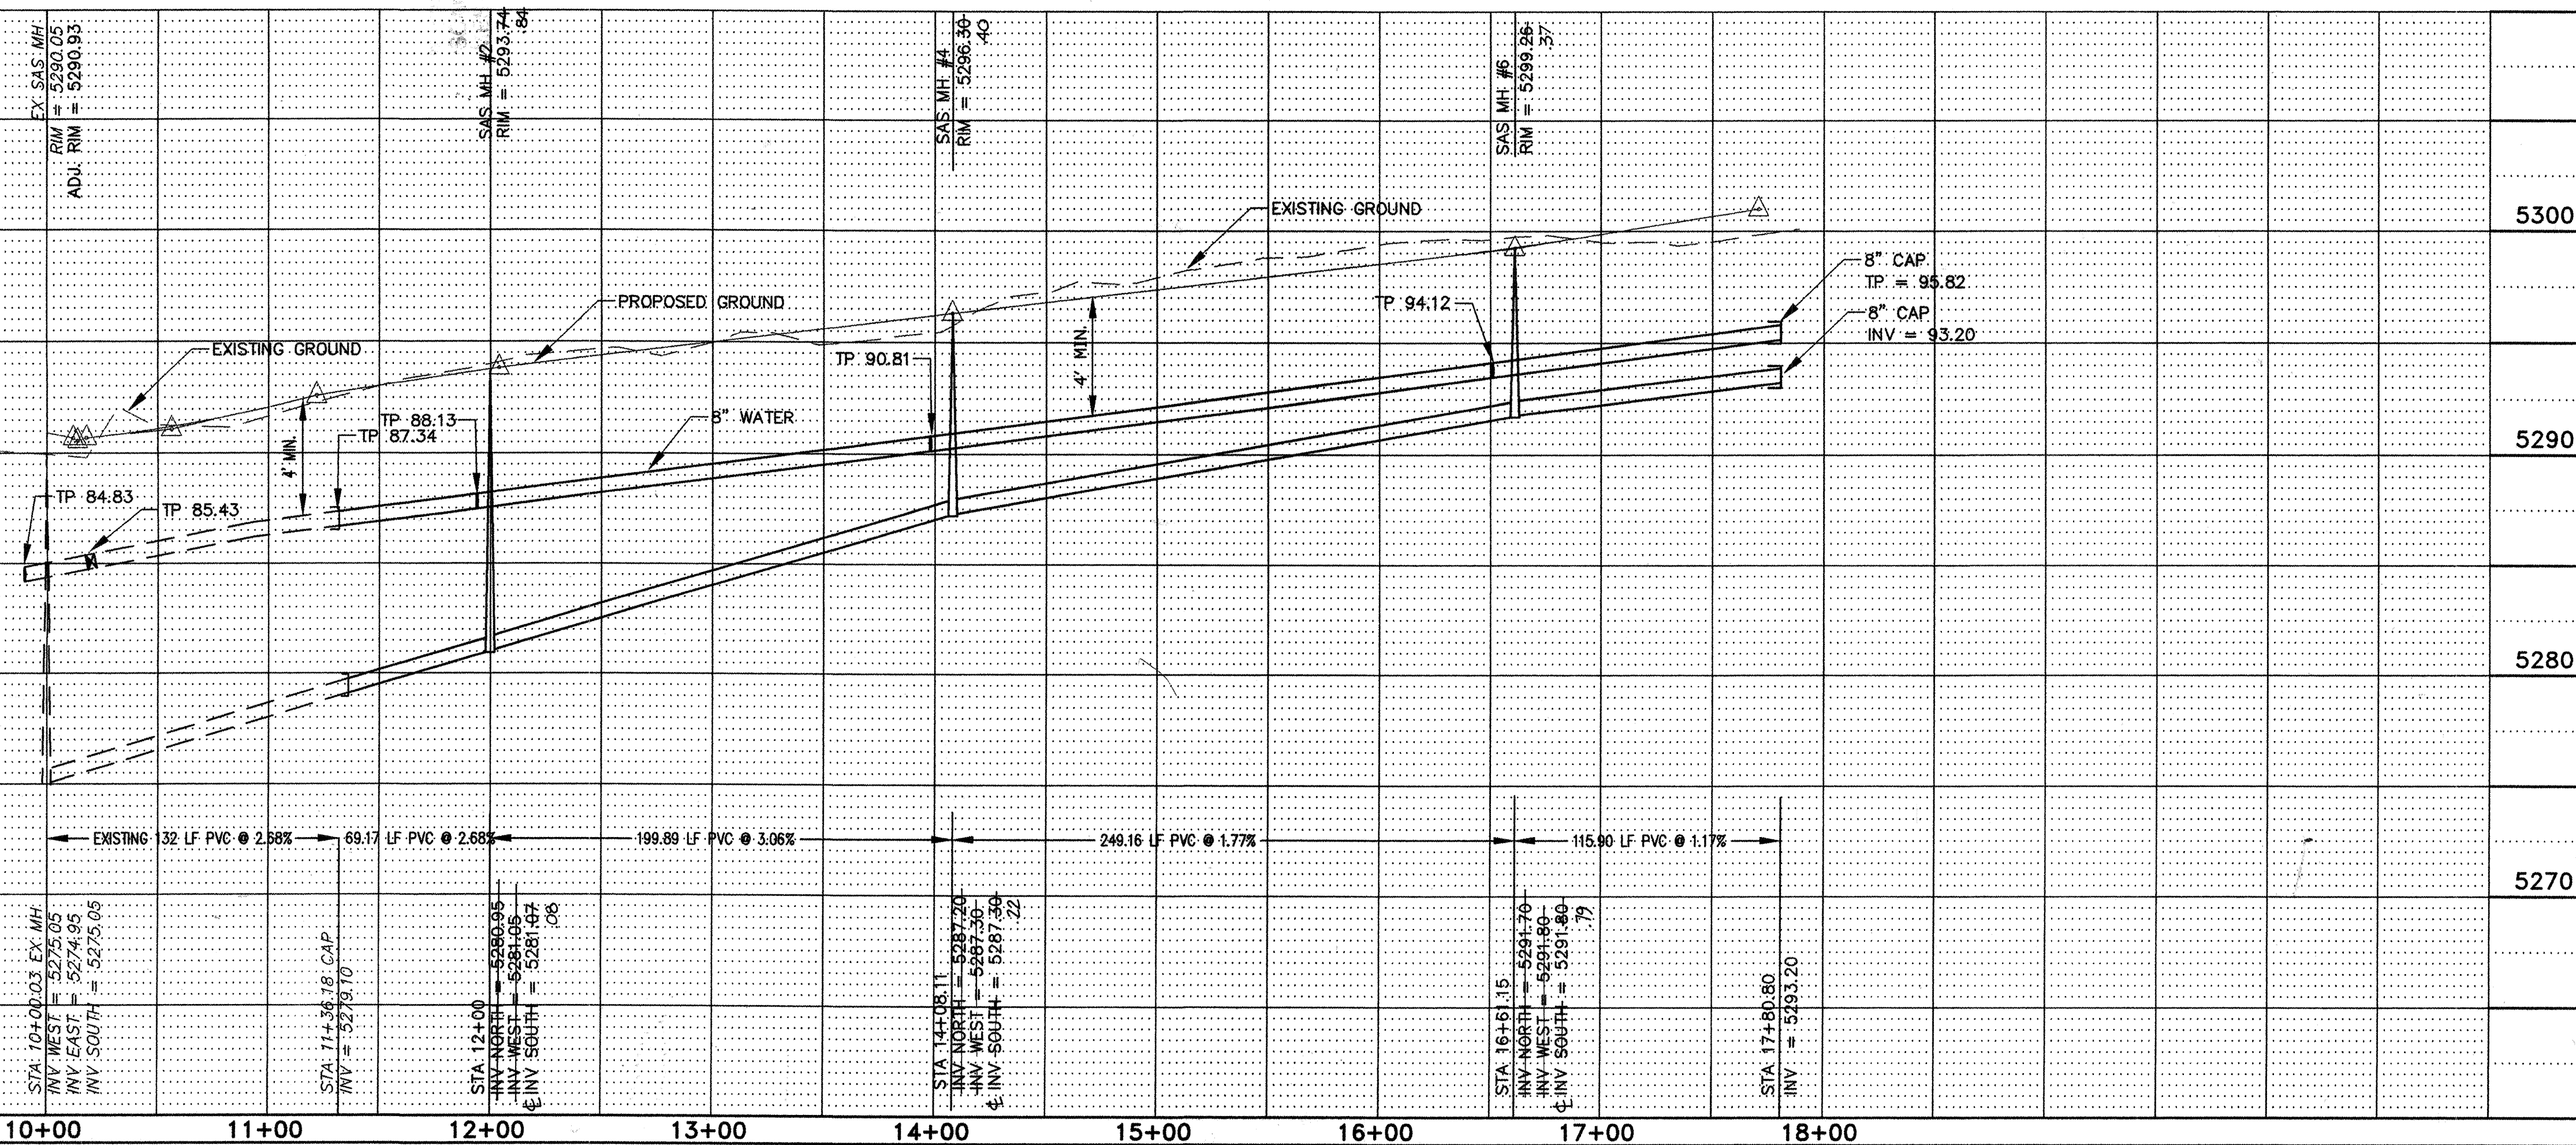

LEGEND:

ROW LINE
LOT LINE
PUBLIC UTILITY EASEMENT

PROPOSED
EXISTING

ROW CENTER LINE
EDGE OF PAVEMENT
SUBDIVISION BOUNDARY
STANDARD CURB & GUTTER

SAS LINE & MANHOLE
WATER LINE
FIRE HYDRANT
GATE VALVE
WATER LINE TEE
WATER SERVICE
SAS SERVICE
STORM DRAIN
DROP INLET

CONSTRUCTION NOTES:

- BUILD SANITARY SEWER MANHOLE PER COA STANDARD #2101
- BUILD SANITARY SEWER SERVICE PER NMUI REQUIREMENTS
- BUILD 8" PVC GATE VALVE PER COA STANDARD #SERIES 2326
- BUILD FIRE HYDRANT ASSEMBLY PER COA STANDARD #2340 & 2347
- BUILD WATER SERVICE LATERALS AND TYPICAL UTILITY LAYOUT PER NMUI REQUIREMENTS

GENERAL NOTES:

- ALL CURVE DATA AND DIMENSIONS REFER CENTERLINE OF PIPE OR MANHOLE. ALL SAS SLOPES ARE FROM INVERT TO INVERT.
- CONTRACTOR IS RESPONSIBLE FOR REPAIR AND/OR REPLACEMENT OF ALL UTILITY CONDUITS AND EXISTING LINES.
- CONTRACTOR SHALL PROVIDE THE INSPECTORS WITH PROPOSED HYDROSTATIC TESTING PLAN. THE PLAN MUST BE APPROVED BEFORE TESTING OPERATIONS BEGIN.
- ANY DAMAGE TO THE EXISTING FACILITIES (CURB AND GUTTER, PAVEMENT, CONDUITS, LANDSCAPING, UTILITY LINES, ETC.) DURING CONSTRUCTION SHALL BE REPLACED AT THE CONTRACTORS' EXPENSE.
- CONTRACTOR TO BLOCK ALL JOINTS IN ACCORDANCE WITH STD. DWG. 2320
- WATER AND SEWER WILL BE CONSTRUCTED IN ACCORDANCE WITH NMUI REQUIREMENTS FOR ACCEPTANCE AND MAINTENANCE

0 25 50 100 150
GRAPHIC SCALE IN FEET

NEW MEXICO UTILITIES

QuikDraw
ENGINEERING, L.L.C.

P.O. Box 729
Corrales, NM 87048
Office (505) 896-0389 Fax (505) 897-0389

Community
Sciences
Corporation

LAND PLANNING ENGINEERING SURVEYING
P.O. Box 1328 Corrales, New Mexico 87048

JOB NO.: N291-33

CITY OF ALBUQUERQUE
PUBLIC WORKS DEPARTMENT
ENGINEERING DEVELOPMENT GROUP

TITLE: RIDGEVIEW VILLAGE UNIT II
UTILITY PLAN & PROFILE
PINON VERDE DR.

APPROVE
DESIGN REVIEW COMMITTEE
DEC 17 2002

APPROVE
CITY ENGINEER
DEC 24 2002

Mo./Day/Yr
Mo./Day/Yr

City Project No.
683082

Zone Map No.
A-11

Sheet 24 of 24