

CONSTRUCTION PLANS

FOR

ALBUQUERQUE WAL-MART
#831-02


UTILITY & PAVING
IMPROVEMENTS

CITY OF ALBUQUERQUE
NEW MEXICO
MAY 2002

Handwritten signature/initials

INDEX TO DRAWINGS

1. TITLE SHEET
2. PLAT
3. SITE PLAN FOR BUILDING PERMIT
4. PAVING IMPROVEMENTS
DECELERATION LANE
5. UTILITY IMPROVEMENTS
MASTER UTILITY PLAN
6. UTILITY IMPROVEMENTS
ON-SITE SAS AND WATER
7. TYPICAL TRAFFIC CONTROL & SIGNING EXAMPLES
8. SIGNING AND CONSTRUCTION TRAFFIC CONTROL STANDARDS

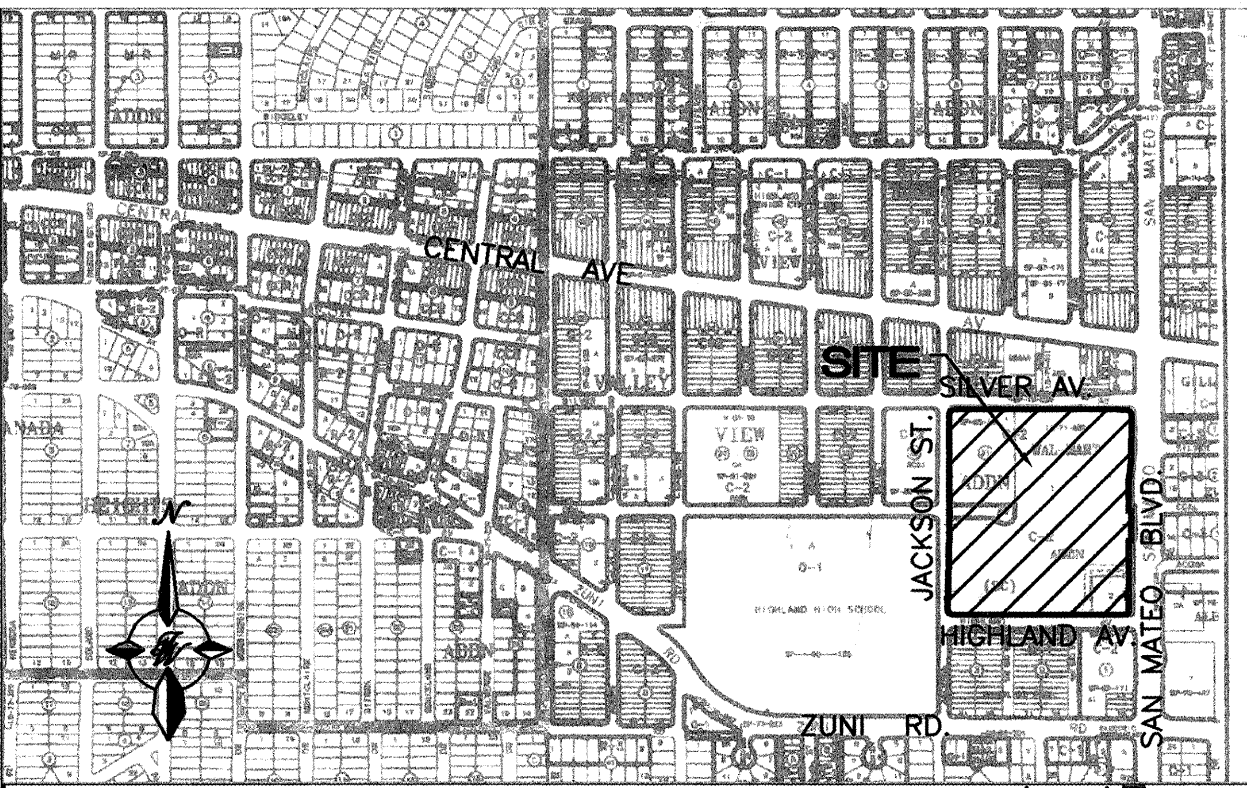

VICINITY MAP ZONE ATLAS K-17-Z P-16-Z

NOTICE TO CONTRACTORS

1. ALL WORK DETAILED ON THESE PLANS TO BE PERFORMED UNDER CONTRACT SHALL, EXCEPT AS OTHERWISE STATED OR PROVIDED FOR HEREON, BE CONSTRUCTED IN ACCORDANCE WITH THE CITY OF ALBUQUERQUE STANDARD SPECIFICATIONS FOR PUBLIC WORKS CONSTRUCTION, 1986 EDITION (UPDATE #6).
2. TWO WORKING DAYS PRIOR TO ANY EXCAVATION, THE CONTRACTOR MUST CONTACT NEW MEXICO ONE CALL SYSTEM (260-1990) FOR LOCATION OF EXISTING UTILITIES.
3. ANY WORK AFFECTING AN ARTERIAL ROADWAY REQUIRES 24-HOUR CONSTRUCTION.
4. PRIOR TO CONSTRUCTION, THE CONTRACTOR SHALL EXCAVATE AND VERIFY THE HORIZONTAL AND VERTICAL LOCATIONS OF ALL OBSTRUCTIONS. SHOULD A CONFLICT EXIST, THE CONTRACTOR SHALL NOTIFY THE ENGINEER OR SURVEYOR IMMEDIATELY SO THAT THE CONFLICT CAN BE RESOLVED WITH A MINIMUM AMOUNT OF DELAY.
5. FIVE (5) WORKING DAYS PRIOR TO BEGINNING OF CONSTRUCTION, THE CONTRACTOR SHALL SUBMIT TO CONSTRUCTION COORDINATIONS DIVISION A DETAILED CONSTRUCTION SCHEDULE. TWO(2) WORKING DAYS PRIOR TO CONSTRUCTION, THE CONTRACTOR SHALL OBTAIN A BARRICADING PERMIT FROM THE CONST. COORDINATION DIVISION. CONTRACTOR SHALL NOTIFY BARRICADE ENGINEER (768-2551) PRIOR TO OCCUPYING AN INTERSECTION. REFER TO STANDARD SPECIFICATIONS.
6. ALL STREET STRIPING ALTERED OR DESTROYED SHALL BE REPLACED WITH PLASTIC REFLECTORIZED PAVEMENT MARKINGS BY THE CONTRACTOR TO LOCATION AS EXISTING OR AS INDICATED BY THIS PLAN SET.
7. CONTRACTOR SHALL NOTIFY THE ENGINEER NOT LESS THAN SEVEN (7) DAYS PRIOR TO STARTING WORK IN ORDER THAT THE ENGINEER MAY TAKE NECESSARY MEASURES TO INSURE THE PRESERVATION OF SURVEY MONUMENTS. CONTRACTOR SHALL NOT DISTURB PERMANENT SURVEY MONUMENTS WITHOUT THE CONSENT OF THE ENGINEER AND SHALL NOTIFY THE ENGINEER AND BEAR THE EXPENSE OF REPLACING ANY THAT MAY BE DISTURBED WITHOUT PERMISSION. REPLACEMENT SHALL BE DONE ONLY BY THE CITY SURVEYOR. WHEN A CHANGE IS MADE IN THE FINISHED ELEVATIONS OF THE PAVEMENT OF ANY ROADWAY IN WHICH A PERMANENT SURVEY MONUMENT IS LOCATED, CONTRACTOR SHALL, AT HIS OWN EXPENSE, ADJUST THE MONUMENT COVER TO THE NEW GRADE UNLESS OTHERWISE SPECIFIED. REFER TO SECTION 4.4 OF THE GENERAL CONDITIONS OF THE STANDARD SPECIFICATIONS. ANY PERMANENT SURVEY MONUMENT LOCATED WITHIN 50' OF THIS PROJECT THAT IS NOT SHOWN ON THE PLAN AND IS DESTROYED DURING CONSTRUCTION WILL BE REPLACED AT THE DESIGNER'S EXPENSE.
8. FOR STORM DRAIN CONSTRUCTION, RCP PIPE JOINTS SHALL NOT BE GROUTED PRIOR TO FINAL INSPECTION. FINAL INSPECTION WILL DETERMINE JOINTS TO BE GROUTED FOR FINAL ACCEPTANCE OF THE CONSTRUCTION.

THE FOLLOWING NOTES ALSO APPLY WHEN CHECKED


- ☒ ALL UTILITIES AND UTILITY SERVICE LINES SHALL BE INSTALLED PRIOR TO PAVING.
- ☒ BACKFILL COMPACTION SHALL BE ACCORDING TO SPECIFIED STREET USE.
- ☐ TACK COAT REQUIREMENTS SHALL BE DETERMINED BY THE CITY ENGINEER.
- ☒ SIDEWALKS AND WHEELCHAIR RAMPS WITHIN THE CURB RETURNS SHALL BE CONSTRUCTED WHEREVER A NEW CURB RETURN IS CONSTRUCTED.
- ☐ IF CURB IS DEPRESSED FOR A DRIVEPAD, THE DRIVEPAD SHALL BE CONSTRUCTED PRIOR TO ACCEPTANCE OF CURB AND GUTTER.
- ☒ ALL STORM DRAINAGE FACILITIES SHALL BE COMPLETED PRIOR TO FINAL ACCEPTANCE.

CERTIFICATE OF SUBSTANTIAL COMPLIANCE ON PLANS

I, Ronald R. Bohannon, of the firm of Tierra West LLC, a Registered Professional Engineer in the State of New Mexico, do hereby certify, to the best of my knowledge and belief, that the infrastructure installed as part of this project has been inspected by me or by a qualified person under my direct supervision and has been constructed in accordance with the plans and specifications approved by the City Engineer and that the original design intent of the approved plans has been met, except as noted by me on the as-built construction drawings. This Certification is based on site inspections by me, or personnel under my direction with survey information provided by Larry Medrano, of Precision Surveys, NMPs number 11993.

APPROVED AS RECORD DRAWINGS
DESIGN REVIEW SECTION
CITY CONSTRUCTION ENGINEER
DATE: 5/15/02

APPROVED AS RECORD DRAWINGS
DESIGN REVIEW SECTION
CITY CONSTRUCTION ENGINEER
DATE: 5/15/02

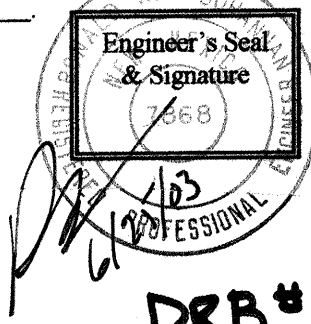

DRB # 1001525

TIERRA WEST, LLC
8509 JEFFERSON NE
ALBUQUERQUE, NEW MEXICO 87113
(505)858-3100

26 68578.8/1 1 K1/2

REV	SHEETS	CITY ENGINEER	DATE	USER DEPT.	DATE	USER DEPT.	DATE
ENGINERS STAMP & SIGNATURE		APPROVALS		ENGINEER		DATE	
		DRC Chairman		[Signature]		6-25-02	
		Transportation		[Signature]		5/15/02	
		Water/Wastewater		[Signature]		5/21/02	
		Hydrology		[Signature]		5-21-02	
		C.I.P.					
		Constr. Mngmt.					
		Constr. Coord.		[Signature]		6-25-02	
		CITY PROJECT NO.		685781		SHEET	
						1 OF 8	

GRAPHIC SCALE

50 25 0 25 50

SCALE: 1"=50'

SAN MATEO BOULEVARD

6+35.51 7+00 8+00 9+00 10+00

11'5" ROW 17' 39' 127' ROW 51' 12' 12.00'

5259.83 5261.16 5261.92 5260.53 5260.62 5261.48 5260.39 5258.89 5260.00 5260.34 5260.53 5260.65 5260.39 5260.36

S00°14'26"W S00°14'26"W S00°14'26"W S00°14'26"W

STA: 7+20.41
OFFSET: 47.48 R
BEGIN NEW C&G
MATCH EX. C&G
FL=5259.55

SAWCUT 1' FROM EX. C&G

STA: 7+62.05 PRC
OFFSET: 53.52 R
FL=5259.80

REMOVE EX. C&G

NEW PAVING. SEE DETAIL THIS SHEET

STA: 8+04.33
OFFSET: 47.96 R
BEGIN NEW 4" PLASTIC REFLECTIVE SOLID WHITE STRIPING

NEW RIGHT TURN ARROW STRIPE

150' RIGHT TURN LANE

EXISTING WHITE STRIPING TO BE ERADICATED AND RESTRIPE

ERADICATE RESTRIPE RIGHT TURN ARROW

STA: 9+54.33
OFFSET: 47.39 R
END 4" PLASTIC REFLECTIVE SOLID WHITE STRIPING

STA: 10+00
OFFSET: 0.00 L
CL OF SURVEY
TIE TO PROPERTY CORNER

MATCH EX. 6" SIDEWALK WITH NEW SIDEWALK

STREET LIGHT EXISTING CONDUIT LOCATION AND DEPTH TO BE FIELD VERIFIED. RELOCATE IF NECESSARY BEHIND NEW CURB NO SPLICING ALLOWED

NEW 6" SIDEWALK


STA: 8+04.33 PT
OFFSET: 59.56 R
FL=5260.12

STA: 8+50.88
OFFSET: 59.52 R
MATCH EX. CURB
FL=5260.48



N08°22'52"E 84.74°

S89°45'34"E 62.00'

S89°45'34"E 12.00'

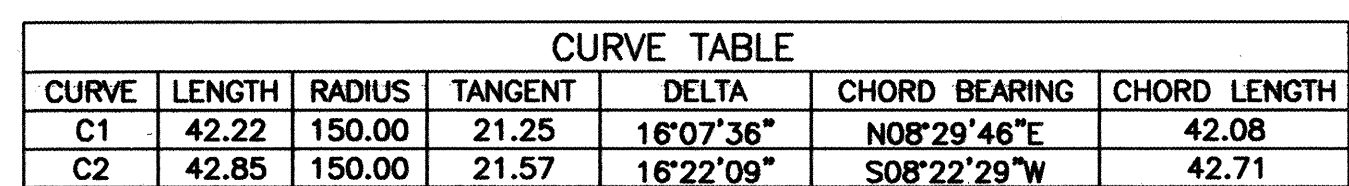

I, Ronald R. Bohanan, of the firm of Tierra West LLC, a Registered Professional Engineer in the State of New Mexico, do hereby certify, to the best of my knowledge and belief, that the infrastructure installed as part of this project has been inspected by me or by a qualified person under my direct supervision and has been constructed in accordance with the plans and specifications approved by the City Engineer and that the original design intent of the approved plans has been met, except as noted by me on the as-built construction drawings. This Certification is based on site inspections by me, or personnel under my direction with survey information provided by Larry Medrano, of Precision Surveys, NMPMS number 11993.

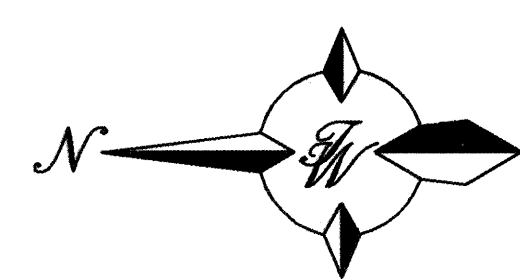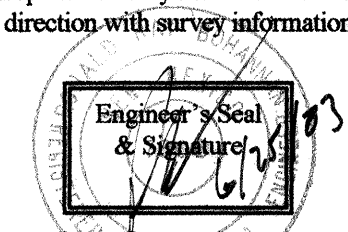

1" PLANT MIX SEAL COAT

TACK COAT AS REQUIRED BY THE ENGINEER BETWEEN ALL ASPHALT/AGGREGATE MATERIAL LIFTS.

4" (2 LIFTS) ASPHALT CONCRETE, 1800 LBS. STABILITY, TYPE B GRADATION.

3" (1 LIFT) ASPHALT CONCRETE, TYPICAL FINISH COURSE PLACED AFTER ALL MANHOLES, VALVES, COVERS/RINGS ARE SET TO GRADE. 1800 LBS. STABILITY TYPE B GRADATION.

1'

STANDARD C&G PER COA STD DWG #2415

95% COMPACTED SUBGRADE

FINISH SURFACE OF SUBGRADE SHALL BE MOISTURE CONTROLLED AT COMPACTION MOISTURE RANGE, OR PRIME COAT APPLIED AS REQUIRED BY THE ENGINEER UNTIL NEXT/FINAL SURFACE IS COMPLETED. SUBGRADE PREPARATION SHALL BE PERFORMED AFTER ALL SUBSURFACE R/W UTILITIES CONSTRUCTION IS COMPLETED.

12" SUBGRADE SOIL. R-VALUE>50. 95% MIN. COMPACTION, AT OPT. MOISTURE $\pm$ 2.0%, ASTM D1557, OR OPT. MOISTURE TO $\pm$ 4%, ASTM D688 FOR SOIL W/35% OR MORE MATERIAL PASSING THE NO. 200 SIEVE. SOIL NOT HAVING THE MIN. R-VALUE OF 50, SHALL BE REMOVED TO A DEPTH OF 2 FEET AND REPLACED BY THE CONTRACTOR WITH SUITABLE MATERIAL OR A PAVEMENT SHALL BE DESIGNED BY TIERRA WEST, LLC ACCOMMODATING THE EXISTING R-VALUE PER C.O.A. STANDARD SPECIFICATIONS.

12" SUBGRADER-VALUE>50. 95% MIN. COMPACTION, AT OPT. MOISTURE $\pm$ 2.0%, ASTM D1557, OR OPT.

CONSTRUCTION JOINT

TIERRA

TIERRA WEST, LLC
4421 McLEOD ROAD, N.E., SUITE D
ALBUQUERQUE, NEW MEXICO 87109
(505)883-7592

CITY OF ALBUQUERQUE
PUBLIC WORKS DEPARTMENT
ENGINEERING GROUP

TITLE: **ALBUQUERQUE WAL-MART #831**
PAVING IMPROVEMENTS
DECELERATION LANE EXTENSION

DESIGN REVIEW COMMITTEE

APPROVE

APR 25 2002

DESIGN
REVIEW COMMITTEE

LAST DESIGN UPDATE

MO.

_____/DAY/YR

MO./DAY/

CITY PROJECT NO.

685781

ZONE MAP NO.	
--------------	--

	SH
--	----

SHEET

OF

685781

K-17-7


1

1000

4

8

SCANNED BY
MESA REPRO

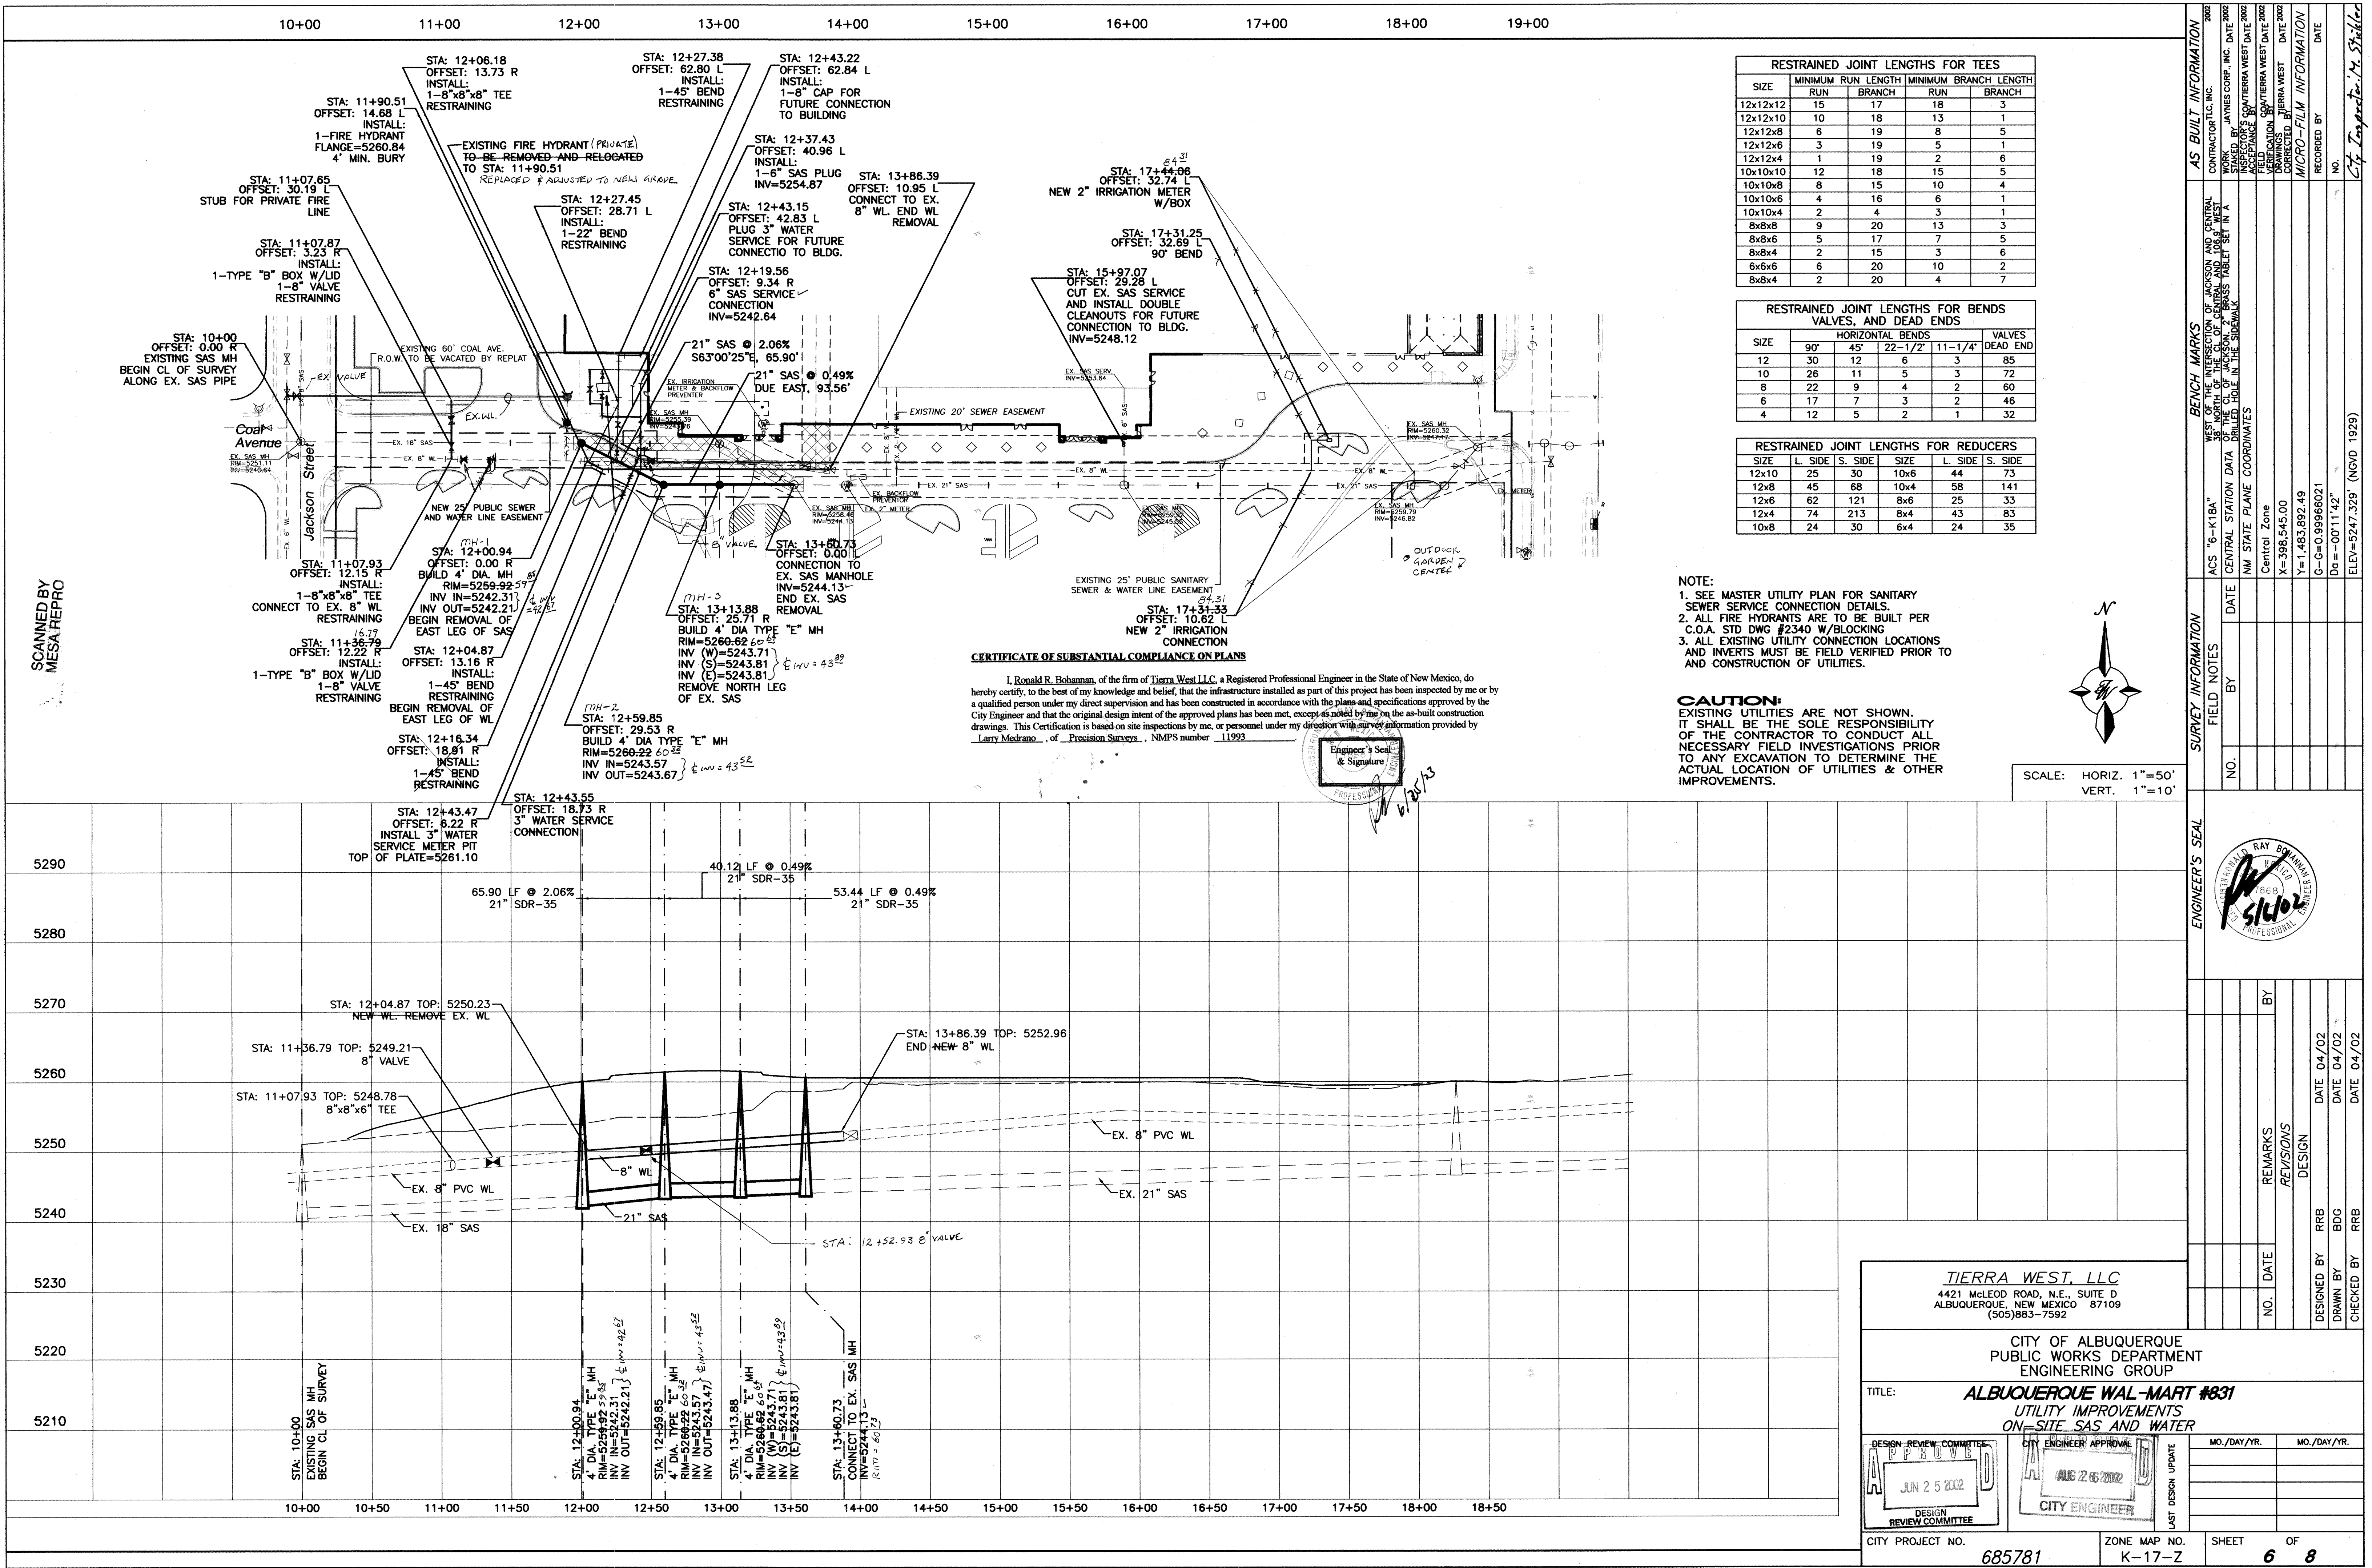


RESTRAINED JOINT LENGTHS FOR TEES				
SIZE	MINIMUM RUN	MINIMUM BRANCH	MINIMUM RUN	MINIMUM BRANCH
12x12x12	15	17	18	3
12x12x10	10	18	13	1
12x12x8	6	19	8	5
12x12x6	3	19	5	1
12x12x4	1	19	2	6
10x10x10	12	18	15	5
10x10x8	8	15	10	4
10x10x6	4	16	6	1
10x10x4	2	4	3	1
8x8x8	9	20	13	3
8x8x6	5	17	7	5
8x8x4	2	15	3	6
6x6x6	6	20	10	2
8x8x4	2	20	4	7

RESTRAINED JOINT LENGTHS FOR BENDS, VALVES, AND DEAD ENDS				
SIZE	HORIZONTAL BENDS			
	90°	45°	22-1/2°	11-1/4°
12	30	12	6	3
10	26	11	5	3
8	22	9	4	2
6	17	7	3	2
4	12	5	2	1
SIZE	VALVES			
	DEAD END	DEAD END	DEAD END	DEAD END
12	85			
10	72			
8	60			
6	46			
4	32			

RESTRAINED JOINT LENGTHS FOR REDUCERS				
SIZE	L. SIDE	S. SIDE	SIZE	L. SIDE
12x10	25	30	10x6	44
12x8	45	68	10x4	58
12x6	62	121	8x6	25
12x4	74	213	8x4	43
10x8	24	30	6x4	24

NOTE:
1. SEE MASTER UTILITY PLAN FOR SANITARY SEWER SERVICE CONNECTION DETAILS.
2. ALL FIRE HYDRANTS ARE TO BE BUILT PER C.O.A. STD DWG #2340 W/BLOCKING
3. ALL EXISTING UTILITY CONNECTION LOCATIONS AND INVERTS MUST BE FIELD VERIFIED PRIOR TO AND CONSTRUCTION OF UTILITIES.

CAUTION:
EXISTING UTILITIES ARE NOT SHOWN. IT SHALL BE THE SOLE RESPONSIBILITY OF THE CONTRACTOR TO CONDUCT ALL NECESSARY FIELD INVESTIGATIONS PRIOR TO ANY EXCAVATION TO DETERMINE THE ACTUAL LOCATION OF UTILITIES & OTHER IMPROVEMENTS.

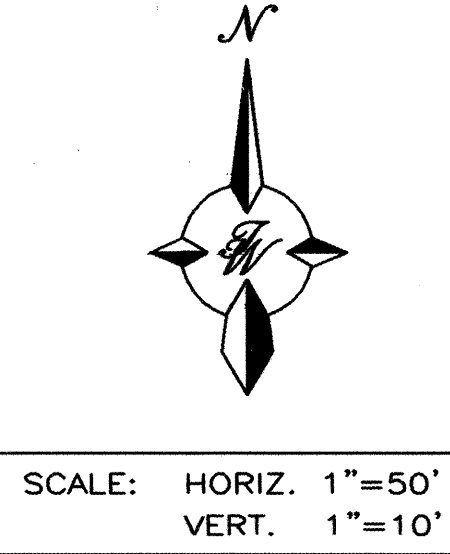

CERTIFICATE OF SUBSTANTIAL COMPLIANCE ON PLANS
I, Ronald R. Bohannon, of the firm of Tierra West LLC, a Registered Professional Engineer in the State of New Mexico, do hereby certify, to the best of my knowledge and belief, that the infrastructure installed as part of this project has been inspected by me or by a qualified person under my direct supervision and has been constructed in accordance with the plans and specifications approved by the City Engineer and that the original design intent of the approved plans has been met, except as noted by me on the as-built construction drawings. This Certification is based on site inspections by me, or personnel under my direction with survey information provided by Larry Mestramo, of Precision Surveys, NMPs number 11993.

Engineer's Seal & Signature
6/25/02

TIERRA WEST, LLC
4421 McLEOD ROAD, N.E., SUITE D
ALBUQUERQUE, NEW MEXICO 87109
(505)883-7592

CITY OF ALBUQUERQUE
PUBLIC WORKS DEPARTMENT
ENGINEERING GROUP

TITLE: **ALBUQUERQUE WAL-MART #831**
UTILITY IMPROVEMENTS
ON-SITE SAS AND WATER

DESIGN REVIEW COMMITTEE
APPROVED
JUN 25 2002
DESIGN REVIEW COMMITTEE

CITY ENGINEER APPROVAL
APPROVED
AUG 26 2002
CITY ENGINEER

LAST DESIGN UPDATE

CITY PROJECT NO. **685781**

ZONE MAP NO. **K-17-Z**

SHEET **6** OF **8**




NO. DATE

REVISIONS

DESIGNED BY RRB DATE 04/02

DRAWN BY BGC DATE 04/02

CHECKED BY RRB DATE 04/02

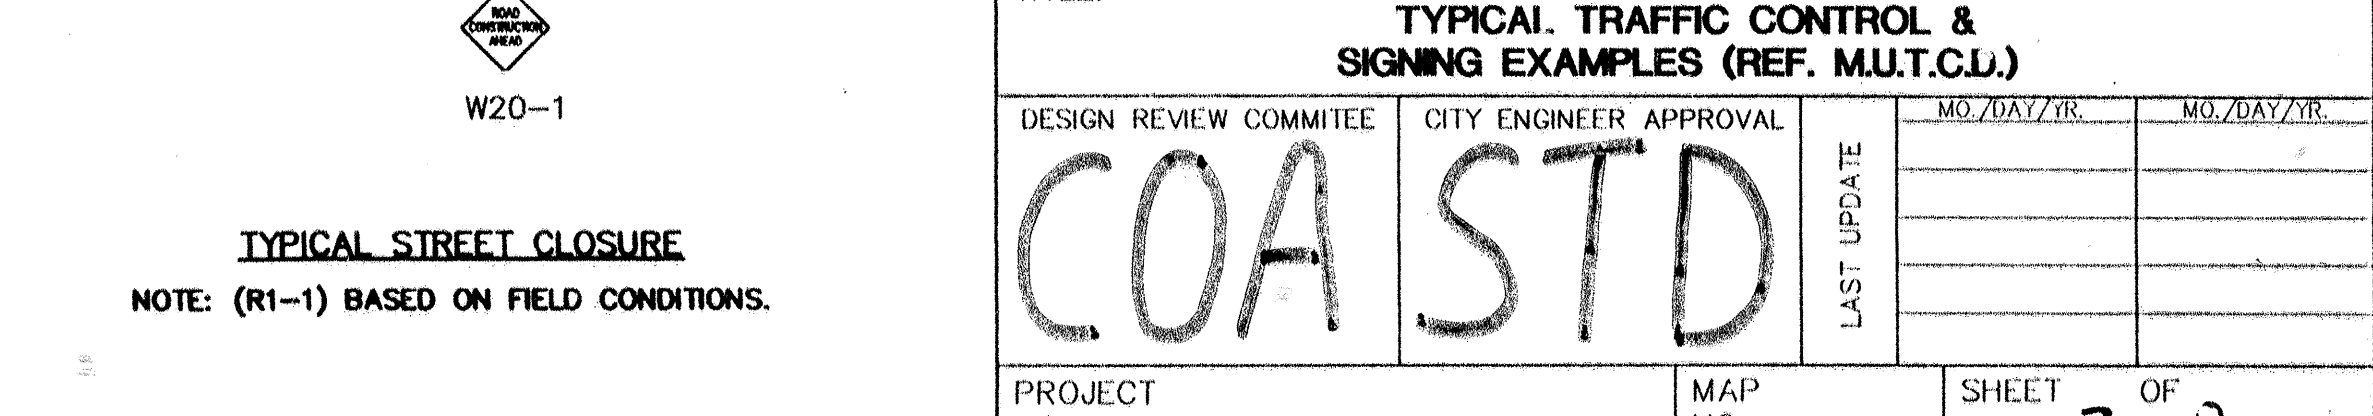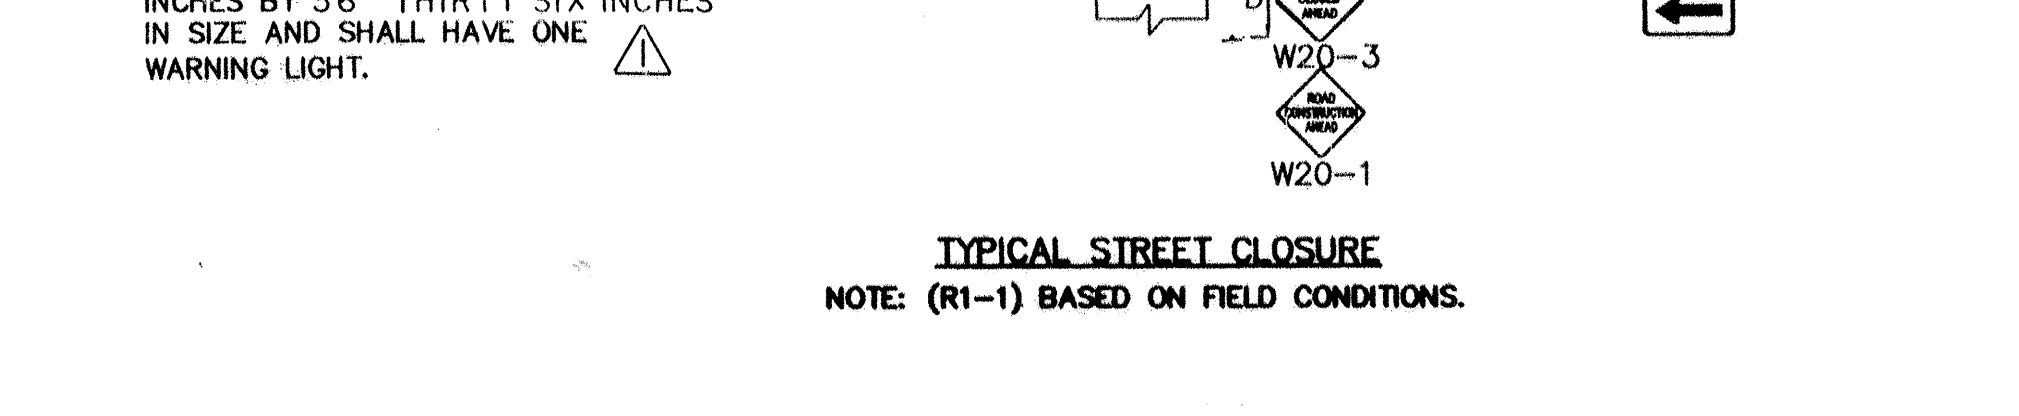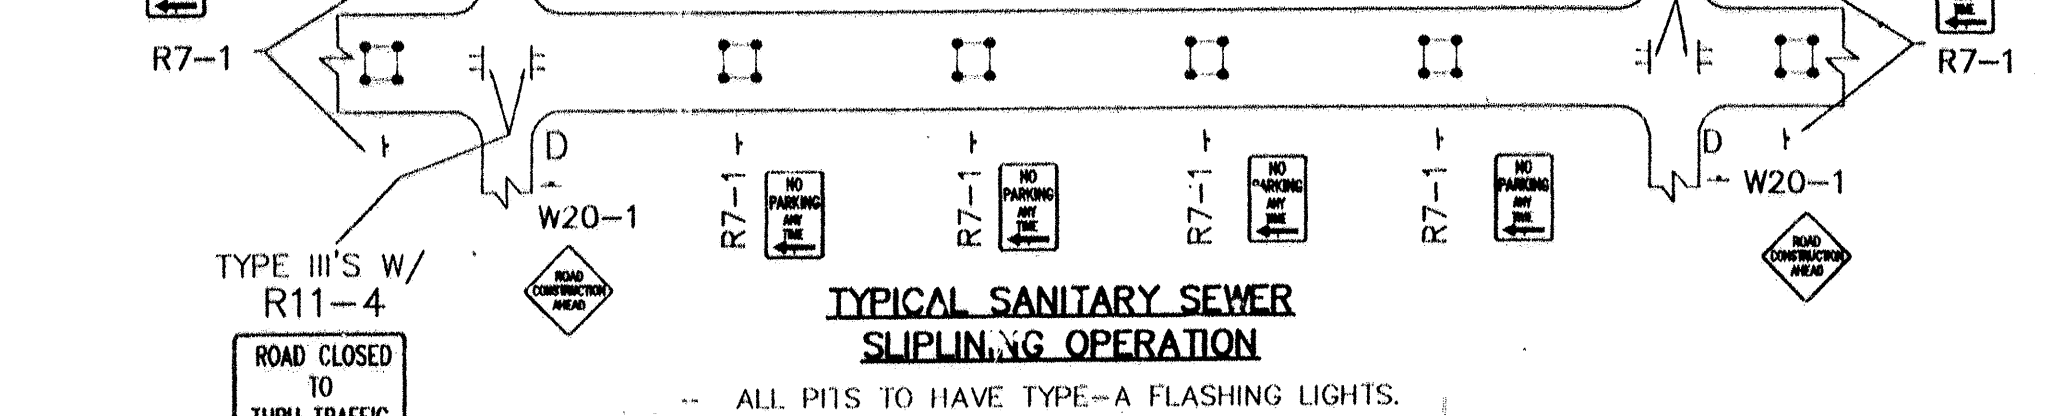

CITY OF ALBUQUERQUE PUBLIC WORKS DEPARTMENT ENGINEERING DEVELOPMENT GROUP				
TITLE: TYPICAL. TRAFFIC CONTROL & SIGNING EXAMPLES (REF. M.U.T.C.D.)				
DESIGN REVIEW COMMITTEE COA	CITY ENGINEER APPROVAL STD	LAST UPDATE	MO./DAY/YR. 	MO./DAY/YR.
PROJECT NO.	MAP NO.	SHEET 7 OF 8		

