



FOUR HILL VILLAGE - UNITS 5

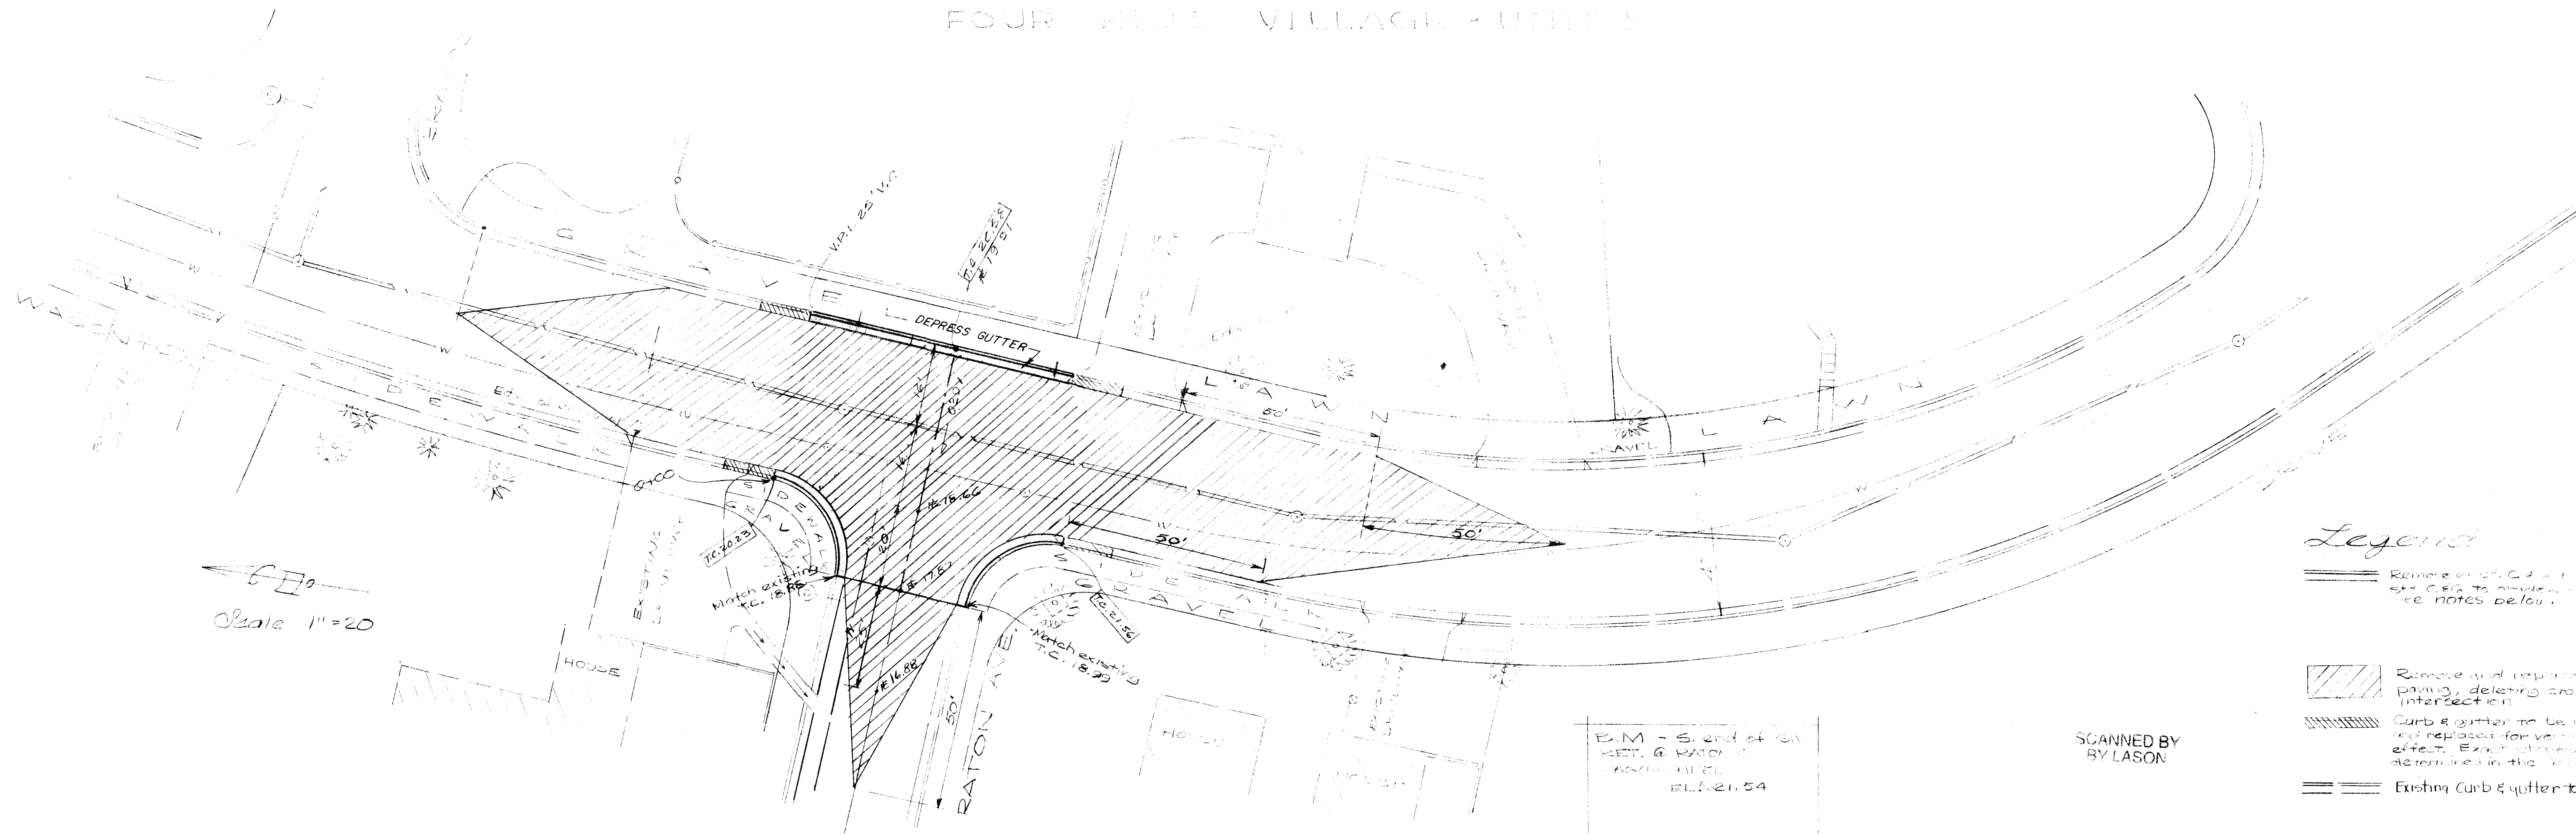

- NOTES:
- Do not damage existing sidewalk. Install rubber-based joint filler between sidewalk and new curb.
 - Check actual depth of water line. Lower only if resulting new cover is less than 3 feet.
 - Install expansion joint filler between new curb and existing curb.
- MAP-M-22

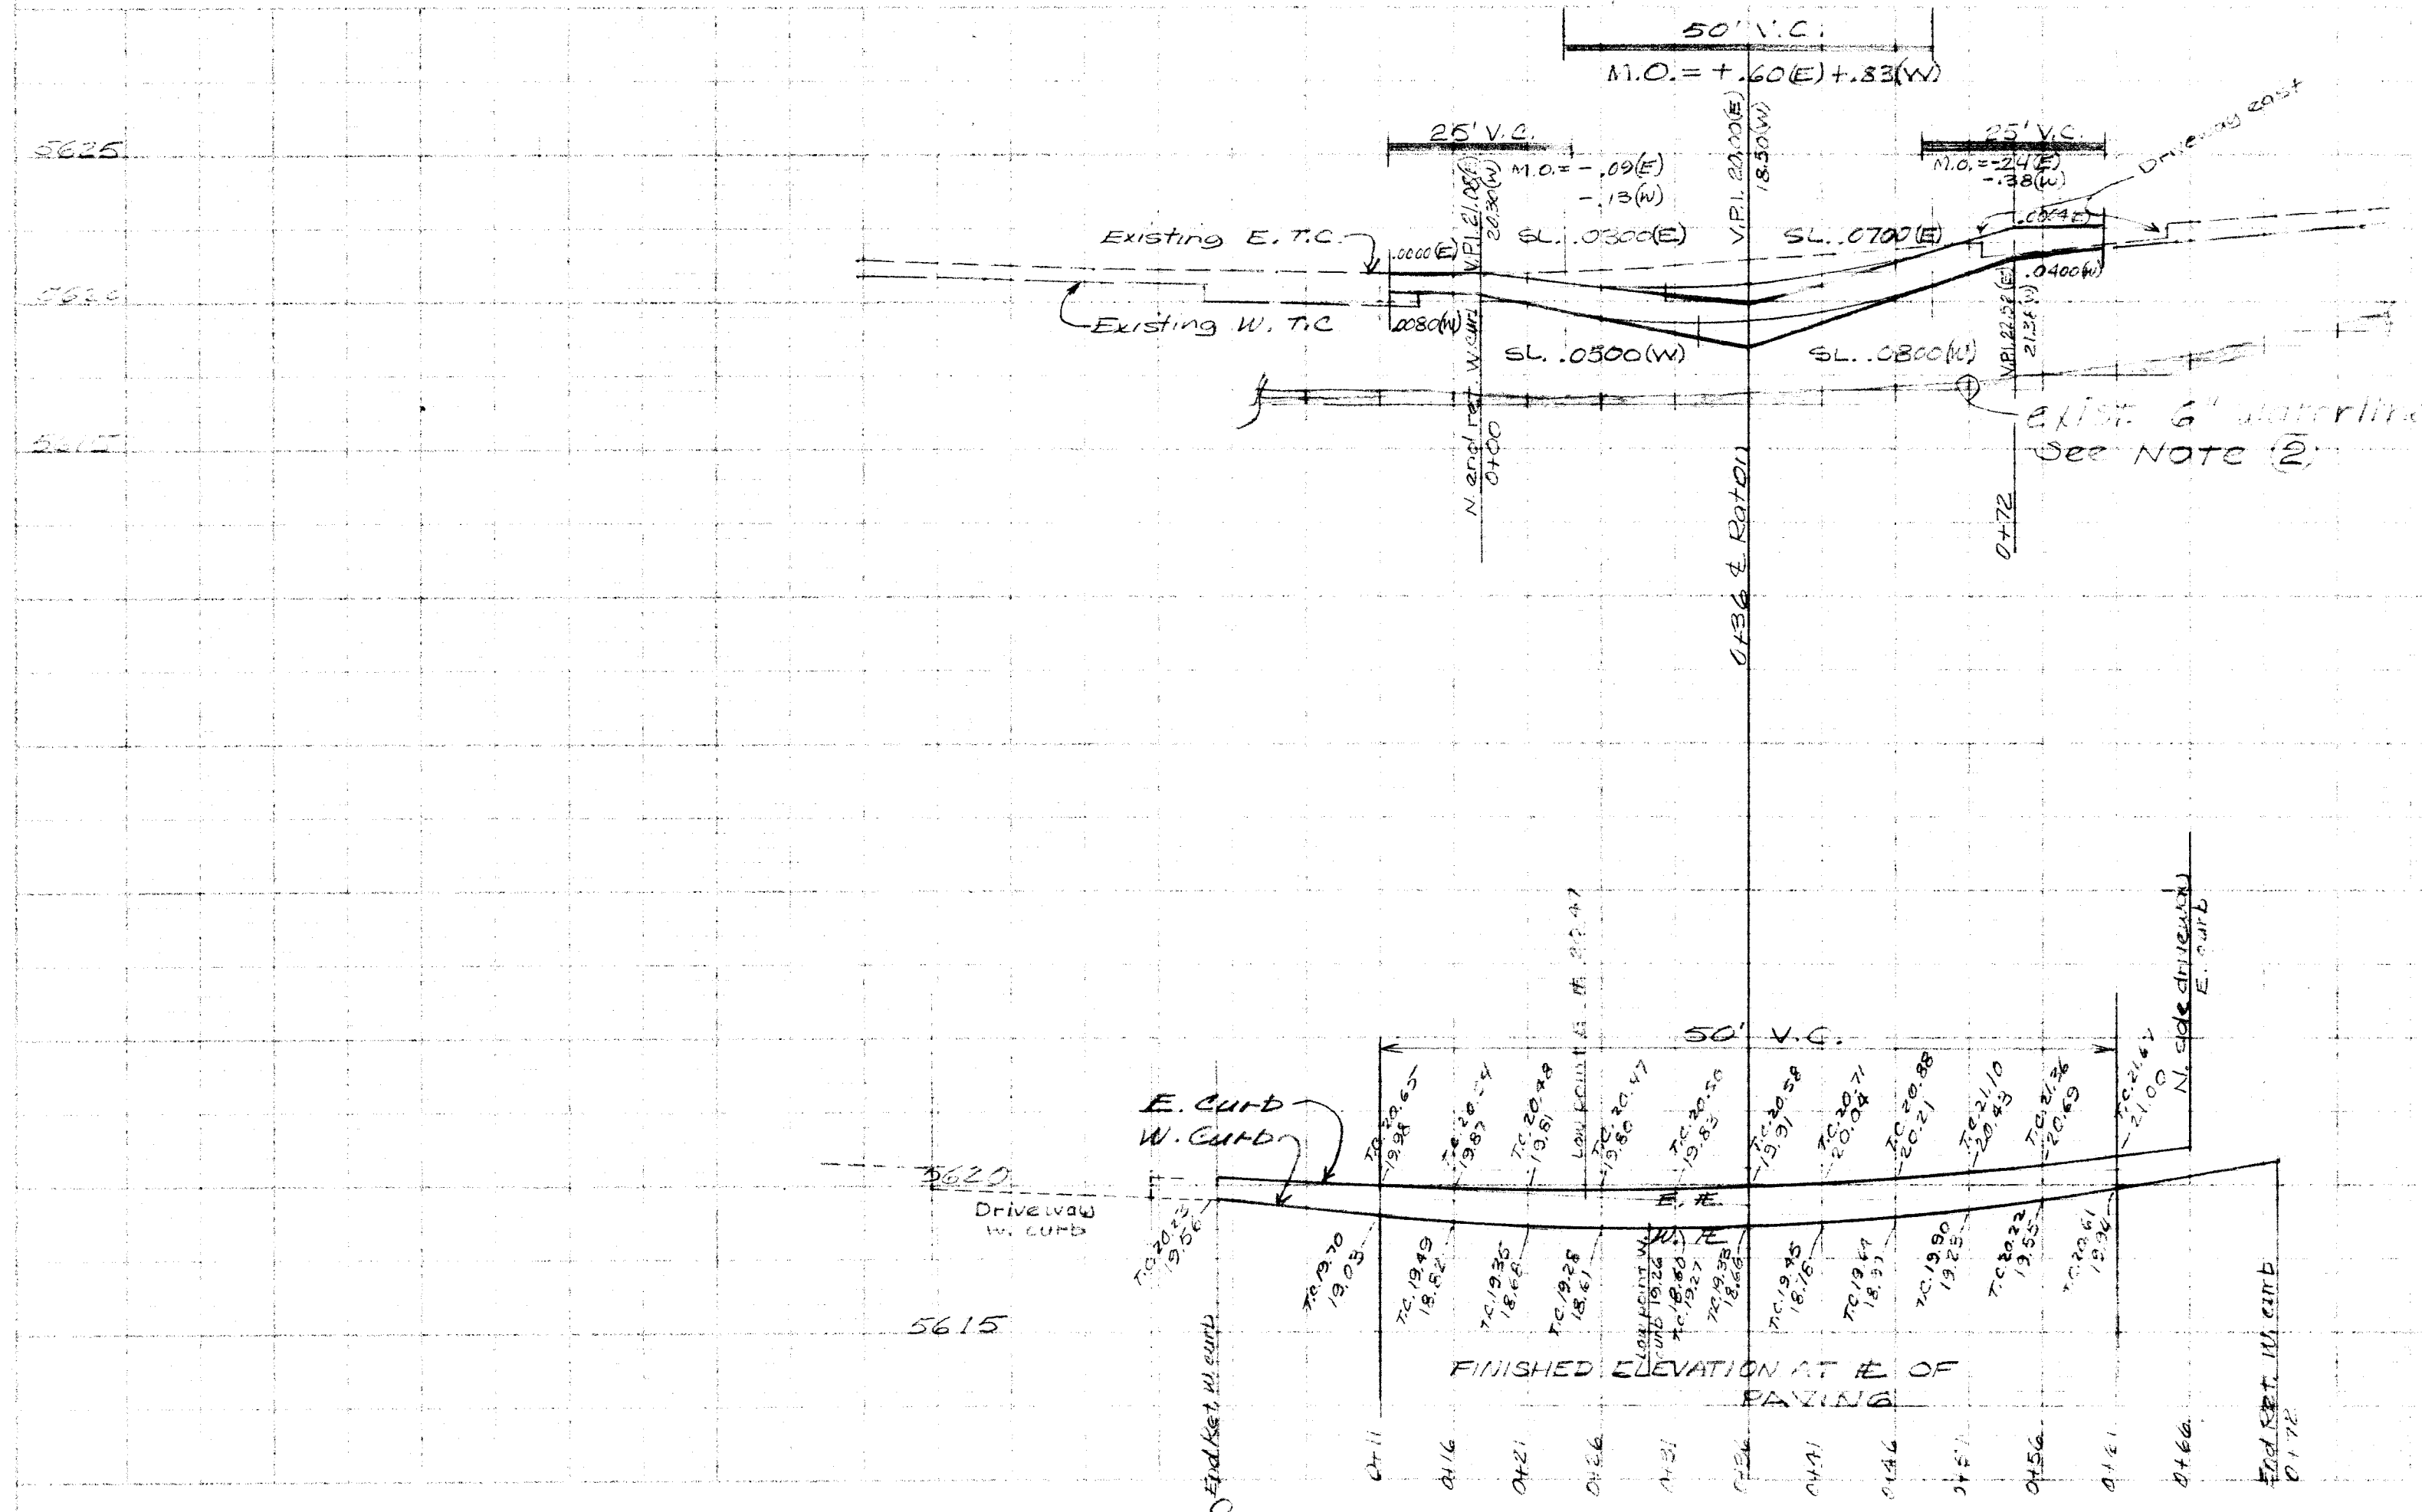

24 068 0175 01 5522276

NO.	DATE	REMARKS	REVISOR

CITY OF ALBUQUERQUE
PUBLIC WORKS DEPARTMENT
ENGINEERING DIVISION

TITLE: REGRAIDING INTERSECTION OF WAGONTRAIN DR. & RATON AVE		AS BUILT
DESIGNED BY: CE	DRAWN BY: CE	SUBMITTED BY:
TITLE: CE	TITLE: CE	TITLE:
DATE: 8/22/75	DATE:	DATE:
APPROVAL		DATE:
ASST. CITY ENGINEER	CITY ENGINEER	RECORDED BY:
DATE: 8/22/75	DATE: 8/22/75	DATE:
TRAIL ENGINEER	LIQUID WASTE ENGINEER	SHEET NO. 1
DATE: 8/22/75	DATE:	
DRAWING NUMBER: P-68-75		