
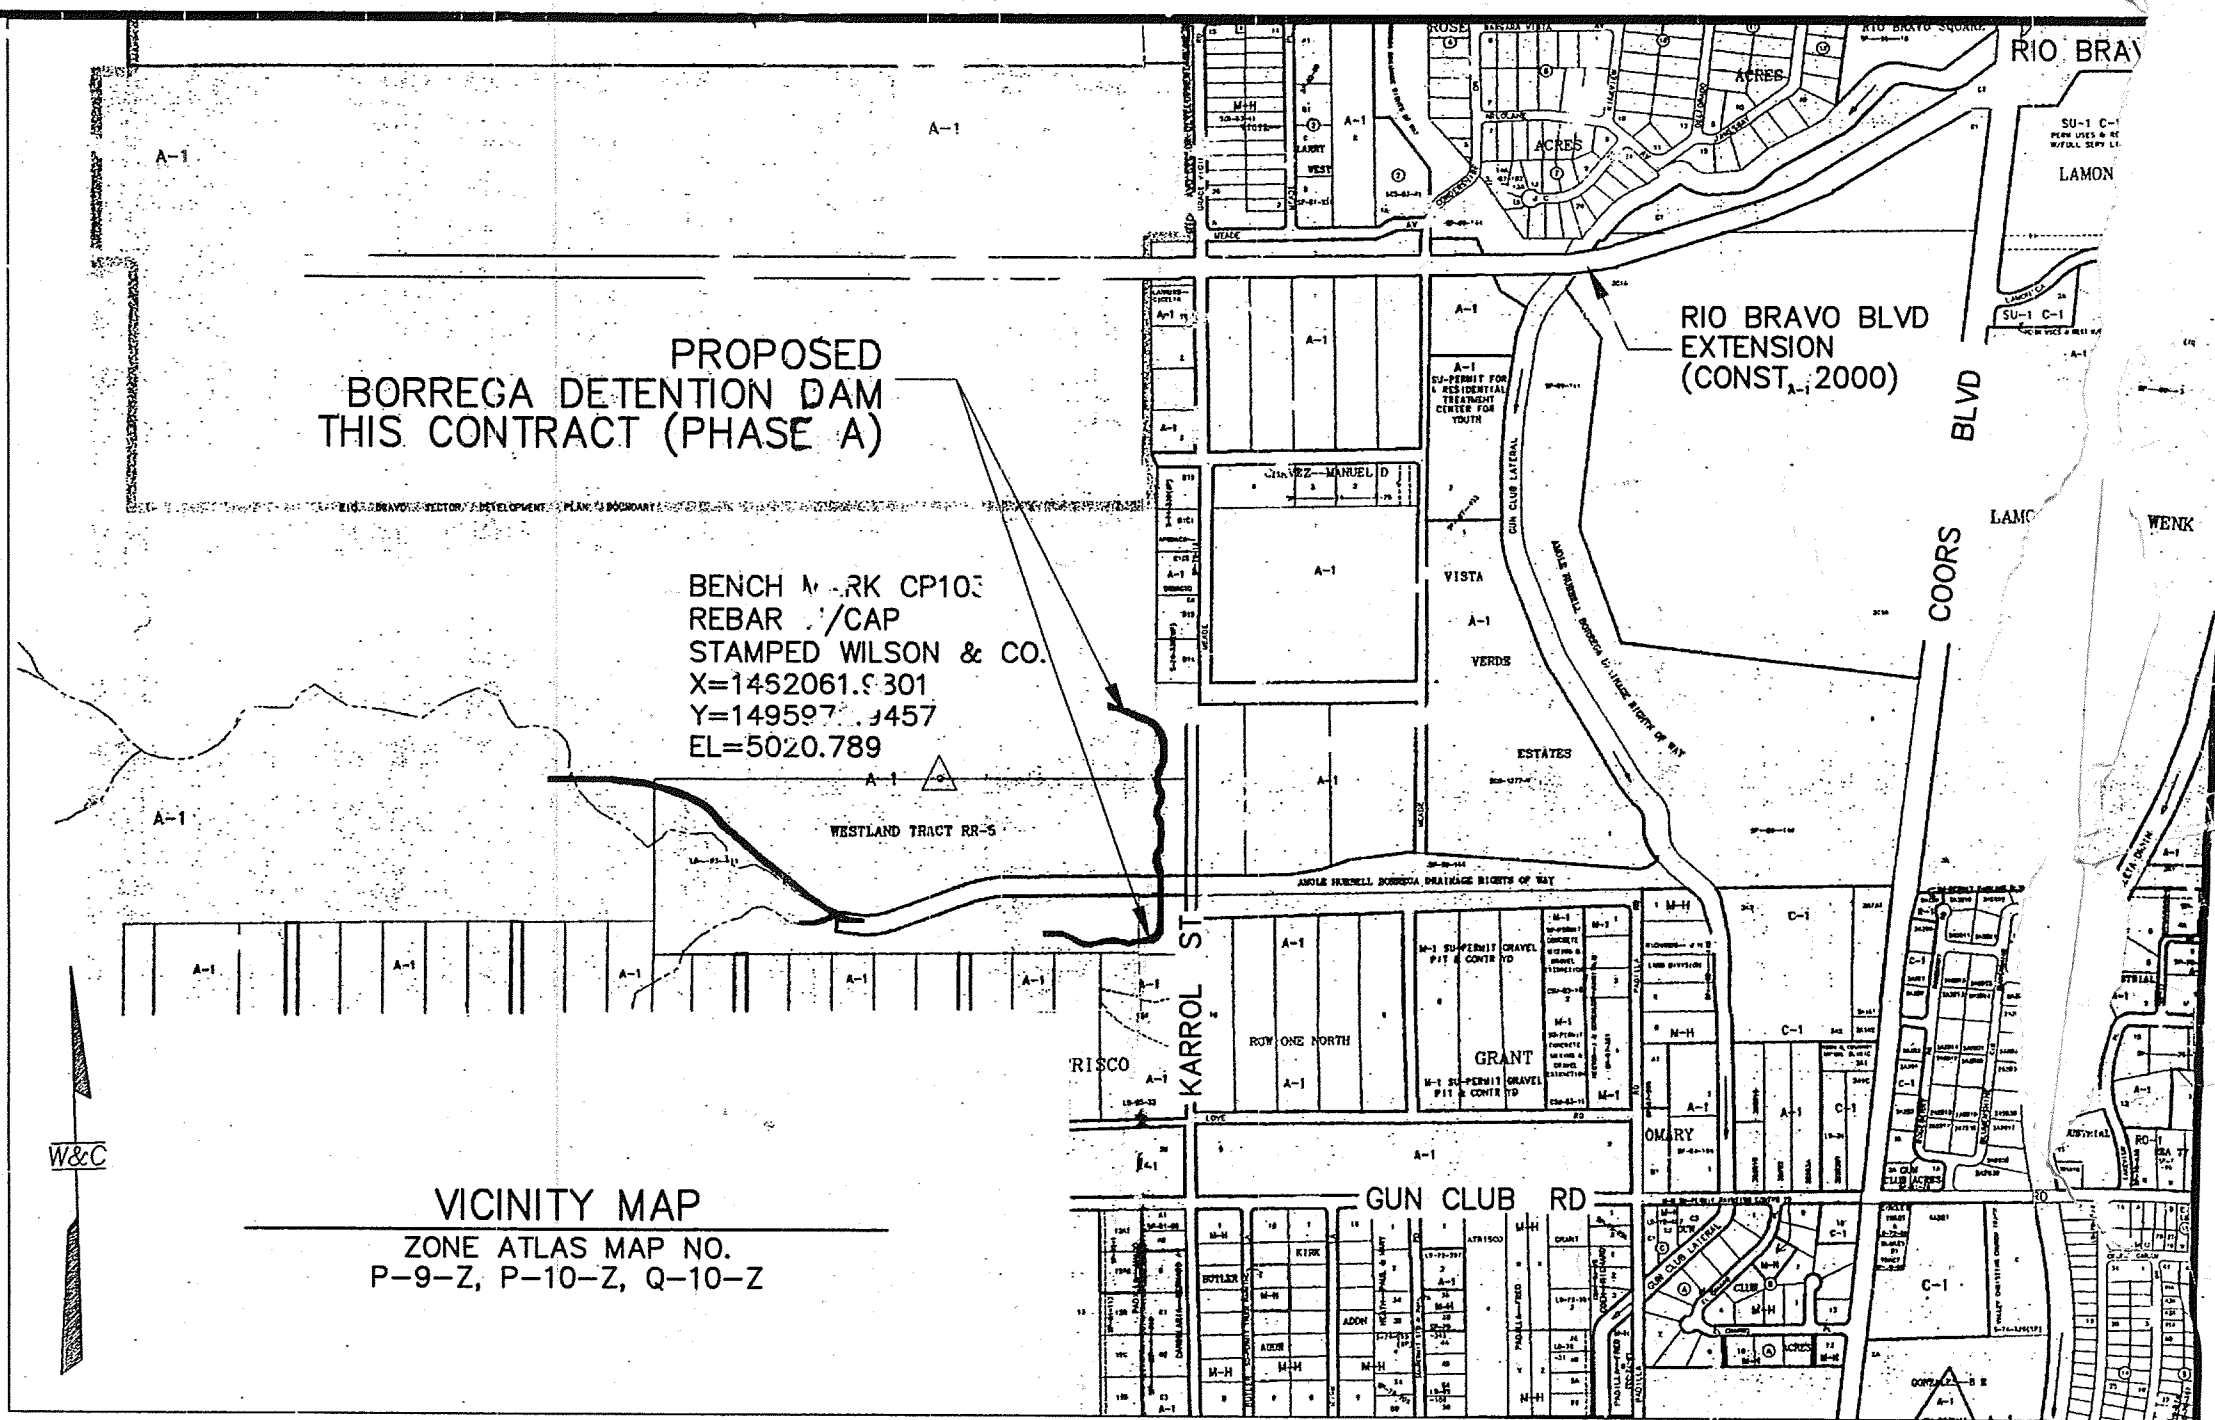


ALBUQUERQUE METROPOLITAN ARROYO FLOOD CONTROL AUTHORITY

CONSTRUCTION PLANS FOR BORREGA DETENTION DAM

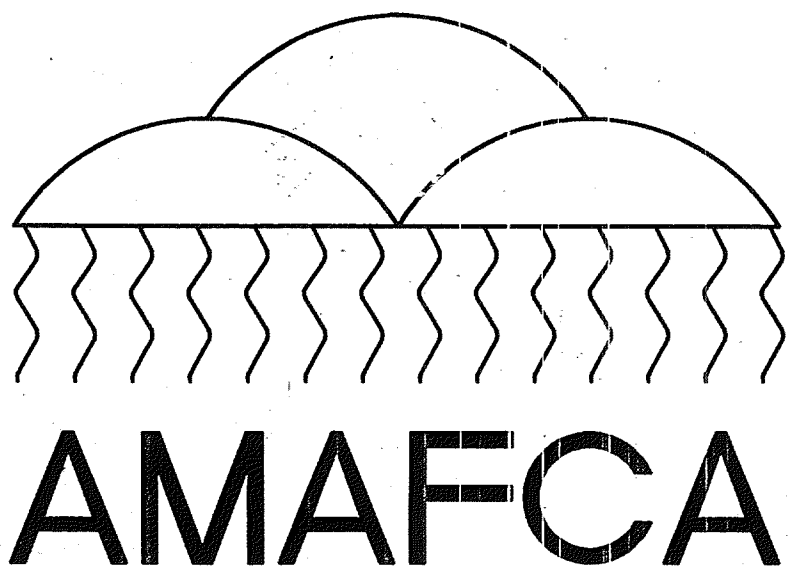

REFERENCE DOCUMENTS


- Amole-Hubbell Drainage Management Plan, for AMAFCA by
Leedshill-Herkenhoff, Inc., 1999.
- Borrega Diversion Sediment Issues Floodplain Study for AMAFCA, for Bohannon-
Huston Inc. by Resource Consultants, Inc. June 1992.
- Design Analysis Report for Borrega Detention Dam and Narrows Borrega Channel,
for AMAFCA by Wilson & Company, March 2000.

FOR INFORMATION ONLY

INDEX

DESCRIPTION	SHEET NO.	DESCRIPTION	SHEET NO.
COVER SHEET	1	DAM CROSS SECTIONS STA 1+50 TO STA 6+50	16
DAM FILING SHEET	2	DAM CROSS SECTIONS STA 7+00 TO STA 11+50	17
BASIN MAP	3	DAM CROSS SECTIONS STA 11+80.62 TO STA 19+06.10	18
GENERAL NOTES & SUMMARY OF QUANTITIES	4	DAM CROSS SECTIONS STA 19+50 TO STA 24+00	19
DAM LAYOUT - PHASE "A" GRADING	5	BORREGA DIVERSION STORM DRAIN - PLAN & PROFILE	20
DAM LAYOUT - PHASE "B" GRADING	6	STORM DRAIN DETAILS	21
DAM CENTERLINE PROFILE	7	72" RCP HEADWALL & RIP RAP DETAILS	22
PRINCIPAL SPILLWAY OUTLET PIPE - PLAN & PROFILE	8	ACCESS ROAD PLAN & PROFILE	23
CHANNEL CHUTE - PLAN & PROFILE	9	KARROL STREET PLAN & PROFILE	24
ANTI-SEEP COLLAR DETAILS	10	FENCING & REVEGETATION PLAN	25
RISER DETAILS	11	FENCING DETAILS	26
EMERGENCY SPILLWAY DETAILS	12	RUNDOWN AND CHANNEL DETAILS	27
EMERGENCY SPILLWAY LIFTS 1-4	13	PRINCIPAL SPILLWAY OUTLET STRUCTURE DETAILS	28-32
EMERGENCY SPILLWAY LIFTS 5-10	14	36" STORM DRAIN PLAN & PROFILE	33
EMERGENCY SPILLWAY LIFTS 11-13	15	SLOPE STABILITY AND SEEPAGE ANALYSIS	34

FOR INFORMATION ONLY

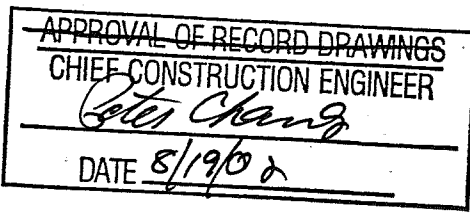

RECORD DRAWING
DATE 2-20-01









RECORD DRAWINGS
THE DRAWING HAS BEEN REVISED TO
REFLECT THE CONSTRUCTED FIELD
CONDITIONS IN ACCORDANCE WITH
INFORMATION AS PROVIDED BY
WILSON AND COMPANY.

APPROVED FOR CONSTRUCTION

John P. Kelly 4-25-00
JOHN P. KELLY, P.E. DATE
EXECUTIVE ENGINEER
ALBUQUERQUE METROPOLITAN ARROYO FLOOD CONTROL AUTHORITY

City Project No. 6922.91	
ALBUQUERQUE METROPOLITAN ARROYO FLOOD CONTROL AUTHORITY	
BORREGA DETENTION DAM COVER SHEET	
	DATE APRIL 2000
	FILE 99099
	SHEET 1 OF 34
WILSON & COMPANY 4900 LANG AVENUE N.E. ALBUQUERQUE, NM 87109 (505) 348-4000	

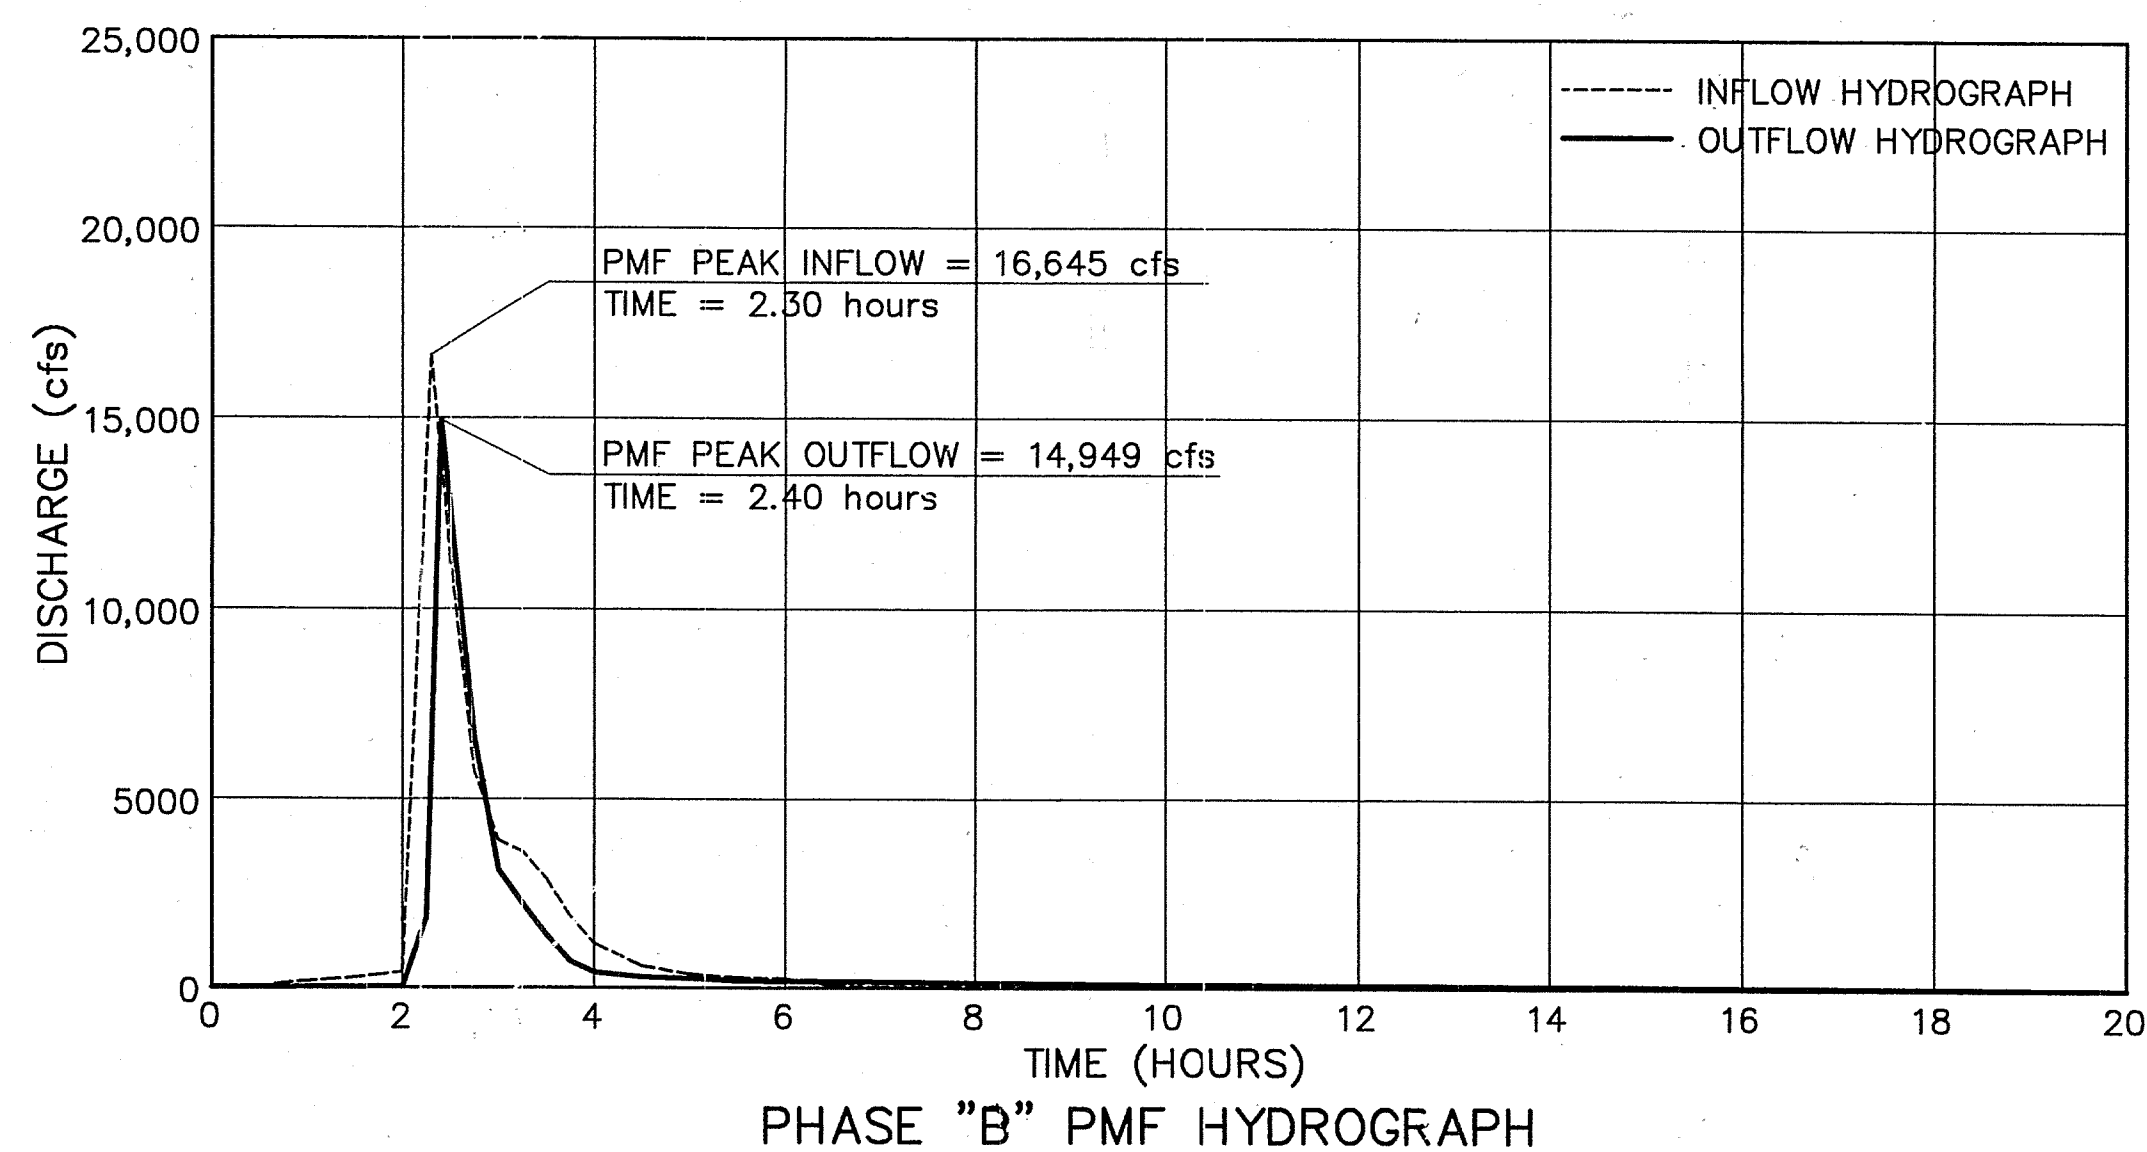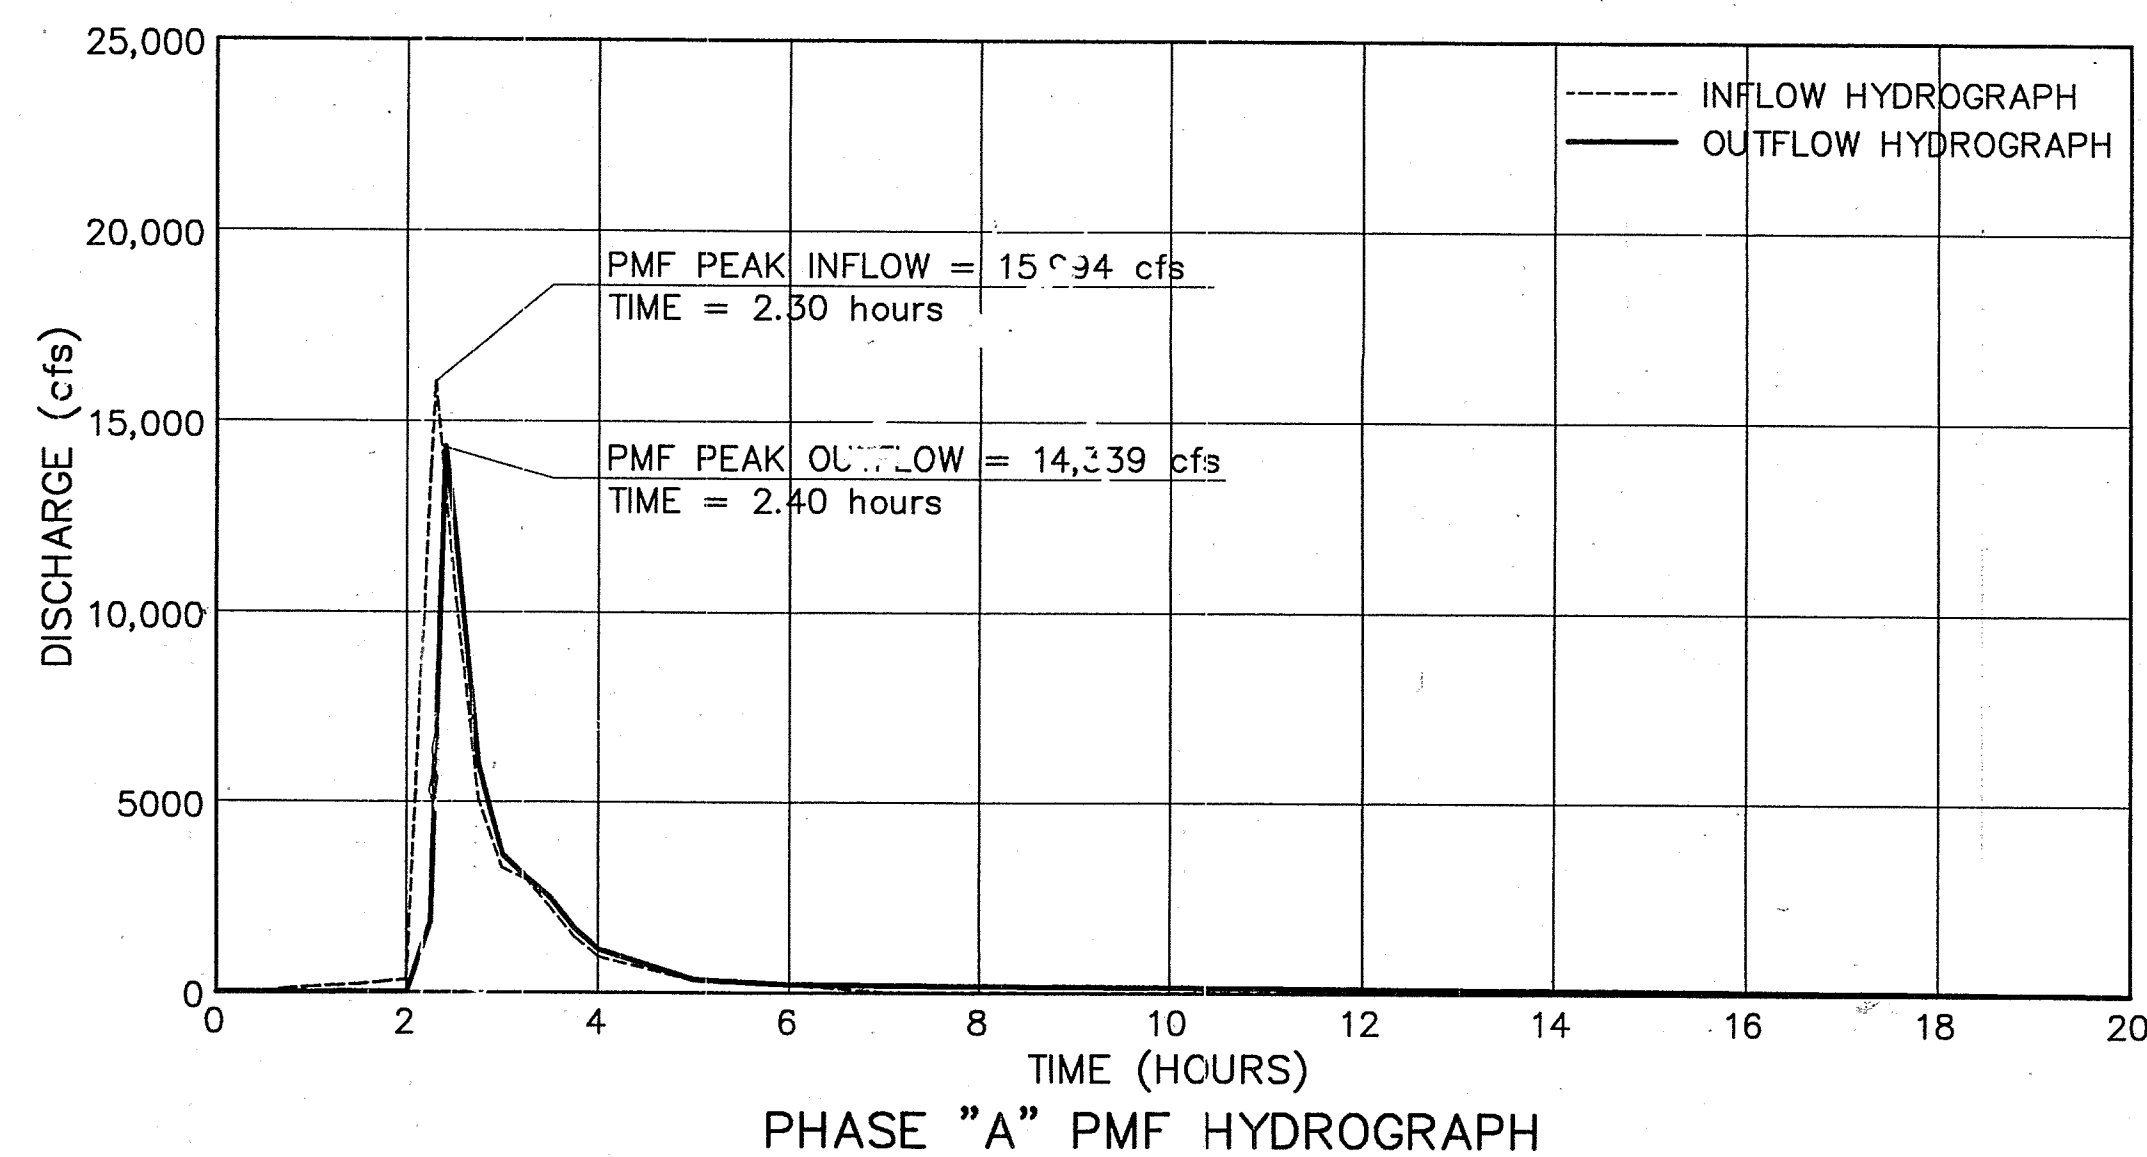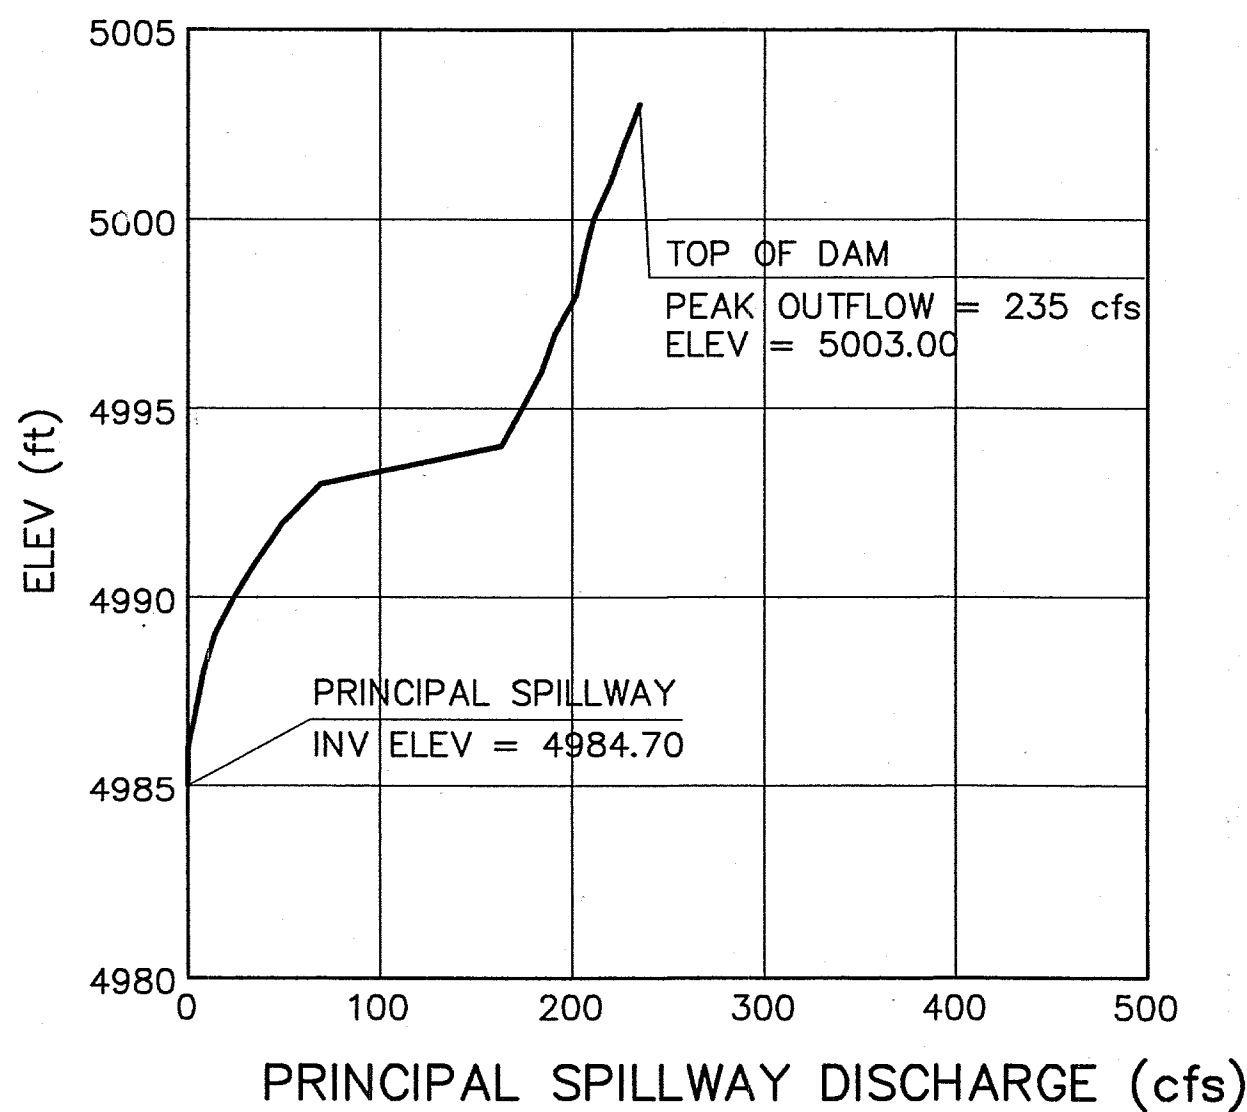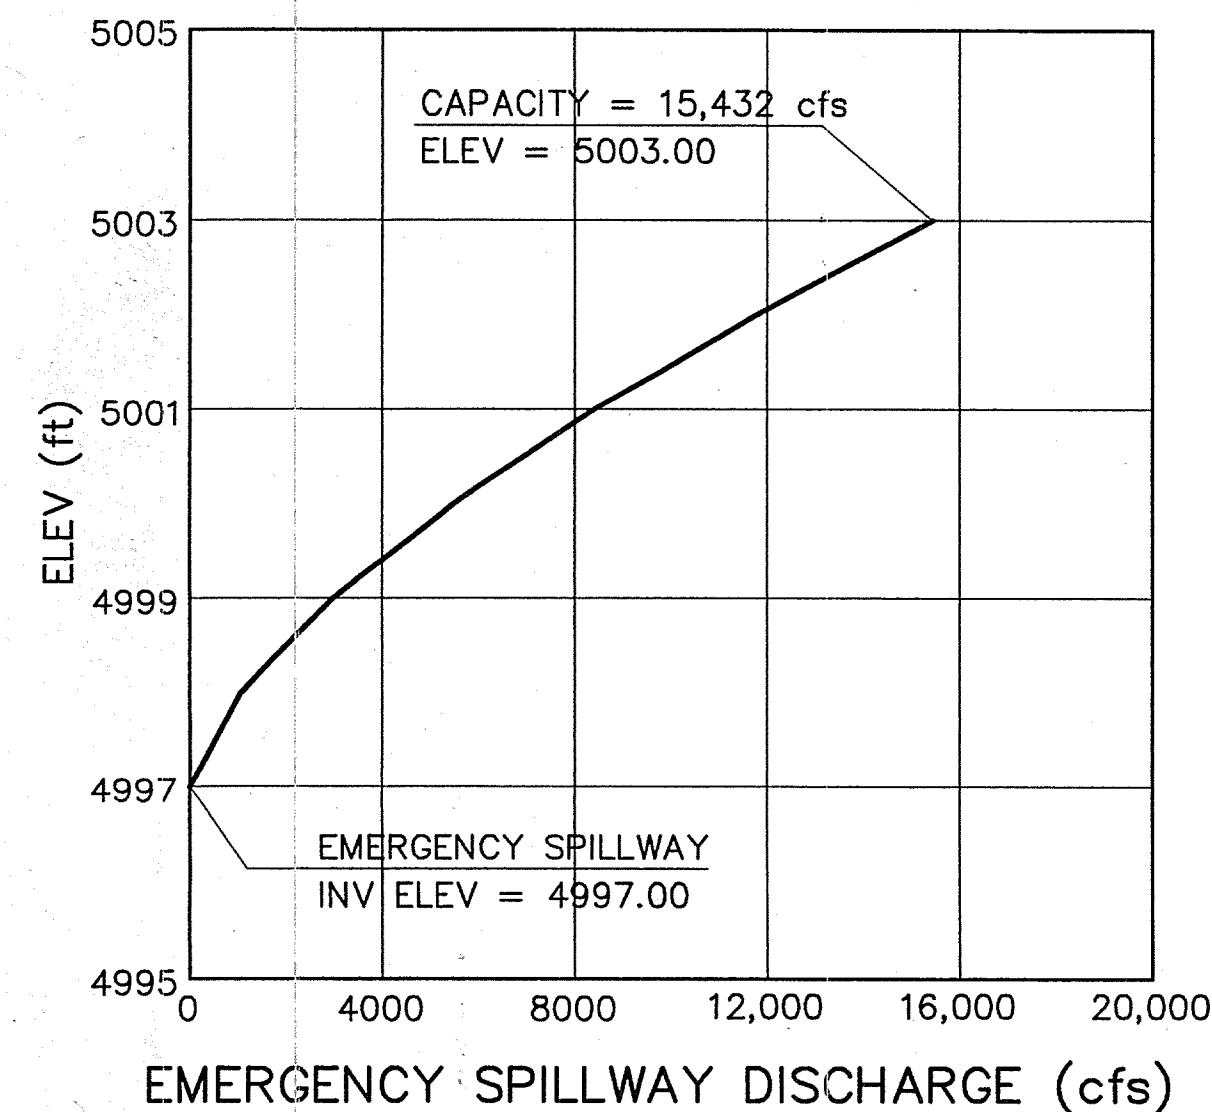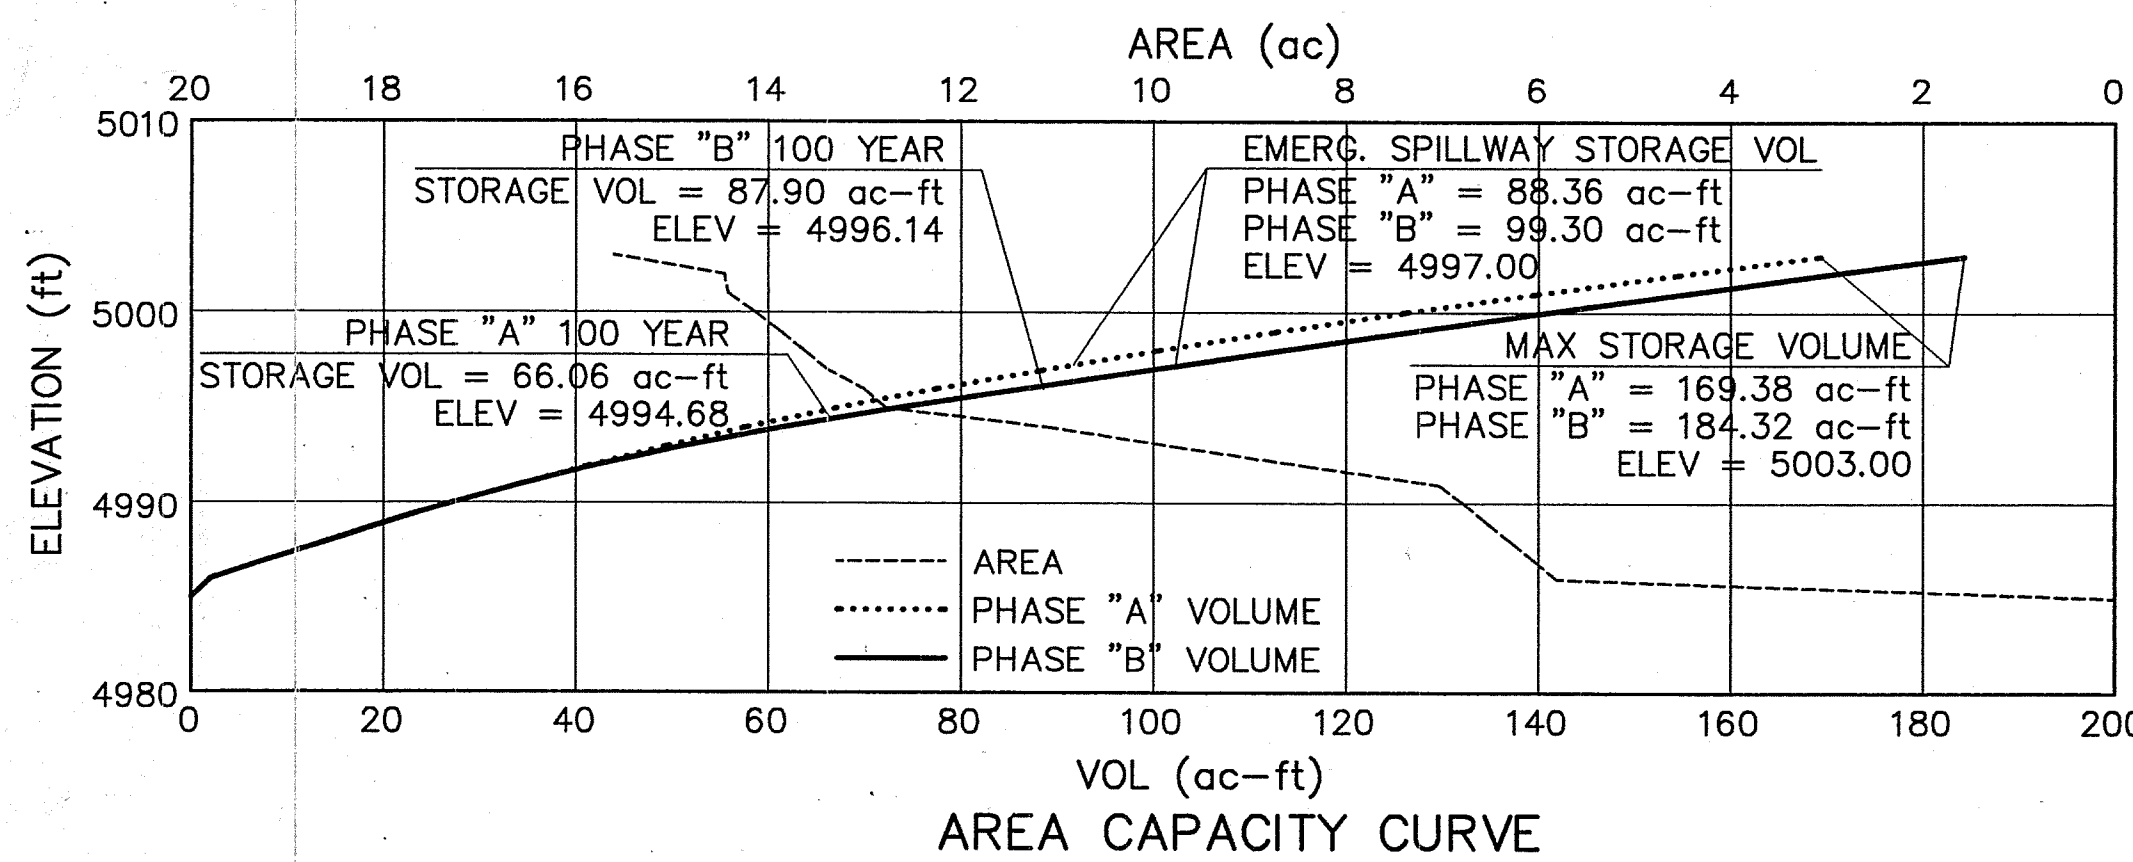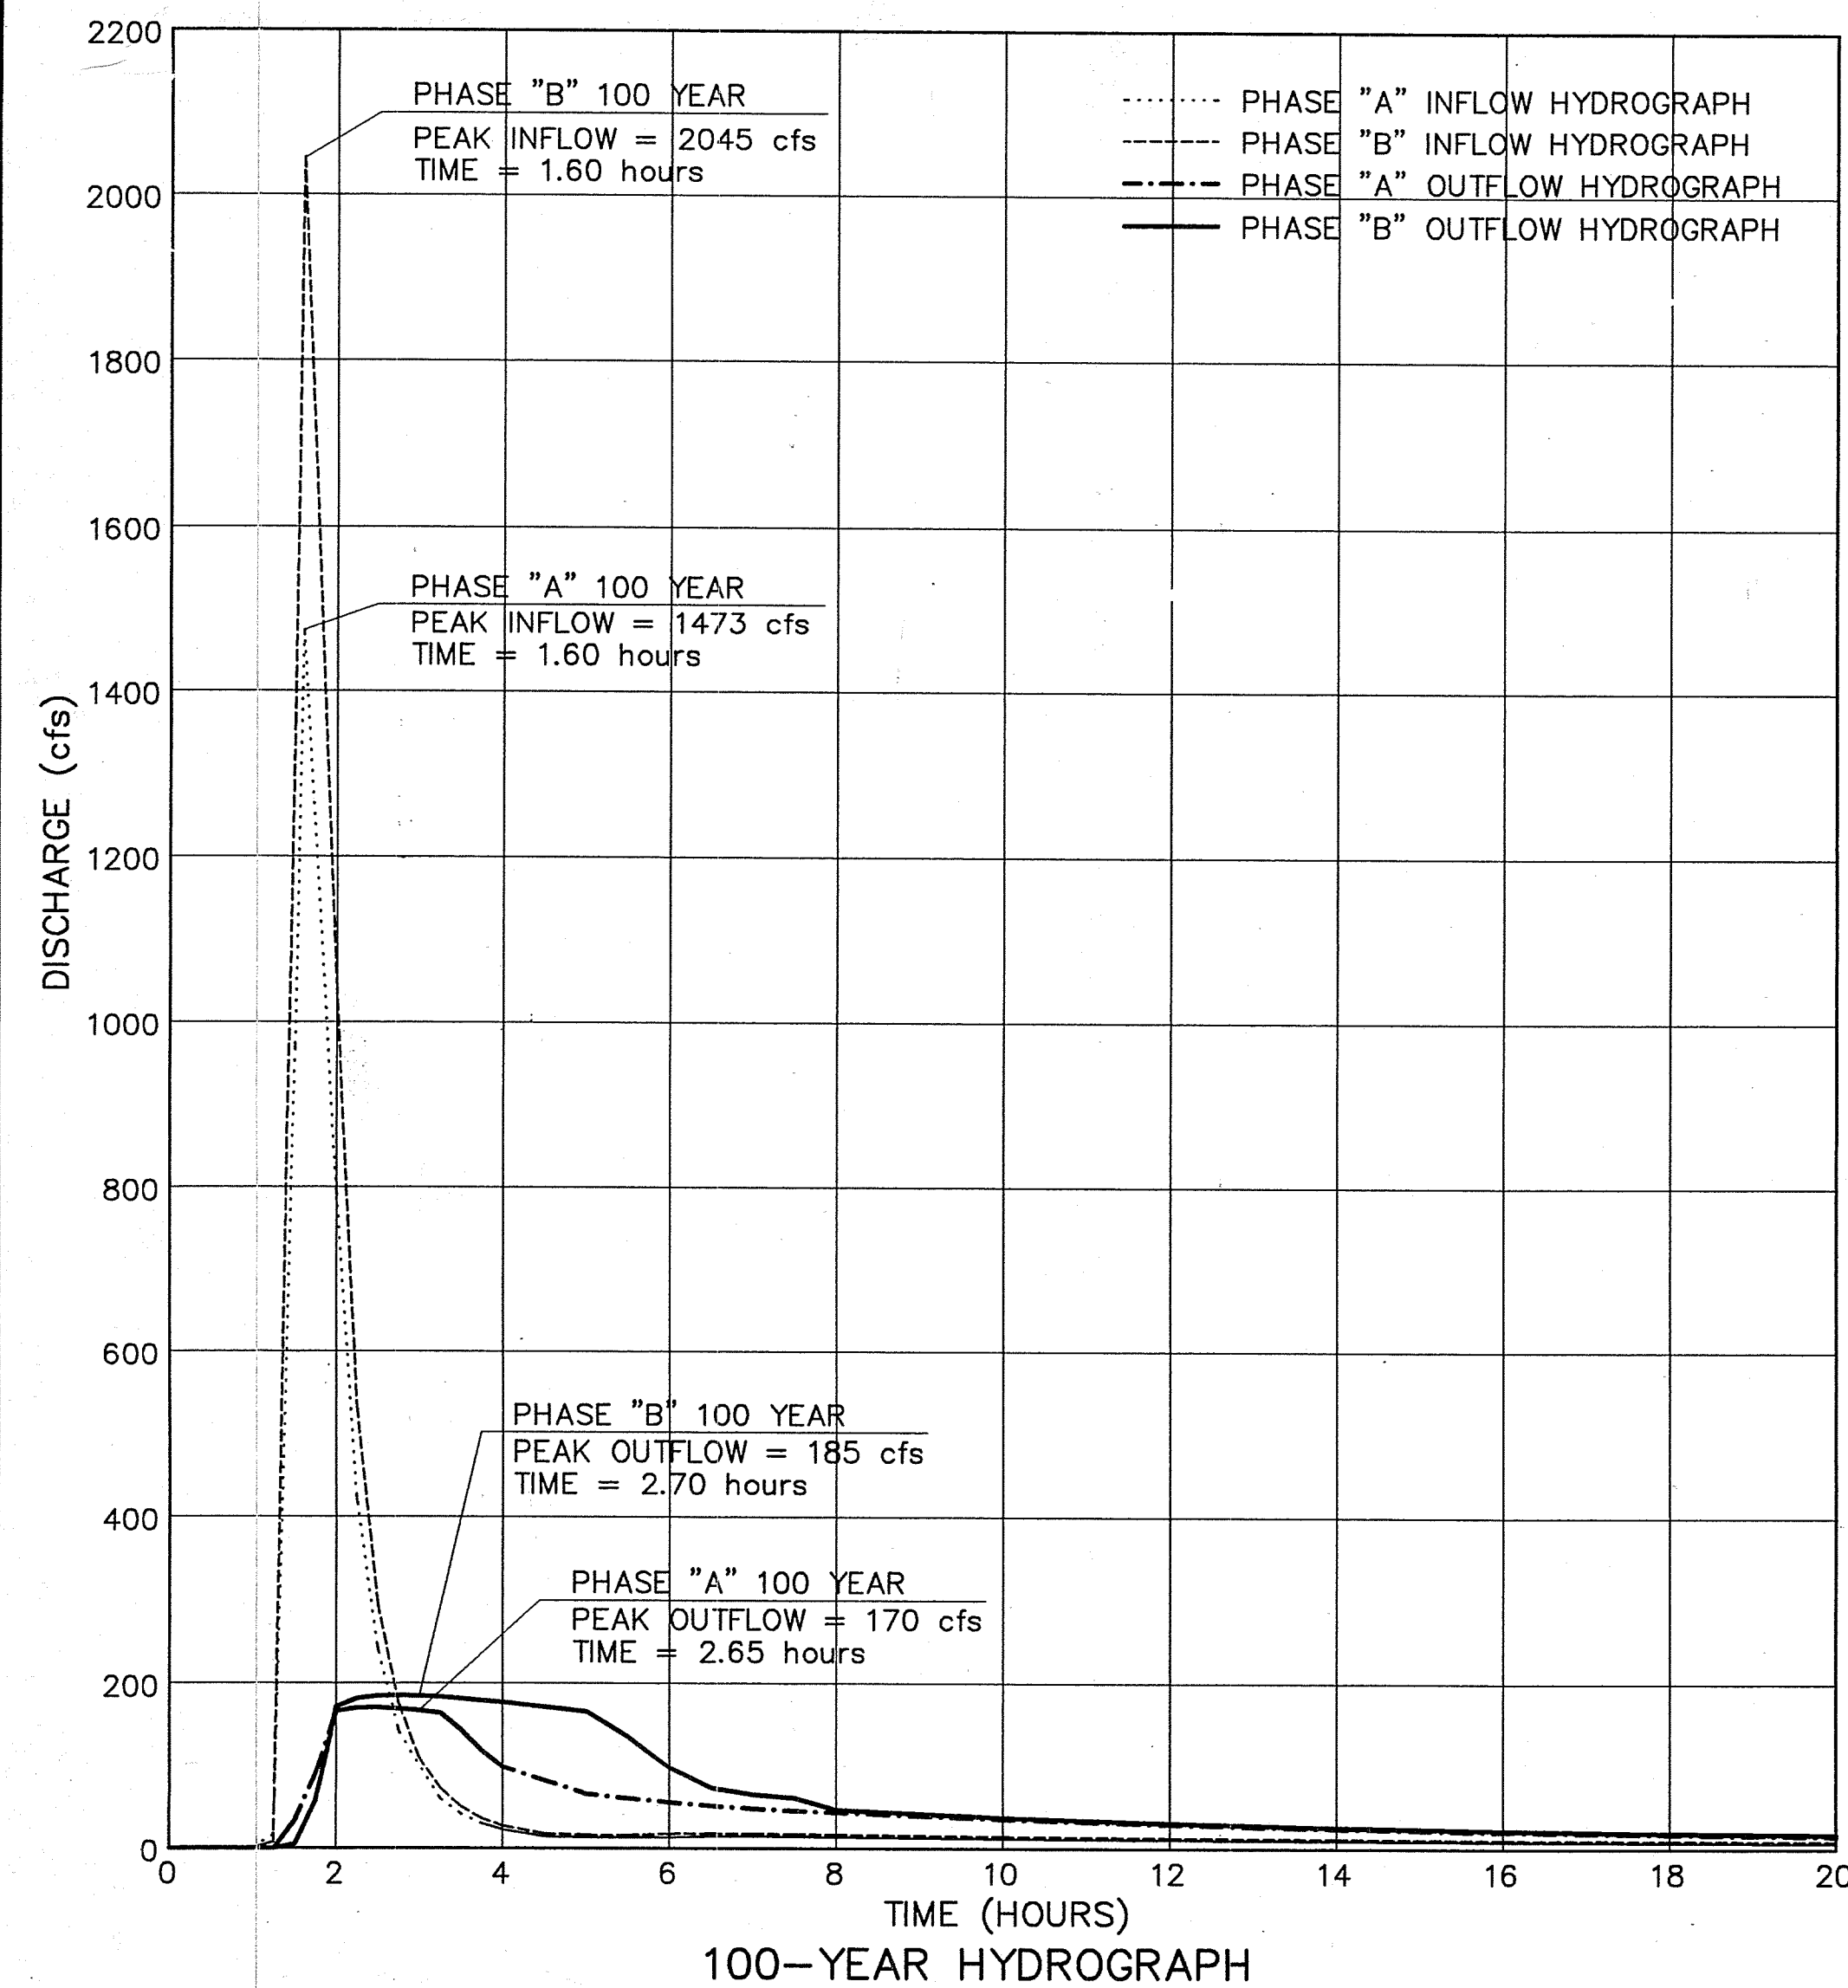

BORREGA DAM CHARACTERISTICS				
ELEVATION (ft)	OUTFLOW (cfs)	STORAGE (ac-ft)		AREA (ac)
		PHASE "A"	PHASE "B"	
4984.7 = PRINCIPAL SPILLWAY INV	0	0	0	0
4985	0	0	0	0
4986	0 + 3.0	2.02	2.02	5.91
4987	16.0	7.94	7.94	6.04
4988	25.0	14.10	14.10	6.28
4989	32.0	20.51	20.51	6.54
4990	49.0	27.17	27.17	6.78
4991	62.0	34.08	34.08	7.03
4992	73.0	41.36	41.78	8.39
4993	97.0	49.21	50.84	9.75
4994	163	57.72	61.26	11.07
4995	174	67.03	73.20	12.78
4996	184	77.26	86.10	13.01
4997 = EMERG. SPILLWAY INV	191	88.36	99.30	13.38
4998	1252	100.23	112.80	13.63
4999	3176	112.77	126.55	13.88
5000	5667	125.94	140.56	14.14
5001	8620	139.90	154.85	14.42
5002	11,966	154.34	169.29	14.46
5003	15,667	169.38	184.32	15.61

BORREGA DAM PROPERTIES	
MAXIMUM GRADE ABOVE EXISTING GRADE AT CENTERLINE	13 FT
LENGTH	2300 FT
MAXIMUM WIDTH AT BASE	150 FT
CREST WIDTH	20 FT
SLOPE UPSTREAM FACE	3:1
SLOPE DOWNSTREAM FACE	VARIES 2.5:1 TO 6:1
ELEVATION AT TOP OF DAM	5003
FLOWLINE ELEVATION OF PRINCIPAL SPILLWAY OUTLET AT INTAKE	4984.70
ELEVATION OF EMERGENCY SPILLWAY CREST	4997
WIDTH OF EMERGENCY SPILLWAY PERPENDICULAR TO FLOW	350 FT
DISCHARGE CAPACITY OF EMERG. SPILLWAY AT TOP OF DAM ELEV 5003	15,432 cfs
OUTLET CONDUIT SIZE AND TYPE	47 1/2" ORIFICE PLATE ON 54" PCPP
OUTLET CONDUIT CAPACITY AT ELEVATION 4997	191 cfs
EVACUATION TIME FOR 100-YR EVENT (PHASE "A", Qout < 2 cfs)	57 hours
DRAINAGE AREA PHASE "A" / PHASE "B"	1.246 / 1.748 sq. mi.
100-YEAR 24 HOUR DESIGN RAINFALL	2.66 inches
HAZARD CLASSIFICATION (NCRS DEFINITION)	HIGH
PMF 6 HOUR LOCAL STORM DESIGN RAINFALL	16.0 inches

I HEREBY CERTIFY THAT THE ACCOMPANYING MAP(S) AND STATEMENTS HAVE BEEN EXAMINED BY ME AND APPROVED AS TO FORM AND CONTENT, AND WERE DULY ACCEPTED FOR FILING ON THE 28th DAY OF April, 2000.

Thomas C. Turney, P.E.
THOMAS C. TURNEY, P.E. Chief Technical Division
NEW MEXICO STATE ENGINEER

I, JOHN P. KELLY, EXECUTIVE ENGINEER OF THE ALBUQUERQUE METROPOLITAN ARROYO FLOOD CONTROL AUTHORITY, ALBUQUERQUE, NEW MEXICO, BEING FIRST DULY SWORN AUTHORITY UPON MY OATH, STATE I HAVE READ AND EXAMINED THE ACCOMPANYING MAP AND STATEMENTS (MAP AND STATEMENTS CONSISTING OF 34 SHEETS) AND KNOW THE CONTENTS THEREOF AND REPRESENTATIONS THEREON AND STATE THAT THE SAME ARE TRUE TO THE BEST OF MY KNOWLEDGE AND BELIEF.

John P. Kelly
JOHN P. KELLY, P.E.
EXECUTIVE ENGINEER
ALBUQUERQUE METROPOLITAN ARROYO FLOOD CONTROL AUTHORITY


SUBSCRIBED AND SWORN TO BEFORE ME THIS 25 DAY OF April 2000

I, DANIEL S. AGUIRRE, BEING FIRST DULY SWORN UPON MY OATH, STATE THAT I AM THE REGISTERED PROFESSIONAL ENGINEER WHO MADE THE MAP(S) OF BORREGA DAM, THAT SUCH MAP(S) CONSISTING OF 34 SHEETS WERE PREPARED FROM FIELD NOTES OF ACTUAL SURVEYS MADE BY ME OR UNDER MY DIRECTION, AND THAT THE SAME ARE TRUE AND CORRECT TO THE BEST OF MY KNOWLEDGE AND BELIEF.

Daniel S. Aguirre
DANIEL S. AGUIRRE, P.E.
NEW MEXICO REGISTERED PROFESSIONAL ENGINEER
LICENSE NO. 11995

SUBSCRIBED AND SWORN TO BEFORE ME THIS 25th DAY OF April 2000

THE PLANS WERE DESIGNED AND ASSEMBLED BY WILSON & COMPANY
(505)348-4000. CONTACT PERSON: DANIEL S. AGUIRRE, P.E.

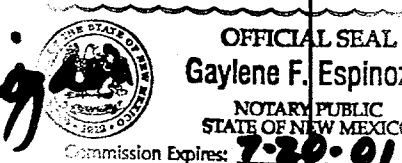


NOTE:

BORREGA DAM PHASE "A" AND ONLY PHASE "A" SHALL BE CONSTRUCTED WITH THIS PROJECT.

2-20-01

6922.91	
ALBUQUERQUE METROPOLITAN ARROYO FLOOD CONTROL AUTHORITY	
BORREGA DETENTION DAM DAM FILING SHEET	
	DATE MARCH 2000
	FILE 99099
	SHEET 2 OF 34

REVISIONS	BY
NO. DATE	
1	WILSON & COMPANY, ENGINEERS & ARCHITECTS
2	DESIGNED BY NM FEBRUARY 2000
3	DRAWN BY PJM FEBRUARY 2000
4	CHECKED BY DSA FEBRUARY 2000

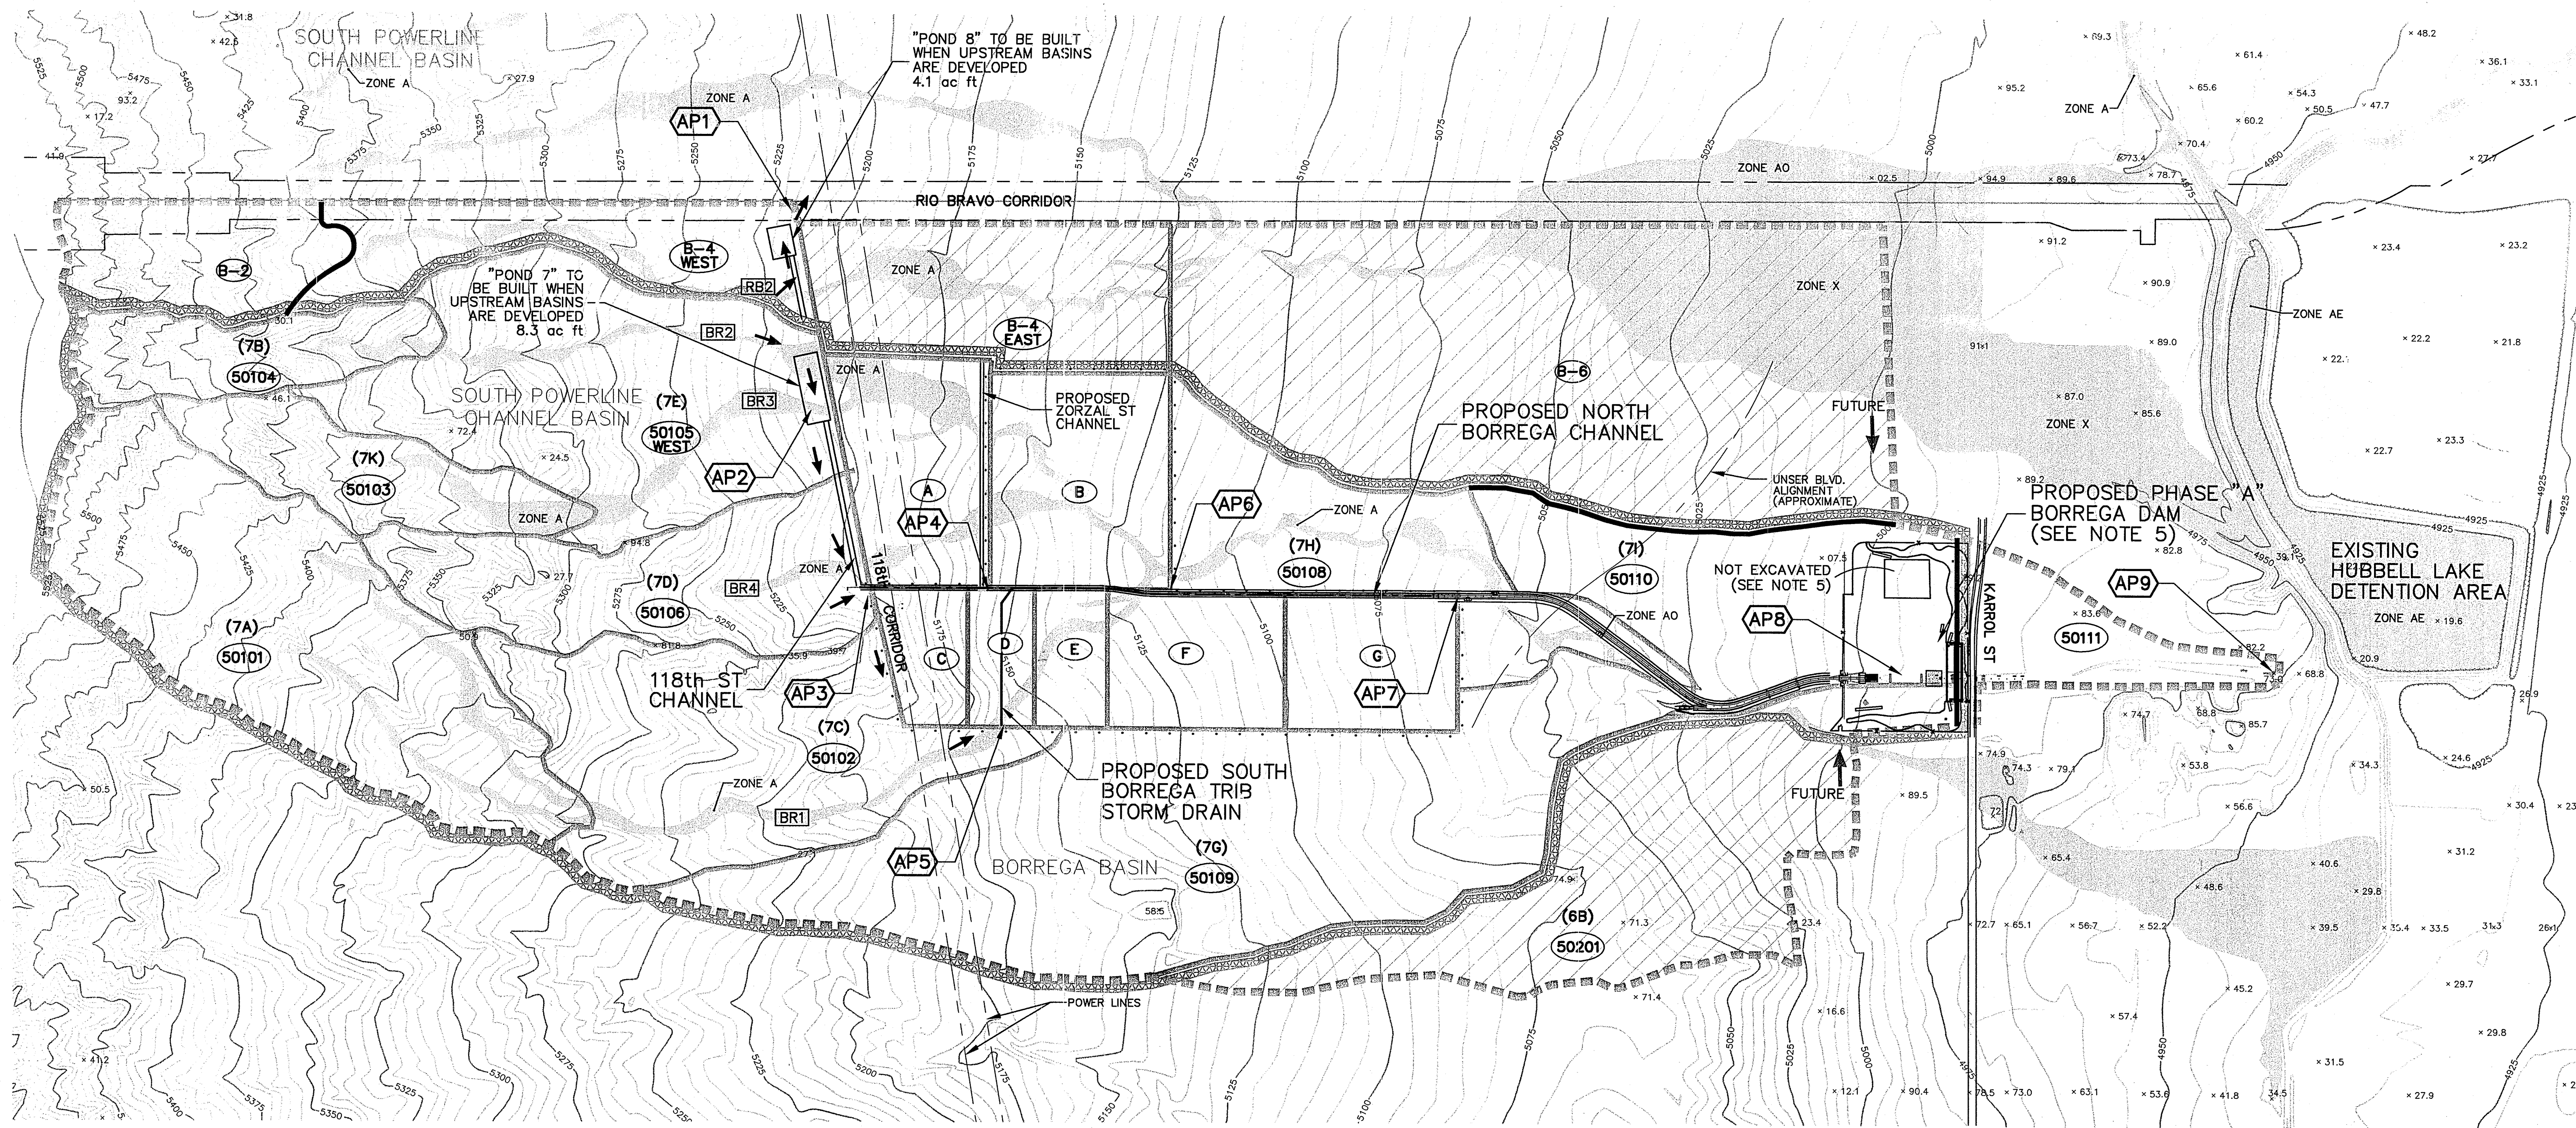

INTERIM CONDITIONS - PHASE "A" DAM:

- ALL BASINS DISCHARGING TO THE DAM ARE ANALYZED AS DEVELOPED WITH NO BULKING.
- BASINS 50103, 50104, & 50105 WEST ARE ANALYZED AS DEVELOPED WITH NO BULKING, AND ARE ROUTED THROUGH "POND 7" PER THE AMOLE-HUBBELL DMP (A-H DMP). DISCHARGE FROM "POND 7" IS ROUTED SOUTH TO THE CULVERT UNDER 118TH ST (AP3).
- BASINS B-2 AND B-4 WEST ARE ANALYZED AS DEVELOPED WITH NO BULKING, ROUTED TO "POND 8" PER THE A-H DMP, THEN DISCHARGED THROUGH A CULVERT TO THE CHANNEL ON THE NORTH SIDE OF RIO BRAVO BLVD.
- PONDS ALONG WEST SIDE OF 118TH ST PER THE A-H DMP. POND 7 IS TO BE LOCATED IN BASIN 50105 WEST. STORAGE VOLUME = 8.3 AC-FT. POND 8 IS TO BE LOCATED IN BASIN B-4 WEST. STORAGE VOLUME = 4.1 AC-FT.
- THE BORREGA DAM IS TO BE BUILT IN 2 PHASES: PHASE "A" & PHASE "B". THE FIRST PHASE (NOT-FULLY EXCAVATED) IS CALLED "PHASE "A". WHEN BASINS B-4 EAST AND B-6 ARE DEVELOPED, THEY WILL BE DIVERTED TO THE BORREGA DAM. WHEN BASIN 50201 IS DEVELOPED, IT WILL BE DIVERTED TO THE BORREGA DAM. THE DAM WILL THEN BE FULLY EXCAVATED. THE FULLY EXCAVATED BORREGA DAM IS CALLED PHASE "B".

LEGEND

- 5070 EXISTING INTERMEDIATE CONTOUR
- 5071 EXISTING INDEX CONTOUR
- DRAINAGE STUDY AREA BOUNDARY
- BASIN BOUNDARY
- AREA DISCHARGING TO DAM
- PAAKWEREE DEVELOPMENT BOUNDARY
- ANALYSIS POINT
- ARROYO CHANNEL NUMBER FROM FIGURE SH-4 AMOLE-HUBBELL DMP
- BASIN ID
- FEMA FLOOD PLAIN
- BASINS TO BE DIVERTED TO THE DAM IN THE FUTURE. THE DAM WILL BE THEN BE FULLY EXCAVATED PER PHASE "B" DAM
- DIRECTION OF FLOW

ANALYSIS POINT SUMMARY


AP NO.	DESCRIPTION	INTERIM			
		HYD. NO.	DRAINAGE AREA (sq. mi)	Q100 24 hr (cfs)	VOL100 24 hr (ac-ft)
1	Culvert to north under Rio Bravo Blvd @ 118th St.	RB_CULV	0.1086	43	7.9
2	Inflow to "Pond 7"	POND7.IN	0.2346	428	18.5
3	118th St Channel @ North Borrega Channel	106.20	0.3202	198	25.7
4	N. Borrega Chan @ Avestruz St	105E.1	0.3853	275	29.1
5	Intake of culvert @ South property line of Paakwerree	S_CULV	0.2814	344	22.8
6	N. Borrega Chan @ Perdiz St	107.10	0.7599	728	59.9
7	N. Borrega Chan @ Pandal St	107.50	0.8287	854	65.7
8	Borrega Dam	110.20	1.2462	1473	99.1
9	Borrega Inlet to Hubbell Lake	BR_DMP1.HYD	1.2841	192	98.9

BASIN SUMMARY

BASIN	AREA (sq. mi)	AREA (ac)	%A	%B	%C	%D	INTERIM	
							Q100 24 hr (cfs)	VOL100 24 hr (ac-ft)
B-2	0.0445	28.5	0	33	33	34	87	3.2
B-4 West	0.0641	41.0	0	33	33	34	126	4.7
50101	0.1540	98.6	0	38	20	42	271	12.0
50102	0.1277	81.7	0	28	23	49	272	10.9
50103	0.0540	34.5	0	48	17	35	102	3.8
50104	0.0393	25.2	0	53	15	32	72	2.7
50105 West	0.1413	90.4	0	28	23	49	271	12.0
50106	0.0856	54.8	0	28	23	49	171	7.3
50108	0.0813	52.0	0	60	15	25	100	5.0
50109	0.2344	150.0	0	28	23	49	391	20.0
50110	0.1018	65.2	4	26	22	48	212	8.5
50111	0.0379	24.3	0	45	10	45	76	3.0
A	0.0513	32.8	0	40	55	5	85	2.5
B	0.0641	41.0	0	28	23	49	137	5.5
C	0.0138	8.8	0	30	42	28	27	0.9
D	0.0144	9.2	0	28	23	49	31	1.2
E	0.0144	9.2	0	28	23	49	31	1.2
F	0.0336	21.5	0	28	23	49	72	2.9
G	0.0352	22.5	0	28	23	49	75	3.0

RECORD DRAWING
DATE 2-20-01

GRAPHIC SCALE

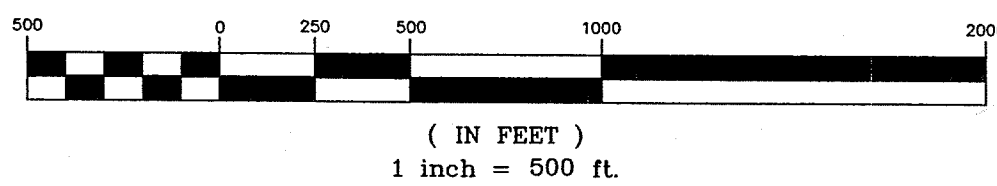

6922.91

ALBUQUERQUE METROPOLITAN ARROYO FLOOD CONTROL AUTHORITY	
BORREGA DETENTION DAM BASIN MAP INTERIM CONDITIONS - PHASE "A" DAM	
	DATE APRIL 2000
4900 LANG AVENUE N.E. ALBUQUERQUE, NM 87109 (505) 348-4000	FILE 99099
	SHEET 3 OF 34

GENERAL NOTES:

1. NEW MEXICO STATE HIGHWAY DEPARTMENT "STANDARD SPECIFICATIONS FOR ROAD AND BRIDGE CONSTRUCTION, EDITION OF 1994", AND SUPPLEMENTAL SPECIFICATIONS AND SPECIAL PROVISIONS THERETO SHALL GOVERN CONSTRUCTION OF THIS PROJECT.
2. ELEVATIONS ARE SHOWN IN FEET ABOVE MEAN SEA LEVEL DATUM. VERTICAL DATUM NAVD 1988.
3. ALL STATIONING FOR THE ROADWAYS, EMBANKMENTS AND CHANNELS REFER TO THE MEASURED HORIZONTAL DISTANCE. LEFT AND RIGHT OF CENTERLINE ARE LOOKING IN THE DIRECTION OF INCREASING STATION.
4. WHERE WIRE FENCES IS SHOWN ALONG PROPERTY LINES, CONSTRUCT THE CENTERLINE OF THE FENCE POSTS SIX (6) INCHES TO THE INSIDE OF THE PROPERTY LINE.
5. WHEN COORDINATES ARE SHOWN, HEREIN (N,E) THEY REFER TO GROUND COORDINATES. COORDINATES ARE BASED ON TRUE GROUND DISTANCES AND STATE GRID BEARINGS FROM PROJECT BENCHMARKS CP103 AND CP105. SEE SHEET 25 FOR LOCATION.

6. ADDITIONAL CONSTRUCTION AT WIRE GATES AND WALK GAPS SHALL BE CONSIDERED INCIDENTAL TO THE COST OF THE CONSTRUCTION OF THE FENCE.
7. LIMITS OF WORK IS SHOWN ON THE PLANS. THE CONTRACTOR SHALL CONFINE HIS OPERATIONS TO WITHIN THE PROJECT RIGHT OF WAY. THE CONTRACTOR WILL BE HELD RESPONSIBLE FOR ANY AGREEMENTS NECESSARY OR DAMAGE BY HIS OPERATION TO PUBLIC OR PRIVATE PROPERTY INCLUDING UTILITIES.
8. FILL MATERIALS FROM EXCAVATION OR BORROW WHICH REQUIRES MORE THAN ONE HANDLING PRIOR TO FINAL PLACEMENT, INCLUDING STOCKPILING AND BLENDING TO MEET GRADATION REQUIREMENTS OR STOCKPILING FOR LATER DISPOSAL, WILL BE CONSIDERED INCIDENTAL TO THE CONTACT UNIT PRICE FOR UNCLASSIFIED EXCAVATION. NO SEPARATE PAYMENT SHALL BE MADE FOR BLENDING OR MULTIPLE HANDLING AND FINAL PAYMENT SHALL BE MADE ON THE BASIS OF QUANTITIES REMOVED FROM ORIGINAL LOCATION.
9. ANY DISTURBED AREAS NOT INCLUDED ON THE PLANS SHALL BE TREATED WITH TYPE "A" SEEDING, AND NO MEASUREMENT OR PAYMENT WILL BE MADE THEREFORE.


10. WATERING, AS REQUIRED FOR CONSTRUCTION AND DUST CONTROL, SHALL BE CONSIDERED AN INCIDENTAL TO CONSTRUCTION AND NO MEASUREMENT OR PAYMENT SHALL BE MADE. CONSTRUCTION AREAS SHALL BE WATERED FOR DUST POLLUTION ABATEMENT AS DIRECTED BY THE ENGINEER. THE CONTRACTOR SHALL BE RESPONSIBLE FOR LOCATING AND SUPPLYING WATER AS REQUIRED.
11. ~~AUTHORITY OF THE STATE ENGINEER.~~ THE NEW MEXICO STATE ENGINEER SHALL HAVE FULL AUTHORITY TO PERFORM INSPECTION DURING CONSTRUCTION. SEE SPECIAL CONDITIONS IN THE "SPECIFICATIONS AND CONTRACT DOCUMENTS". A REPRESENTATIVE OF THE STATE ENGINEER OFFICE SHALL BE PROVIDED A 72 HOUR NOTICE OPPORTUNITY TO PERFORM INSPECTION PRIOR TO BACK FILL OF KEY TRENCH AND PRINCIPAL SPILLWAY PIPE.
12. THE CONTRACTOR WILL BE RESPONSIBLE TO REPLACE AT HIS OWN EXPENSE ANY AND ALL PROPERTY CORNERS OR MONUMENTS DESTROYED IN THE PROCESS OF CONSTRUCTION. ALL PROPERTY CORNERS OR MONUMENTS MUST BE RESET BY A REGISTERED PROFESSIONAL SURVEYOR.
13. NO PAYMENT ABOVE THE COST OF EXCAVATION WILL BE MADE FOR PLACEMENT OF SURPLUS FILL AT DESIGNATED WASTE AREAS OR THE CONTRACTOR'S SELECTED DISPOSAL SITE.
14. PLACE STRIPINGS OVER EMBANKMENT SLOPES AND OTHER DISTURBED AREAS PRIOR TO SEEDING AS DIRECTED BY THE ENGINEER. THIS WORK SHALL BE INCIDENTAL TO THE COST OF THE CLEARING AND GRUBBING ITEM.
15. MINOR CHANGES IN ELEVATIONS AND SLOPES FOR EXCAVATION AND FILL MAY BE MADE TO SUIT FIELD CONDITIONS, AS APPROVED BY THE ENGINEER.
16. PRIOR TO CONSTRUCTION, THE CONTRACTOR SHALL EXCAVATE AND VERIFY THE HORIZONTAL AND VERTICAL LOCATIONS OF ALL OBSTRUCTIONS. SHOULD A CONFLICT EXIST, THE CONTRACTOR SHALL NOTIFY THE ENGINEER SO THAT THE CONFLICT CAN BE RESOLVED WITH A MINIMUM AMOUNT OF DELAY. ALL UTILITY LOCATIONS SHOWN ARE APPROXIMATE.
17. AMAFCA SHALL SET TBM'S AND FLAG FOUND PROPERTY CORNERS AS REQUIRED TO ESTABLISH PROJECT CONTROL. THE CONTRACTOR SHALL BE REQUIRED TO MAINTAIN THESE MARKERS AND PROVIDE CONSTRUCTION STAKING REQUIRED FOR ESTABLISHING CORRECT LINE AND GRADES SHOWN ON THE PLANS. NO DIRECT PAYMENT WILL BE PROVIDED FOR THIS WORK AND IT WILL BE CONSIDERED INCIDENTAL TO OTHER PAY ITEMS.
18. BARRICADES AND TRAFFIC CONTROL SHALL BE ERECTED AND MAINTAINED BY THE CONTRACTOR. THE COST AND PAYMENT IS AN INCIDENTAL COST TO THE PROJECT, ALSO COSTS FOR CONSTRUCTION SIGNS SHALL BE AN INCIDENTAL COST TO THE PROJECT.
19. CLEARING AND GRUBBING MATERIAL MAY BE DISPOSED OF ON-SITE ONLY AT THE DIRECTION OF THE ENGINEER. REFERENCE NOTE 14 ABOVE.
20. ALL TRAFFIC CONTROL SIGNS TO COMPLY WITH THE LATEST EDITION OF M.U.T.C.D. SIGN LOCATIONS SUBJECT TO APPROVAL OF THE COUNTY TRAFFIC CONTROL MANAGER (848-1575) BOB BAKER.
21. CONTRACTOR SHALL BE REQUIRED TO OBTAIN NECESSARY PERMITS FROM BERNALILLO COUNTY PUBLIC WORKS DEPARTMENT FOR CONSTRUCTION OF ROADWAYS. CONTACT G.J. FOSTER AT 848-1523. CONTACT ROSE ARONS FOR EXCAVATION PERMITS AT 848-1574.
22. EXCESS EXCAVATION TO BE PLACED AS SHOWN ON PAGE EX-1 IN THE SPECIFICATIONS.
23. THE PHASE "A" GRADING (SEE SHEET 5 OF THESE PLANS) SHALL BE CONSTRUCTED WITH THIS PROJECT. THE PHASE "B" GRADING (SEE SHEET 6) AND ALL CONSTRUCTION ASSOCIATED WITH PHASE "B" SHALL BE COMPLETED IN THE FUTURE AT SUCH DATE THE OWNER OF THE PROPERTY NORTH AND NORTHWEST OF THE DAM HAS DEVELOPED HIS PROPERTY AND IS READY TO DISCHARGE HIS ALLOWED RUNOFF TO THE DAM PER THE "FIRST AMENDMENT TO AGREEMENT, BORREGA DETENTION DAM AND UPSTREAM BORREGA ARROYO CHANNEL," DATED 16 DECEMBER 1999.
24. QUANTITIES SHOWN HEREIN FOR THE VARIOUS BID ITEMS ARE FOR THE CONTRACTOR'S INFORMATION ONLY. PAYMENT SHALL BE BASED ON ACTUAL QUANTITIES AS CONSTRUCTED.
25. ALL SCARIFYING, EXCAVATION AND COMPACTION SHALL BE SUBJECT TO THE APPROVAL OF THE ENGINEER AND IN ACCORDANCE WITH THE GEOTECHNICAL STUDY PREPARED BY AGRA, DATED 15 MARCH 2000.
26. THE CONTRACTOR SHALL INCLUDE IN HIS CONSTRUCTION SEQUENCE PROVISIONS WHICH WILL ALLOW FOR THE SAFE PASSAGE OF WATER FROM ARROYOS AND DITCHES THROUGH THE PROJECT SITE WITHOUT DAMAGE TO FACILITIES BEING CONSTRUCTED, COMPLETED FACILITIES, OR ADJACENT PRIVATE PROPERTY.
27. THE COST FOR REQUIRED CONSTRUCTION OF AIR QUALITY MITIGATION SHALL BE INCIDENTAL TO THE PROJECT COST.
28. ALL STORM WATER DISCHARGES FROM THE PROJECT SITE SHALL MEET THE REQUIREMENTS OF THE REGULATIONS OF THE NATIONAL POLLUTANT DISCHARGE ELIMINATION SYSTEM (NPDES) AS WELL AS APPLICABLE STATE AND LOCAL REGULATIONS.
29. PROJECT IS SUBJECT TO THE REQUIREMENTS OF COUNTY ORDINANCE NO. 96-3 AND 95-12. THE CONTRACTOR IS RESPONSIBLE FOR ACQUIRING ALL PERMITS NECESSARY. CONTRACTOR SHALL CALL 848-1500 FOR FURTHER INFORMATION.
30. THE CONTRACTOR SHALL SUBMIT A TRAFFIC CONTROL PLAN TO THE COUNTY TRAFFIC CONTROL MANAGER AT LEAST 72 HOURS PRIOR TO COMMENCEMENT OF WORK. TRAFFIC CONTROL PLANS SHALL BE PREPARED IN ACCORDANCE WITH NOTED REQUIREMENTS AND BY CERTIFIED PERSONNEL AND MUST BE APPROVED PRIOR TO COMMENCEMENT OF WORK ON THE PROJECT. CALL 848-1504 FOR FURTHER INFORMATION.

31. A DAILY TRAFFIC CONTROL LOG SHALL BE MAINTAINED BY THE CONTRACTOR REFLECTING THE TYPES AND LOCATIONS OF ALL TRAFFIC CONTROL DEVICES, SIGNS, BARRICADES, ETC. BE USED ON THE PROJECT IN COMPLIANCE WITH THE APPROVED TRAFFIC CONTROL PLAN. THIS LOG SHALL BE SUBMITTED TO THE BERNALILLO COUNTY TRAFFIC CONTROL MANAGER UPON COMPLETION OF THE PROJECT CONSTRUCTION OR WHEN SO REQUESTED BY THE PROJECT OR THE BERNALILLO COUNTY TRAFFIC CONTROL MANAGER.
32. THE CONTRACTOR SHALL PROVIDE A WEEKLY CONSTRUCTION ACTIVITY SCHEDULE TO BERNALILLO COUNTY PUBLIC WORKS DIVISION ATTN: HOSS FOSTER.
33. THE CONTRACTOR SHALL FILE WEEKLY WRITTEN REPORT TO THE TRAFFIC CONTROL MANAGER DESCRIBING THE TRAFFIC CONTROL PLAN THAT WILL BE IN EFFECT FOR THE FOLLOWING WEEK.
34. SUBJECT TO THE APPROVED TRAFFIC CONTROL PLAN, AT LEAST ONE LANE SHALL BE OPEN TO TRAFFIC AT ALL TIMES. CONTRACTOR SHALL PROVIDE PROPER SIGNAGE AND FLAGMAN AND SHALL MAINTAIN THE TRAFFIC LANE IN SUCH A MANNER AS TO ASSURE PROPER SAFETY TO THE TRAVELING PUBLIC ON ALL AFFECTED ROADS. THE CONTRACTOR SHALL PROVIDE ACCESS TO ALL PRIVATE AND PUBLIC PROPERTY AT ALL TIMES, EXCEPT WHEN GRADING, EXCAVATION, AND BACKFILL OPERATIONS ARE BEING CONDUCTED IMMEDIATELY IN FRONT OF THE PROPERTY, IN WHICH CASE ACCESS WILL NOT BE DENIED FOR MORE THAN 4 HOURS WITHOUT APPROVAL BY THE COUNTY.
35. TRAFFIC LANES PROVIDED DURING CONSTRUCTION SHALL BE MAINTAINED, IN SUCH A CONDITION UNDER ALL WEATHER CONDITIONS, SO AS TO PERMIT THE REASONABLE PASSAGE OF PASSENGER VEHICLES, AND SHALL KEPT GRADED AND SMOOTH, AND WATERED SEVERAL TIMES DAILY TO CONTROL DUST.

SUMMARY OF QUANTITIES			PHASE "A"		KARROL ST.		TOTAL	
ITEM NO.	ITEM	UNIT	APPROX.	FINAL	APPROX.	FINAL	APPROX.	FINAL
1	MOBILIZATION	LS	1		0		1	100%
2	CONSTRUCTION STAKING	LS	1		0		1	100%
3	FIELD OFFICE	LS	1		0		1	100%
4	PROTECTION OF PROJECT FROM WATER DURING CONSTRUCTION	LS	1		0		1	100%
5	NPDES STORM WATER PERMITTANCE	LS	1		0		1	100%
6	SITE CLEARING AND GRUBBING	AC	28		0		28	28
7	REMOVAL OF MISCELLANEOUS DEBRIS AND RUBBLE	LS	1		0		1	100%
8	FOUNDATION TREATMENT	CY	20100		0		20100	12,900
9	UNCLASSIFIED EXCAVATION	CY	62798		0		62798	62,798
10	SOIL CEMENT	CY	5406		0		5406	4,998
11	CEMENT FOR SOIL CEMENT AND CEMENT TREATED SOIL	TON	1058		0		1058	1,027.9
12	8" SHOTCRETE, 4000 PSI	SY	530		0		530	800
13	LINEAR GRADING	LF	990		0		990	990
14	36" RCP, CLASS III C.I.P. INCLUDING TRENCHING AND BACKFILL	LF	465		0		465	465
15	54" RCP CLASS III C.I.P. INCLUDING TRENCHING AND BACKFILL	LF	57		0		57	57
16	66" RCP CLASS III C.I.P. INCLUDING TRENCHING AND BACKFILL	LF	306		0		306	271
17	72" RCP CLASS III RING CHAMBER C.I.P. INCLUDING TRENCHING AND BACKFILL	LF	32		0		32	32
18	72" x 66" RCP CLASS III REDUCER C.I.P. INCLUDING TRENCHING AND BACKFILL	EA	1		0		1	1
19	66" RCP PLUG	EA	1		0		1	1
20	54" PCCP C.I.P. INCLUDING TRENCHING AND BACKFILL	LF	176		0		176	176
21	8' DIAMETER MH - TYPE "C" 6' TO 10' DEEP W/ NEENAH R4370-24 GRATE	EA	1		0		1	1
22	8' DIAMETER MH - TYPE "C" 6' TO 10' DEEP W/ PILL BOX INLET	EA	1		0		1	1
23	4' DIAMETER TEE-TYPE MANHOLE W/ PILL BOX INLET	EA	1		0		1	1
24	STRUCTURAL CONCRETE, 4000 PSI	CY	152		0		152	142.55
25	RISER GRATE AND LADDER C.I.P.	LS	1		0		1	100%
26	WEATHERED GUARD RAIL W/ POSTS C.I.P.	LF	28		0		28	28
27	WEATHERED GUARD RAIL STAND, TERMINAL END SECTION	EA	4		0		4	4
28	DUMPED ROCK RIP RAP, TYPE "D" C.I.P.	CY	103		0		103	120
29	GRANULAR FILTER MATERIAL AND FILTER FABRIC	SY	193		0		193	213
30	SEEDING TYPE "A" C.I.P. (COMMON AREA) WITH STRAW MULCH	AC	7		0		7	7
31	SEEDING TYPE "B" C.I.P. (DAM POOL AREA) WITH STRAW MULCH	AC	15		0		15	10
32	SEEDING TYPE "C" C.I.P. (DAM SLOPES) WITH GRAVEL MULCH	AC	6		0		6	60
33	SMOOTH WIRE FENCE & WALK GAPS C.I.P.	LF	4137		0		4137	4,546
34	GATES, 14' WIDE	EA	4		0		4	4.0
35	ROADWAY SUBGRADE PREPARATION, 12" DEPTH	SY	0		3806		3806	7,526
36	6" CLASS II-B BASE COURSE	SY	5531		1626		7157	7,526
37	3" PMBP, TYPE I	SY	0		1626		1626	2,133
38	TAACK COAT	SY	0		1626		1626	
39	4" DOUBLE YELLOW CENTERLINE MARKINGS	LF	0		552		552	600
40	4" SINGLE WHITE SHOULDER MARKINGS	LF	0		1104		1104	1,200
41	MDI 5' x 5' C.I.P. INCLUDING CONCRETE COLLAR C.I.P.	EA	2		0		2	2
42	2" DIA. PIPE RAIL FENCE (9 GAUGE), 4' TALL, C.I.P.	LF	56		0		56	159.6
43	22" STEEL PIPE CASING, INCLUDING PLUGGING BOTH ENDS	LF	0		22		22	20
CONTRACT ADJUSTMENTS (change orders)								
1	PURCHASE OF SOIL CEMENT AGGREGATES							7,000
2	HAUL ROAD MAINTENANCE							7
3	ADDITIONAL UNCLASSIFIED EXCAVATION							87,493
4	INCENTIVE BONUS							9


RECORD DRAWING
DATE 2-20-01

ALBUQUERQUE METROPOLITAN ARROYO FLOOD CONTROL AUTHORITY	
BORREGA DETENTION DAM	
GENERAL NOTES & SUMMARY OF QUANTITIES	
	 4900 LANG AVENUE N.E. ALBUQUERQUE, NM 87109 (505) 348-4000
DATE APRIL 2000	DESIGNED BY NM NOV 1999
FILE 99099	DRAWN BY PJM NOV 1999
SHEET 4	CHECKED BY DSA NOV 1999

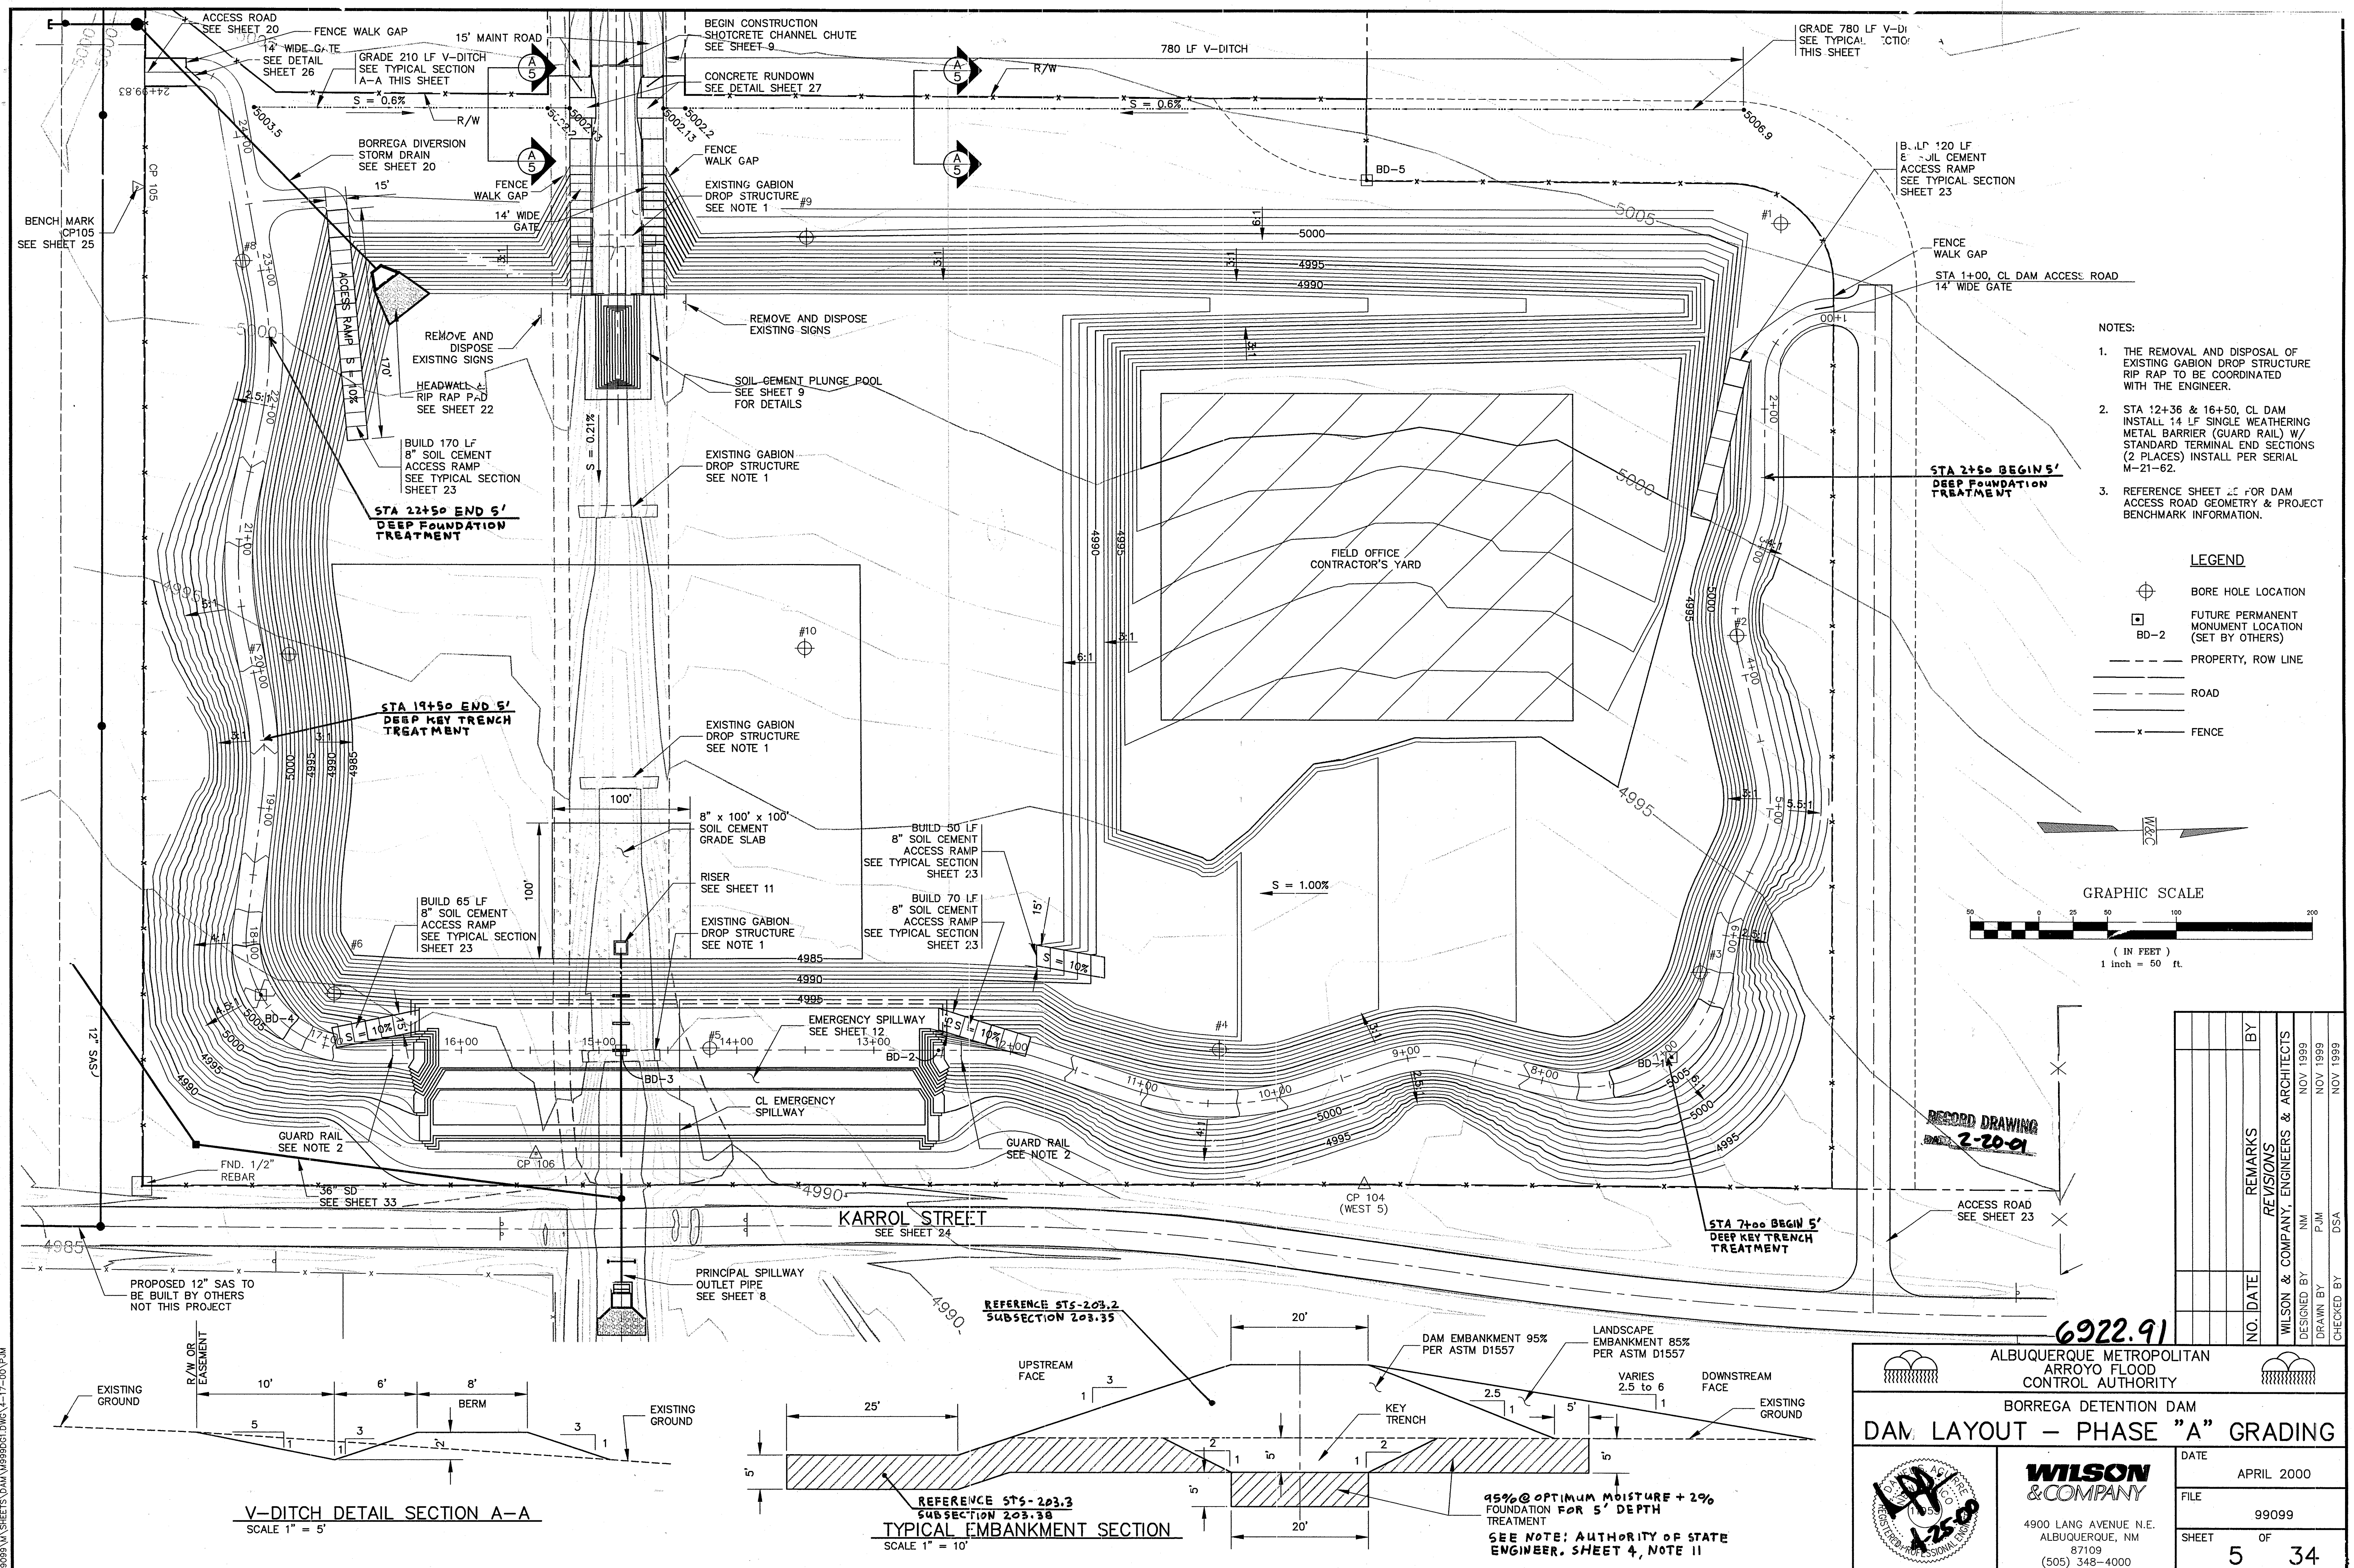

- NOTES:
1. THE REMOVAL AND DISPOSAL OF EXISTING GABION DROP STRUCTURE RIP RAP TO BE COORDINATED WITH THE ENGINEER.
 2. STA 12+36 & 16+50, CL DAM INSTALL 14 LF SINGLE WEATHERING METAL BARRIER (GUARD RAIL) W/ STANDARD TERMINAL END SECTIONS (2 PLACES) INSTALL PER SERIAL M-21-62.
 3. REFERENCE SHEET 22 FOR DAM ACCESS ROAD GEOMETRY & PROJECT BENCHMARK INFORMATION.

- LEGEND
- BORE HOLE LOCATION
 - FUTURE PERMANENT MONUMENT LOCATION (SET BY OTHERS)
 - PROPERTY, ROW LINE
 - ROAD
 - FENCE

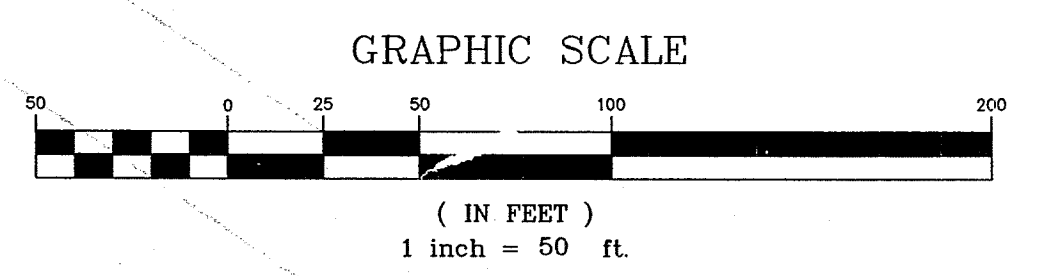

NO.	DATE	REVISIONS	BY
1		DESIGNED BY	WILSON & COMPANY, ENGINEERS & ARCHITECTS
2		DRAWN BY	NOV 1999
3		CHECKED BY	NOV 1999

ALBUQUERQUE METROPOLITAN ARROYO FLOOD CONTROL AUTHORITY

BORREGA DETENTION DAM

DAM LAYOUT - PHASE "A" GRADING

DATE: APRIL 2000

FILE: 99099

SHEET: 5 OF 34

WILSON & COMPANY


4900 LANG AVENUE N.E. ALBUQUERQUE, NM 87109 (505) 348-4000

6922.91

RECORD DRAWING 2-20-01

99099 VAI SHEETS DAM V99099C.DWG 14-17-00 P.M.

99099 IN SHEETS DAM \99099.DWG 3-7-00 10:41 AM

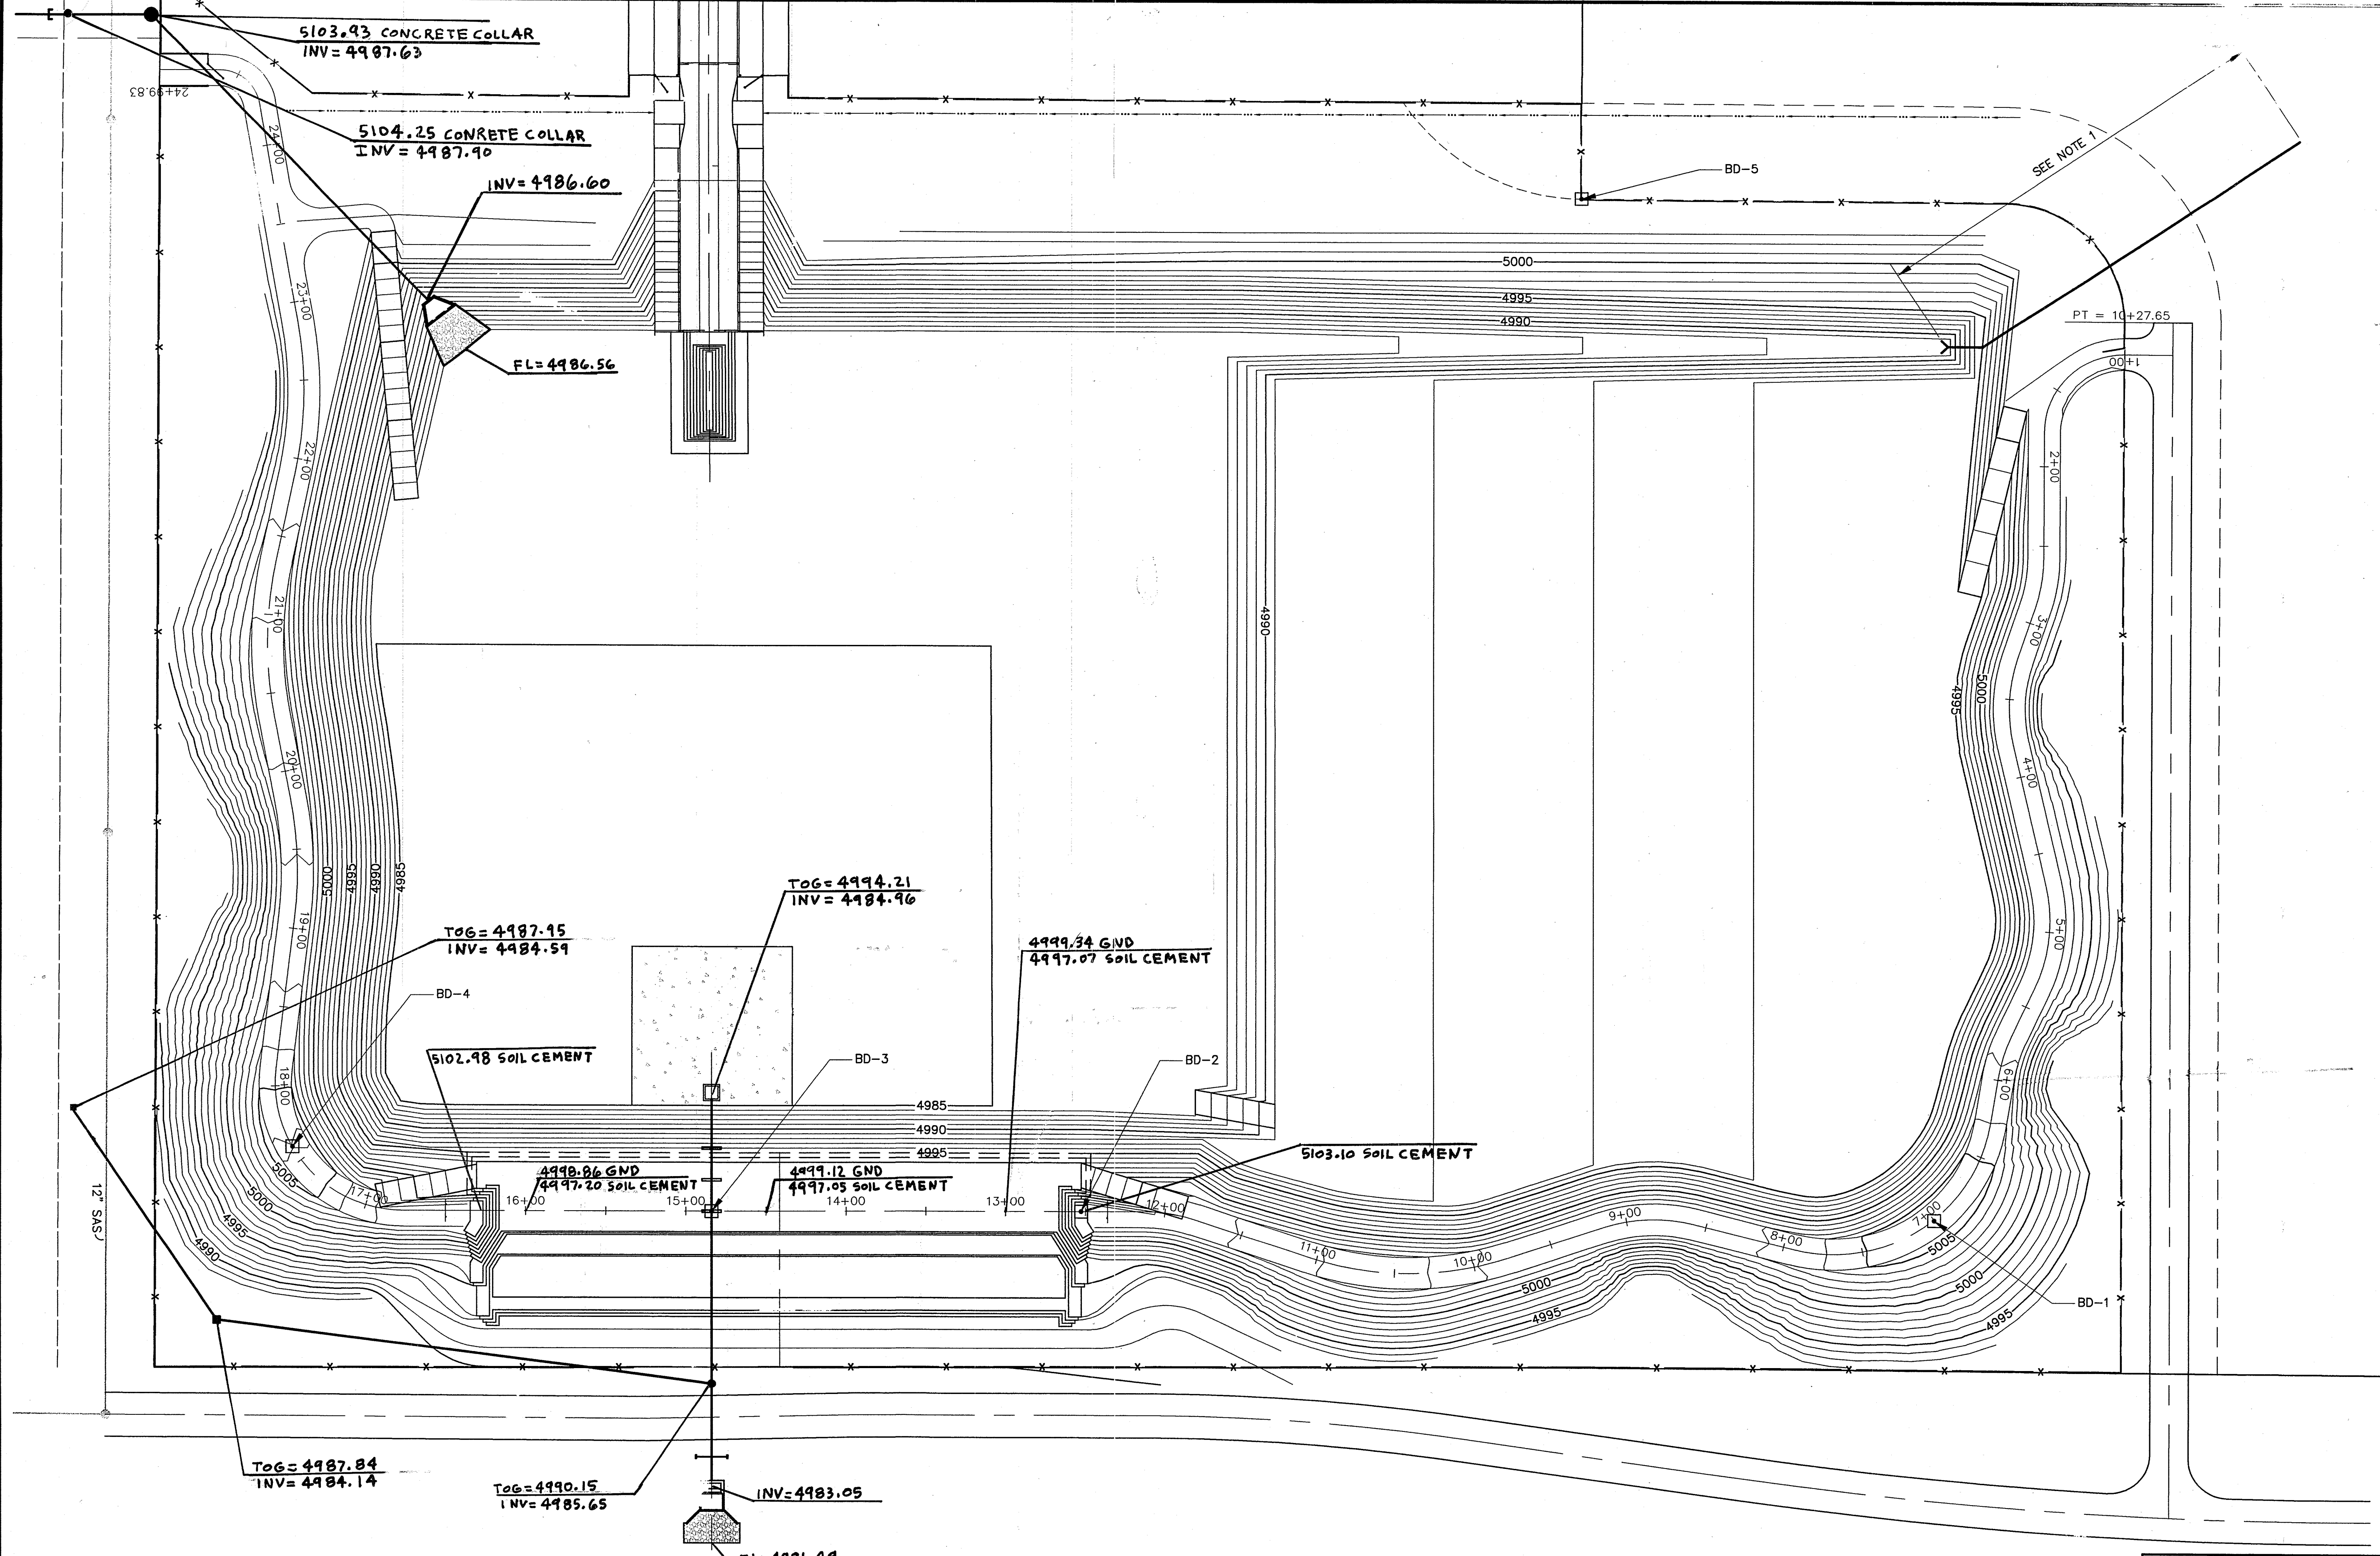


- NOTES:
1. STORM DRAIN W/ ENERGY DISSIPATOR AT OUTLET TO BE DESIGNED AND BUILT BY OTHERS AT THE TIME OF PHASE "B" GRADING.
- LEGEND
- BD-5 [Symbol] FUTURE PERMANENT MONUMENT LOCATION (SET BY OTHERS)
 - PROPERTY ROW LINE
 - ROAD
 - FENCE

RECORD DRAWING
2-20-01

NO.	DATE	REVISIONS	BY
1		DESIGNED BY	WILSON & COMPANY, ENGINEERS & ARCHITECTS
2		DRAWN BY	NM
3		CHECKED BY	PJM
4			NOV 1999
5			NOV 1999

PERMANENT MONUMENT LOCATION TABLE					
MONUMENT	STA	ELEV	X	Y	DATE
BD-1		5005.189	97343.493	62182.7487	
BD-2		5002.478	97345.7124	61818.9247	
BD-3		5005.513	97300.7396	61255.9046	
BD-4		5004.398	96701.1407	62059.2375	
BD-5					

BORREGA DAM - PHASE "B" GRADING
FOR INFORMATION PURPOSE ONLY
FUTURE

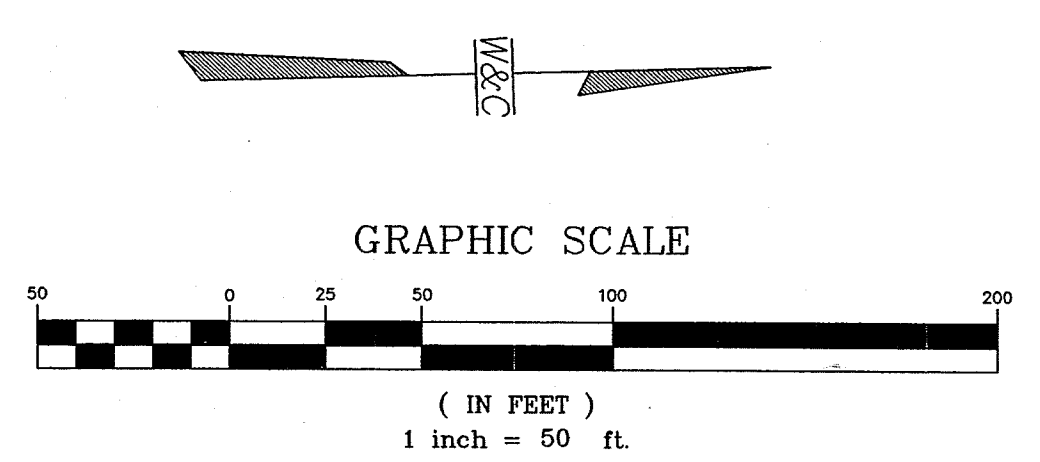

6922.91

ALBUQUERQUE METROPOLITAN
ARROYO FLOOD
CONTROL AUTHORITY

BORREGA DETENTION DAM
DAM LAYOUT - PHASE "B" GRADING

WILSON
& COMPANY

4900 LANG AVENUE N.E.
ALBUQUERQUE, NM
87109
(505) 348-4000




DATE
APRIL 2000

FILE
99099

SHEET
6 OF 34



90099 (A) SHEETS DAM VASOPPEI.DWG (3-7-00) P.M.

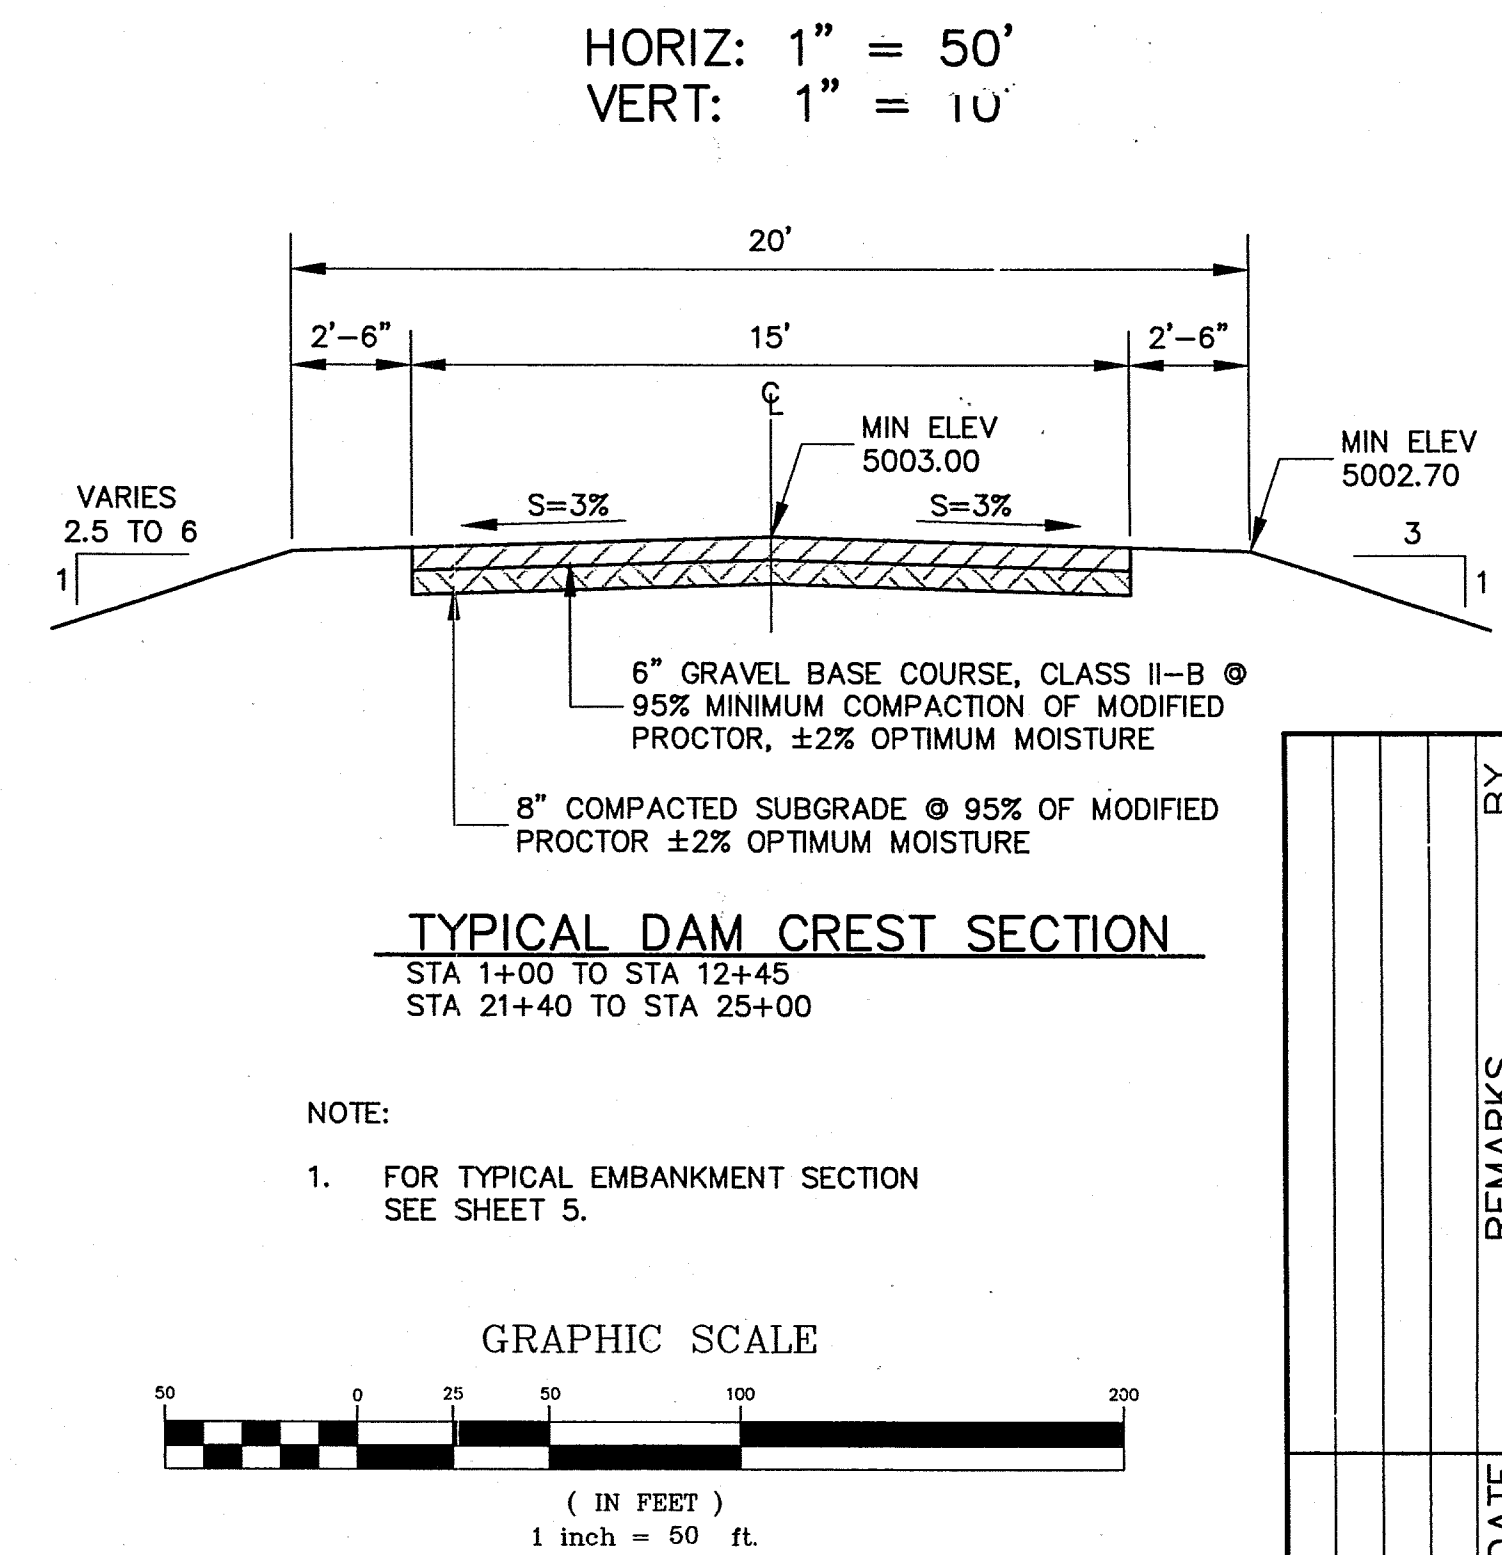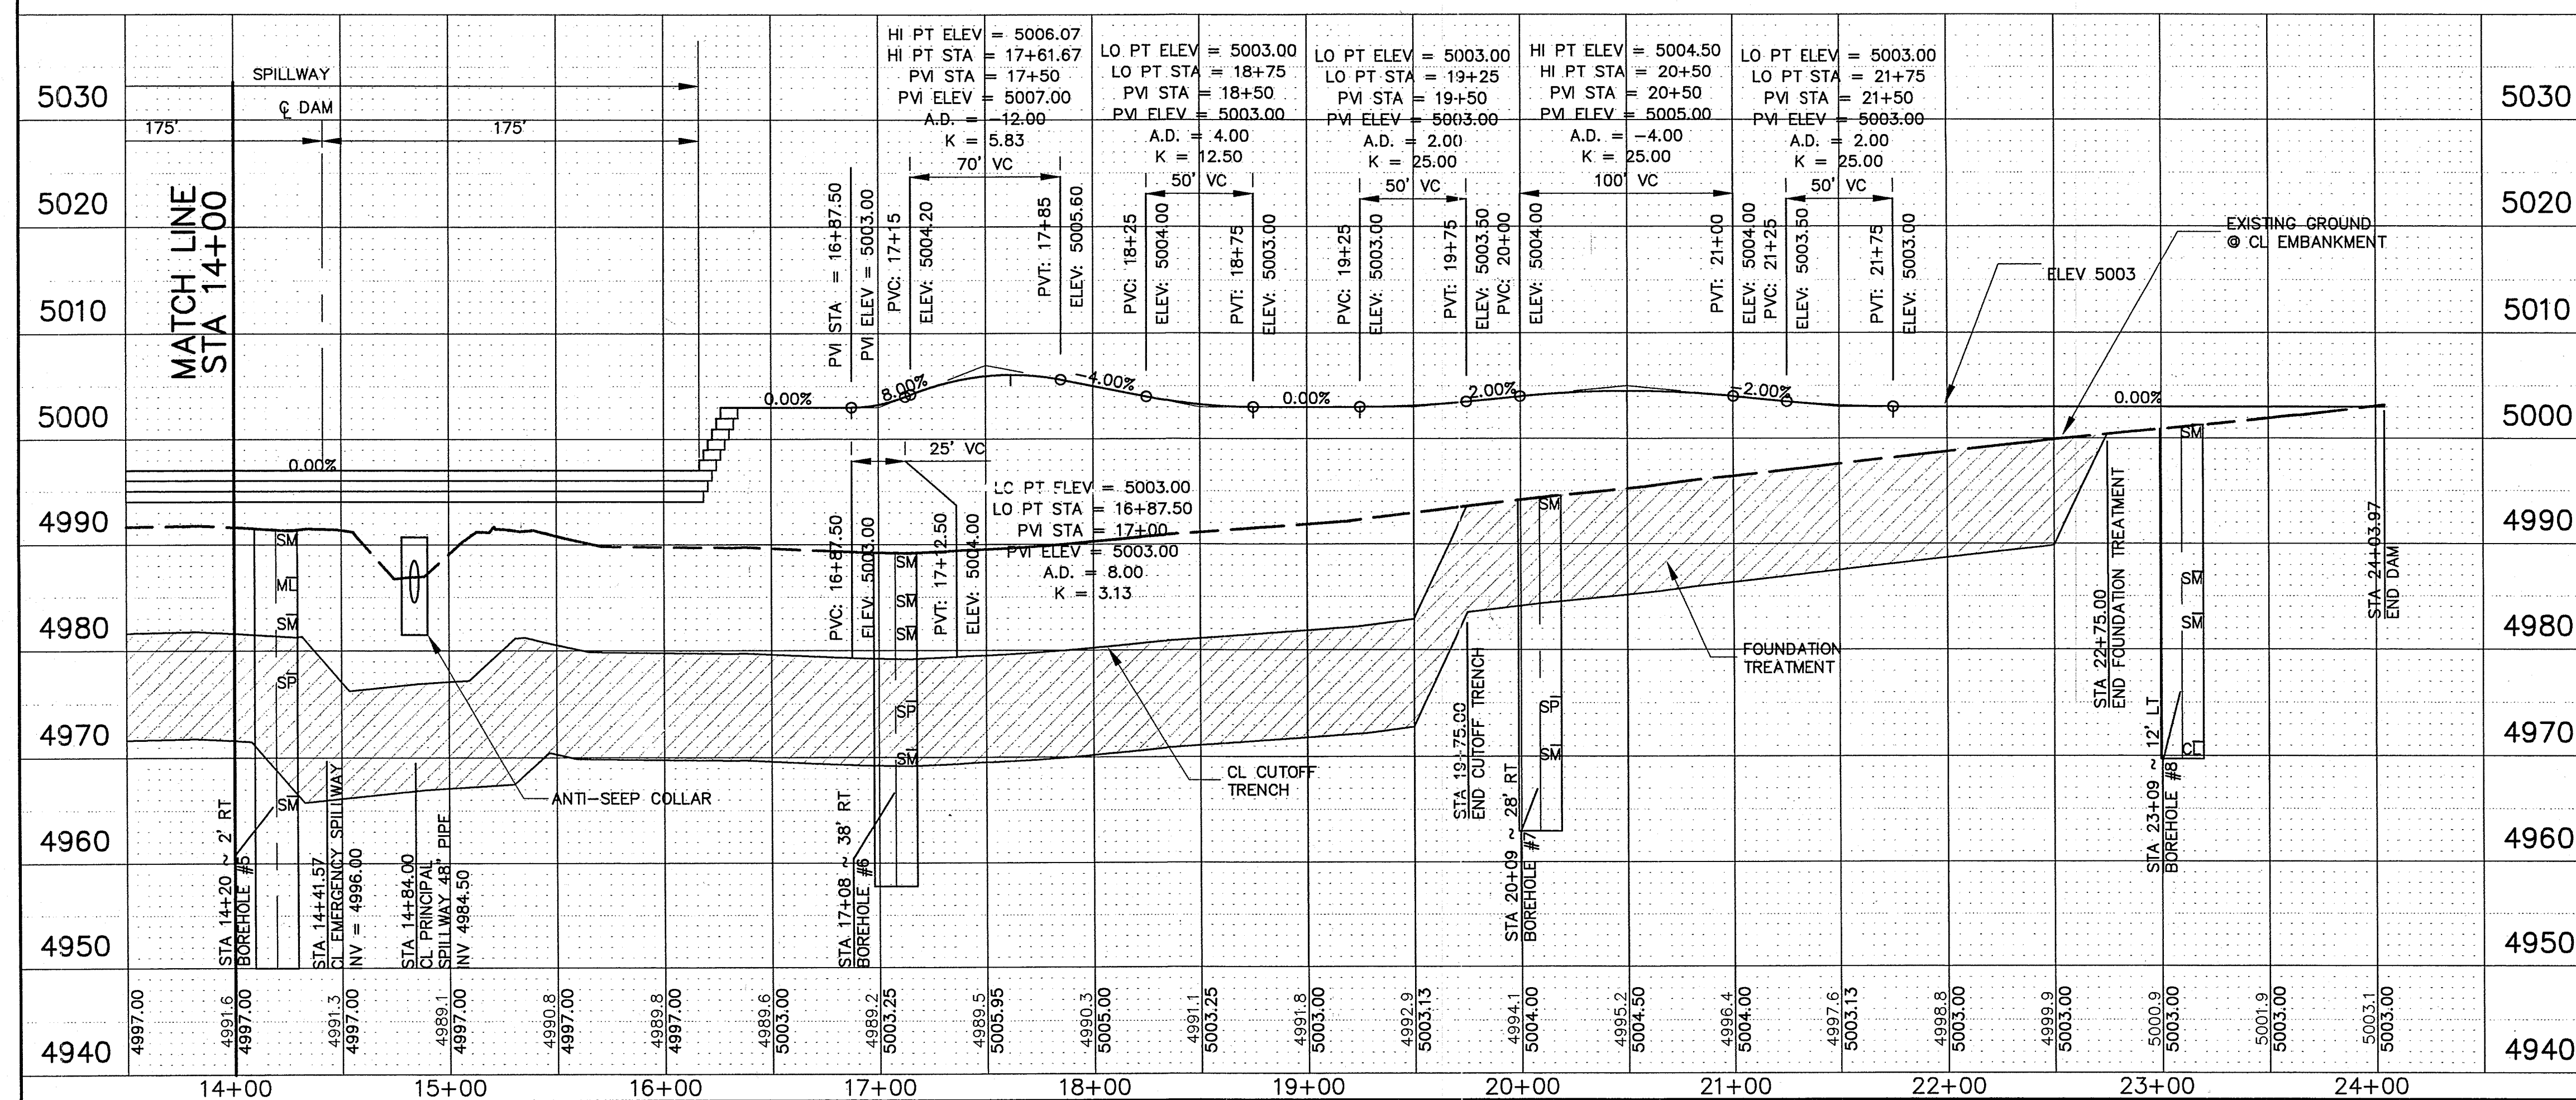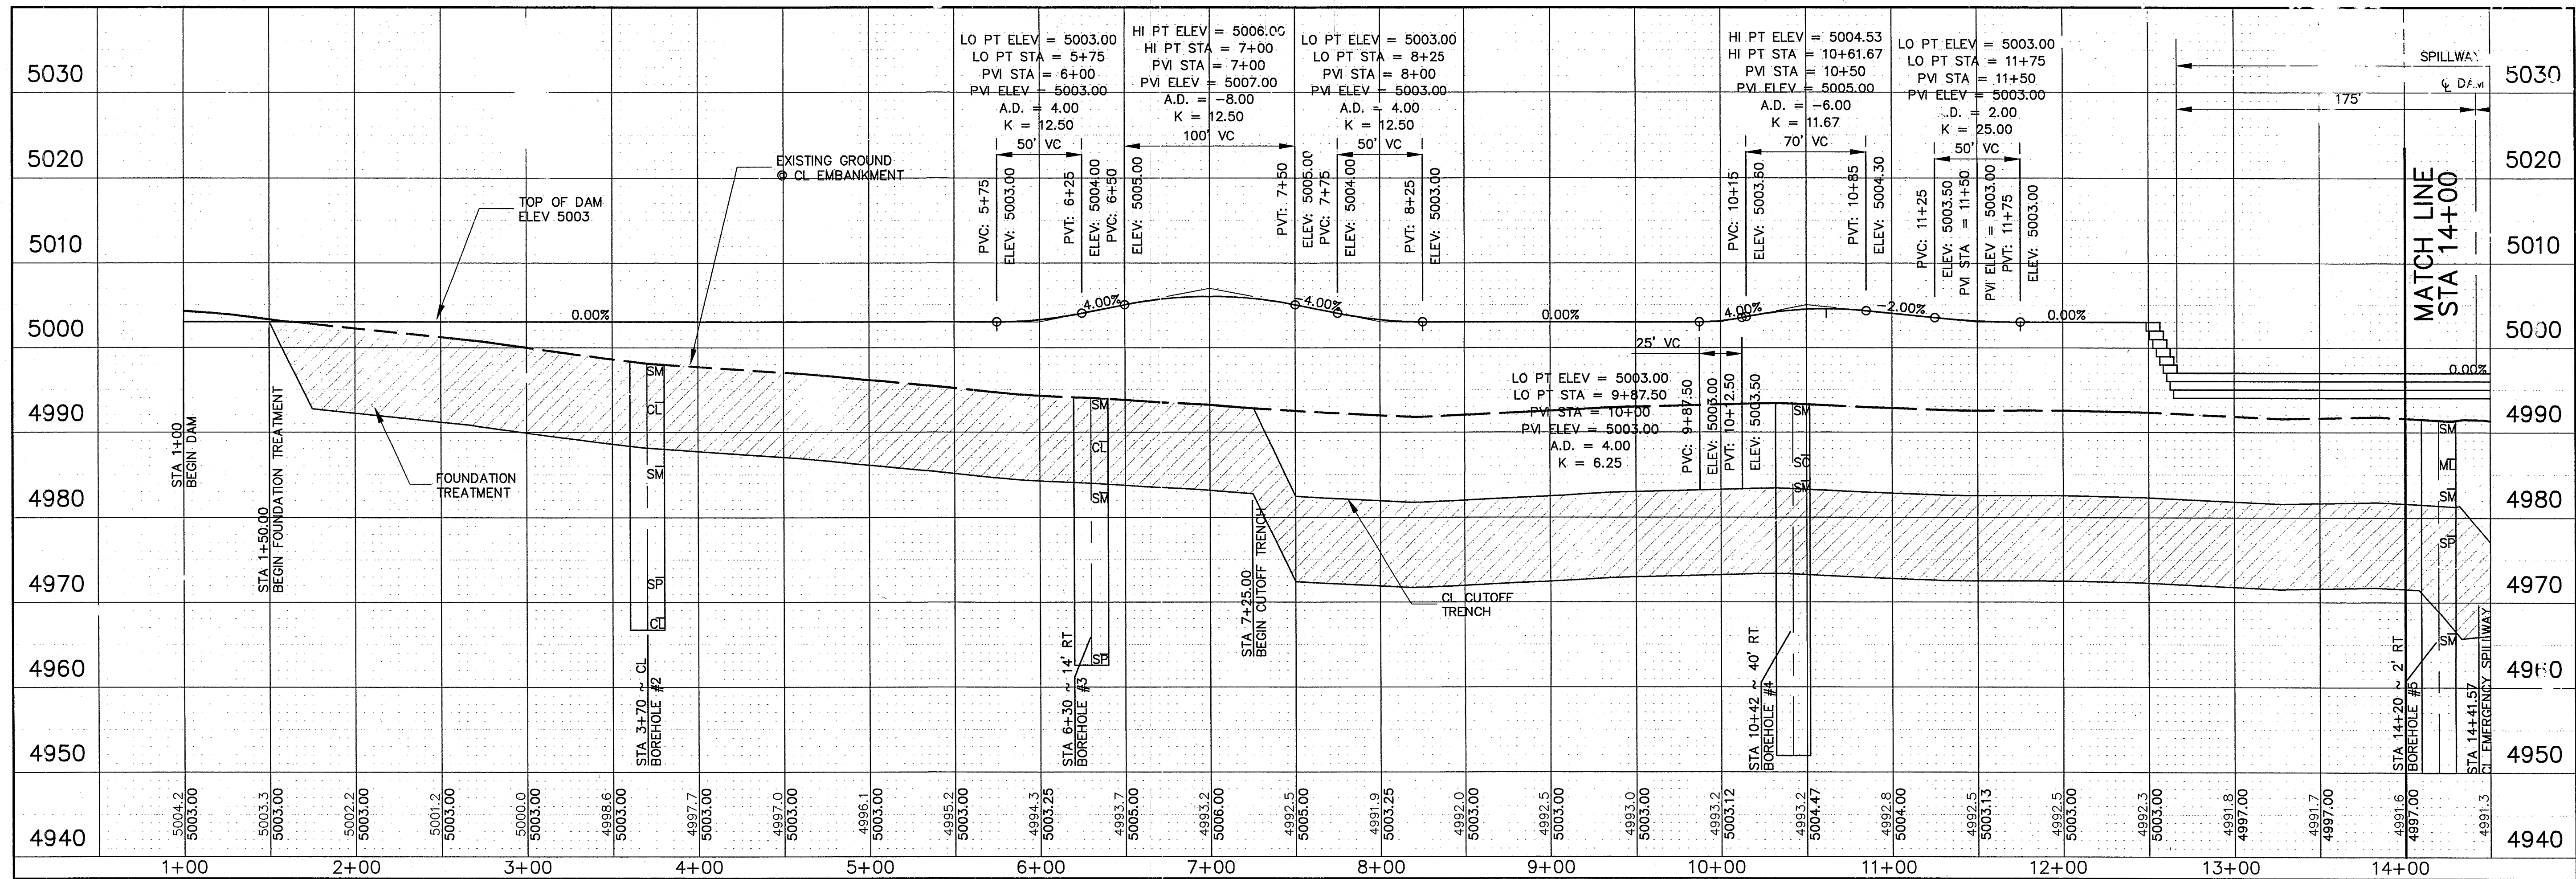

RECORD DRAWING
2-20-01

ALBUQUERQUE METROPOLITAN ARROYO FLOOD CONTROL AUTHORITY	
BORREGA DETENTION DAM DAM CENTERLINE PROFILE	
DATE MARCH 2000	FILE 99099
SHEET 7	OF 34


6922.91

WILSON & COMPANY
4900 LANG AVENUE N.E.
ALBUQUERQUE, NM
(505) 348-4000

DESIGNED BY
PJM
NOV 1999


CHECKED BY
DSA
NOV 1999

REVISIONS
NO. DATE REMARKS BY

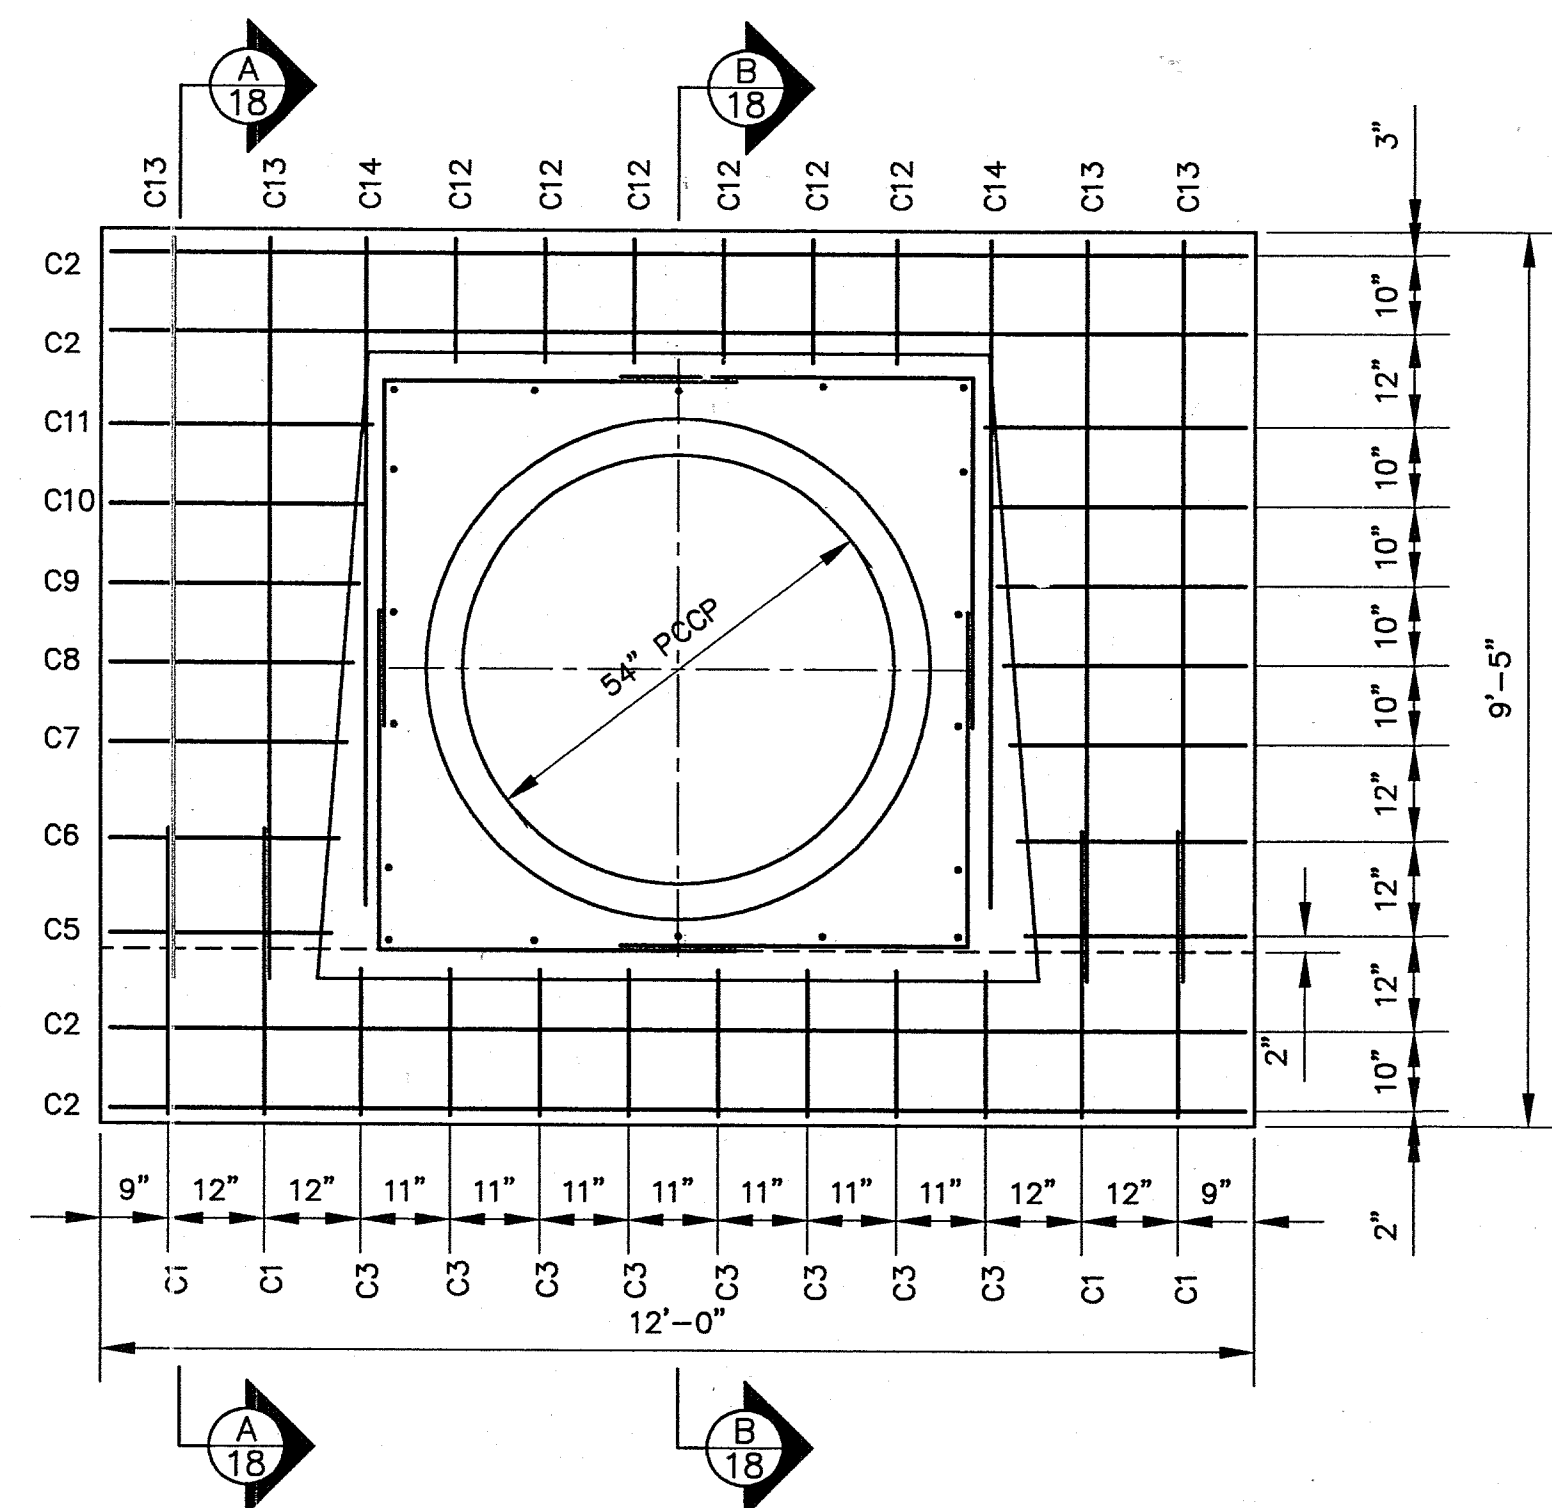


ANTI-SEEP COLLAR
1" = 2'


- NOTES:
- ANTI-SEEP COLLAR TO BE PAID PER CY UNDER BID ITEM STRUCTURAL CONCRETE.

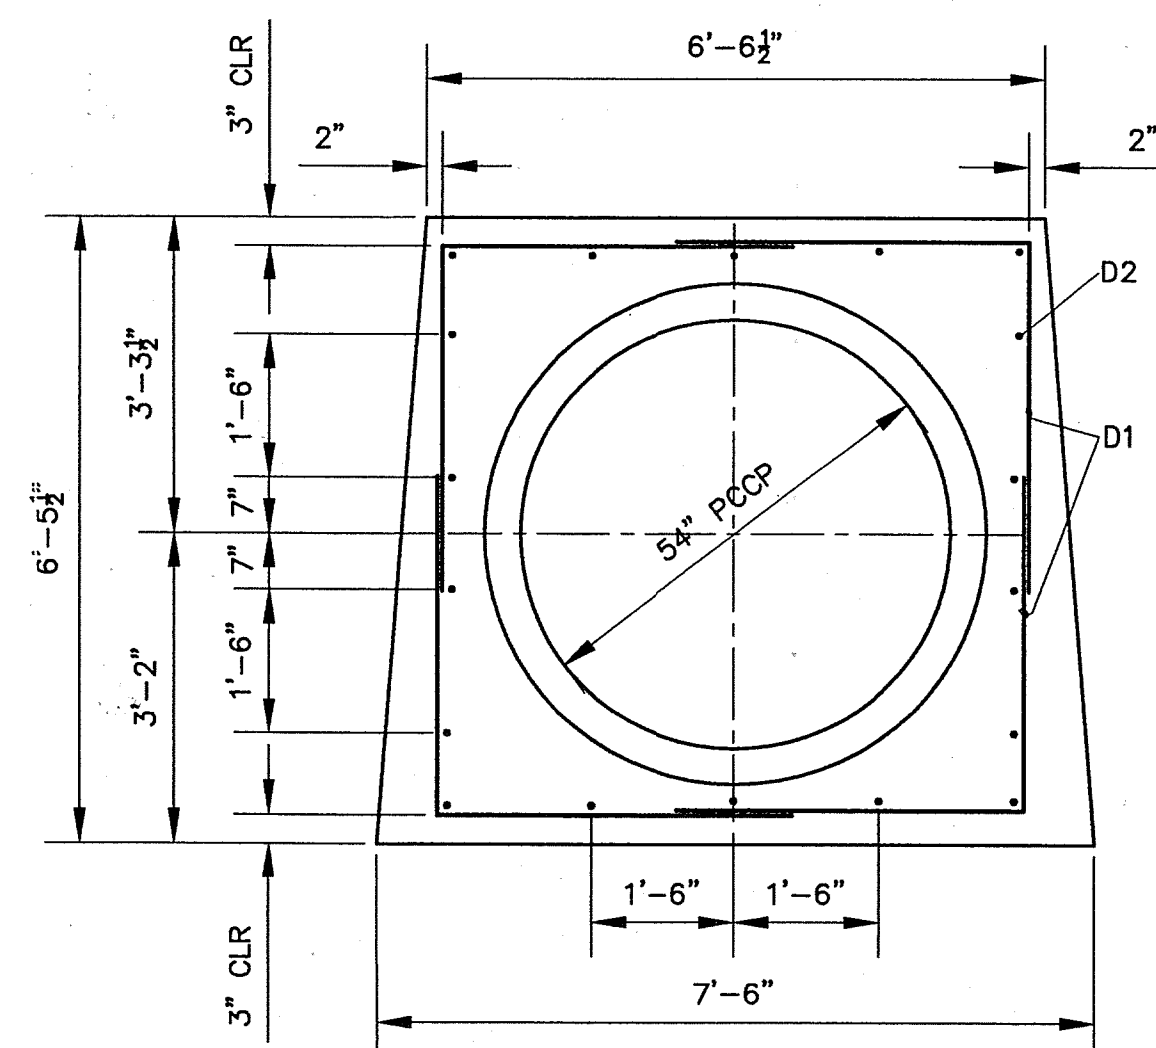


ANTI-SEEP COLLAR YOKE DETAIL
1" = 2'

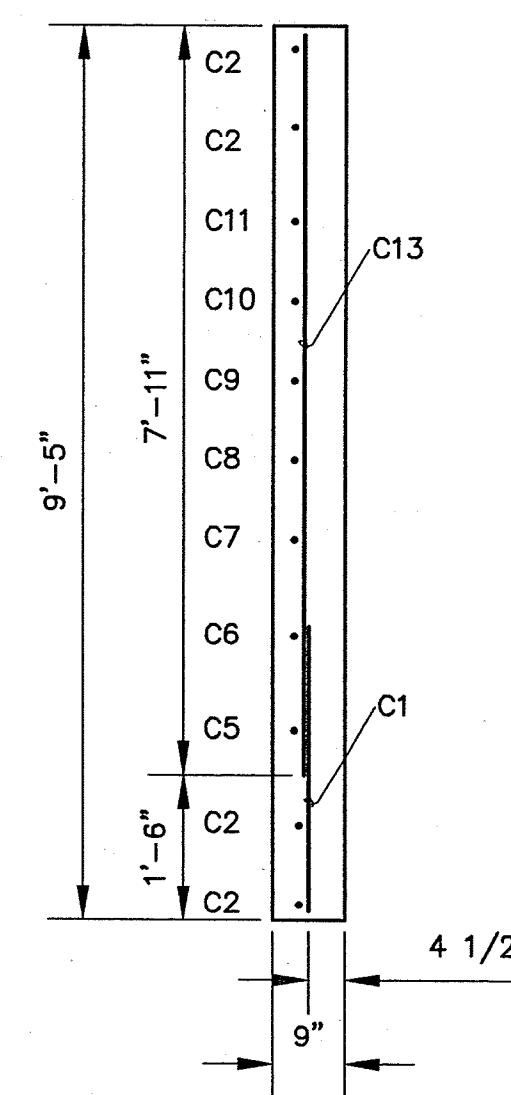

SECTION A-A
1" = 2'

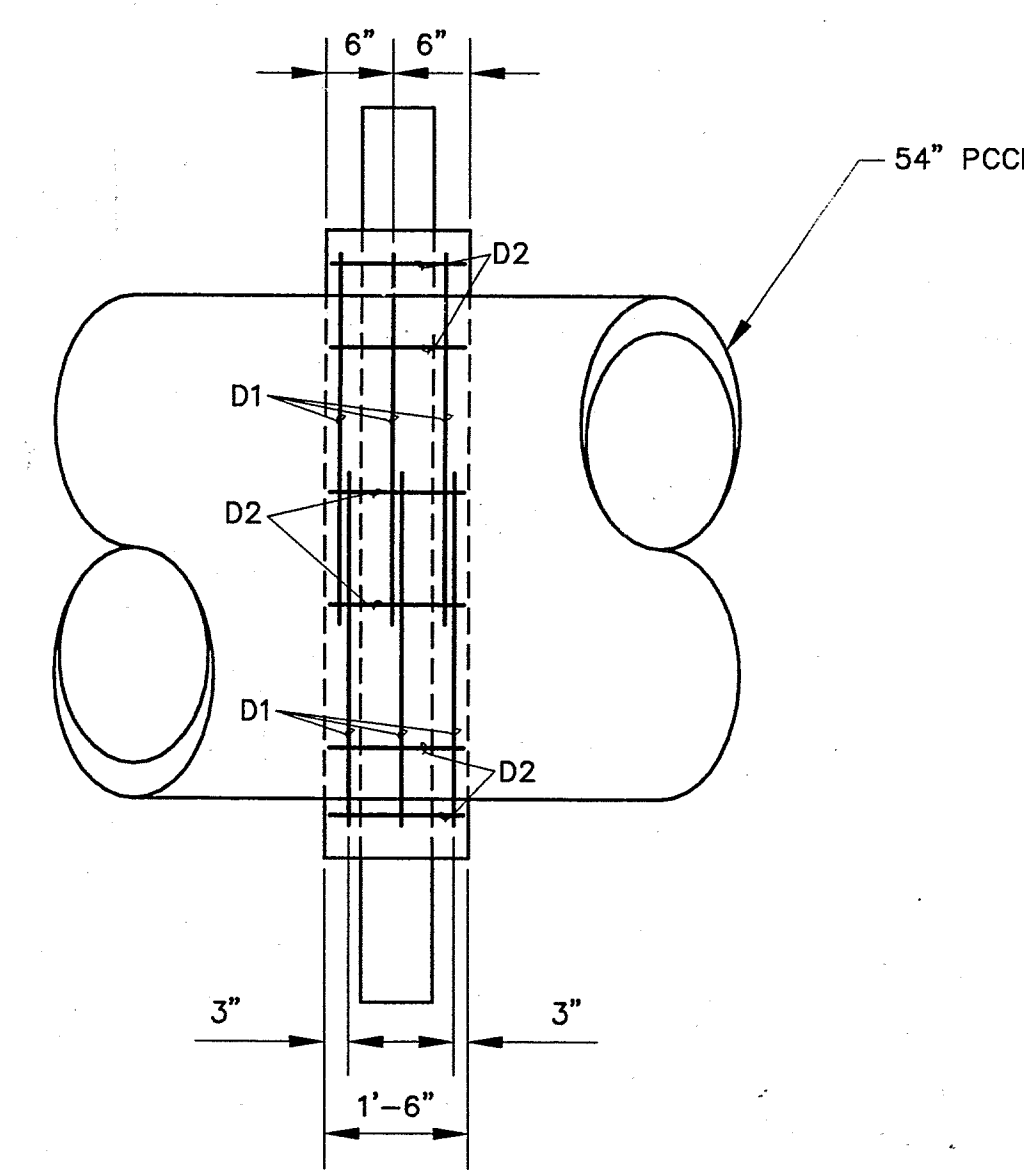

SECTION B-B
1" = 2'

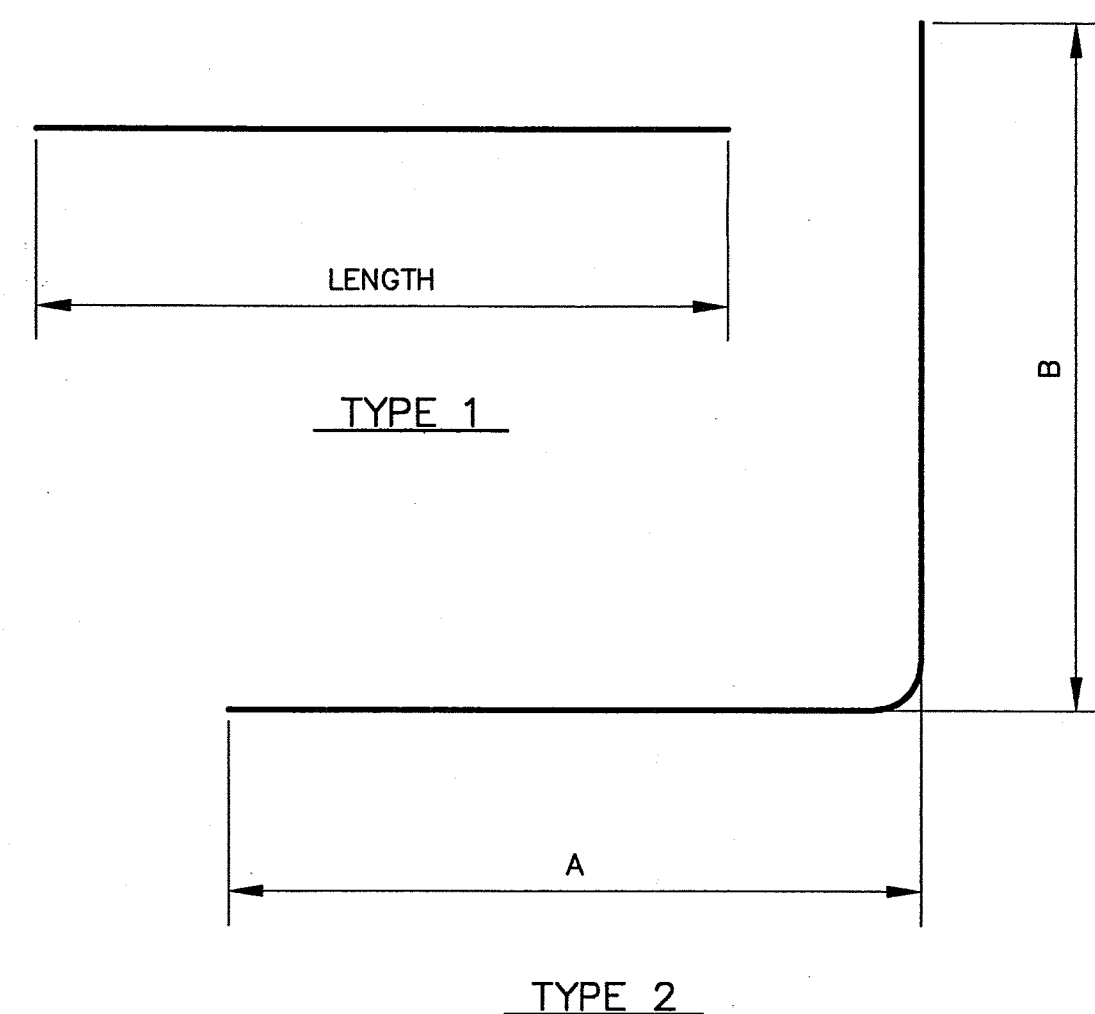

ANTI-SEEP COLLAR BAR TYPES
NTS



REBAR PER COLLAR						
ANTI-SEEP COLLAR						
NO. of BARS	LABEL	LENGTH	SIZE	TYPE	A	B
4	C1	2'-10"	#4	1	-	-
4	C2	11'-8"	#4	1	-	-
8	C3	1'-10"	#4	1	-	-
2	C4	7'-0"	#4	1	-	-
2	C5	2'-9"	#4	1	-	-
2	C6	2'-10"	#4	1	-	-
2	C7	2'-11"	#4	1	-	-
2	C8	3'-0"	#4	1	-	-
2	C9	3'-1"	#4	1	-	-
2	C10	3'-2"	#4	1	-	-
2	C11	3'-3"	#4	1	-	-
6	C12	1'-0"	#4	1	-	-
4	C13	7'-8"	#4	1	-	-
ANTI-SEEP COLLAR YOKE						
12	D1	7'-4"	#4	2	3'-8"	3'-8"
18	D2	1'-0"	#4	1	-	-

NOTE: 2" CLEARANCE MINIMUM BETWEEN REBAR AND CONCRETE FORMS


RECORD DRAWING
2-20-01

6922.91


ALBUQUERQUE METROPOLITAN ARROYO FLOOD CONTROL AUTHORITY		BORREGA DETENTION DAM	
ANTI-SEEP COLLAR DETAILS			
	WILSON & COMPANY 4900 LANG AVENUE N.E. ALBUQUERQUE, NM 87109 (505) 348-4000		DATE MARCH 2000 FILE 99099 SHEET 10 OF 34
	DESIGNED BY DRAWN BY CHECKED BY		NO. DATE REMARKS REVISIONS WILSON & COMPANY, ENGINEERS & ARCHITECTS NOV 1999 NOV 1999
	99099		BY NOV 1999

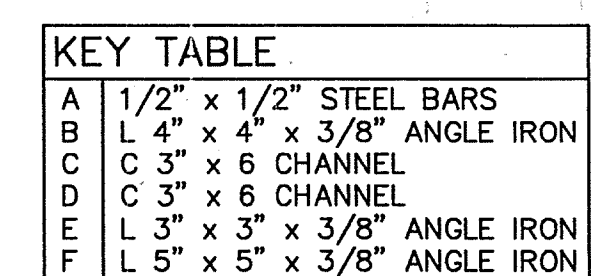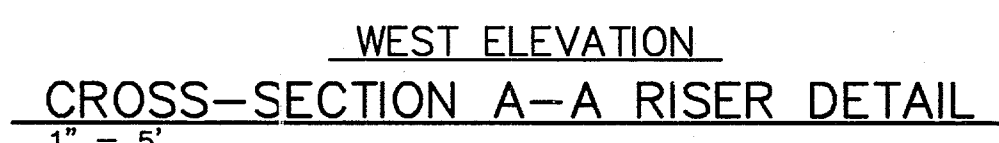

* EXPANDED METAL DECKING
MIL-M-1719D TYPE 1 CLASS 1
NORMAL .92" x 2" OPENING
1.8#/SF (MIN)
OVERALL THICKNESS .312"

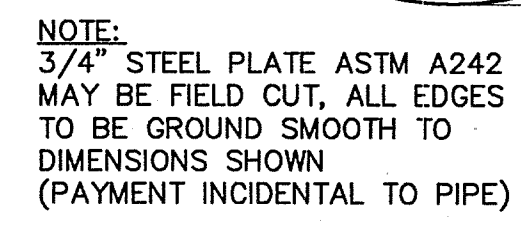

SECTION B-B
NTS

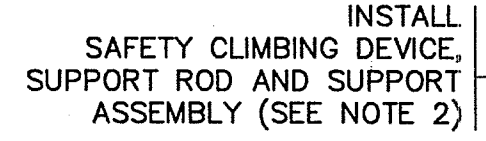

SAFETY LADDER NOTES:

1. SAFETY LADDER SHALL BE GALVANIZED A-36 STEEL AND SHALL MEET ALL REQUIREMENTS OF OSHA REGARDLESS OF DETAILS SHOWN
 2. SAFETY CLIMBING DEVICE AND ASSEMBLY SHALL BE "SAF-T-CLIMB" FALL PREVENTION SYSTEM BY NORTH CONSUMER PRODUCTS
2664 SATURN STREET
BREA CALIFORNIA 92621
(714) 524-1655
- ATTACHMENT DETAILS SHALL MEET OSHA REQUIREMENTS REGARDLESS OF DETAILS SHOWN

DETAIL "A"
SAFETY LADDER CLIMBING DEVICE
NTS



RECORD DRAWING
2-20-01



WILSON & COMPANY, ENGINEERS & ARCHITECTS					
<i>REVISIONS</i>					
NO.	DATE	REMARKS	BY		
				DESIGNED BY	NM NOV 1999
				DRAWN BY	PJM NOV 1999
				CHECKED BY	xxx NOV 1999

6922.91






ALBUQUERQUE METROPOLITAN
ARROYO FLOOD
CONTROL AUTHORITY

BORREGA DETENTION DAM
RISER DETAILS

WILSON
& COMPANY

4900 LANG AVENUE N.E.
ALBUQUERQUE, NM
87109
(505) 348-4000

DATE	MARCH 2000
FILE	99099
SHEET	OF 34

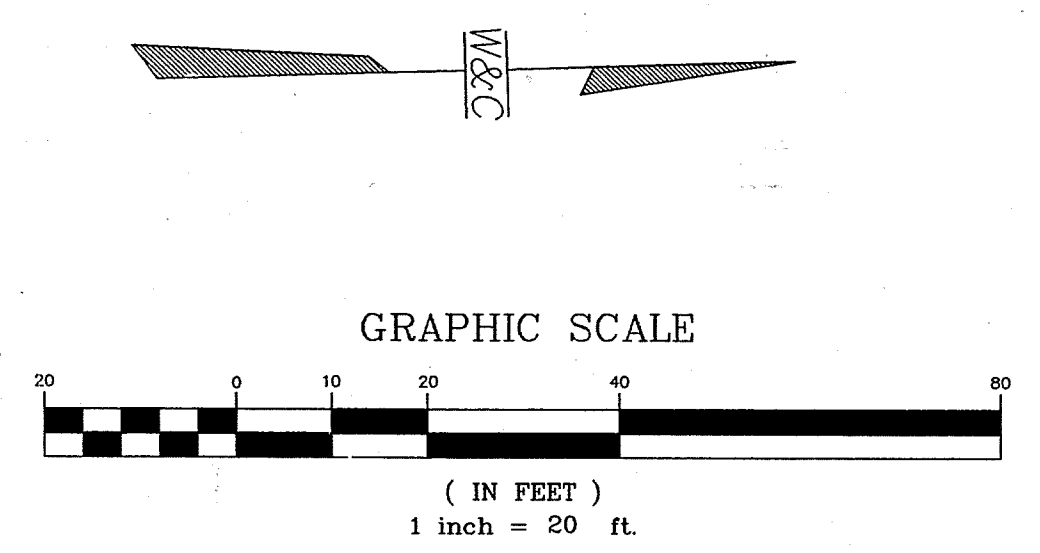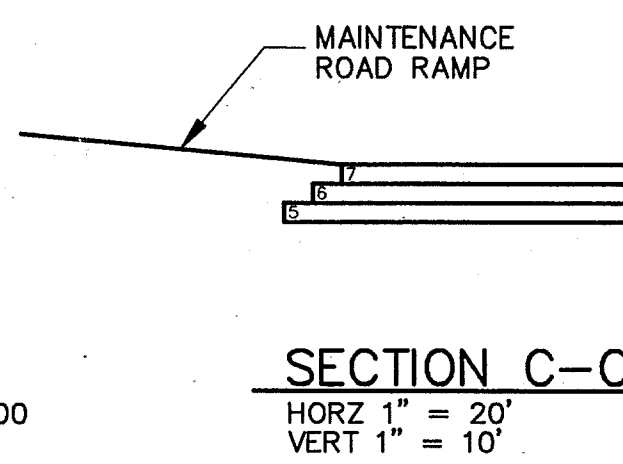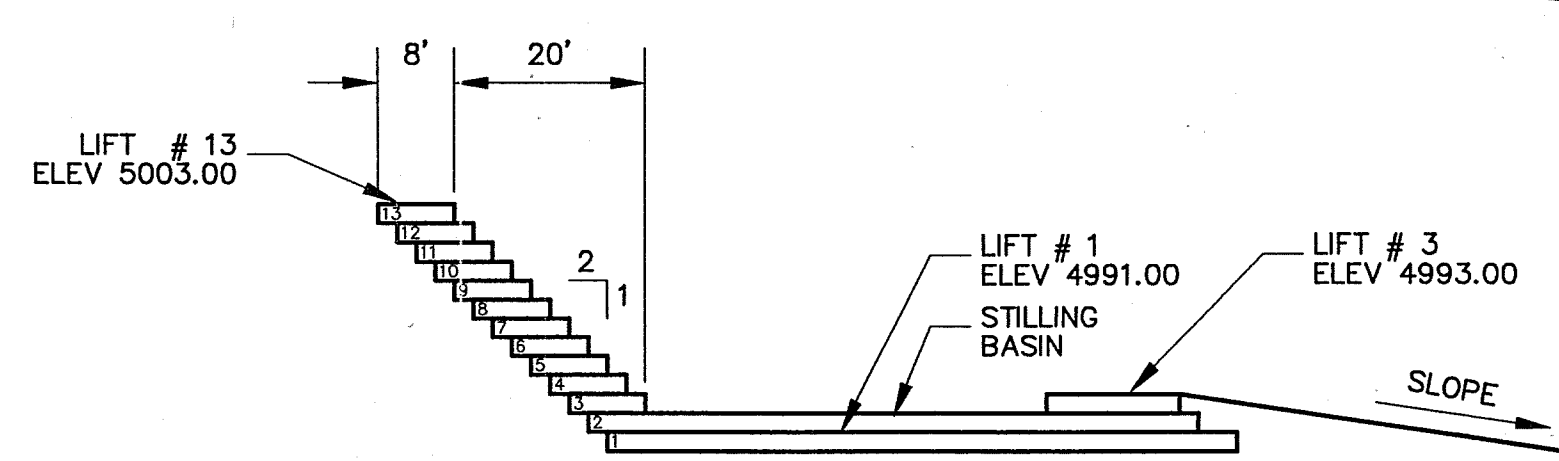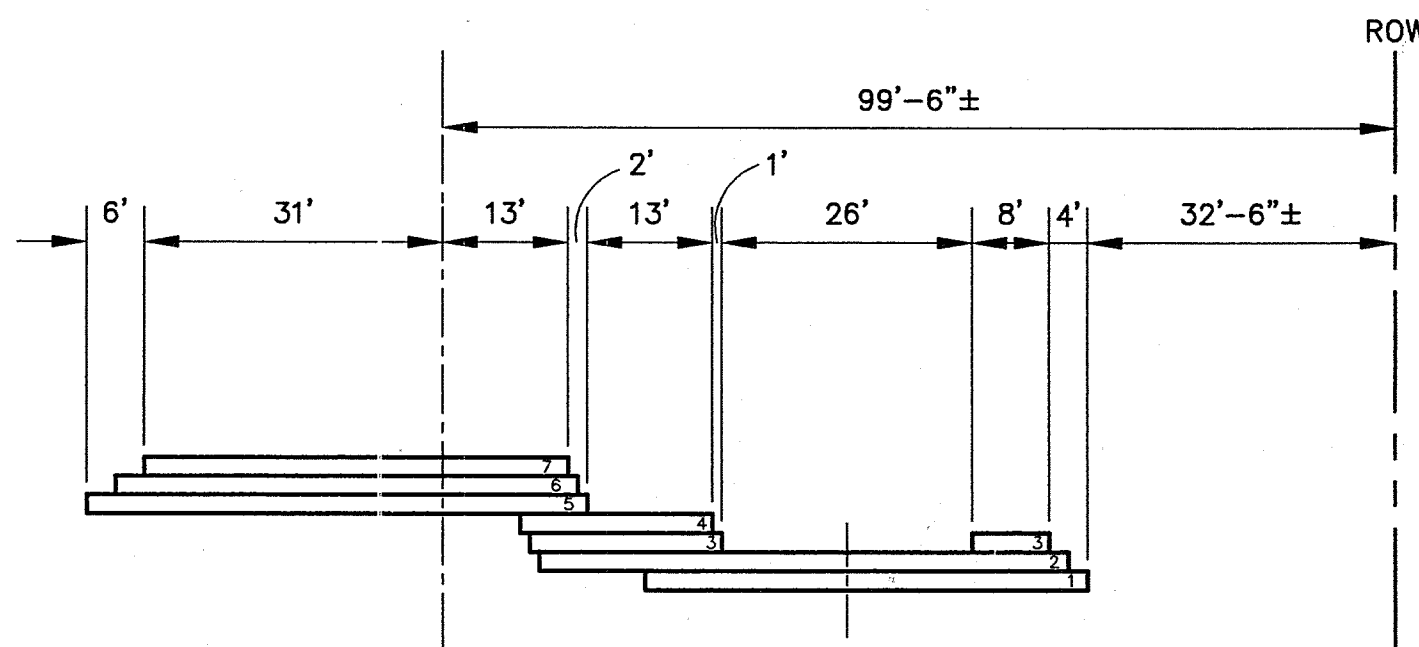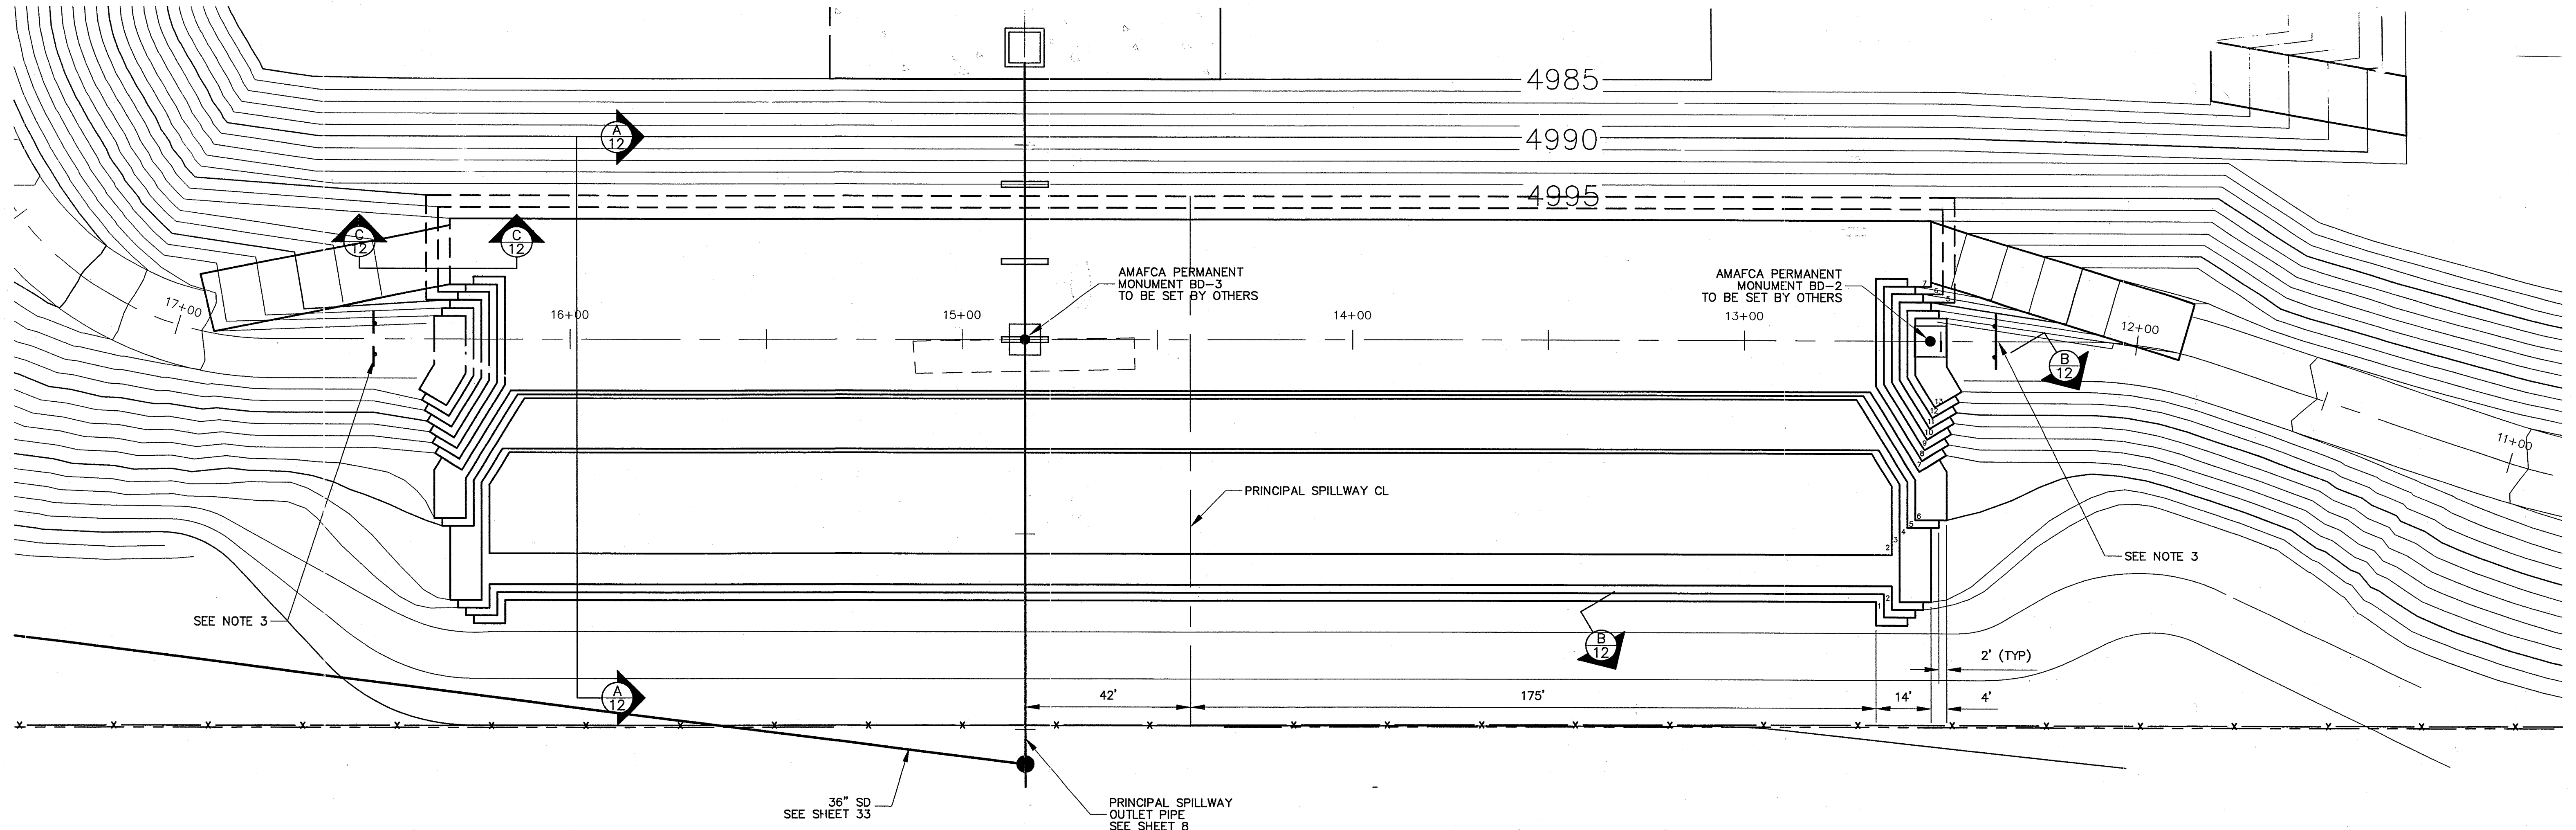


NOTES

1. AFTER SOIL CEMENT HAS CURED AND BEEN INSPECTED, EXCESS EXCAVATION MATERIAL IS TO BE PLACED IN THE AREA INDICATED AS "UNCOMPACTED WASTE FILL" ON SHEET 8. NO COMPACTION IS REQUIRED. PAYMENT FOR THIS BACKFILL PLACEMENT SHALL BE CONSIDERED INCIDENTAL TO THE VARIOUS RELATED BID ITEMS.
2. ALL SOIL CEMENT LIFTS FOR THE EMERGENCY SPILLWAY SHALL HAVE A MINIMUM DEPTH OF 1.0' (MEASURED IN PLACE) UNLESS OTHERWISE SHOWN ON THE PLANS.
3. STA 12+36 & 16+50, CL DAM
INSTALL 14 LF SINGLE RAIL WEATHERING METAL BARRIER (GUARD RAIL) WITH STANDARD TERMINAL END SECTIONS (2 PLACES).
INSTALL PER SERIAL M-21-62.

RECORD DRAWING
DATE 2-22-01


6922.91

		ALBUQUERQUE METROPOLITAN ARROYO FLOOD CONTROL AUTHORITY	
BORREGA DETENTION DAM EMERGENCY SPILLWAY DETAILS			
	WILSON & COMPANY 4900 LANG AVENUE N.E. ALBUQUERQUE, NM 87109 (505) 348-4000		DATE MARCH 2000
			FILE 99099
			SHEET 12 OF 34
NO. DATE REMARKS REVISIONS WILSON & COMPANY, ENGINEERS & ARCHITECTS DESIGNED BY NM NOV 1999 DRAWN BY PJM NOV 1999 CHECKED BY DSA NOV 1999			

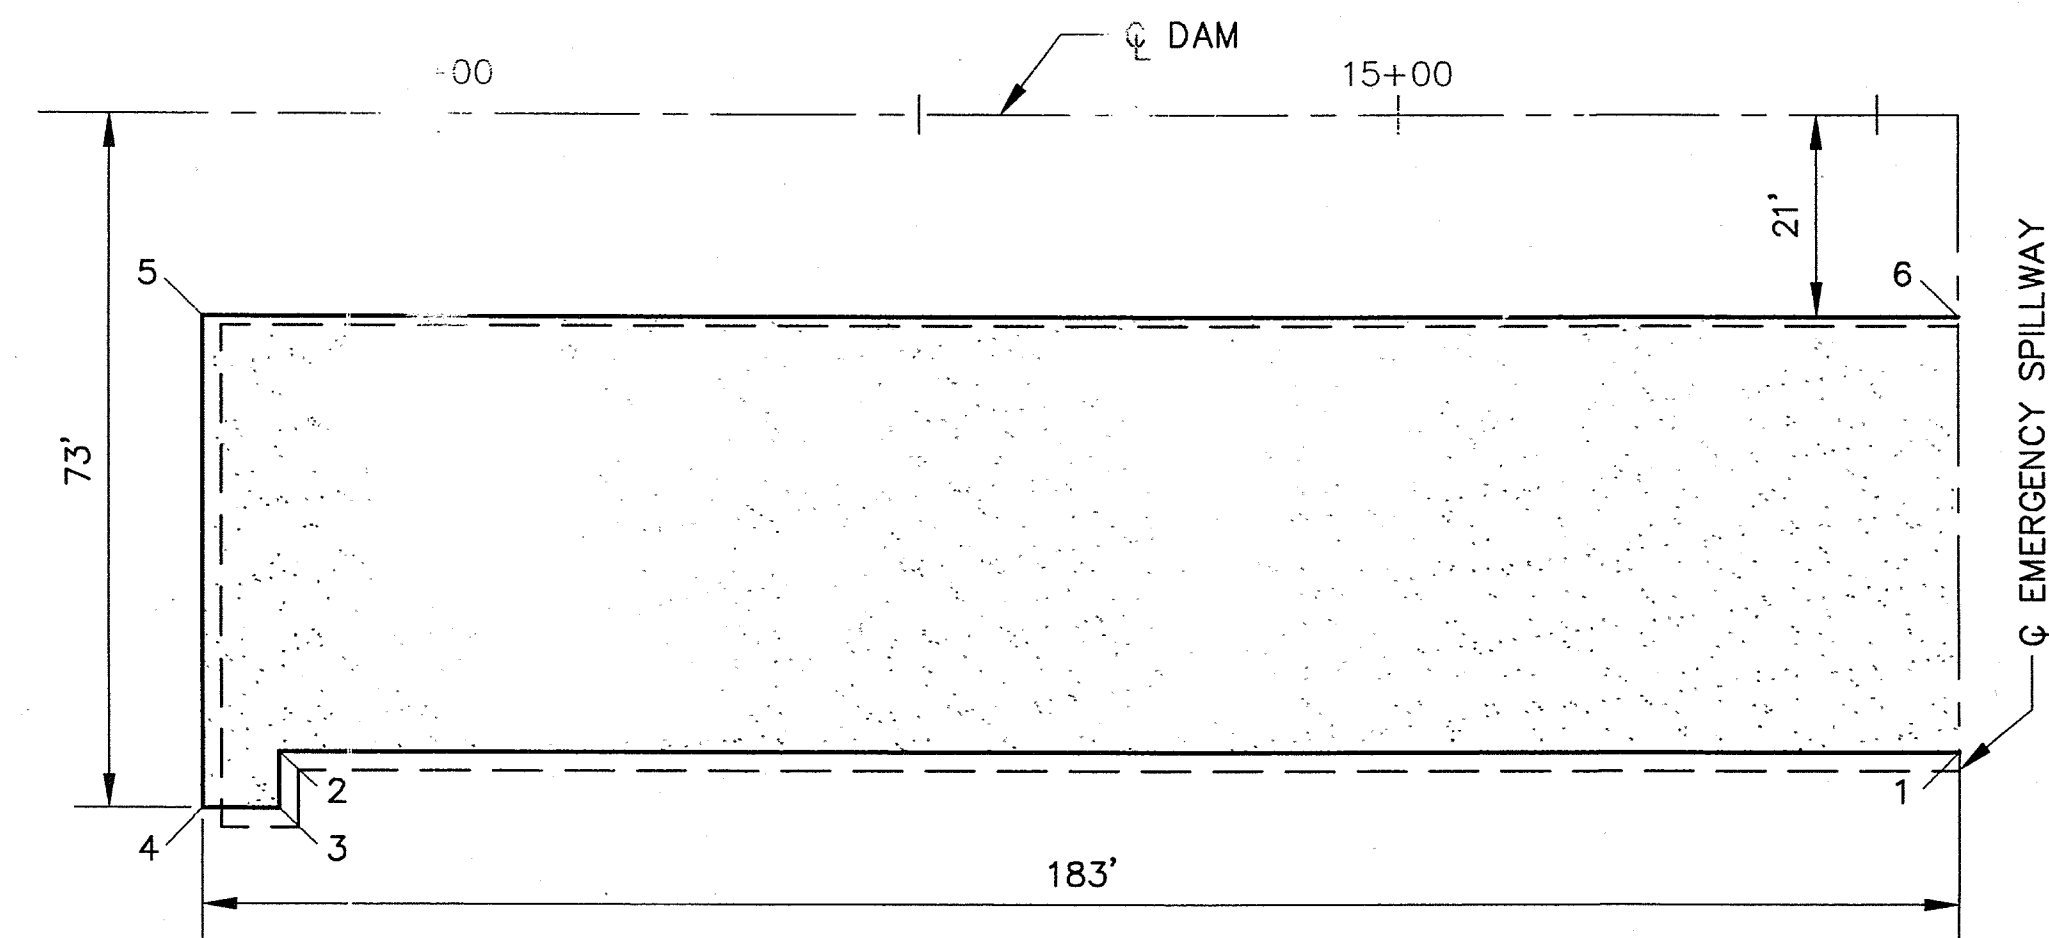


LIFT #1
LIFT ELEV = 4991

LIFT #1			
NO.	STATION	OFFSET	
		LEFT	RIGHT
1	14+41.57	67.00'	---
2	16+16.57	67.00'	---
3	16+16.57	73.00'	---
4	16+24.57	73.00'	---
5	16+24.57	24.00'	---
6	14+41.57	24.00'	---

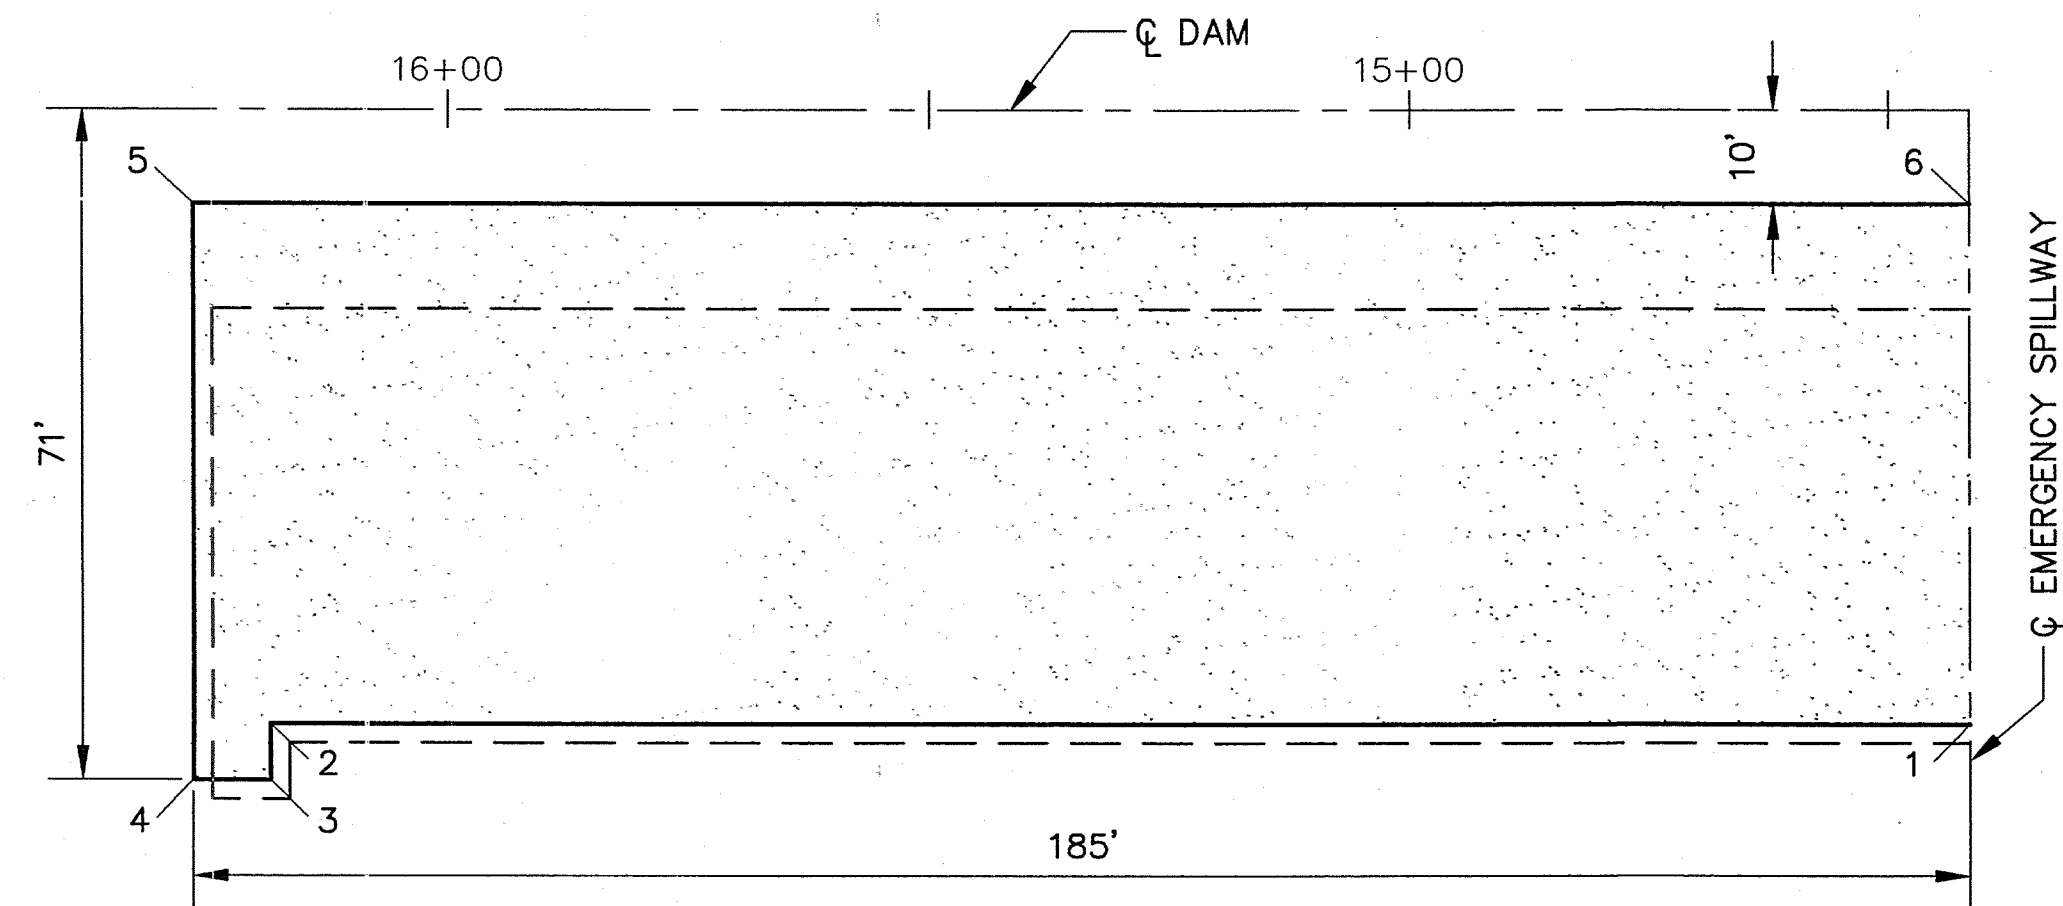


LIFT #2
LIFT ELEV = 4992

LIFT #2			
NO.	STATION	OFFSET	
		LEFT	RIGHT
1	14+41.57	65.00'	---
2	16+18.57	65.00'	---
3	16+18.57	71.00'	---
4	16+26.57	71.00'	---
5	16+26.57	10.00'	---
6	14+41.57	10.00'	---

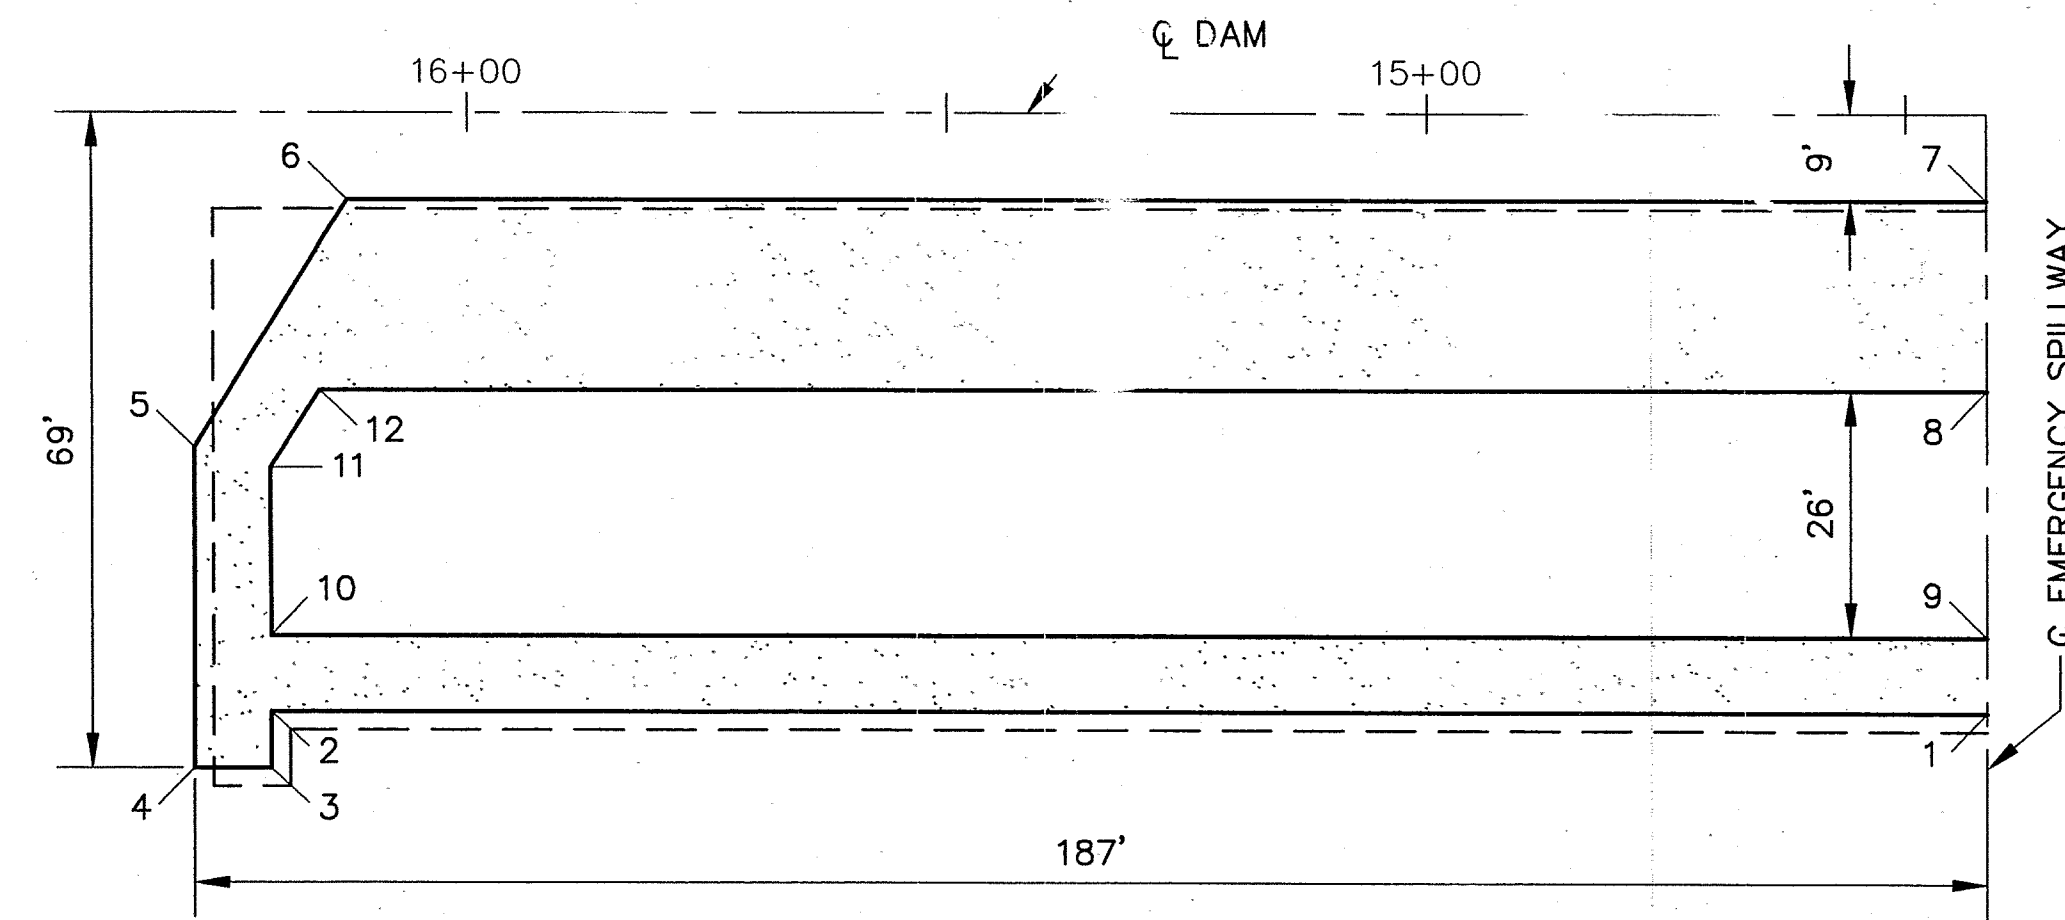

LIFT #3
LIFT ELEV = 4993


LIFT #3			
NO.	STATION	OFFSET	
		LEFT	RIGHT
1	14+41.57	63.00'	---
2	16+20.57	63.00'	---
3	16+20.57	69.00'	---
4	16+28.57	69.00'	---
5	16+28.57	35.03'	---
6	16+12.65	9.00'	---
7	14+41.57	9.00'	---
8	14+41.57	29.00'	---
9	14+41.57	55.00'	---
10	16+20.57	55.00'	---
11	16+20.57	37.29'	---
12	16+15.50	29.00'	---

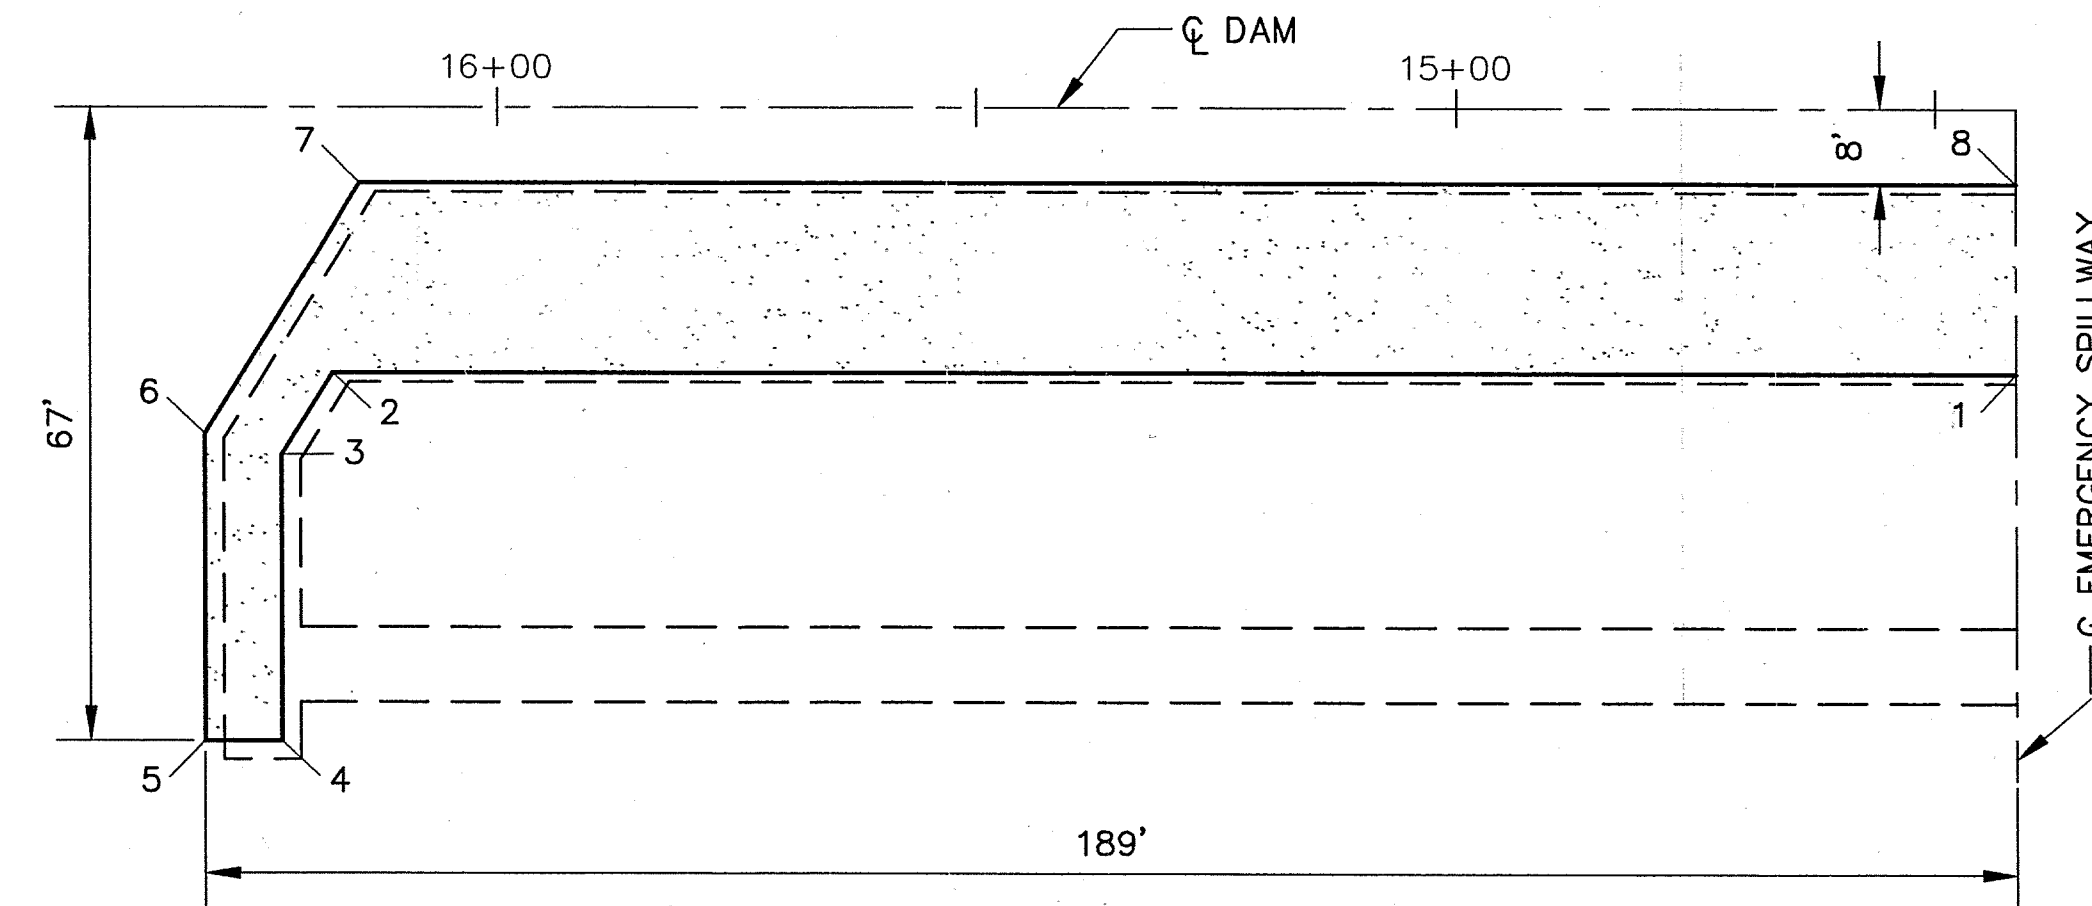


LIFT #4
LIFT ELEV = 4994

LIFT #4			
NO.	STATION	OFFSET	
		LEFT	RIGHT
1	14+41.57	28.00'	---
2	16+17.24	28.00'	---
3	16+22.57	36.72'	---
4	16+22.57	67.00'	---
5	16+30.57	67.00'	---
6	16+30.57	34.47'	---
7	16+14.38	8.00'	---
8	14+41.57	8.00'	---

RECORD DRAWING
2-20-01

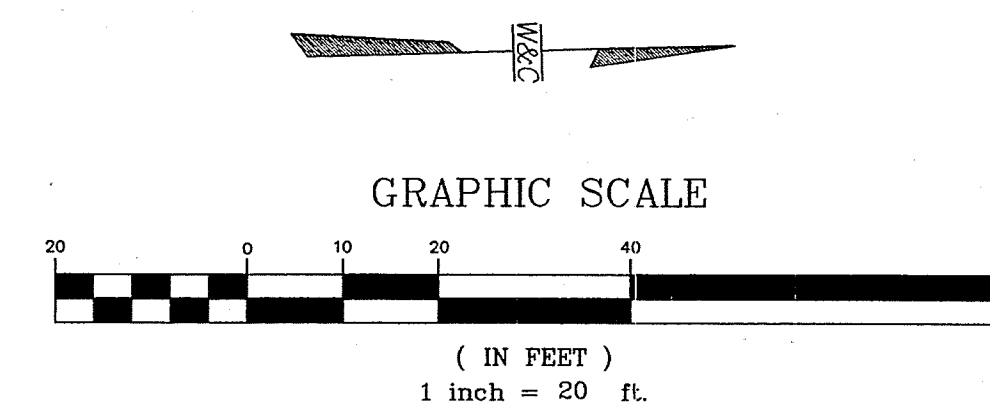


6922.91		NO. DATE		REVISIONS		BY	
ALBUQUERQUE METROPOLITAN ARROYO FLOOD CONTROL AUTHORITY		DESIGNED BY		WILSON & COMPANY, ENGINEERS & ARCHITECTS		NOV 1999	
BORREGA DETENTION DAM		DRAWN BY		PJM		NOV 1999	
E EMERGENCY SPILLWAY LIFTS 1-4		CHECKED BY		DSA		NOV 1999	
DATE		MARCH 2000		FILE		99099	
SHEET		13		OF		34	

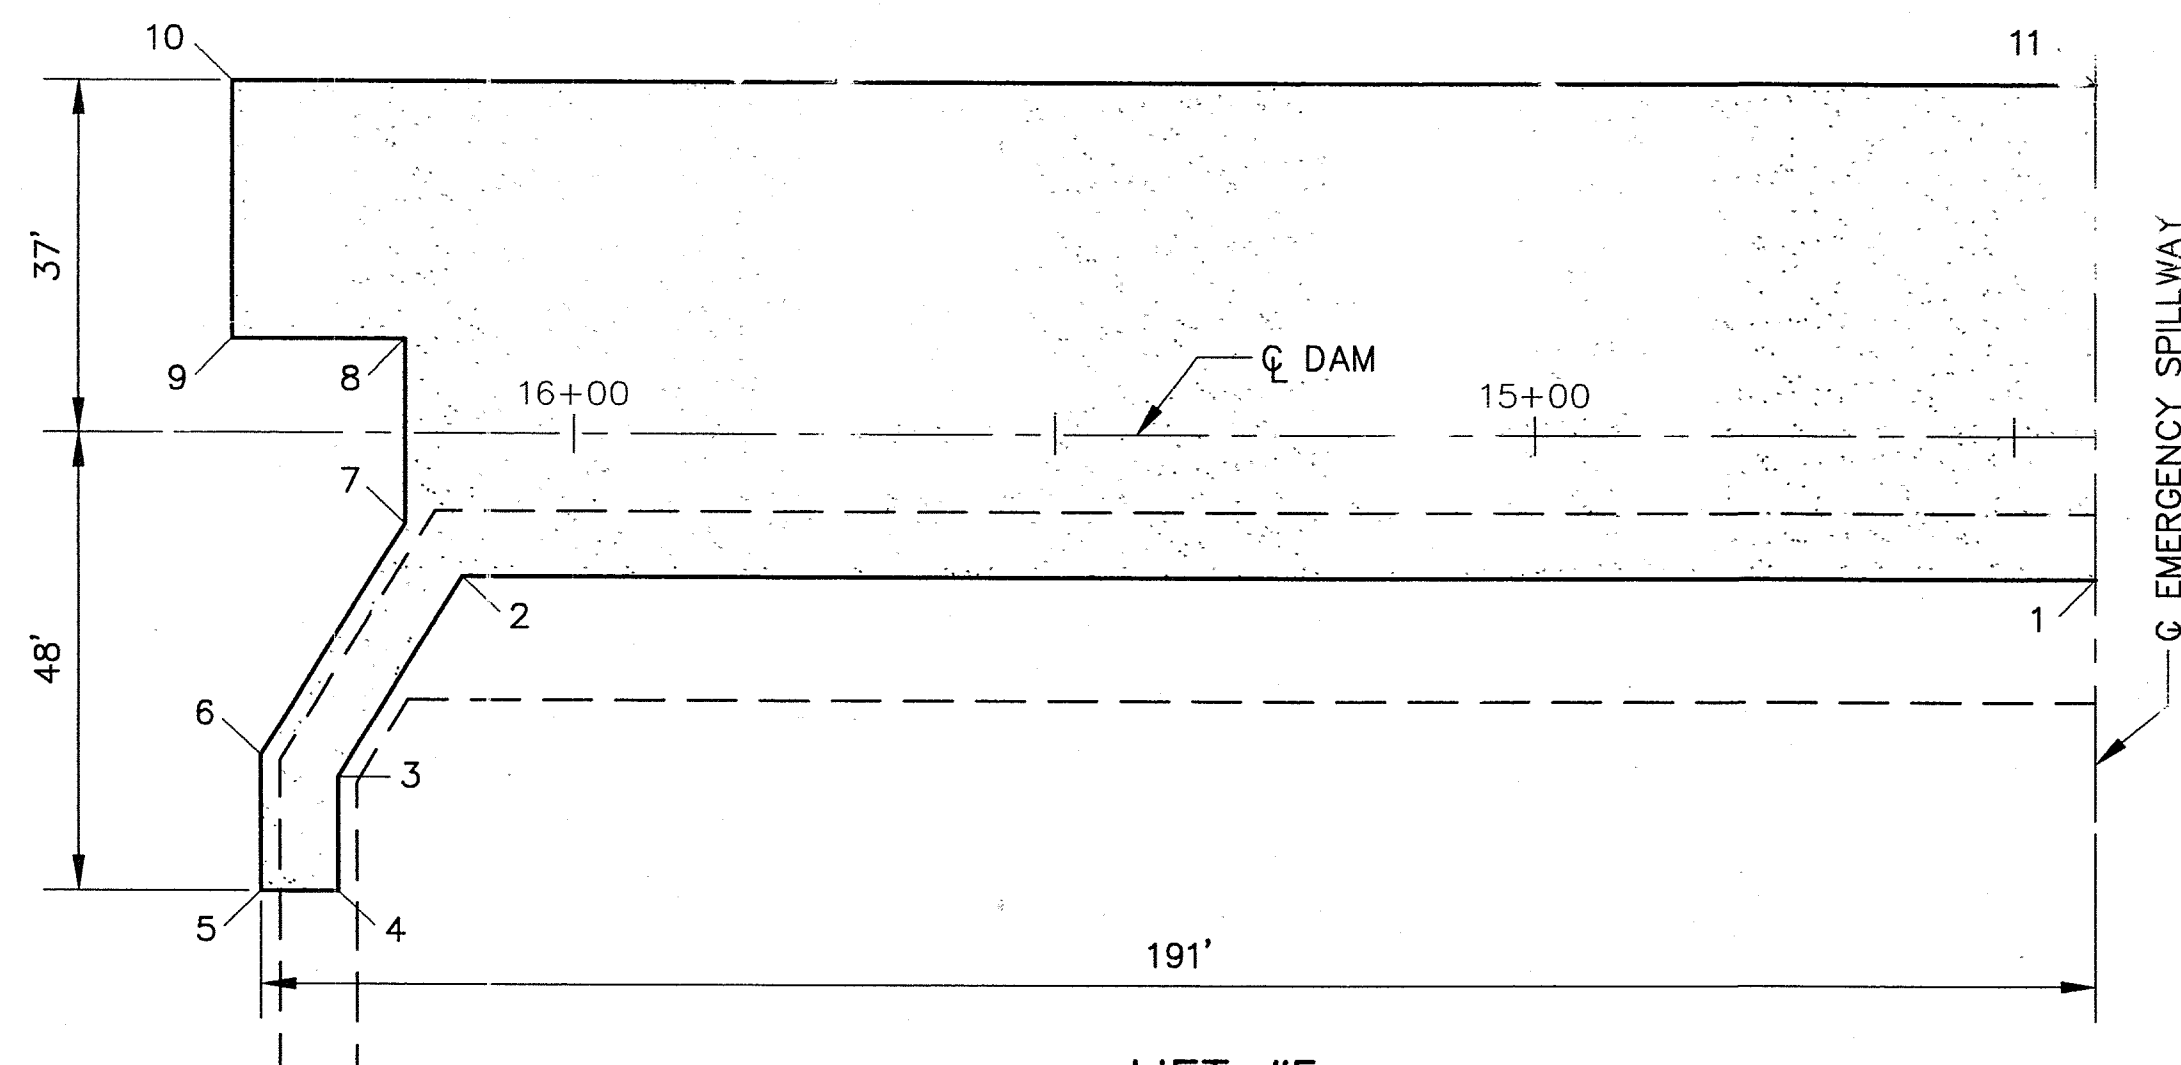


LIFT #5
LIFT ELEV = 4995

LIFT #5			
NO.	STATION	OFFSET DISTANCE	
		LEFT	RIGHT
1	14+41.57	15.00'	---
2	16+11.63	15.00'	---
3	16+24.57	36.16'	---
4	16+24.57	48.00'	---
5	16+32.57	48.00'	---
6	16+32.57	33.91'	---
7	14+17.57	9.37'	---
8	14+17.57	---	10.00'
9	14+35.57	---	10.00'
10	16+35.57	---	37.00'
11	14+41.57	---	37.00'

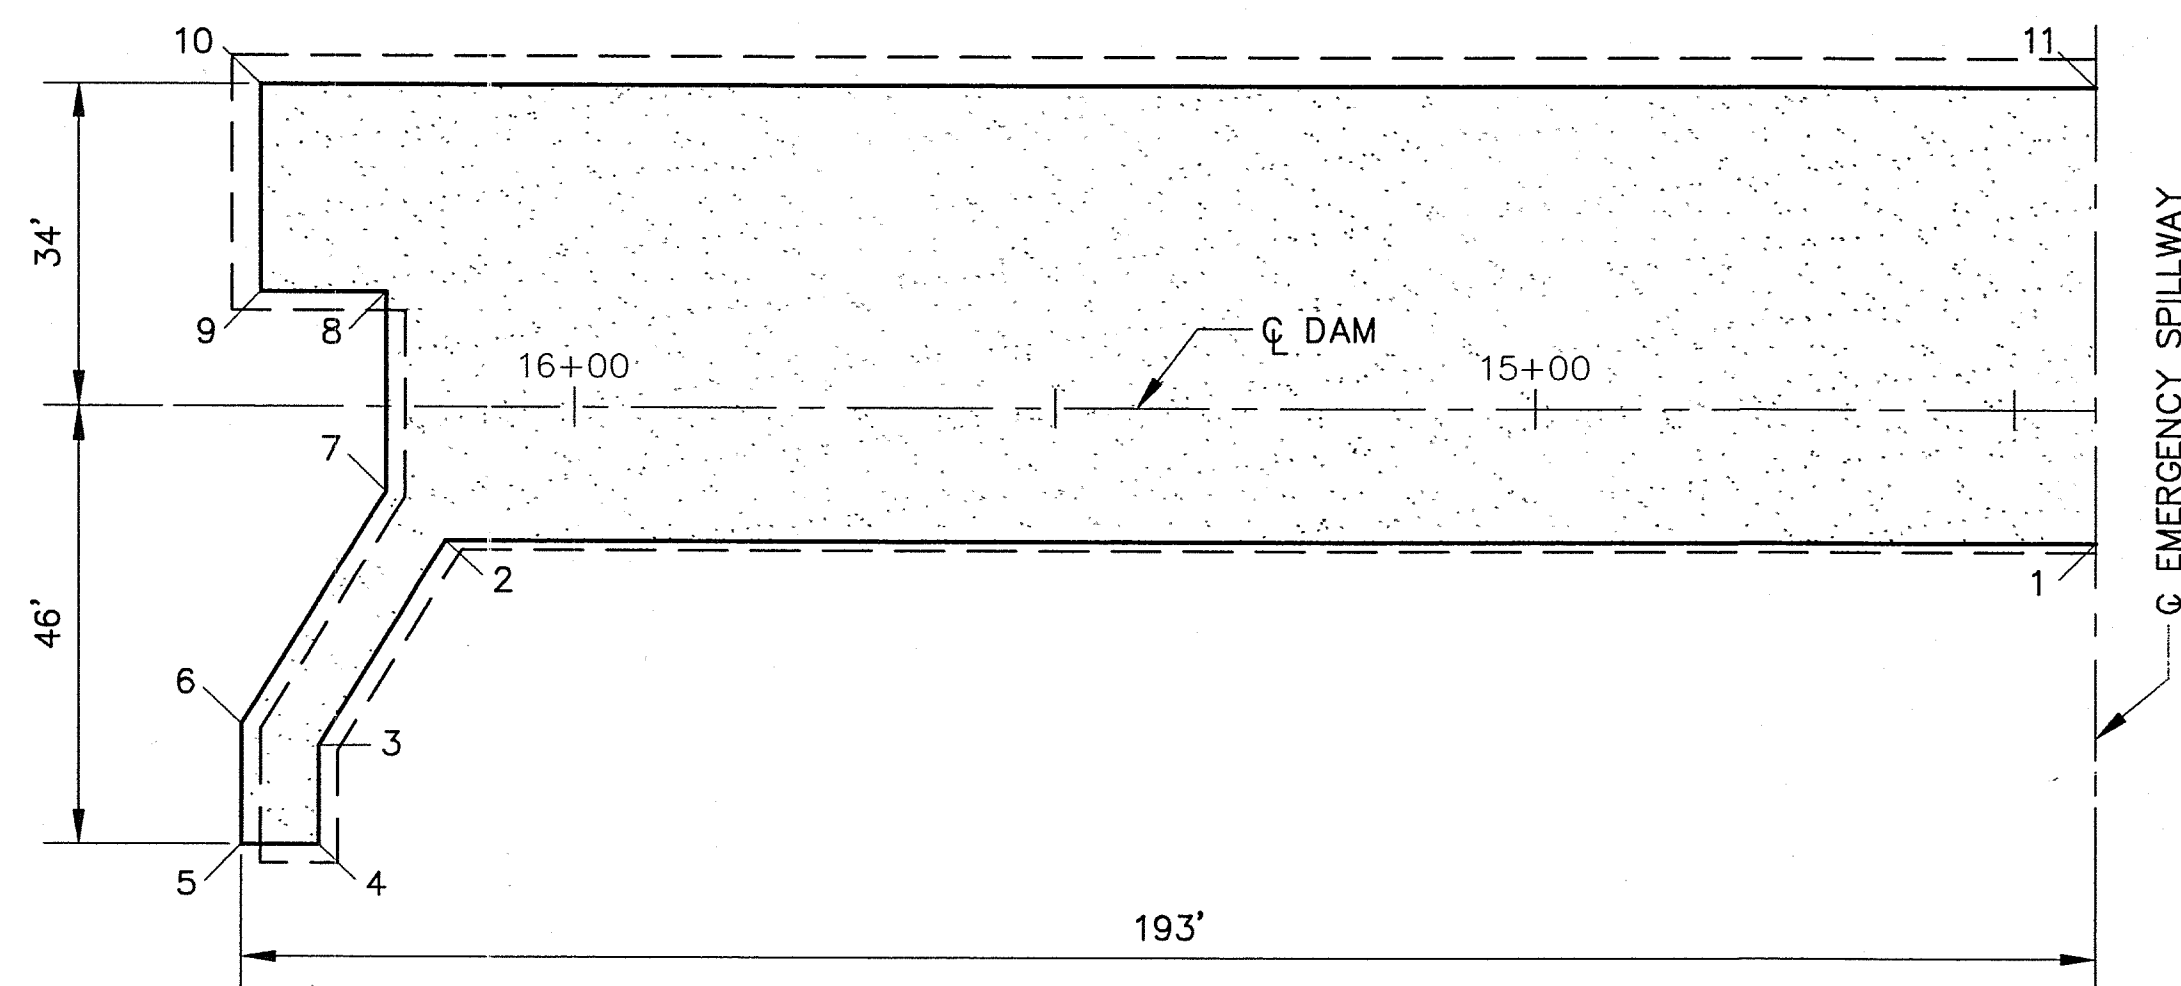


LIFT #6
LIFT ELEV = 4996

LIFT #6			
NO.	STATION	OFFSET DISTANCE	
		LEFT	RIGHT
1	14+41.57	14.00'	---
2	16+13.36	14.00'	---
3	16+26.57	35.60'	---
4	16+26.57	46.00'	---
5	16+34.57	46.00'	---
6	16+34.57	33.34'	---
7	16+19.57	8.81'	---
8	16+19.57	---	12.00'
9	16+32.57	---	13.00'
10	16+32.57	---	34.00'
11	14+41.57	---	34.00'

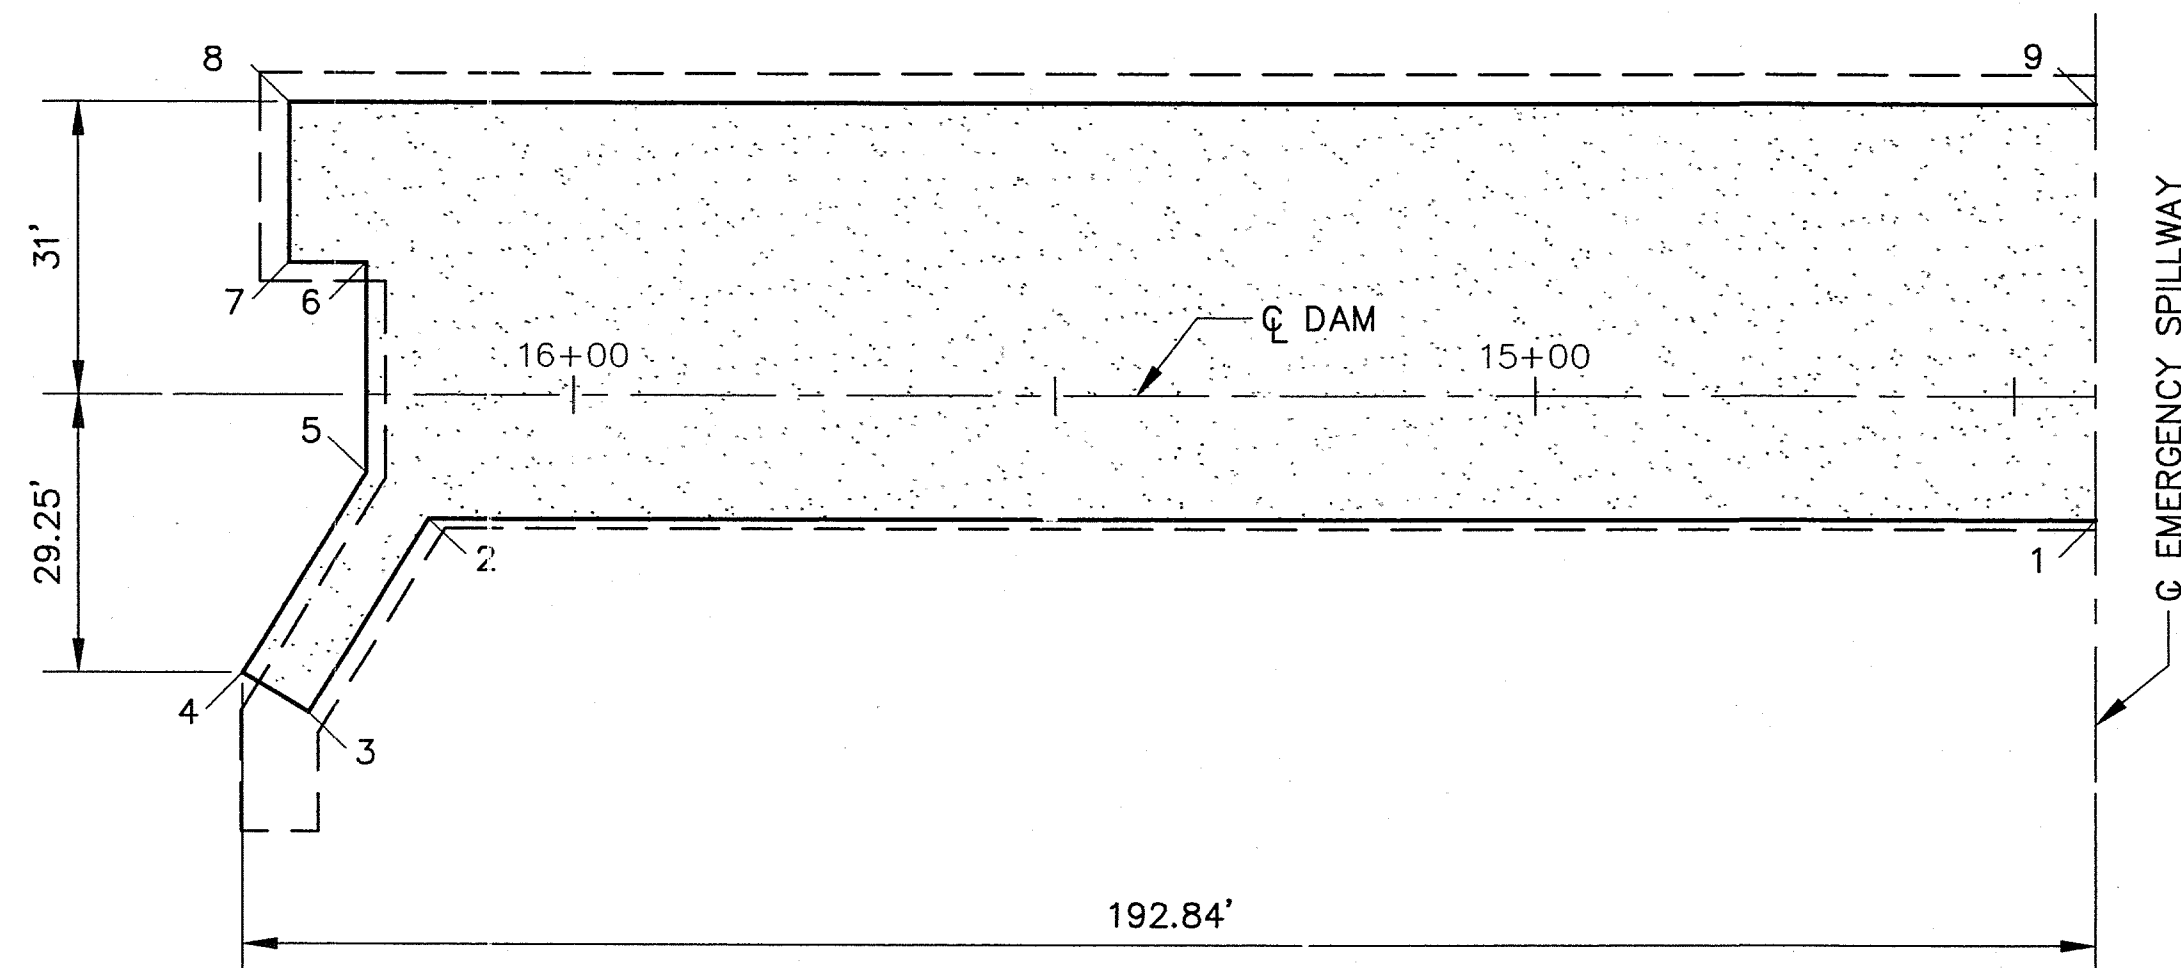


LIFT #7
LIFT ELEV = 4997

LIFT #7			
NO.	STATION	OFFSET DISTANCE	
		LEFT	RIGHT
1	14+41.57	13.00'	---
2	16+15.10	13.00'	---
3	16+27.58	33.42'	---
4	16+34.41	29.25'	---
5	16+21.57	8.25'	---
6	16+21.57	---	14.00'
7	16+29.57	---	14.00'
8	16+29.57	---	31.00'
9	14+41.57	---	31.00'

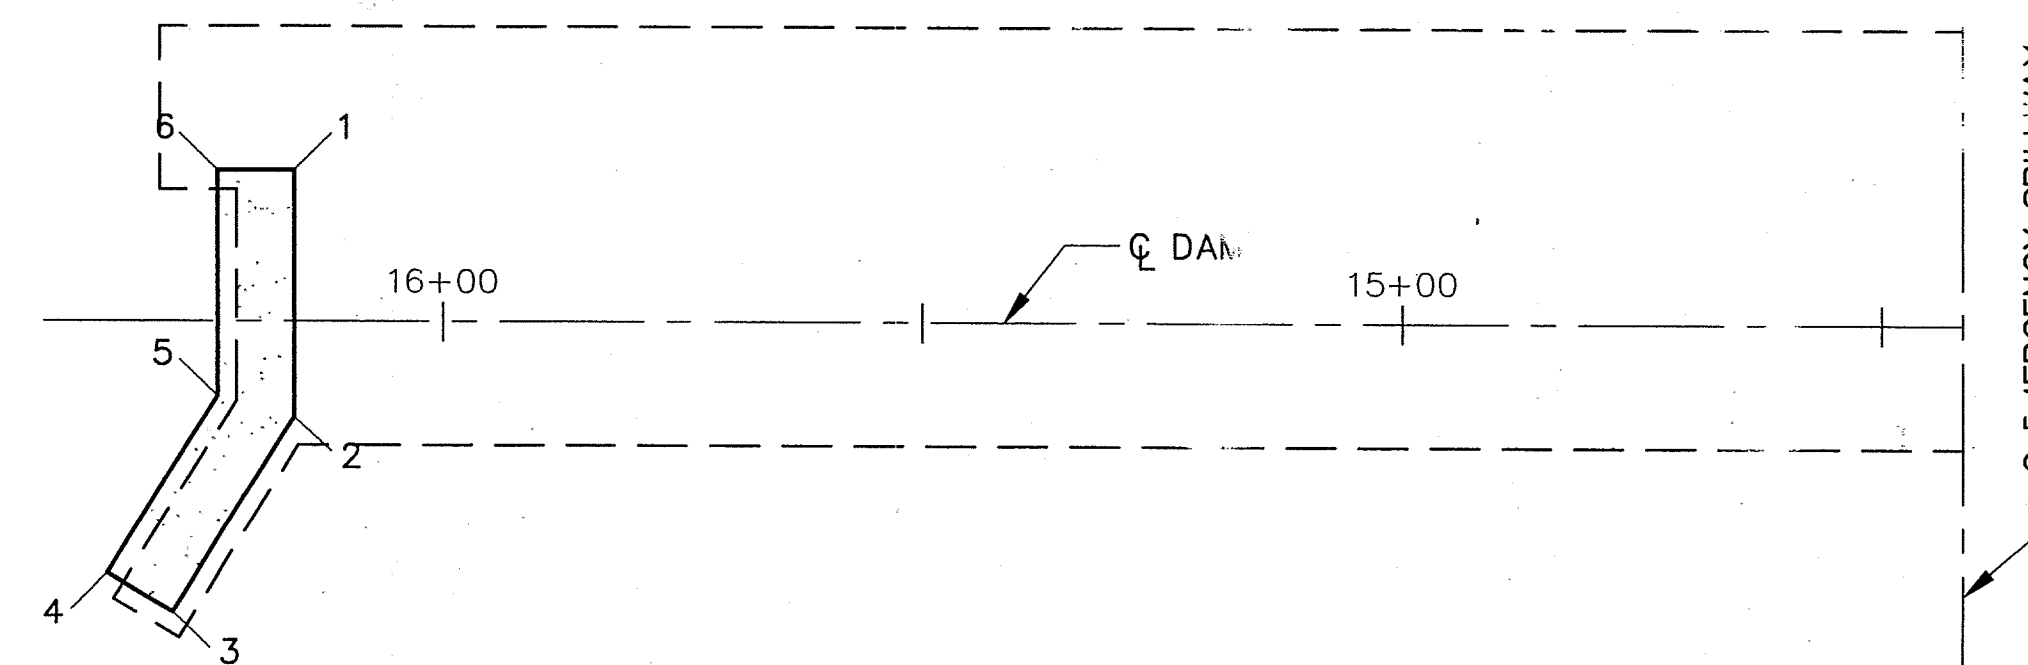


LIFT #8
LIFT ELEV = 4998

LIFT #8			
NO.	STATION	OFFSET DISTANCE	
		LEFT	RIGHT
1	14+15.57	---	16.00'
2	16+15.57	9.94'	---
3	16+28.24	30.67'	---
4	16+35.07	26.50'	---
5	16+23.57	7.68'	---
6	16+23.57	---	16.00'

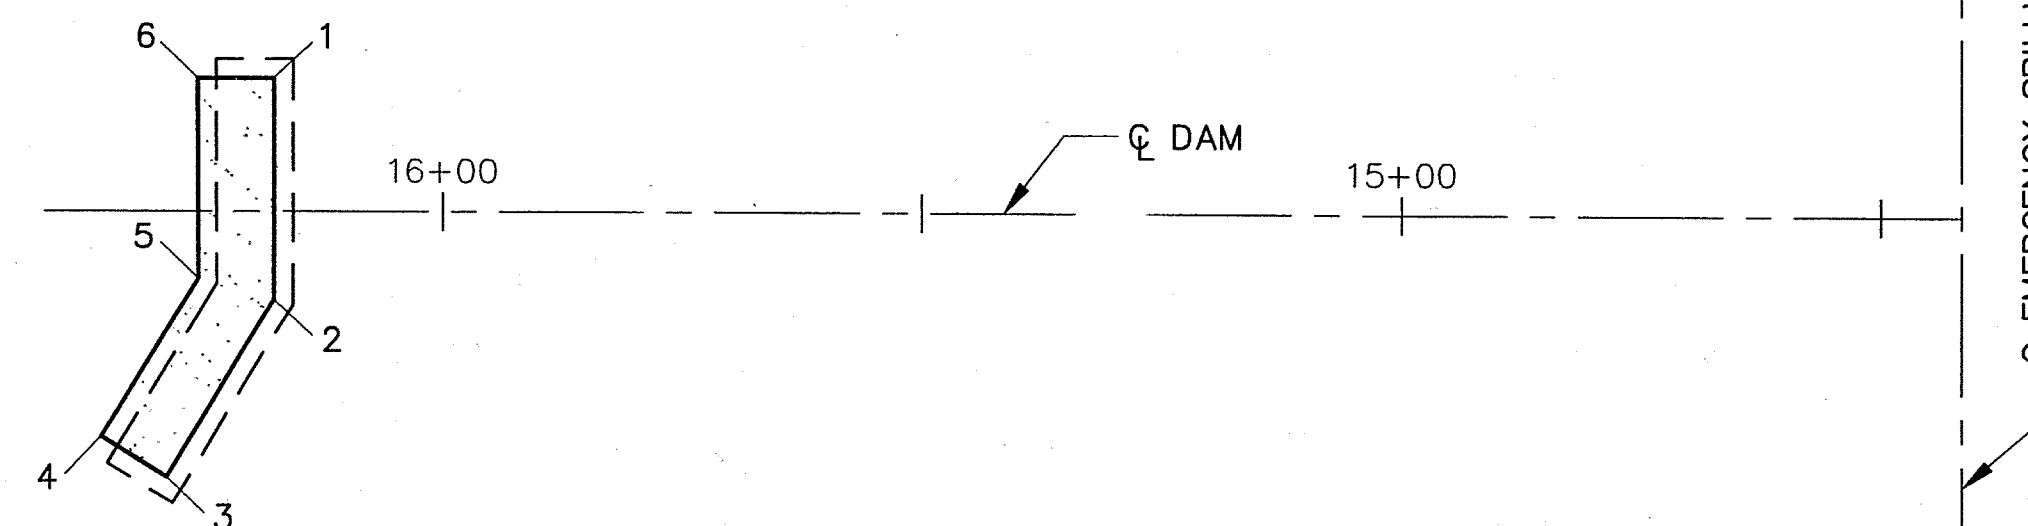

LIFT #9
LIFT ELEV = 4999

LIFT #9			
NO.	STATION	OFFSET DISTANCE	
		LEFT	RIGHT
1	16+17.57	---	14.00'
2	16+17.57	9.37'	---
3	16+28.24	27.92'	---
4	16+35.07	23.75'	---
5	16+25.57	7.12'	---
6	16+25.57	---	14.00'

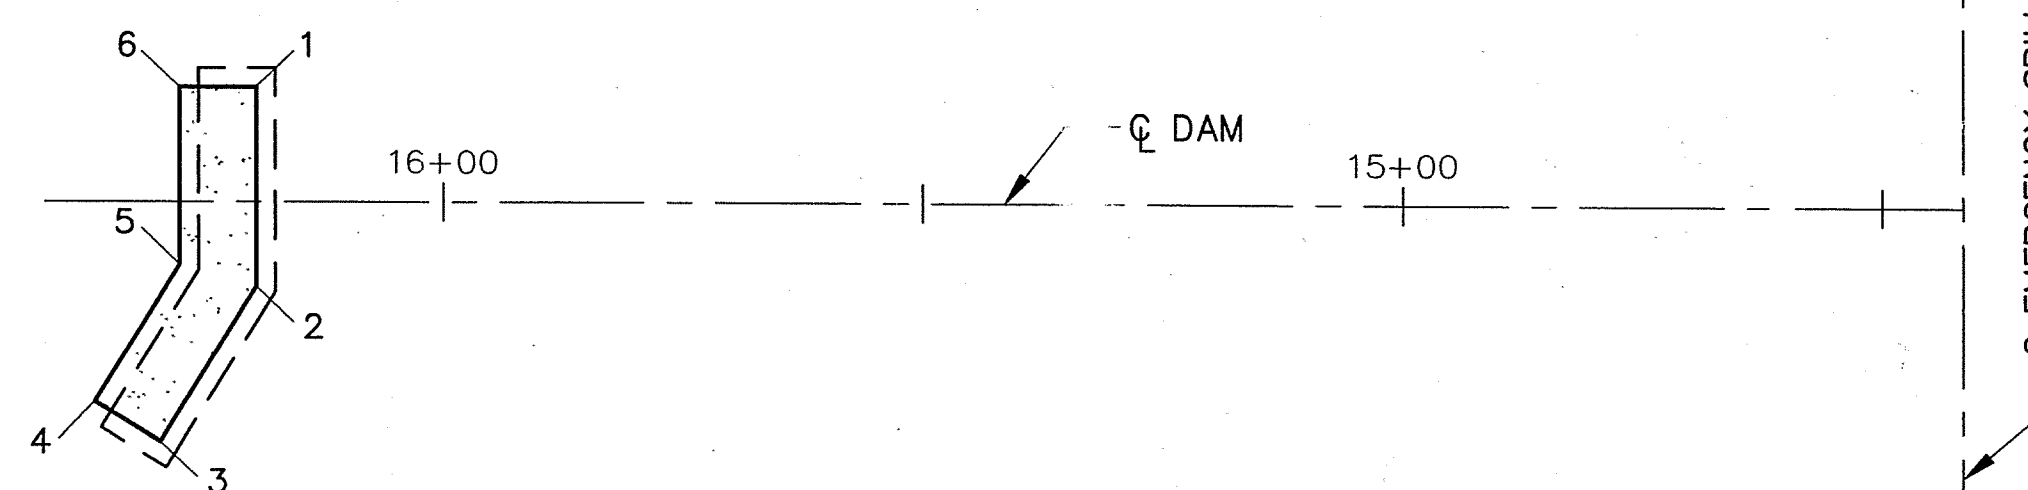


LIFT #10
LIFT ELEV = 5000


LIFT #10			
NO.	STATION	OFFSET DISTANCE	
		LEFT	RIGHT
1	16+19.57	---	12.00'
2	16+19.57	8.81'	---
3	16+29.57	25.17'	---
4	16+36.04	21.00'	---
5	16+27.57	6.56'	---
6	16+27.57	---	12.00'

RECORD DRAWING
DATE 2-20-01

6922.91


		ALBUQUERQUE METROPOLITAN ARROYO FLOOD CONTROL AUTHORITY BORREGA DETENTION DAM EMERGENCY SPILLWAY LIFTS 5-10	
	4900 LANG AVENUE N.E. ALBUQUERQUE, NM 87109 (505) 348-4000	NO. DATE 99099 SHEET OF	REMARKS BY DESIGNED BY DRAWN BY CHECKED BY
	DATE MARCH 2000	99099	NOV 1999 NOV 1999 NOV 1999
	14	34	99099

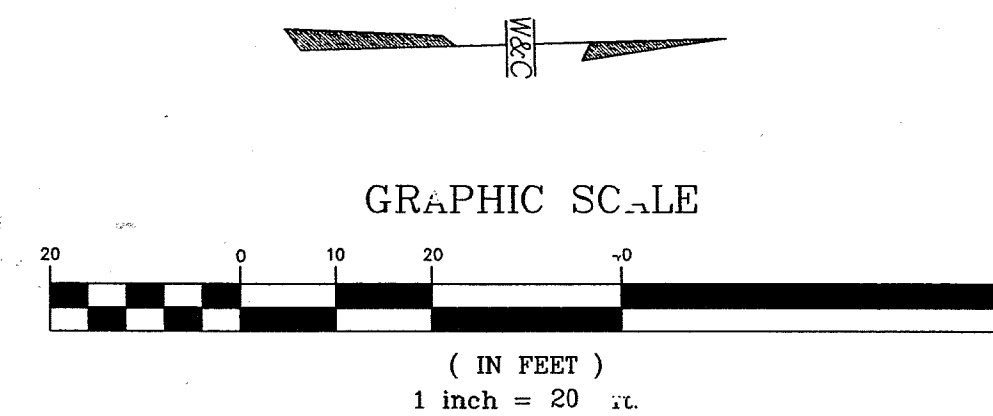

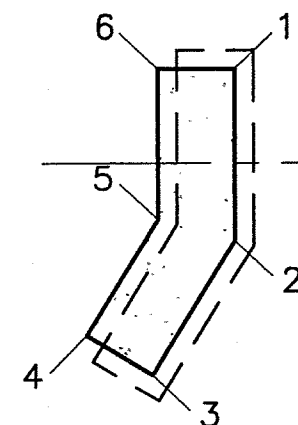


LIFT #11
LIFT ELEV = 5001

LIFT #11			
NO.	STATION	OFFSET	
		LEFT	RIGHT
1	16+21.57	---	10.00'
2	16+21.57	8.25'	---
3	16+30.23	22.42'	---
4	16+37.06	18.25'	---
5	16+29.57	6.00'	---
6	16+29.57	---	10.00'

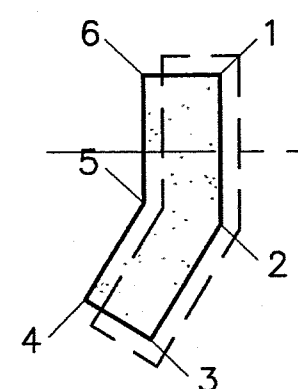

LIFT #12
LIFT ELEV = 5002

LIFT #12			
NO.	STATION	OFFSET	
		LEFT	RIGHT
1	16+23.57	---	8.00'
2	16+23.57	7.68'	---
3	16+30.90	19.67'	---
4	16+37.72	15.50'	---
5	16+31.57	5.43'	---
6	16+31.57	---	8.00'

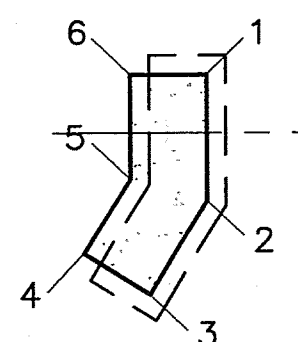

LIFT #13
LIFT ELEV = 5003

LIFT #13			
NO.	STATION	OFFSET	
		LEFT	RIGHT
1	16+25.57	---	6.00'
2	16+25.57	7.12'	---
3	16+31.56	16.92'	---
4	16+38.39	12.75'	---
5	16+33.57	4.87'	---
6	16+33.57	---	6.00'

EMERGENCY SPILLWAY

EMERGENCY SPILLWAY

EMERGENCY SPILLWAY

RECORD DRAWING
2-20-01

6922.91



ALBUQUERQUE METROPOLITAN
ARROYO FLOOD
CONTROL AUTHORITY




BORREGA DETENTION DAM
EMERGENCY SPILLWAY LIFTS 11-13







**WILSON
& COMPANY**

4900 LANG AVENUE N.E.
ALBUQUERQUE, NM
87109
(505) 348-4000

NO.	DATE	REVISIONS	BY
1		DESIGNED BY	WILSON & COMPANY, ENGINEERS & ARCHITECTS
2		DRAWN BY	NM NOV 1999
3		CHECKED BY	DSA NOV 1999

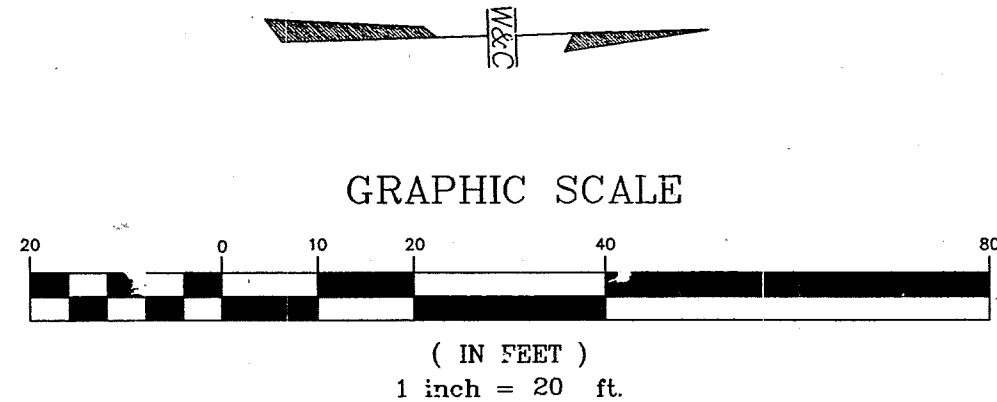

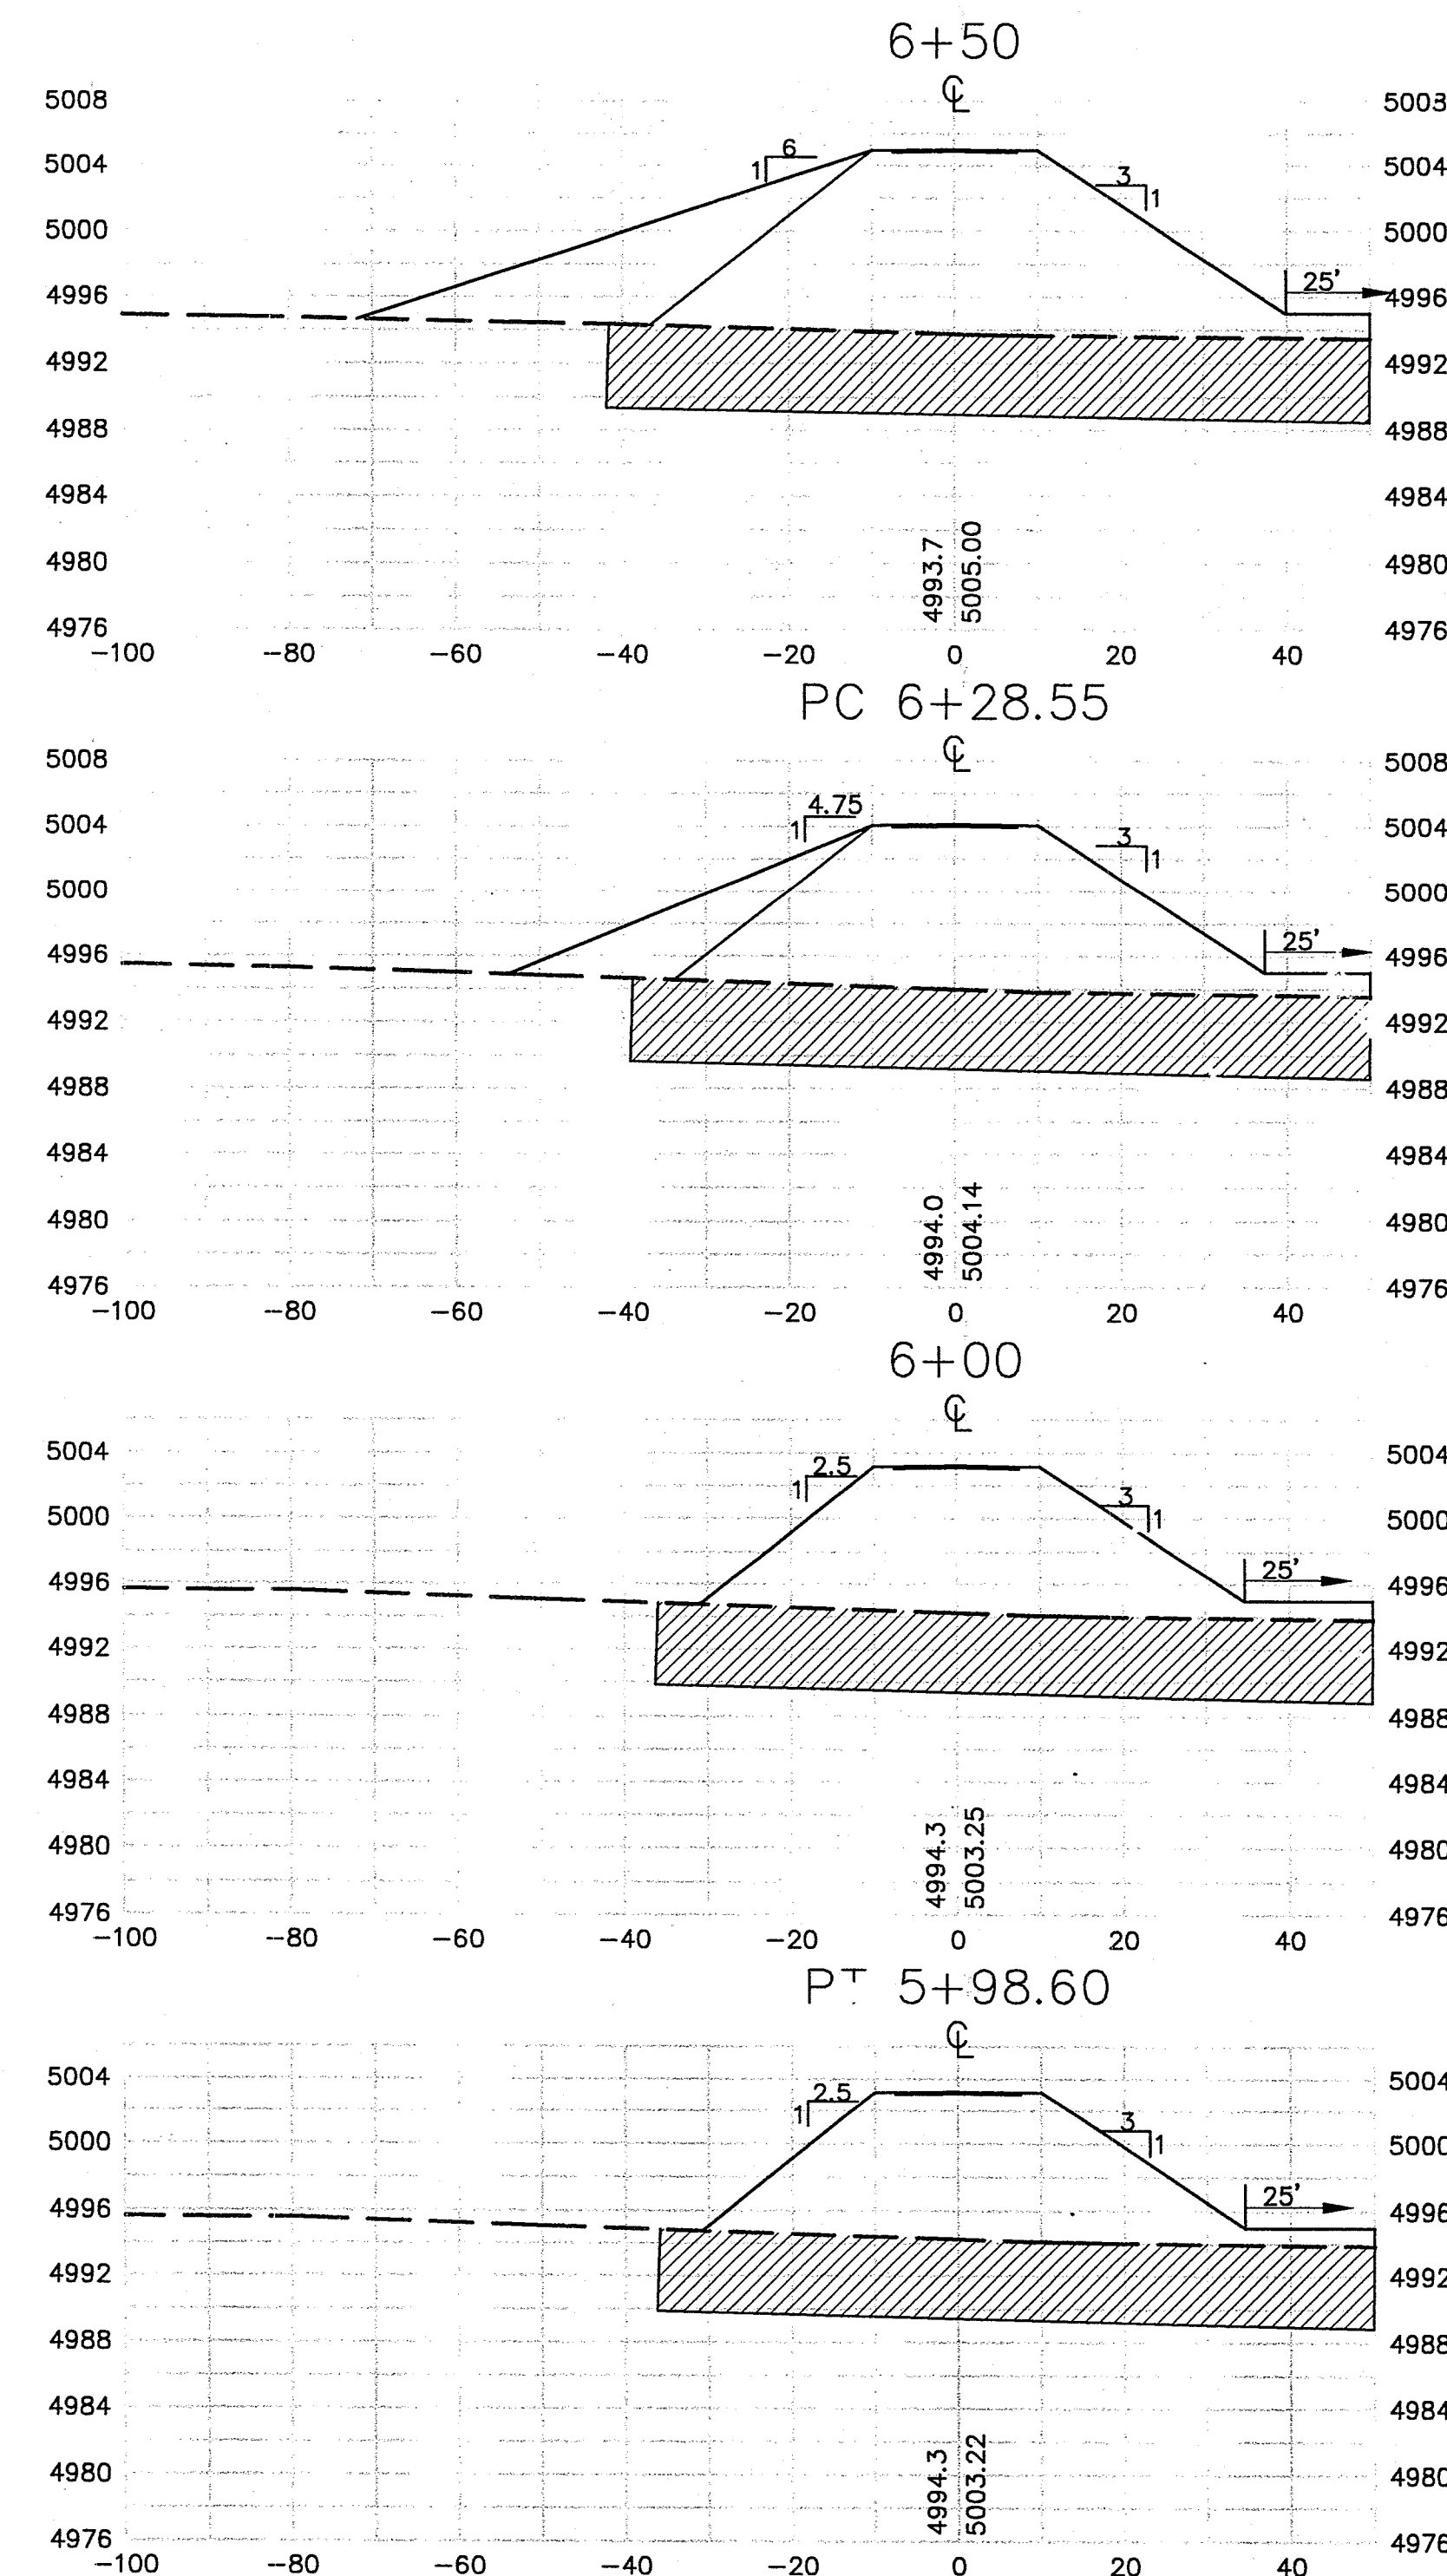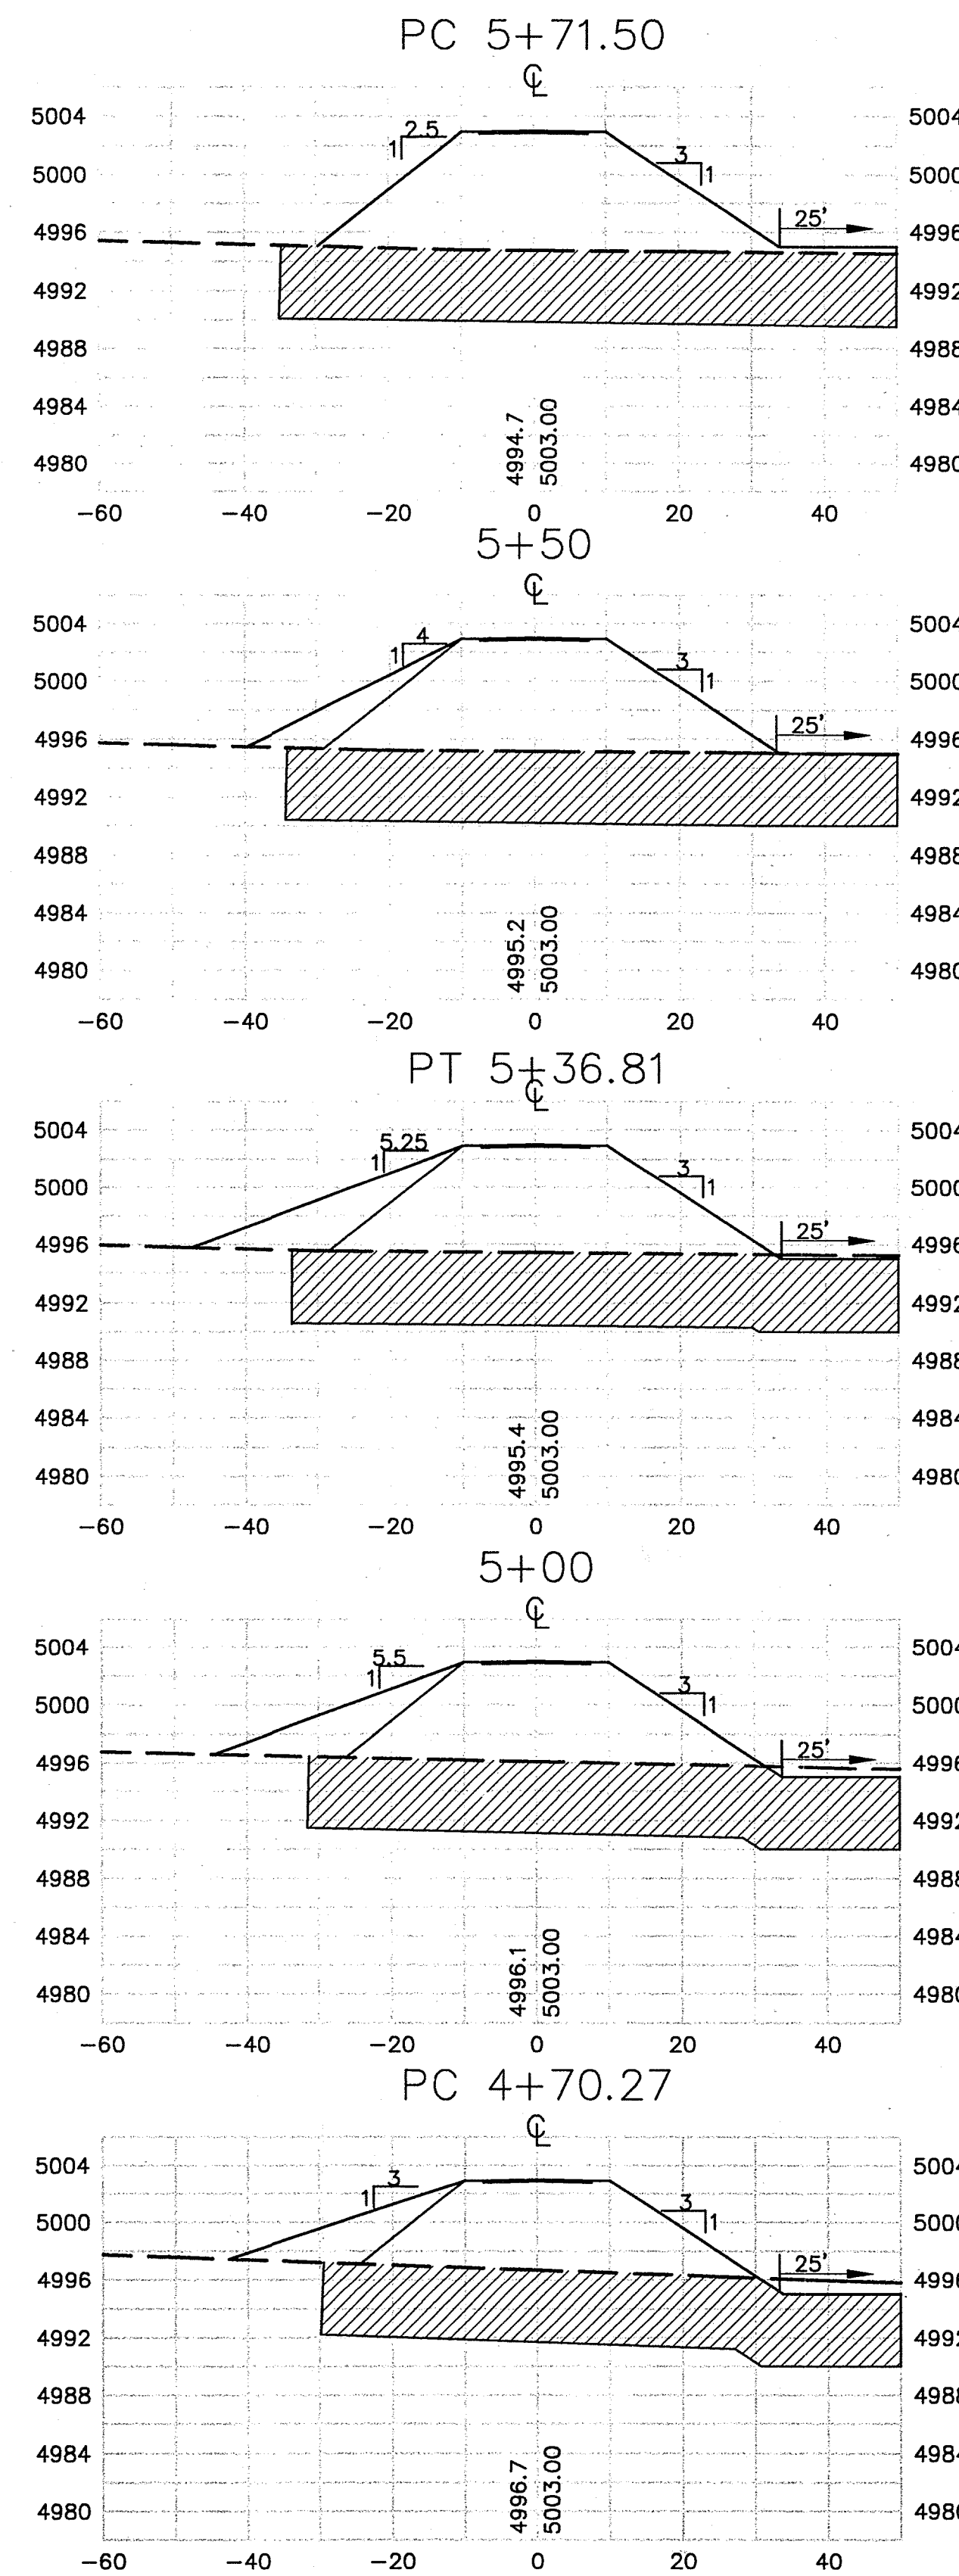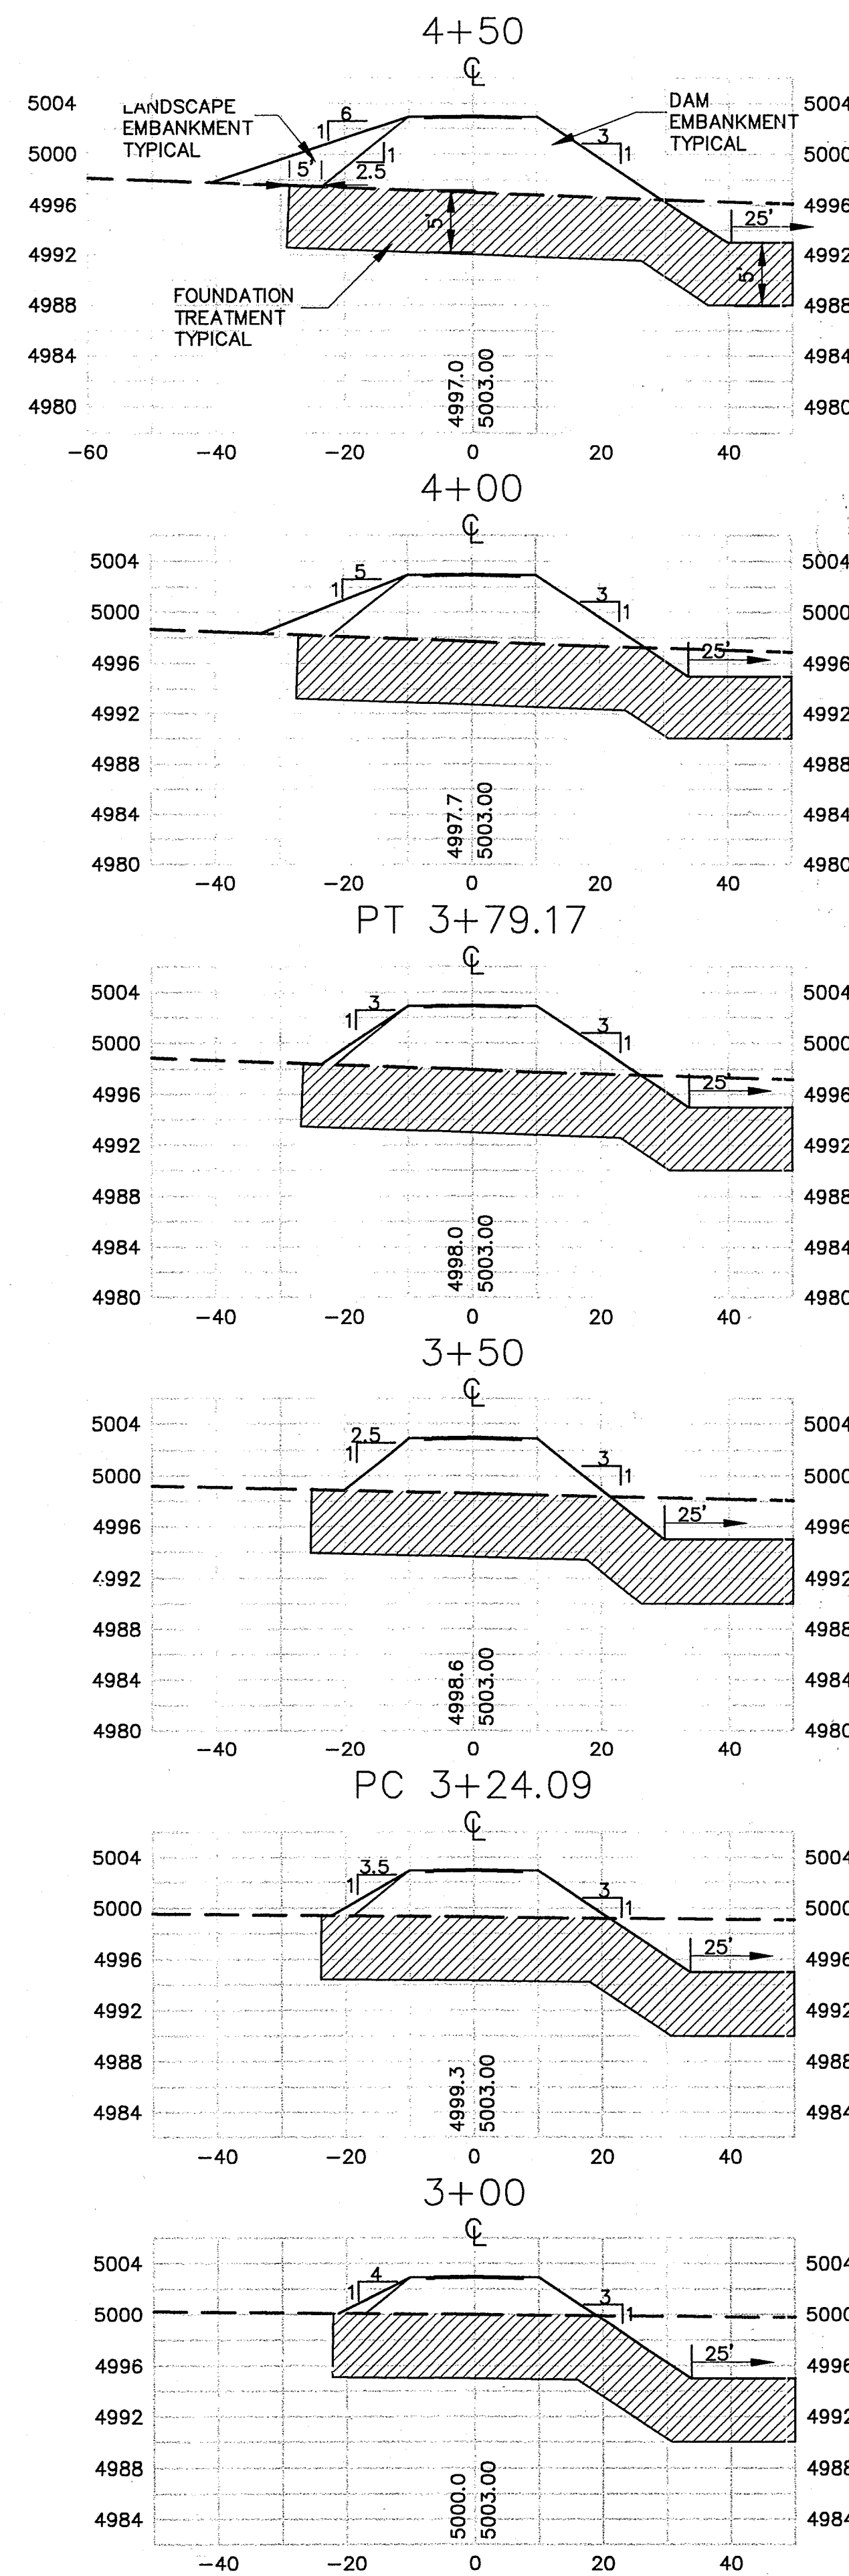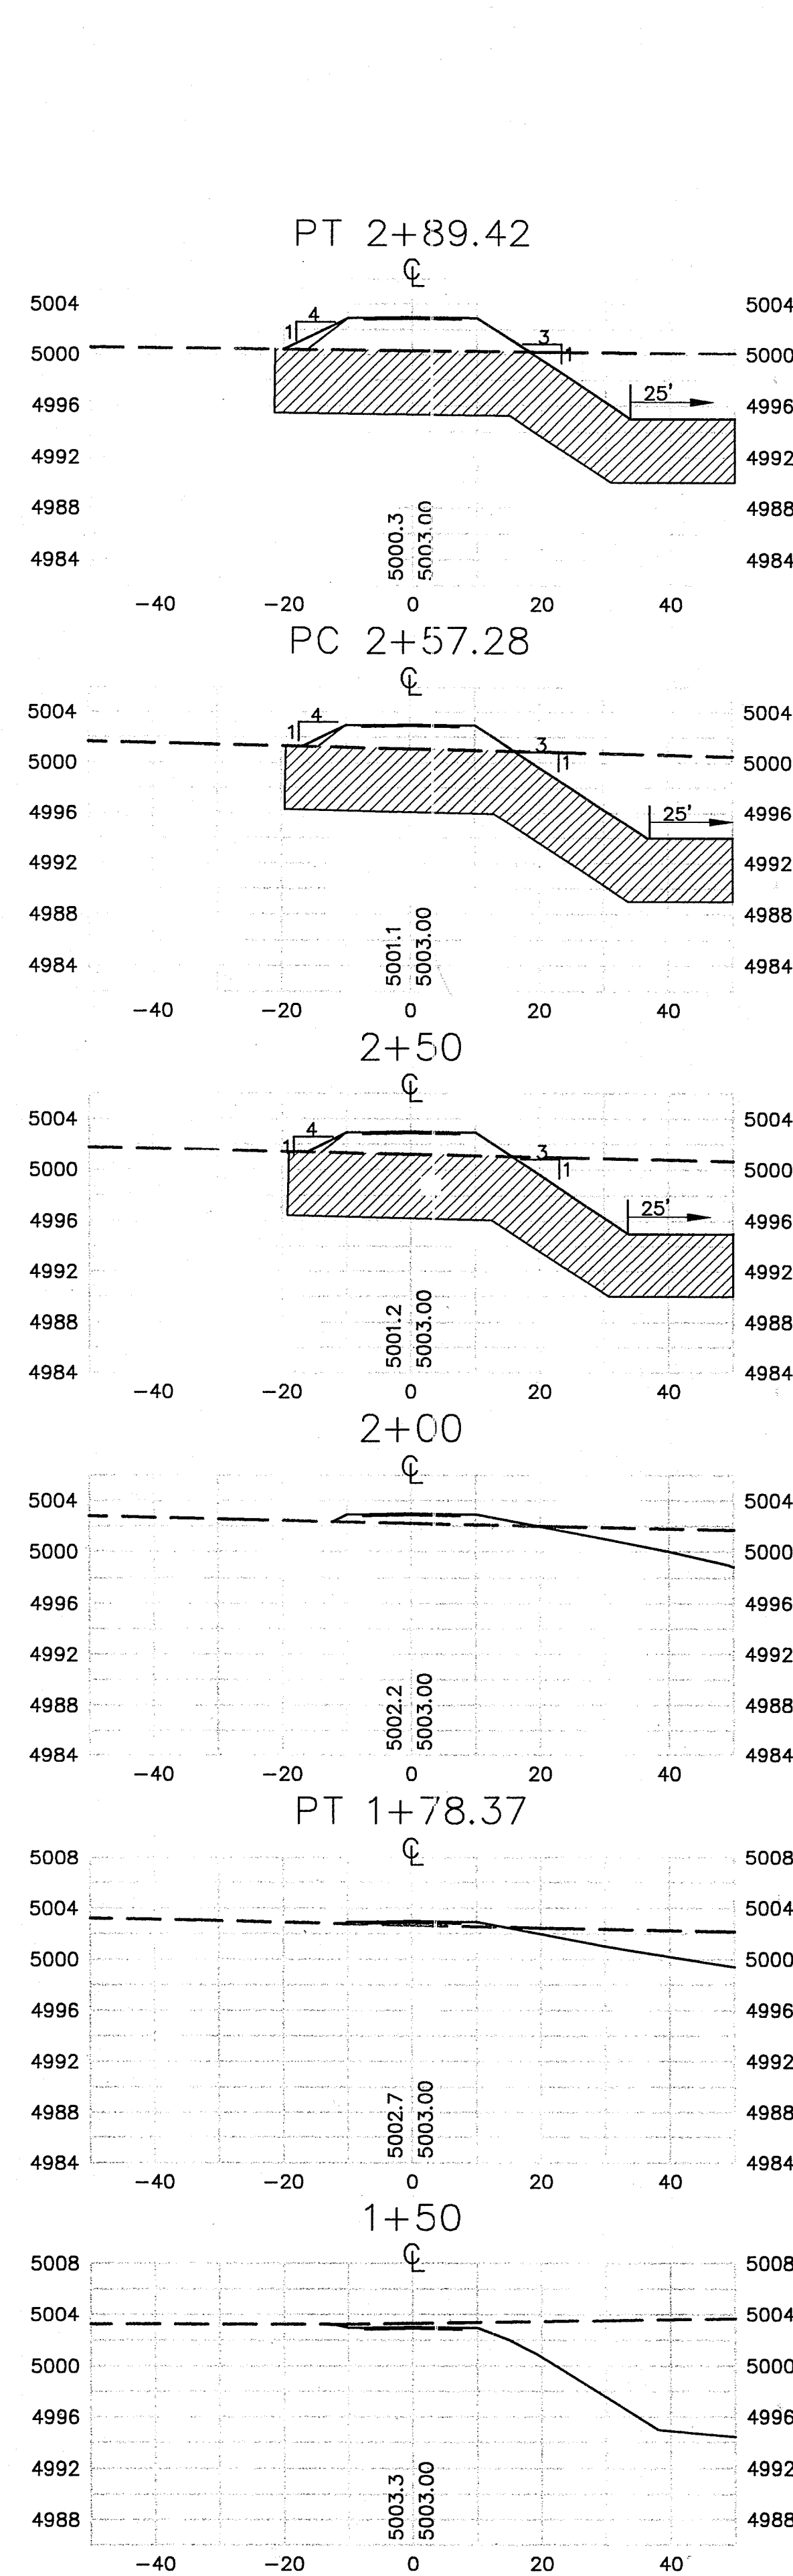




SCALE: HZ 1" = 20'
VT 1" = 10'

6922.91

 ALBUQUERQUE METROPOLITAN ARROYO FLOOD CONTROL AUTHORITY BORREGA DETENTION DAM DAM SECTIONS STA 1+50 - 6+50		DATE MARCH 2000 FILE 99099 SHEET 16 OF 34	
NO. DATE REMARKS REVISIONS WILSON & COMPANY, ENGINEERS & ARCHITECTS DESIGNED BY DRAWN BY CHECKED BY		BY NOV 1999 NOV 1999 NOV 1999	

RECORD DRAWING
2-20-01

99099A\\SHEETS\\DAM\\V0690D\\S2\\DWG\\3-7-00\\P.M

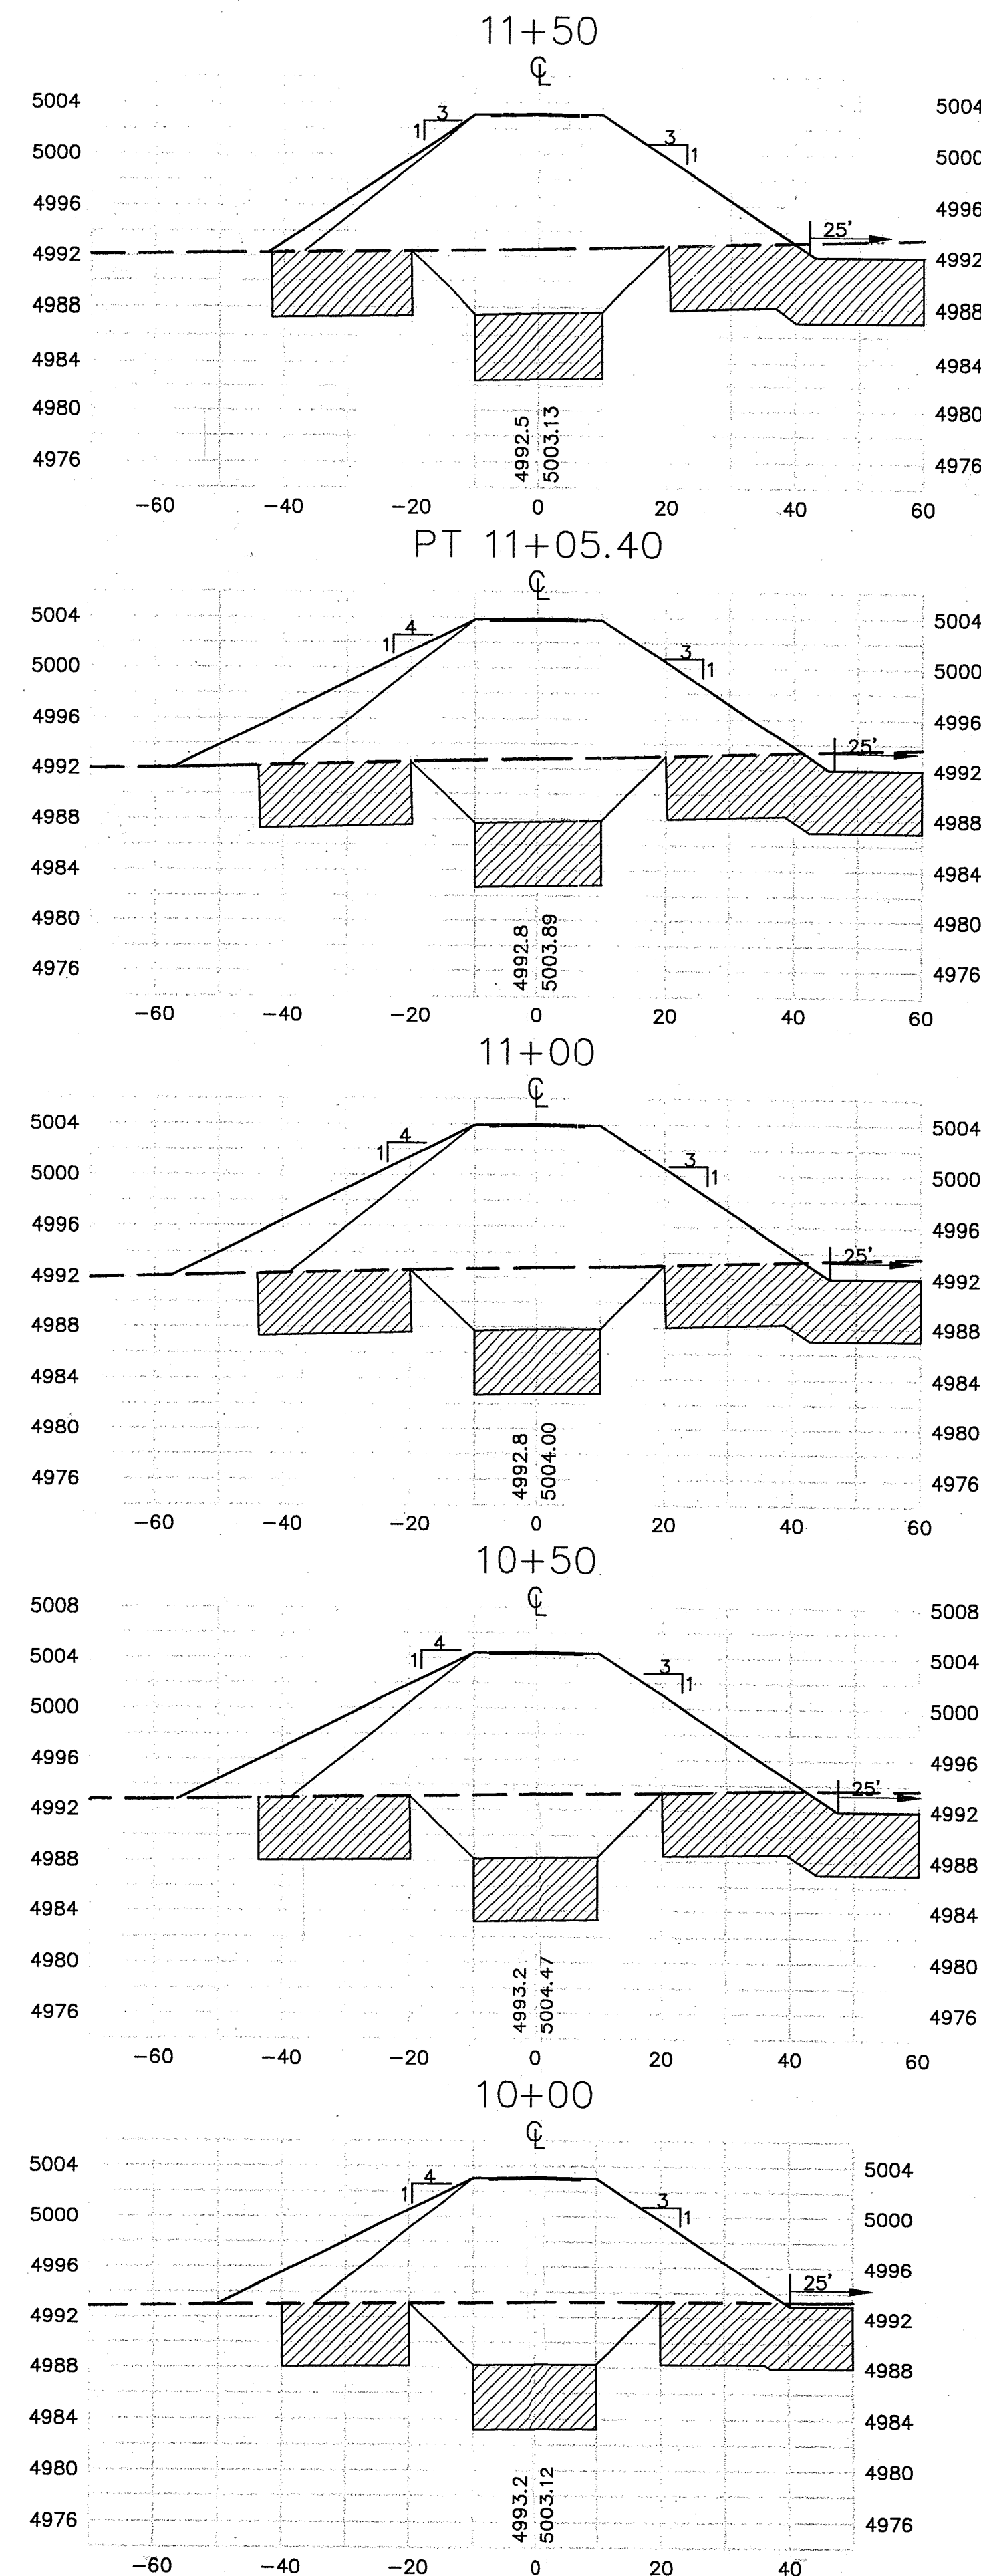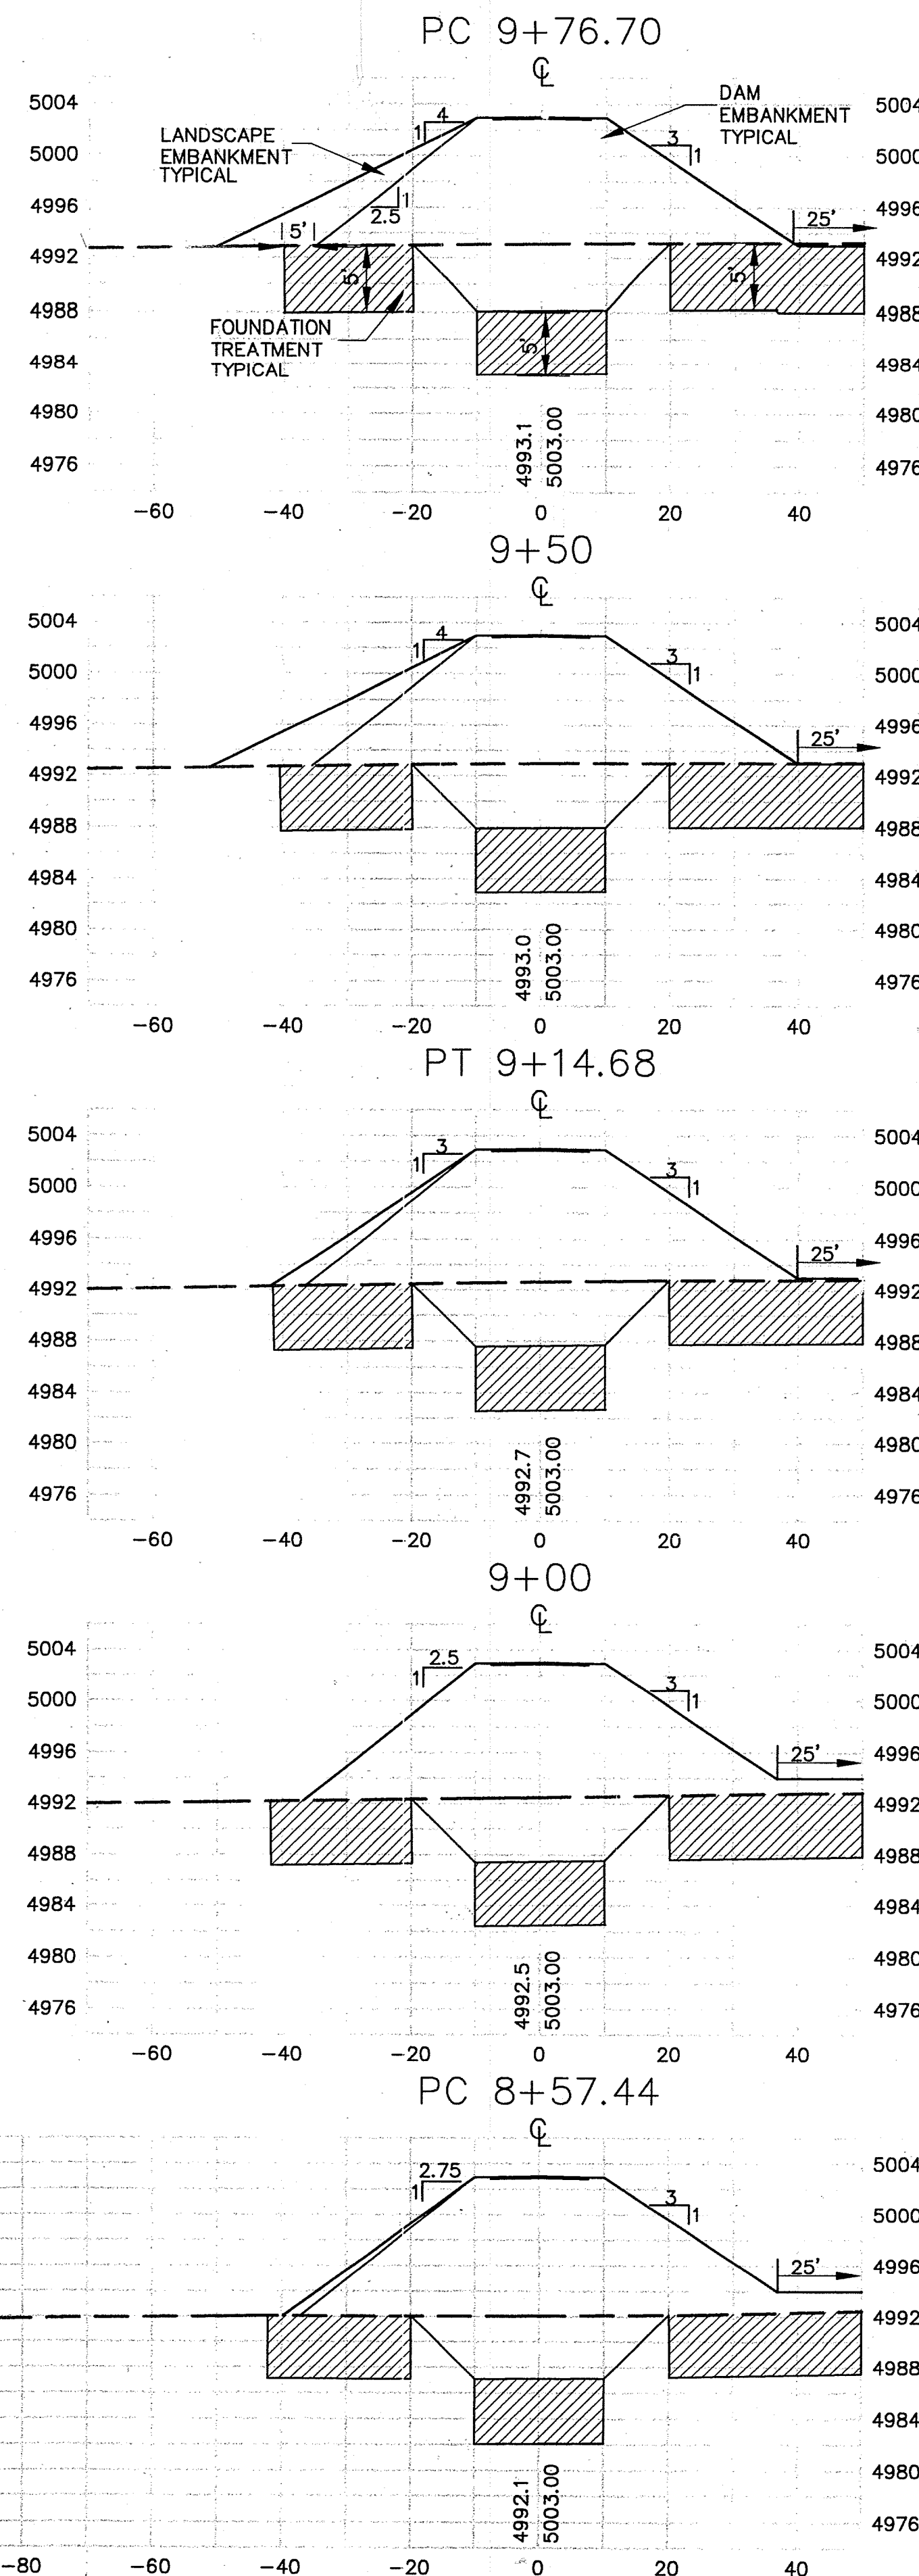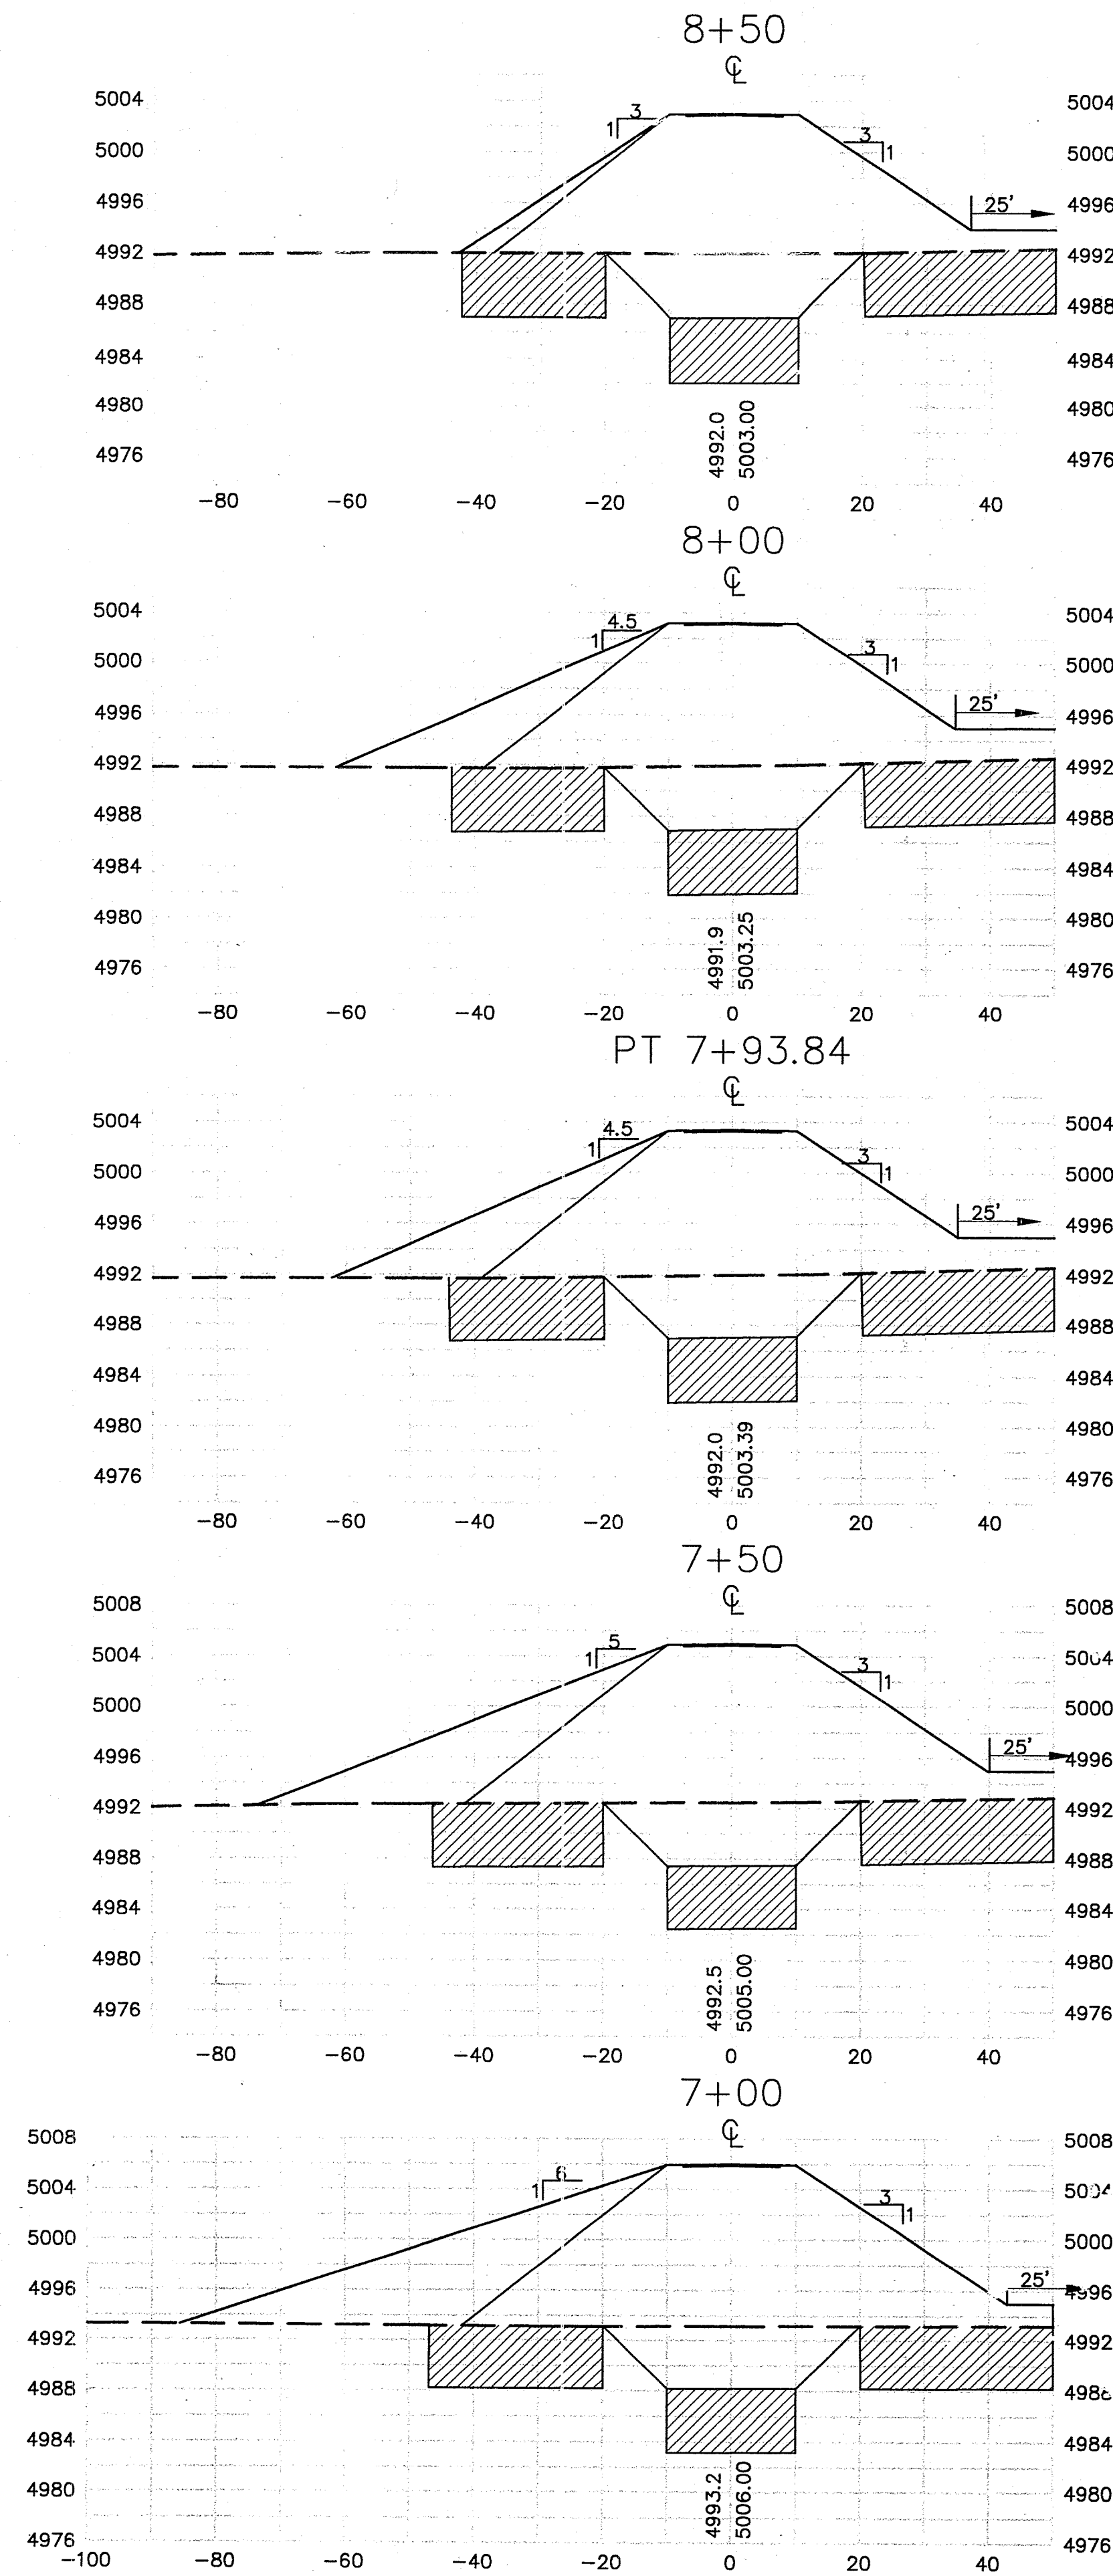

2-20-01

SCALE: HZ 1" = 20'
VT 1" = 10'













6922.91

ALBUQUERQUE METROPOLITAN ARROYO FLOOD CONTROL AUTHORITY	
BORREGA DETENTION DAM	
DAM SECTIONS STA 7+00 - 11+50	
DATE MARCH 2000	REVISIONS NO. DATE BY 1 11/1999 WILSON & COMPANY, ENGINEERS & ARCHITECTS 2 11/1999 NM 3 11/1999 PJM 4 11/1999 DSA
FILE 99099	CHECKED BY
SHEET 17	OF 34



WILSON & COMPANY
4900 LANG AVENUE N.E.
ALBUQUERQUE, NM
87109
(505) 348-4000

NOTE: STA PT 12+12.80 TO STA PC 16+76.20
SEE SHEET 12 (EMERGENCY SPILLWAY)

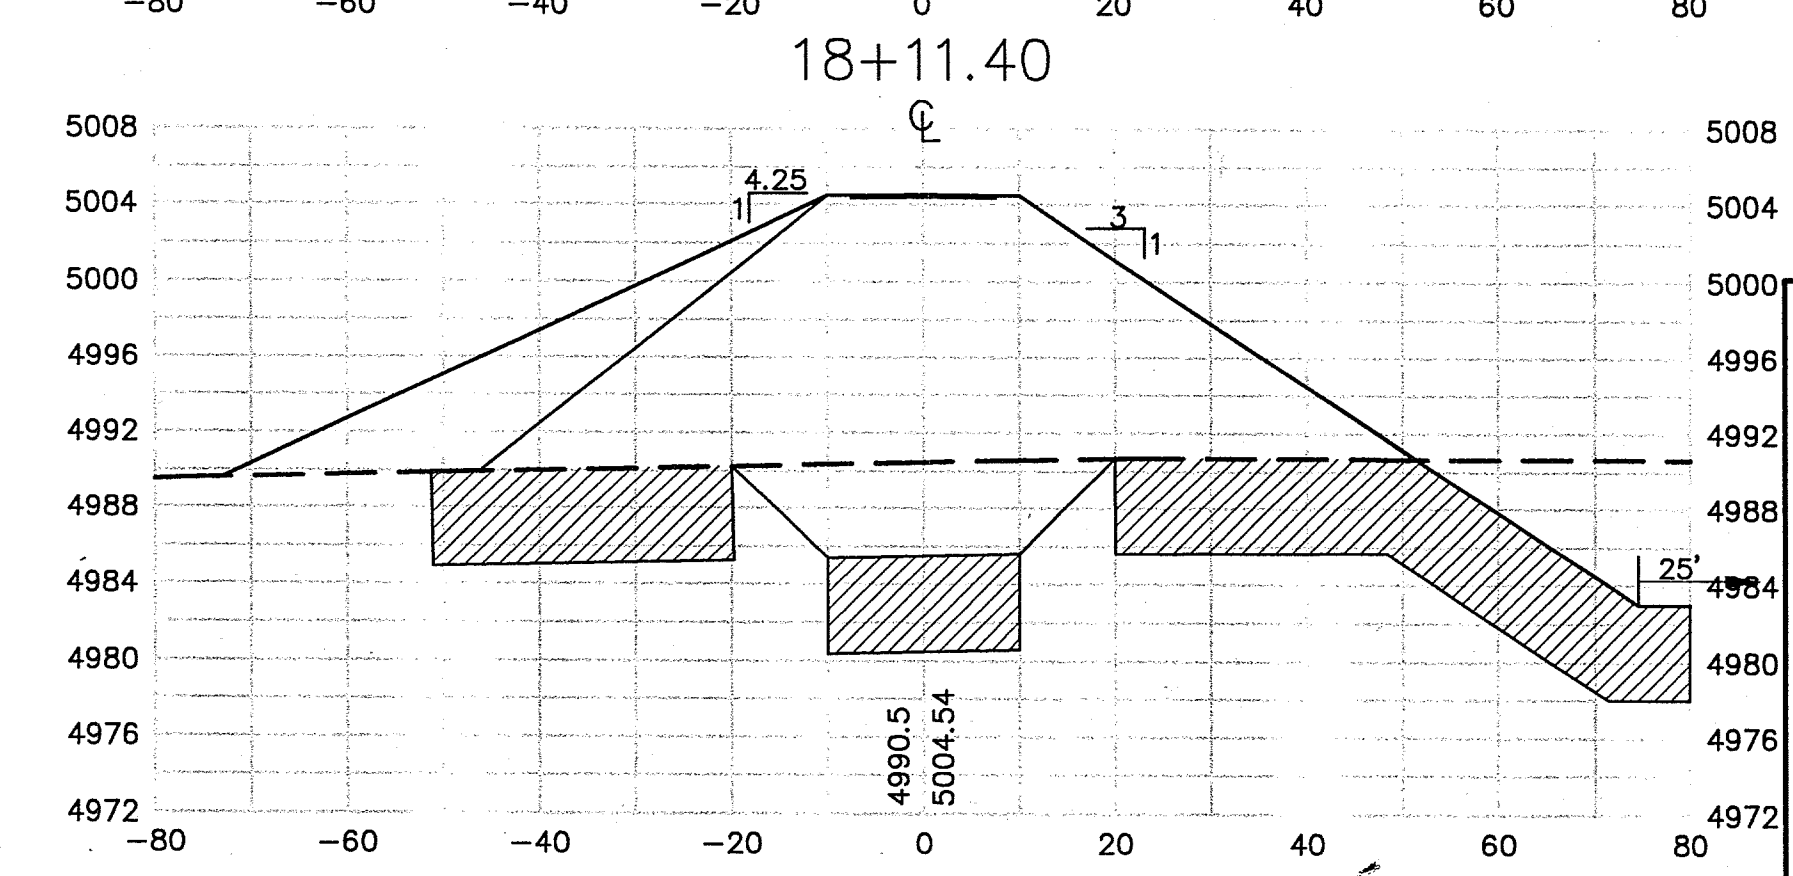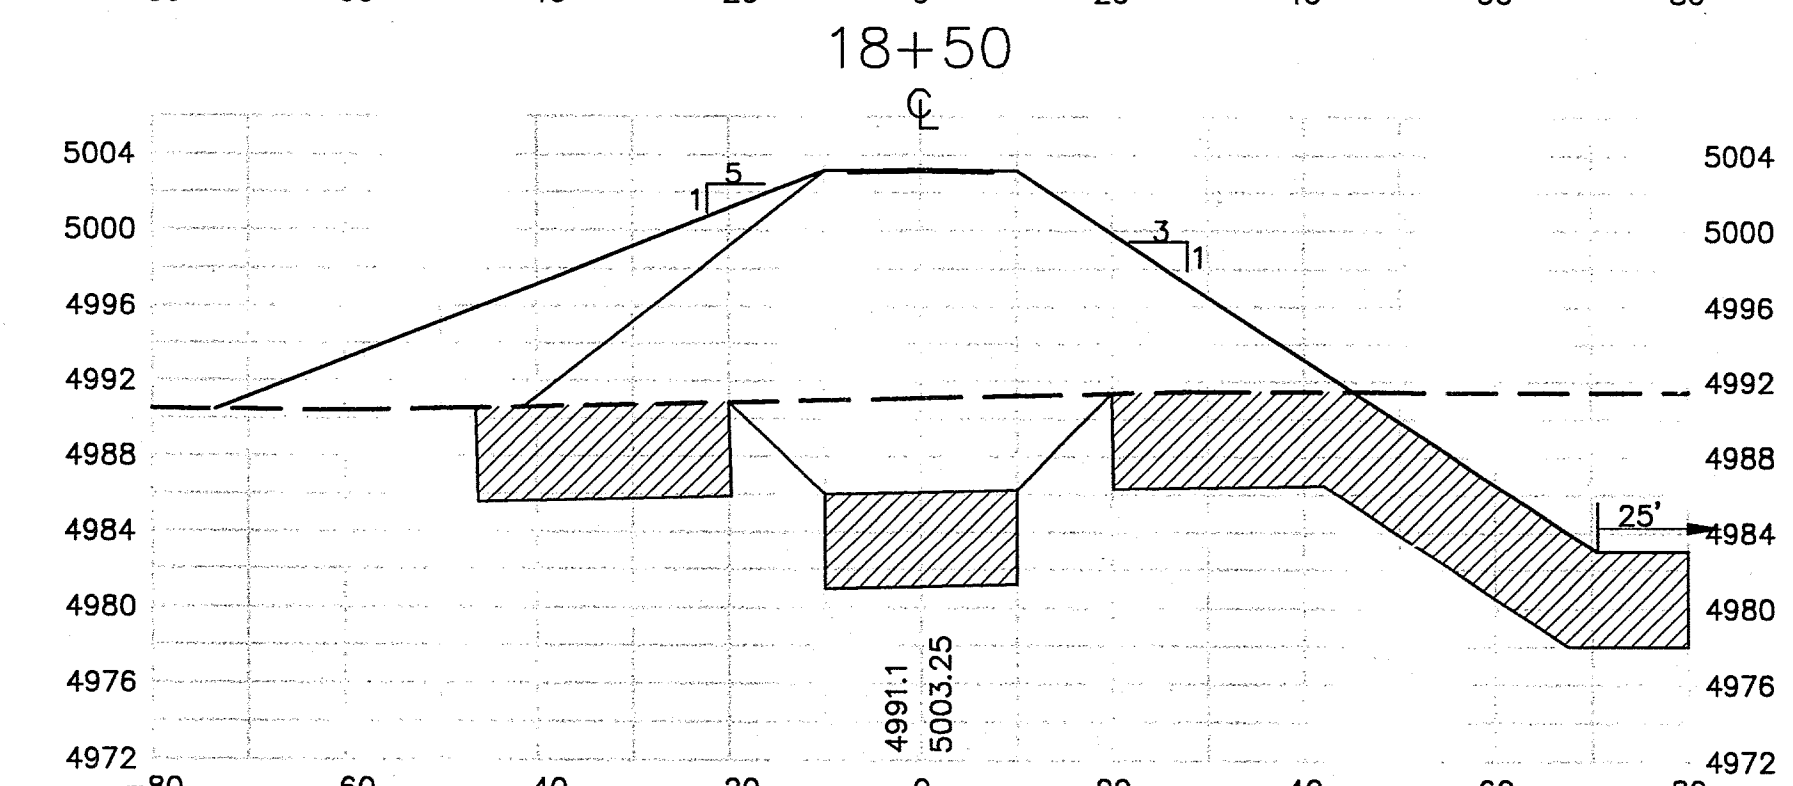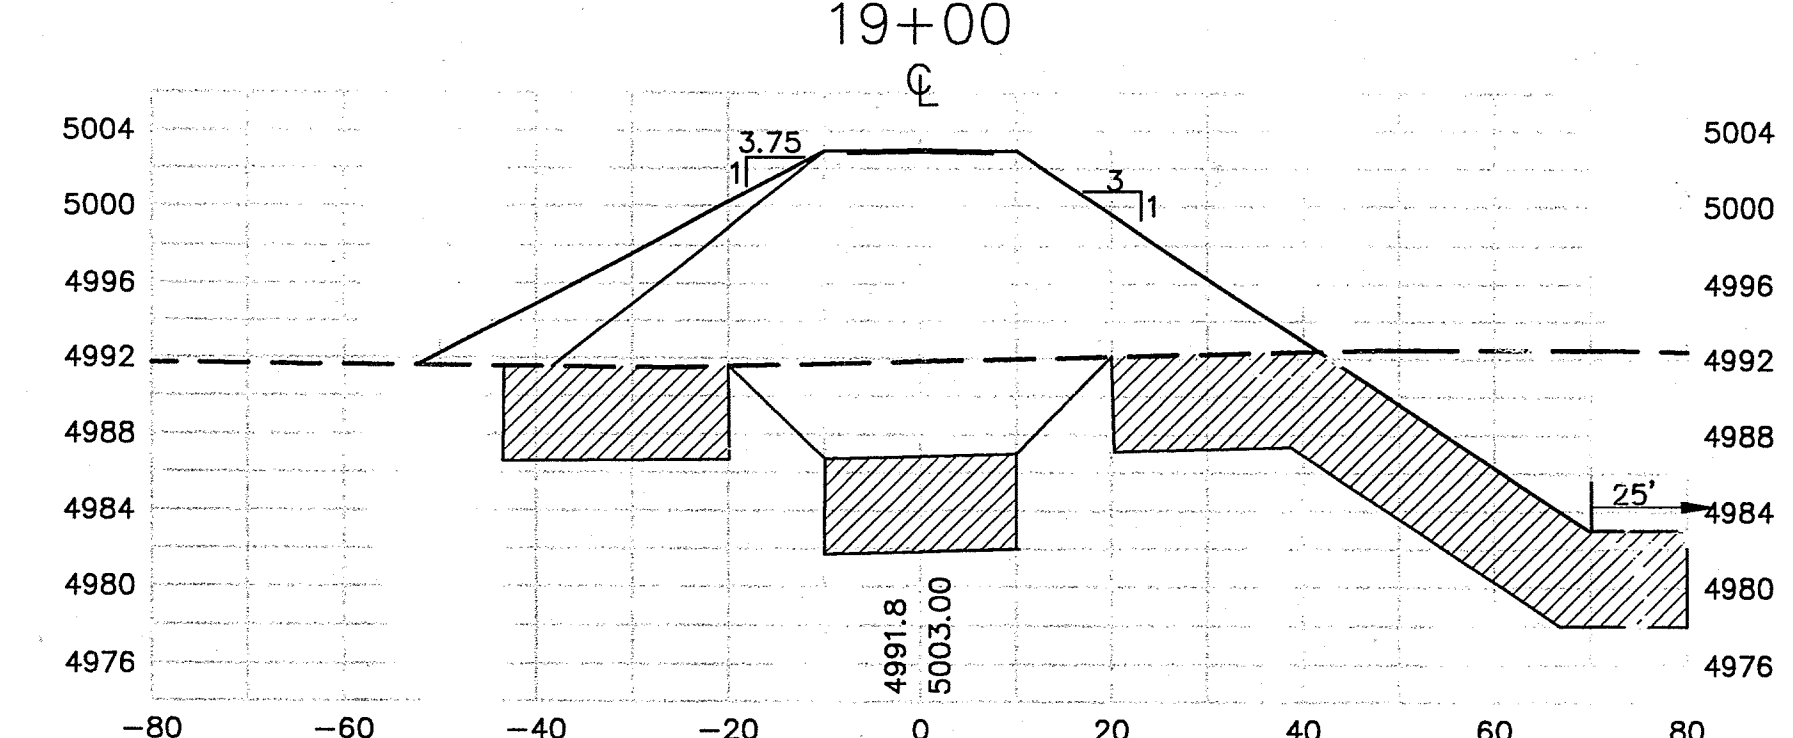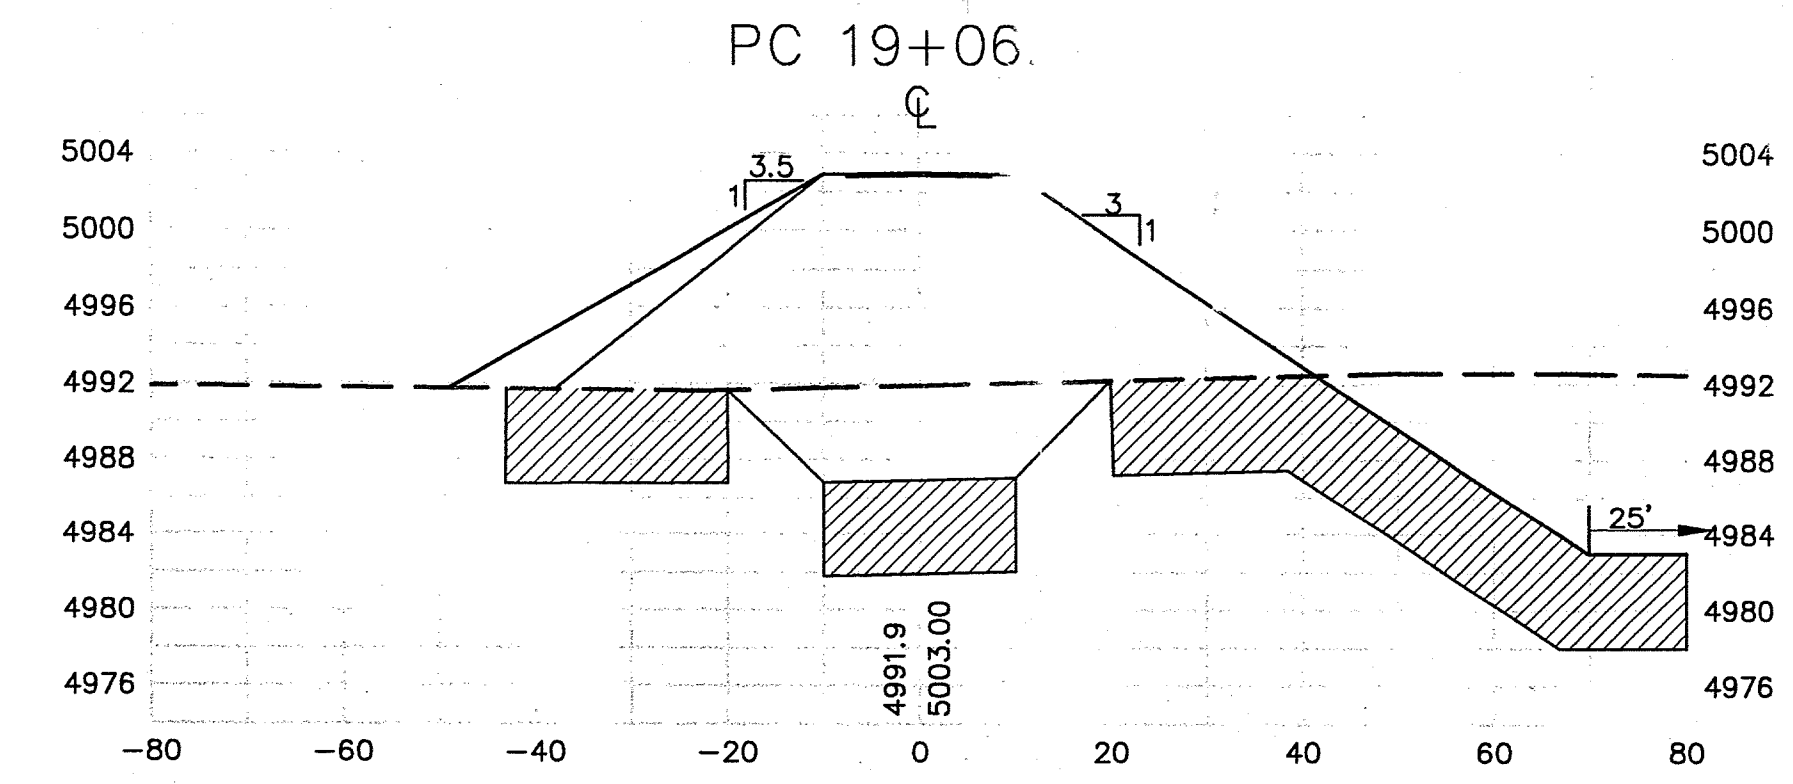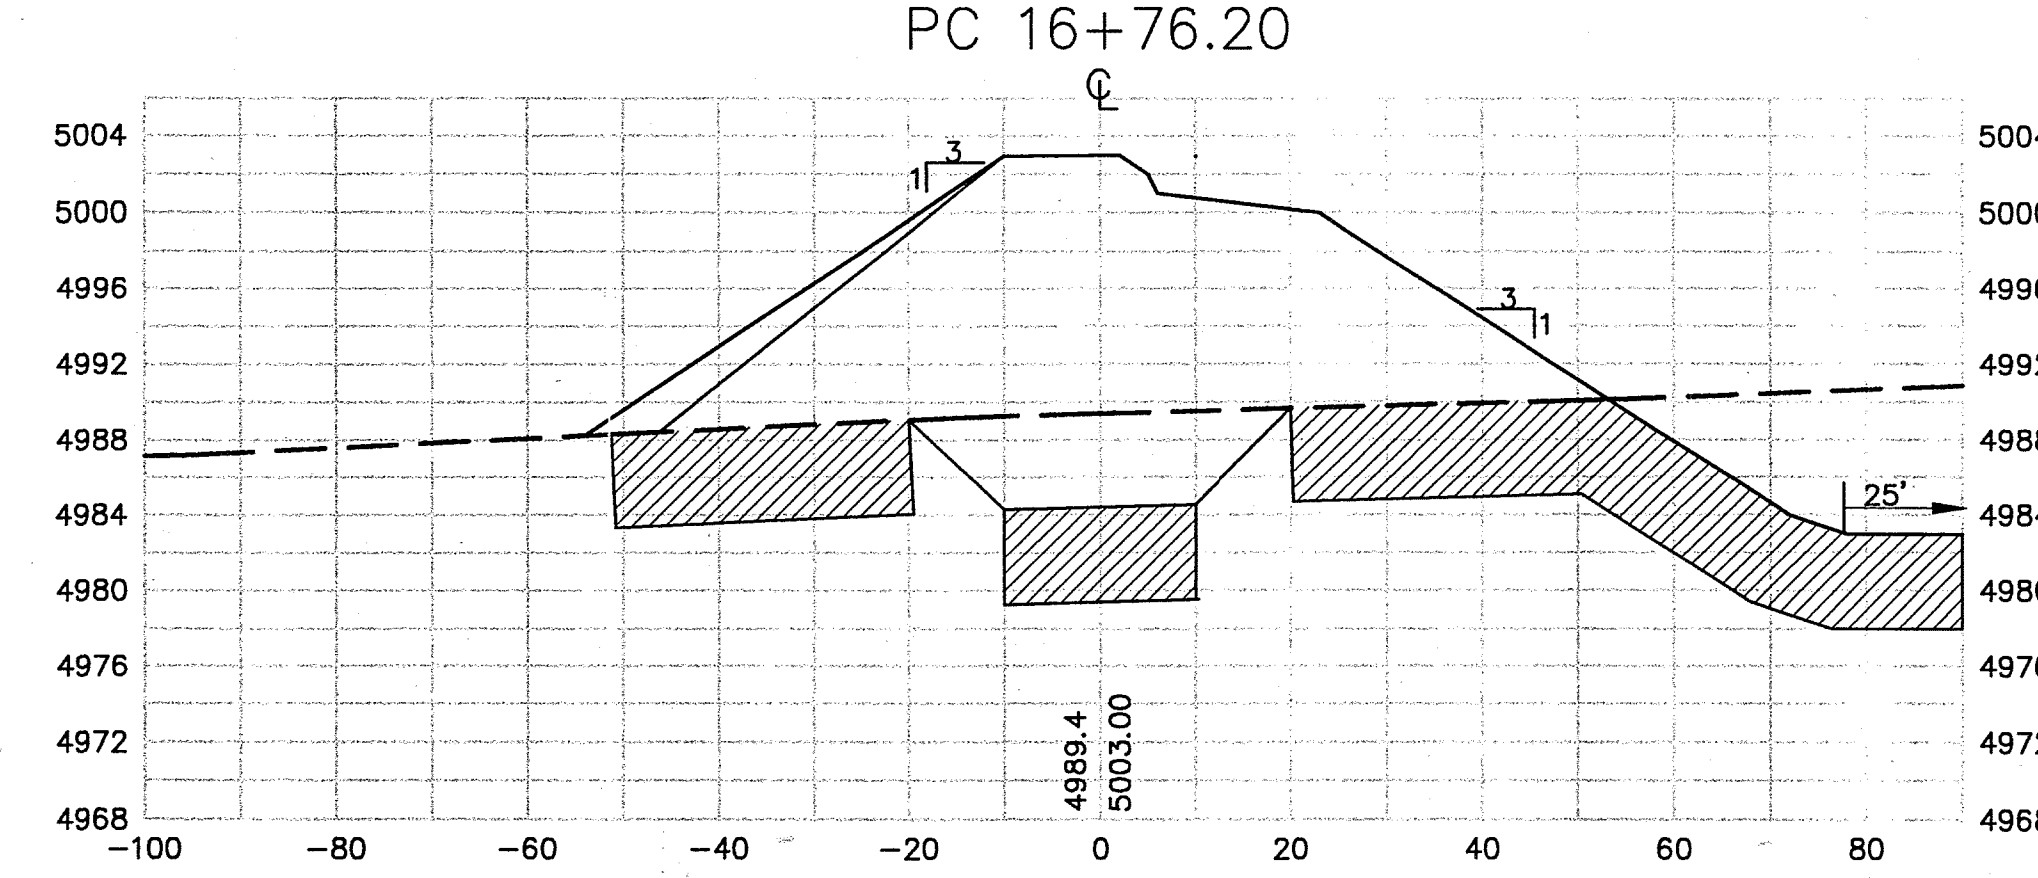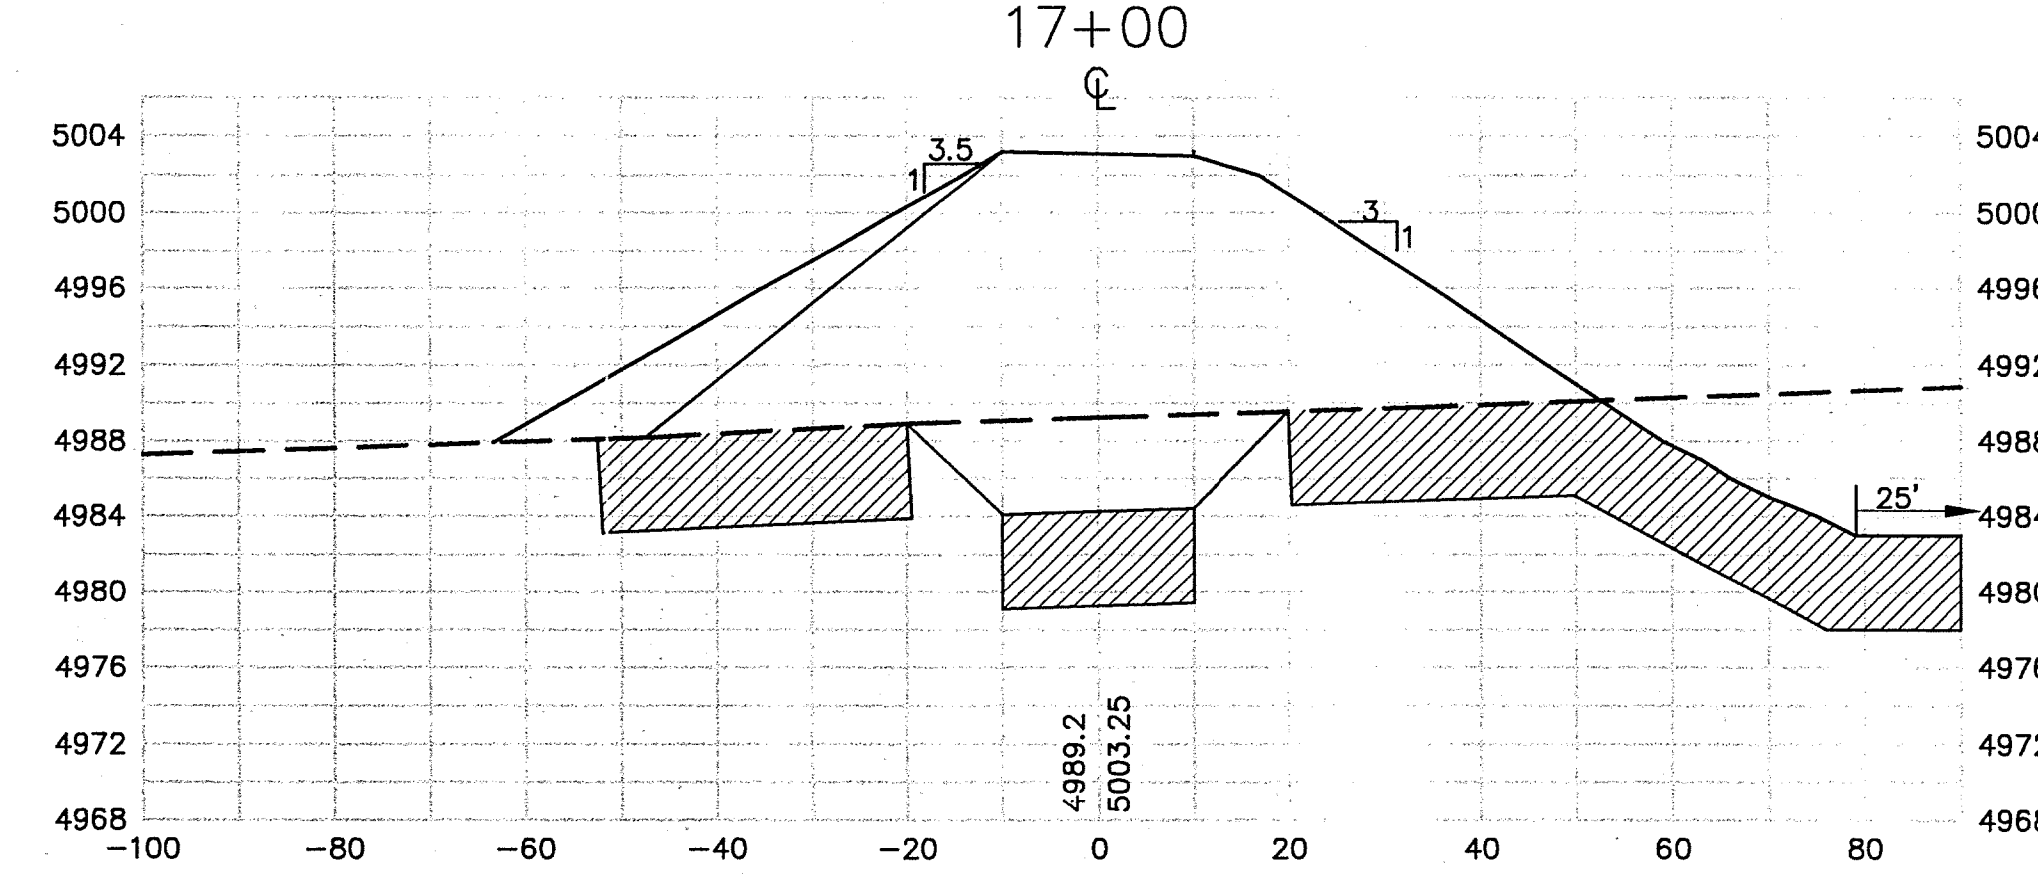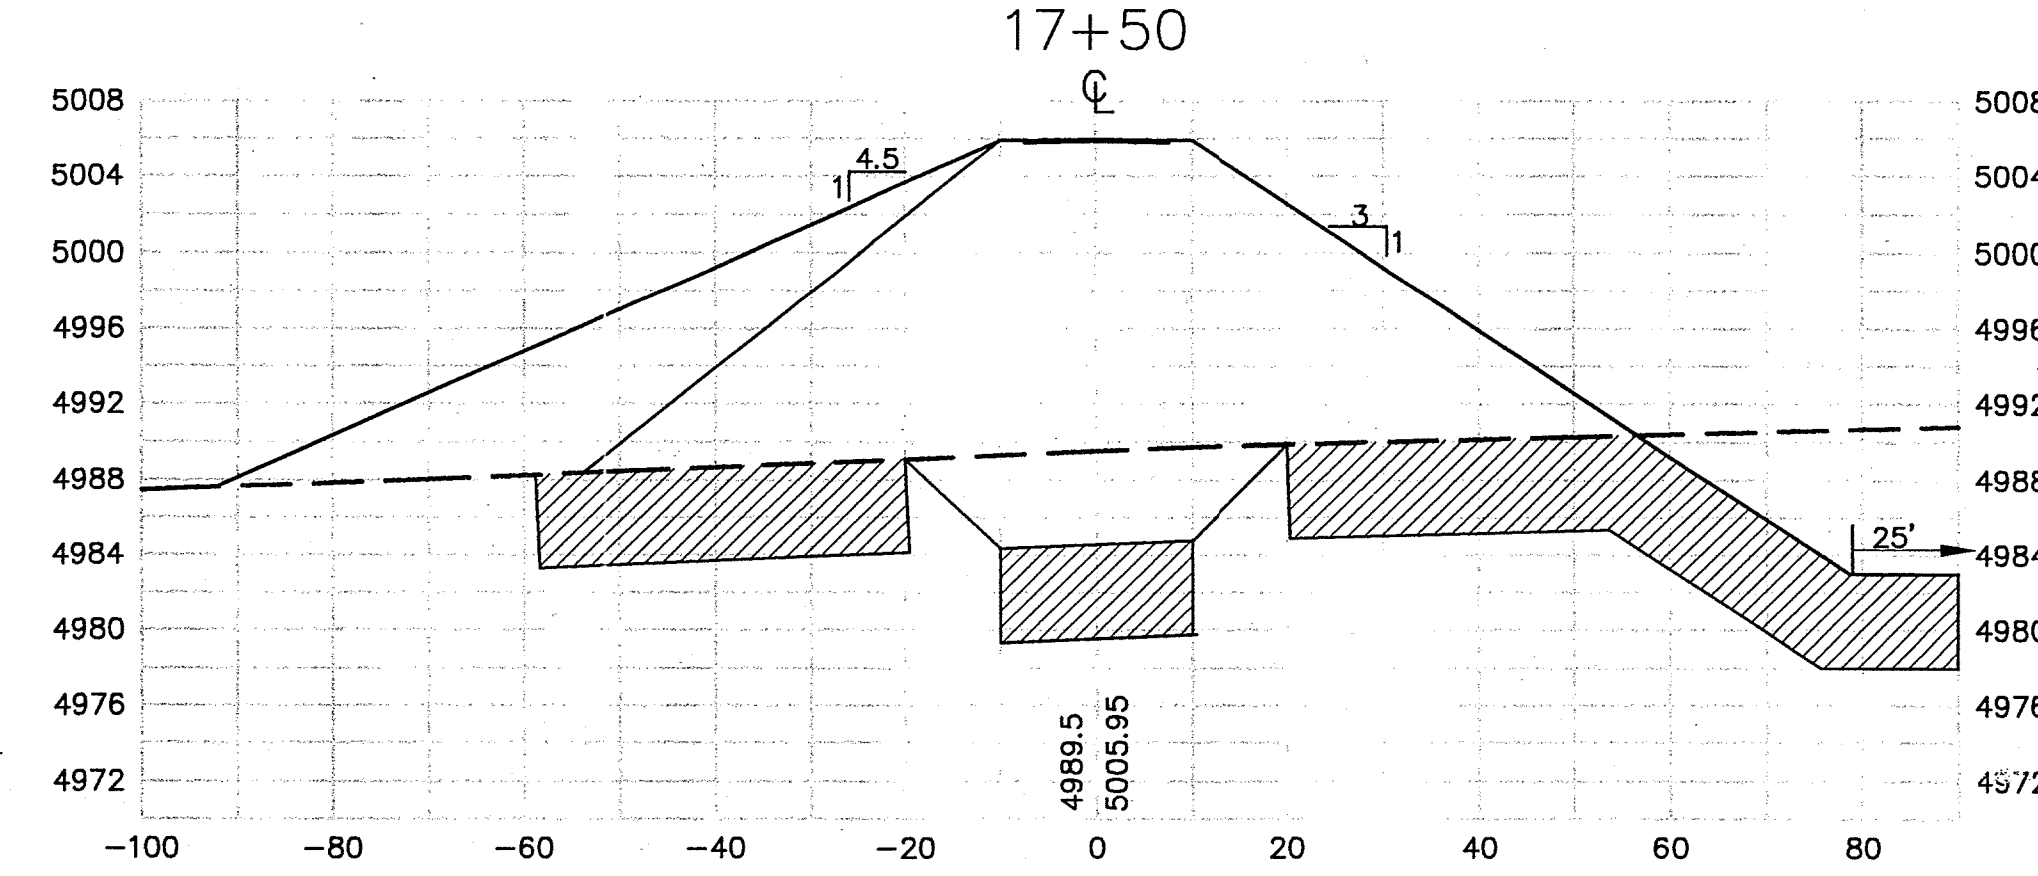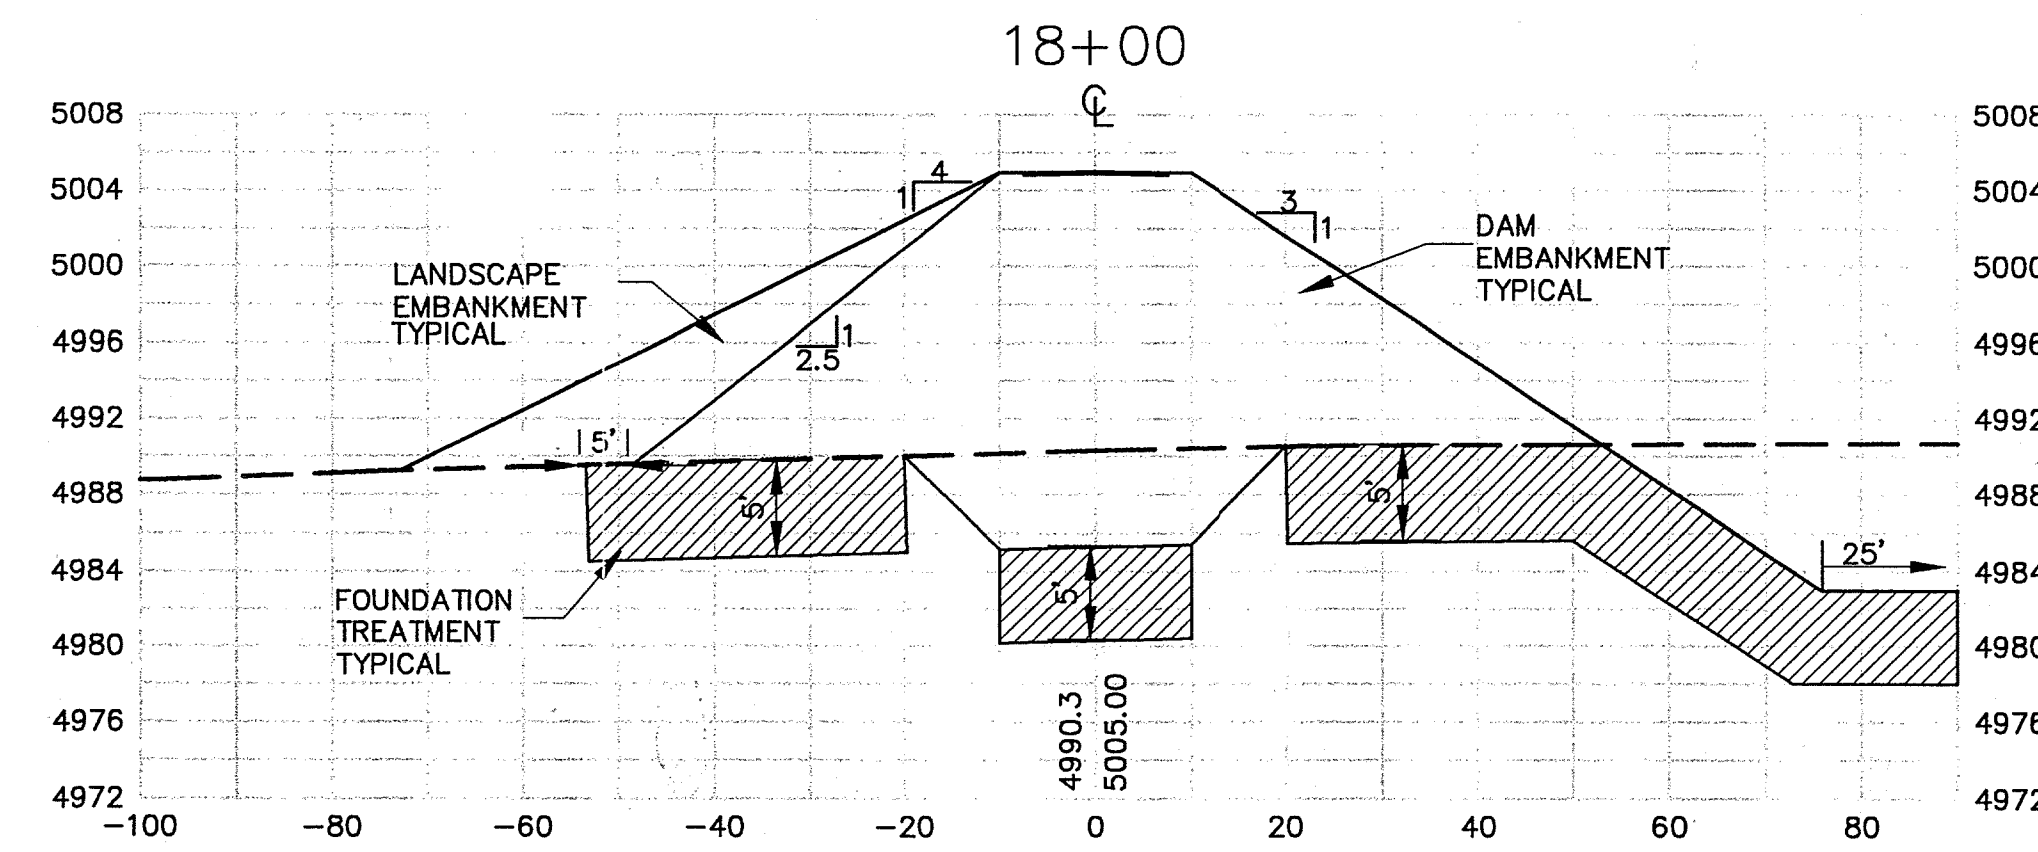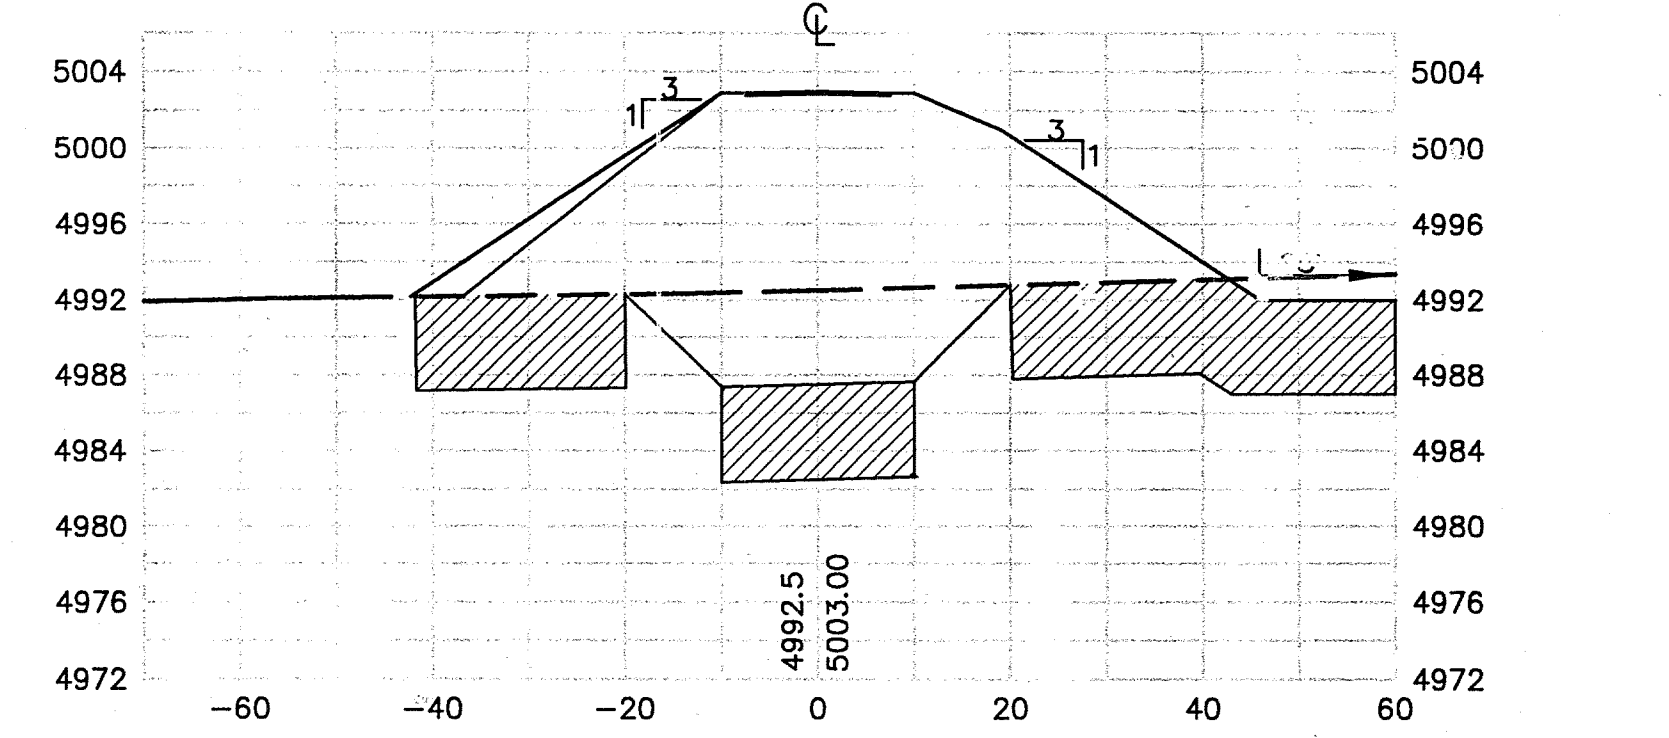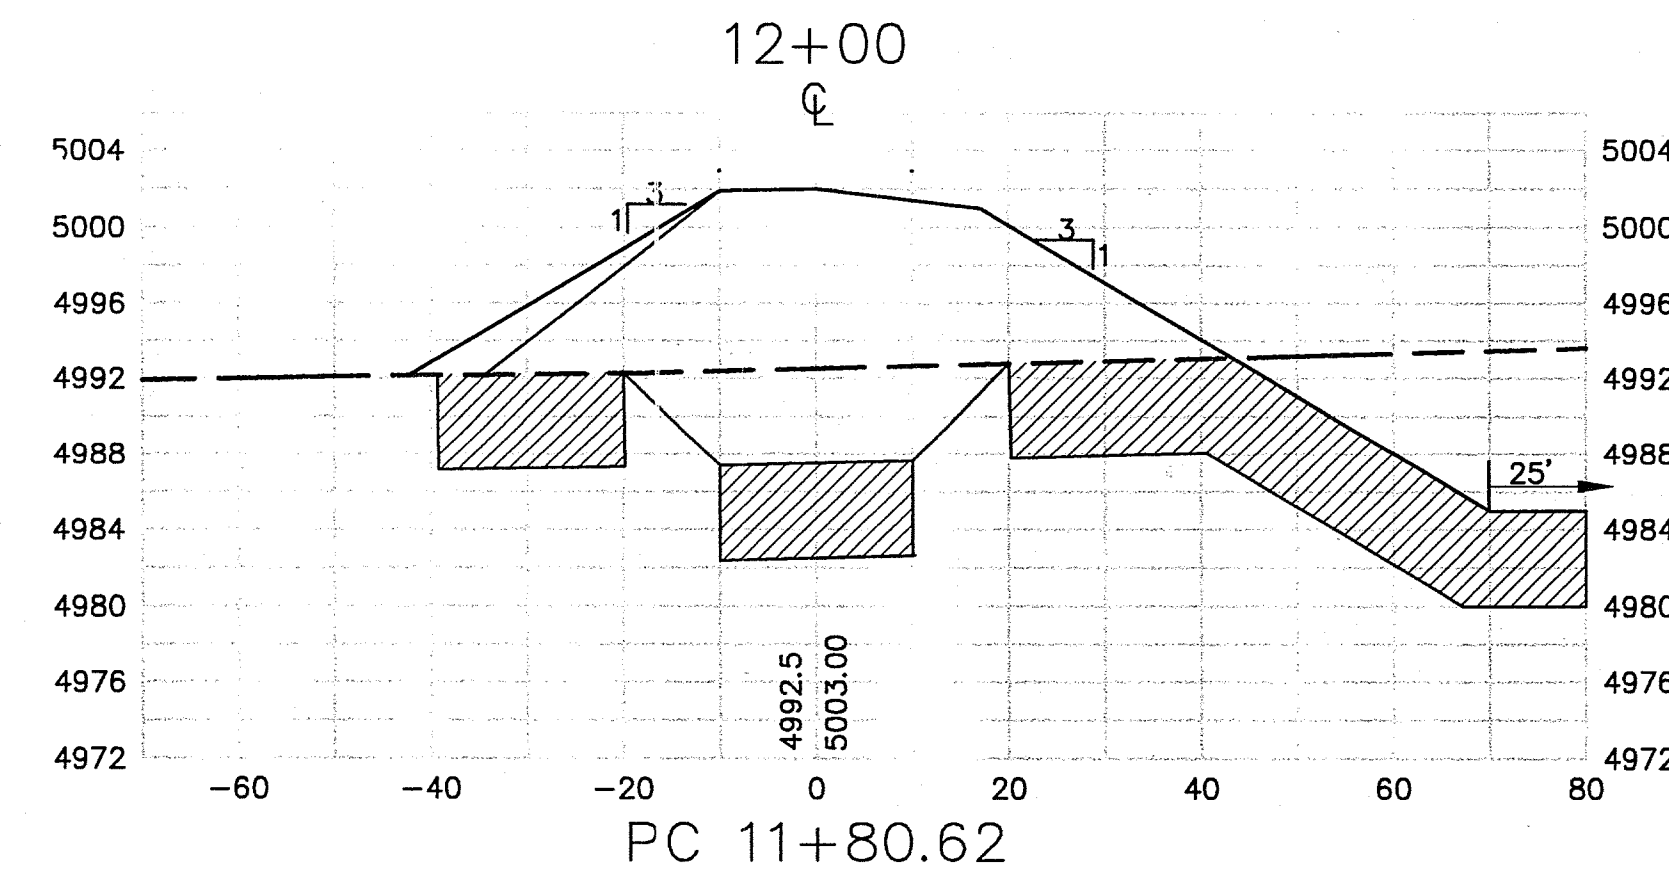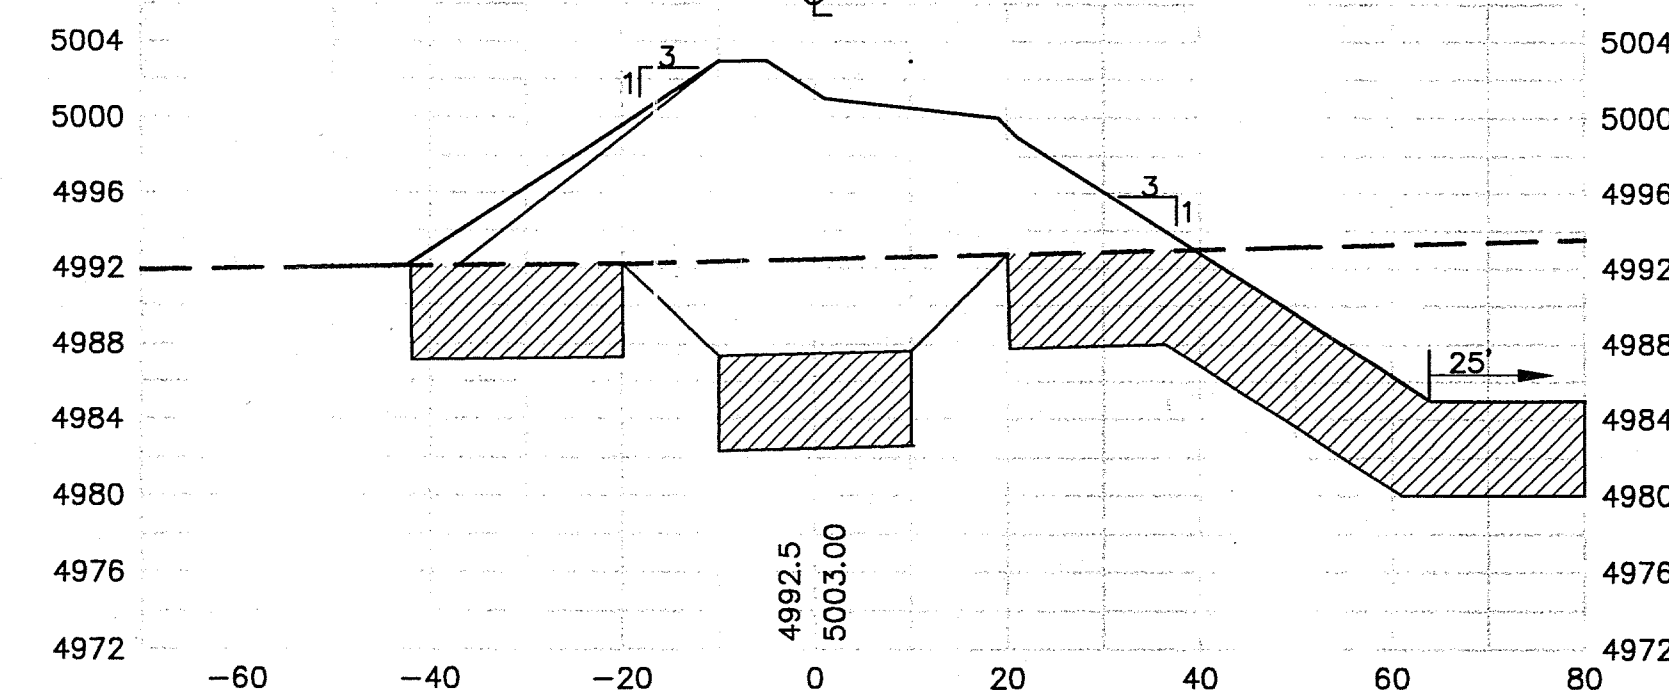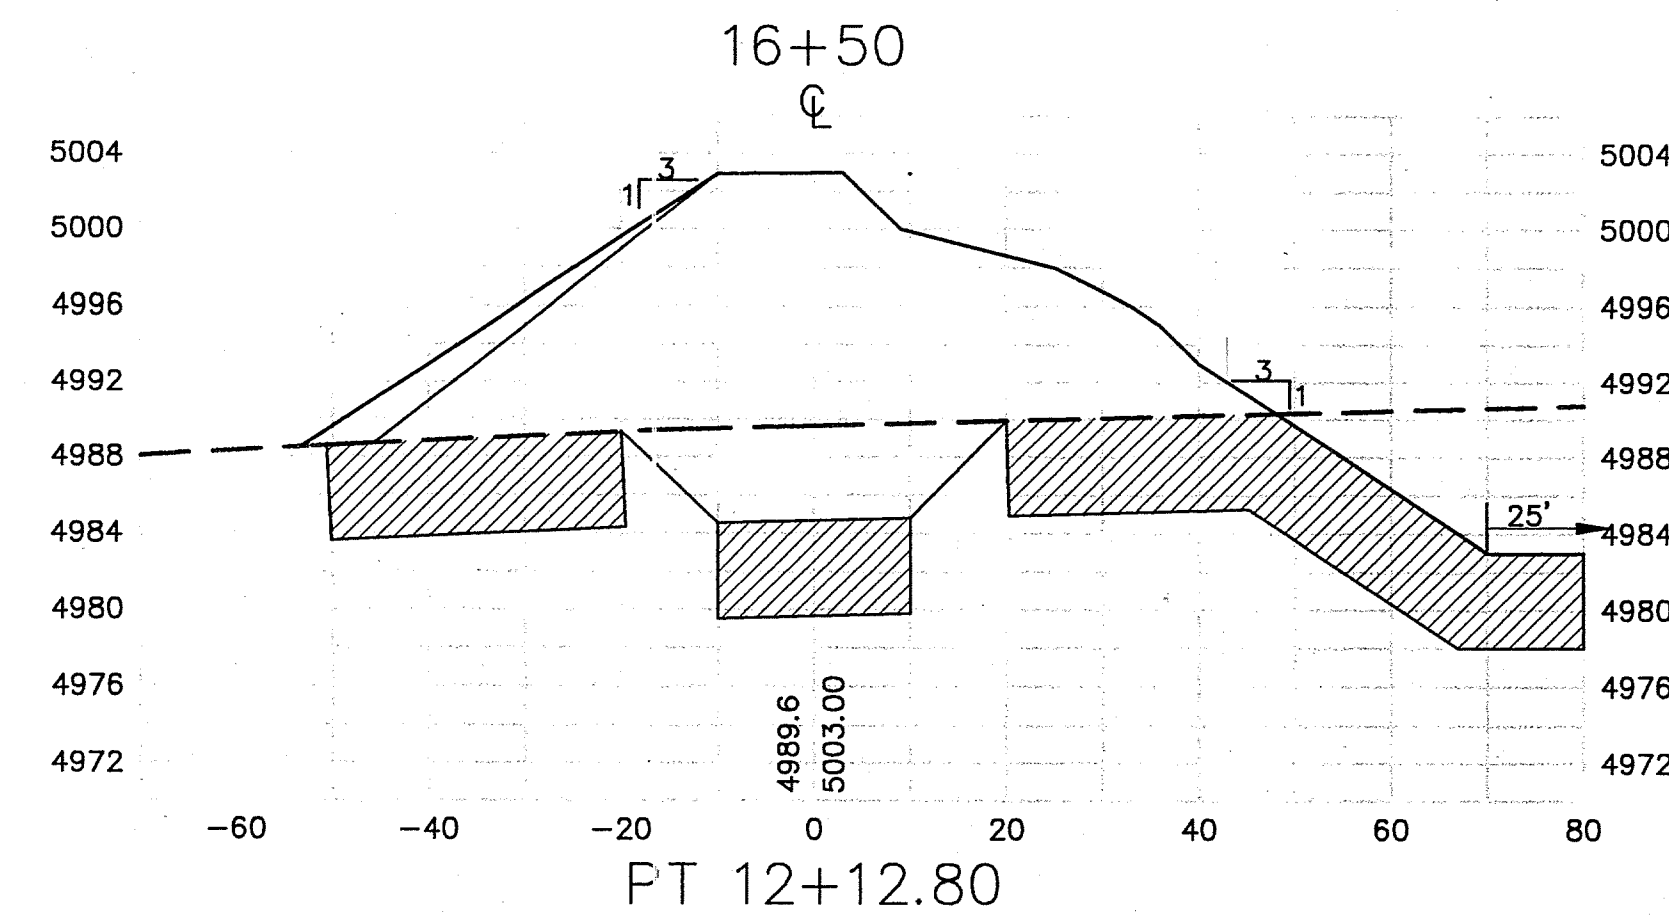

SCALE: HZ 1" = 20'
VT 1" = 10'




6922.91

ALBUQUERQUE METROPOLITAN ARROYO FLOOD CONTROL AUTHORITY		BORREGA DETENTION DAM	
DAM SECTIONS STA 11+80.62 - 19+06.10			
			
4900 LANG AVENUE N.E. ALBUQUERQUE, NM 87109 (505) 348-4000		DATE MARCH 2000 FILE 99099 SHEET 18 OF 34	

RECORD DRAWING
2-20-01

99099\ASSETS\Drawings\99099\DWG\3-7-00\3-7-00.dwg

99099 V1 SHEETS (DAM) (W99099.DWG) (3-1-00) (P. 1)

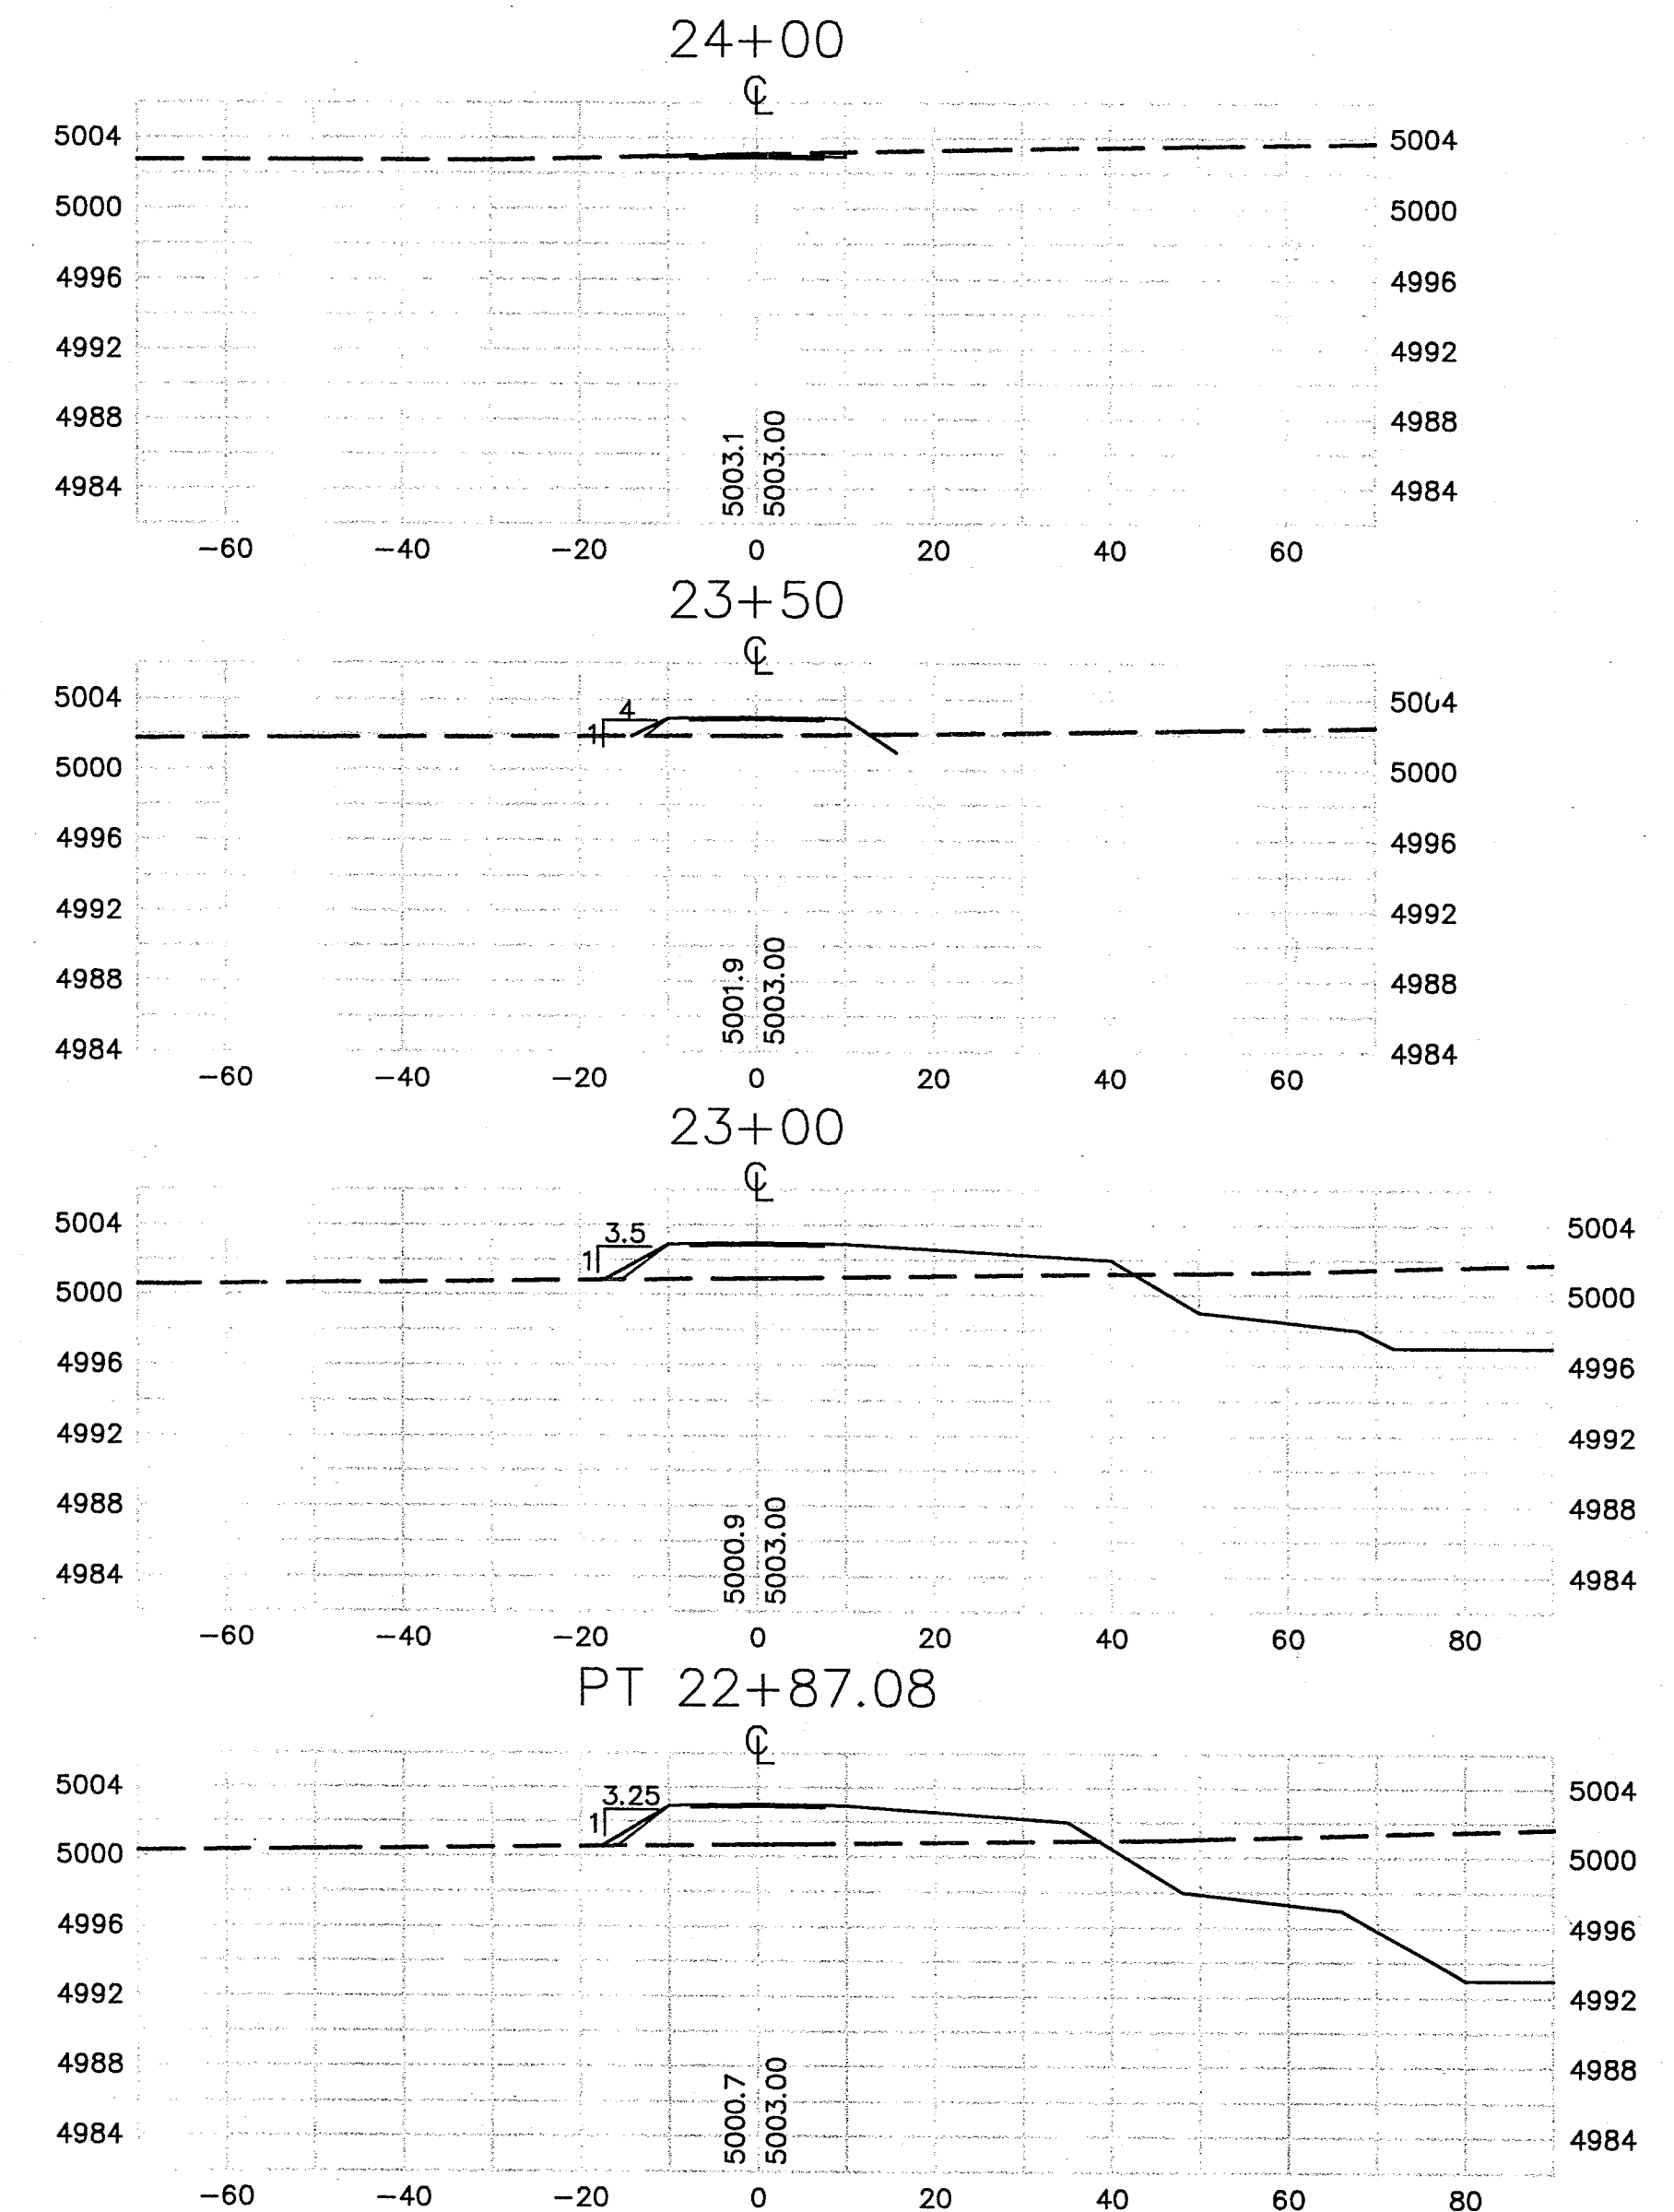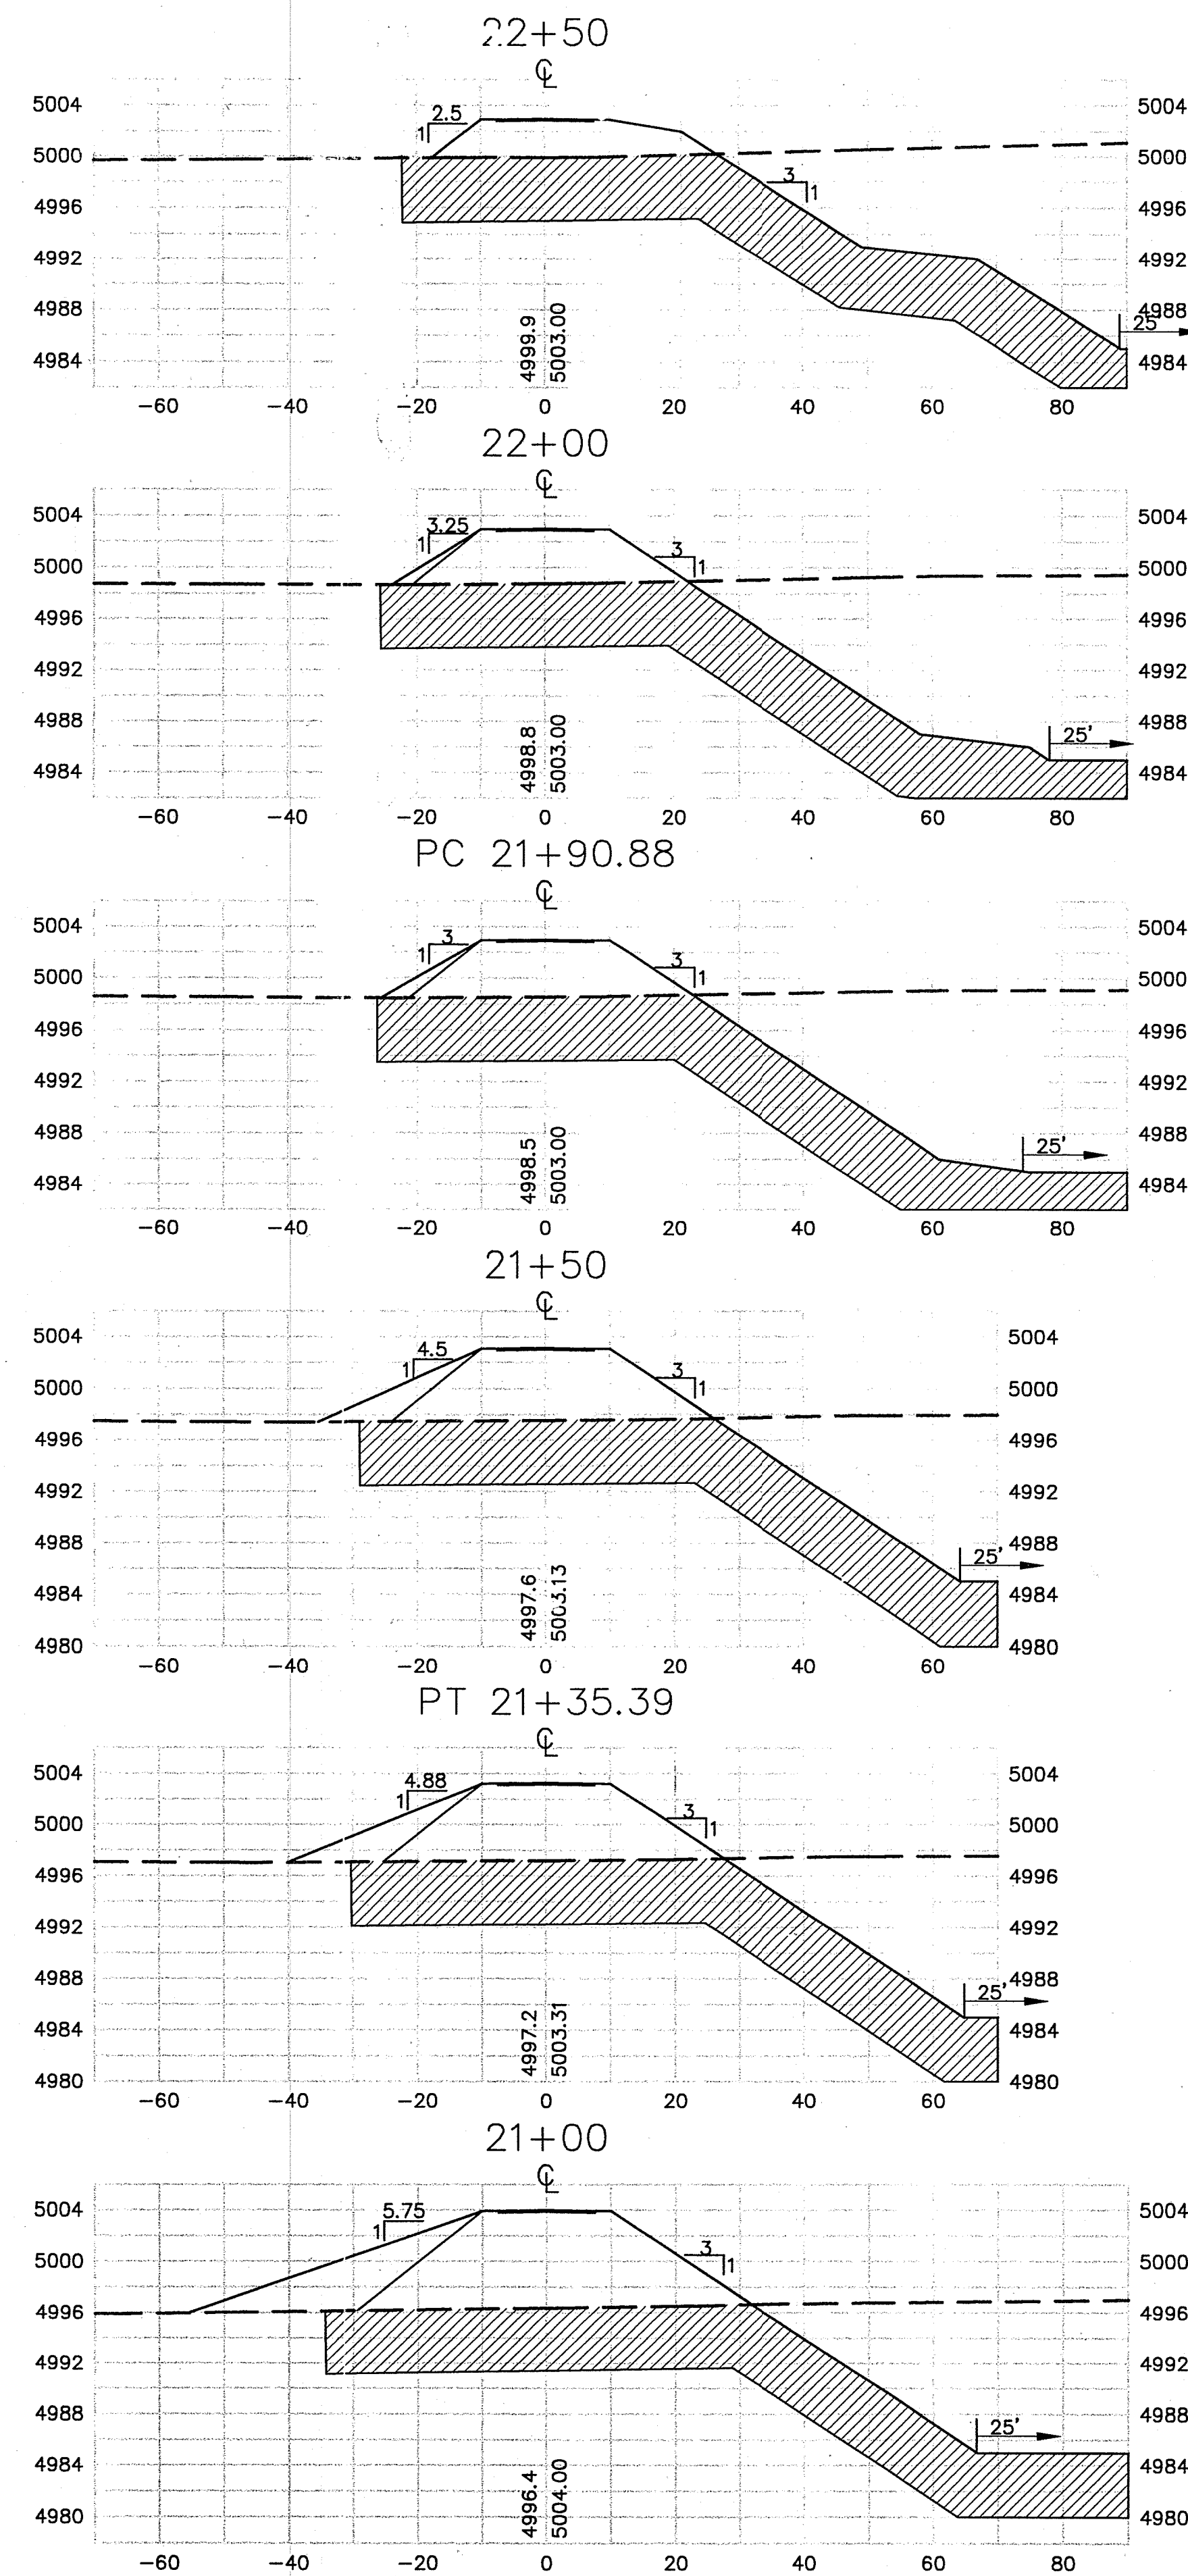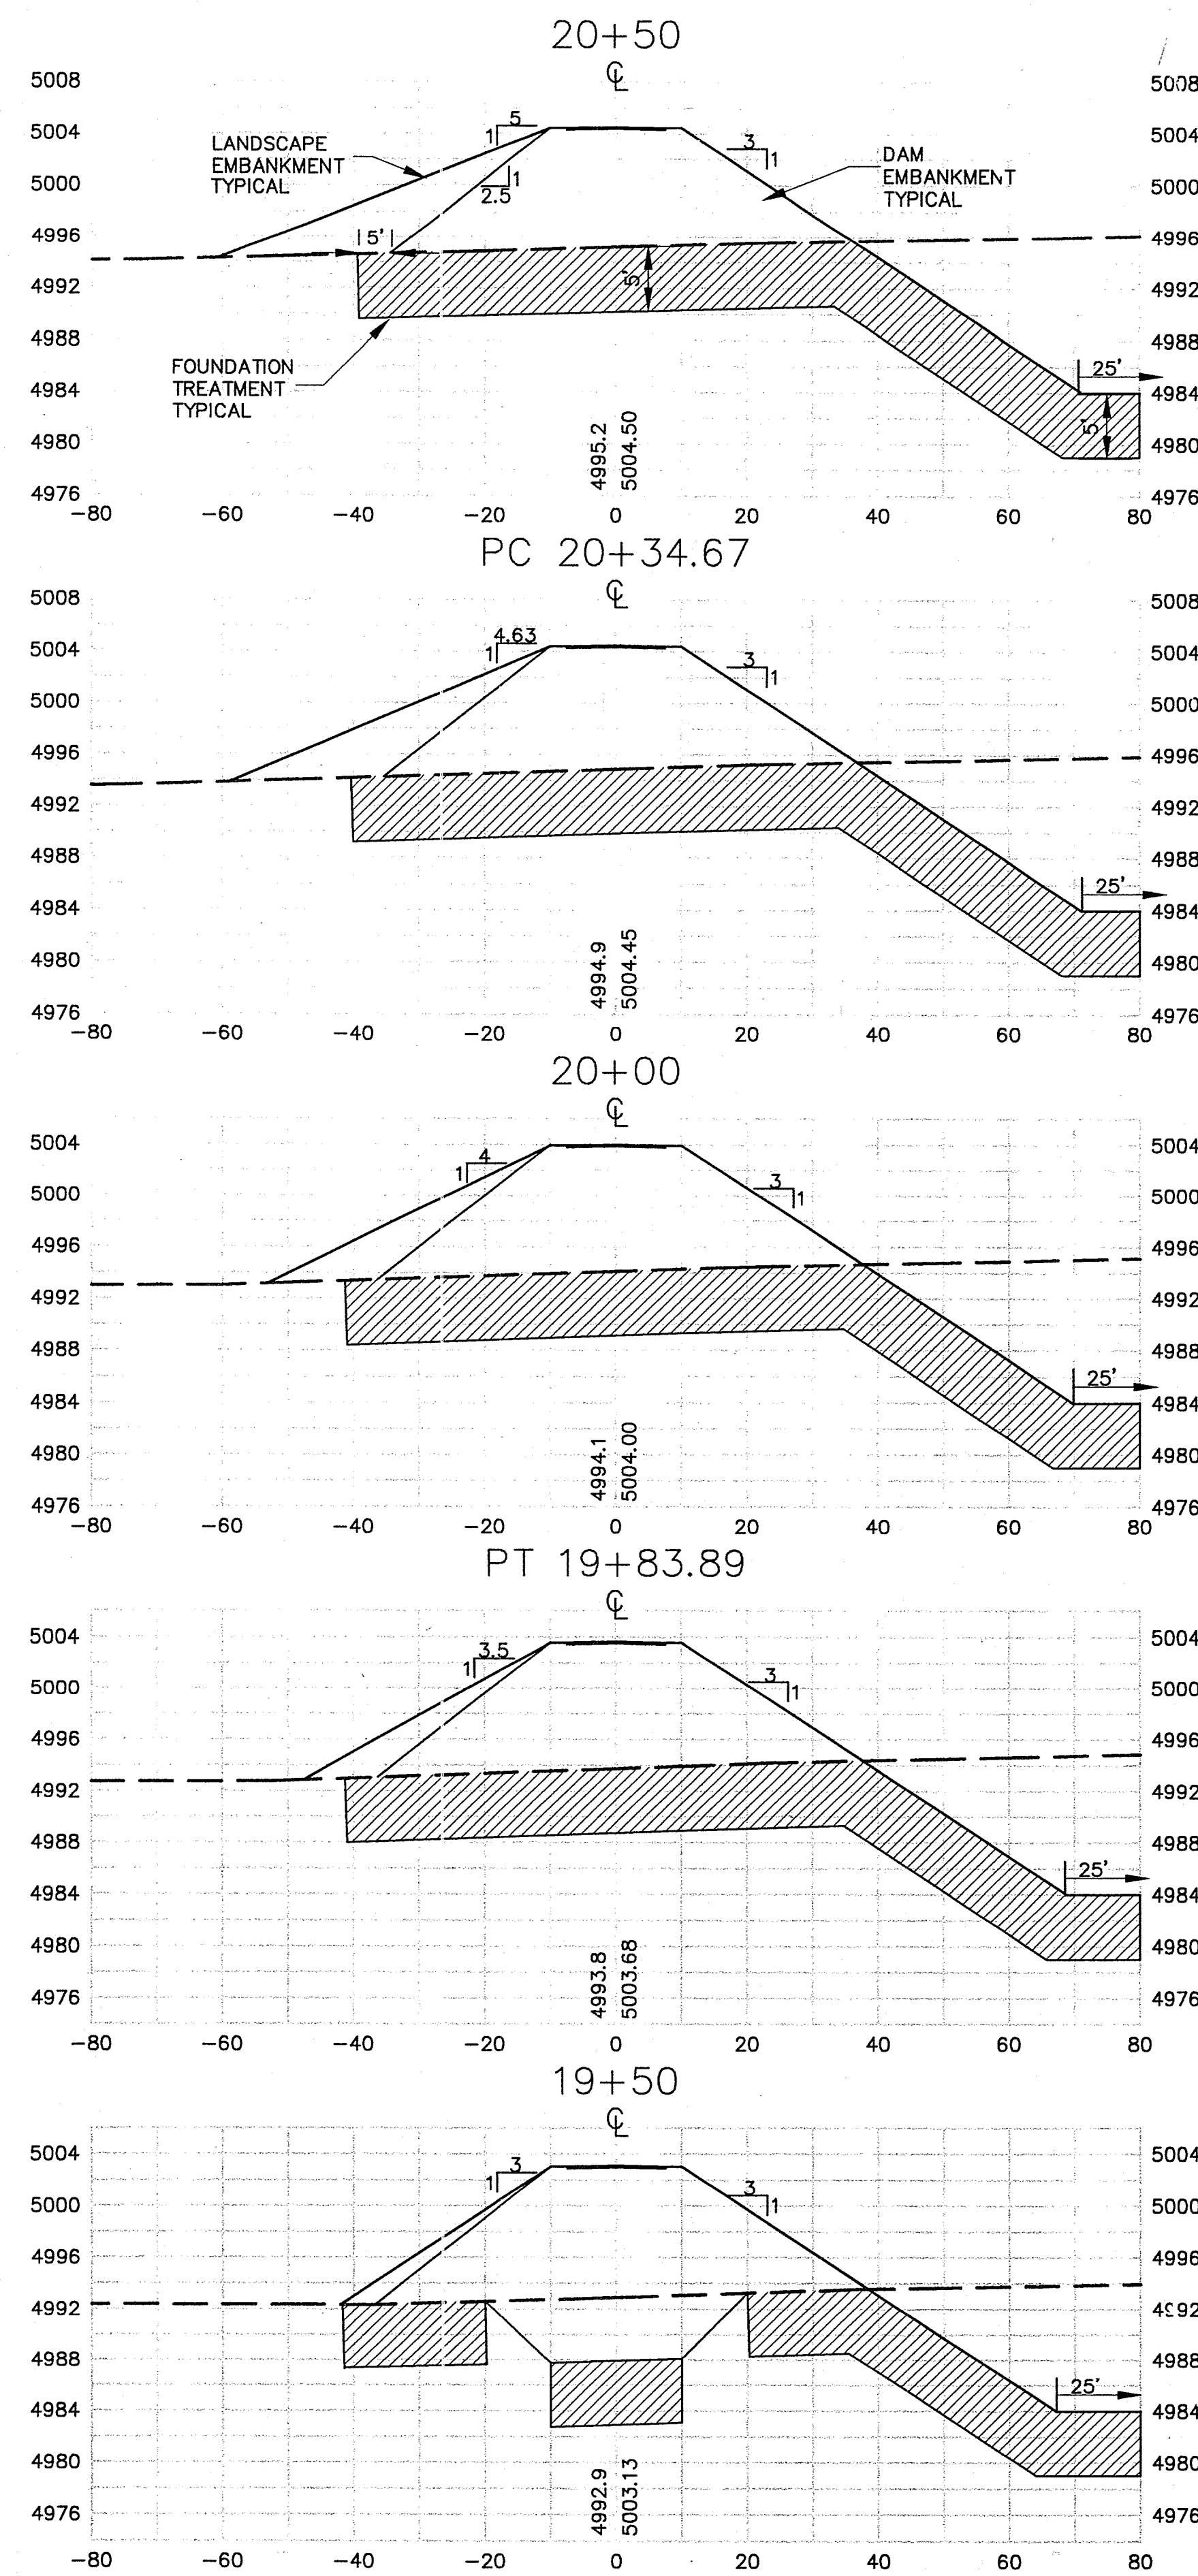

SCALE: HZ 1" = 20'
VT 1" = 10'

6922.91



REVISIONS		BY
NO.	DATE	
WILSON & COMPANY, ENGINEERS & ARCHITECTS		
DESIGNED BY NM		
DRAWN BY PJM		
CHECKED BY DSA		
NOV 1999		
NOV 1999		

ALBUQUERQUE METROPOLITAN ARROYO FLOOD CONTROL AUTHORITY	
BORREGA DETENTION DAM	
DAM SECTIONS STA 19+50 - 24+00	
DATE	MARCH 2000
FILE	99099
SHEET	OF
19	34



RECORD DRAWING
2-20-01





WILSON & COMPANY
4900 LANG AVENUE N.E.
ALBUQUERQUE, NM
87109
(505) 348-4000

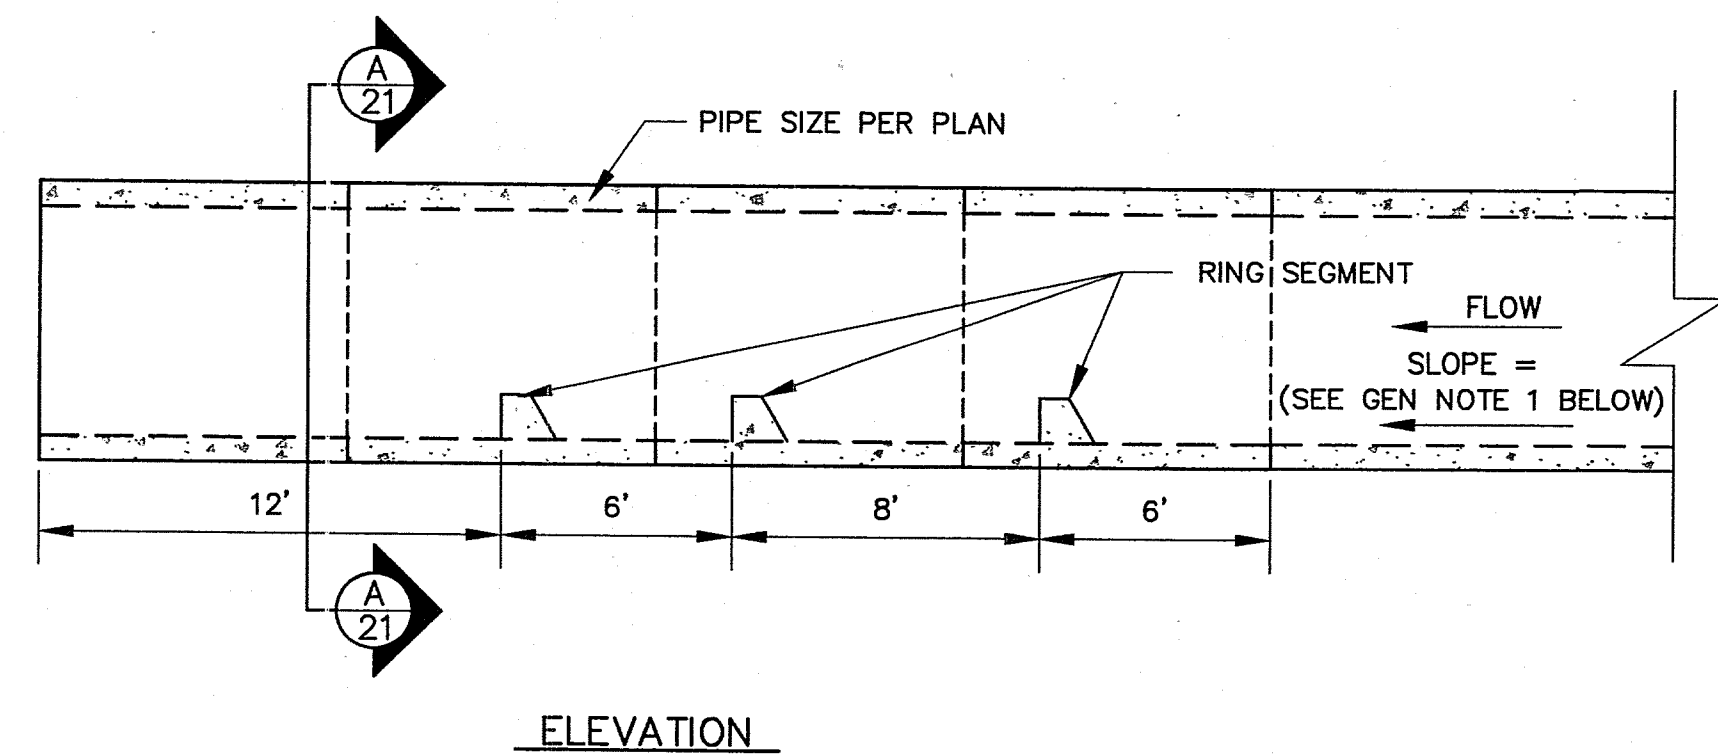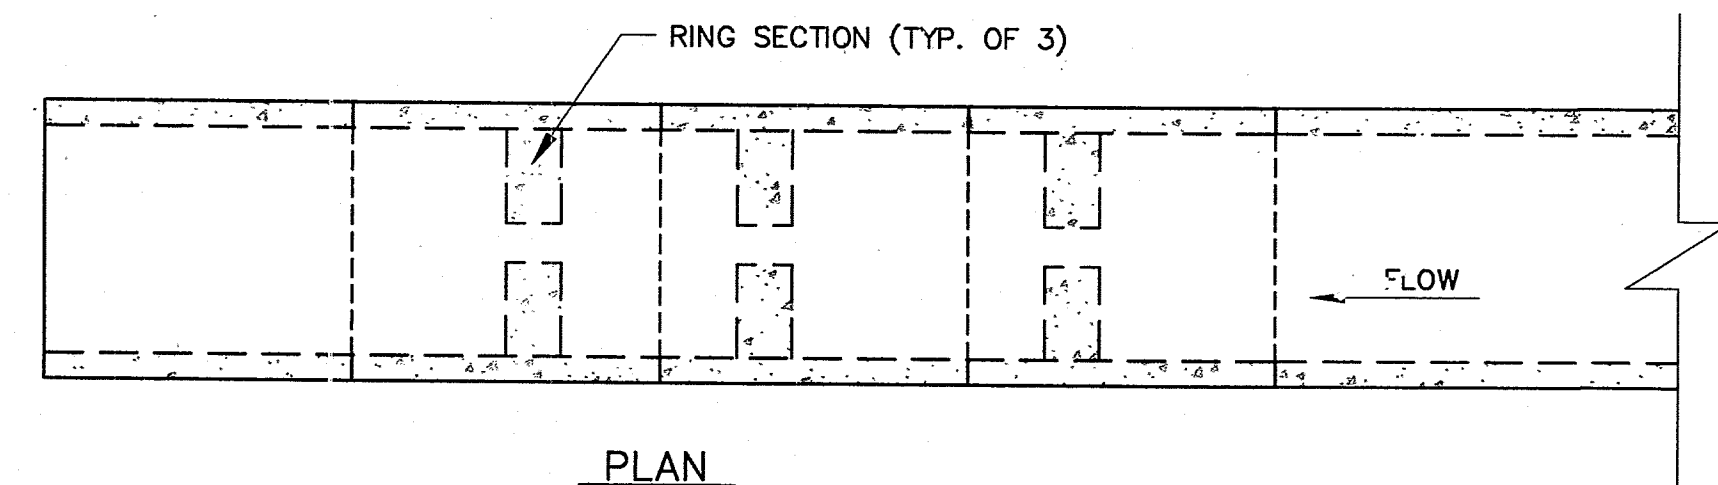



RING CHAMBER STORM DRAIN OUTLET
SCALE: 1" = 5'

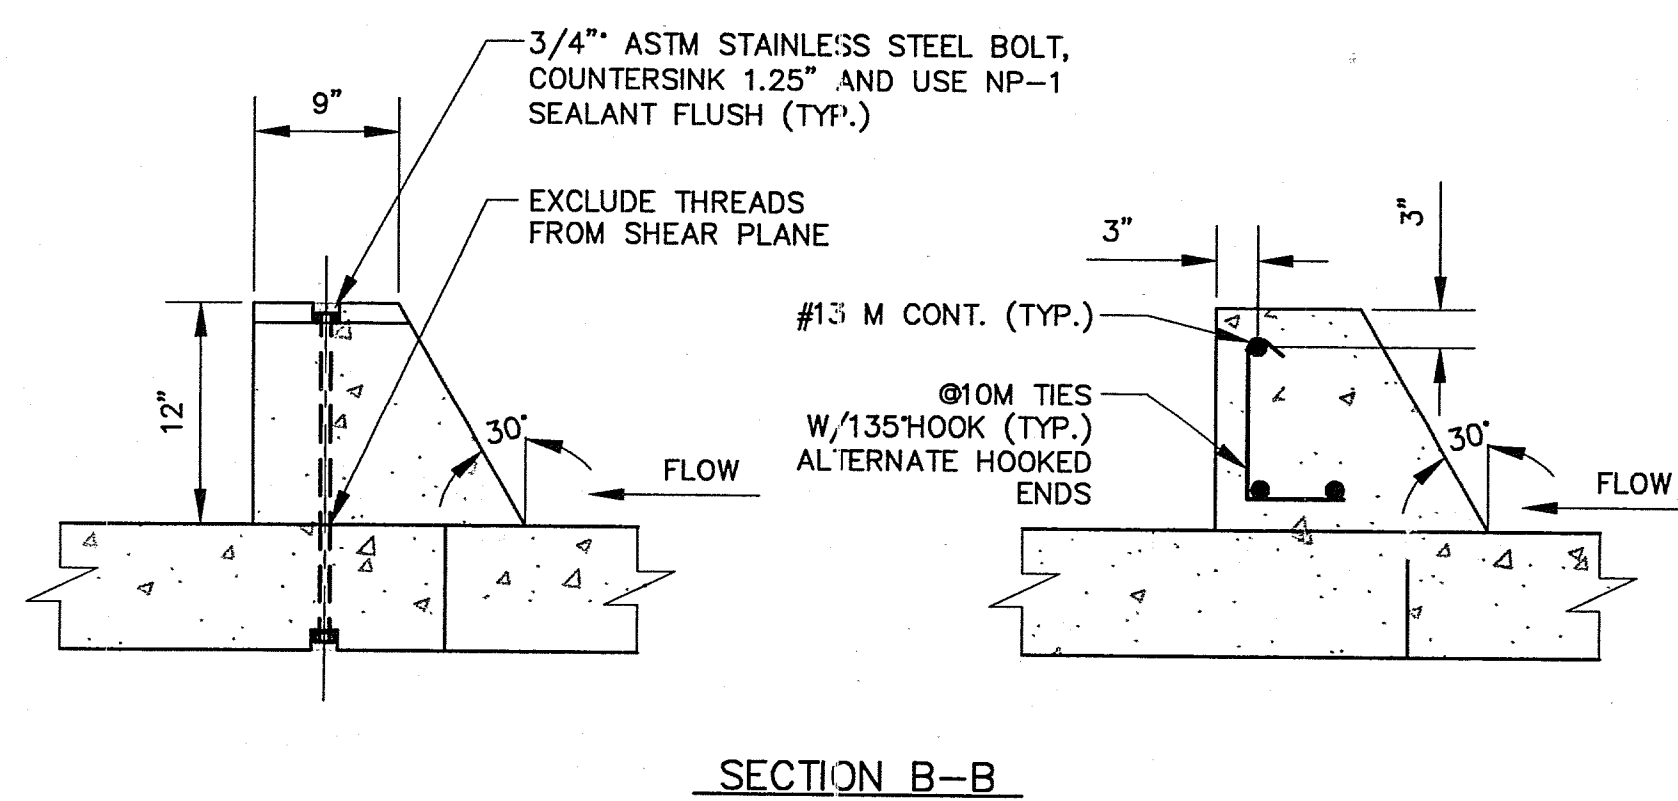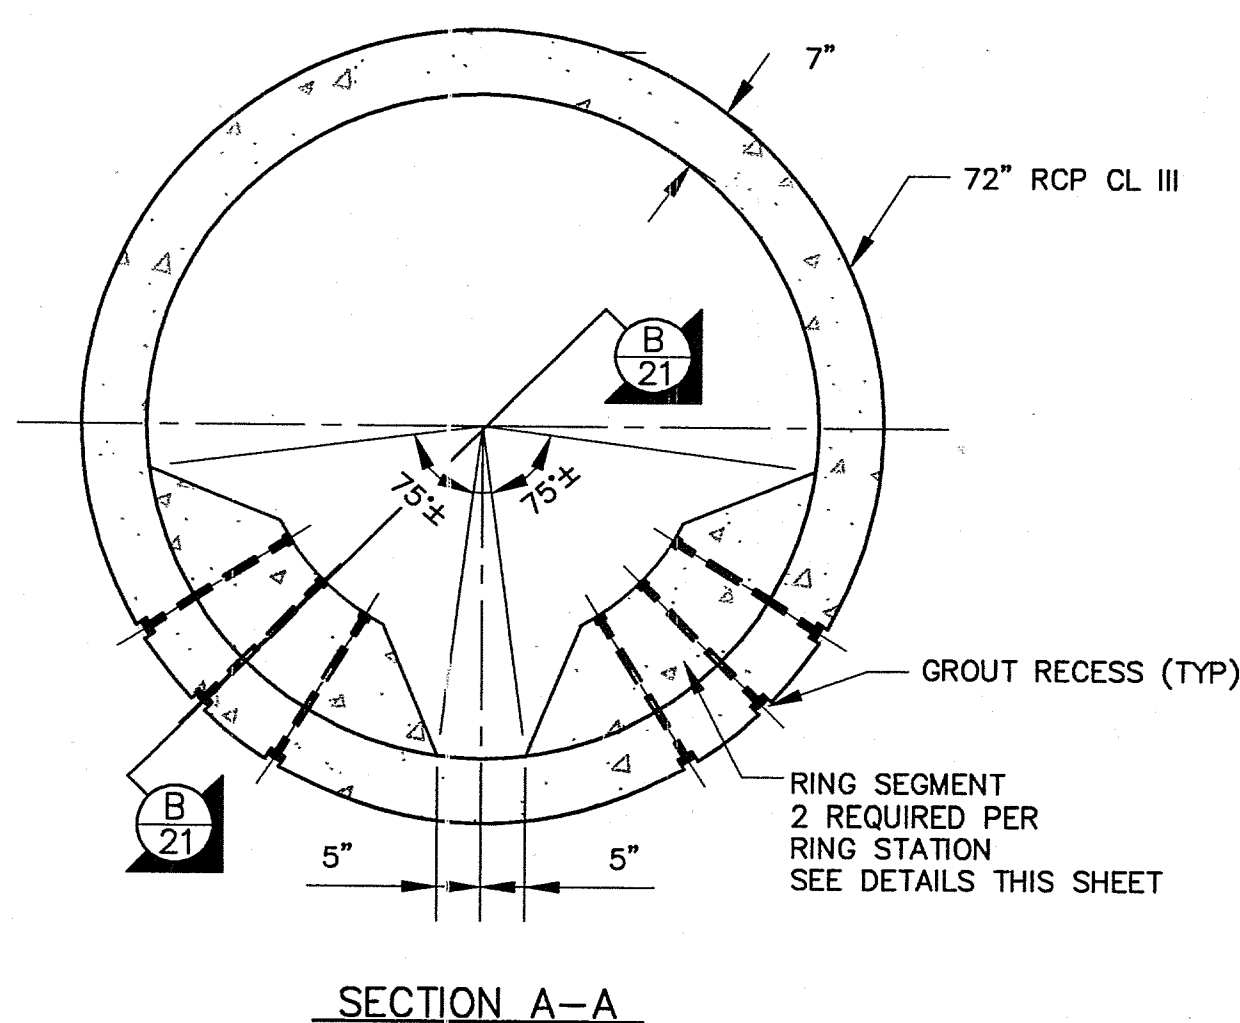

RING SEGMENT
NTS

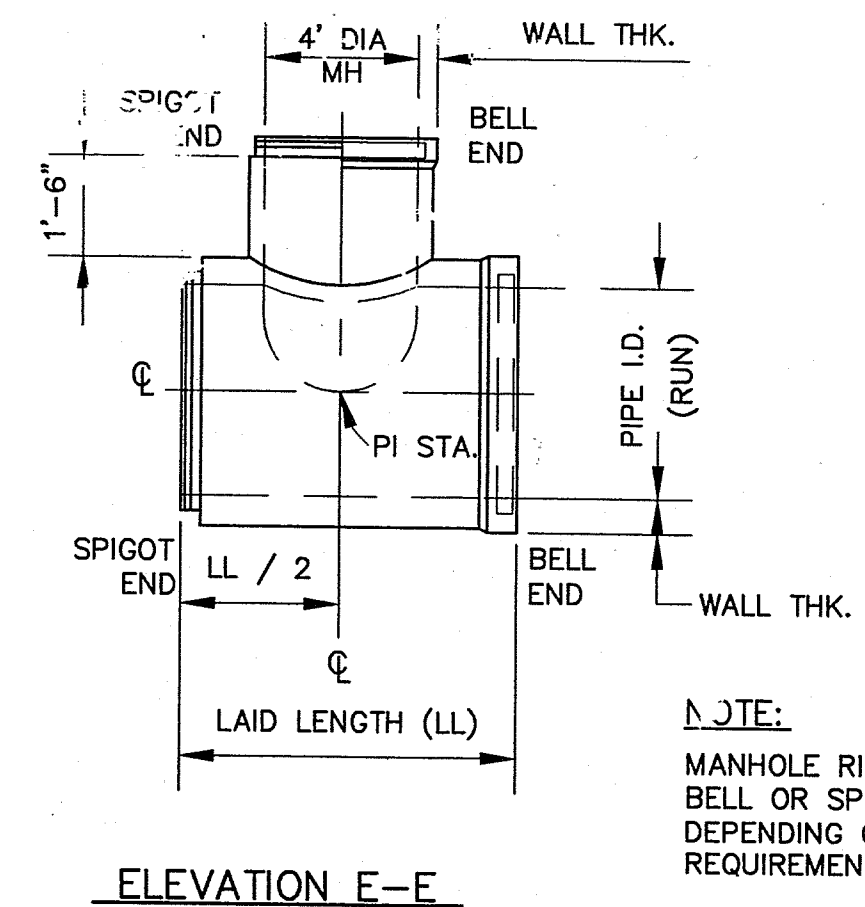
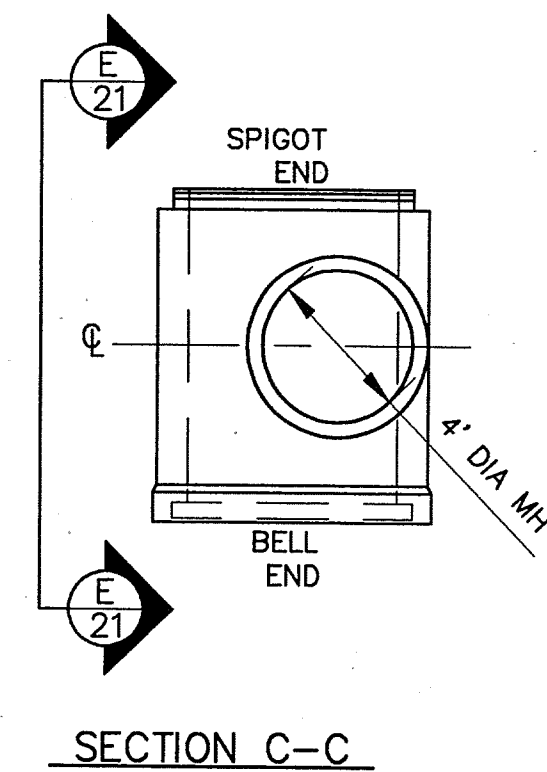


NOTE:
MANHOLE RISER TO BE
BELL OR SPIGOT,
DEPENDENT ON JOB
REQUIREMENTS.

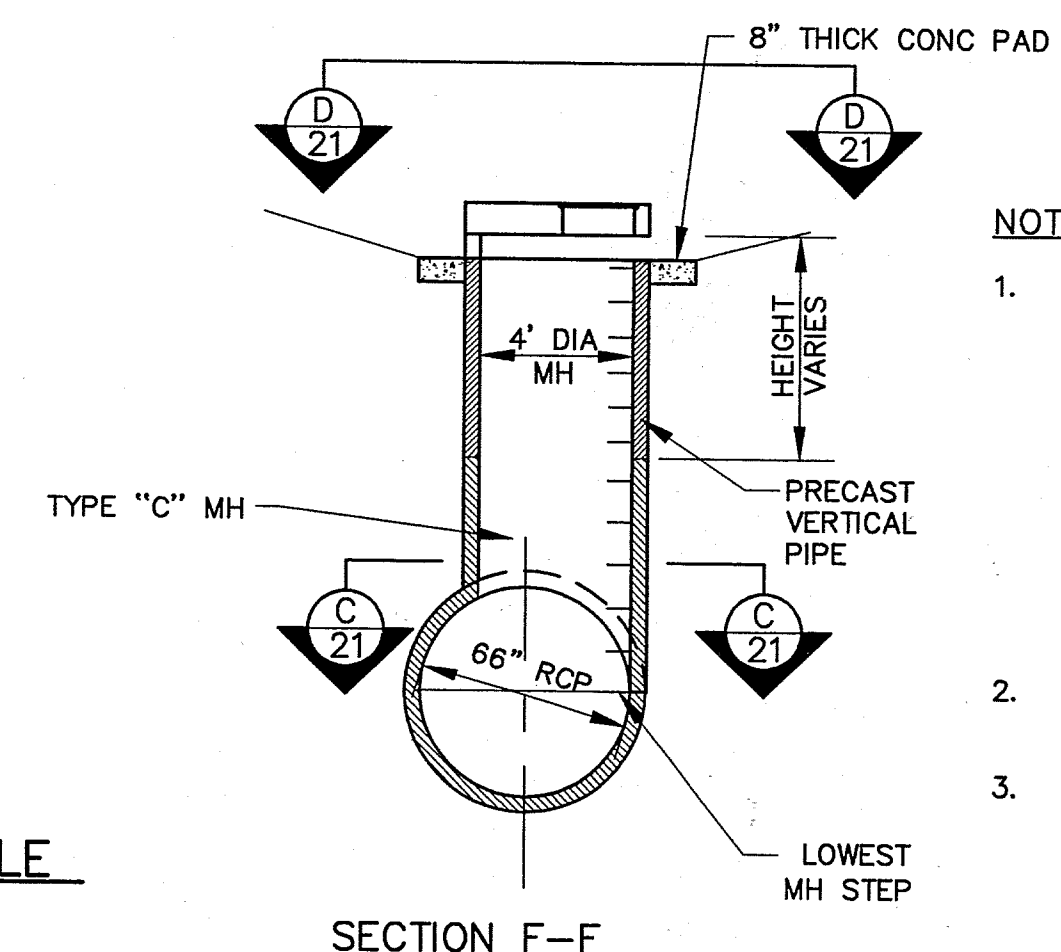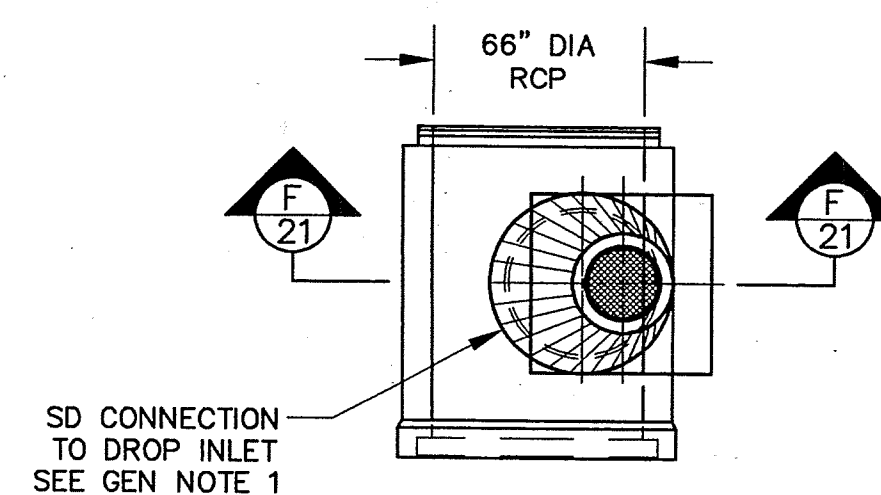

- NOTES:
- THE OFFSET MANHOLE TEE ASSEMBLY SHALL CONSIST OF THE FOLLOWING:
A. PILL BOX INLET W/ MH COVER
B. GRADE RINGS
C. CONCENTRIC CONE
D. RISERS AS REQUIRED
E. OFFSET TEE
F. MANHOLE STEPS.
 - USE NON-SHRINK GROUT FOR JOINTS, FILLETS AND PIPE PENETRATIONS.
 - COMPACT ALL BACKFILL AROUND MANHOLE TO 95% OF MODIFIED PROCTOR. ASTM-D-1557

TEE PIPE MANHOLE
SCALE: 1" = 5'

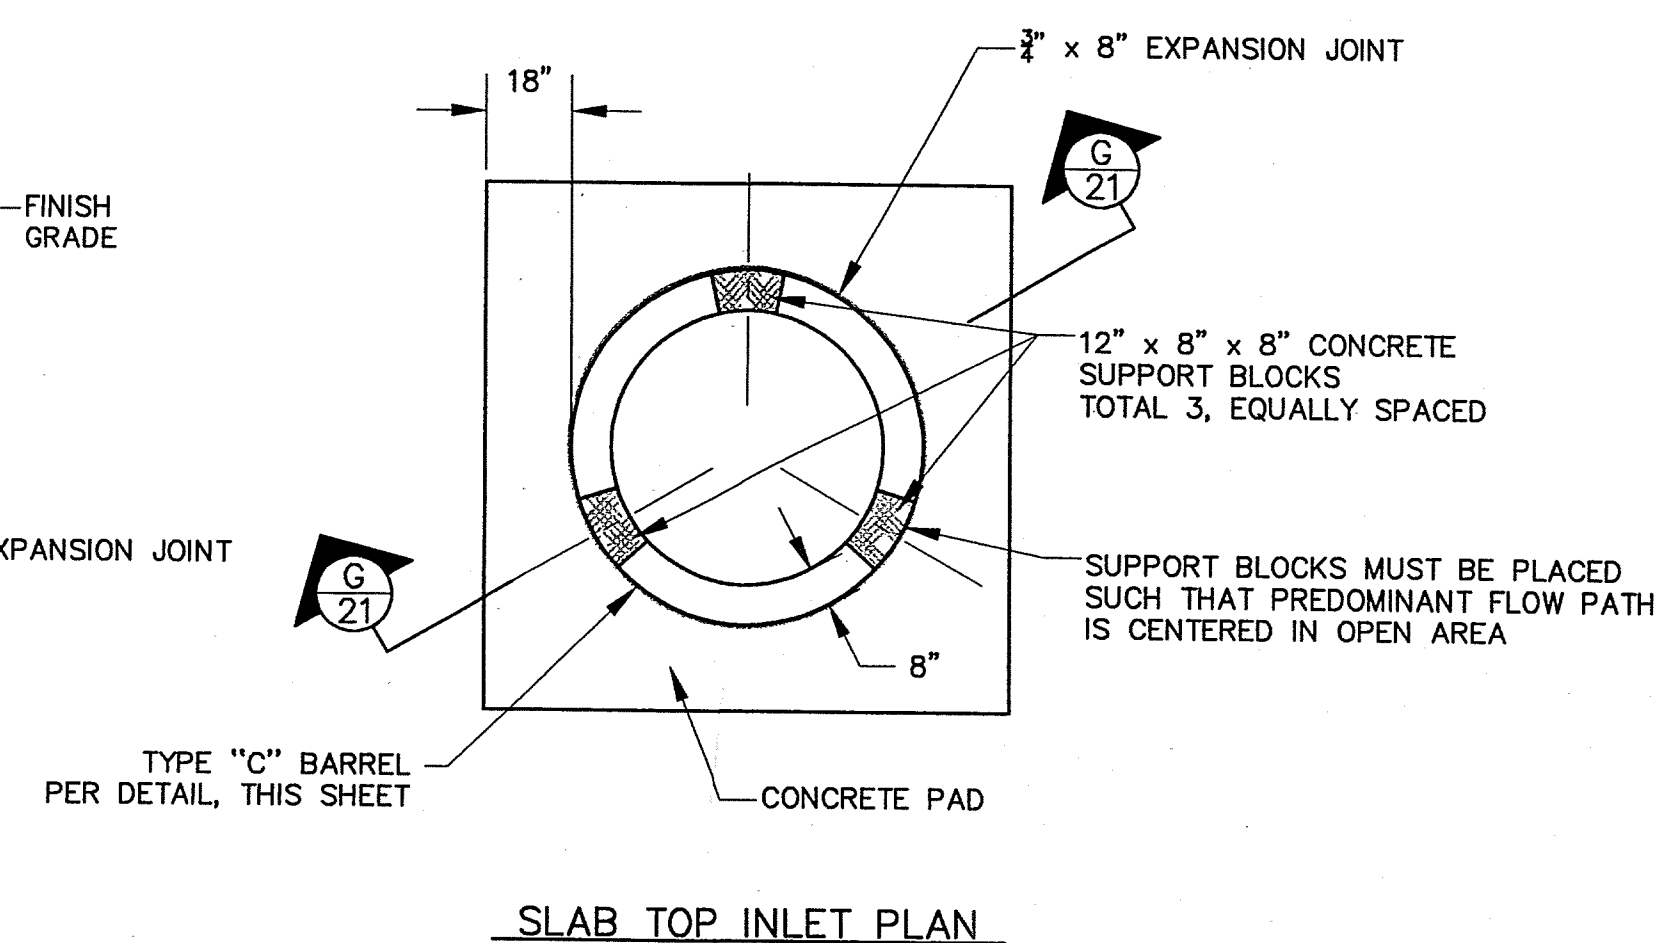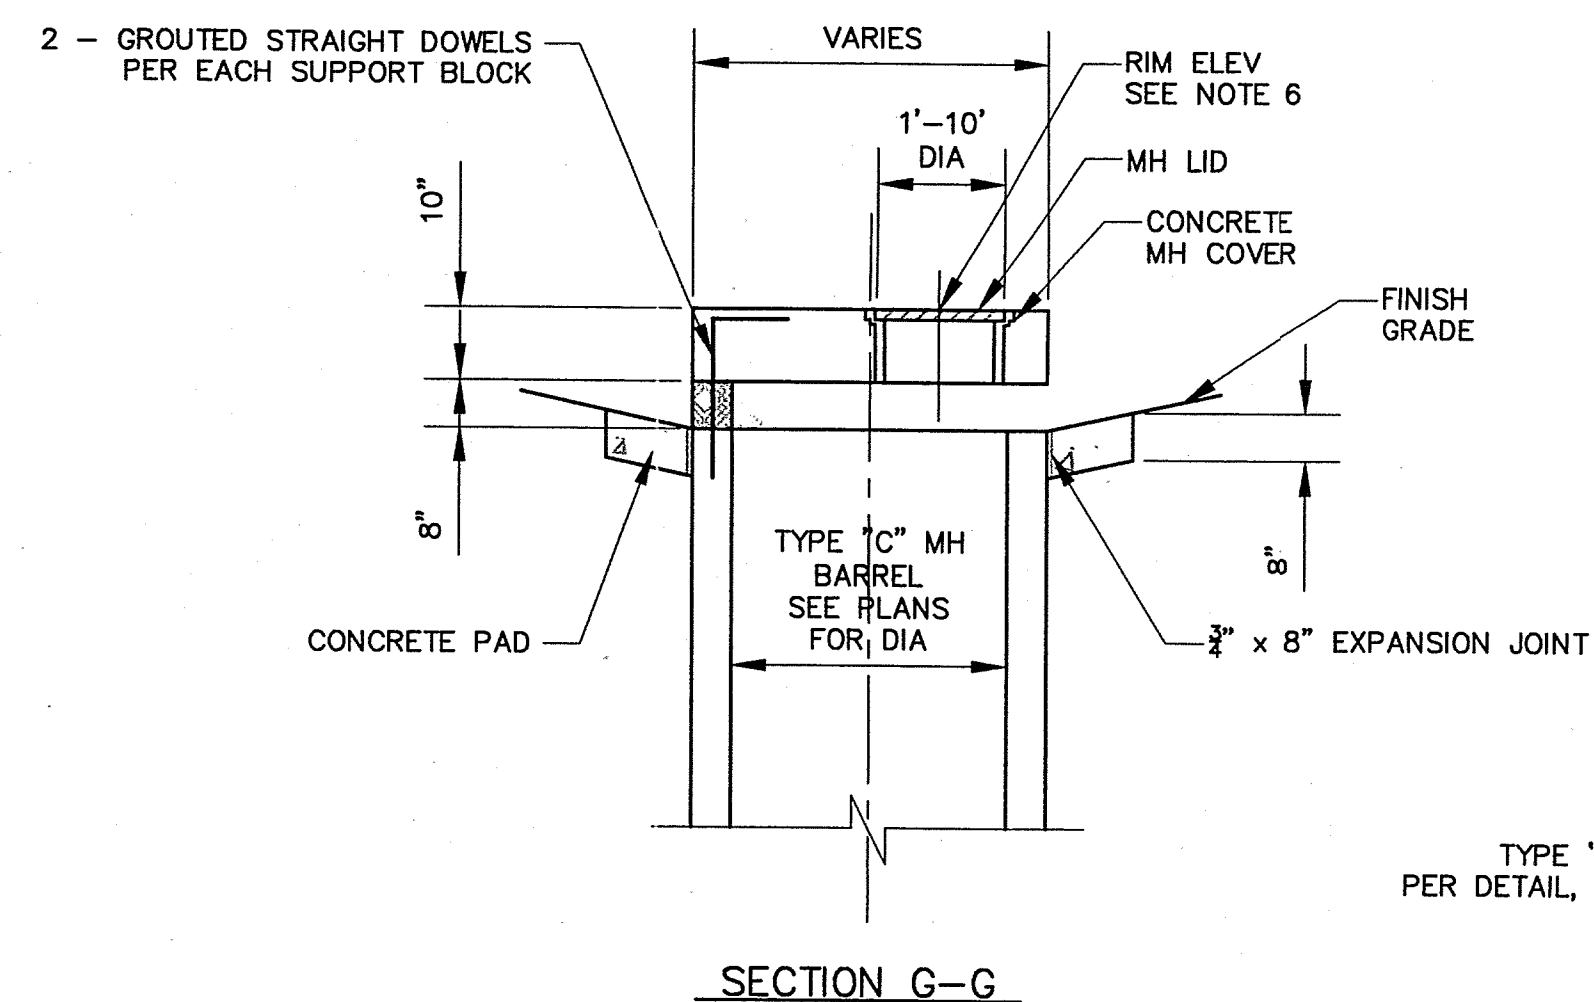

PILL BOX INLET
NTS




GENERAL NOTES

- SEE PLAN & PROFILE SHEETS FOR SD SLOPE, PIPE SIZE, AND INVERT ELEVATION.
- CONCRETE FOR PRECAST RING SEGMENTS SHALL HAVE A MINIMUM COMPRESSIVE STRENGTH OF 5000 PSI @ 28 DAYS.
- CEMENT GROUT ALL RECESS AREAS PER SECTION S 23 OF THE NMSH & TD SPECIFICATION, 1994 EDITION.
- ALL BOLTS SHALL BE STAINLESS STEEL ASTM A325 BOLTS.
- BOLT THREADS SHALL BE EXCLUDED FROM SHEAR PLANE CONNECTION.
- PILL BOX INLET MH RIM IS 18" ABOVE FINISH GRADE. USE CITY OF ALBUQUERQUE MANHOLE FRAME & COVER STD DWG 2110. CHANGE CITY OF ALBUQUERQUE TO BERNALILLO COUNTY AND INCLUDE STORM.

RECORD DRAWING
2-20-01

6922.91

ALBUQUERQUE METROPOLITAN ARROYO FLOOD CONTROL AUTHORITY		BORREGA DETENTION DAM STORM DRAIN DETAILS	
 WILSON & COMPANY 4900 LANG AVENUE N.E. ALBUQUERQUE, NM 87109 (505) 348-4000		DATE APRIL 2000 FILE 99099 SHEET 21 OF 34	

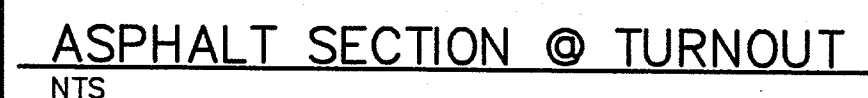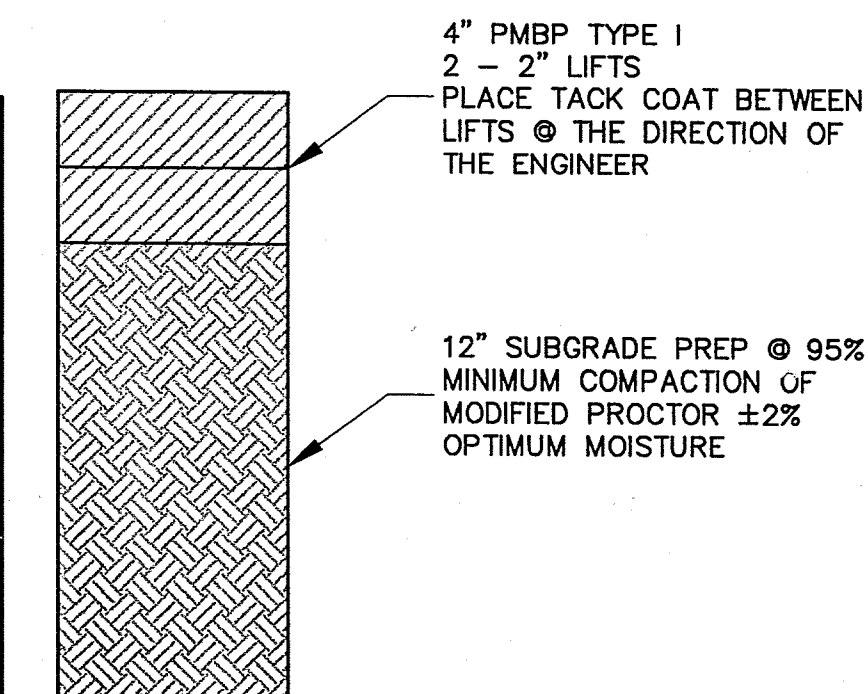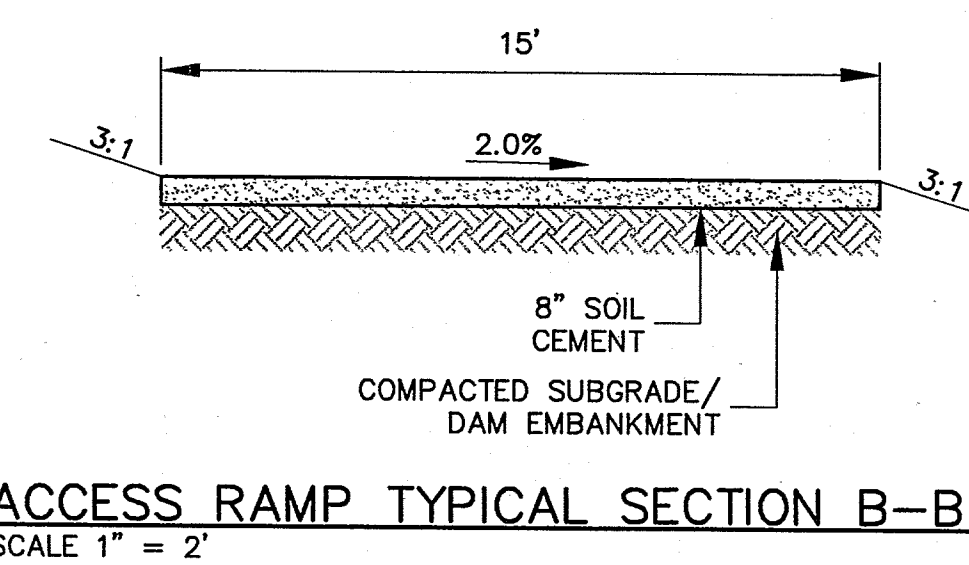

RECORD DRAWING
DATE 2-20-0

NOTES:

1. KARROL STREET EDGE OF EXISTING PAVEMENT:
SAWCUT 12" INTO EXISTING PAVEMENT
IN KARROL STREET LEAVING A NEAT
STRAIGHT LINE PRIOR TO LAYING NEW
ASPHALT EDGE TO BE TACK COATED.

6922.91



ALBUQUERQUE METROPOLITAN
ARROYO FLOOD
CONTROL AUTHORITY

BORREGA DETENTION DAM

ACCESS ROAD - PLAN AND PROFILE



WILSON
& COMPANY

4900 LANG AVENUE N.E.
ALBUQUERQUE, NM
87109
(505) 348-4000

DATE	MARCH 2000	
FILE	99099	
SHEET	23	OF 34

SURVEY INFORMATION			BENCH MARKS	AS-BUILT INFORMATION
NO.	FIELD NOTES			
	BY	DATE		
			CPI103 (SEE SHEET 1 FOR LOCATION)	CONTRACTOR <u>CHAVA</u>
			REBAR W/ ALUMINUM CAP	WORK ORDERED BY <u>CHAVA</u>
			STAMPED WILSON & COMPANY	INSPECTOR'S DATE <u>2-9-01</u>
			N = 1462061.9801	ACCEPTANCE BY <u>WCEA</u>
			E = 1495972.9457	DRAWINGS BY <u>WCEA</u>
			ELEVATION = 5020.789 FT	DATE
				MICRO-FILM INFORMATION
				RECORDED BY
				DATE
				NO.

<i>REVISIONS</i>					
WILSON & COMPANY, ENGINEERS & ARCHITECTS					
DESIGNED BY		NM			NOV 1999
DRAWN BY		PJM			NOV 1999
CHECKED BY		DSA			NOV 1999
			REMARKS		BY

NOTES:

1. CENTERLINE OF NEW FENCE TO BE LOCATED 6" INSIDE OF AMAFCA PROPERTY. FOR FENCE DETAILS SEE SHEET 26.
2. INSTALL 14 LF SINGLE RAIL WEATHERING METAL BARRIER (GUARD RAIL) WITH STANDARD TERMINAL END SECTIONS, 2 PLACES. INSTALLATION PER SERIAL M-21-62.
3. SEED MIXTURE DESCRIPTIONS:
"A" - GRASS & SHRUB MIX WITH STRAW MULCH
"B" - GRASS MIX WITH STRAW MULCH
"C" - GRASS & SHRUB MIX WITH GRAVEL MULCH
4. TOTAL AREA
"A" = 7 ac
"B" = 15 ac
"C" = 6 ac

LEGEND

_____ x _____

_____ - - - - -

7"

4 STRAND SMOOTH WIRE

ROW

GATE

SEED MIXTURE TYPE "A"

SEED MIXTURE TYPE "B"

SEED MIXTURE TYPE "C"

RECORD DRAWING
DATE 2-20-01

BENCH MARKS

CP 103
REBAR W/ALUMINUM CAP
STAMPED WILSON & COMPANY
Y* = 1462061.9801
X* = 1495972.9457
ELEVATION = 5020.789

CP 105
REBAR W/ALUMINUM CAP
STAMPED WILSON & COMPANY
Y~~x~~ = 1461166.0861
x~~x~~ = 1496704.4382
ELEVATION = 5002.362

[illegible]

ALBUQUERQUE METROPOLITAN
ARROYO FLOOD
CONTROL AUTHORITY

FENCING AND REVEGETATION PLAN

WILSON
& COMPANY


4900 LANG AVENUE N.E.
ALBUQUERQUE, NM
87109
(505) 348-4000


DATE	APRIL 2000
------	------------

FILE 000000

SHEET 05 OF 74


6922.91

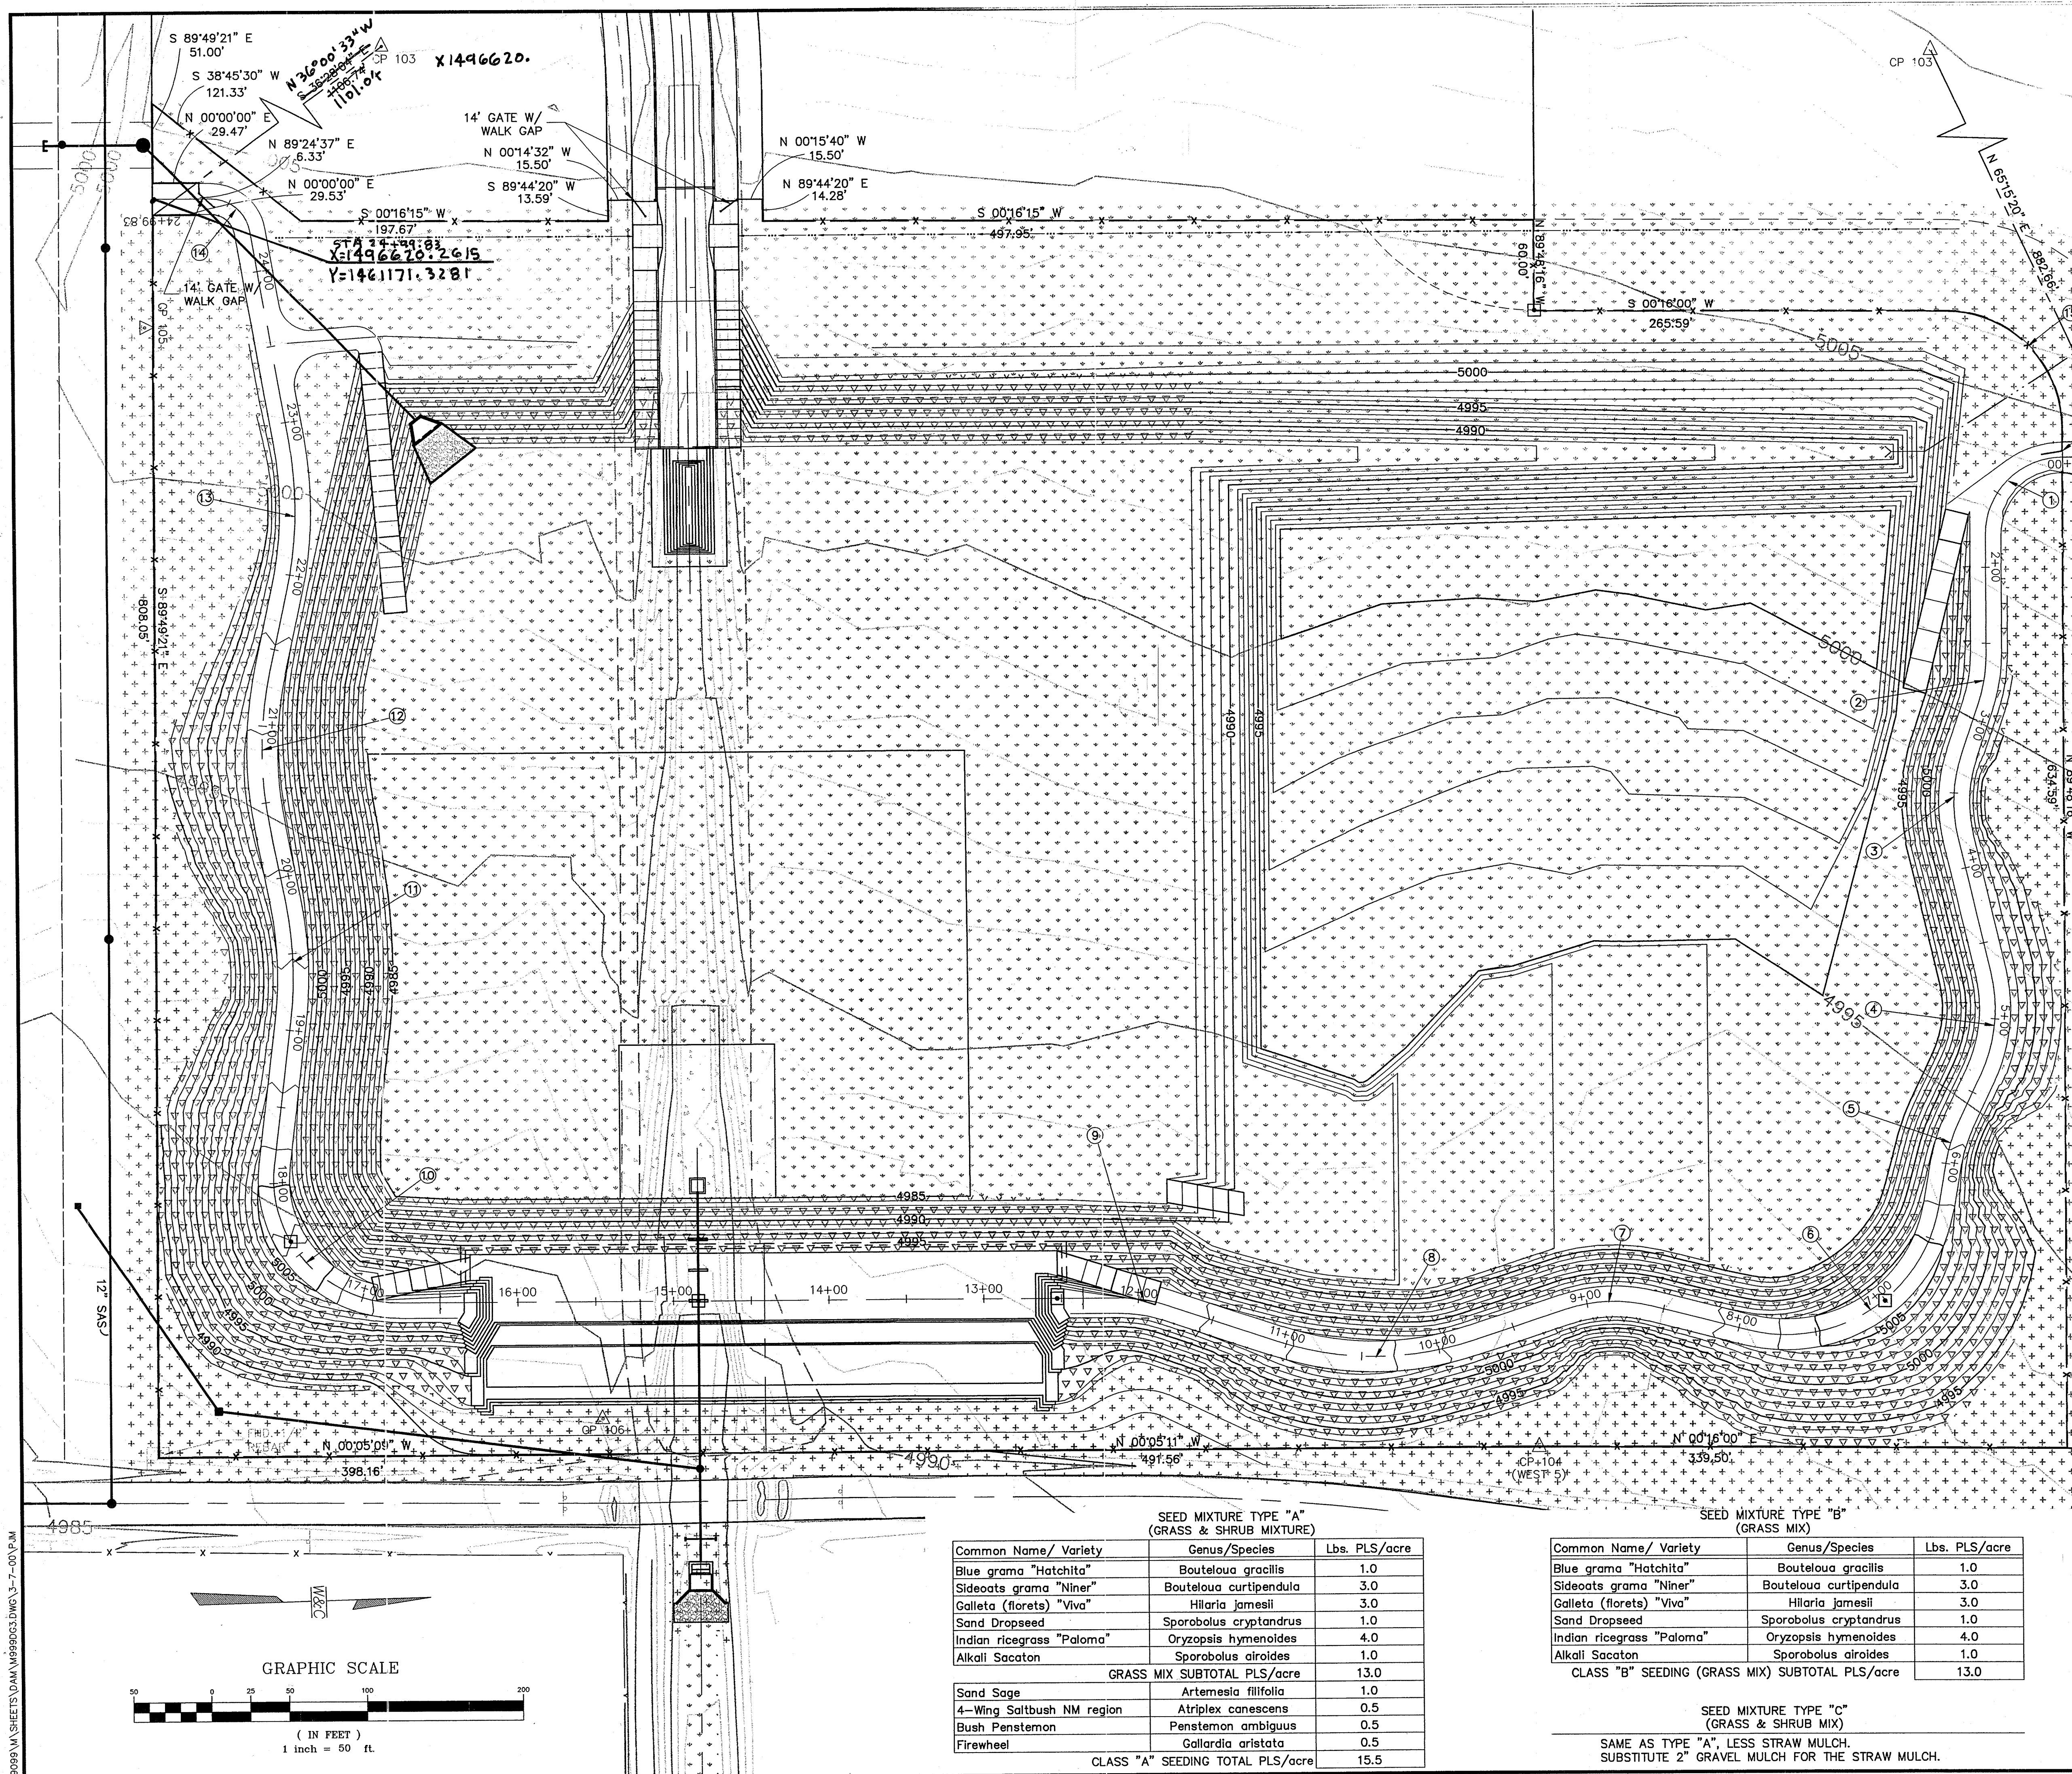

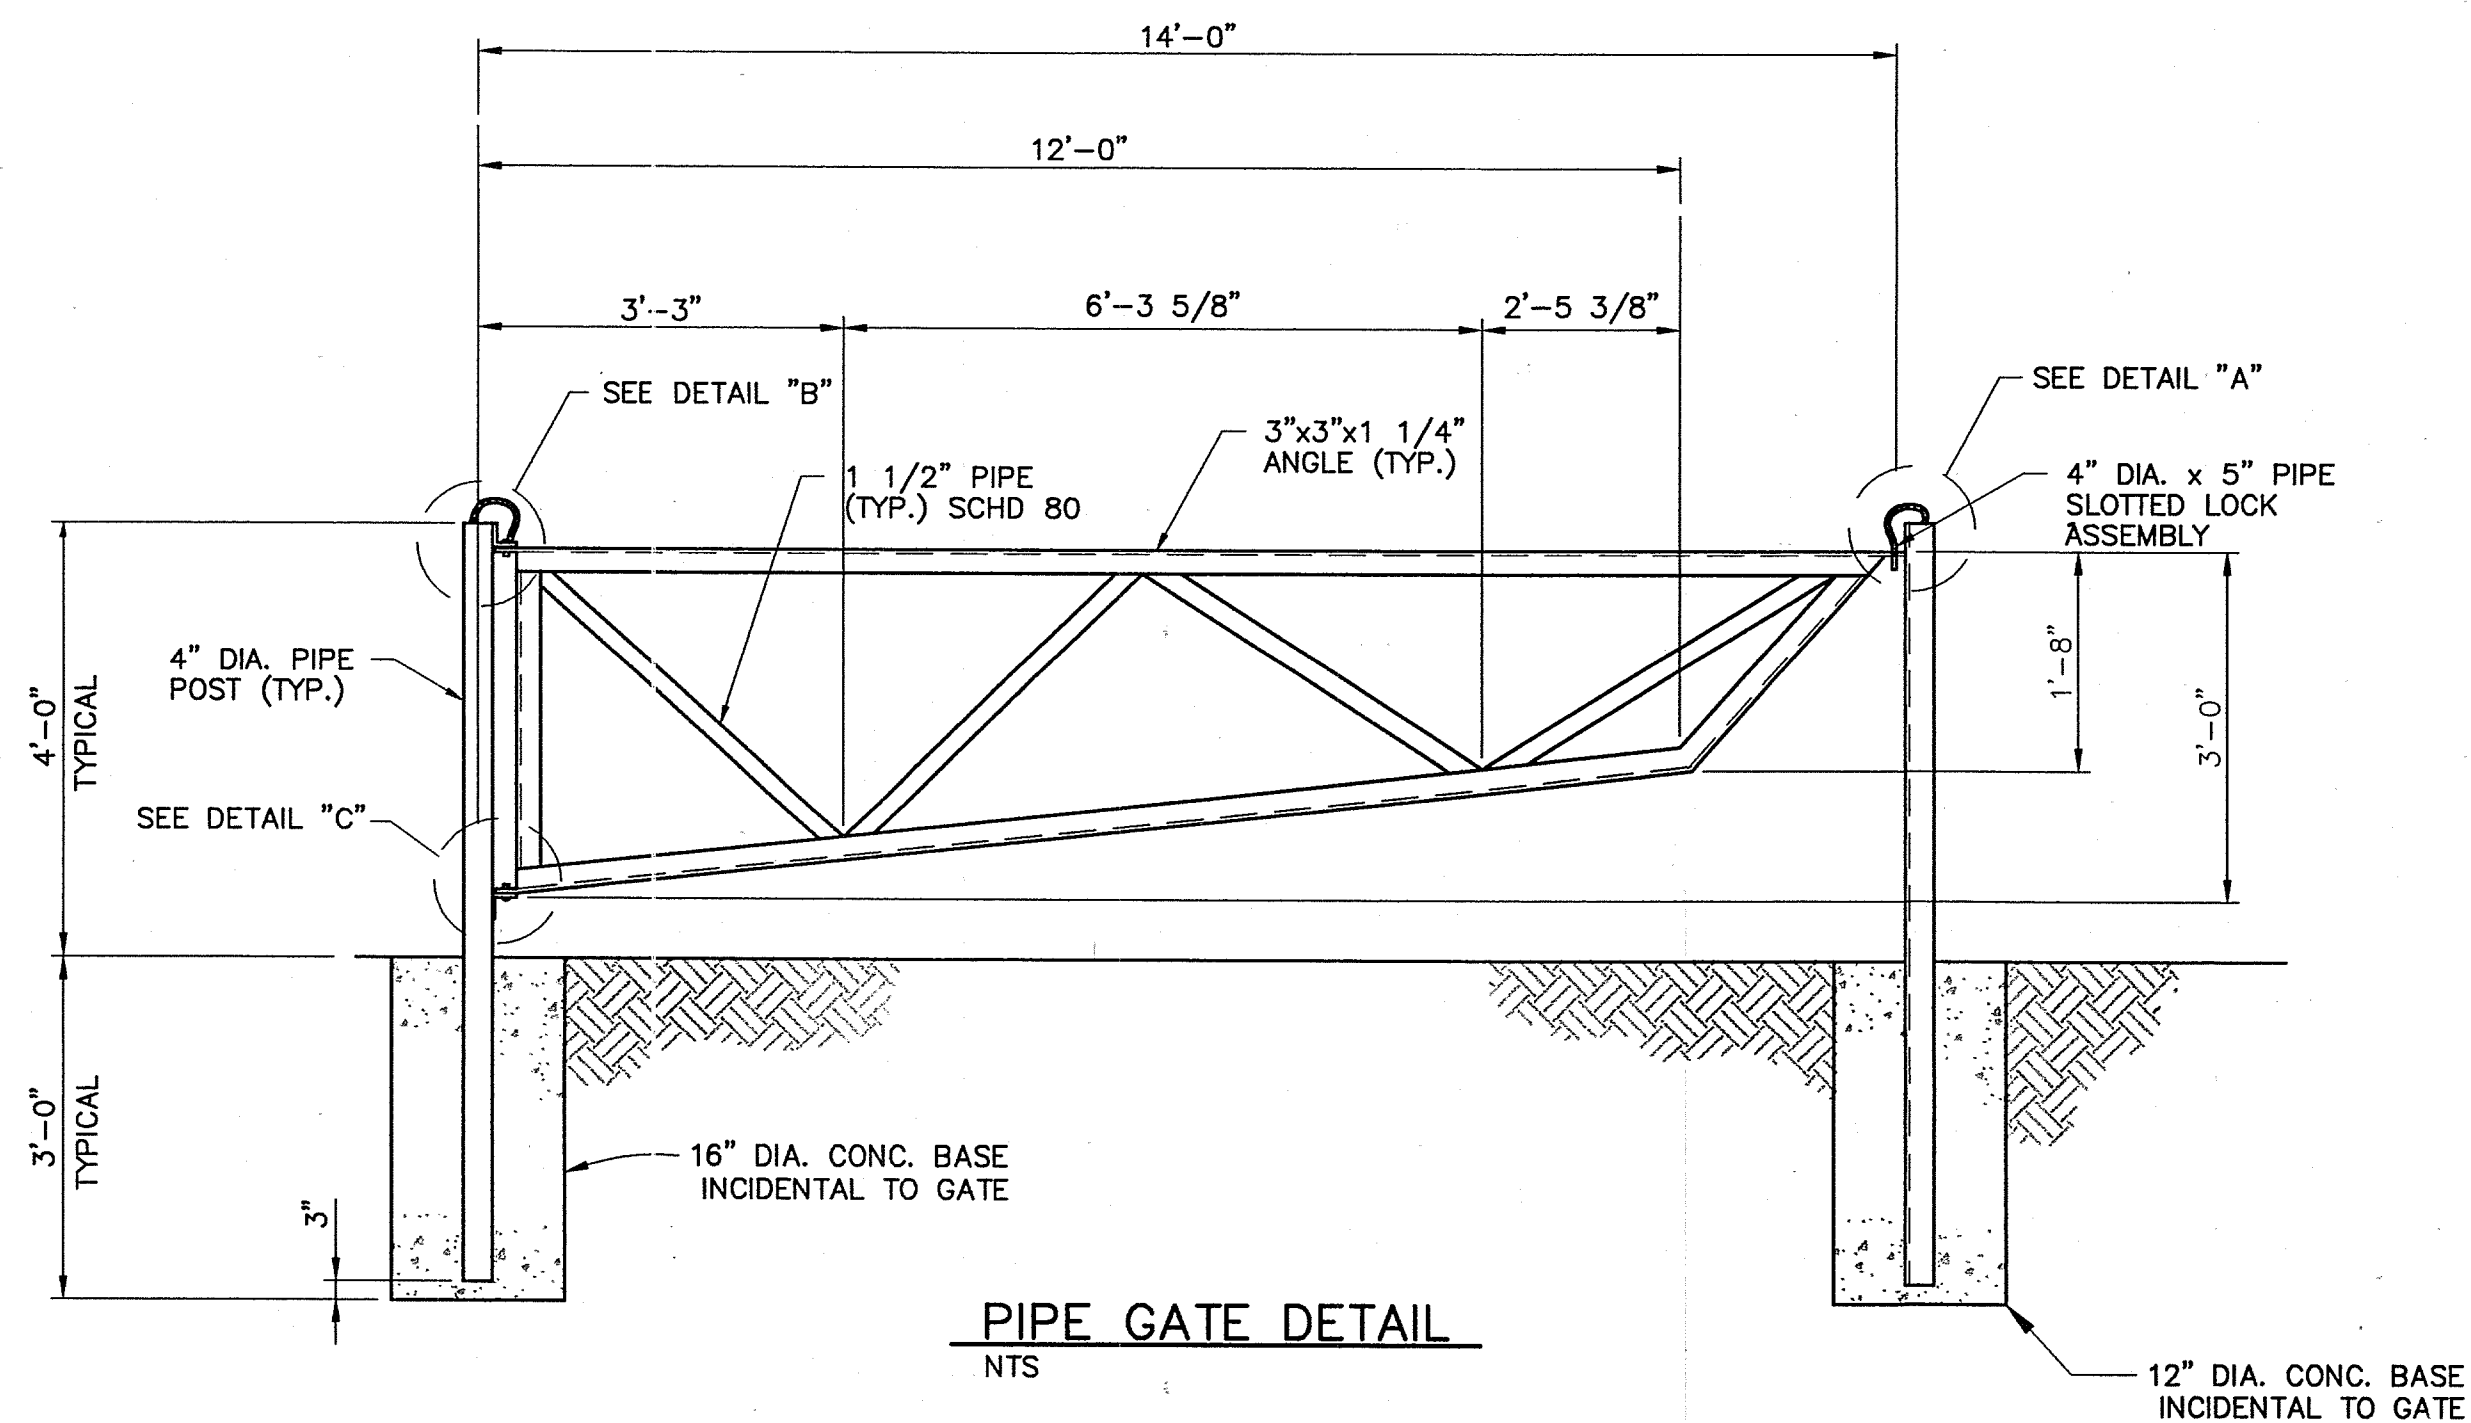


PIPE GATE DETAIL
NTS


NOTE: CLEAN AND PAINT ALL PIPE HANDRAIL WITH 1 COAT PRIMER AND 2 COATS SAFETY BLUE (OR APPROVED EQUAL BY PROJECT ENGINEER). PAINT INCIDENTAL TO COST OF PIPE GATE.

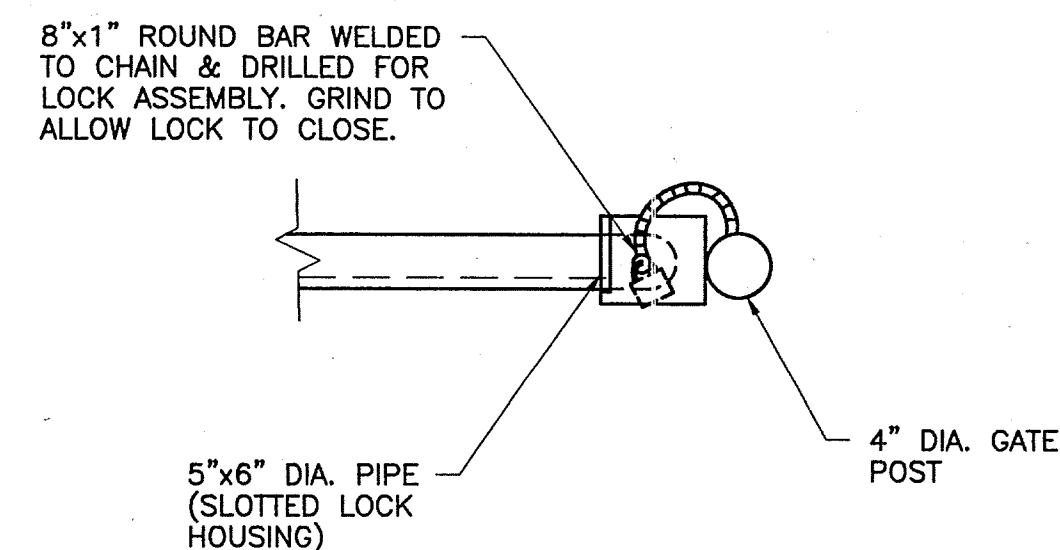

PLAN

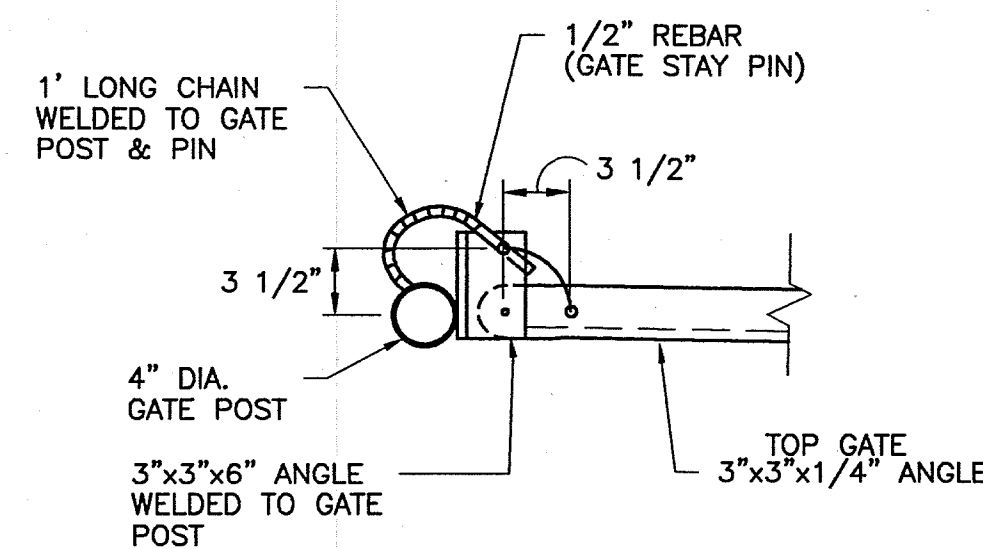


DETAIL B
NTS

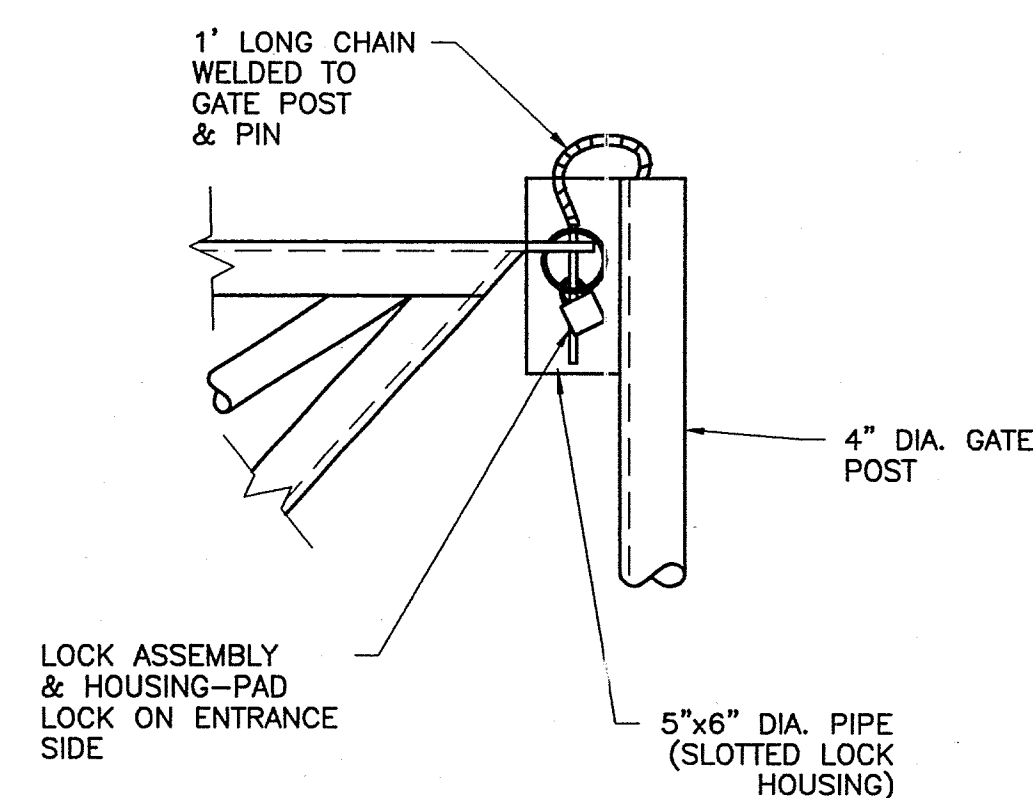


ELEVATION

DETAIL A
NTS

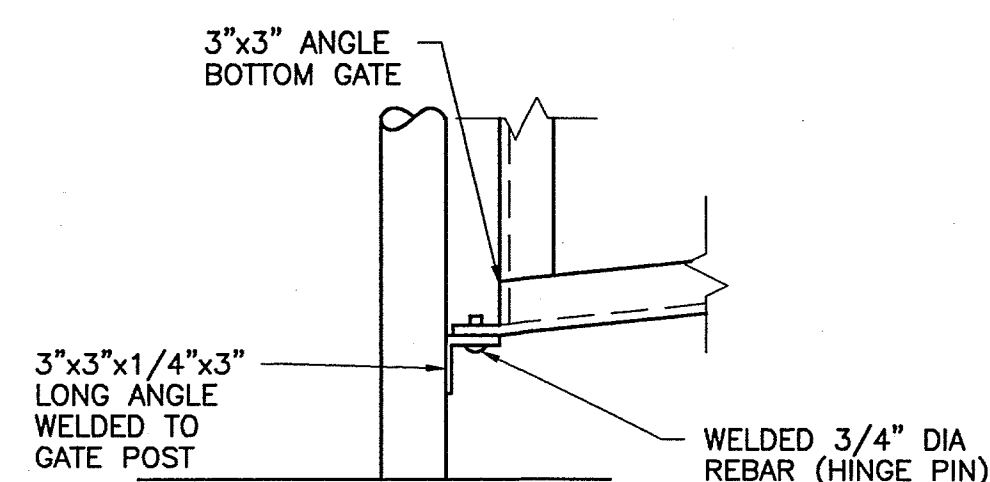


DETAIL C
NTS

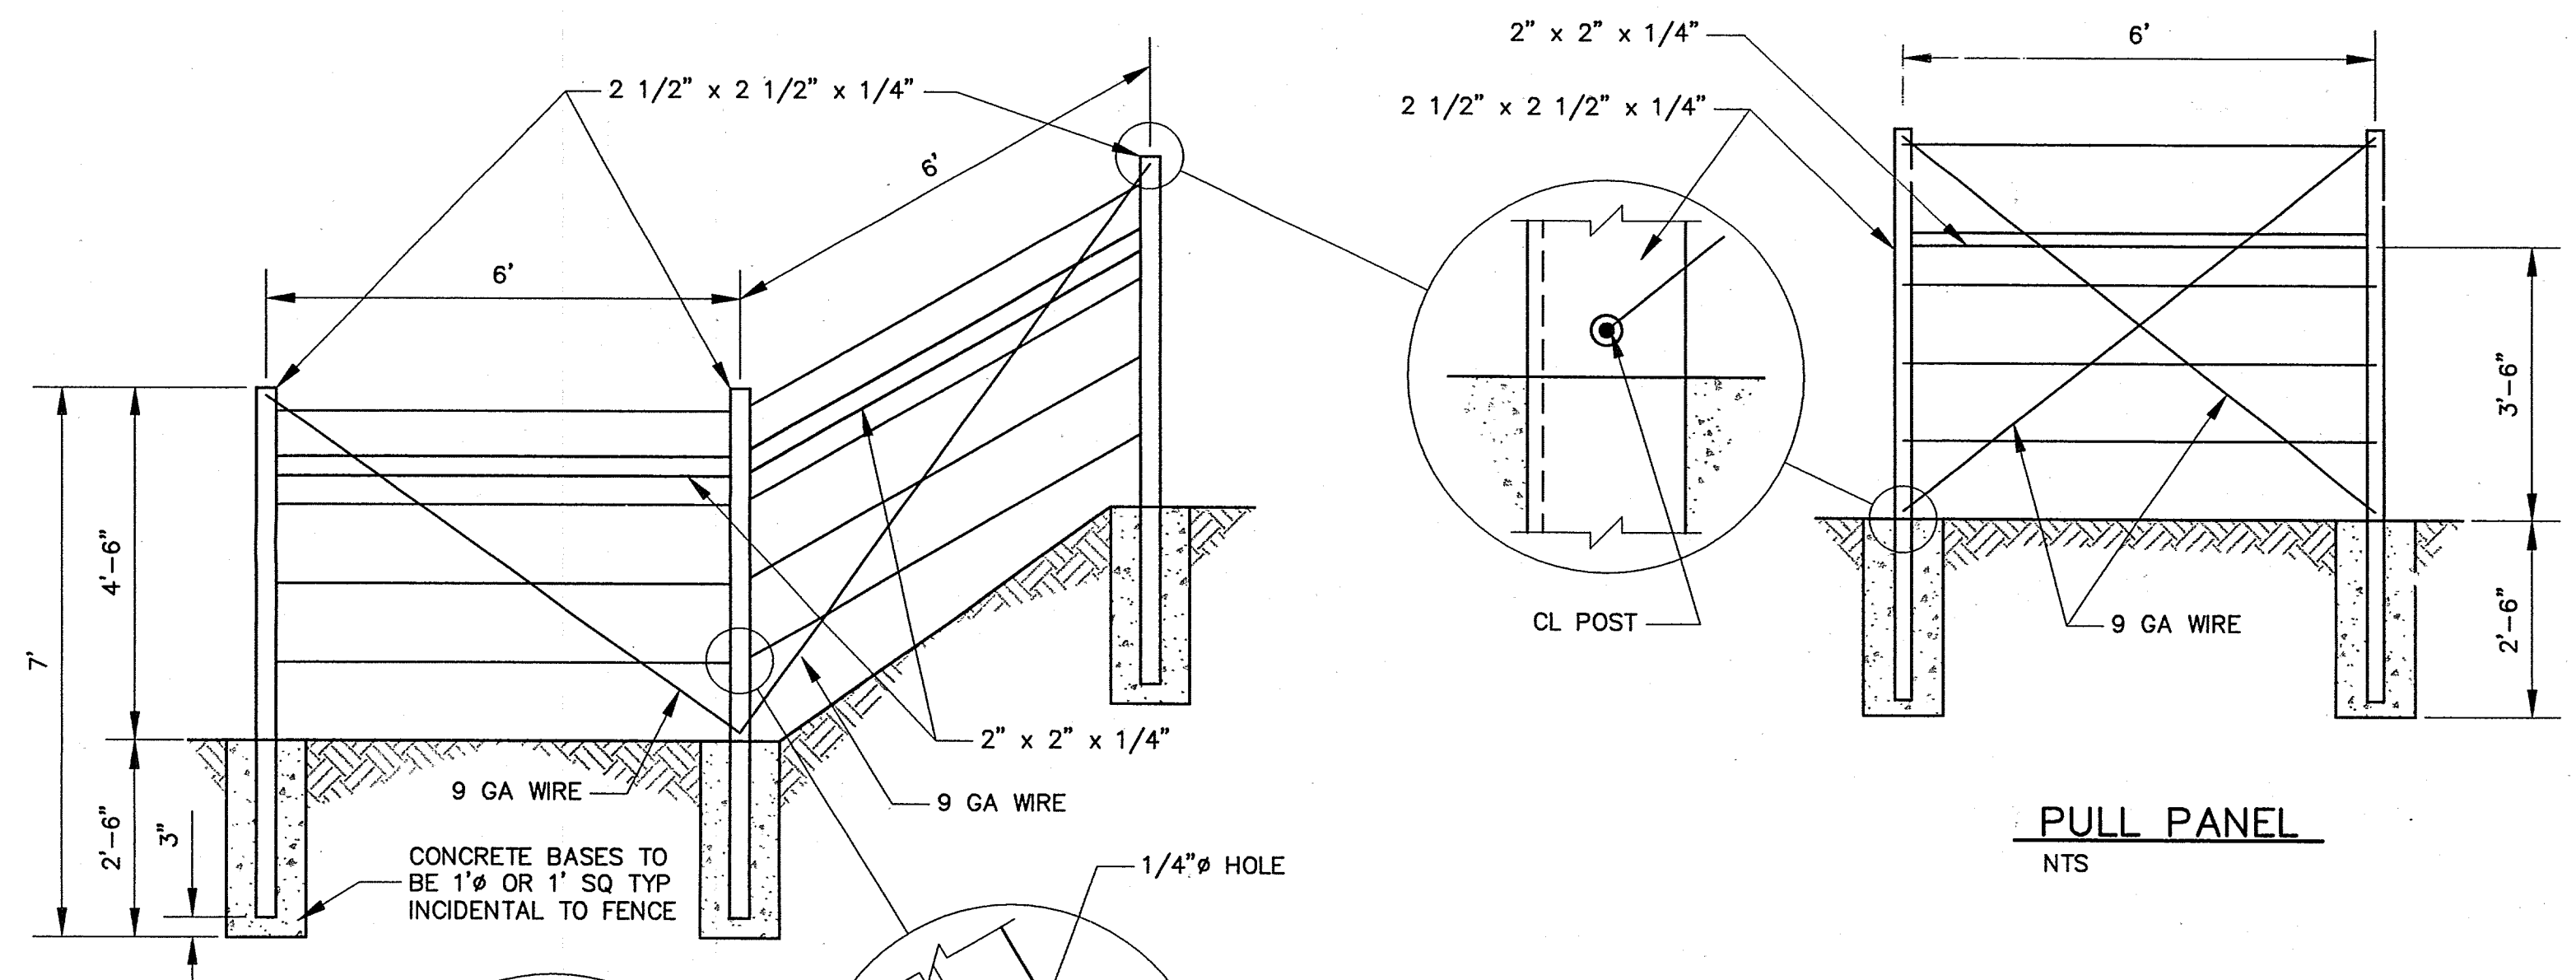


PULL PANEL
NTS


CORNER PANEL
NTS

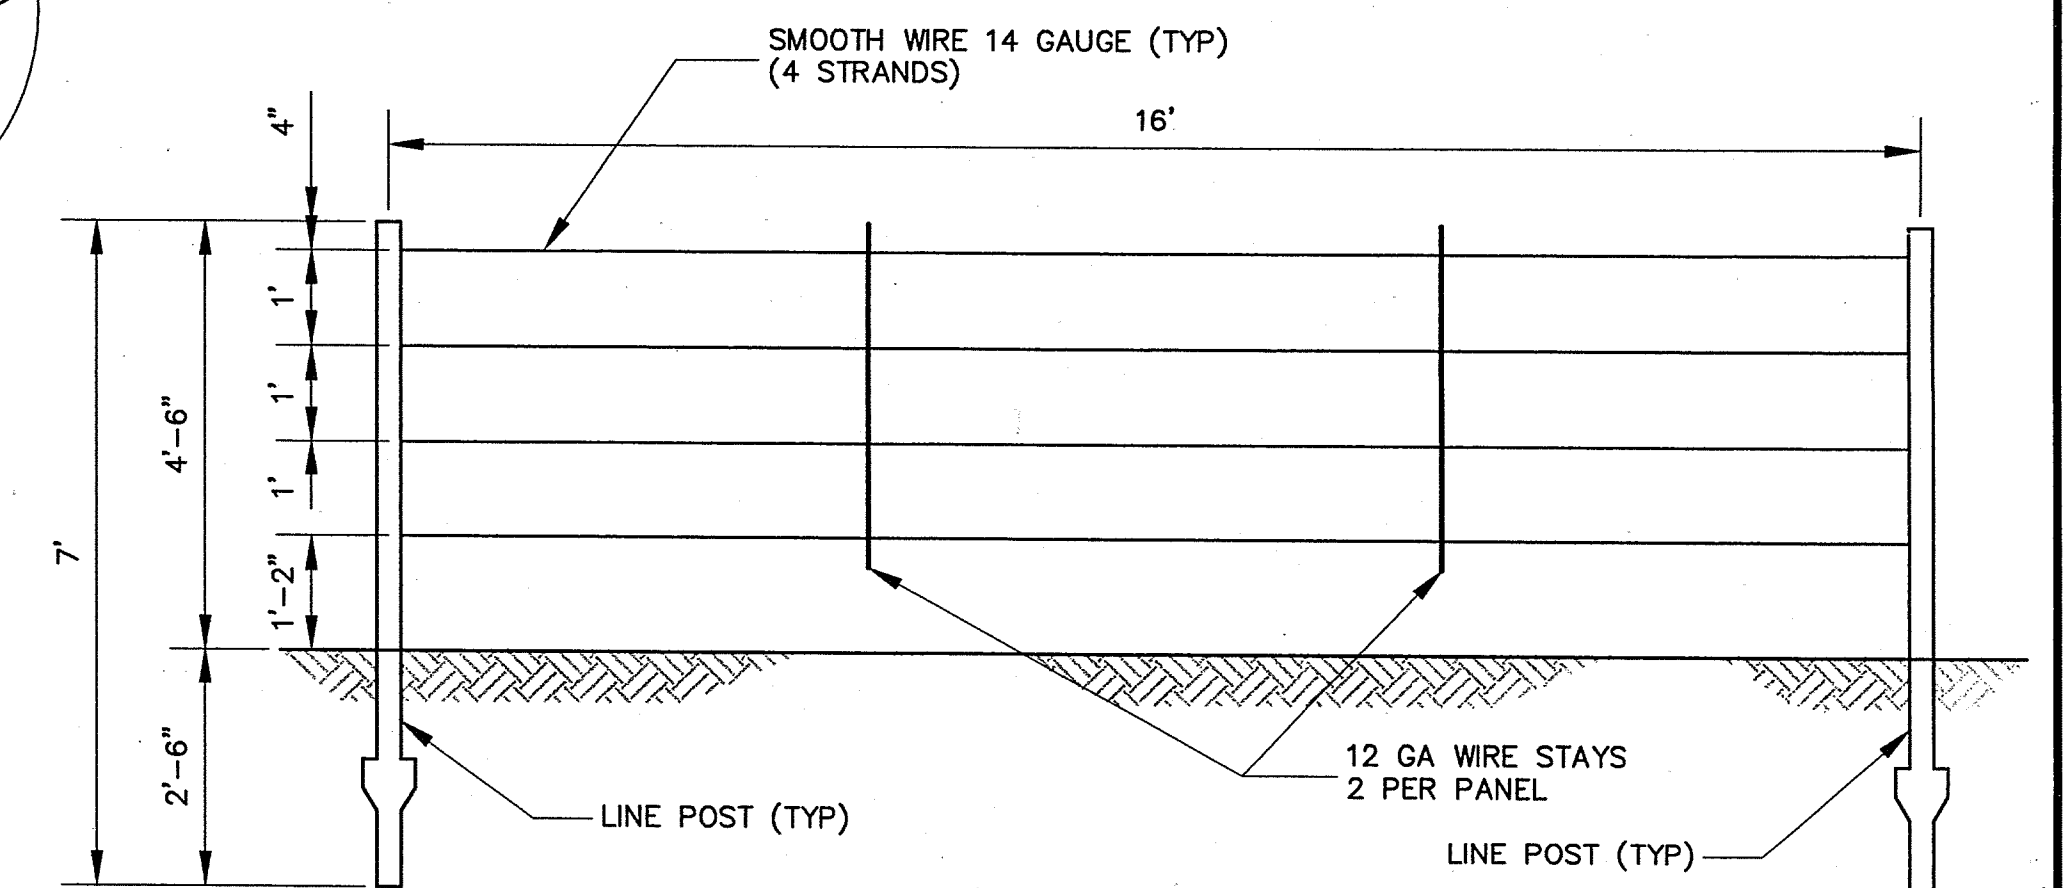

SMOOTH WIRE FENCE PANEL
NTS

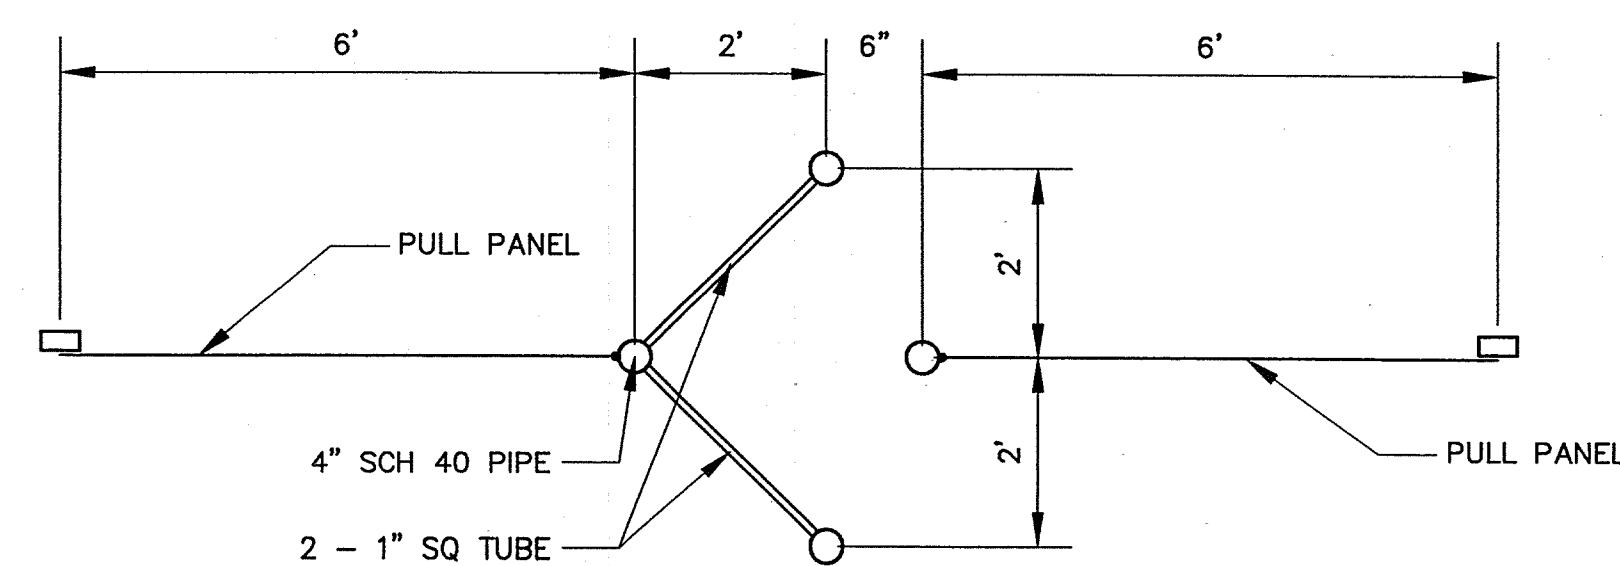

WALK GAP PLAN
NTS

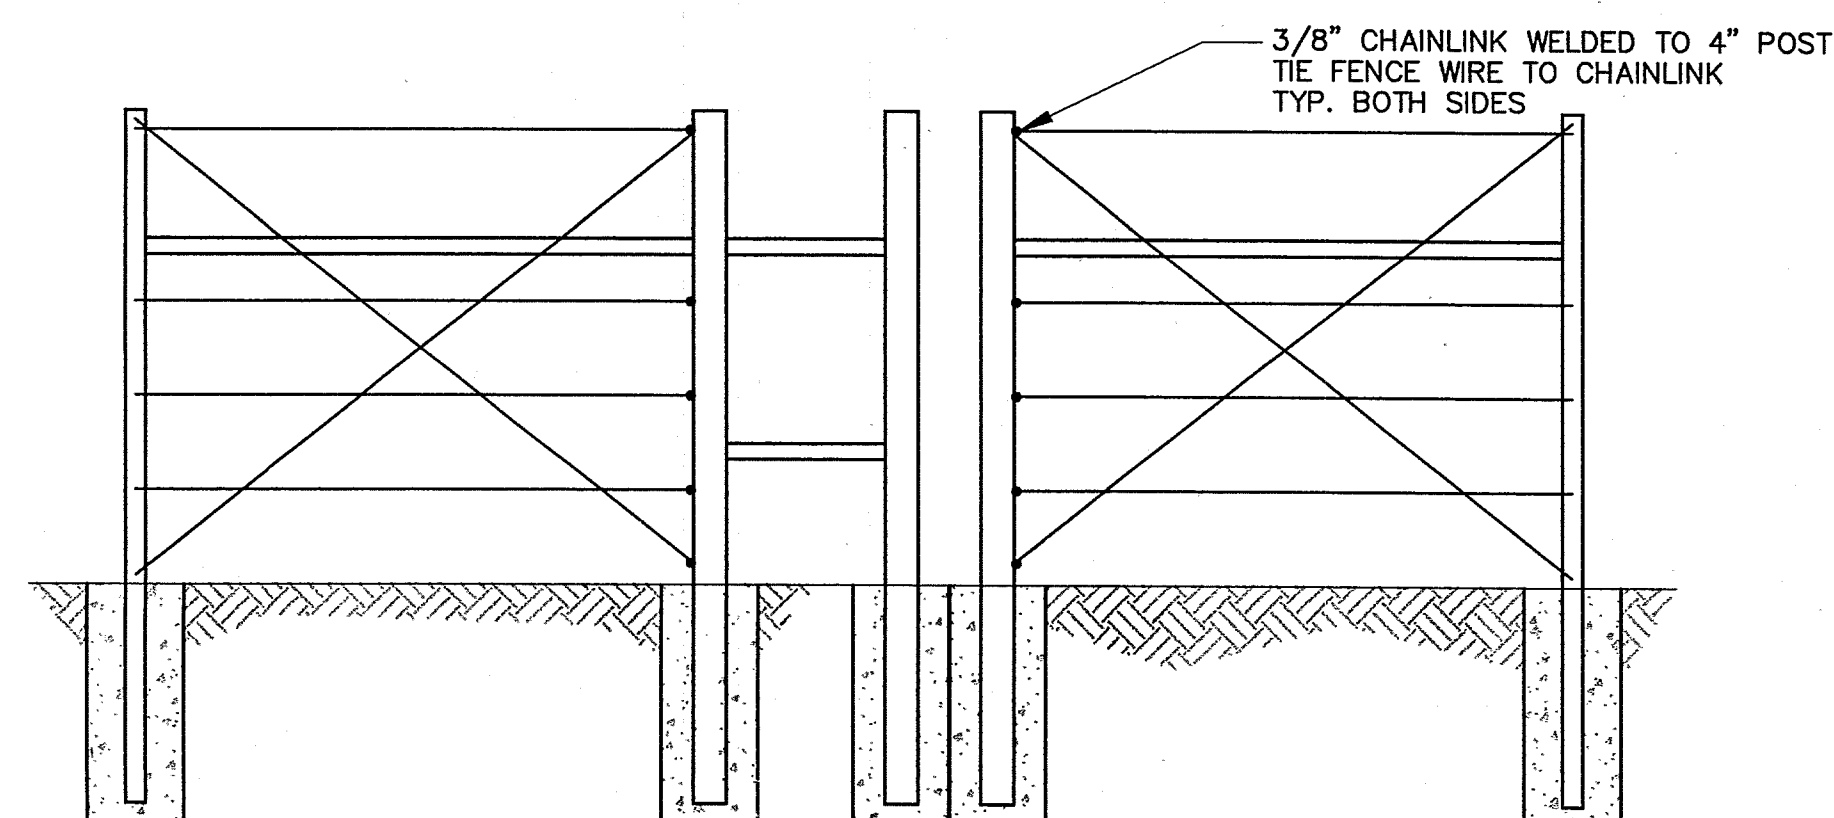

WALK GAP ELEVATION
NTS

REVISION
2-20-01

NO.	DATE	REVISIONS	BY
1		DESIGNED BY	WILSON & COMPANY, ENGINEERS & ARCHITECTS
2		DRAWN BY	NM NOV 1999
3		CHECKED BY	PJM NOV 1999
4			DSA NOV 1999

6922.91

ALBUQUERQUE METROPOLITAN ARROYO FLOOD CONTROL AUTHORITY

BORREGA DETENTION DAM

FENCE DETAILS


DATE: APRIL 2000

FILE: 99099


SHEET 26 OF 34

WILSON & COMPANY
4900 LANG AVENUE N.E.
ALBUQUERQUE, NM 87109
(505) 348-4000


DESIGNED BY: WILSON & COMPANY, ENGINEERS & ARCHITECTS
DRAFTER: NM
CHECKED BY: PJM
DATE: NOV 1999

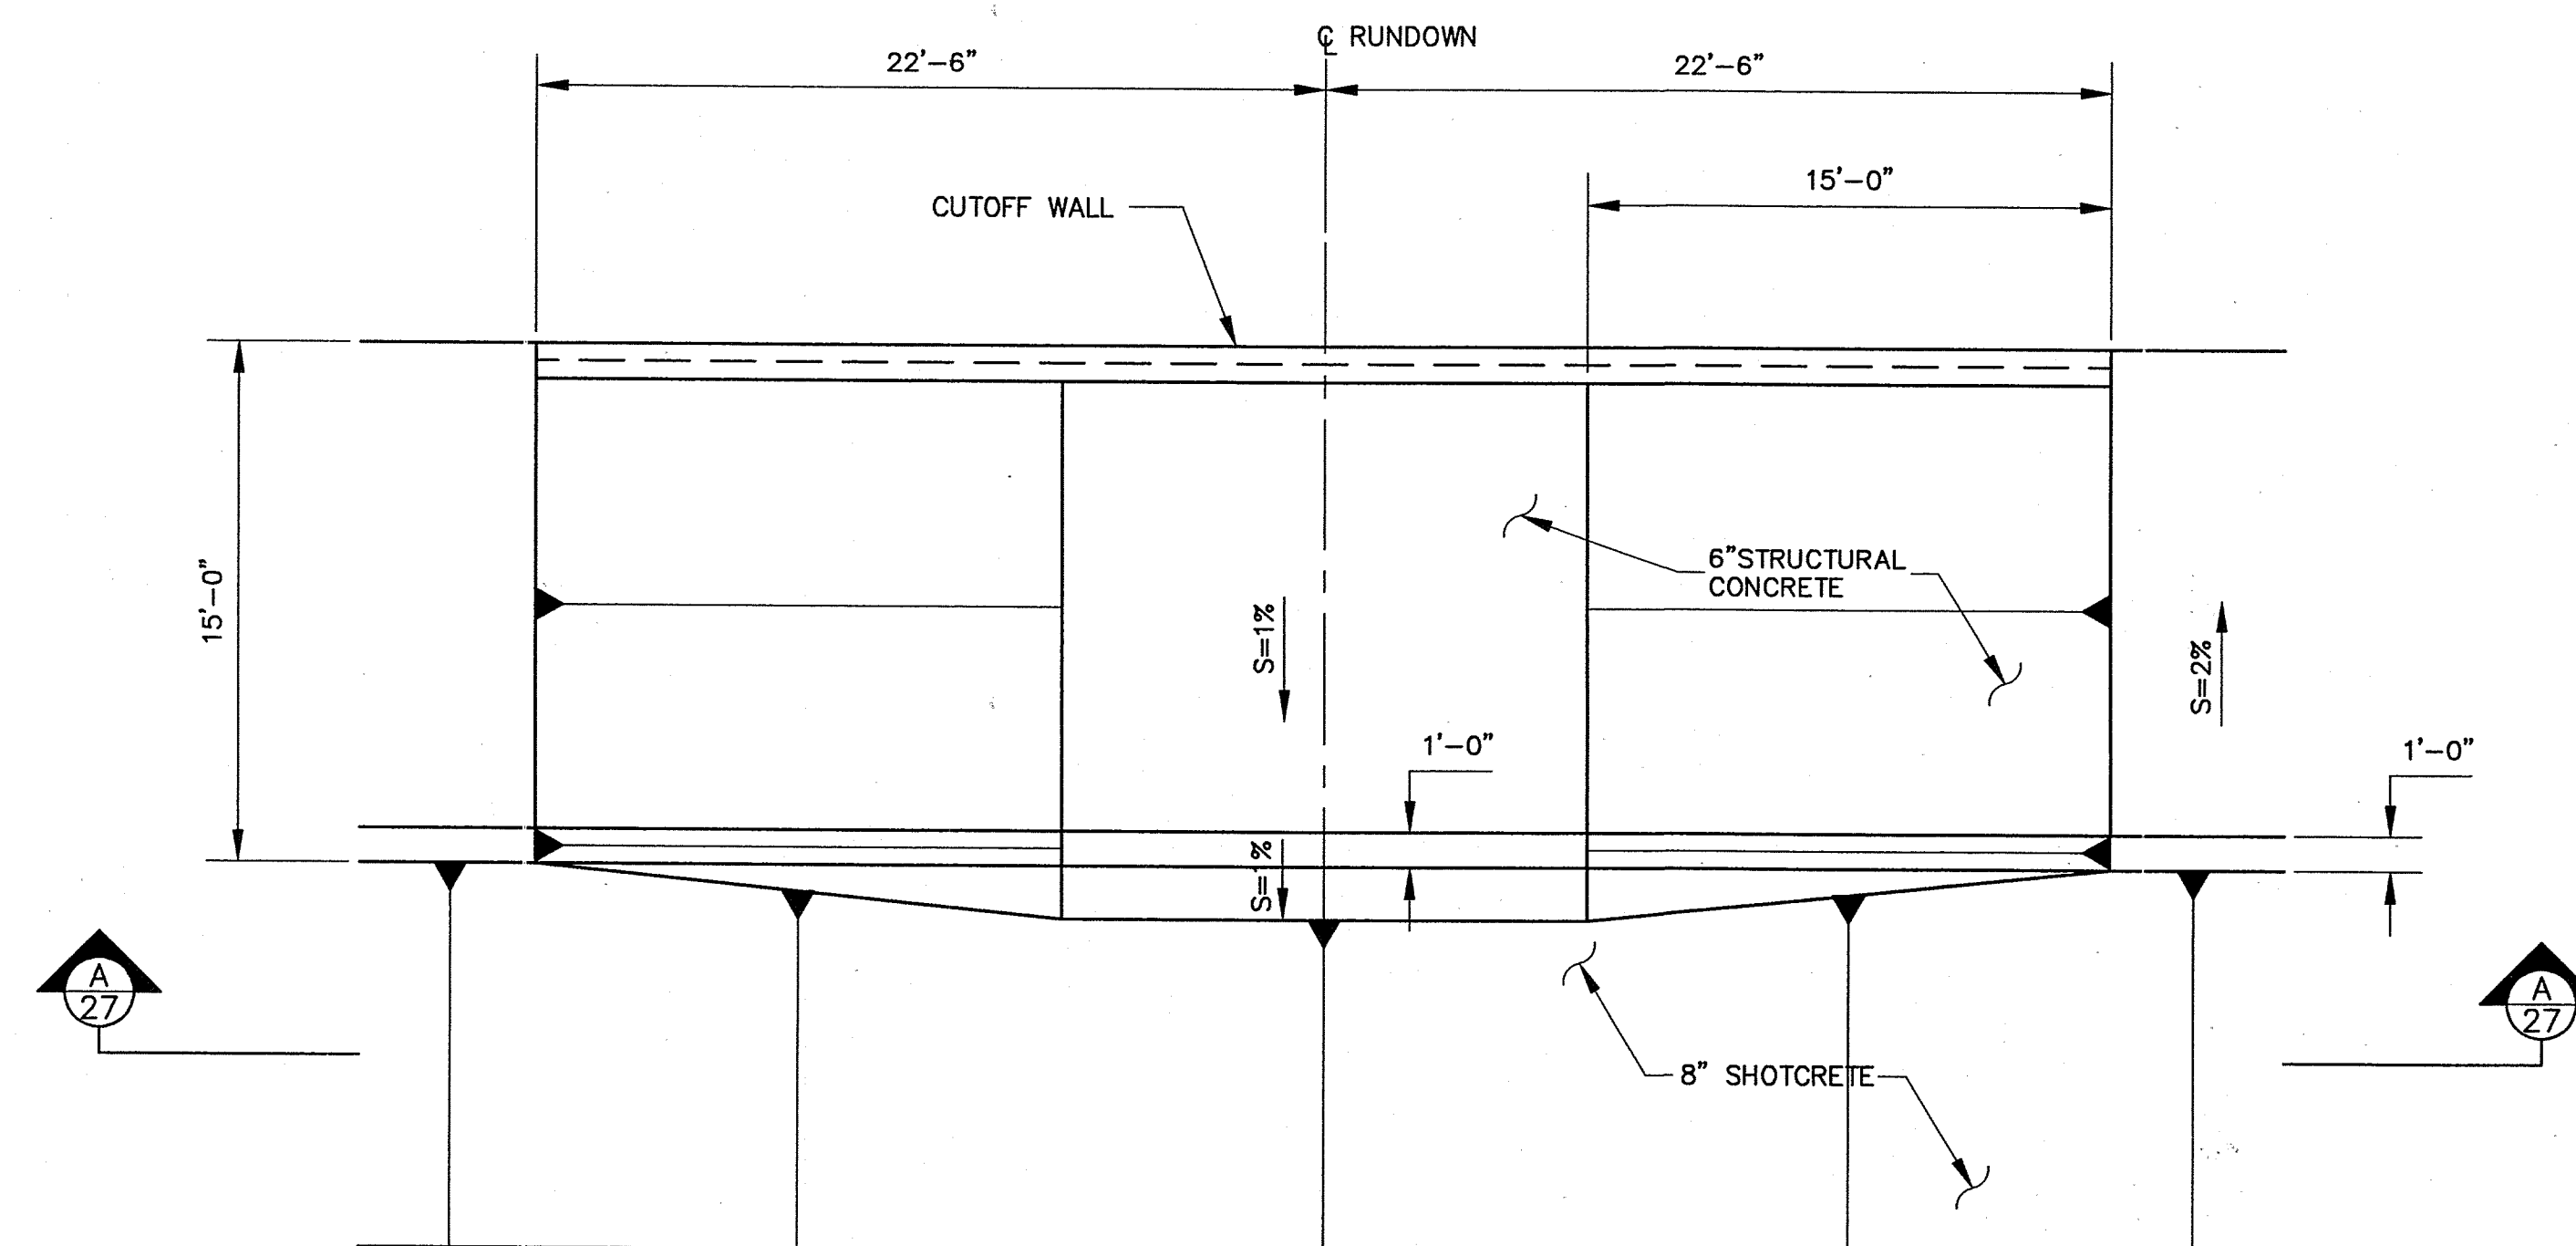

PLAN
SCALE 1" = 5'

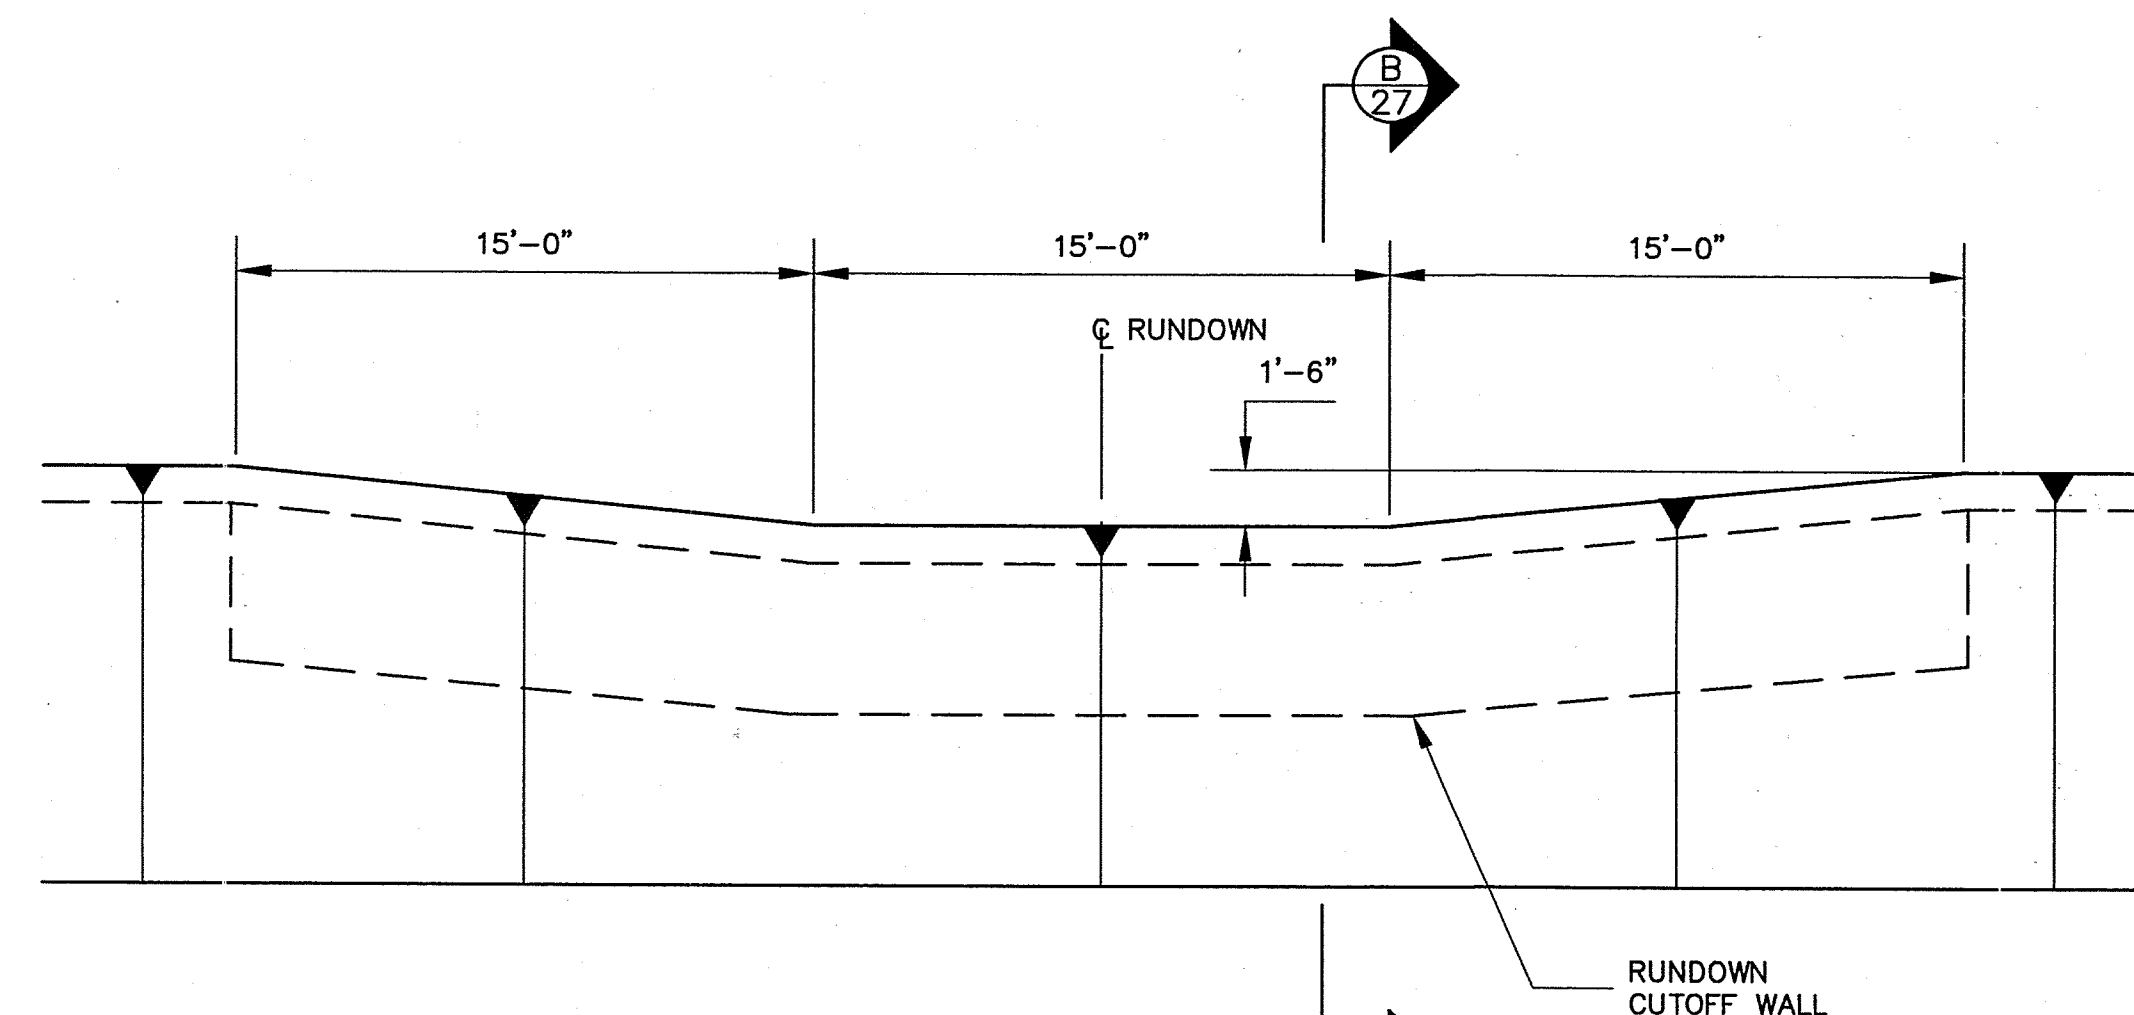


SECTION A-A
SCALE 1" = 5'

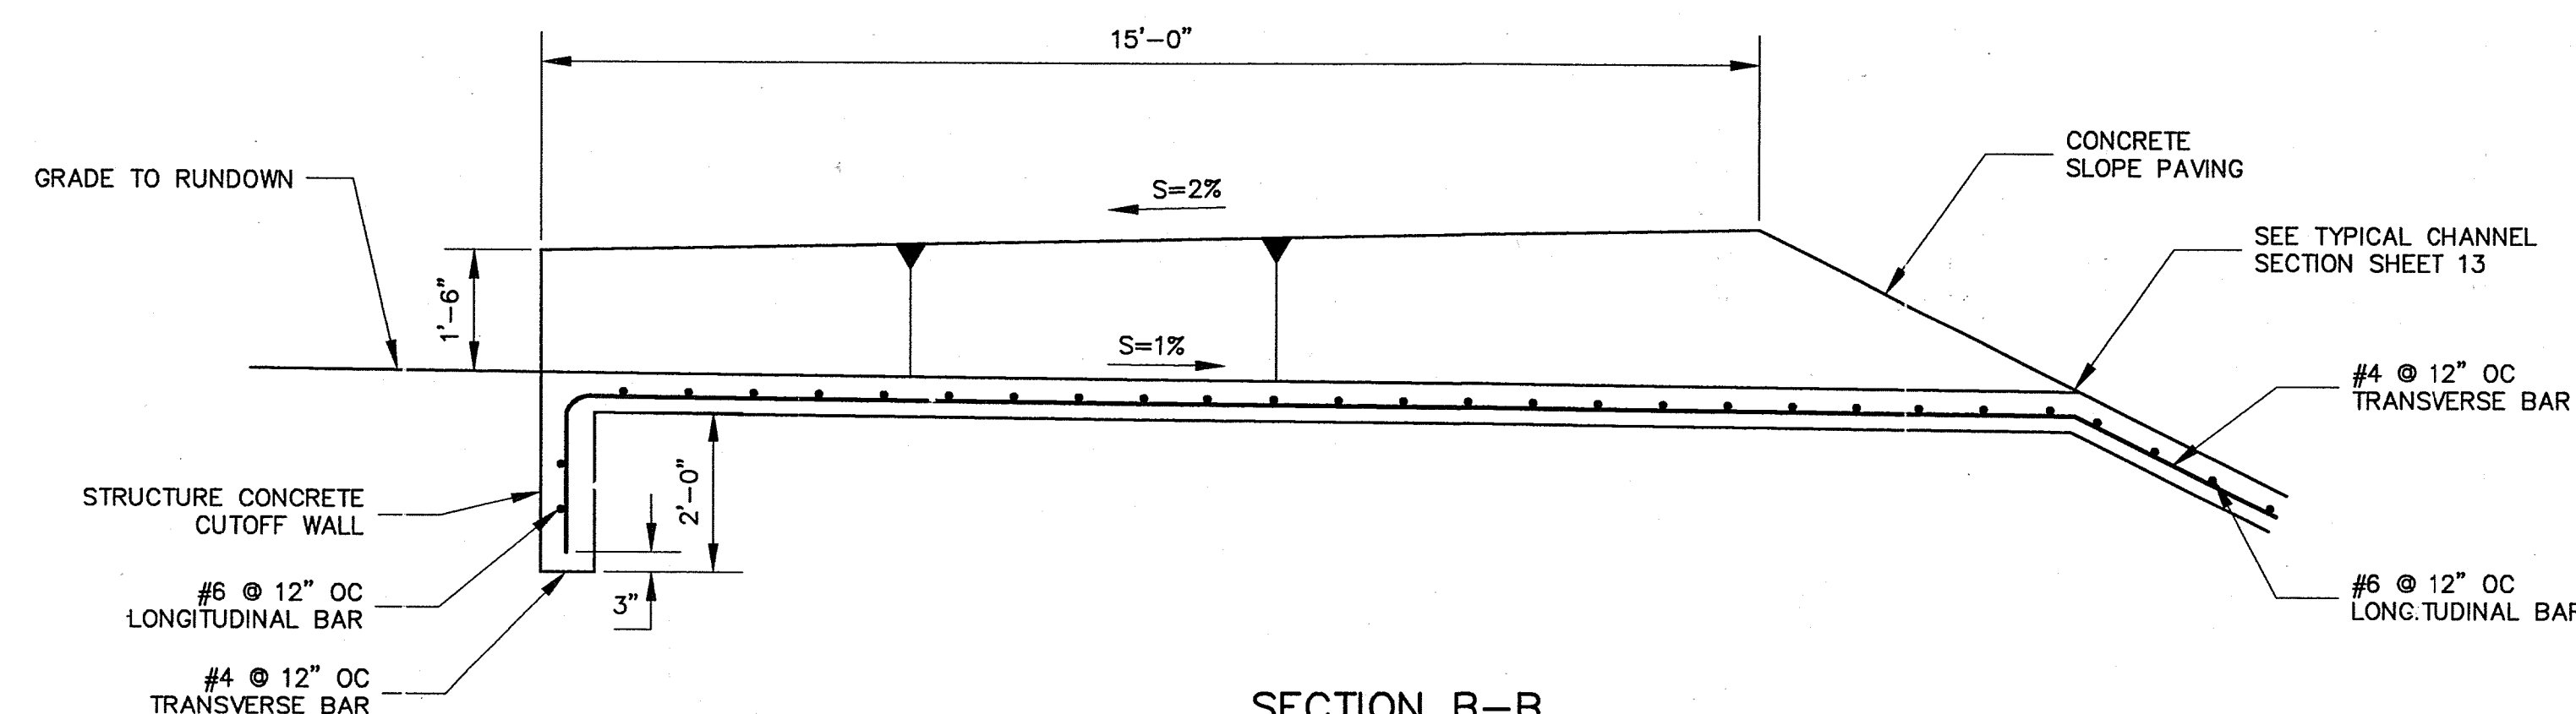


SECTION B-B
SCALE 1" = 2'

TYPICAL TYPE 'B' CHANNEL RUNDOWN DETAILS
SCALE: VARIES

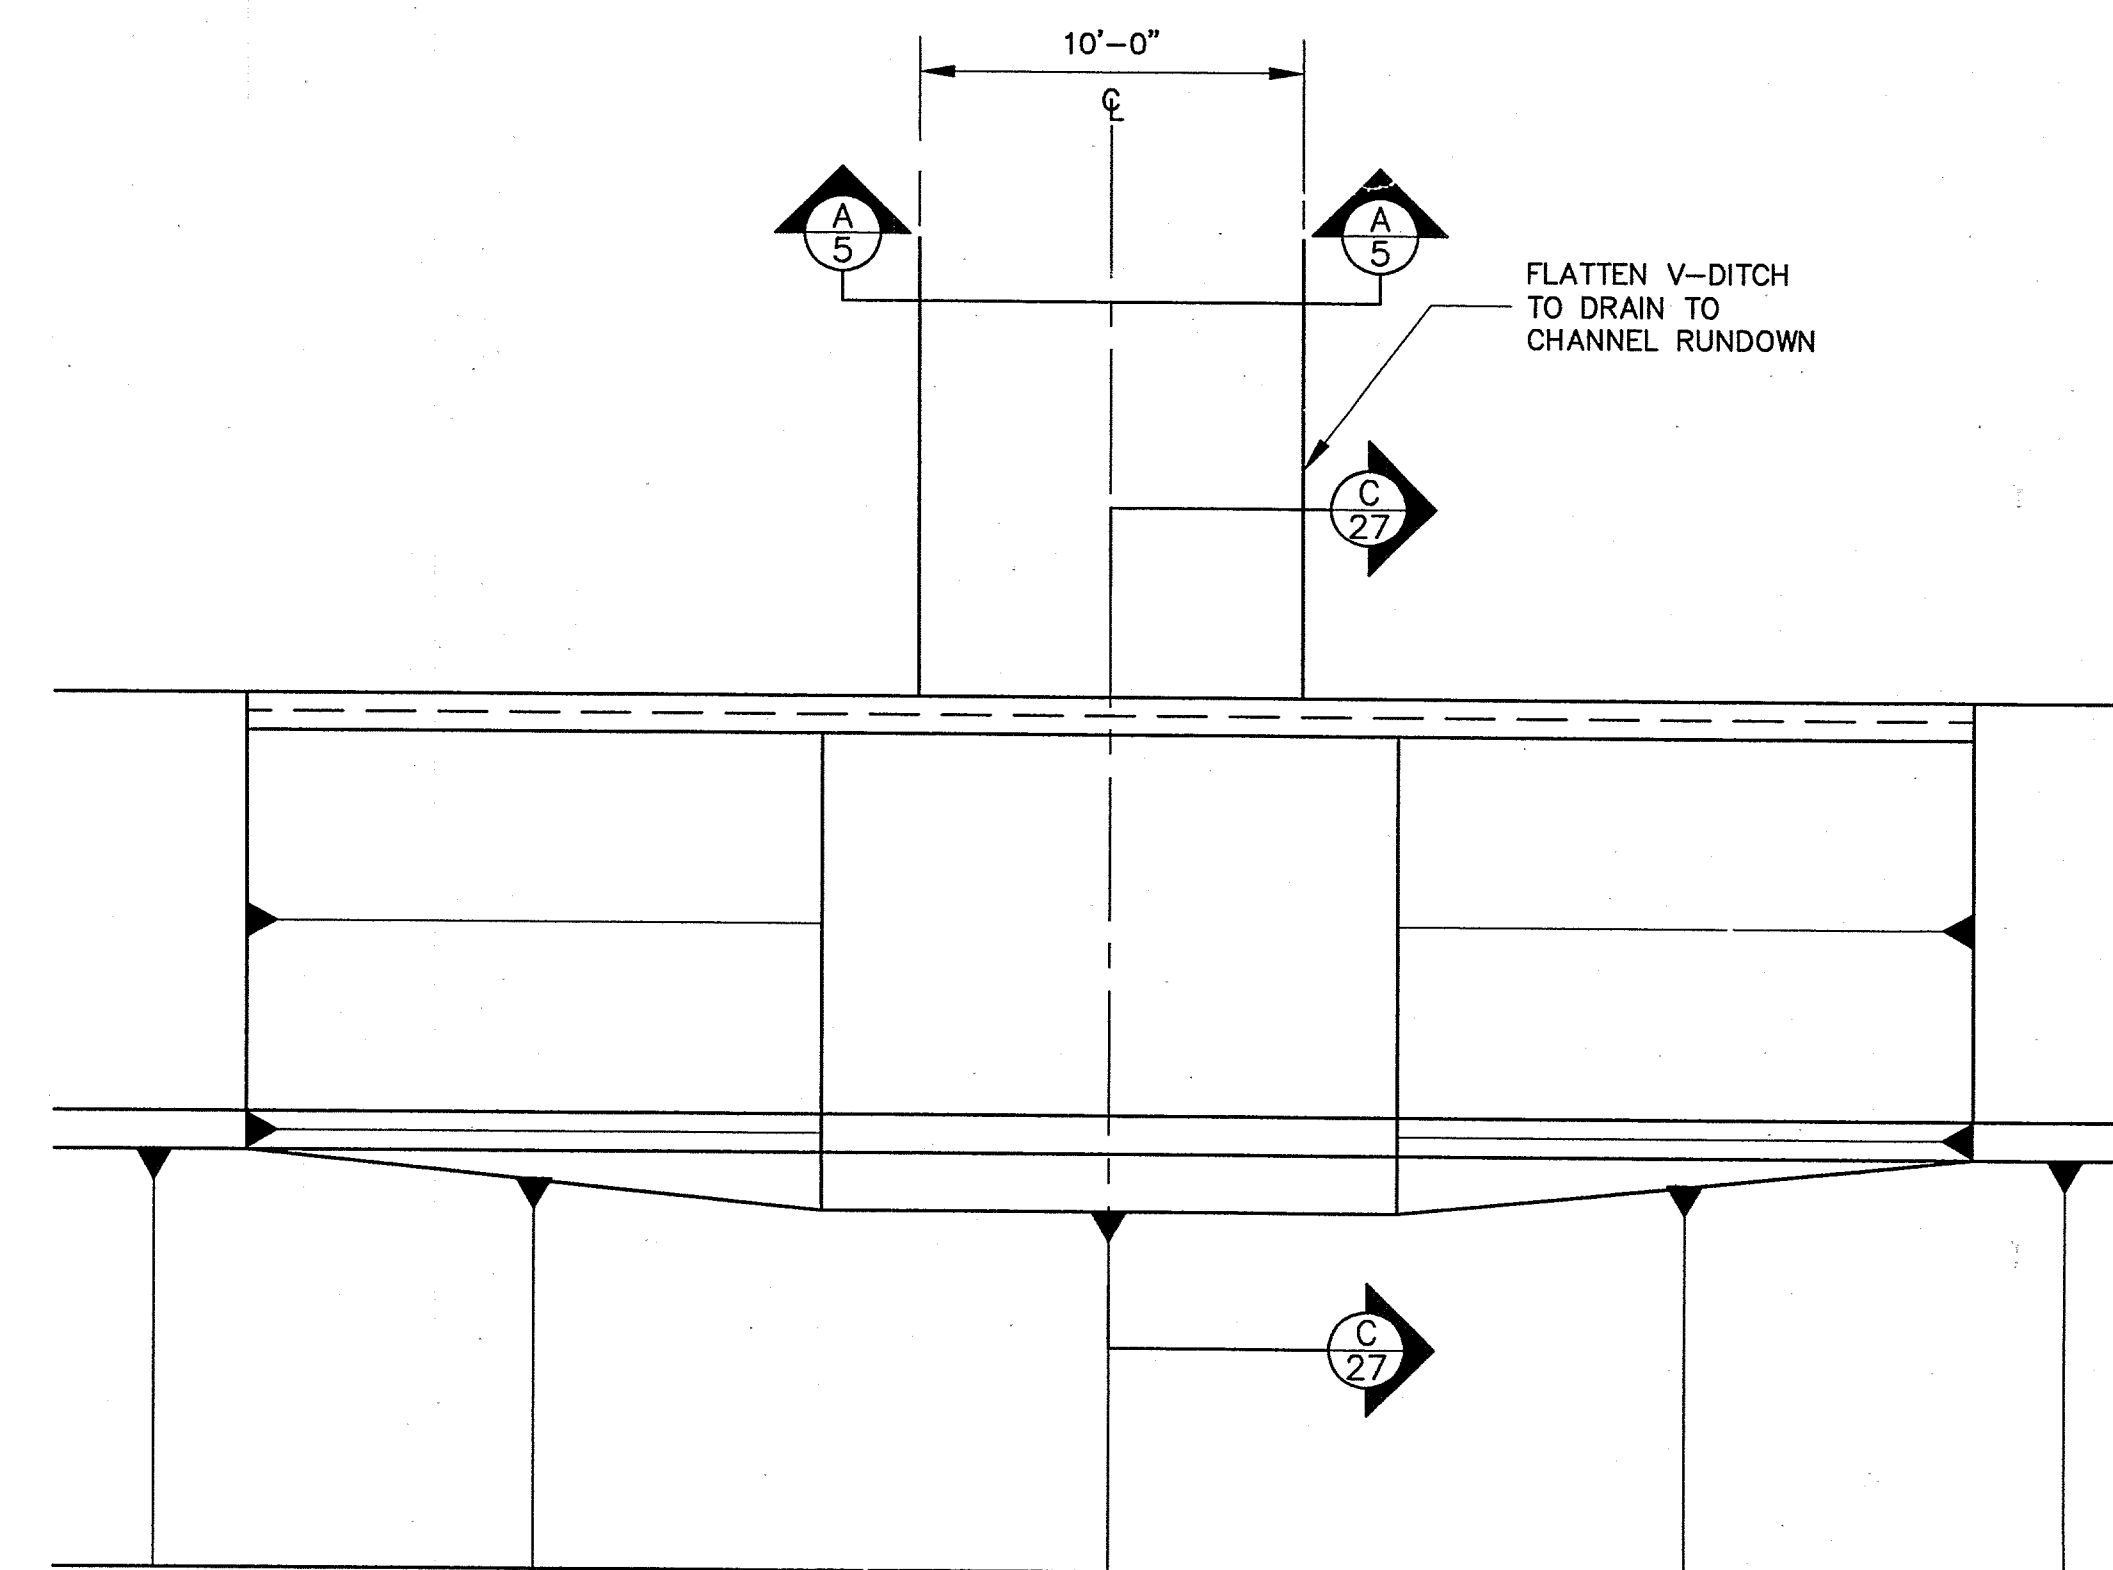

JUNCTION OF V-DITCH & CHANNEL RUNDOWN
SCALE 1" = 5'

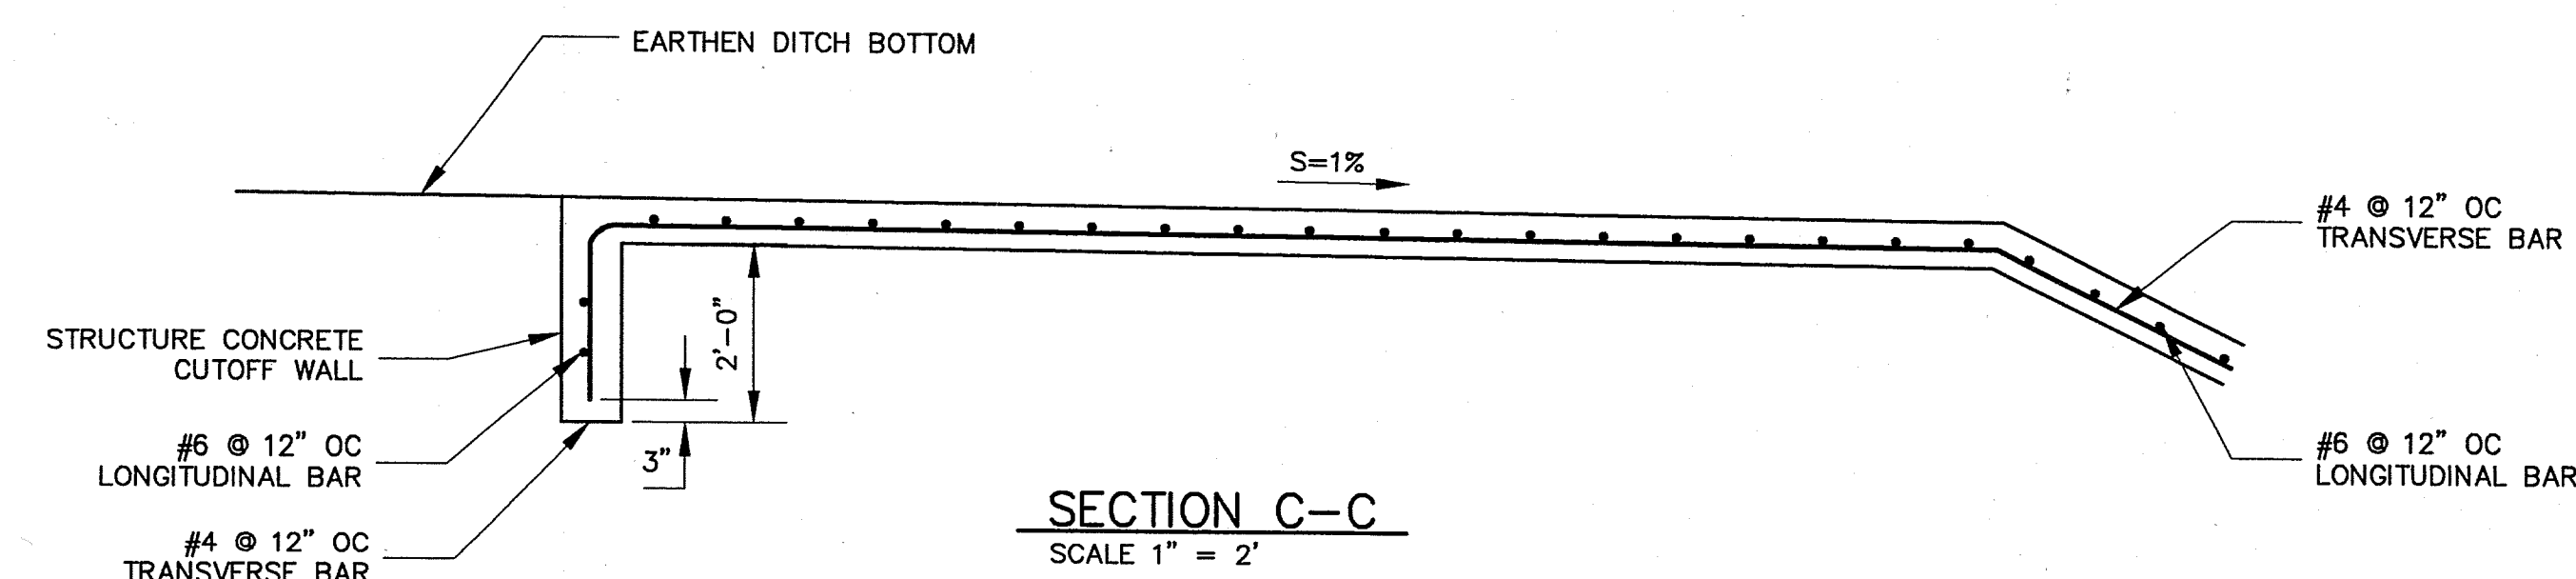


SECTION C-C
SCALE 1" = 2'

RECORD DRAWING
DATE 2-20-01


6922.91

ALBUQUERQUE METROPOLITAN ARROYO FLOOD CONTROL AUTHORITY		BORREGA DETENTION DAM	
RUNDOWN AND CHANNEL DETAILS			
WILSON & COMPANY 4900 LANG AVENUE N.E. ALBUQUERQUE, NM 87109 (505) 348-4000		DATE MARCH 2000 FILE 99099 SHEET 27 OF 34	


NO.	DATE	REVISIONS	BY
1		DESIGNED BY	WM
2		DRAWN BY	PJM
3		CHECKED BY	DSA
4		DESIGNED BY	WM
5		DRAWN BY	PJM
6		CHECKED BY	DSA

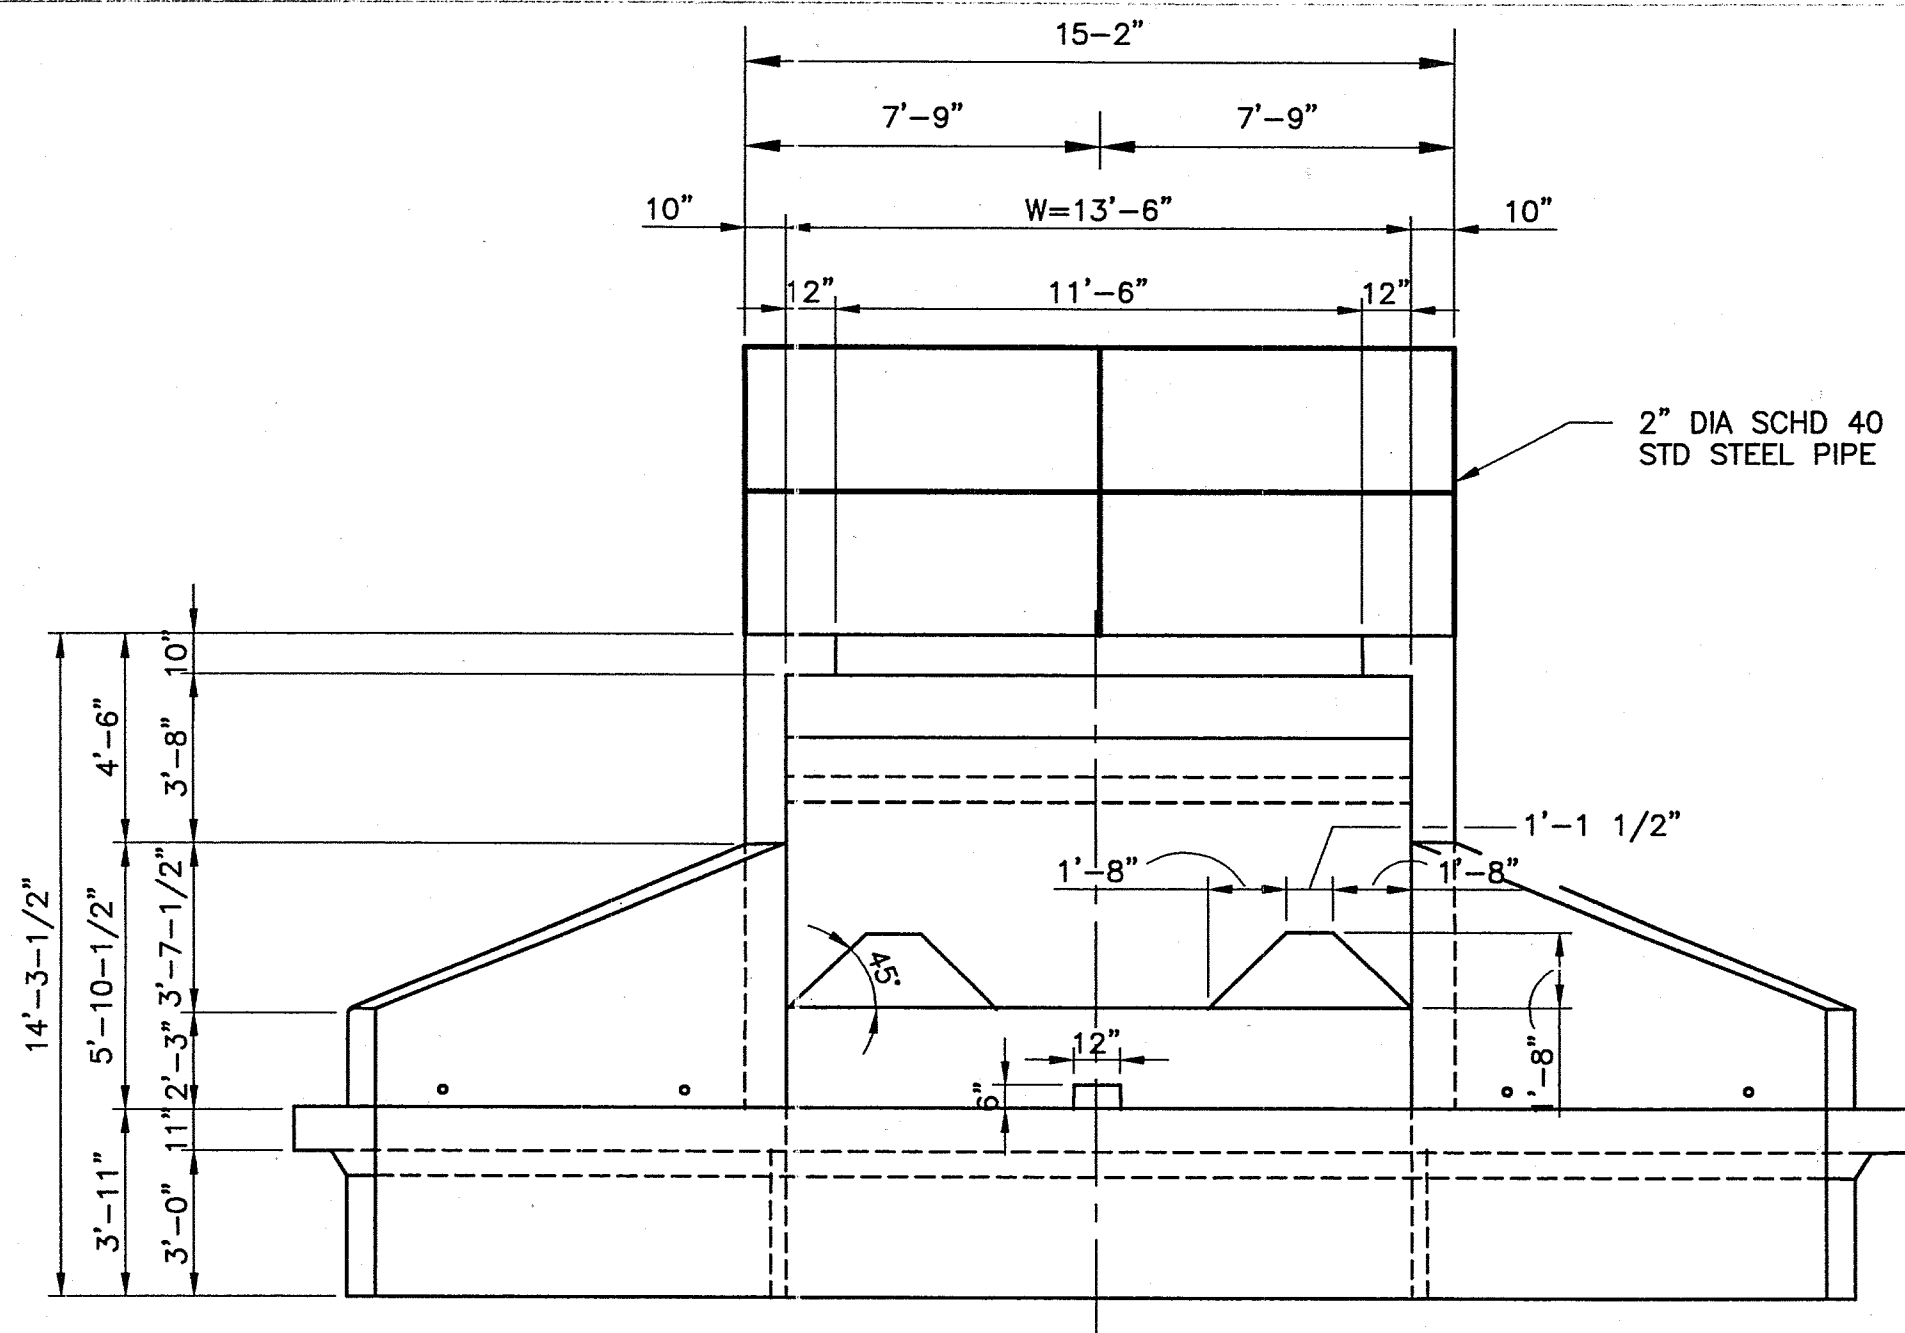


DOWNSTREAM ELEVATION
NTS

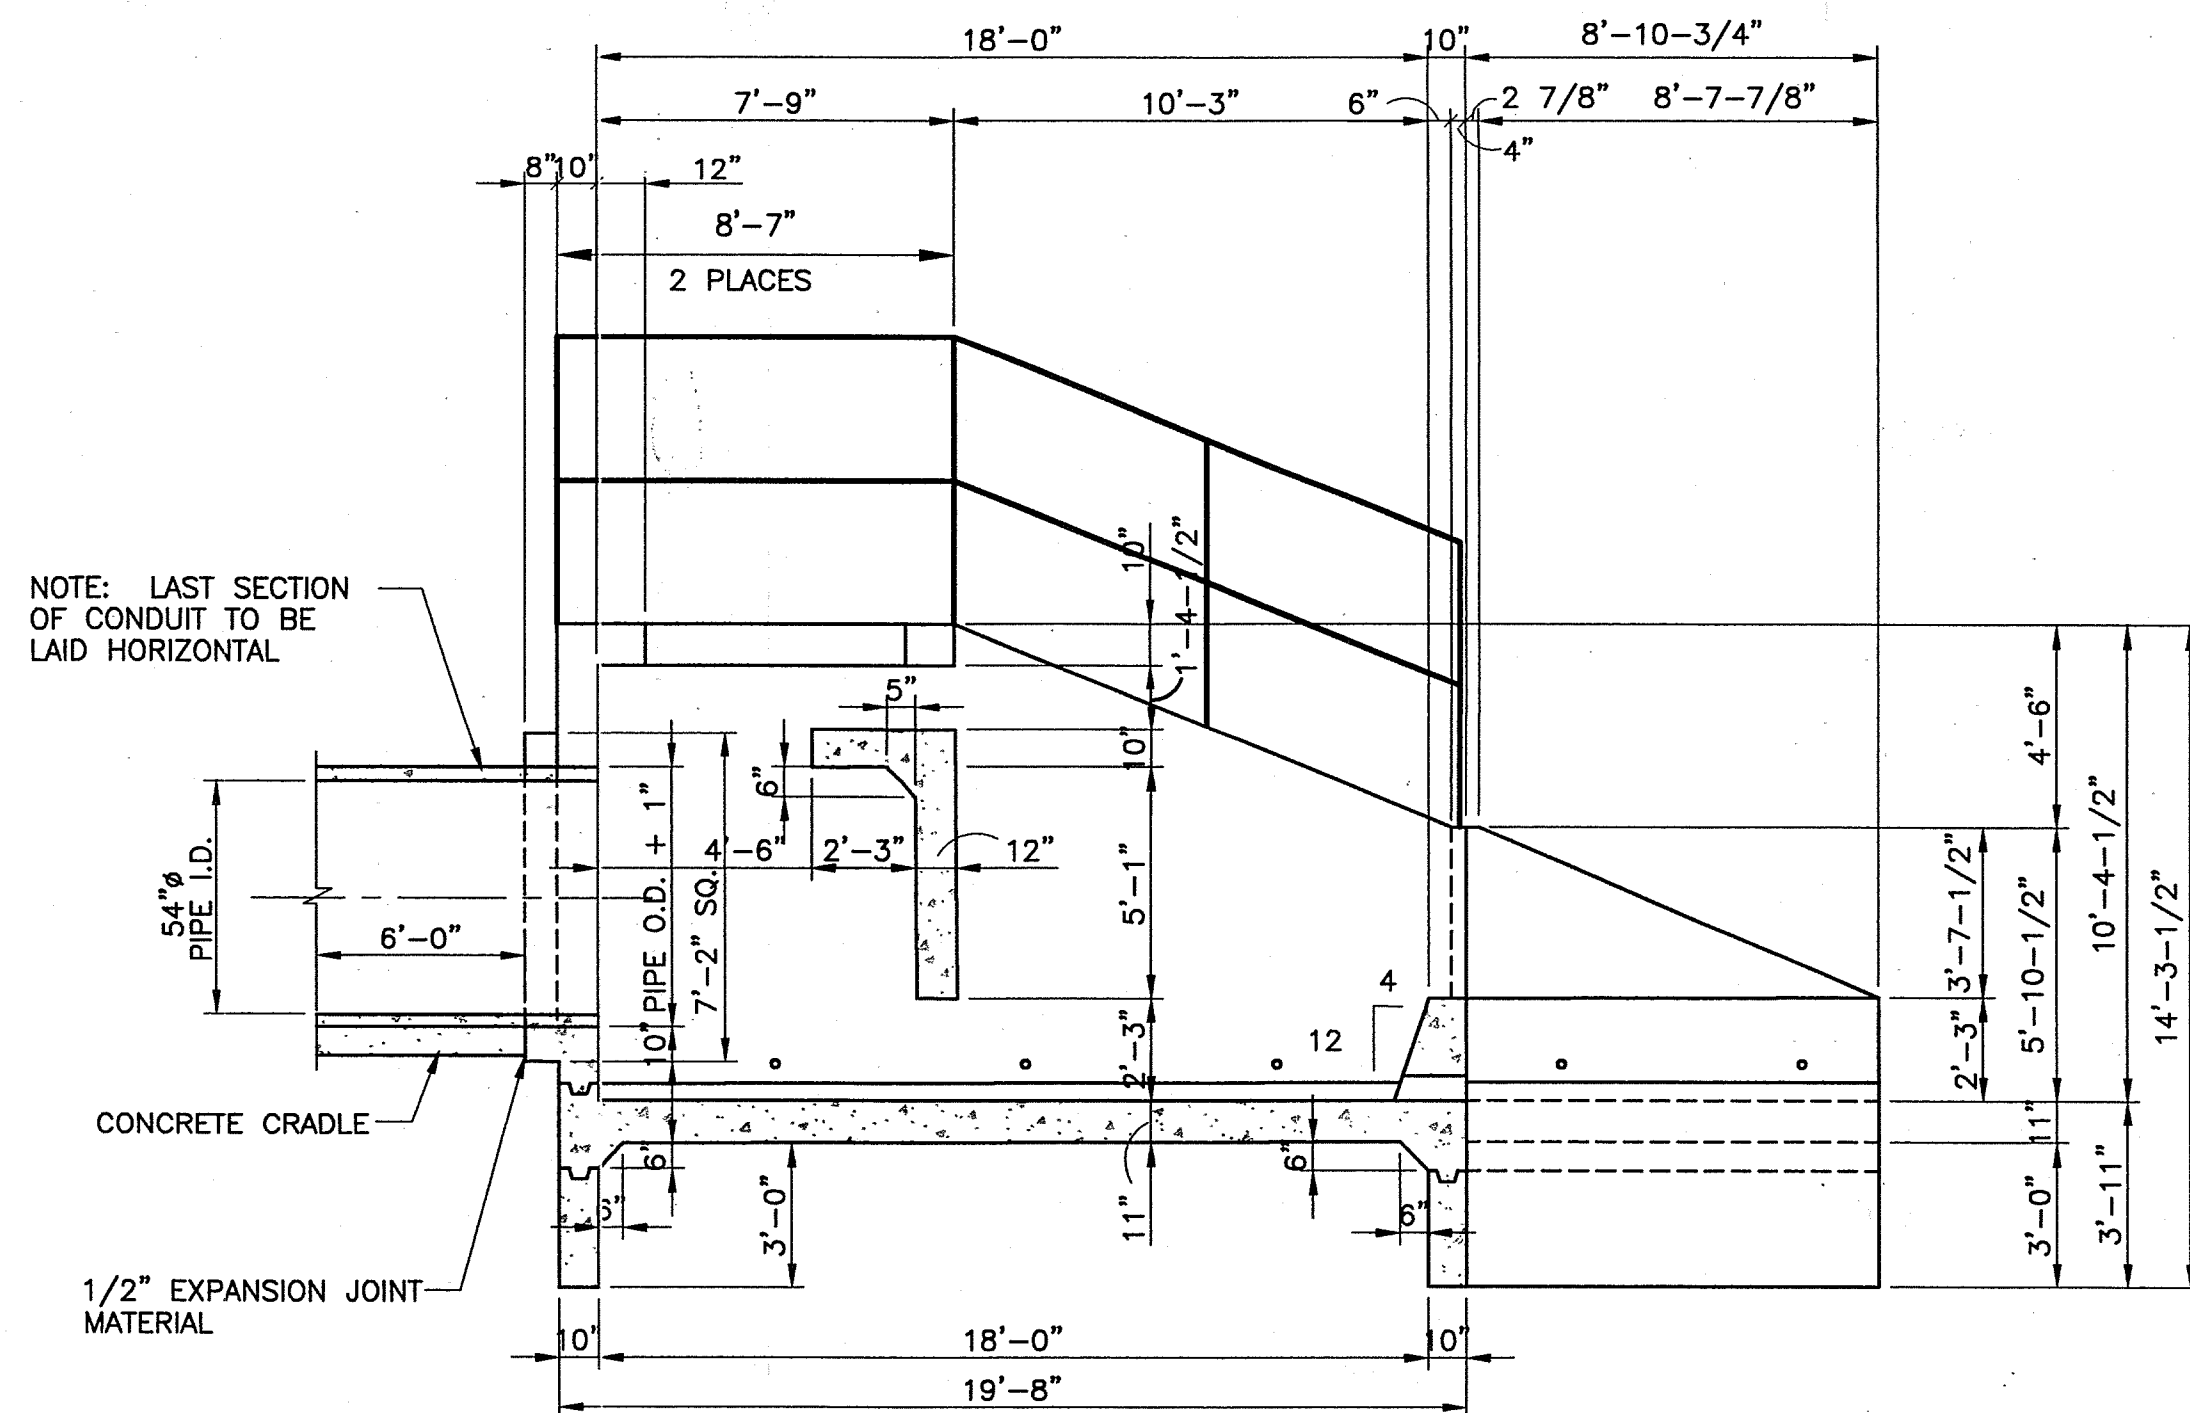

SECTION ON CENTERLINE
NTS

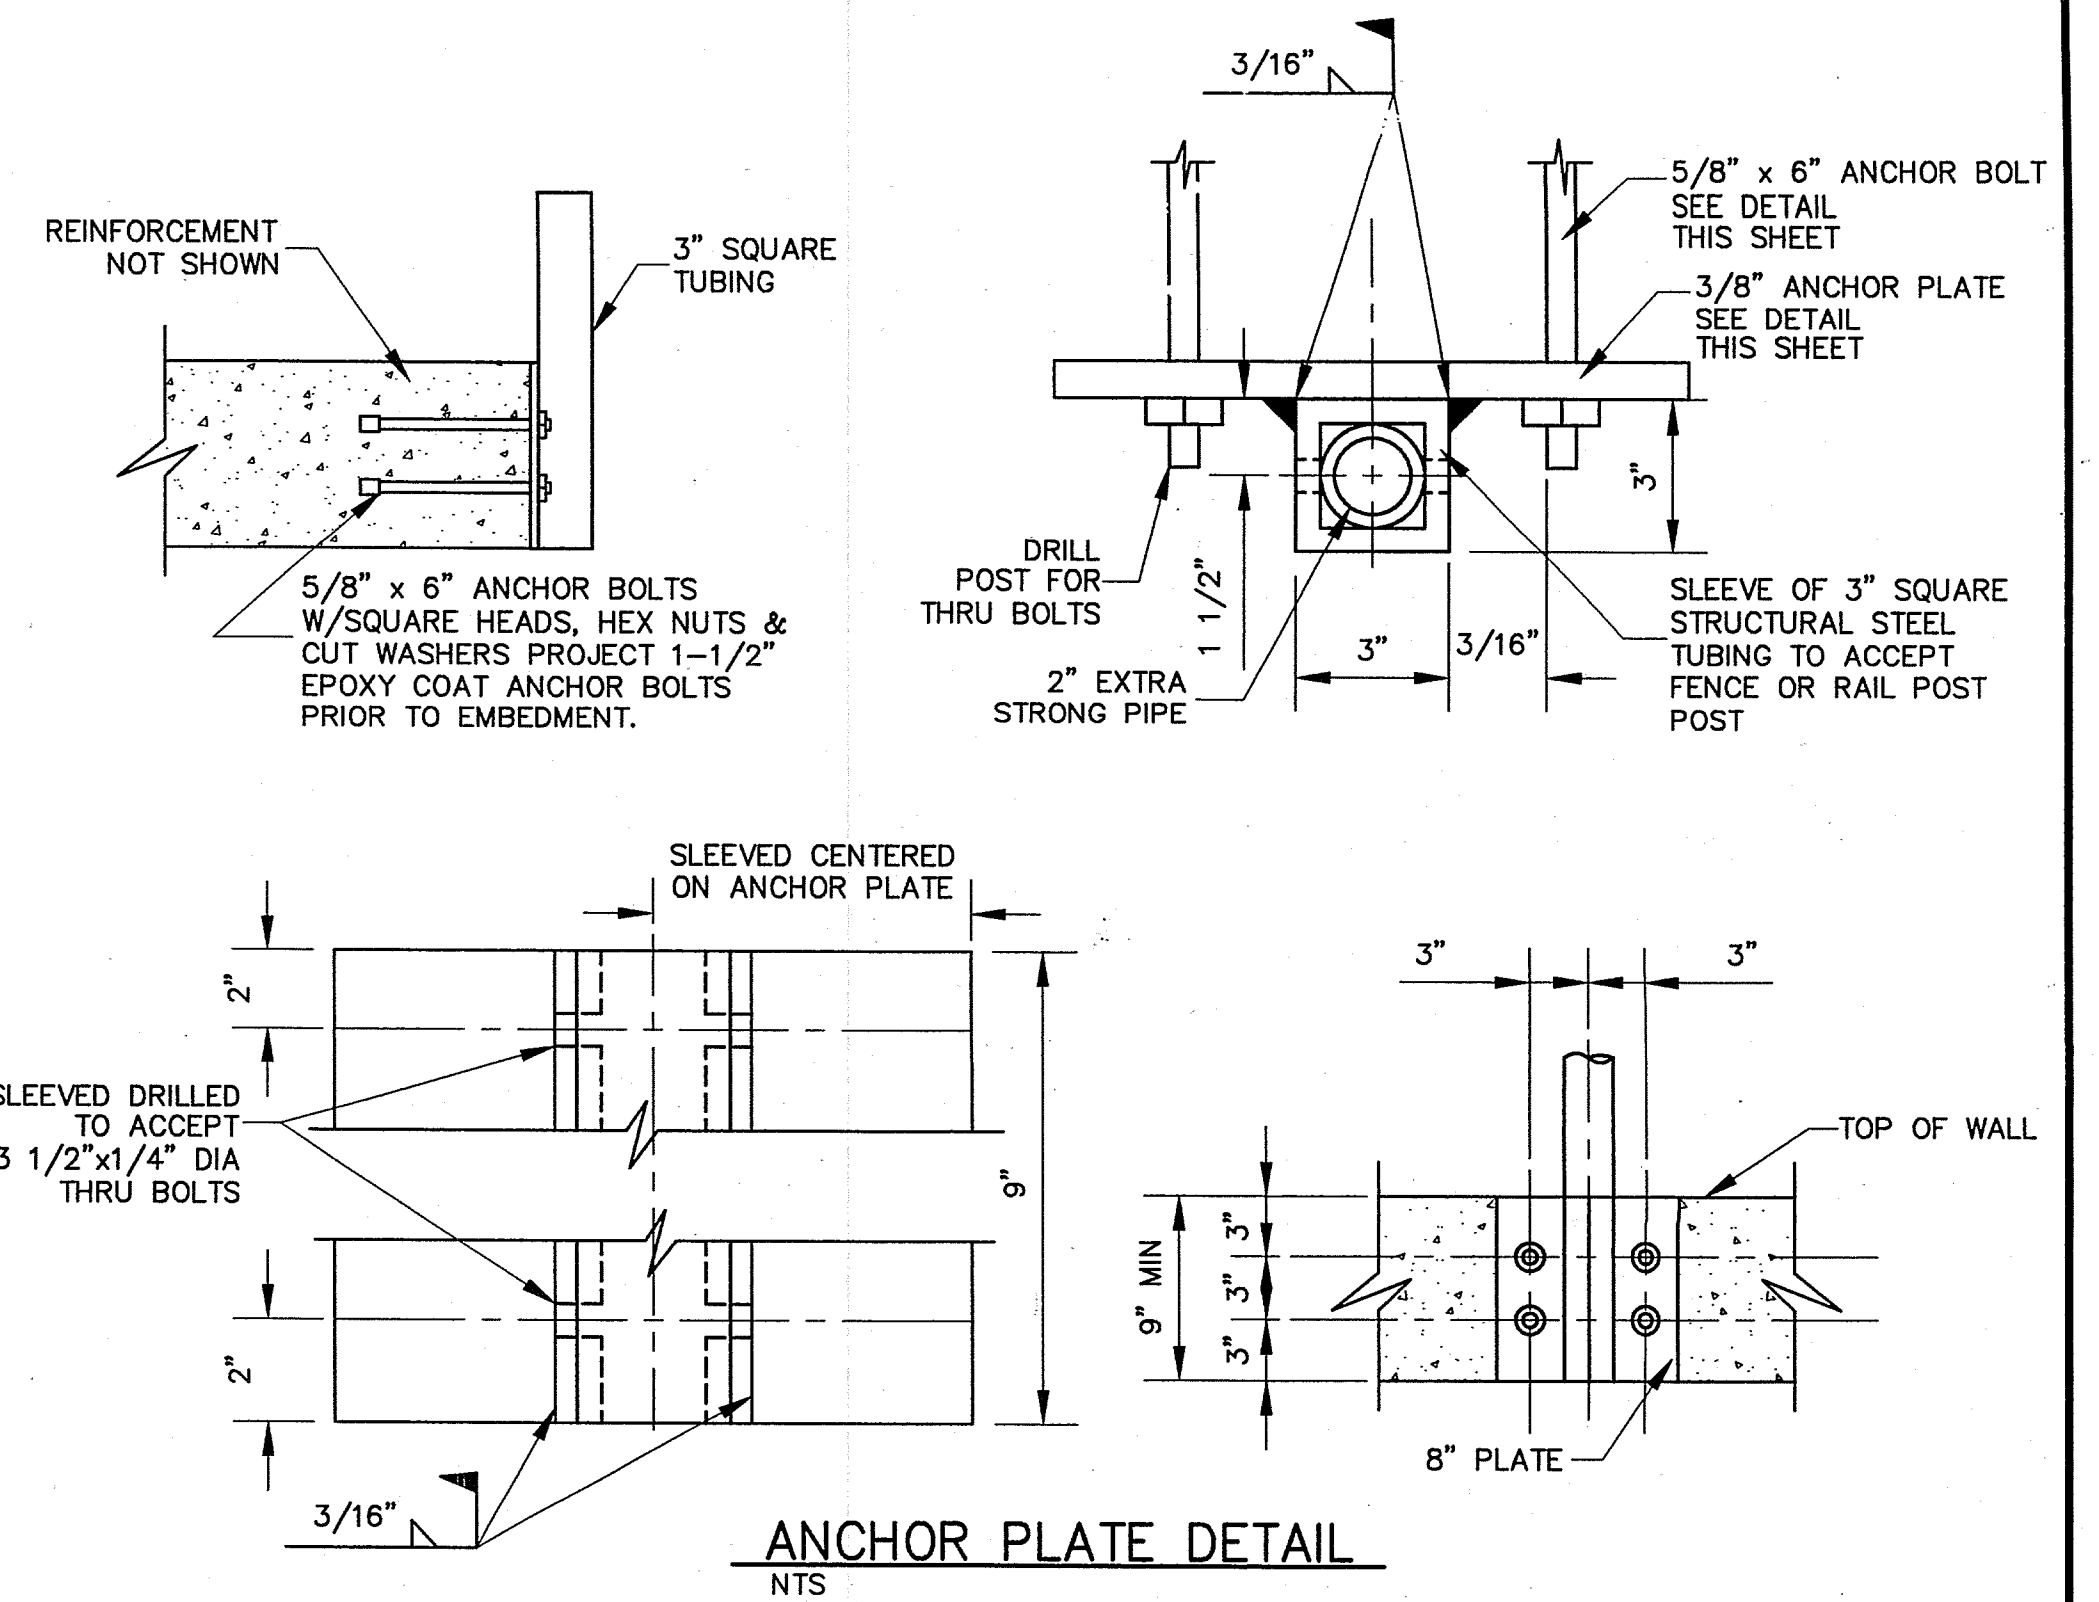


ANCHOR PLATE DETAIL
NTS

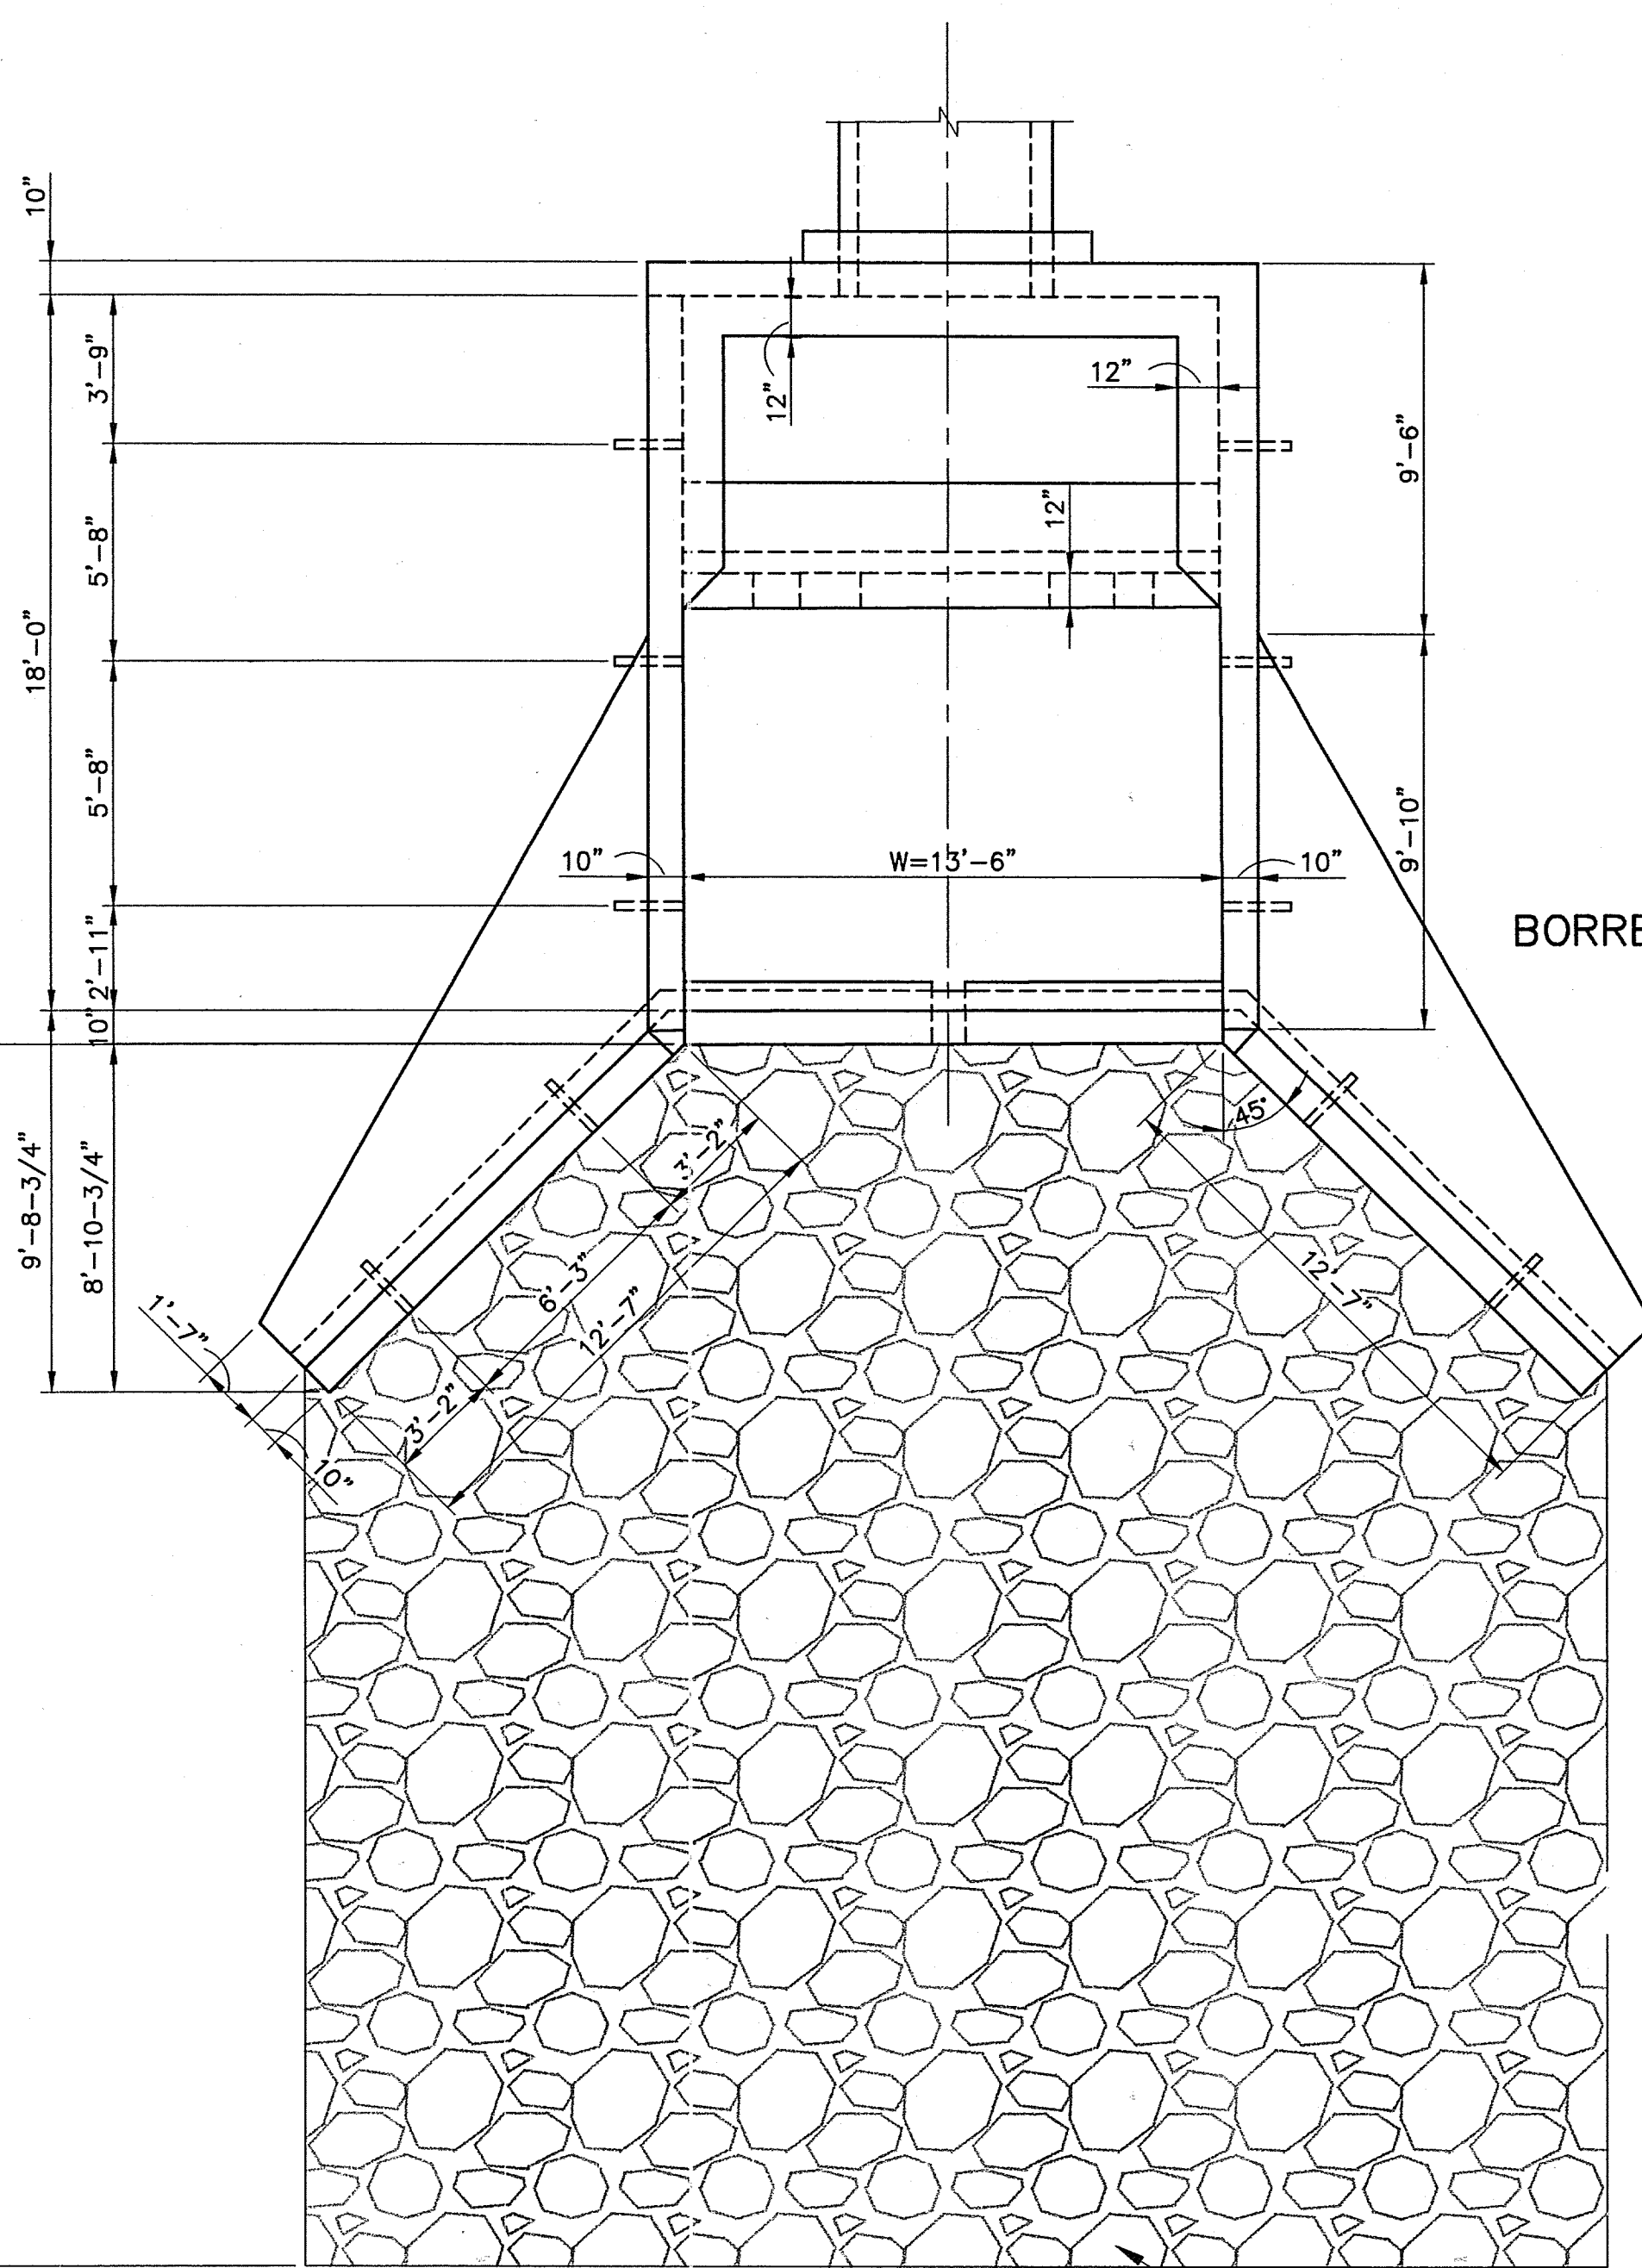


PLAN

SEE RIP RAP DETAIL SHEET 22

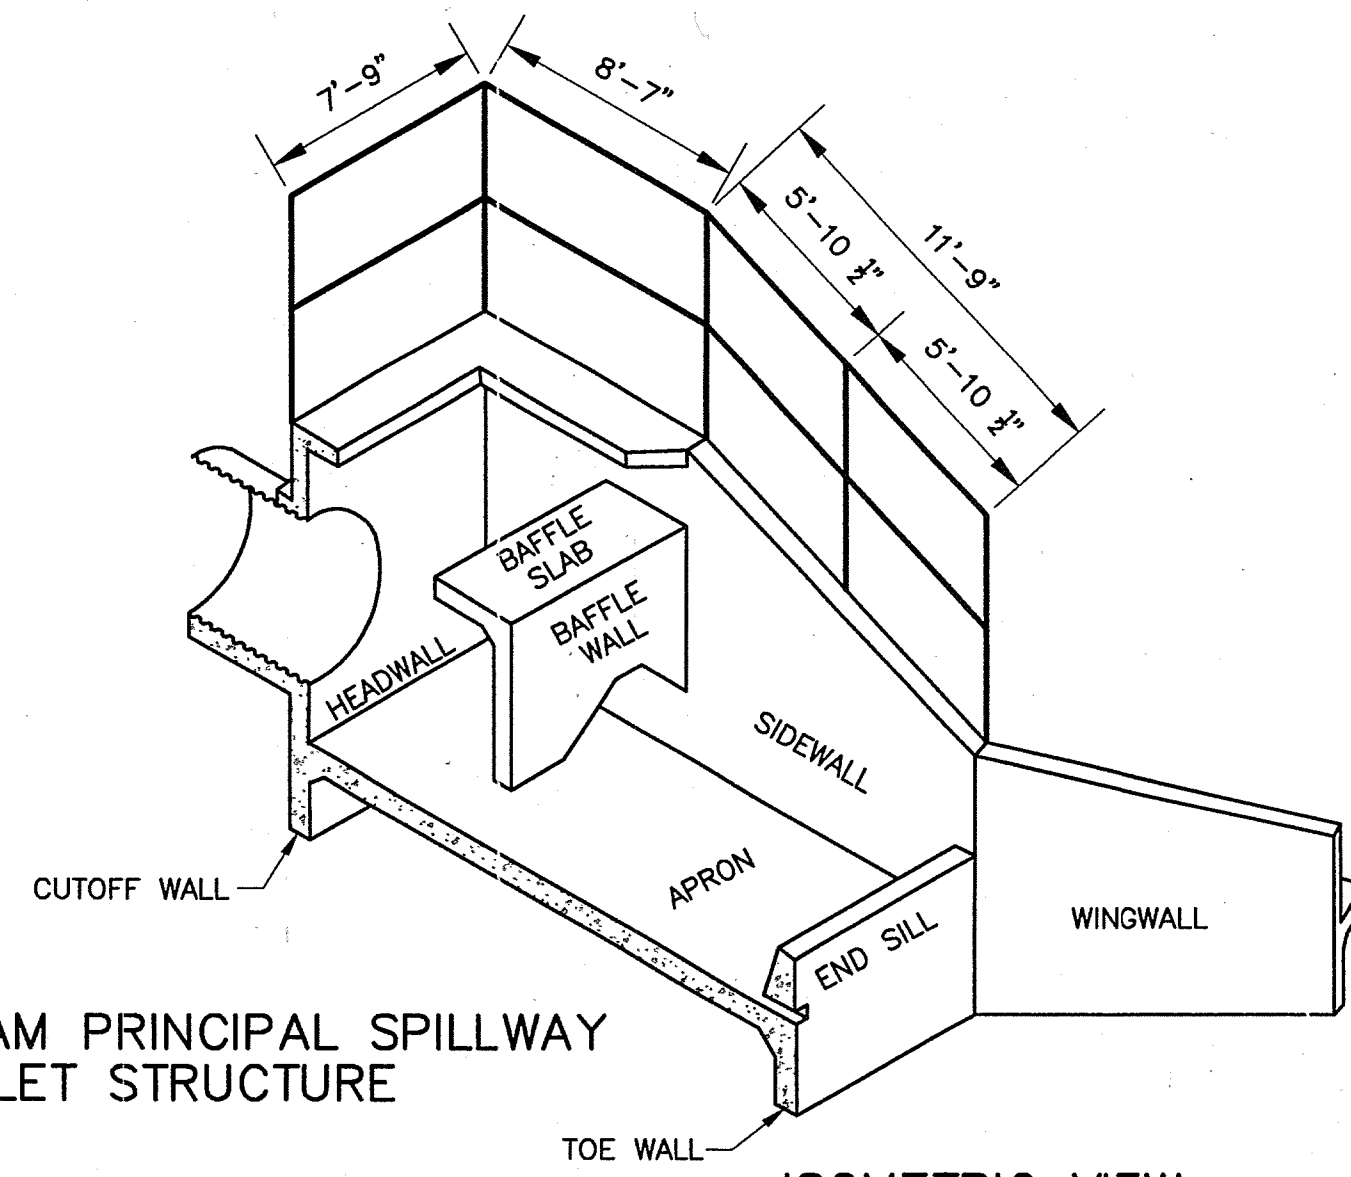


ISOMETRIC VIEW
NTS

**BORREGA DAM PRINCIPAL SPILLWAY
OUTLET STRUCTURE**

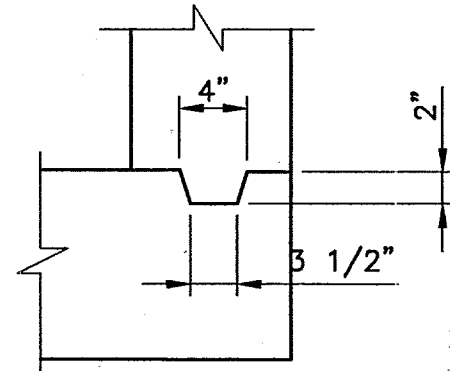

CONSTRUCTION JOINT DETAIL
NTS

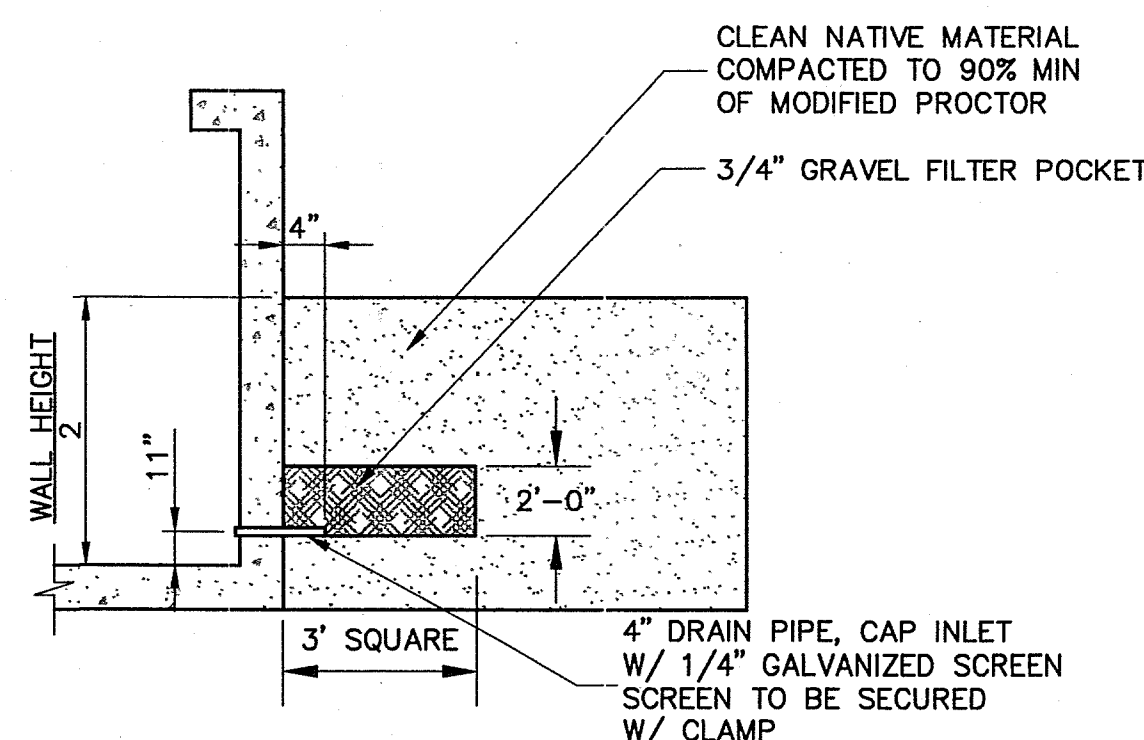

SECTION THROUGH DRAIN & FILTER
NTS

GENERAL NOTES

WORKMANSHIP SHALL CONFORM TO THE BORREGA DETENTION DAM PROJECT SPECIFICATIONS.

CONCRETE FOR STRUCTURAL CAST-IN-PLACE CONCRETE SHALL BE 4000 PSI. CHAMFER ALL EXPOSED EDGES OF CONCRETE STRUCTURES 3/4 INCH UNLESS OTHERWISE NOTED ON THE DETAILS.

REINFORCING BARS SHALL CONFORM TO AASHTO SPECIFICATIONS M-31, GRADE 60 UNLESS NOTED OTHERWISE ON THE DETAILS. DIMENSIONS REFER TO THE CENTERLINE OF BARS UNLESS NOTED OTHERWISE.

FLOW DATA

$D_o = 54"$

$Q_{100} = 195 \text{ cfs}$

DESIGN DATA

DESIGN STRESSES:

REINFORCED CONCRETE:

$f'_c = 4000 \text{ PSI AT 28 DAYS}$

$f_c = 1600 \text{ PSI}$

$f_s = 20,000 \text{ PSI GRADE 40}$

HORIZONTAL EARTH PRESSURE:


70 PCF EQUIVALENT FLUID PRESSURE PLUS 2 FOOT FOR SURCHARGE PRESSURE

NOTE:

TACK WELD CHAIN LINK FABRIC AT 3 POINTS ALONG EACH FRAME MEMBER. PAINT AREA AROUND EACH WELD WITH GALVANIZED COATING.

TOP RAIL IS CONTINUOUS, CENTER AND BOTTOM RAILS AND POSTS ARE SADDLE CUT.

2" RAIL WITH CHAIN LINK FENCE AND DETAILS
NTS

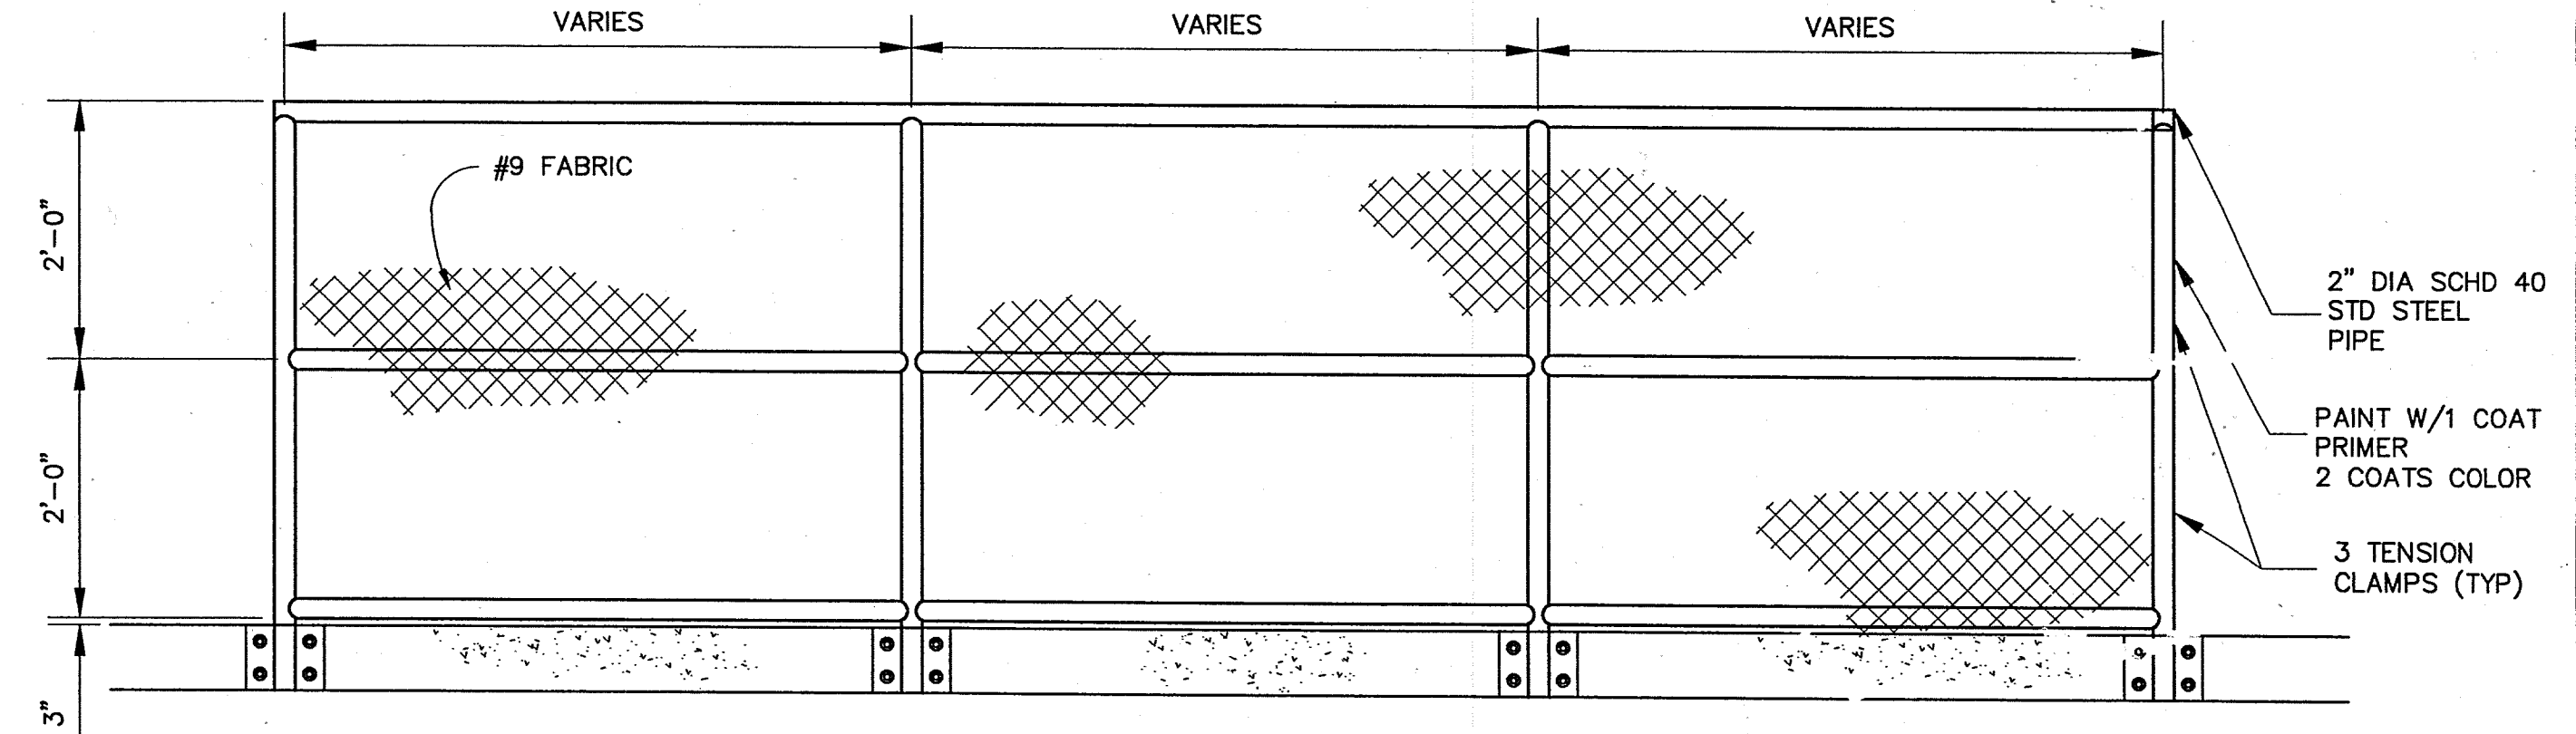

NOTE:

TACK WELD CHAIN LINK FABRIC AT 3 POINTS ALONG EACH FRAME MEMBER. PAINT AREA AROUND EACH WELD WITH GALVANIZED COATING.

TOP RAIL IS CONTINUOUS, CENTER AND BOTTOM RAILS AND POSTS ARE SADDLE CUT.

2" RAIL WITH CHAIN LINK FENCE AND DETAILS
NTS

REWORK DRAWING
2-20-01

6922.91

ALBUQUERQUE METROPOLITAN
ARROYO FLOOD
CONTROL AUTHORITY

BORREGA DETENTION DAM
PRINCIPAL SPILLWAY OUTLET STRUCTURE

WILSON & COMPANY


4900 LANG AVENUE N.E.
ALBUQUERQUE, NM
87109
(505) 348-4000

NO.	DATE	REMARKS	BY
1	NOV 1999	DESIGNED BY	NM
2	NOV 1999	DRAWN BY	PJM
3	NOV 1999	CHECKED BY	DSA

DATE: MARCH 2000

FILE: 99099

SHEET: 28 OF 34

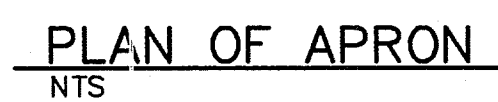[illegible]

RECORD DRAWING
2-20-01

6922.91

ALBUQUERQUE METROPOLITAN
ARROYO FLOOD
CONTROL AUTHORITY

BORREGA DETENTION DAM

PRINCIPAL SPILLWAY OUTLET STRUCTURE


**WILSON**
 & COMPANY

4900 LANG AVENUE N.E.
ALBUQUERQUE, NM
87109
(505) 348-4000

DATE	MARCH 2000
------	------------

FILE 99099


SHEET 29 OF 34

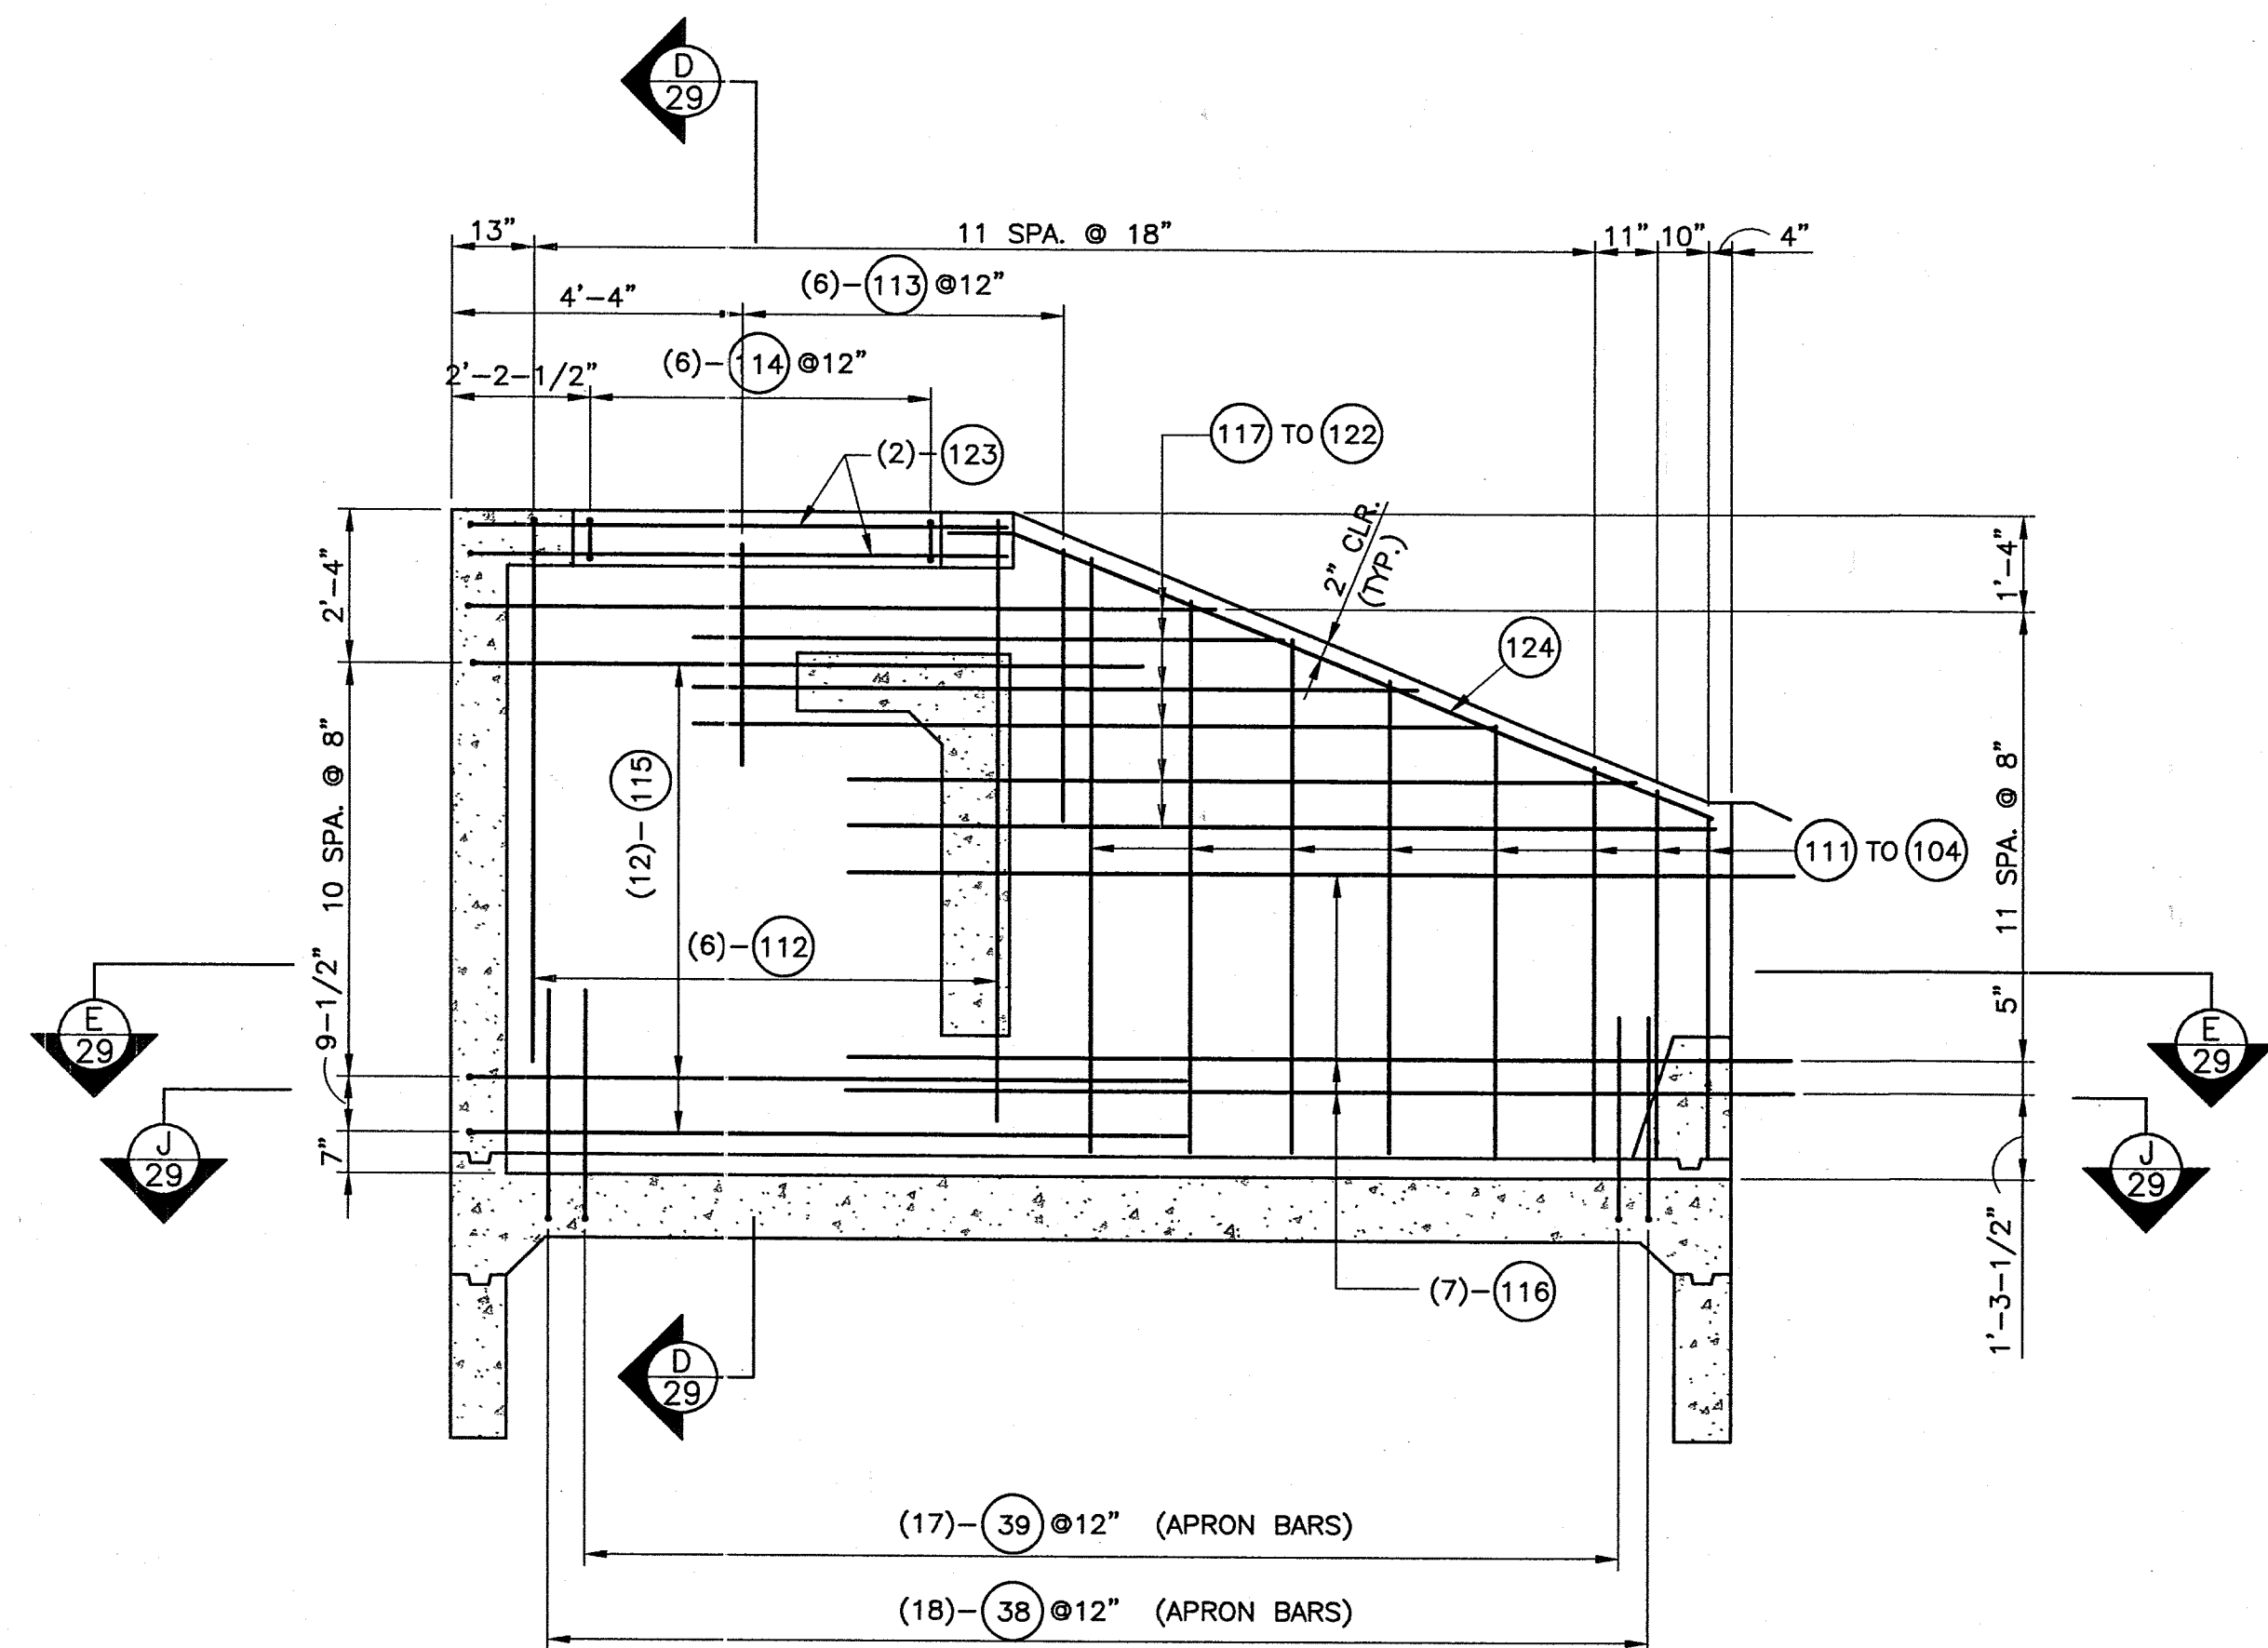


UNEXPOSED FACE

SIDEWALL ELEVATION


NTS

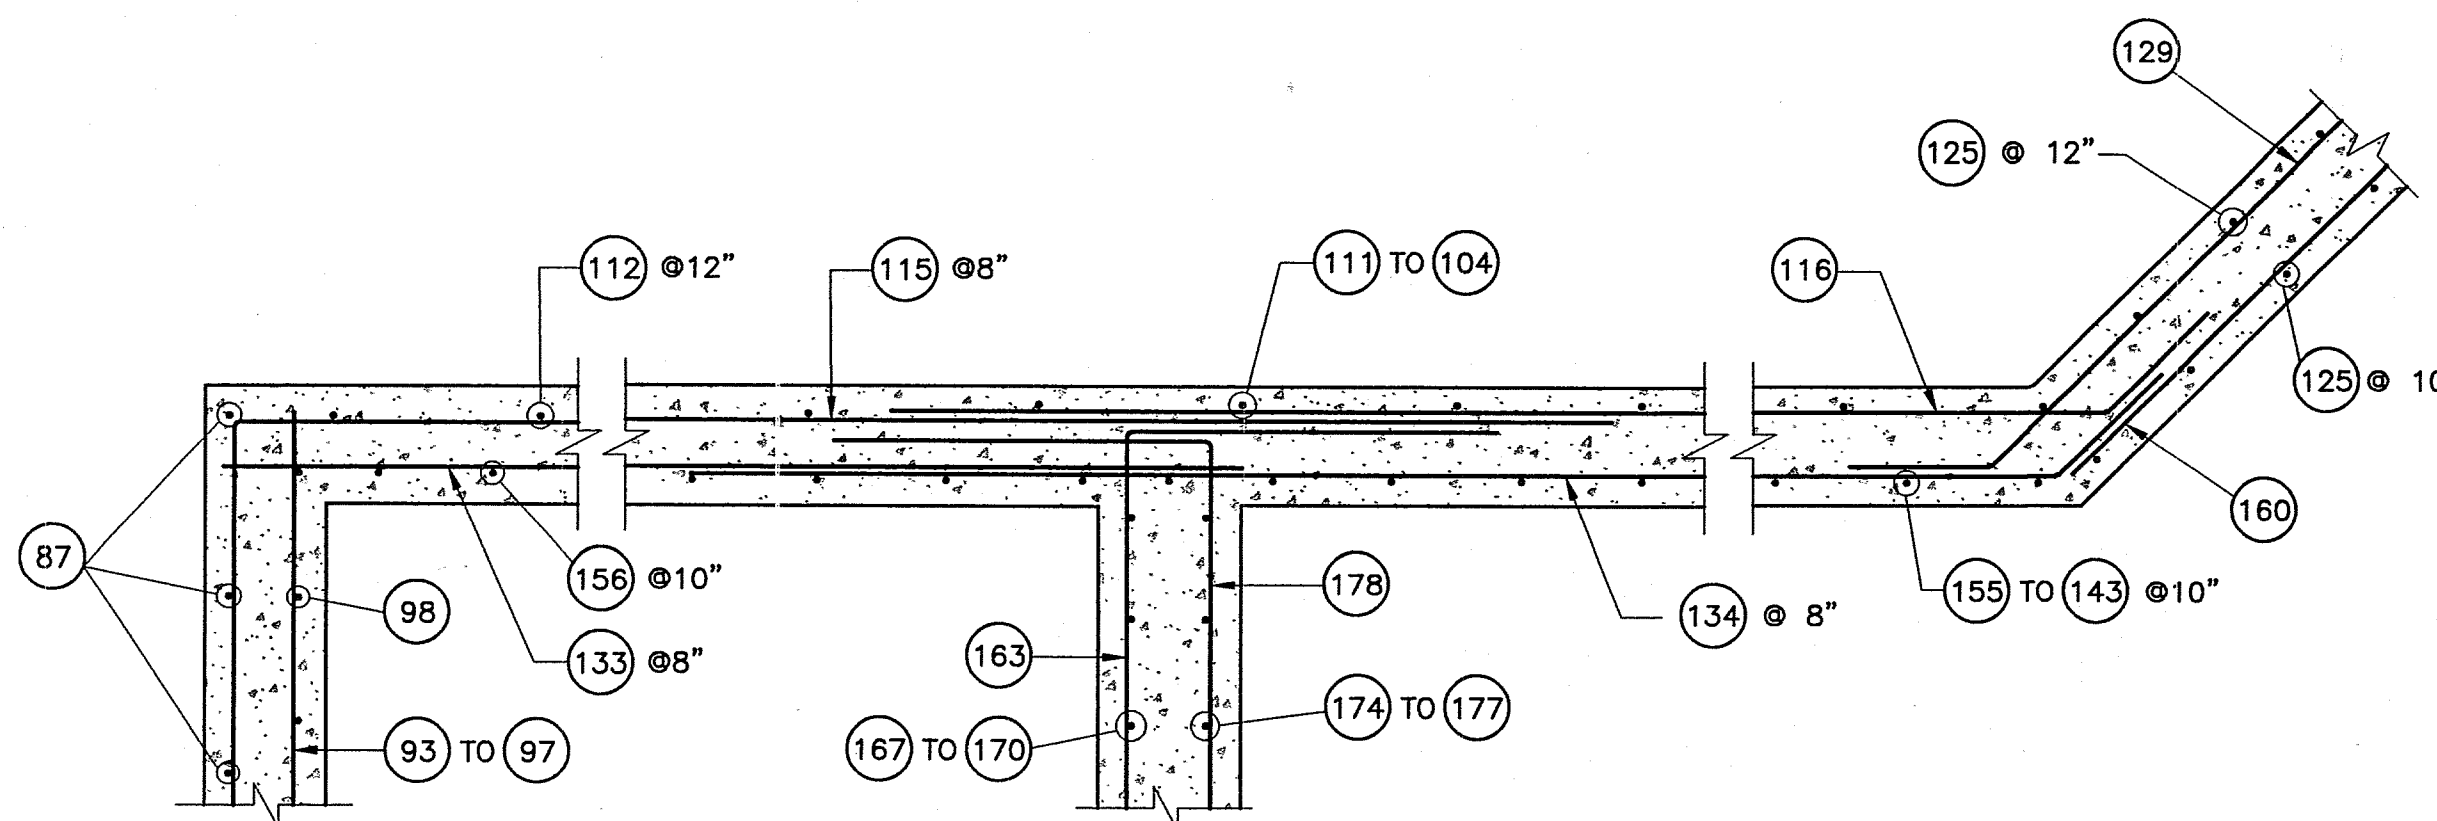

SECTION E-E
NTS

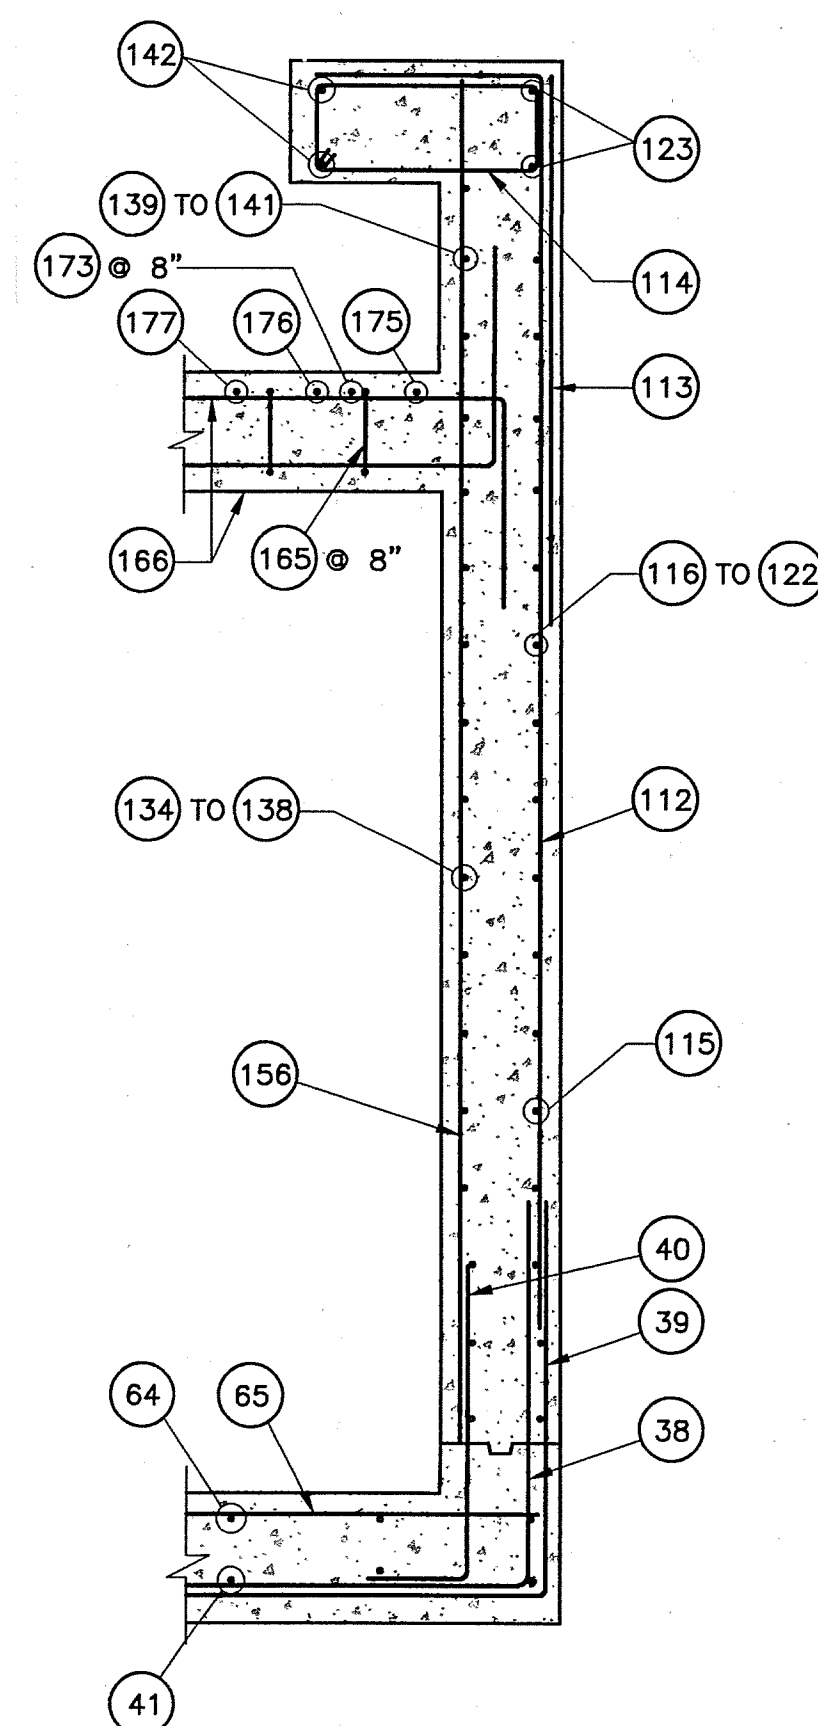


SECTION D-D
NTS

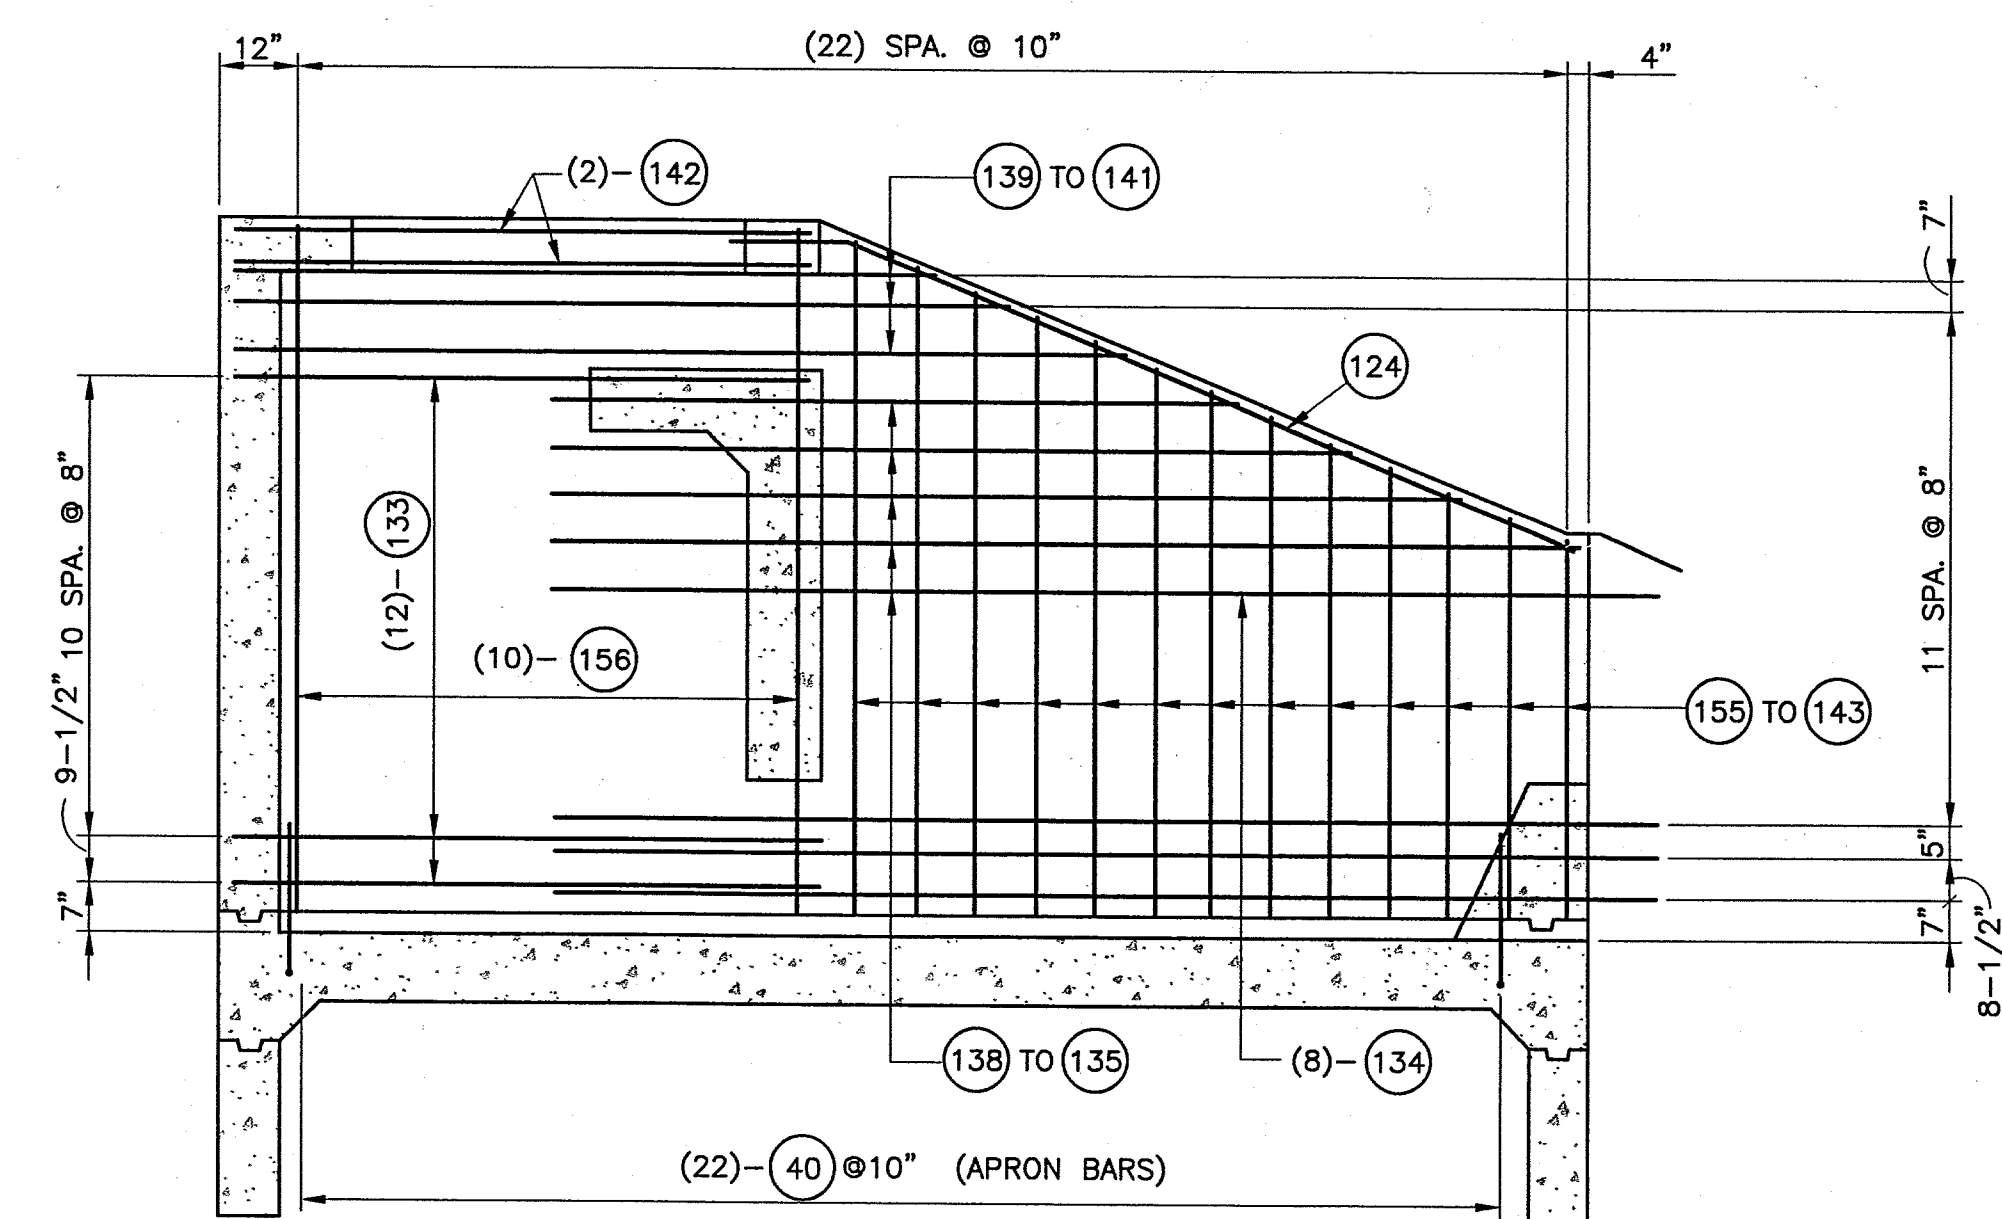


EXPOSED FACE

SIDEWALL ELEVATION

NTS

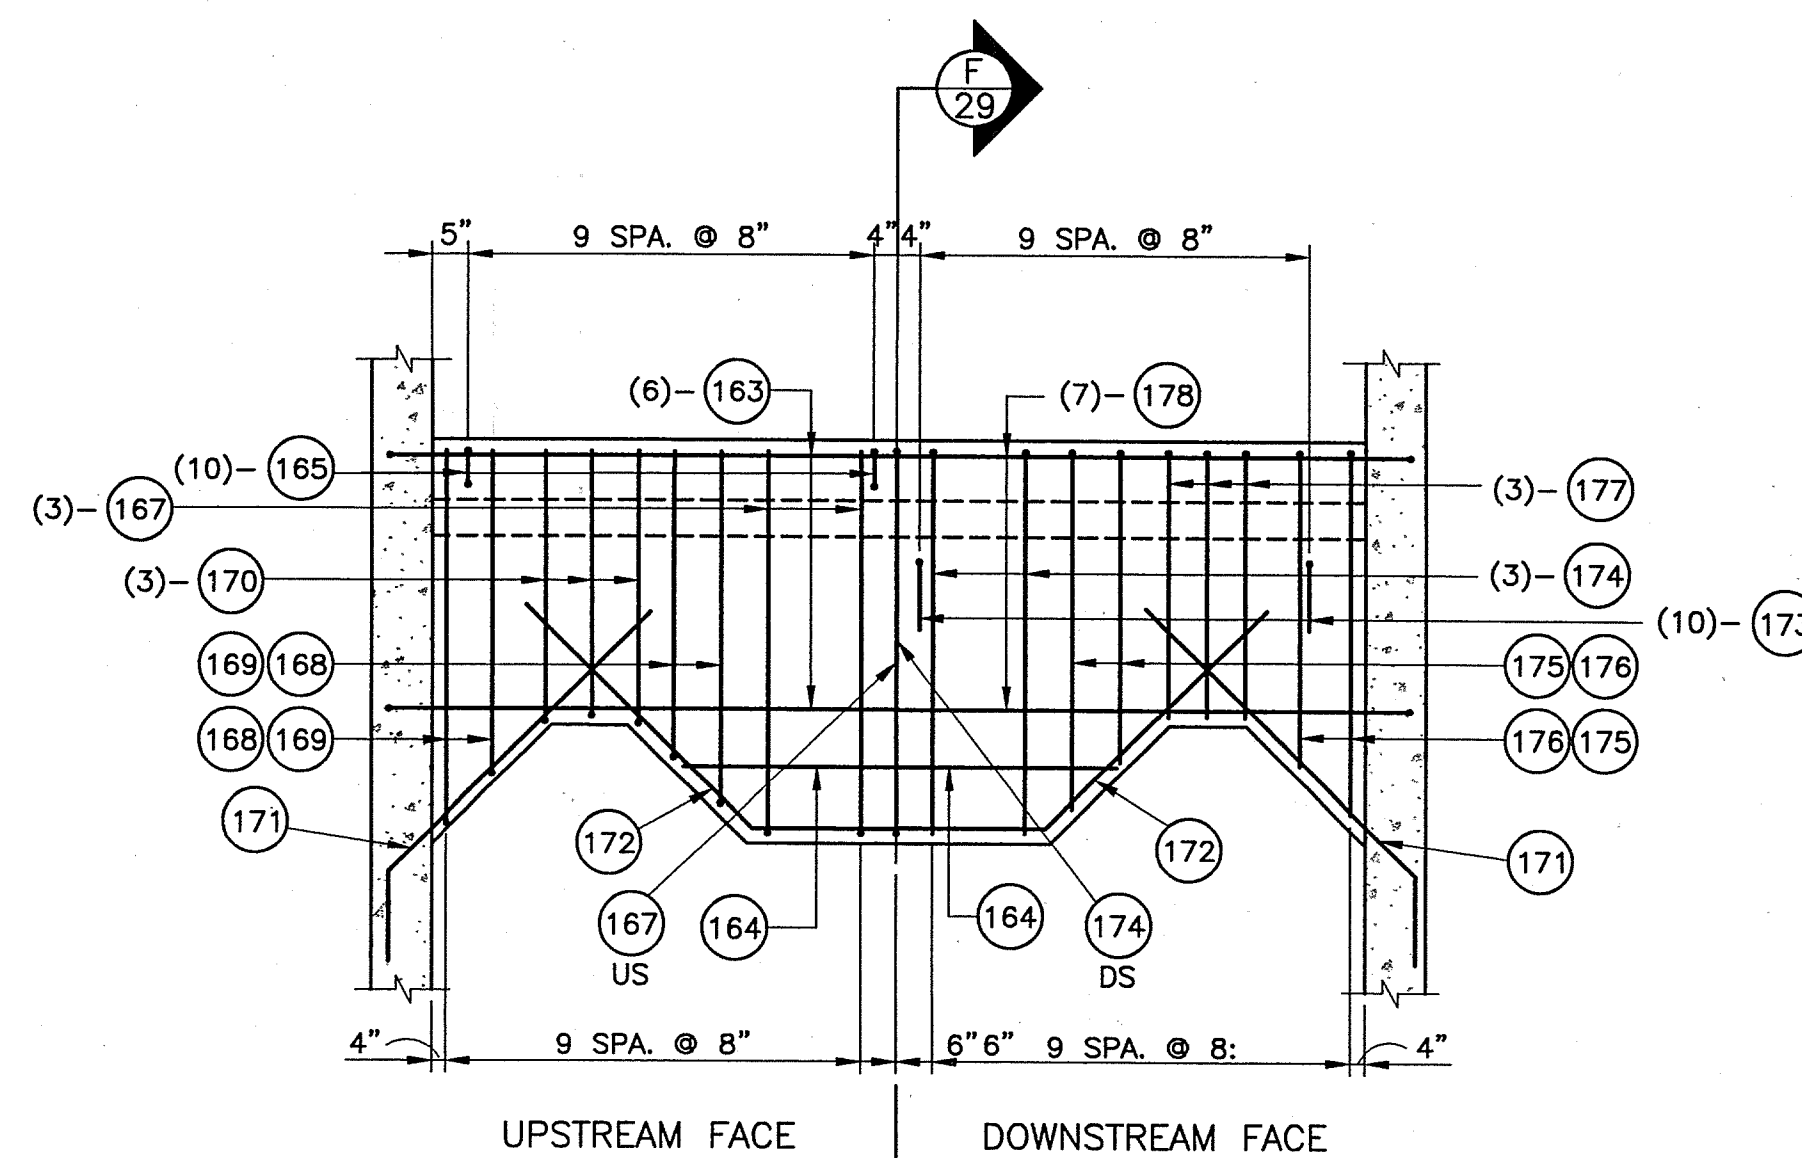

BAFFLE ELEVATION
NTS

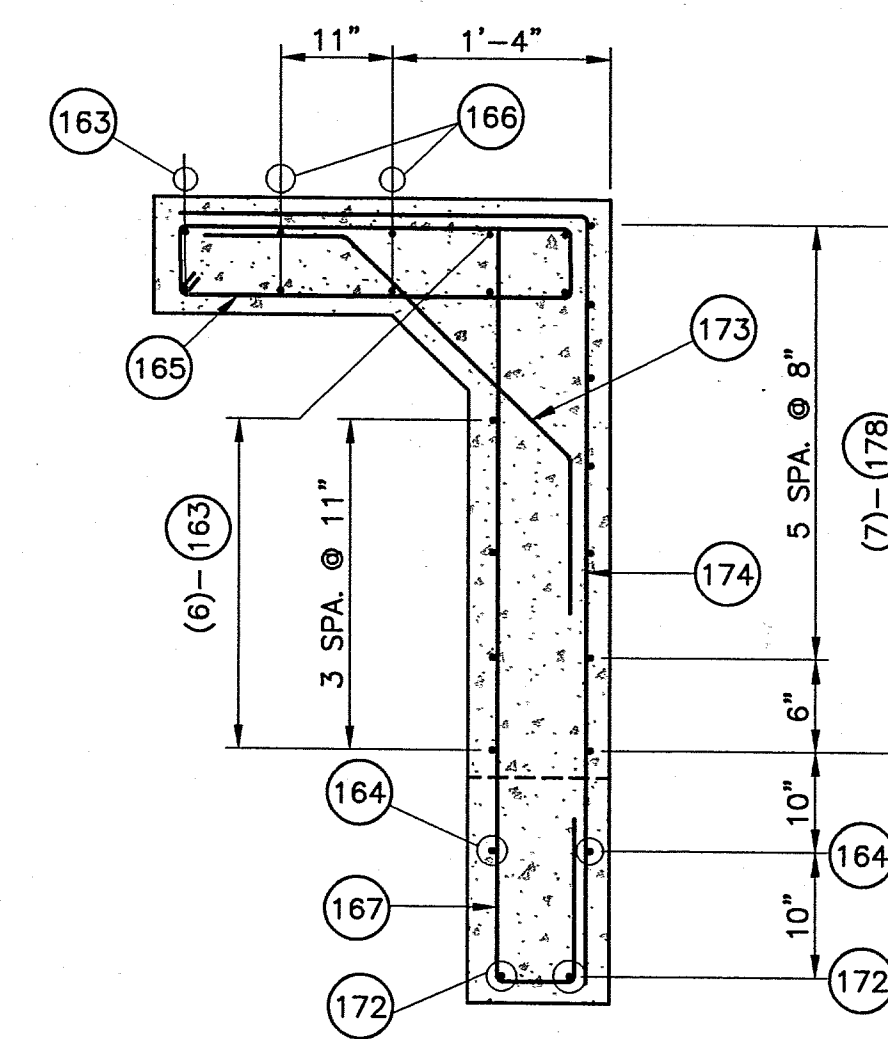

SECTION F-F
NTS

[illegible]

6922.91

ALBUQUERQUE METROPOLITAN
ARROYO FLOOD
CONTROL AUTHORITY

BORREGA DETENTION DAM

PRINCIPAL SPILLWAY OUTLET STRUCTURE



WILSON
& COMPANY


4900 LANG AVENUE N.E.
ALBUQUERQUE, NM
87109
(505) 348-4000

DATE	MARCH 2000
------	------------


FILE	99099
------	-------

SHEET 30 OF 34


RECORD DRAWING
DATE 2-26-0

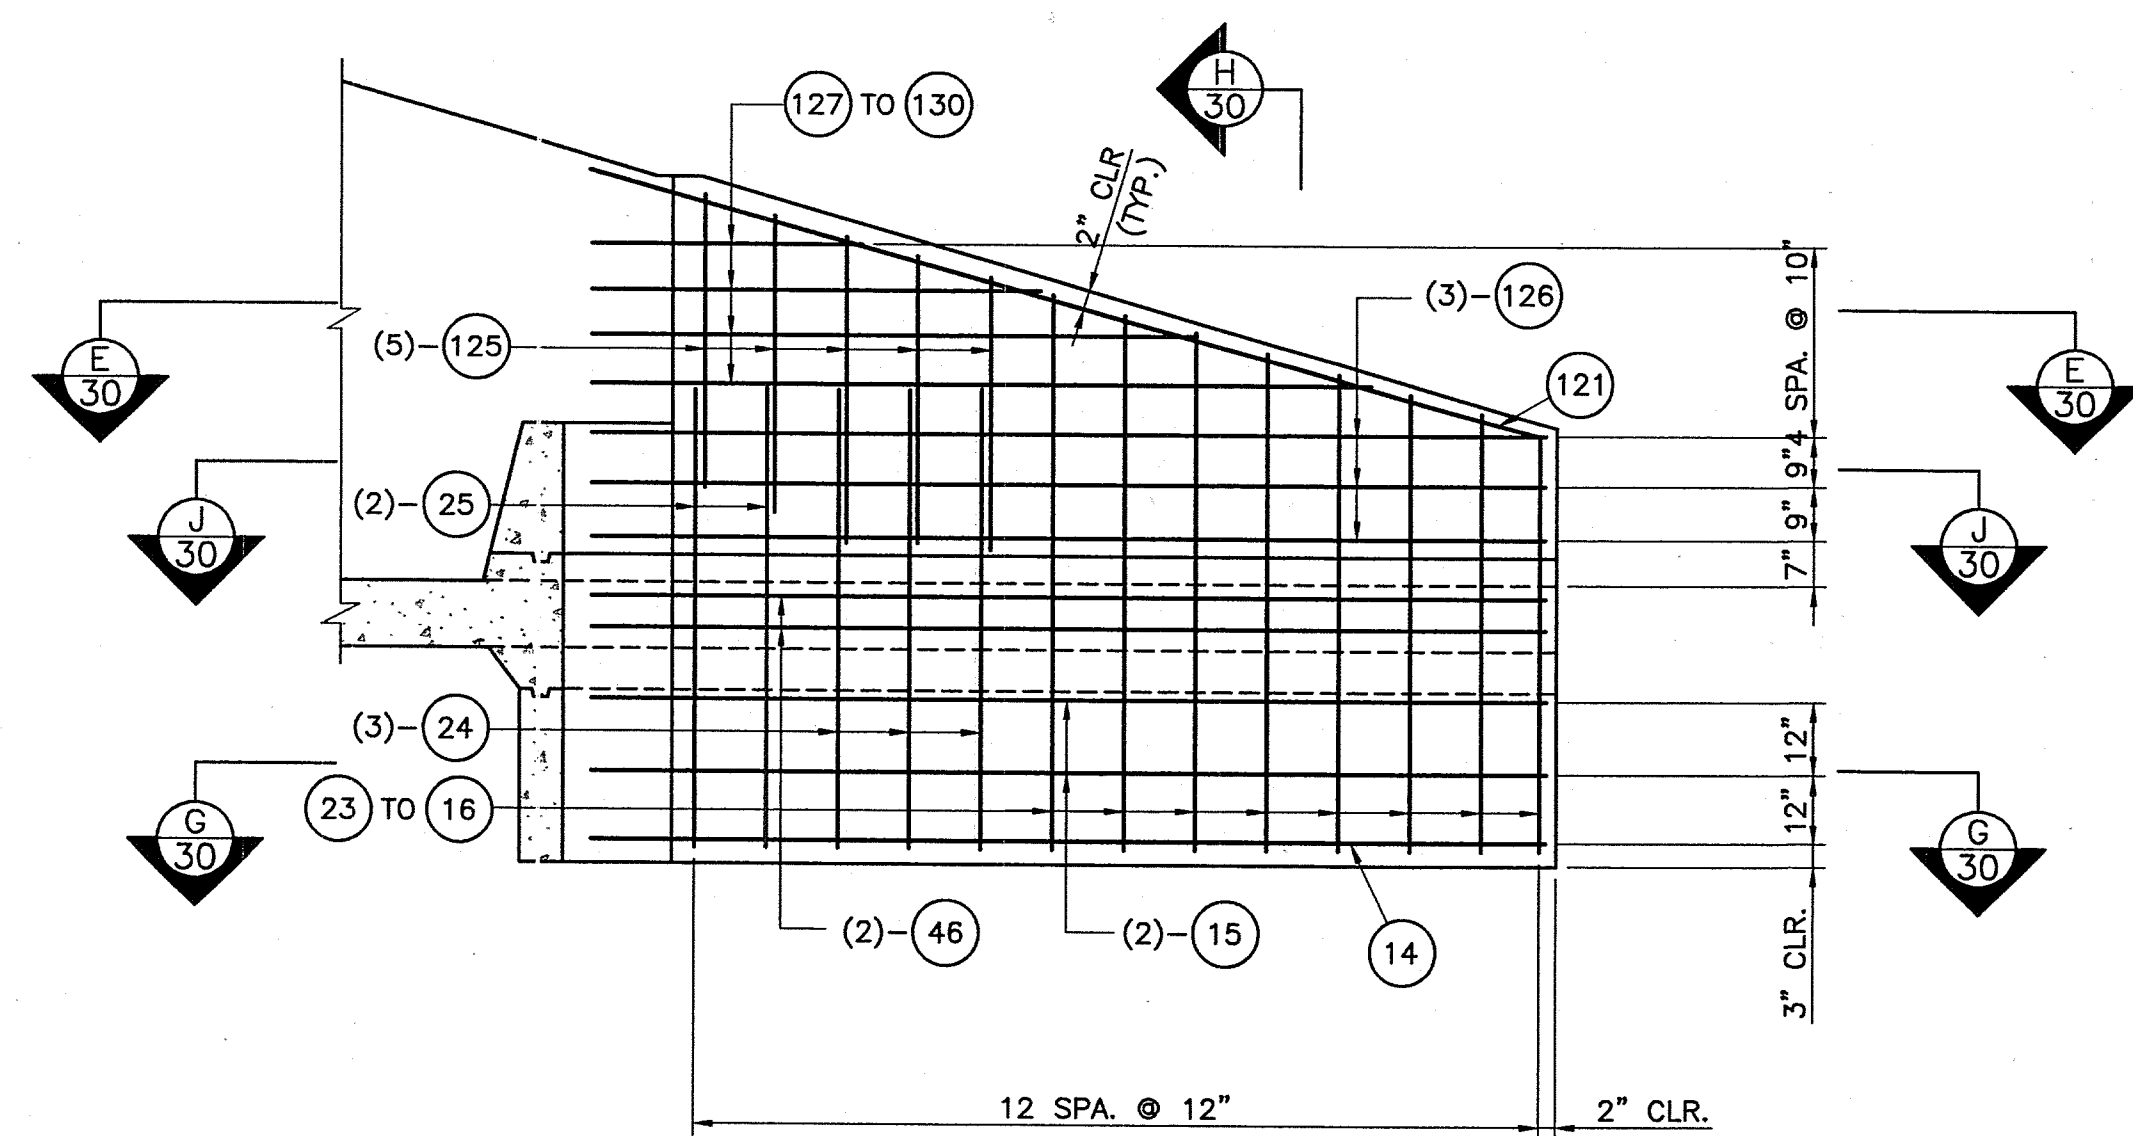


WINGWALL ELEVATION
NTS

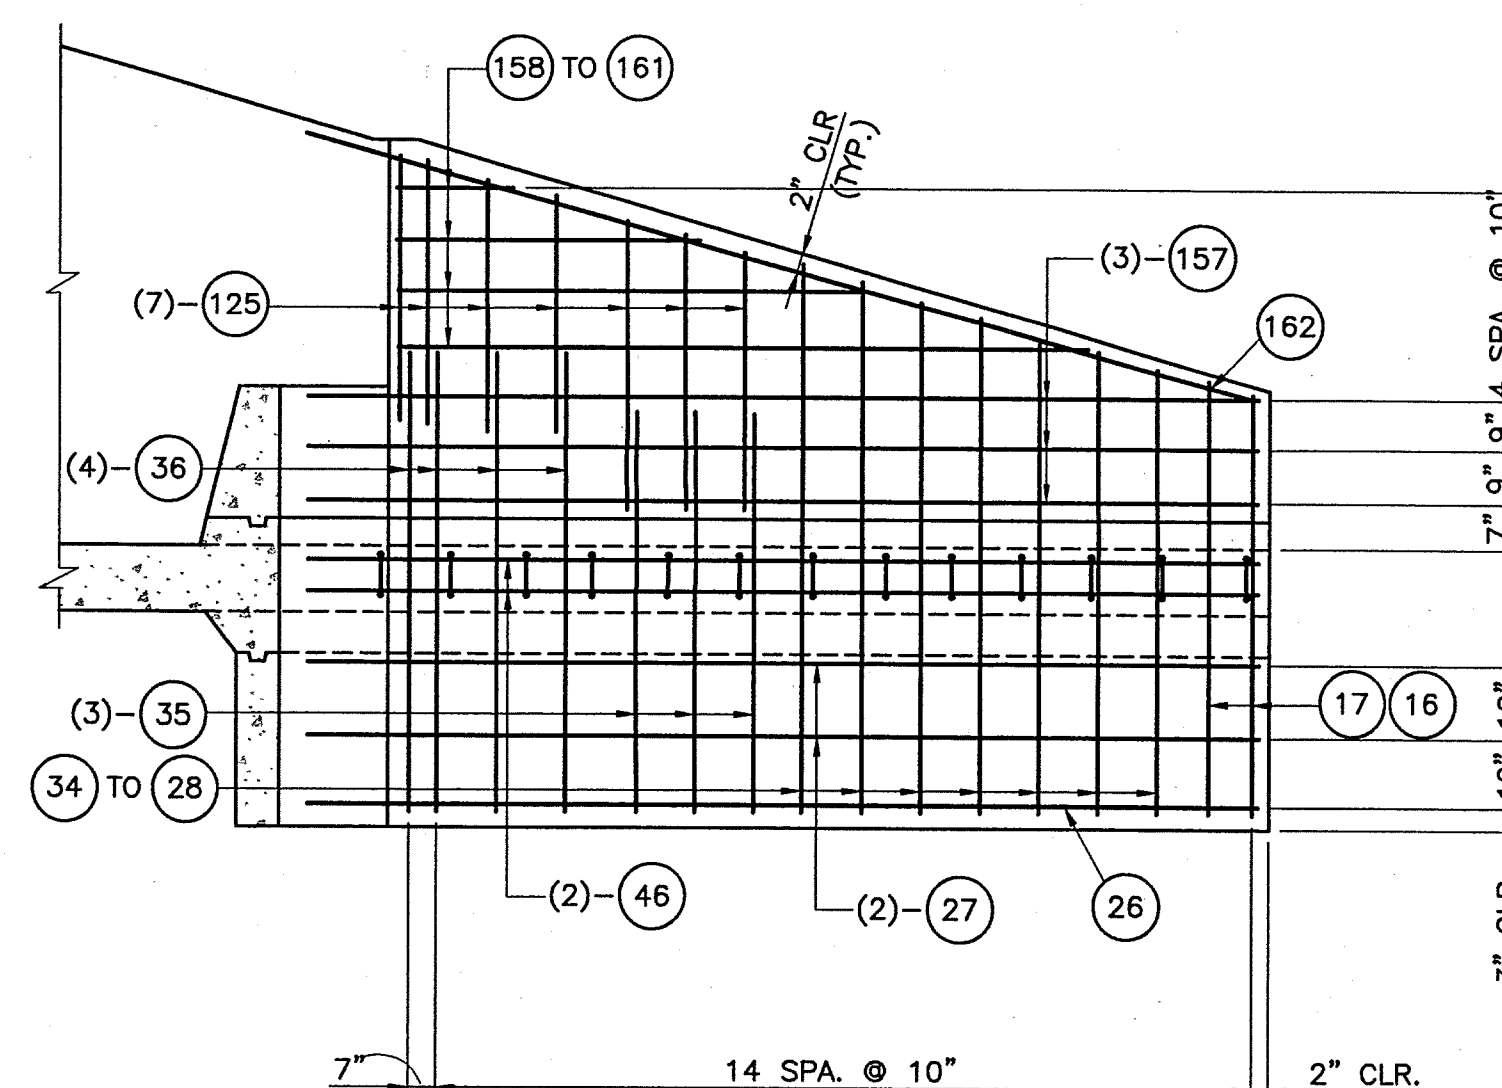


WINGWALL ELEVATION
NTS

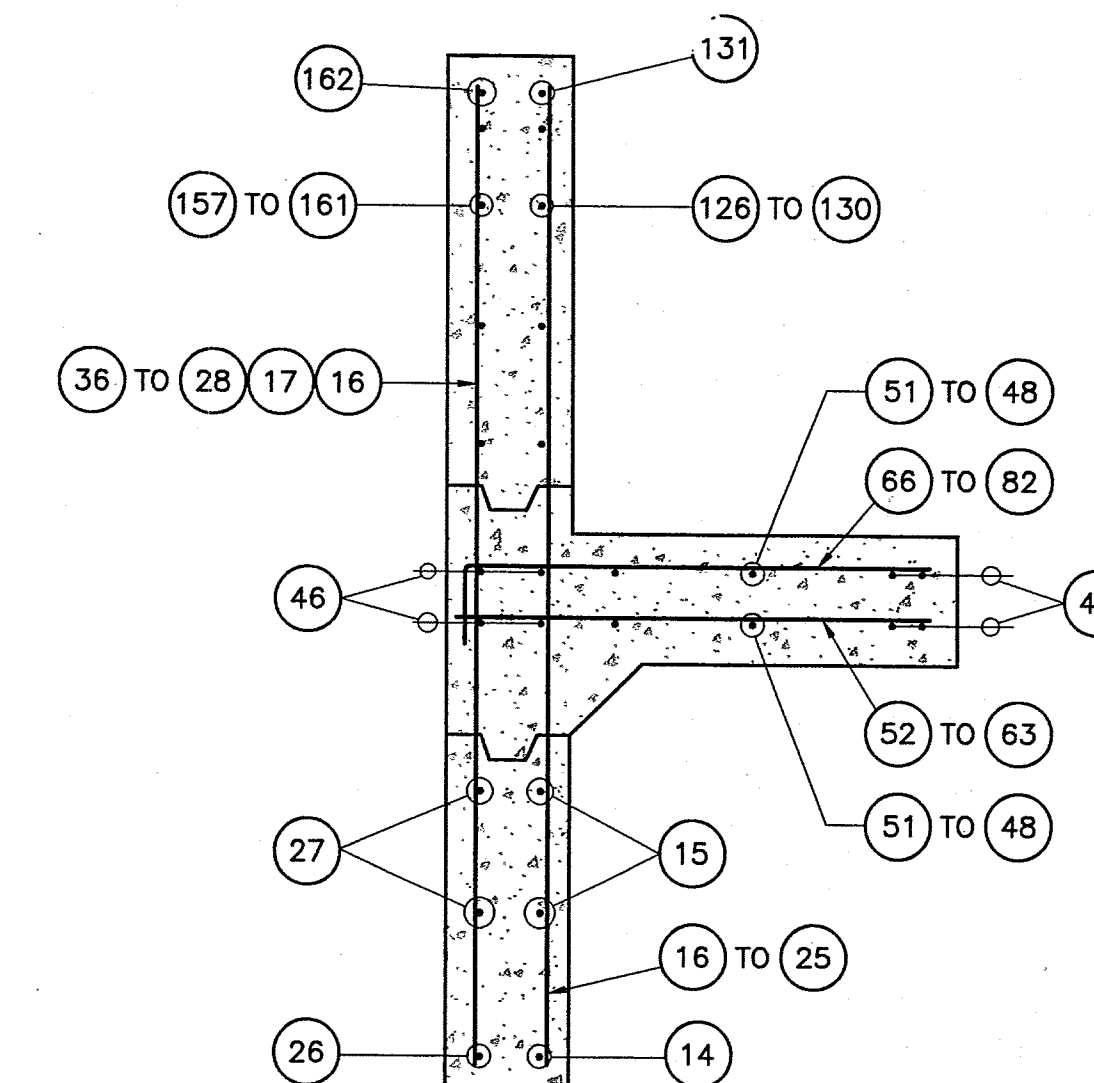


SECTION H-H
NTS

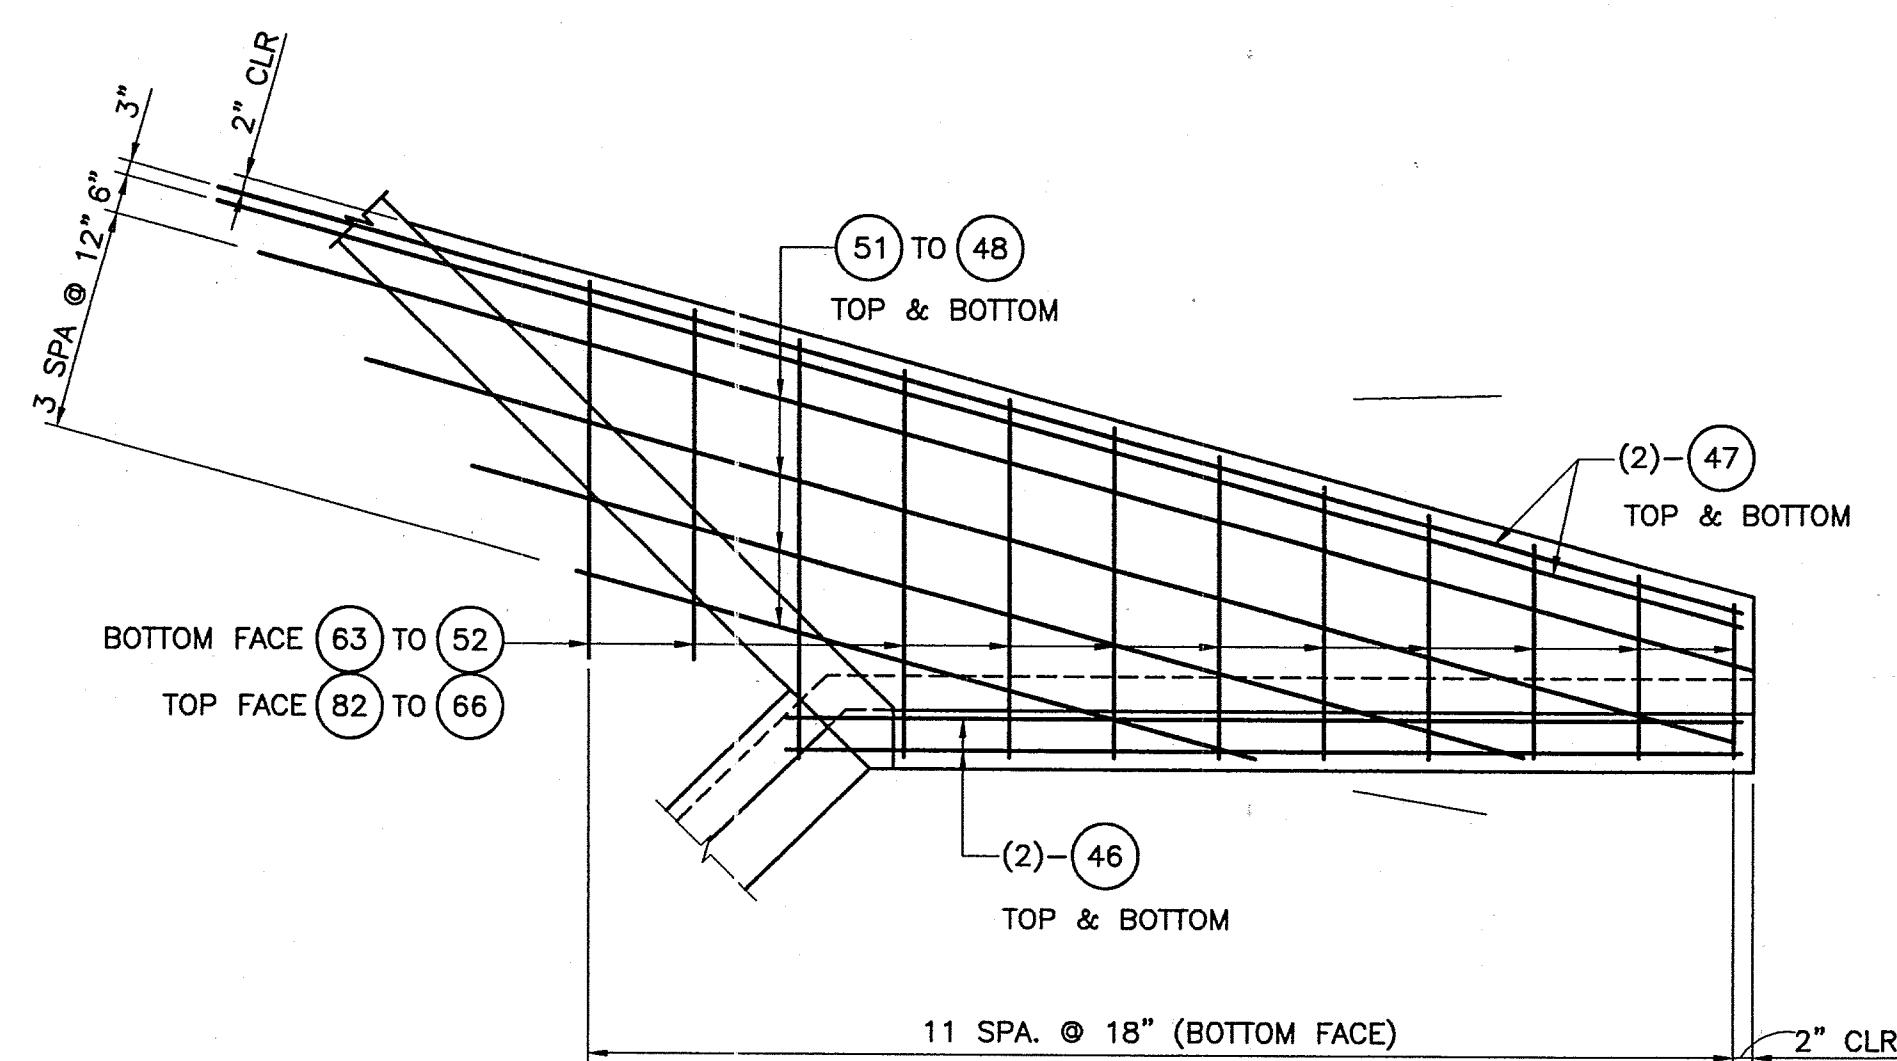


PLAN WINGWALL FOOTING
NTS

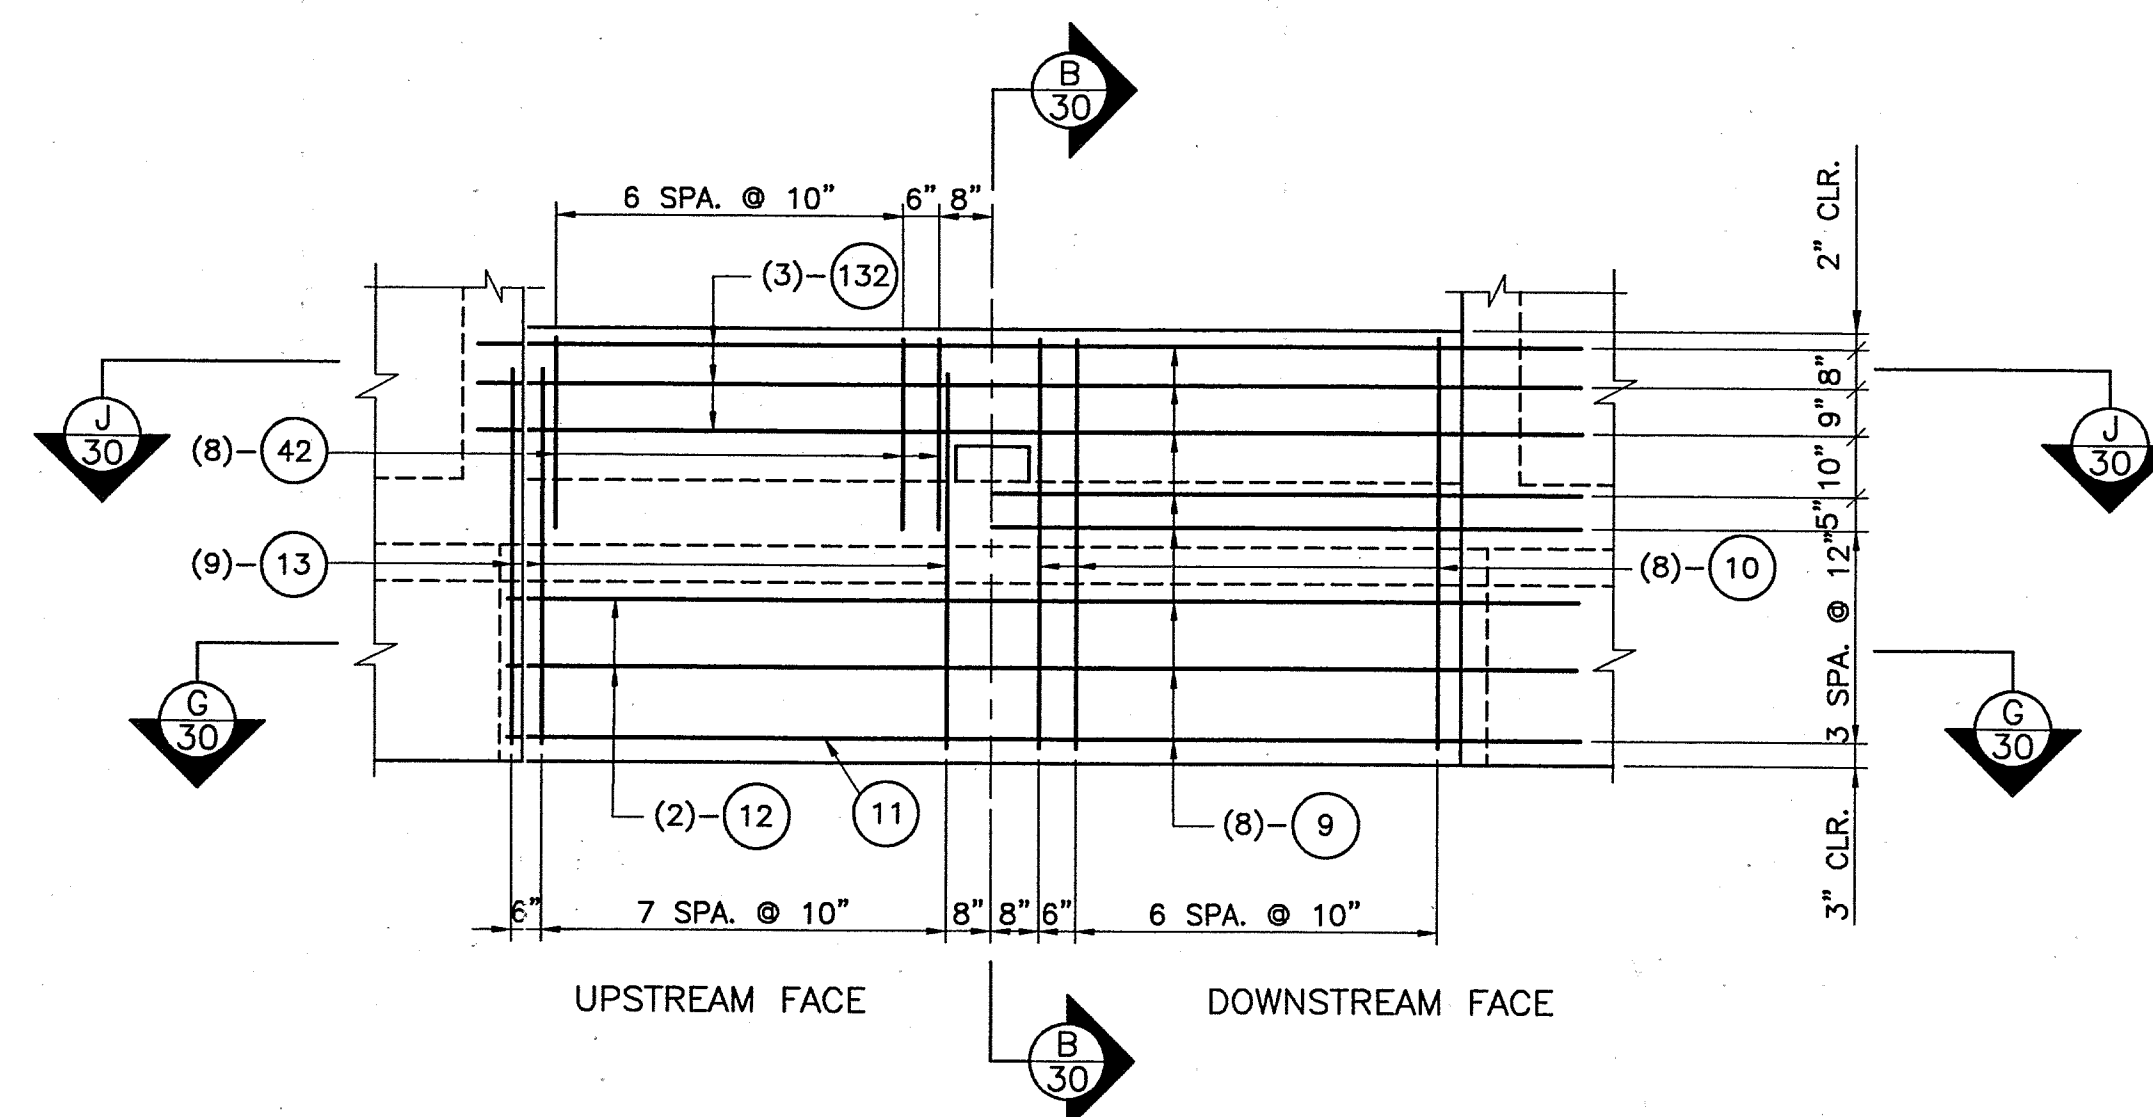

ELEVATION OF END SILL & TOE WALL
NTS

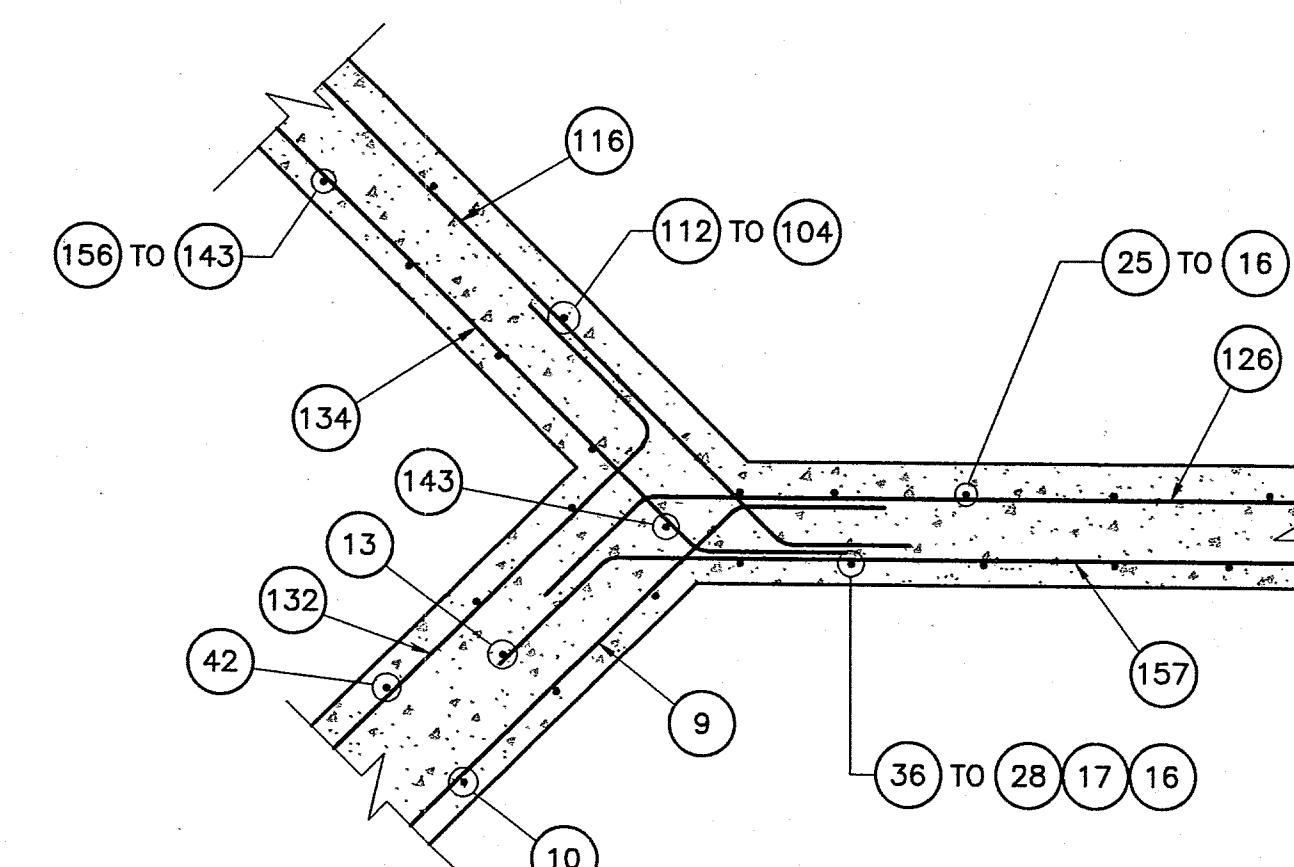

SECTION J-J
NTS

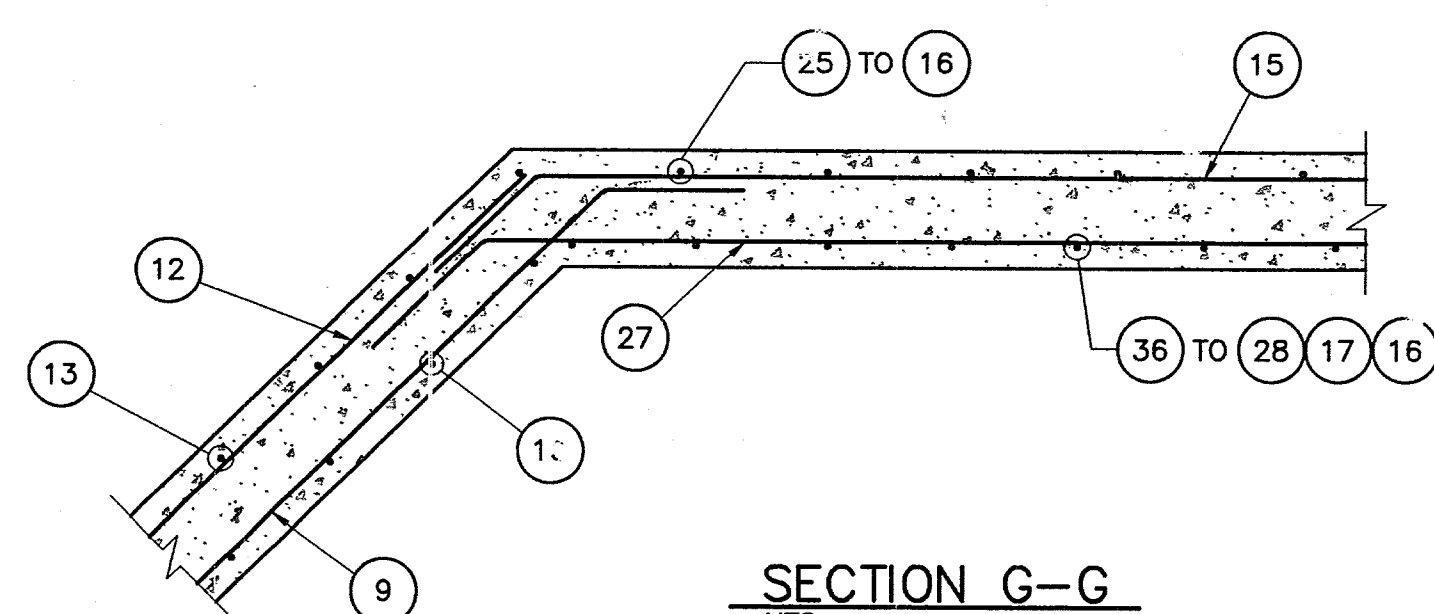

SECTION G-G
NTS

RECORD DRAWING
DATE 2-20-01


6922.91

ALBUQUERQUE METROPOLITAN ARROYO FLOOD CONTROL AUTHORITY		BORREGA DETENTION DAM PRINCIPAL SPILLWAY OUTLET STRUCTURE	
 WILSON & COMPANY 4900 LANG AVENUE N.E. ALBUQUERQUE, NM 87109 (505) 348-4000		NO. DATE REMARKS BY REVISIONS WILSON & COMPANY, ENGINEERS & ARCHITECTS DESIGNED BY NM NOV 1999 DRAWN BY PJM NOV 1999 CHECKED BY DSA NOV 1999	
SHEET 31 OF 34		DATE MARCH 2000 FILE 99099	


LOCATION	MARK	SIZE	QUAN	LENGTH	TYPE	B	C	TOTAL LENGTH
Headwall	1	5	2	14'-10"	St			28'-8"
"	2	4	4	14'-10"	St			59'-4"
"	3	4	12	5'-3"	St			63'-0"
"	4	4	4	5'-5"	St			21'-8"
"	5	4	2	6'-0"	St			12'-0"
"	6	4	10	6'-8"	St			66'-8"
"	7	4	2	5'-9"	St			11'-6"
"	8	4	2	6'-8"	St			13'-4"
Endsill	9	5	8	17'-4"	7	14'-10"	1'-3"	138'-8"
"	10	5	16	5'-9"	St			92'-0"
"	11	5	1	14'-1"	St			14'-1"
"	12	4	2	14'-1"	St			28'-2"
"	13	4	18	5'-2"	St			93'-0"
Wingwall	14	5	2	13'-10"	19	1'-3"	12'-7"	27'-8"
"	15	4	4	13'-7"	19	1'-0"	12'-7"	54'-4"
"	16	5	4	5'-9"	St			23'-0"
"	17	4	4	6'-0"	St			24'-0"
"	18	4	2	6'-4"	St			12'-8"
"	19	4	2	6'-7"	St			13'-2"
"	20	4	2	6'-11"	St			13'-10"
"	21	4	2	7'-2"	St			14'-4"
"	22	4	2	7'-6"	St			15'-0"
"	23	4	2	7'-9"	St			15'-0"
"	24	5	6	5'-11"	St			35'-6"
"	25	5	4	6'-7"	St			26'-4"
"	26	5	2	14'-4"	St	1'-3"	13'-1"	28'-8"
"	27	4	4	14'-1"	19	1'-0"	13'-1"	56'-4"
"	28	4	2	6'-2"	St			12'-4"
"	29	4	2	6'-5"	St			12'-10"
"	30	4	2	6'-8"	St			13'-4"
"	31	4	2	6'-11"	St			13'-10"
"	32	4	2	7'-2"	St			14'-4"
"	33	4	2	7'-5"	St			14'-10"
"	34	4	2	7'-8"	St			15'-0"
"	35	4	6	5'-8"	St			34'-0"
"	36	4	8	6'-5"	St			51'-4"
Apron	37	5	4	14'-10"	St			59'-4"
"	38	5	36	11'-9"	21	3'-8"	8'-1"	423'-0"
"	39	4	34	8'-3"	21	3'-8"	4'-7"	280'-6"
"	40	4	44	2'-8"	21	2'-0"	0'-8"	117'-4"
"	41	4	15	19'-4"	St			290'-0"
"	42	5	16	3'-9"	22	1'-0"	2'-9"	60'-0"
"	43	5	2	6'-5"	21	2'-3"	4'-2"	12'-10"
"	44	5	2	6'-9"	21	2'-7"	4'-2"	13'-6"
"	45	5	10	7'-10"	21	3'-8"	4'-2"	78'-4"
Wingwall	46	4	8	13'-7"	St			108'-8"
"	47	5	8	22'-4"	St			178'-8"
"	48	4	4	21'-3"	St			85'-0"
"	49	4	4	19'-10"	St			79'-4"
"	50	4	4	15'-10"	St			63'-4"
"	51	4	4	10'-6"	St			42'-0"
"	52	4	2	2'-1"	St			4'-2"
"	53	4	2	2'-6"	St			5'-0"
"	54	4	2	2'-11"	St			5'-10"
"	55	4	2	3'-4"	St			6'-8"
"	56	4	2	3'-9"	St			7'-6"
"	57	4	2	4'-2"	St			8'-4"
"	58	4	2	4'-7"	St			9'-2"
"	59	4	2	5'-0"	St			10'-0"

LOCATION	MARK	SIZE	QUAN	LENGTH	TYPE	B	C	TOTAL LENGTH
Wingwall	60	4	2	5'-5"	St			10'-10"
"	61	4	2	5'-10"	St			11'-8"
"	62	4	2	4'-9"	St			9'-6"
"	63	4	2	3'-8"	St			7'-4"
Apron	64	4	21	19'-4"	St			406'-0"
"	65	5	35	14'-10"	St			519'-2"
Wingwall	66	4	2	2'-9"	21	0'-8"	2'-1"	5'-6"
"	67	4	2	3'-0"	21	0'-8"	2'-4"	6'-0"
"	68	4	2	3'-3"	21	0'-8"	2'-7"	6'-6"
"	69	4	2	3'-7"	21	0'-8"	2'-11"	7'-2"
"	70	4	2	3'-10"	21	0'-8"	3'-2"	7'-8"
"	71	4	2	4'-1"	21	0'-8"	3'-5"	8'-2"
"	72	4	2	4'-5"	21	0'-8"	3'-9"	8'-10"
"	73	4	2	4'-8"	21	0'-8"	4'-0"	9'-4"
"	74	5	2	5'-1"	21	0'-10"	4'-3"	10'-2"
"	75	5	2	5'-5"	21	0'-10"	4'-7"	10'-10"
"	76	5	2	5'-8"	21	0'-10"	4'-10"	11'-4"
"	77	5	2	5'-11"	21	0'-10"	5'-1"	11'-10"
"	78	5	2	6'-3"	21	0'-10"	5'-5"	12'-6"
"	79	5	2	5'-8"	St			11'-4"
"	80	4	2	5'-6"	St			11'-0"
"	81	4	2	4'-8"	St			9'-4"
"	82	5	2	4'-0"	St			8'-0"
Headwall	83	4	1	4'-3"	21	1'-6"	2'-9"	4'-3"
"	84	4	2	4'-6"	21	1'-6"	3'-0"	9'-0"
"	85	4	2	6'-0"	21	1'-6"	4'-6"	12'-0"
"	86	5	2	11'-4"	21	9'-10"	1'-6"	22'-8"
"	87	4	8	9'-8"	21	1'-6"	8'-2"	77'-4"
"	88	4	12	4'-9"	T1	0'-3"	1'-6"	57'-0"
"	89	4	3	10'-6"	St			31'-6"
"	90	5	8	14'-10"	St			118'-8"
"	91	4	6	4'-6"	St			27'-0"
"	92	5	8	6'-6"	St			52'-0"
"	93	4	5	14'-10"	St			74'-2"
"	94	4	2	4'-6"	St			9'-0"
"	95	4	4	4'-7"	St			18'-4"
"	96	4	4	5'-0"	St			20'-0"
"	97	4	4	5'-11"	St			23'-8"
"	98	4	10	9'-10"	St			98'-4"
"	99	5	2	9'-10"	St			19'-8"
"	100	4	1	2'-9"	St			2'-9"
"	101	4	2	2'-10"	St			5'-8"
"	102	4	2	3'-3"	St			6'-6"
"	103	4	2	4'-1"	St			8'-2"
Sidewall	104	4	2	5'-4"	St			10'-8"
"	105	4	2	5'-8"	St			11'-4"
"	106	4	2	4'-7"	St			9'-2"
"	107	4	2	5'-3"	St			10'-6"
"	108	4	2	5'-10"	St			11'-8"
"	109	4	2	6'-6"	St			13'-0"
"	110	4	2	7'-2"	St			14'-4"
"	111	4	2	7'-9"	St			15'-6"
"	112	4	12	9'-11"	21	8'-5"	1'-6"	119'-0"
"	113	4	12	4'-0"	St			48'-0"
"	114	4	12	4'-9"	T1	0'-6"	1'-6"	57'-0"
"	115	5	24	13'-10"	21	3'-4"	10'-6"	332'-0"
"	116	4	14	15'-1"	19	1'-0"	14'-1"	211'-2"
"	117	4	2	13'-6"	St			27'-0"
"	118	4	2	11'-10"	St			23'-8"

LOCATION	MARK	SIZE	QUAN	LENGTH	TYPE	B	C	TOTAL LENGTH
Sidewall	119	4	2	12'-6"	St			25'-0"
"	120	4	2	10'-11"	St			21'-10"
"	121	4	2	9'-4"	St			18'-8"
"	122	4	2	14'-6"	21	3'-4"	11'-2"	29'-0"
"	123	5	4	9'-8"	21	1'-3"	8'-5"	38'-8"
"	124	5	4	13'-0"	23	1'-3"	11'-9"	52'-0"
Wingwall	125	4	24	4'-0"	St			96'-0"
"	126	4	6	13'-8"	19	1'-0"	12'-8"	82'-0"
"	127	4	2	10'-11"	19	1'-0"	9'-11"	21'-10"
"	128	4	2	8'-1"	19	1'-0"	7'-1"	16'-2"
"	129	4	2	5'-3"	19	1'-0"	4'-3"	10'-6"
"	130	4	2	2'-5"	19	1'-0"	1'-5"	4'-10"
"	131	5	2	14'-5"	19	1'-3"	13'-2"	28'-10"
Endsill	132	5	2	17'-2"	17	1'-3"	14'-8"	51'-6"
Sidewall	133	4	24	8'-5"	St			202'-0"
"	134	5	16	16'-0"	19	1'-3"	14'-9"	256'-0"
"	135	5	2	14'-8"	St			29'-4"
"	136	5	2	13'-0"	St			26'-0"
"	137	5	2	11'-5"	St			22'-10"
"	138	4	2	9'-11"	St			19'-10"
"	139	4	2	12'-9"	St			25'-6"
"	140	4	2	11'-2"	St			22'-4"
"	141	4	2	9'-9"	St			19'-6"
"	142	5	4	9'-3"	19	2'-1"	7'-2"	37'-0"
"	143	4	2	5'-4"	St			10'-8"
"	144	4	2	5'-8"	St			11'-4"
"	145	4	2	6'-0"	St			12'-0"
"	146	4	2	6'-5"	St			12'-10"
"	147	4	2	6'-9"	St			13'-6"
"	148	4	2	7'-1"	St			14'-2"
"	149	4	2	7'-5"	St			14'-10"
"	150	4	2	7'-9"	St			15'-6"
"	151	4	2	8'-2"	St			16'-4"
"	152	4	2	8'-6"	St			17'-0"
"	153	4	2	8'-10"	St			17'-8"
"	154	4	2	9'-2"	St			18'-4"
"	155	4	2	9'-6"	St			19'-0"
"	156	4	20	9'-10"	St			196'-8"
Wingwall	157	4	6	14'-1"	19	1'-0"	13'-1"	84'-6"
"	158	4	2	9'-7"	St			19'-2"
"	159	4	2	6'-9"	St			13'-6"
"	160	4	2	4'-0"	St			8'-0"
"	161	4	2	1'-2"	St			2'-4"
"	162	5	2	14'-0"	19	1'-3"	12'-9"	28'-0"
Baffle	163	5	8	20'-0"	17	2'-8"	14'-8"	160'-0"
"	164	5	2	6'-0"	St			12'-0"
"	165	4	20	7'-5"	T1	0'-6"	2'-10"	148'-4"
"	166	5	4	17'-8"	17	1'-6"	14'-8"	70'-8"
"	167	5	7	7'-3"	24	5'-6"	0'-6"	50'-9"
"	168	5	4	6'-11"	24	5'-2"	0'-6"	27'-8"
"	169	5	4	6'-3"	24	4'-6"	0'-6"	25'-0"
"	170	5	6	5'-7"	24	3'-10"	0'-6"	33'-6"
"	171	5	4	6'-7"	19	1'-3"	5'-4"	26'-4"
"	172	5	2	13'-2"	7	4'-4"	4'-5"	26'-4"
"	173	5	20	4'-8"	7	2'-2"	1'-3"	93'-4"
"	174	5	7	8'-5"	21	2'-10"	5'-7"	58'-11"
"	175	5	4	8'-1"	21	2'-10"	5'-3"	32'-4"
"	176	5	4	7'-5"	21	2'-10"	4'-7"	29'-8"
"	177	5	6	6'-9"	21	2'-10"	3'-11"	40'-6"
"	178	5	7	20'-0"	17	2'-8"	14'-8"	140'-0"

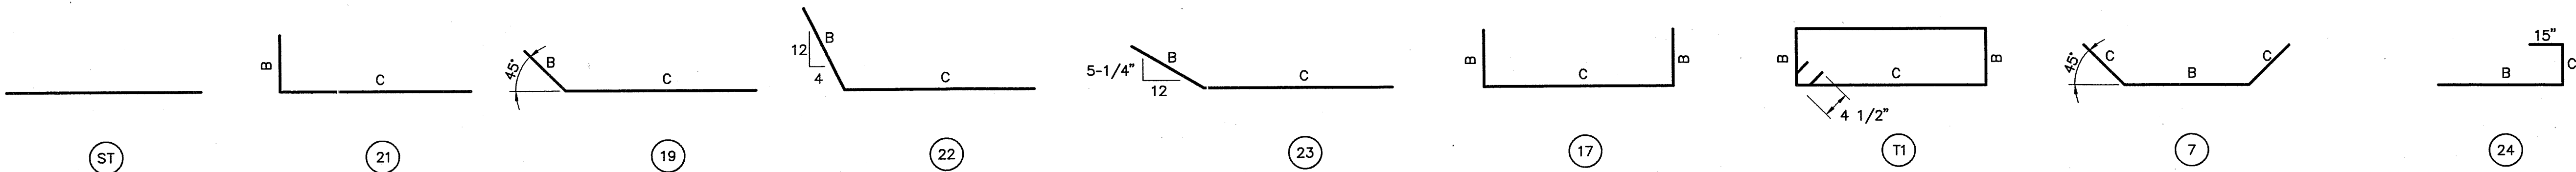

6922.91

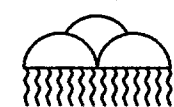

ALBUQUERQUE METROPOLITAN
ARROYO FLOOD
CONTROL AUTHORITY

BORREGA DETENTION DAM
PRINCIPAL SPILLWAY OUTLET STRUCTURE






**WILSON
& COMPANY**

4900 LANG AVENUE N.E.
ALBUQUERQUE, NM
87109
(505) 348-4000

DATE
MARCH 2000
FILE
99099
SHEET
32 OF 34
CHECKED BY
NOV 1999

RECORD DRAWING
DATE 2-20-01

99099A.M (SHEETS) DAM W99099P8.DWG (3-7-00) P.M

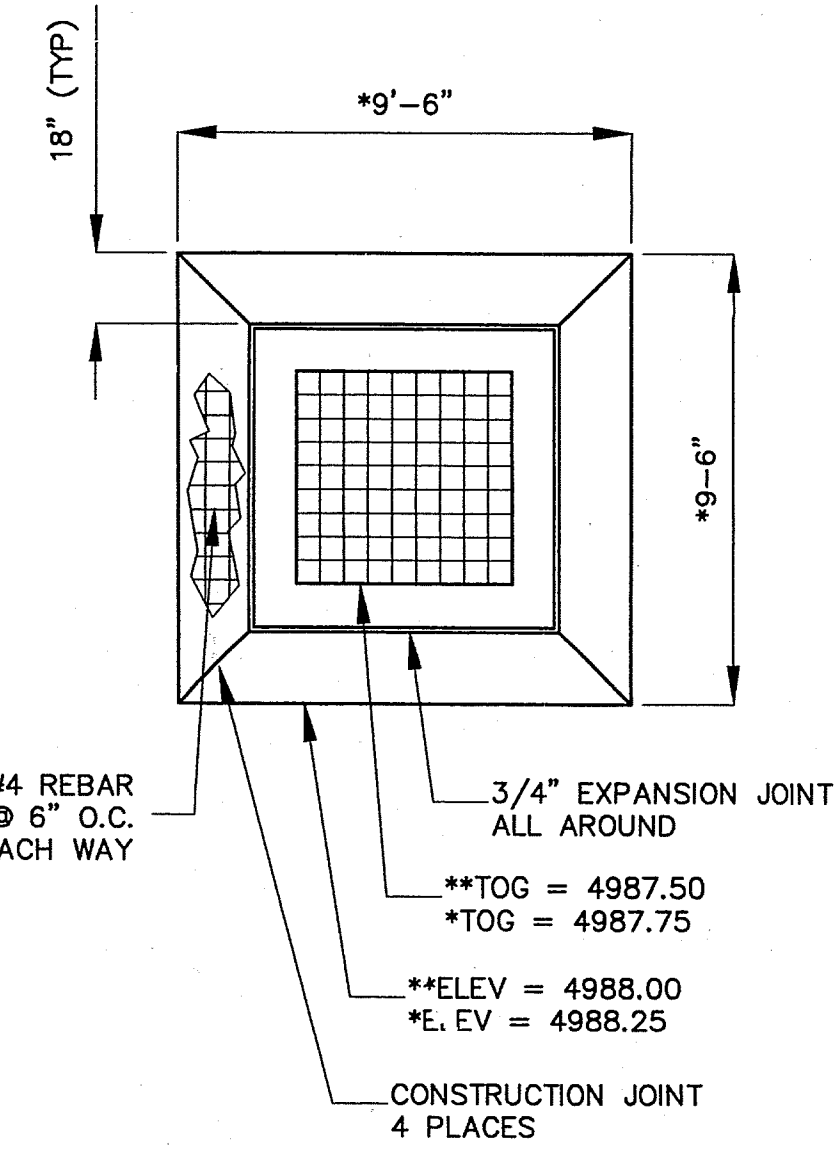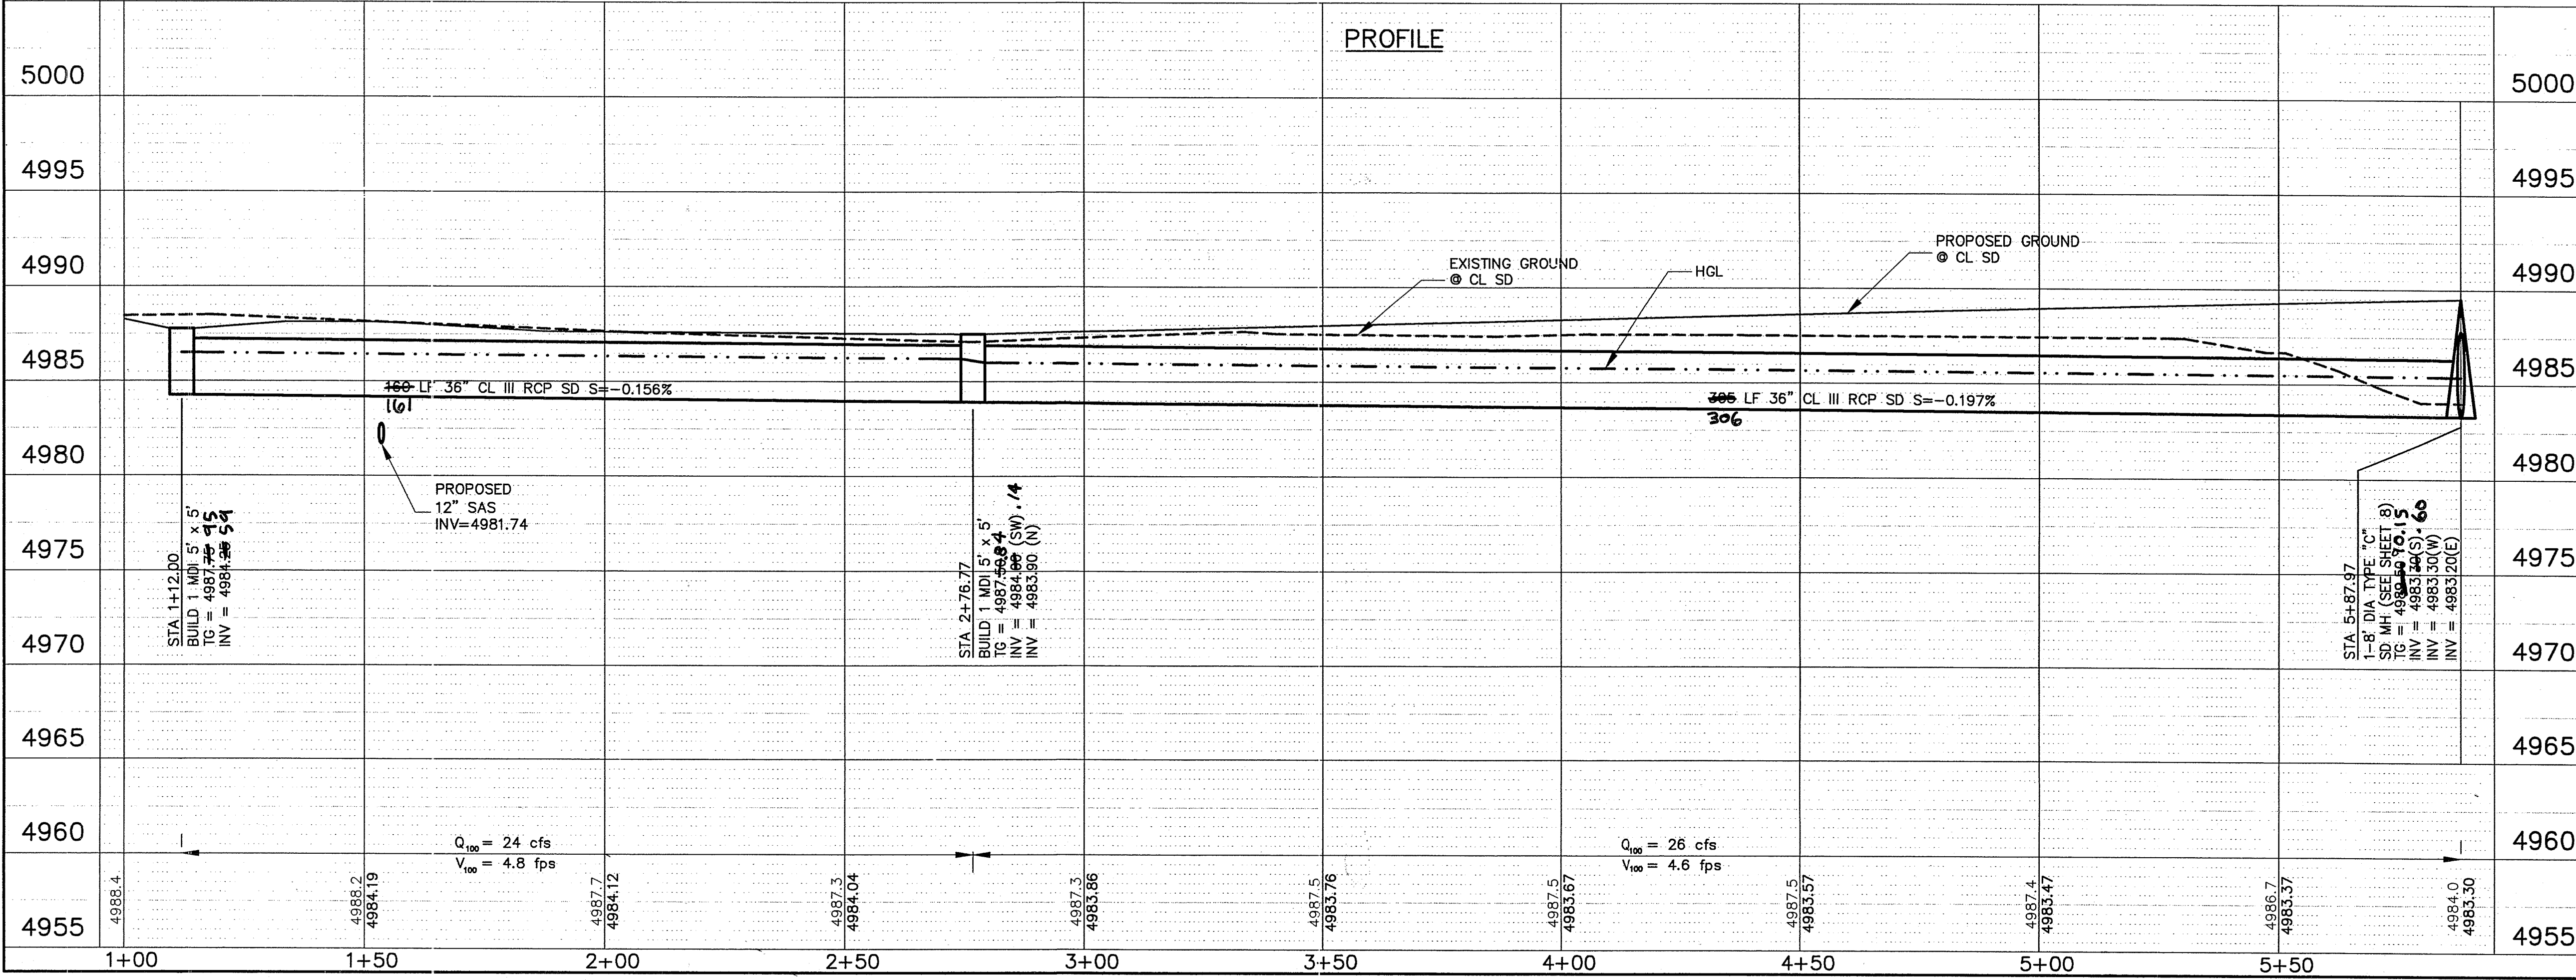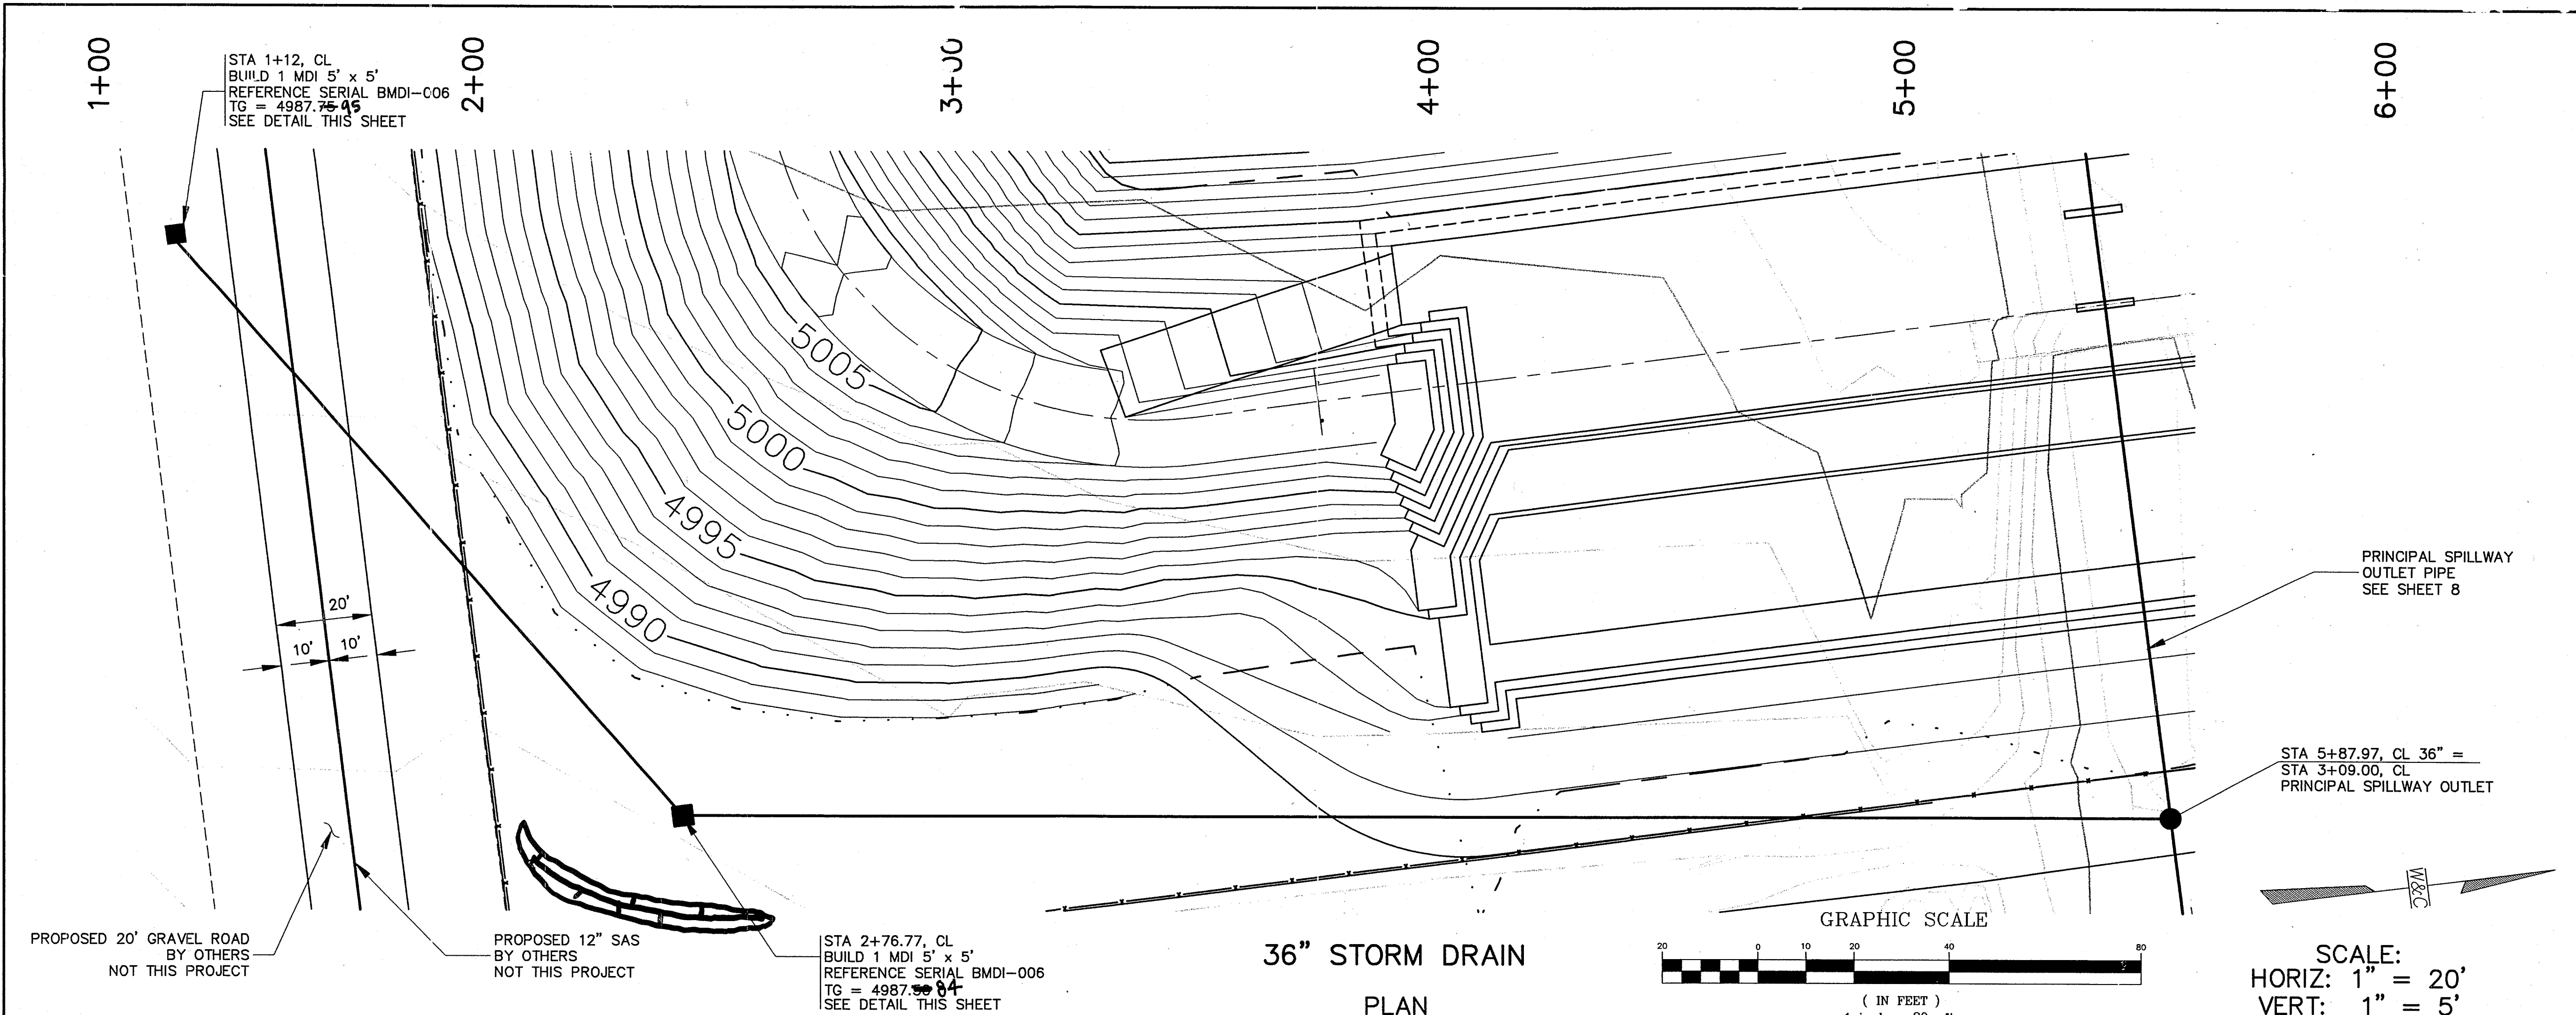

NOTE:
1. *STA 1+12 MDI 5' x 5'
2. **STA 2+76.77 MDI 5' x 5'
3. CONCRETE COLLAR TO BE CONSTRUCTED 6" THICK AND REINFORCED WITH #4 REBAR @ 6" CENTERS.

MDI STRUCTURE
NTS

RECORD DRAWING
DATE 2-20-01

6922.91

ALBUQUERQUE METROPOLITAN
ARROYO FLOOD
CONTROL AUTHORITY

BORREGA DETENTION DAM

36" STORM DRAIN PLAN & PROFILE


WILSON & COMPANY
4900 LANG AVENUE N.E.
ALBUQUERQUE, NM 87109
(505) 348-4000

DATE
APRIL 2000

FILE
99099

SHEET
33 OF 34

SURVEY INFORMATION			BENCH MARKS			AS-BUILT INFORMATION		
FIELD NOTES			CP103 (SEE SHEET 1 FOR LOCATION)			CONTRACTOR CHAVA		
NO.			REBAR W/ ALUMINUM CAP			CHAVA		
BY			STAMPED WILSON & COMPANY			WCEA		
DATE			N = 1462061.9801			WCEA		
			E = 1495972.9457			WCEA		
			ELEVATION = 5020.789 FT			MICRO-FILM INFORMATION		

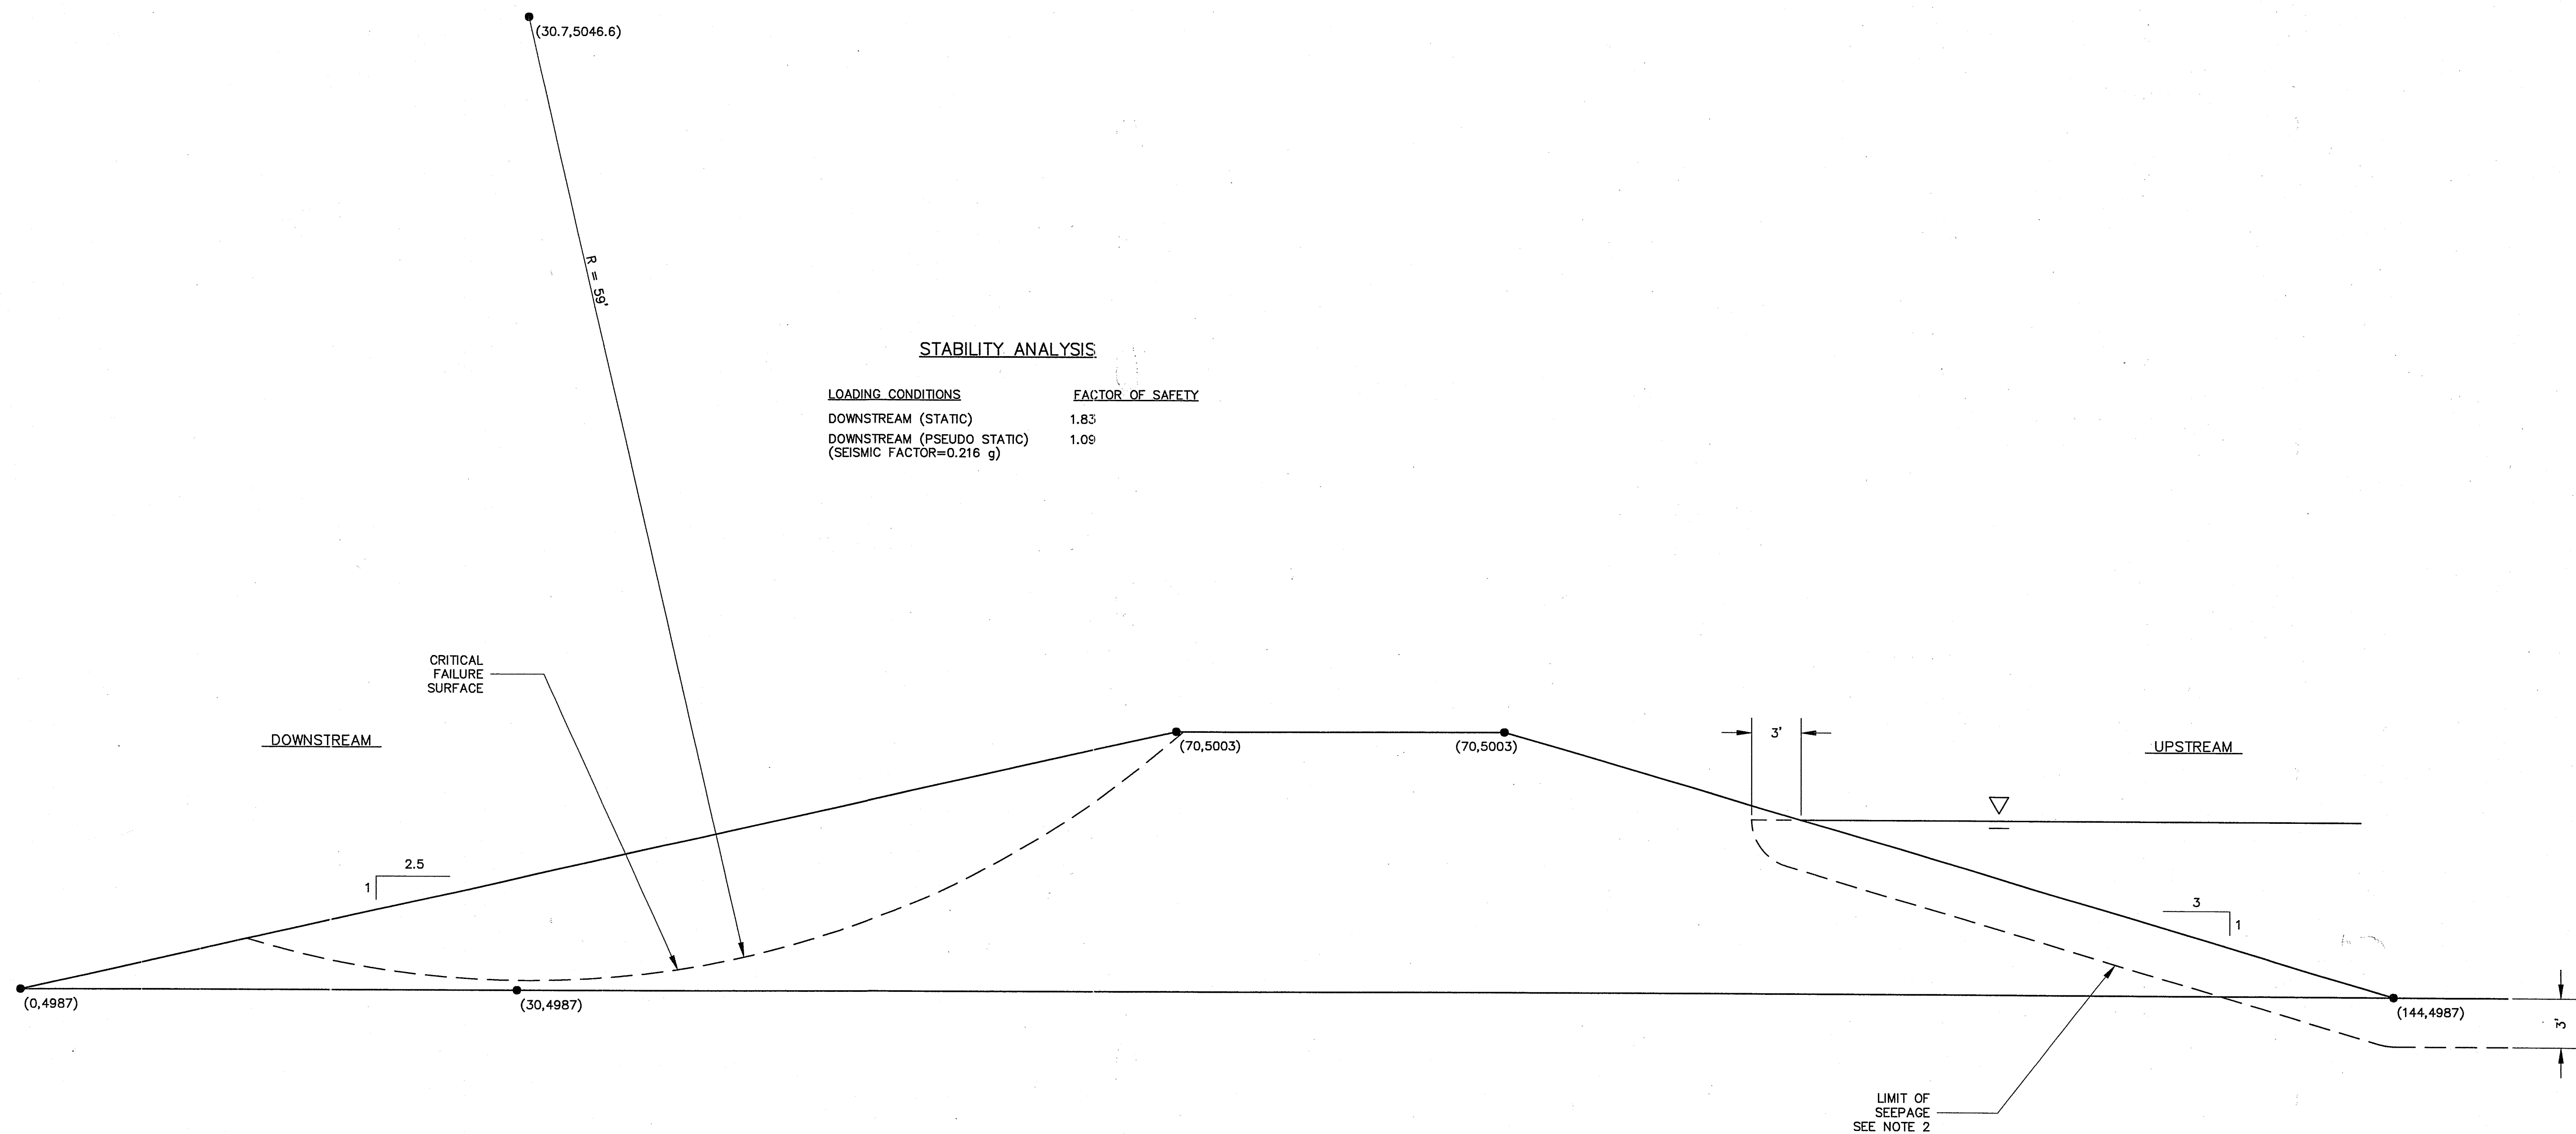

STABILITY ANALYSIS:

CRITICAL
FAILURE
SURFACE

UPSTREAM

DAM SECTION FOR ANALYSIS

LIMIT OF
SEEPAGE
SEE NOTE 2

		REVISIONS	
NO.	DATE	REMARKS	BY
WILSON & COMPANY, ENGINEERS & ARCHITECTS			
DESIGNED BY		NM	NOV 1999
DRAWN BY		PJM	NOV 1999
CHECKED BY		DSA	NOV 1999

DATE	APRIL 2000
------	------------

NOTES: