

PUBLIC IMPROVEMENT PLANS
FOR
WALGREENS
AT UNSER BLVD/SAPPHIRE ST

ALBUQUERQUE, NEW MEXICO


NOVEMBER 2002

PREPARED FOR:
CAP II, c/o PETERSON PROPERTIES
2325 SAN PEDRO DR NE
ALBUQUERQUE, NM 87110

PREPARED BY:
ISAACSON & ARFMAN, P.A.
128 MONROE ST. NE
ALBUQUERQUE, NM 87108


INDEX TO DRAWINGS

SHEET NO.	TITLE
1	COVER SHEET
2-3	PLAT
4	OVERALL GRADING PLAN
STORM DRAIN & PAVING PLANS	
5	MASTER PAVING & STORM DRAIN PLAN
6	SAPPHIRE STREET PAVING & STORM DRAIN PLAN & PROFILE
7	UNSER BLVD PAVING & STORM DRAIN PLAN & PROFILE
8	UNSER TEMPORARY CONNECTION & CURB PROFILE
UTILITY PLANS	
9	MASTER UTILITY PLAN
10	SAPPHIRE STREET UTILITY PLAN & PROFILE
11	UNSER BLVD UTILITY PLAN & PROFILE
12	WATER SHUTOFF PLAN & UTILITY DETAILS
13	STRIPING AND SIGNAGE PLAN
13A	CONDUIT AND PULLBOX PLAN & DETAILS
14	SIGNING & CONSTRUCTION TRAFFIC CONTROL STANDARDS
15	TRAFFIC CONTROL & SIGNING EXAMPLES

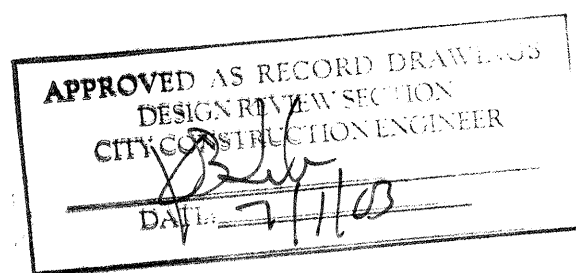

CERTIFICATE OF SUBSTANTIAL COMPLIANCE ON PLANS


I, Fred C. Arfman, NMPE No. 7322 of the firm of Isaacson & Arfman, P.A. a Registered Professional Engineer in the State of New Mexico, do hereby certify, to the best of my knowledge and belief, that the infrastructure installed as part of this project has been inspected by me or by a qualified person under my direct supervision and has been constructed in accordance with the plans and specifications approved by the City Engineer and that the original design intent of the approved plans has been met, except as noted by me on the as-built construction drawings. This Certification is based on site inspections by me or personnel under my direction and survey information provided by Walker Surveying, Inc., NMPS No. 6401.

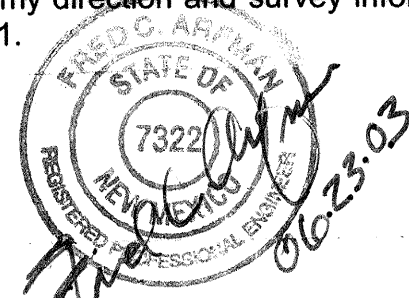

SURVEYOR'S CERTIFICATION

I, Stephen E. Walker, a duly qualified Registered Professional Land Surveyor under the laws of the State of New Mexico, do hereby certify that the "As-Built" information shown on these drawings was obtained from field construction and "As-built" surveys performed by me or under my supervision; that the "As-built" information shown on these drawings was added by me or under my supervision, and that this "As-built" information is true and correct to the best of my knowledge and belief. Walker Surveying is not responsible for any of the design concepts, calculations, engineering, or intent of the record drawings.

Stephen E. Walker, NMPS No. 6401, Date 06-20-03

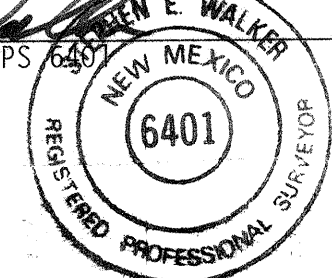

BENCHMARK NOTE:

THE ELEVATIONS ON THIS PLAN ARE IN LOCAL DATUM. WHEN THE AREAS SURROUNDING THIS SITE WERE DEVELOPED, THE SURVEYS WERE BASED ON THREE MONUMENTS WITH PUBLISHED INCORRECT ELEVATIONS, RESULTING IN ELEVATIONS 0.66 FEET LOWER THAN THE NGVD 29 DATUM.

THIS PROBLEM WAS CORRECTED AND THE FAULTY MONUMENTS ARE NO LONGER PUBLISHED. SINCE ALL AS-BUILTS AND ALL SURVEY FILES FOR THE SURROUNDING AREAS REFERENCE THE LOCAL DATUM, THE SAME DATUM WILL BE USED FOR THIS PROJECT.

TO CONVERT TO NGVD 29, ADD 0.66 FEET TO THE LOCAL ELEVATION.


1 2 3 4 5 6 7 8 9 10 11 12 13 14 15
26 6953.81 03

GENERAL NOTES

- ALL WORK DETAILED ON THESE PLANS TO BE PERFORMED UNDER CONTRACT SHALL, EXCEPT AS OTHERWISE STATED OR PROVIDED FOR HEREON, BE CONSTRUCTED IN ACCORDANCE WITH THE CITY OF ALBUQUERQUE STANDARD SPECIFICATIONS FOR PUBLIC WORKS CONSTRUCTION 1986 EDITION AS AMENDED WITH UPDATE NO. 6.
- ALL WORK ON THIS PROJECT SHALL BE PERFORMED IN ACCORDANCE WITH APPLICABLE FEDERAL, STATE, AND LOCAL LAWS, RULES, AND REGULATIONS CONCERNING CONSTRUCTION SAFETY AND HEALTH.
- PRIOR TO CONSTRUCTION, THE CONTRACTOR SHALL EXCAVATE & VERIFY THE HORIZONTAL AND VERTICAL LOCATIONS OF ALL OBSTRUCTIONS. SHOULD A CONFLICT EXIST, THE CONTRACTOR SHALL NOTIFY THE ENGINEER SO THAT THE CONFLICT CAN BE RESOLVED WITH MINIMUM DELAY.
- TWO (2) WORKING DAYS PRIOR TO ANY EXCAVATION, CONTRACTOR MUST CONTACT THE LINE LOCATION SERVICE, NM ONE CALL SYSTEM @ 260-1990 FOR LOCATION OF EXISTING UTILITIES.
- CONTRACTOR SHALL CONDUCT HIS OPERATIONS IN A MANNER WHICH WILL MINIMIZE INTERFERENCE WITH LOCAL TRAFFIC. CONTRACTOR SHALL COMPLY WITH ALL APPLICABLE LAWS, ORDINANCES, RULES, REGULATIONS, AND ORDERS OF ANY PUBLIC BODY HAVING JURISDICTION FOR THE SAFETY OF PERSONS OR PROPERTY, AND TO PROTECT THEM FROM DAMAGE, INJURY, OR LOSS. CONTRACTOR SHALL ERECT AND MAINTAIN, AS REQUIRED BY THE CONDITIONS AND PROGRESS OF THE WORK, ALL NECESSARY SAFEGUARDS FOR SAFETY CONTINUOUSLY AND NOT LIMITED TO NORMAL WORKING HOURS, THROUGHOUT THE DURATION OF THE PROJECT. CONTRACTOR SHALL ADHERE TO SECTION 19 OF THE GENERAL CONDITIONS OF THE CITY OF ALBUQUERQUE STANDARD SPECIFICATIONS FOR PUBLIC WORKS CONSTRUCTION, 1986, AS AMENDED WITH UPDATE NO. 6.
- THE CONTRACTOR AGREES THAT HE SHALL ASSUME THE SOLE AND COMPLETE RESPONSIBILITY FOR THE JOB SITE CONDITIONS DURING THE COURSE OF CONSTRUCTION OF THIS PROJECT, INCLUDING SAFETY OF ALL PERSONS AND PROPERTY; THAT THIS REQUIREMENT SHALL APPLY CONTINUOUSLY AND NOT BE LIMITED TO NORMAL WORKING HOURS; AND THAT THE CONTRACTOR SHALL DEFEND, INDEMNIFY, AND HOLD HARMLESS THE OWNER, THE ENGINEER & THE CITY OF ALBUQUERQUE FROM ANY AND ALL LIABILITY REAL OR ALLEGED IN CONNECTION WITH THE PERFORMANCE OF WORK ON THIS PROJECT, EXCEPTING LIABILITY ARISING FROM THE SOLE NEGLIGENCE OF THE OWNER OR ENGINEER OR THE CITY OF ALBUQUERQUE.
- TRAFFIC CONTROL: FIVE (5) WORKING DAYS PRIOR TO BEGINNING CONSTRUCTION THE CONTRACTOR SHALL SUBMIT TO THE CONSTRUCTION COORDINATION DIVISION A DETAILED CONSTRUCTION SCHEDULE. TWO (2) WORKING DAYS PRIOR TO CONSTRUCTION, THE CONTRACTOR SHALL OBTAIN A BARRICADING PERMIT FROM THE CONSTRUCTION COORDINATION DIVISION. CONTRACTOR SHALL NOTIFY BARRICADE ENGINEER (924-3400) PRIOR TO OCCUPYING AN INTERSECTION. SEE SECTION 19 OF THE SPECIFICATIONS. ALL STREET STRIPING ALTERED OR DESTROYED SHALL BE REPLACED WITH PLASTIC REFLECTORIZED PAVEMENT MARKINGS BY CONTRACTOR TO LOCATION AS EXISTING OR AS SHOWN IN THIS PLAN SET.
- WHEN ABUTTING EXISTING PAVEMENT TO NEW, SAWCUT EXISTING PAVEMENT TO A STRAIGHT EDGE AND AT A RIGHT ANGLE, OR AS APPROVED BY THE FIELD ENGINEER. REMOVAL OF BROKEN OR CRACKED PAVEMENT WILL ALSO BE REQUIRED.
- EXISTING CURB AND GUTTER NOT TO BE REMOVED UNDER THE CONTRACT WHICH IS DAMAGED OR DISPLACED BY THE CONTRACTOR SHALL BE REMOVED AND REPLACED BY THE CONTRACTOR AT HIS EXPENSE.
- ALL FINAL BACKFILL FOR TRENCHES SHALL BE COMPACTED TO A MINIMUM 90% MAXIMUM DENSITY PER ASTM D-1557 AND AS DIRECTED BY SECTION 701.14.2 AND STANDARD DRAWING NUMBER 2315.
- THE CONTRACTOR SHALL PROMPTLY CLEAN UP ANY MATERIAL EXCAVATED WITHIN THE PUBLIC RIGHT-OF-WAY OR PRIVATE ROADWAY EASEMENTS SO THAT THE EXCAVATED MATERIAL IS NOT SUSCEPTIBLE TO BEING WASHED DOWN THE STREET OR INTO ANY PUBLIC DRAINAGE FACILITY.
- PROPOSED WATERLINE MATERIALS SHALL BE EITHER PVC PIPE MEETING AWWA C900 REQUIREMENTS (6"-12") OR DUCTILE IRON PIPE, THICKNESS CLASS 50 (6"-16").
- ALL FITTINGS ON WATERLINES SHALL HAVE RESTRAINED JOINTS AS NOTED ON THE PLANS.
- CONTRACTOR SHALL SUPPORT ALL EXISTING, UNDERGROUND UTILITY LINES WHICH BECOME EXPOSED DURING CONSTRUCTION. PAYMENT FOR SUPPORTING WORK SHALL BE INCIDENTAL TO WATER-LINE AND/OR SEWERLINE COSTS.
- CONTRACTOR SHALL ASSIST THE ENGINEER/INSPECTOR IN THE RECORDING OF DATA ON ALL UTILITY LINES AND ACCESSORIES AS REQUIRED BY THE CITY OF ALBUQUERQUE FOR THE PREPARATION OF RECORD DRAWINGS. CONTRACTOR SHALL NOT COVER UTILITY LINES AND ACCESSORIES UNTIL ALL DATA HAS BEEN RECORDED.
- THE CONTRACTOR SHALL NOTIFY THE ENGINEER NOT LESS THAN SEVEN (7) DAYS PRIOR TO STARTING WORK IN ORDER THAT THE ENGINEER MAY TAKE NECESSARY MEASURES TO INSURE THE PRESERVATION OF SURVEY MONUMENTS. CONTRACTOR SHALL NOT DISTURB PERMANENT SURVEY MONUMENTS WITHOUT THE CONSENT OF THE ENGINEER AND SHALL NOTIFY THE ENGINEER AND BEAR THE EXPENSE OF REPLACING ANY THAT MAY BE DISTURBED WITHOUT PERMISSION. REPLACEMENT SHALL BE DONE ONLY BY THE CITY SURVEYOR. WHEN A CHANGE IS MADE IN THE FINISHED ELEVATIONS OF THE PAVEMENT OF ANY ROADWAY IN WHICH A PERMANENT SURVEY MONUMENT IS LOCATED, CONTRACTOR SHALL, AT HIS OWN EXPENSE, ADJUST THE MONUMENT COVER TO THE NEW GRADE UNLESS OTHERWISE SPECIFIED. REFER TO SECTION 4.4 OF THE GENERAL CONDITIONS OF THE STANDARD SPECIFICATIONS.
- PNM WILL PROVIDE AT NO COST TO THE CITY OR THE CONTRACTOR THE REQUIRED PERSONNEL FOR INSPECTION OR OBSERVATION DEEMED NECESSARY BY PNM WHILE THE CONTRACTOR IS EXPOSING PNM'S CABLES. HOWEVER, THE CONTRACTOR SHALL BE CHARGED THE TOTAL COST ASSOCIATED WITH REPAIRS TO ANY DAMAGED CABLES OR FOR ANY COST ASSOCIATED WITH SUPPORTING OR RELOCATING THE POLES AND CABLES DURING CONSTRUCTION.
- WARNING--EXISTING UTILITY LINE LOCATIONS ARE SHOWN IN AN APPROXIMATE MANNER ONLY, AND SUCH LINES MAY EXIST WHERE NONE ARE SHOWN. THE LOCATION OF ANY SUCH EXISTING LINES IS BASED UPON INFORMATION PROVIDED BY THE UTILITY COMPANY, THE OWNER, OR BY OTHERS, AND THE INFORMATION MAY BE INCOMPLETE OR MAY BE OBSOLETE BY THE TIME CONSTRUCTION COMMENCES.

THE ENGINEER HAS UNDERTAKEN NO FIELD VERIFICATION OF THE LOCATION, DEPTH, SIZE, OR TYPE OF EXISTING UNDERGROUND UTILITY LINES, MAKES NO REPRESENTATION PERTAINING THERETO, AND ASSUMES NO RESPONSIBILITY OR LIABILITY THEREFOR. THE CONTRACTOR SHALL INFORM ITSELF OF THE LOCATION OF ANY UTILITY LINE IN OR NEAR THE AREA OF THE WORK IN ADVANCE OF AND DURING EXCAVATION WORK. THE CONTRACTOR IS FULLY RESPONSIBLE FOR ANY AND ALL DAMAGE CAUSED BY ITS FAILURE TO LOCATE, IDENTIFY, AND PRESERVE ANY AND ALL EXISTING UTILITIES. THE CONTRACTOR SHALL COMPLY WITH STATE STATUTES, MUNICIPAL AND LOCAL ORDINANCES, RULES AND REGULATIONS PERTAINING TO THE LOCATION OF THESE LINES AND FACILITIES, IN PLANNING AND CONDUCTING EXCAVATION, WHETHER BY CALLING OR NOTIFYING THE UTILITIES, COMPLYING WITH "BLUE STAKES" PROCEDURES, OR OTHERWISE.

REV.	SHEETS	CITY ENGINEER	DATE	USER DEPARTMENT	DATE	USER DEPARTMENT	DATE
ENGINEERS STAMP & SIGNATURE		APPROVALS		ENGINEER	DATE	*****	
		DRC Chairman	<i>[Signature]</i>	12/17/02	12/17/02	APPROVED FOR CONSTRUCTION	
		Transportation	<i>[Signature]</i>	12/17/02	12/17/02		
		Water/Wastewater	<i>[Signature]</i>	12/17/02	12/17/02		
		Hydrology	<i>[Signature]</i>	12/17/02	12/17/02		
		AMAFCA	<i>[Signature]</i>	12/17/02	12/17/02		
		Constr. Mngmt.	<i>[Signature]</i>	12/17/02	12/17/02		
		Constr. Coord.	<i>[Signature]</i>	12/17/02	12/17/02		
City Project No.		6953.81		Sheet 1 Of 15			

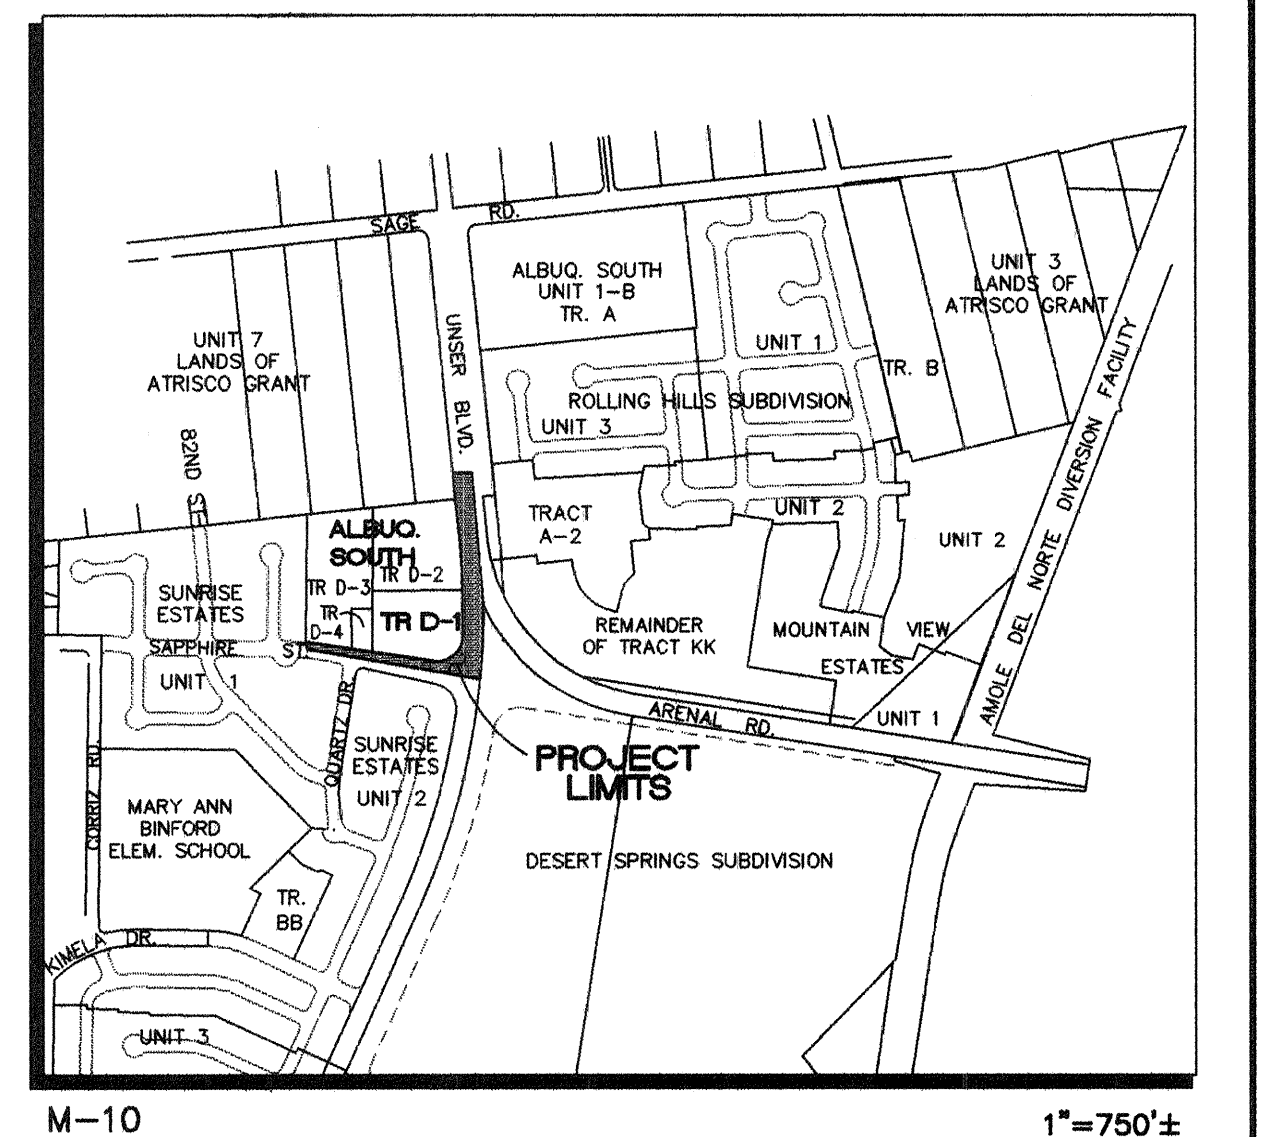

M-10

VICINITY MAP

1"=750'

TRACTS D-1, D-2, D-3 & D-4
ALBUQUERQUE SOUTH, UNIT 1

BEING A REPEAT OF
TRACT D, ALBUQUERQUE SOUTH UNIT 1
WITHIN THE
TOWN OF ATRISCO GRANT
PROJECTED SECTION 34
TOWNSHIP 10 NORTH, RANGE 2 EAST, NMP
CITY OF ALBUQUERQUE
BERNALILLO COUNTY, NEW MEXICO
AUGUST 2002

A tract of land situate within the Town of Atiscro Grant within projected Section 34, Township 10 North, Range 2 East, New Mexico Principal Meridian, City of Albuquerque, Bernalillo County, New Mexico, being all of TRACT D, ALBUQUERQUE SOUTH UNIT 1, as the same is shown and designated on said plot filed for record in the office of the County Clerk of Bernalillo County, New Mexico, on August 3, 1987, in Volume C34, Folio 74, and containing (413,101 s.f.) 9.4835 acres more or less.

 $1'' = 750' \pm$

DISCLOSURE STATEMENT

1. Total Number of Existing Tracts: 1
2. Total Number of Tracts created: 4
3. Total Number of Lots created: 0
4. Gross Subdivision Acreage: 9.4835 Ac.
5. Total Mileage of Full Width Streets Created: 0
6. Total Mileage of Half Width Streets Created: 0
7. Bearings are New Mexico State Plane Grid Bearings (Central Zone).
8. Distances are ground distances.
9. Bearings and distances in parenthesis are record.
10. Basis of boundary are the following plots (and documents) of record entitled:
"TRACTS A THROUGH F, ALBUQUERQUE SOUTH, UNIT 1" (8-3-87, C34-74),
"PLAT SHOWING A PORTION OF TRACTS ALLOTTED FROM TOWN OF ATRISCO
GRANT" (12-5-44, 0-117),
"SUNRISE ESTATES UNIT 1" (8-4-95, C35-286)
"CORRECTED PLAT FOR SUNRISE ESTATES UNIT TWO" (5-21-97, C37-162)
all being records of Bernalillo County, New Mexico.
11. Field Survey performed August 2002.
12. Unless otherwise noted, all property corners are SET 5/8" REBAR with cap "ALS LS
7719".
13. Title Report: Albuquerque Title Company, File No. 196631SD, Effective Date: 10/23/01
14. This property is apparently affected by reservations, restrictions and agreements
of easements, documents and memorandums as listed within the above
mentioned Title Report.
15. City Standard Utility Note 1i: "City of Albuquerque Water and Sanitary Sewer Service
to subject property must be verified and coordinated with the Public Works Department,
City of Albuquerque."
16. There shall be no direct access to Unser Blvd.

The subdivision shown herein is with the free consent and in accordance with the terms assigned hereto by the Proprietor(s) thereof and said Owner(s) of the City of Albuquerque in fee simple with warranty covenants and do hereby grant: all access, utility, drainage and landscape easements shown herein including the right to construct, operate, inspect, and maintain facilities therein; and all public utility easements shown herein for the common and joint use of gas, electrical power and communication services for overhead and/or buried distribution lines, conduits, and pipes for underground and/or overhead utilities where shown or indicated, and including the right of ingress and egress for construction and maintenance, and the right of ingress and egress for the use of the same by the Owner(s) and do hereby consent to all of the foregoing and do hereby certify that this subdivision is their free act and deed.

ALBUQUERQUE SOUTH, A NEW MEXICO GENERAL PARTNERSHIP
BY: ARJAY, INC., ITS CO-MANAGING PARTNER

BY: JOSEPH L. WERNITZ, PRESIDENT
OF ARJAY, INC.

Date _____

STATE OF NEW MEXICO)

COUNTY OF _____)

I, _____,
Notary Public
for said County and State,
do hereby certify that _____
is duly qualified as a Notary Public
in and for said County and State.
My commission expires _____

This instrument was acknowledged before me on _____ 2002, by Joseph L. Wentz as President of ARJAY, Inc., a New Mexico Corporation, being a Co-Managing Partner of Albuquerque South, a New Mexico General Partnership, on behalf of said partnership.

My Commission Expires:

Notary Public

1231PT1.DWGanw 8/7/02

**ALDRICH LAND
SURVEYING**

P.O. BOX 30701, ALBQ., N.M. 87190
505-884-1990

FOR
TRACTS D-1, D-2, D-3 & D-4
ALBUQUERQUE SOUTH, UNIT 1

BEING A REPLAT OF
TRACT D, ALBUQUERQUE SOUTH UNIT 1
WITHIN THE
TOWN OF ATRISCO GRANT
PROJECTED SECTION 34
TOWNSHIP 10 NORTH, RANGE 2 EAST, NMP
CITY OF ALBUQUERQUE
BERNALILLO COUNTY, NEW MEXICO
AUGUST 2002

A horizontal scale bar with markings at 0, 25, 50, and 100 feet. The bar is divided into four equal segments, each representing 25 feet.

DECLARATION OF COVENANTS, CONDITIONS, RESTRICTIONS AND CROSS
EASEMENTS FOR DRAINAGE, ACCESS AND UTILITIES AS RECORDED IN
THE OFFICE OF THE COUNTY CLERK OF BERNALILLO COUNTY ON
SEPTEMBER 16, 2002, IN BK. A41, PG. 8218.

- 10' PUBLIC UTILITY EASEMENT GRANTED BY THIS PLAT
EXISTING PUBLIC EASEMENT, SANITARY SEWER AND WATERLINE
EASEMENT (6/28/01, A25-2598)

EXISTING 20' PUBLIC WATERLINE EASEMENT
(6/15/73, BK. WISC. 327, PG. 336-339)

EXISTING 40' TEMPORARY ROADWAY EASEMENT
(07-19-94, BK. 94-21, PG. 7033-7036)
VACATED BY THIS PLAT (APPL. # D02B8-01273)

EXISTING 25' PUBLIC ROADWAY EASEMENT
(7/19/94, BK. 94-21, PG. 7023-7032)

EXISTING 40' ROADWAY EASEMENT
(7/19/94, BK. 94-21, PG. 7025-7032)
- 10' PEDESTRIAN ACCESS TO THE FUTURE COMMERCIAL DEVELOPMENT OF TRACT 484, TRACT 485 AND TRACT 486, SHOWN HEREIN AS BEING LOCATED ON THE EAST SIDE OF TRACT 484 AND TRACT 485, IS NOT A NECESSARY PASSAGEWAY FOR THE PURPOSES DETERMINED BY THE APPROVED SITE DESIGN PLAN OF EITHER TRACT 483, TRACT 484 OR TRACT 2-1, WHICHEVER IS APPROVED

TRACTS D-2 AND D-4 SHALL BE SUBJECT TO A SITE DEVELOPMENT PLAN FOR BUILDING PERMIT OR AN AMENDMENT TO AN APPROVED SITE DEVELOPMENT PLAN FOR BUILDING PERMIT PRIOR TO DEVELOPMENT.

CURVE	RADIUS	CURVE TABLE			BEARING	DELTA
		LENGTH	TANGENT	CHORD		
C1	759.20	258.73	129.45	253.21	S 153° 40' E	192° 08'
		258.73				(517.60)
		258.73				(517.60)
C2	2800.00	200.49	145.38	290.36	N 02° 34' 50" E	9° 53' 15"
		200.49				(578.20)
		200.49				(578.20)
C3	1000.00	165.93	109.26	147.54	S 49° 40' 21" E	95° 34' 15"
C4	2000.00	205.35	128.65	25.35	N 89° 25' 41" E	0° 50' 15"
C5	143.00	61.12	31.03	60.65	N 11° 29' 31" W	2° 49' 15"
C6	2722.00	364.97	182.76	364.69	N 01° 42' 14" W	7° 40' 56"
C7	2722.00	193.73	86.89	173.70	N 00° 18' 32" E	3° 39' 25"
C8	2722.00	171.24	95.66	171.20	N 03° 31' 56" W	4° 00' 31"

CURVE AND LINE TABLES

LINE TABLE		
LINE	BEARING	DISTANCE
L1	N 00°45'08" E	20.16
L2	S 36°55'54" E	41.02

EASEMENT LINE TABLE

LINE TABLE		
LINE	BEARING	DISTANCE
EL1	S 84°03'24" W	16.61
EL2	N 84°01'09" E	36.87
EL3	S 51°05'45" E	1.42
EL4	S 05°57'06" E	30.00
EL5	N 00°45'08" E	31.23

1.6348 AC. PUBLIC
RIGHT-OF-WAY DEDICATED TO
THE CITY OF ALBUQUERQUE

J231PT1.DWGgnw 9/20/02

PLAT
FOR
TRACTS D-1, D-2, D-3 & D-4
BERNALILLO COUNTY, NEW MEXICO
ALBUQUERQUE SOUTH, UNIT 1
BEING A REPLAT OF
TRACT D, ALBUQUERQUE SOUTH UNIT 1
WITHIN THE
TOWN OF ATRISCO GRANT
PROJECTED SECTION 34
TOWNSHIP 10 NORTH, RANGE 2 EAST, N10PM
CITY OF ALBUQUERQUE
BERNALILLO COUNTY, NEW MEXICO
AUGUST 2002

PUBLIC UTILITY EASEMENTS

PUBLIC UTILITY EASEMENTS SHOWN ON THIS PLAT ARE GRANTED FOR THE COMMON AND JOINT USE OF:

1. THE PUBLIC SERVICE CO. OF NM—ELECTRIC SERVICES DIVISION FOR THE INSTALLATION, MAINTENANCE, AND SERVICE OF UNDERGROUND/OVERHEAD ELECTRICAL LINES, TRANSFORMERS, EQUIPMENT, AND OTHER RELATED FACILITIES REASONABLY NECESSARY TO PROVIDE ELECTRICAL SERVICE.
2. QWEST FOR THE INSTALLATION, MAINTENANCE AND SERVICE OF ALL BURIED COMMUNICATION LINES AND OTHER RELATED EQUIPMENT AND FACILITIES REASONABLY NECESSARY TO PROVIDE COMMUNICATION SERVICES INCLUDING BUT NOT LIMITED TO ABOVE GROUND PEDESTALS AND CLOSURES.
3. COMCAST FOR THE INSTALLATION, MAINTENANCE, AND SERVICE OF SUCH LINES, CABLE, AND OTHER RELATED EQUIPMENT AND FACILITIES REASONABLY NECESSARY TO PROVIDE CABLE TV SERVICE.
4. THE PUBLIC SERVICE CO. OF NM—GAS SERVICES DIVISION FOR THE INSTALLATION, MAINTENANCE, AND SERVICE OF SUCH DISTRIBUTION AND SERVICE LINES AND FACILITIES REASONABLY NECESSARY TO PROVIDE GAS SERVICE.

INCLUDED IS THE RIGHT TO BUILD, REBUILD, RECONSTRUCT, RELOCATE, RELOCATE, CHANGE, REMOVE, MODIFY, RENEW, OPERATE, AND MAINTAIN UTILITIES AND FACILITIES REASONABLY NECESSARY TO PROVIDE FREE ACCESS TO, FROM, AND OVER SAID EASEMENT, INCLUDING SUFFICIENT WORKING AREA SPACE FOR ELECTRIC TRANSFORMERS, WITH THE RIGHT AND PRIVILEGE TO TRIM AND REMOVE TREES, SHRUBS, OR BUSHES WHICH INTERFERE WITH THE PURPOSES SET FORTH HEREIN. NO BUILDING, SIGN, OR OTHER STRUCTURE SHALL BE ERECTED OR CONSTRUCTED ON SAID EASEMENTS, NOR SHALL ANY WELL BE DRILLED OR OPERATED THEREON. NEVERTHELESS, THE PUBLIC SERVICE CO. OF NM SHALL BE RESPONSIBLE FOR ANY VIOLATIONS OF NATIONAL ELECTRICAL SAFETY CODES BY ANY CONSTRUCTION OF POOLS, DECKING, OR ANY STRUCTURES ADJACENT TO OR NEAR EASEMENTS SHOWN ON THIS PLAT.


EASEMENTS FOR ELECTRIC TRANSFORMERS/SWITCHGEARS, AS INSTALLED, SHALL EXTEND TEN FEET (10') IN FRONT OF TRANSFORMER/SWITCHGEAR DOORS AND FIVE FEET (5') ON EACH SIDE.

In approving this plat, PNM Electric Services and Gas Services (PNM) did not conduct a Title Search of the properties shown hereon. Consequently, PNM does not waive nor release any easement or easement rights to which it may be entitled.

LEGEND

- EXISTING CURB & GUTTER
- ROADWAY IMPROVEMENTS (TO BE CONSTRUCTED WITH RESIDENTIAL SITE)
- FUTURE ROADWAY IMPROVEMENTS ADJACENT TO TRACT 'D' (TO BE CONSTRUCTED WITH THE COMMERCIAL SITE)
- EXISTING CONTOUR INTERVAL (1VF)
- EXISTING SPOT ELEVATION
- EXISTING TOP OF CURB ELEVATION FLOWLINE ELEVATION
- POTHOLE LOCATION NUMBER TOP OF 36" WL
- PROPOSED TOP OF CURB ELEVATION FLOWLINE
- PROPOSED TC ELEVATION
- PROPOSED STORM DRAIN (TO BE CONSTRUCTED WITH THIS PROJECT)
- PROPOSED INLET (TO BE CONSTRUCTED WITH THIS PROJECT)

ELEVATIONS ARE IN LOCAL DATUM. TO CONVERT TO NGVD 29 ADD 0.66 FEET. ELEVATIONS IN () UNDER BENCH MARKS ARE NGVD 29.

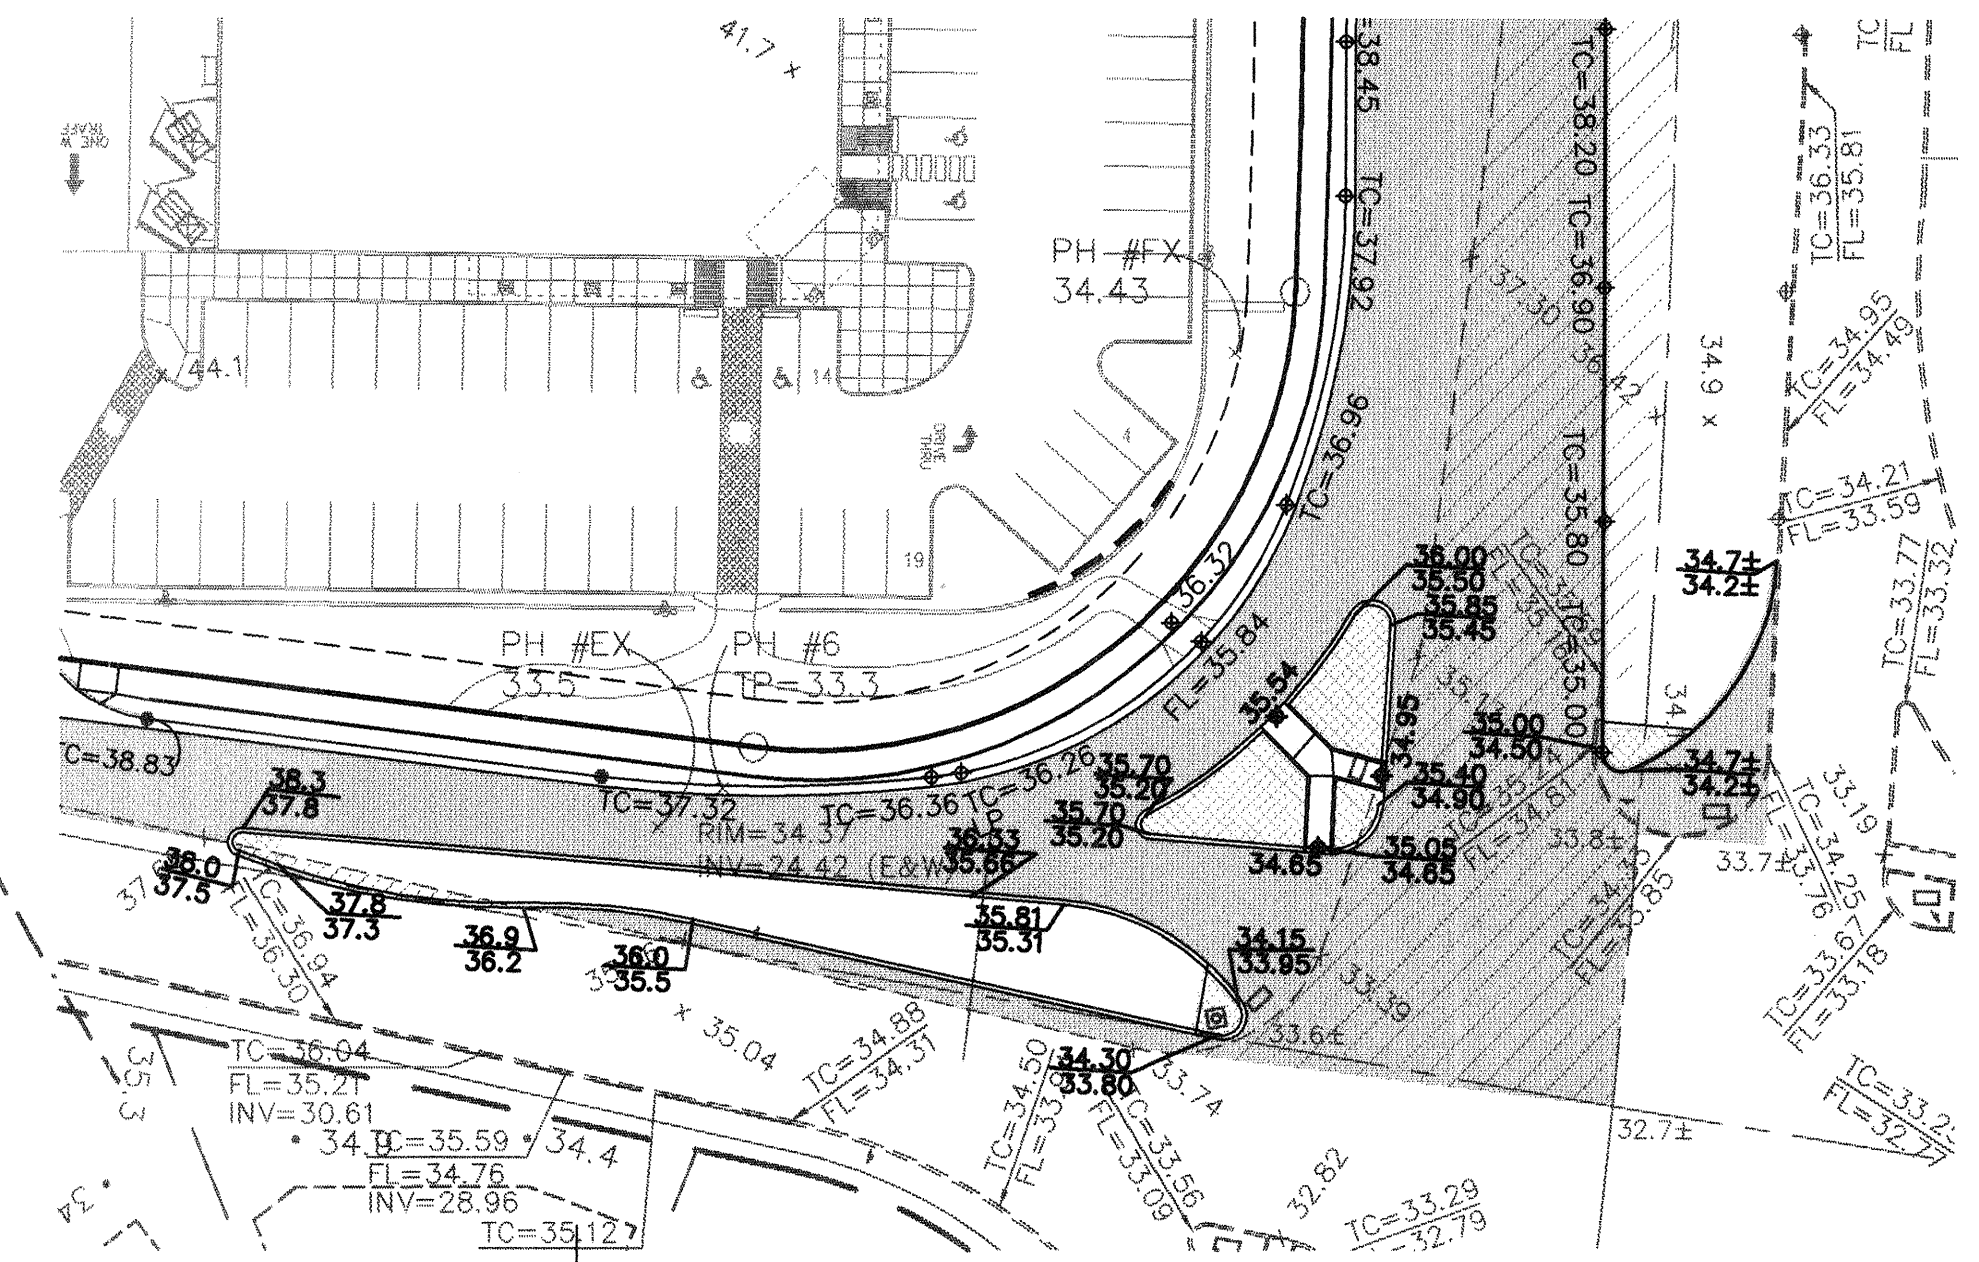

INTERSECTION GRADING DETAIL

SEE INTERSECTION GRADING DETAIL THIS SHEET

ISAACSON & ARFMAN, P.A.
Consulting Engineering Associates
128 Monroe Street N.E.
Albuquerque New Mexico 87102
1236GR02.DWGaw 12/17/02

CITY OF ALBUQUERQUE
PUBLIC WORKS DEPARTMENT
ENGINEERING GROUP

TITLE: WALGREENS AT UNSER BLVD & SAPPHIRE ST
OVERALL GRADING & DETAIL PLAN

Design Review Committee	City Engineer Approval	Mo./Day/Yr.	Mo./Day/Yr.
For Information Only			
City Project No. 6953.81	Zone Map No. M-10	Sheet 4	Of 15




NO.	DATE	REMARKS	BY
1.	10/02	DESIGN	ANW
2.	10/02	REVISIONS	ANW
3.	10/02	CHECKED BY	FCA


SURVEY INFORMATION	FIELD NOTES
ALDRICH LAND SURVEYING	9/02

AS-BUILT INFORMATION	BENCH MARKS
CONTRACTOR: Franklin	ACS 3 1/4" ALUM. CAP STAMPED, "12-L11, 1989"
INSPECTOR: J. Walker	X=362,793.28, Y=1,478,563.63, NM STATE PLANE COORDINATES
DATE: 12/17/02	CENTRAL ZONE (NAD 1927). STATION IS LOCATED IN THE NORTH
FIELD VERIFICATION: J. Walker	MEDIAN NOSE OF THE INTERSECTION OF COORS BLVD AND
DATE: 12/17/02	SAN YONACIO RD SW.
CORRECTED BY: J. Walker	ELEVATION=5007.402, LOCAL DATUM, (5008.062), NGVD 1929
DATE: 12/17/02	TBM: ACS MONUMENT "1-M10"
RECORDED BY: J. Walker	ELEVATION=5079.88, LOCAL DATUM


SCANNED BY
MESA REPRO

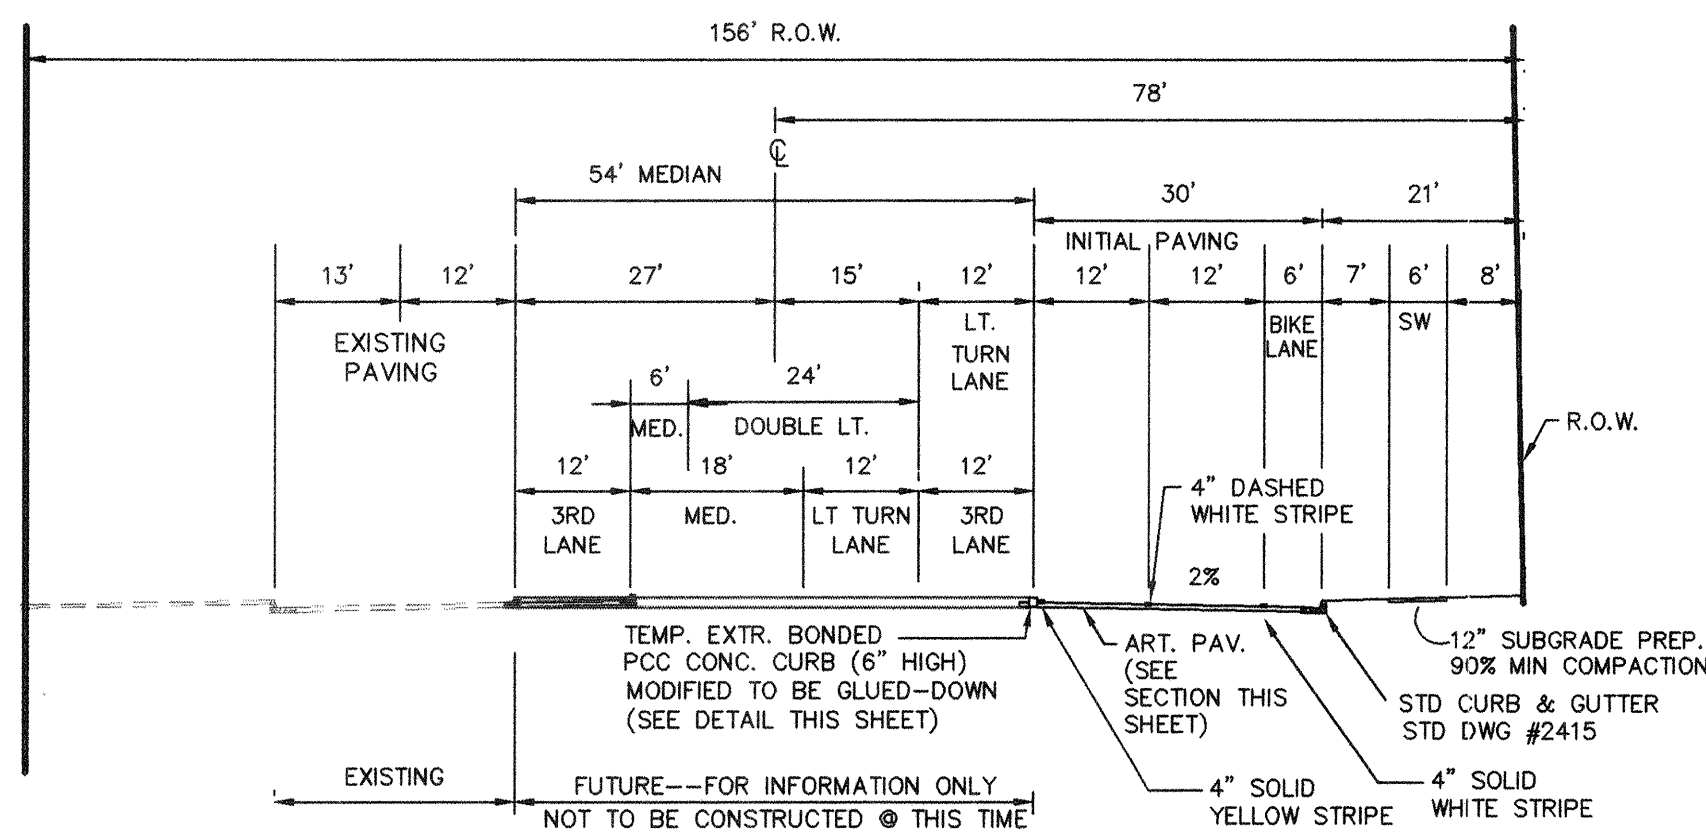


SECTION A2
UNBLVD SECTION
1"=20'

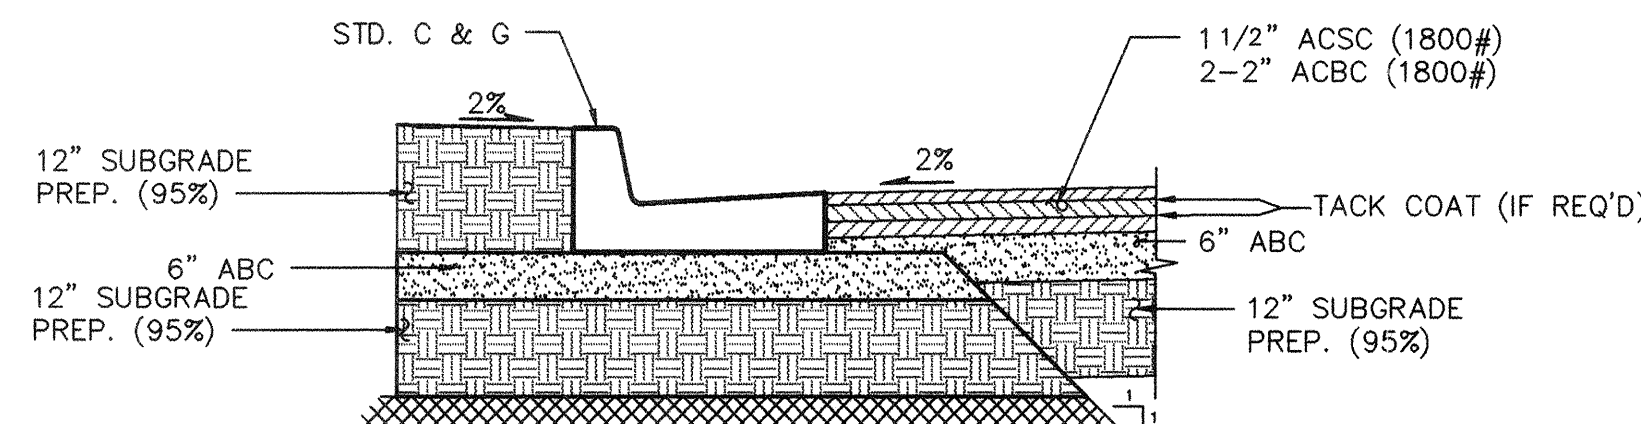

UNBLVD. PERMANENT PAVING SECTION (COA PROJ. #5057.91)
CURB / ASPHALT PAVEMENT MODULE
SCALE: 1"=2'-0"

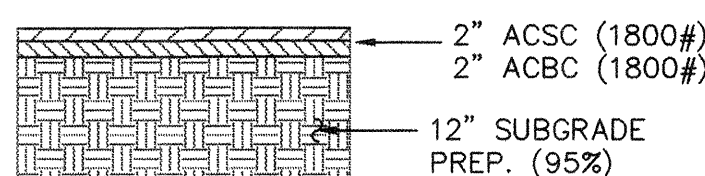


UNBLVD. TEMPORARY PAVING SECTION
NTS

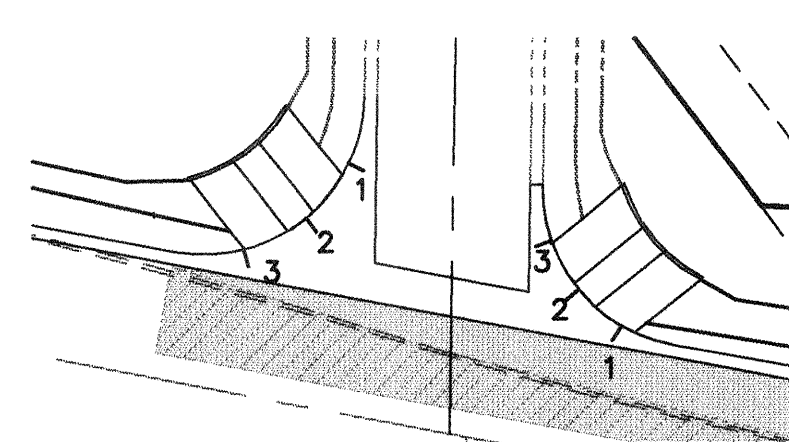

NOTE:
QUARTER POINT GRADES ARE REFERENCED AS 1, 2 & 3
ALONG THE FACE OF CURB IN A CLOCKWISE DIRECTION.

QUARTER POINT DETAIL
1"=30'

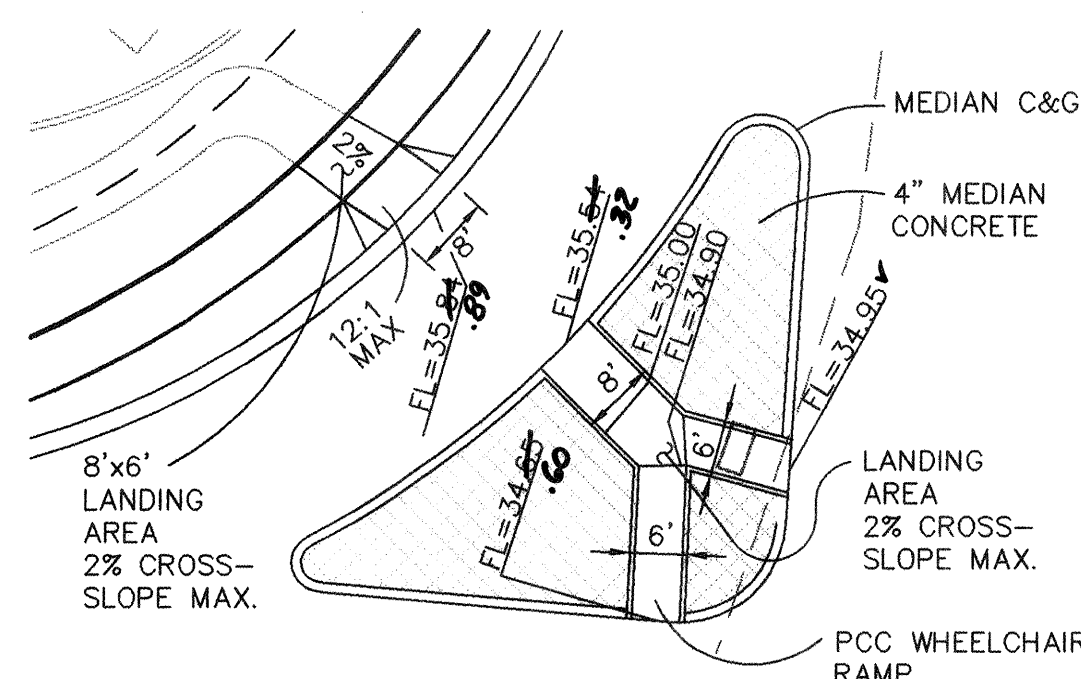

HANDICAP RAMP DETAIL
1"=10'

TEMP. PAVING SECTION

SCALE:
1"=40'

EXISTING 30' PUBLIC
DRAINAGE, SANITARY SEWER
AND WATERLINE EASEMENT

MATCHLINE
SEE LEFT

TRACT D-2

6' SIDEWALK

SD MH #2

SD MH #1

SD MH #3

SD MH #4

SD MH #5

SD MH #6

SD MH #7


SD MH #8

SD MH #9


SD MH #10

SD MH #11

SD MH #12

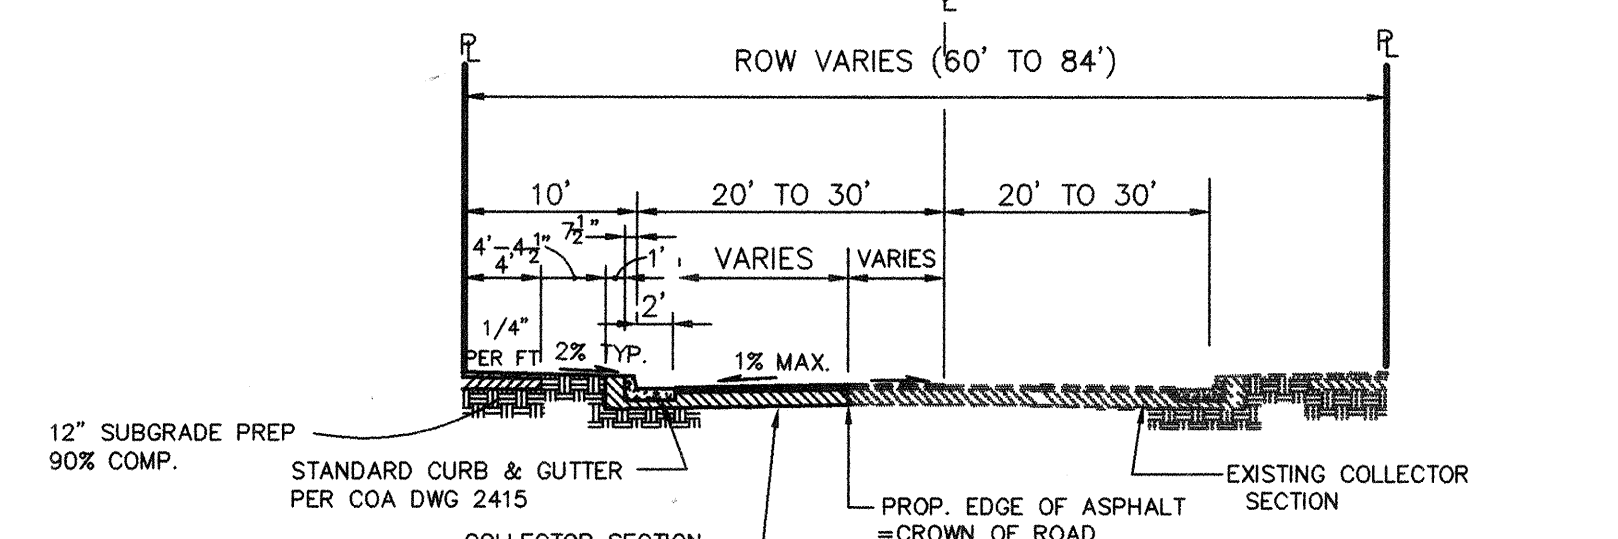

SECTION A1
SAPPHERE STREET SECTION
NTS

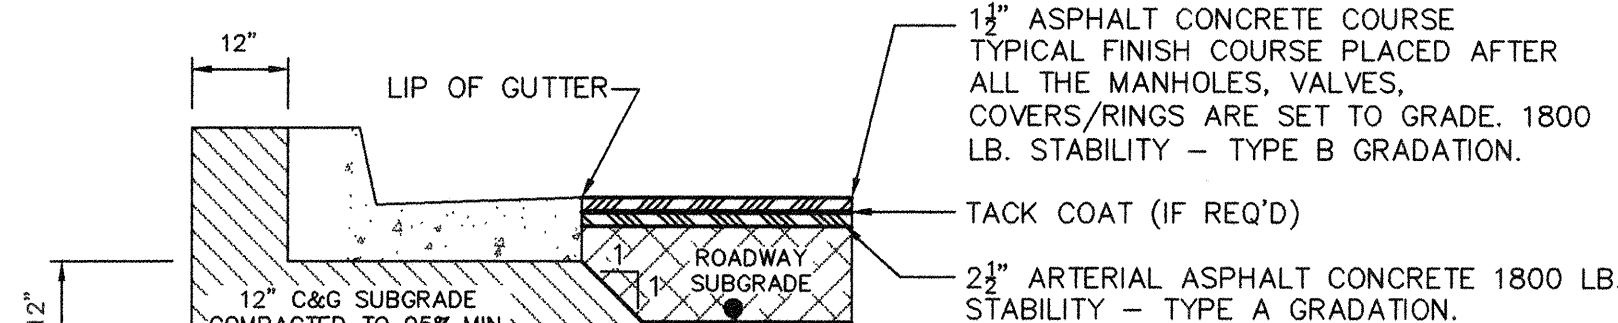


NOTE: **
CONTRACTOR SHALL BE RESPONSIBLE
FOR UPGRADING ANY SOIL WHERE
THE R-VALUE IS LESS THAN 50 FOR
A MIN. 2' DEPTH.


SAPPHERE STREET PAVING SECTION (COA PROJ. #5057.91)
SCALE: 1"=2'-0" (PER COA STD. DWG. No. 2405)

KEYED NOTES

- SEAL SURFACES WITH TROWEL PRIOR TO CURING
- CSS I BITUMENS ON ASPHALTIC PAVEMENT EPOXY
RESIN ON CONCRETE PAVEMENT (PROBOND 820
SERIES OR APPROVED EQUAL).
- EXTRUDED CONCRETE CURB PER COA STANDARD
SPEC. 101 & 340 WITH FOLLOWING EXCEPTIONS:
--1.5 # PER CY OF POLYPROPYLENE, COLLATED
FIBRILLATED FIBERS (FIBER MESH OR APPROVED
EQUAL)
--NON-CHLORIDE RETARDER PER MANUFACTURER'S
RECOMMENDATION
- CONSTRUCTION JOINTS SHALL BE INSTALLED EVERY
15 LINEAL FEET.
- NO. 4 REBAR PINS x 23" LONG DRIVEN 18"
INTO PAVEMENT & SUBGRADE. DRILL HOLES IN
PAVEMENT & SUBGRADE IF NECESSARY TO
DRIVE PINS TO DEPTH AND SEAL WITH EPOXY.
PLACE PINS AT 2 FOOT CENTERS AT THE
LOCATION SHOWN ON TYPICAL MEDIAN DETAIL
THIS SHEET.

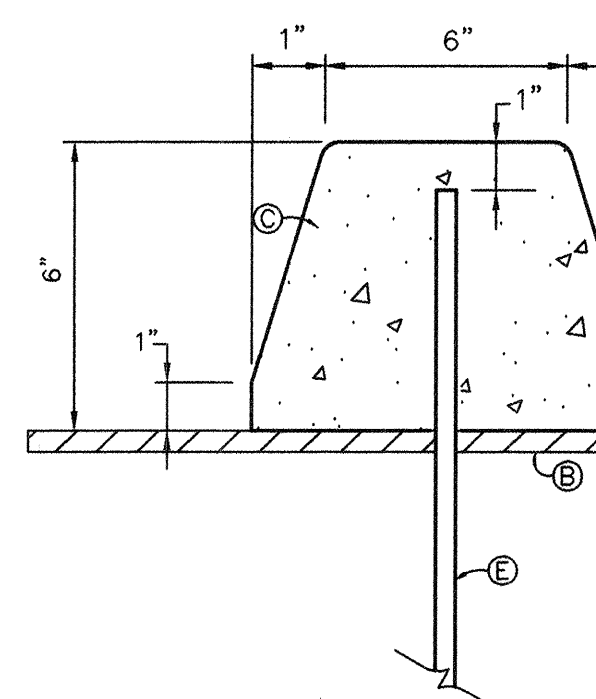

6' EXTRUDED/BONDED
CONCRETE MEDIAN CURB
SCALE: 3"=1'

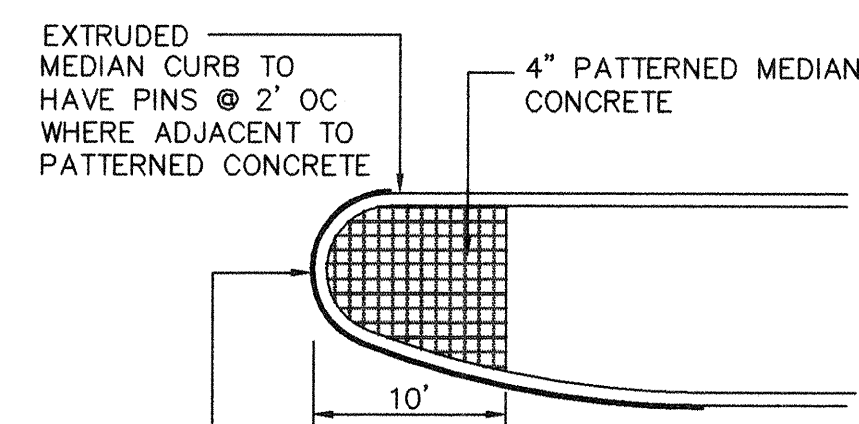

PAIN MEDIAN NOSE YELLOW

MEDIAN NOSE DETAIL
1"=10'

LEGEND

- EXISTING CURB & GUTTER
- PROPOSED CURB & GUTTER
- WHEEL CHAIR RAMP
- VALLEY GUTTER
- STORM DRAIN CATCH BASIN
- STORM DRAIN W/ MANHOLE
- PROPOSED SIDEWALK
- PROPOSED STREET LIGHT
- PAVEMENT REMOVAL
- TEMPORARY PAVEMENT
- PERMANENT PAVEMENT

ISAACSON & ARFMAN, P.A.
Consulting Engineering Associates
128 Monroe Street N.E.
Albuquerque, New Mexico 87102
1236PMSTR2.DWGaww 12/17/02

CITY OF ALBUQUERQUE
PUBLIC WORKS DEPARTMENT
ENGINEERING GROUP

TITLE: WALGREENS AT UNSER BLVD & SAPPHERE ST
MASTER PAVING & STORM DRAIN PLAN

Design Review Committee City Engineer Approval
APPROVED DEC 17 2002 APPROVED MAR 11 2003
DESIGN REVIEW COMMITTEE CITY ENGINEER

City Project No. 6953.81 Zone Map No. M-10 Sheet 5 Of 15


AS-BUILT INFORMATION
CONTRACTOR: Isaacson & Arfman, P.A.
STATIONED BY: Isaacson & Arfman, P.A.
INSPECTOR'S NAME: Isaacson & Arfman, P.A.
DATE: 12/17/02
FIELD VERIFICATION BY: Isaacson & Arfman, P.A.
DATE: 12/17/02
CORRECTED BY: Isaacson & Arfman, P.A.
DATE: 12/17/02
MICRO-FILM INFORMATION
RECORDED BY: Isaacson & Arfman, P.A.
DATE: 12/17/02

BENCH MARKS
ACS 3 1/4" ALUM. CAP STAMPED "12-L11, 1989"
X=362,793.28 Y=1,478,563.63 NM STATE PLANE COORDINATES
CENTRAL ZONE (NAD 1927). STATION IS LOCATED IN THE NORTH
MEDIAN NOSE OF THE INTERSECTION OF COORS BLVD AND
SAN YONACIO RD SW.
ELEVATION=5007.402, LOCAL DATUM. (5008.062), NGVD 1929
TBM: ACS MONUMENT "1-M10"
ELEVATION=5079.88, LOCAL DATUM

AS-BUILT INFORMATION
FIELD NOTES
1. ALDRICH LAND SURVEYING
REMARKS
NEW MEASUREMENTS
12-17-02

ENGINEER'S SEAL
FRED C. ARFMAN
NEW MEXICO
7322
12-17-02

REVISIONS
NO. DATE BY
DESIGNED BY: ANW DATE: 10/02
DRAWN BY: ANW DATE: 10/02
CHECKED BY: FCA DATE: 10/02

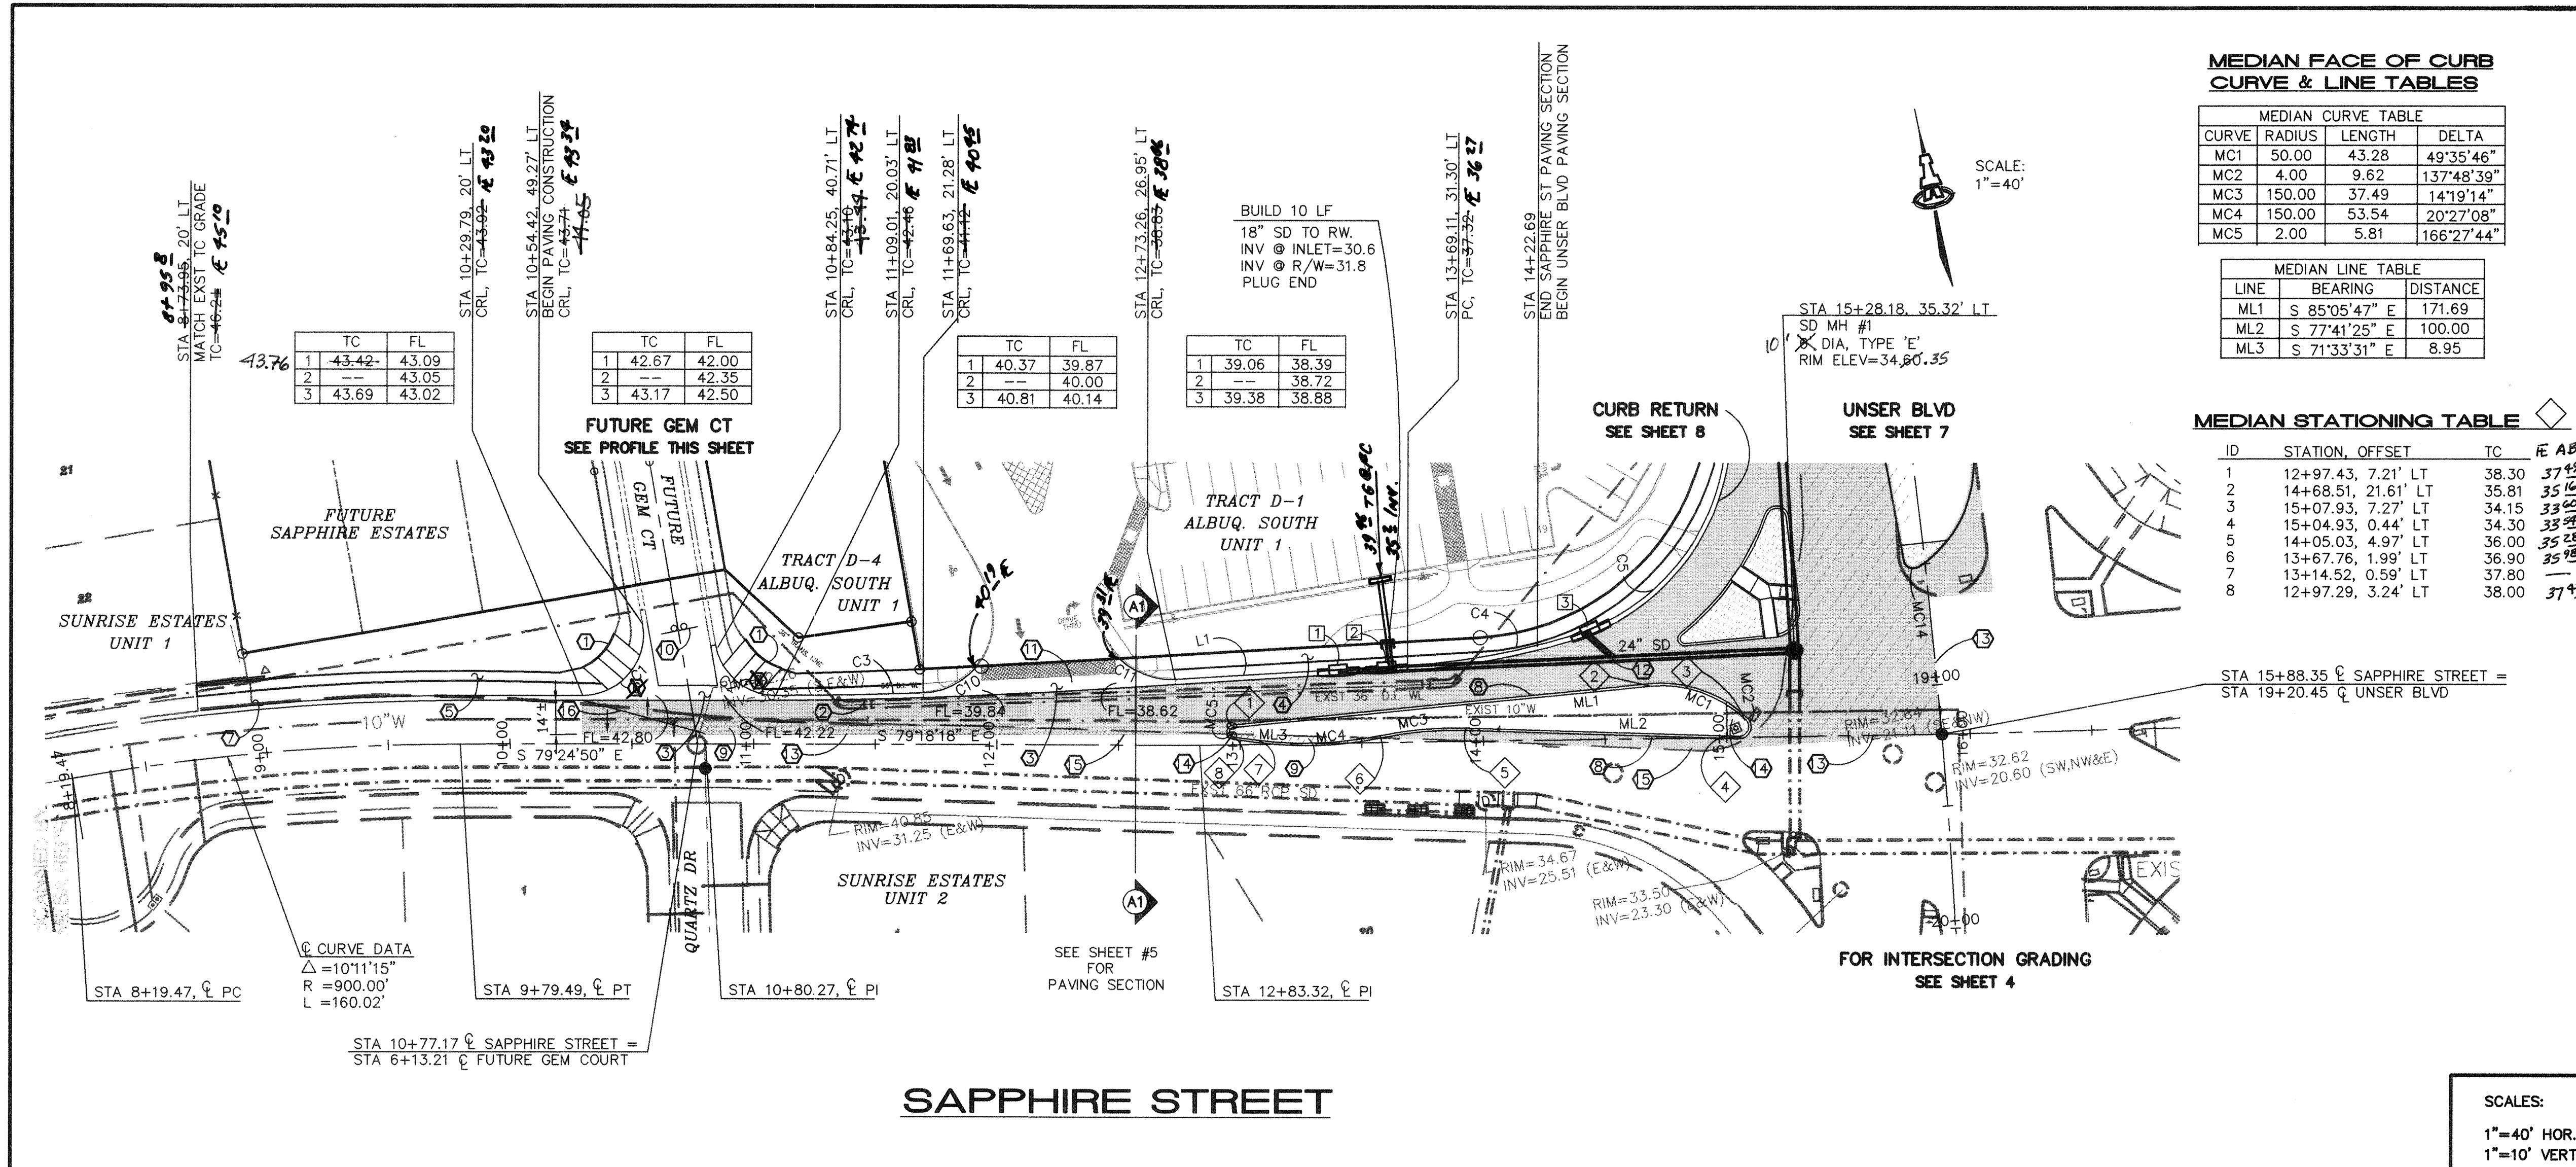

MEDIAN FACE OF CURB CURVE & LINE TABLES

CURVE	RADIUS	LENGTH	DELTA
MC1	50.00	43.28	49°35'46"
MC2	4.00	9.62	137°48'39"
MC3	150.00	37.49	14°19'14"
MC4	150.00	53.54	20°27'08"
MC5	2.00	5.81	166°27'44"

LINE	BEARING	DISTANCE
ML1	S 85°05'47" E	171.69
ML2	S 77°41'25" E	100.00
ML3	S 71°33'31" E	8.95

MEDIAN STATIONING TABLE

ID	STATION, OFFSET	TC	E AB
1	12+97.43, 7.21' LT	38.30	37.99
2	14+68.51, 21.61' LT	35.81	35.16
3	15+07.93, 7.27' LT	34.15	33.50
4	15+04.93, 0.44' LT	34.30	33.94
5	14+05.03, 4.97' LT	36.00	35.28
6	13+67.76, 1.99' LT	36.90	35.98
7	13+14.52, 0.59' LT	37.80	36.98
8	12+97.29, 3.24' LT	38.00	37.97

KEYED CONSTRUCTION NOTES

- CONSTRUCT HANDICAP RAMP PER COA STD DWG #2441, CASE II.
- BUILD STANDARD CURB & GUTTER PER COA STD DWG #2415.
- CONSTRUCT PCC VALLEY GUTTER 6' WIDE, 1 1/2" INVERT PER COA STD DWG #2420.
- PROPOSED 6' WIDE PCC SIDEWALK PER COA STD DWG # 2430.
- PROPOSED 4' WIDE PCC SIDEWALK PER COA STD DWG # 2430.
- TRANSITION FROM STANDARD CURB & GUTTER TO MOUNTABLE CURB & GUTTER THROUGH CURB RETURN PER COA STD DWG #2418.
- STA 8+73.95-11+36± REMOVE & DISPOSE 276 LF EXISTING TEMPORARY ASPHALT CURB.
- BUILD MEDIAN CURB & GUTTER PER COA STD DWG #2415.
- REMOVE & DISPOSE EXISTING ARTERIAL PAVEMENT.
- 1-TYPE III BARRICADES.
- BUILD PRIVATE ENTRANCE WITH UNI-DIRECTIONAL HANDICAP RAMPS PER COA STD DWG #2426.
- 1-24"x18" WYE--CONTRACTOR SHALL PROVIDE SHOP DRAWINGS.
- SAWCUT EDGE OF ASPHALT.
- 4" MEDIAN CONCRETE--10' FROM MEDIAN NOSE.
- PROVIDE SMOOTH RIDING TRANSITION BETWEEN EXISTING AND NEW PAVING.
- CROWN TRANSITION OVER 50' (OR AS NECESSARY).

FACE OF CURB CURVE & LINE TABLES

CURVE	RADIUS	LENGTH	DELTA
C1	25.00	43.56	99°50'01"
C2	25.00	35.07	80°22'12"
C3	2010.00	60.64	1°43'43"
C4	300.00	68.82	13°08'38"
C10	30.00	25.13	48°00'05"
C11	30.00	25.20	48°07'25"

LINE	BEARING	DISTANCE
L1	S 82°47'33" E	95.47

STORM DRAIN INLET INFORMATION

INLET NO.	INLET TYPE	STATION* & OFFSET	TOP GR. EL.	INV. OUT
1	TYPE A	13+42.45, 30.13' LT	36.83	29.7
2	TYPE A	13+62.43, 31.00' LT	36.52	27.8
3	TYPE A	14+42.77, 44.80' LT	35.36	30.3

*STATIONING IS TO MIDPOINT OF GRATE @ FACE OF CURB

CONNECTOR PIPE INFORMATION


FROM INLET NO.	O (CFS)	DIA. (IN)	LENGTH (FT)	SLOPE (FT/FT)
1	5.4	18"	17	.16
2	5.4	18"	164.3	.005
3	9.6	18"	13.3	.29

ISAACSON & ARFMAN, P.A.
Consulting Engineering Associates
128 Monroe Street N.E.
Albuquerque New Mexico
1236PV2.DWGonw 11/25/02

CITY OF ALBUQUERQUE
PUBLIC WORKS DEPARTMENT
ENGINEERING GROUP

TITLE: WALGREENS AT UNSER BLVD & SAPPHIRE ST
SAPPHIRE STREET
PAVING & STORM DRAIN PLAN & PROFILE

Design-Review Committee
City Engineer Approval
Last Design Update
City Project No. 6953.81
Zone Map No. M-10
Sheet 6 of 15

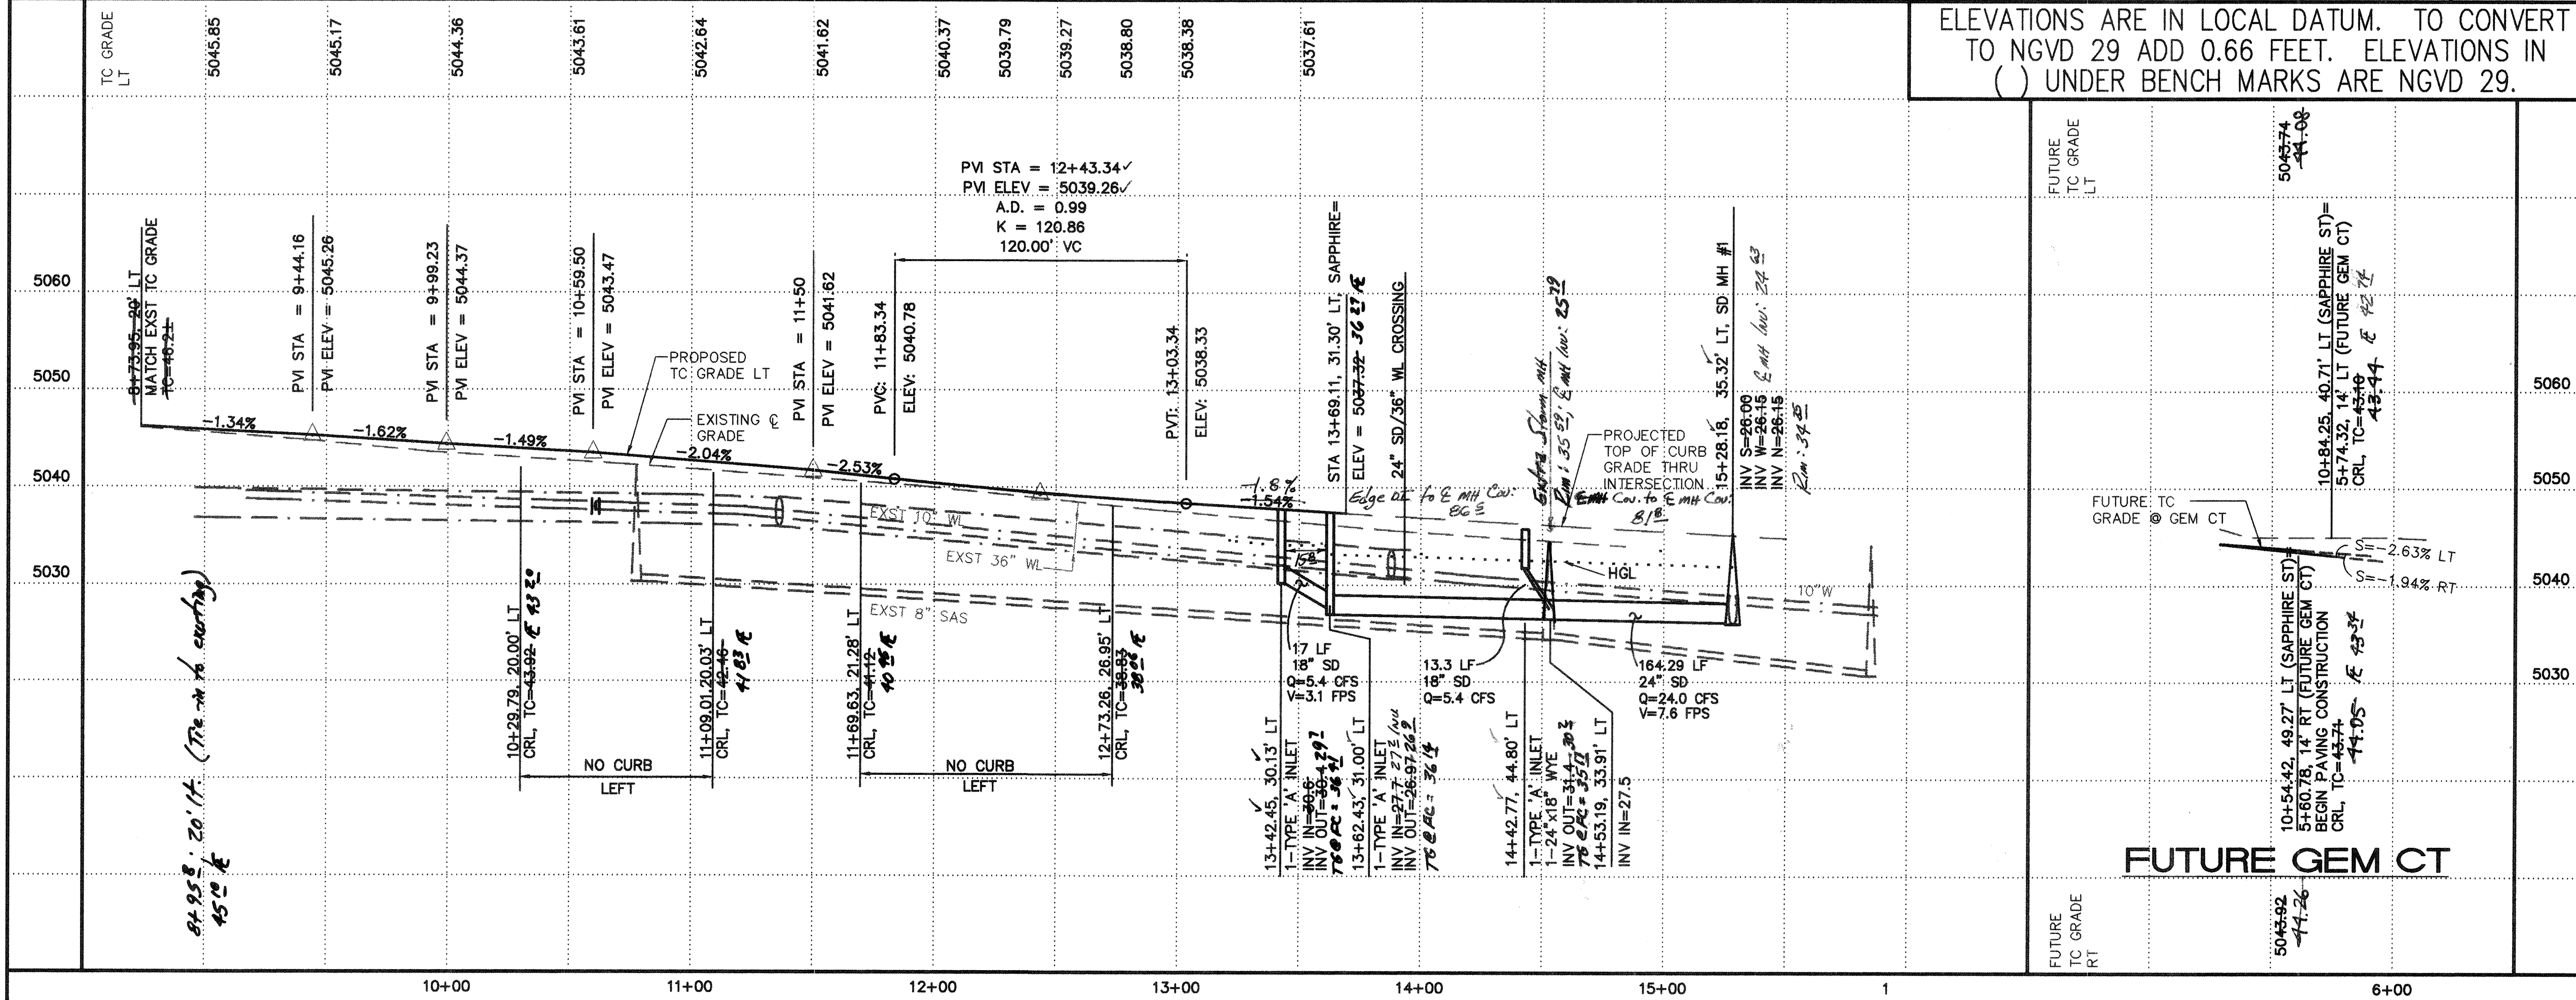

ELEVATIONS ARE IN LOCAL DATUM. TO CONVERT TO NGVD 29 ADD 0.66 FEET. ELEVATIONS IN () UNDER BENCH MARKS ARE NGVD 29.

SCALES:
1"=40' HOR.
1"=10' VERT.

AS-BUILT INFORMATION

CONTRACTOR: *Sunrise/Arfman*

INSPECTOR: *Michael Long*

DATE: *11/25/02*

VERIFICATION BY: *11/25/02*

CORRECTED BY: *11/25/02*

RECORDED BY: *11/25/02*

NO.

BENCH MARKS

ACS 3 1/4" ALUM. CAP STAMPED, "12-LIT, 1989"

X=362.783, Y=1478.563, 63.63 NM STATE PLANE COORDINATES.

CENTRAL ZONE (NAD 1927). STATION IS LOCATED IN THE NORTH

MEDIAN NOSE OF THE INTERSECTION OF COORS BLVD AND

SAN YGNACIO RD SW.

ELEVATION=5007.402, LOCAL DATUM, (5008.062), NGVD 1929

TBM: ACS MONUMENT "1-M10"

ELEVATION=5079.88, LOCAL DATUM

SURVEY INFORMATION

FIELD NOTES

9/02

ALDRICH LAND SURVEYING

ENGINEER'S SEAL

NEW MEXICO

7322

PROFESSIONAL ENGINEER

12-17-02

REVISIONS


NO. DATE

DESIGNED BY: *ANW* DATE: 10/02



DRAWN BY: *ANW* DATE: 10/02

CHECKED BY: *FCA* DATE: 10/02


Figure 1

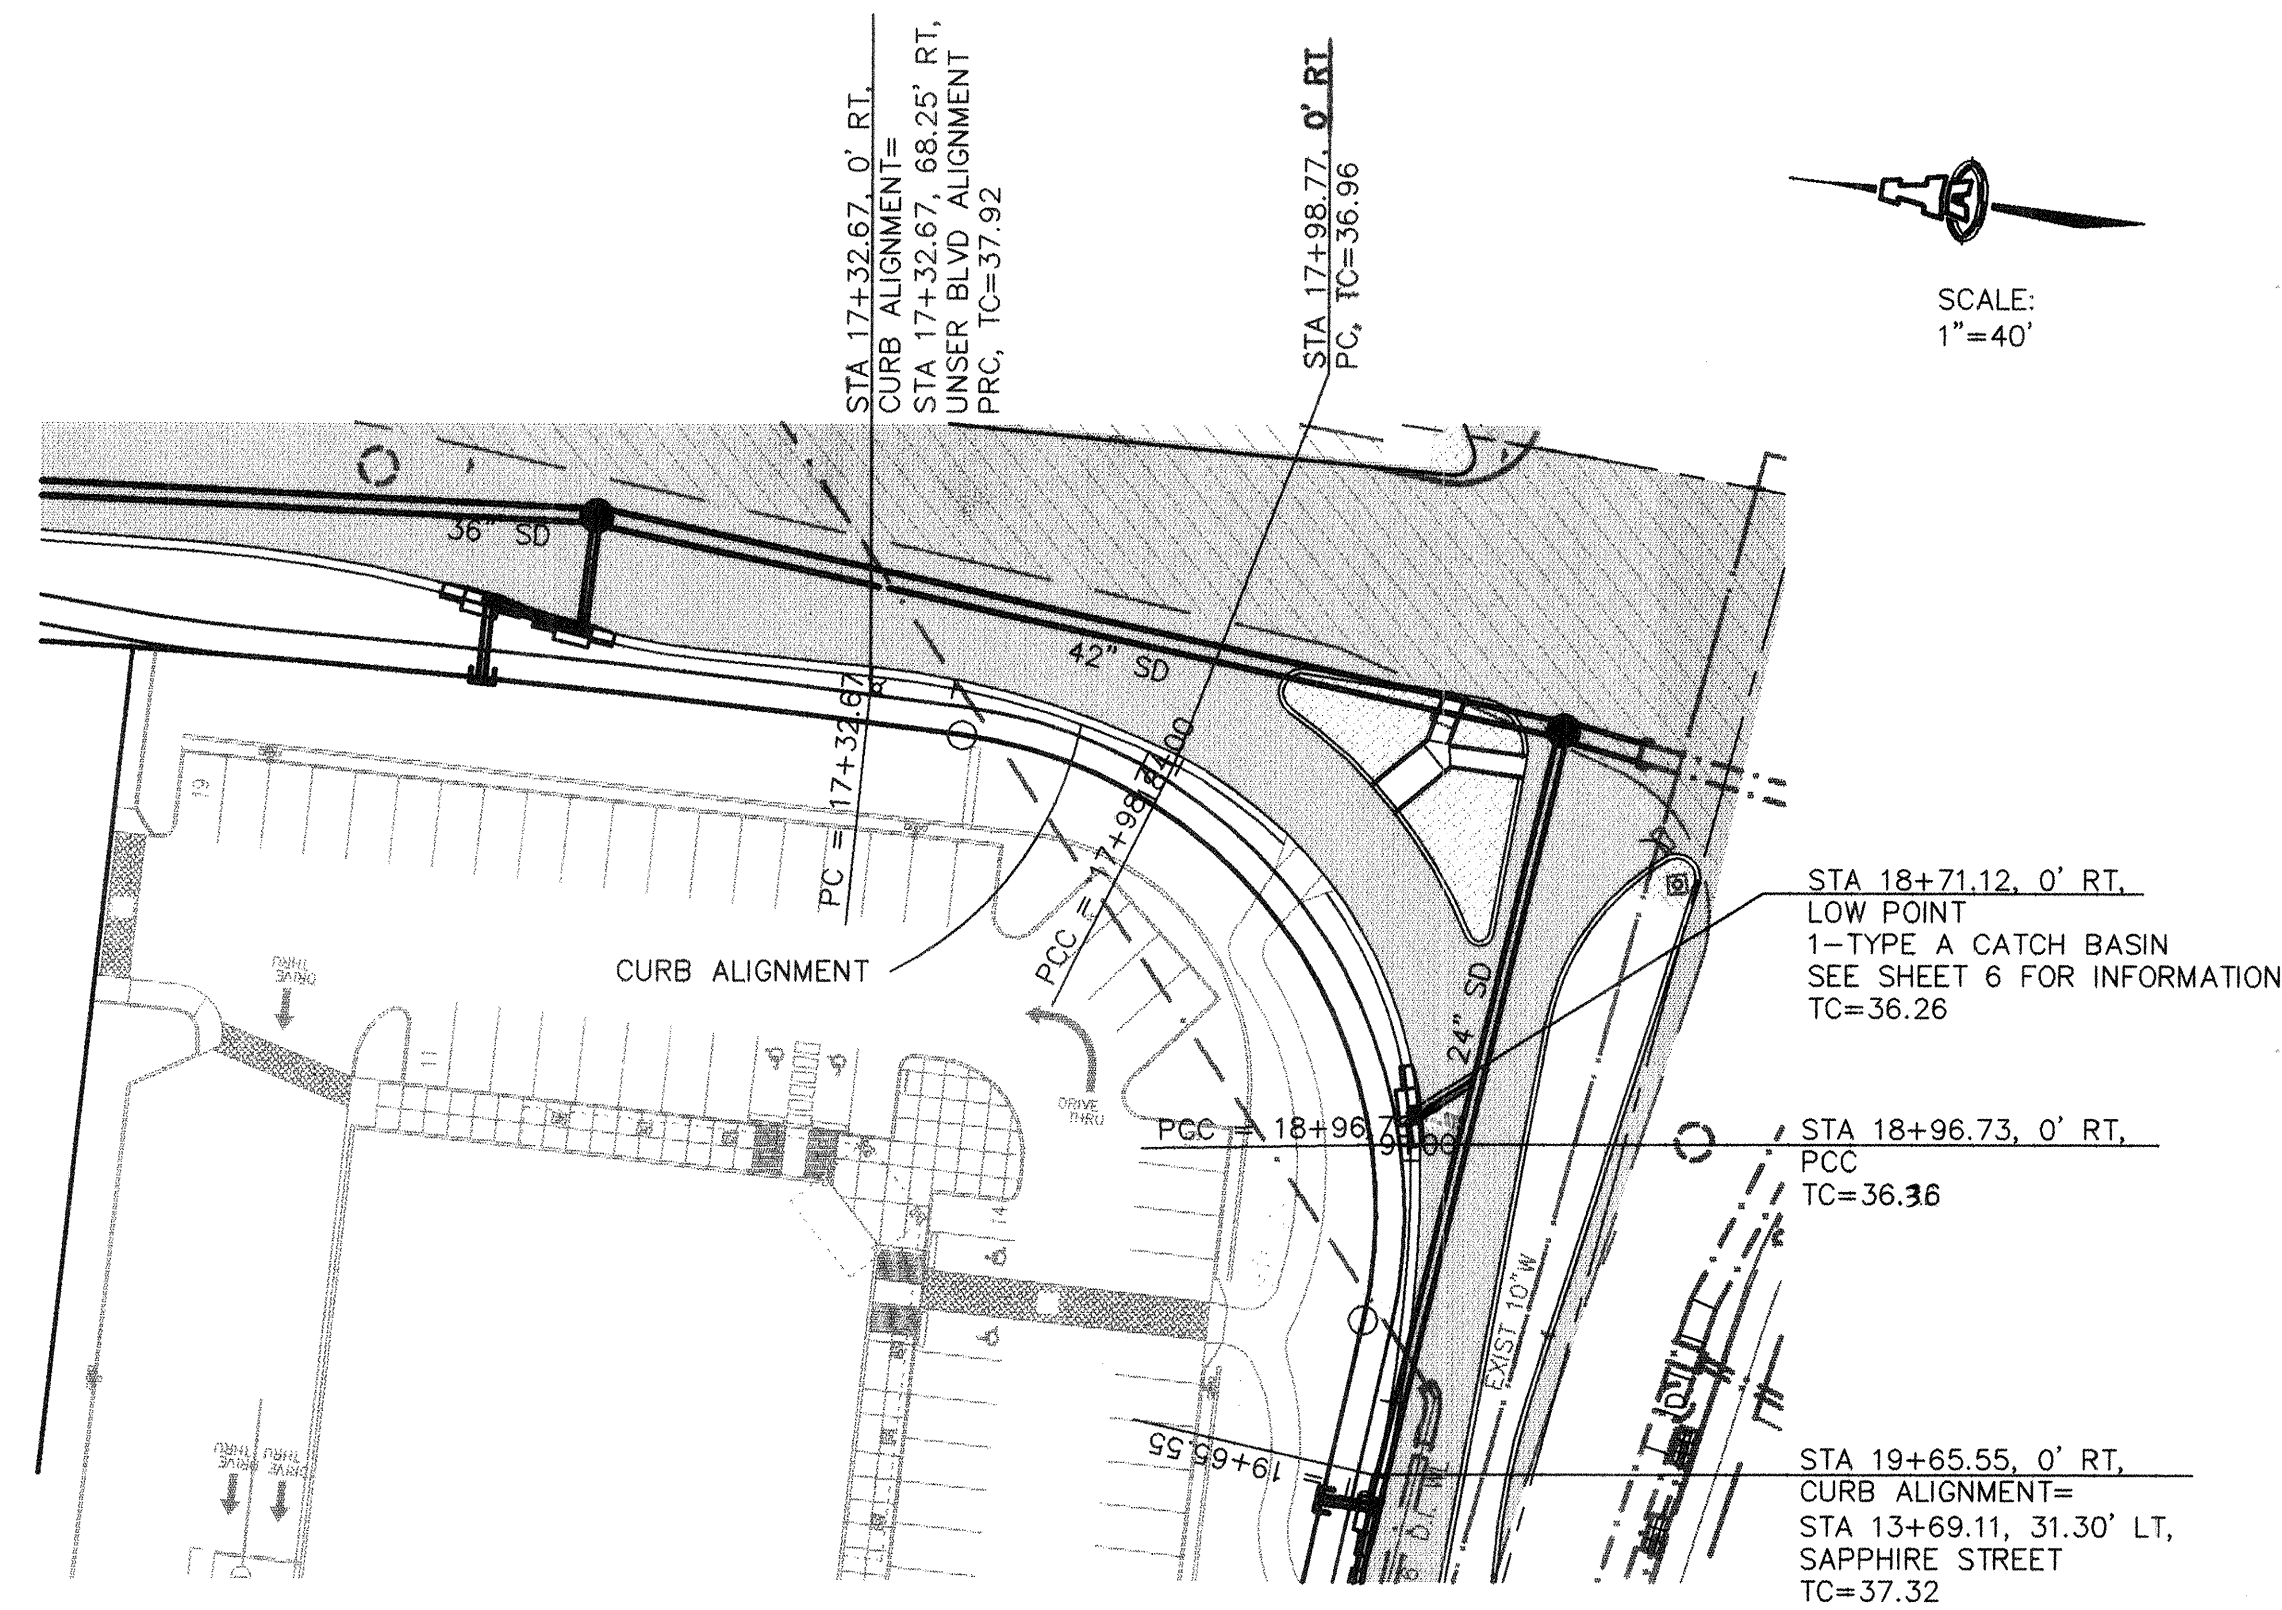

CURB RETURN

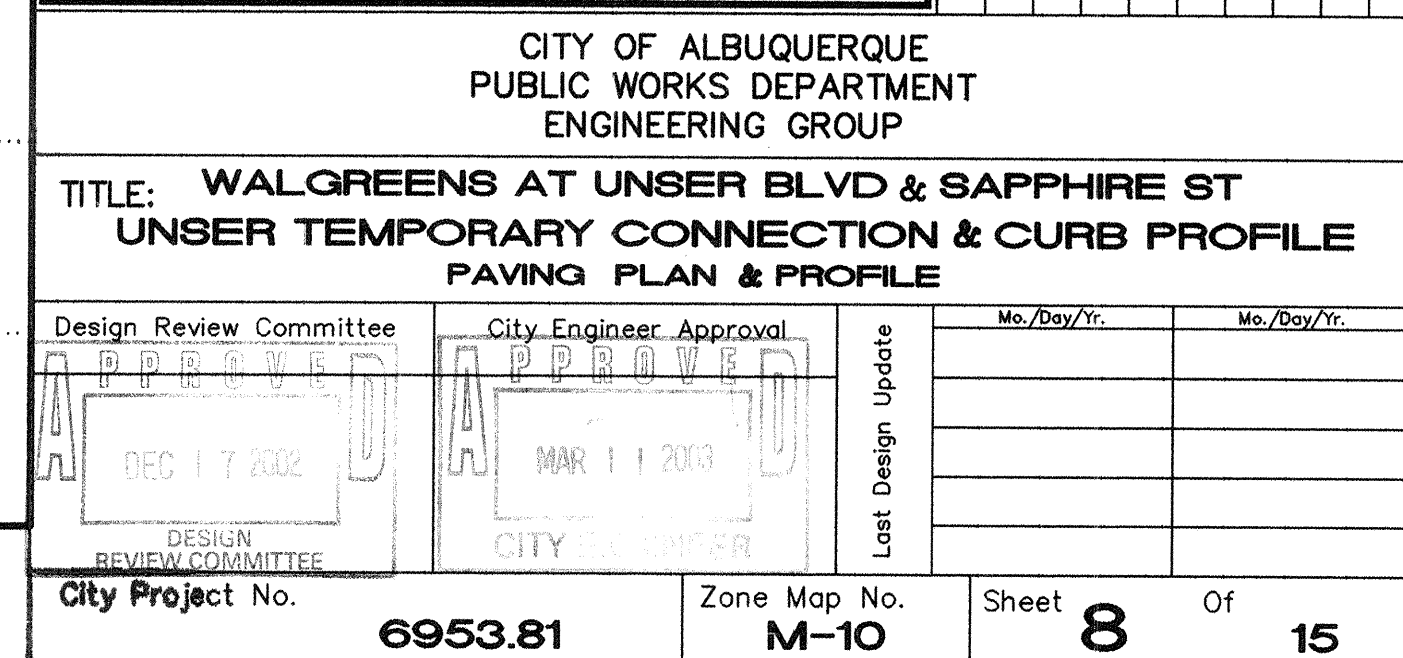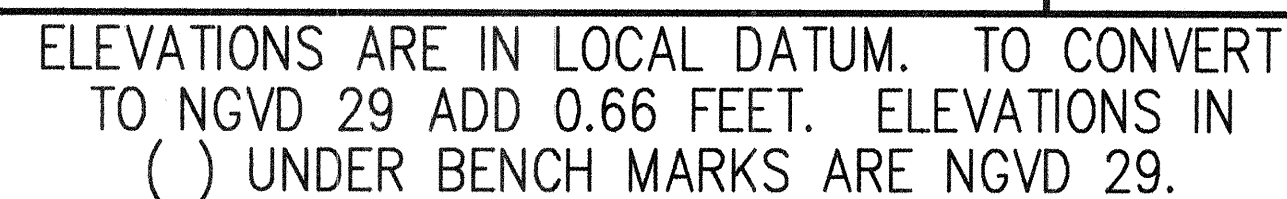

SURVEY INFORMATION		BENCH MARKS		AS-BUILT INFORMATION	
FIELD NOTES					
1.	ALDRICH LAND SURVEYING RECORD 16-01 PROFESSIONAL SURVEYOR	9	ACS 3 1/4" ALUM. CAP STAMPED, "12-L11, 1989" X=362,793.28 , Y=1,478,583.63, NM STATE PLANE COORDINATES, CENTRAL ZONE (NAD 1927). STATION IS LOCATED IN THE NORTH MEDIAN NOSE OF THE INTERSECTION OF COORS BLVD AND SAN YONACIO RD SW ELEVATION=5007.402, LOCAL DATUM, NGVD 1929 TBM: ACS MONUMENT "1-M10" ELEVATION=5079.88, LOCAL DATUM	CONTRACTOR <i>Franklin Earthmoving</i> WORK STARTED BY <i>Walter Longmire</i> OF <i>06/23/89</i> ACCOMPISHED BY <i>Longmire</i> DATE <i>06/23/89</i> REPLICATION BY <i>Walker</i> DATE <i>5/83</i> DRAWINGS CORRECTED BY DATE <i>06/83</i> MICRO-FILM INFORMATION RECORDED BY DATE NO.	

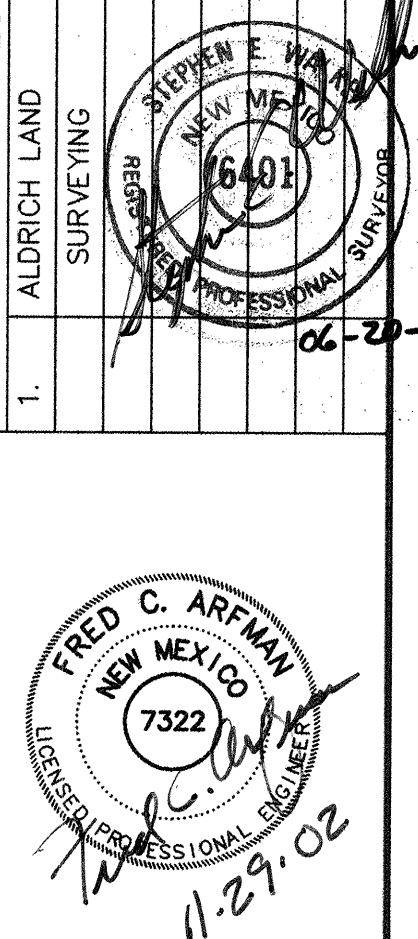

1. ALL MECHANICAL JOINTS SHALL BE RESTRAINED AT THE FITTING.
2. THE CONTRACTOR SHALL PROVIDE A MINIMUM PIPE LENGTH OF 20 LF FROM ALL MECHANICAL JOINTS. ALL MECHANICAL JOINTS WITHIN 20 LF OF A MECHANICAL JOINT SHALL BE RESTRAINED AT THE CONTRACTOR'S EXPENSE.
3. THE CONTRACTOR SHALL RESTRAIN ALL PIPE JOINTS IN THE SPECIFIED DISTANCE LISTED IN THE TABLE ON THIS SHEET.
4. THE CONTRACTOR SHALL RESTRAIN ALL FIRE HYDRANT JOINTS FROM THE TEE ON THE MAIN TO THE FIRE HYDRANT FLANGE.

RESTRAINED JOINT LENGTHS, L_T , FOR HORIZONTAL BENDS, VALVES, AND DEAD ENDS, (FT.)					
SIZE	HORZ. BENDS				VALVES & DEAD ENDS
	90°	45°	22 1/2°	11 1/4°	
12	30	12	6	3	85
10	26	11	5	3	72
8	22	9	4	2	60
6	17	7	3	2	46
4	12	5	2	1	32

RESTRAINED JOINT LENGTHS, L_r, FOR REDUCERS, (FT.) MINIMUM UNOBSTRUCTED, STRAIGHT—RUN LENGTH: RESTRAIN EITHER LARGE PIPE, OR SMALL PIPE.					
SIZE	LARGE SIDE	SMALL SIDE	SIZE	LARGE SIDE	SMALL SIDE
12x10	25	30	10x6	44	73
12x8	45	68	10x4	48	141
12x6	62	121	8x6	25	131
12x4	74	213	8x4	43	83
10x8	24	30	6x4	24	35

RESTRAINED JOINT LENGTHS, L_T , FOR VERTICAL BENDS	
6" 45° VERT. BEND	
UPPER BEND	LOWER BEND
23	5

RESTRAINED JOINT LENGTHS, L _T , FOR VERTICAL BENDS	
10° 45° VERT. BEND	
UPPER BEND	LOWER BEND
24	5

DEPTH OF BURY	3.0 FT. FOR 6" WL; 4.0 FT FOR 12" WL
FACTOR OF SAFETY	1.25
MATERIAL	PVC PIPE
SOIL TYPE:	GM/SM - SILTY GRAVELS AND SILTY SANDS, GRAVEL-SAND-SILT MIXTURES.
TEST PRESSURE	150 PSI
TRENCH TYPE 4:	PIPE BEDDED IN SAND, GRAVEL, OR CRUSHED STONE TO DEPTH OF 1/8 PIPE DIAMETER, 4 INCH MINIMUM; BACKFILL COMPACTED TO TOP OF PIPE.

DIFFERENT CRITERIA, E.G., DUCTILE IRON PIPE, GREATER DEPTH OF BURY, ETC., WILL REQUIRE DIFFERENT RESTRAINED LENGTHS. THESE MUST BE CALCULATED BY A QUALIFIED PROFESSIONAL ENGINEER AND APPROVED BY THE PUBLIC WORKS DEPARTMENT.

LEGEND

EXISTING:

-  WATER LINE
-  SANITARY SEWER W/ MANHOLE
-  STORM DRAIN W/ MANHOLE

PROPOSED:

-  WATER METER & BOX
-  GATE VALVE W/ VALVE BOX
-  FIRE HYDRANT
-  WATER LINE W/ FITTING
-  STORM DRAIN CATCH BASIN
-  STORM DRAIN W/ MANHOLE

AFD PLANS CHECKING OFFICE
924-3611
~~APPROVED/DISAPPROVED~~
HYDRANT(S) ONLY
James Lenoir 12/17/0
SIGNATURE & DATE

 **ISAACSON & ARFMAN, P.A.**
Consulting Engineering Associates
128 Monroe Street N.E.
Albuquerque New Mexico
1236UMSTR2.DWGanw 11/29/02

CITY OF ALBUQUERQUE
PUBLIC WORKS DEPARTMENT
ENGINEERING GROUP

TITLE: WALGREENS AT UNSER BLVD & SAPPHIRE ST
MASTER UTILITY PLAN

Design Review Committee	City Engineer Approval	Last Design Update
		
City Project No.	Zone Map No.	

6953.81 Zone Map No. **M-10** Sheet **9** of **15**

AS-BUILT INFORMATION	DATE
CONTRACTOR <i>Sanderson (Franklin)</i>	
WORK	
STANDARD BY <i>Winter-Simpy</i>	DATE <i>6/63</i>
INSPECTOR'S ACCEPTANCE	DATE <i>6/63</i>
VERIFICATION BY <i>I & A</i>	DATE <i>5/63</i>
DRAWINGS	DATE <i>6/63</i>
CREATED BY <i>Walker</i>	
<i>MICRO-FILM</i> INFORMATION	
RECORDED BY	DATE
NO.	


BENCH	MARKS
ACS 3 1/4" ALUM. CAP STAMPED, "12-U11, 1989"	
X=362,792.28, Y=1,478,583.63, NM STATE PLANE COORDINATES, CENTRAL ZONE (NAD 1927). STATION IS LOCATED IN THE NORTH MEDIAN NOSE OF THE INTERSECTION OF COORS BLVD AND SAN YGNACIO RD SW.	
ELEVATION=5007.402, LOCAL DATUM, (5008.062), NGVD 1929	
TM: ACS MONUMENT "1"-10"	
ELEVATION=5079.88, LOCAL DATUM	

SURVEY INFORMATION		FIELD NOTES	
	ALDRICH LAND	SURVEYING	
1.			

"AS BUILT" (HORIZONTAL) AND VERTICAL LOCATION
 9
 6801
 06-2

[illegible]


NT SAPPHIRE ST PLAN	
Mo./Boy/Yr.	Mo./Boy/Yr.
Sheet 9 Of	15

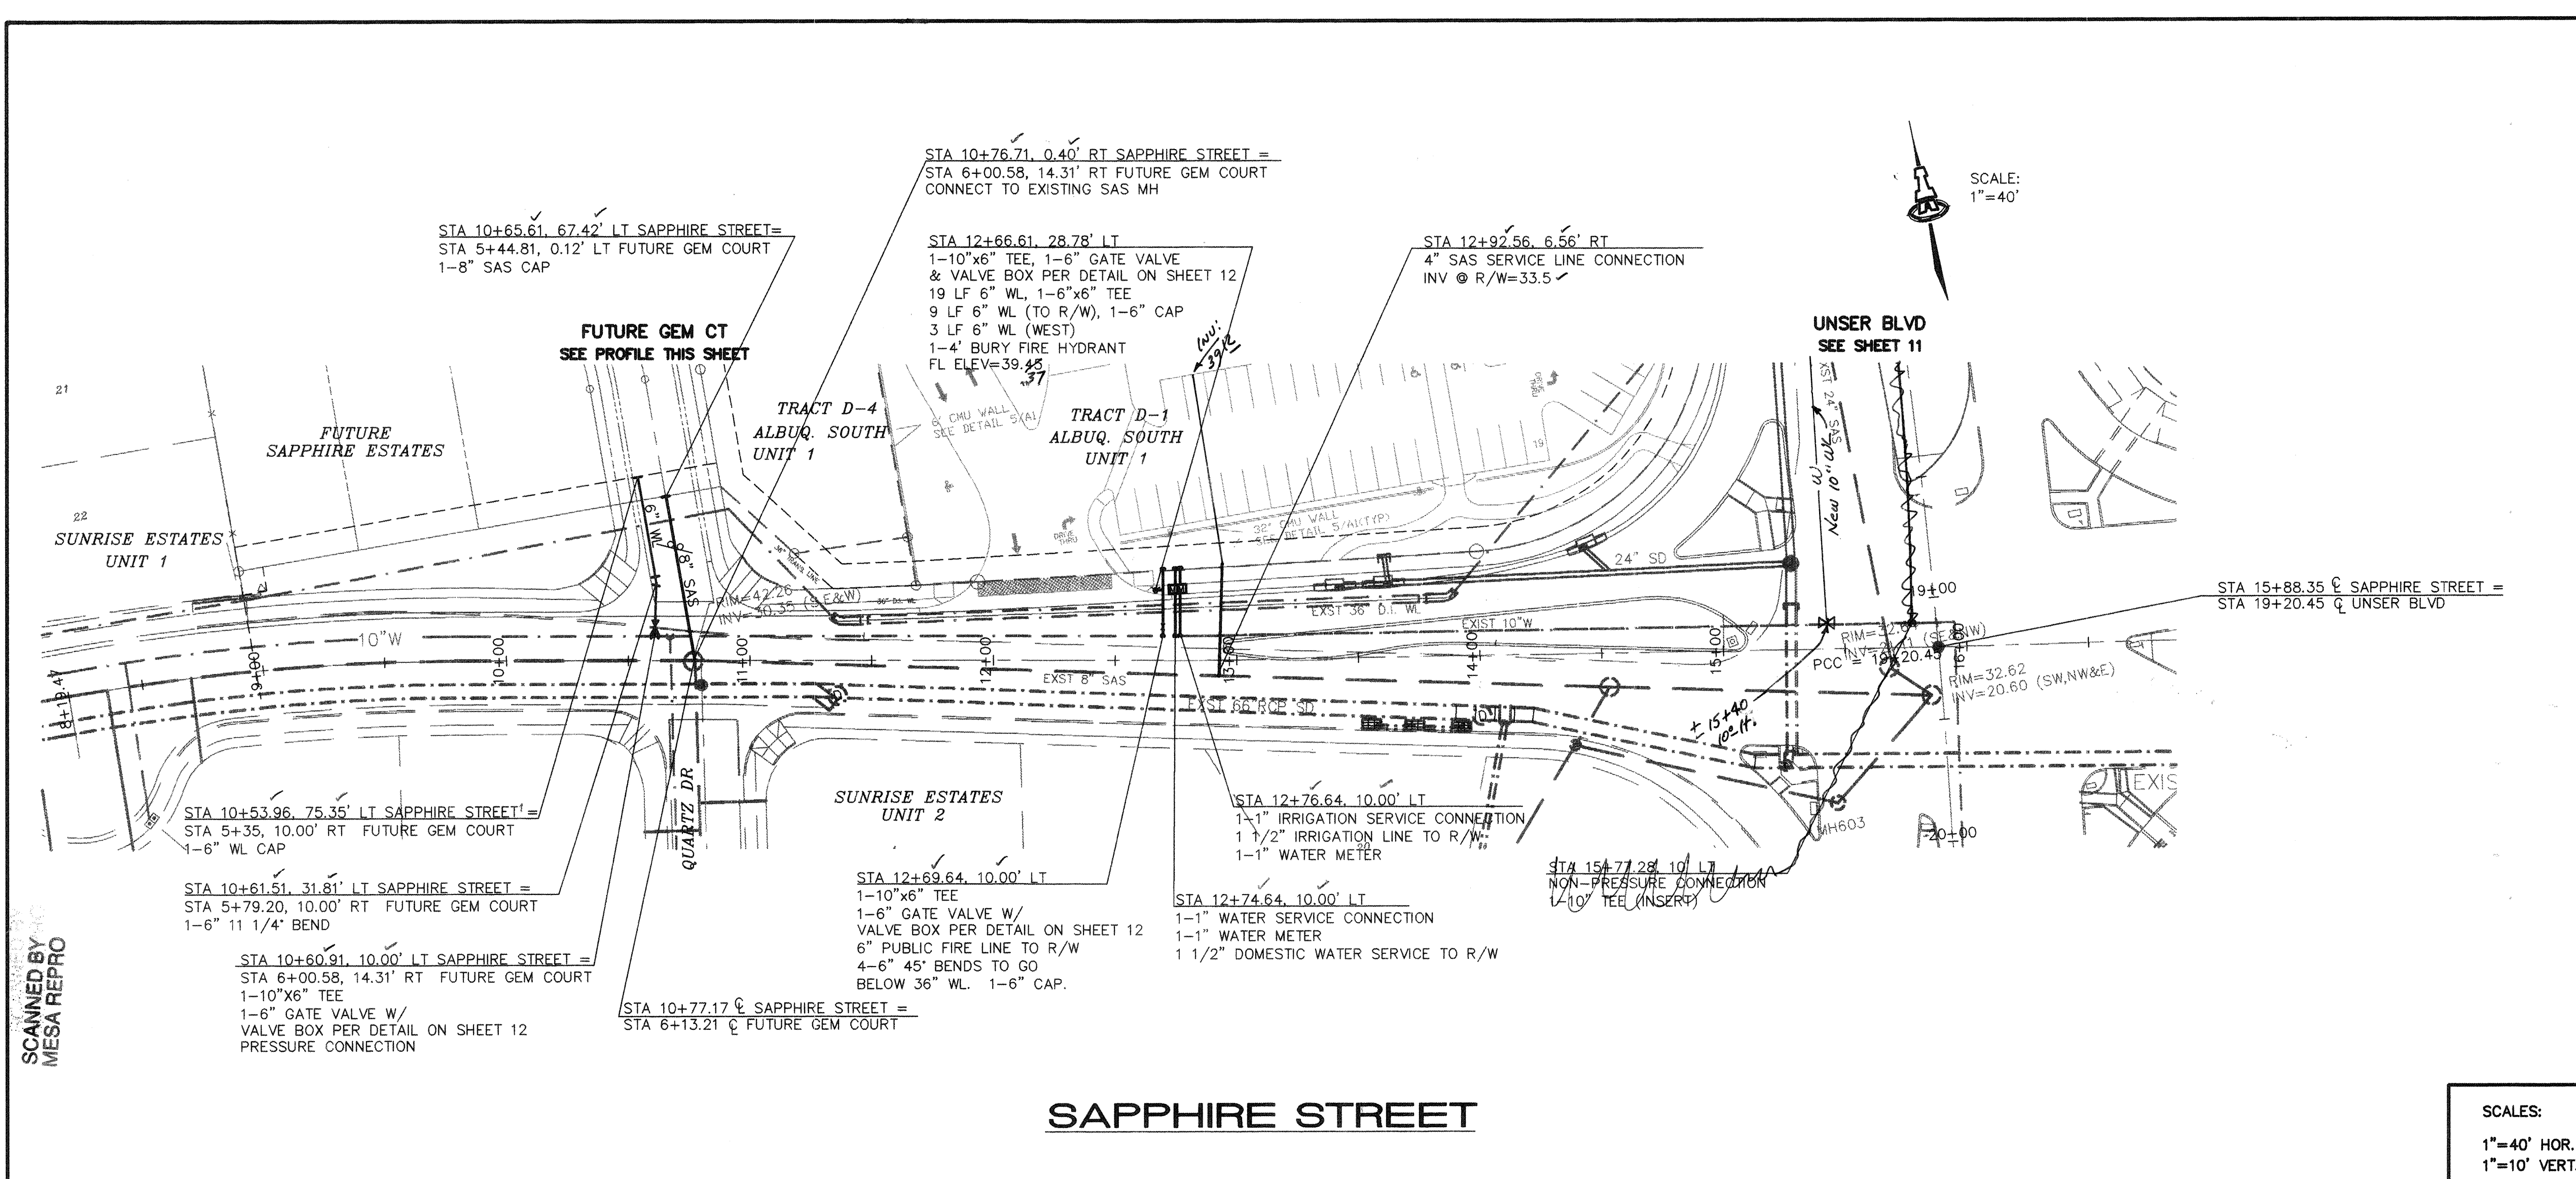

SCANNED BY
MESA REPRO

SAPPHIRE STREET

SCALES:
1"=40' HOR.
1"=10' VERT.

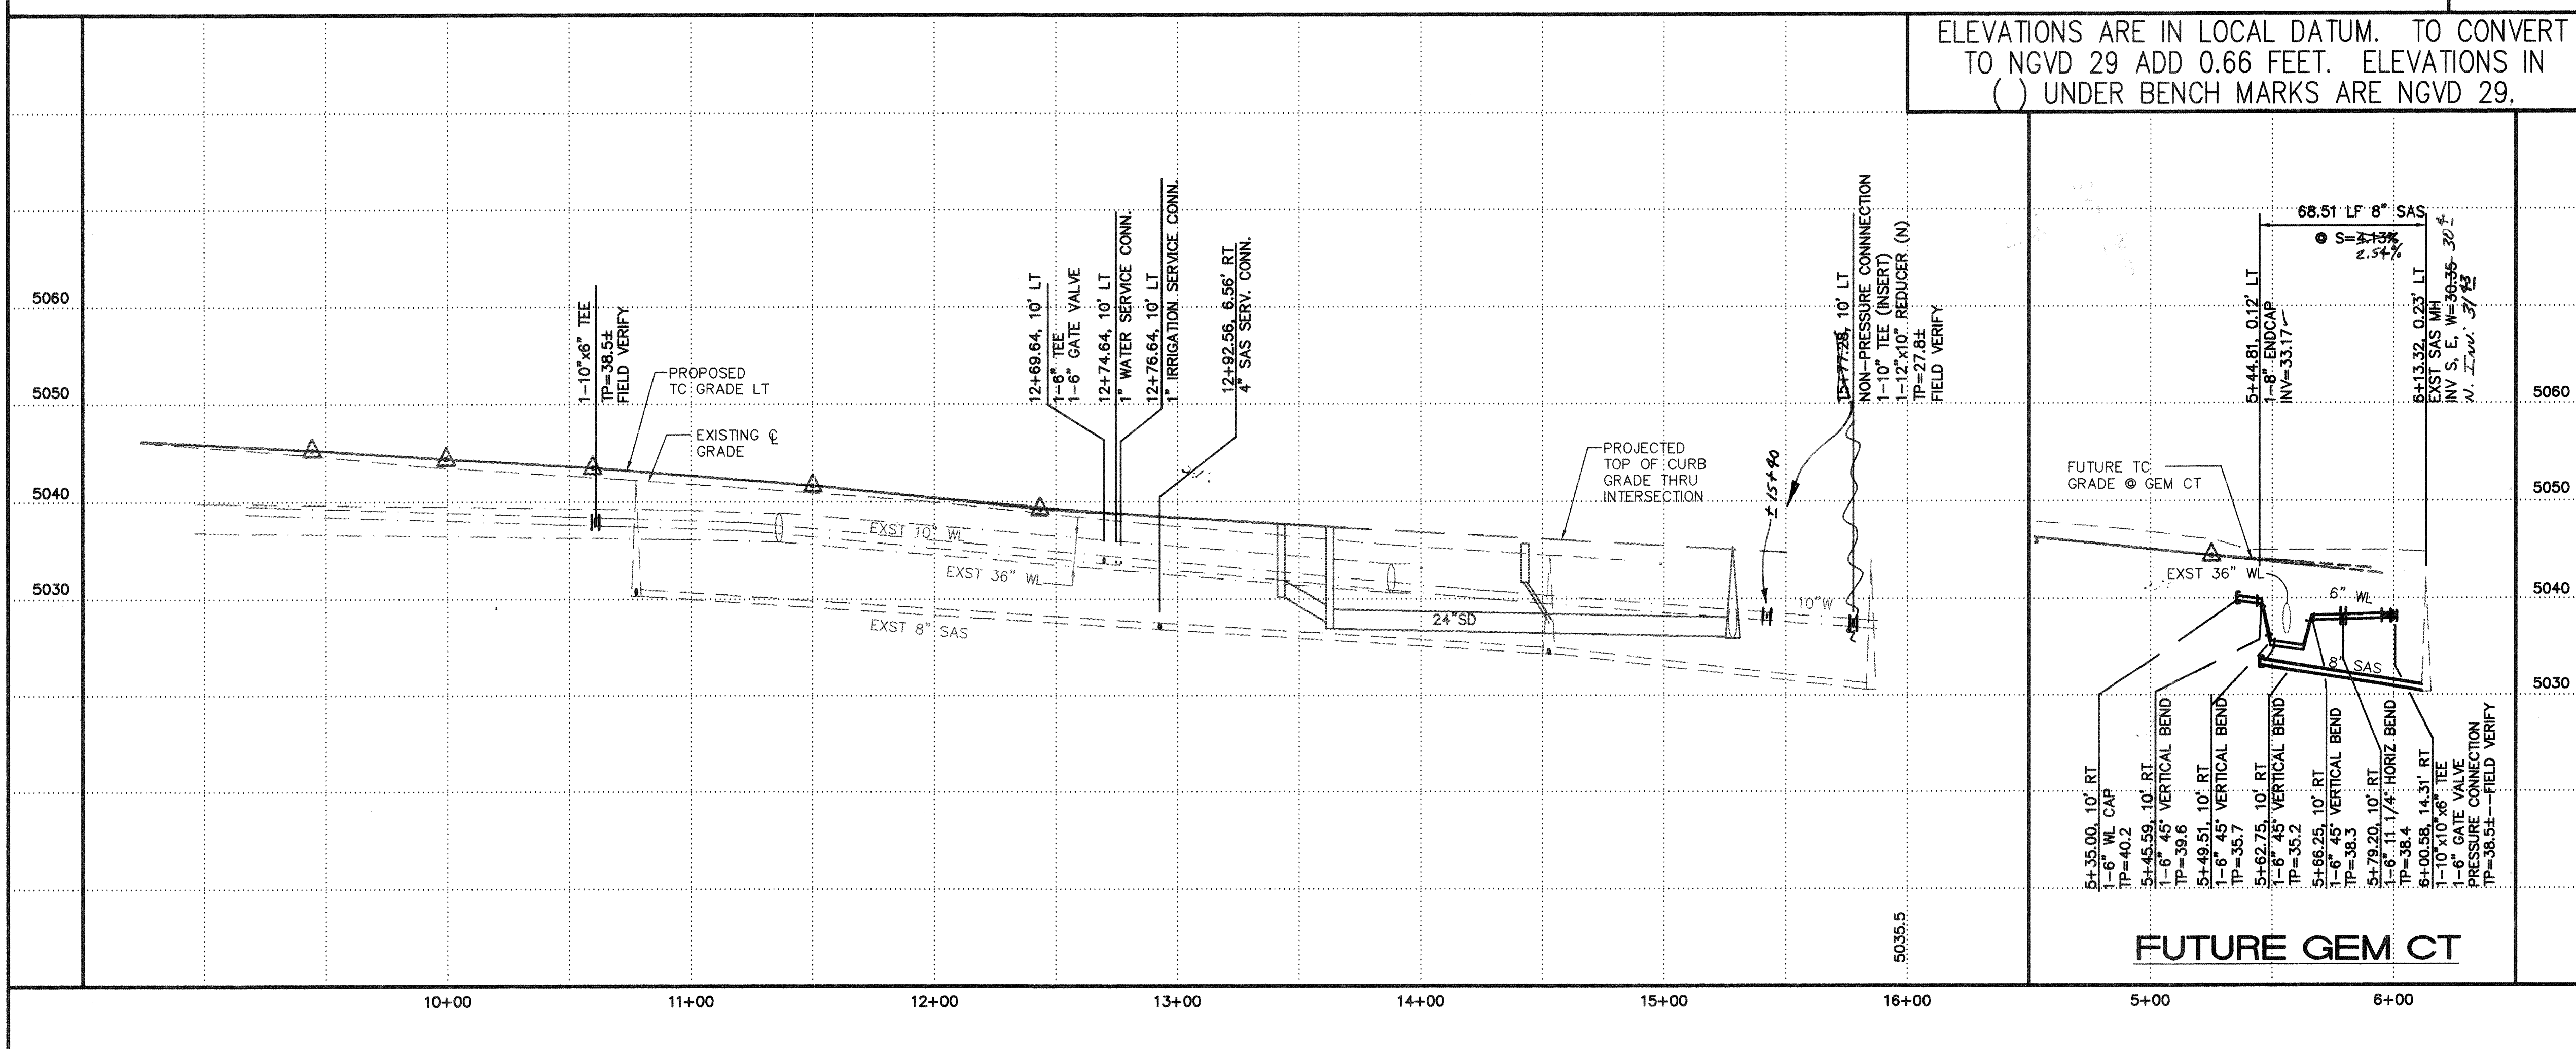

ELEVATIONS ARE IN LOCAL DATUM. TO CONVERT TO NGVD 29 ADD 0.66 FEET. ELEVATIONS IN () UNDER BENCH MARKS ARE NGVD 29.

- GENERAL NOTES**
1. CONSTRUCT SAS SERVICES PER COA STD DWG #2125.
 2. CONSTRUCT ALL SINGLE & DOUBLE WATER SERVICES PER COA STD DWG #2361 & #2362. SEE SHEET 12 FOR DETAILS.
 3. SEE SHEET 12 FOR WATER SHUT-OFF PLAN.
 4. SEE SHEET 9 FOR RESTRAINED JOINT LENGTHS FOR WATER LINE FITTINGS.
 5. CONSTRUCT FIRE HYDRANTS PER DESIGNATED DEPTHS & LENGTHS PER COA STD DWG #2340.
 6. SEE DETAIL ON SHEET 12 FOR VALVE RING & COVER DETAIL.

AS-BUILT INFORMATION		BENCH MARKS		SURVEY INFORMATION		ENGINEER'S SEAL			
CONTRACTOR	ISAACSON & ARFMAN, P.A.	ALUM. CAP	ALUM. CAP	FIELD NOTES	ALDRICH LAND		NO. DATE	REMARKS	BY
DATE	12/11/02	DATE	12/11/02	DATE	12/11/02				
WORK	WALGREENS AT UNSER BLVD & SAPPHIRE ST	DATE	12/11/02	DATE	12/11/02	DESIGNED BY	ANW	DATE	10/02
FIELD	STEPHEN E. WALKER	DATE	12/11/02	DATE	12/11/02	DRAWN BY	ANW	DATE	10/02
REVISIONS		DATE	12/11/02	DATE	12/11/02	CHECKED BY	FCA	DATE	10/02
DATE	12/11/02	DATE	12/11/02	DATE	12/11/02				

ISAACSON & ARFMAN, P.A.
Consulting Engineering Associates
128 Monroe Street N.E.
Albuquerque, New Mexico 87102
1236UTL2.DWG
12/16/02

CITY OF ALBUQUERQUE
PUBLIC WORKS DEPARTMENT
ENGINEERING GROUP

TITLE: WALGREENS AT UNSER BLVD & SAPPHIRE ST
SAPPHIRE STREET
UTILITY PLAN & PROFILE

Design Review Committee City Engineer Approval
APPROVED DEC 17 2002 APPROVED MAR 11 2003
DESIGN REVIEW COMMITTEE CITY ENGINEER
City Project No. 6953.81 Zone Map No. M-10 Sheet 10 Of 15

SCANNED BY
MESA REPRO

SCALE:
1"=100'







WATER SHUT-OFF PLAN

SHUT OFF THE FOLLOWING VALVES TO PROVIDE NON-PRESSURE CONNECTIONS:

1 2 3 4 5 6 & 7


THE CONTRACTOR SHALL CONTACT WATER SYSTEMS DIVISION (857-8200) 7 WORKING DAYS PRIOR TO SHUT-OFF OR TURN-ON AT VALVES. ONLY CITY PERSONNEL ARE ALLOWED TO OPERATE VALVES.

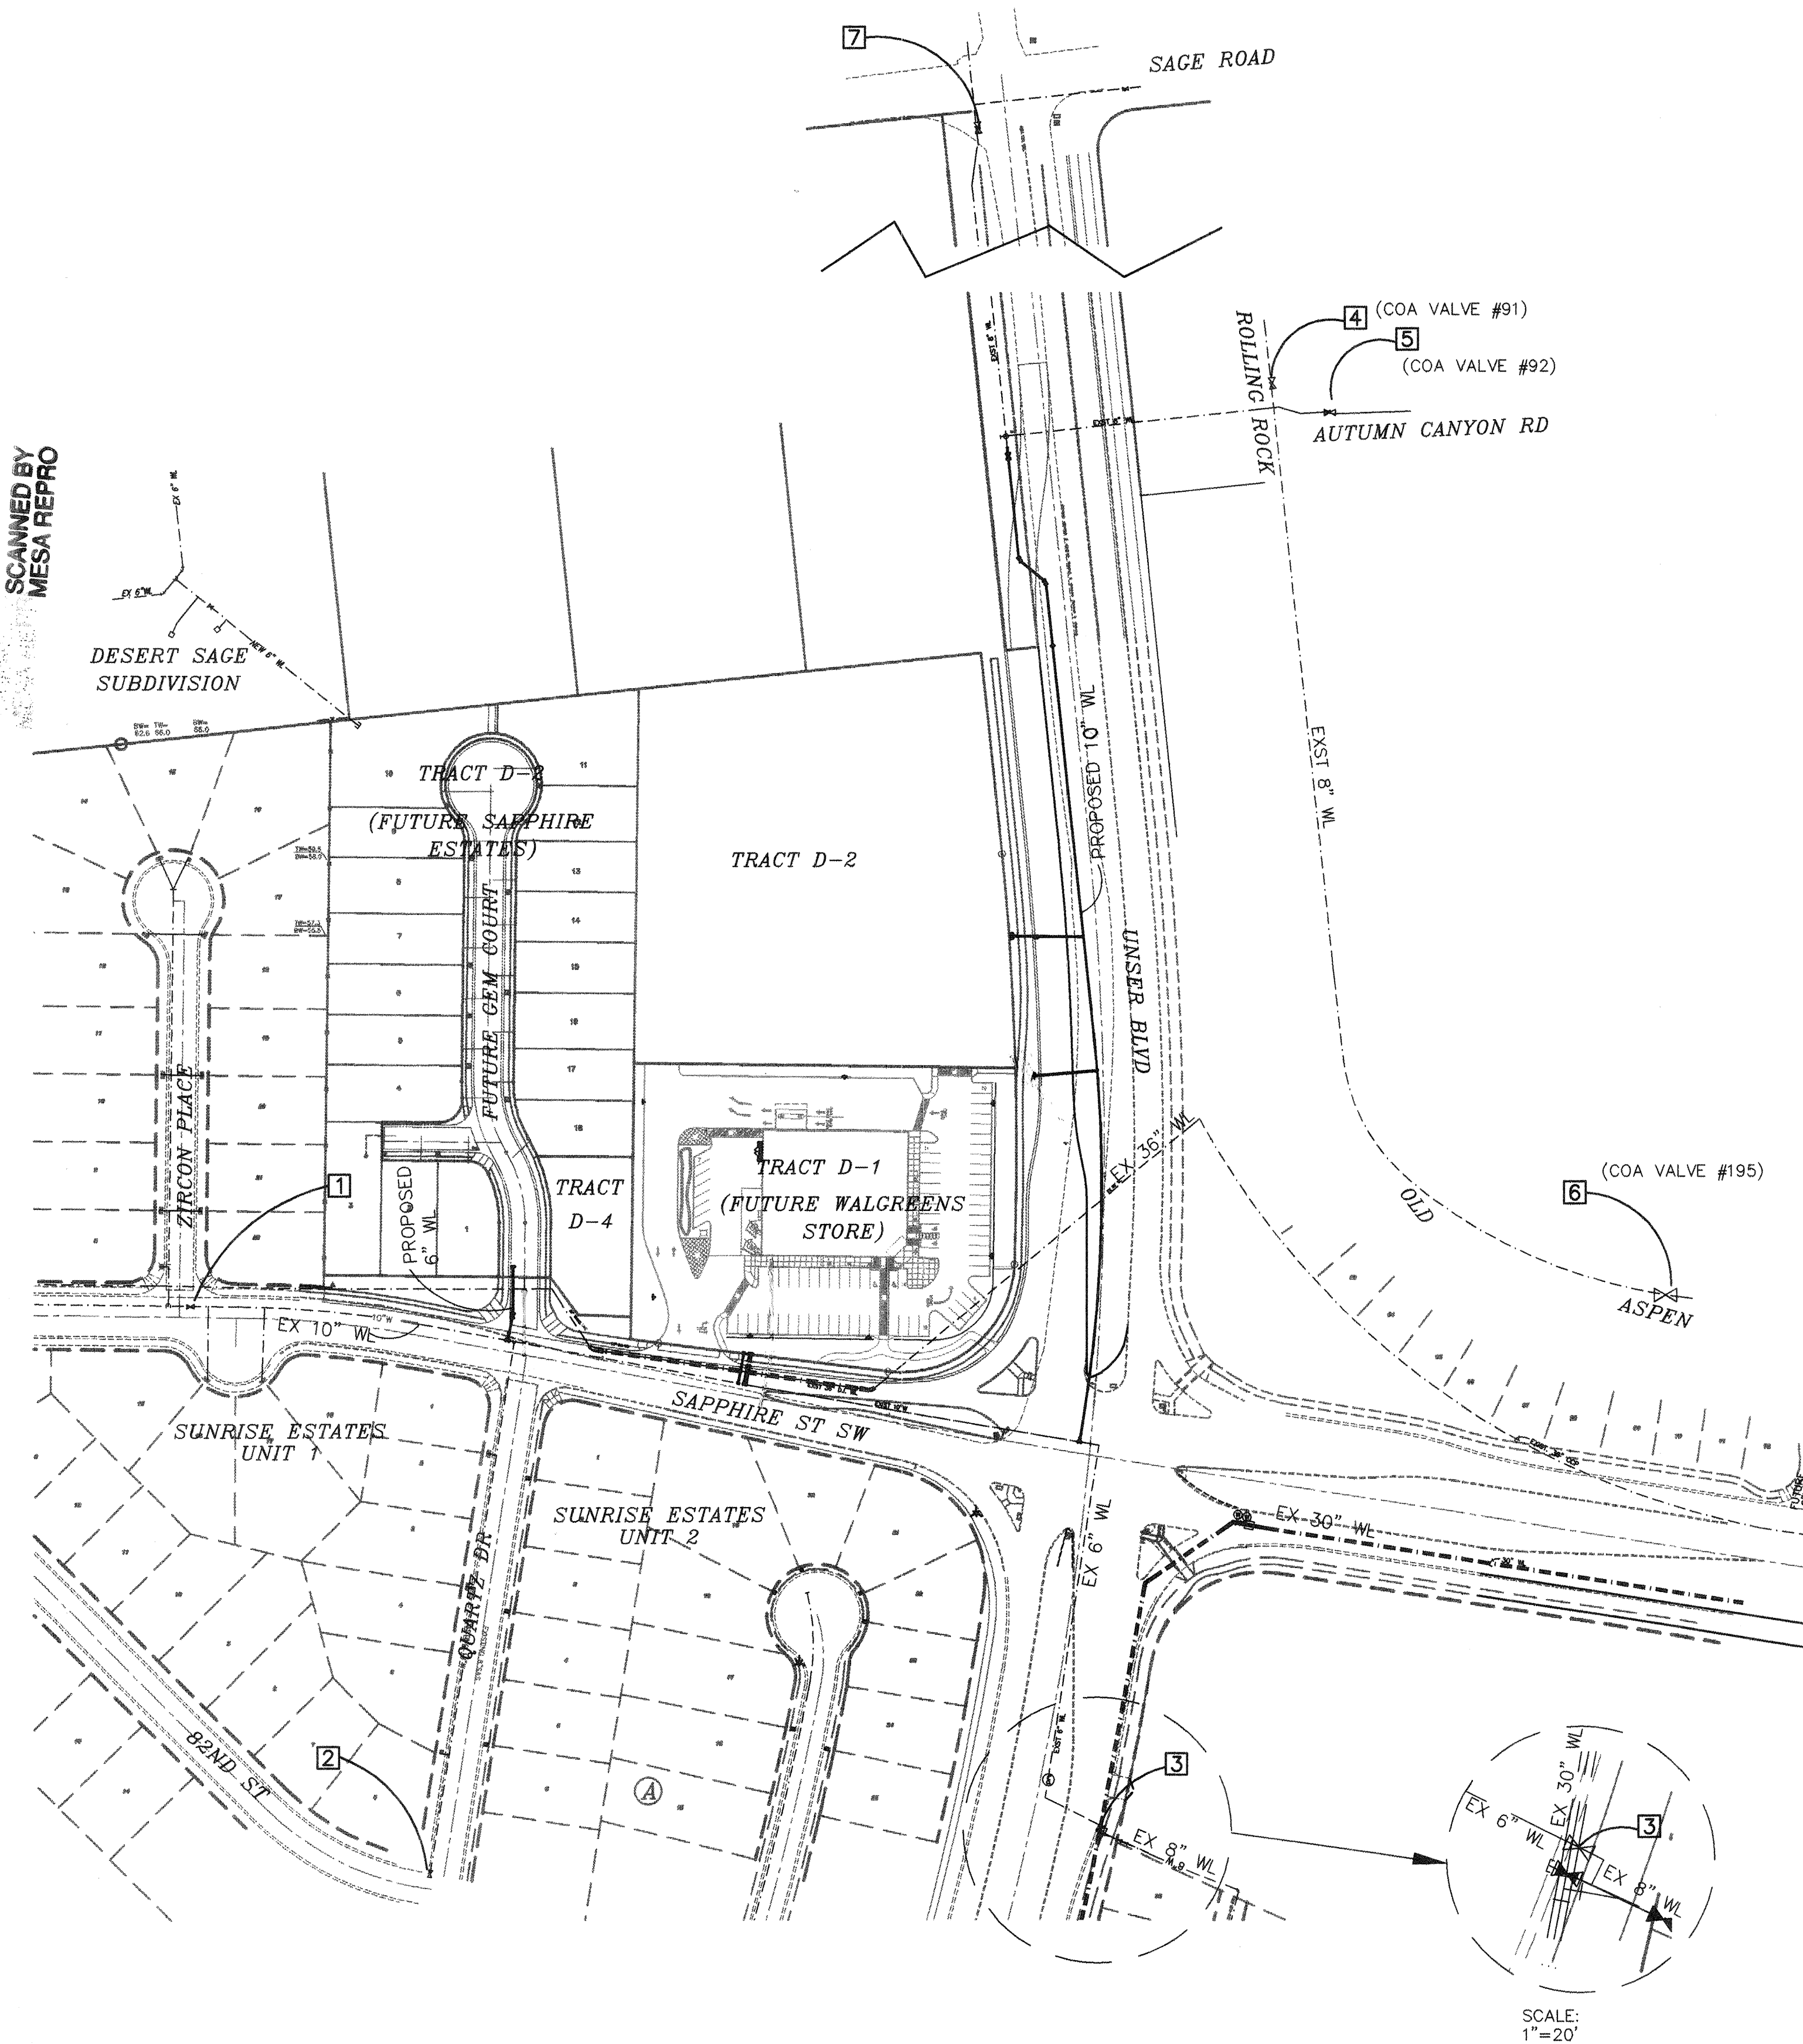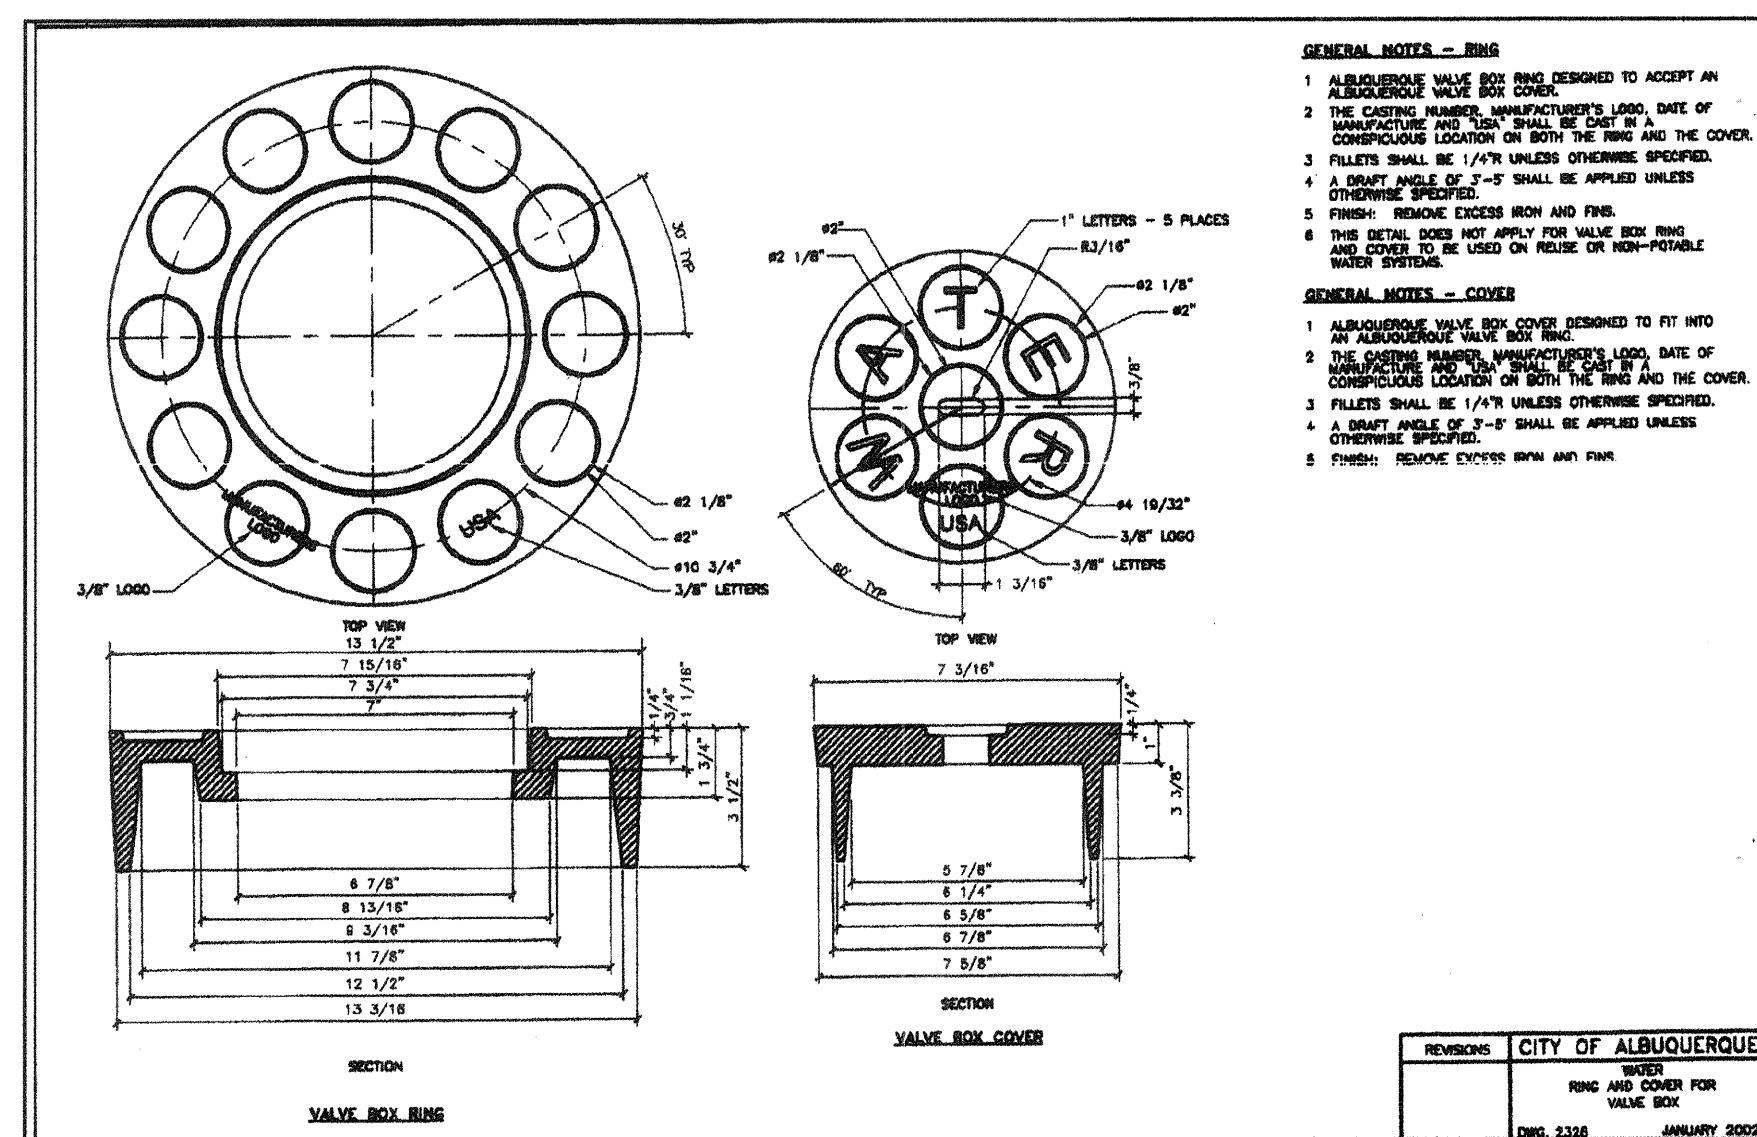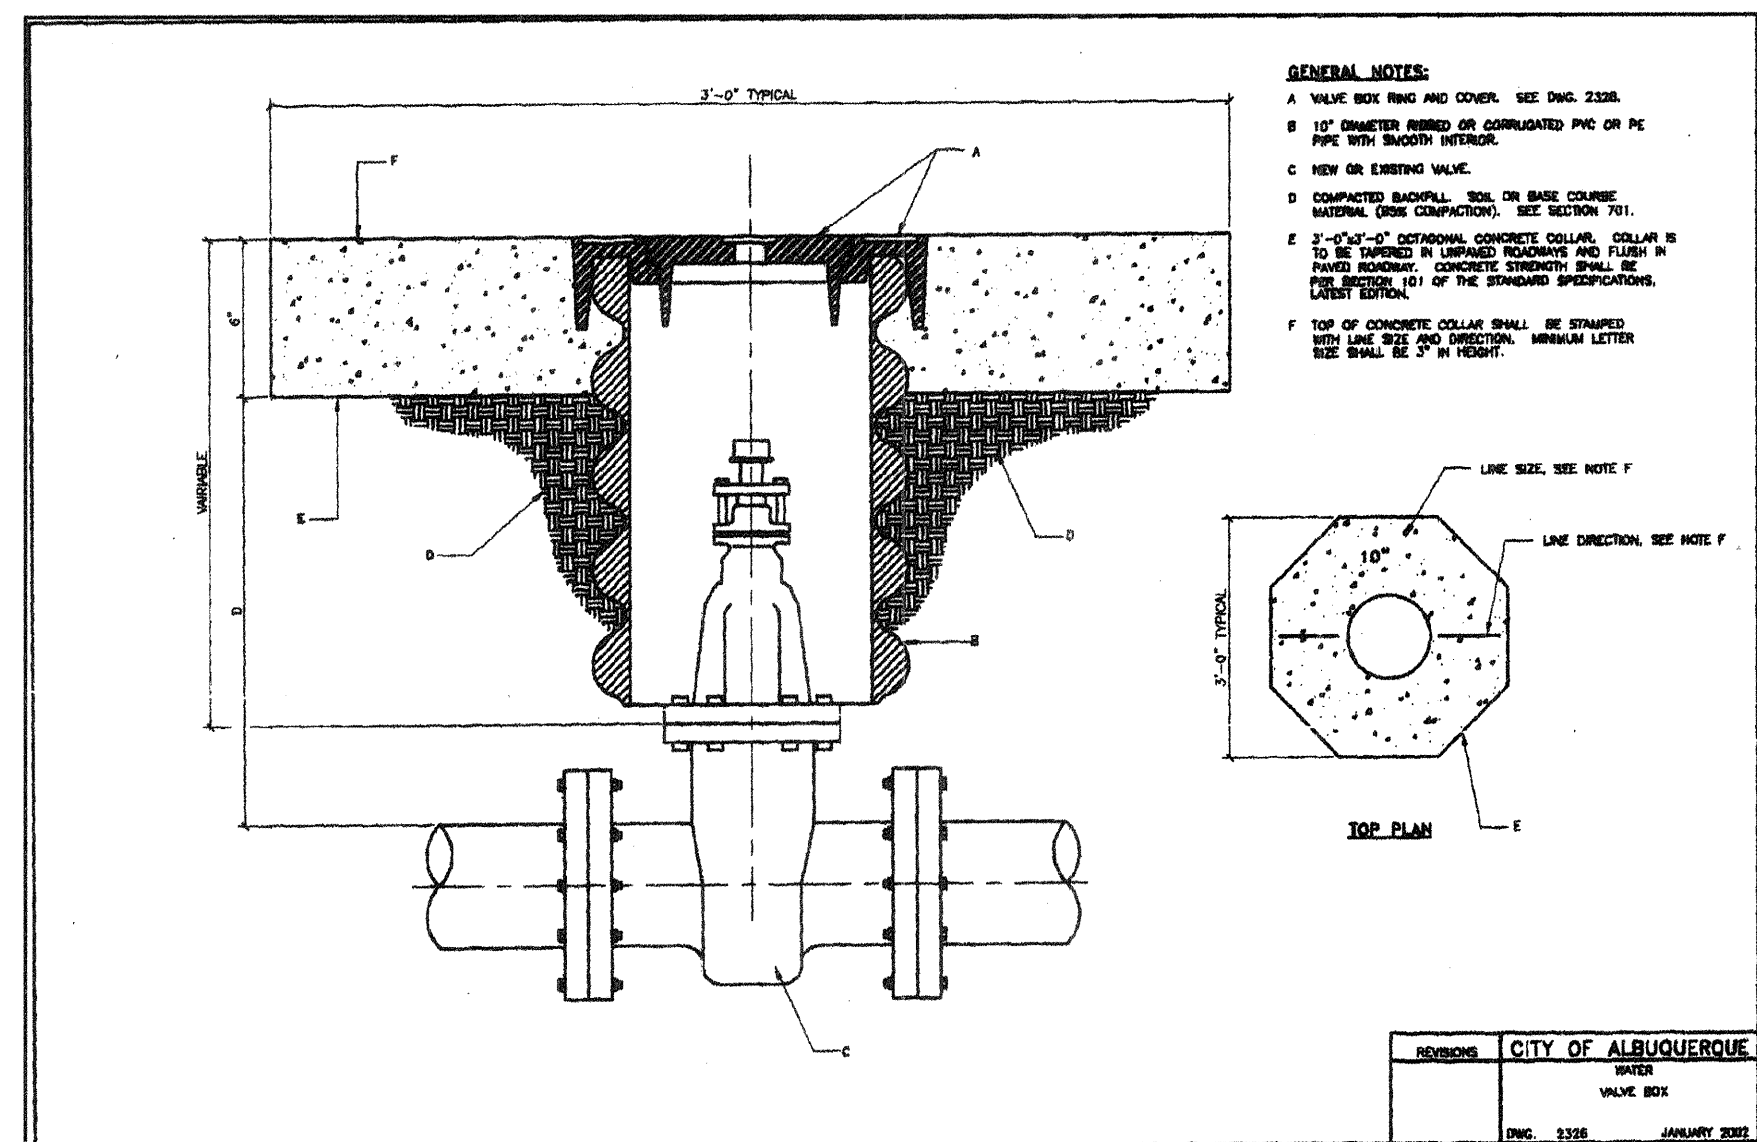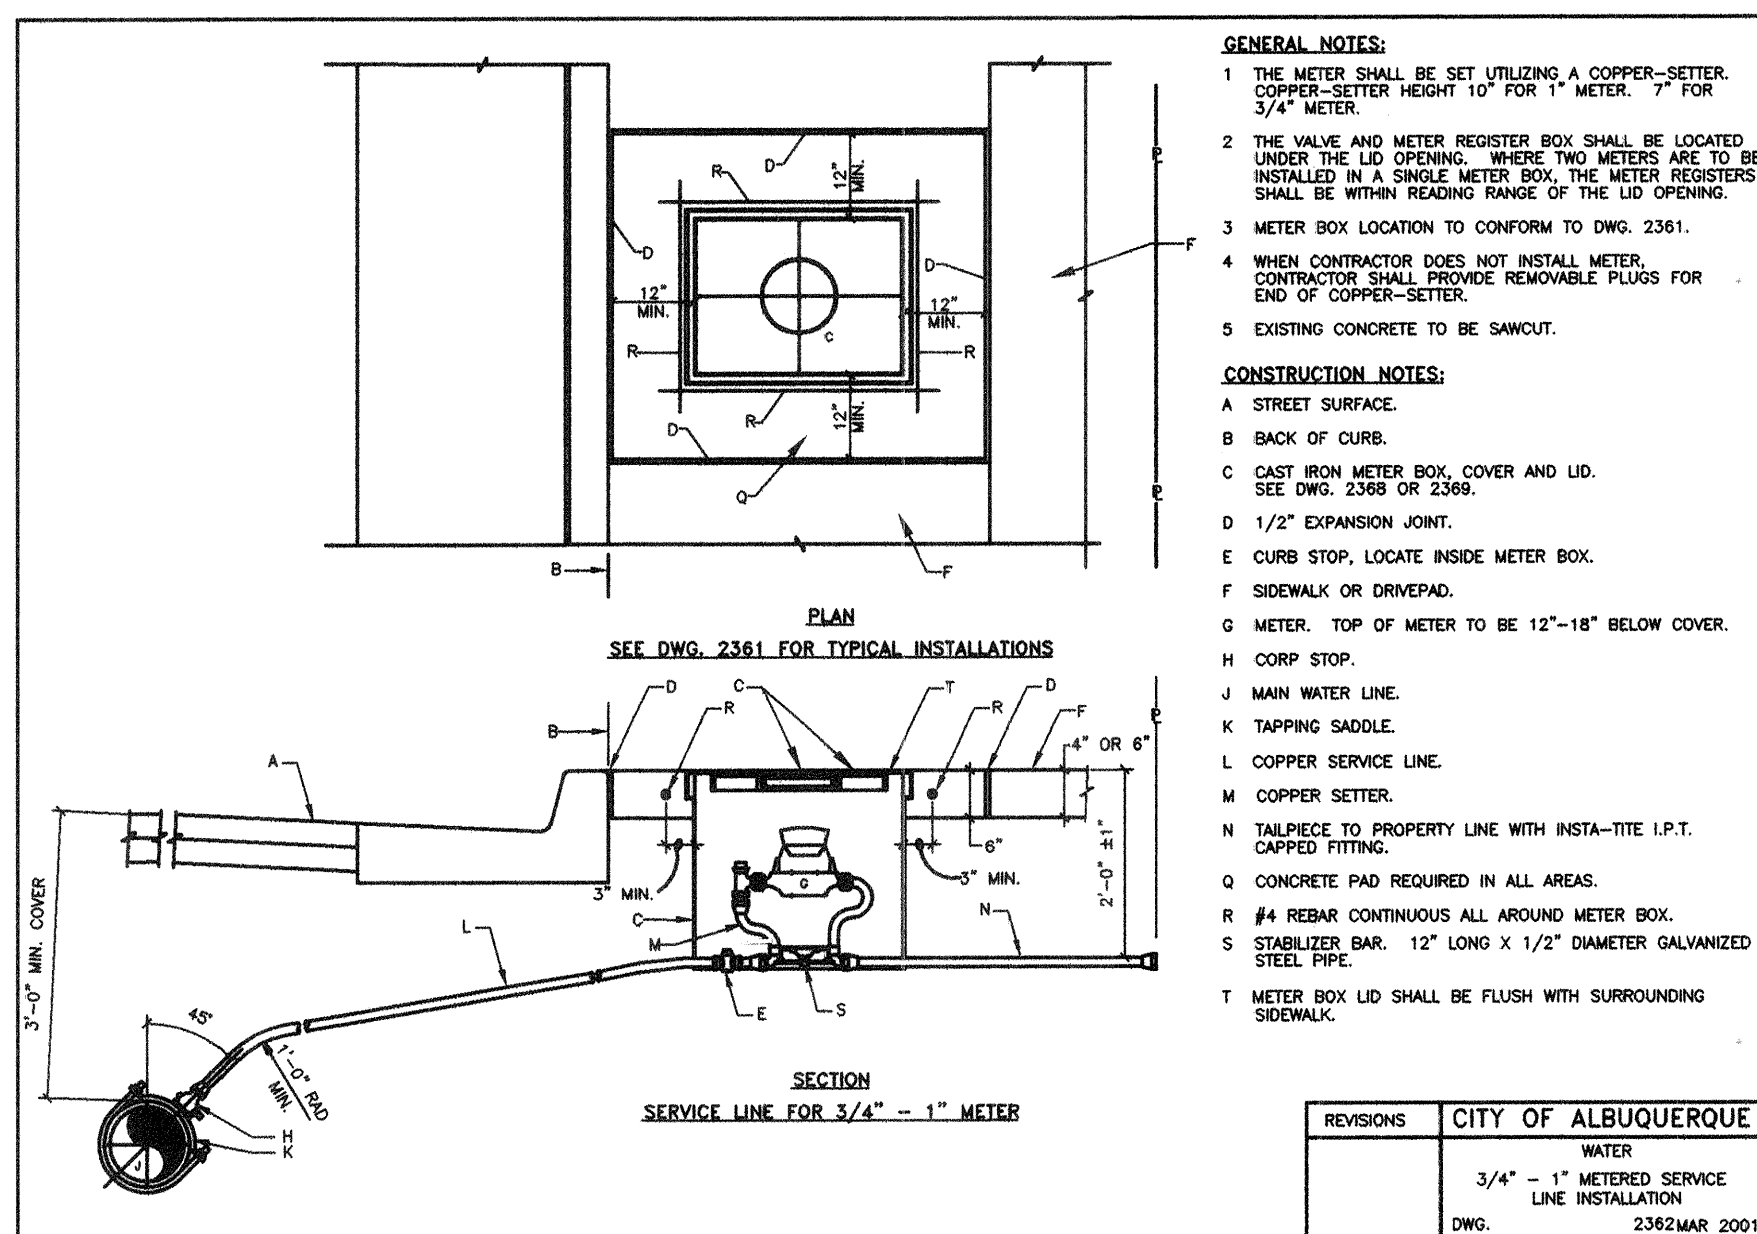

AS-BUILT INFORMATION	
CONTRACTOR	DATE
STAMPED BY	DATE
INSPECTOR'S	DATE
FIELD VERIFICATION BY	DATE
CORRECTED BY	DATE
MICRO-FILM INFORMATION	
RECORDED BY	DATE
NO.	

BENCH MARKS	
ACS 3 1/4" ALUM. CAP STAMPED, "12-LIT, 1989"	9/02
X=362,793.28, Y=1,478,563.63, NM STATE PLANE COORDINATES.	
CENTRAL ZONE (NAD 1927). STATION IS LOCATED IN THE NORTH	
MEDIAN NOSE OF THE INTERSECTION OF COORS BLVD AND	
SAN YONACIO RD SW.	
ELEVATION=5007.402, LOCAL DATUM. (5008.062), NGVD 1929	
TBM: ACS MONUMENT "1-M10"	
ELEVATION=5079.88, LOCAL DATUM	

SURVEY INFORMATION	
FIELD NOTES	
ALDRICH LAND SURVEYING	
1.	

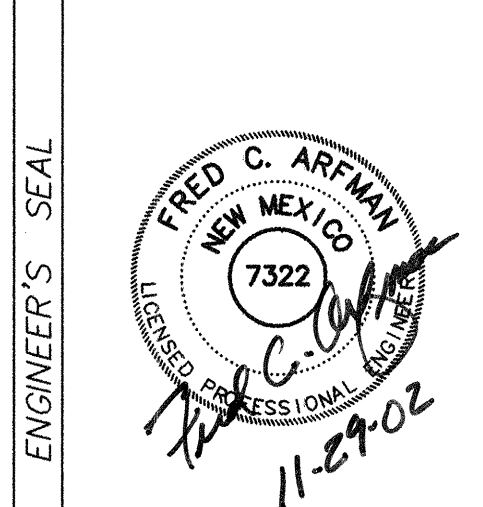

ENGINEER'S SEAL	
BY	DATE
REVISIONS	DATE
DESIGN	DATE
ANW	10/02
ANW	10/02
FCA	10/02


ISAACSON & ARFMAN, P.A.
Consulting Engineering Associates
128 Monroe Street N.E.
Albuquerque, New Mexico 87102
12360UDTL.DWGonw

**CITY OF ALBUQUERQUE
PUBLIC WORKS DEPARTMENT
ENGINEERING GROUP**

**TITLE: WALGREENS AT UNSER BLVD & SAPHIRE ST
WATER SHUT-OFF PLAN & UTILITY DETAILS**

Design Review Committee	City Engineer Approval
APPROVED	APPROVED
DEC 17 2002	MAR 11 2003
DESIGN REVIEW COMMITTEE	CITY ENGINEER

City Project No. **6953.81** Zone Map No. **M-10** Sheet **12** Of **15**

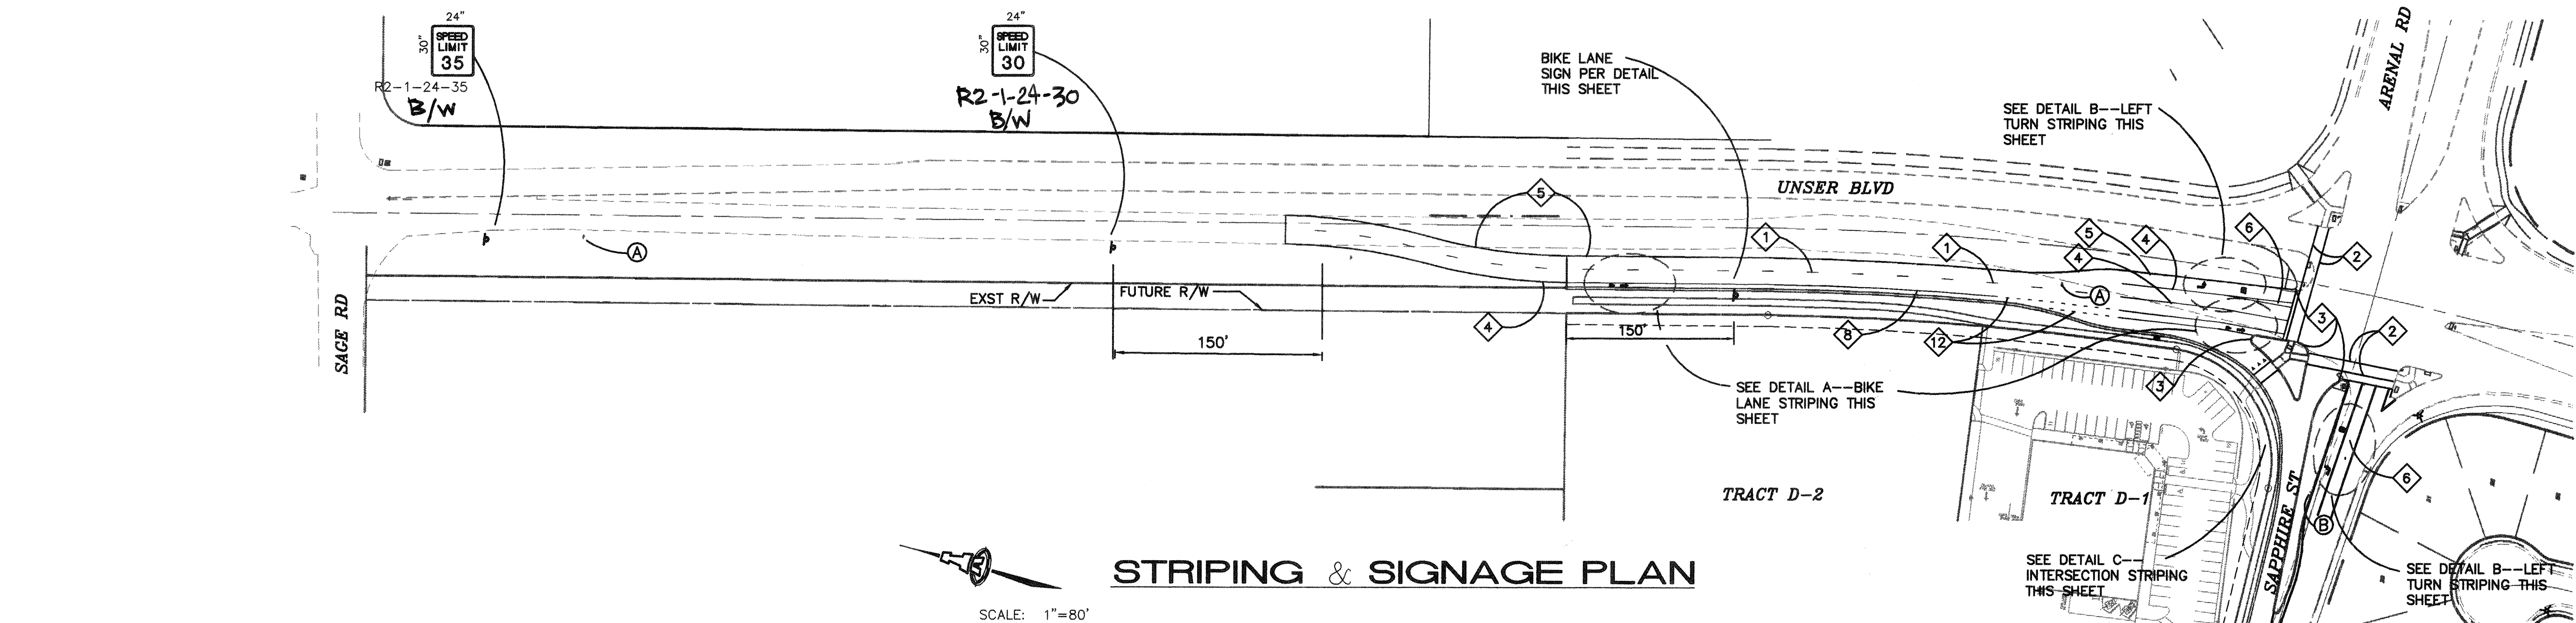

SCALE: 1"=80'

STRIPING NOTES


- 4" WHITE DASHED REFLECTORIZED PLASTIC MARKING. 10' STRIPES w/ 30" GAPS.
- 12" WHITE SOLID REFLECTORIZED PLASTIC CROSS WALK MARKING SPACED 10' APART.
- PAINT MEDIAN NOSE YELLOW.
- 4" WHITE SOLID REFLECTORIZED PLASTIC MARKING.
- 4" YELLOW SOLID REFLECTORIZED PLASTIC MARKING.
- 4" SOLID DOUBLE YELLOW STRIPES--SKIP BETWEEN CURB RETURNS AT FUTURE GEM COURT AND ENTRANCE TO WALGREENS.
- 12" WHITE SOLID REFLECTORIZED PLASTIC STOP BAR.
- 4" WHITE SOLID REFLECTORIZED PLASTIC BIKE LANE LINE.
- REFLECTORIZED PLASTIC SYMBOL, BICYCLE.
- REFLECTORIZED PLASTIC ARROW, THRU.
- LEFT TURN ARROW, WORD "ONLY".
- 4" WHITE DASHED REFLECTORIZED PLASTIC MARKING. 3' STRIPES w/ 7' GAPS.
- 24" WHITE YIELD REFLECTORIZED PLASTIC MARKINGS.

TRAFFIC SIGN REMOVALS AND INSTALLATION:


ALL EXISTING TRAFFIC SIGNS AND POSTS LOCATED IN MEDIANS SHALL BE REMOVED AND DELIVERED TO TRAFFIC ENGINEERING OPERATION AT PINO YARDS WHEN SIGNALIZATION IS INSTALLED AND FUNCTIONING. NEW SIGNS AND POSTS SHALL BE INSTALLED PER TRAFFIC ENGINEERING OPERATION INSTALLATION STANDARDS. PAYMENT FOR NEW SIGNS SHALL INCLUDE COORDINATION WITH TRAFFIC ENGINEERING OPERATION.

SIGN RELOCATION/REMOVAL NOTES


- REMOVE SIGN AND DELIVER TO PINO YARDS.
- RELOCATE SIGN BETWEEN SIDEWALK AND CURB.

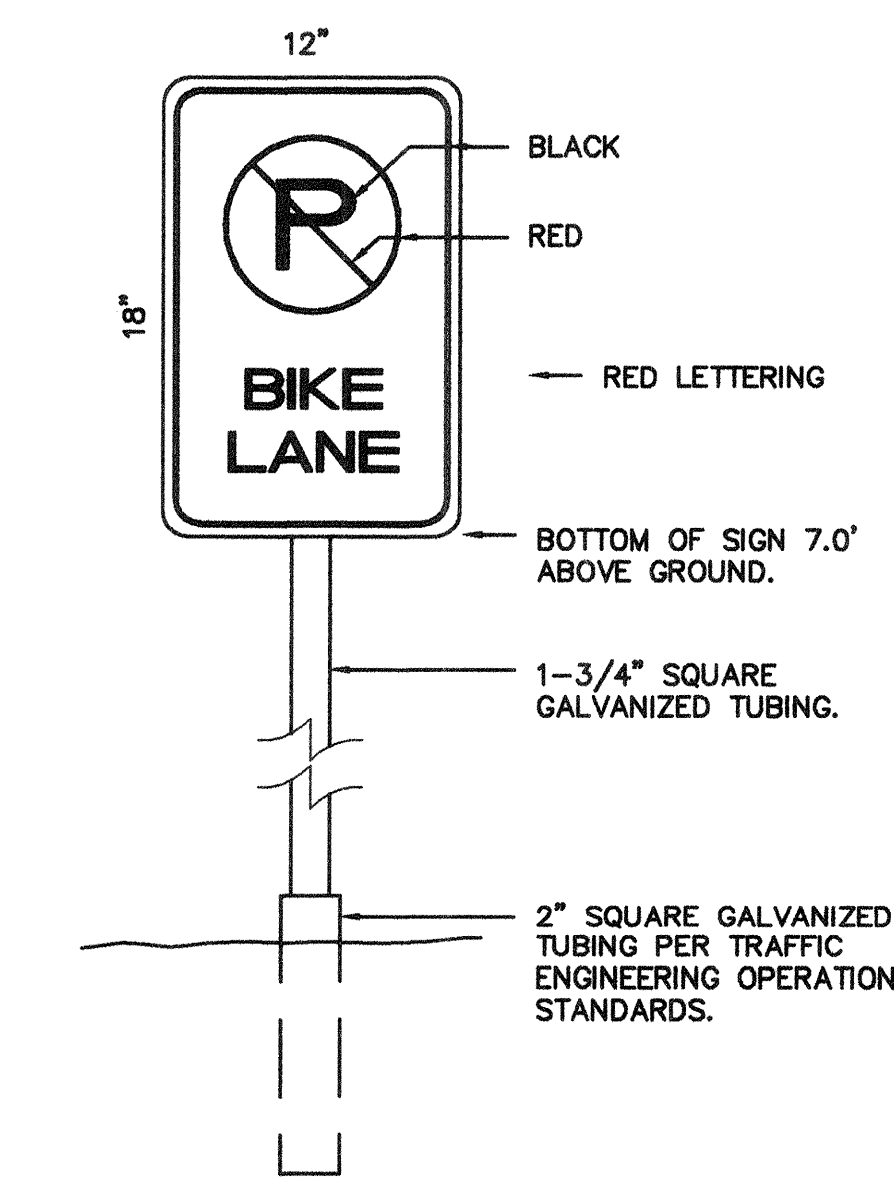


BIKE LANE SIGN AND POST (R7-9A)
NO SCALE

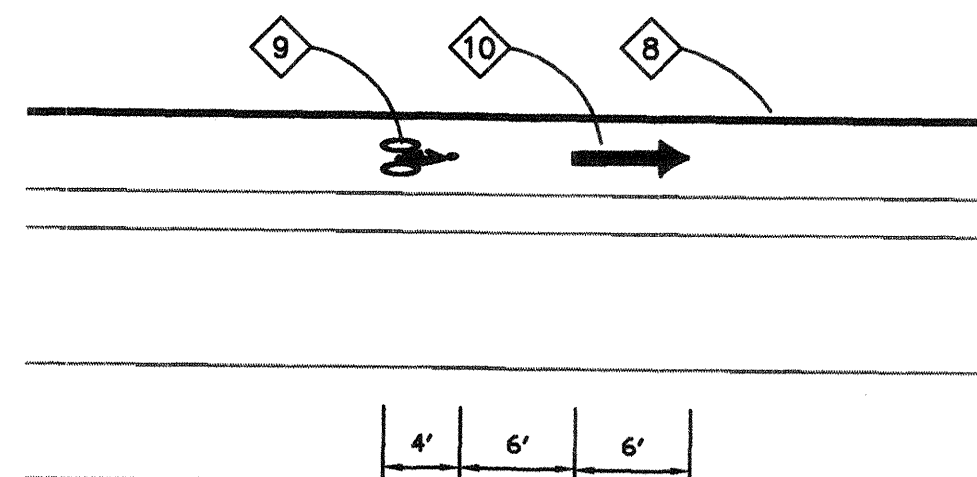

DETAIL A
BIKE LANE STRIPING
SCALE: 1"=10'

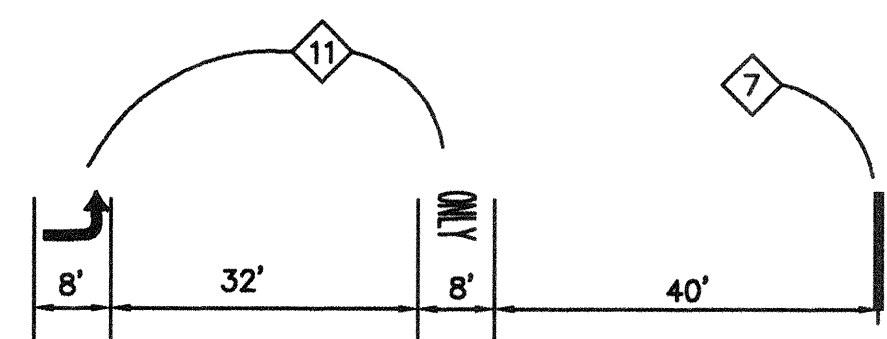

DETAIL B
LEFT TURN STRIPING
SCALE: 1"=20'

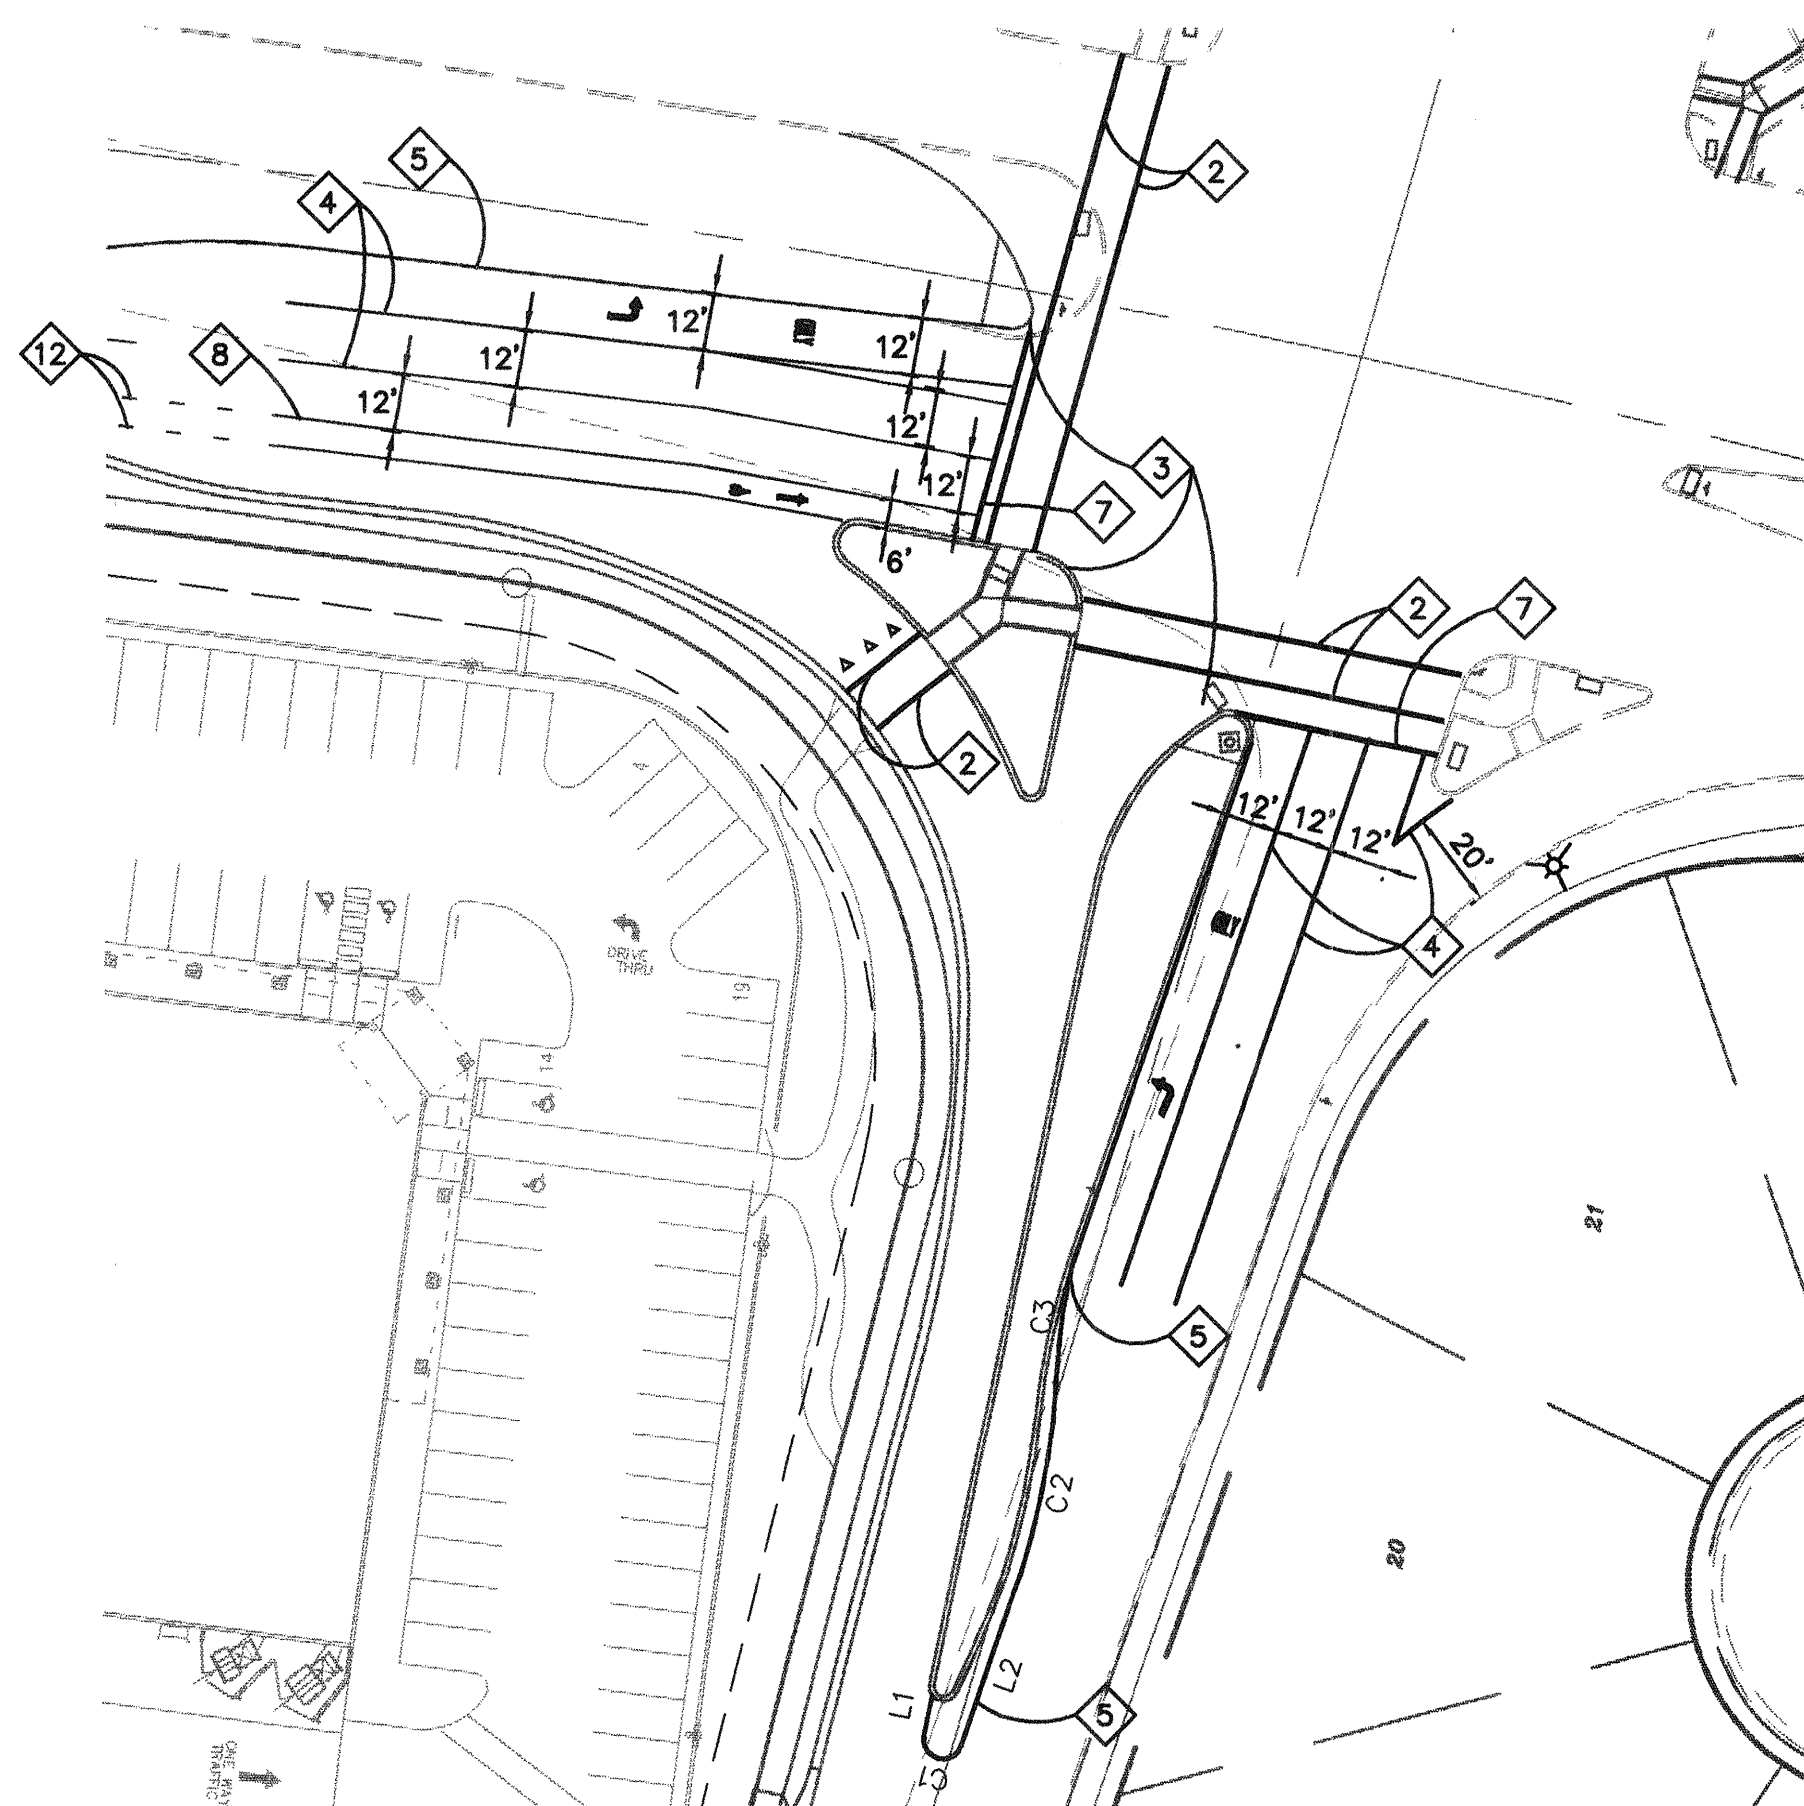

SCALE: 1"=40'

DETAIL C
INTERSECTION STRIPING

CURVE TABLE			
CURVE	RADIUS	LENGTH	DELTA
C1	4.00	12.05	172°35'38"
C2	150.00	42.57	161°5'37"
C3	150.00	24.93	9°31'25"

LINE TABLE		
LINE	BEARING	DISTANCE
L1	N 85°05'47" W	8.65
L2	S 77°41'25" E	36.15

ERADICATION NOTE

DOUBLE YELLOW LINES IN SAPPHIRE STREET SHALL BE ERADICATED FROM APPROXIMATELY STATION 94+70 EASTWARD WHERE EXISTING PAVING REMAINS BY WATER BLASTING OR SURFACE PLANING.

GENERAL NOTES:

- ALL STRIPING AND MARKINGS ARE PER MUTCD.
- NEW STRIPING AND MARKING IS REQUIRED FOR THE FULL LENGTH OF THE PROJECT.
- ALL MARKINGS SHALL BE PREFORMED PLASTIC.

ISAACSON & ARFMAN, P.A.
Consulting Engineering Associates
128 Monroe Street N.E.
Albuquerque, New Mexico 87102
1236STRP.DWGanw 12/17/02

CITY OF ALBUQUERQUE
PUBLIC WORKS DEPARTMENT
ENGINEERING GROUP

TITLE: WALGREENS AT UNSER BLVD & SAPPHIRE ST
STRIPING & SIGNAGE PLAN


Design Review Committee: *[Signature]* City Engineer Approval: *[Signature]*
APPROVED: DEC 17 2002
DESIGN REVIEW COMMITTEE: *[Signature]* CITY ENGINEER: *[Signature]*

City Project No. 6953.81


Zone Map No. M-10

Sheet 13 of 15

SURVEY INFORMATION		FIELD NOTES	
1.	ALDRICH LAND SURVEYING	9/02	
AS-BUILT INFORMATION		BENCH MARKS	
CONTRACTOR	DATE	CONTRACTOR	DATE
INSPECTOR	DATE	INSPECTOR	DATE
FIELD VERIFICATION BY	DATE	FIELD VERIFICATION BY	DATE
CORRECTED BY	DATE	CORRECTED BY	DATE
MICRO-FILM INFORMATION		MICRO-FILM INFORMATION	
RECORDED BY	DATE	RECORDED BY	DATE
NO.		NO.	

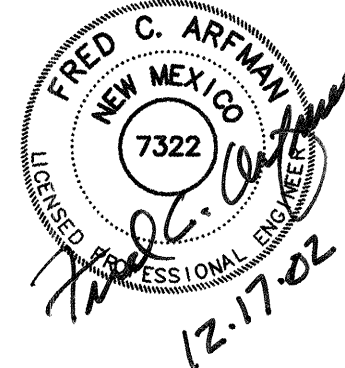


SCANNED BY
MESA REPRO

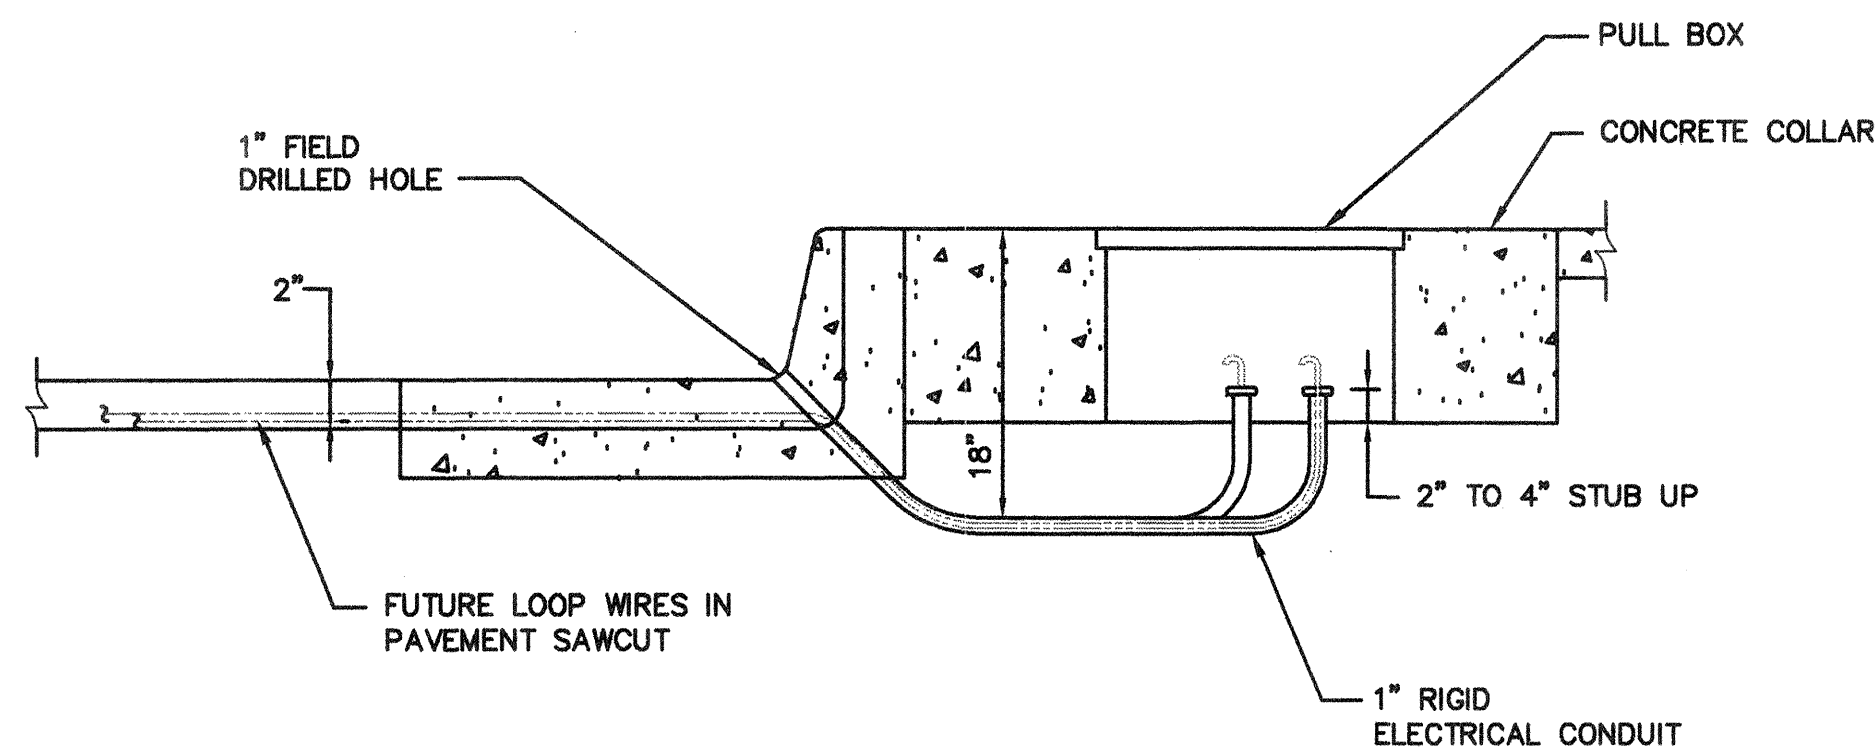

LOOP DETECTOR CONDUIT DETAIL

SCALE: 1"=1'

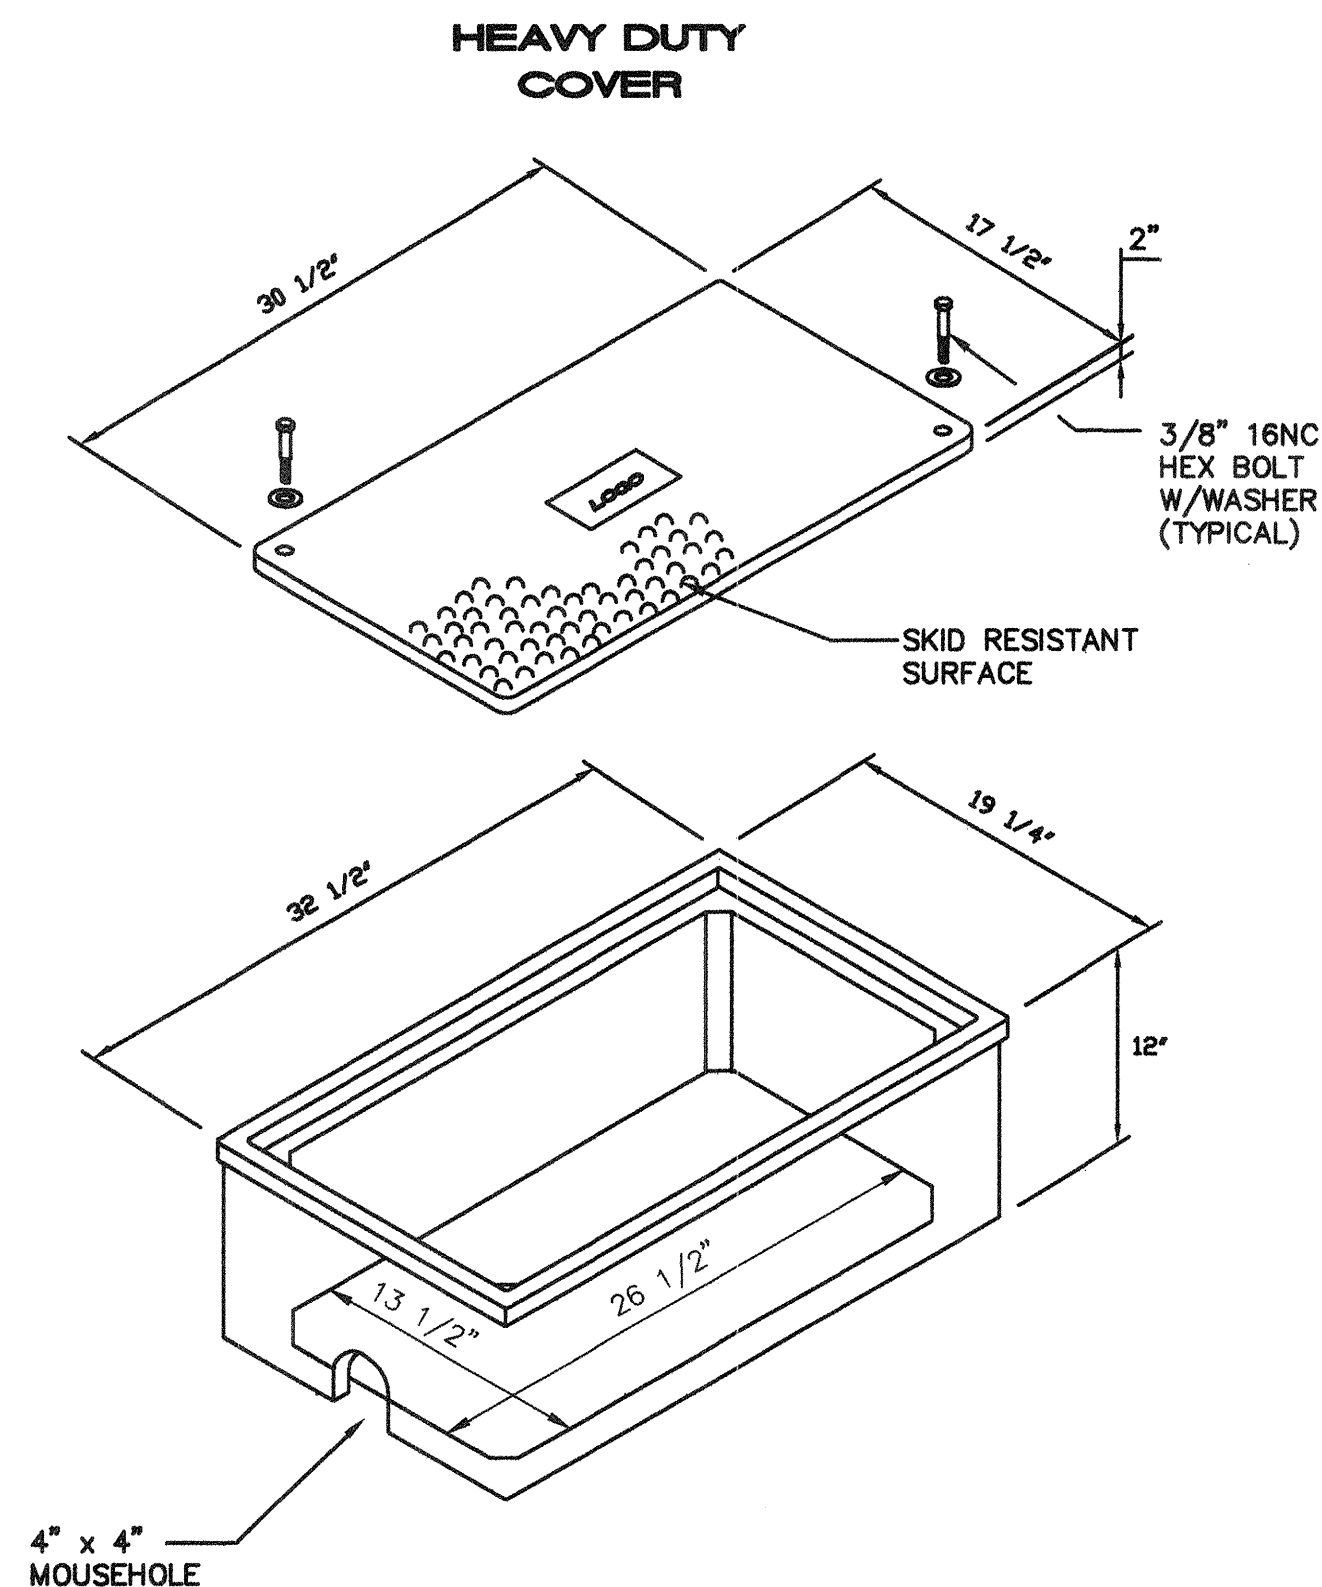


LARGE PULL BOX

SCALE: 1"=1'


NOTES FOR HEAVY DUTY REINFORCED
POLYMER MORTAR PULL BOX AND COVERS

1. MATERIAL TO BE AGGREGATE CONSISTING OF SAND AND GRAVEL BOND TOGETHER WITH A POLYMER AND REINFORCED WITH CONTINUOUS WOVEN GLASS STRANDS. THE MATERIAL MUST HAVE THE FOLLOWING MECHANICAL PROPERTIES: COMPRESSIVE STRENGTH - 11,000 PSI, TENSILE STRENGTH - 1,700 PSI, FLEXURAL STRENGTH - 7,500 PSI.
2. ALL PULL BOX COVERS SHALL BE HEAVY DUTY REINFORCED POLYMER MORTAR, HAVING A SERVICE LOAD OF 22,568 LBS. OVER 10" SQUARE (225 PSI).
3. PULL BOX LOGO SHALL READ "TS".
4. THE DIMENSIONS OF THE PULL BOXES SHOWN NOMINAL DIMENSIONS AND MAY VARY AS TO THE MANUFACTURER'S RECOMMENDATIONS.

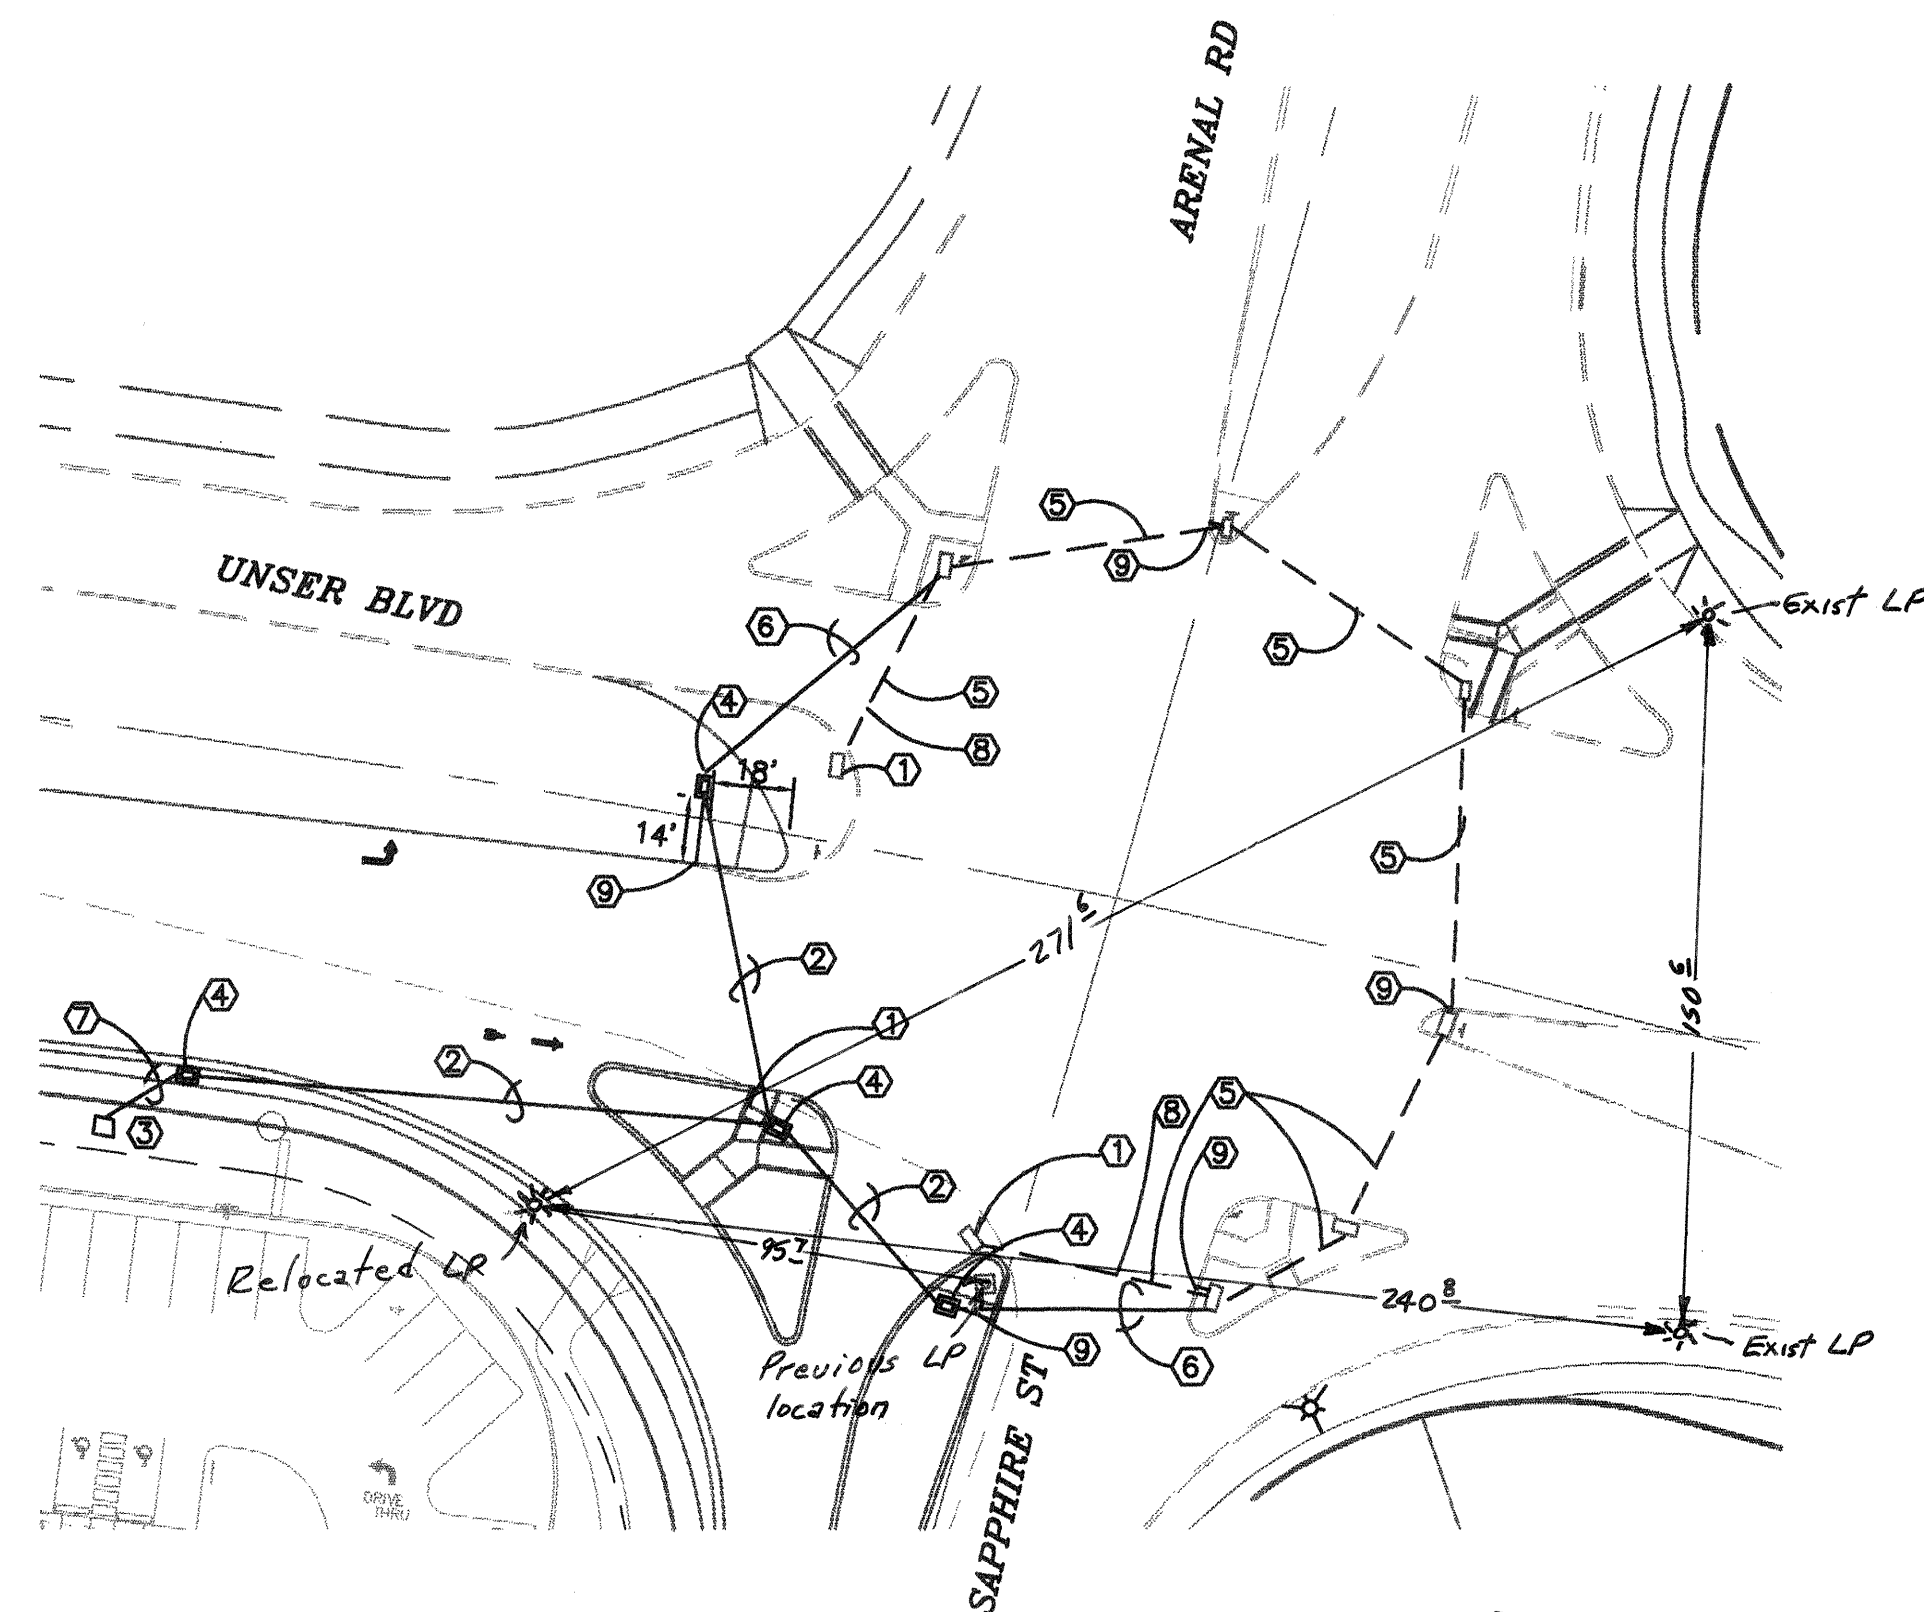

CONDUIT AND PULLBOX PLAN

SCALE:
1"=40'

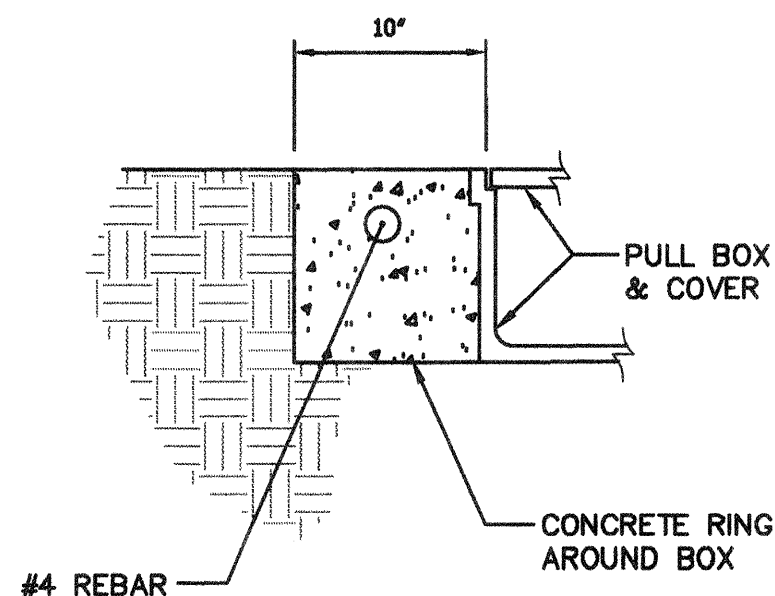


CONCRETE COLLAR DETAIL

NOTE: THE CONCRETE COLLAR FOR THE PULL BOXES WILL BE CONSIDERED INCIDENTAL TO THE PULL BOX BID ITEMS.

CONSTRUCTION NOTES

1. REMOVE EXISTING PULLBOX.
2. 1-3" ELECTRICAL CONDUITS & 1-2" ELECTRICAL CONDUIT BY TRENCHING, BACKFILL & PATCHING.
3. ELECTRICAL POWER SUPPLY & METER SETTING FOR TRAFFIC SIGNALIZATION (BY OTHERS). LOCATION MAY VARY PER PNM REQUIREMENTS.
4. NEW LARGE PULLBOX PER DETAIL THIS SHEET.
5. EXISTING ELEC. CONDUIT.
6. 1-3" ELECTRICAL CONDUITS & 1-2" ELECTRICAL CONDUIT BY PUSHING, BORING & JACKING.
7. 1-2" ELECTRICAL CONDUIT.
8. REMOVE & DISPOSE EXISTING ELEC. CONDUIT.
9. 1-1" ELECTRICAL CONDUIT FOR LOOP DETECTOR--SEE DETAIL THIS SHEET.

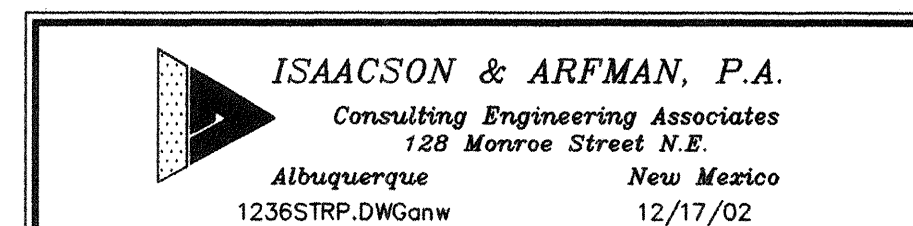

CITY OF ALBUQUERQUE PUBLIC WORKS DEPARTMENT ENGINEERING GROUP	
TITLE: WALGREENS AT UNSER BLVD & SAPPHIRE ST CONDUIT AND PULLBOX PLAN & DETAILS	
Design Review Committee APPROVED DEC 17 2002 DESIGN REVIEW COMMITTEE	City Engineer Approval APPROVED DEC 17 2002 CITY ENGINEER
City Project No. 6953.81	Zone Map No. M-10
Sheet 13A	Of 15


SURVEY INFORMATION		BENCH MARKS		AS-BUILT INFORMATION	
FIELD NOTES	ALDRICH LAND	CONTRACTOR	CONTRACTOR	CONTRACTOR	CONTRACTOR
1. SURVEYING	1. SURVEYING	1. SURVEYING	1. SURVEYING	1. SURVEYING	1. SURVEYING
2. SURVEYING	2. SURVEYING	2. SURVEYING	2. SURVEYING	2. SURVEYING	2. SURVEYING
3. SURVEYING	3. SURVEYING	3. SURVEYING	3. SURVEYING	3. SURVEYING	3. SURVEYING
100. SURVEYING	100. SURVEYING	100. SURVEYING	100. SURVEYING	100. SURVEYING	100. SURVEYING

CONSTRUCTION TRAFFIC CONTROL GENERAL NOTES


1. CONTRACTOR MUST OBTAIN FROM CONSTRUCTION COORDINATION AN EXCAVATION/BARRICADING PERMIT BEFORE ENGAGING IN ANY CONSTRUCTION, MAINTENANCE OR REPAIR WORK IN ANY OF THE CITY OF ALBUQUERQUE'S RIGHTS-OF-WAY. EMERGENCY WORK THAT WOULD PRESERVE LIFE OR PROPERTY IS EXCLUDED WITH THE UNDERSTANDING, THAT A PERMIT SHALL BE OBTAINED WITHIN 24 TO 48 HOURS.
2. CONTRACTOR SHALL AT THE TIME OF PERMIT REQUEST, SUBMIT FOR APPROVAL BY CONSTRUCTION COORDINATION, A TRAFFIC CONTROL PLAN DETAILING ALL EXISTING TOPOGRAPHY SUCH AS LANE WIDTHS, DRIVEWAYS, AND BUSINESS/RESIDENTIAL ACCESSES. THE TRAFFIC CONTROL PLAN SHALL INCLUDE ALL PHASES OF WORK AND SCHEDULES INVOLVED IN THE CONSTRUCTION PROJECT. ANY SEPERATE PHASES OF A CONSTRUCTION PROJECT SHALL BE GIVEN AN INDIVIDUAL PERMIT EACH. BLANKET PERMITS WILL NOT BE ISSUED.
3. THESE TYPICAL TRAFFIC CONTROL PLANS DO NOT REFLECT THE EXISTING TOPOGRAPHY SUCH AS DRIVEWAYS, LANE WIDTHS, AND BUSINESS/RESIDENTIAL ACCESSES. EVERY LOCATION THAT REQUIRES CONSTRUCTION TRAFFIC CONTROL SHALL HAVE A DETAILED TRAFFIC CONTROL PLAN SHOWING ALL EXISTING TOPOGRAPHY.
4. CONSTRUCTION SHALL NOT BEGIN UNLESS A TRAFFIC CONTROL PLAN HAS BEEN APPROVED AND VERIFIED BY CONSTRUCTION COORDINATION.
5. CONSTRUCTION COORDINATION SHALL BE NOTIFIED 48 HOURS PRIOR TO ANY TRAFFIC CONTROL CHANGES NEEDED BY CONTRACTOR, THAT WERE NOT PREVIOUSLY APPROVED. THESE TRAFFIC CONTROL CHANGES SHALL BE REQUESTED IN WRITING ACCOMPANIED WITH A TRAFFIC CONTROL PLAN REFLECTING SUCH CHANGES.
6. ALL CONSTRUCTION TRAFFIC CONTROL DEVICES SHALL COMPLY TO THE MANUAL ON UNIFORM TRAFFIC CONTROL DEVICES (MUTCD), LATEST EDITION. IT IS THE RESPONSIBILITY OF THE CONTRACTOR TO INSTALL, SERVICE AND MAINTAIN ALL TRAFFIC CONTROL DEVICES. TRAFFIC CONTROL DEVICES SHALL NOT BE REMOVED OR ALTERED IN ANY WAY WITHOUT THE APPROVAL OF CONSTRUCTION COORDINATION, PER SECTION 6A-4 OF THE MUTCD, LATEST EDITION.
7. THE CONSTRUCTION TRAFFIC CONTROL INITIAL SET-UP SHALL BE BY AN AMERICAN TRAFFIC SAFETY SERVICES ASSOCIATION (ATSSA) CERTIFIED WORKSITE TRAFFIC SUPERVISOR. THE MAINTENANCE AND SERVICING SHALL ALSO BE DONE BY AN ATSSA CERTIFIED WORKSITE TRAFFIC SUPERVISOR OR EQUIVALENT.
8. CONTRACTOR IS RESPONSIBLE TO MAINTAIN AND SERVICE ALL TRAFFIC CONTROL DEVICES 24 HOURS A DAY, 7 DAYS A WEEK THROUGHOUT LENGTH OF PROJECT. CONTRACTOR IS RESPONSIBLE THAT ALL TRAFFIC CONTROL DEVICES COMPLY WITH THE MUTCD, LATEST EDITION.
9. ALL ADVANCE WARNING SIGNS SHALL BE DOUBLE INDICATED WHENEVER THERE ARE MULTI-LANE TRAFFIC IN ANY ONE GIVEN DIRECTION AND THERE IS SUFFICIENT MEDIAN SPACE.
10. ALL BARRICADES IN ALL TAPERS AND TANGENTS SHALL BE PLACED APART, A DISTANCE MEASURED IN FEET, EQUAL TO THAT OF THE POSTED SPEED LIMIT. NO EXCEPTIONS UNLESS APPROVED BY CONSTRUCTION COORDINATION PER MUTCD SECTION 6A-4.
11. ALL WORK IN ARTERIAL ROADWAYS SHALL BE ON A CONTINUOUS 24 HOUR PER DAY BASIS UNTIL COMPLETED.
12. CONTRACTOR IS RESPONSIBLE TO PROVIDE CONSTRUCTION COORDINATION, A WEEKLY LOG OF DAILY INSPECTIONS OF BARRICADE AND MAINTENANCE SCHEDULES ON PROJECTS THAT ARE OVER ONE WEEK DURATION.
13. EQUIPMENT OR MATERIALS SHALL NOT BE STORED WITHIN 15 FEET OF A TRAVELED TRAFFIC LANE DURING NON-WORKING HOURS WITHOUT THE APPROVAL OF CONSTRUCTION COORDINATION.
14. CONTRACTOR SHALL PROVIDE AND MAINTAIN A SAFE AND ADEQUATE MEANS OF CHANNELIZING PEDESTRIAN TRAFFIC AROUND AND THROUGH THE CONSTRUCTION AREA.
15. CONTRACTOR IS RESPONSIBLE FOR OBLITERATION OF ANY CONFLICTING STRIPING AND RESPONSIBLE FOR ALL TEMPORARY STRIPING.
16. CONTRACTOR SHALL MAINTAIN ACCESS TO ALL FACILITIES, BUSINESSES AND/OR RESIDENTS AT ALL TIMES.
17. CONTRACTOR SHALL PROVIDE ACCESS SIGNS FOR BUSINESSES LOCATED WITHIN THE CONSTRUCTION AREA UNDER THE SUPERVISION OF CONSTRUCTION COORDINATION. EACH ACCESS SIGN SHALL HAVE 5 INCH, WHITE OPAQUE LETTERING ON BLUE REFLECTORIZED BACKGROUND. ACCESS SIGNS SHALL BE CONSIDERED INCIDENTAL TO THE BID AND NOT PART OF THE CONTRACT UNLESS OTHERWISE STATED. NO MORE THAN 3 BUSINESSES SHALL BE LISTED ON A ACCESS SIGN. SHOPPING CENTERS AND MALLS SHALL BE LISTED AS SUCH.
18. ALL ADVANCE WARNING SIGNS SHALL MEET THE MINIMUM REFLECTIVE INTENSITY REQUIREMENTS SET FORTH BY THE CITY OF ALBUQUERQUE. CONSTRUCTION COORDINATION SHALL DETERMINE ALL REQUIREMENTS AND APPROVE OR DISAPPROVE ANY ADVANCE WARNING SIGN PER SECTION 6A-4 OF THE MUTCD, LATEST EDITION.
19. 48 HOURS PRIOR TO OCCUPYING OR CLOSING OF A RIGHT-OF-WAY, CONTRACTOR SHALL NOTIFY: POLICE, FIRE DEPARTMENT, SCHOOLS, HOSPITALS, TRANSIT AUTHORITY, BUSINESSES AND/OR RESIDENTS THAT WILL BE AFFECTED BY THE CONSTRUCTION.
20. ANY FIELD ADJUSTMENTS SHALL BE APPROVED BY CONSTRUCTION COORDINATION.
21. EXCAVATIONS SHALL BE PLATED, TEMPORARILY PATCHED OR RESURFACED PRIOR TO OPENING OF TRAFFIC. A MINIMUM OF 11 FEET SHALL BE PROVIDED FOR TRAFFIC IN ANY GIVEN DIRECTION. CONTRACTOR IS RESPONSIBLE FOR ANY WORK INVOLVED IN SATISFYING THESE REQUIREMENTS.
22. CONTRACTOR SHALL AT ALL TIMES COMPLY WITH THE FOLLOWING:
- STANDARDS AND REQUIREMENTS SET FORTH IN THE MANUAL ON UNIFORM TRAFFIC CONTROL DEVICES, LATEST EDITION.
 - THE CITY OF ALBUQUERQUE TRAFFIC CODE, LATEST EDITION.
 - SECTION 19 OF THE CITY OF ALBUQUERQUE'S STANDARD SPECIFICATIONS FOR PUBLIC WORK CONSTRUCTION, AS WELL AS OTHER SECTIONS.
23. FAILURE TO COMPLY WITH ANY OF THE ABOVE MENTIONED, WILL BE ADEQUATE CAUSE TO CEASE ALL WORK ON ANY CONSTRUCTION PROJECT. WORK WILL NOT RESUME UNTIL ALL REQUIREMENTS ARE ADDRESSED AND APPROVED BY CONSTRUCTION COORDINATION.
24. ALL TRAFFIC CONTROL DEVICES SHALL BE KEPT IN NEW-CLEAN CONDITION, WASHING OF EQUIPMENT IS INCIDENTAL TO IT'S PLACEMENT AND MAINTENANCE.

SPECIAL PROJECT TRAFFIC CONTROL NOTES

1. CONTRACTOR SHALL PERFORM AS MUCH WORK AS POSSIBLE PRIOR TO AFFECTING TRAFFIC ON EITHER UNSER BLVD. OR SAPPHIRE STREET.
2. LANE CLOSURES IN UNSER BLVD. ARE SUBJECT TO ARTERIAL/COLLECTOR ROAD USAGE FEES OF \$0.01 PER SQUARE FOOT OF BARRICADED AREA PER DAY.
3. CONTRACTOR SHALL MAINTAIN AT LEAST ONE LANE IN EACH DIRECTION ON BOTH UNSER BLVD. AND SAPPHIRE STREET AT ALL TIMES, INCLUDING LEFT TURN LANES IN ALL FOUR DIRECTIONS.

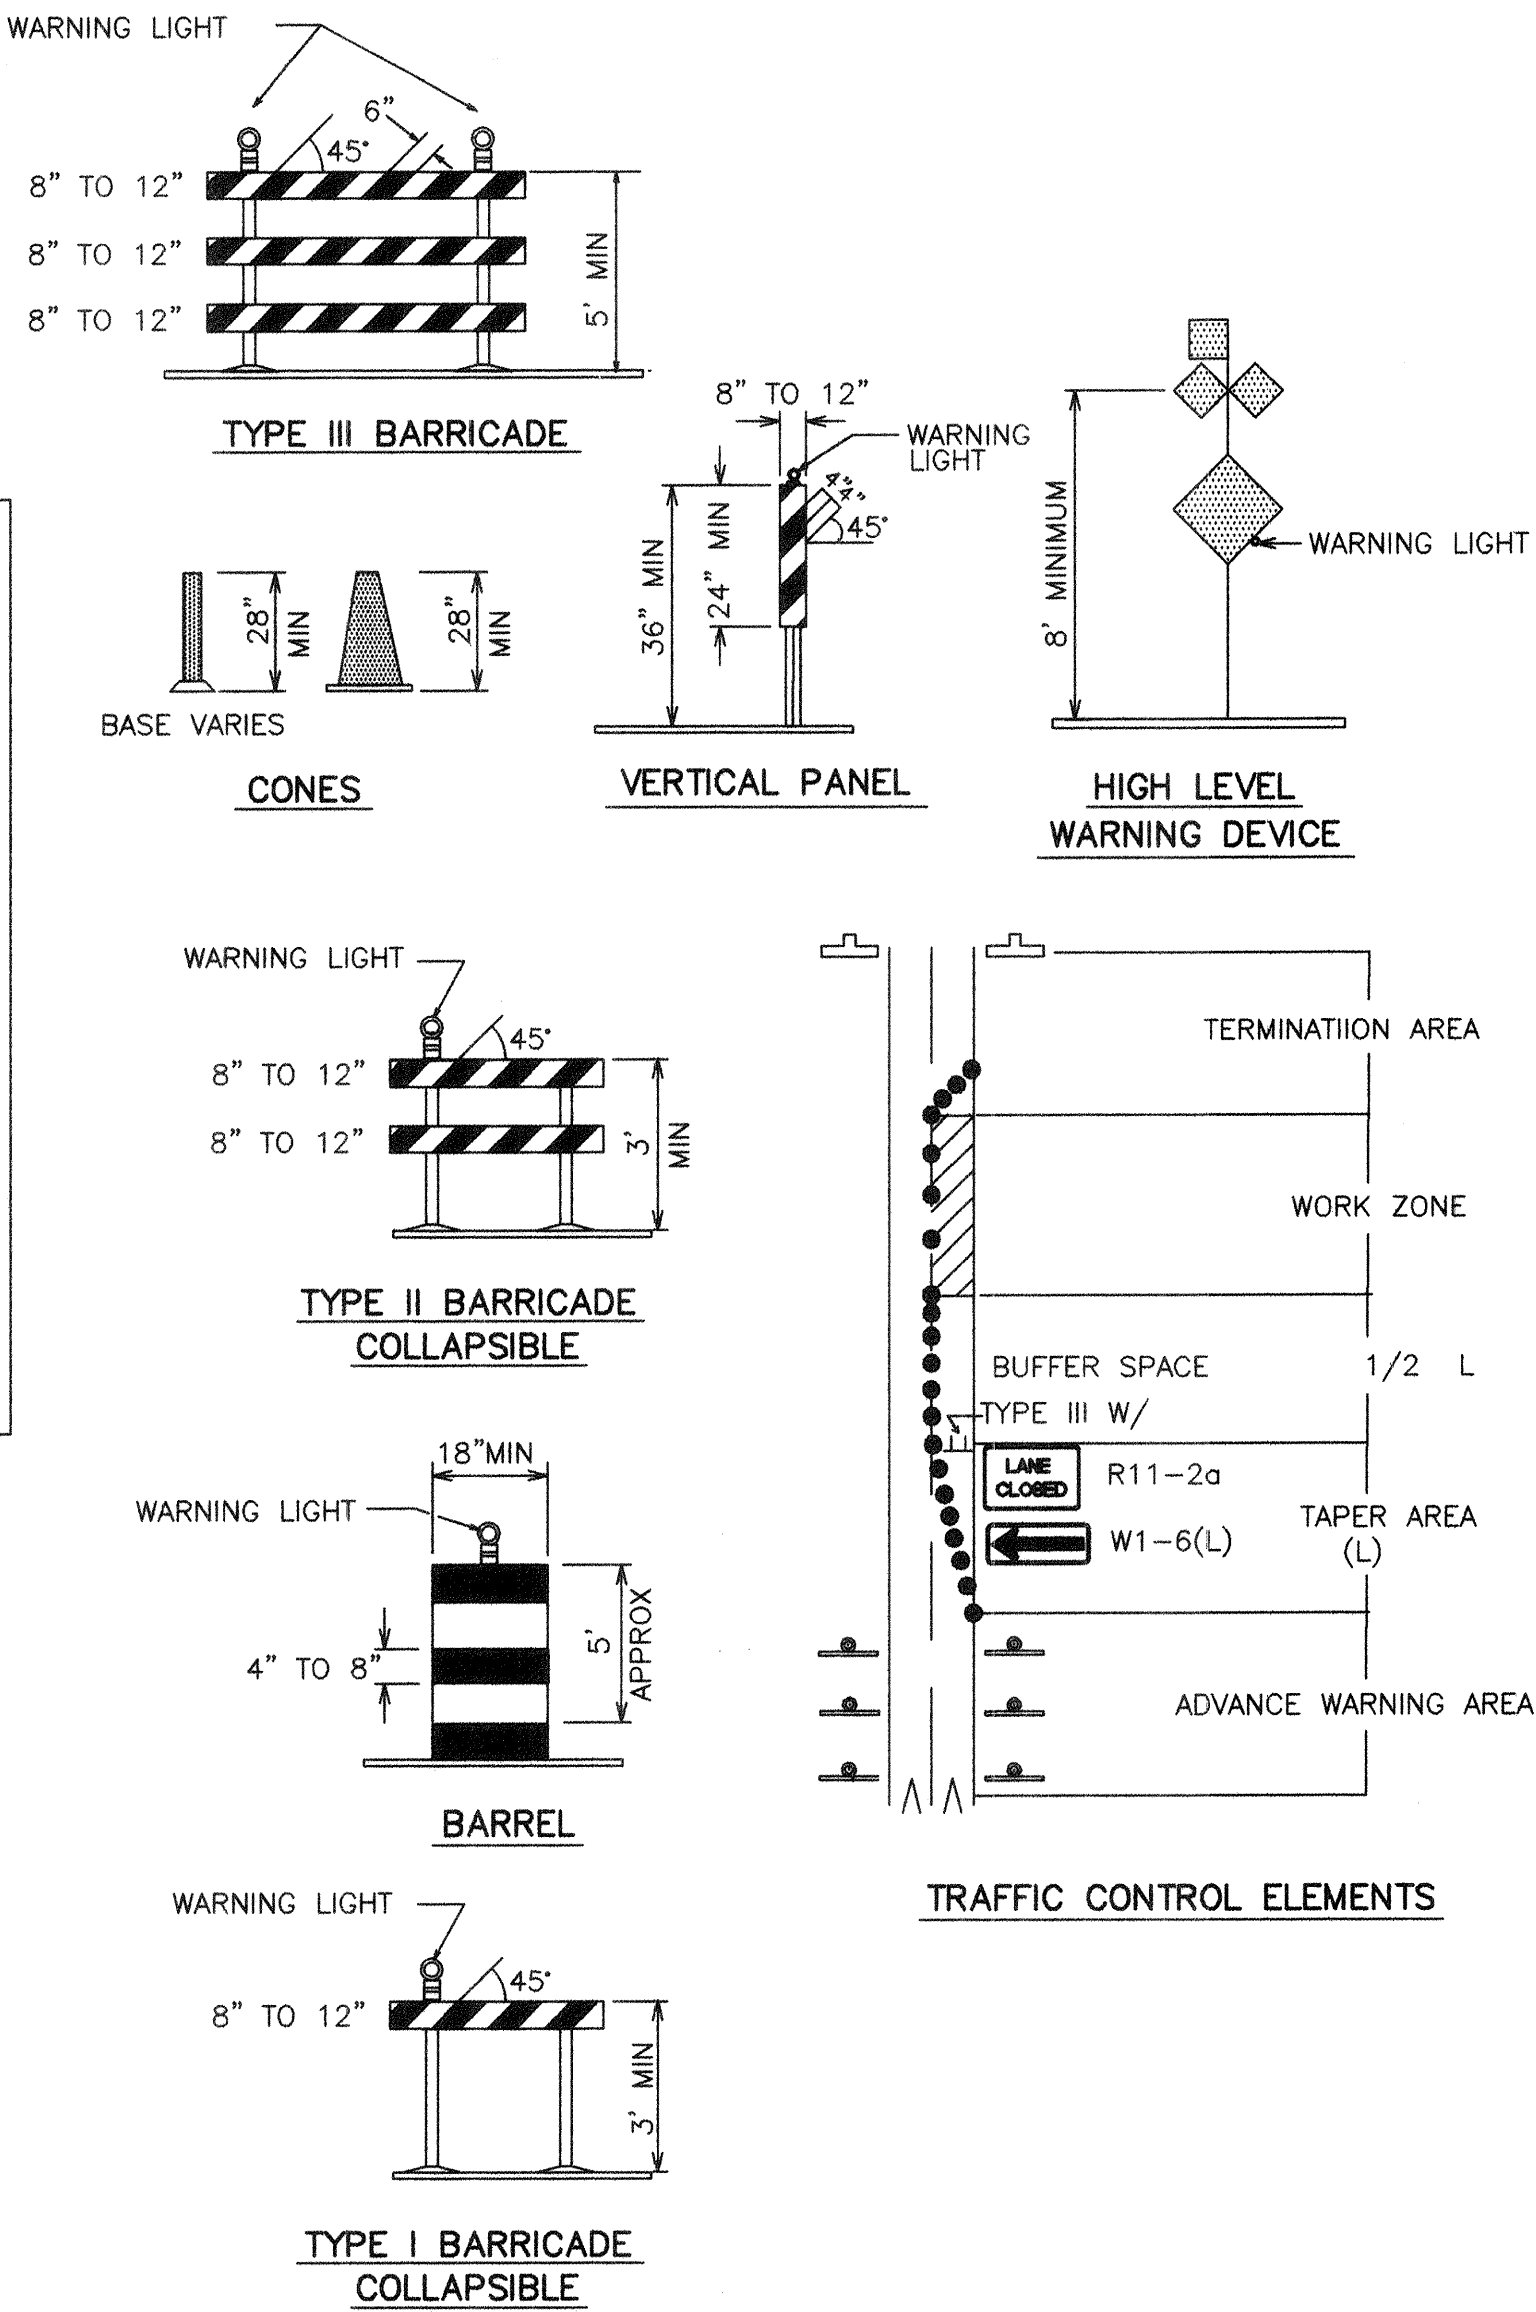

SIGN FACE DETAILS

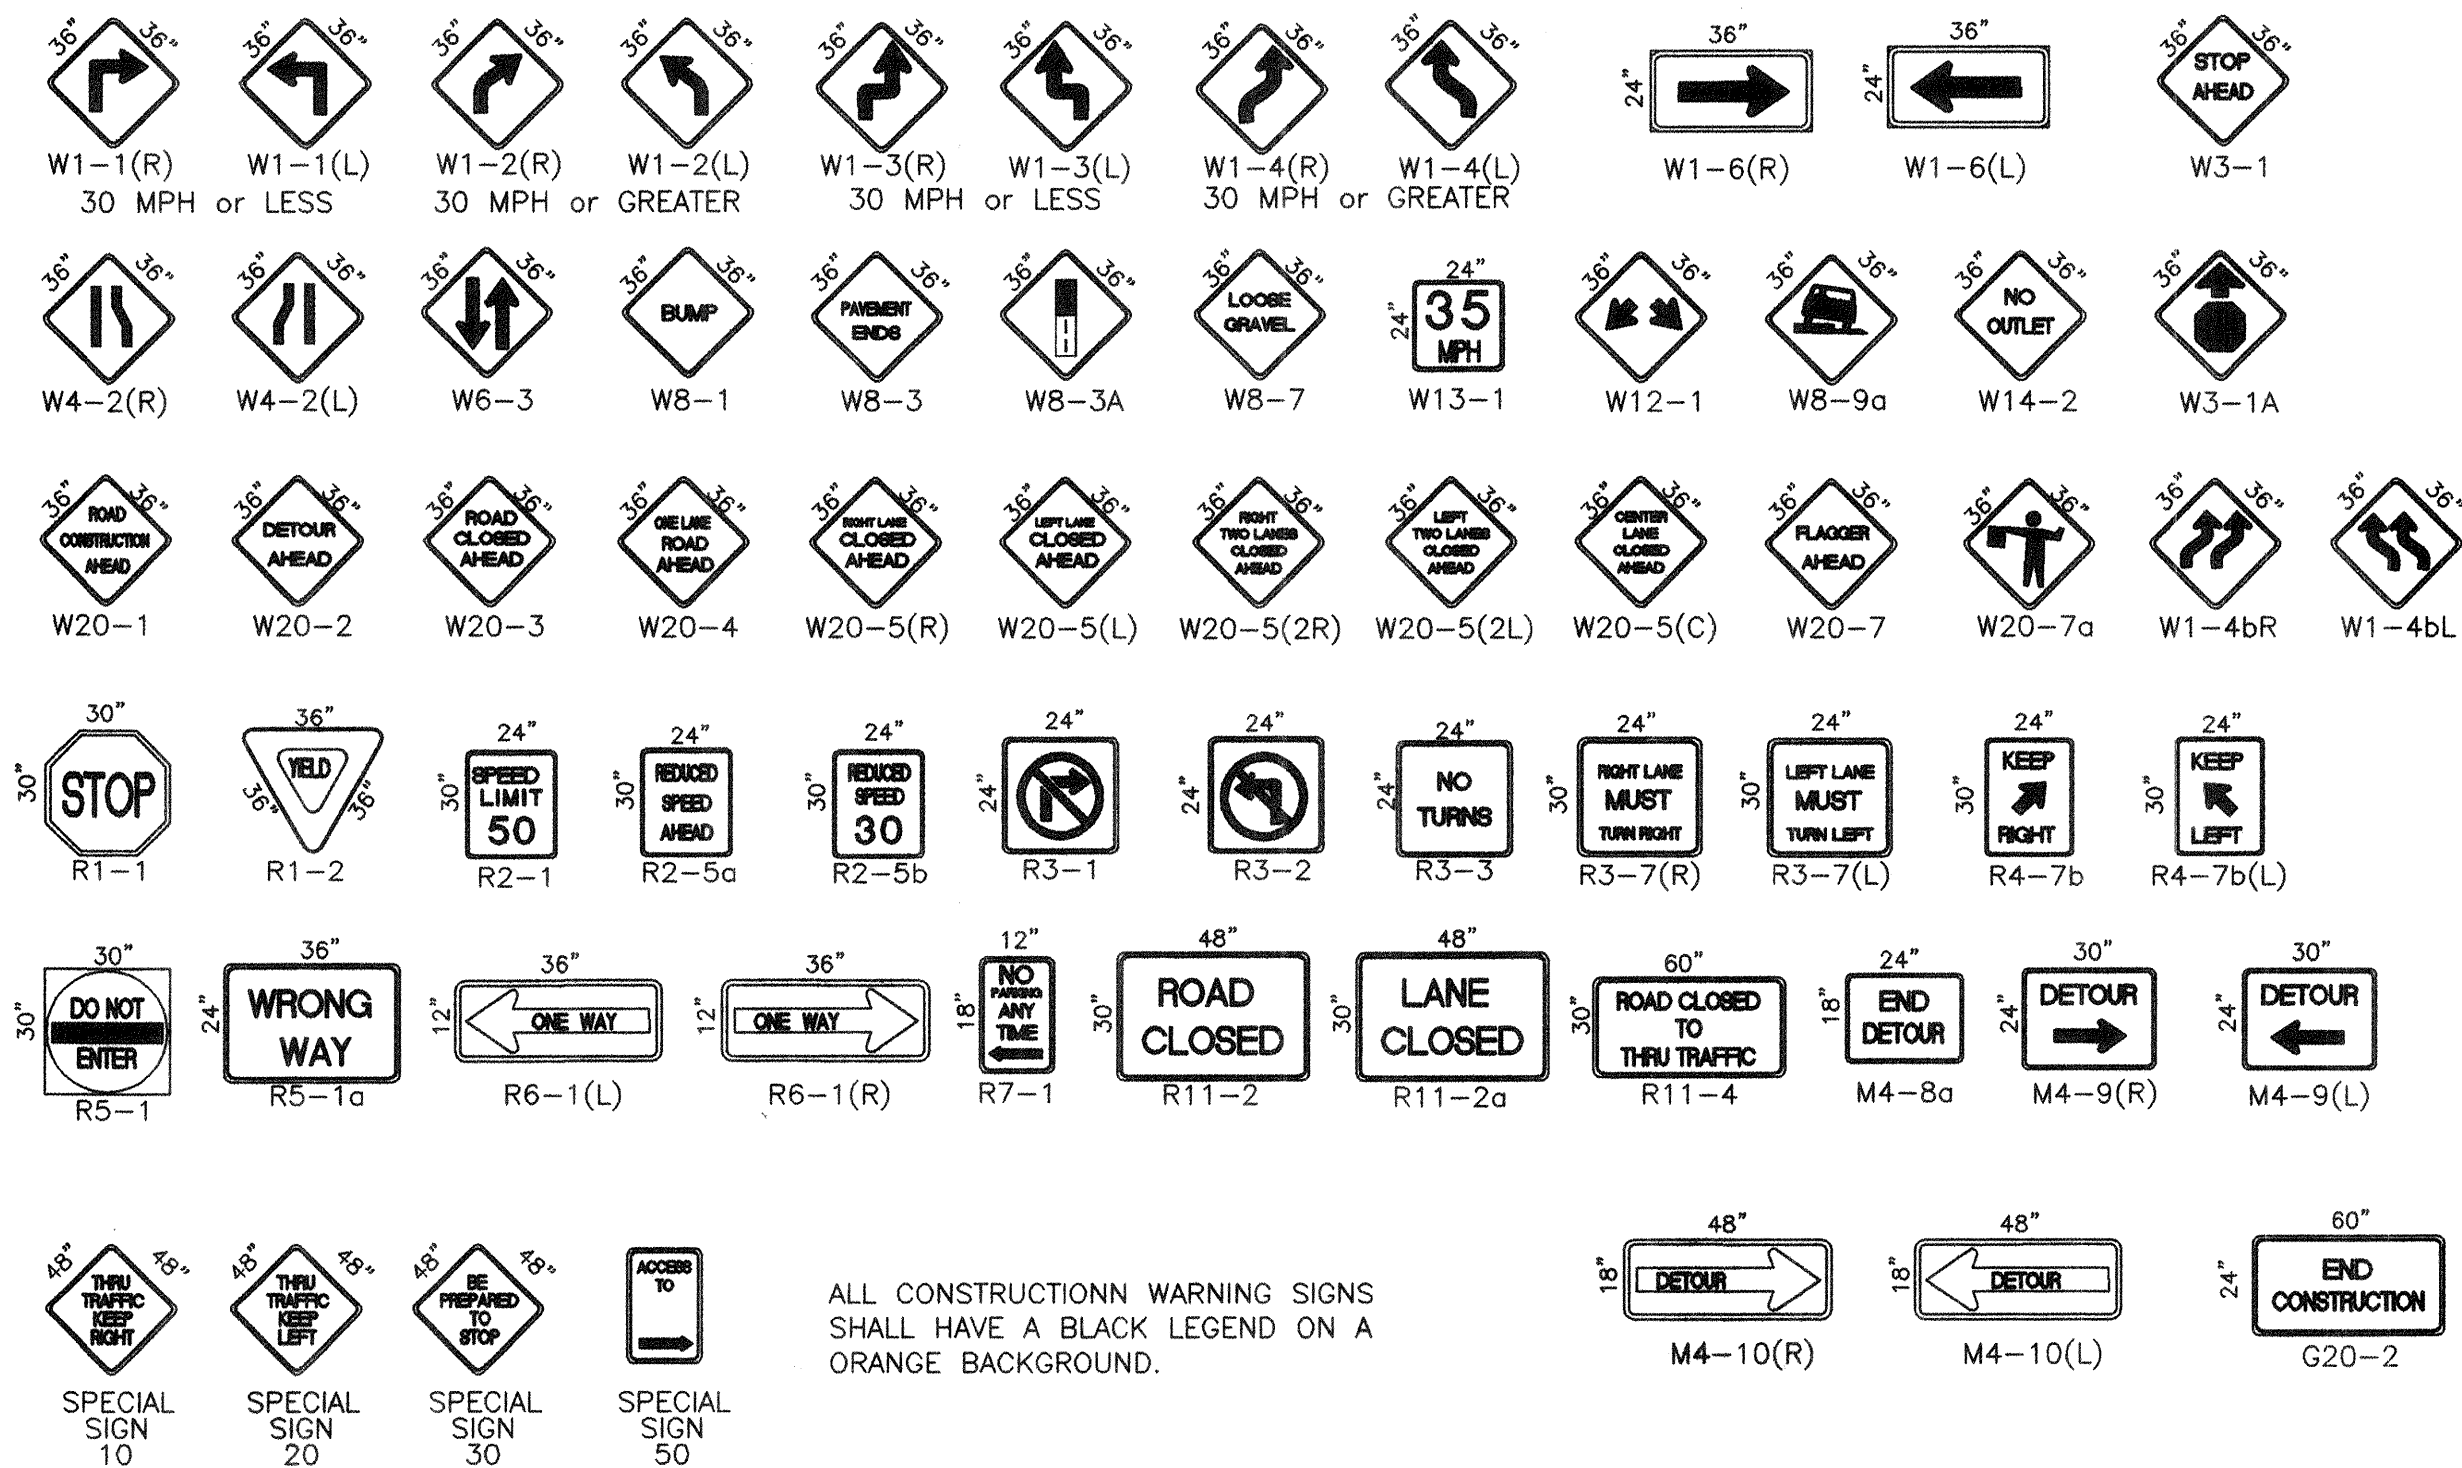

ALL CONSTRUCTION WARNING SIGNS SHALL HAVE A BLACK LEGEND ON A ORANGE BACKGROUND.

LEGEND

- WORK AREA
BARRICADE - TYPE I, TYPE II, OR BARREL
BARRICADE - TYPE III
VERTICAL PANEL
WARNING SIGN
DISTANCE BETWEEN SIGNS - A DISTANCE MEASURED IN FEET EQUAL TO A VALUE OF TEN TIMES THE SPEED LIMIT OF THE STREET
FLAGMAN POSITION
SPACING BETWEEN BARRICADES - A DISTANCE MEASURED IN FEET EQUAL TO THE SPEED LIMIT OF THE STREET
TAPER LENGTH - SEE CHART BELOW

THE TANGENT LENGTH IS EQUAL TO THE TAPER LENGTH FOR A GIVEN STREET.

TAPER REQUIREMENT

SPEED LIMIT (MPH)	TAPER LENGTH(L) (FEET)				MINIMUM NUMBER OF DEVICES FOR TAPER	MAXIMUM DEVICE SPACING IN FEET	
	10' LANE	11' LANE	12' LANE			ALONG TAPER	AFTER TAPER
20	70	75	80		5	20	20
25	105	115	125		6	25	25
30	150	165	180		7	30	30
35	205	225	245		8	35	35
40	270	295	320		9	40	40
45	450	495	540		13	45	45
50	500	550	600		13	50	50
55	550	605	660		13	55	55

RECOMMENDED SIGN SPACING(D) FOR ADVANCE WARNING SIGN SERIES

SPEED MILES PER HOUR	MINIMUM DISTANCE BETWEEN SIGNS	FROM LAST SIGN TO TAPER
0-20	10 X SPEED LIMIT	10 X SPEED LIMIT
25-30	10 X SPEED LIMIT	10 X SPEED LIMIT
30-35	10 X SPEED LIMIT	10 X SPEED LIMIT
40-45	10 X SPEED LIMIT	10 X SPEED LIMIT
50-60	10 X SPEED LIMIT	10 X SPEED LIMIT


TAPER CRITERIA

TYPE OF TAPER	TAPER LENGTH
UPSTREAM TAPER:	
MERGING TAPER	L MINIMUM
SHIFTING TAPER	1/2 L MINIMUM
SHOULDER TAPER	1/2 L MINIMUM
TWO-WAY TRAFFIC TAPER	100 FEET MAXIMUM
DOWNSTREAM TAPERS	100 FEET PER LANE

TAPER LENGTH COMPUTATION

SPEED LIMIT	
40 MPH OR LESS	$L = \frac{WS^2}{60}$
40 MPH OR GREATER	$L = W \times S$

L = TAPER LENGTH
W = WIDTH OF OFFSET IN FEET
S = POSTED SPEED OR OFF-PEAK 85-PERCENTILE SPEED IN MPH

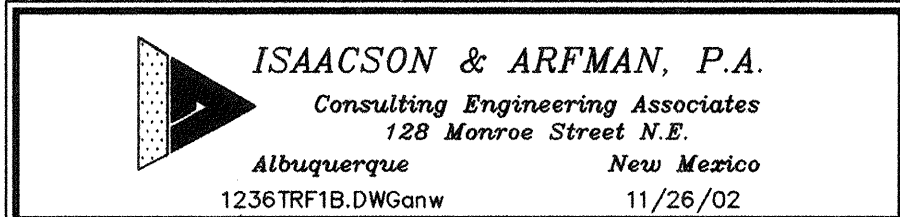


CITY OF ALBUQUERQUE
PUBLIC WORKS DEPARTMENT
ENGINEERING GROUP


TITLE: WALGREENS AT UNSER BLVD & SAPPHIRE ST
TRAFFIC CONTROL
SIGNING & CONSTRUCTION TRAFFIC CONTROL STANDARDS

Design Review Committee	City Engineer Approval	Mo./Day/Yr.	Mo./Day/Yr.
COA	STD		
City Project No.	Zone Map No.	Sheet	Of
6953.81	M-10	14	15


SCANNED BY
MESA REPRO

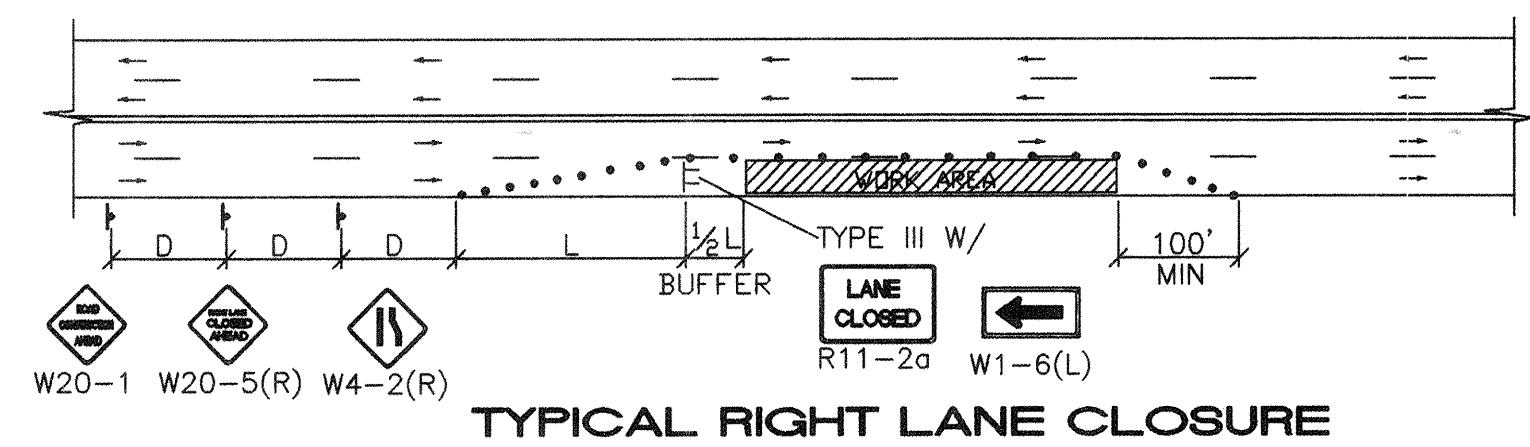


TYPICAL RIGHT LANE CLOSURE

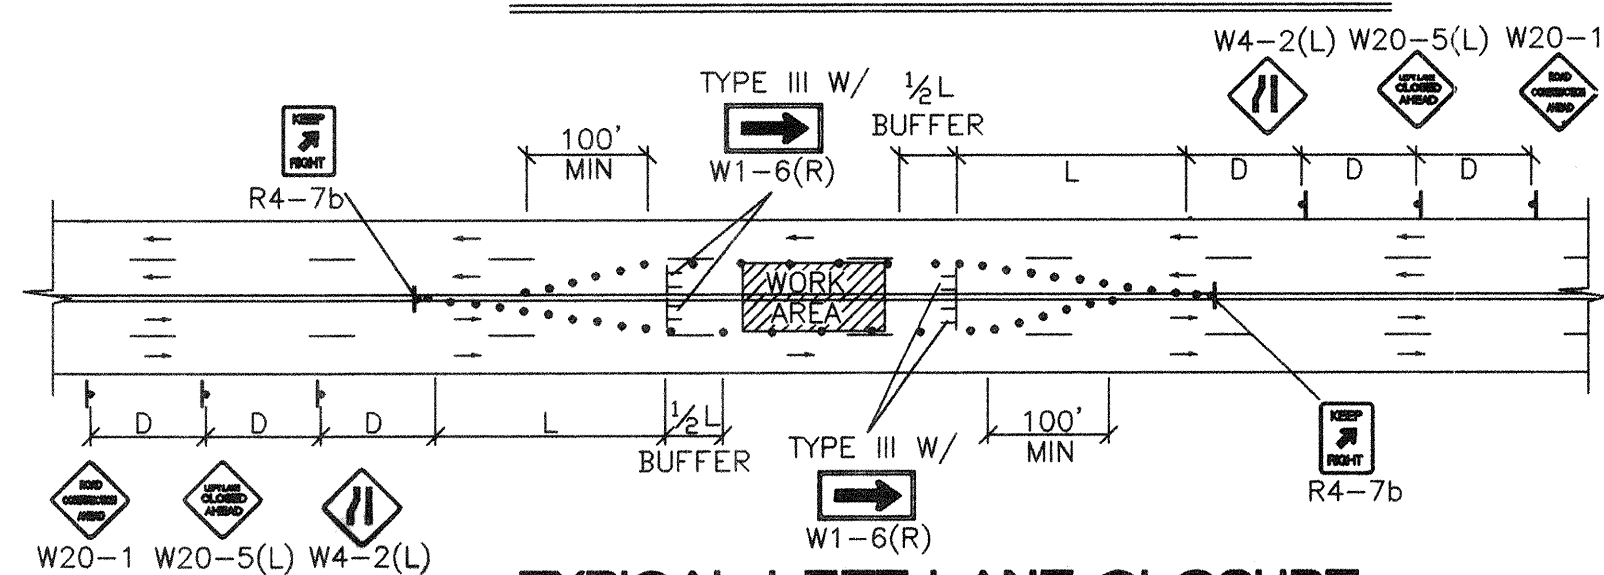


TYPICAL LEFT LANE CLOSURE

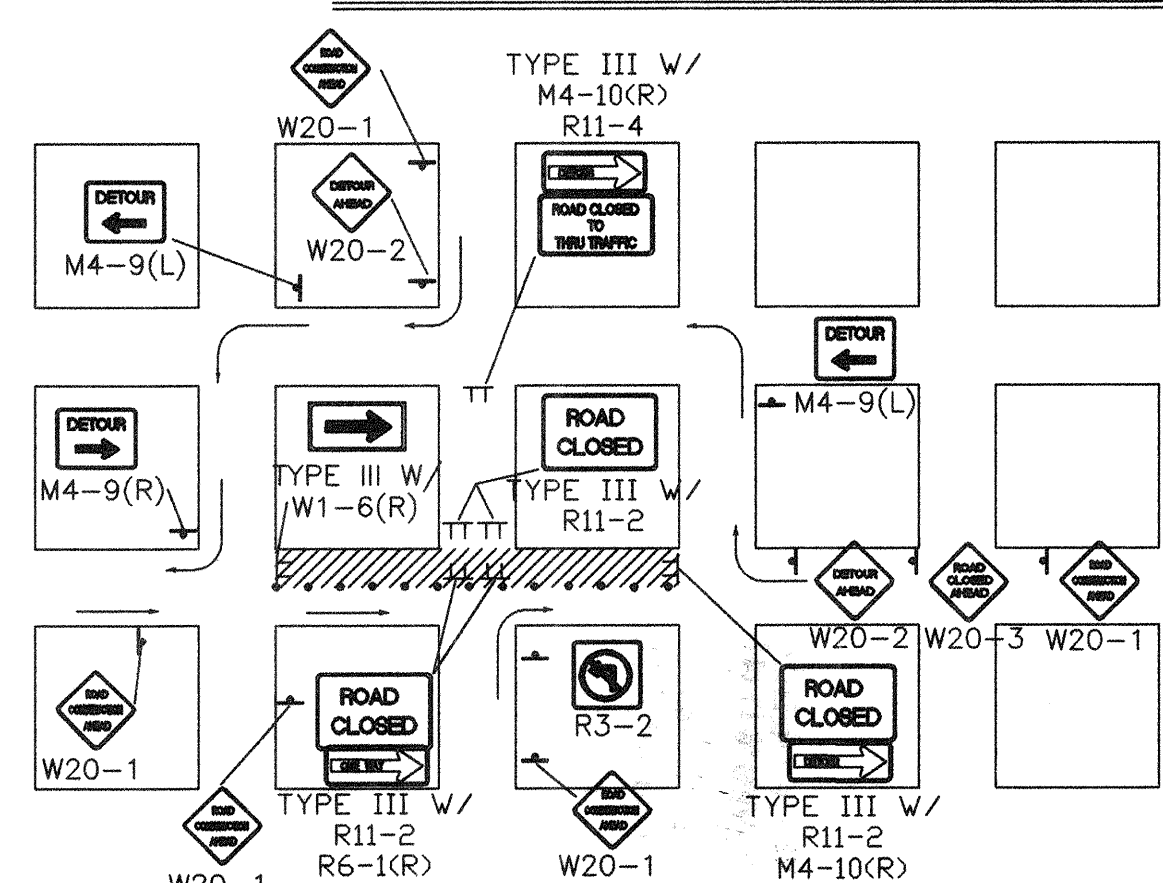

TYPICAL ONE DIRECTION DETOUR

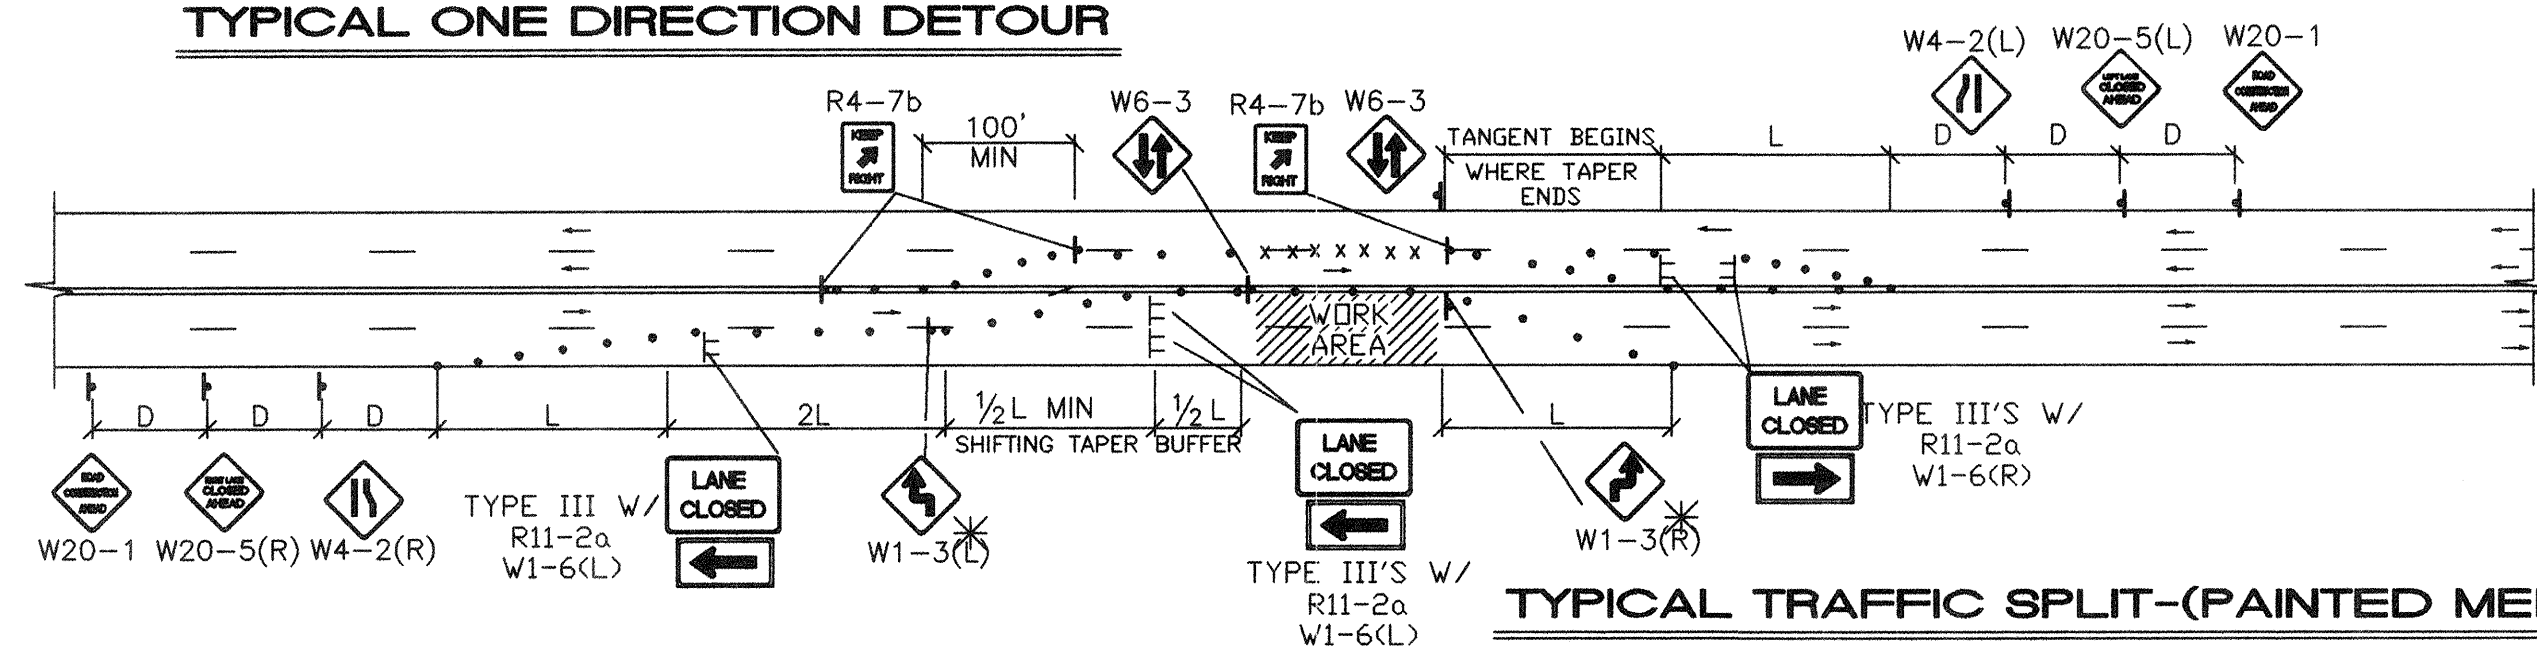


TYPICAL TRAFFIC SPLIT - (PAINTED MEDIAN)

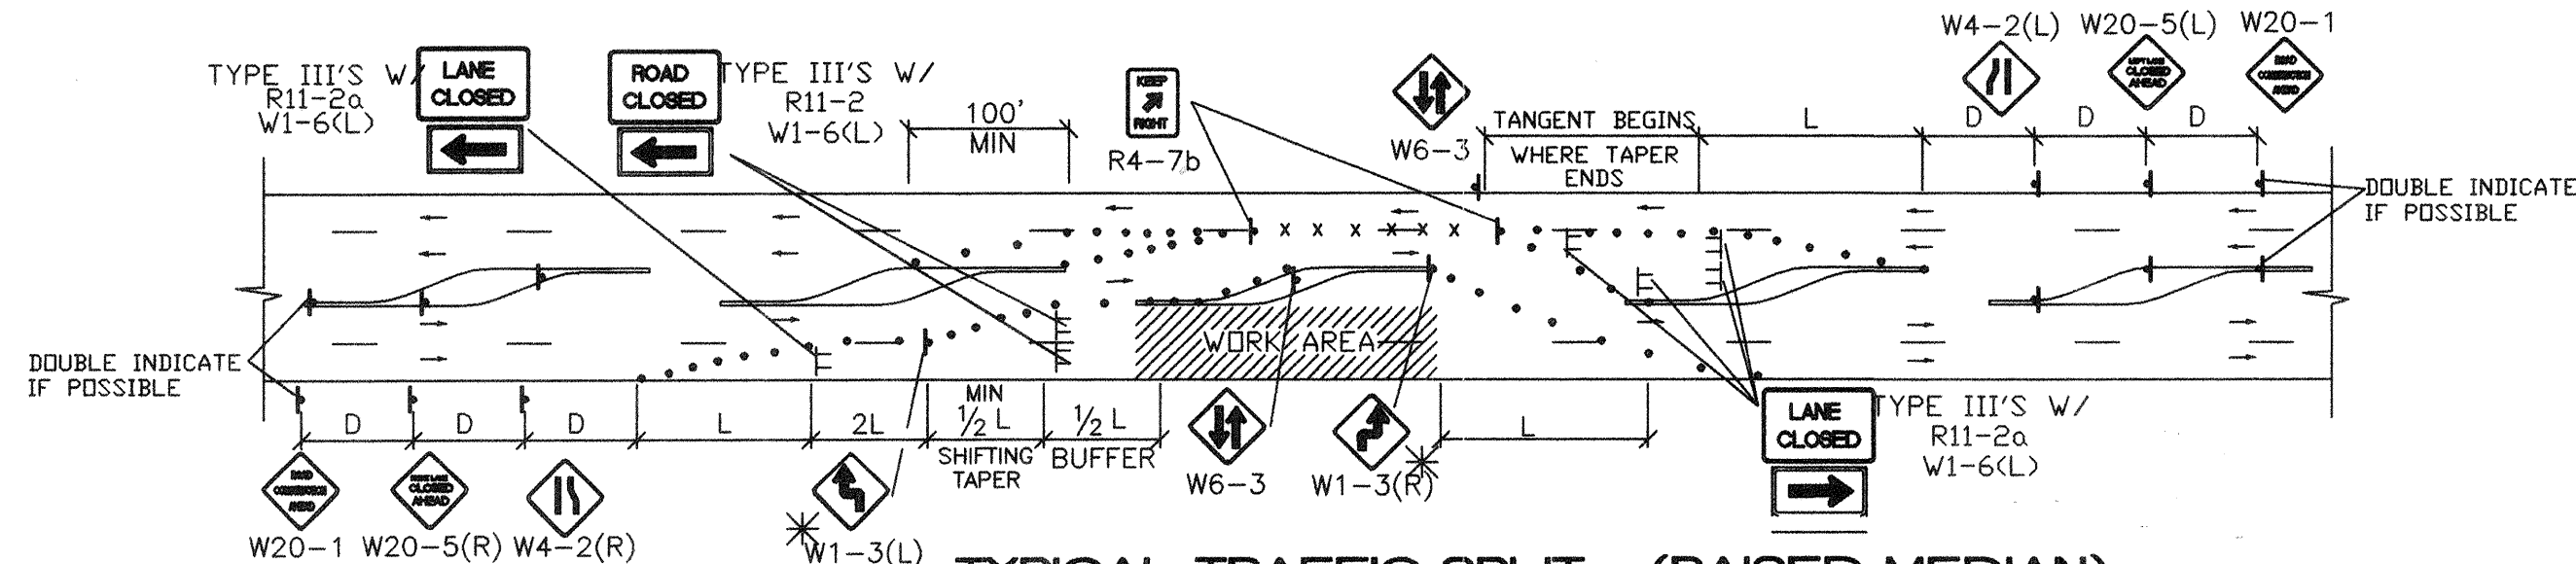

TYPICAL TRAFFIC SPLIT - (RAISED MEDIAN)

TRAFFIC SPLIT NOTES:


1. THE OFFSET DISTANCE MUST BE CALCULATED IN ALL SHIFTING TAPERS. THE OFFSET DISTANCES SHALL INCLUDE LANE WIDTHS PLUS MEDIAN WIDTHS.
2. 1/2 L IS THE MINIMUM DISTANCE FOR SHIFTING TAPERS.
3. REVERSE CURVES MAY BE IMPLEMENTED. ALL CURVE DATA SHALL BE CALCULATED.
4. MEDIAN REMOVAL SHALL BE REQUIRED IF 1/2 L OR REVERSE CURVE IS NOT SUFFICIENT. MEDIAN REMOVAL SHALL TAKE PLACE BEFORE SPLITS.
5. REDUCED SPEED MAY BE CONSIDERED.
6. * USE W1-3 FOR 30 MPH OR LESS, W1-4 FOR SPEED 35 MPH OR GREATER.

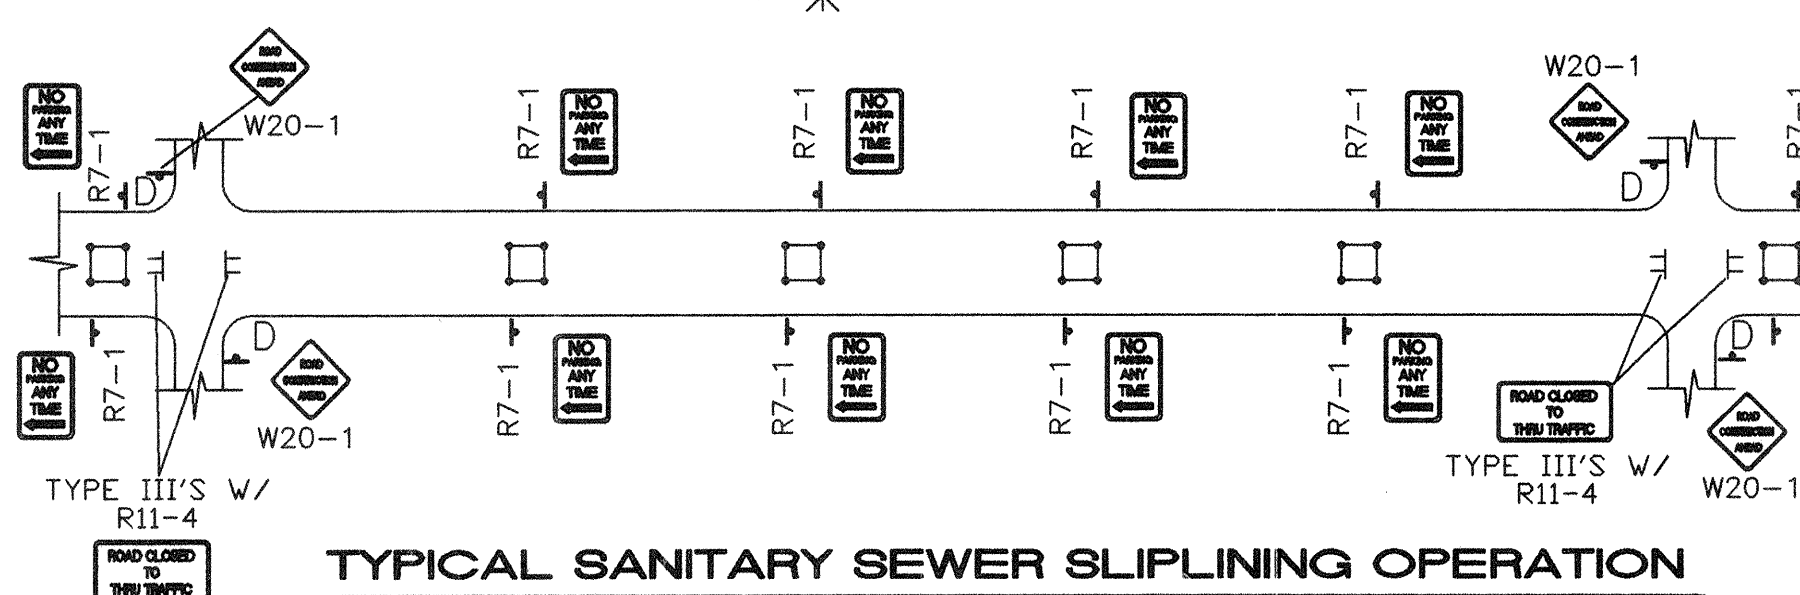

TYPICAL SANITARY SEWER SLIPLINING OPERATION


- ALL PITS TO HAVE TYPE-A FLASHING LIGHTS
- ALL PITS TO HAVE FLAGLINE

NOTE:
MAY REQUIRE LEFT LANE
CLOSURE DEPENDING ON
FIELD CONDITIONS.

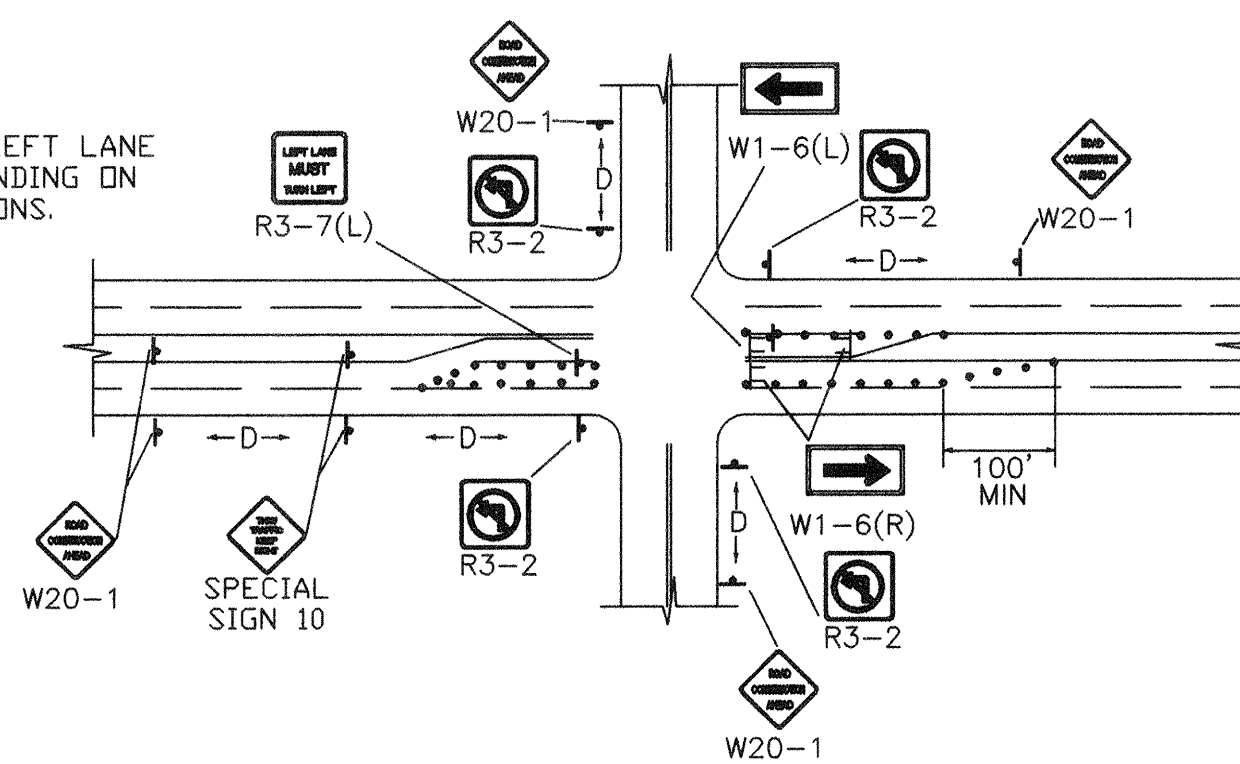


TYPICAL LANE CLOSURE AT INTERSECTION

NOTE: DEPENDING ON WORK ZONE LOCATION.

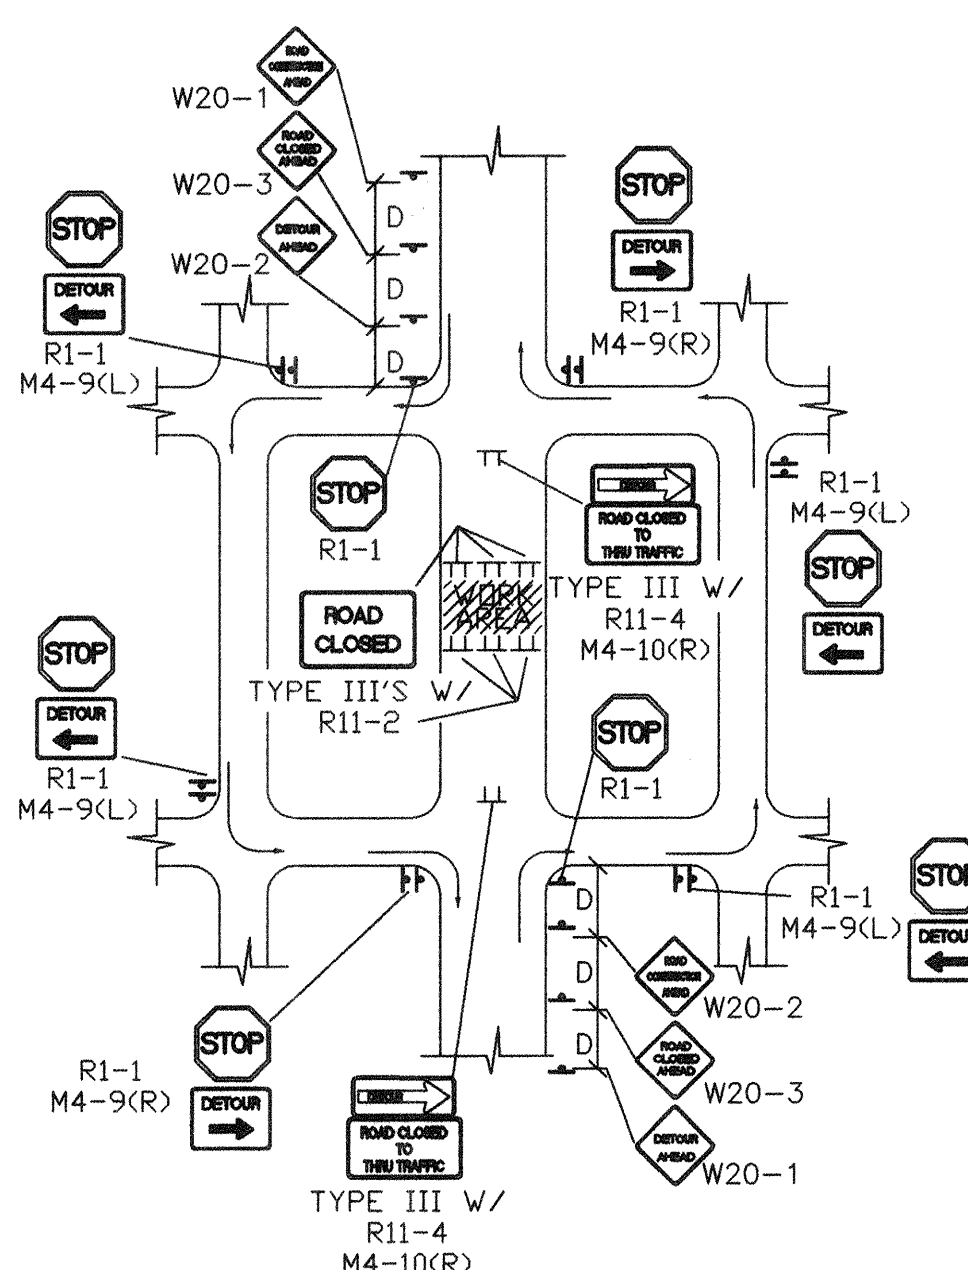


TYPICAL MID-BLOCK CLOSURE

NOTE: (R1-1) BASED ON FIELD CONDITIONS.

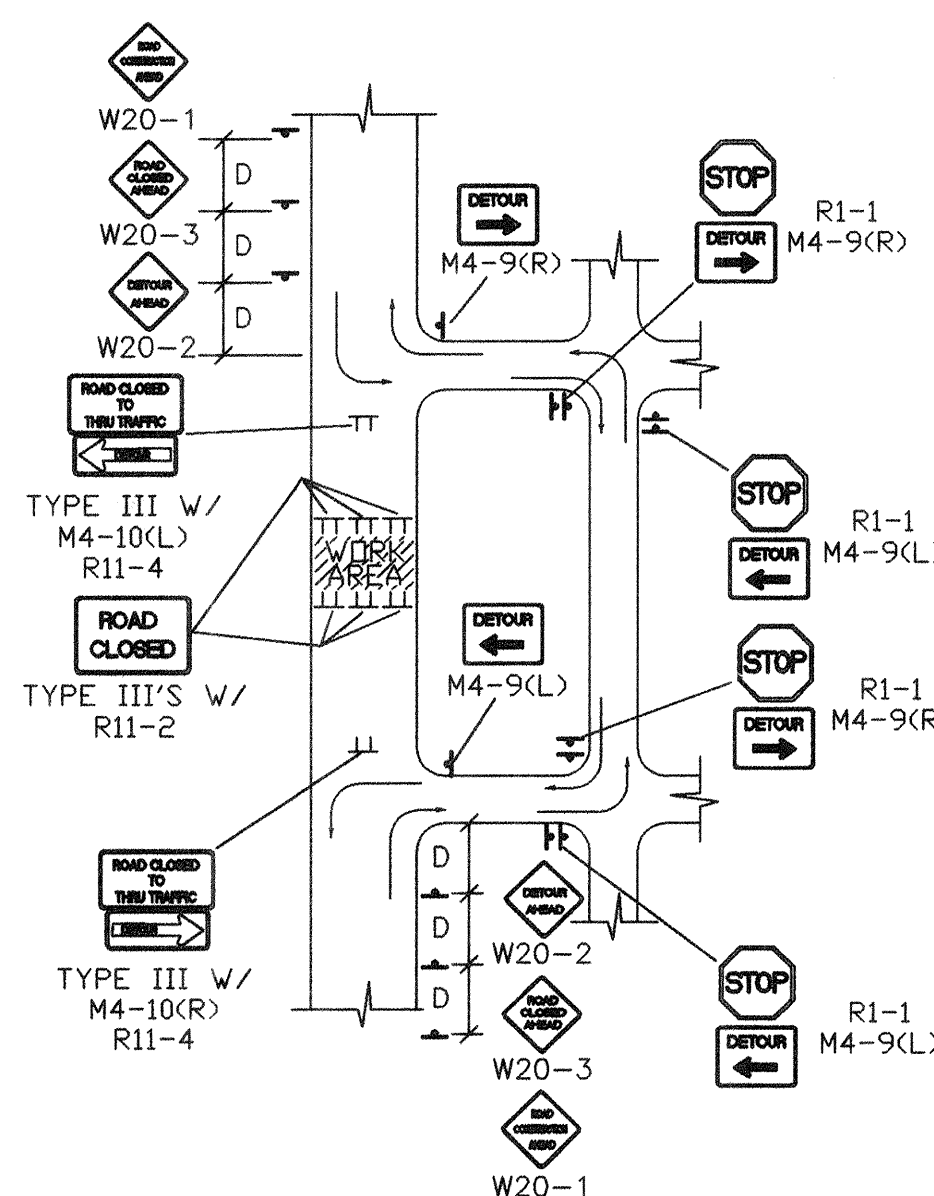


TYPICAL STREET CLOSURE


NOTE: (R1-1) BASED ON FIELD CONDITIONS.

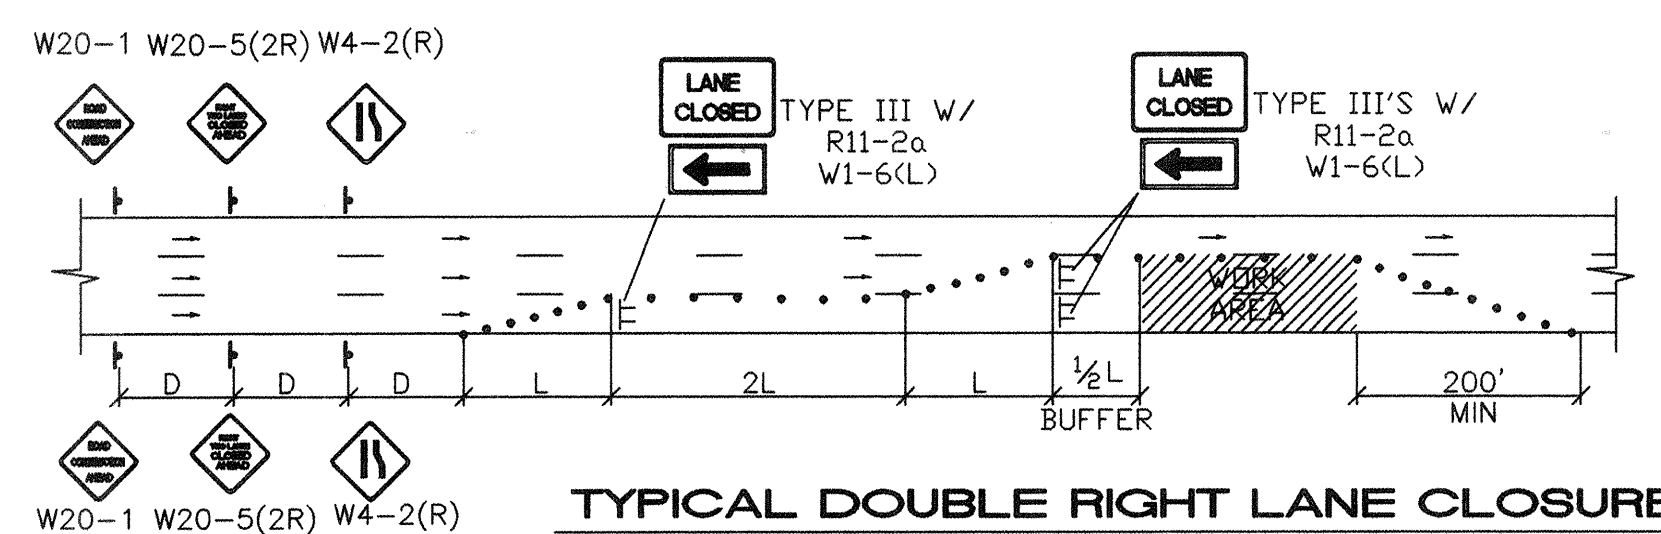


TYPICAL DOUBLE RIGHT LANE CLOSURE

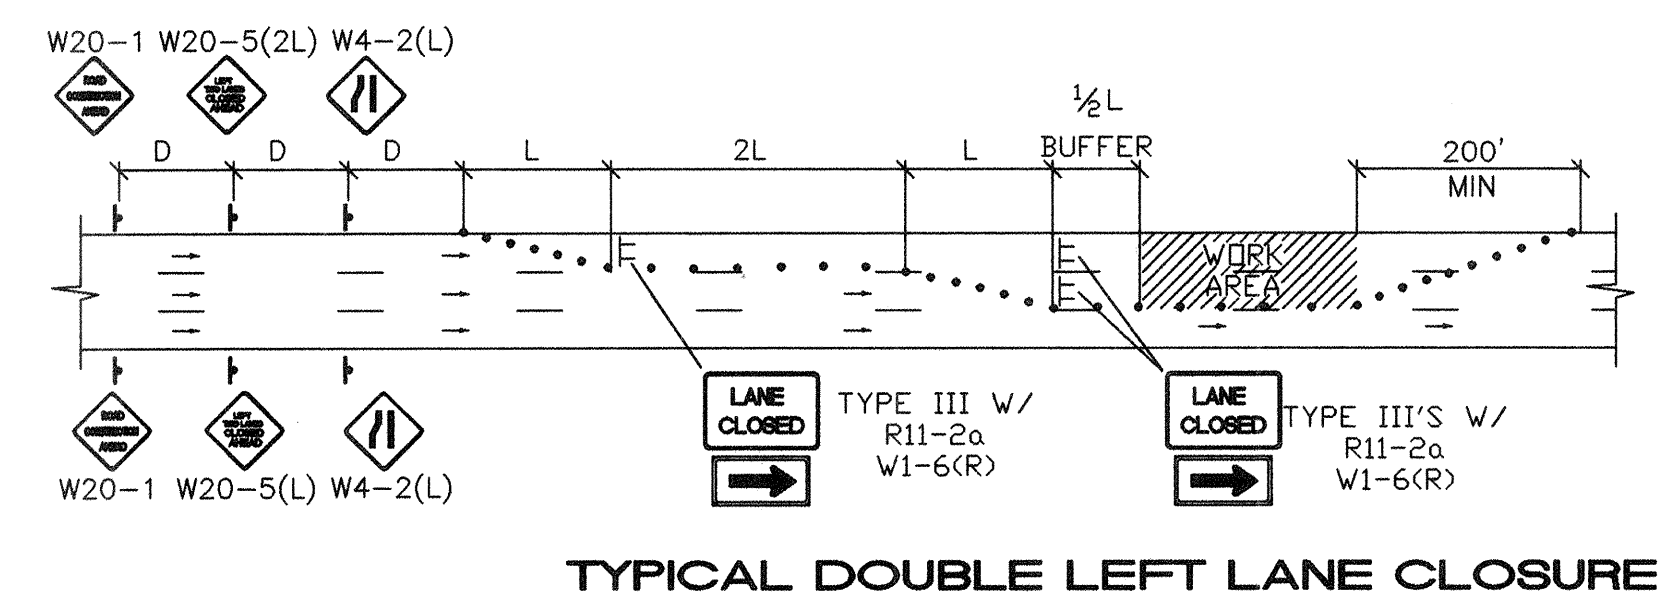

TYPICAL DOUBLE LEFT LANE CLOSURE

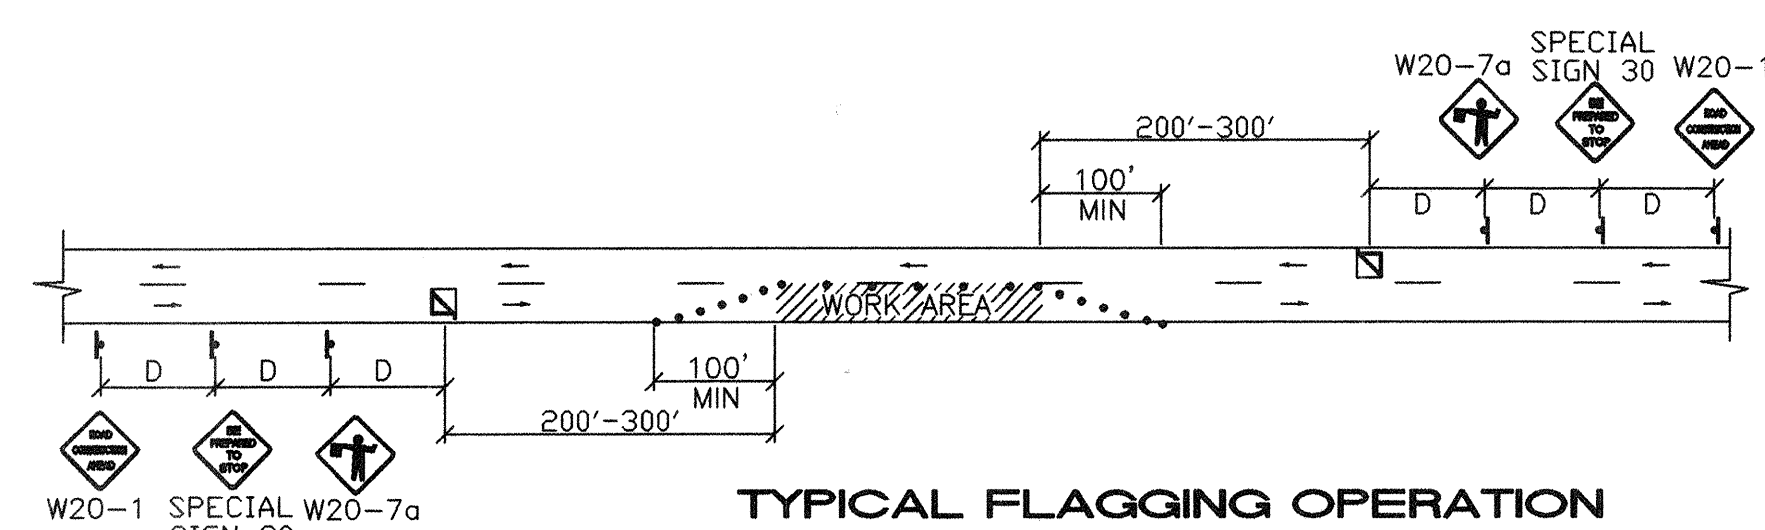


TYPICAL FLAGGING OPERATION

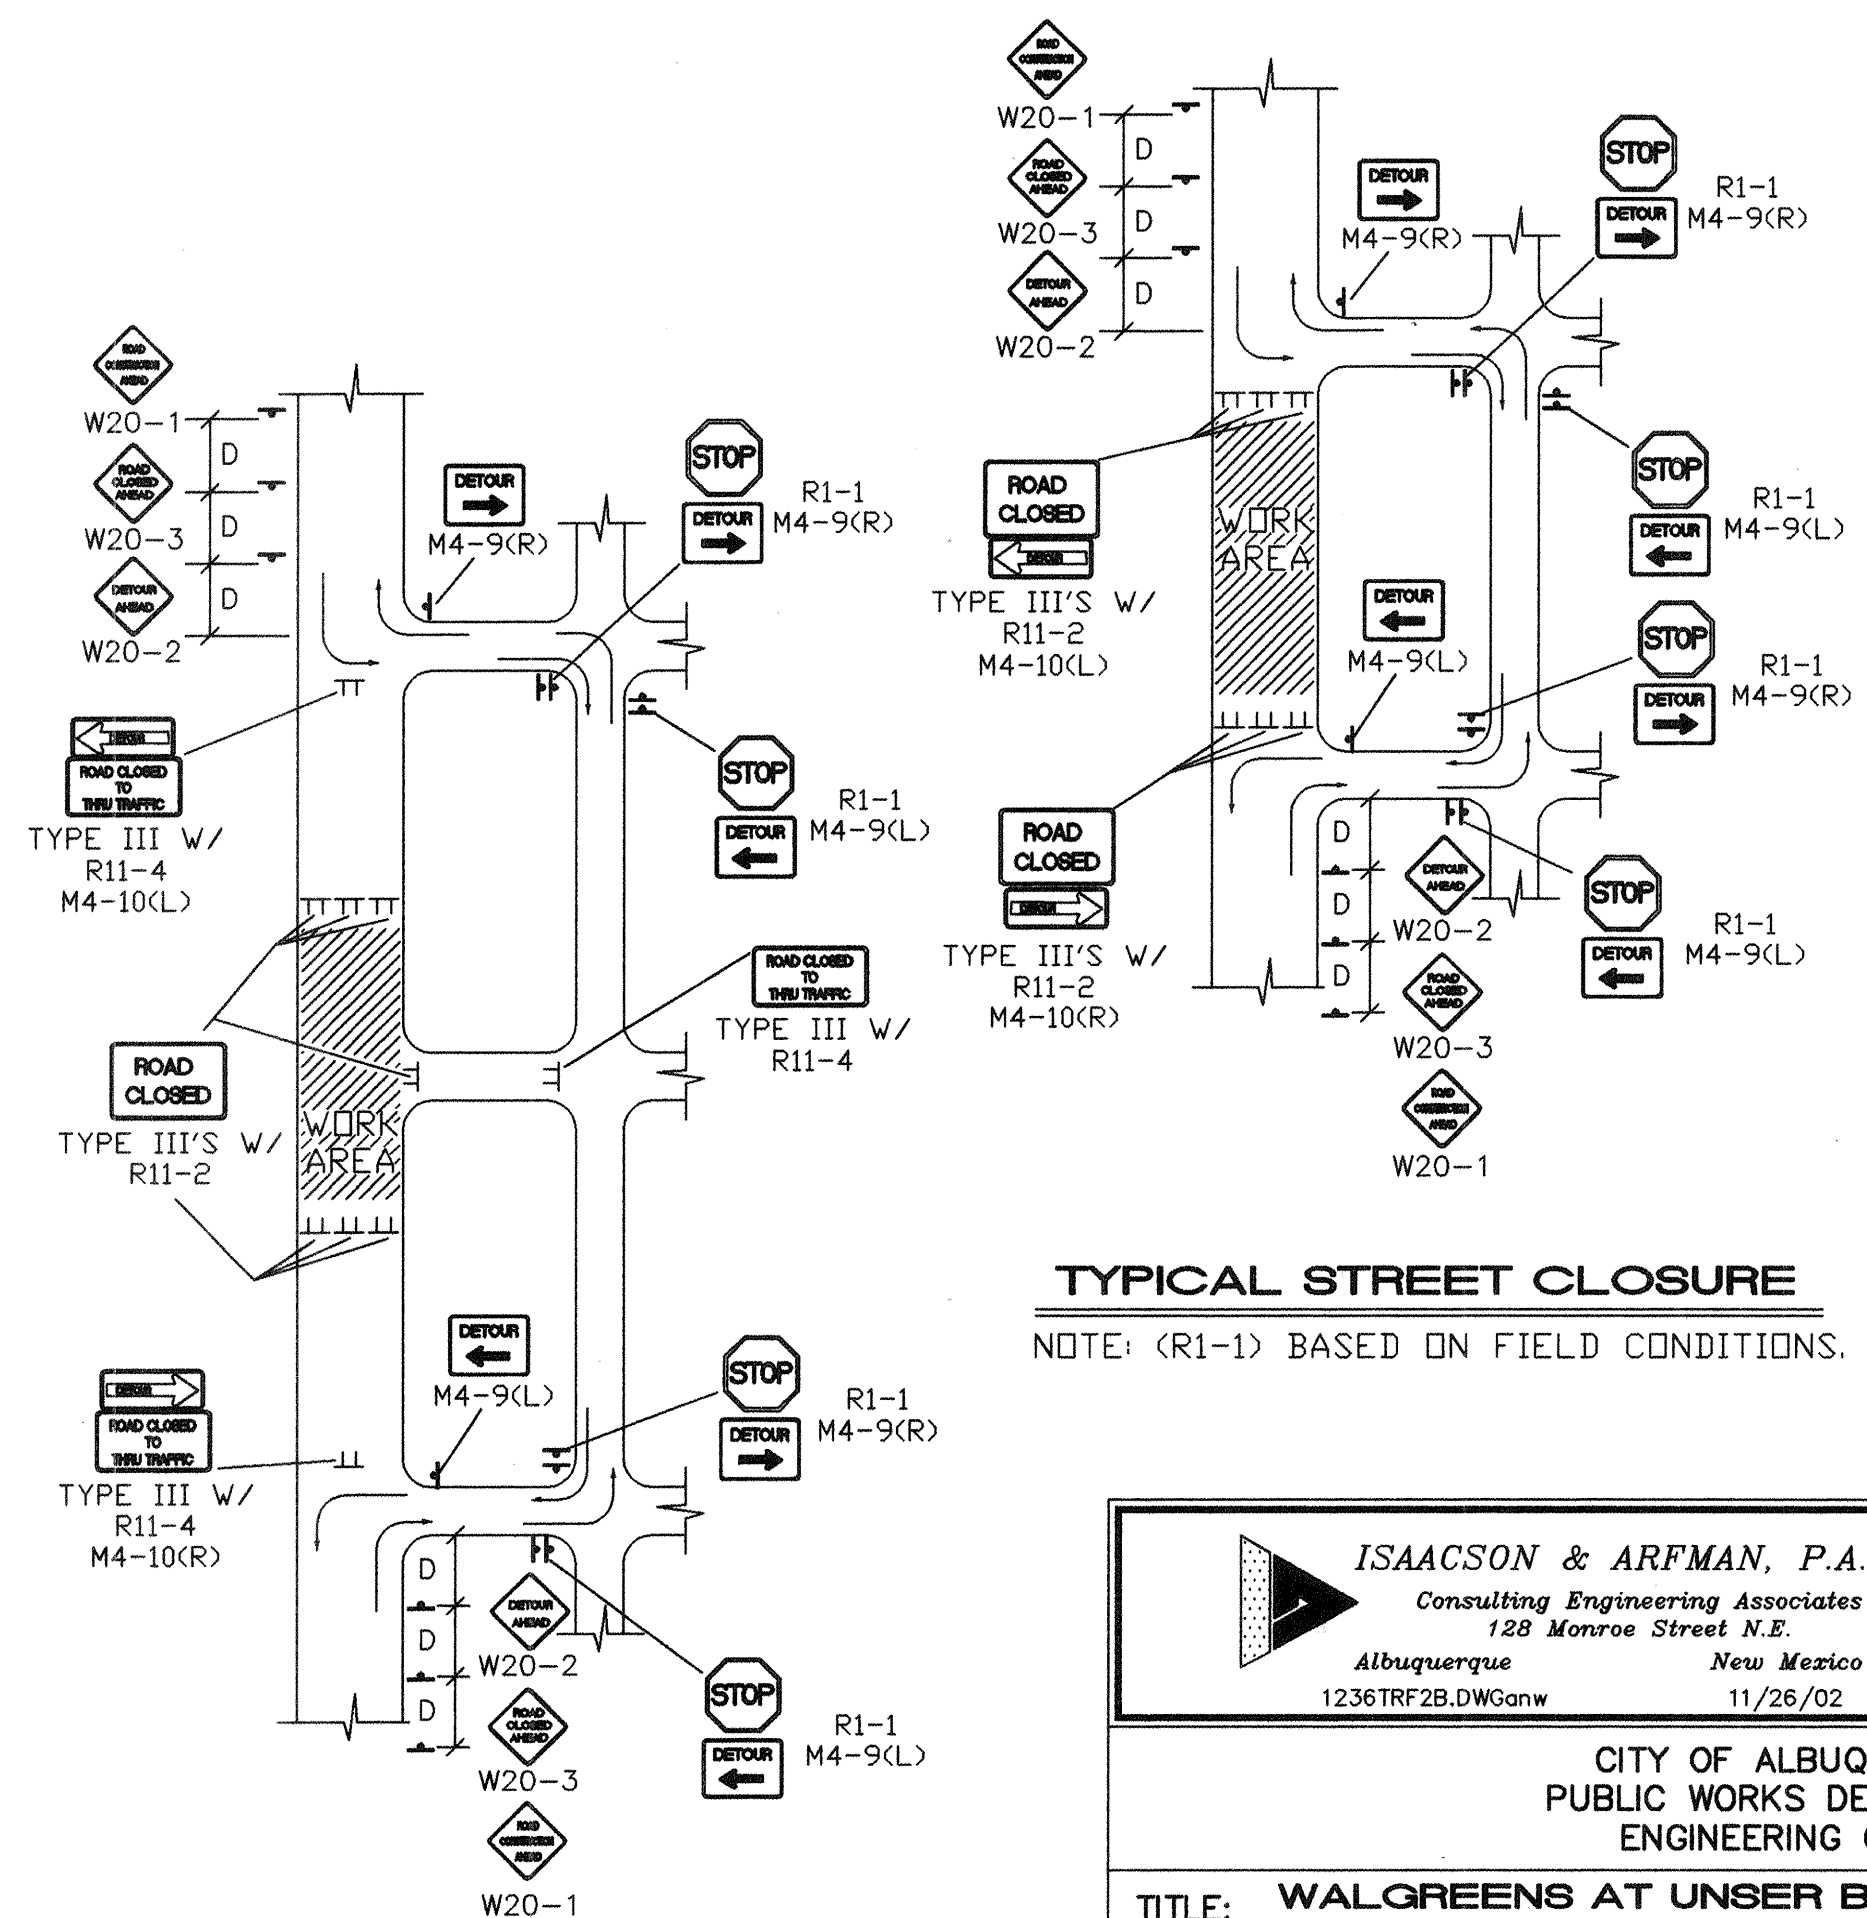

TYPICAL STREET CLOSURE

NOTE: (R1-1) BASED ON FIELD CONDITIONS.

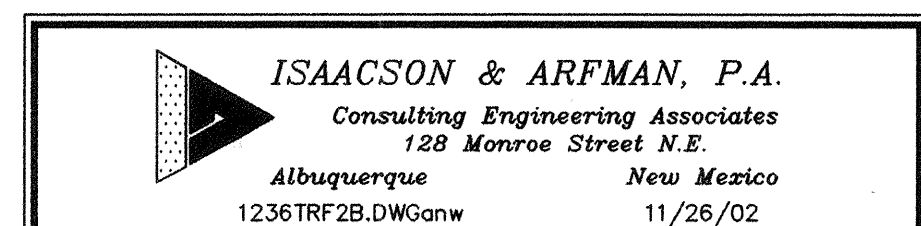

CITY OF ALBUQUERQUE
PUBLIC WORKS DEPARTMENT
ENGINEERING GROUP

TITLE: WALGREENS AT UNSER BLVD & SAPPHIRE ST
TRAFFIC CONTROL & SIGNING EXAMPLES

Design Review Committee	City Engineer Approval	Mo./Day/Yr.	Mo./Day/Yr.
COA	STD		
City Project No.	Zone Map No.	Sheet	Of
6953.81	M-10	15	15

AS-BUILT INFORMATION				
CONTRACTOR				
WORK STAMPED BY	DATE	DATE	DATE	DATE
INSPECTOR'S ACCEPTANCE BY	DATE	DATE	DATE	DATE
FIELD VERIFICATION BY	DATE	DATE	DATE	DATE
DRAWINGS CORRECTED BY	DATE	DATE	DATE	DATE
MICRO-FILM INFORMATION				
RECORDED BY	DATE	DATE	DATE	DATE
NO.				

BENCH MARKS

FIELD NOTES

ENGINEER'S SEAL

CITY
STANDARD
DRAWING