

2 3 4 5 6 7 8 9 10 11 12 13 14 15
20 10 9 8 7 6 5 4 3 2 1

PLANNING
SCANNED BY

SAINTS PETER AND PAUL CHURCH

INFRASTRUCTURE IMPROVEMENTS

INDEX

- 1 TITLE PAGE
- 2 SITE PLAN
- 3 CURB AND PAVEMENT, OURAY ROAD NW
AND MIAMI ROAD NW
- 4 STORM DRAIN INLET, MIAMI ROAD

CERTIFICATE OF SUBSTANTIAL COMPLIANCE

I, Marvin R. Kortum, a Registered Professional Engineer in the State of New Mexico, and Project Engineer for the construction of Infrastructure for Saints Peter and Paul Church Project Number 6981.81, consisting of 4 sheets,


Including Storm Drainage, Water, Curb and Gutter, and Paving.

as constructed by Rodgers Plumbing and Heating Co. Inc. under contract to The Society of St. Pius X, 333 58th Street, NW, Albuquerque, New Mexico 87105

do hereby certify, to the best of my knowledge and belief, that the infrastructure installed as part of the project noted above has been inspected by me or by a qualified person under my direct supervision, and has been constructed in accordance with the plans and specifications approved by the City Engineer and that the original design intent of the approved plans has been met, except as noted by me on the as-built construction drawings. This Certification is based on site inspections by me.

The constructed facilities being certified are further defined on the attached Infrastructure List, DRB Project # 1000400. Items on the Infrastructure List included in the construction project and part of this certification are identified by my initials in the left margin. Items on the Infrastructure List not constructed or certified as part of the noted project are either lined out or have N/A in the inspector column.


Marvin R. Kortum *Nov 1, 2006*
Marvin R. Kortum Date
N. M. P. E. 6519

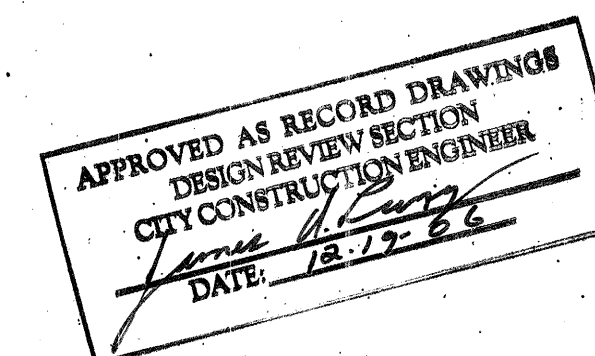

MARVIN R. KORTUM, P.E.
Civil Engineer
NM PE 6519

1605 Speakman Drive, S.E.
Albuquerque, New Mexico 87123
(505) 299-0774

DRB 1000400

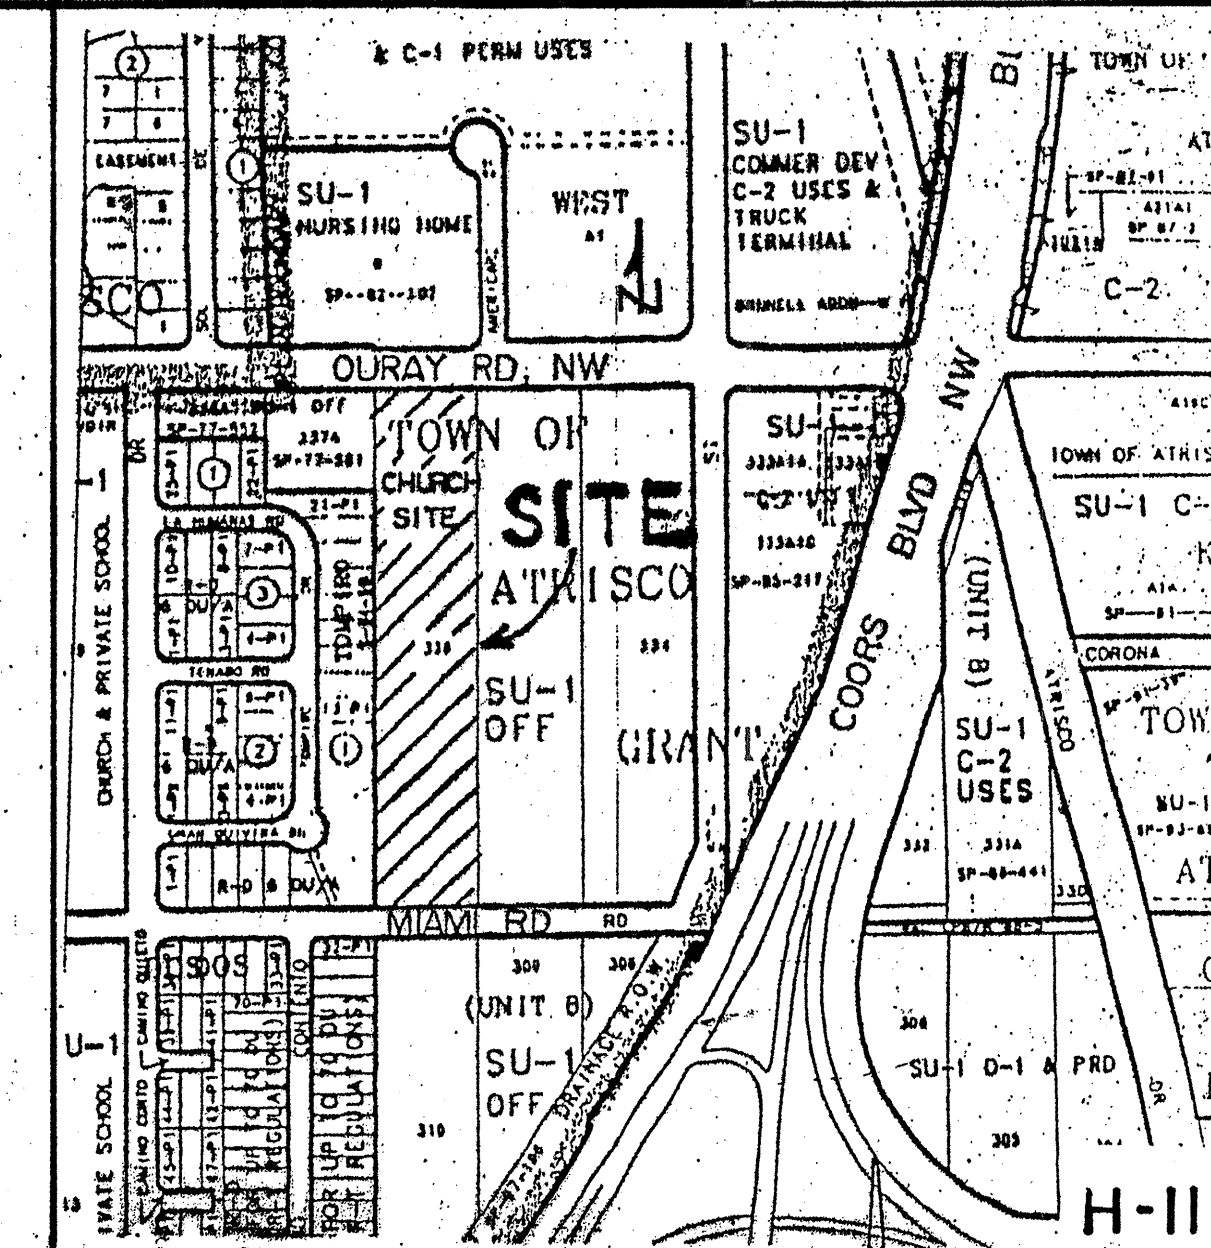


NOTICE TO CONTRACTORS

1. ALL WORK DETAILED ON THESE PLANS TO BE PERFORMED UNDER CONTRACT SHALL, EXCEPT AS OTHERWISE STATED OR PROVIDED FOR HEREON, BE CONSTRUCTED IN ACCORDANCE WITH THE CITY OF ALBUQUERQUE STANDARD SPECIFICATIONS FOR PUBLIC WORKS CONSTRUCTION, 1986 EDITION, AS AMENDED THROUGH UPDATE 7.
2. TWO (2) WORKING DAYS PRIOR TO ANY EXCAVATION, THE CONTRACTOR MUST CONTACT NEW MEXICO ONE-CALL SYSTEMS, 280-1980, FOR LOCATION OF EXISTING UTILITIES.
3. PRIOR TO CONSTRUCTION, THE CONTRACTOR SHALL EXCAVATE AND VERIFY THE HORIZONTAL AND VERTICAL LOCATIONS OF ALL OBSTRUCTIONS. SHOULD A CONFLICT EXIST, THE CONTRACTOR SHALL NOTIFY THE ENGINEER OR SURVEYOR SO THAT THE CONFLICT CAN BE RESOLVED WITH A MINIMUM AMOUNT OF DELAY.
4. CONTRACTOR SHALL NOTIFY THE ENGINEER NOT LESS THAN SEVEN (7) DAYS PRIOR TO STARTING WORK IN ORDER THAT THE ENGINEER MAY TAKE NECESSARY MEASURES TO INSURE THE PRESERVATION OF SURVEY MONUMENTS. CONTRACTOR SHALL NOT DISTURB PERMANENT SURVEY MONUMENTS WITHOUT THE CONSENT OF THE ENGINEER AND SHALL NOTIFY THE ENGINEER AND BEAR THE EXPENSE OF REPLACING ANY THAT MAY BE DISTURBED WITHOUT PERMISSION. REPLACEMENT SHALL BE DONE ONLY BY THE CITY SURVEY SECTION. WHEN A CHANGE IS MADE IN THE FINISHED ELEVATION OF THE PAVEMENT OF ANY ROADWAY IN WHICH A PERMANENT SURVEY MONUMENT IS LOCATED, CONTRACTOR SHALL AT HIS OWN EXPENSE ADJUST THE MONUMENT TO COVER TO THE NEW GRADE UNLESS OTHERWISE SPECIFIED. REFER TO SECTION 4.4 OF GENERAL CONDITIONS OF STANDARD SPECIFICATIONS.
5. FIVE (5) WORKING DAYS PRIOR TO CONSTRUCTION, CONTRACTOR SHALL SUBMIT TO THE CONSTRUCTION COORDINATING DIVISION, A DETAILED CONSTRUCTION SCHEDULE. TWO (2) DAYS PRIOR TO CONSTRUCTION THE CONTRACTOR SHALL OBTAIN A BARRICADING PERMIT FROM THE CONSTRUCTION COORDINATING DIVISION. CONTRACTOR SHALL NOTIFY THE BARRICADING ENGINEER (942-3400) PRIOR TO OCCUPYING AN INTERSECTION. SEE SECTION 19 OF THE SPECIFICATION.
6. ALL STREET STRIPING ALTERED OR DESTROYED SHALL BE REPLACED WITH PLASTIC REFLECTORIZED PAVEMENT MARKINGS BY THE CONTRACTOR TO LOCATION AS EXISTED OR INDICATED BY THIS PLAN SET.

- ☐ ALL UTILITIES AND UTILITY SERVICE LINES SHALL BE INSTALLED PRIOR TO PAVING.
- ☐ BACKFILL COMPACTION SHALL BE ACCORDING TO SPECIFIED STREET USE.
- ☐ TACK COAT REQUIREMENTS SHALL BE DETERMINED BY THE ENGINEER.
- ☐ SIDEWALKS AND WHEEL CHAIR RAMPS WITHIN THE CURB RETURNS SHALL BE CONSTRUCTED WHEREVER A NEW CURB RETURN IS CONSTRUCTED.
- ☐ IF CURB IS DEEPENED FOR A DRIVEPAD OR A HANDICAP RAMP, THE DRIVEPAD OR RAMP SHALL BE CONSTRUCTED PRIOR TO ACCEPTANCE OF THE CURB AND GUTTER.
- ☐ ALL STORM DRAINAGE FACILITIES SHALL BE COMPLETED PRIOR TO FINAL ACCEPTANCE.

REV. SHEETS	CITY ENGINEER	DATE	USER DEPARTMENT	DATE	USER DEPARTMENT	DATE
ENGINEERS STAMP, SIGNATURE	APPROVALS	ENGINEER	DATE	APPROVED FOR CONSTRUCTION		
	DRC Chairman	<i>[Signature]</i>	5-13-05	<i>[Signature]</i> 10-25-05 City Engineer Date		
	Transportation	<i>[Signature]</i>	4-29-05			
	Water/Wastewater	<i>[Signature]</i>	4-14-05			
	Hydrology	<i>[Signature]</i>	5-14-05			
	Parks	<i>[Signature]</i>	5-14-05			
Constr. Mngmnt.	<i>[Signature]</i>	5-14-05	Sheet 1 of 4			
CONST. COORD.	<i>[Signature]</i>	5-14-05				
City Project No.	6981.81					

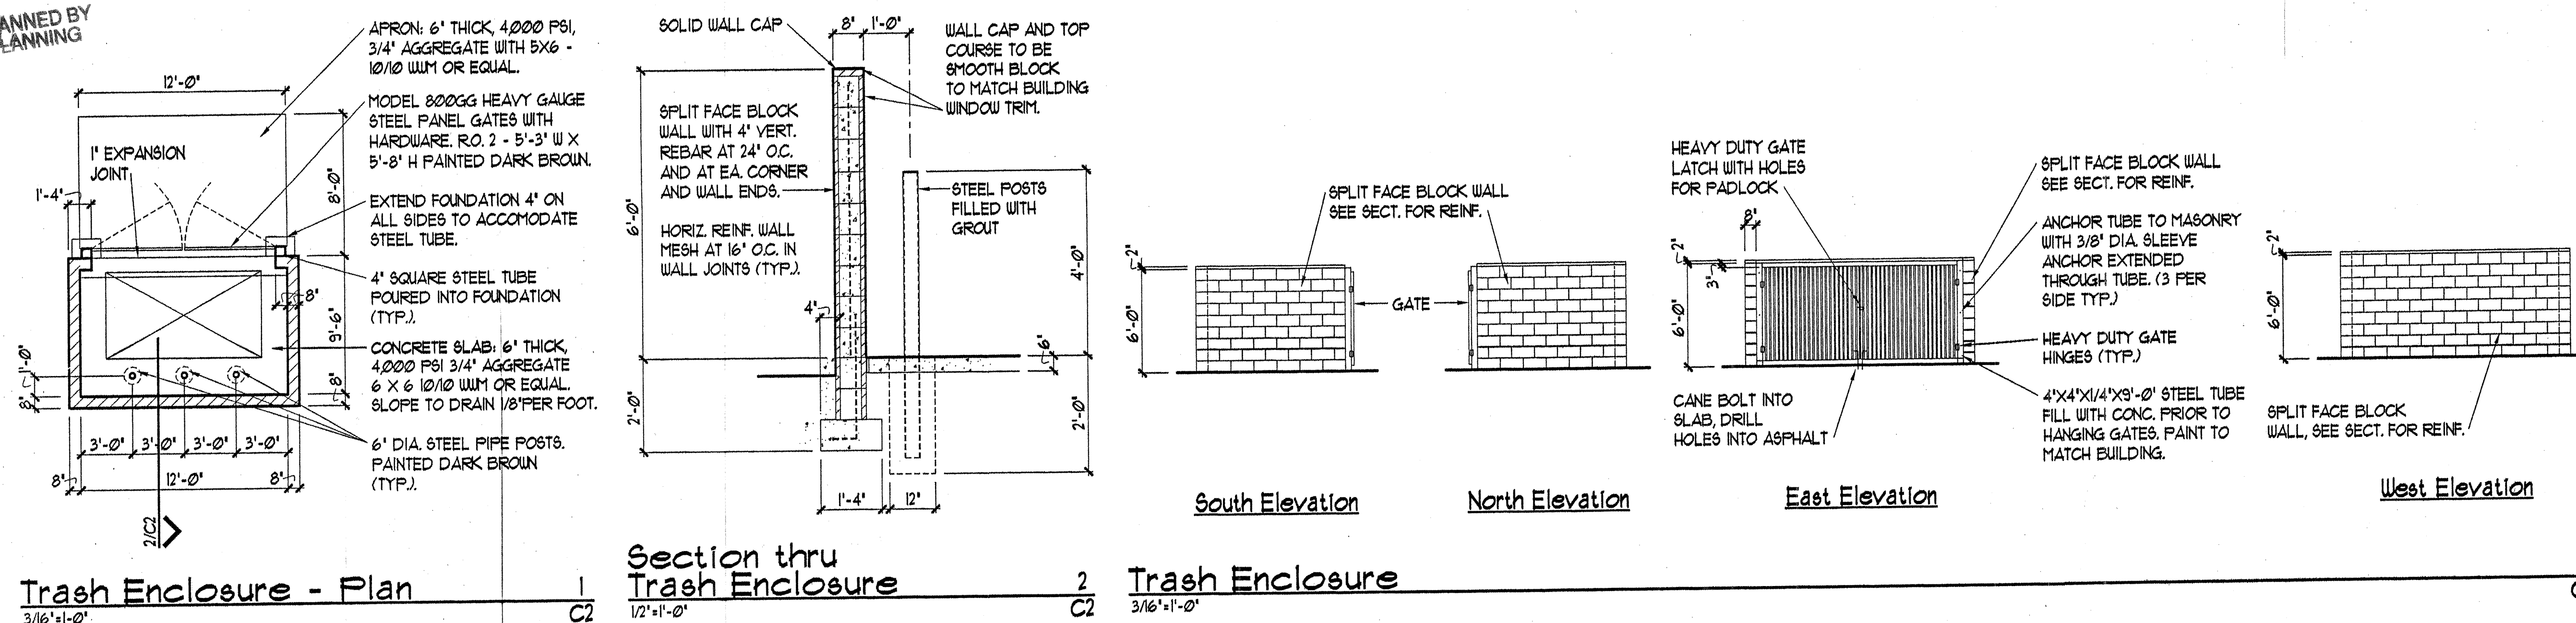

Keyed Notes C2:

1. PAINT CURB RED FOR FIRE LANE ACCESS WITH LETTERING "FIRE LANE NO PARKING".
2. ASPHALT TO BE FLUSH WITH SIDEWALK AT ACCESSIBLE SPACES, TYPICAL.
3. SLOPED SIDEWALK FOR TRANSITION.
4. ACCESSIBLE PARKING SIGN, CENTER WITH STALL (TYPICAL).
5. UNIDIRECTIONAL SIDEWALK RAMP.

General Notes:

1. BLOCK WALLS FOR FENCES AND TRASH ENCLOSURES SHALL MATCH THE CMU OF THE BUILDING.
2. THERE WILL BE NO ROOF TOP HVAC EQUIPMENT. ANY ROOFTOP PENETRATIONS SHALL BE PAINTED TO MATCH THE ROOF COLOR. ALL GROUND MOUNTED EQUIPMENT SHALL BE SCREENED BY SCREEN WALLS WITH TOP OF EQUIPMENT BELOW TOP OF SCREEN WALL.

Project Number: _____ 1000400

Wanda Sue Bara - July 30
Solid Waste Department Date

Richard D. Dant 7-25-01
Traffic Engineer, Transportation Division Date

William E. Andelaris 7-25-01
Parks & General Services Department Date

Maurya Dismukes 7-25-01
Public Works, Water Utilities Division Date

City Engineer, Engineering Division / AMAFCA Date

Approval and Conditional Acceptance: as specified by the
Development Process Manual.

City Planner, Albuquerque / Bernalillo
County Planning Division Date

DRB Plans

Sts. Peter and Paul Traditional
Catholic Church
5800 Ouray Road NW
Albuquerque, New Mexico

Project Title

Drawn By EB Checked By WS
Proj. 200012 Date 7/20/00

©2000 KEVIN GEORGES & ASSOCIATES, PA


7/20/01
Revisions

ENLARGED SITE PLAN
SITE DETAILS

W. O. PROJECT NO

6981.81

2 / 4

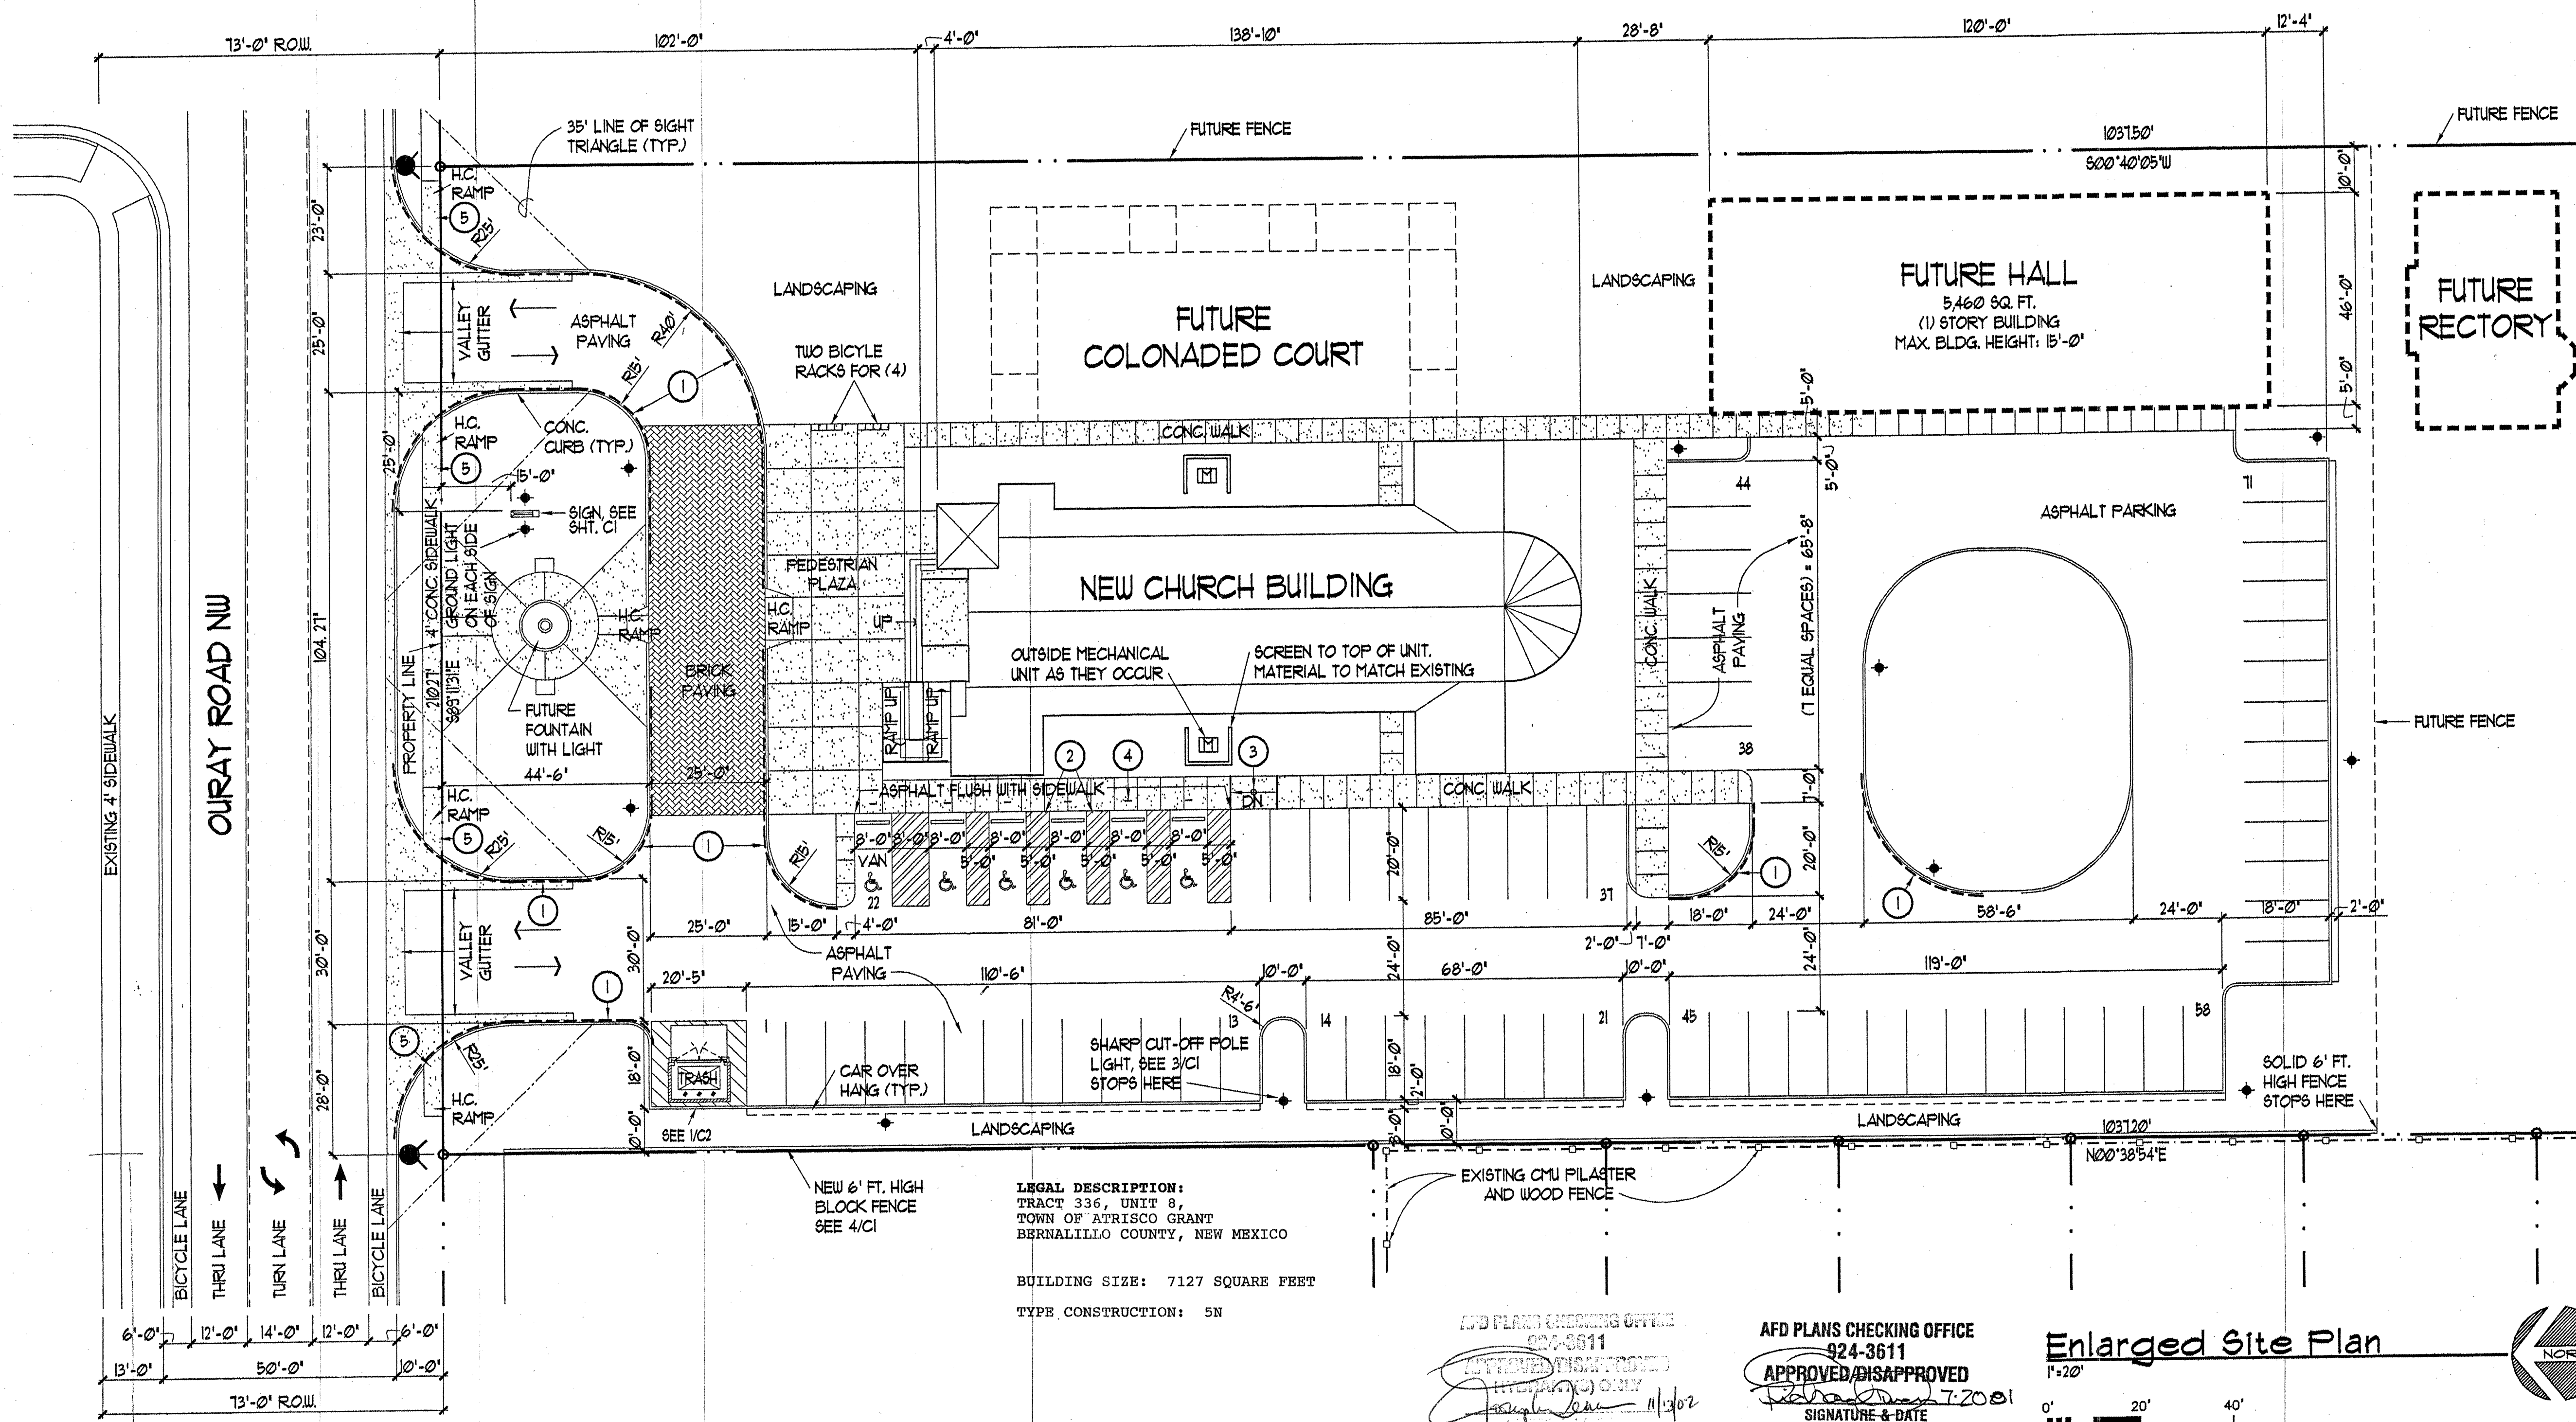

LEGAL DESCRIPTION:
TRACT 336, UNIT 8,
TOWN OF ATRISCO GRANT
BERNALILLO COUNTY, NEW MEXICO

BUILDING SIZE: 7127 SQUARE FEET
TYPE CONSTRUCTION: 5N

AFD PLANS CHIEFING OFFICE
024-8611

AED PLANS CHECKING OFFICE

924-3611


APPROVED/DISAPPROVED

Richard D. [Signature] 7-2
SIGNATURE & DATE


Enlarged Site Plan

 $\overline{I^*} = 20'$

0' 20' 4

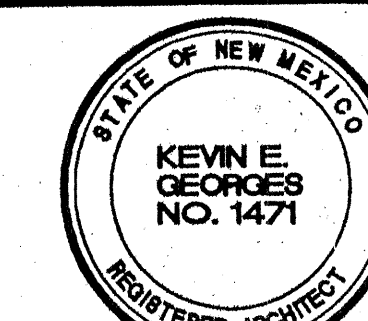[illegible]


C2

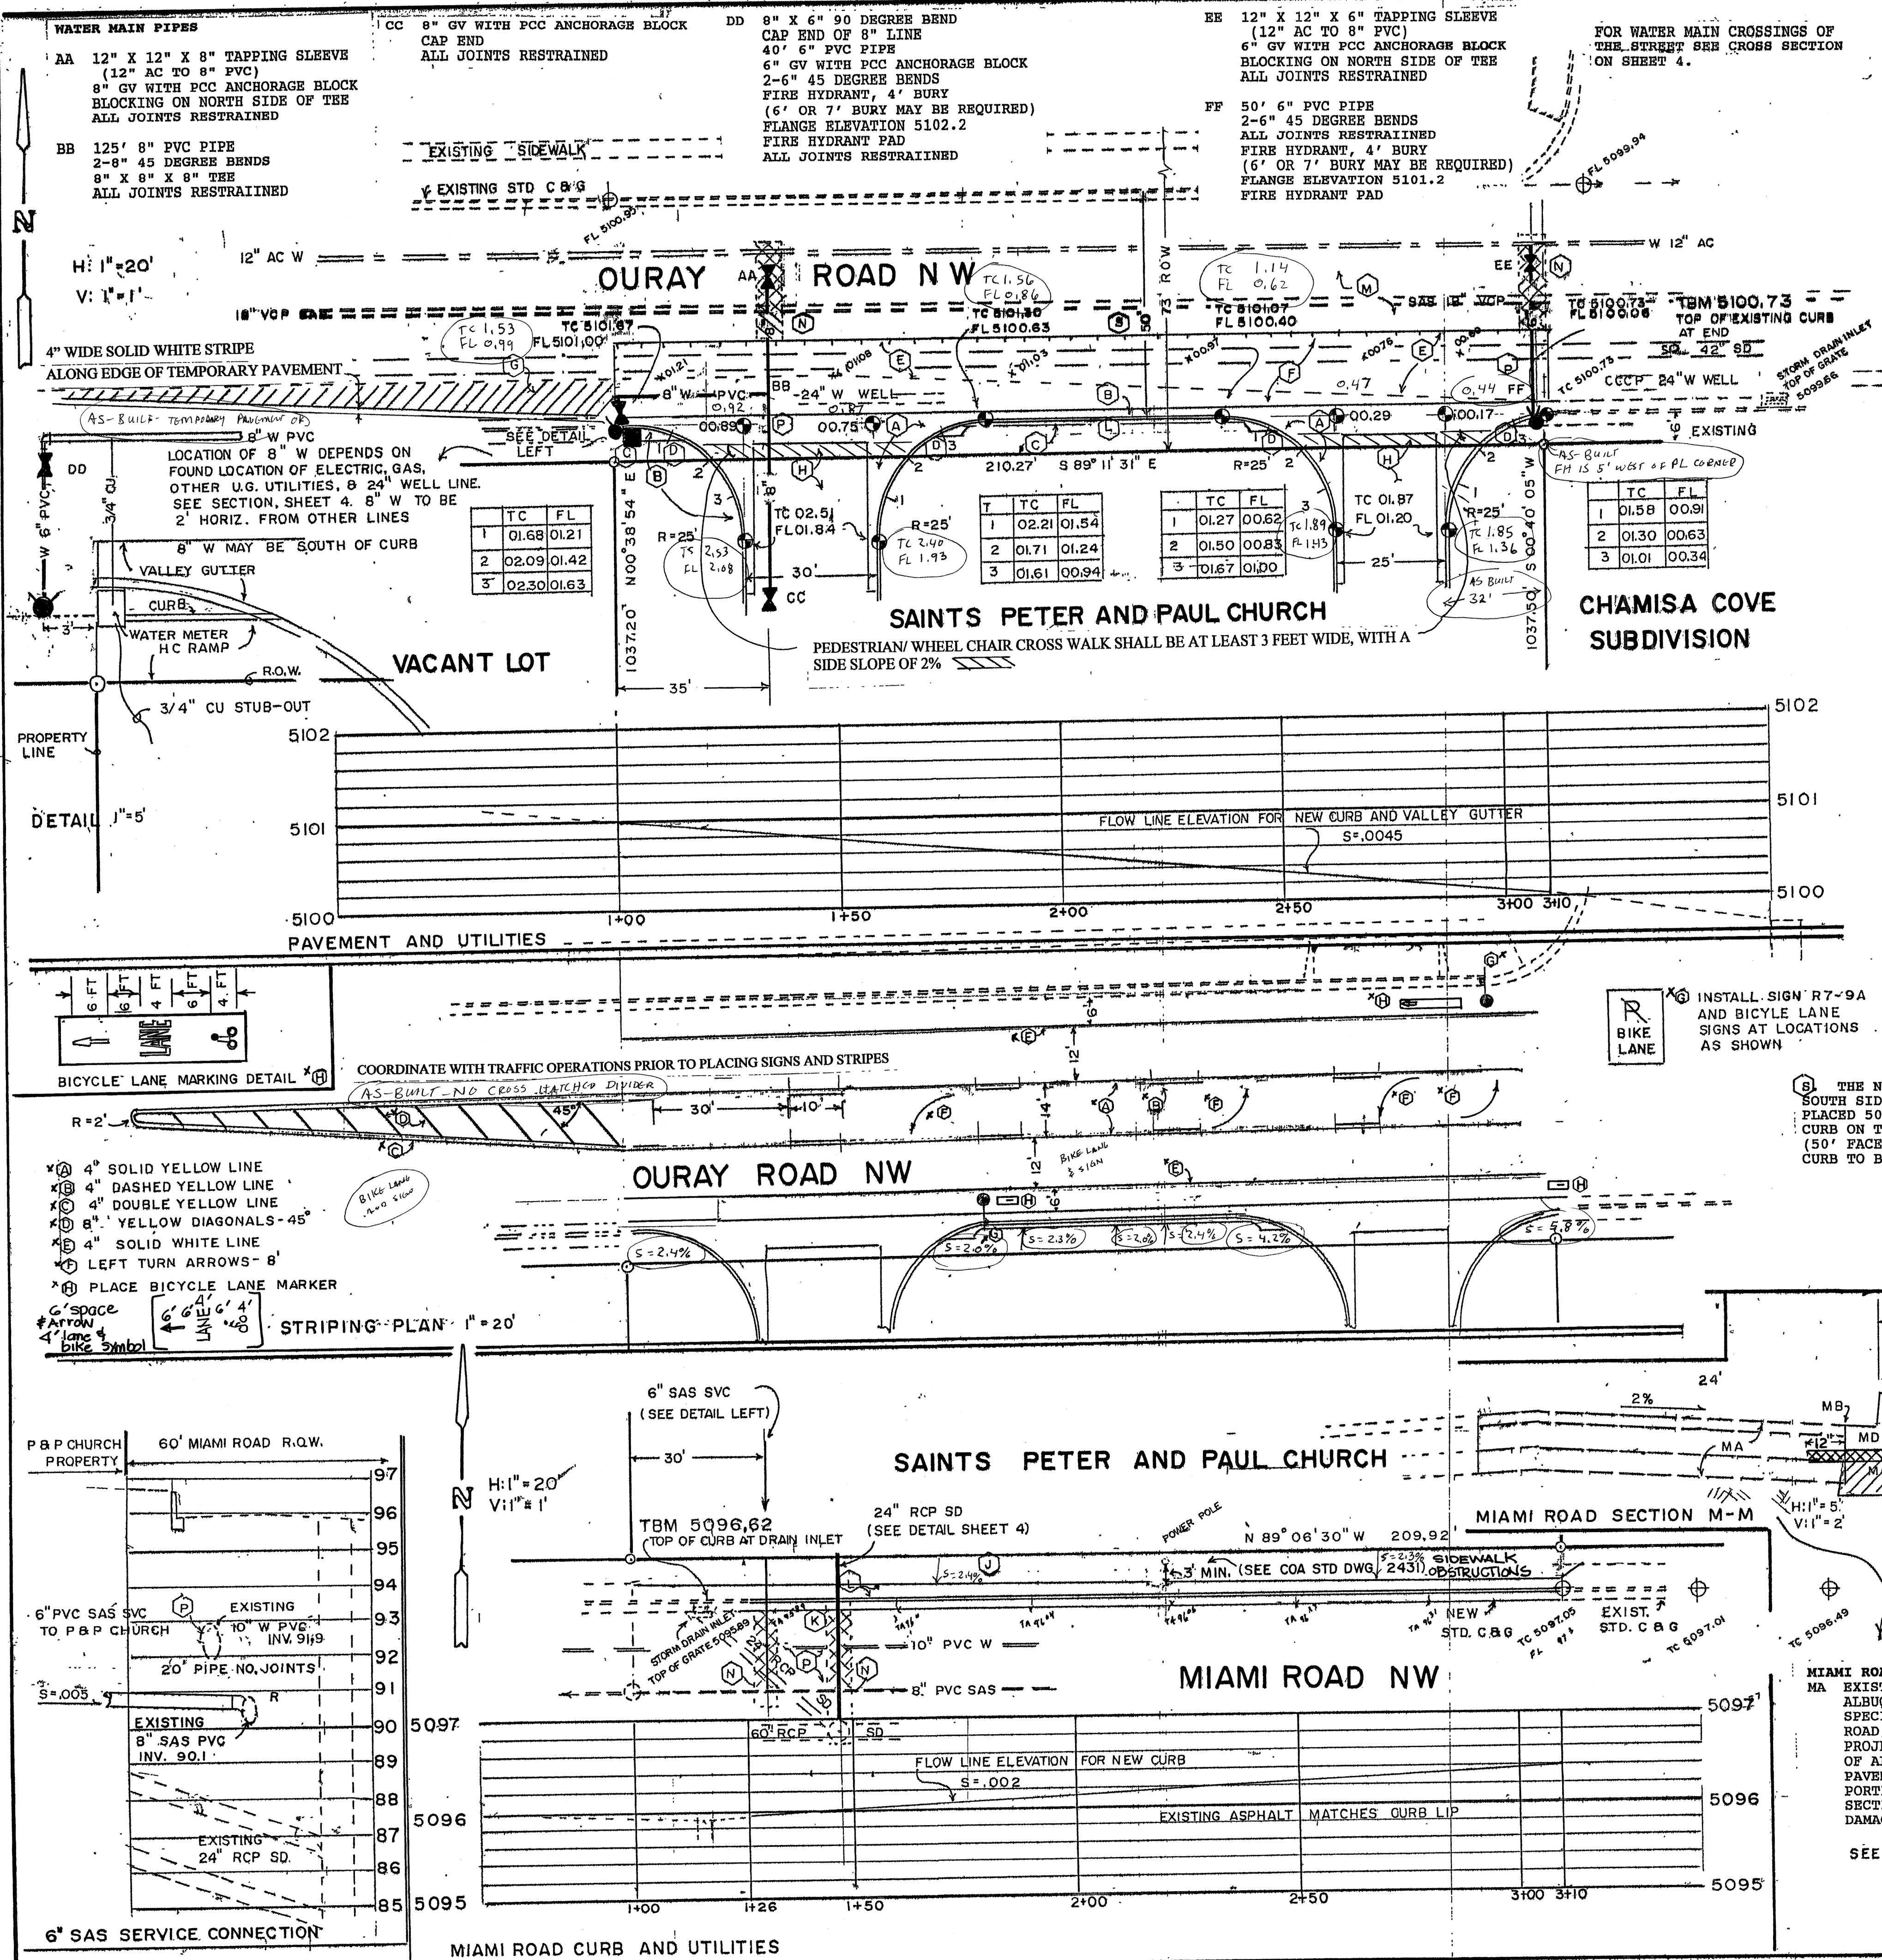

NOTES: 

- (A) CONSTRUCT 6 FEET WIDE VALLEY GUTTER, REFERENCE STD DWG 2420.
- (B) CONSTRUCT STANDARD CURB AND GUTTER, WITH THE CURB RETURN EXTENDING 25 FEET FROM THE STREET FLOW LINE INTO THE PRIVATE LOT, REFERENCE STD DWG 2415 A.
- (C) CONSTRUCT 6 FEET WIDE SIDEWALK MATCH EXISTING SIDEWALK SURFACE AT THE EAST END. REFERENCE STD DWG 2430.
- (D) CONSTRUCT WHEEL CHAIR RAMP WITH SIDE CURBS, SLOPE PARALLEL TO STREET TO BE NO GREATER THAN 1/12. REFERENCE STD DWG 2426.
- (E) REMOVE EXISTING TEMPORARY ASPHALT PAVEMENT. SAW CUT ALONG LINE OF NEW PAVEMENT.
- (F) PLACE NEW ASPHALT PAVEMENT TO THE STREET SECTION SHOWN ON THIS SHEET. NEW PAVEMENT TO BE PLACED FROM GUTTER LINE OUT 17 FEET, AND FRONTAGE DISTANCE OF 210 FEET. MATCH EDGES TO THE EXISTING PAVEMENT SURFACE.
- (G) PLACE TEMPORARY PAVEMENT SECTION FROM THE WEST EDGE OF THE NEW CURB AND GUTTER, TAPERING TO A DISTANCE OF 170 FEET, ALONG THE EDGE OF THE EXISTING PAVEMENT. MATCH TO THE EXISTING SURFACE OF THE PAVEMENT, SLOPING AT 2% SLOPE TO THE SOUTH. REFERENCE STD DWG 2415 A.
- (H) PLACE ASPHALT TO RESIDENTIAL STANDARD OR BETTER, REFERENCE STD DWG 2405.
- (J) CONSTRUCT 6 FEET WIDE SIDEWALK ALONG PROPERTY LINE, WITH A 10 FEET TAPER TO THE 4 FEET WIDE SIDEWALK ON THE EAST END. MATCH EXISTING SIDEWALK SURFACES AT BOTH EAST AND WEST END. DIVERS SIDEWALK AROUND THE EXISTING TOWER POLE TO PROVIDE A MINIMUM UNOBSTRUCTED WIDTH OF 3 FEET. COMPACT THE SOIL UNDER THE SIDEWALK PRIOR TO PLACING THE SIDEWALK TO A DENSITY OF 95% MAXIMUM DRY DENSITY. REFERENCE STD DWG 2430 AND 2431.

- ALONG THE LINE OF THE GUTTER. COMPACT THE SOIL TO A DEPTH OF 18 INCHES, AND A WIDTH OF 4 FEET FROM THE EDGE OF THE CUT ASPHALT, TO DENSITY OF 95% MAXIMUM DRY DENSITY. CONSTRUCT A STANDARD CURB AND GUTTER ADJACENT TO THE CUT ASPHALT WITH THE SLOPE OF THE FLOW LINE OF THE GUTTER FROM EAST TO WEST TO BE A STRAIGHT SLOPE FROM THE GUTTER ON THE EAST END TO THE GUTTER ON THE WEST END. SAW CUT THE EXISTING CURB AND GUTTER ON EACH END TO OBTAIN A FLUSH JOINT. REFERENCE STD DWG 2415 A.
- (L) BACKFILL THE AREA BETWEEN THE NEW CURB AND GUTTER AND THE NEW SIDEWALK. FINISH THE SURFACE OF THE BACKFILL TO A SMOOTH SURFACE, SLOPING FROM ONE INCH BELOW THE CURB SIDE OF THE SIDEWALK TO THE TOP OF THE BACK OF THE CURB. NO TRASH OR BROKEN CONCRETE SHALL BE INCLUDED IN THE BACKFILL.
- (M) NEW STRIPING TO PROVIDE FOR ONE 12 FEET WIDE LANE IN EACH DIRECTION, EAST AND WEST, WITH A CENTER TURN LANE, AND A 6 FEET WIDE BICYCLE PATH ON EACH SIDE. SEE STRIPING PLAN. CONTACT EDWARD TOLEDO PRIOR TO PLACING ANY STRIPING, TELEPHONE 857-8004.
- (N) PAVEMENT AREAS WHICH HAVE BEEN DISTURBED BY TRENCHING FOR UTILITIES SHALL BE BACKFILLED AND RESURFACED, EITHER AS REQUIRED BY NEW PAVEMENT AS SHOWN ON THESE DRAWINGS, OR ACCORDING TO STANDARD SPECIFICATION 2465, ARTERIAL FOR OURAY ROAD, RESIDENTIAL FOR MIAMI ROAD, FOR AREAS NOT SCHEDULED FOR NEW PAVEMENT.
- (P) SUPPORT PIPES CROSSING OPEN TRENCH.
- (R) CONNECT NEW 6" SAS SERVICE LINE TO EXISTING 8" SAS MAIN WITH AN "X8"X"6" DIRECTIONAL WYE, WITH THE FLOW DIRECTION TO THE WEST. 45 DEGREE BEND ALSO REQUIRED.

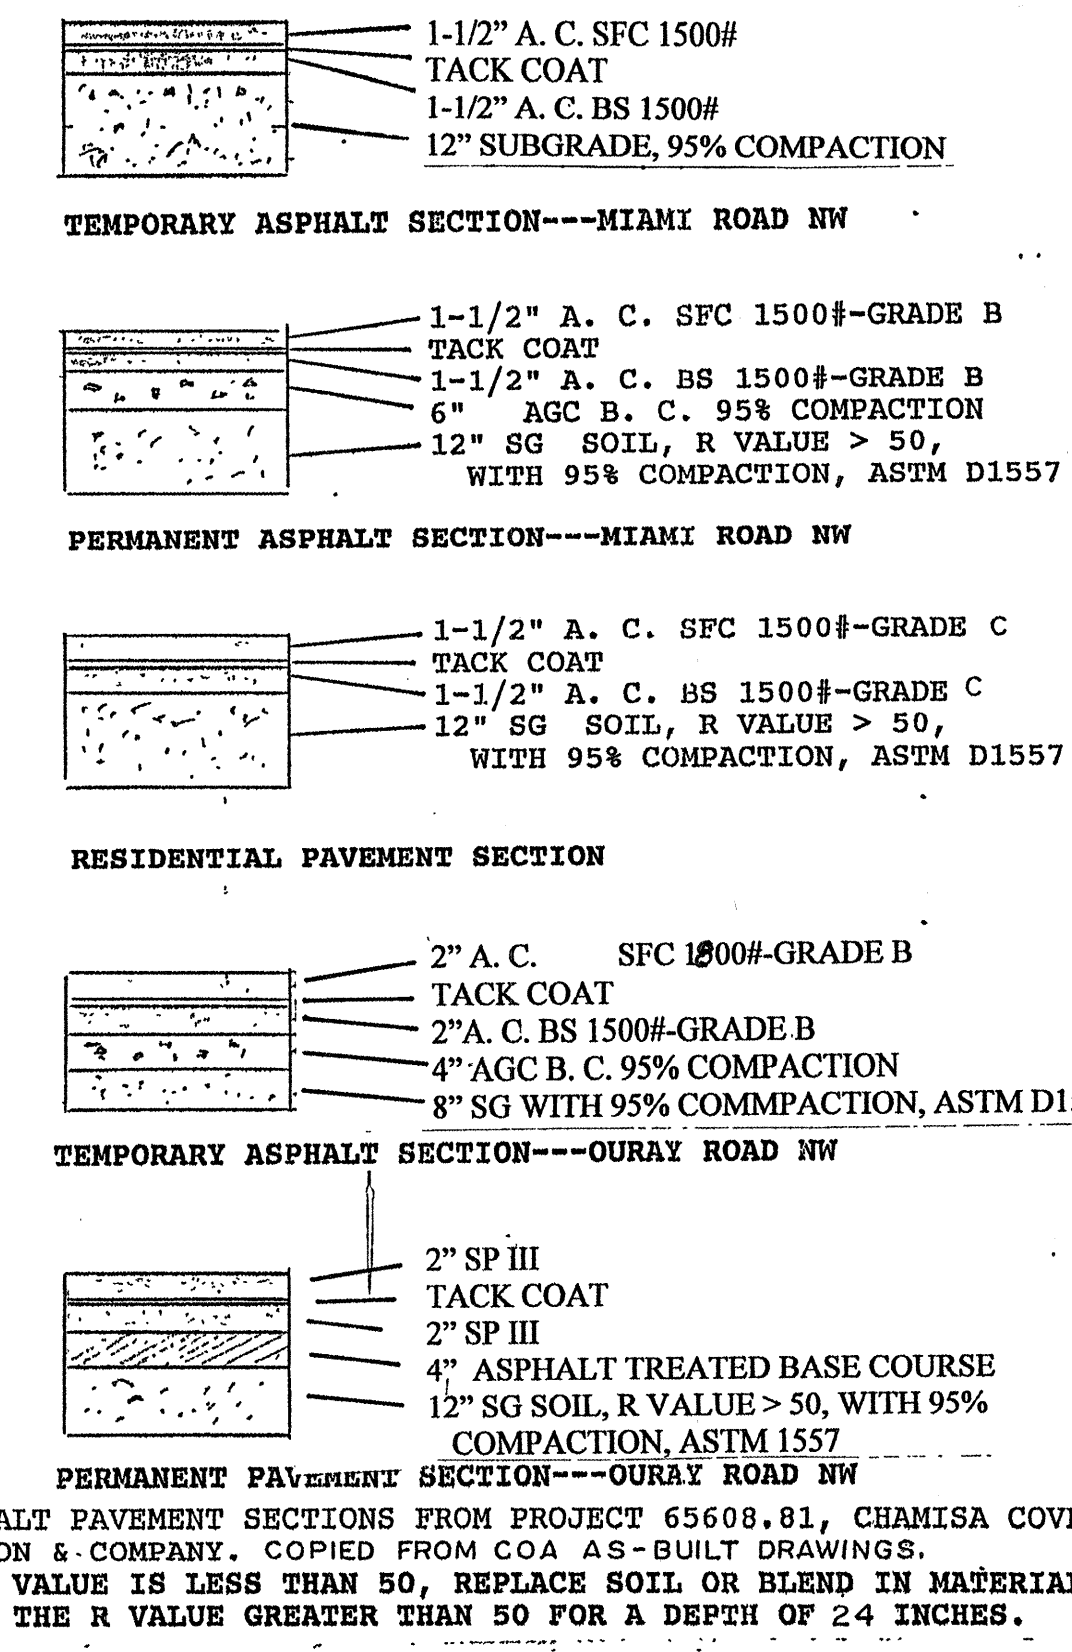

MIAMI ROAD CROSS SECTION M-M NOTES
MA EXISTING PAVEMENT PLACED UNDER CITY OF
ALBUQUEQUE PROJECT 6560.81. PAVEMENT IS
SPECIFIED TO BE THE TEMPORARY SECTION FOR MIAMI
ROAD, AS SHOWN ABOVE. INFORMATION IS FROM
PROJECT 6560.81, AS-BUILTS ON FILE AT THE CITY
OF ALBUQUEQUE PUBLIC WORKS DEPARTMENT. THIS
PAVEMENT IS TO REMAIN IN PLACE EXCEPT FOR THOSE
PORTIONS CUT TO PLACE THE NEW CURB; THOSE
SECTIONS REMOVED FOR TRENCHING; AND AREAS
DAMAGED BY THIS PROJECT 6981.81 CONTRACTOR.

SEE SHEET 4 FOR NOTES MB, MC, MD, ME


AS BUILT INFORMATION		BENCH MARKS		SURVEY FIELD NOTES		ENGINEER'S SEAL		REVISIONS		DESIGN													
CONTRACTOR	DRAWN BY	DATE	ELEVATION	NO.	BY	DATE	SEAL	NO.	DATE	DESIGNED BY	CHECKED BY												
K SAW CUT EXISTING ASPHALT SURFACE ALONG THE LINE OF THE EXISTING FACE OF THE GUTTERS. COMPACT THE SOIL TO A DEPTH OF 18 INCHES, AND A WIDTH OF 4 FEET FROM THE EDGE OF THE CURB ASPHALT, TO DENSITY OF 95% MAXIMUM DRY DENSITY. CONSTRUCT A STANDARD CURB AND GUTTER ADJACENT TO THE CURB ASPHALT WITH THE SLOPE OF THE FLOW LINE OF THE GUTTER FROM EAST TO WEST TO BE A STRAIGHT SLOPE FROM THE GUTTER ON THE EAST END TO THE GUTTER ON THE WEST END. SAW CUT THE EXISTING CURB AND GUTTER ON EACH END TO OBTAIN A FLUSH JOINT. REFERENCE STD DWG 2415.A.			BENCHMARK: 11-HILL, 1989; ELEVATION 5096.514 (1928 DATUM). LOCATED IN SOUTH OF THE INTERSECTION WITH I-40.							DESIGNED BY M R KORTUM	CHECKED BY M R K												
L BACKFILL THE AREA BETWEEN THE NEW CURB AND GUTTER AND THE NEW SIDEWALK. FINISH THE SURFACE OF THE BACKFILL TO A SMOOTH SURFACE, SLOPING FROM 1 INCH BELOW THE CURB SIDE EDGE OF THE SIDEWALK TO THE TOP OF THE BACK OF THE CURB. NO TRASH OR BROKEN CONCRETE SHALL BE INCLUDED IN THE BACKFILL.																							
M NEW STRIPING TO PROVIDE FOR ONE 12 FEET WIDE LANE IN EACH DIRECTION, EAST AND WEST, WITH A CENTER TURN LANE, AND A 6 FEET WIDE BICYCLE PATH ON EACH SIDE. SEE STRIPING PLAN. CONTACT EDWARD TORRES PRIOR TO PLACING ANY STRIPING, TELEPHONE 857-8004.																							
N PAVEMENT AREAS WHICH HAVE BEEN DISTURBED BY TRENCING FOR UTILITIES SHALL BE BACKFILLED AND RESURFACED, EITHER AS REQUIRED BY NEW PAVEMENT AS SHOWN ON THESE DRAWINGS, OR ACCORDING TO STANDARD SPECIFICATION 2469, ARTERIAL FOR OURAY ROAD, RESIDENTIAL FOR MIAMI ROAD, FOR AREAS NOT SCHEDULED FOR NEW PAVEMENT.																							
P SUPPORT PIPES CROSSING OPEN TRENCH.																							
R CONNECT NEW 6" SAS SERVICE LINE TO EXISTING 8" SAS MAIN WITH AN 8"x8"x6" DIRECTIONAL WYE, WITH THE FLOW DIRECTION TO THE WEST. .45 DEGREE BEND ALSO REQUIRED.																							
1-1/2" A.C. SFC 1500# TACK COAT 1-1/2" A.C. BS 1500# 12" SUBGRADE, 95% COMPACTION ALT SECTION---MIAMI ROAD NW 1-1/2" A.C. SFC 1500#--GRADE B TACK COAT 1-1/2" A.C. BS 1500#--GRADE B 6" AGC B.C. 95% COMPACTION 12" SG SOIL, R VALUE > 50, WITH 95% COMPACTION, ASTM D1557 ALT SECTION---MIAMI ROAD NW 1-1/2" A.C. SFC 1500#--GRADE C TACK COAT 1-1/2" A.C. BS 1500#--GRADE C 12" SG SOIL, R VALUE > 50, WITH 95% COMPACTION, ASTM D1557 MENT SECTION 2" A.C. SFC 1500#--GRADE B TACK COAT 2" A.C. BS 1500#--GRADE B 4" AGC B.C. 95% COMPACTION 8" SG WITH 95% COMPACTION, ASTM D1557 LT SECTION---OURAY ROAD NW 2" SP III TACK COAT 2" SP III 4" ASPHALT TREATED BASE COURSE 12" SG SOIL, R VALUE > 50, WITH 95% COMPACTION, ASTM D1557 MENT SECTION---OURAY ROAD NW CONS FROM PROJECT 65608.81, CHAMISA COVE, BY FROM COA AS-BUILT DRAWINGS. N 50, REPLACE SOIL OR BLEND IN MATERIAL TO ER THAN 50 FOR A DEPTH OF 24 INCHES.																							
CITY OF ALBUQUERQUE PUBLIC WORKS DEPARTMENT ENGINEERING DEVELOPMENT GROUP TITLE: SAINTS PETER AND PAUL CHURCH CURB AND PAVEMENT, WATER & SANITARY SEWER OURAY ROAD, NW AND MIAMI ROAD, NW <table border="1"> <tr> <td>Design Review Committee</td> <td>City Engineer Approval</td> <td>No./Day/Yr.</td> <td>No./Day/Yr.</td> </tr> <tr> <td>(Signature)</td> <td>(Signature)</td> <td></td> <td></td> </tr> <tr> <td>Design Review Committee</td> <td>CITY ENGINEER</td> <td></td> <td></td> </tr> </table> City Project No. 6981.81 Zone Map No. H-11 Sheet 3 Of 4												Design Review Committee	City Engineer Approval	No./Day/Yr.	No./Day/Yr.	(Signature)	(Signature)			Design Review Committee	CITY ENGINEER		
Design Review Committee	City Engineer Approval	No./Day/Yr.	No./Day/Yr.																				
(Signature)	(Signature)																						
Design Review Committee	CITY ENGINEER																						

CONSTRUCTION OF DOUBLE D DROP INLET AND CONNECTION TO THE EXISTING STORM DRAIN MANHOLE IN MIAMI ROAD, NW:

- LOCATE AND UNCOVER THE EXISTING 8 FEET DIAMETER STORM DRAIN MANHOLE. THE MANHOLE IS LOCATED ABOUT 44 FEET EAST OF THE SOUTHWEST CORNER OF THE CHURCH PROPERTY, AND 40 FEET SOUTH OF THE CHURCH PROPERTY LINE, IN THE MIAMI ROAD RIGHT-OF-WAY. THE MANHOLE COVER IS PRESENTLY COVERED WITH TEMPORARY ASPHALT SURFACING AND GRAVEL.
- SAW CUT THE EXISTING PAVEMENT FROM THE STORM DRAIN MANHOLE TOWARD THE CHURCH PROPERTY. THE SAW CUT SHOULD BE SUFFICIENTLY WIDE TO PERMIT TRENCHING TO THE REQUIRED DEPTH TO PLACE THE 24 INCHES DIAMETER RCP STORM DRAIN.
- TRENCH TO THE REQUIRED DEPTH TO PLACE THE NEW STORM DRAIN PIPE. THE TOP OF THE TRENCH MUST BE WIDE ENOUGH TO PERMIT SLOPING OF THE TRENCH SIDES SO THAT THERE IS NO DANGER OF THE TRENCH COLLAPSING. ALTERNATIVELY, SHORING MAY BE REQUIRED TO PREVENT THE TRENCH FROM COLLAPSING.

- VERIFY THAT THERE IS SUFFICIENT DEPTH BELOW THE EXISTING WATER MAIN AND SANITARY SEWER MAIN TO PLACE THE NEW STORM AS SHOWN. THE STORM DRAIN PIPE MUST BE PLACED TO PROVIDE AT LEAST ONE FOOT OF CLEARANCE BETWEEN THE WATER AND SANITARY SEWER PIPES.
- CHECK THAT THERE IS NO INTERFERENCE WITHIN THE MANHOLE WHERE THE NEW STORM DRAIN PIPE WILL ENTER. THE STEPS WITHIN THE MANHOLE MAY REQUIRE RELOCATING IF THEY ARE ON THE NORTH SIDE OF THE MANHOLE.
- CUT A HOLE IN THE MANHOLE SO THAT THE NEW STORM DRAIN PIPE MAY ENTER THE MANHOLE. PLACE THE NEW PIPE FROM THE MANHOLE TO THE NEW DROP INLET. ADD PORTLAND CEMENT CONCRETE REINFORCEMENT AT THE MANHOLE.
- CONSTRUCT DOUBLE D DROP INLET (STD DWG 2206) WITHIN THE CHURCH PROPERTY AS SHOWN. THE ELEVATION OF THE GRATE AND ASPHALT APRON SHOULD BE ONE FOOT ABOVE THE BOTTOM OF THE SEDIMENT SETTLING POND. CONSTRUCT A REINFORCED BLOCK WALL ON THE PROPERTY LINE TO A HEIGHT OF AT LEAST TWO FEET ABOVE THE TOP OF THE GRATE, AND AT LEAST ONE FOOT ABOVE THE TOP SURFACE OF THE SIDEWALK WITHIN THE RIGHT-OF-WAY (8" CONCRETE REINFORCING BARS AT 12" HORIZONTALLY AND

- BACKFILL AND COMPACT THE TRENCHING TO 95% MAXIMUM DRY DENSITY. PLACE ASPHALT SURFACE WITH ASPHALT SECTION SHOWN FOR PERMANENT MIAMI ROAD SURFACE. LEVEL THE STORM DRAIN MANHOLE COVER TO THE STREET SURFACE AND PLACE ASPHALT SURFACE AROUND COVER AND RIM FOR A DISTANCE OF 5 FEET FROM THE RIM.
- PLACE CURB AND SIDEWALK AS SHOWN ON THESE DRAWINGS, SHEET 3.
- PROVIDE BARRICADING AS REQUIRED ON SHEETS 5 AND 6. MIAMI ROAD MAY BE CLOSED WHEN DOING THE CONSTRUCTION.
- FOR STORM DRAIN CONSTRUCTION, PCP PIPE JOINTS SHALL NOT BE GROUTED PRIOR TO FINAL INSPECTION. FINAL INSPECTION WILL DETERMINE JOINTS TO BE GROUTED FOR FINAL ACCEPTANCE OF THE CONSTRUCTION.

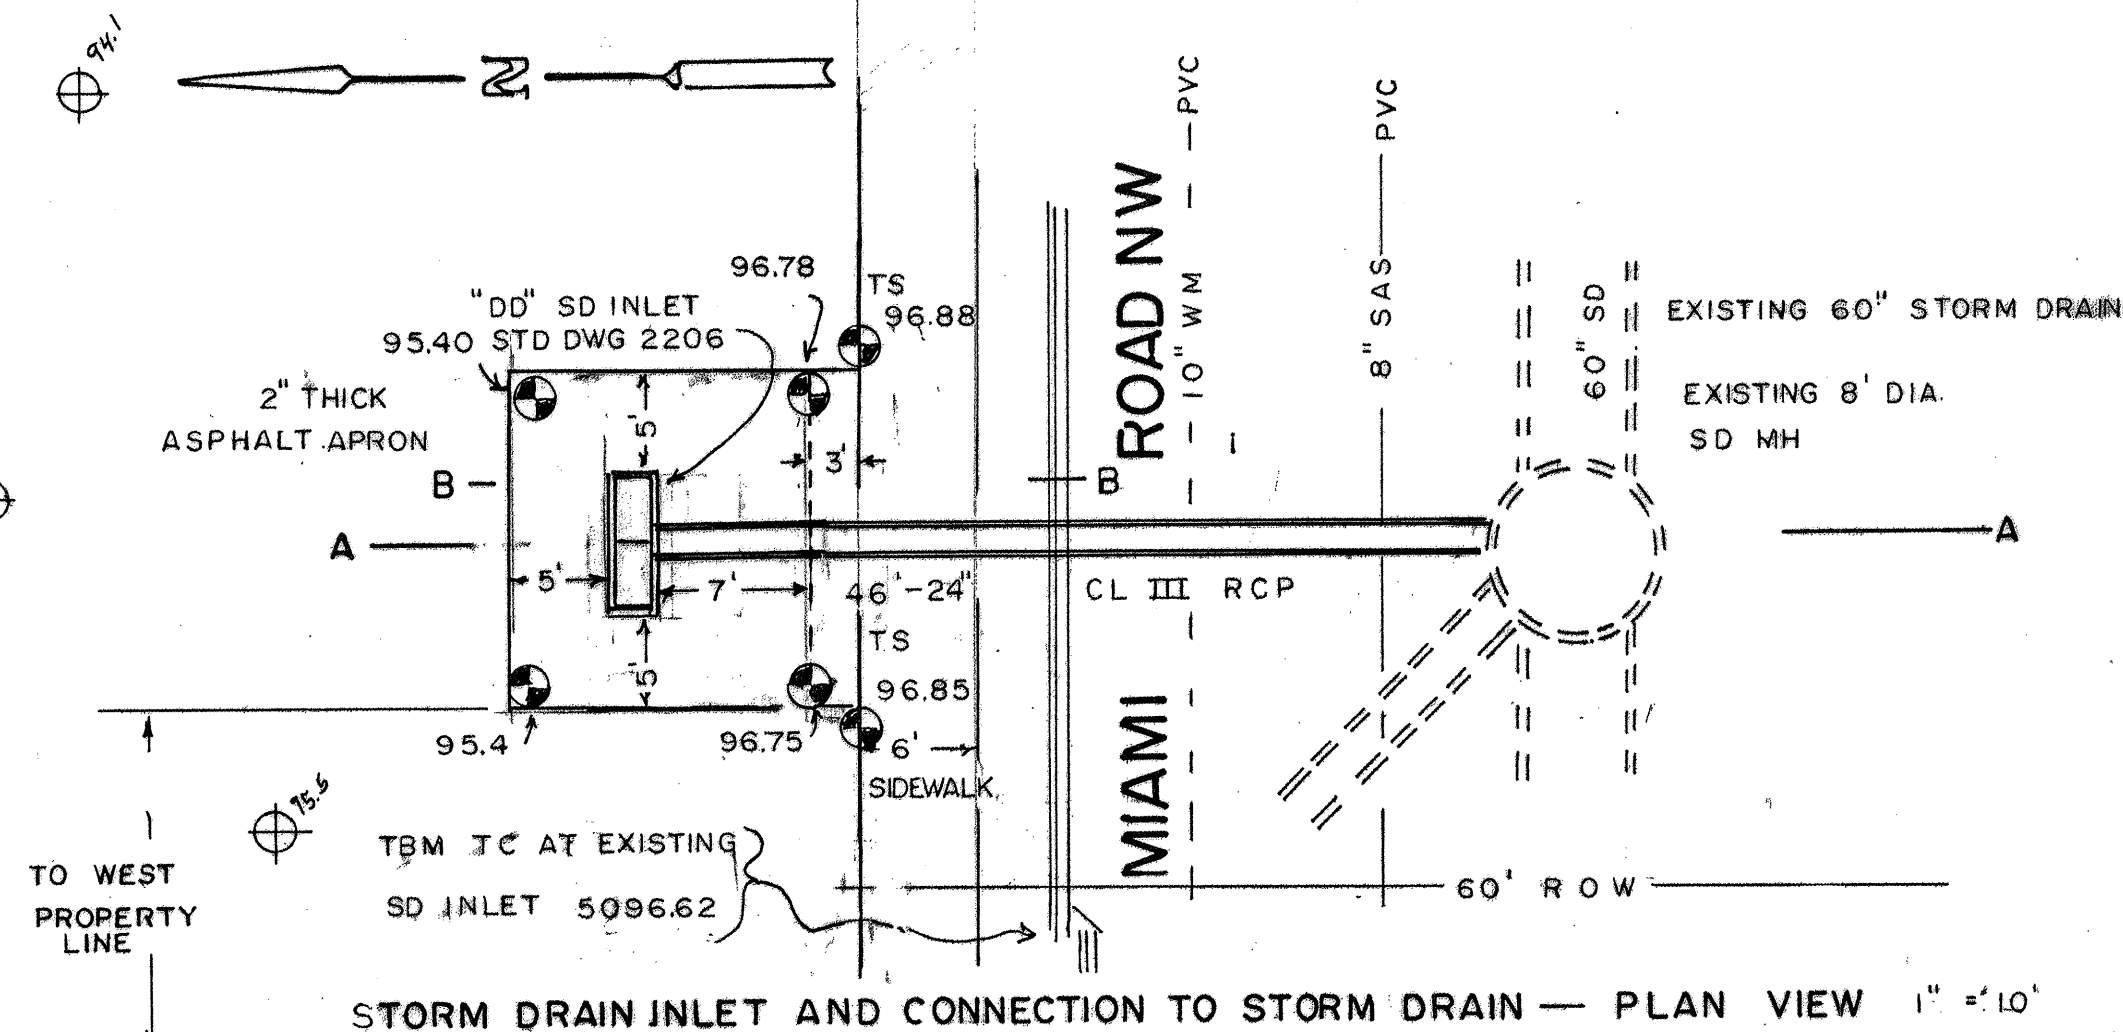


WATER MAIN SHUT-OFF REQUIREMENTS

THE CONTRACTOR SHALL BE RESPONSIBLE FOR TIMING AND COORDINATION OF THE WATER MAIN SHUT-OFF REQUIREMENTS TO CONSTRUCT THIS PROJECT.

AT LEAST SEVEN (7) WORKING DAYS PRIOR TO CONSTRUCTION, CONTRACTOR SHALL CONTACT THE PWD/WATER SYSTEMS DIVISION (857-8200) TO START THIS SHUT-OFF PLAN.

THE VALVES LISTED BELOW, SHOWN ON THE PLAN DRAWING, AND LOCATED AT THE INTERSECTION OF TODOS SANTOS ROAD AND RIO GRANDE BOULEVARD, MUST BE CLOSED PRIOR TO A NON-PRESSURE CONNECTION: (VALVES ARE TO BE OPERATED ONLY BY CITY PERSONNEL)

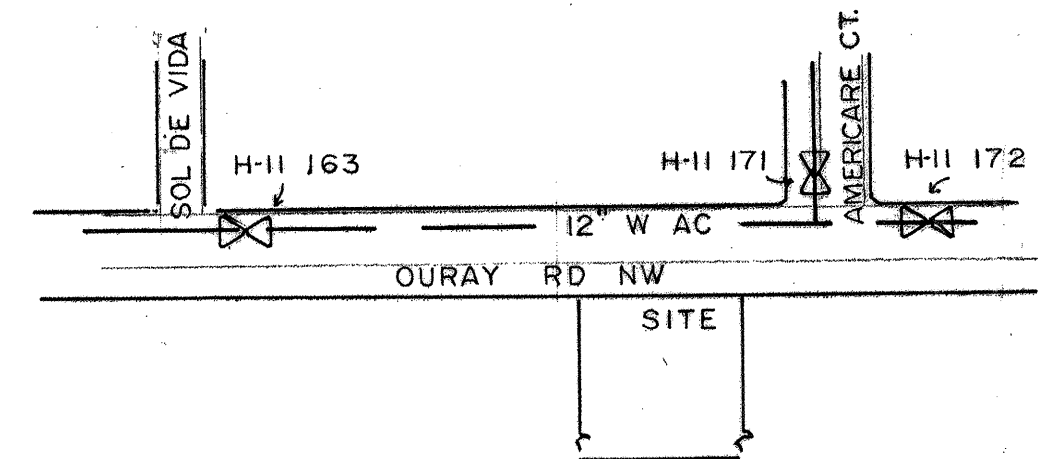

ADDITIONAL NOTES FOR MIAMI ROAD SECTION M-M, SHEET 3


MB CUT EXISTING ASPHALT AT LIP OF NEW CURB. PRIOR TO PLACING THE NEW CURB HAVE THE CITY OF ALBUQUERQUE STREET MAINTENANCE PERSONNEL INSPECT EDGE OF THE CUT ASPHALT. IF THE CUT EDGE IS NOT SOUND AND ON THE DESIGNED CURB ALIGNMENT, THE ASPHALT MAY HAVE TO BE CUT BACK 12 INCHES AND REPLACED ACCORDING TO CITY OF ALBUQUERQUE CRITERIA. THE LIP OF THE NEW CONCRETE CURB WHICH IS ADJACENT TO THE EXISTING ASPHALT SHALL BE SET TRUE TO THE DESIGN OF THE CURB, AND THE TOP SURFACE OF THE ASPHALT SHALL BE BROUGHT TO THE REQUIRED SURFACE ELEVATION TO MATCH

THE CURB, EITHER BY ADDITION OF A FEATHER EDGE OVERLAY, OR BY CUTTING THE ASPHALT SURFACE. THE REQUIRED ELEVATION OF THE TOP SURFACE OF THE ASPHALT SHALL BE ZERO TO 1/2 INCHES ABOVE THE CURB LIP.


MC COMPACT SUBGRADE FOR NEW CURB TO 95% OF MAXIMUM DRY DENSITY.

MD PLACE NEW STANDARD CURB TO ELEVATIONS AS SPECIFIED ON PROFILE.

ME NEW 6 FEET WIDE SIDEWALK PLACED ALONG PROPERTY LINE/NORTH RIGHT-OF-WAY LINE OF MIAMI ROAD.

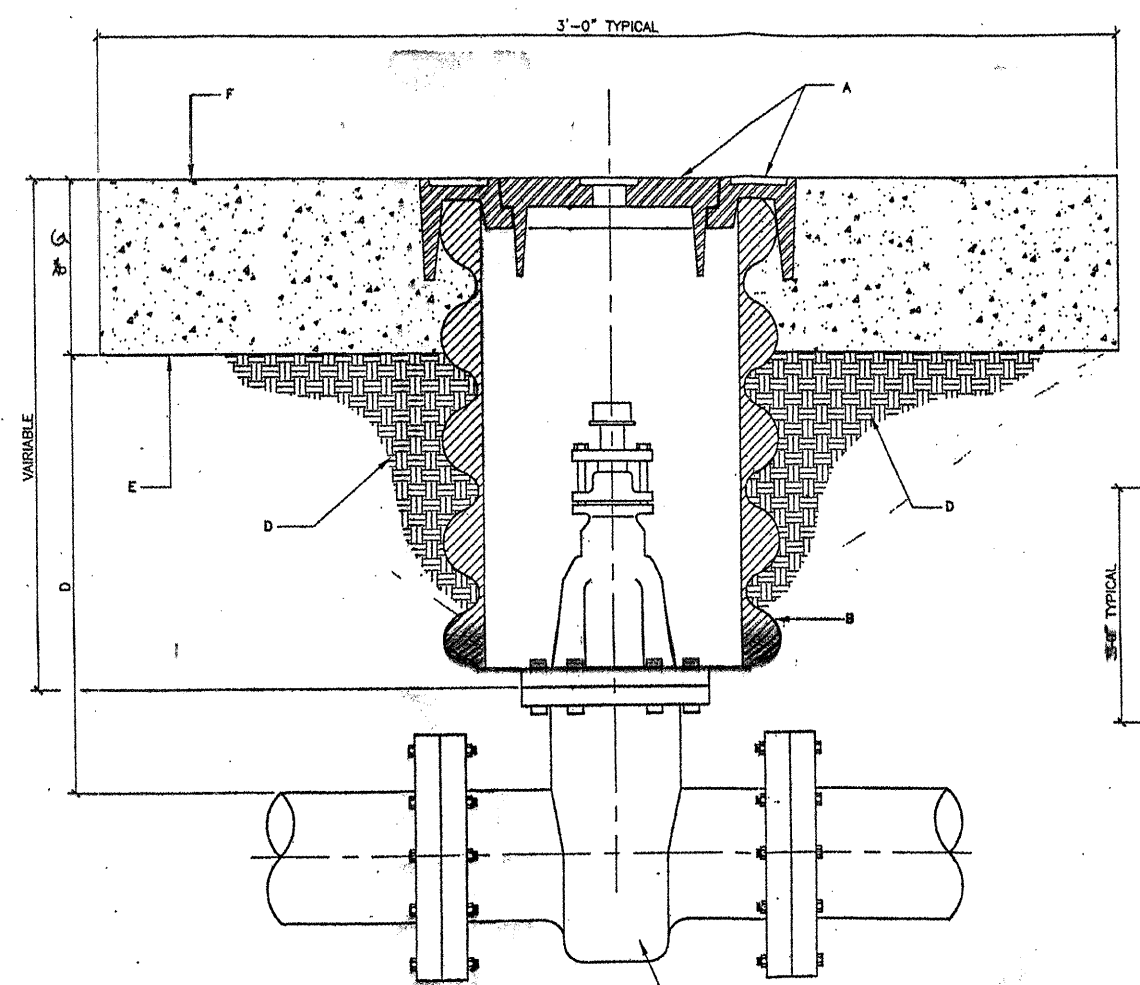

SEE DWG 2326, COA STD SPECS

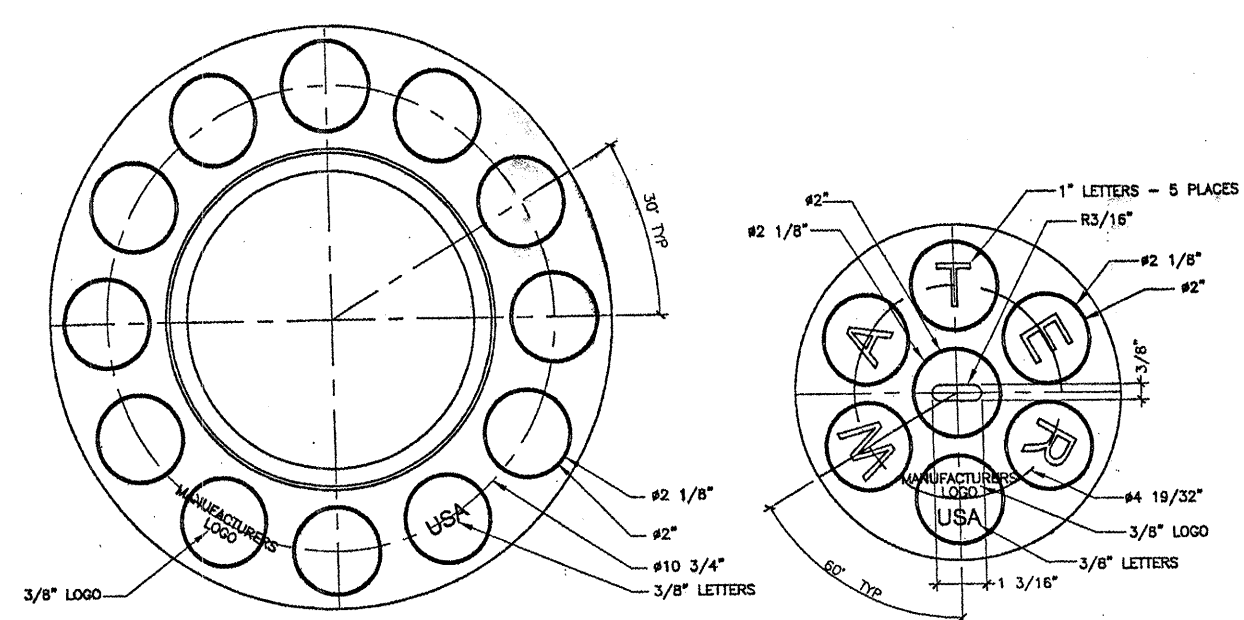

SEE DWG 2328, COA STD SPECS

REFER TO THE FOLLOWING STANDARD DRAWINGS

- SEWER
- 2107 Concrete Manhole Cover Type "C"
 - 2110 Manhole Frame and Cover
 - 2111 Manhole Cover Adjustment Ring
 - 2125 Service Line Details
 - 2136 Riser Details Flexible
 - 2145 Sewer Line Dead-End Marker

DRAINAGE


- 2206 Storm Inlet Double D
- 2215 Storm Inlet Center Support Assembly
- 2216 Storm Inlet Frame
- 2220 Storm Inlet Albuquerque Grate
- 2221 Storm Inlet Alternative Grate
- 2229 Step Details

WATER


- 2301 Water Connection Details
- 2315 Pipe Trench Terminology
- 2320 Concrete Blocking Design
- 2325 Valve Box Type "A"
- 2328 Ring and Cover for Valve Box
- (See draft changes to standards for 2325 and 2328, this sheet)
- 2333 Water Valve Anchorage
- 2340 Fire Hydrant Installation
- 2360 Meter Box Location
- 2361 Typical Meter Box Installations
- 2362 Metered Service Line Installation (See COA Draft)
- 2366 Double Meter Box for 3/4" and 1" Meters (See COA Draft)
- 2368 Meter Box Cover and Lid
- 2369 Heavyweight Meter Box Cover and Lid

PAVING


- 2401 Typical Residential Street Intersections
- 2405 Residential Street Section
- 2415 Curb and Gutter Section
- 2420 Concrete Valley Gutter (Intersection)
- 2426 Private Entrance Details
- 2430 Sidewalk Details
- 2432 Sidewalk Transitions
- 2450 Concrete Joints
- 2465 Citywide Pavement Cuts for All Utilities

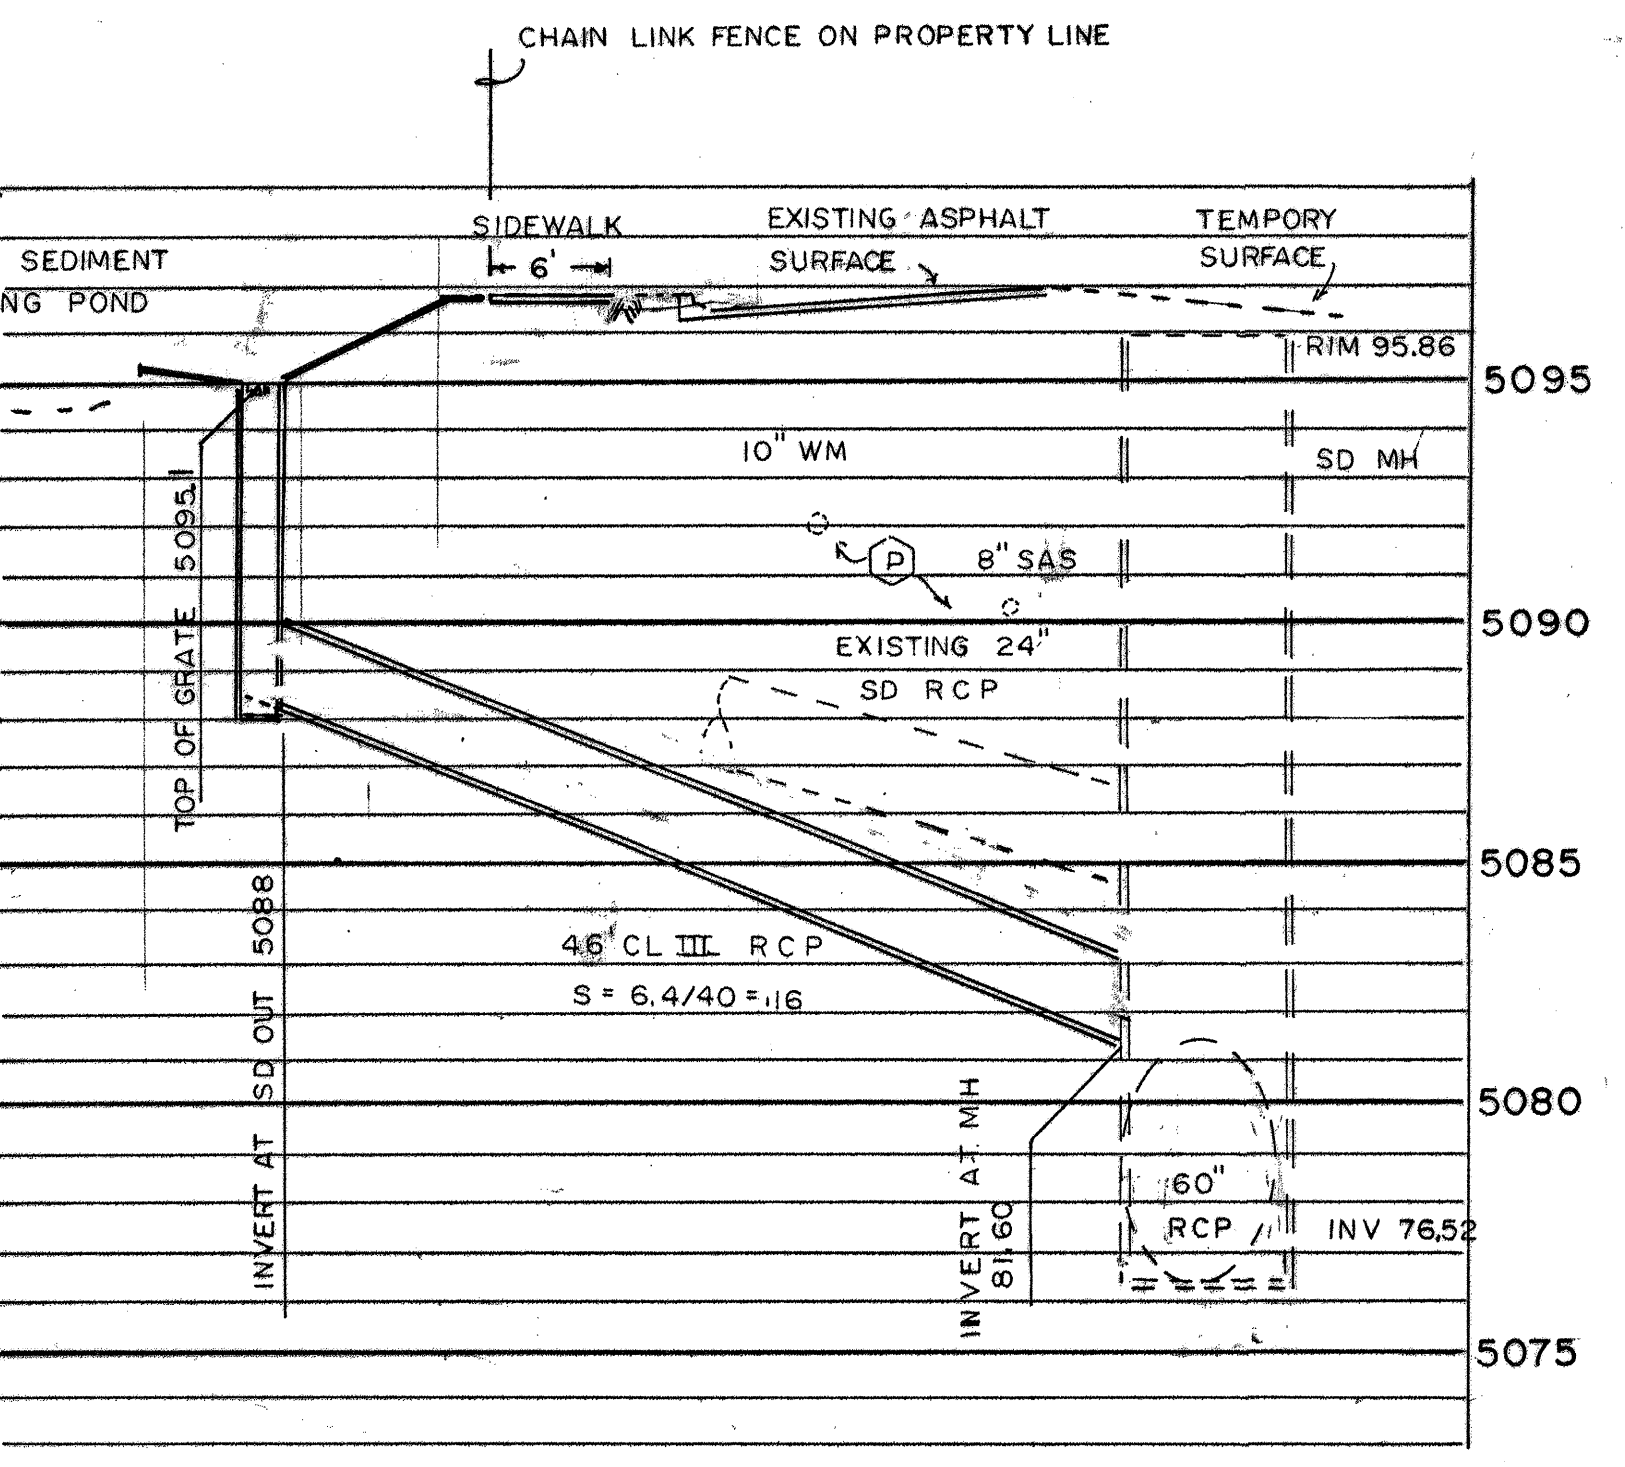

SECTION A-A

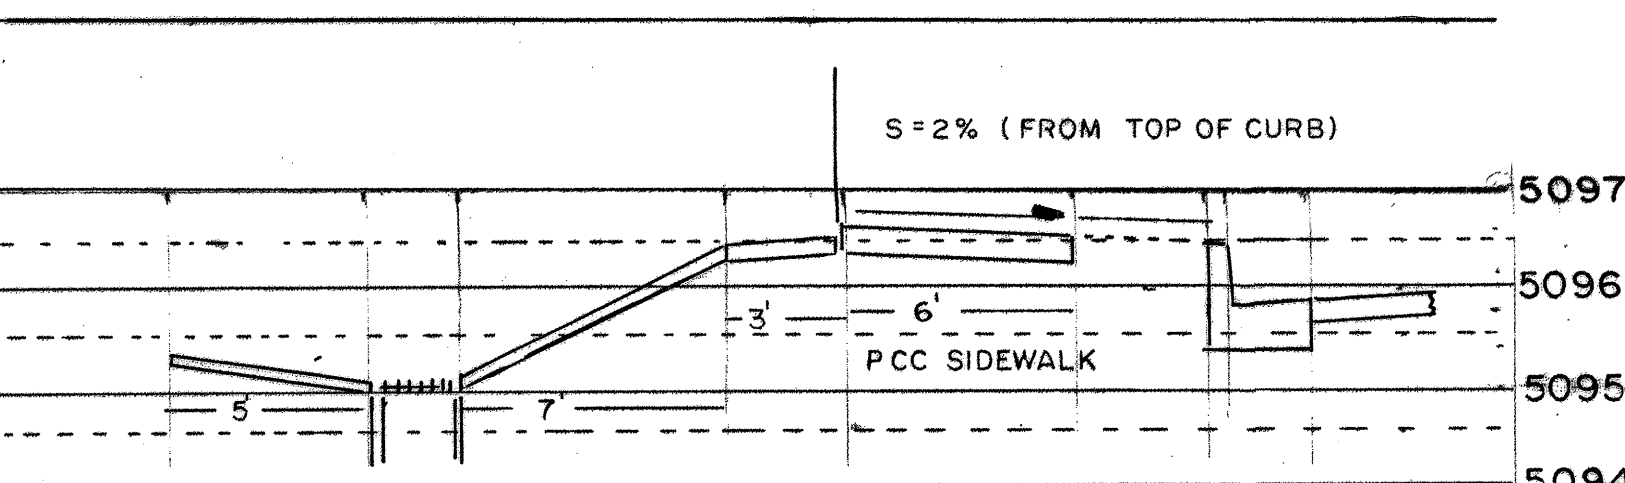

SECTION B-B SURFACE DETAILS

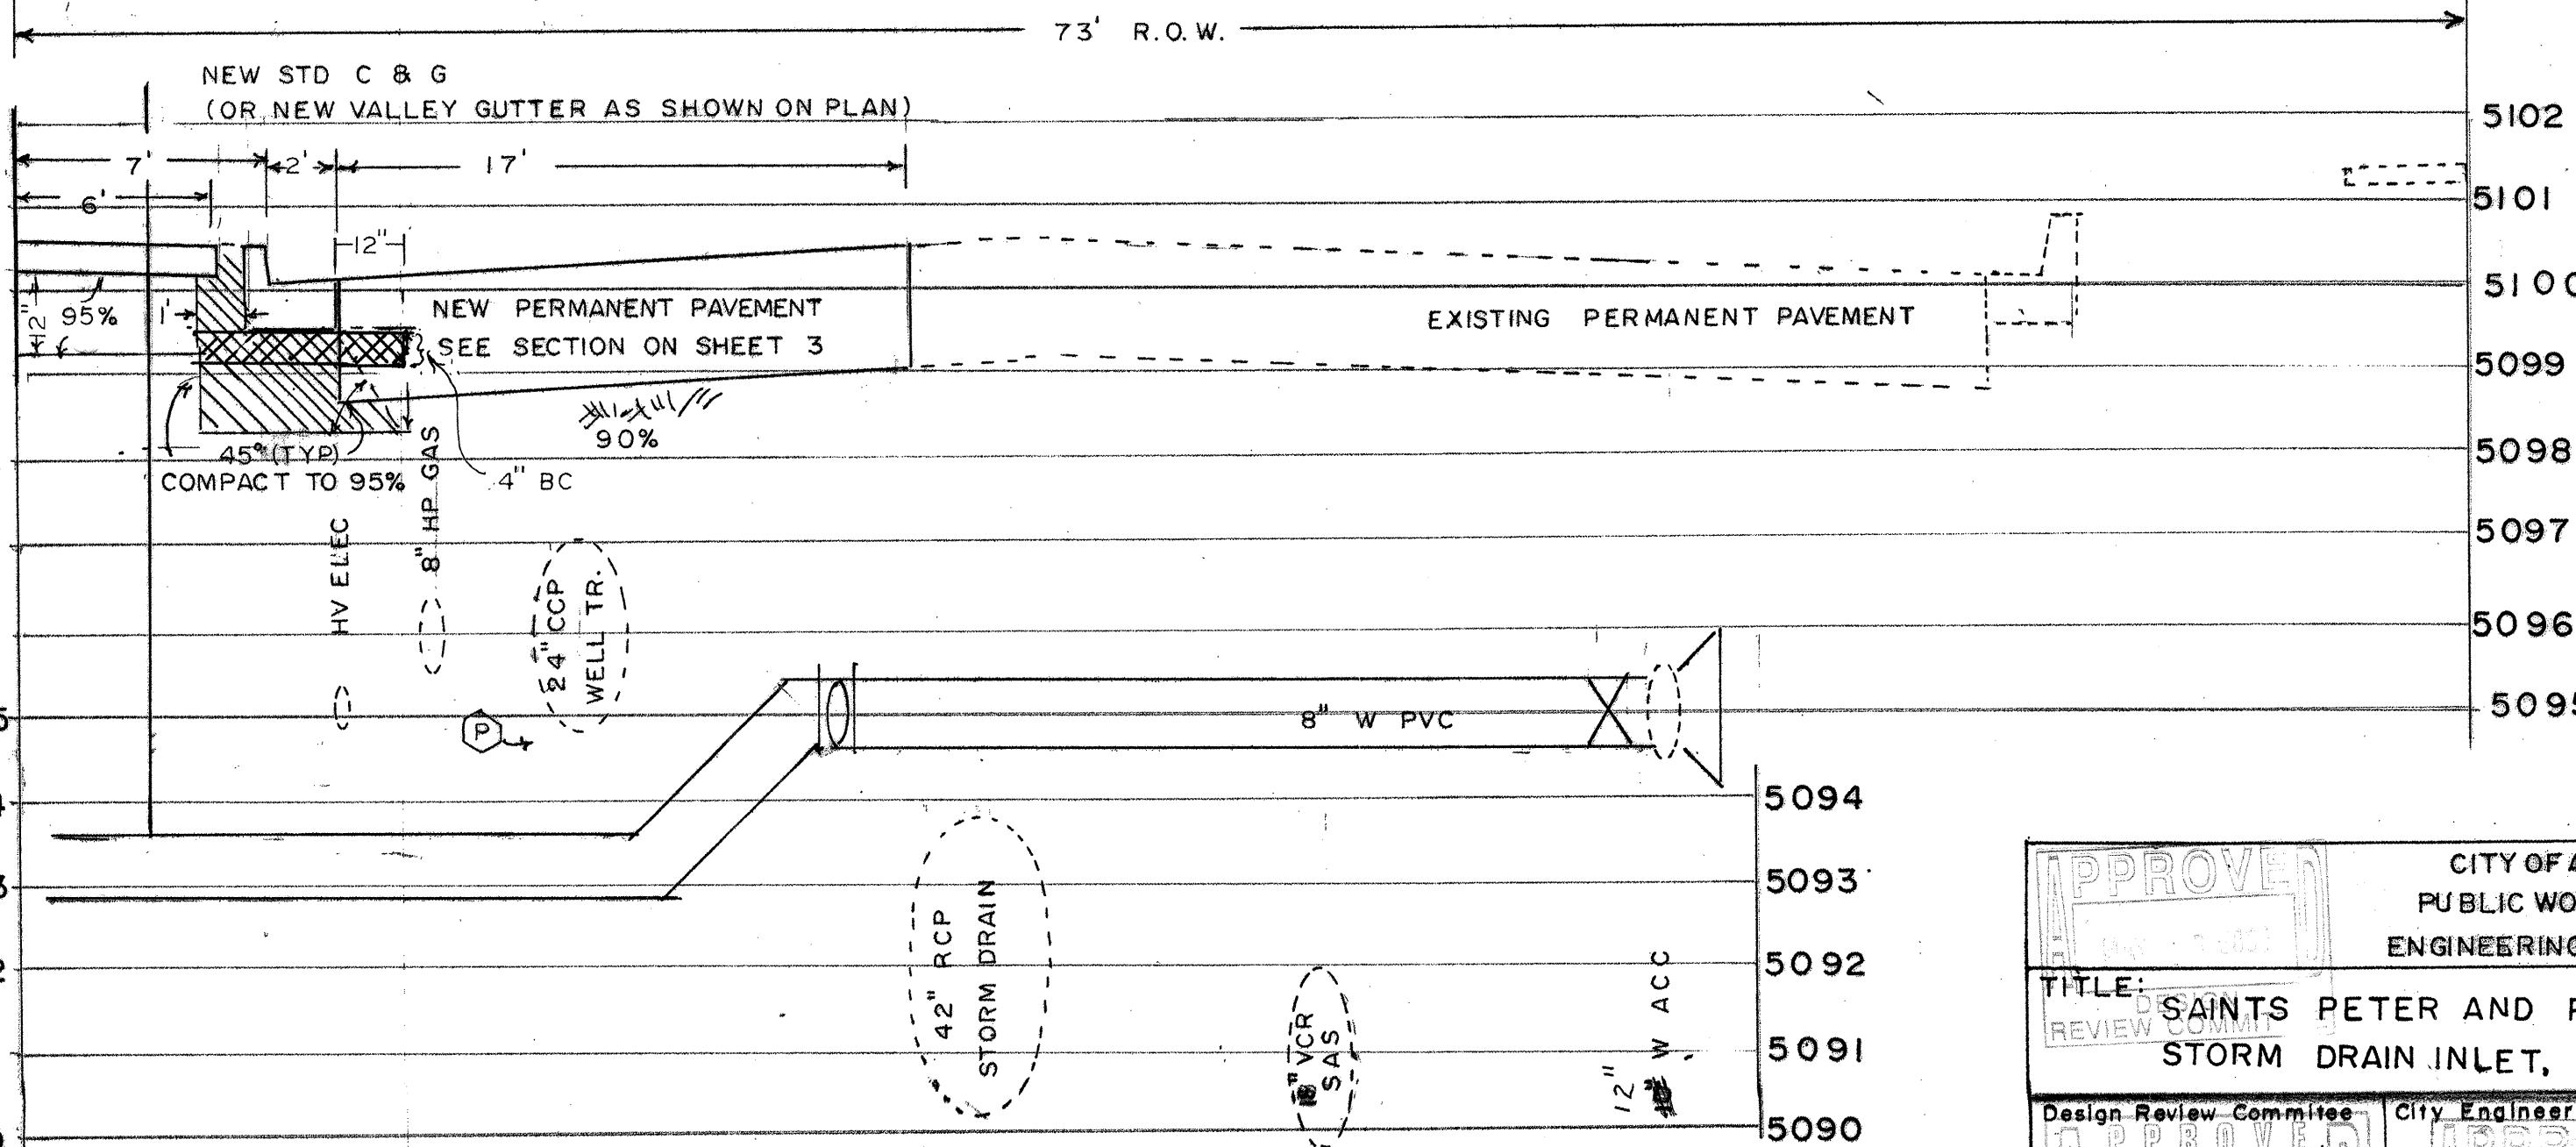

PAVEMENT SECTION WATER LINE CROSSINGS OF OURAY ROAD

VERIFY AND RECORD ALL SUB-SURFACE UTILITIES LOCATIONS
SEE SHEET 3 FOR REQUIRED FITTINGS
FITTINGS ARE DIFFERENT FOR EACH CROSSING

GENERAL NOTES

- VALVE BOX RING AND COVER. SEE DWG 2328.
- 1/2" CHAMFER RING OR CORRUGATED PVC OR PE PIPE WITH SMOOTH INTERIOR.
- NEW OR EXISTING VALVE.
- COMPACTED SUBGRADE. SEE OR BASE COURSE MATERIAL (SEE COMPACTOR, SEE SECTION 701).
- 2'-4'-6" O.D. CONCRETE COLLAR. COLLAR IS TO BE TYPED IN UNITS OF INCHES AND FLUSH IN PAVED ROADWAY. CONCRETE STRENGTH SHALL BE PER SECTION 101 OF THE TRENCHING SPECIFICATIONS.
- TOP OF CONCRETE COLLAR SHALL BE FINISHED WITH LINE AND DIRECTION. MINIMUM LETTER SIZE SHALL BE 2" IN HEIGHT.
- REVISIONS: SEE DWG 2326, COA STD SPECS

GENERAL NOTES - RING

- ALBUQUERQUE VALVE BOX RING DESIGNED TO ACCEPT AN
- THE CASTING NUMBER, MANUFACTURER'S LOGO, DATE OF MANUFACTURE AND "MADE IN" SHALL BE CAST IN A CONSPICUOUS LOCATION ON BOTH THE RING AND THE COVER.
- FILES SHALL BE 1/4" UNLESS OTHERWISE SPECIFIED.
- A DRAFT ANGLE OF 3-5° SHALL BE APPLIED UNLESS OTHERWISE SPECIFIED.
- FINISH: REMOVE EXCESS RIM AND FINISH.
- THIS DETAIL DOES NOT APPLY FOR VALVE BOX RING AND COVER TO BE USED ON HOUSE OR NON-POTABLE OVERSIDE SPECIFIED.

GENERAL NOTES - COVER

- ALBUQUERQUE VALVE BOX COVER DESIGNED TO FIT INTO AN ALBUQUERQUE VALVE BOX RING.
- THE CASTING NUMBER, MANUFACTURER'S LOGO, DATE OF MANUFACTURE AND "MADE IN" SHALL BE CAST IN A CONSPICUOUS LOCATION ON BOTH THE RING AND THE COVER.
- FILES SHALL BE 1/4" UNLESS OTHERWISE SPECIFIED.
- A DRAFT ANGLE OF 3-5° SHALL BE APPLIED UNLESS OTHERWISE SPECIFIED.
- FINISH: REMOVE EXCESS RIM AND FINISH.

ENGINEER'S SEAL				SURVEY INFORMATION		BENCH MARKS		AS BUILT INFORMATION	
MAURICIO R. KORTUM NEW MEXICO 6819 APR 30 2003 REGISTERED PROFESSIONAL ENGINEER APR 31 2003 <i>M. Kortum</i> APR 25 2005 <i>no hole</i>				FIELD NOTES		BENCHMARK:		CONTRACTOR	
				NO. BY DATE		11-HILL, 1989; ELEVATION		CONTRACTOR: 200606 PLUMBING AND	
						5098.514 (1929 DATUM); LOCATED IN		WORK: HEATING & HVAC	
						THE MEDIAN ON CORNS BLVD., .31 MI		INSPECTOR'S NAME: JI	
						SOUTH OF THE INTERSECTION WITH I-40.		DATE: 200605	
NO. DATE		REMARKS		BY		DATE		DATE	
						FIELD		DATE	
						VERIFICATION BY		DATE	
						CORRECTED BY		DATE	
						MICRO-FILM INFORMATION			
DESIGNED BY		M R KORTUM		DATE JAN 31, 2003		RECORDED BY		DATE	
DRAWN BY		M R K		DATE "		NO			
CHECKED BY		M R K		DATE "					