	NEW CURB AND GUTTER & SIDEWALK	(\$)	EX SAS MANHOLE	—8" SAS—	PROPOSED SANITARY SEWER LINE
	EX CURB AND GUTTER & SIDEWALK	S	PROP SAS MANHOLE	SAS	EX SANITARY SEWER LINE
ď.	PROP FIRE HYDRANT	®	PROP WATER METER	——6" W——	PROPOSED WATER LINE
M	PROP WATER VALVE	 \$3	PROPOSED SANITARY SEWER SERVICE	8*W	EX WATER LINE
**************************************	PROPERTY LINE	(S 83 39'25" W)	RECORD BEARING AND DISTANCES	N 00°07'27" W	MEASURED BEARING AND DISTANCES


WATER UTILITY AUTHORITY City/County Government Center One Civic Plaza NW Albuquerque, New Mexico, 87102 289-3040

Sheri Compton 4201 Edith Blvd. NE Mail Stop ES55 Albuquerque, New Mexico 87107 (505) 241-514


NEW MEXICO GAS CO. Albuquerque, New Mexico 87199 (505) 241-7759 / 401-7542 Earl.Hoskins@nmgco.com

OWEST COMMUNICATIONS AT&T 111 Third ST., NW Albuquerque, New Mexico 87103 (505) 842-2806

COMCAST CABLE Robert Martinez 4611 Montbel Pl. NE Albuquerque, NM 87107 (505) 761-6221 Robert_Martinez@cable.comcast.com RECORD

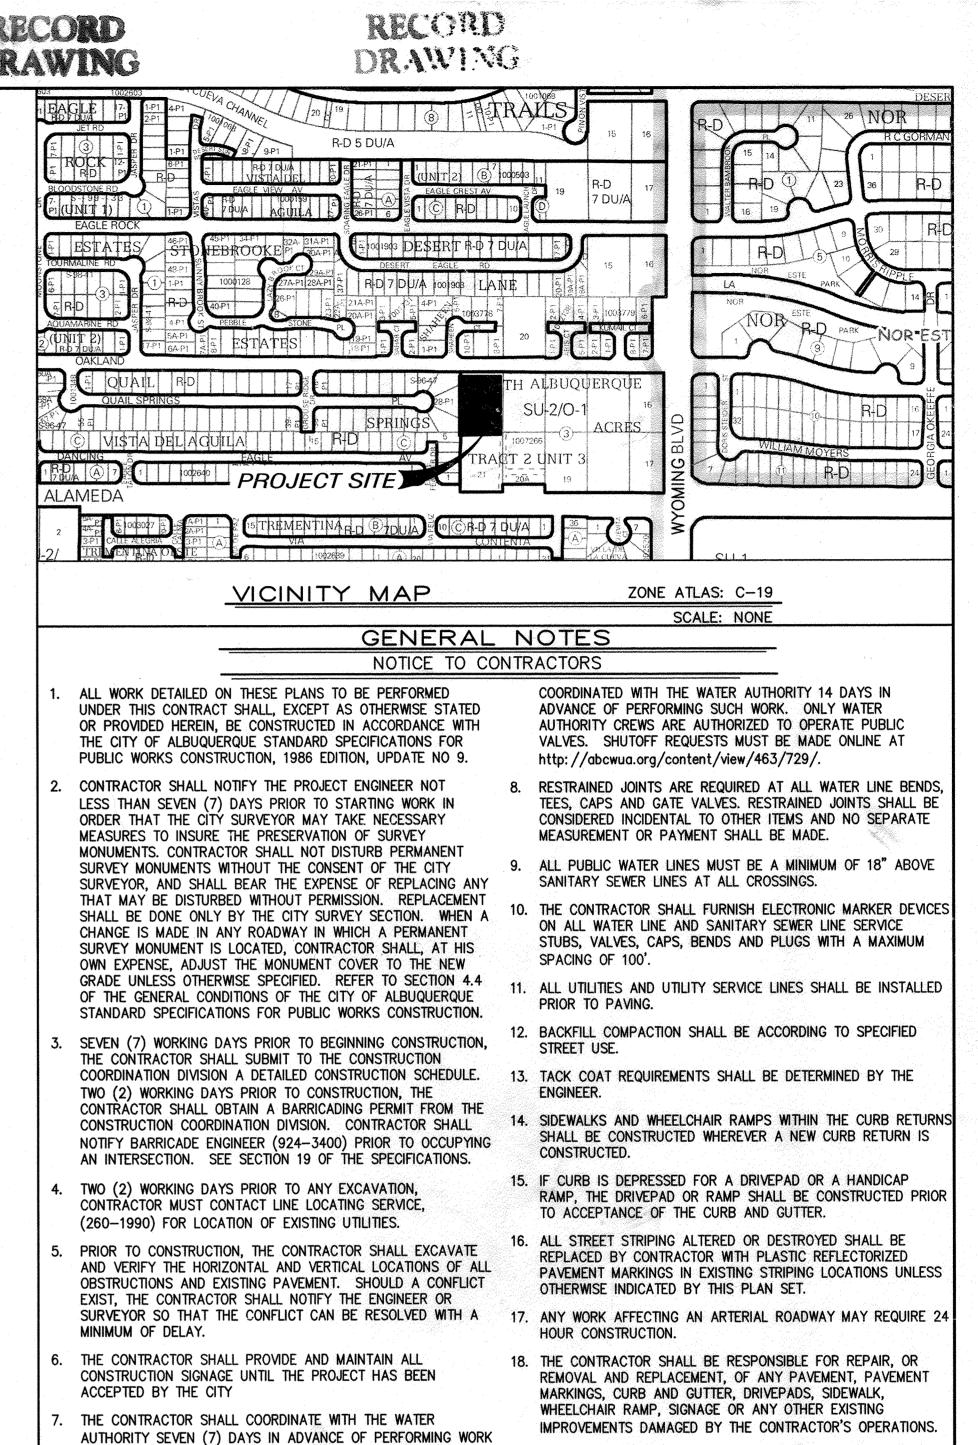

- THAT WILL AFFECT THE PUBLIC WATER OR SANITARY SEWER INFRASTRUCTURE. WORK REQUIRING SHUTOFF OF FACILITIES DESIGNATED AS MASTER PLAN FACILITIES MUST BE
- 19. ALL EXCAVATION, TRENCHING, AND SHORING ACTIVITIES MUST BE CARRIED OUT IN ACCORDANCE WITH OSHA 29 CFR 1926.650 SUB-PART P.

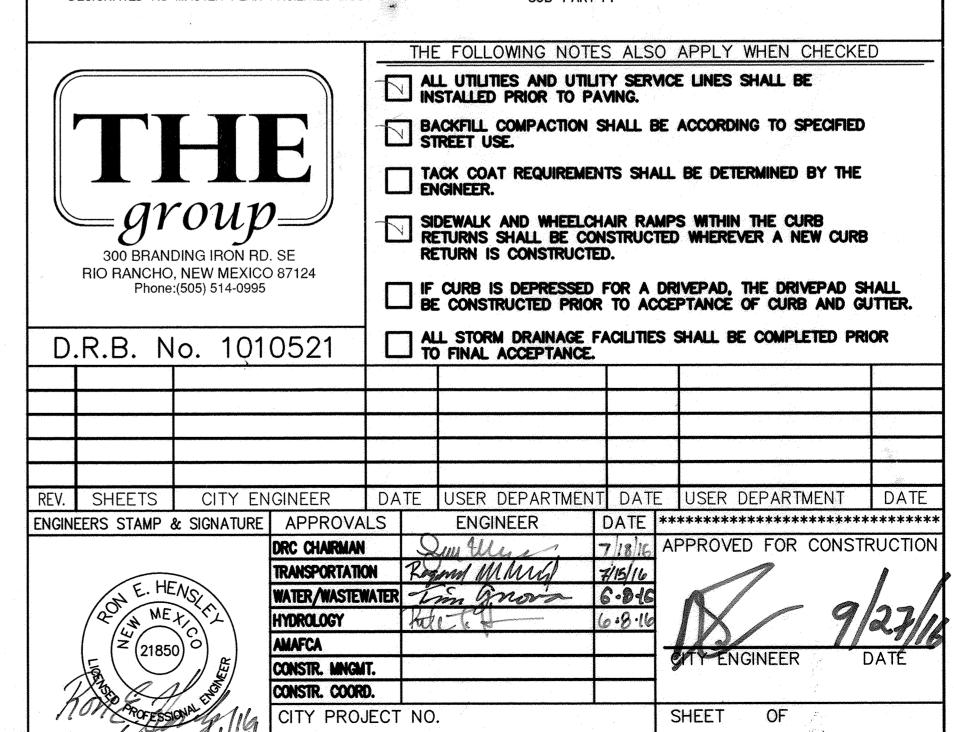

698682

TCC = TOP OF CONCRETE CURB

= UNDERGROUND ELECTRIC

= UNDERGROUND TELEPHONE

TS = TOP OF SIDEWALK

= WATER METER

WV = WATER VALVE

TW = TOP OF WALL


TYP = TYPICAL

UTILITY COMPANY CONTACTS

ALBUQUERQUE BERNALILLO COUNTY

Earl Hoskins P.O. Box 97500

400 Tijeras Ave. NW, Suite 520 Albuquerque, New Mexico 87102 (505) 245-8967

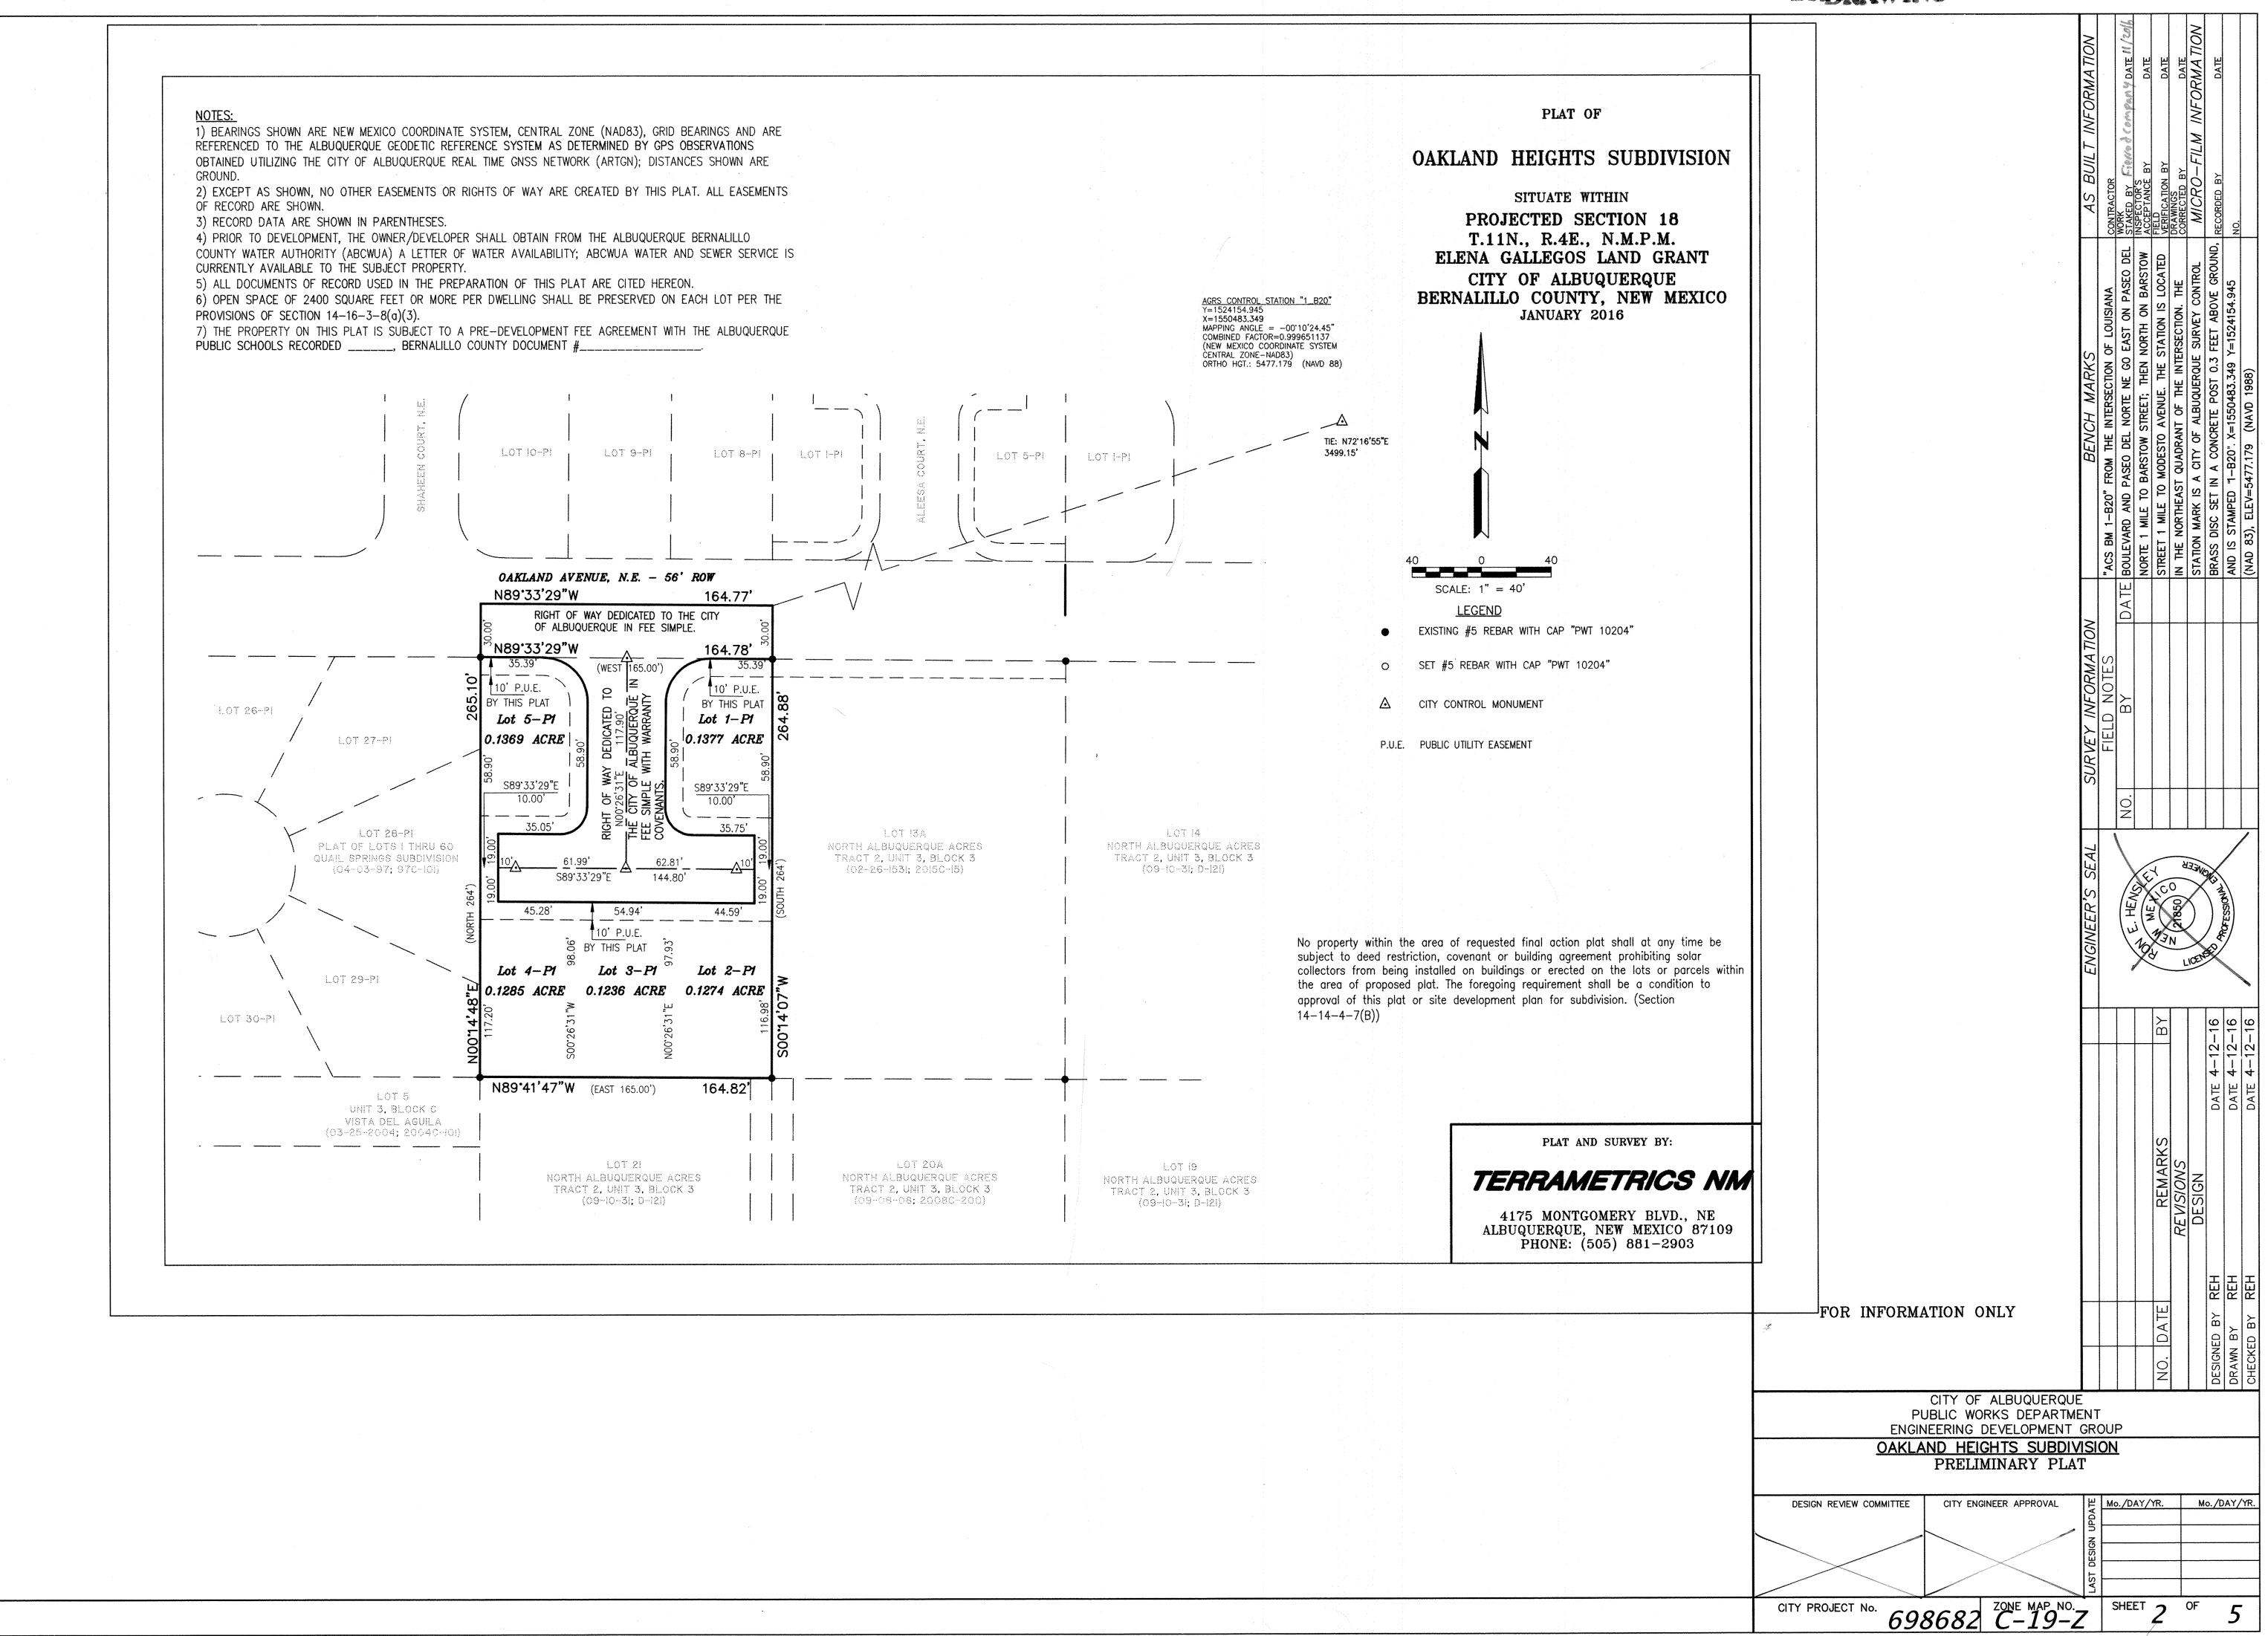

RECORD RECORD

