



CITY OF ALBUQUERQUE
PUBLIC WORKS DEPARTMENT

CONSTRUCTION PLANS
FOR

SEVILLE SUBDIVISION

UNIT 3A

GRADING, PAVING, UTILITIES, & STORM DRAIN

INDEX TO DRAWINGS

SHEET No.	DESCRIPTION
1	COVER
2-4	SUBDIVISION PLAT
5-6	NOT USED
7-8	EROSION CONTROL PLAN
9-11	GRADING PLANS
12	GRADING / RETAINING WALL DETAILS
13	TYPICAL PAVING SECTIONS & PAVING DETAILS
14	COMPOSITE PAVING PLAN
14-A	KAYENTA PAVING PLAN & PROFILE
15	TOLEDO ST. PAVING PLAN & PROFILE
16	PAMPLONA ST. PAVING PLAN & PROFILE
17	BILBAO ST. PAVING PLAN & PROFILE
18	CADIZ ST. PAVING PLAN & PROFILE
19	SORIA AVE. PAVING PLAN & PROFILE
20	ALDEA AVE. PAVING PLAN & PROFILE
21 20-A	SEGOVIA PAVING, UTILITY PLAN & PROFILE
21	PAVON COURT PAVING PLAN & PROFILE

SHEET No.	DESCRIPTION
22	COMPOSITE UTILITY PLAN
23	TOLEDO ST. WATER & SEWER PLAN & PROFILE
24	PAMPLONA ST. WATER & SEWER PLAN & PROFILE
25	BILBAO ST. WATER & SEWER PLAN & PROFILE
26	CADIZ ST. WATER & SEWER PLAN & PROFILE
27	SORIA AVE. WATER & SEWER PLAN & PROFILE
28	ALDEA AVE. WATER & SEWER PLAN & PROFILE
29	PAVON COURT WATER & SEWER PLAN & PROFILE
30	TOLEDO ST. STORM DRAIN PLAN & PROFILE
31	SORIA AVE. STORM DRAIN PLAN & PROFILE
31-A	CADIZ ST. STORM DRAIN PLAN & PROFILE
32	CALABACILLAS ARROYO IMPROVEMENTS
32-A	CALABACILLAS ARROYO SLOPE STABILIZATION PLAN & PROFILE
32-B	CALABACILLAS ARROYO SLOPE STABILIZATION DETAILS

CERTIFICATE OF SUBSTANTIAL COMPLIANCE ON PLANS

I, Chris A. Perea, of the firm of Wilson & Company, A Registered Professional Engineer in the state of New Mexico, do hereby certify, to the best of my knowledge and belief, that the infrastructure installed as part of the project has been inspected by me or by a qualified person under my direct supervision and has been constructed in accordance with the plans and specifications approved by the city engineer and that the original design intent of the approved plans has been met, except as noted by me on the as-built construction drawings. This certification is based on the site inspections by me or personnel under my direction and survey information provided by Russ P. Hugg, NMPS number 9750.



NOTE

THE ENGINEER HAS UNDERTAKEN LIMITED FIELD VERIFICATION OF THE LOCATION, DEPTH, SIZE, OR TYPE OF EXISTING UNDERGROUND UTILITY LINES. MAKES NO REPRESENTATION PERTAINING THERETO AND ASSUMES NO RESPONSIBILITY OR LIABILITY THEREFORE. THE CONTRACTOR SHALL INFORM ITSELF OF THE LOCATION OF ANY UTILITY LINE IN OR NEAR THE AREA OF THE WORK IN ADVANCE OF AND DURING EXCAVATION WORK. THE CONTRACTOR IS FULLY RESPONSIBLE FOR ANY AND ALL DAMAGE CAUSED BY ITS FAILURE TO LOCATE, IDENTIFY, AND PRESERVE ANY AND ALL EXISTING UTILITIES. THE CONTRACTOR SHALL COMPLY WITH STATE STATUTES, MUNICIPAL AND LOCAL ORDINANCES, RULES AND REGULATIONS PERTAINING TO THE LOCATION OF THESE LINES AND FACILITIES IN PLANNING AND CONDUCTING EXCAVATION, WHETHER BY CALLING OR NOTIFYING THE UTILITIES, COMPLYING WITH "BLUE STAKES" PROCEDURES, OR OTHERWISE.

NOTE

THESE DRAWINGS DO NOT INCLUDE NECESSARY COMPONENTS FOR CONSTRUCTION SAFETY WHICH SHALL REMAIN THE RESPONSIBILITY OF THE CONTRACTOR.

NOTE

THIS DOCUMENT, AND THE IDEAS AND DESIGNS INCORPORATED HEREIN, ARE INTENDED FOR USE ON THIS PROJECT AND IS NOT TO BE USED, IN WHOLE OR IN PART, FOR ANY OTHER PROJECT WITHOUT THE WRITTEN AUTHORIZATION OF WILSON & COMPANY, IN THE EVENT OF UNAUTHORIZED USE, THE USER ASSUMES ALL RESPONSIBILITY AND LIABILITY WHICH RESULTS.


SURVEYORS CERTIFICATION

I, Russ P. Hugg, New Mexico Professional Surveyor Number 9750, hereby certify that the as-built information shown hereon is the result of an actual field survey performed by me or under my direct supervision and that the same is true and correct to the best of my knowledge and belief.

Russ P. Hugg
NMPS No. 9750
12-2-05




RECORD DRAWING
DATE 12-02-05

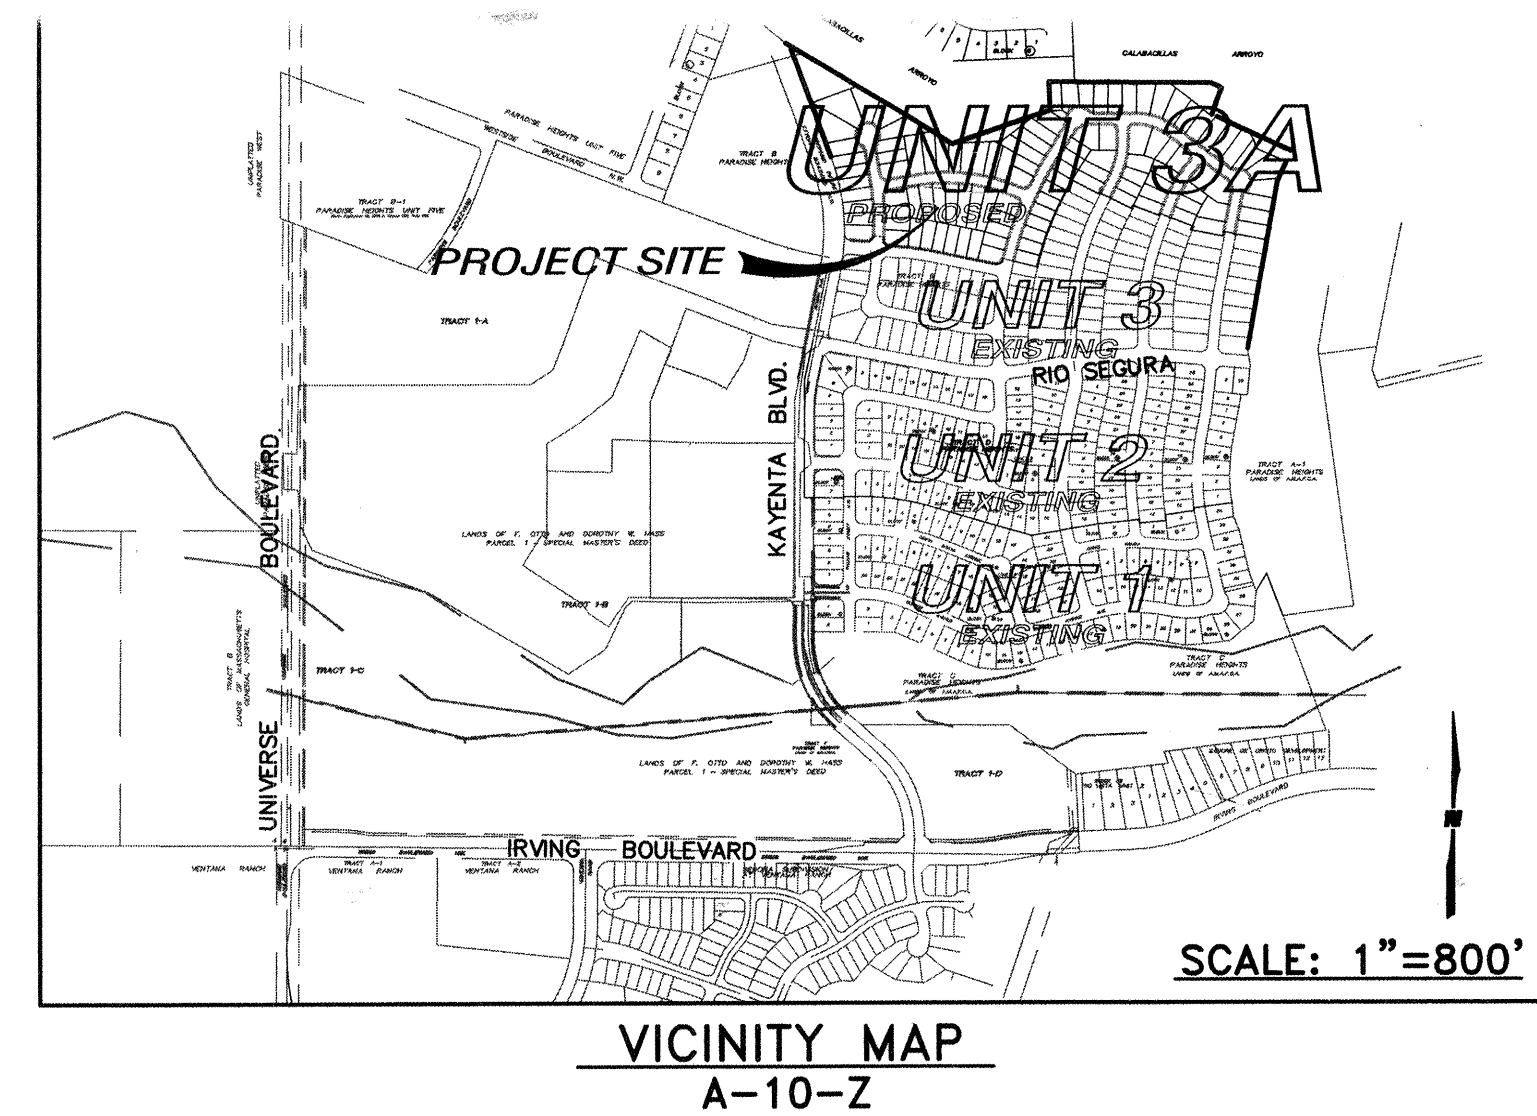

GENERAL NOTES

- ALL WORK DETAILED ON THESE PLANS TO BE PERFORMED UNDER THIS CONTRACT SHALL, EXCEPT AS OTHERWISE STATED OR PROVIDED HEREIN, BE CONSTRUCTED IN ACCORDANCE WITH THE CITY OF ALBUQUERQUE STANDARD SPECIFICATIONS FOR PUBLIC WORKS CONSTRUCTION, 2003 EDITION AS AMENDED THRU UPDATE NO. 7.
- CONTRACTOR SHALL NOTIFY THE PROJECT ENGINEER NOT LESS THAN SEVEN (7) DAYS PRIOR TO STARTING WORK IN ORDER THAT THE ENGINEER MAY TAKE NECESSARY MEASURES TO INSURE THE PRESERVATION OF SURVEY MONUMENTS. CONTRACTOR SHALL NOT DISTURB PERMANENT SURVEY MONUMENTS WITHOUT THE CONSENT OF THE ENGINEER, AND SHALL BEAR THE EXPENSE OF REPLACING ANY THAT MAY BE DISTURBED WITHOUT PERMISSION. REPLACEMENT SHALL BE DONE ONLY BY THE CITY SURVEY SECTION. WHEN A CHANGE IS MADE IN ANY ROADWAY IN WHICH A PERMANENT SURVEY MONUMENT IS LOCATED, CONTRACTOR SHALL, AT HIS OWN EXPENSE, ADJUST THE MONUMENT COVER TO THE NEW GRADE UNLESS OTHERWISE SPECIFIED. REFER TO SECTION 4.4 OF GENERAL CONDITIONS OF THE CITY OF ALBUQUERQUE STANDARD SPECIFICATIONS FOR PUBLIC WORKS CONSTRUCTION.
- FIVE (5) WORKING DAYS PRIOR TO BEGINNING CONSTRUCTION, THE CONTRACTOR SHALL SUBMIT TO THE CONSTRUCTION COORDINATION DIVISION A DETAILED CONSTRUCTION SCHEDULE. TWO (2) WORKING DAYS PRIOR TO CONSTRUCTION, THE CONTRACTOR SHALL OBTAIN A BARRICADE PERMIT FROM THE CONSTRUCTION COORDINATION DIVISION. CONTRACTOR SHALL NOTIFY BARRICADE ENGINEER (924-3200) PRIOR TO OCCUPYING AN INTERSECTION. SEE SECTION 19 OF THE SPECIFICATIONS.
- TWO (2) WORKING DAYS PRIOR TO ANY EXCAVATION, CONTRACTOR MUST CONTACT NEW MEXICO ONE CALL SYSTEM, INC. (260-1990) FOR LOCATION OF EXISTING UTILITIES.
- PRIOR TO CONSTRUCTION, THE CONTRACTOR SHALL EXCAVATE AND VERIFY THE HORIZONTAL AND VERTICAL LOCATIONS OF ALL OBSTRUCTIONS AND EXISTING PAVEMENT. SHOULD A CONFLICT EXIST, THE CONTRACTOR SHALL NOTIFY THE ENGINEER OR SURVEYOR SO THAT THE CONFLICT CAN BE RESOLVED WITH A MINIMUM OF DELAY.
- ALL UTILITY WORK SHALL BE CONSTRUCTED IN ACCORDANCE WITH NEW MEXICO UTILITIES, INC. SPECIFICATIONS FOR WATER AND WASTE WATER FACILITIES (MOST RECENT REVISIONS).
- THE CONTRACTOR SHALL NOTIFY NEW MEXICO UTILITIES (898-2661) THREE WORKING DAYS PRIOR TO BEGINNING THE CONSTRUCTION OF THE UTILITIES.
- THE PUBLIC WATER LINE MUST BE A MINIMUM OF 18" ABOVE THE SEWER LINE AT ALL CROSSINGS.
- THE CONTRACTOR SHALL FURNISH EMD'S ON ALL WATER AND SEWER SERVICE STUBS, CAPS AND PLUGS.
- ALL UTILITIES AND UTILITY SERVICE LINES SHALL BE INSTALLED PRIOR TO PAVING.
- BACKFILL COMPACTION SHALL BE ACCORDING TO SPECIFIED STREET USE.
- TACK COAT REQUIREMENTS SHALL BE DETERMINED BY THE ENGINEER.
- SIDEWALKS AND WHEELCHAIR RAMPS WITHIN THE CURB RETURNS SHALL BE CONSTRUCTED WHEREVER A NEW CURB RETURN IS CONSTRUCTED.
- IF CURB IS DEPRESSED FOR A DRIVEPAD OR A HANDICAP RAMP, THE DRIVEPAD OR RAMP SHALL BE CONSTRUCTED PRIOR TO ACCEPTANCE OF THE CURB AND GUTTER.
- ALL STREET STRIPING ALTERED OR DESTROYED SHALL BE REPLACED BY CONTRACTOR WITH PLASTIC REFLECTORIZED PAVEMENT MARKINGS IN EXISTING STRIPING LOCATIONS UNLESS OTHERWISE INDICATED BY THIS PLAN SET.
- ANY WORK AFFECTING AN ARTERIAL ROADWAY REQUIRES 24 HOUR CONSTRUCTION.
- THE CONTRACTOR SHALL BE RESPONSIBLE FOR REPAIR, OR REMOVAL AND REPLACEMENT, OF ANY PAVEMENT, PAVEMENT MARKINGS, CURB AND GUTTER, DRIVEPADS, SIDEWALK, WHEELCHAIR RAMP OR ANY OTHER EXISTING IMPROVEMENTS DAMAGED BY THE CONTRACTOR'S OPERATIONS.

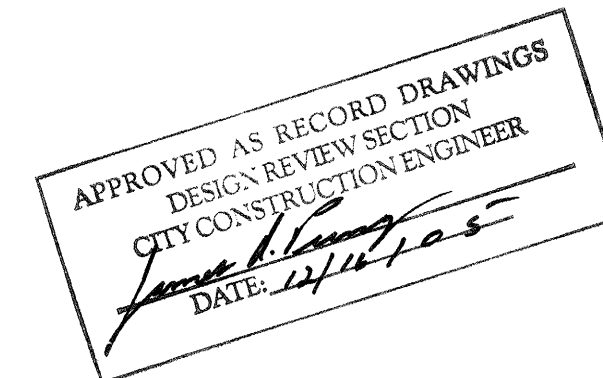

NOTE

APPROVAL SIGNATURES REQUIRED FOR ENTITIES OTHER THAN CITY OF ALBUQUERQUE ARE PROVIDED ON INDIVIDUAL SHEETS.

DRB CASE No. 1003471

WILSON & COMPANY

2600 THE AMERICAN ROAD S.E.
SUITE 100
RIO RANCHO, NEW MEXICO
87124
(505) 898-8021

NEW MEXICO UTILITIES
(Water & Sanitary Sewer)
Bob Gay
4700 Irving Blvd., NW
Suite 201
Albuquerque, New Mexico 87114
(505) 898-2261

PNM ELECTRIC
4201 Edith Blvd. NE
Albuquerque, New Mexico 87107
Rocky Ferran
(505) 241-0525

QWEST
201 3rd Street, NW Suite 700
Albuquerque, New Mexico 87102
David Muller
(505) 245-8706


Comcast Digital Cable
Rita Erickson
4611 Montbel Pl., NE
Albuquerque, NM 87107
(505) 761-8235

AMAPCA
Executive Engineer
John Kelly
2800 Prospect Ave., NE
Albuquerque, New Mexico 87107
(505) 884-2215

PNM GAS
4625 Edith Blvd., NE
Albuquerque, New Mexico 87107
Elizabeth Goble
(505) 241-7745

AT&T
Dave Crowl
111 3rd ST., NW
Albuquerque, New Mexico 87103
(505) 842-2911

--	--	
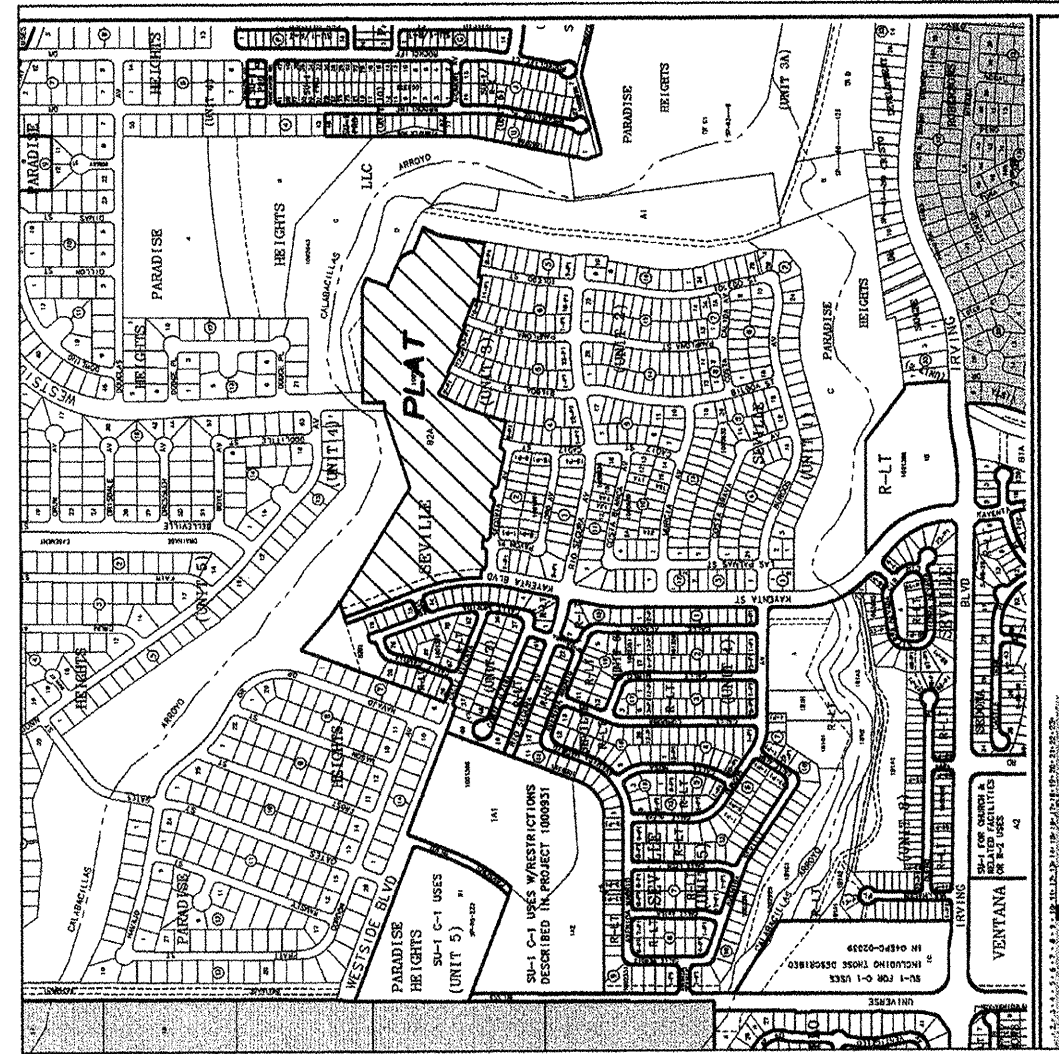

Vicinity Map
N.T.S.

GENERAL NOTES

1. Boundaries are based upon the New Mexico State Plane Survey of 1983, Zone 12N, and are related to grid at the Albuquerque Survey Control Monument "SANDBERN".
2. Distances are ground.
3. Record plot bearings and distances where they differ from those measured by field survey are shown in parentheses ().
4. All corners are a 5/8" rebar and cap stamped "HUGO L.S. 9750" unless otherwise indicated herein.
5. Albuquerque City Zone Atlas page A-10.
6. All street centerline monumentation shall be installed at all centerline P.C.'s, P.T.'s, angle points and street intersections and shown thus. All centerline monumentation will be set by the City of Albuquerque Survey Control Monument "SANDBERN" and will be set flush with the final asphalt lift.
7. Markholes will be offset at all points of curvature, points of tangency, and points of intersection of other angle points to the centerline monumentation.
8. Total number of existing Tracts: 1
9. Total number of Lots created: 105
10. Total number of Tracts created: 3
11. Gross Subdivision acreage: 23.53 acres.
12. Total mileage of full width streets created: 0.52 mile.
13. Current Zoning is R-1.
14. Minimum Lot size is 5,000 square feet.
15. Minimum Lot width is 50' feet.
16. U.C.L.S. Log Number: _____

SHEET INDEX

- Approvals, General Notes, Etc.:
SHEET 1 OF 6 -
SHEET 2 OF 6 -
Overall Bulk Plat Boundary
SHEET 3 OF 6 -
West 1/3 of Unit 3-A Subdivision Plat
SHEET 4 OF 6 -
North 1/3 of Unit 3-A Subdivision Plat
SHEET 5 OF 6 -
East 1/3 of Unit 3-A Subdivision Plat
SHEET 6 OF 6 -
Curve and Line Tables

040484_FINAL PLAT-SHT2.DWG

SEVILLE SUBDIVISION UNIT 3-A

(BEING A REPLAT OF TRACT B-2-A, SEVILLE)

WITHIN

THE TOWN OF ALAMEDA GRANT

IN

PROJECTED SECTION 3, TOWNSHIP 11 NORTH, RANGE 2 EAST

NEW MEXICO PRINCIPAL MERIDIAN

CITY OF ALBUQUERQUE

BERNALILLO COUNTY, NEW MEXICO

OCTOBER, 2004

PROJECT NUMBER _____

Application Number: _____

PLAT APPROVAL

Utility Approvals:

PNM Electric Services _____ Date _____

PNM Gas Services _____ Date _____

QWest Corporation _____ Date _____

Comcast _____ Date _____

New Mexico Utilities _____ Date _____

Note: These properties lie within the New Mexico Utilities, PNM Electric Services, PNM Gas Services, QWest Corporation, Comcast, and New Mexico Utilities, and their capabilities are based upon the NMU, Inc. facilities, not the City of Albuquerque.

City Approvals

City Surveyor _____ Date _____

Real Property Division _____ Date _____

Environmental Health Department _____ Date _____

Traffic Engineering, Transportation Division _____ Date _____

Utilities Development _____ Date _____

Parks and Recreation Department _____ Date _____

AMAFCA _____ Date _____

City Engineer _____ Date _____

DRB Chairperson, Planning Department _____ Date _____


SURVEYORS CERTIFICATION

I, Russ P. Hugg, New Mexico Professional Surveyor Number 9750, hereby certify that this plat of survey was prepared by me or under my supervision; that it meets the Standards for Professional Surveyors as set forth in the Rules and Regulations of the State Board of Registration for Professional Engineers and Professional Surveyors; that it meets the minimum requirements of the Albuquerque Subdivision Ordinance; that it shows all easements of record; and that it is true and correct to the best of my knowledge and belief.

Russ P. Hugg, S.D.
September 20, 2004

SURVOTEK, INC.
Consulting Surveyors
5643 Paradise Blvd., N.W. Albuquerque, New Mexico 87114
Phone: 505-897-3966
Fax: 505-897-3577

SHEET 1 OF 6

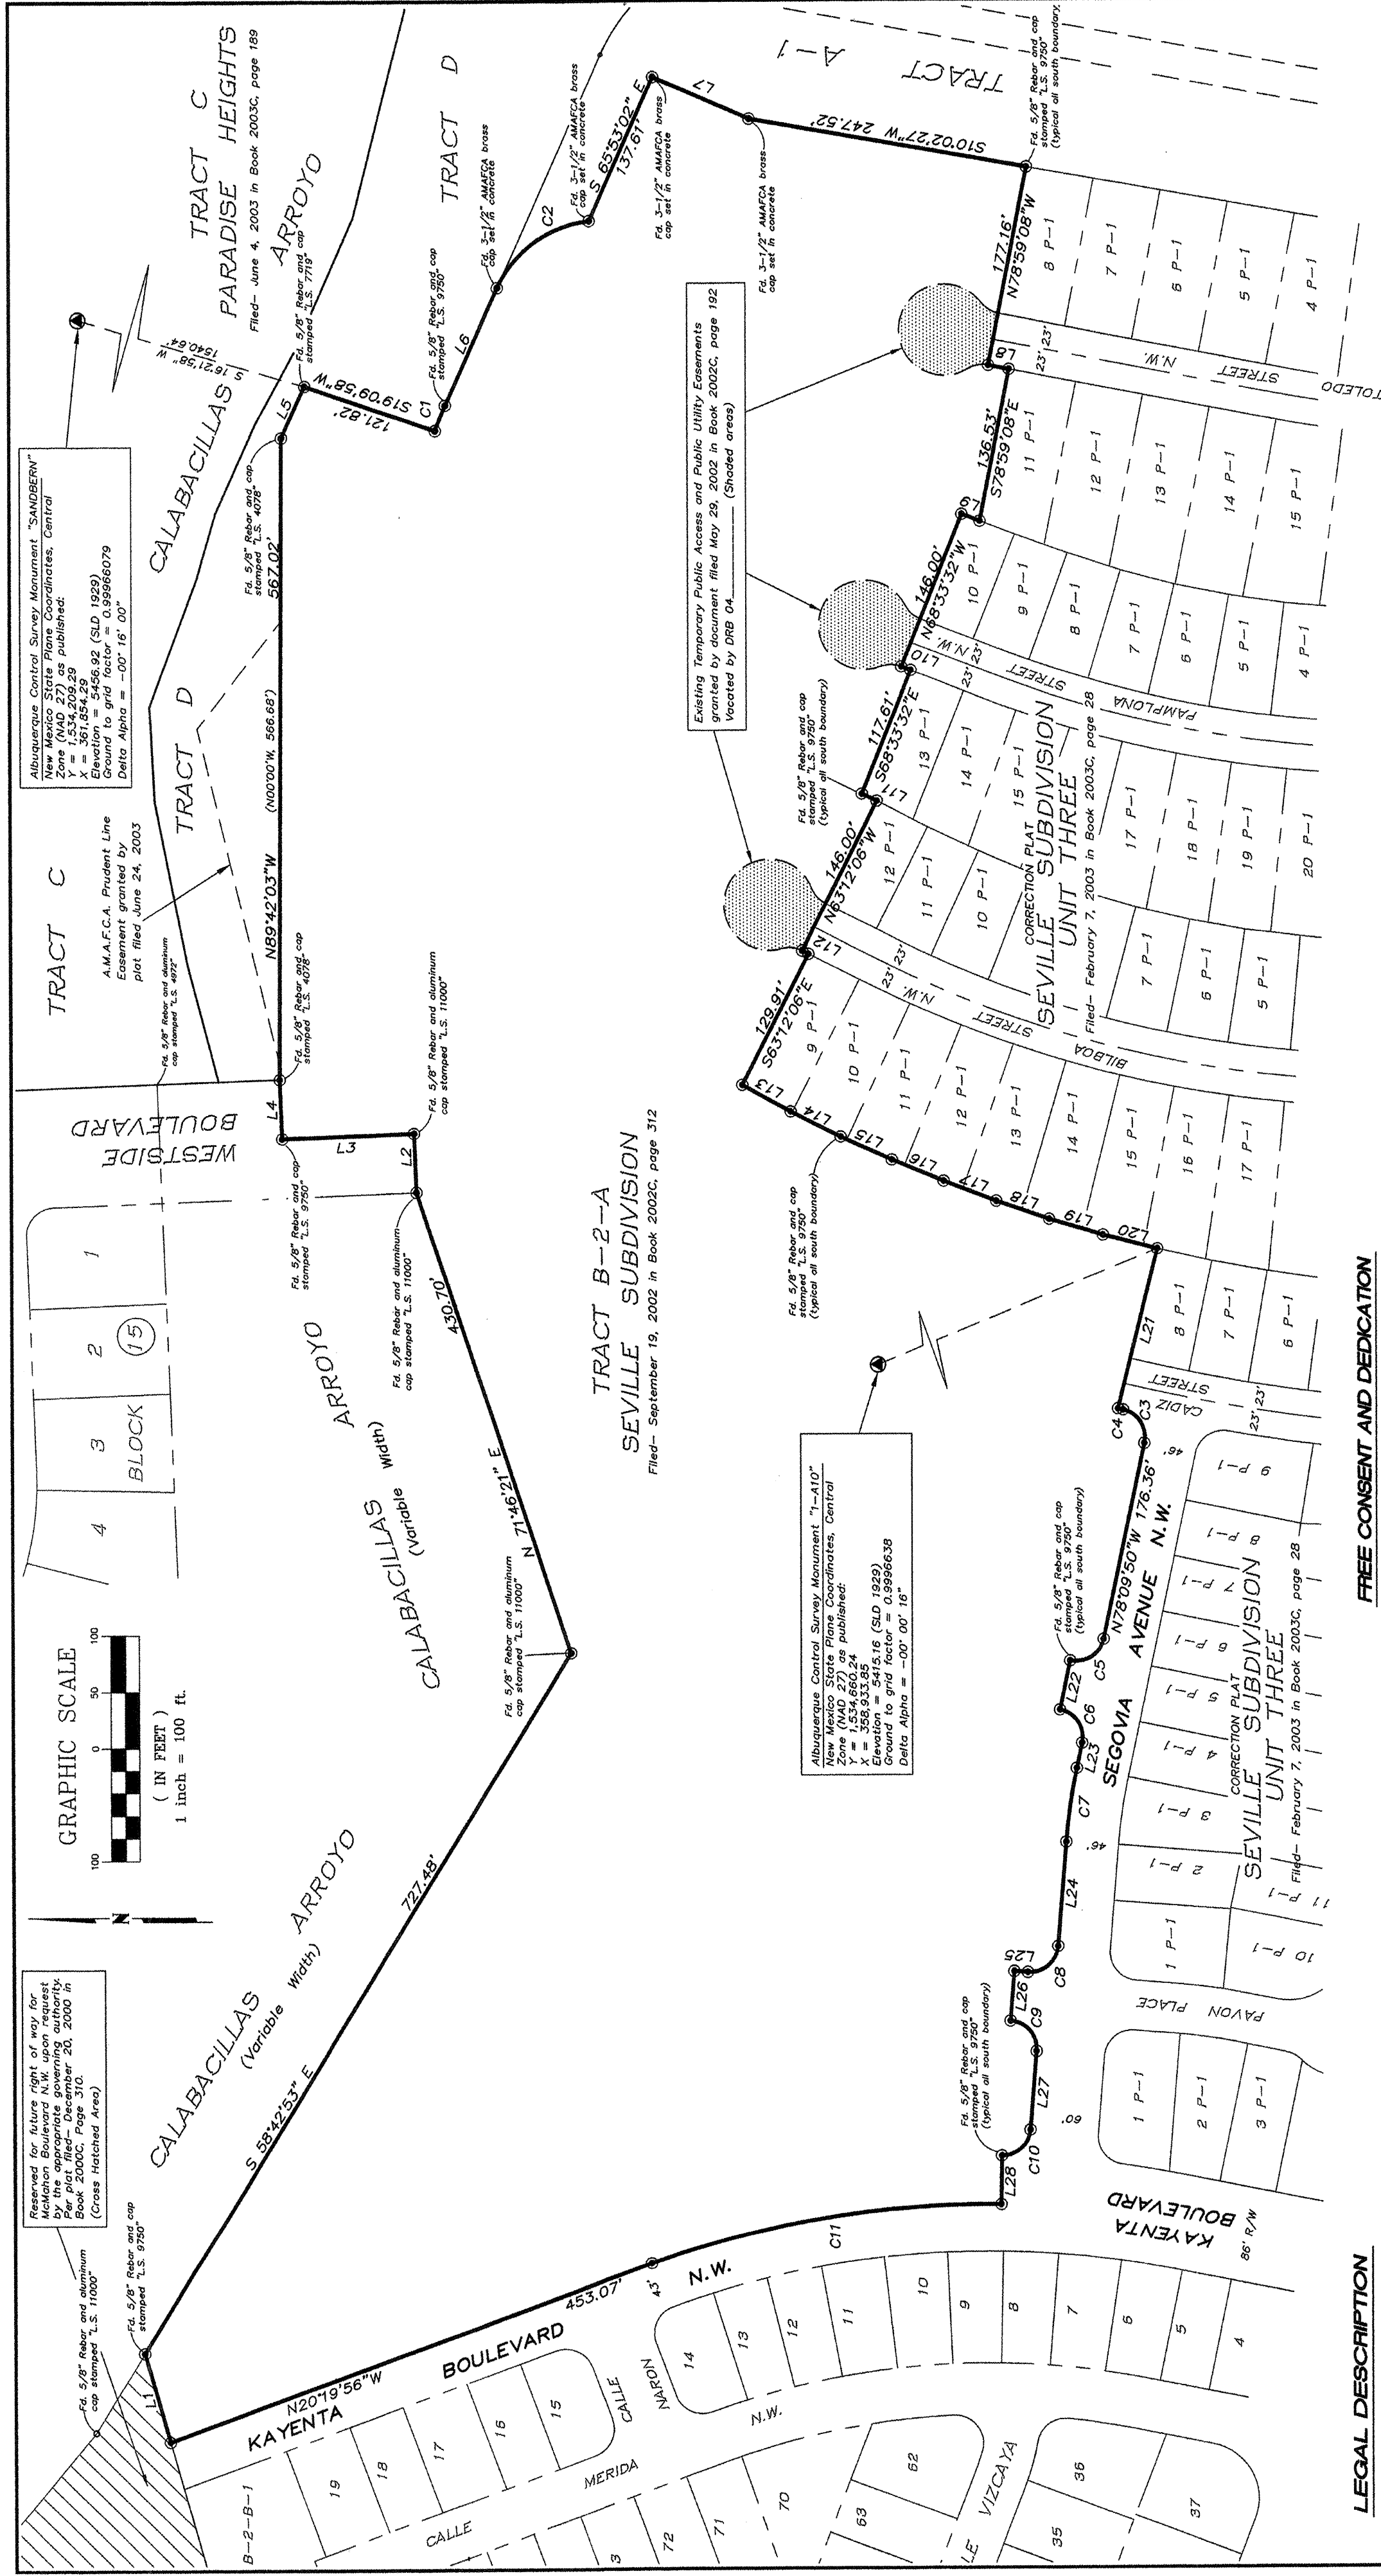

LEGAL DESCRIPTION

That certain parcel of land situated within the Town of Alameda Grant in projected Section 3, Township 11 North, Range 2 East, East 1/4 of Section 3, Township 11 North, Range 2 East, New Mexico, comprising all of Tract B-2-A, SEVILLE as the same is shown and designated on the plat of Tract B-2-A, SEVILLE, and being a replat of Tracts 1-A, 1-B, 1-C, 1-D, 1-E, 1-F, 1-G, 1-H, 1-I, 1-J, 1-K, 1-L, 1-M, 1-N, 1-O, 1-P, 1-Q, 1-R, 1-S, 1-T, 1-U, 1-V, 1-W, 1-X, 1-Y, 1-Z, 1-AA, 1-AB, 1-AC, 1-AD, 1-AE, 1-AF, 1-AG, 1-AH, 1-AI, 1-AJ, 1-AL, 1-AM, 1-AN, 1-AO, 1-AP, 1-AQ, 1-AR, 1-AS, 1-AT, 1-AU, 1-AV, 1-AW, 1-AX, 1-AY, 1-AZ, 1-BA, 1-BB, 1-BC, 1-BD, 1-BE, 1-BF, 1-BG, 1-BH, 1-BI, 1-BJ, 1-BK, 1-BL, 1-BM, 1-BN, 1-BO, 1-BP, 1-BQ, 1-BR, 1-BS, 1-BT, 1-BU, 1-BV, 1-BW, 1-BX, 1-BY, 1-BZ, 1-CA, 1-CB, 1-CC, 1-CD, 1-CE, 1-CF, 1-CG, 1-CH, 1-CI, 1-CJ, 1-CK, 1-CL, 1-CM, 1-CN, 1-CO, 1-CP, 1-CQ, 1-CR, 1-CS, 1-CT, 1-CU, 1-CV, 1-CW, 1-CX, 1-CY, 1-CZ, 1-DA, 1-DB, 1-DC, 1-DD, 1-DE, 1-DF, 1-DG, 1-DH, 1-DI, 1-DJ, 1-DK, 1-DM, 1-DN, 1-DO, 1-DP, 1-DQ, 1-DR, 1-DS, 1-DT, 1-DU, 1-DV, 1-DW, 1-DX, 1-DY, 1-DZ, 1-EA, 1-EB, 1-EC, 1-ED, 1-EE, 1-EF, 1-EG, 1-EH, 1-EI, 1-EJ, 1-EK, 1-EL, 1-EM, 1-EN, 1-EO, 1-EP, 1-EQ, 1-ER, 1-ES, 1-ET, 1-EU, 1-EV, 1-EW, 1-EX, 1-EY, 1-EZ, 1-FA, 1-FB, 1-FC, 1-FD, 1-FE, 1-FG, 1-FH, 1-FI, 1-FJ, 1-FK, 1-FL, 1-FM, 1-FN, 1-FO, 1-FP, 1-FQ, 1-FR, 1-FS, 1-FT, 1-FU, 1-FV, 1-FW, 1-FX, 1-FY, 1-FZ, 1-GA, 1-GB, 1-GC, 1-GD, 1-GE, 1-GF, 1-GG, 1-GH, 1-GI, 1-GJ, 1-GK, 1-GL, 1-GM, 1-GN, 1-GO, 1-GP, 1-GQ, 1-GR, 1-GS, 1-GT, 1-GU, 1-GV, 1-GW, 1-GX, 1-GY, 1-GZ, 1-HA, 1-HB, 1-HC, 1-HD, 1-HE, 1-HF, 1-HG, 1-HH, 1-HI, 1-HJ, 1-HK, 1-HL, 1-HM, 1-HN, 1-HO, 1-HP, 1-HQ, 1-HR, 1-HS, 1-HT, 1-HU, 1-HV, 1-HW, 1-HX, 1-HY, 1-HZ, 1-IA, 1-IB, 1-IC, 1-ID, 1-IE, 1-IF, 1-IG, 1-IH, 1-II, 1-IJ, 1-IK, 1-IL, 1-IM, 1-IN, 1-IO, 1-IP, 1-IQ, 1-IR, 1-IS, 1-IT, 1-IU, 1-IV, 1-IW, 1-IX, 1-IY, 1-IZ, 1-JA, 1-JB, 1-JC, 1-JD, 1-JE, 1-JF, 1-JG, 1-JH, 1-JI, 1-JJ, 1-JK, 1-JL, 1-JM, 1-JN, 1-JO, 1-JP, 1-JQ, 1-JR, 1-JS, 1-JT, 1-JU, 1-JV, 1-JW, 1-JX, 1-JY, 1-JZ, 1-KA, 1-KB, 1-KC, 1-KD, 1-KE, 1-KF, 1-KG, 1-KH, 1-KI, 1-KJ, 1-KK, 1-KL, 1-KM, 1-KN, 1-KO, 1-KP, 1-KQ, 1-KR, 1-KS, 1-KT, 1-KU, 1-KV, 1-KW, 1-KX, 1-KY, 1-KZ, 1-LA, 1-LB, 1-LC, 1-LD, 1-LE, 1-LF, 1-LG, 1-LH, 1-LI, 1-LJ, 1-LK, 1-LL, 1-LM, 1-LN, 1-LO, 1-LP, 1-LQ, 1-LR, 1-LS, 1-LT, 1-LU, 1-LV, 1-LW, 1-LX, 1-LY, 1-LZ, 1-MA, 1-MB, 1-MC, 1-MD, 1-ME, 1-MF, 1-MG, 1-MH, 1-MI, 1-MJ, 1-MK, 1-ML, 1-MN, 1-MO, 1-MP, 1-MQ, 1-MR, 1-MS, 1-MT, 1-MU, 1-MV, 1-MW, 1-MX, 1-MY, 1-MZ, 1-NA, 1-NB, 1-NC, 1-ND, 1-NE, 1-NF, 1-NG, 1-NH, 1-NI, 1-NJ, 1-NK, 1-NL, 1-NM, 1-NO, 1-NP, 1-NQ, 1-NR, 1-NS, 1-NT, 1-NU, 1-NV, 1-NW, 1-NX, 1-NY, 1-NZ, 1-OA, 1-OB, 1-OC, 1-OD, 1-OE, 1-OF, 1-OG, 1-OH, 1-OI, 1-OJ, 1-OK, 1-OL, 1-OM, 1-ON, 1-OO, 1-OP, 1-OQ, 1-OR, 1-OS, 1-OT, 1-OU, 1-OV, 1-OW, 1-OX, 1-OY, 1-OZ, 1-PA, 1-PB, 1-PC, 1-PD, 1-PE, 1-PF, 1-PG, 1-PH, 1-PI, 1-PJ, 1-PK, 1-PL, 1-PM, 1-PN, 1-PO, 1-PP, 1-PQ, 1-PR, 1-PS, 1-PT, 1-PU, 1-PV, 1-PW, 1-PX, 1-PY, 1-PZ, 1-QA, 1-QB, 1-QC, 1-QD, 1-QE, 1-QF, 1-QG, 1-QH, 1-QI, 1-QJ, 1-QK, 1-QL, 1-QM, 1-QN, 1-QO, 1-QP, 1-QQ, 1-QR, 1-QS, 1-QT, 1-QU, 1-QV, 1-QW, 1-QX, 1-QY, 1-QZ, 1-RA, 1-RB, 1-RC, 1-RD, 1-RE, 1-RF, 1-RG, 1-RH, 1-RI, 1-RJ, 1-RK, 1-RL, 1-RM, 1-RN, 1-RO, 1-RP, 1-RQ, 1-RR, 1-RS, 1-RT, 1-RU, 1-RV, 1-RW, 1-RX, 1-RY, 1-RZ, 1-SA, 1-SB, 1-SC, 1-SD, 1-SE, 1-SF, 1-SG, 1-SH, 1-SI, 1-SJ, 1-SK, 1-SL, 1-SM, 1-SN, 1-SO, 1-SP, 1-SQ, 1-SR, 1-SS, 1-ST, 1-SU, 1-SV, 1-SW, 1-SX, 1-SY, 1-SZ, 1-TA, 1-TB, 1-TC, 1-TD, 1-TE, 1-TF, 1-TG, 1-TH, 1-TI, 1-TJ, 1-TK, 1-TL, 1-TM, 1-TN, 1-TO, 1-TP, 1-TQ, 1-TR, 1-TS, 1-TT, 1-TU, 1-TV, 1-TW, 1-TX, 1-TY, 1-TZ, 1-UA, 1-UB, 1-UC, 1-UD, 1-UE, 1-UF, 1-UG, 1-UH, 1-UI, 1-UJ, 1-UK, 1-UL, 1-UM, 1-UN, 1-UO, 1-UP, 1-UQ, 1-UR, 1-US, 1-UT, 1-UT, 1-UU, 1-UV, 1-UW, 1-UX, 1-UY, 1-UZ, 1-VA, 1-VB, 1-VC, 1-VD, 1-VE, 1-VF, 1-VG, 1-VH, 1-VI, 1-VJ, 1-VK, 1-VL, 1-VM, 1-VN, 1-VO, 1-VP, 1-VQ, 1-VR, 1-VS, 1-VT, 1-VU, 1-VV, 1-VW, 1-VX, 1-VY, 1-VZ, 1-WA, 1-WB, 1-WC, 1-WD, 1-WE, 1-WF, 1-WG, 1-WH, 1-WI, 1-WJ, 1-WK, 1-WL, 1-WM, 1-WN, 1-WO, 1-WP, 1-WQ, 1-WR, 1-WS, 1-WT, 1-WU, 1-WV, 1-WW, 1-WX, 1-WY, 1-WZ, 1-XA, 1-XB, 1-XC, 1-XD, 1-XE, 1-XF, 1-XG, 1-XH, 1-XI, 1-XJ, 1-XK, 1-XL, 1-XM, 1-XN, 1-XO, 1-XP, 1-XQ, 1-XR, 1-XS, 1-XT, 1-XU, 1-XV, 1-XW, 1-XX, 1-XY, 1-XZ, 1-YA, 1-YB, 1-YC, 1-YD, 1-YE, 1-YF, 1-YG, 1-YH, 1-YI, 1-YJ, 1-YK, 1-YL, 1-YM, 1-YN, 1-YO, 1-YP, 1-YQ, 1-YR, 1-YS, 1-YT, 1-YU, 1-YV, 1-YW, 1-YX, 1-YZ, 1-ZA, 1-ZB, 1-ZC, 1-ZD, 1-ZE, 1-ZF, 1-ZG, 1-ZH, 1-ZI, 1-ZJ, 1-ZK, 1-ZL, 1-ZM, 1-ZN, 1-ZO, 1-ZP, 1-ZQ, 1-ZR, 1-ZS, 1-ZT, 1-ZU, 1-ZV, 1-ZW, 1-ZX, 1-ZY, 1-ZZ, 1-AA, 1-AB, 1-AC, 1-AD, 1-AE, 1-AF, 1-AG, 1-AH, 1-AI, 1-AJ, 1-AL, 1-AM, 1-AN, 1-AO, 1-AP, 1-AQ, 1-AR, 1-AS, 1-AT, 1-AU, 1-AV, 1-AW, 1-AX, 1-AY, 1-AZ, 1-BA, 1-BB, 1-BC, 1-BD, 1-BE, 1-BF, 1-BG, 1-BH, 1-BI, 1-BJ, 1-BK, 1-BL, 1-BM, 1-BN, 1-BO, 1-BP, 1-BQ, 1-BR, 1-BS, 1-BT, 1-BU, 1-BV, 1-BW, 1-BX, 1-BY, 1-BZ, 1-CA, 1-CB, 1-CC, 1-CD, 1-CE, 1-CF, 1-CG, 1-CH, 1-CI, 1-CJ, 1-CK, 1-CL, 1-CM, 1-CN, 1-CO, 1-CP, 1-CQ, 1-CR, 1-CS, 1-CT, 1-CU, 1-CV, 1-CW, 1-CX, 1-CY, 1-CZ, 1-DA, 1-DB, 1-DC, 1-DD, 1-DE, 1-DF, 1-DG, 1-DH, 1-DI, 1-DJ, 1-DK, 1-DM, 1-DN, 1-DO, 1-DP, 1-DQ, 1-DR, 1-DS, 1-DT, 1-DU, 1-DV, 1-DW, 1-DX, 1-DY, 1-DZ, 1-EA, 1-EB, 1-EC, 1-ED, 1-EE, 1-EF, 1-EG, 1-EH, 1-EI, 1-EJ, 1-EK, 1-EL, 1-EM, 1-EN, 1-EO, 1-EP, 1-EQ, 1-ER, 1-ES, 1-ET, 1-EU, 1-EV, 1-EW, 1-EX, 1-EY, 1-EZ, 1-FA, 1-FB, 1-FC, 1-FD, 1-FE, 1-FG, 1-FH, 1-FI, 1-FJ, 1-FK, 1-FL, 1-FM, 1-FN, 1-FO, 1-FP, 1-FQ, 1-FR, 1-FS, 1-FT, 1-FU, 1-FV, 1-FW, 1-FX, 1-FY, 1-FZ, 1-GA, 1-GB, 1-GC, 1-GD, 1-GE, 1-GF, 1-GG, 1-GH, 1-GI, 1-GJ, 1-GK, 1-GL, 1-GM, 1-GN, 1-GO, 1-GP, 1-GQ, 1-GR, 1-GS, 1-GT, 1-GU, 1-GV, 1-GW, 1-GX, 1-GY, 1-GZ, 1-HA, 1-HB, 1-HC, 1-HD, 1-HE, 1-HF, 1-HG, 1-HH, 1-HI, 1-HJ, 1-HK, 1-HL, 1-HM, 1-HN, 1-HO, 1-HP, 1-HQ, 1-HR, 1-HS, 1-HT, 1-HU, 1-HV, 1-HW, 1-HX, 1-HY, 1-HZ, 1-IA, 1-IB, 1-IC, 1-ID, 1-IE, 1-IF, 1-IG, 1-IH, 1-II, 1-IJ, 1-IK, 1-IL, 1-IM, 1-IN, 1-IO, 1-IP, 1-IQ, 1-IR, 1-IS, 1-IT, 1-IU, 1-IV, 1-IW, 1-IX, 1-IY, 1-IZ, 1-JA, 1-JB, 1-JC, 1-JD, 1-JE, 1-JF, 1-JG, 1-JH, 1-JI, 1-JJ, 1-JK, 1-JL, 1-JM, 1-JN, 1-JO, 1-JP, 1-JQ, 1-JR, 1-JS, 1-JT, 1-JU, 1-JV, 1-JW, 1-JX, 1-JY, 1-JZ, 1-KA, 1-KB, 1-KC, 1-KD, 1-KE, 1-KF, 1-KG, 1-KH, 1-KI, 1-KJ, 1-KK, 1-KL, 1-KM, 1-KN, 1-KO, 1-KP, 1-KQ, 1-KR, 1-KS, 1-KT, 1-KU, 1-KV, 1-KW, 1-KX, 1-KY, 1-KZ, 1-LA, 1-LB, 1-LC, 1-LD, 1-LE, 1-LF, 1-LG, 1-LH, 1-LI, 1-LJ, 1-LK, 1-LL, 1-LM, 1-LN, 1-LO, 1-LP, 1-LQ, 1-LR, 1-LS, 1-LT, 1-LU, 1-LV, 1-LW, 1-LX, 1-LY, 1-LZ, 1-MA, 1-MB, 1-MC, 1-MD, 1-ME, 1-MF, 1-MG, 1-MH, 1-MI, 1-MJ, 1-MK, 1-ML, 1-MN, 1-MO, 1-MP, 1-MQ, 1-MR, 1-MS, 1-MT, 1-MU, 1-MV, 1-MW, 1-MX, 1-MY, 1-MZ, 1-NA, 1-NB, 1-NC, 1-ND, 1-NE, 1-NF, 1-NG, 1-NH, 1-NI, 1-NJ, 1-NK, 1-NL, 1-NM, 1-NO, 1-NP, 1-NQ, 1-NR, 1-NS, 1-NT, 1-NU, 1-NV, 1-NW, 1-NX, 1-NY, 1-NZ, 1-OA, 1-OB, 1-OC, 1-OD, 1-OE, 1-OF, 1-OG, 1-OH, 1-OI, 1-OJ, 1-OK, 1-OL, 1-OM, 1-ON, 1-OO, 1-OP, 1-OQ, 1-OR, 1-OS, 1-OT, 1-OU, 1-OV, 1-OW, 1-OX, 1-OY, 1-OZ, 1-PA, 1-PB, 1-PC, 1-PD, 1-PE, 1-PF, 1-PG, 1-PH, 1-PI, 1-PJ, 1-PK, 1-PL, 1-PM, 1-PN, 1-PO, 1-PP, 1-PQ, 1-PR, 1-PS, 1-PT, 1-PU, 1-PV, 1-PW, 1-PX, 1-PY, 1-PZ, 1-QA, 1-QB, 1-QC, 1-QD, 1-QE, 1-QF, 1-QG, 1-QH, 1-QI, 1-QJ, 1-QK, 1-QL, 1-QM, 1-QN, 1-QO, 1-QP, 1-QQ, 1-QR, 1-QS, 1-QT, 1-QU, 1-QV, 1-QW, 1-QX, 1-QY, 1-QZ, 1-RA, 1-RB, 1-RC, 1-RD, 1-RE, 1-RF, 1-RG, 1-RH, 1-RI, 1-RJ, 1-RK, 1-RL, 1-RM, 1-RN, 1-RO, 1-RP, 1-RQ, 1-RR, 1-RS, 1-RT, 1-RU, 1-RV, 1-RW, 1-RX, 1-RY, 1-RZ, 1-SA, 1-SB, 1-SC, 1-SD, 1-SE, 1-SF, 1-SG, 1-SH, 1-SI, 1-SJ, 1-SK, 1-SL, 1-SM, 1-SN, 1-SO, 1-SP, 1-SQ, 1-SR, 1-SS, 1-ST, 1-SU, 1-SV, 1-SW, 1-SX, 1-SY, 1-SZ, 1-TA, 1-TB, 1-TC, 1-TD, 1-TE, 1-TF, 1-TG, 1-TH, 1-TI, 1-TJ, 1-TK, 1-TL, 1-TM, 1-TN, 1-TO, 1-TP, 1-TQ, 1-TR, 1-TS, 1-TT, 1-TU, 1-TV, 1-TW, 1-TX, 1-TY, 1-TZ, 1-UA, 1-UB, 1-UC, 1-UD, 1-UE, 1-UF, 1-UG, 1-UH, 1-UI, 1-UJ, 1-UK, 1-UL, 1-UM, 1-UN, 1-UO, 1-UP, 1-UQ, 1-UR, 1-US, 1-UT, 1-UT, 1-UU, 1-UV, 1-UW, 1-UX, 1-UY, 1-UZ, 1-VA, 1-VB, 1-VC, 1-VD, 1-VE, 1-VF, 1-VG, 1-VH, 1-VI, 1-VJ, 1-VK, 1-VL, 1-VM, 1-VN, 1-VO, 1-VP, 1-VQ, 1-VR, 1-VS, 1-VT, 1-VU, 1-VV, 1-VW, 1-VX, 1-VY, 1-VZ, 1-WA, 1-WB, 1-WC, 1-WD, 1-WE, 1-WF, 1-WG, 1-WH, 1-WI, 1-WJ, 1-WK, 1-WL, 1-WM, 1-WN, 1-WO, 1-WP, 1-WQ, 1-WR, 1-WS, 1-WT, 1-WU, 1-WV, 1-WW, 1-WX, 1-WY, 1-WZ, 1-XA, 1-XB, 1-XC, 1-XD, 1-XE, 1-XF, 1-XG, 1-XH, 1-XI, 1-XJ, 1-XK, 1-XL, 1-XM, 1-XN, 1-XO, 1-XP, 1-XQ, 1-XR, 1-XS, 1-XT, 1-XU, 1-XV, 1-XW, 1-XX, 1-XY, 1-XZ, 1-YA, 1-YB, 1-YC, 1-YD, 1-YE, 1-YF, 1-YG, 1-YH, 1-YI, 1-YJ, 1-YK, 1-YL, 1-YM, 1-YN, 1-YO, 1-YP, 1-YQ, 1-YR, 1-YS, 1-YT, 1-YU, 1-YV, 1-YW, 1-YX, 1-YZ, 1-ZA, 1-ZB, 1-ZC, 1-ZD, 1-ZE, 1-ZF, 1-ZG, 1-ZH, 1-ZI, 1-ZJ, 1-ZK, 1-ZL, 1-ZM, 1-ZN, 1-ZO, 1-ZP, 1-ZQ, 1-ZR, 1-ZS, 1-ZT, 1-ZU, 1-ZV, 1-ZW, 1-ZX, 1-ZY, 1-ZZ, 1-AA, 1-AB, 1-AC, 1-AD, 1-AE, 1-AF, 1-AG, 1-AH, 1-AI, 1-AJ, 1-AL, 1-AM, 1-AN, 1-AO, 1-AP, 1-AQ, 1-AR, 1-AS, 1-AT, 1-AU, 1-AV, 1-AW, 1-AX, 1-AY, 1-AZ, 1-BA, 1-BB, 1-BC, 1-BD, 1-BE, 1-BF, 1-BG, 1-BH, 1-BI, 1-BJ, 1-BK, 1-BL, 1-BM, 1-BN, 1-BO, 1-BP, 1-BQ, 1-BR, 1-BS, 1-BT, 1-BU, 1-BV, 1-BW, 1-BX, 1-BY, 1-BZ, 1-CA, 1-CB, 1-CC, 1-CD, 1-CE, 1-CF, 1-CG, 1-CH, 1-CI, 1-CJ, 1-CK, 1-CL, 1-CM, 1-CN, 1-CO, 1-CP, 1-CQ, 1-CR, 1-CS, 1-CT, 1-CU, 1-CV, 1-CW, 1-CX, 1-CY, 1-CZ, 1-DA, 1-DB, 1-DC, 1-DD, 1-DE, 1-DF, 1-DG, 1-DH, 1-DI, 1-DJ, 1-DK, 1-DM, 1-DN, 1-DO, 1-DP, 1-DQ, 1-DR, 1-DS, 1-DT, 1-DU, 1-DV, 1-DW, 1-DX, 1-DY, 1-DZ, 1-EA, 1-EB, 1-EC, 1-ED, 1-EE, 1-EF, 1-EG, 1-EH, 1-EI, 1-EJ, 1-EK, 1-EL, 1-EM, 1-EN, 1-EO, 1-EP, 1-EQ, 1-ER, 1-ES, 1-ET, 1-EU, 1-EV, 1-EW, 1-EX, 1-EY, 1-EZ, 1-FA, 1-FB, 1-FC, 1-FD, 1-FE, 1-FG, 1-FH, 1-FI, 1-FJ, 1-FK, 1-FL, 1-FM, 1-FN, 1-FO, 1-FP, 1-FQ, 1-FR, 1-FS, 1-FT, 1-FU, 1-FV, 1-FW, 1-FX, 1-FY, 1-FZ, 1-GA, 1-GB, 1-GC, 1-GD, 1-GE, 1-GF, 1-GG, 1-GH, 1-GI, 1-GJ, 1-GK, 1-GL, 1-GM, 1-GN, 1-GO, 1-GP, 1-GQ, 1-GR, 1-GS, 1-GT, 1-GU, 1-GV, 1-GW, 1-GX, 1-GY, 1-GZ, 1-HA, 1-HB, 1-HC, 1-HD, 1-HE, 1-HF, 1-HG, 1-HH, 1-HI, 1-HJ, 1-HK, 1-HL, 1-HM, 1-HN, 1-HO, 1-HP, 1-HQ, 1-HR, 1-HS, 1-HT, 1-HU, 1-HV, 1-HW, 1-HX, 1-HY, 1-HZ, 1-IA, 1-IB, 1-IC, 1-ID, 1-IE, 1-IF, 1-IG, 1-IH, 1-II, 1-IJ, 1-IK, 1-IL, 1-IM, 1-IN, 1-IO, 1-IP, 1-IQ, 1-IR, 1-IS, 1-IT, 1-IU, 1-IV, 1-IW, 1-IX, 1-IY, 1-IZ, 1-JA, 1-JB, 1-JC, 1-JD, 1-JE, 1-JF, 1-JG, 1-JH, 1-JI, 1-JJ, 1-JK, 1-JL, 1-JM, 1-JN, 1-JO, 1-JP, 1-JQ, 1-JR, 1-JS, 1-JT, 1-JU, 1-JV, 1-JW, 1-JX, 1-JY, 1-JZ, 1-KA, 1-KB, 1-KC, 1-KD, 1-KE, 1-KF, 1-KG, 1-KH, 1-KI, 1-KJ, 1-KK, 1-KL, 1-KM, 1-KN, 1-KO, 1-KP, 1-KQ, 1-KR, 1-KS, 1-KT, 1-KU, 1-KV, 1-KW, 1-KX, 1-KY, 1-KZ, 1-LA, 1-LB, 1-LC, 1-LD, 1-LE, 1-LF, 1-LG, 1-LH, 1-LI, 1-LJ, 1-LK, 1-LL, 1-LM, 1-LN, 1-LO, 1-LP, 1-LQ, 1-LR, 1-LS, 1-LT, 1-LU, 1-LV, 1-LW, 1-LX, 1-LY, 1-LZ, 1-MA, 1-MB, 1-MC, 1-MD, 1-ME, 1-MF, 1-MG, 1-MH, 1-MI, 1-MJ, 1-MK, 1-ML, 1-MN, 1-MO, 1-MP, 1-MQ, 1-MR, 1-MS, 1-MT, 1-MU, 1-MV, 1-MW, 1-MX, 1-MY, 1-MZ, 1-NA, 1-NB, 1-NC, 1-ND, 1-NE, 1-NF, 1-NG, 1-NH, 1-NI, 1-NJ, 1-NK, 1-NL, 1-NM, 1-NO, 1-NP, 1-NQ, 1-NR, 1-NS, 1-NT, 1-NU, 1-NV, 1-NW, 1-NX, 1-NY, 1-NZ, 1-OA, 1-OB, 1-OC, 1-OD, 1-OE, 1-OF, 1-OG, 1-OH, 1-OI, 1-OJ, 1-OK, 1-OL, 1-OM, 1-ON, 1-OO, 1-OP, 1-OQ, 1-OR, 1-OS, 1-OT, 1-OU, 1-OV, 1-OW, 1-OX, 1-OY, 1-OZ, 1-PA, 1-PB, 1-PC, 1-PD, 1-PE, 1-PF, 1-PG, 1-PH, 1-PI, 1-PJ, 1-PK, 1-PL, 1-PM, 1-PN, 1-PO, 1-PP, 1-PQ, 1-PR, 1-PS, 1-PT, 1-PU, 1-PV, 1-PW, 1-PX, 1-PY, 1-PZ, 1-QA, 1-QB, 1-QC, 1-QD, 1-QE, 1-QF, 1-QG, 1-QH, 1-QI, 1-QJ, 1-QK, 1-QL, 1-QM, 1-QN, 1-QO, 1-QP, 1-QQ, 1-QR, 1-QS, 1-QT, 1-QU, 1-QV, 1-QW, 1-QX, 1-QY, 1-QZ, 1-RA, 1-RB, 1-RC, 1-RD, 1-RE, 1-RF, 1-RG, 1-RH, 1-RI, 1-RJ, 1-RK, 1-RL, 1-RM, 1-RN, 1-RO, 1-RP, 1-RQ, 1-RR, 1-RS, 1-RT, 1-RU, 1-RV, 1-RW, 1-RX, 1-RY, 1-RZ, 1-SA, 1-SB, 1-SC, 1-SD, 1-SE, 1-SF, 1-SG, 1-SH, 1-SI, 1-SJ, 1-SK, 1-SL, 1-SM, 1-SN, 1-SO, 1-SP, 1-SQ, 1-SR, 1-SS, 1-ST, 1-SU, 1-SV, 1-SW, 1-SX, 1-SY, 1-SZ, 1-TA, 1-TB, 1-TC, 1-TD, 1-TE, 1-TF, 1-TG, 1-TH, 1-TI, 1-TJ, 1-TK, 1-TL, 1-TM, 1-TN, 1-TO, 1-TP, 1-TQ, 1-TR, 1-TS, 1-TT, 1-TU, 1-TV, 1-TW, 1-TX, 1-TY, 1-TZ, 1-UA, 1-UB, 1-UC, 1-UD, 1-UE, 1-UF, 1-UG, 1-UH, 1-UI, 1-UJ, 1-UK, 1-UL, 1-UM, 1-UN, 1-UO, 1-UP, 1-UQ, 1-UR, 1-US, 1-UT, 1-UT, 1-UU, 1-UV, 1-UW, 1-UX, 1-UY, 1-UZ, 1-VA, 1-VB, 1-VC, 1-VD, 1-VE, 1-VF, 1-VG, 1-VH, 1-VI, 1-VJ, 1-VK, 1-VL, 1-VM, 1-VN, 1-VO, 1-VP, 1-VQ, 1-VR, 1-VS, 1-VT, 1-VU,

SCANNED BY
MESA REPRO

- ## SOLID & HAZARDOUS WASTE CONTROLS

-
- The diagram shows a cross-section of a road and a catch basin. On the left, a stack of gravel-filled sandbags is shown, with arrows indicating runoff flowing into a spillway. The sandbags are labeled 'GRAVEL FILLED SANDBAGS STACKED TIGHTLY.' and 'SPILLWAY'. Above the sandbags, a line indicates the 'BACK OF SIDEWALK'. To the right, a catch basin is shown with a 'CATCH BASIN' and a 'CURB INLET'. The 'BACK OF CURB' is also indicated. A label 'BURLAP SACKS TO OVERLAP ONTO CURB.' points to the area where the sandbags meet the curb. A list of instructions is provided on the right side of the diagram:
1. PLACE CURB TYPE GENTLY SLOPING WATER CAN POND SEPARATE FROM
 2. SANDBAGS OF EIT 'GEOTEXTILE' FABR LAYERED AND PAC
 3. LEAVE A ONE SAN TO PROVIDE A SP
 4. INSPECT BARRIERS AFTER EACH STOR

Diagram illustrating the Plan View of a curb and gutter cross-section. The diagram shows a central rectangular catch basin with a grid pattern, labeled "CATCH BASIN" and "CURB INLET". The catch basin is flanked by two sloped sections labeled "SPILLWAY". The outer edges of the spillways are labeled "GRAVEL FILLED SANDBAGS ARE STACKED TIGHTLY." and "BACK OF CURB". The top and bottom edges of the diagram are labeled "BACK OF SIDEWALK". Arrows indicate the flow of water from the spillways into the catch basin. A vertical line labeled "A" passes through the center of the catch basin.

A cross-sectional diagram of a curb inlet and catch basin assembly. The diagram shows a sidewalk on the right, leading to a curb inlet. Below the curb is a catch basin with a grate. To the left of the catch basin is a spillway. Above the spillway is a ponding height. The diagram is labeled with the following components: PONDING HEIGHT, CURB INLET, SPILLWAY, SIDEWALK, and CATCH BASIN. The section is identified as SECTION A - A.

The diagram consists of two cross-sectional views of a hillside. The top view, labeled 'STEPPED SLOPE', shows a hillside with a 'DIVERSION' at the top left. A 'NORMAL SLOPE LINE' is shown as a straight line with a '1 1/2:1 OR FLATTER' ratio. The 'ORIGINAL GRADE' is the natural slope of the hill. The 'STEPPED SLOPE' is created by a series of horizontal cuts and vertical fills, forming a staircase pattern. A 'DITCH' is shown at the base of the slope. The bottom view, labeled 'TERRACED SLOPE', shows a similar hillside but with a 'TERRACE' in the middle. The 'TERRACE' is a flat area created by a '30 FT MAX CUTS' and a '25 FT MAX FILLS'. The 'TERRACE' is 6 1/2 FT MIN wide. A 'DITCH' is also shown at the base of the slope. To the right of the 'TERRACED SLOPE' diagram, there are 'NOTES: 1. VERTICAL CUT HORIZONTAL D 2. VERTICAL CUT SOFT MATERIAL'.

STEPPED SLOPE

DIVERSION

NORMAL SLOPE LINE
1 1/2:1 OR FLATTER

ORIGINAL GRADE

DITCH

TERRACED SLOPE

30 FT MAX CUTS

TERRACE

6 1/2 FT MIN

25 FT MAX FILLS

NOTES:
1. VERTICAL CUT
HORIZONTAL D
2. VERTICAL CUT
SOFT MATERIAL

'TRACKING' WITH MACHINERY ON SANDY SOIL PROVIDES ROUGHENING WITHOUT UNDUE COMPACTION.

SPREAD STRAW MULCH (TYPICAL)

NOTES:

1. ROUGHEN SLOPE WITH BULLDOZER
2. BROADCAST SEED AND FERTILIZER.

NOTE:
'T' = THICKNESS : THICKNESS SHALL BE DETERMINED BY THE ENGINEER.
MINIMUM THICKNESS SHALL BE 1.5x THE MAXIMUM STONE DIAMETER, NEVER
LESS THAN 6 INCHES.

The map shows a section of San Francisco with Irving Boulevard running horizontally across the bottom. To the left of Irving Boulevard is the 'UNIVERSE' area, and to the right is the 'RIVERVIEW' area. A red line, representing the project site, runs diagonally from the top left towards the center. This line is labeled 'PROJECT SITE' in large, bold, black letters. The map also shows several streets: KAYENTA BLVD. running vertically, RIVIERA BLVD. running horizontally, and IRVING BOULEVARD running horizontally. Other streets include KAYENTA BLVD., RIVIERA BLVD., and IRVING BOULEVARD. The map is divided into three main sections labeled 'UNIT 3A', 'UNIT 3', and 'UNIT 7'. 'UNIT 3A' is at the top, 'UNIT 3' is in the middle, and 'UNIT 7' is at the bottom. The map also shows various lots, including 'LOT 10', 'LOT 11', 'LOT 12', 'LOT 13', 'LOT 99', 'LOT 100'. The map also shows various landmarks, including 'KAYENTA BLVD.', 'RIVIERA BLVD.', and 'IRVING BOULEVARD'. The map is a detailed street map of the Irving Boulevard area in San Francisco, showing the project site and surrounding streets.

NOTES:

1. EMBED BALES 4" INTO THE SOIL AND 'KEY' BALES INTO THE CHANNEL BANKS.
2. POINT 'A' MUST BE HIGHER THAN POINT 'B' (SPILLWAY HEIGHT)
3. PLACE BALES PERPENDICULAR TO THE FLOW WITH ENDS TIGHTLY ABUTTING. USE STRAW, ROCKS OR FILTER FABRIC TO FILL ANY GAPS AND TAMP BACKFILL MATERIAL TO PREVENT EROSION OR FLOW AROUND THE BALES.
4. SPILLWAY HEIGHT SHALL NOT EXCEED 24".
5. INSPECT AFTER EACH SIGNIFICANT STORM, MAINTAIN AND REPAIR PROMPTLY.

PHASE I - MASS GRADING-INSTALL PERIMETER WIND FENCE/
PERIMETER WALL, CONSTRUCT TEMPORARY SEDIMENT
CONTROL DIKE AND POND. MAINTAIN FLOW PATH FOR
EXISTING CULVERT DRAINAGE.

PHASE II - FINAL GRADING--ADD FRONT YARD SEDIMENT CONTROL DEPRESSIONS. DEPRESSION SHALL BE FILL IN WITH MATERIAL EXCAVATED FOR FOUNDATION WHEN HOUSE IS CONSTRUCTED.

PHASE III - AS SURFACE INFRASTRUCTURE IS CONSTRUCTED
ADD STRAW BALE PROTECTION IN BAR DITCHES AS
SHOWN.

WILSON
& COMPANY

2600 THE AMERICAN ROAD S.E.
SUITE 100
RIO RANCHO, NEW MEXICO
87124
(505) 898-8021

CITY OF ALBUQUERQUE
PUBLIC WORKS DEPARTMENT
ENGINEERING GROUP


SEVILLE SUBDIVISION – UNIT 3A
EROSION CONTROL PLAN

Design Review Committee	City Engineer Approval
-------------------------	------------------------

City Project No.

Zone Map No.

Sheet

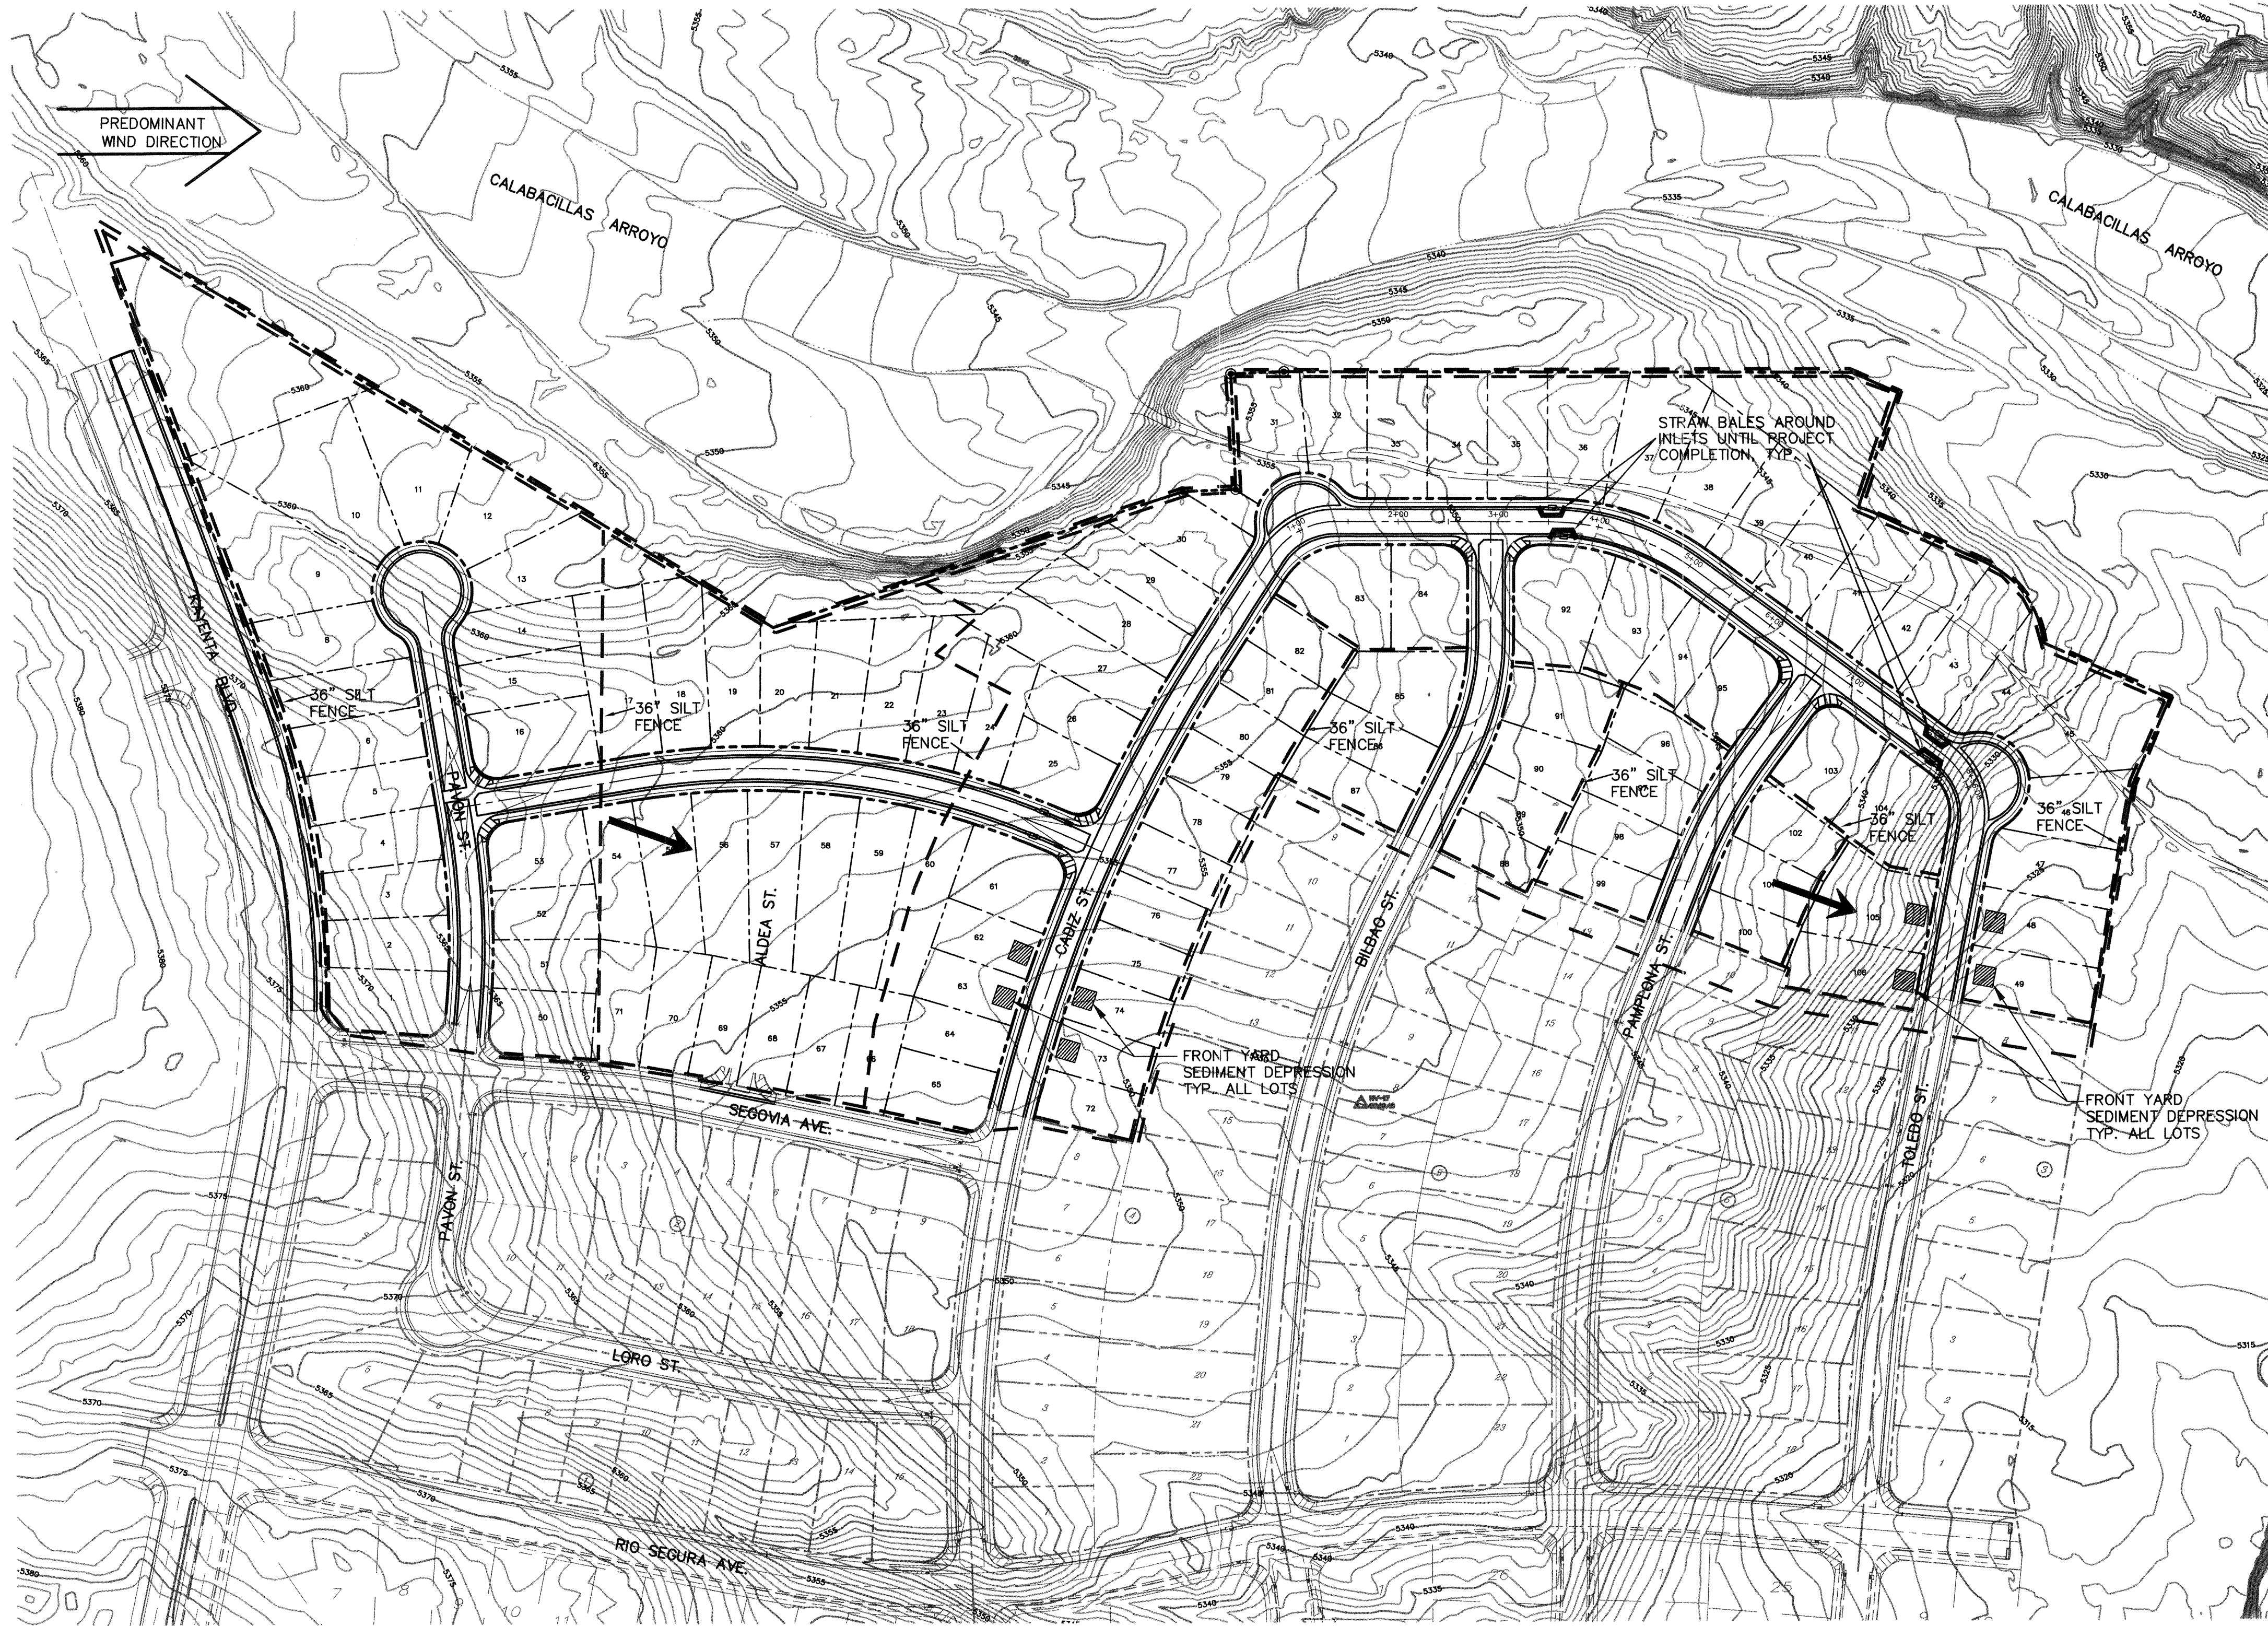

LEGEND

- EXTENT OF LAND DISTURBANCE
- PERIMETER WALL
- SILT FENCE
- STRAW BALES
- DOWNHILL RUNOFF DIRECTION
- FRONT YARD SEDIMENT CONTROL DEPRESSION

NOTES


- TOTAL AREA OF SOIL DISTURBING ACTIVITIES: 22.93 ACRES
- FREE DISCHARGE TO THE MAIN CALLABAILLAS ARROYO.
- AMAFCA FIELD ENGINEER SHALL BE NOTIFIED 48-HOURS PRIOR TO ANY WORK WITHIN THE AMAFCA R/W
TEL. JERRY LOVATO 884-2215.
- NO WORK WILL BE PERFORMED IN THE AMAFCA R/W BETWEEN MAY 15 AND OCTOBER 15 WITHOUT WRITTEN PERMISSION FROM AMAFCA.
- ALL SUBGRADE, BACKFILL AND EMBANKMENT SHALL BE COMPACTED TO 95% (MODIFIED PROCTOR) WITHIN THE AMAFCA R/W. TESTING REPORTS SHALL BE PROVIDED TO AMAFCA FIELD ENGINEER.
- AMAFCA FIELD ENGINEER WILL BE NOTIFIED 48-HOURS PRIOR TO FINAL INSPECTION OF ANY FACILITIES WITHIN THE AMAFCA R/W.

TOTAL RUNOFF VOLUME


DEVELOPED CONDITIONS:
2.70 AC-Ft DRAINS TO THE MAIN CALABACILLAS ARROYO

HISTORIC CONDITIONS:
1.60 AC-Ft DRAINS TO THE MAIN CALABACILLAS ARROYO


- NOTES:
- THE ENTRANCE SHALL BE MAINTAINED IN A CONDITION THAT WILL PREVENT TRACKING OR FLOWING OF SEDIMENT ONTO PUBLIC RIGHTS-OF-WAY. THIS MAY REQUIRE TOP DRESSING, REPAIR AND/OR CLEANOUT OF ANY MEASURES USED TO TRAP SEDIMENT.
 - WHEN NECESSARY, WHEELS SHALL BE CLEANED PRIOR TO ENTRANCE ONTO PUBLIC RIGHT-OF-WAY.
 - WHEN WASHING IS REQUIRED, IT SHALL BE DONE ON AN AREA STABILIZED WITH CRUSHED STONE THAT DRAINS INTO AN APPROVED SEDIMENT TRAP OR SEDIMENT BASIN.

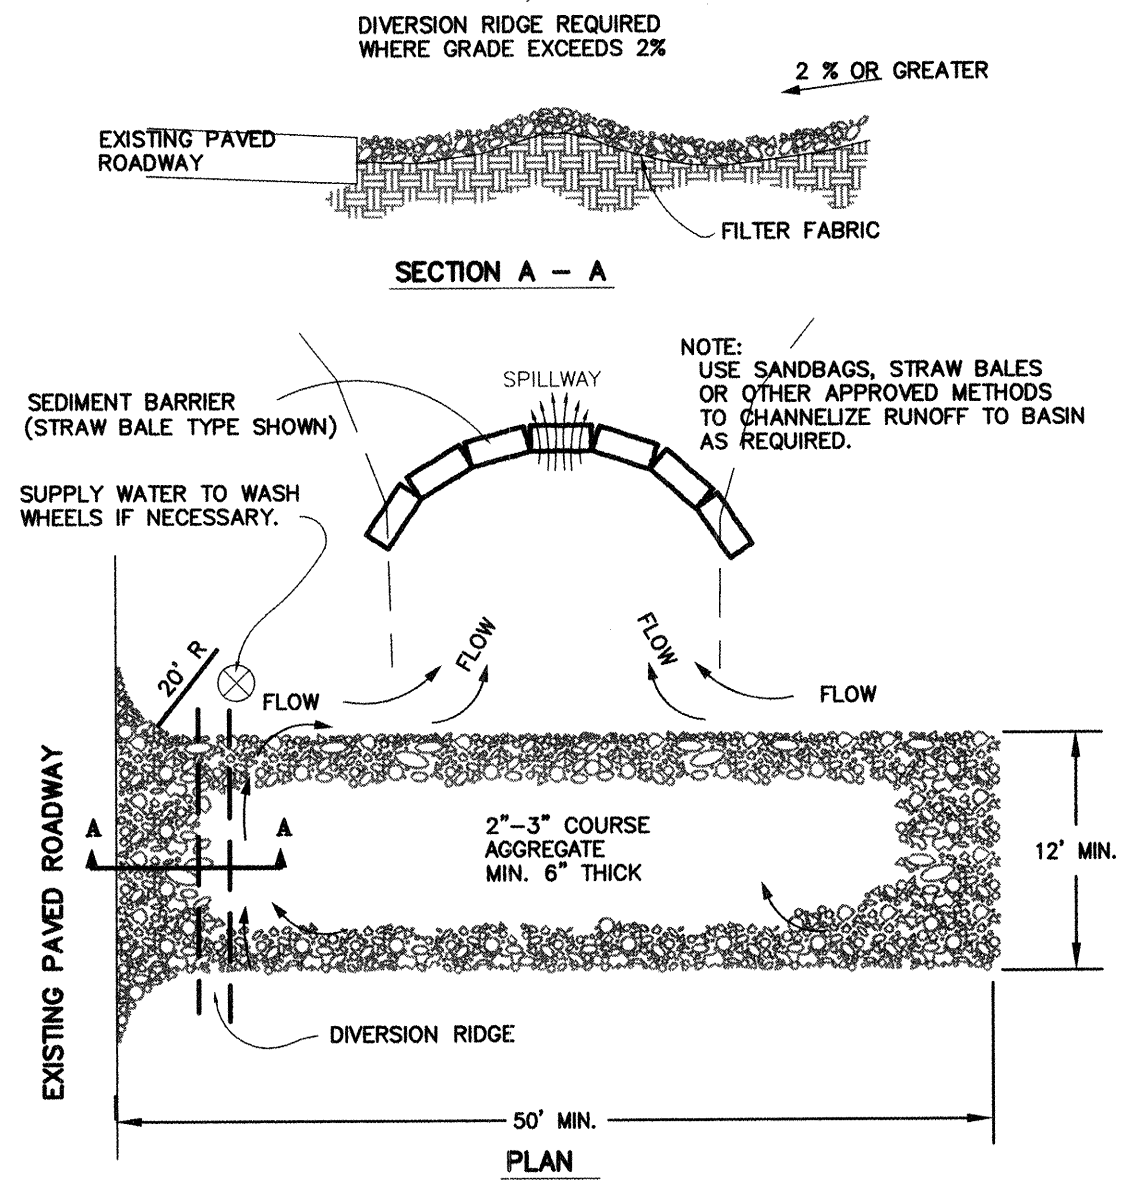

STABILIZED CONSTRUCTION ENTRANCE
NTS

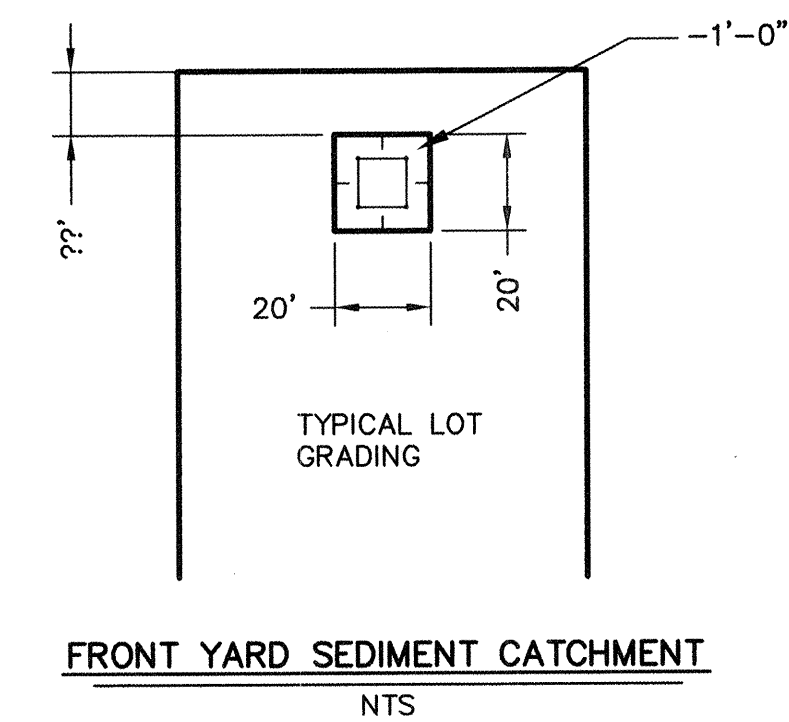


FRONT YARD SEDIMENT CATCHMENT
NTS

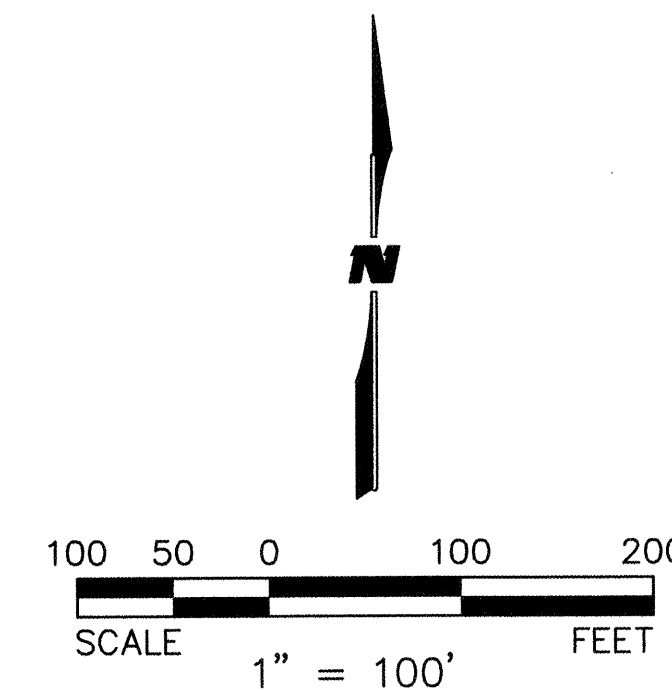

WILSON & COMPANY		2600 THE AMERICAN ROAD S.E. SUITE 100 RIO RANCHO, NEW MEXICO 87124 (505) 898-8021	
CITY OF ALBUQUERQUE PUBLIC WORKS DEPARTMENT ENGINEERING GROUP			
SEVILLE SUBDIVISION - UNIT 3A EROSION CONTROL PLAN			
Design Review Committee	City Engineer Approval	Mo./Day/Yr.	Mo./Day/Yr.
For Information Only			
City Project No.	Zone Map No.	Sheet	Of
702082	A-10-Z	8	32

SURVEY INFORMATION		BENCH MARKS		AS-BUILT INFORMATION	
NO.	BY	DATE	A.C.S. Survey Monument "SANDBERN"	CONTRACTOR	DATE
	PHOTOGRAMMETRY BY	11/13/22/09	New Mexico State Plane Coord's, Central Zone (NAD 27) as published:	STAGED BY	DATE
	T.R. MANN & ASSOC.		Y = 1,534,209.29	ACCEPTANCE BY	DATE
	FIELD SURVEYS BY		X = 361,854.29	VERIFICATION BY	DATE
	SURV-TEK, INC.		Elevation = 5456.92 (SLD 1929)	DRAWINGS BY	DATE
			Ground to grid factor = 0.99966079	COMPILED BY	DATE
				RECORDED BY	DATE
				NO.	

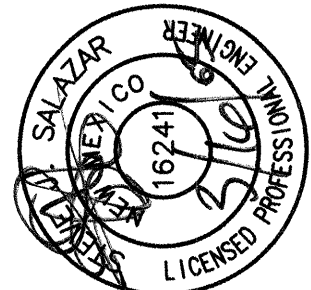


ENGINEER'S SEAL		REVISIONS	
NO.	DATE	REMARKS	BY




NOTE:
1. BACKYARD SLOPES ARE ALL 3:1 UNLESS OTHERWISE NOTED.
2. LOTS SHOWN IN HATCHED AREA SHALL BE PLATTED ONCE PRUDENT LINE IS ELIMINATED.

LEGEND
--- RETAINING WALL
~ HIGH POINT
--- DIRECTION OF FLOW
••••• LINE ELEVATION

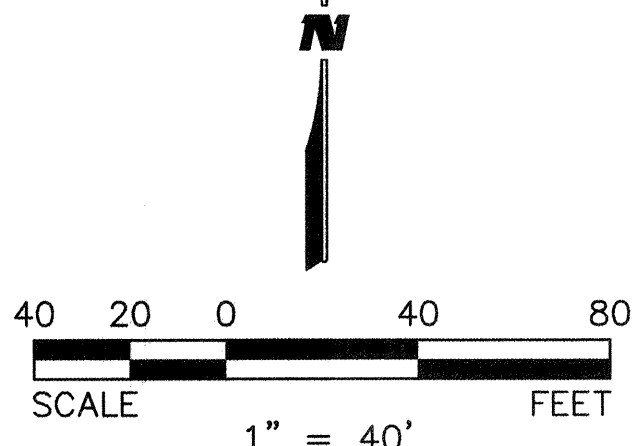

RETAINING WALL TABLE				
WALL POINT	TOP OF WALL ELEV	TOP OF FOOTING ELEV	WALL HEIGHT (FT)	APPROX. WALL LENGTH (FT)
2-1	55.67	53.00	2.67	43.00
2-2	55.67/56.33	53.00	3.33	21.00
2-3	56.33/57.00	53.00/53.67	3.33-2.00	20.00
2-4	57.00	55.00		
3-1	51.67	50.33		
3-2	51.67	50.33	1.33	43.00
3-2A	47.00	50.33/43.00	1.33-4.00	33.00
3-3	51.67/52.33	50.33/47.00	1.33-5.33	52.00
3-4	52.33	47.00/46.33	5.33-6.00	15.00
3-5	52.33	46.33/47.00	6.00	44.00
3-6	52.33	47.00	5.33	20.00
3-7	52.33	47.00/48.33		
3-8	52.33	48.33	4.00	15.00
3-9	52.33	48.33/49.67	4.00	36.00
3-10	52.33	49.67	4.00-1.33	15.00

5-1	42.67	39.33		
5-2	42.67/43.33	39.33	3.33	50.00
5-3	43.33/44.00	39.33/38.00	4.00	28.00
5-4	44.00	38.00	6.00	72.00
5-5	44.00	41.33	6.00-2.67	48.00
5-6	44.00	42.67	2.67-1.33	50.00
6-1	40.00	37.33		
6-2	40.00/40.67	37.33/38.00	2.67	31.00
6-3	40.67	38.00	2.67	54.00

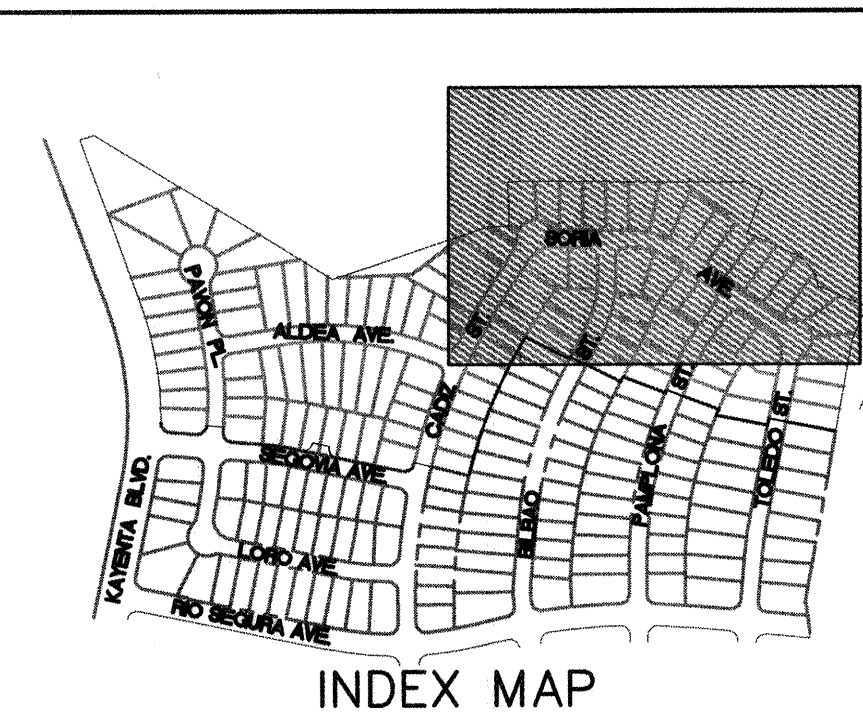

WILSON & COMPANY
2600 THE AMERICAN ROAD S.E.
SUITE 100
RIO RANCHO, NEW MEXICO
87124
(505) 898-8021

CITY OF ALBUQUERQUE
PUBLIC WORKS DEPARTMENT
ENGINEERING GROUP

SEVILLE SUBDIVISION - UNIT 3A
GRADING & DRAINAGE PLAN

Design Review Committee City Engineer Approval
For Information Only
Last Design Update

City Project No. 702082 Zone Map No. A-10-Z

AS-BUILT INFORMATION	
CONTRACTOR	DATE
STAINED BY	DATE
FIELD ACCEPTANCE BY	DATE
FIELD DRAWING BY	DATE
CORRECTED BY	DATE
RECORDED BY	DATE

BENCH MARKS	
A.C.S. Survey Monument "SANDBERN"	DATE
New Mexico State Plane Coord's, Central Zone (NAD 27) as published:	DATE
Y = 1,534,209.29	DATE
X = 361,854.29	DATE
Elevation = 5456.92 (SLD 1929)	DATE
Ground to grid factor = 0.99966079	DATE

SURVEY INFORMATION	
FIELD NOTES	DATE
BY	DATE
PHOTOGRAMMETRY BY 3/22/99	DATE
T.R. MANN & ASSOC.	DATE
FIELD SURVEYS BY	DATE
SURV-TEK, INC.	DATE

ENGINEER'S SEAL	
NO.	DATE
REVISIONS	DATE
WILSON & COMPANY, ENGINEERS & ARCHITECTS	DATE
DESIGNED BY	DATE
DRAWN BY	DATE
CHECKED BY	DATE

Mo./Day/Yr.	Mo./Day/Yr.
Sheet 9	Of 32

SCANNED BY
MESA REPHO



RETAINING WALL TABLE



WALL POINT	TOP OF WALL ELEV	TOP OF FOOTING ELEV	WALL HEIGHT (FT)	APPROX. WALL LENGTH (FT)
2-1	55.67	53.00	2.67	43.00
2-2	55.67/56.33	53.00	3.33	21.00
2-3	56.33/57.00	53.00/53.67	3.33-2.00	20.00
2-4	57.00	55.00		

WALL POINT	TOP OF WALL ELEV	TOP OF FOOTING ELEV	WALL HEIGHT (FT)	APPROX. WALL LENGTH (FT)
7-1	69.33	66.67	2.67	58.00
7-2	69.33	64.33	3.33	115.00
7-3	67.67/70.00	67.33/68.33	3.33	55.00
7-4	64.00	60.67	3.33	60.00
7-5	63.00	60.33	2.67	

LEGEND

- — — — — RETAINING WALL
- ~ ~ ~ ~ ~ HIGH POINT
- DIRECTION OF FLOW
- XX.XX E LINE ELEVATION

- NOTE:
1. BACKYARD SLOPES ARE ALL 3:1 UNLESS OTHERWISE NOTED.
2. LOTS SHOWN IN HATCHED AREA SHALL BE PLATTED ONCE PRUDENT LINE IS ELIMINATED.

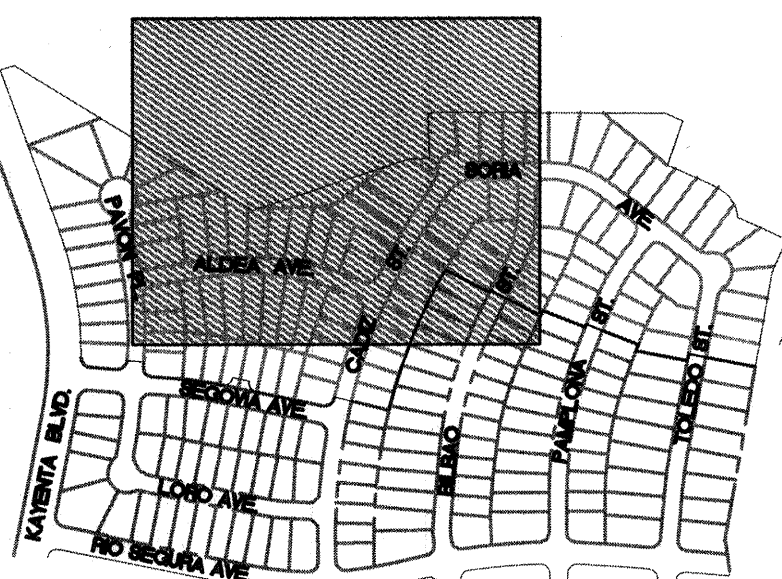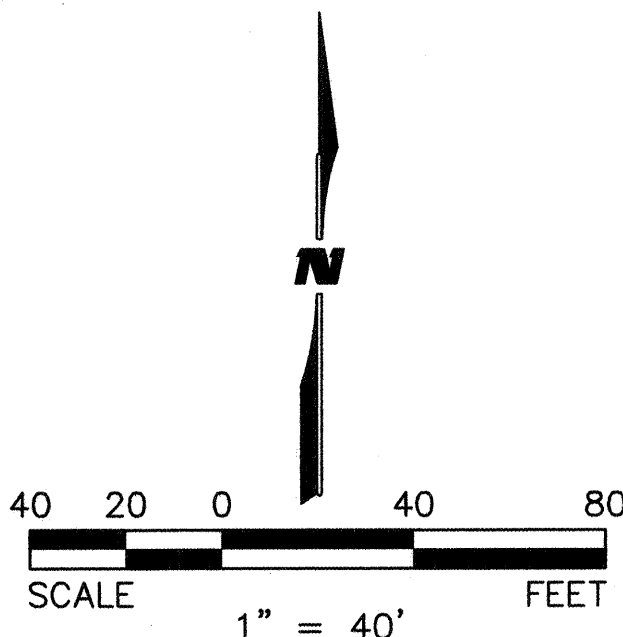

INDEX MAP

WILSON & COMPANY

2600 THE AMERICAN ROAD S.E.
SUITE 100
RIO RANCHO, NEW MEXICO
87124
(505) 898-8021

CITY OF ALBUQUERQUE
PUBLIC WORKS DEPARTMENT
ENGINEERING GROUP

SEVILLE SUBDIVISION — UNIT 3A
GRADING & DRAINAGE PLAN

Design Review Committee City Engineer Approval


For Information Only

City Project No. 702082 Zone Map No. A-10-Z

AS-BUILT INFORMATION		BENCH MARKS		SURVEY INFORMATION		ENGINEER'S SEAL		REVISIONS		NO. DATE		BY	
A.C.S. Survey Monument "SANDBERN"		New Mexico State Plane Coord's, Central Zone (NAD 27) as published:		DATE BY		PHOTOGRAMMETRY BY 3/22/99		T.R. MANN & ASSOC.		FIELD SURVEYS BY		SURV-TEK, INC.	
CONTRACTOR		INSPECTOR'S		DATE		DATE		DATE		DATE		DATE	
STAMPED BY		FIELD CHECK BY		DATE		DATE		DATE		DATE		DATE	
MICRO-FILM INFORMATION		RECORDED BY		NO.		Elevation = 5456.92 (SLD 1929)		Ground to grid factor = 0.99966079		REMARKS		DATE DEC. 04	
										DESIGNED BY JDV		DATE DEC. 04	
										DRAWN BY JDV		DATE DEC. 04	
										CHECKED BY SJS		DATE DEC. 04	


City Project No.	Zone Map No.	Sheet	Of
702082	A-10-Z	11	32

UNIT 3A	
PLAN	
Mo./Day/Yr.	Mo./Day/Yr.
Sheet	Of
11	32

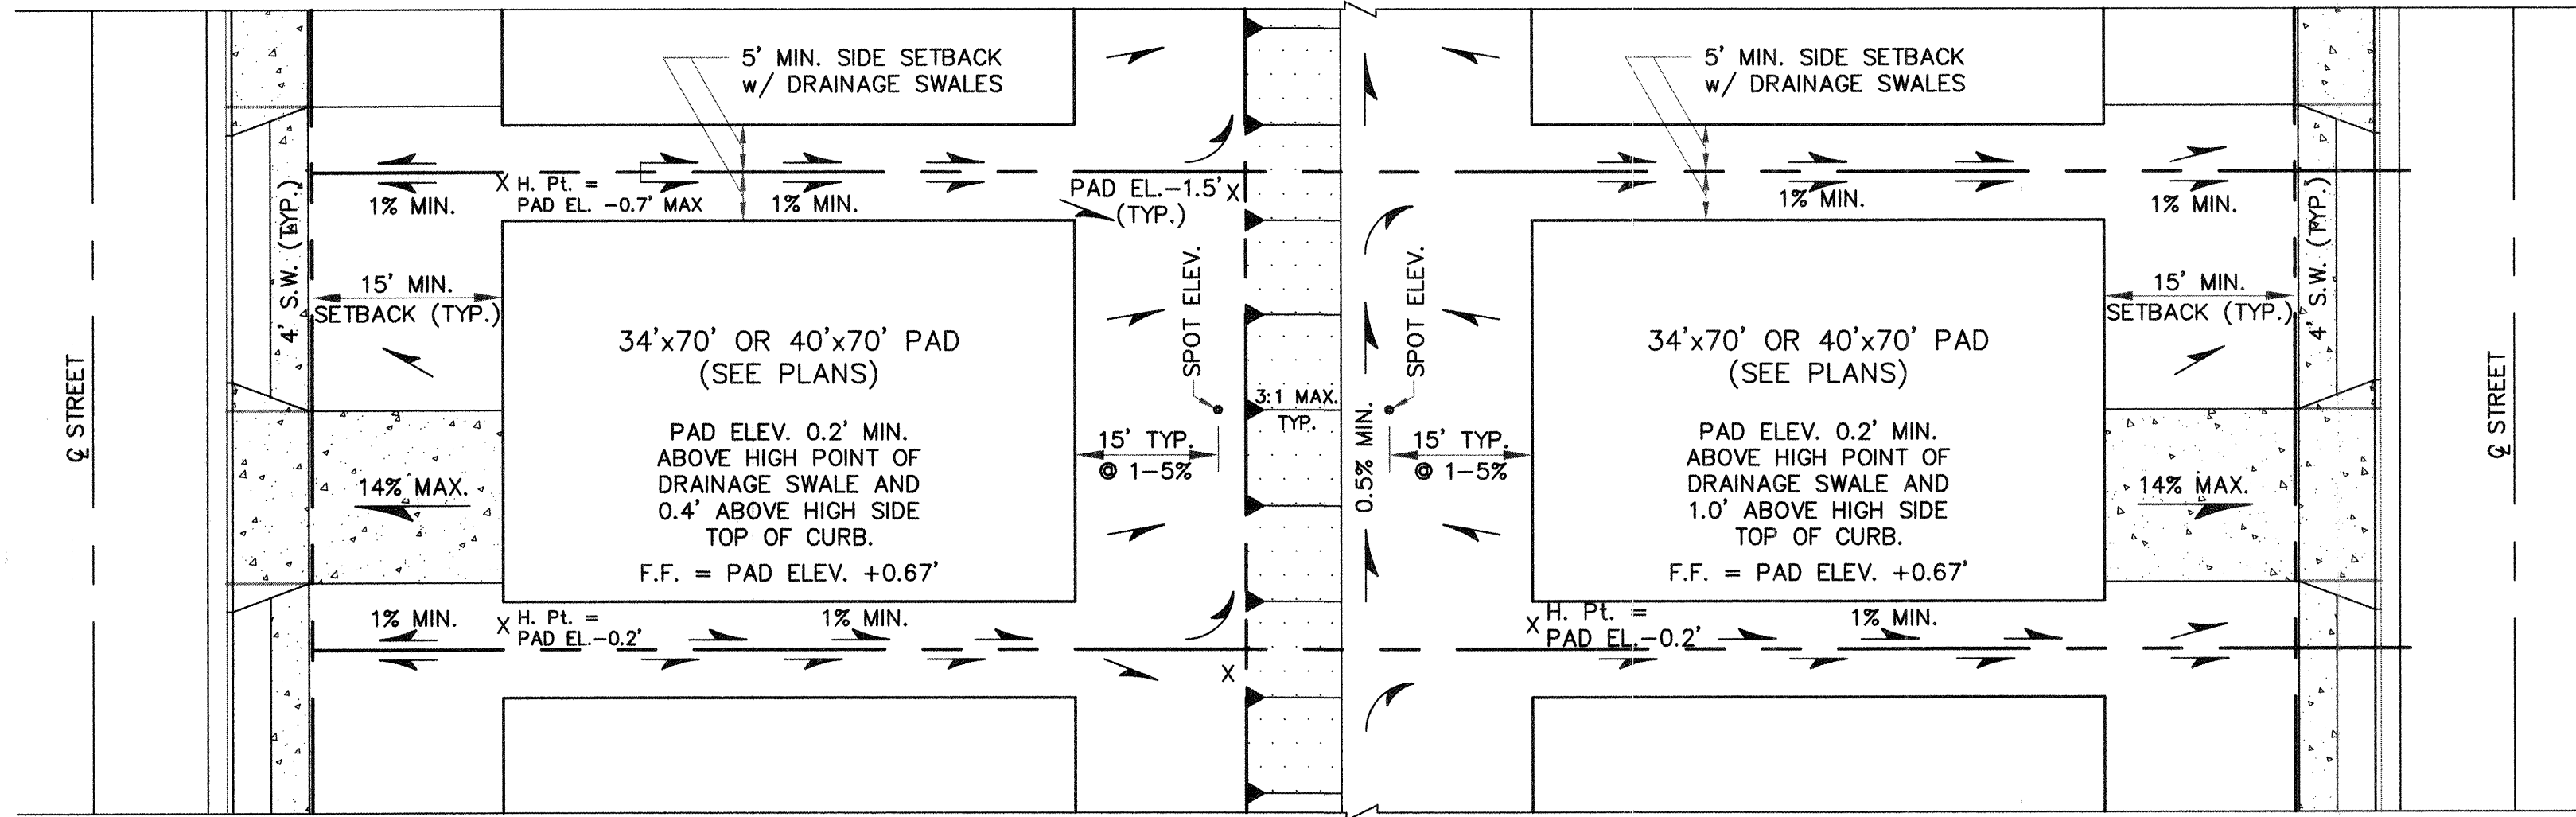


TYPICAL LOT GRADING
NTS


THE DETAILS BELOW ARE SHOWN AS BEING CENTERED ON LOT LINES. ALL RETAINING WALLS AND FOUNDATIONS MUST BE PLACED OUTSIDE OF CITY OF ALBUQUERQUE RIGHT-OF-WAY.

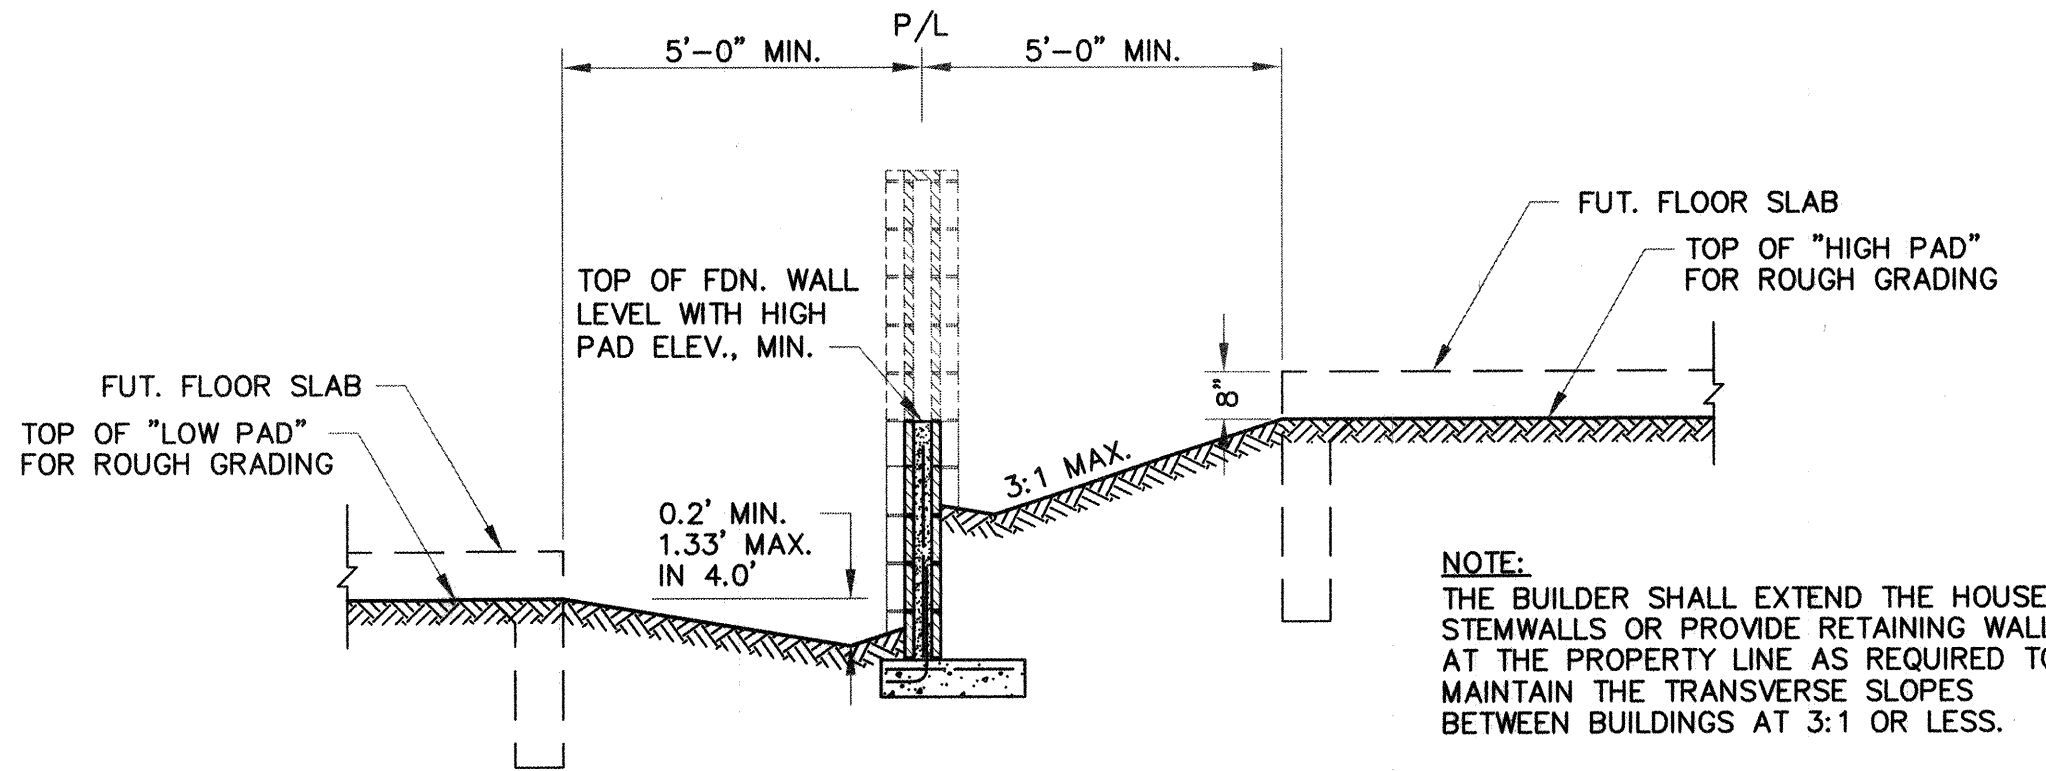


TYPICAL DETAIL @ SIDEYARD DRAINAGE SWALES
3/8" = 1'-0"

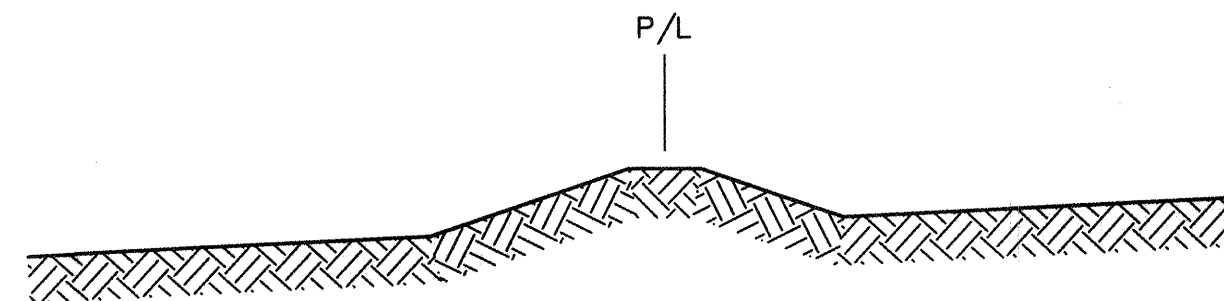


TYPICAL GRADING DETAIL
@ PROPERTY LINES IN FRONT SETBACK
NO SCALE

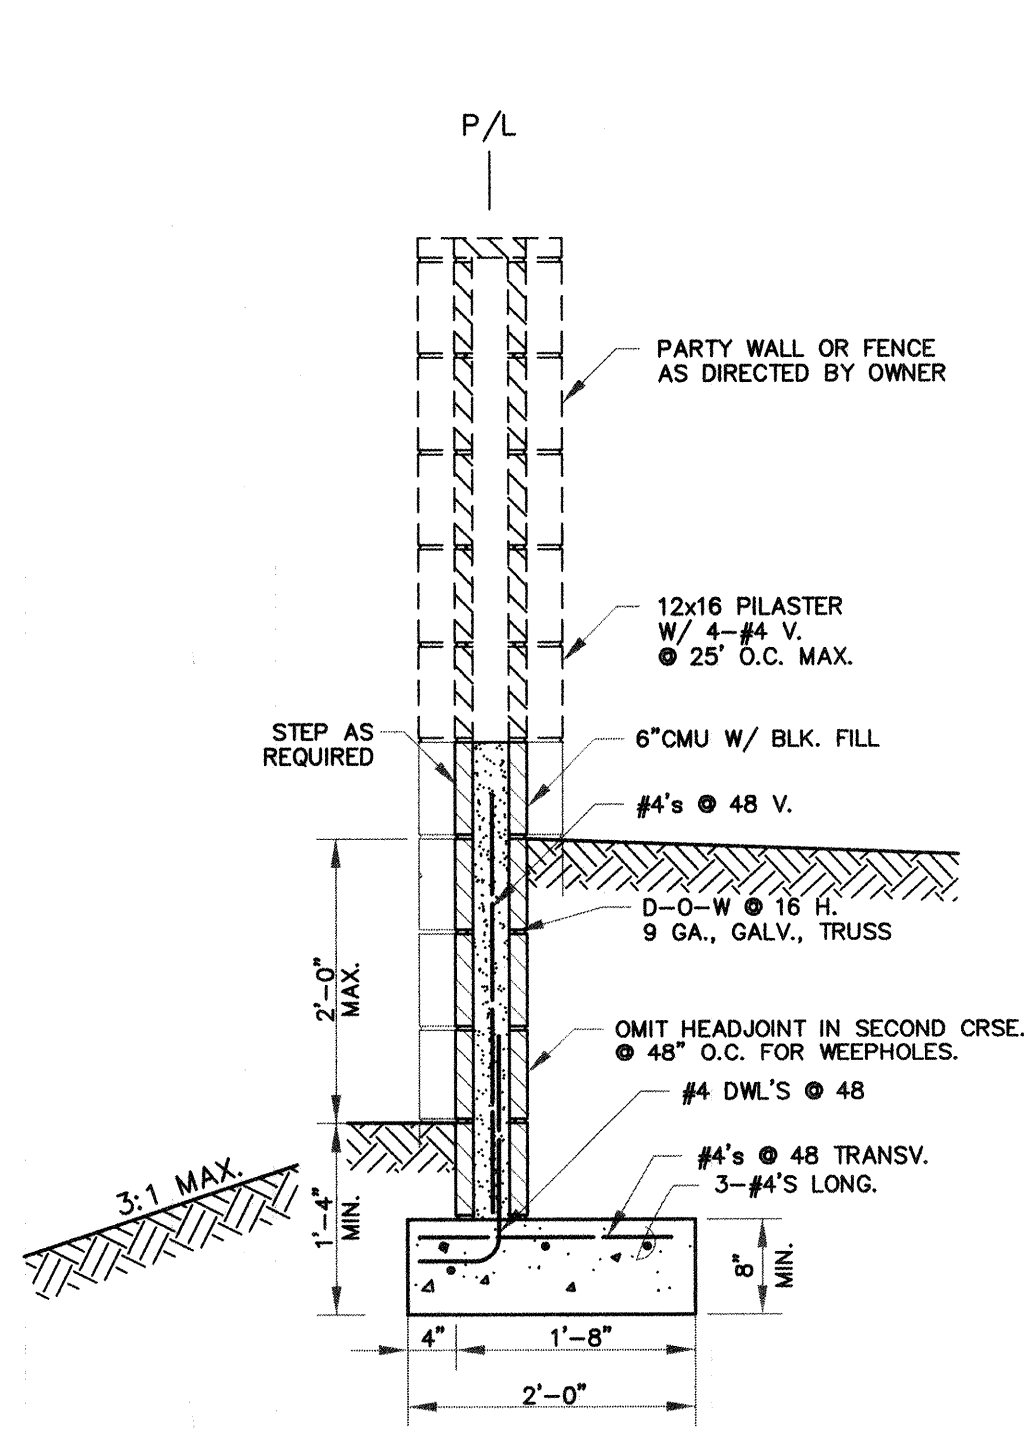


RETAINING WALL - TYPE A
3/4" = 1'-0"

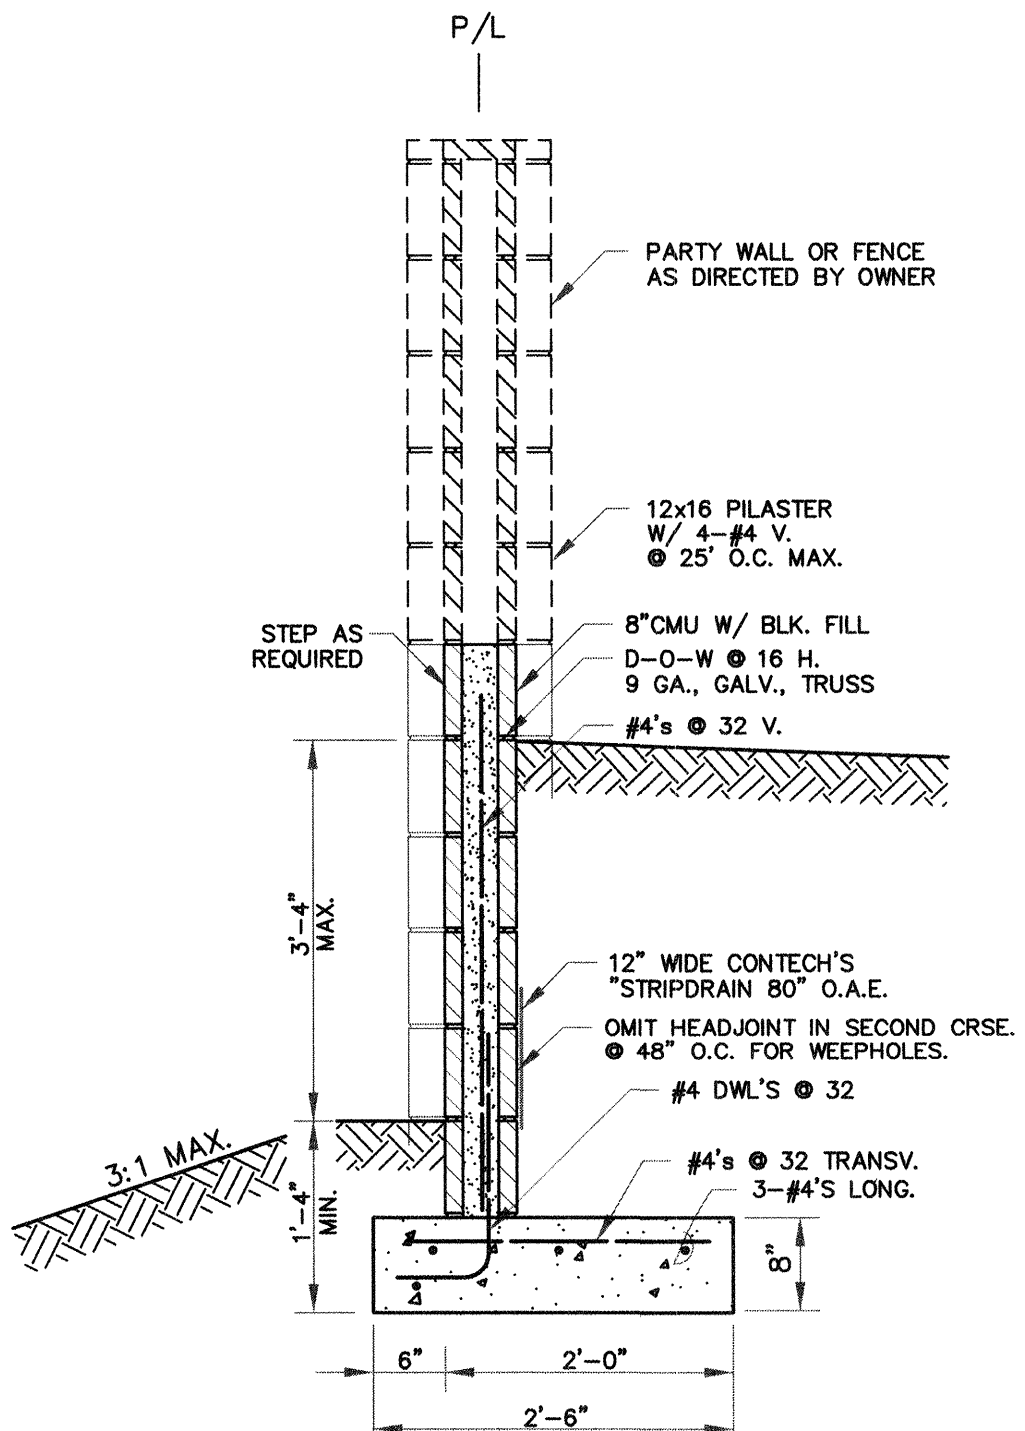


RETAINING WALL - TYPE B
3/4" = 1'-0"

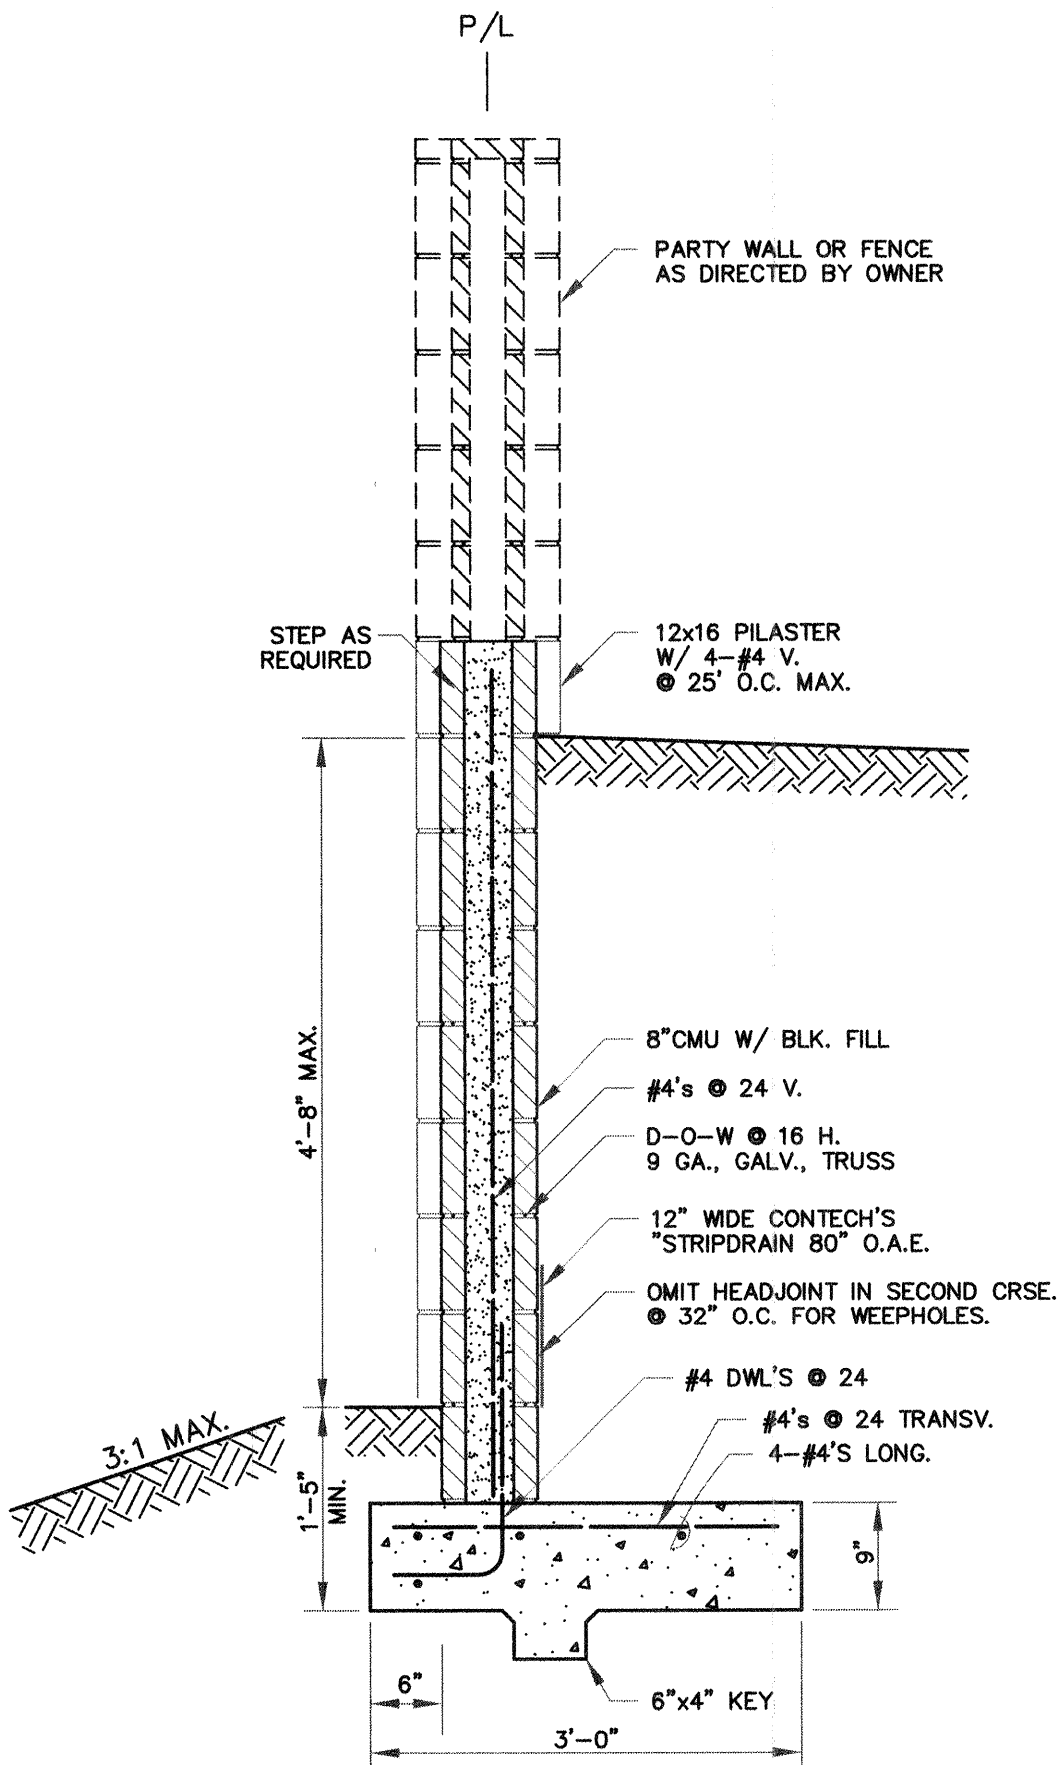

RETAINING WALL - TYPE C
3/4" = 1'-0"

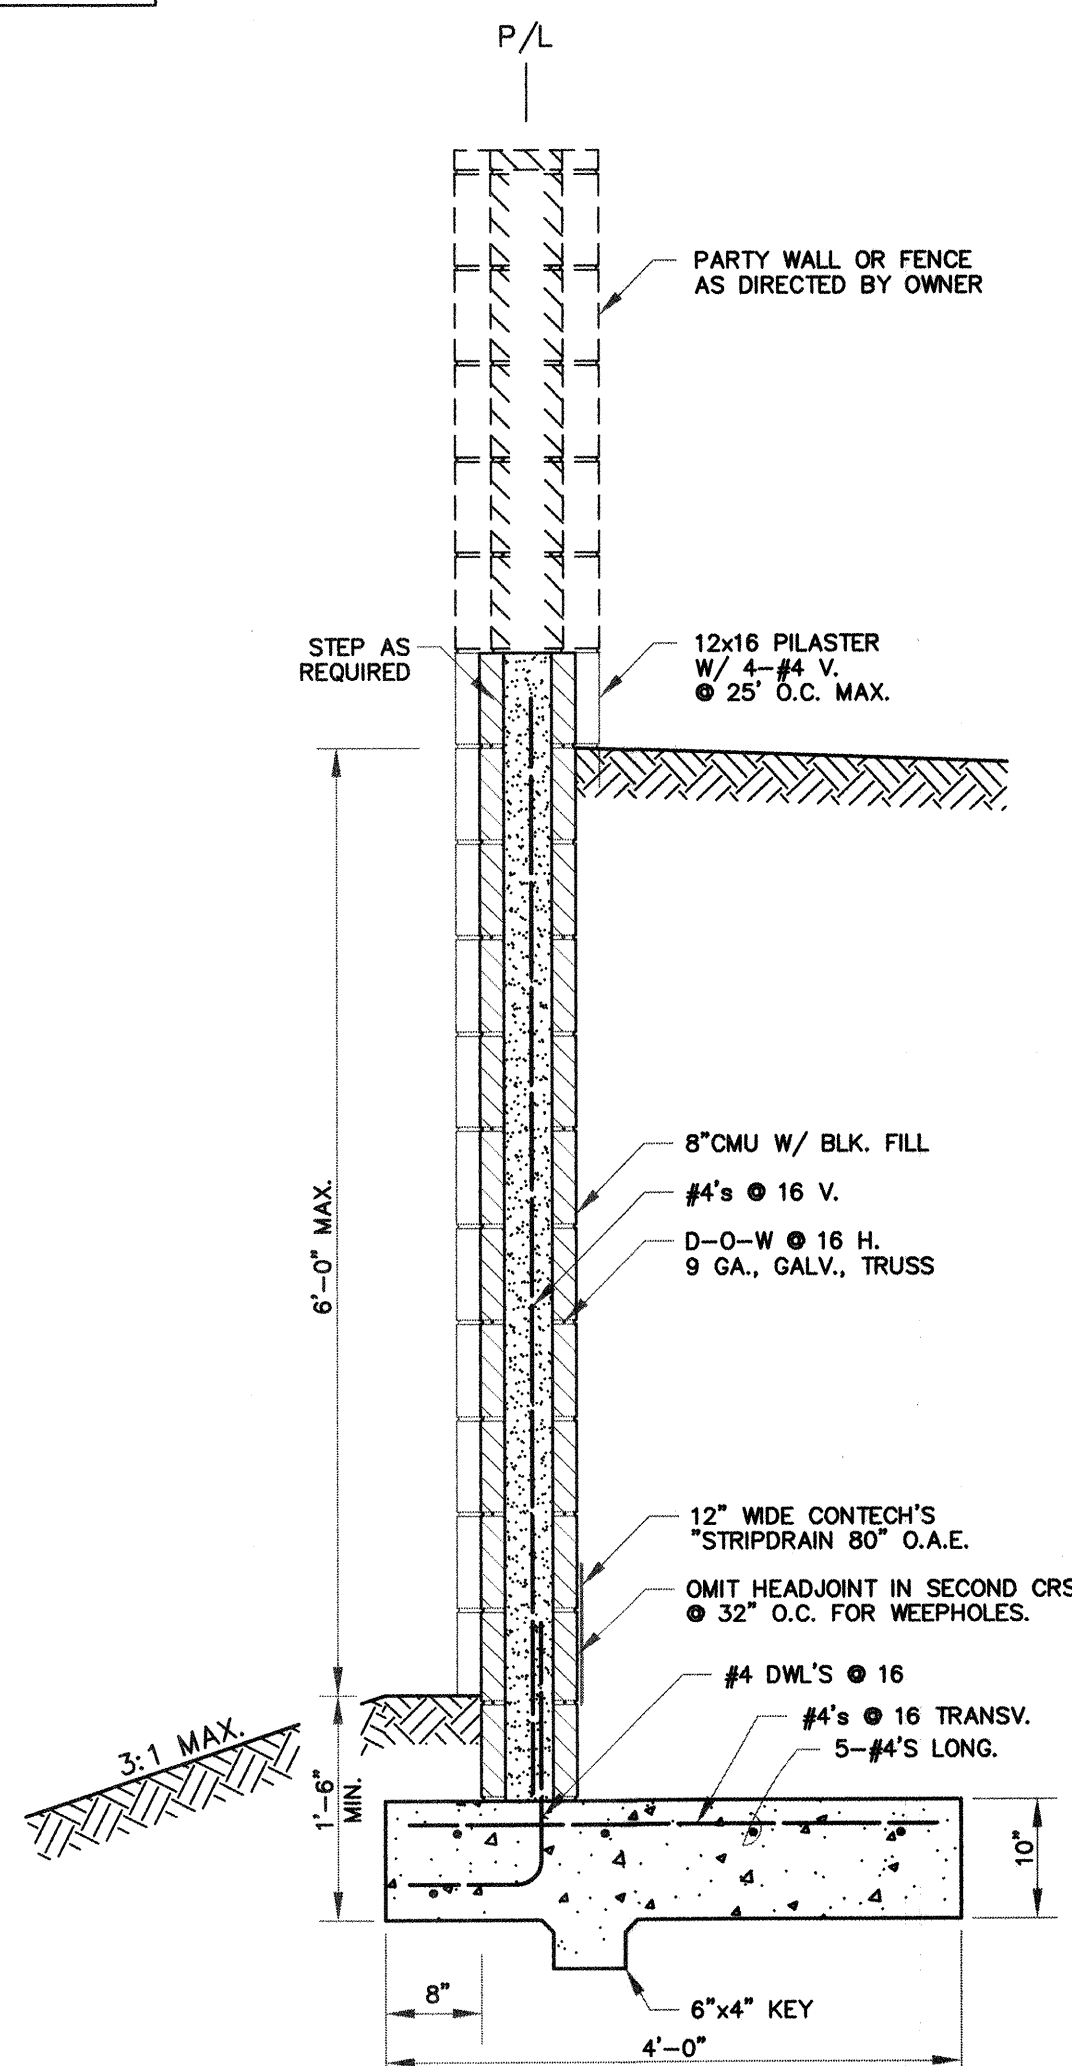

RETAINING WALL - TYPE D
3/4" = 1'-0"

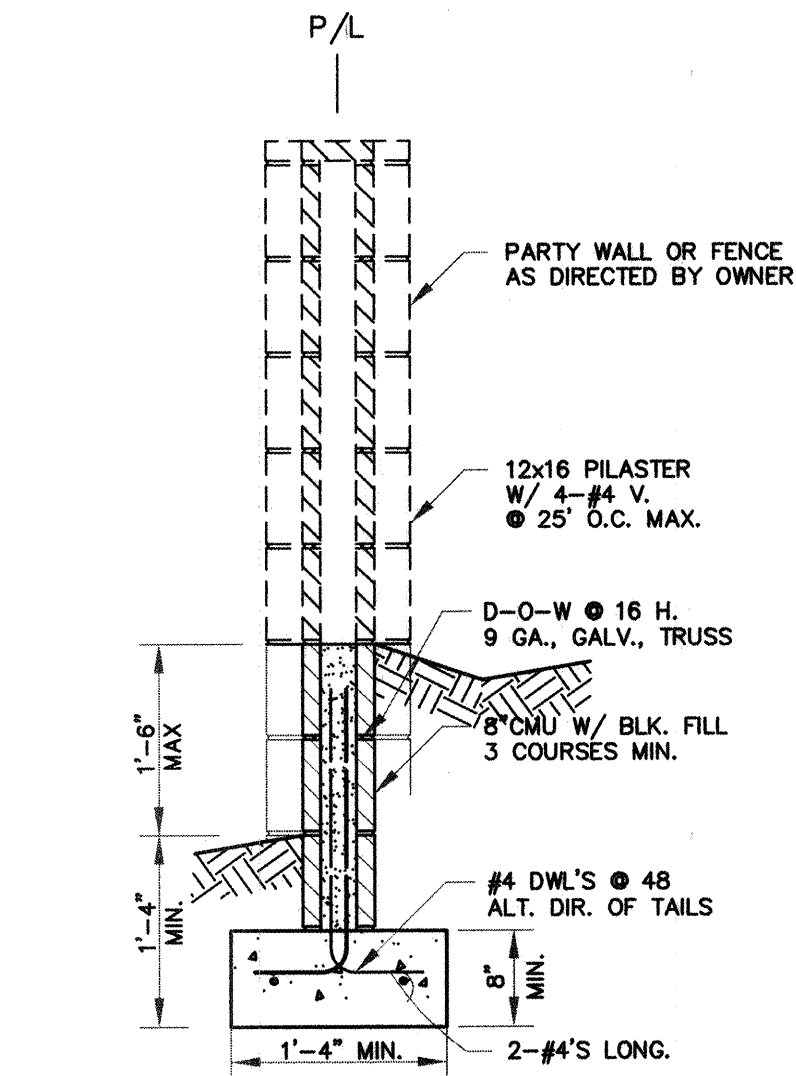

FENCE FOUNDATION WALL
(ELEV. DIFF. < 1.5 FT.)
3/4" = 1'-0"

WILSON & COMPANY 2600 THE AMERICAN ROAD S.E. SUITE 100 RIO RANCHO, NEW MEXICO 87124 (505) 898-8021

CITY OF ALBUQUERQUE
PUBLIC WORKS DEPARTMENT
ENGINEERING GROUP





SEVILLE SUBDIVISION - UNIT 3A
TYPICAL LOT GRADING
GRADING/ RETAINING WALL DETAILS

Design Review Committee City Engineer Approval
For Information Only

Mo./Day/Yr. Mo./Day/Yr.

City Project No. 702082 Zone Map No. A-10-Z Sheet 12 Of 32


AS-BUILT INFORMATION				BENCH MARKS				SURVEY INFORMATION				ENGINEER'S SEAL			
CONTRACTOR	DATE	INSPECTOR'S SIGNATURE	DATE	A.C.S. Survey Monument "SANDERN"	DATE	PHOTOGRAPHY BY	DATE	NO.	BY	DATE	NO.				
CONTRACTOR	DATE	INSPECTOR'S SIGNATURE	DATE	New Mexico State Plane Coord's, Central Zone (NAD 27) as published:	DATE	T.R. MANN & ASSOC.	DATE	NO.	BY	DATE	NO.				
CONTRACTOR	DATE	INSPECTOR'S SIGNATURE	DATE	Y = 1,534,209.29	DATE	FIELD SURVEYS BY	DATE	NO.	BY	DATE	NO.				
CONTRACTOR	DATE	INSPECTOR'S SIGNATURE	DATE	X = 361,854.29	DATE	SURV-TEK, INC.	DATE	NO.	BY	DATE	NO.				
CONTRACTOR	DATE	INSPECTOR'S SIGNATURE	DATE	Elevation = 5456.92 (SLD 1929)	DATE		DATE	NO.	BY	DATE	NO.				
CONTRACTOR	DATE	INSPECTOR'S SIGNATURE	DATE	Ground to grid factor = 0.99966079	DATE		DATE	NO.	BY	DATE	NO.				
CONTRACTOR	DATE	INSPECTOR'S SIGNATURE	DATE		DATE		DATE	NO.	BY	DATE	NO.				

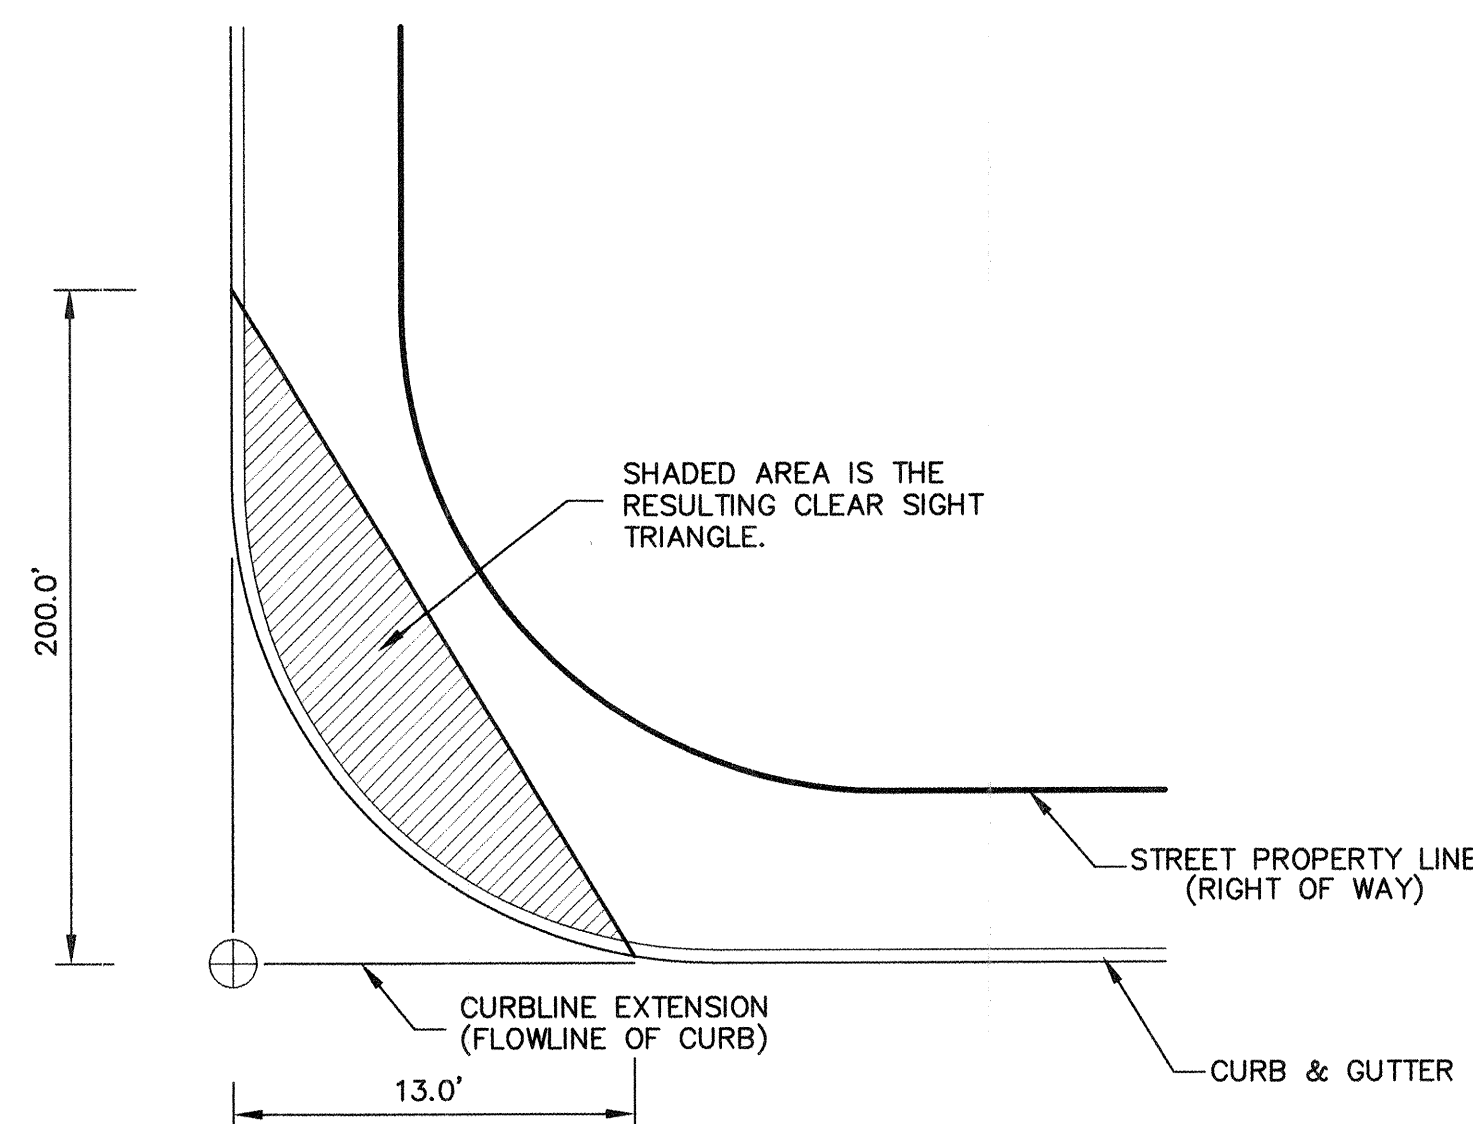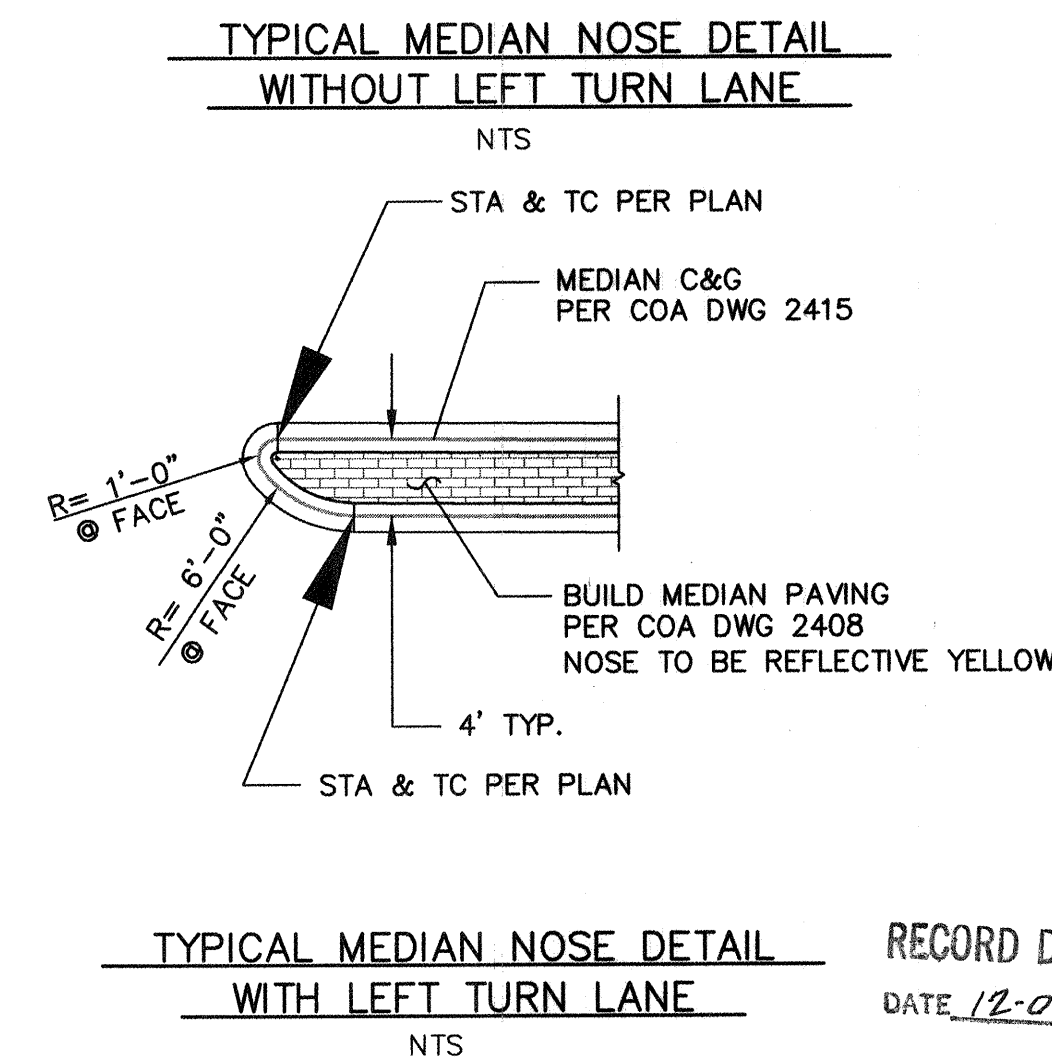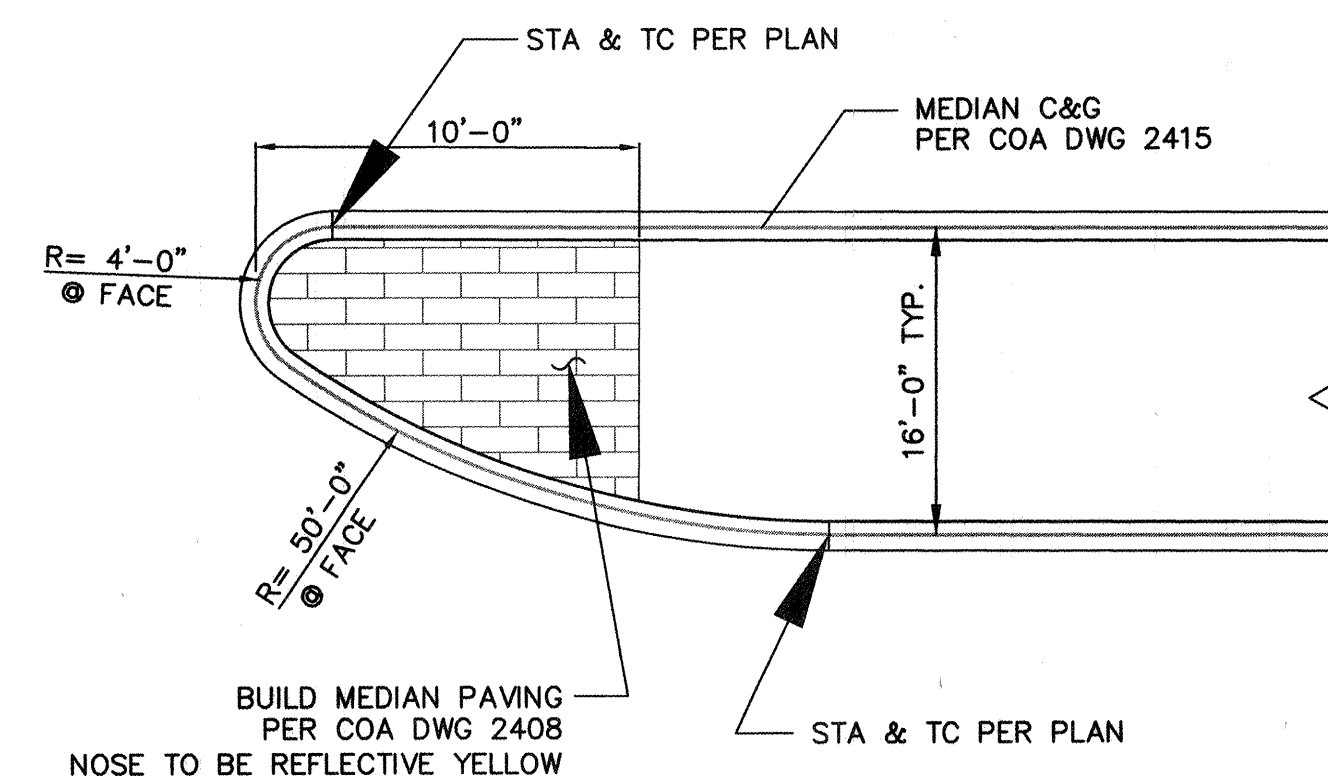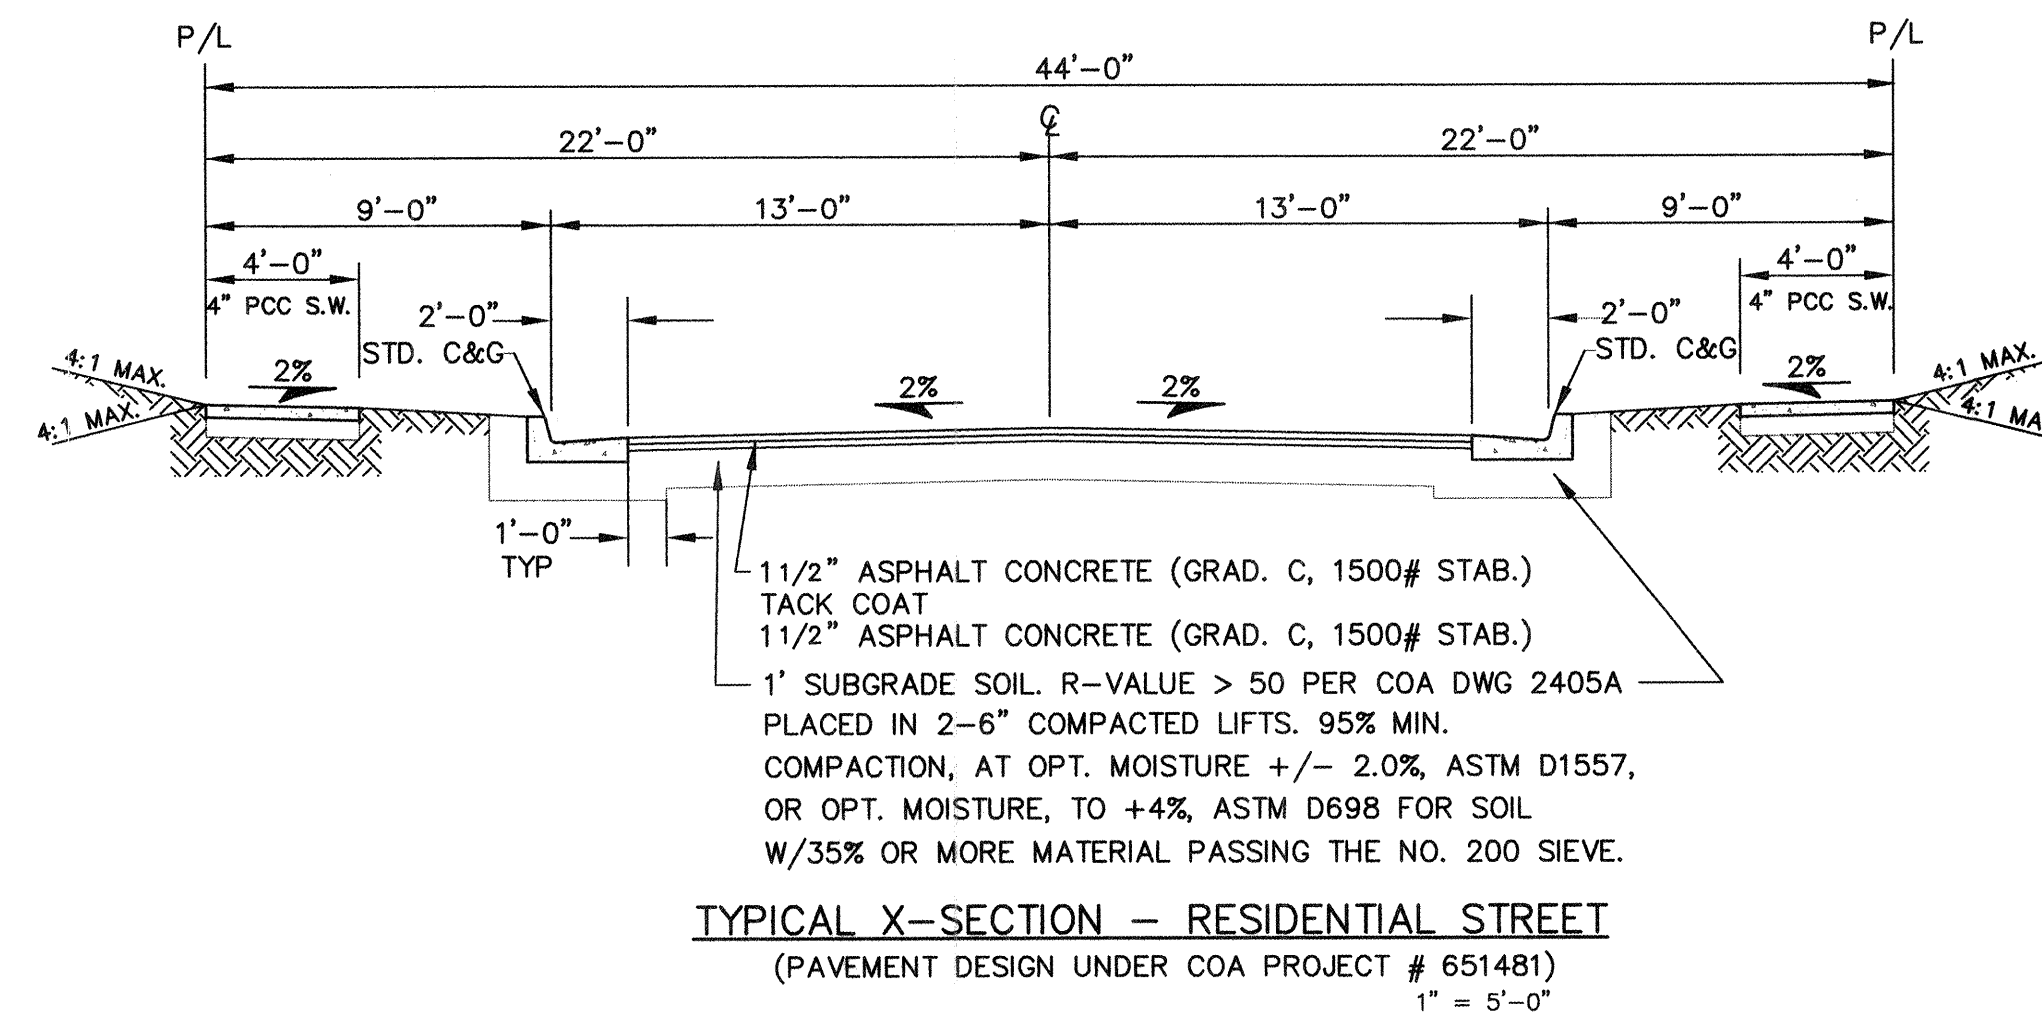

NOTE:

1. USE ROLL-TYPE CURB: GUTTER ONLY WHERE INDICATED ON PLANS. PROVIDE 10' TRANSITION SECTIONS BETWEEN DIFFERENT CURB TYPES PER STD. DWG 2418
2. PAVING TO BE CONSTRUCTED AS DETAILED PER COA STD DWG. 2405A, EXCEPT PAVING SECTIONS SHALL CONSIST OF COMPONENTS AS SHOWN.
3. IN THE EVENT SOILS EXHIBITING AN R-VALUE LESS THAN 50 ARE ENCOUNTERED AT SUBGRADE DEPTH, THESE SOILS SHOULD BE REMOVED TO A DEPTH OF TWENTY-FOUR INCHES AND BE REPLACED WITH SOIL WITH A MINIMUM R-VALUE OF 50. IF "SUGAR SAND" IS ENCOUNTERED IT SHOULD BE REMOVED AND REPLACED AS SPECIFIED IN THE CITY OF ALBUQUERQUE STANDARD SPECIFICATIONS FOR PUBLIC WORKS CONSTRUCTION.


[illegible]

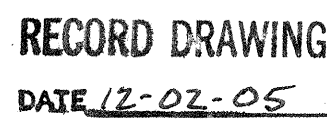

<u>NEW</u>	<u>EXISTING</u>
------------	-----------------

NEW	EXISTING
	
	
	
	
 FH	 FH
	
	
	
 SS	
	
	
	
	
	
	
	
	
	
	

1. THIS DRAWING SHOWS THE DESIRED STREET LIGHT LAYOUT ONLY. DESIGN OF THE ELECTRICAL WIRING AND APPURTENANCES REQUIRED TO COMPLETE THE SYSTEM WILL BE PROVIDED BY OTHERS.
2. STREET LIGHTS IN THE INTERIOR OF THE SUBDIVISION SHALL BE 100W HPS LIGHTS WITH 25' MOUNTING HEIGHT.
3. STREET LIGHTS ALONG KAYENTA BLVD. SHALL BE 250W. HPS LIGHTS WITH 30 FT MOUNTING HEIGHT.

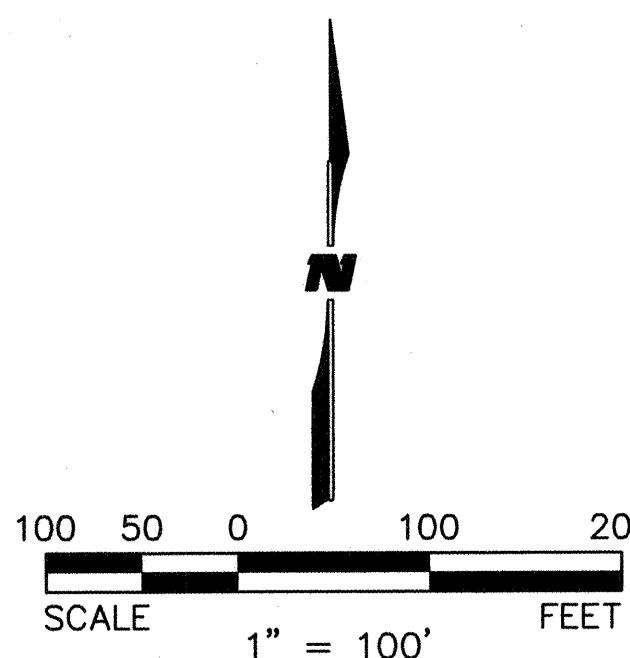

2600 THE AMERICAN ROAD S.E.
SUITE 100
RIO RANCHO, NEW MEXICO
87124
(505) 898-8021

CITY OF ALBUQUERQUE
PUBLIC WORKS DEPARTMENT
ENGINEERING GROUP

SEVILLE SUBDIVISION – UNIT 3A
COMPOSITE PAVING PLAN

City Engineer Approv

APPROVED

AUG 15 1965

CITY ENGINEER

Zone Map No.

A-10-Z

To./Day/Yr.	Mo./Day/Yr.

Sheet Of
 14 3

AS-BUILT INFORMATION	
CONTRACTOR	FRANKLIN'S EARTHWORKS
WORK ORDER	
INSPECTOR'S NAME	DATE
BY Russ Hugel	9-05
FIELD VERIFICATION BY	DATE
R. Hugel	9-05
DRAWINGS	DATE
CORRECTED BY R. Hugel	9-05
MICRO-FILM INFORMATION	
RECORDED BY	DATE



BENCH MARKS

A.A.C.S. Survey Monument "SANDBERN"
New Mexico State Plane Coord's, Central
Zone (NAD 27) as published:
Y = 1,534,209.29
X = 561,854.29
Elevation = 5456.92 (SLD 1929)
Ground to grid factor = 0.99966079

SURVEY INFORMATION		
FIELD NOTES		
NO.	BY	DATE
	PHOTOGRAMMETRY BY	3/22
	T.R. MANN & ASSOC.	
	FIELD SURVEYS BY	
	SURV-TEK, INC.	

NO.	DATE	REMARKS	BY
REVISIONS			
WILSON & COMPANY, ENGINEERS & ARCHITECTS			
DESIGNED BY	DEC	DATE	DEC. 04

SCANNED BY
MESA REPRO

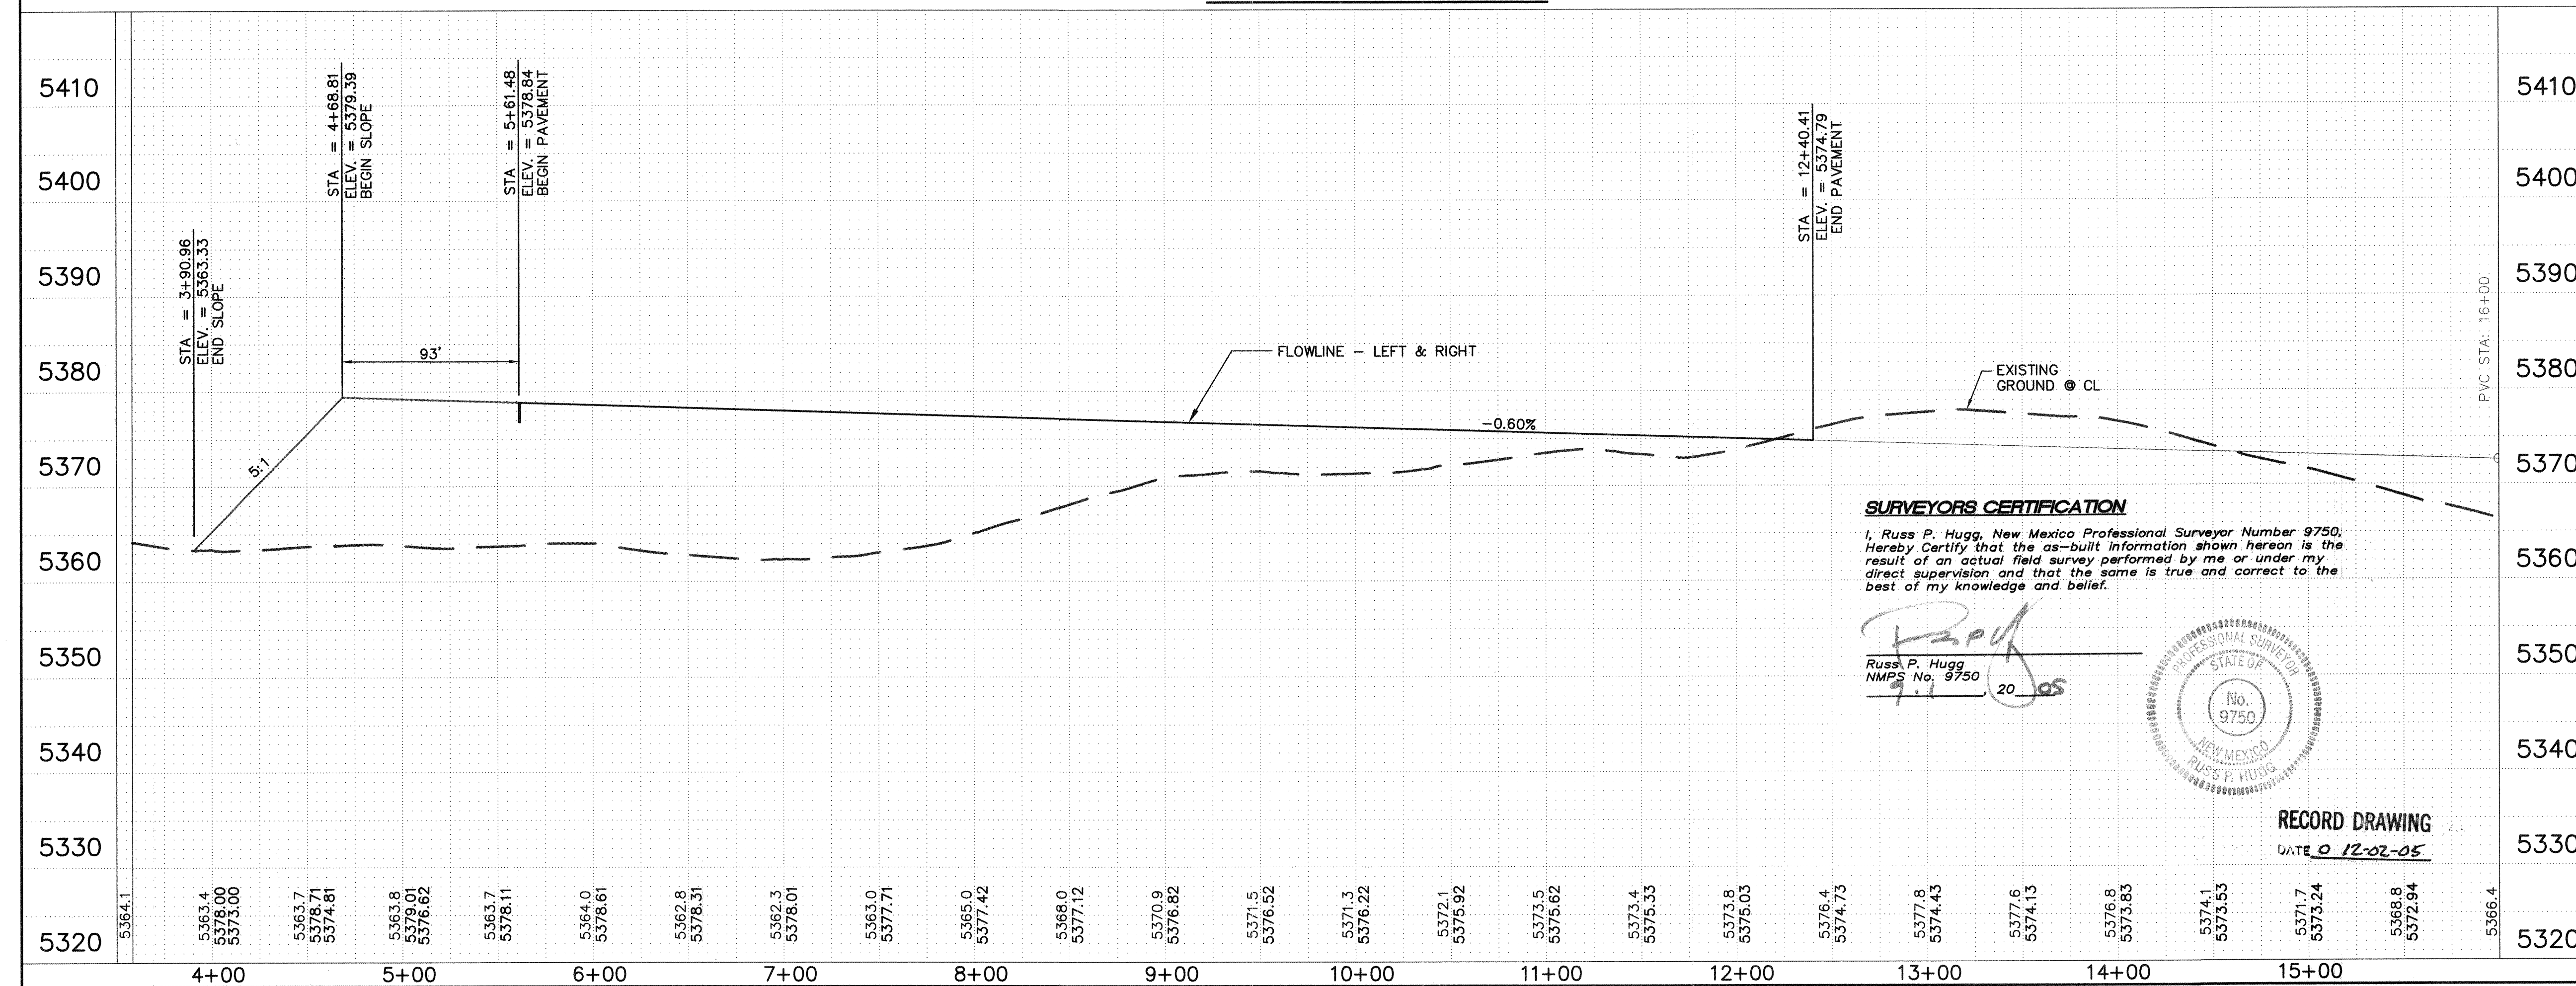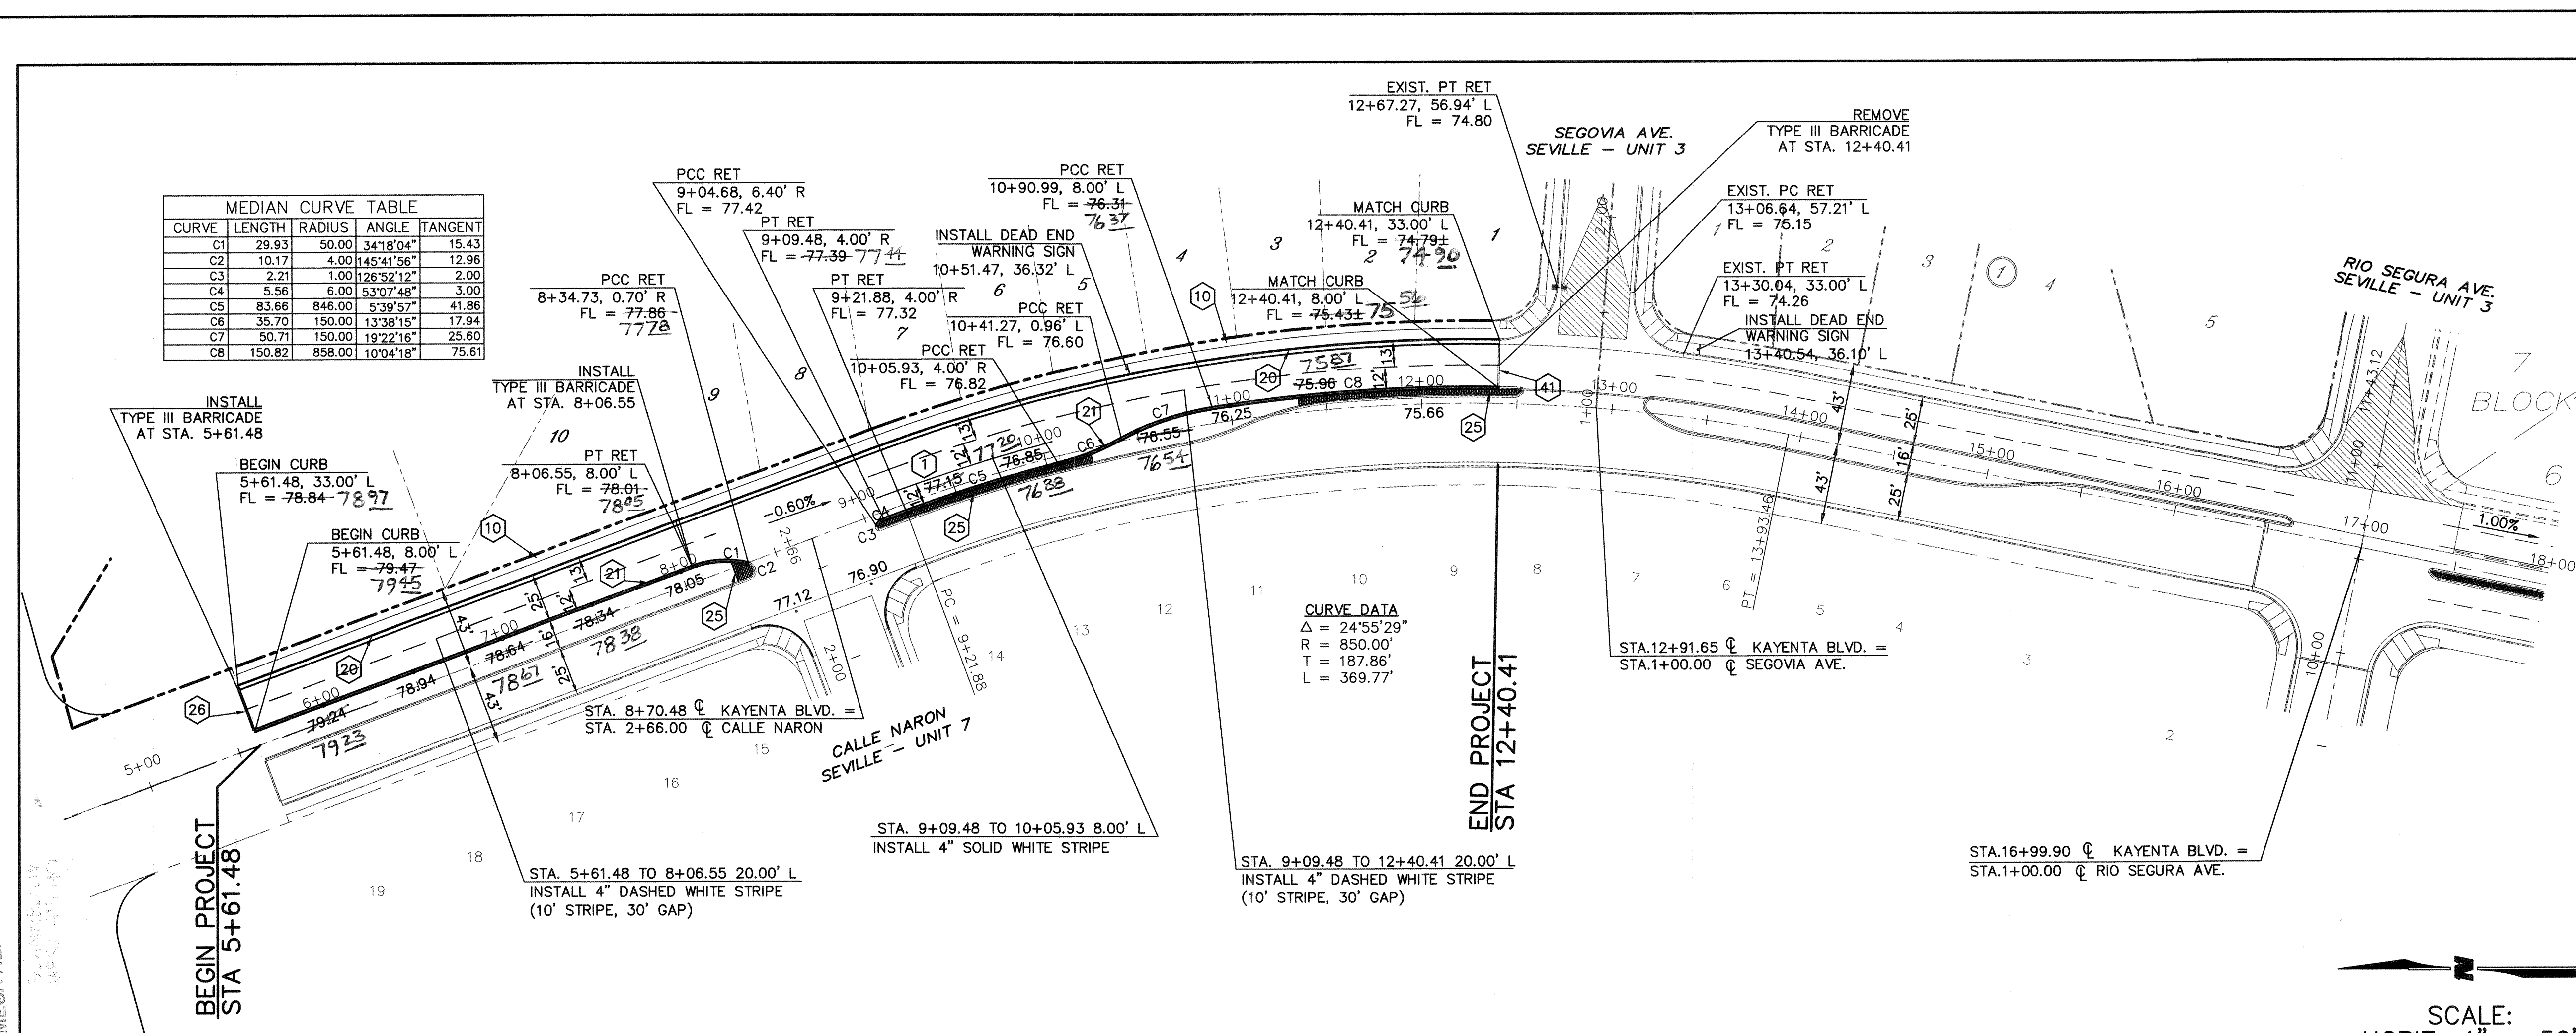

PAVING CONSTRUCTION NOTES	
I.D.#	DESCRIPTION
1	BUILD ASPHALT PAVING, PER TYPICAL SECTION (SEE SHEET 13)
10	BUILD 6' PCC SIDEWALK, PER COA STD. DWG. 2430
20	BUILD PCC STD. CURB AND GUTTER, PER COA STD. DWG. 2415A
21	BUILD PCC MEDIAN CURB AND GUTTER, PER PER STD. DWG. 2415B
25	BUILD PCC MEDIAN PAVEMENT, PER COA STD. DWG. 2408
26	BUILD PCC CUT-OFF WALL, PER COA STD. DWG. 2415B
41	REMOVE PCC CUT-OFF WALL

LEGEND	
SYMBOL	DESCRIPTION
TC	TOP OF STANDARD TYPE CURB
FL	FLOW LINE
TRC	TOP OF ROLL TYPE CURB
39.85*	TOP OF ROLL TYPE CURB ELEVATION AT WHEEL CHAIR RAMP TRANSITION.
39.85	FLOWLINE ELEVATION AT INTERSECTION OF PROJECTED FACE OF CURB.
////	MATCHLINE OF NEW TO EXISTING ASPHALT PAVEMENT.
▨	TRANSITION CROWN PER COA STD DWG 2401

GENERAL NOTES	
1.	ALL CURB RETURNS HAVE 25' RADIUS AT THEORETICAL FACE OF CURB (FLOWLINE) PER COA STD DWG 2415A, UNLESS OTHERWISE INDICATED
2.	ALL STATIONS AND OFFSETS ARE TO THEORETICAL FACE OF CURB (FLOWLINE) PER COA STD DWG 2415A, UNLESS OTHERWISE INDICATED
3.	ALL CURB LAYOUT DATA IS AT THEORETICAL FACE OF CURB (FLOWLINE) PER COA STD DWG 2415A, UNLESS OTHERWISE INDICATED. CURB LAYOUT THAT IS A DIRECT OFFSET OF PLATTED BASELINE IS NOT SHOWN
4.	ADJUST ALL MANHOLE RIMS AND VALVE COVERS PER COA STD. DWG. 2460

INDEX MAP	

WILSON & COMPANY	
2600 THE AMERICAN ROAD S.E. SUITE 100 RIO RANCHO, NEW MEXICO 87124 (505) 898-8021	
CITY OF ALBUQUERQUE PUBLIC WORKS DEPARTMENT ENGINEERING GROUP	
SEVILLE SUBDIVISION - UNIT 3A KAYENTA BLVD. PAVING PLAN & PROFILE	
Design Review Committee	City Engineer Approval
APR 28 2005	APR 28 2005
DESIGN REVIEW COMMITTEE	CITY ENGINEER


City Project No.	Zone Map No.	Sheet	Of
702082	A-10-Z	14A	32

SCANNED BY
MESA REPRO

NOTE: FOR KNUCKLE AND VALLEY GUTTER CONSTRUCTION INFORMATION SEE SHEET 19 (SORIA AVE)


KNUCKLE CURVE DATA			
Δ	R	T	L
1) 52°41'41"	25.00'	12.38'	22.99'
2) 169°41'23"	41.00'	45.37'	121.42'
3) 52°47'34"	25.00'	12.41'	23.04'

① C CURVE DATA
Δ = 64°11'10"
R = 75.00'
T = 47.03'
L = 84.02'
CH = 84.02'
COURSE = N21°04'43"W

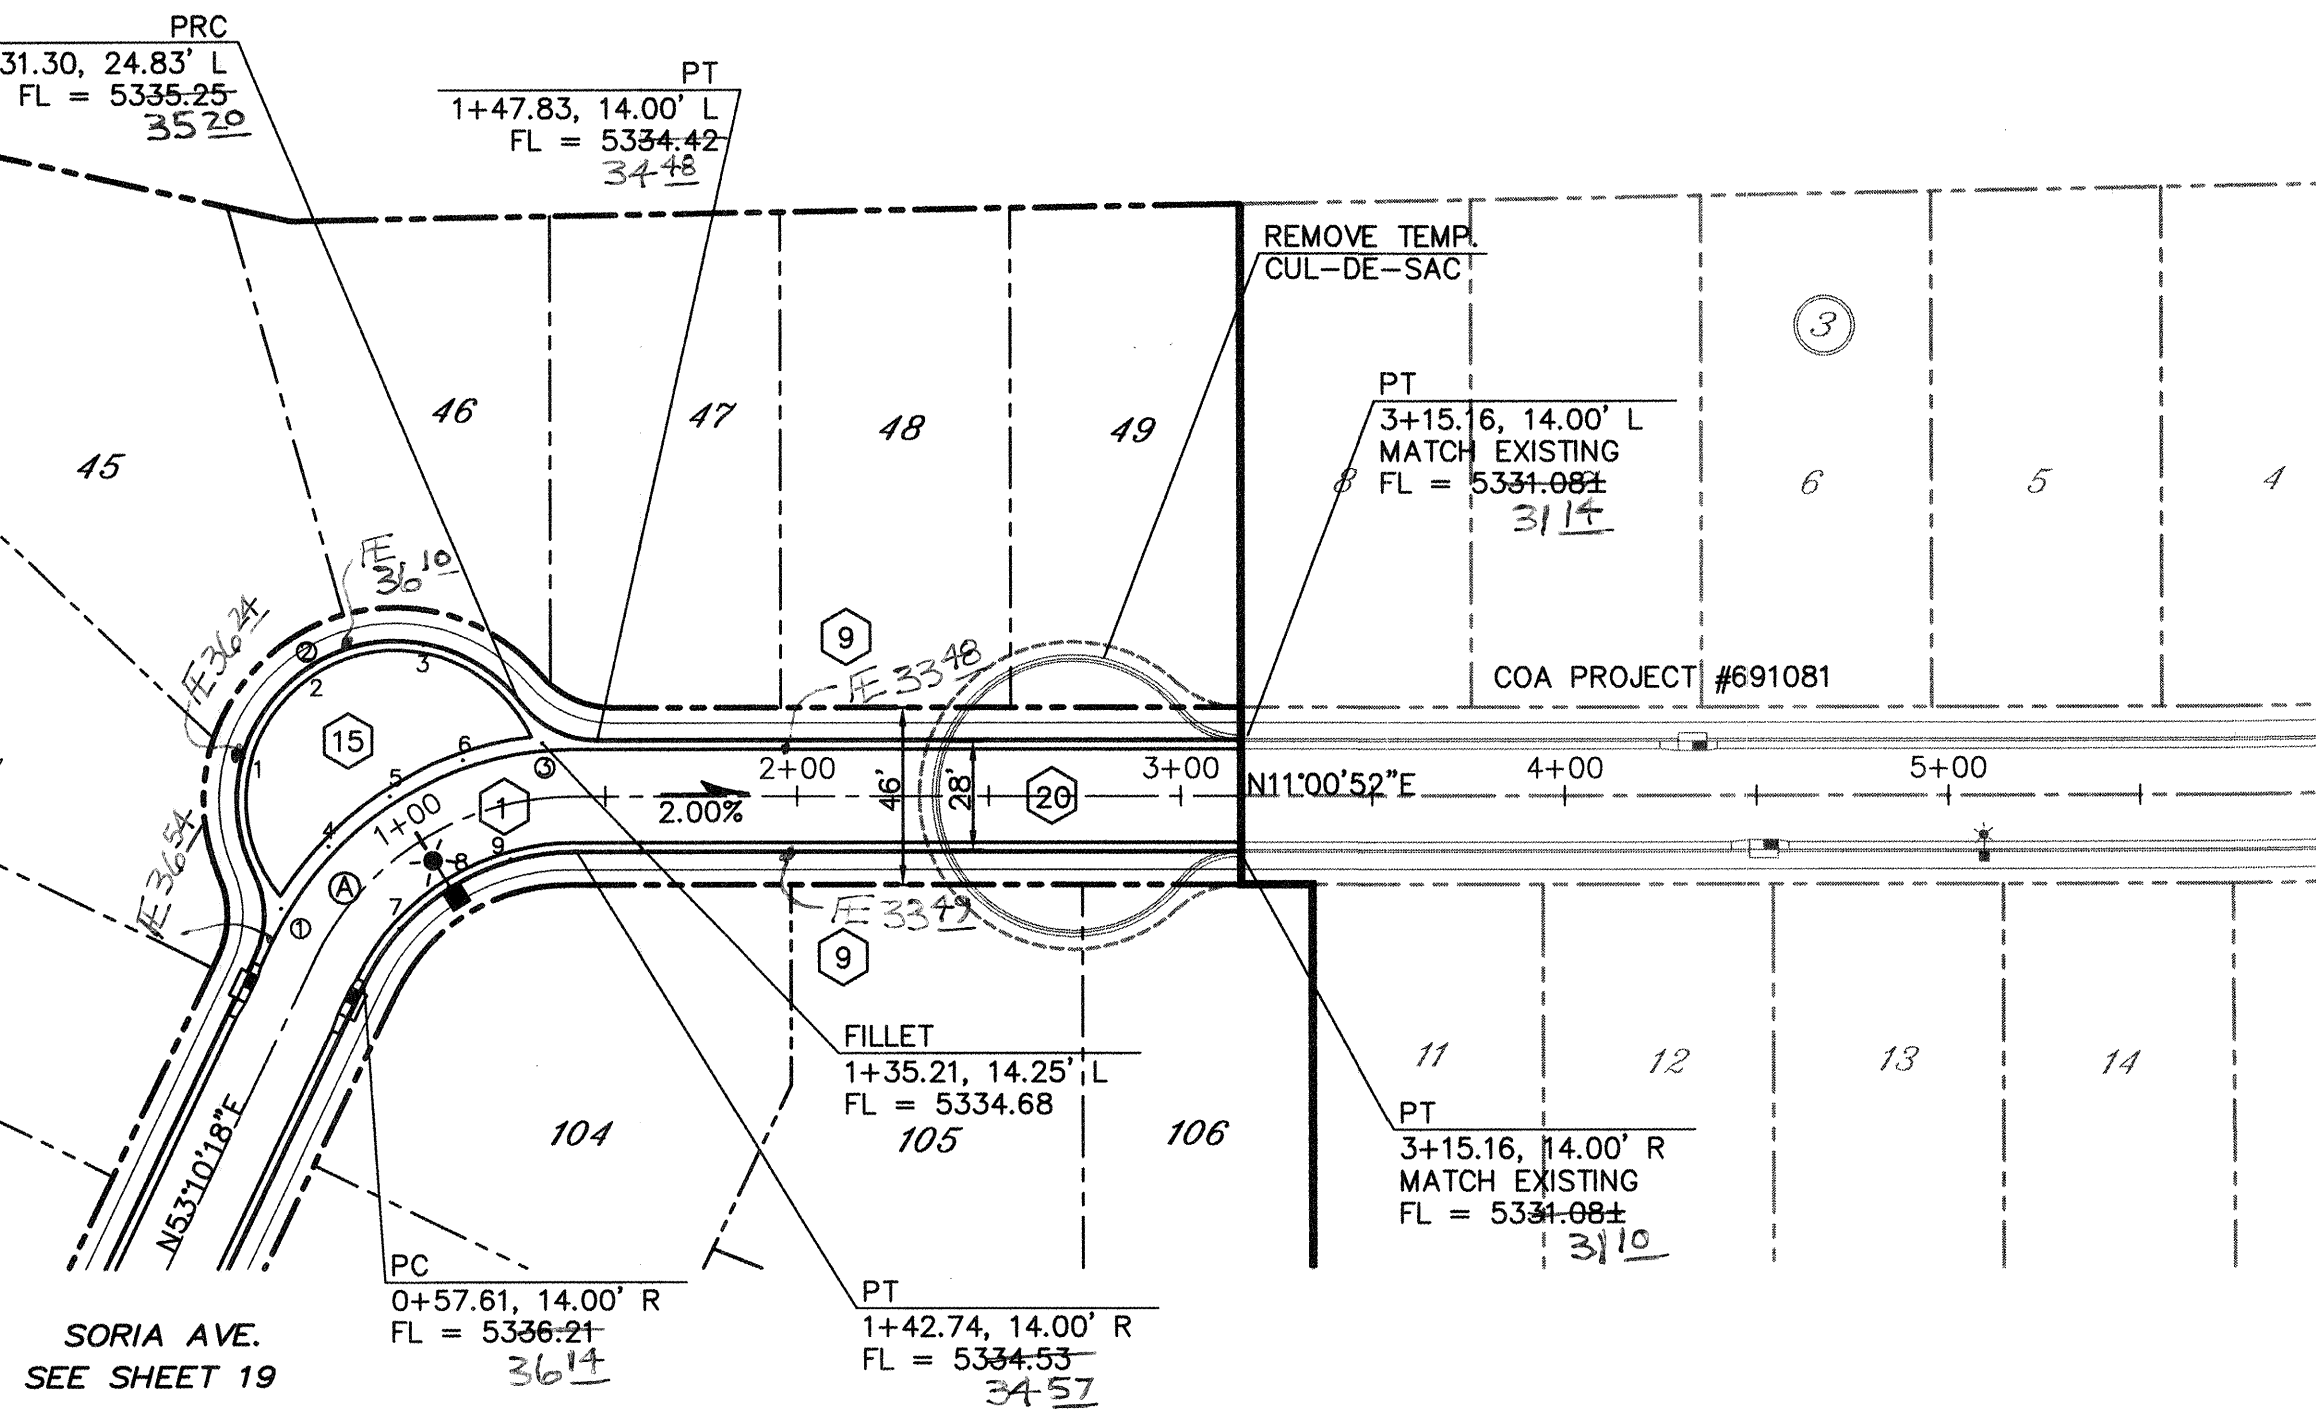

TOLEDO STREET N.W.

SCALE:
HORIZ: 1" = 50'
VERT: 1" = 10'

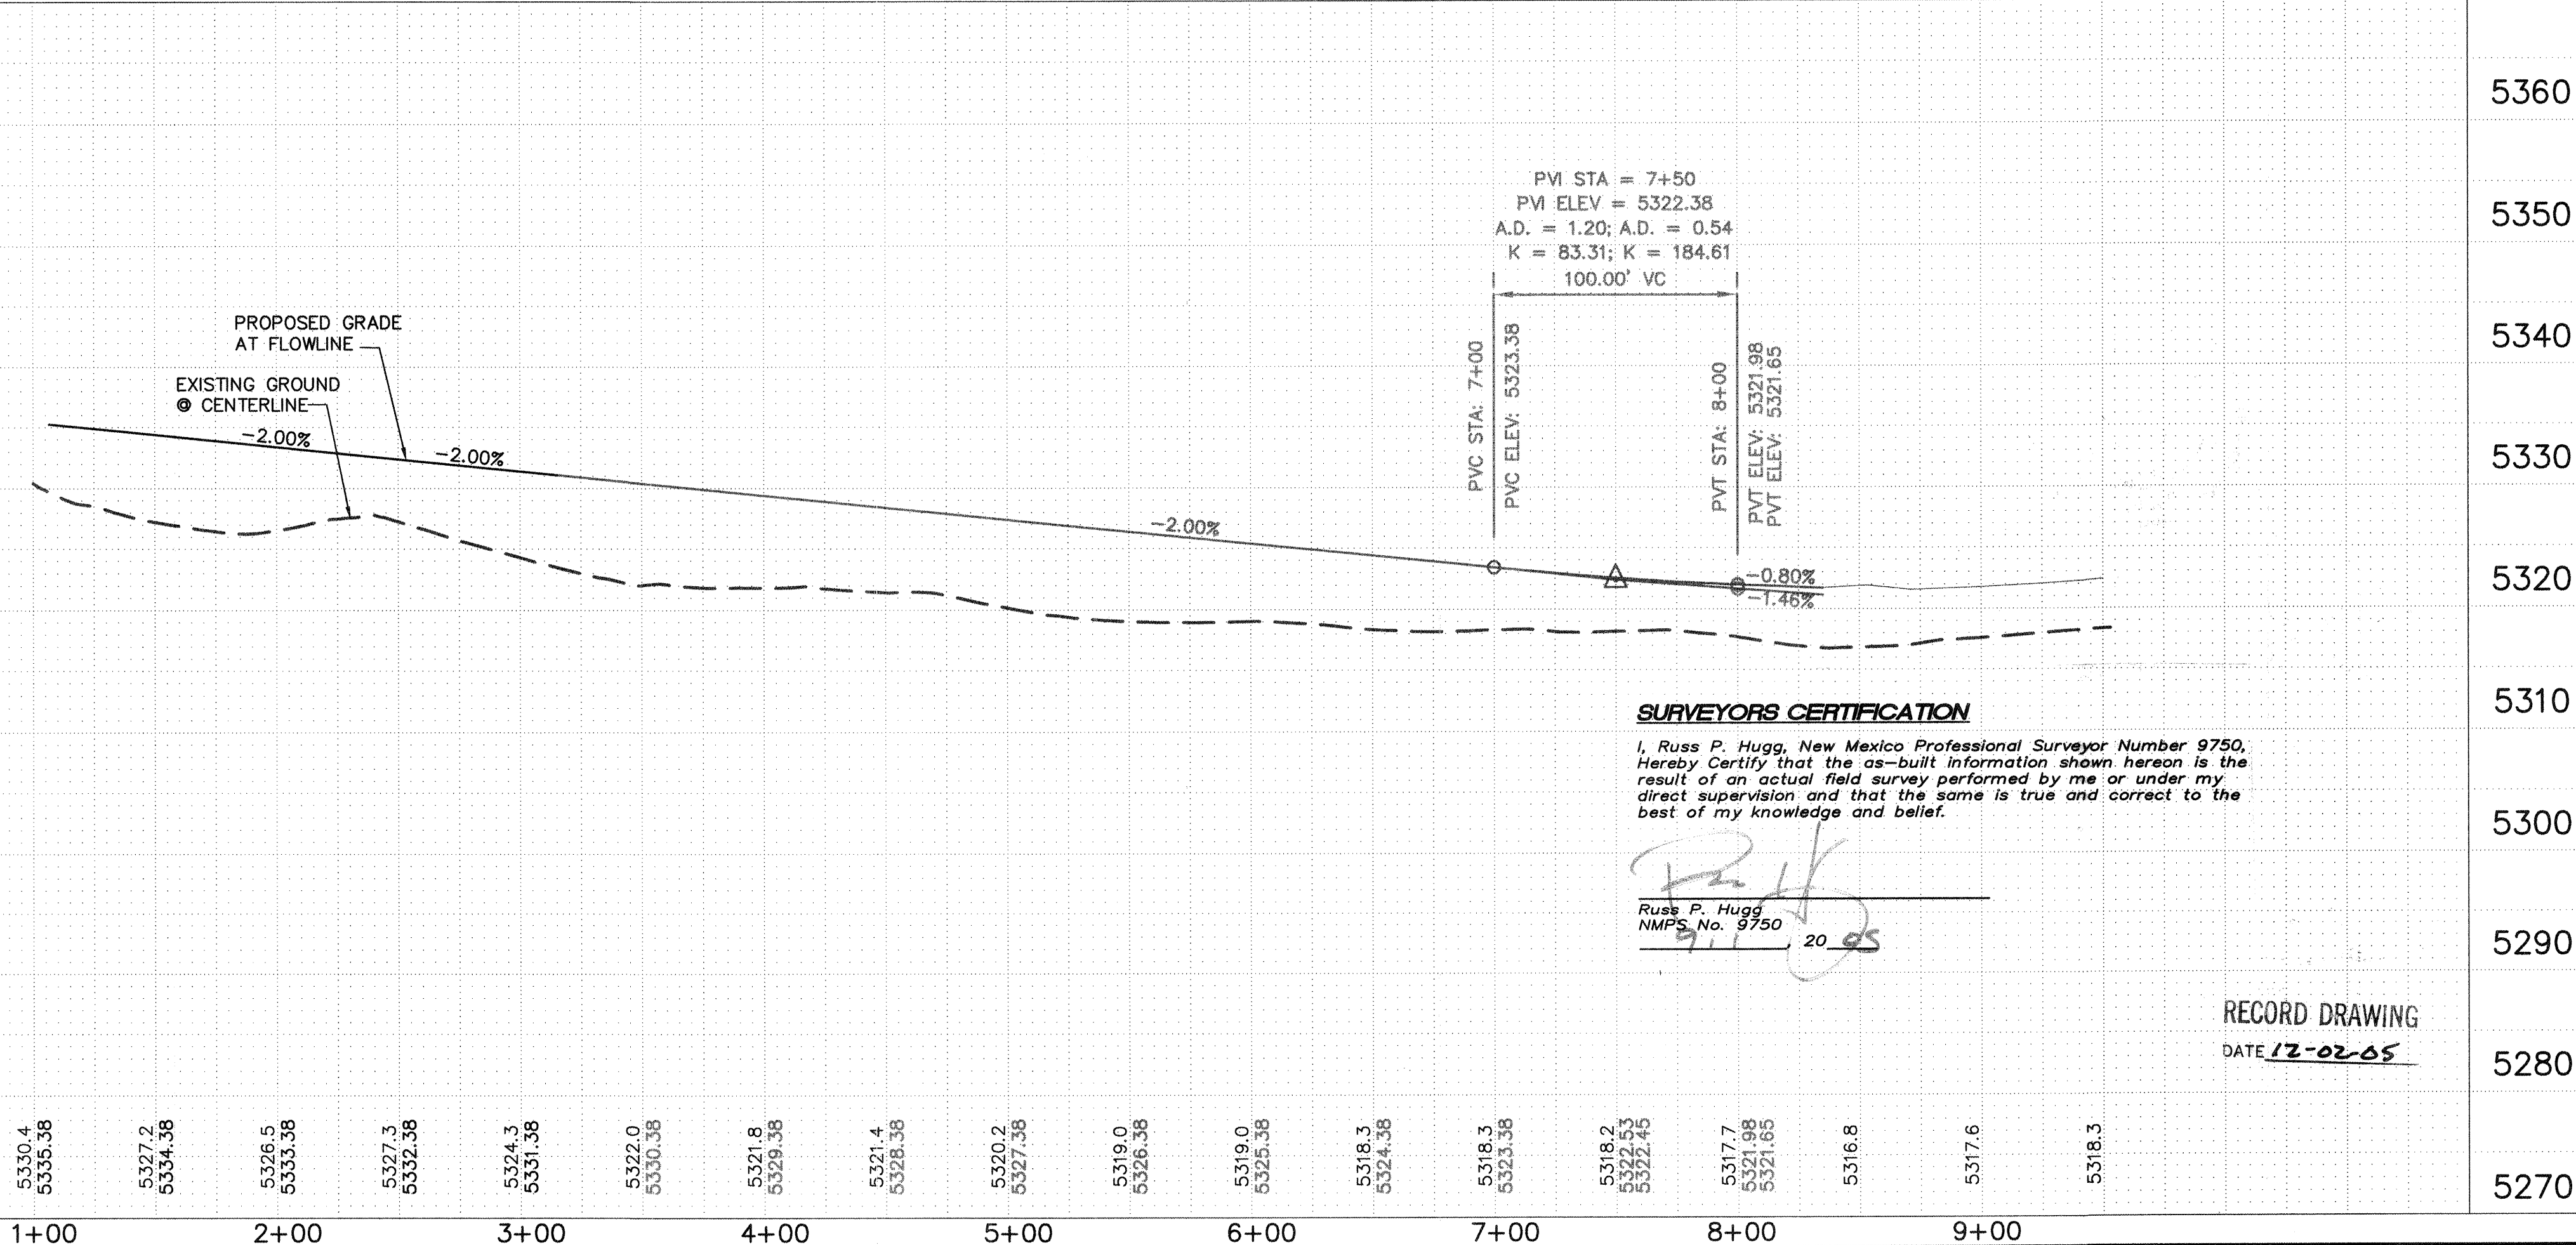

SURVEYORS CERTIFICATION

I, Russ P. Hugg, New Mexico Professional Surveyor Number 9750, Herby Certify that the as-built information shown hereon is the result of an actual field survey performed by me or under my direct supervision and that the same is true and correct to the best of my knowledge and belief.

Russ P. Hugg
NMPS No. 9750
20 05

RECORD DRAWING
DATE 12-02-05

PAVING CONSTRUCTION NOTES

I.D.#	DESCRIPTION
1	BUILD ASPHALT PAVING, PER TYPICAL SECTION (SEE SHEET 13)
9	BUILD 4' PCC SIDEWALK, PER COA STD. DWG. 2430 (DEFERRED)
15	BUILD 4' PCC VALLEY GUTTER AT "KNUCKLE" PER COA STD. DWG. 2421
20	BUILD PCC STD. CURB AND GUTTER, PER COA STD. DWG. 2415A

LEGEND

TC	TOP OF STANDARD TYPE CURB
FL	FLOW LINE
TRC	TOP OF ROLL TYPE CURB
39.85'	TOP OF ROLL TYPE CURB ELEVATION AT WHEEL CHAIR RAMP TRANSITION.
39.85	FLOWLINE ELEVATION AT INTERSECTION OF PROJECTED FACE OF CURB.
////	MATCHLINE OF NEW TO EXISTING ASPHALT PAVEMENT.
▨	TRANSITION CROWN PER COA STD DWG 2401

GENERAL NOTES


- ALL CURB RETURNS HAVE 25' RADIUS AT THEORETICAL FACE OF CURB (FLOWLINE) PER COA STD DWG 2415A, UNLESS OTHERWISE INDICATED
- ALL STATIONS AND OFFSETS ARE TO THEORETICAL FACE OF CURB (FLOWLINE) PER COA STD DWG 2415A, UNLESS OTHERWISE INDICATED. CURB LAYOUT THAT IS A DIRECT OFFSET OF PLATTED BASELINE IS NOT SHOWN
- ALL CURB LAYOUT DATA IS AT THEORETICAL FACE OF CURB (FLOWLINE) PER COA STD DWG 2415A, UNLESS OTHERWISE INDICATED. CURB LAYOUT THAT IS A DIRECT OFFSET OF PLATTED BASELINE IS NOT SHOWN

AS-BUILT INFORMATION			
CONTRACTOR	FRANKLIN'S ENTERPRISES, INC.	DATE	07/05
WORK	STAKED BY SURV. TEK	DATE	07/05
FIELD	ACCEPTANCE BY J. L. L. & CO.	DATE	09/05
DRAWINGS	SURV. TEK	DATE	09/05
CORRECTED BY	SURV. TEK	DATE	09/05
MICRO-FILM INFORMATION			
RECORDED BY		DATE	
NO.		DATE	

BENCH MARKS			
CONTRACTOR	A.C.S. Survey Monument "SANDBERN"	DATE	
WORK	New Mexico State Plane Coord's, Central Zone (NAD 27) as published:	DATE	
FIELD	PHOTOGRAMMETRY BY 3/22/99	DATE	
DRAWINGS	Y = 1,534.209.29	DATE	
CORRECTED BY	X = 361,854.29	DATE	
NO.	Elevation = 5456.92 (SLD 1929)	DATE	
	Ground to grid factor = 0.99966079	DATE	

SURVEY INFORMATION			
FIELD NOTES	BY	DATE	
NO.	PHOTOGRAMMETRY BY 3/22/99	DATE	
	T.R. MANN & ASSOC.	DATE	
	FIELD SURVEYS BY	DATE	
	SURV-TEK, INC.	DATE	

ENGINEER'S SEAL			
NO.	DATE	DATE	DATE
	REVISIONS	DATE	DATE
	WILSON & COMPANY, ENGINEERS & ARCHITECTS	DATE	DATE
	DESIGNED BY	DATE	DATE
	DRAWN BY	DATE	DATE
	CHECKED BY	DATE	DATE

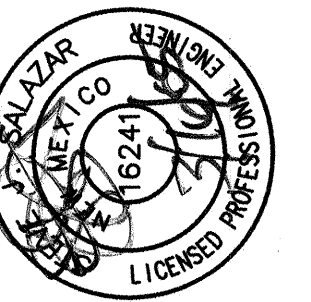

INDEX MAP

WILSON & COMPANY
2600 THE AMERICAN ROAD S.E.
SUITE 100
RIO RANCHO, NEW MEXICO
87124
(505) 898-8021

CITY OF ALBUQUERQUE
PUBLIC WORKS DEPARTMENT
ENGINEERING GROUP

SEVILLE SUBDIVISION - UNIT 3A
TOLEDO STREET
PAVING PLAN & PROFILE

Design	Review	Committee	City Engineer Approval	Update
APPROVE	APPROVE	APPROVE	APPROVE	APPROVE
APR 28 2005	APR 28 2005	APR 28 2005	APR 28 2005	APR 28 2005
DESIGN REVIEW COMMITTEE	DESIGN REVIEW COMMITTEE	DESIGN REVIEW COMMITTEE	DESIGN REVIEW COMMITTEE	DESIGN REVIEW COMMITTEE

City Project No.	Zone Map No.	Sheet	Of
702082	A-10-Z	15	32




SCALE:
HORIZ: 1" = 50'
VERT: 1" = 10'




I, Russ P. Hugg, New Mexico Professional Surveyor Number 9750,
Hereby Certify that the as-built information shown hereon is the
result of an actual field survey performed by me or under my
direct supervision and that the same is true and correct to the
best of my knowledge and belief.

Russ P. Hugg
NMPS No. 9750
9.1

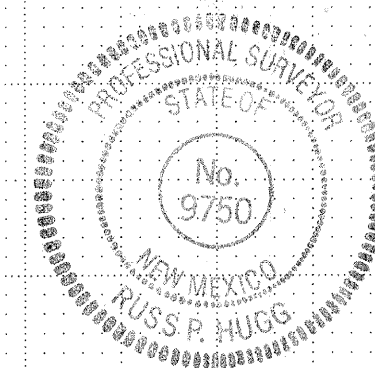

RECORD DRAWING
DATE 12-02-05

CONSTRUCTION NOTES		AS-BUILT INFORMATION		BENCH MARKS		SURVEY INFORMATION		ENGINEER'S SEAL		INDEX MAP		CITY OF ALBUQUERQUE PUBLIC WORKS DEPARTMENT ENGINEERING GROUP		SEVILLE SUBDIVISION - UNIT 3A PAMPLONA STREET PAYING PLAN & PROFILE		Design Review Committee		City Engineer Approval		Last Design Update		Mo./Day/Yr.		Mo./Day/Yr.	
I.D.#	DESCRIPTION	CONTRACTOR: Franklins Landmark Homes		A.C.S. Survey Monument "SANDBERN"		FIELD NOTES		ENGINEER'S SEAL		INDEX MAP		CITY OF ALBUQUERQUE PUBLIC WORKS DEPARTMENT ENGINEERING GROUP		SEVILLE SUBDIVISION - UNIT 3A PAMPLONA STREET PAYING PLAN & PROFILE		Design Review Committee		City Engineer Approval		Last Design Update		Mo./Day/Yr.		Mo./Day/Yr.	
(1)	BUILD ASPHALT PAVING, PER TYPICAL SECTION (SEE SHEET 13)	DATE: 07/16/09		New Mexico State Plane Coord's, Central Zone (NAD 27) as published:		BY DATE		NEW MEXICO ENGINEERING PROFESSIONAL SEAL		INDEX MAP		CITY OF ALBUQUERQUE PUBLIC WORKS DEPARTMENT ENGINEERING GROUP		SEVILLE SUBDIVISION - UNIT 3A PAMPLONA STREET PAYING PLAN & PROFILE		Design Review Committee		City Engineer Approval		Last Design Update		Mo./Day/Yr.		Mo./Day/Yr.	
(9)	BUILD 4' PCC SIDEWALK, PER COA STD. DWG. 2430 (DEFERRED)	DATE: 09-20-09		Y = 1,534,209.29		NO. BY DATE		NEW MEXICO ENGINEERING PROFESSIONAL SEAL		INDEX MAP		CITY OF ALBUQUERQUE PUBLIC WORKS DEPARTMENT ENGINEERING GROUP		SEVILLE SUBDIVISION - UNIT 3A PAMPLONA STREET PAYING PLAN & PROFILE		Design Review Committee		City Engineer Approval		Last Design Update		Mo./Day/Yr.		Mo./Day/Yr.	
(12)	BUILD PCC WHEELCHAIR RAMP, PER COA STD. DWG. 2441 (SEE SHEET 13)	DATE: 09/10/09		X = 361,854.29		PHOTOGRAMMETRY BY 3/22/98		NEW MEXICO ENGINEERING PROFESSIONAL SEAL		INDEX MAP		CITY OF ALBUQUERQUE PUBLIC WORKS DEPARTMENT ENGINEERING GROUP		SEVILLE SUBDIVISION - UNIT 3A PAMPLONA STREET PAYING PLAN & PROFILE		Design Review Committee		City Engineer Approval		Last Design Update		Mo./Day/Yr.		Mo./Day/Yr.	
(14)	BUILD 6' PCC VALLEY GUTTER, PER COA STD. DWG. 2420	DATE: 09/10/09		Elevation = 5456.92 (SLD 1929)		T.R. MANN & ASSOC.		NEW MEXICO ENGINEERING PROFESSIONAL SEAL		INDEX MAP		CITY OF ALBUQUERQUE PUBLIC WORKS DEPARTMENT ENGINEERING GROUP		SEVILLE SUBDIVISION - UNIT 3A PAMPLONA STREET PAYING PLAN & PROFILE		Design Review Committee		City Engineer Approval		Last Design Update		Mo./Day/Yr.		Mo./Day/Yr.	
(22)	BUILD PCC ROLL-TYPE C&G, PER COA STD. DWG. 2415A	DATE: 09/10/09		Ground to grid factor = 0.999966079		FIELD SURVEYS BY SURV-TEK, INC.		NEW MEXICO ENGINEERING PROFESSIONAL SEAL		INDEX MAP		CITY OF ALBUQUERQUE PUBLIC WORKS DEPARTMENT ENGINEERING GROUP		SEVILLE SUBDIVISION - UNIT 3A PAMPLONA STREET PAYING PLAN & PROFILE		Design Review Committee		City Engineer Approval		Last Design Update		Mo./Day/Yr.		Mo./Day/Yr.	
(30)	CROWN TRANSITION, PER COA STD. DWG. 2401	DATE: 09/10/09				NO. BY DATE		NEW MEXICO ENGINEERING PROFESSIONAL SEAL		INDEX MAP		CITY OF ALBUQUERQUE PUBLIC WORKS DEPARTMENT ENGINEERING GROUP		SEVILLE SUBDIVISION - UNIT 3A PAMPLONA STREET PAYING PLAN & PROFILE		Design Review Committee		City Engineer Approval		Last Design Update		Mo./Day/Yr.		Mo./Day/Yr.	
		DATE: 09/10/09				NO. BY DATE		NEW MEXICO ENGINEERING PROFESSIONAL SEAL		INDEX MAP		CITY OF ALBUQUERQUE PUBLIC WORKS DEPARTMENT ENGINEERING GROUP		SEVILLE SUBDIVISION - UNIT 3A PAMPLONA STREET PAYING PLAN & PROFILE		Design Review Committee		City Engineer Approval		Last Design Update		Mo./Day/Yr.		Mo./Day/Yr.	
		DATE: 09/10/09				NO. BY DATE		NEW MEXICO ENGINEERING PROFESSIONAL SEAL		INDEX MAP		CITY OF ALBUQUERQUE PUBLIC WORKS DEPARTMENT ENGINEERING GROUP		SEVILLE SUBDIVISION - UNIT 3A PAMPLONA STREET PAYING PLAN & PROFILE		Design Review Committee		City Engineer Approval		Last Design Update		Mo./Day/Yr.		Mo./Day/Yr.	
		DATE: 09/10/09				NO. BY DATE		NEW MEXICO ENGINEERING PROFESSIONAL SEAL		INDEX MAP		CITY OF ALBUQUERQUE PUBLIC WORKS DEPARTMENT ENGINEERING GROUP		SEVILLE SUBDIVISION - UNIT 3A PAMPLONA STREET PAYING PLAN & PROFILE		Design Review Committee		City Engineer Approval		Last Design Update		Mo./Day/Yr.</			

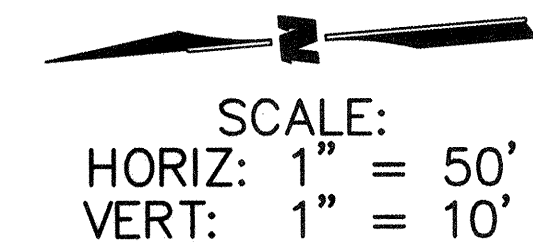


SURVEYORS CERTIFICATION

I, Russ P. Hugg, New Mexico Professional Surveyor Number 9750,
Hereby Certify that the as-built information shown hereon is the
result of an actual field survey performed by me or under my
direct supervision and that the same is true and correct to the
best of my knowledge and belief.

Russ P. Hugg
NMPS No. 9750



PVI STA = 10+87.06
PVI ELEV = 5341.74
A.D. = -2.20
K = 45.45
100.00' VC

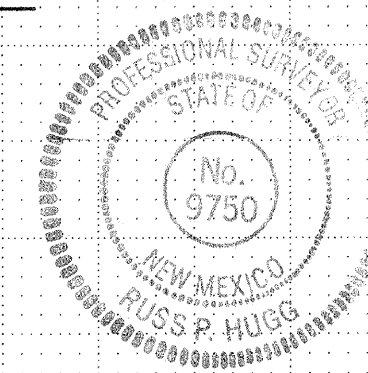

RECORD DRAWING
DATE 12-02-05

PAVING CONSTRUCTION NOTES		AS-BUILT INFORMATION		BENCH MARKS		SURVEY INFORMATION		ENGINEER'S SEAL														
I.D.#	DESCRIPTION	CONTRACTOR	DATE	INSPECTOR'S	DATE	FIELD	DATE	FIELD	DATE													
1	BUILD ASPHALT PAVING, PER TYPICAL SECTION (SEE SHEET 13)	FRANKLIN'S Earthworks	07/18/05	SURV TEK	09-09-05	VERIFICATION BY	07/18/05	CORRECTED BY	07/18/05													
9	BUILD 4' PCC SIDEWALK, PER COA STD. DWG. 2430 (DEFERRED)																					
12	BUILD PCC WHEELCHAIR RAMP, PER COA STD. DWG. 2441 (SEE SHEET 13)																					
14	BUILD 6" PCC VALLEY GUTTER, PER COA STD. DWG. 2420																					
22	BUILD PCC ROLL-TYPE C&G, PER COA STD. DWG. 2415A																					
30	CROWN TRANSITION, PER COA STD. DWG. 2401																					
<u>LEGEND</u> TC TOP OF STANDARD TYPE CURB FL FLOW LINE TRC TOP OF ROLL TYPE CURB 39.85* TOP OF ROLL TYPE CURB ELEVATION AT WHEEL CHAIR RAMP TRANSITION. 39.85 FLOWLINE ELEVATION AT INTERSECTION OF PROJECTED FACE OF CURB. ////// MATCHLINE OF NEW TO EXISTING ASPHALT PAVEMENT. TRANSITION CROWN PER COA STD DWG 2401 <u>GENERAL NOTES</u> - ALL CURB RETURNS HAVE 25' RADIUS AT THEORETICAL FACE OF CURB (FLOWLINE) PER COA STD DWG 2415A, UNLESS OTHERWISE INDICATED - ALL STATIONS AND OFFSETS ARE TO THEORETICAL FACE OF CURB (FLOWLINE) PER COA STD DWG 2415A, UNLESS OTHERWISE INDICATED - ALL CURB LAYOUT DATA IS AT THEORETICAL FACE OF CURB (FLOWLINE) PER COA STD DWG 2415A, UNLESS OTHERWISE INDICATED. CURB LAYOUT THAT IS A DIRECT OFFSET OF PLATTED BASELINE IS NOT SHOWN		A.C.S. Survey Monument "SANDBERN" New Mexico State Plane Coord's, Central Zone (NAD 27) as published: Y = 1,534,209.29 X = 361,854.29 Elevation = 5456.92 (SLD 1929) Ground to grid factor = 0.99966079		FIELD NOTES <table border="1" style="width: 100%; border-collapse: collapse;"> <thead> <tr> <th>NO.</th> <th>BY</th> <th>DATE</th> </tr> </thead> <tbody> <tr> <td></td> <td>PHOTOGRAMMETRY BY</td> <td>3/22/98</td> </tr> <tr> <td></td> <td>T.R. MANN & ASSOC.</td> <td></td> </tr> <tr> <td></td> <td>FIELD SURVEYS BY</td> <td></td> </tr> <tr> <td></td> <td>SURV-TEK, INC.</td> <td></td> </tr> </tbody> </table>		NO.	BY	DATE		PHOTOGRAMMETRY BY	3/22/98		T.R. MANN & ASSOC.			FIELD SURVEYS BY			SURV-TEK, INC.			
NO.	BY	DATE																				
	PHOTOGRAMMETRY BY	3/22/98																				
	T.R. MANN & ASSOC.																					
	FIELD SURVEYS BY																					
	SURV-TEK, INC.																					
INDEX MAP		<table border="1" style="width: 100%; border-collapse: collapse;"> <thead> <tr> <th>NO.</th> <th>DATE</th> <th>REMARKS</th> <th>BY</th> </tr> </thead> <tbody> <tr> <td></td> <td></td> <td></td> <td></td> </tr> </tbody> </table>		NO.	DATE	REMARKS	BY					WILSON & COMPANY 2600 THE AMERICAN ROAD S.E. SUITE 100 RIO RANCHO, NEW MEXICO 87124 (505) 898-8021										
NO.	DATE	REMARKS	BY																			
CITY OF ALBUQUERQUE PUBLIC WORKS DEPARTMENT ENGINEERING GROUP																						
SEVILLE SUBDIVISION – UNIT 3A BILBAO STREET PAVING PLAN & PROFILE																						
Design Review Committee APR 28 2005 DESIGN REVIEW COMMITTEE		City Engineer Approval APR 28 2005 CITY ENGINEER		Last Design Update		Mo./Day/Yr.		Mo./Day/Yr.														
City Project No. 702082		Zone Map No. A-10-Z		Sheet 17		Of 32																

SCANNED BY
MESA REPRO

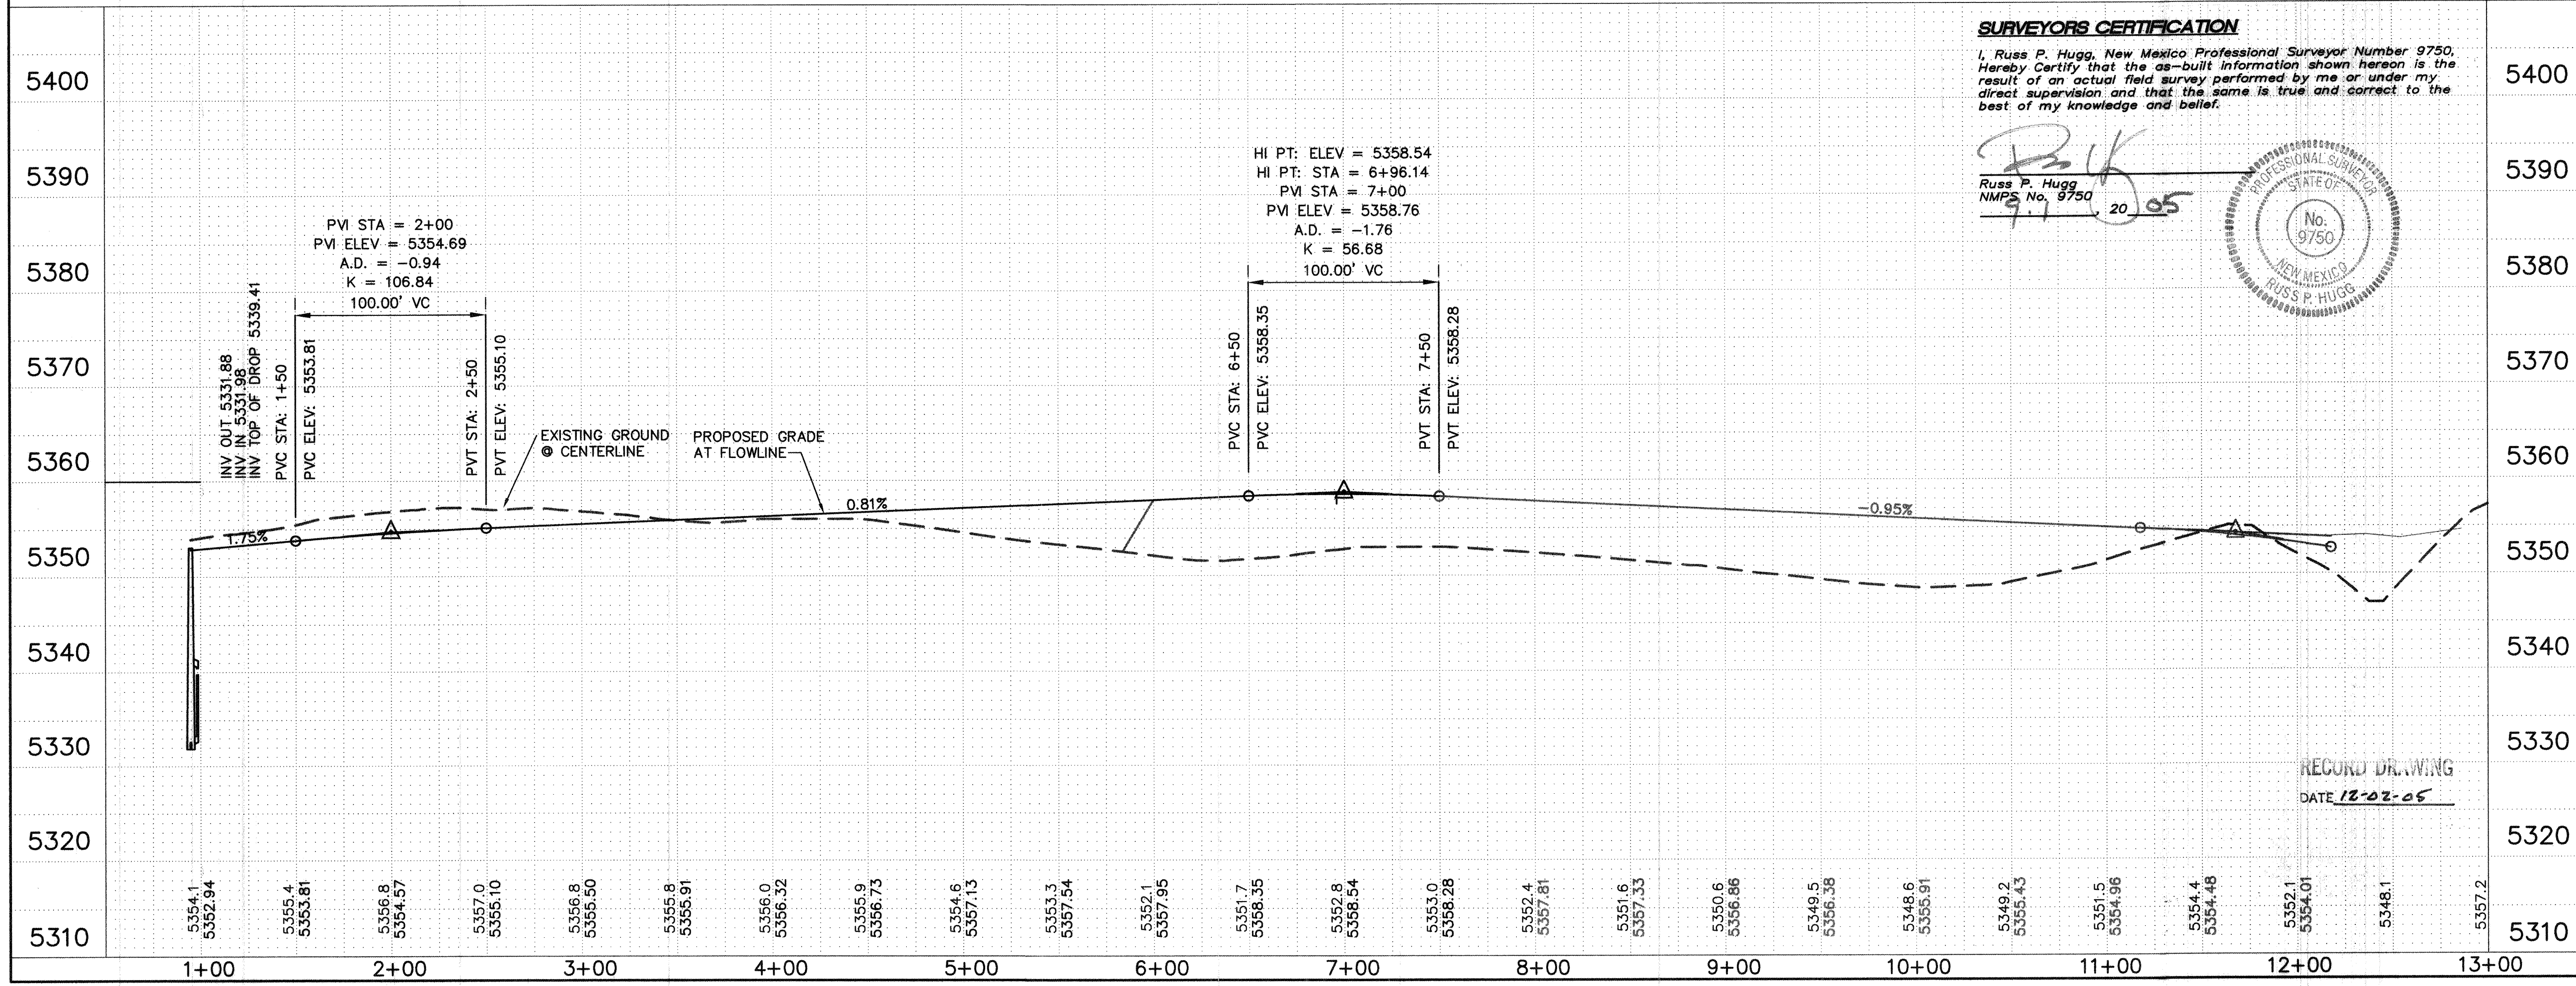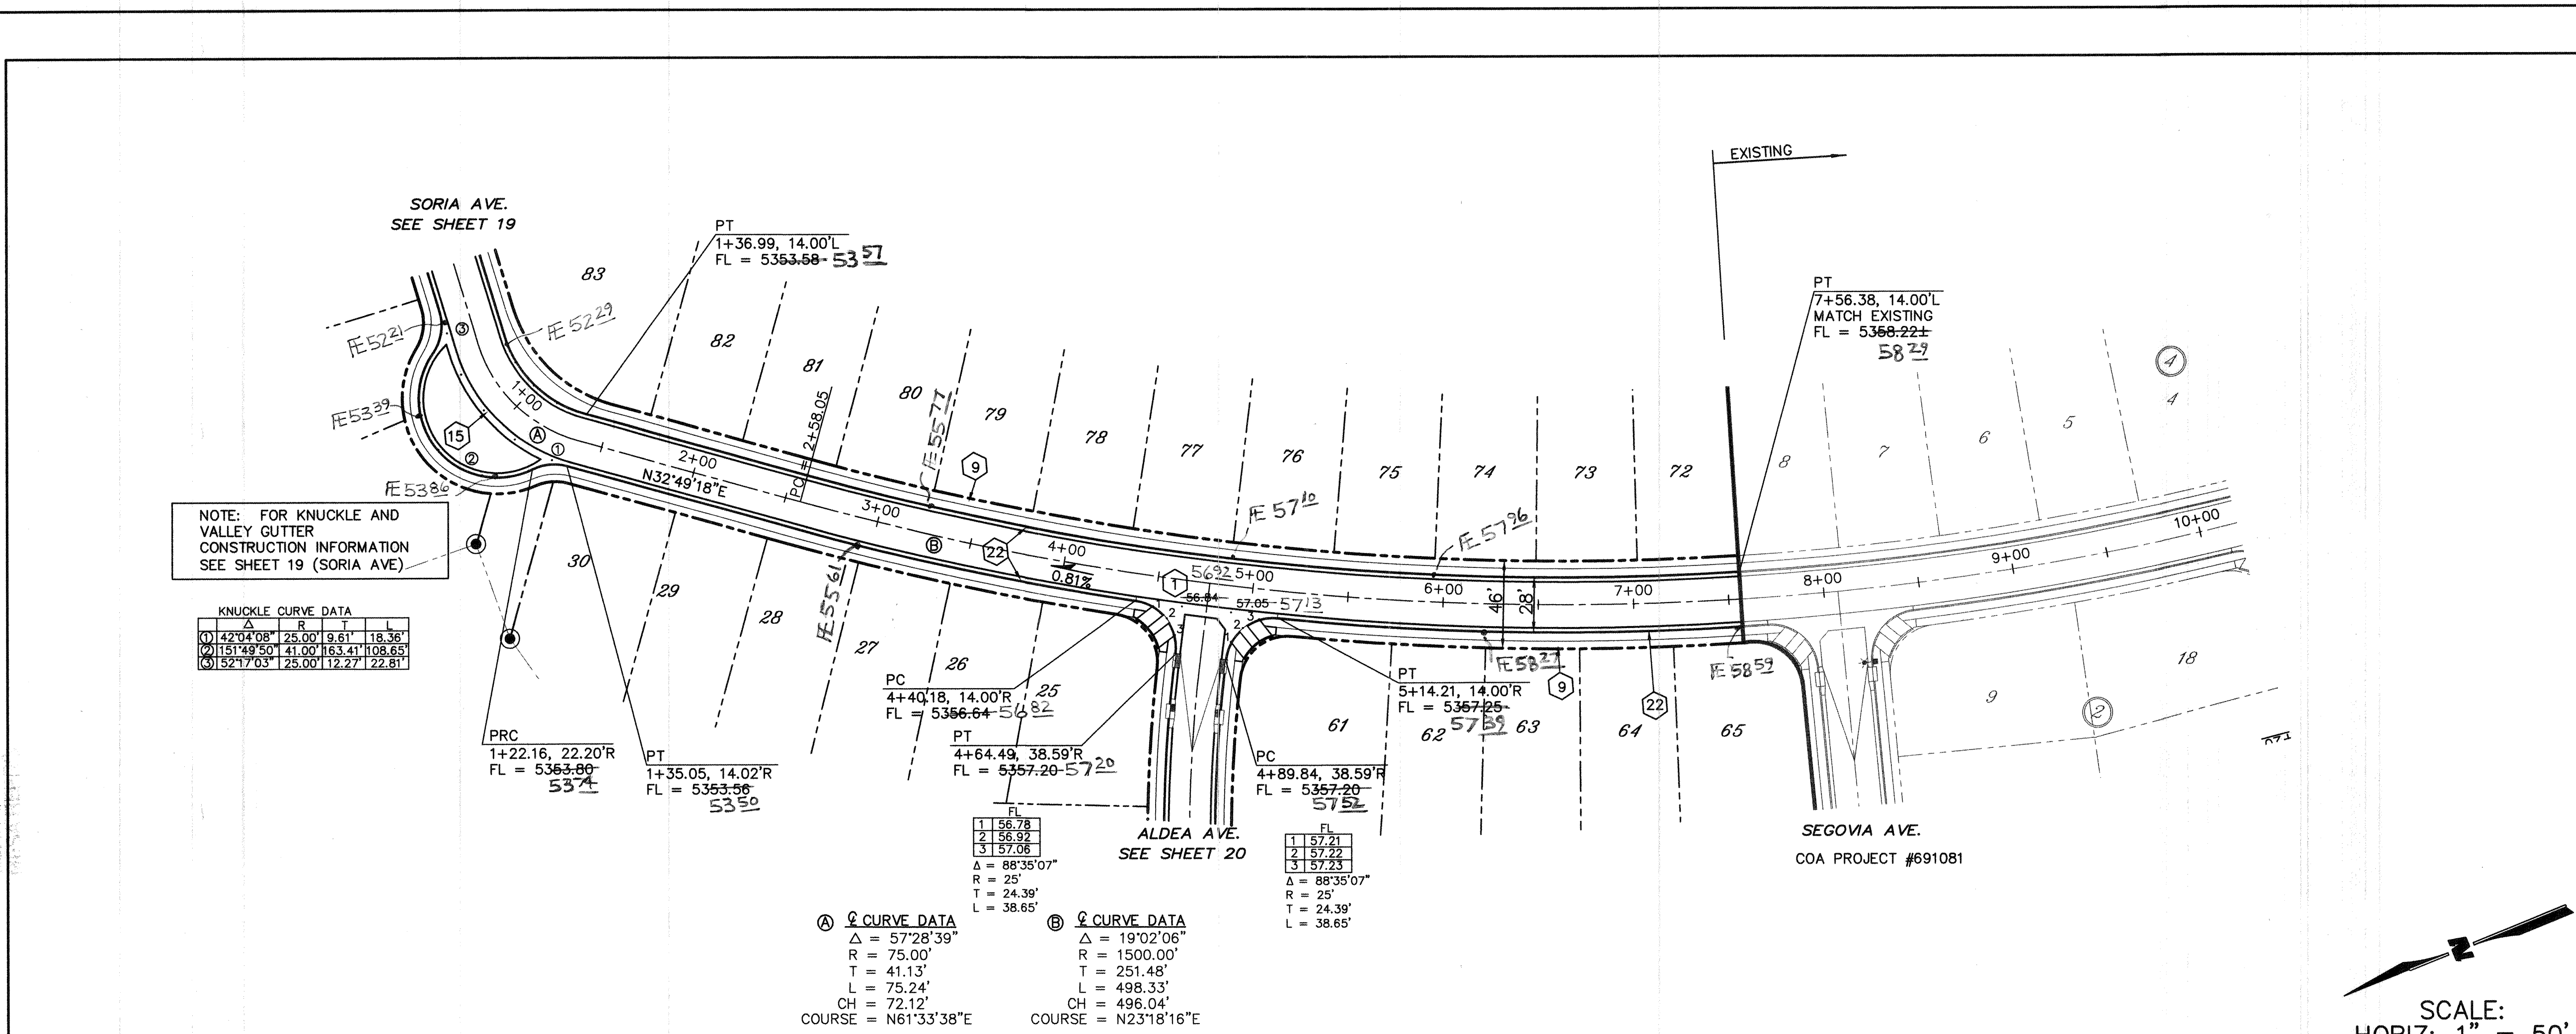

PAVING CONSTRUCTION NOTES

I.D.#	DESCRIPTION
1	BUILD ASPHALT PAVING, PER TYPICAL SECTION (SEE SHEET 13)
9	BUILD 4" PCC SIDEWALK, PER COA STD. DWG. 2430 (DEFERRED)
15	BUILD 4" PCC VALLEY GUTTER AT "KNUCKLE" PER COA STD. DWG. 2421
20	BUILD PCC STD. CURB AND GUTTER, PER COA STD. DWG. 2415A
22	BUILD PCC ROLL-TYPE C&G, PER COA STD. DWG. 2415A

STORM DRAIN CONSTRUCTION NOTES

I.D.#	DESCRIPTION
4	INSTALL 24" STORM DRAIN PIPE
30	INSTALL 4' DIA. MANHOLE PER COA STD. DTL. 2101

LEGEND

TC	TOP OF STANDARD TYPE CURB
FL	FLOW LINE
TRC	TOP OF ROLL TYPE CURB
39.85*	TOP OF ROLL TYPE CURB ELEVATION AT WHEEL CHAIR RAMP TRANSITION.
39.85	FLOWLINE ELEVATION AT INTERSECTION OF PROJECTED FACE OF CURB.
////	MATCHLINE OF NEW TO EXISTING ASPHALT PAVEMENT.
▨	TRANSITION CROWN PER COA STD DWG 2401

GENERAL NOTES

- ALL CURB RETURNS HAVE 25' RADIUS AT THEORETICAL FACE OF CURB (FLOWLINE) PER COA STD DWG 2415A, UNLESS OTHERWISE INDICATED
- ALL STATIONS AND OFFSETS ARE TO THEORETICAL FACE OF CURB (FLOWLINE) PER COA STD DWG 2415A, UNLESS OTHERWISE INDICATED. CURB LAYOUT THAT IS A DIRECT OFFSET OF PLATTED BASELINE IS NOT SHOWN
- ALL CURB LAYOUT DATA IS AT THEORETICAL FACE OF CURB (FLOWLINE) PER COA STD DWG 2415A, UNLESS OTHERWISE INDICATED. CURB LAYOUT THAT IS A DIRECT OFFSET OF PLATTED BASELINE IS NOT SHOWN

AS-BUILT INFORMATION

CONTRACTOR	Final Link Earth Movers
DATE	07/05
INSPECTOR	TEK
DATE	09/05
FIELD	TEK
DATE	09/05
CORRECTION	TEK
DATE	09/05
RECORDED BY	TEK
DATE	09/05

BENCH MARKS

A.C.S. Survey Monument "SANDBERN"	DATE	07/05
New Mexico State Plane Coord's, Central Zone (NAD 27) as published:	PHOTOGRAMMETRY BY	07/05
Y = 1,534,209.29	T.R. MANN & ASSOC.	07/05
X = 361,854.29	FIELD SURVEYS BY	07/05
Elevation = 5456.92 (SLD 1929)	SURV-TEK, INC.	07/05
Ground to grid factor = 0.9996079		

SURVEY INFORMATION

NO.	BY	DATE
1	TEK	07/05
2	TEK	07/05
3	TEK	07/05
ENGINEER'S SEAL

REMARKS	BY
REVISIONS	
WILSON & COMPANY, ENGINEERS & ARCHITECTS	
DESIGNED BY	DEC. 04
DRAWN BY	DEC. 04
CHECKED BY	DEC. 04

INDEX MAP

WILSON & COMPANY

2600 THE AMERICAN ROAD S.E.
SUITE 100
RIO RANCHO, NEW MEXICO
87104
(505) 898-8021

CITY OF ALBUQUERQUE

PUBLIC WORKS DEPARTMENT
ENGINEERING GROUP

SEVILLE SUBDIVISION - UNIT 3A

CADIZ STREET
PAVING PLAN & PROFILE

Design Review Committee

APR 28 2005
DESIGN REVIEW COMMITTEE

City Engineer Approval

APR 29 2005
CITY ENGINEER

Mo./Day/Yr.

Mo./Day/Yr.

City Project No.

702082

Zone Map No.



A-10-Z

Sheet

18

Of


32

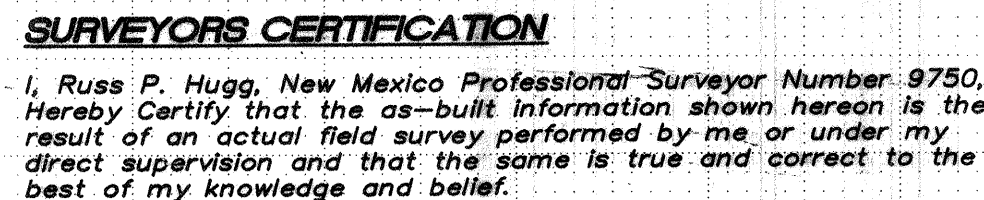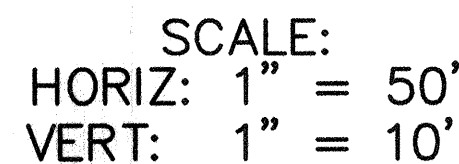

Russ P. Hugg
NMPS No. 9750
9.1.2005




RECORD DRAWING
DATE 12-02-05

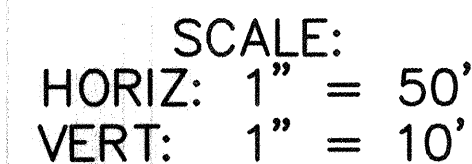

SCALE:
HORIZ: 1" = 50'
VERT: 1" = 10'



Russ P. Hugg
NMPS No. 9750
9.1 2005

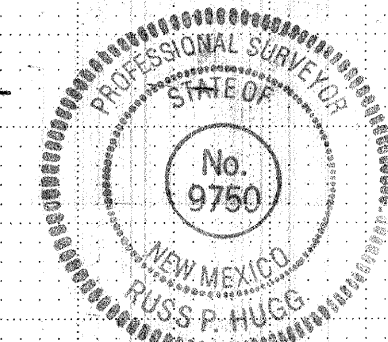**WILSON**
& COMPANY

CITY OF ALBUQUERQUE
PUBLIC WORKS DEPARTMENT
ENGINEERING GROUP

SEVILLE SUBDIVISION - UNIT 3A
ALDEA AVENUE
PAVING PLAN & PROFILE

Design Review Committee

City Engineer Approval

APPROVED
APR 28 2005
DESIGN
REVIEW COMMITTEE


APPROVED
APR 29 2005
CITY ENGINEER

City Project No.

Zone Map No.

Sheet	Of
20	32

SCANNED BY
MESA REPRO

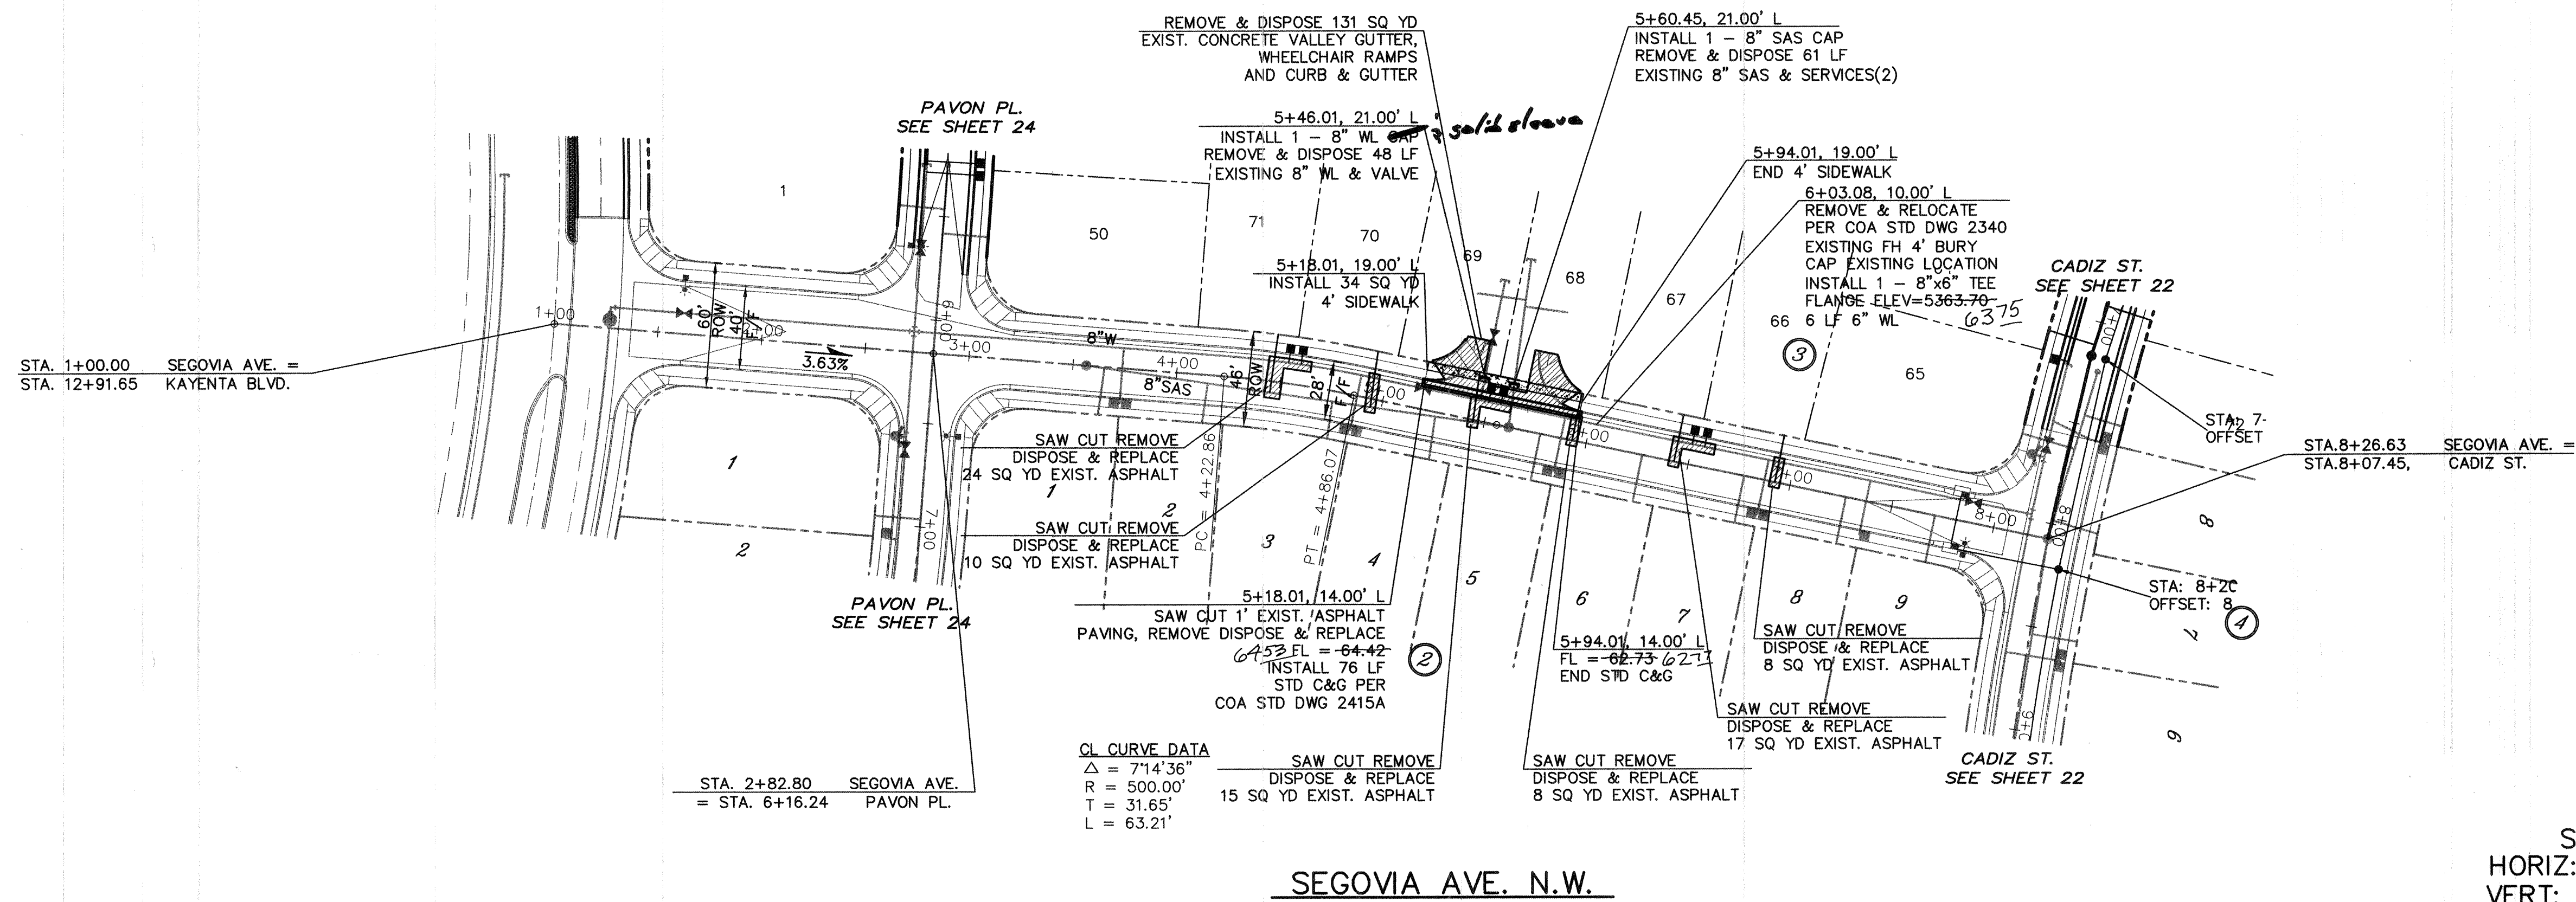


- LEGEND**
- TC TOP OF STANDARD TYPE CURB
 - FL FLOW LINE
 - TRC TOP OF ROLL TYPE CURB
 - 39.85* TOP OF ROLL TYPE CURB ELEVATION AT WHEEL CHAIR RAMP TRANSITION.
 - * 39.85 FLOWLINE ELEVATION AT INTERSECTION OF PROJECTED FACE OF CURB.
 - MATCHLINE OF NEW TO EXISTING ASPHALT PAVEMENT.
 - REMOVAL
 - TEMPORARY PAVEMENT
- GENERAL NOTES**
- ALL STATIONS AND OFFSETS ARE TO THEORETICAL FACE OF CURB (FLOWLINE) PER COA STD DWG 2415, UNLESS OTHERWISE INDICATED
 - NEW 3/4" DOUBLE SERVICE WATER METERS TO BE INSTALLED: LOTS 66 THRU 70 (3)
 - DISPOSE AND REPLACE EXISTING PAVEMENT PER COA DWG 2465
DISPOSE AND REPLACE EXISTING SIDEWALK PER COA DWG 2465
DISPOSE AND REPLACE EXISTING C & G PER COA DWG 2465
- SEWER SERVICE LOCATIONS**
- | BLOCK-LOT | STATION/OFFSET | INV. @ P/L |
|-----------|----------------|------------|
| 3-66 | 6+93, 23' L | 5381.0 |
| 3-67 | 6+43, 23' L | 5380.0 |
| 3-68 | 5+93, 23' L | 5358.9 |
| 3-69 | 5+43, 23' L | 5358.7 |
| 3-70 | 4+93, 23' L | 5356.6 |
| 3-71 | 4+46, 23' L | 5355.5 |




SURVEYORS CERTIFICATION
I, Russ P. Hugg, New Mexico Professional Surveyor Number 9750, Hereby Certify that the as-built information shown hereon is the result of an actual field survey performed by me or under my direct supervision and that the same is true and correct to the best of my knowledge and belief.

Russ P. Hugg
NMPS No. 9750
20 05

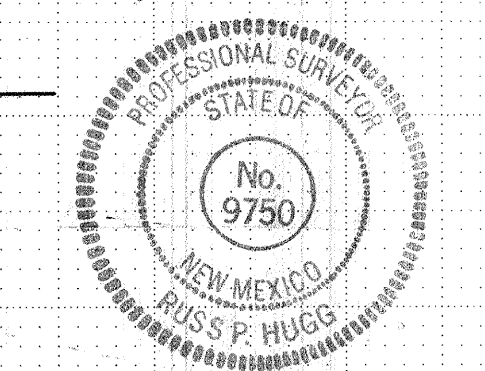

RECORD DATE 12-02-05

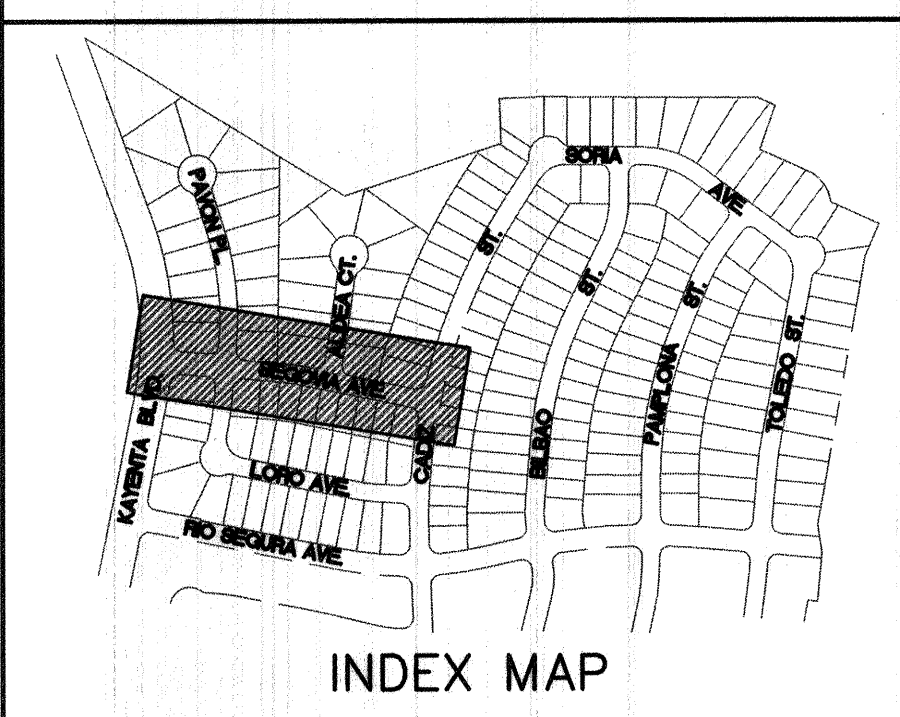

APPROVED FOR CONSTRUCTION
NEW MEXICO UTILITIES INC. DATE 7-27-05
WILSON & COMPANY 2600 THE AMERICAN ROAD S.E. SUITE 100 RIO RANCHO, NEW MEXICO 87124 (505) 938-8021


CITY OF ALBUQUERQUE
PUBLIC WORKS DEPARTMENT
ENGINEERING GROUP
SEVILLE SUBDIVISION - UNIT 3A
SEGOVIA AVE.
UTILITY, PAVING PLAN & PROFILE

Design Review Committee APPROVED APR 28 2005
City Engineer APPROVED APR 29 2005
Last Design Update

UNIT 3A		PROFILE		SHEET		ENGINEER'S SEAL		SURVEY INFORMATION		BENCH MARKS		AS-BUILT INFORMATION	



LEGEND		NEW	EXISTING
PHASE BOUNDARY			
RIGHT-OF-WAY LINE			
PAVEMENT EDGE			
WATERLINE			
SANITARY SEWER LINE			
STORMDRAIN LINE			
WATER VALVE			
REDUCER			
FIRE HYDRANT			
3/4" SINGLE WATER SERVICE, U.N.O.			
3/4" DOUBLE WATER SERVICE, U.N.O.			
SAS MANHOLE			
STORM DRAIN MANHOLE			
SANITARY SEWER SERVICE			

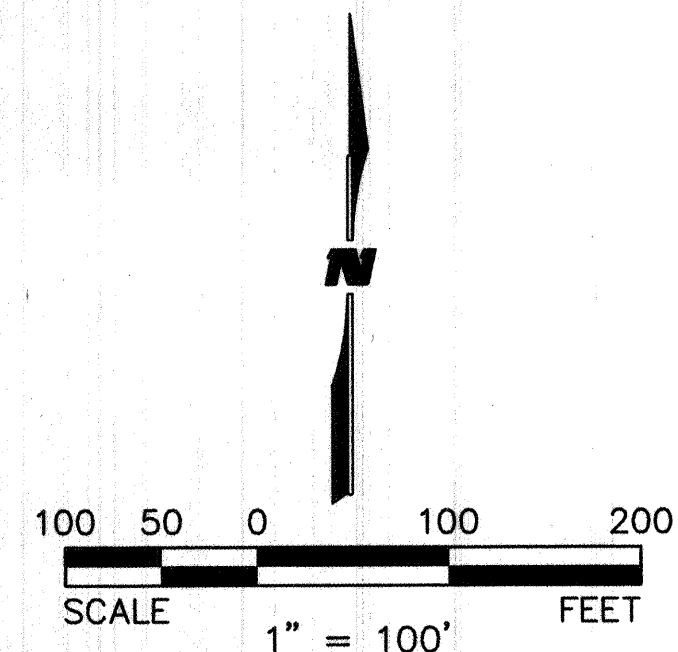


RECORD DRAWING
DATE 12-02-05

APPROVED FOR CONSTRUCTION	
NEW MEXICO UTILITIES INC. DATE 12-02-05	
WILSON & COMPANY	
2600 THE AMERICAN ROAD S.E. SUITE 100 RIO RANCHO, NEW MEXICO 87124 (505) 898-8021	
CITY OF ALBUQUERQUE PUBLIC WORKS DEPARTMENT ENGINEERING GROUP	
SEVILLE SUBDIVISION - UNIT 3A COMPOSITE UTILITY & STORM DRAIN PLAN	
Design Review Committee DESIGN REVIEW COMMITTEE	City Engineer Approval CITY ENGINEER
City Project No. 702082	Zone Map No. A-10-Z
Sheet 22	Of 32

SURVEY INFORMATION		BENCH MARKS		AS-BUILT INFORMATION	
FIELD NOTES		A.C.S. Survey Monument "SANDBERN"		CONTRACTOR: New Concepts	
NO.		New Mexico State Plane Coord's, Central Zone (NAD 27) as published:		WORK STAGED BY: SURV-TEK	
BY		DATE		DATE	
PHOTOGRAMMETRY BY: 8/22/99		T.R. MANN & ASSOC.		DATE 8-28-99	
FIELD SURVEYS BY		SURV-TEK, INC.		DATE 9-05-05	
NO.		X = 361,854.29		DATE 9-05-05	
Elevation = 5456.92 (SLD 1929)		Ground to grid factor = 0.9996079		DATE 9-05-05	
RECORDED BY		NO.		MICRO-FILM INFORMATION	
DATE		DATE		DATE	


ENGINEER'S SEAL

REVISIONS		REMARKS	
NO.	DATE	BY	DATE
1	DEC. 04		
2	DEC. 04		
3	DEC. 04		
4	DEC. 04		

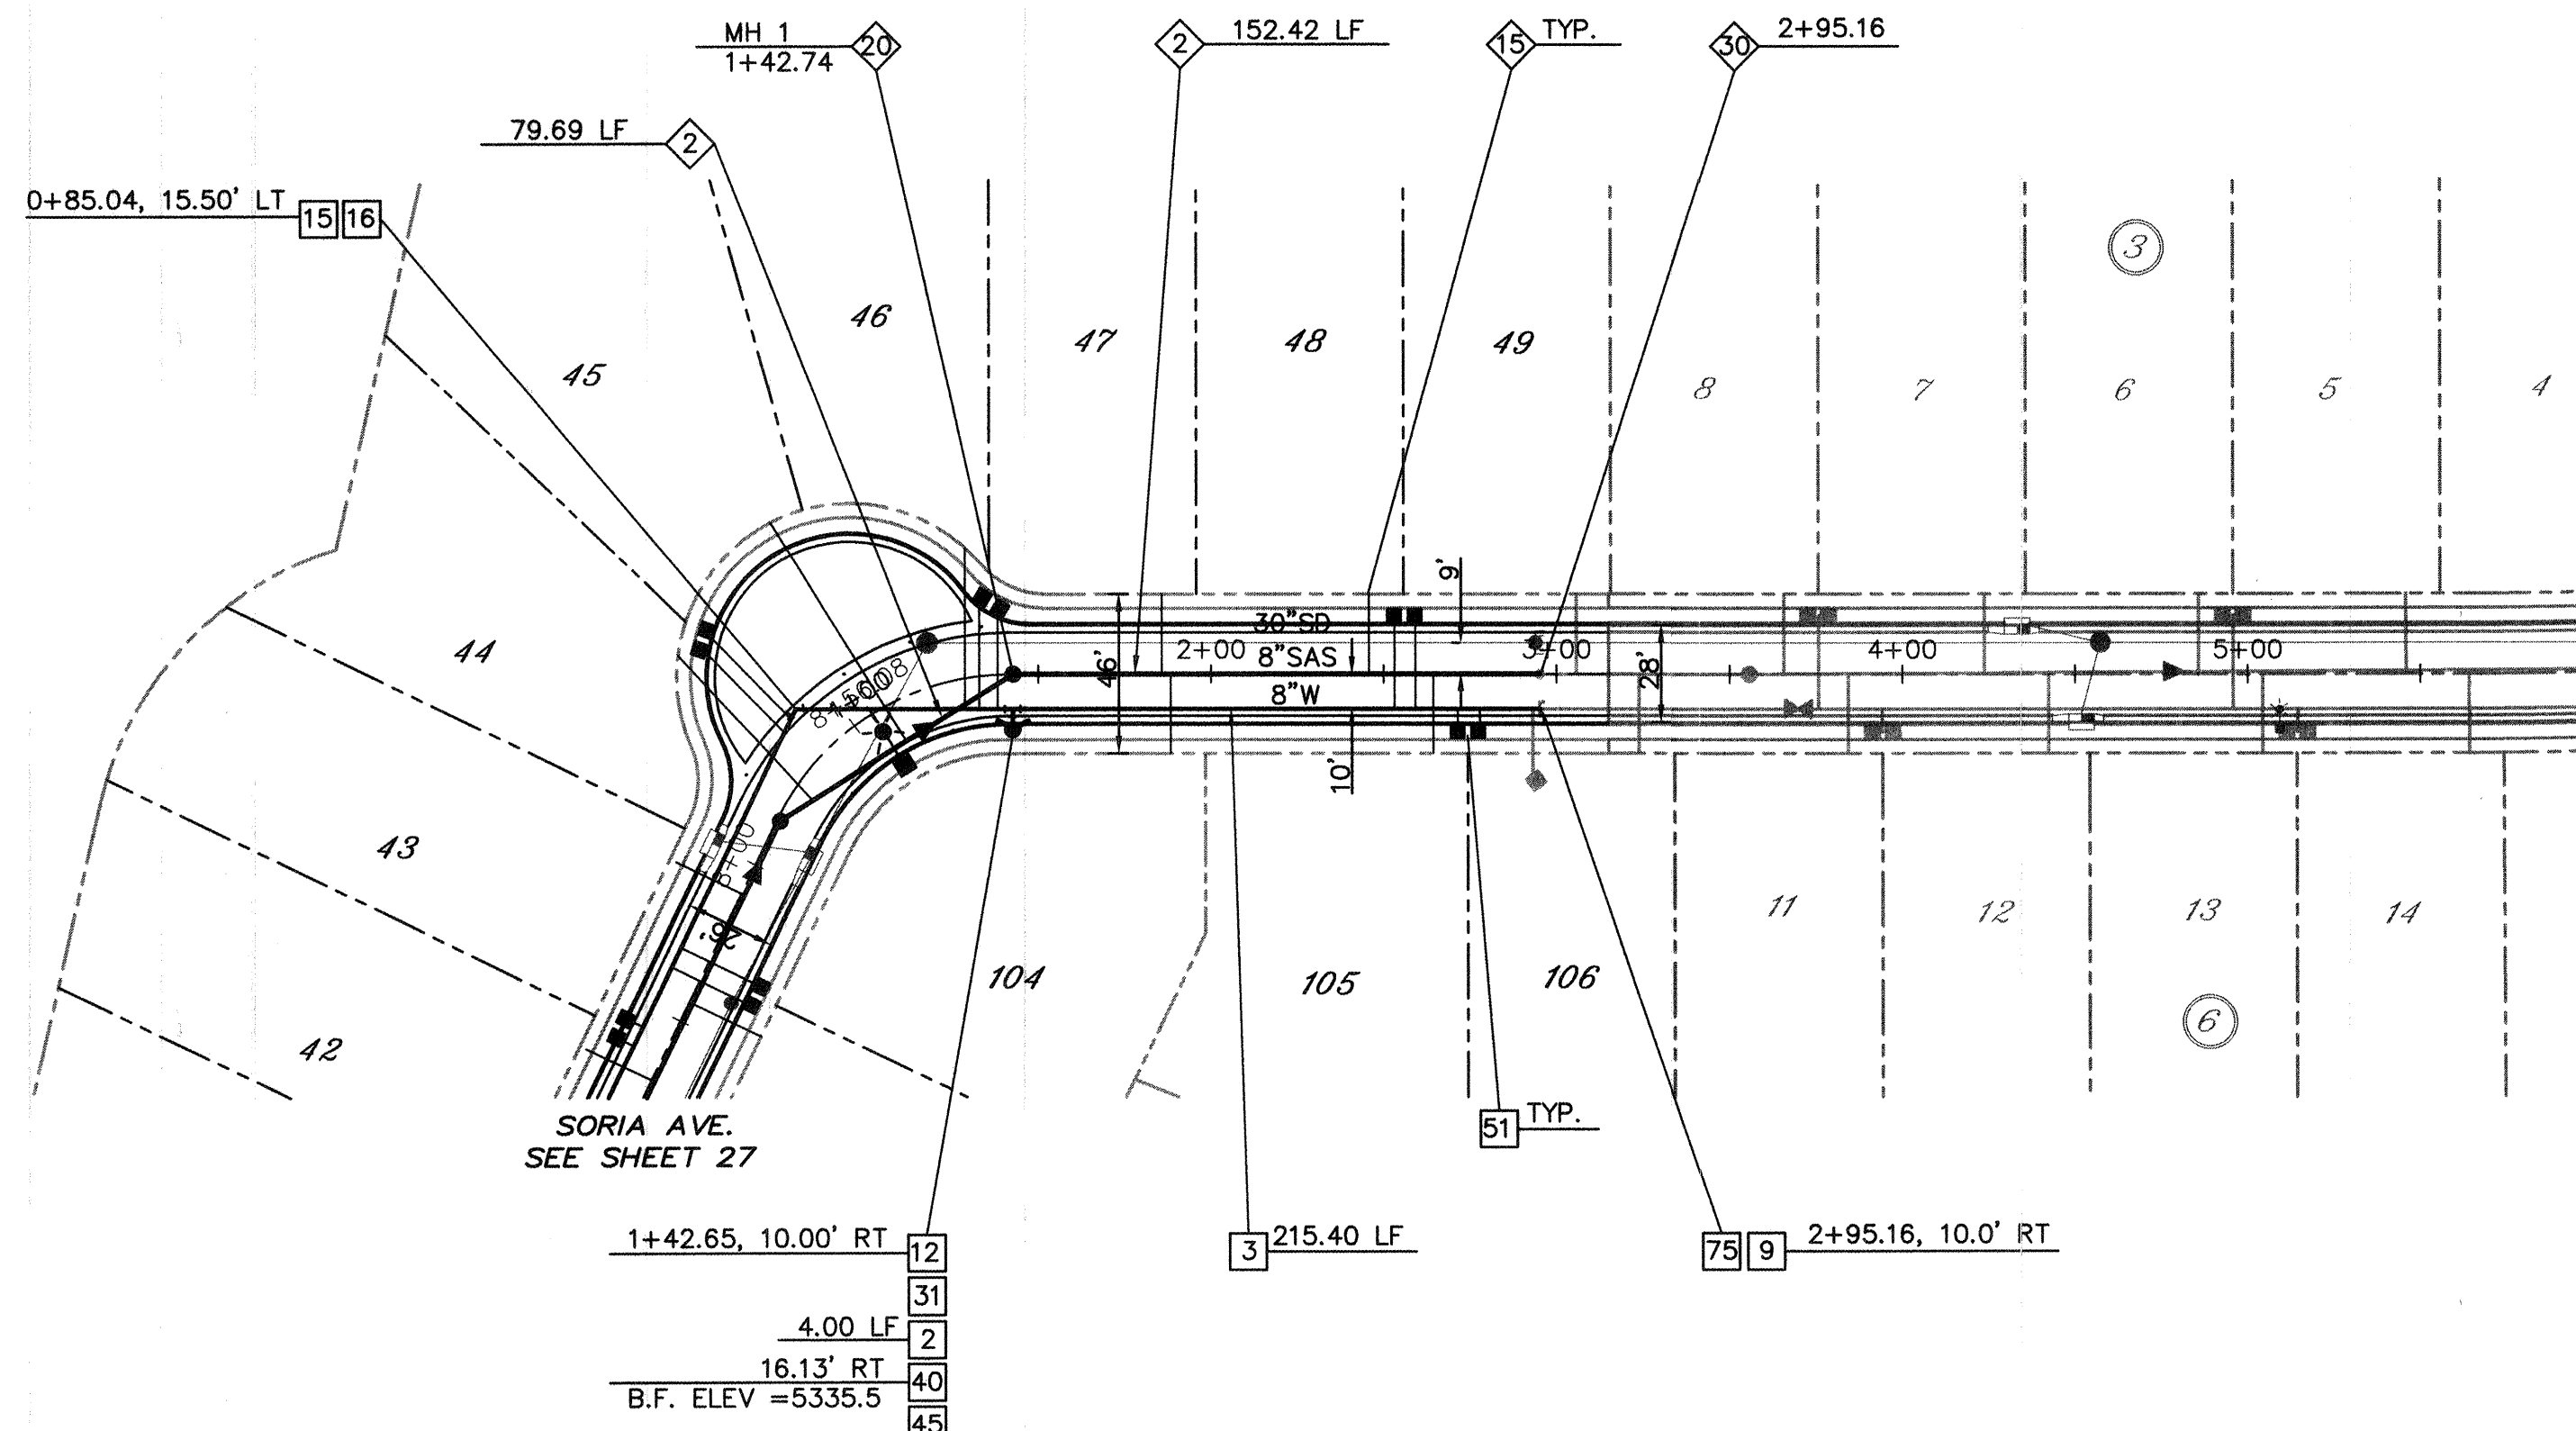

TOLEDO STREET N.W.


SCALE:
HORIZ: 1" = 50'
VERT: 1" = 10'

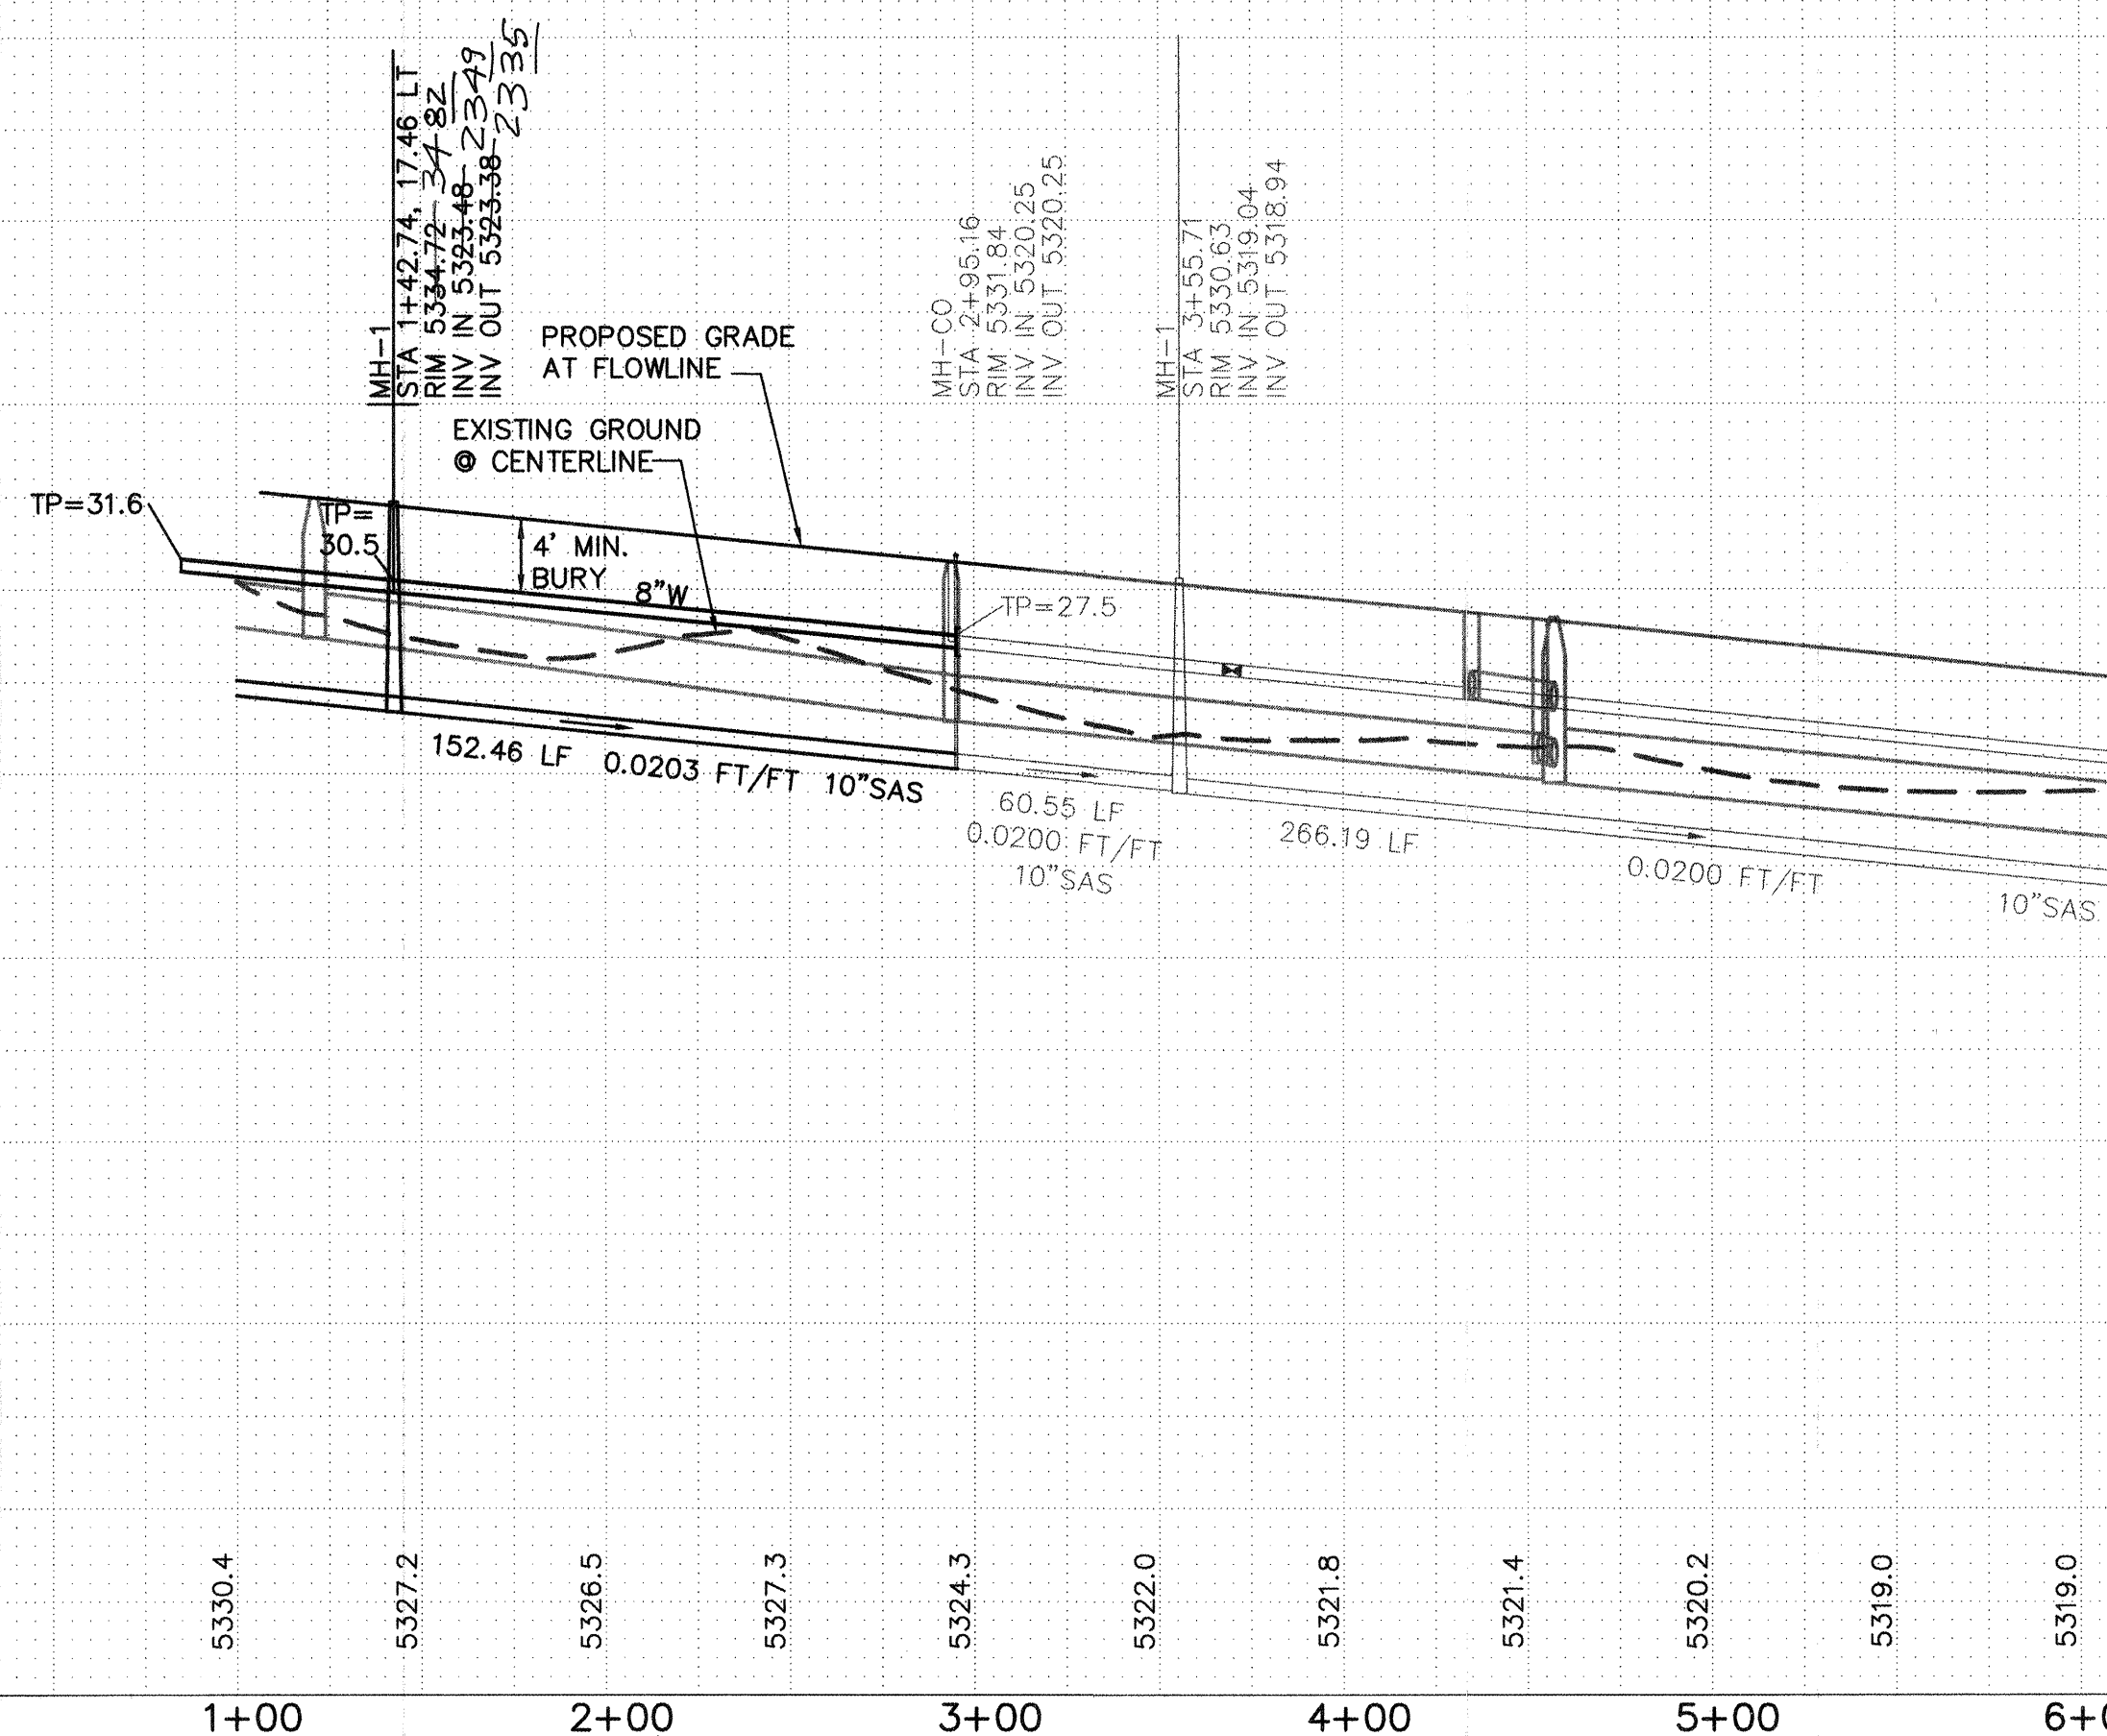

SURVEYORS CERTIFICATION:


I, Russ P. Hugg, New Mexico Professional Surveyor Number 9750, Hereby Certify that the as-built information shown hereon is the result of an actual field survey performed by me or under my direct supervision and that the same is true and correct to the best of my knowledge and belief.

Russ P. Hugg
NMPS No. 9750
20 05

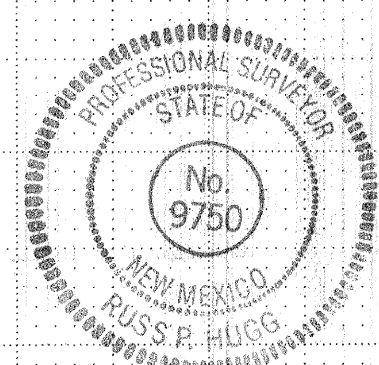

RECORD DRAWING
DATE 12-02-05

SEWER SERVICE LOCATIONS			
TOLEDO STREET			
LOT	STATION/OFFSET	INV. @ P/L	
104	1+88, 33' R	5325.6	*
105	2+84, 33' R	5324.0	*
45	1+01, 63' L	5327.3	*
46	1+33, 37' L	5326.7	*
47	1+86, 33' L	5325.6	*
48	2+45, 33' L	5324.4	*
* = 8.5' DEEP AT PL			

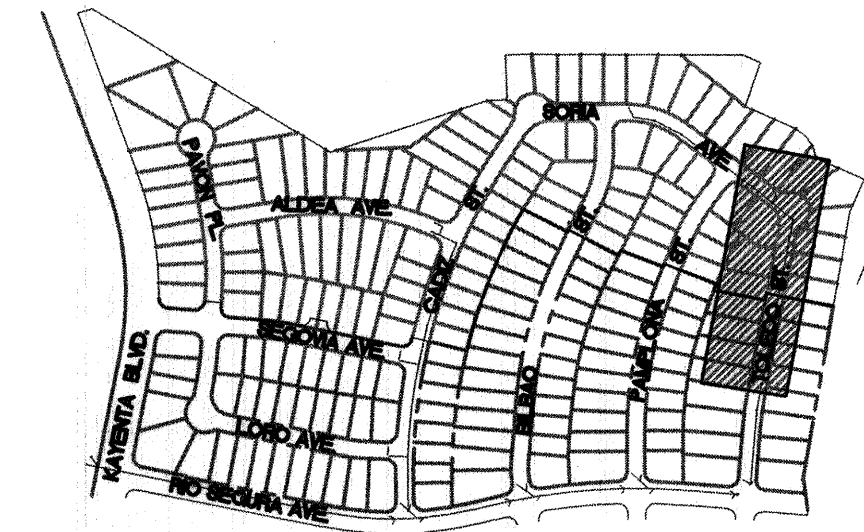

INDEX MAP

APPROVED FOR CONSTRUCTION

NEW MEXICO UTILITIES INC. DATE

WILSON & COMPANY 2600 THE AMERICAN ROAD S.E.
SUITE 100
RIO RANCHO, NEW MEXICO
87124
(505) 898-8021


CITY OF ALBUQUERQUE
PUBLIC WORKS DEPARTMENT
ENGINEERING GROUP

SEVILLE SUBDIVISION - UNIT 3A
TOLEDO STREET
WATER & SANITARY SEWER PLAN & PROFILE

Design Review Committee	City Engineer Approval	Mo./Day/Yr.	Mo./Day/Yr.
APPROVED APR 28 2005 DESIGN REVIEW COMMITTEE	APPROVED APR 28 2005 CITY ENGINEER		




City Project No. 702082 Zone Map No. A-10-Z

SURVEY INFORMATION	
FIELD NOTES	NO.
DATE	
BY	
PHOTOGRAPHY BY	
T.R. MANN & ASSOC.	
FIELD SURVEYS BY	
SURV-TEK, INC.	

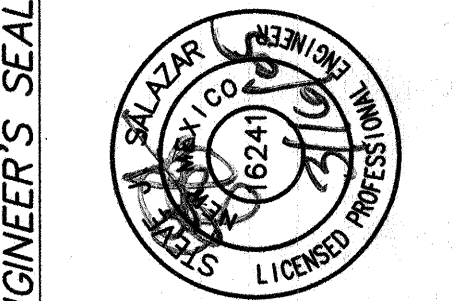


ENGINEER'S SEAL	
REVISIONS	BY
NO.	DATE
1	DEC. 04
2	DEC. 04
SEVILLE SUBDIVISION - UNIT 3A	
TOLEDO STREET	
WATER & SANITARY SEWER PLAN & PROFILE	
Design Review Committee	City Engineer Approval
APPROVED APR 28 2005 DESIGN REVIEW COMMITTEE	APPROVED APR 28 2005 CITY ENGINEER
City Project No. 702082	Zone Map No. A-10-Z
Sheet 23	Of 32

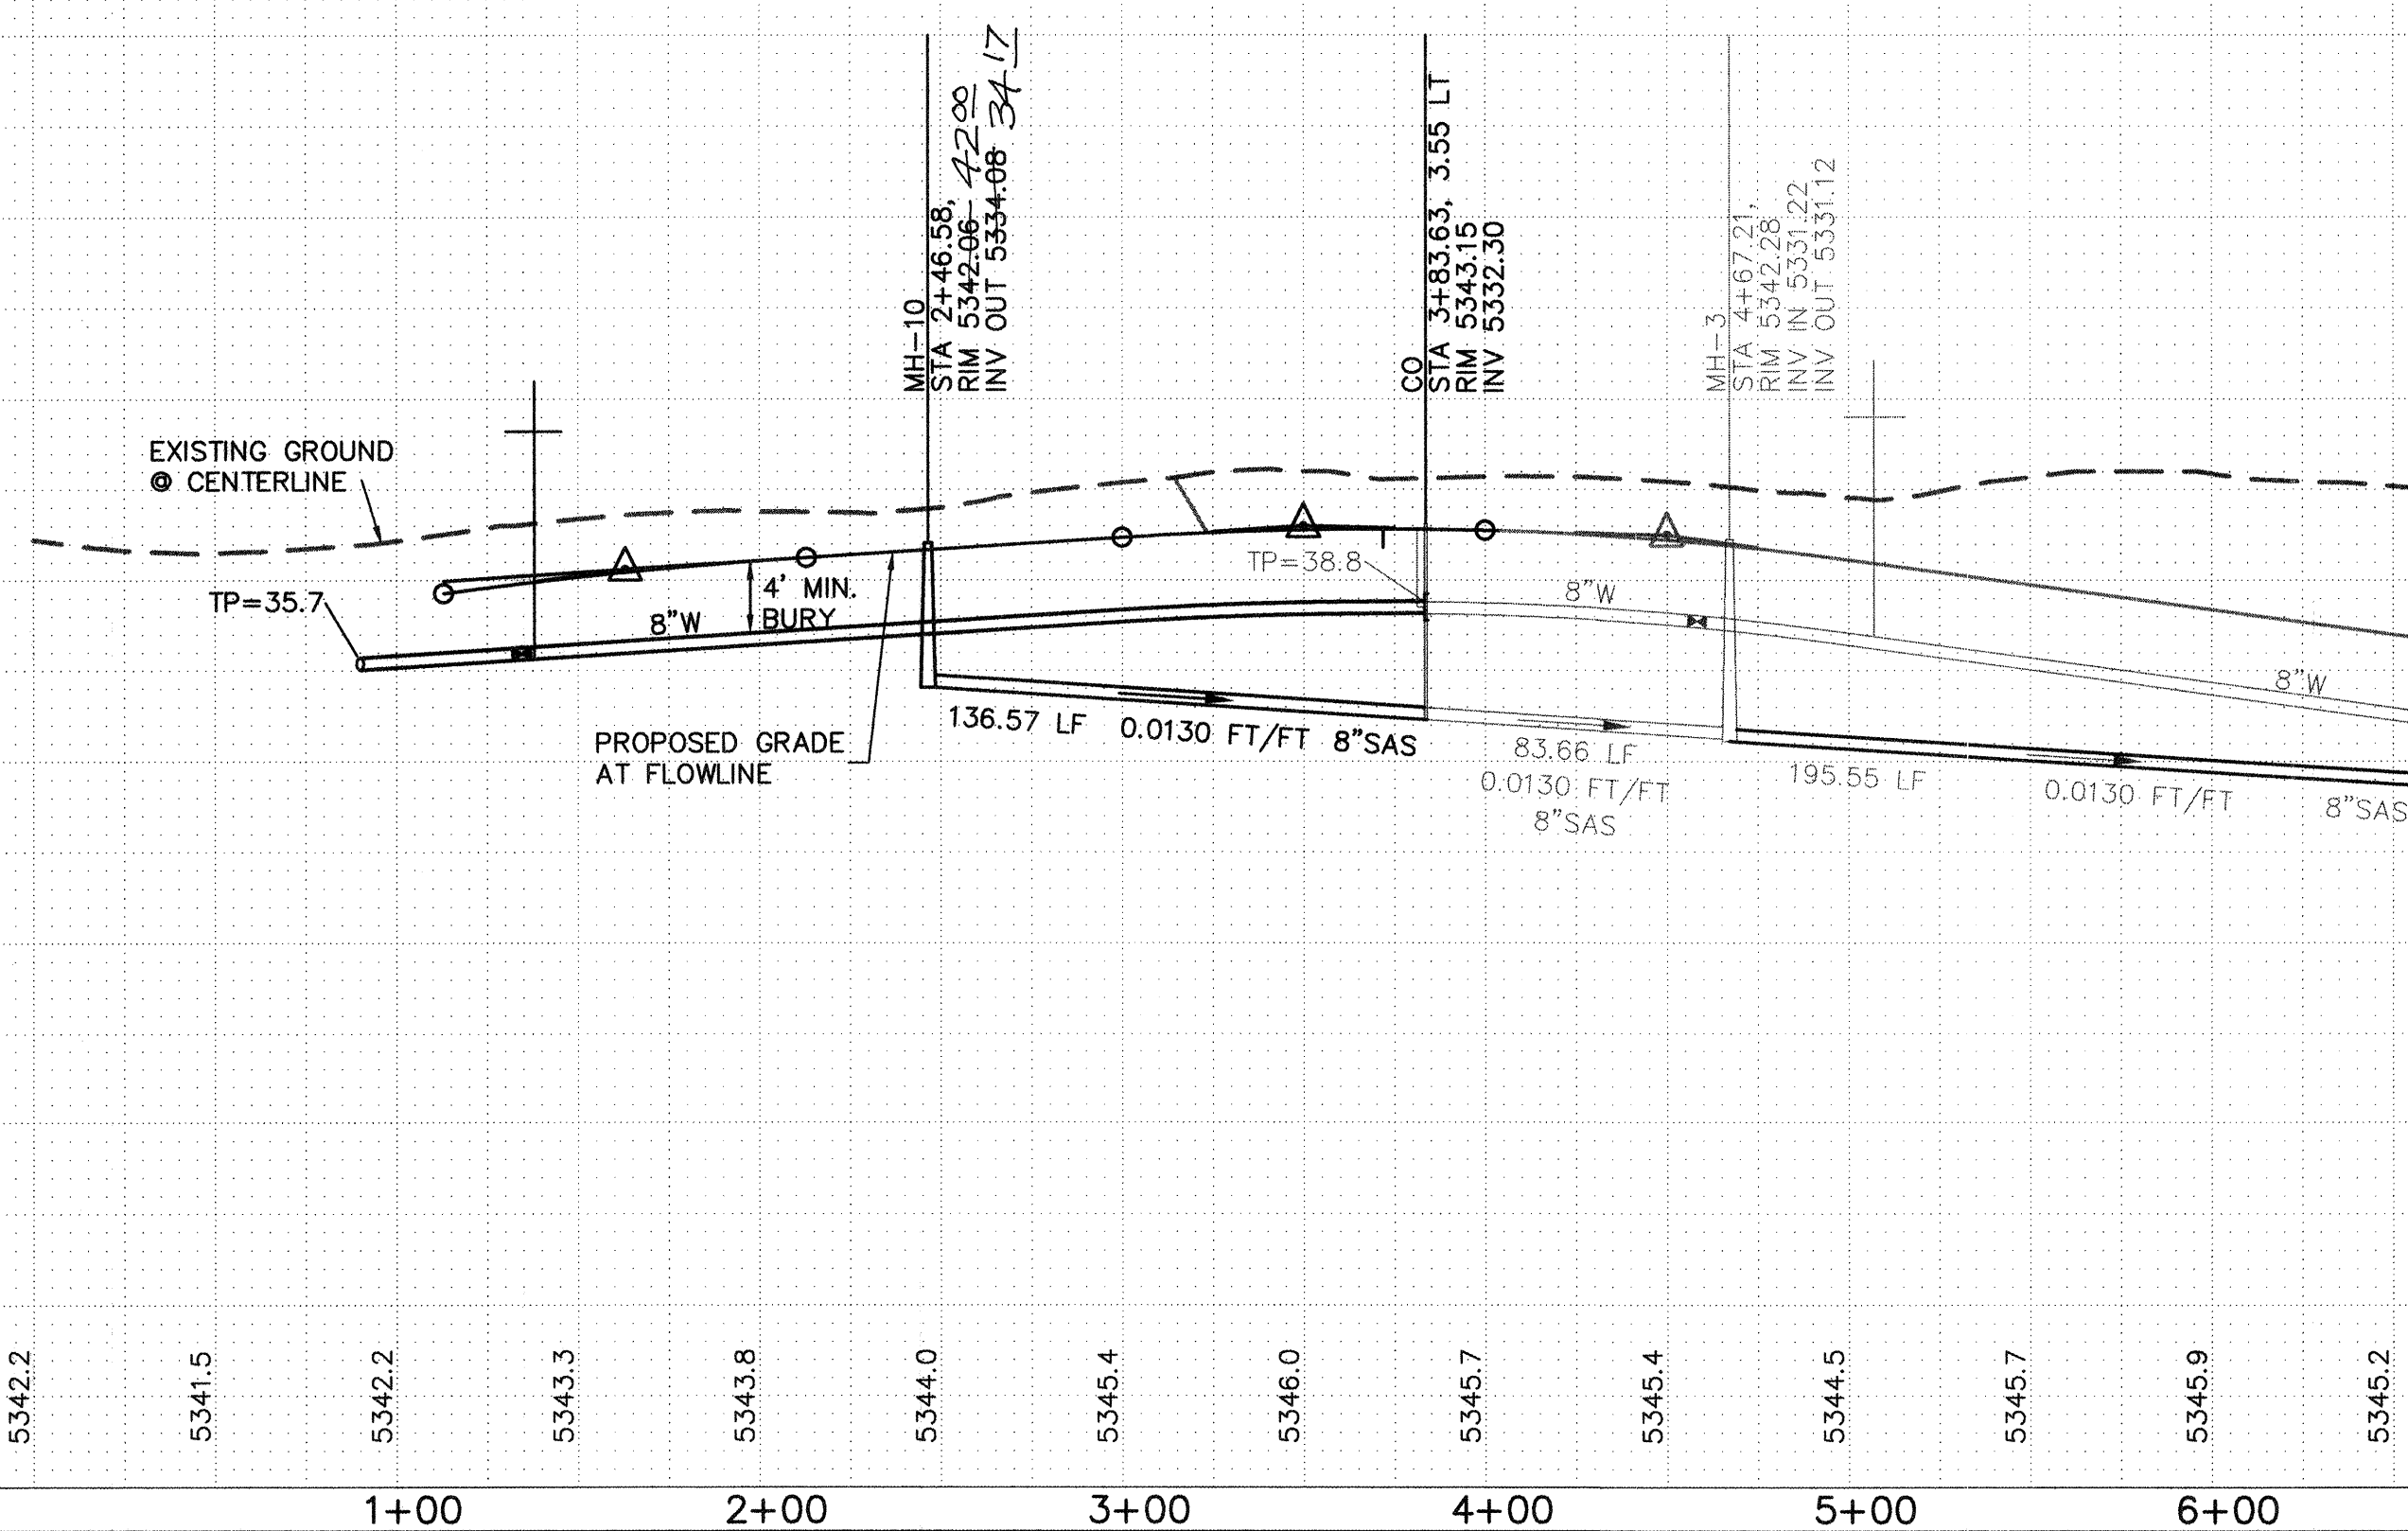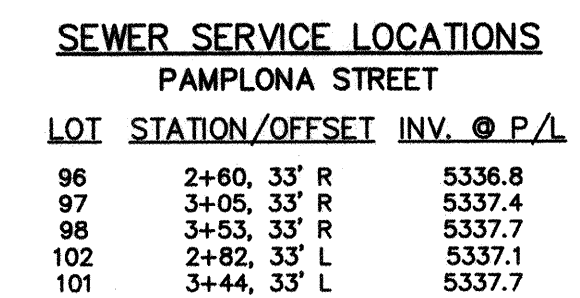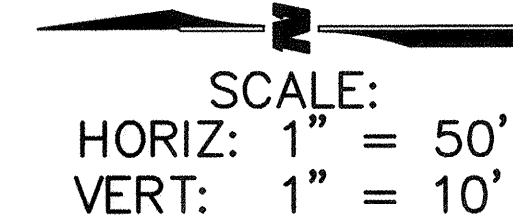


I, Russ P. Hugg, New Mexico Professional Surveyor Number 9750,
Hereby Certify that the as-built information shown hereon is the
result of an actual field survey performed by me or under my
direct supervision and that the same is true and correct to the
best of my knowledge and belief.

Russ P. Hugg
NMPS No. 9750

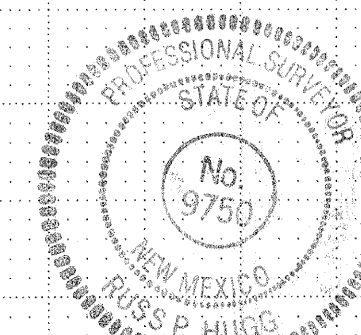

RECORD DRAWING
DATE 12-02-05


SEWER CONSTRUCTION NOTES									
I.D.#	DESCRIPTION								
2	INSTALL 8" SEWER PIPE PER STD. SPEC. SEC. 901								
15	INSTALL 4" SEWER SERVICE PER COA STD SPEC 2125								
20	INSTALL 4' DIA. MANHOLE PER COA STD. DTL. 2101								
30	REMOVE EXISTING CLEANOUT AND CONNECT NEW SEWER LINE TO EXISTING SEWER LINE								
WATER CONSTRUCTION NOTES									
I.D.#	DESCRIPTION								
2	INSTALL 6" D.I. WATERLINE PER STD. SPEC. SEC. 801								
3	INSTALL 8" WATERLINE PER STD. SPEC. SEC. 801								
9	CONNECT NEW WATERLINE TO EXISTING WATERLINE								
12	INSTALL 8" x 6" TEE								
13	INSTALL 8" x 8" TEE								
31	INSTALL 6" GATE VALVE AND VALVE BOX PER COA STD. DTL. 2326								
32	INSTALL 8" GATE VALVE AND VALVE BOX PER COA STD. DTL. 2326								
40	INSTALL FIRE HYDRANT								
45	"MEG A LUG" ALL FITTINGS AND JOINTS FROM TEE TO FIRE HYDRANT								
50	INSTALL 3/4" SINGLE WATER SERVICE								
51	INSTALL 3/4" DOUBLE WATER SERVICE								
75	REMOVE EXISTING TAPPED CAP								
SEWER SERVICE LOCATIONS PAMPLONA STREET LOT STATION/OFFSET INV. @ P/L									
96	2+60, 33' R	5336.8							
97	3+05, 33' R	5337.4							
98	3+53, 33' R	5337.7							
102	2+82, 33' L	5337.1							
101	3+44, 33' L	5337.7							
INDEX MAP									
APPROVED FOR CONSTRUCTION									
NEW MEXICO UTILITIES INC. DATE									
WILSON & COMPANY 2600 THE AMERICAN ROAD S.E. SUITE 100 RIO RANCHO, NEW MEXICO 87124 (505) 898-8021									
CITY OF ALBUQUERQUE PUBLIC WORKS DEPARTMENT ENGINEERING GROUP									
SEVILLE SUBDIVISION - UNIT 3A PAMPLONA STREET WATER & SANITARY SEWER PLAN & PROFILE									
Design Review Committee		City Engineer Approval		Last Design Update		Mo./Day/Yr.		Mo./Day/Yr.	
APR 28 2005 DESIGN REVIEW COMMITTEE		APR 28 2005 CITY ENGINEER							
City Project No.		Zone Map No.		Sheet		Of			
702082		A-10-Z		24		32			

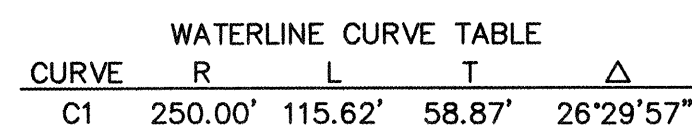


SCALE:
HORIZ: 1" = 50'
VERT: 1" = 10'



Russ P. Hugg
NMPS No. 9750
9.11.2005

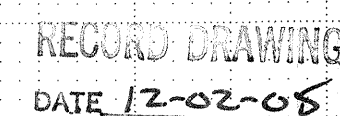


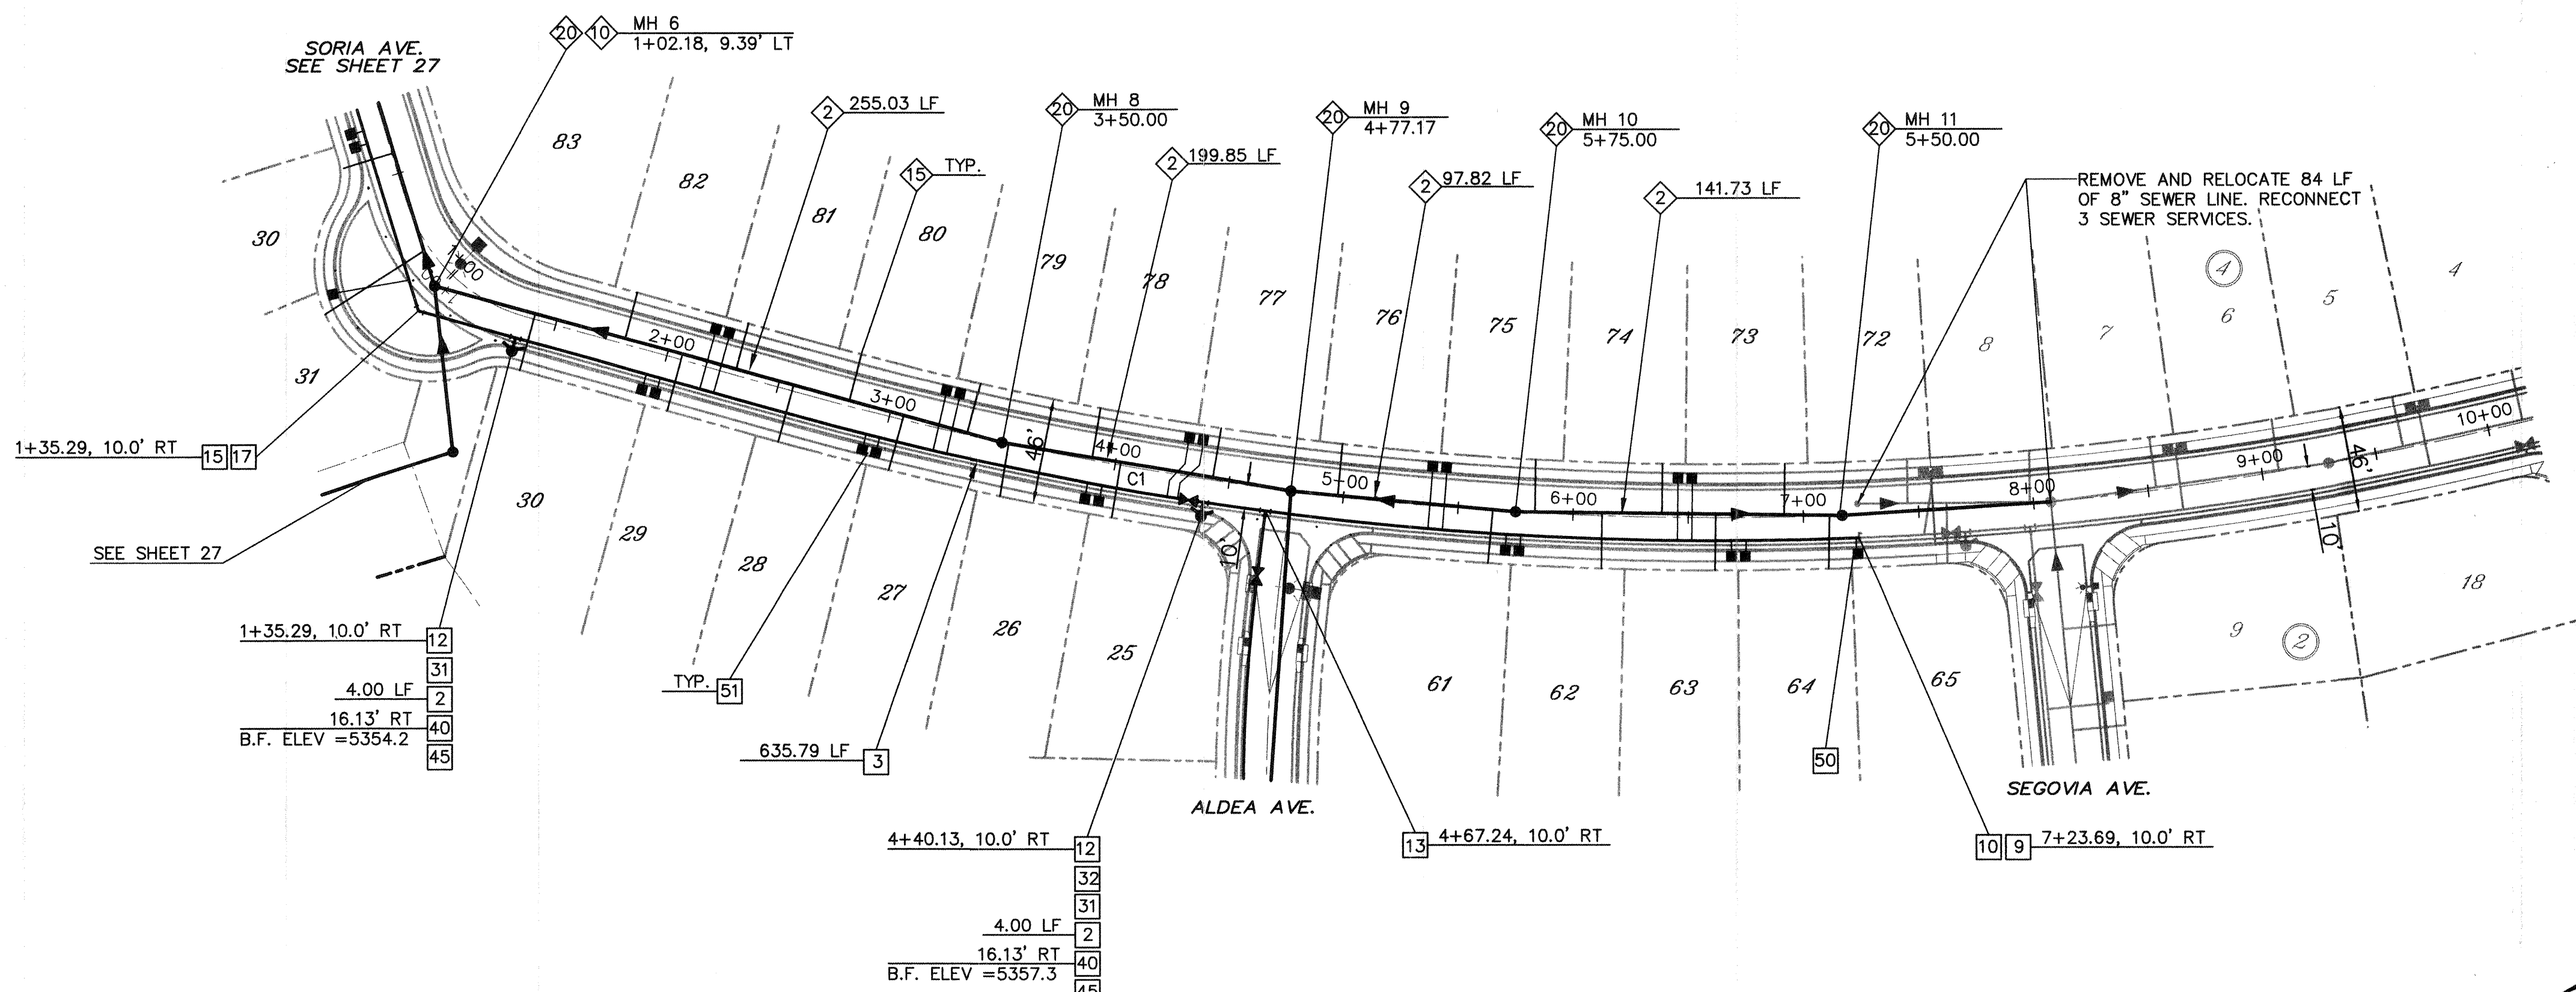


WATERLINE CURVE TABLE

CURVE	R	L	T	Δ
C1	1510.00'	468.75'	236.27'	17°47'11"

CADIZ STREET N.W.

SURVEYORS CERTIFICATION
I, Russ P. Hugg, New Mexico Professional Surveyor Number 9750, Hereby Certify that the as-built information shown hereon is the result of an actual field survey performed by me or under my direct supervision and that the same is true and correct to the best of my knowledge and belief.

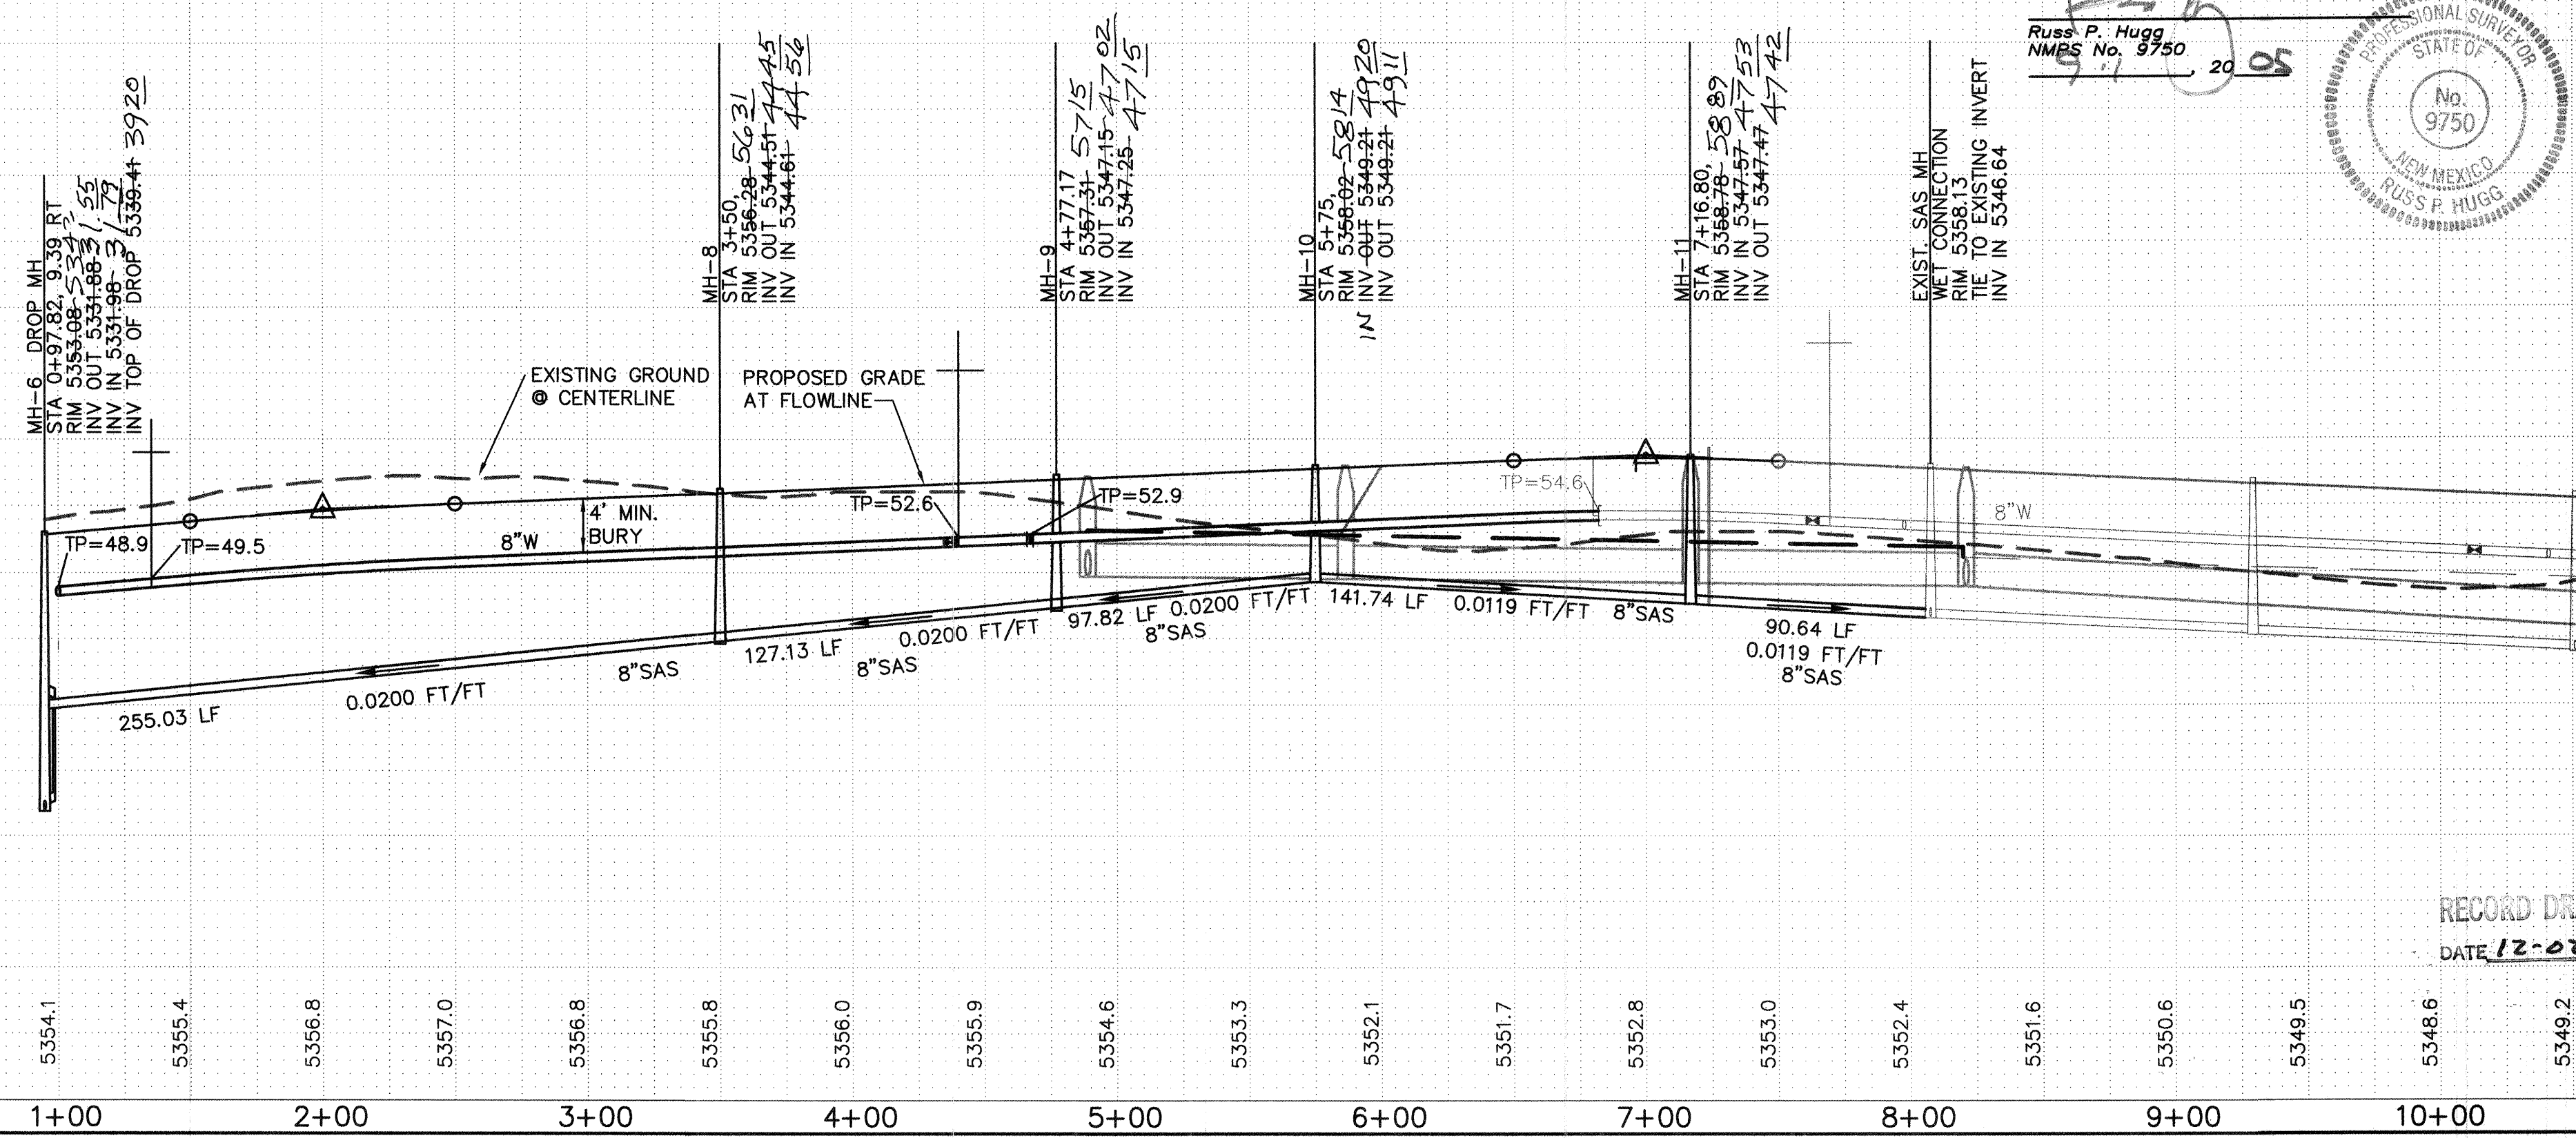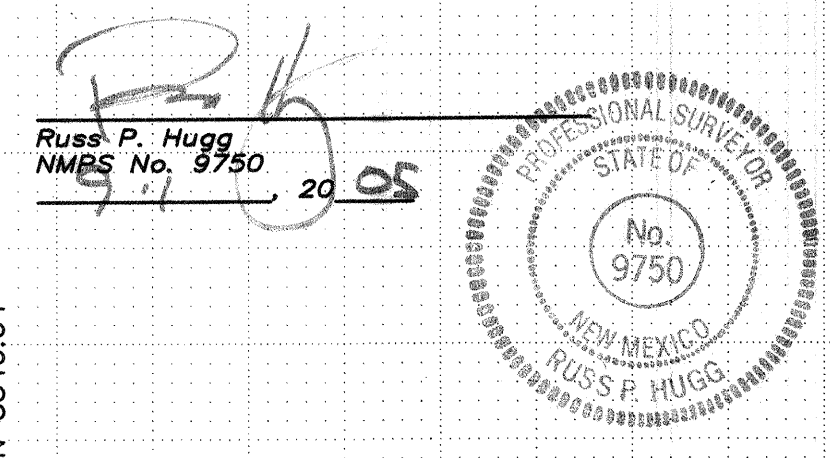

SEWER CONSTRUCTION NOTES

I.D.#	DESCRIPTION
10	INSTALL 8" SEWER PIPE PER STD. SPEC. SEC. 901
10	INSTALL VERTICAL DROP SEWER CONNECTION AT MH PER COA STD. DTL. 2116
15	INSTALL 4" SEWER SERVICE
20	INSTALL 4' DIA. MANHOLE PER COA STD. DTL. 2101

WATER CONSTRUCTION NOTES

I.D.#	DESCRIPTION
2	INSTALL 6" WATERLINE PER STD. SPEC. SEC. 801
3	INSTALL 8" WATERLINE PER STD. SPEC. SEC. 801
9	CONNECT NEW WATERLINE TO EXISTING WATERLINE
10	REMOVE EXISTING FITTING
12	INSTALL 8" x 6" TEE
13	INSTALL 8" x 8" TEE
15	INSTALL 8" 45° BEND
17	INSTALL 8" 11 1/4° BEND
31	INSTALL 6" GATE VALVE AND TYPE "A" VALVE BOX PER COA STD. DTL. 2333
32	INSTALL 8" GATE VALVE AND TYPE "A" VALVE BOX PER COA STD. DTL. 2333
40	INSTALL FIRE HYDRANT
45	"MEG A LUG" ALL FITTINGS AND JOINTS FROM TEE TO FIRE HYDRANT
50	INSTALL 3/4" SINGLE WATER SERVICE
51	INSTALL 3/4" DOUBLE WATER SERVICE

SEWER SERVICE LOCATIONS

LOT	STATION/OFFSET	INV. @ P/L
25	4+02, 23' R	5351.3
26	3+53, 23' R	5350.9
27	3+05, 23' R	5350.5
28	2+56, 23' R	5350.2
29	2+06, 23' R	5349.7
30	1+40, 23' R	5348.6
64	7+10, 23' R	5353.5
63	6+61, 23' R	5353.4
62	6+13, 23' R	5353.1
61	5+64, 23' R	5353.4
73	6+92, 23' L	5353.5
74	6+38, 23' L	5353.3
75	5+82, 23' L	5352.8
76	4+97, 23' L	5352.1
77	4+43, 23' L	5351.7
78	3+89, 23' L	5351.2
79	3+35, 23' L	5350.8
80	2+81, 23' L	5350.4
81	2+30, 23' L	5349.9
82	1+80, 23' L	5349.3

INDEX MAP

APPROVED FOR CONSTRUCTION

WILSON & COMPANY 2600 THE AMERICAN ROAD S.E. SUITE 100 RIO RANCHO, NEW MEXICO 87124 (505) 898-8021

CITY OF ALBUQUERQUE PUBLIC WORKS DEPARTMENT ENGINEERING GROUP

SEVILLE SUBDIVISION - UNIT 3A CADIZ STREET WATER & SANITARY SEWER PLAN & PROFILE

Design Review Committee	City Engineer Approval	Mo./Day/Yr.	Mo./Day/Yr.
APPROVED APR 28 2005	APPROVED APR 28 2005		

DESIGN REVIEW COMMITTEE	CITY ENGINEER	Last Design Update

City Project No.	Zone Map No.	Sheet	Of
702082	A-10-Z	26	32

0+98.73
122.99' LT

155.00 LF

1+00

0+99.19, 21.38' RT

192.11' LF

2+51.58, 9.0' RT

2+82.48, 9.00' RT

377.83 LF

31

32

33

30

32

33

34

1+00

2+00

3+00

4+00

5+00

6+00

7+00

8+00

8+50

MH 7
1+84.29, 6.25' RT
OFFSITE

MH 6
1+01.26, 8.80' LT

MH 5
3+54.25, 0.96' RT

MH 4
4+29.25, 1.05' RT

MH 3
5+04.26, 0.96' RT

MH 2
8+14+56, 1.0' RT

72.48 LF

255.66 LF

74.42 LF

74.42 LF

310.27 LF

79.69 LF

8+41.03, 14.74' LT

191.05 LF

6+54.59, 9.0' LT

6+23.62, 8.98' LT

BILBAO ST.
SEE SHEET 36

CADIZ ST.
SEE SHEET 26

PAMPLONA ST.
SEE SHEET 36

TOLEDO ST.
SEE SHEET 23

TYP.

TYP.




TYP.

WATERLINE CURVE TABLE


CURVE	R	L	T	Δ
C1	260.00'	165.76'	85.81'	36°31'45"

SORIA AVE. N.W.

SCALE:
HORIZ: 1" = 50'

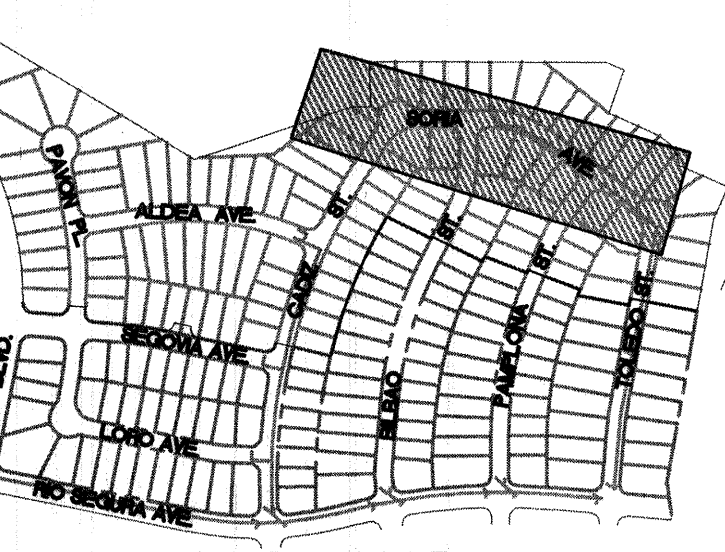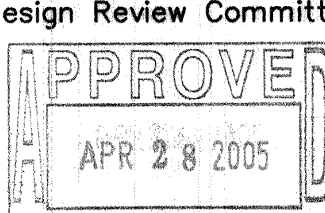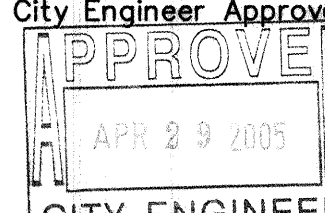SEWER CONSTRUCTION NOTES		AS-BUILT INFORMATION	
I.D.#	DESCRIPTION	CONTRACTOR NELJ CONCEPTS	DATE 07/05/05
[4]	INSTALL 10" SEWER PIPE PER STD. SPEC. SEC. 901	INSPECTOR'S STAMP SURV TEK FIELD OFFICE BY Lillemo & Co. VERIFICATION BY SURV TEK CORRECTED BY SURV TEK MICRO-FILM INFORMATION RECORDED BY _____ NO. _____	07/05/05
[10]	INSTALL VERTICAL DROP SEWER CONNECTION AT MH PER COA STD. DTL. 2116		09/05/05
[15]	INSTALL 4" SEWER SERVICE		07/05/05
[20]	INSTALL 4' DIA. MANHOLE PER COA STD. DTL. 2101		07/05/05
[25]	INSTALL PLUG AND DEAD END MARKER PER COA STD. DTL. 2145		07/05/05
WATER CONSTRUCTION NOTES		BENCH MARKS	
I.D.#	DESCRIPTION		
[3]	INSTALL 8" WATERLINE PER STD. SPEC. SEC. 801	A.C.S. Survey Monument "SANDBERN" New Mexico State Plane Coord's, Central Zone (NAD 27) as published: Y = 1,534,209.29 X = 361,854.29 Elevation = 5456.92 (SLD 1929) Ground to grid factor = 0.99966079	
[13]	INSTALL 8" x 8" TEE		
[15]	INSTALL 8" 45° BEND		
[16]	INSTALL 8" 22 1/2° BEND		
[32]	INSTALL 8" GATE VALVE AND VALVE BOX PER COA STD. DTL. 2326		
[51]	INSTALL 3/4" DOUBLE WATER SERVICE		
SEWER SERVICE LOCATIONS			
SORIA AVE.			
LOT	STATION/OFFSET	INV. @ P/L	
31	1+16, 54' L	5347.2	
32	1+59, 22' L	5346.8	
33	2+19, 21' L	5345.6	
34	2+79, 21' L	5344.2	
35	3+39, 21' L	5342.7	
36	3+91, 21' L	5341.4	
37	4+42, 21' L	5340.1	
38	4+93, 21' L	5338.9	
39	5+51, 21' L	5337.4	
40	6+11, 21' L	5335.9	
41	6+71, 21' L	5334.4	
42	7+31, 21' L	5333.0	
43	7+91, 21' L	5331.6	
44	8+33, 50' L	5330.8	
45	1+00, 53' L	5327.3 *	
83	1+83, 23' R	5343.4 *	
84	2+45, 22' R	5342.0 *	
92	4+15, 23' R	5337.4 *	
93	5+11, 23' R	5334.8 *	
94	5+64, 22' R	5332.5	
95	6+17, 23' R	5330.3	
103	7+56, 23' R	5346.4	
* = 8.5' DEEP AT PL			
UTILITY CROSSING			
	SAS	SD	WL
(A)		41.30 TP	43.11 BP
(B)	34.57 TP	39.30 BP	
(C)		30.28 TP	32.01 BP
(D)	26.40 TP	28.06 BP	
(E)	25.20 TP		30.84 BP
(F)		29.00 TP	30.68 BP
(G)	24.81 TP	26.31 BP	
			
INDEX MAP			
APPROVED FOR CONSTRUCTION			
 NEW MEXICO UTILITIES INC.		 WILSON & COMPANY	
		2600 THE AMERICAN ROAD S.E. SUITE 100 RIO RANCHO, NEW MEXICO 87124 (505) 898-8021	
CITY OF ALBUQUERQUE PUBLIC WORKS DEPARTMENT ENGINEERING GROUP			
SEVILLE SUBDIVISION - UNIT 3A			
SORIA AVE. WATER & SANITARY SEWER PLAN & PROFILE			
Design Review Committee		City Engineer Approval	
 DESIGN COMMITTEE		 CITY ENGINEER	
City Project No.		Zone Map No.	
702082		A-10-Z	
Sheet		Of	
27		32	

RECORD DRAWING
DATE 12-02-05

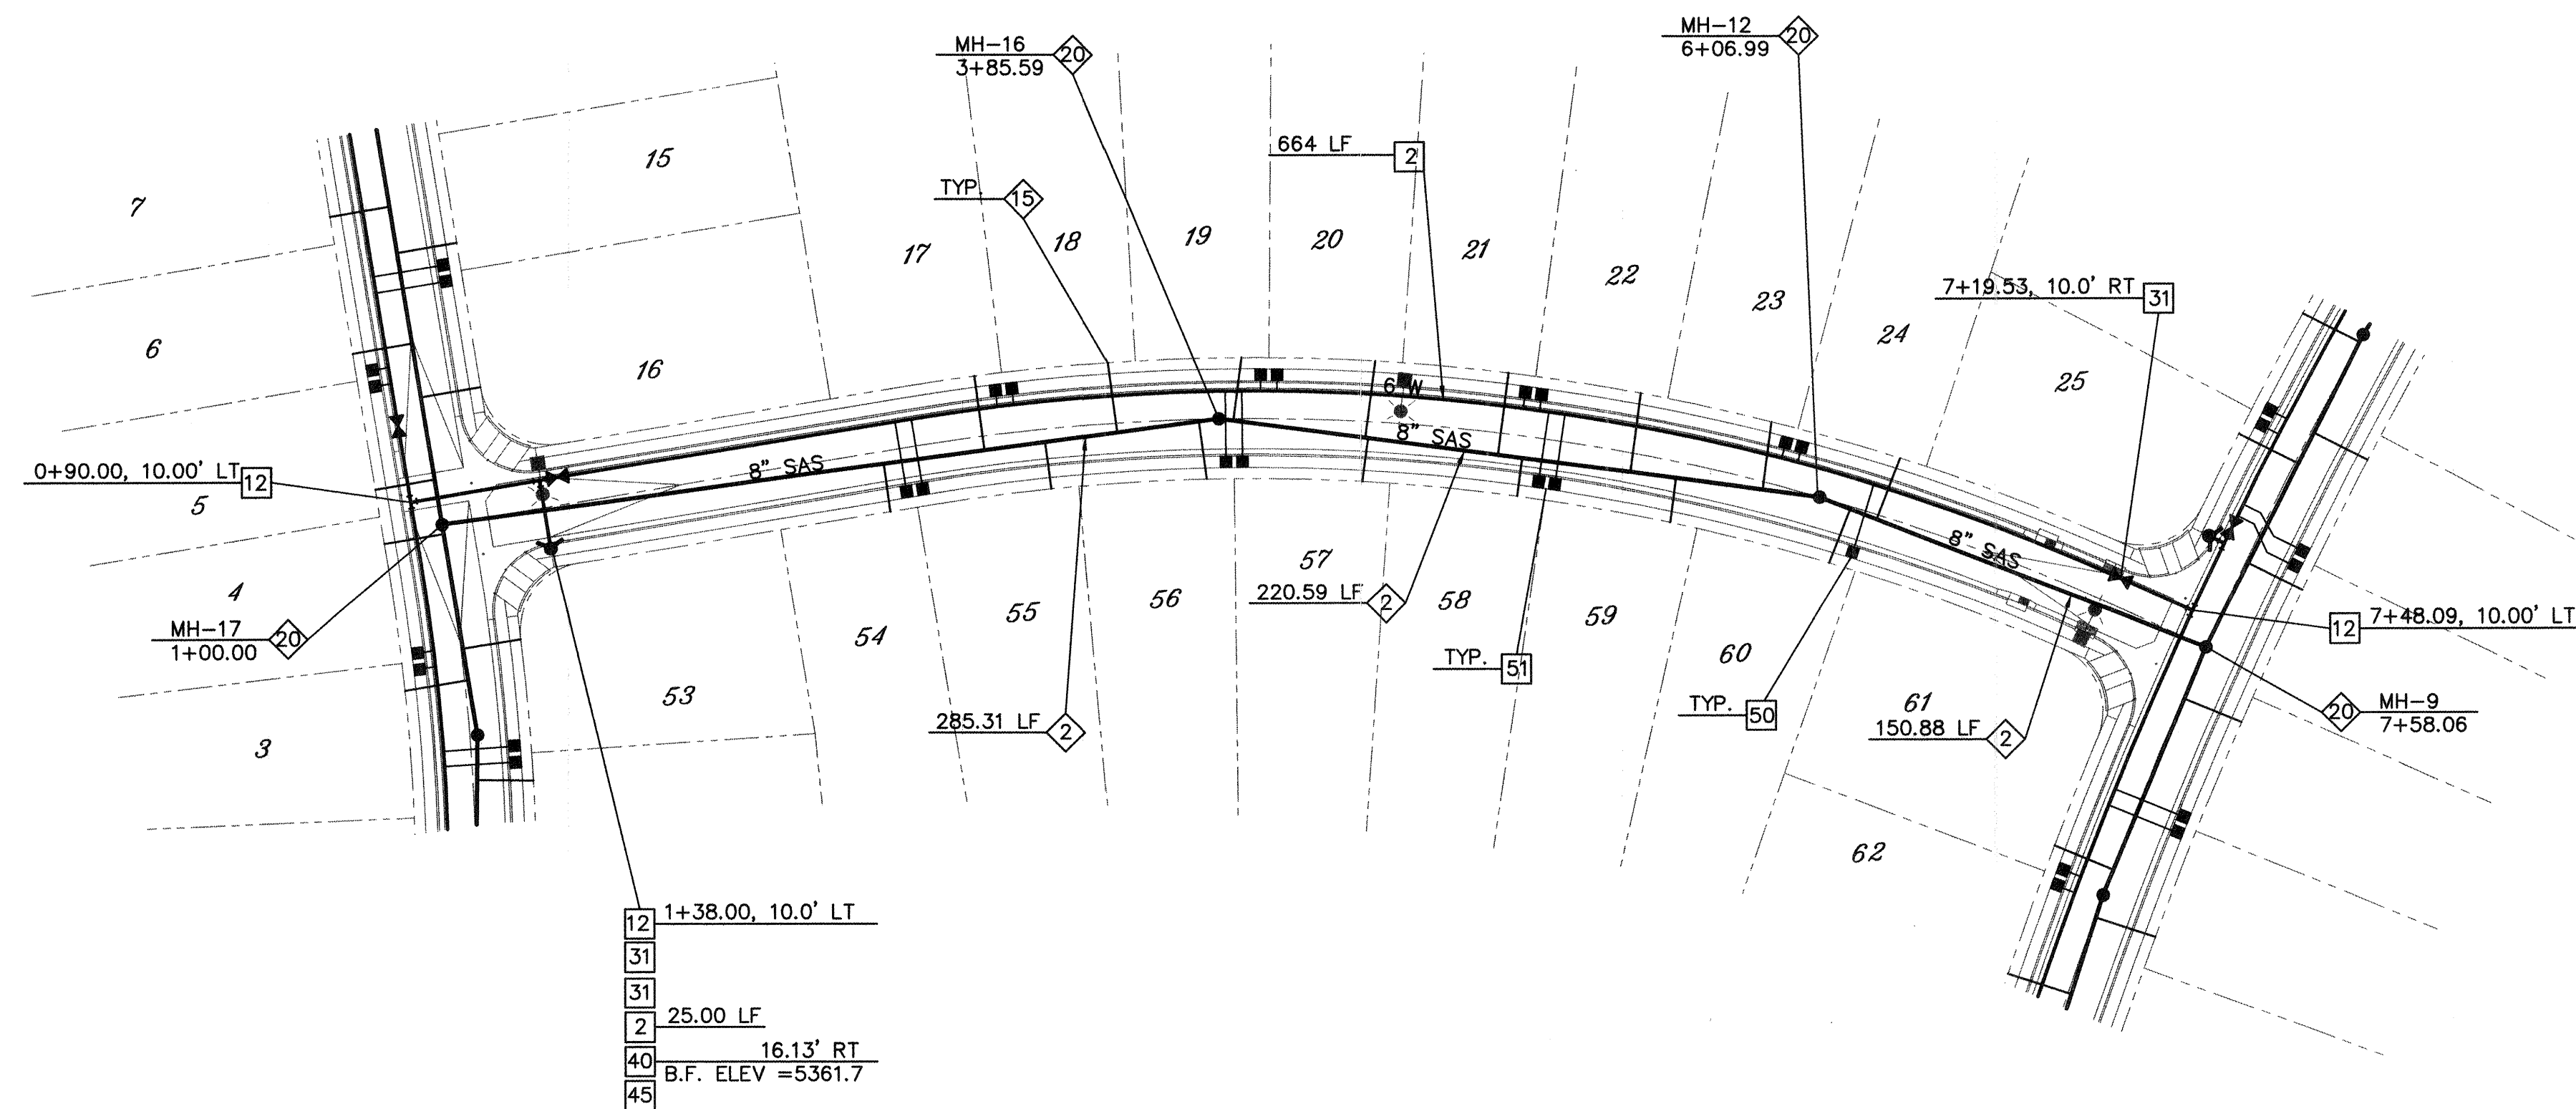

SCALE:
HORIZ: 1" = 50'
VERT: 1" = 10'


ALDEA AVENUE N.W.

SEWER CONSTRUCTION NOTES	
I.D.#	DESCRIPTION
2	INSTALL 8" SEWER PIPE PER STD. SPEC. SEC. 901
9	REMOVE EXISTING PLUG AND CONNECT NEW SEWER LINE TO EXISTING SEWER LINE
15	INSTALL 4" SEWER SERVICE
20	INSTALL 4' DIA. MANHOLE PER COA STD. DTL. 2101

WATER CONSTRUCTION NOTES	
I.D.#	DESCRIPTION
2	INSTALL 6" D.I. WATERLINE PER STD. SPEC. SEC. 801
3	INSTALL 6" WATERLINE PER STD. SPEC. SEC. 801
9	CONNECT NEW WATERLINE TO EXISTING WATERLINE
10	REMOVE EXISTING FITTING
12	INSTALL 8" x 6" TEE
17	INSTALL 8" 11 1/4" BEND
21	INSTALL 8" x 6" REDUCER
31	INSTALL 6" GATE VALVE AND TYPE "A" VALVE BOX PER COA STD. DTL. 2333
40	INSTALL FIRE HYDRANT
45	"MEG A LUG" ALL FITTINGS AND JOINTS FROM TEE TO FIRE HYDRANT
50	INSTALL 3/4" SINGLE WATER SERVICE
51	INSTALL 3/4" DOUBLE WATER SERVICE

SEWER SERVICE LOCATIONS
ALDEA COURT

LOT	STATION/OFFSET	INV. @ P/L
54	2+62, 17.37' R	5355.4
55	3+22, 17.13' R	5355.1
56	3+81, 21.30' R	5354.7
57	4+39, 15.97' R	5354.4
58	4+97, 13.85' R	5354.0
59	5+56, 16.13' R	5353.7
60	6+17, 21.05' R	5353.3
17	2+24, 27.30' L	5354.7
18	2+74, 25.57' L	5354.4
19	3+24, 22.98' L	5354.1
20	1+26, 28.08' L	5353.9
21	1+74, 30.11' L	5353.6
22	2+24, 28.07' L	5353.3
23	2+74, 24.96' L	5353.0
24	3+24, 23.80' L	5352.7

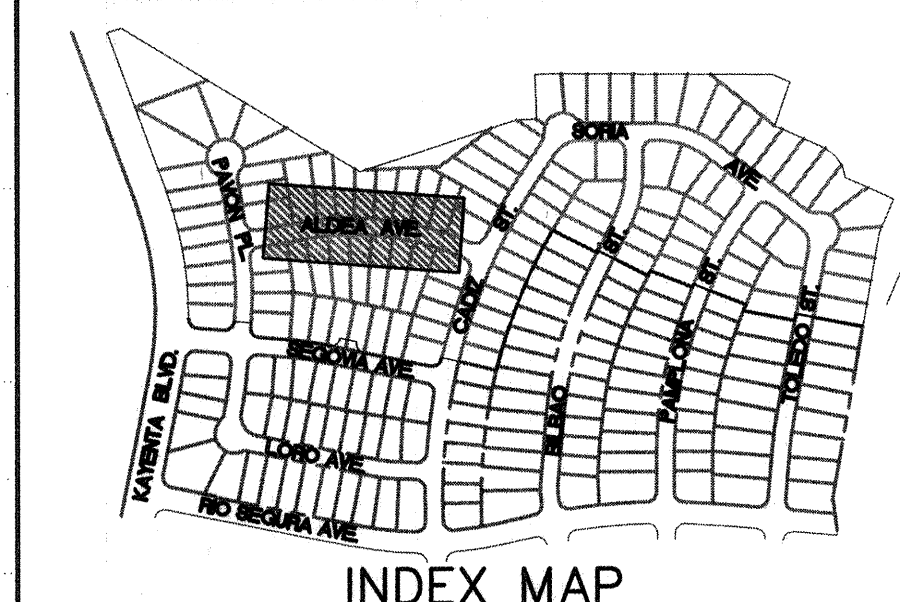

APPROVED FOR CONSTRUCTION
NEW MEXICO UTILITIES INC. DATE 12/2/05

WILSON & COMPANY 2600 THE AMERICAN ROAD S.E. SUITE 100 RIO RANCHO, NEW MEXICO 87124 (505) 898-8021

CITY OF ALBUQUERQUE
PUBLIC WORKS DEPARTMENT
ENGINEERING GROUP

SEVILLE SUBDIVISION - UNIT 3A
ALDEA AVE.
WATER & SANITARY SEWER PLAN & PROFILE


Design Review Committee	City Engineer Approval	Mo./Day/Yr.	Mo./Day/Yr.
APPROVE APR 28 2005 DESIGN REVIEW COMMITTEE	APPROVE APR 28 2005 CITY ENGINEER		

City Project No. 702082 Zone Map No. A-10-Z


AS-BUILT INFORMATION		BENCH MARKS	A.C.S. Survey Monument "SANDBERN" New Mexico State Plane Coord's, Central Zone (NAD 27) as published: Y = 1,534,209.29 X = 361,854.29 Elevation = 5456.92 (SLD 1929) Ground to grid factor = 0.99966079		
CONTRACTOR	DATE				
INSPECTOR BY: SURV-TEK	DATE				
VERIFICATION BY: SURV-TEK	DATE				
SURVEY INFORMATION		ENGINEER'S SEAL	REVISIONS		
FIELD NOTES	DATE				
BY	DATE				
NO.	DATE				
PHOTOGRAMMETRY BY 3/22/98		REMARKS	NO. DATE		
T.R. MANN & ASSOC.					
FIELD SURVEYS BY					
SURV-TEK, INC.					
DESIGNED BY		DESIGNED BY	CHECKED BY		
DRAWN BY					
DATE					
DEC. 04					
SJS		DATE DEC. 04			

SURVEYORS CERTIFICATION
I, Russ P. Hugg, New Mexico Professional Surveyor Number 9750, Hereby Certify that the as-built information shown hereon is the result of an actual field survey performed by me or under my direct supervision and that the same is true and correct to the best of my knowledge and belief.

Russ P. Hugg
NMPs No. 9750
9/1/05

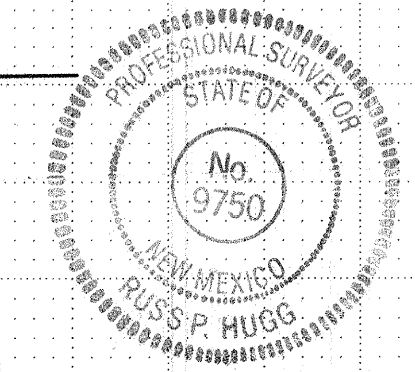


RECORD DRAWING
DATE 12-02-05

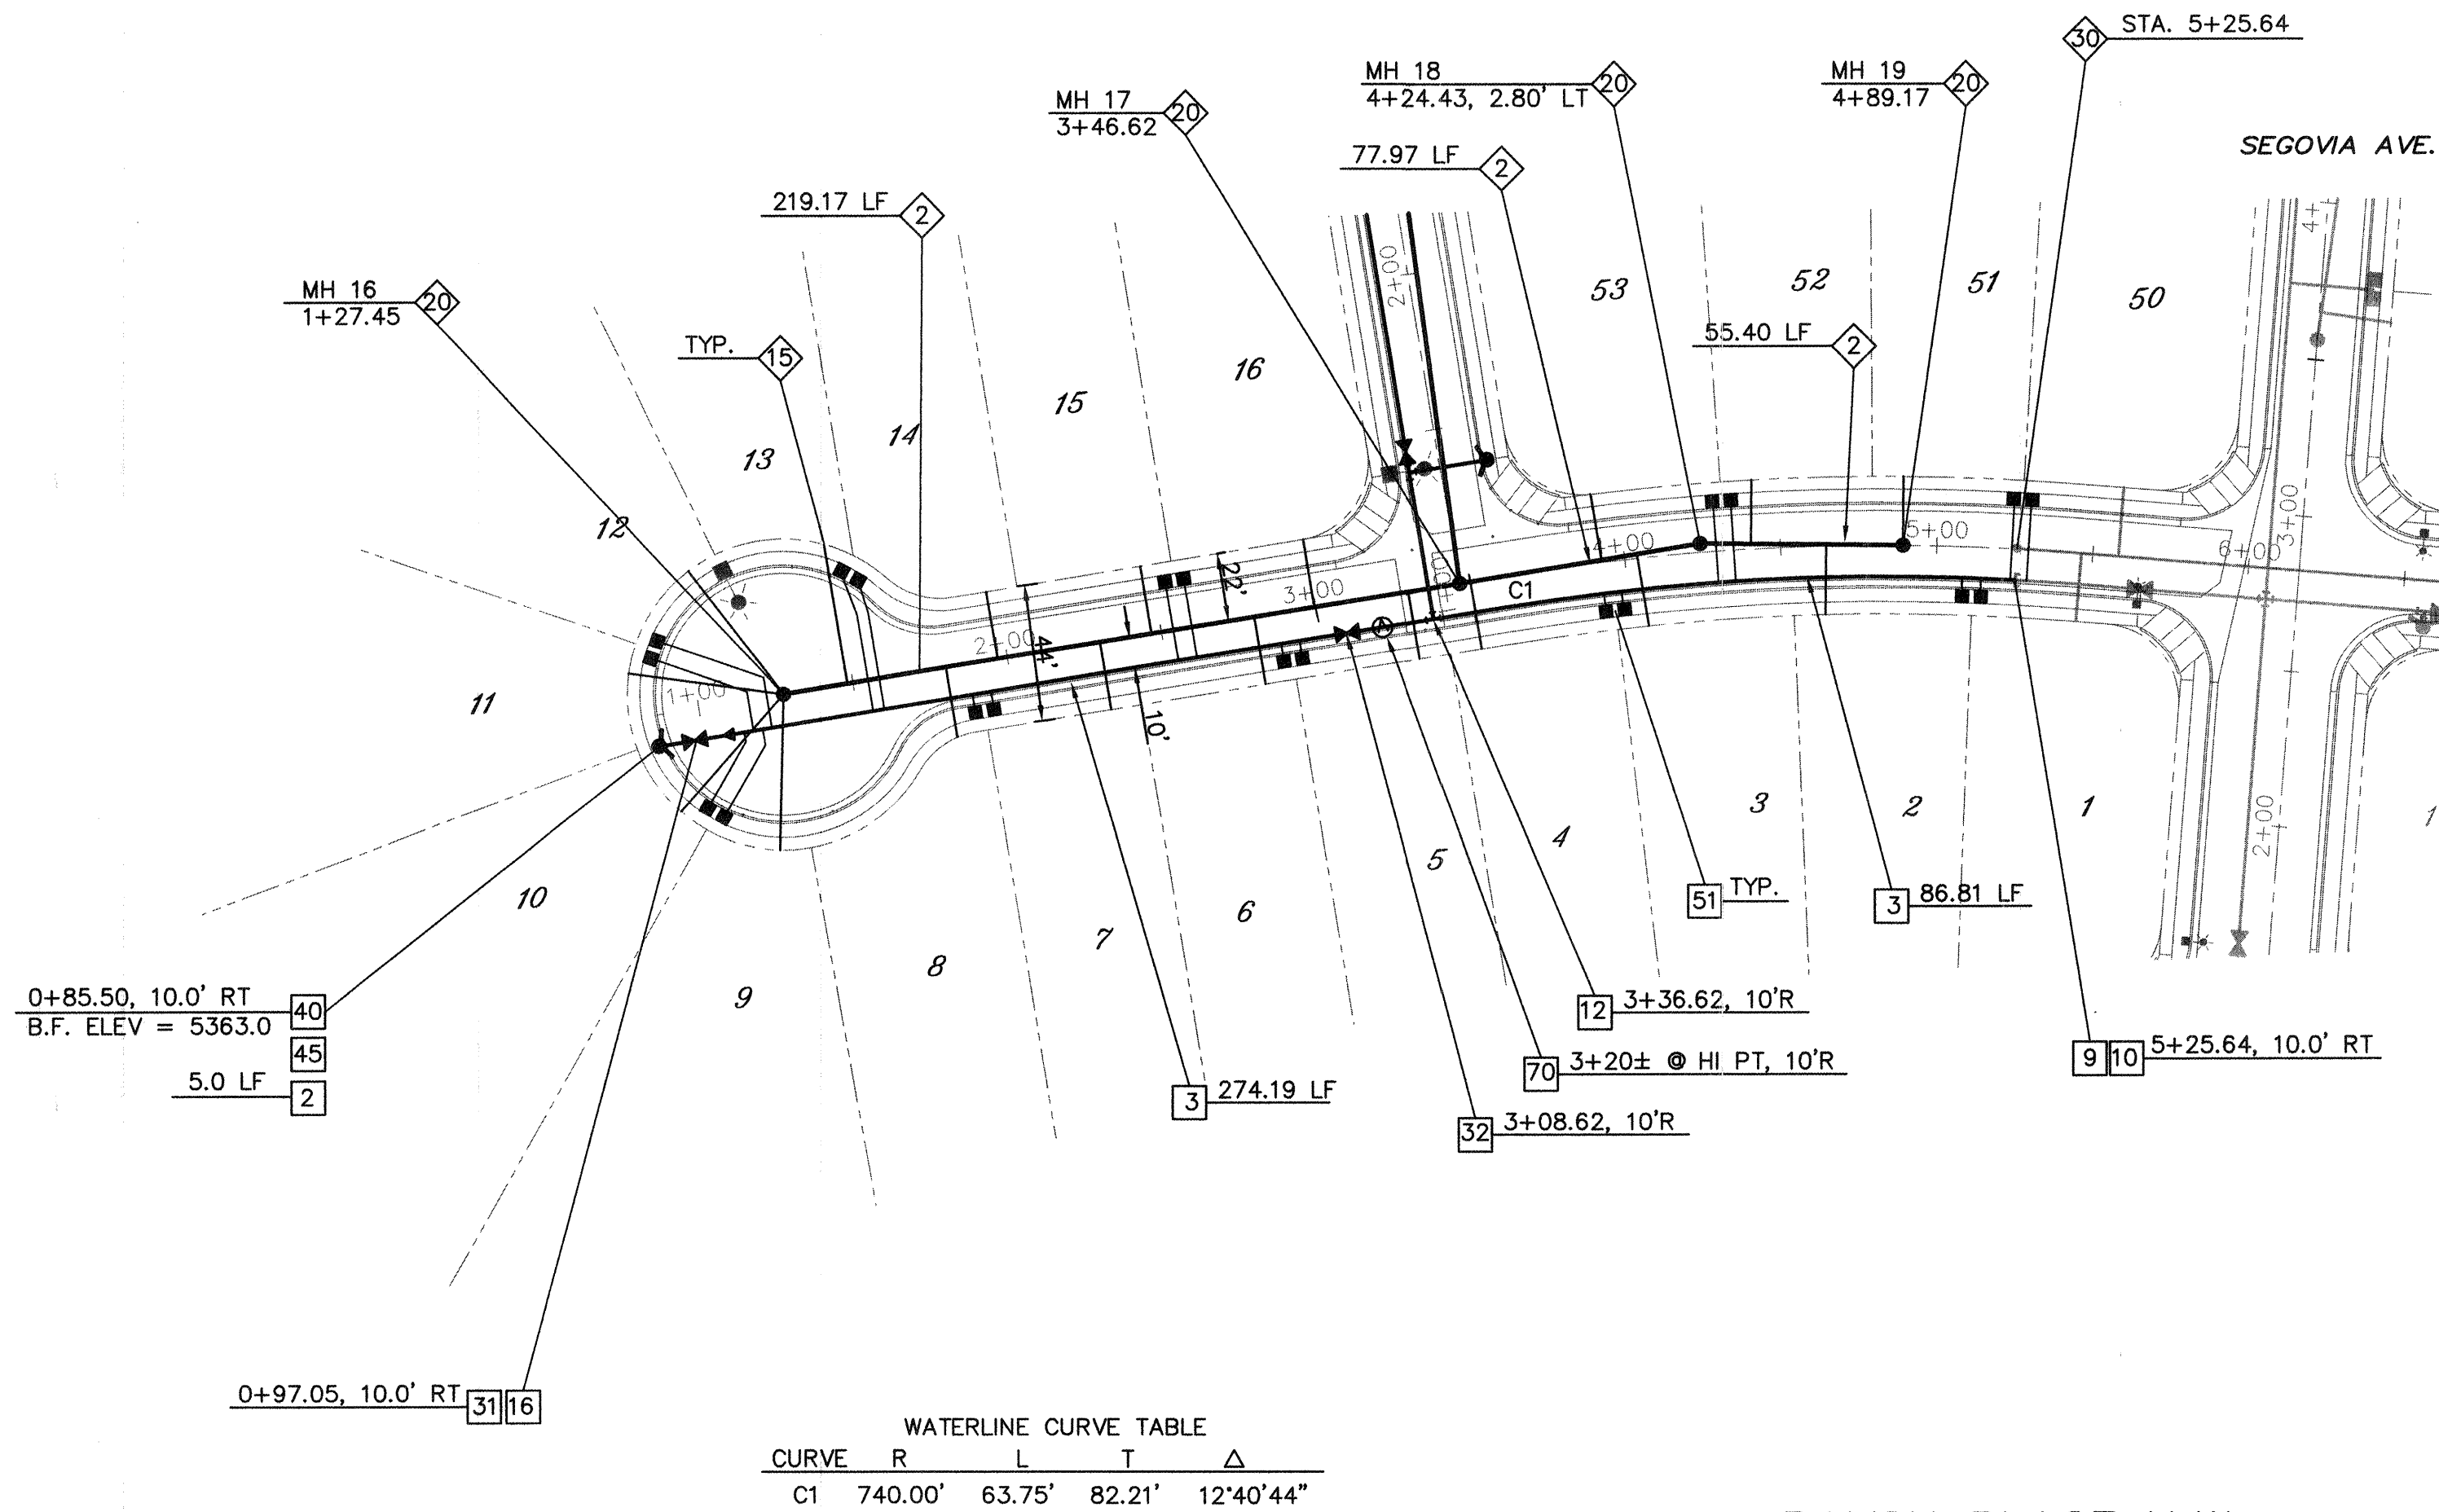

PAVON PLACE N.W.

SCALE:
HORIZ: 1" = 50'
VERT: 1" = 10'

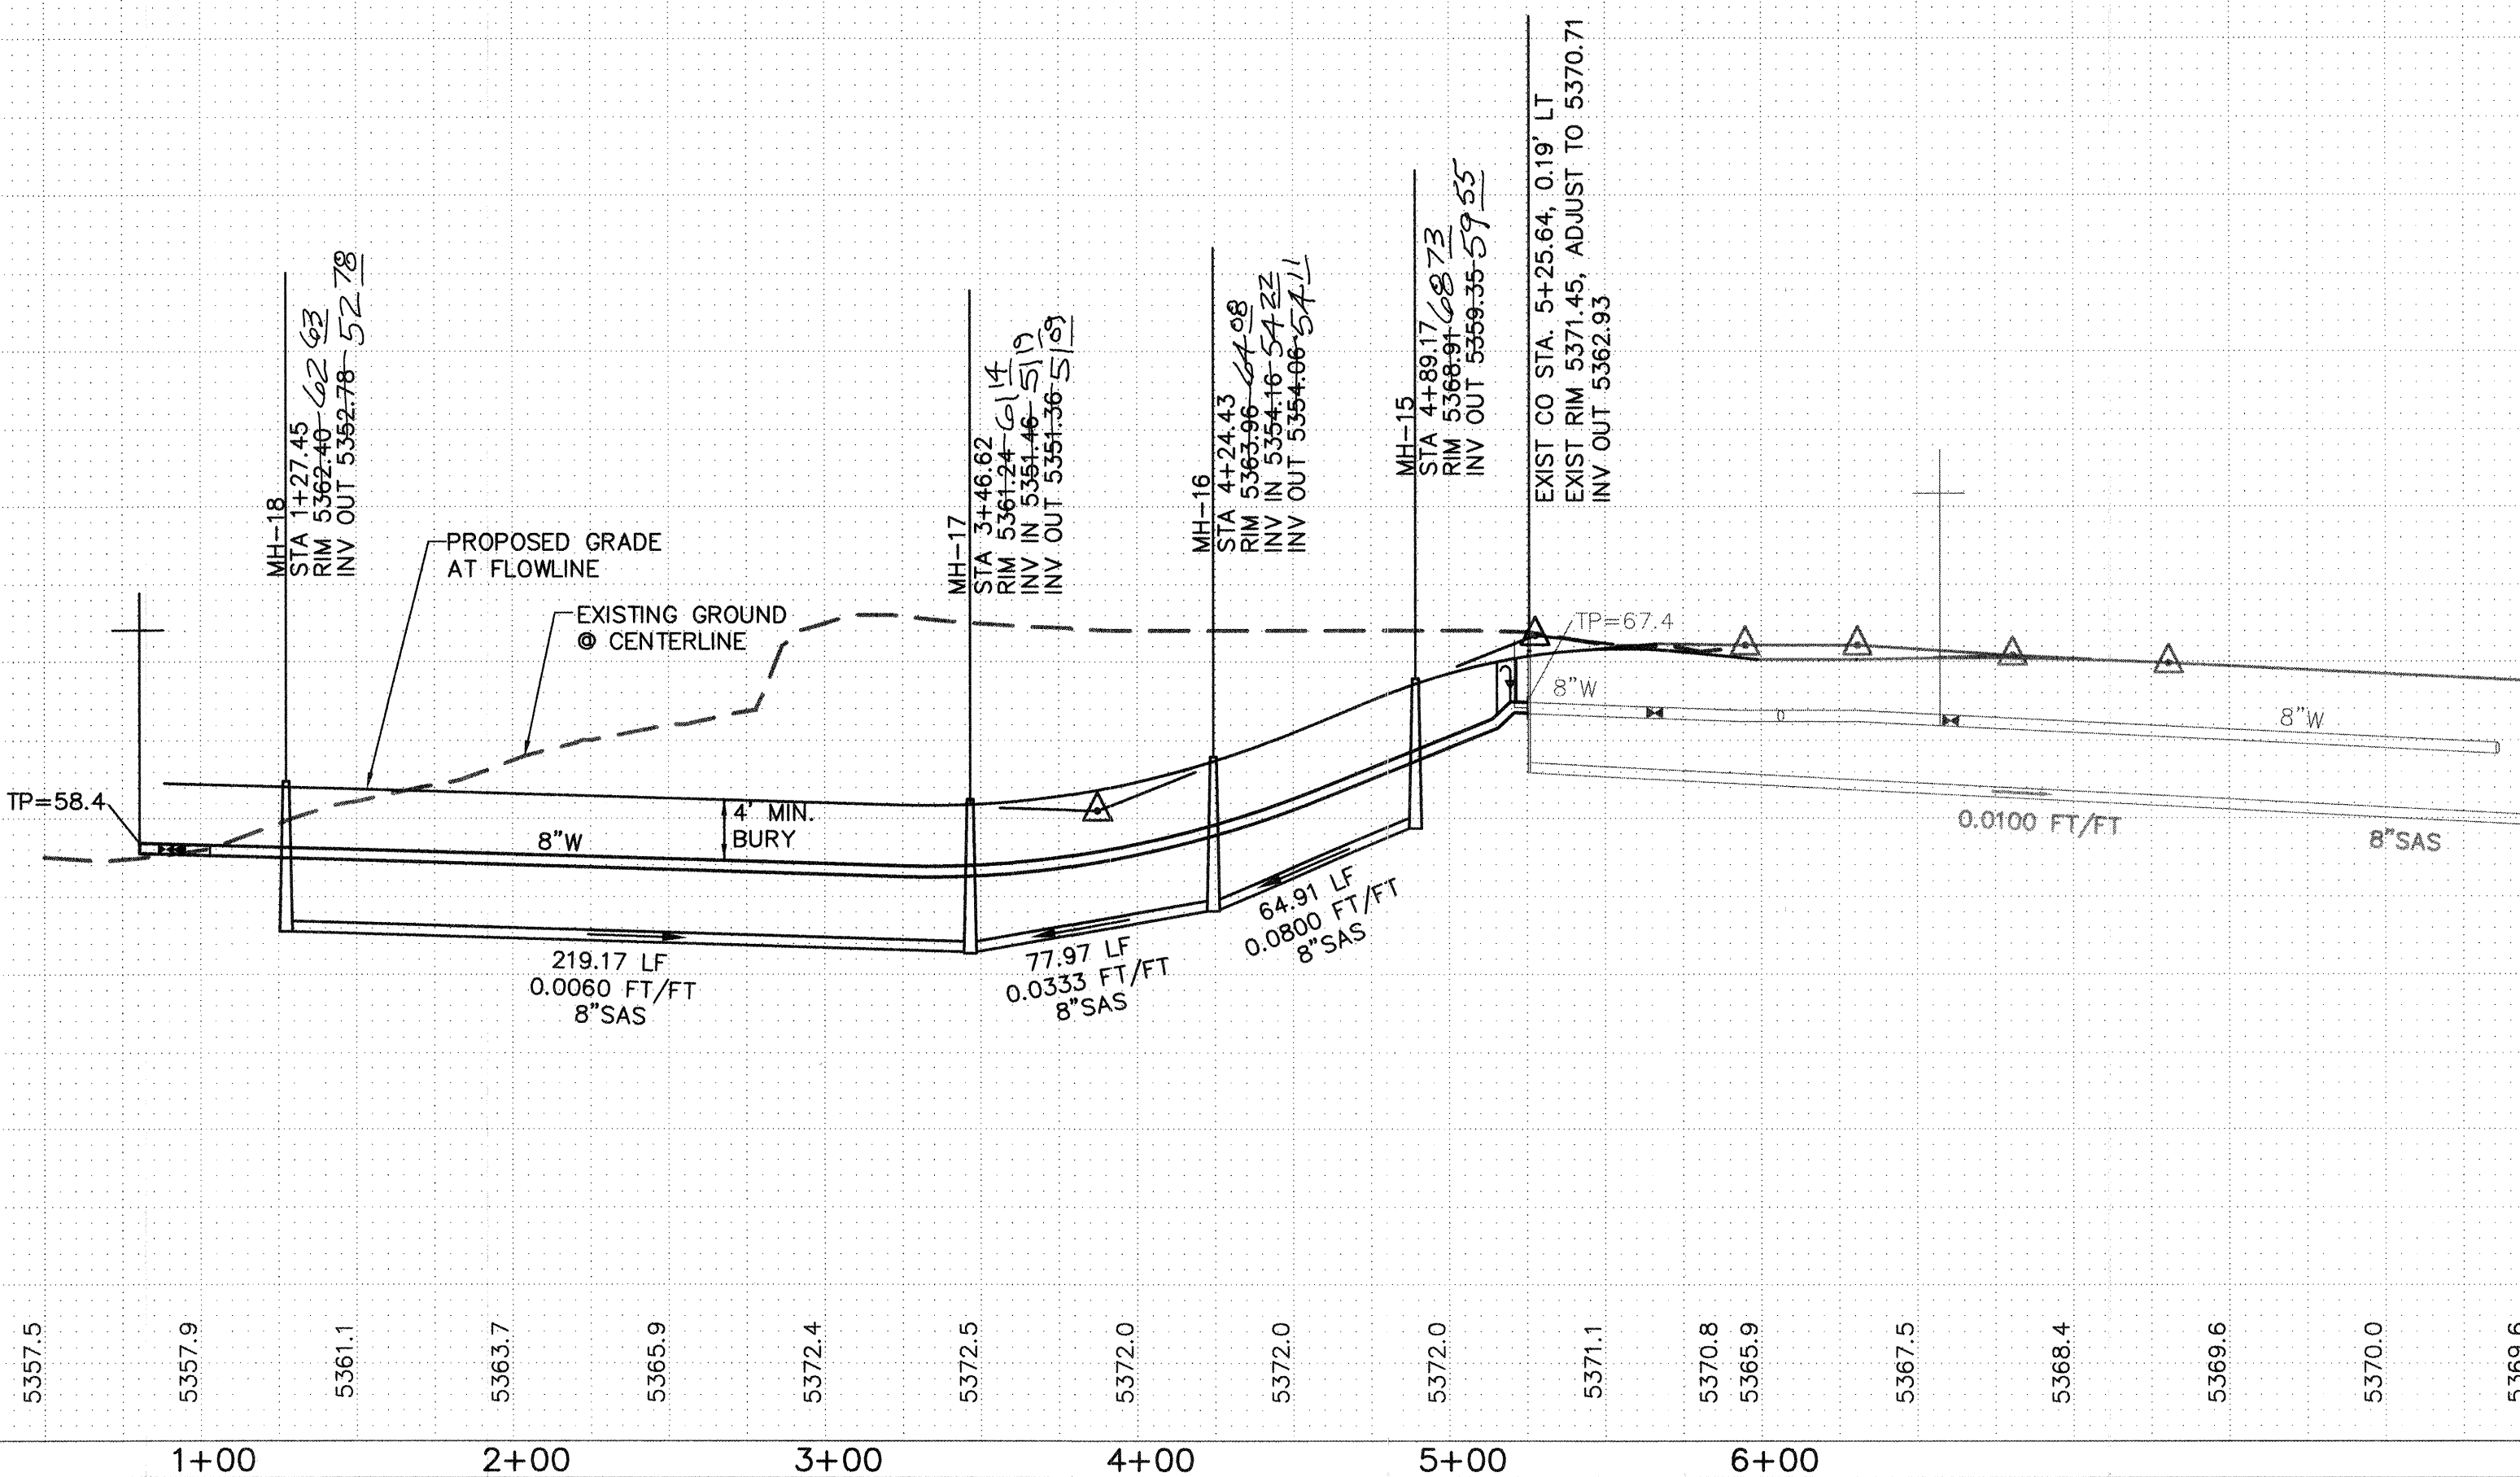

SURVEYORS CERTIFICATION
I, Russ P. Hugg, New Mexico Professional Surveyor Number 9750, Hereby Certify that the as-built information shown hereon is the result of an actual field survey performed by me or under my direct supervision and that the same is true and correct to the best of my knowledge and belief.

Russ P. Hugg
NMPS No. 9750
DATE 12-02-05

RECORD DRAWING
DATE 12-02-05

SEWER CONSTRUCTION NOTES	
I.D.#	DESCRIPTION
2	INSTALL 8" SEWER PIPE PER STD. SPEC. SEC. 901
15	INSTALL 4" SEWER SERVICE
20	INSTALL 4" DIA. MANHOLE PER COA STD. DTL. 2101
30	REMOVE EXISTING CLEANOUT AND CONNECT NEW SEWER LINE TO EXISTING SEWER LINE

WATER CONSTRUCTION NOTES	
I.D.#	DESCRIPTION
2	INSTALL 6" D.I. WATERLINE PER STD. SPEC. SEC. 801
3	INSTALL 8" WATERLINE PER STD. SPEC. SEC. 801
9	CONNECT NEW WATERLINE TO EXISTING WATERLINE
10	REMOVE EXISTING FITTING
21	INSTALL 8" x 6" REDUCER
31	INSTALL 6" GATE VALVE AND TYPE "A" VALVE BOX PER COA STD. DTL. 2333
32	INSTALL 8" GATE VALVE AND VALVE BOX PER COA STD. DTL. 2326
40	INSTALL FIRE HYDRANT
45	"MEG A LUG" ALL FITTINGS AND JOINTS FROM TEE TO FIRE HYDRANT
51	INSTALL 3/4" DOUBLE WATER SERVICE
70	INSTALL VALVMATIC 201-C CAV (OR NMUI APPROVED EQUAL) PER NMUI DETAIL

SEWER SERVICE LOCATIONS	
PAVON PLACE	
LOT	STATION/OFFSET INV. @ P/L
2	4+64, 22' R 5362.3
3	4+05, 23' R 5358.3
4	3+50, 22' R 5356.6
5	3+30, 22' R 5356.5
6	2+80, 22' R 5356.8
7	2+30, 22' R 5357.1
8	1+80, 23' R 5357.4
9	1+18, 49' R 5357.6
10	0+80, 32' R 5357.7
11	0+80, 15' L 5357.8
12	1+04, 44' L 5357.6
13	1+48, 45' L 5357.5
14	1+97, 22' L 5357.3
15	2+47, 22' L 5357.0
16	3+00, 22' L 5356.7
53	3+92, 21' L 5357.7
52	4+42, 20' L 5360.5
51	4+89, 22' L 5364.2

SEWER SERVICE LOCATIONS	
PAVON PLACE	
LOT	STATION/OFFSET INV. @ P/L
2	4+64, 22' R 5362.3
3	4+05, 23' R 5358.3
4	3+50, 22' R 5356.6
5	3+30, 22' R 5356.5
6	2+80, 22' R 5356.8
7	2+30, 22' R 5357.1
8	1+80, 23' R 5357.4
9	1+18, 49' R 5357.6
10	0+80, 32' R 5357.7
11	0+80, 15' L 5357.8
12	1+04, 44' L 5357.6
13	1+48, 45' L 5357.5
14	1+97, 22' L 5357.3
15	2+47, 22' L 5357.0
16	3+00, 22' L 5356.7
53	3+92, 21' L 5357.7

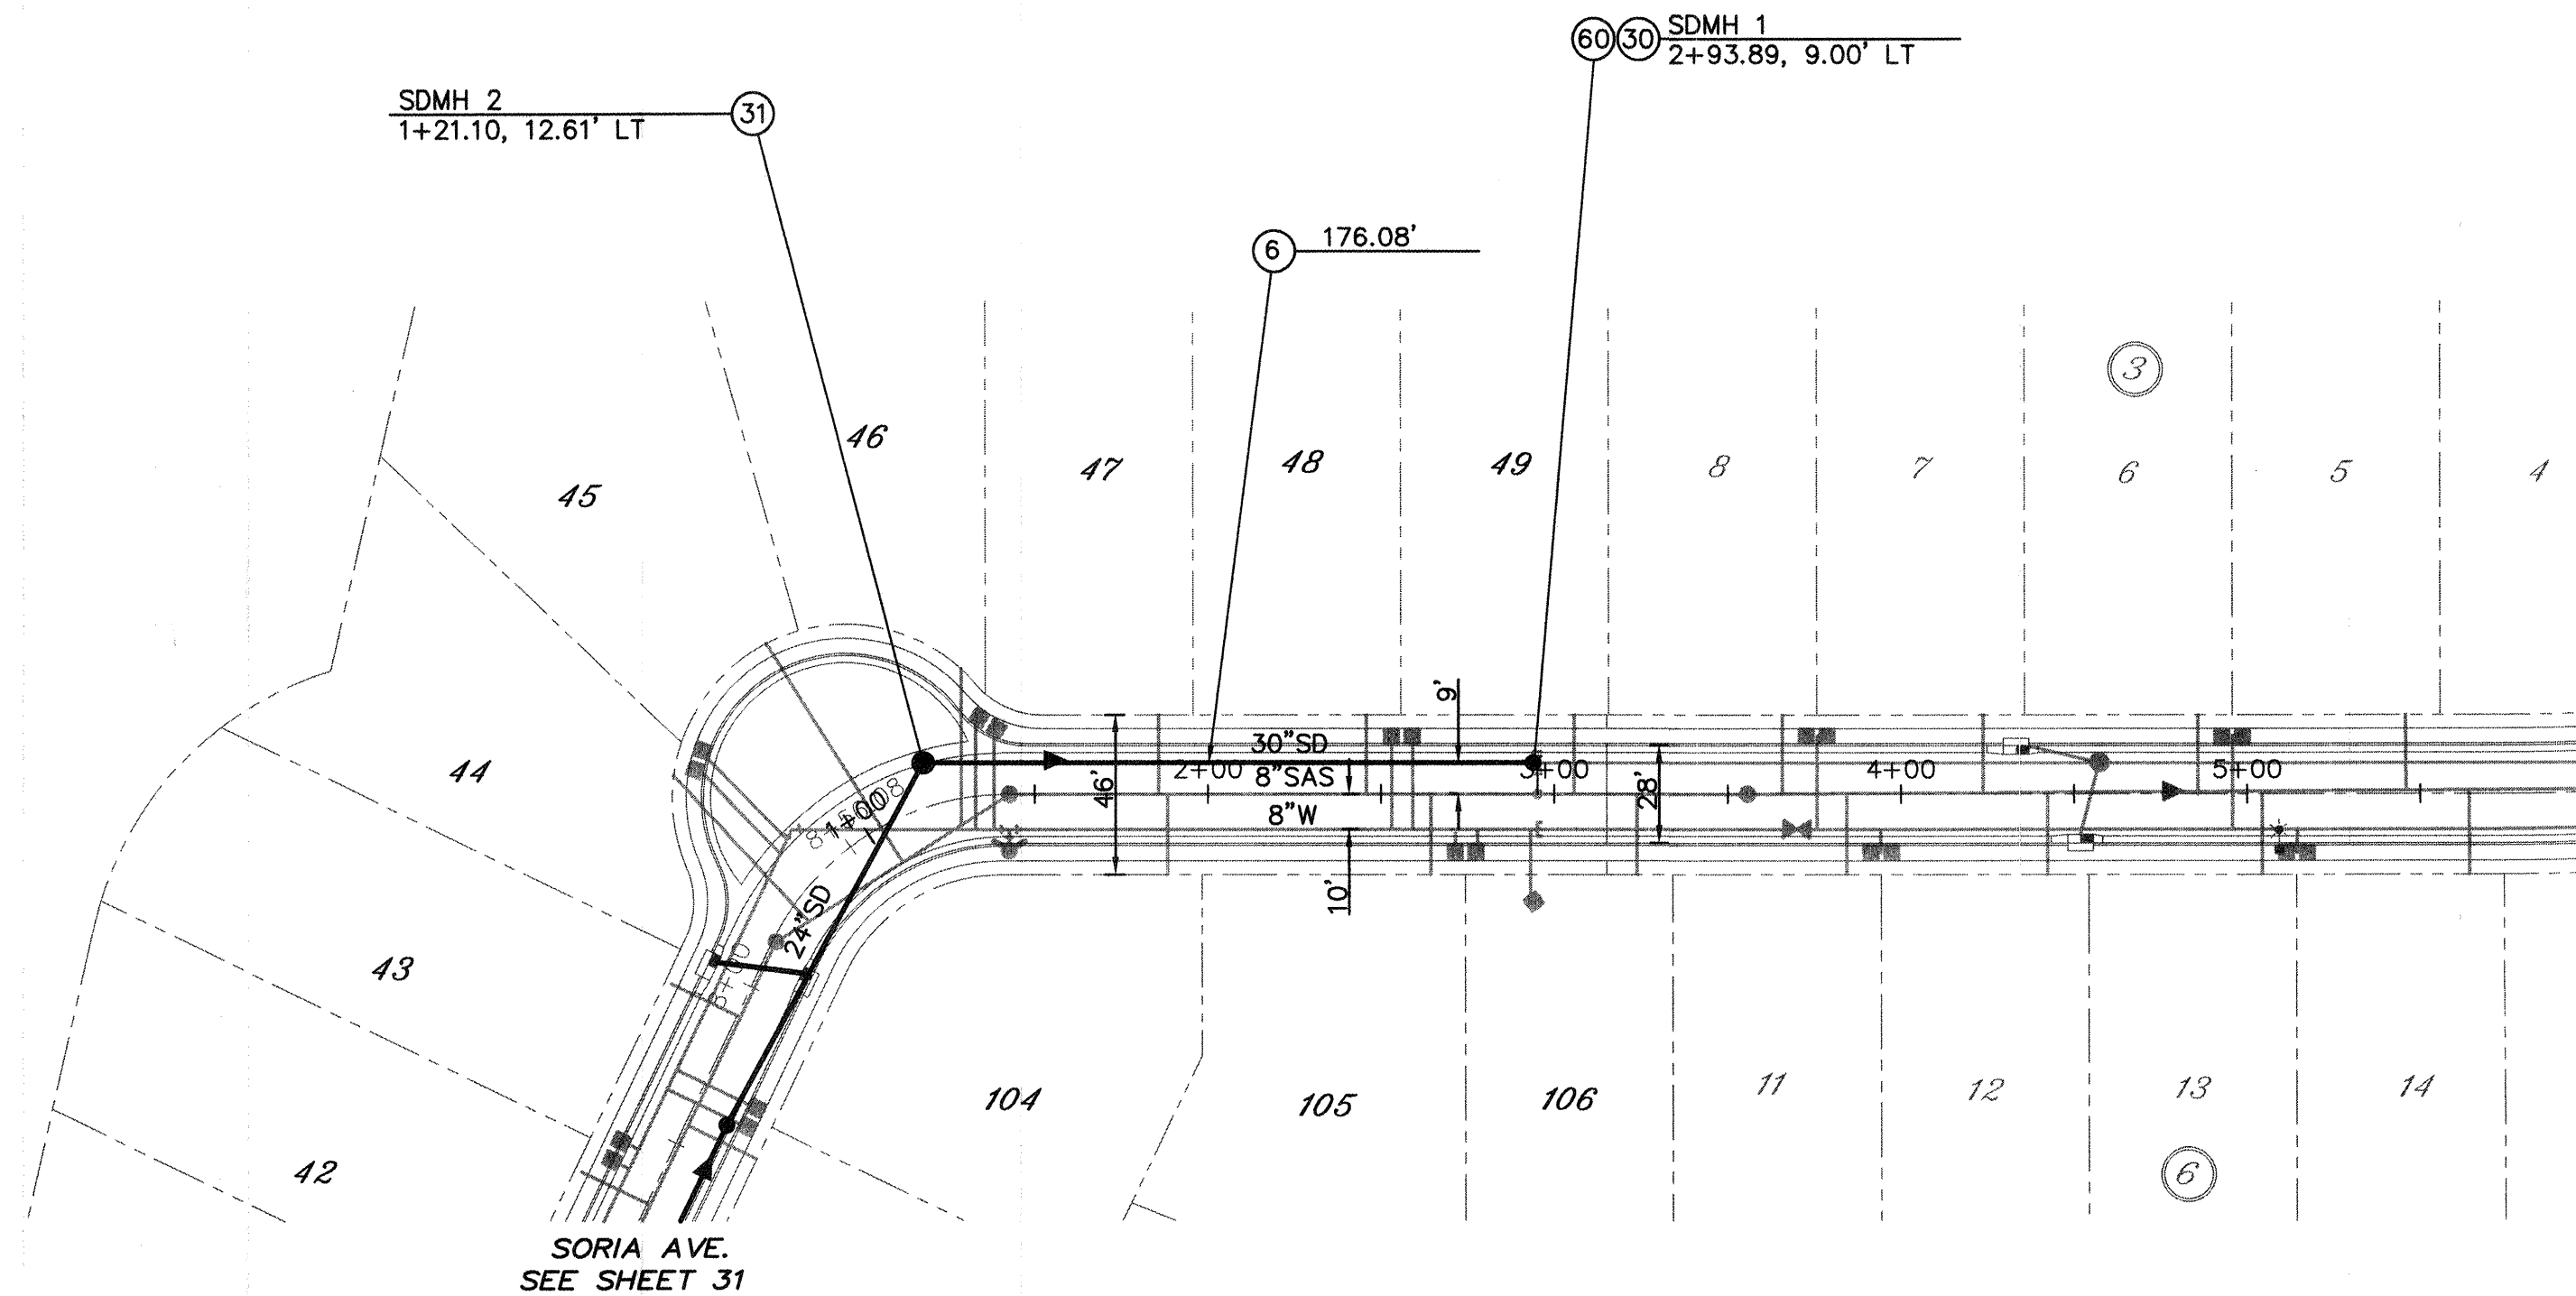

TOLEDO STREET N.W.


SCALE:
HORIZ: 1" = 50'
VERT: 1" = 10'

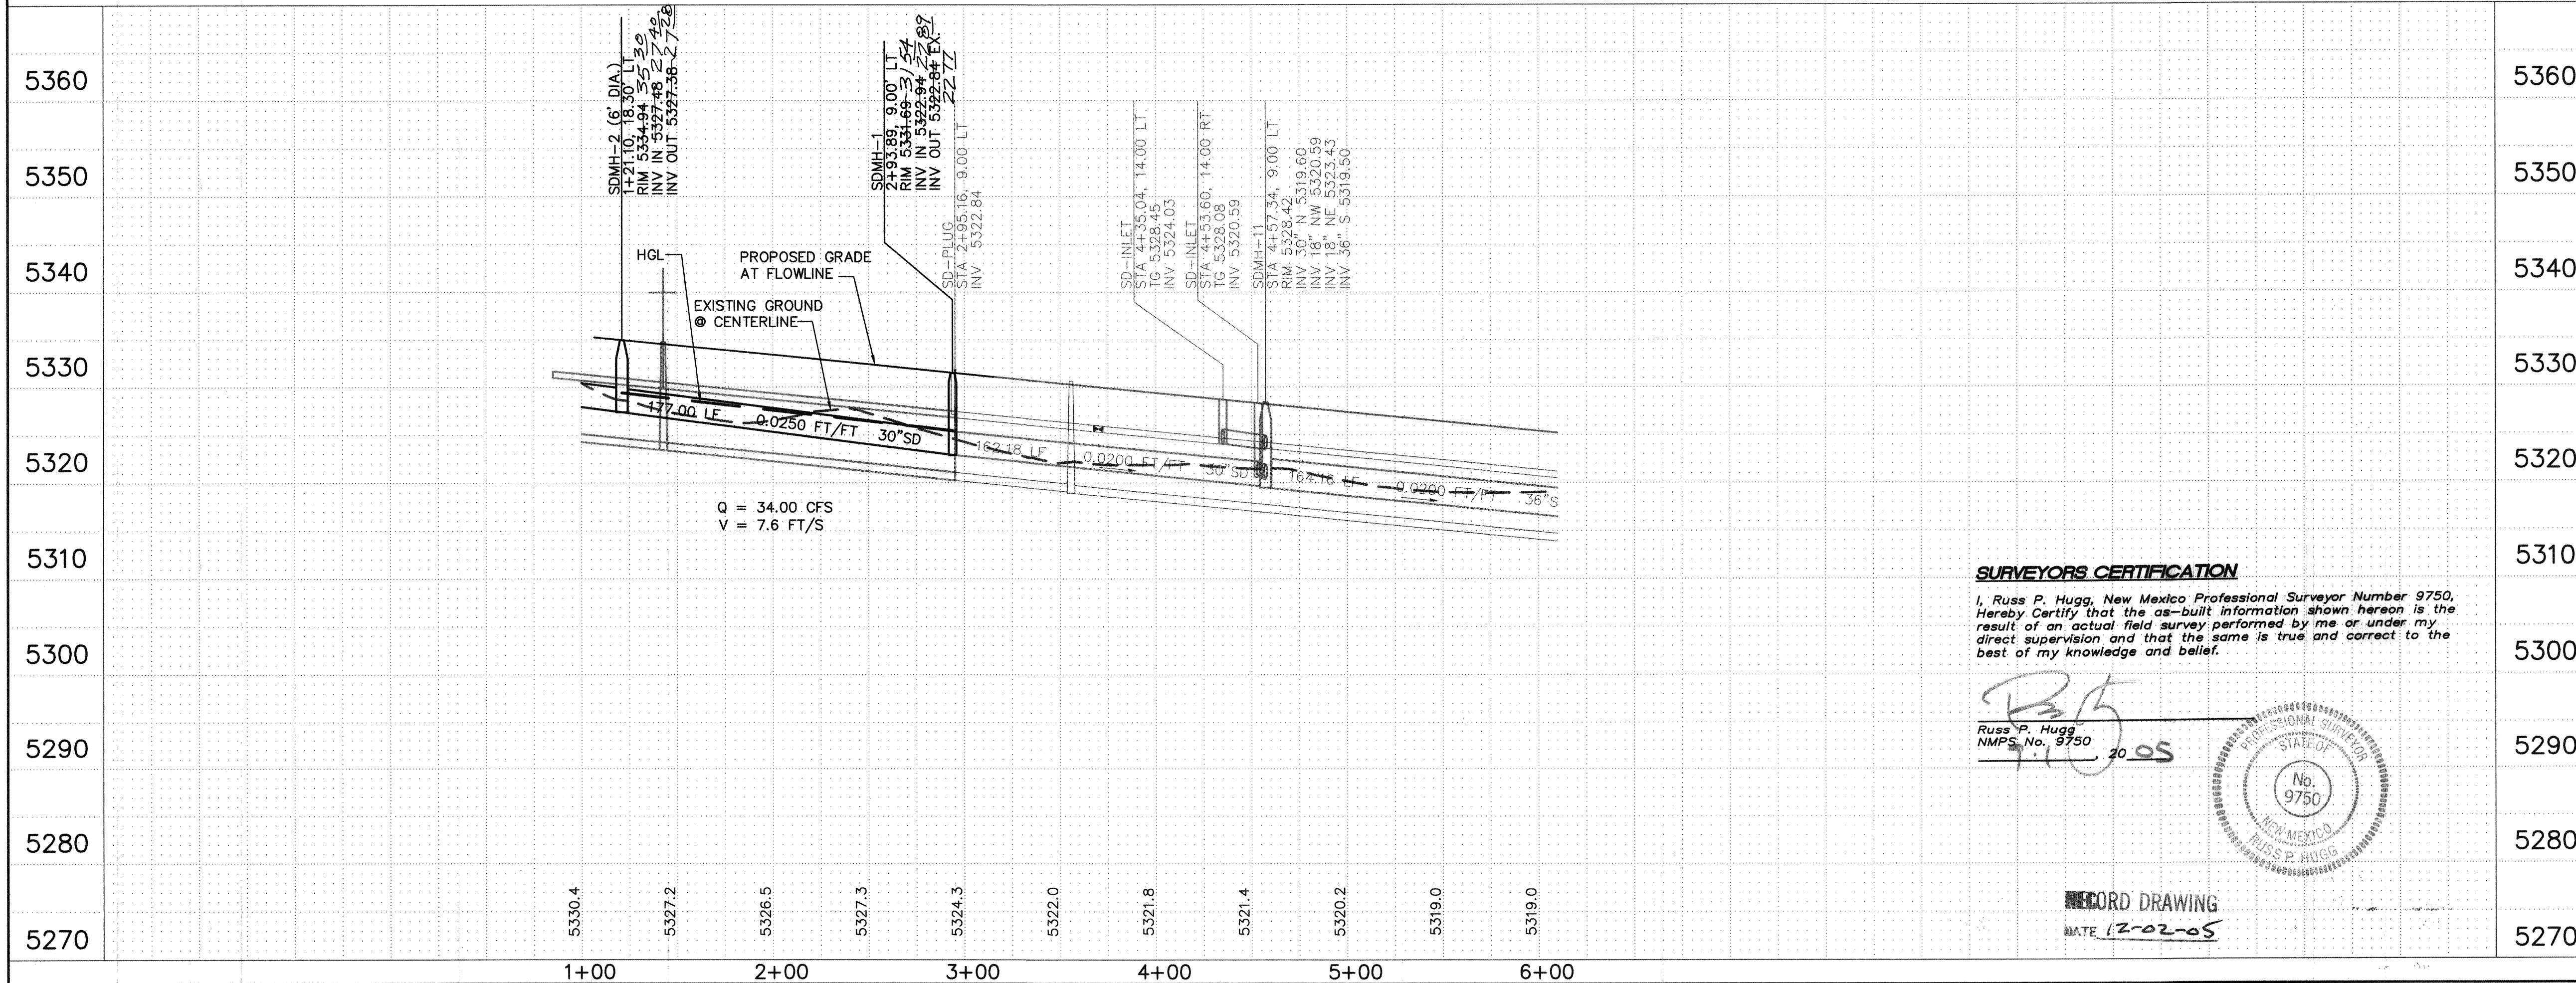

SURVEYORS CERTIFICATION

I, Russ P. Hugg, New Mexico Professional Surveyor Number 9750, Hereby Certify that the as-built information shown hereon is the result of an actual field survey performed by me or under my direct supervision and that the same is true and correct to the best of my knowledge and belief.

Russ P. Hugg
NMPS No. 9750
20.05

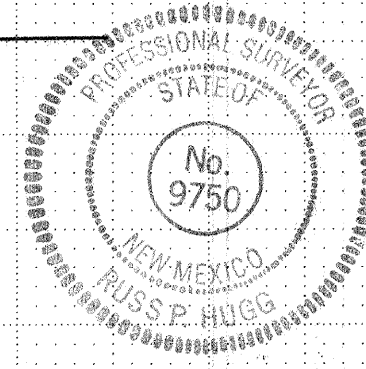

RECORD DRAWING
DATE 12-02-05

STORM DRAIN CONSTRUCTION NOTES	
I.D.#	DESCRIPTION
6	INSTALL 30" STORM DRAIN PIPE
30	INSTALL 4' DIA. MANHOLE PER COA STD. DTL. 2101
31	INSTALL 6" DIA. MANHOLE PER COA STD. DTL. 2101
60	REMOVE EXISTING STORM DRAIN PLUG AND CONNECT NEW STORM DRAIN TO EXISTING

NOTE: FOR STORM DRAIN CONSTRUCTION, RCP PIPE JOINTS SHALL NOT BE GROUTED PRIOR TO FINAL INSPECTION. FINAL INSPECTION WILL DETERMINE JOINTS TO BE GROUTED FOR FINAL ACCEPTANCE OF THE CONSTRUCTION.

AS-BUILT INFORMATION	
CONTRACTOR	DATE
NEW CONCEPTS	01/01/05

BENCH MARKS	
CONTRACTOR	DATE
A.C.S. Survey Monument "SANDBERN"	01/01/05

SURVEY INFORMATION	
FIELD NOTES	DATE
PHOTOGRAMMETRY BY 3/22/08	01/01/05
T.R. MANN & ASSOC.	01/01/05
FIELD SURVEYS BY	01/01/05
SURV-TEK, INC.	01/01/05

ENGINEER'S SEAL	
REMARKS	BY
REVISIONS	
WILSON & COMPANY, ENGINEERS & ARCHITECTS	
DESIGNED BY	DATE DEC. 04
DRAWN BY	DATE DEC. 04
CHECKED BY	DATE DEC. 04


INDEX MAP	
NO.	DATE
1	01/01/05

WILSON & COMPANY	
DESIGNED BY	DATE DEC. 04
2600 THE AMERICAN ROAD S.E. SUITE 100 RIO RANCHO, NEW MEXICO 87124 (505) 898-8021	DATE DEC. 04

CITY OF ALBUQUERQUE PUBLIC WORKS DEPARTMENT ENGINEERING GROUP	
SEVILLE SUBDIVISION - UNIT 3A TOLEDO STREET STORM DRAIN PLAN & PROFILE	
Design Review Committee	City Engineer Approval
APPROVED APR 28 2005	APPROVED APR 28 2005
DESIGN REVIEW COMMITTEE	CITY ENGINEER


City Project No.	
Zone Map No.	Sheet Of
702082	A-10-Z

30 32	
-------	--

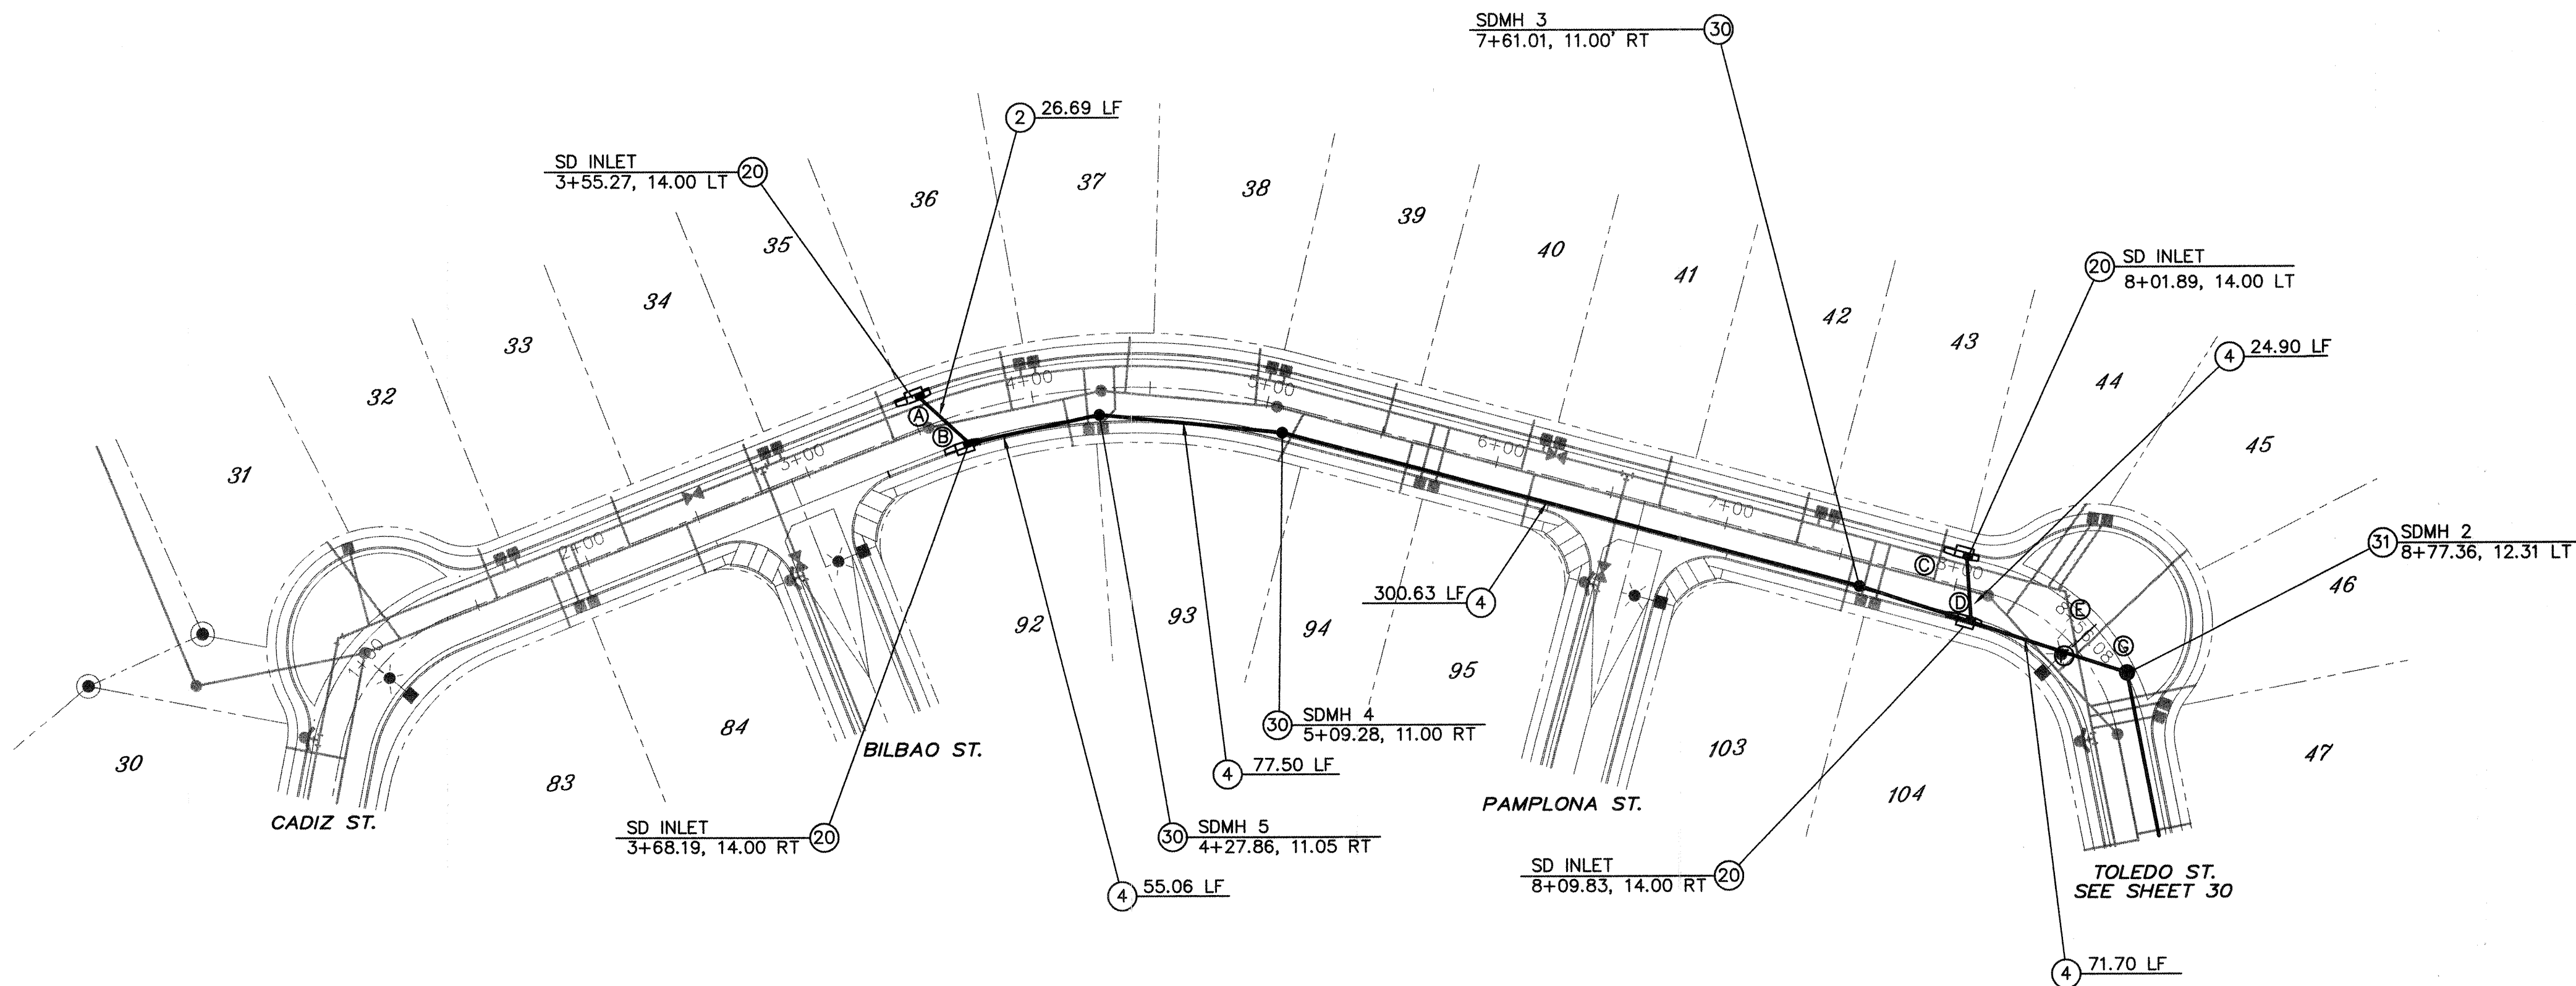

SORIA AVENUE N.W.


SCALE:
HORIZ: 1" = 50'
VERT: 1" = 10'

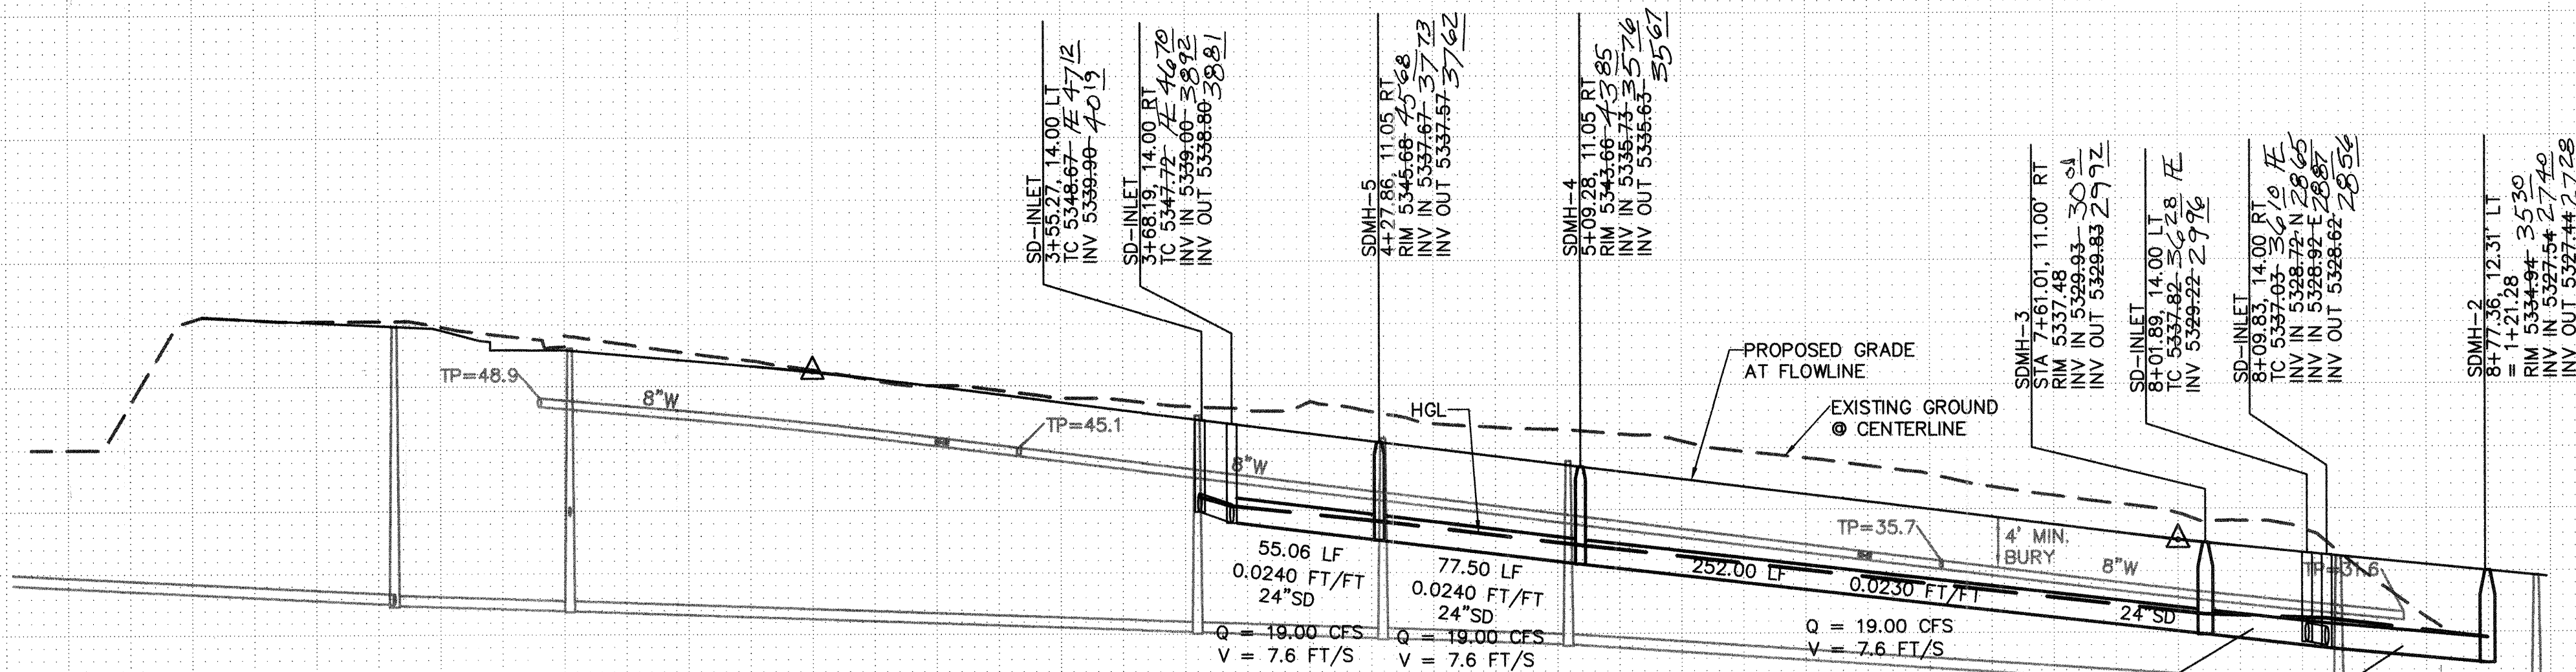

SURVEYORS CERTIFICATION

I, Russ P. Hugg, New Mexico Professional Surveyor Number 9750, hereby certify that the as-built information shown hereon is the result of an actual field survey performed by me or under my direct supervision and that the same is true and correct to the best of my knowledge and belief.

Russ P. Hugg
NMPs No. 9750
7/1/2005

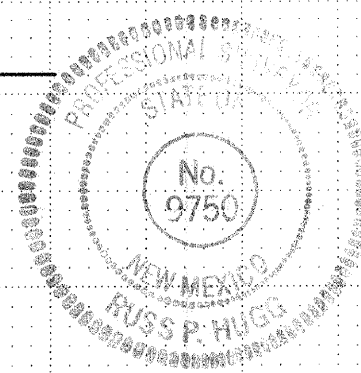

I.D.#	DESCRIPTION
2	INSTALL 18" STORM DRAIN PIPE
4	INSTALL 24" STORM DRAIN PIPE
20	INSTALL TYPE A CATCH BASIN SINGLE GRATE PER COA STD. DTL. 2201
30	INSTALL 4' DIA. MANHOLE PER COA STD. DTL. 2101
31	INSTALL 6' DIA. MANHOLE PER COA STD. DTL. 2101



UTILITY CROSSING		
SAS	SD	WL
34.57 TP	41.30 TP	43.11 BP
26.40 TP	30.28 TP	32.01 BP
25.20 TP	28.06 BP	
24.81 TP	29.00 TP	30.84 BP
	26.31 BP	

NOTE: FOR STORM DRAIN CONSTRUCTION, RCP PIPE JOINTS SHALL NOT BE GROUTED PRIOR TO FINAL INSPECTION. FINAL INSPECTION WILL DETERMINE JOINTS TO BE GROUTED FOR FINAL ACCEPTANCE OF THE CONSTRUCTION.

AS-BUILT INFORMATION	
CONTRACTOR	DATE
NEW CONCEPTS	07/05
INSPECTED BY SURV-TEK	07/05
FIELD CHECKED BY SURV-TEK	07/05
CORRECTED BY SURV-TEK	07/05

BENCH MARKS	
MARK	COORDINATES
A.C.S. Survey Monument "SANDBERN"	
New Mexico State Plane Coord's, Central Zone	
Zone 27 as published:	
Y = 1,534,209.29	
X = 361,854.29	
Elevation = 5456.92 (SLD 1929)	
Ground to grid factor = 0.99966079	

SURVEY INFORMATION	
FIELD NOTES	DATE
PHOTOGRAMMETRY BY	07/05
T.R. MANN & ASSOC.	
FIELD SURVEYS BY	
SURV-TEK, INC.	

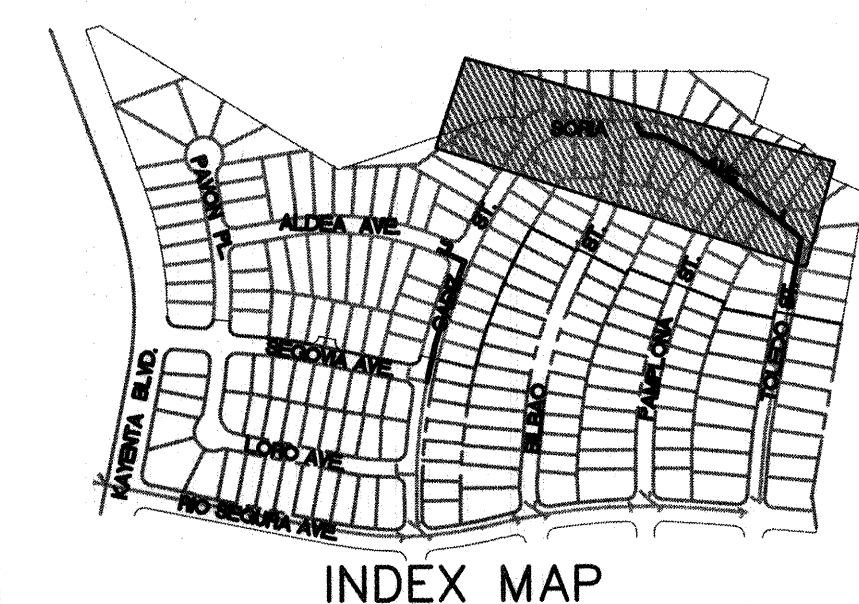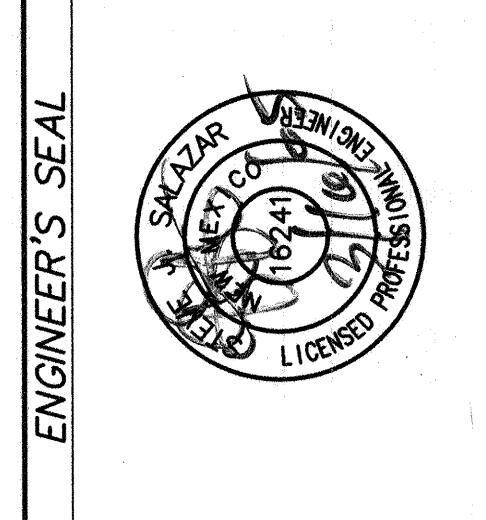


WILSON & COMPANY
2600 THE AMERICAN ROAD S.E.
SUITE 100
RIO RANCHO, NEW MEXICO
87124
(505) 898-8021

CITY OF ALBUQUERQUE
PUBLIC WORKS DEPARTMENT
ENGINEERING GROUP

SEVILLE SUBDIVISION - UNIT 3A
SORIA AVE.
STORM DRAIN PLAN & PROFILE

Design Review Committee	City Engineer Approval	Mo./Day/Yr.	Mo./Day/Yr.
APPROVED APR 28 2005 DESIGN REVIEW COMMITTEE	APPROVED APR 28 2005 CITY ENGINEER		
Last Design Update			

City Project No.	Zone Map No.	Sheet	Of
702082	A-10-Z	31	32

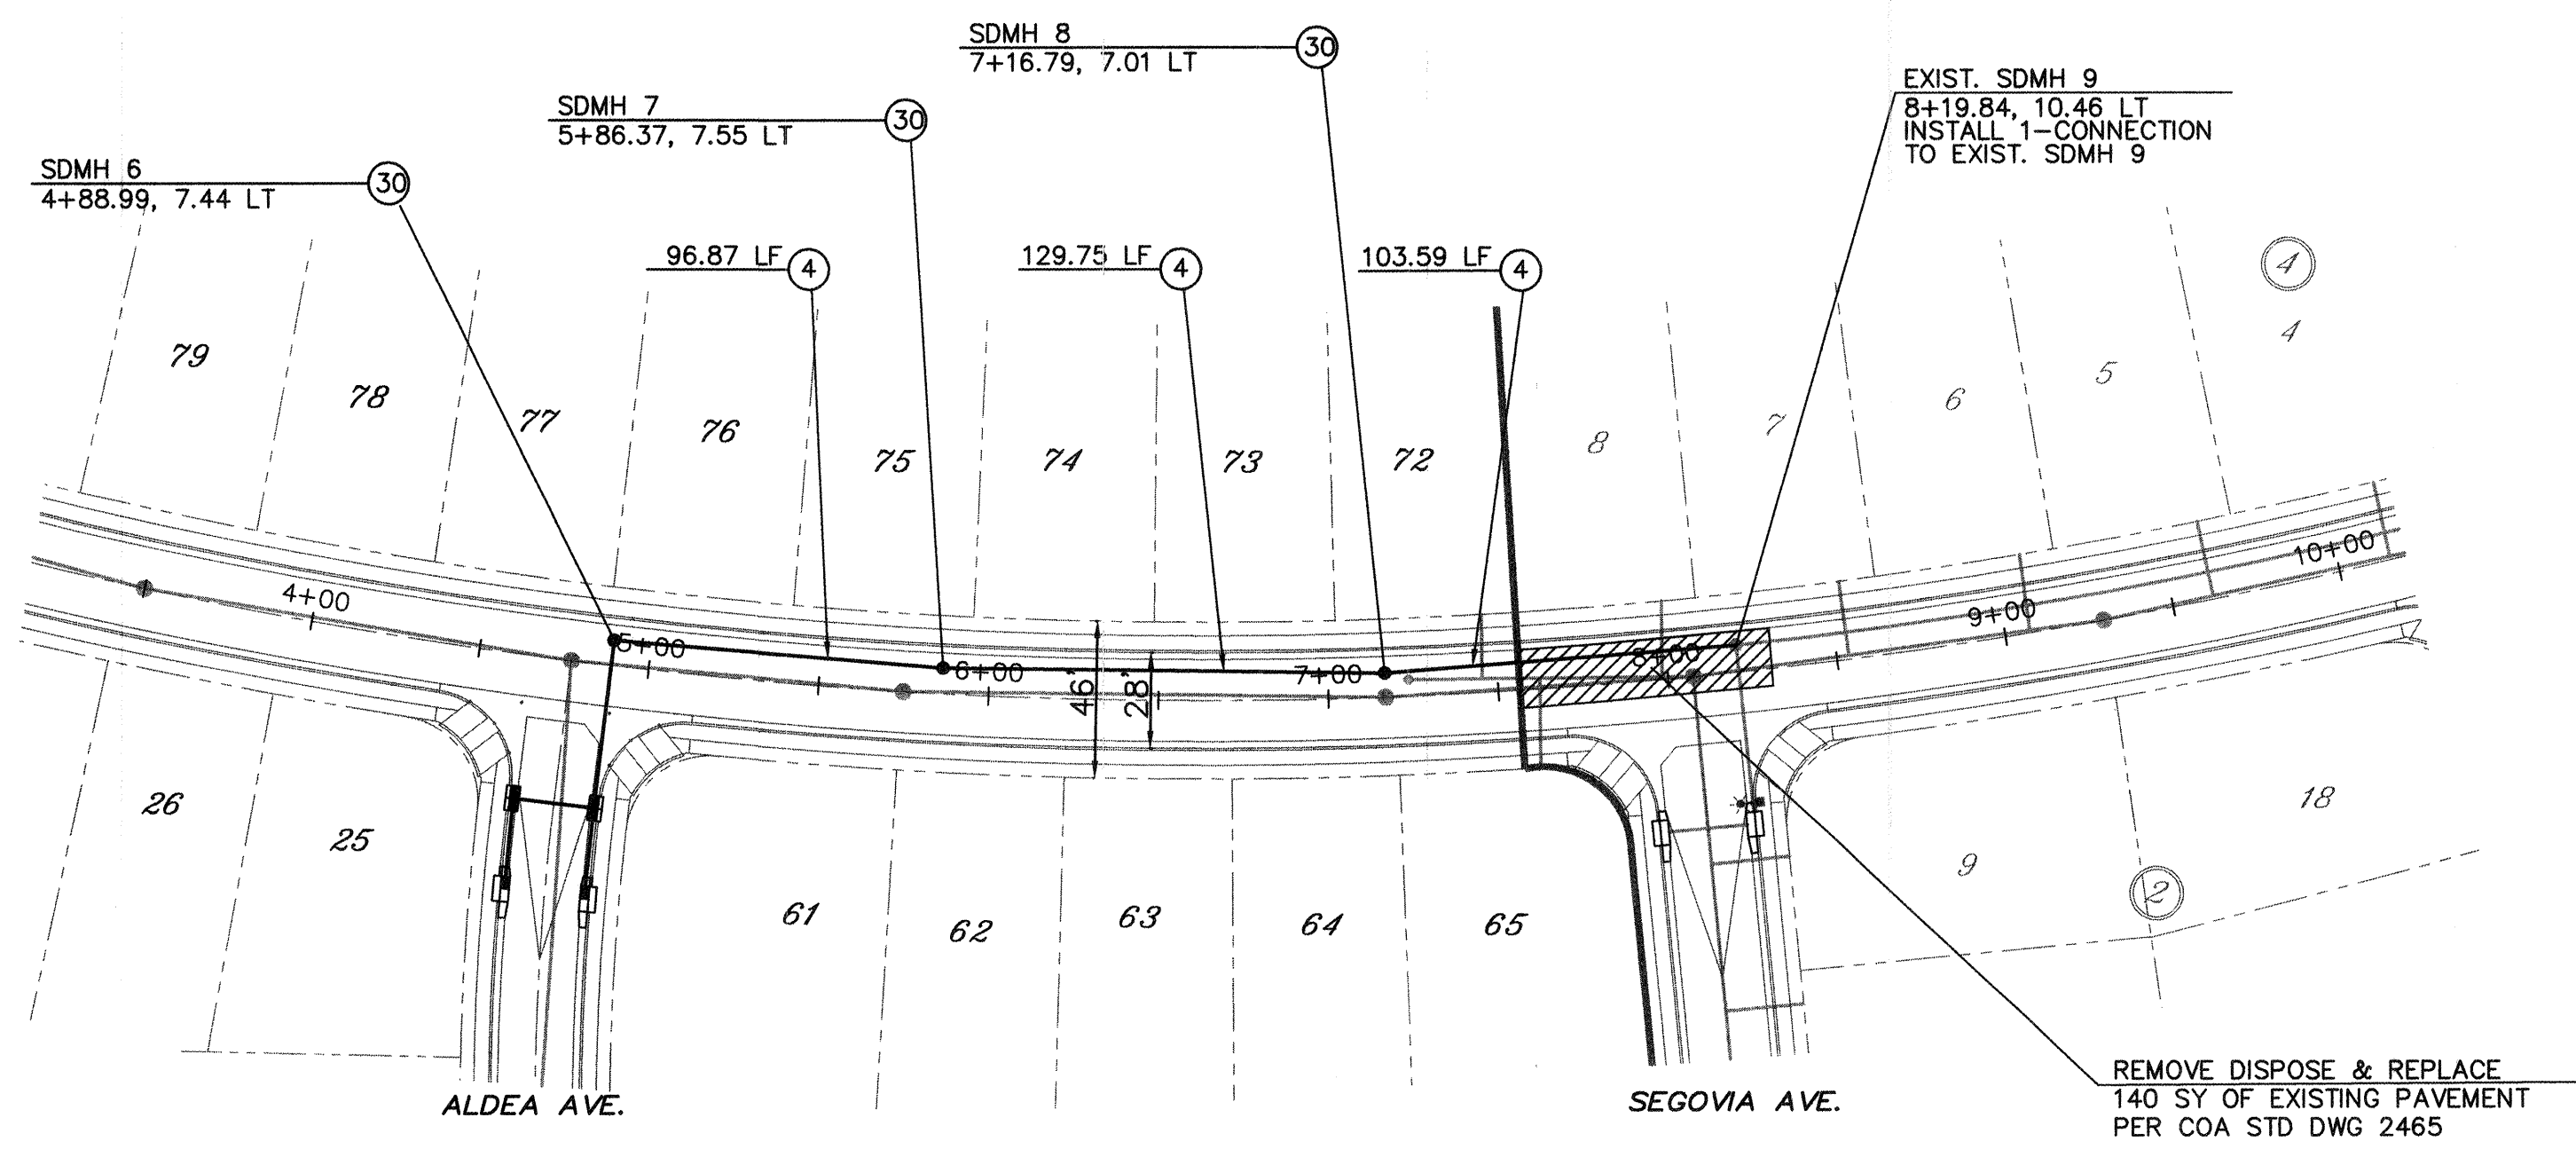



SCALE:
HORIZ: 1" = 50'
VERT: 1" = 10'

CADIZ STREET N.W.


SURVEYORS CERTIFICATION

I, Russ P. Hugg, New Mexico Professional Surveyor Number 9750, Hereby Certify that the as-built information shown hereon is the result of an actual field survey performed by me or under my direct supervision and that the same is true and correct to the best of my knowledge and belief.

Russ P. Hugg
NMPS No. 9750
2005

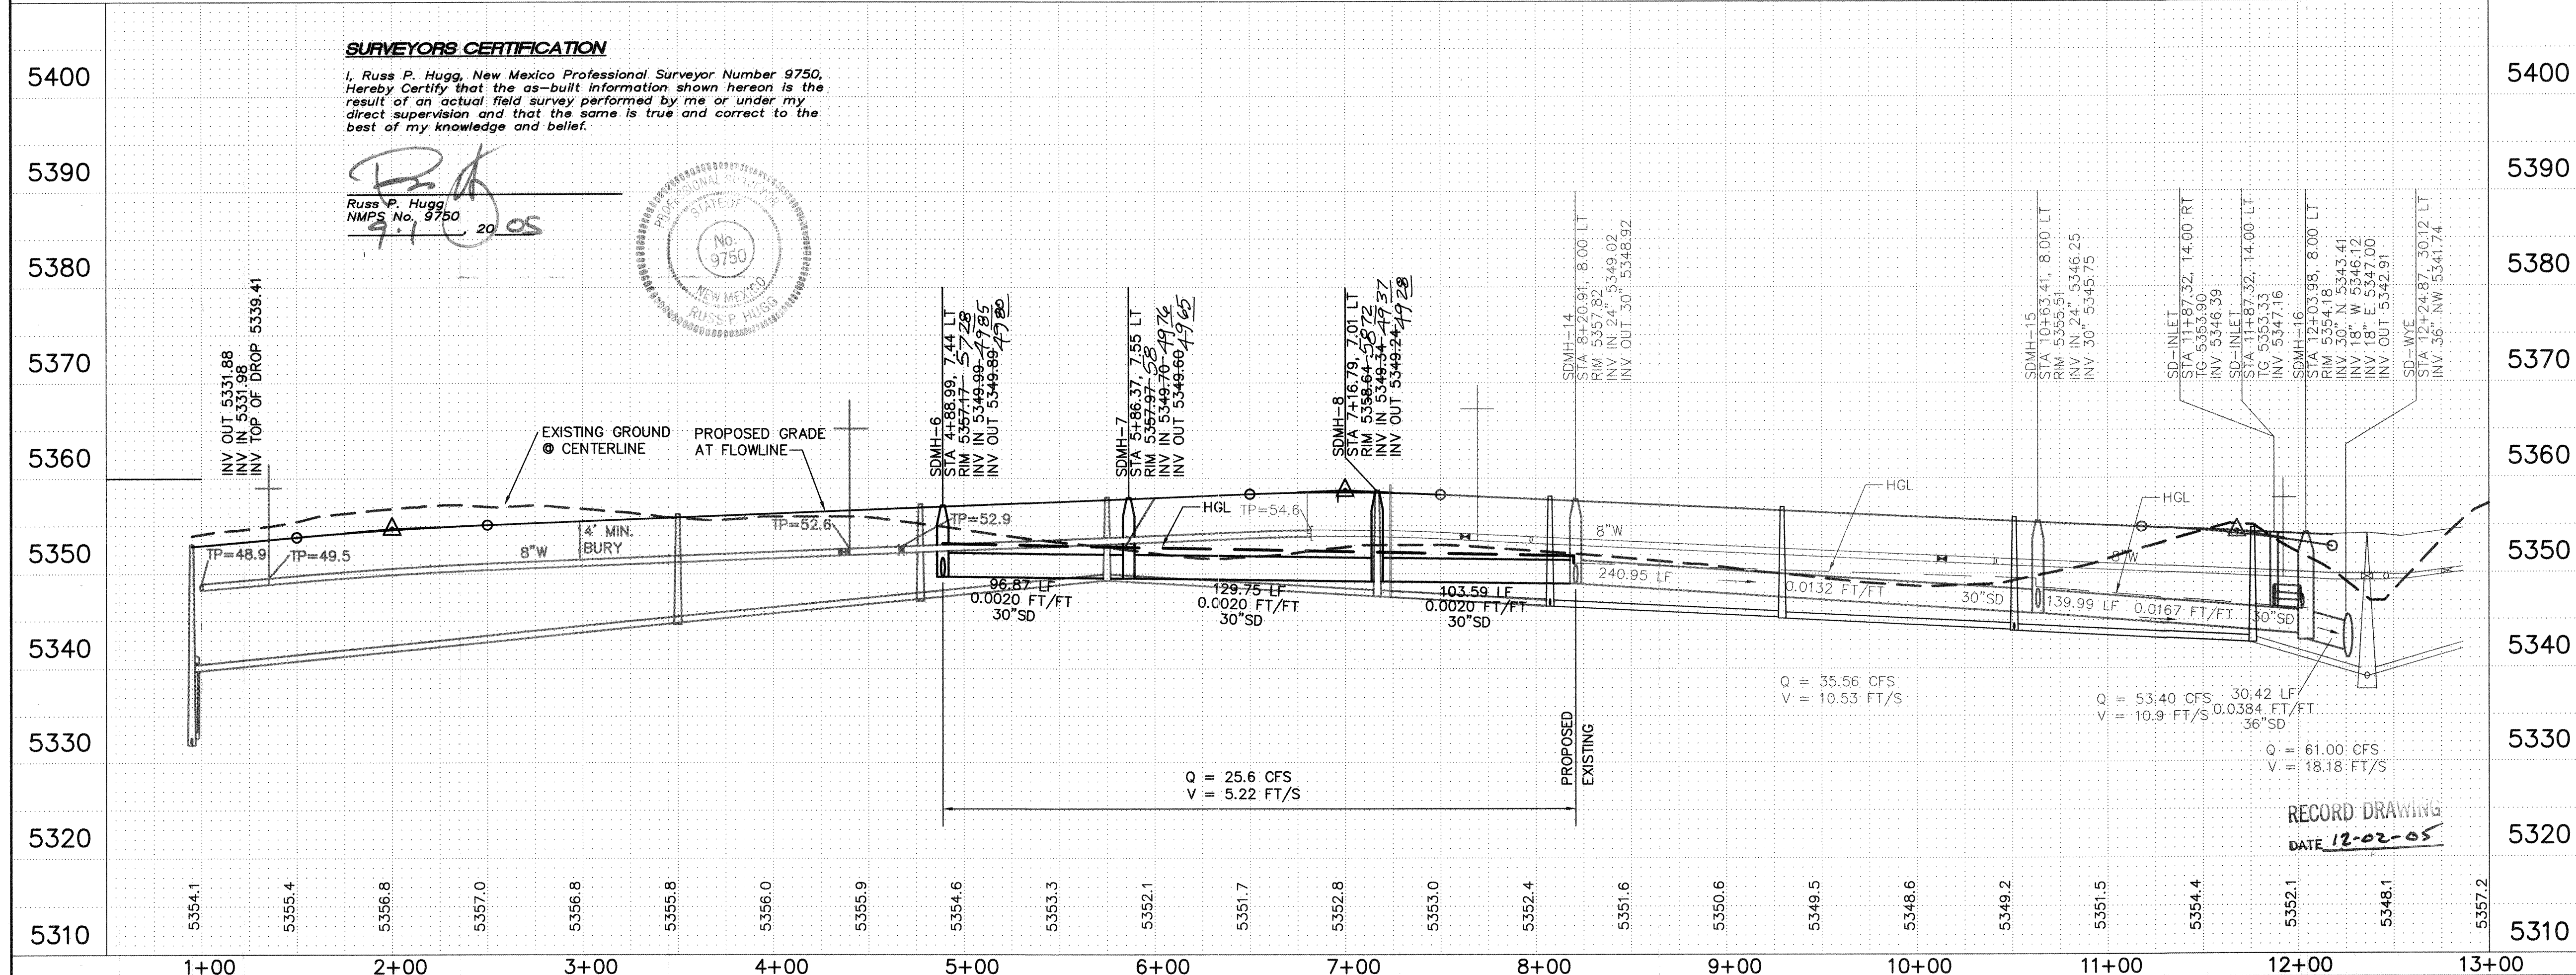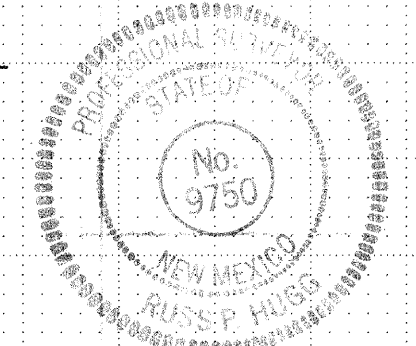

STORM DRAIN CONSTRUCTION NOTES		AS-BUILT INFORMATION		BENCH MARKS		SURVEY INFORMATION		ENGINEER'S SEAL	
I.D.#	DESCRIPTION	NO.	DATE	NO.	DATE	NO.	DATE	NO.	DATE
4	INSTALL 24" STORM DRAIN PIPE								
30	INSTALL 4' DIA. MANHOLE PER COA STD. DTL. 2101								
		A.C.S. Survey Monument "SANDBERN"		New Mexico State Plane Coord's, Central Zone (NAD 27) as published:		PHOTOGRAMMETRY BY T.R. MANN & ASSOC.		REVISIONS	
		Y = 1,534,209.29		X = 361,854.29		FIELD SURVEYS BY SURV-TEK, INC.		NO. DATE	
		Elevation = 5456.92 (SLD 1929)		Ground to grid factor = 0.99966079				WILSON & COMPANY, ENGINEERS & ARCHITECTS	
								DESIGNED BY DEC DEC. 04	
								DRAWN BY DEC DEC. 04	
								CHECKED BY SJS DATE DEC. 04	
INDEX MAP WILSON & COMPANY 2600 THE AMERICAN ROAD S.E. SUITE 100 RIO RANCHO, NEW MEXICO 87124 (505) 898-8021 CITY OF ALBUQUERQUE PUBLIC WORKS DEPARTMENT ENGINEERING GROUP SEVILLE SUBDIVISION - UNIT 3A CADIZ STREET STORM DRAIN PLAN & PROFILE Design Review Committee APPROVED APR 28 2005 City Engineer Approval APPROVED APR 28 2005 City Project No. 702082 Zone Map No. A-10-Z Sheet 31A Of 32									

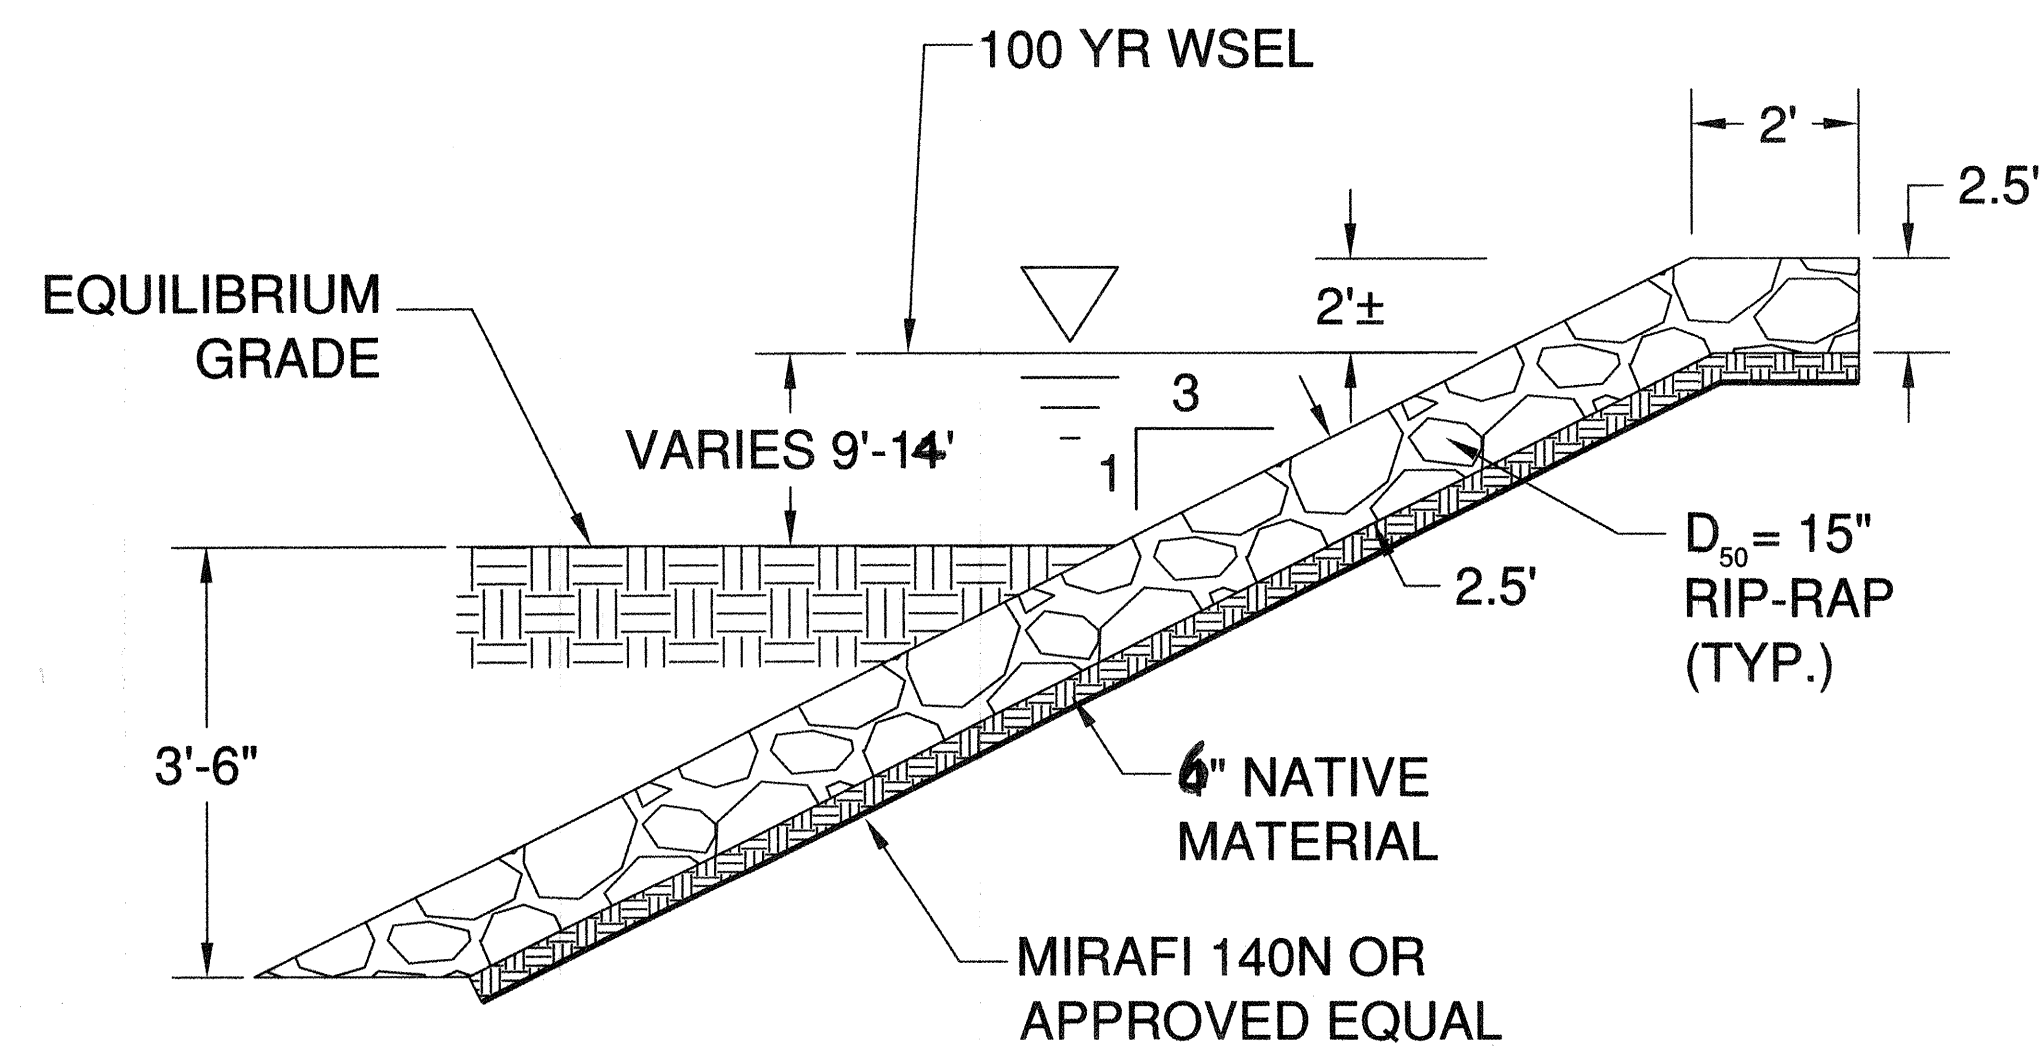



↓
A

1	N	1533226.6997	E	360135.6219
2	N	1533199.8956	E	360119.3342
3	N	1533229.6570	E	360197.7962
4	N	1533203.2889	E	360190.6741
5	N	1533175.2617	E	360281.7077
6	N	1533153.4447	E	360267.5650
7	N	1533124.3350	E	360367.7686
8	N	1533100.5707	E	360357.2207
9	N	1533098.0830	E	360464.2613
10	N	1533072.2503	E	360461.3158
11	N	1533101.9389	E	360564.1869
12	N	1533076.4100	E	360569.1143
13	N	1533135.5486	E	360658.3696
14	N	1533112.6679	E	360670.7175
15	N	1533195.8260	E	360738.1609
16	N	1533177.6943	E	360756.7953
17	N	1533273.4125	E	360801.2507
18	N	1533255.3537	E	360819.9557
19	N	1533337.4752	E	360906.5436
20	N	1533309.7444	E	360905.2284
21	N	1533317.4096	E	360953.2737
22	N	1533293.5190	E	360943.0152

1. AMAFCA FIELD ENGINEER SHALL BE NOTIFIED 48 HOURS PRIOR TO ANY WORK WITHIN THE AMAFCA R/W. TEL 865-2215 JERRY LAVATO.
2. NO WORK WILL BE PERFORMED IN THE AMAFCA R/W BETWEEN MAY 15 AND OCTOBER 15 WITHOUT WRITTEN PERMISSION FROM AMAFCA.
3. ALL SUBGRADE, BACKFILL, AND EMBANKMENT SHALL BE COMPACTED TO 95% (MODIFIED PROCTOR) WITHIN THE AMAFCA R/W. TESTING REPORTS SHALL BE PROVIDED TO AMAFCA FIELD ENGINEER.
4. AMAFCA FIELD ENGINEER WILL BE NOTIFIED 48 HOURS PRIOR TO FINAL INSPECTION OF ANY FACILITIES WITHIN THE AMAFCA R/W.

702082	Zone Map No. A-10-Z	Sheet 32	of 32
--------	------------------------	-------------	----------

SCANNED BY
MESA PERRO

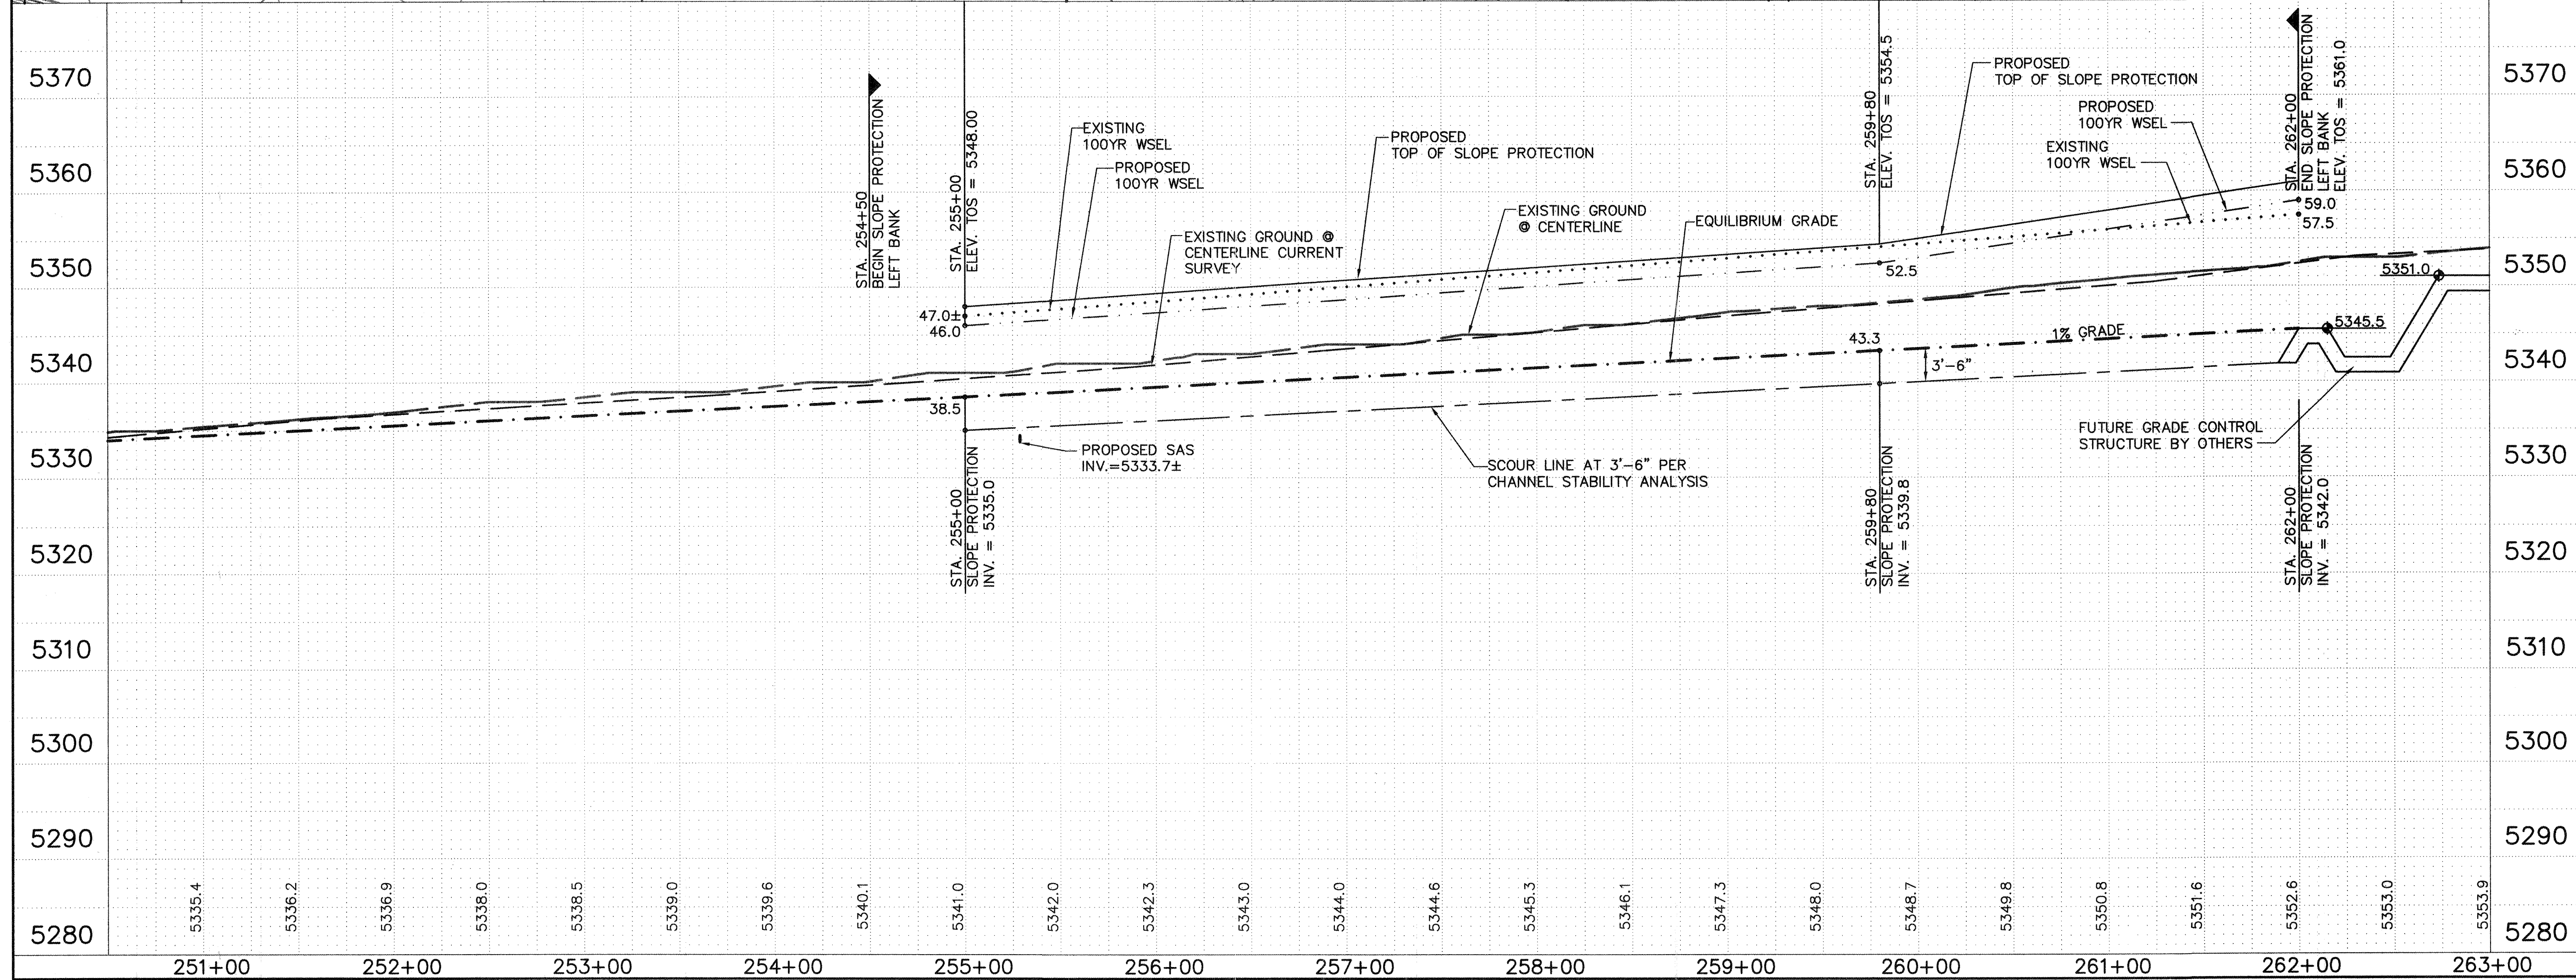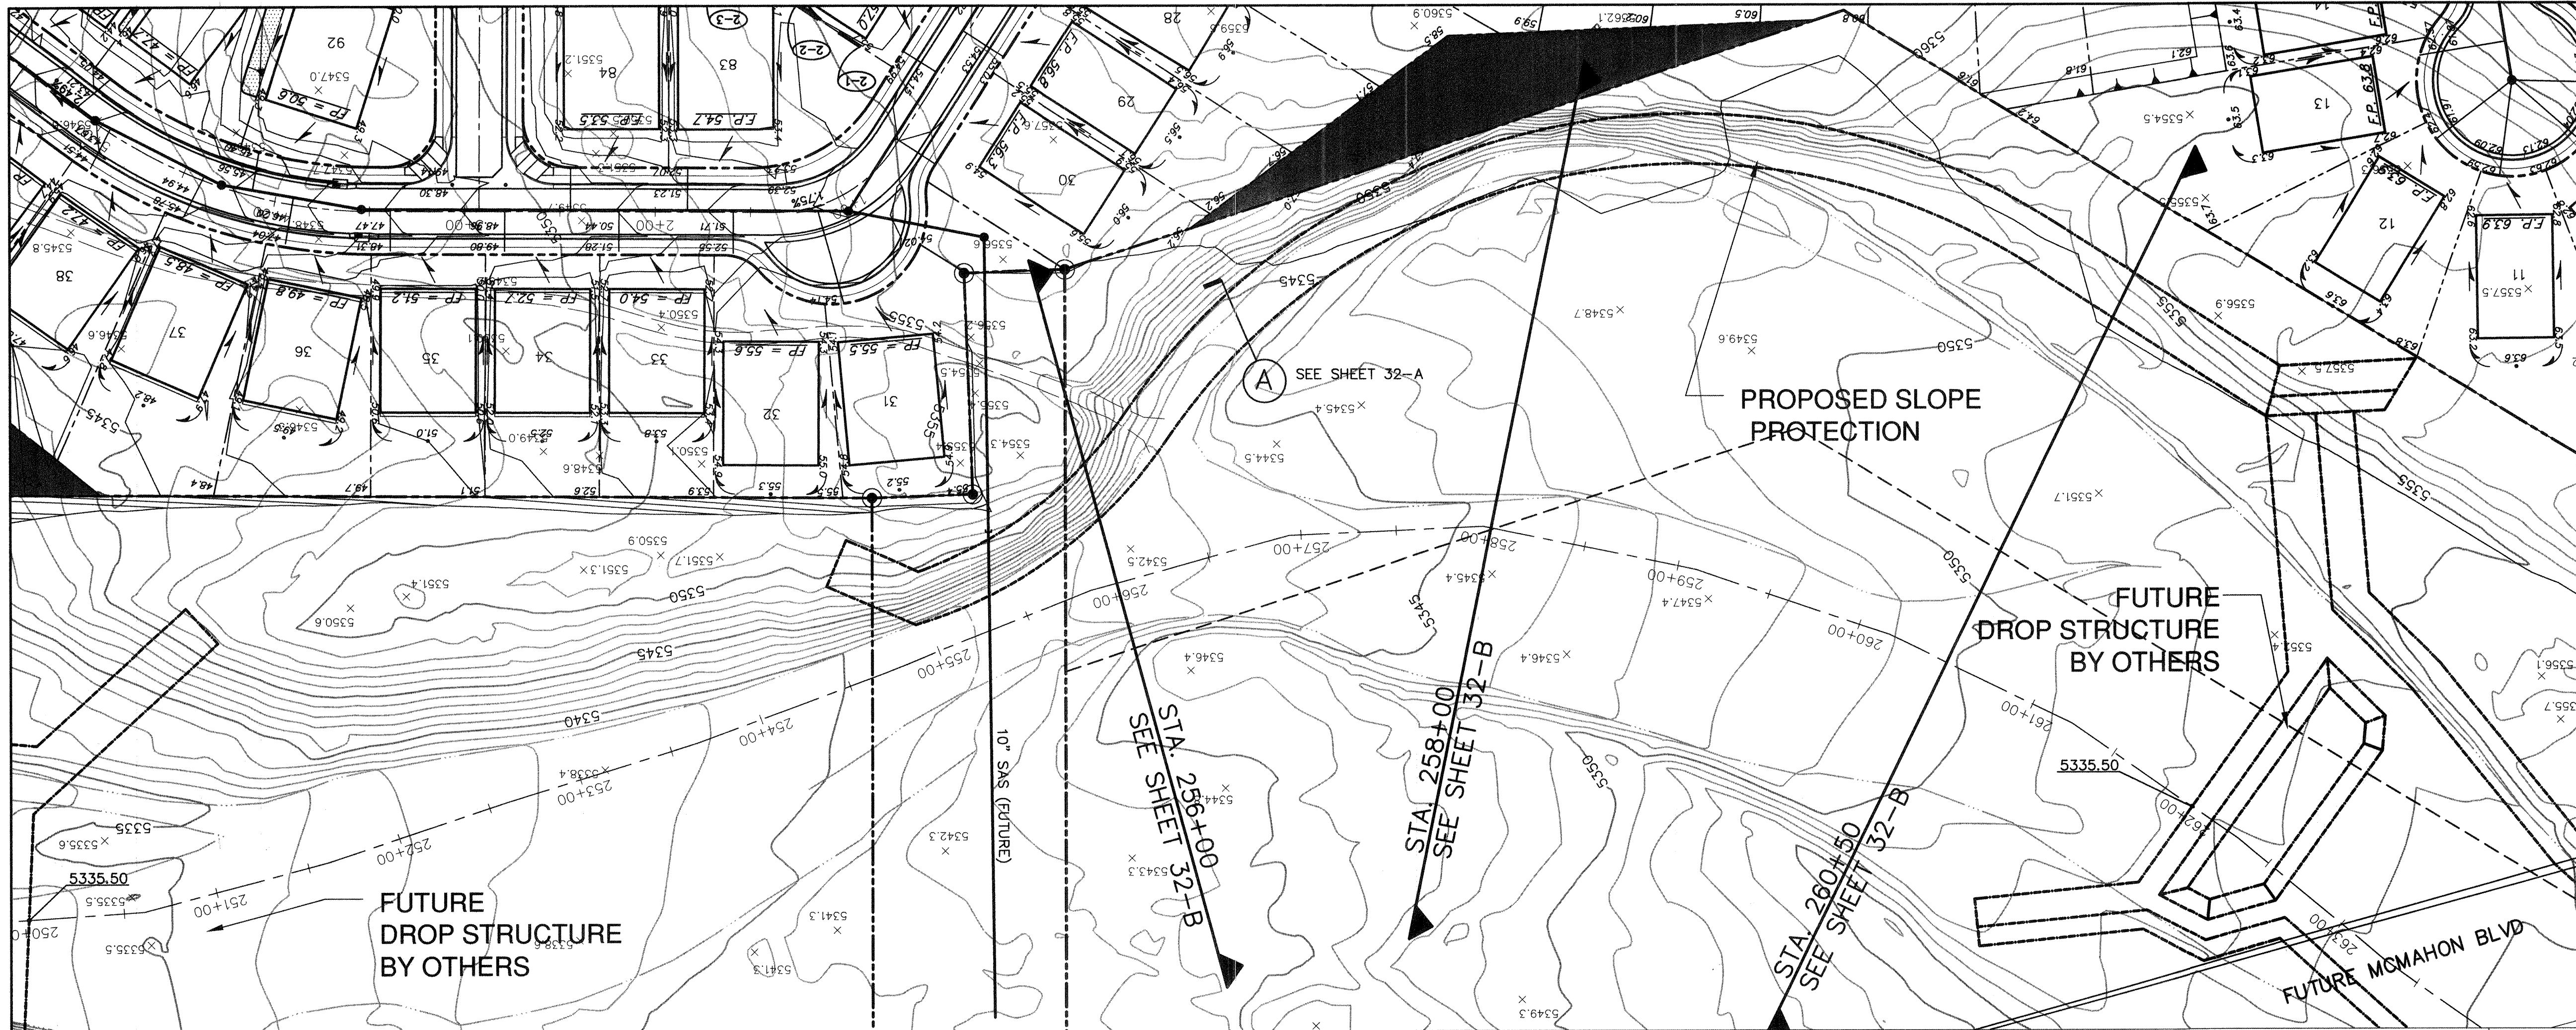

T:\Projects\X1218051\W\3A\SHEETS\32CHANNEL-01.dwg 3/16/2005 8:59:54 AM MST

SCALE:
HORIZ: 1" = 50'
VERT: 1" = 10'

APPROVED FOR CONSTRUCTION

Don M. Meyer 4-5-05
AMAFCA DATE

WILSON & COMPANY

2600 THE AMERICAN ROAD S.E.
SUITE 100
RIO RANCHO, NEW MEXICO
87124
(505) 698-8021

CITY OF ALBUQUERQUE
PUBLIC WORKS DEPARTMENT
ENGINEERING GROUP

SEVILLE SUBDIVISION - UNIT 3A
CALABACILLAS ARROYO IMPROVEMENTS

Design Review Committee
APR 28 2005
DESIGN REVIEW COMMITTEE

City Engineer Approval
APR 5 9 2005
CITY ENGINEER

Last Design Update

Mo./Day/Yr. Mo./Day/Yr.
SUS DEC. 04 SUS DEC. 04
SUS DEC. 04 SUS DEC. 04

City Project No.

Zone Map No.

Sheet

Of

702082

A-10-Z

32A


32

AS-BUILT INFORMATION	
CONTRACTOR	
WORKED BY	
INSPECTOR'S	
ACCEPTANCE BY	
DATE	
DATE	
DATE	
DATE	




BENCH MARKS	
A.C.S. Survey Monument "SANDBERN"	
New Mexico State Plane Coord's, Central	
Zone (NAD 27) as published:	
Y = 1,534,209.29	
X = 361,854.29	
Elevation = 5456.92 (SLD 1929)	
Ground to grid factor = 0.99966079	

SURVEY INFORMATION	
FIELD NOTES	
NO.	
BY	
DATE	
PHOTOGRAMMETRY BY 3/22/98	
T.R. MANN & ASSOC.	
FIELD SURVEYS BY	
SURV-TEK, INC.	


ENGINEER'S SEAL	
NO.	
BY	
DATE	
REVISIONS	
WILSON & COMPANY, ENGINEERS & ARCHITECTS	
DESIGNED BY	
DRAWN BY	
CHECKED BY	

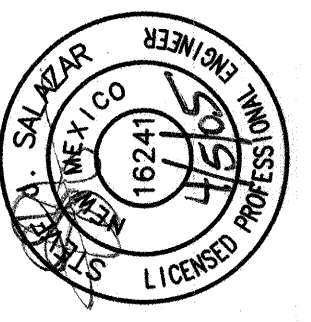

CANNED BY
ESA REPRO

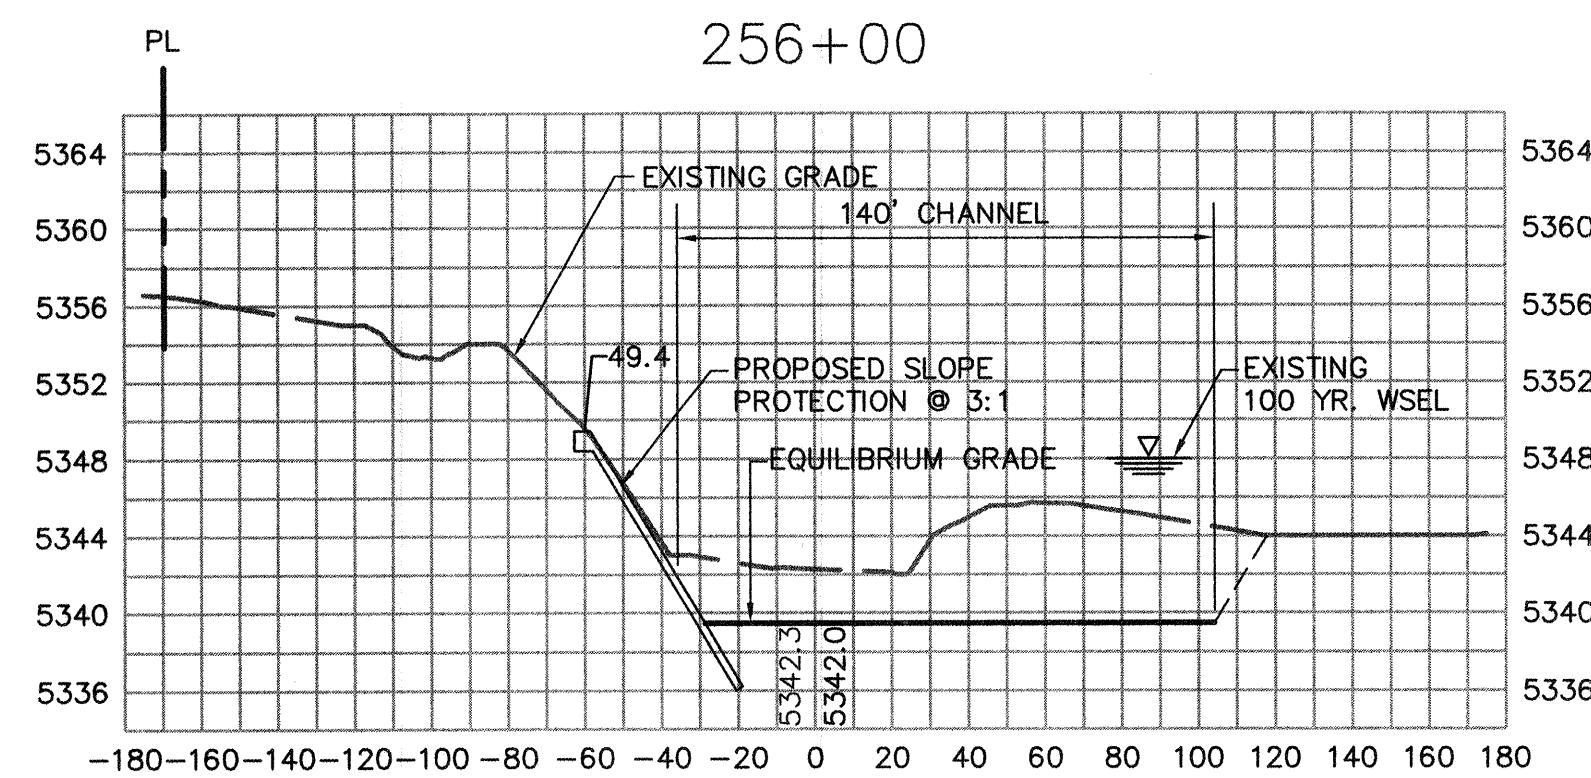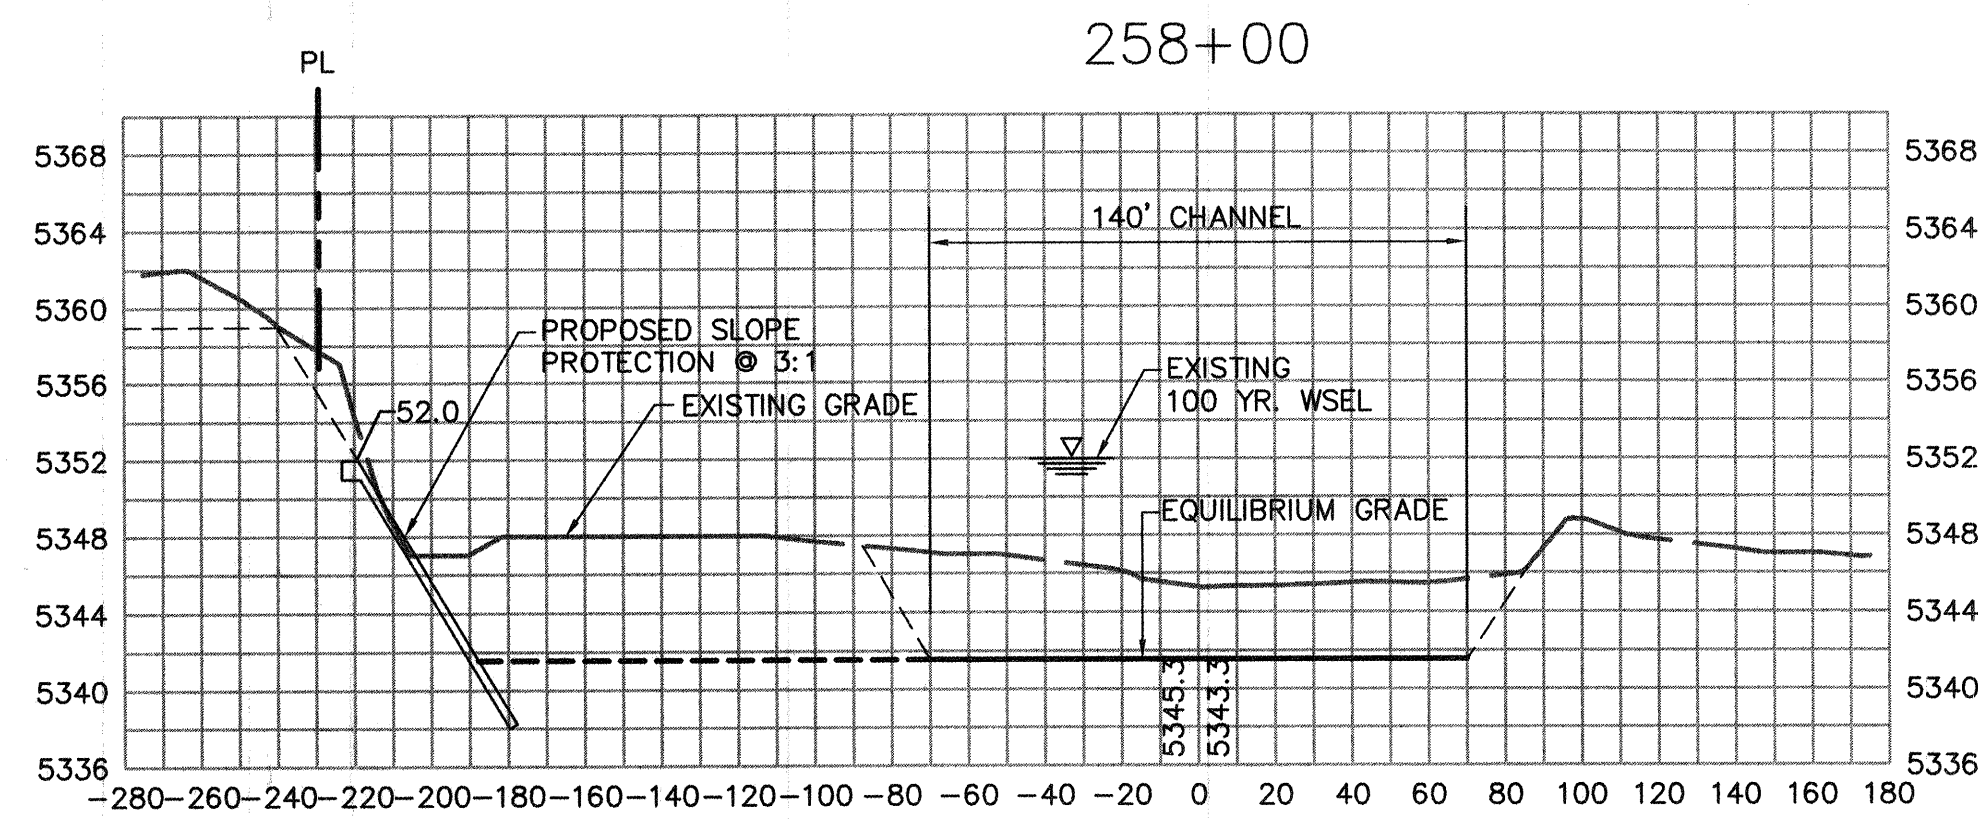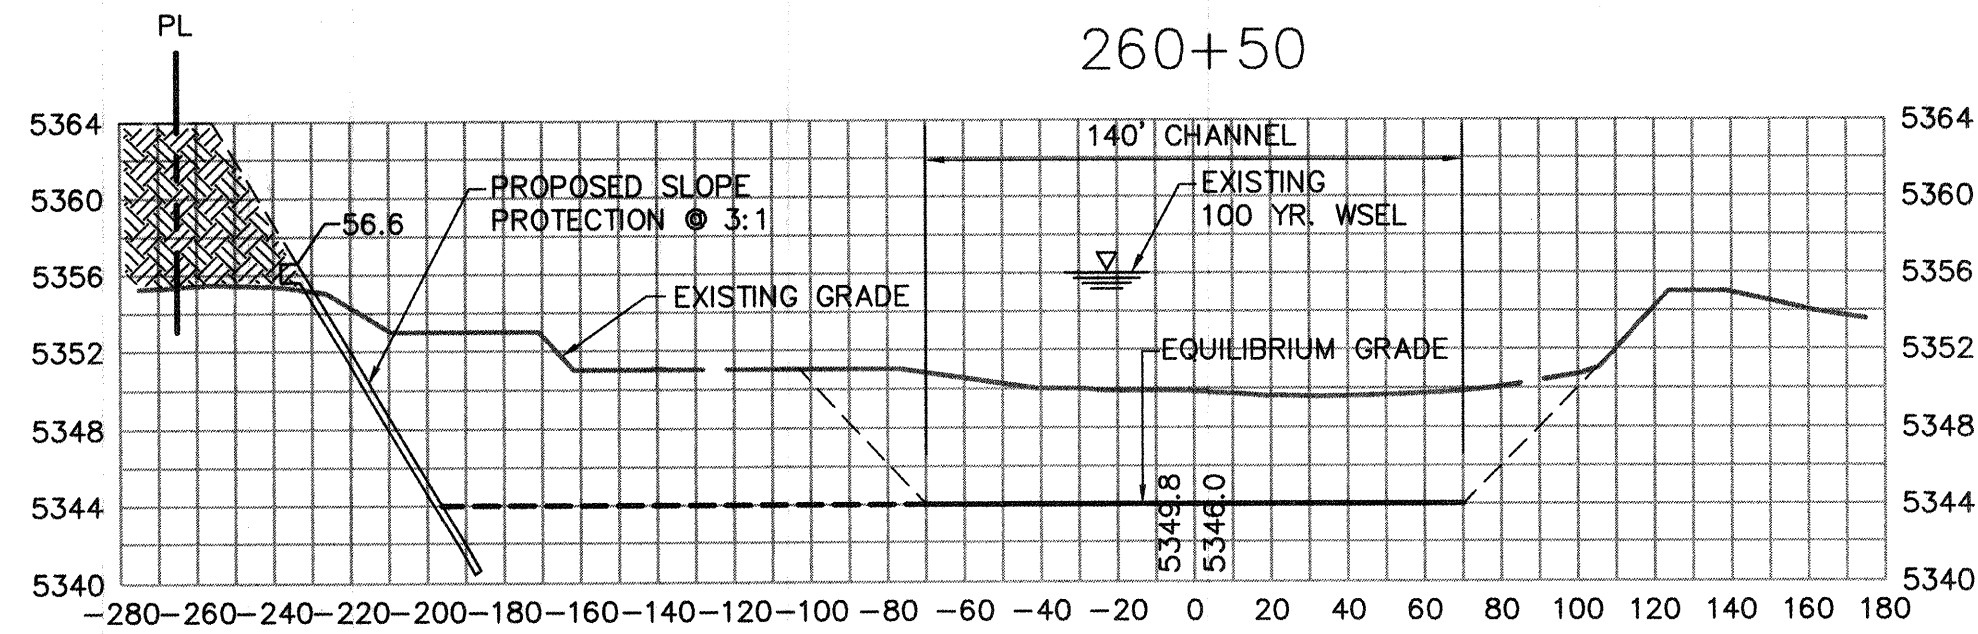

SCALE:
HORIZ: 1" = 50'
VERT: 1" = 10'

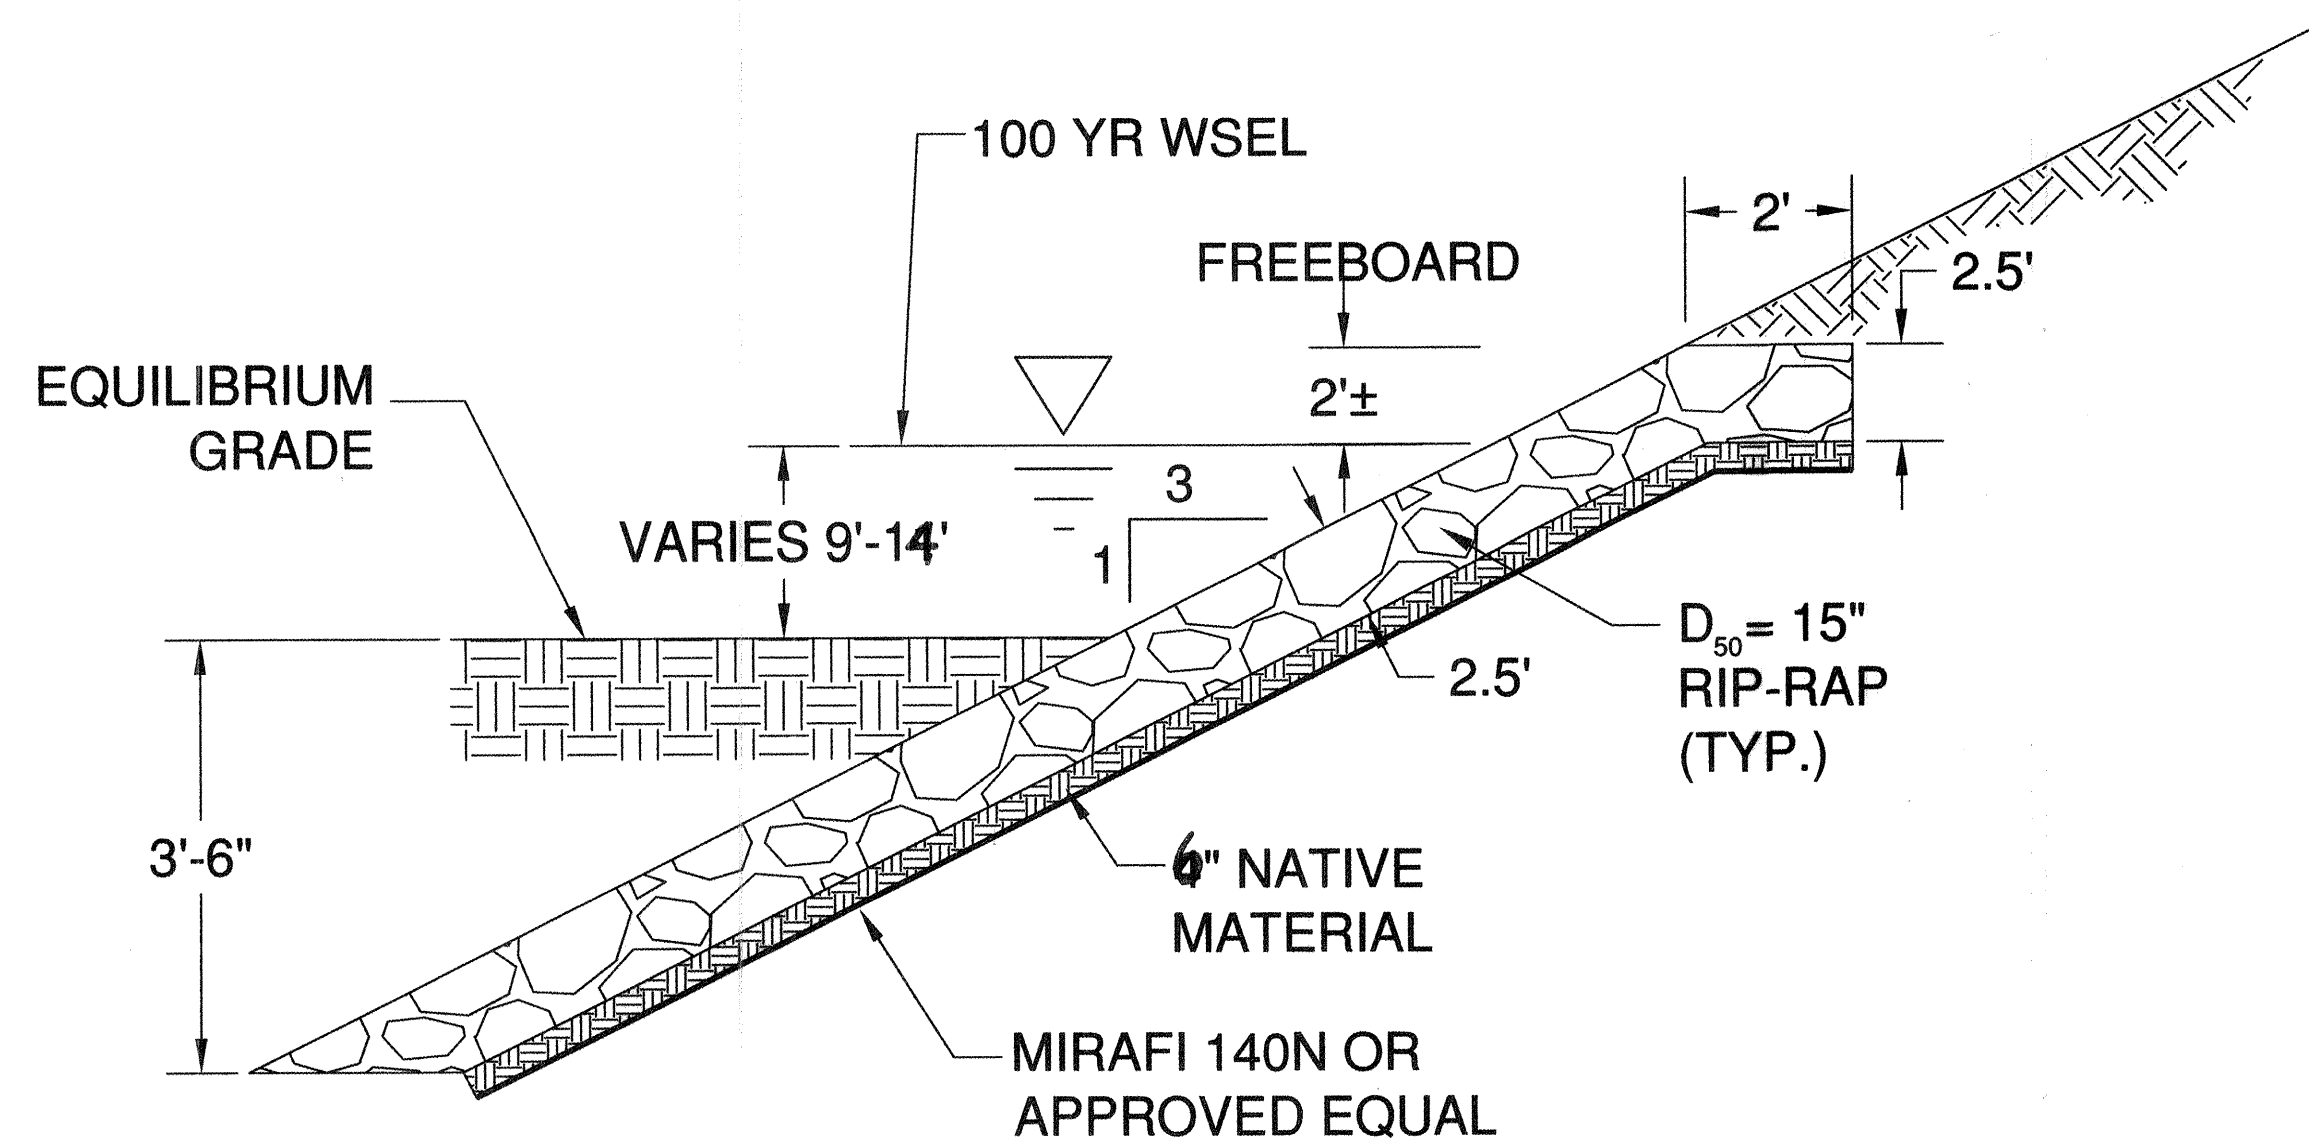

CROSS SECTION A
SCALE: NTS

APPROVED FOR CONSTRUCTION	
AMAFCA DATE 4-5-05	
WILSON & COMPANY 2600 THE AMERICAN ROAD S.E. SUITE 100 RIO RANCHO, NEW MEXICO 87124 (505) 898-8021	
CITY OF ALBUQUERQUE PUBLIC WORKS DEPARTMENT ENGINEERING GROUP	
SEVILLE SUBDIVISION - UNIT 3A CALABACILLAS ARROYO IMPROVEMENTS	
Design Review Committee	City Engineer Approval
APR 28 2005	APR 28 2005
DESIGN REVIEW COMMITTEE	CITY ENGINEER
City Project No.	Zone Map No.
702082	A-10-Z
Sheet	Of
32-B	32

ENGINEER'S SEAL		SURVEY INFORMATION		BENCH MARKS		AS-BUILT INFORMATION	
		FIELD NOTES		A.C.S. Survey Monument "SANDBERN"		CONTRACTOR	
		NO.	BY	DATE	DATE	NO.	DATE
REVISIONS		PHOTOGRAMMETRY BY 3/22/98		New Mexico State Plane Coord's, Central Zone (NAD 27) as published:		INSPECTOR'S	
		T.R. MANN & ASSOC.		Y = 1,534,209.29		FIELD VERIFICATION BY	
NO. DATE		FIELD SURVEYS BY		X = 361,854.29		DATE	
		SURV-TEK, INC.		Elevation = 5456.92 (SLD 1929)		DATE	
WILSON & COMPANY, ENGINEERS & ARCHITECTS		Ground to grid factor = 0.99866079		MICRO-FILM INFORMATION		RECORDED BY	
		DESIGNED BY		NO.		DATE	
DRAWN BY		DATE		DATE		DATE	
		DEC. 04		DEC. 04		DEC. 04	
CHECKED BY		DATE		DATE		DATE	
		DEC. 04		DEC. 04		DEC. 04	