



CONSTRUCTION PLANS FOR UNIVERSE BLVD. STREET IMPROVEMENTS (A PORTION OF UNIVERSE BLVD.) ALBUQUERQUE, NEW MEXICO

INDEX

SHEET NUMBER	DESCRIPTION
1	TITLE SHEET
2	SITE DESCRIPTION PLAN
3	OVERALL PAVING PLAN
4-7	PAVING PLAN AND PROFILE SHEETS UNIVERSE BOULEVARD
8	CONTROL PLAN SHEETS UNIVERSE BLVD. / IRVING BLVD.
9	STRIPING, SIGNING AND PULL BOX DETAILS
10	SIGNING AND CONSTRUCTION TRAFFIC CONTROL STANDARDS
11	TYPICAL TRAFFIC CONTROL AND SIGNING EXAMPLES (REF. M.U.T.C.D.)
12-19	LANDSCAPE PLANS

RECORD DRAWINGS

I, PATRICK CONLEY of the firm of SMITH ENG. CO.
A Registered Professional Engineer in the State of New Mexico, do hereby certify, to
the best of my knowledge and belief, that the structure installed as part of this
project has been inspected by me or by a qualified person under my direct supervision
and has been constructed in accordance with the plans and specifications, while
someone from Smith Engineering Company was onsite, approved by the City Engineer
and that the original design intent of the approved plans has been met, except as noted
by me on the as-built construction drawings. This Certification is based on site
inspections by me or personnel under my direction and survey information provided by
TIM ALDRICH (Surveyor Name) NMPS number 7719 (PS #).
(ALDRICH LAND SURVEYING)

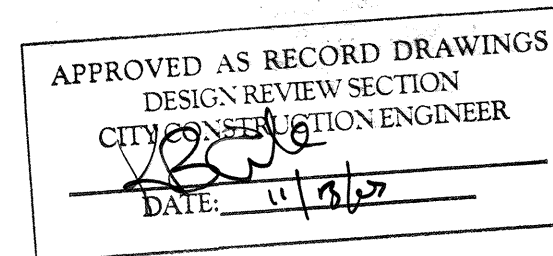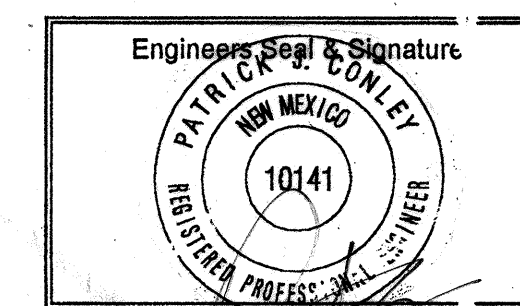

SURVEYOR'S CERTIFICATION


"I, Timothy Aldrich, a duly qualified Registered Professional Land
Surveyor under the laws of the State of New Mexico, do hereby
certify that the 'as-built' information shown on these drawings was
obtained from field construction and 'as-built' surveys performed
by me or under my supervision, that the 'as-built' information
shown on these drawings was added by me or under my supervision,
and that this 'as-built' information is true and correct to the
best of my knowledge and belief." Aldrich Land Surveying is not
responsible for any of the design concepts, calculations,
engineering, or intent of the record drawings.



Timothy Aldrich, P.S. No. 7719

03-30-03 Date

Bohannon & Huston
Courtyard 1 7500 Jefferson St. NE Albuquerque, NM 87109-4335
ENGINEERING & SPATIAL DATA & ADVANCED TECHNOLOGIES

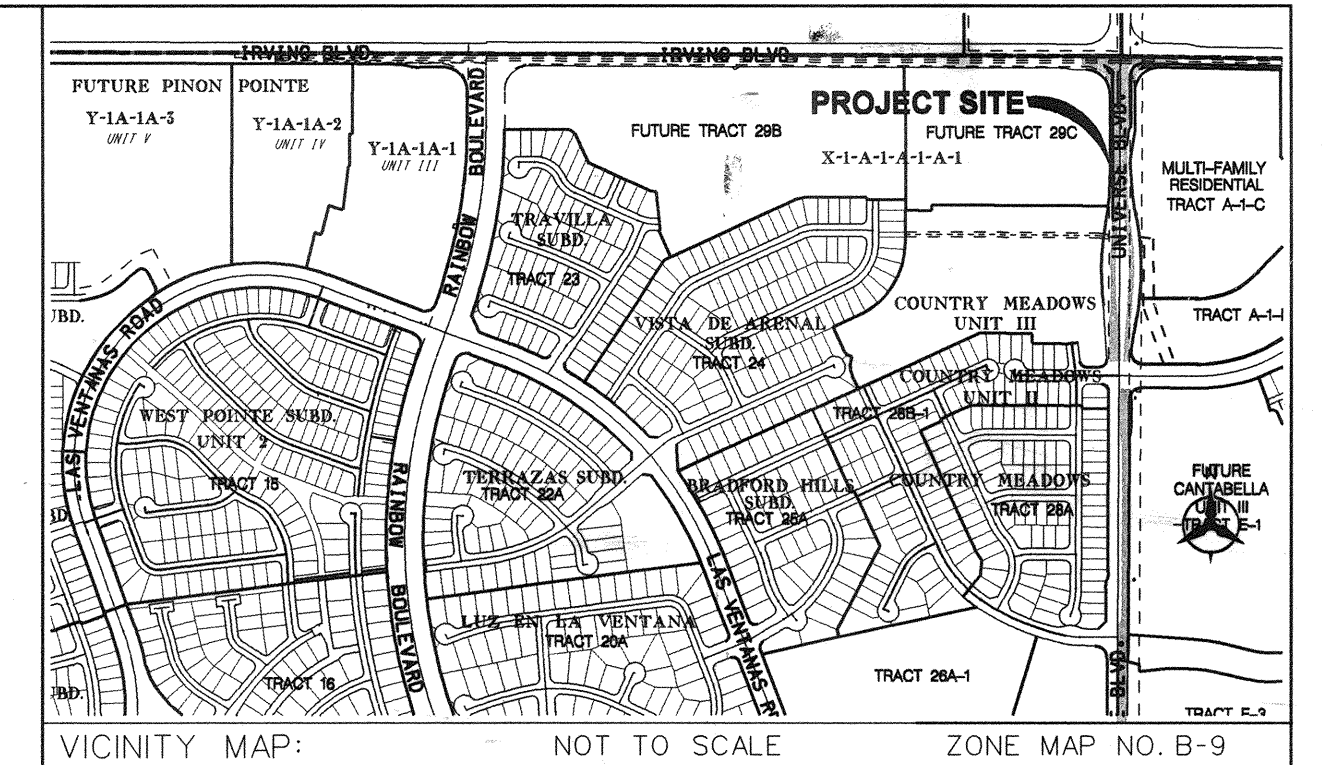

NOTICE TO CONTRACTORS



- ALL WORK DETAILED ON THESE PLANS TO BE PERFORMED UNDER CONTRACT SHALL EXCEPT AS OTHERWISE STATED OR PROVIDED FOR HEREON, BE CONSTRUCTED IN ACCORDANCE WITH THE CITY OF ALBUQUERQUE STANDARD SPECIFICATIONS FOR PUBLIC WORKS CONSTRUCTION, 1986 EDITION AND SHALL INCLUDE UPDATE No. 6.
- TWO WORKING DAYS PRIOR TO ANY EXCAVATION, THE CONTRACTOR MUST CONTACT NEW MEXICO ONE CALL SYSTEM (260-1990) FOR LOCATION OF EXISTING UTILITIES.
- PRIOR TO CONSTRUCTION, THE CONTRACTOR SHALL EXCAVATE AND VERIFY THE HORIZONTAL AND VERTICAL LOCATIONS OF ALL OBSTRUCTIONS. SHOULD A CONFLICT EXIST, THE CONTRACTOR SHALL NOTIFY THE ENGINEER OR SURVEYOR IMMEDIATELY SO THAT THE CONFLICT CAN BE RESOLVED WITH A MINIMUM AMOUNT OF DELAY.
- FIVE (5) WORKING DAYS PRIOR TO BEGINNING CONSTRUCTION, THE CONTRACTOR SHALL SUBMIT TO CONSTRUCTION COORDINATION DIVISION A DETAILED CONSTRUCTION SCHEDULE. TWO (2) WORKING DAYS PRIOR TO CONSTRUCTION, THE CONTRACTOR SHALL OBTAIN A BARRICADING PERMIT FROM THE CONST. COORDINATION DIVISION. CONTRACTOR SHALL NOTIFY BARRICADE ENGINEER (924-3400) PRIOR TO OCCUPYING AN INTERSECTION. REFER TO SECTION 19 OF THE GENERAL CONDITIONS OF THE STANDARD SPECIFICATIONS.
- ALL PERMANENT STREET STRIPING ALTERED OR DESTROYED SHALL BE REPLACED W/ PLASTIC REFLECTORIZED PAVEMENT MARKING BY CONTRACTOR TO LOCATION AS EXISTING OR AS INDICATED BY THIS PLAN SET.
- CONTRACTOR SHALL NOTIFY THE ENGINEER NOT LESS THAN SEVEN (7) DAYS PRIOR TO STARTING WORK IN ORDER THAT THE CITY SURVEYOR MAY TAKE NECESSARY MEASURES TO INSURE THE PRESERVATION OF SURVEY MONUMENTS. CONTRACTOR SHALL NOT DISTURB PERMANENT SURVEY MONUMENTS WITHOUT THE CONSENT OF THE CITY SURVEYOR AND SHALL NOTIFY THE CITY SURVEYOR AND BEAR THE EXPENSE OF REPLACING ANY THAT MAY BE DISTURBED WITHOUT PERMISSION. REPLACEMENT SHALL BE DONE ONLY BY THE CITY SURVEYOR. WHEN A CHANGE IS MADE IN THE FINISHED ELEVATIONS OF THE PAVEMENT OF ANY ROADWAY IN WHICH A PERMANENT SURVEY MONUMENT IS LOCATED, CONTRACTOR SHALL, AT HIS OWN EXPENSE, ADJUST THE MONUMENT COVER TO THE NEW GRADE UNLESS OTHERWISE SPECIFIED. REFER TO SECTION 4.4 OF THE GENERAL CONDITIONS OF THE STANDARD SPECIFICATIONS.
- ANY WORK WITHIN AN ARTERIAL ROADWAY REQUIRES TWENTY-FOUR HOUR CONSTRUCTION.
- ALL UTILITY WORK SHALL BE CONSTRUCTED IN ACCORDANCE WITH NEW MEXICO UTILITIES, INC. SPECIFICATIONS FOR WATER AND WASTEWATER FACILITIES (MOST RECENT REVISIONS).
- THE CONTRACTOR SHALL NOTIFY NEW MEXICO UTILITIES, (898-2661) THREE WORKING DAYS PRIOR TO BEGINNING THE CONSTRUCTION OF THE UTILITIES.
- CONTRACTOR SHALL MAINTAIN A GRAFFITI-FREE WORK SITE. CONTRACTOR SHALL PROMPTLY REMOVE ANY GRAFFITI FROM ALL EQUIPMENT, WHETHER PERMANENT OR TEMPORARY.
- FOR STORM DRAIN CONSTRUCTION, RCP PIPE JOINTS SHALL NOT BE GROUTED PRIOR TO FINAL INSPECTION. FINAL INSPECTION WILL DETERMINE JOINTS TO BE GROUTED FOR FINAL ACCEPTANCE OF THE CONSTRUCTION.

THE FOLLOWING NOTES ALSO APPLY WHEN CHECKED

- ☒ ALL UTILITIES AND UTILITY SERVICE LINES SHALL BE INSTALLED PRIOR TO PAVING.
- ☒ BACKFILL COMPACTION SHALL BE ACCORDING TO SPECIFIED STREET USE.
- ☐ TACK COAT REQUIREMENTS SHALL BE DETERMINED BY THE ENGINEER.
- ☒ SIDEWALKS AND WHEELCHAIR RAMPS WITHIN THE CURB RETURNS SHALL BE CONSTRUCTED WHEREVER A NEW CURB RETURN IS CONSTRUCTED.
- ☐ IF CURB IS DEPRESSED FOR A DRIVEPAD, THE DRIVEPAD SHALL BE CONSTRUCTED PRIOR TO ACCEPTANCE OF CURB AND GUTTER.
- ☒ ALL STORM DRAINAGE FACILITIES SHALL BE COMPLETED PRIOR TO FINAL ACCEPTANCE.
- ☒ THE REQUESTOR OR DEVELOPER SHALL BE RESPONSIBLE FOR REPAIR OR REPLACEMENT OF ALL CURB AND GUTTER OR SIDEWALK DAMAGED AFTER APPROVAL BY THE CITY ENGINEER OF WORK COMPLETED BY THE CONTRACTOR.

REV.	SHEETS	CITY ENGINEER	DATE	USER DEPARTMENT	DATE	USER DEPARTMENT	DATE
ENGINEERS STAMP & SIGNATURE		APPROVALS		ENGINEER		DATE	
		DRC Chairman				4-7-03	
		Transportation				3/11/03	
		Water/Wastewater				3/11/03	
		Hydrology				3/11/03	
		CIP				4-7-03	
DRB Case Number		City Project No.		702381		Sheet 1 Of 19	

HAB

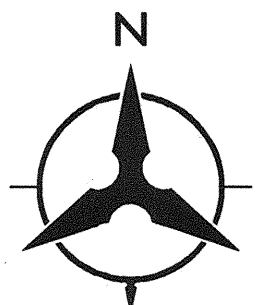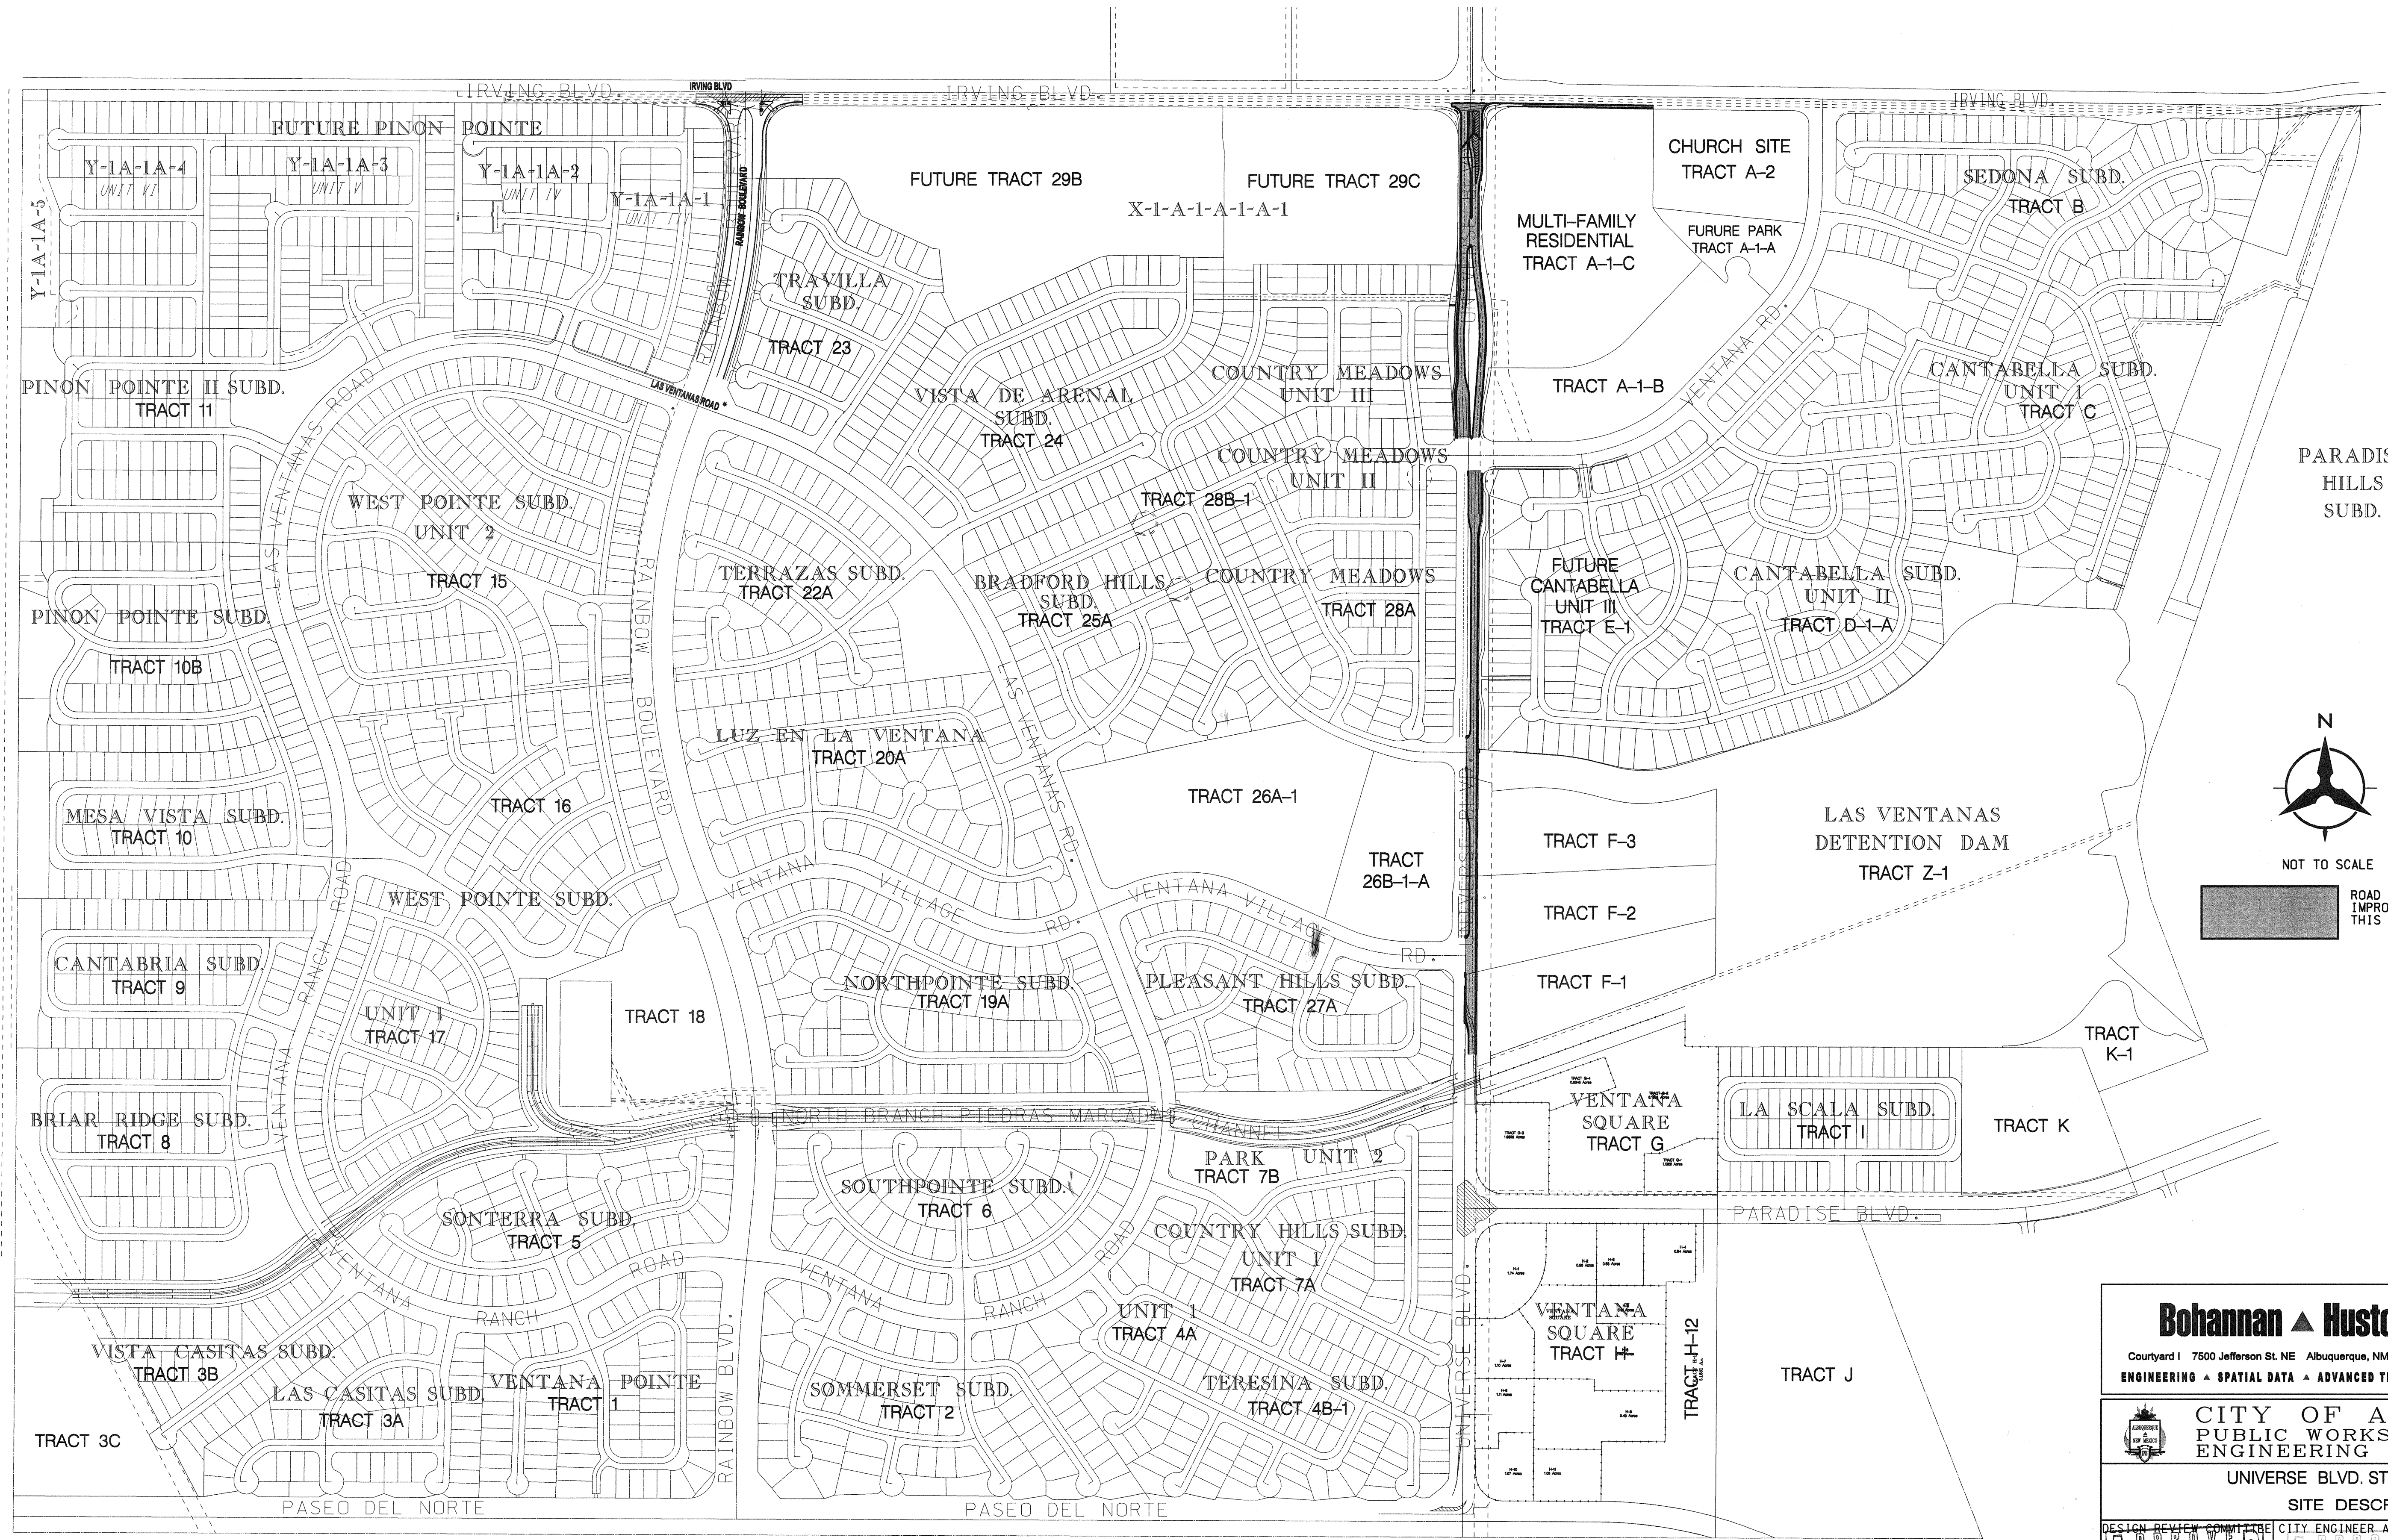

NOT TO SCALE

ROAD / UTILITY
IMPROVEMENTS
THIS PROJECT

Bohannon & Huston



Courtyard I 7500 Jefferson St. NE Albuquerque, NM 87109-4335
ENGINEERING • SPATIAL DATA • ADVANCED TECHNOLOGIES



CITY OF ALBUQUERQUE
PUBLIC WORKS DEPARTMENT
ENGINEERING DEVELOPMENT GROUP

UNIVERSITY BLVD. STREET IMPROVEMENTS


SITE DESCRIPTION PLAN

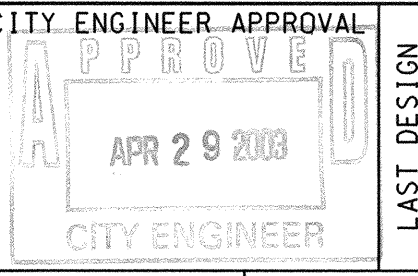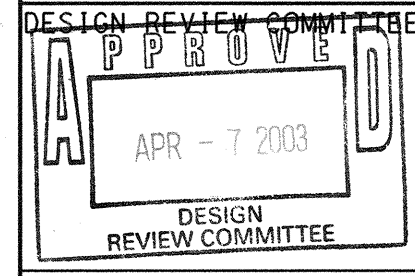

LAST DESIGN
UPDATE







CITY PROJECT NO. 702381 ZONE MAP NO. B-9 SHEET 2 OF 19

ENGINEER'S SEAL SURVEY INFORMATION		BENCH MARKS		AS-BUILT INFORMATION	
NO.	DATE	BY	DATE	CONTRACTOR	DATE
1	8/95	BOHANNAN-HUSTON INC.	8/95	CONTRACTOR	8/95
GEOGRAPHIC POSITION (NAD 1927)		INSPECTOR'S		DATE	
N.M. STATE PLANE COORDINATES		ACCEPTANCE BY		DATE	
(CENTRAL ZONE) X=355,077.00		VERIFICATION BY		DATE	
Y=1,529,056.93		DRAWINGS BY		DATE	
GROUND-TO-GRID FACTOR = .99966334		MICRO-FILM INFORMATION		DATE	
DELTA ALPHA -00'16" 47"		RECORDED BY		NO.	
NGVD 1929 ELEVATION = 5450.51					

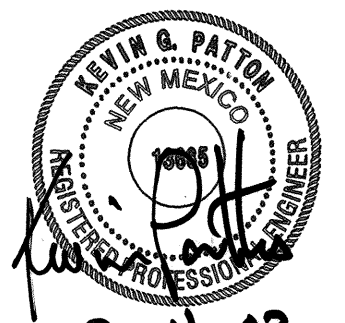


2-11-03

NO.	DATE	REMARKS	BY
		REVISIONS	
		DESIGN	
DESIGNED BY	YOP		
DRAWN BY	DLM		
CHECKED BY	KGP		
DATE	02/2002		
DATE	02/2002		
DATE	02/2002		

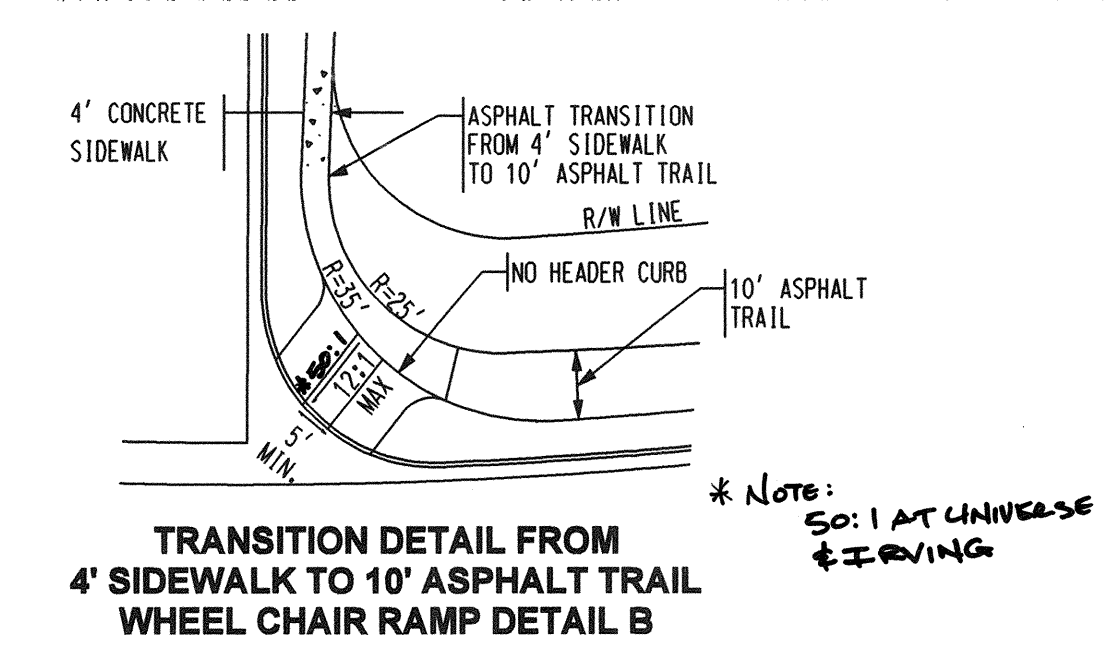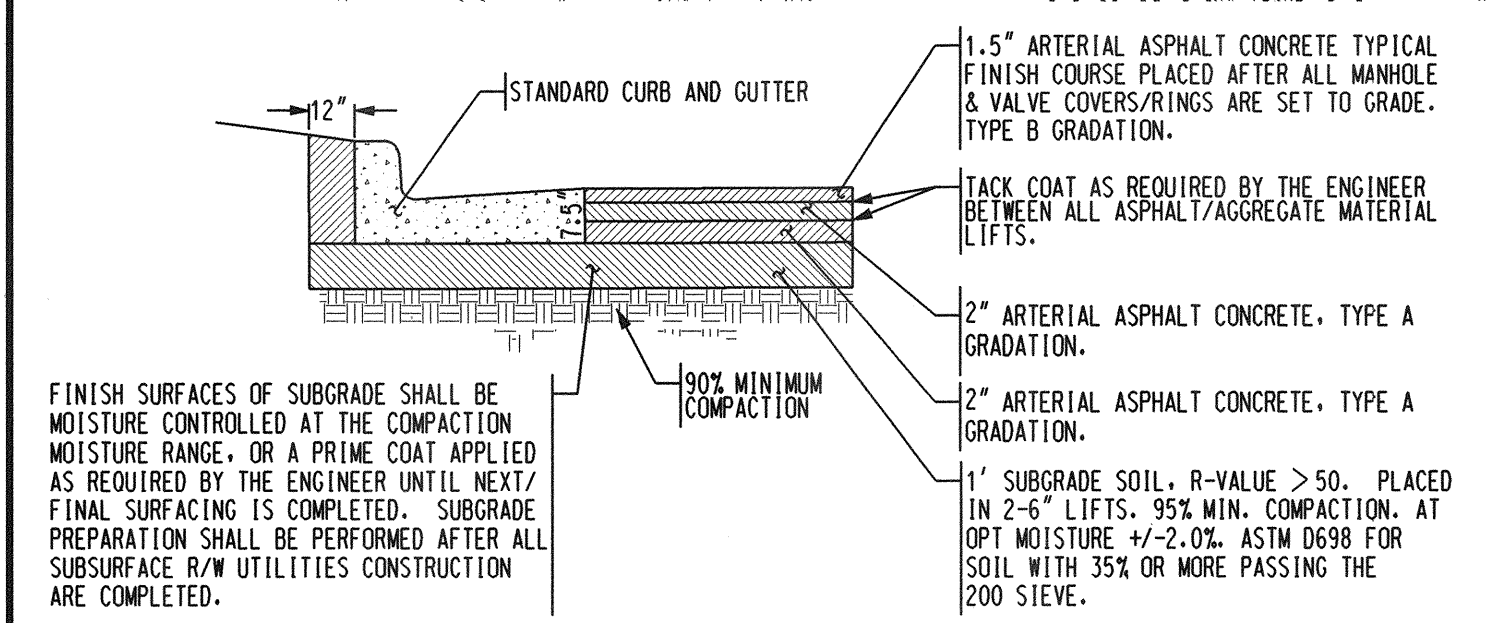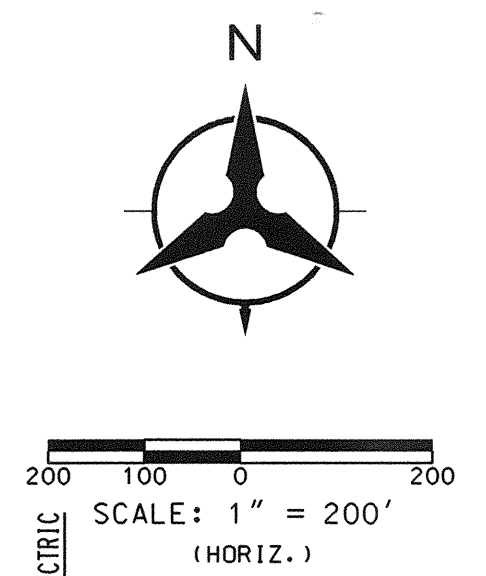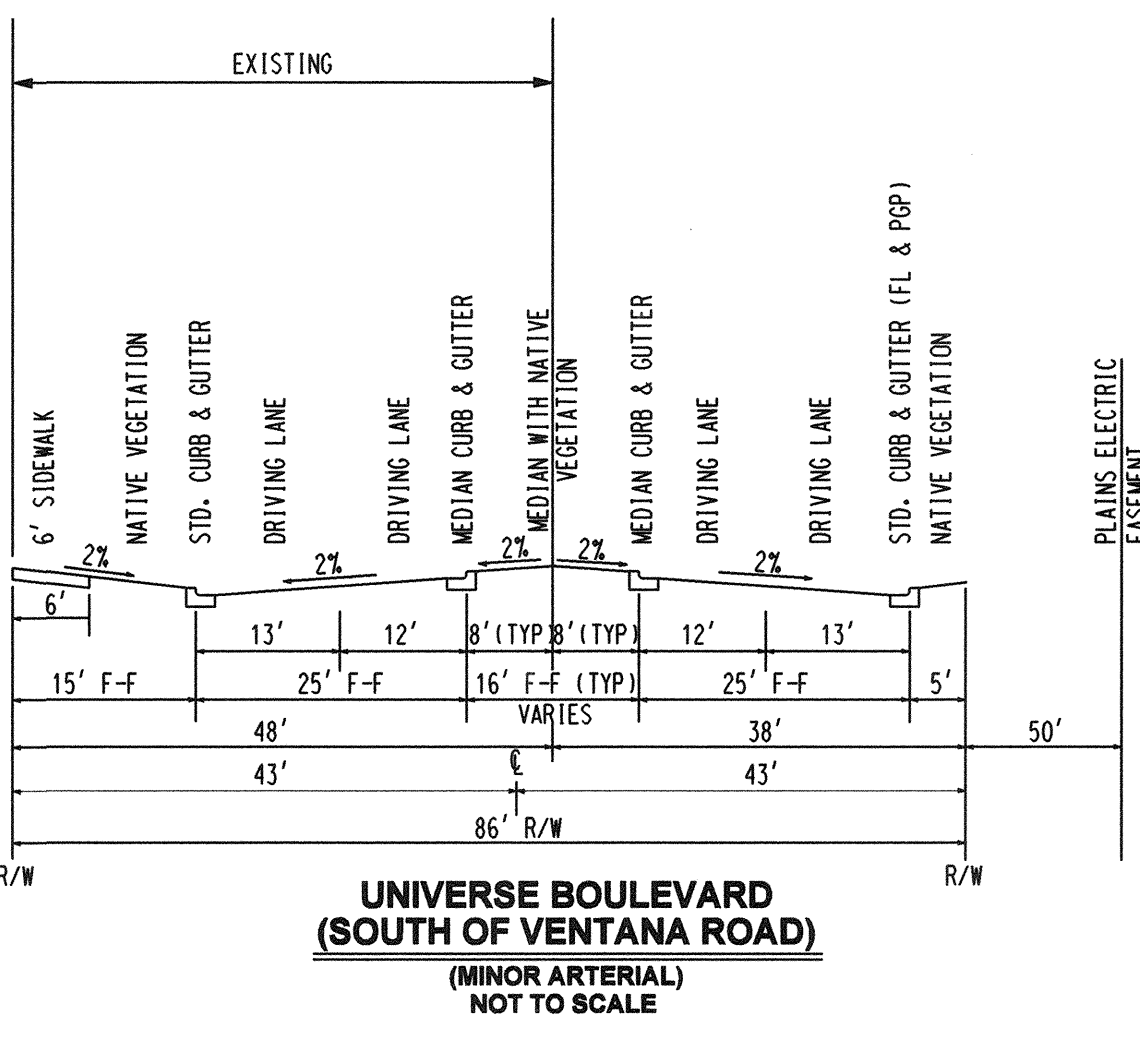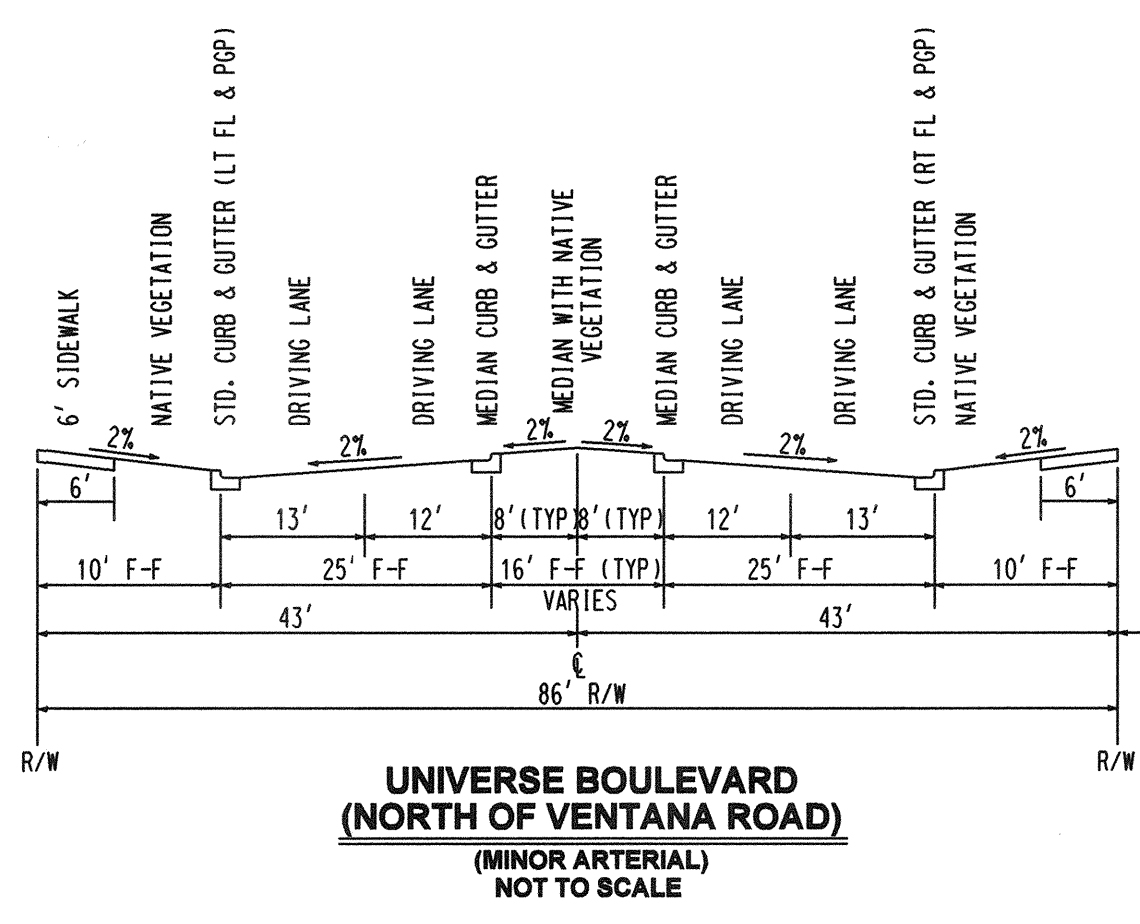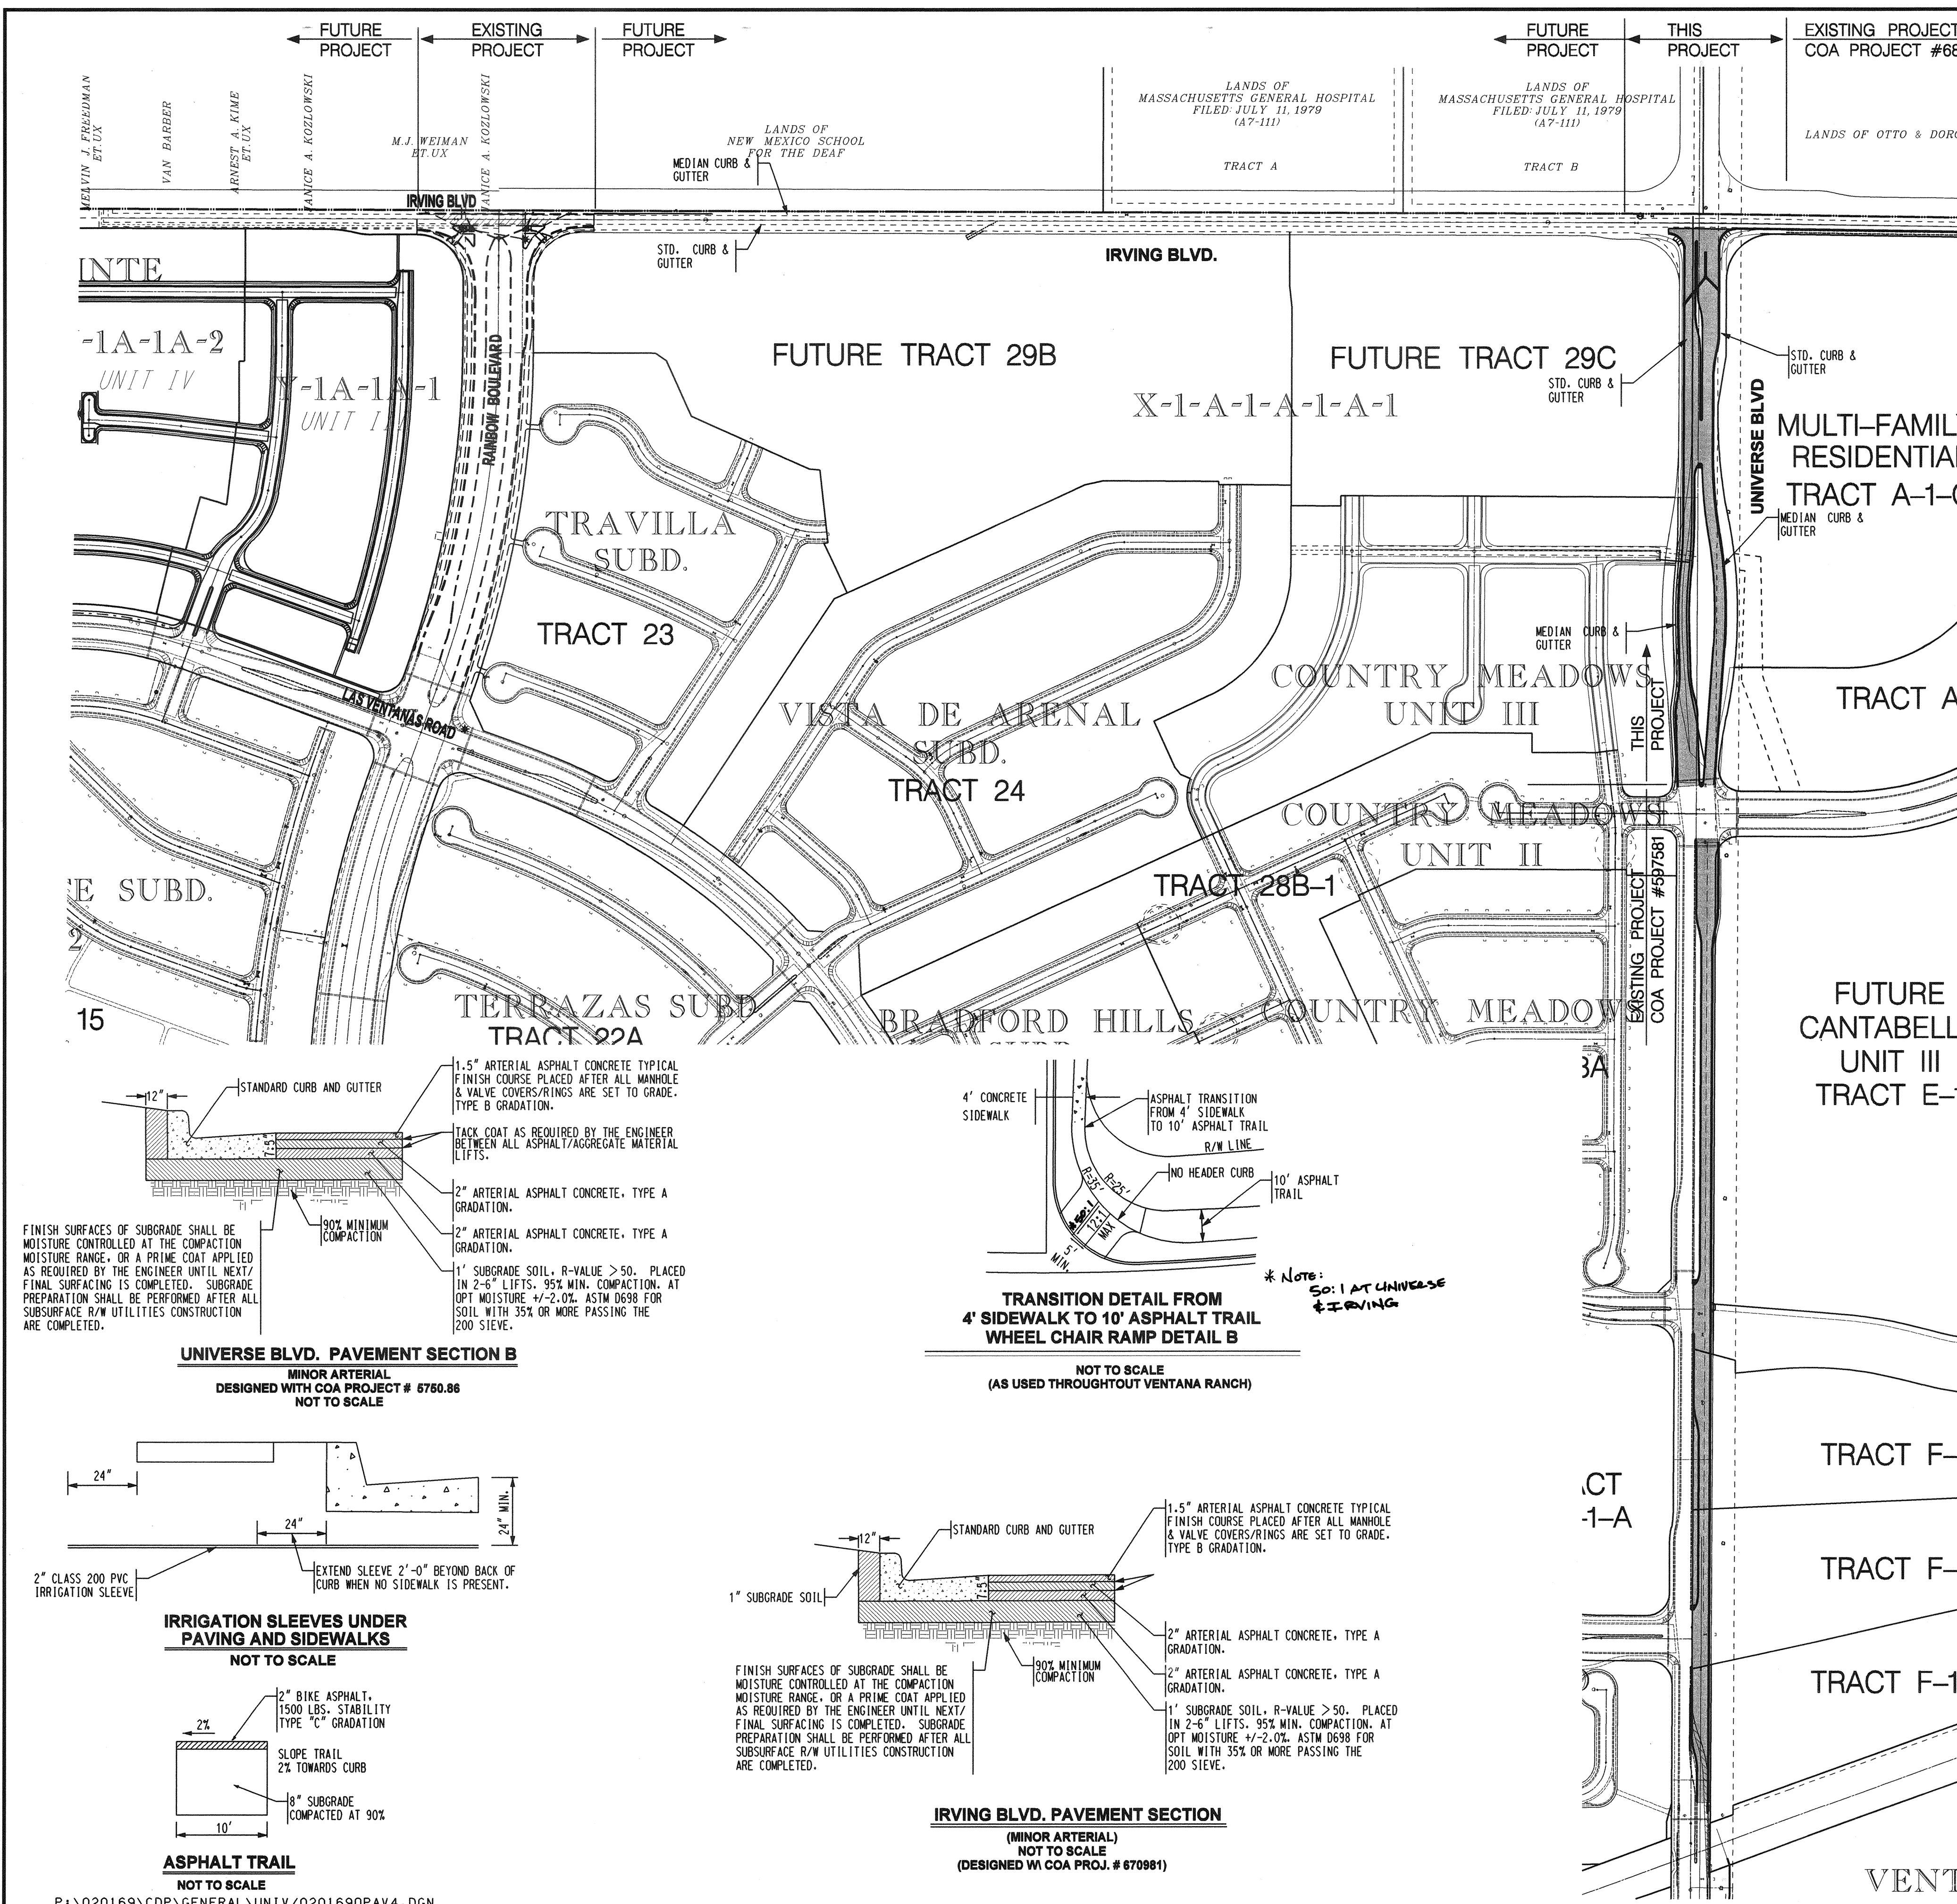


UNIVERSE BLVD. PAVEMENT SECTION B
(MINOR ARTERIAL)
DESIGNED WITH COA PROJECT # 5750.86
NOT TO SCALE


TRANSITION DETAIL FROM
4' SIDEWALK TO 10' ASPHALT TRAIL
WHEEL CHAIR RAMP DETAIL B
NOT TO SCALE
(AS USED THROUGHOUT VENTANA RANCH)

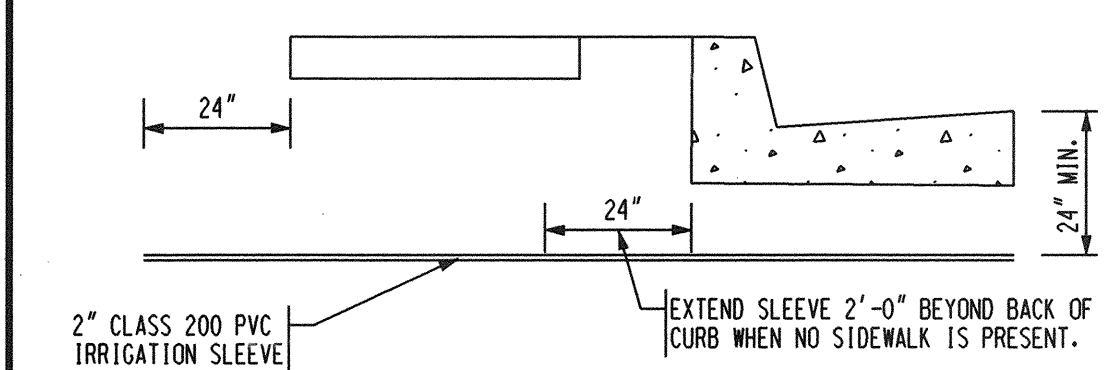

IRRIGATION SLEEVES UNDER
PAVING AND SIDEWALKS
NOT TO SCALE

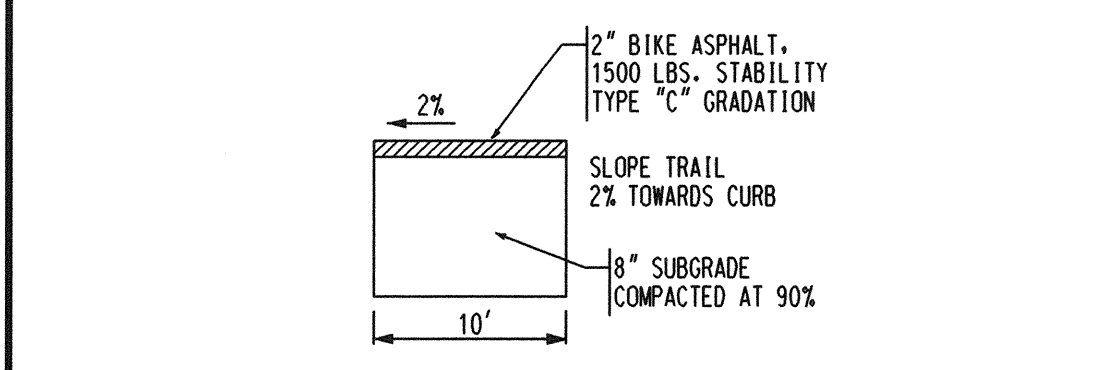

ASPHALT TRAIL
NOT TO SCALE

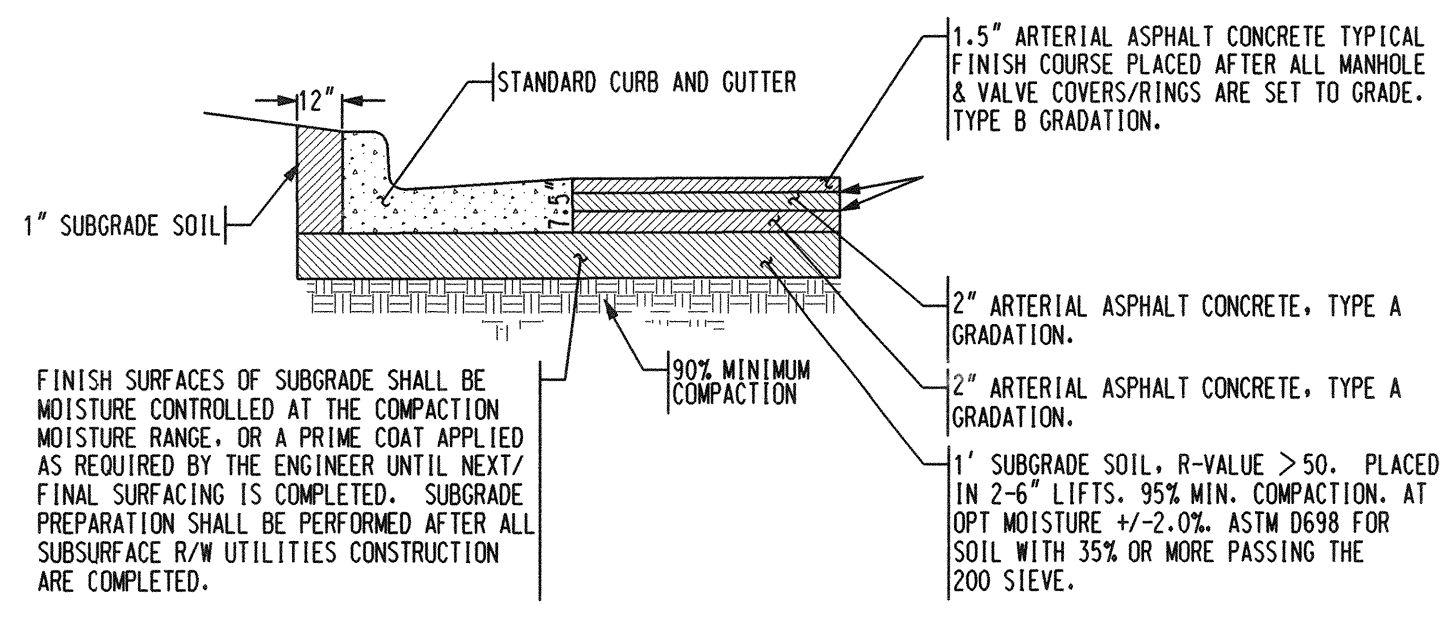

IRVING BLVD. PAVEMENT SECTION
(MINOR ARTERIAL)
NOT TO SCALE
(DESIGNED WITH COA PROJ. # 570981)

- LEGEND**
- PROPOSED CURB AND GUTTER
 - EXISTING CURB AND GUTTER
 - FUTURE CURB AND GUTTER
 - PROPOSED STORM DRAIN MANHOLE
 - EXISTING STORM DRAIN MANHOLE
 - PROPOSED SANITARY SEWER MANHOLE
 - EXISTING SANITARY SEWER MANHOLE
 - PROPOSED FIRE HYDRANT
 - PROPOSED GATE VALVE
 - EXISTING GATE VALVE
 - PROPOSED STREET LIGHT
 - 6' SIDEWALK



Bohannon & Huston
Courtyard I 7500 Jefferson St. NE Albuquerque, NM 87109-4335
ENGINEERING • SPATIAL DATA • ADVANCED TECHNOLOGIES



CITY OF ALBUQUERQUE
PUBLIC WORKS DEPARTMENT
ENGINEERING DEVELOPMENT GROUP
UNIVERSE BLVD. STREET IMPROVEMENTS
OVERALL PAVING PLAN



DESIGN REVIEW COMMITTEE CITY ENGINEER APPROVAL
APR - 7 2003 APR 29 2003
DESIGN REVIEW COMMITTEE CITY ENGINEER

CITY PROJECT NO. 702381 ZONE MAP NO. B-9 SHEET 3 OF 19

ENGINEER'S SEAL SURVEY INFORMATION		BENCH MARKS		AS-BUILT INFORMATION	
NO.	DATE	BY	NOTES	CONTRACTOR	DATE
1	8/95	BOHANNAN-HUSTON INC	ACCS BRASS TABLE STAMPED "1-B9 1980" INSPECTOR'S POSITION (NAD 1927) N.M. STATE PLANE COORDINATES (CENTRAL ZONE) X=535,077.00 Y=1,529,056.93 GROUND-TO-GRID FACTOR = .99966334 DELTA ALPHA = 00°16'47" NGVD 1929 ELEVATION = 5450.51	BOHANNAN-HUSTON	9/03
REVISIONS		DATE	BY	MICRO-FILM INFORMATION	
DESIGN		03/2002	TSG	DATE	
REVISIONS		03/2002	BJG	DATE	
DESIGN		03/2002	PLT	DATE	

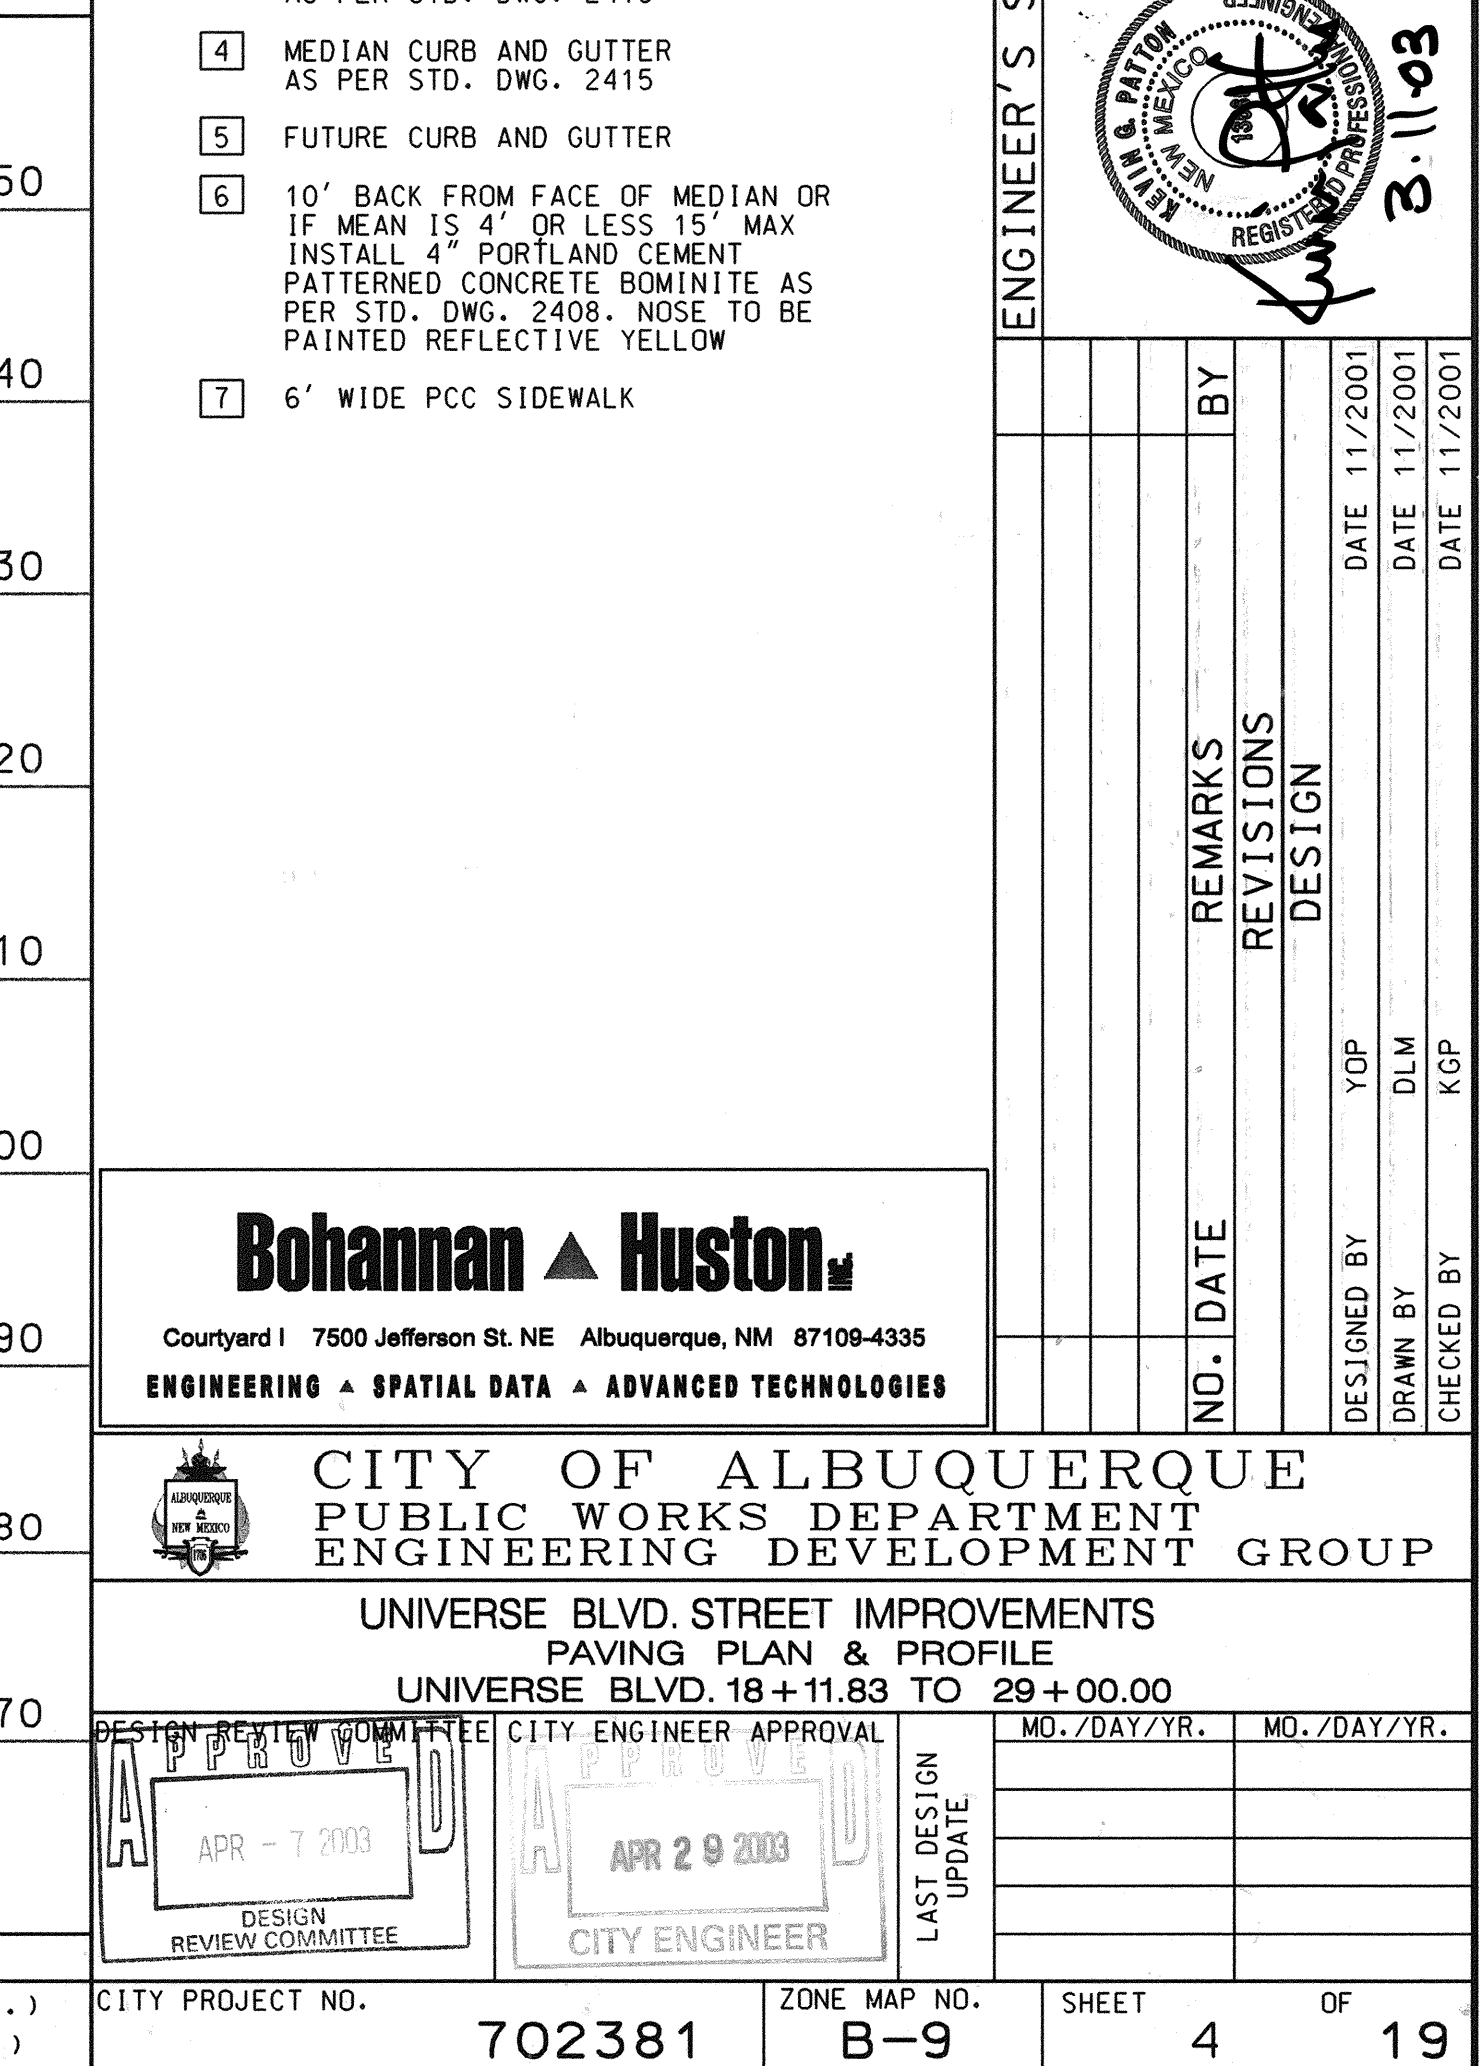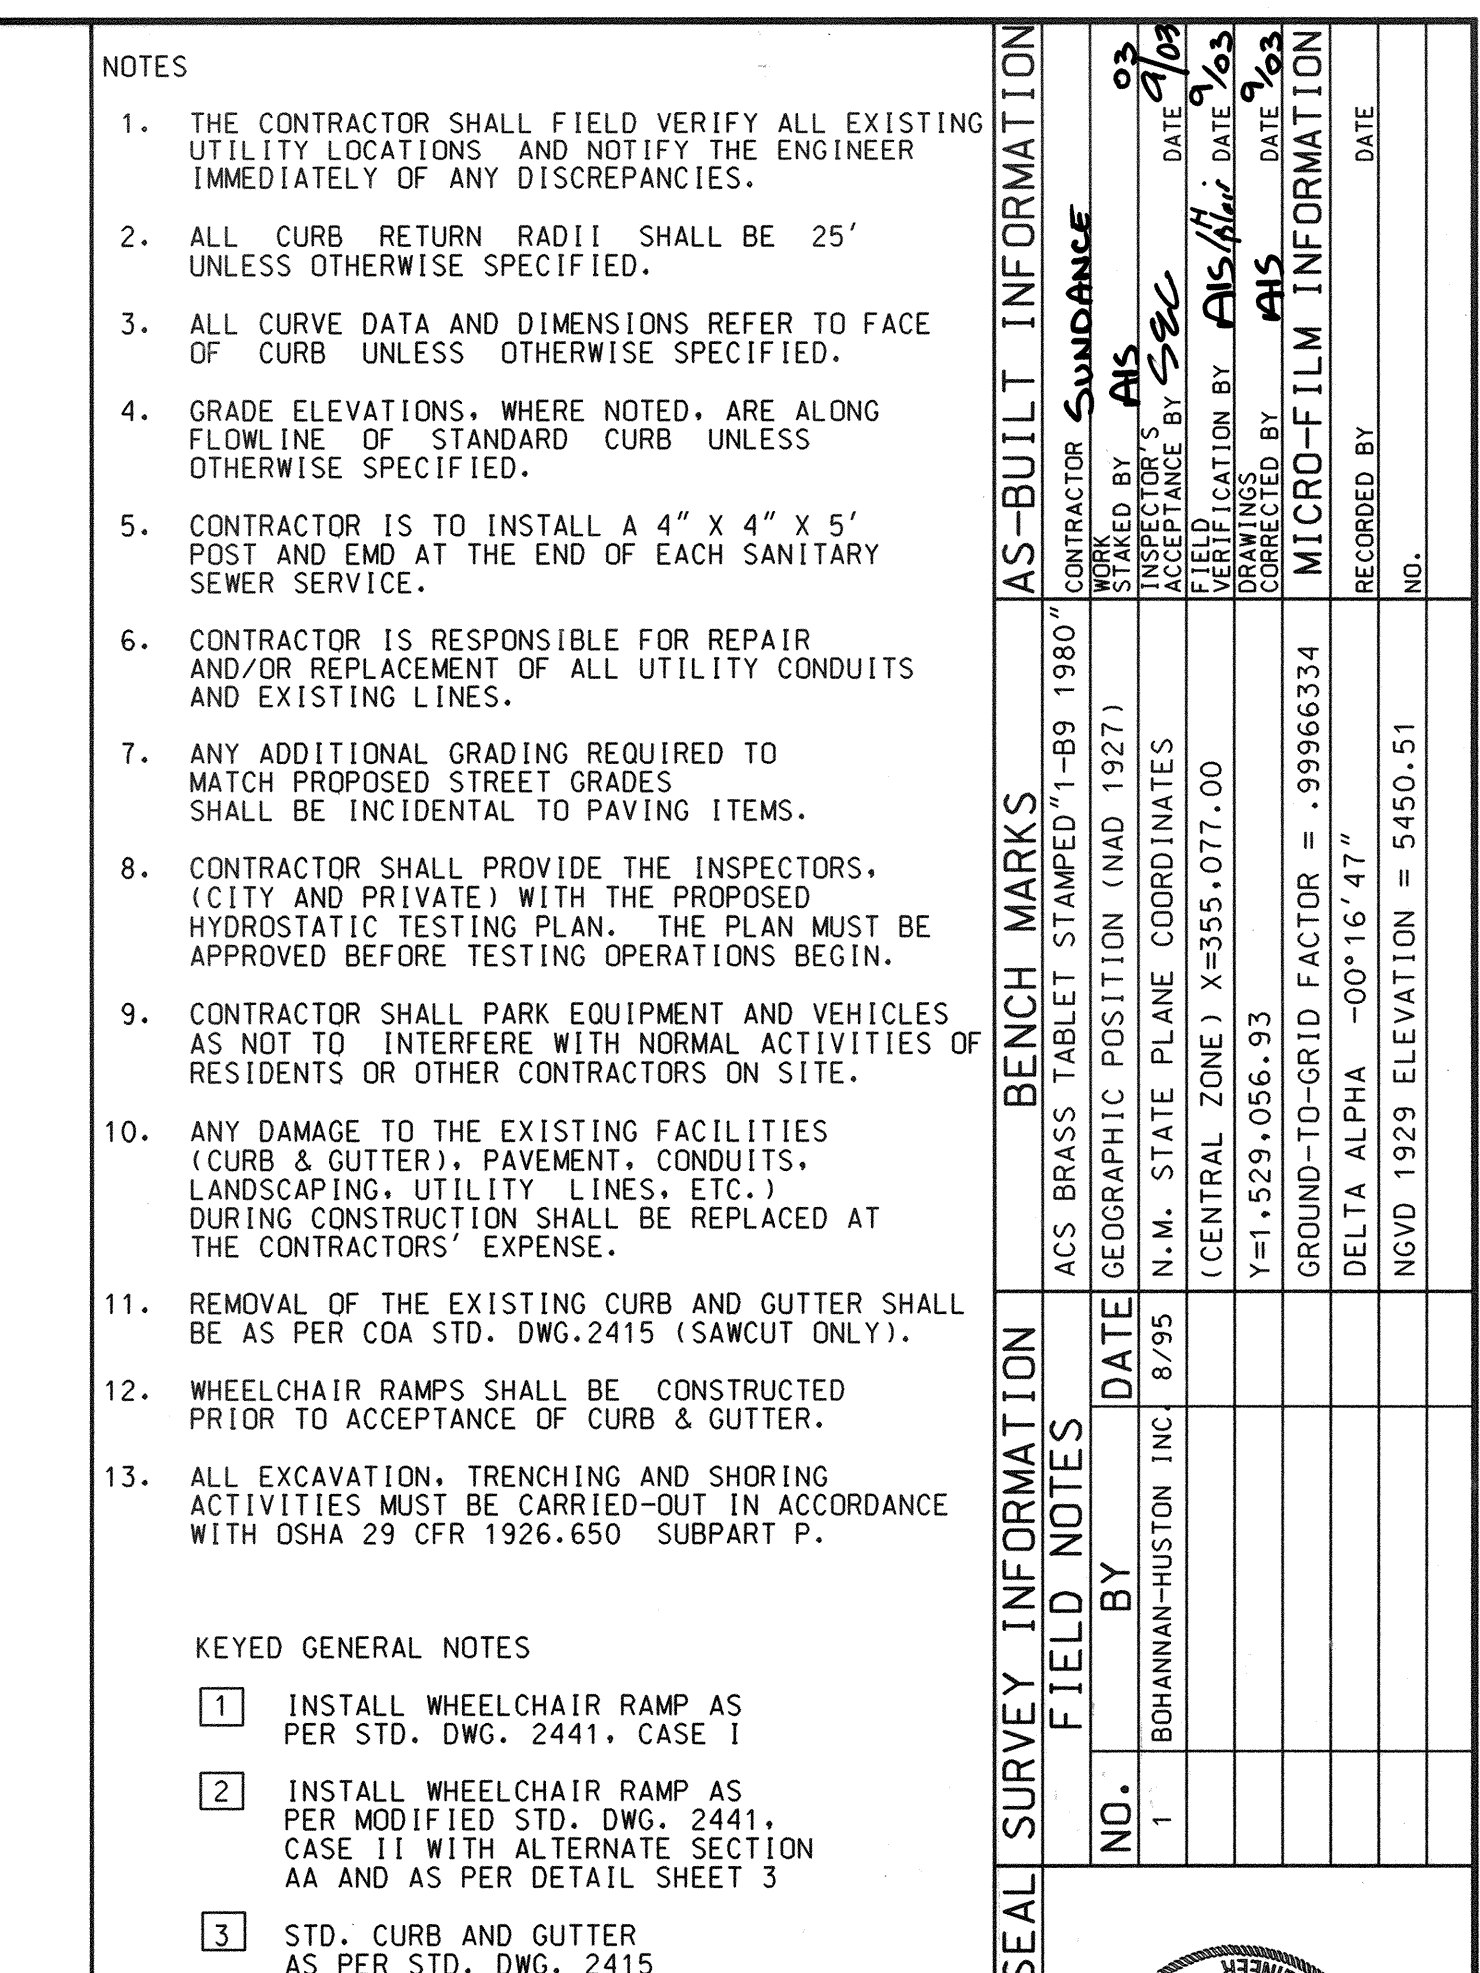

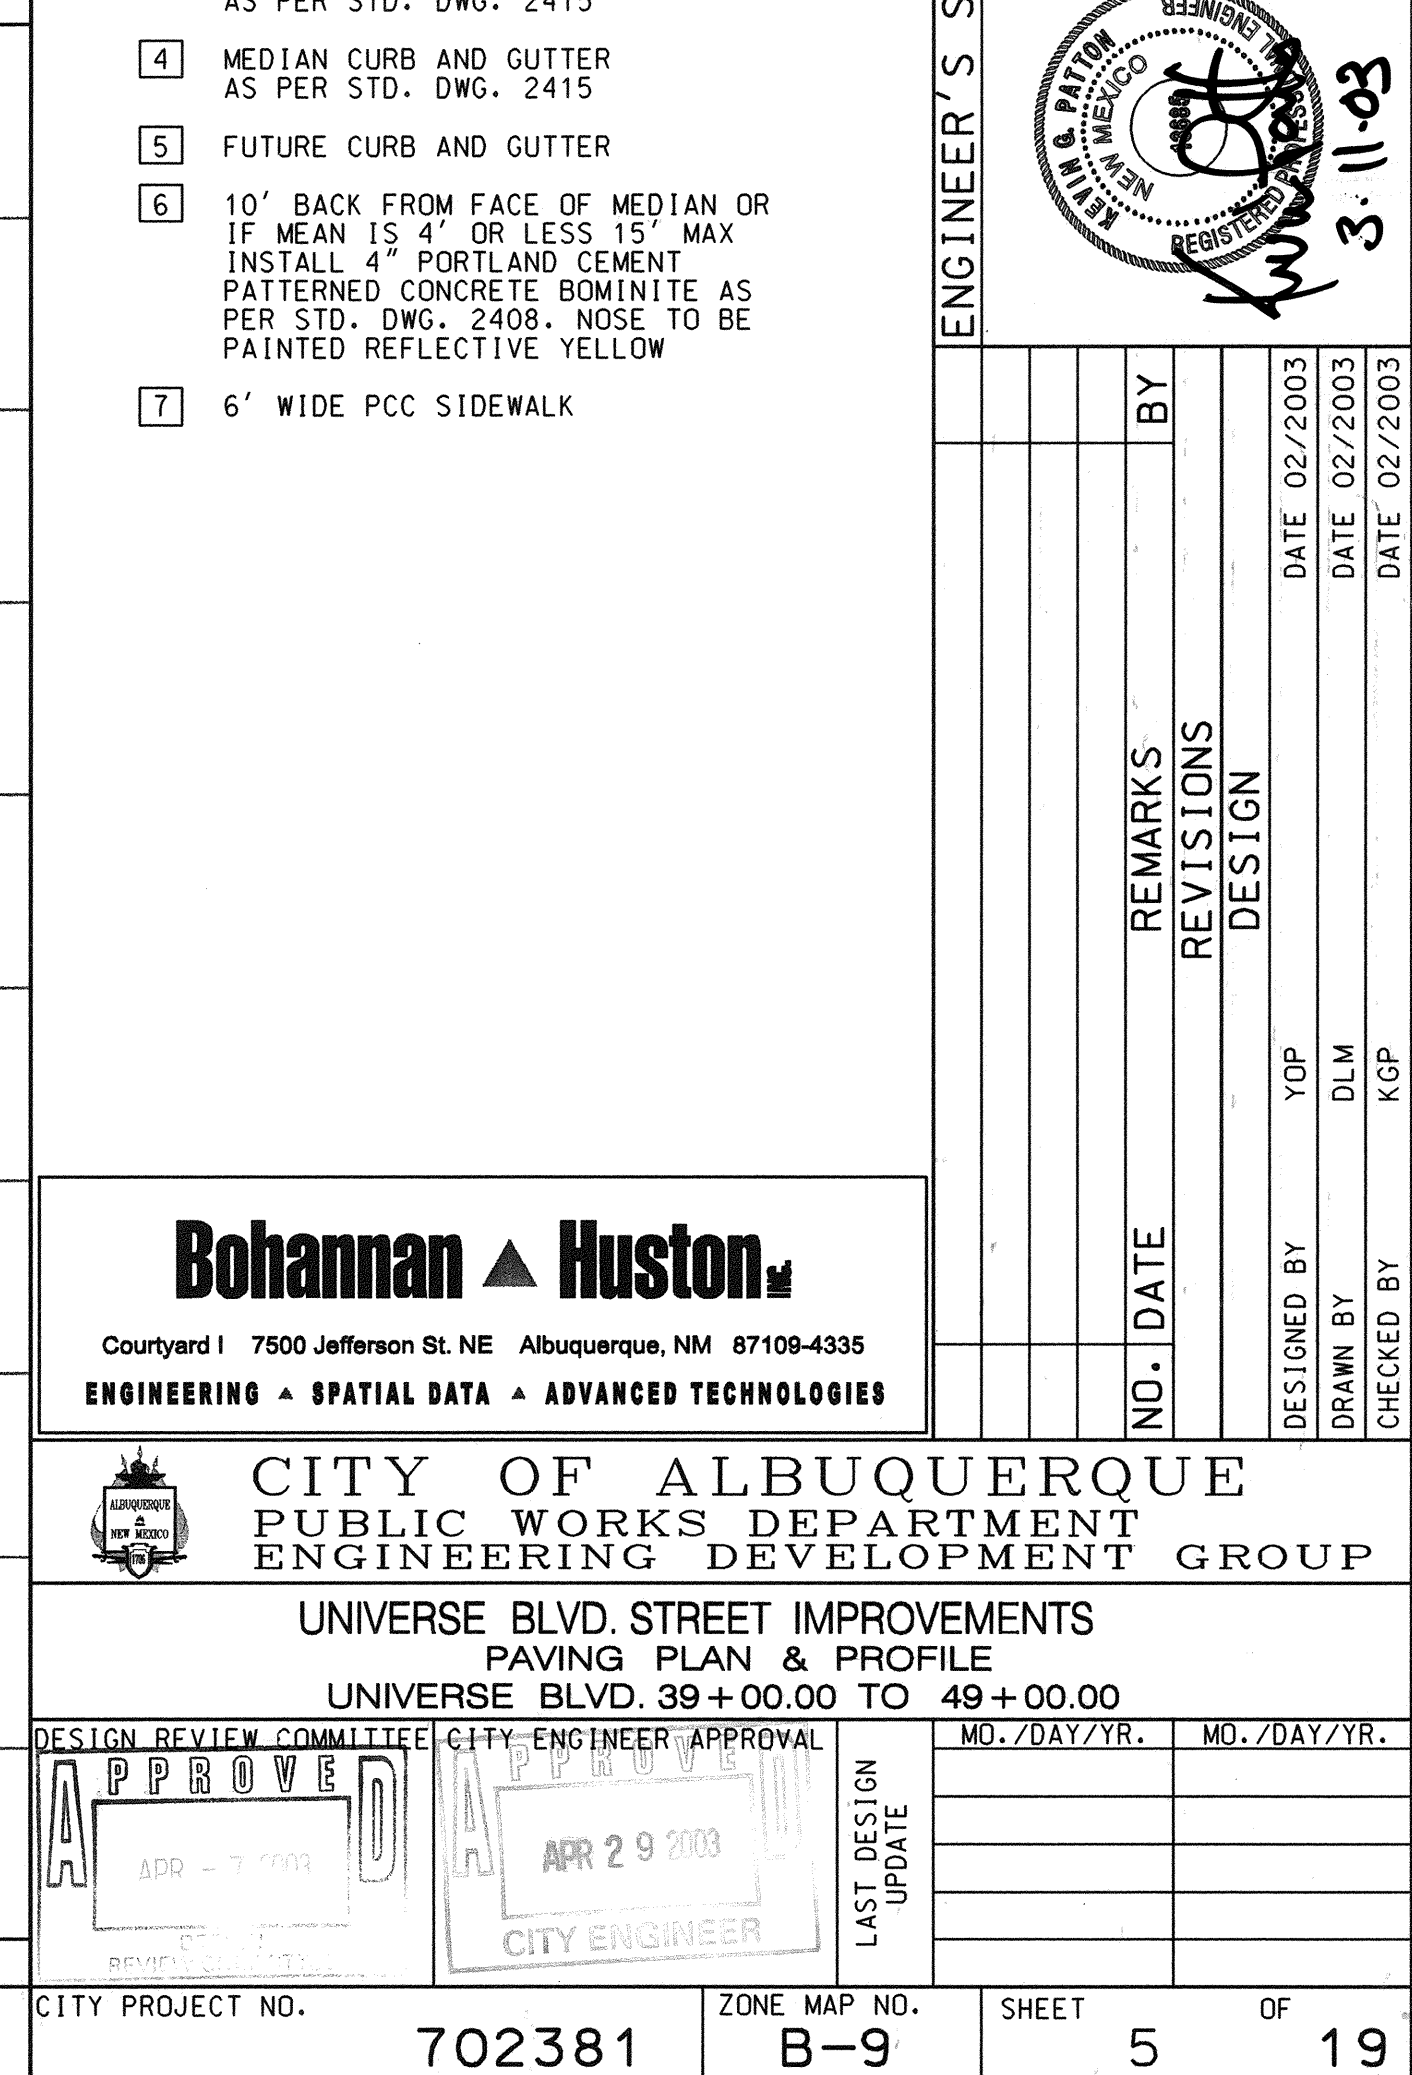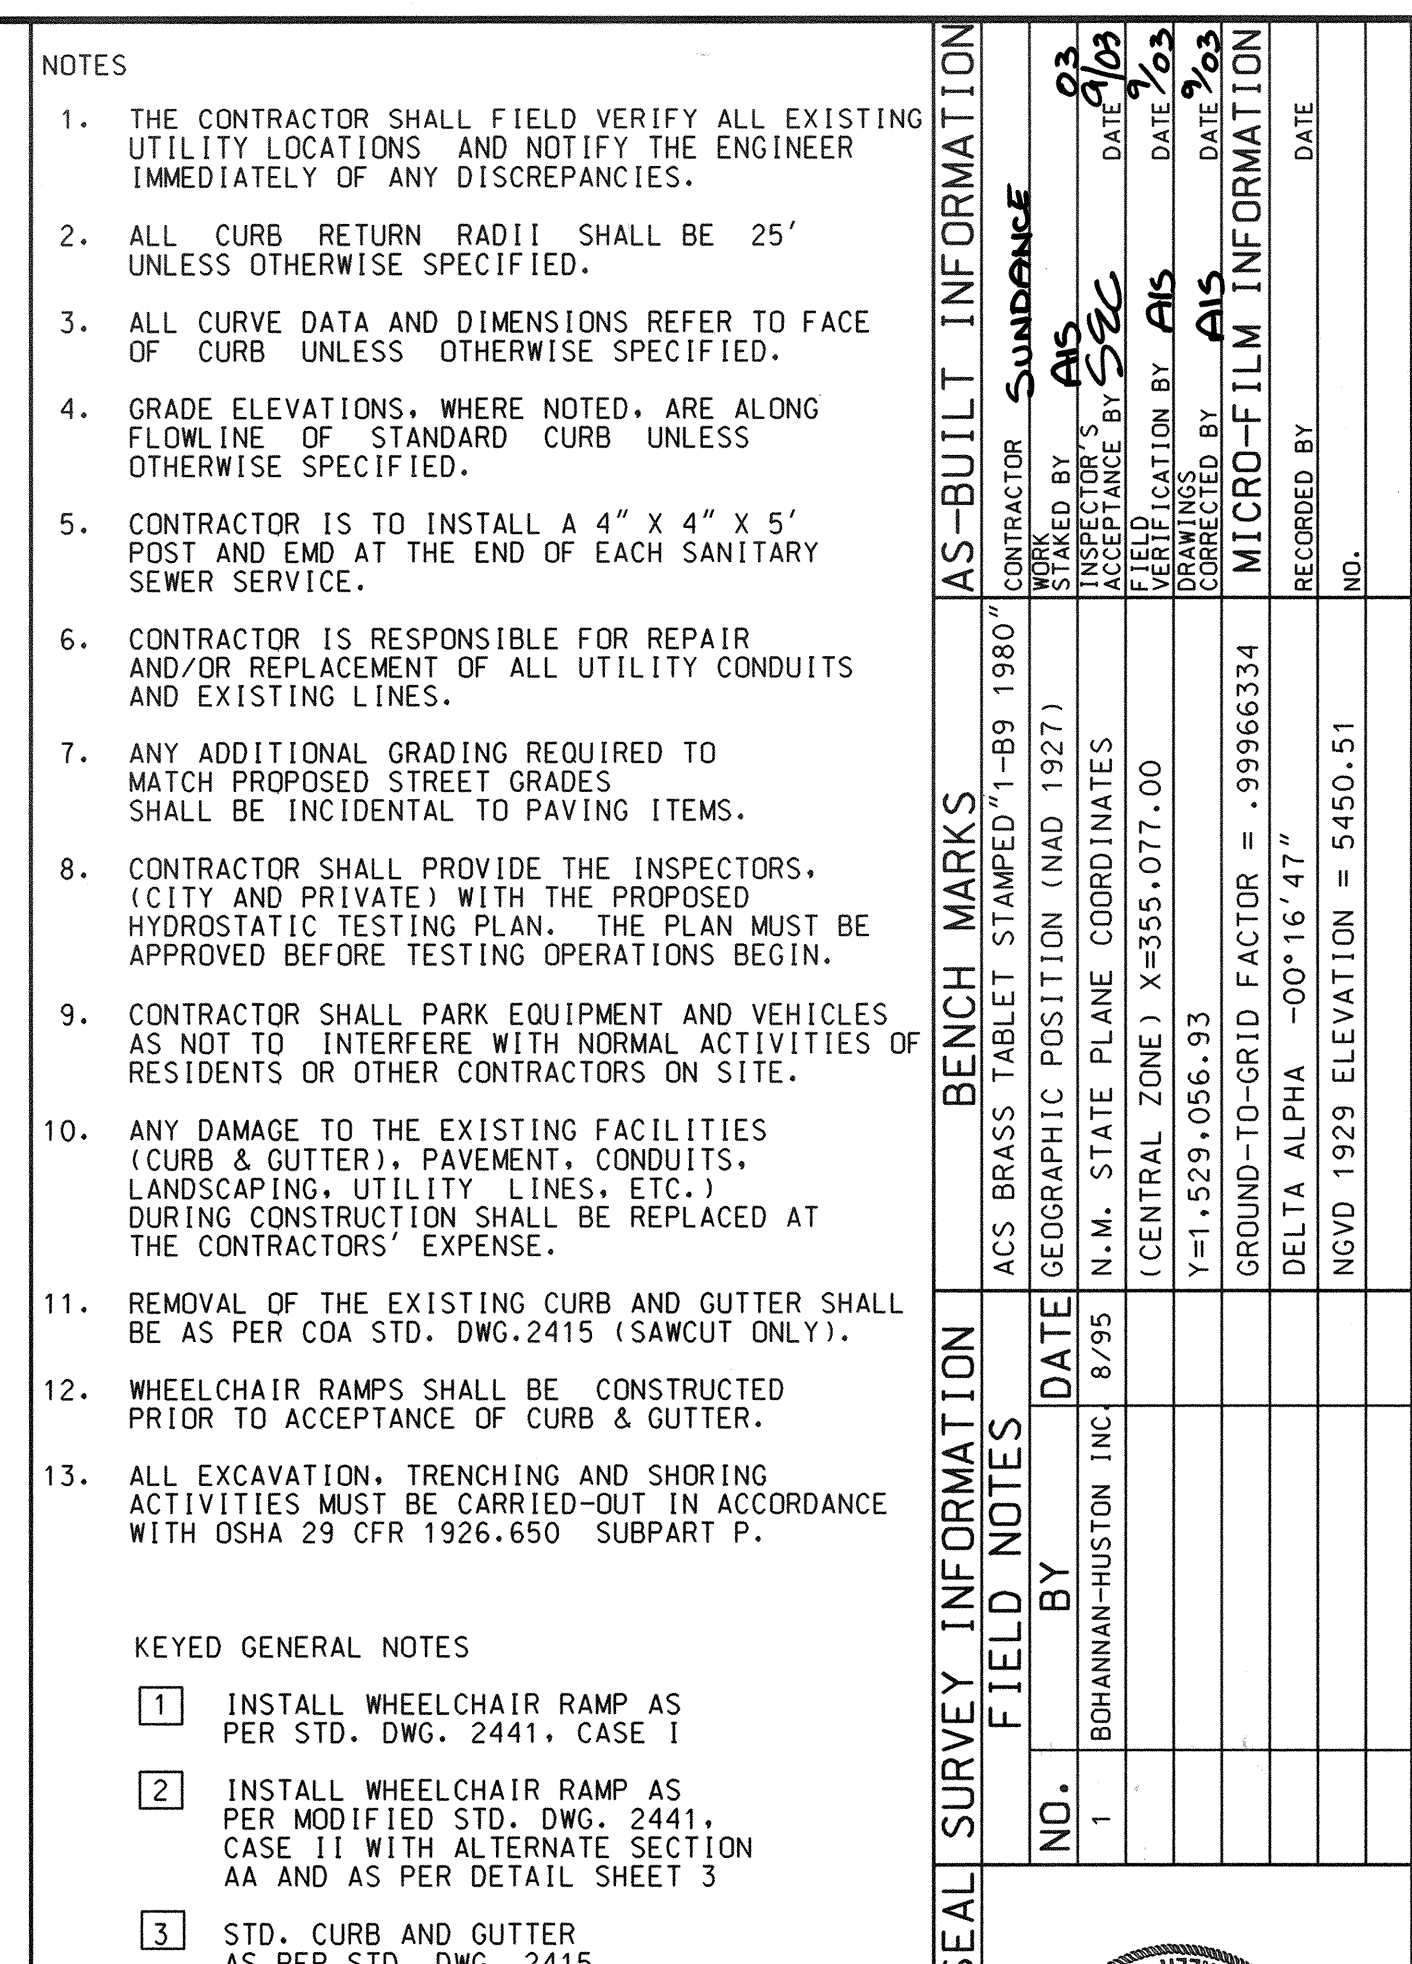

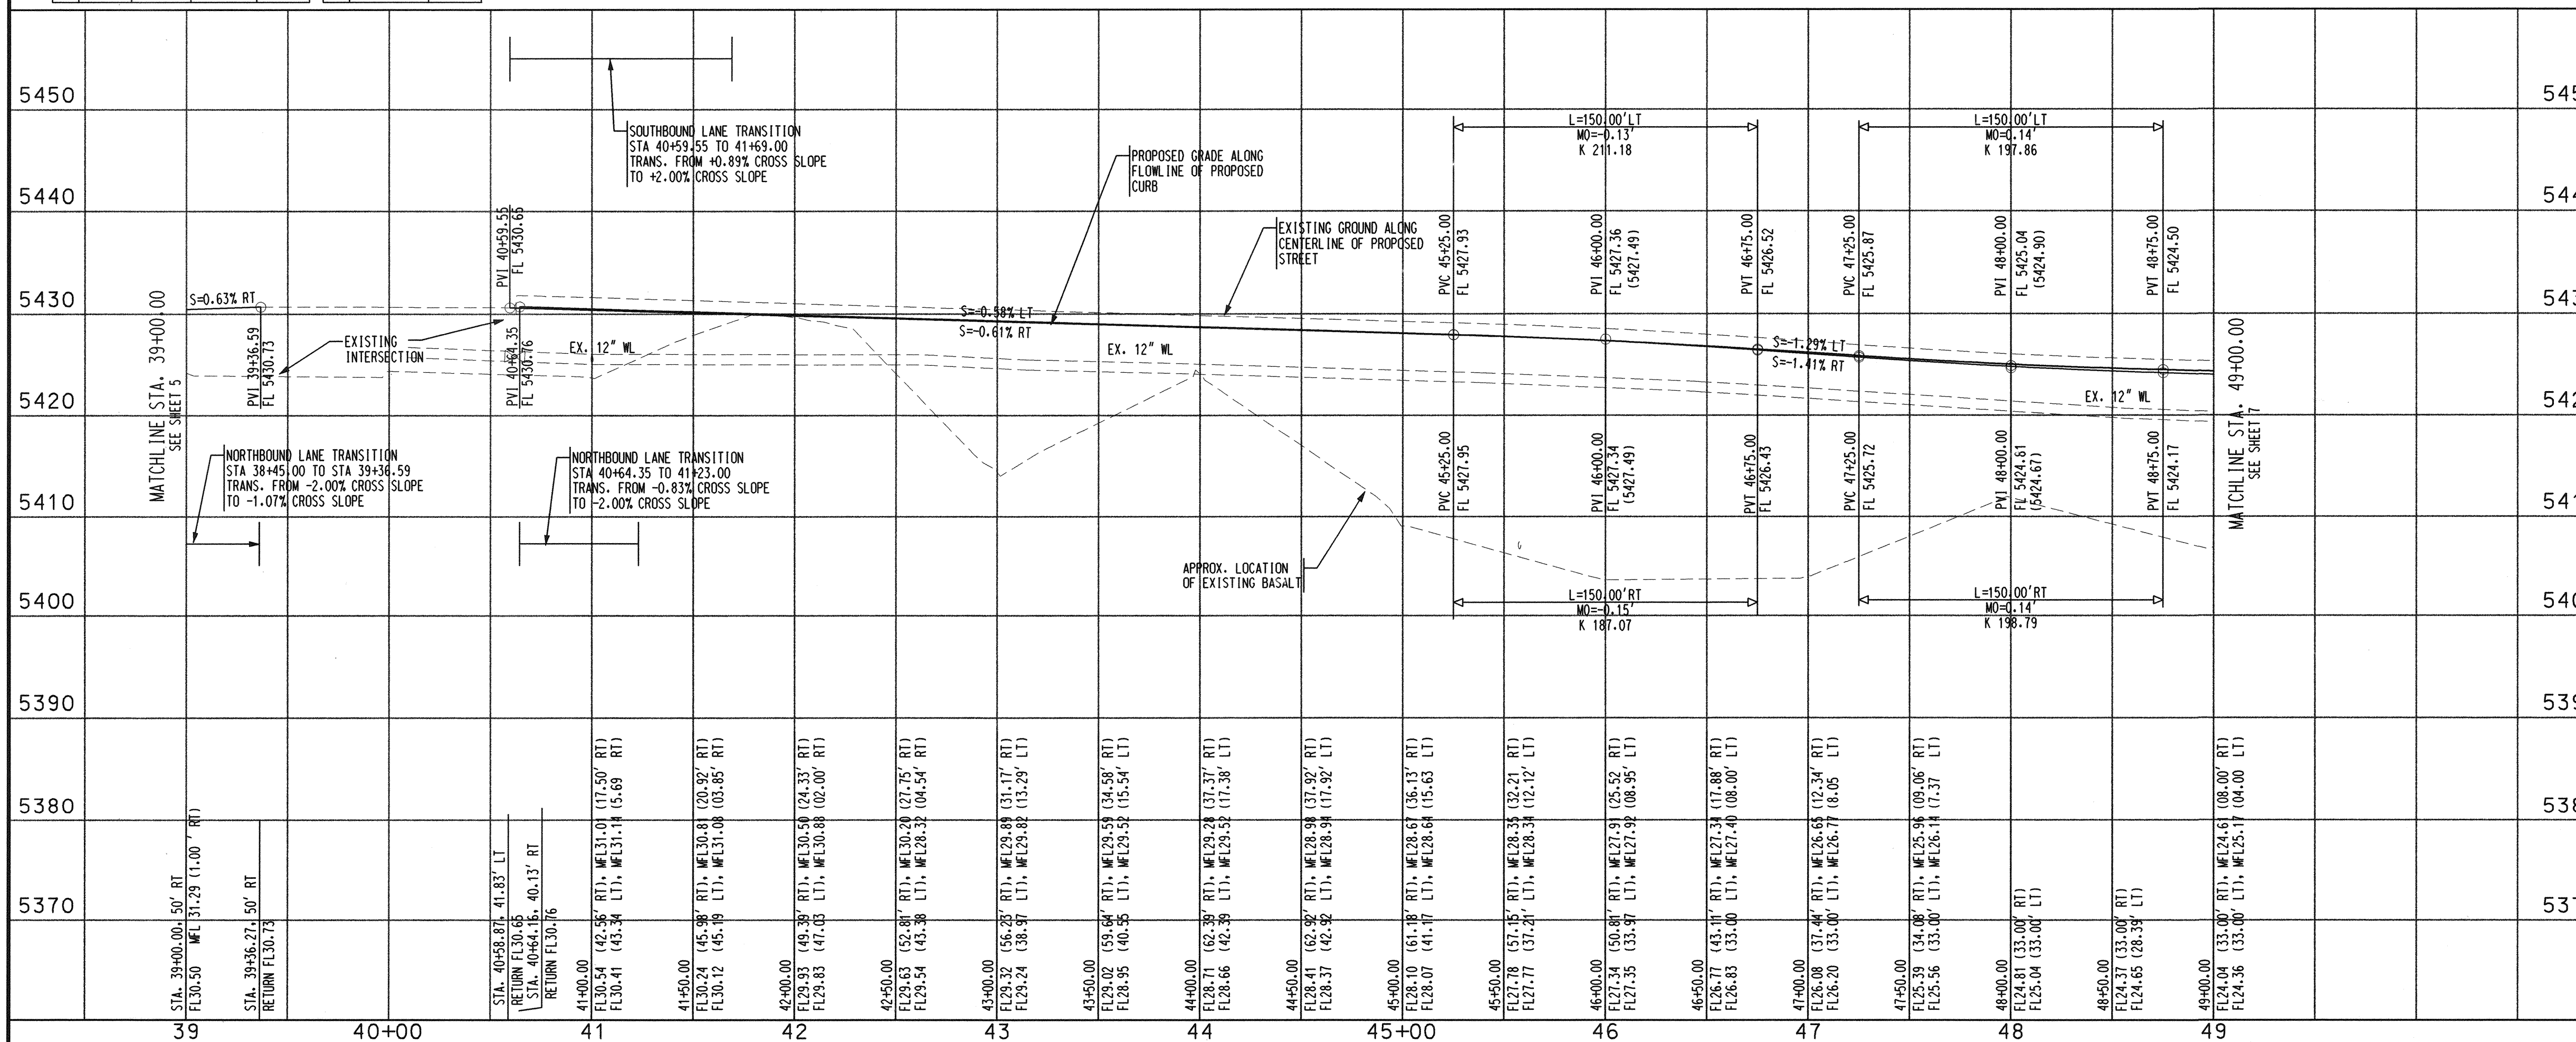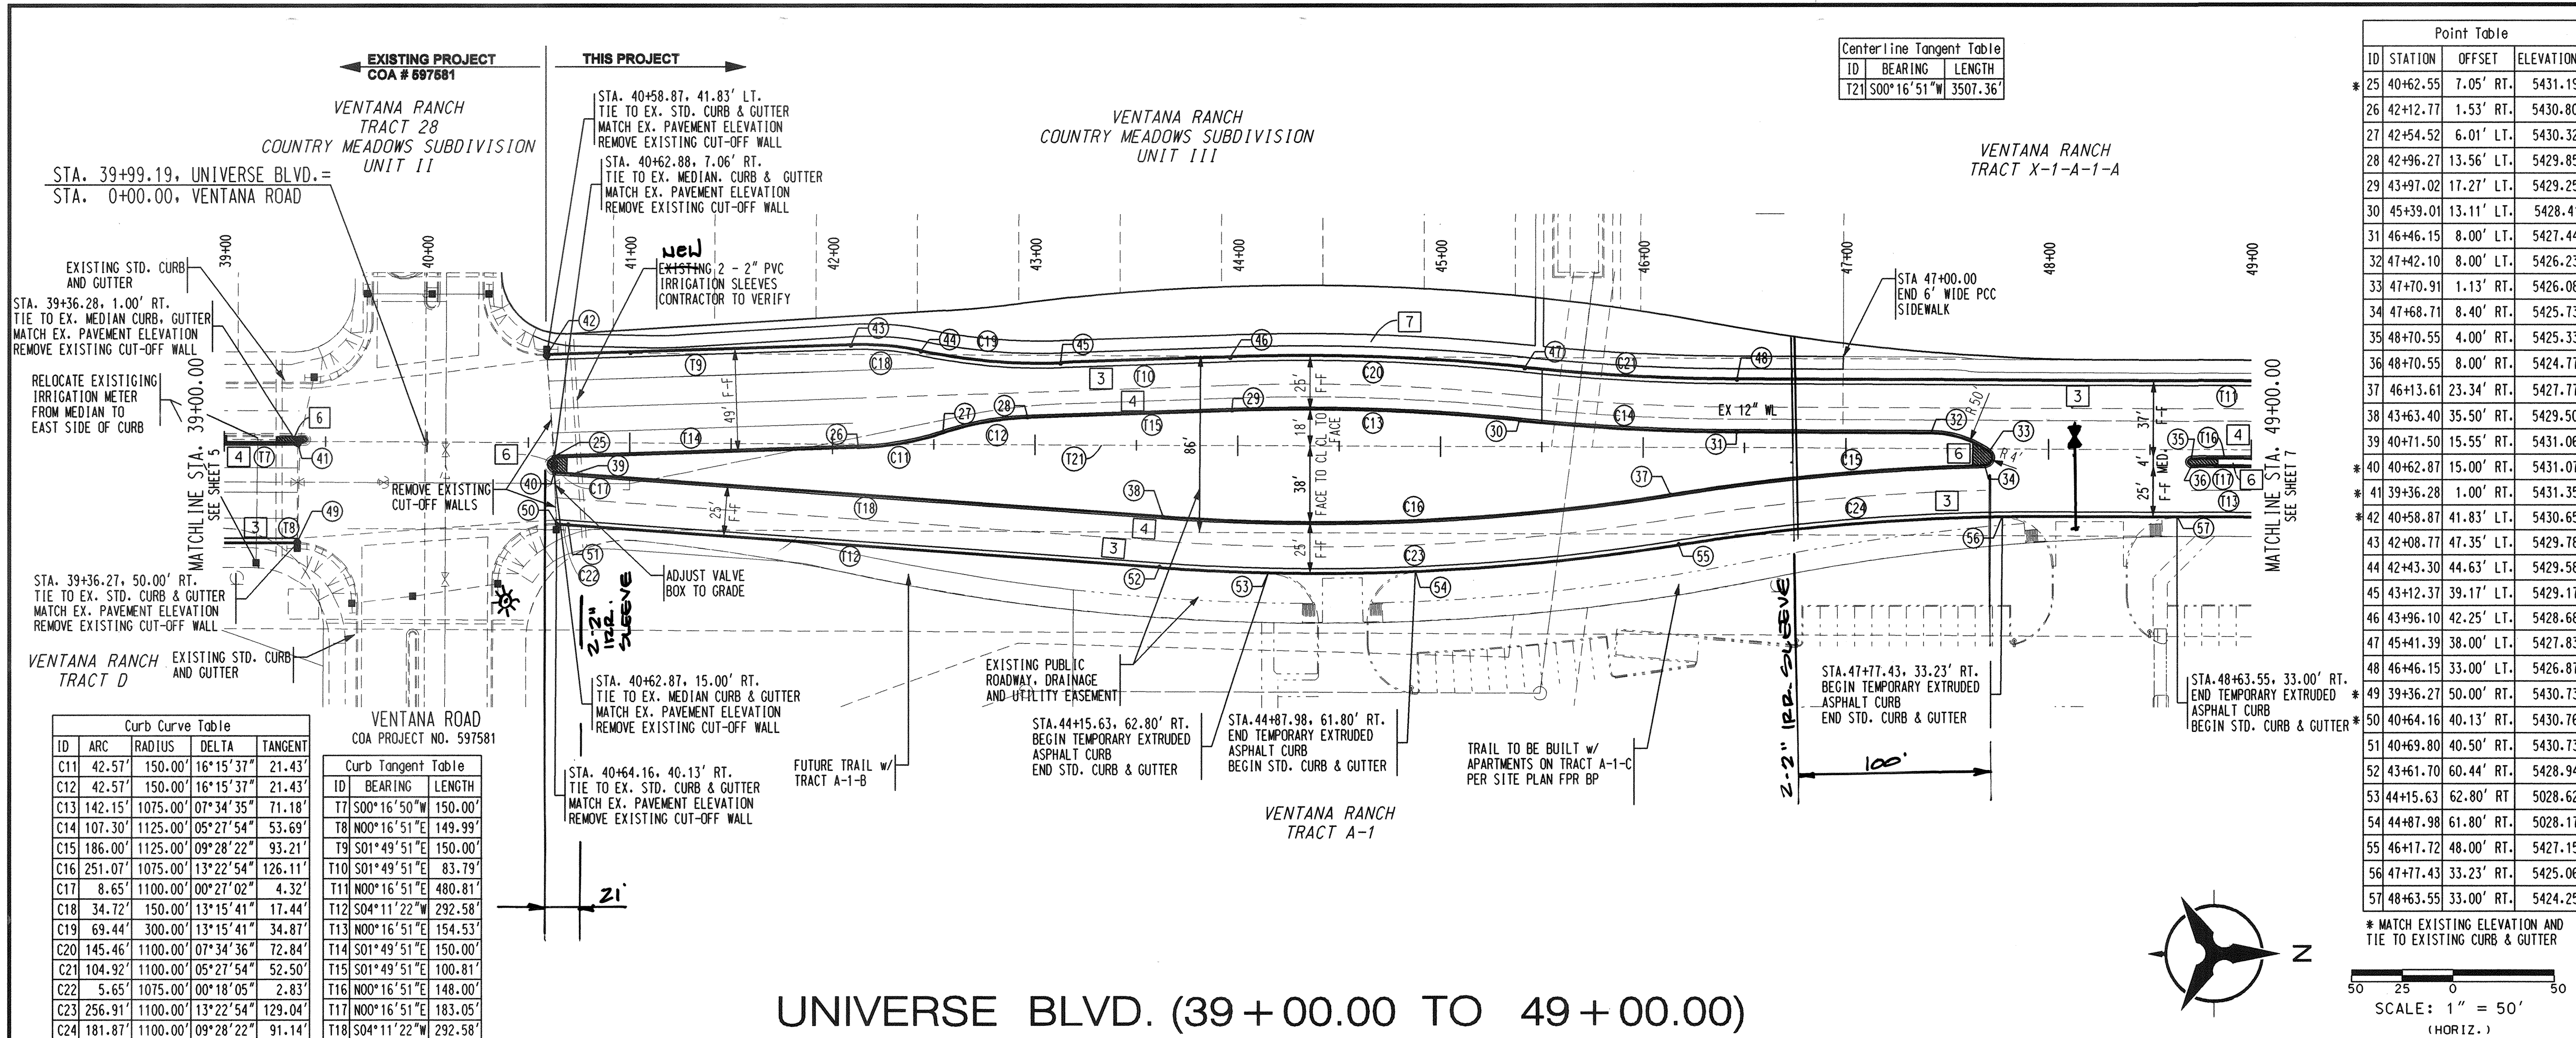

NOTES

- THE CONTRACTOR SHALL FIELD VERIFY ALL EXISTING UTILITY LOCATIONS AND NOTIFY THE ENGINEER IMMEDIATELY OF ANY DISCREPANCIES.
- ALL CURB RETURN RADII SHALL BE 25' UNLESS OTHERWISE SPECIFIED.
- ALL CURVE DATA AND DIMENSIONS REFER TO FACE OF CURB UNLESS OTHERWISE SPECIFIED.
- GRADE ELEVATIONS, WHERE NOTED, ARE ALONG FLOWLINE OF STANDARD CURB UNLESS OTHERWISE SPECIFIED.
- CONTRACTOR IS TO INSTALL A 4" X 4" X 5' POST AND END AT THE END OF EACH SANITARY SEWER SERVICE.
- CONTRACTOR IS RESPONSIBLE FOR REPAIR AND/OR REPLACEMENT OF ALL UTILITY CONDUITS AND EXISTING LINES.
- ANY ADDITIONAL GRADING REQUIRED TO MATCH PROPOSED STREET GRADES SHALL BE INCIDENTAL TO PAVING ITEMS.
- CONTRACTOR SHALL PROVIDE THE INSPECTORS, (CITY AND PRIVATE) WITH THE PROPOSED HYDROSTATIC TESTING PLAN. THE PLAN MUST BE APPROVED BEFORE TESTING OPERATIONS BEGIN.
- CONTRACTOR SHALL PARK EQUIPMENT AND VEHICLES AS NOT TO INTERFERE WITH NORMAL ACTIVITIES OF RESIDENTS OR OTHER CONTRACTORS ON SITE.
- ANY DAMAGE TO THE EXISTING FACILITIES (CURB & GUTTER), PAVEMENT, CONDUITS, LANDSCAPING, UTILITY LINES, ETC.) DURING CONSTRUCTION SHALL BE REPLACED AT THE CONTRACTORS' EXPENSE.
- REMOVAL OF THE EXISTING CURB AND GUTTER SHALL BE AS PER COA STD. DWG.2415 (SAWCUT ONLY).
- WHEELCHAIR RAMPS SHALL BE CONSTRUCTED PRIOR TO ACCEPTANCE OF CURB & GUTTER.
- ALL EXCAVATION, TRENCHING AND SHORING ACTIVITIES MUST BE CARRIED-OUT IN ACCORDANCE WITH OSHA 29 CFR 1926.650 SUBPART P.

KEYED GENERAL NOTES

- INSTALL WHEELCHAIR RAMP AS PER STD. DWG. 2441, CASE 1
- INSTALL WHEELCHAIR RAMP AS PER MODIFIED STD. DWG. 2441, CASE II WITH ALTERNATE SECTION AA AND AS PER DETAIL SHEET 3
- STD. CURB AND GUTTER AS PER STD. DWG. 2415
- MEDIAN CURB AND GUTTER AS PER STD. DWG. 2415
- FUTURE CURB AND GUTTER
- 10' BACK FROM FACE OF MEDIAN OR IF MEAN IS 4' OR LESS 15' MAX INSTALL 4" PORTLAND CEMENT PATTERNED CONCRETE BOMINITE AS PER STD. DWG. 2408, NOSE TO BE PAINTED REFLECTIVE YELLOW
- 6' WIDE PCC SIDEWALK

AS-BUILT INFORMATION

CONTRACTOR: **Bohannon & Huston**

DATE: **8/9/03**

BY: **AS**

REVISIONS

DESIGN

DATE: **02/2002**

BY: **YOP**

DATE: **02/2002**

CHECKED BY: **KGP**

DATE: **02/2002**

CITY OF ALBUQUERQUE
PUBLIC WORKS DEPARTMENT
ENGINEERING DEVELOPMENT GROUP

UNIVERSE BLVD. STREET IMPROVEMENTS
PAVING PLAN & PROFILE
UNIVERSE BLVD. 39 + 00.00 TO 49 + 00.00


APPROVED
APR 29 2003
CITY ENGINEER

APPROVED
APR 29 2003
DESIGN REVIEW COMMITTEE

LAST DESIGN UPDATE

MO./DAY/YR.

MO./DAY/YR.

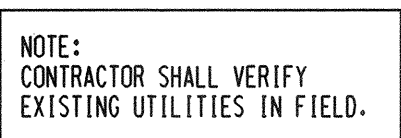


Centerline Tangent Table		
ID	BEARING	LENGTH
T21	S00°16'51"W	3507.36'

NOTE:
CONTRACTOR SHALL VERIFY
EXISTING UTILITIES IN FIELD.

● Point Table				
	STATION	OFFSET	RT.	ELEVATION
58	50+18.55	4.00'	RT.	5424.54
59	50+60.55	2.00'	LT.	5424.27
60	51+02.55	8.00'	LT.	5423.74
61	52+56.83	8.00'	LT.	5422.31
62	52+56.83	4.00'	LT.	5422.41
63	51+56.83	4.00'	LT.	5423.37
64	51+14.83	2.00'	RT.	5423.51
65	50+72.83	8.00'	RT.	5423.81
66	52+74.15	35.00'	RT.	5422.37
67	52+41.93	35.00'	LT.	5422.54
68	52+39.74	35.00'	RT.	5421.94
69	52+73.83	35.00'	RT.	5421.68
70	52+31.11	33.00'	LT.	5422.54
71	51+39.26	42.18'	LT.	5423.58
72	49+53.28	33.00'	RT.	5423.66
73	50+22.10	41.00'	RT.	5423.20
74	50+56.51	45.00'	RT.	5422.98
75	52+50.48	45.00'	RT.	5421.10

Crossings					
DES	SD		WL		Clearance
A	18" TP	17.29	12" TP	18.86	0.50
	18" INV	15.37	12" INV	17.78	

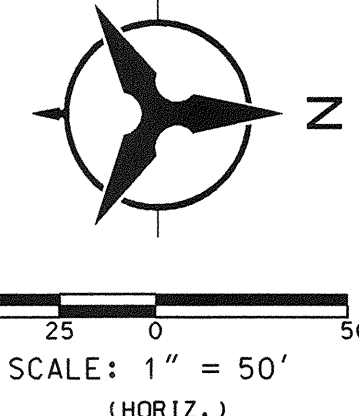


ID	BEARING	LENGTH
T22	S38°35'28"W	76.66'
T23	S44°36'41"E	43.19'
T24	S00°13'42"W	55.75'

NUMBER	Q(cfs)	V(cfs)	DEPTH	LENGTH	SIZE	SLOPE
T22	7.65	6.99	11.40"	76.66'	18"	1.00%
T23	6.77	12.31	6.29"	43.19'	18"	6.04%
T24	14.42	6.14	16.29"	55.75'	24"	0.58%

KEYED GENERAL NOTES

1	INSTALL WHEELCHAIR RAMP AS PER STD. DWG. 2441, CASE 1
2	INSTALL WHEELCHAIR RAMP AS PER MODIFIED STD. DWG. 2441, CASE 11 WITH ALTERNATE SECTION AA AND AS PER DETAIL SHEET 3
3	STD. CURB AND GUTTER AS PER STD. DWG. 2415
4	MEDIAN CURB AND GUTTER AS PER STD. DWG. 2415
5	FUTURE CURB AND GUTTER
6	10' BACK FROM FACE OF MEDIAN OR 10' MEAN IS 4' OR LESS 15' MAX INSTALL 4" POLYMER CONCRETE PATTERNEED CONCRETE BOMINITE AS PER STD. DWG. 2408. NOISE TO BE PAINTED REFLECTIVE YELLOW
7	6' WIDE PCC SIDEWALK

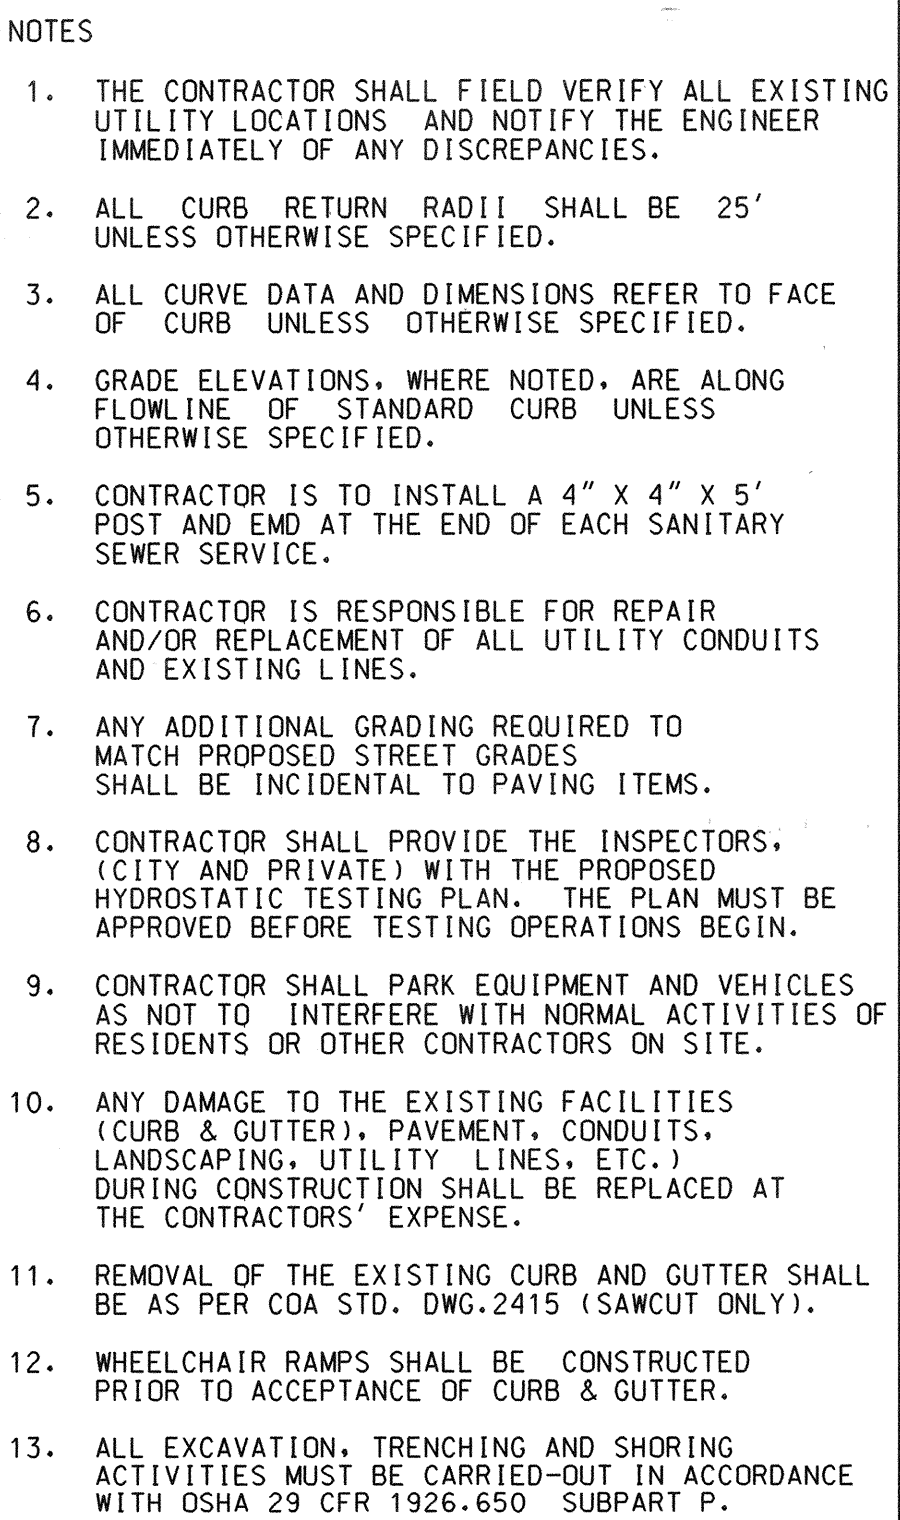

QUERQUE																																																																																																																																																																																																																																																																																																																																																																																																																																																																																																																																																																																																																																																																																																																																																																																																																																																																																																																																																																																																																																																																																																																																																																																																																																																																																																																																																																															
DEPARTMENT										GROUP																																																																																																																																																																																																																																																																																																																																																																																																																																																																																																																																																																																																																																																																																																																																																																																																																																																																																																																																																																																																																																																																																																																																																																																																																																																																																																																																																																					
ELEMENTS																																																																																																																																																																																																																																																																																																																																																																																																																																																																																																																																																																																																																																																																																																																																																																																																																																																																																																																																																																																																																																																																																																																																																																																																																																																																																																																																																																															
FILE																																																																																																																																																																																																																																																																																																																																																																																																																																																																																																																																																																																																																																																																																																																																																																																																																																																																																																																																																																																																																																																																																																																																																																																																																																																																																																																																																																															
53 + 19.19																																																																																																																																																																																																																																																																																																																																																																																																																																																																																																																																																																																																																																																																																																																																																																																																																																																																																																																																																																																																																																																																																																																																																																																																																																																																																																																																																																															
MO./DAY/YR.										MO./DAY/YR.																																																																																																																																																																																																																																																																																																																																																																																																																																																																																																																																																																																																																																																																																																																																																																																																																																																																																																																																																																																																																																																																																																																																																																																																																																																																																																																																																																					
																																																																																																																																																																																																																																																																																																																																																																																																																																																																																																																																																																																																																																																																																																																																																																																																																																																																																																																																																																																																																																																																																																																																																																																																																																																																																																																																																																															</

Bohannon ▲ Huston
 Courtyard | 7500 Jefferson St. NE Albuquerque, NM 87109-4335
ENGINEERING ▲ SPATIAL DATA ▲ ADVANCED TECHNOLOGIES




CITY OF ALBUQUERQUE
PUBLIC WORKS DEPARTMENT
ENGINEERING DEVELOPMENT GROUP

UNIVERSE BLVD. STREET IMPROVEMENTS
PAVING PLAN & PROFILE
UNIVERSE BLVD. 49+00.00 to 53+19.19

DESIGN REVIEW COMMITTEE		CITY ENGINEER APPROVAL	MU./DAY/TR.	MU./DAY/TR.
APR - 7 2003 DESIGN REVIEW COMMITTEE	APR 29 2003 CITY ENGINEER	LAST DESIGN UPDATE		

CITY PROJECT NO.	702381	ZONE MAP NO.	B-9	SHEET	7	OF	19
------------------	--------	--------------	-----	-------	---	----	----

HAB

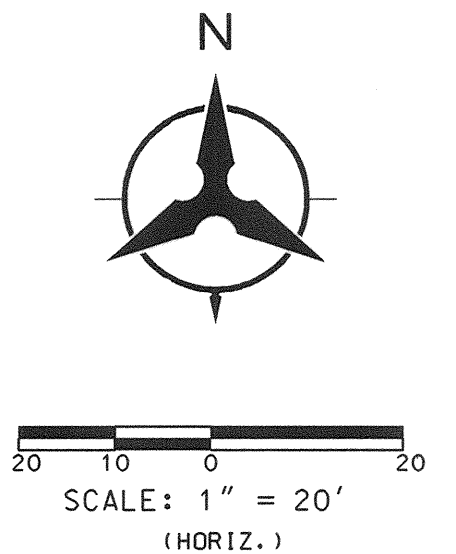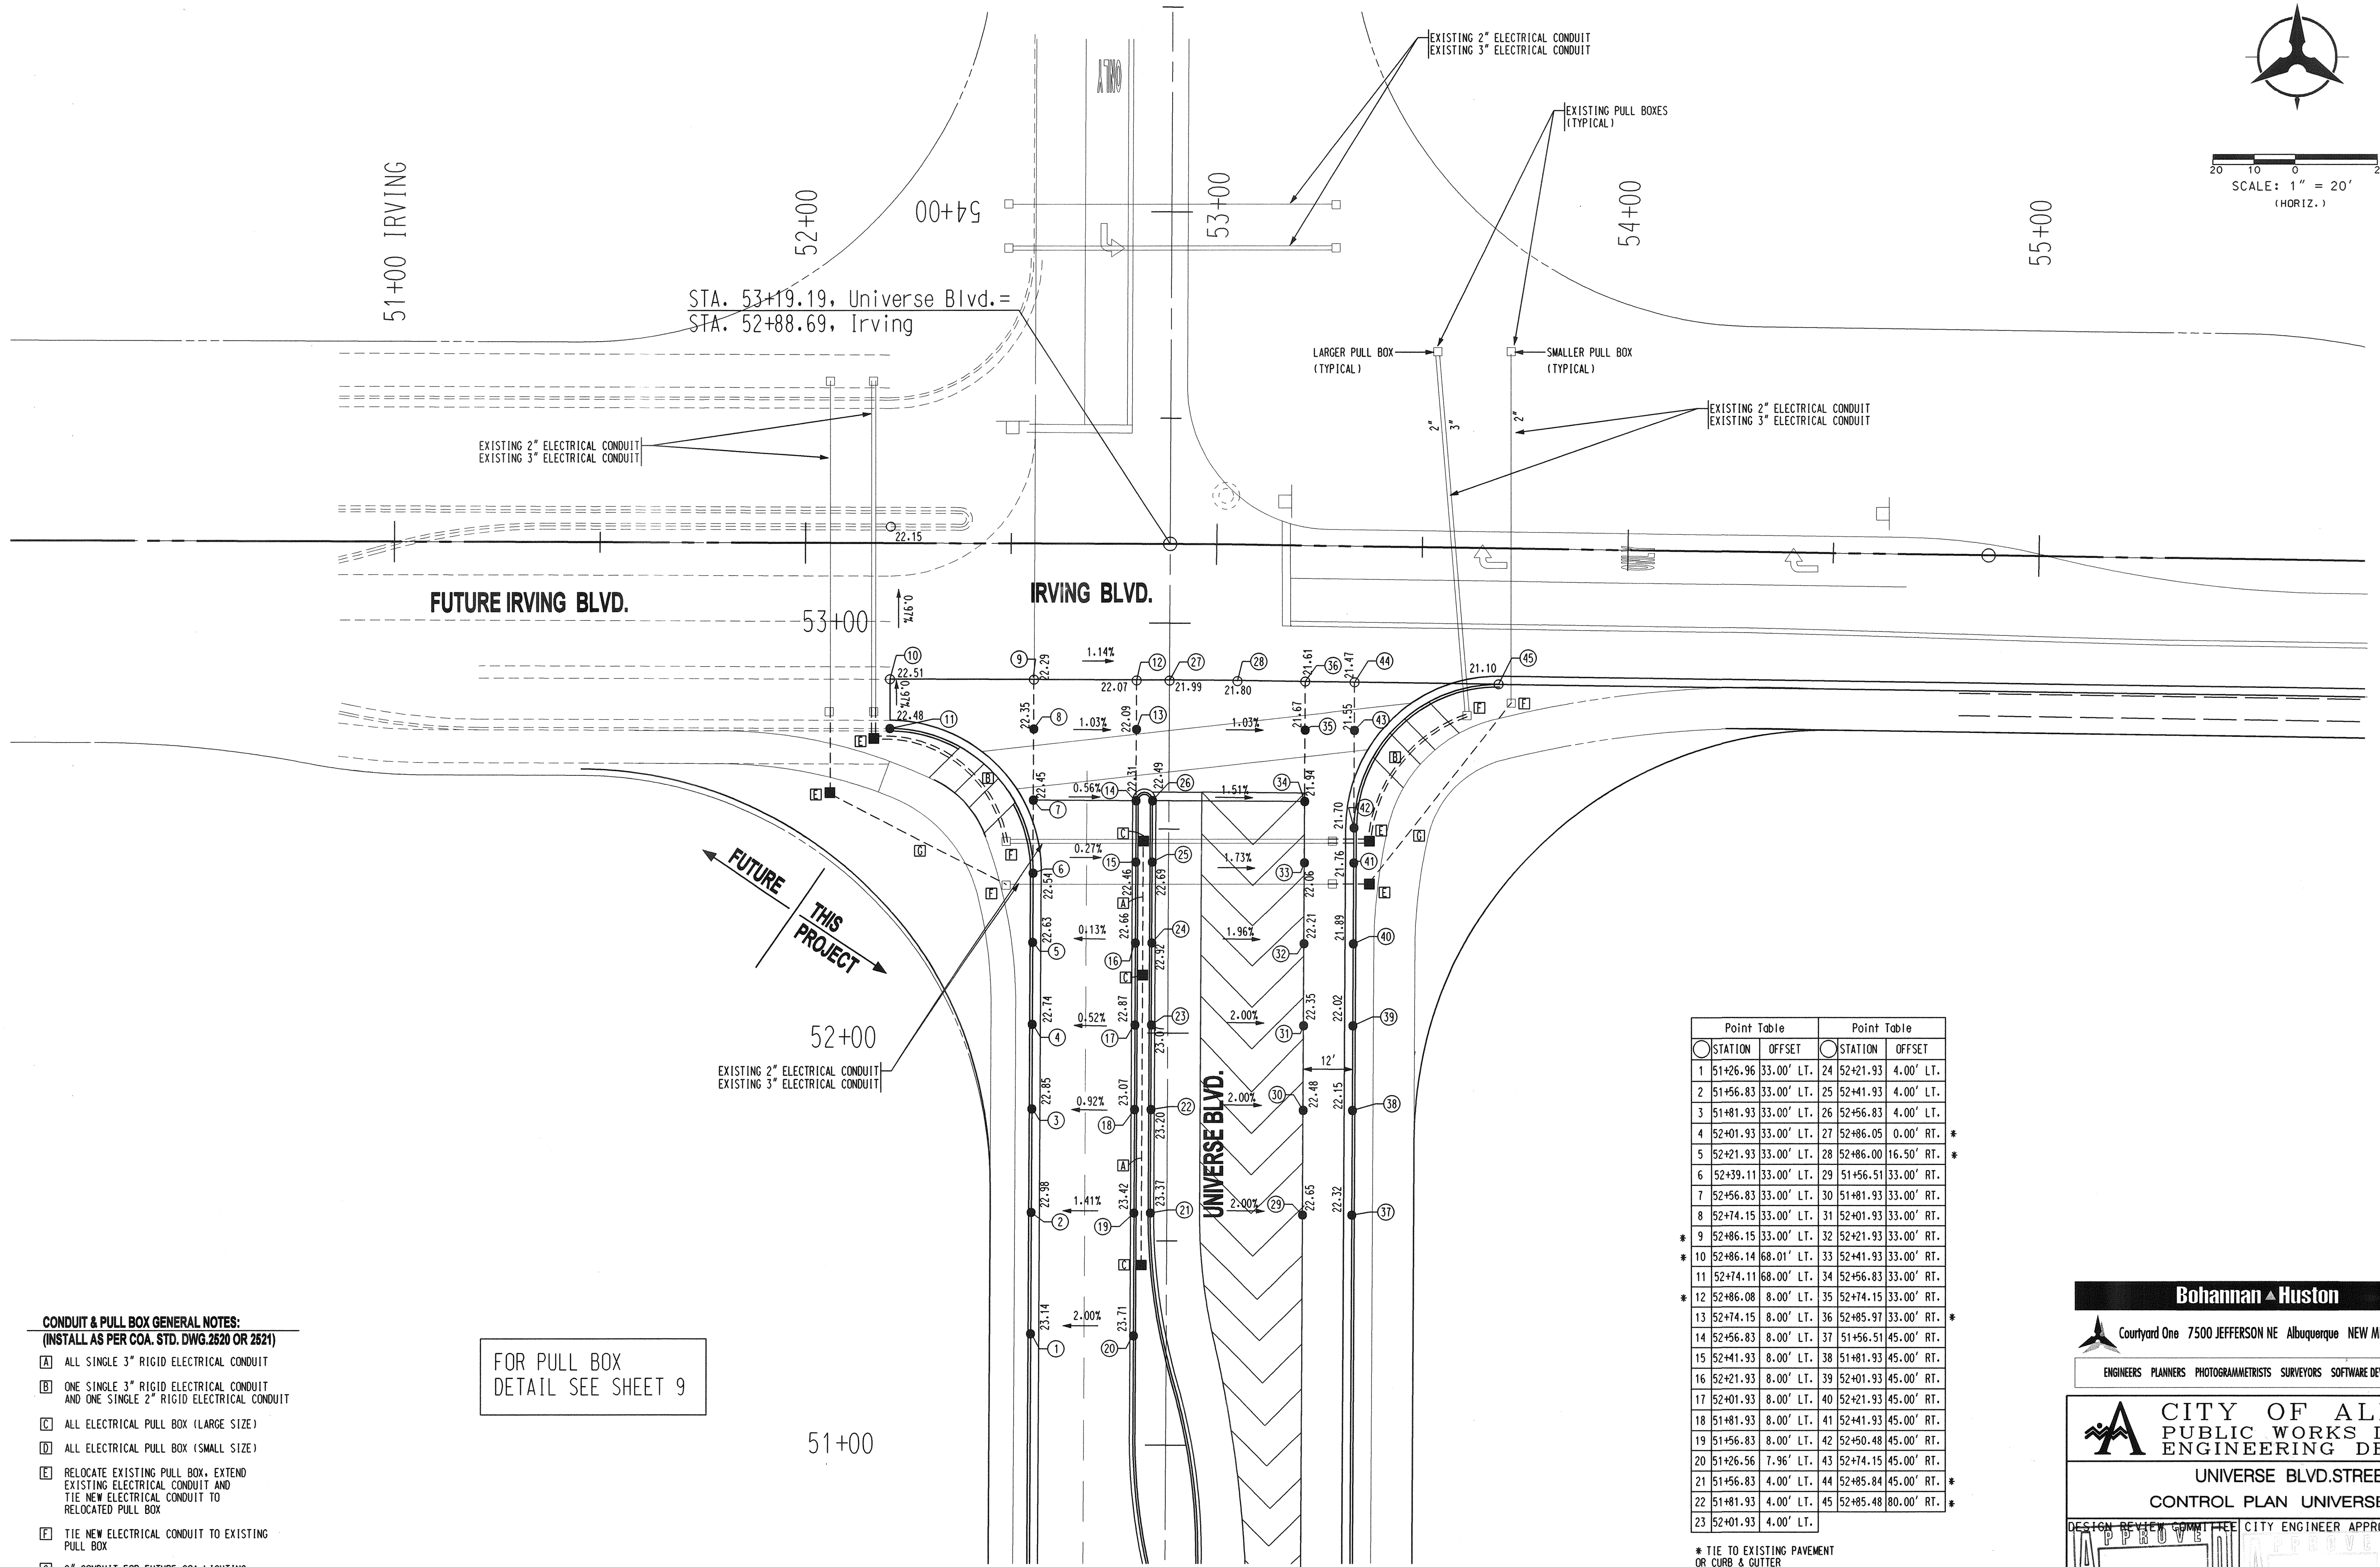

- CONDUIT & PULL BOX GENERAL NOTES:**
(INSTALL AS PER COA. STD. DWG. 2520 OR 2521)
- [A] ALL SINGLE 3" RIGID ELECTRICAL CONDUIT
 - [B] ONE SINGLE 3" RIGID ELECTRICAL CONDUIT AND ONE SINGLE 2" RIGID ELECTRICAL CONDUIT
 - [C] ALL ELECTRICAL PULL BOX (LARGE SIZE)
 - [D] ALL ELECTRICAL PULL BOX (SMALL SIZE)
 - [E] RELOCATE EXISTING PULL BOX, EXTEND EXISTING ELECTRICAL CONDUIT AND TIE NEW ELECTRICAL CONDUIT TO RELOCATED PULL BOX
 - [F] TIE NEW ELECTRICAL CONDUIT TO EXISTING PULL BOX
 - [G] 2" CONDUIT FOR FUTURE COA LIGHTING
 - [H] PROVIDE 3" RIGID CONDUIT STUB-OUT (5') AND CAP FOR FUTURE

FOR PULL BOX
DETAIL SEE SHEET 9

Point Table		Point Table	
STATION	OFFSET	STATION	OFFSET
1	51+26.96 33.00' LT.	24	52+21.93 4.00' LT.
2	51+56.83 33.00' LT.	25	52+41.93 4.00' LT.
3	51+81.93 33.00' LT.	26	52+56.83 4.00' LT.
4	52+01.93 33.00' LT.	27	52+86.05 0.00' RT.
5	52+21.93 33.00' LT.	28	52+86.00 16.50' RT.
6	52+39.11 33.00' LT.	29	51+56.51 33.00' RT.
7	52+56.83 33.00' LT.	30	51+81.93 33.00' RT.
8	52+74.15 33.00' LT.	31	52+01.93 33.00' RT.
9	52+86.15 33.00' LT.	32	52+21.93 33.00' RT.
10	52+86.14 68.01' LT.	33	52+41.93 33.00' RT.
11	52+74.11 68.00' LT.	34	52+56.83 33.00' RT.
12	52+86.08 8.00' LT.	35	52+74.15 33.00' RT.
13	52+74.15 8.00' LT.	36	52+85.97 33.00' RT.
14	52+56.83 8.00' LT.	37	51+56.51 45.00' RT.
15	52+41.93 8.00' LT.	38	51+81.93 45.00' RT.
16	52+21.93 8.00' LT.	39	52+01.93 45.00' RT.
17	52+01.93 8.00' LT.	40	52+21.93 45.00' RT.
18	51+81.93 8.00' LT.	41	52+41.93 45.00' RT.
19	51+56.83 8.00' LT.	42	52+50.48 45.00' RT.
20	51+26.56 7.96' LT.	43	52+74.15 45.00' RT.
21	51+56.83 4.00' LT.	44	52+85.84 45.00' RT.
22	51+81.93 4.00' LT.	45	52+85.48 80.00' RT.
23	52+01.93 4.00' LT.		

* TIE TO EXISTING PAVEMENT OR CURB & GUTTER

Bohannon & Huston
 Courtyard One 7500 JEFFERSON NE Albuquerque NEW MEXICO 87109
 ENGINEERS PLANNERS PHOTOGRAMMETRISTS SURVEYORS SOFTWARE DEVELOPERS

CITY OF ALBUQUERQUE
 PUBLIC WORKS DEPARTMENT
 ENGINEERING DEVELOPMENT GROUP

UNIVERSE BLVD. STREET IMPROVEMENTS
 CONTROL PLAN UNIVERSE BLVD./IRVING BLVD.

DESIGN REVIEW COMMITTEE CITY ENGINEER APPROVAL
 APR - 7 2003 APR 29 2003
 DESIGN REVIEW COMMITTEE CITY ENGINEER

CITY PROJECT NO. **702381** ZONE MAP NO. **B-9** SHEET **8** OF **19**

ENGINEER'S SEAL		BENCH MARKS		AS-BUILT INFORMATION	
		ACS BRASS TABLET STAMPED "1-B9 1980" GEOGRAPHIC POSITION (NAD 1927) N.M. STATE PLANE COORDINATES (CENTRAL ZONE) X=355,077.00 Y=1,529,056.93 GROUND-TO-GRID FACTOR = .99966334 DELTA ALPHA -00°16'47" NGVD 1929 ELEVATION = 5450.51		CONTRACTOR SUNDANCE WORK BY ALB SUPERVISOR'S ACCEPTANCE BY SEC DATE 9/23 FIELD LOCATION BY ALB DATE 9/23 DRAWINGS CORRECTED BY ALB DATE 9/23 MICRO-FILM INFORMATION RECORDED BY DATE	
		NO. 1 BOHANNAN-HUSTON INC. 8/95 DATE BY		NO. DATE BY	
NO. DATE REMARKS REVISIONS DESIGN		NO. DATE REMARKS REVISIONS DESIGN		NO. DATE REMARKS REVISIONS DESIGN	
DESIGNED BY YOP DRAWN BY DLM CHECKED BY KGP		DATE 03/2002 DATE 03/2002 DATE 03/2002		NO. DATE	

STRIPING & SIGNING GENERAL NOTES:

- ALL STRIPES ARE TO BE 4" UNLESS OTHERWISE SPECIFIED.
- ALL MEDIAN NOSES SHALL BE PAINTED REFLECTIVE YELLOW.
- EACH SIGN FACE SHOWN ON THE PLANS SHALL MEET THE SPECIFICATIONS IN THE STANDARD HIGHWAY SIGNS MANUAL (1979 EDITION) FOR PROPER ARRANGEMENT, SPACING OF LETTERS, LETTER HEIGHT, LETTER SERIES, SYMBOLS, AND BORDERS FOR THE SPECIFIED SIZE AND MESSAGE AS SHOWN ON PLANS.
- ALL SIGNS SHALL BE ALUMINUM.
- POST LENGTHS AND SECTIONS ARE BASED ON 7'-0" CLEARANCE HEIGHT FROM THE TOP OF SIDEWALK TO THE BOTTOM OF THE SIGN. FINAL POST LENGTHS AND SECTIONS ARE TO BE DETERMINED IN THE FIELD.
- PAVEMENT MARKINGS SHALL CONFORM TO THE REQUIREMENTS OF THE SUPPLEMENTAL TECHNICAL SPECIFICATION SECTION 440 FOR THE REFINISHED PLASTIC PAVEMENT SYMBOLS, LEGENDS, STRIPES, AND MARKINGS. **PERFORMED**
- FOR EXACT LOCATION OF SIGNING, CONTACT ED TOLEDO AT 857-8004.

GENERAL STRIPING & SIGNING LEGEND


- REFLECTORIZED LEFT TURN ARROW (PREFORMED PLASTIC)
- REFLECTORIZED RIGHT TURN ARROW (PREFORMED PLASTIC)
- REFLECTORIZED STRAIGHT ARROW (PREFORMED PLASTIC)
- REFLECTORIZED "ONLY"
- EXISTING SIGN
- PROPOSED SIGN
- EXISTING TYPE III BARRICADE
- PROPOSED STREET LIGHT
- EXISTING STREET LIGHT

STRIPING LEGEND


- 4" SOLID YELLOW REFLECTIVE STRIPE
- 4" DOUBLE SOLID YELLOW REFLECTIVE STRIPE
- 4" DASHED WHITE REFLECTIVE STRIPE (10' STRIPE, 30' SKIP)
- 4" SOLID WHITE REFLECTIVE STRIPE
- 4" DASHED YELLOW REFLECTIVE STRIPE (10' STRIPE, 30' SKIP)
- 12" SOLID WHITE REFLECTIVE STOP BAR STRIPE
- 12" SOLID WHITE REFLECTIVE CROSSWALK STRIPE
- REMOVE 4" DOUBLE YELLOW & REPLACE WITH 4" DASHED REFLECTIVE PLASTIC STRIPE (10' STRIPE, 30' GAP)
- INSTALL CHEVRONS AT 10' SPACING, 45° ANGLE OF 4" WHITE REFLECTIVE PLASTIC. (SEE DETAIL THIS SHEET)
- NOSE TO BE PAINTED REFLECTIVE YELLOW

CONDUIT & PULL BOX GENERAL NOTES: (INSTALL AS PER COA, STD. DWG. 2620 OR 2621)


- ALL SINGLE 3" RIGID ELECTRICAL CONDUIT
- ALL DOUBLE 3" RIGID ELECTRICAL CONDUIT
- ALL ELECTRICAL PULL BOX (LARGE SIZE)
- PROVIDE 3" RIGID CONDUIT STUB-OUT (5') AND CAP FOR FUTURE
- CAP RIGID CONDUIT FOR FUTURE JUST BEYOND NEW PAVEMENT LIMITS
- 2" CONDUIT FOR FUTURE LIGHTING

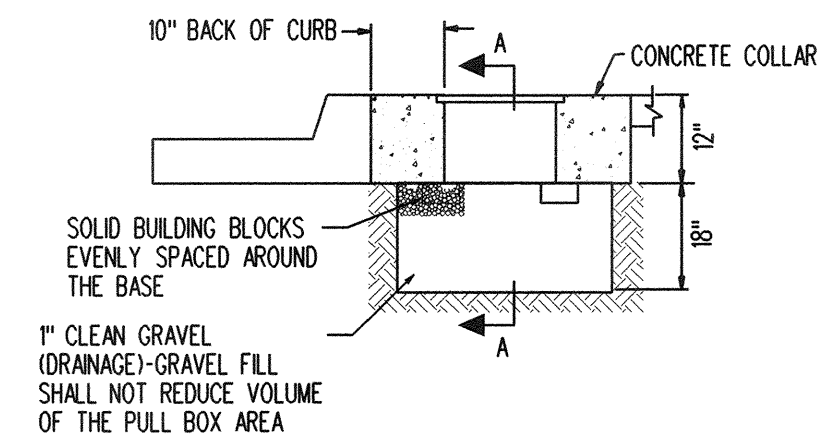


TYPICAL PULL BOX INSTALLATION
NOTE: SEE "CONCRETE COLLAR DETAIL"

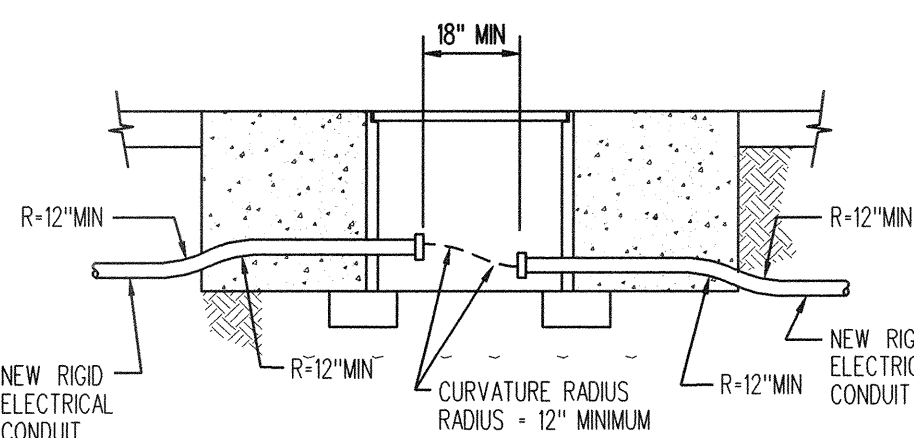


TRAFFIC SIGNAL PULL BOX (TYPICAL)
NEW CONDUIT INSTALLATION

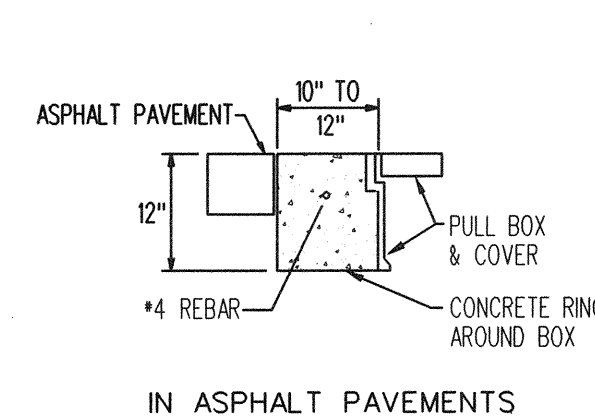

CONCRETE COLLAR DETAILS
NOTE: THE CONCRETE COLLAR FOR THE PULL BOXES WILL BE CONSIDERED INCIDENTAL TO THE PULL BOX BID ITEMS

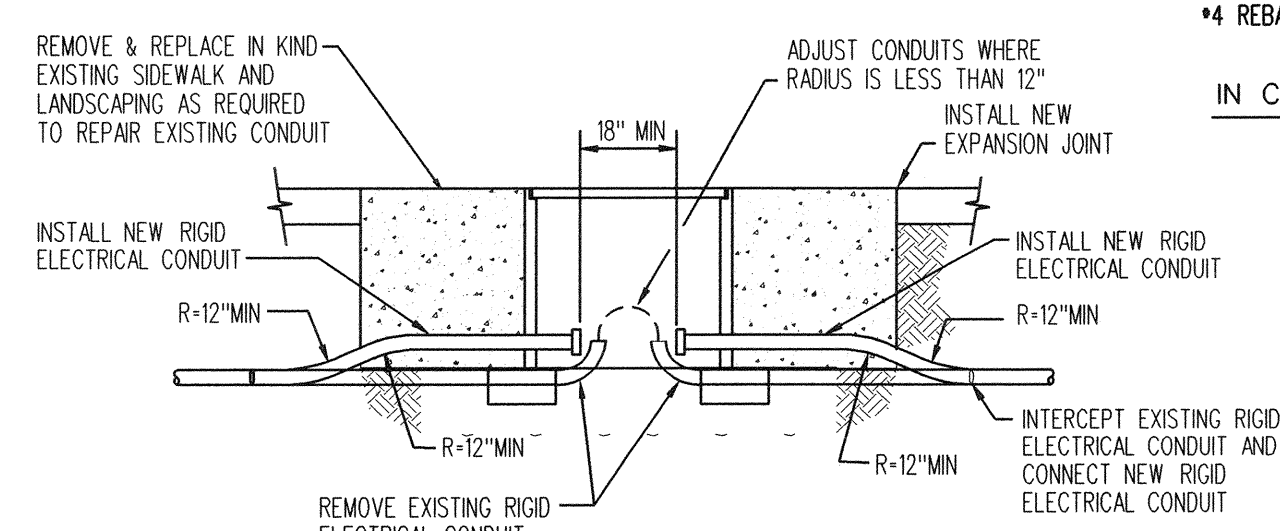

TRAFFIC SIGNAL PULL BOX (TYPICAL)
RETROFIT INSTALLATION

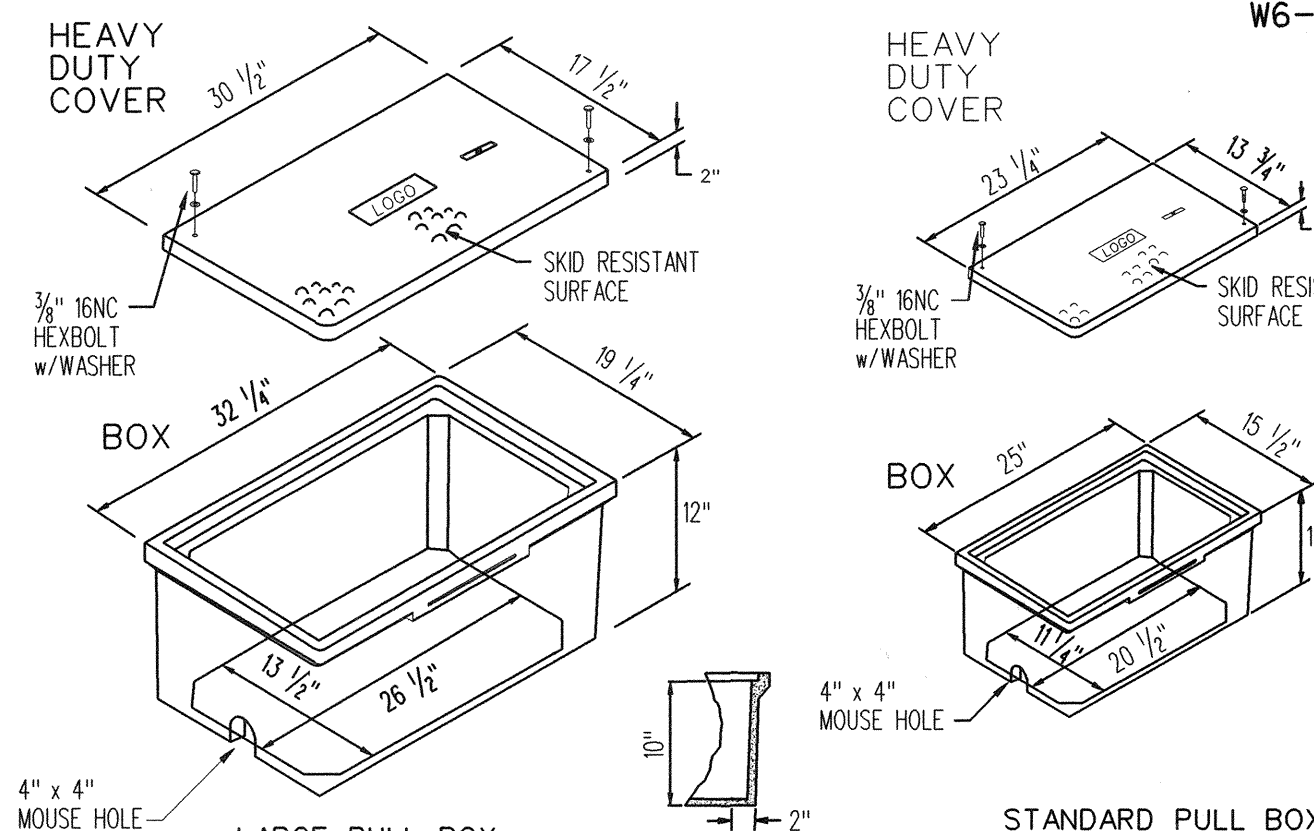

NOTES FOR HEAVY DUTY REINFORCED POLYMER MORTAR PULL BOX AND COVERS

- MATERIAL TO BE AN AGGREGATE CONSISTING OF SAND AND GRAVEL BOUND TOGETHER WITH A POLYMER AND REINFORCED WITH CONTINUOUS WOVEN GLASS STRANDS. THE MATERIAL MUST HAVE THE FOLLOWING MECHANICAL PROPERTIES:
COMPRESSIVE STRENGTH - 11,000 PSI, TENSILE STRENGTH - 1,700 PSI, FLEXURAL STRENGTH - 7,500 PSI
- ALL PULL BOX COVERS SHALL BE HEAVY DUTY REINFORCED POLYMER MORTAR, HAVING A SERVICE LOAD OF 22,568 LBS. OVER 10" SQUARE (225 PSI).
- PULL BOX TYPE AND LOGO SHALL BE APPROVED BY THE PROJECT MANAGER.
- THE DIMENSIONS OF THE PULL BOXES SHOWN ARE NOMINAL DIMENSIONS AND MAY VARY AS TO THE MANUFACTURER'S RECOMMENDATIONS. ALL DIMENSIONS SHALL BE VERIFIED BY THE PROJECT MANAGER.
- ELECTRICAL PULL BOX (STANDARD) SHALL BE A HEAVY DUTY REINFORCED POLYMER MORTAR PULL BOX AND COVER MEASURING 13 3/4" x 23 3/4" x 2".

Bohannon & Huston
Court yard | 7500 Jefferson St. NE Albuquerque, NM 87109-4335
ENGINEERING & SPATIAL DATA & ADVANCED TECHNOLOGIES

CITY OF ALBUQUERQUE
PUBLIC WORKS DEPARTMENT
ENGINEERING DEVELOPMENT GROUP

UNIVERSE BLVD. STREET IMPROVEMENTS
STRIPING, SIGNING, INTERCONNECT AND PULL BOX DETAILS

DESIGN REVIEW COMMITTEE	CITY ENGINEER APPROVAL	MO. 7 DAY / YR.
APR - 7 2003	APR 29 2003	
DESIGN REVIEW COMMITTEE	CITY ENGINEER	
CITY PROJECT NO.	ZONE - MAP NO.	SHEET OF
702381	B-9	9 19

1. CONTRACTOR MUST OBTAIN FROM CONSTRUCTION COORDINATION AN EXCAVATION/BARRICADING PERMIT BEFORE ENGAGING IN ANY CONSTRUCTION, MAINTENANCE OR REPAIR WORK IN ANY OF THE CITY OF ALBUQUERQUE'S RIGHTS-OF-WAY. EMERGENCY WORK THAT WOULD PRESERVE LIFE OR PROPERTY IS EXCLUDED WITHIN THE UNDERSTANDING, THAT A PERMIT SHALL BE OBTAINED WITHIN 24 TO 48 HOURS.

3. THESE TYPICAL TRAFFIC CONTROL PLANS DO NOT REFLECT THE EXISTING TOPOGRAPHY SUCH AS DRIVEWAYS, LANE WIDTHS, AND BUSINESS/RESIDENTIAL ACCESSES. EVERY LOCATION THAT REQUIRES CONSTRUCTION TRAFFIC CONTROL SHALL HAVE A DETAILED TRAFFIC CONTROL PLAN SHOWING ALL EXISTING TOPOGRAPHY.

5. CONSTRUCTION COORDINATION SHALL BE NOTIFIED 48 HOURS PRIOR TO ANY TRAFFIC CONTROL CHANGES NEEDED BY CONTRACTOR, THAT WERE NOT PREVIOUSLY APPROVED. THESE TRAFFIC CONTROL CHANGES SHALL BE REQUESTED IN WRITING ACCOMPANIED WITH A TRAFFIC CONTROL PLAN REFLECTING SUCH CHANGES.

7. THE CONSTRUCTION TRAFFIC CONTROL INITIAL SET-UP SHALL BE BY AN AMERICAN TRAFFIC SAFETY SERVICES ASSOCIATION (ATSSA) CERTIFIED WORKSITE TRAFFIC SUPERVISOR. THE MAINTENANCE AND SERVICING SHALL ALSO BE DONE BY AN ATSSA CERTIFIED WORKSITE TRAFFIC SUPERVISOR OR EQUIVALENT.

9. ALL ADVANCE WARNING SIGNS SHALL BE DOUBLE INDICATED WHENEVER THERE ARE MULTI-LANE TRAFFIC IN ANY ONE GIVEN DIRECTION AND THERE IS SUFFICIENT MEDIAN SPACE.

11. ALL WORK IN ARTERIAL ROADWAYS SHALL BE ON A CONTINUOUS 24 HOUR PER DAY BASIS UNTIL COMPLETED.

13. EQUIPMENT OR MATERIALS SHALL NOT BE STORED WITHIN 15 FEET OF A TRAVELED TRAFFIC LANE DURING NON-WORKING HOURS WITHOUT THE APPROVAL OF CONSTRUCTION COORDINATION.

15. CONTRACTOR IS RESPONSIBLE FOR OBLITERATION OF ANY CONFLICTING STRIPING AND RESPONSIBLE FOR ALL TEMPORARY STRIPING.

17. CONTRACTOR SHALL PROVIDE ACCESS SIGNS FOR BUSINESSES LOCATED WITHIN THE CONSTRUCTION AREA UNDER THE SUPERVISION OF CONSTRUCTION COORDINATION. EACH ACCESS SIGN SHALL HAVE 5 INCH, WHITE OPAQUE LETTERING ON BLUE REFLECTORIZED BACKGROUND. ACCESS SIGNS SHALL BE CONSIDERED INCIDENTAL TO THE BID AND NOT PART OF THE CONTRACT UNLESS OTHERWISE STATED. NO MORE THAN 3 BUSINESSES SHALL BE LISTED ON A ACCESS SIGN. SHOPPING CENTERS AND MALLS SHALL BE LISTED AS SUCH.

19. 48 HOURS PRIOR TO OCCUPYING OR CLOSING OF A RIGHT-OF-WAY, CONTRACTOR SHALL NOTIFY: POLICE, FIRE DEPARTMENT, SCHOOLS, HOSPITALS, TRANSIT AUTHORITY, BUSINESSES AND/OR RESIDENTS THAT WILL BE AFFECTED BY THE CONSTRUCTION.

21. EXCAVATIONS SHALL BE PLATED, TEMPORARILY PATCHED OR RESURFACED PRIOR TO OPENING OF TRAFFIC. A MINIMUM OF 11 FEET SHALL BE PROVIDED FOR TRAFFIC IN ANY GIVEN DIRECTION. CONTRACTOR IS RESPONSIBLE FOR ANY WORK INVOLVED IN SATISFYING THESE REQUIREMENTS.

22. CONTRACTOR SHALL AT ALL TIMES COMPLY WITH THE FOLLOWING:

1. STANDARDS AND REQUIREMENTS SET FORTH IN THE MANUAL ON UNIFORM TRAFFIC CONTROL DEVICES, LATEST EDITION.
2. THE CITY OF ALBUQUERQUE TRAFFIC CODE, LATEST EDITION.
3. SECTION 19 OF THE CITY OF ALBUQUERQUE'S STANDARD SPECIFICATIONS FOR PUBLIC WORK CONSTRUCTION, AS WELL AS OTHER SECTIONS.

23. FAILURE TO COMPLY WITH ANY OF THE ABOVE MENTIONED, WILL BE ADEQUATE CAUSE TO CEASE ALL WORK ON ANY CONSTRUCTION PROJECT. WORK WILL NOT RESUME UNTIL ALL REQUIREMENTS ARE ADDRESSED AND APPROVED BY CONSTRUCTION COORDINATION.

24. ALL TRAFFIC CONTROL DEVICES SHALL BE KEPT IN NEW-CLEAN CONDITION, WASHING OF EQUIPMENT IS INCIDENTAL TO IT'S PLACEMENT AND MAINTENANCE.

25. TRAFFIC CONTROL STANDARDS APPLY ONLY WHERE THE CONSTRUCTION TRAFFIC CONTROL PLANS ARE NOT SPECIFIC.

26. ADVANCE WARNING SIGNS SHALL BE 36"x36" MIN. WITH SUPER ENGINEERING GRADE SHEETING OR BETTER. MOUNTING HEIGHT AT TOP OF SIGN SHALL BE THE SAME AS FOR A 48" SIGN AS INDICATED IN THE M.U.T.C.D.

27. CONTRACTOR SHALL MAINTAIN A GRAFFITI-FREE WORKSITE. ALL GRAFFITI SHALL BE PROMPTLY REMOVED FROM ALL EQUIPMENT, BOTH PERMANENT AND TEMPORARY.

1. TWO-WAY TRAFFIC MUST BE MAINTAINED AT ALL TIMES ON UNIVERSE BLVD. BETWEEN PARADISE BLVD. AND VENTANA RD.
2. BARRICADING OF EXISTING LANES ON UNIVERSE BLVD. IS SUBJECT TO ARTERIAL/ COLLECTOR ROAD USAGE FEES OF \$0.01 PER SQUARE FOOT OF BARRICADED AREA PER DAY.
3. MINIMUM DAILY BARRICADE PERMIT FEES OF \$21.00 PER DAY WILL BE ASSESSED ON THE BARRICADE PERMIT WHILE BARRICADES ARE PRESENT ALONG UNIVERSE BLVD.
4. CONTRACTOR SHALL ERADICATE ALL CONFLICTING STRIPING DURING CONSTRUCTION, AND FOLLOWING COMPLETION OF THIS PROJECT.



	WORK AREA
•	BARRICADE — TYPE I, TYPE II, OR BARREL
●	BARRICADE — TYPE III
×	VERTICAL PANEL
X	WARNING SIGN
D	DISTANCE BETWEEN SIGNS — A DISTANCE MEASURED IN FEET EQUAL TO A VALUE OF TEN TIMES THE SPEED LIMIT OF THE STREET
	FLAGMAN POSITION
S	SPACING BETWEEN BARRICADES — A DISTANCE MEASURED IN FEET EQUAL TO THE STREET LIMIT OF THE STREET
L	TAPER LENGTH — SEE CHART BELOW

THE TANGENT LENGTH IS EQUAL TO THE TAPER LENGTH FOR A GIVEN STREET.

SPEED LIMIT (MPH)	TAPER LENGTH(L) (FEET)			MINIMUM NUMBER OF DEVICES FOR TAPER	MAXIMUM DEVICE SPACING IN FEET	
	10' LANE	11' LANE	12' LANE		ALONG TAPER	AFTER TAPER
20	70	75	80	5	20	20
25	105	115	125	6	25	25
30	150	165	180	7	30	30
35	205	225	245	8	35	35
40	270	295	320	9	40	40
45	450	495	540	13	45	45
50	500	550	600	13	50	50
55	550	605	660	13	55	55

SPEED MILES PER HOUR	MINIMUM BETWEEN SIGNS	DISTANCE IN FEET FROM LAST SIGN TO TAPER
0-20	10 X SPEED LIMIT	10 X SPEED LIMIT
25-30	10 X SPEED LIMIT	10 X SPEED LIMIT
30-35	10 X SPEED LIMIT	10 X SPEED LIMIT
40-45	10 X SPEED LIMIT	10 X SPEED LIMIT
50-60	10 X SPEED LIMIT	10 X SPEED LIMIT














TYPE OF TAPER	TAPER LENGTH
UPSTREAM TAPER:	
MERGING TAPER	L MINIMUM
SHIFTING TAPER	1/2 L MINIMUM
SHOULDER TAPER	1/2 L MINIMUM
TWO-WAY TRAFFIC TAPER	100 FEET MAXIMUM
DOWNSTREAM TAPERS	100 FEET PER LANE

SPEED LIMIT	
40 MPH OR LESS	$L = \frac{WS^2}{60}$
40 MPH OR GREATER	$L = W \times S$

L = TAPER LENGTH
W = WIDTH OF OFFSET IN FEET
S = POSTED SPEED OR OFF-PEAK
85-PERCENTILE SPEED IN MPH

BHI JOB #020169001

DATE: DECEMBER, 2002

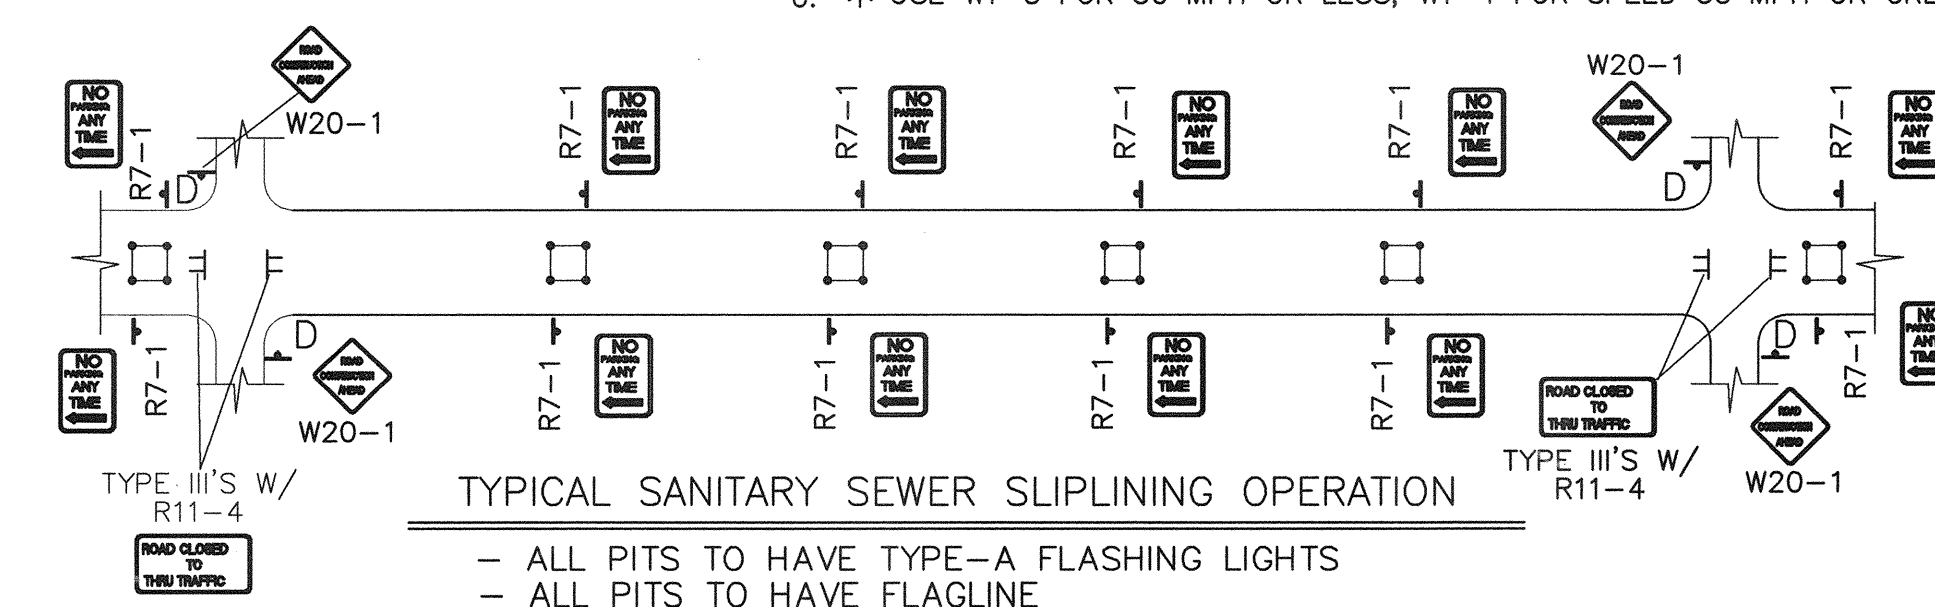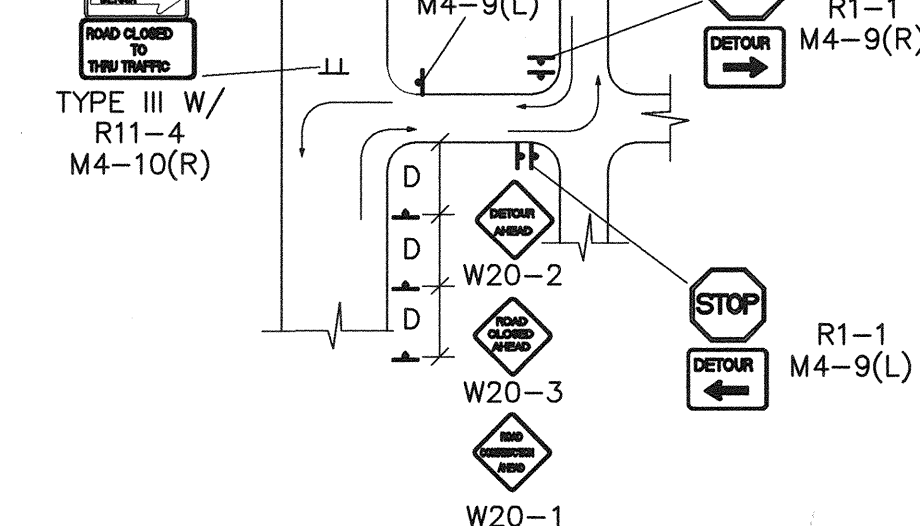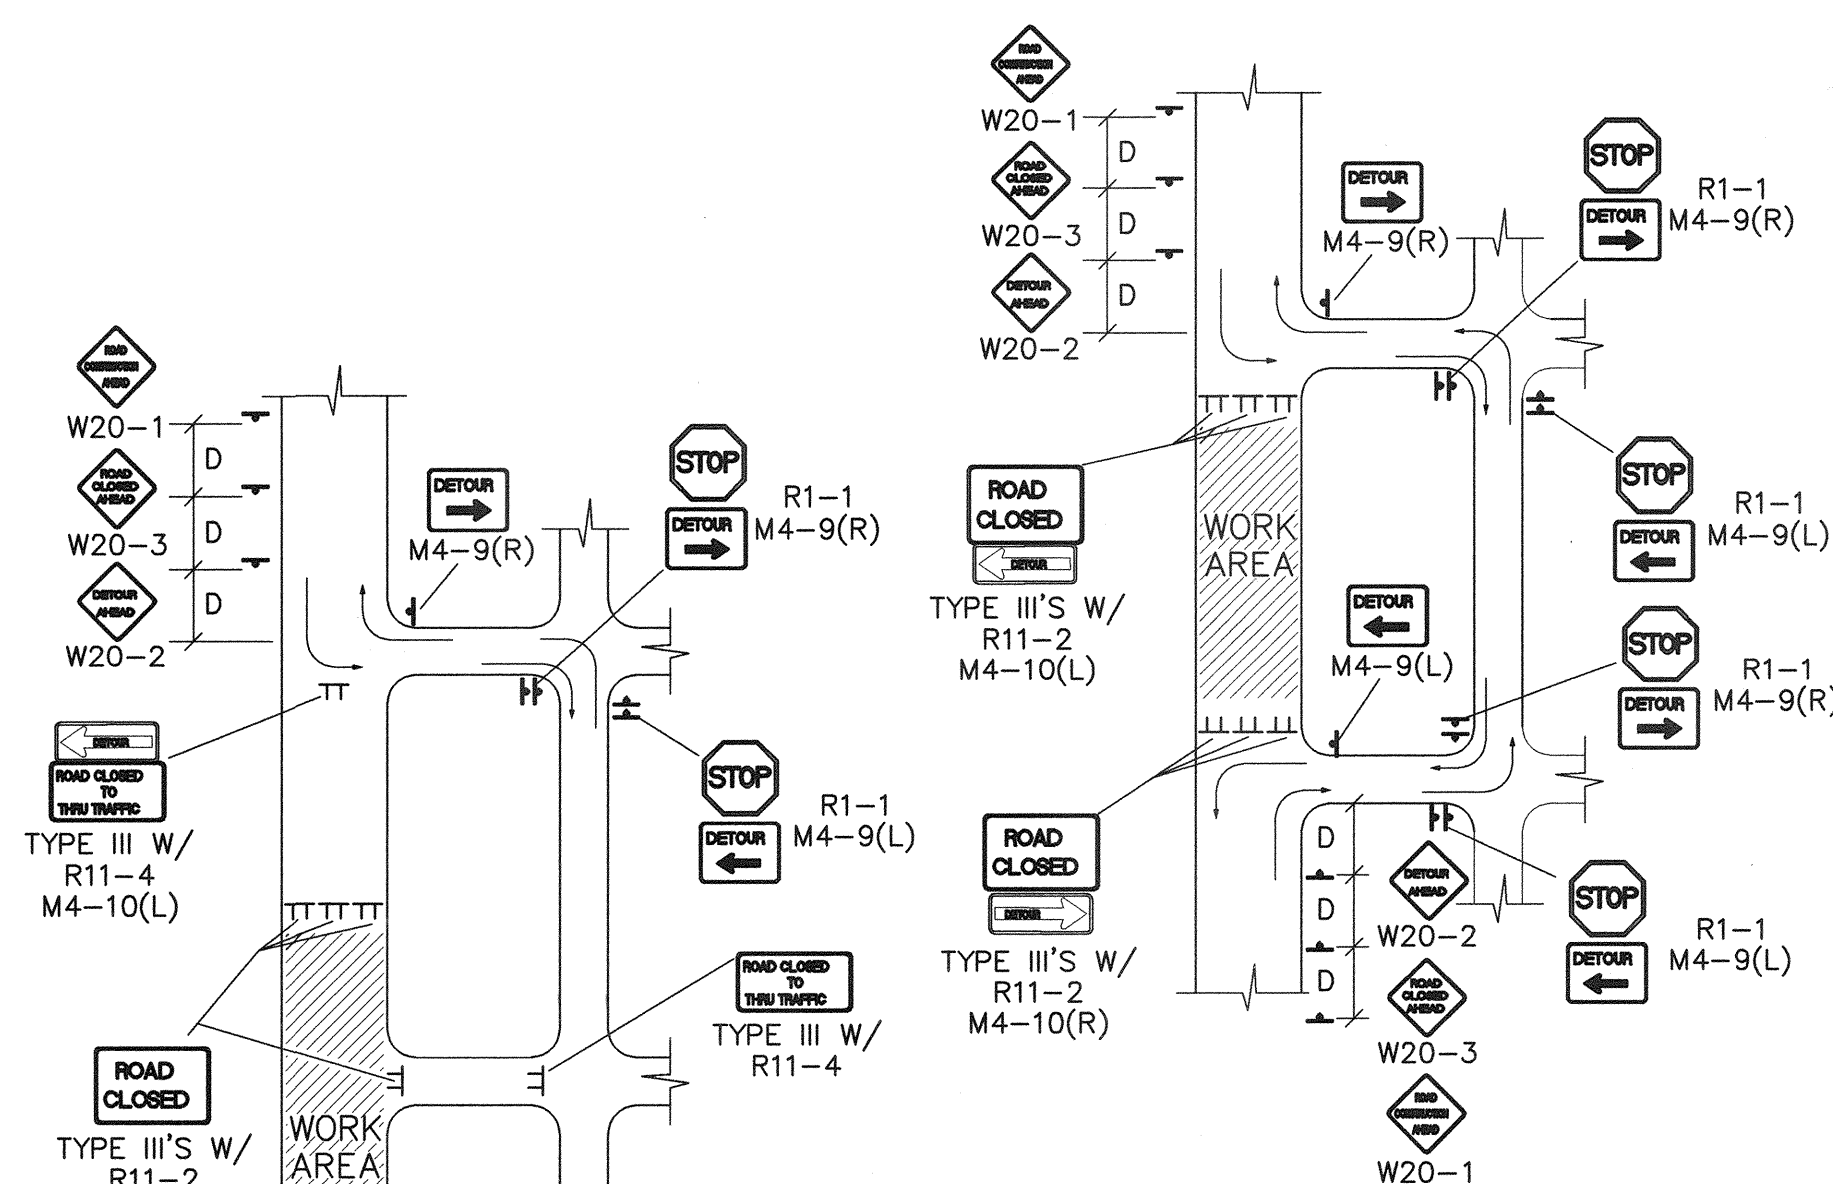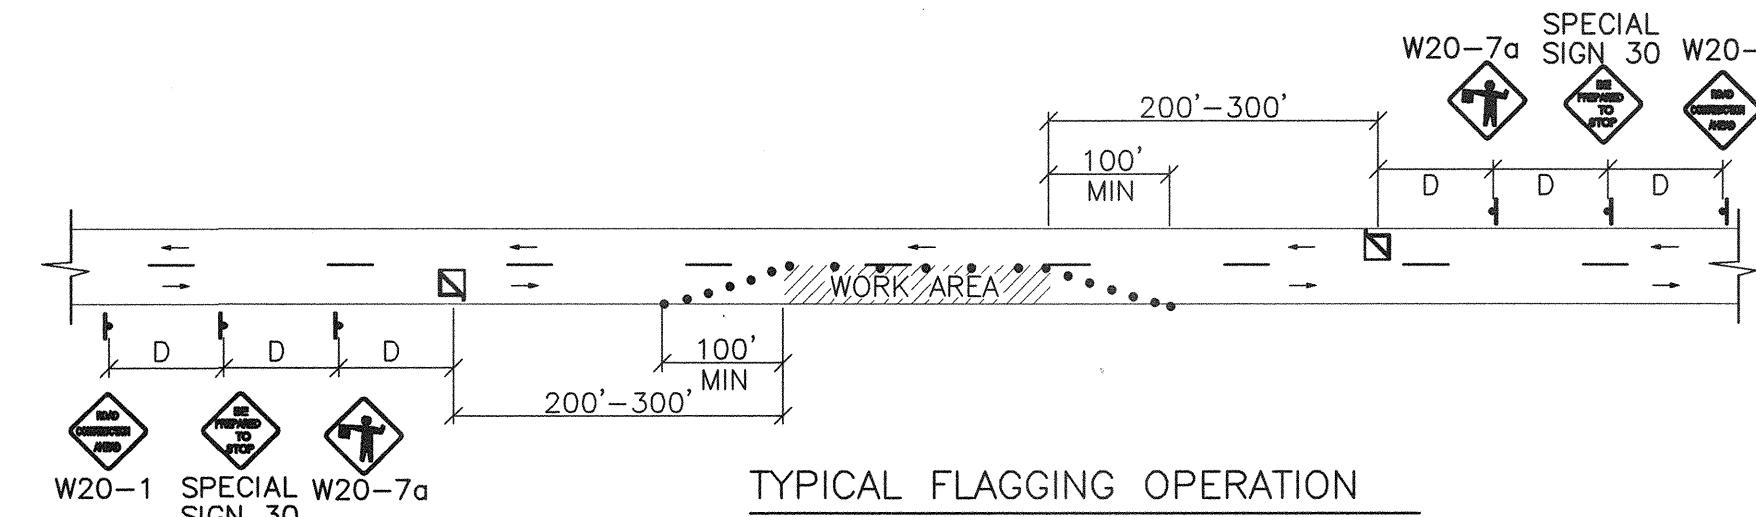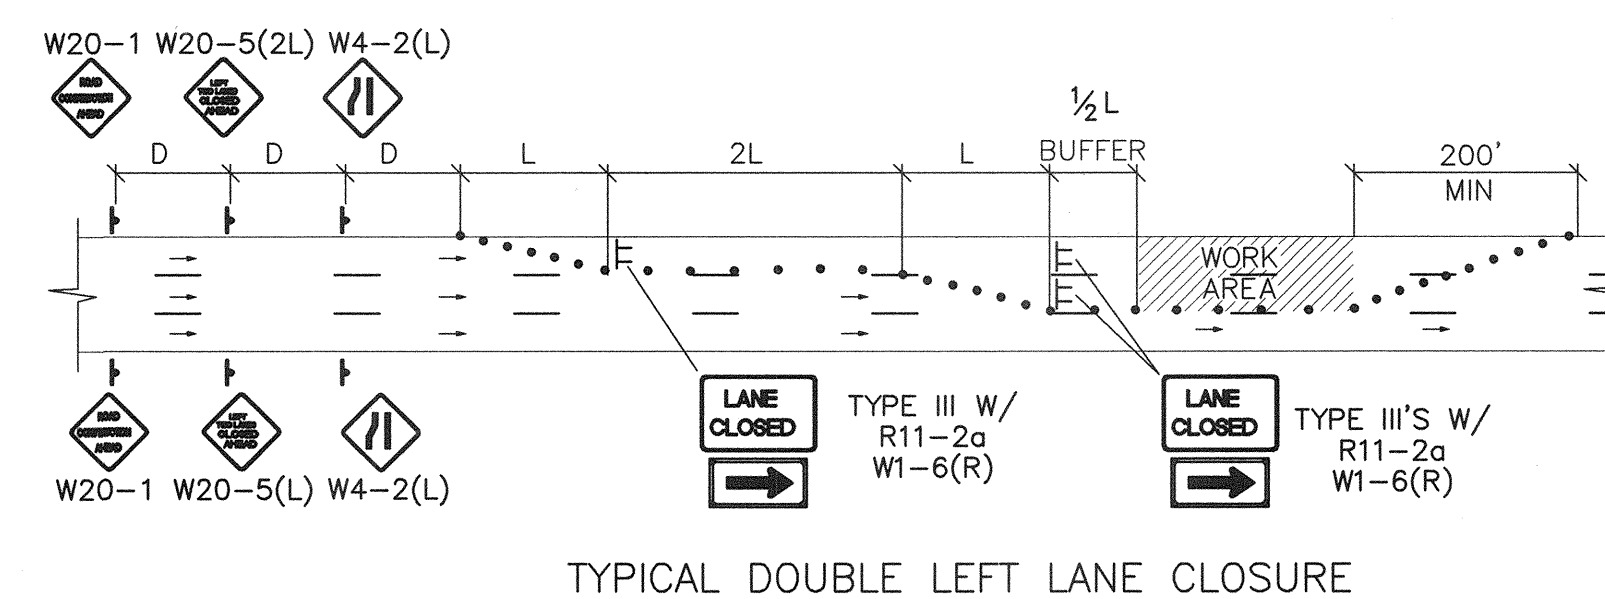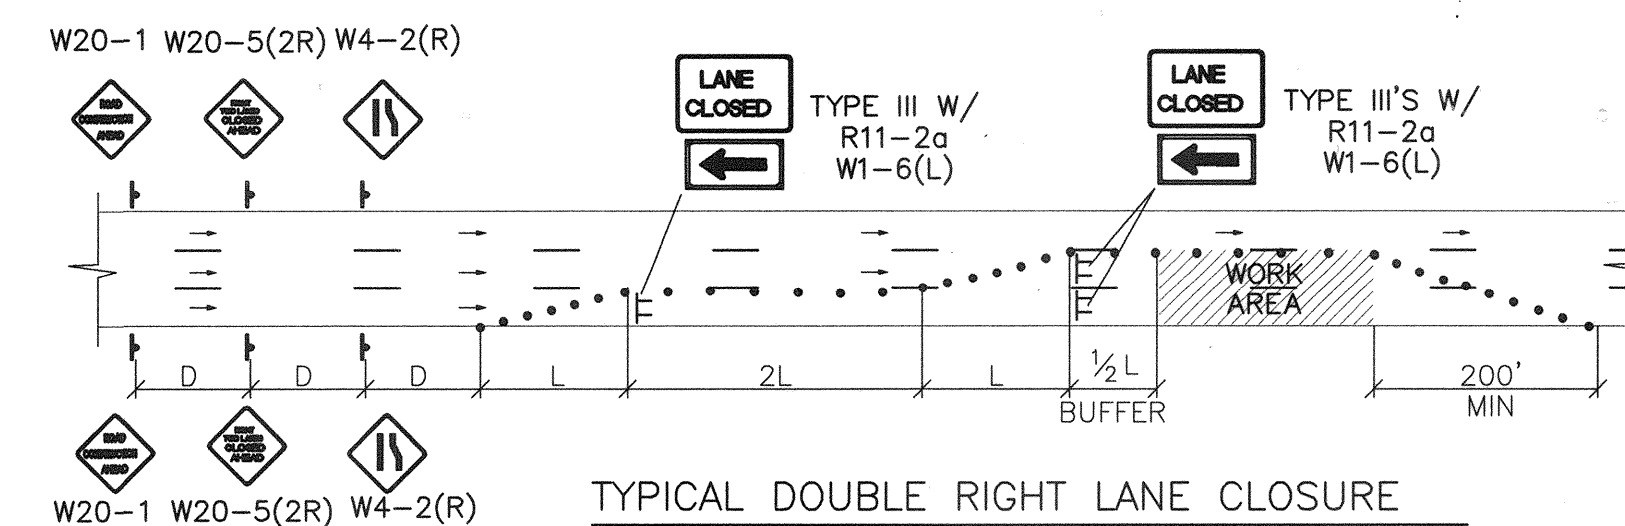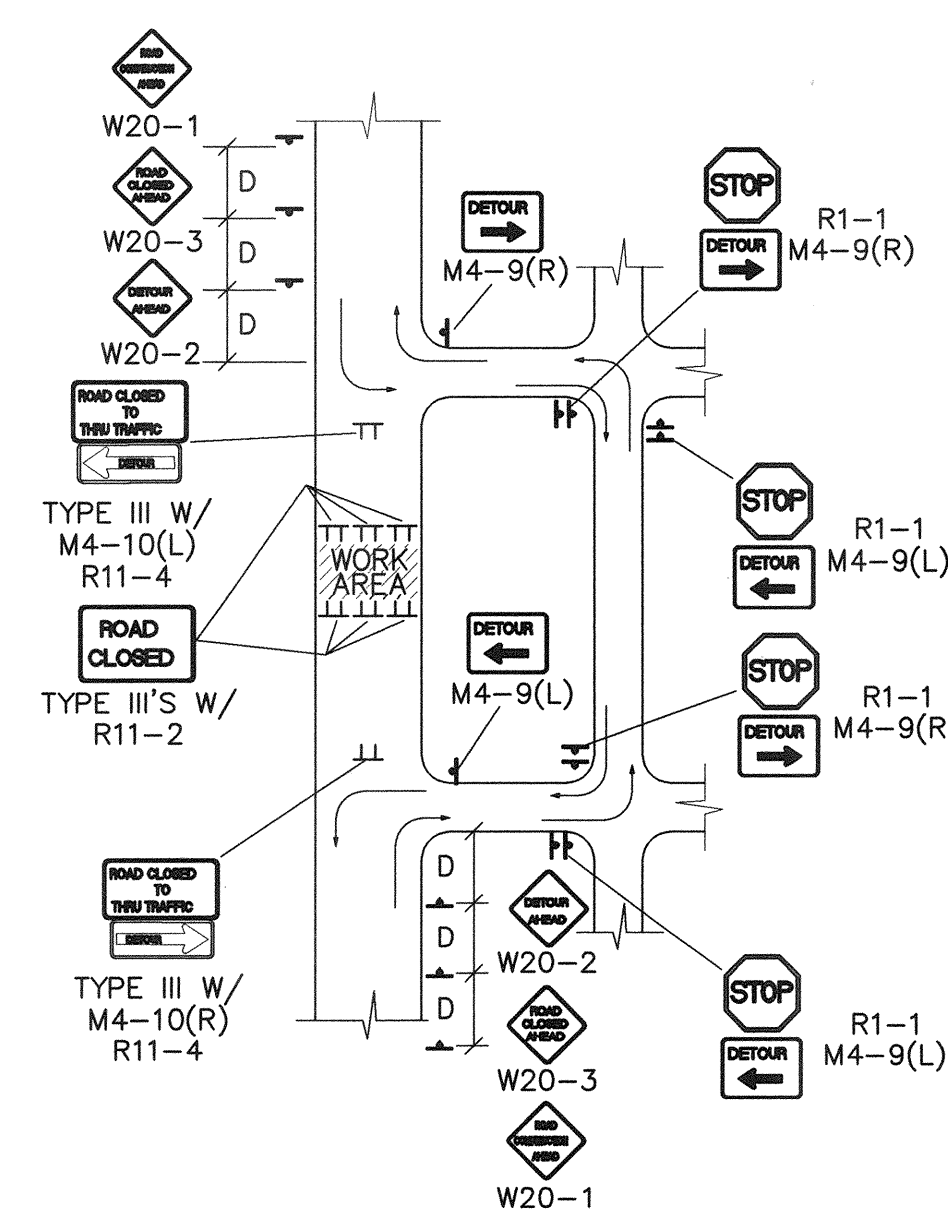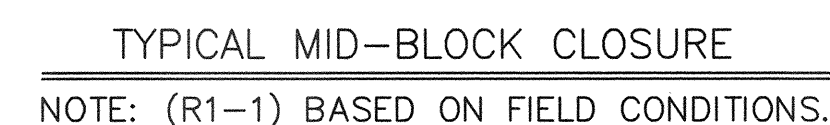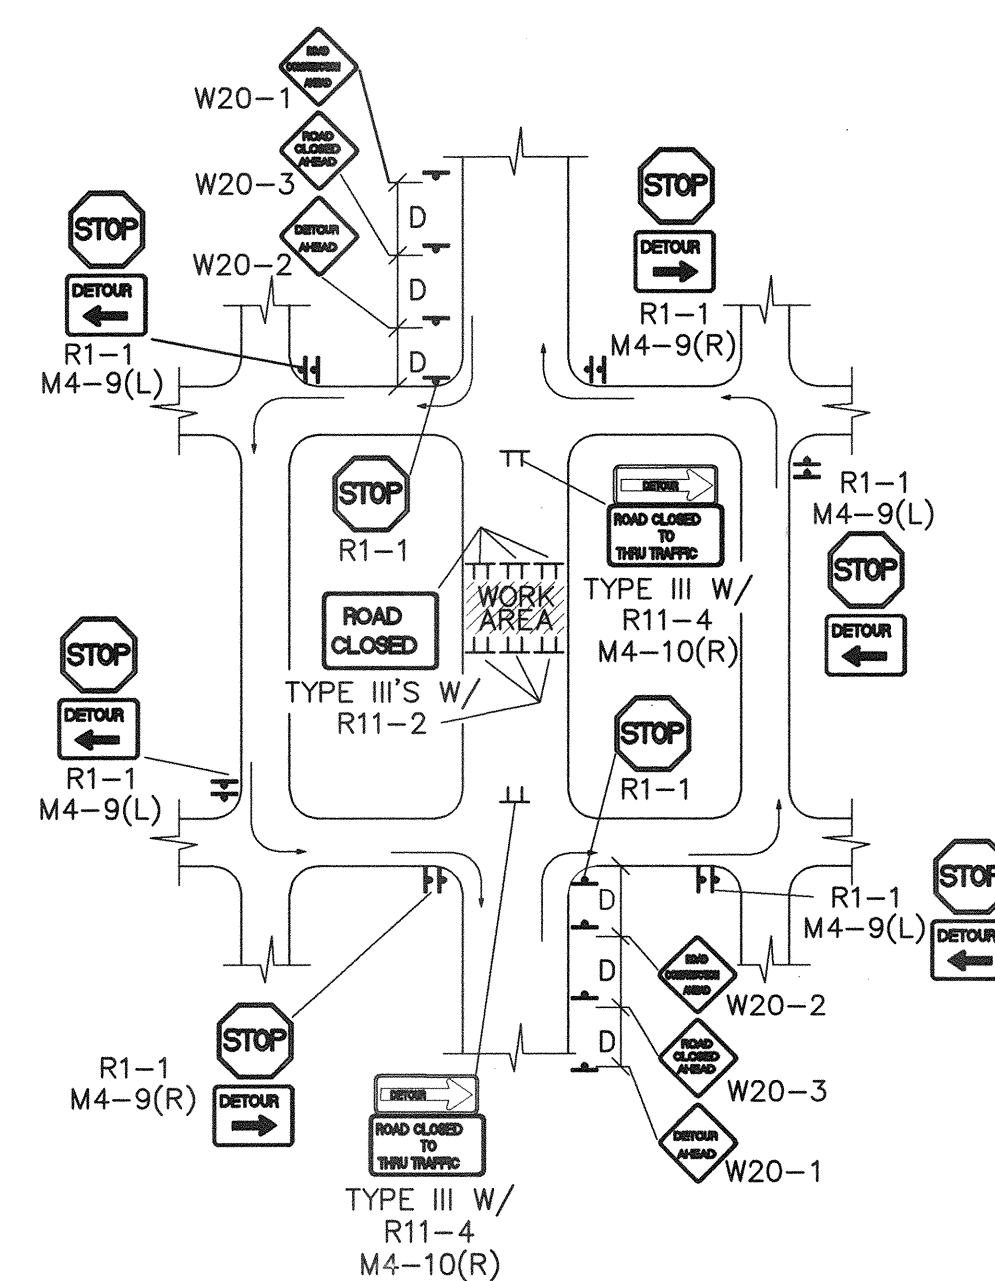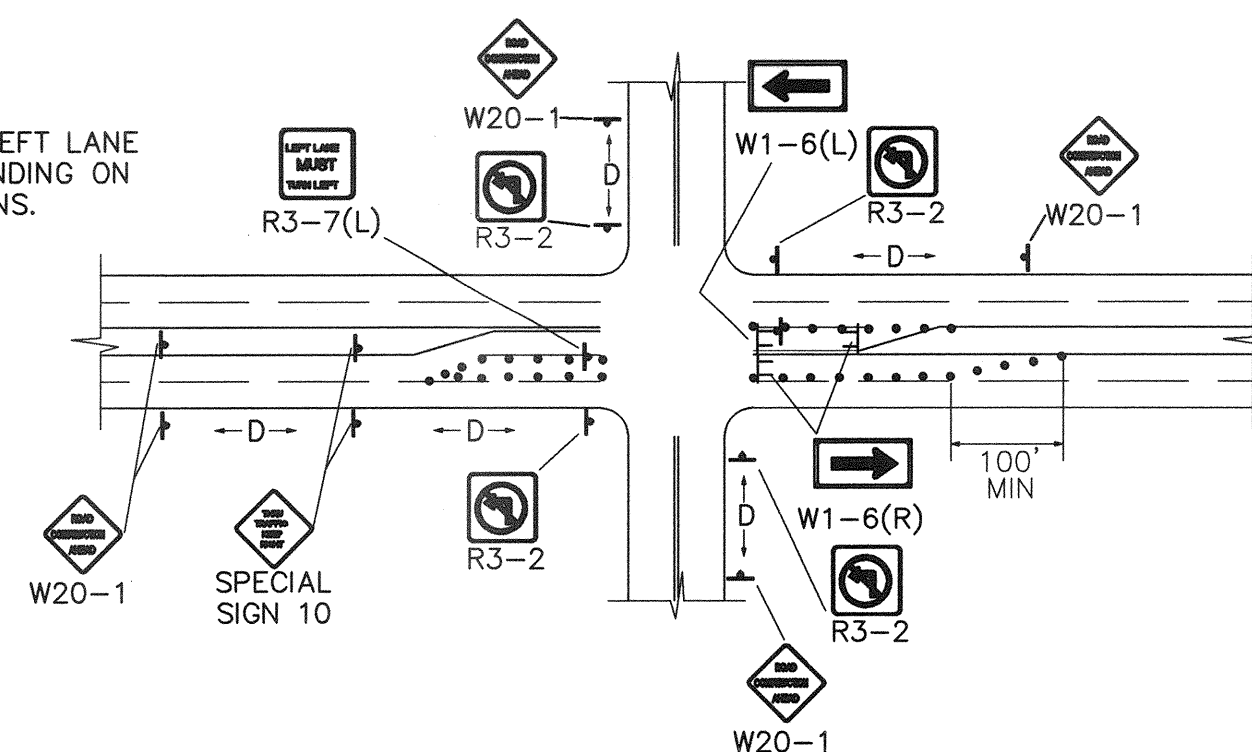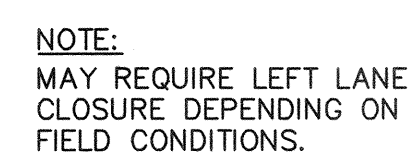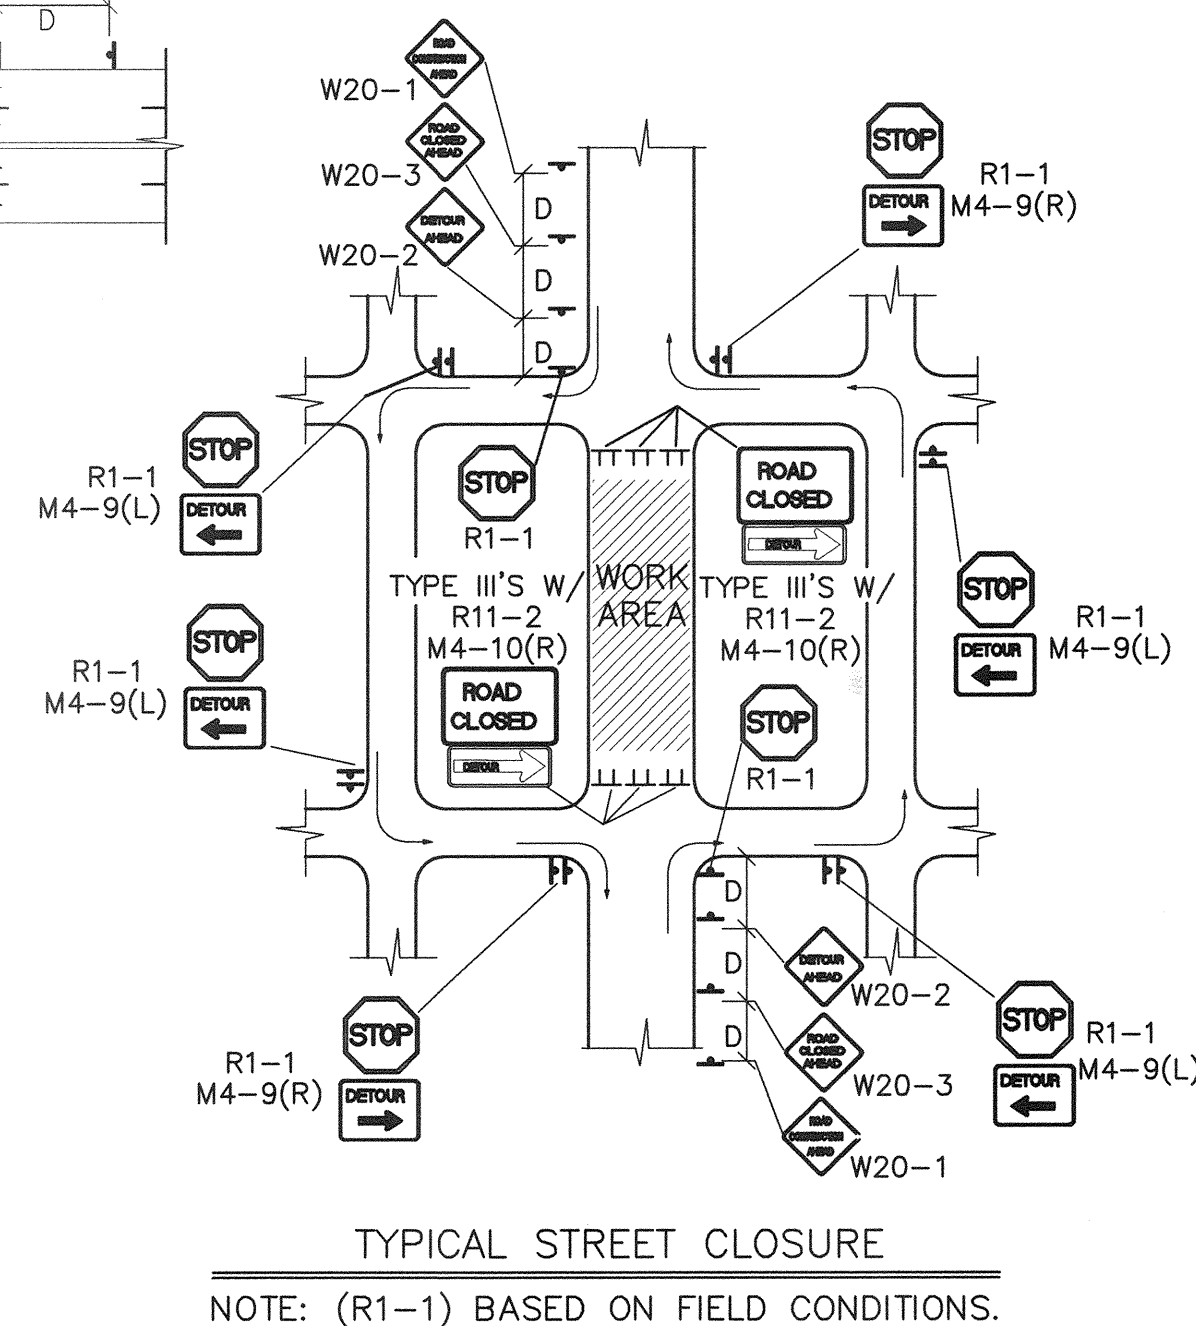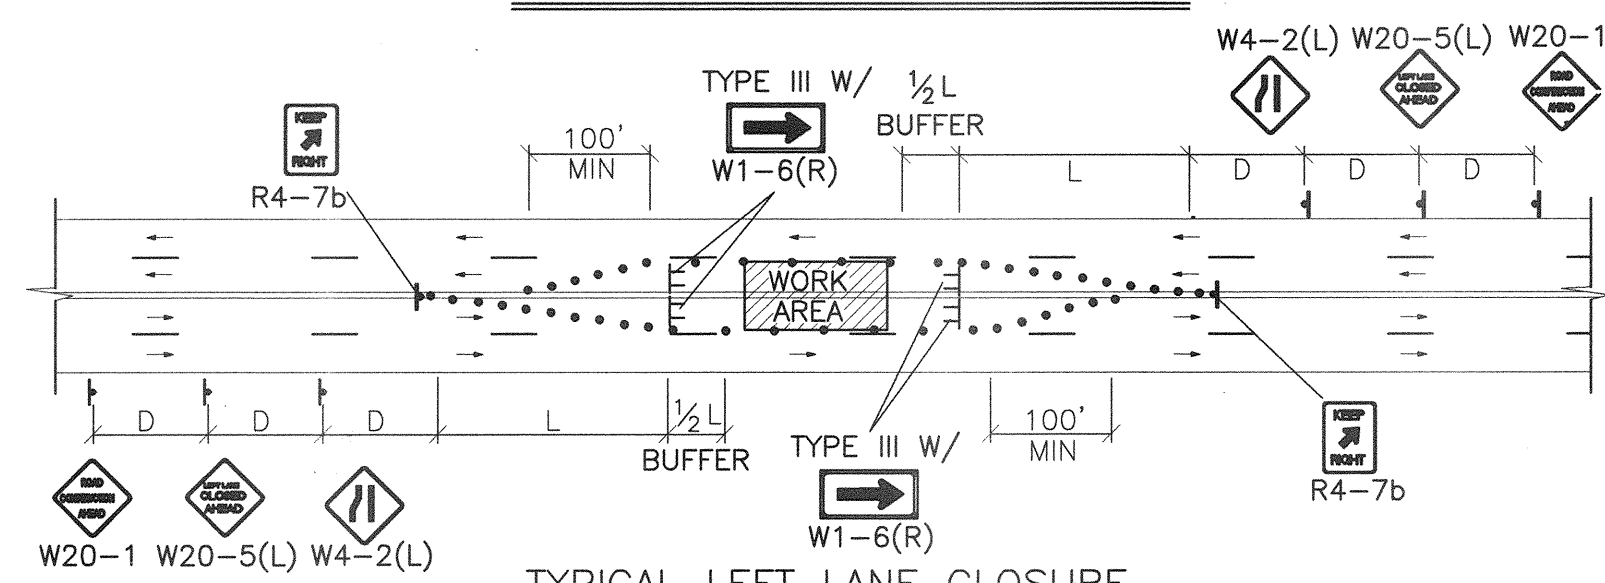



GENERAL NOTE:

ALL CONSTRUCTION WA
SIGNS SHALL HAVE A
LEGEND ON A ORANGE
BACKGROUND.

ALL ADVANCE WARNING SIGNS SHALL BE A MINIMUM OF 36" THIRTY SIX INCHES BY 36" THIRTY SIX INCHES IN SIZE AND SHALL HAVE ONE WARNING LIGHT.

COA STD		ENGINEER'S SEAL		SURVEY INFORMATION		BENCH MARKS		AS-BUILT INFORMATION	
		FIELD NOTES		NO.		BY		DATE	
No.		Date		REMARKS		By		DATE	
REVISIONS		DESIGN		DATE: 12/02		DATE: 12/02		DATE	
Designed By: COA		DRAWN BY:		DATE: 12/02		DATE: 12/02		DATE	
DRAWN BY:		DATE: 12/02		DATE: 12/02		DATE: 12/02		DATE	
NO.		NO.		NO.		NO.		NO.	

COTTON WOOD (H) 3 4" Cal.	PINON PINE (M) 4 6"-8"	VITEX TREE (M) 2 20 Gal.
ASH (H) 9 2 1/2" Cal.	AUSTRIAN PINE (H) 6 6"-8"	DESERT WILLOW (L) 9 15 Gal.
GOLDEN RAIN TREE (M) 3 2 1/2" Cal.	PALM YUCCA (L) 11	BLUE OAT GRASS (L) 6 2 Gal. 9sf
PURPLE ROBE LOCUST (L) 3 2 1/2" Cal.	MUGO PINE (L) 6 15 Gal.	ROSEMARY (M) 3 1 Gal. 36sf
NEW MEXICO OLIVE (M) 3 5 Gal.	AUTUMN SAGE (M) 9 5 Gal. 9sf	POTENTILLA (M) 14 1 Gal.
ALTHEA (M) 1 5 Gal.	APACHE PLUME (L) 3 5 Gal. 25sf	BOSTON IVY (M) 16 1 Gal. 400sf
SILVERBERRY (M) 26 5 Gal. 100sf	BLUE MIST SPIREA (M) 12 5 Gal.	LAVENDER (H) 3 1 Gal. 25sf
COTONEASTER (M) 3 5 Gal.	SCOTCH BROOM (M) 5 5 Gal.	BLUE PIN CUSHION (M) 11 1 Gal. 4sf
BIG SAGE (L) 1 5 Gal.	SERVICE BERRY (L) 1 5 Gal. 36sf	WILDFLOWER 39 1 Gal. 4sf
COYOTE BUSH (L) 15 5 Gal. 36sf	BUFFALO JUNIPER 4 5 Gal. 25sf	PENSTEMON (M) 6 1 Gal. 200sf
RUSSIAN SAGE (M) 3 5 Gal.	MAIDENGRASS (M) 36 5 Gal. 16sf	
TAM JUNIPER (M) 56 5 Gal. 225sf	CHAMISA (L) 2 5 Gal.	

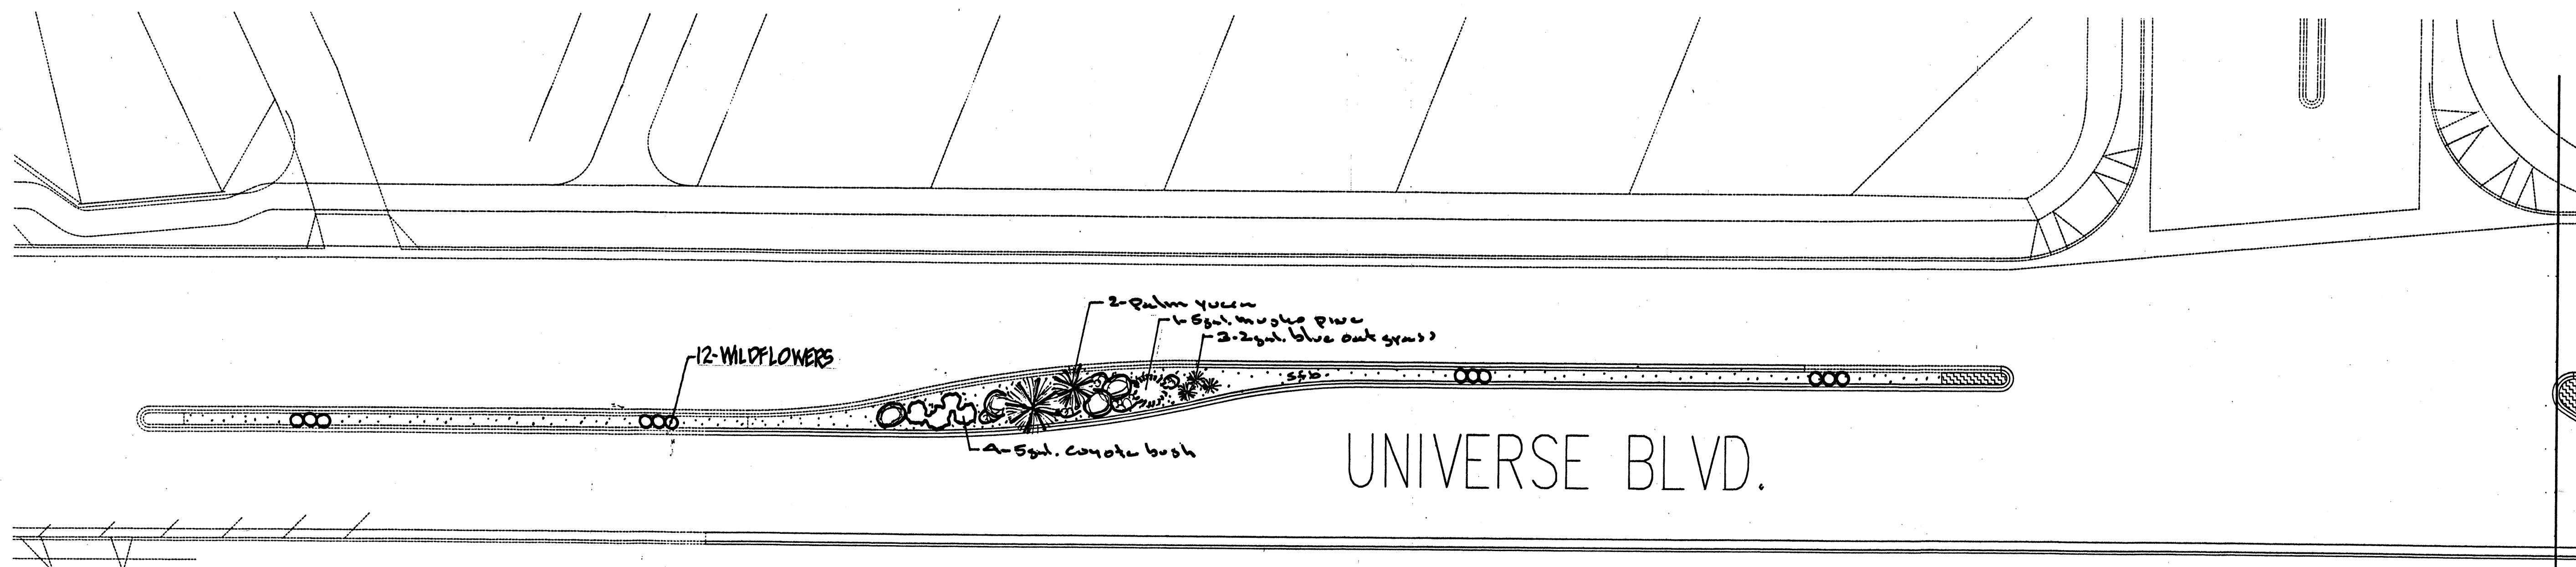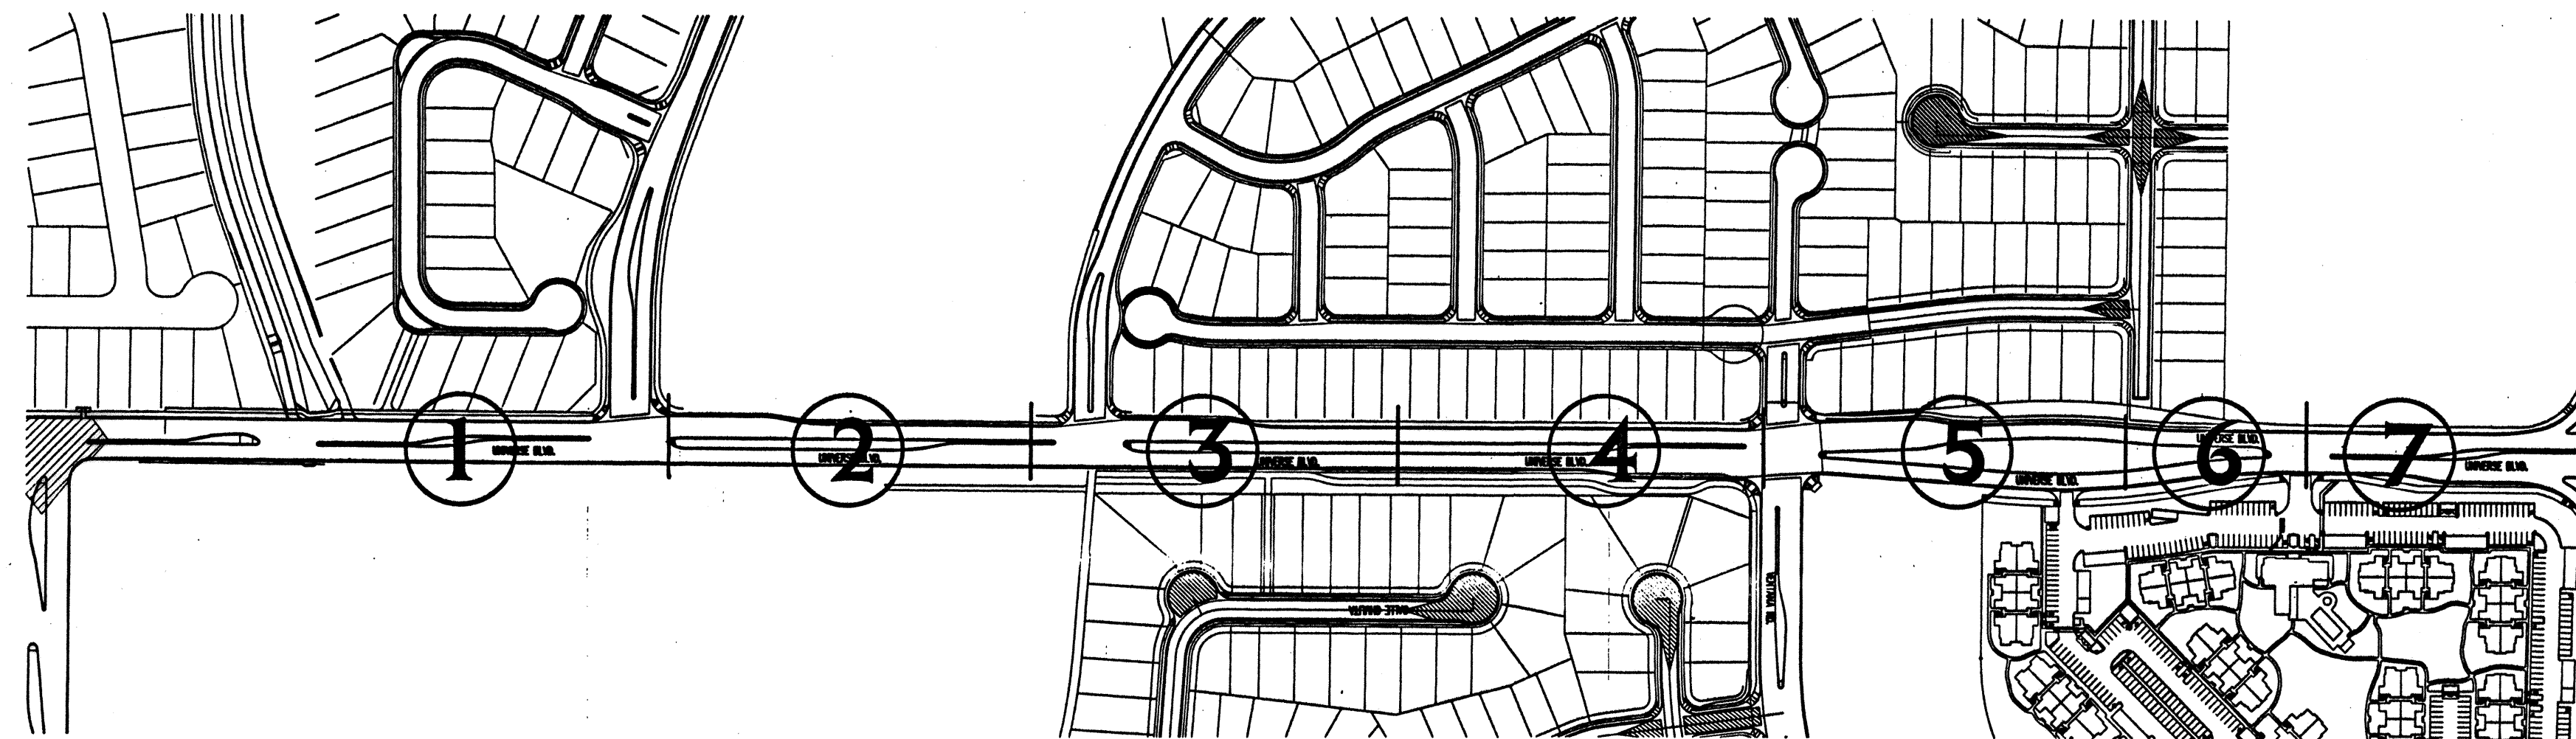

UNIVERSE BLVD.

1

Landscape maintenance shall be the responsibility of the Ventana Ranch Community Association, Inc.

It is the intent of this plan to comply with the City Of Albuquerque Water Conservation Landscaping and Water Waste Ordinance planting restriction approach.

Approval of this plan does not constitute or imply exemption from water waste provisions of the Water Conservation Landscaping and Water Waste Ordinance. Water management is the sole responsibility of the Property Owner.

All landscaping will be in conformance with the City of Albuquerque Zoning Code, Street Tree Ordinance, Pollen Ordinance, and Water Conservation Landscaping and Water Waste Ordinance. In general, water conservative, environmentally sound landscape principles will be followed in design and installation.

Plant beds shall achieve 75% live ground cover at maturity.

Santa Fe Brown Gravel over Filter Fabric shall be placed in all landscape areas which are not designated to receive native seed.

Landscape planting is to be adjusted in the field so that no plant is within 3' off the walk when planted.


Irrigation shall be a complete underground system with Trees to receive (5) 1.0 GPH Drip Emitters and Shrubs to receive (2) 1.0 GPH Drip Emitters. Drip and Bubbler systems to be tied to 1/2" polypipe with flush caps at each end.

Run time per each drip valve will be approximately 15 minutes per day, to be adjusted according to the season.


Point of connection for irrigation system is unknown at current time and will be coordinated in the field.

Irrigation will be operated by automatic controller.
Location of controller to be field determined
and power source for controller to be provided
by others.

Irrigation maintenance shall be the responsibility of the Ventana Ranch Community Association, Inc.

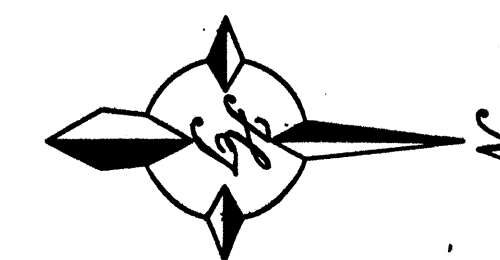

GRAPHIC SCALE

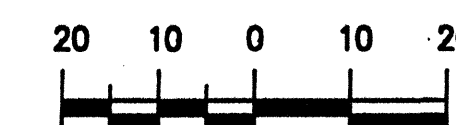

SCALE: 1"=20'

The Hilltop

LANDSCAPE ARCHITECTS & CONTRACTORS
Cont. Lic. #26458
7909 Edith N.E.
Albuquerque, NM 87184
Ph. (505) 898-9690
Fax (505) 898-7737
cmd@hilltoplandscaping.com

THE HILLTOP expressly reserves the common law copyright and other property rights in these plans. These plans are not to be reproduced, changed or copied in any manner whatsoever, nor are they to be assigned to any third party without obtaining the express written permission and consent of **THE HILLTOP**.


 CITY OF ALBUQUERQUE
PUBLIC WORKS DEPARTMENT
ENGINEERING DEVELOPMENT GROUP

**UNIVERSE BLVD. AT VENTANA RANCH
LANDSCAPE PLAN**

[illegible]

CITY PROJECT NO.	702381	ZONE MAP NO.	B-9	SHEET	17	OF	19
------------------	--------	--------------	-----	-------	----	----	----

3

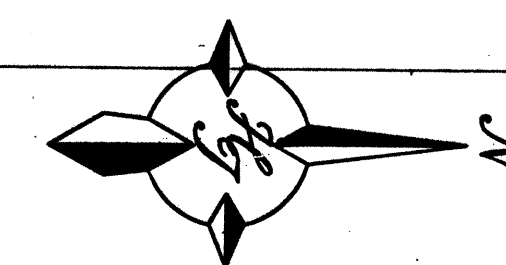

The Hilltop

THE HILLTOP expressly reserves the common law copyright and other property rights in these plans. These plans are not to be reproduced, changed or copied in any manner whatsoever, nor are they to be assigned to any third party without obtaining the express written permission and consent of **THE HILLTOP**.



4 DESIGN REVIEW COMMITTEE

APPROVED

APR - 7 2003

DESIGN




CITY ENGINEER APPROVAL

APR 29 2003

CITY ENGINEER

LAST DESIGN UPDATE	MO./DAY/YR.	MO./DAY/YR.

ZONE MAP NO.	SHEET	OF
8-9	13	19

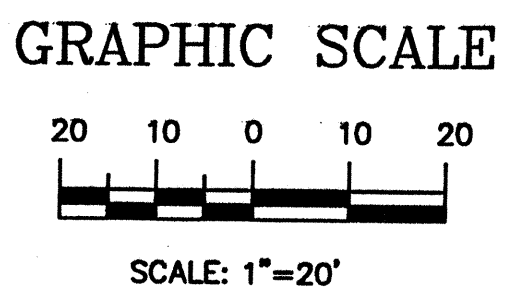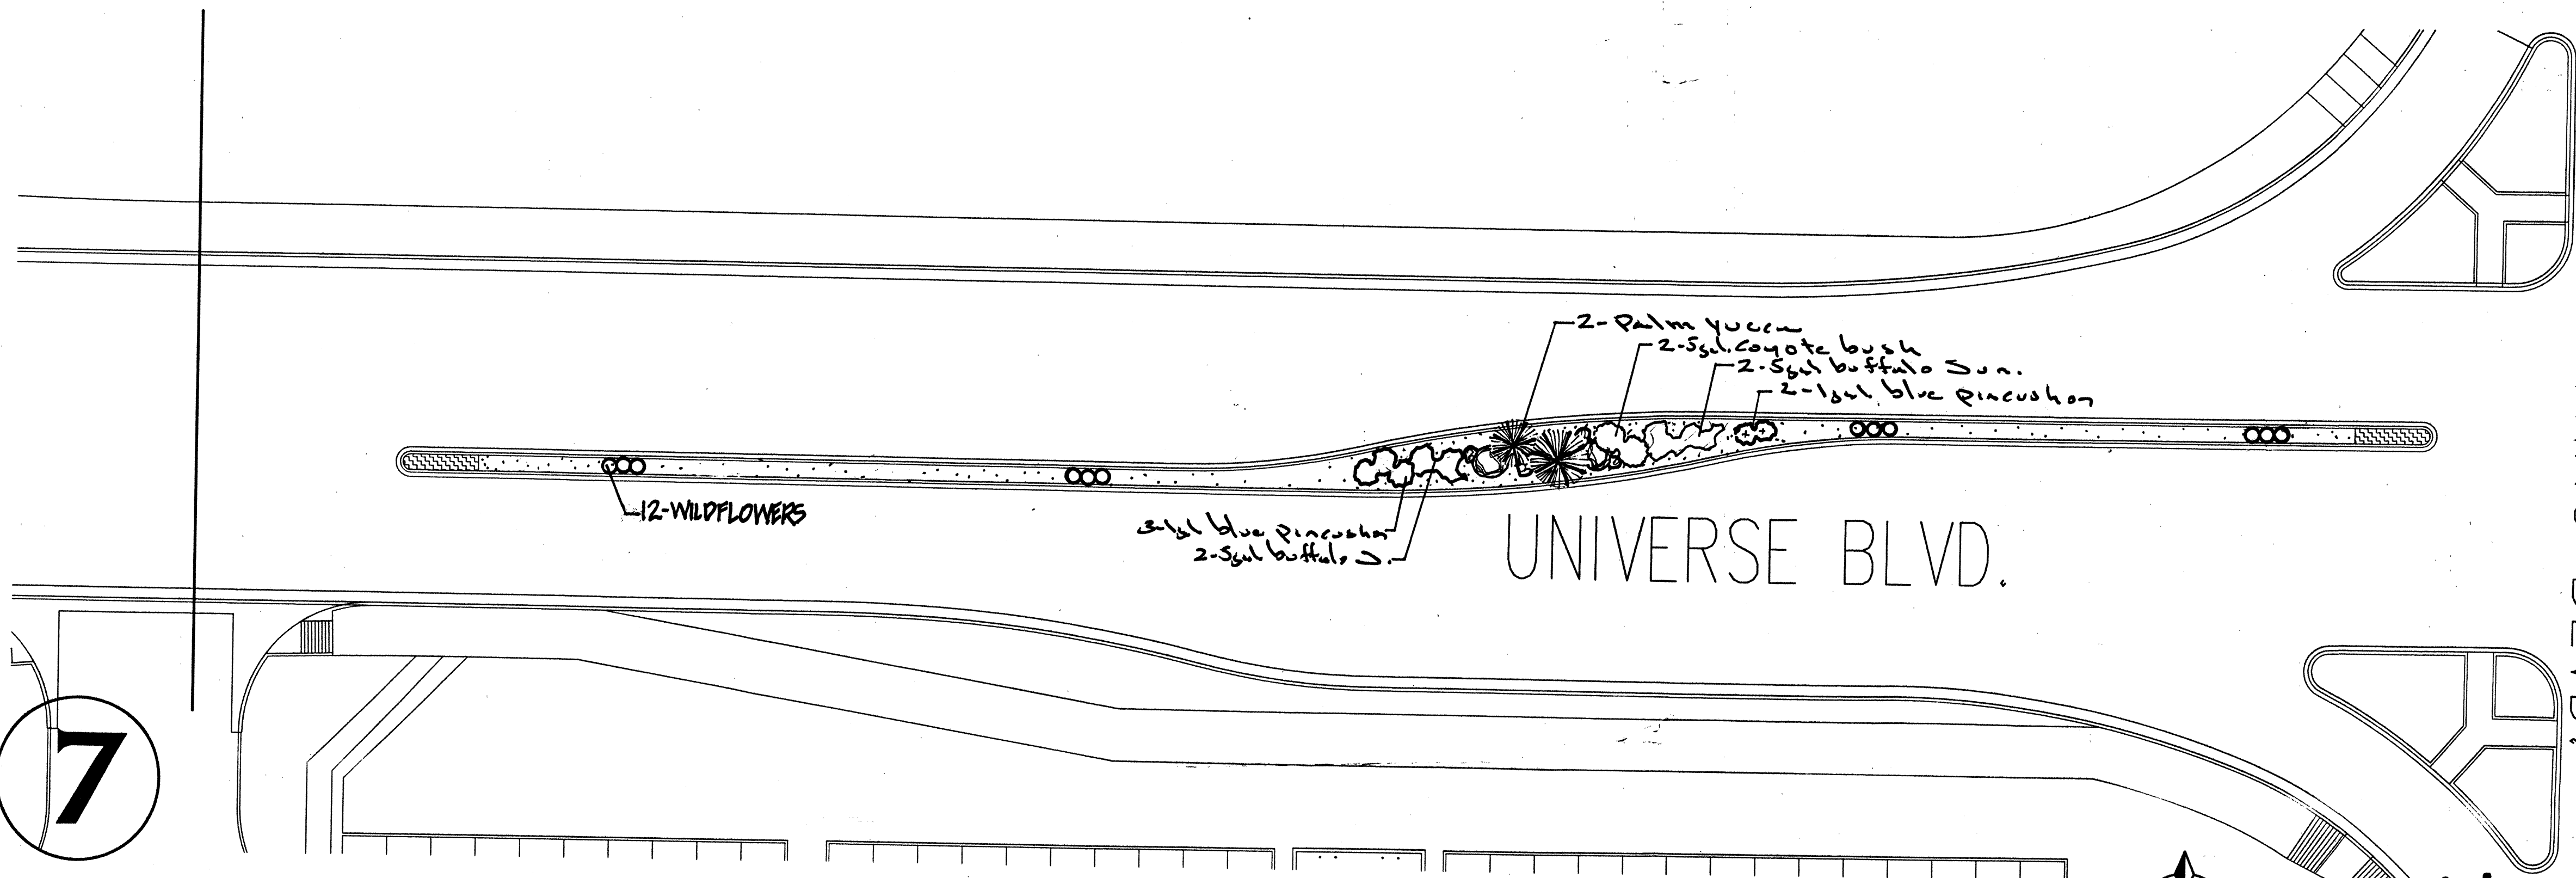
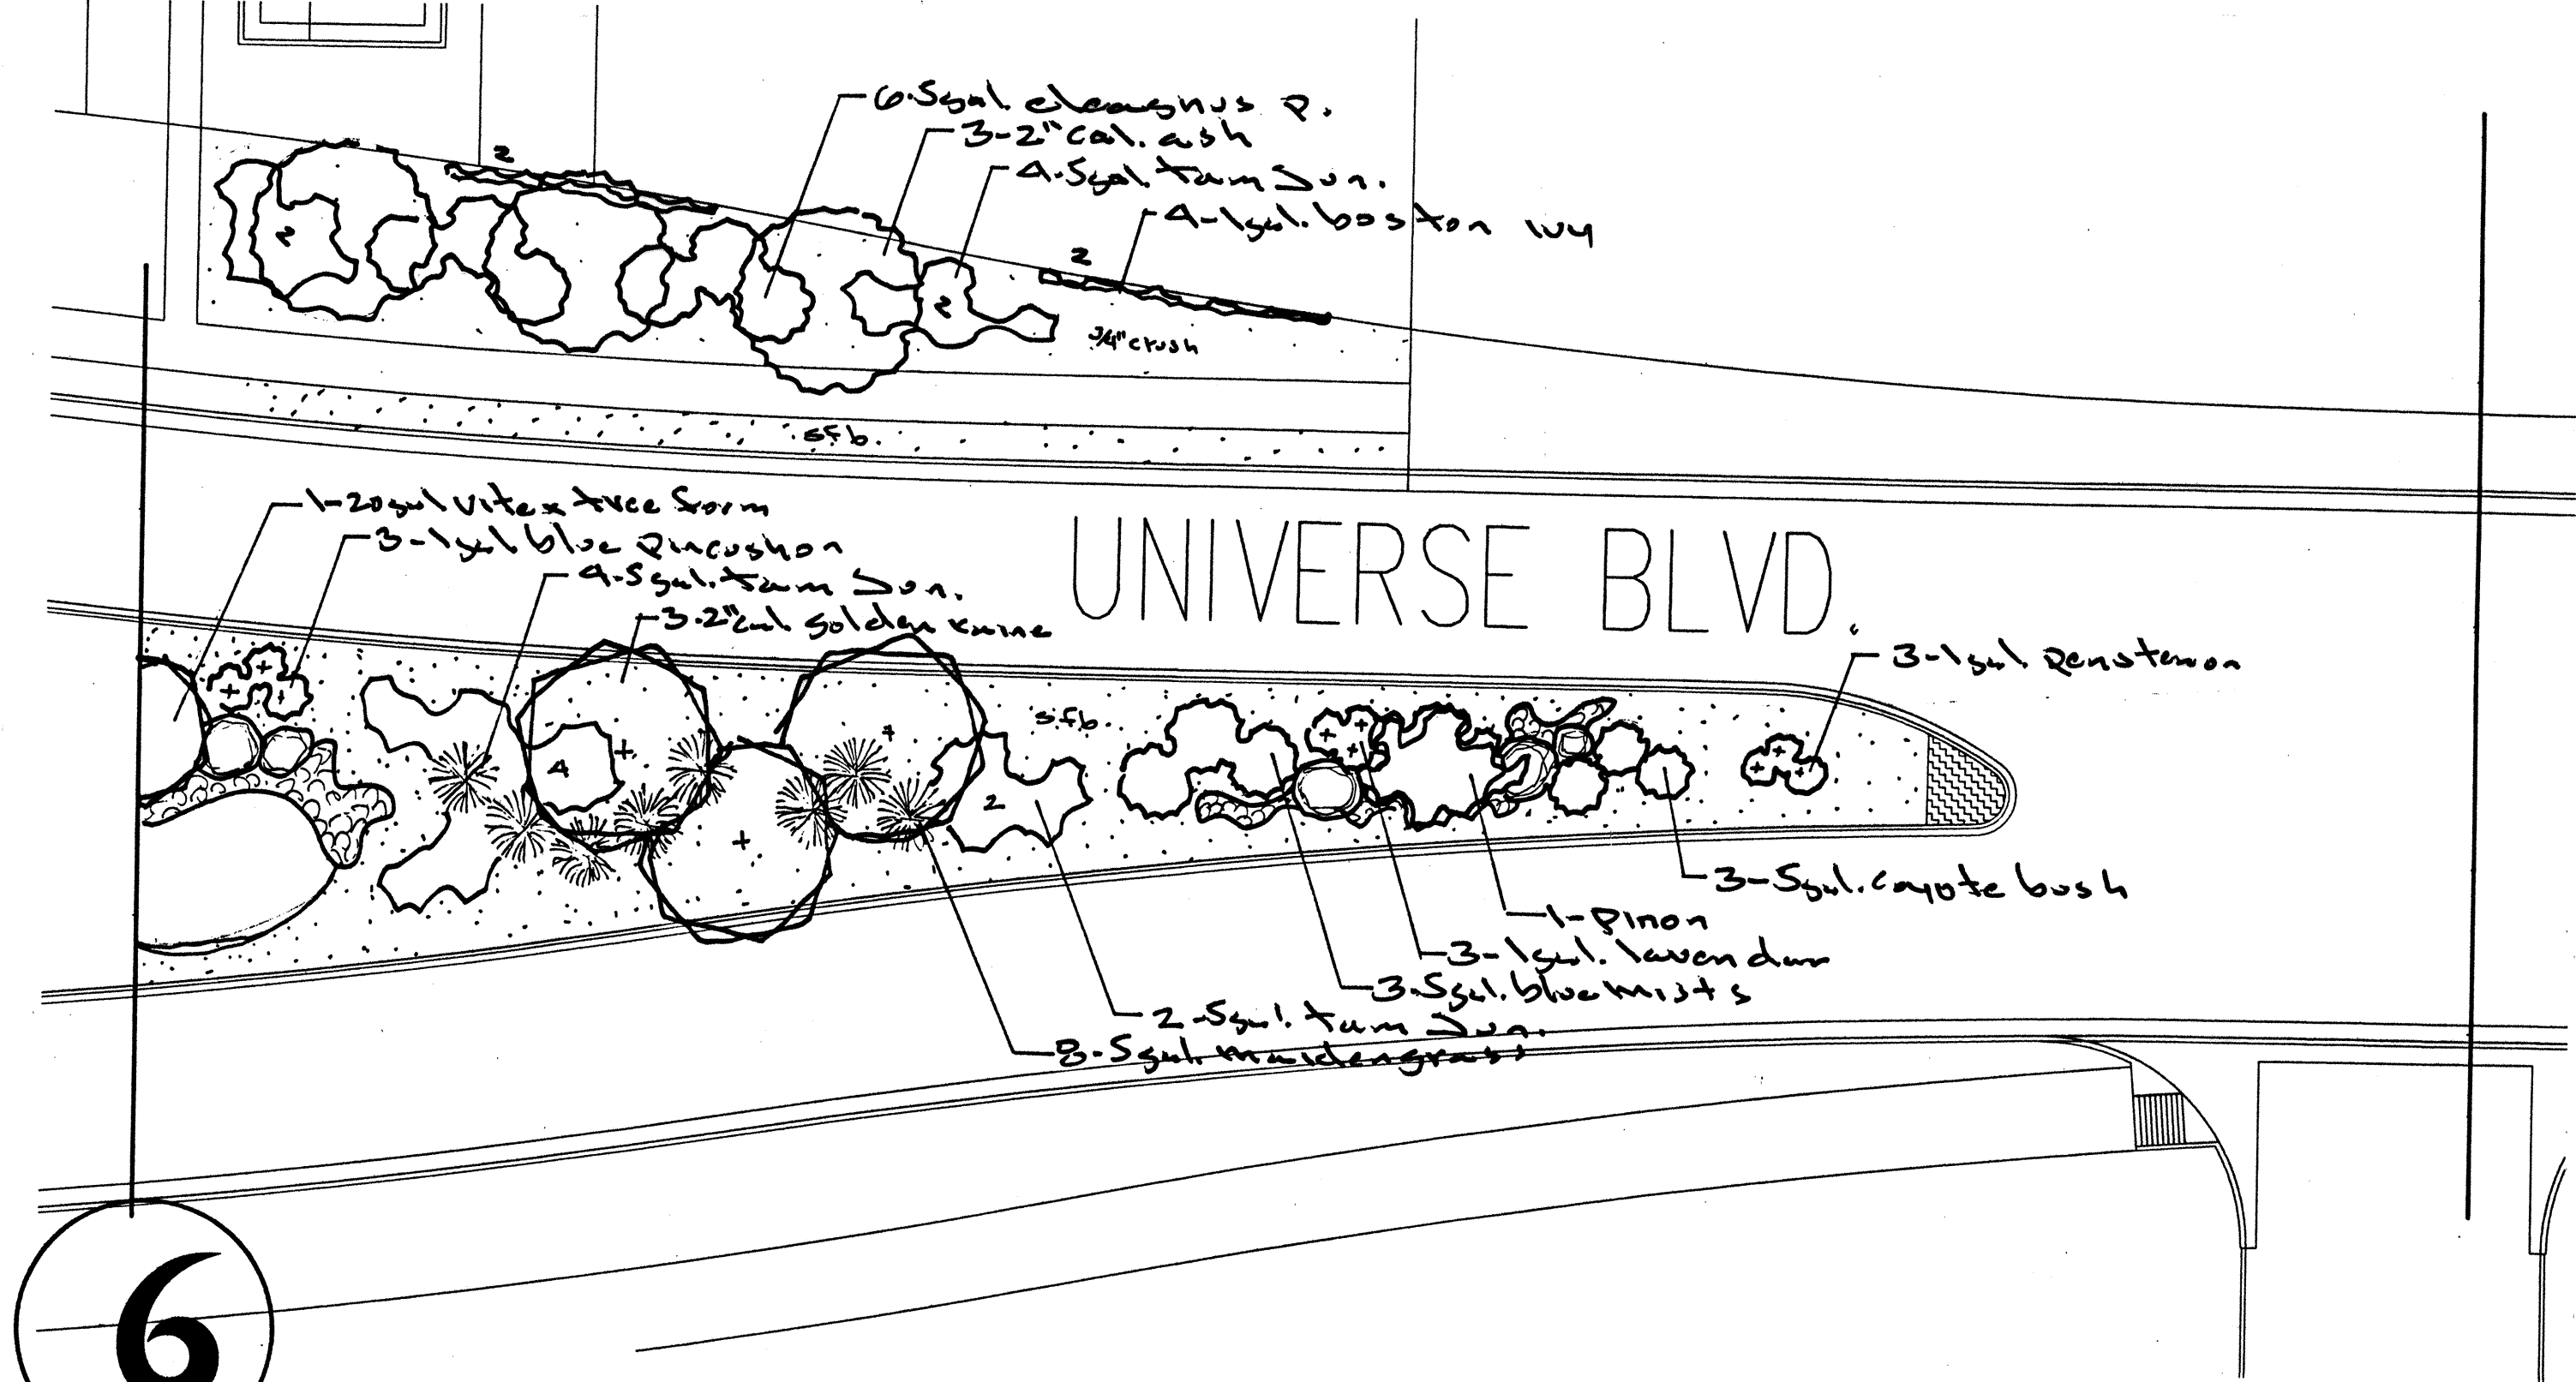


The Hilltop
 LANDSCAPE ARCHITECTS & CONTRACTORS
 Cont. Lic. #26458
 7909 Edith N.E.
 Albuquerque, NM 87184
 Ph. (505) 898-9690
 Fax (505) 898-7737
 cmd@hilltoplandscaping.com

CITY OF ALBUQUERQUE PUBLIC WORKS DEPARTMENT ENGINEERING DEVELOPMENT GROUP			
UNIVERSE BLVD. AT VENTANA RANCH LANDSCAPE PLAN			
DESIGN REVIEW COMMITTEE	CITY ENGINEER APPROVAL	MO./DAY/YR.	MO./DAY/YR.
APR - 7 2003	APR 29 2003		
DESIGN REVIEW COMMITTEE	CITY ENGINEER	LAST DESIGN UPDATE	
CITY PROJECT NO. 702381	ZONE MAP NO. 8-9	SHEET 15	OF 19

ENGINEER'S SEAL		SURVEY INFORMATION		BENCH MARKS		AS-BUILT INFORMATION	
NO.	DATE	BY	DATE			CONTRACTOR	DATE
						SIGNED BY	DATE
						INSPECTED BY	DATE
						FIELD VERIFICATION BY	DATE
						CORRECTED BY	DATE
						MICRO-FILM INFORMATION	
						RECORDED BY	DATE
						NO.	




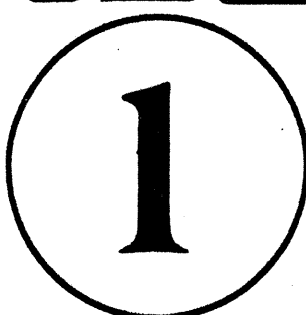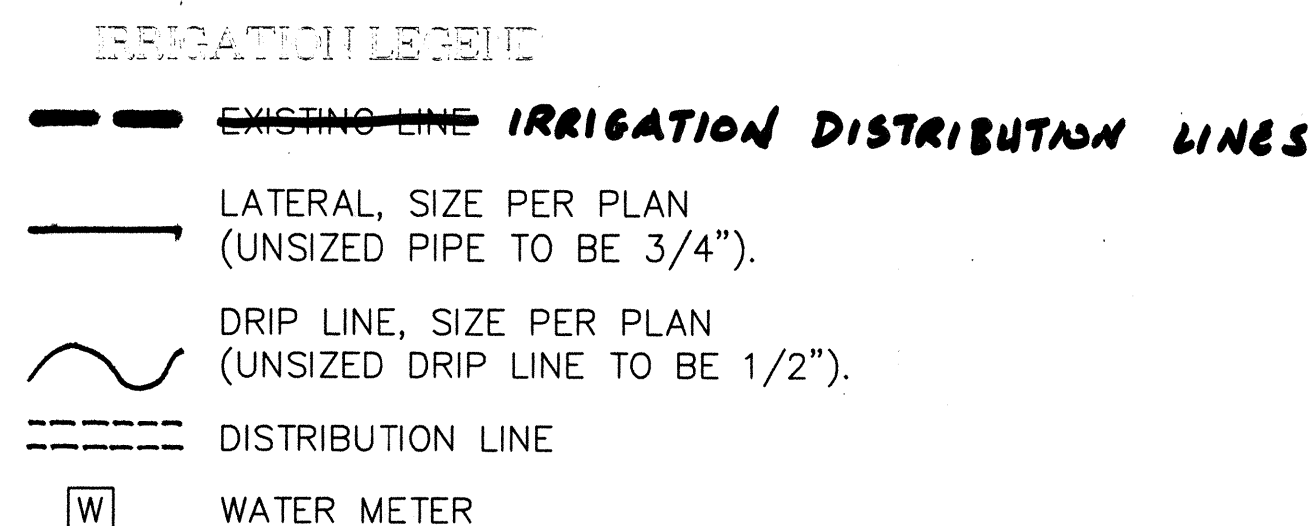

Irrigation maintenance shall be the responsibility of the Ventana Ranch Community Association, Inc.

1 1/2" - 1" IRRIGATION LINE
TIE INTO EXISTING IRRIGATION





UNIVERSE BLVD.

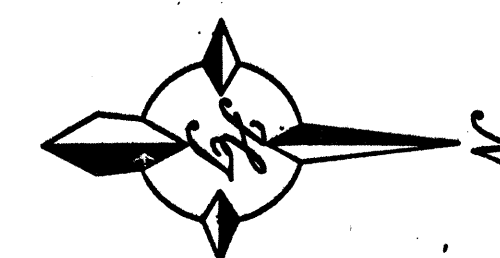

SCALE: 1"=20'

THE HILLTOP expressly reserves the common law copyright and other property rights in these plans. These plans are not to be reproduced, changed or copied in any manner whatsoever, nor are they to be assigned to any third party without obtaining the express written permission and consent of **THE HILLTOP**.

CITY PROJECT NO.	702381	ZONE MAP NO.	B-9	SHEET	16	OF	19
------------------	--------	--------------	-----	-------	----	----	----

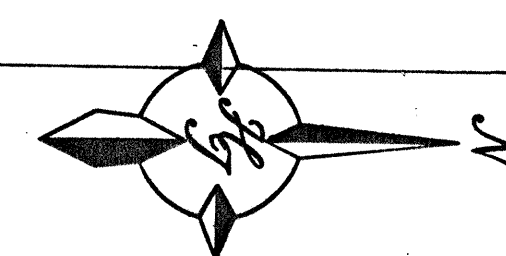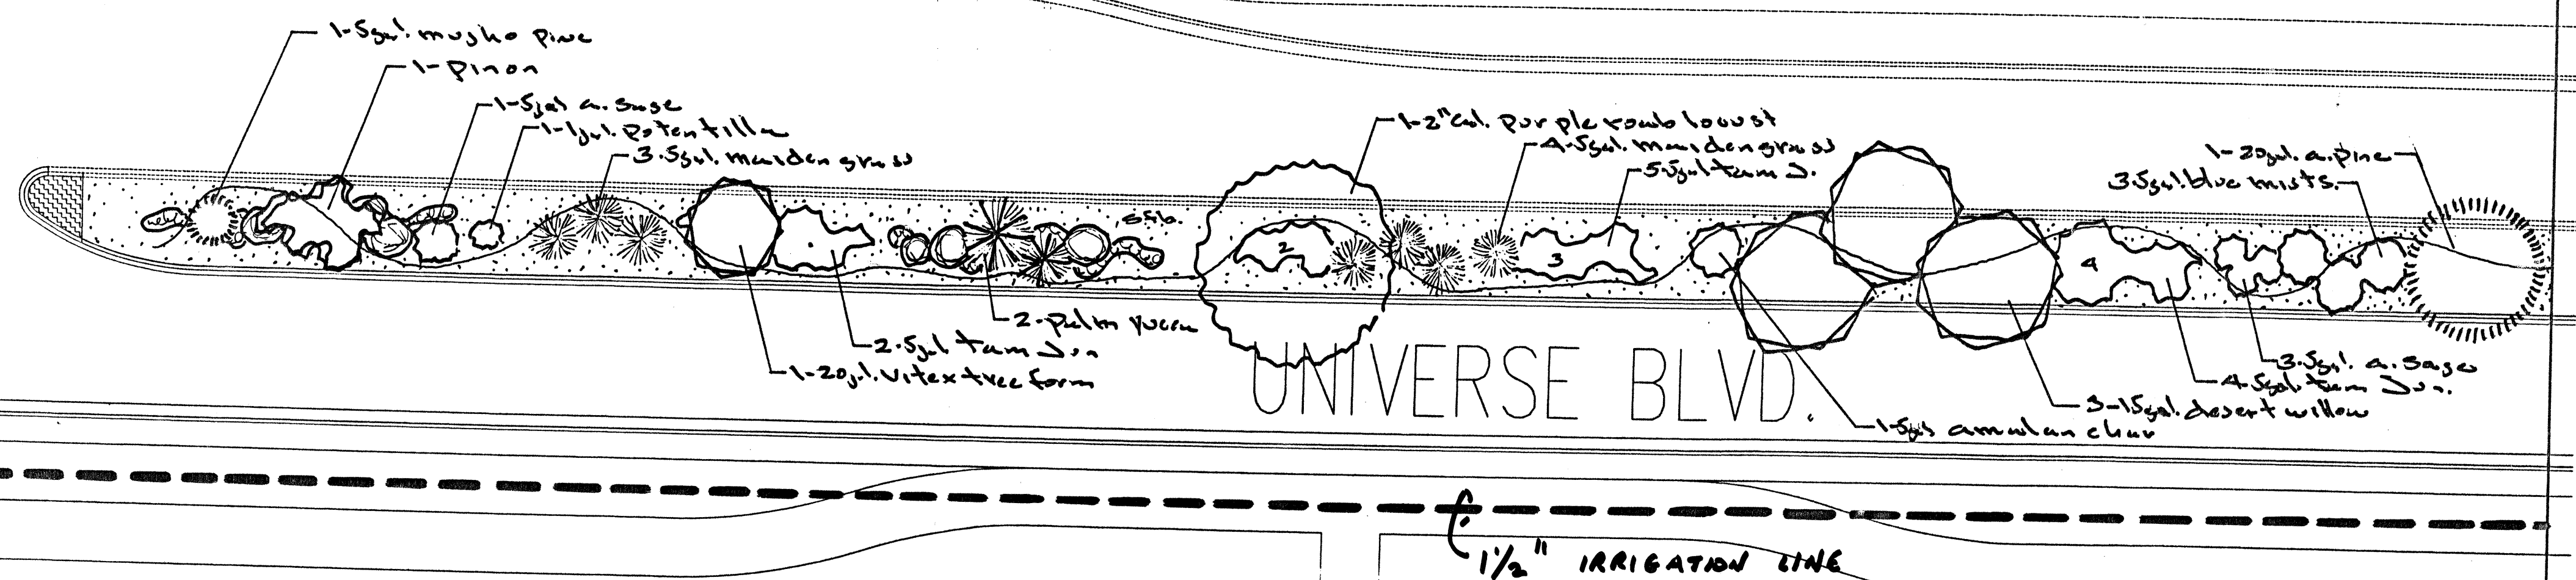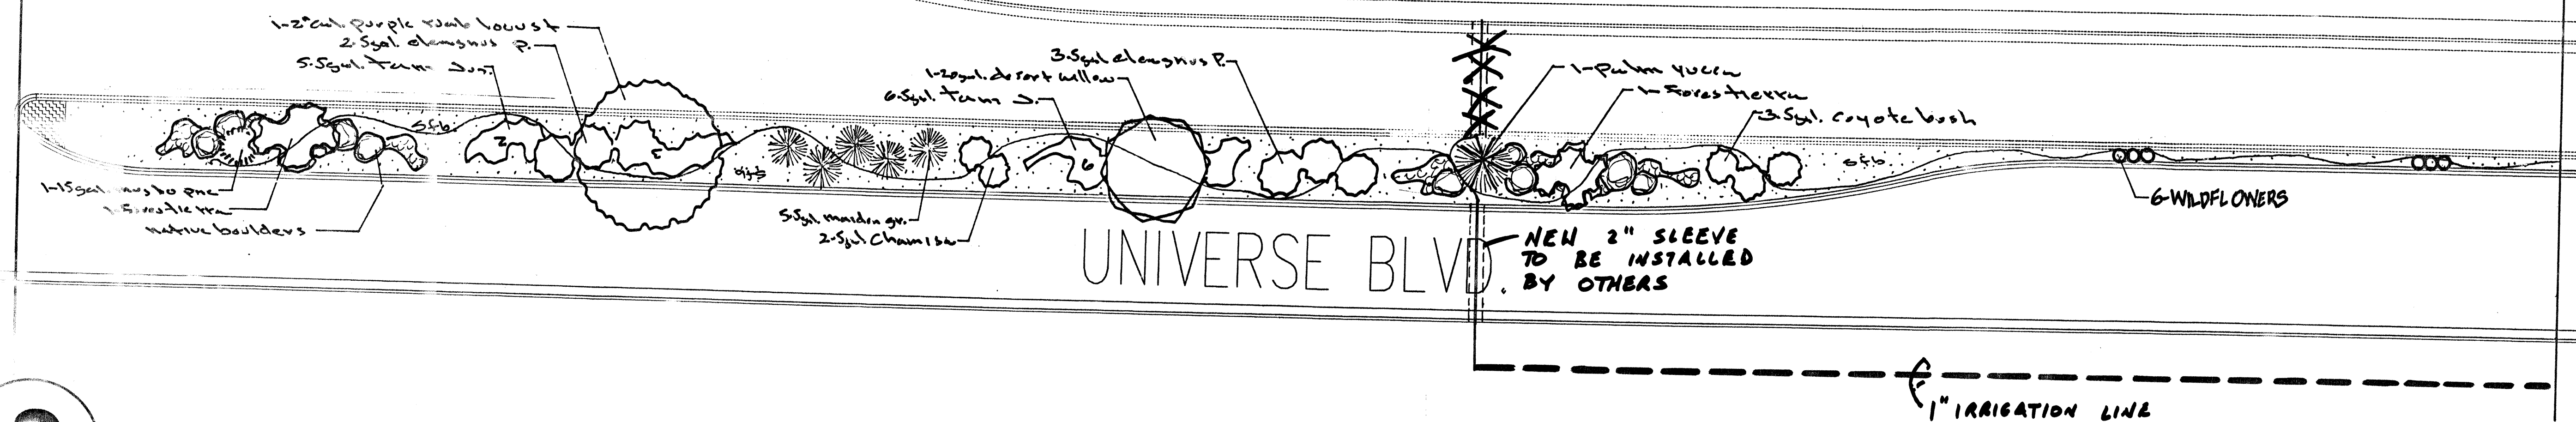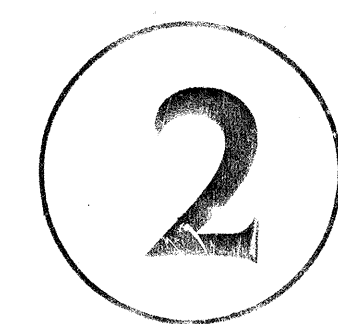

GRAPHIC SCALE

20 10 0 10 20

SCALE: 1"=20'

The Hilltop
LANDSCAPE ARCHITECTS & CONTRACTORS

Cont. Lic. #26458
7909 Edith N.E.
Albuquerque, NM 87184
Ph. (505) 898-9690
Fax (505) 898-7737
cmd@hilltoplandscaping.co

LANDSCAPE ARCHITECTS & CONTRACTORS
Cont. Lic. #26458
7909 Edith N.E.
Albuquerque, NM 87184
Ph. (505) 898-9690
Fax (505) 898-7737
cmd@hilltoplandscaping.co

THE HILLTOP expressly reserves the common law copyright and other property rights in these plans. These plans are not to be reproduced, changed or copied in any manner whatsoever, nor are they to be assigned to any third party without obtaining the express written permission and consent of **THE HILLTOP**.

	CITY OF ALBUQUERQUE PUBLIC WORKS DEPARTMENT ENGINEERING DEVELOPMENT GROUP									
	UNIVERSE BLVD. AT VENTANA RANCH IRRIGATION PLAN									

DESIGN REVIEW COMMITTEE		CITY ENGINEER APPROVAL		LAST DESIGN UPDATE	MO./DAY/YR.	MO./DAY/YR.
APPROVED APR - 7 2003 DESIGN REVIEW COMMITTEE	APPROVED APR 29 2003 CITY ENGINEER					

CITY PROJECT NO.	702381	ZONE MAP NO.	B-9	SHEET	17	OF	19
------------------	--------	--------------	-----	-------	----	----	----

ENGINEER'S SEAL	SURVEY INFORMATION		BENCH MARKS		AS-BUILT INFORMATION	
 1-24-03 3-13-03	FIELD NOTES					
	NO.	BY	DATE			
	REMARKS					
	REVISIONS					
DESIGN						
DESIGNED BY	Hilltop	DATE	4/02			
DRAWN BY	Hilltop	DATE	4/02			
CHECKED BY	Hilltop	DATE	4/02			
				CONTRACTOR <u>SUNDANCE</u>		
				STARTED BY <u>AKS</u>		
				ACCEPTANCE BY <u>AKS</u>		
				FIELD NO. <u>ON BY AKS</u>		
				DRAWINGS <u>DATE 9/03</u>		
				CORRECTED BY <u>AKS</u>		
				MICRO-FILM INFORMATION		
				RECORDED BY		DATE
				NO.		

ERQUE MENT MENT GROUP	
A RANCH AN	
MO./DAY/YR.	MO./DAY/YR.
SHEET	OF
17	19

2025 RELEASE UNDER E.O. 14176

