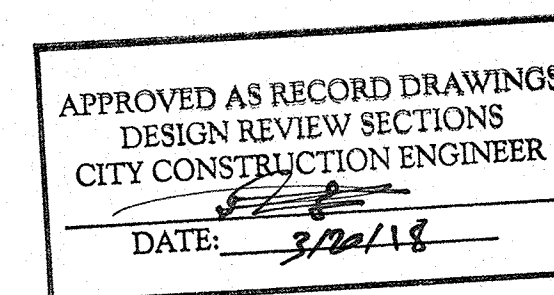


CONSTRUCTION PLANS
FOR
PUERTA DEL BOSQUE
ALBUQUERQUE, NEW MEXICO

VICINITY MAP ZONE ATLAS G-14-2

SCALE: NONE

GENERAL NOTES

NOTICE TO CONTRACTORS

1. AN EXCAVATION/CONSTRUCTION PERMIT WILL BE REQUIRED BEFORE BEGINNING ANY WORK WITHIN THE CITY RIGHT-OF-WAY.
2. ALL WORK DETAILED ON THESE PLANS TO BE PERFORMED UNDER CONTRACT SHALL, EXCEPT AS OTHERWISE STATED OR PROVIDED FOR HEREON, BE CONSTRUCTED IN ACCORDANCE WITH THE CITY OF ALBUQUERQUE STANDARD SPECIFICATIONS FOR PUBLIC WORKS CONSTRUCTION, 1986 EDITION AS REVISED THROUGH UPDATE #9.
3. TWO WORKING DAYS PRIOR TO ANY EXCAVATION, THE CONTRACTOR MUST CONTACT NEW MEXICO ONE CALL SYSTEM (248-1800) FOR EXISTING UTILITIES.
4. PRIOR TO CONSTRUCTION, THE CONTRACTOR SHALL EXCAVATE AND VERIFY THE HORIZONTAL AND VERTICAL LOCATIONS OF ALL OBSTRUCTIONS. SHOULD A CONFLICT EXIST, THE CONTRACTOR SHALL NOTIFY THE ENGINEER IMMEDIATELY SO THAT THE CONFLICT CAN BE RESOLVED WITH A MINIMUM AMOUNT OF DELAY.
5. SEVEN (7) WORKING DAYS PRIOR TO BEGINNING OF CONSTRUCTION, THE CONTRACTOR SHALL SUBMIT TO THE CONSTRUCTION COORDINATION DIVISION A DETAILED CONSTRUCTION SCHEDULE.
6. TWO (2) WORKING DAYS PRIOR TO THE START OF CONSTRUCTION, THE CONTRACTOR SHALL OBTAIN A BARRICADING PERMIT FROM THE CONSTRUCTION COORDINATION DIVISION. CONTRACTOR SHALL NOTIFY THE CONSTRUCTION COORDINATION ENGINEER (924-3400) PRIOR TO OCCUPANCY AN INTERSECTION. REFER TO SECTION 19 OF THE GENERAL CONDITIONS OF THE STANDARD SPECIFICATIONS.
6. ALL AREAS AFFECTING ARTERIAL ROADWAYS MAY REQUIRE TWENTY-FOUR HOUR CONSTRUCTION.
7. ALL STREET STRIPING ALTERED OR DESTROYED SHALL BE REPLACED WITH PLASTIC REFLECTORIZED PAVEMENT MARKING BY CONTRACTOR TO THE SAME LOCATION AS WAS EXISTING, OR AS INDICATED BY THIS PLAN SET.
8. CONTRACTOR SHALL NOTIFY THE ENGINEER NOT LESS THAN SEVEN (7) DAYS PRIOR TO STARTING WORK IN ORDER THAT THE CITY SURVEYOR MAY TAKE NECESSARY MEASURES TO ENSURE THE PRESERVATION OF SURVEY MONUMENTS. CONTRACTOR SHALL NOT DISTURB PERMANENT SURVEY MONUMENTS WITHOUT THE CONSENT OF THE CITY SURVEYOR AND SHALL NOTIFY THE CITY SURVEYOR AND BEAR THE EXPENSE OF REPLACING ANY THAT MAY BE DISTURBED WITHOUT PERMISSION. REPLACEMENT SHALL BE DONE ONLY BY THE CITY SURVEYOR. WHEN A CHANGE IS MADE IN THE FINISHED ELEVATIONS OF THE PAVEMENT OF ANY ROADWAY IN WHICH A PERMANENT SURVEY MONUMENT IS LOCATED, CONTRACTOR SHALL, AT HIS OWN EXPENSE, ADJUST THE MONUMENT COVER TO THE NEW GRADE UNLESS OTHERWISE SPECIFIED. REFER TO SECTION 4.4 OF THE GENERAL CONDITIONS OF THE STANDARD SPECIFICATIONS.
9. CONTRACTOR SHALL RECORD DATA ON ALL UTILITY LINES AND ACCESSORIES AS REQUIRED BY THE CITY OF ALBUQUERQUE FOR THE PREPARATION OF "AS CONSTRUCTED" DRAWINGS. CONTRACTOR SHALL NOT COVER UTILITY LINES AND ACCESSORIES UNTIL ALL DATA HAVE BEEN RECORDED.
10. CONTRACTOR SHALL MAINTAIN A GRAFFITI-FREE WORK SITE. CONTRACTOR SHALL PROMPTLY REMOVE ANY GRAFFITI FROM ALL EQUIPMENT, WHETHER PERMANENT OR TEMPORARY.
11. THE CONTRACTOR SHALL COORDINATE WITH THE WATER AUTHORITY SEVEN (7) DAYS IN ADVANCE OF PERFORMING WORK THAT WILL AFFECT THE PUBLIC WATER OR SANITARY SEWER INFRASTRUCTURE. WORK REQUIRING SHUTOFF OF WELL COLLECTORS, TRANSMISSION LINES, OR FACILITIES DESIGNATED AS MASTER PLAN FACILITIES MUST BE COORDINATED WITH THE WATER AUTHORITY SEVEN (7) DAYS IN ADVANCE OF PERFORMING SUCH WORK. ONLY WATER AUTHORITY CREWS ARE AUTHORIZED TO OPERATE PUBLIC VALVES. SHUTOFF REQUESTS MUST BE MADE ONLINE AT http://www.abqwa.org/Water_Shut_off_and_Turn_on_Procedures.aspx
12. RCP SHALL BE INSTALLED SO THAT THE JOINT GAP AT THE HOME POSITION SHALL CONFORM TO THE APPROVED MANUFACTURER'S RECOMMENDATIONS; MANUFACTURER'S RECOMMENDED JOINT SPACING AND JOINT SPACER SPACING SHALL BE MAINTAINED. THE ENGINEER OR THE ENGINEER FOR APPROVAL PRIOR TO PLACEMENT OF PIPE. RCP JOINTS SHALL NOT BE GROUDED UNLESS DIRECTED BY THE ENGINEER AFTER CITY APPROVAL.
13. ALL EXCAVATION, TRENCHING, AND SHORING ACTIVITIES MUST BE CARRIED-OUT IN ACCORDANCE WITH OSHA 29 CFR 1926.650 SUBPART P.
14. ELECTRONIC MARKER DEVICE (EMD) WILL BE PLACED ACCORDING TO SECTION 170 OF THE CITY OF ALBUQUERQUE STANDARD SPECIFICATIONS FOR PUBLIC WORKS CONSTRUCTION, 1986 EDITION AS REVISED THROUGH UPDATE #9.
15. PRIVATE STREETS REQUIRE STREET NAME SIGNS, STOP SIGNS, AND ANY NECESSARY STRIPING (DEVELOPER'S RESPONSIBILITY).
16. CONTRACTOR SHALL ASSUME RESPONSIBILITY FOR ANY DAMAGE TO EXISTING PAVEMENT, PAVEMENT MARKINGS, CURB & GUTTER, SIGNAGE, HANDICAP RAMPS AND SIDEWALK DURING CONSTRUCTION PART FROM THOSE SECTIONS INDICATED FOR REMOVAL ON THE PLANS AND SHALL REPAIR OR REPLACE ANY DAMAGE TO EXISTING PAVEMENT, SIGNAGE, AT HIS OWN EXPENSE.
17. CONTRACTOR SHALL BE RESPONSIBLE FOR PROVIDING AND MAINTAINING ALL CONSTRUCTION SIGNING UNTIL THE PROJECT HAS BEEN ACCEPTED BY THE CITY OF ALBUQUERQUE.
18. TWO WEEKS PRIOR TO CONSTRUCTION, THE CONTRACTOR SHOULD NOTIFY THE TRANSIT DEPARTMENT OF ANY IMPACT THE PROPOSED PROJECT WILL HAVE ON THE TRANSIT SYSTEM SUCH AS CAUSING A DETOUR, OR CAUSE THE CLOSING OR RELOCATION OF A BUS STOP. CONTACT DOUGLAS GOFF, OFFICE PHONE IS 505-724-3137, CELL PHONE IS 505-206-0151, AND E-MAIL IS dgofff@abqgo.gov.
19. ALL WATER AUTHORITY LINES SHALL HAVE TRACER WIRE FOR LOCATIONS.
20. REQUEST FOR WATER SHUT OFF NEAR SAN JUAN CHAMA LINES WITH ADMIN NO. 9. CONTRACTOR SHALL COMPLY ET, AND SUBMIT ALL REQUIRED DESIGN DOCUMENTATION.

INDEX TO DRAWINGS

SHEET NO.	SHEET NO.
1	TITLE SHEET
2	PLAT
3	GRADING & DRAINAGE PLAN
4	EROSION & SEDEMENTARY CONTROL PLAN
5	PAVING IMPROVEMENTS - PLAN & PROFILE
6	UTILITY IMPROVEMENTS - PLAN & PROFILE

RECORD DRAWING
CERTIFICATE OF SUBSTANTIAL COMPLIANCE ON PLANS

I, Mark Goodwin, NMPE 8948, of the firm Mark Goodwin & Associates, PA, a Registered Professional Engineer in the State of New Mexico, do hereby certify, to the best of my knowledge and belief, that the infrastructure installed as part of this project has been inspected by me or by a qualified person under my direct supervision, and has been constructed in accordance with the plans and specifications approved by the City Engineer and that the original design intent of the approved plans has been met, except as noted by me on the as-built construction drawings. This Certification is based on site inspections by me or personnel under my direction, and survey information provided by Christopher Medina NMPS number 15702.

Mark Goodwin NMPE 8948 11/7/17
Date

This set of drawings is accepted for RECORD purposes by _____ on _____, 2017




DRB NO.

1010812

NOTE: CONTRACTOR SHALL PROVIDE AND MAINTAIN ALL CONSTRUCTION SIGNING UNTIL PROJECT HAS BEEN ACCEPTED BY THE CITY OF ALBUQUERQUE.		TOLERANCE FOR PLACEMENT OF SIZE SHALL BE ADJUSTED TO ENGINEER'S DESIRE. DIRECTED BY THE ENGINEER AFTER CITY APPROVAL. 13. ALL EXCAVATION, TRENCHING, AND SHORING ACTIVITIES MUST BE CARRIED-OUT IN ACCORDANCE WITH OSHA 29 CFR 1926.650 SUBPART P. 14. ELECTRONIC MARKER DEVICE (EMD) WILL BE PLACED ACCORDING TO SECTION 170 OF THE CITY OF ALBUQUERQUE STANDARD SPECIFICATIONS FOR PUBLIC WORKS CONSTRUCTION, 1986 EDITION AS REVISED THROUGH UPDATE AMENDMENT #8. 15. PRIVATE STREETS REQUIRE STREET NAME SIGNS, STOP SIGNS, AND ANY NECESSARY STRIPPING (DEVELOPER'S RESPONSIBILITY). 16. CONTRACTOR SHALL ASSUME RESPONSIBILITY FOR ANY DAMAGE TO EXISTING PAVEMENT, PAVEMENT MARKINGS, CURB & GUTTER, SIGNAGE, HANDICAP RAMPS AND SIDEWALK DURING CONSTRUCTION PART FROM THOSE SECTIONS INDICATED FOR REMOVAL ON THE PLANS AND SHALL REPAIR OR REPLACE, PER CITY OF ALBUQUERQUE STANDARDS, AT HIS OWN EXPENSE. 17. CONTRACTOR SHALL BE RESPONSIBLE FOR PROVIDING AND MAINTAINING ALL CONSTRUCTION SIGNING UNTIL THE PROJECT HAS BEEN ACCEPTED BY THE CITY OF ALBUQUERQUE. 18. TWO WEEKS PRIOR TO CONSTRUCTION, THE CONTRACTOR SHOULD NOTIFY THE TRANSIT DEPARTMENT OF ANY IMPACT THE PROPOSED PROJECT WILL HAVE ON THE TRANSIT SYSTEM SUCH AS CAUSING A DETOUR, OR CAUSE THE CLOSING OR RELOCATION OF A BUS STOP. CONTACT DOUGLAS GOFF, OFFICE PHONE IS 505-724-3137, CELL PHONE IS 505-206-0151, AND E-MAIL IS dgoff@cbqg.gov. 19. ALL WATER AUTHORITY LINES SHALL HAVE TRACER WIRE FOR LOCATIONS. 20. REQUEST FOR WATER SHUT OFF NEAR SAN JUAN CHAMA LINES WITH ADMIN NO. 9. CONTRACTOR SHALL COMPLETE AND SUBMIT ALL REQUIRED DESIGN DOCUMENTATION.					
CAUTION: NOTE THAT ALL EXISTING UTILITIES MAY NOT BE SHOWN. ALL EXISTING SERVICE CONNECTIONS ARE NOT SHOWN. ANY EXISTING UTILITIES THAT ARE SHOWN ARE APPROXIMATE LOCATION ONLY. IT SHALL BE THE SOLE RESPONSIBILITY OF THE CONTRACTOR TO CONTACT ALL THE UTILITY OWNERS AND TO CONDUCT ALL NECESSARY FIELD INVESTIGATIONS PRIOR TO ANY EXCAVATIONS TO DETERMINE THE ACTUAL LOCATION OF UTILITIES AND OTHER IMPROVEMENTS. DISTURBANCE OF EXISTING UTILITIES SHALL BE REPLACED AT THE CONTRACTOR'S EXPENSE.							
 D. MARK GOODWIN & ASSOCIATES, P.A. CONSULTING ENGINEERS P. O. BOX 80606 ALBUQUERQUE, NEW MEXICO 87199 (505) 828-2200, FAX (505) 797-9539							
REV.	SHEETS	CITY ENGINEER	DATE	USER	DEPARTMENT	DATE	USER
ENGINEERS STAMP & SIGNATURE	APPROVALS	ENGINEER	DATE	*****			
	DRC CHAIRMAN	<i>[Signature]</i>	4/3/17	APPROVED FOR CONSTRUCTION			
	TRANSPORTATION	<i>[Signature]</i>	3/29/17				
	WATER/WASTEWATER	<i>[Signature]</i>	3-29-17				
	HYDROLOGY	<i>[Signature]</i>	3/3/17				
	CIP						
	CONSTR. MNGMT.						
CONSTR. COORD.							
CITY PROJECT NO.			703885		SHEET OF		
			1		6		

GENERAL NOTES

1. CONTRACTOR MUST OBTAIN A TOPSOIL DISTURBANCE PERMIT FROM THE ENVIRONMENTAL HEALTH DIVISION PRIOR TO CONSTRUCTION.
2. CITY OF ALBUQUERQUE STANDARD SPECIFICATIONS FOR PUBLIC WORKS CONSTRUCTION, LATEST EDITION SHALL GOVERN ALL WORK.
3. THE CONTRACTOR SHALL CONFORM TO ALL CITY, COUNTY, STATE AND FEDERAL DUST CONTROL MEASURES AND REQUIREMENTS AND WILL BE RESPONSIBLE FOR PREPARING AND OBTAINING ALL NECESSARY APPLICATIONS AND APPROVALS.
4. THE CONTRACTOR SHALL ENSURE THAT NO SOIL ERODES FROM THE LOTS INTO PUBLIC RIGHT-OF-WAY. THIS CAN BE ACHIEVED BY CONSTRUCTING TEMPORARY BERMS AND NETTING THE SOIL TO KEEP IT FROM BLOWING.

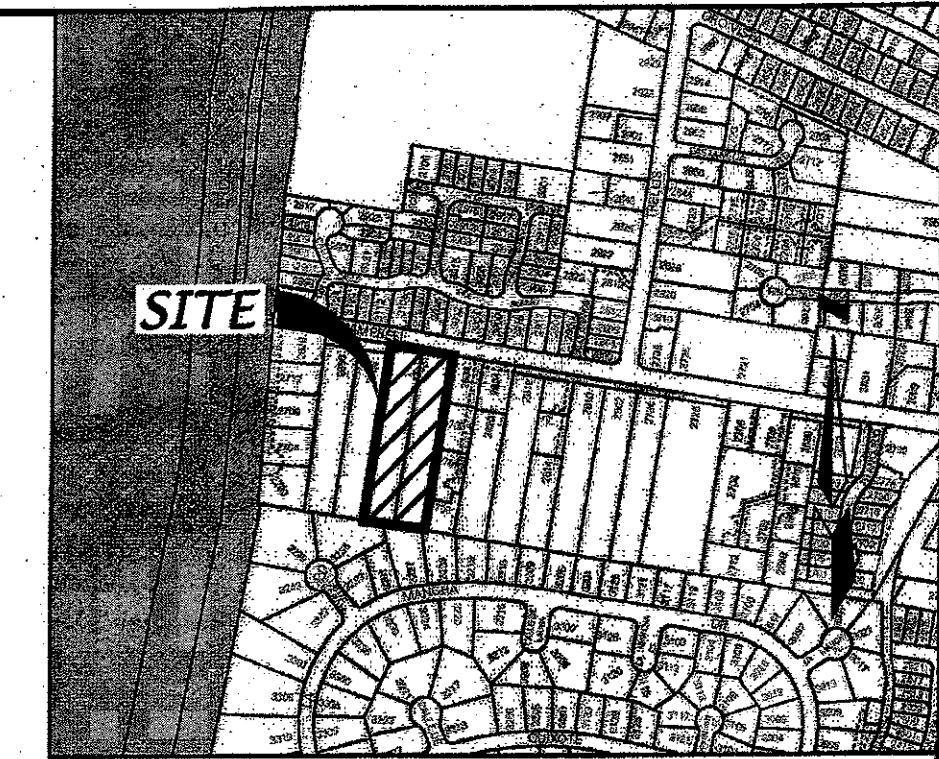

VICINITY MAP



ZONE ATLAS MAP G-14-Z

LEGAL DESCRIPTION


LOTS 15-A AND 16-A,
ALVARADO GARDENS UNIT No. 2
CITY OF ALBUQUERQUE, BERNALILLO COUNTY,
NEW MEXICO

LEGEND


- PERIMETER WALL OR SILT FENCE (TYPICAL)
- CONCRETE WASHOUT AREA
- COMPACTED CONSTRUCTION ENTRANCE
- DUMPSTER AREA
- WATTLES (AROUND SD INLETS TYPICAL)
- REMOVE & REPLACEMENT OF ASPHALT PAVEMENT FOR UTILITY CONNECTIONS

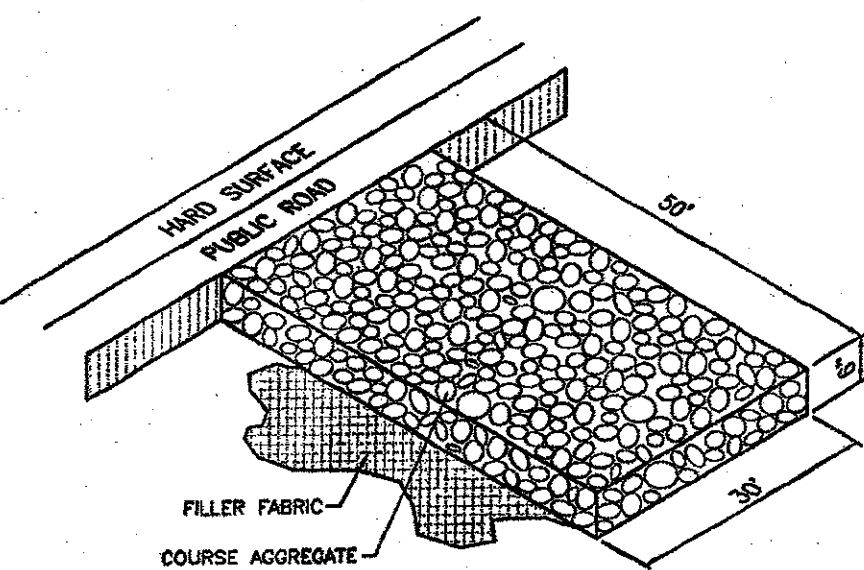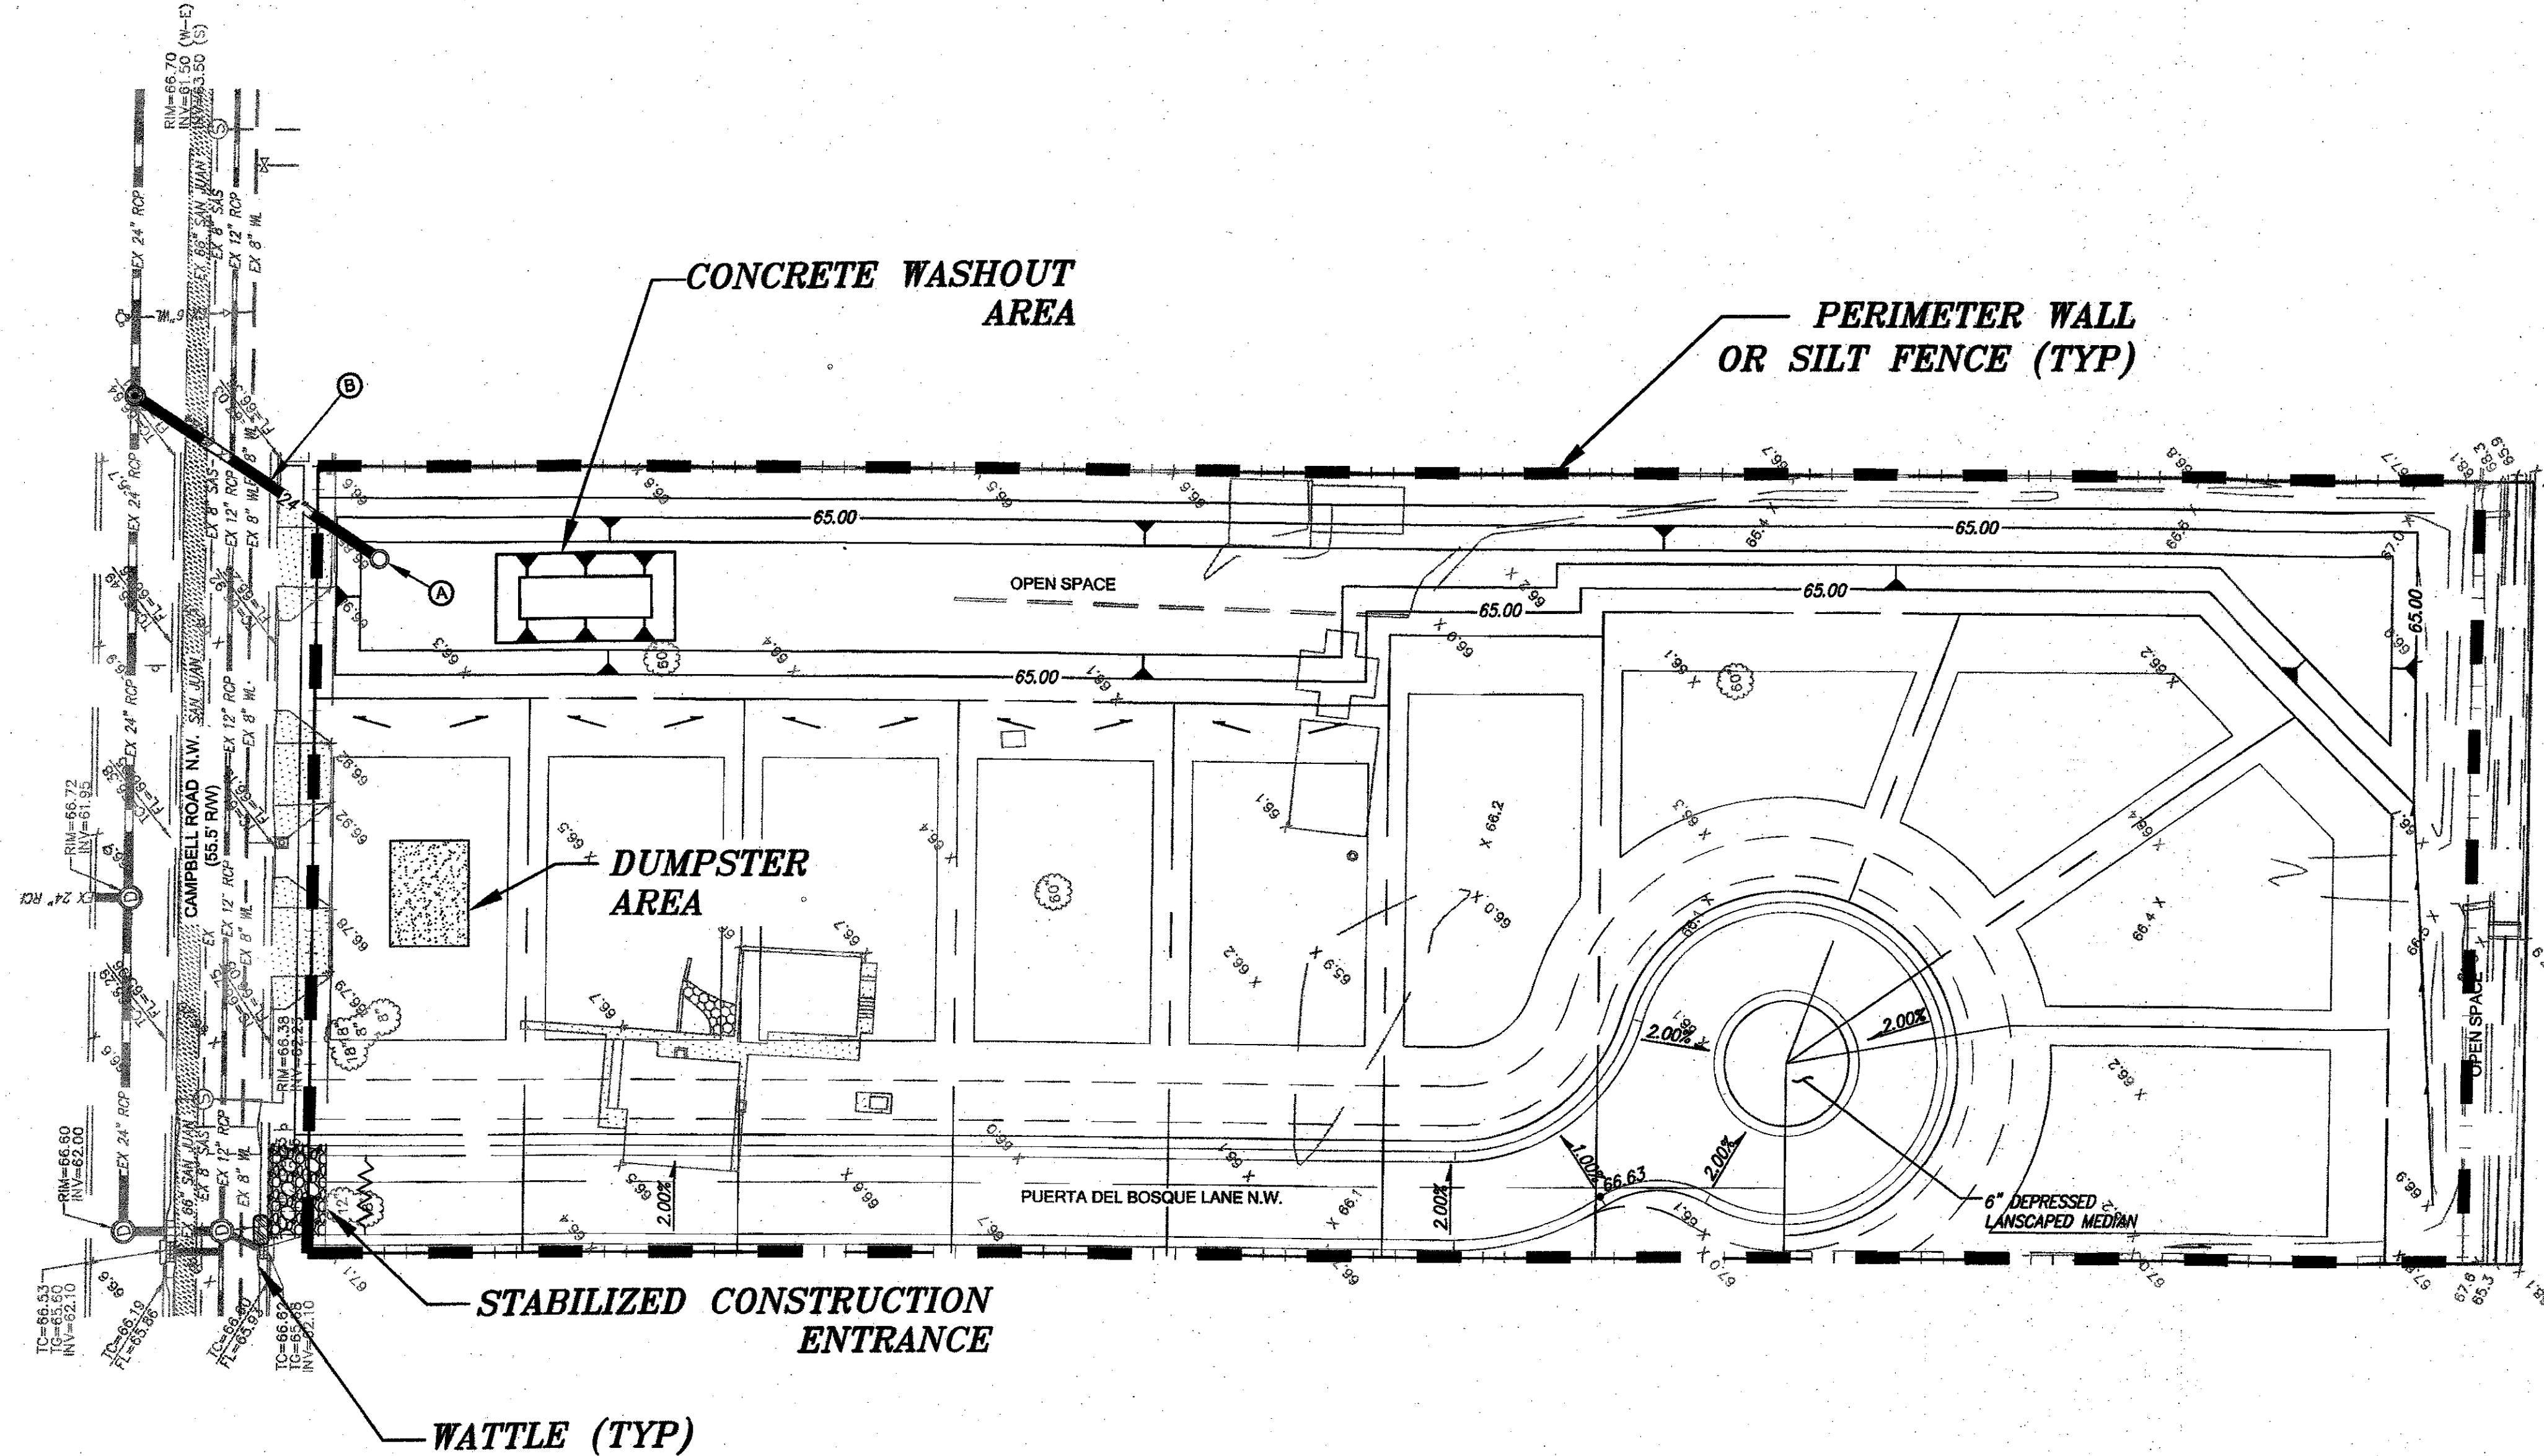



STABILIZED CONSTRUCTION ENTRANCE
N.T.S.

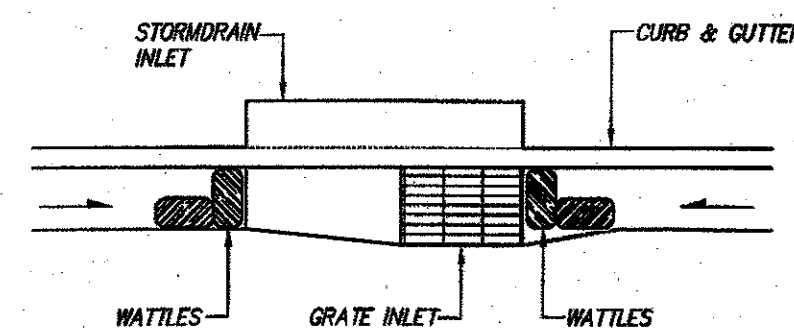

WATTLE DETAIL AT STORM INLET
SCALE 1"=5'

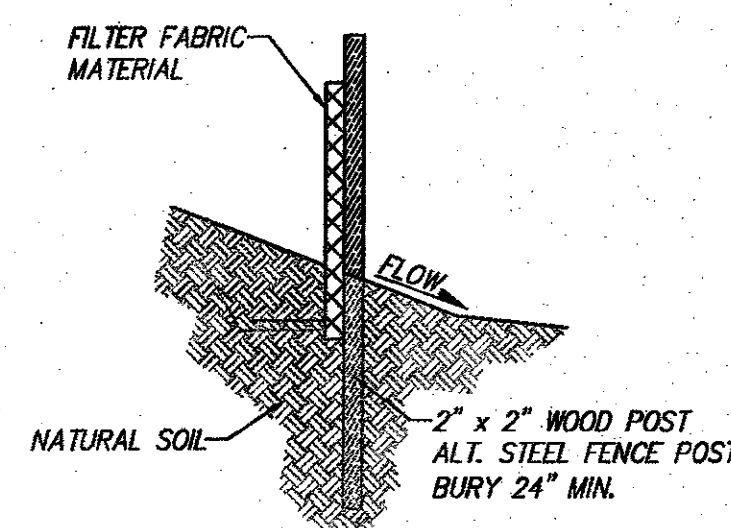


SILT FENCE FOR SEDIMENT CONTROL
N.T.S.

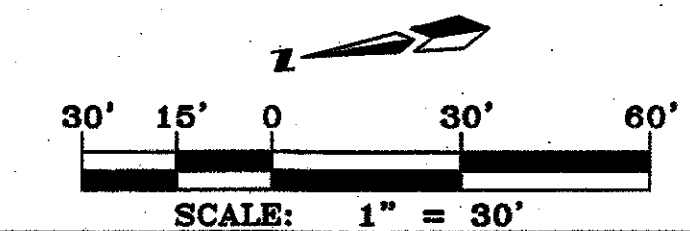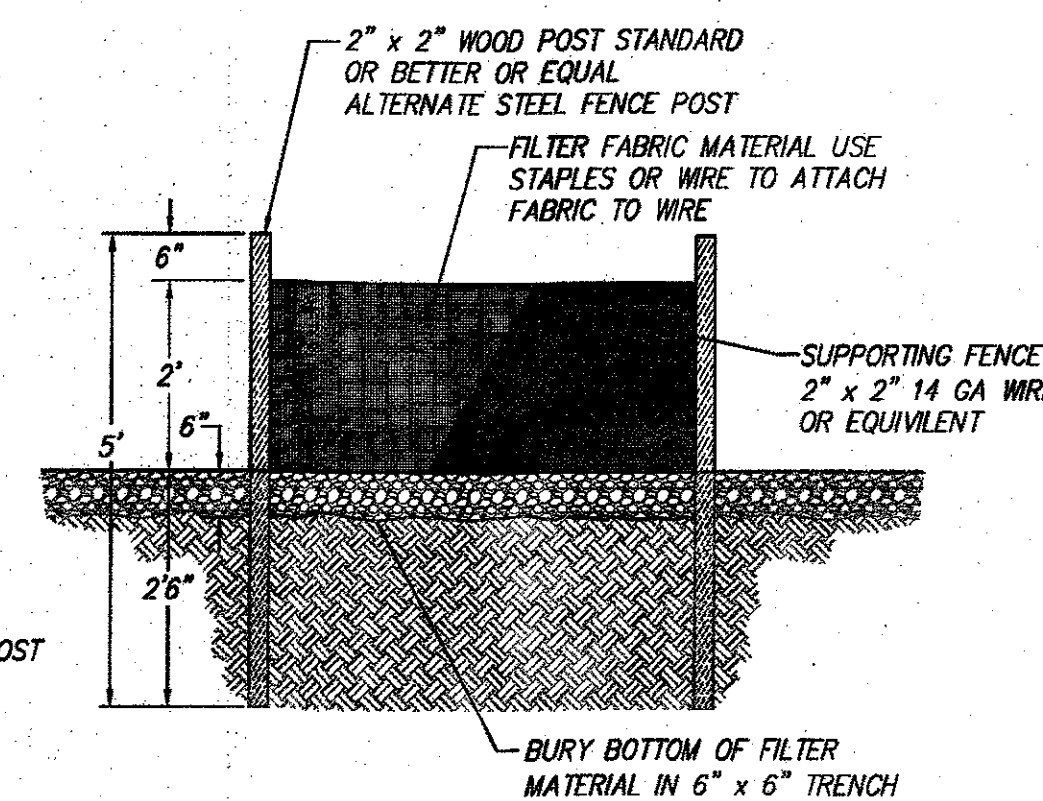

MARK GOODWIN & ASSOCIATES, P.A.
CONSULTING ENGINEERS
P.O. BOX 90608
ALBUQUERQUE, NEW MEXICO 87199
OFFICE (505) 828-2200, FAX (505) 797-9539

CITY OF ALBUQUERQUE PUBLIC WORKS DEPARTMENT	
TITLE: PUERTA DEL BOSQUE EROSION & SEDIMENT CONTROL PLAN	
DESIGN REVIEW COMMITTEE APR 03 2017	CITY ENGINEER APPROVAL MAY 22 2017
CITY PROJECT NO.	ZONE MAP NO. G-14-Z
SHEET 4	OF 6

AS BUILT INFORMATION		BENCH MARKS		SURVEY INFORMATION		ENGINEER'S SEAL		REVISIONS		DESIGNED BY		DRAWN BY		CHECKED BY	
CONTRACTOR	DATE	STATION	DATE	NO.	BY	DATE	DATE	NO.	DATE	DATE	DATE	DATE	DATE	DATE	DATE
ARPS Brass Cap stamped 70-613A															
From the intersection of I-40 and Rio Grande Boulevard, travel north on Rio Grande Boulevard 1.4 miles to the intersection with Candalaria Road and the station on the right in the northeast quadrant of the intersection.															
Geographic Position in feet (NAD83)															
N.M. State Plane Coordinates (Central Zone)															
No Coordinates															
Elevation in feet (NAVD83) = 4970.872															

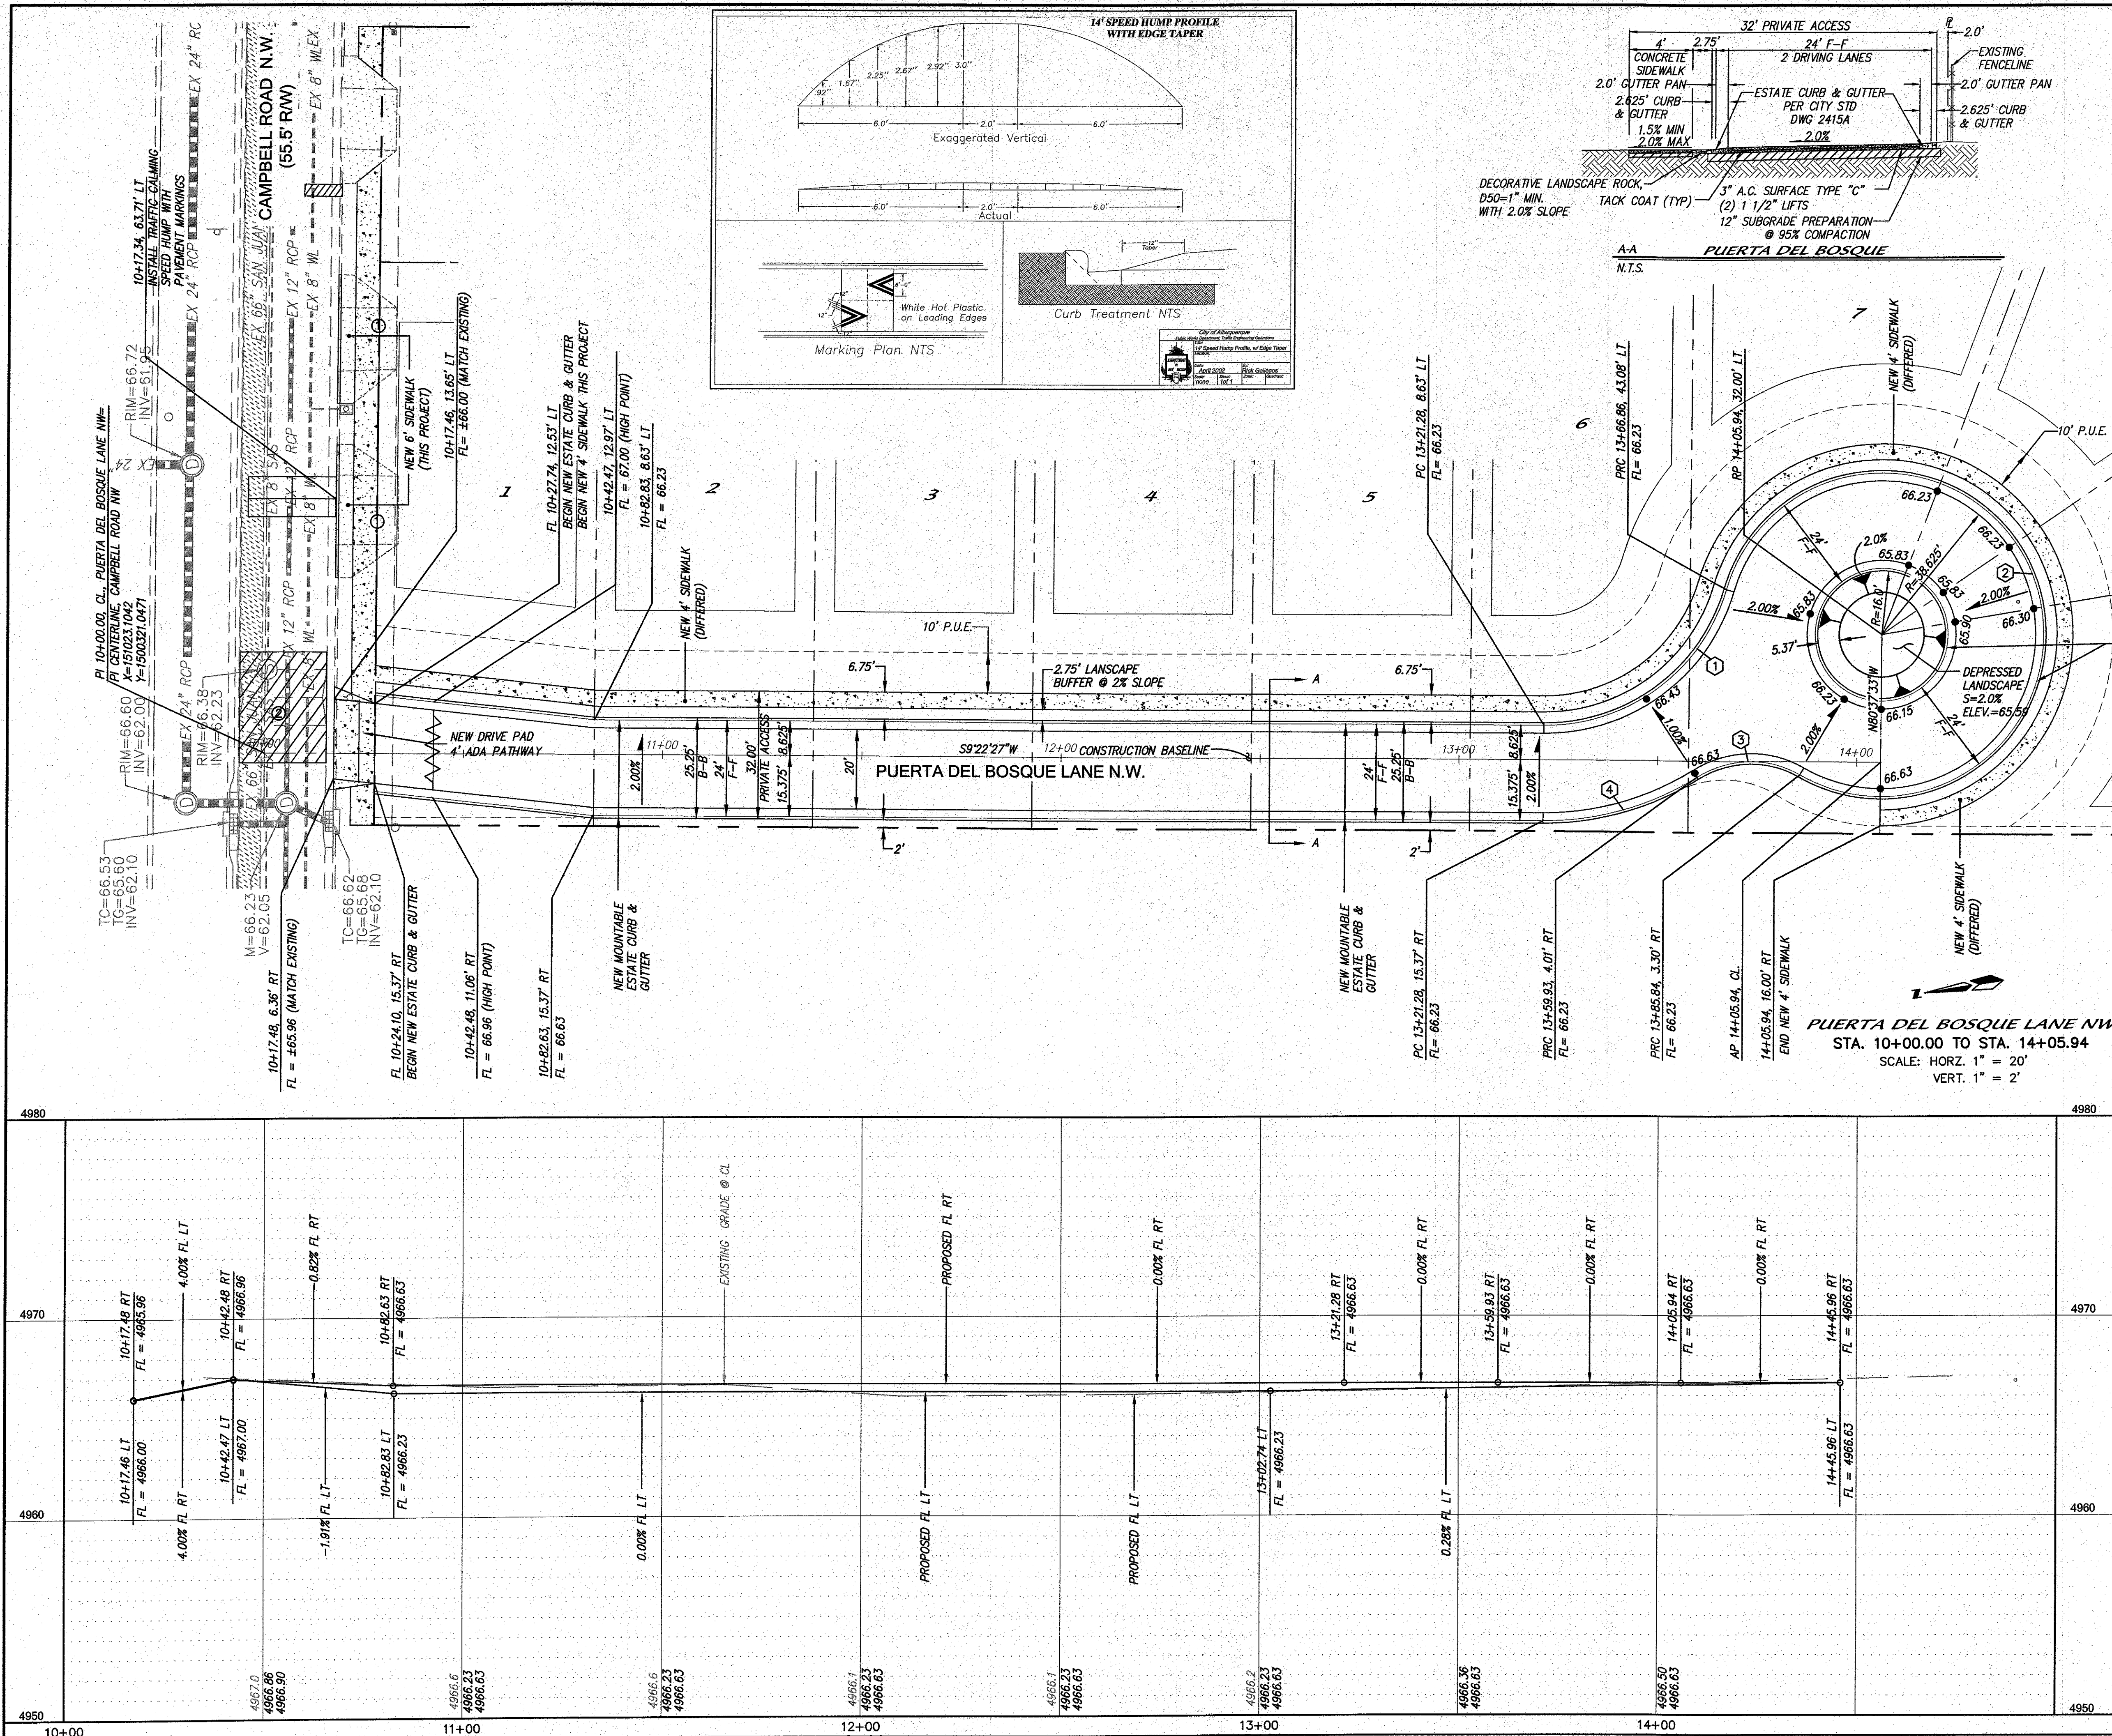

NOTES

1. ALL STATIONING IS BASED OFF CONSTRUCTION BASELINE AS SHOWN.

CURVE DATA - DESCRIBES FACE OF NEW CURB

Station	Delta (°)	Length (ft)	Radius (ft)	Tan (ft)
10+74.02	74.10	24.00	61.33	35.81
10+74.02	283.50	17.00	201.25	31.83
10+74.02	62.26	56.00	27.25	15.16
10+74.02	32.47	70.00	40.84	21.00

KEYED NOTES

1. EXISTING DRIVEPAD TO BE REMOVED.

2. EXISTING SPEED HUMP TO BE REMOVED.

CONSTRUCTION NOTES

1. ALL SIDEWALKS PER CITY OF ALBUQUERQUE STANDARD DWG #2430.

2. TRANSITION FROM MOUNTABLE ROLL CURB AND GUTTER TO STANDARD CURB AND GUTTER SHALL BE 10 FEET WHEN NOT TRANSITIONING AT INTERSECTIONS. TRANSITION FROM MOUNTABLE ROLL CURB TO STANDARD CURB AND GUTTER AT INTERSECTIONS SHALL OCCUR THROUGH THE HC RAMP PER CITY OF ALBUQUERQUE STANDARD DWG #2418.

3. SOIL TESTED BY THE CONTRACTOR AND NOT HAVING THE MINIMUM R-VALUE > 50 FOR STREETS SHALL BE REMOVED TO A DEPTH OF 2 FEET AND REPLACED BY THE CONTRACTOR WITH SUITABLE MATERIAL OR A PAVEMENT SECTION SHALL BE DESIGNED BY THE CONSULTANT ACCORDING TO THE EXISTING R-VALUE PER CITY OF ALBUQUERQUE STANDARD STANDARD SPECIFICATIONS.

4. ALL MOUNTABLE ESTATE TYPE CURB & GUTTER PER CITY OF ALBUQUERQUE STANDARD DWG #2415A.

5. ALL STANDARD CURB & GUTTER PER CITY OF ALBUQUERQUE STANDARD DWG #2415A.

6. ALL SPEED HUMPS BUILT PER CITY OF ALBUQUERQUE STANDARD DWG THIS SHEET.

MARK GOODWIN & ASSOCIATES, P.A.
P.O. BOX 90606
ALBUQUERQUE, NEW MEXICO 87199
(505) 828-2200, FAX (505) 797-9539

CITY OF ALBUQUERQUE
PUBLIC WORKS DEPARTMENT



TITLE:
PUERTA DEL BOSQUE
PUERTA DEL BOSQUE LANE NW
PAVING PLAN & PROFILE

DESIGN REVIEW COMMITTEE	CITY ENGINEER APPROVAL	MO./DAY/YR.	MO./DAY/YR.
APR 03 2017	MAY 22 2017		

DESIGNED BY	REMARKS	BY
HLC	DESIGN	
DER	REVISIONS	
DMG	DESIGN	

DATE	DATE	DATE
01/17	01/17	01/17

CITY PROJECT NO. **703885** ZONE MAP NO. **G-14-Z** SHEET **5** OF **6**

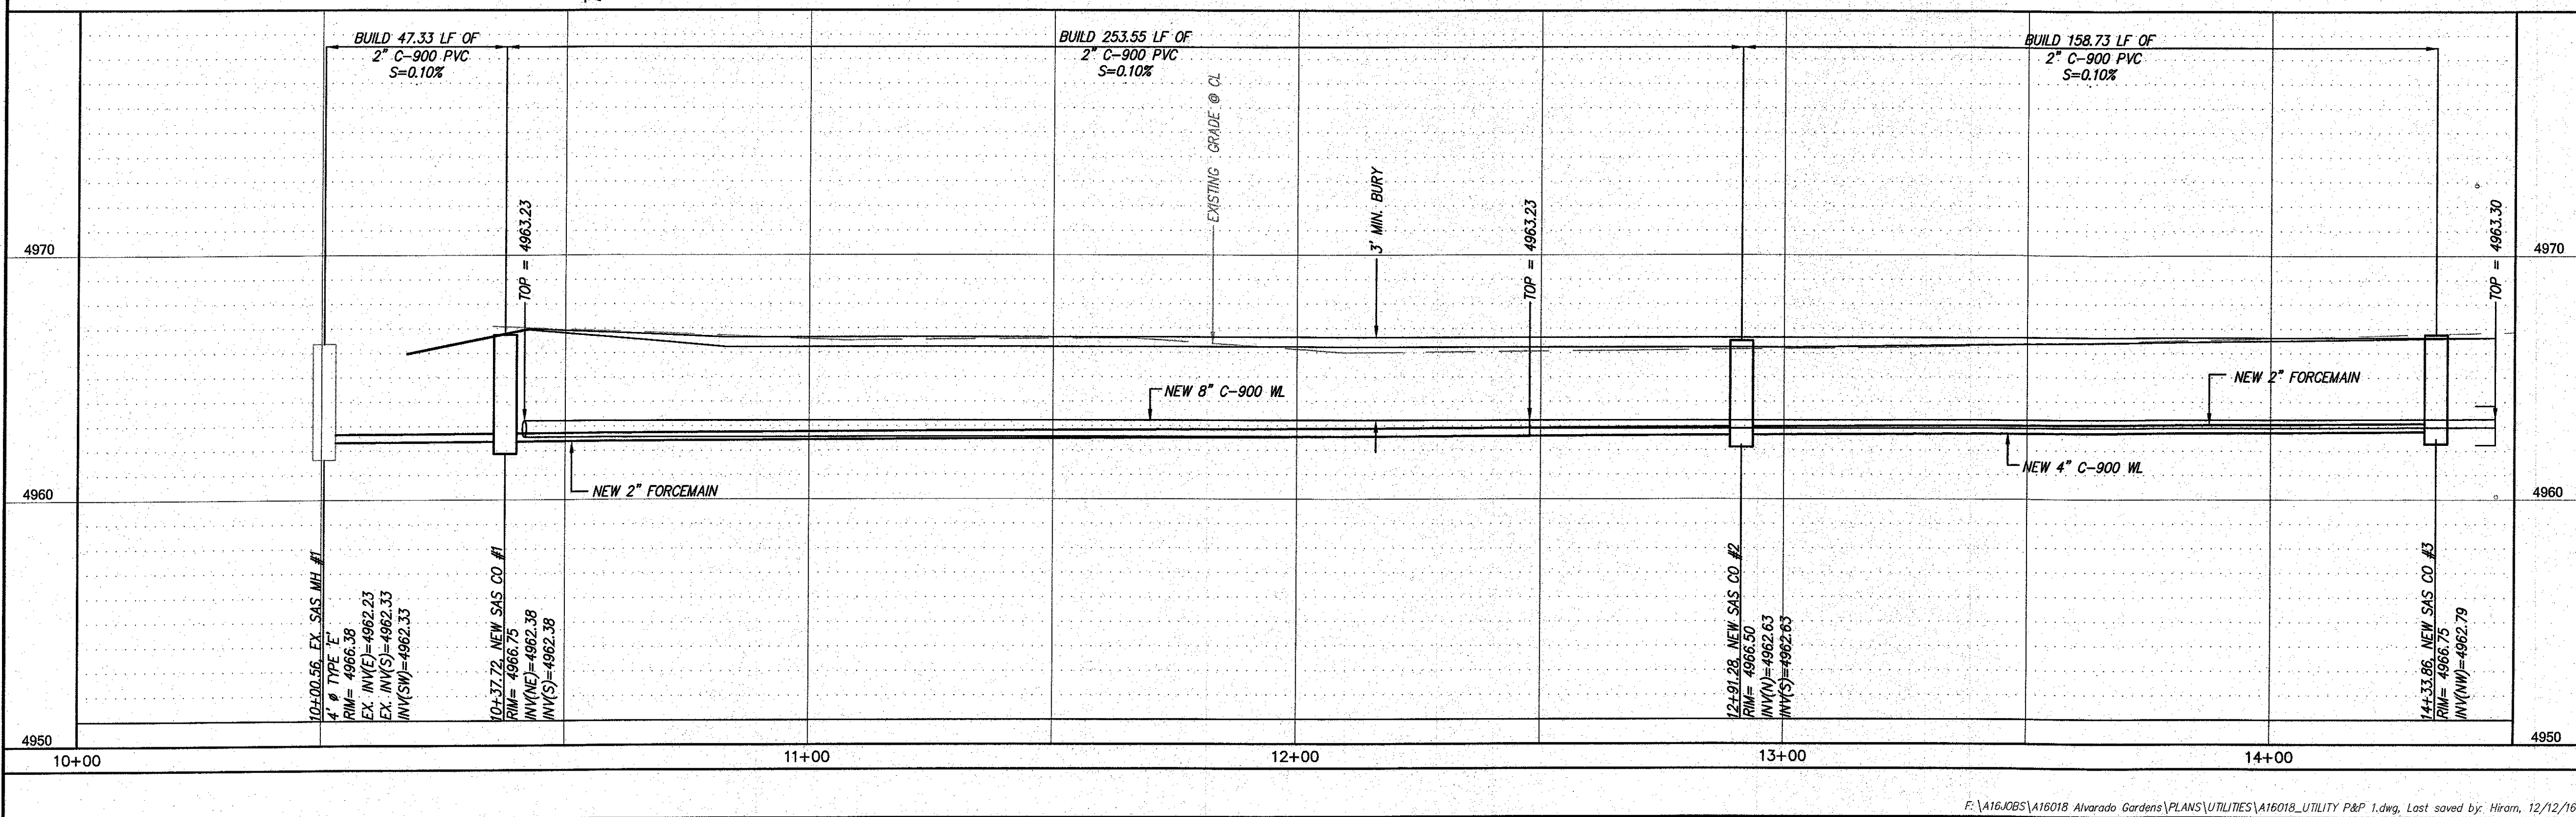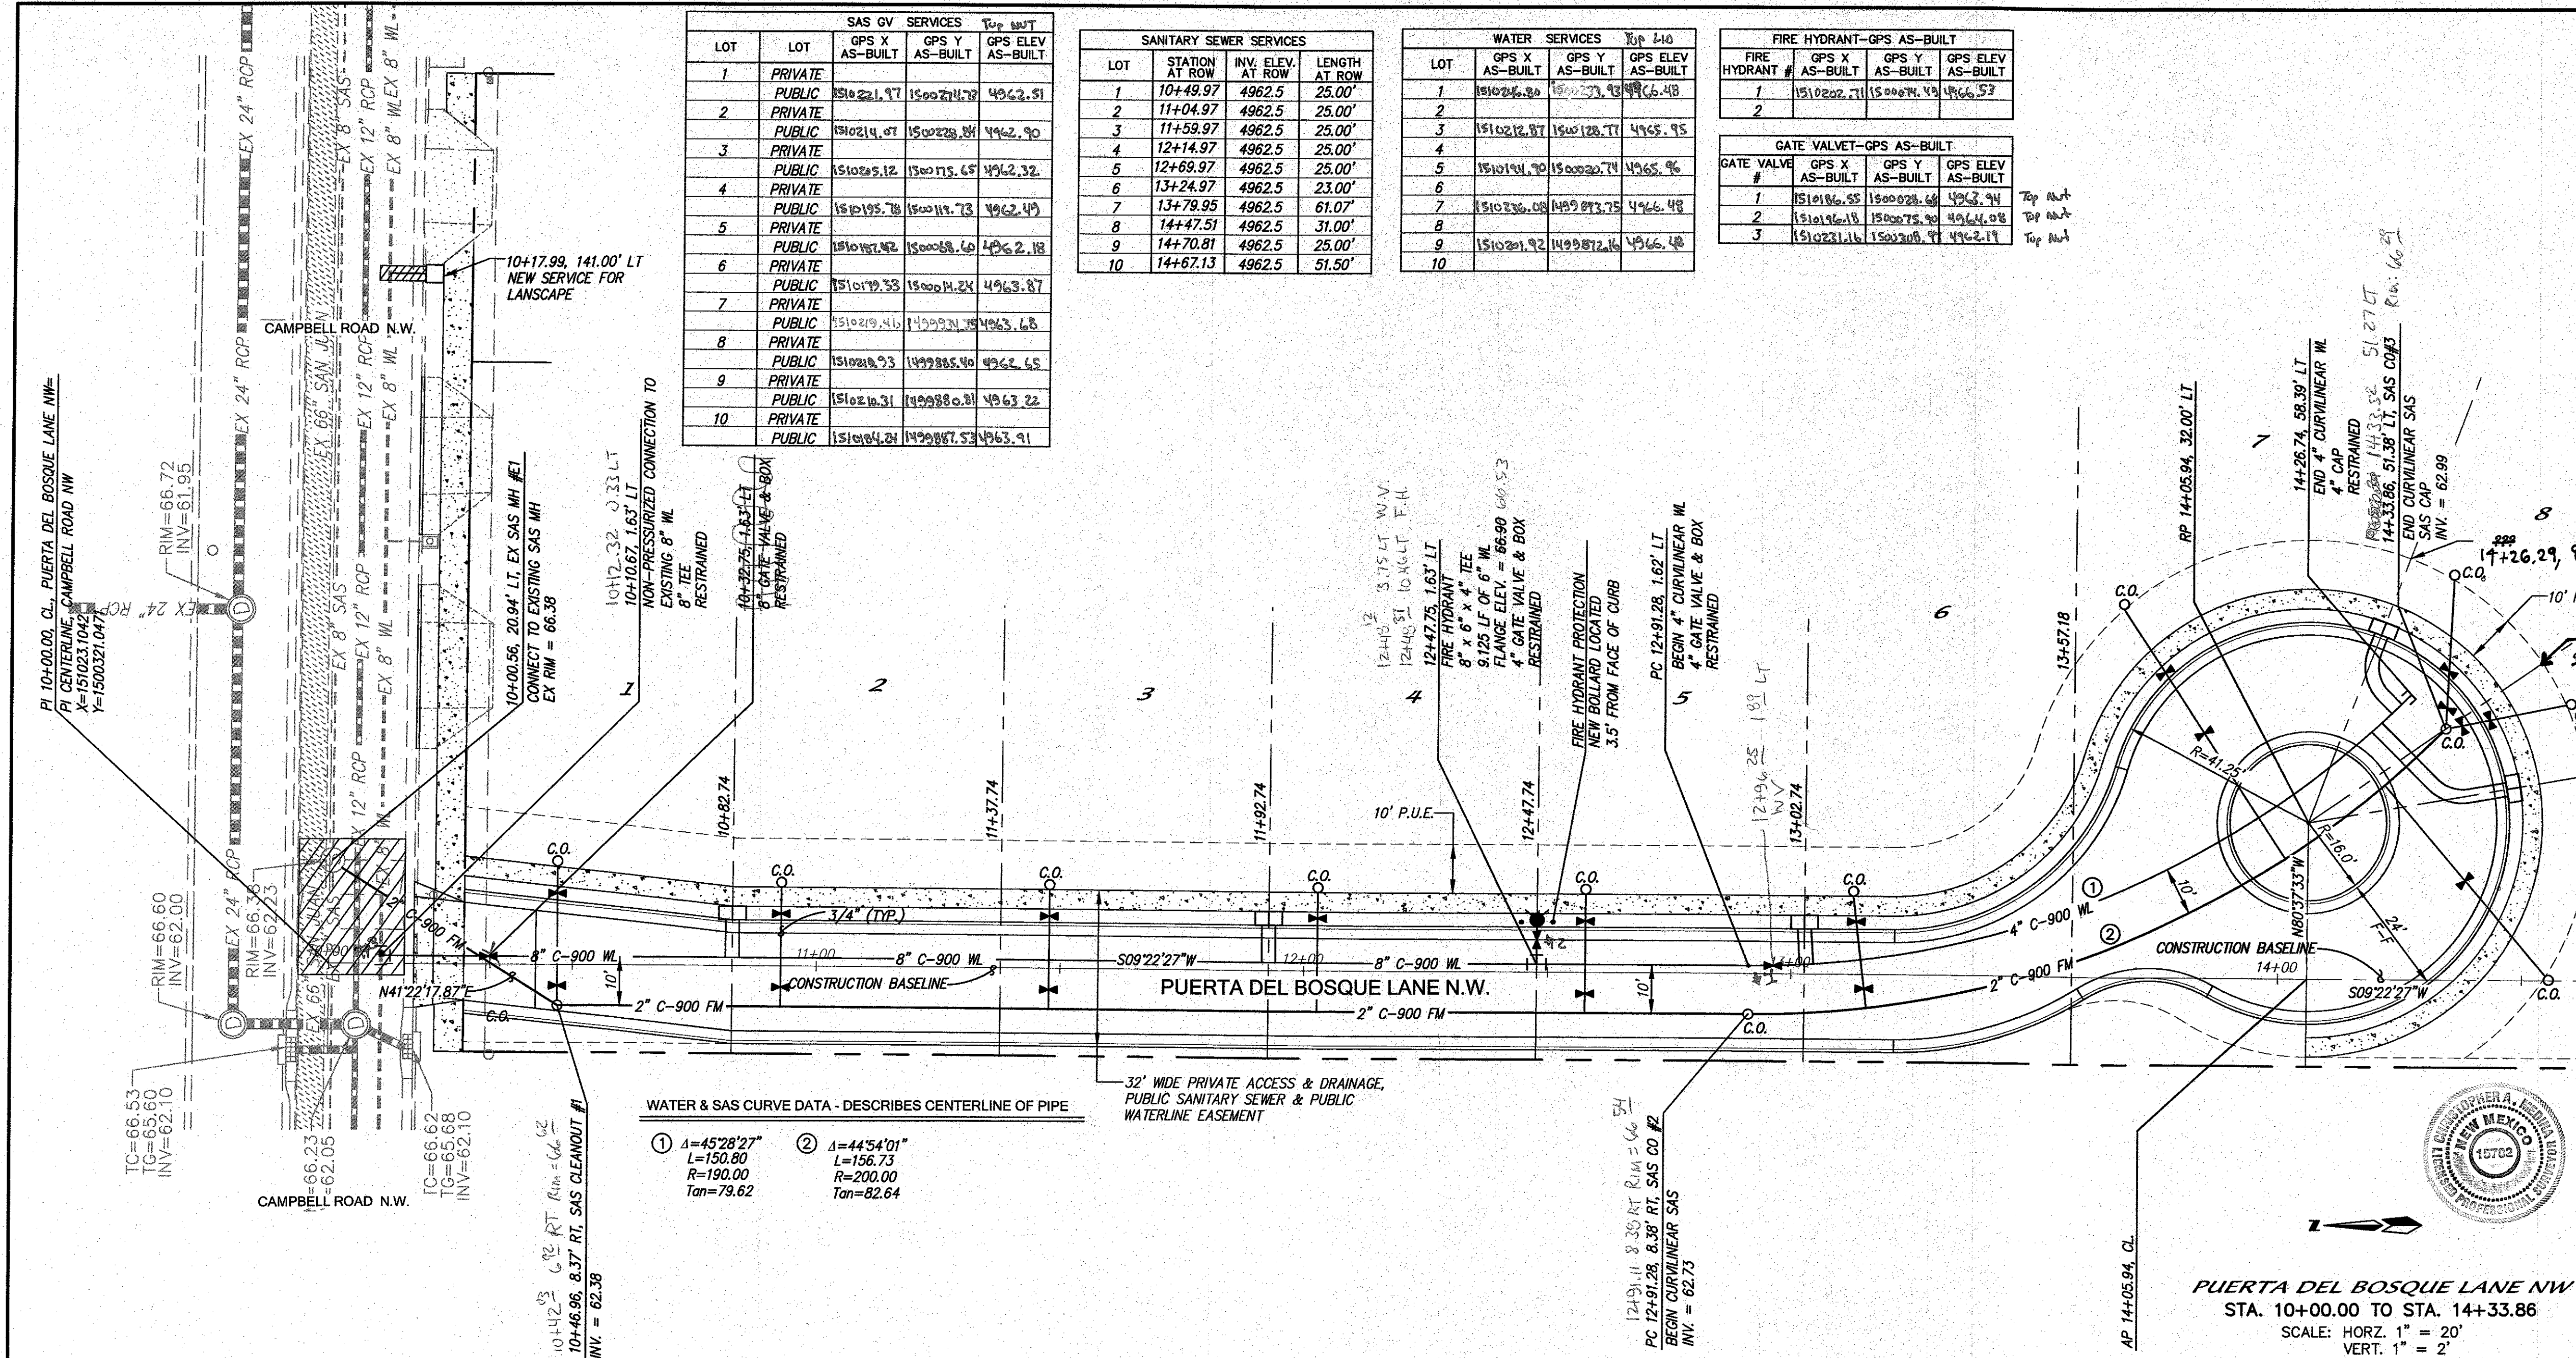

NOTES

1. ALL STATIONING IS BASED OFF CONSTRUCTION BASELINE AS SHOWN.

LEGEND

REMOVE & REPLACE INKING PAVEMENT, LOCAL RESIDENTIAL STREET SECTION, SECTION PER C.O.A. STANDARD DETAIL #2465.

NEW WATER METER SERVICES PER C.O.A. STANDARD DETAIL #2361.

WATER SHUT-OFF PLAN

1. CONTRACTOR SHALL MAKE SHUT OFF REQUEST ONLINE AT <http://abcwua.org/content/view/full/463/729/>

2. VALVES SHALL ONLY BE OPERATED BY WATER AUTHORITY EMPLOYEES.

3. CLOSE EXISTING GATE VALVES #693 AND #6592 TO MAKE NON-PRESSURE WATERLINE CONNECTION #1 IN CAMPBELL RD NW.

4. PRESSURE TEST AND DISINFECT NEW WATERLINE AS PER ABCWUA STANDARD SPECIFICATIONS - SECTION 801.

AS BUILT INFORMATION

CONTRACTOR: **MARK GOODWIN & ASSOCIATES, P.A.**

WORK: **161600S Alvarado Gardens PLANS UTILITIES**

INSPECTORS: **DIANE HOELLER**

ACCEPTANCE: **DATE 01/17**

VERIFICATION: **DATE 01/17**

DRAWING: **DATE 01/17**

DESIGNED BY: **HLC**

DRAWN BY: **DMG**

CHECKED BY: **DMG**

ENGINEER'S SEAL

DATE: **01/17**

NOTES

1. ALL FIRE HYDRANTS PER ABCWUA STD. 2340, WITH BOLLARD PROTECTION PER PER ABCWUA STD. DWG 2347.

2. ALL FIRE HYDRANTS TO HAVE A 6" GATE VALVE & BOX PER ABCWUA STD. DWG #2326; CONTRACTOR TO USE POLY COATED CMP FOR VALVE BOXES.

3. ALL METER BOXES ADJACENT TO MOUNTABLE CURB SHALL HAVE DUCTILE IRON METER BOX COVER & LID PER ABCWUA STD. DWG 2368; WATER METER BOX PER ABCWUA STD. DWG #2366; WATER SERVICE PER ABCWUA STD. DWG #2362.

4. FORCE MAIN PUMP SYSTEM DESIGNED FOR ENVIRONMENT ONE MODEL NO. DH151 PUMP OR APPROVED EQUAL TO BE CONSTRUCTED WITH THE HOME.

5. ALL SANITARY SEWER CLEANOUTS SHALL BE PER COA STD. DWG 2182.

6. ALL SANITARY SEWER SERVICE LINES SHALL BE PER COA STD. DWG 2185.

7. ALL STATIONARY BOLLARDS FOR FIRE HYDRANT PROTECTION SHALL BE PER COA STD. DWG 2250.

8. ALL FORCE MAIN SEWER SERVICE LINES SHALL BE PER COA STD. DWG 2185.

MARK GOODWIN & ASSOCIATES, P.A.
CONSULTING ENGINEERS
P.O. BOX 90606
ALBUQUERQUE, NEW MEXICO 87199
(505) 828-2200, FAX (505) 797-9539

CITY OF ALBUQUERQUE
PUBLIC WORKS DEPARTMENT

TITLE: **PUERTA DEL BOSQUE PUERTA DEL BOSQUE LANE NW UTILITY PLAN & PROFILE**

DESIGN REVIEW COMMITTEE: **APR 03 2017**

CITY ENGINEER APPROVAL: **MAY 22 2017**

LAST DESIGN UPDATE: **MO./DAY/YR.**

CITY PROJECT NO.: **703885**

ZONE MAP NO.: **G-14-Z**

SHEET: **6** OF **6**