


LEGEND


MATERIALS

CONCRETE
RIP-RAP

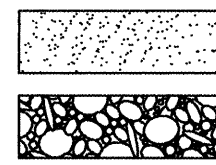


LINES

SUBDIVISION BOUNDARY
PROPERTY LINE (PLAN)
PROPERTY LINE (SECTION)
CENTERLINE
EASEMENT LINE
MATCH LINE
SECTION CUT LINE

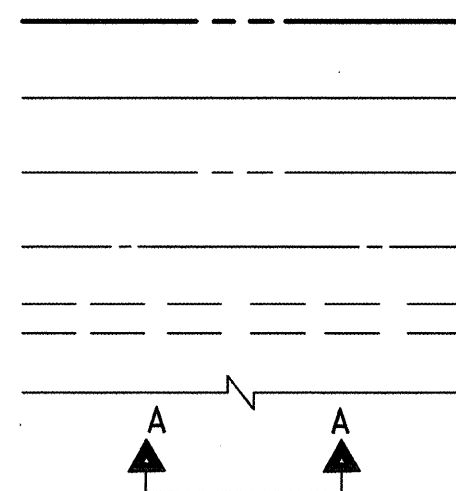


EARTHWORK

CONTOUR LINE
SPOT ELEVATION
PROJECT / PHASE BOUNDARY
FLOWLINE
DIRECTION OF FLOW

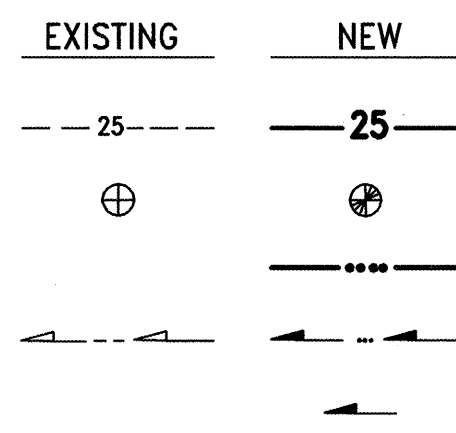


MISCELLANEOUS UTILITIES

GAS LINE
UNDERGROUND TELEPHONE
UNDERGROUND ELECTRICAL
STORM DRAIN
STORM DRAIN MANHOLE
STORM DRAIN INLET

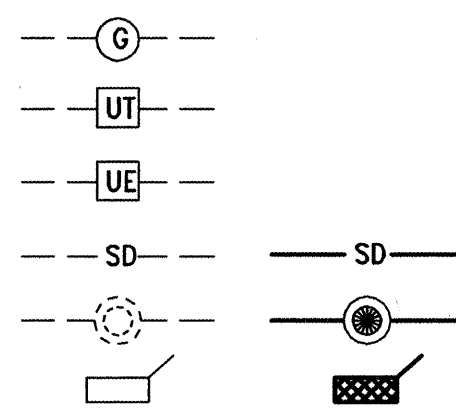


SANITARY SEWER

SANITARY SEWER LINE
SANITARY SEWER MANHOLE
SAS SERVICE CONNECTIONS
SAS CAP OR PLUG
ENCASEMENT

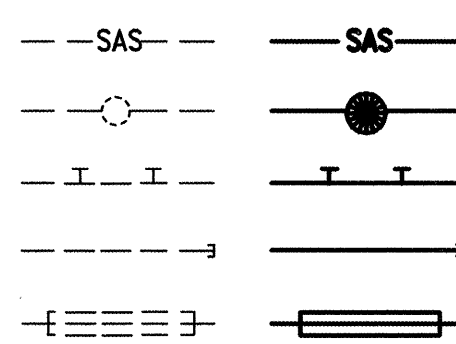


WATER

WATER LINE
WATER SERVICE CONNECTIONS
GATE VALVE
FIRE HYDRANT
BUTTERFLY VALVE
REDUCER
WATER PRESSURE ZONE BOUNDARY

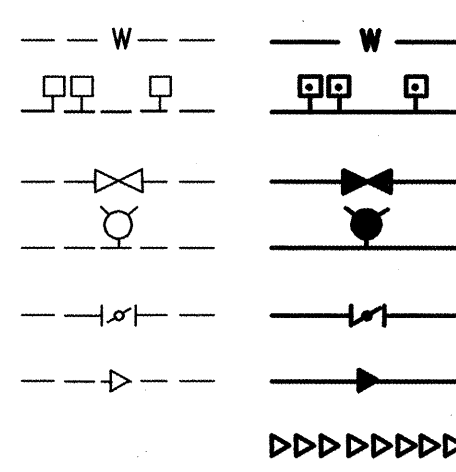


WATER FITTINGS

CAPS AND PLUGS
ELBOW
CROSS
TEE

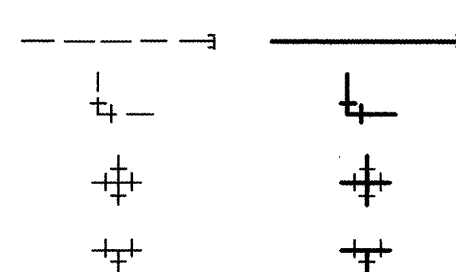

MISCELLANEOUS

CHAINLINK FENCE
FIELD FENCE
COMMON YARD WALL
RETAINING WALL
POWER OR TELEPHONE POLE

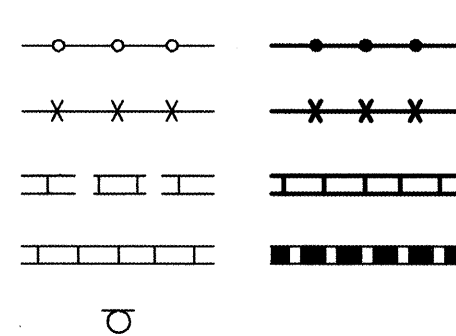

CONSTRUCTION PLANS

for

VINEYARD ESTATES, UNIT IV-B

ALBUQUERQUE, NEW MEXICO

NOVEMBER, 2003

CERTIFICATE OF SUBSTANTIAL COMPLIANCE
I, J. GRAEME MEANS, NMPE 13676, OF THE FIRM JEFF MORTENSEN & ASSOCIATES, INC., HEREBY CERTIFY THAT THE INFRASTRUCTURE CONSTRUCTED AS PART OF THIS PROJECT HAS BEEN INSPECTED BY ME OR PERSONNEL UNDER MY DIRECT SUPERVISION AND, TO THE BEST OF MY KNOWLEDGE AND BELIEF, HAS BEEN CONSTRUCTED IN ACCORDANCE WITH THE PLANS AND SPECIFICATIONS AND THE ORIGINAL DESIGN INTENT OF THE CITY ENGINEER APPROVED PLANS. THE RECORD INFORMATION EDITED ONTO THIS ORIGINAL DESIGN DOCUMENT HAS BEEN OBTAINED BY CHARLES G. CALA, JR., NMPS 11184, ALSO OF THE FIRM JEFF MORTENSEN & ASSOCIATES, INC. THIS RECORD INFORMATION IS NOT NECESSARILY COMPLETE AND INTENDED ONLY TO VERIFY SUBSTANTIAL COMPLIANCE WITH THE DESIGN INTENT OF THIS PROJECT. THOSE RELYING ON THIS DOCUMENT ARE ADVISED TO OBTAIN INDEPENDENT VERIFICATION OF ITS ACCURACY BEFORE USING IT FOR ANY OTHER PURPOSE. THIS CERTIFICATION IS SUBMITTED IN SUPPORT OF A REQUEST FOR ACCEPTANCE OF THIS PROJECT BY THE CITY ENGINEER.


J. Graeme Means
J. GRAEME MEANS, NMPE 13676
04/02/2004
DATE

INDEX OF DRAWINGS

SHEET	DESCRIPTION
1	COVER SHEET, VICINITY MAP, GENERAL NOTES, LEGEND AND INDEX OF DRAWINGS
2, 3	SUBDIVISION PLAT
4	DRB APPROVED GRADING PLAN
5	SECTIONS AND DETAILS
6	CARMEL AVENUE N.E. PAVING IMPROVEMENTS PLAN AND PROFILE
7	VISALIA WAY N.E. PAVING IMPROVEMENTS PLAN AND PROFILE
8	VISALIA WAY N.E. WATER AND SANITARY SEWER EXTENSIONS PLAN AND PROFILE

APPROVED AS RECORD DRAWINGS
DESIGN REVIEW SECTION
CITY CONSTRUCTION ENGINEER
DATE: 4/2/04

RECORD DRAWING

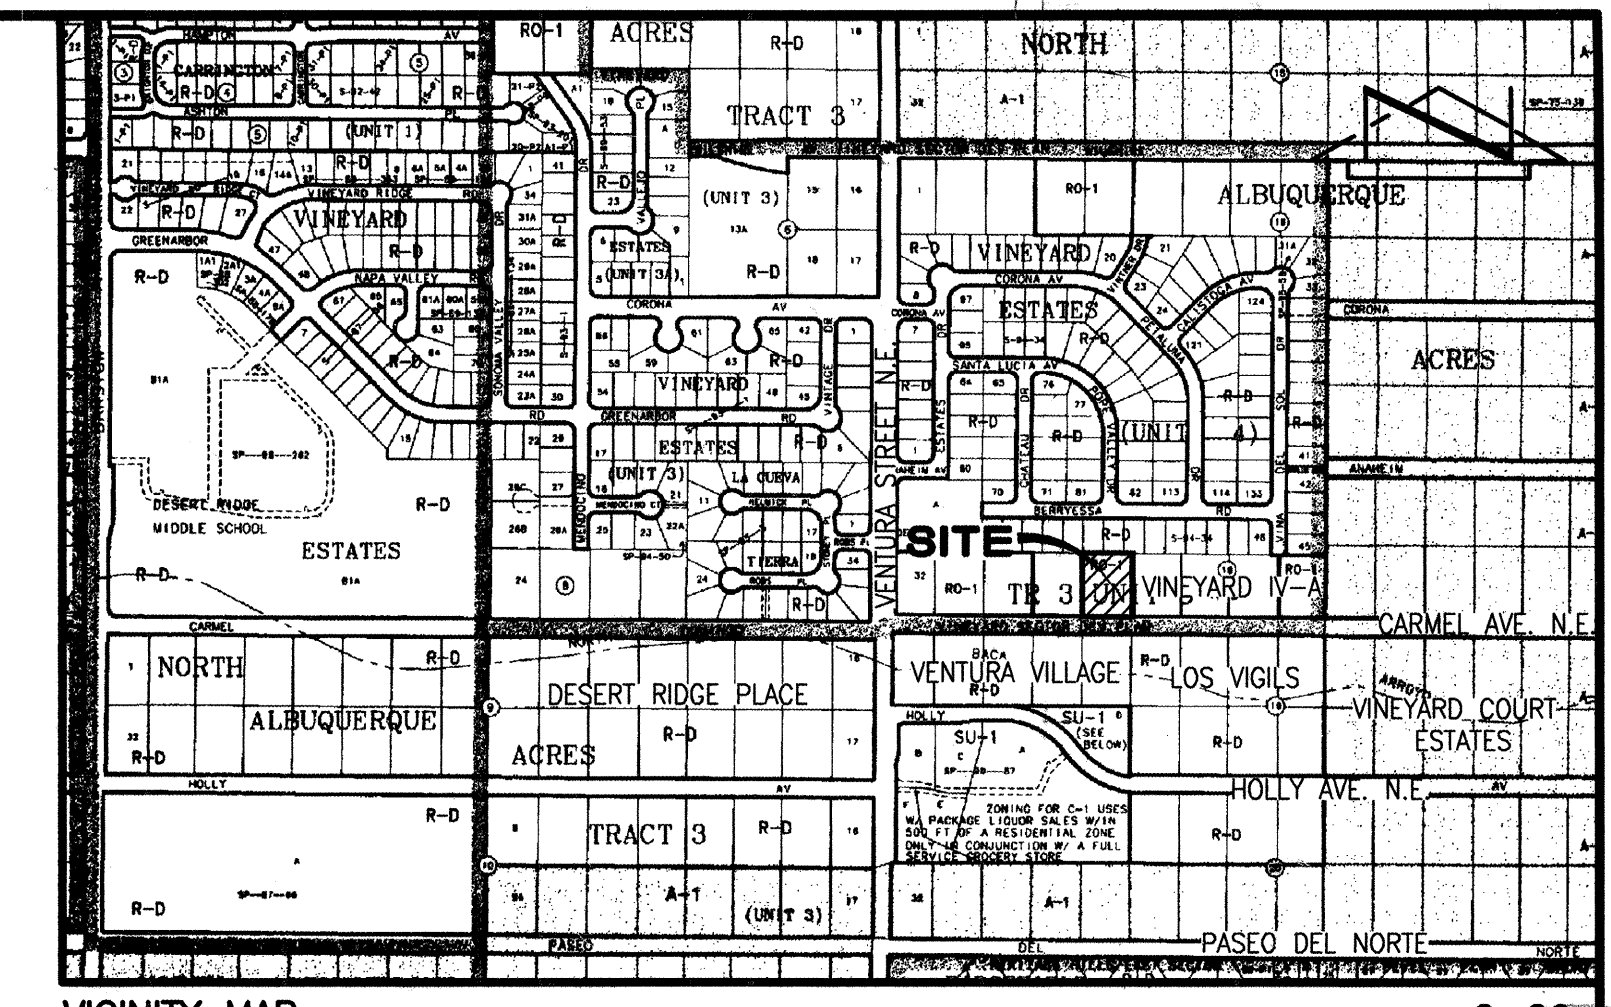

VICINITY MAP

SCALE: 1" = 750'

C-20


GENERAL NOTES:

- ALL WORK DETAILED ON THESE PLANS TO BE PERFORMED UNDER CONTRACT SHALL, EXCEPT AS OTHERWISE STATED OR PROVIDED FOR HEREON, BE CONSTRUCTED IN ACCORDANCE WITH THE CITY OF ALBUQUERQUE STANDARD SPECIFICATIONS-PUBLIC WORKS CONSTRUCTION-1986 - UPDATE NO. 7.
- TWO (2) WORKING DAYS PRIOR TO ANY EXCAVATION, CONTRACTOR MUST CONTACT NEW MEXICO ONE CALL SYSTEM, 260-1990, (ALBUQUERQUE AREA) 1-800-321-ALERT (2537) (STATEWIDE) FOR LOCATION OF EXISTING UTILITIES.
- IF ANY UTILITY LINES, PIPELINES, OR UNDERGROUND UTILITY LINES ARE SHOWN ON THESE DRAWINGS, THEY ARE SHOWN IN AN APPROXIMATE MANNER ONLY, AND SUCH LINES MAY EXIST WHERE NONE ARE SHOWN. IF ANY SUCH EXISTING LINES ARE SHOWN, THE LOCATION IS BASED UPON INFORMATION PROVIDED BY THE OWNER OF SAID UTILITY, AND THE INFORMATION MAY BE INCOMPLETE, OR MAY BE OBSOLETE BY THE TIME CONSTRUCTION COMMENCES. THE ENGINEER HAS CONDUCTED ONLY PRELIMINARY INVESTIGATION OF THE LOCATION, DEPTH, SIZE, OR TYPE OF EXISTING UTILITY LINES, PIPELINES, OR UNDERGROUND UTILITY LINES. THIS INVESTIGATION IS NOT CONCLUSIVE, AND MAY NOT BE COMPLETE, THEREFORE, MAKES NO REPRESENTATION PERTAINING THERETO, AND ASSUMES NO RESPONSIBILITY OR LIABILITY THEREFOR. THE CONTRACTOR SHALL INFORM ITSELF OF THE LOCATION OF ANY UTILITY LINE, PIPELINE, OR UNDERGROUND UTILITY LINE IN OR NEAR THE AREA OF THE WORK IN ADVANCE OF AND DURING EXCAVATION WORK. THE CONTRACTOR IS FULLY RESPONSIBLE FOR ANY AND ALL DAMAGE CAUSED BY ITS FAILURE TO LOCATE, IDENTIFY AND PRESERVE ANY AND ALL EXISTING UTILITIES, PIPELINES, AND UNDERGROUND UTILITY LINES. IN PLANNING AND CONDUCTING EXCAVATION, THE CONTRACTOR SHALL COMPLY WITH STATE STATUTES, MUNICIPAL AND LOCAL ORDINANCES, RULES AND REGULATIONS, IF ANY, PERTAINING TO THE LOCATION OF THESE LINES AND FACILITIES.
- SHOULD A CONFLICT EXIST BETWEEN THESE PLANS AND ACTUAL FIELD CONDITIONS, THE CONTRACTOR SHALL PROMPTLY NOTIFY THE ENGINEER IN WRITING SO THAT THE CONFLICT CAN BE RESOLVED WITH A MINIMUM AMOUNT OF DELAY FOR ALL PARTIES.
- THE CONTRACTOR SHALL MAINTAIN ACCESS TO ADJACENT PROPERTIES DURING CONSTRUCTION.
- ALL WORK ON THIS PROJECT SHALL BE PERFORMED IN ACCORDANCE WITH APPLICABLE FEDERAL, STATE AND LOCAL LAWS, RULES AND REGULATIONS CONCERNING SAFETY AND HEALTH.
- ALL UTILITIES AND UTILITY SERVICE LINES SHALL BE INSTALLED PRIOR TO PAVING.
- BACKFILL COMPACTION SHALL BE ACCORDING TO SPECIFIED STREET USE.
- TACK COAT REQUIREMENTS SHALL BE DETERMINED DURING CONSTRUCTION BY THE PROJECT ENGINEER.
- SIDEWALKS AND WHEELCHAIR RAMPS WITHIN THE CURB RETURNS SHALL BE CONSTRUCTED WHEREVER A NEW CURB RETURN IS CONSTRUCTED.
- IF CURB IS DEPRESSED FOR A DRIVEPAD OR A HANDICAP RAMP, THE DRIVEPAD OR RAMP SHALL BE CONSTRUCTED PRIOR TO ACCEPTANCE OF THE CURB AND GUTTER.
- ALL STORM DRAINAGE FACILITIES SHALL BE COMPLETED PRIOR TO FINAL ACCEPTANCE.
- CONTRACTOR SHALL COORDINATE WITH THE WATER SYSTEM DIVISION FOR THE EXECUTION OF THE VALVE SHUT OFF PLAN, NOT LESS THAN SEVEN (7) WORKING DAYS IN ADVANCE OF ANY WORK THAT MAY AFFECT THE EXISTING PUBLIC WATER UTILITIES. ONLY WATER SYSTEM DIVISION PERSONNEL SHALL OPERATE EXISTING VALVES. REFER TO SECTION 18 OF THE SPECIFICATIONS. THE WATER SYSTEM DIVISION PHONE NUMBER IS 857-8200.
- CONTRACTOR SHALL NOTIFY THE CITY SURVEYOR NOT LESS THAN SEVEN (7) DAYS PRIOR TO STARTING WORK IN ORDER THAT THE CITY SURVEYOR MAY TAKE NECESSARY MEASURES TO INSURE THE PRESERVATION OF SURVEY MONUMENTS. CONTRACTOR SHALL NOT DISTURB PERMANENT SURVEY MONUMENTS WITHOUT THE CONSENT OF THE CITY SURVEYOR AND SHALL NOTIFY THE CITY SURVEYOR AND BEAR THE EXPENSE OF REPLACING ANY THAT MAY BE DISTURBED WITHOUT PERMISSION. REPLACEMENT SHALL BE DONE ONLY BY THE CITY SURVEYOR. WHEN A CHANGE IS MADE IN THE FINISHED ELEVATION OF THE PAVEMENT OF ANY ROADWAY IN WHICH A PERMANENT SURVEY MONUMENT IS LOCATED, CONTRACTOR SHALL, AT HIS OWN EXPENSE, ADJUST THE MONUMENT COVER TO THE NEW GRADE UNLESS OTHERWISE SPECIFIED. REFER TO SECTION 4.4 OF THE SPECIFICATIONS.
- FIVE (5) WORKING DAYS PRIOR TO BEGINNING CONSTRUCTION THE CONTRACTOR SHALL SUBMIT TO THE CONSTRUCTION CO-ORDINATION DIVISION A DETAILED CONSTRUCTION SCHEDULE. TWO (2) WORKING DAYS PRIOR TO CONSTRUCTION THE CONTRACTOR SHALL OBTAIN A BARRICADE PERMIT FROM THE CONSTRUCTION CO-ORDINATION DIVISION. CONTRACTOR SHALL NOTIFY BARRICADE ENGINEER (924-3400) PRIOR TO OCCUPYING AN INTERSECTION. CONTRACTOR MUST REFER TO SECTION 19 OF THE STANDARD SPECIFICATION FOR TRAFFIC CONTROL.
- ALL STREET STRIPING ALTERED OR DESTROYED SHALL BE REPLACED WITH PLASTIC REFLECTORIZED STRIPING BY CONTRACTOR TO EXISTING LOCATION OR AS INDICATED BY THIS PLAN SET.
- CAUTION: THESE DRAWINGS DO NOT INCLUDE NECESSARY COMPONENTS FOR CONSTRUCTION SAFETY WHICH SHALL REMAIN THE RESPONSIBILITY OF THE CONTRACTOR. ALL EXCAVATION, TRENCHING AND SHORING ACTIVITIES MUST BE CARRIED-OUT IN ACCORDANCE WITH OSHA 29 CFR 1926, SUBPART P-EXCAVATIONS.
- ANY WORK OCCURRING WITHIN AN ARTERIAL ROADWAY REQUIRES TWENTY-FOUR HOUR CONSTRUCTION.
- CONTRACTOR SHALL MAINTAIN A GRAFFITI-FREE WORK SITE. CONTRACTOR SHALL PROMPTLY REMOVE ANY AND ALL GRAFFITI FROM EQUIPMENT, WHETHER PERMANENT OR TEMPORARY.
- WHEN APPLICABLE, CONTRACTOR SHALL SECURE "TOPSOIL DISTURBANCE PERMIT" FROM THE CITY AND/OR FILE A NOTICE OF INTENT (N.O.I.) WITH THE EPA PRIOR TO BEGINNING CONSTRUCTION.

Jma JEFF MORTENSEN & ASSOCIATES, INC.
8010-B MIDWAY PARK BLVD. N.E.
ALBUQUERQUE, NEW MEXICO 87109
ENGINEERS SURVEYORS (SOS) 345-4250
FAX: 505 345-4254 E-mail: jma@jma-inc.com

2003.044.7

REV.	SHEETS	CITY ENGINEER	DATE	USER	DEPARTMENT	DATE	USER	DEPARTMENT	DATE
ENGINEERS STAMP & SIGNATURE		APPROVALS		ENGINEER		DATE		***** APPROVED FOR CONSTRUCTION	
		DRC Chairman		12-03-03		12-03-03		 City Engineer Date	
		Transportation		12-01-03		12-01-03			
		Water/Wastewater		12-01-03		12-01-03			
		Hydrology		11-21-03		11-21-03			
		C.I.P.							
Const. Mngmt.									
Const. Coord.						12-03-03			
City Project No.		705283		SHEET		1		OF 8	

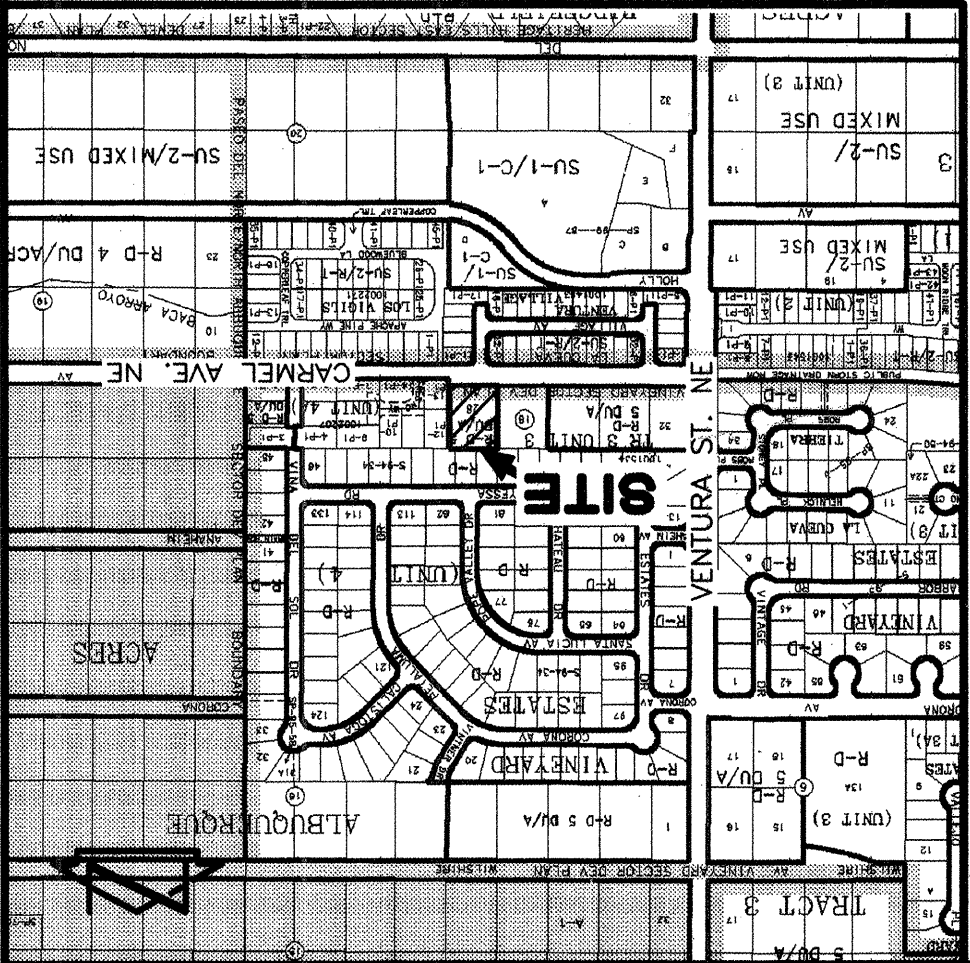

VICINITY MAP
SCALE: 1" = 750'

DEDICATION AND FREE CONSENT

The subdivision hereon is with the free consent and in accordance with the desires of the undersigned owner and does hereby dedicate to the City of Albuquerque in fee simple the public street rights-of-way with respect to the north-half of Carmel Avenue N.E. and grant the easements as shown, including the rights of ingress and egress and the right to trim interfering trees.

Justin D. Hoeh, Secretary
Hoeh's Real Estate Corporation
ACKNOWLEDGEMENT
STATE OF NEW MEXICO)
COUNTY OF BERNALILLO) SS
This instrument was acknowledged before me on this 17th day of December, 2003, by Justin D. Hoeh, Secretary, Hoeh's Real Estate Corporation.
Charles G. Cala, Jr.
Notary Public
OFFICIAL SEAL
CHARLES G. CALA, JR.
NOTARY PUBLIC, STATE OF NEW MEXICO
My Commission Expires 5-8-2005

11-14-03
Date

Public Utility easements shown on this plat are ten (10) feet wide and are granted for the common and joint use of:

1. The P.N.M. Electric Services for the installation, maintenance, and service of overhead and underground electrical lines, transformers, poles and other equipment, fixtures, structures and related facilities reasonably necessary to provide electrical service.
2. The P.N.M. Gas Services for installation, maintenance, and service of natural gas lines, valves and other equipment and facilities reasonably necessary to provide natural gas.
3. Qwest Corporation for the installation, maintenance, and service of all buried and aerial communication lines and other related equipment and facilities reasonably necessary to provide communication services, but not limited to, above ground pedestals and closures.
4. Comcast Cable Vision of New Mexico, Inc. for the installation, maintenance, and service of such lines, cables, and other related equipment and facilities reasonably necessary to provide Cable TV service.

Included, is the right to build, rebuild, construct, reconstruct, locate, relocate, change, remove, modify, renew, operate, and maintain facilities for the purposes described above, together with free access to, from, and over said easements, including sufficient working area space for electric transformers, with the right and privilege to trim and remove trees, shrubs or bushes situated on the easement or easements, and to erect, maintain, or replace any structure (aboveground or subsurface) hot tub, concrete or wood pool decking, or other structure shall be erected or constructed on said easements, nor shall any well be drilled or operated thereon. Property owners shall be solely responsible for correcting any violations of the National Electric Safety Code caused by construction or pools, decking, or any structures adjacent to within or near easements shown on this Plat.

DESCRIPTION

A certain tract of land located within the Corporate Limits of the City of Albuquerque, New Mexico, comprising Lot 28, Block 18, North Albuquerque Acres, Tract 3, Unit 3, also being the same is shown and designated on the plat filed in the Office of the County Clerk of Bernalillo County, New Mexico on September 10, 1931, Book D, Page 121, and being more particularly described as follows:

Beginning at the northeast corner of the parcel herein described, being the northeast property corner of said Lot 28, also being the northwest property corner of Lot 12-P1, the Vineyard Estates, Unit IV-A, as the same is shown and designated on the plat filed in the Office of the County Clerk of Bernalillo County, New Mexico on September 10, 1931, Book D, Page 121, and being the southeast property corner of said Lot 28, also being the northwest property corner of Lot 28, also being the northeast property corner of Lot 29, of said Block 18, North Albuquerque Acres, Tract 3, Unit 3, and also being the south property corner of Lot 25, of said Block 18, and containing 1.0009 acres more or less.

PLAT OF
VINEYARD ESTATES, UNIT IV-B
ALBUQUERQUE, BERNALILLO COUNTY, NEW MEXICO
NOVEMBER, 2003

HOECH REAL ESTATE CORPORATION
OWNER
PROJECTED
SUBDIVISION
VINEYARD ESTATES, UNIT IV-B
SUBDIVISION

2003217365
12/24/2003 03:00P
Page 1 of 3
Bk-2003C-17365
Bl-2003C-17365

COUNTY CLERK FILING DATA

DRB PROJECT NUMBER 1002933
APPLICATION NUMBER 03DRB-01443, 03DRB-01444, 03DRB-01446

APPROVALS:

Sharon Watson
SBB CHAIRPERSON, PLANNING DEPARTMENT, CITY OF ALBUQUERQUE, NEW MEXICO
DATE 11/24/03
Roger A. Shuman
UTILITIES DEVELOPMENT, CITY OF ALBUQUERQUE, NEW MEXICO
DATE 11-26-03
Bruce J. Byham
CITY ENGINEER, CITY OF ALBUQUERQUE, NEW MEXICO
DATE 11/26/03
Martin W. Elkhart
A.M.A.F.C.A.
DATE 12-2-03

Mike Zar
TRAFFIC ENGINEERING, TRANSPORTATION DIVISION, CITY OF ALBUQUERQUE, NEW MEXICO
DATE 11-26-03

Christine Sandford
PARKS AND RECREATION DEPARTMENT, CITY OF ALBUQUERQUE, NEW MEXICO
DATE 11/26/03

Mike Zar
CITY SURVEYOR, CITY OF ALBUQUERQUE, NEW MEXICO
DATE 11-17-03

N/A
REAL PROPERTY DIVISION, CITY OF ALBUQUERQUE, NEW MEXICO
DATE

Paul D. Hunt
P.N.M. ELECTRIC SERVICES
DATE 11-24-03


David R. Mulla
QWEST TELECOMMUNICATIONS
DATE 11-25-03

Paul D. Hunt
P.N.M. GAS SERVICES
DATE 11-24-03

Rita E. Eichen
COMCAST CABLE VISION OF NEW MEXICO, INC.
DATE 11-26-03

SURVEYORS CERTIFICATION

I, Charles G. Cala, Jr., New Mexico Professional Surveyor No. 11184, do hereby certify: that this Plat and the actual survey on the ground upon which it is based were performed by me or under my direct supervision; that the survey shows all easements made known to me by the owner, utility companies, or other parties expressing an interest; that this survey complies with the minimum requirements for Monumentation and Surveys of the Albuquerque Subdivision Ordinance; that this survey meets the Minimum Standards for Surveying in New Mexico, and that it is true and correct to the best of my knowledge and belief.

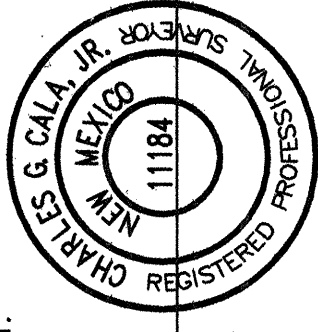

Charles G. Cala, Jr.
Charles G. Cala, Jr., NMPS 11184
Date 11-14-2003



JEFF MORTENSEN & ASSOCIATES, INC.
600-B MIDWAY PARK BLVD. N.E.
ALBUQUERQUE, NEW MEXICO 87109
PH: 505-263-8383 FAX: 505-263-8384
JOB #2003.044.1 FINAL

SHEET 1 OF 3


PLAT OF
VINEYARD ESTATES, UNIT IV-B
ALBUQUERQUE, BERNALILLO COUNTY, NEW MEXICO
NOVEMBER, 2003

2003217365
12/24/2003 03:00P
Page 2 of 3
Bk-2003C-17365
Bl-2003C-17365

COUNTY CLERK FILING DATA

- Notes:
1. A boundary survey was performed in July, 2003. Property corners were found or set as indicated.
 2. All distances are ground distances.
 3. Site located within projected Section 17, Township 11 North, Range 4 East, N.M.P.M. (Elena Gallegos Grant).
 4. Bearings are New Mexico State Plane Grid Bearings, Central Zone.
 5. Record bearings and distances are shown in parenthesis.
 6. Private street mileage created by this plat = 0.03 miles (full-width).
 7. Upon completion of the construction of the streets, City of Albuquerque and Associates, Inc. shall be placed at all intersections or as otherwise indicated in lieu of subdivision block corner monumentation. Location of said monuments are designated with a "C" symbol.
 8. The purpose of this plat is to:
 - a. Grant the necessary public waterline, public water meter, public sanitary sewer, public utility, private access, private storm drain, private waterline and private sanitary sewer easements as shown.
 - b. Create 4 (four) residential lots from Lot 28, Block 18, North Albuquerque Acres, Tract 3, Unit 3.
 - c. Vacate the nonspecific easement and/or right-of-way for road and/or pipeline purposes (water, gas or sewage), telephone and electric easements and easements shown on the plat filed hereon, (03DRB-01443).
 - d. Dedicate in fee simple the necessary public street rights-of-way for the north half of Carmel Avenue N.E.
 9. Prior to development, City of Albuquerque Water and Sanitary Sewer Service to Lots 1-4, Vineyard Estates, Unit IV-B must be verified and coordinated with the Public Works Department, City of Albuquerque.
 10. The following documents and instruments were used for the performance and preparation of this survey:
 - a. Plat of North Albuquerque Acres, Tract 3, Unit 3, filed 09-10-1931, Book D, Page 121, Records of Bernalillo County, New Mexico.
 - b. Plat of Vineyard Estates, Unit IV, filed 09-15-1994, Book 94C, Page 309, Records of Bernalillo County, New Mexico.
 - c. Boundary Survey, JMA Job #2001.059.2, prepared by Jeff Mortensen and Associates, Inc. dated 01-30-2002 (unrecorded).
 - d. Boundary Survey, JMA Job #2001.056.2, prepared by Jeff Mortensen and Associates, Inc. dated 09-18-2002 (unrecorded).
 - e. Warranty Deed filed 07-14-2003, Book 460, Page 426, Doc. #2003120683, Records of Bernalillo County, New Mexico (Lot 28).
 - f. Policy Number 1798619, File No. 05230299-BEV(rp) prepared by First American Title Insurance Company dated 08-30-2003.
 - g. Plat of Vineyard Estates, Unit IV-A, filed 05-01-2003, Book 2003C, Page 117, Records of Bernalillo County, New Mexico.
 - h. Plat of Los Vigils, filed 05-01-2003, Book 2003C, Page 118, Records of Bernalillo County, New Mexico.
 - i. Plat of Los Vigils, filed 04-29-2003, Book 2003C, Page 114, Records of Bernalillo County, New Mexico.
 11. Gross subdivision acreage = 1.0009 acres.
 12. The residential lots created by this platting action shall satisfy the 2400 square feet per lot open space requirement.



RECORD DRAWING

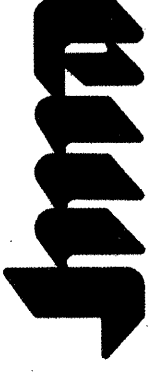

JEFF MORTENSEN & ASSOCIATES, INC.
600-B MIDWAY PARK BLVD. N.E.
ALBUQUERQUE, NEW MEXICO 87109
PH: 505-263-8383 FAX: 505-263-8384
JOB #2003.044.1 FINAL


SHEET 2 OF 3

SP #2003352050

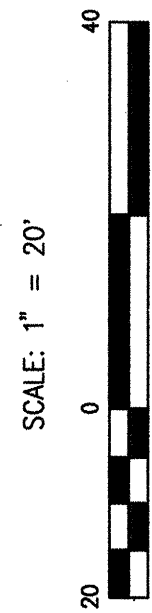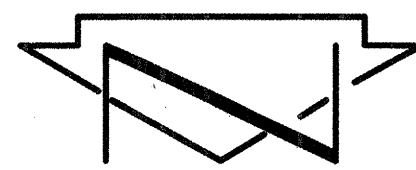

PLAT OF
VINEYARD ESTATES, UNIT IV-B
ALBUQUERQUE, BERNALILLO COUNTY, NEW MEXICO
NOVEMBER, 2003

2003217305
2003217305
Page 3 of 3
12/04/2003 03:00P
Mesa Perro
Bent Co. Plot
11/1/03 04:28:02 Pg-354
BK 2003C Pg 364
COUNTY CLERK FILING DATA

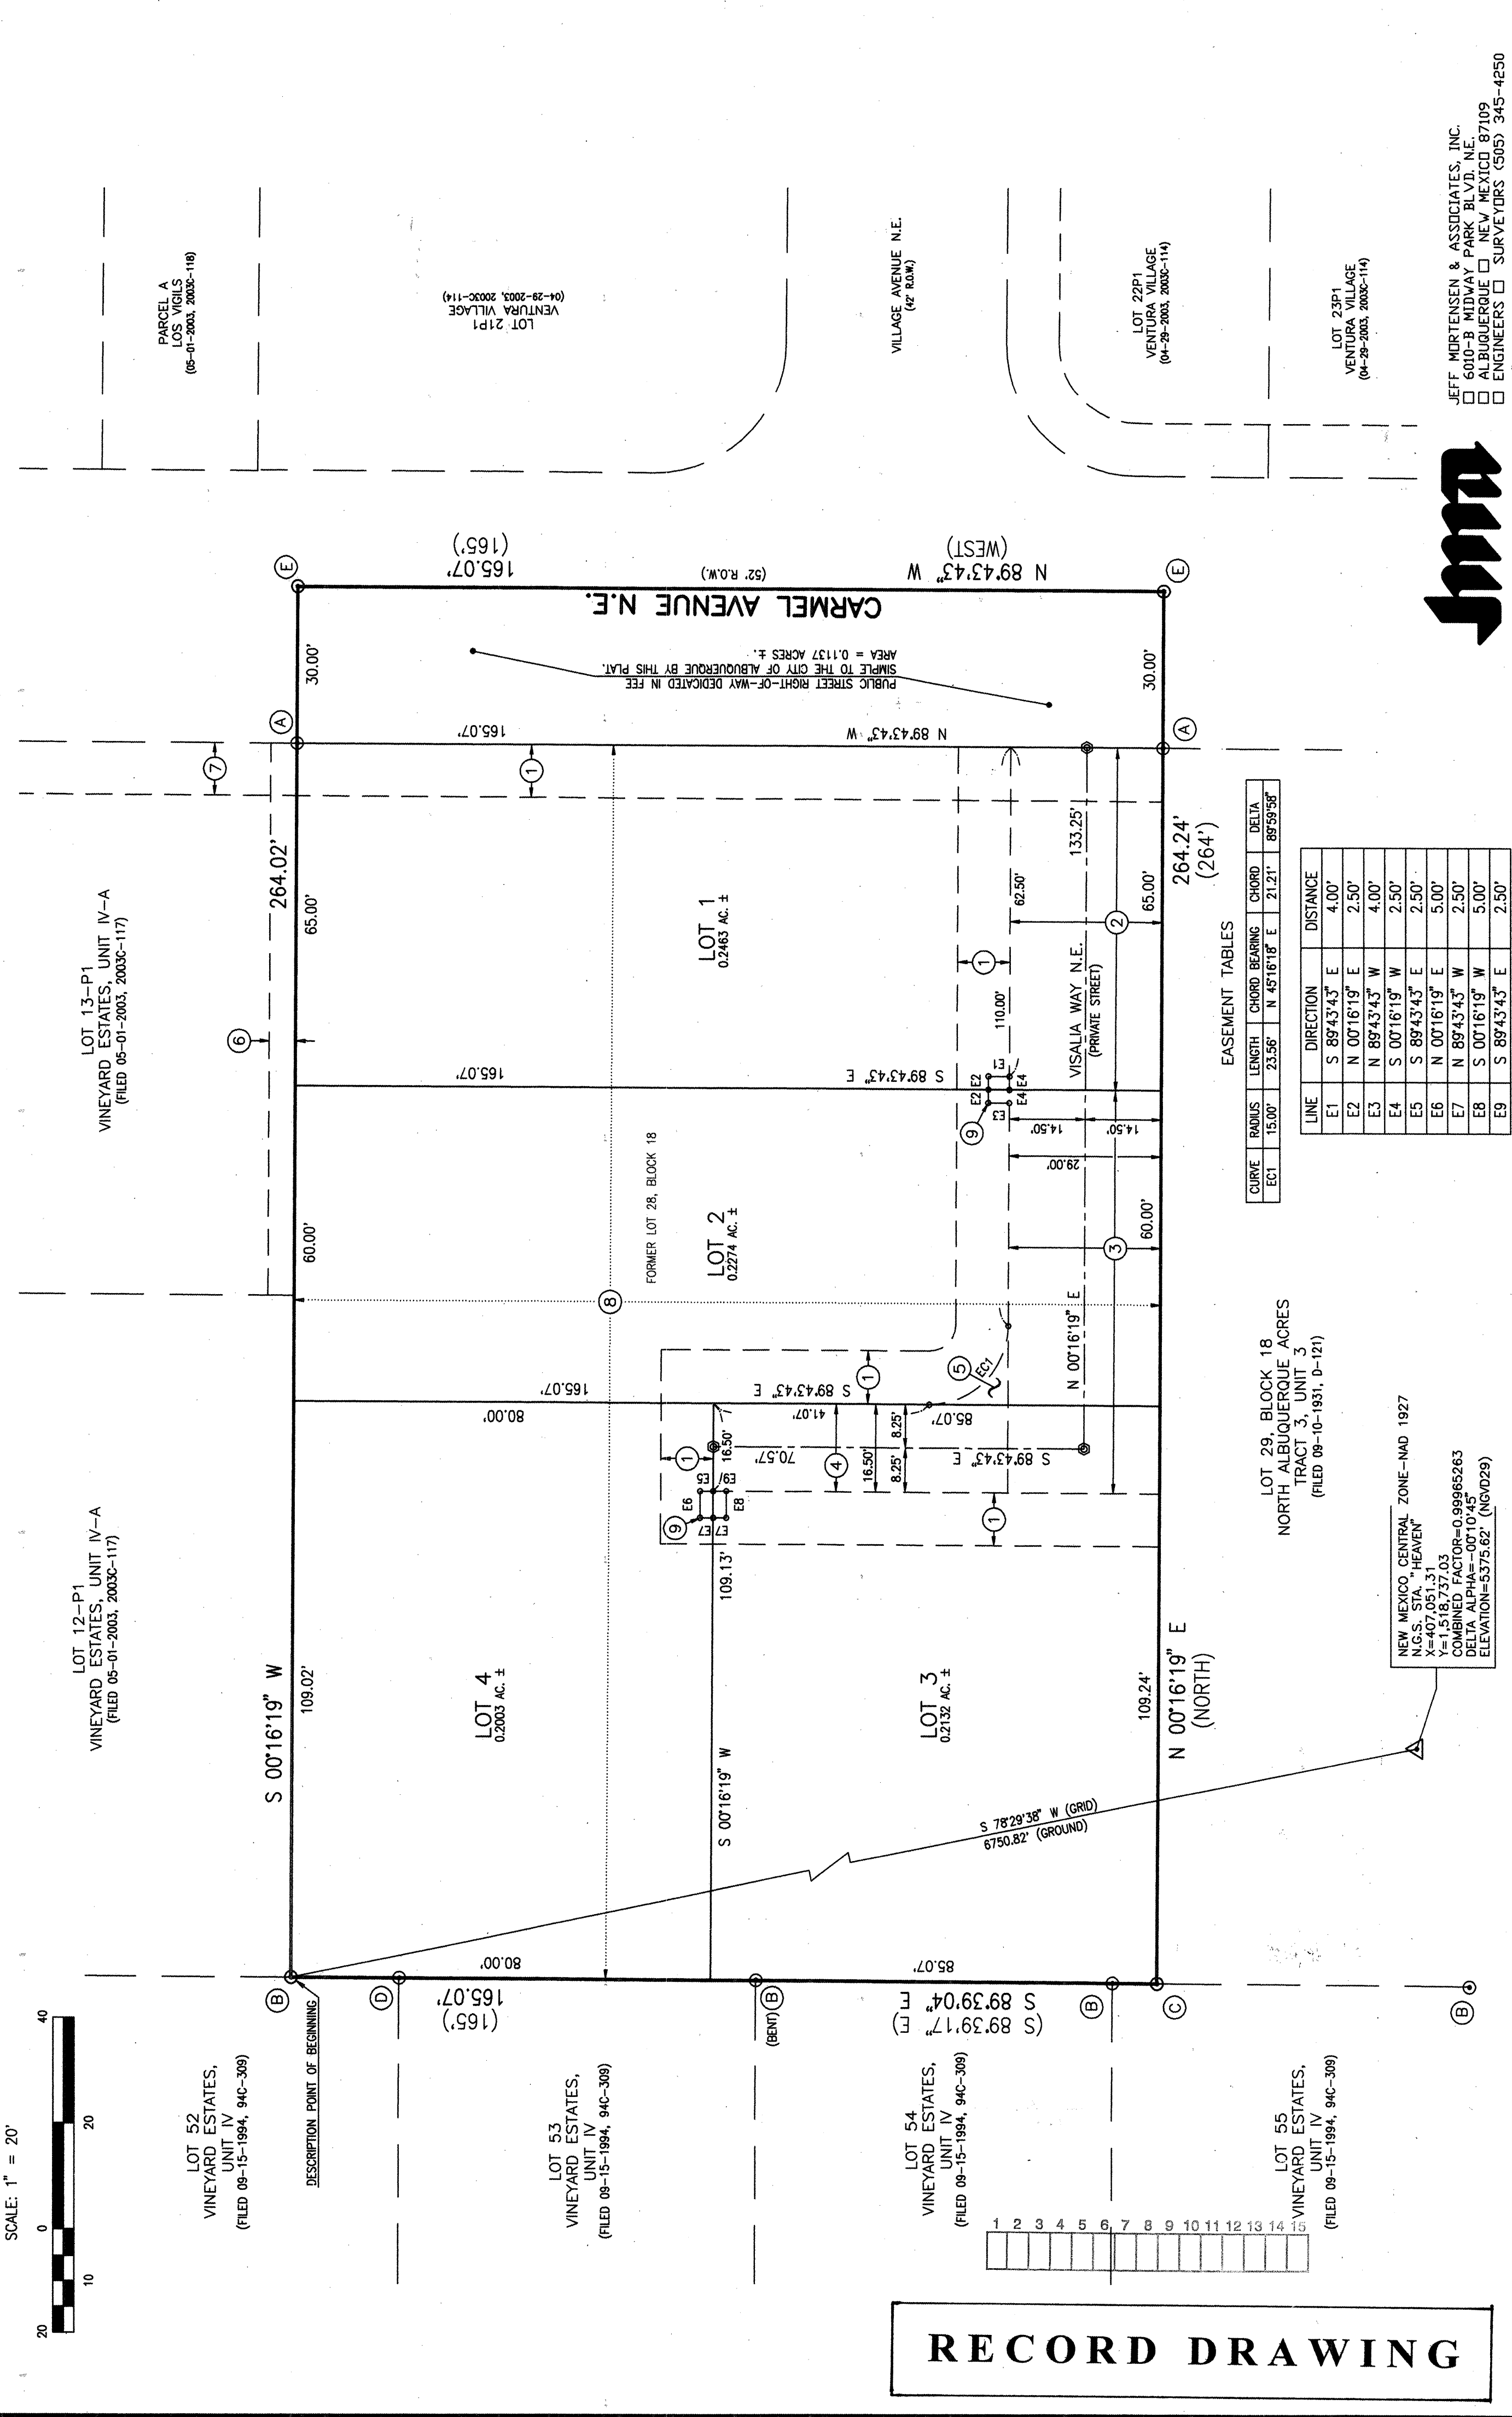

RECORD DRAWING

EASEMENT TABLES

CURVE	RADIUS	LENGTH	CHORD BEARING	CHORD	DELTA
C1	15.00'	23.56'	N 45°16'18" E	21.21'	88°59'56"

LINE	DIRECTION	DISTANCE
E1	S 89°43'43" E	4.00'
E2	N 00°16'19" E	2.50'
E3	N 89°43'43" W	4.00'
E4	S 00°16'19" W	2.50'
E5	S 89°43'43" E	2.50'
E6	N 00°16'19" E	5.00'
E7	N 89°43'43" W	2.50'
E8	S 00°16'19" W	5.00'
E9	S 89°43'43" E	2.50'

LOT 29, BLOCK 18
NORTH ALBUQUERQUE ACRES
TRACT 3, UNIT 3
(FILED 09-10-1931, D-121)

NEW MEXICO CENTRAL ZONE-NAD 1927
N.G.S. STA. "HEAVEN"
NAD 83 ELEVATION=5375.62
COMBINED FACTOR=0.99995263
NAD 83 ELEVATION=5375.62 (NAD029)



JEFF MORTENSEN & ASSOCIATES, INC.
10000 ALBUQUERQUE BLVD. N.W.
ALBUQUERQUE, NEW MEXICO 87109
ENGINEERS SURVEYORS (505) 345-4250
JOB #2003.044.1 FINAL

KEYED NOTES

NEW EASEMENTS (TO BE GRANTED BY PLAT)



- ① 10' PUBLIC UTILITY EASEMENT.
- ② 29' PRIVATE ACCESS, PRIVATE STORM DRAINAGE, AND CITY OF ALBUQUERQUE PUBLIC WATER LINE AND PUBLIC SANITARY SEWER EASEMENTS SERVING LOTS 1, 2, 3 AND 4. MAINTENANCE OF THE PRIVATE EASEMENTS SHALL BE THE RESPONSIBILITY OF THE OWNERS OF LOTS 1, 2, 3 AND 4.
- ③ 29' PRIVATE ACCESS, PRIVATE STORM DRAINAGE, AND CITY OF ALBUQUERQUE PUBLIC WATER LINE AND PUBLIC SANITARY SEWER EASEMENTS SERVING LOTS 2, 3 AND 4. MAINTENANCE OF THE PRIVATE EASEMENTS SHALL BE THE RESPONSIBILITY OF THE OWNERS OF LOTS 2, 3 AND 4.
- ④ 16.50' PRIVATE ACCESS, PRIVATE STORM DRAINAGE, PRIVATE WATER LINE AND PRIVATE SANITARY SEWER EASEMENTS SERVING LOT 4. MAINTENANCE SHALL BE THE RESPONSIBILITY OF THE OWNERS OF LOTS 3 AND 4.
- ⑤ PRIVATE ACCESS AND PRIVATE STORM DRAINAGE EASEMENT SERVING LOTS 3 AND 4. MAINTENANCE SHALL BE THE RESPONSIBILITY OF THE OWNERS OF LOTS 2, 3 AND 4.

EXISTING EASEMENTS - OFFSITE

- ⑥ 5' PRIVATE DRAINAGE EASEMENT GRANTED BY PLAT 2003C-117
- ⑦ 10' PUBLIC UTILITY EASEMENT GRANTED BY PLAT 2003C-117

MONUMENTS

- A #5 REBAR, NO I.D., TAGGED W/WASHER STAMPED "NMPS 11184"
- B #5 REBAR W/CAP STAMPED "NEW MEXICO PS 11184"
- C #5 REBAR W/CAP STAMPED "NEW MEXICO PS 11184"
- D P.K. NAIL W/WASHER STAMPED "NMPS 11184"
- E CALCULATED POSITION, NO POINT SET.

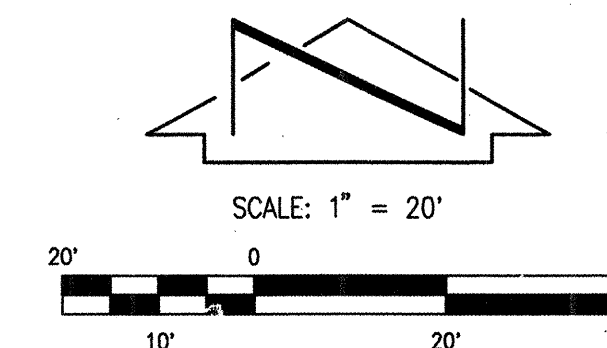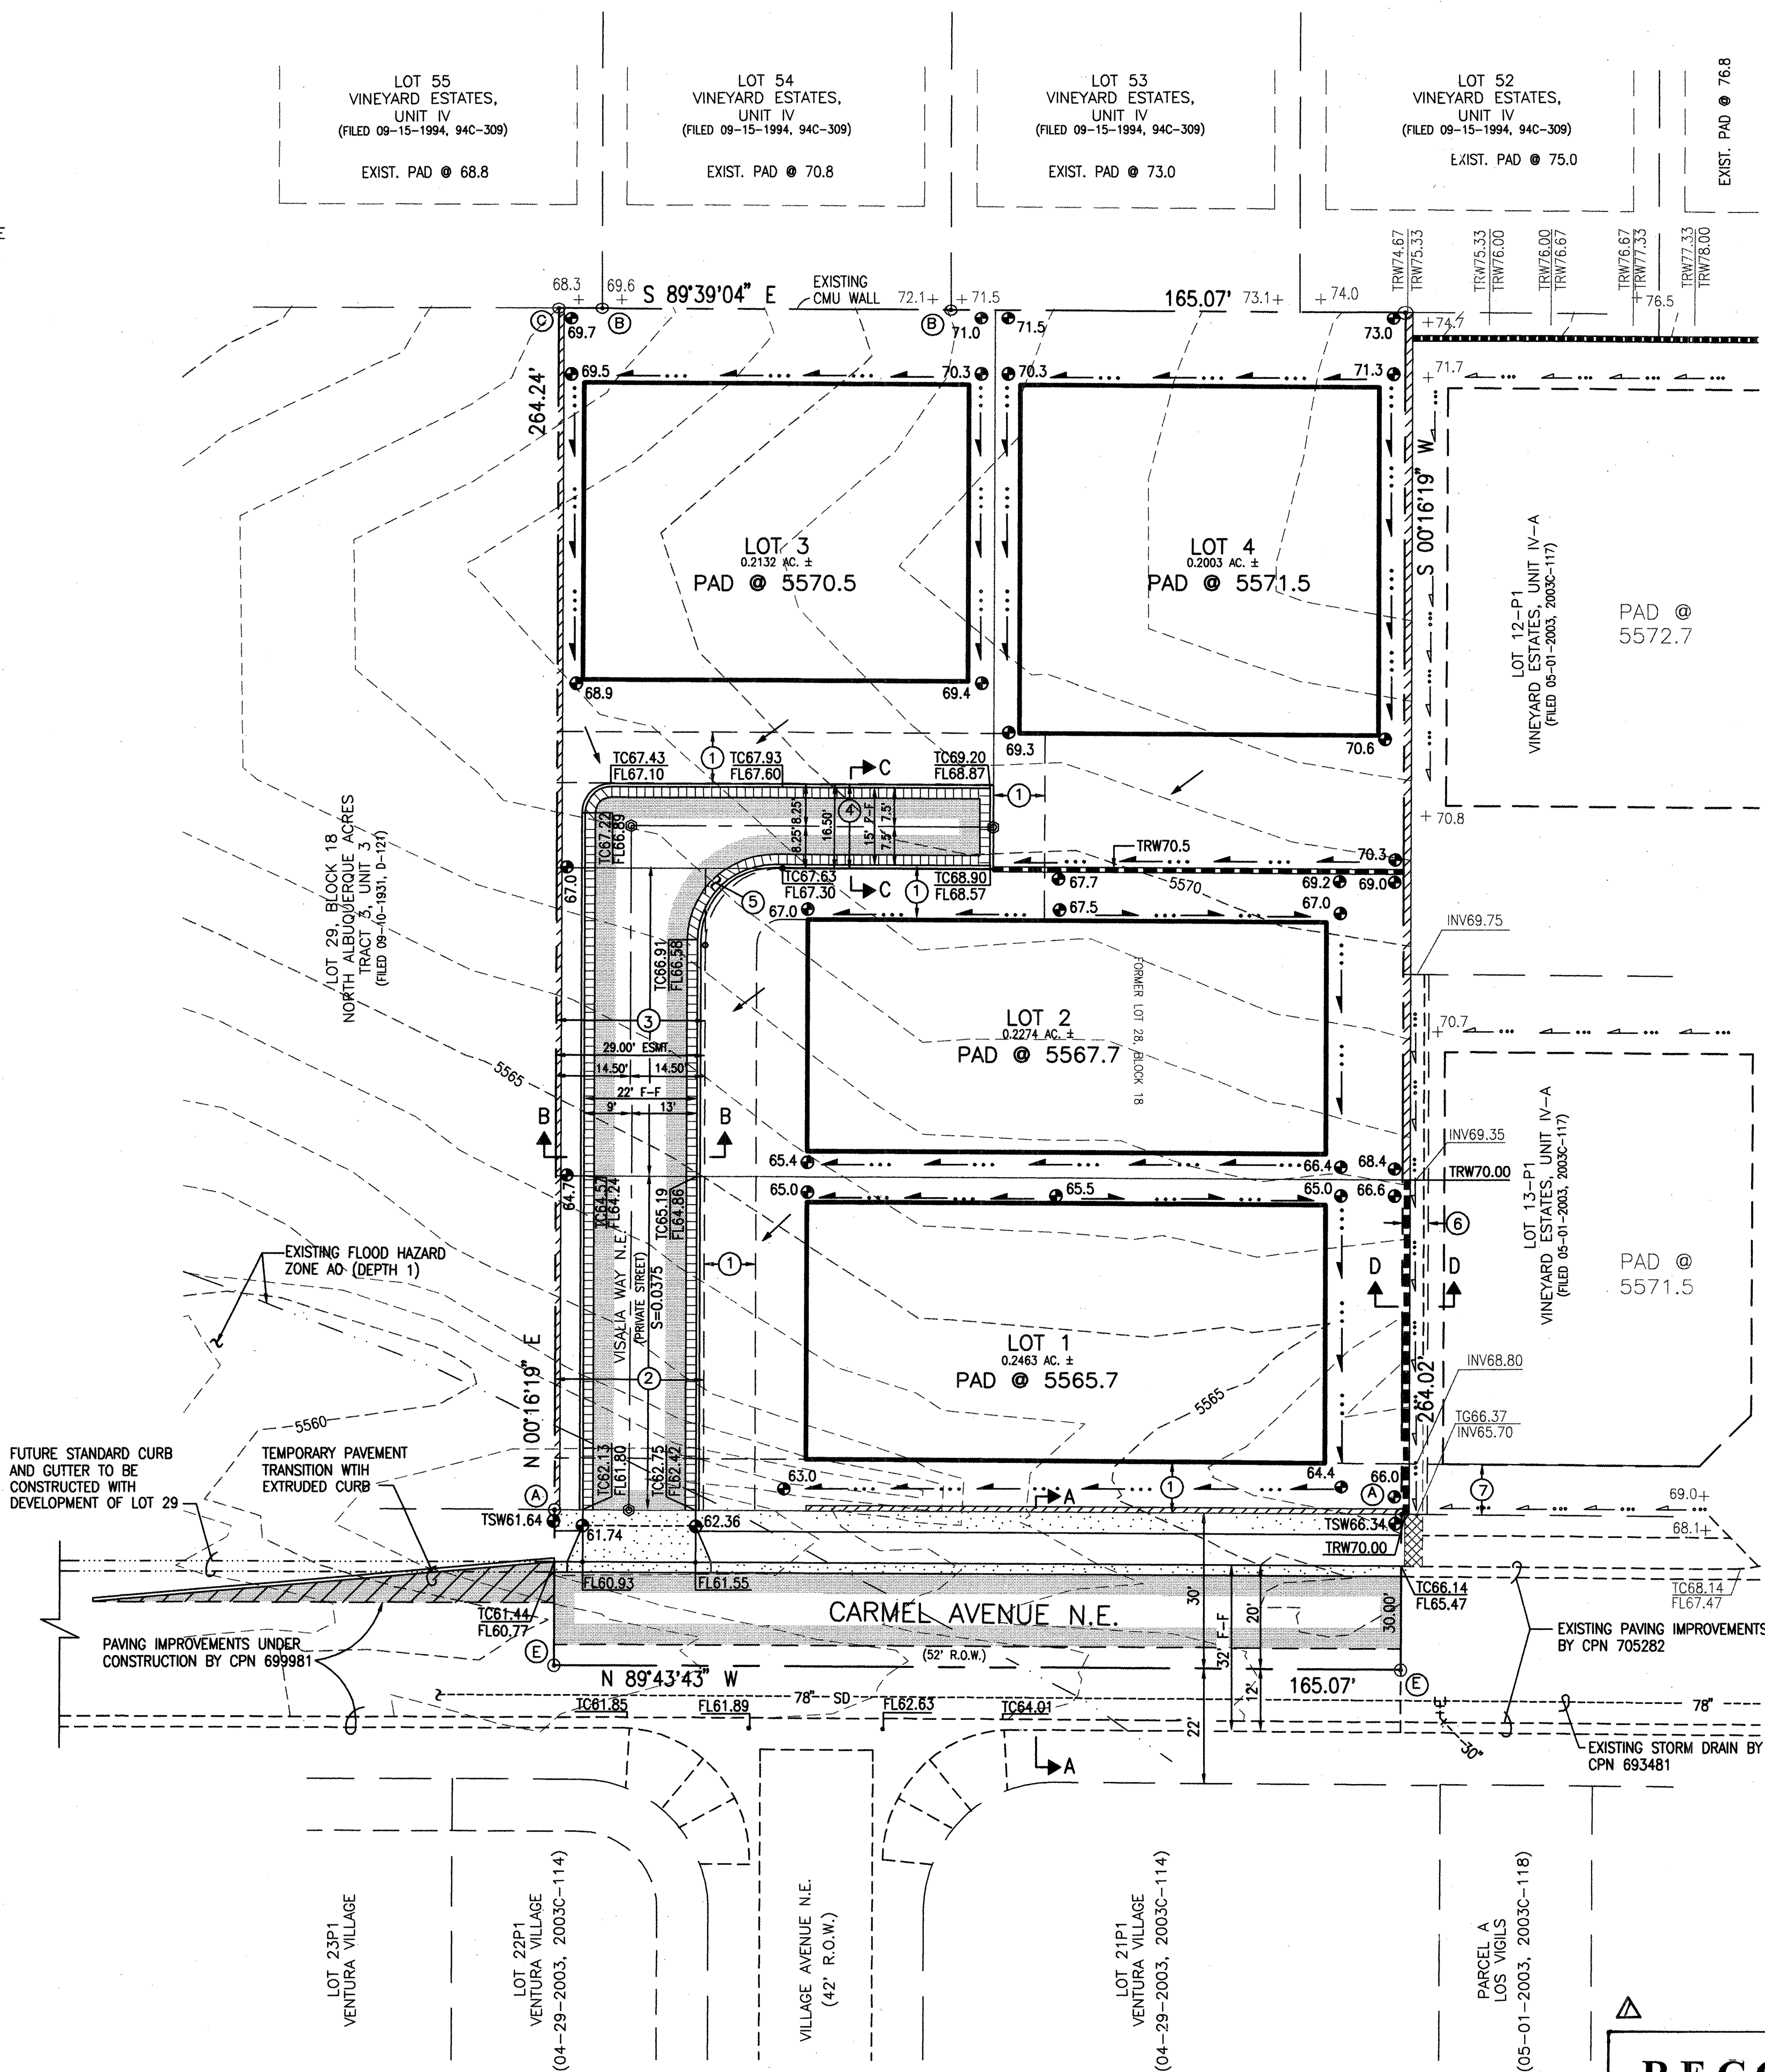

PROJECT BENCHMARK

ACS STATION "HEAVEN" (TIED TO PASEO DEL NORTE ROADWAY CONSTRUCTION IN 1999)
PREVIOUS ELEVATION = 5378.79 FEET (NGVD 1929)

THIS BENCHMARK HAS BEEN USED TO PROVIDE UNIFORMITY BETWEEN THIS SURVEY AND THE PREVIOUS SURVEYS CONDUCTED FOR RELATED NORTH DOMINGO BACA ARROYO PROJECTS.

THE ELEVATION FOR ACS STATION "5-C20", AN ACS 1 3/4" ALUMINUM DISK STAMPED "ACS BM, 5-C20", EPOXIED TO THE TOP OF THE CONCRETE DROP INLET, AT THE NNE CURB RETURN IN THE NORTHEAST QUADRANT OF THE INTERSECTION OF VENTURA STREET AND ANAHEIM AVENUE N.E., BASED UPON THIS DATUM IS 5552.84 FEET (NGVD 1929). THE C.O.A. PUBLISHED ELEVATION IS 5552.71 FEET (NGVD 1929)

LEGEND

---	EXISTING CONTOUR
+	EXISTING SPOT ELEVATION
●	PROPOSED SPOT ELEVATION
---	EXISTING FLOWLINE
---	PROPOSED FLOWLINE
---	DIRECTION OF FLOW
---	EXISTING RETAINING WALL
---	PROPOSED RETAINING WALL
---	GARDEN WALL
---	MOUNTABLE CURB
TC	TOP OF CURB
FL	FLOWLINE
INV	INVERT
TRW	TOP OF RETAINING WALL
TG	TOP OF GRATE
---	PROPOSED ASPHALT PAVEMENT
---	PROPOSED TEMPORARY PAVEMENT

THIS IS NOT A BOUNDARY SURVEY. APPARENT PROPERTY CORNERS ARE SHOWN HEREON FOR INFORMATION ONLY. BOUNDARY DATA IS TAKEN FROM THE PRELIMINARY PLAT FOR THIS PROJECT PREPARED BY THIS OFFICE. EXISTING TOPOGRAPHY SHOWN HEREON IS FROM A TOPOGRAPHIC SURVEY CONDUCTED BY THIS OFFICE 09/02/03. IMPROVEMENTS AND GRADES FOR VINEYARD ESTATES UNIT IV-A AND FOR VENTURA VILLAGE ARE TAKEN FROM THE APPROVED PLANS FOR THESE PROJECTS, CPN'S 705282 AND 699981, RESPECTIVELY, AND SHOWN AS EXISTING (CONSTRUCTION CURRENTLY IN PROGRESS).

RECORD DRAWING



NO.	DATE	BY	REVISIONS	JOB NO.
1	4/04 G.M.		RECORDED DRAWING	2003.0443
DESIGNED BY	G.M.			DATE
DRAWN BY	S.G.H.			08-2003
APPROVED BY	G.M.			SHEET 2 OF 3




JEFF MORTENSEN & ASSOCIATES, INC.
6010-B MIDWAY PARK BLVD. N.E.
ALBUQUERQUE, N.M. 87109
ENGINEERS & SURVEYORS (0505) 345-4250
FAX: 505 345-4254 Email: jma@jma-inc.com

APPROVED FOR ROUGH GRADING
Brad L. Biker 9/25/03
CITY HYDROLOGY DATE

GRADING PLAN

VINEYARD ESTATES, UNIT IV-B

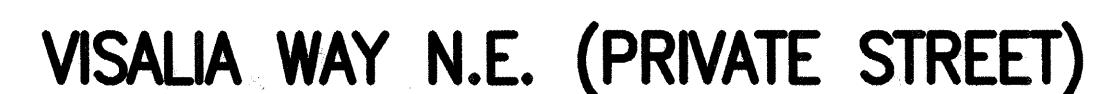

SCALE:
HORIZONTAL: 1" = 20'
VERTICAL: 1" = 10'

CURVE	RADIUS	LENGTH	DELTA
C1	15.00'	23.56'	89°59'58"
C2	5.00'	7.85'	89°59'58"

Jmra
2003.044.4

☐ JEFF MORTENSEN & ASSOCIATES, INC.
☐ 6010-B MIDWAY PARK BLVD. N.E.
☐ ALBUQUERQUE ☐ NEW MEXICO 87109
☐ ENGINEERS ☐ SURVEYORS (505) 345-4250
☐ FAX: 505 345-4254 ☐ E mail: jmainc@swcp.com

2003.044.A 7

CITY OF ALBUQUERQUE
PUBLIC WORKS DEPARTMENT
ENGINEERING DEVELOPMENT GROUP

TITLE: VINEYARD ESTATES, UNIT IV-B
PAVING IMPROVEMENTS PLAN AND PROFILE
VISALIA WAY N.E.

Design Review Committee
APPROVE
DEC - 3 2003
DESIGN REVIEW COMMITTEE

City Engineer Approval

te

Mo./Day/Yr.

Mo./A

Day/Yr. _____

Sheet 7 Of 8


SCANNED BY
MESA REPRO



NEW EASEMENTS

- ① 10' PUBLIC UTILITY EASEMENT
- ② 29' PRIVATE ACCESS, PRIVATE STORM DRAINAGE, AND CITY OF ALBUQUERQUE PUBLIC WATERLINE AND PUBLIC SANITARY SEWER EASEMENTS SERVING LOTS 1, 2, 3 AND 4. MAINTENANCE OF THE PRIVATE EASEMENTS SHALL BE THE RESPONSIBILITY OF THE OWNERS OF LOTS 1, 2, 3 AND 4.
- ③ 29' PRIVATE ACCESS, PRIVATE STORM DRAINAGE, AND CITY OF ALBUQUERQUE PUBLIC WATERLINE AND PUBLIC SANITARY SEWER EASEMENTS SERVING LOTS 2, 3 AND 4. MAINTENANCE OF THE PRIVATE EASEMENTS SHALL BE THE RESPONSIBILITY OF THE OWNERS OF LOTS 2, 3 AND 4.
- ④ 16.50' PRIVATE ACCESS, PRIVATE STORM DRAINAGE, CITY OF ALBUQUERQUE PUBLIC WATERLINE AND PRIVATE SANITARY SEWER EASEMENTS SERVING LOTS 3 AND 4. MAINTENANCE OF THE PRIVATE EASEMENTS SHALL BE THE RESPONSIBILITY OF THE OWNERS OF LOTS 3 AND 4.
- ⑤ PRIVATE ACCESS AND PRIVATE STORM DRAINAGE EASEMENT SERVING LOTS 3 AND 4. MAINTENANCE SHALL BE THE RESPONSIBILITY OF THE OWNERS OF LOTS 2, 3 AND 4.
- ⑥ PUBLIC WATER METER EASEMENT

WATER VALVE SHUTOFF PLAN

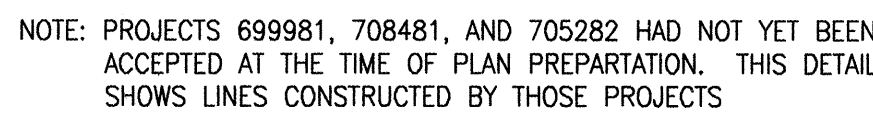


WATER VALVE SHUTOFF PLAN NOTES:

1. AT A MINIMUM, THE FOLLOWING VALVES SHALL BE CLOSED TO FACILITATE THE PROPOSED NON-PRESSURE CONNECTION:
 "A" AND "B"
2. WATER SYSTEMS PERSONNEL SHALL PERFORM ALL SHUTOFFS. THE CONTRACTOR SHALL NOT OPERATE ANY VALVES THAT MAY AFFECT SYSTEM OPERATIONS.
3. THE CONTRACTOR SHALL REQUEST A WATER SHUTOFF IN WRITING, A MINIMUM OF SEVEN (7) WORKING DAYS IN ADVANCE PER STANDARD CITY OF ALBUQUERQUE PROCEDURES.
4. WITHIN FIVE (5) DAYS AFTER RECEIPT OF CONTRACTOR'S SHUTOFF REQUEST, TRIAL SHUTOFFS WILL BE CONDUCTED. CITY TO FURNISH LABOR AND APPURTENANCES NECESSARY TO VERIFY COMPLETENESS OF SHUTOFFS.
5. THE CONTRACTOR SHALL HAVE ALL FITTINGS, MATERIALS AND EQUIPMENT ON SITE PRIOR TO VALVE SHUTOFF. ALL EXCAVATION SHALL BE COMPLETE EXCEPT AS NECESSARY TO MAINTAIN SAFE SYSTEM OPERATION WHILE UNDER PRESSURE.
6. THE CONTRACTOR SHALL PROVIDE ALL RESTRAINTS AND THROTTLE BLOCKS NECESSARY TO EFFECT ALL NECESSARY SHUTOFFS AND CONNECTIONS.
7. AT THE TIME OF WATER SHUTOFF APPLICATION, THE CONTRACTOR SHALL REQUEST THAT WATER SYSTEMS DIVISION NOTIFY ALL AFFECTED PROPERTY OWNERS AT LEAST TWENTY-FOUR (24) HOURS IN ADVANCE OF THE RESPECTIVE SHUTOFFS.

RECORD DRAWING

SCALE:
HORIZONTAL: 1" = 20'
VERTICAL: 1" = 10'

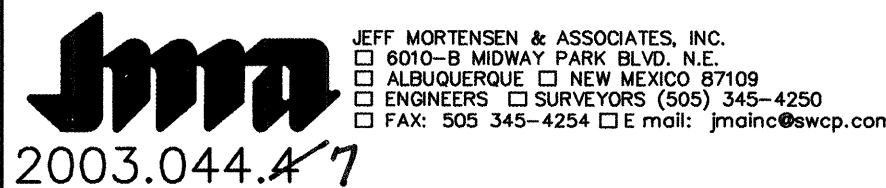

CITY OF ALBUQUERQUE
PUBLIC WORKS DEPARTMENT
ENGINEERING DEVELOPMENT GROUP

TITLE: VINEYARD ESTATES, UNIT IV-B
WATER AND SANITARY SEWER IMPROVEMENTS PLAN AND PROFILE
VISALIA WAY N.E.



Last Design Update

City Project No. 705283

Zone Map No.
C-20

Sheet 8

Of

ELEVATIONS ARE IN NGVD 1929

24-710521.83-2012

KEYED NOTES

NEW EASEMENTS (TO BE GRANTED BY PLAT)



- ① 10' PUBLIC UTILITY EASEMENT.
- ② 29' PRIVATE ACCESS, PRIVATE STORM DRAINAGE, AND CITY OF ALBUQUERQUE PUBLIC WATER LINE AND PUBLIC SANITARY SEWER EASEMENTS SERVING LOTS 1, 2, 3 AND 4. MAINTENANCE OF THE PRIVATE EASEMENTS SHALL BE THE RESPONSIBILITY OF THE OWNERS OF LOTS 1, 2, 3 AND 4.
- ③ 29' PRIVATE ACCESS, PRIVATE STORM DRAINAGE, AND CITY OF ALBUQUERQUE PUBLIC WATER LINE AND PUBLIC SANITARY SEWER EASEMENTS SERVING LOTS 2, 3 AND 4. MAINTENANCE OF THE PRIVATE EASEMENTS SHALL BE THE RESPONSIBILITY OF THE OWNERS OF LOTS 2, 3 AND 4.
- ④ 16.50' PRIVATE ACCESS, PRIVATE STORM DRAINAGE, PRIVATE WATER LINE AND PRIVATE SANITARY SEWER EASEMENTS SERVING LOT 4. MAINTENANCE SHALL BE THE RESPONSIBILITY OF THE OWNERS OF LOTS 3 AND 4.
- ⑤ PRIVATE ACCESS AND PRIVATE STORM DRAINAGE EASEMENT SERVING LOTS 3 AND 4. MAINTENANCE SHALL BE THE RESPONSIBILITY OF THE OWNERS OF LOTS 2, 3 AND 4.

EXISTING EASEMENTS - OFFSITE

- ⑥ 5' PRIVATE DRAINAGE EASEMENT GRANTED BY PLAT 2003C-117
- ⑦ 10' PUBLIC UTILITY EASEMENT GRANTED BY PLAT 2003C-117

MONUMENTS

- Ⓐ #5 REBAR, NO I.D., TAGGED W/WASHER STAMPED "NMPS 11184"
- Ⓑ #5 REBAR W/CAP STAMPED "NEW MEXICO PS 11184"
- Ⓒ #5 REBAR W/CAP STAMPED "NEW MEXICO PS 11184"
- Ⓓ P.K. NAIL W/WASHER STAMPED "NMPS 11184"
- Ⓔ CALCULATED POSITION, NO POINT SET.

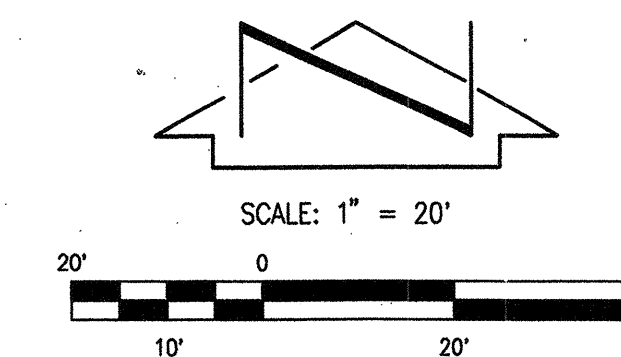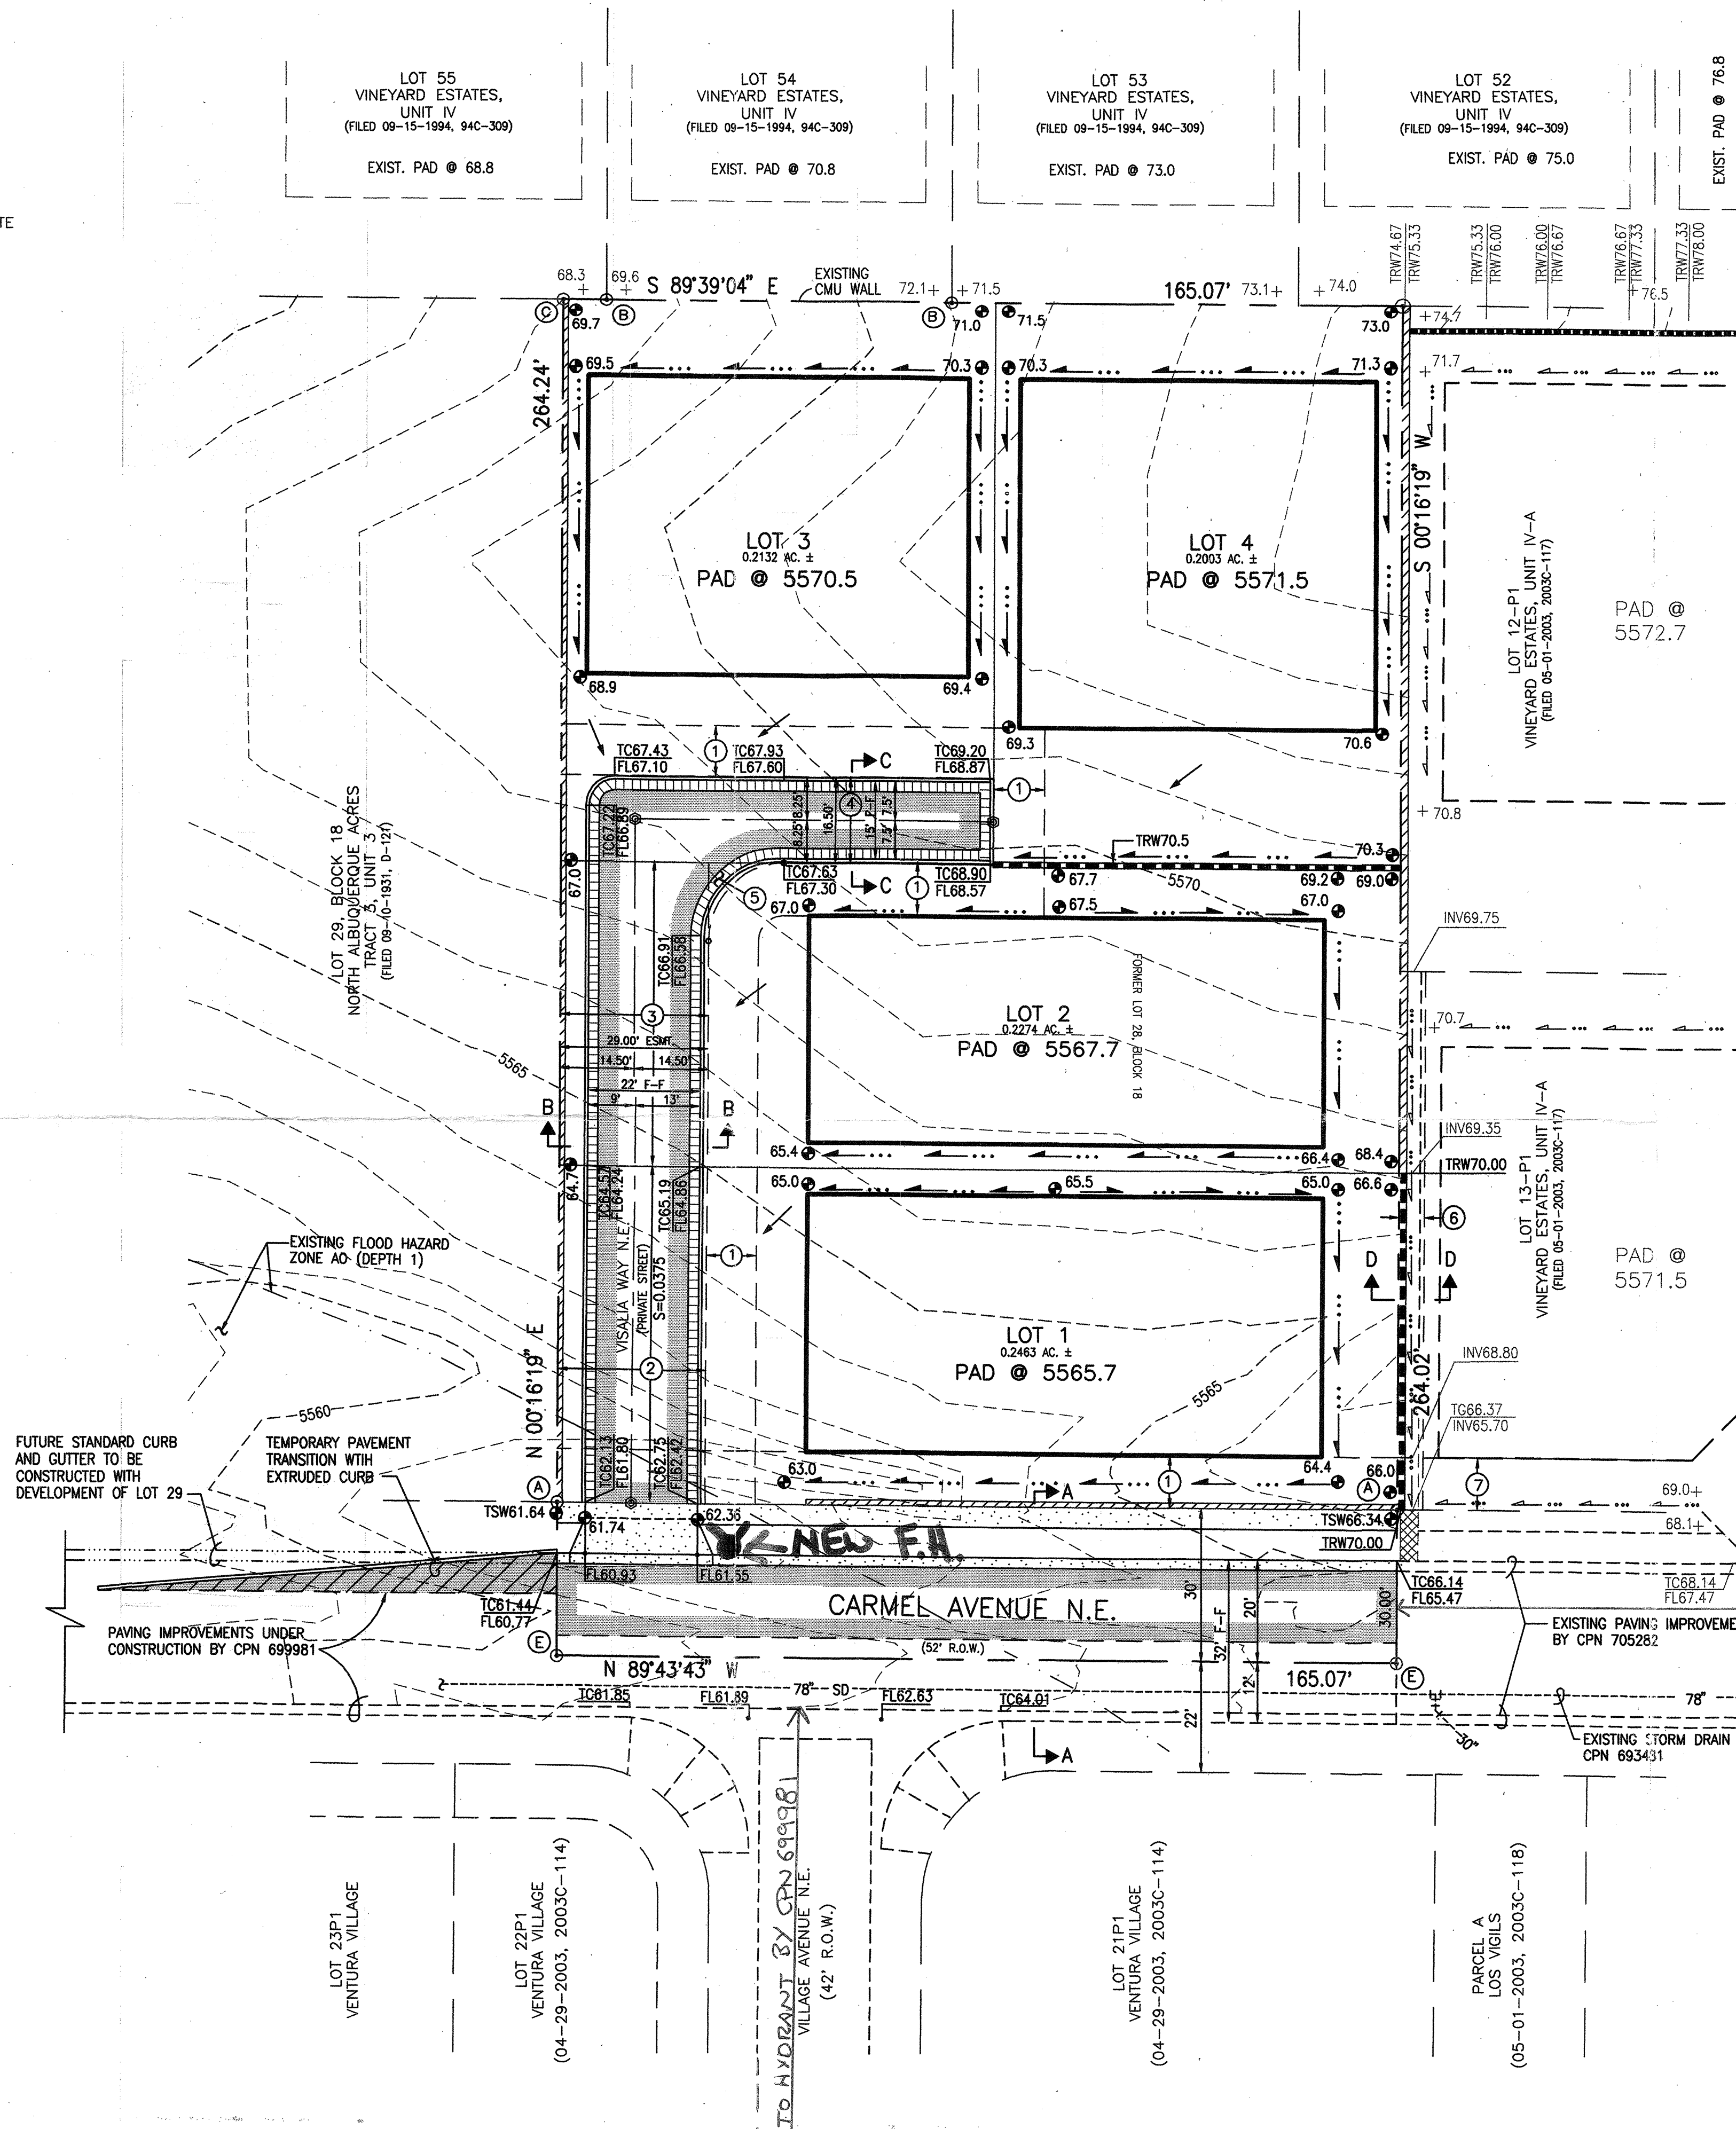

PROJECT BENCHMARK

ACS STATION "HEAVEN" (TIED TO PASEO DEL NORTE ROADWAY CONSTRUCTION IN 1999)
PREVIOUS ELEVATION = 5378.79 FEET (NGVD 1929)
THIS BENCHMARK HAS BEEN USED TO PROVIDE UNIFORMITY BETWEEN THIS SURVEY AND THE PREVIOUS SURVEYS CONDUCTED FOR RELATED NORTH DOMINGO BACA ARROYO PROJECTS.
THE ELEVATION FOR ACS STATION "5-C20", AN ACS 1 3/4" ALUMINUM DISK STAMPED "ACS BM 5-C20", EPOXYED TO THE TOP OF THE CONCRETE DROP INLET, AT THE NNE CURB RETURN IN THE NORTHEAST QUADRANT OF THE INTERSECTION OF VENTURA STREET AND ANAHEIM AVENUE N.E., BASED UPON THIS DATUM IS 5552.84 FEET (NGVD 1929). THE C.O.A. PUBLISHED ELEVATION IS 5552.71 FEET (NGVD 1929)

LEGEND

- +74.0 EXISTING CONTOUR
- +75.55 EXISTING SPOT ELEVATION
- ... PROPOSED SPOT ELEVATION
- ... EXISTING FLOWLINE
- ... PROPOSED FLOWLINE
- ... DIRECTION OF FLOW
- ... EXISTING RETAINING WALL
- ... PROPOSED RETAINING WALL
- ... GARDEN WALL
- ... MOUNTABLE CURB
- TC TOP OF CURB
- FL FLOWLINE
- INV INVERT
- TRW TOP OF RETAINING WALL
- TG TOP OF GRATE
- ... PROPOSED ASPHALT PAVEMENT
- ... PROPOSED TEMPORARY PAVEMENT

THIS IS NOT A BOUNDARY SURVEY. APPARENT PROPERTY CORNERS ARE SHOWN HEREON FOR INFORMATION ONLY. BOUNDARY DATA IS TAKEN FROM THE PRELIMINARY PLAT FOR THIS PROJECT PREPARED BY THIS OFFICE. EXISTING TOPOGRAPHY SHOWN HEREON IS FROM A TOPOGRAPHIC SURVEY CONDUCTED BY THIS OFFICE 09/02/03. IMPROVEMENTS AND GRADES FOR VINEYARD ESTATES UNIT IV-A AND FOR VENTURA VILLAGE ARE TAKEN FROM THE APPROVED PLANS FOR THESE PROJECTS, CPN'S 705282 AND 699981, RESPECTIVELY, AND SHOWN AS EXISTING (CONSTRUCTION CURRENTLY IN PROGRESS).

AFD PLANS CHECKING OFFICE
924-3611
APPROVED/DISAPPROVED
5.3.03
SIGNATURE & DATE



CPN# 705282

08/28/2003

GRADING PLAN
VINEYARD ESTATES, UNIT IV-B

DESIGNED BY	DATE	BY	REVISIONS	JOB NO.
G.M.				2003.044.3
DRAWN BY	DATE	BY	REVISIONS	JOB NO.
S.G.H.				08-2003
APPROVED BY	DATE	BY	REVISIONS	JOB NO.
G.M.				2 OF 3

