


CONSTRUCTION PLANS
FOR
HIGHLANDS AT ANDERSON HILLS
UNIT 3
ALBUQUERQUE, NEW MEXICO

SCANNED BY
MESA REPRO

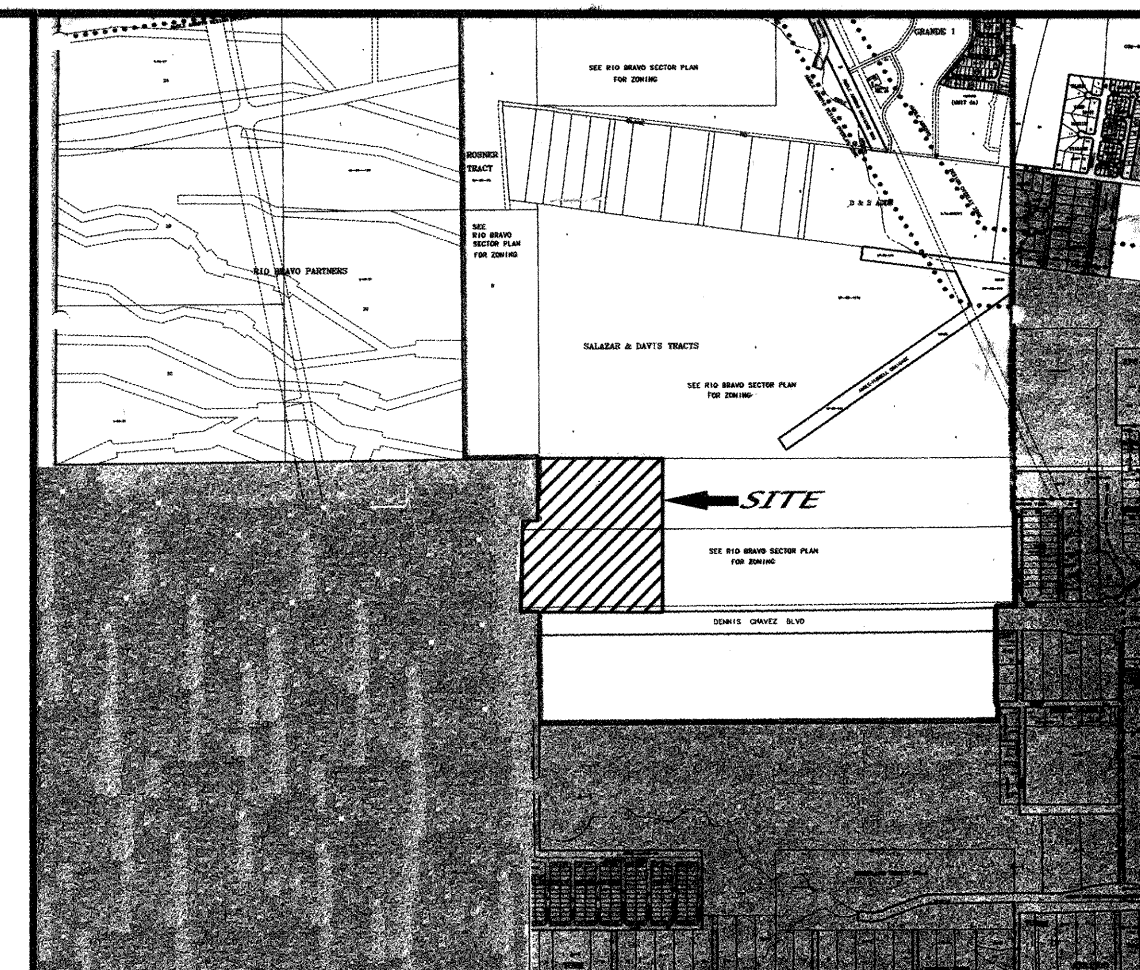

VICINITY MAP ZONE ATLAS P-9
SCALE: NONE

GENERAL NOTES

NOTICE TO CONTRACTORS

1. AN EXCAVATION/CONSTRUCTION PERMIT WILL BE REQUIRED BEFORE BEGINNING ANY WORK WITHIN THE CITY RIGHT-OF-WAY.
 2. ALL WORK DETAILED ON THESE PLANS TO BE PERFORMED UNDER CONTRACT SHALL, EXCEPT AS OTHERWISE STATED OR PROVIDED FOR HEREON, BE CONSTRUCTED IN ACCORDANCE WITH THE CITY OF ALBUQUERQUE STANDARD SPECIFICATIONS FOR PUBLIC WORKS CONSTRUCTION, 1986 EDITION AS REVISED THROUGH UPDATE #7.
 3. TWO WORKING DAYS PRIOR TO ANY EXCAVATION, THE CONTRACTOR MUST CONTACT NEW MEXICO ONE CALL SYSTEM (260-1990) FOR LOCATION OF EXISTING UTILITIES.
 4. PRIOR TO CONSTRUCTION, THE CONTRACTOR SHALL EXCAVATE AND VERIFY THE HORIZONTAL AND VERTICAL LOCATIONS OF ALL OBSTRUCTIONS. SHOULD A CONFLICT EXIST, THE CONTRACTOR SHALL NOTIFY THE ENGINEER IMMEDIATELY SO THAT THE CONFLICT CAN BE RESOLVED WITH A MINIMUM AMOUNT OF DELAY.
 5. FIVE (5) WORKING DAYS PRIOR TO BEGINNING OF CONSTRUCTION, THE CONTRACTOR SHALL SUBMIT TO CONSTRUCTION COORDINATION DIVISION A DETAILED CONSTRUCTION SCHEDULE. TWO (2) WORKING DAYS PRIOR TO THE START OF CONSTRUCTION, THE CONTRACTOR SHALL OBTAIN A BARRICADING PERMIT FROM THE CONSTRUCTION COORDINATION DIVISION. CONTRACTOR SHALL NOTIFY THE CONSTRUCTION COORDINATION ENGINEER (924-3400) PRIOR TO OCCUPYING AN INTERSECTION. REFER TO SECTION 19 OF THE GENERAL CONDITIONS OF THE STANDARD SPECIFICATIONS.
 6. ALL WORK AFFECTING ARTERIAL ROADWAYS REQUIRES TWENTY-FOUR HOUR CONSTRUCTION.
 7. ALL STREET STRIPING ALTERED OR DESTROYED SHALL BE REPLACED WITH PLASTIC REFLECTORIZED PAVEMENT MARKING BY CONTRACTOR TO THE SAME LOCATION AS WAS EXISTING, OR AS INDICATED BY THIS PLAN SET.
 8. CONTRACTOR SHALL NOTIFY THE ENGINEER NOT LESS THAN SEVEN (7) DAYS PRIOR TO STARTING WORK IN ORDER THAT THE CITY SURVEYOR MAY TAKE NECESSARY MEASURES TO INSURE THE PRESERVATION OF SURVEY MONUMENTS. CONTRACTOR SHALL NOT DISTURB PERMANENT SURVEY MONUMENTS WITHOUT THE CONSENT OF THE CITY SURVEYOR AND SHALL NOTIFY THE CITY SURVEYOR AND BEAR THE EXPENSE OF REPLACING ANY THAT MAY BE DISTURBED WITHOUT PERMISSION. REPLACEMENT SHALL BE DONE ONLY BY THE CITY SURVEYOR. WHEN A CHANGE IS MADE IN THE FINISHED ELEVATIONS OF THE PAVEMENT OF ANY ROADWAY IN WHICH A PERMANENT SURVEY MONUMENT IS LOCATED, CONTRACTOR SHALL, AT HIS OWN EXPENSE, ADJUST THE MONUMENT TO COVER THE NEW GRADE UNLESS OTHERWISE SPECIFIED. REFER TO SECTION 4.4 OF THE GENERAL CONDITIONS OF THE STANDARD SPECIFICATIONS. CONTRACTOR SHALL RECORD DATA ON ALL UTILITY LINES AND ACCESSORIES AS REQUIRED BY THE CITY OF ALBUQUERQUE FOR THE PREPARATION OF "AS CONSTRUCTED" DRAWINGS. CONTRACTOR SHALL NOT COVER UTILITY LINES AND ACCESSORIES UNTIL ALL DATA HAVE BEEN RECORDED.
 10. CONTRACTOR SHALL MAINTAIN A GRAFFITI-FREE WORK SITE. CONTRACTOR SHALL PROMPTLY REMOVE ANY GRAFFITI FROM ALL EQUIPMENT, WHETHER PERMANENT OR TEMPORARY.
 11. CONTRACTOR SHALL COORDINATE WITH THE CITY OF ALBUQUERQUE WATER SYSTEMS DIVISION (857-8200) SEVEN (7) WORKING DAYS IN ADVANCE OF ANY WORK THAT MAY AFFECT EXISTING PUBLIC WATER OR SEWER UTILITIES. EXISTING VALVES TO BE OPERATED BY CITY PERSONNEL ONLY. CONTRACTOR SHALL CONTACT THE WATER SYSTEMS DIVISION SEVEN (7) WORKING DAYS PRIOR TO NEEDING VALVES TURNED ON OR OFF.
 12. FOR STORM DRAIN CONSTRUCTION, RCP JOINTS SHALL NOT BE GROUTED PRIOR TO FINAL INSPECTION. FINAL INSPECTION WILL DETERMINE JOINTS TO BE GROUTED FOR FINAL ACCEPTANCE OF THE CONSTRUCTION.
 13. CONSTRUCTION WORK DONE WITHIN DENNIS CHAVEZ BLVD. RIGHT-OF-WAY IS UNDER BERNALILLO COUNTY JURISDICTION AND SHALL REQUIRE EXCAVATION AND PAVING PERMITS. CALL BERNALILLO COUNTY PUBLIC WORKS AT 848-1513 (ERIC ZAMORA).
- THE FOLLOWING NOTES ALSO APPLY WHEN CHECKED

- ☒ ALL UTILITIES AND UTILITY SERVICE LINES SHALL BE INSTALLED PRIOR TO PAVING.
- ☒ BACKFILL COMPACTION SHALL BE ACCORDING TO SPECIFIED STREET USE.
- ☐ TACK COAT REQUIREMENTS SHALL BE DETERMINED BY THE ENGINEER.
- ☒ SIDEWALK AND WHEELCHAIR RAMPS WITHIN THE CURB RETURNS SHALL BE CONSTRUCTED WHEREVER A NEW CURB RETURN IS CONSTRUCTED.
- ☐ IF CURB IS DEPRESSED FOR A DRIVEPAD, THE DRIVEPAD SHALL BE CONSTRUCTED PRIOR TO ACCEPTANCE OF CURB AND GUTTER.
- ☒ ALL STORM DRAINAGE FACILITIES SHALL BE COMPLETED PRIOR TO FINAL ACCEPTANCE.

APPROVED AS RECORD DRAWINGS
DESIGN REVIEW SECTION
CITY CONSTRUCTION ENGINEER
James M. Hines
DATE: 11-11-05

SURVEYOR'S CERTIFICATION

"I, Timothy Aldrich, a duly qualified Registered Professional Land Surveyor under the laws of the State of New Mexico, do hereby certify that the 'as-built' information shown on these drawings was obtained from field construction and 'as-built' surveys performed by me or under my supervision, that the 'as-built' information shown on these drawings was added by me or under my supervision, and that this 'as-built' information is true and correct to the best of my knowledge and belief." Aldrich Land Surveying is not responsible for any of the design concepts, calculations, or measurements shown on the drawings.

Timothy Aldrich, P.S. No. 7719




INDEX TO DRAWINGS

SHEET NO.	SHEET
1	TITLE SHEET
2	PLAT
3-6	GRADING AND DRAINAGE PLAN
7	MASTER PAVING PLAN
8-13	PAVING IMPROVEMENTS
14	MASTER UTILITY PLAN
15-20	UTILITY IMPROVEMENTS

CERTIFICATE OF SUBSTANTIAL COMPLIANCE ON PLANS

I, Diane L. Hoelzer, NMPE 11967, of the firm Mark Goodwin & Associates, P.A., a Registered Professional Engineer in the State of New Mexico, do hereby certify, to the best of my knowledge and belief, that the infrastructure installed as part of this project has been inspected by me or by a qualified person under my direct supervision, and has been constructed in accordance with the plans and specifications approved by the City Engineer and that the original design intent of the approved plans has been met, except as noted by me on the as-built construction drawings. This Certification is based on site inspections by me or personnel under my direction, and survey information provided by ALS, Inc., NMPS number 7719.

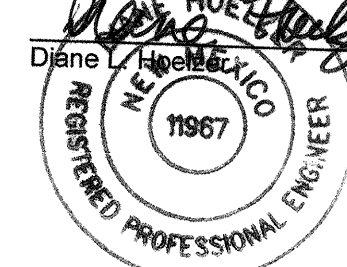

DRB PROJECT NO.
1002857

CAUTION:
NOTE THAT ALL EXISTING UTILITIES MAY NOT BE SHOWN. ALL EXISTING SERVICE CONNECTIONS ARE NOT SHOWN. ANY EXISTING UTILITIES THAT ARE SHOWN ARE APPROXIMATE LOCATION ONLY. IT SHALL BE THE SOLE RESPONSIBILITY OF THE CONTRACTOR TO CONTACT ALL THE UTILITY OWNERS AND TO CONDUCT ALL NECESSARY FIELD INVESTIGATIONS PRIOR TO ANY EXCAVATIONS TO DETERMINE THE ACTUAL LOCATION OF UTILITIES AND OTHER IMPROVEMENTS.

dmg D. MARK GOODWIN & ASSOCIATES, P.A.
CONSULTING ENGINEERS
P. O. BOX 90606
ALBUQUERQUE, NEW MEXICO 87199
(505) 828-2200, FAX (505) 797-9539

SCANNED BY
MESA REPRO

ACS MONUMENT "TRANS"
Y=1471822.67
X=354889.45
G=0.99967921
Δα=00°16'42"
CENTRAL ZONE
(NAD 1927)

Limits of FEMA Floodplain
Until such time that the LOMR is issued by FEMA to remove the floodplain, this area and any future lots that develop in this area, flood insurance may be required by the mortgage company.

TRACT A
LANDS OF SALAZAR FAMILY TRUST
SALAZAR QUATRO TRUST
JSJ INVESTMENT COMPANY
ANF FALBA HANNET
(07-23-03, 2003C-223)

- EASEMENTS
- PROPOSED 7' PUBLIC UTILITY EASEMENT (PUE) (GRANTED WITH UNIT 1 PLATTING)
 - EXISTING PUBLIC DRAINAGE, WATERLINE AND SANITARY SEWER EASEMENT (GRANTED WITH UNIT 1 PLATTING)
 - EXISTING 25' PUBLIC DRAINAGE AND SANITARY SEWER EASEMENT (GRANTED WITH UNIT 1 PLATTING)
 - 7' PUBLIC UTILITY EASEMENT (PUE) GRANTED WITH THIS PLAT
 - EXISTING 38' PUBLIC DRAINAGE, WATERLINE, SANITARY SEWER & PEDESTRIAN ACCESS EASEMENT (GRANTED WITH UNIT 1 PLATTING)
 - EXISTING 40' PUBLIC DRAINAGE, WATERLINE AND SANITARY SEWER EASEMENT (GRANTED WITH UNIT 1 PLATTING)
 - 25' PUBLIC DRAINAGE AND SANITARY SEWER EASEMENT GRANTED WITH THIS PLAT

PRELIMINARY PLAT
THE HIGHLANDS AT ANDERSON HILLS
UNITS 2 AND 3
WITHIN THE
TOWN OF ATRISCO GRANT
PROJECTED SECTIONS 8, 9 & 10
TOWNSHIP 9 NORTH, RANGE 2 EAST, NMPM
CITY OF ALBUQUERQUE
BERNALILLO COUNTY, NEW MEXICO
OCTOBER, 2003

SUBDIVISION DATA

GROSS ACREAGE	34.1537 AC
ZONE ATLAS NO.	N-9-Z P-9-Z
NO. OF UNIT 2 LOTS CREATED	66 LOTS
NO. OF UNIT 3 LOTS CREATED	87 LOTS
TOTAL NO. OF LOTS CREATED	153 LOTS
NO. OF TRACTS CREATED	13 TRACTS
NO. OF PARCELS CREATED	10 PARCEL
AREA DEDICATED TO CITY	8.8640 AC
ZONING	RLT
DATE OF SURVEY	OCTOBER 2002

- NOTES
- UNLESS OTHERWISE NOTED, ALL BOUNDARY CORNERS SHOWN THUS SHALL BE MARKED BY A #5 REBAR W/CAP STAMPED "ALS LS 7719" (TYP.).
 - ALL STREET CENTERLINE MONUMENTATION SHALL BE INSTALLED AT ALL CENTERLINE P.C.'S, P.T.'S, ANGLE POINTS, AND STREET INTERSECTIONS, AND SHOWN THUS , WILL BE MARKED BY A FOUR INCH (4") ALUMINUM CAP STAMPED:
"CITY OF ALBUQUERQUE CENTERLINE MONUMENTATION"
"DO NOT DISTURB"
PS#7719"
 - BOUNDARY SHALL BE TIED TO THE NEW MEXICO STATE PLANE COORDINATE SYSTEM AS SHOWN.
 - BASIS OF BEARING SHALL BE NEW MEXICO STATE PLANE GRID BEARINGS.
 - ALL DISTANCES SHALL BE GROUND DISTANCES.
 - MANHOLES WILL BE OFFSET AT ALL POINTS OF CURVATURE, POINTS OF TANGENCY, STREET INTERSECTIONS, AND ALL OTHER ANGLE POINTS TO ALLOW USE OF CENTERLINE MONUMENTATION.
 - TRACTS "G" THRU "P" ARE FOR THE BENEFIT OF AND TO BE OWNED AND MAINTAINED BY THE ANDERSON HILLS HOMEOWNERS ASSOCIATION FOR LANDSCAPING PURPOSES.

- LEGEND
- LOT NUMBER
 - BLOCK NUMBER
 - CENTER LINE MONUMENT
 - EXIST. CENTER LINE MONUMENT
 - ROW RIGHT-OF-WAY
 - UNIT BOUNDARY
 - VACATION
 - FLOOD PLAIN LIMITS

SITE BENCHMARK
ACS MONUMENT
"3-P10"
ELEVATION=4935.735
(SLD 1929)

DESCRIPTION
A tract of land situate within the Town of Atrisco Grant, projected Sections 8, 9, and 10, Township 9 North, Range 2 East, New Mexico Principal Meridian, Bernalillo County, New Mexico being a part of Parcel 1, THE HIGHLANDS AT ANDERSON HILLS UNIT 1 as the same is shown and designated on said plat filed for record in the office of the County Clerk of Bernalillo County, New Mexico on in Book , Page , and containing 34.2074 acres more or less.

ENGINEERS
D. MARK GOODWIN & ASSOCIATES, P.A.
CONSULTING ENGINEERS
P.O. BOX 90606
ALBUQUERQUE, NEW MEXICO 87199
(505) 828-2200


SURVEYOR
ALDRICH LAND SURVEYING
P.O. BOX 30701
ALBUQUERQUE, N.M. 87190
(505) 884-1990

OWNERS
ANDERSON HILLS, LLC
PO BOX 12317
ALBUQUERQUE, N.M. 87195
(505) 822-5562




ROBERT LUPTON
Manager, Anderson Hills, LLC
2-19-2004
DATE

APPROVED FOR MONUMENTATION AND STREET NAMES

City Surveyor, City of Albuquerque, N.M.
2-19-04
Date

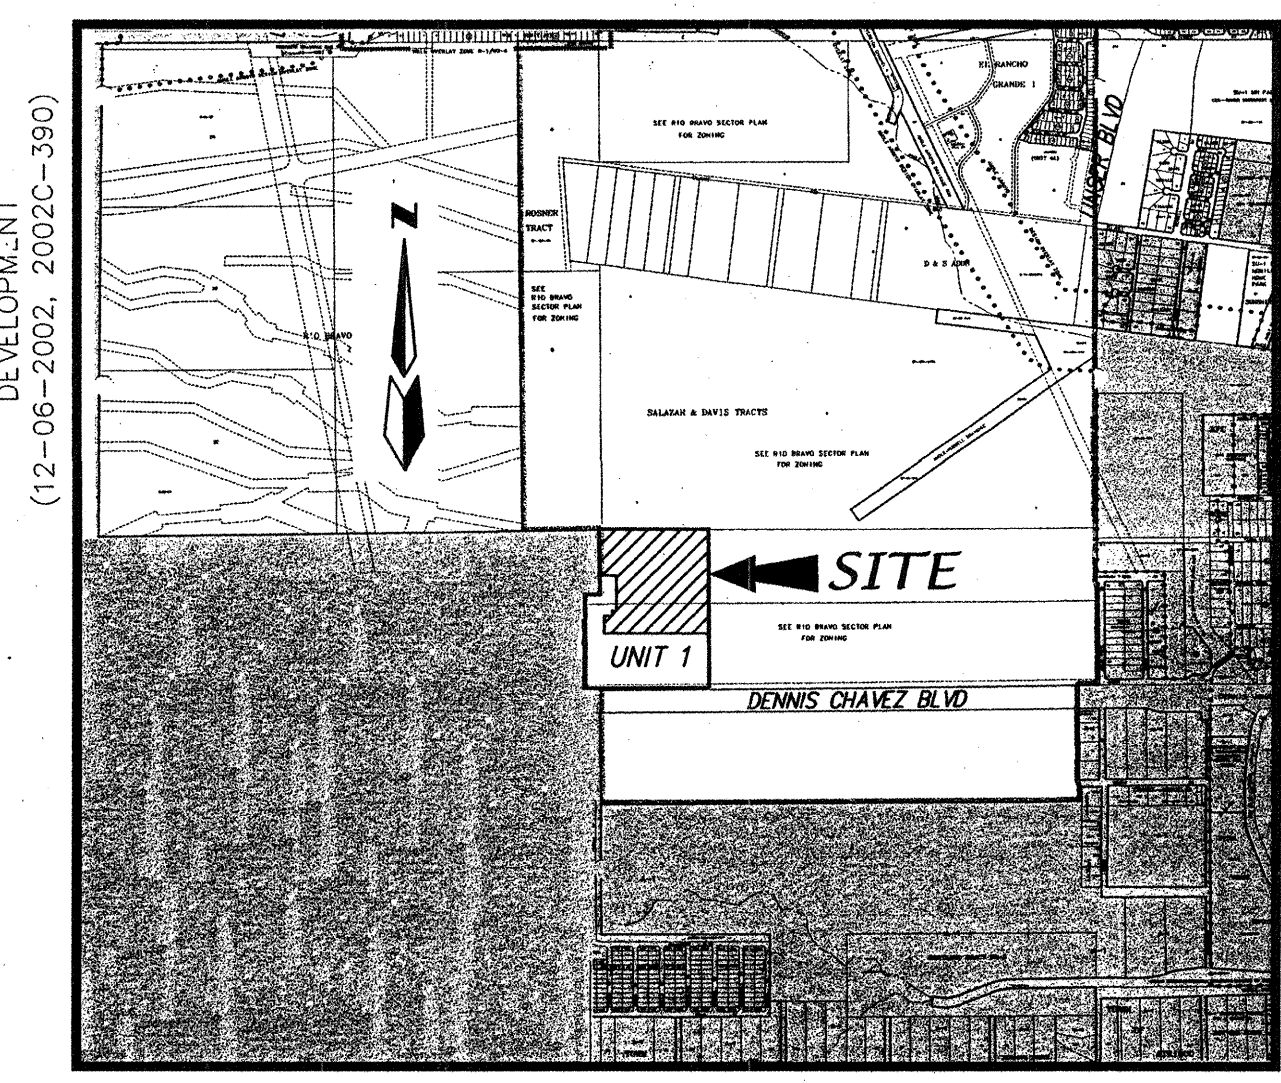


ZONE ATLAS: N-9-Z & P-9-Z

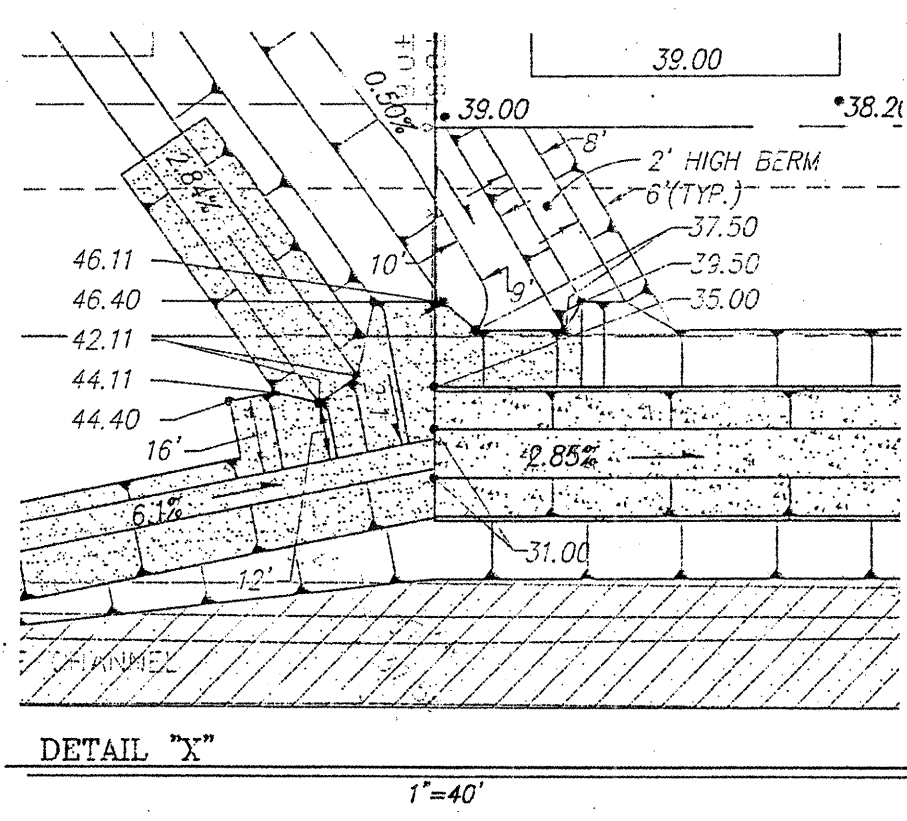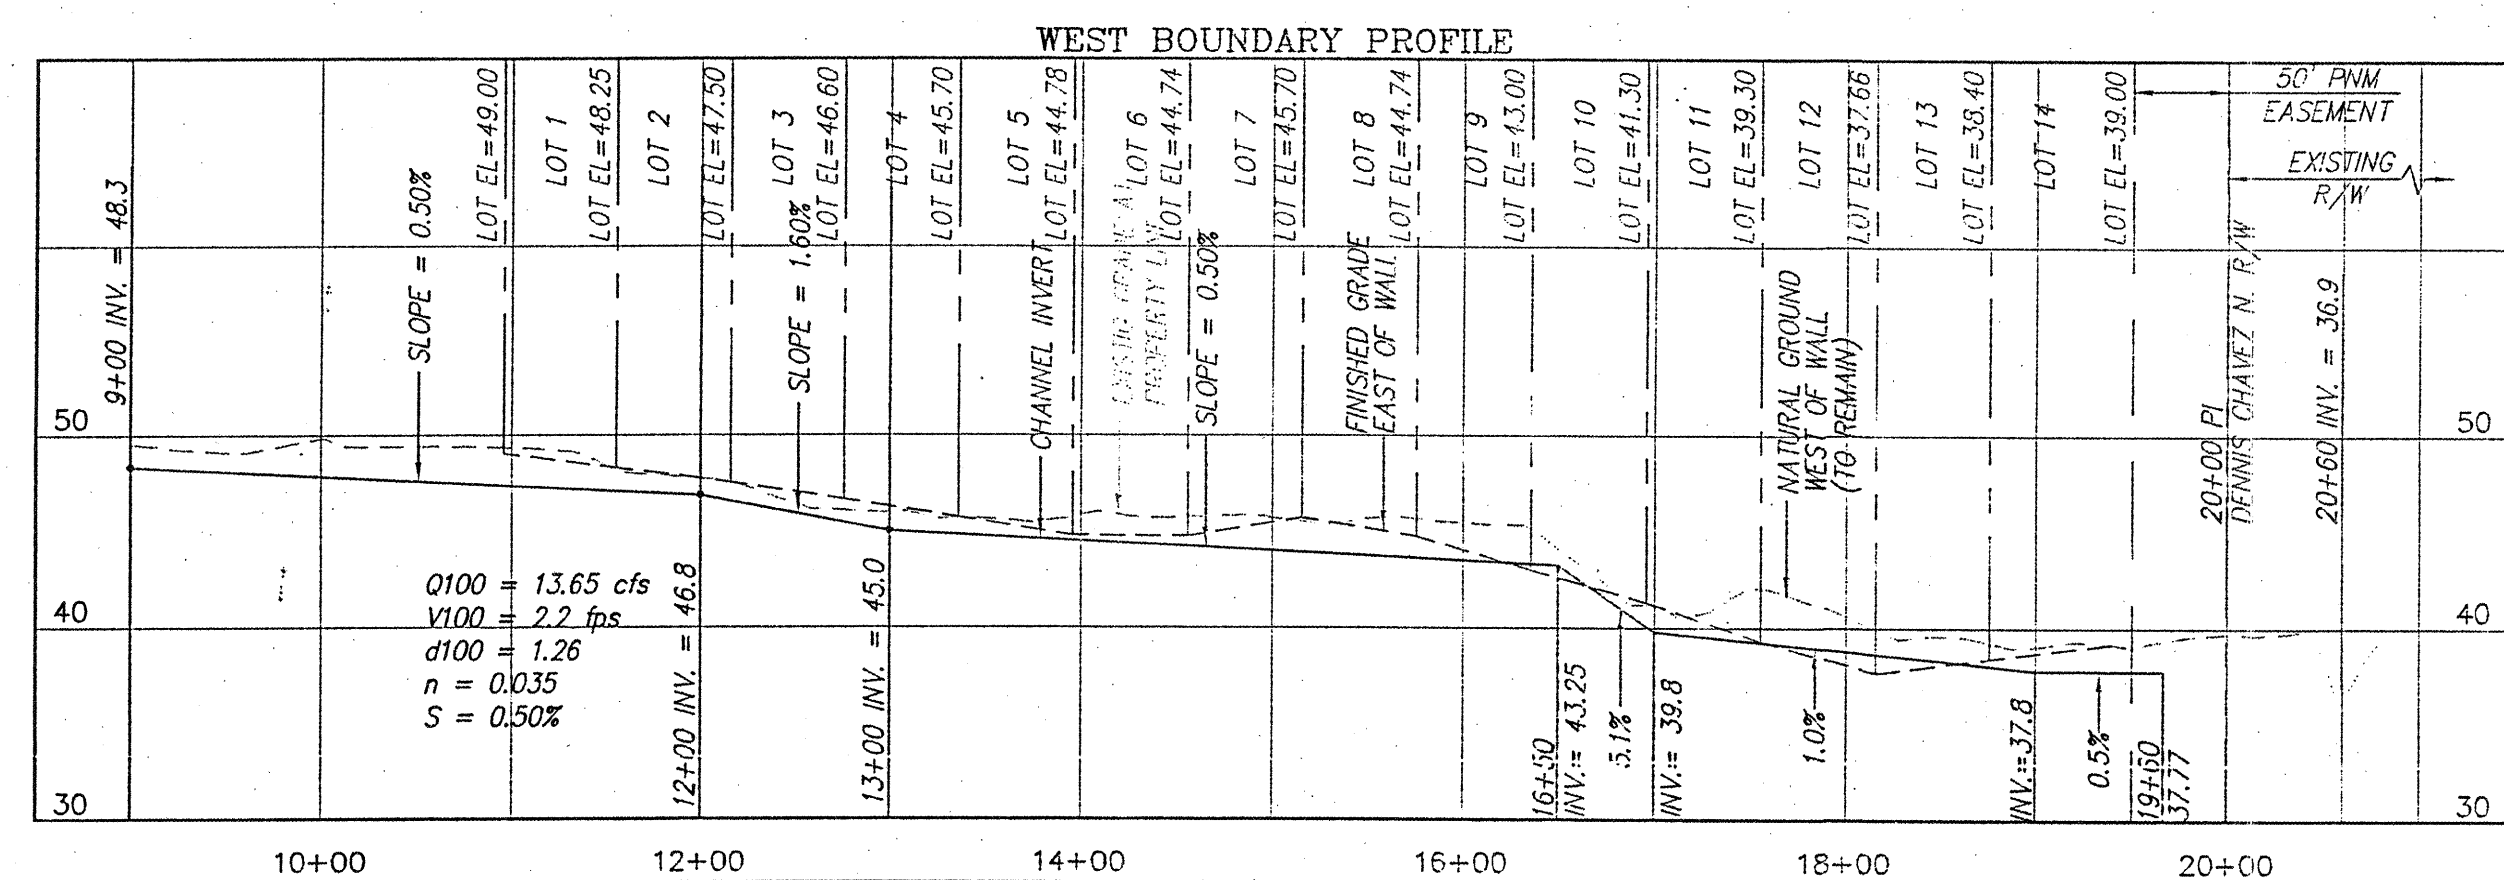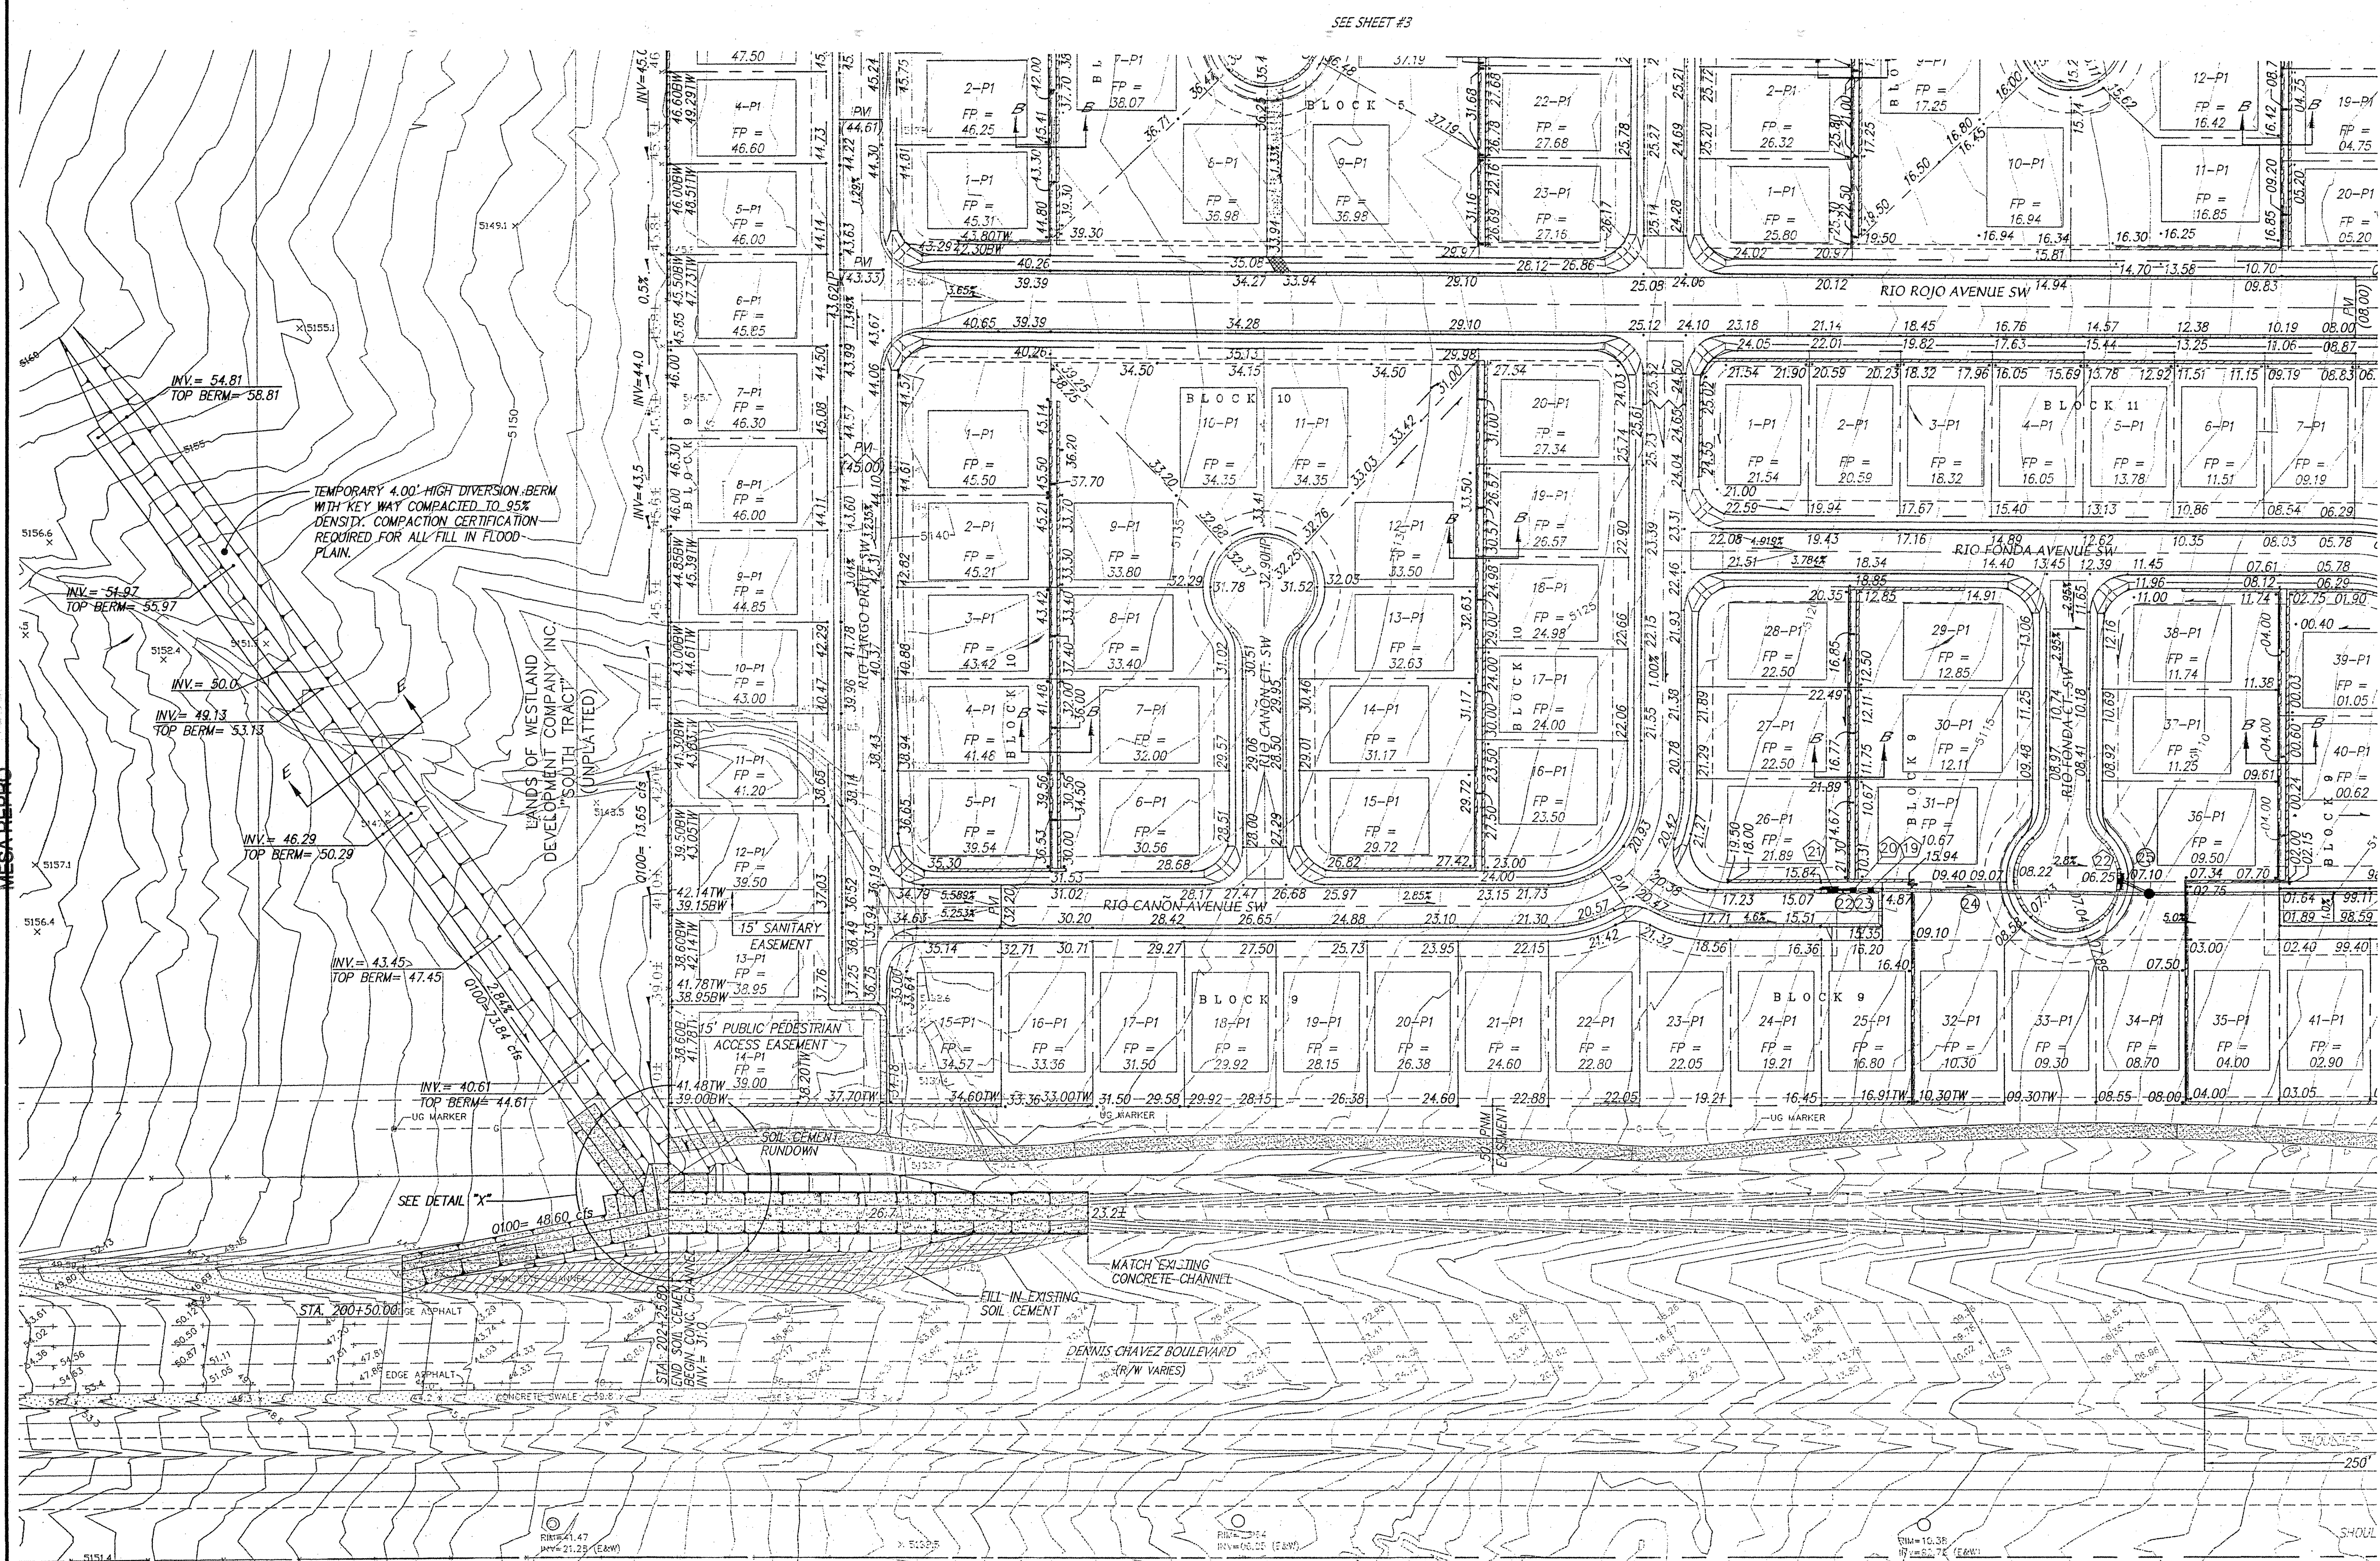


GRADING APPROVAL PER THIS PLAN ON LANDS DATE
OF WESTLAND DEVELOPMENT COMPANY, INC.
"SOUTH TRACT"


APPROVED ROUGH GRADING $\pm 18"$

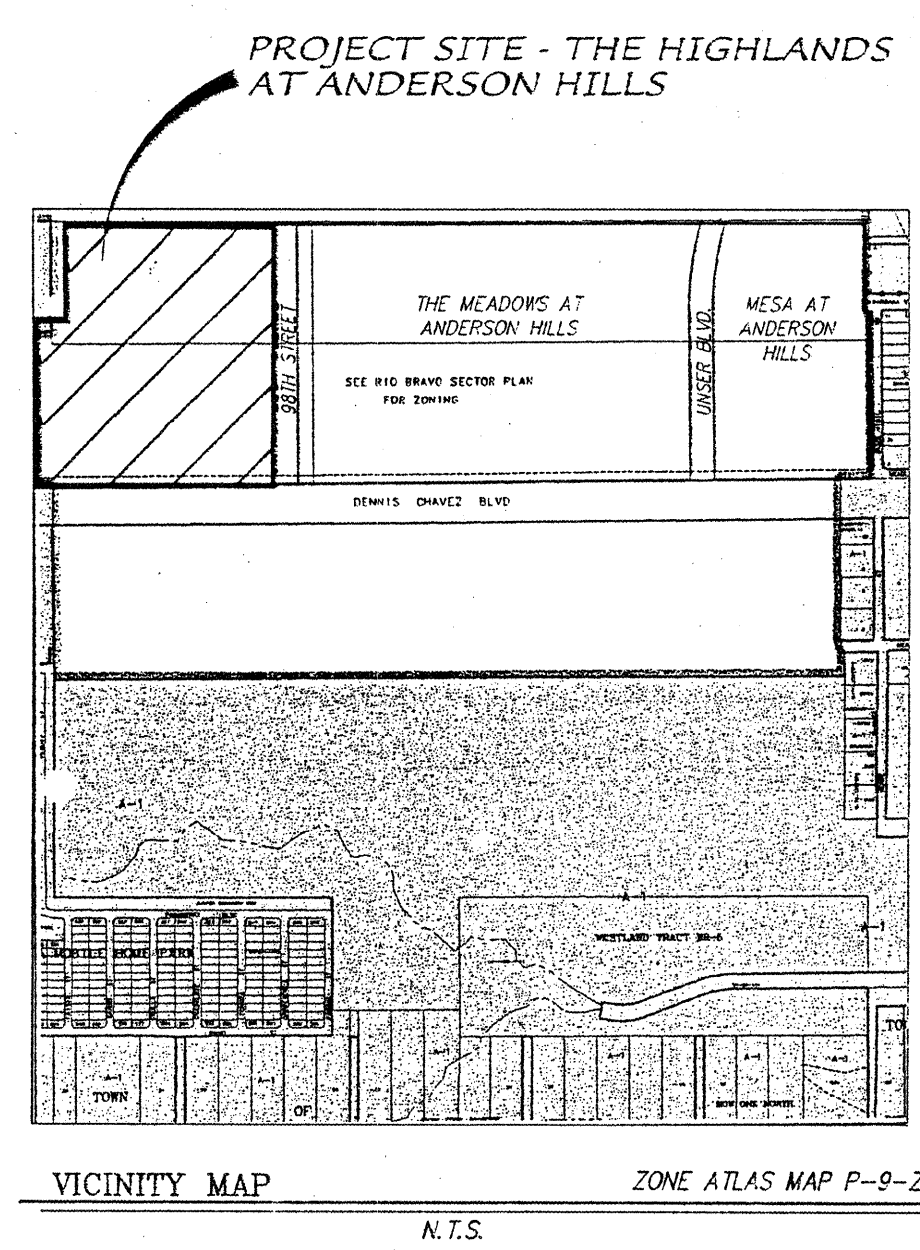CITY HYDROLOGY DATE




NOTES

  LEGEND






 .45.50
 FP = 50.0

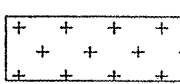  




 



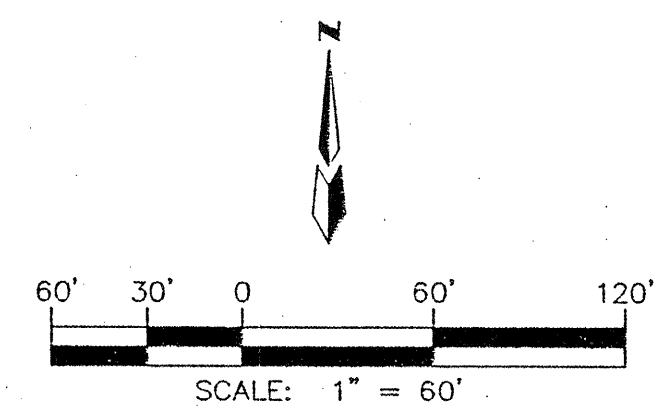


PROPOSED STANDARD CURB & GUTTER
 PROPOSED MOUNTABLE CURB & GUTTER
 PROPOSED SIDEWALK
 PROPOSED SPOT ELEVATION
 PROPOSED FINISHED PAD ELEVATION
 PROPOSED DIRECTION OF FLOW
 PROPOSED SLOPE
 PROPOSED RETAINING WALL
 PROPOSED GARDEN WALL
 PROPOSED PARK
 EXISTING PAVEMENT
 EXISTING CHANNEL
 STORM SEWER MANHOLE
 STORM SEWER
 INLETS



dmg MARK GOODWIN & ASSOCIATES, P.A.
CONSULTING ENGINEERS
P.O. BOX 90605
ALBUQUERQUE, NEW MEXICO 87199
(505) 828-2200, FAX (505) 797-9539

CITY OF ALBUQUERQUE
PUBLIC WORKS DEPARTMENT


TITLE: *THE HIGHLANDS AT ANDERSON HILLS
GRADING & DRAINAGE PLAN*

DESIGN REVIEW COMMITTEE	CITY ENGINEER APPROVAL
<i>For Information Only</i>	


CITY PROJECT NO. **708183**

ZONE MAP NO.
P-9

SHEET **3 of 20**

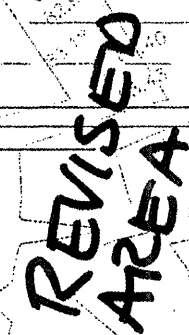

NOTES			
STORM DRAIN INLET TABLE			
INLET #	TYPE	INV.	GRATE
1	A	—	—
2	A	—	—
3	C	—	—
4	C	—	—
5	A	—	—
6	C	—	—
7	C	—	—
8	C	—	—
9	C	—	—
10	C	—	—
11	A	—	—
12	A	—	—
13	A	—	—
14	C	—	—
15	A	—	—
16	DBL A (ST)	—	—
17	DBL A (ST)	—	—
18	A	—	—
19	C	—	—
20	C	—	—
21	DBL A (ST)	—	—
22	SGL A (DT)	—	—
23	SGL A (DT)	—	—
24	A	—	—
25	DBL C	—	—
26	A	—	—
27	C	—	—
28	SGL A (DT)	—	—
29	A	—	—
30	C	—	—
31	SGL A (DT)	—	—

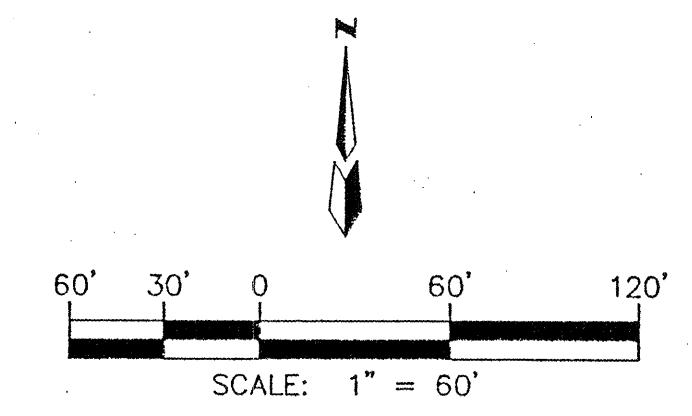

NOTES			
STORM DRAIN INLET TABLE			
INLET #	TYPE	INV.	GRATE
1	A	-	-
2	A	-	-
3	C	-	-
4	C	-	-
5	A	-	-
6	C	-	-
7	C	-	-
8	C	-	-
9	C	-	-
10	C	-	-
11	A	-	-
12	A	-	-
13	A	-	-
14	C	-	-
15	A	-	-
16	DBL A (ST)	-	-
17	DBL A (ST)	-	-
18	A	-	-
19	C	-	-
20	C	-	-
21	DBL A (ST)	-	-
22	SGL A (DT)	-	-
23	SGL A (DT)	-	-
24	A	-	-
25	DBL C	-	-
26	A	-	-
27	C	-	-
28	SGL A (DT)	-	-
29	A	-	-
30	C	-	-
31	SGL A (DT)	-	-

80'
30'
0
60'
120'

SCALE: 1" = 60'

ENGINEER'S SEAL

SURVEY INFORMATION	
FIELD NOTES	DATE
NO.	
BY	

MARK GOODWIN & ASSOCIATES, P.A.
CONSULTING ENGINEERS
P.O. BOX 90605
ALBUQUERQUE, NEW MEXICO 87199
(505) 828-2200, FAX (505) 797-9539

NO.	DATE	REMARKS	BY

CITY OF ALBUQUERQUE

PUBLIC WORKS DEPARTMENT

TITLE: **THE HIGHLANDS AT ANDERSON HILLS GRADING & DRAINAGE PLAN**

DESIGN REVIEW COMMITTEE

CITY ENGINEER APPROVAL

LAST DESIGN UPDATE

MO./DAY/YR.

MO./DAY/YR.

For Information Only

CITY PROJECT NO.


708183

ZONE MAP NO.

P-9

SHEET

4 of 20

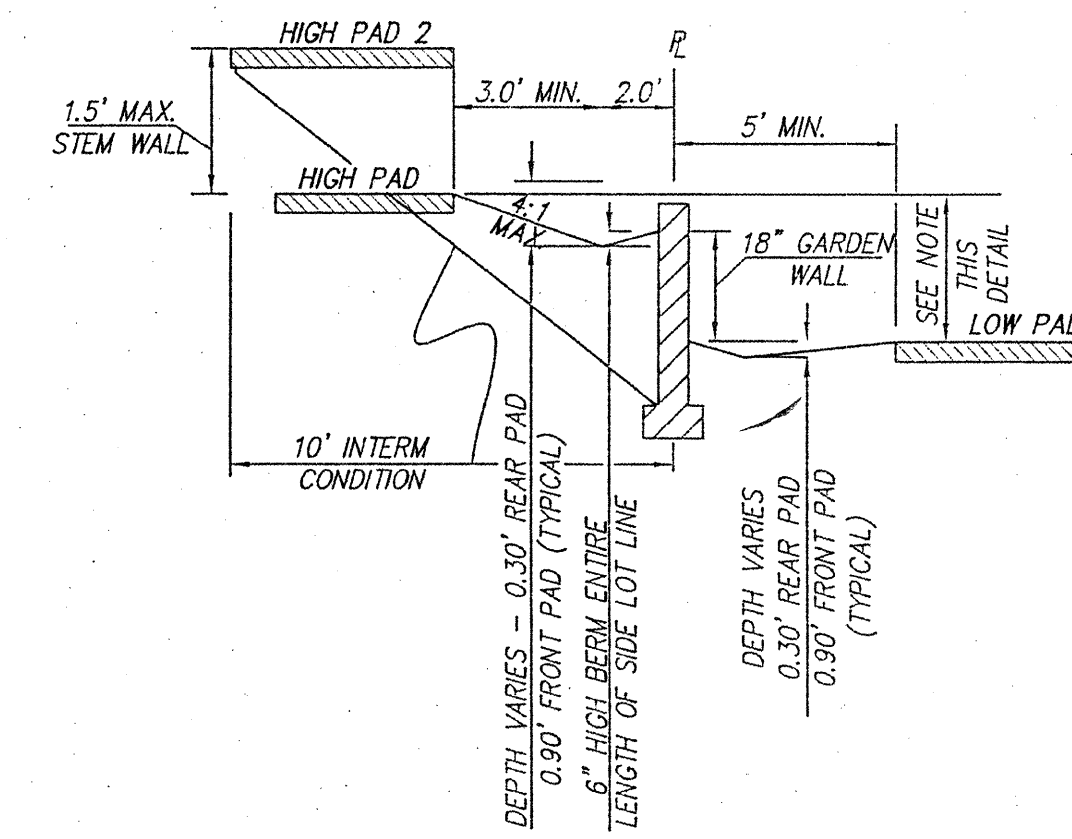


*PAD TO PAD 1.5' $\geq$ 3.0', SECTION B-B
CONSTRUCT STEM WALL

*PAD TO PAD < 1.5', SECTION B-B
CONSTRUCT GARDEN WALL

*PAD TO PAD > 3.0', SECTION B-B
CONSTRUCT RETAINING WALL


SIDEYARD DETAIL.

N.T.S.

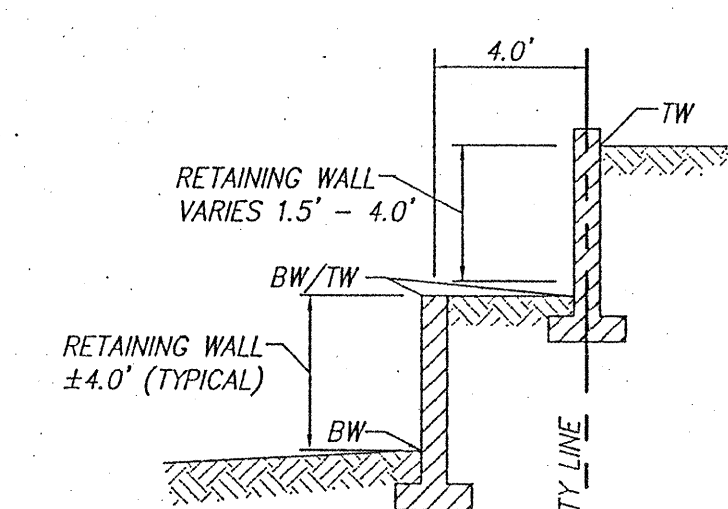


DOUBLE RETAINING WALL DETAIL






N.T.S.

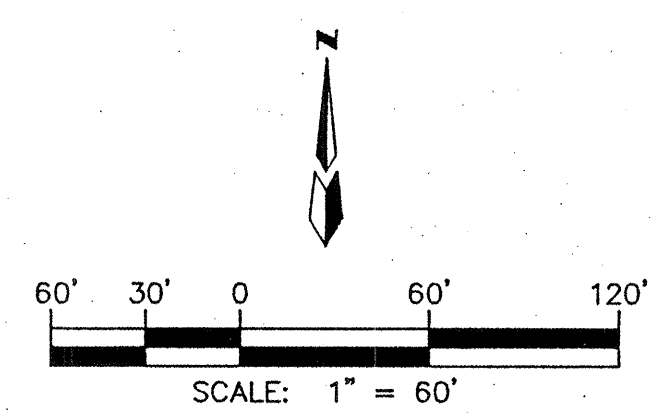

NOTES

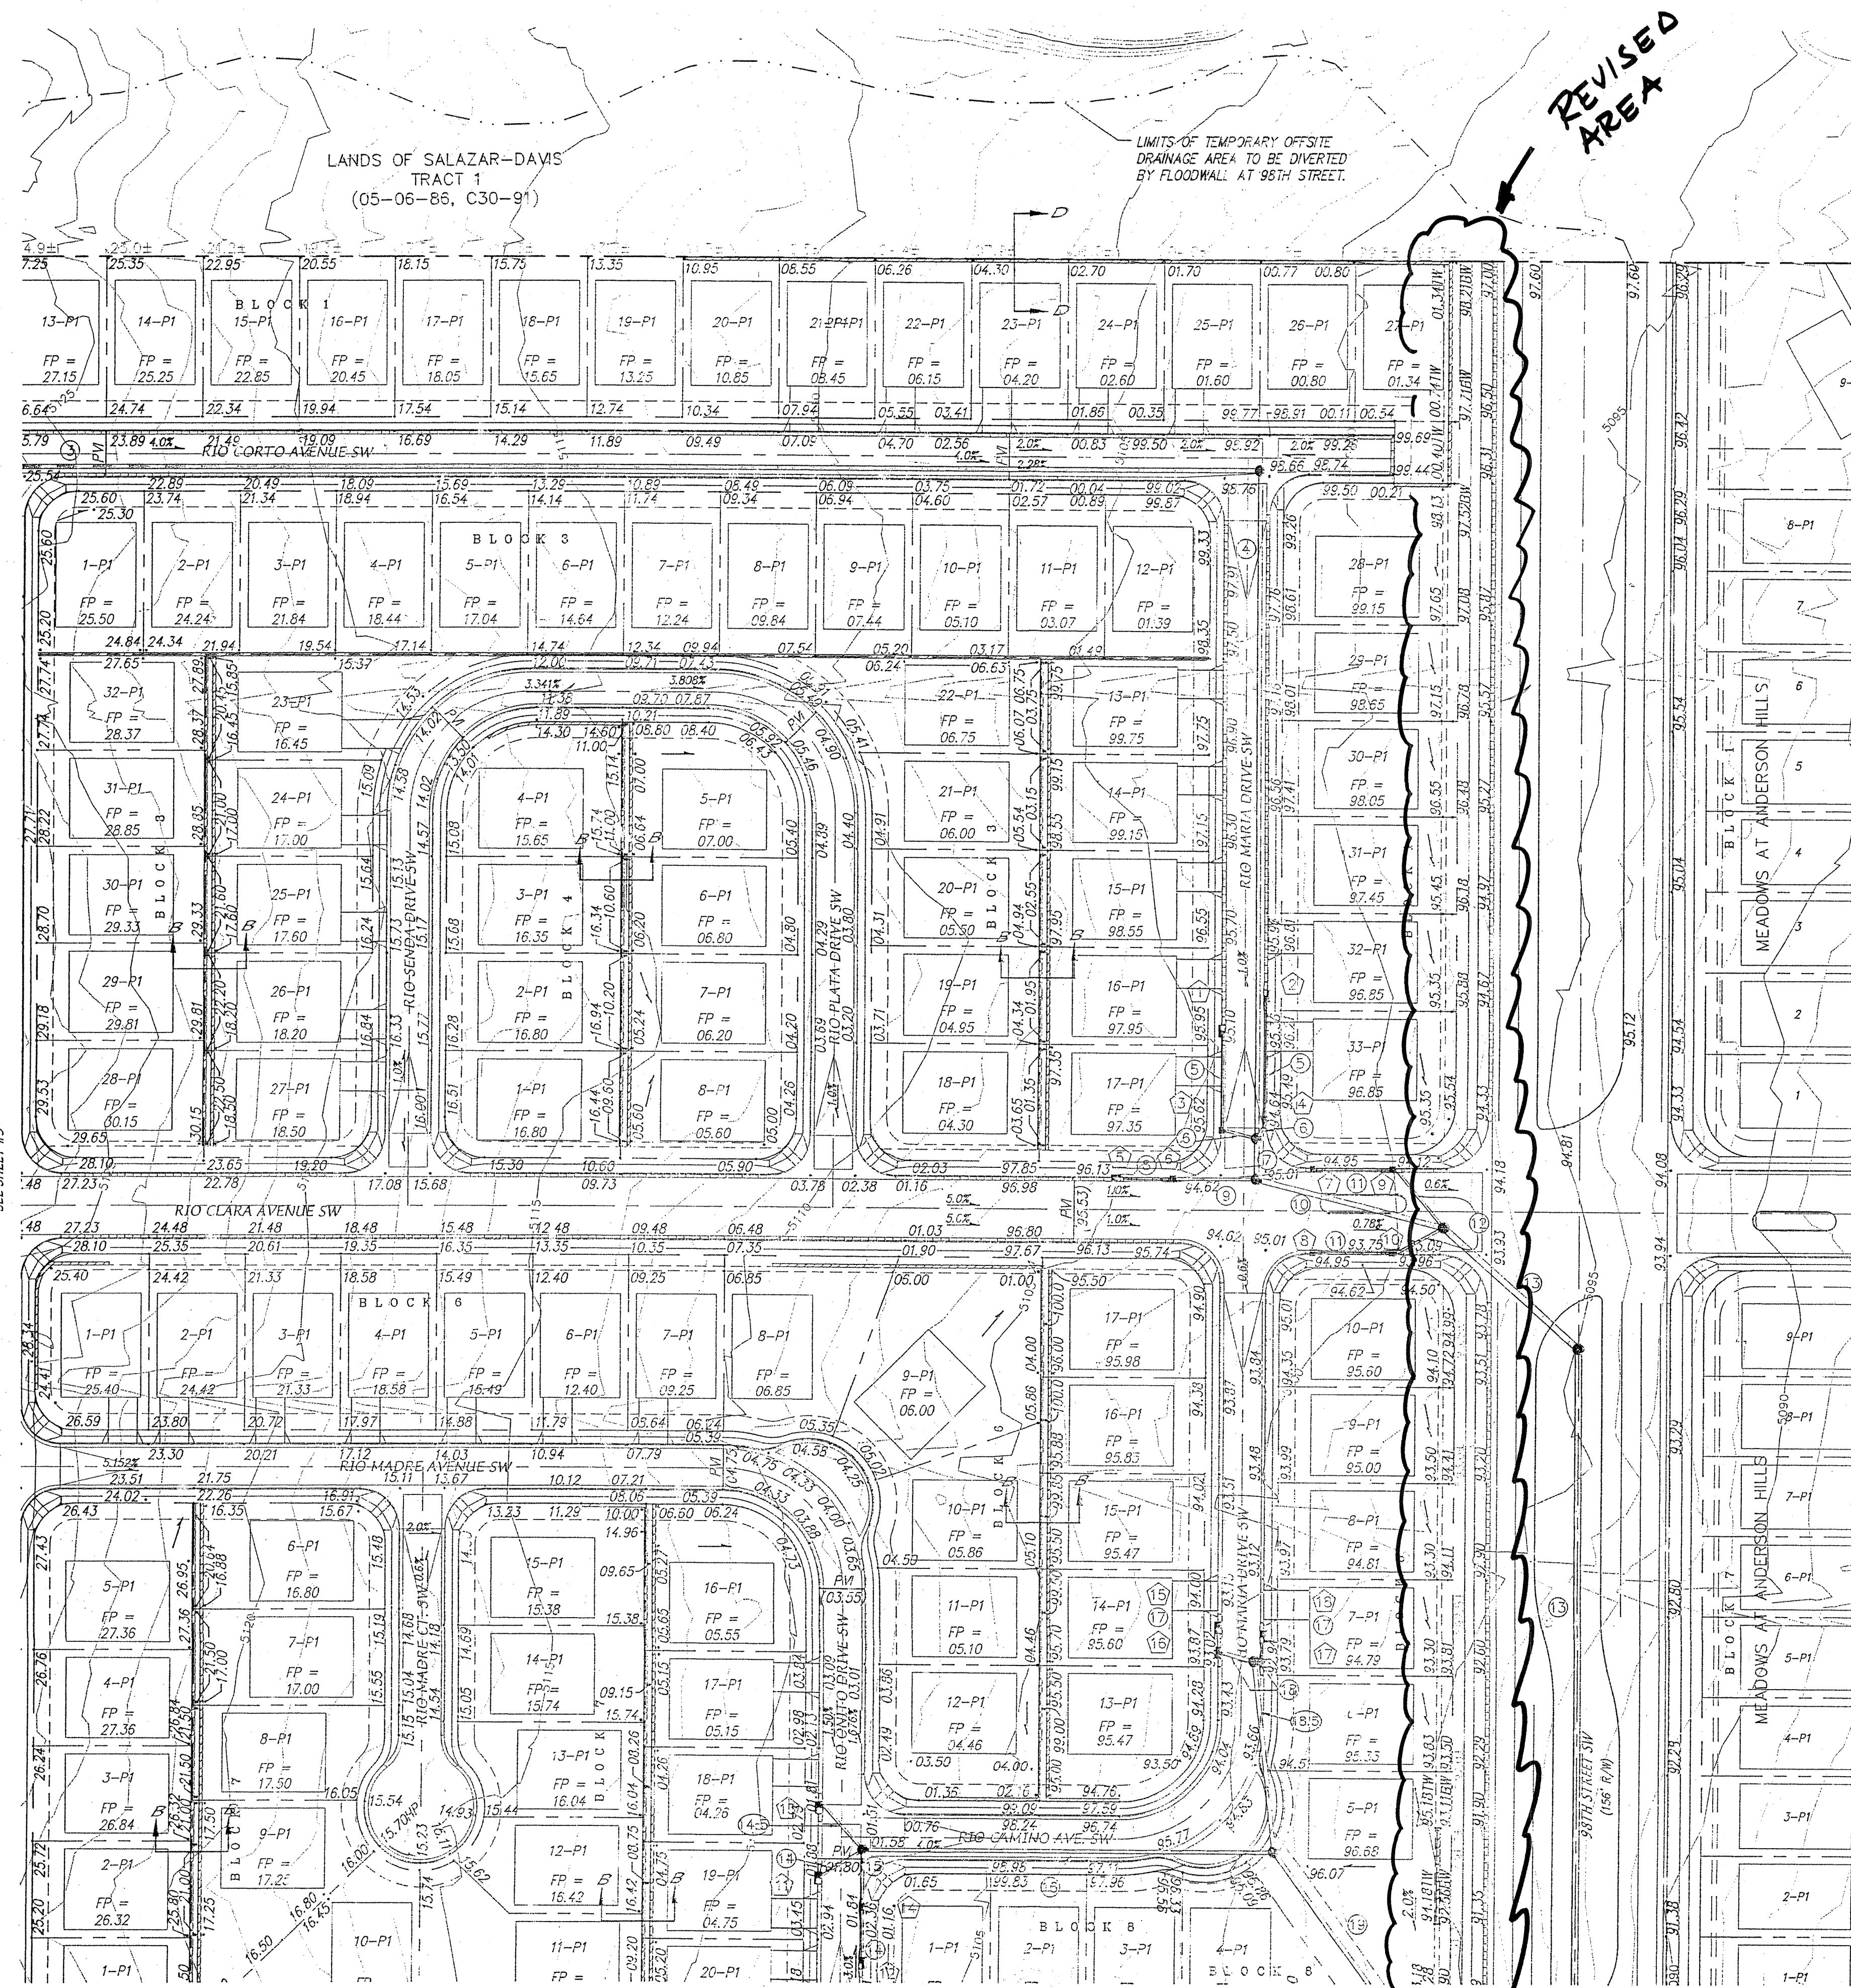

REVISED
AREA

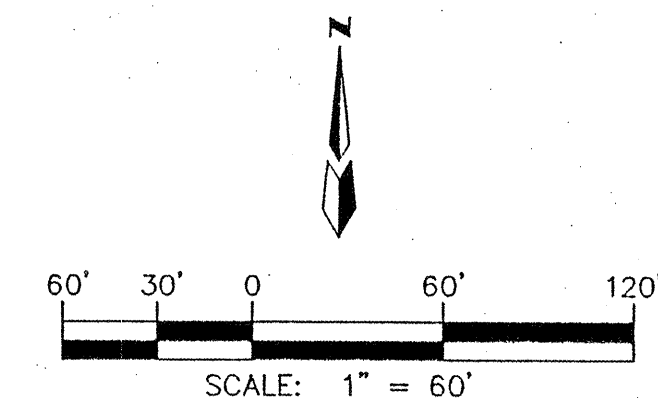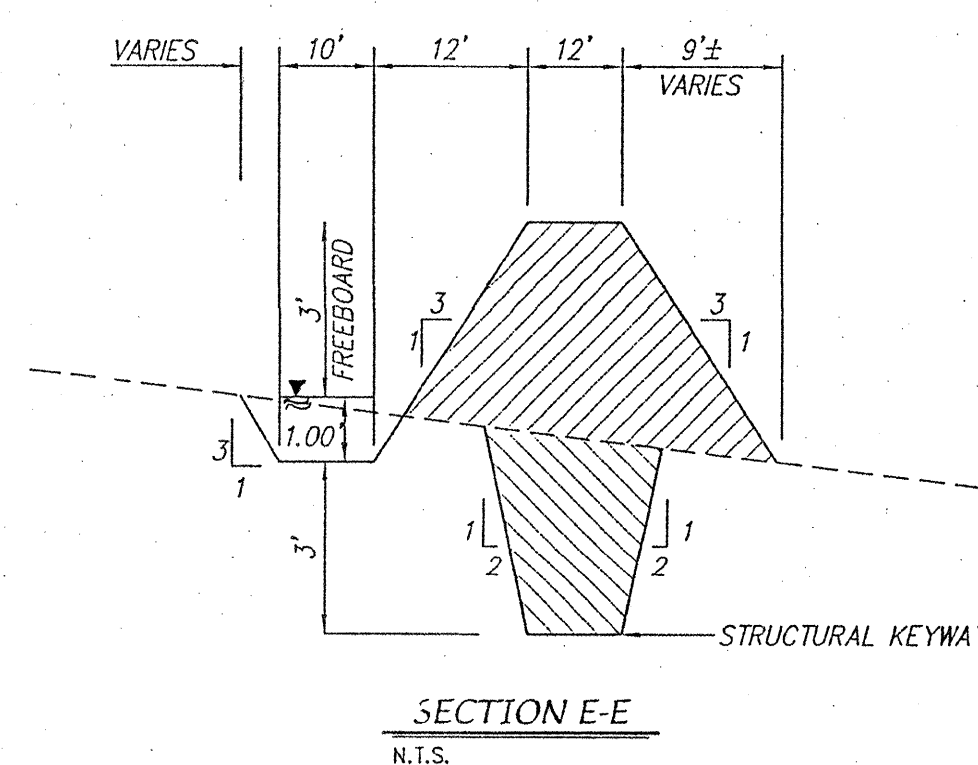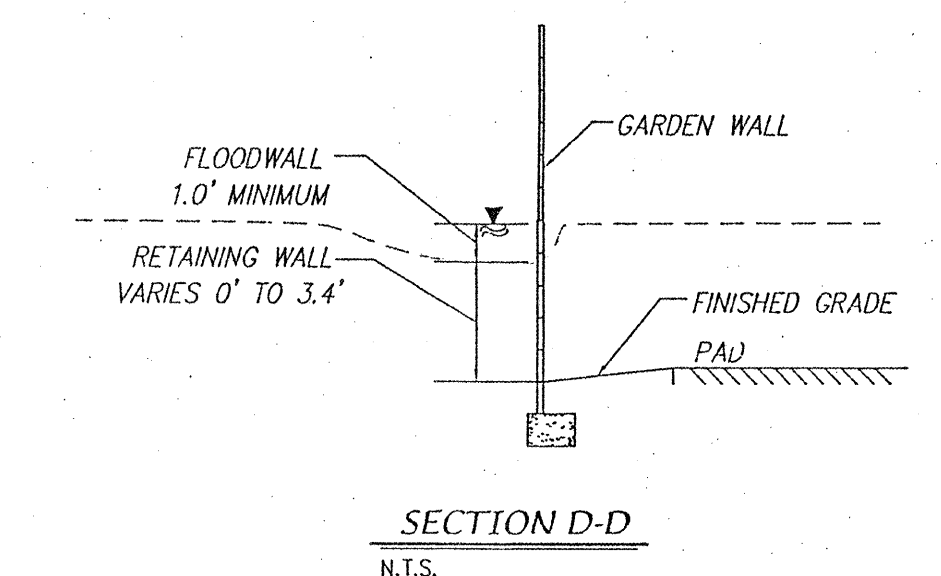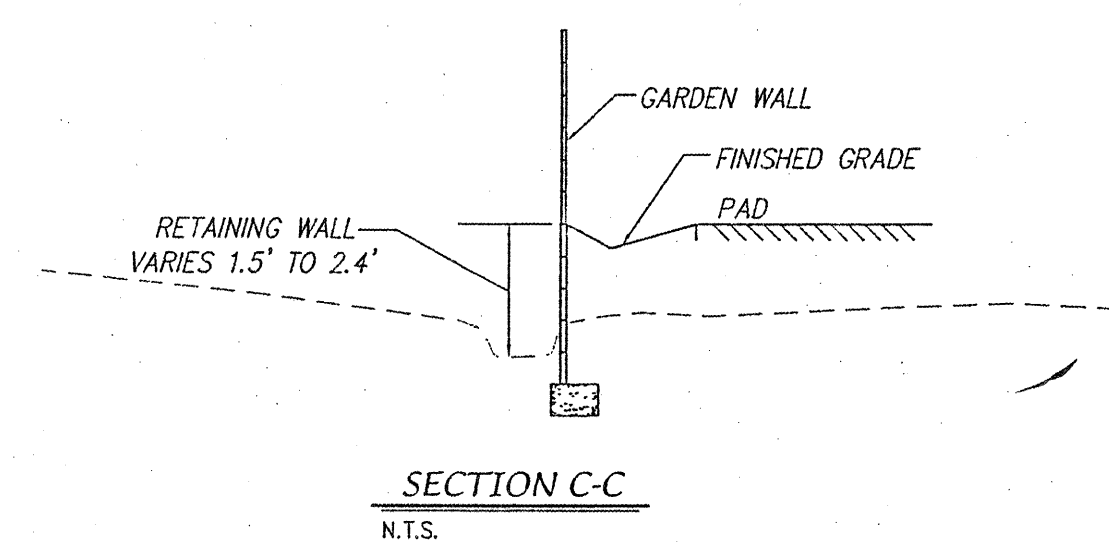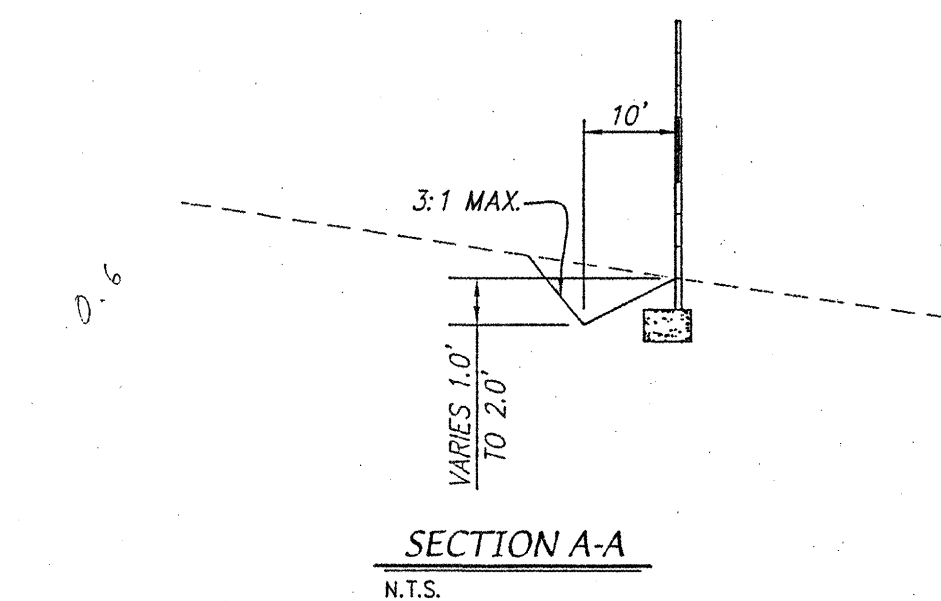

dmg MARK GOODWIN & ASSOCIATES, P.A.
CONSULTING ENGINEERS
P.O. BOX 90606
ALBUQUERQUE, NEW MEXICO 87199
(505) 828-2200, FAX (505) 797-9539

 CITY OF ALBUQUERQUE
PUBLIC WORKS DEPARTMENT

TITLE: *THE HIGHLANDS AT ANDERSON HILLS
GRADING & DRAINAGE PLAN*

DESIGN REVIEW COMMITTEE CITY ENGINEER APPROVAL
For Information Only
LAST DESIGN UPDATE

CITY PROJECT NO. 708183

ZONE MAP NO.	SHEET
88	6 of 20

ENGINEER'S SEAL		SURVEY INFORMATION		BENCH MARKS	AS BUILT INFORMATION	
		FIELD NOTES			CONTRACTOR	
		NO.	BY	DATE	WORK RECORDED BY	DATE
					Hydro System	
					AIS	
					AIS	8/06
					AIS	8/06
					MICRO-FILM	
					RECORDED BY	DATE
					NO.	

STATION "2-P10" IS LOCATED 4.9 MI. SW OF DOWNTOWN ALBUQUERQUE TO REACH STATION FROM INT. OF COORS AND DENNIS CHAVEZ BLVD. (FORMERLY RIO BRAVO), GO N ON COORS 0.1 MI. TO FLORA VISTA AND GO WEST ON FLORA VISTA 0.5 MI. TO CONDESHIRE, THEN GO S. ON CONDESHIRE 0.4 MI. TO A POINT APPROX. 50 FT. W. OF THE STATION. STATION MARK IS AN ACS 3 1/4" ALUM CAP STAMPED "2-P10, 1987" RIVETED TO A PIPE PROJECTING 0.25 FT ABOVE THE GROUND. X=359411.3, Y=146349.24 (NAD 27) Z=4991 (NGVD 29).

10-82-1


DESIGNED BY	DATE	I/O#
DH	DATE	1/03
DWG	DATE	1/03

A circular official stamp from the New Mexico Department of Transportation. The outer ring contains the text "NEW MEXICO" at the top and "DEPARTMENT OF TRANSPORTATION" at the bottom. The inner circle contains the year "1967". A handwritten signature is scrawled across the center of the stamp. Above the stamp, the file number "40-22-1-123-04" is handwritten.


				B
NO.	DATE	REMARKS		
<i>REVIEWS</i>				
<i>DESIGN</i>				
DESIGNED BY	<i>DLH</i>	DATE	<i>1/03</i>	
DRAWN BY	<i>NHE</i>	DATE	<i>1/03</i>	
CHECKED BY	<i>DNG</i>	DATE	<i>1/03</i>	

FUTURE UNIT 3




- ROSNER TRACTS
TRACT B
(04-30-99, 99C-104)

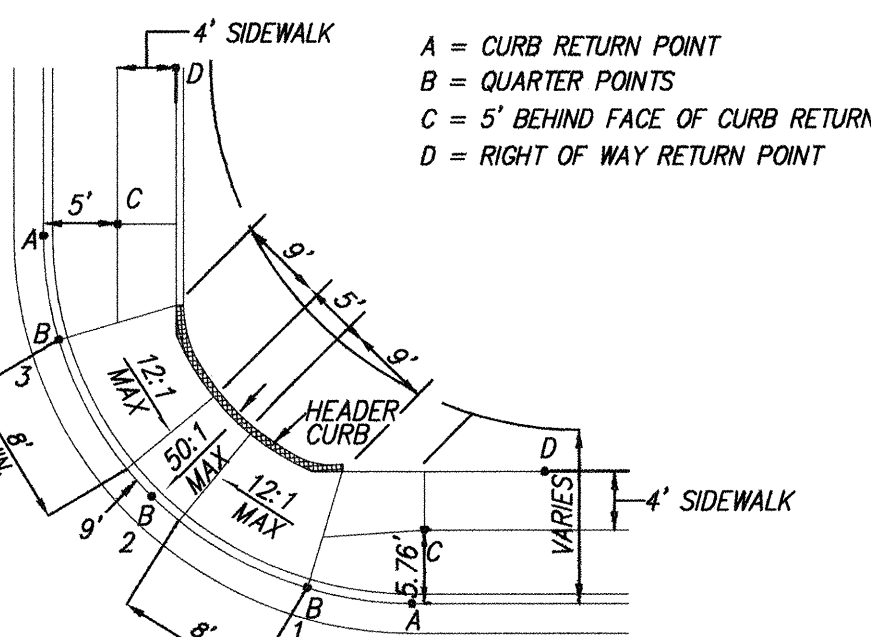

ARTERIAL WHEEL CHAIR RAMP DETAIL

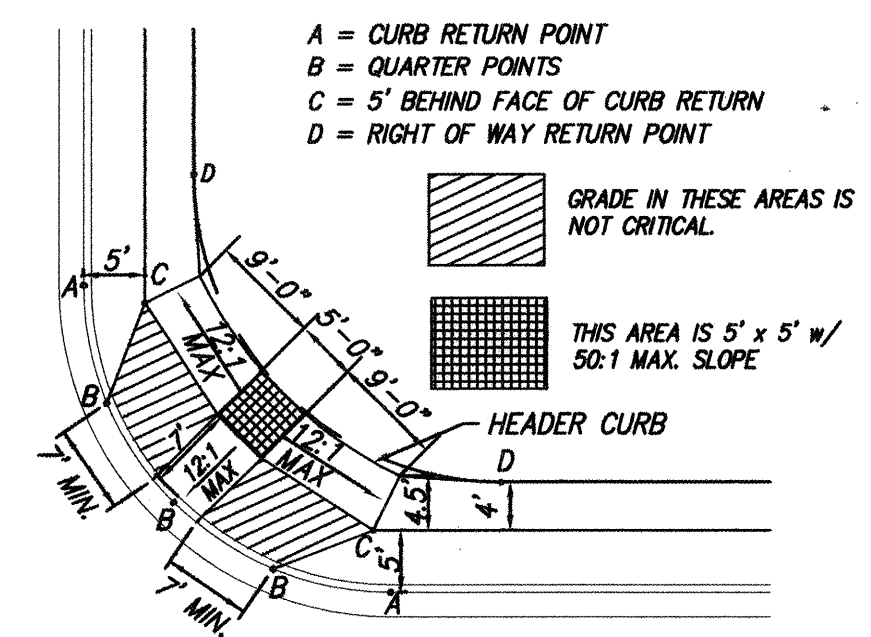


GENERAL WHEEL CHAIR RAMP DETAIL
NOT TO SCALE (NOTE: PER COA STD. DETAIL 2441)

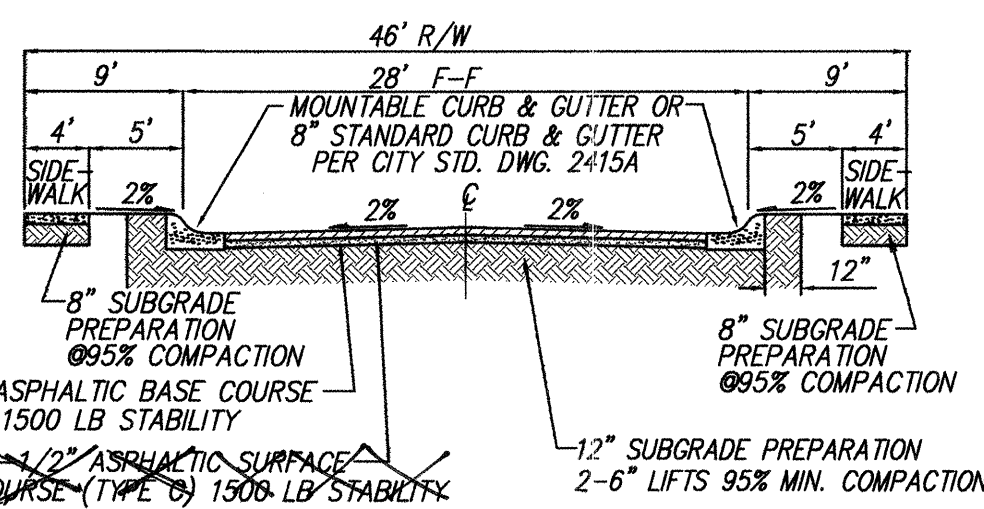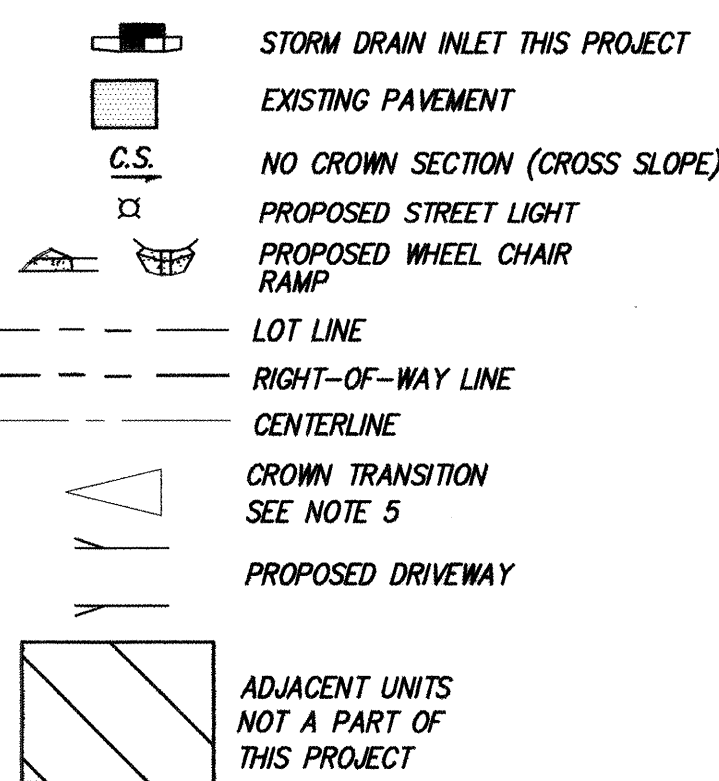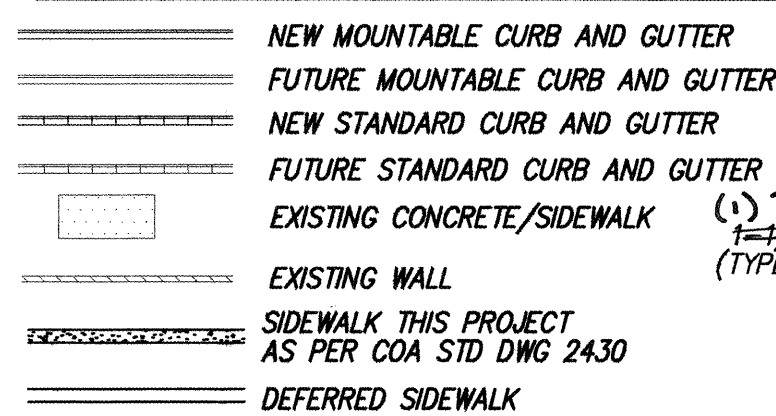


28' RESIDENTIAL STREET SECTION (WITH CROWN)

NOTE: RESIDENTIAL STREET SECTION PER
COA STD DWG 2405A.

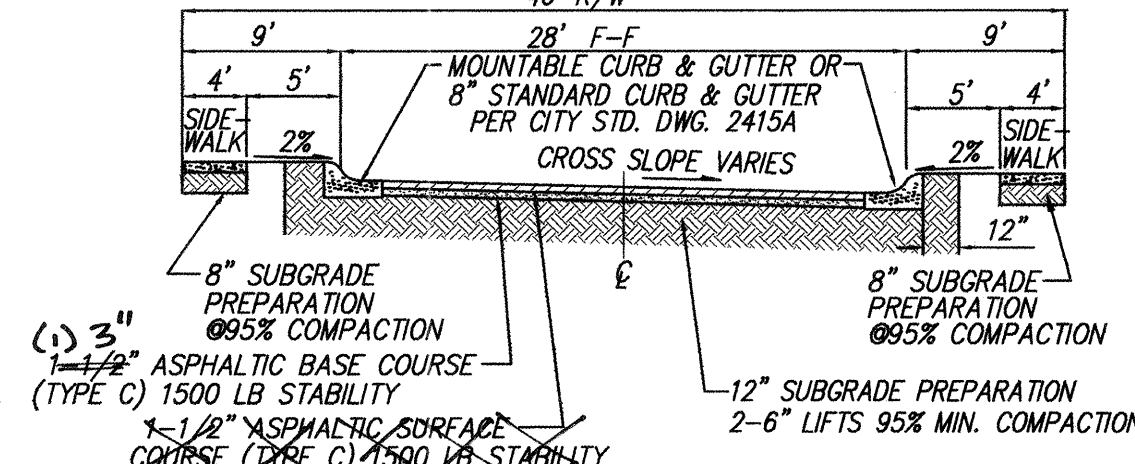

28' RESIDENTIAL STREET SECTION (NO CROWN)



NOTE: RESIDENTIAL STREET SECTION PER
COA STD DWG 2405A.

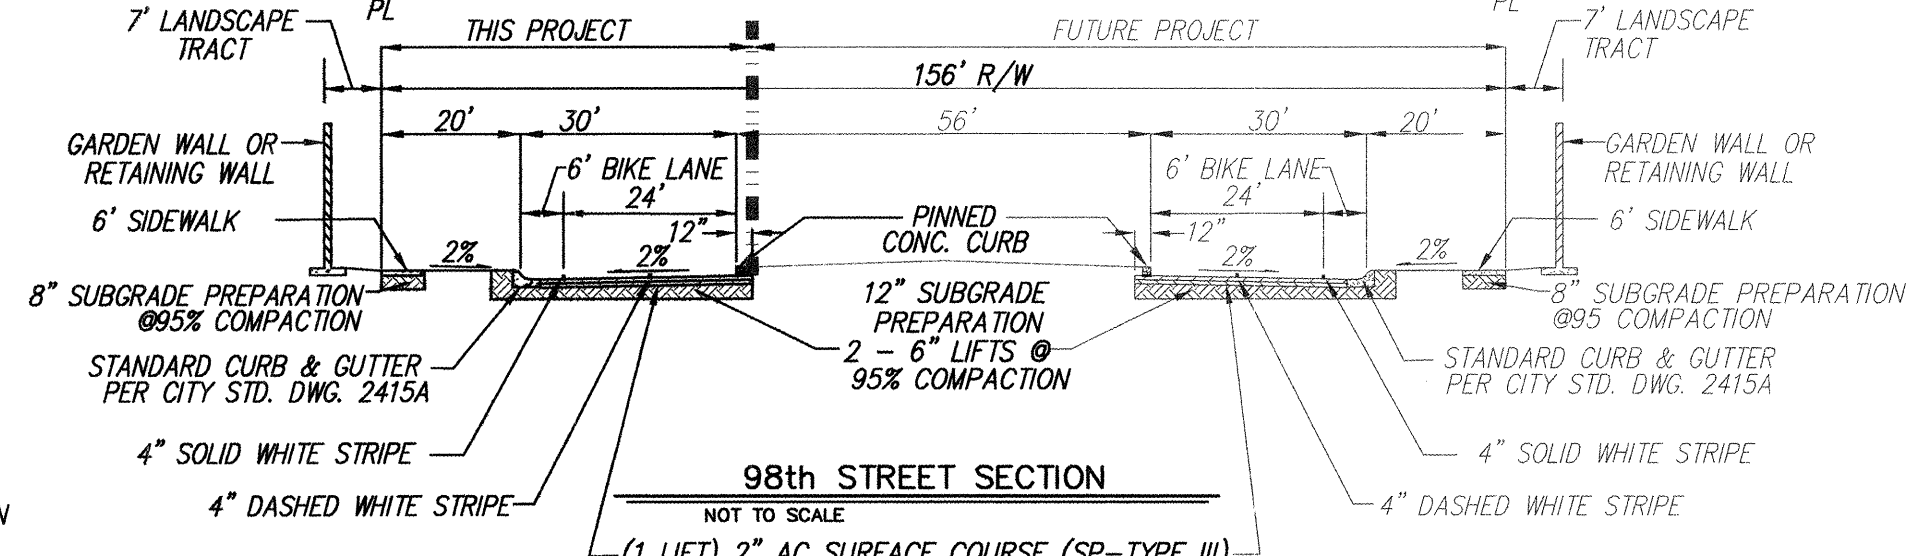

98th STREET SECTION

—(1 LIFT) 2" AC SURFACE COURSE (SP-TYPE III)
(2 LIFTS) 3" AC BASE COURSE (SP-TYPE II)
ALL LIFTS USE 1800 LB STABILITY


I, Diane L. Hoelzer, NMPE 11967, of the firm Mark Goodwin & Associates, PA, a Registered Professional Engineer in the State of New Mexico, do hereby certify, to the best of my knowledge and belief, that the infrastructure installed as part of this project has been inspected by me or by a qualified person under my direct supervision, and has been constructed in accordance with the plans and specifications approved by the City Engineer and that the original design intent of the approved plans has been met, except as noted by me on the as-built construction drawings. This Certification is based on site inspections by me or personnel under my direction, and survey information provided by ALS, Inc., NMPS number 7719.

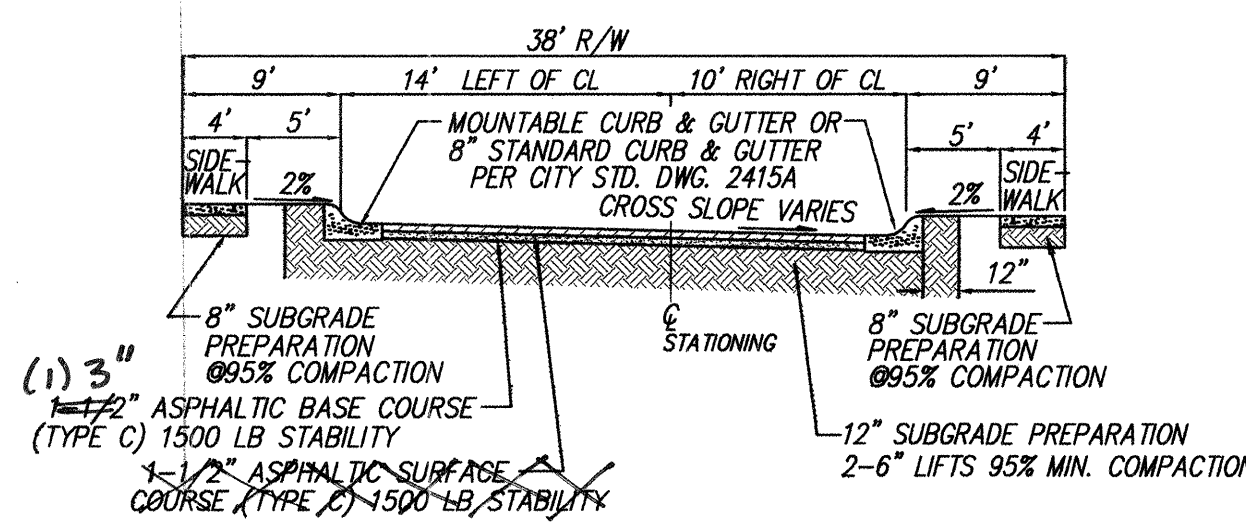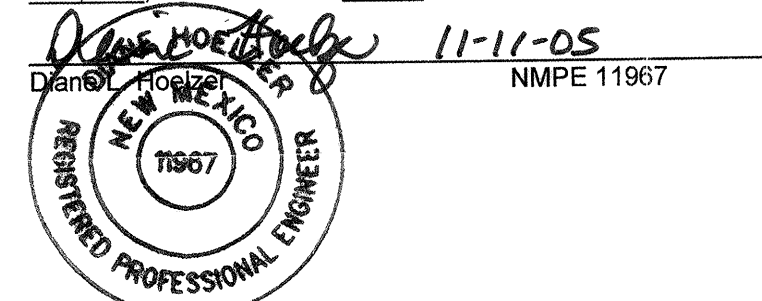

24' RESIDENTIAL STUB STREET SECTION

NOTE: RESIDENTIAL STREET SECTION PER
PER COA STD DWG 2405A.

9 STREET LIGHTS TOTAL -DLH
11-11-05
- 1 moved by PNM
- 1 deleted by PNM

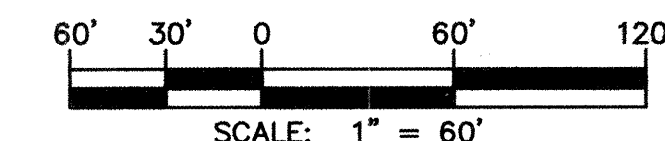

P.O. BOX 90806
ALBUQUERQUE, NEW MEXICO 87199
(505) 828-2200, FAX (505) 797-9539



TITLE: **HIGHLANDS AT ANDERSON HILLS UNIT 3
MASTER PAVING PLAN**

DESIGN REVIEW COMMITTEE

APPROVED

SEP 6 1964

DESIGN
REVIEW COMMITTEE

CITY ENGINEER APPROVAL

APPROVED

FEB 28 2005

CITY ENGINEER

CITY PROJECT NO.

ZONE MAP NO.

OF


708183


P-9

72

A2106ANH/dwg/HIGHLANDS/plans-U3/2106-mpav3-W 08-23-04 RDQ NHE TAS

Path: \\AU2J0B3\AZ106\ANH\dwg\HIGHLANDS\PLANS-03\AZ106-mpdvs-w.dwg, sheet 1-20, 6/24/2004 8:24:07 AM.

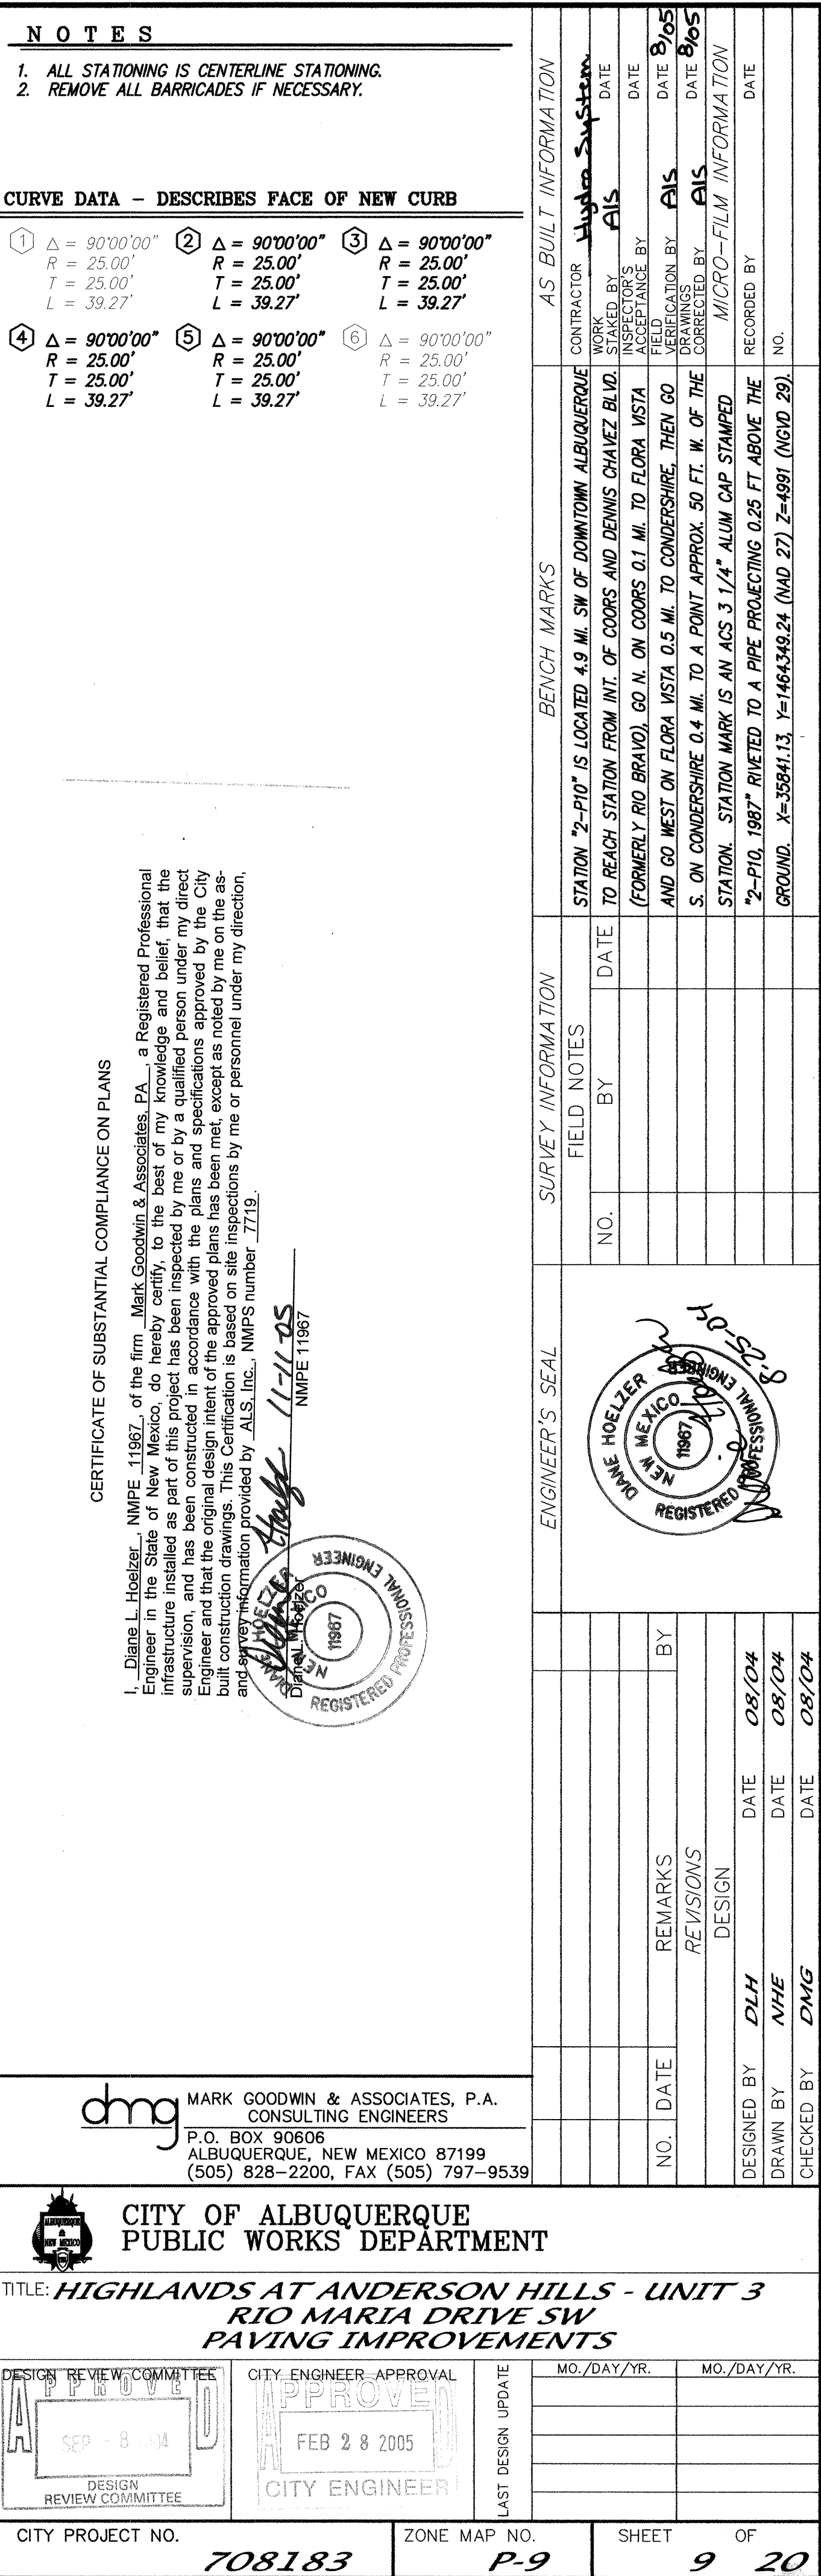

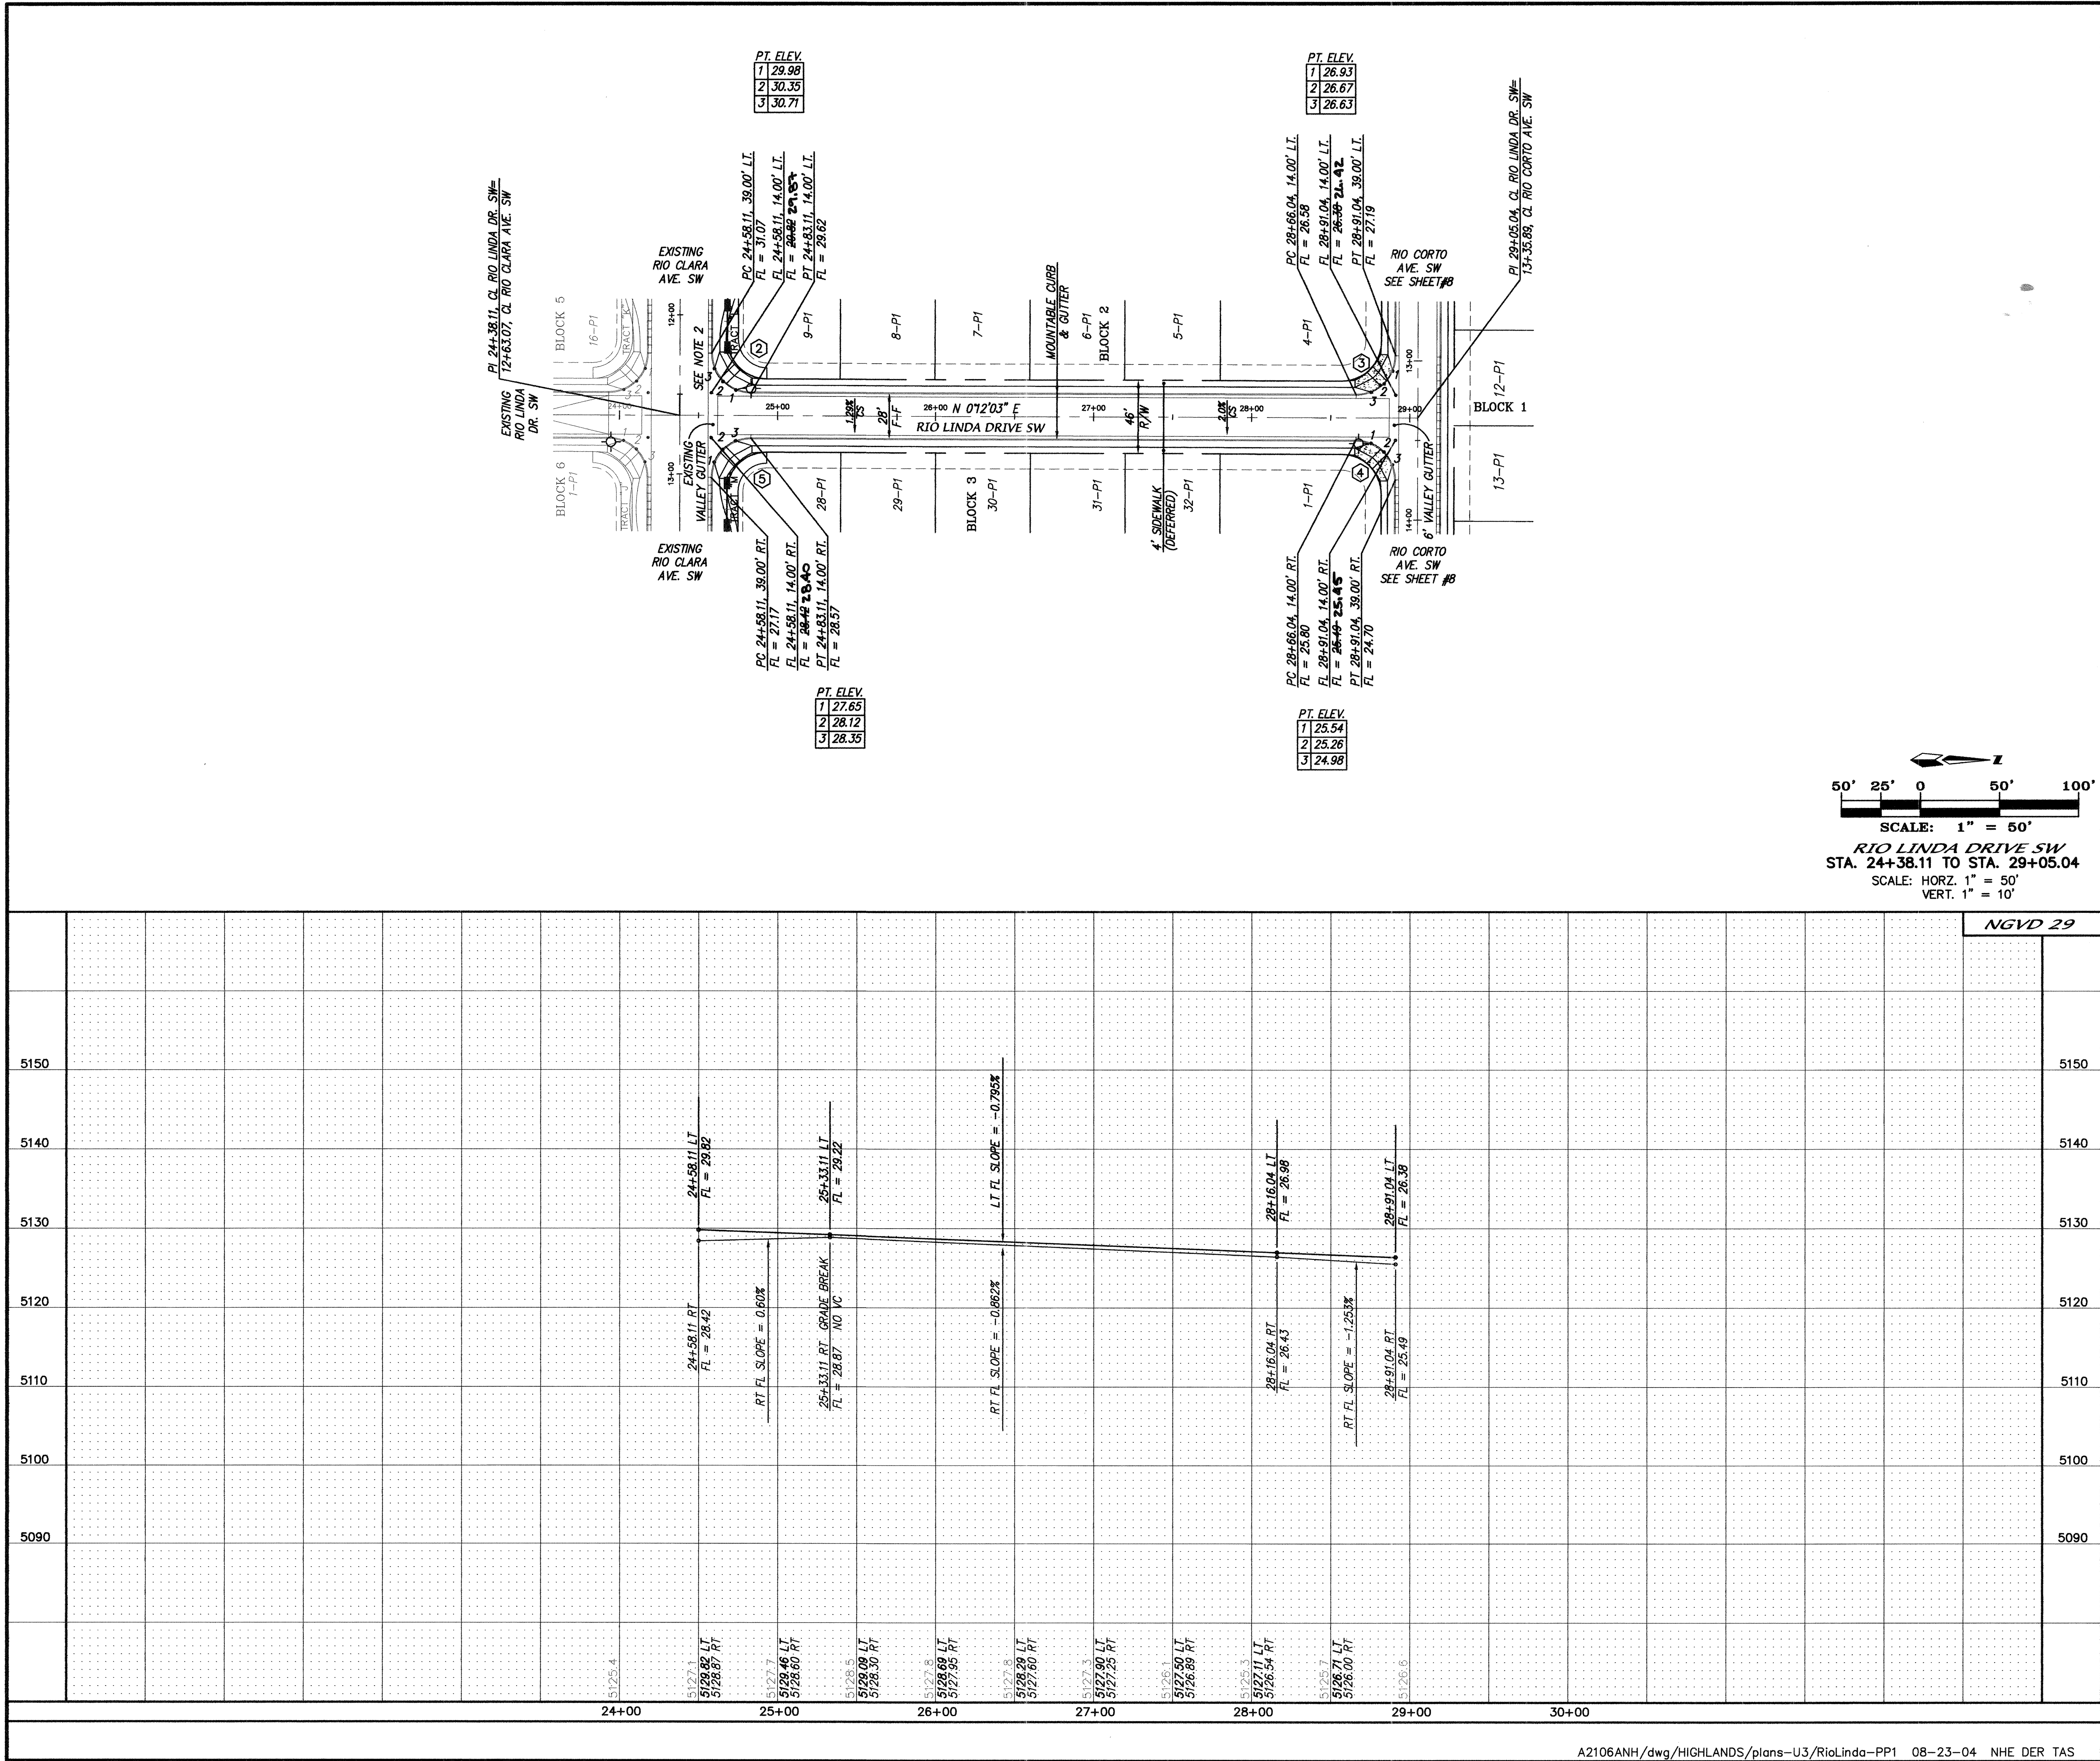

NOTES

1. ALL STATIONING IS CENTERLINE STATIONING.
2. REMOVE ALL BARRICADES IF NECESSARY.

CURVE DATA - DESCRIBES FACE OF NEW CURB

- | | | | |
|--|--|--|--|
| ② $\Delta = 90^{\circ}00'00''$
$R = 25.00'$
$T = 25.00'$
$L = 39.27'$ | ③ $\Delta = 90^{\circ}00'00''$
$R = 25.00'$
$T = 25.00'$
$L = 39.27'$ | ④ $\Delta = 90^{\circ}00'00''$
$R = 25.00'$
$T = 25.00'$
$L = 39.27'$ | ⑤ $\Delta = 90^{\circ}00'00''$
$R = 25.00'$
$T = 25.00'$
$L = 39.27'$ |
|--|--|--|--|

CERTIFICATE OF SUBSTANTIAL COMPLIANCE ON PLANS

I, Diana L. Hoelzer, NMPE 11987, of the firm Mark Goodwin & Associates, P.A., a Registered Professional Engineer in the State of New Mexico, hereby certify to the best of my knowledge and belief, that the infrastructure installed as part of this project has been constructed in accordance with the plans and specifications of the City of Albuquerque, and that the original design intent of the approved plans has been met, except as noted by me on the City built construction drawings. This Certification is based on site inspections by me or personnel under my direction, and any other information provided by ALS, Inc., NMPS number 7719.


Diana L. Hoelzer 11-11-05
NMPE 11987

dmg MARK GOODWIN & ASSOCIATES, P.A.
CONSULTING ENGINEERS
P.O. BOX 90606
ALBUQUERQUE, NEW MEXICO 87199
(505) 828-2200, FAX (505) 797-9539



**CITY OF ALBUQUERQUE
PUBLIC WORKS DEPARTMENT**

**TITLE: HIGHLANDS AT ANDERSON HILLS UNIT 3
RIO LINDA DRIVE SW
PAVING IMPROVEMENTS**

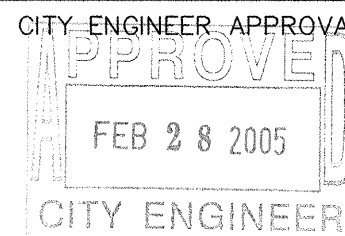

LAST DESIGN UPDATE	MO./DAY/YR.	MO./DAY/YR.

CITY PROJECT NO.

ZONE MAP NO.


SHEET

OF


708183

P-9

11 20

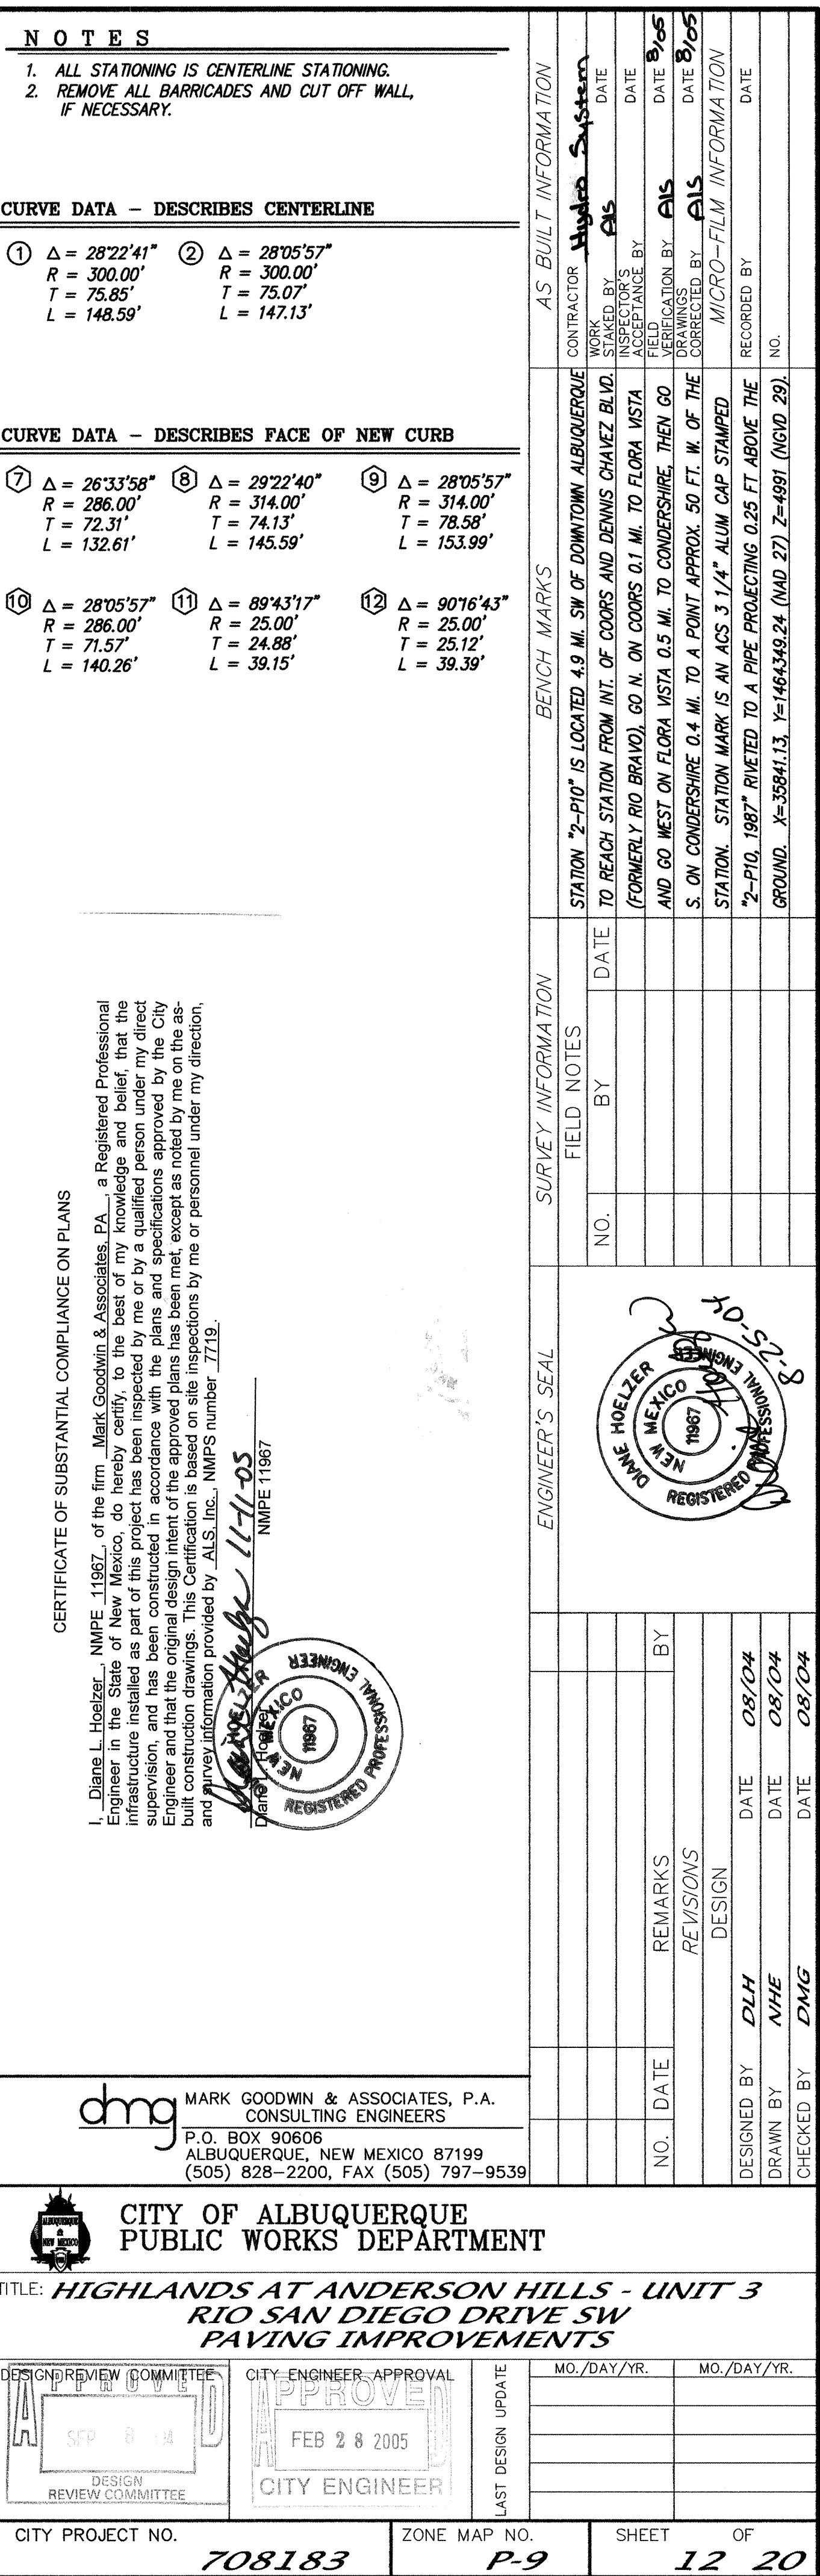

NOTES									
1. ALL STATIONING IS CENTERLINE STATIONING. 2. REMOVE ALL BARRICADES AND CUT OFF WALL, IF NECESSARY.									
CURVE DATA - DESCRIBES CENTERLINE									
① $\Delta = 28'22.41"$ $R = 300.00'$ $T = 75.85'$ $L = 148.59'$		② $\Delta = 28'05.57"$ $R = 300.00'$ $T = 75.07'$ $L = 147.13'$							
CURVE DATA - DESCRIBES FACE OF NEW CURB									
⑦ $\Delta = 26'33.58"$ $R = 286.00'$ $T = 72.31'$ $L = 132.61'$		⑧ $\Delta = 29'22.40"$ $R = 314.00'$ $T = 74.13'$ $L = 145.59'$		⑨ $\Delta = 28'05.57"$ $R = 314.00'$ $T = 78.58'$ $L = 153.99'$					
⑩ $\Delta = 28'05.57"$ $R = 286.00'$ $T = 71.57'$ $L = 140.26'$		⑪ $\Delta = 89'43.17"$ $R = 25.00'$ $T = 24.88'$ $L = 39.15'$		⑫ $\Delta = 90'16.43"$ $R = 25.00'$ $T = 25.12'$ $L = 39.39'$					
CERTIFICATE OF SUBSTANTIAL COMPLIANCE ON PLANS I, <u>Diane L. Hoelzer</u>, of the firm <u>Mark Goodwin & Associates, P.A.</u>, a Registered Professional Engineer, do hereby certify, to the best of my knowledge and belief, that the infrastructure installed as part of this project was designed and constructed under my direct supervision, and that the original design intent of the approved plans has been met, except as noted by me on the as-built construction drawings. This Certification is based on site inspections by me or personnel under my direction, and survey information provided by <u>AIS, Inc.</u>, NMPIS number <u>7719</u>. Date: <u>11-11-05</u> NMPIS 11987 									
ENGINEER'S SEAL STATION "2-P10" IS LOCATED 4.9 MI. SW OF DOWNTOWN ALBUQUERQUE TO REACH STATION FROM INT. OF COOPS AND DENNIS CHAVEZ BLVD. (FORMERLY RIO BRAVO), GO N. ON COOPS 0.1 MI. TO FLORA VISTA (FORMERLY RIO BRAVO), GO N. ON COOPS 0.1 MI. TO FLORA VISTA AND GO WEST ON FLORA VISTA 0.5 MI. TO CONDERSHIRE, THEN GO S. ON CONDERSHIRE 0.4 MI. TO A POINT APPROX. 50 FT. W. OF THE STATION. STATION MARK IS AN ACS 3 1/4" ALUM C. STAMPED "2-P10, 1987" RIVETED TO A PIPE PROTECTING 0.25 FT. ABOVE THE GROUND. X=39941.13, Y=1464349.24 (NAD 83) Z=4991 (NGVD 29).									
SURVEY INFORMATION									
NO.		BY		DATE		CONTRACTOR <u>Hydrex System</u>			
						INSPECTOR'S DATE <u>AS</u>			
						FIELD PERFORMANCE BY <u>AS</u>			
						VERIFICATION BY <u>AS</u>			
						CORRECTED BY <u>AS</u>			
						MICRO-FILM INFORMATION			
						RECORDED BY			
						NO.			
BENCH MARKS									
STATION "2-P10" IS LOCATED 4.9 MI. SW OF DOWNTOWN ALBUQUERQUE TO REACH STATION FROM INT. OF COOPS AND DENNIS CHAVEZ BLVD. (FORMERLY RIO BRAVO), GO N. ON COOPS 0.1 MI. TO FLORA VISTA (FORMERLY RIO BRAVO), GO N. ON COOPS 0.1 MI. TO FLORA VISTA AND GO WEST ON FLORA VISTA 0.5 MI. TO CONDERSHIRE, THEN GO S. ON CONDERSHIRE 0.4 MI. TO A POINT APPROX. 50 FT. W. OF THE STATION. STATION MARK IS AN ACS 3 1/4" ALUM C. STAMPED "2-P10, 1987" RIVETED TO A PIPE PROTECTING 0.25 FT. ABOVE THE GROUND. X=39941.13, Y=1464349.24 (NAD 83) Z=4991 (NGVD 29).									
REMARKS									
NO. DATE REMARKS BY DESIGNED BY <u>DLH</u> DATE <u>08/04</u> DRAWN BY <u>NHE</u> DATE <u>08/04</u> CHECKED BY <u>DMG</u> DATE <u>08/04</u>									
DESIGN REVIEW COMMITTEE									
CITY ENGINEER APPROVAL FEB 28 2005 CITY ENGINEER									
CITY PROJECT NO.									
708183									
ZONE MAP NO.									
P-9									
SHEET									
12 OF 20									

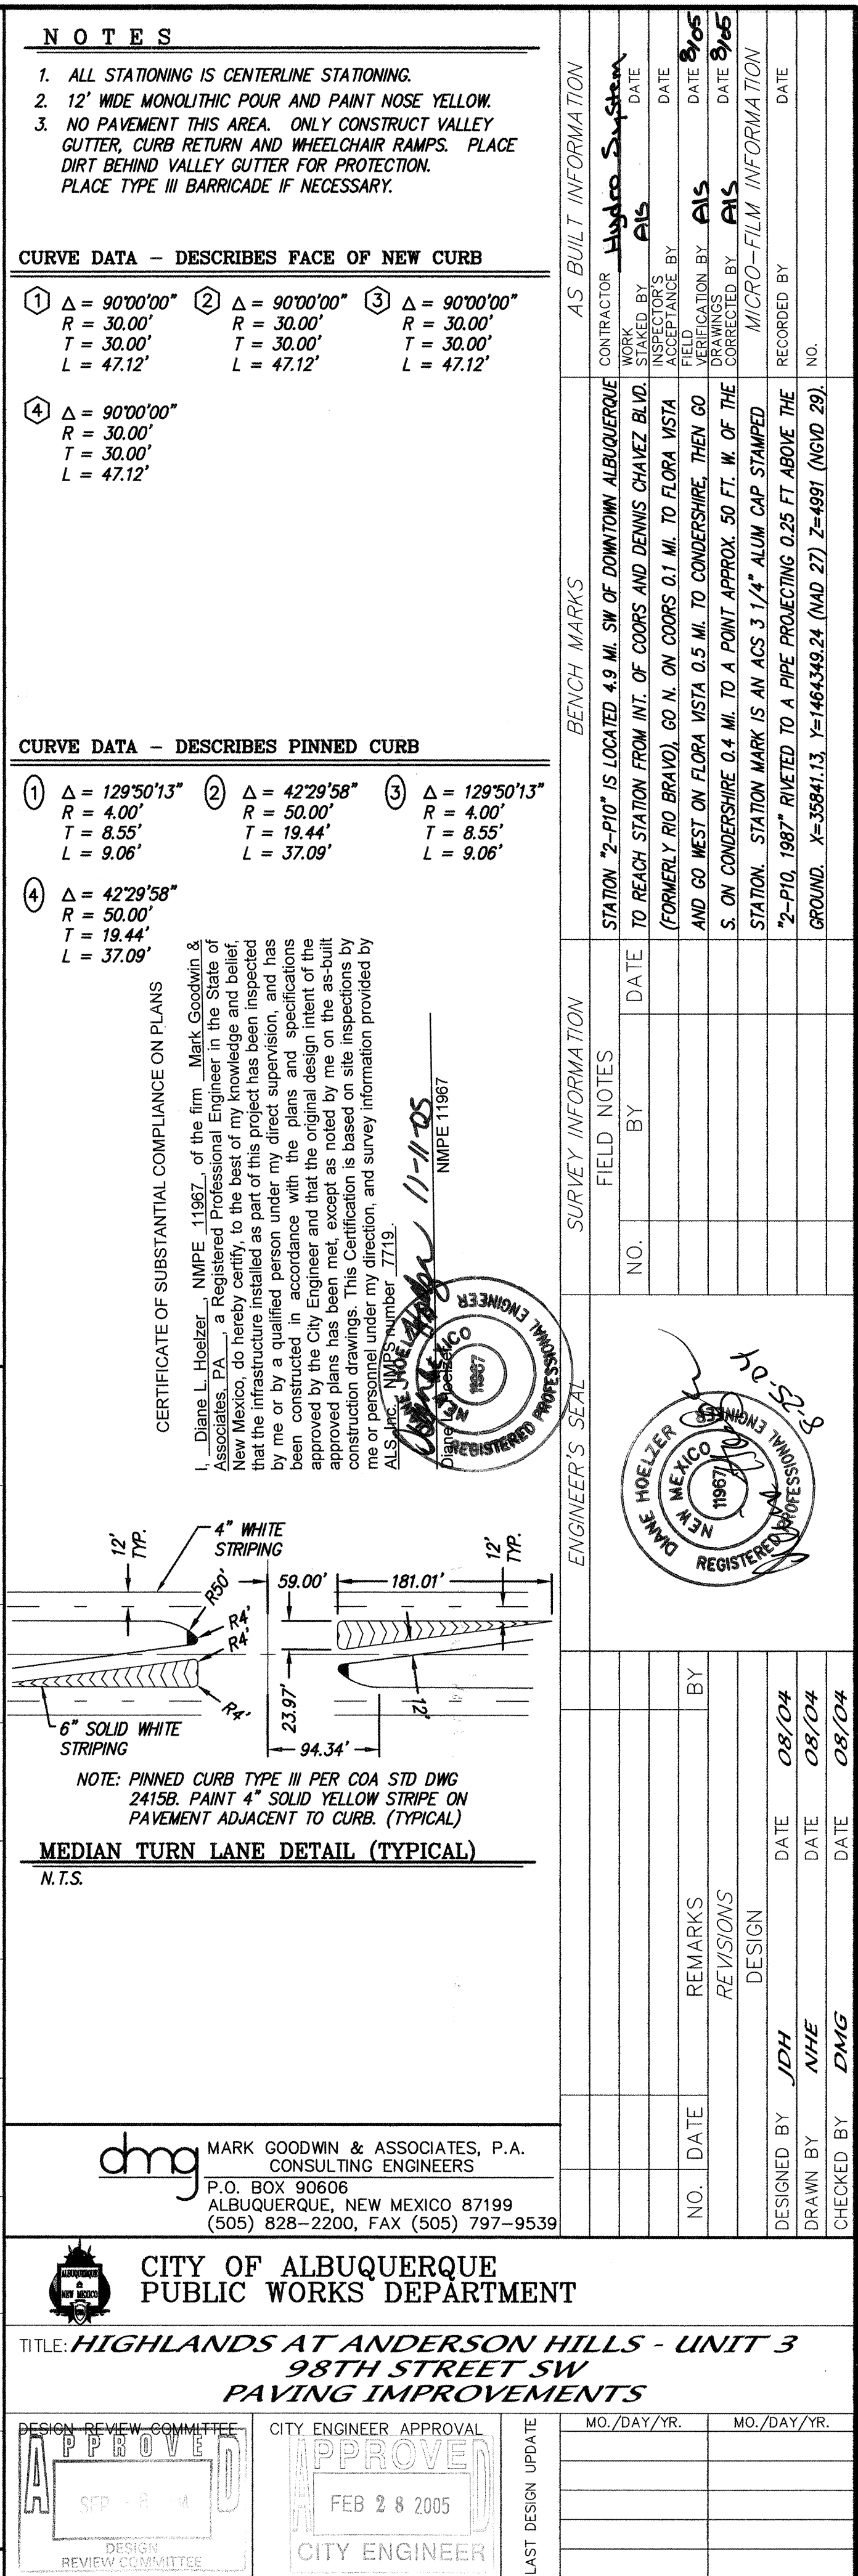

NAME Uaine Hodge 11-11-05
NMPE 11967

LANDS OF WESTLAND
DEVELOPMENT COMPANY INC.
"SOUTH TRACT"
(UNPLATTED)

MATCHLINE - SEE CONTINUATION THIS SHEET


EXISTING WL BUILT WITH
HIGHLANDS UNIT 1
PROJECT NO 708181

HIGHLANDS UNIT 2 (CPN 708182)

3-P1	4-P1	5-P1	6-P1	7-P1	8-P1
(9923)	(9919)	(9915)	(9909)	(9905)	(9901)

UNDER CONSTRUCTION

MEADOWS UNIT 5 (FUTURE)

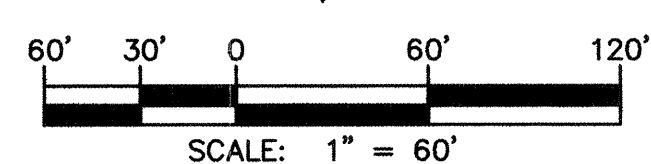

TITLE: **HIGHLANDS AT ANDERSON HILLS UNIT 3
MASTER UTILITY PLAN**

DESIGN REVIEW COMMITTEE
APPROVED

CITY ENGINEER APPROVAL

SEP 8 1966

FEB 28 2005

CITY PROJECT NO.

ZONE MAP NO.

EET OF

708183

P-9


14 2


			ENGINEER'S SEAL		SURVEY INFORMATION		BENCH MARKS		AS BUILT INFORMATION	
					FIELD NOTES		STATION "2-P10" IS LOCATED 4.9 MI. SW OF DOWNTOWN ALBUQUERQUE TO REACH STATION FROM INT. OF COORS AND DENNIS CHAVEZ BLVD. (FORMERLY RIO BRAVO), GO N. ON COORS 0.1 MI. TO FLORA VISTA AND GO WEST ON FLORA VISTA 0.5 MI. TO CONDERSHIRE, THEN GO S. ON CONDERSHIRE 0.4 MI. TO A POINT APPROX. 50 FT. W. OF THE STATION. STATION MARK IS AN ACS 3 1/4" ALUM CAP STAMPED "2-P10, 1987" RIVETED TO A PIPE PROJECTING 0.25 FT ABOVE THE GROUND. X=358411.13, Y=146349.24 (NAD 27) =4991 (NGVD 29).	CONTRACTOR Hydro Systems	WORK STARTED BY ACCEPTANCE BY DATE	DATE
NO.	BY	DATE								
		REMARKS								
		BY								
DESIGNED BY			DLH		DATE	08/04				
DRAWN BY			NHE		DATE	08/04				
CHECKED BY			DMG		DATE	08/04				
DESIGN										
VERIFICATION BY			AJS		DATE	8/9/04				
CORRECTED BY			AJS		DATE	8/9/04				
MICRO-FILM INFORMATION					RECORDED BY					
					NO.					

8-25-25-HA



DANE HOELZER
NEW MEXICO
1987
REGISTERED PROFESSIONAL ENGINEER

[illegible]

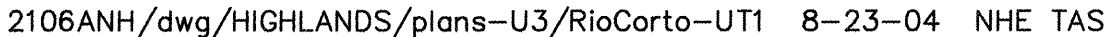

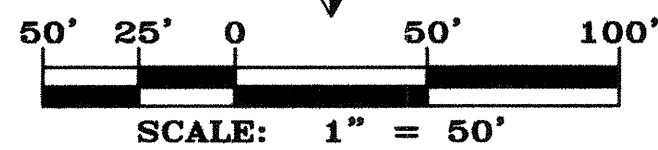

OFFSITE UTILITIES / RIO CORTO AVE. SW
STA. 21+74.23 TO STA. 27+28.98
SCALE: HORIZ. 1" = 50'
VERT. 1" = 10'

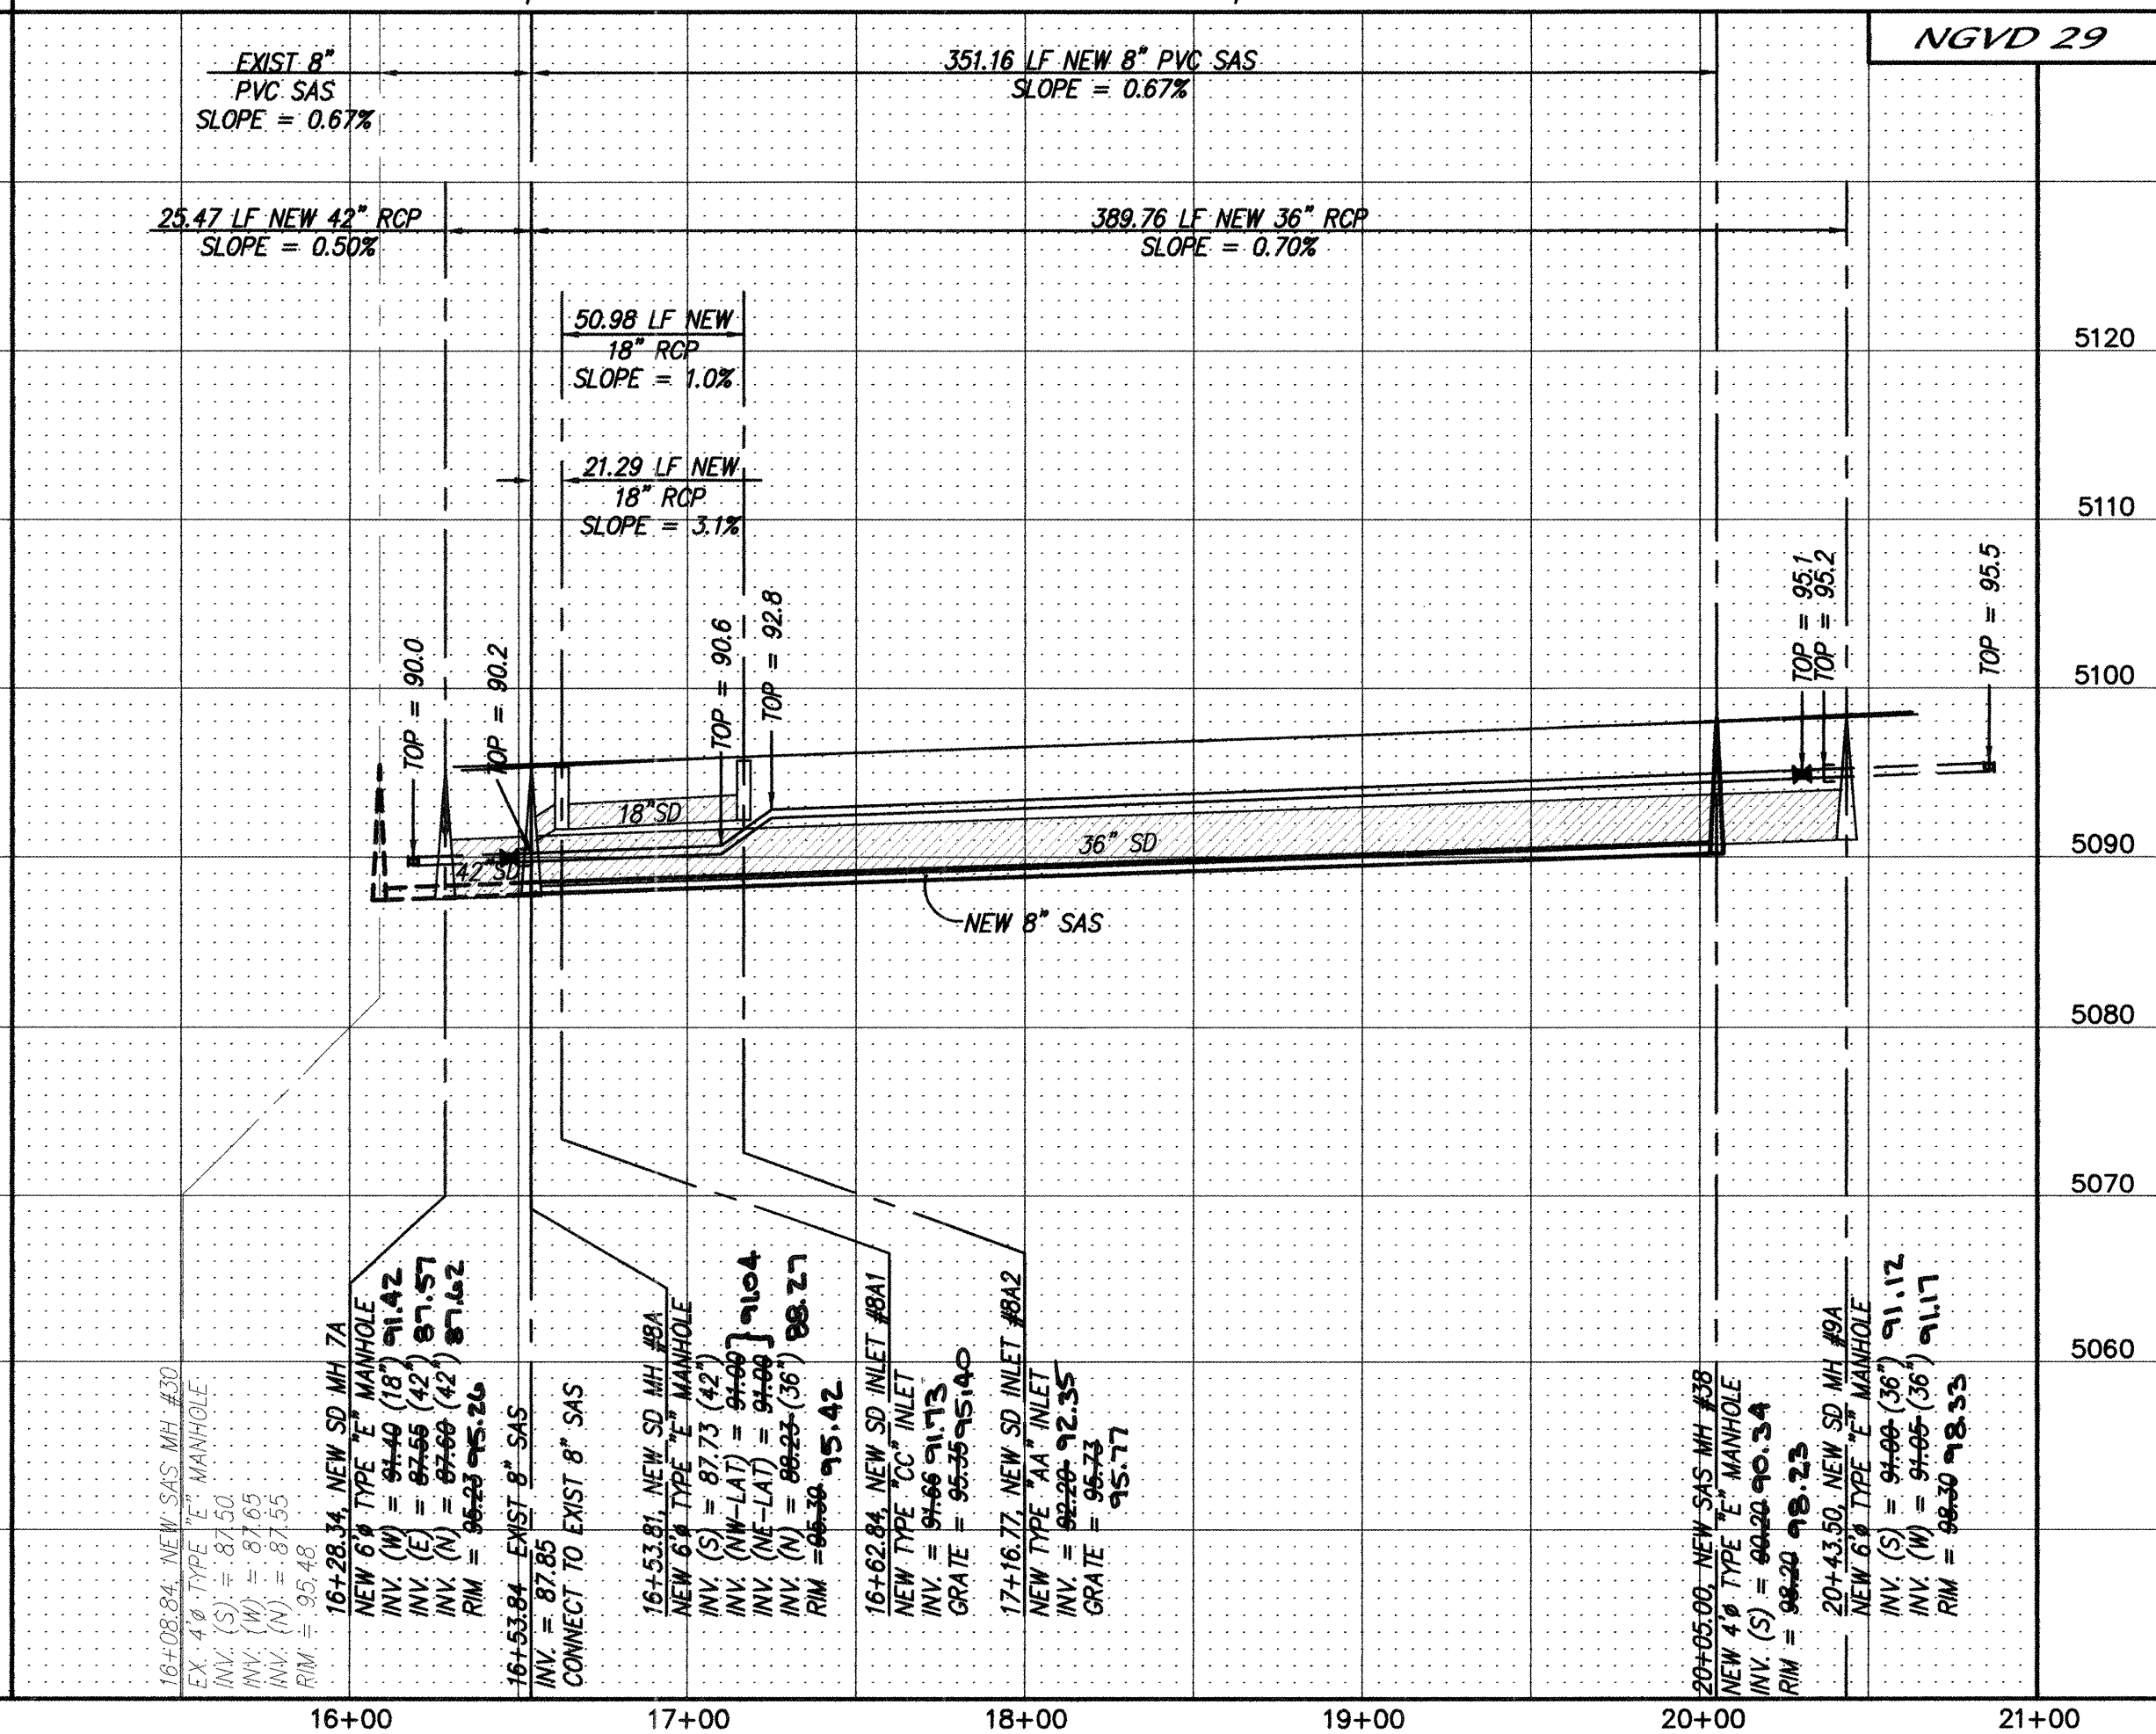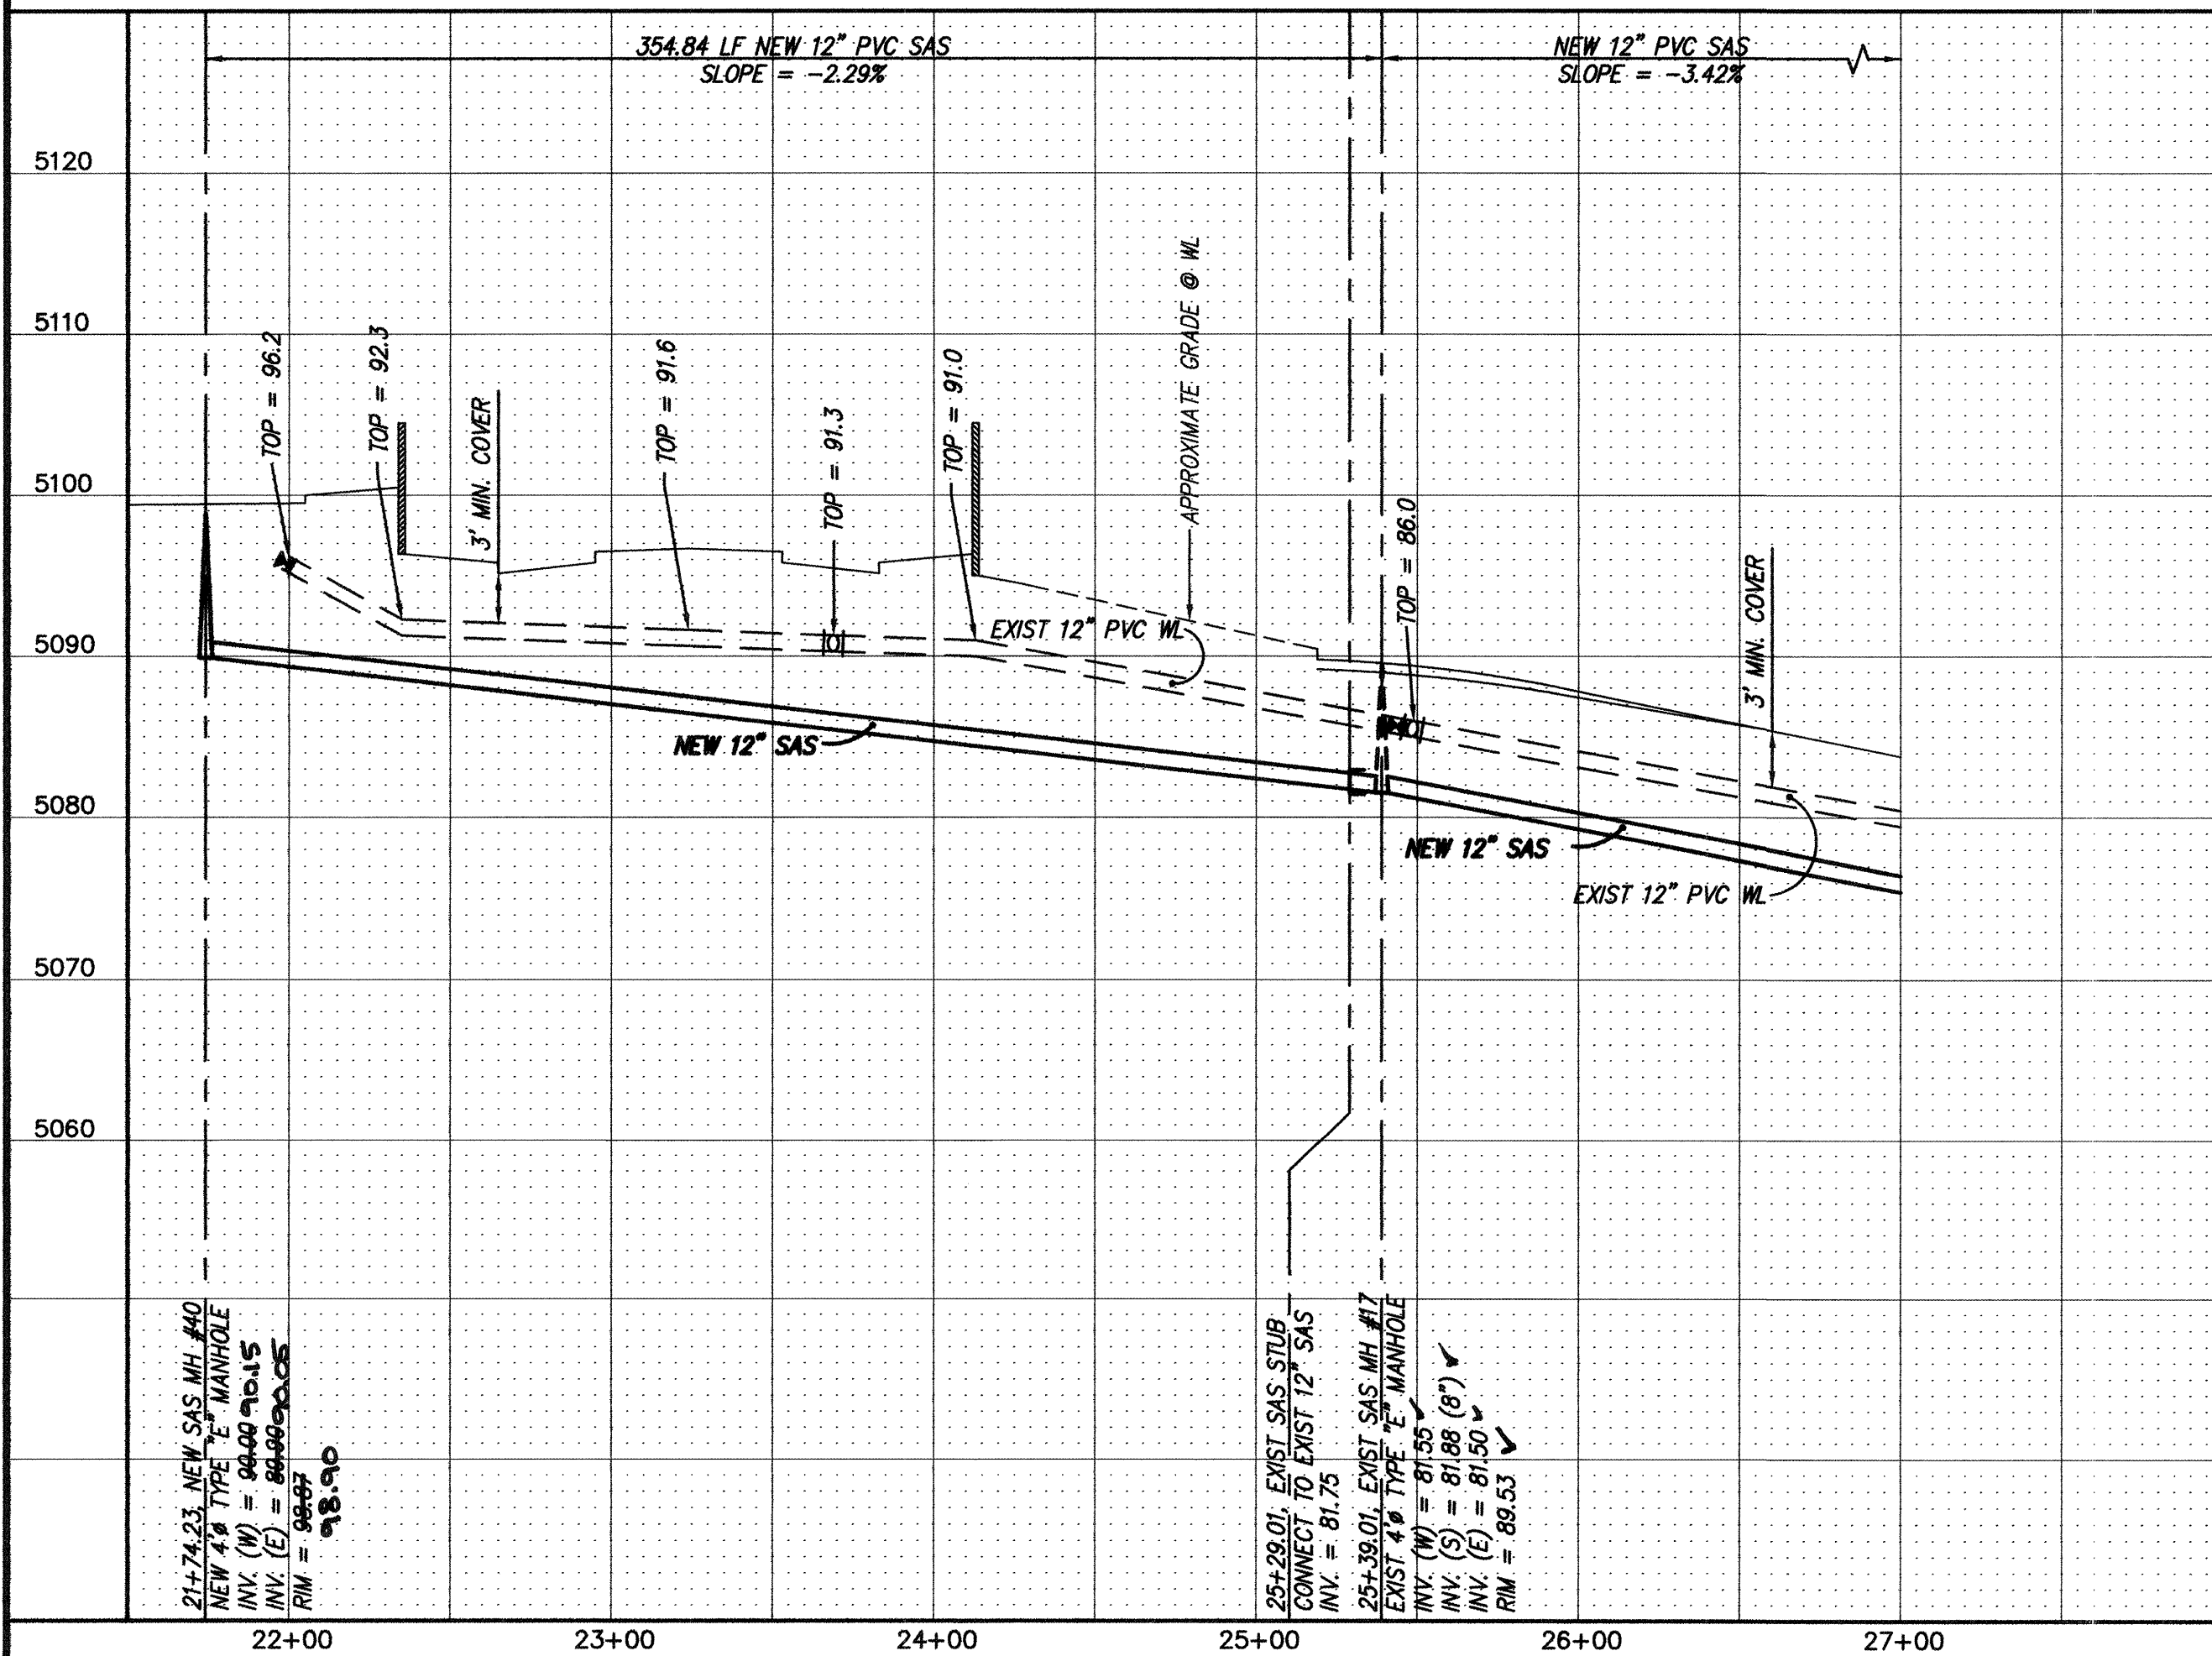


NOTES

1. ALL STATIONING IS CENTERLINE STATIONING.
2. ALL WATERLINE PIPE IS C-900 PVC PIPE AND ALL SAS PIPE IS SDR35 PVC PIPE UNLESS NOTED OTHERWISE.

CERTIFICATE OF SUBSTANTIAL COMPLIANCE ON PLANS

I, Diana L. Hoelzer, of the firm Mark Goodwin & Associates, P.A., a Registered Professional Engineer in the State of New Mexico, do hereby certify, to the best of my knowledge and belief, that the project has been constructed in accordance with the plans and specifications of the City of Albuquerque, New Mexico, and that the original design intent of the approved plans has been met, except as noted by me on the as-built construction drawings. This Certification is based on site inspections by me or personnel under my direction, and supervision provided by A.L.S. Inc., NMPS number 7718.

DATE: 11-11-05
NAME: Diana Hoelzer

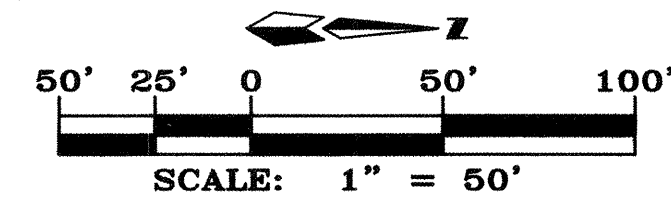


RIO MARIA DR. SW
STA. 16+08.84 TO STA. 20+75.77
SCALE: HORIZ. 1" = 50'
VERT. 1" = 10'

STORM DRAIN SUMMARY TABLE		
LOCATION	GRD. ELEV.	HGL
MH 7A	95.23	91.31
MH 8A	95.39	91.90
MH 9A	98.30	96.90

SANITARY SEWER SERVICES				
BLOCK	LOT	STATION AT PUE	INV. ELEV. AT PUE	LENGTH AT PUE
C * 1.5.5	28-P1	20+02.56	5090.04	33.00'
C * 1.5.0	29-P1	19+42.56	5091.28	33.00'
C * 1.4.7	30-P1	18+82.56	5091.71	33.00'
C * 1.4.2	31-P1	18+22.56	5092.15	33.00'
C * 1.4.15	32-P1	17+62.56	5092.56	33.00'
C * 1.4.1	33-P1	17+02.56	5092.99	33.00'
3	13-P1	19+20.77	5090.63	33.00'
3	14-P1	18+60.77	5091.13	33.00'
3	15-P1	18+00.77	5091.55	33.00'
3	16-P1	17+40.77	5091.98	33.00'
3	17-P1	16+80.77	5090.63	33.00'

C* = CUT BELOW PAD.

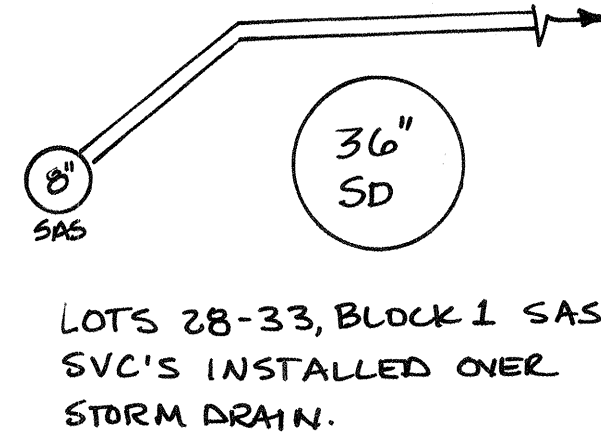

dmg MARK GOODWIN & ASSOCIATES, P.A.
CONSULTING ENGINEERS
P.O. BOX 90606
ALBUQUERQUE, NEW MEXICO 87199
(505) 828-2200, FAX (505) 797-9539



**CITY OF ALBUQUERQUE
PUBLIC WORKS DEPARTMENT**

TITLE: **HIGHLANDS AT ANDERSON HILLS - UNIT 3
98th STREET / RIO MARIA DRIVE SW
UTILITY IMPROVEMENTS**

DESIGN REVIEW COMMITTEE
APPROVED
SEP - 8 - 2004

CITY ENGINEER APPROVAL
APPROVED
FEB 28 2005

LAST DESIGN UPDATE
MO./DAY/YR.
MO./DAY/YR.

CITY PROJECT NO.



ZONE MAP NO.

SHEET OF

708183

P-9

16 20

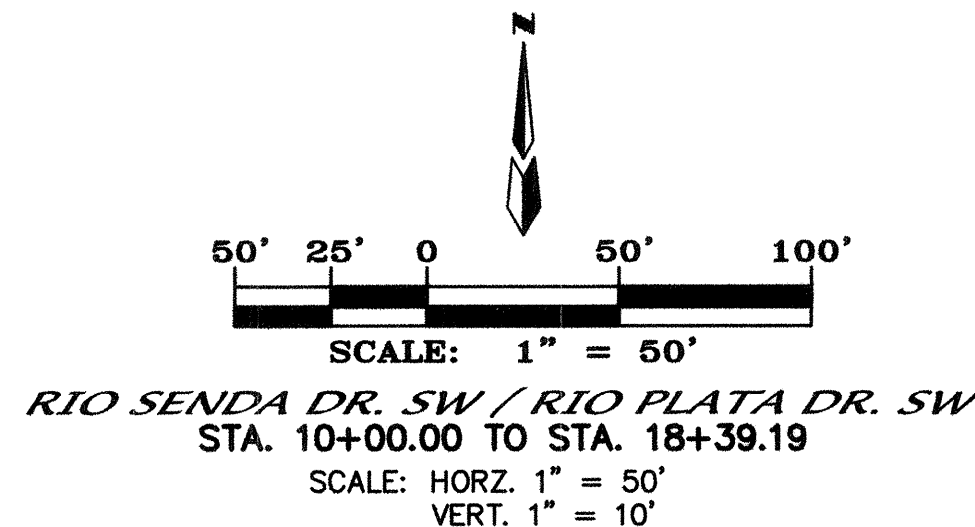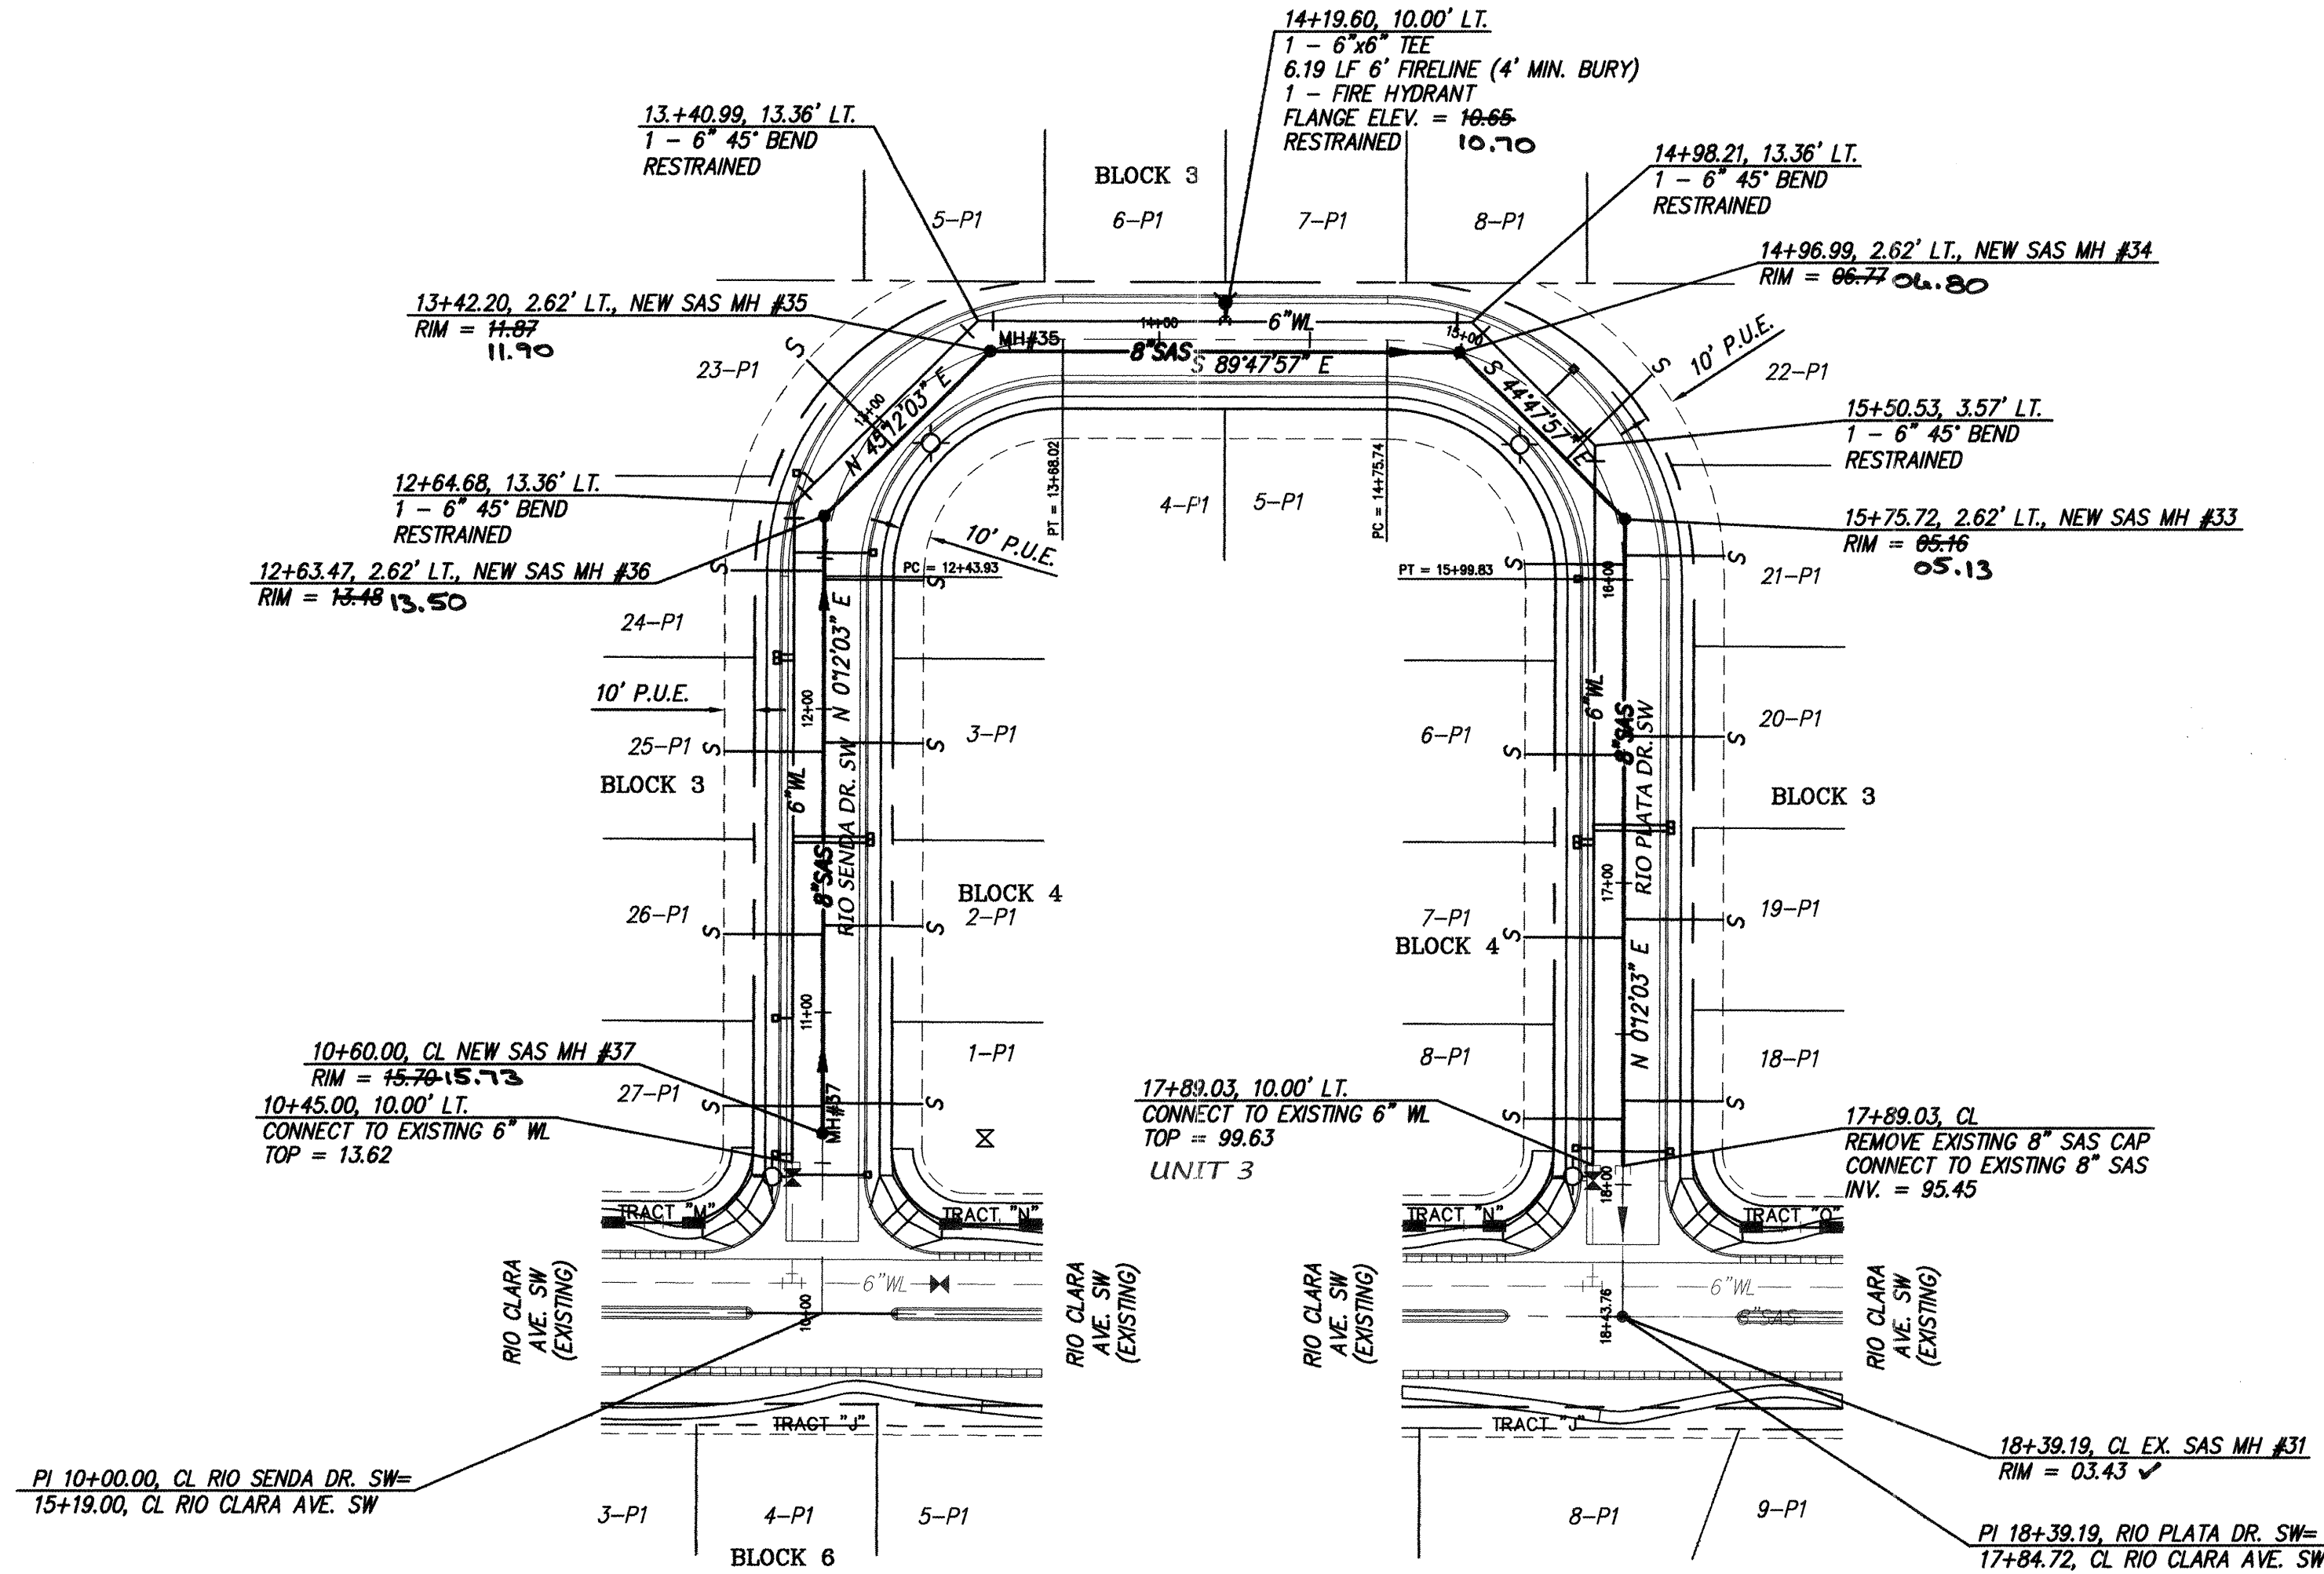

RIO SENDA DR. SW / RIO PLATA DR. SW
STA. 10+00.00 TO STA. 18+39.19

SCALE: HORZ. 1" = 50'
VERT. 1" = 10'

NOTES


1. ALL STATIONING IS CENTERLINE STATIONING.

SANITARY SEWER SERVICES				
BLOCK	LOT	STATION AT PUE	INV. ELEV. AT PUE	LENGTH AT PUE
3	18-P1	17+67.27	5098.3	33.00'
3	19-P1	17+07.27	5098.3	33.00'
3	20-P1	16+47.27	5098.4	33.00'
3	21-P1	15+87.27	5098.8	33.00'
3	22-P1	15+44.18	5100.1	40.24'
3	23-P1	12+98.24	5108.2	40.63'
3	24-P1	12+45.30	5108.9	33.00'
3	25-P1	11+85.86	5109.5	33.00'
3	26-P1	11+25.86	5110.1	33.00'
3	27-P1	10+69.00	5110.98	36.25'
4	1-P1	10+70.00	5110.12	37.12'
4	2-P1	11+28.86	5108.5	33.00'
4	3-P1	11+88.86	5108.9	33.00'
4	4-P1	12+48.86	5108.3	33.00'
4	5-P1	15+86.32	5099.8	33.00'
4	6-P1	16+53.34	5099.9	33.00'
4	7-P1	17+13.34	5099.5	33.00'
4	8-P1	17+73.34	5099.0	33.00'

CERTIFICATE OF SUBSTANTIAL COMPLIANCE ON PLANS

I, Diane L. Hoelzel, N.M.P.E. 11987, of the firm, Mark Goodwin & Associates, P.A., a Registered Professional Engineer in the State of New Mexico, do hereby certify that the plans and specifications for the project described herein have been prepared by me or by a qualified person under my direct supervision, and that the original design intent of the approved plans has been met, except as noted by me on the as-built construction drawings. This Certification is based on site inspections by me or personnel under my direction, and any information provided by A.L.S. Inc., N.M.P.E. number 17719.

Diane L. Hoelzel
N.M.P.E. 11987
11-11-05


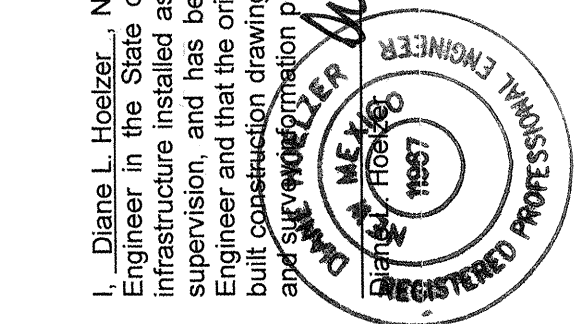


dmg MARK GOODWIN & ASSOCIATES, P.A.
CONSULTING ENGINEERS
P.O. BOX 90606
ALBUQUERQUE, NEW MEXICO 87199
(505) 828-2200, FAX (505) 797-9539



**CITY OF ALBUQUERQUE
PUBLIC WORKS DEPARTMENT**

TITLE: **HIGHLANDS AT ANDERSON HILLS - UNIT 3
RIO SENDA DR. SW / RIO PLATA DR. SW
UTILITY IMPROVEMENTS**

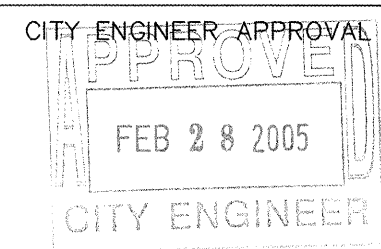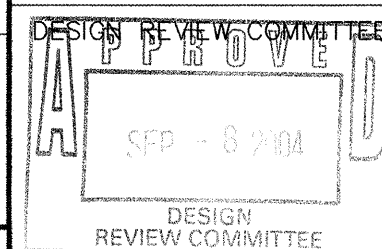

LAST DESIGN UPDATE	MO./DAY/YR.	MO./DAY/YR.

CITY PROJECT NO.



708183

ZONE MAP NO.

P-9

SHEET

17 20

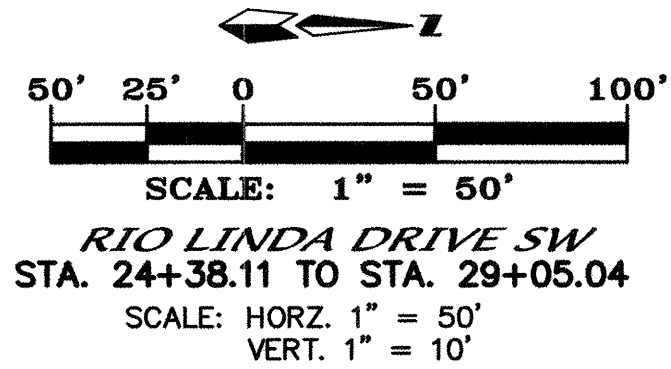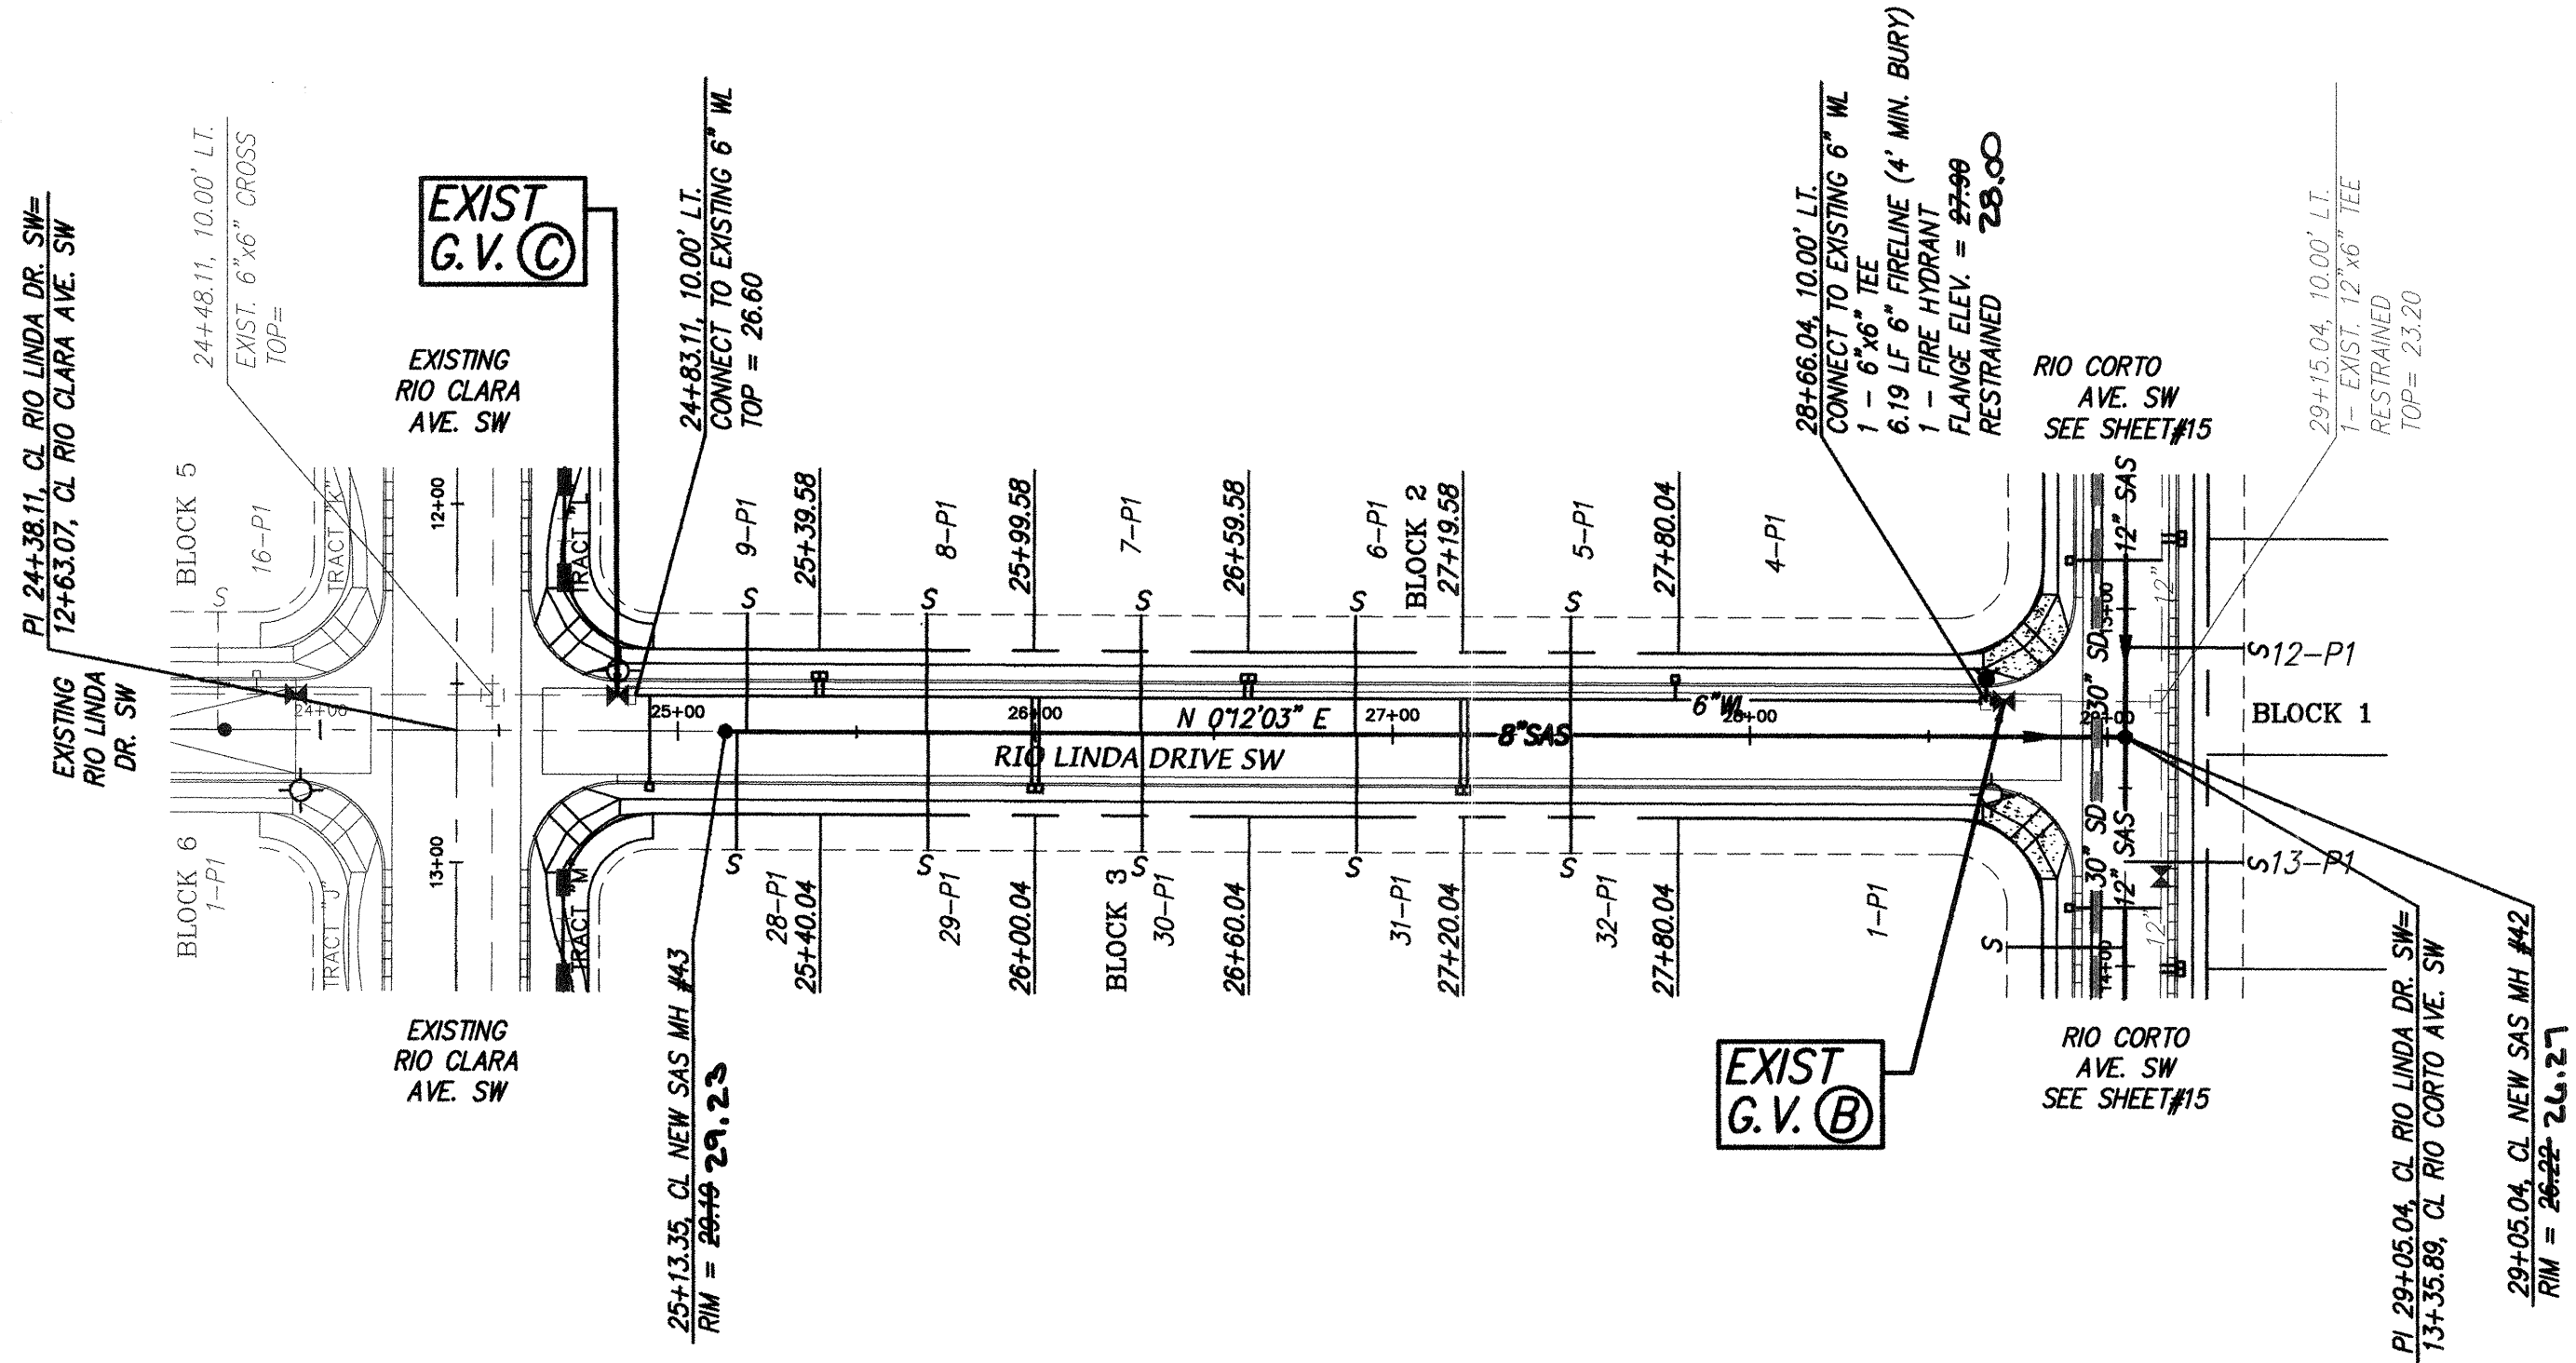

- NOTES**
1. ALL STATIONING IS CENTERLINE STATIONING.
 2. ALL WATERLINE PIPE IS C-900 PVC PIPE AND ALL SAS PIPE IS SDR35 PVC PIPE UNLESS NOTED OTHERWISE.

CERTIFICATE OF SUBSTANTIAL COMPLIANCE ON PLANS

I, Diana L. Hoelzer, NMPE, 11967, of the firm, Mark Goodwin & Associates, P.A., a Registered Professional Engineer in the State of New Mexico, do hereby certify, to the best of my knowledge and belief, that the infrastructure installed as part of this project has been inspected by me or by a qualified person under my direct supervision, and has been constructed in accordance with the plans and specifications approved by the City of Albuquerque. This certificate is given in full and complete satisfaction of all requirements of the City of Albuquerque and the State of New Mexico. This certificate is given on the basis of the information provided by the City of Albuquerque and the State of New Mexico. This certificate is given on the basis of the information provided by the City of Albuquerque and the State of New Mexico. This certificate is given on the basis of the information provided by the City of Albuquerque and the State of New Mexico.

DATE: 11-11-05

dmg MARK GOODWIN & ASSOCIATES, P.A.
CONSULTING ENGINEERS
P.O. BOX 90606
ALBUQUERQUE, NEW MEXICO 87199
(505) 828-2200, FAX (505) 797-9539



**CITY OF ALBUQUERQUE
PUBLIC WORKS DEPARTMENT**

TITLE: **HIGHLANDS AT ANDERSON HILLS UNIT 3
RIO LINDA DRIVE SW
UTILITY IMPROVEMENTS**

DESIGN REVIEW COMMITTEE
APPROVED
SEP - 8 2004
DESIGN REVIEW COMMITTEE

CITY ENGINEER APPROVAL
APPROVED
FEB 2 8 2005
CITY ENGINEER

LAST DESIGN UPDATE
MO./DAY/YR.
MO./DAY/YR.

CITY PROJECT NO. **708183** ZONE MAP NO. **P-9** SHEET **18** OF **20**





REVISIONS
NO. DATE REMARKS BY
1 08/04 DLH
2 09/04 NHE
3 08/04 DMG

DESIGNED BY **DLH** DATE **08/04**
DRAWN BY **NHE** DATE **09/04**
CHECKED BY **DMG** DATE **08/04**

AS BUILT INFORMATION
CONTRACTOR **Hydra System**
WORK ORDER NO. **115**
INSPECTED BY **ALS** DATE **8/05**
ACCEPTANCE BY **ALS** DATE **8/05**
DRAWINGS BY **ALS** DATE **8/05**
CORRECTED BY **ALS** DATE **8/05**
MICRO-FILM INFORMATION
RECORDED BY **ALS** DATE **8/05**
NO.

STATION "2-P10" IS LOCATED 4.9 MI. SW OF DOWNTOWN ALBUQUERQUE TO REACH STATION FROM INT. OF COORS AND DENNIS CHAVEZ BLVD. (FORMERLY RIO BRAVO), GO N. ON COORS 0.1 MI. TO FLORA VISTA AND GO WEST ON FLORA VISTA 0.5 MI. TO CONDERSHIRE, THEN GO S. ON CONDERSHIRE 0.4 MI. TO A POINT APPROX. 50 FT. W. OF THE STATION. STATION MARK IS AN ACS 3 1/4" ALUM. CAP STAMPED "2-P10, 1987" RIVETED TO A PIPE PROJECTING 0.25 FT ABOVE THE GROUND. X=55841.13, Y=1464349.24 (NAD 27) Z=4891 (NGVD 29).

on provided by ALS, Inc., NMPS number
Marie Hoyle 11-11-05
 NMPE 11967

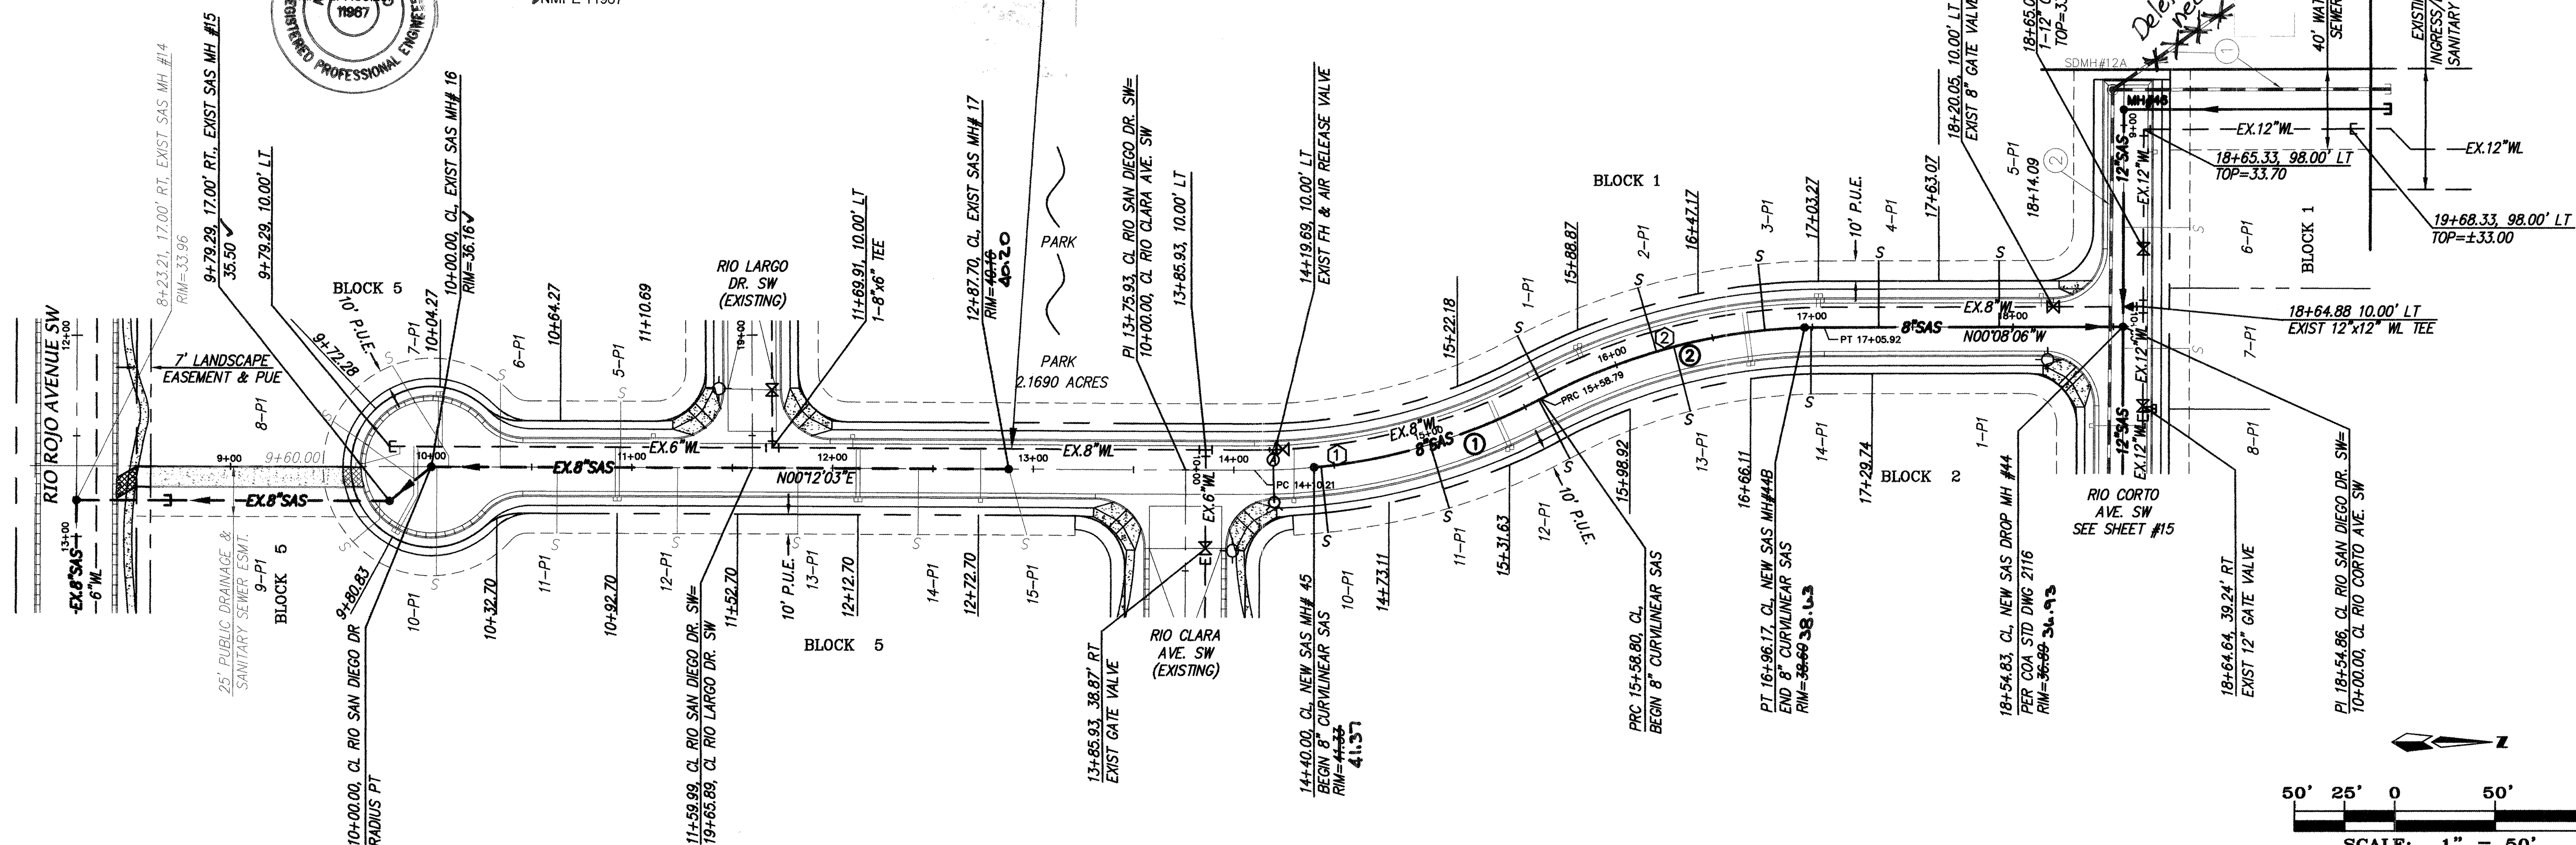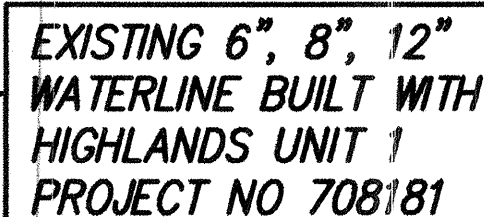

50' 25' 0 50' 100
SCALE: 1" = 50'
RIO SAN DIEGO DR. SW
STA. 10+00.00 TO STA. 18+54.86
SCALE: HORZ. 1" = 50'
VERT. 1" = 10'

NOTES

1. ALL STATIONING IS CENTERLINE STATIONING.
2. Anderson Heights developing - not necessary

CURVE DATA - DESCRIBES CURVILINEAR SAS

① $\Delta = 182^{\circ}35'$ $R = 300'$ $T = 48.48'$ $L = 96.13'$	② $\Delta = 267^{\circ}14'$ $R = 300'$ $T = 69.92'$ $L = 137.38'$
---	--

CURVE DATA - DESCRIBES CURVILINEAR WL	
① $\Delta = 28^{\circ}22'50''$ $R = 290'$ $T = 73.33'$ $L = 143.65'$	② $\Delta = 26^{\circ}74'14''$ $R = 310'$ $T = 72.25'$ $L = 141.96'$

RESTRAINED JOINT LENGTH FOR BENDS, VALVES, DEAD ENDS (FT.)					
PIPE SIZE	90°	45°	22.5°	11.25°	VALVE
6"	17'	7'	3'	2'	46'
8"	22'	9'	4'	2'	60'
12"	30'	12'	6'	3'	95'

LENGTH OF RESTRAINED PIPE ON EACH SIDE OF THE BEND. RESTRAIN BRANCH AT FITTING ONLY MINIMUM ATTACHED PIPE LENGTH, RUN SIDE OF TEE: 10.00 FEET.

RESTRAINED JOINT LENGTH FOR TEES (FT.)		
PIPE SIZE	RUN	BRANCH
12"x12"x8"	8'	5'
8"x6"x6"	7'	5'
6"x6"x6"	10'	2'

SANITARY SEWER SERVICES				
BLOCK	LOT	STATION AT PUE	INV. AT ELEV. PUE	LENGTH AT PUE
1	1	15+62.85	34.97	37.06'
1	2	16+21.15	34.92	34.52'
1	3	16+76.27	33.55	33.18'
1	4	17+33.07	32.88	33.08'
1	5	17+97.07	31.94	33.08'
2	10	14+43.52	36.29	33.00'
2	11	14+99.06	35.64	34.69'
2	12	15+37.69	34.05	37.00'
2	13	16+21.15	34.09	34.00'
2	14	16+98.41	33.29	33.05'

 MARK GOODWIN & ASSOCIATES, P.A.
CONSULTING ENGINEERS
P.O. BOX 90606
ALBUQUERQUE, NEW MEXICO 87199
(505) 828-2200, FAX (505) 797-9530



CITY OF ALBUQUERQUE
PUBLIC WORKS DEPARTMENT

TITLE: *HIGHLANDS AT ANDERSON HILLS - UNIT 3*
RIO SAN DIEGO DRIVE SW
UTILITY IMPROVEMENTS

DESIGN REVIEW COMMITTEE 	CITY ENGINEER APPROVAL 	LIST DESIGN UPDATE	MO./DAY/YR.	MO./DAY/YR.

CITY PROJECT NO.		ZONE MAP NO.	SHEET	OF
708183		P-9	19	20

[illegible]

