


SCANNED BY
MESA REPRO

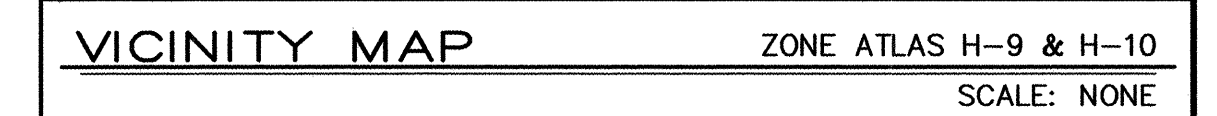

NOTICE TO CONTRACTORS

1. AN EXCAVATION/CONSTRUCTION PERMIT WILL BE REQUIRED BEFORE BEGINNING ANY WORK WITHIN THE CITY RIGHT-OF-WAY.
2. ALL WORK DETAILED ON THESE PLANS TO BE PERFORMED UNDER CONTRACT SHALL, EXCEPT AS OTHERWISE STATED OR PROVIDED FOR HEREON, BE CONSTRUCTED IN ACCORDANCE WITH THE CITY OF ALBUQUERQUE STANDARD SPECIFICATIONS FOR PUBLIC WORKS CONSTRUCTION, 1986 EDITION AS REVISED THROUGH UPDATE J6.
3. TWO WORKING DAYS PRIOR TO ANY EXCAVATION, THE CONTRACTOR MUST CONTACT NEW MEXICO ONE CALL SYSTEM (260-1990) FOR LOCATION OF EXISTING UTILITIES.
4. PRIOR TO CONSTRUCTION, THE CONTRACTOR SHALL EXCAVATE AND VERIFY THE HORIZONTAL AND VERTICAL LOCATIONS OF ALL OBSTRUCTIONS. SHOULD A CONFLICT EXIST, THE CONTRACTOR SHALL NOTIFY THE ENGINEER IMMEDIATELY SO THAT THE CONFLICT CAN BE RESOLVED WITH A MINIMUM AMOUNT OF DELAY.
5. FIVE (5) WORKING DAYS PRIOR TO BEGINNING OF CONSTRUCTION, THE CONTRACTOR SHALL SUBMIT TO CONSTRUCTION COORDINATION DIVISION A DETAILED CONSTRUCTION SCHEDULE. TWO (2) WORKING DAYS PRIOR TO THE START OF CONSTRUCTION, THE CONTRACTOR SHALL OBTAIN A BARRICADING PERMIT FROM THE CONSTRUCTION COORDINATION DIVISION. CONTRACTOR SHALL NOTIFY THE CONSTRUCTION COORDINATION ENGINEER (924-3400) PRIOR TO OCCUPYING AN INTERSECTION. REFER TO SECTION 19 OF THE GENERAL CONDITIONS OF THE STANDARD SPECIFICATIONS.
6. ALL WORK AFFECTING ARTERIAL ROADWAYS REQUIRES TWENTY-FOUR HOUR CONSTRUCTION.
7. ALL STREET STOPPING ALTERED OR DESTROYED SHALL BE REPLACED WITH PLASTIC REFLECTORIZED PAVEMENT MARKING BY CONTRACTOR TO THE SAME LOCATION AS WAS EXISTING, OR AS INDICATED BY THIS PLAN SET.
8. CONTRACTOR SHALL NOTIFY THE ENGINEER NOT LESS THAN SEVEN (7) DAYS PRIOR TO STARTING WORK IN ORDER THAT THE CITY SURVEYOR MAY TAKE NECESSARY MEASURES TO INSURE THE PRESERVATION OF SURVEY MONUMENTS. CONTRACTOR SHALL NOT DISTURB PERMANENT SURVEY MONUMENTS WITHOUT THE CONSENT OF THE CITY SURVEYOR AND SHALL NOTIFY THE CITY SURVEYOR AND BEAR THE EXPENSE OF REPLACING ANY THAT MAY BE DAMAGED WITHOUT DELAY. NO REPLACEMENT SHALL BE DONE ONLY BY THE CITY SURVEYOR. WHEN A CHANGE IS MADE IN THE FINISHED ELEVATIONS OF THE PAVEMENT AT ANY ROADWAY IN WHICH A PERMANENT SURVEY MONUMENT IS LOCATED, CONTRACTOR SHALL, AT HIS OWN EXPENSE, ADJUST THE MONUMENT TO COVER THE NEW GRADE UNLESS OTHERWISE SPECIFIED. REFER TO SECTION 4.4 OF THE GENERAL CONDITIONS OF THE STANDARD SPECIFICATIONS.
- CONTRACTOR SHALL RECORD DATA ON ALL UTILITY LINES AND ACCESSORIES AS REQUIRED BY THE CITY OF ALBUQUERQUE FOR THE PREPARATION OF "AS CONSTRUCTED" DRAWINGS. CONTRACTOR SHALL NOT COVER UTILITY LINES AND ACCESSORIES UNTIL ALL DATA HAVE BEEN RECORDED.
10. CONTRACTOR SHALL MAINTAIN A GRAFFITI-FREE WORK SITE. CONTRACTOR SHALL PROMPTLY REMOVE ANY GRAFFITI FROM ALL EQUIPMENT, WHETHER PERMANENT OR TEMPORARY.
11. CONTRACTOR SHALL COORDINATE WITH THE CITY OF ALBUQUERQUE WATER SYSTEMS DIVISION (857-8200) SEVEN (7) WORKING DAYS IN ADVANCE OF ANY WORK THAT MAY AFFECT EXISTING PUBLIC WATER OR SEWER UTILITIES. EXISTING VALVES TO BE OPERATED BY CITY PERSONNEL ONLY. CONTRACTOR SHALL CONTACT THE WATER SYSTEMS DIVISION SEVEN (7) WORKING DAYS PRIOR TO NEEDING VALVES TURNED ON OR OFF.
12. FOR STORM DRAIN CONSTRUCTION, RCP JOINTS SHALL NOT BE GROUTED PRIOR TO FINAL INSPECTION. FINAL INSPECTION WILL DETERMINE JOINTS TO BE GROUTED FOR FINAL ACCEPTANCE OF THE CONSTRUCTION.
13. ALL EXCAVATION, TRENCHING AND SHORING ACTIVITIES MUST BE CARRIED-OUT IN ACCORDANCE WITH OSHA 29 CFR 1926.956 SUBPART P.

☒ ALL UTILITIES AND UTILITY SERVICE LINES SHALL BE INSTALLED PRIOR TO PAVING.

☒ BACKFILL COMPACTION SHALL BE ACCORDING TO SPECIFIED STREET USE.

☐ TACK COAT REQUIREMENTS SHALL BE DETERMINED BY THE ENGINEER.

☒ SIDEWALK AND WHEELCHAIR RAMPS WITHIN THE CURB RETURNS SHALL BE CONSTRUCTED WHEREVER A NEW CURB RETURN IS CONSTRUCTED.

☐ IF CURB IS DEPRESSIONED FOR A DRIVEPAD, THE DRIVEPAD SHALL BE CONSTRUCTED PRIOR TO ACCEPTANCE OF CURB AND GUTTER.

☒ ALL STORM DRAINAGE FACILITIES SHALL BE COMPLETED PRIOR TO FINAL ACCEPTANCE.

CAUTION:
NOTE THAT ALL EXISTING UTILITIES MAY NOT BE SHOWN. ALL EXISTING SERVICE CONNECTIONS ARE NOT SHOWN. ANY EXISTING UTILITIES THAT ARE SHOWN ARE APPROXIMATE LOCATION ONLY. IT SHALL BE THE SOLE RESPONSIBILITY OF THE CONTRACTOR TO CONTACT ALL THE UTILITY OWNERS AND TO CONDUCT ALL NECESSARY FIELD INVESTIGATIONS PRIOR TO ANY EXCAVATIONS TO DETERMINE THE ACTUAL LOCATION OF UTILITIES AND OTHER IMPROVEMENTS.

dmg D. MARK GOODWIN & ASSOCIATES, P.A.
CONSULTING ENGINEERS
P. O. BOX 90606
ALBUQUERQUE, NEW MEXICO 87199
(505) 828-2200, FAX (505) 797-9531

HAB

A2031WRD/PLANS/UNIT 2/A2031COVER/03-26-03/ACH

SHEET NO.	SHEET
1	COVER SHEET
2-5	PLAT
6-7	GRADING AND DRAINAGE PLAN
8	<u>MASTER PAVING PLAN</u>
9	AUSTIN AVE. PAVING
10	WOODHILL DR. & BIXBY ST. PAVING
11	KYLE RD. & WEXFORD ST. PAVING
12	ANGEL DR. PAVING
13	<u>UTILITY MASTER PLAN</u>
14	AUSTIN AVE. UTILITY
15	WOODHILL DR. & BIXBY ST. UTILITY
16	KYLE RD. & WEXFORD ST. UTILITY
17	ANGEL DR. UTILITY
18	WATER DETAILS

APPROVED AS RECORD DRAWING
DESIGN REVIEW SECTION
CITY CONSTRUCTION ENGINEER
DATE: 2/7/08


SURVEYOR'S CERTIFICATION

CERTIFICATE OF SUBSTANTIAL COMPLIANCE ON PLANS

I, James D. Hughes, NMPE 11674, of the firm Mark Goodwin & Associates, PA, a Registered Professional Engineer in the State of New Mexico, do hereby certify, to the best of my knowledge and belief, that the infrastructure installed as part of this project has been inspected by me or by a qualified person under my direct supervision, and has been constructed in accordance with the plans and specifications approved by the City Engineer and that the original intent of the plans has been met, except as noted by me on the as-built construction drawings. This Certification is based on site inspections by me or personnel under the direction, and survey information provided by ALS, Inc., NMPS number 7719.

James D Hughes

12-14-04

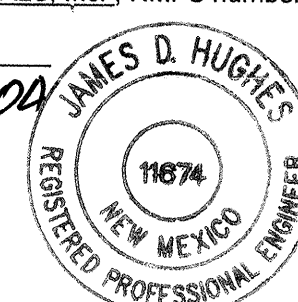


"I, Timothy Aldrich, a duly qualified Registered Professional Land Surveyor under the laws of the State of New Mexico, do hereby certify that the 'as-built' information shown on these drawings was obtained from field construction and 'as-built' surveys performed by me or under my supervision, that the 'as-built' information shown on these drawings was added by me or under my supervision, and that this 'as-built' information is true and correct to the best of my knowledge and belief." Aldrich Land Surveying is not responsible for any of the design concepts, calculations, engineering, or intent of the record drawings.

Timothy Aldrich S. No. 7318 Date 05-12-04

Timothy Aldrich S. No. 7738

DRB NO.

1001932

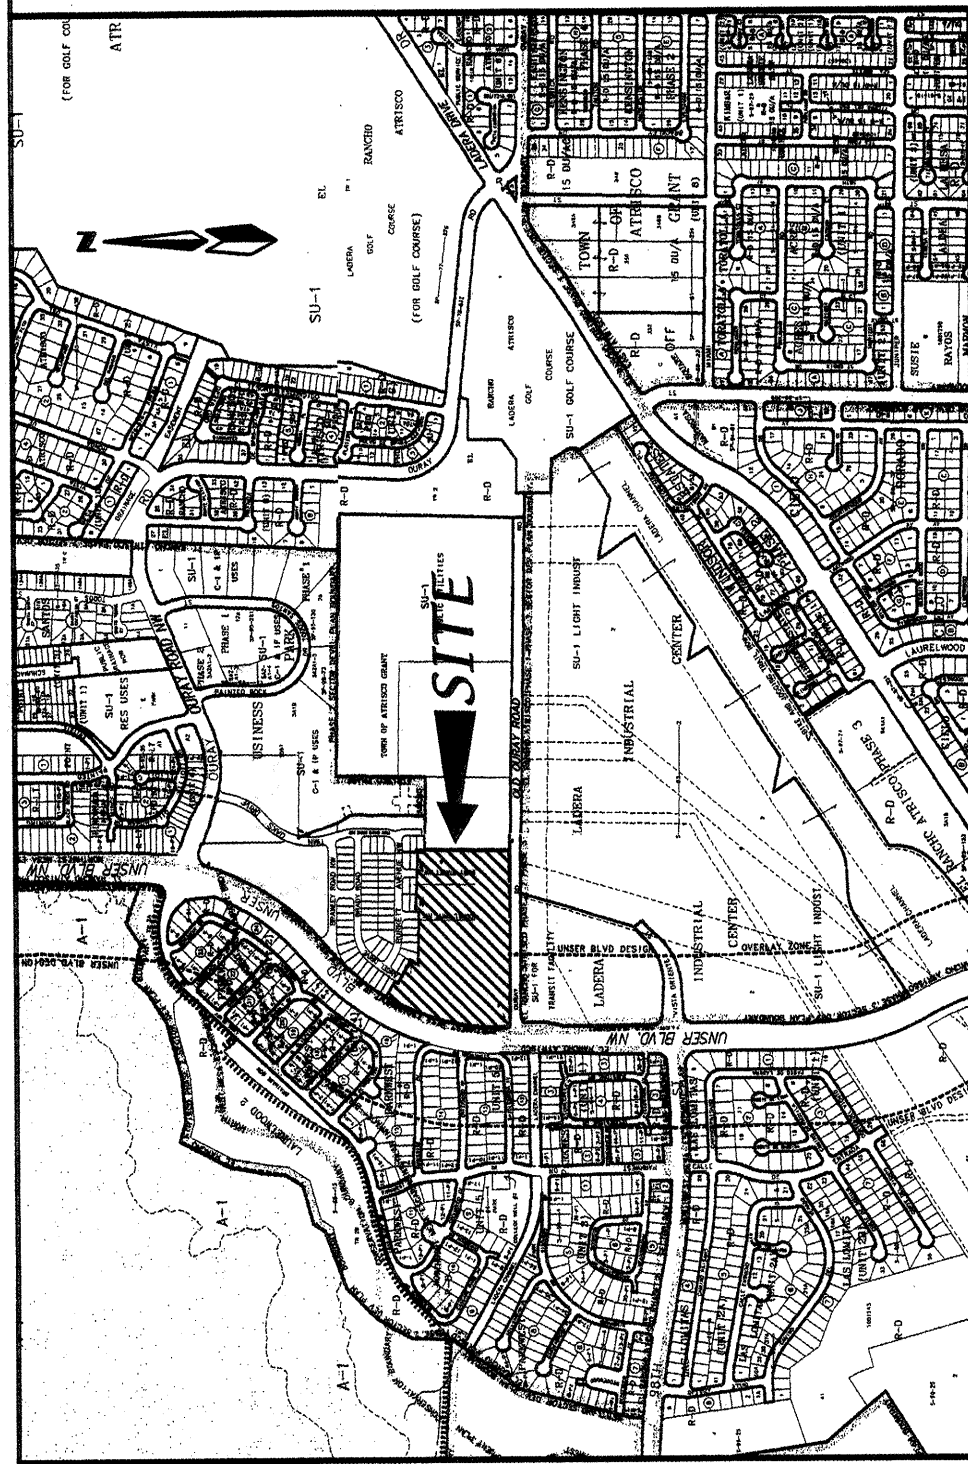

LEGAL DESCRIPTION

(SEE SHEET 2)

NOTES:

(SEE SHEET 2)

PURPOSE OF PLAT

1. Subdivide one existing tract into 100 Residential Lots.
2. Grant easements as shown hereon.
3. Dedicate right-of-way as shown hereon.

PUBLIC UTILITY EASEMENTS

PUBLIC UTILITY EASEMENTS
PUBLIC UTILITY EASEMENTS shown on this plat are granted for the common and joint use of:

1. The PNM Electric Services Division for the installation, maintenance and service of overhead and underground electrical lines, transformers, poles and any other electrical fixtures, structures and related facilities reasonably necessary to provide electric service.
2. The PNM Gas Services Division for installation, maintenance and service of natural gas lines, valves and any other equipment and facilities reasonably necessary to provide natural gas.
3. Qwest for installation, maintenance and service of such lines, cable and other related equipment and facilities reasonably necessary to provide communication services, including but not limited to above ground pedestals and closures.
4. Comcast cable for installation, maintenance and service of such lines, cable and other related facilities reasonably necessary to provide Cable TV service.

included, is the right to build, rebuild, construct, reconstruct, locate, relocate, change, remove, modify, renew, operate and maintain facilities for the purposes described above, together with the free access to, from and over said easement, including sufficient working area for electric transformers, with the right and privilege to trim and remove trees, shrubs or bushes which interfere with the purposes set forth herein. No building, sign, pool (above ground or subsurface), hot tub, concrete or wood pool deck, or other structure shall be erected or constructed on said easements, nor shall any well be drilled or opened on the easement. The easement shall not be used for storage of any material, nor shall it be used for any purpose prohibited by the Electrical Safety Code caused by construction of pools, decking or any structures adjacent to within or near easements shown on this plat.

In approving this plat, the utility companies did not conduct a Title Search of the properties shown hereon. Consequently, the utility companies do not waive or release any easement or easement rights which may have been granted by prior plat, replat or other document and which are not shown on this plat.

Easements for electric transformers/switchgears, as installed, shall extend ten feet (10') in front of transformer/switchgear doors and five feet (5') on each side.

FREE CONSENT AND DEDICATION:

The subdivision herein described is with the free consent and in accordance with the desires of the undersigned owner(s) and/or proprietor(s) thereof and said owner(s) and/or proprietor(s) do hereby dedicate all streets, public right-of-ways shown hereon to the City of Albuquerque in fee simple with warranty covenants and do hereby grant to the City of Albuquerque in fee simple with warranty covenants and do hereby grant to all access, utility and drainage easements shown herein, including the right to construct, operate, inspect and maintain facilities therein, and all public utility easements shown hereon for the common and joint use of gas, electrical power and communication services for the buried distribution lines, conduits, and pipes for underground utilities where shown or indicated, and including the right of ingress and egress for construction and maintenance, and the right to trim interfering trees and shrubs. Said owner(s) and/or proprietor(s) do hereby consent to all of the foregoing(s) and hereby certify that this subdivision is their free act and deed. Said owner(s) warrant that they hold among them complete and indefeasible title to the land subdivided.

OWNER: KB HOME New Mexico, Inc., a New Mexico Corporation
BY: Greg Breedlove, Vice-President of Land Development

Greg Breedlove 3/21/03 DATE


OWNER'S ACKNOWLEDGMENT

STATE OF NEW MEXICO
COUNTY OF BERNALILLO

This instrument was acknowledged before me on _____
By Greg Breedlove, Vice-President of Land Development for KB HOMES New Mexico, Inc.,
A New Mexico Corporation on behalf of said corporation

NOTARY PUBLIC

MY COMMISSION EXPIRES

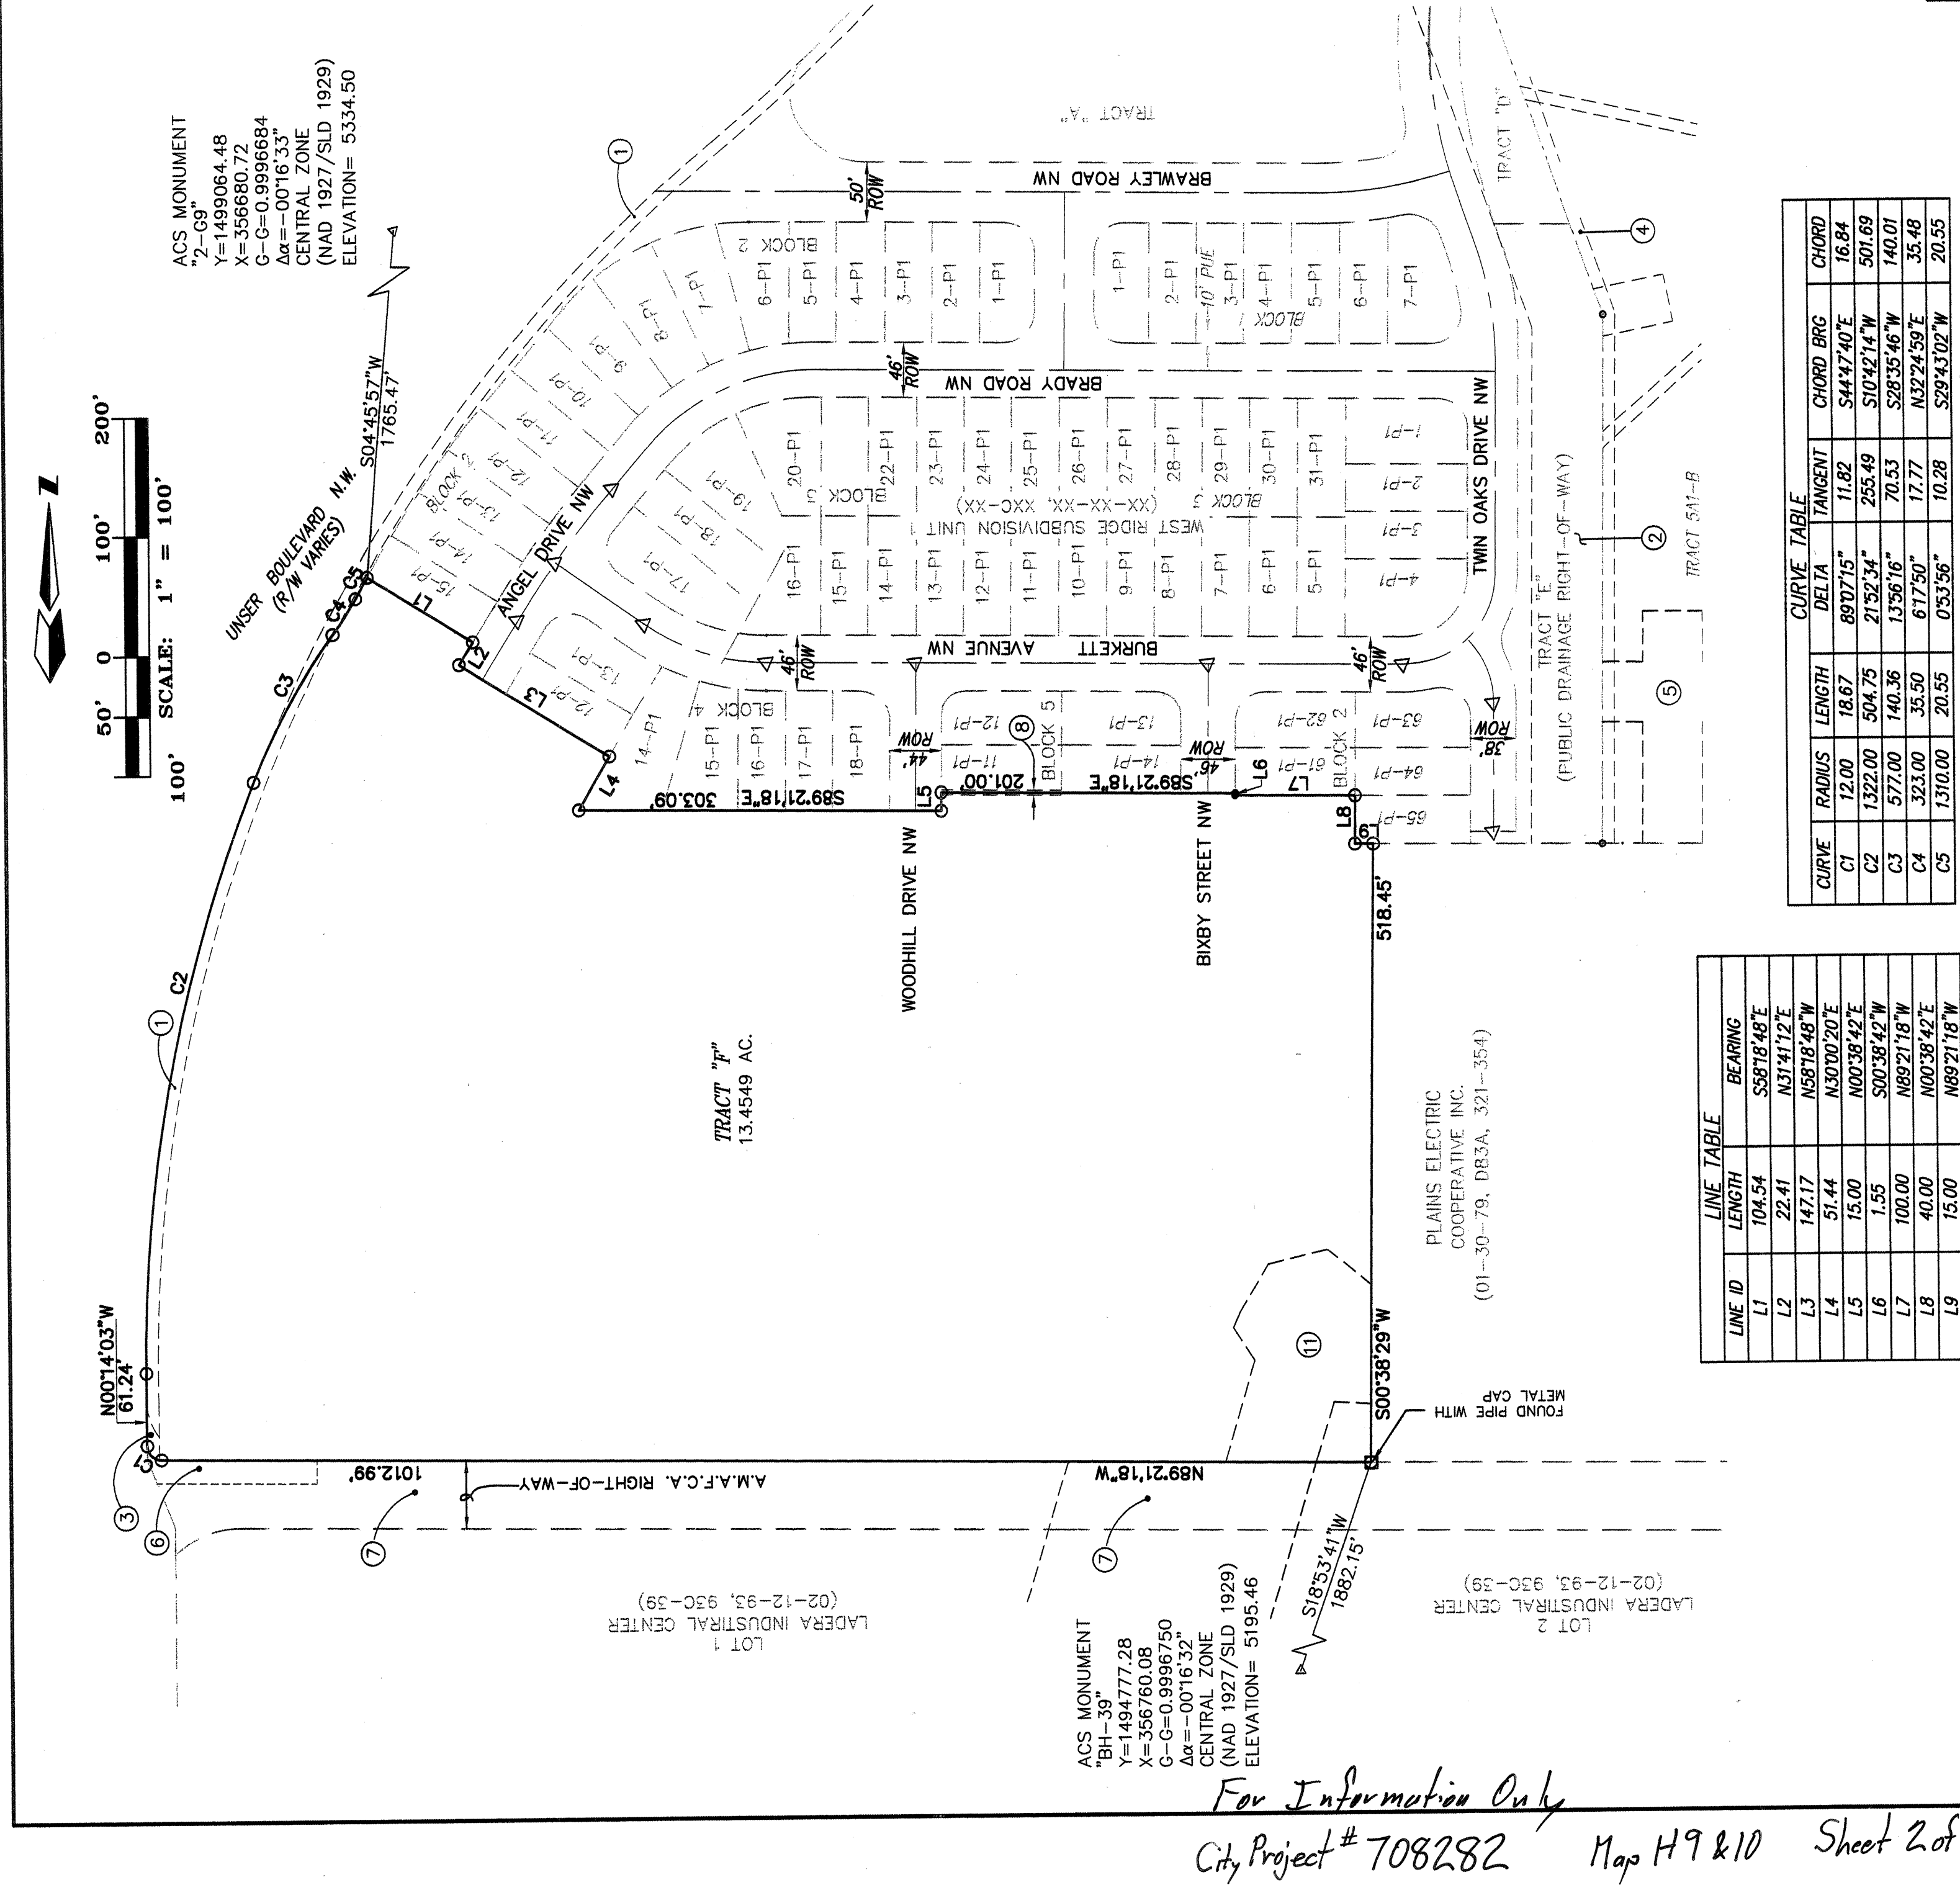

SURVEYOR'S CERTIFICATION

"I, Timothy Aldrich, a duly qualified Registered Professional Land Surveyor under the laws of the State of New Mexico, certify that this plat and description were prepared by me and that the same are true and correct. This plat and description were prepared by me and the use of the surveys and shows all easements as shown on the plat of record or made known to me by the owners and/or proprietors of the subdivision shown herein, utility companies and other parties expressing an interest and meets the minimum requirements for monumentation and surveys of the Aboveque Subdivision Ordinance, and further meets the Minimum Standards for Land Surveying in the State of New Mexico, and is true and correct to the best of my knowledge and belief."

Timothy Aldrich P.S. No. 7719

Dwg: A2031U2SHT1.dwg	Drawn: RICHARD	Checked: ALS	Sheet I of 5
Scale: N/A	Date: 03/21/03	Job: A02031	

PLAT FOR
WEST RIDGE SUBDIVISION

UNIT 2
WITHIN THE

TOWN OF ATRISCO GRANT
PROJECTED SECTIONS 9 AND 10
TOWNSHIP 10 NORTH, RANGE 2 EAST, NMPM

CITY OF ALBUQUERQUE
BERNALILLO COUNTY, NEW MEXICO
MARCH, 2003

LEGAL DESCRIPTION

A tract of land situated within the Town of Africo Grant, projected Sections 9 and 10, Township 10 North, Range 2 East, New Mexico Principal Meridian, City of Albuquerque, Bernalillo County, New Mexico being all of TRACT "F", WEST RIDGE SUBDIVISION UNIT 1 as the same is shown and designated on said plat filed for record in the office of the County Clerk of Bernalillo County, New Mexico on _____, 2003 in Book _____ and containing 13,454.9 acres more or less.

NOTES:

1. Bearings are grid based on the New Mexico State Plane Coordinate System (Central Zone).
2. Distances are ground distances.
3. Bearings and distances in parenthesis are record.
4. Basis of boundary are the following plats of record entitled:


PLAT FOR "LAJERA INDUSTRIAL CENTER, LOTS 1 AND 2", (02-12-93, 93C-39)
PLAT FOR "VOLCANO BUSINESS PARK", (03-26-02, 02C-96)
PLAT FOR "VOLCANO BUSINESS PARK, PHASE I", (04-24-86, C30-78)
PLAT FOR "VOLCANO BUSINESS PARK, PHASE II", (04-03-98, 98C-89)
PLAT FOR "EL RANCHO ATRISCO, PHASE 3, TRACTS 5-A & 6-A", (02-12-87, C32-184)
PLAT FOR "EL RANCHO ATRISCO, PHASE 2, TRACTS A-1 & B-1", (02-12-87, C32-185)
PIMA SWITCHING STATION (WD: 05-04-61, BK D593, PG. 223)
PLAINS ELECTRIC COOPERATIVE, INC. (WD: 09-14-64, BK D756, PG. 258)
PLAINS ELECTRIC COOPERATIVE, INC. (QCD: 01-30-79, BK D83A, PGS. 321-354)

all being records of Bernalillo County, New Mexico.
5. Title Report: provided by First American Title Insurance Company, Commitment No. 05020221 (Effective date: 04-25-02) (TRI-STATE TRACT)
6. Total remaining Open Space requirements are met via a cash payment to the City of Albuquerque per the provisions of Section 14-16-3-6 (A) (3).
7. Setbacks are as shown and noted on the Amended Site Development Plan for Subdivision. (Case No. 02DRB-01581)
8. New 38' Public Water, Sanitary Sewer and Pedestrian Access Easement granted to, for the benefit of, and to be maintained by the City of Albuquerque.

SEE EASEMENT KEYED NOTES ON SHEET 3

Dwg: A2031U2SHT2&3.dwg	Drawn: RICHARD	Checked: ALS	Sheet 2 of 5
Scale: 1"=100'	Date: 03/21/03	Job: A02031	

SCANNED BY
MESA REPRO

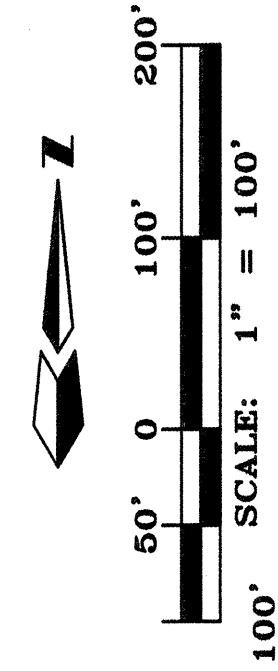

PLAT FOR
WEST RIDGE SUBDIVISION
UNIT 2

WITHIN THE
TOWN OF ATRISCO GRANT
PROJECTED SECTIONS 9 AND 10
TOWNSHIP 10 NORTH, RANGE 2 EAST, NMPM
CITY OF ALBUQUERQUE
BERNALILLO COUNTY, NEW MEXICO
MARCH, 2003


EASEMENTS:

1. Existing 10' PNM and Mountain Bell Easement (Buried utilities only) (02-12-87, C32-185)
2. Existing 60' Plains Electric Easement (02-12-87, C32-185) (12-23-87, BK. MISC. 571A, PG. 394)
3. Existing 10' (PUE) Public Utility Easement. (XX-XX-03, 03C-XX)
4. Existing 10' PNM Easement (03-26-02, 02C-96)
5. Existing 50' PNM Easement (04-24-86, C30-78)
6. Existing 20' Pedestrian Access Easement granted to, for the benefit of, and to be maintained by the City of Albuquerque. Existing 20' (PUE) Public Utility Easement (XX-XX-03, 03C-XX)
7. Existing A.M.A.F.C.A. Drainage Right-of-way. Existing City of Albuquerque Public Water, Sanitary Sewer, and Drainage Easement. Existing Private Access Easement granted to the owners of the Lands of Plains Electric Generation and Transmission Co-op, Inc. (01-30-79, Bk d83a, Pg. 321-354) and the Lands of PNM (05-04-61, Bk. D-593, Pg. 223). Its successors and assigns, and to be jointly maintained by said owners. access by beneficiaries shall be free and unrestricted. (xx-xx-03, 03c-xx)
8. Existing 2' Private Drainage Easement centered on lot line (xx-xx-03, 2003c-xx)

NOTE: ▲
CENTERLINE (IN LIEU OF R/W) MONUMENTATION IS TO BE INSTALLED AT ALL CENTERLINE P.C.'S, P.T.'S, ANGLE POINTS AND STREET INTERSECTIONS AS SHOWN HEREON, AND WILL CONSIST OF A FOUR INCH (4") ALUMINUM ALLOY CAP STAMPED "CITY OF ALBUQUERQUE", "CENTERLINE MONUMENT", "DO NOT DISTURB", "PLS # 7719".

ABBREVIATIONS
10' PUE = PUBLIC UTILITY EASEMENTS
GRANTED WITH THIS PLAT
ROW = RIGHT-OF-WAY


ALL STREETS SHOWN
HEREON ARE HEREBY
DEDICATED AS PUBLIC
RIGHT-OF-WAY

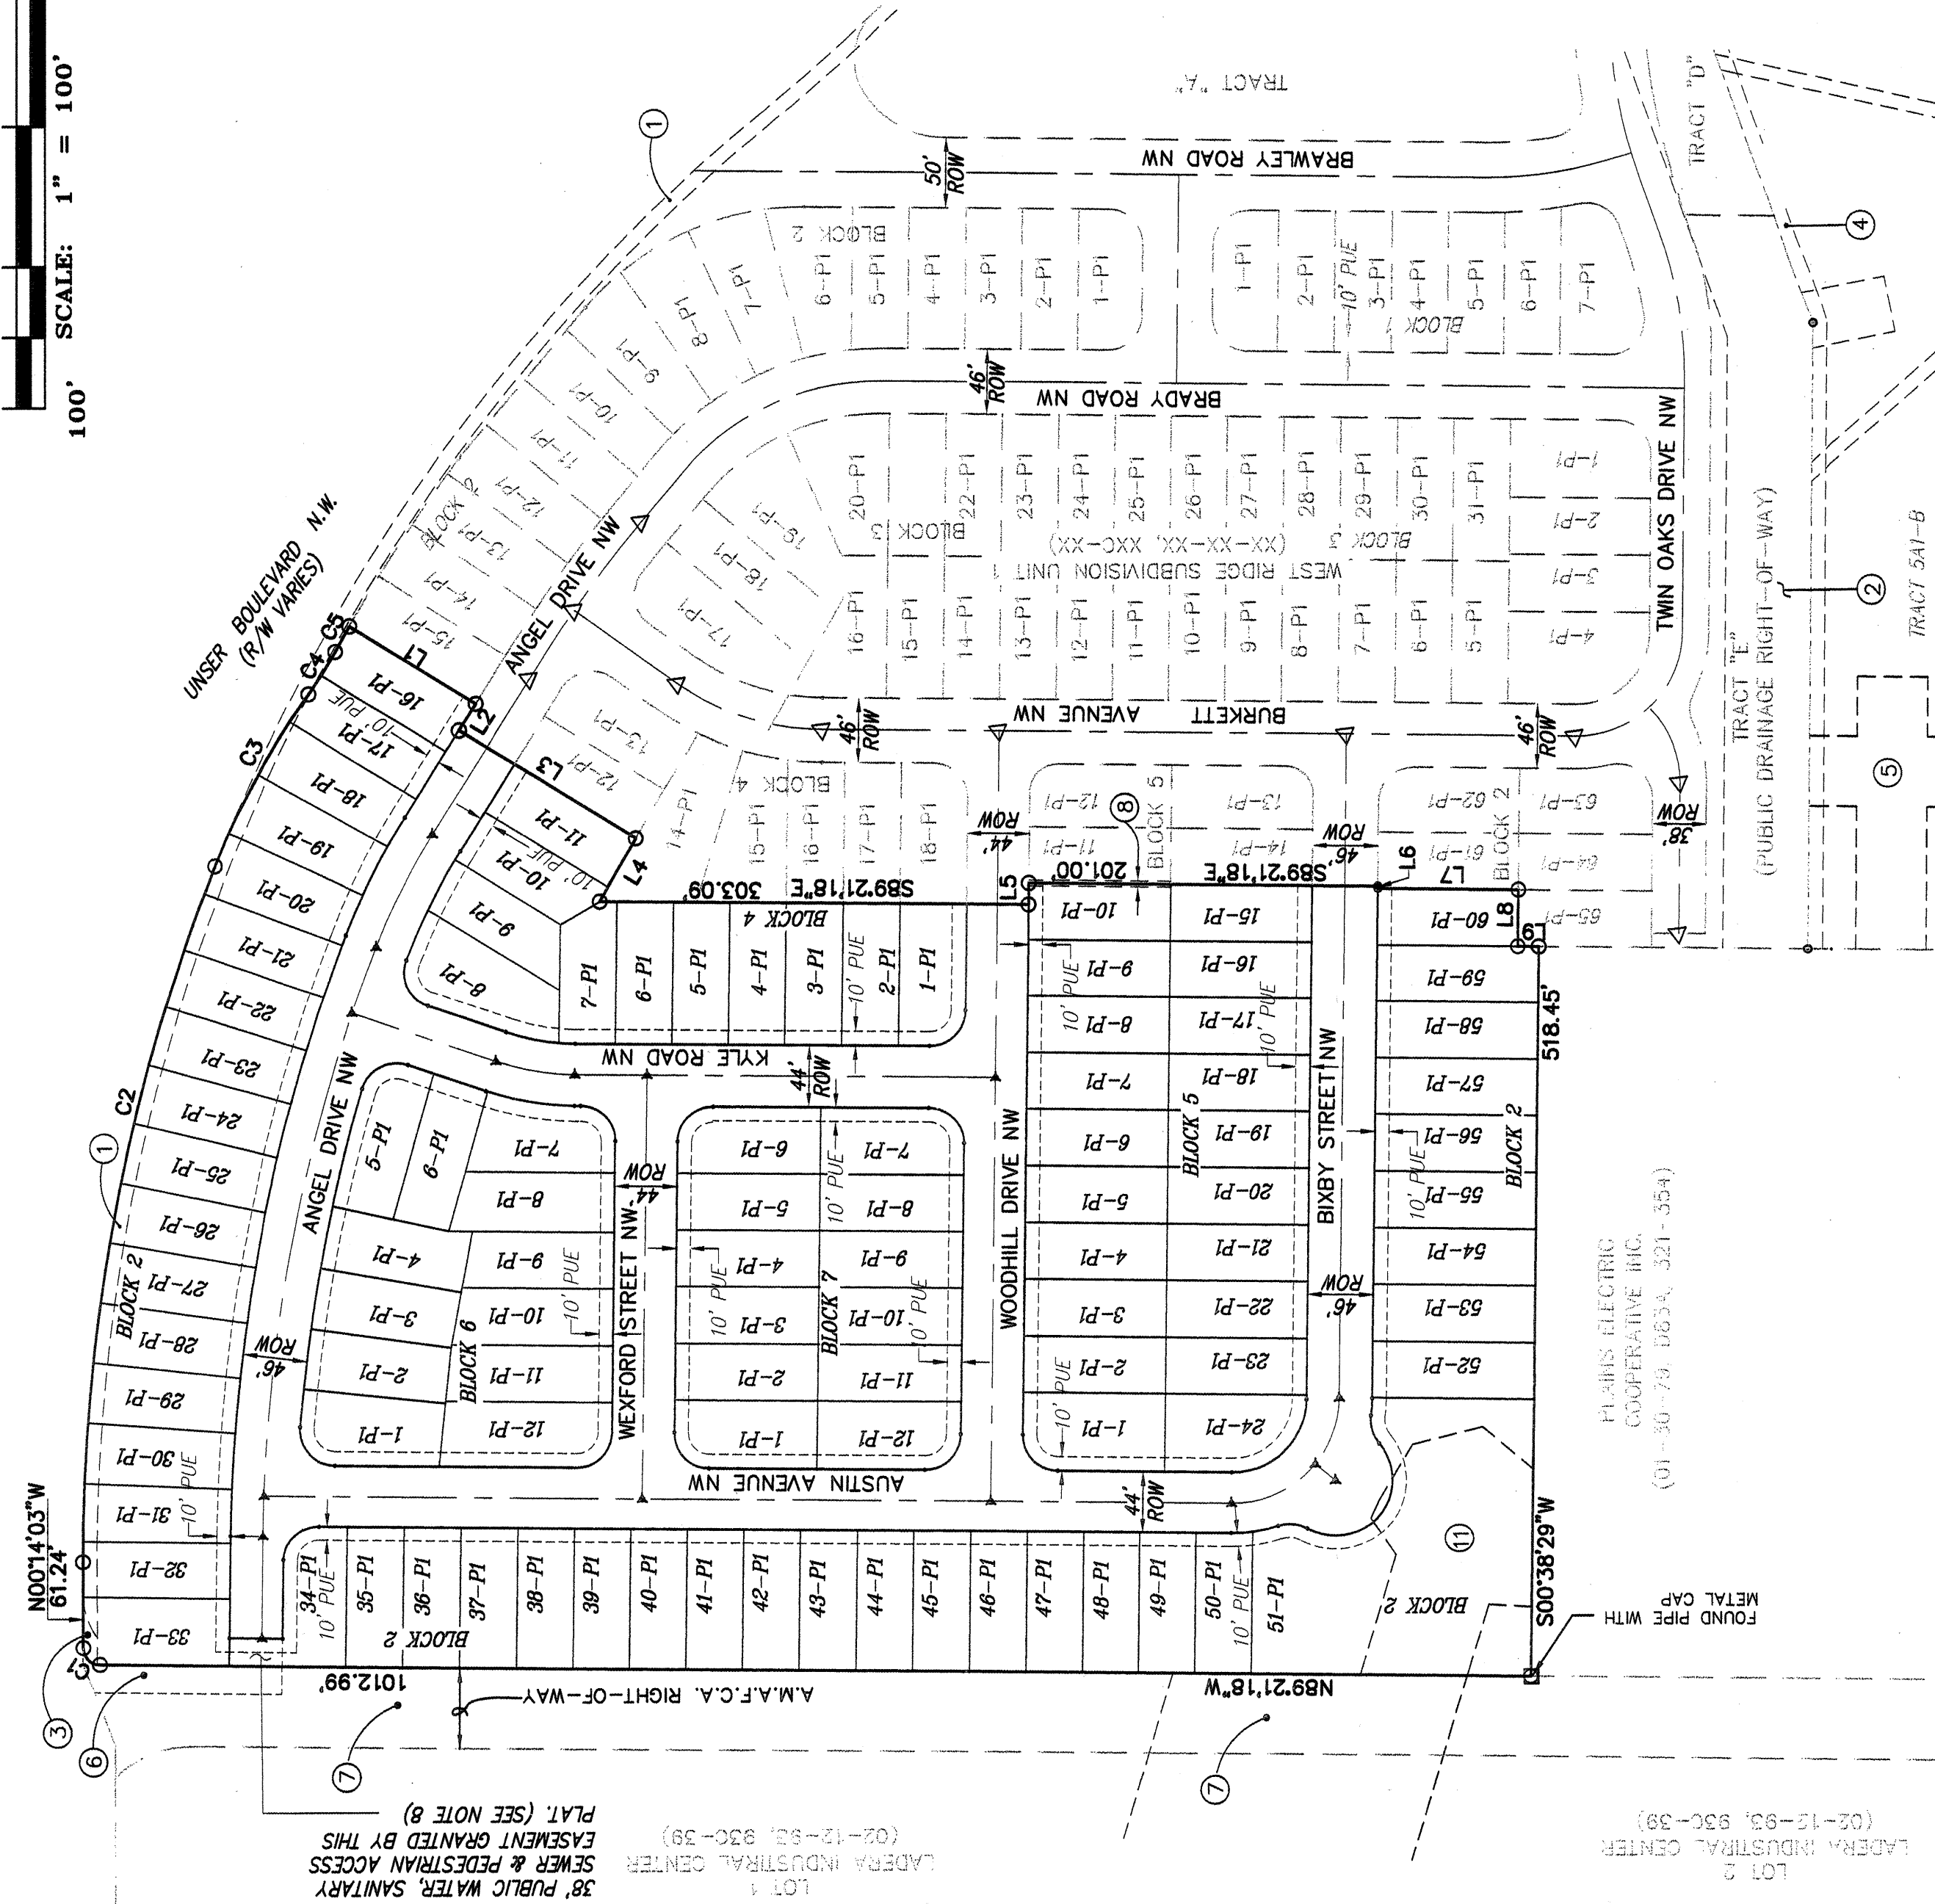

For Information Only
City Project #708292 Map #H9&10 Sht 3 of 18

PLAT FOR
**WEST RIDGE SUBDIVISION
UNIT 2**

WITHIN THE
TOWN OF ATRISCO GRANT
PROJECTED SECTIONS 3, 4, 9 AND 10
TOWNSHIP 10 NORTH, RANGE 2 EAST, NMPM
CITY OF ALBUQUERQUE
BERNALILLO COUNTY, NEW MEXICO
MARCH, 2003

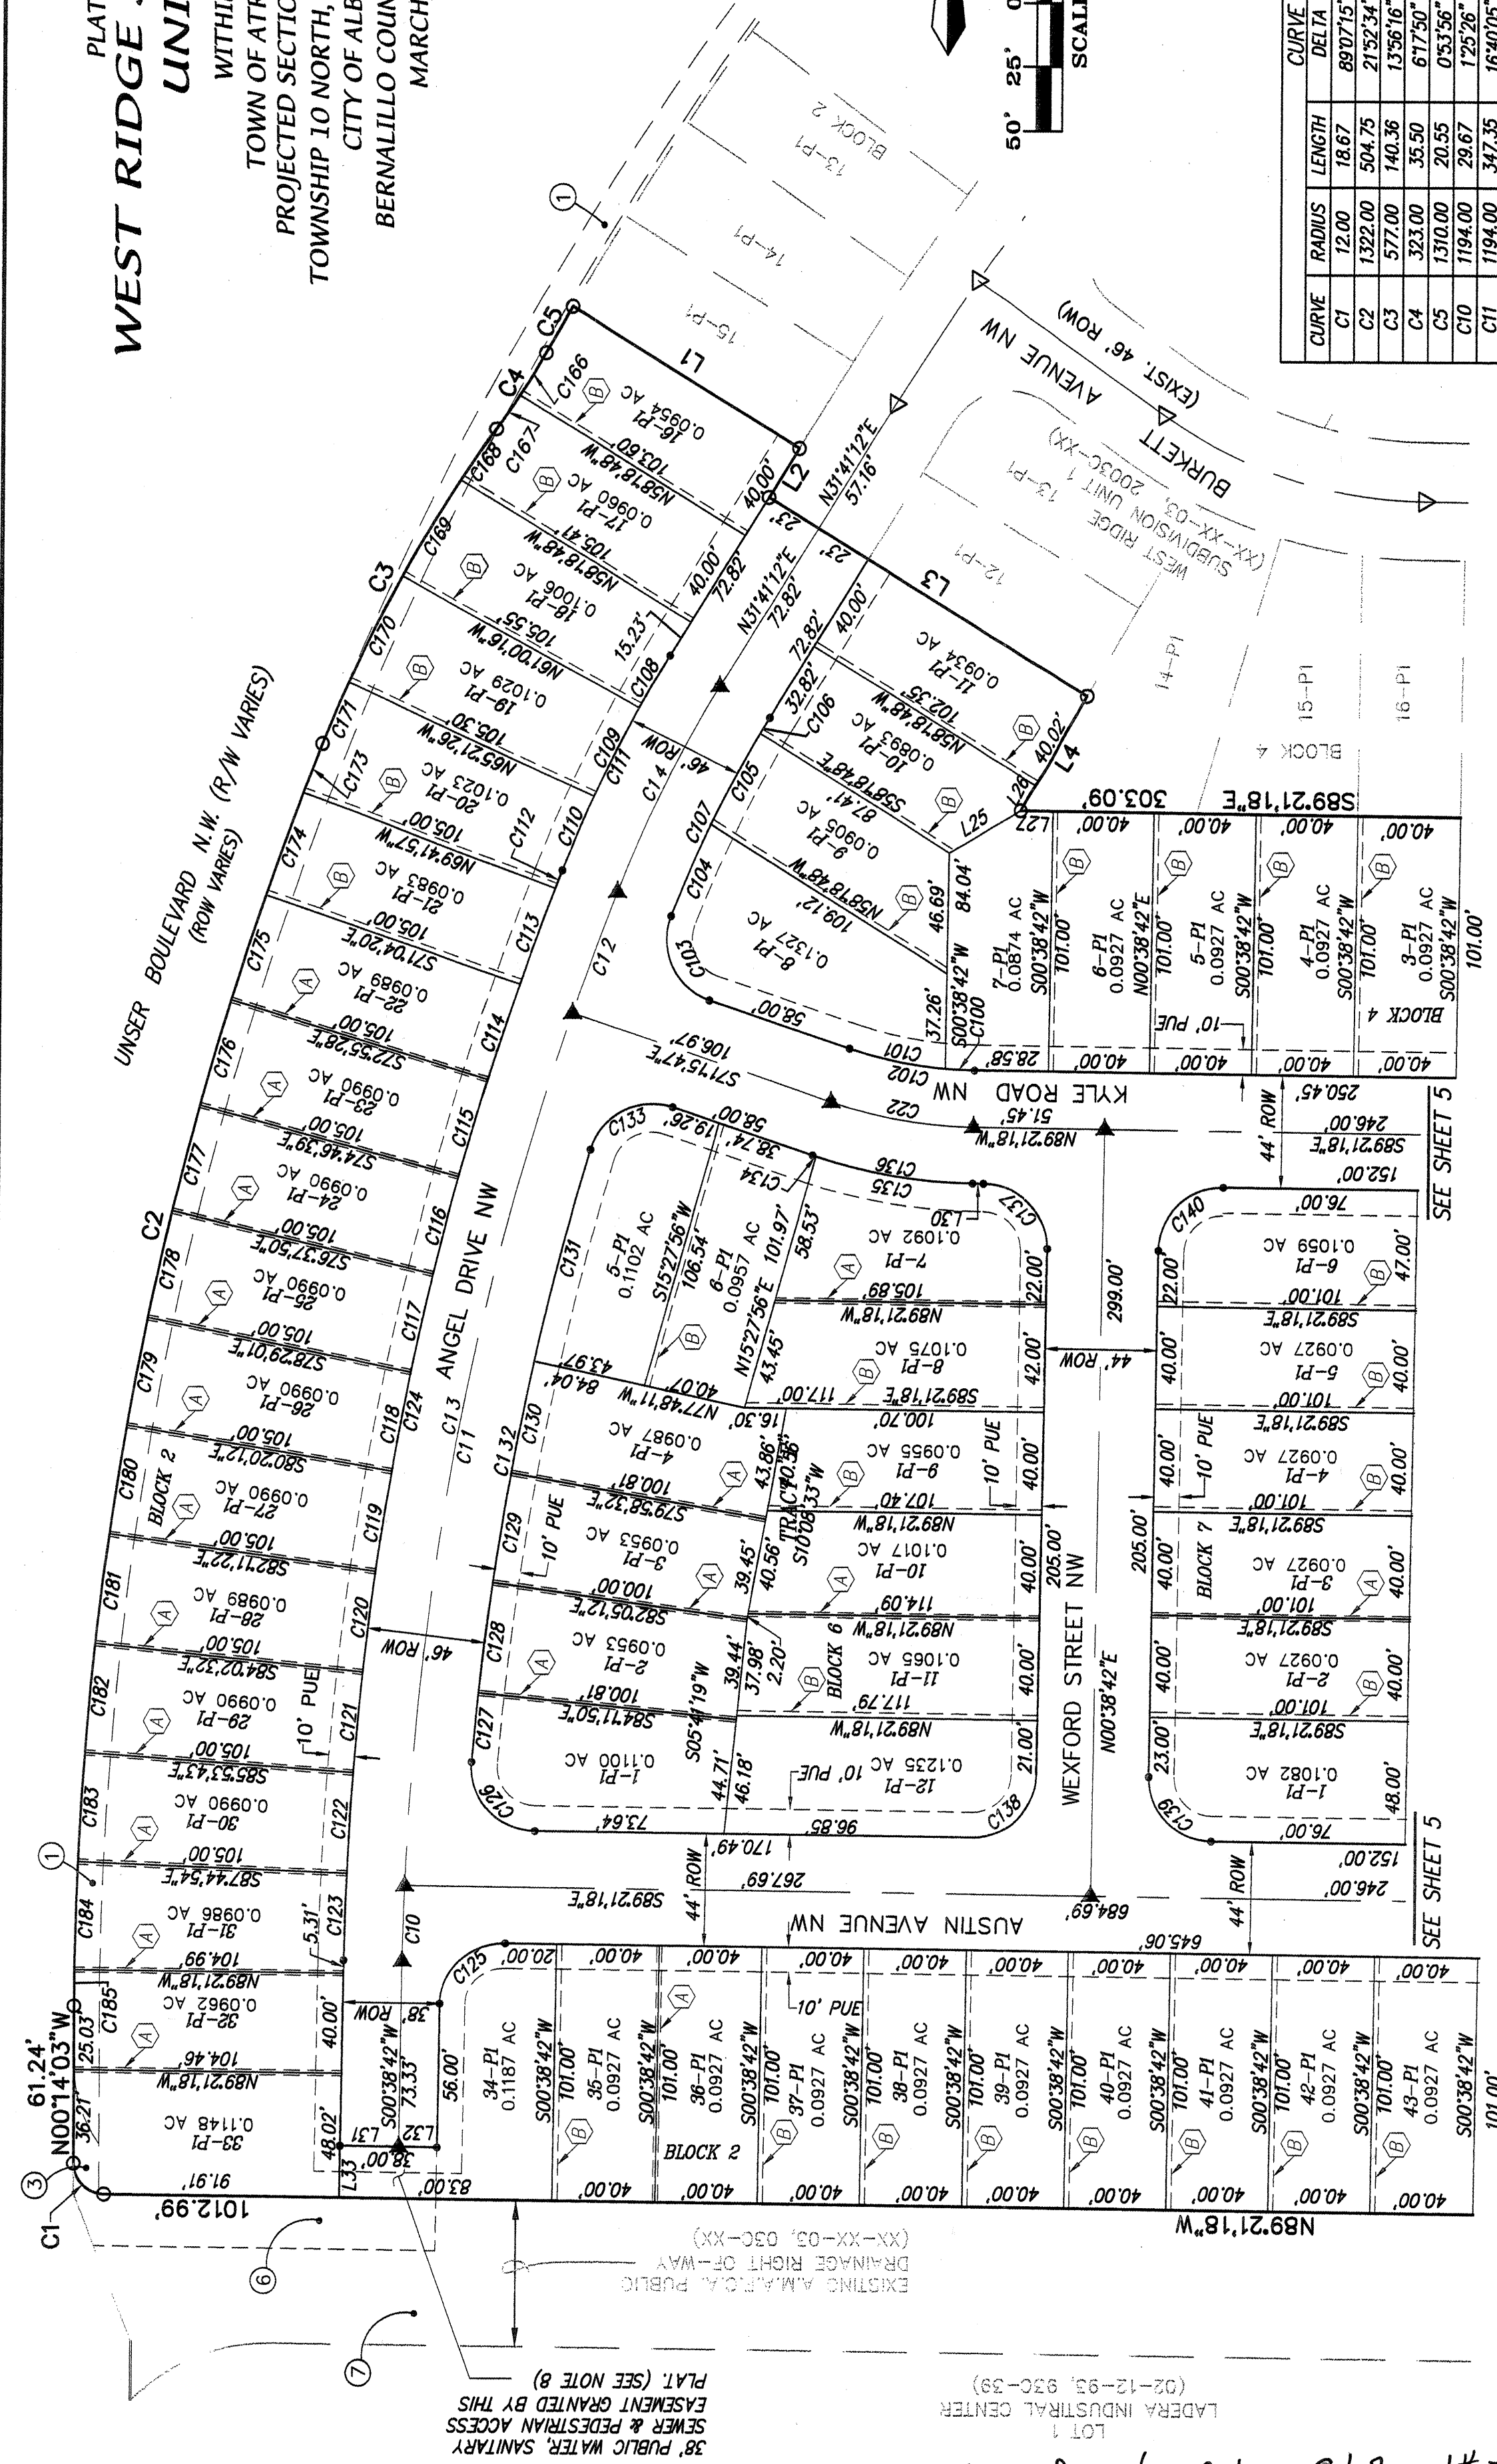

CURVE	RADIUS	LENGTH	DELTA	TANGENT	CHORD	BRG
C1	12.00	18.67	89.0715°	11.82	S44.4740°E	16.84
C2	13.00	504.75	21.5234°	255.49	S10.4214°W	501.69
C3	577.00	140.36	13.5616°	70.53	S28.3546°W	140.01
C4	323.00	35.50	6.1750°	17.77	N37.2459°E	35.48
C5	1310.00	20.55	0.5356°	10.28	S29.4302°W	20.55
C6	1194.00	29.67	1.2526°	14.84	S01.2125°W	29.67
C7	1194.00	347.35	16.4005°	174.91	S10.2411°W	346.12
C8	1194.00	50.03	2.2402°	25.02	S19.5614°W	50.02
C9	1194.00	427.05	20.2931°	215.63	S10.5328°W	424.77
C10	484.04	88.12	10.3258°	44.69	S26.2444°W	88.00
C11	180.00	108.96	18.0531°	28.66	S80.0832°E	56.60
C12	180.00	108.96	34.4104°	56.71	S77.0046°E	107.31
C13	75.00	67.48	51.3254°	36.71	N4.5201°E	65.22
C14	75.00	50.33	39.2708°	26.16	N19.5215°E	49.39
C15	25.00	39.27	90.0000°	25.00	N43.3842°E	35.36
C16	158.00	8.08	2.5551°	4.04	S07.5312°E	8.08
C17	158.00	38.46	13.565°	19.33	S28.1415°E	38.37
C18	158.00	49.89	19.0271°	25.15	S00.7632°E	49.88
C19	158.00	40.26	32.1628°	26.01	S23.0745°E	38.67
C20	461.04	38.69	4.4828°	10.35	S23.2434°W	40.07
C21	461.04	7.18	0.5352°	3.59	S37.1426°W	7.18
C22	461.04	65.95	10.4031°	43.10	S26.2047°W	65.82
C23	507.04	23.82	2.4129°	11.91	S30.2028°W	23.82
C24	507.04	36.32	4.2110°	19.27	S26.4909°W	36.51

EASEMENTS

- (A) 2' PRIVATE DRAINAGE EASEMENT
CENTERED ON LOT LINE
(SEE NOTE THIS SHEET)
- (B) 2' PRIVATE DRAINAGE EASEMENT
ON LOW SIDE OF LOT LINE
(SEE NOTE THIS SHEET)

PRIVATE DRAINAGE EASEMENTS:

2' wide private drainage easements are located in some side yards as shown hereon. Where the difference in elevation between the two adjacent pads is 0.8' or less the easement is centered on the lot line. Where the difference is more than 0.8' but less than 1.4' the easement is entirely on the low side of the lot line and immediately adjacent to that lot line. Where the easement is centered on the lot line it is for the mutual benefit of both lot owners and is to be jointly maintained. Where the easement is entirely on the low side of the lot line the easement is for the benefit of the adjacent "high side" lot owner and shall be maintained by the underlying "low side" lot owner. Neither lot owner is allowed to change the planned grade within the 2' wide private drainage easement, nor shall either lot owner place any loose material adjacent to the easement that has the potential to be moved into the drainage easement or in any other way block drainage in any portion of the easement, except that a fence or block wall may be centered on the lot line. Under no circumstances shall the grade adjacent to the easement on either side of the easement be changed except by a structurally sound retaining wall, as designed by a registered professional engineer or architect. Where no easement is shown on the plat each lot owner must construct, operate and maintain his own separate swale all the way to the street and cross lot drainage will be prevented by some combination of walls and berms on the common lot line to be jointly maintained by both lot owners.

NOTE: CENTERLINE (IN LIEU OF R/W) MONUMENTATION IS TO BE INSTALLED AT THE CENTERLINE OF EACH LOT, AT THE INTERSECTION OF A LOT LINE AND A STREET OR INTERSECTION OF A LOT LINE AND A CENTERLINE MONUMENT, TO NOT DISTURB, PLS # 1719.

ABBREVIATIONS

- 10' PUE = PUBLIC UTILITY EASEMENTS
GRANTED WITH THIS PLAT
- ROW = RIGHT-OF-WAY

ALL STREETS SHOWN
HEREON ARE HEREBY
DEDICATED AS PUBLIC
RIGHT-OF-WAY

NOTE:
CENTERLINE (IN LIEU OF R/W) MONUMENTATION IS TO BE INSTALLED
CENTERLINE P.C.'S, P.T.'S, ANGLE POINTS AND STREET
INTERSECTION POINTS, HEREON, AND WILL CONSIST OF A FOUR
INCH (4") WOODEN NAIL CAP STAMPED "CITY OF ALBUQUERQUE".
CENTERLINE MONUMENT: DO NOT DISTURB. P.T.S # 17719.

ALL STREETS SHOWN
HEREON ARE HEREBY
DEDICATED AS PUBLIC
RIGHT-OF-WAY


EASEMENTS

- (A) 2' PRIVATE DRAINAGE EASEMENT
CENTERED ON LOT LINE
(SEE NOTE ON SHEET 4)
- (B) 2' PRIVATE DRAINAGE EASEMENT
ON LOW SIDE OF LOT LINE
(SEE NOTE ON SHEET 4)

LINE ID	LENGTH	BEARING	LINE ID	LENGTH	BEARING
L1	104.54	S89°18'48"E	L31	23.00	N89°21'18"W
L2	22.41	N31°41'12"E	L32	15.00	N89°21'18"W
L3	147.17	N89°18'48"W	L33	20.00	S00°38'42"W
L4	51.44	N30°00'20"E	L36	68.38	N16°22'38"E
L5	15.00	N00°38'42"E	L37	32.42	N33°03'06"W
L6	1.55	S00°38'42"W	L38	14.96	N23°50'44"E
L7	100.00	N89°21'18"W	L39	45.32	N37°07'45"E
L8	40.00	N00°38'42"E	L40	50.93	N76°17'00"E
L9	15.00	N89°21'18"W	L41	46.73	S50°54'18"E
L25	32.38	N59°43'02"E	L42	53.15	N16°40'26"E
L26	11.42	N30°00'20"E	L43	30.70	S86°36'04"E
L27	12.22	S89°21'18"E	L44	10.01	N00°30'08"E
L30	4.45	S89°21'18"E			


PLAT FOR
WEST RIDGE SUBDIVISION
UNIT 2
WITHIN THE
TOWN OF ATRISCO GRANT
PROJECTED SECTIONS 3, 4, 9 AND 10
TOWNSHIP 10 NORTH, RANGE 2 EAST, NMPM
CITY OF ALBUQUERQUE
BERNALILLO COUNTY, NEW MEXICO
MARCH, 2003

CURVE	RADIUS	LENGTH	DELTA	TANGENT	CHORD	BRG	CHORD
C110	507.04	31.02	330°19"	15.52	522°32'4"W	31.02	522°32'4"W
C111	507.04	63.36	103°32'58"	46.81	S26°24'44"W	93.22	S26°24'44"W
C112	1217.00	7.40	0°20'55"	3.70	S20°57'47"W	7.40	S20°57'47"W
C113	1217.00	38.53	1°51'39"	19.77	S19°51'30"W	38.53	S19°51'30"W
C114	1217.00	38.53	1°51'08"	19.67	S18°00'06"W	38.34	S18°00'06"W
C115	1217.00	38.36	1°51'11"	19.68	S16°08'57"W	38.36	S16°08'57"W
C116	1217.00	38.36	1°51'11"	19.68	S14°17'46"W	38.36	S14°17'46"W
C117	1217.00	38.36	1°51'11"	19.68	S12°26'35"W	38.36	S12°26'35"W
C118	1217.00	38.35	1°51'10"	19.68	S10°35'23"W	38.35	S10°35'23"W
C119	1217.00	38.35	1°51'10"	19.68	S08°44'13"W	38.35	S08°44'13"W
C120	1217.00	38.35	1°51'10"	19.68	S06°53'03"W	38.35	S06°53'03"W
C121	1217.00	38.35	1°51'10"	19.68	S05°01'52"W	38.35	S05°01'52"W
C122	1217.00	38.36	1°51'11"	19.68	S03°10'41"W	38.36	S03°10'41"W
C123	1217.00	34.12	1°36'24"	17.06	S01°26'54"W	34.12	S01°26'54"W
C124	1217.00	43.52	2°29'33"	21.99	S00°53'28"W	43.52	S00°53'28"W
C125	25.00	39.27	90°00'00"	25.00	S45°38'42"W	35.36	S45°38'42"W
C126	25.00	40.94	93°49'56"	26.73	S42°26'20"E	36.52	S42°26'20"E
C127	1171.00	27.01	17°19'18"	13.51	S05°08'31"W	27.01	S05°08'31"W
C128	1171.00	43.14	2°06'38"	21.57	S06°51'29"W	43.13	S06°51'29"W
C129	1171.00	43.15	2°06'40"	21.58	S08°58'08"W	43.14	S08°58'08"W
C130	1171.00	44.40	2°10'21"	22.20	S11°06'19"W	44.40	S11°06'19"W
C131	1171.00	55.63	4°11'22"	42.83	S14°17'30"W	55.61	S14°17'30"W
C132	1171.00	243.32	11°54'19"	122.10	S10°26'02"W	242.88	S10°26'02"W
C133	25.00	40.29	92°20'48"	26.05	S02°33'49"W	36.07	S02°33'49"W
C134	202.00	1.33	0°22'45"	0.66	S77°27'04"E	1.33	S77°27'04"E
C135	202.00	62.46	1°24'56"	31.48	S80°23'50"E	62.21	S80°23'50"E
C136	202.00	63.78	1°05'31"	32.16	S83°18'32"E	63.52	S83°18'32"E
C137	25.00	39.27	90°00'00"	25.00	N44°21'18"W	35.36	N44°21'18"W
C138	25.00	39.27	90°00'00"	25.00	N45°38'42"E	35.36	N45°38'42"E
C139	25.00	39.27	90°00'00"	25.00	N47°07'18"E	35.36	N47°07'18"E
C140	25.00	39.27	90°00'00"	25.00	N48°36'02"E	35.36	N48°36'02"E
C141	25.00	39.27	90°00'00"	25.00	N49°49'14"E	35.36	N49°49'14"E
C142	25.00	39.27	90°00'00"	25.00	N50°54'18"E	35.36	N50°54'18"E
C143	25.00	39.27	90°00'00"	25.00	N51°58'42"E	35.36	N51°58'42"E
C146	52.00	81.68	90°00'00"	52.00	N53°58'42"E	73.34	N53°58'42"E
C147	97.00	12.85	83°14'	7.82	N57°12'51"E	14.99	N57°12'51"E
C148	97.00	12.85	107°32'	8.36	N76°18'14"E	14.99	N76°18'14"E
C149	25.00	33.56	19°49'14"	16.95	N84°39'22"W	33.39	N84°39'22"W
C150	25.00	21.40	49°02'19"	11.40	N89°41'02"E	20.75	N89°41'02"E
C151	25.00	171.85	160°21'31"	13.20	N93°12'27"E	78.83	N93°12'27"E
C152	25.00	21.06	708°08"	6.11	N00°38'42"E	20.45	N00°38'42"E
C153	33.00	19.46	37°08"	9.73	N03°58'38"E	19.46	N03°58'38"E
C156	93.00	12.20	70°08"	8.02	N34°08'33"E	16.04	N34°08'33"E
C167	57.00	16.04	2°50'42"	12.00	S3°22'23"W	24.00	S3°22'23"W
C169	57.00	24.01	2°23'02"	22.02	S3°59'46"W	44.00	S3°59'46"W
C170	57.00	46.53	4°27'14"	23.28	S8°30'03"W	46.52	S8°30'03"W
C171	57.00	25.81	2°33'48"	12.91	S27°53'35"W	25.81	S27°53'35"W
C173	132.00	20.59	0°53'30"	10.29	S27°11'46"W	20.58	S27°11'46"W
C174	132.00	42.04	1°49'20"	21.02	S19°50'20"W	42.04	S19°50'20"W
C175	132.00	42.74	1°51'08"	21.37	S18°00'06"W	42.73	S18°00'06"W
C176	132.00	42.76	1°51'11"	21.38	S16°08'57"W	42.75	S16°08'57"W
C177	132.00	42.76	1°51'11"	21.38	S14°17'46"W	42.76	S14°17'46"W
C178	132.00	42.76	1°51'11"	21.38	S12°26'35"W	42.75	S12°26'35"W
C179	132.00	42.76	1°51'11"	21.38	S10°35'23"W	42.76	S10°35'23"W
C180	132.00	42.75	1°51'10"	21.38	S08°44'13"W	42.75	S08°44'13"W
C181	132.00	42.75	1°51'10"	21.38	S06°53'03"W	42.75	S06°53'03"W
C182	132.00	42.76	1°51'11"	21.38	S05°01'52"W	42.75	S05°01'52"W
C183	132.00	42.76	1°51'11"	21.38	S03°10'41"W	42.76	S03°10'41"W
C184	132.00	42.38	1°50'12"	21.19	S01°20'00"W	42.37	S01°20'00"W
C185	132.00	14.98	0°38'57"	7.49	S00°05'25"W	14.98	S00°05'25"W

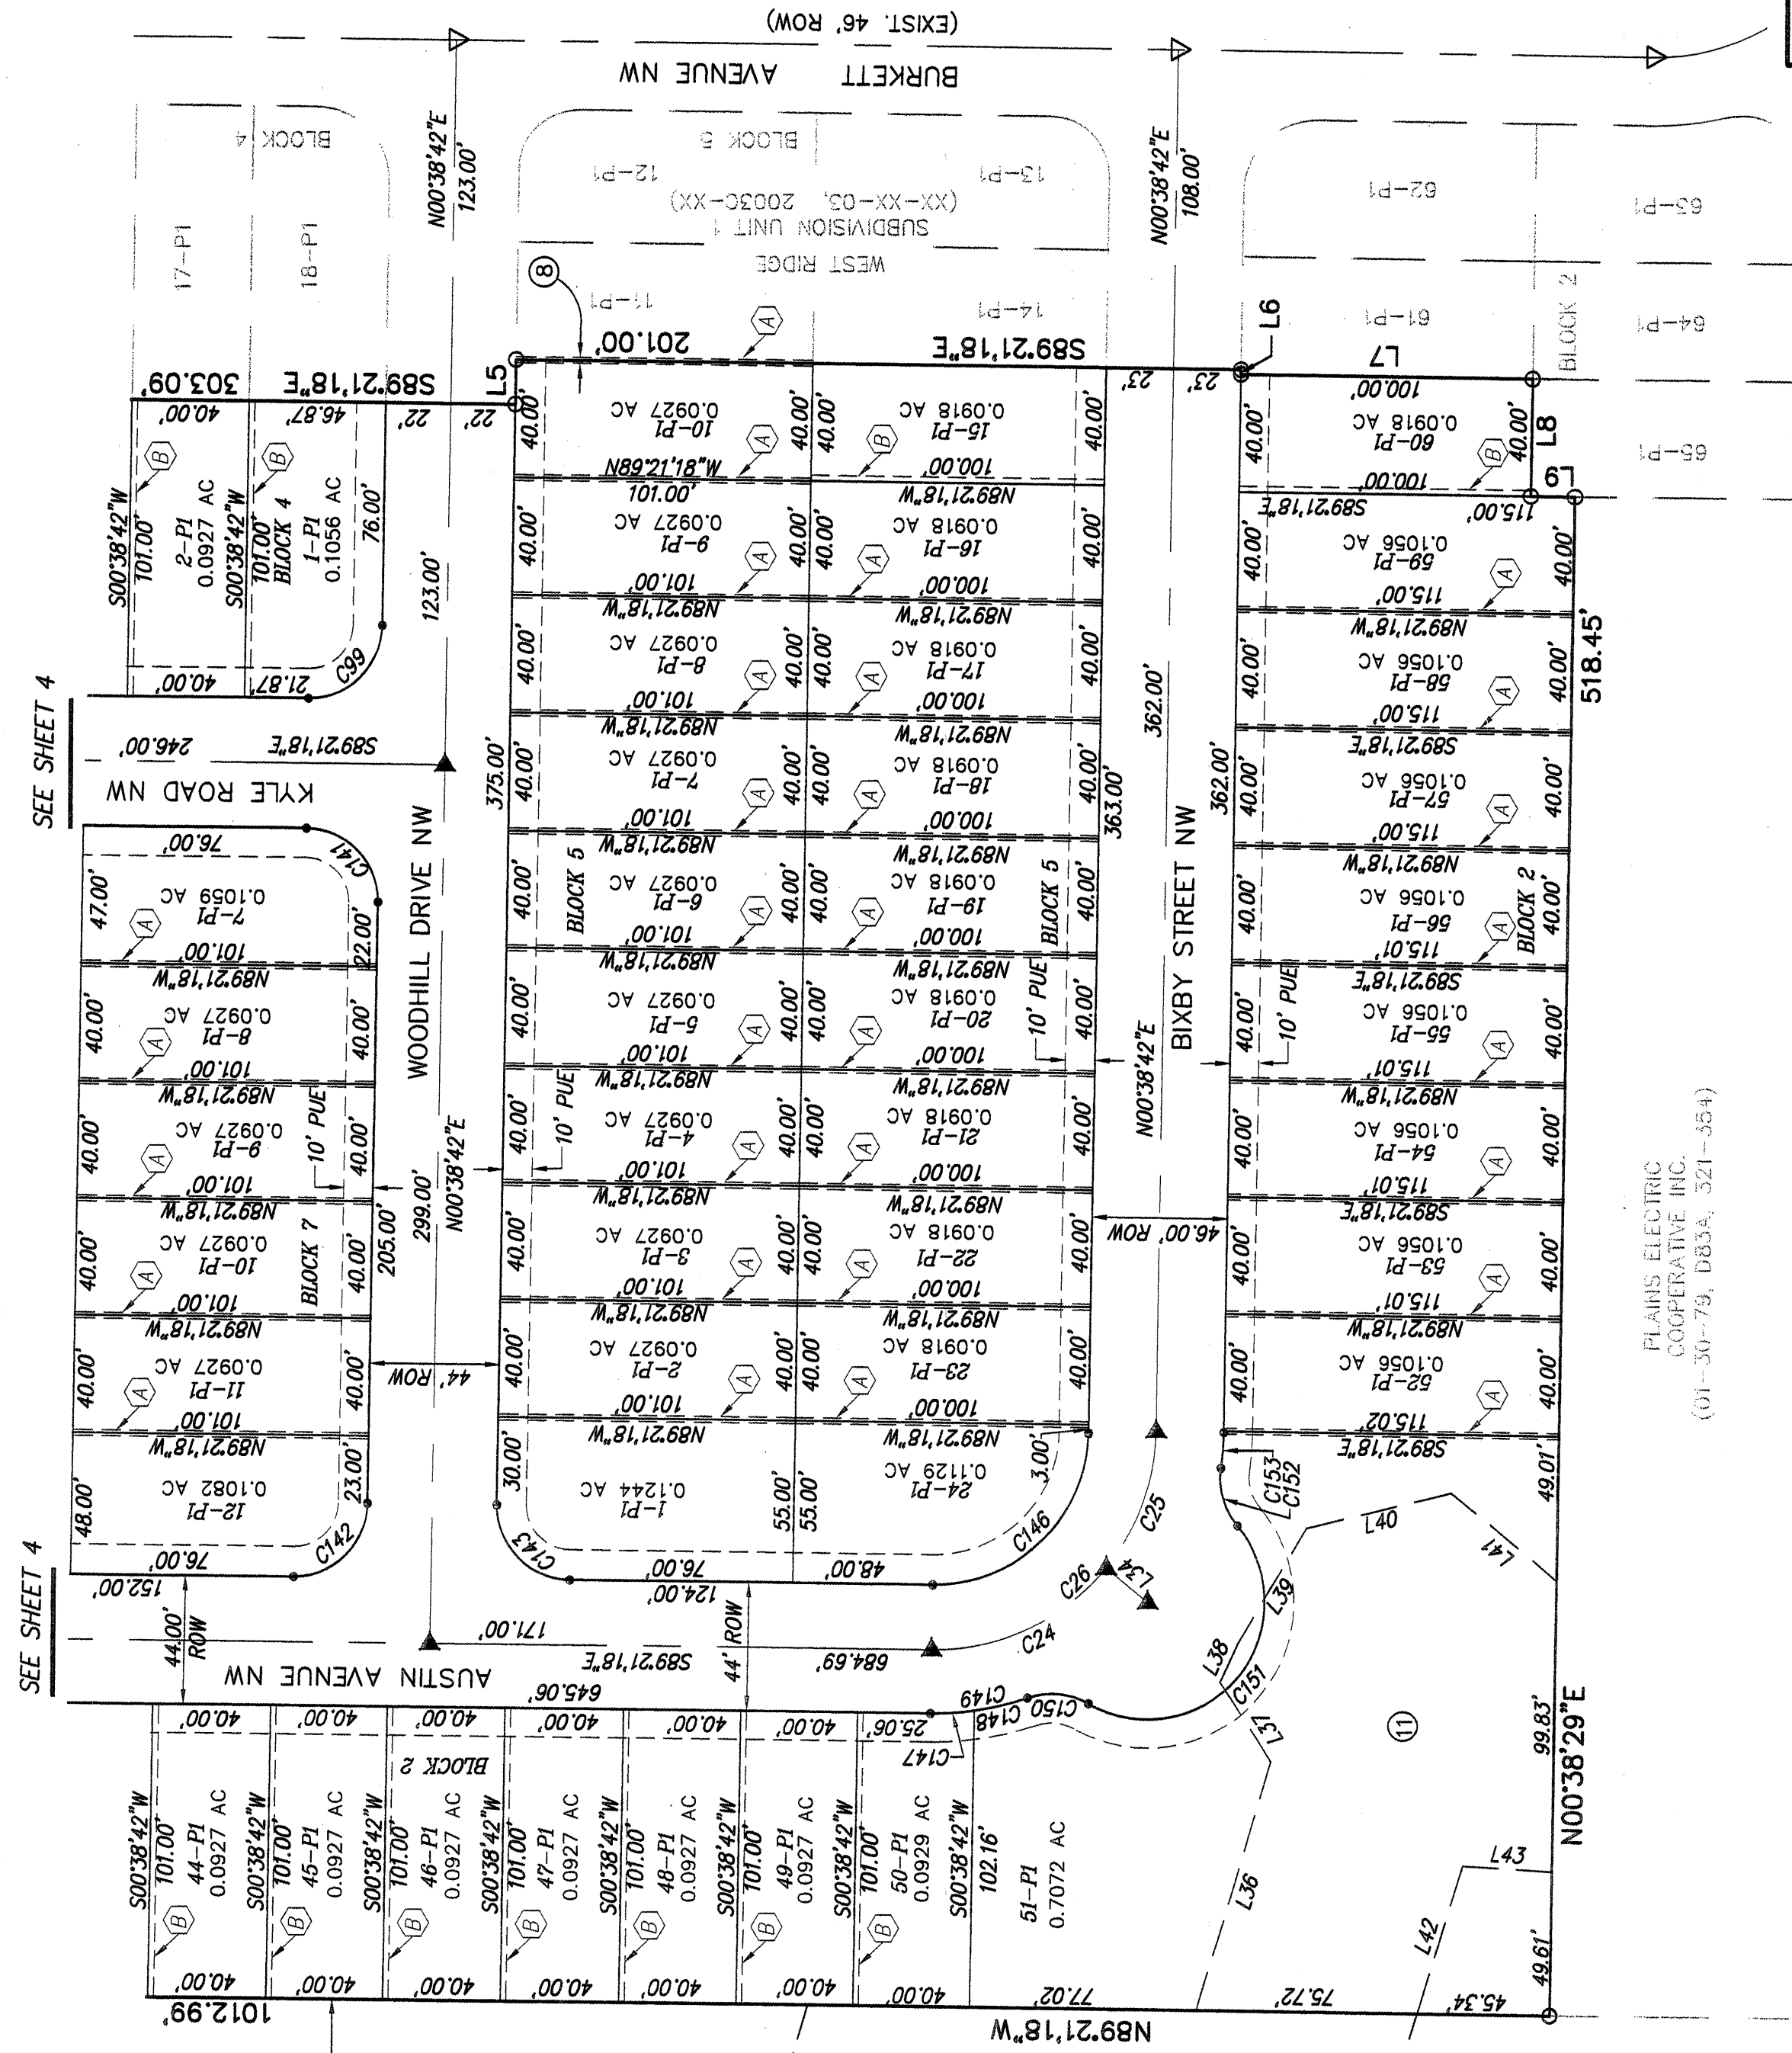


For Information Only

City of Albuquerque
Project # 708282 Map H9&10 Sht #5 of 18

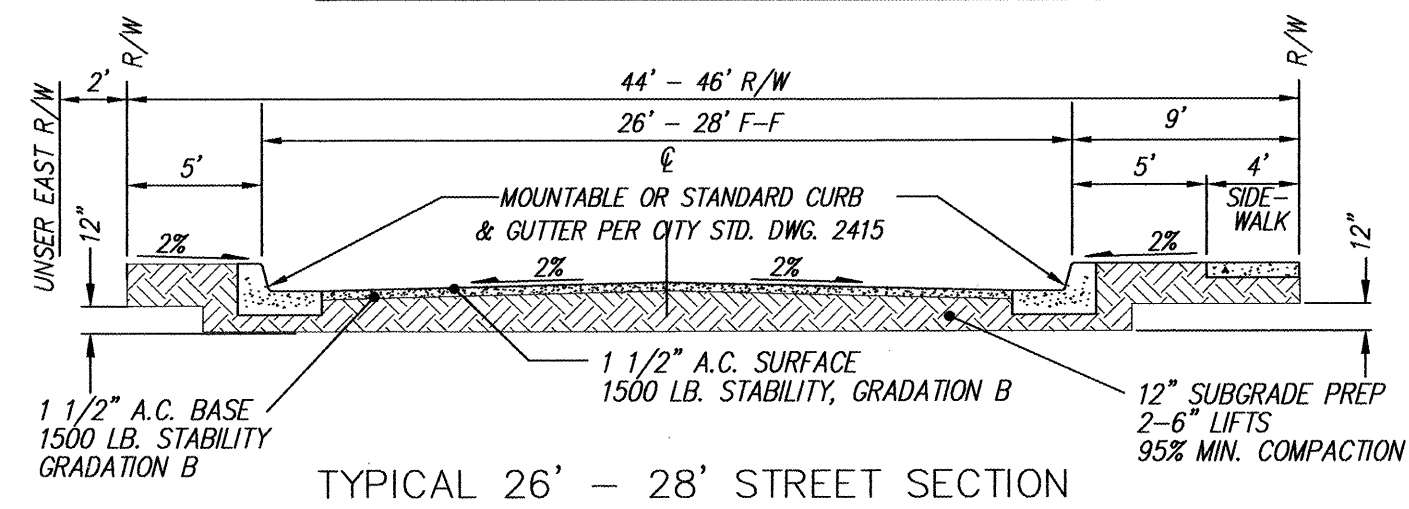

I, James D. Hughes, NMPE 11674, of the firm Mark Goodwin & Associates, PA, a Registered Professional Engineer in the State of New Mexico, do hereby certify, to the best of my knowledge and belief, that the infrastructure installed as part of this project has been inspected by me or by a qualified person under my direct supervision, and has been constructed in accordance with the plans and specifications approved by the City Engineer and that the original design intent of the approved plans has been met, except as noted by me on the as-built construction drawings. This Certification is based on site inspections by me or personnel under my direction, and survey information provided by ALS, Inc., NMPS number 7719.

 

	STANDARD CURB & GUTTER
	MOUNTABLE CURB & GUTTER, ROLL TYPE
	4" AC PAVEMENT
	ARTERIAL PAVEMENT
	MEDIAN PAVING PER COA STD DWG 2408
	EXIST. CABLE T.V. PEDESTAL
	EXIST. OVERHEAD ELECTRIC LINE
	EXIST. OVERHEAD TELEPHONE LINE
	EXIST. P.P.
	EXIST. DROP INLET
	EXISTING EDGE OF PAVEMENT
	EXISTING CURB & GUTTER
	FUTURE CURB & GUTTER
	NEW STREET LIGHTS

dmg MARK GOODWIN & ASSOCIATES, P.A.
CONSULTING ENGINEERS
P.O. BOX 90606
ALBUQUERQUE, NEW MEXICO 87199
(505) 828-2200, FAX (505) 797-9539

CITY OF ALBUQUERQUE
PUBLIC WORKS DEPARTMENT

TITLE: ***WEST RIDGE SUBDIVISION - UNIT 2
MASTER PAVING PLAN***

DESIGN REVIEW COMMITTEE

APPROVED

JAN - 8 2004

DESIGN
REVIEW COMMITTEE

CITY ENGINEER APPROVAL

APPROVE

JAN - 8 2004

CITY PROJECT NO.	ZONE MAP NO.	SHEET OF
708282	H-9 & 10	8 18

NOTE:
REQUIRED WHERE 4' RESIDENTIAL PAVING IS INDICATED THIS SHEET

2" ASPHALT CONC. TYPICAL FINISH COURSE PLACED AFTER ALL MANHOLE VALVES, COVERS/RINGS ARE SET TO GRADE. 1500 LBS. STABILITY TYPE B GRADATION.

2" ASPHALT CONCRETE 1500 LBS. STABILITY, TYPE B GRADATION.

12" SUBGRADE SOIL. R-VALUE > 50. PLACED IN 2-6" COMPACTED LISTS. 95% MIN. COMPACTION; AT OPT. MOISTURE # 1.00. MAX. ALLOW. 0.15% OPT. MOISTURE TO +.4% ASTM D698 FOR SOIL W/35% OR MORE MATERIAL PASSING THE NO. 200 SIEVE TO EXTEND FULL WIDTH OF ROADWAY TO 1.0' BAWD OF NEW CURB PER SECTION 301.1.

1-1/2" ASPHALT CONC. TYPICAL FINISH
COURSE PLACED AFTER ALL MANHOLE,
VALVES COVERS/RINGS ARE SET TO GRADE
1500 LBS. STABILITY TYPE B GRADATION.

1-1/2" ASPHALT CONCRETE 1500 LBS.
STABILITY, TYPE B GRADATION.

5" SUBBASE TO BE ADDED AFTER COMPLETION
OF CURB AND TAPERED TO 0" IN 10± FROM
EDGE OF GUTTER. SUBGRADE PREP SHALL NOT
EXTEND BELOW THE BOTTOM OF THE GUTTER
— PER SECTION 301.4.1

RESIDENTIAL PAVEMENT SECTION

N.T.S. (PER CITY STD. DWG. 2405)



NOTE: IF R-VALUE IS LESS THAN 50
CONTRACTOR WILL REPLACE 12" OF SUBGRADE
WITH MATERIAL WITH AN R-VALUE OF 50 OR
GREATER.

TYPICAL 32' STREET SECTION (4" PAVING)

N.T.S.

A2031WRD/PLANS/UNIT 2/A2031MPAV-2.DWG/12-17-03 KJS ACH DER

SCANNED BY
MESA REPRO

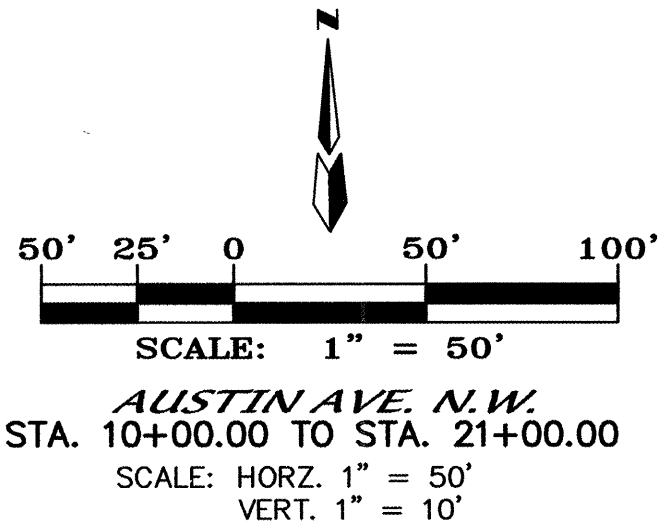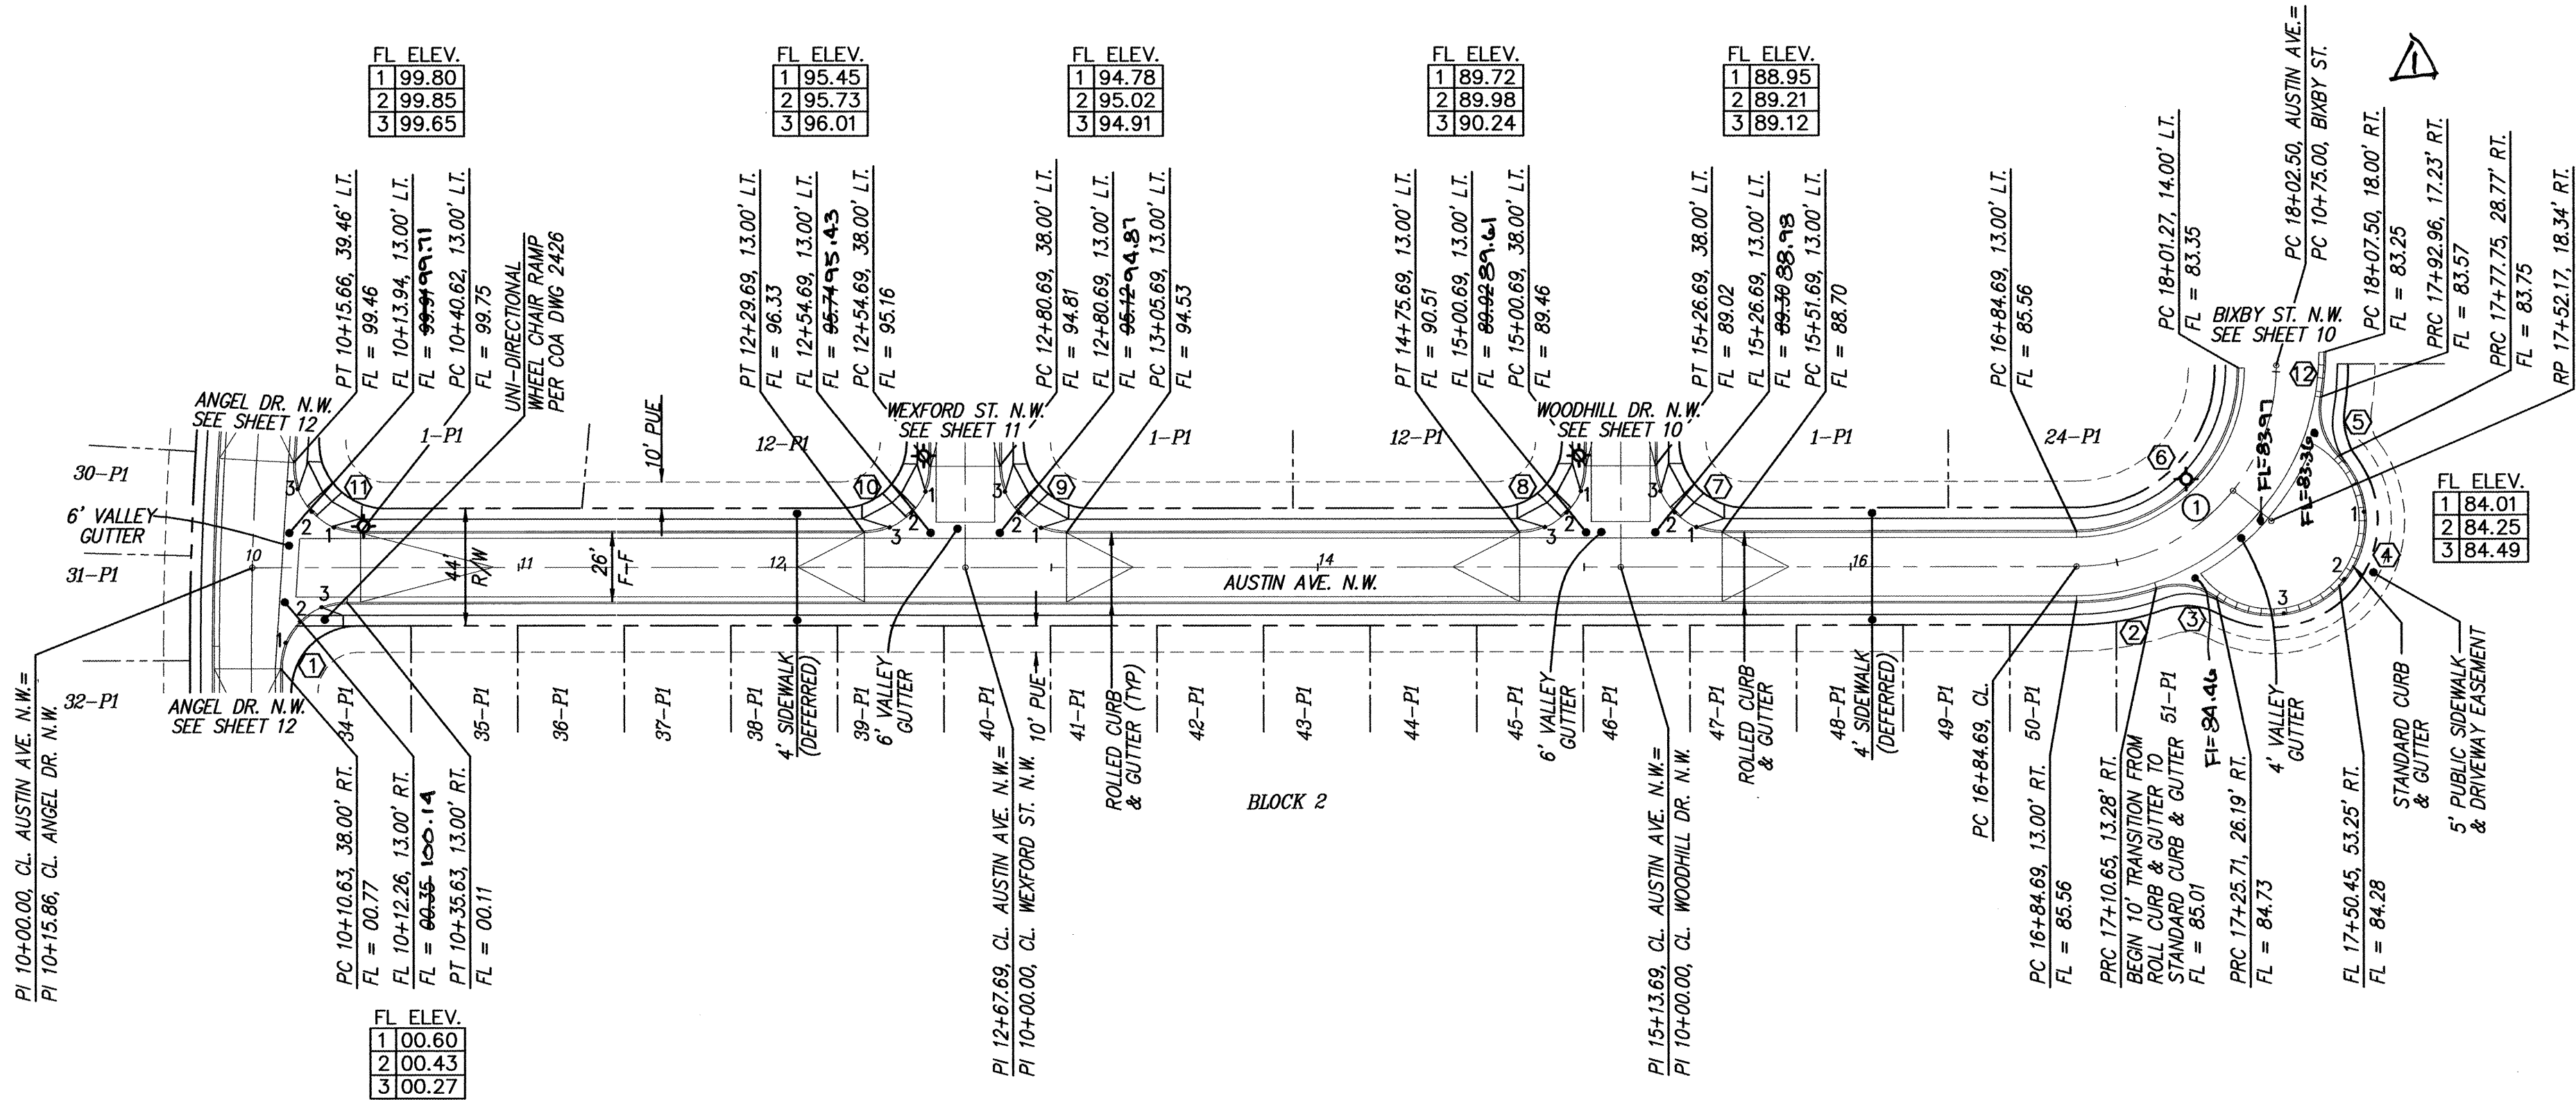

NOTES

1. ALL STATIONING IS CENTERLINE STATIONING.

CURVE DATA - DESCRIBES FACE OF CURB

① $\Delta = 90^{\circ}00'00''$ $R = 25.00'$ $L = 39.27'$ $T = 25.00'$	② $\Delta = 18^{\circ}47'21''$ $R = 93.00'$ $L = 30.50'$ $T = 15.39'$
③ $\Delta = 54^{\circ}34'49''$ $R = 25.00'$ $L = 23.82'$ $T = 12.90'$	④ $\Delta = 170^{\circ}01'45''$ $R = 35.00'$ $L = 103.86'$ $T = 401.23'$
⑤ $\Delta = 55^{\circ}34'49''$ $R = 25.00'$ $L = 23.82'$ $T = 12.90'$	⑥ $\Delta = 90^{\circ}00'00''$ $R = 61.00'$ $L = 95.82'$ $T = 61.00'$
⑦ $\Delta = 90^{\circ}00'00''$ $R = 25.00'$ $L = 39.27'$ $T = 25.00'$	⑧ $\Delta = 90^{\circ}00'00''$ $R = 25.00'$ $L = 39.27'$ $T = 25.00'$
⑨ $\Delta = 90^{\circ}00'00''$ $R = 25.00'$ $L = 39.27'$ $T = 25.00'$	⑩ $\Delta = 90^{\circ}00'00''$ $R = 25.00'$ $L = 39.27'$ $T = 25.00'$
⑪ $\Delta = 93^{\circ}21'32''$ $R = 25.00'$ $L = 40.74'$ $T = 26.44'$	⑫ $\Delta = 10^{\circ}20'32''$ $R = 93.00'$ $L = 16.79'$ $T = 8.42'$


CURVE DATA - DESCRIBES CENTERLINE

① $\Delta = 90^{\circ}00'00''$ $R = 75.00'$ $L = 117.81'$ $T = 75.00'$

CERTIFICATE OF SUBSTANTIAL COMPLIANCE ON PLANS

I, James D. Hughes, NMPE 11674, of the firm Mark Goodwin & Associates, P.A., a Registered Professional Engineer in the State of New Mexico, do hereby certify, to the best of my knowledge and belief, that the infrastructure installed as part of this project has been inspected by me or by a qualified person under my direct supervision, and has been constructed in accordance with the plans and specifications approved by the City Engineer and that the original design intent of the approved plans has been met, except as noted by me on the as-built construction drawings. This Certification is based on site inspections by me or personnel under my direction, and survey information provided by A.S. Inc., NMPS number 7719.

James D. Hughes
12-14-04

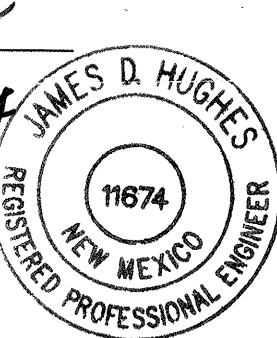

dmg MARK GOODWIN & ASSOCIATES, P.A.
CONSULTING ENGINEERS
P.O. BOX 90606
ALBUQUERQUE, NEW MEXICO 87199
(505) 828-2200, FAX (505) 797-9539




CITY OF ALBUQUERQUE
PUBLIC WORKS DEPARTMENT

TITLE: WEST RIDGE SUBDIVISION - UNIT 2
AUSTIN AVE. N.W.
PAVING IMPROVEMENTS

DESIGN REVIEW COMMITTEE	CITY ENGINEER APPROVAL	MO./DAY/YR.	MO./DAY/YR.
APPROVED JAN - 8 2004	APPROVED JAN - 8 2004		
DESIGN REVIEW COMMITTEE	CITY ENGINEER	LAST DESIGN UPDATE	

CITY PROJECT NO. 708282 ZONE MAP NO. H-9 & 10 SHEET 9 OF 18

SCANNED BY
MESA REPRO

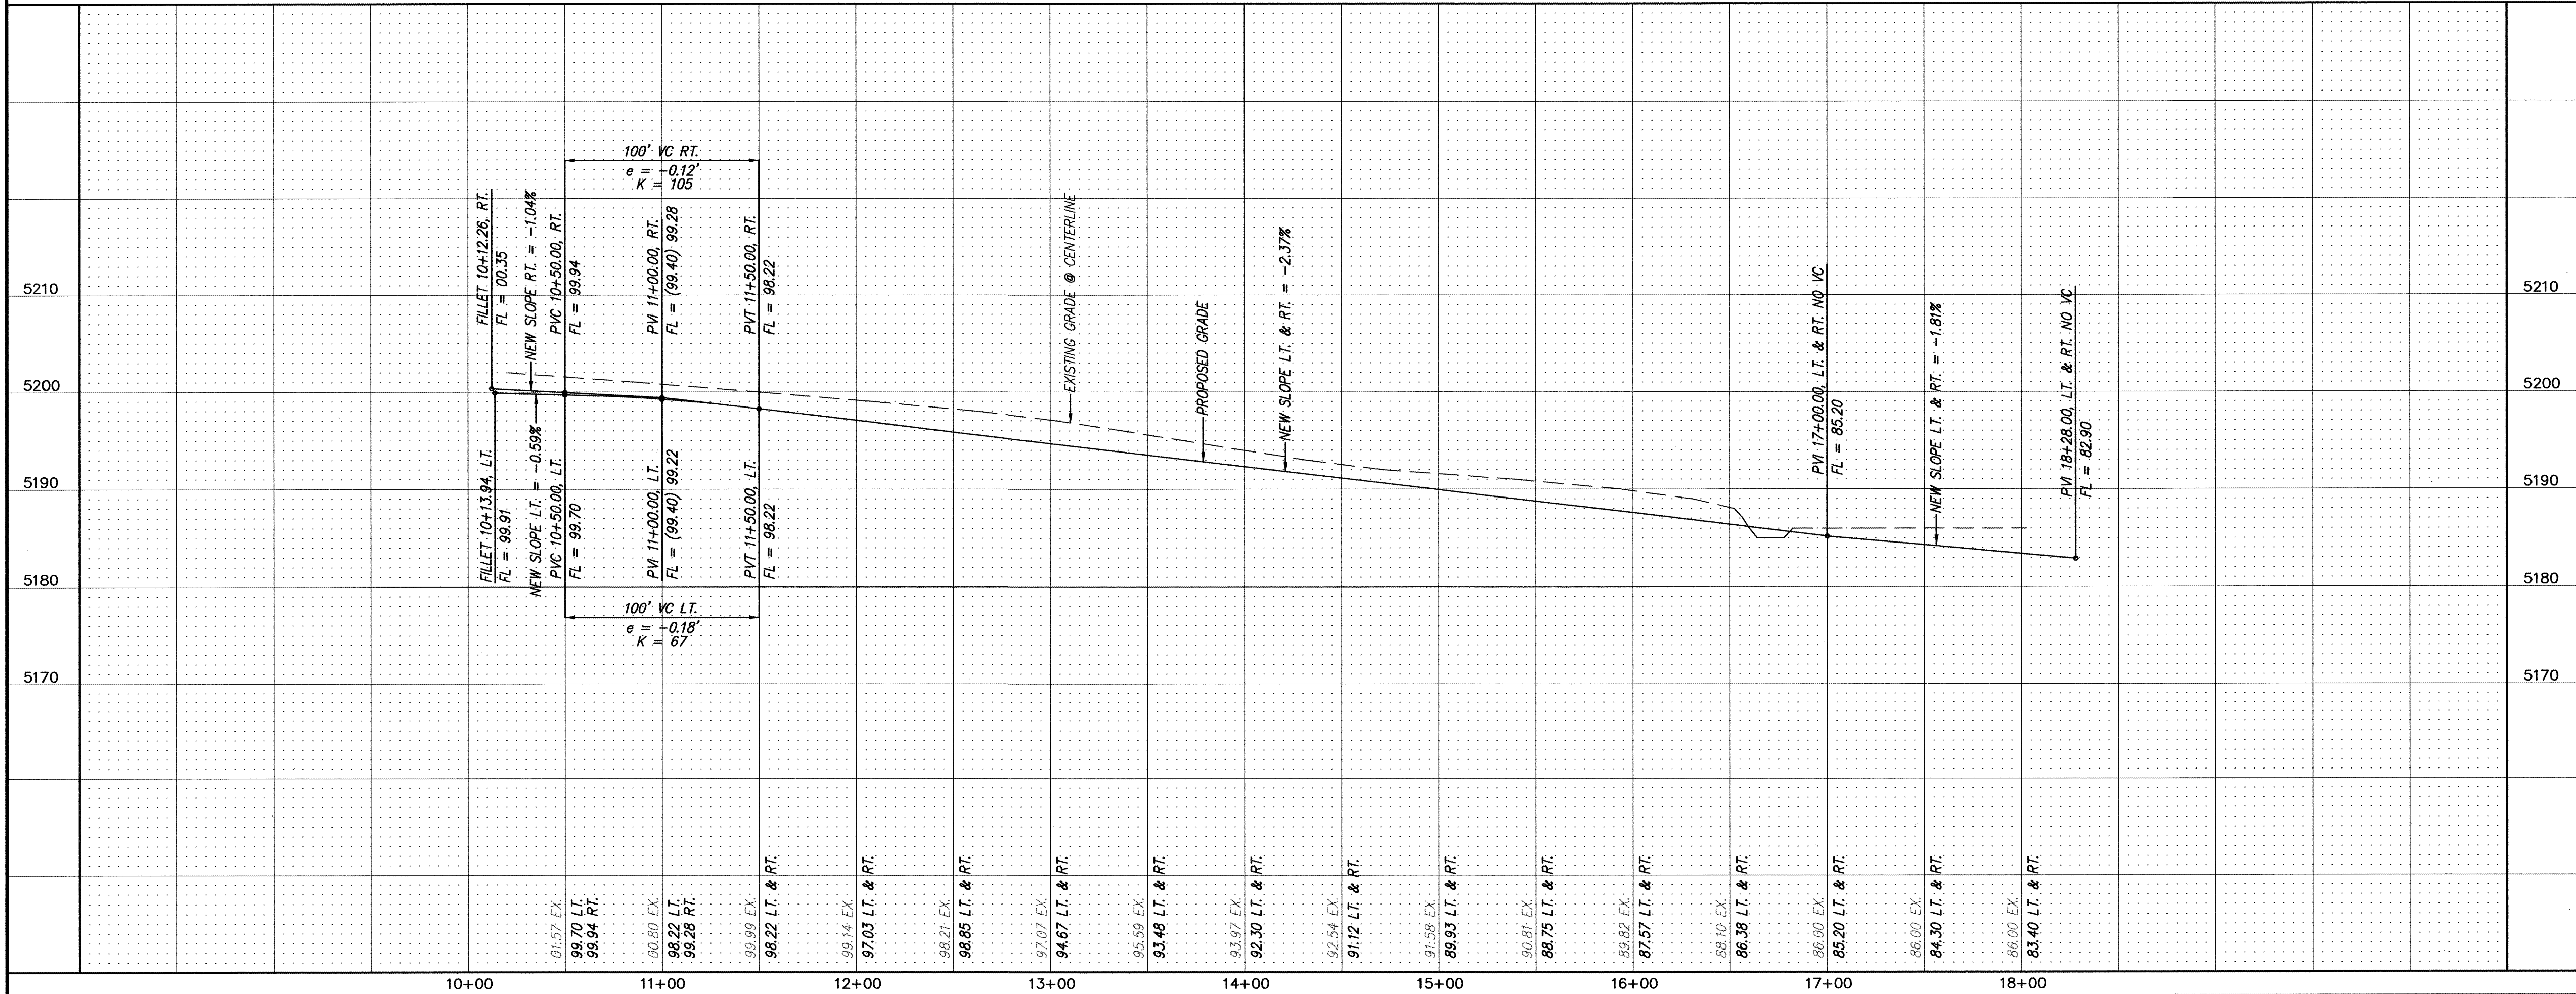


NOTES
1. ALL STATIONING IS CENTERLINE STATIONING.

CURVE DATA - DESCRIBES FACE OF CURB

- | | |
|---|--|
| ① $\Delta = 90^{\circ}00'00''$
$R = 25.00'$
$L = 39.27'$
$T = 25.00'$ | ② $\Delta = 19^{\circ}30'25''$
$R = 88.00'$
$L = 29.96'$
$T = 14.96'$ |
| ③ $\Delta = 55^{\circ}37'12''$
$R = 25.00'$
$L = 24.27'$
$T = 13.12'$ | ④ $\Delta = 174^{\circ}25'32''$
$R = 35.00'$
$L = 106.55'$
$T = N/A$ |
| ⑤ $\Delta = 55^{\circ}37'12''$
$R = 25.00'$
$L = 24.27'$
$T = 13.12'$ | ⑥ $\Delta = 90^{\circ}00'00''$
$R = 62.00'$
$L = 97.39'$
$T = 62.00'$ |
| ⑦ $\Delta = 90^{\circ}00'00''$
$R = 25.00'$
$L = 39.27'$
$T = 25.00'$ | ⑧ $\Delta = 90^{\circ}00'00''$
$R = 25.00'$
$L = 39.27'$
$T = 25.00'$ |
| ⑨ $\Delta = 90^{\circ}00'00''$
$R = 25.00'$
$L = 39.27'$
$T = 25.00'$ | ⑩ $\Delta = 90^{\circ}00'00''$
$R = 25.00'$
$L = 39.27'$
$T = 25.00'$ |
| ⑪ $\Delta = 93^{\circ}21'32''$
$R = 75.00'$
$L = 117.81'$
$T = 75.00'$ | |

CURVE DATA - DESCRIBES CENTERLINE


- | |
|---|
| ① $\Delta = 90^{\circ}00'00''$
$R = 75.00'$
$L = 117.81'$
$T = 75.00'$ |
|---|

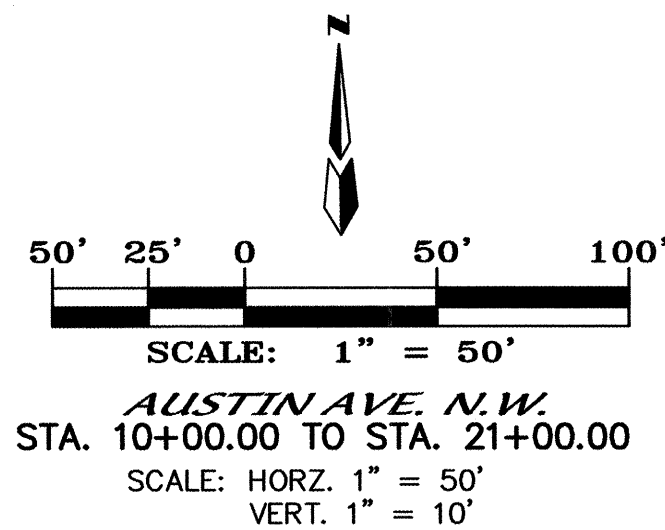

CERTIFICATE OF SUBSTANTIAL COMPLIANCE ON PLANS

I, James D. Hughes, NMPE 11674, of the firm, Mark Goodwin & Associates, P.A., a Registered Professional Engineer in the State of New Mexico, do hereby certify, to the best of my knowledge and belief, that the infrastructure installed as part of this project has been inspected by me or by a qualified person under my direct supervision, and has been constructed in accordance with the plans and specifications approved by the City Engineer and that the original design intent of the approved plans has been met, except as noted by me on the as-built construction drawings. This Certification is based on site inspections by me or personnel under my direction, and survey information provided by A.L.S. Inc., NMPS number 7719.

James D. Hughes
12-14-04

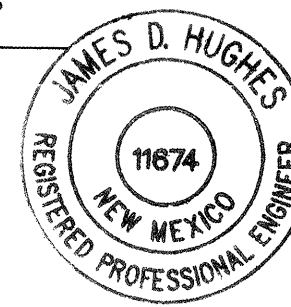


MARK GOODWIN & ASSOCIATES, P.A.
CONSULTING ENGINEERS
P.O. BOX 90606
ALBUQUERQUE, NEW MEXICO 87199
(505) 828-2200, FAX (505) 797-9539





CITY OF ALBUQUERQUE
PUBLIC WORKS DEPARTMENT

TITLE: WEST RIDGE SUBDIVISION - UNIT 2
AUSTIN AVE. N.W.
PAVING IMPROVEMENTS

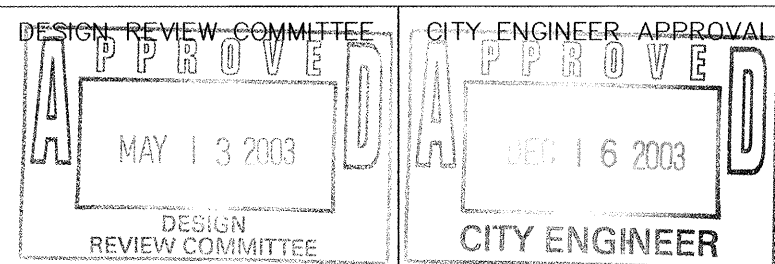

CITY PROJECT NO. 708282 ZONE MAP NO. H-9 & 10 SHEET 9 OF 18

SCANNED BY
MESA REPRO

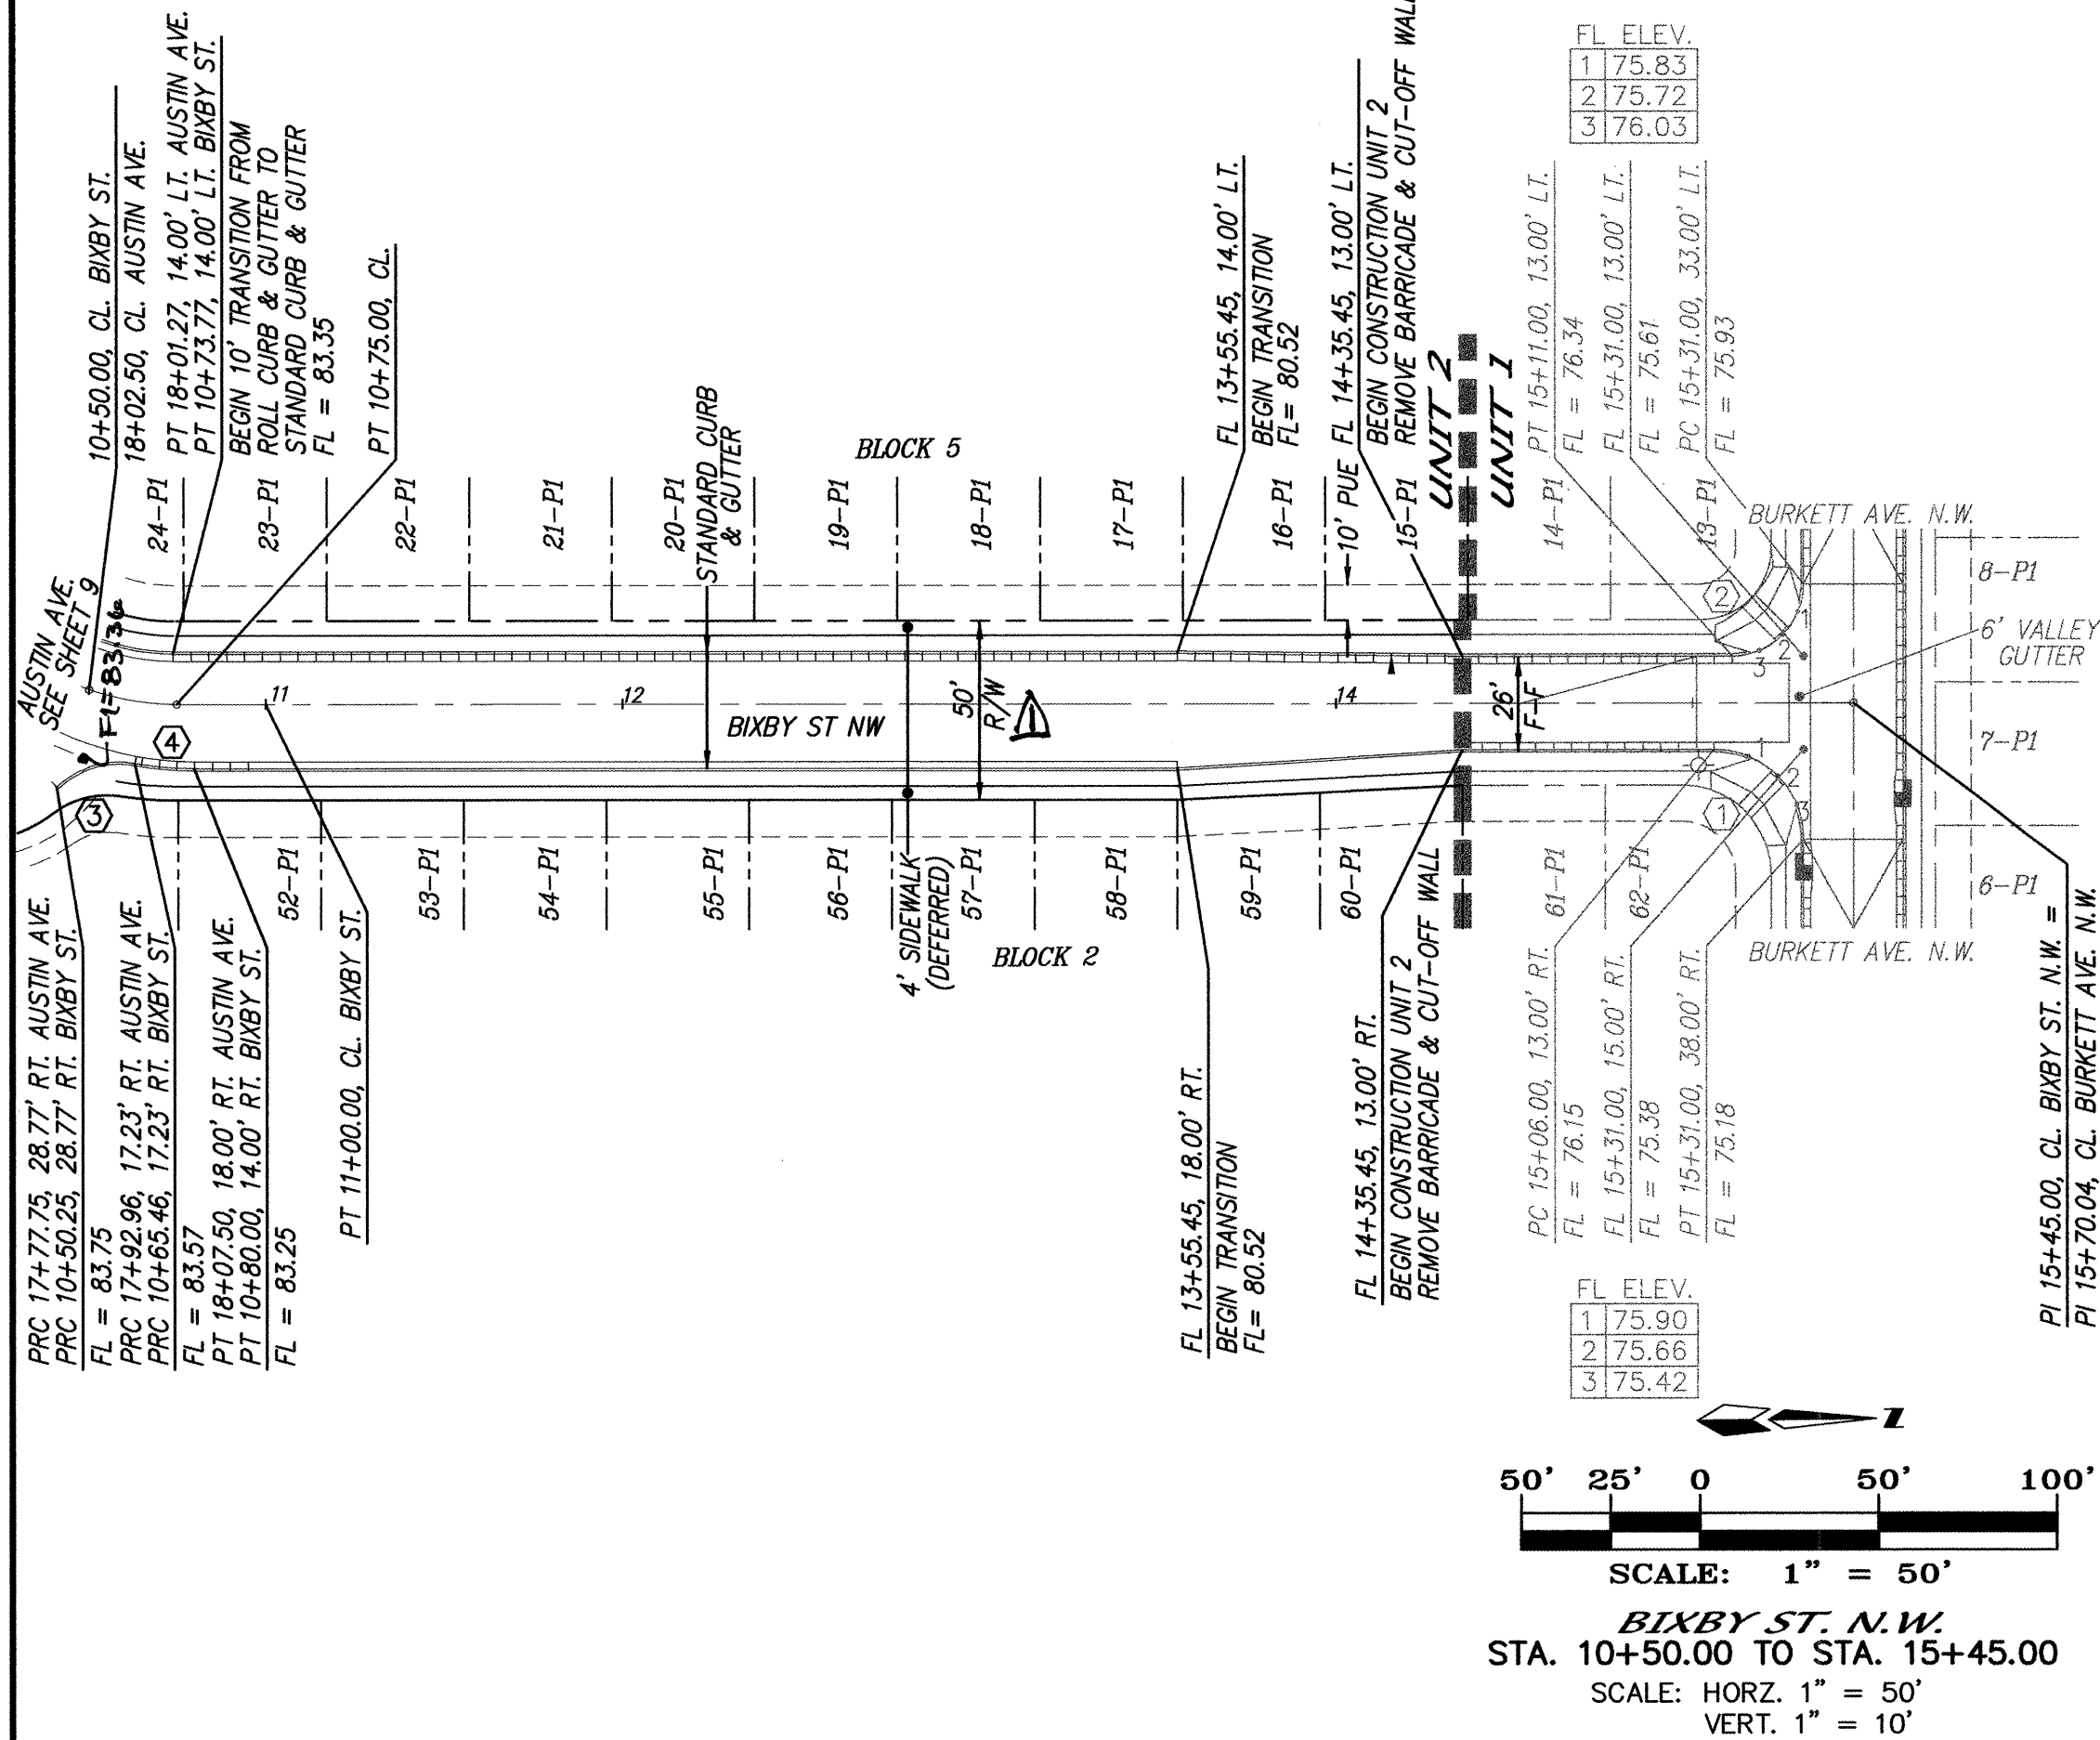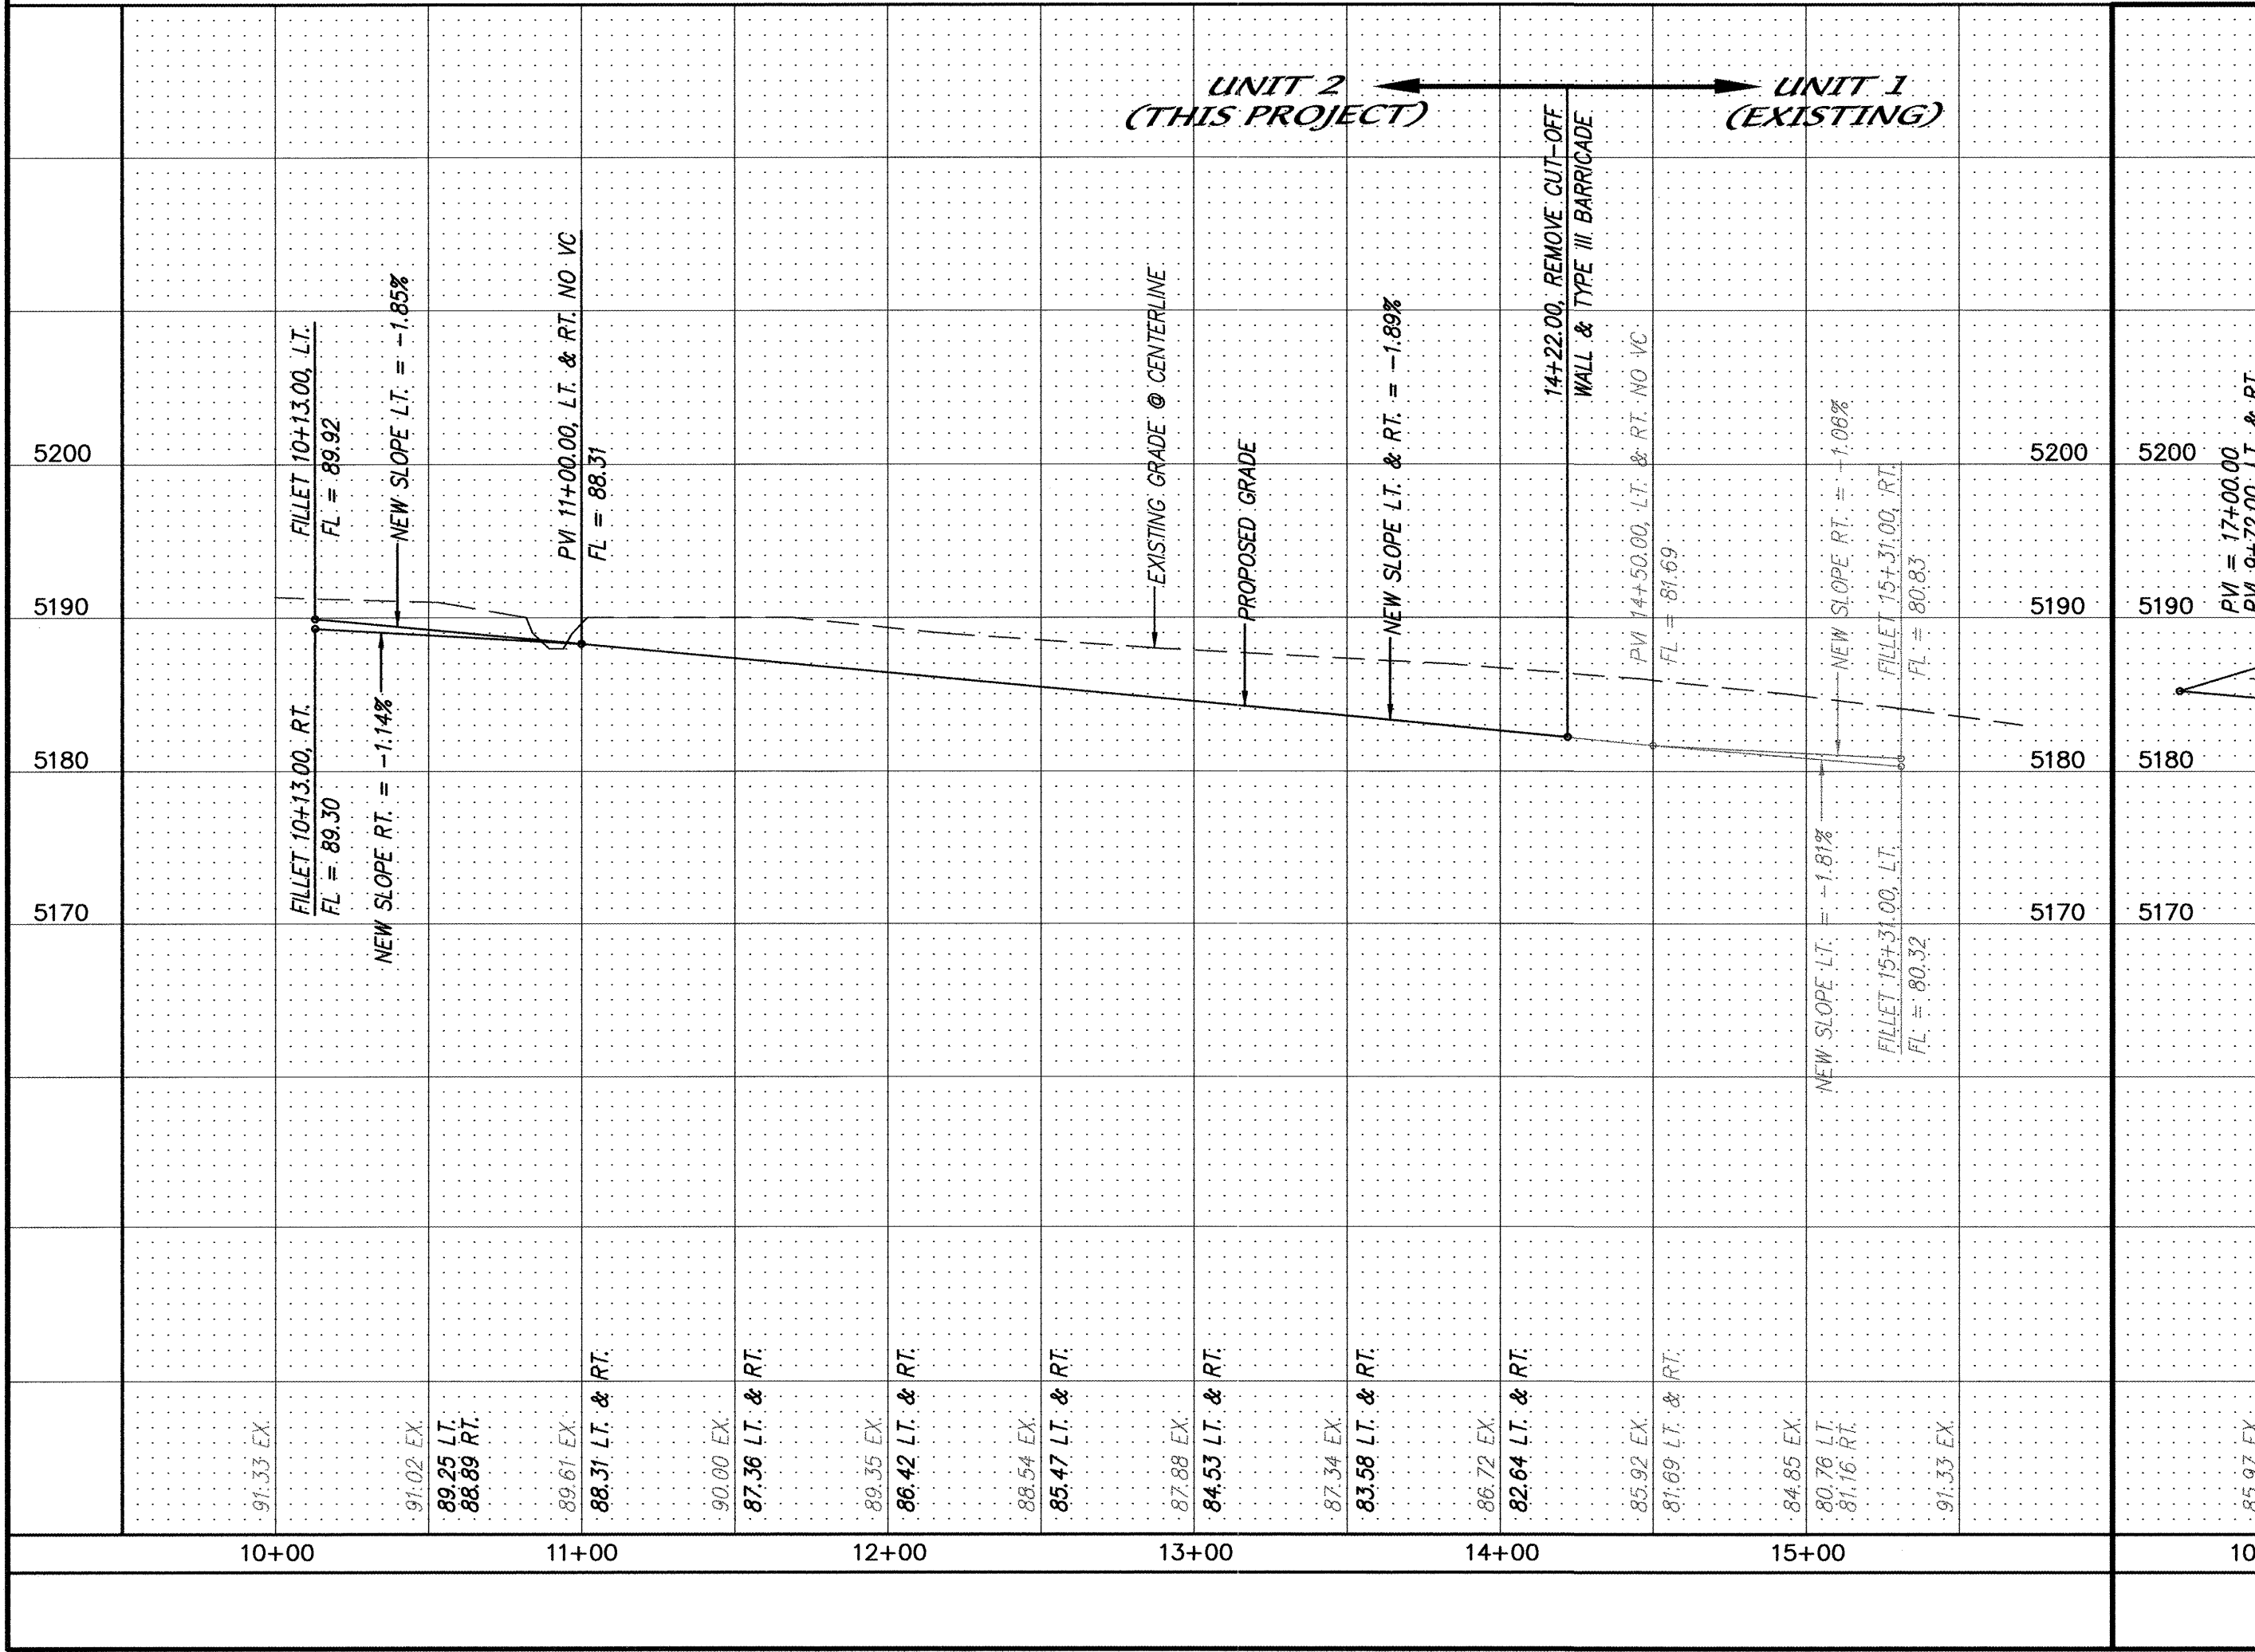

NOTES

1. ALL STATIONING IS CENTERLINE STATIONING.

WOODHILL DR. N.W.

CURVE DATA - DESCRIBES FACE OF CURB

- ① $\Delta = 90^{\circ}00'00''$
 $R = 25.00'$
 $L = 39.27'$
 $T = 25.00'$
- ② $\Delta = 90^{\circ}00'00''$
 $R = 20.00'$
 $L = 31.42'$
 $T = 20.00'$
- ③ $\Delta = 90^{\circ}00'00''$
 $R = 25.00'$
 $L = 39.27'$
 $T = 25.00'$
- ④ $\Delta = 90^{\circ}00'00''$
 $R = 25.00'$
 $L = 39.27'$
 $T = 25.00'$
- ⑤ $\Delta = 90^{\circ}00'00''$
 $R = 25.00'$
 $L = 39.27'$
 $T = 25.00'$
- ⑥ $\Delta = 90^{\circ}00'00''$
 $R = 25.00'$
 $L = 39.27'$
 $T = 25.00'$

BIXBY ST. N.W.

CURVE DATA - DESCRIBES FACE OF CURB

- ① $\Delta = 90^{\circ}00'00''$
 $R = 25.00'$
 $L = 39.27'$
 $T = 25.00'$
- ② $\Delta = 90^{\circ}00'00''$
 $R = 20.00'$
 $L = 31.42'$
 $T = 20.00'$
- ③ $\Delta = 55^{\circ}34'49''$
 $R = 25.00'$
 $L = 23.82'$
 $T = 12.90'$
- ④ $\Delta = 10^{\circ}20'32''$
 $R = 93.00'$
 $L = 16.79'$
 $T = 8.42'$

CERTIFICATE OF SUBSTANTIAL COMPLIANCE ON PLANS

I, James D. Hughes, NMPE 11674, of the firm Mark Goodwin & Associates, P.A., a Registered Professional Engineer in the State of New Mexico, do hereby certify, to the best of my knowledge and belief, that the infrastructure installed as part of this project has been inspected by me or by a qualified person under my direct supervision, and has been constructed in accordance with the plans and specifications approved by the City Engineer and that the original design intent of the approved plans has been met, except as noted by me on the as-built construction drawings. This Certification is based on site inspections by me or personnel under my direction, and survey information provided by ALS, Inc., NMPS number 7719.



James D. Hughes
12-14-04
REGISTERED PROFESSIONAL ENGINEER
NEW MEXICO
11674

dmg MARK GOODWIN & ASSOCIATES, P.A.
CONSULTING ENGINEERS
P.O. BOX 90606
ALBUQUERQUE, NEW MEXICO 87199
(505) 828-2200, FAX (505) 797-9539



**CITY OF ALBUQUERQUE
PUBLIC WORKS DEPARTMENT**

TITLE: **WEST RIDGE SUBDIVISION - UNIT 2
WOODHILL DR. N.W. & BIXBY ST. N.W.
PAVING IMPROVEMENTS**

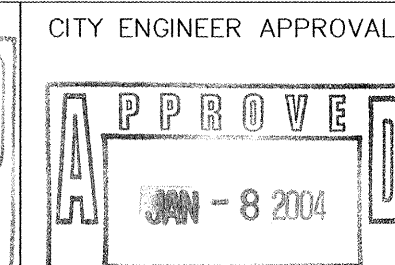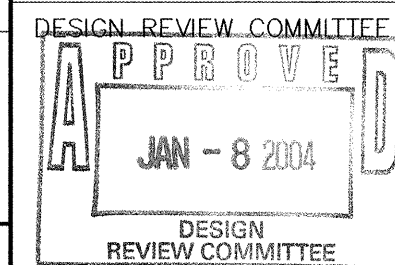

CITY PROJECT NO.

CITY ENGINEER'S MAP NO.

708282 H-9 & 10

SHEET OF

10 18

ENGINEER'S SEAL

72H

12-18-03 Bixby & Winder

NO. DATE

REMARKS

DESIGN

DATE

DATE

CHECKED BY

DATE

AS BUILT INFORMATION

CONTRACTOR

WORK

INSPECTOR'S

FIELD

VERIFICATION BY

CORRECTED BY

RECORDED BY

NO.

DATE

DATE



DATE




DATE



DATE

DATE

DATE

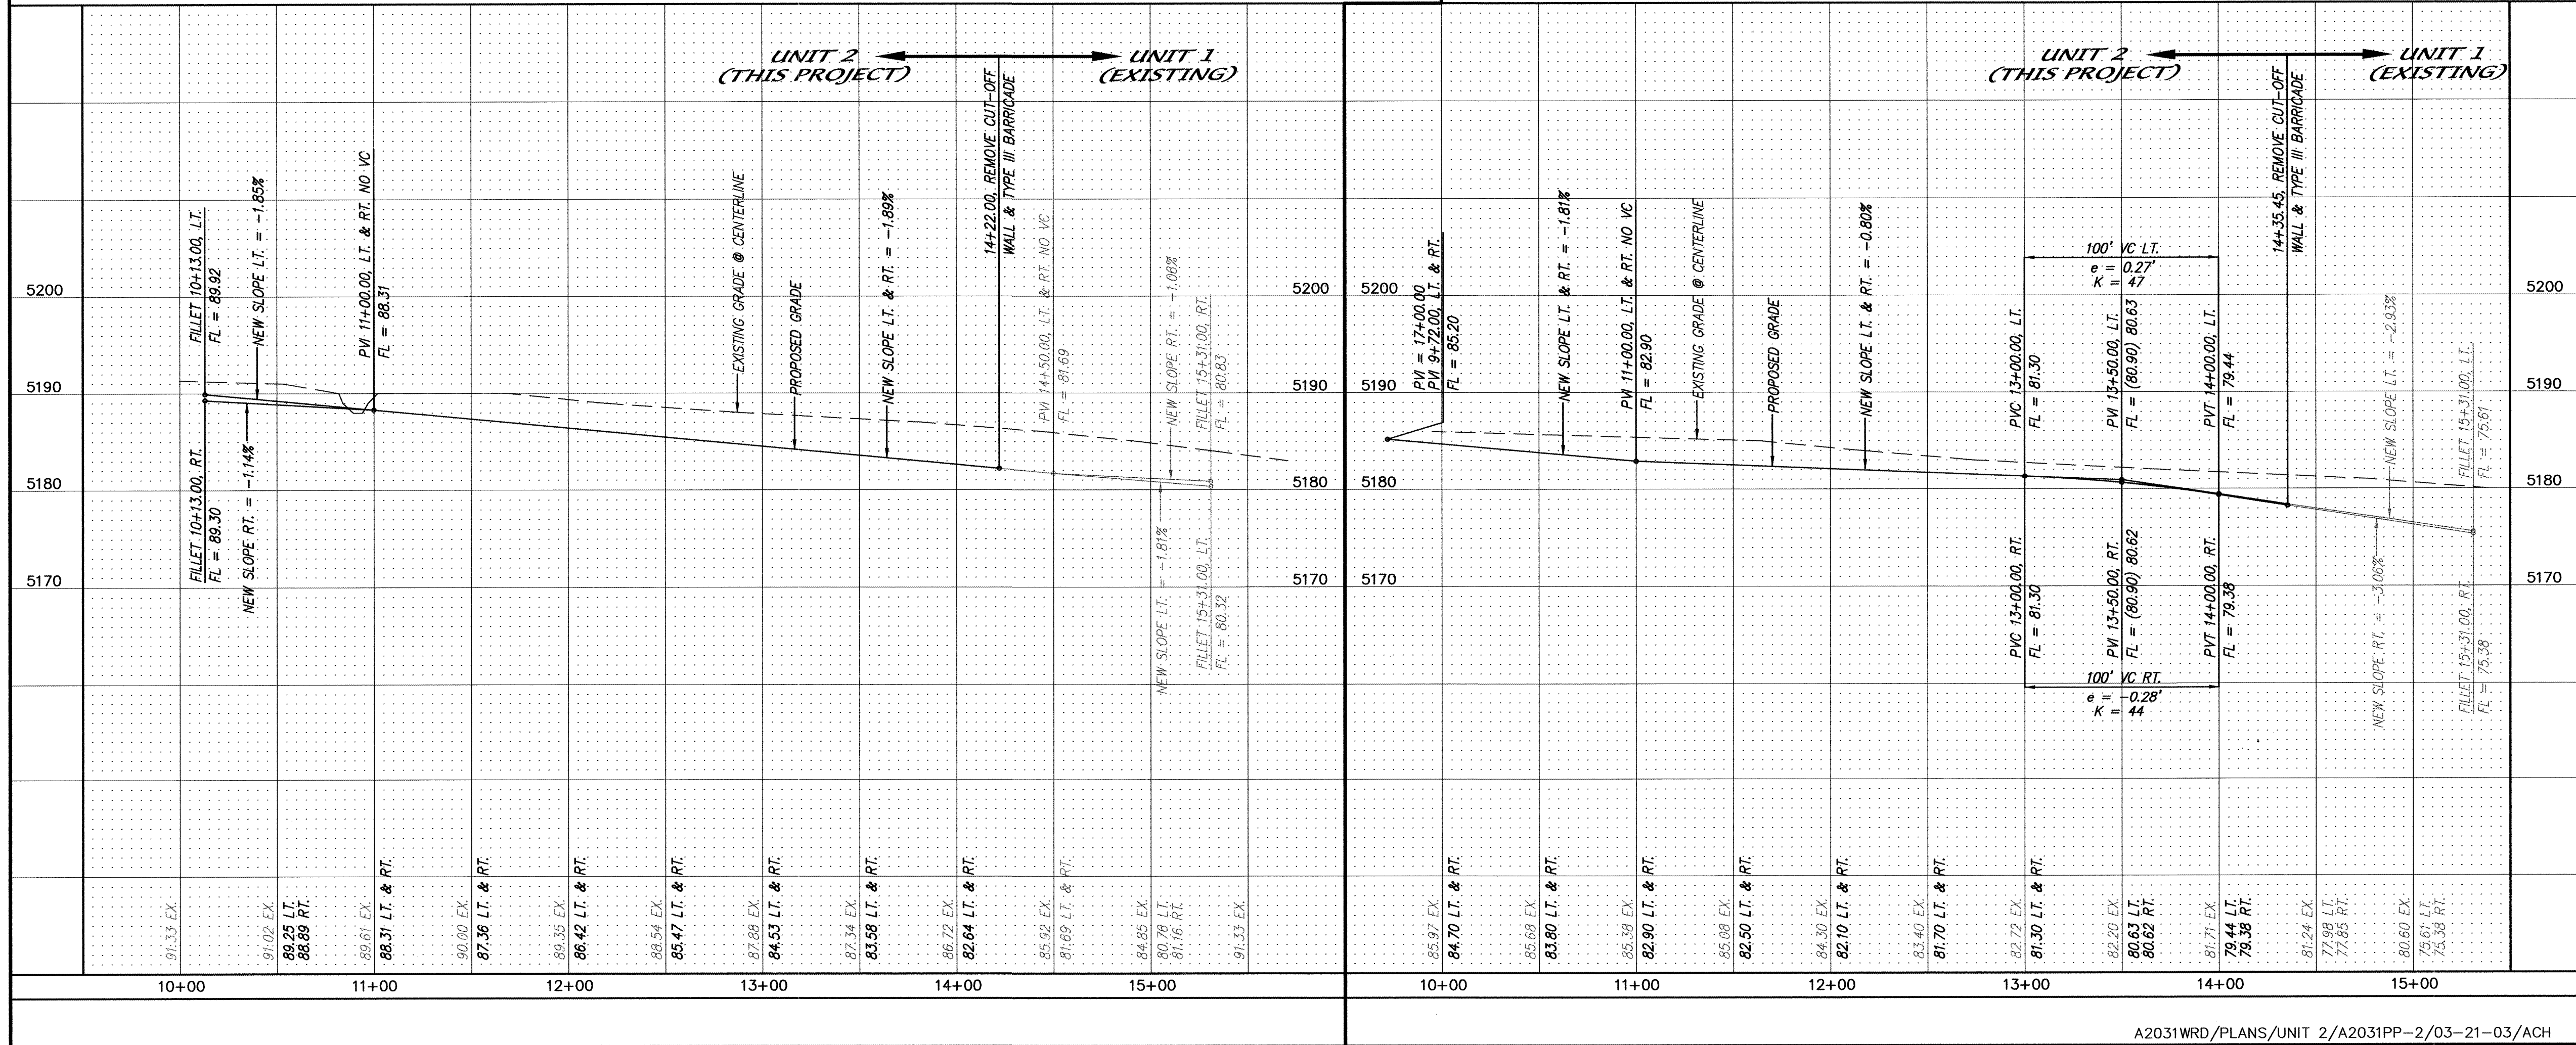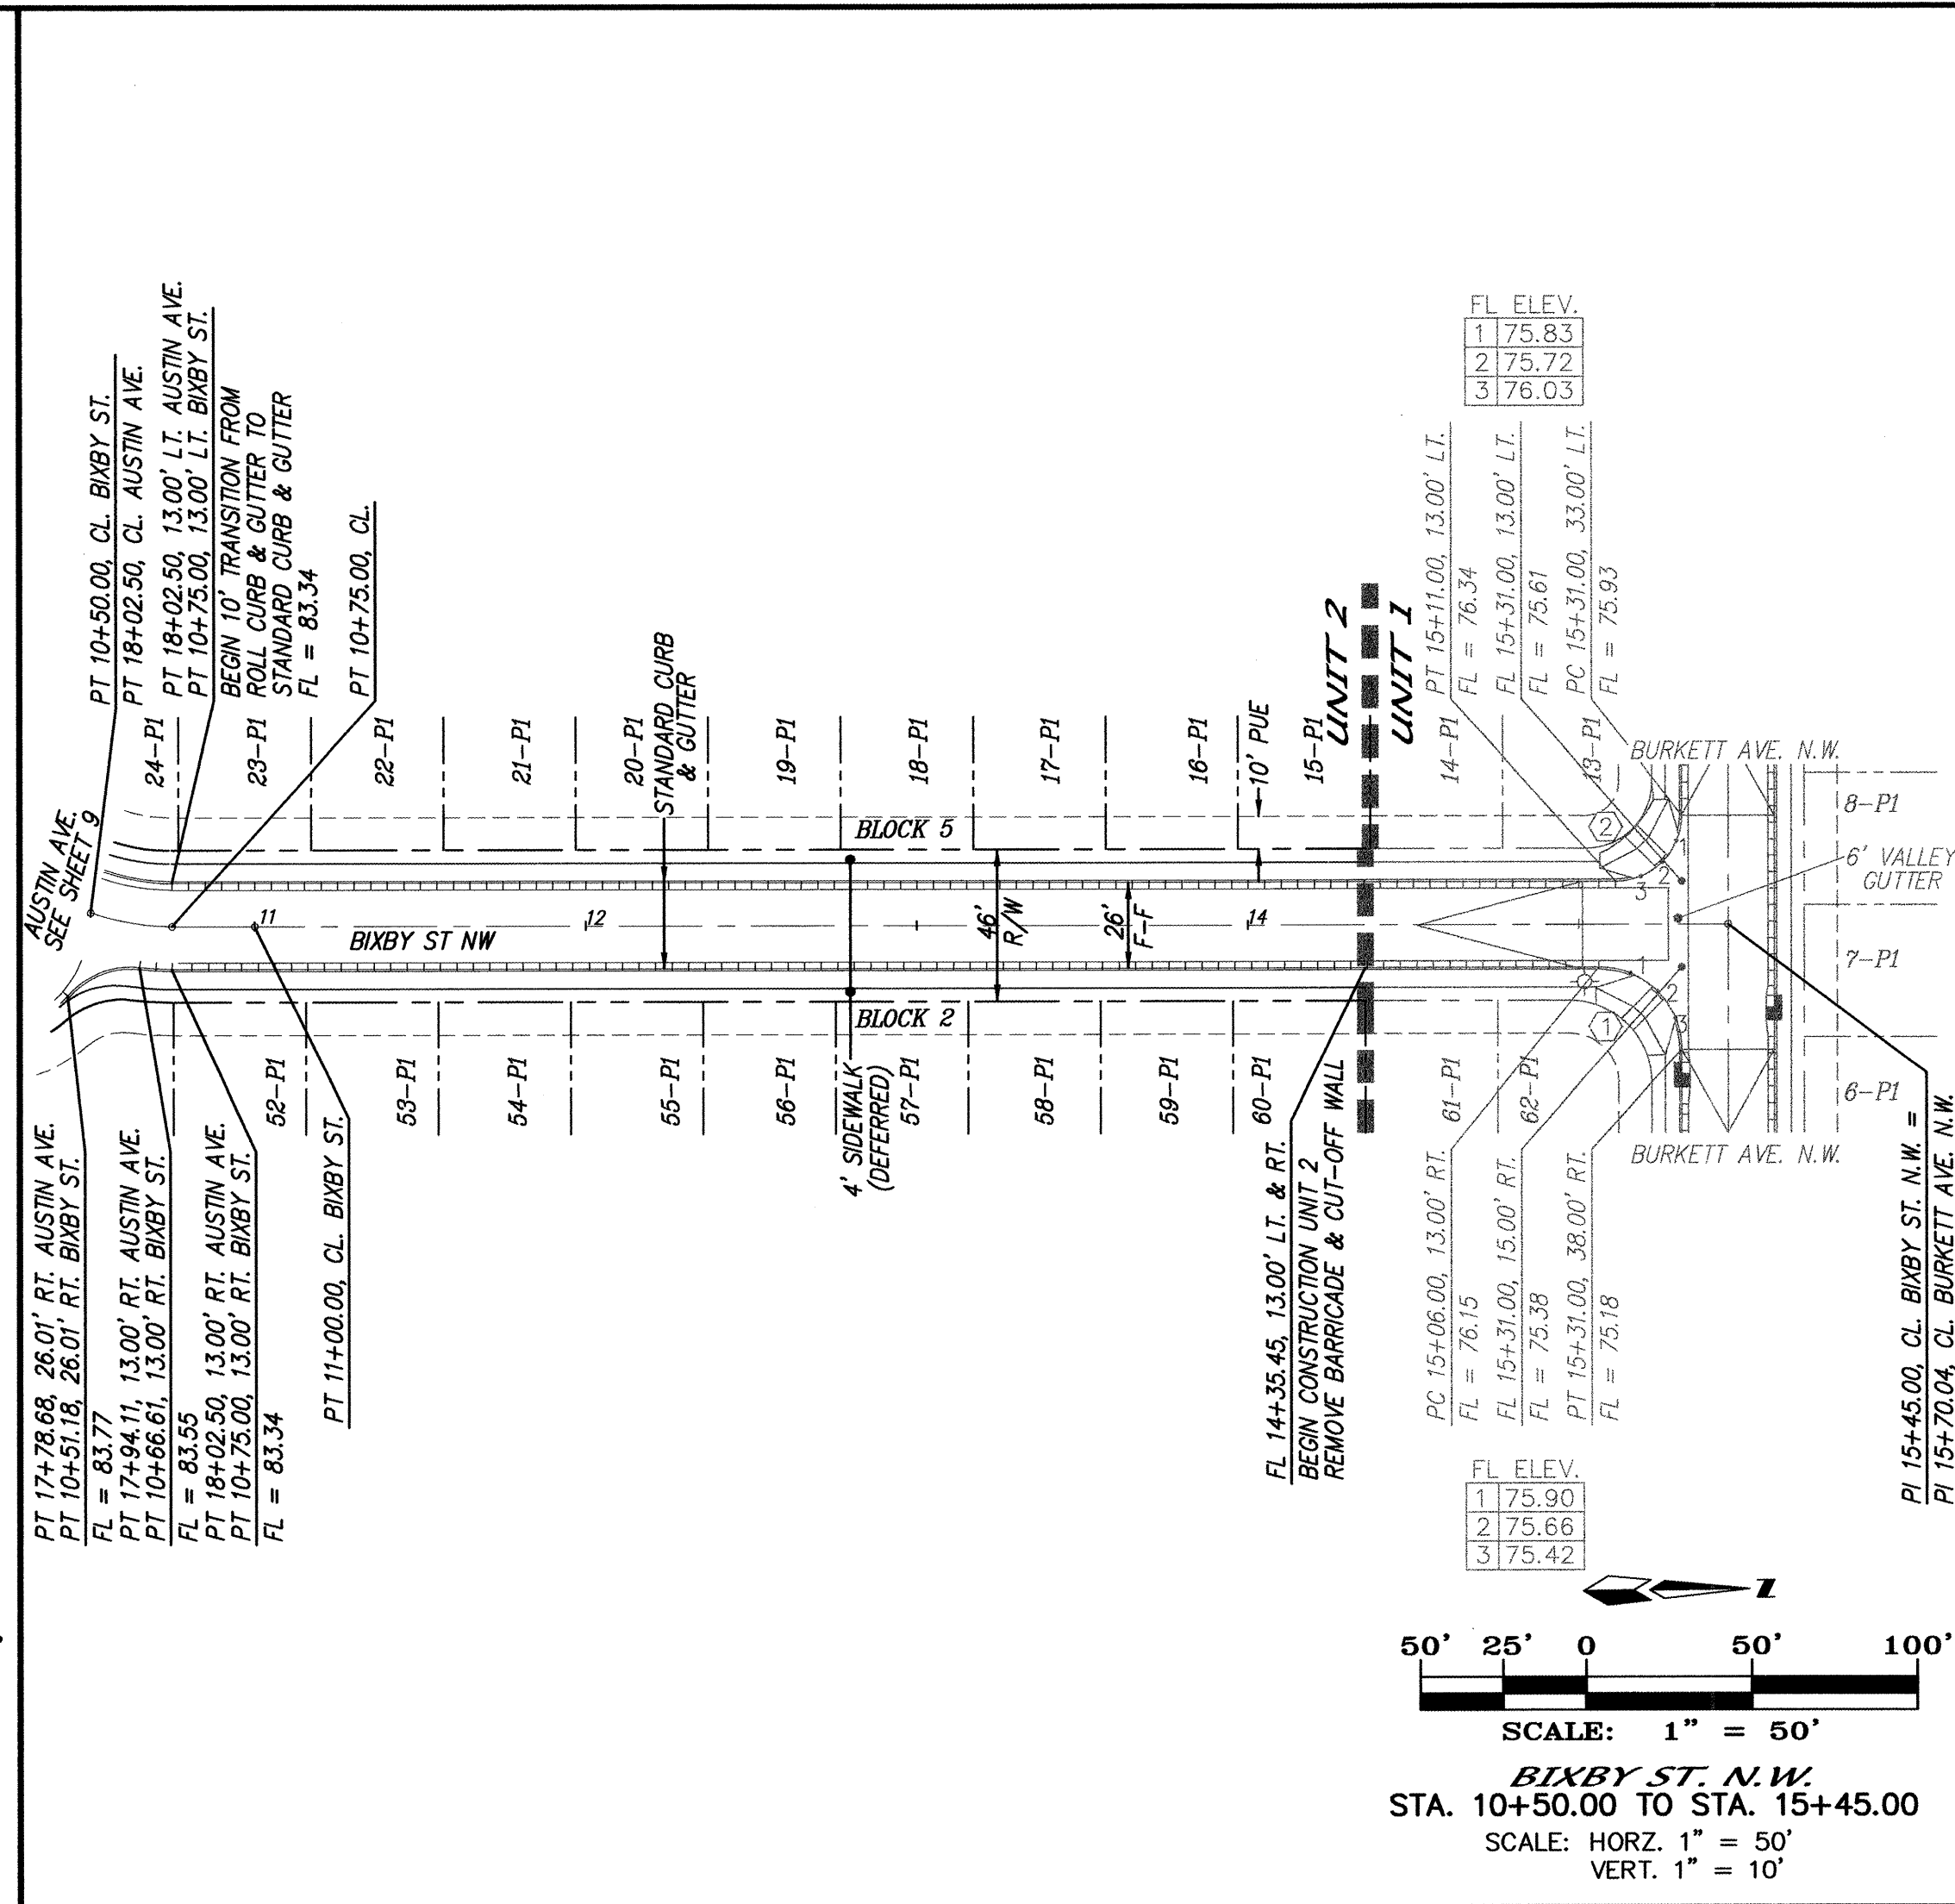

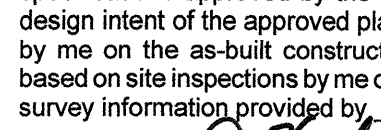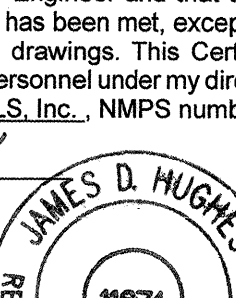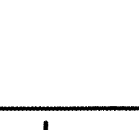NOTES		AS BUILT INFORMATION	
1. ALL STATIONING IS CENTERLINE STATIONING.		CONTRACTOR ALS WORK STARTED BY ALS DATE 12/10/03 FIELD ACCEPTANCE BY ALS DATE 12/10/03 DRAWINGS ALS DATE 12/10/03 REVISIONS ALS DATE 12/10/03 RECORDED BY ALS DATE 12/10/03 NO.	
WOODHILL DR. N.W. CURVE DATA - DESCRIBES FACE OF CURB		BENCH MARKS ACS BRASS CAP STAMPED "BH-39" FROM THE INTERSECTION OF COORS RD. N.W. AND I-40, 0.4 MILES NORTH ON OURAY RD. THEN LEFT 0.7 MILES TO END OF PAVEMENT. CONTINUING ON DIRT ROAD 0.9 MILES PASSED A POWER SUBSTATION TO A CROSSROAD. TURN LEFT 0.4 MILES TO A CROSSROAD. THEN LEFT 0.1 MILES TO THE STATION ON THE RIGHT. GEOGRAPHIC POSITION (NAD 1927), IN FT N.M. STATE PLANE COORDINATES (CENTRAL ZONE) X=556,760.08, Y=1,494,777.28 ELEVATION=5195.46, NGVD29, IN FT.	
① Δ = 90°00'00" R = 25.00' L = 39.27' T = 25.00'		② Δ = 90°00'00" R = 20.00' L = 31.42' T = 20.00'	
③ Δ = 90°00'00" R = 25.00' L = 39.27' T = 25.00'		④ Δ = 90°00'00" R = 25.00' L = 39.27' T = 25.00'	
⑤ Δ = 90°00'00" R = 25.00' L = 39.27' T = 25.00'		⑥ Δ = 90°00'00" R = 25.00' L = 39.27' T = 25.00'	
BIXBY ST. N.W. CURVE DATA - DESCRIBES FACE OF CURB		ENGINEER'S SEAL 	
① Δ = 90°00'00" R = 25.00' L = 39.27' T = 25.00'		② Δ = 90°00'00" R = 20.00' L = 31.42' T = 20.00'	
CERTIFICATE OF SUBSTANTIAL COMPLIANCE ON PLANS I, James D. Hughes, NMPE 11674, of the firm Mark Goodwin & Associates, P.A., a Registered Professional Engineer in the State of New Mexico, do hereby certify, to the best of my knowledge and belief, that the infrastructure installed as part of this project has been inspected by me or by a qualified person under my direct supervision, and has been constructed in accordance with the plans and specifications approved by the City Engineer and that the original design intent of the approved plans has been met, except as noted by me on the as-built construction drawings. This Certification is based on site inspections by me or personnel under my direction, and survey information provided by ALS, Inc., NMPS number 7719.  12-14-04 		REMARKS REVISIONS DESIGN DATE 12/03 DATE 12/02 DATE 12/02	
 MARK GOODWIN & ASSOCIATES, P.A. CONSULTING ENGINEERS P.O. BOX 90606 ALBUQUERQUE, NEW MEXICO 87199 (505) 828-2200, FAX (505) 797-9539		NO. DATE REMARKS REVISIONS DESIGN DATE 12/03 DATE 12/02 DATE 12/02	
 CITY OF ALBUQUERQUE PUBLIC WORKS DEPARTMENT			
TITLE: WEST RIDGE SUBDIVISION - UNIT 2 WOODHILL DR. N.W. & BIXBY ST. N.W. PAVING IMPROVEMENTS			
DESIGN REVIEW COMMITTEE APPROVED MAY 13 2003 DESIGN REVIEW COMMITTEE		CITY ENGINEER - APPROVAL APPROVED DEC 16 2003 CITY ENGINEER	
CITY PROJECT NO. 708282		ZONE MAP NO. H-9 & 10	
SHEET 10		OF 18	

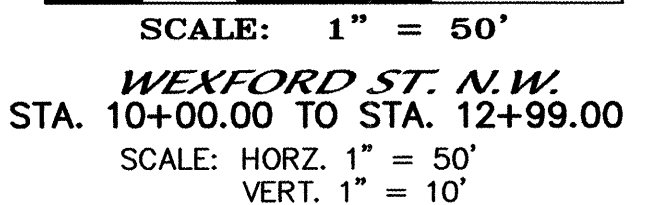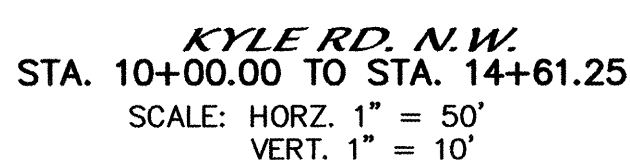

--



CITY PROJECT NO.	ZONE MAP NO.	SHEET	OF
708282	H-9 & 10	11	18

SURVEY INFORMATION			BENCH MARKS		AS BUILT INFORMATION		
NO.	BY	DATE	FIELD NOTES	DATE	CONTRACTOR	WORK STAMPED BY	DATE
			ACS BRASS CAP STAMPED "BH-39" FROM THE INTERSECTION OF COORS RD. N.W. AND I-40, 0.4 MILES NORTH ON OURAY RD. THEN LEFT 0.7 MILES TO END OF PAVEMENT. CONTINUING ON DIRT ROAD 0.9 MILES PASSED A POWER SUBSTATION TO A CROSSROAD. TURN LEFT 0.4 MILES TO A CROSSROAD. THEN LEFT 0.1 MILES TO THE STATION ON THE RIGHT.			SALES	
			GEOGRAPHIC POSITION (NAD 1927), IN FT" M. STATE PLANE COORDINATES (CENTRAL ZONE) Y=356,760.08, X=1,494,777.28 ELEVATION=5195.46, NG0219, IN FT.			ACCEPTANCE BY DRAWING CORRECTED BY	DATE DATE DATE
						MICRO-FILM INFORMATION	
						RECORDED BY	DATE
						NO.	


ENGINEER'S SEAL

 42-1-03

[illegible]

T	
N - UNIT 2	
D ST. N.W.	
ENTS	
MO./DAY/YR.	MO./DAY/YR.
10	SHEET OF 11 18

SCANNED BY
MESA REPRO

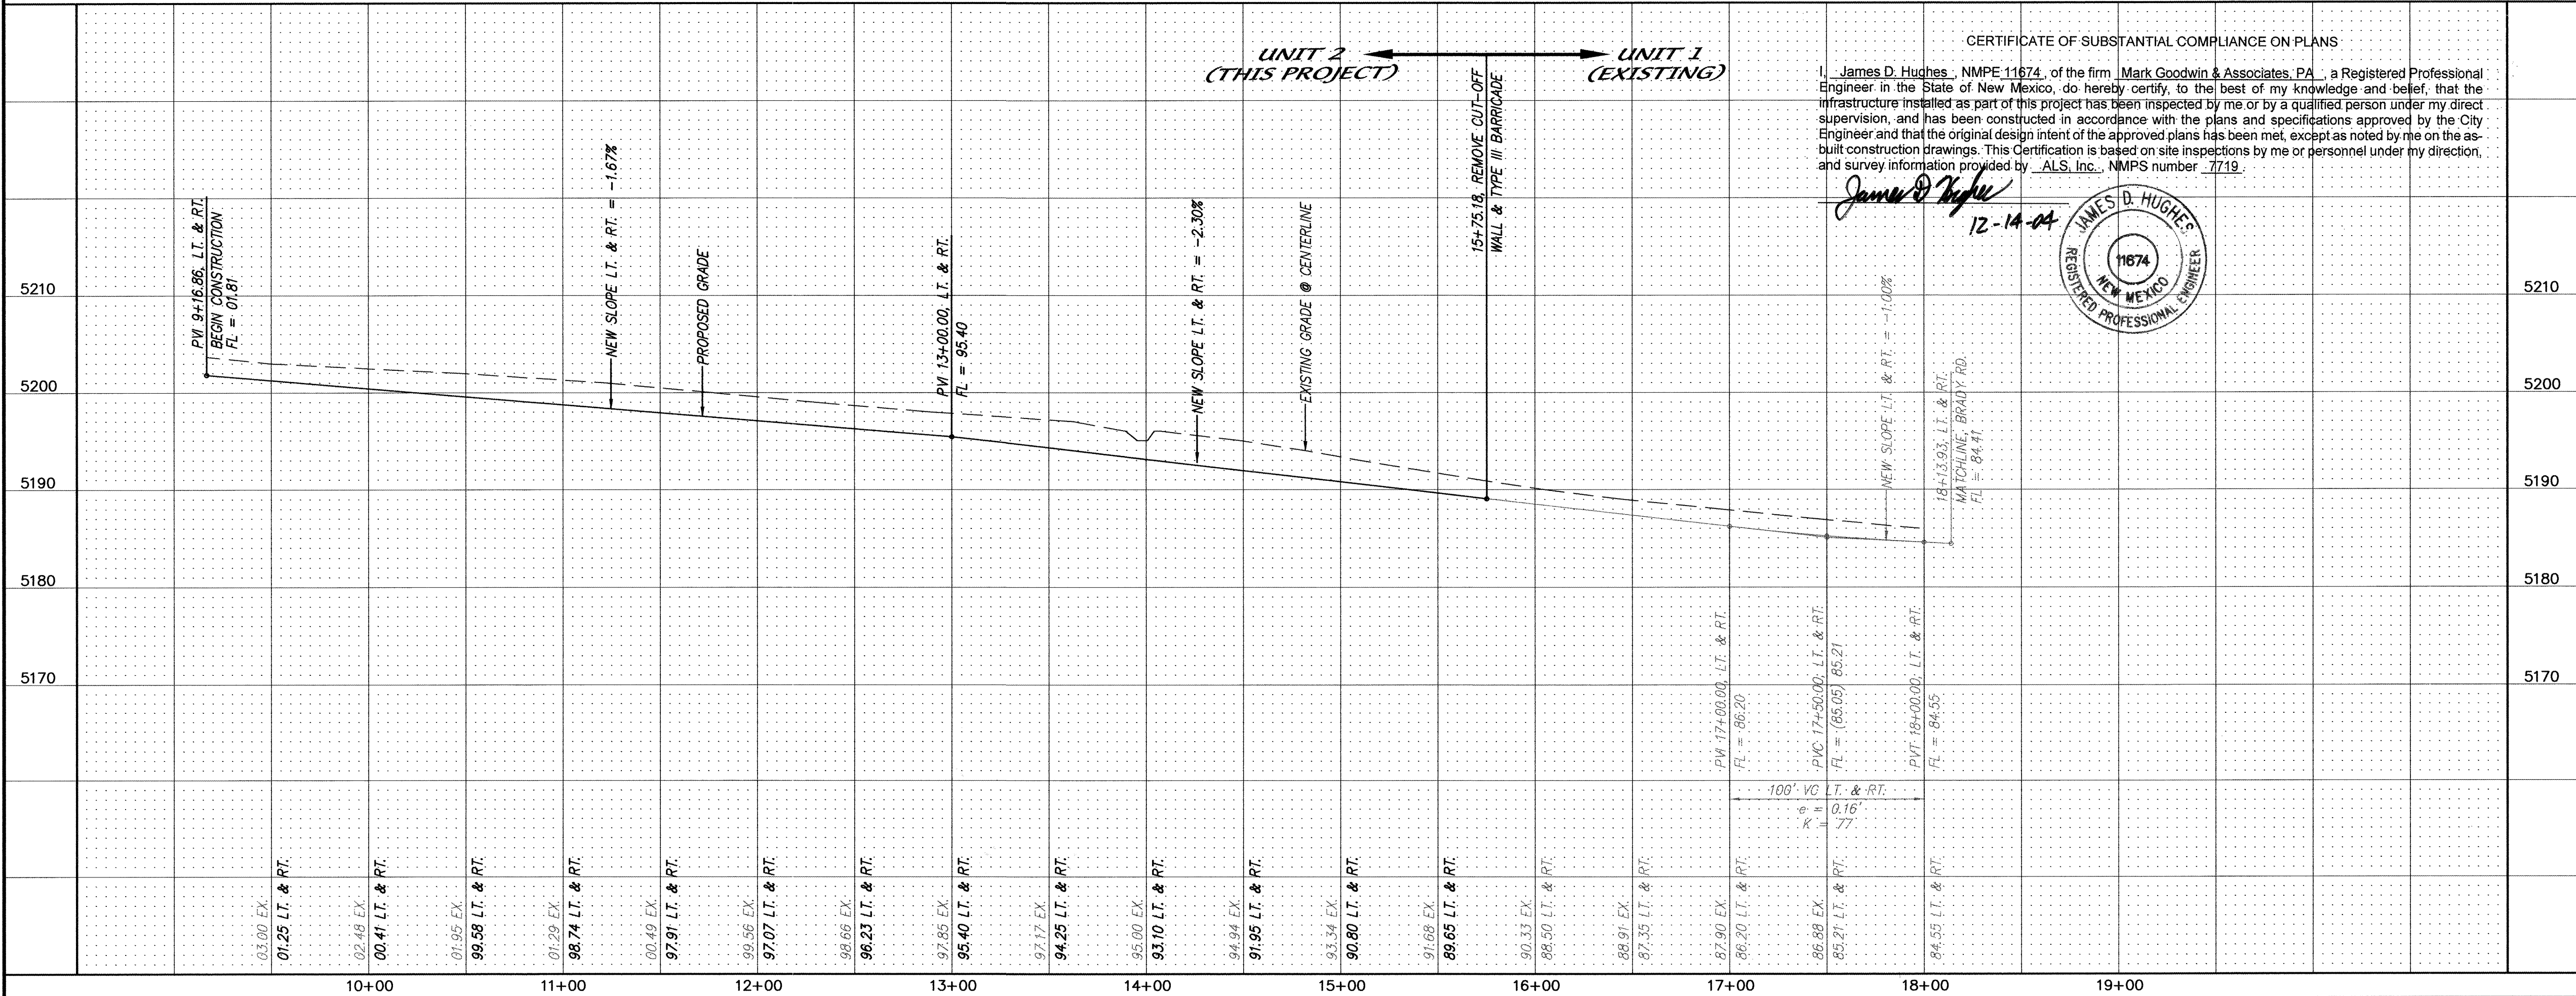

CERTIFICATE OF SUBSTANTIAL COMPLIANCE ON PLANS

I, James D. Hughes, NMPE 11674, of the firm Mark Goodwin & Associates, P.A., a Registered Professional Engineer in the State of New Mexico, do hereby certify, to the best of my knowledge and belief, that the infrastructure installed as part of this project has been inspected by me or by a qualified person under my direct supervision, and has been constructed in accordance with the plans and specifications approved by the City Engineer and that the original design intent of the approved plans has been met, except as noted by me on the as-built construction drawings. This Certification is based on site inspections by me or personnel under my direction, and survey information provided by ALS, Inc., NMPS number 7719.

James D. Hughes
12-14-04

JAMES D. HUGHES
11674
REGISTERED PROFESSIONAL ENGINEER
NEW MEXICO

NOTES


1. ALL STATIONING IS CENTERLINE STATIONING.

CURVE DATA - DESCRIBES FACE OF CURB

- | | |
|--|--|
| ① $\Delta = 90^{\circ}00'00''$
$R = 25.00'$
$L = 39.27'$
$T = 25.00'$ | ② $\Delta = 93^{\circ}21'32''$
$R = 25.00'$
$L = 40.74'$
$T = 26.44'$ |
| ③ $\Delta = 12^{\circ}50'52''$
$R = 1180.00'$
$L = 264.60'$
$T = 129.29'$ | ④ $\Delta = 91^{\circ}53'07''$
$R = 25.00'$
$L = 40.09'$
$T = 25.68'$ |
| ⑤ $\Delta = 91^{\circ}53'07''$
$R = 25.00'$
$L = 40.39'$
$T = 25.68'$ | ⑥ $\Delta = 10^{\circ}32'58''$
$R = 470.04'$
$L = 86.54'$
$T = 42.47'$ |
| ⑦ $\Delta = 92^{\circ}34'25''$
$R = 25.00'$
$L = 110.80'$
$T = 26.04'$ | ⑧ $\Delta = 92^{\circ}34'25''$
$R = 25.00'$
$L = 110.80'$
$T = 26.04'$ |
| ⑨ $\Delta = 2^{\circ}22'11''$
$R = 893.58'$
$L = 36.96'$
$T = 17.32'$ | ⑩ $\Delta = 8^{\circ}35'10''$
$R = 921.58'$
$L = 138.10'$
$T = 67.28'$ |
| ⑪ $\Delta = 10^{\circ}32'58''$
$R = 498.04'$
$L = 91.70'$
$T = 45.00'$ | ⑫ $\Delta = 20^{\circ}29'33''$
$R = 1208.00'$
$L = 432.05'$
$T = 216.19'$ |

CURVE DATA - DESCRIBES CENTERLINE

- | | |
|---|--|
| ① $\Delta = 0^{\circ}39'46''$
$R = 1194.00'$
$L = 13.81'$
$T = 4.11'$ | ② $\Delta = 19^{\circ}49'47''$
$R = 1194.00'$
$L = 413.24'$
$T = 205.11'$ |
| ③ $\Delta = 10^{\circ}32'58''$
$R = 484.04'$
$L = 89.12'$
$T = 43.74'$ | ④ $\Delta = 8^{\circ}35'10''$
$R = 907.58'$
$L = 136.01'$
$T = 66.26'$ |

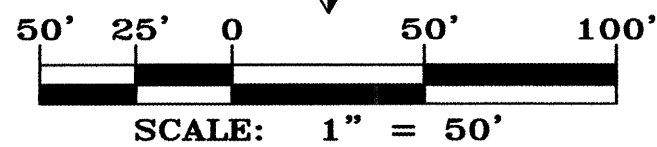

ANGEL DR. N.W.
STA. 10+00.00 TO STA. 21+00.00
SCALE: HORZ. 1" = 50'
VERT. 1" = 10'

dmg MARK GOODWIN & ASSOCIATES, P.A.
CONSULTING ENGINEERS
P.O. BOX 90606
ALBUQUERQUE, NEW MEXICO 87199
(505) 828-2200, FAX (505) 797-9539

CITY OF ALBUQUERQUE
PUBLIC WORKS DEPARTMENT

TITLE: WEST RIDGE SUBDIVISION - UNIT 2
ANGEL DR. N.W.
PAVING IMPROVEMENTS

DESIGN REVIEW COMMITTEE
APPROVED
MAY 13 2003
DESIGN REVIEW COMMITTEE

CITY ENGINEER APPROVAL
APPROVED
DEC 16 2003
CITY ENGINEER


MO./DAY/YR.	MO./DAY/YR.

ZONE MAP NO.	SHEET	OF
708282	H-9 & 10	12 18

A2031WRD/PLANS/UNIT 2/A2031PP-7/03-26-03/ACH

LEGEND


- | | |
|--|---------------------------------|
| | NEW MOUNTABLE CURB & GUTTER |
| | NEW STANDARD 8" CURB & GUTTER |
| | NEW FIRE HYDRANT |
| | NEW SAS MH |
| | NEW LOT NUMBERS |
| | NEW GATE VALVE |
| | NEW TEE |
| | NEW BEND |
| | NEW LOT BOUNDARY |
| | NEW RIGHT OF WAY |
| | NEW EASEMENTS |
| | NEW WATERLINE |
| | NEW SANITARY SEWER |
| | NEW STORM SEWER |
| | NEW CENTERLINE OF ROAD |
| | EXISTING CURB & GUTTER |
| | EXISTING SANITARY SEWER MANHOLE |
| | EXISTING WATER VALVE |
| | EXISTING WATERLINE |
| | EXISTING FIRE HYDRANT |
| | EXISTING STORM SEWER MANHOLE |
| | EXISTING SANITARY SEWER |
| | EXISTING EDGE OF PAVEMENT |
| | NEW SIDEWALK |
| | NEW LOT ADDRESS |
| | NEW STREET LIGHTS |

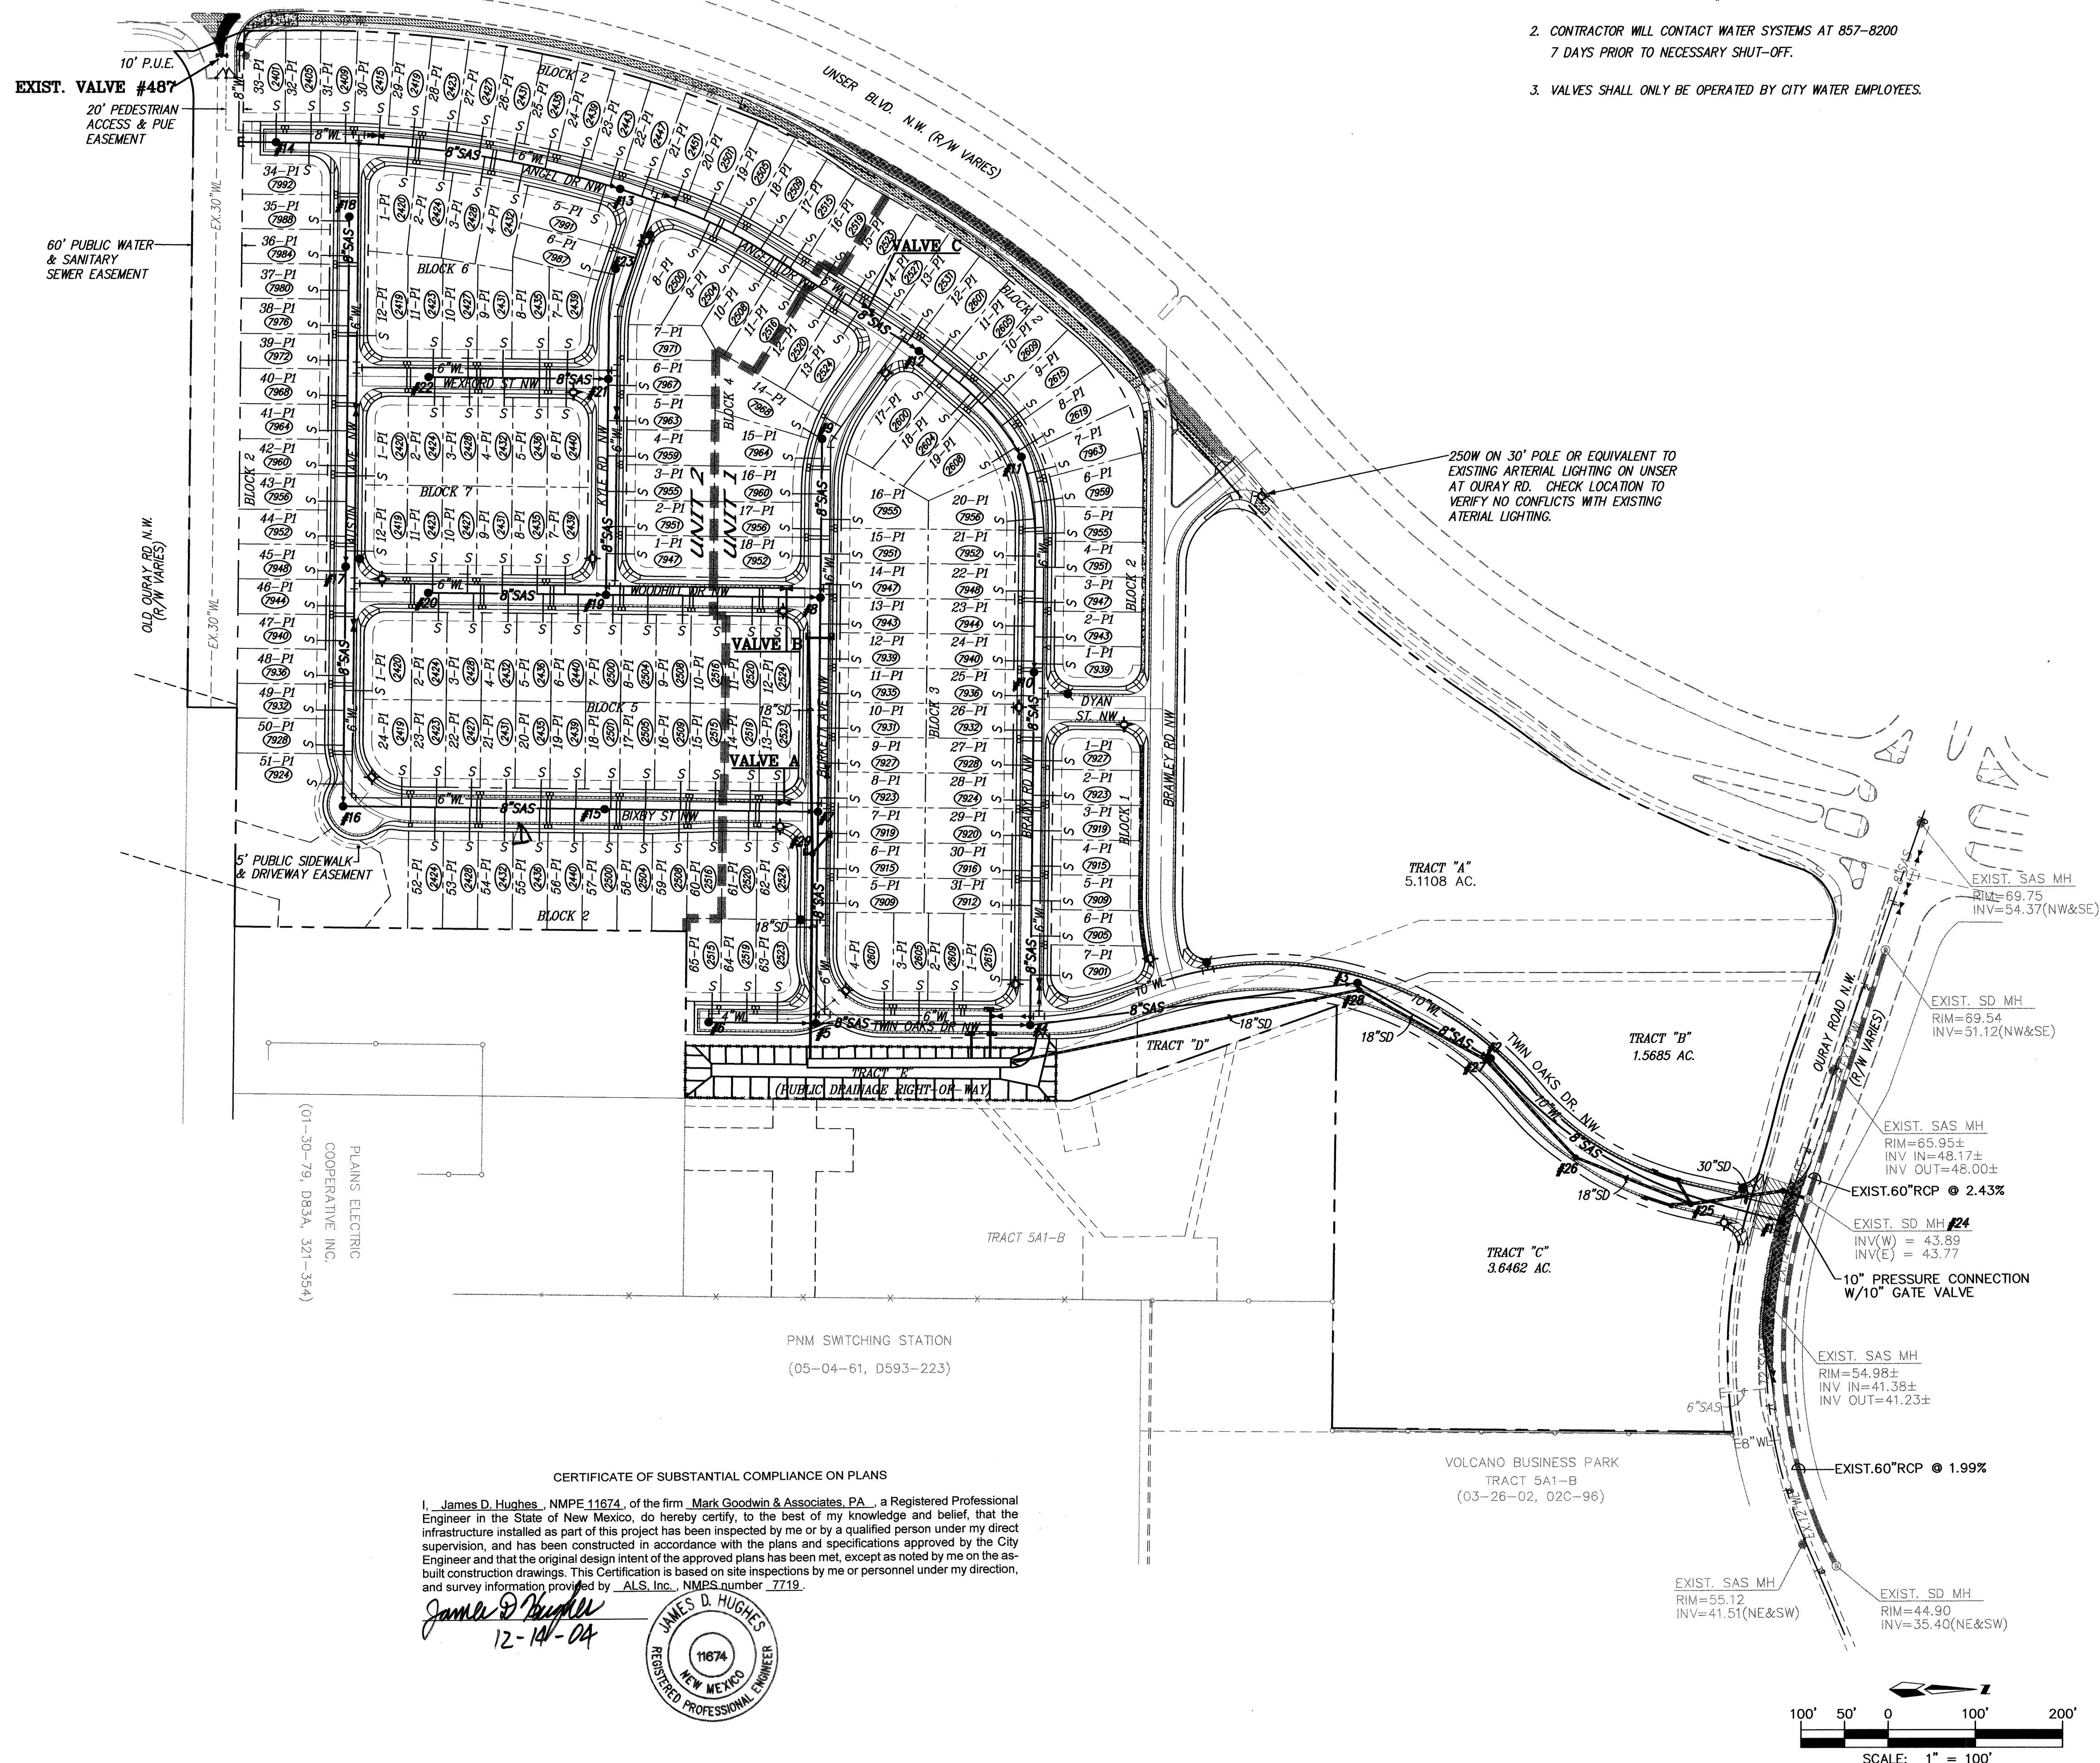

CERTIFICATE OF SUBSTANTIAL COMPLIANCE ON PLANS

I, James D. Hughes, NMPC 11674, of the firm Mark Goodwin & Associates, P.A., a Registered Professional Engineer in the State of New Mexico, do hereby certify, to the best of my knowledge and belief, that the infrastructure installed as part of this project has been inspected by me or by a certified person under my direct supervision, and has been constructed in accordance with the approved plans and specifications approved by the City Engineer and that the original design intent of the approved plans has been met, except as noted by me on the as-built construction drawings. This Certification is based on site inspections by me or personnel under my direction, and survey information provided by ALS, Inc., NMPS number 7719.

James D. Hughes
12-14-04

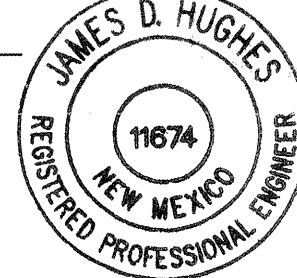

		MARK GOODWIN & ASSOCIATES, P.A. CONSULTING ENGINEERS						 N	12-7							
		P.O. BOX 90606 ALBUQUERQUE, NEW MEXICO 87199 (505) 828-2200, FAX (505) 797-9539											NO. DATE			
		CITY OF ALBUQUERQUE PUBLIC WORKS DEPARTMENT														
TITLE: <i>WEST RIDGE SUBDIVISION - UNIT 2 MASTER UTILITY PLAN</i>																
DESIGN REVIEW COMMITTEE				CITY ENGINEER APPROVAL				LAST DESIGN UPDATE	MO./DAY/YR.			MO./DAY/YR.				
DESIGNED BY CITIRKIN ARCHITECTS				CHECKED BY CITY ENGINEER												
708282								H-9 & 10				SHEET OF 13 18				

SANITARY SEWER SERVICES				
BLOCK	LOT	STATION AT PUE	INV. ELEV. AT PUE	LENGTH AT PUE
5	2	11+07.00	83.40	32.00'
5	3	11+47.00	82.60	32.00'
5	4	11+87.00	81.90	32.00'
5	5	12+27.00	81.10	32.00'
5	6	12+67.00	80.60	32.00'
5	7	13+07.00	79.80	32.00'
5	8	13+47.00	79.10	32.00'
5	9	13+87.00	78.40	32.00'
5	10	14+27.00	77.60	32.00'
5	11	14+67.00	76.90	32.00'
5	12	15+02.00	76.00	32.00'
7	7	12+52.00	80.20	32.00'
7	8	12+20.00	80.80	32.00'
7	9	11+80.00	81.60	32.00'
7	10	11+40.00	82.30	32.00'
7	11	11+00.00	83.10	32.00'
2	52	11+05.45	78.50	37.00'
2	53	11+45.45	78.20	37.00'
2	54	11+85.45	77.90	37.00'
2	55	12+25.45	77.60	37.00'
2	56	12+65.45	77.30	37.00'
2	57	13+05.45	77.00	37.00'
2	58	13+45.45	76.30	37.00'
2	59	13+85.45	75.30	35.51'
2	60	14+25.45	74.10	33.00'
2	61	14+65.45	72.80	33.00'
2	62	14+97.00	71.70	33.00'
5	13	15+02.00	72.00	33.00'
5	14	14+67.00	72.30	33.00'
5	15	14+27.00	73.40	33.00'
5	16	13+87.00	74.50	33.00'
5	17	13+47.00	75.60	33.00'
5	18	13+07.00	76.20	33.00'
5	19	12+67.00	76.50	33.00'
5	20	12+27.00	76.80	33.00'
5	21	11+87.00	77.20	33.00'
5	22	11+47.00	77.50	33.00'
5	23	11+07.00	77.80	33.00'
5	24	10+60.69	78.20	33.59'

RESTRAINED JOINT LENGTH FOR BENDS, VALVES, DEAD ENDS (FT.)					
PIPE SIZE	90°	45°	22.5°	11.25°	VALVE
6"	17'	7'	-	-	46'
10"	-	11'	5'	3'	72'

RESTRAINED JOINT LENGTHS FOR REDUCERS (FT.)		
PIPE SIZE	LARGE SIDE	SMALL SIDE
10" X 6"	44'	-

RESTRAINED JOINT LENGTH FOR TEES (FT.)		
PIPE SIZE	RUN	BRANCH
10"x10"x10"	15'	5'
10"x10"x6"	6'	1'
6"x6"x6"	10'	2'

MARK GOODWIN & ASSOCIATES, P.A.
CONSULTING ENGINEERS
P.O. BOX 90606
ALBUQUERQUE, NEW MEXICO 87199
(505) 828-2200, FAX (505) 797-9539

**CITY OF ALBUQUERQUE
PUBLIC WORKS DEPARTMENT**

TITLE: **WEST RIDGE SUBDIVISION - UNIT 2
WOODHILL DR. N.W. & BIXBY ST. N.W.
UTILITY IMPROVEMENTS**


DESIGN REVIEW COMMITTEE		CITY ENGINEER APPROVAL		LAST DESIGN UPDATE		MO./DAY/YR.		MO./DAY/YR.	
CITY DESIGN		CITY ENGINEER		CITY ENGINEER					

CITY DESIGN NO. **708282**


ZONE MAP NO. **H-9 & 10**

SHEET **15** OF **18**

SCANNED BY
MESA REPRO

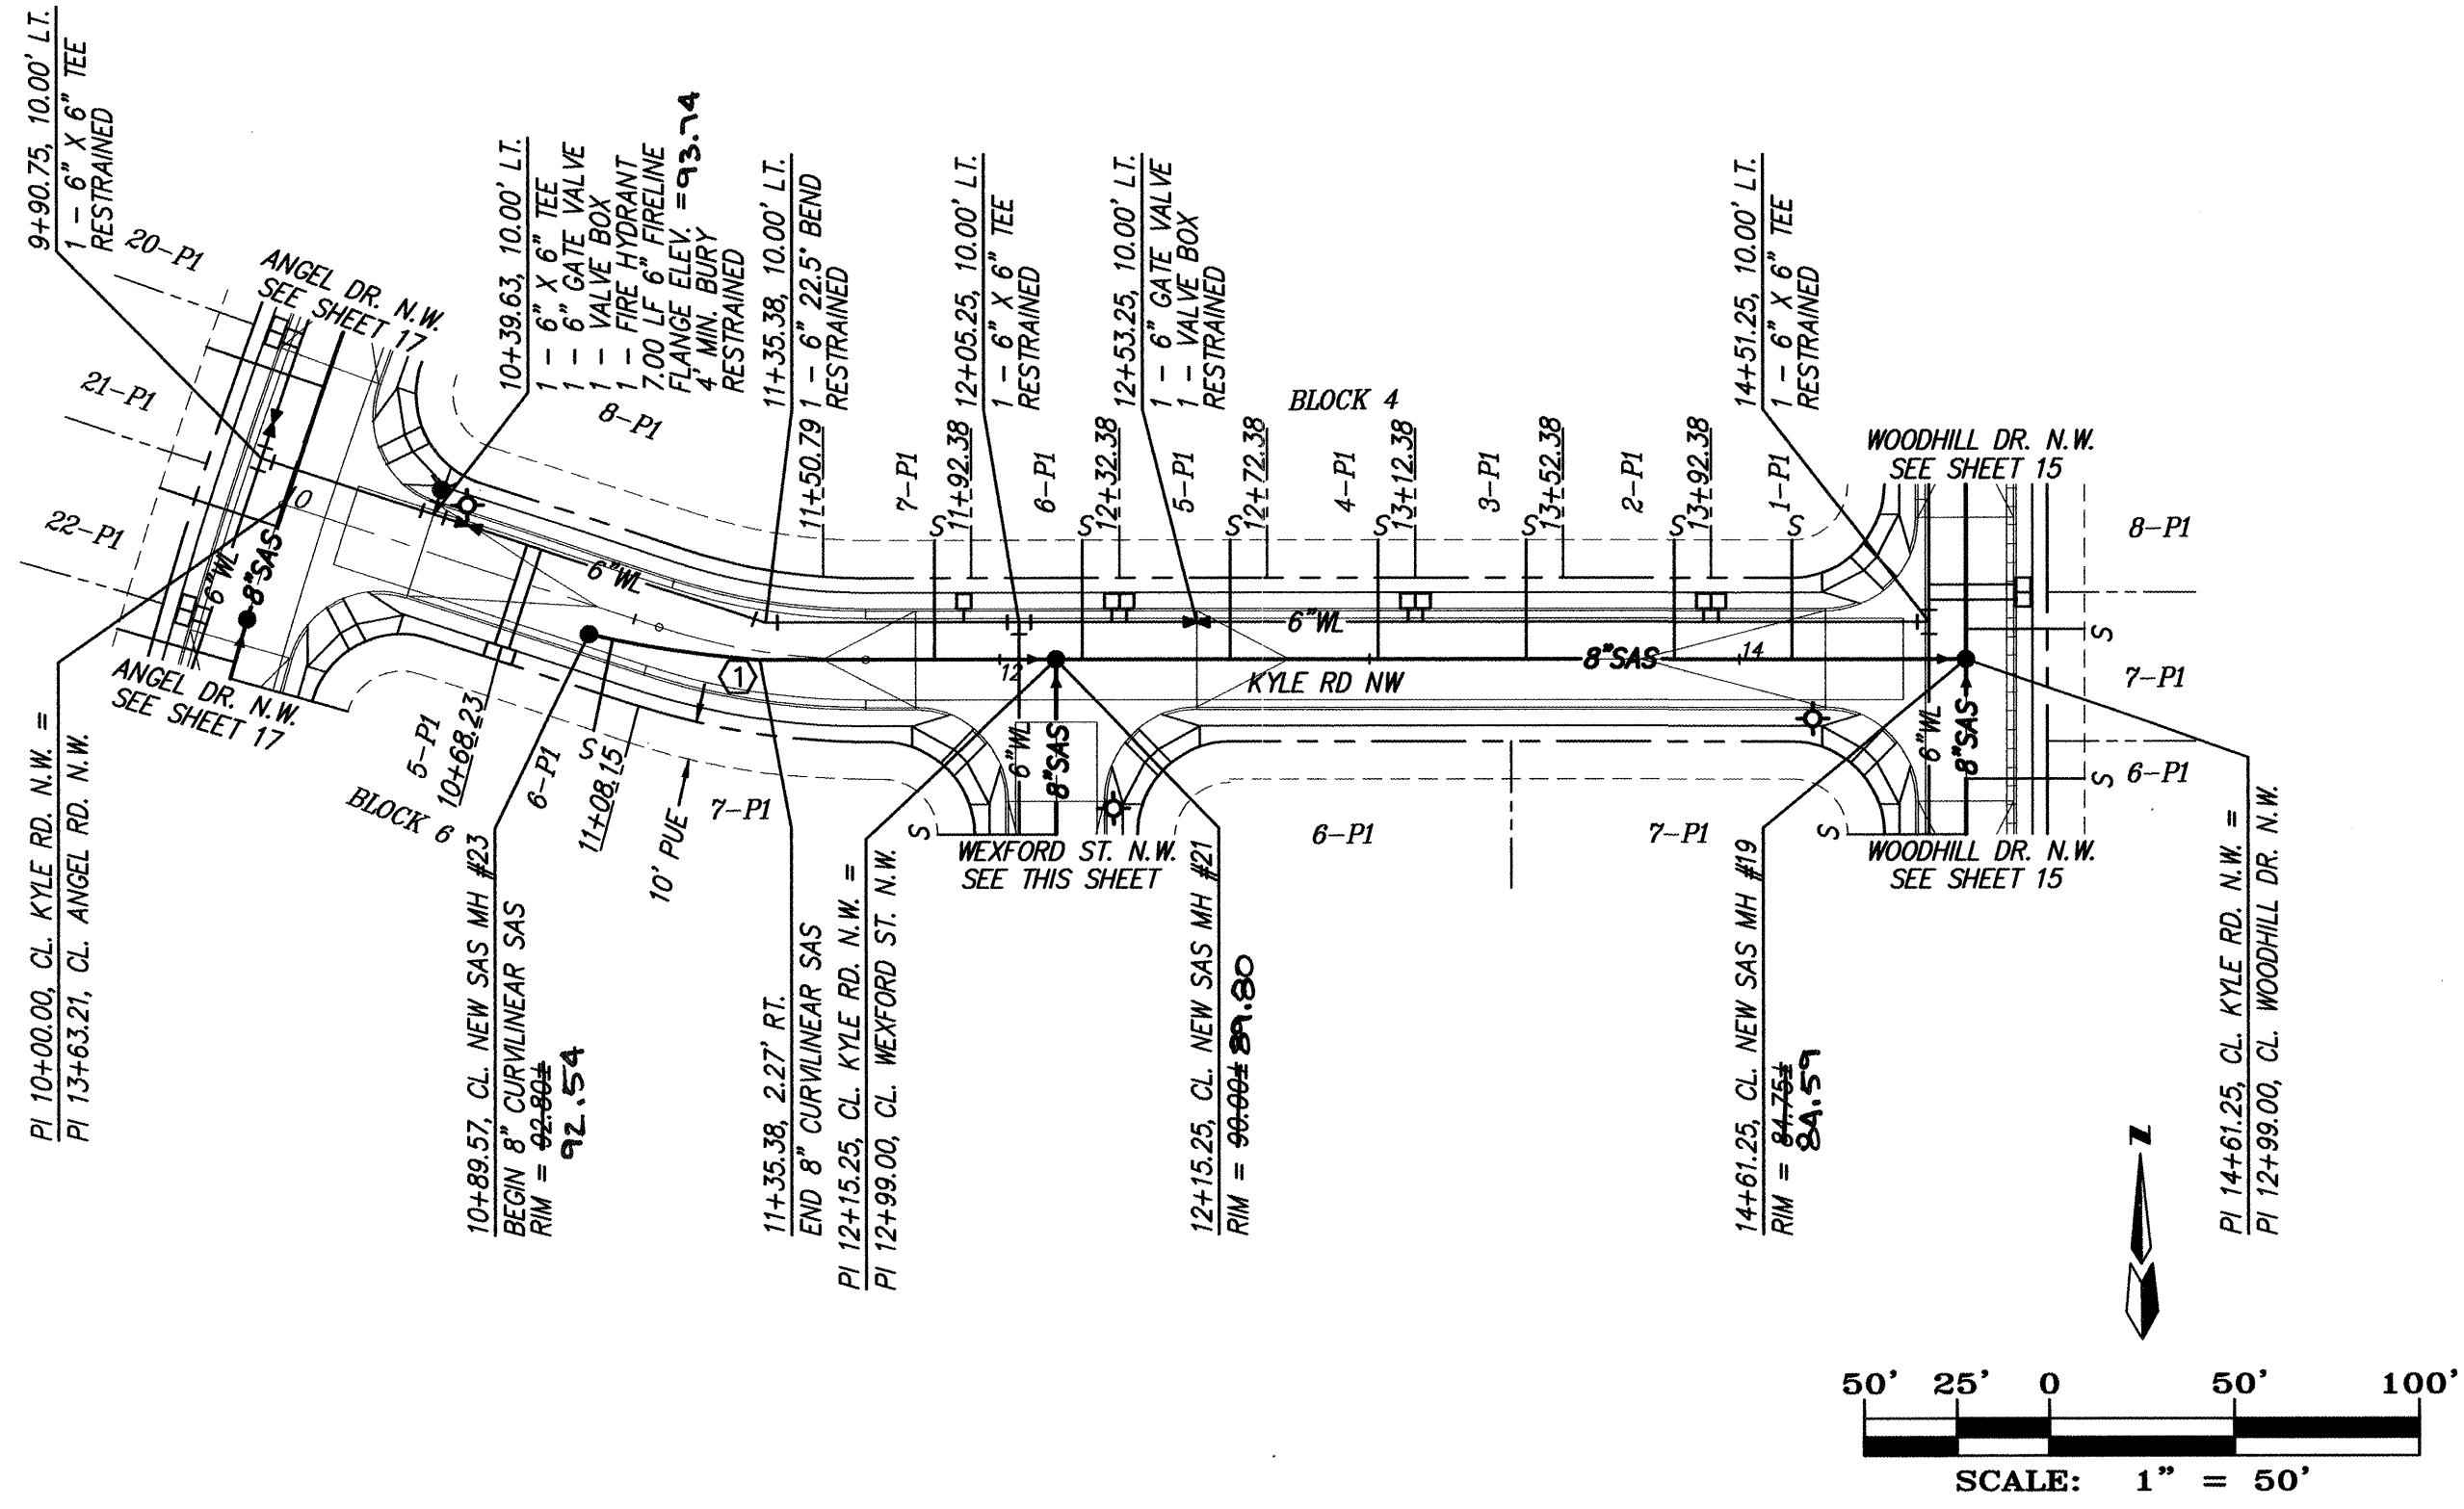


KYLE RD. N.W.
STA. 10+00.00 TO STA. 14+61.25
SCALE: HORZ. 1" = 50'
VERT. 1" = 10'

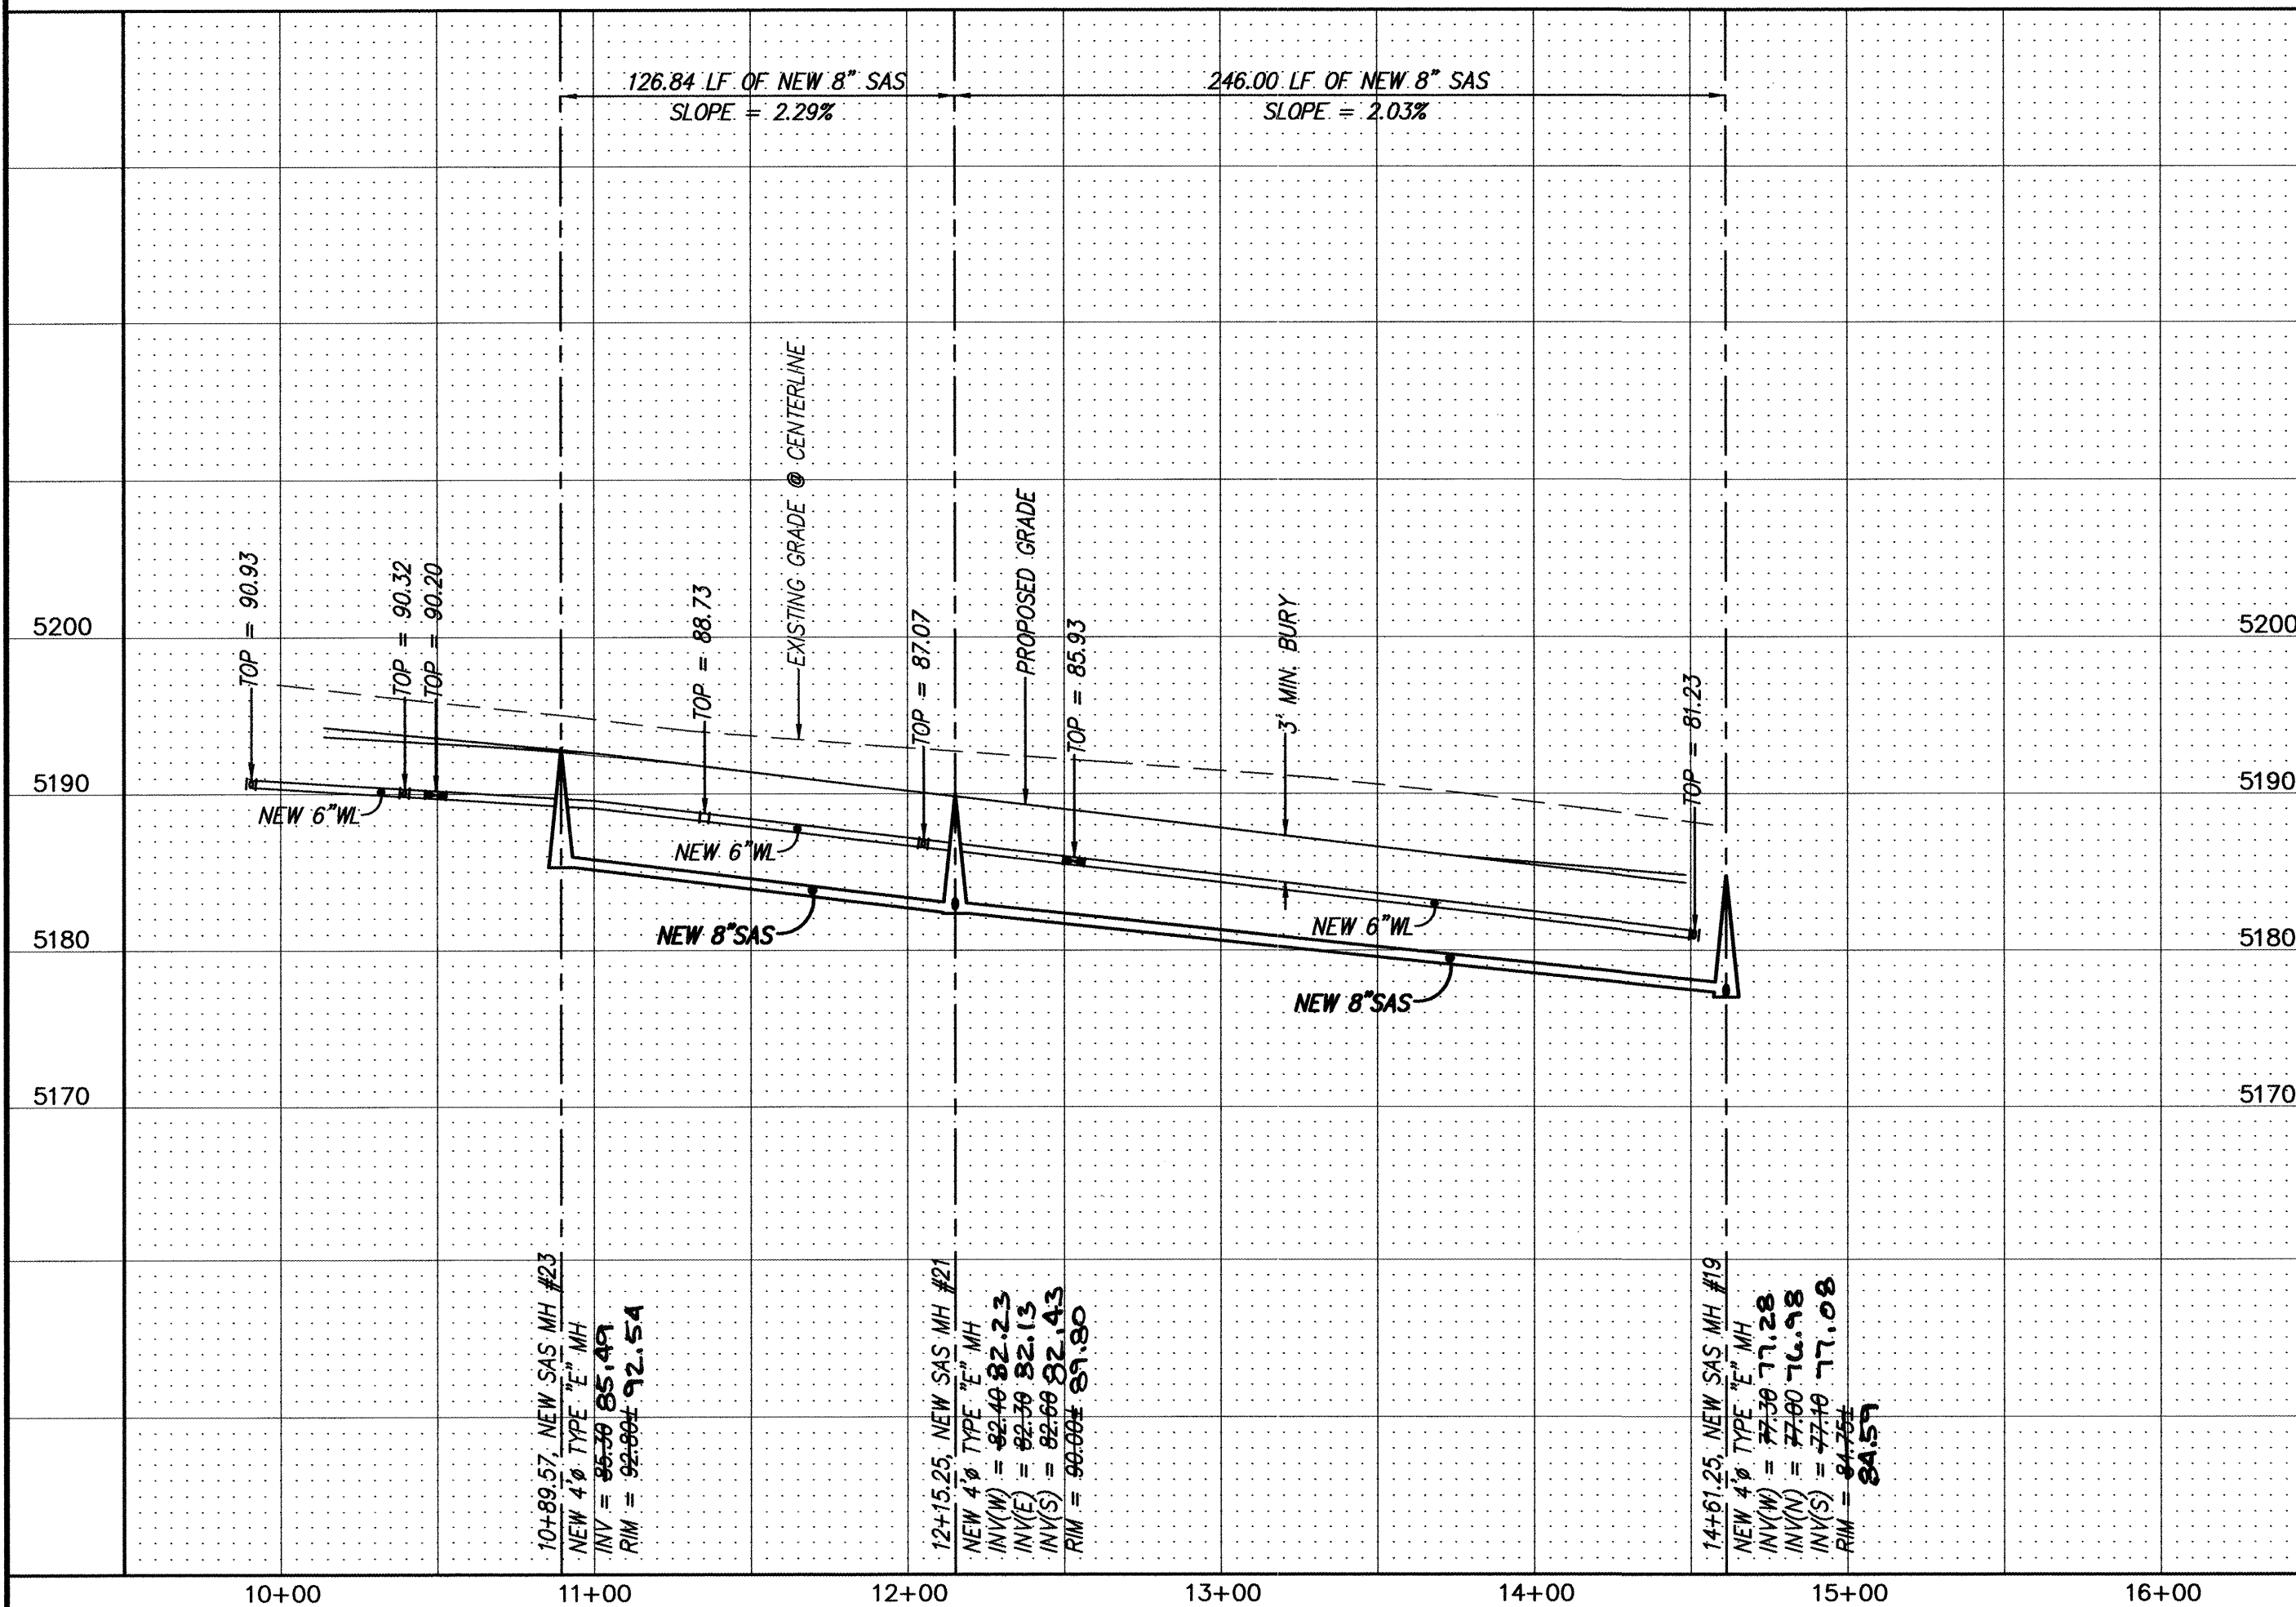


CERTIFICATE OF SUBSTANTIAL COMPLIANCE ON PLANS

I, James D. Hughes, NMPE 11674, of the firm Mark Goodwin & Associates, P.A., a Registered Professional Engineer in the State of New Mexico, do hereby certify, to the best of my knowledge and belief, that the infrastructure installed as part of this project has been inspected by me or by a qualified person under my direct supervision, and has been constructed in accordance with the plans and specifications approved by the City Engineer and that the original design intent of the approved plans has been met, except as noted by me on the as-built construction drawings. This Certification is based on site inspections by me or personnel under my direction, and survey information provided by ALS, Inc., NMPS number 7719.

James D. Hughes
12-14-04
JAMES D. HUGHES
11674
NEW MEXICO
REGISTERED PROFESSIONAL ENGINEER

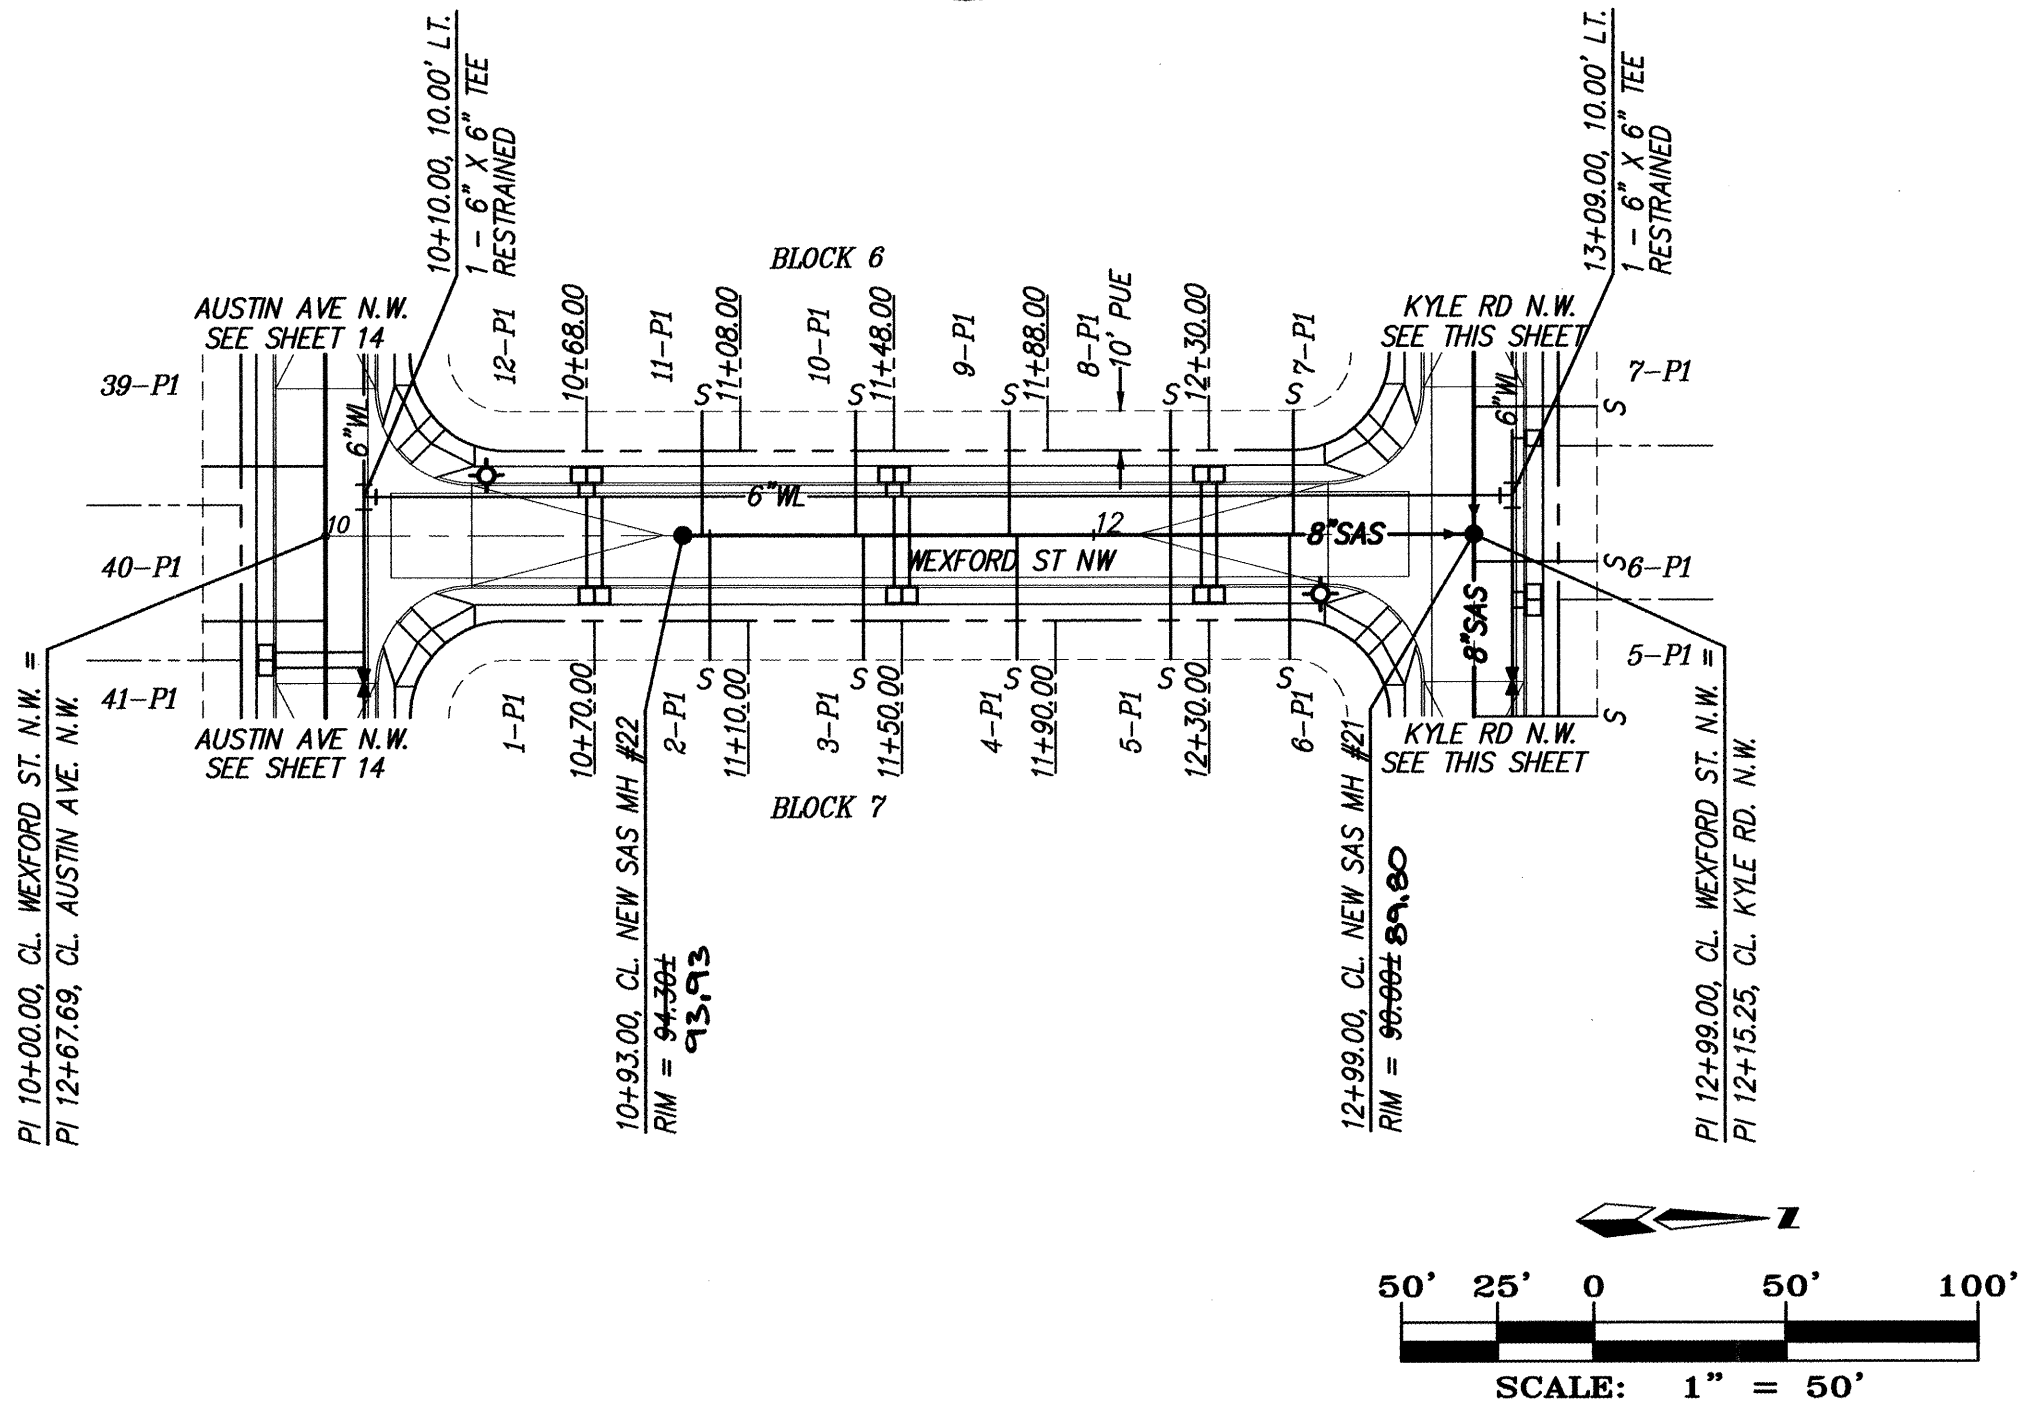

WEXFORD ST. N.W.
STA. 10+00.00 TO STA. 12+99.00
SCALE: HORZ. 1" = 50'
VERT. 1" = 10'

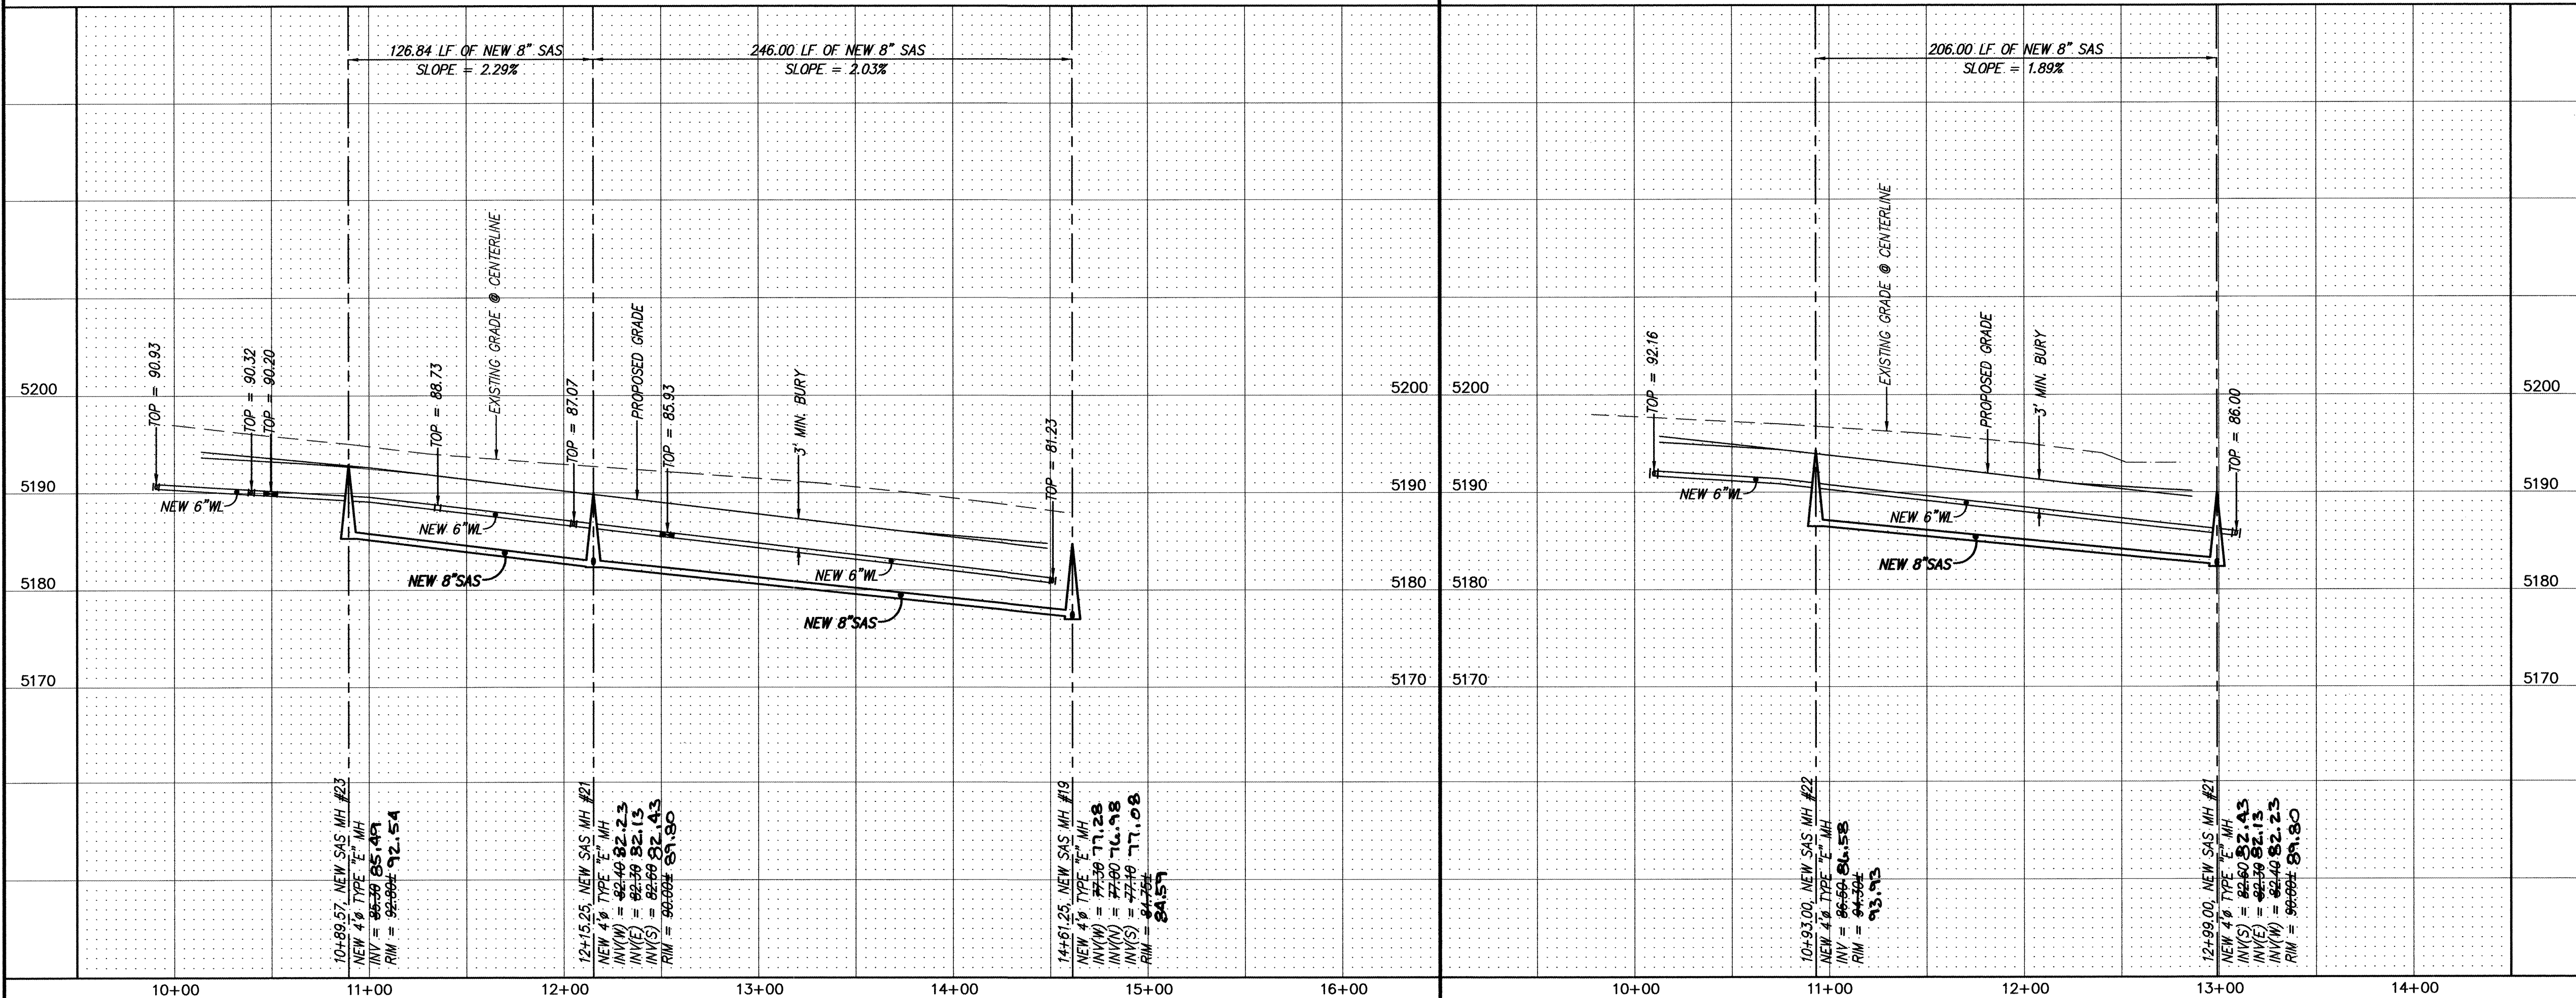

NOTES

1. ALL STATIONING IS CENTERLINE STATIONING.
2. SEE GATE VALVE BOX DETAIL ON SHEET ##

KYLE RD.
CURVE DATA - DESCRIBES SAS

- ① 4 = 8°55'27"
R = 300.00'
L = 46.73'
T = 22.43'

SANITARY SEWER SERVICES

BLOCK	LOT	STATION AT PUE	INV. ELEV. AT PUE	LENGTH AT PUE
4	1	14+14.25	80.00	32.00'
4	2	13+82.38	80.60	32.00'
4	3	13+42.38	81.60	32.00'
4	4	13+02.38	82.60	32.00'
4	5	12+62.38	83.50	32.00'
4	6	12+22.38	84.50	32.00'
4	7	11+82.38	85.40	32.00'
6	6	10+98.85	87.80	25.13'
6	7	12+52.00	85.50	32.00'
6	8	12+20.00	85.90	32.00'
6	9	11+78.00	86.80	32.00'
6	10	11+38.00	87.70	32.00'
6	11	10+98.00	88.60	32.00'
7	2	11+00.00	88.90	32.00'
7	3	11+40.00	88.00	32.00'
7	4	11+80.00	87.10	32.00'
7	5	12+20.00	86.20	32.00'
7	6	12+51.00	85.20	32.00'

RESTRAINED JOINT LENGTH FOR BENDS, VALVES, DEAD ENDS (FT.)

PIPE SIZE	90°	45°	22.5°	11.25°	VALVE
6"	17'	7'	-	-	46'
10"	-	11'	5'	3'	72'

LENGTH OF RESTRAINED PIPE ON EACH SIDE OF THE BEND. RESTRAIN BRANCH AT FITTING ONLY MINIMUM ATTACHED PIPE LENGTH, RUN SIDE OF TEE: 10.00 FEET.

RESTRAINED JOINT LENGTHS FOR REDUCERS (FT.)

PIPE SIZE	LARGE SIDE	SMALL SIDE
10" X 6"	44'	-

RESTRAINED JOINT LENGTH FOR TEES (FT.)



PIPE SIZE	RUN	BRANCH
10"x10"x10"	15'	5'
10"x10"x6"	6'	1'
6"x6"x6"	10'	2'

dmg MARK GOODWIN & ASSOCIATES, P.A.
CONSULTING ENGINEERS
P.O. BOX 90606
ALBUQUERQUE, NEW MEXICO 87199
(505) 828-2200, FAX (505) 797-9539



CITY OF ALBUQUERQUE
PUBLIC WORKS DEPARTMENT

TITLE: WEST RIDGE SUBDIVISION - UNIT 2
KYLE RD. N.W. & WEXFORD ST. N.W.
UTILITY IMPROVEMENTS

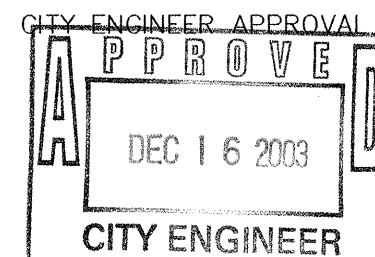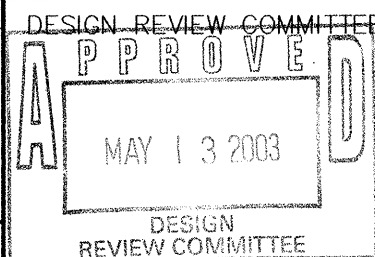

CITY PROJECT NO.

 
 
 
ZONE MAP NO.


SHEET OF

708282

H-9 & 10

16 18

	NEW MOUNTABLE CURB & GUTTER
	NEW STANDARD 8" CURB & GUTTER
	NEW FIRE HYDRANT
	NEW SAS MH
20	NEW LOT NUMBERS
	NEW GATE VALVE
	NEW TEE
	NEW BEND
- - -	NEW LOT BOUNDARY
	NEW RIGHT OF WAY
	NEW EASEMENTS
W	NEW WATERLINE
SAS	NEW SANITARY SEWER
	NEW STORM SEWER
- - -	NEW CENTERLINE OF ROAD
	EXISTING CURB AND GUTTER
	EXISTING SANITARY SEWER MANHOLE
	EXISTING WATER VALVE
- - 8" W	EXISTING WATERLINE
	EXISTING FIRE HYDRANT
	EXISTING STORM SEWER MANHOLE
- - - SAS	EXISTING SANITARY SEWER
	EXISTING EDGE OF PAVEMENT
	NEW SIDEWALK
8309	NEW LOT ADDRESS
	NEW STREET LIGHTS

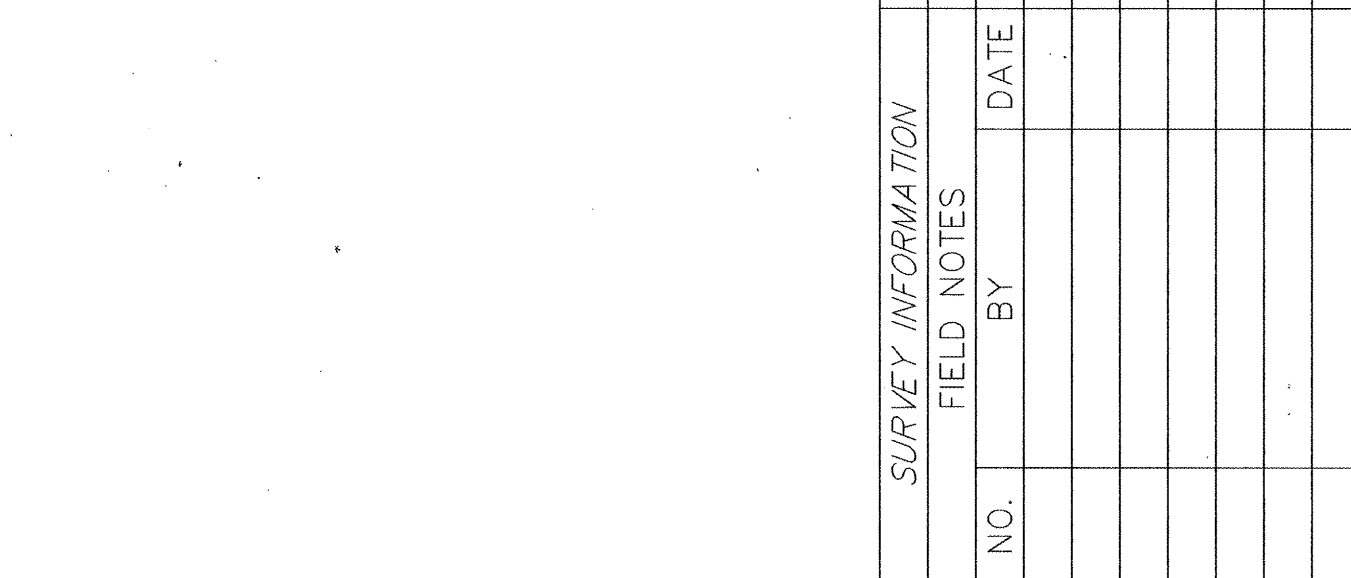

PLAINS ELECTRIC
COOPERATIVE INC.
(01-30-79, D83A, 321-354)

I, James D. Hughes, NMPE 11674, of the firm Mark Goodwin & Associates, PA, a Registered Professional Engineer in the State of New Mexico, do hereby certify, to the best of my knowledge and belief, that the infrastructure installed as part of this project has been inspected by me or by a qualified person under my direct supervision, and has been constructed in accordance with the plans and specifications approved by the City Engineer and that the original design intent of the approved plans has been met, except as noted by me on the as-built construction drawings. This Certification is based on site inspections by me or personnel under my direction, and survey information provided by ALS, Inc., NMPS number 7719.

and survey information provided by ALS, Inc., NMPS number

James D Hughes
12-14-04



AFD PLANS CHECKING OFFICE
924-3611
APPROVED/DISAPPROVED
HYDRANT(S) ONLY
R.E. Smith 4-2
SIGNATURE & DATE

dmg MARK GOODWIN & ASSOCIATES, P.A.
CONSULTING ENGINEERS
P.O. BOX 90606
ALBUQUERQUE, NEW MEXICO 87199
(505) 828-2200, FAX (505) 797-9539



**WEST RIDGE SUBDIVISION - UNIT 2
MASTER UTILITY PLAN**

DESIGN REVIEW COMMITTEE

APPROVE

MAY 13 2003

DESIGN
REVIEW COMMITTEE

CITY ENGINEER APPROVAL
APPROVED
DEC 16 2003
CITY ENGINEER

CITY PROJECT NO.

ZONE MAP NO.

SHEET OF



1. ALL STATIONING IS CENTERLINE STATIONING.

① $\Delta = 15^{\circ}07'00''$
 $R = 1194.00'$
 $L = 315.02'$
 $T = 157.94'$

③ $\Delta = 21^{\circ}44'05''$
 $R = 300.00'$
 $L = 113.80'$
 $T = 56.80'$

$$\begin{array}{ll} \textcircled{1} \Delta = 15^{\circ}07'47'' & \textcircled{2} \Delta = 13^{\circ}31'23'' \\ R = 1204.00' & R = 494.04' \\ L = 317.93' & L = 116.60' \\ T = 159.31' & T = 57.65' \end{array}$$

③ $\Delta = 21^{\circ}54'47''$
 $R = 310.00'$
 $L = 118.56'$
 $T = 58.98'$

BLOCK	LOT	STATION AT PUE	INV. ELEV. AT PUE	LENGTH AT PUE
2	11	17+81.10	79.20	32.28'
2	12	17+42.23	80.70	33.14'
2	13	17+04.06	80.90	34.29'
2	14	16+65.89	81.80	35.90'
2	15	16+27.53	82.80	35.85'
2	16	15+87.59	83.70	35.16'
2	17	15+47.59	84.60	34.46'
2	18	15+07.59	85.30	33.76'
2	19	14+70.26	86.00	33.59'
2	20	14+33.49	87.00	33.44'
2	21	13+96.16	87.90	33.47'
2	22	13+57.42	88.60	33.62'
2	23	13+18.86	89.80	33.00'
2	24	12+80.24	90.60	33.00'
2	25	12+41.63	91.30	33.00'
2	26	12+03.01	91.90	33.00'
2	27	11+64.39	92.60	33.00'
2	28	11+25.78	93.30	33.00'
2	29	10+87.17	93.90	33.00'
2	30	10+48.56	95.50	33.00'
2	31	10+10.59	95.10	33.13'
2	32	9+70.88	95.70	33.17'
2	33	9+30.86	96.50	33.00'
2	34	9+68.96	96.10	24.84'
3	17	17+58.17	80.60	33.04'
3	18	17+98.54	80.30	33.61'
4	8	14+40.83	87.20	32.53'
4	9	14+83.91	86.30	32.35'
4	10	15+25.18	85.40	31.92'
4	11	15+65.18	84.50	31.22'
4	12	16+05.18	83.60	30.53'
4	13	16+39.23	82.70	28.94'
6	1	10+83.39	94.40	33.00'
6	2	11+27.37	93.60	33.00'
6	3	11+71.37	92.90	33.00'
6	4	12+16.64	92.10	33.00'
6	5	13+14.23	90.40	33.00'

PIPE SIZE	90°	45°	22.5°	11.25°	VALVE
6"	17'	7'	—	—	46'
10"	—	11'	5'	3'	72'

LENGTH OF RESTRAINED PIPE ON EACH SIDE OF THE BEND. RESTRAIN BRANCH AT FITTING ONLY
MINIMUM ATTACHED PIPE LENGTH, RUN SIDE OF TEE: 10.00 FEET.

PIPE SIZE	LARGE SIDE	SMALL SIDE
10" X 6"	44'	—

PIPE SIZE	RUN	BRANCH
10"x10"x10"	15'	5'
10"x10"x6"	6'	1'
6"x6"x6"	10'	2'

dmg MARK GOODWIN & ASSOCIATES, P.A.
CONSULTING ENGINEERS
P.O. BOX 90606
ALBUQUERQUE, NEW MEXICO 87199
(505) 828-2200, FAX (505) 797-9

 CITY OF ALBUQUERQUE
PUBLIC WORKS DEPARTMENT

TITLE: **WEST RIDGE SUBDIVISION - UNIT 2**
ANGEL DR. N.W.
UTILITY IMPROVEMENTS

DESIGN REVIEW COMMITTEE

A P P R O V E

MAY 13 2003

DESIGN
REVIEW COMMITTEE

APPROVED
DEC 16 2003
CITY ENGINEER

CITY PROJECT NO

ZONE MAP NO.

SHEET OF

17 18

A2031WRD/PLANS/UNIT 2/A2031UP-7/03-26-03/ACH

708282

ZONE MAP NO.
H-9 & 10

SHEET OF

17 18

SCANNED BY
MESA REPRO

F:\A02\JOBS\A2031\WRD\PLANS\UNIT2\A2031UP-7.dwg Fri Mar 28 11:47:08 2003 D. MARK GOODWIN & ASSOCIATES: PLTTED BY: ACH

43.02 LF OF
NEW 8" SAS

SLOPE
= 1.0%

400.00 LF OF NEW 8" SAS
SLOPE = 1.80%

1.18 LF OF NEW 8" SAS
SLOPE = 2.22%

167.62 LF OF EXIST. 8" SAS
SLOPE = 2.22%

69.71 LF OF EXIST. 8" SAS
SLOPE = 1.41%





$NNV = 95.03$
 $9 + 30.88$, NEW SAS MH #
 NEW 4th TYPE "E" MH
 $NNV(S) = 94.60$ 94.57
 $NNV(N) = 94.50$ 94.47
 $RIM = 94.90$ 91.51

13+30.88, NEW SAS MH #13
NEW 4" TYPE "E" MH
NV(S) = 8730.87.37
NV(N) = ~~8720~~ 87.27
RIM = 94.98± 94.77

17+22.92	EXIST. SAS. MH. #12.
EXIST. AØ TYPE "E". NH	
NV(S) = 78.50	
NV(N) = 78.40	
NH = 85.00	

18+93.06, EXIST. SAS. MH. #11

SCANNED BY
MESA REPRO

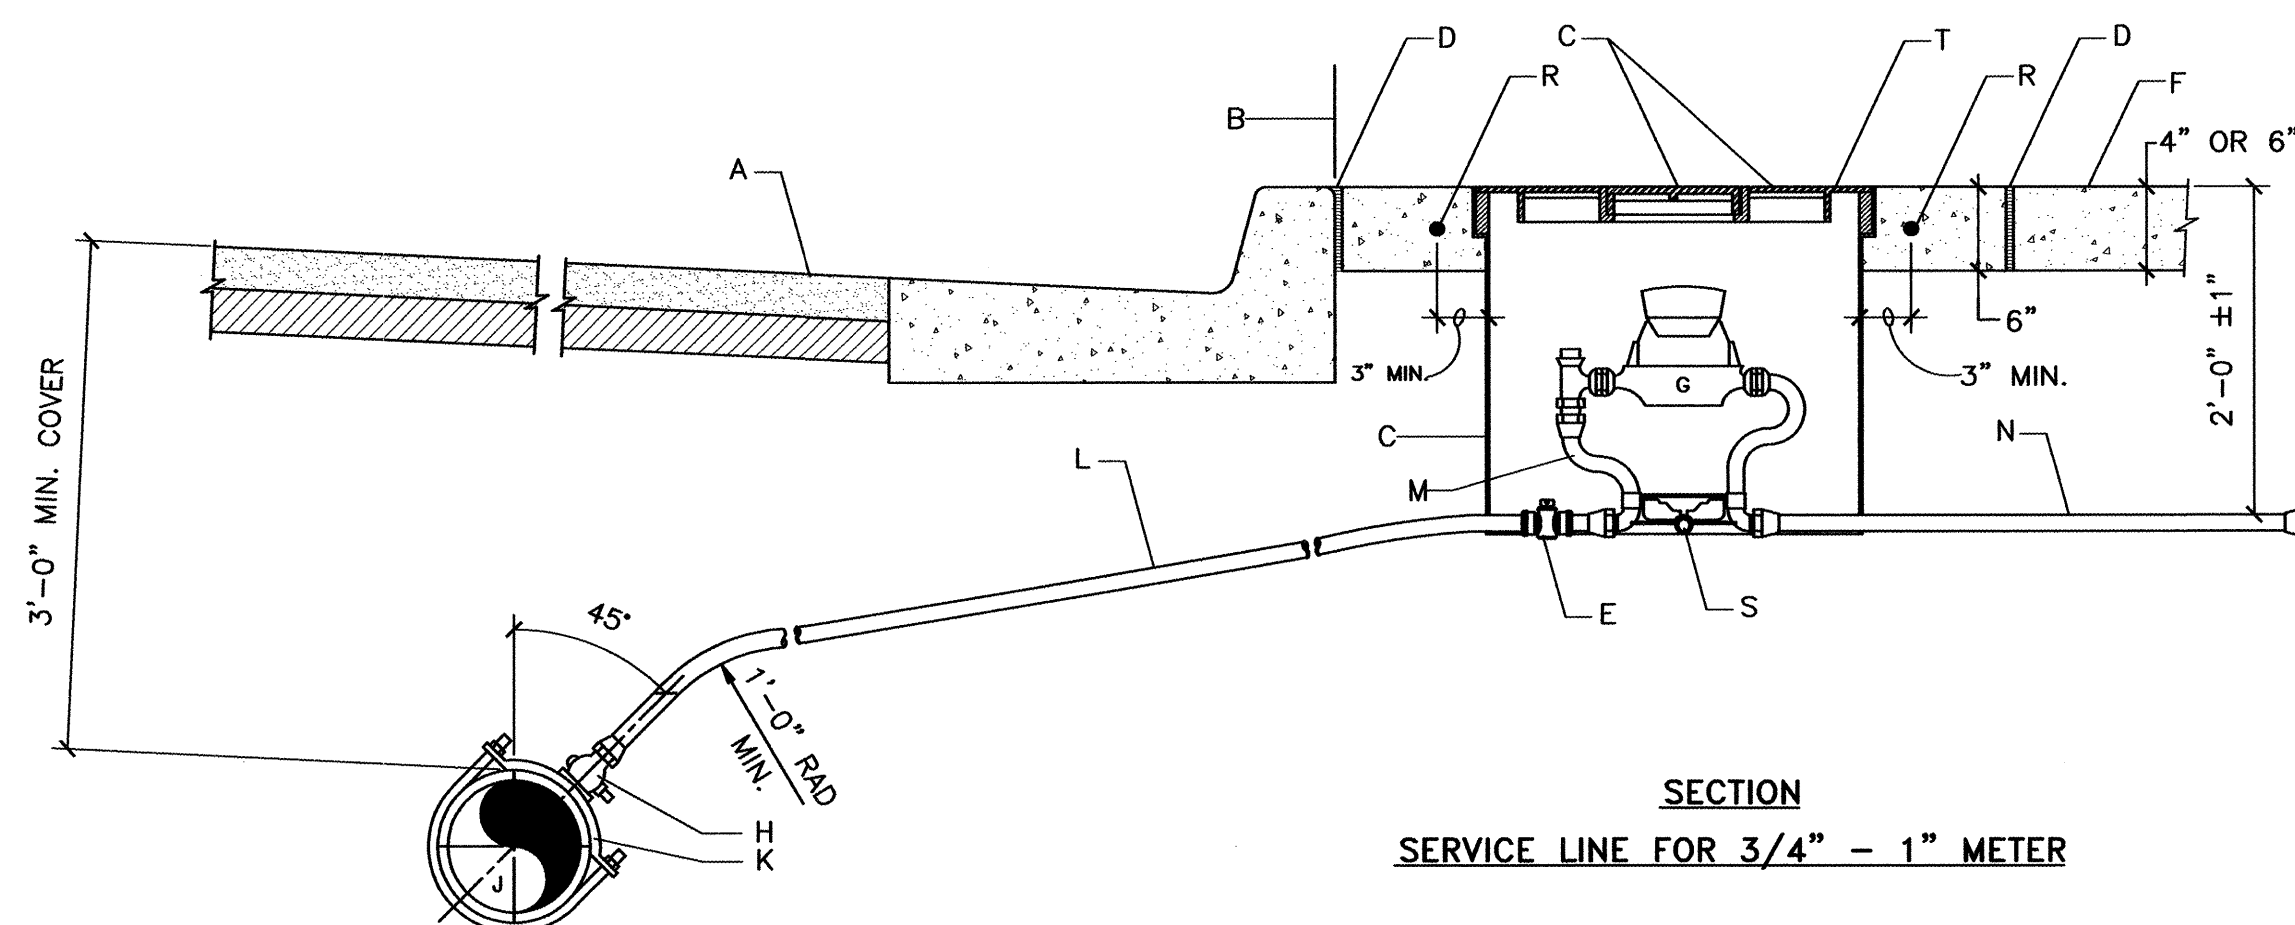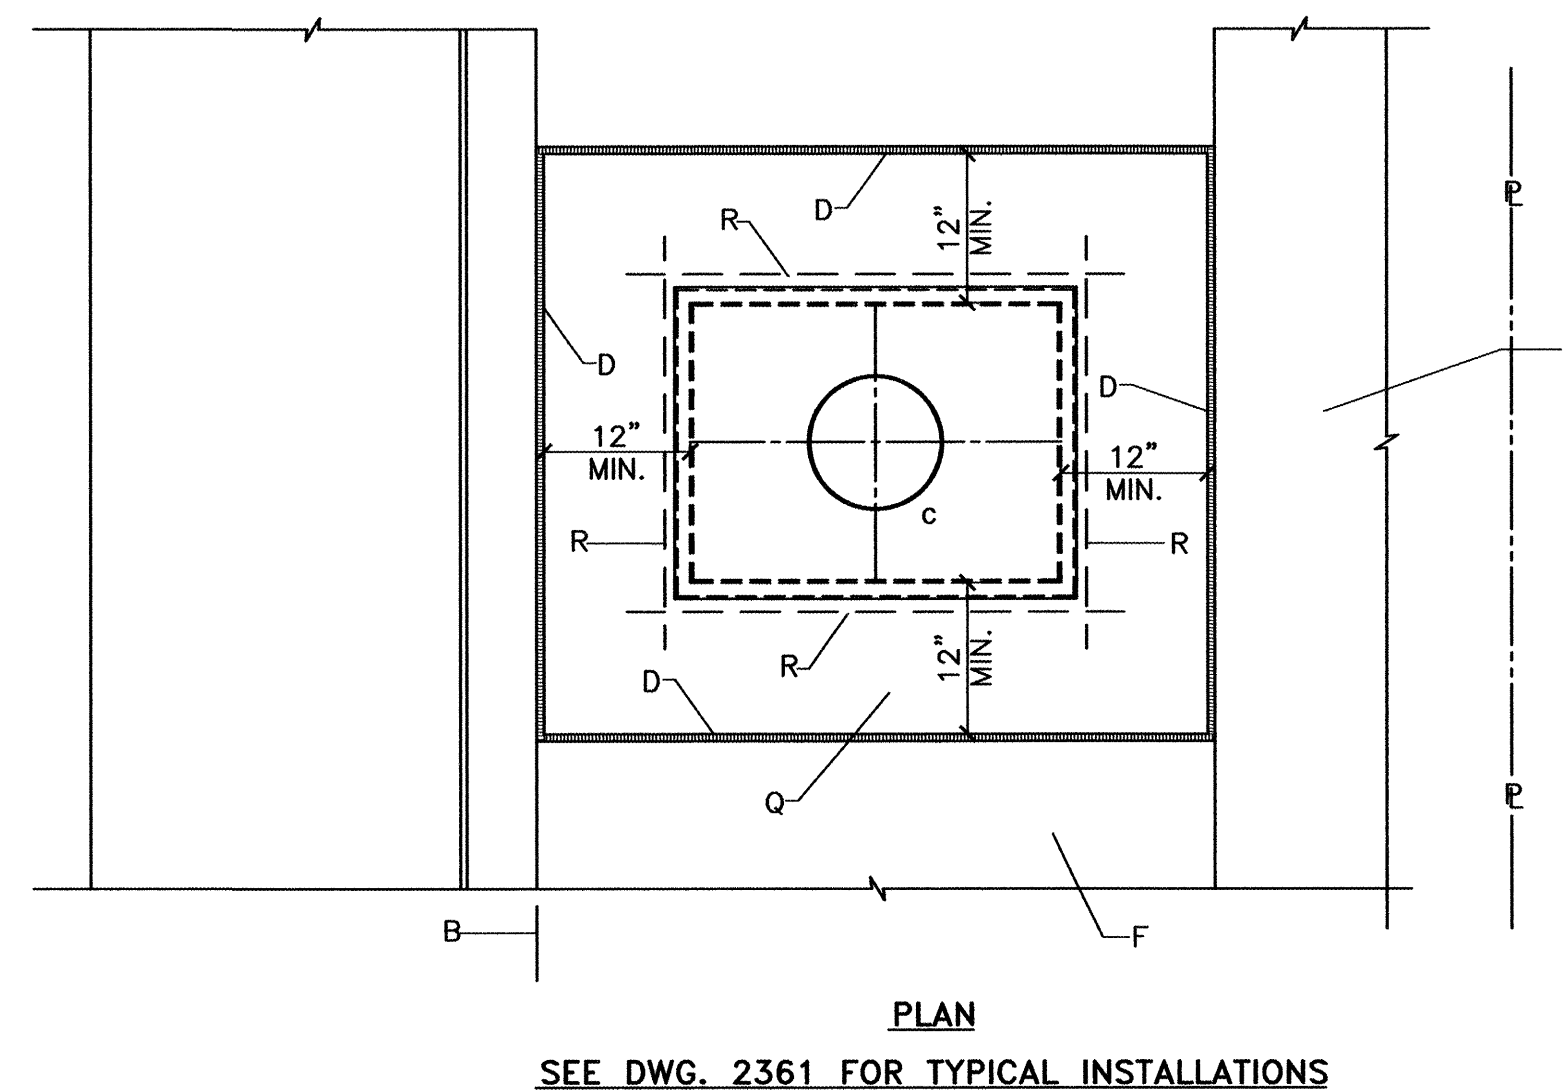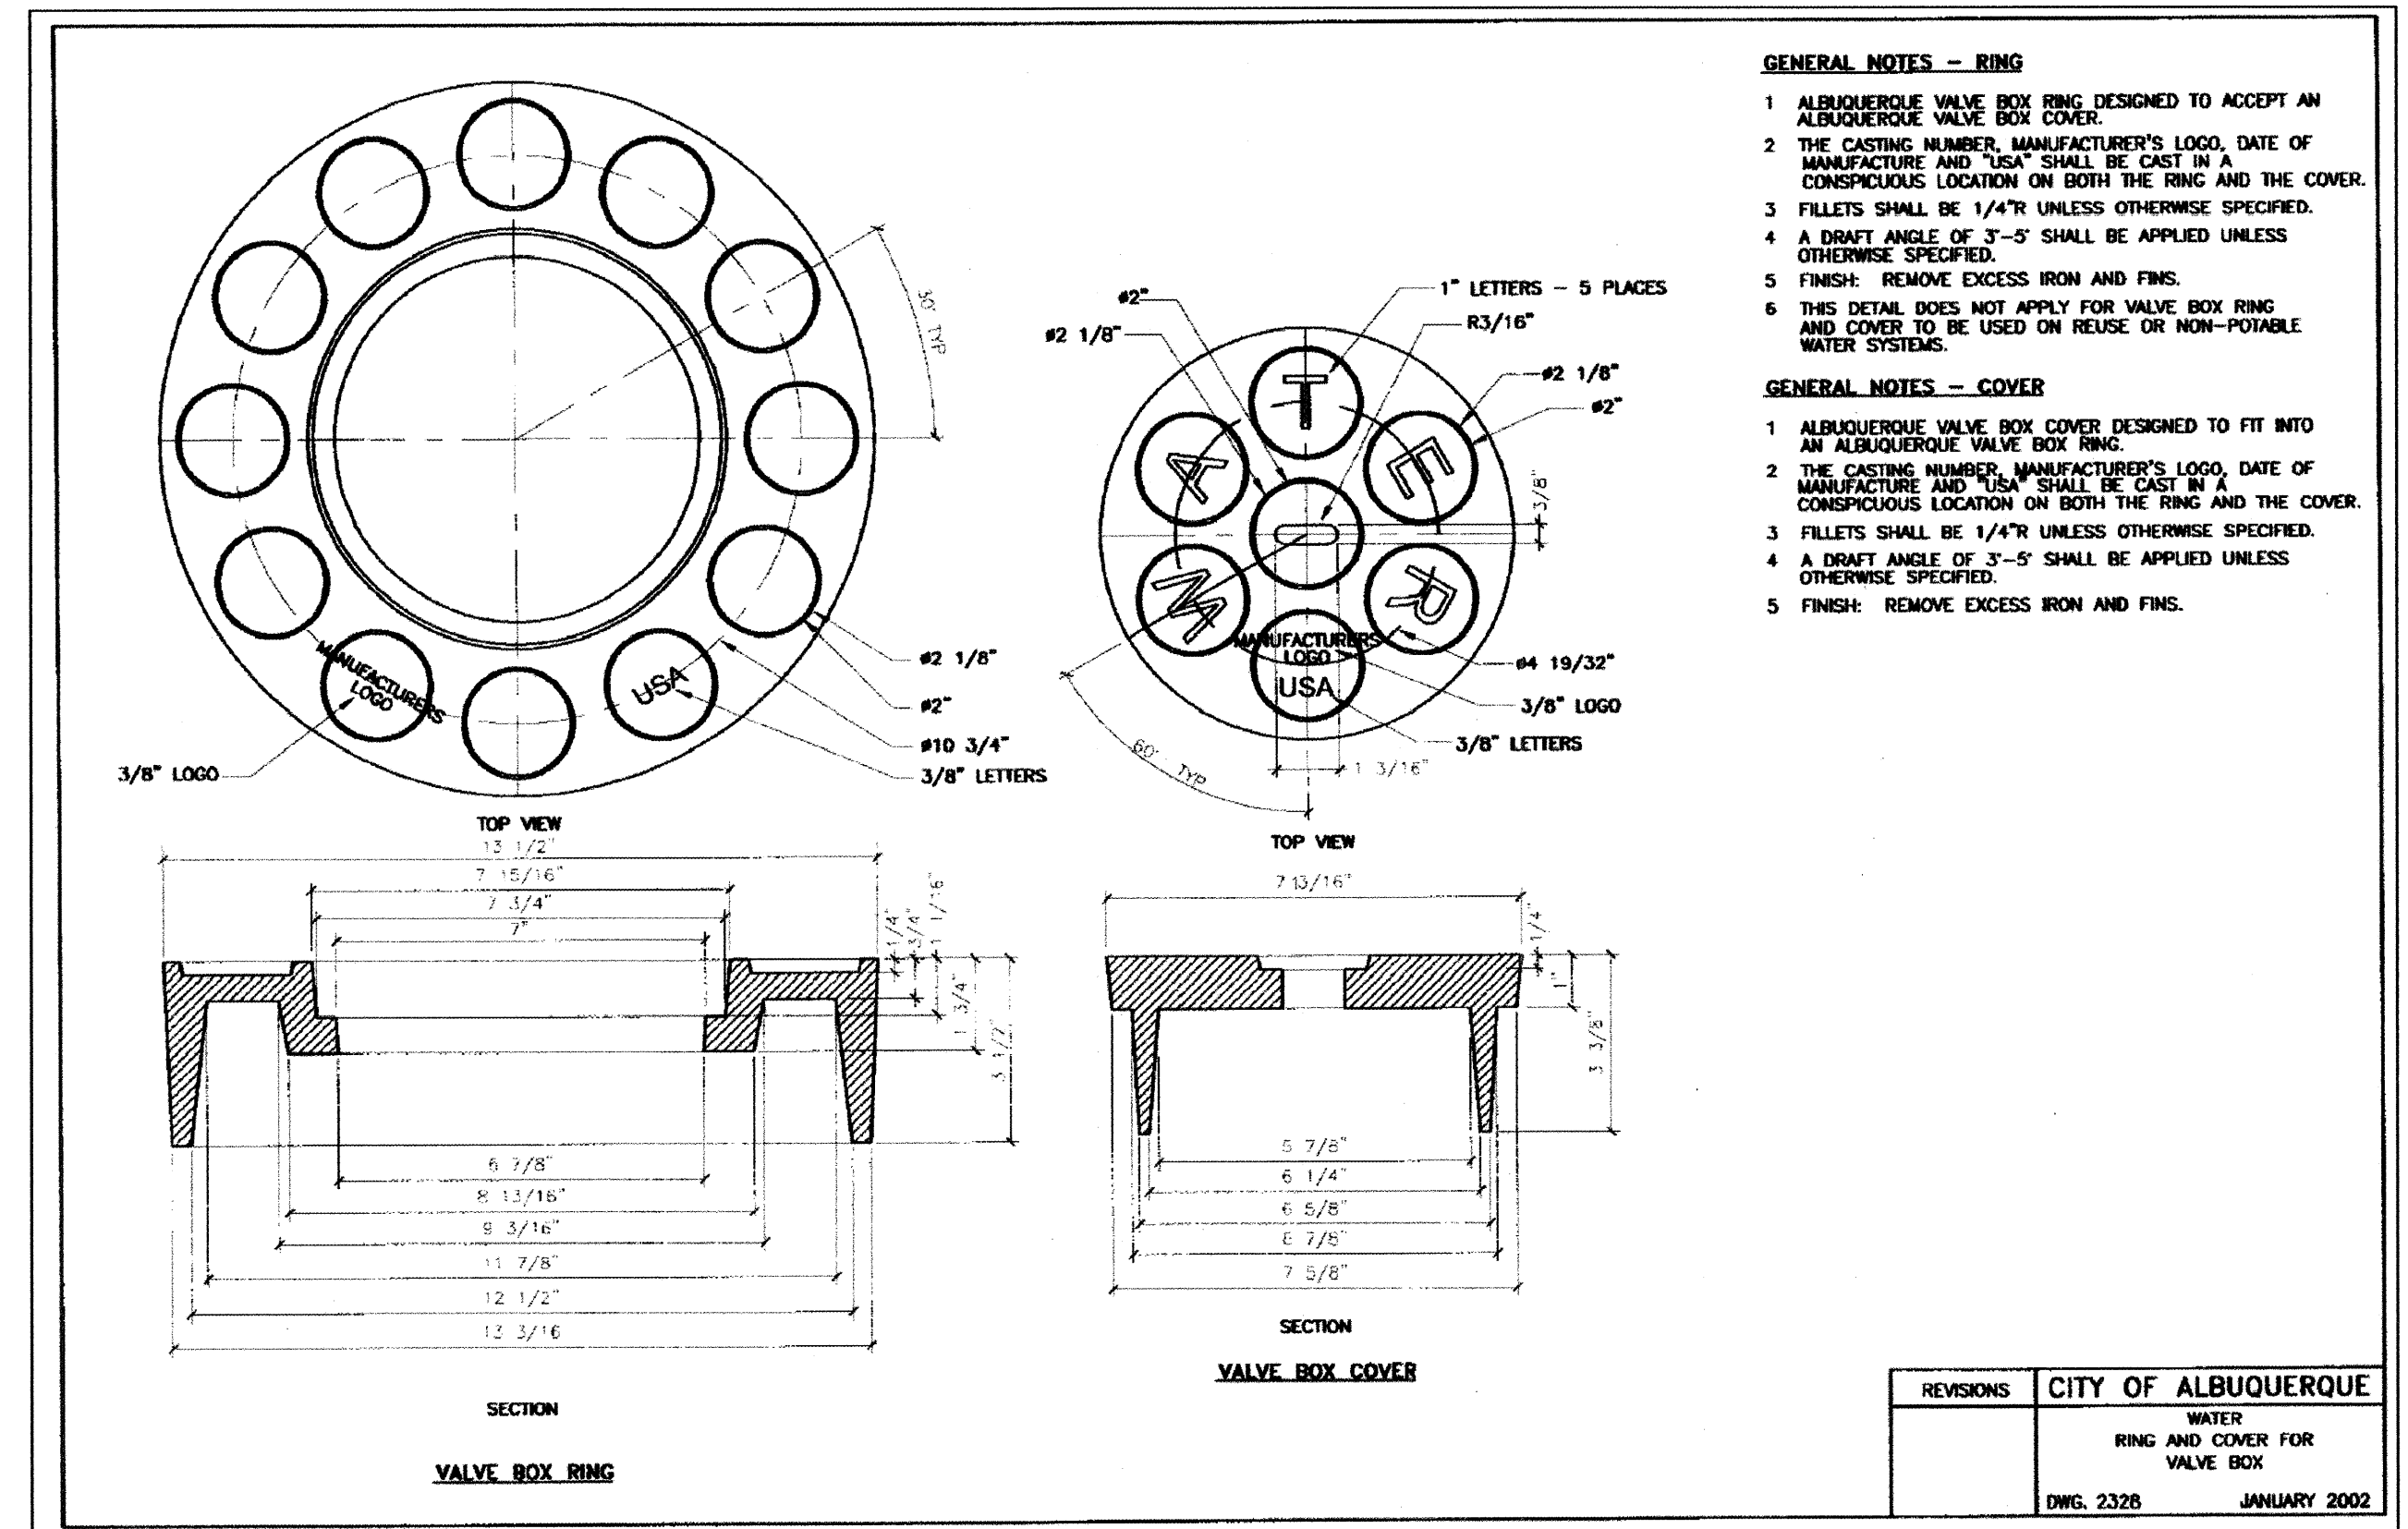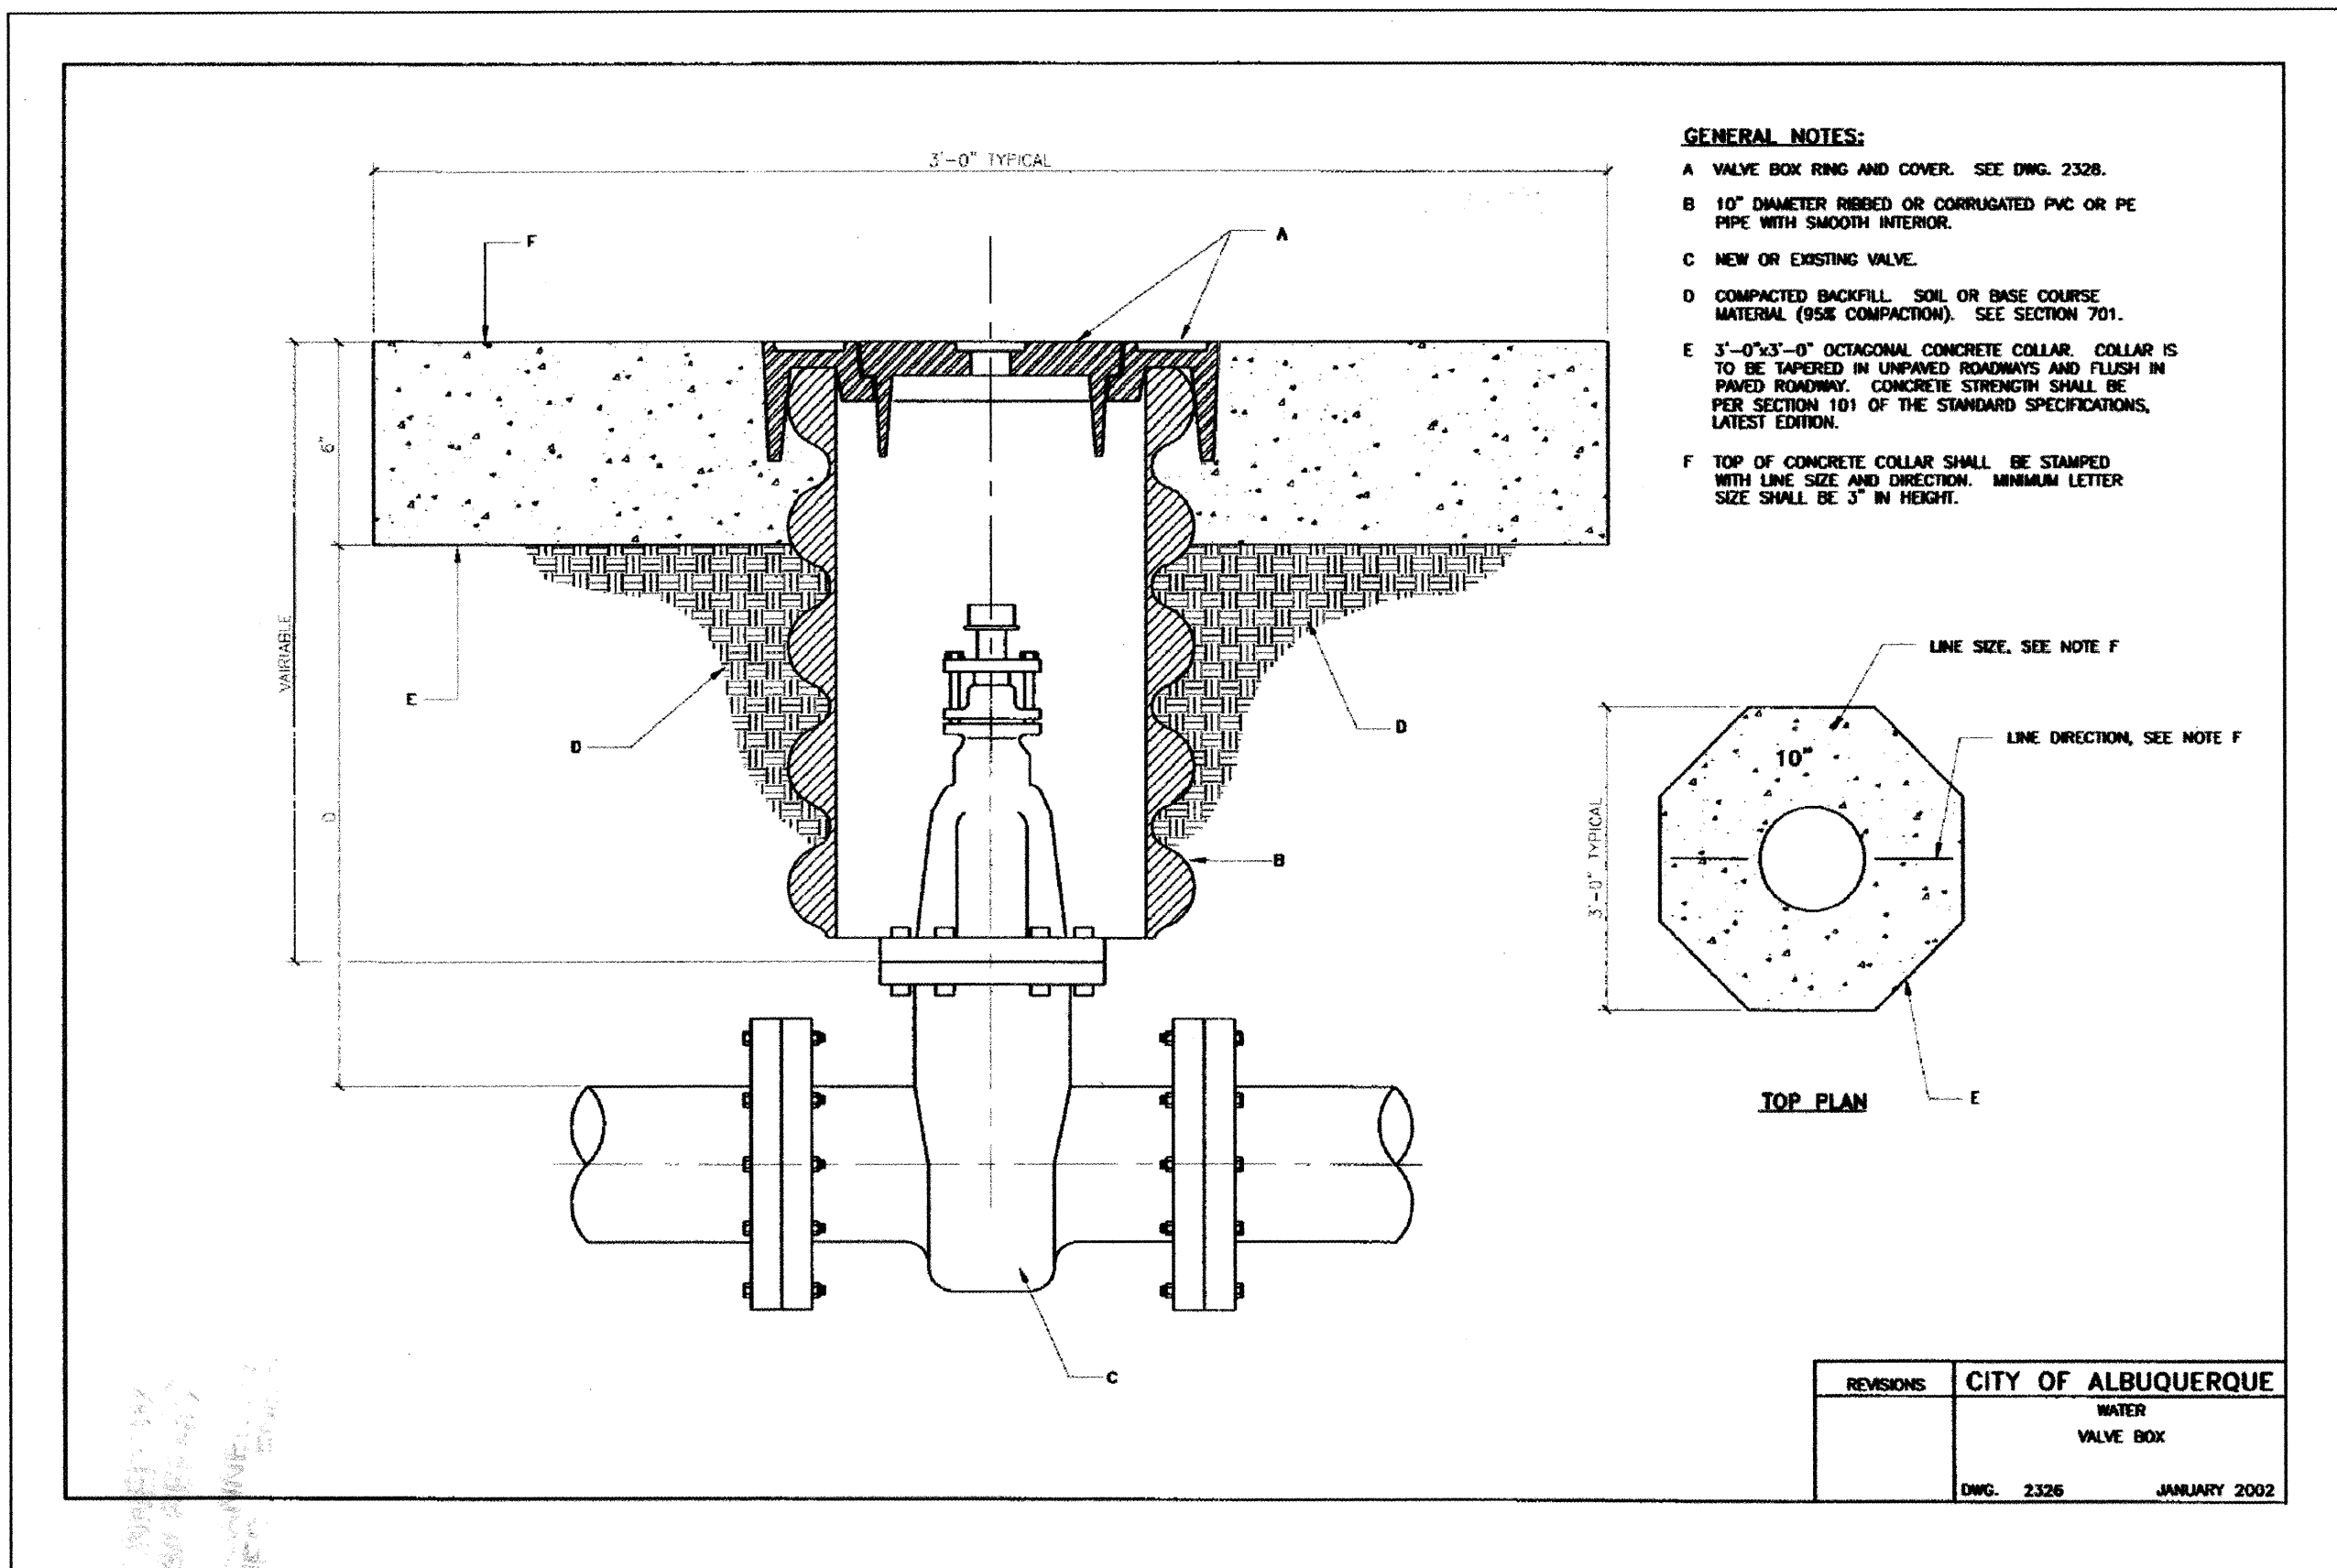

GENERAL NOTES:

- 1 THE METER SHALL BE SET UTILIZING A COPPER-SETTER. COPPER-SETTER HEIGHT 10" FOR 1" METER. 7" FOR 3/4" METER.
- 2 THE VALVE AND METER REGISTER BOX SHALL BE LOCATED UNDER THE LID OPENING. WHERE TWO METERS ARE TO BE INSTALLED IN A SINGLE METER BOX, THE METER REGISTERS SHALL BE WITHIN READING RANGE OF THE LID OPENING.
- 3 METER BOX LOCATION TO CONFORM TO DWG. 2361.
- 4 WHEN CONTRACTOR DOES NOT INSTALL METER, CONTRACTOR SHALL PROVIDE REMOVABLE PLUGS FOR END OF COPPER-SETTER.
- 5 EXISTING CONCRETE TO BE SAWCUT.

CONSTRUCTION NOTES:

- A STREET SURFACE.
- B BACK OF CURB.
- C CAST IRON METER BOX, COVER AND LID. SEE DWG. 2368 OR 2369.
- D 1/2" EXPANSION JOINT.
- E CURB STOP, LOCATE INSIDE METER BOX.
- F SIDEWALK OR DRIVEPAD.
- G METER. TOP OF METER TO BE 12"-18" BELOW COVER.
- H CORP STOP.
- J MAIN WATER LINE.
- K TAPPING SADDLE.
- L COPPER SERVICE LINE.
- M COPPER SETTER.
- N TAILPIECE TO PROPERTY LINE WITH INSTA-TITE I.P.T. CAPPED FITTING.
- Q CONCRETE PAD REQUIRED IN ALL AREAS.
- R #4 REBAR CONTINUOUS ALL AROUND METER BOX.
- S STABILIZER BAR. 12" LONG X 1/2" DIAMETER GALVANIZED STEEL PIPE.
- T METER BOX LID SHALL BE FLUSH WITH SURROUNDING SIDEWALK.

dmg MARK GOODWIN & ASSOCIATES, P.A.
CONSULTING ENGINEERS
P.O. BOX 90606
ALBUQUERQUE, NEW MEXICO 87199
(505) 828-2200, FAX (505) 797-9539

CITY OF ALBUQUERQUE
PUBLIC WORKS DEPARTMENT

TITLE: WEST RIDGE SUBDIVISION - UNIT 2
WATER DETAILS

DESIGN REVIEW COMMITTEE	CITY ENGINEER APPROVAL	DATE	MO./DAY/YR.	MO./DAY/YR.
C.O.A. STANDARD	C.O.A. STANDARD			

CITY PROJECT NO. 708282 ZONE MAP NO. H-9 & 10 SHEET 18 OF 18

DRAFT
C.O.A. STANDARD

SURVEY INFORMATION		FIELD NOTES		ENGINEER'S SEAL	
NO.	BY	DATE	BY	REMARKS	REVISIONS
					DESIGN
					DATE
					DATE
					DATE

AS BUILT INFORMATION		BENCH MARKS	
CONTRACTOR	DATE	CONTRACTOR	DATE
WORK	DATE	WORK	DATE
INSPECTION	DATE	INSPECTION	DATE
ACCEPTANCE	DATE	ACCEPTANCE	DATE
VEGETATION	DATE	VEGETATION	DATE
DRAWINGS	DATE	DRAWINGS	DATE
CORRECTED	DATE	CORRECTED	DATE
RECORDED	DATE	RECORDED	DATE
NO.		NO.	