




# Graves Park

## Phase II

January, 2007

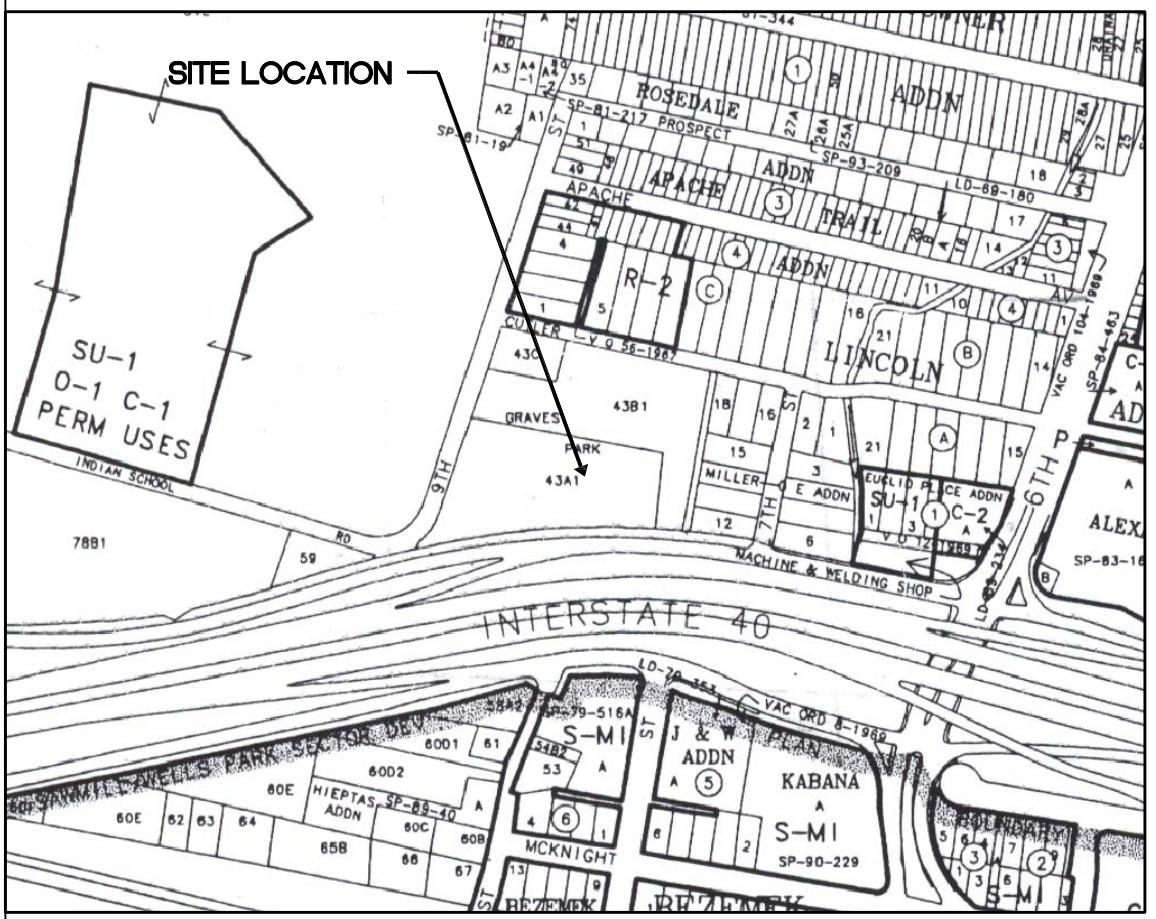

VICINITY MAP: ZONE MAP H-14-Z

CITY OF ALBUQUERQUE  
DEPARTMENT OF MUNICIPAL DEVELOPMENT– Managing Department  
Park Design and Construction Division

RECORD DRAWINGS JUNE, 2009

This set of Record Documents consists of corrected plans showing the reported location of the work, conforming to the construction records provided by the Contractor. While the information submitted by the Contractor and incorporated by the Landscape Architect into the Record Documents is assumed to be reliable, the Landscape Architect has not verified the accuracy and/or completeness of the information and shall not be responsible for any errors or omissions which may be incorporated herein as a result. Those relying on these Record Documents are advised to obtain independent verification of their accuracy before applying it for any purpose.

Parks and Recreation Department – Owner

**UTILITY COMPANY CONTACTS**

CITY OF ALBUQUERQUE  
UTILITY DEVELOPMENT

P.O. Box 1293  
Albuquerque, New Mexico 87103  
(505) 768-2719

PNM-ELECTRIC

4201 Edith Boulevard NE  
Albuquerque, New Mexico 87107  
(505)-241-0525

PNM-GAS

4625 Edith Boulevard NE  
Albuquerque, New Mexico 87107  
(505)-241-7745

**CALL BEFORE YOU DIG!**

**STATEWIDE**  
**1-800-321-ALERT**  
**ALBUQUERQUE**  
**260-1990**

### Property Information


Meter Address: NA  
Zone: H-14-Z  
Project Acres: 4.9

### Legal Description

City park bounded by Cutler Rd. on the north, the I-40 frontage road on the south, the BIA building on the west, and the Miller residential addition on the east.

### Index of Drawings

- 1. Cover
- 2. General Notes/Acceptance Form
- 3. Demolition Plan
- 4. Construction Plan
- 5. Layout Plan
- 6. Irrigation Plan
- 7. Planting Plan
- 8. Details

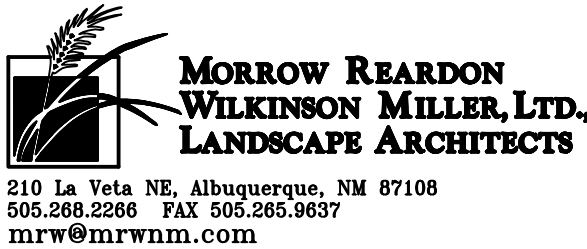


REV.	SHEETS	CITY ENGINEER	DATE	USER DEPARTMENT	DATE	USER DEPARTMENT	DATE
ENGINEERS STAMP AND SIGNATURE		APPROVALS	ENGINEER	DATE	APPROVED FOR CONSTRUCTION		
		DRC CHAIRMAN			City Eng. _____ Date _____		
		TRANSPORTATION					
		WATER/WASTEWATER					
		HYDROLOGY					
		C.I.P.			Division Mngmt. _____ Date _____		
		CONSTR. MNGMNT.					
		DIVISION MNGMNT.					
Date: Jan. 2007		City Project No. 709405				1 of 8	







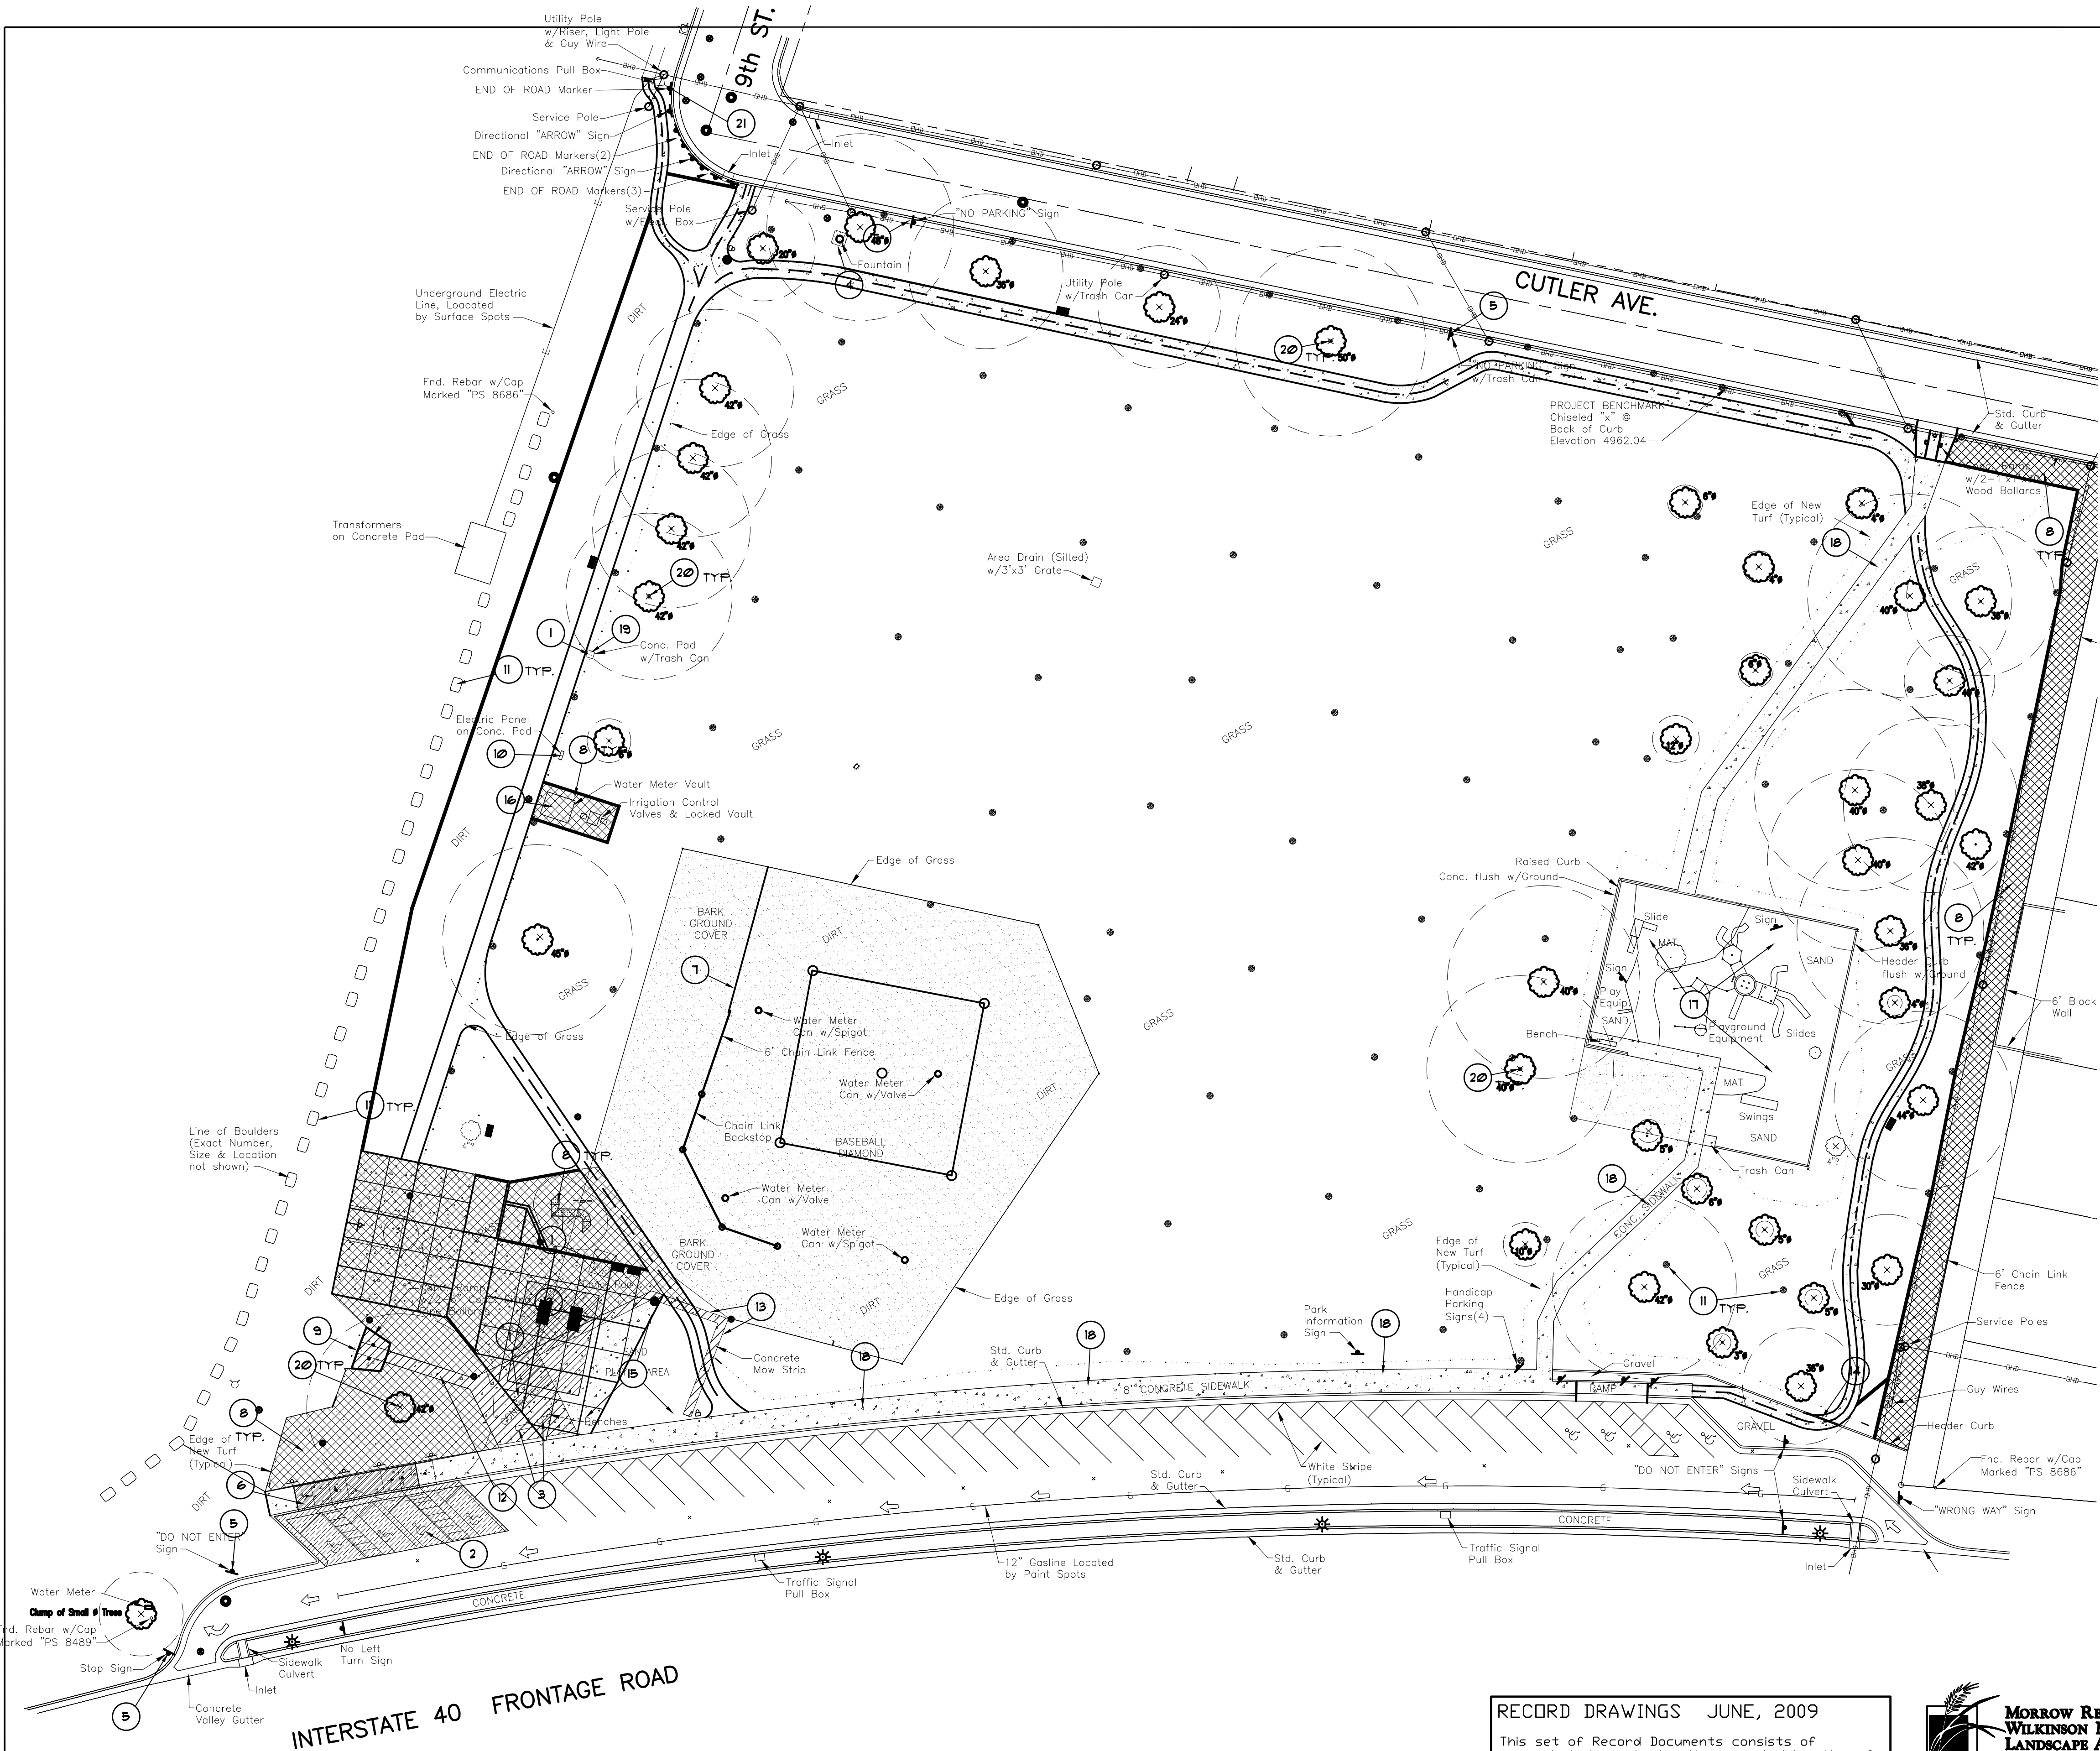

**DEMOLITION NOTES**

1. ALL ITEMS NOT NOTED TO BE REMOVED SHALL REMAIN.

2. CONTRACTOR SHALL PROTECT ALL EXISTING ITEMS TO REMAIN FROM DAMAGE DURING CONSTRUCTION OPERATIONS. IF DAMAGE OCCURS, CONTRACTOR SHALL REPAIR OR REPLACE ITEMS AT NO ADDITIONAL COST TO THE OWNER.

3. CONTRACTOR SHALL ENSURE THAT EXISTING IRRIGATION TO PLANTING AREAS TO REMAIN IS OPERATIONAL THROUGHOUT CONSTRUCTION OPERATIONS, OTHERWISE CONTRACTOR SHALL BE RESPONSIBLE FOR "HAND WATERING" EXISTING LANDSCAPE AREAS TO REMAIN. CONTRACTOR SHALL BE RESPONSIBLE FOR REPLACEMENT OF ALL EXISTING PLANT MATERIALS LOST AS A RESULT OF A LACK OF IRRIGATION. REPLACEMENT OF PLANT MATERIALS WILL BE "IN KIND" AND VALUE WILL BE BASED ON EXISTING SIZE. (I.E. A 10" CALIPER TREE WILL BE VALUED AS A 10" CALIPER TREE.)

4. THE CONTRACTOR SHALL REMOVE EXISTING TURF AS NECESSARY TO CONSTRUCT NEW CONCRETE SIDEWALK. THE CONTRACTOR SHALL MINIMIZE THE AMOUNT OF TURF TO BE REMOVED TO THE GREATEST EXTENT POSSIBLE. REFERENCE THE CONSTRUCTION PLAN FOR NEW SIDEWALK LOCATION.

- DEMOLITION KEYED NOTES**
- 1 CONTRACTOR SHALL REMOVE AND DISPOSE OF EXISTING CONCRETE PAD.
  - 2 EXISTING PARKING STRIPES TO BE REMOVED.
  - 3 CONTRACTOR SHALL REMOVE EXISTING BENCHES AND RETURN TO PARK MANAGEMENT.
  - 4 CONTRACTOR SHALL REMOVE AND DISPOSE OF EXISTING WATER FOUNTAIN AND ASSOCIATED CONCRETE PAD.
  - 5 EXISTING SIGN TO REMAIN.
  - 6 EXISTING CONCRETE WALK AND CURB & GUTTER TO BE REMOVED.
  - 7 EXISTING CHAINLINK BACKSTOP AND ASSOCIATED FENCE TO REMAIN.
  - 8 EXISTING TURF TO BE REMOVED.
  - 9 CONTRACTOR SHALL REMOVE AND DISPOSE OF EXISTING CONCRETE RAMP AND ASSOCIATED PIPE BOLLARDS.
  - 10 EXISTING CONCRETE PAD WITH ELECTRICAL PANEL TO REMAIN.
  - 11 EXISTING BOULDERS TO REMAIN.
  - 12 CONTRACTOR SHALL REMOVE AND DISPOSE OF EXISTING CONCRETE WALK.
  - 13 CONTRACTOR SHALL REMOVE AND DISPOSE OF EXISTING CONCRETE MOW STRIP.
  - 14 CONTRACTOR SHALL REMOVE EXISTING HEADER CURB AS REQUIRED TO BUILD NEW SIDEWALK. REFERENCE CONSTRUCTION PLAN.
  - 15 CONTRACTOR SHALL REMOVE AND DISPOSE OF EXISTING PLAY AREA SAND.
  - 16 EXISTING WATER METER AND ASSOCIATED VAULT TO REMAIN.
  - 17 EXISTING PLAY AREA TO REMAIN. AREA INCLUDES EQUIPMENT SURFACING AND CONTAINMENT WALL.
  - 18 EXISTING CONCRETE SIDEWALK TO REMAIN.
  - 19 CONTRACTOR SHALL REMOVE EXISTING TRASH RECEPTACLE AND RETURN TO PARK MANAGEMENT.
  - 20 EXISTING TREES TO REMAIN.
  - 21 EXISTING COMMUNICATION BOX TO BE RELOCATED. OWNER TO COORDINATE WITH UTILITY COMPANY.

**RECORD DRAWINGS JUNE, 2009**

This set of Record Documents consists of corrected plans showing the reported location of the work, conforming to the construction records provided by the Contractor. While the information submitted by the Contractor and incorporated by the Landscape Architect into the Record Documents is assumed to be reliable, the Landscape Architect has not verified the accuracy and/or completeness of the information and shall not be responsible for any errors or omissions which may be incorporated herein as a result. Those relying on these Record Documents are advised to obtain independent verification of their accuracy before applying it for any purpose.

**MORROW REARDON  
WILKINSON MILLER, LTD.,  
LANDSCAPE ARCHITECTS**

210 La Veta NE, Albuquerque, NM 87108  
505.268.2266 FAX 505.265.9637  
mrw@mrwnm.com

0 15 30 60 90  
SCALE: 1" = 30'

		<b>CITY OF ALBUQUERQUE</b>	
		<b>DEPARTMENT OF MUNICIPAL DEVELOPMENT</b>	
		<b>PARKS DESIGN AND CONSTRUCTION DIVISION</b>	
TITLE: DEMOLITION PLAN			
Design Review Committee	City Engineer Approval	Last Design Updates	
		Mo/Day/Yr.	Mo/Day/Yr.
PROJECT # 709405		ZONE MAP NO. H-14-Z	SHEET 3 OF 8

AS BUILT INFORMATION		BENCH MARKS		SURVEY INFORMATION FIELD NOTES		ENGINEER'S SEAL	
CONTRACTOR				NO.	BY	REMARKS	DATE
WORK BY							
INSPECTOR'S							
ACCEPTANCE BY							
DATE							
DATE							
DATE							
DATE							
MICRO-FILM INFORMATION							
RECORDED BY							
NO.							

DESIGNED BY	JSP	DATE: 8/26/04
DRAWN BY	JSP	DATE: 8/26/04
CHECKED BY	ECR	DATE: 8/26/04



CONSTRUCTION KEYED NOTES


- 1 CONTRACTOR SHALL CONSTRUCT 6" CONCRETE MOWSTRIP PER COA STD. DETAIL DWG. #2127
- 2 CONTRACTOR SHALL CONSTRUCT LANDSCAPE EDGER WALL AT PLAY AREA PER COA STD. DETAIL DWG. #2124
- 3 CONTRACTOR SHALL INSTALL "COLORADO" 25' x 35' RECTANGULAR SHADE STRUCTURE (CLASSIC RECREATION SYSTEMS, INC.) PER MANUFACTURER'S INSTRUCTIONS. AVAILABLE FROM SCHOOL EQUIPMENT, INC. (505-888-5454).
- 4 CONTRACTOR SHALL PAINT LINES FOR BASKETBALL COURT. REFERENCE DETAIL B/8.
- 5 CONTRACTOR SHALL INSTALL "SPORTSPRAY" REINFORCED BENT POST BACKSTOP (MODEL #541-424) PER MANUFACTURER'S INSTRUCTIONS. BACKSTOP AVAILABLE FROM EXERPLAY (1-800-457-5444).
- 6 CONTRACTOR SHALL CONSTRUCT ADA ACCESSIBLE RAMP. REFERENCE DETAIL A/8.
- 7 CONTRACTOR SHALL CONSTRUCT CONCRETE TURNDOWN SLAB AT PLAY AREA PER COA STD. DETAIL DWG. #2128
- 8 CONTRACTOR SHALL CONSTRUCT BOLLARD AND CHAIN FENCING. REFERENCE DETAIL C/8.
- 9 CONTRACTOR SHALL CONSTRUCT NEW 6' CONCRETE SIDEWALK PER COA STD. DETAIL DWG. #2120
- 10 CONTRACTOR SHALL CONSTRUCT NEW 5' CONCRETE SIDEWALK PER COA STD. DETAIL DWG. #2120
- 11 CONTRACTOR SHALL INSTALL 7 PANEL MOBIUS CLIMBER (MODEL #150637) PER MANUFACTURER'S INSTRUCTIONS. CLIMBER AVAILABLE FROM EXERPLAY (1-800-457-5444).
- 12 FURNISH AND INSTALL BENCHES. BENCHES SHALL BE DUMOR MODEL #57-60PL S2, FINISH TO BE CEDAR W/BLACK POWDERCOAT. INSTALL PER MANUFACTURER'S INSTRUCTIONS ON CONCRETE PAD. SEE DETAIL D/8.
- 13 FURNISH AND INSTALL LITTER RECEPTACLE. RECEPTACLE SHALL BE MCCLINTOCK R50-25. INSTALL PER MANUFACTURER'S INSTRUCTIONS.
- 14 FURNISH AND INSTALL TABLE ON NEW CONCRETE PLAZA. TABLE AVAILABLE FROM DUMOR (505-281-0151), MODEL #100-60-PL S-2. COLOR SHALL BE CEDAR WITH BLACK POWDERCOAT FINISH.
- 15 CONTRACTOR SHALL PAINT STRIPING FOR ADA ACCESSIBLE PARKING SPACES PER COA STANDARDS.
- 16 CONTRACTOR SHALL INSTALL A 16" DEPTH OF BARK MULCH OVER 45% COMPACTED SUBGRADE THROUGHOUT PLAY EQUIPMENT AREA.
- 17 CONTRACTOR SHALL CONSTRUCT CONCRETE ROLL-DOWN RAMP PER DETAIL E/8.
- 18 CONTRACTOR SHALL INSTALL ACCESSIBLE PARKING SIGN. REFERENCE DETAIL F/8.
- 19 CONTRACTOR SHALL INSTALL VAN ACCESSIBLE PARKING SIGN. REFERENCE DETAIL F/8.
- 20 CONTRACTOR SHALL CONSTRUCT CONCRETE PLAZA. PLAZA SHALL BE 4" THICK 4000 PSI CONCRETE W/ EXPANSION JOINTS @ 20' O.C. AND SAWCUT CONTROL JOINTS @ 10' O.C., TYP.
- 21 CONTRACTOR SHALL INSTALL "MUTT-MITTS" DISPENSER PER MANUFACTURER'S INSTRUCTIONS.
- 22 CONTRACTOR SHALL INSTALL AGE APPROPRIATE SIGNAGE FOR PLAY EQUIPMENT. MODEL #100106A, AGES 5-12. AVAILABLE FROM EXERPLAY (505-281-0151).

PLAY EQUIPMENT NOTES:

1. THE GROUND SPACE (GS) AND USE ZONE (UZ) FOR EACH PIECE OF PLAY EQUIPMENT SHALL BE AS REQUIRED BY THE EQUIPMENT MANUFACTURER. THE GROUND SPACE IS THE ACTUAL SPACE THAT THE EQUIPMENT OCCUPIES. THE USE ZONE IS THE REQUIRED OBSTACLE FREE SURFACE AROUND THE EQUIPMENT.
2. PRIOR TO FINAL ACCEPTANCE BY THE OWNER, THE CONTRACTOR SHALL PROVIDE RECORD DRAWINGS TO DOCUMENT THAT EACH PIECE OF PLAY EQUIPMENT IS CONSTRUCTED WITH THE REQUIRED USE ZONE.
3. PRIOR TO FINAL ACCEPTANCE BY THE OWNER, THE CONTRACTOR SHALL PROVIDE WRITTEN AUTHORIZATION THAT THE CONSTRUCTION AND INSTALLATION OF EACH PIECE OF PLAY EQUIPMENT HAS BEEN INSPECTED BY A REPRESENTATIVE OF THE EQUIPMENT MANUFACTURER AND THAT THE CONSTRUCTION AND INSTALLATION OF EACH PIECE OF EQUIPMENT FULLY COMPLIES WITH THE ASTM F-1487-95 AND THE U.S. CONSUMER PRODUCT SAFETY COMMISSION HANDBOOK FOR PUBLIC PLAYGROUND SAFETY.
4. PRIOR TO FINAL ACCEPTANCE BY THE OWNER, THE CONTRACTOR SHALL PROVIDE WRITTEN CERTIFICATION THAT THE SAFETY SURFACE HAS BEEN INSPECTED AND TESTED BY A CERTIFIED PLAYGROUND AUDITOR AND THAT THE SURFACES MEET THE FALL HEIGHT REQUIREMENTS FOR EACH PIECE OF EQUIPMENT AS REQUIRED TO COMPLY WITH THE ASTM F-1487-95 AND THE U.S. CONSUMER PRODUCT SAFETY COMMISSION HANDBOOK FOR PUBLIC PLAYGROUND SAFETY.

RECORD DRAWINGS MONTH, YEAR

This set of Record Documents consists of corrected plans showing the reported location of the work, conforming to the construction records provided by the Contractor. While the information submitted by the Contractor and incorporated by the Landscape Architect into the Record Documents is assumed to be reliable, the Landscape Architect has not verified the accuracy and/or completeness of the information and shall not be responsible for any errors or omissions which may be incorporated herein as a result. Those relying on these Record Documents are advised to obtain independent verification of their accuracy before applying it for any purpose.

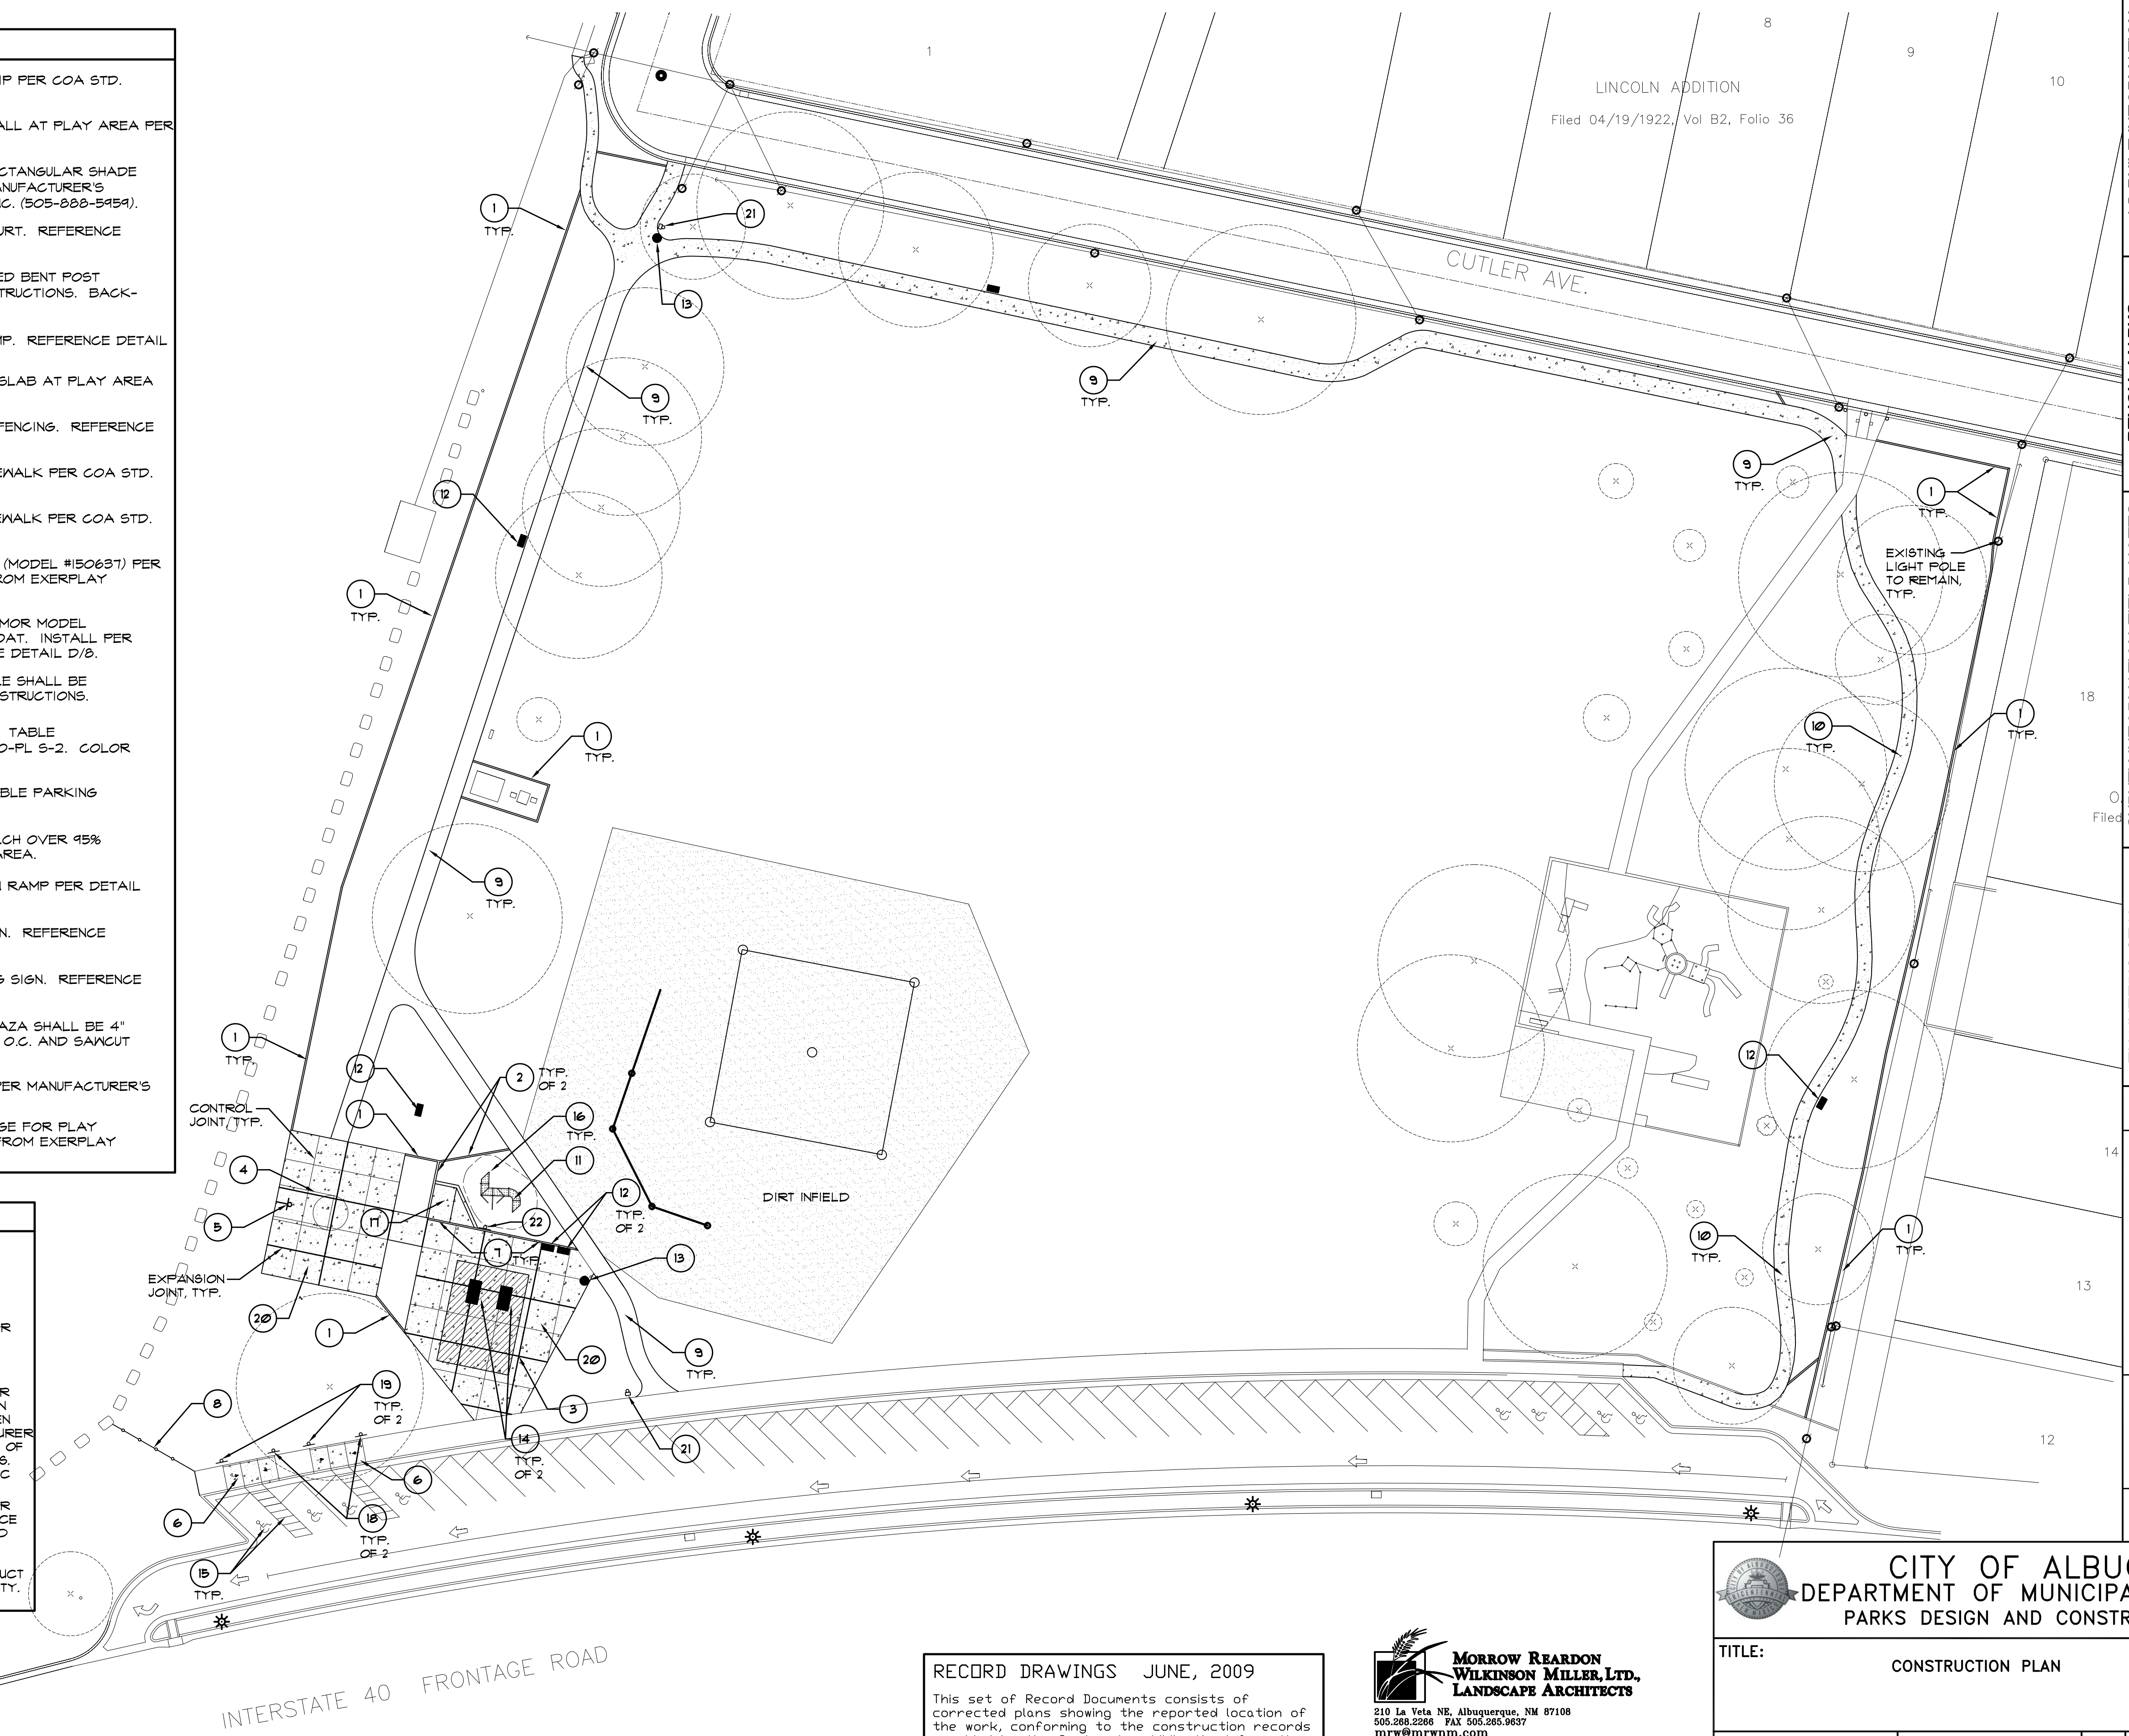

RECORD DRAWINGS JUNE, 2009

This set of Record Documents consists of corrected plans showing the reported location of the work, conforming to the construction records provided by the Contractor. While the information submitted by the Contractor and incorporated by the Landscape Architect into the Record Documents is assumed to be reliable, the Landscape Architect has not verified the accuracy and/or completeness of the information and shall not be responsible for any errors or omissions which may be incorporated herein as a result. Those relying on these Record Documents are advised to obtain independent verification of their accuracy before applying it for any purpose.

0 15 30 60 90

SCALE: 1" = 30'

**MORROW REARDON  
WILKINSON MILLER, LTD.,  
LANDSCAPE ARCHITECTS**

210 La Veta NE, Albuquerque, NM 87108  
505.268.2286 FAX 505.265.9637  
mrw@mrwnm.com

**CITY OF ALBUQUERQUE**  
DEPARTMENT OF MUNICIPAL DEVELOPMENT  
PARKS DESIGN AND CONSTRUCTION DIVISION

TITLE:  
CONSTRUCTION PLAN

Design Review Committee	City Engineer Approval	Last Design Updates	Mo/Day/Yr.	Mo/Day/Yr.

PROJECT # 709405


ZONE MAP NO.  
H-14-Z

SHEET 4 OF 8

AS BUILT INFORMATION		BENCH MARKS		SURVEY INFORMATION FIELD NOTES		ENGINEER'S SEAL	
CONTRACTOR	DATE	STAKED BY	DATE	NO.	BY	REMARKS	DATE
INSPECTOR'S	DATE	FIELD	DATE				
VERIFICATION BY	DATE	DESIGNED BY	DATE				
CONTRACTOR	DATE	DRAWN BY	DATE				
NO.		CHECKED BY	DATE				


MICRO-FILM INFORMATION	
DESIGNED BY	DATE: 8/26/04
DRAWN BY	DATE: 8/26/04
CHECKED BY	DATE: 8/26/04



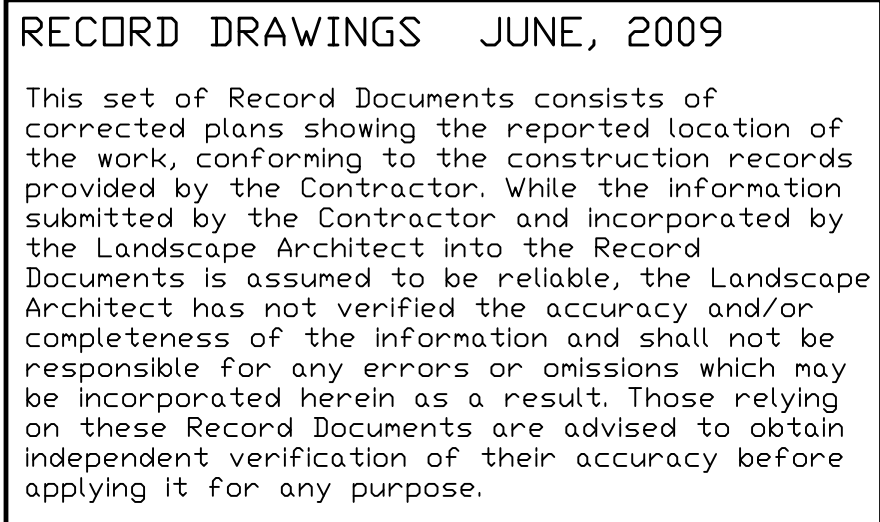

# COORDINATE POINTS:

1	X=379431.4200	Y=1495079.1976
2	X=379403.3319	Y=1495095.2416
3	X=379441.0808	Y=1495081.1913
4	X=379458.7317	Y=1495084.6123
5	X=379470.7684	Y=1495086.9781
6	X=379488.6099	Y=1495090.2333
7	X=379527.0729	Y=1495096.6864
8	X=379514.3101	Y=1495117.1349
9	X=379503.1938	Y=1495126.6586
10	X=379543.0137	Y=1495099.1366
11	X=379582.3191	Y=1495104.6128
12	X=379597.0022	Y=1495106.4653
13	X=379586.2545	Y=1495112.2157
14	X=379578.0575	Y=1495136.6065
15	X=379567.9995	Y=1495146.8921
16	X=379545.8662	Y=1495146.3619
17	X=379562.2413	Y=1495155.3526
18	X=379555.9844	Y=1495169.9386
19	X=379528.3820	Y=1495162.3377
20	X=379521.7715	Y=1495176.9757
21	X=379511.2906	Y=1495165.8636
22	X=379509.2603	Y=1495156.0398
23	X=379493.4968	Y=1495138.8769
24	X=379454.2999	Y=1495146.9572
25	X=379497.5076	Y=1495158.4644
26	X=379499.5346	Y=1495168.2892
27	X=379459.3511	Y=1495171.4416
28	X=379464.4023	Y=1495195.9259
29	X=379497.6930	Y=1495189.0580
30	X=379504.6461	Y=1495208.0393
31	X=379503.5692	Y=1495187.8457
32	X=379515.3217	Y=1495185.4211
33	X=379538.9872	Y=1495189.6357
34	X=379533.5137	Y=1495203.0477
35	X=379507.0839	Y=1495240.0988
36	X=379497.6932	Y=1495278.4904
37	X=379505.7494	Y=1495317.9578
38	X=379522.8016	Y=1495309.5571
39	X=379548.8040	Y=1495301.2184
40	X=379552.9919	Y=1495314.0607
41	X=379526.9872	Y=1495322.4002
42	X=379525.6331	Y=1495353.5583
43	X=379545.2651	Y=1495388.9372
44	X=379552.8689	Y=1495428.2545
45	X=379564.8412	Y=1495466.1812
46	X=379576.9886	Y=1495500.0206
47	X=379565.9759	Y=1495524.1342
48	X=379562.6029	Y=1495563.1498
49	X=379593.3827	Y=1495527.4539
50	X=379599.2813	Y=1495526.2164
51	X=379588.1258	Y=1495509.1085
52	X=379591.3317	Y=1495496.8095
53	X=379630.9590	Y=1495494.8926
54	X=379670.0704	Y=1495486.5084
55	X=379709.1855	Y=1495478.1433
56	X=379748.2942	Y=1495469.7397
57	X=379787.4047	Y=1495461.3576
58	X=379826.7156	Y=1495455.7167
59	X=379864.0046	Y=1495464.2543
60	X=379903.1819	Y=1495456.1372
61	X=379942.3405	Y=1495448.0240
62	X=379981.5086	Y=1495439.9089
63	X=380006.9797	Y=1495432.1313
64	X=380052.5286	Y=1495422.3269
65	X=379993.2337	Y=1495414.1304
66	X=379997.1981	Y=1495409.3881
67	X=380000.7228	Y=1495389.1079
68	X=380011.6956	Y=1495369.9169
69	X=380017.2423	Y=1495331.1792
70	X=380004.4494	Y=1495293.3062
71	X=380002.8771	Y=1495253.6026
72	X=379989.8999	Y=1495216.3980
73	X=379977.1751	Y=1495178.9958
74	X=379975.3341	Y=1495139.2336
75	X=379982.8453	Y=1495097.5129
76	X=379966.6611	Y=1495103.3703
77	X=379932.9683	Y=1495113.0953

 <div style="text-align: center;"> <h2 style="margin: 0;">CITY OF ALBUQUERQUE</h2> <h3 style="margin: 0;">DEPARTMENT OF MUNICIPAL DEVELOPMENT</h3> <h4 style="margin: 0;">PARKS DESIGN AND CONSTRUCTION DIVISION</h4> </div>			
<b>TITLE:</b>			
<div style="font-size: 2em; font-weight: bold;">LAYOUT PLAN</div>			

Design Review Committee	City Engineer Approval	Last Design Updates	Mo/Day/yr.	Mo/Day/yr.

<b>PROJECT #</b> 709405	<b>ZONE MAP NO.</b> H-14-Z	<b>SHEET</b> 5 <b>OF</b> 8
-------------------------	-------------------------------	----------------------------

	ENGINEER'S SEAL		SURVEY INFORMATION		BENCH MARKS	AS BUILT INFORMATION
	NO.	DATE	REMARKS	BY		
						CONTRACTOR
						WORK ORDERED BY
						INSPECTION ACCEPTANCE BY
						FIELD LOCATION BY
						DRAWINGS CORRECTED BY
						DATE
<b>MICRO-FILM INFORMATION</b>						
						RECORDED BY
						DATE
						N.O.
DESIGNED BY	JSP	DATE:	8/26/04			
DRAWN BY	JSP	DATE:	8/26/04			
CHECKED BY	EGR	DATE:	8/26/04			



IRRIGATION LEGEND

-----

EXISTING MAINLINE.

=====

24-VOLT IRRIGATION WIRE SLEEVE PIPING, CLASS 200, SDR-21, BELL-END, SOLVENT WELD PVC, SEE NOTE NO. 2 BELOW.

-----

LATERAL PIPING, SCH. 40, BELL END, SOLVENT WELD PVC. SIZE AS SHOWN ON PLAN. DEPTH OF BURIAL, 18". SIZES NOT SHOWN ON PLAN SHALL BE 1/2".

REMOTE CONTROL VALVE ASSEMBLY, WEATHERMATIC 11024-FCR PLASTIC BODY 24-VOLT AUTOMATIC VALVE, CONNECT TO EXISTING MAINLINE.

SOLVENT WELD CAP, SCH. 40 PVC, LINE SIZE.

EXISTING METER

3" FEGCO 880V REVERSE PRESSURE BACKFLOW PREVENTER AND MASTER VALVE.

MM FLOW METER

HUNTER 1-25-ADV-5 ROTOR

HUNTER 1-20-ADV-306R ROTOR

HUNTER 1-20-ADV-306R ROTOR

HUNTER 1-20-ADV-155R ROTOR

HUNTER 1-20-ADV-155R ROTOR

PRESSURE COMPENSATING BUBBLER ASSEMBLIES, RAIN BIRD 1400 SERIES, AS FOLLOWS: SEE DETAIL F/L2

MODEL NO.	GPM	PSI
1401	25	30

3 BUBBLERS PER SYMBOL

IRRIGATION CONTROLLER, 16 STATION IRRITROL, PROVIDED BY OWNER. CONTRACTOR SHALL EXTEND CONTROL WIRES AS NEEDED TO ACCOMMODATE NEW CONTROL LOCATION.

MASTERMETER FLOWMETER. SIZED PER LINE.

IRRIGATION KEYED NOTES

1

RELOCATE PART CIRCLE HEAD AND ADJUST ARC. EXTEND EXISTING LATERAL TO NEW HEAD LOCATION.

2

EXTEND EXISTING LATERAL TO NEW HEAD LOCATION.

IRRIGATION GENERAL NOTES

1.

ALL IRRIGATION EQUIPMENT SHALL BE INSTALLED PER COA STANDARD DRAWINGS AND SPECIFICATIONS.

2.

ALL LATERAL PIPING EXTENSIONS TO RELOCATED HEADS SHALL BE THE SAME SIZE AS THE EXISTING PIPE.

3.

THESE IRRIGATION MODIFICATIONS ARE INTENDED TO ADDRESS THE CONSTRUCTION OF THE NEW SITE ELEMENTS WITHIN AN EXISTING SYSTEM. THE MODIFICATIONS ARE NOT INTENDED TO MEET THE COA WATER AUDIT REQUIREMENTS FOR DISTRIBUTION UNIFORMITY. THE OPERATION AND SCHEDULING OF THE IRRIGATION ZONES IS INTENDED TO MEET PRE-CONSTRUCTION PERFORMANCE STANDARDS.

4.


ANY TRENCHING UNDER THE DRIPLINE OF AN EXISTING TREE SHALL BE DONE BY HAND. NO ROOTS LARGER THAN 1" DIAMETER SHALL BE CUT DURING HAND TRENCHING OPERATIONS.

5.

ALL NEW OR RELOCATED ROTOR HEADS SHALL MATCH THE MODEL AND NOZZLE OF SIMILAR ARC EXISTING HEADS WITHIN THE PARK.


6.

SYSTEM ADJUSTMENTS MAY NEED TO BE MADE TO REDUCE OVERSPRAY ONTO THE CONCRETE BASKETBALL COURT, THE CONCRETE PLAZA ASSOCIATED WITH THE SHADE STRUCTURE, OR PLAY EQUIPMENT AREA. MODIFICATIONS TO ADDITIONAL HEADS WITH REGARD TO NOZZLING OR RELOCATION WAS NOT CONSIDERED IN THE DESIGN. ADDITIONAL MODIFICATIONS SHOULD BE BROUGHT TO THE ATTENTION OF THE LANDSCAPE ARCHITECT.

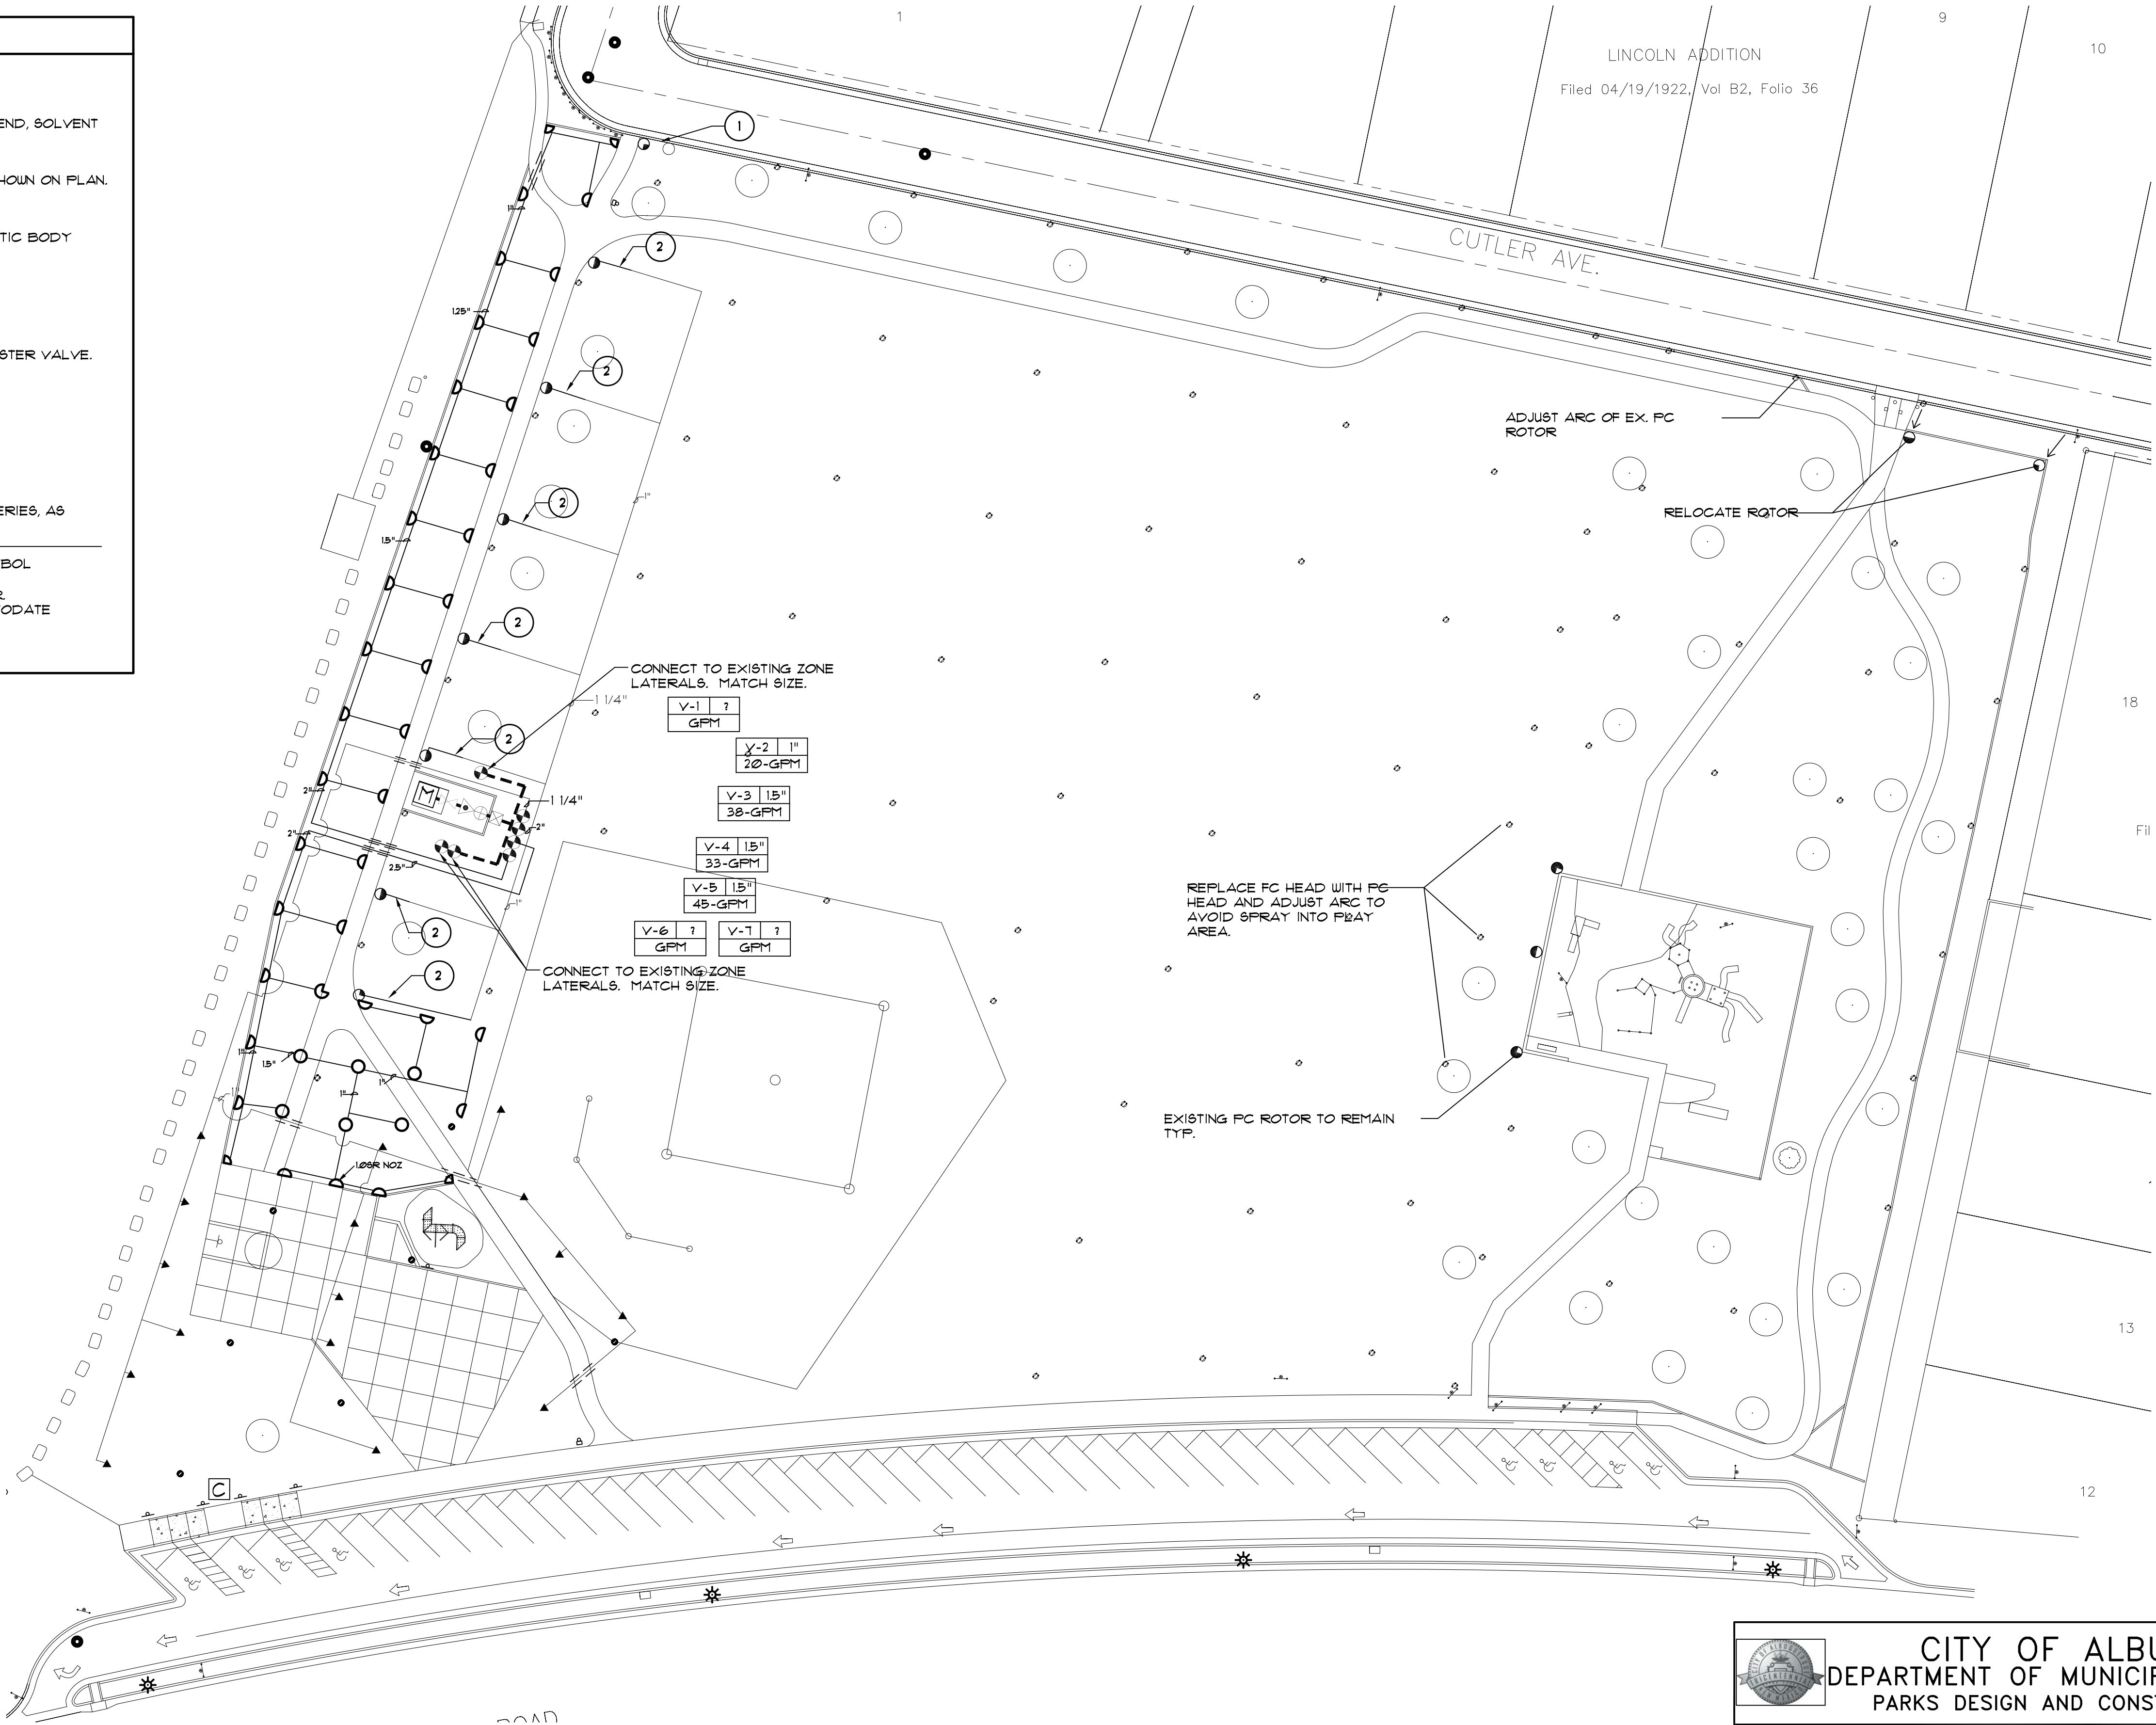

RECORD DRAWINGS JUNE, 2009

This set of Record Documents consists of corrected plans showing the reported location of the work, conforming to the construction records provided by the Contractor. While the information submitted by the Contractor and incorporated by the Landscape Architect into the Record Documents is assumed to be reliable, the Landscape Architect has not verified the accuracy and/or completeness of the information and shall not be responsible for any errors or omissions which may be incorporated herein as a result. Those relying on these Record Documents are advised to obtain independent verification of their accuracy before applying it for any purpose.

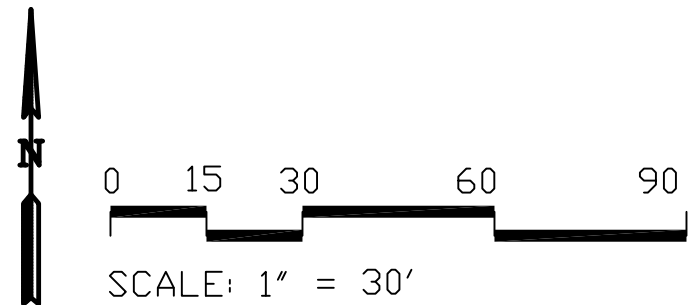

CITY OF ALBUQUERQUE  
DEPARTMENT OF MUNICIPAL DEVELOPMENT  
PARKS DESIGN AND CONSTRUCTION DIVISION

TITLE:

IRRIGATION PLAN

Design Review Committee

City Engineer Approval

Mo/Day/Yr.

Mo/Day/Yr.

PROJECT # 709405

ZONE MAP NO. H-14-Z

SHEET 6 OF 8

RECORD DRAWINGS ☒ FINAL FOR CONSTRUCTION

PROJECT# 709405

Graves Park Phase II

DATE: JULY 10, 2009




PLANT LIST

SYMBOL	BOTANICAL NAME	COMMON NAME	QUANTITY	SIZE MATURE	REMARKS
TREES					
LPT	Platanus acerifolia	London plane tree	3	50' ht. 4 40' spd.	2"-2 1/2" Cal.
CLE	Ulmus parvifolia	Chinese lacebark elm	10	25' ht. 4 spd.	2"-2 1/2" Cal.
OP	Pyrus calleryana spp.	Ornamental pear	4	25' ht. 4 20' spd.	2"-2 1/2" Cal.
WC	Catalpa speciosa	Western catalpa	1	70' ht. 4 30' spd.	2"-2 1/2" Cal.
APA	Fraxinus americana 'Autumn Purple'	Autumn Purple Ash	3	40' ht. 4 25' spd.	2"-2 1/2" Cal.
MC	Taxodium mucronatum	Montezuma Cypress	4	60' ht. 4 40' spd.	2"-2 1/2" Cal.

PLANTING NOTES

- IN CASE OF DISCREPANCY IN PLANT QUANTITIES SHOWN ON THE PLANT LIST AND THOSE SHOWN ON THE PLANTING PLAN, THE QUANTITIES SHOWN ON THE PLAN SHALL GOVERN. CONTRACTOR SHALL VERIFY ALL QUANTITIES PRIOR TO BID AND INSTALLATION. NO ADDITIONAL PAYMENT WILL BE MADE FOR ANY DISCREPANCIES IN QUANTITIES BETWEEN THE PLANTING PLAN AND THE PLANT LIST.
- A 4" DEPTH OF 3/4" 'SANTA FE BROWN' CRUSHED GRAVEL MULCH WITH FILTER FABRIC UNDER SHALL BE INSTALLED AS NOTED ON PLAN. FILTER FABRIC SHALL BE MIN. 4 OZ. WOVEN NEEDLE PUNCHED POLYPROPYLENE (DEWITT OR EQUIVALENT). OVERLAP ENDS 3", TURN DOWN EDGES 6".
- THE CONTRACTOR SHALL PRUNE LOWER BRANCHES OF DECIDUOUS TREES TO 6 FEET ABOVE FINISH GRADE.

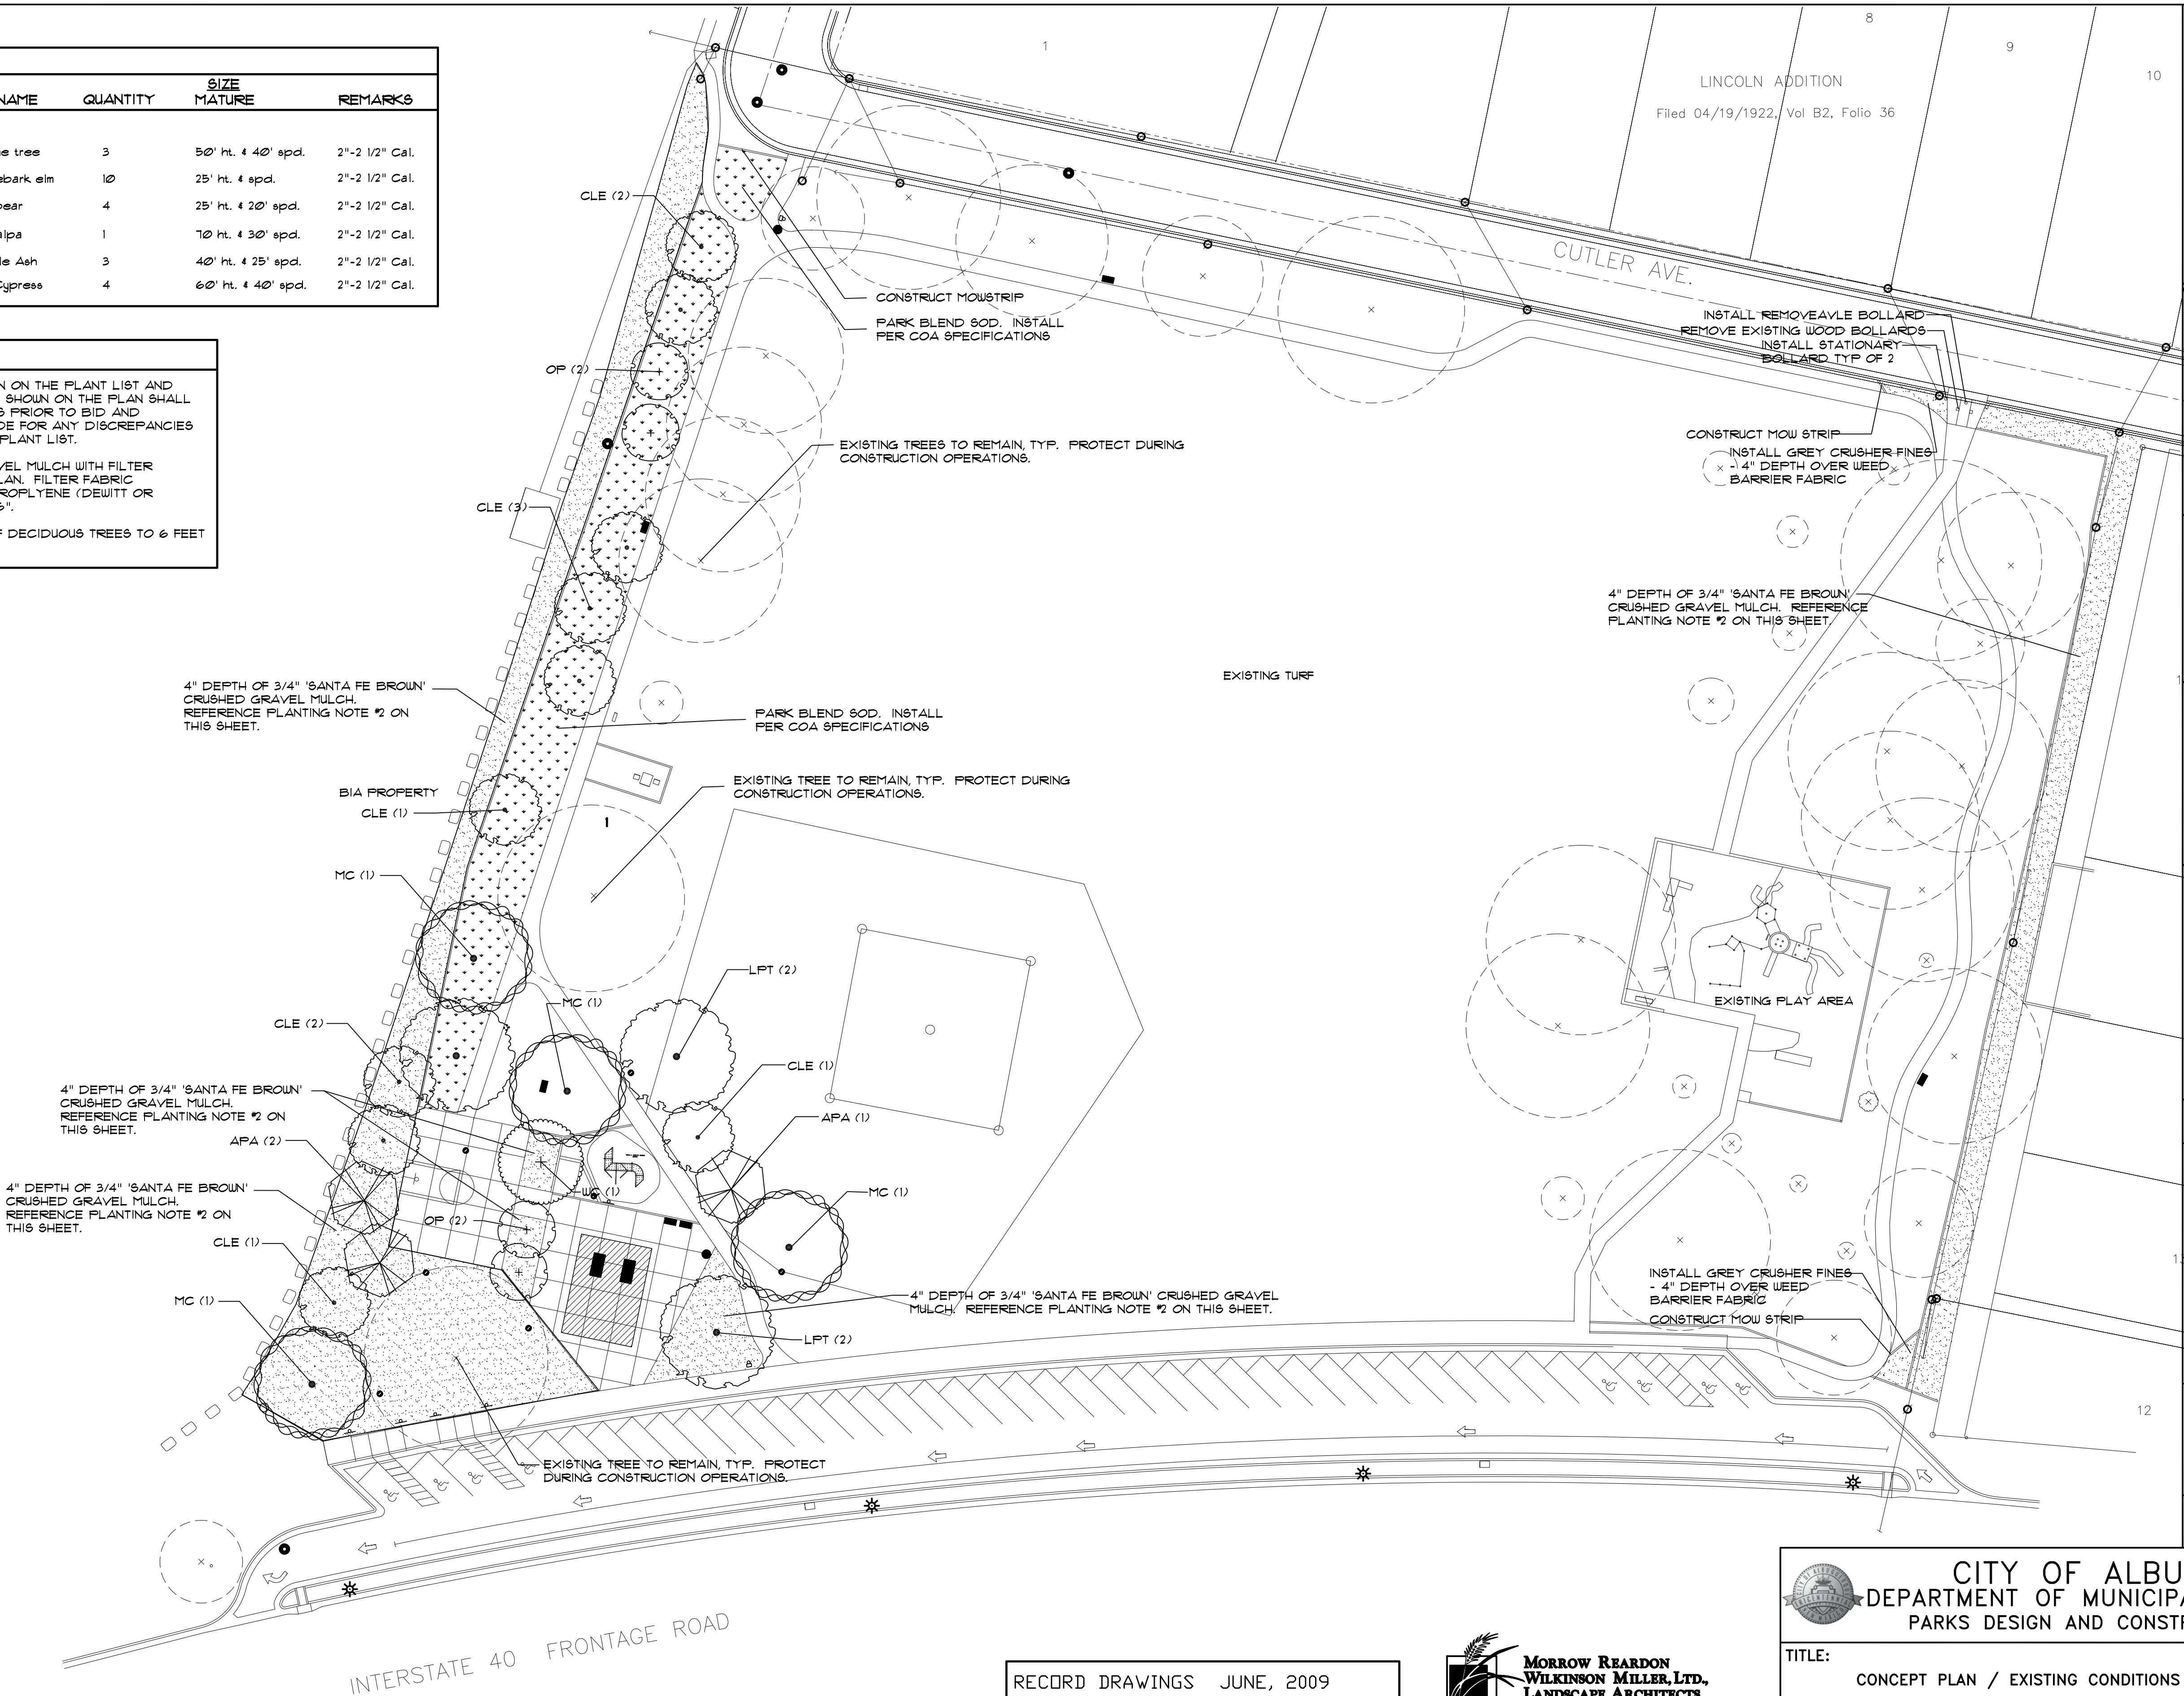

RECORD DRAWINGS JUNE, 2009

This set of Record Documents consists of corrected plans showing the reported location of the work, conforming to the construction records provided by the Contractor. While the information submitted by the Contractor and incorporated by the Landscape Architect into the Record Documents is assumed to be reliable, the Landscape Architect has not verified the accuracy and/or completeness of the information and shall not be responsible for any errors or omissions which may be incorporated herein as a result. Those relying on these Record Documents are advised to obtain independent verification of their accuracy before applying it for any purpose.


**MORROW REARDON  
WILKINSON MILLER, LTD.,  
LANDSCAPE ARCHITECTS**

210 La Veta NE, Albuquerque, NM 87108  
505.268.2266 FAX 505.265.9637  
mrw@mrwm.com


0 15 30 60 90  
SCALE: 1" = 30'

CITY OF ALBUQUERQUE DEPARTMENT OF MUNICIPAL DEVELOPMENT PARKS DESIGN AND CONSTRUCTION DIVISION			
TITLE: CONCEPT PLAN / EXISTING CONDITIONS			
Design Review Committee	City Engineer Approval	Mo/Day/Yr.	
		Mo/Day/Yr.	
		Mo/Day/Yr.	
		Mo/Day/Yr.	
		Mo/Day/Yr.	
PROJECT # 709405		ZONE MAP NO. H-14-Z	SHEET 7 OF 8




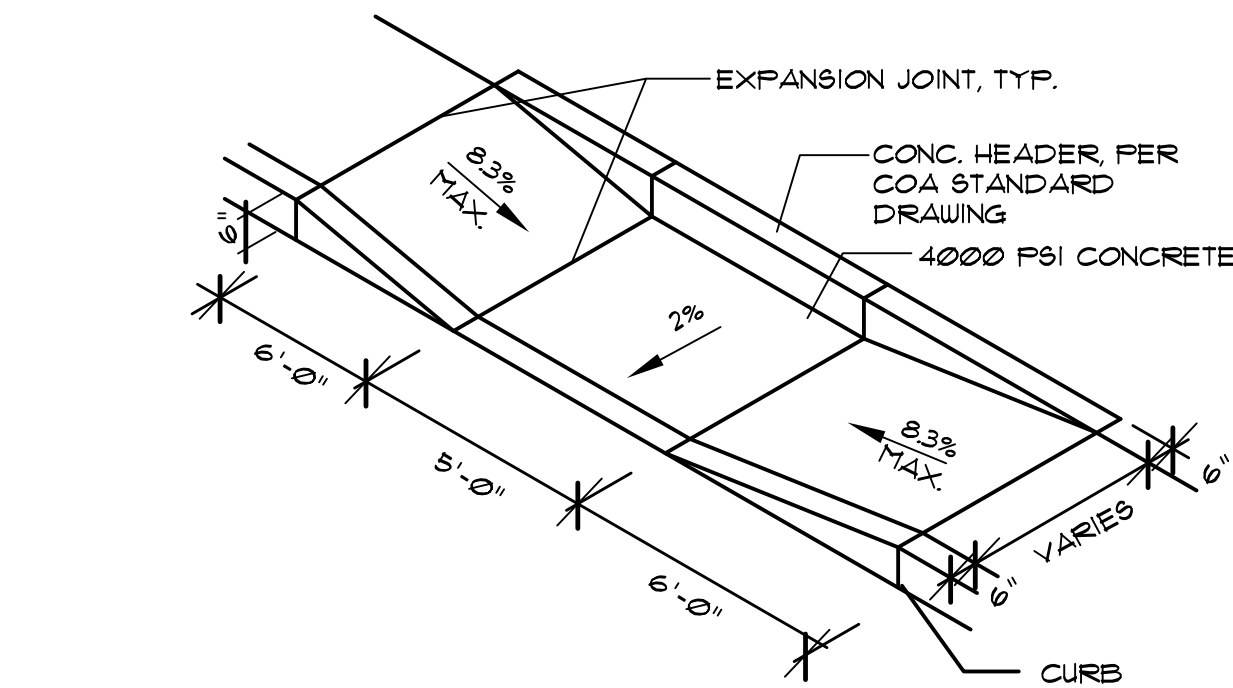



**A**  
**8** ACCESSIBLE RAMP -TYPE A  
ACCESS RAMP-A 1/30/03 NT6

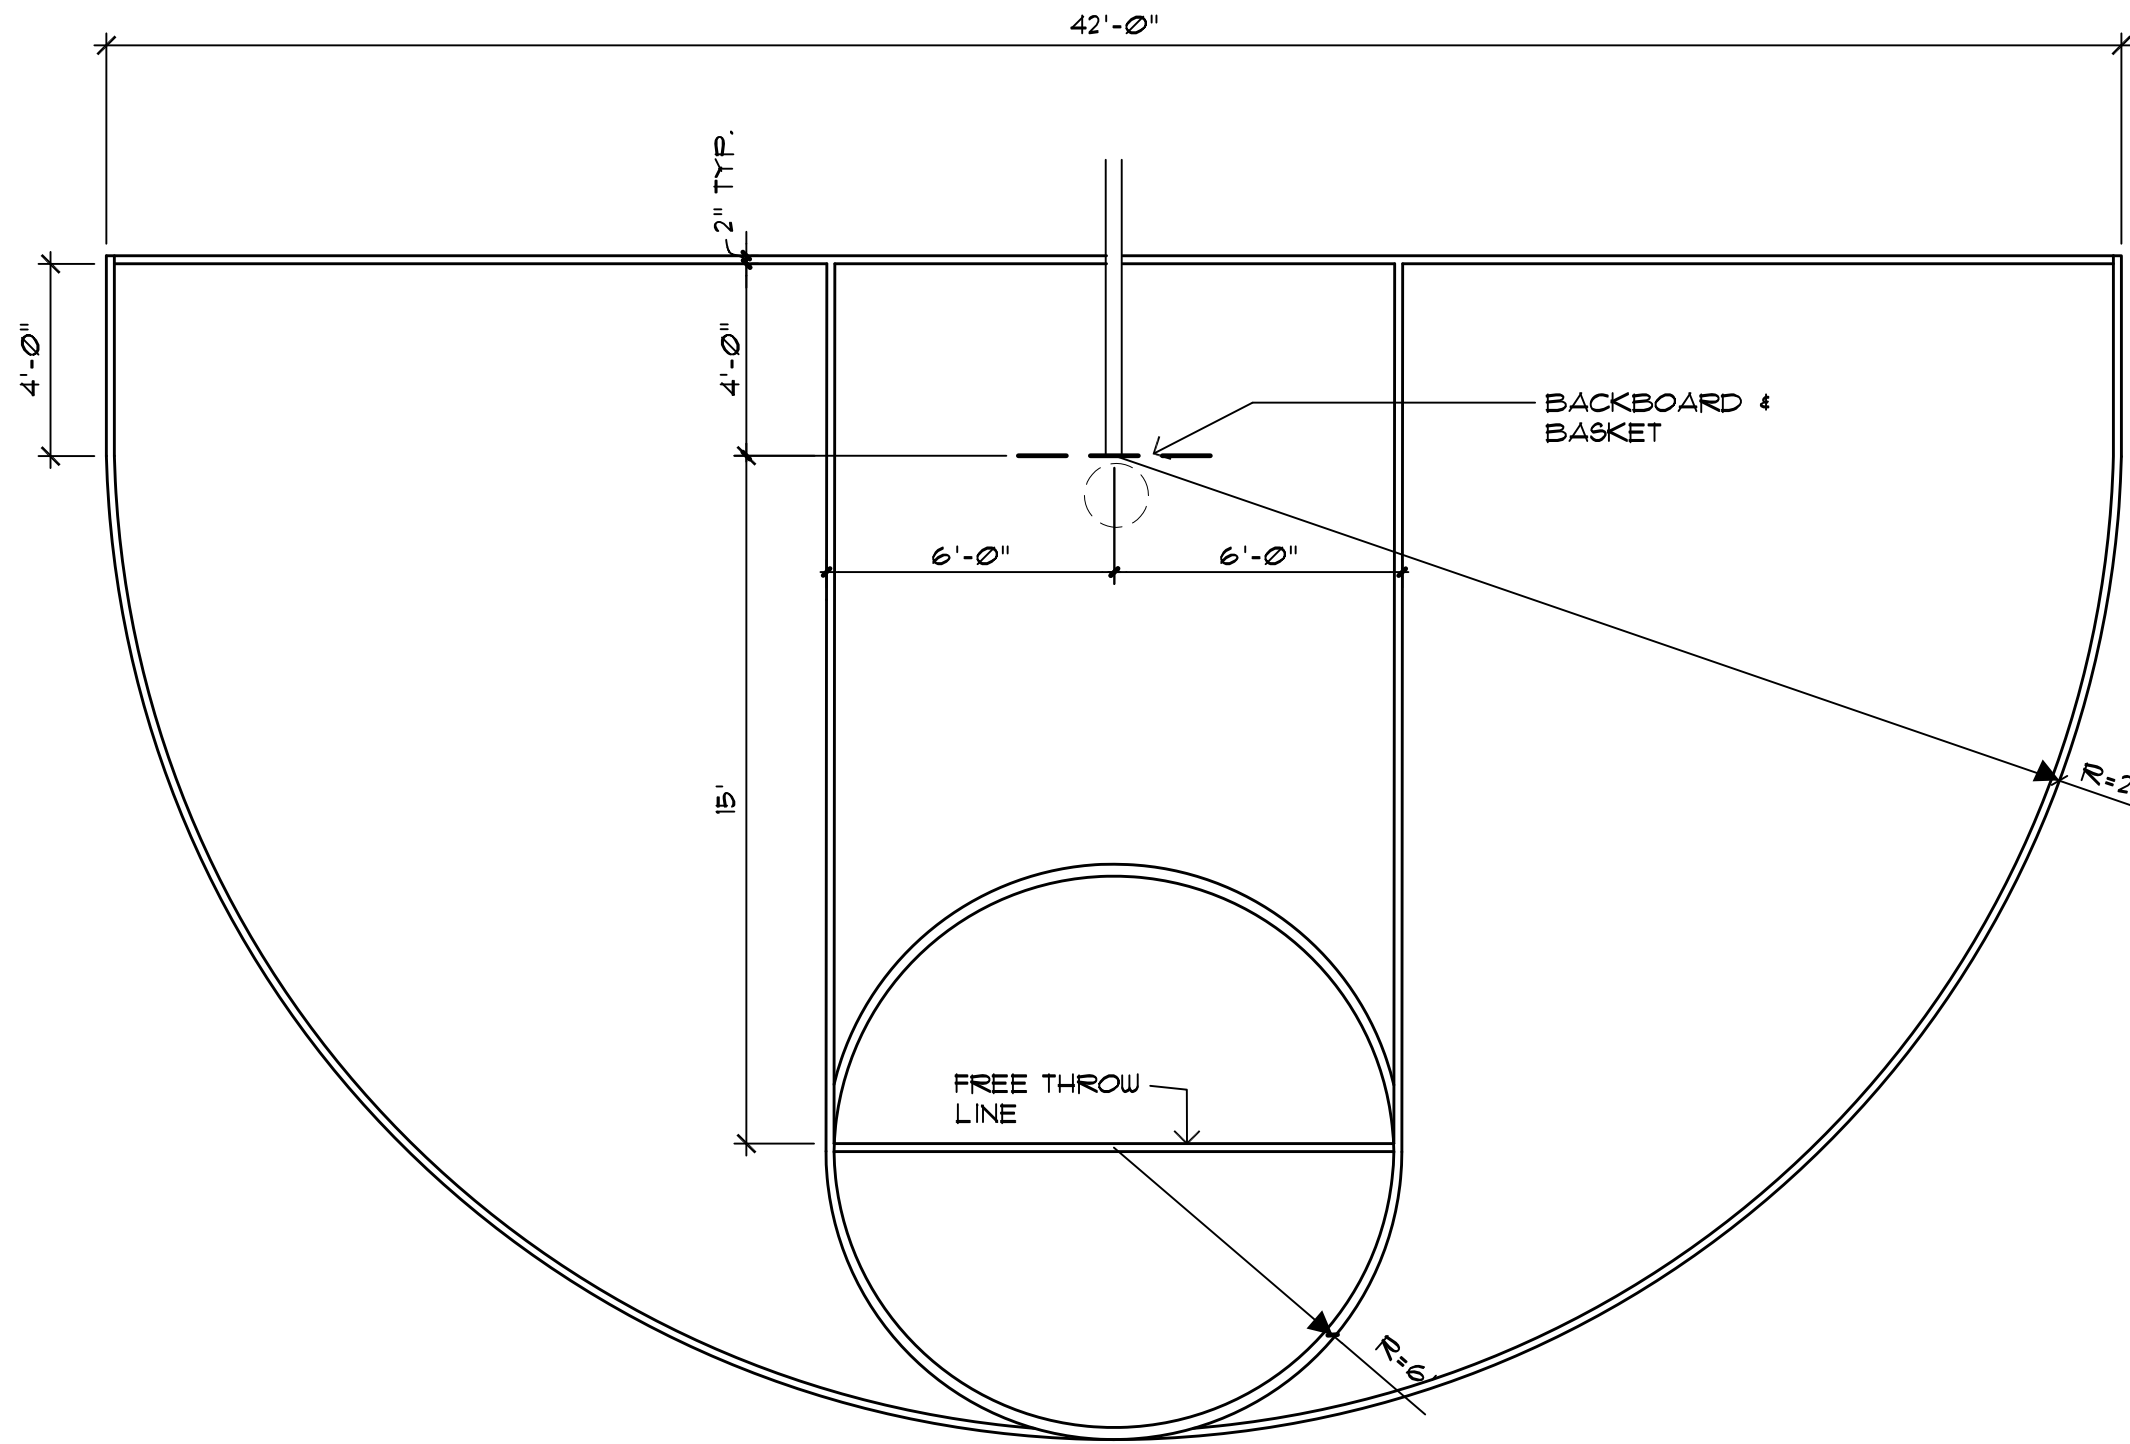


**B**  
**8** COURT PLAN  
MCD-0031 110035 NT6

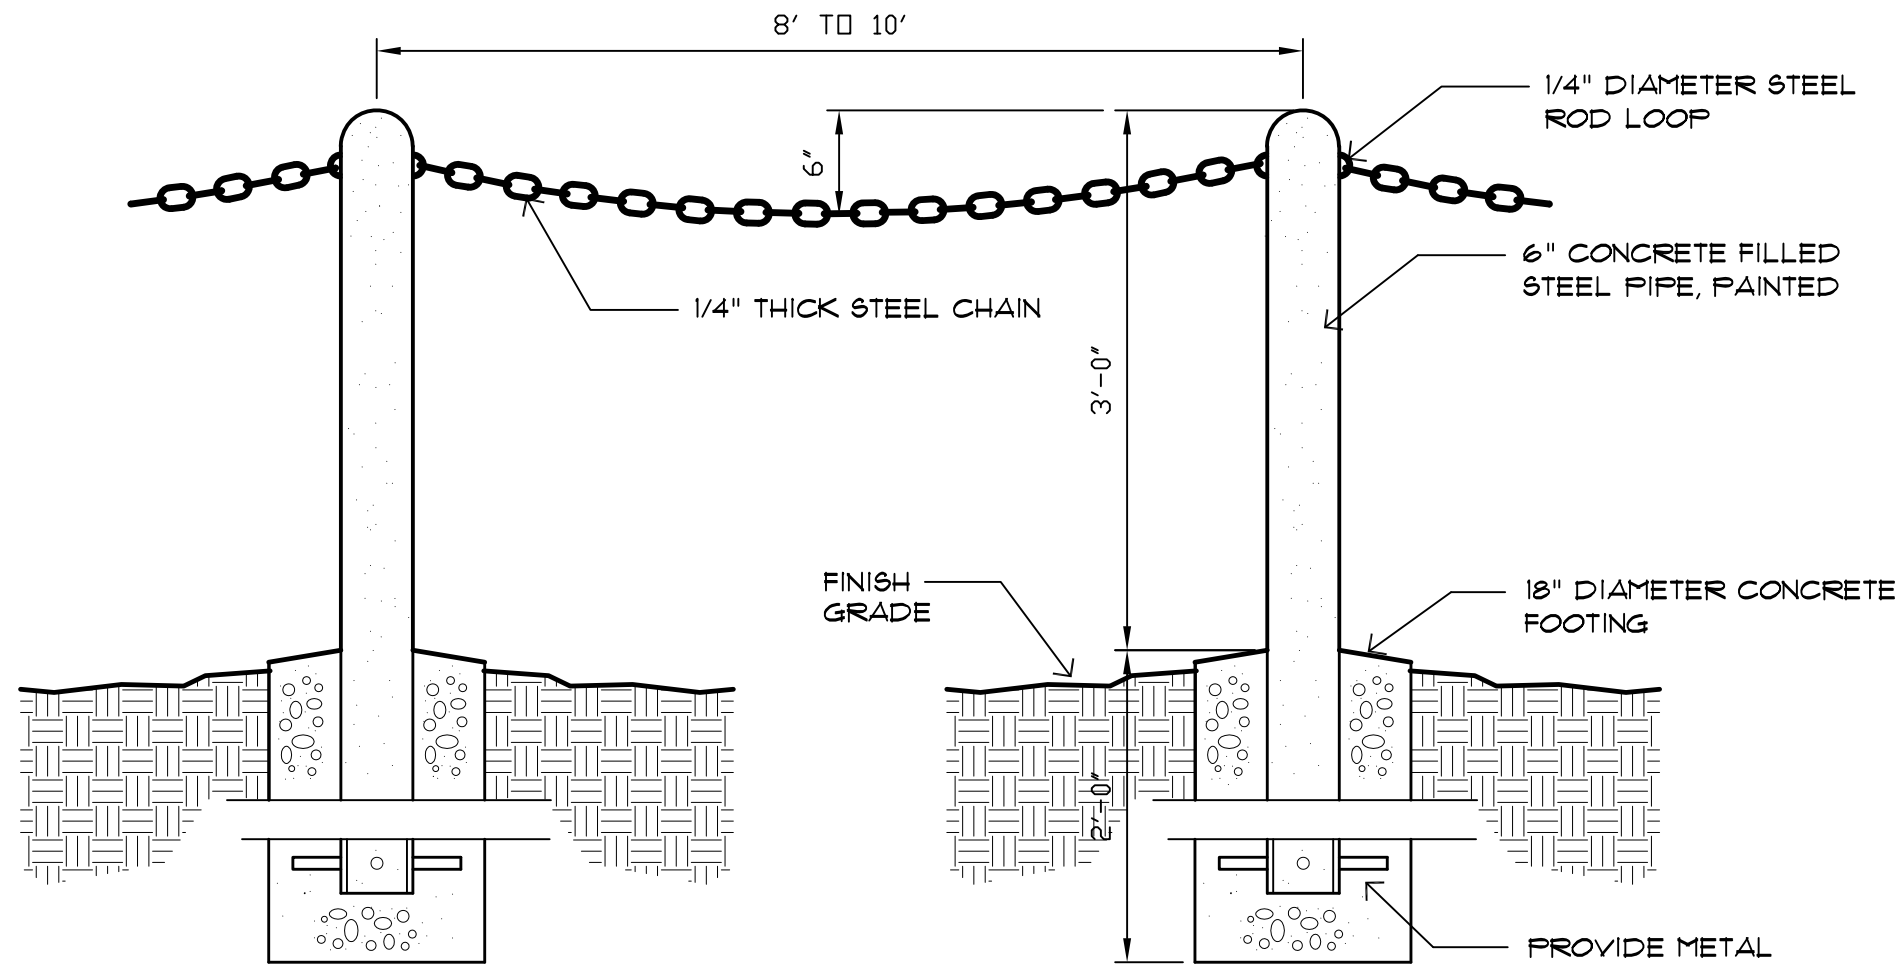

**C**  
**8** PIPE BOLLARD & CHAIN FENCING  
MCD-0071 092195 N.T.S.

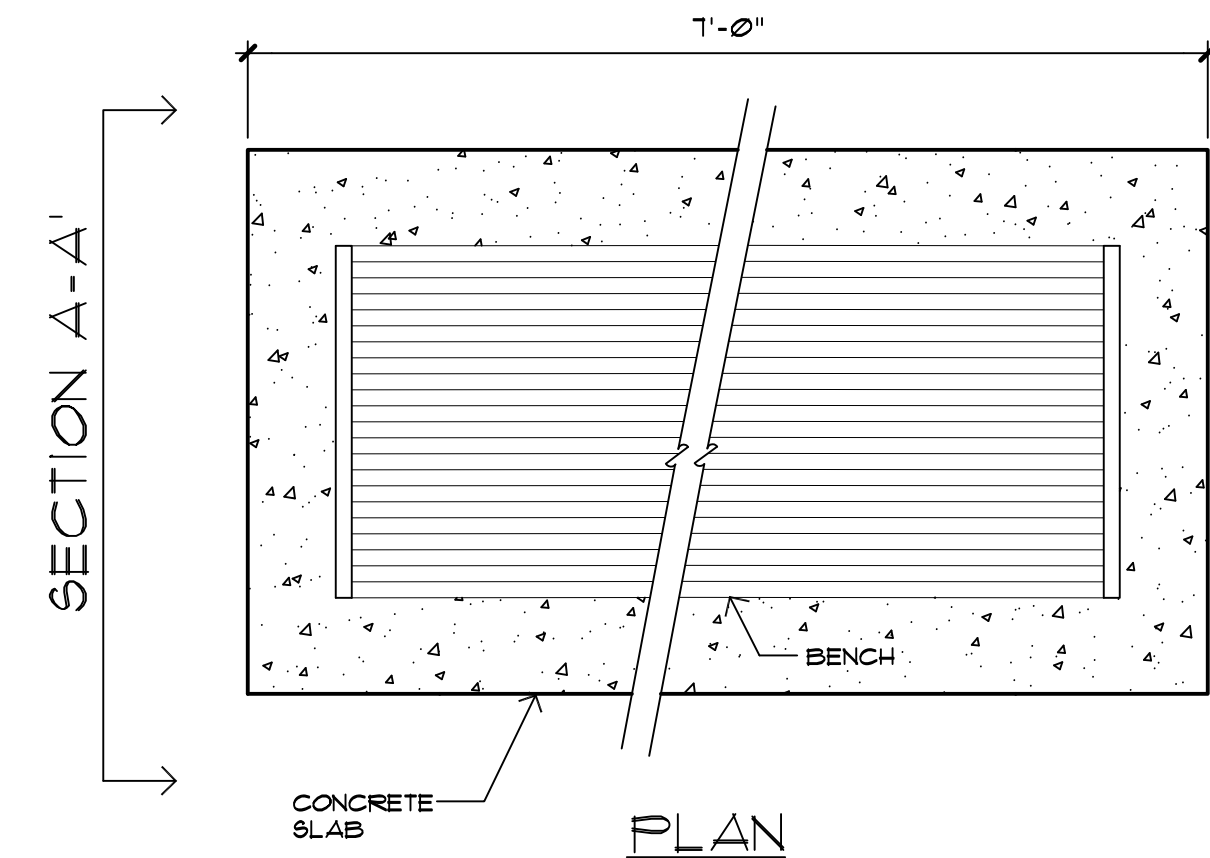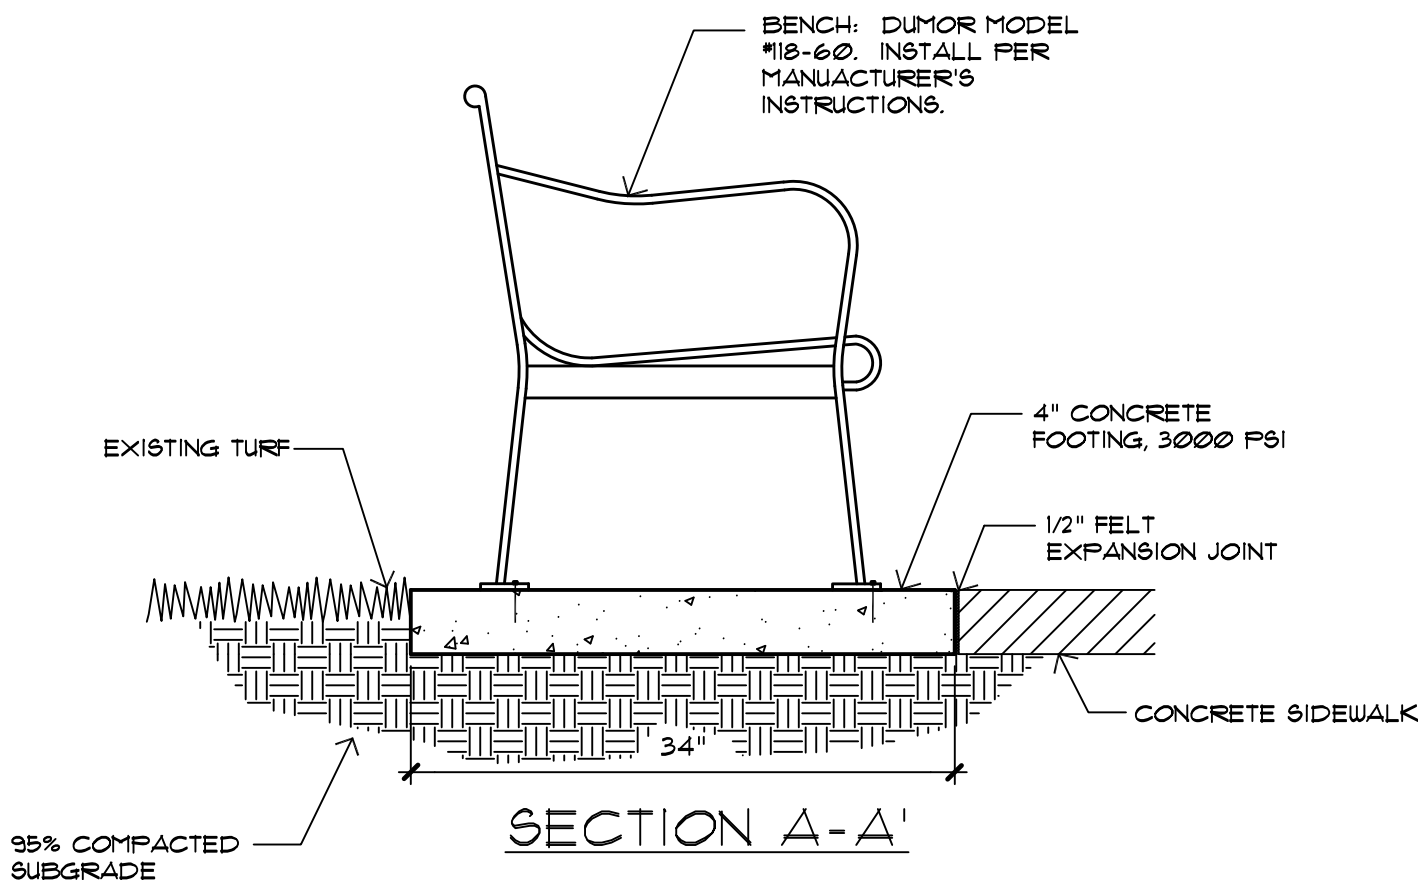

**D**  
**8** BENCH DETAIL  
L-D BENCH 110105 1" = 1'-0"

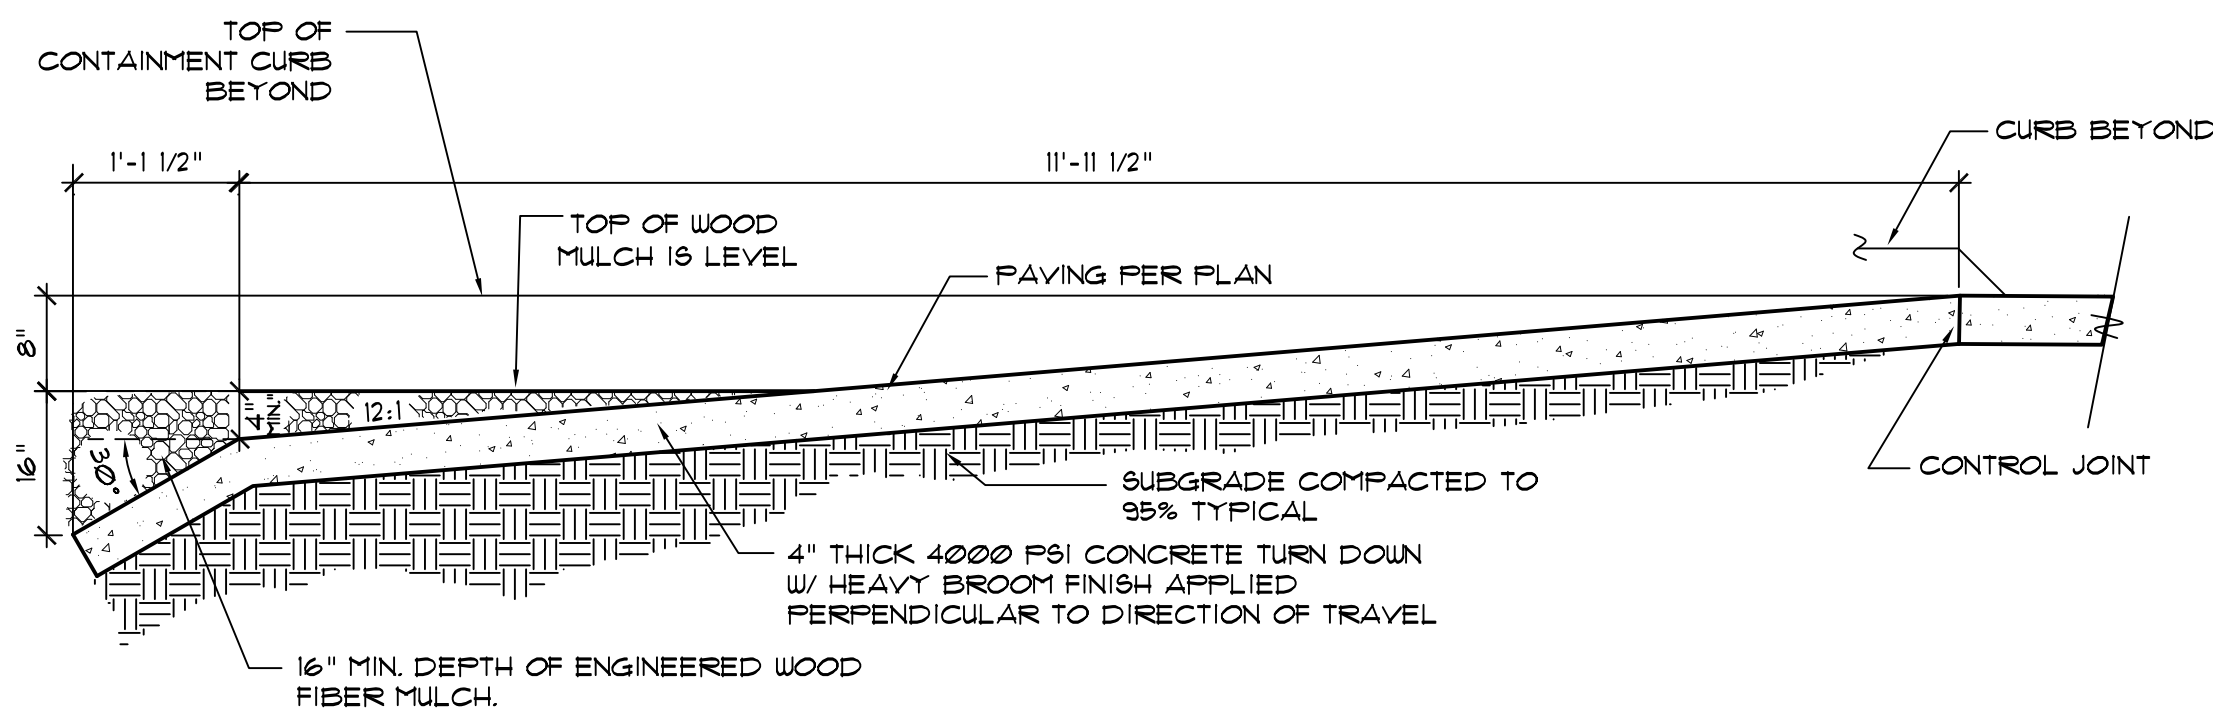

**F**  
**8** ACCESSIBLE SIGN  
ACCESSIBLE-S 9-4-02 1/2" = 1'-0"

RECORD DRAWINGS JUNE, 2009

This set of Record Documents consists of corrected plans showing the reported location of the work, conforming to the construction records provided by the Contractor. While the information submitted by the Contractor and incorporated by the Landscape Architect into the Record Documents is assumed to be reliable, the Landscape Architect has not verified the accuracy and/or completeness of the information and shall not be responsible for any errors or omissions which may be incorporated herein as a result. Those relying on these Record Documents are advised to obtain independent verification of their accuracy before applying it for any purpose.

**MORROW REARDON  
WILKINSON MILLER, LTD.,  
LANDSCAPE ARCHITECTS**

210 La Veta NE, Albuquerque, NM 87108  
505.265.2266 FAX 505.265.9657  
mrw@mrwmn.com

**CITY OF ALBUQUERQUE  
DEPARTMENT OF MUNICIPAL DEVELOPMENT  
PARKS DESIGN AND CONSTRUCTION DIVISION**

TITLE:		DETAILS	
Design Review Committee	City Engineer Approval	Mo/Day/Yr.	Mo/Day/Yr.
Last Design Updates			
PROJECT # 709405		ZONE MAP NO. H-14-Z	SHEET 8 OF 8

FINAL FOR CONSTRUCTION

Graves Park Phase II

PROJECT# 709405

RECORD DRAWINGS

DATE: JULY 10, 2008