


CONSTRUCTION PLANS
FOR
VILLAGE AT LA ORILLA
ALBUQUERQUE, NEW MEXICO

APPROVED AS RECORD DRAWINGS
DESIGN REVIEW SECTIONS
CITY CONSTRUCTION ENGINEER
DATE: 7/31/2018

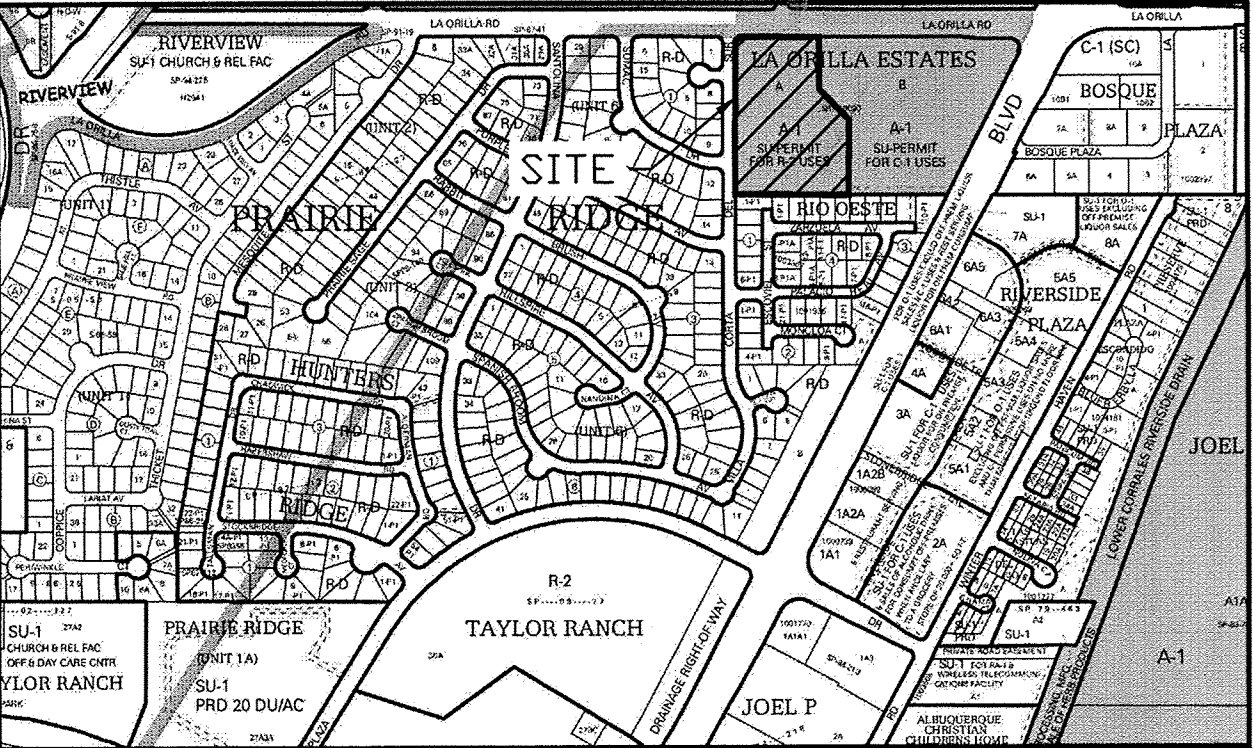

VICINITY MAP
E-12-Z

INDEX

SHEET NUMBER	DESCRIPTION
1	COVER SHEET
2A - 2C	PRELIMINARY PLAT
3	GRADING PLAN
4	OVERALL PAVING PLAN
5	OVERALL UTILITY PLAN

STATEMENT CERTIFICATION:
This firm, hereby certifies to the best of their knowledge, that the infrastructure designed by **Bohannon-Huston (BHI)** (Engineer of Record), with observation services performed by **SPINELLO-DCS, LLC** (Part-time), was constructed in accordance with the plans and specifications provided by the Engineer of Record, while we were On-Site. Changes and modifications agreed to have been made a part of the As-Built/Record Drawings. All warranties, guarantees and quality of work are the responsibility of the Contractor of record and their subcontractors.

[Signature] 06/07/18
CERTIFYING ENGINEER DATE
ACG ENGINEERING & CONSTRUCTION MANAGEMENT, LLC
AUGUSTINE C. GRACE, PE
NM PE 10861



SURVEYOR'S CERTIFICATION
I, BRIAN J. MARTINEZ, A DULY QUALIFIED, REGISTERED, PROFESSIONAL LAND SURVEYOR UNDER THE LAWS OF THE STATE OF NEW MEXICO, DO HEREBY CERTIFY THAT THE "AS-BUILT" INFORMATION SHOWN ON THESE DRAWINGS WAS OBTAINED FROM FIELD CONSTRUCTION AND "AS-BUILT" SURVEYS PERFORMED BY ME OR UNDER MY SUPERVISION, AND THAT THIS "AS-BUILT" INFORMATION WAS ADDED BY ME OR UNDER MY SUPERVISION, AND THAT THIS "AS-BUILT" INFORMATION IS TRUE AND CORRECT TO THE BEST OF MY KNOWLEDGE AND BELIEF. I AM NOT RESPONSIBLE FOR ANY OF THE DESIGN CONCEPTS, CALCULATIONS, ENGINEERING, OR INTENT OF THE RECORDED DRAWINGS.

[Signature] 5/7/18
BRIAN J. MARTINEZ, NMS 18374



CONSTRUCTION NOTES:

1. THE CONTRACTOR SHALL ABIDE BY ALL LOCAL, STATE, AND FEDERAL LAWS, RULES AND REGULATIONS WHICH APPLY TO THE CONSTRUCTION OF THESE IMPROVEMENTS.
2. PRIOR TO CONSTRUCTION, CONTRACTOR SHALL EXCAVATE AND VERIFY THE HORIZONTAL AND VERTICAL LOCATIONS OF ALL POTENTIAL OBSTRUCTIONS. SHOULD A CONFLICT EXIST, THE CONTRACTOR SHALL NOTIFY THE ENGINEER OR CONSTRUCTION OBSERVER SO THAT THE CONFLICT CAN BE RESOLVED WITH A MINIMUM AMOUNT OF DELAY.
3. ALL ELECTRICAL, TELEPHONE, CABLE TV, GAS AND OTHER UTILITY LINES, CABLES AND APPURTENANCES ENCOUNTERED DURING CONSTRUCTION THAT REQUIRE RELOCATION, SHALL BE COORDINATED WITH THAT UTILITY. THE CONTRACTOR SHALL BE RESPONSIBLE FOR COORDINATION OF ALL NECESSARY UTILITY ADJUSTMENTS. NO ADDITIONAL COMPENSATION WILL BE ALLOWED FOR DELAYS OR INCONVENIENCES CAUSED BY UTILITY COMPANY WORK CREWS. THE CONTRACTOR MAY BE REQUIRED TO RESCHEDULE HIS ACTIVITIES TO ALLOW UTILITY CREWS TO PERFORM THEIR REQUIRED WORK.
4. DISPOSAL SITE FOR ALL EXCESS EXCAVATION MATERIAL, AND UNSUITABLE MATERIAL SHALL BE OBTAINED BY THE CONTRACTOR IN COMPLIANCE WITH APPLICABLE ENVIRONMENTAL REGULATIONS AND APPROVED BY THE CONSTRUCTION OBSERVER. ALL COSTS INCURRED IN OBTAINING A DISPOSAL SITE AND HAUL THERE TO BE CONSIDERED INCIDENTAL TO THE PROJECT AND NO SEPARATE MEASUREMENT OR PAYMENT SHALL BE MADE.

5. THE CONTRACTOR IS RESPONSIBLE FOR PROTECTING THE EXISTING UTILITY LINES WITHIN THE CONSTRUCTION AREA. ANY DAMAGE TO EXISTING FACILITIES CAUSED BY CONSTRUCTION ACTIVITY SHALL BE REPAIRED OR REPLACED AT THE CONTRACTOR'S EXPENSE AND APPROVED BY THE CONSTRUCTION OBSERVER.
6. CONSTRUCTION ACTIVITY SHALL BE LIMITED TO THE PROPERTY AND/OR PROJECT LIMITS. ANY DAMAGE TO ADJACENT PROPERTIES RESULTING FROM THE CONSTRUCTION PROCESS IS THE RESPONSIBILITY OF THE CONTRACTOR. ANY COSTS INCURRED FOR REPAIRS SHALL BE THE COST OF THE CONTRACTOR.
7. OVERNIGHT PARKING OF CONSTRUCTION EQUIPMENT SHALL NOT OBSTRUCT DRIVEWAYS OR DESIGNATED TRAFFIC LANES. THE CONTRACTOR SHALL NOT STORE ANY EQUIPMENT OR MATERIAL WITHIN THE PUBLIC RIGHT-OF-WAY.
8. THE CONTRACTOR SHALL OBTAIN ALL THE NECESSARY PERMITS FOR THE PROJECT PRIOR TO COMMENCING CONSTRUCTION (I.E. BARRICADING, SURFACE DISTURBANCE).
9. THE CONTRACTOR SHALL BE RESPONSIBLE TO REPLACE AT HIS EXPENSE ANY AND ALL PROPERTY CORNERS DESTROYED DURING CONSTRUCTION. ALL PROPERTY CORNERS MUST BE RESET BY A REGISTERED LAND SURVEYOR.
10. ALL PERMANENT PAVEMENT MARKING AND TRAFFIC SIGNING SHALL BE FURNISHED AND PLACED BY THE CONTRACTOR PER PLAN.

11. THE CONTRACTOR SHALL COORDINATE WITH THE CITY OF ALBUQUERQUE, DMD CONSTRUCTION COORDINATION DIVISION, PRIOR TO BEGINNING ANY CONSTRUCTION WORK ON OR ADJACENT TO EXISTING STREETS.
12. ALL BARRICADES AND CONSTRUCTION SIGNING SHALL CONFORM TO APPLICABLE SECTIONS OF THE "MANUAL ON UNIFORM TRAFFIC CONTROL DEVICES" (MUTCD), U.S. DEPARTMENT OF TRANSPORTATION, LATEST EDITION.
13. THE CONTRACTOR SHALL BE RESPONSIBLE FOR PROVIDING AND MAINTAINING CONSTRUCTION SIGNAGE UNTIL THE PROJECT HAS BEEN ACCEPTED BY THE CITY OF ALBUQUERQUE. THE CONTRACTOR SHALL VERIFY THE PROPER LOCATION OF ALL BARRICADING AT THE END AND BEGINNING OF EACH DAY.
14. ALL SAWCUT PAVEMENT SHALL HAVE A UNIFORM EDGE, WHEN ABUTTING NEW ASPHALT (ONLY), EDGE SHALL BE SPRAYED WITH TACK.
15. THE CONTRACTOR SHALL ASSUME RESPONSIBILITY FOR ANY DAMAGE TO EXISTING PAVEMENTS, SIGNAGE, PAVEMENT MARKINGS, CURB & GUTTER, DRIVE PADS, WHEELCHAIR RAMPS, AND SIDEWALK DURING CONSTRUCTION, APART FROM THOSE SECTIONS INDICATED FOR REMOVAL ON THE PLANS AND SHALL REPAIR OR REPLACE PER COA STANDARDS, AT HIS OWN EXPENSE.

17. AN SO 19 PERMIT IS REQUIRED TO PLACE ANY MATERIAL ON OR AROUND A STORM DRAIN INLET IN THE CITY RIGHT-OF-WAY THAT WOULD INTERFERE WITH THE INLET RECEIVING STORM WATER PER THE ENGINEER'S DESIGN. CITY PERSONNEL MAY REMOVE THIS MATERIAL AT ANY TIME WITHOUT NOTICE. THE PREFERRED BMP IS TO REMOVE SEDIMENT/POLLUTANTS ON THE PROPERTY WHERE CONSTRUCTION ACTIVITY IS OCCURRING.
18. ALL EXCAVATION, TRENCHING, AND SHORING ACTIVITIES MUST BE CARRIED-OUT IN ACCORDANCE WITH OSHA 29 CFR 1926.650 SUBPART P.
19. CONTRACTOR WILL ENSURE THE ASPHALT HAS A SMOOTH, UNIFORM EDGE WHEN REMOVING AND REPLACING CURB AND GUTTER. IF THE ASPHALT EDGE IS NOT SMOOTH AND UNIFORM, CONTRACTOR WILL SAW CUT AND REPLACE A ONE-FOOT STRIP OF ASPHALT ALONG THE FULL SECTION BEING REPLACED; REFER TO COA STANDARD DRAWING # 2465 WITH THE APPROPRIATE PAVING SECTION BASED ON ROADWAY CLASSIFICATION.

NOTICE TO CONTRACTORS

1. AN EXCAVATION/CONSTRUCTION PERMITS WILL BE REQUIRED BEFORE BEGINNING ANY WORK WITHIN THE CITY RIGHT-OF-WAY.
2. ALL WORK DETAILED ON THESE PLANS TO BE PERFORMED UNDER CONTRACT SHALL, EXCEPT AS OTHERWISE STATED OR PROVIDED FOR HEREON, BE CONSTRUCTED IN ACCORDANCE WITH THE CITY OF ALBUQUERQUE STANDARD SPECIFICATIONS FOR PUBLIC WORKS CONSTRUCTION, 1986 EDITION AS REVISED THROUGH UPDATE #0.
3. TWO WORKING DAYS PRIOR TO ANY EXCAVATION, THE CONTRACTOR MUST CONTACT NEW MEXICO ONE CALL SYSTEM (260-1990) FOR LOCATION OF EXISTING UTILITIES.
4. PRIOR TO CONSTRUCTION, THE CONTRACTOR SHALL EXCAVATE AND VERIFY THE HORIZONTAL AND VERTICAL LOCATIONS OF ALL OBSTRUCTIONS. SHOULD A CONFLICT EXIST, THE CONTRACTOR SHALL NOTIFY THE ENGINEER IMMEDIATELY SO THAT THE CONFLICT CAN BE RESOLVED WITH A MINIMUM AMOUNT OF DELAY.
5. SEVEN (7) WORKING DAYS PRIOR TO BEGINNING CONSTRUCTION, THE CONTRACTOR SHALL SUBMIT TO CONSTRUCTION COORDINATION DIVISION A DETAILED CONSTRUCTION SCHEDULE. TWO (2) WORKING DAYS PRIOR TO THE START OF CONSTRUCTION, THE CONTRACTOR SHALL OBTAIN A BARRICADING PERMIT FROM THE CONSTRUCTION COORDINATION DIVISION, CONTRACTOR SHALL NOTIFY THE CONSTRUCTION COORDINATION ENGINEER (924-3400) PRIOR TO OCCUPANCY AN INTERSECTION. REFER TO SECTION 19 OF THE GENERAL CONDITIONS OF THE STANDARD SPECIFICATIONS.
6. ALL WORK AFFECTING ARTERIAL ROADWAYS MAY REQUIRE TWENTY-FOUR HOUR CONSTRUCTION.
7. ALL STREET STRIPING ALTERED OR DESTROYED SHALL BE REPLACED WITH PLASTIC REFLECTORIZED PAVEMENT MARKING BY CONTRACTOR TO THE SAME LOCATION AS WAS EXISTING, OR AS INDICATED BY THIS PLAN SET.
8. CONTRACTOR SHALL NOTIFY THE ENGINEER NOT LESS THAN SEVEN (7) DAYS PRIOR TO STARTING WORK IN ORDER THAT THE CITY SURVEYOR MAY TAKE NECESSARY MEASURES TO INSURE THE PRESERVATION OF SURVEY MONUMENTS. CONTRACTOR SHALL NOT DISTURB PERMANENT SURVEY MONUMENTS WITHOUT THE CONSENT OF THE CITY SURVEYOR AND SHALL NOTIFY THE CITY SURVEYOR AND BEAR THE EXPENSE OF REPLACING ANY THAT MAY BE DISTURBED WITHOUT PERMISSION. REPLACEMENT SHALL BE DONE ONLY BY THE CITY SURVEYOR. WHEN A CHANGE IS MADE IN THE FINISHED ELEVATIONS OF THE PAVEMENT OF ANY ROADWAY IN WHICH A PERMANENT SURVEY MONUMENT IS LOCATED, CONTRACTOR SHALL, AT HIS OWN EXPENSE, ADJUST THE MONUMENT COVER TO THE NEW GRADE UNLESS OTHERWISE SPECIFIED. REFER TO SECTION 4.4 OF THE GENERAL CONDITIONS OF THE STANDARD SPECIFICATIONS.
9. CONTRACTOR SHALL RECORD DATA ON ALL UTILITY LINES AND ACCESSORIES AS REQUIRED BY ABCWUA FOR THE PREPARATION OF "AS CONSTRUCTED" DRAWINGS. CONTRACTOR SHALL NOT COVER UTILITY LINES AND ACCESSORIES UNTIL ALL DATA HAS BEEN RECORDED.
10. CONTRACTOR SHALL MAINTAIN A GRAFFITI-FREE WORK SITE. CONTRACTOR SHALL PROMPTLY REMOVE ANY GRAFFITI FROM ALL EQUIPMENT, WHETHER PERMANENT OR TEMPORARY.
11. THE CONTRACTOR SHALL COORDINATE WITH THE WATER AUTHORITY SEVEN (7) DAYS IN ADVANCE OF PERFORMING WORK THAT WILL AFFECT THE PUBLIC WATER OR SANITARY SEWER INFRASTRUCTURE. WORK REQUIRING SHUTOFF OF WELL COLLECTORS, TRANSMISSION LINES, OR FACILITIES DESIGNATED AS MASTER PLAN FACILITIES MUST BE COORDINATED WITH THE WATER AUTHORITY 14 DAYS IN ADVANCE OF PERFORMING SUCH WORK. ONLY WATER AUTHORITY CREWS ARE AUTHORIZED TO OPERATE PUBLIC VALVES. SHUTOFF REQUESTS MUST BE MADE ONLINE AT http://www.abcwua.org/Water_Shut_Off_and_Turn_on_Procedures.aspx.

THE FOLLOWING NOTES ALSO APPLY WHEN CHECKED

- ☒ ALL UTILITIES AND UTILITY SERVICE LINES SHALL BE INSTALLED PRIOR TO PAVING.
- ☒ BACKFILL COMPACTION SHALL BE ACCORDING TO SPECIFIED STREET USE.
- ☒ SIDEWALKS AND WHEELCHAIR RAMPS WITHIN THE CURB RETURNS SHALL BE CONSTRUCTED WHEREVER A NEW CURB RETURN IS CONSTRUCTED.
- ☒ IF CURB IS DEPRESSED FOR A DRIVEPAD, THE DRIVEPAD SHALL BE CONSTRUCTED PRIOR TO ACCEPTANCE OF CURB AND GUTTER.
- ☒ ALL STORM DRAINAGE FACILITIES SHALL BE COMPLETED PRIOR TO FINAL ACCEPTANCE.
- ☒ THE REQUESTOR OR DEVELOPER SHALL BE RESPONSIBLE FOR REPAIR OR REPLACEMENT OF ALL CURB AND GUTTER OR SIDEWALK DAMAGED AFTER APPROVAL BY THE CITY ENGINEER OF WORK COMPLETED BY THE CONTRACTOR.


REV.	SHEETS	CITY ENGINEER	DATE	USER DEPARTMENT	DATE	USER DEPARTMENT	DATE
ENGINEERS STAMP & SIGNATURE		APPROVALS		ENGINEER	DATE	*****	
		DRC Chairman	<i>[Signature]</i>	11/22/17	APPROVED FOR CONSTRUCTION		
		Transportation	<i>[Signature]</i>	11-15-17			
		Water/Wastewater	<i>[Signature]</i>	11-15-17			
		Hydrology	<i>[Signature]</i>	11/22/17			
		Parks					
		Const. Coord.					
City Project No.		713483		Sheet		Of	
				1		5	

Curve Table

CURVE	RADIUS	ARC LENGTH	DELTA ANGLE	TANGENT	CHORD BEARING	CHORD LENGTH
C1	25.00'	39.26'	89°57'42"	54.38'	S 43°31'41" W	55.34'
C2	1557.57'	56.78'	5°49'57"	28.40'	N 86°45'25" W	58.74'
C3	1554.69'	57.80'	5°52'36"	28.99'	S 86°50'08" E	57.64'
C4	35.00'	71.52'	117°05'15"	57.21'	N 31°7'00" W	59.71'
C5	46.00'	20.34'	25°19'55"	10.34'	N 39°53'35" E	20.17'
C6	48.00'	25.97'	25°21'19"	13.00'	S 39°54'47" W	25.46'


RECORDING STAMP

Plat of
Tracts B-1 through B-4
La Orilla Estates
Bernalillo County, New Mexico
December 2013

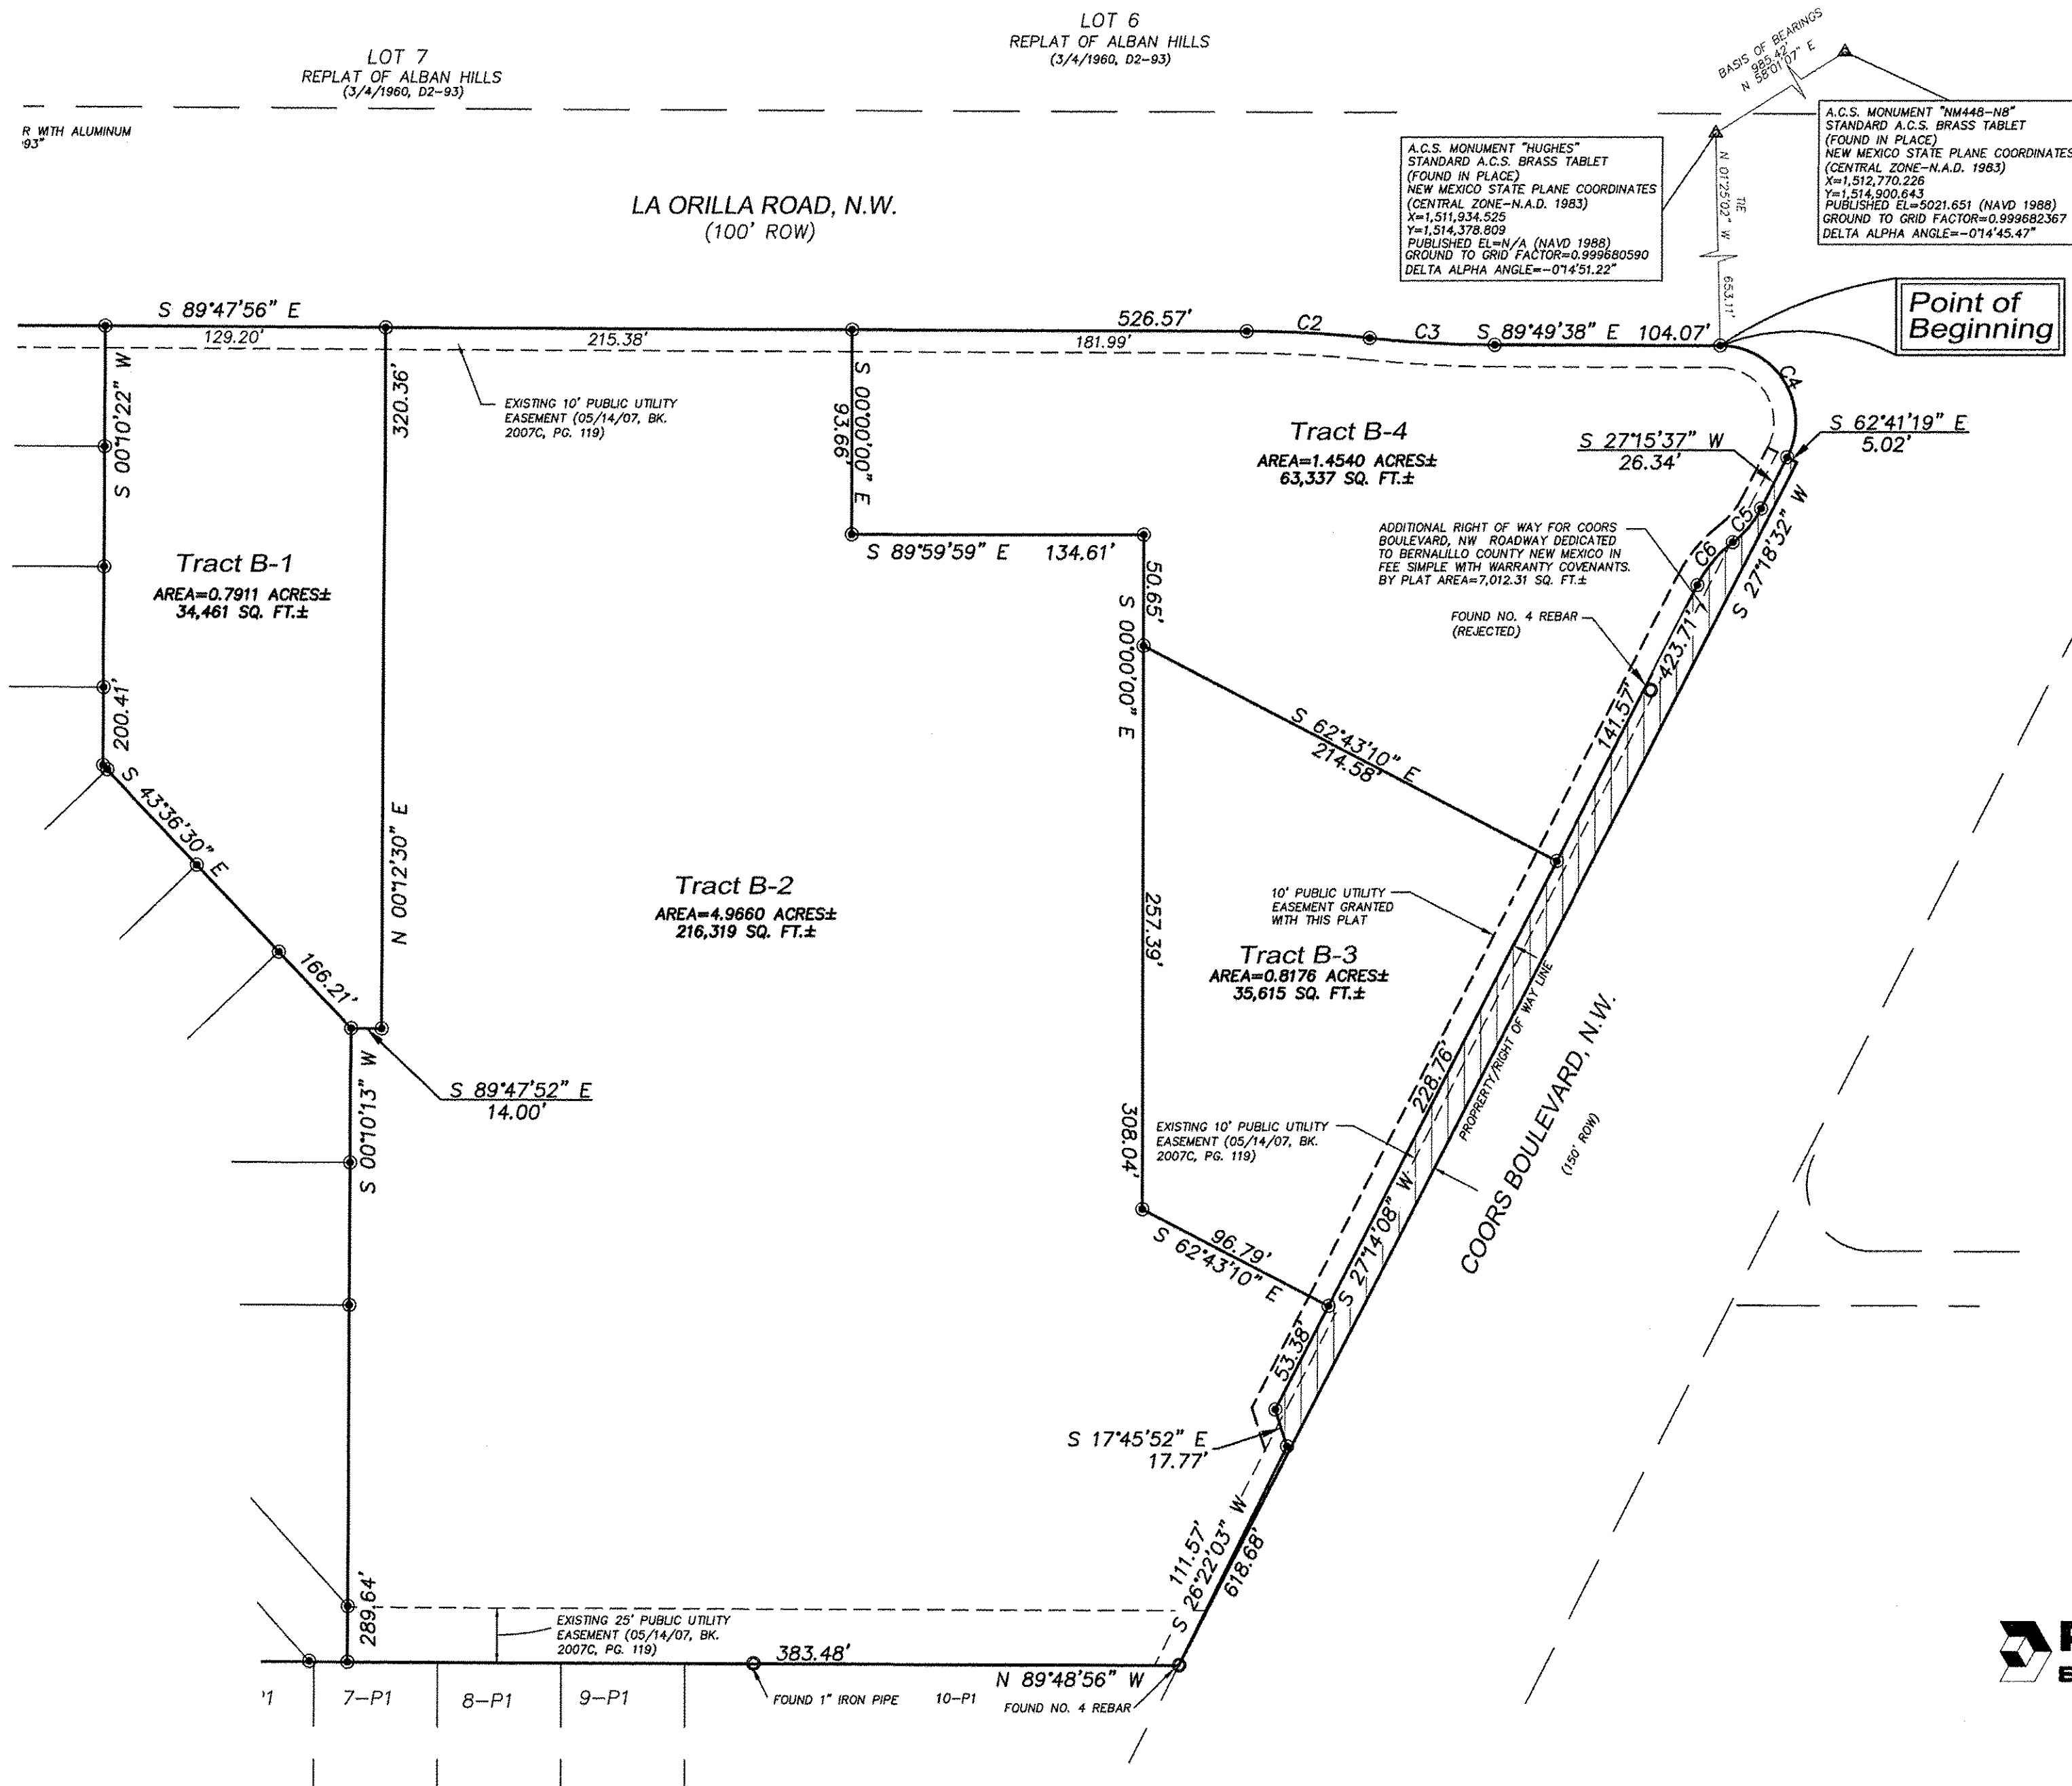

Legend

- N 90°00'00" E MEASURED BEARING AND DISTANCES
(N 90°00'00" E)
○ RECORD BEARINGS AND DISTANCES
○ FOUND AND USED MONUMENT AS DESIGNATED
○ DENOTES NO. 4 REBAR WITH YELLOW PLASTIC CAP "PS 11993" SET THIS SURVEY
△ FOUND ALUMINUM AGRS MONUMENT AS DESIGNATED
▲ FOUND ALUMINUM CENTERLINE MONUMENT AS DESIGNATED
△ CENTERLINE (IN LIEU OF R/W MONUMENTATION)
TO BE INSTALLED AT ALL CENTERLINE P.C.'S, P.T.'S, ANGLE POINTS AND STREET INTERSECTIONS PRIOR TO ACCEPTANCE OF SUBDIVISION STREET IMPROVEMENTS AND WILL CONSIST OF A STANDARD FOUR-INCH (4") ALUMINUM ALLOY CAP STAMPED "CITY OF ALBUQUERQUE", "CENTERLINE MONUMENTATION", "SURVEY MARKER", "DO NOT DISTURB", "PLS# 11993"

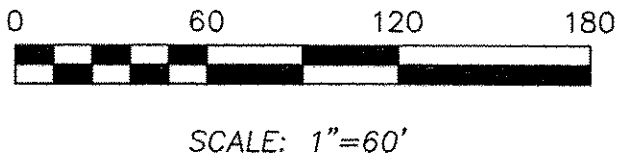


PRECISION SURVEYS, INC.


OFFICE LOCATION:
5571 Midway Park Place, NE
Albuquerque, NM 87109
MAILING ADDRESS:
PO Box 90636
Albuquerque, NM 87199
866.442.8011 TOLL FREE
505.856.5700 PHONE
505.856.7900 FAX

Sheet 2 of 2
134218P3


AS BUILT INFORMATION		BENCH MARKS		SURVEY INFORMATION		ENGINEER'S SEAL		REVISIONS		DESIGN		CHECKED BY: VP	
CONTRACTOR	DATE	10-E12	DATE	NO.	BY	NO.	DATE	NO.	DATE	NO.	DATE	NO.	DATE
STAMPED BY	DATE	CENTRAL STATION DATA	DATE										
INSPECTOR'S	DATE	NM STATE PLANE COORDINATES	DATE										
FIELD CHECK	DATE	CENTRAL ZONE - NAD 1983	DATE										
VERIFICATION BY	DATE	X=1511103.769	DATE										
CORRECTED BY	DATE	Y=1511660.634	DATE										
MICRO-FILM INFORMATION	DATE	G-G=0.999883427	DATE										
RECORDED BY	DATE	Dd=-0.14.56.74	DATE										
NO.		Elev=5009.741											

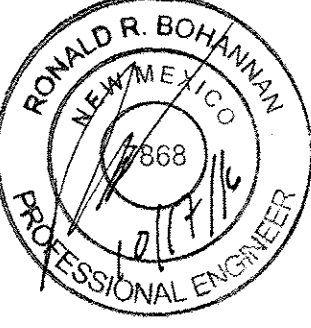

TERRA WEST, LLC 5571 MIDWAY PARK PLACE NE ALBUQUERQUE, NM 87109 (505) 856-3100 www.twestllc.com	
CITY OF ALBUQUERQUE PUBLIC WORKS DEPARTMENT ENGINEERING GROUP	
TITLE: LA ORILLA ESTATES LA ORILLA RD. GRADING IMPROVEMENTS PLAT	
DESIGN REVIEW COMMITTEE	REVIEW ENGINEER APPROVAL
MO./DAY/YR.	MO./DAY/YR.
CITY PROJECT NO. 713482	ZONE MAP NO. E-12-Z
SHEET 2	OF 8





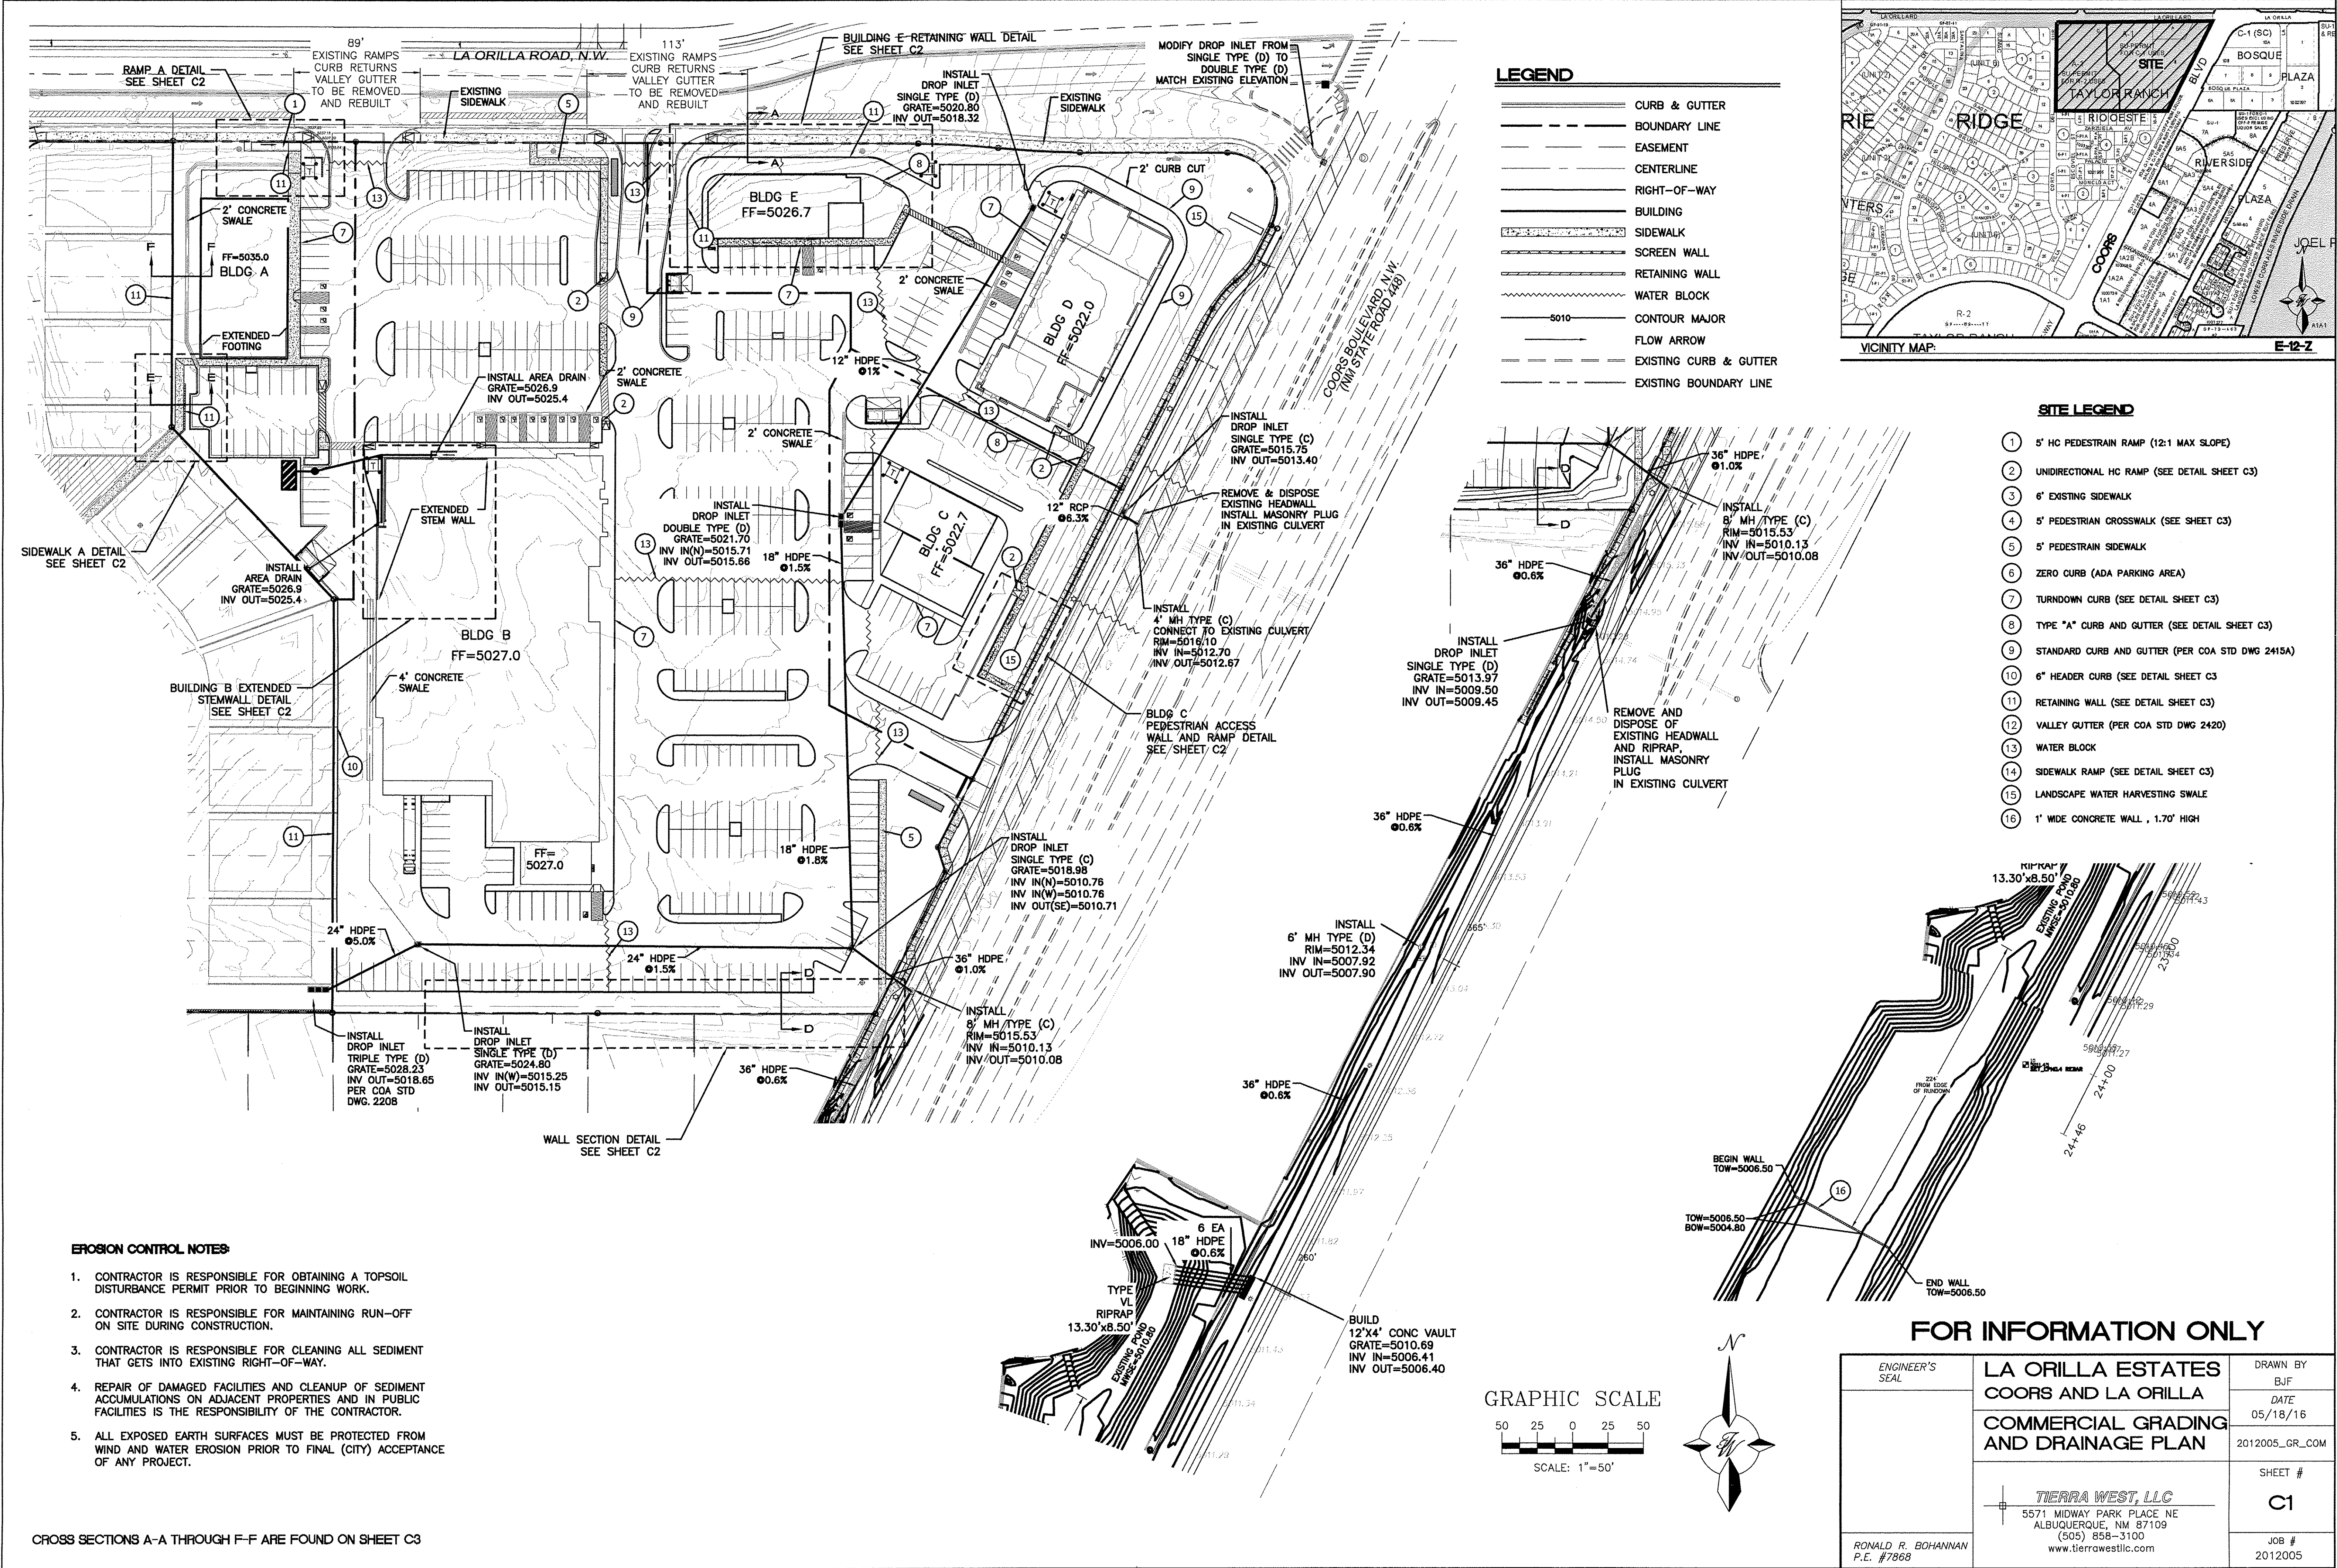


CROSS SECTIONS A-A THROUGH F-F ARE FOUND ON SHEET C3

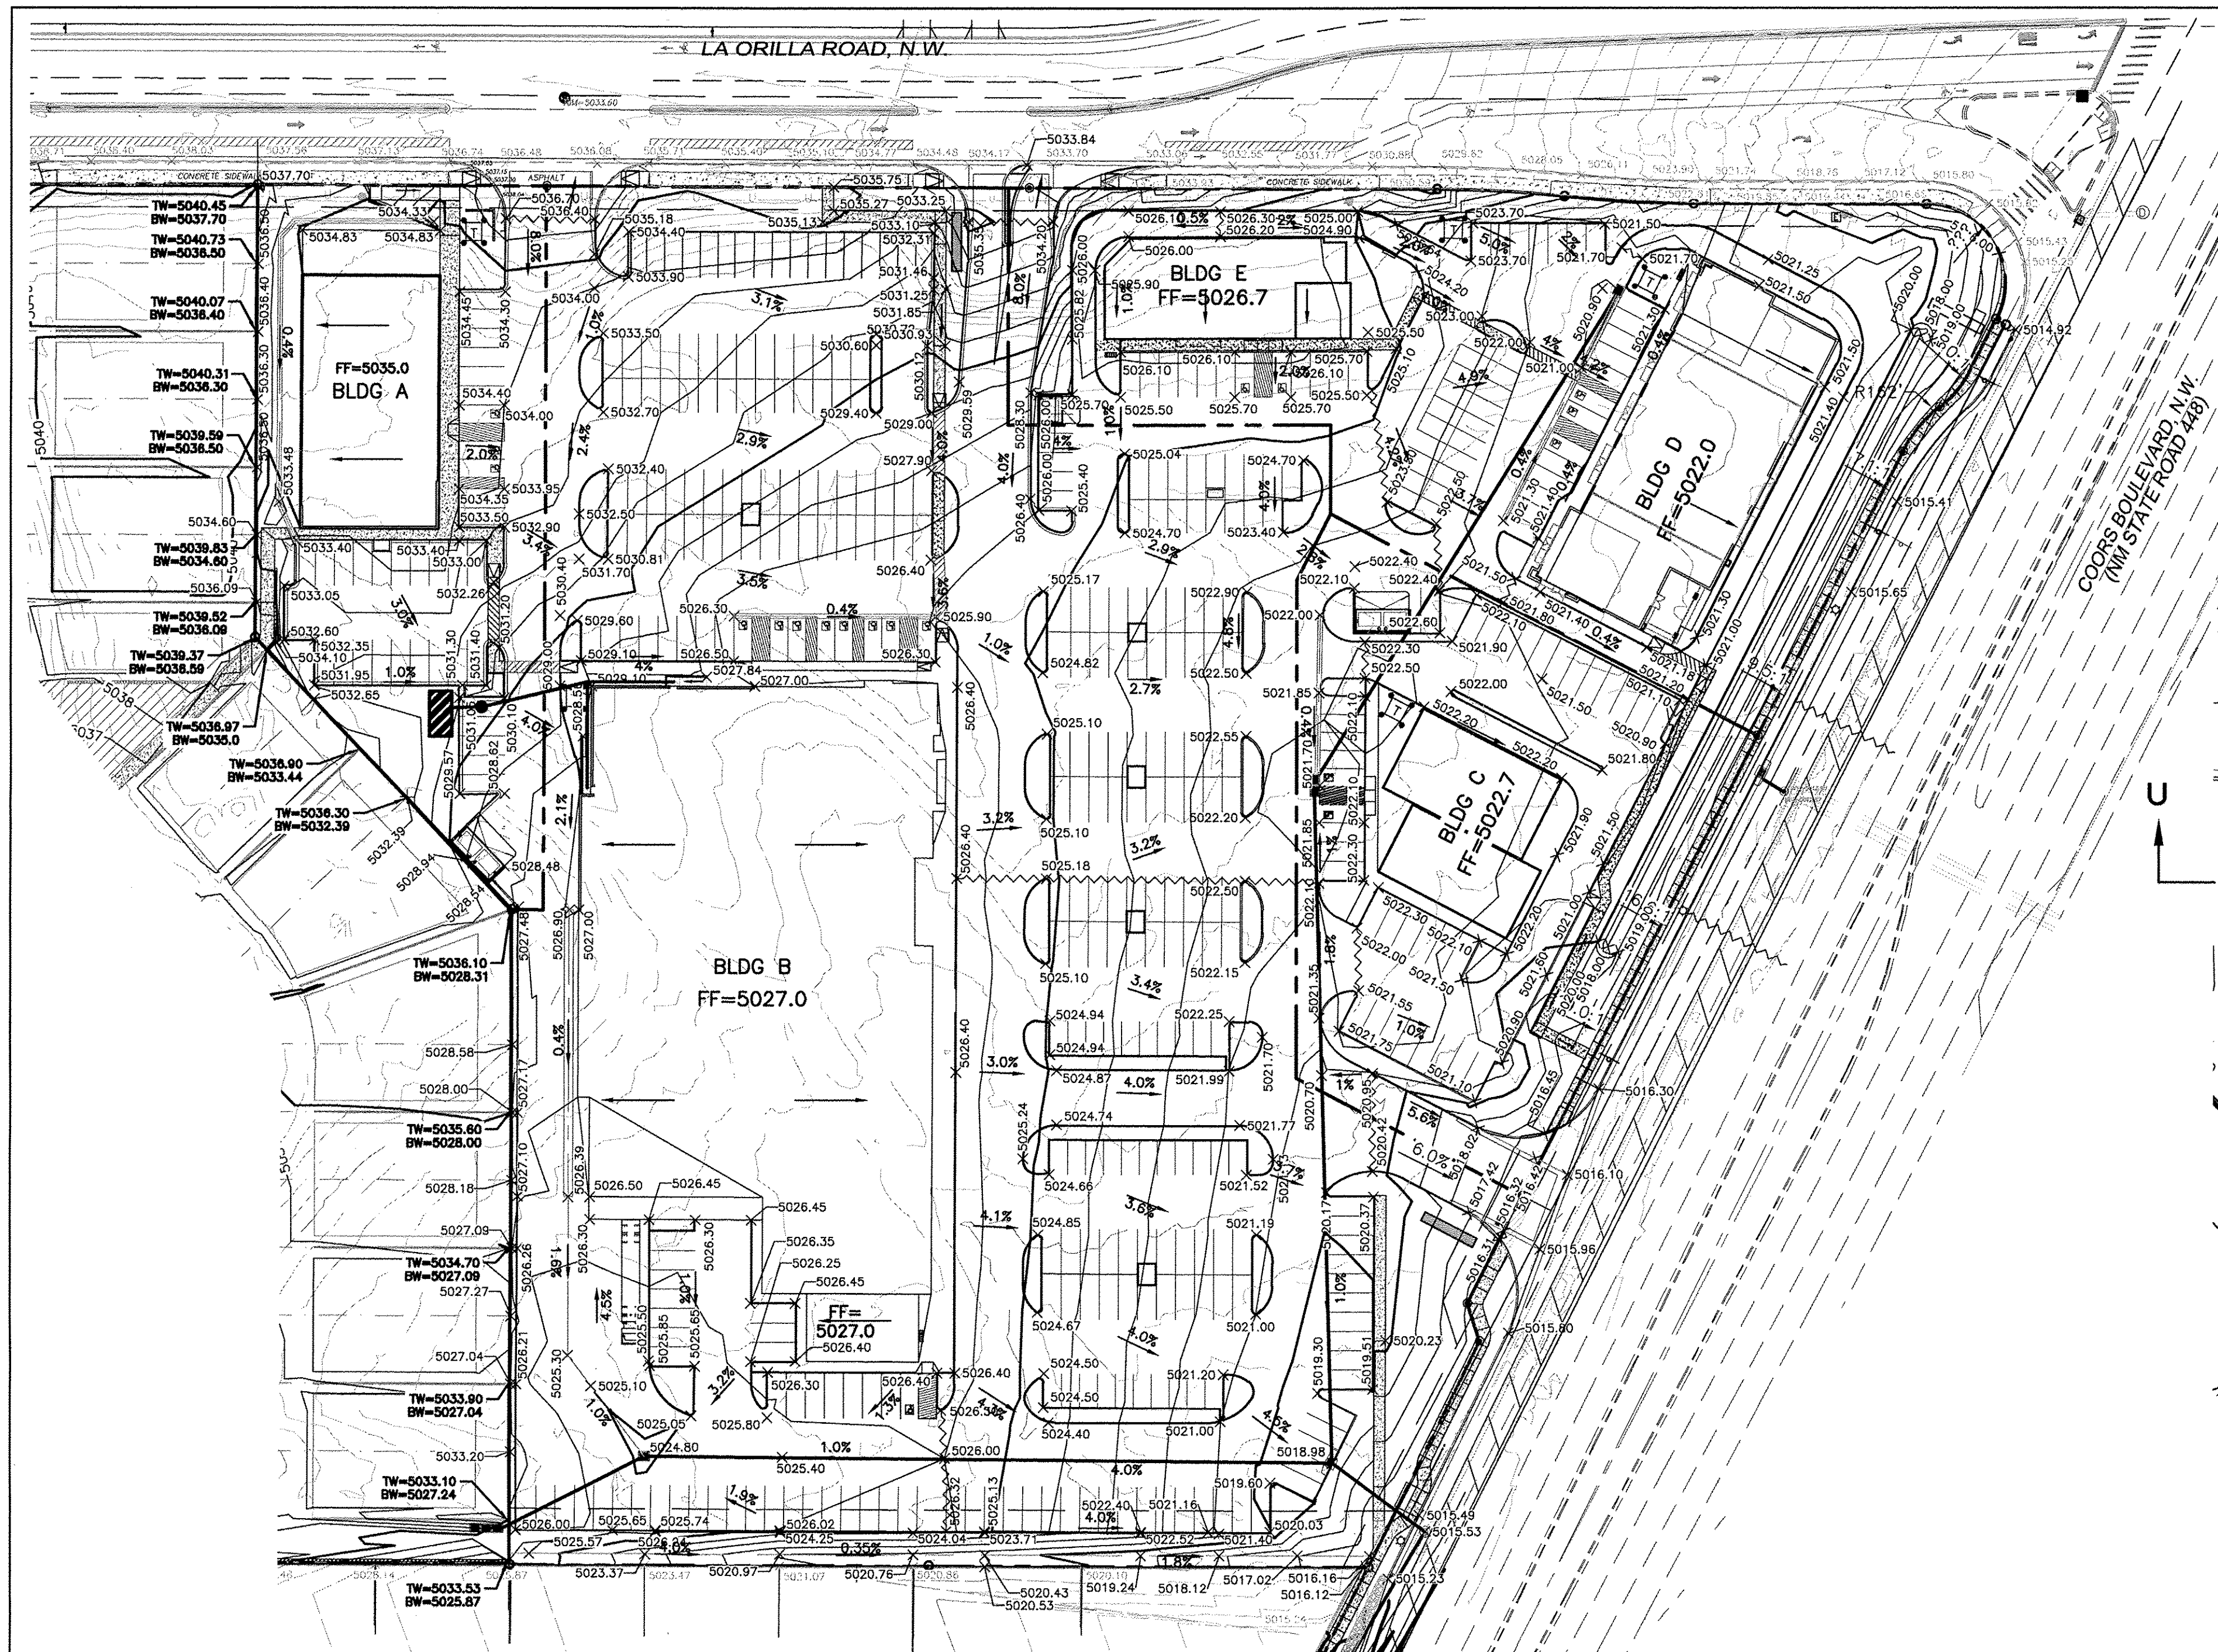



LEGEND

- CURB & GUTTER
- BOUNDARY LINE
- - - EASEMENT
- - - CENTERLINE
- - - RIGHT-OF-WAY
- ▬ BUILDING
- ▬ SIDEWALK
- ▬ SCREEN WALL
- ▬ RETAINING WALL
- ▬ WATER BLOCK
- 5010 — CONTOUR MAJOR
- FLOW ARROW
- - - EXISTING CURB & GUTTER
- - - EXISTING BOUNDARY LINE

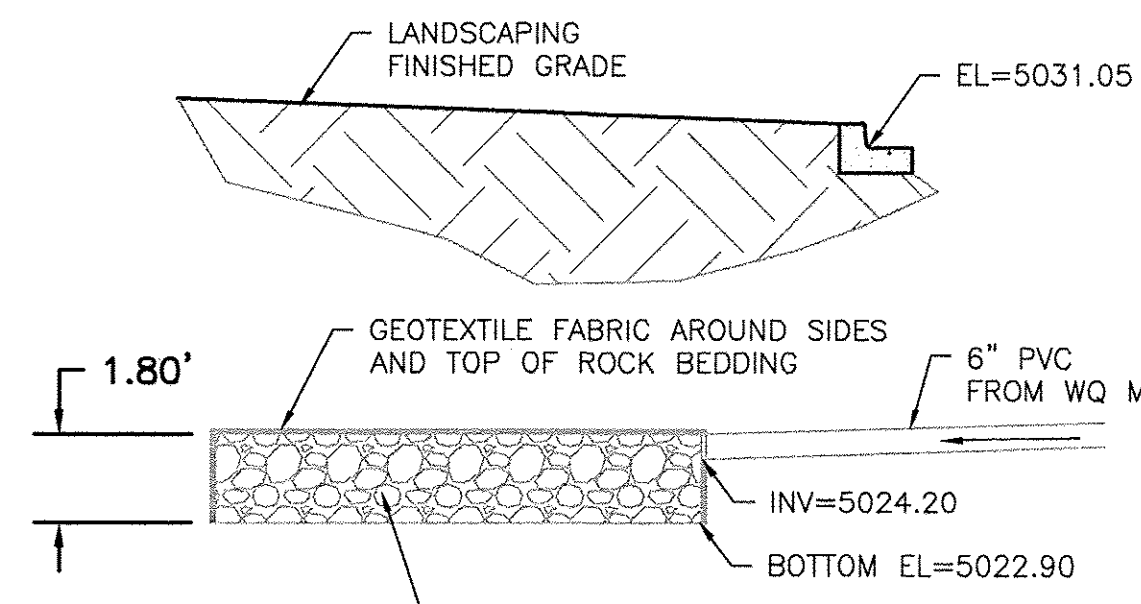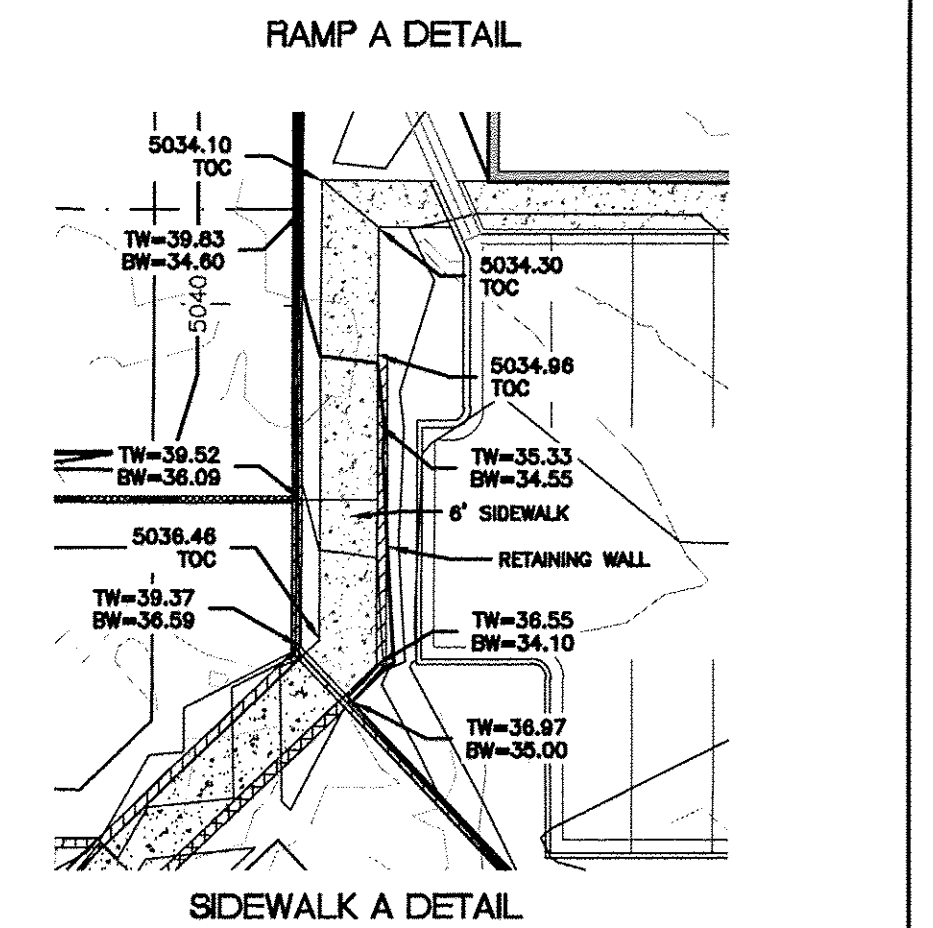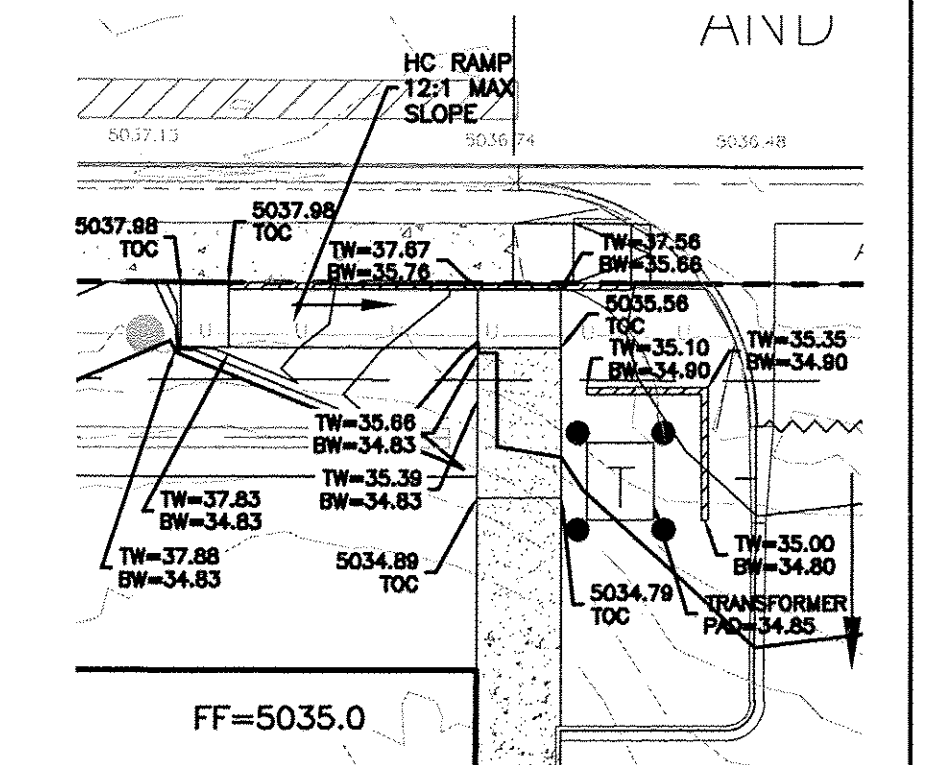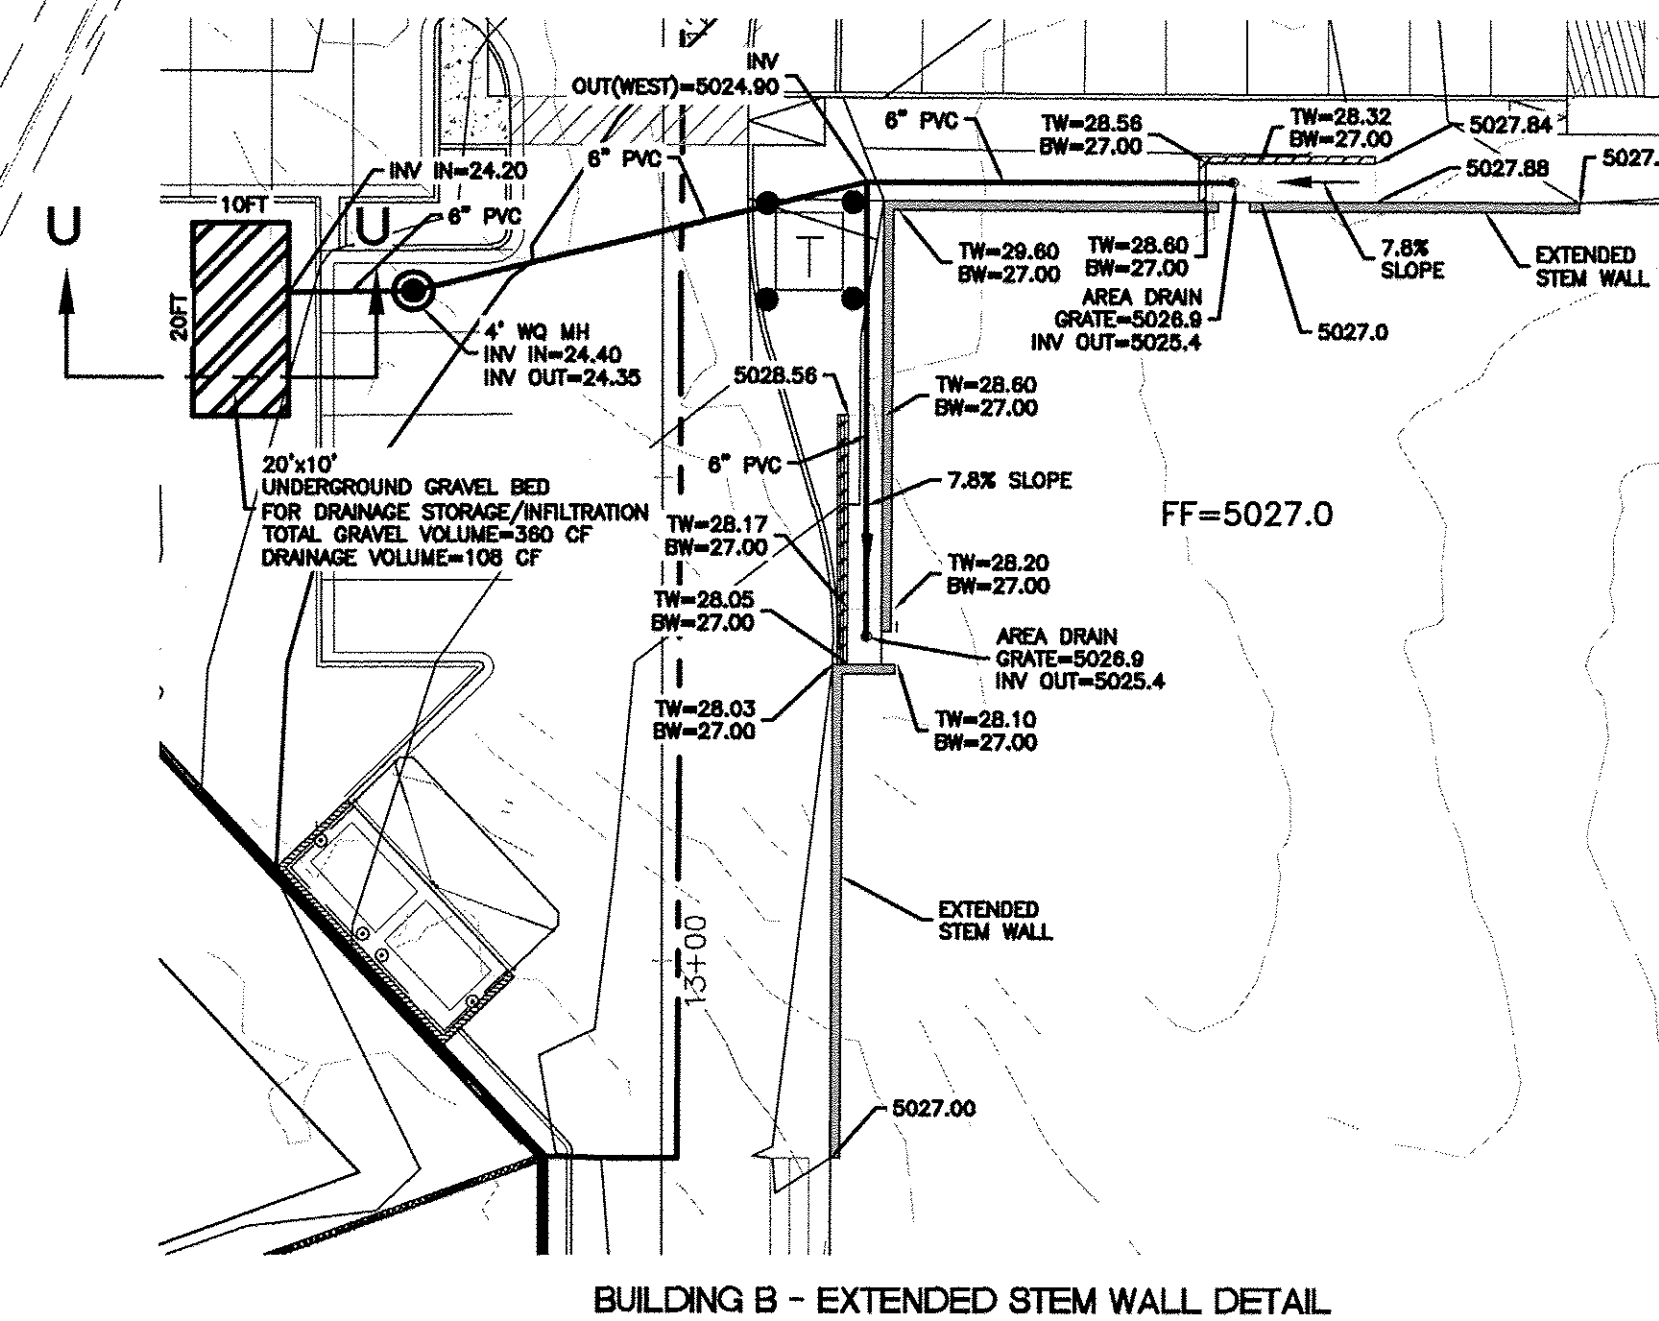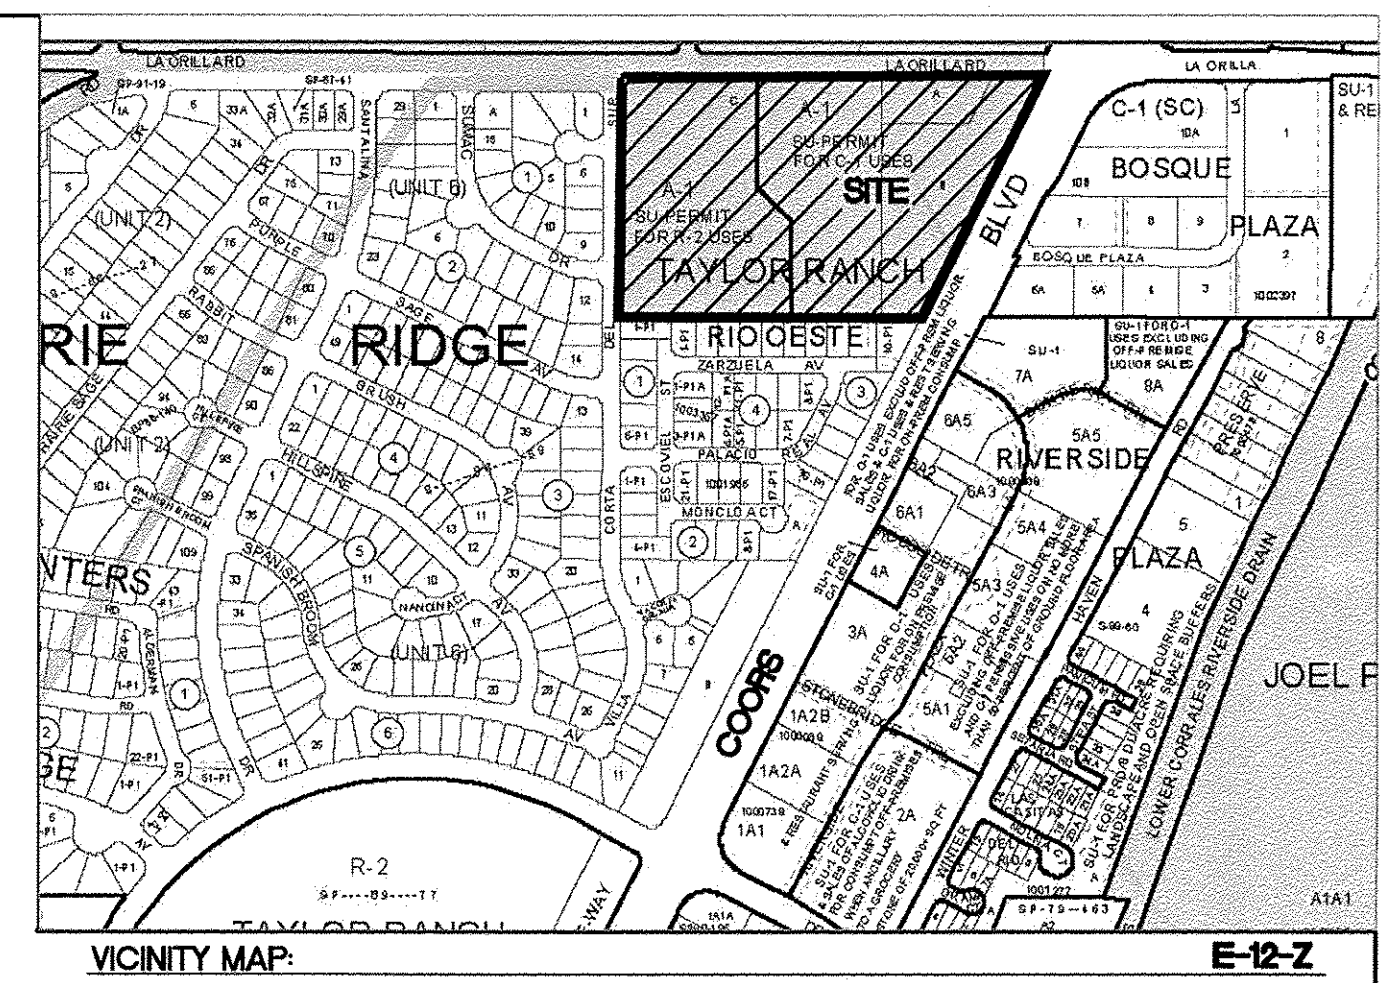

SECTION U-U

GRAPHIC SCALE


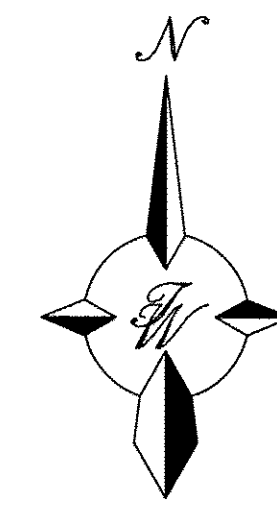
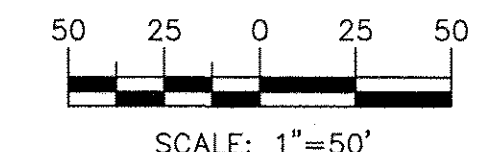


EROSION CONTROL NOTES:

1. CONTRACTOR IS RESPONSIBLE FOR OBTAINING A TOPSOIL DISTURBANCE PERMIT PRIOR TO BEGINNING WORK.
2. CONTRACTOR IS RESPONSIBLE FOR MAINTAINING RUN-OFF ON SITE DURING CONSTRUCTION.
3. CONTRACTOR IS RESPONSIBLE FOR CLEANING ALL SEDIMENT THAT GETS INTO EXISTING RIGHT-OF-WAY.
4. REPAIR OF DAMAGED FACILITIES AND CLEANUP OF SEDIMENT ACCUMULATIONS ON ADJACENT PROPERTIES AND IN PUBLIC FACILITIES IS THE RESPONSIBILITY OF THE CONTRACTOR.
5. ALL EXPOSED EARTH SURFACES MUST BE PROTECTED FROM WIND AND WATER EROSION PRIOR TO FINAL (CITY) ACCEPTANCE OF ANY PROJECT.



FOR INFORMATION ONLY

ENGINEER'S SEAL	LA ORILLA ESTATES COORS AND LA ORILLA	DRAWN BY BJF
	COMMERCIAL GRADING AND DRAINAGE PLAN	DATE 05/18/16
 5571 MIDWAY PARK PLACE NE ALBUQUERQUE, NM 87109 (505) 858-3100 www.tierrawestllc.com		2012005_GR_COM
		SHEET # C2
RONALD R. BOHANNAN P.E. #7868		JOB # 2012005

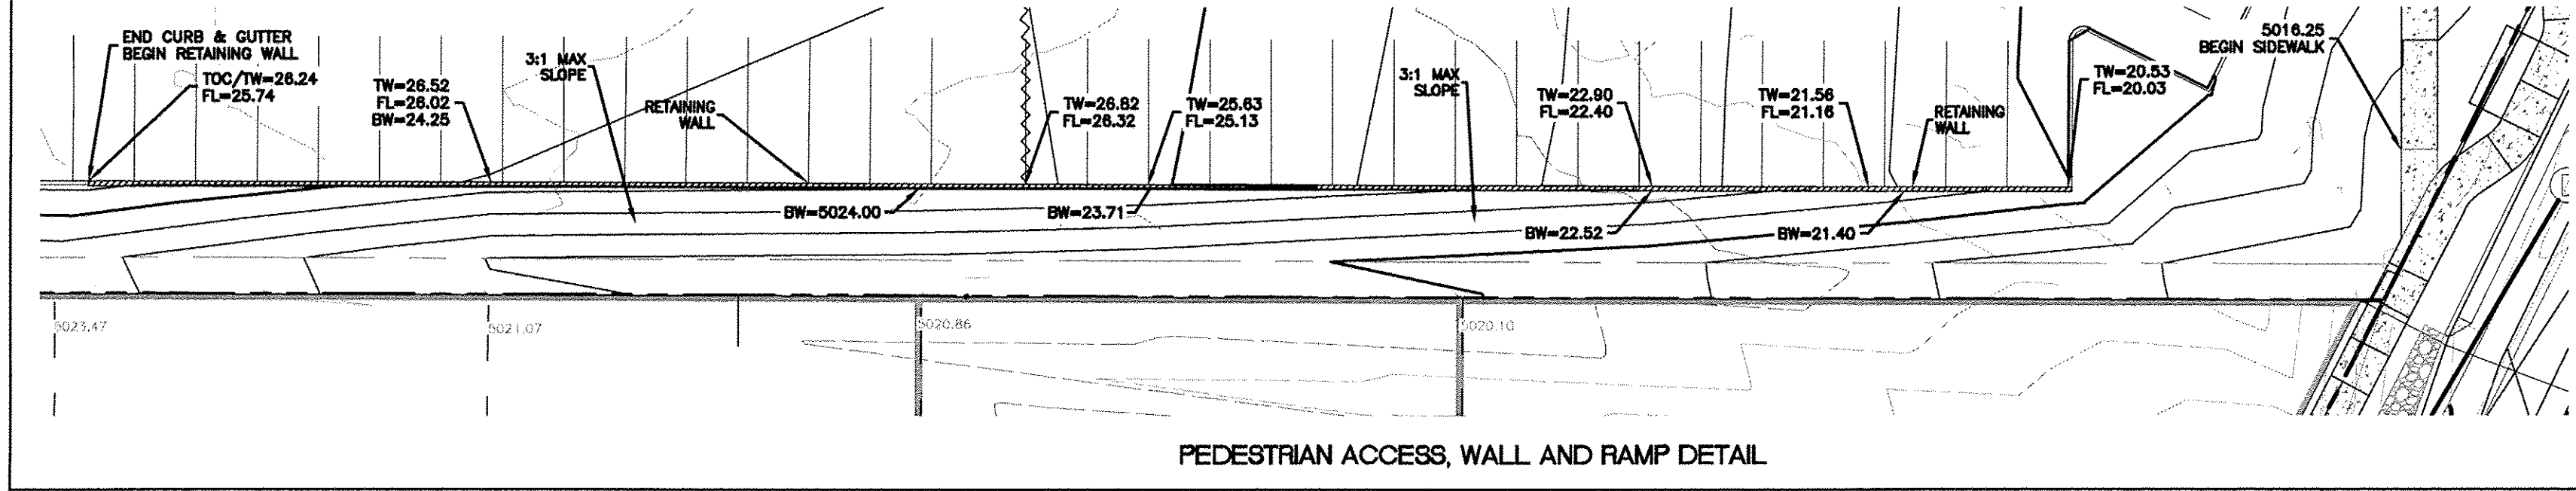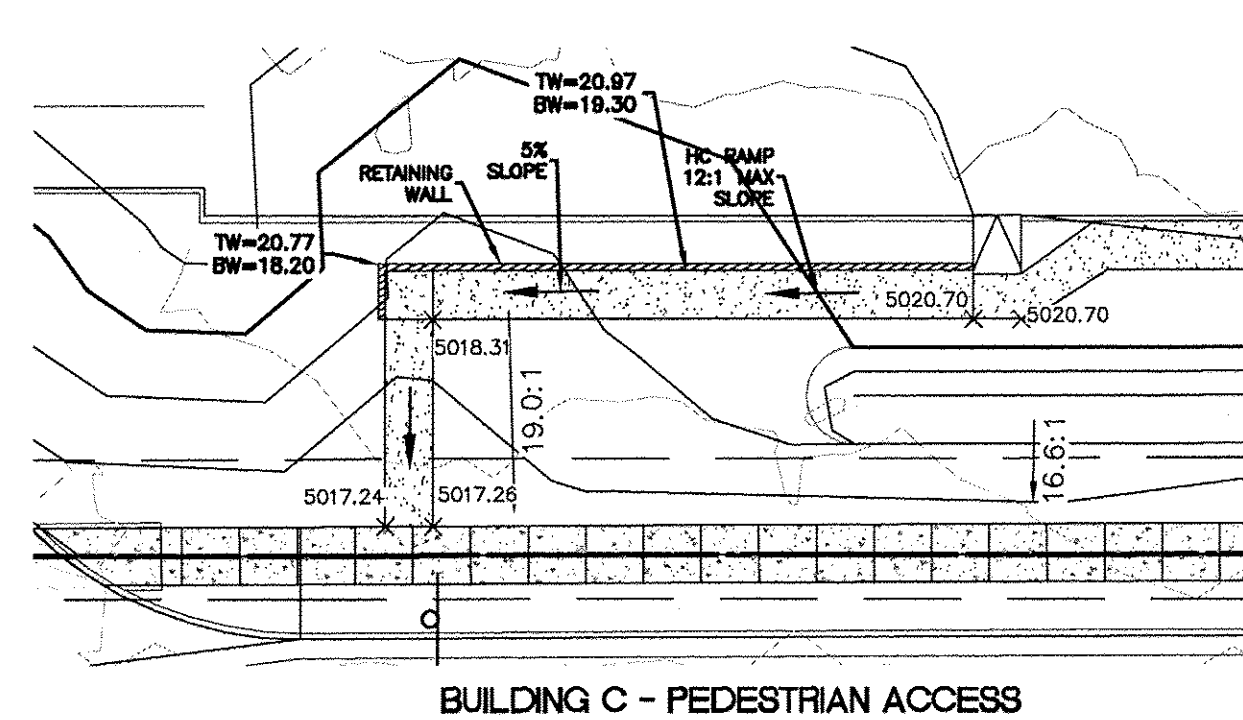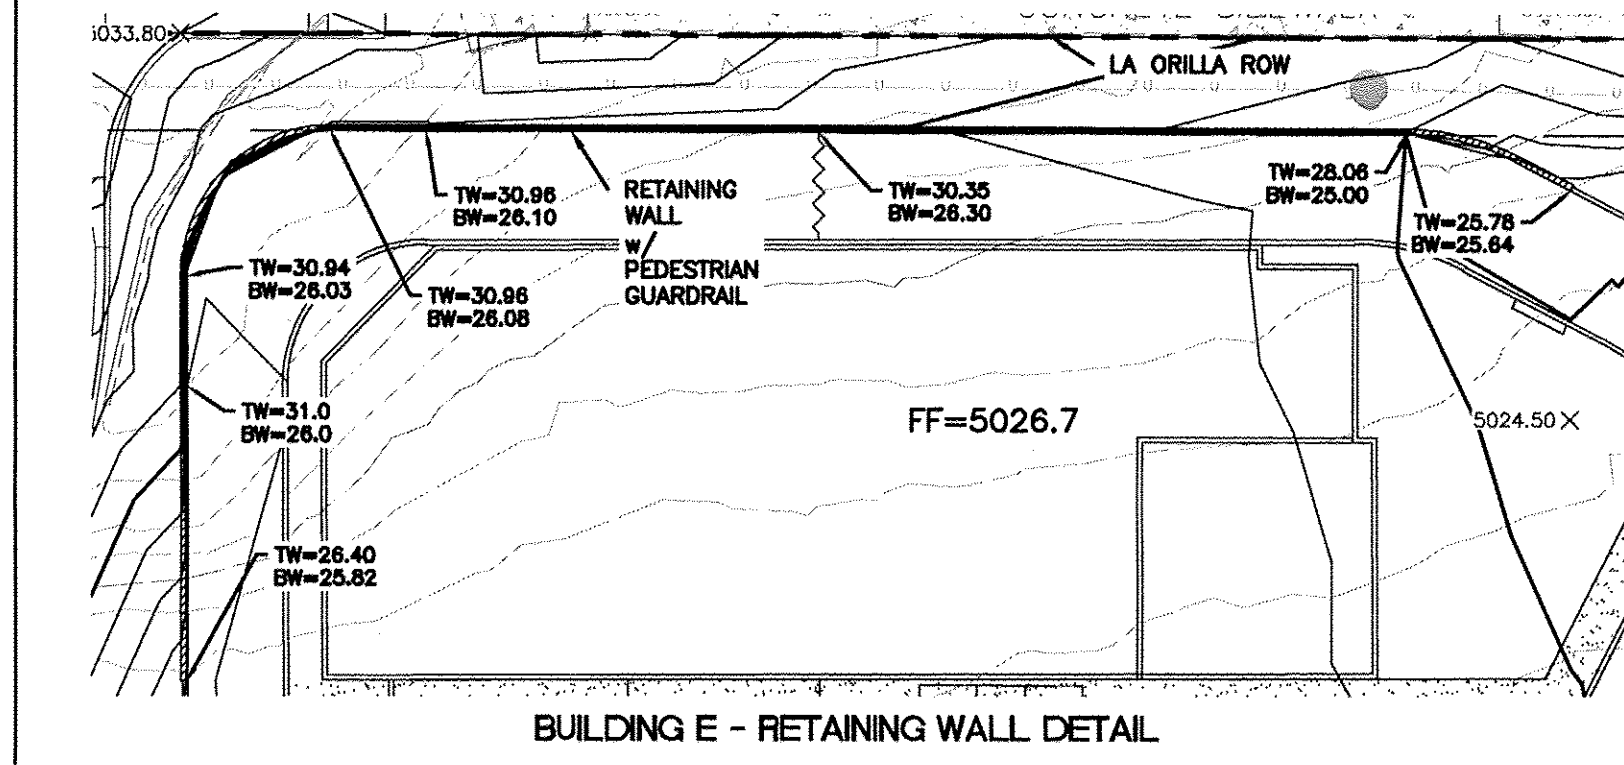



ALL SPOT ELEVATION ARE AT FLOWLINE UNLESS OTHERWISE SPECIFIED.

EX. SAS MH #5
RIM=13.79
INV (SW)=8.96
INV (SE)=8.76
INV (N)=8.83

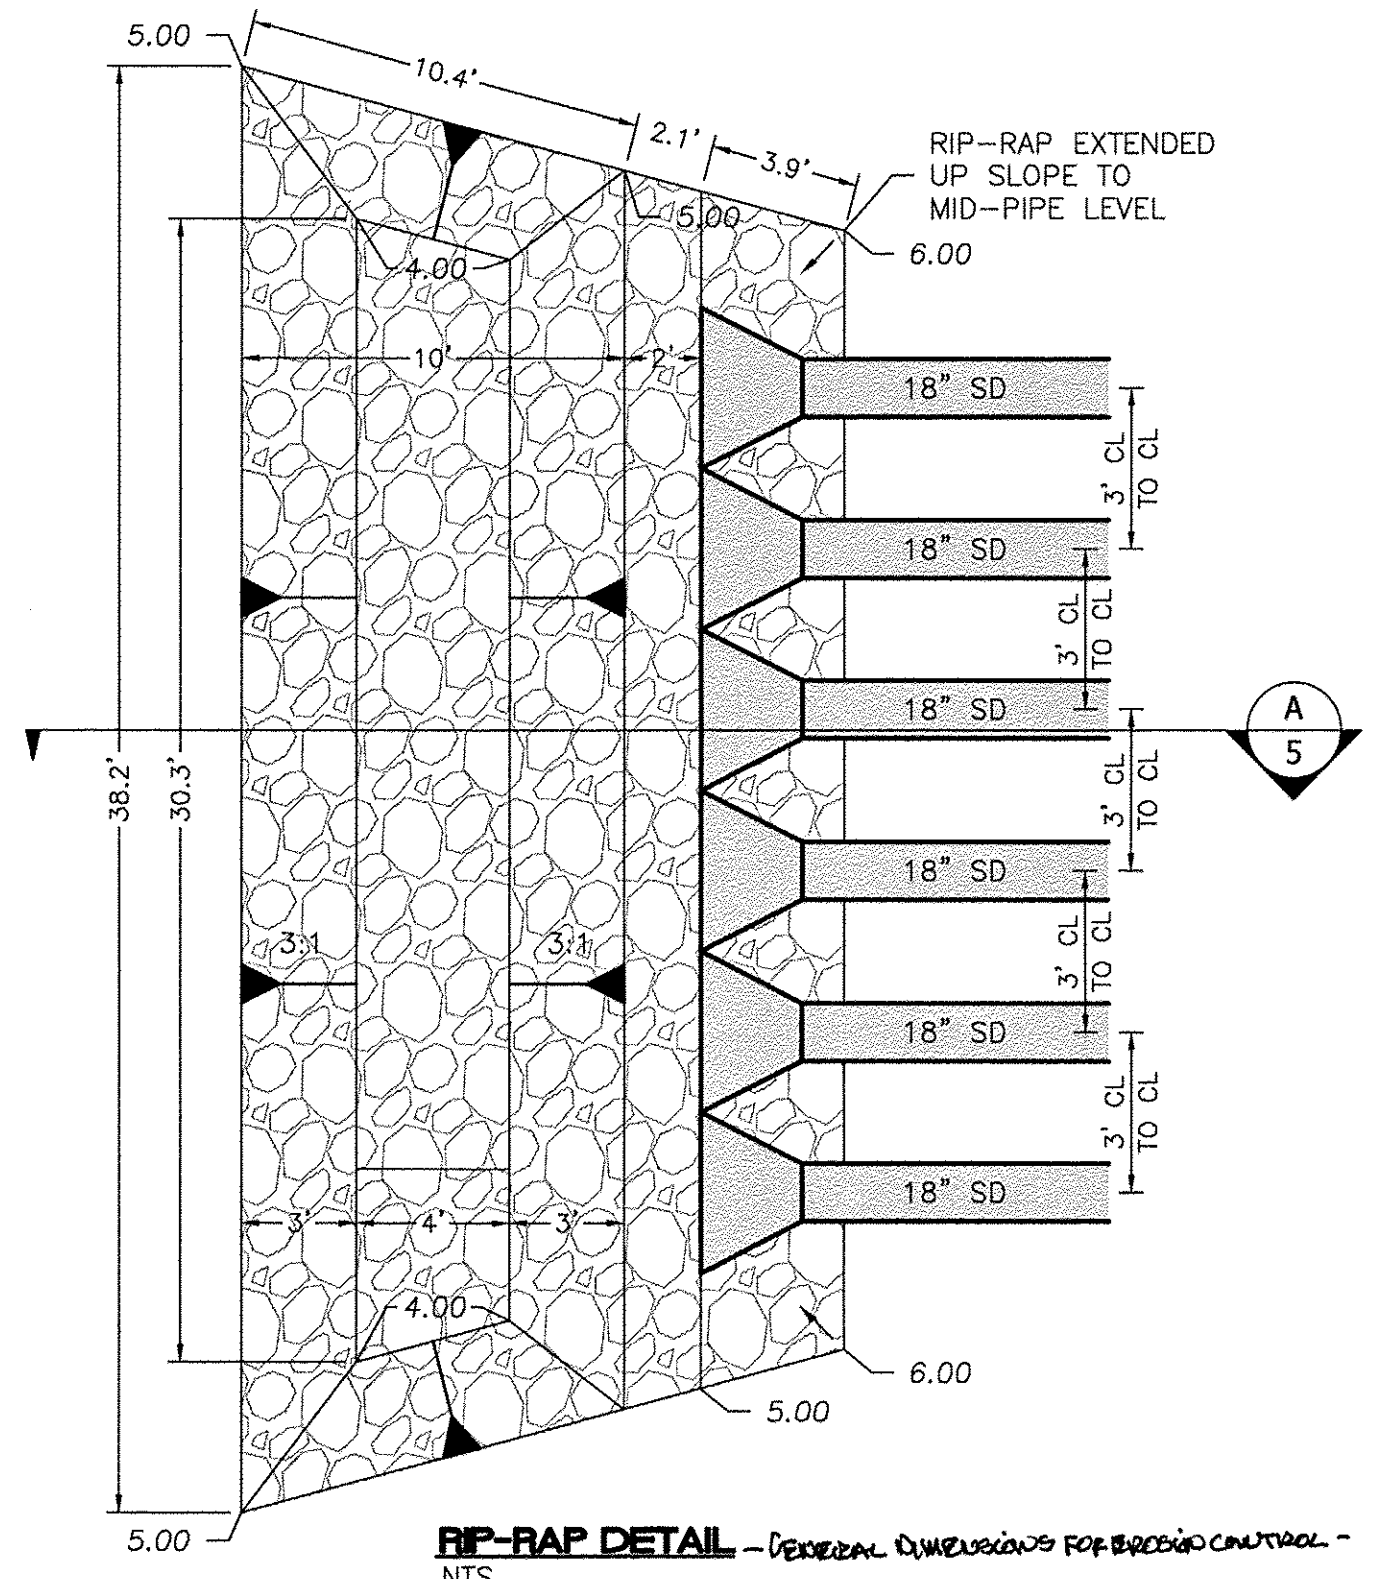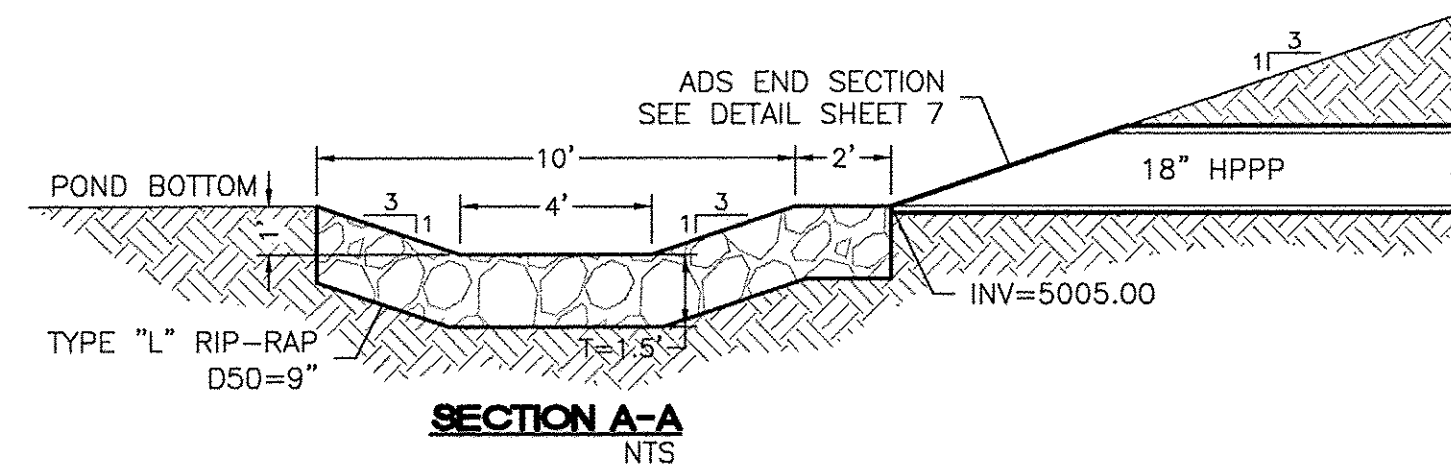

CONSTRUCTION NOTES:

- A. FRAME & GRATE - REFER TO COA STD DWG 2216, 2220, & 2221.
B. NO. 4 BARS @ 6" O.C. EACH WAY.

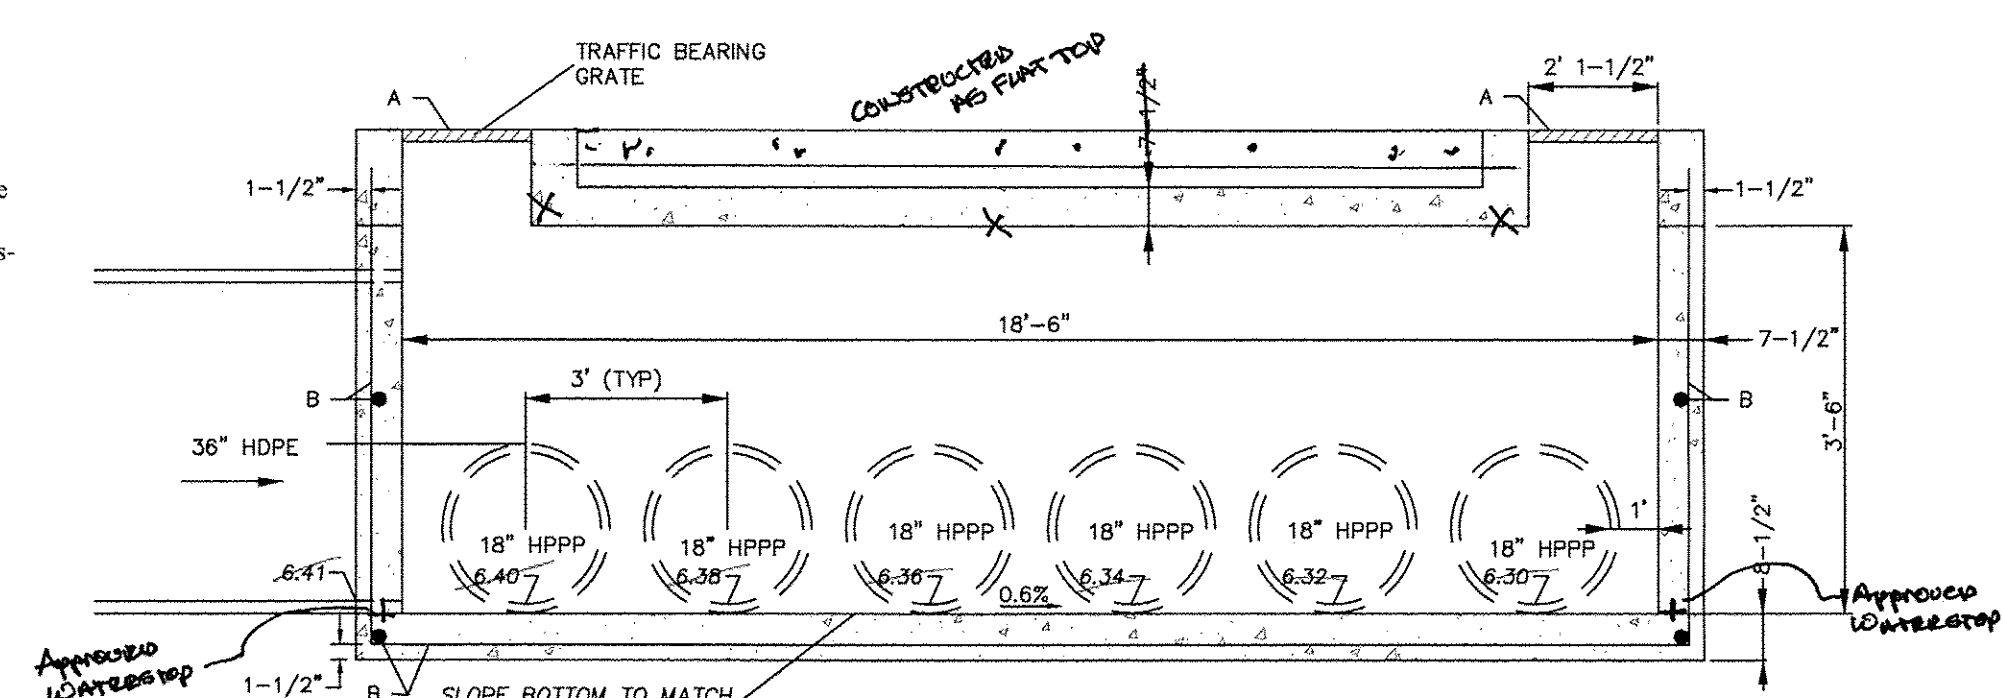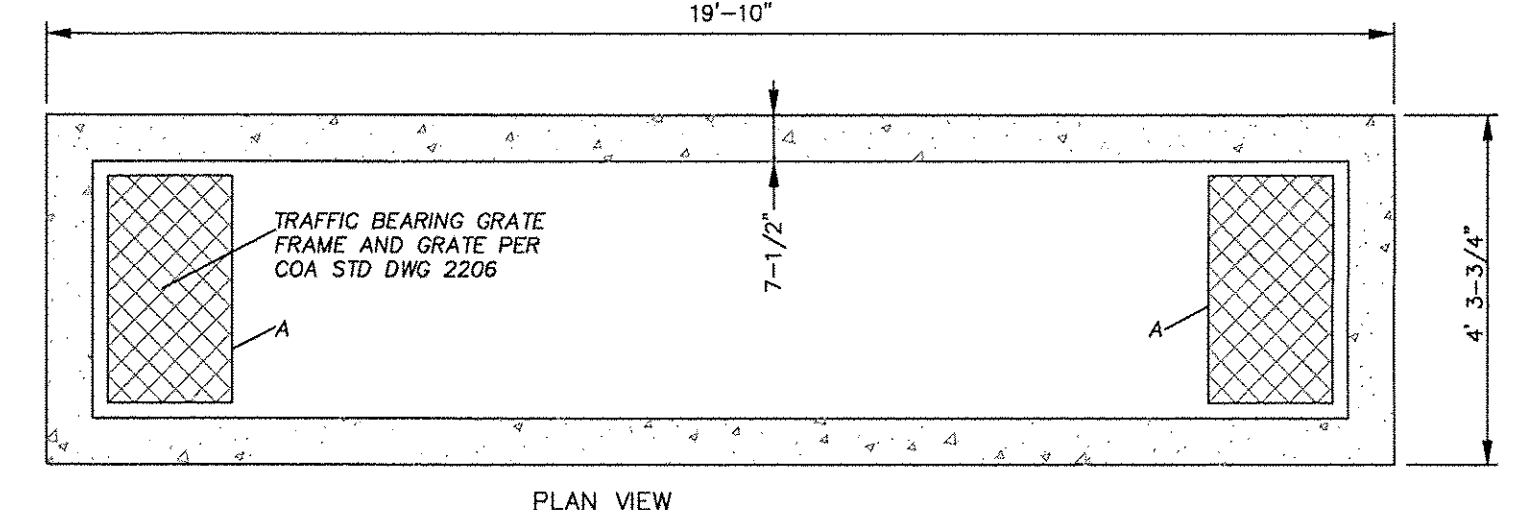

VAULT DETAIL
NOT TO SCALE


Certification
THE CHANGES SHOWN HEREON ARE BASED UPON A FIELD SURVEY CONDUCTED BY ME OR UNDER MY SUPERVISION AND REFLECT THE LOCATIONS (VERTICALLY AND HORIZONTALLY) TO THE BEST OF MY KNOWLEDGE AND BELIEF.

TIERRA WEST, LLC
5571 MIDWAY PARK PLACE NE
ALBUQUERQUE, NM 87109
(505) 858-3100
www.tierrowestllc.com

CITY OF ALBUQUERQUE
PUBLIC WORKS DEPARTMENT
ENGINEERING GROUP

LA ORILLA ESTATES
LA ORILLA RD. GRADING IMPROVEMENTS
STORM DRAIN - POND OUTFALL CONNECTION

DESIGN REVIEW COMMITTEE	REVIEW ENGINEER APPROVAL	MO./DAY/YR.	MO./DAY/YR.
APPROVED OCT 24 2016 DESIGN REVIEW COMMITTEE	APPROVED DEC 05 2016 CITY ENGINEER		
CITY PROJECT NO.	713482	ZONE MAP NO.	E-12-Z
SHEET	5	OF	8

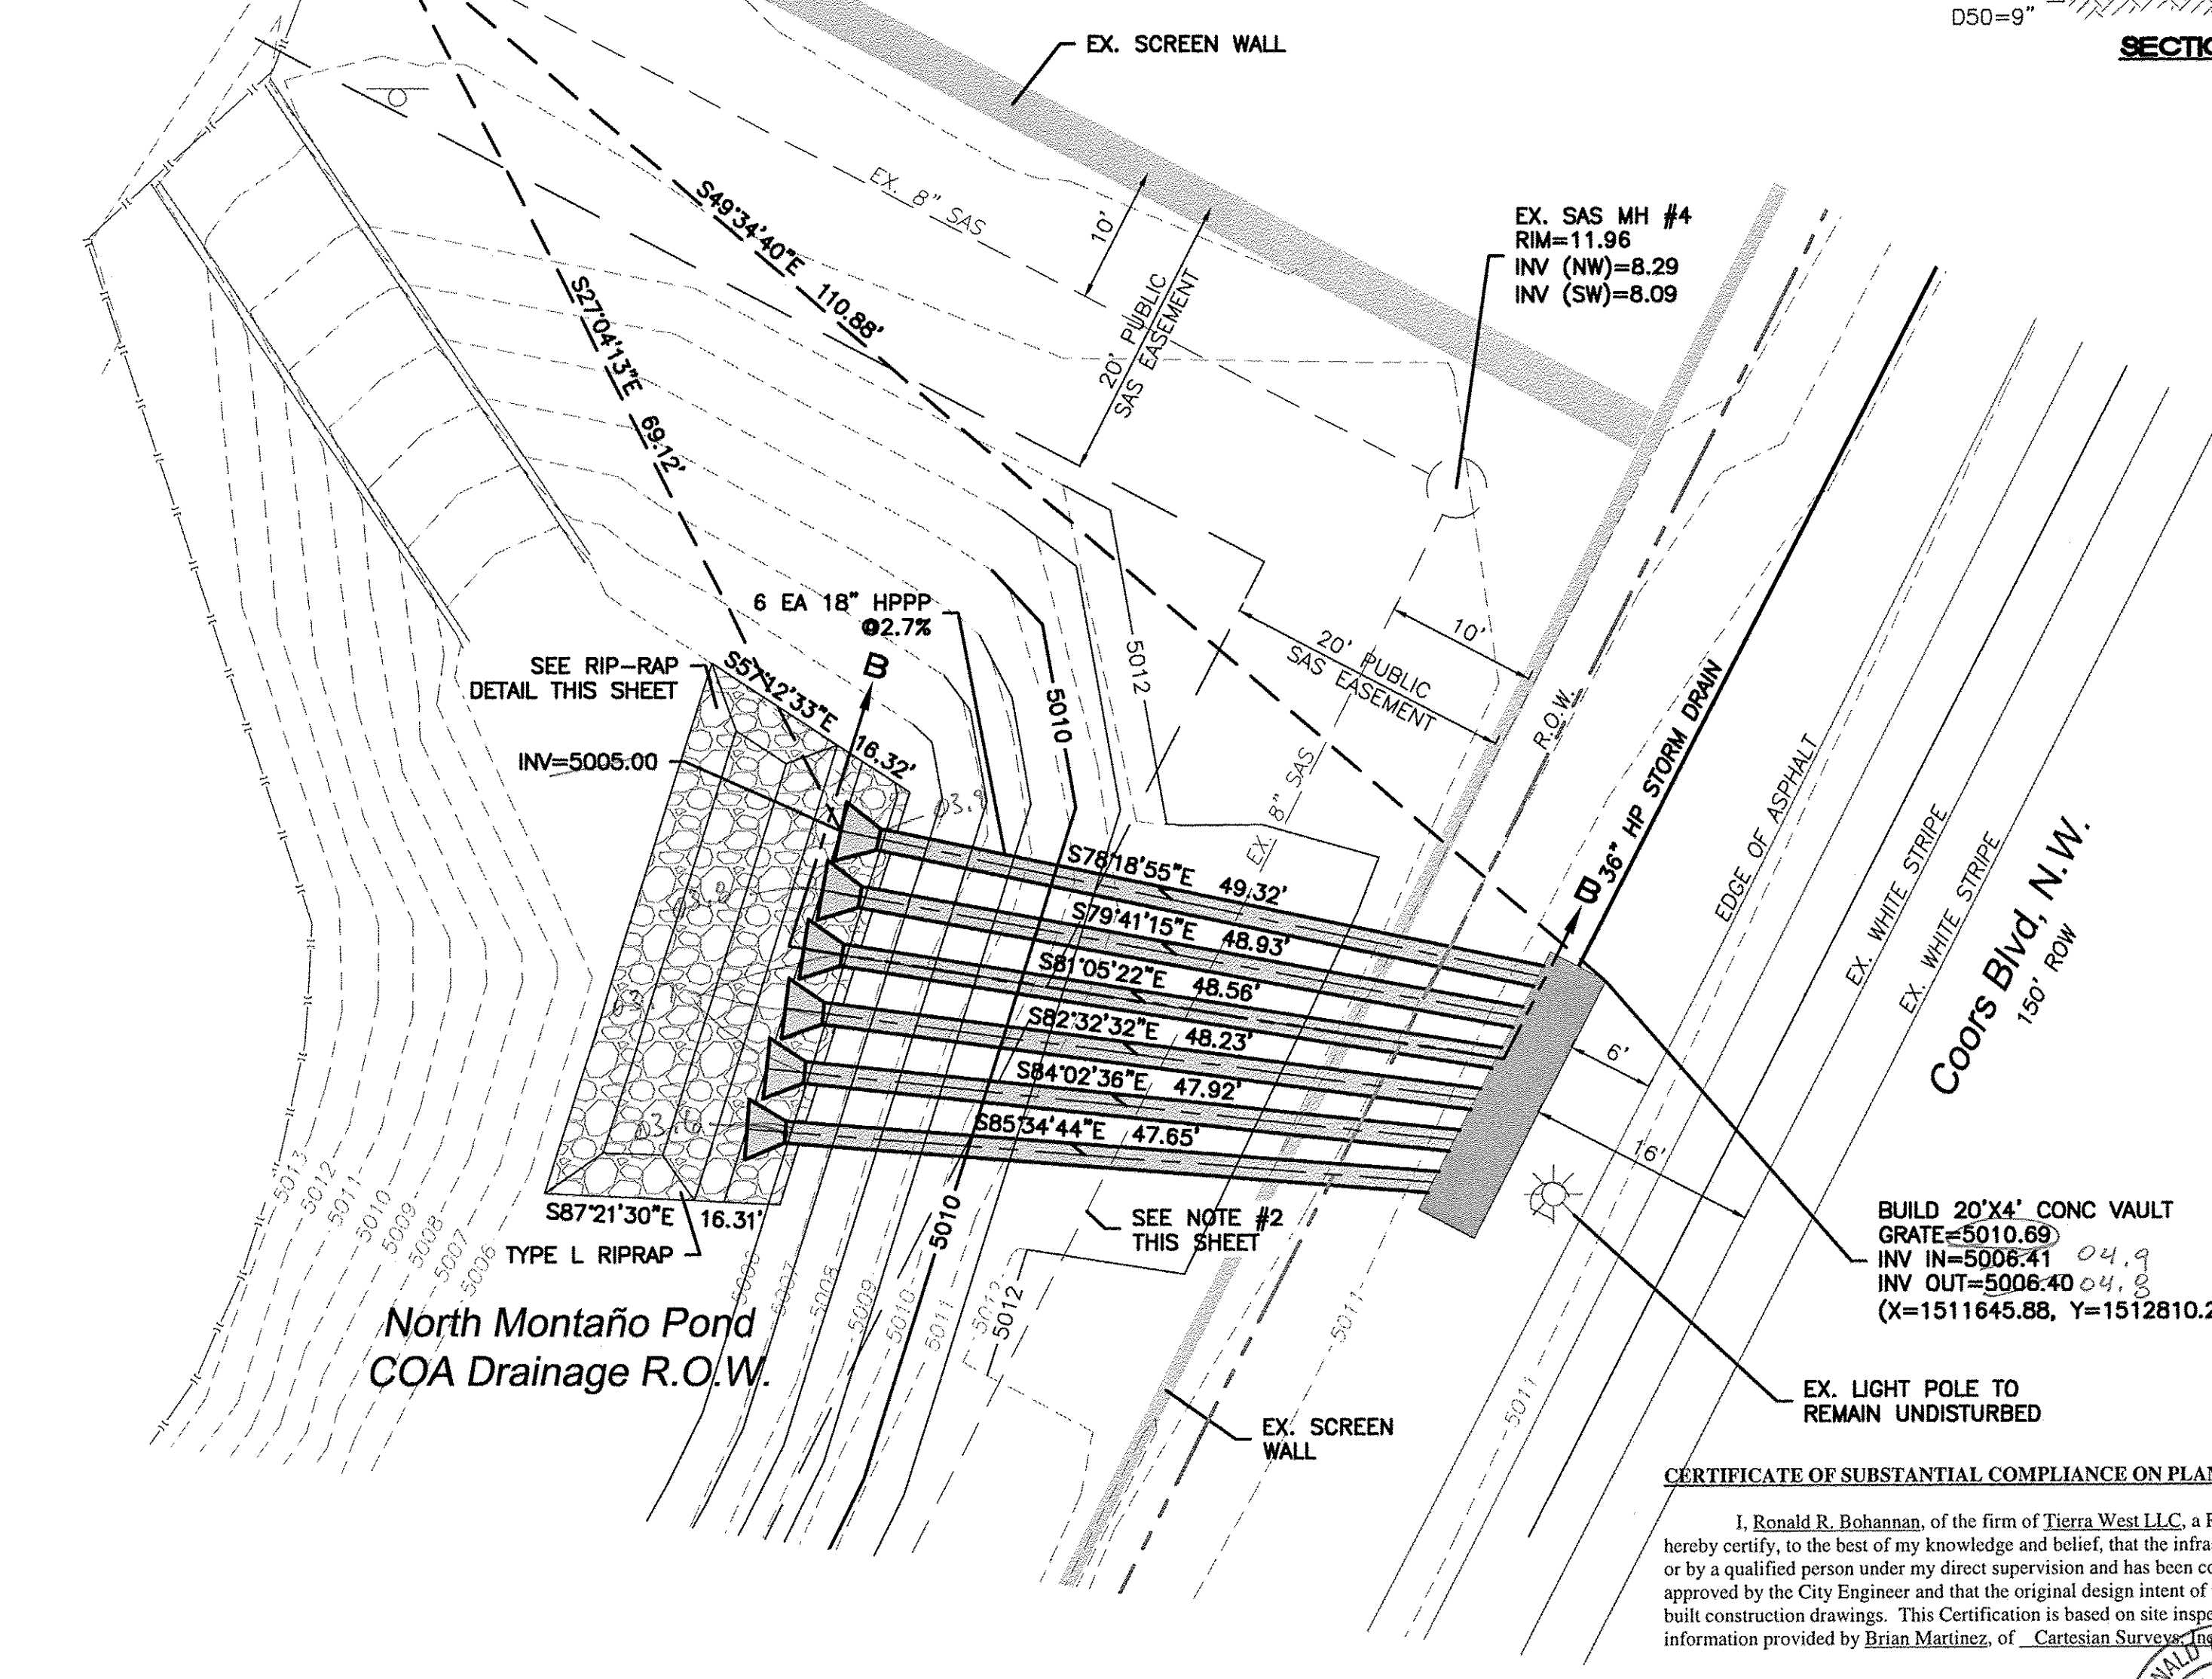

BUILD 20'X4' CONC VAULT
GRATE=5010.69
INV IN=5006.41
INV OUT=5006.40
(X=1511645.88, Y=1512810.20) - END OF 36" HP SD

CERTIFICATE OF SUBSTANTIAL COMPLIANCE ON PLANS

I, Ronald R. Bohannon, of the firm of Tierra West LLC, a Registered Professional Engineer in the State of New Mexico, do hereby certify, to the best of my knowledge and belief, that the infrastructure installed as part of this project has been inspected by me or by a qualified person under my direct supervision and has been constructed in accordance with the plans and specifications approved by the City Engineer and that the original design intent of the approved plans has been met, except as noted by me on the as-built construction drawings. This Certification is based on site inspections by me, or personnel under my direction with survey information provided by Brian Martinez, of Cartesian Surveys, Inc. DMS number 18374

Engineer's Seal & Signature
RONALD R. BOHANNON
NEW MEXICO
7868
REGISTERED PROFESSIONAL ENGINEER

NOTES:


- EXISTING SAS LINE TO BE POTHOLED BY CONTRACTOR FOR DEPTH AND LOCATION VERIFICATION PRIOR TO STORM DRAIN INSTALLATION.
- CONTRACTOR SHALL PROTECT EXIST. 8" SAS IN PLACE OR REMOVE AND REPLACE PIPE SECTION FOR STORM INSTALLATION AS NECESSARY. UPSTREAM SAS FLOW SHALL BE PLUGGED AT UPSTREAM MH AND PUMPED TO NEXT DOWNSTREAM MH USING VACTOR TRUCK OR OTHER ACCEPTABLE METHODS AS DETERMINED BY ENGINEER.
- USE LEAN FILL AROUND SD PIPES FOR SPAN OF EX. 8" SAS CROSSING.

GENERAL NOTES:

- ANY DAMAGE PRIOR TO CONSTRUCTION, THE CONTRACTOR SHOULD NOTIFY THE TRANSIT DEPARTMENT OF ANY IMPACT THE PROPOSED PROJECT WILL HAVE ON THE TRANSIT SYSTEM SUCH AS CAUSING A DETOUR, OR CAUSE THE CLOSING OR RELOCATION OF A BUS STOP. THE CONTACT PERSON IS DOUGLAS GOFF, OFFICE PHONE 505-724-3137, CELL PHONE 505-206-0151 AND EMAIL DGOFF@CABQ.GOV
- ANY DAMAGE TO EXISTING CURB AND GUTTER, PAVEMENT, SIDEWALK, STRIPING AND SIGNAGE DURING CONSTRUCTION SHALL BE REPLACED.


LEGEND

- CURB & GUTTER
- BOUNDARY LINE
- EASEMENT
- CENTERLINE
- RIGHT-OF-WAY
- BUILDING
- SIDEWALK
- SCREEN WALL
- RETAINING WALL
- WATER BLOCK
- CONTOUR MAJOR
- FLOW ARROW
- EXISTING CURB & GUTTER
- EXISTING BOUNDARY LINE

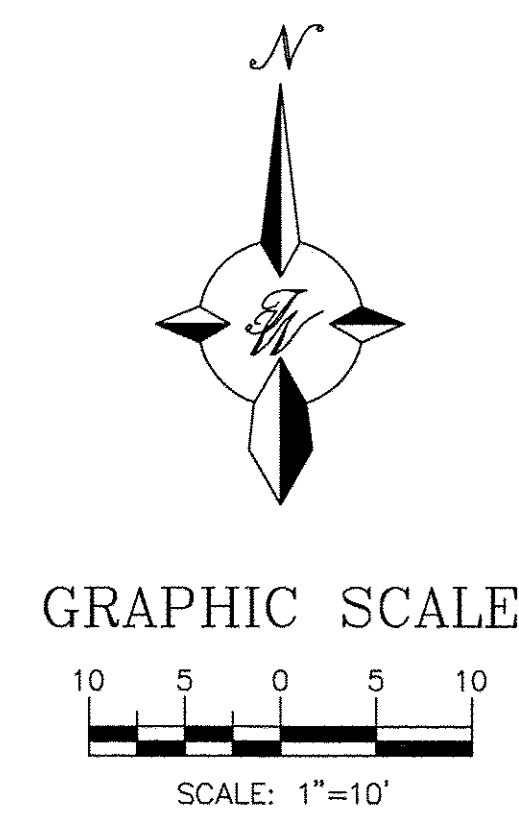

EROSION CONTROL NOTES:

- CONTRACTOR IS RESPONSIBLE FOR OBTAINING A TOPSOIL DISTURBANCE PERMIT PRIOR TO BEGINNING WORK.
- CONTRACTOR IS RESPONSIBLE FOR MAINTAINING RUN-OFF ON SITE DURING CONSTRUCTION.
- CONTRACTOR IS RESPONSIBLE FOR CLEANING ALL SEDIMENT THAT GETS INTO EXISTING RIGHT-OF-WAY.
- REPAIR OF DAMAGED FACILITIES AND CLEANUP OF SEDIMENT ACCUMULATIONS ON ADJACENT PROPERTIES AND IN PUBLIC FACILITIES IS THE RESPONSIBILITY OF THE CONTRACTOR.
- ALL EXPOSED EARTH SURFACES MUST BE PROTECTED FROM WIND AND WATER EROSION PRIOR TO FINAL (CITY) ACCEPTANCE OF ANY PROJECT.

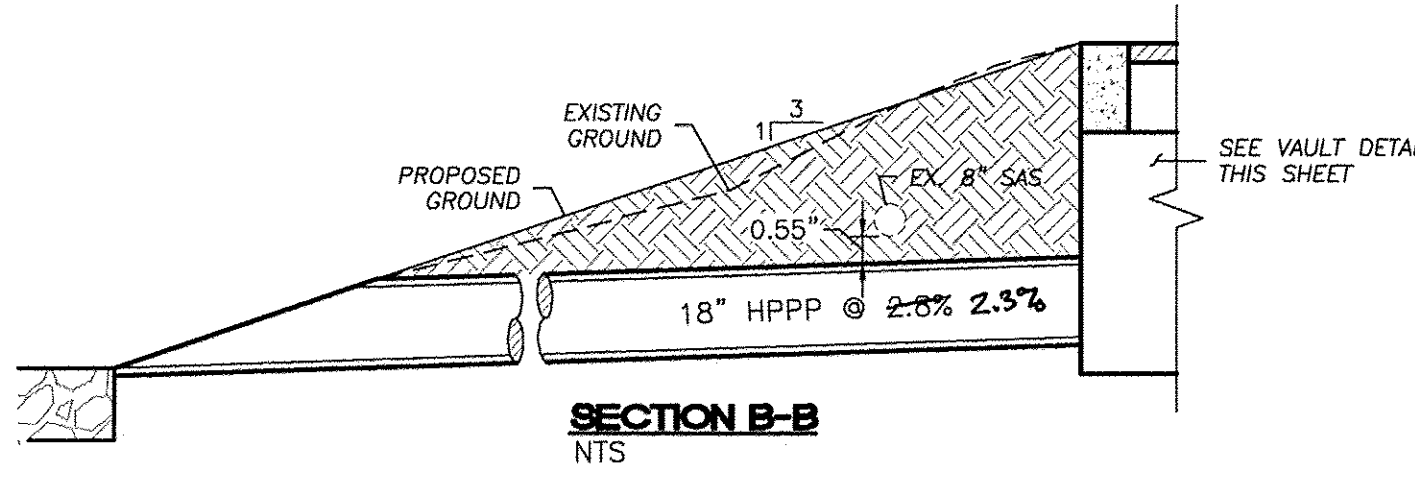

EROSION CONTROL NOTES:


1. CONTRACTOR IS RESPONSIBLE FOR OBTAINING A TOPSOIL DISTURBANCE PERMIT PRIOR TO BEGINNING WORK.
2. CONTRACTOR IS RESPONSIBLE FOR MAINTAINING RUN-OFF ON SITE DURING CONSTRUCTION.
3. CONTRACTOR IS RESPONSIBLE FOR CLEANING ALL SEDIMENT THAT GETS INTO EXISTING RIGHT-OF-WAY.
4. REPAIR OF DAMAGED FACILITIES AND CLEANUP OF SEDIMENT ACCUMULATIONS ON ADJACENT PROPERTIES AND IN PUBLIC FACILITIES IS THE RESPONSIBILITY OF THE CONTRACTOR.
5. ALL EXPOSED EARTH SURFACES MUST BE PROTECTED FROM WIND AND WATER EROSION PRIOR TO FINAL (CITY) ACCEPTANCE OF ANY PROJECT.

GENERAL NOTES:


1. ANY DAMAGE PRIOR TO CONSTRUCTION, THE CONTRACTOR SHOULD NOTIFY THE TRANSIT DEPARTMENT OF ANY IMPACT THE PROPOSED PROJECT WILL HAVE ON THE TRANSIT SYSTEM SUCH AS CAUSING A DETOUR, OR CAUSE THE CLOSING OR RELOCATION OF A BUS STOP. THE CONTACT PERSON IS DOUGLAS GOFF, OFFICE PHONE 505-724-3137, CELL PHONE 505-206-0151 AND EMAIL DGOFF@CABQ.GOV
2. ANY DAMAGE TO EXISTING CURB AND GUTTER, PAVEMENT, SIDEWALK, STRIPING AND SIGNAGE DURING CONSTRUCTION SHALL BE REPLACED.
3. CONTRACTOR SHALL PROTECT EXIST. 8" SAS IN PLACE OR REMOVE AND REPLACE PIPE SECTION FOR STORM INSTALLATION AS NECESSARY. UPSTREAM SAS FLOW SHALL BE PLUGGED AT UPSTREAM MH AND PUMPED TO NEXT DOWNSTREAM MH USING VACTOR TRUCK OR OTHER ACCEPTABLE METHODS AS DETERMINED BY ENGINEER.

LEGEND

- | | |
|--|------------------------|
| | CURB & GUTTER |
| | BOUNDARY LINE |
| | EASEMENT |
| | CENTERLINE |
| | RIGHT-OF-WAY |
| | BUILDING |
| | SIDEWALK |
| | SCREEN WALL |
| | RETAINING WALL |
| | WATER BLOCK |
| | CONTOUR MAJOR |
| | FLOW ARROW |
| | EXISTING CURB & GUTTER |
| | EXISTING BOUNDARY LINE |

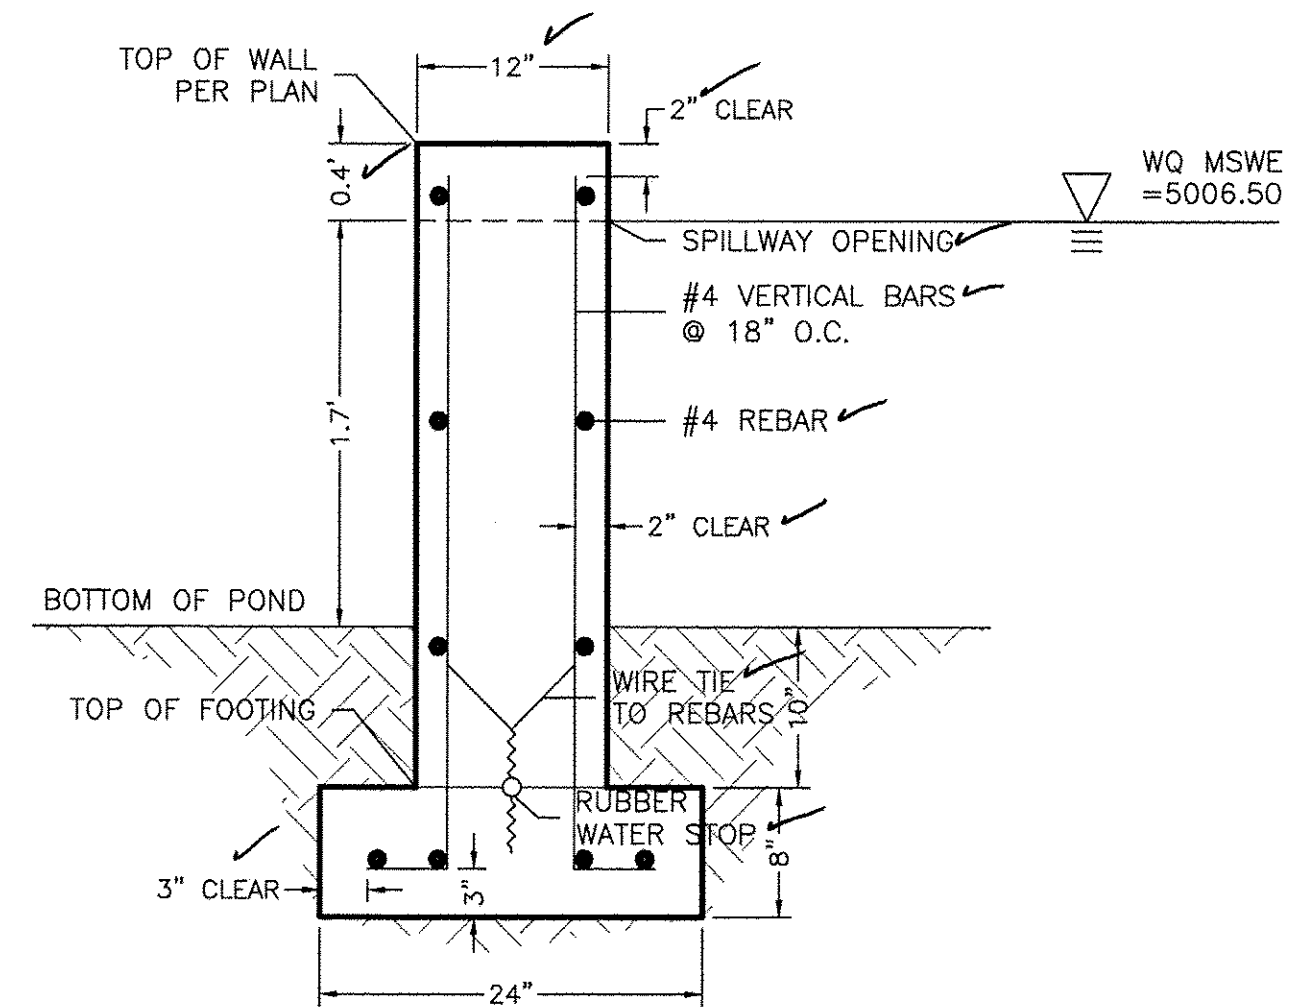

WALL DETAIL
NTS

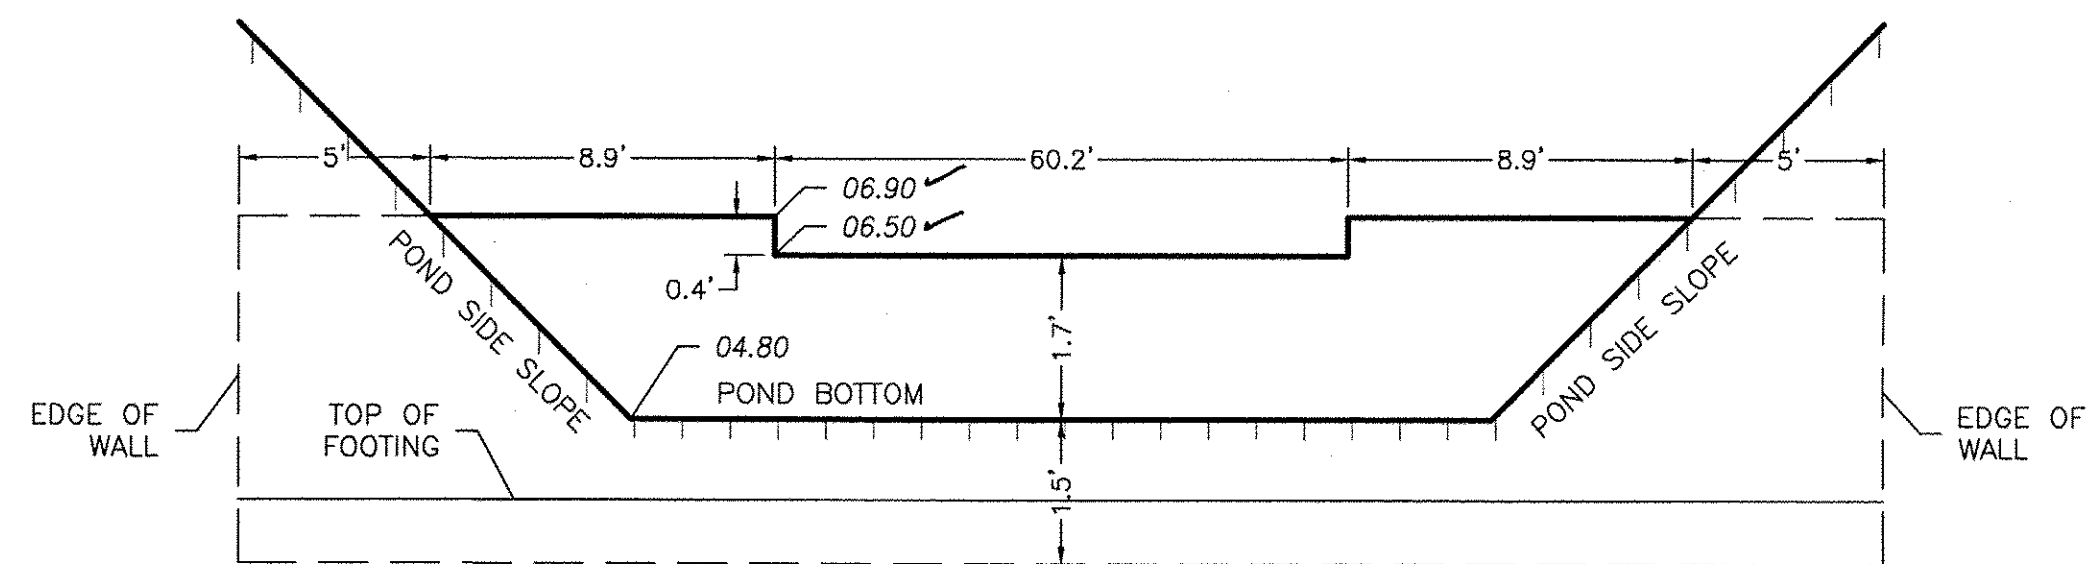

SECTION B-B
NTS

Certification

THE CHANGES SHOWN HEREON ARE BASED UPON A FIELD SURVEY CONDUCTED BY ME OR UNDER MY SUPERVISION AND REFLECT THE LOCATIONS (VERTICALLY AND HORIZONTALLY) TO THE BEST OF MY KNOWLEDGE AND BELIEF.

B-A-M

TIERRA WEST, LLC
571 MIDWAY PARK PLACE NE
ALBUQUERQUE, NM 87109
(505)858-3100
www.tierrawestllc.com

CITY OF ALBUQUERQUE
PUBLIC WORKS DEPARTMENT
ENGINEERING GROUP

TITLE: **LA ORILLA ESTATES**
LA ORILLA RD. GRADING IMPROVEMENTS
FIRST FLUSH RETAINING WALL & DETAIL

DESIGN REVIEW COMMITTEE

APPROVED

OCT 24 2016

DESIGN
REVIEW COMMITTEE

REVIEW ENGINEER APPROVAL

DEC 05 2016

CITY ENGINEER


LAST DESIGN UPDATE	MO./DAY/YR.	MO./DAY/YR.

CITY PROJECT NO.	713482	ZONE MAP NO.	E-12-7	SHEET	6	OF	8
------------------	--------	--------------	--------	-------	---	----	---

CERTIFICATE OF SUBSTANTIAL COMPLIANCE ON PLANS

I, Ronald R. Bohanan, of the firm of Tierra West LLC, a Registered Professional Engineer in the State of New Mexico, do hereby certify, to the best of my knowledge and belief, that the infrastructure installed as part of this project has been inspected by me or by a qualified person under my direct supervision and has been constructed in accordance with the plans and specifications approved by the City Engineer and that the original design intent of the approved plans has been met, except as noted by me on the as-built construction drawings. This Certification is based on site inspections by me, or personnel under my direction with survey information provided by Brian Martinez, of Cartesian Surveys, Inc., NMPs number 18374.


Engineer's Seal
& Signature

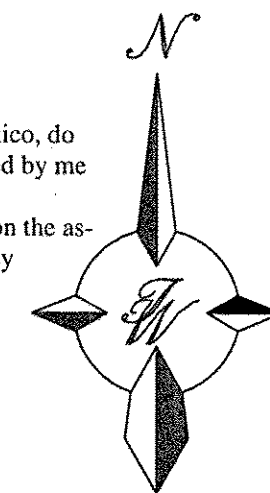


GRAPHIC SCALE




SCALE: 1"=20'

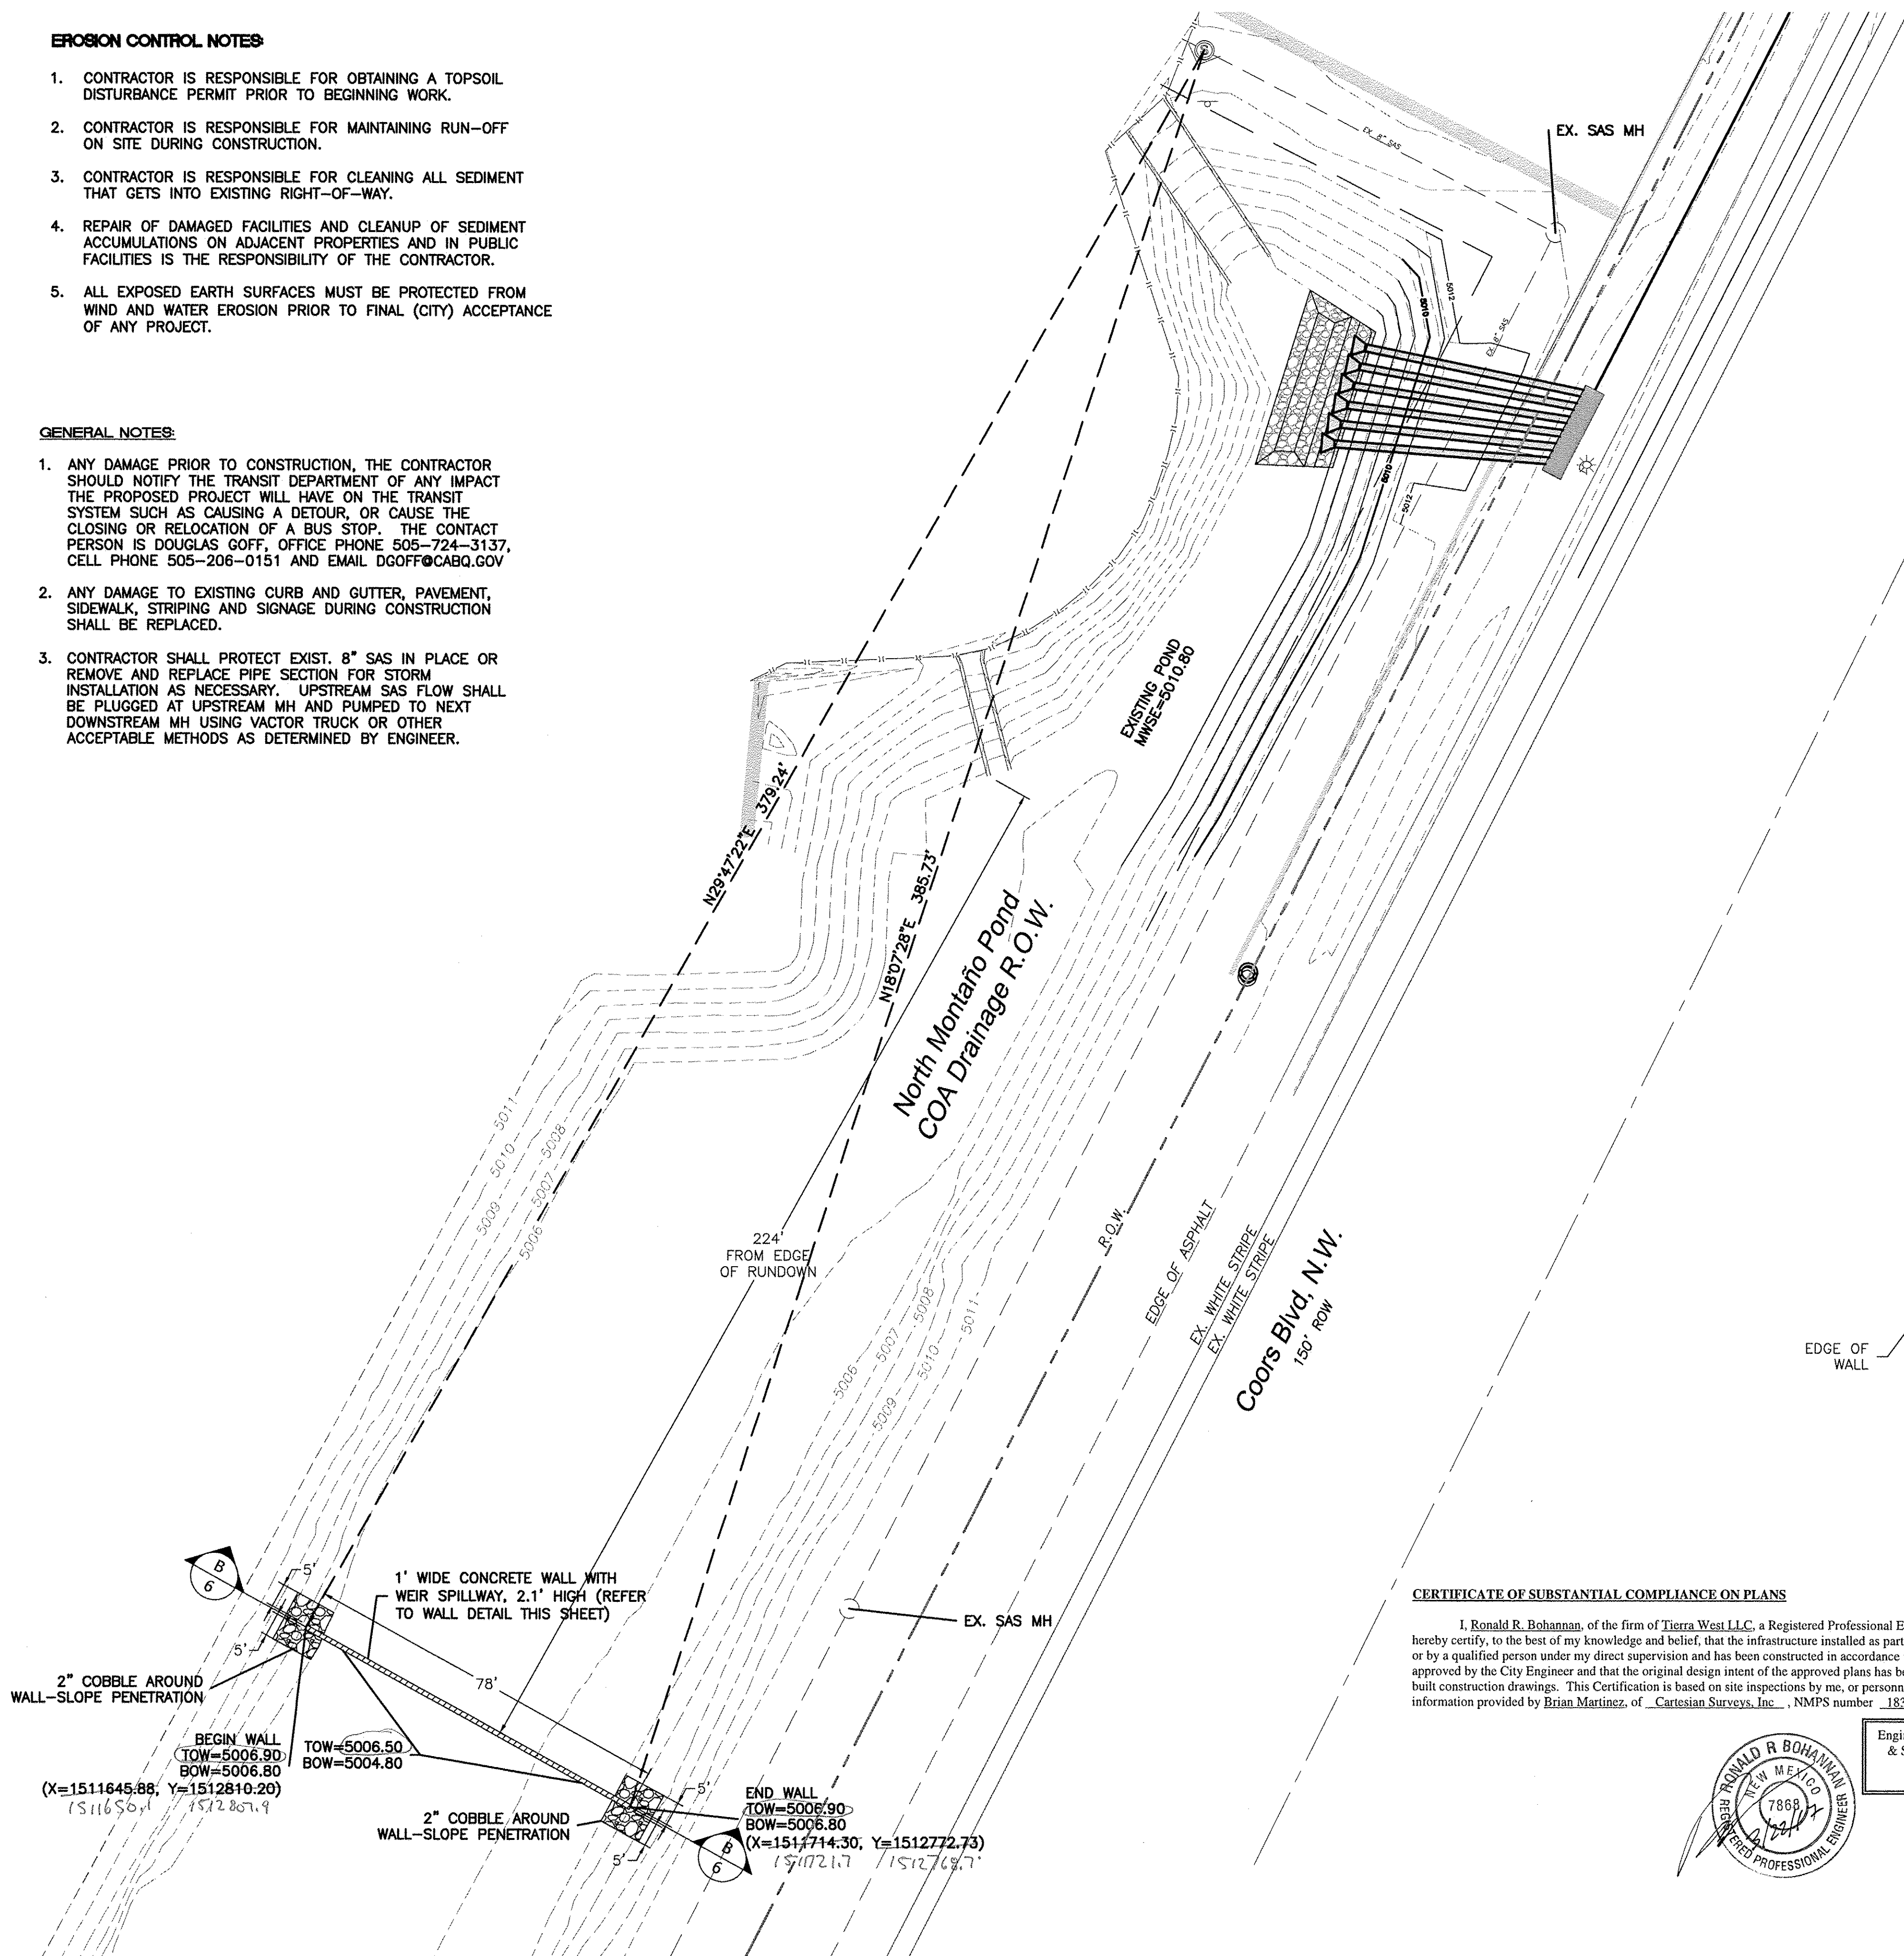

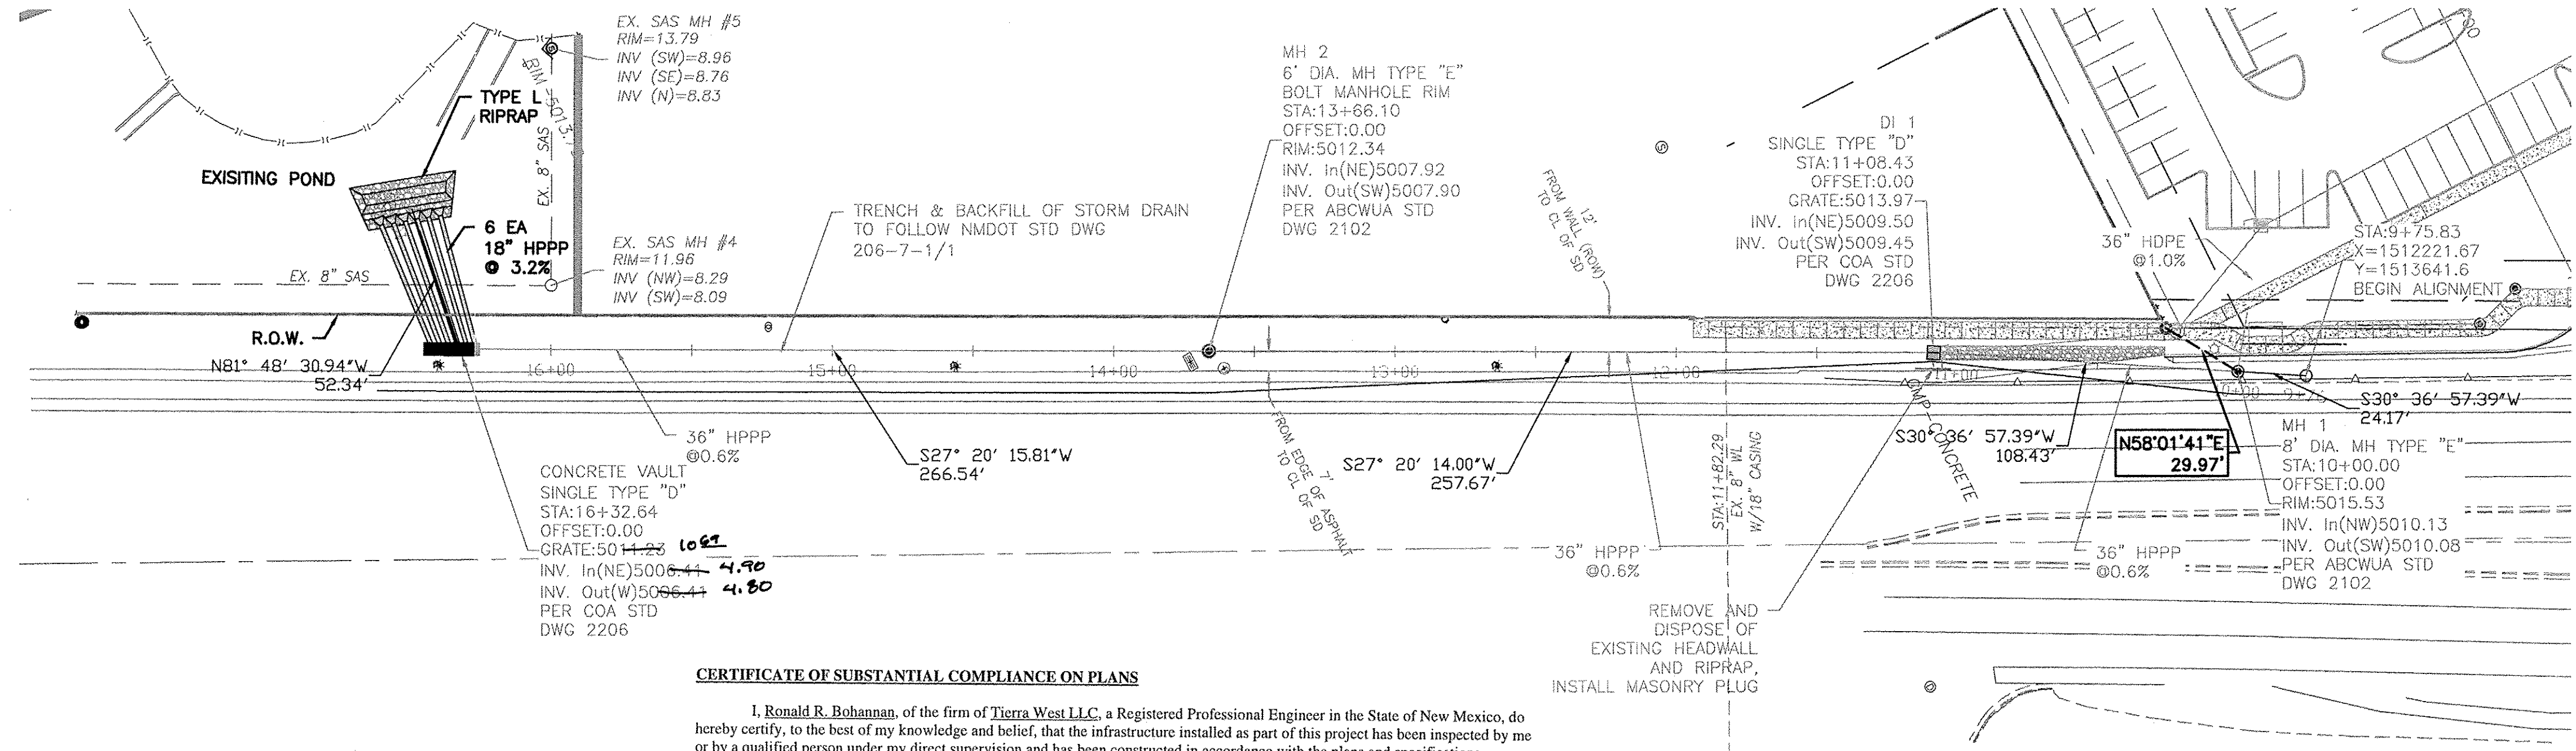


CERTIFICATE OF SUBSTANTIAL COMPLIANCE ON PLANS

I, Ronald R. Bohannon, of the firm of Tierra West LLC, a Registered Professional Engineer in the State of New Mexico, do hereby certify, to the best of my knowledge and belief, that the infrastructure installed as part of this project has been inspected by me or by a qualified person under my direct supervision and has been constructed in accordance with the plans and specifications approved by the City Engineer and that the original design intent of the approved plans has been met, except as noted by me on the as-built construction drawings. This Certification is based on site inspections by me, or personnel under my direction with survey information provided by Brian Martinez, of Cartesian Surveys, Inc., NMPS number 18374

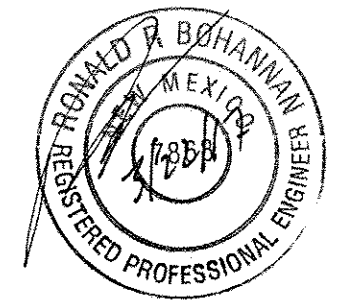

Engineer's Seal & Signature


COORS ROW
← COA →
NMDOT NOT A PART →

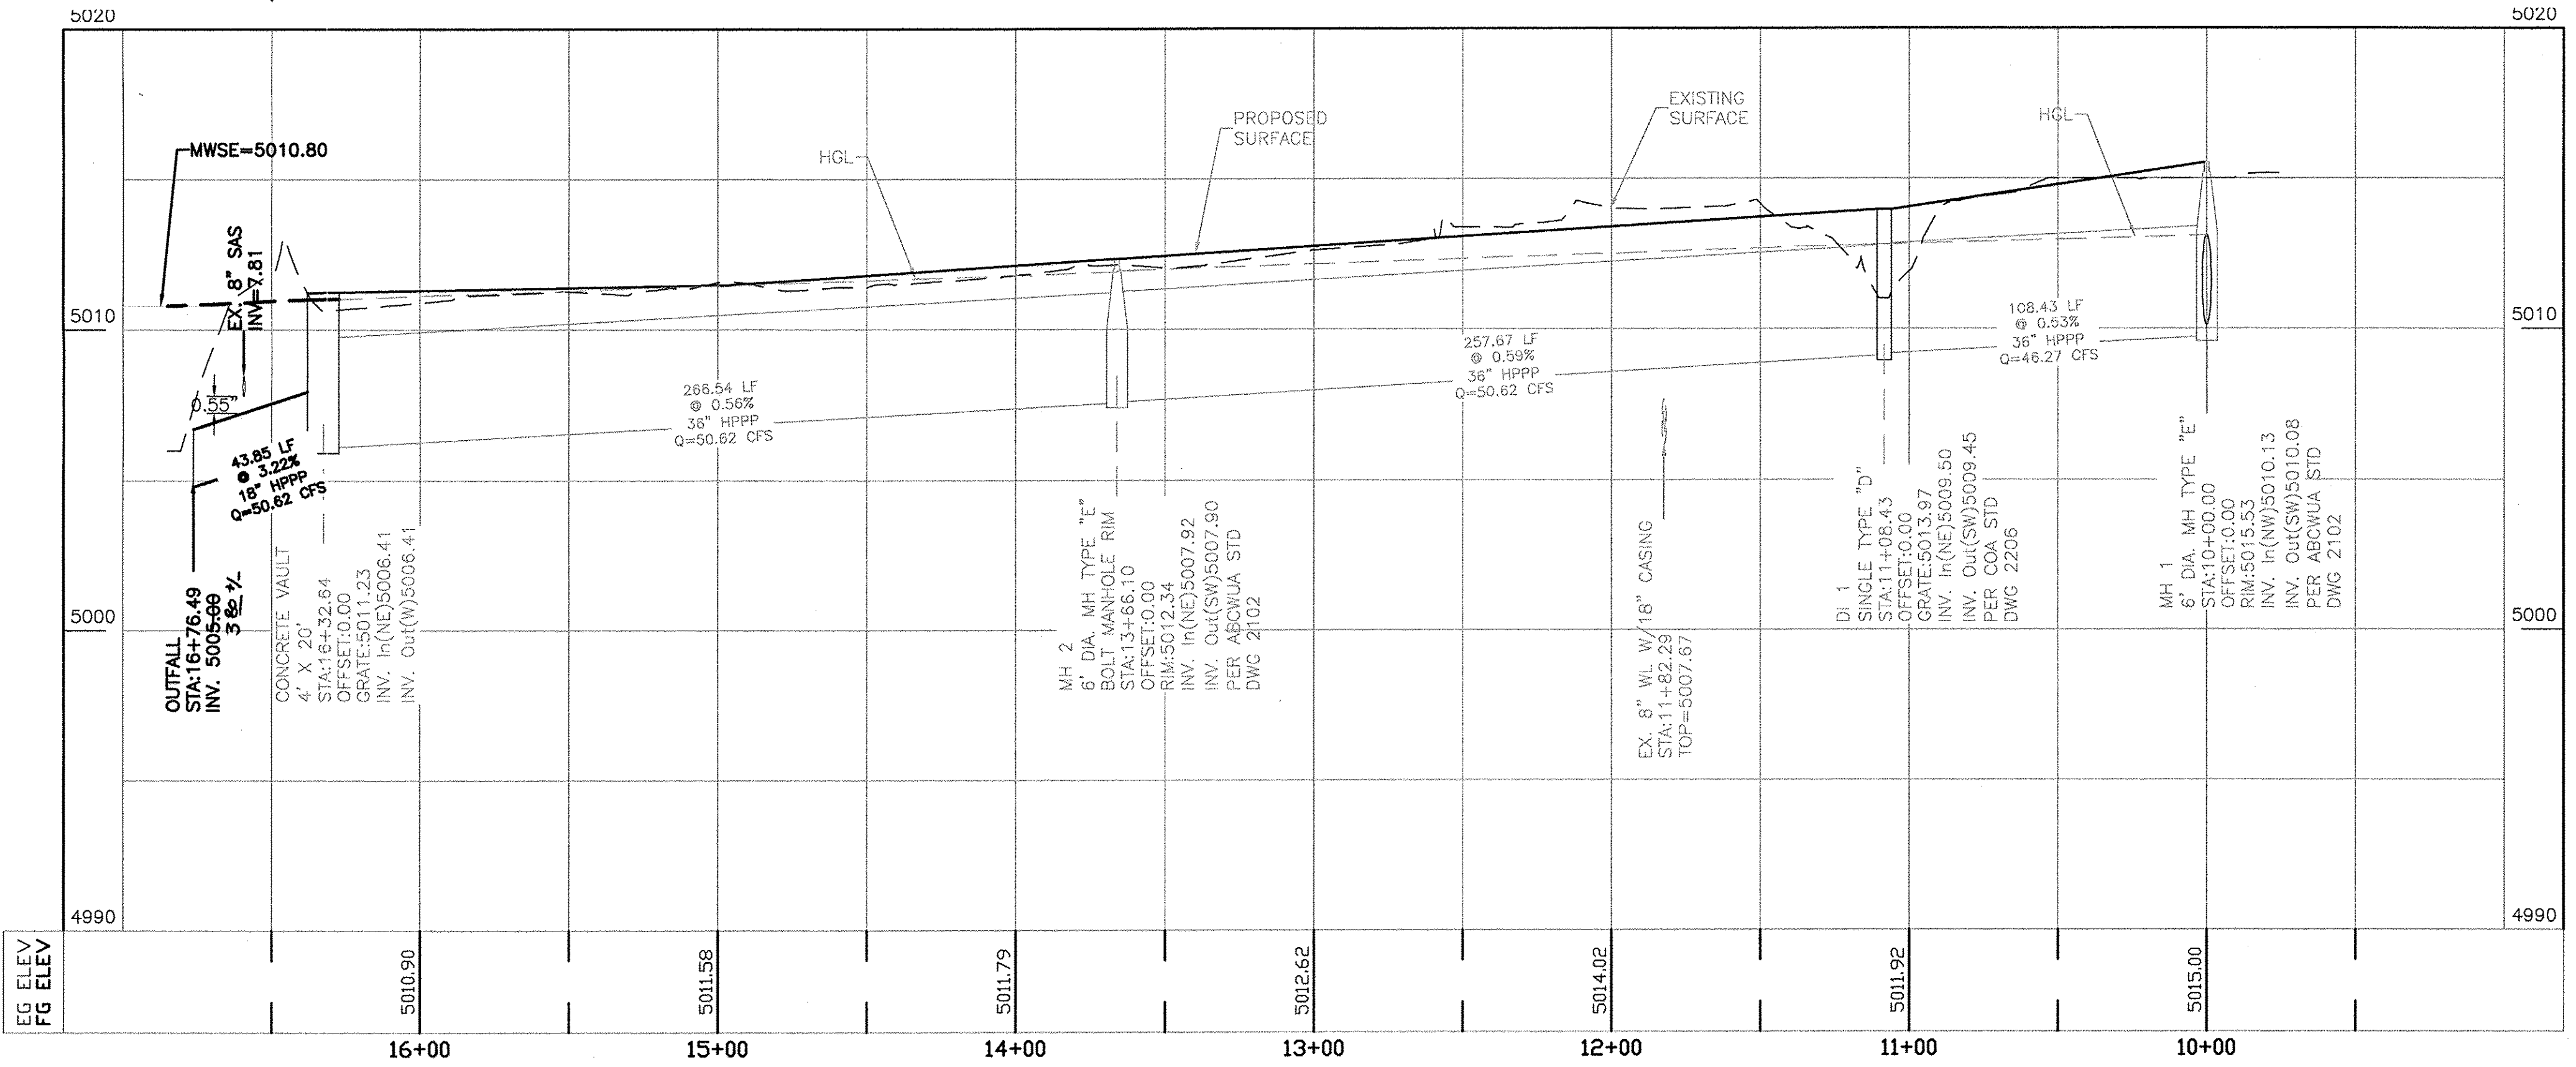

Coors SD Alignment PROFILE

Certification
THE CHANGES SHOWN HEREON ARE BASED UPON A FIELD SURVEY CONDUCTED BY ME OR UNDER MY SUPERVISION AND REFLECT THE LOCATIONS (VERTICALLY AND HORIZONTALLY) TO THE BEST OF MY KNOWLEDGE AND BELIEF.

- GENERAL NOTES:**
1. ANY DAMAGE PRIOR TO CONSTRUCTION, THE CONTRACTOR SHOULD NOTIFY THE TRANSIT DEPARTMENT OF ANY IMPACT THE PROPOSED PROJECT WILL HAVE ON THE TRANSIT SYSTEM SUCH AS CAUSING A DETOUR, OR CAUSE THE CLOSING OR RELOCATION OF A BUS STOP. THE CONTACT PERSON IS DOUGLAS GOFF, OFFICE PHONE 505-724-3137, CELL PHONE 505-206-0151 AND EMAIL DGOFF@CABQ.GOV
 2. ANY DAMAGE TO EXISTING CURB AND GUTTER, PAVEMENT, SIDEWALK, STRIPING AND SIGNAGE DURING CONSTRUCTION SHALL BE REPLACED.
 3. TO NOT DAMAGE WL CASING, FLOW FILL AROUND SD ABOVE CASING FOR 10 FEET ON BOTH SIDES OF WATERLINE - CALL WUA INSPECTOR BEFORE BACKFILLING.
 4. CONTRACTOR SHALL PROTECT EXIST. 8" SAS IN PLACE OR REMOVE AND REPLACE PIPE SECTION FOR STORM INSTALLATION AS NECESSARY. UPSTREAM SAS FLOW SHALL BE PLUGGED AT UPSTREAM MH AND PUMPED TO NEXT DOWNSTREAM MH USING VACTOR TRUCK OR OTHER ACCEPTABLE METHODS AS DETERMINED BY ENGINEER.

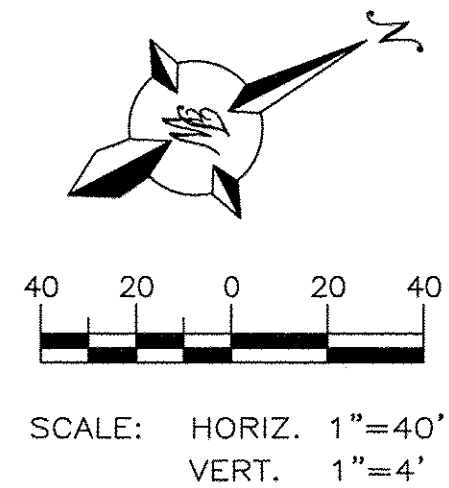

TIERRA WEST, LLC 5571 MIDWAY PARK PLACE NE ALBUQUERQUE, NM 87109 (505)858-3100 www.tierrawestllc.com	
CITY OF ALBUQUERQUE PUBLIC WORKS DEPARTMENT ENGINEERING GROUP	
TITLE: LA ORILLA ESTATES LA ORILLA RD. GRADING IMPROVEMENTS STORM DRAIN - PLAN & PROFILE	
DESIGN REVIEW COMMITTEE	REVIEW ENGINEER APPROVAL
LAST DESIGN UPDATE	
CITY PROJECT NO. 713482	ZONE MAP NO. E-12-Z
SHEET 7 OF 8	

AS BUILT INFORMATION		BENCH MARKS		SURVEY INFORMATION		ENGINEER'S SEAL	
CONTRACTOR	DATE	NO.	DATE	FIELD NOTES	BY	NO.	DATE
Cartesian Surveys Inc.	8/12/16						
STAKE BY	DATE						
ACCEPTANCE BY	DATE						
FIELD CORRECTIONS	DATE						
DRAWINGS	DATE						
CORRECTED BY	DATE						
MICRO-FILM INFORMATION	DATE						
RECORDED BY	DATE						
NO.							

