


SCALE
1" = 20' HORIZ.
1" = 2' VERT.



SCANNED BY
MESA REPRO

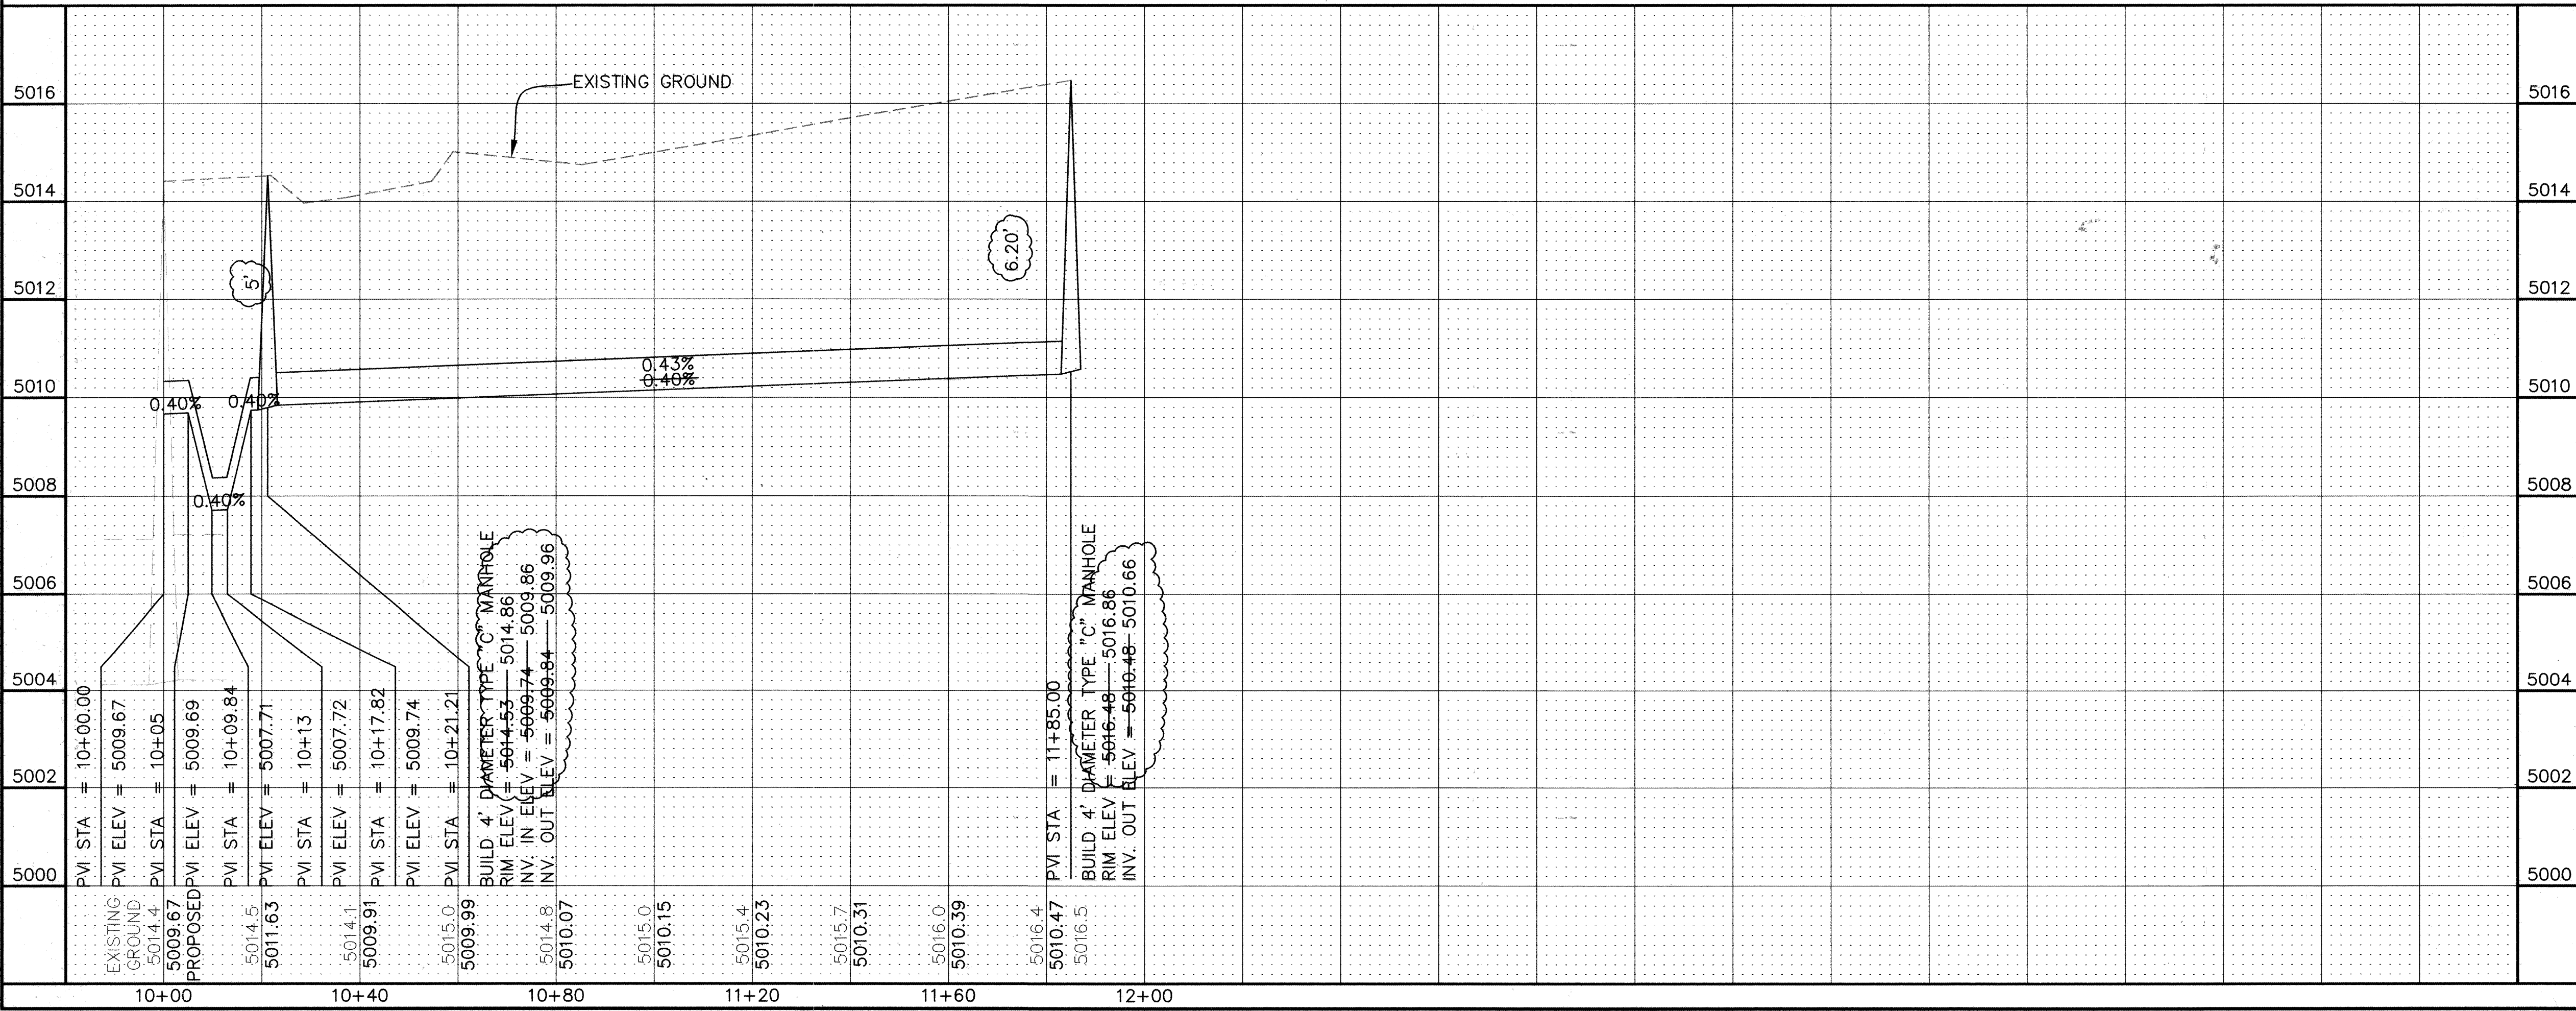

STA. 10+00.00
CONNECT TO EXISTING
TYPE "E" MANHOLE
WITH DROP CONNECTION
(SEE COA STD. DWG. 2116)

STA. 10+00.00 TO 10+05.00
BUILD 5 L.F. 8" PVC
SEWER LINE

STA. 10+05.00 TO 10+17.82
BUILD 8" PVC AIR TRAP
4-22.5' BENDS & 14 L.F.
8" PVC SEWER LINE

STA. 10+17.82 TO 10+21.21
BUILD 4 L.F. 8" PVC
SEWER LINE

STA. 10+21.21
BUILD 1-4' DIAMETER
TYPE "C" MANHOLE
(SEE COA STD. DWG. 2101)

STA. 10+21.21 TO 11+85.00
BUILD 164 L.F. 8" PVC
SEWER LINE

STA. 11+85.00
BUILD 1-4' DIAMETER
TYPE "C" MANHOLE
(SEE COA STD. DWG. 2101)

RECORD DRAWING
Drawing revised to reflect the
best information available. Do
not use without field verification.

SEWER SERVICE SCHEDULE	
ADDRESS/LOT	LOCATION

NOTES

- CONTRACTOR SHALL RECONNECT EXISTING SERVICE LINES TO NEW 8" SEWER AT 501, 503, 505, AND 507 ARROYO SECO. CONTRACTOR SHALL PROVIDE SERVICE LINE TO 6714 CANONCITO TO PROPERTY LINE.
- CONTRACTOR SHALL NOTIFY RESIDENTS 24 HOURS IN ADVANCE OF SERVICE LINE WORK.
- NO RESIDENCE SHALL BE WITHOUT SERVICE FOR LONGER THAN 4 HOURS.
- ALL MANHOLE TAPS SHALL BE CORE DRILLED AND SEALED WITH LINK SEAL.

PROVAL OF RECORD DRAWINGS
CHIEF CONSTRUCTION ENGINEER
G. Chang
DATE 8-19-05

SYMBOLS LEGEND

- SEWER = EXISTING UNDERGROUND SEWER LINE
- WATER = EXISTING UNDERGROUND WATER LINE
- ⊙ = EXISTING SEWER MANHOLE
- = EXISTING WATER METER
- = EXISTING SEWER CLEANOUT
- = EXISTING CABLE TV RISER
- ⊗ = EXISTING GAS METER
- ⊞ = EXISTING MAILBOX
- = EXISTING BLOCK WALL
- x- = EXISTING FENCE
- = PROPOSED UNDERGROUND SEWER LINE
- = PROPOSED SANITARY SEWER MANHOLE
- ⊕ = CENTERLINE
- ⊞ = PROPERTY LINE

ENGINEER'S SEAL

WILLIAM E. LEVENDEKER
REGISTERED PROFESSIONAL ENGINEER
NEW MEXICO
5315

AS-BUILT INFORMATION

CONTRACTOR	TLC	DATE

SURVEY INFORMATION

FIELD NOTES	DATE	BY

REVISIONS

NO.	DATE	REMARKS	BY

DESIGN REVIEW COMMITTEE

Mo./Day/Yr.	Mo./Day/Yr.

CITY OF ALBUQUERQUE
PUBLIC WORKS DEPARTMENT
ENGINEERING DEVELOPMENT GROUP

TITLE: ARROYO SECO SEWER LINE
SEWER LINE PLAN & PROFILE

City Project No. 714207 Zone Map No. E-16-Z Sheet 1 of 1