

7150.08
 PNC 2003-1
 TLC




LEGAL DESCRIPTION	REMARKS
1. 10. 1	1. 10. 1
2. 10. 2	2. 10. 2
3. 10. 3	3. 10. 3
4. 10. 4	4. 10. 4

SECTION	REMARKS
1. 10. 1	1. 10. 1
2. 10. 2	2. 10. 2
3. 10. 3	3. 10. 3
4. 10. 4	4. 10. 4


For the purpose of this map, the following information is provided: The map is based on the latest available aerial photography and is not a survey. The map is not to be used for any purpose other than the purpose for which it was prepared. The map is not to be used for any purpose other than the purpose for which it was prepared.

MAP NUMBER	DATE
1. 10. 1	1. 10. 1
2. 10. 2	2. 10. 2
3. 10. 3	3. 10. 3
4. 10. 4	4. 10. 4

K-16-Z
 K-16-Z

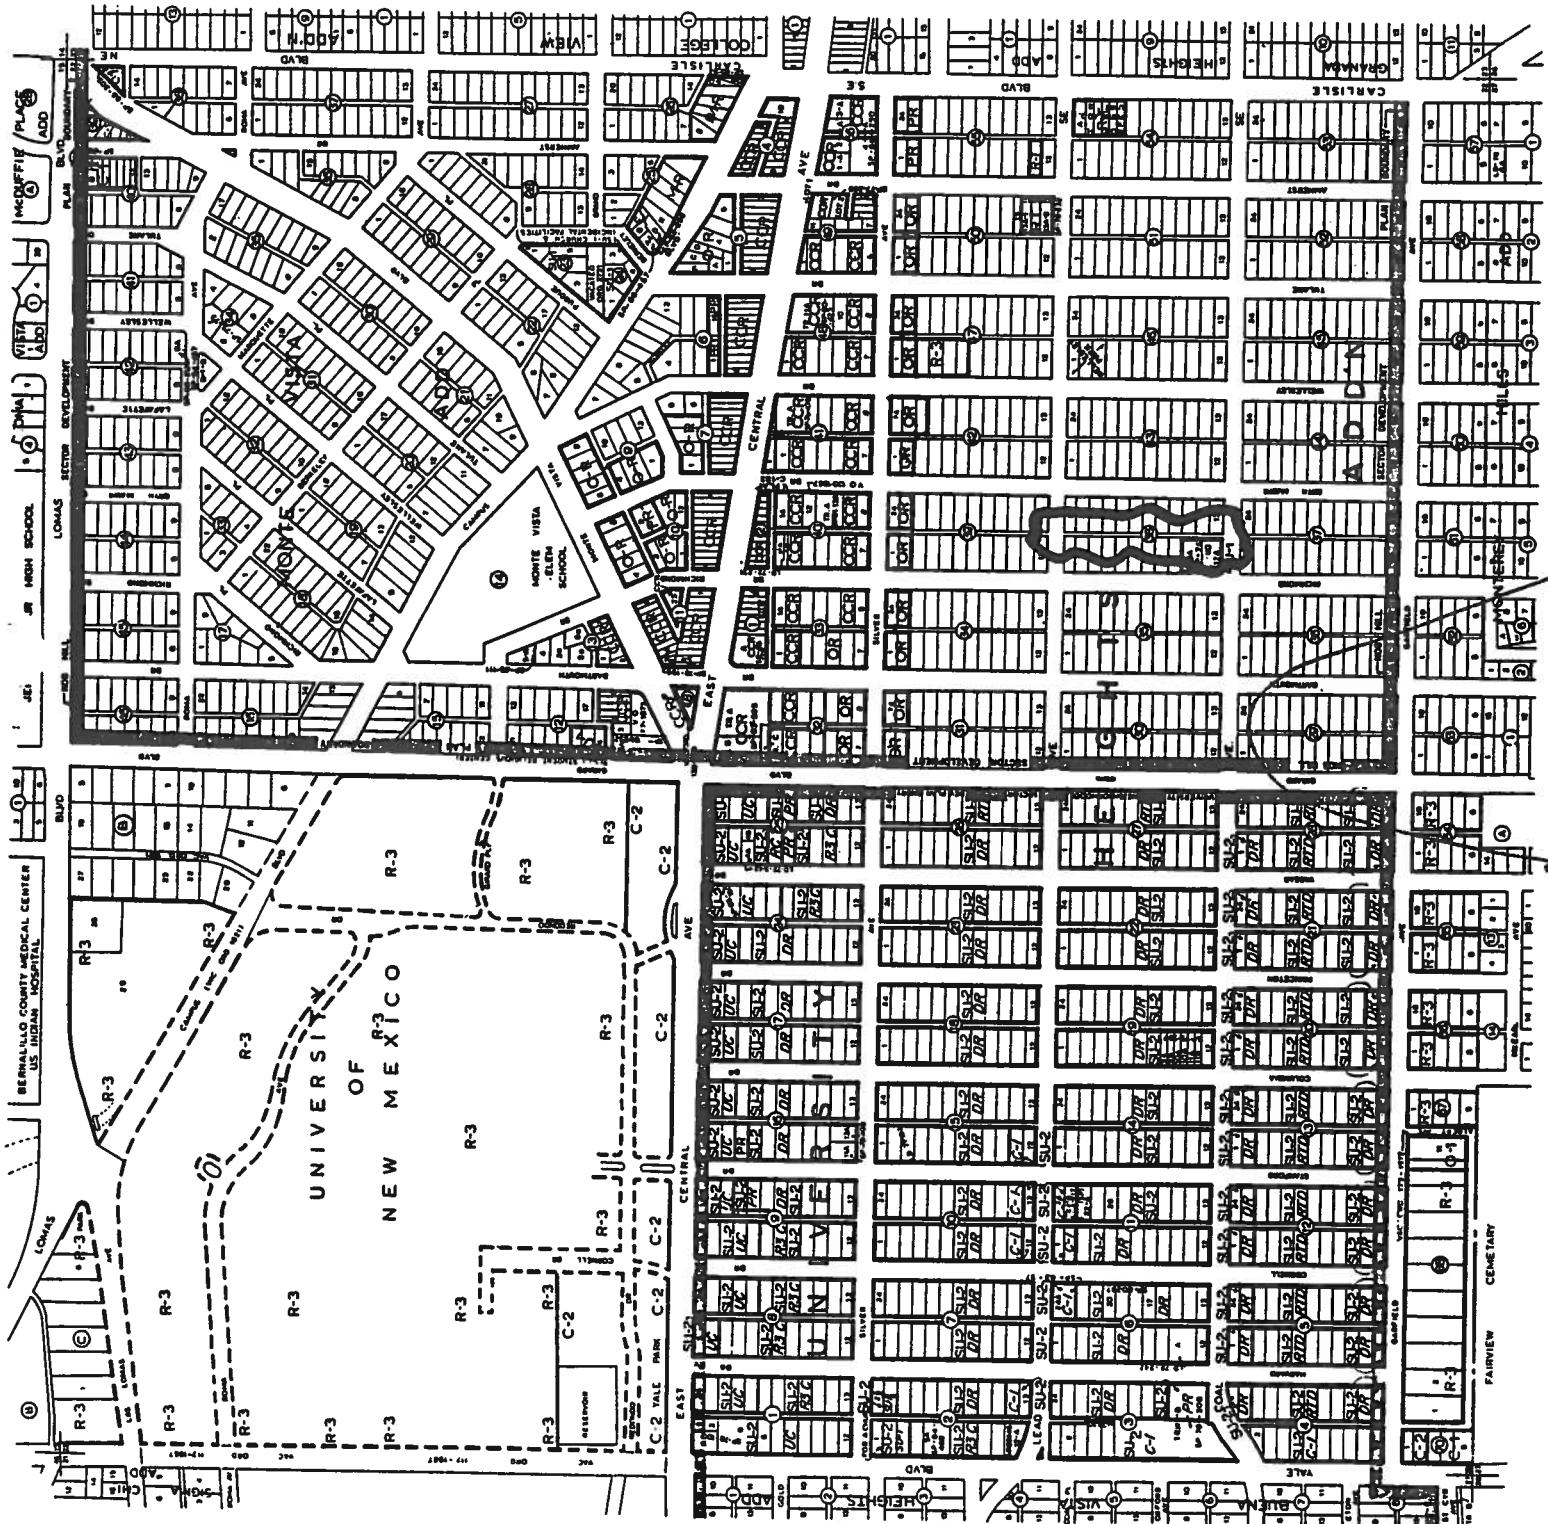

Alley Between
Bryn Mawr & Richmond
650' of w/h 6" pvc C-900

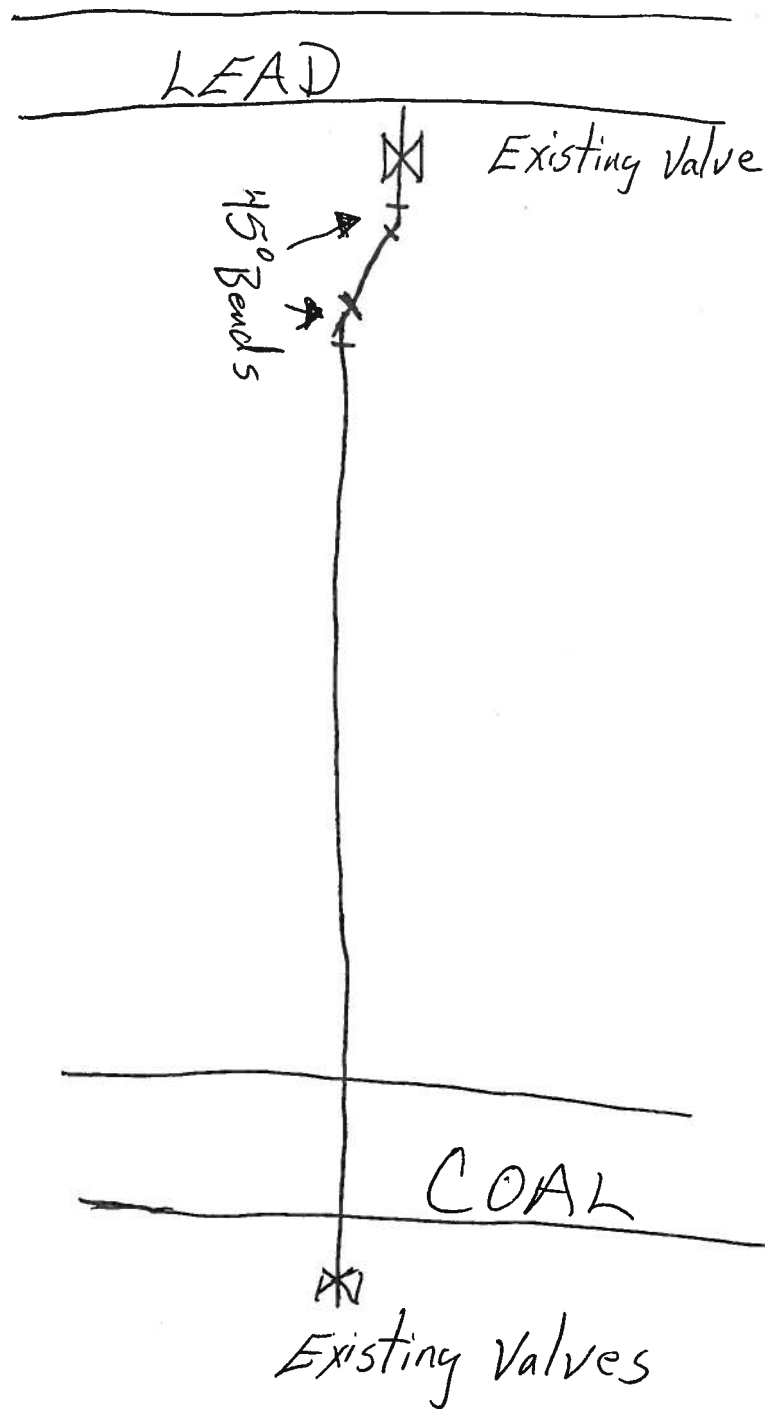

7150.08

TLC

Clifton Spencer

11-2003