




PNC 2003-1
7150.16
TLC

LEGAL DESCRIPTION
T 10 N
R 2 E
SEC 12
WGS84 MAP 30


UNIFORM PROPERTY CODE
T-01-055

MAP AMENDED THROUGH
MAY 1988

H-12-Z
CITY OF ALBUQUERQUE
PLANNING DEPARTMENT

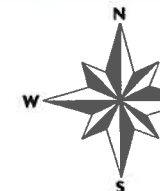

7150.16 Carlota, SAS
PWC 2003-1
TLC
Emergency Replacement

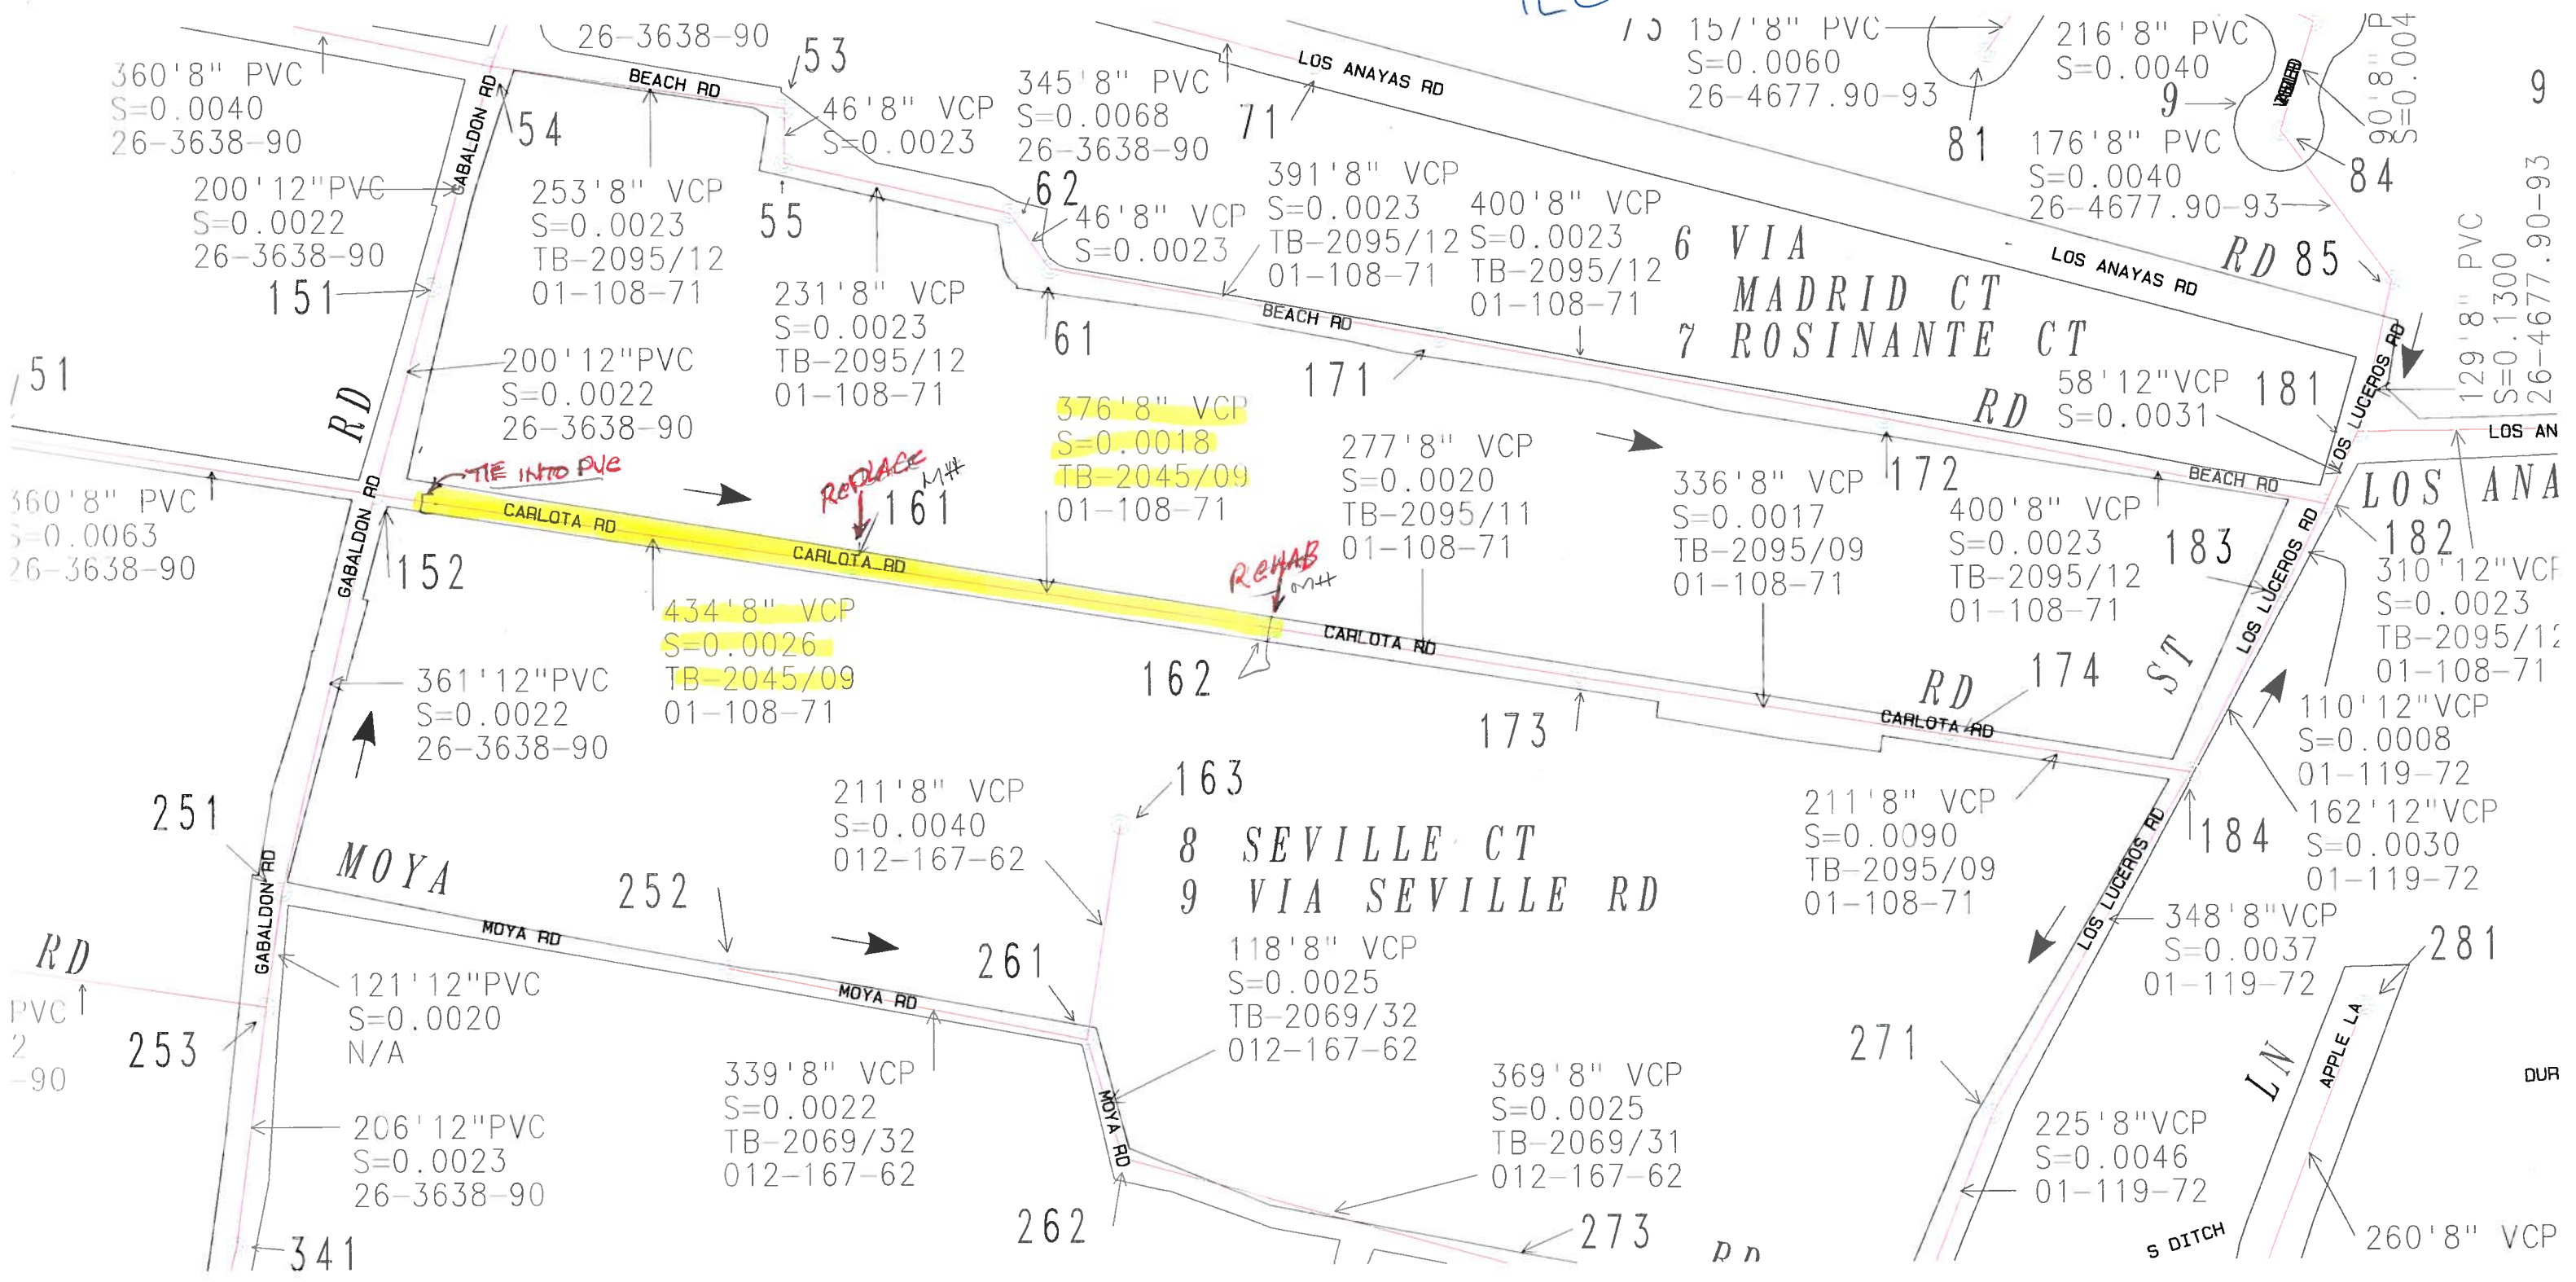

434
376