



Traffic Engineering Division

WORK ORDER

NO. 7150.19

INITIATED BY LCBrown

SIGNS

EMERGENCY ☐

DATE 03/16/04

APPROVED BY REZ

MARKINGS

RUSH ☐

LOCATION Dartmouth/ Central

ZONE LOCATION K16

Contractor TLC
2003-1
7150.19
C. Spencer

Sidewalk

Dartmouth

gutter

existing
striping

gutter


**SIGN
HERE**



K16

alley

Install 6" concrete fill
medians

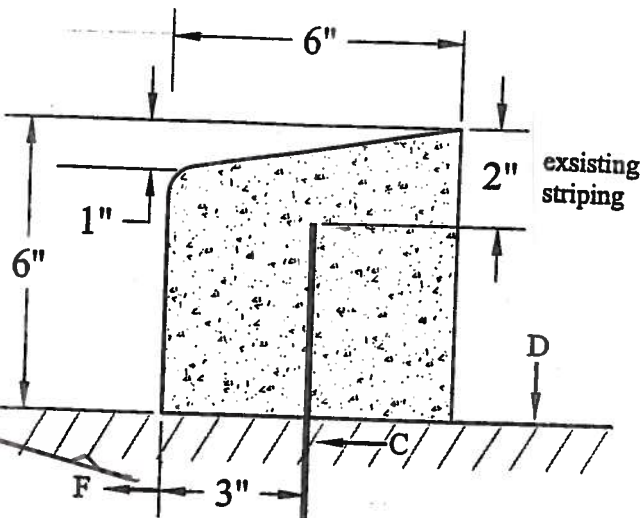

PINNED CURB

MAINT VISTA

GENERAL NOTES:

1. CURBS WILL BE CONSTRUCTED OF PORTLAND CEMENT CONCRETE

CONSTRUCTION NOTES:

- C. DRIVE NO. 4 BARS 18" DEEP IN HOLES DRILLED 1.5' O.C. IN EXIST. PAVEMENT, SEAL WITH EPOXY
- D. EXIST. A.C. OR P.C.C. PAVEMENT
- F. TRAFFIC SIDE

APPROVAL OF RECORD DRAWINGS
CHIEF CONSTRUCTION ENGINEER

DATE 1-31-05