
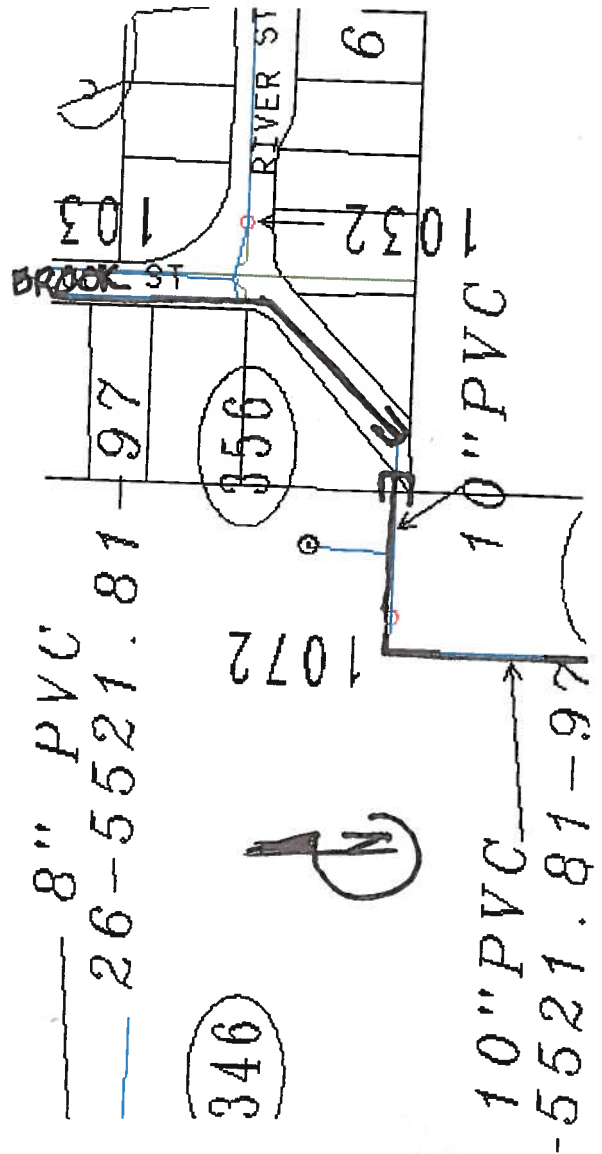


Wilshire Mobile Home Park

As Builts

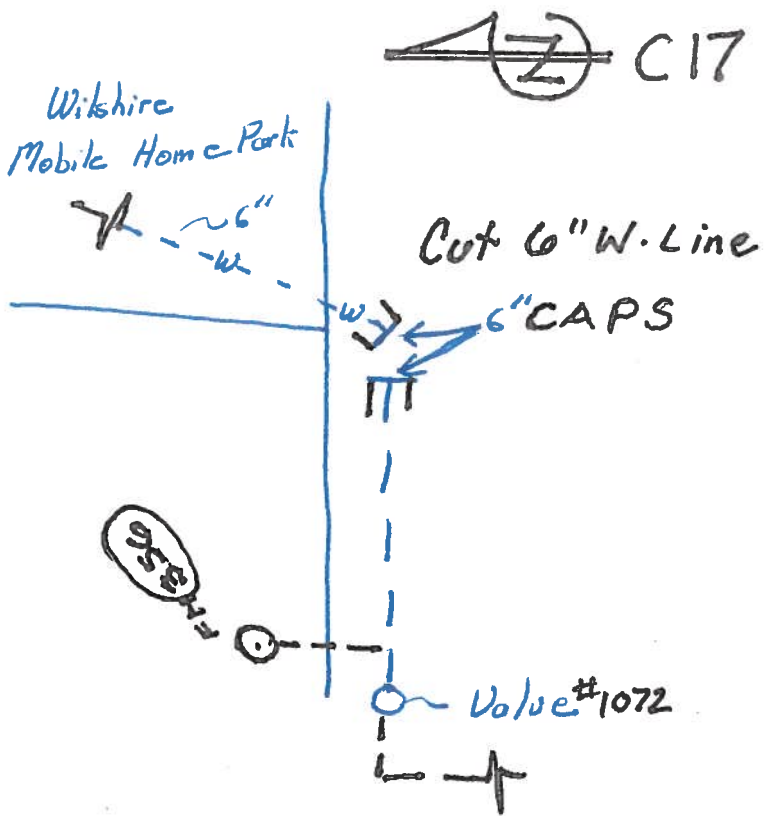

Contractor TLC

2003-1

**SIGN
HERE**

7150

Rick Duran / Tom Shoemaker

APPROVAL OF RECORD DRAWINGS
CHIEF CONSTRUCTION ENGINEER
<i>Peter Chang</i>
DATE 1/31/05

