


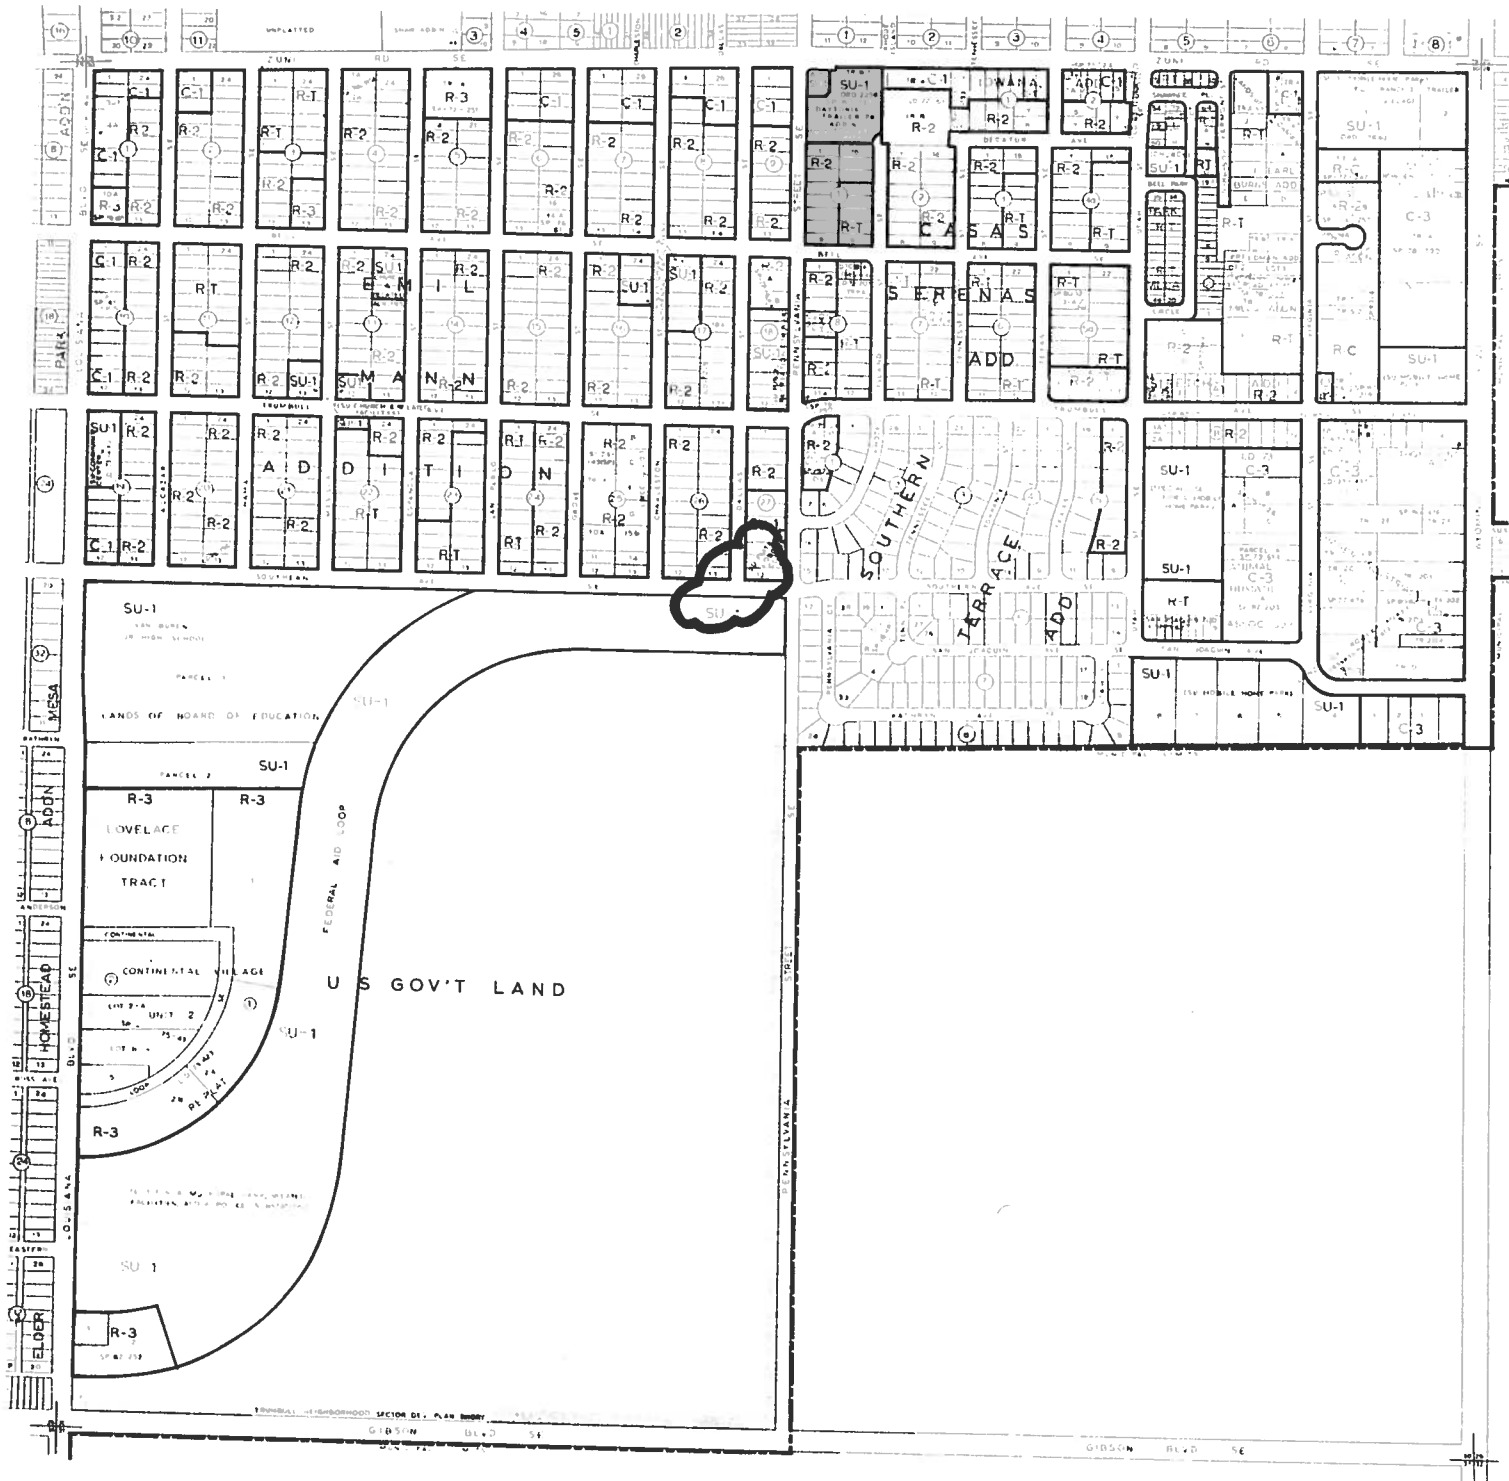

7150.25
 PNC 2003-1
 TLC

LEGAL DESCRIPTION
 T. 10 N.
 R. 4 E.
 SEC. 10

UNIFORM PRESENT CODE
 1988-90

MAP AMENDED BY
 MAY 1988

L-19-7
 CITY OF ALBUQUERQUE
 PLANNING DEPARTMENT