

PUBLIC IMPROVEMENT PLANS
FOR
THE PRESERVE
ALBUQUERQUE, NEW MEXICO

JUNE 2003

PREPARED FOR:

REMBE/CALOTT
7620 JEFFERSON ST, NE
ALBUQUERQUE, NM 87109

PREPARED BY:


ISAACSON & ARFMAN, P.A.
128 MONROE ST. NE
ALBUQUERQUE, NM 87108

INDEX TO DRAWINGS

SHEET NO.	TITLE
1	COVER SHEET
2A, 2B	PLAT
3	GRADING & DRAINAGE PLAN
4	WINTERHAVEN ROAD NW UTILITY AND PAVING PLAN
5	8" PUBLIC SANITARY SEWER PLAN & PROFILE
6	UTILITY DETAILS
7	SIGNING & CONSTRUCTION CONTROL STANDARDS
8	TRAFFIC CONTROL & SIGNING EXAMPLES

CERTIFICATE OF SUBSTANTIAL COMPLIANCE ON PLANS

I, FRED C. ARFMAN of the firm of ISAACSON & ARFMAN,
a Registered Professional Engineer in the State of New Mexico, do hereby certify, to the best of
my knowledge and belief, that the infrastructure installed as part of this project has been
inspected by me or by a qualified person under my direct supervision and has been constructed
in accordance with the plans and specifications approved by the City Engineer and that the
original design intent of the approved plans has been met, except as noted by me on the as-built
construction drawings. This Certification is based on site inspections by me or personnel under
my direction and survey information provided by SURV-TEK, INC., NMPS
number 9750.

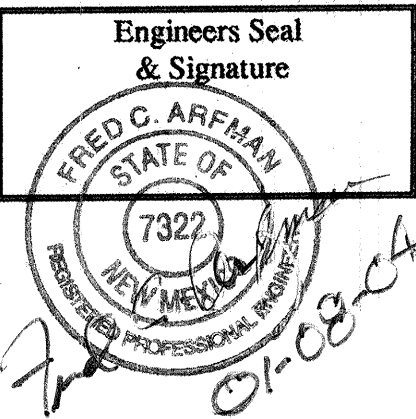

SURVEYORS CERTIFICATION

I, Russ P. Hugg, New Mexico Professional Surveyor Number 9750,
hereby certify that the as-built information shown hereon is the
result of an actual field survey performed by me or under my direct
supervision and that the same is true and correct to the best of my
knowledge and belief.

Russ P. Hugg
NMPS No. 9750
12-17-2003




APPROVED AS RECORD DRAWINGS
DESIGN REVIEW SECTION
CITY ENGINEER
DATE: 9/10/03

GENERAL NOTES

- ALL WORK DETAILED ON THESE PLANS TO BE PERFORMED UNDER CONTRACT SHALL, EXCEPT AS OTHERWISE STATED OR PROVIDED FOR HEREON, BE CONSTRUCTED IN ACCORDANCE WITH THE CITY OF ALBUQUERQUE STANDARD SPECIFICATIONS FOR PUBLIC WORKS CONSTRUCTION 1986 EDITION AS AMENDED WITH UPDATE NO. 6.
- ALL WORK ON THIS PROJECT SHALL BE PERFORMED IN ACCORDANCE WITH APPLICABLE FEDERAL, STATE, AND LOCAL LAWS, RULES, AND REGULATIONS CONCERNING CONSTRUCTION SAFETY AND HEALTH.
- PRIOR TO CONSTRUCTION, THE CONTRACTOR SHALL EXCAVATE & VERIFY THE HORIZONTAL AND VERTICAL LOCATIONS OF ALL OBSTRUCTIONS. SHOULD A CONFLICT EXIST, THE CONTRACTOR SHALL NOTIFY THE ENGINEER SO THAT THE CONFLICT CAN BE RESOLVED WITH MINIMUM DELAY.
- TWO (2) WORKING DAYS PRIOR TO ANY EXCAVATION, CONTRACTOR MUST CONTACT LINE LOCATING SERVICE @ 260-1990 FOR LOCATION OF EXISTING UTILITIES.
- CONTRACTOR SHALL CONDUCT HIS OPERATIONS IN A MANNER WHICH WILL MINIMIZE INTERFERENCE WITH LOCAL TRAFFIC. CONTRACTOR SHALL COMPLY WITH ALL APPLICABLE LAWS, ORDINANCES, RULES, REGULATIONS, AND ORDERS OF ANY PUBLIC BODY HAVING JURISDICTION FOR THE SAFETY OF PERSONS OR PROPERTY, AND TO PROTECT THEM FROM DAMAGE, INJURY, OR LOSS. CONTRACTOR SHALL ERECT AND MAINTAIN, AS REQUIRED BY THE CONDITIONS AND PROGRESS OF THE WORK, ALL NECESSARY SAFEGUARDS FOR SAFETY CONTINUOUSLY AND NOT LIMITED TO NORMAL WORKING HOURS, THROUGHOUT THE DURATION OF THE PROJECT. CONTRACTOR SHALL ADHERE TO SECTION 19 OF THE GENERAL CONDITIONS OF THE CITY OF ALBUQUERQUE STANDARD SPECIFICATIONS FOR PUBLIC WORKS CONSTRUCTION, 1986, AS AMENDED WITH UPDATE NO. 6.
- THE CONTRACTOR AGREES THAT HE SHALL ASSUME THE SOLE AND COMPLETE RESPONSIBILITY FOR THE JOB SITE CONDITIONS DURING THE COURSE OF CONSTRUCTION OF THIS PROJECT, INCLUDING SAFETY OF ALL PERSONS AND PROPERTY; THAT THIS REQUIREMENT SHALL APPLY CONTINUOUSLY AND NOT BE LIMITED TO NORMAL WORKING HOURS; AND THAT THE CONTRACTOR SHALL DEFEND, INDEMNIFY, AND HOLD HARMLESS THE OWNER & ENGINEER FROM ANY AND ALL LIABILITY REAL OR ALLEGED, IN CONNECTION WITH THE PERFORMANCE OF WORK ON THIS PROJECT, EXCEPTING LIABILITY ARISING FROM THE SOLE NEGLIGENCE OF THE OWNER OR ENGINEER.
- TRAFFIC CONTROL: FIVE (5) WORKING DAYS PRIOR TO BEGINNING CONSTRUCTION THE CONTRACTOR SHALL SUBMIT TO THE CONSTRUCTION COORDINATION DIVISION A DETAILED CONSTRUCTION SCHEDULE. TWO (2) WORKING DAYS PRIOR TO CONSTRUCTION, THE CONTRACTOR SHALL OBTAIN A BARRICADE PERMIT FROM THE CONSTRUCTION COORDINATION DIVISION. CONTRACTOR SHALL NOTIFY BARRICADE ENGINEER (924-3400) PRIOR TO OCCUPYING AN INTERSECTION. SEE SECTION 19 OF THE SPECIFICATIONS. ALL STREET STRIPING ALTERED OR DESTROYED SHALL BE REPLACED WITH PLASTIC REFLECTORIZED PAVEMENT MARKINGS BY CONTRACTOR TO LOCATION AS EXISTING OR AS SHOWN IN THIS PLAN SET.
- WHEN ABUTTING EXISTING PAVEMENT TO NEW, SAWCUT EXISTING PAVEMENT TO A STRAIGHT EDGE AND AT A RIGHT ANGLE, OR AS APPROVED BY THE FIELD ENGINEER. REMOVAL OF BROKEN OR CRACKED PAVEMENT WILL ALSO BE REQUIRED.
- EXISTING CURB AND GUTTER NOT TO BE REMOVED UNDER THE CONTRACT WHICH IS DAMAGED OR DISPLACED BY THE CONTRACTOR SHALL BE REMOVED AND REPLACED BY THE CONTRACTOR AT HIS EXPENSE.
- ALL FINAL BACKFILL FOR TRENCHES SHALL BE COMPACTED TO A MINIMUM 90% MAXIMUM DENSITY PER ASTM D-1557 AND AS DIRECTED BY SECTION 701.14.2 AND STANDARD DRAWING NUMBER 2315.
- THE CONTRACTOR SHALL PROMPTLY CLEAN UP ANY MATERIAL EXCAVATED WITHIN THE PUBLIC RIGHT-OF-WAY OR PRIVATE ROADWAY EASEMENTS SO THAT THE EXCAVATED MATERIAL IS NOT SUSCEPTIBLE TO BEING WASHED DOWN THE STREET OR INTO ANY PUBLIC DRAINAGE FACILITY.
- PROPOSED WATERLINE MATERIALS SHALL BE EITHER PVC PIPE MEETING AWWA C900 REQUIREMENTS (6"-12") OR DUCTILE IRON PIPE, THICKNESS CLASS 50 (6"-16").
- ALL FITTINGS ON WATERLINES SHALL HAVE RESTRAINED JOINTS AS NOTED ON THE PLANS.
- CONTRACTOR SHALL SUPPORT ALL EXISTING, UNDERGROUND UTILITY LINES WHICH BECOME EXPOSED DURING CONSTRUCTION. PAYMENT FOR SUPPORTING WORK SHALL BE INCIDENTAL TO WATER-LINE AND/OR SEWERLINE COSTS.
- CONTRACTOR SHALL ASSIST THE ENGINEER/INSPECTOR IN THE RECORDING OF DATA ON ALL UTILITY LINES AND ACCESSORIES AS REQUIRED BY THE CITY OF ALBUQUERQUE FOR THE PREPARATION OF RECORD DRAWINGS. CONTRACTOR SHALL NOT COVER UTILITY LINES AND ACCESSORIES UNTIL ALL DATA HAS BEEN RECORDED.
- THE CONTRACTOR SHALL NOTIFY THE ENGINEER NOT LESS THAN SEVEN (7) DAYS PRIOR TO STARTING WORK IN ORDER THAT THE ENGINEER MAY TAKE NECESSARY MEASURES TO INSURE THE PRESERVATION OF SURVEY MONUMENTS. CONTRACTOR SHALL NOT DISTURB PERMANENT SURVEY MONUMENTS WITHOUT THE CONSENT OF THE ENGINEER AND SHALL NOTIFY THE ENGINEER AND BEAR THE EXPENSE OF REPLACING ANY THAT MAY BE DISTURBED WITHOUT PERMISSION. REPLACEMENT SHALL BE DONE ONLY BY THE CITY SURVEYOR. WHEN A CHANGE IS MADE IN THE FINISHED ELEVATIONS OF THE PAVEMENT OF ANY ROADWAY IN WHICH A PERMANENT SURVEY MONUMENT IS LOCATED, CONTRACTOR SHALL, AT HIS OWN EXPENSE, ADJUST THE MONUMENT COVER TO THE NEW GRADE, UNLESS OTHERWISE SPECIFIED. REFER TO SECTION 4.4 OF THE GENERAL CONDITIONS OF THE STANDARD SPECIFICATIONS.
- PNM WILL PROVIDE AT NO COST TO THE CITY OR THE CONTRACTOR THE REQUIRED PERSONNEL FOR INSPECTION OR OBSERVATION DEEMED NECESSARY BY PNM WHILE THE CONTRACTOR IS EXPOSING PNM'S CABLES. HOWEVER, THE CONTRACTOR SHALL BE CHARGED THE TOTAL COST ASSOCIATED WITH REPAIRS TO ANY DAMAGED CABLES OR FOR ANY COST ASSOCIATED WITH SUPPORTING OR RELOCATING THE POLES AND CABLES DURING CONSTRUCTION.
- WARNING--EXISTING UTILITY LINE LOCATIONS ARE SHOWN IN AN APPROXIMATE MANNER ONLY, AND SUCH LINES MAY EXIST WHERE NONE ARE SHOWN. THE LOCATION OF ANY SUCH EXISTING LINES IS BASED UPON INFORMATION PROVIDED BY THE UTILITY COMPANY, THE OWNER, OR BY OTHERS, AND THE INFORMATION MAY BE INCOMPLETE OR MAY BE OBSOLETE BY THE TIME CONSTRUCTION COMMENCES.

THE ENGINEER HAS UNDERTAKEN NO FIELD VERIFICATION OF THE LOCATION, DEPTH, SIZE, OR TYPE OF EXISTING UNDERGROUND UTILITY LINES, MAKES NO REPRESENTATION PERTAINING THERETO, AND ASSUMES NO RESPONSIBILITY OR LIABILITY THEREFOR. THE CONTRACTOR SHALL INFORM ITSELF OF THE LOCATION OF ANY UTILITY LINE IN OR NEAR THE AREA OF THE WORK IN ADVANCE OF AND DURING EXCAVATION WORK. THE CONTRACTOR IS FULLY RESPONSIBLE FOR ANY AND ALL DAMAGE CAUSED BY ITS FAILURE TO LOCATE, IDENTIFY, AND PRESERVE ANY AND ALL EXISTING UTILITIES. THE CONTRACTOR SHALL COMPLY WITH STATE STATUTES, MUNICIPAL AND LOCAL ORDINANCES, RULES AND REGULATIONS PERTAINING TO THE LOCATION OF THESE LINES AND FACILITIES, IN PLANNING AND CONDUCTING EXCAVATION, WHETHER BY CALLING OR NOTIFYING THE UTILITIES, COMPLYING WITH "BLUE STAKES" PROCEDURES, OR OTHERWISE.
- ANY WORK OCCURRING WITHIN AN ARTERIAL ROADWAY REQUIRES 24 HR. CONSTRUCTION.
- ALL EXCAVATION, TRENCHING AND SHORING ACTIVITIES MUST BE ACCOMPLISHED IN ACCORDANCE WITH OSHA 29CFR 1926.650 SUBPART P.
- CONTRACTOR SHALL MAINTAIN A GRAFFITI-FREE WORK SITE. CONTRACTOR SHALL PROMPTLY REMOVE ANY AND ALL GRAFFITI FROM EQUIPMENT, WHETHER PERMANENT OR TEMPORARY.

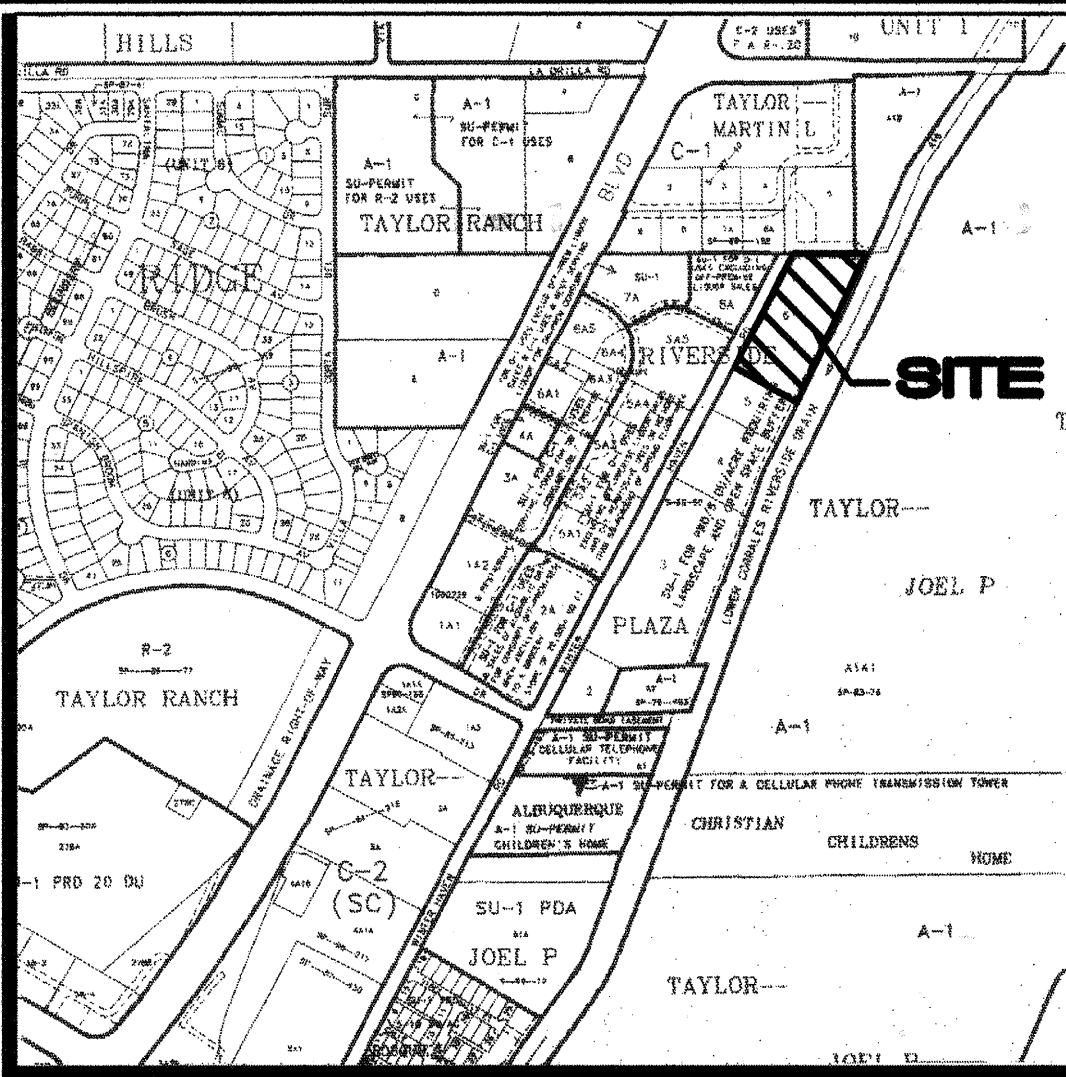

E-12


VICINITY MAP

1"=750'


1 2 3 4 5 6 7 8 9 10 11 12 13 14 15
26 7168.81 04

DRB NO.
1002479

ISAACSON & ARFMAN, P.A.
Consulting Engineering Associates
128 Monroe Street N.E.
Albuquerque New Mexico
1276CVR.DWGjs 07/15/03

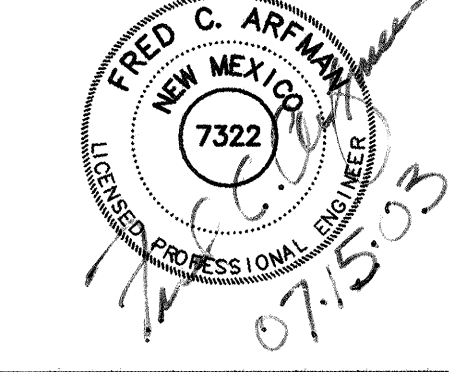

REV.	SHEETS	CITY ENGINEER	DATE	USER	DEPARTMENT	DATE	USER	DEPARTMENT	DATE
ENGINEERS STAMP & SIGNATURE		APPROVALS		ENGINEER		*****			
		DRC Chairman		7-30-03		APPROVED FOR CONSTRUCTION			
		Transportation		7/24/03					
		Water/Wastewater		7/29/03					
		Hydrology		7/29/03					
		AMAFCA							
		Constr. Mngmt.		7/29/03					
		Constr. Coord.		7-30-03					
		City Project No.		716181					
		Sheet		1		Of 8			

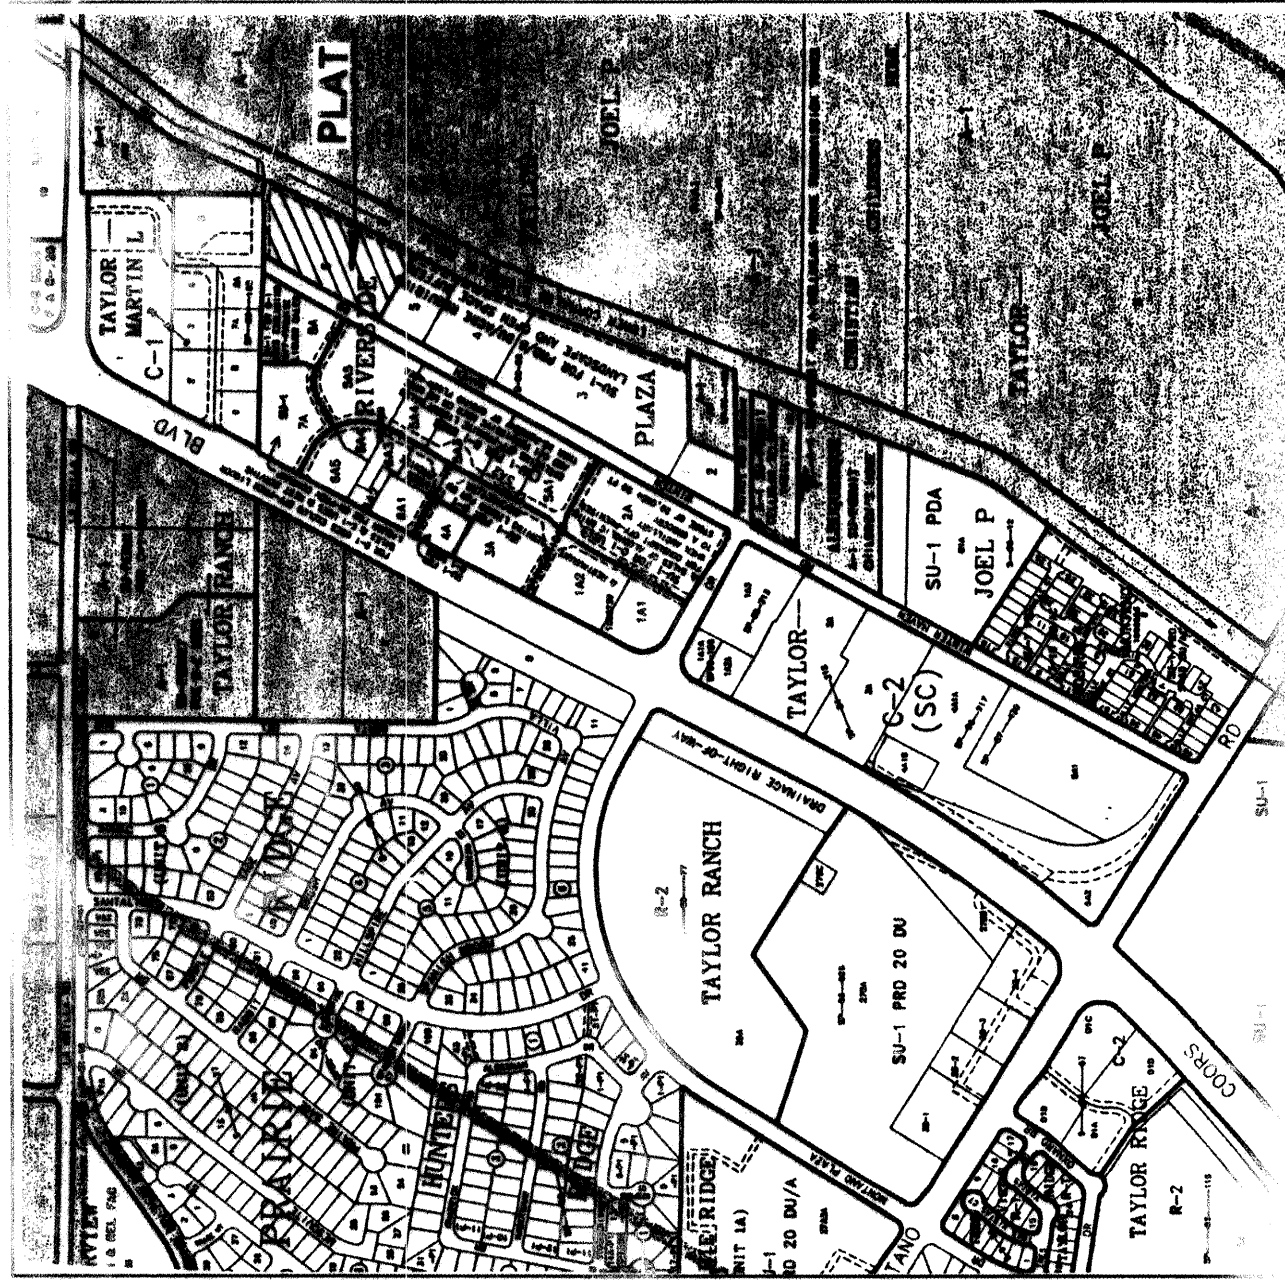

SCANNED BY
MESA REPHO

THE PRESERVE
(BEING A REPLAT OF LOT 6, RIVERSIDE PLAZA)

WITHIN
SECTION 25, TOWNSHIP 11 NORTH, RANGE 2 EAST
NEW MEXICO PRINCIPAL MERIDIAN
CITY OF ALBUQUERQUE
BERNALILLO COUNTY, NEW MEXICO
MAY, 2003

PROJECT NUMBER 1008-078
APPLICATION NUMBER 0308B-00000-00718

APPROVALS

Traffic Engineer, City of Albuquerque
Public Works Department
Date 6-5-03

City Engineer, City of Albuquerque
Public Works Department
Date

Utility Development Division, City of Albuquerque
Public Works Department
Date

Albuquerque Metropolitan Arroyo Flood
Control Authority
Date

City Engineer, City of Albuquerque
Public Works Department
Date

Property Management, City of Albuquerque
Date

Parks and Recreation, City of Albuquerque
Date

Middle Rio Grande Conservancy District
Date

APPROVAL as specified by the Albuquerque Subdivision Ordinance

Chair, Albuquerque Development Review Board
Date

SCANNED BY
MESA REPHO

THE PRESERVE
(BEING A REPLAT OF LOT 6, RIVERSIDE PLAZA)

WITHIN
SECTION 25, TOWNSHIP 11 NORTH, RANGE 2 EAST
NEW MEXICO PRINCIPAL MERIDIAN
CITY OF ALBUQUERQUE
BERNALILLO COUNTY, NEW MEXICO
MAY, 2003

PROJECT NUMBER 1008-078
APPLICATION NUMBER 0308B-00000-00718

APPROVALS

Traffic Engineer, City of Albuquerque
Public Works Department
Date 6-5-03

City Engineer, City of Albuquerque
Public Works Department
Date

Utility Development Division, City of Albuquerque
Public Works Department
Date

Albuquerque Metropolitan Arroyo Flood
Control Authority
Date

City Engineer, City of Albuquerque
Public Works Department
Date

Property Management, City of Albuquerque
Date

Parks and Recreation, City of Albuquerque
Date

Middle Rio Grande Conservancy District
Date

APPROVAL as specified by the Albuquerque Subdivision Ordinance

Chair, Albuquerque Development Review Board
Date

GENERAL NOTES

- Bearings are grid based upon the New Mexico State Plane Coordinate System, Central Zone (NAD 27). Grid bearings for all lines shown herein shall be given to the nearest second. All centerline monumentation will be set by the City of Albuquerque, Bernalillo County, New Mexico, and will be set flush with the final asphalt lift.
- Distances are ground.
- Record plot bearings and distances where they differ from those measured by field survey are shown in parentheses ().
- All corners are a 5/8" rebar and cap stamped "HUGO L.S. 9750" unless otherwise indicated herein.
- Albuquerque City Zone Atlas page E-12.
- All street centerline monumentation shall be installed at all centerline PC's, PT's, angle points and street intersections and shown thus (). All centerline monumentation will be set by the City of Albuquerque, Bernalillo County, New Mexico, and will be set flush with the final asphalt lift.
- Monuments will be offset at all points of curvature, points of tangency, street intersections, and all other angle points to allow use of centerline monumentation.
- U.C.L.S. Log Number 2003210274.
- Total plot acreage = 3.3365 Acres, more or less.
- Number of existing Lots = 1
- Number of New Lots created = 8
- Number of New Parcels created = 1
- Total Mileage of full width streets created = 0.075

DISCLOSURE STATEMENT

The purpose of this replat is to: 1.) Create the 8 residential lots as shown herein; 2.) Dedicate the additional street right of way as shown herein; 3.) Show the portion of existing Temporary easement vacated by 0308B-00000-00718(VPE) and; 4.) Grant the various Public and Private easements as shown and noted herein.

LEGAL DESCRIPTION

Lot numbered Six (6) of Riverside Plaza, as the same is shown and designated on the plat entitled "LOTS 2 THRU 8 AND TRACTS 1 THRU 8, RIVERSIDE PLAZA (BEING A REPLAT OF A WESTERN PORTION OF TRACT A-1-NORTH, RANGE 2 EAST, NEW MEXICO PRINCIPAL MERIDIAN, BERNALILLO COUNTY, NEW MEXICO," filed in the office of the County Clerk of Bernalillo County, New Mexico on May 18, 1999 in Plat Book 99C, Page 121.

Said lot contains 3.3365 acres, more or less.

FREE CONSENT AND DEDICATION

WE, the undersigned, do hereby consent and dedicate the PRESERVE (BEING A REPLAT OF LOT 6, RIVERSIDE PLAZA) WITHIN SECTION 25, TOWNSHIP 11 NORTH, RANGE 2 EAST, NEW MEXICO PRINCIPAL MERIDIAN, CITY OF ALBUQUERQUE, BERNALILLO COUNTY, NEW MEXICO with the free consent of all owners and proprietor(s) hereof. Said owner(s) and proprietor(s) do hereby dedicate the additional street right of way for Winter Haven Road N.W. to the City of Albuquerque in fee simple with all private and public easements as shown herein. Said owner(s) and proprietor(s) do hereby represent that they are so authorized to act.


OWNER
Winter Haven Partners, LLC
by *[Signature]*
Joy Rembe

ACKNOWLEDGMENT

STATE OF NEW MEXICO
COUNTY OF BERNALILLO SS


This instrument was acknowledged before me on this 3 day of June, by Joy Rembe.

Notary Public
[Signature]
My commission expires 8-11-04

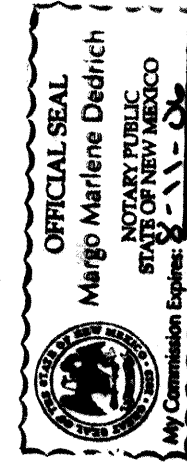

SHEET 1 OF 3

SURVOTEK, INC.
Consulting Surveyors
6043 Paradise Blvd. N.E. Albuquerque, New Mexico 87114
Phone: 505-897-3366
Fax: 505-897-3377

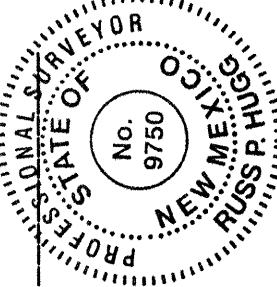

SURVEYORS CERTIFICATION

I, Russ P. Hugo, New Mexico Professional Surveyor Number 9750, hereby certify that this plat of survey was prepared from field notes of an actual survey conducted by me and that the same conform to the standards for the State of New Mexico as adopted by the New Mexico State Board of Registration for Professional Engineers and Land Surveyors. I am duly qualified to perform the requirements for surveys and monumentation of the Bernalillo County and City of Albuquerque Subdivision Ordinance and that the same conform to the best of my knowledge and belief.

[Signature]
Russ P. Hugo
NMPS No. 9750
May 14, 2003

THE PRESERVE


(BEING A REPLAT OF LOT 6, RIVERSIDE PLAZA)

WITHIN
SECTION 25, TOWNSHIP 11 NORTH, RANGE 2 EAST
NEW MEXICO PRINCIPAL MERIDIAN
CITY OF ALBUQUERQUE
BERNALILLO COUNTY, NEW MEXICO
MAY, 2003

LINE	LENGTH	BEARING
L1	32.09	N61°38'17"W
L2	34.50	N61°32'28"W
L3	23.38	N61°38'17"W
L4	23.38	N61°38'17"W
L5	22.34	N61°38'17"W
L6	9.26	S40°41'00"E
L7	15.00	S40°41'00"E
L8	21.89	S40°41'00"E

CURVE TABLE

CURVE	LENGTH	RADIUS	TANGENT	CHORD	CHORD BEARING	DELTA
C1	12.08	20.00	6.23	11.90	S45°40'13"W	24°42'34"
C2	65.78	49.67	38.72	61.08	N25°02'18"E	75°52'48"
C3	8.63	20.00	4.36	8.56	S40°43'00"W	09°54'27"
C4	3.45	20.00	1.73	3.45	S88°01'30"W	34°37'07"
C5	16.33	30.00	8.24	16.28	N37°33'40"E	18°42'57"
C6	65.75	250.00	33.07	65.56	N20°42'08"E	150°41'09"
C7	101.52	250.00	51.47	100.83	S24°48'04"W	237°16'09"
C8	16.21	20.00	8.58	15.77	N59°31'08"E	46°22'07"
C9	104.83	250.00	51.47	104.13	S24°48'04"W	237°16'09"
C10	104.83	250.00	51.47	104.13	S24°48'04"W	237°16'09"
C11	98.39	238.00	49.90	97.68	S25°00'34"W	234°11'01"
C12	68.91	262.00	34.65	68.71	N20°42'08"E	150°41'09"
C13	20.25	62.00	10.22	20.16	N37°35'40"E	18°42'56"
C14	15.03	20.00	7.51	14.98	S29°51'32"W	34°30'30"
C15	15.03	20.00	7.51	14.98	S29°51'32"W	34°30'30"
C16	12.41	38.00	6.26	12.36	N37°33'40"E	18°42'56"
C17	10.43	20.00	5.34	10.31	N10°05'41"E	28°52'40"
C18	42.61	262.00	21.35	42.56	S18°34'55"W	91°19'02"
C19	15.04	585.00	7.52	15.04	S24°43'31"W	1°31'29"
C20	33.03	262.00	16.54	33.01	S18°44'36"W	21°13'23"
C21	11.30	262.00	5.65	11.30	S21°35'25"W	2°28'15"
C22	16.51	262.00	8.26	16.51	S24°37'52"W	3°36'39"

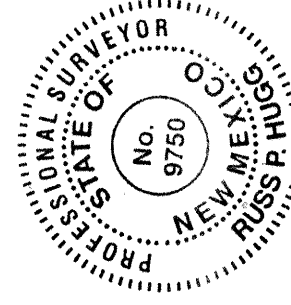

SHEET 2 OF 3

SURVOTEK, INC.
Consulting Surveyors
6043 Paradise Blvd. N.E. Albuquerque, New Mexico 87114
Phone: 505-897-3366
Fax: 505-897-3377

SURVEYORS CERTIFICATION

I, Russ P. Hugg, New Mexico Professional Surveyor Number 9750, hereby certify that the as-built information shown hereon is the result of an actual field survey performed by me or under my direct supervision and that the same is true and correct to the best of my knowledge and belief.

Russ P. Hugg
NMPS No. 9750
12-17-2003




PROPOSED SOLID
WASTE COLLECTION
AREA, TYP.

PROPOSED 8'
CMU WALL

WINTER HAVEN ROAD N.W.
(60' R.O.W.)

GATED ENTRANCE
(SWING OR ROLL
GATES)

EXST. 50' TEMPORARY
CUL-DE-SAC EASEMENT
(5/18/99, 99C-121)
[POSSIBLE VARIATION]

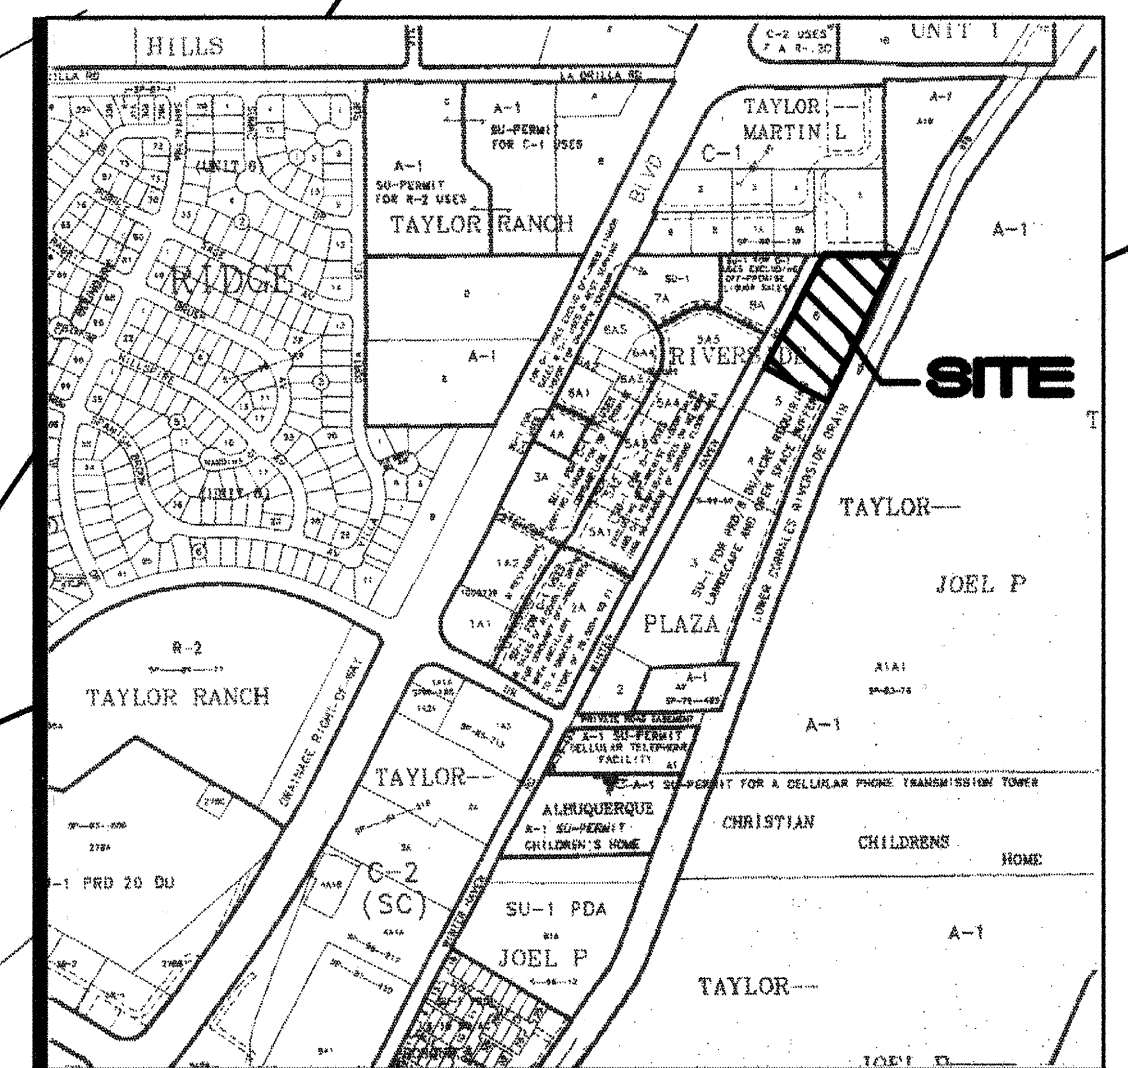

VICINITY MAP

PROPOSED 8'
CMU WALL

ZERO BUILDING SETBACK ALONG COMMON
BUILDING ENVELOPE AND NORTH
PROPERTY LINE.

20' EXST. WATERLINES & PEDESTRIAN
ACCESS EASEMENT (5/18/99, 99C-121)
EASEMENT AREA MAY BE DEDICATED TO
THE CITY OF ALBUQUERQUE, PARKS &
REC. AT TIME OF FINAL PLAT

SCALE:
1"=20'

20 15 10 5 0 20 40 FEET

TRACT A-1
LANDS OF JOEL TAYLOR
Filed 3/11/80 C16-104

LOT 5
RIVERSIDE PLAZA
(05-18-99, BK 99C-PG 121)

OWNER:
THE STROSNIDER COMPANY
6121 INDIAN SCHOOL RD. NE STE. 275
ALBUQUERQUE, NM 87110

ENGINEER:
ISAACSON & ARFMAN P.A.
128 MONROE ST. NE
ALBUQUERQUE, NM 87106

SURVEYOR:
SURV-TEK INC.
5643 PARADISE BLVD. NW
ALBUQUERQUE, NM 87114

LEGAL DESCRIPTION:
LOT 6, RIVERSIDE PLAZA, BERNALILLO
COUNTY, NEW MEXICO (MAY 18, 1999;
BOOK 99C, PAGE 121)

BENCHMARK:
ACS "NM-448-NTA", NEW MEXICO STATE PLANE,
CENTRAL ZONE (NAD 1927)
ELEV. = 5006.41

FLOOD ZONE DESIGNATION:
ZONE X, THIS SITE IS OUTSIDE OF THE 100 YR.
FLOOD PLAIN AS DESIGNATED ON PANEL 116 OF 825,
FEMA FLOOD INS. RATE MAPS, SEPTEMBER 20, 1996.

EXISTING CONDITIONS:
LOT 6 IS 100% UNDEVELOPED WINTERHAVEN RD.
NW(60' R.O.W.) IS FULLY DEVELOPED EXCEPT FOR
SIDEWALK AND ABUTS THE WESTERLY PROPERTY LINE.
NO STORM WATERS ARE ACCEPTED FROM THE WEST.
MINOR SHEET FLOWS CURRENTLY ENTER THE SITE ON
THE NORTH AND VERY MINIMAL STORM WATER CROSS
ONTO THE SITE FROM THE SOUTH. ALL STORM
WATERS GENERATED ON THIS SITE CURRENTLY SHEET
FLOW TO THE EAST WHERE THEY ARE RETAINED BY
NATURE FEATURES OR DISCARDED INTO THE LOWER
CORRALES MAIN DRAIN.

PROPOSED CONDITIONS:
THE PROPOSED EIGHT(8) LOT SUBDIVISION
WILL CONSIST OF DETACHED SINGLE FAMILY
RESIDENCES. ACCESS OFF OF WINTER HAVEN
RD. SHALL CONSIST OF A SINGLE VEHICULAR
ENTRANCE WITH A PAVED INTERNAL COMMON
ACCESS WAY ALONG THE EASTERLY PORTION
OF THE INTERIOR SIX(6) LOTS. STORM WATERS
GENERATED FROM THE WESTERLY 100 FEET
SHALL BE COLLECTED IN THE PAVED ACCESS
WAY AND CONVEYED TO A SINGLE DISCHARGE
POINT ONTO WINTER HAVEN RD. THE
REMAINING SITE STORM WATERS ARE ALLOWED
TO SHEET FLOW TO THE EAST AND FINALLY
RETAINED ONSITE ALONG THE EASTERLY
PROPERTY LINE WITHIN INDIVIDUAL LOT
RETENTION PONDS. PONDS ARE SIZED TO
HOLD THE 10 DAY-100 YR. STORM EVENT.
POND REQUIRED VOLUMES AND CAPACITIES
ARE PRESENTED ON THE FOLLOWING TABLE:

DRAINAGE CALCULATIONS SUMMARY:
PRECIPITATION ZONE: 1

BASIN "W" (Ac=1.157Ac.)			
LAND TREAT.	%	Ac.	CFS/Ac
B	25	0.29	2.03
D	75	0.86	4.37
			Q _{avg} = 4.35

BASIN "E-1" (Ac=1.612Ac.)			
LAND TREAT.	%	Ac.	INCHES
B	38	0.93	0.67
D	62	0.68	1.97
			Val. ft. = 7125 cu. ft.

BASIN "E-2" (Ac=0.510Ac.)			
LAND TREAT.	%	Ac.	INCHES
B	68	0.93	0.67
D	32	0.68	2x1.97
			Val. ft. = 1240

REQUIRED POND RETENTION			
LAND TREAT.	%	Ac.	INCHES
B	68	0.93	2262
D	32	0.68	9726
			Val. ft. = 11,988 cu. ft.

STORM WATERS SHALL BE ALLOWED TO DISCHARGE
OFF OF THE SIDE-SLOPE PER HISTORICAL RUNOFF
PATTERNS.

LOT NO.	POND CAP. (cu. ft.)	REQUIRED VOL. (100mm-10yr.)
1	1762	1442
2	1638	1443
3	1520	1442
4	1506	1443
5	1579	1442
6	1500	1443
7	1508	1442
8	1988	1891

* PONDS SHALL BE FREE FORM AND RECONFIGURED
TO BE IN CORPORATED INTO THE FINAL SITE
LANDSCAPING WHILE PROVIDING EQUAL POND
CAPACITY.

LEGEND

EXISTING CONTOUR	INVERT ELEVATION
PROPOSED CONTOUR	DRAIN LINE WITH SIZE
PROPOSED SPOT ELEVATION	STORM DRAIN MANHOLE
FLOW ARROW	FLOW ARROW
FINISH FLOOR ELEVATION	EXISTING FLOW
SIDEWALK CULVERT	SHEET FLOW
TOP OF CURB ELEVATION	EDGE OF PAVEMENT
PROPOSED FLOODWALL	FLOWLINE
AREA DRAIN	PAD GRADE

Sanitary Sewer Manhole
Rim Elev. = 4986.47 4986.4
(Unable To Open Manhole)
INV OUT (6) = 4972.21
INV IN (5) = 4973.01



THE PRESERVE
LOT 6, RIVERSIDE PLAZA
GRADING/ DRAINAGE
PLAN

ISAACSON & ARFMAN, P.A.
Consulting Engineering Associates
128 Monroe Street N.E.
Albuquerque New Mexico

12766RD.DWG/its 07/15/03

SHEET 3 OF 8

716181

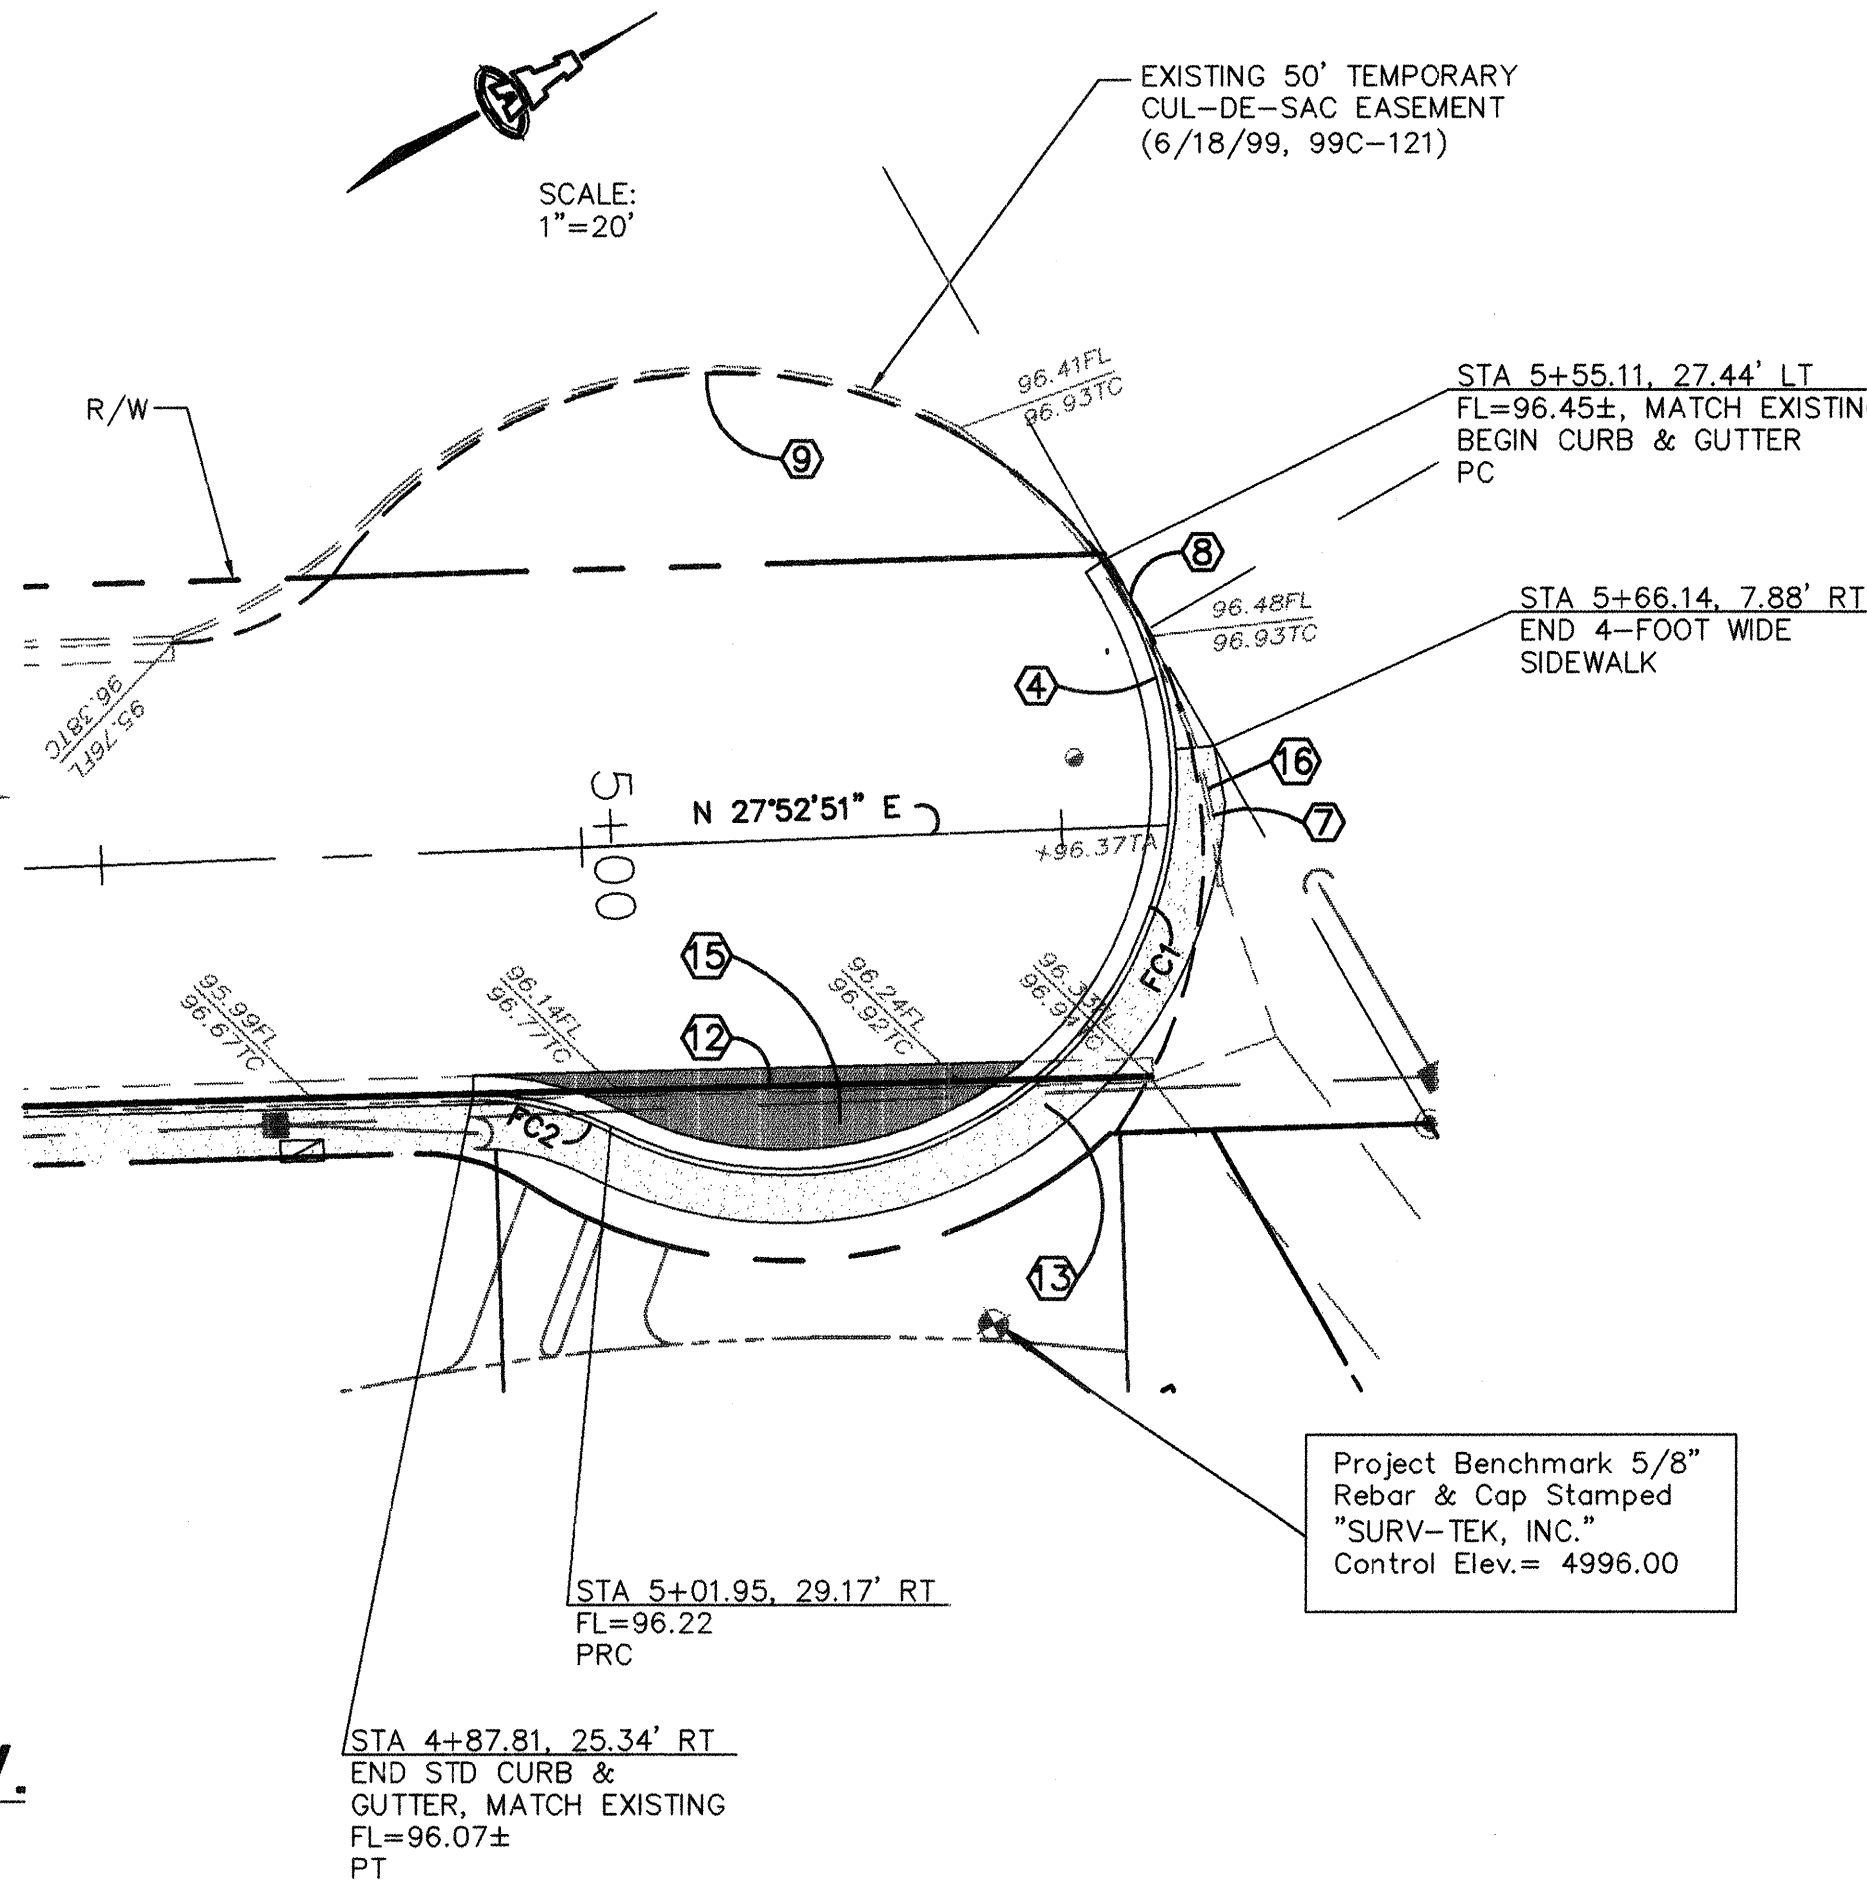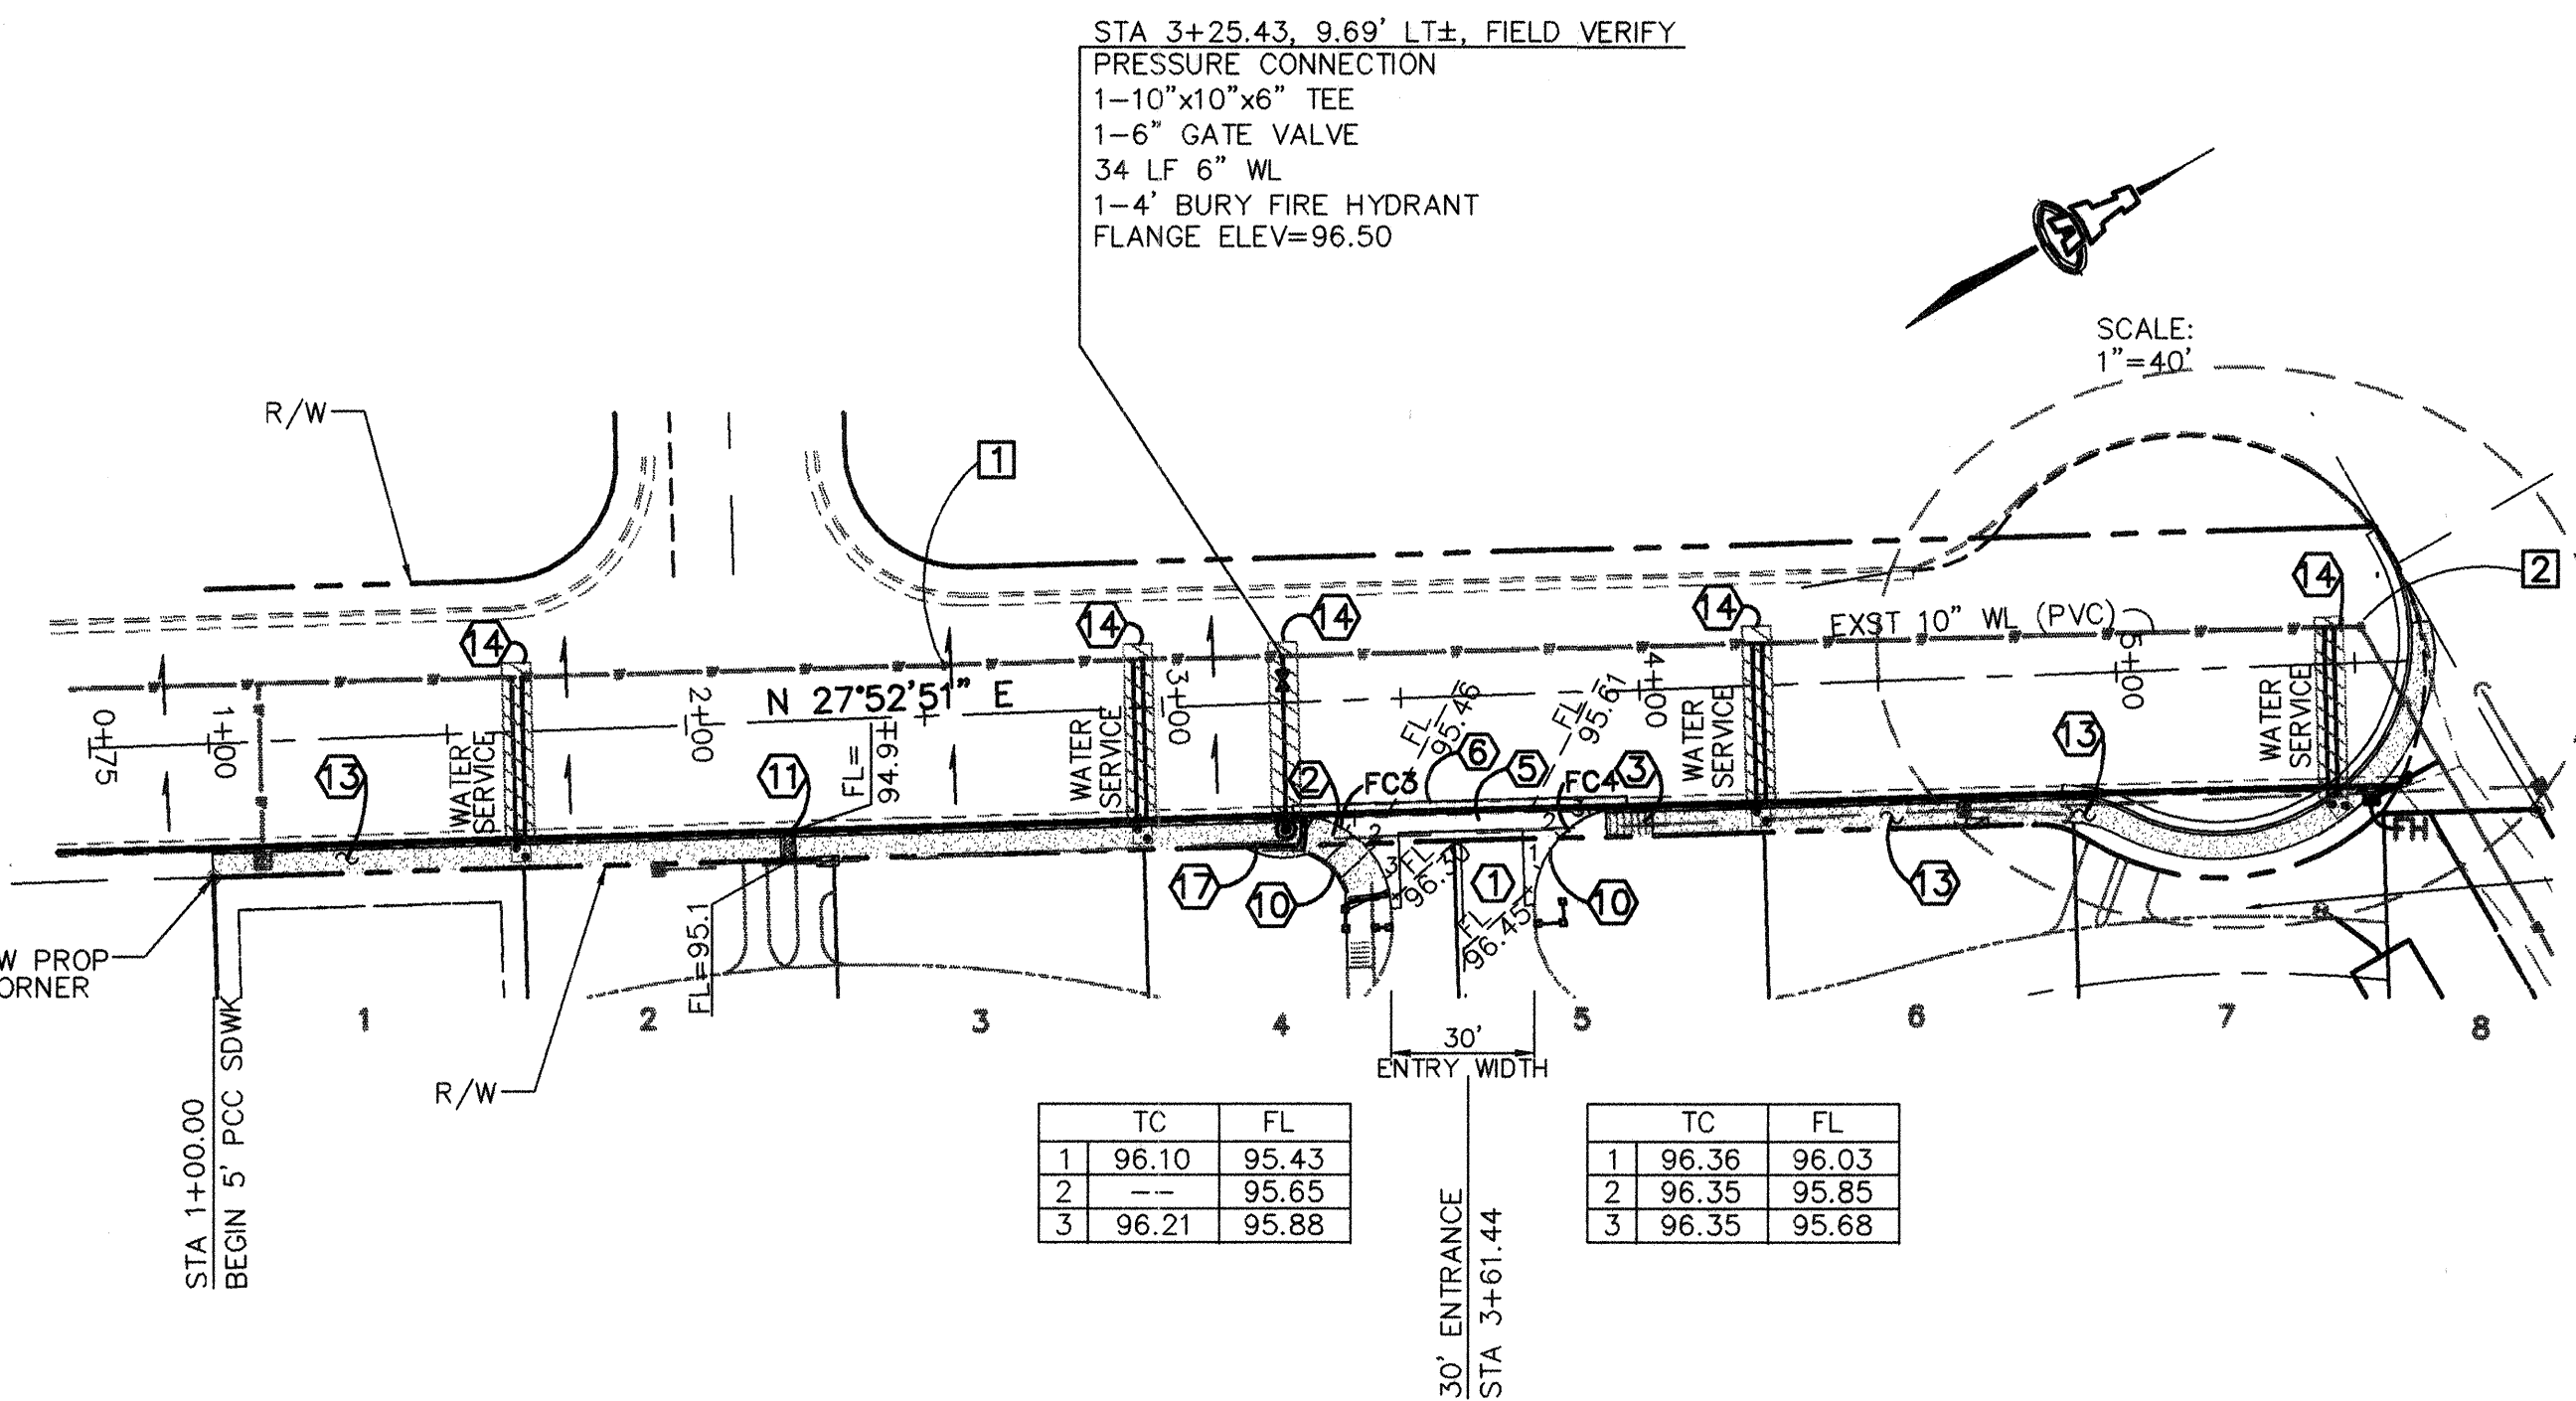

WATER SERVICE TABLE

LOT NO.	STATION
	WATER, LENGTH
1	1+65.00, 35'
2	
3	2+95.00, 35'
4	
5	4+25.00, 35'
6	
7	5+44.50, 36'
8	

ALL WATER SERVICES ARE DOUBLE

WATER SHUT-OFF PLAN

SHUT-OFF VALVES 1 & 2 TO PROVIDE NON-PRESSURE CONNECTION. THE CONTRACTOR SHALL CONTACT WATER SYSTEMS DIVISION (857-8200) 7 WORKING DAYS PRIOR TO SHUT-OFF OR TURN-ON AT VALVES. ONLY CITY PERSONNEL ARE ALLOWED TO OPERATE VALVES.

RESTRAINED JOINT LENGTHS, L _r , FOR TEES, (FT.)		
ALL JOINTS AT THE TEE MUST BE RESTRAINED.		
SIZE	RUN	BRANCH
12x12x12	15	17
12x12x10	10	18
12x12x8	6	19
12x12x6	3	19
12x12x4	1	19
10x10x10	12	18
10x10x8	8	15
10x10x6	4	16
10x10x4	2	4
8x8x8	9	20
8x8x6	5	17
8x8x4	2	15
6x6x6	6	20
6x6x4	2	20

RESTRAINED JOINT LENGTHS, L _r , FOR HORIZONTAL BENDS, VALVES, AND DEAD ENDS, (FT.)					
SIZE	HORZ. BENDS				VALVES & DEAD ENDS
	90°	45°	22 1/2°	11 1/4°	
12	30	12	6	3	85
10	26	11	5	3	72
8	22	9	4	2	60
6	17	7	3	2	46
4	12	5	2	1	32

RESTRAINED JOINT LENGTHS, L _r , FOR REDUCERS, (FT.)					
MINIMUM UNOBSTRUCTED, STRAIGHT-RUN LENGTH: RESTRAIN EITHER LARGE PIPE, OR SMALL PIPE.					
SIZE	LARGE SIDE	SMALL SIDE	SIZE	LARGE SIDE	SMALL SIDE
12x10	25	30	10x6	44	73
12x8	45	68	10x4	58	141
12x6	62	121	8x6	25	33
12x4	74	213	8x4	43	83
10x8	24	30	6x4	24	35

THIS TABLE IS BASED UPON THE FOLLOWING CRITERIA:

DEPTH OF BURY 3.0 FT. MINIMUM
FACTOR OF SAFETY 1.25
MATERIAL PVC PIPE
SOIL TYPE: GM/SM - SILTY GRAVELS AND SILTY SANDS, GRAVEL-SAND-SILT MIXTURES.
TEST PRESSURE 150 PSI
TRENCH TYPE 4: PIPE BEDDED IN SAND, GRAVEL, OR CRUSHED STONE TO DEPTH OF 1/8 PIPE DIAMETER, 4 INCH MINIMUM; BACKFILL COMPACTED TO TOP OF PIPE.

DIFFERENT CRITERIA, E.G., DUCTILE IRON PIPE, GREATER DEPTH OF BURY, ETC., WILL REQUIRE DIFFERENT RESTRAINED LENGTHS. THESE MUST BE CALCULATED BY A QUALIFIED PROFESSIONAL ENGINEER AND APPROVED BY THE PUBLIC WORKS DEPARTMENT.

RESTRAINED JOINT LENGTHS FOR WATERLINE FITTINGS

WINTERHAVEN ROAD N.W.

TACK COAT AS REQUIRED BY THE ENGINEER BETWEEN ALL ASPHALT/AGGREGATE MATERIAL LIFTS.

2 1/2" ASPHALT CONCRETE, 1800 LBS. STABILITY, TYPE B GRADATION.


5" BITUMINOUS TREATED BASE COURSE

FINISH SURFACE OF SUBGRADE SHALL BE MOISTURE CONTROLLED AT COMPACTION MOISTURE RANGE, OR PRIME COAT APPLIED AS REQUIRED BY THE ENGINEER UNTIL NEXT/FINAL SURFACE IS COMPLETED. SUBGRADE PREPARATION SHALL BE PERFORMED AFTER ALL SUBSURFACE R/W UTILITIES CONSTRUCTION IS COMPLETED.

1' SUBGRADE SOIL, R-VALUE > 50 PLACED IN 2-6" COMPACTED LIFTS. 95% MIN. COMPACTION, AT OPT. MOISTURE ± 2.0% ASTM D1557, OR OPT. MOISTURE, TO +4% ASTM D698 FOR SOIL W/35% OR MORE MATERIAL PASSING THE NO. 200 SIEVE. SOIL NOT HAVING THE MIN. R-VALUE OF 50, SHALL BE REMOVED TO A DEPTH OF 2 FEET AND REPLACED BY THE CONTRACTOR WITH SUITABLE MATERIAL OR A PAVEMENT SHALL BE DESIGNED TO ACCOMMODATE THE EXISTING R-VALUE PER C.O.A. STANDARD SPECIFICATIONS.

NOTES:

- ALL MECHANICAL JOINTS SHALL BE RESTRAINED AT THE FITTING.
- THE CONTRACTOR SHALL PROVIDE A MINIMUM PIPE LENGTH OF 20 LF FROM ALL MECHANICAL JOINTS. ALL PIPE JOINTS WITHIN 20 LF OF A MECHANICAL JOINT SHALL BE RESTRAINED AT THE CONTRACTOR'S EXPENSE.
- THE CONTRACTOR SHALL RESTRAIN ALL PIPE JOINTS IN THE SPECIFIED DISTANCE LISTED IN THE TABLE ON THIS SHEET.
- THE CONTRACTOR SHALL RESTRAIN ALL FIRE HYDRANT JOINTS FROM THE TEE ON THE MAIN TO THE FIRE HYDRANT FLANGE.

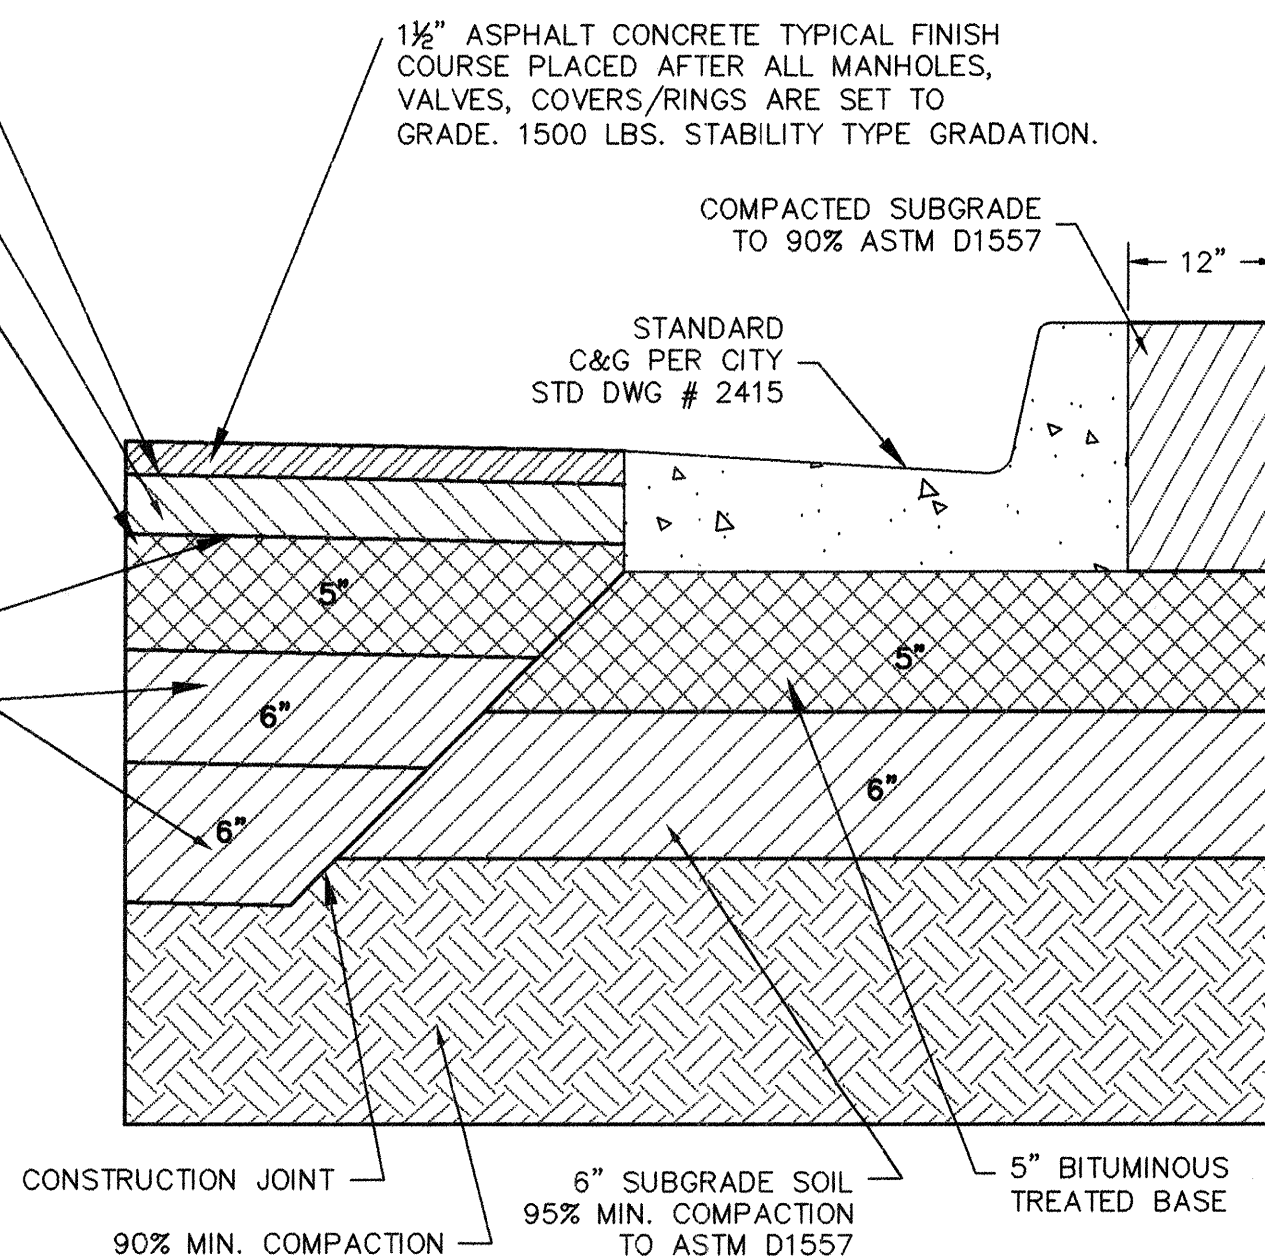

MATCH EXISTING PAVING, REFER TO CITY PROJECT #608982

WINTER HAVEN ROAD PAVING SECTION
NTS

GENERAL UTILITY NOTES

- CONSTRUCT ALL DOUBLE WATER SERVICES PER COA STD DWG #2361, #2362, & #2363. SEE SHEET 6 FOR DRAFT COA STD DWG #2362.
- SEE THIS SHEET FOR WATER SHUT-OFF PLAN.
- SEE THIS SHEET FOR RESTRAINED JOINT LENGTHS FOR WATER LINE FITTINGS.
- CONSTRUCT FIRE HYDRANTS PER DESIGNATED DEPTHS & LENGTHS PER COA STD DWG #2340.
- SEE COA DRAFT STD DWGS #2326 & 2328 ON SHEET 6 FOR VALVE RING & COVER DETAIL.

KEYED PAVING NOTES

- CONSTRUCT PRIVATE ENTRANCE PER COA STD DWG #2426.
- CONSTRUCT HANDICAP RAMP PER COA STD DWG #2441, CASE II.
- CONSTRUCT UNIDIRECTIONAL HANDICAP RAMP PER COA STD DWG #2426.
- STANDARD CURB & GUTTER PER COA STD DWG #2415.
- CONSTRUCT PCC VALLEY GUTTER 6' WIDE, 1 1/2" INVERT PER COA STD DWG #2420.
- REMOVE & DISPOSE 70 LF DEPRESSED CURB & GUTTER.
- REMOVE & DISPOSE 37 LF ASPHALT CURB.
- TRANSITION FROM 6-INCH HIGH ASPHALT CURB TO 8-INCH HIGH STD CURB & GUTTER OVER 5 FEET.
- EXISTING 6-INCH HIGH ASPHALT CURB.
- TRANSITION FROM STANDARD TO MOUNTABLE CURB THRU RETURN PER COA STD DWG #2418.
- STA 2+20.54, 23' RT--CONSTRUCT 1-24" SIDEWALK CULVERT PER COA STD DWG #2236.
- REMOVE & DISPOSE 71 LF STD CURB & GUTTER.
- CONSTRUCT 5-FOOT WIDE SIDEWALK PER COA STD DWG #2430.
- SAWCUT, REMOVE AND REPLACE 25 SY PAVING PER COA STD DWG #2465. HAND BORE WATER SERVICE OPENING BELOW 12" SUBGRADE. DISPLACE C&G, STONE TO BE REMOVED AND REPLACED AT CONTRACTOR'S EXPENSE.
- 32 SY PAVING--ASPHALT CONCRETE TO BE 2" THICKER THAN EXISTING ASPHALT PAVEMENT.
- TRANSITION FROM 5-FOOT TO 4-FOOT WIDE SIDEWALK OVER 5 FEET.
- PROVIDE ADDITIONAL PCC SIDEWALK TO ACCOMMODATE APPROPRIATE CLEARANCE PER C.O.A. STD. DWG. 2431.

FACE OF CURB CURVE TABLE

CURVE	RADIUS	LENGTH	DELTA
FC1	40.00	106.24	152°11'05"
FC2	30.00	14.80	28°16'09"
FC3	20.00	31.37	89°51'37"
FC4	20.00	31.36	89°50'22"

ISAACSON & ARFMAN, P.A.
Consulting Engineering Associates
128 Monroe Street, N.E.
Albuquerque, New Mexico 87103
1275PVI.DWGits 07/24/03

CITY OF ALBUQUERQUE
PUBLIC WORKS DEPARTMENT
ENGINEERING GROUP

TITLE: THE PRESERVE
WINTERHAVEN ROAD N.W.
UTILITY AND PAVING PLAN

Design Review Committee	City Engineer Approval	Mo./Day/Yr.	Mo./Day/Yr.
APPROVED JUL 30 2003 DESIGN REVIEW COMMITTEE	APPROVED SEP 16 2003 CITY ENGINEER		
City Project No.	Zone Map No.	Sheet	Of


716181

E-12

4 Of 8

AS-BUILT INFORMATION	BENCH MARKS	SURVEY INFORMATION	ENGINEER'S SEAL
CONTRACTOR: SAULS Bros. Co. Inc.	ALBUQUERQUE CONTROL SURVEY MONUMENT "7-E12"	FIELD NOTES: SURV-TEK	
WORK BY: ISAACSON & ARFMAN, P.A.	ELEV=5004.24 (NGVD 29)	1.	
DATE: 07/03			REVISIONS
DATE: 07/03			DESIGN
DATE: 07/03			DATE: 6/03
DATE: 07/03			DATE: 6/03
DATE: 07/03			DATE: 6/03


SCANNED BY
MESAREPRO

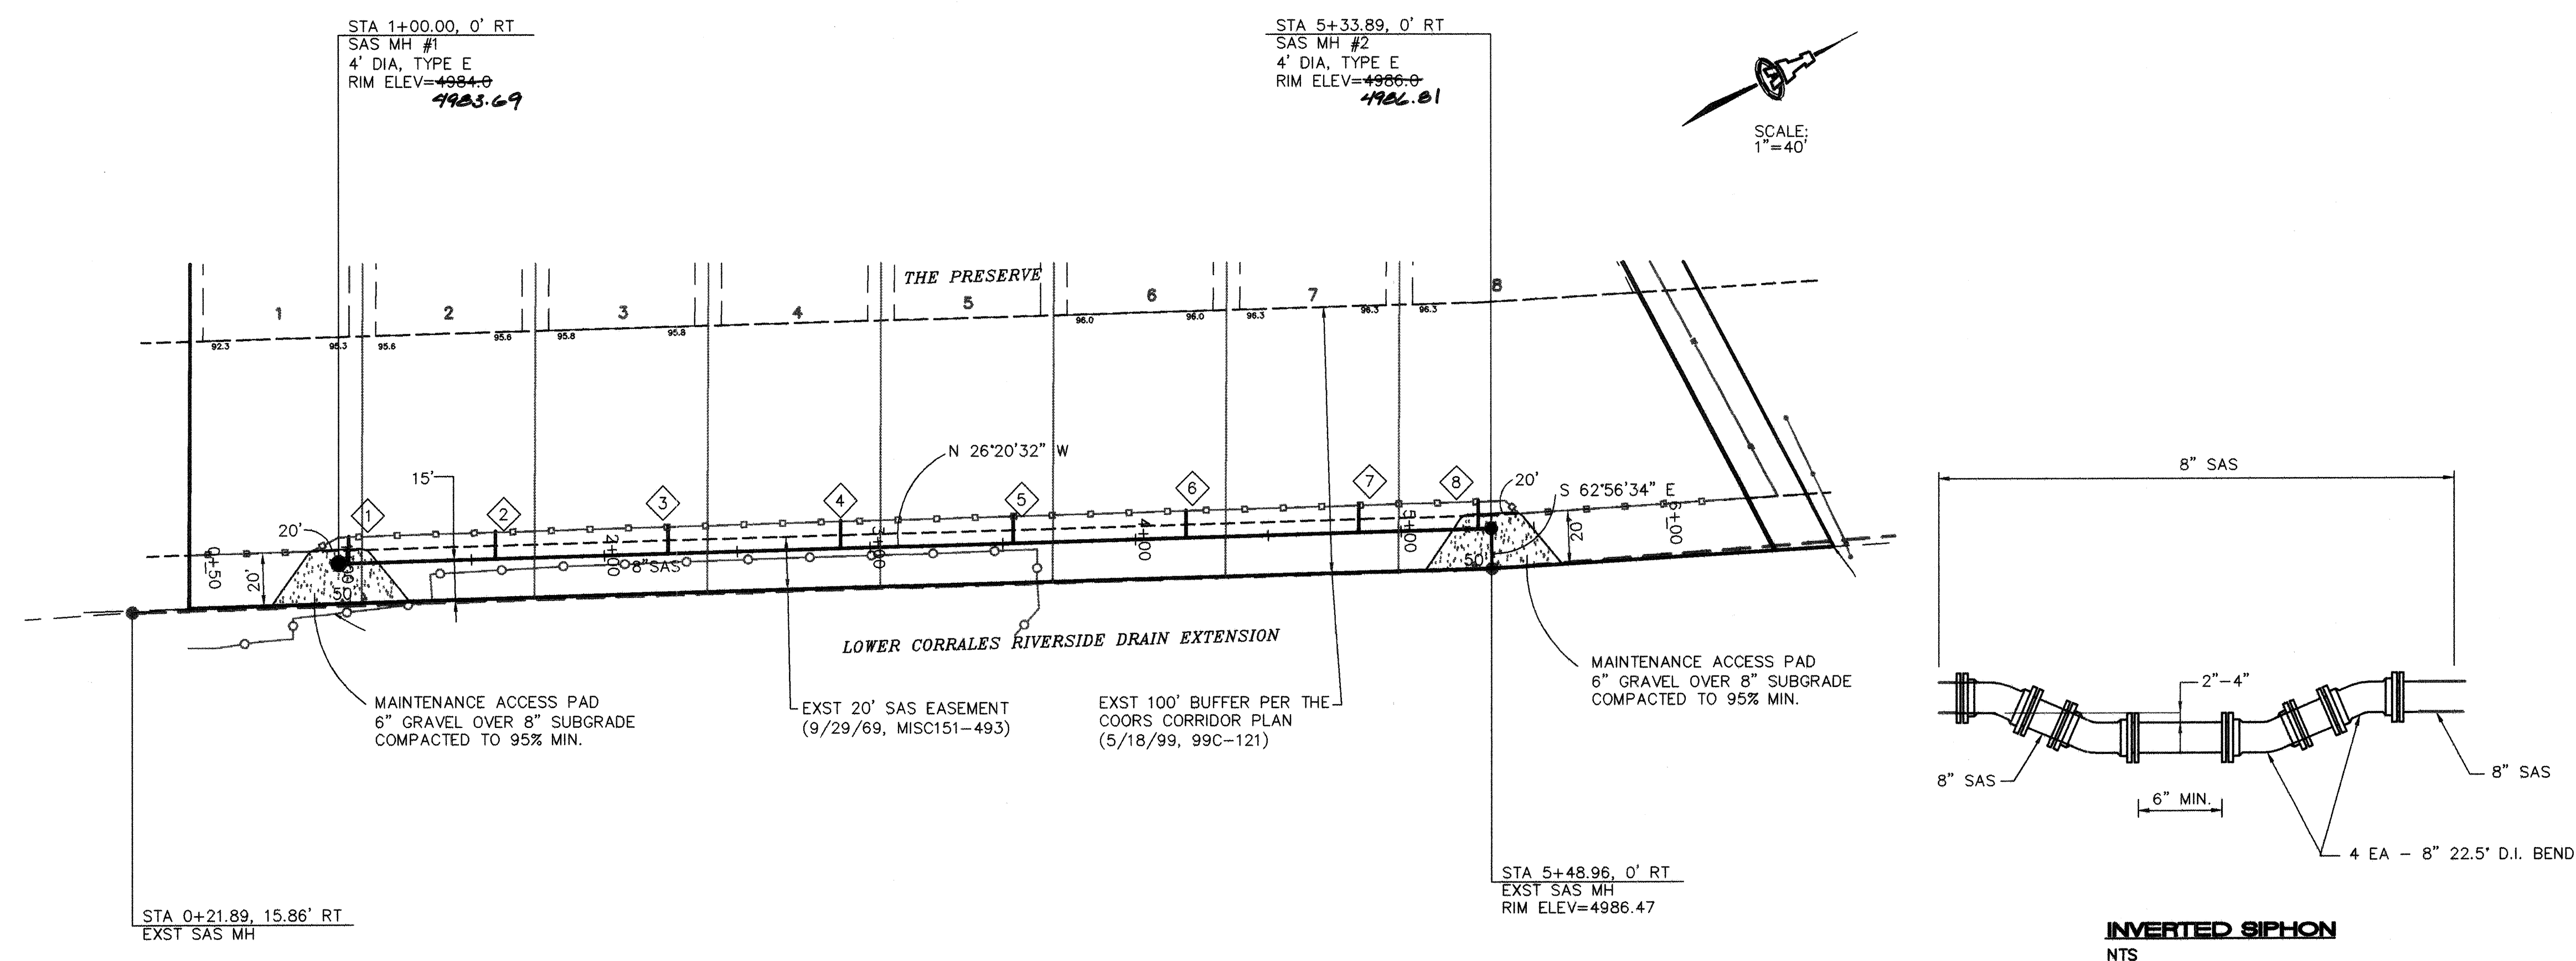

8" PUBLIC SANITARY SEWER

SCALES:
1"=40' HOR.
1"=10' VERT.

Elevation Datum: NGVD 29

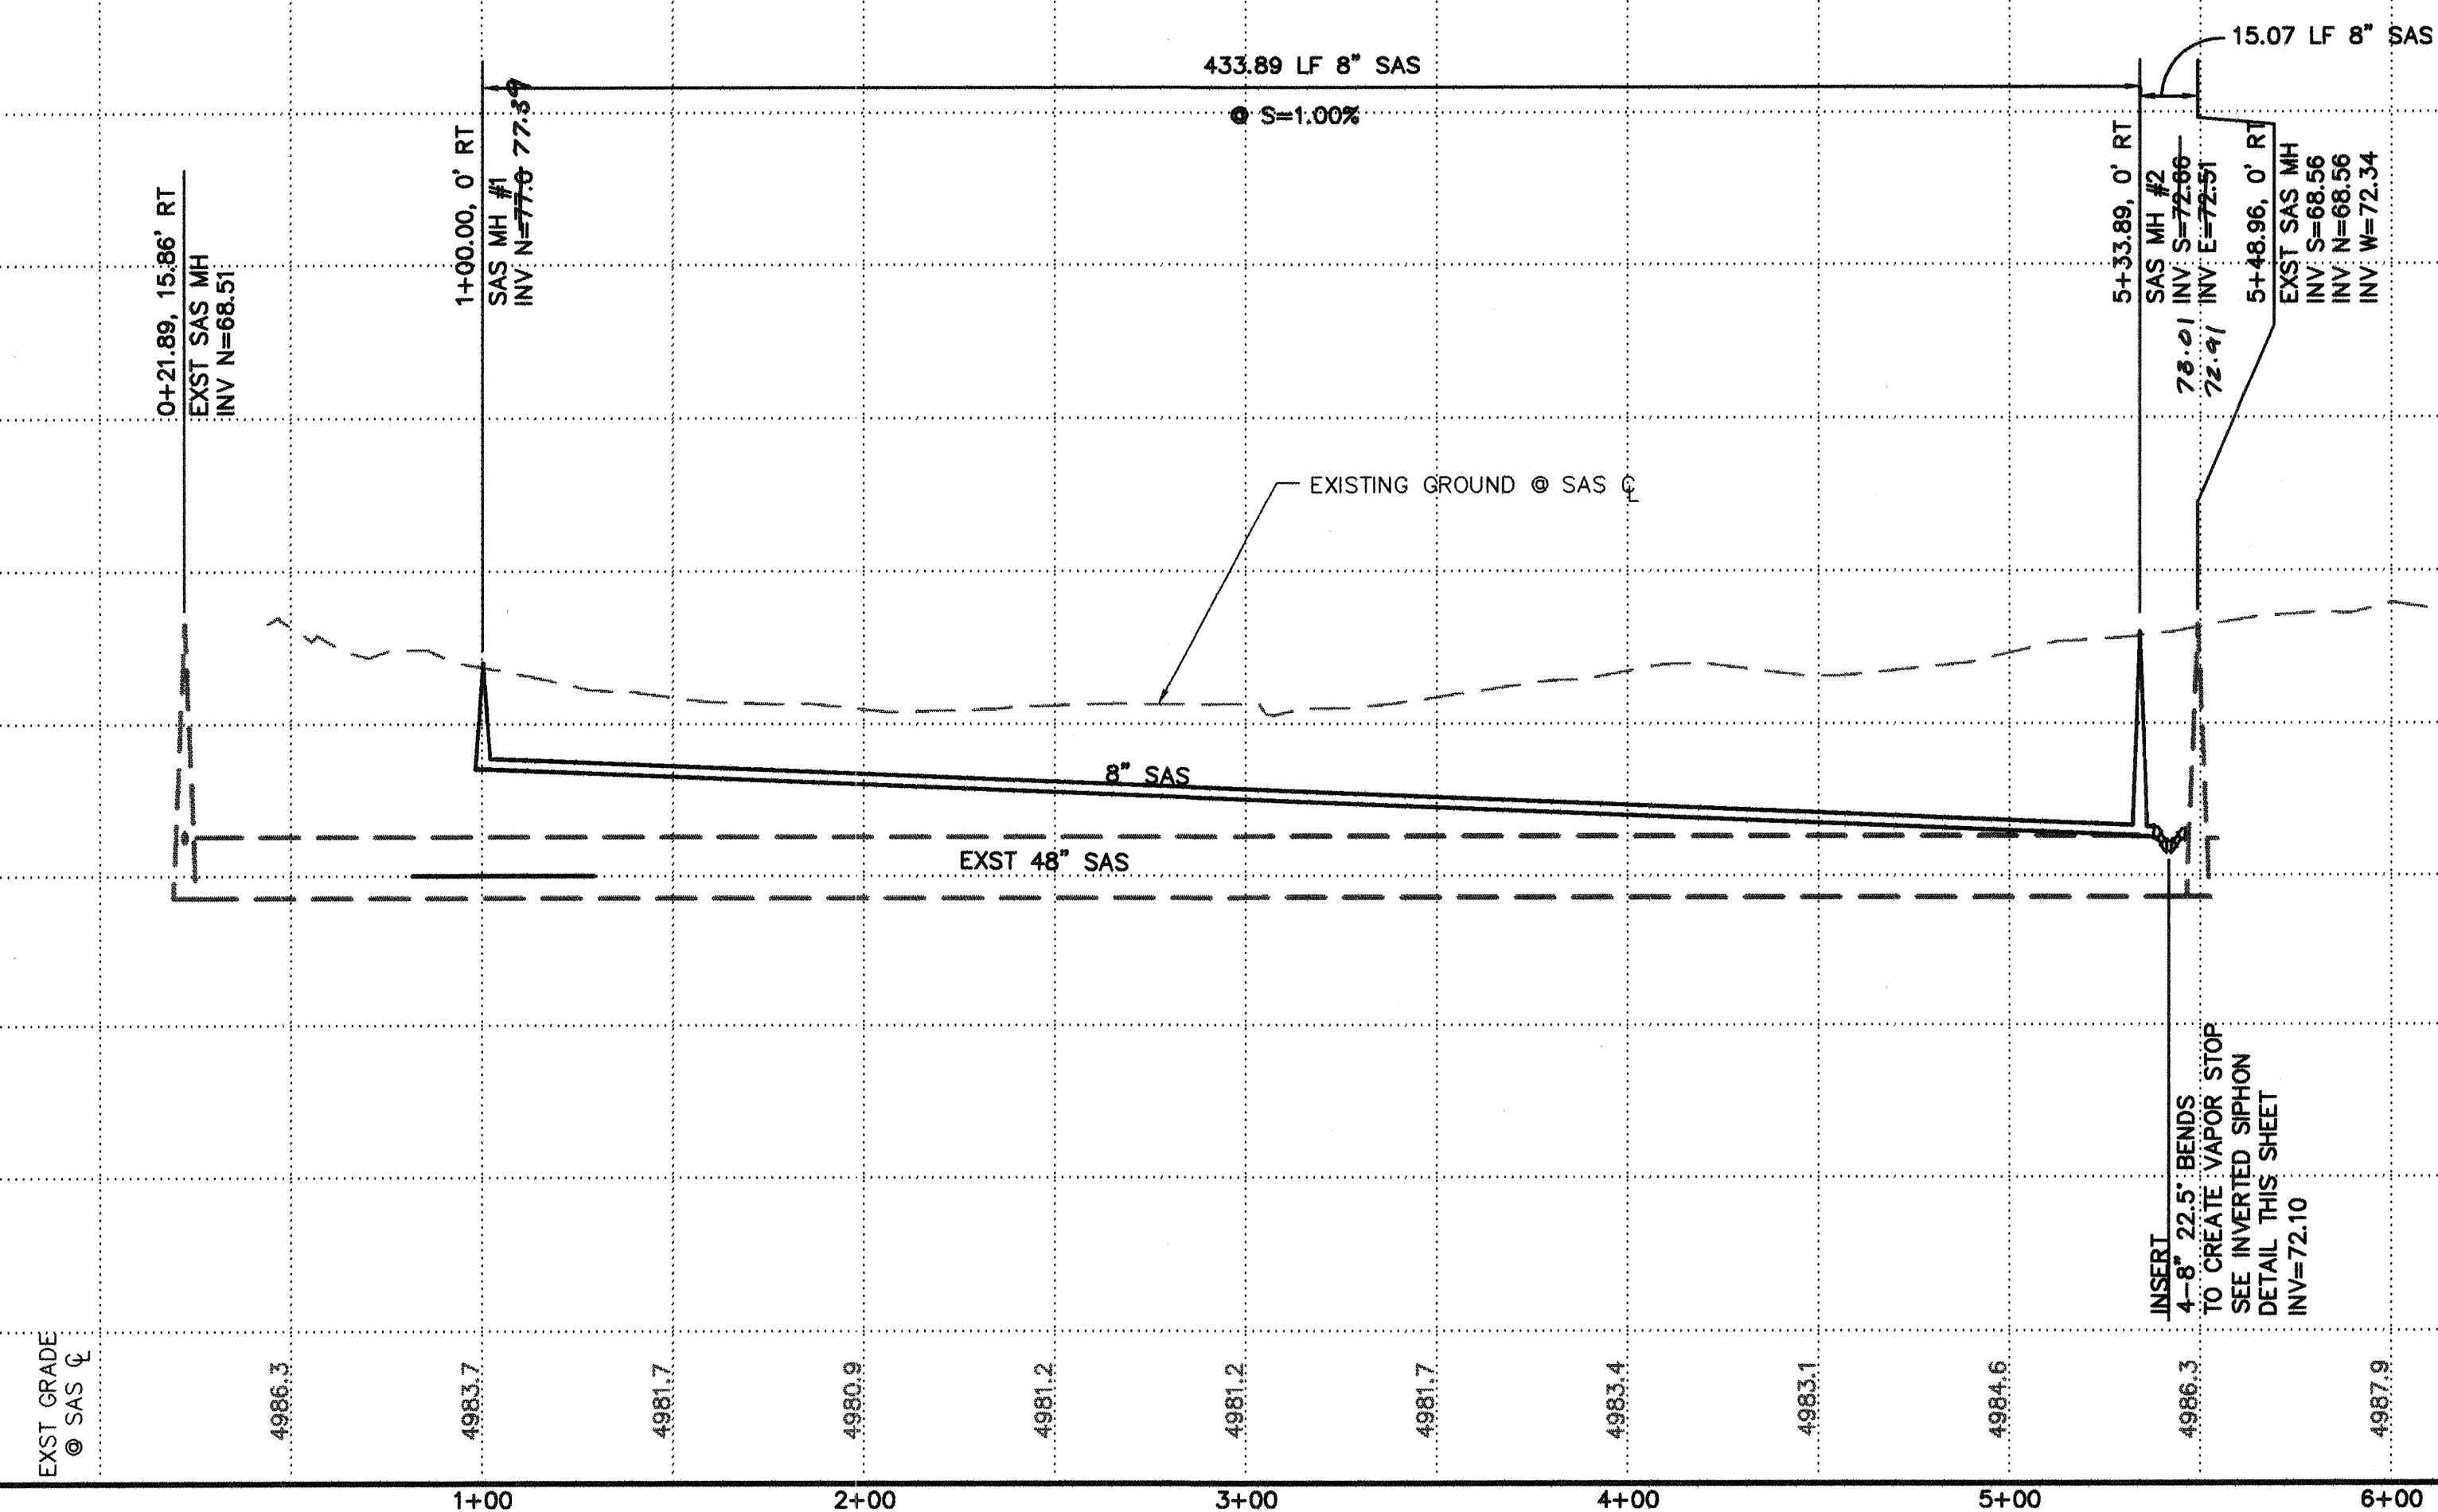


GENERAL NOTES

1. CONSTRUCT SAS SERVICES PER COA
STD DWG #2125.

SAS SERVICE TABLE

LOT NO.	STATION
	SAS, LENGTH
1	1+03.74, 10.5'
2	1+58.94, 10.5'
3	2+23.97, 10.5'
4	2+88.84, 10.5'
5	3+53.88, 10.5'
6	4+18.92, 10.5'
7	4+83.95, 10.5'
8	5+28.89, 10.5'

SURVEY INFORMATION		BENCH MARKS	AS-BUILT INFORMATION	
	FIELD NOTES		CONTRACTOR	STATUS
1.	SURV-TEK	ALBUQUERQUE CONTROL SURVEY MONUMENT "7-E12"	STAGED BY SURV-TEK	DATE 10/03
			INSPECTOR'S VERIFICATION BY ALBUQUERQUE	DATE 01/04
		ELEV=5004.24 (NGVD 29)	FIELD VERIFICATION BY SURV-TEK	DATE 11/17/03
			CONTRACTOR'S CORRECTION BY SURV-TEK	DATE 01/04
			MICRO-FILM INFORMATION	
			RECORDED BY	DATE
			MIC (COA) Inspector: <i>[Signature]</i>	

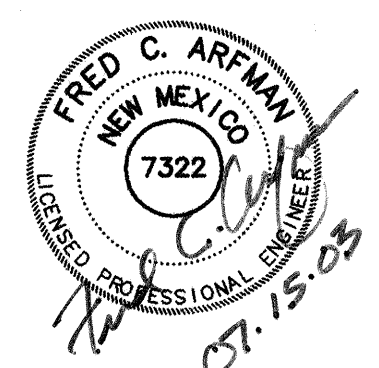[illegible]

ISAACSON & ARFMAN, P.A.
Consulting Engineering Associates
128 Monroe Street N.E.
Albuquerque New Mexico
1276UTL1.DWGrfh 7/08/03

CITY OF ALBUQUERQUE
PUBLIC WORKS DEPARTMENT
ENGINEERING GROUP

TITLE: THE PRESERVE
8" PUBLIC SANITARY SEWER

Design Review Committee		City Engineer Approval		Last Design Update	Mo./Day/Yr.	Mo./Day/Yr.
APPROVE		APPROVE				
JUL 30 2003		SEP 16 2003				
DESIGN REVIEW COMMITTEE		CITY ENGINEER				
City Project No.		Zone Map No.		Sheet	Of	
716181		E-12		5		8

CONSTRUCTION TRAFFIC CONTROL GENERAL NOTES

1. CONTRACTOR MUST OBTAIN FROM CONSTRUCTION COORDINATION AN EXCAVATION/BARRICADING PERMIT BEFORE ENGAGING IN ANY CONSTRUCTION, MAINTENANCE OR REPAIR WORK IN ANY OF THE CITY OF ALBUQUERQUE'S RIGHTS-OF-WAY. EMERGENCY WORK THAT WOULD PRESERVE LIFE OR PROPERTY IS EXCLUDED WITH THE UNDERSTANDING, THAT A PERMIT SHALL BE OBTAINED WITHIN 24 TO 48 HOURS.
2. CONTRACTOR SHALL AT THE TIME OF PERMIT REQUEST, SUBMIT FOR APPROVAL BY CONSTRUCTION COORDINATION, A TRAFFIC CONTROL PLAN DETAILING ALL EXISTING TOPOGRAPHY SUCH AS LANE WIDTHS, DRIVEWAYS, AND BUSINESS/RESIDENTIAL ACCESSES. THE TRAFFIC CONTROL PLAN SHALL INCLUDE ALL PHASES OF WORK AND SCHEDULES INVOLVED IN THE CONSTRUCTION PROJECT. ANY SEPERATE PHASES OF A CONSTRUCTION PROJECT SHALL BE GIVEN AN INDIVIDUAL PERMIT EACH. BLANKET PERMITS WILL NOT BE ISSUED.
3. THESE TYPICAL TRAFFIC CONTROL PLANS DO NOT REFLECT THE EXISTING TOPOGRAPHY SUCH AS DRIVEWAYS, LANE WIDTHS, AND BUSINESS/RESIDENTIAL ACCESSES. EVERY LOCATION THAT REQUIRES CONSTRUCTION TRAFFIC CONTROL SHALL HAVE A DETAILED TRAFFIC CONTROL PLAN SHOWING ALL EXISTING TOPOGRAPHY.
4. CONSTRUCTION SHALL NOT BEGIN UNLESS A TRAFFIC CONTROL PLAN HAS BEEN APPROVED AND VERIFIED BY CONSTRUCTION COORDINATION.
5. CONSTRUCTION COORDINATION SHALL BE NOTIFIED 48 HOURS PRIOR TO ANY TRAFFIC CONTROL CHANGES NEEDED BY CONTRACTOR, THAT WERE NOT PREVIOUSLY APPROVED. THESE TRAFFIC CONTROL CHANGES SHALL BE REQUESTED IN WRITING ACCOMPANIED WITH A TRAFFIC CONTROL PLAN REFLECTING SUCH CHANGES.
6. ALL CONSTRUCTION TRAFFIC CONTROL DEVICES SHALL COMPLY TO THE MANUAL ON UNIFORM TRAFFIC CONTROL DEVICES (MUTCD), LATEST EDITION. IT IS THE RESPONSIBILITY OF THE CONTRACTOR TO INSTALL, SERVICE AND MAINTAIN ALL TRAFFIC CONTROL DEVICES. TRAFFIC CONTROL DEVICES SHALL NOT BE REMOVED OR ALTERED IN ANY WAY WITHOUT THE APPROVAL OF CONSTRUCTION COORDINATION, PER SECTION 6A-4 OF THE MUTCD, LATEST EDITION.
7. THE CONSTRUCTION TRAFFIC CONTROL INITIAL SET-UP SHALL BE BY AN AMERICAN TRAFFIC SAFETY SERVICES ASSOCIATION (ATSSA) CERTIFIED WORKSITE TRAFFIC SUPERVISOR. THE MAINTENANCE AND SERVICING SHALL ALSO BE DONE BY AN ATSSA CERTIFIED WORKSITE TRAFFIC SUPERVISOR OR EQUIVALENT.
8. CONTRACTOR IS RESPONSIBLE TO MAINTAIN AND SERVICE ALL TRAFFIC CONTROL DEVICES 24 HOURS A DAY, 7 DAYS A WEEK THROUGHOUT LENGTH OF PROJECT. CONTRACTOR IS RESPONSIBLE THAT ALL TRAFFIC CONTROL DEVICES COMPLY WITH THE MUTCD, LATEST EDITION.
9. ALL ADVANCE WARNING SIGNS SHALL BE DOUBLE INDICATED WHENEVER THERE ARE MULTI-LANE TRAFFIC IN ANY ONE GIVEN DIRECTION AND THERE IS SUFFICIENT MEDIAN SPACE.
10. ALL BARRICADES IN ALL TAPERS AND TANGENTS SHALL BE PLACED APART, A DISTANCE MEASURED IN FEET, EQUAL TO THAT OF THE POSTED SPEED LIMIT. NO EXCEPTIONS UNLESS APPROVED BY CONSTRUCTION COORDINATION PER MUTCD SECTION 6A-4.
11. ALL WORK IN ARTERIAL ROADWAYS SHALL BE ON A CONTINUOUS 24 HOUR PER DAY BASIS UNTIL COMPLETED.
12. CONTRACTOR IS RESPONSIBLE TO PROVIDE CONSTRUCTION COORDINATION, A WEEKLY LOG OF DAILY INSPECTIONS OF BARRICADE AND MAINTENANCE SCHEDULES ON PROJECTS THAT ARE OVER ONE WEEK DURATION.
13. EQUIPMENT OR MATERIALS SHALL NOT BE STORED WITHIN 15 FEET OF A TRAVELED TRAFFIC LANE DURING NON-WORKING HOURS WITHOUT THE APPROVAL OF CONSTRUCTION COORDINATION.
14. CONTRACTOR SHALL PROVIDE AND MAINTAIN A SAFE AND ADEQUATE MEANS OF CHANNELIZING PEDESTRIAN TRAFFIC AROUND AND THROUGH THE CONSTRUCTION AREA.
15. CONTRACTOR IS RESPONSIBLE FOR OBLITERATION OF ANY CONFLICTING STRIPING AND RESPONSIBLE FOR ALL TEMPORARY STRIPING.
16. CONTRACTOR SHALL MAINTAIN ACCESS TO ALL FACILITIES, BUSINESSES AND/OR RESIDENTS AT ALL TIMES.
17. CONTRACTOR SHALL PROVIDE ACCESS SIGNS FOR BUSINESSES LOCATED WITHIN THE CONSTRUCTION AREA UNDER THE SUPERVISION OF CONSTRUCTION COORDINATION. EACH ACCESS SIGN SHALL HAVE 5 INCH, WHITE OPAQUE LETTERING ON BLUE REFLECTORIZED BACKGROUND. ACCESS SIGNS SHALL BE CONSIDERED INCIDENTAL TO THE BID AND NOT PART OF THE CONTRACT UNLESS OTHERWISE STATED. NO MORE THAN 3 BUSINESSES SHALL BE LISTED ON A ACCESS SIGN. SHOPPING CENTERS AND MALLS SHALL BE LISTED AS SUCH.
18. ALL ADVANCE WARNING SIGNS SHALL MEET THE MINIMUM REFLECTIVE INTENSITY REQUIREMENTS SET FORTH BY THE CITY OF ALBUQUERQUE. CONSTRUCTION COORDINATION SHALL DETERMINE ALL REQUIREMENTS AND APPROVE OR DISAPPROVE ANY ADVANCE WARNING SIGN PER SECTION 6A-4 OF THE MUTCD, LATEST EDITION.
19. 48 HOURS PRIOR TO OCCUPYING OR CLOSING OF A RIGHT-OF-WAY, CONTRACTOR SHALL NOTIFY: POLICE, FIRE DEPARTMENT, SCHOOLS, HOSPITALS, TRANSIT AUTHORITY, BUSINESSES AND/OR RESIDENTS THAT WILL BE AFFECTED BY THE CONSTRUCTION.
20. ANY FIELD ADJUSTMENTS SHALL BE APPROVED BY CONSTRUCTION COORDINATION.
21. EXCAVATIONS SHALL BE PLATED, TEMPORARILY PATCHED OR RESURFACED PRIOR TO OPENING OF TRAFFIC. A MINIMUM OF 11 FEET SHALL BE PROVIDED FOR TRAFFIC IN ANY GIVEN DIRECTION. CONTRACTOR IS RESPONSIBLE FOR ANY WORK INVOLVED IN SATISFYING THESE REQUIREMENTS.

22. CONTRACTOR SHALL AT ALL TIMES COMPLY WITH THE FOLLOWING:
1. STANDARDS AND REQUIREMENTS SET FORTH IN THE MANUAL ON UNIFORM TRAFFIC CONTROL DEVICES, LATEST EDITION.
 2. THE CITY OF ALBUQUERQUE TRAFFIC CODE, LATEST EDITION.
 3. SECTION 19 OF THE CITY OF ALBUQUERQUE'S STANDARD SPECIFICATIONS FOR PUBLIC WORK CONSTRUCTION, AS WELL AS OTHER SECTIONS.


23. FAILURE TO COMPLY WITH ANY OF THE ABOVE MENTIONED, WILL BE ADEQUATE CAUSE TO CEASE ALL WORK ON ANY CONSTRUCTION PROJECT. WORK WILL NOT RESUME UNTIL ALL REQUIREMENTS ARE ADDRESSED AND APPROVED BY CONSTRUCTION COORDINATION.

24. ALL TRAFFIC CONTROL DEVICES SHALL BE KEPT IN NEW-CLEAN CONDITION, WASHING OF EQUIPMENT IS INCIDENTAL TO IT'S PLACEMENT AND MAINTENANCE.

25. TRAFFIC CONTROL STANDARDS APPLY ONLY WHERE THE CONSTRUCTION TRAFFIC CONTROL PLANS ARE NOT SPECIFIC.

26. ADVANCE WARNING SIGNS SHALL BE 36"x36" MIN. WITH SUPER ENGINEERING GRADE SHEETING OR BETTER. MOUNTING HEIGHT AT TOP OF SIGN SHALL BE THE SAME AS FOR A 48" SIGN AS INDICATED IN THE M.U.T.C.D.

27. CONTRACTOR SHALL MAINTAIN A GRAFFITI-FREE WORKSITE. ALL GRAFFITI SHALL BE PROMPTLY REMOVED FROM ALL EQUIPMENT, BOTH PERMANENT AND TEMPORARY.

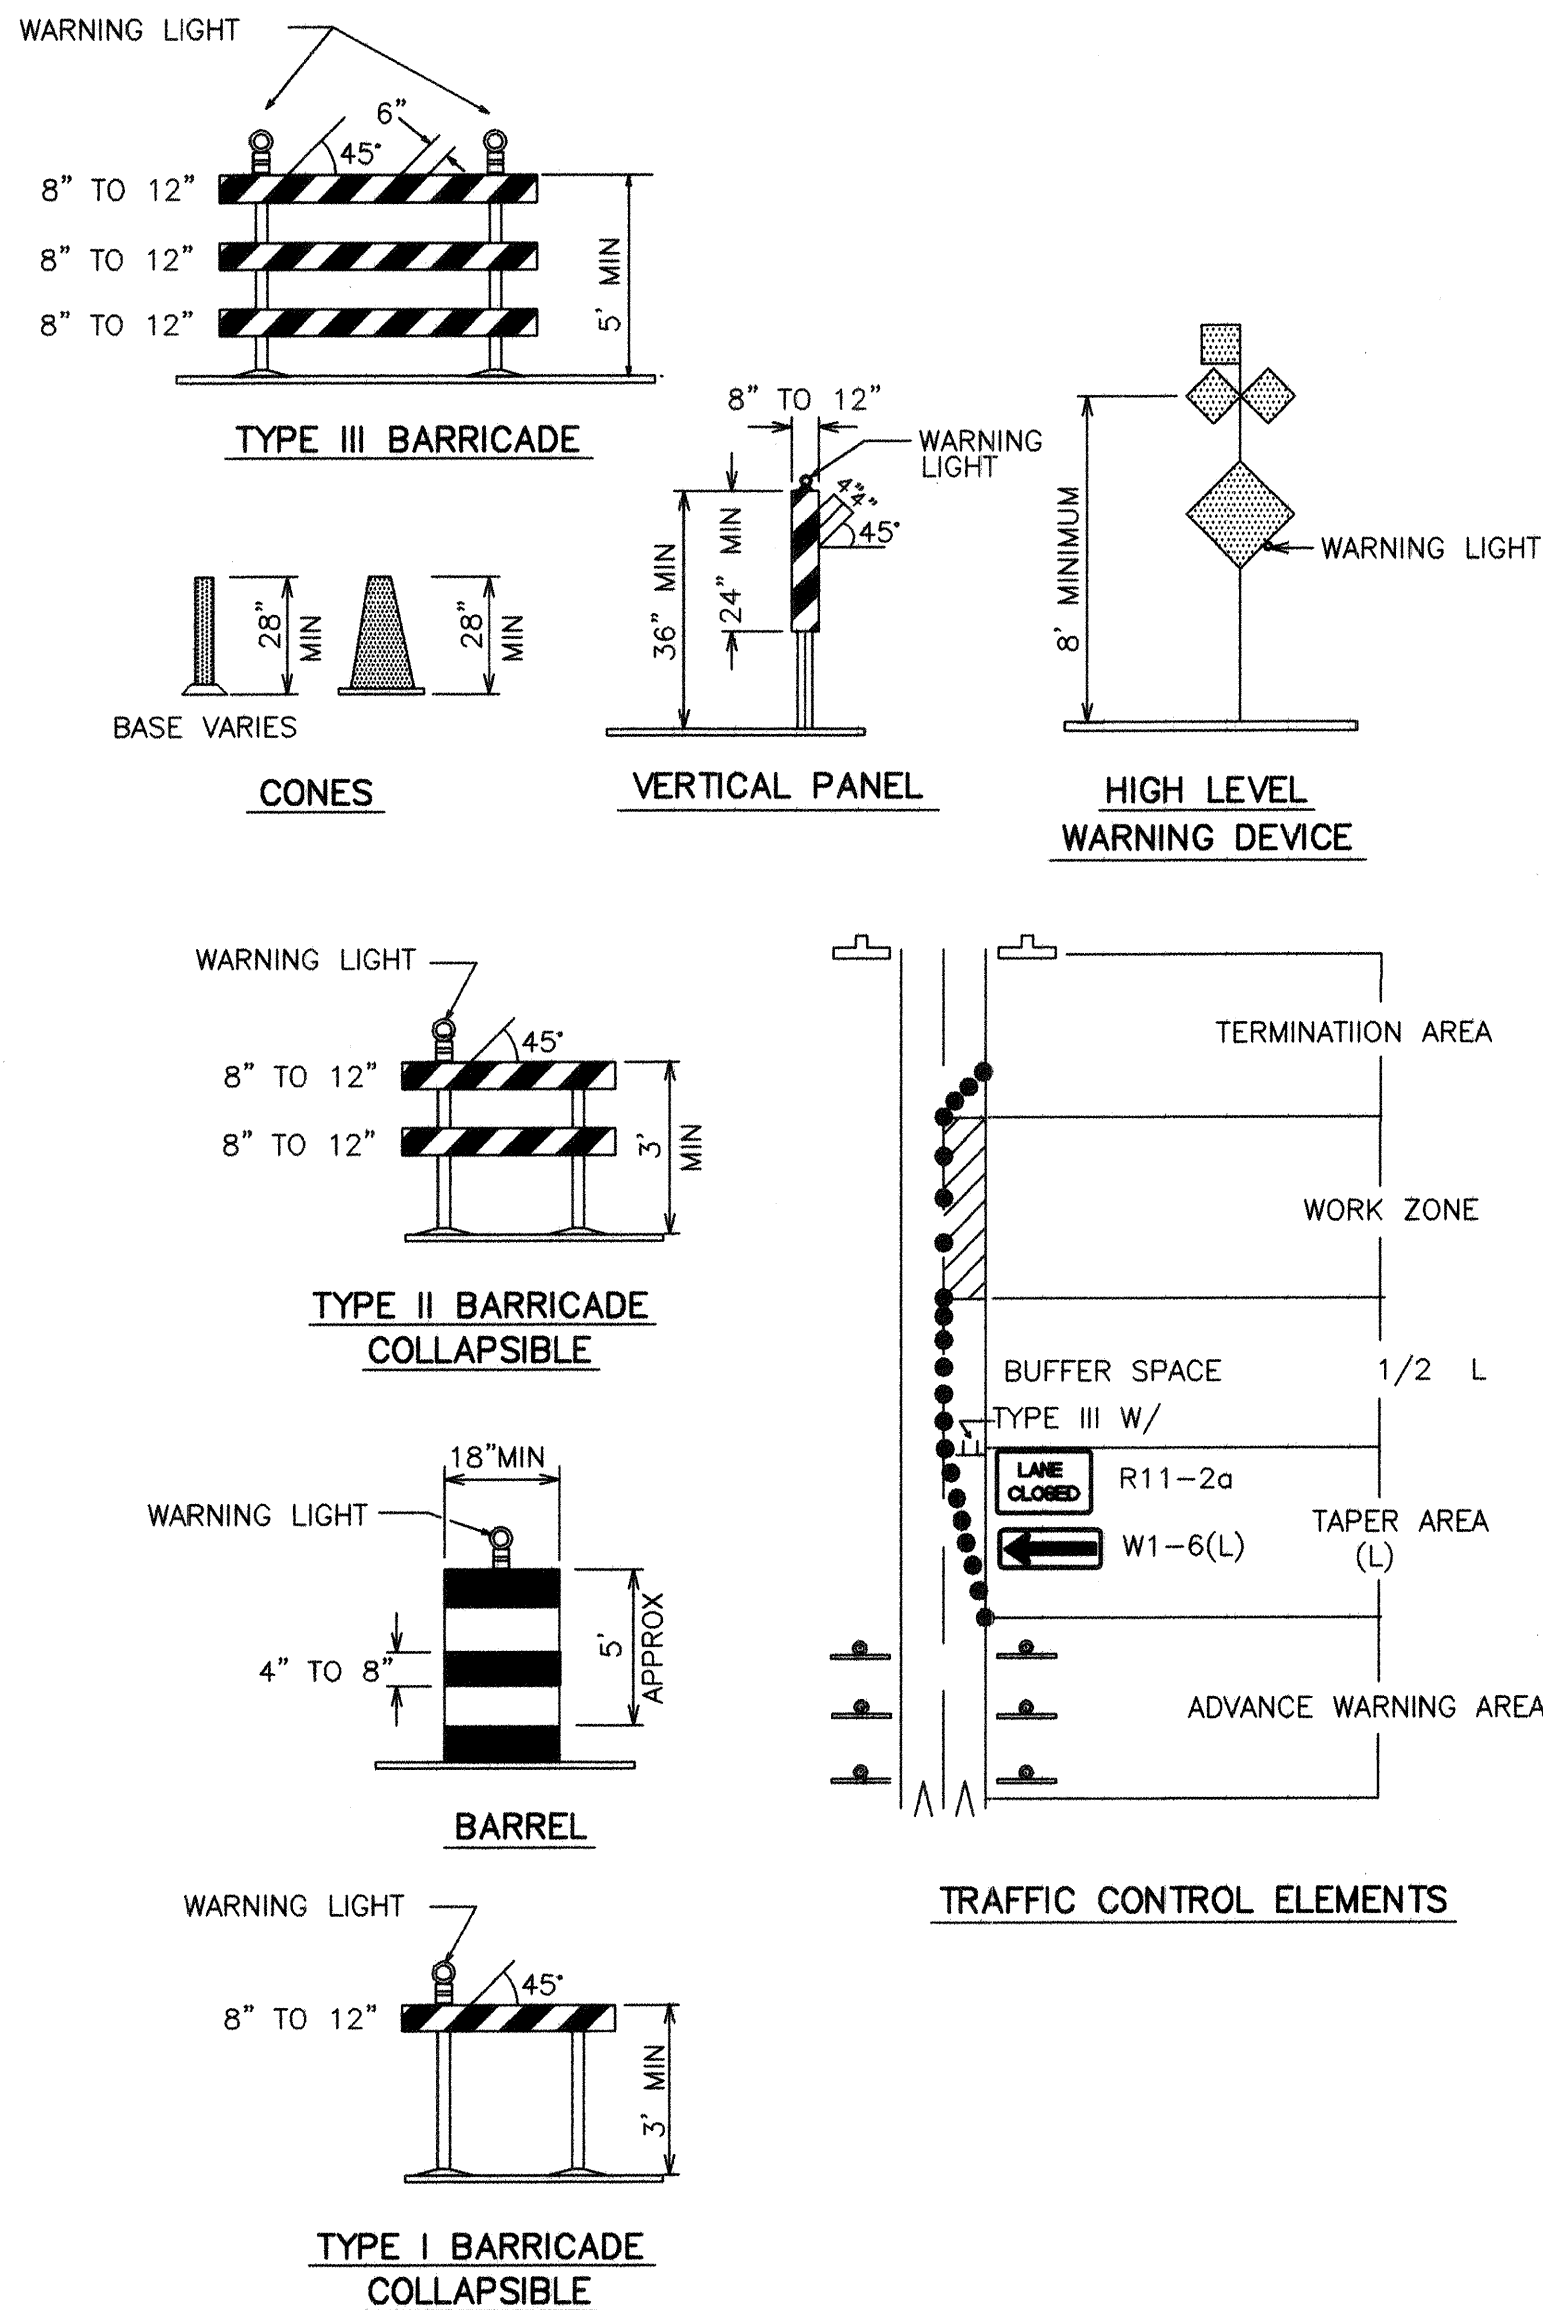

LEGEND

- WORK AREA
BARRICADE - TYPE I, TYPE II, OR BARREL
BARRICADE - TYPE III
VERTICAL PANEL
WARNING SIGN
DISTANCE BETWEEN SIGNS - A DISTANCE MEASURED IN FEET EQUAL TO A VALUE OF TEN TIMES THE SPEED LIMIT OF THE STREET
FLAGMAN POSITION
SPACING BETWEEN BARRICADES - A DISTANCE MEASURED IN FEET EQUAL TO THE SPEED LIMIT OF THE STREET
TAPER LENGTH - SEE CHART BELOW

THE TANGENT LENGTH IS EQUAL TO THE TAPER LENGTH FOR A GIVEN STREET.

TAPER REQUIREMENT

SPEED LIMIT (MPH)	TAPER LENGTH(L) (FEET)			MINIMUM NUMBER OF DEVICES FOR TAPER	MAXIMUM DEVICE SPACING IN FEET	
	10' LANE	11' LANE	12' LANE		ALONG TAPER	AFTER TAPER
20	70	75	80	5	20	20
25	105	115	125	6	25	25
30	150	165	180	7	30	30
35	205	225	245	8	35	35
40	270	295	320	9	40	40
45	450	495	540	13	45	45
50	500	550	600	13	50	50
55	550	605	660	13	55	55

RECOMMENDED SIGN SPACING(D) FOR ADVANCE WARNING SIGN SERIES

SPEED MILES PER HOUR	MINIMUM DISTANCE IN FEET BETWEEN SIGNS	FROM LAST SIGN TO TAPER
0-20	10 X SPEED LIMIT	10 X SPEED LIMIT
25-30	10 X SPEED LIMIT	10 X SPEED LIMIT
30-35	10 X SPEED LIMIT	10 X SPEED LIMIT
40-45	10 X SPEED LIMIT	10 X SPEED LIMIT
50-60	10 X SPEED LIMIT	10 X SPEED LIMIT


TAPER CRITERIA

TYPE OF TAPER	TAPER LENGTH
UPSTREAM TAPER:	
MERGING TAPER	L MINIMUM
SHIFTING TAPER	1/2 L MINIMUM
SHOULDER TAPER	1/2 L MINIMUM
TWO-WAY TRAFFIC TAPER	100 FEET MAXIMUM
DOWNSTREAM TAPERS	100 FEET PER LANE

TAPER LENGTH COMPUTATION

SPEED LIMIT	
40 MPH OR LESS	$L = \frac{WS^2}{60}$
40 MPH OR GREATER	$L = W \times S$

L = TAPER LENGTH
W = WIDTH OF OFFSET IN FEET
S = POSTED SPEED OR OFF-PEAK 85-PERCENTILE SPEED IN MPH

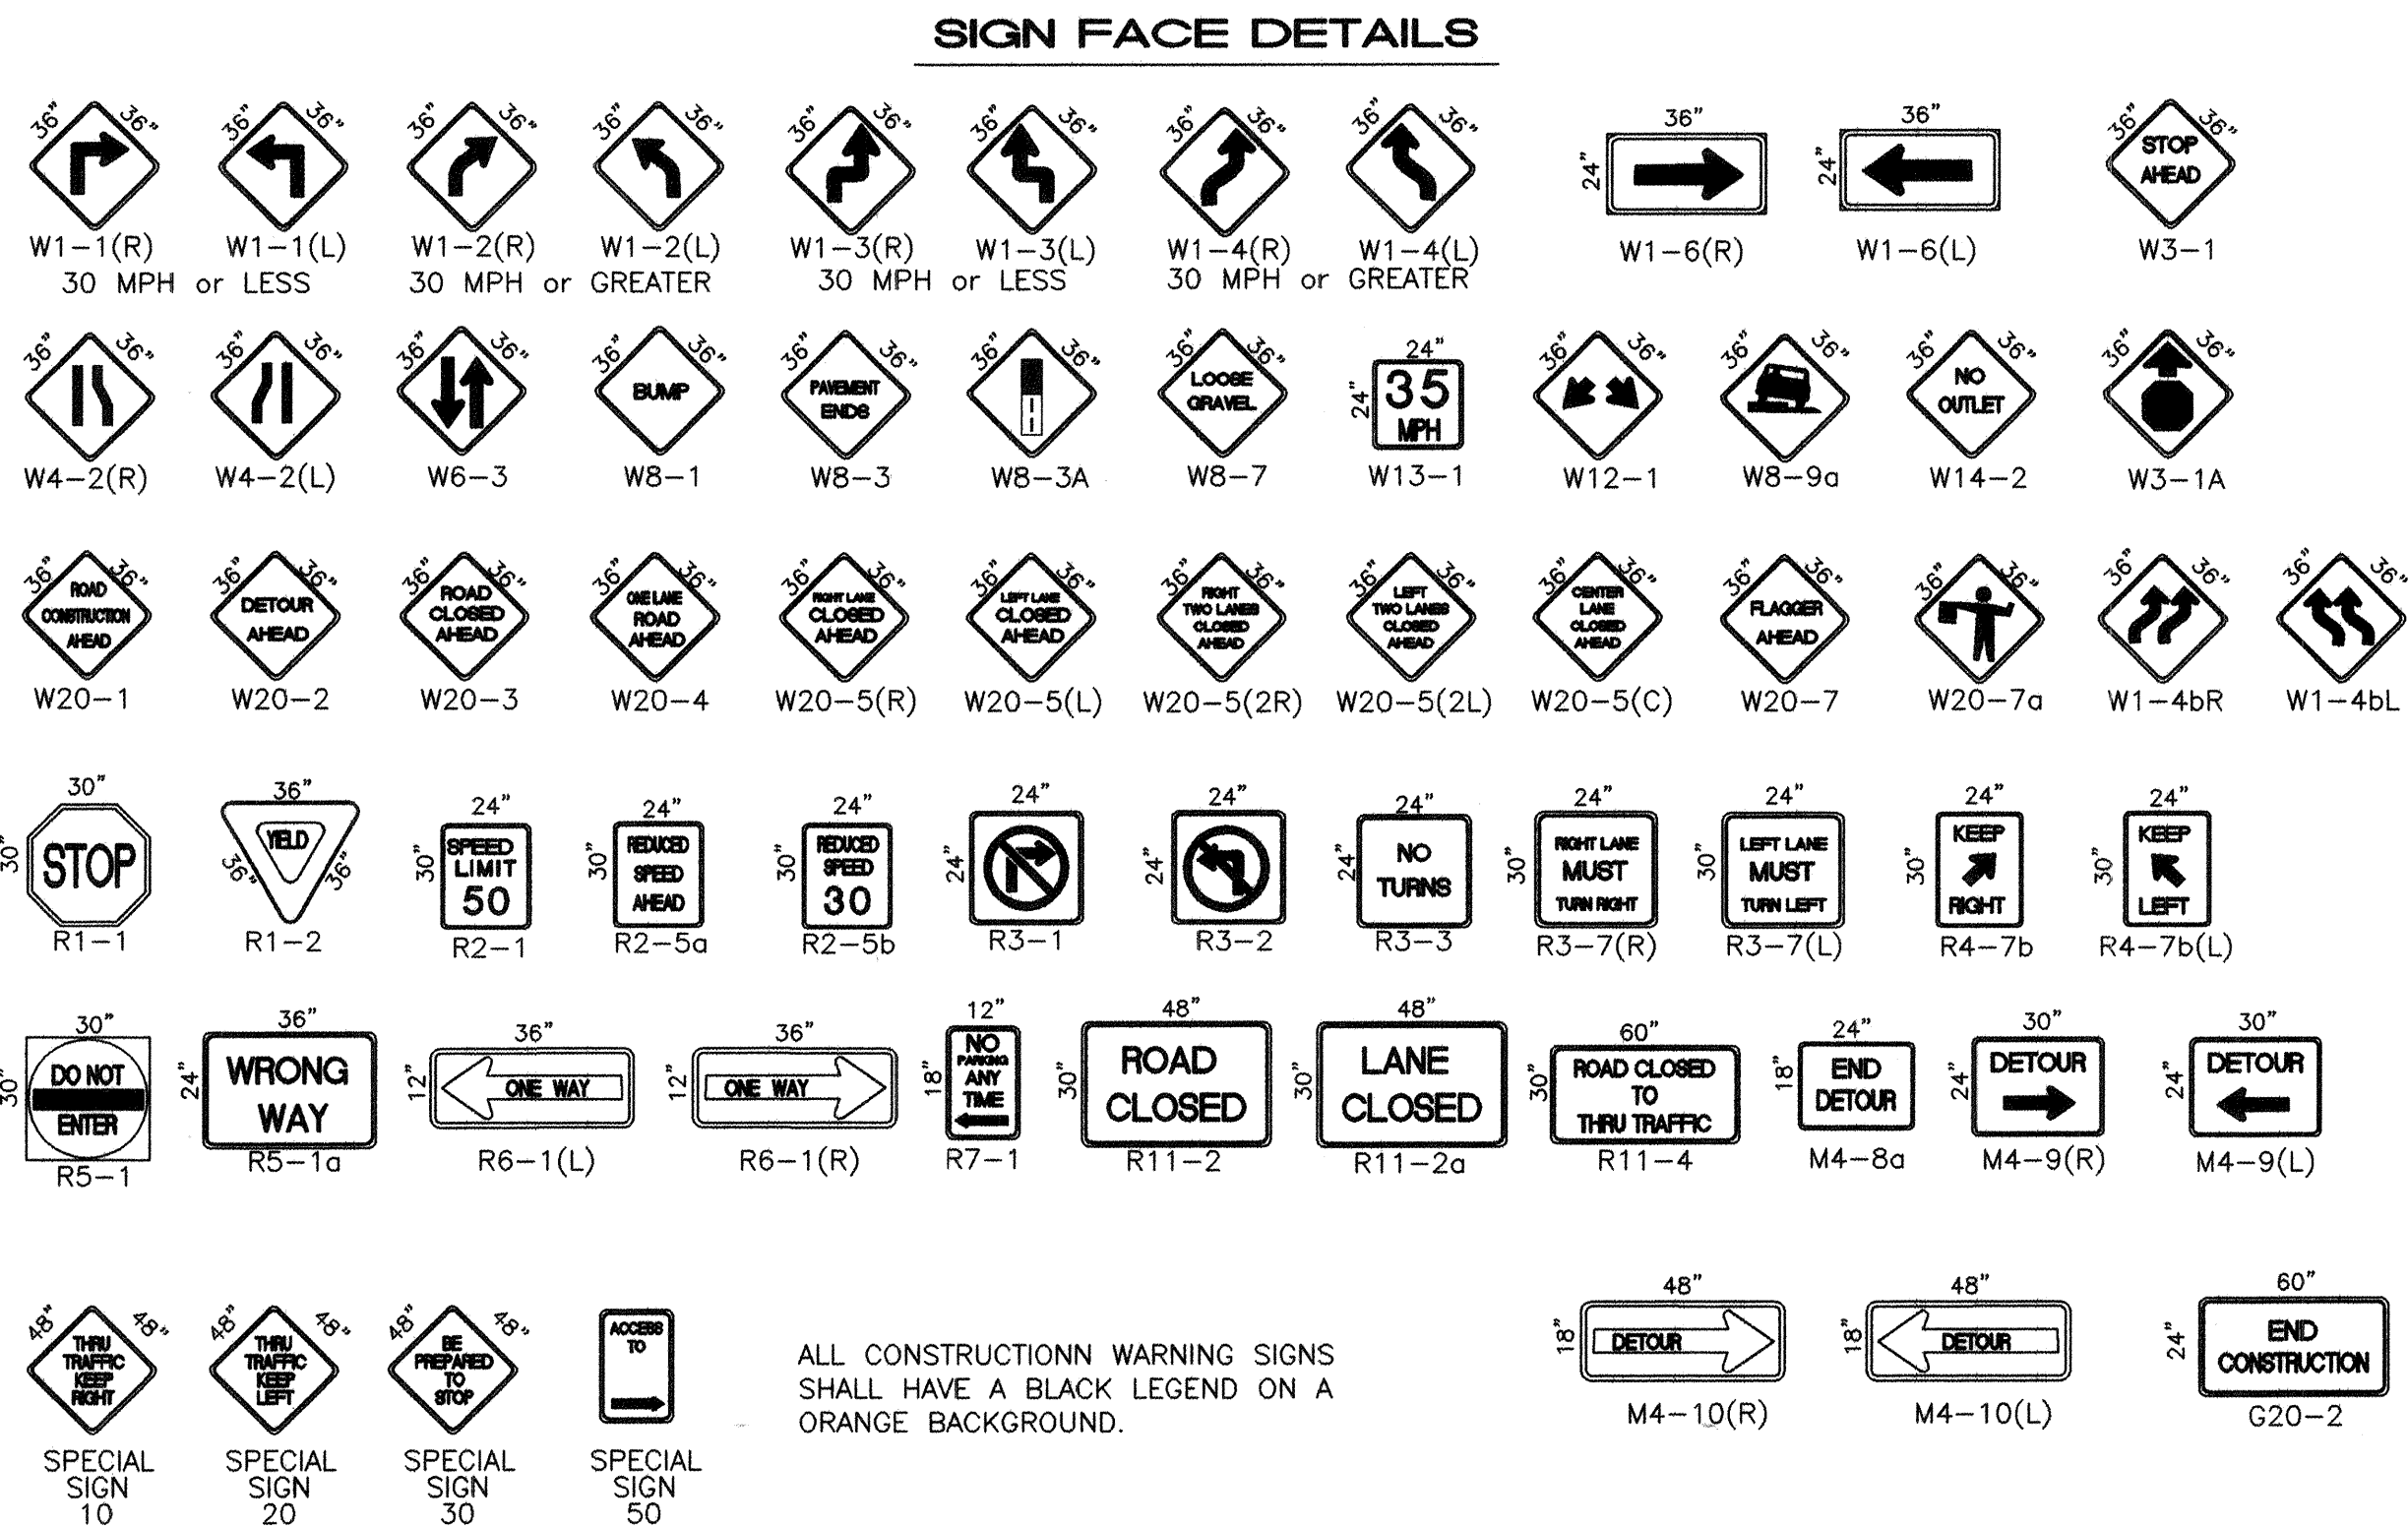

ALL CONSTRUCTION WARNING SIGNS SHALL HAVE A BLACK LEGEND ON A ORANGE BACKGROUND.

ISAACSON & ARFMAN, P.A.
Consulting Engineering Associates
128 Monroe Street N.E.
Albuquerque New Mexico
1276TRF1.DWGanw 6/24/03

CITY OF ALBUQUERQUE
PUBLIC WORKS DEPARTMENT
ENGINEERING GROUP

TITLE: THE PRESERVE
SIGNING & CONSTRUCTION TRAFFIC CONTROL STANDARDS

Design Review Committee	City Engineer Approval	Mo./Day/Yr.	Mo./Day/Yr.

TYPICAL RIGHT LANE CLOSURE

TYPICAL LEFT LANE CLOSURE

TYPICAL ONE DIRECTION DETOUR

TYPICAL TRAFFIC SPLIT-(PAINTED MEDIAN)

TYPICAL TRAFFIC SPLIT - (RAISED MEDIAN)

- TRAFFIC SPLIT NOTES:**
1. THE OFFSET DISTANCE MUST BE CALCULATED IN ALL SHIFTING TAPERS. THE OFFSET DISTANCES SHALL INCLUDE LANE WIDTHS PLUS MEDIAN WIDTHS.
 2. 1/2 L IS THE MINIMUM DISTANCE FOR SHIFTING TAPERS.
 3. REVERSE CURVES MAY BE IMPLEMENTED. ALL CURVE DATA SHALL BE CALCULATED.
 4. MEDIAN REMOVAL SHALL BE REQUIRED IF 1/2 L OR REVERSE CURVE IS NOT SUICIDE MEDIAN REMOVAL SHALL TAKE PLACE BEFORE SPLITS.
 5. REDUCED SPEED MAY BE CONSIDERED.
 6. * USE W1-3 FOR 30 MPH OR LESS, W1-4 FOR SPEED 35 MPH OR GREATER.

TYPICAL SANITARY SEWER SLIPLINING OPERATION

- ALL PITS TO HAVE TYPE-A FLASHING LIGHTS
- ALL PITS TO HAVE FLAGLINE

NOTE:
MAY REQUIRE LEFT LANE
CLOSURE DEPENDING ON
FIELD CONDITIONS.

TYPICAL LANE CLOSURE AT INTERSECTION

NOTE: DEPENDING ON WORK ZONE LOCATION.

TYPICAL MID-BLOCK CLOSURE

NOTE: (R1-1) BASED ON FIELD CONDITIONS.

TYPICAL STREET CLOSURE

NOTE: (R1-1) BASED ON FIELD CONDITIONS.


TYPICAL DOUBLE RIGHT LANE CLOSURE

TYPICAL DOUBLE LEFT LANE CLOSURE

TYPICAL FLAGGING OPERATION

TYPICAL STREET CLOSURE

NOTE: (R1-1) BASED ON FIELD CONDITIONS.

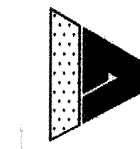

ISAACSON & ARFMAN, P.A.
Consulting Engineering Associates
128 Monroe Street N.E.
Albuquerque New Mexico
1276TRF2.DWGanw 6/24/03

CITY OF ALBUQUERQUE
PUBLIC WORKS DEPARTMENT
ENGINEERING GROUP

TITLE: THE PRESERVE
TRAFFIC CONTROL
TRAFFIC CONTROL & SIGNING EXAMPLES

City Project No.




Zone Map No.	
--------------	--

Sheet

Of

**CITY
STANDARD
DRAWING**

SCANNED BY
PLANNING

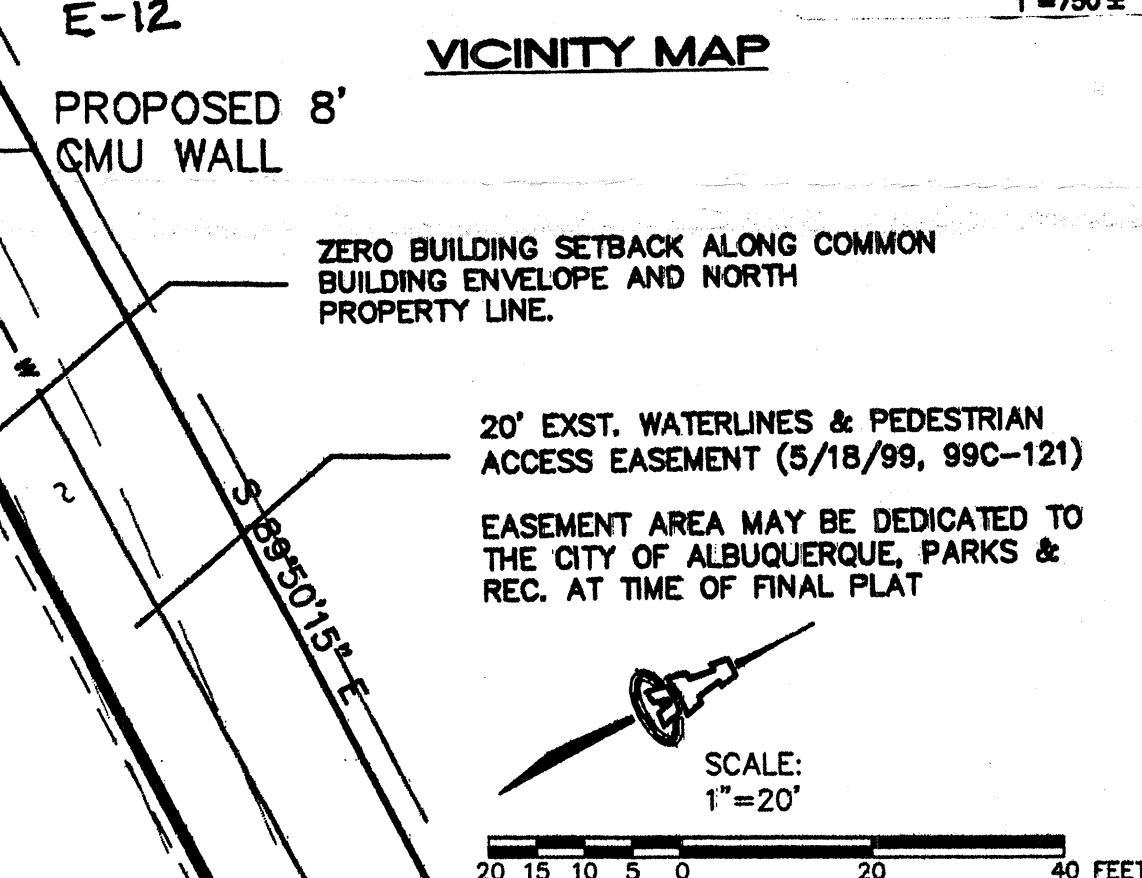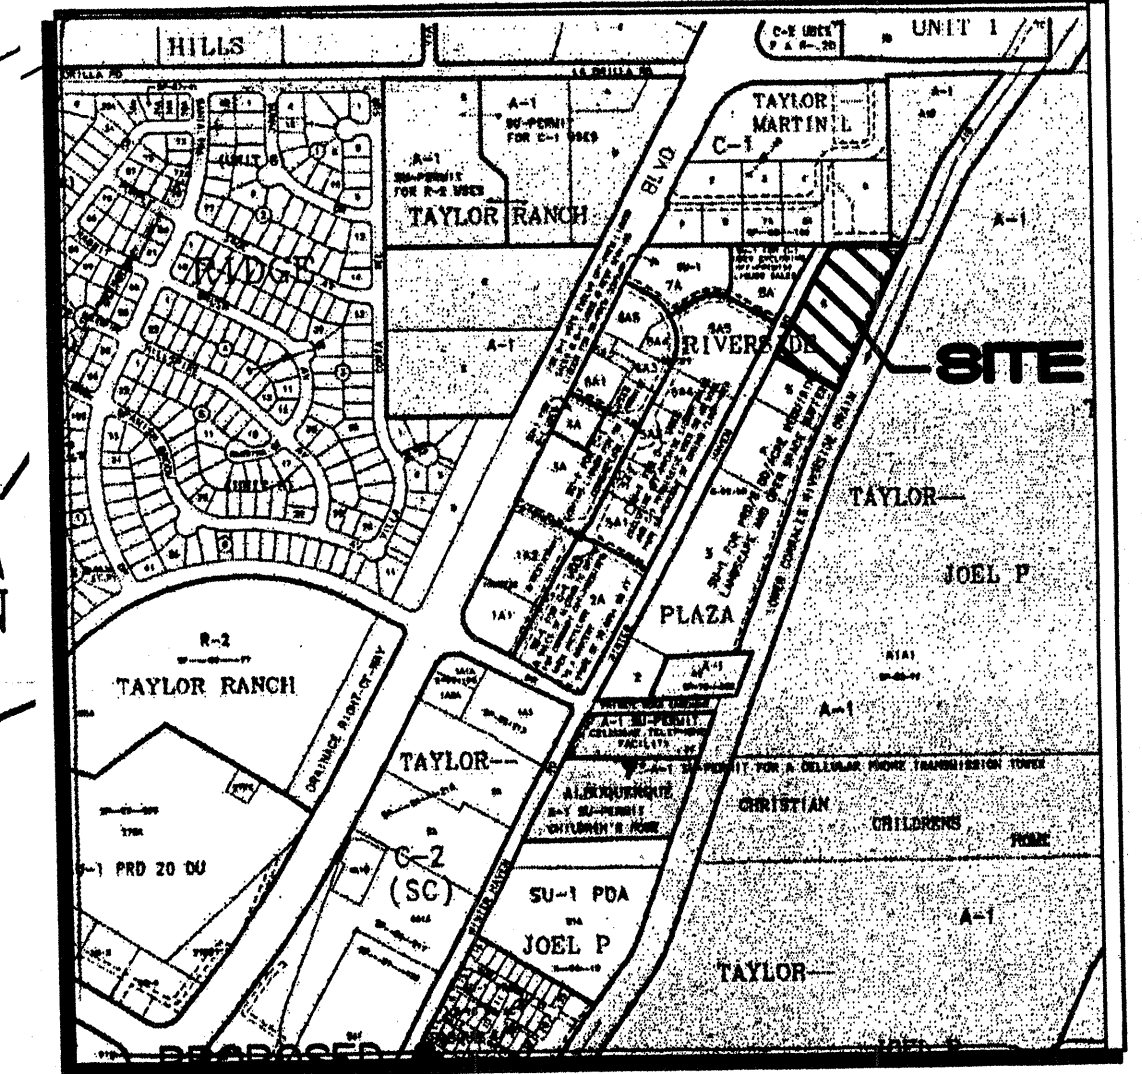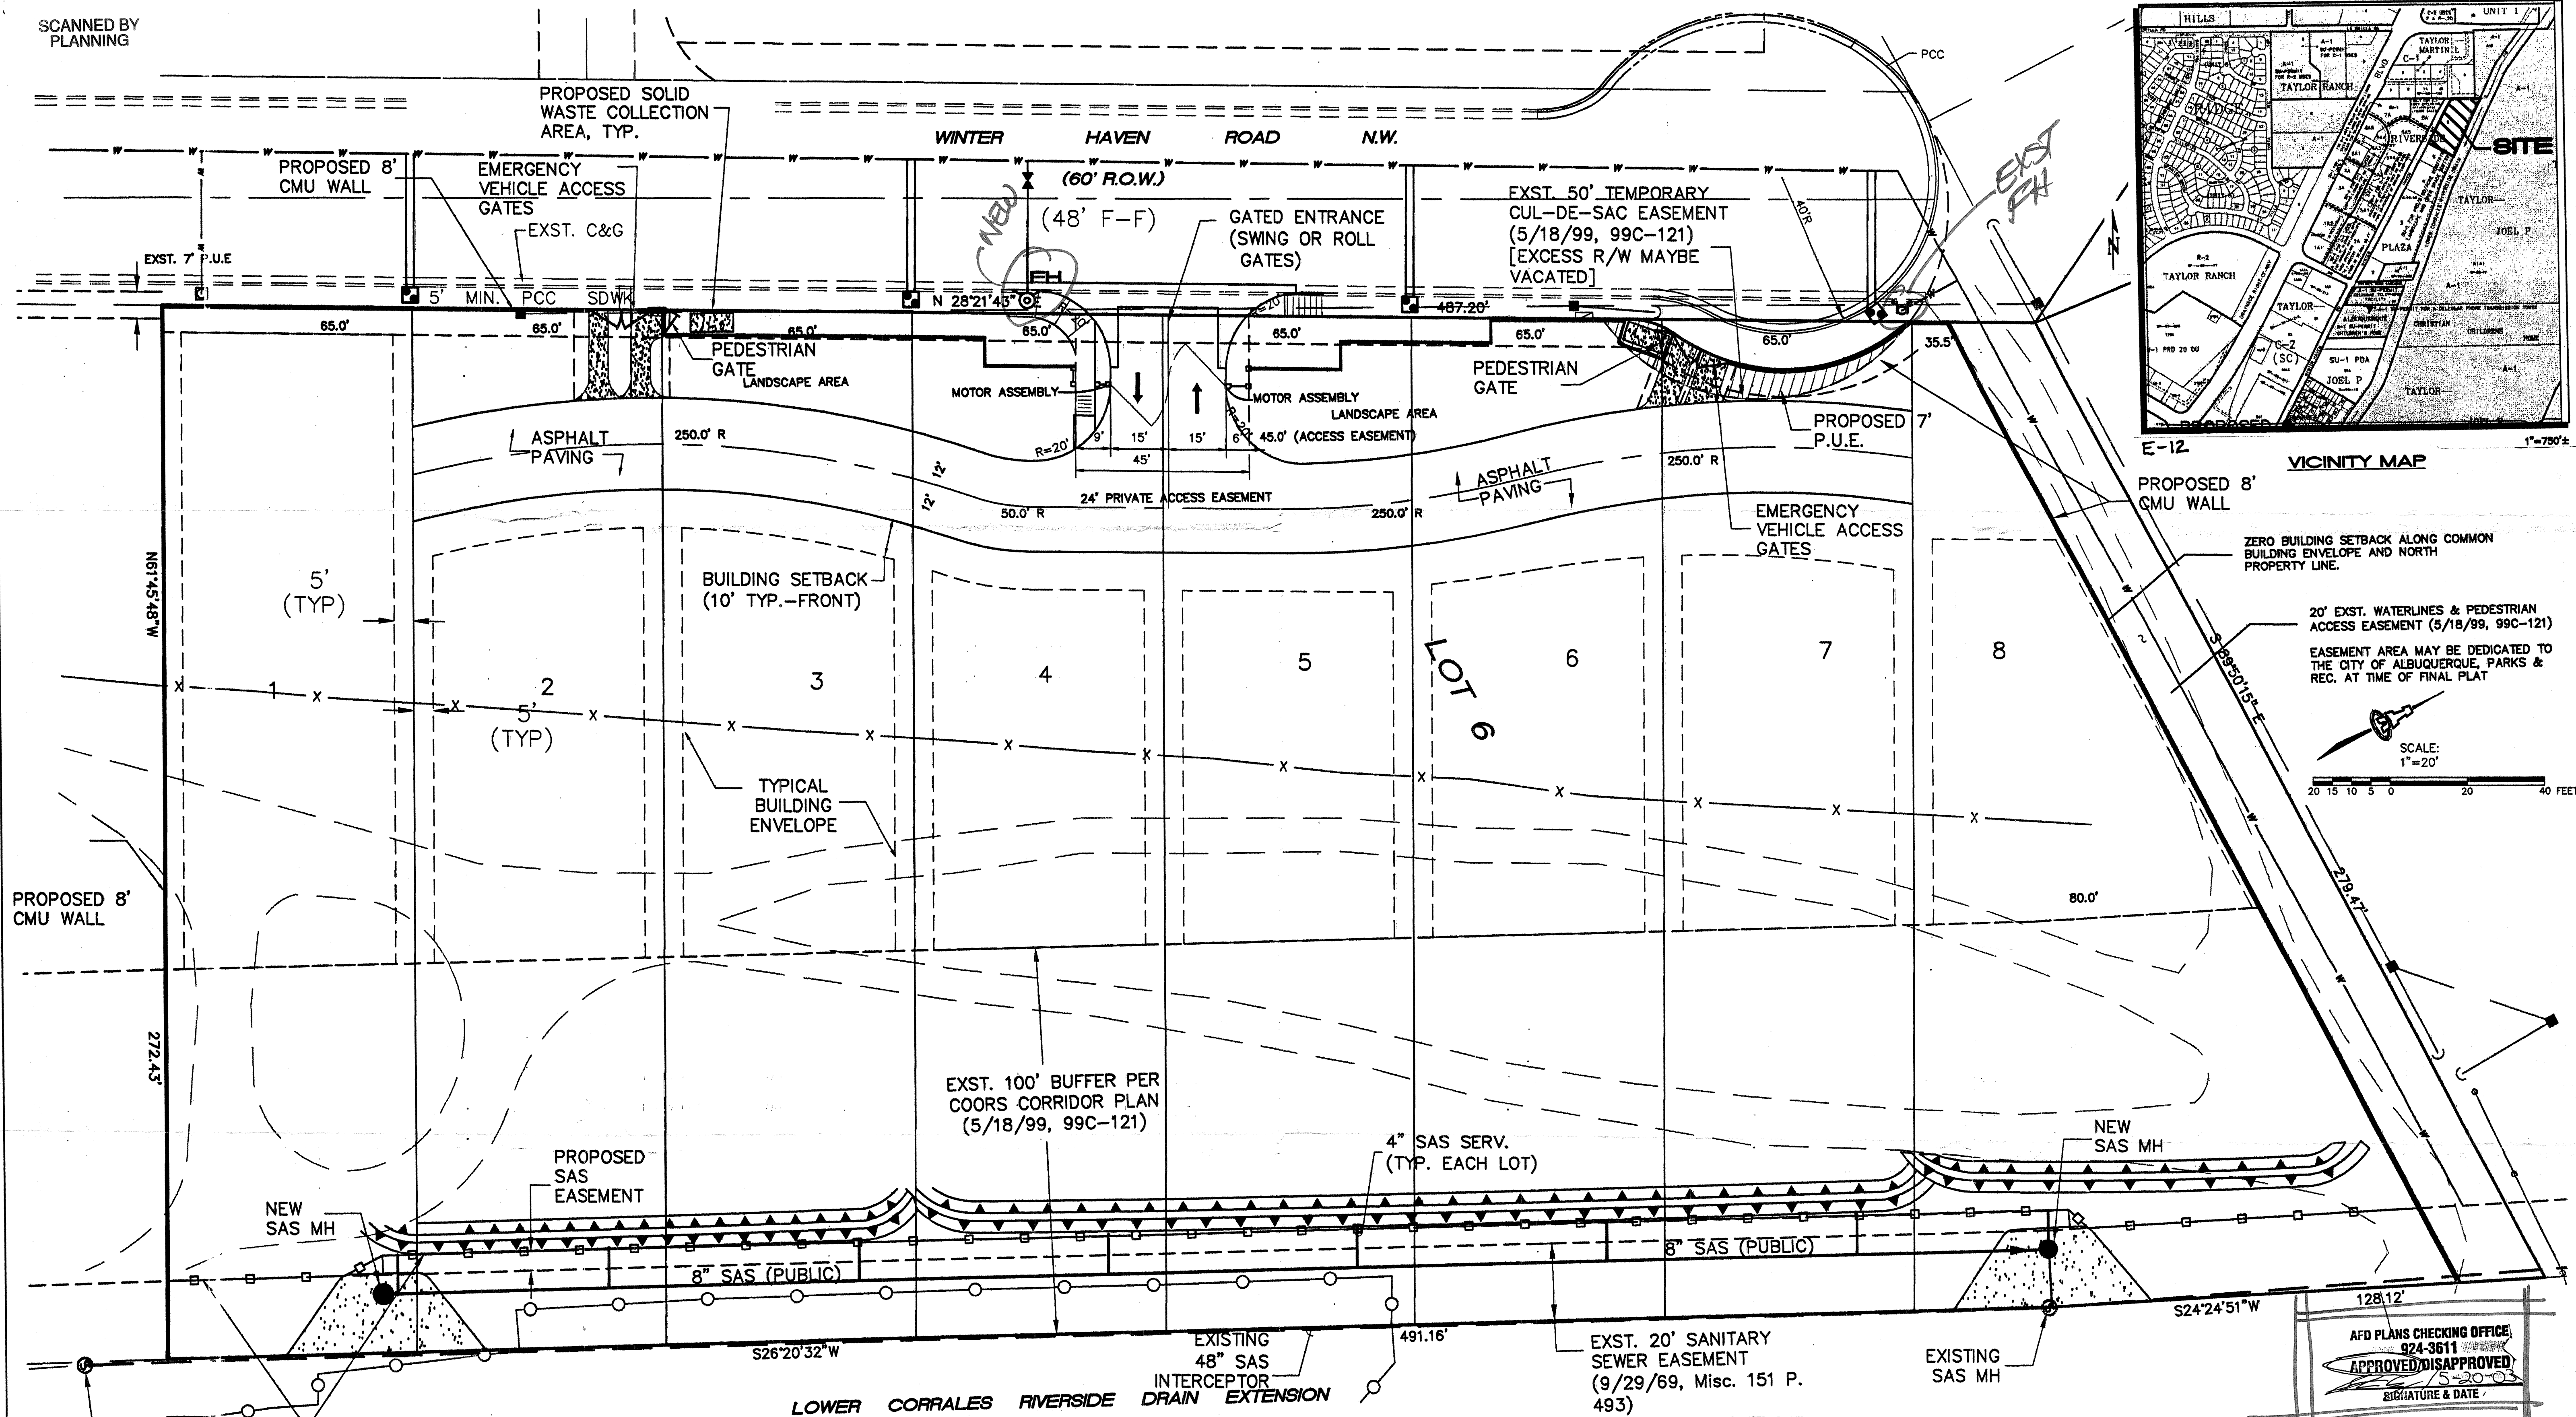

NOTES:

1. EACH LOT SHALL ACCOMMODATE SINGLE-FAMILY RESIDENCE.
2. DRIVEWAY SHALL NOT BE LESS THAN 20 FT. LONG.

PROJECT NUMBER: .

APPLICATION NUMBER: .

This plan is consistent with the specific Site Development Plan approved by the Environmental Planning Commission (EPC, dated _____ and the Findings and Conditions in the Official Notification of Decision are satisfied.

DRB SITE DEVELOPMENT PLAN APPROVAL:

Traffic Engineer, Transportation Division _____ Date _____

Utilities Development _____ Date _____

Parks and Recreation Department _____ Date _____

City Engineer _____ Date _____

Solid Waste Management _____ Date _____

DRB Chairperson, Planning Department _____ Date _____

LEGEND

- GRAVEL EMERGENCY ACCESS
- BUILDING ENVELOPE
- SINGLE WATER METER & BOX
- DOUBLE WATER METER & BOX
- GATE VALVE W/ TYPE 'A' VALVE BOX
- FIRE HYDRANT
- SAS MANHOLE
- WATER LINE W/ FITTING

THE PRESERVE LOT 6, RIVERSIDE PLAZA SITE PLAN

ISAACSON & ARFMAN, P.A.
Consulting Engineering Associates
128 Monroe Street N.E.
Albuquerque, New Mexico

1276SDP.DWG 05/19/03

SHEET 1 OF 1

OPN# 7/6/81